

工程指示 / 要求簡箋(E.I.)

工程指示編號：EI / 2891 / 20

修改版次：-

工程編號：J - 852

工程名稱：亞皆老街中電

工程項目：吊趟 3 號 大圖

收件人：生統 / 王良

發件人：Ant Yeung

日期：31/12/2020

要求提供 / 確認 事項：

- | | | |
|------------------------------------|-------------------------------------|-------------------------------|
| <input type="checkbox"/> 初步鋁料 B.M. | <input type="checkbox"/> 加工拆圖，然後生產 | <input type="checkbox"/> 尺寸表 |
| <input type="checkbox"/> 正式鋁料 B.M. | <input type="checkbox"/> 技術上資料 / 指示 | <input type="checkbox"/> 報價 |
| <input type="checkbox"/> 配件 B.M. | <input type="checkbox"/> 樣辦或貨品說明書 | <input type="checkbox"/> 分判合約 |
| <input type="checkbox"/> 其他：_____ | | |

內容：

請查看大圖。謝謝

請在 2021.1.2 前完成上列要求。

附：-

以上項目為：

- 原合約工程包 原合約工程加 / 減賬 新工程報價

原因：-

分發東莞各部門：

- | | | | |
|--|---|--|---|
| <input type="checkbox"/> 生產技術總監 <input type="checkbox"/> 連附件 | <input type="checkbox"/> 技術部 <input type="checkbox"/> 連附件 | <input type="checkbox"/> 生產部 <input type="checkbox"/> 連附件 | <input type="checkbox"/> 機械設計部 <input type="checkbox"/> 連附件 |
| <input type="checkbox"/> 採購部 <input type="checkbox"/> 連附件 | <input checked="" type="checkbox"/> 生產統籌部 <input checked="" type="checkbox"/> 連附件 | <input checked="" type="checkbox"/> 小羅 & 清 <input checked="" type="checkbox"/> 連附件 | |
| <input type="checkbox"/> 質檢部 <input type="checkbox"/> 連附件 | <input type="checkbox"/> 會計部 <input type="checkbox"/> 連附件 | <input type="checkbox"/> 報關組 <input type="checkbox"/> 連附件 | <input type="checkbox"/> 其他 <u>楊榮輝</u> <input type="checkbox"/> 連附件 |

分發其他分判：

- (v) 水洪 連附件

分發香港各部門：


- 行政部 連附件 會計部 連附件 統籌部 連附件 工程部地盤科文 連附件 寶誠
 採購部 連附件 QS 部 連附件 維修部 連附件 其他 _____ 連附件

傳遞編號：

HK 2992 / 20

發件人簽署：

項目經理簽署：

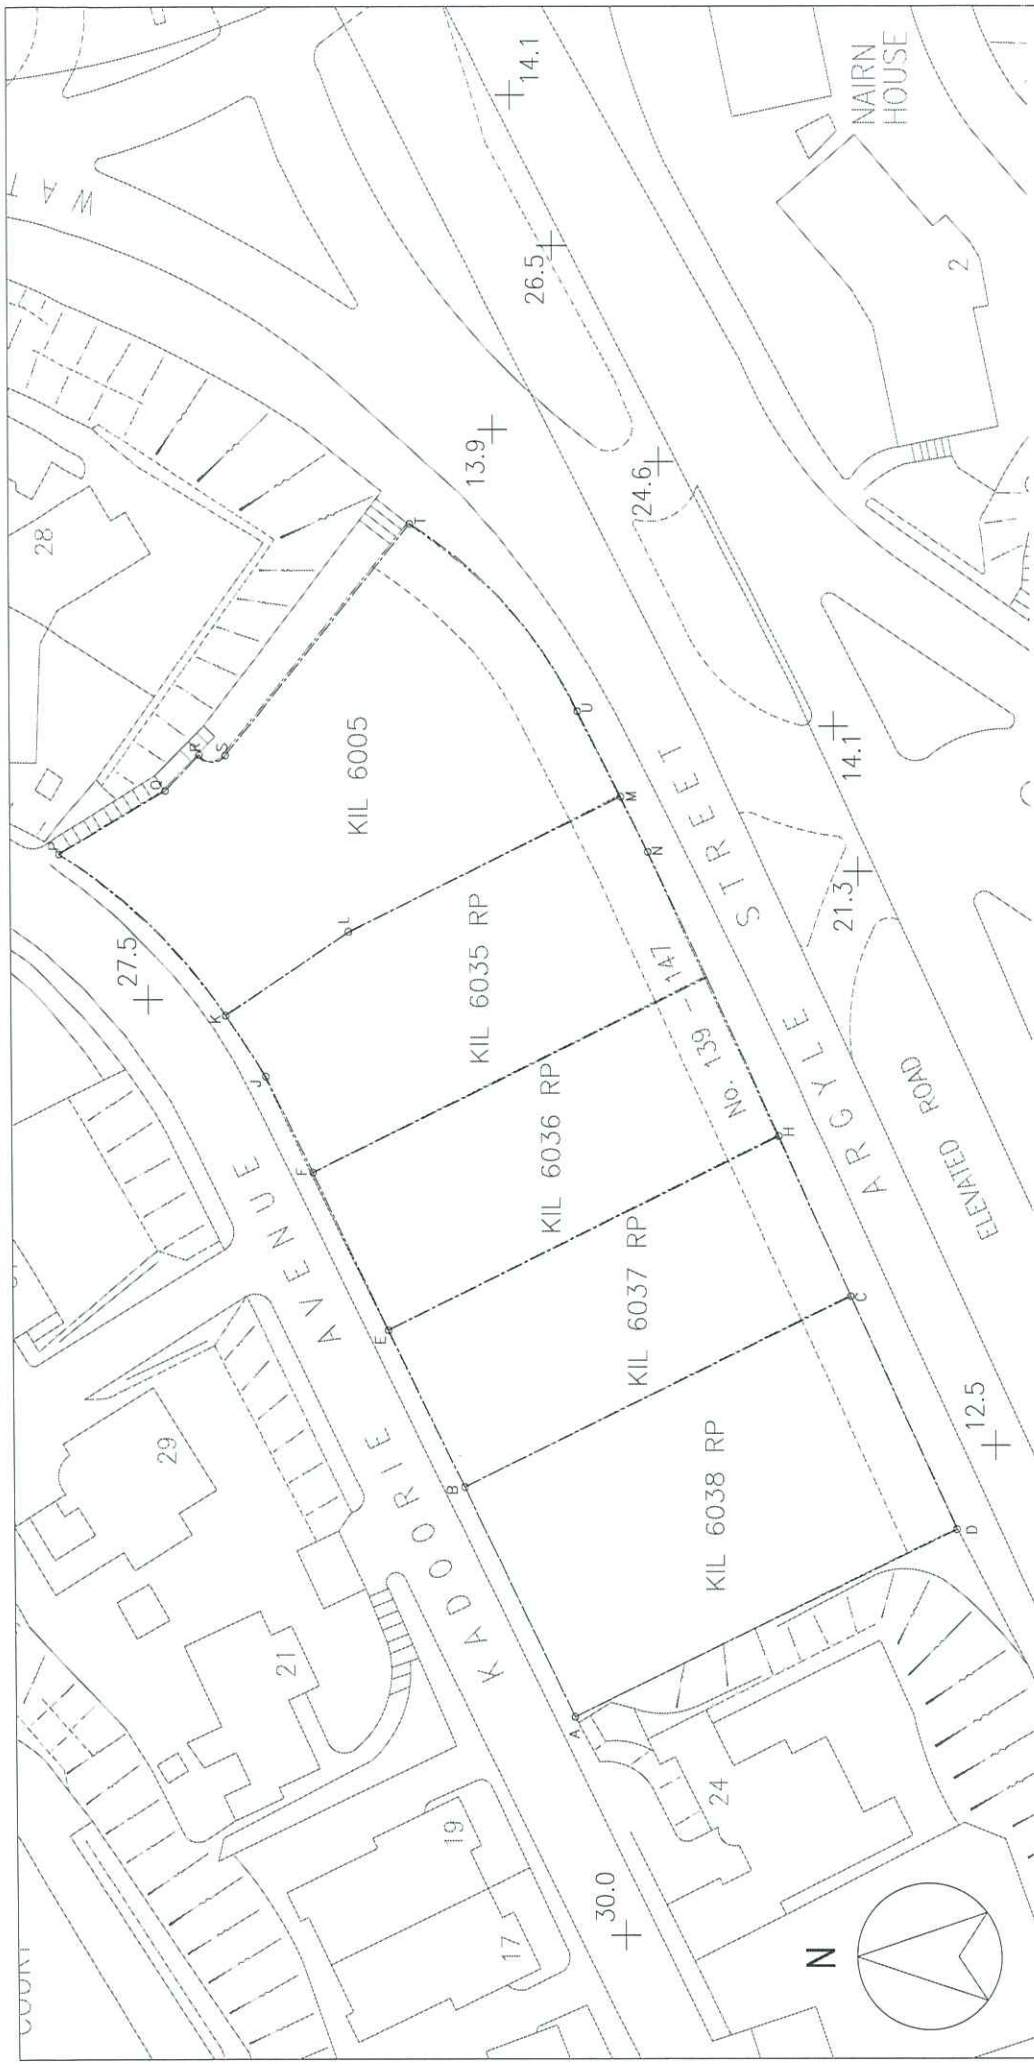


**PROJECT : PROPOSED RESIDENTIAL DEVELOPMENT AT 139 - 147 ARGYLE STREET,
 NKIL 6005, 6035 R.P., 6036 R.P., 6037 R.P. & 6038 R.P.**

3

**TITLE : ACOUSTIC SLIDING DOOR
 SHOPDRAWING SUBMISSION**

DATE: 16 - Nov - 2020

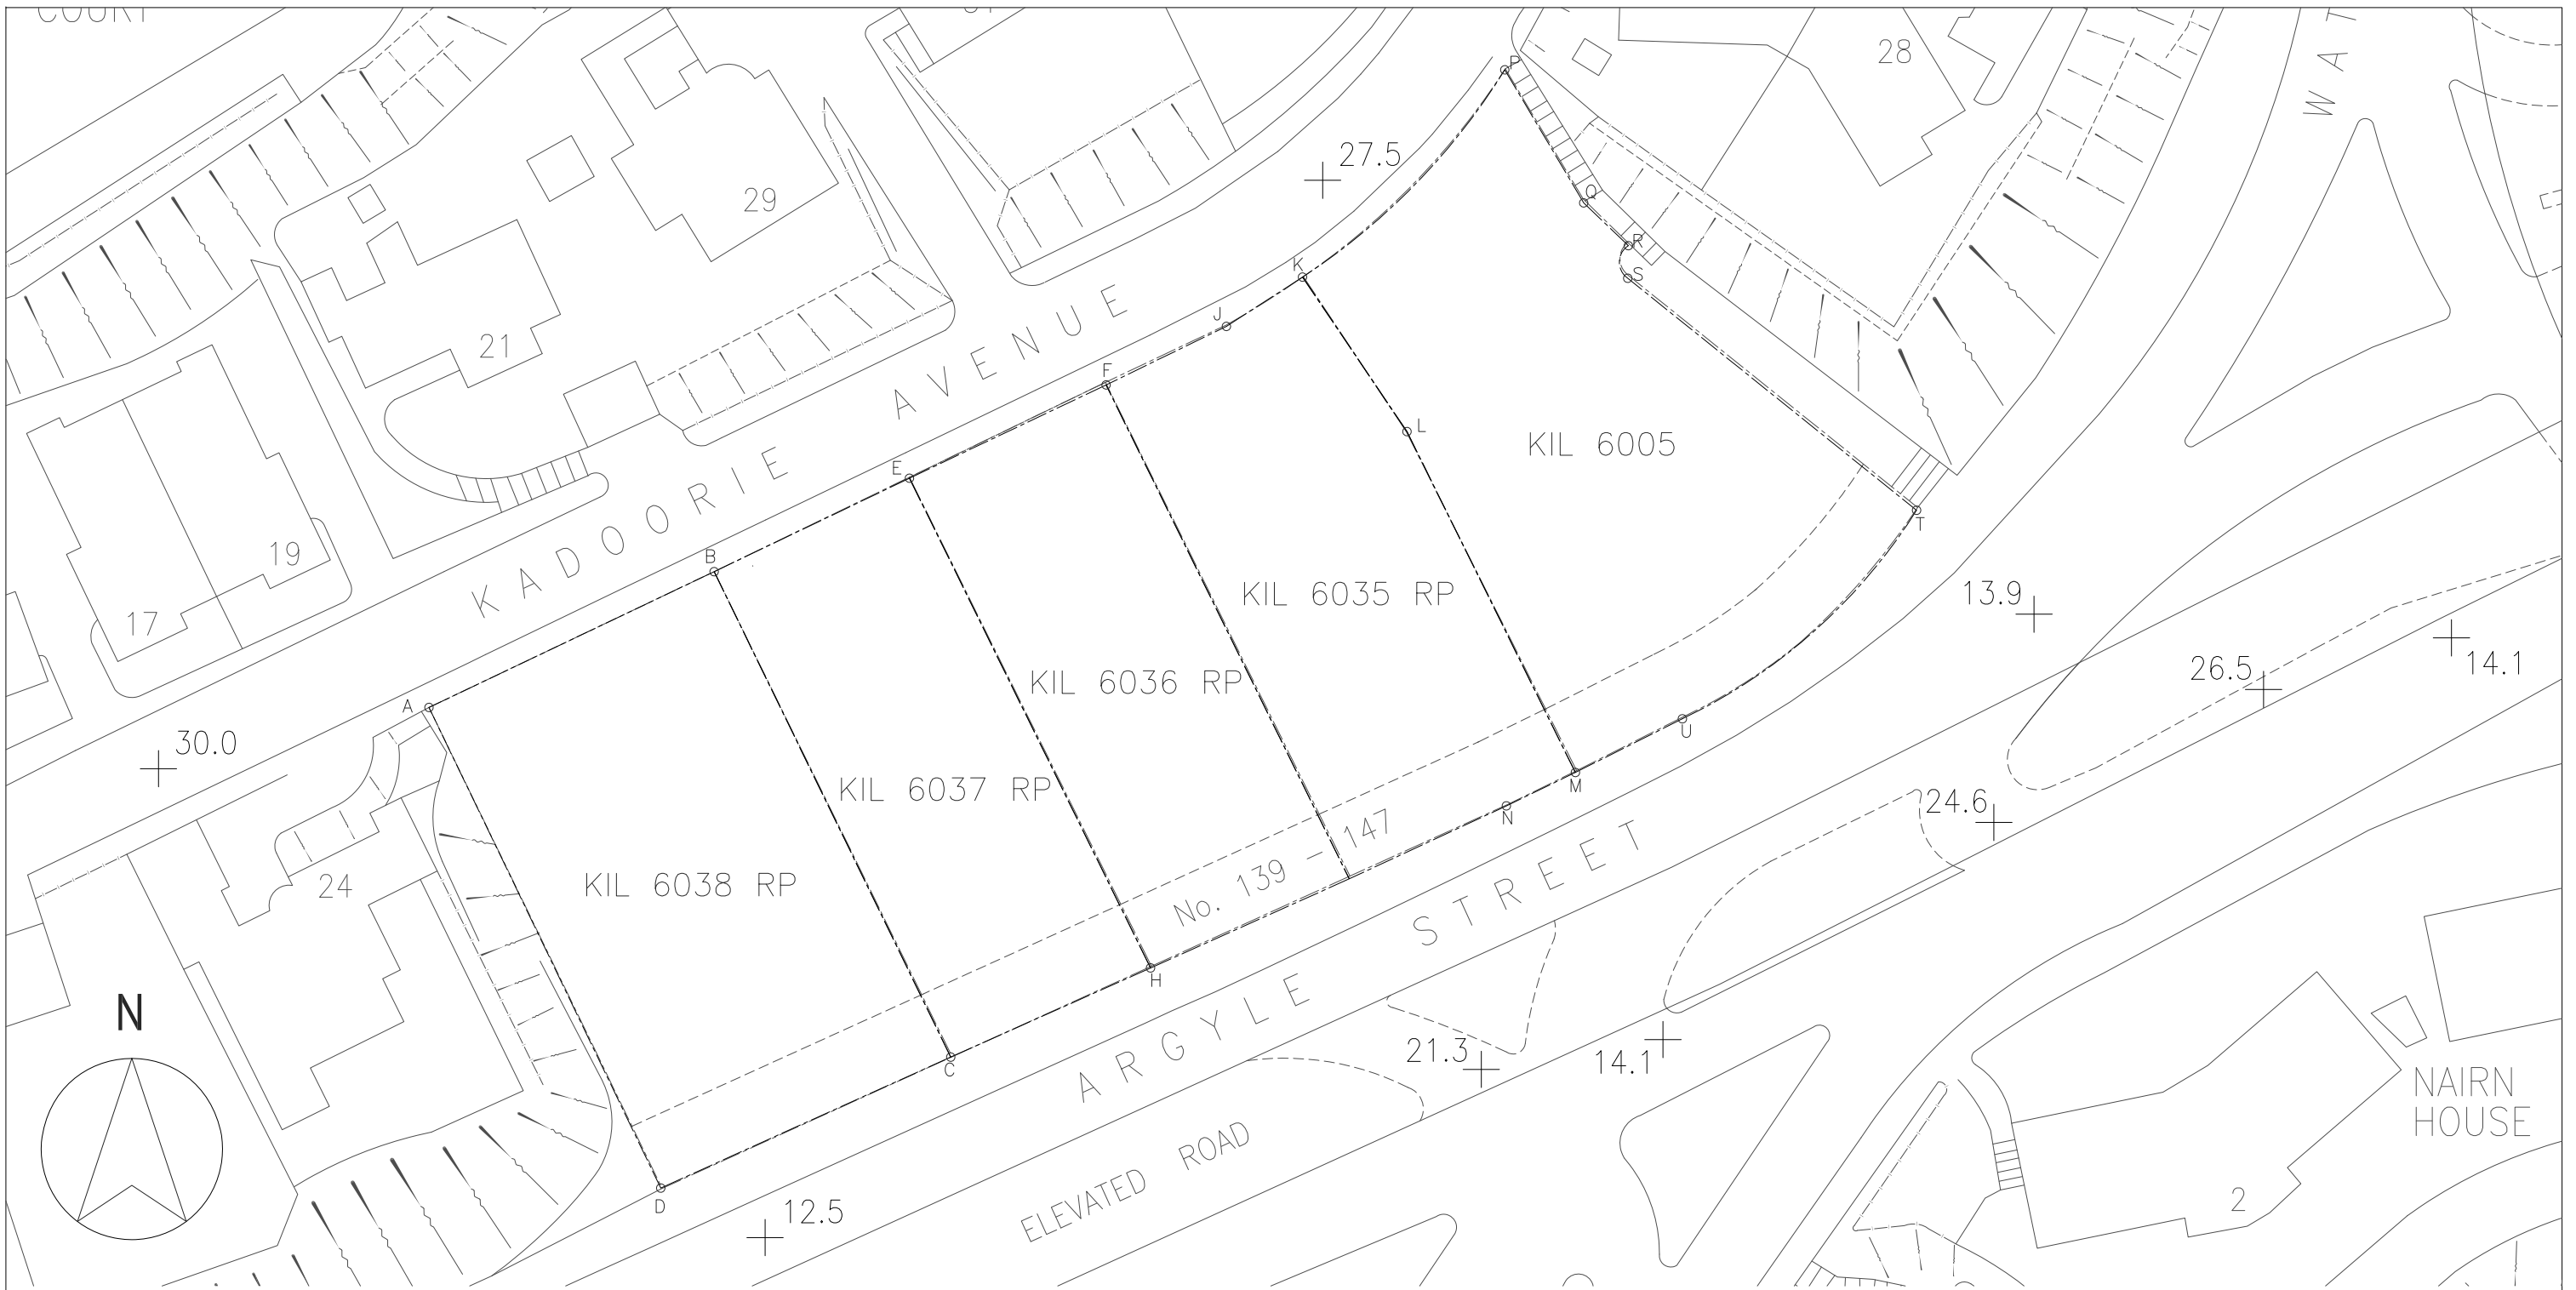

**PROJECT : PROPOSED RESIDENTIAL DEVELOPMENT AT 139 - 147 ARGYLE STREET,
NKIL 6005, 6035 R.P., 6036 R.P., 6037 R.P. & 6038 R.P.**

3

**TITLE : ACOUSTIC SLIDING DOOR
SHOPDRAWING SUBMISSION**

DATE: 16 - Nov - 2020

DRAWING SUBMISSION REGISTER

PROJECT: PROPOSED RESIDENTIAL DEVELOPMENT AT 139-147 ARGYLE STREET, NKIL 6006, 6035 R.P., 6036 R.P., TITLE: ACOUSTIC SLIDING DOOR SHOPDRAWING SUBMISSION	DATE OF ISSUE										SUBMISSION STATE (FOR B.D / A.S.D)			SUBMISSION STATE (FOR CLIENT / CONSULTANT)			SUBMISSION STATE (FOR ARCHITECT)			FABRICATION / CONSTRUCTION STATE						
	ISSUE	1	2	3								AP - APPROVED			AP - APPROVED			AP - APPROVED			ISSUE TO CHINA OFFICE		ISSUE TO SITE		ISSUE TO SUB-CONTRACTOR	
	DAY	20	24	16								AC - APPROVED SUB. TO CONDITION			AC - APPROVED SUB. TO CONDITION			AC - APPROVED SUB. TO CONDITION								
	MONTH	8	8	11								NA - NOT APPROVED			NA - NOT APPROVED			NA - NOT APPROVED								
	YEAR	20	20	20																						
DRAWING TITLE	DWG. NO.	REVISIONS										COMMENT DATE	REV.	STATE	COMMENT DATE	REV.	STATE	COMMENT DATE	REV.	STATE	REV.	DATE	REV.	DATE	REV.	DATE
COVER PAGE	J852-SD-ASD-0000	-	A	B																						
DRAWING REGISTER	J852-SD-ASD-0001	-	A	B																						
DRAWING REGISTER	J852-SD-ASD-0002	-	A	B																						
SECTION PROPERTIES FOR NOISE SCREEN	J852-SD-ASD-1101	-	-	-																						
PART PLAN FOR ACOUSTIC SLIDING DOOR OF TOWER 1 (1/F)	J852-SD-ASD-3101	-	-	-																						
PART PLAN FOR ACOUSTIC SLIDING DOOR OF TOWER 1 (2-21/F)	J852-SD-ASD-3102	-	-	-																						
PART PLAN FOR ACOUSTIC SLIDING DOOR OF TOWER 1 (22/F)	J852-SD-ASD-3103	-	-	-																						
PART PLAN FOR ACOUSTIC SLIDING DOOR OF TOWER 1 (23/F)	J852-SD-ASD-3104	-	-	-																						
PART PLAN FOR ACOUSTIC SLIDING DOOR OF TOWER 2 (1/F)	J852-SD-ASD-3201	-	-	-																						
PART PLAN FOR ACOUSTIC SLIDING DOOR OF TOWER 2 (2-21/F)	J852-SD-ASD-3202	-	-	-																						
PART PLAN FOR ACOUSTIC SLIDING DOOR OF TOWER 2 (22/F)	J852-SD-ASD-3203	-	-	-																						
PART PLAN FOR ACOUSTIC SLIDING DOOR OF TOWER 2 (23/F)	J852-SD-ASD-3204	-	-	-																						
PART PLAN FOR ACOUSTIC SLIDING DOOR OF TOWER 3 (1/F)	J852-SD-ASD-3301	-	-	B																						
PART PLAN FOR ACOUSTIC SLIDING DOOR OF TOWER 3 (2-21/F)	J852-SD-ASD-3302	-	-	-																						
PART PLAN FOR ACOUSTIC SLIDING DOOR OF TOWER 3 (22/F)	J852-SD-ASD-3303	-	-	-																						
PART PLAN FOR ACOUSTIC SLIDING DOOR OF TOWER 3 (23/F)	J852-SD-ASD-3304	-	-	-																						
PART ELEVATION, PLAN & SECTION FOR ACOUSTIC SLIDING DOOR	J852-SD-ASD-4101	-	A	B																						
PART ELEVATION, PLAN & SECTION FOR ACOUSTIC SLIDING DOOR	J852-SD-ASD-4101A	-	A	B																						
PART ELEVATION, PLAN & SECTION FOR ACOUSTIC SLIDING DOOR	J852-SD-ASD-4102	-	A	B																						
PART ELEVATION, PLAN & SECTION FOR ACOUSTIC SLIDING DOOR	J852-SD-ASD-4102A	-	A	B																						
PART ELEVATION, PLAN & SECTION FOR ACOUSTIC SLIDING DOOR	J852-SD-ASD-4103	-	A	B																						
PART ELEVATION, PLAN & SECTION FOR ACOUSTIC SLIDING DOOR	J852-SD-ASD-4103A	-	A	B																						
PART ELEVATION, PLAN & SECTION FOR ACOUSTIC SLIDING DOOR	J852-SD-ASD-4104	-	A	B																						
PART ELEVATION, PLAN & SECTION FOR ACOUSTIC SLIDING DOOR	J852-SD-ASD-4105	-	A	B																						
PART ELEVATION, PLAN & SECTION FOR ACOUSTIC SLIDING DOOR	J852-SD-ASD-4106	-	A	B																						
PART ELEVATION, PLAN & SECTION FOR ACOUSTIC SLIDING DOOR	J852-SD-ASD-4107	-	A	B																						
PART ELEVATION, PLAN & SECTION FOR ACOUSTIC SLIDING DOOR	J852-SD-ASD-4108	-	A	B																						
PART ELEVATION, PLAN & SECTION FOR ACOUSTIC SLIDING DOOR	J852-SD-ASD-4109	-	A	B																						
PART ELEVATION, PLAN & SECTION FOR ACOUSTIC SLIDING DOOR	J852-SD-ASD-4109A	-	A	B																						
PART ELEVATION, PLAN & SECTION FOR ACOUSTIC SLIDING DOOR	J852-SD-ASD-4201	-	A	B																						
PART ELEVATION, PLAN & SECTION FOR ACOUSTIC SLIDING DOOR	J852-SD-ASD-4201A	-	A	B																						
PART ELEVATION, PLAN & SECTION FOR ACOUSTIC SLIDING DOOR	J852-SD-ASD-4202	-	A	B																						
PART ELEVATION, PLAN & SECTION FOR ACOUSTIC SLIDING DOOR	J852-SD-ASD-4202A	-	A	B																						
PART ELEVATION, PLAN & SECTION FOR ACOUSTIC SLIDING DOOR	J852-SD-ASD-4203	-	A	B																						
PART ELEVATION, PLAN & SECTION FOR ACOUSTIC SLIDING DOOR	J852-SD-ASD-4203A	-	A	B																						
PART ELEVATION, PLAN & SECTION FOR ACOUSTIC SLIDING DOOR	J852-SD-ASD-4204	-	A	B																						
PART ELEVATION, PLAN & SECTION FOR ACOUSTIC SLIDING DOOR	J852-SD-ASD-4204A	-	A	B																						
PART ELEVATION, PLAN & SECTION FOR ACOUSTIC SLIDING DOOR	J852-SD-ASD-4205	-	A	B																						
PART ELEVATION, PLAN & SECTION FOR ACOUSTIC SLIDING DOOR	J852-SD-ASD-4205A	-	A	B																						
PART ELEVATION, PLAN & SECTION FOR ACOUSTIC SLIDING DOOR	J852-SD-ASD-4205B	-	A	B																						
PART ELEVATION, PLAN & SECTION FOR ACOUSTIC SLIDING DOOR	J852-SD-ASD-4206	-	A	B																						
PART ELEVATION, PLAN & SECTION FOR ACOUSTIC SLIDING DOOR	J852-SD-ASD-4206A	-	A	B																						
PART ELEVATION, PLAN & SECTION FOR ACOUSTIC SLIDING DOOR	J852-SD-ASD-4206B	-	A	B																						
PART ELEVATION, PLAN & SECTION FOR ACOUSTIC SLIDING DOOR	J852-SD-ASD-4207	-	A	B																						

IN-HOUSE DESIGN CHECKER



MIDI ALUMINIUM FABRICATOR LTD.
 Units 6-8, Sunray Industrial Centre, 1/F
 610 Cha Kwo Ling Road, Kowloon
 Tel:23489211-4 Fax:(852)27727666

DWG NO. : J852-SD-ASD-0001 REV. : B

DRAWING SUBMISSION REGISTER

PROJECT: PROPOSED RESIDENTIAL DEVELOPMENT AT 139-147 ARGYLE STREET, NKIL 6006, 6035 R.P., 6036 R.P., TITLE: ACOUSTIC SLIDING DOOR SHOPDRAWING SUBMISSION	DATE OF ISSUE										SUBMISSION STATE (FOR B.D / A.S.D)			SUBMISSION STATE (FOR CLIENT / CONSULTANT)			SUBMISSION STATE (FOR ARCHITECT)			FABRICATION / CONSTRUCTION STATE						
	ISSUE	1	2	3								AP - APPROVED			AP - APPROVED			AP - APPROVED			ISSUE TO CHINA OFFICE		ISSUE TO SITE		ISSUE TO SUB-CONTRACTOR	
	DAY	20	24	16								AC - APPROVED SUB. TO CONDITION			AC - APPROVED SUB. TO CONDITION			AC - APPROVED SUB. TO CONDITION								
	MONTH	8	8	11								NA - NOT APPROVED			NA - NOT APPROVED			NA - NOT APPROVED								
	YEAR	20	20	20																						

DRAWING TITLE	DWG. NO.	REVISIONS	COMMENT DATE	REV.	STATE	COMMENT DATE	REV.	STATE	COMMENT DATE	REV.	STATE	REV.	DATE	REV.	DATE	REV.	DATE
PART ELEVATION, PLAN & SECTION FOR ACOUSTIC SLIDING DOOR	J852-SD-ASD-4207A	- A B															
PART ELEVATION, PLAN & SECTION FOR ACOUSTIC SLIDING DOOR	J852-SD-ASD-4301	- A B															
PART ELEVATION, PLAN & SECTION FOR ACOUSTIC SLIDING DOOR	J852-SD-ASD-4301A	- A B															
PART ELEVATION, PLAN & SECTION FOR ACOUSTIC SLIDING DOOR	J852-SD-ASD-4302	- A B															
PART ELEVATION, PLAN & SECTION FOR ACOUSTIC SLIDING DOOR	J852-SD-ASD-4302A	- A B															
PART ELEVATION, PLAN & SECTION FOR ACOUSTIC SLIDING DOOR	J852-SD-ASD-4303	- A B															
PART ELEVATION, PLAN & SECTION FOR ACOUSTIC SLIDING DOOR	J852-SD-ASD-4303A	- A B															
PART ELEVATION, PLAN & SECTION FOR ACOUSTIC SLIDING DOOR	J852-SD-ASD-4304	- A B															
PART ELEVATION, PLAN & SECTION FOR ACOUSTIC SLIDING DOOR	J852-SD-ASD-4304A	- A B															
PART ELEVATION, PLAN & SECTION FOR ACOUSTIC SLIDING DOOR	J852-SD-ASD-4305	- A B															
PART ELEVATION, PLAN & SECTION FOR ACOUSTIC SLIDING DOOR	J852-SD-ASD-4306	- A B															
PART ELEVATION, PLAN & SECTION FOR ACOUSTIC SLIDING DOOR	J852-SD-ASD-4307	- A B															
PART ELEVATION, PLAN & SECTION FOR ACOUSTIC SLIDING DOOR	J852-SD-ASD-4308	- A B															
PART ELEVATION, PLAN & SECTION FOR ACOUSTIC SLIDING DOOR	J852-SD-ASD-4309	- A B															
PART ELEVATION, PLAN & SECTION FOR ACOUSTIC SLIDING DOOR	J852-SD-ASD-4310	- A B															
PART ELEVATION, PLAN & SECTION FOR ACOUSTIC SLIDING DOOR	J852-SD-ASD-4311	- A B															
PART ELEVATION, PLAN & SECTION FOR ACOUSTIC SLIDING DOOR	J852-SD-ASD-4312	- A B															
TYPICAL DETAILS FOR ACOUSTIC SLIDING DOOR	J852-SD-ASD-5001	- - -															
TYPICAL DETAILS FOR ACOUSTIC SLIDING DOOR	J852-SD-ASD-5002	- - B															
TYPICAL DETAILS FOR ACOUSTIC SLIDING DOOR	J852-SD-ASD-5002A	/ / B															
TYPICAL DETAILS FOR ACOUSTIC SLIDING DOOR	J852-SD-ASD-5003	- - -															
TYPICAL DETAILS FOR ACOUSTIC SLIDING DOOR	J852-SD-ASD-5004	- - -															
TYPICAL DETAILS FOR ACOUSTIC SLIDING DOOR	J852-SD-ASD-5005	- - -															
TYPICAL DETAILS FOR ACOUSTIC SLIDING DOOR	J852-SD-ASD-6001	- - B															
TYPICAL DETAILS FOR ACOUSTIC SLIDING DOOR	J852-SD-ASD-6002	- - B															
TYPICAL DETAILS FOR ACOUSTIC SLIDING DOOR	J852-SD-ASD-6002A	/ / B															
TYPICAL DETAILS FOR ACOUSTIC SLIDING DOOR	J852-SD-ASD-6003	- - B															
TYPICAL DETAILS FOR ACOUSTIC SLIDING DOOR	J852-SD-ASD-6004	- - B															

IN-HOUSE DESIGN CHECKER
美特鋁質有限公司 MIDI ALUMINIUM FABRICATOR LTD. Units 6-8, Sunray Industrial Centre, 1/F 610 Cha Kwo Ling Road, Kowloon Tel:23489211-4 Fax:(852)27727666
DWG NO. : J852-SD-ASD-0002 REV. : B

MEMBER: AL-ASD01
GRADE: 6063-T6
FINISH: PVF2 3-COATING

REGIONS

Area (mm ²):	290.28
Perimeter (mm):	296.17
Bounding Box - X (mm):	-9.81 to 25.19
Bounding Box - Y (mm):	-33.11 to 33.89
Centroid - X (mm):	0.00
Centroid - Y (mm):	0.00
Moments of inertia - X (mm ⁴):	192156.86
Moments of inertia - Y (mm ⁴):	31082.00
Product of inertia - XY (mm ⁴):	136.29
Principal moments along X-Y (mm ⁴):	192156.98 along [1.00 0.00]
Principal moments along Y-X (mm ⁴):	31082.48 along [0.00 1.00]
Elastic Modulus - Zx (mm ³):	I / y-max= 5670.05
Elastic Modulus - Zy (mm ³):	I / x-max= 1234.11

MEMBER: AL-ASD02
GRADE: 6063-T6
FINISH: PVF2 3-COATING

REGIONS

Area (mm ²):	397.70
Perimeter (mm):	314.34
Bounding Box - X (mm):	-11.14 to 21.86
Bounding Box - Y (mm):	-33.87 to 28.53
Centroid - X (mm):	0.00
Centroid - Y (mm):	0.00
Moments of inertia - X (mm ⁴):	160789.18
Moments of inertia - Y (mm ⁴):	28266.54
Product of inertia - XY (mm ⁴):	10360.70
Principal moments along X-Y (mm ⁴):	161568.36 along [1.00 0.00]
Principal moments along Y-X (mm ⁴):	27507.36 along [-0.08 1.00]
Elastic Modulus - Zx (mm ³):	I / y-max= 4747.07
Elastic Modulus - Zy (mm ³):	I / x-max= 1294.19

MEMBER: AL-ASD03
GRADE: 6063-T5
FINISH: PVF2 3-COATING

REGIONS

Area (mm ²):	45.48
Perimeter (mm):	43.91
Bounding Box - X (mm):	-1.63 to 3.50
Bounding Box - Y (mm):	-7.30 to 7.30
Centroid - X (mm):	0.00
Centroid - Y (mm):	0.00
Moments of inertia - X (mm ⁴):	902.80
Moments of inertia - Y (mm ⁴):	50.04
Product of inertia - XY (mm ⁴):	0.00
Principal moments along X-Y (mm ⁴):	902.80 along [1.00 0.00]
Principal moments along Y-X (mm ⁴):	50.04 along [0.00 1.00]
Elastic Modulus - Zx (mm ³):	I / y-max= 123.67
Elastic Modulus - Zy (mm ³):	I / x-max= 14.29

MEMBER: AL-ASD04
GRADE: 6063-T6
FINISH: PVF2 3-COATING

REGIONS

Area (mm ²):	155.98
Perimeter (mm):	188.27
Bounding Box - X (mm):	-33.28 to 33.72
Bounding Box - Y (mm):	-6.77 to 2.96
Centroid - X (mm):	0.00
Centroid - Y (mm):	0.00
Moments of inertia - X (mm ⁴):	237.68
Moments of inertia - Y (mm ⁴):	62182.46
Product of inertia - XY (mm ⁴):	-58.02
Principal moments along X-Y (mm ⁴):	237.63 along [1.00 0.00]
Principal moments along Y-X (mm ⁴):	62182.51 along [0.00 1.00]
Elastic Modulus - Zx (mm ³):	I / y-max= 38.51
Elastic Modulus - Zy (mm ³):	I / x-max= 1843.94

MEMBER: AL-ASD05
GRADE: 6063-T6
FINISH: PVF2 3-COATING

REGIONS

Area (mm ²):	321.15
Perimeter (mm):	287.36
Bounding Box - X (mm):	-31.68 to 41.32
Bounding Box - Y (mm):	-27.94 to 7.06
Centroid - X (mm):	0.00
Centroid - Y (mm):	0.00
Moments of inertia - X (mm ⁴):	28859.96
Moments of inertia - Y (mm ⁴):	20794.49
Product of inertia - XY (mm ⁴):	-23295.72
Principal moments along X-Y (mm ⁴):	25873.52 along [0.99 0.13]
Principal moments along Y-X (mm ⁴):	210577.04 along [-0.13 0.99]
Elastic Modulus - Zx (mm ³):	I / y-max= 1033.07
Elastic Modulus - Zy (mm ³):	I / x-max= 5023.60

MEMBER: AL-ASD06
GRADE: 6063-T6
FINISH: PVF2 3-COATING

REGIONS

Area (mm ²):	138.98
Perimeter (mm):	159.85
Bounding Box - X (mm):	-28.84 to 30.16
Bounding Box - Y (mm):	-6.51 to 1.49
Centroid - X (mm):	0.00
Centroid - Y (mm):	0.00
Moments of inertia - X (mm ⁴):	280.52
Moments of inertia - Y (mm ⁴):	44351.23
Product of inertia - XY (mm ⁴):	-262.07
Principal moments along X-Y (mm ⁴):	273.34 along [1.00 0.01]
Principal moments along Y-X (mm ⁴):	44358.42 along [-0.01 1.00]
Elastic Modulus - Zx (mm ³):	I / y-max= 43.08
Elastic Modulus - Zy (mm ³):	I / x-max= 1478.41

B.D. REF :

CLIENT :

ARCHITECT :
AGC DESIGN LTD

MAIN CONTRACTOR :
Gammon

STRUCTURAL ENGINEER :
ARUP

FACADE CONSULTANT:
MEINHARDT

NOTE :
1. ALL DIMENSIONS ARE IN mm.
2. ALL ELEVATIONS ARE VIEWED FROM OUTSIDE.
3. ALL DIMENSIONS TO BE VERIFIED ON SITE BEFORE FABRICATION.

LEGEND :
X1 --- DETAIL MARK NO.
X001 --- REFER SHEET NO.

1. F.F.L. --- FINISHED FLOOR LEVEL
2. S.F.L. --- STRUCTURAL FLOOR LEVEL
3. (R) --- REVERSED DETAIL

NO.	DATE	REVISION	BY
B	13-11-2020	REVISION SUBJECT TO COMMENTS	MN

JOB NO. : J-852
PROJECT : PROPOSED RESIDENTIAL DEVELOPMENT AT 139 - 147 ARGYLE STREET, NKIL 6005, 6035 R.P., 6036 R.P., 6037 R.P. & 6038 R.P.


TITLE : SECTION PROPERTIES FOR ACOUSTIC SLIDING DOOR (ALUM. EXTRUSIONS)

DATE : 19-Aug-20 SCALE : 1:4

DRAWN BY : LHR CHECKED BY : DW

美特鋁質有限公司
MIDI ALUMINIUM FABRICATOR LTD.
Units 6-8, Sunray Industrial Centre, 1/F
610 Cha Kwo Ling Road, Kowloon
Tel:23489211-4 Fax:(852)2727666

DWG NO. : J852-SD-ASD-1101 REV. : B

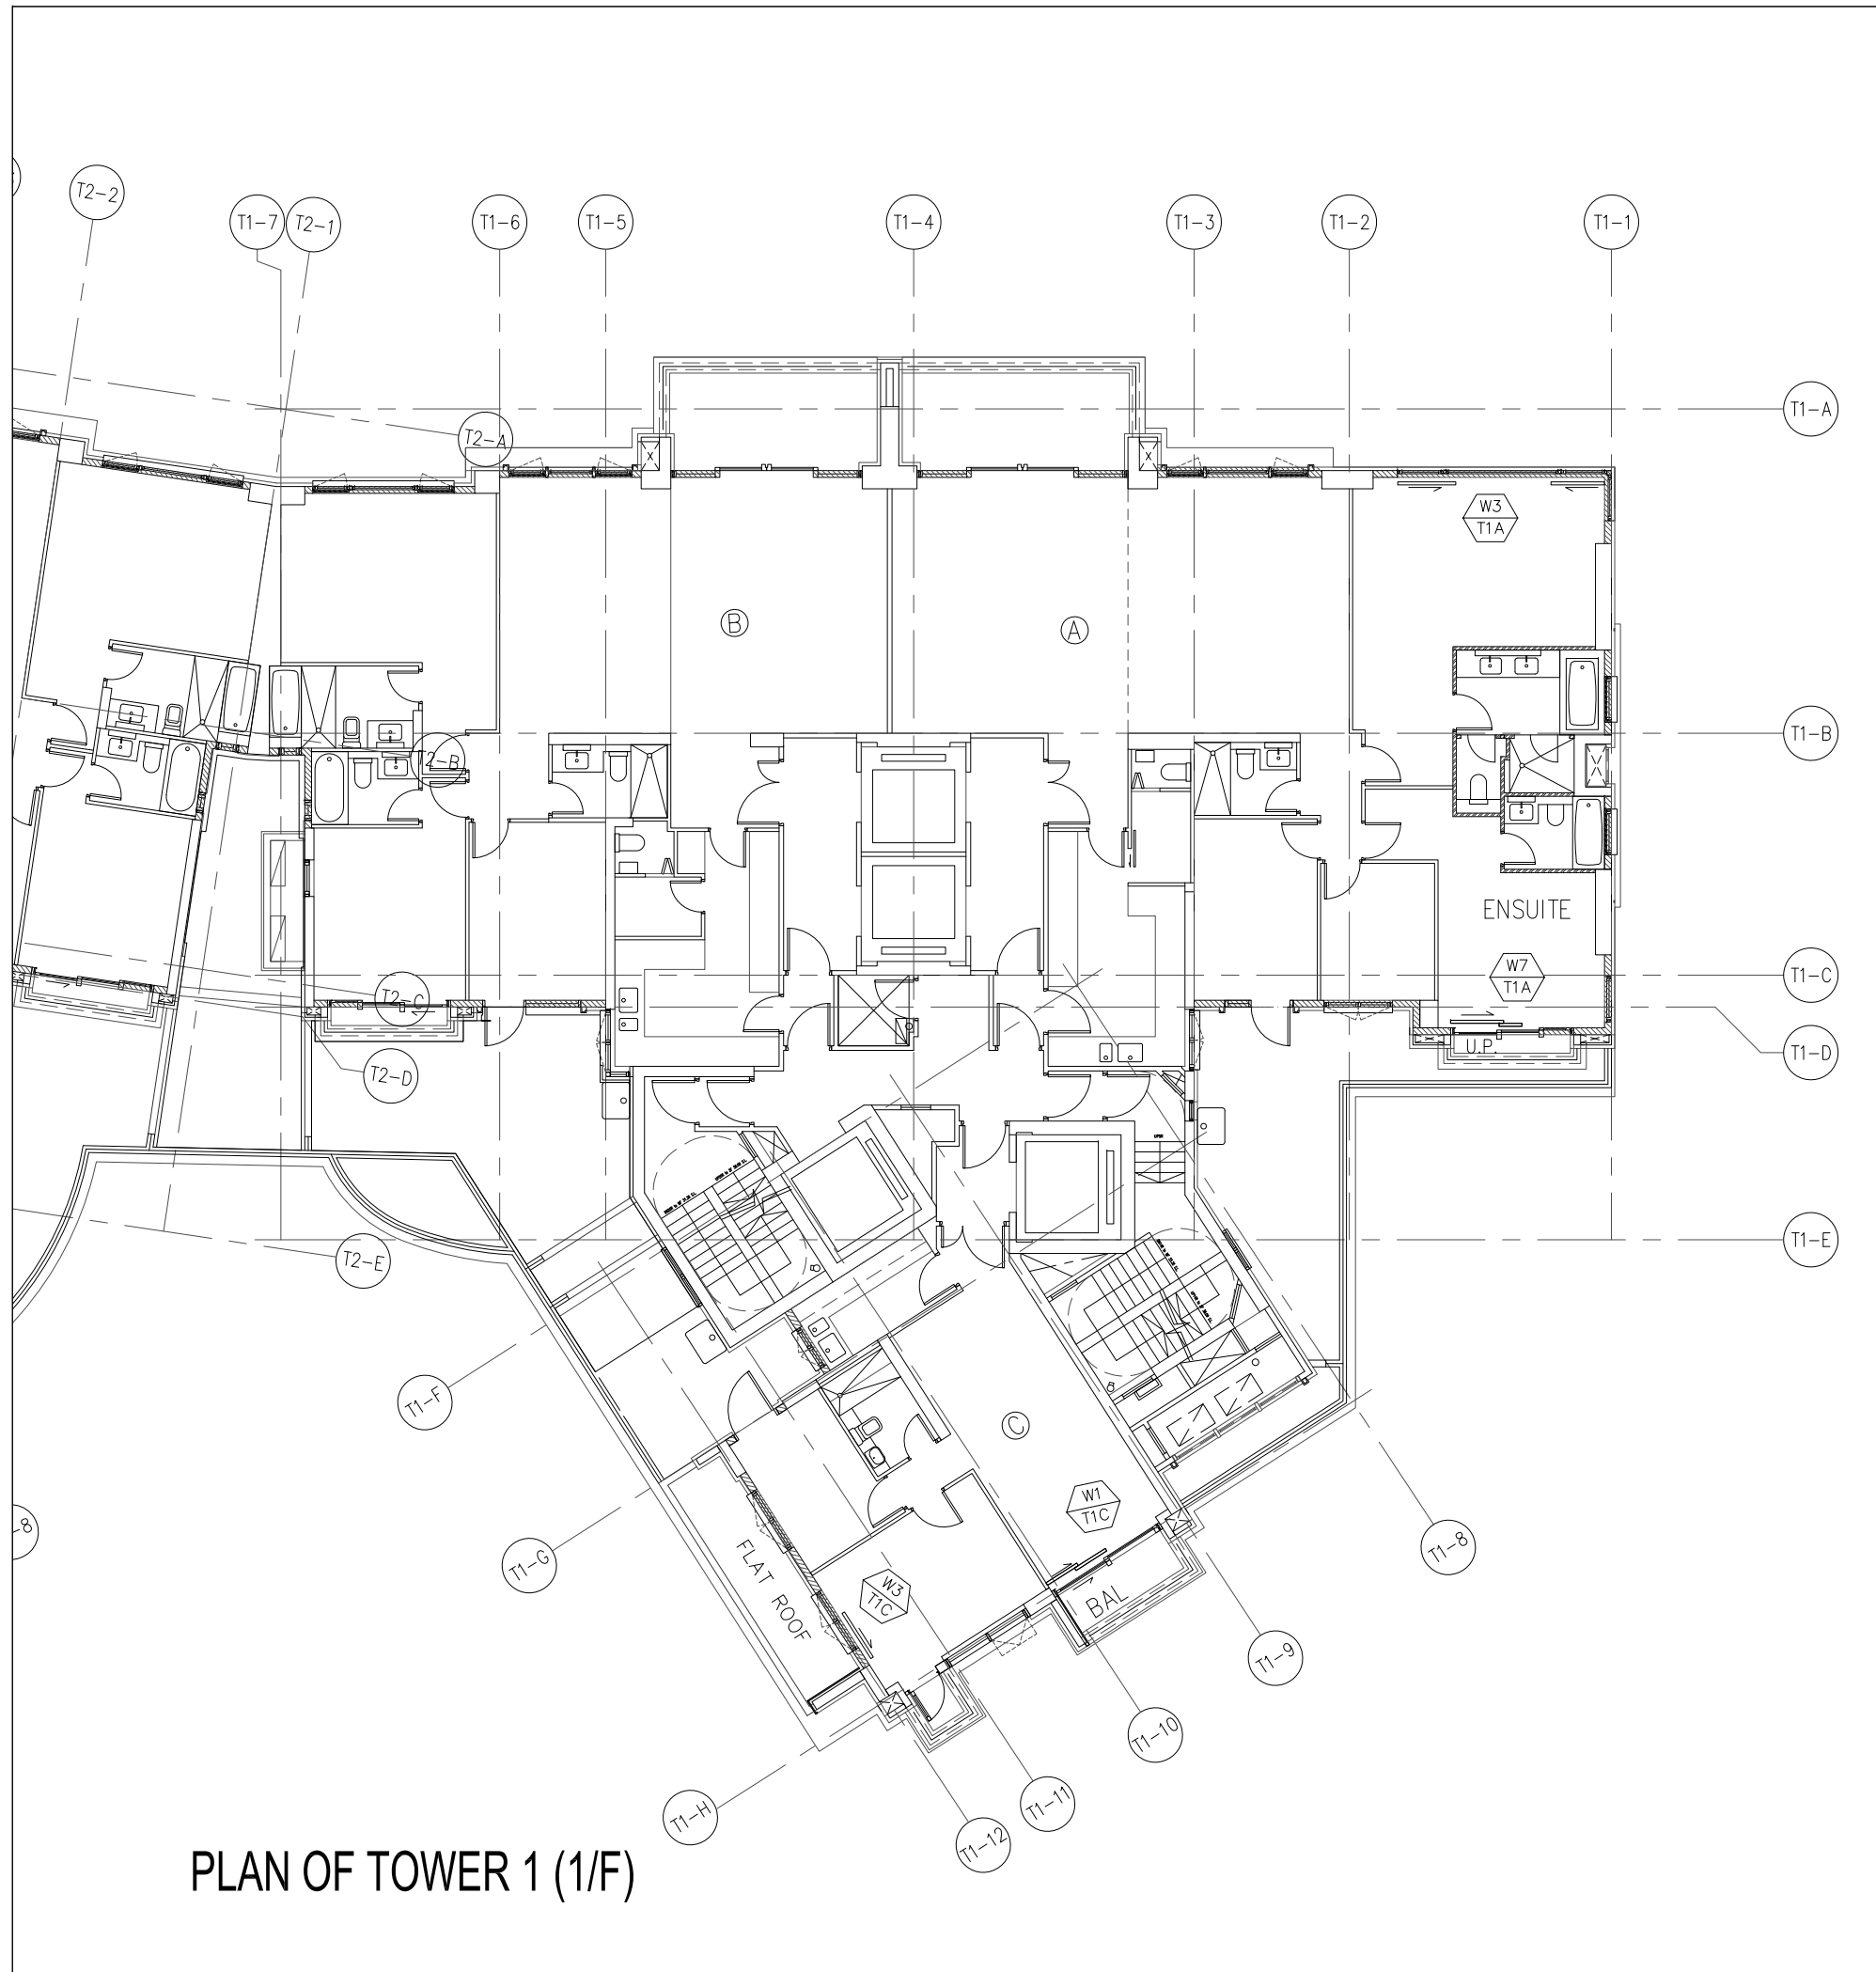

PLAN OF TOWER 1 (1/F)

WINDOW MARK	FLAT	FLOOR	Q.T.	TOTAL
W3/T1A	FLAT A	1F	1	1x1=1
W7/T1A	FLAT A	1F	1	1x1=1
W1/T1C	FLAT C	1F	1	1x1=1
W3/T1C	FLAT C	1F	1	1x1=1
		TOTAL	4	4

B.D. REF :
 CLIENT :

ARCHITECT :
AGC DESIGN LTD
 161, 162, 163,1000

MAIN CONTRACTOR :
Gammon

STRUCTURAL ENGINEER :
ARUP

FACADE CONSULTANT:
MEINHARDT

NOTE :
 1. ALL DIMENSIONS ARE IN mm.
 2. ALL ELEVATIONS ARE VIEWED FROM OUTSIDE.
 3. ALL DIMENSIONS TO BE VERIFIED ON SITE BEFORE FABRICATION.

LEGEND :
 (X1) --- DETAIL MARK NO.
 (X001) --- REFER SHEET NO.
 1. F.F.L. --- FINISHED FLOOR LEVEL
 2. S.F.L. --- STRUCTURAL FLOOR LEVEL
 3. (R) --- REVERSED DETAIL

NO.	DATE	REVISED	BY

JOB NO. : J-852
 PROJECT : PROPOSED RESIDENTIAL DEVELOPMENT AT 139 - 147 ARGYLE STREET, NKIL 6005, 6035 R.P., 6036 R.P., 6037 R.P. & 6038 R.P.


TITLE : PART PLAN FOR ACOUSTIC SLIDING DOOR OF TOWER 1 (1/F)

DATE : 16-Jul-2020 SCALE : 1:150

DRAWN BY : LHR CHECKED BY : DW

美特鋁質有限公司
MIDI ALUMINIUM FABRICATOR LTD.
 Units 6-8, Sunray Industrial Centre, 1/F
 610 Cha Kwo Ling Road, Kowloon
 Tel: 23489211-4 Fax: (852)27727666

DWG NO. : J852-SD-ASD-3101 REV. : -

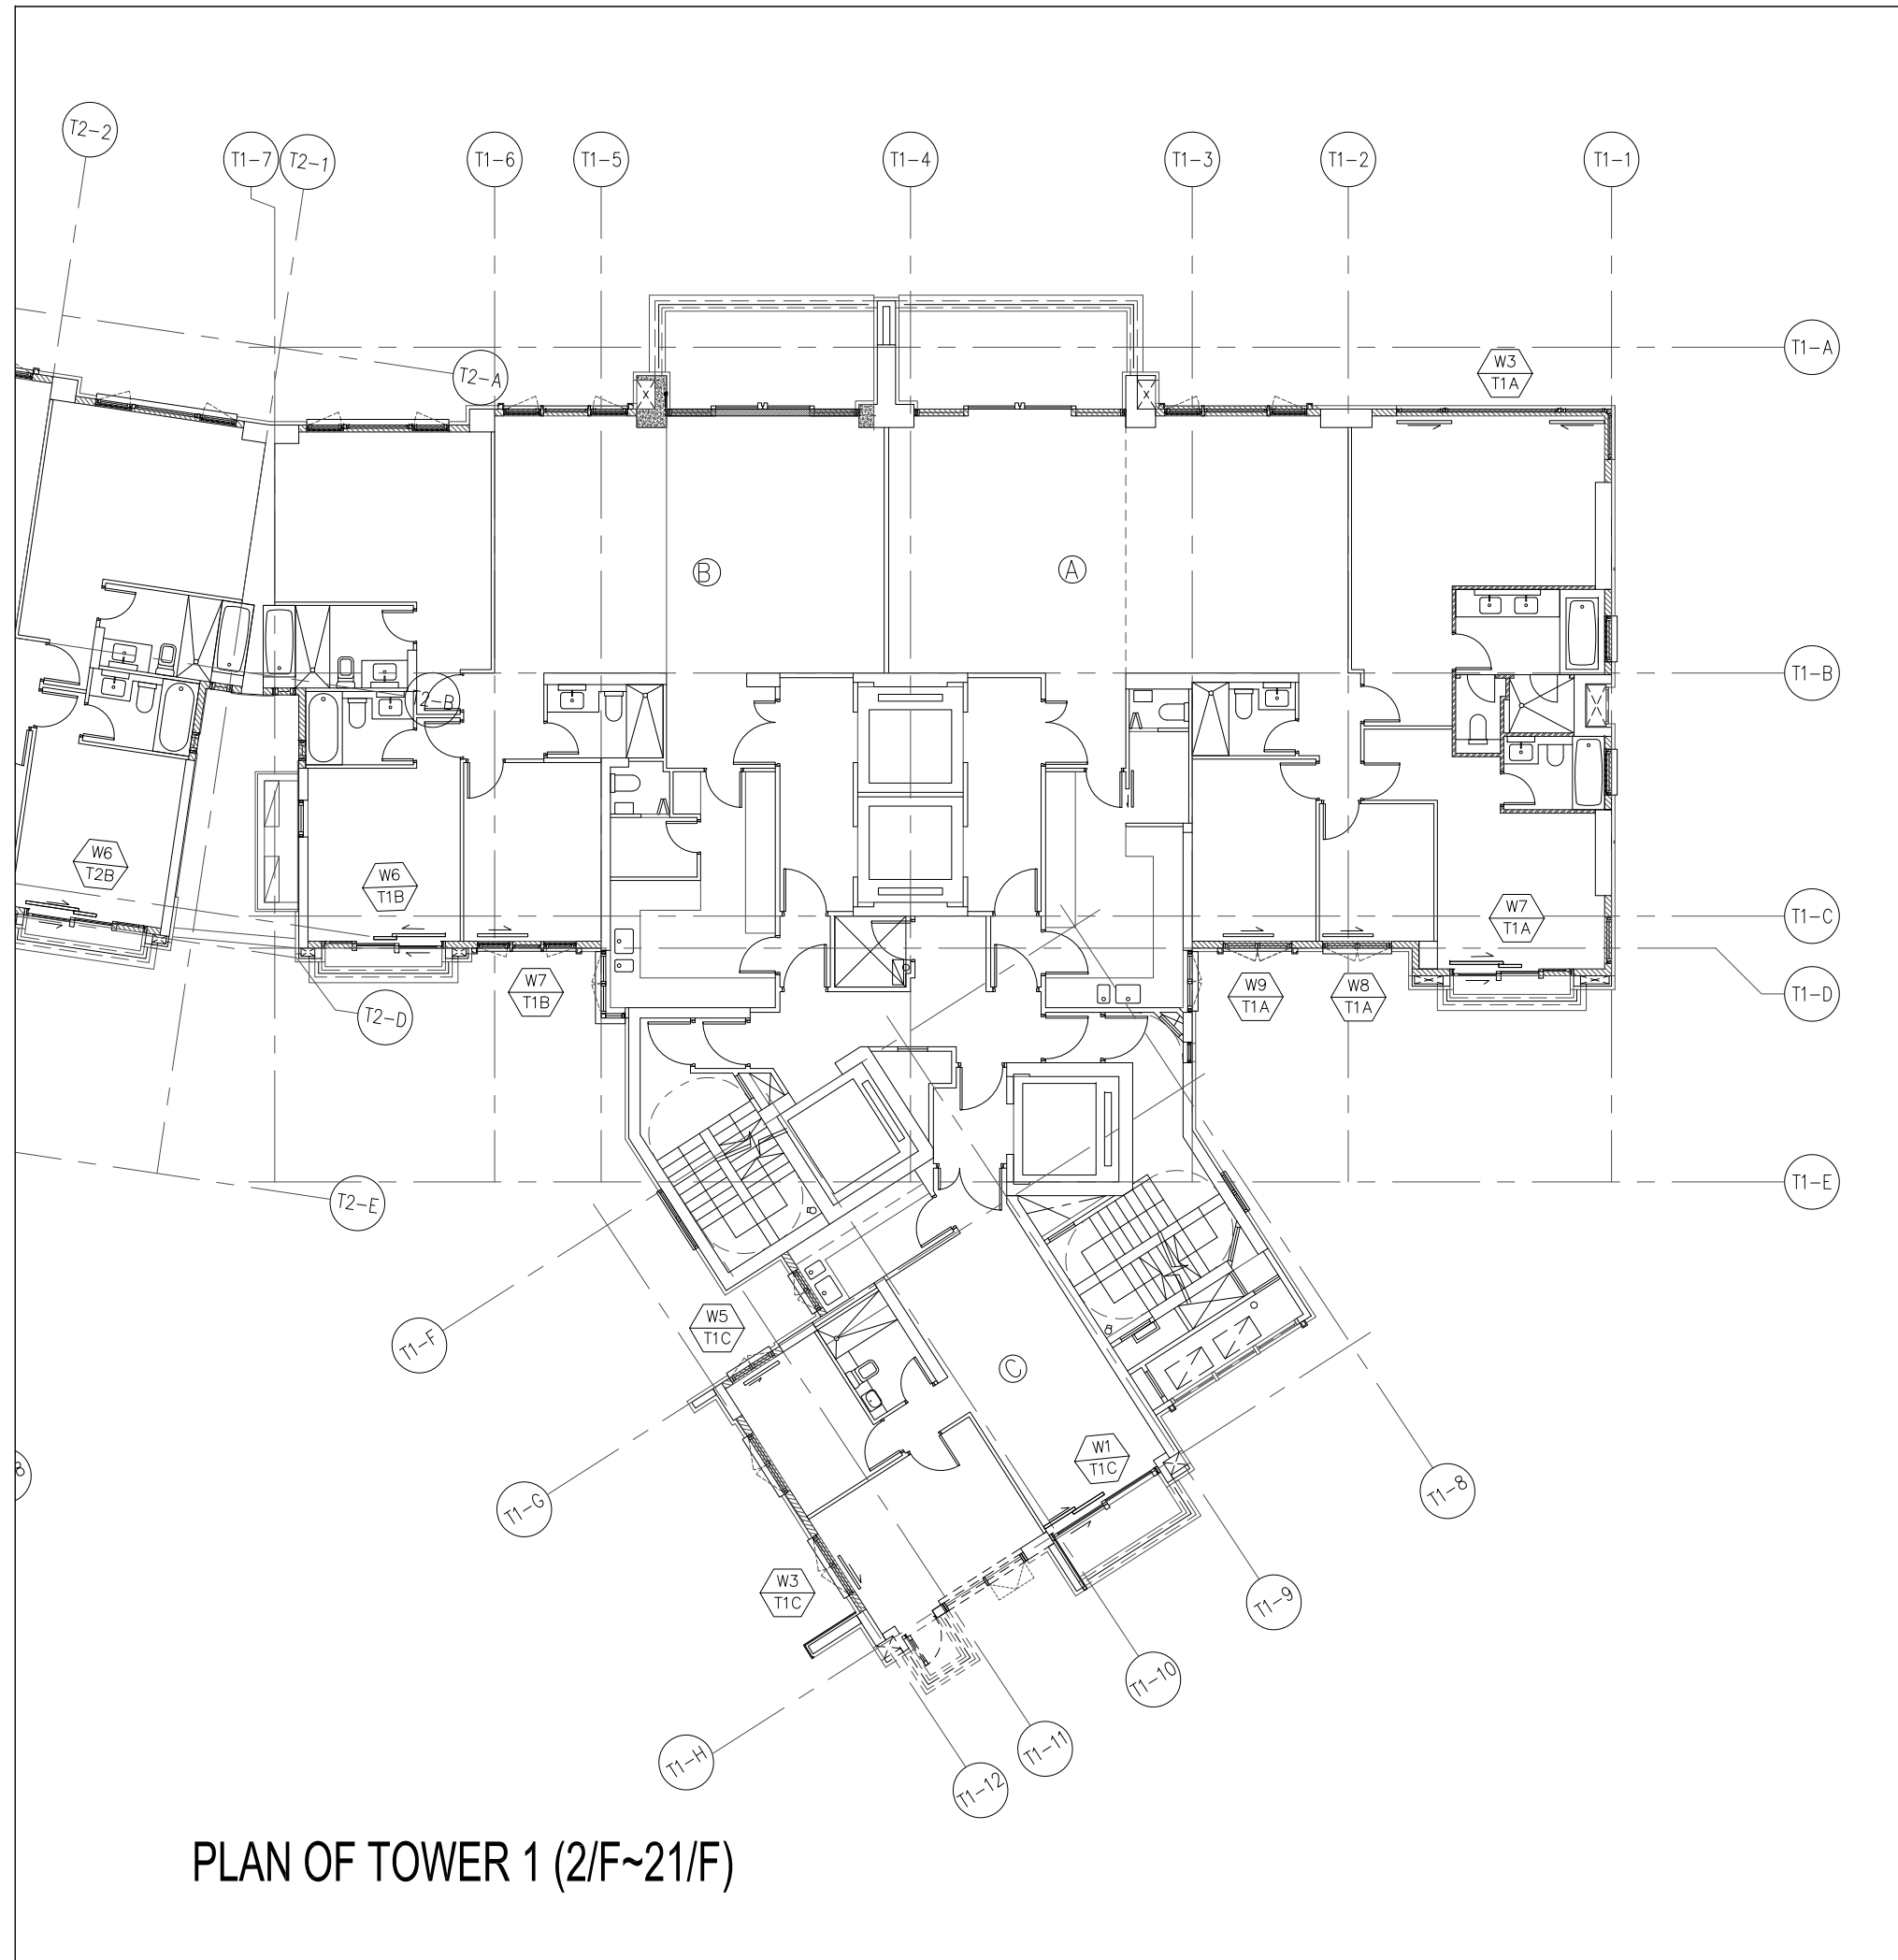

PLAN OF TOWER 1 (2/F~21/F)

WINDOW MARK	FLAT	FLOOR	Q.T.	TOTAL
W3/T1A	FLAT A	2F-21F	1	1x17=17
W7/T1A	FLAT A	2F-21F	1	1x17=17
W8/T1A	FLAT A	2F-21F	1	1x17=17
W9/T1A	FLAT A	2F-21F	1	1x17=17
W1/T1C	FLAT C	2F-21F	1	1x17=17
W3/T1C	FLAT C	2F-21F	1	1x17=17
W5/T1C	FLAT C	2F-21F	1	1x17=17
W6/T1B	FLAT B	2F-21F	1	1x17=17
W7/T1B	FLAT B	2F-21F	1	1x17=17
		TOTAL	9	153

B.D. REF :

CLIENT :

ARCHITECT :
AGC DESIGN LTD
 161, 162, 163,1000

MAIN CONTRACTOR :
Gammon

STRUCTURAL ENGINEER :
ARUP

FACADE CONSULTANT:
MEINHARDT

NOTE :
 1. ALL DIMENSIONS ARE IN mm.
 2. ALL ELEVATIONS ARE VIEWED FROM OUTSIDE.
 3. ALL DIMENSIONS TO BE VERIFIED ON SITE BEFORE FABRICATION.

LEGEND :
 (x1) --- DETAIL MARK NO.
 (x001) --- REFER SHEET NO.
 1. F.F.L. --- FINISHED FLOOR LEVEL
 2. S.F.L. --- STRUCTURAL FLOOR LEVEL
 3. (R) --- REVERSED DETAIL

NO.	DATE	REVISED	BY

JOB NO. : J-852
 PROJECT : PROPOSED RESIDENTIAL DEVELOPMENT AT 139 - 147 ARGYLE STREET, NKIL 6005, 6035 R.P., 6036 R.P., 6037 R.P. & 6038 R.P.


TITLE : PART PLAN FOR ACOUSTIC SLIDING DOOR OF TOWER 1 (2~21/F)

DATE : 16-Jul-2020 SCALE : 1:150

DRAWN BY : LHR CHECKED BY : DW

美特鋁質有限公司
MIDI ALUMINIUM FABRICATOR LTD.
 Units 6-8, Sunray Industrial Centre, 1/F
 610 Cha Kwo Ling Road, Kowloon
 Tel: 23489211-4 Fax: (852)27727666

DWG NO. : J852-SD-ASD-3102 REV. : -

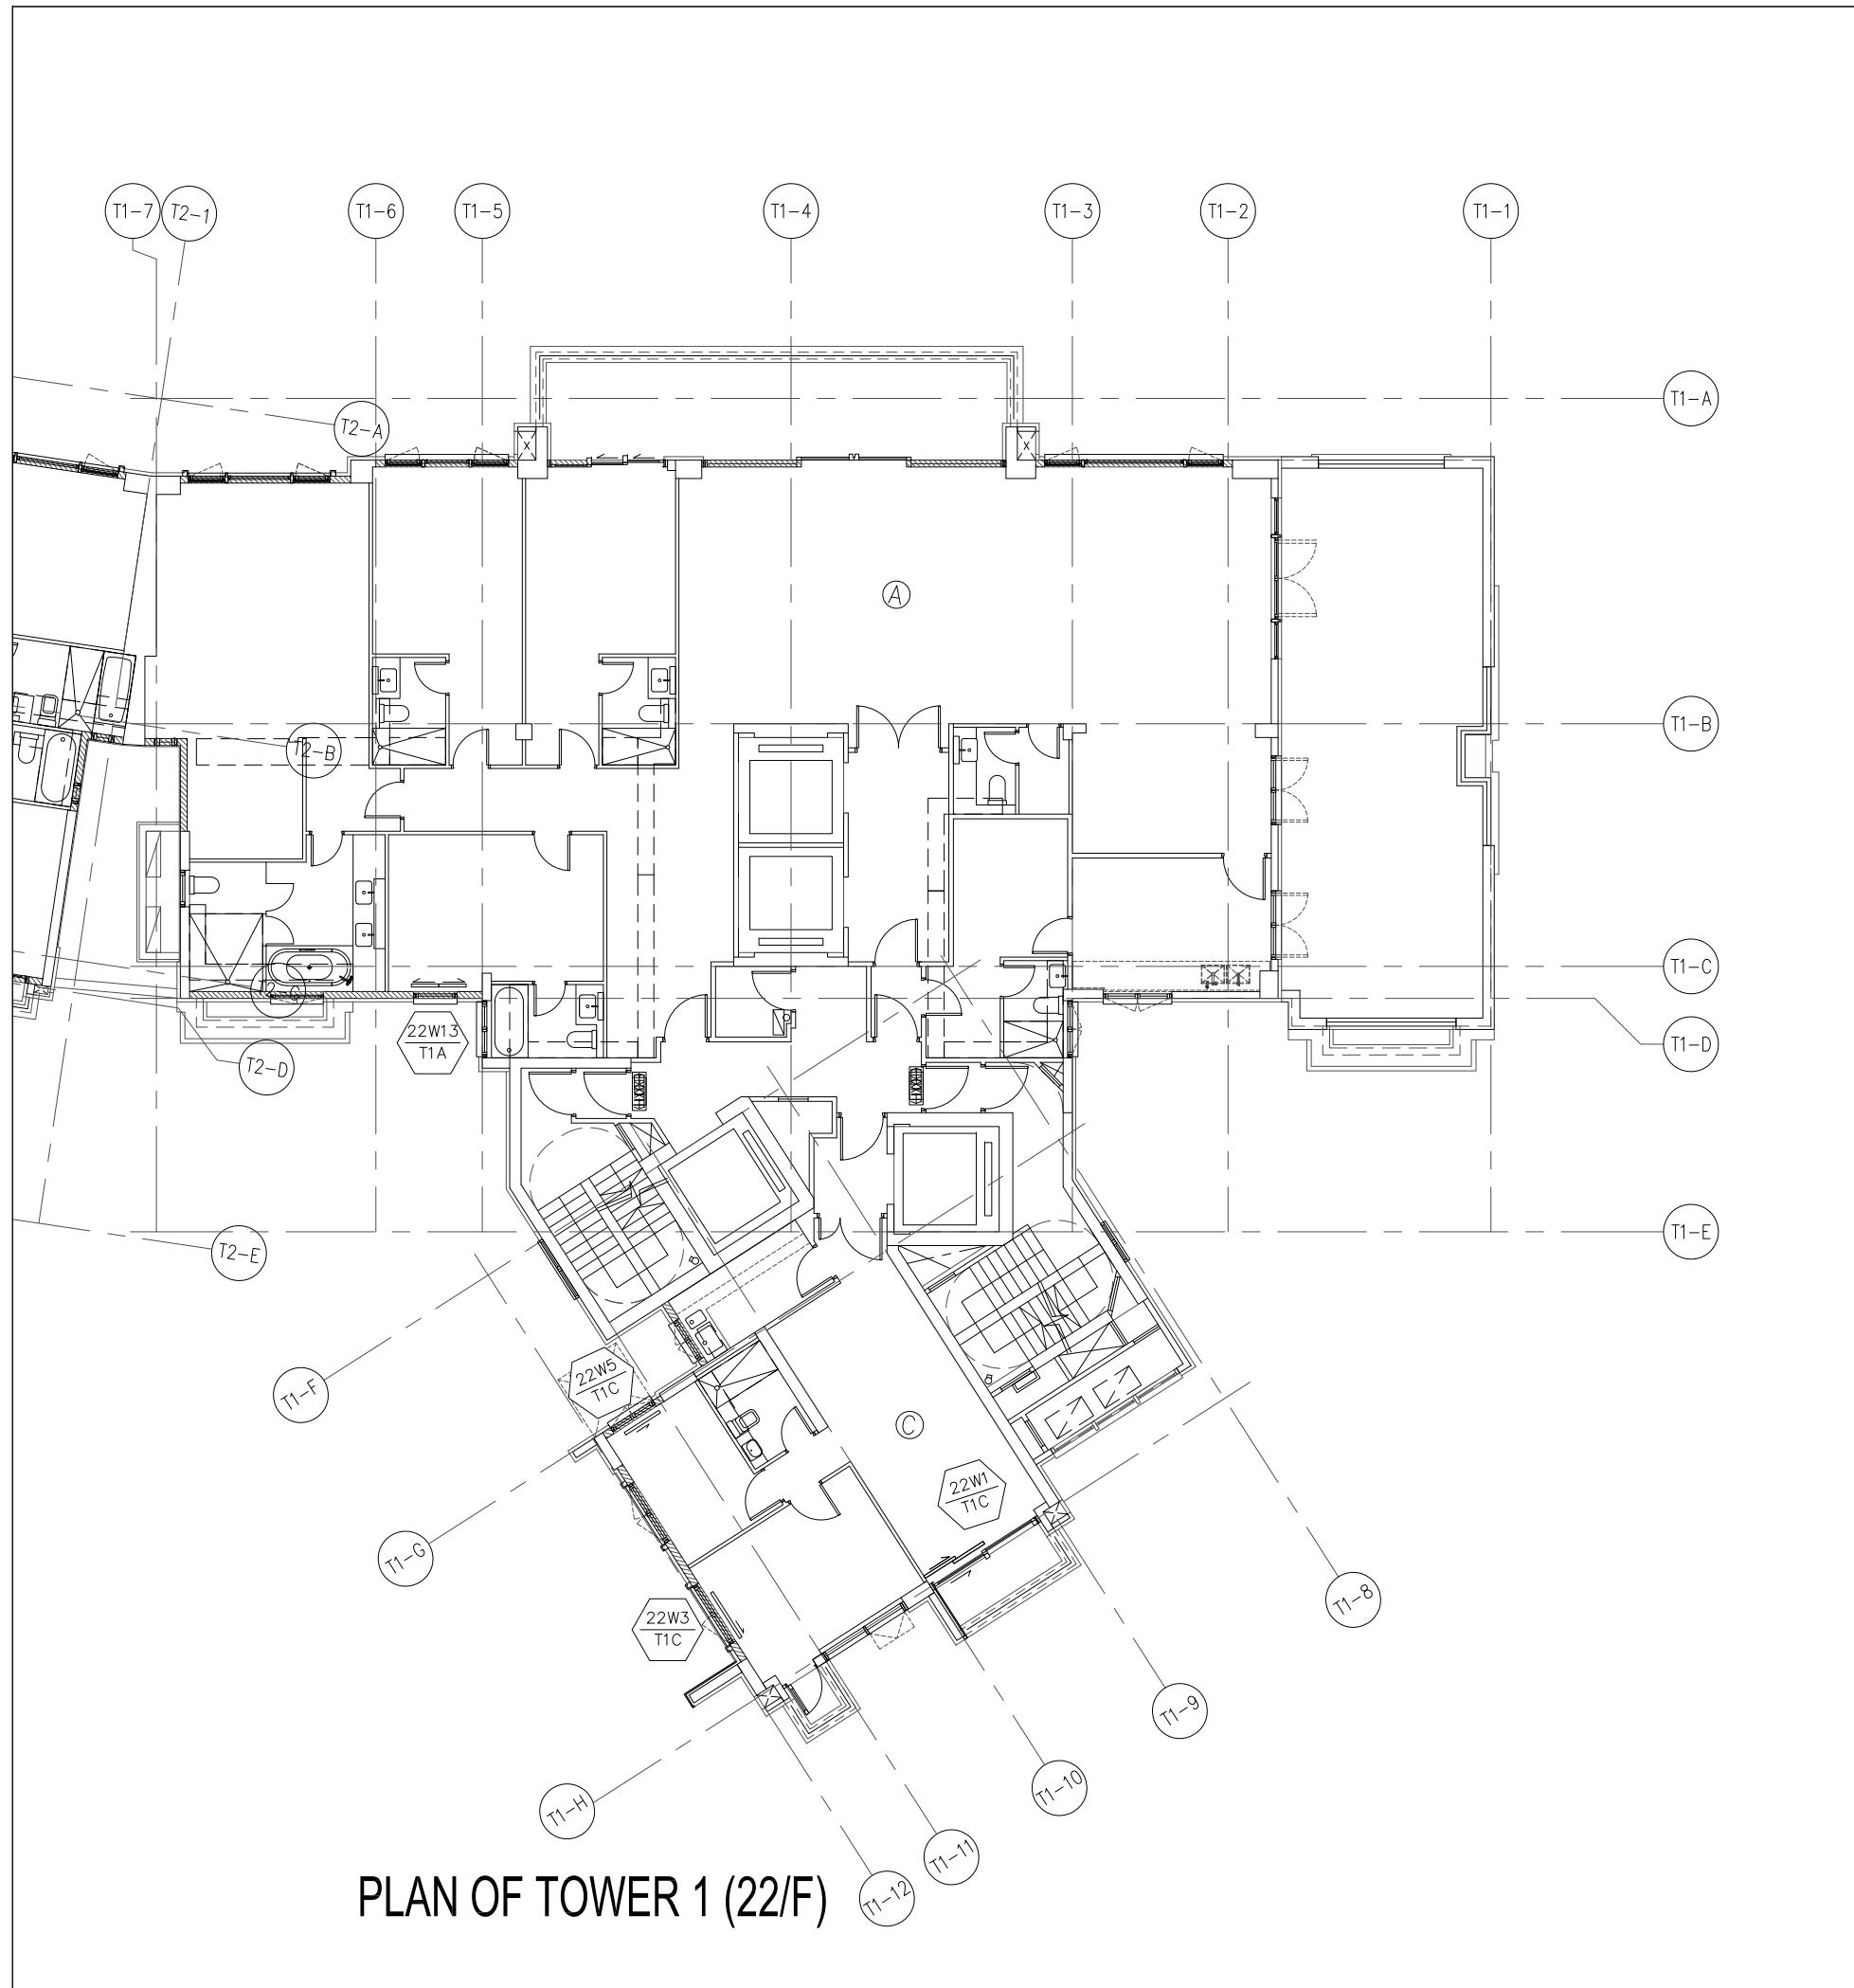

PLAN OF TOWER 1 (22/F)

WINDOW MARK	FLAT	FLOOR	Q.T.	TOTAL
22W13/T1A	FLAT A	22F	1	1x1=1
22W1/T1C	FLAT C	22F	1	1x1=1
22W3/T1C	FLAT C	22F	1	1x1=1
22W5/T1C	FLAT C	22F	1	1x1=1
		TOTAL	4	4

B.D. REF :

CLIENT :

ARCHITECT :
AGC DESIGN LTD

MAIN CONTRACTOR :
Gammon

STRUCTURAL ENGINEER :
ARUP

FACADE CONSULTANT:
MEINHARDT

NOTE :
 1. ALL DIMENSIONS ARE IN mm.
 2. ALL ELEVATIONS ARE VIEWED FROM OUTSIDE.
 3. ALL DIMENSIONS TO BE VERIFIED ON SITE BEFORE FABRICATION.

LEGEND :
 (x1) --- DETAIL MARK NO.
 (x001) --- REFER SHEET NO.
 1. F.F.L. --- FINISHED FLOOR LEVEL
 2. S.F.L. --- STRUCTURAL FLOOR LEVEL
 3. (R) --- REVERSED DETAIL

NO.	DATE	REVISED	BY

JOB NO. : J-852
 PROJECT : PROPOSED RESIDENTIAL DEVELOPMENT AT 139 - 147 ARGYLE STREET, NKIL 6005, 6035 R.P., 6036 R.P., 6037 R.P. & 6038 R.P.


TITLE : PART PLAN FOR ACOUSTIC SLIDING DOOR OF TOWER 1 (22/F)

DATE : 16-Jul-2020 SCALE : 1:150

DRAWN BY : LHR CHECKED BY : DW

美特鋁質有限公司
MIDI ALUMINIUM FABRICATOR LTD.
 Units 6-8, Sunray Industrial Centre, 1/F
 610 Cha Kwo Ling Road, Kowloon
 Tel: 23489211-4 Fax: (852) 27727666

DWG NO. : J852-SD-ASD-3103 REV. : -

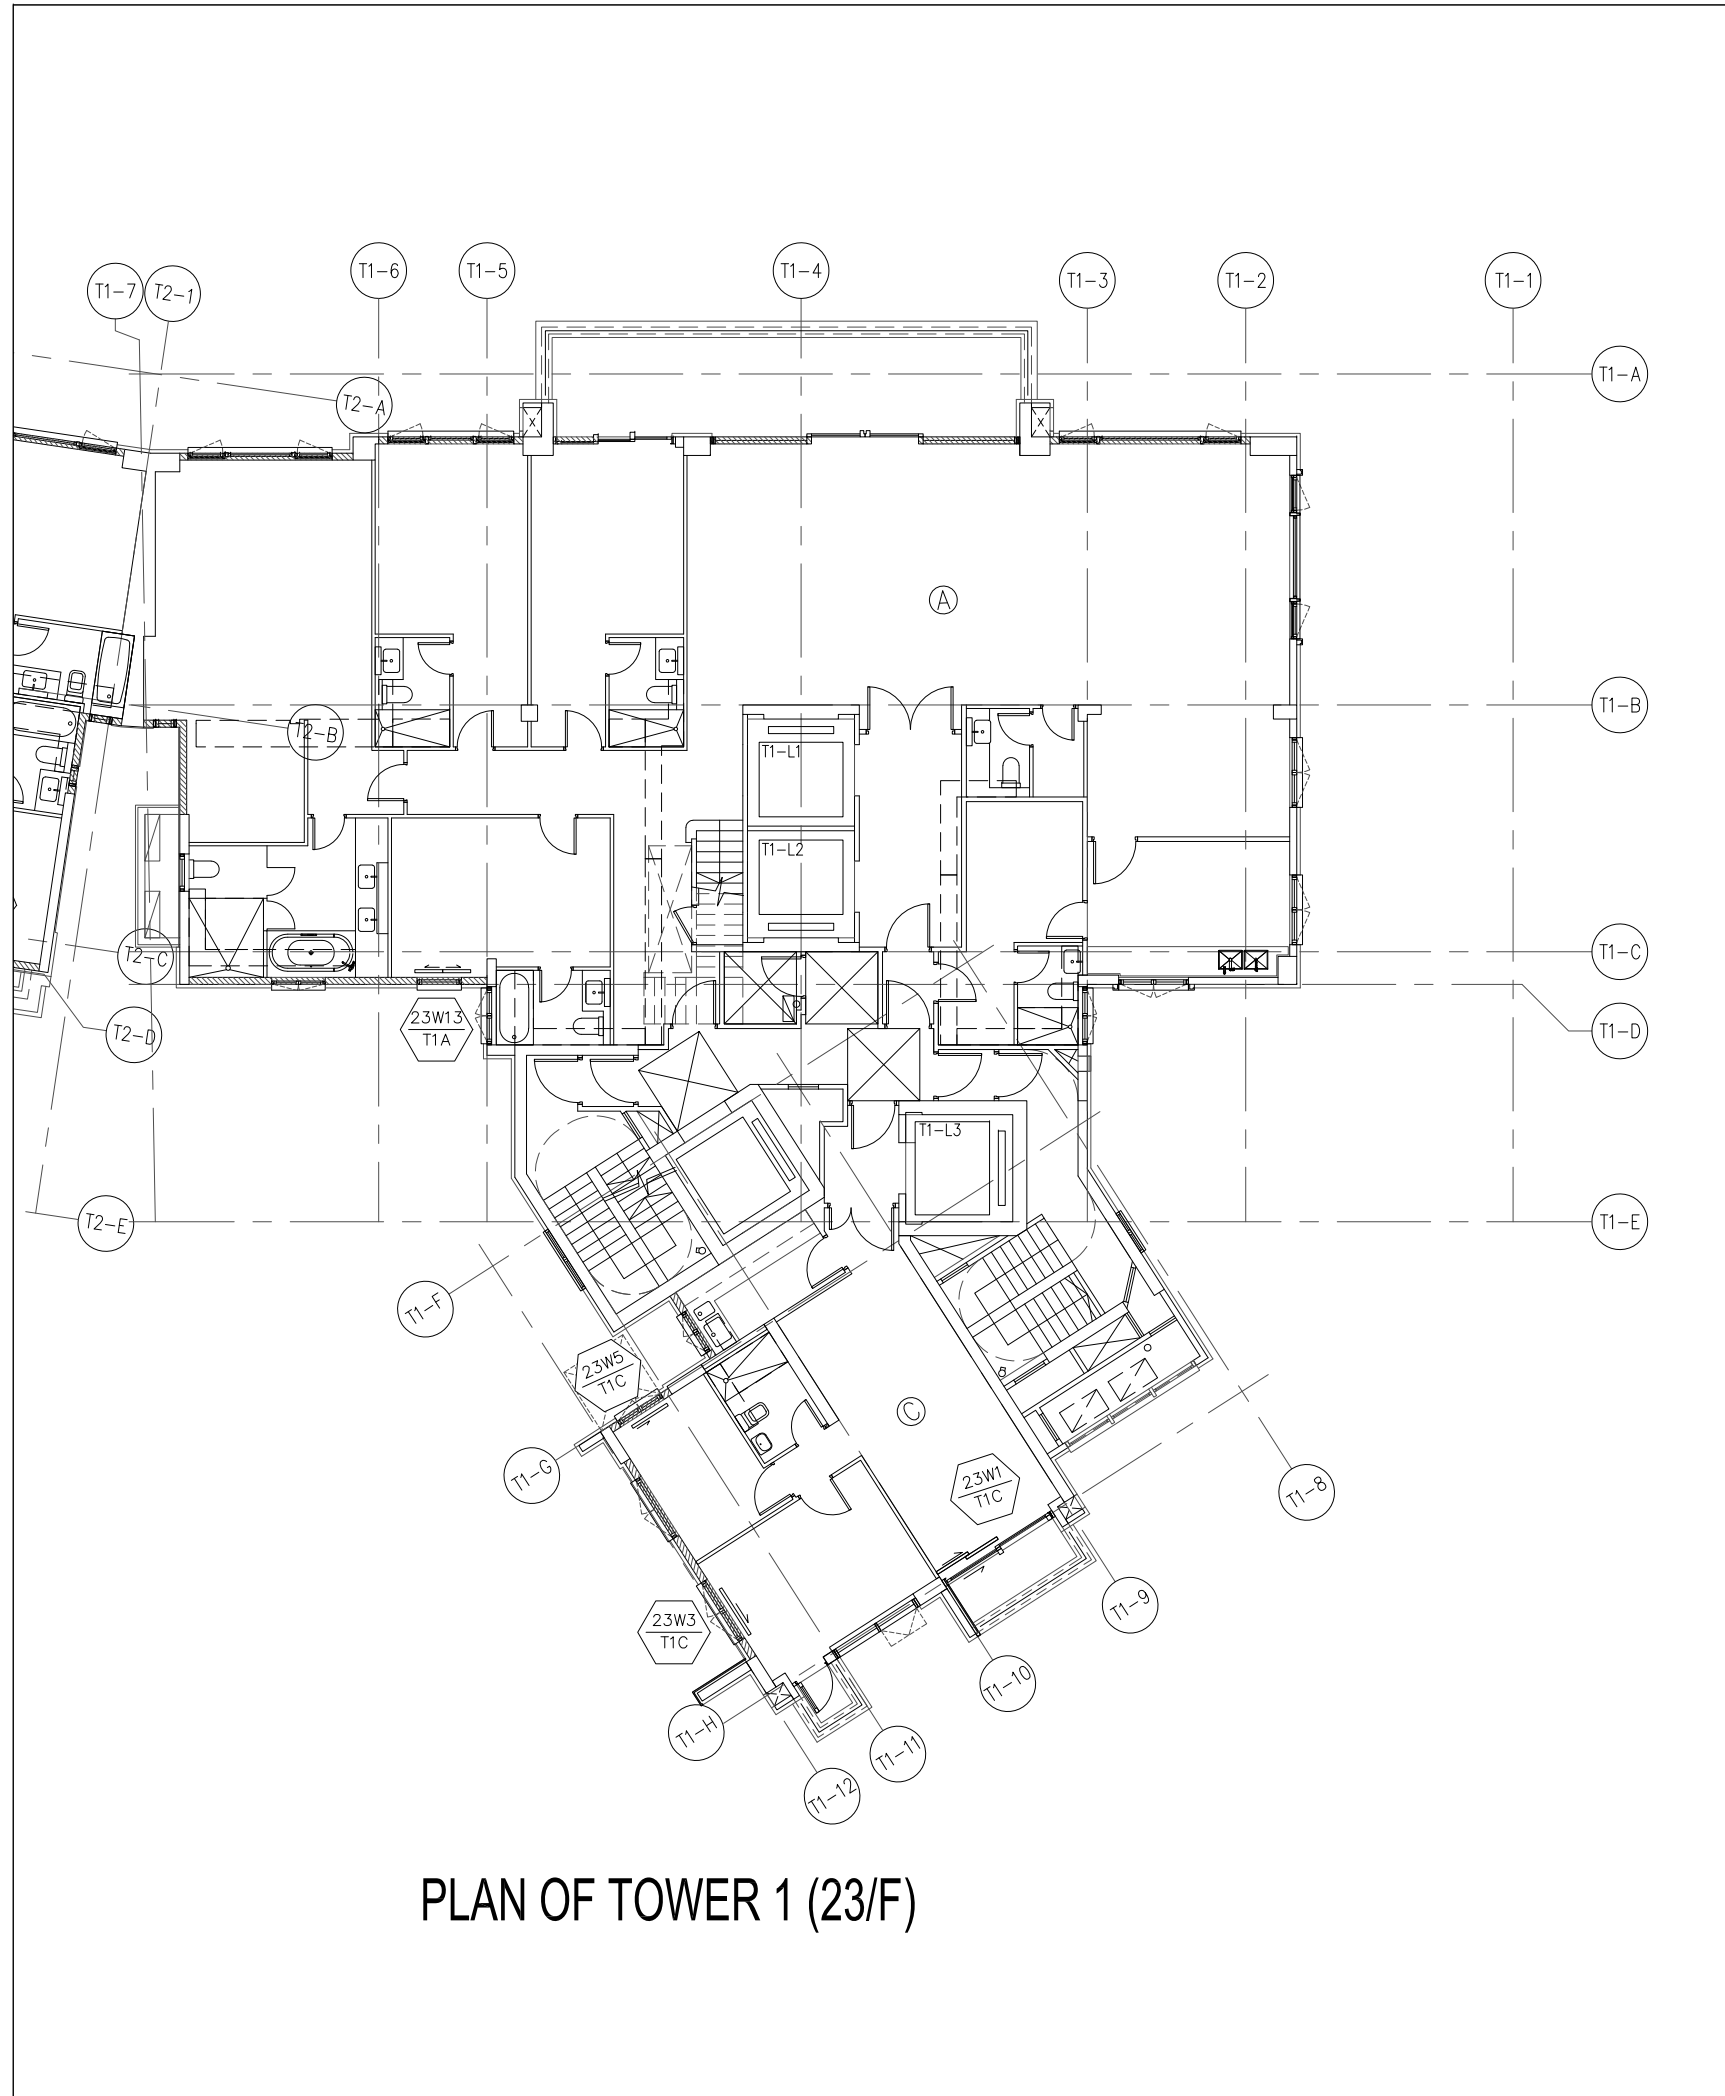

WINDOW MARK	FLAT	FLOOR	Q.T.	TOTAL
23W13/T1A	FLAT A	23F	1	1x1=1
23W1/T1C	FLAT C	23F	1	1x1=1
23W3/T1C	FLAT C	23F	1	1x1=1
23W5/T1C	FLAT C	23F	1	1x1=1
		TOTAL	4	4

B.D. REF :

CLIENT :

ARCHITECT :
AGC DESIGN LTD
 110, 112, 114,1000

MAIN CONTRACTOR :
Gammon

STRUCTURAL ENGINEER :
ARUP

FACADE CONSULTANT:
MEINHARDT

NOTE :
 1. ALL DIMENSIONS ARE IN mm.
 2. ALL ELEVATIONS ARE VIEWED FROM OUTSIDE.
 3. ALL DIMENSIONS TO BE VERIFIED ON SITE BEFORE FABRICATION.

LEGEND :
 (x1) --- DETAIL MARK NO.
 (x001) --- REFER SHEET NO.
 1. F.F.L. --- FINISHED FLOOR LEVEL
 2. S.F.L. --- STRUCTURAL FLOOR LEVEL
 3. (A) --- REVERSED DETAIL

NO.	DATE	REVISED	BY

JOB NO. : J-852
 PROJECT : PROPOSED RESIDENTIAL DEVELOPMENT AT 139 - 147 ARGYLE STREET, NKIL 6005, 6035 R.P., 6036 R.P., 6037 R.P. & 6038 R.P.

TITLE : PART PLAN FOR ACOUSTIC SLIDING DOOR OF TOWER 1 (23/F)

DATE : 16-Jul-2020 SCALE : 1:150

DRAWN BY : LHR CHECKED BY : DW

美特鋁質有限公司
MIDI ALUMINIUM FABRICATOR LTD.
 Units 6-8, Sunray Industrial Centre, 1/F
 610 Cha Kwo Ling Road, Kowloon
 Tel: 23489211-4 Fax: (852)2727666

DWG NO. : J852-SD-ASD-3104 REV. : -



PLAN OF TOWER 2 (1/F)

WINDOW MARK	FLAT	FLOOR	Q.T.	TOTAL
W1/T2C	FLAT C	1F	1	1x1=1
W3/T2C	FLAT C	1F	1	1x1=1
		TOTAL	2	2

B.D. REF :

CLIENT :

ARCHITECT :
AGC DESIGN LTD
 161, 162, 163,1000

MAIN CONTRACTOR :
Gammon

STRUCTURAL ENGINEER :
ARUP

FACADE CONSULTANT:
MEINHARDT

NOTE :
 1. ALL DIMENSIONS ARE IN mm.
 2. ALL ELEVATIONS ARE VIEWED FROM OUTSIDE.
 3. ALL DIMENSIONS TO BE VERIFIED ON SITE BEFORE FABRICATION.

LEGEND :
 (X1) --- DETAIL MARK NO.
 (X001) --- REFER SHEET NO.
 1. F.F.L. --- FINISHED FLOOR LEVEL
 2. S.F.L. --- STRUCTURAL FLOOR LEVEL
 3. (R) --- REVERSED DETAIL

NO.	DATE	REVISED	BY

JOB NO. : J-852
 PROJECT : PROPOSED RESIDENTIAL DEVELOPMENT AT 139 - 147 ARGYLE STREET, NKIL 6005, 6035 R.P., 6036 R.P., 6037 R.P. & 6038 R.P.

TITLE : PART PLAN FOR ACOUSTIC SLIDING DOOR OF TOWER 2 (1/F)

DATE : 16-Jul-2020 SCALE : 1:150
 DRAWN BY : LHR CHECKED BY : DW

美特鋁質有限公司
MIDI ALUMINIUM FABRICATOR LTD.
 Units 6-8, Sunray Industrial Centre, 1/F
 610 Cha Kwo Ling Road, Kowloon
 Tel: 23489211-4 Fax: (852)27727666

DWG NO. : J852-SD-ASD-3201 REV. : -



WINDOW MARK	FLAT	FLOOR	Q.T.	TOTAL
W6/T2A	FLAT A	3F-21F	1	1x16=16
W7/T2A	FLAT A	3F-21F	1	1x16=16
W6/T2B	FLAT B	2F-21F	1	1x17=17
W7/T2B	FLAT B	3F-21F	1	1x16=16
W1/T2C	FLAT C	2F-21F	1	1x17=17
W3/T2C	FLAT C	2F-21F	1	1x17=17
W5/T2C	FLAT C	2F-21F	1	1x17=17
		TOTAL	7	116

B.D. REF :

CLIENT :

ARCHITECT :



MAIN CONTRACTOR :



STRUCTURAL ENGINEER :



FACADE CONSULTANT:



NOTE :

1. ALL DIMENSIONS ARE IN mm.
2. ALL ELEVATIONS ARE VIEWED FROM OUTSIDE.
3. ALL DIMENSIONS TO BE VERIFIED ON SITE BEFORE FABRICATION.

LEGEND :

- x1 --- DETAIL MARK NO.
- x001 --- REFER SHEET NO.

1. F.F.L. --- FINISHED FLOOR LEVEL
2. S.F.L. --- STRUCTURAL FLOOR LEVEL
3. R --- REVERSED DETAIL

NO.	DATE	REVISED	BY

JOB NO. : J-852

PROJECT :
PROPOSED RESIDENTIAL DEVELOPMENT
AT 139 - 147 ARGYLE STREET,
NKIL 6005, 6035 R.P., 6036 R.P.,
6037 R.P. & 6038 R.P.

TITLE :
PART PLAN FOR
ACOUSTIC SLIDING DOOR
OF TOWER 2 (2~21/F)

DATE : 16-Jul-2020 SCALE : 1:150

DRAWN BY : LHR CHECKED BY : DW

美特鋁質有限公司
MIDI ALUMINIUM FABRICATOR LTD.
Units 6-8, Sunray Industrial Centre, 1/F
610 Cha Kwo Ling Road, Kowloon
Tel: 23489211-4 Fax: (852)27727666

DWG NO. : J852-SD-ASD-3202 REV. : -



PLAN OF TOWER 2 (22/F)

WINDOW MARK	FLAT	FLOOR	Q.T.	TOTAL
22W6/T2A	FLAT A	22F	1	1x1=1
22W7/T2A	FLAT A	22F	1	1x1=1
22W7/T2B	FLAT B	22F	1	1x1=1
22W6/T2B	FLAT B	22F	1	1x1=1
22W1/T2C	FLAT C	22F	1	1x1=1
22W3/T2C	FLAT C	22F	1	1x1=1
22W5/T2C	FLAT C	22F	1	1x1=1
		TOTAL	7	7

B.D. REF :

CLIENT :

ARCHITECT :
AGC DESIGN LTD
 110, 112, 114,1000

MAIN CONTRACTOR :
Gammon

STRUCTURAL ENGINEER :
ARUP

FAÇADE CONSULTANT:
MEINHARDT

NOTE :
 1. ALL DIMENSIONS ARE IN mm.
 2. ALL ELEVATIONS ARE VIEWED FROM OUTSIDE.
 3. ALL DIMENSIONS TO BE VERIFIED ON SITE BEFORE FABRICATION.

LEGEND :
 (x1) --- DETAIL MARK NO.
 (x001) --- REFER SHEET NO.
 1. F.F.L. --- FINISHED FLOOR LEVEL
 2. S.F.L. --- STRUCTURAL FLOOR LEVEL
 3. (R) --- REVERSED DETAIL

NO.	DATE	REVISED	BY

JOB NO. : J-852
 PROJECT : PROPOSED RESIDENTIAL DEVELOPMENT AT 139 - 147 ARGYLE STREET, NKIL 6005, 6035 R.P., 6036 R.P., 6037 R.P. & 6038 R.P.


TITLE : PART PLAN FOR ACOUSTIC SLIDING DOOR OF TOWER 2 (22/F)

DATE : 16-Jul-2020 SCALE : 1:150

DRAWN BY : LHR CHECKED BY : DW

美特鋁質有限公司
MIDI ALUMINIUM FABRICATOR LTD.
 Units 6-8, Sunray Industrial Centre, 1/F
 610 Cha Kwo Ling Road, Kowloon
 Tel: 23489211-4 Fax: (852)2727666

DWG NO. : J852-SD-ASD-3203 REV. : -

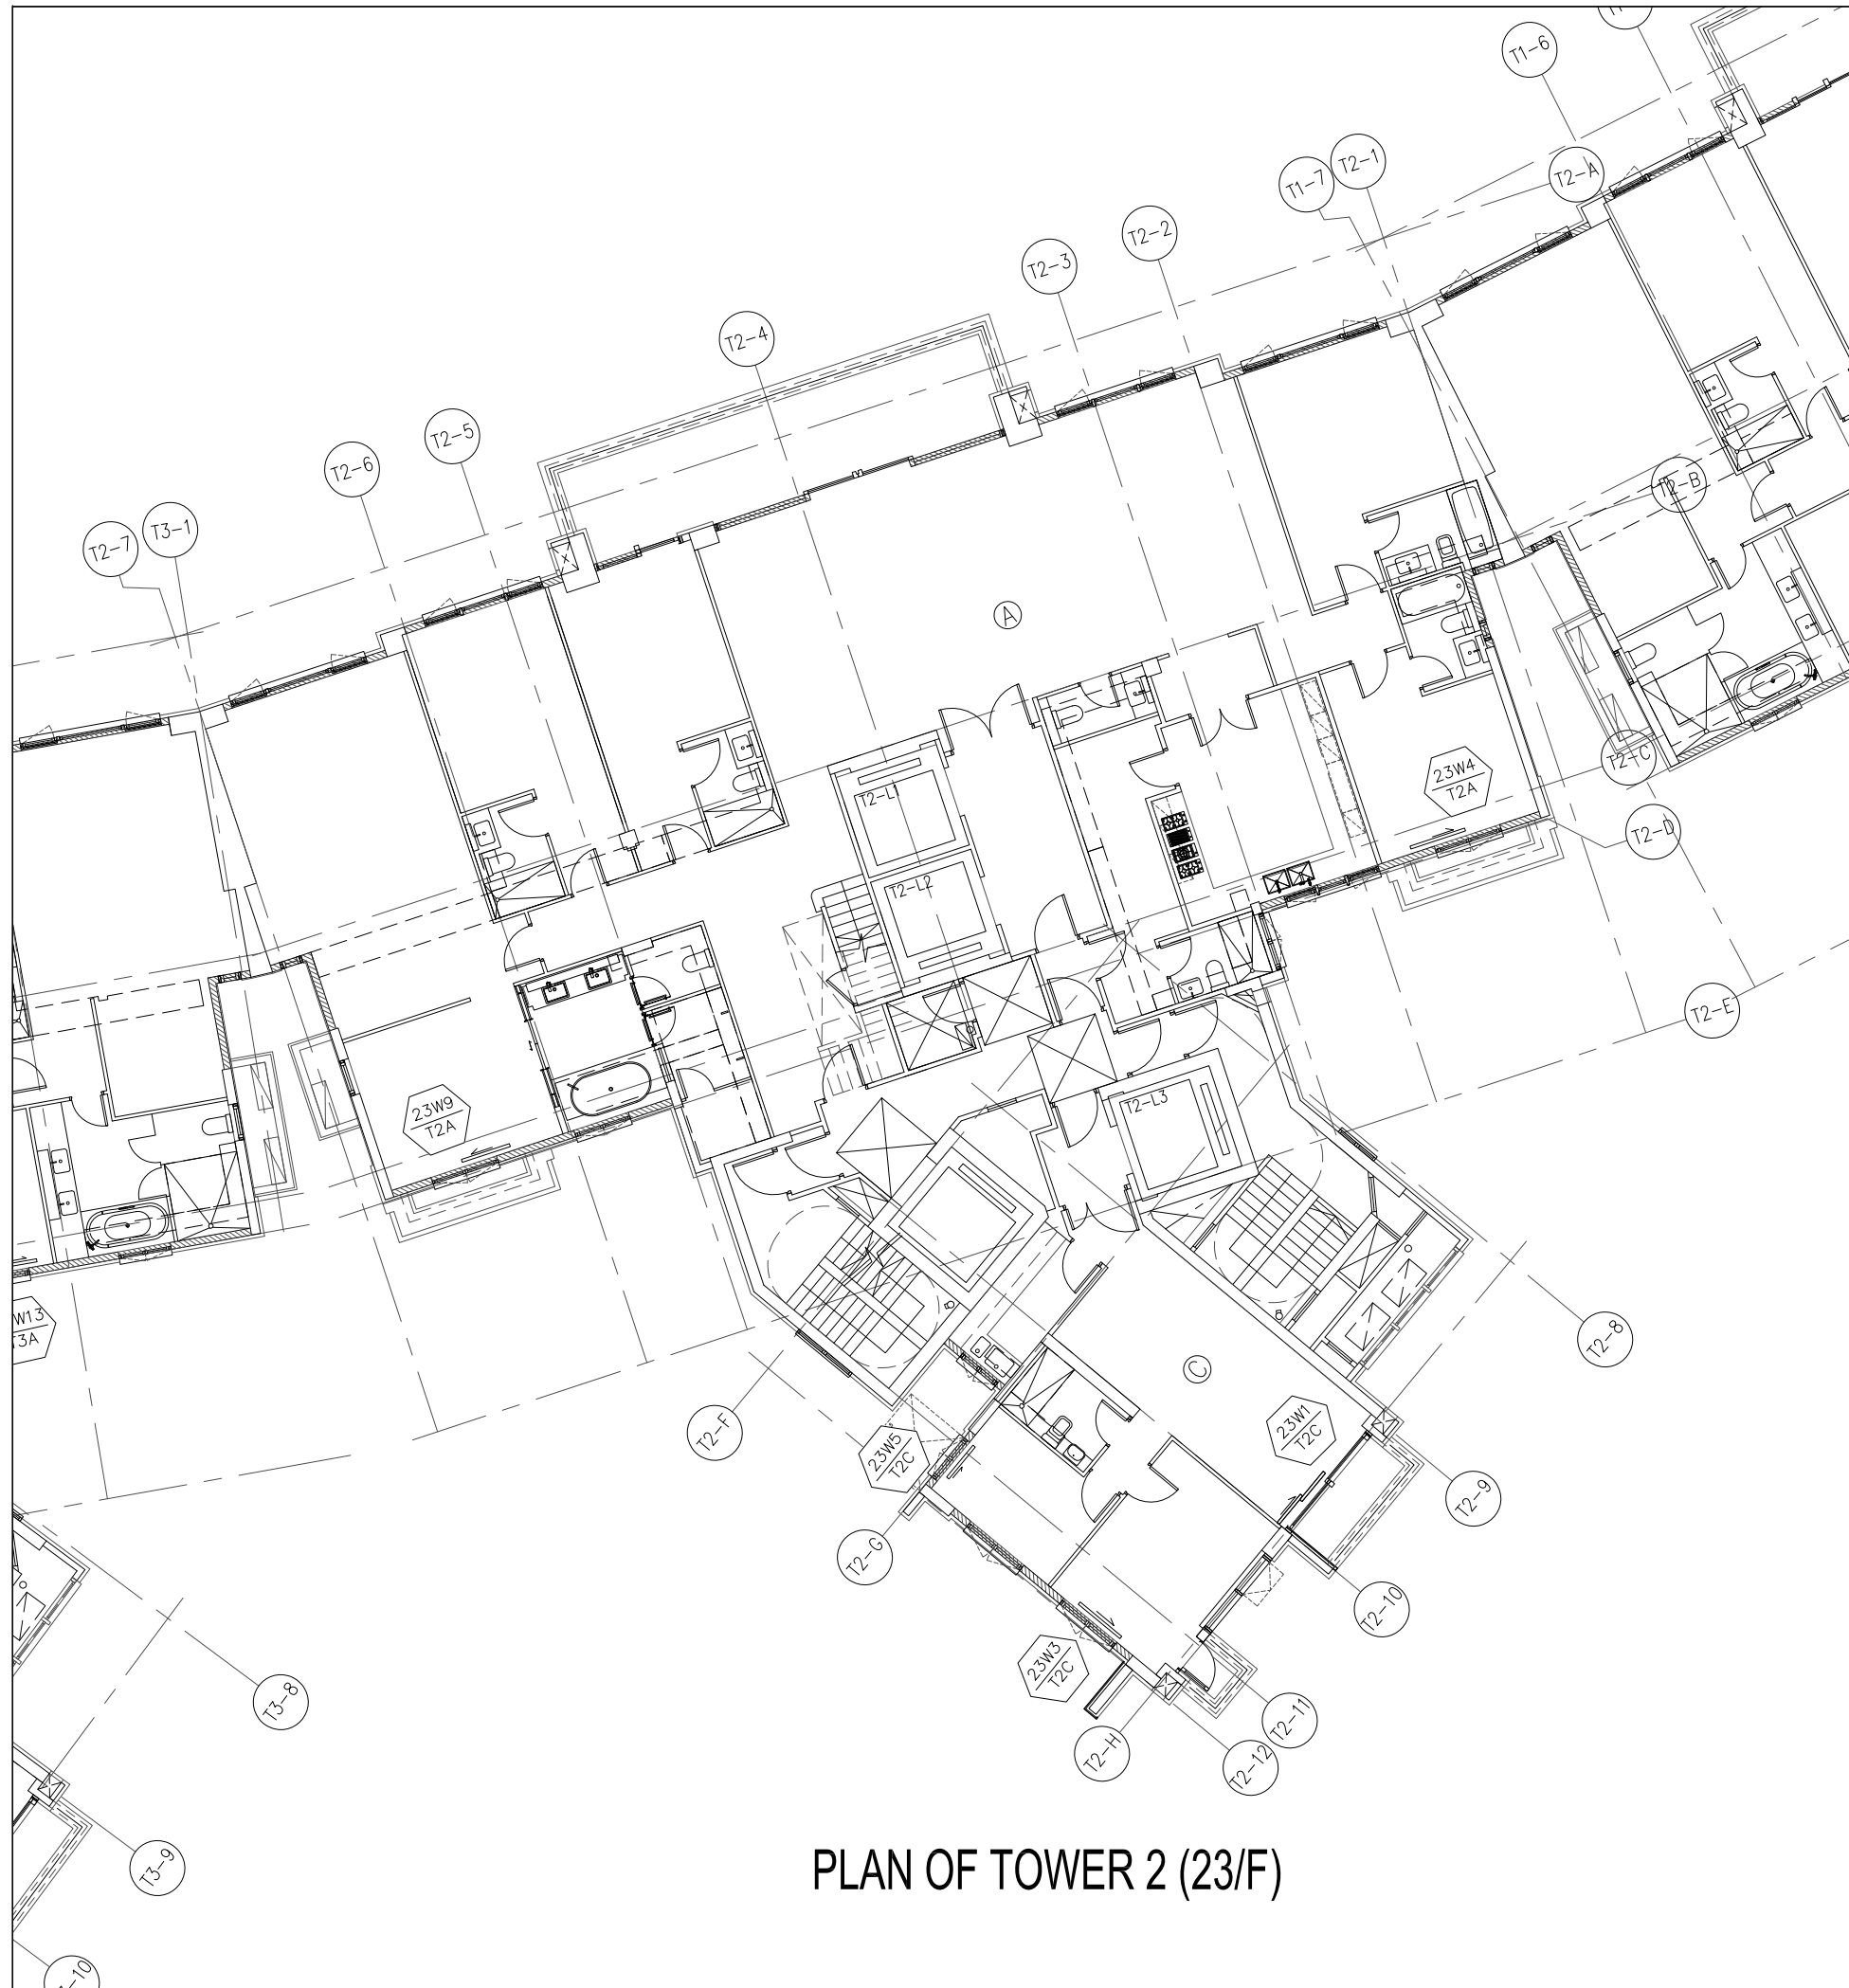

PLAN OF TOWER 2 (23/F)

WINDOW MARK	FLAT	FLOOR	Q.T.	TOTAL
23W9/T2A	FLAT A	23F	1	1x1=1
23W4/T2A	FLAT A	23F	1	1x1=1
23W1/T2C	FLAT C	23F	1	1x1=1
23W3/T2C	FLAT C	23F	1	1x1=1
23W5/T2C	FLAT C	23F	1	1x1=1
		TOTAL	5	5

B.D. REF :

CLIENT :

ARCHITECT :

AGC
DESIGN LTD

MAIN CONTRACTOR :

Gammon

STRUCTURAL ENGINEER :

ARUP

FACADE CONSULTANT:

MEINHARDT

NOTE :

1. ALL DIMENSIONS ARE IN mm.
2. ALL ELEVATIONS ARE VIEWED FROM OUTSIDE.
3. ALL DIMENSIONS TO BE VERIFIED ON SITE BEFORE FABRICATION.

LEGEND :

- (x1) — DETAIL MARK NO.
- (x001) — REFER SHEET NO.

1. F.F.L. --- FINISHED FLOOR LEVEL
2. S.F.L. --- STRUCTURAL FLOOR LEVEL
3. (R) --- REVERSED DETAIL

NO.	DATE	REVISED	BY

JOB NO. : J-852

PROJECT :
PROPOSED RESIDENTIAL DEVELOPMENT
AT 139 - 147 ARGYLE STREET,
NKIL 6005, 6035 R.P., 6036 R.P.,
6037 R.P. & 6038 R.P.

TITLE :
PART PLAN FOR
ACOUSTIC SLIDING DOOR
OF TOWER 2 (23/F)

DATE : 16-Jul-2020 SCALE : 1:150

DRAWN BY : LHR CHECKED BY : DW

美特鋁質有限公司
MIDI ALUMINIUM FABRICATOR LTD.
Units 6-8, Sunray Industrial Centre, 1/F
610 Cha Kwo Ling Road, Kowloon
Tel: 23489211-4 Fax: (852)27727666

DWG NO. : J852-SD-ASD-3204 REV. : -



PLAN OF TOWER 3 (1/F)

WINDOW MARK	FLAT	FLOOR	Q.T.	TOTAL
W3/T3A	FLAT A	1F	1	1x1=1
W2/T3A	FLAT A	1F	1	1x1=1
W7/T3A	FLAT A	1F	1	1x1=1
W2/T3B	FLAT B	1F	1	1x1=1
W3/T3B	FLAT B	1F	1	1x1=1
W1/T3C	FLAT C	1F	1	1x1=1
TOTAL			6	6

B.D. REF :

CLIENT :

ARCHITECT :
AGC DESIGN LTD
 101, 102, 103,1000

MAIN CONTRACTOR :
Gammon

STRUCTURAL ENGINEER :
ARUP

FACADE CONSULTANT:
MEINHARDT

NOTE :
 1. ALL DIMENSIONS ARE IN mm.
 2. ALL ELEVATIONS ARE VIEWED FROM OUTSIDE.
 3. ALL DIMENSIONS TO BE VERIFIED ON SITE BEFORE FABRICATION.

LEGEND :
 (x1) — DETAIL MARK NO.
 (x001) — REFER SHEET NO.
 1. F.F.L. — FINISHED FLOOR LEVEL
 2. S.F.L. — STRUCTURAL FLOOR LEVEL
 3. (R) — REVERSED DETAIL

NO.	DATE	REVISION SUBJECT TO COMMENTS	BY
B	13-11-2020	REVISION SUBJECT TO COMMENTS	MN

JOB NO. : J-852
 PROJECT : PROPOSED RESIDENTIAL DEVELOPMENT AT 139 - 147 ARGYLE STREET, NKIL 6005, 6035 R.P., 6036 R.P., 6037 R.P. & 6038 R.P.

TITLE : PART PLAN FOR ACOUSTIC SLIDING DOOR OF TOWER 3 (1/F)

DATE : 16-Jul-2020 SCALE : 1:150
 DRAWN BY : LHR CHECKED BY : DW

美特鋁質有限公司
MIDI ALUMINIUM FABRICATOR LTD.
 Units 6-8, Sunray Industrial Centre, 1/F
 610 Cha Kwo Ling Road, Kowloon
 Tel: 23489211-4 Fax: (852)2727666

DWG NO. : J852-SD-ASD-3301 REV. : B



PLAN OF TOWER 3 (2/F~21/F)

WINDOW MARK	FLAT	FLOOR	Q.T.	TOTAL
W3/T3A	FLAT A	2F-5F	1	1x3=3
W2/T3A	FLAT A	2F-5F	1	1x3=3
W7/T3A	FLAT A	2F-21F	1	1x17=17
W8/T3A	FLAT A	2F-21F	1	1x17=17
W9/T3A	FLAT A	2F-21F	1	1x17=17
W6/T3B	FLAT B	3F-21F	1	1x16=16
W7/T3B	FLAT B	3F-21F	1	1x16=16
W1/T3C	FLAT C	2F-21F	1	1x17=17
W3/T3C	FLAT C	2F-21F	1	1x17=17
W5/T3C	FLAT C	2F-21F	1	1x17=17
		TOTAL	10	140

B.D. REF :

CLIENT :

ARCHITECT :
AGC DESIGN LTD
 161, 162, 163,1000

MAIN CONTRACTOR :
Gammon

STRUCTURAL ENGINEER :
ARUP

FAÇADE CONSULTANT:
MEINHARDT

NOTE :
 1. ALL DIMENSIONS ARE IN mm.
 2. ALL ELEVATIONS ARE VIEWED FROM OUTSIDE.
 3. ALL DIMENSIONS TO BE VERIFIED ON SITE BEFORE FABRICATION.

LEGEND :
 x1 --- DETAIL MARK NO.
 x001 --- REFER SHEET NO.
 1. F.F.L. --- FINISHED FLOOR LEVEL
 2. S.F.L. --- STRUCTURAL FLOOR LEVEL
 3. (R) --- REVERSED DETAIL

NO.	DATE	REVISED	BY

JOB NO. : J-852
 PROJECT : PROPOSED RESIDENTIAL DEVELOPMENT AT 139 - 147 ARGYLE STREET, NKIL 6005, 6035 R.P., 6036 R.P., 6037 R.P. & 6038 R.P.

TITLE : PART PLAN FOR ACOUSTIC SLIDING DOOR OF TOWER 3 (2~21/F)

DATE : 16-Jul-2020 SCALE : 1:150

DRAWN BY : LHR CHECKED BY : DW

美特鋁質有限公司
MIDI ALUMINIUM FABRICATOR LTD.
 Units 6-8, Sunray Industrial Centre, 1/F
 610 Cha Kwo Ling Road, Kowloon
 Tel: 23489211-4 Fax: (852)2727666

DWG NO. : J852-SD-ASD-3302 REV. : -



PLAN OF TOWER 3 (22/F)

WINDOW MARK	FLAT	FLOOR	Q.T.	TOTAL
22W13/T3A	FLAT A	22F	1	1x1=1
22W1/T3C	FLAT C	22F	1	1x1=1
22W3/T3C	FLAT C	22F	1	1x1=1
22W5/T3C	FLAT C	22F	1	1x1=1
		TOTAL	4	4

B.D. REF :

CLIENT :

ARCHITECT :
AGC DESIGN LTD
 181, 183, 185,999

MAIN CONTRACTOR :
Gammon

STRUCTURAL ENGINEER :
ARUP

FAÇADE CONSULTANT:
MEINHARDT

NOTE :
 1. ALL DIMENSIONS ARE IN mm.
 2. ALL ELEVATIONS ARE VIEWED FROM OUTSIDE.
 3. ALL DIMENSIONS TO BE VERIFIED ON SITE BEFORE FABRICATION.

LEGEND :
 (X1) --- DETAIL MARK NO.
 (X001) --- REFER SHEET NO.
 1. F.F.L. --- FINISHED FLOOR LEVEL
 2. S.F.L. --- STRUCTURAL FLOOR LEVEL
 3. (R) --- REVERSED DETAIL

NO.	DATE	REVISED	BY
-----	------	---------	----

JOB NO. : J-852
 PROJECT : PROPOSED RESIDENTIAL DEVELOPMENT AT 139 - 147 ARGYLE STREET, NKIL 6005, 6035 R.P., 6036 R.P., 6037 R.P. & 6038 R.P.

TITLE : PART PLAN FOR ACOUSTIC SLIDING DOOR OF TOWER 3 (22/F)

DATE : 16-Jul-2020 SCALE : 1:150

DRAWN BY : LHR CHECKED BY : DW

美特鋁質有限公司
MIDI ALUMINIUM FABRICATOR LTD.
 Units 6-8, Sunray Industrial Centre, 1/F
 610 Cha Kwo Ling Road, Kowloon
 Tel: 23489211-4 Fax: (852)2727666

DWG NO. : J852-SD-ASD-3303 REV. : -



PLAN OF TOWER 3 (23/F)

WINDOW MARK	FLAT	FLOOR	Q.T.	TOTAL
23W13/T3A	FLAT A	23F	1	1x1=1
23W1/T3C	FLAT C	23F	1	1x1=1
23W3/T3C	FLAT C	23F	1	1x1=1
23W5/T3C	FLAT C	23F	1	1x1=1
		TOTAL	4	4

B.D. REF :

CLIENT :

ARCHITECT :

AGC
DESIGN LTD

MAIN CONTRACTOR :

Gammon

STRUCTURAL ENGINEER :

ARUP

FACADE CONSULTANT:

MEINHARDT

NOTE :

1. ALL DIMENSIONS ARE IN mm.
2. ALL ELEVATIONS ARE VIEWED FROM OUTSIDE.
3. ALL DIMENSIONS TO BE VERIFIED ON SITE BEFORE FABRICATION.

LEGEND :

- (x1) — DETAIL MARK NO.
- (x001) — REFER SHEET NO.

1. F.F.L. -- FINISHED FLOOR LEVEL
2. S.F.L. -- STRUCTURAL FLOOR LEVEL
3. (R) -- REVERSED DETAIL

NO.	DATE	REVISED	BY

JOB NO. : J-852

PROJECT :
PROPOSED RESIDENTIAL DEVELOPMENT
AT 139 - 147 ARGYLE STREET,
NKIL 6005, 6035 R.P., 6036 R.P.,
6037 R.P. & 6038 R.P.

TITLE :
PART PLAN FOR
ACOUSTIC SLIDING DOOR
OF TOWER 3 (23/F)



DATE : 16-Jul-2020 SCALE : 1:150

DRAWN BY : LHR CHECKED BY : DW


美特鋁質有限公司
MIDI ALUMINIUM FABRICATOR LTD.
Units 6-8, Sunray Industrial Centre, 1/F
610 Cha Kwo Ling Road, Kowloon
Tel: 23489211-4 Fax: (852)2727666

DWG NO. : J852-SD-ASD-3304 REV. : -


ELEVATION

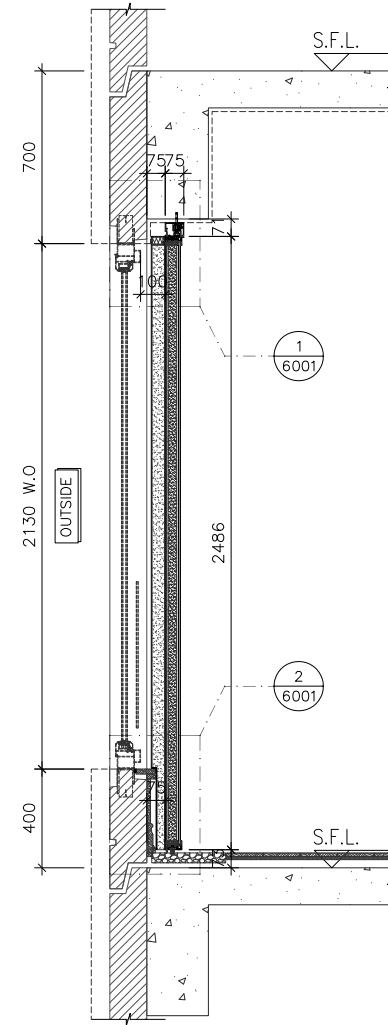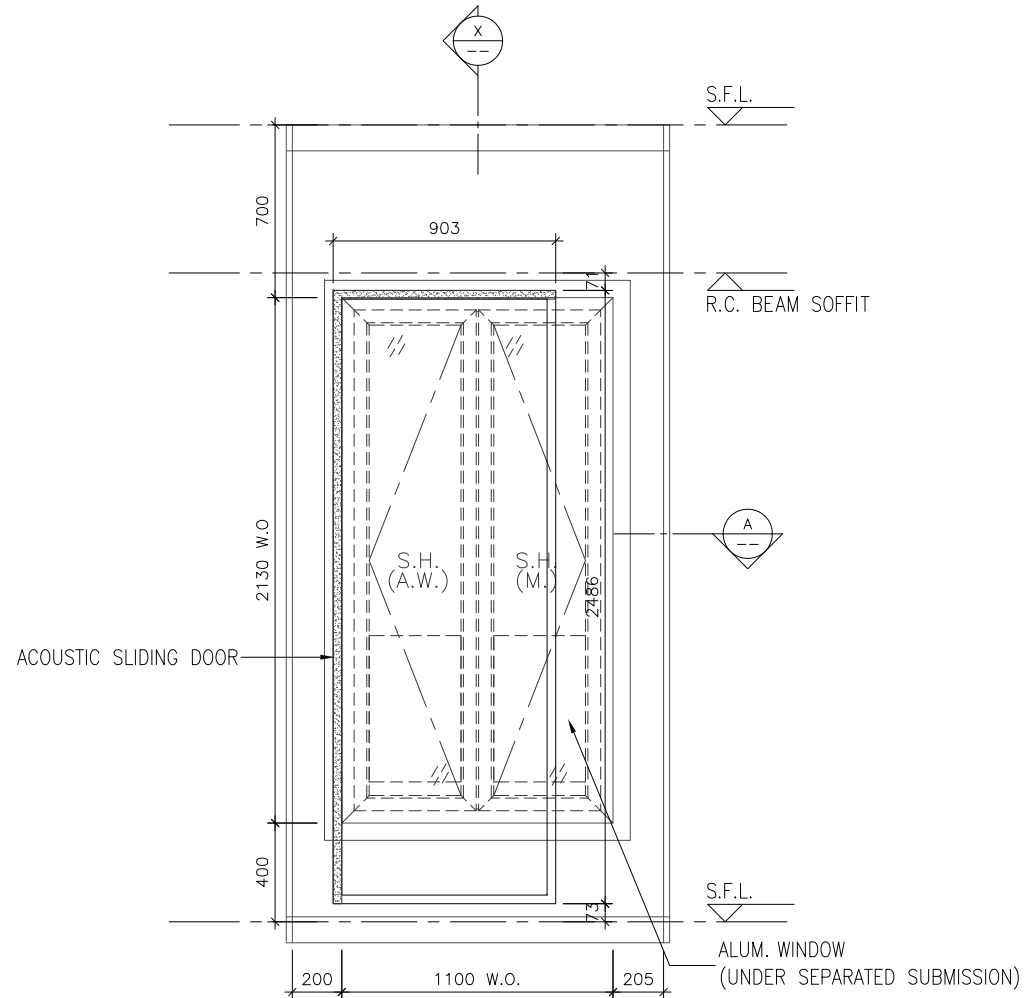

SECTION "X-X"

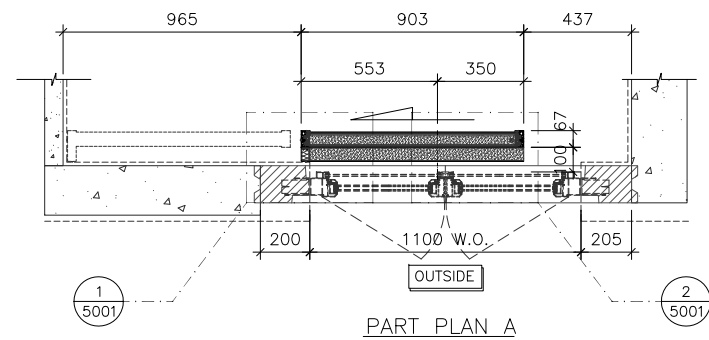

PART PLAN A

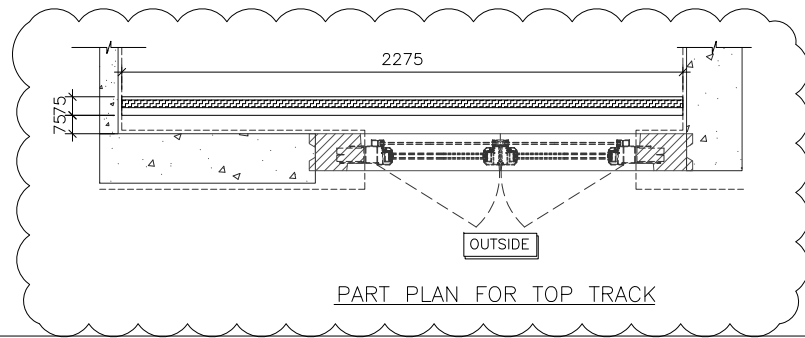

PART PLAN FOR TOP TRACK

WINDOW MARK
W5
T1C

LOCATION 2/F-21/F B.R.2 AT TOWER 1 FLAT C

SECTION -

GLAZING -

QUANTITY 17

REMARKS NSR: T1-01/TESTED CASE: W108B

B.D. REF :

CLIENT :

ARCHITECT :

AGC
DESIGN LTD

MAIN CONTRACTOR :

Gammon

STRUCTURAL ENGINEER :

ARUP

FACADE CONSULTANT:

MEINHARDT

NOTE :

1. ALL DIMENSIONS ARE IN mm.
2. ALL ELEVATIONS ARE VIEWED FROM OUTSIDE.
3. ALL DIMENSIONS TO BE VERIFIED ON SITE BEFORE FABRICATION.

LEGEND :

- (X1) --- DETAIL MARK NO.
- (X001) --- REFER SHEET NO.

1. F.F.L. --- FINISHED FLOOR LEVEL
2. S.F.L. --- STRUCTURAL FLOOR LEVEL
3. (R) --- REVERSED DETAIL

NO.	DATE	REVISED	BY
B	13-11-2020	REVISION SUBJECT TO COMMENTS	MN
A	24-08-2020	REVISION SUBJECT TO COMMENTS	MN

JOB NO. : J-852

PROJECT :
PROPOSED RESIDENTIAL DEVELOPMENT
AT 139 - 147 ARGYLE STREET,
NKIL 6005, 6035 R.P., 6036 R.P.,
6037 R.P. & 6038 R.P.

TITLE :
PART ELEVATION, PLAN & SECTION
FOR ACOUSTIC SLIDING DOOR





DATE : 20-Jul-20 SCALE : 1:30

DRAWN BY : LHR CHECKED BY : DW

美特鋁質有限公司
MIDI ALUMINIUM FABRICATOR LTD.
Units 6-8, Sunray Industrial Centre, 1/F
610 Cha Kwo Ling Road, Kowloon
Tel:23489211-4 Fax:(852)27727666

DWG NO. : J852-SD-ASD-4101 REV. : B

ELEVATION

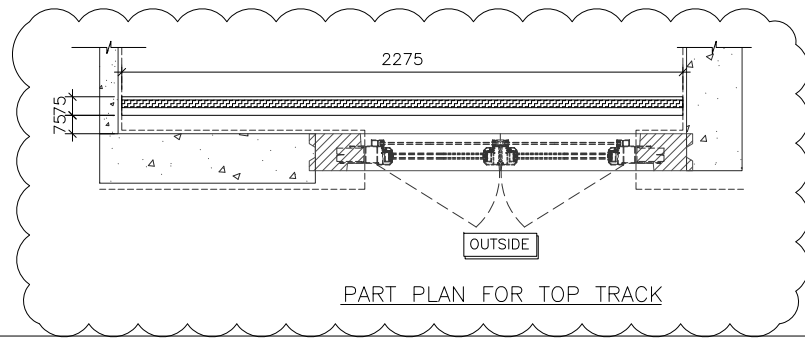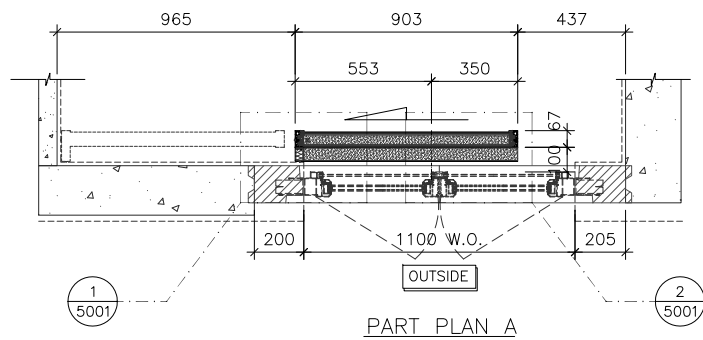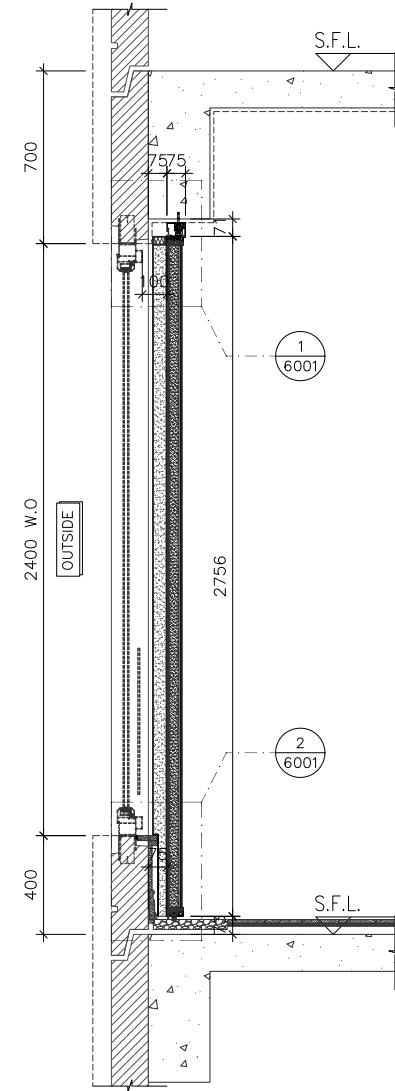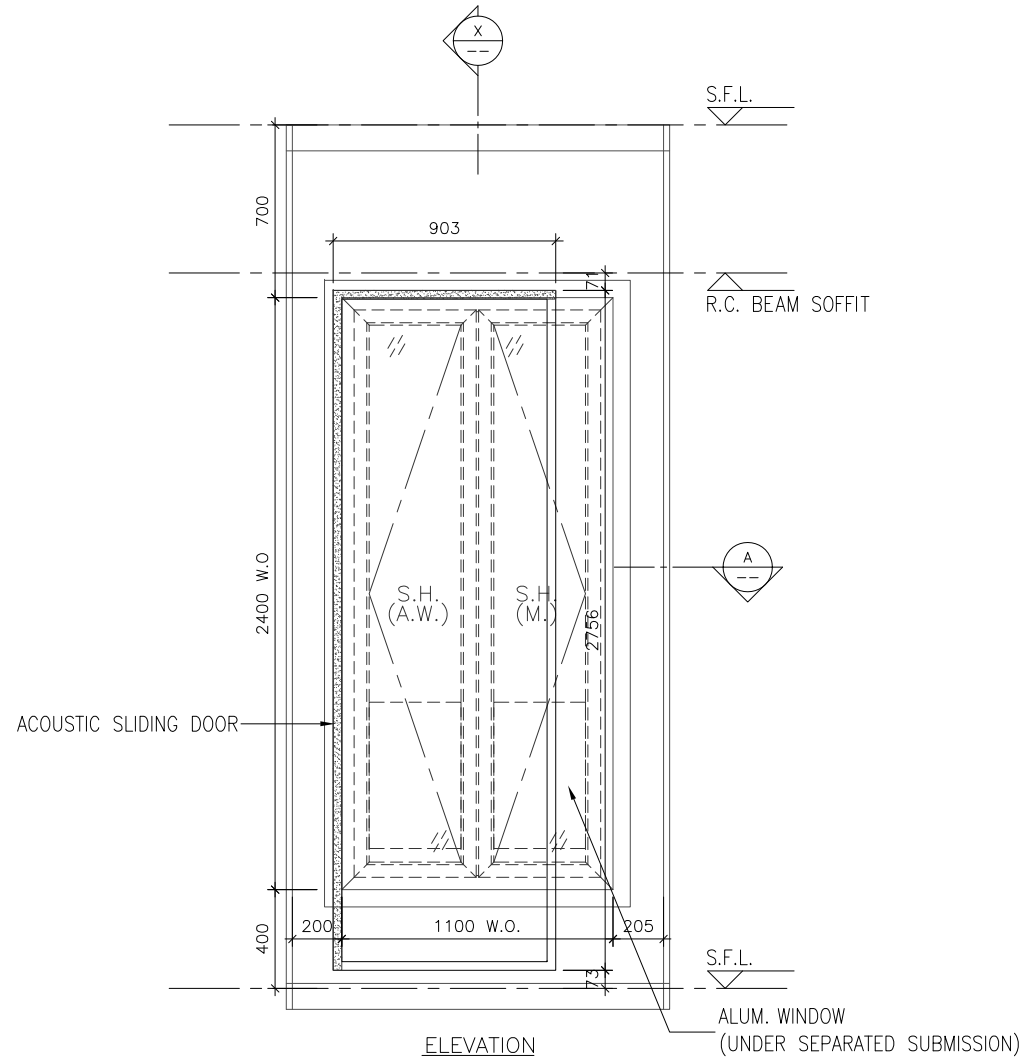

WINDOW MARK	22W5 TIC & 23W5 TIC
LOCATION	22/F~23/F B.R.2 AT TOWER 1 FLAT C
SECTION	-
GLAZING	-
QUANTITY	2
REMARKS	NSR: T1-01/TESTED CASE: W108A

B.D. REF :

CLIENT :

ARCHITECT :
AGC DESIGN LTD
 101, 102, 103,1000

MAIN CONTRACTOR :
Gammon

STRUCTURAL ENGINEER :
ARUP

FACADE CONSULTANT:
MEINHARDT

NOTE :
 1. ALL DIMENSIONS ARE IN mm.
 2. ALL ELEVATIONS ARE VIEWED FROM OUTSIDE.
 3. ALL DIMENSIONS TO BE VERIFIED ON SITE BEFORE FABRICATION.

LEGEND :
 (X1) --- DETAIL MARK NO.
 (X001) --- REFER SHEET NO.
 1. F.F.L. --- FINISHED FLOOR LEVEL
 2. S.F.L. --- STRUCTURAL FLOOR LEVEL
 3. (R) --- REVERSED DETAIL

B	13-11-2020	REVISION SUBJECT TO COMMENTS	MN
A	24-08-2020	REVISION SUBJECT TO COMMENTS	MN
NO.	DATE	REVISED	BY





JOB NO. : J-852
 PROJECT :
 PROPOSED RESIDENTIAL DEVELOPMENT
 AT 139 - 147 ARGYLE STREET,
 NKIL 6005, 6035 R.P., 6036 R.P.,
 6037 R.P. & 6038 R.P.

TITLE :
 PART ELEVATION, PLAN & SECTION
 FOR ACOUSTIC SLIDING DOOR

DATE : 20-Jul-20 SCALE : 1:30
 DRAWN BY : LHR CHECKED BY : DW

美特鋁質有限公司
MIDI ALUMINIUM FABRICATOR LTD.
 Units 6-8, Sunray Industrial Centre, 1/F
 610 Cha Kwo Ling Road, Kowloon
 Tel:23489211-4 Fax:(852)2727666
 DWG NO. : J852-SD-ASD-4101A REV. : B

ELEVATION

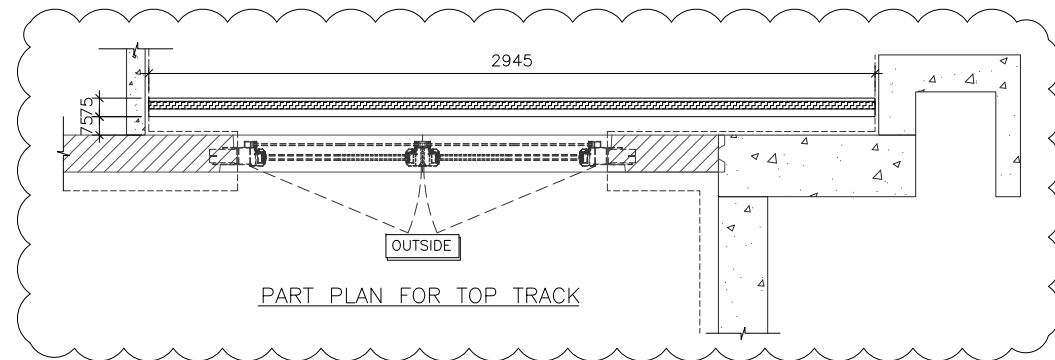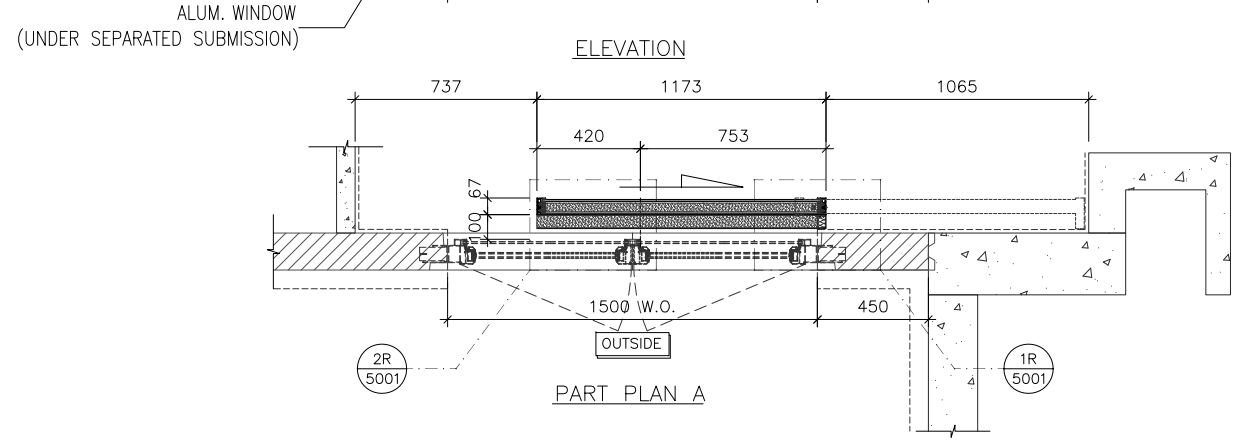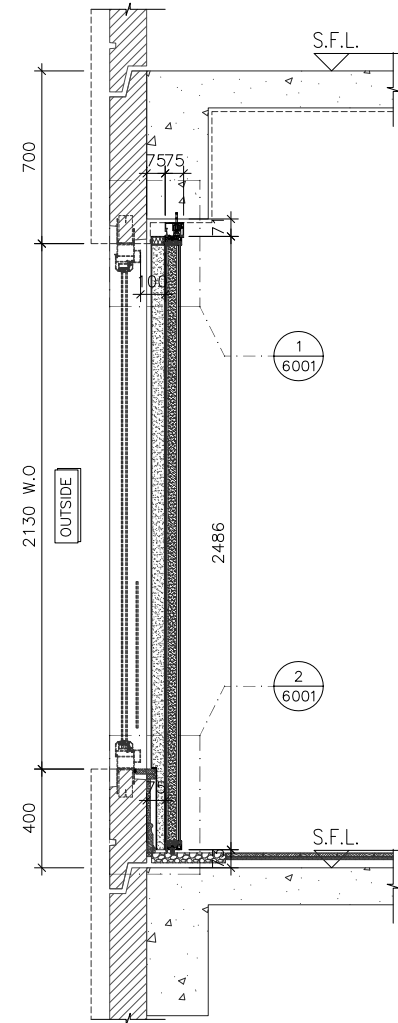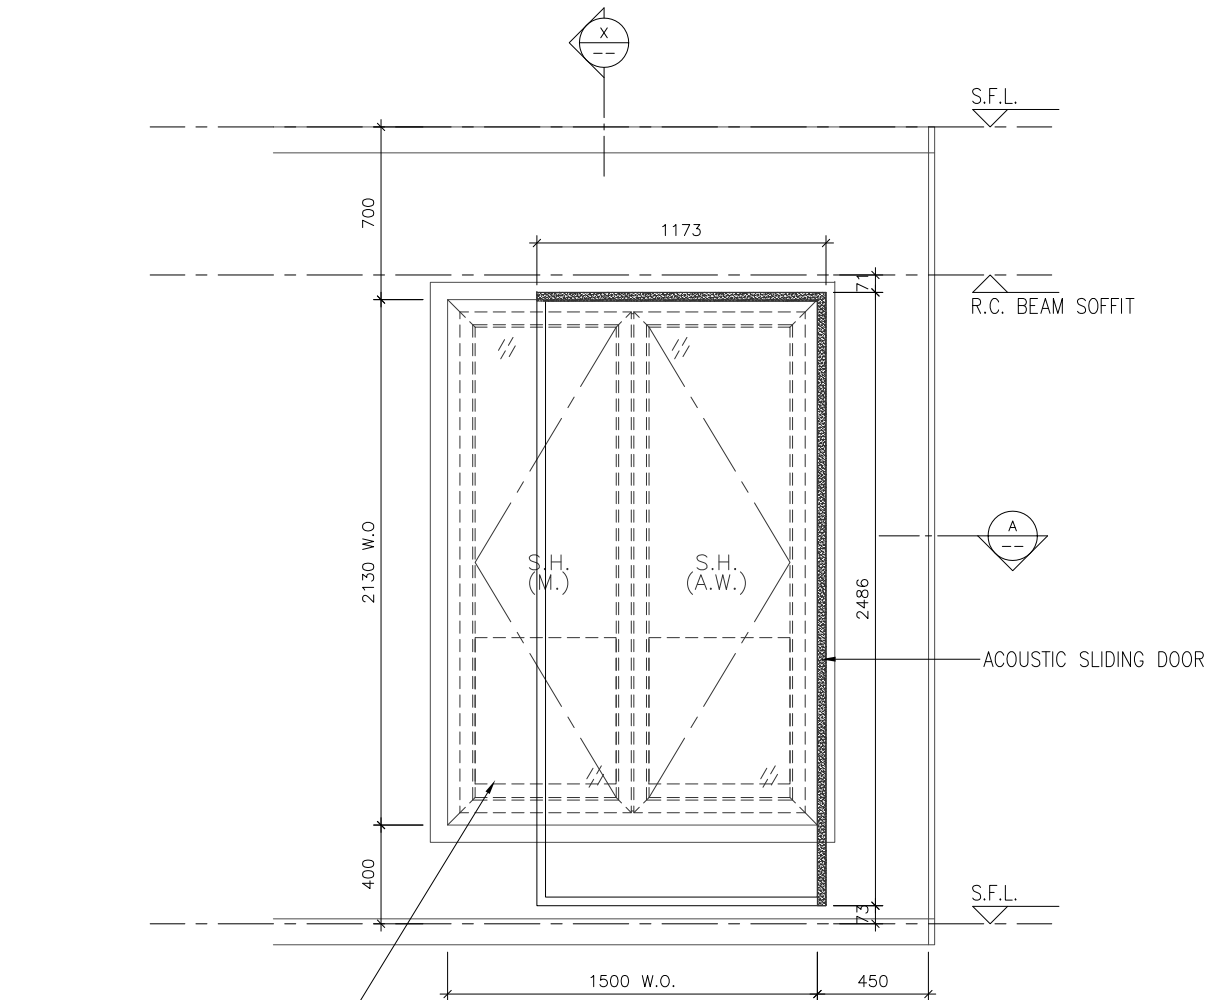

WINDOW MARK	W3 T1C
LOCATION	1/F-21/F M.B.R.1 AT TOWER 1 FLAT C
SECTION	-
GLAZING	-
QUANTITY	18
REMARKS	NSR: T1-02/TESTED CASE: W107D

B.D. REF :

CLIENT :

ARCHITECT :
AGC DESIGN LTD
AGC DESIGN LTD
101, 102, 103,1000

MAIN CONTRACTOR :
Gammon

STRUCTURAL ENGINEER :
ARUP

FACADE CONSULTANT:
MEINHARDT

NOTE :
1. ALL DIMENSIONS ARE IN mm.
2. ALL ELEVATIONS ARE VIEWED FROM OUTSIDE.
3. ALL DIMENSIONS TO BE VERIFIED ON SITE BEFORE FABRICATION.

LEGEND :
X1 -- DETAIL MARK NO.
X001 -- REFER SHEET NO.
1. F.F.L. -- FINISHED FLOOR LEVEL
2. S.F.L. -- STRUCTURAL FLOOR LEVEL
3. (R) -- REVERSED DETAIL



B	13-11-2020	REVISION SUBJECT TO COMMENTS	MN
A	24-08-2020	REVISION SUBJECT TO COMMENTS	MN
NO.	DATE	REVISED	BY

JOB NO. : J-852
PROJECT : PROPOSED RESIDENTIAL DEVELOPMENT AT 139 - 147 ARGYLE STREET, NKIL 6005, 6035 R.P., 6036 R.P., 6037 R.P. & 6038 R.P.
TITLE : PART ELEVATION, PLAN & SECTION FOR ACOUSTIC SLIDING DOOR



DATE : 20-Jul-20 SCALE : 1:30
DRAWN BY : LHR CHECKED BY : DW

美特鋁質有限公司
MIDI ALUMINIUM FABRICATOR LTD.
Units 6-8, Sunray Industrial Centre, 1/F
610 Cha Kwo Ling Road, Kowloon
Tel:23489211-4 Fax:(852)2727666
DWG NO. : J852-SD-ASD-4102 REV. : B

ELEVATION

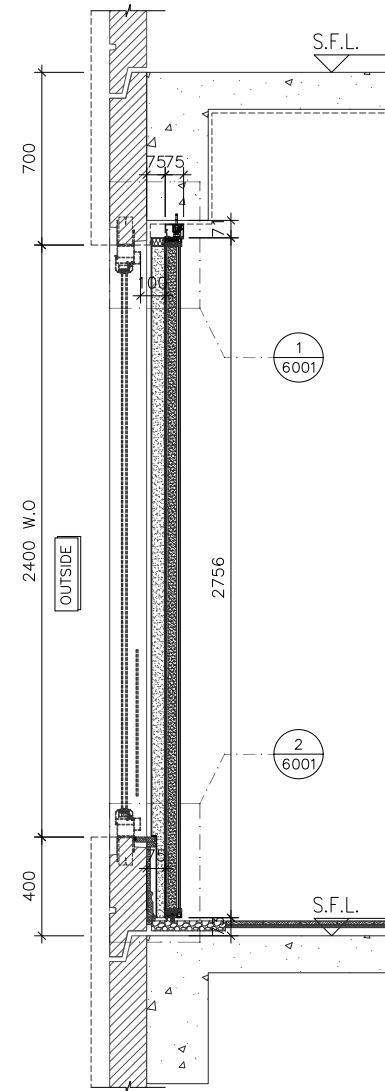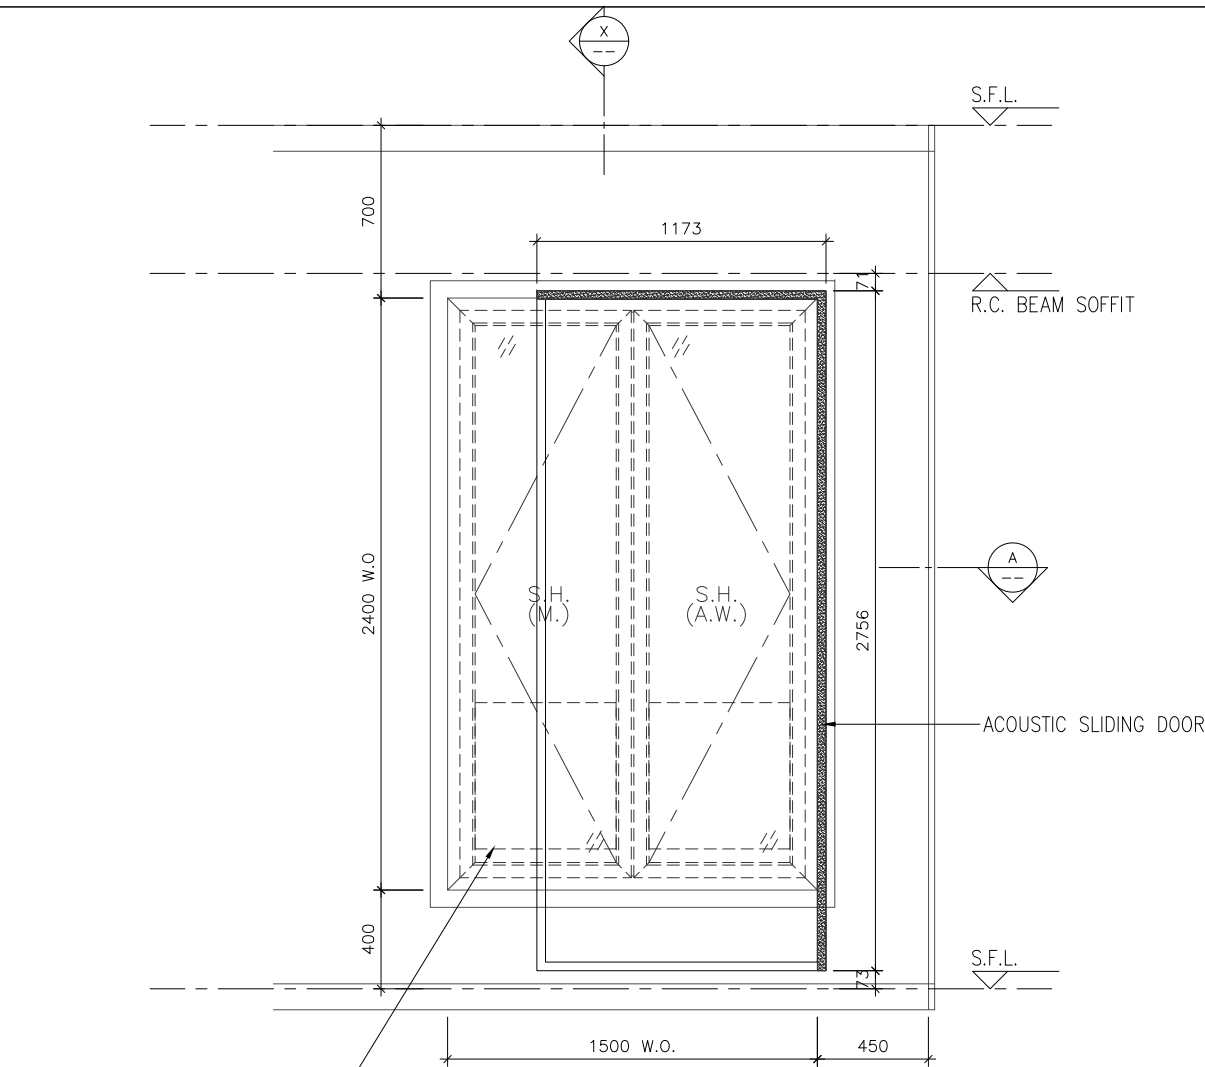

ALUM. WINDOW
(UNDER SEPARATED SUBMISSION)

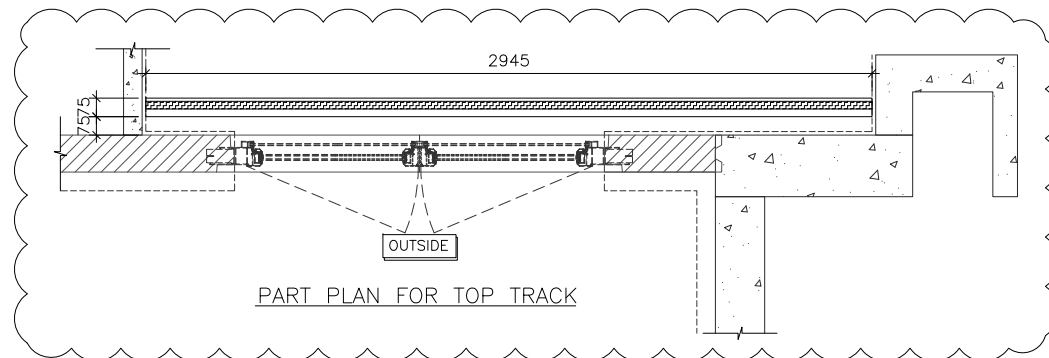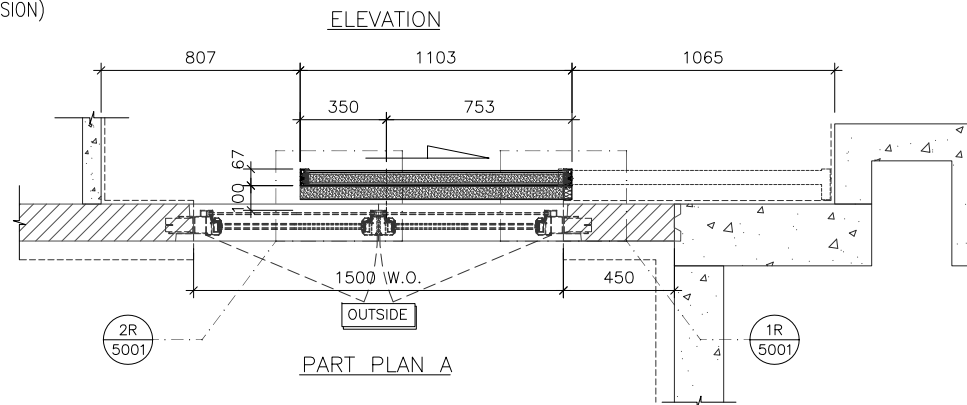

WINDOW MARK	22W3 TIC & 23W3 TIC
LOCATION	22/F~23/F M.B.R.1 AT TOWER 1 FLAT C
SECTION	-
GLAZING	-
QUANTITY	2
REMARKS	NSR: T1-02/TESTED CASE: W107C

B.D. REF :

CLIENT :

ARCHITECT :
AGC DESIGN LTD
101, 102, 103,1000

MAIN CONTRACTOR :
Gammon

STRUCTURAL ENGINEER :
ARUP

FACADE CONSULTANT:
MEINHARDT

NOTE :
1. ALL DIMENSIONS ARE IN mm.
2. ALL ELEVATIONS ARE VIEWED FROM OUTSIDE.
3. ALL DIMENSIONS TO BE VERIFIED ON SITE BEFORE FABRICATION.

LEGEND :
X1 — DETAIL MARK NO.
X001 — REFER SHEET NO.
1. F.F.L. -- FINISHED FLOOR LEVEL
2. S.F.L. -- STRUCTURAL FLOOR LEVEL
3. (R) -- REVERSED DETAIL

B	13-11-2020	REVISION SUBJECT TO COMMENTS	MN
A	24-08-2020	REVISION SUBJECT TO COMMENTS	MN
NO.	DATE	REVISED	BY



JOB NO. : J-852
PROJECT : PROPOSED RESIDENTIAL DEVELOPMENT AT 139 - 147 ARGYLE STREET, NKIL 6005, 6035 R.P., 6036 R.P., 6037 R.P. & 6038 R.P.

TITLE : PART ELEVATION, PLAN & SECTION FOR ACOUSTIC SLIDING DOOR

DATE : 20-Jul-20 SCALE : 1:30
DRAWN BY : LHR CHECKED BY : DW

美特鋁質有限公司
MIDI ALUMINIUM FABRICATOR LTD.
Units 6-8, Sunray Industrial Centre, 1/F
610 Cha Kwo Ling Road, Kowloon
Tel:23489211-4 Fax:(852)2727666
DWG NO. : J852-SD-ASD-4102A REV. : B

ELEVATION

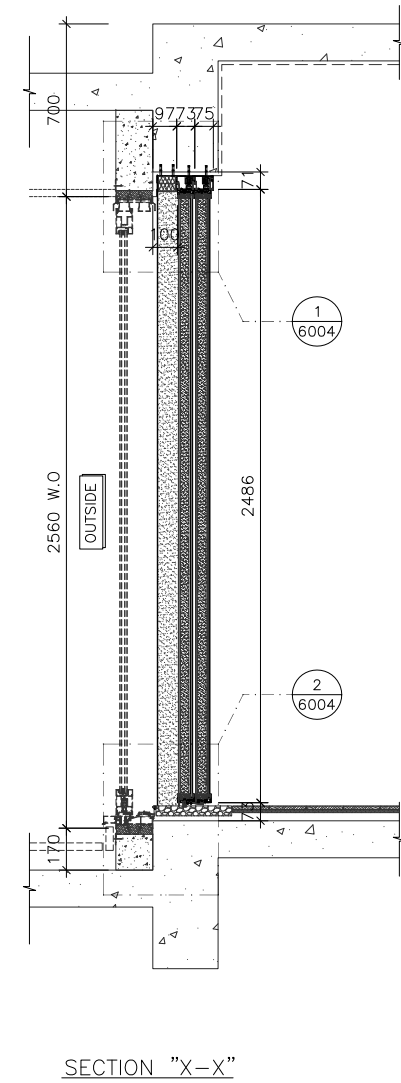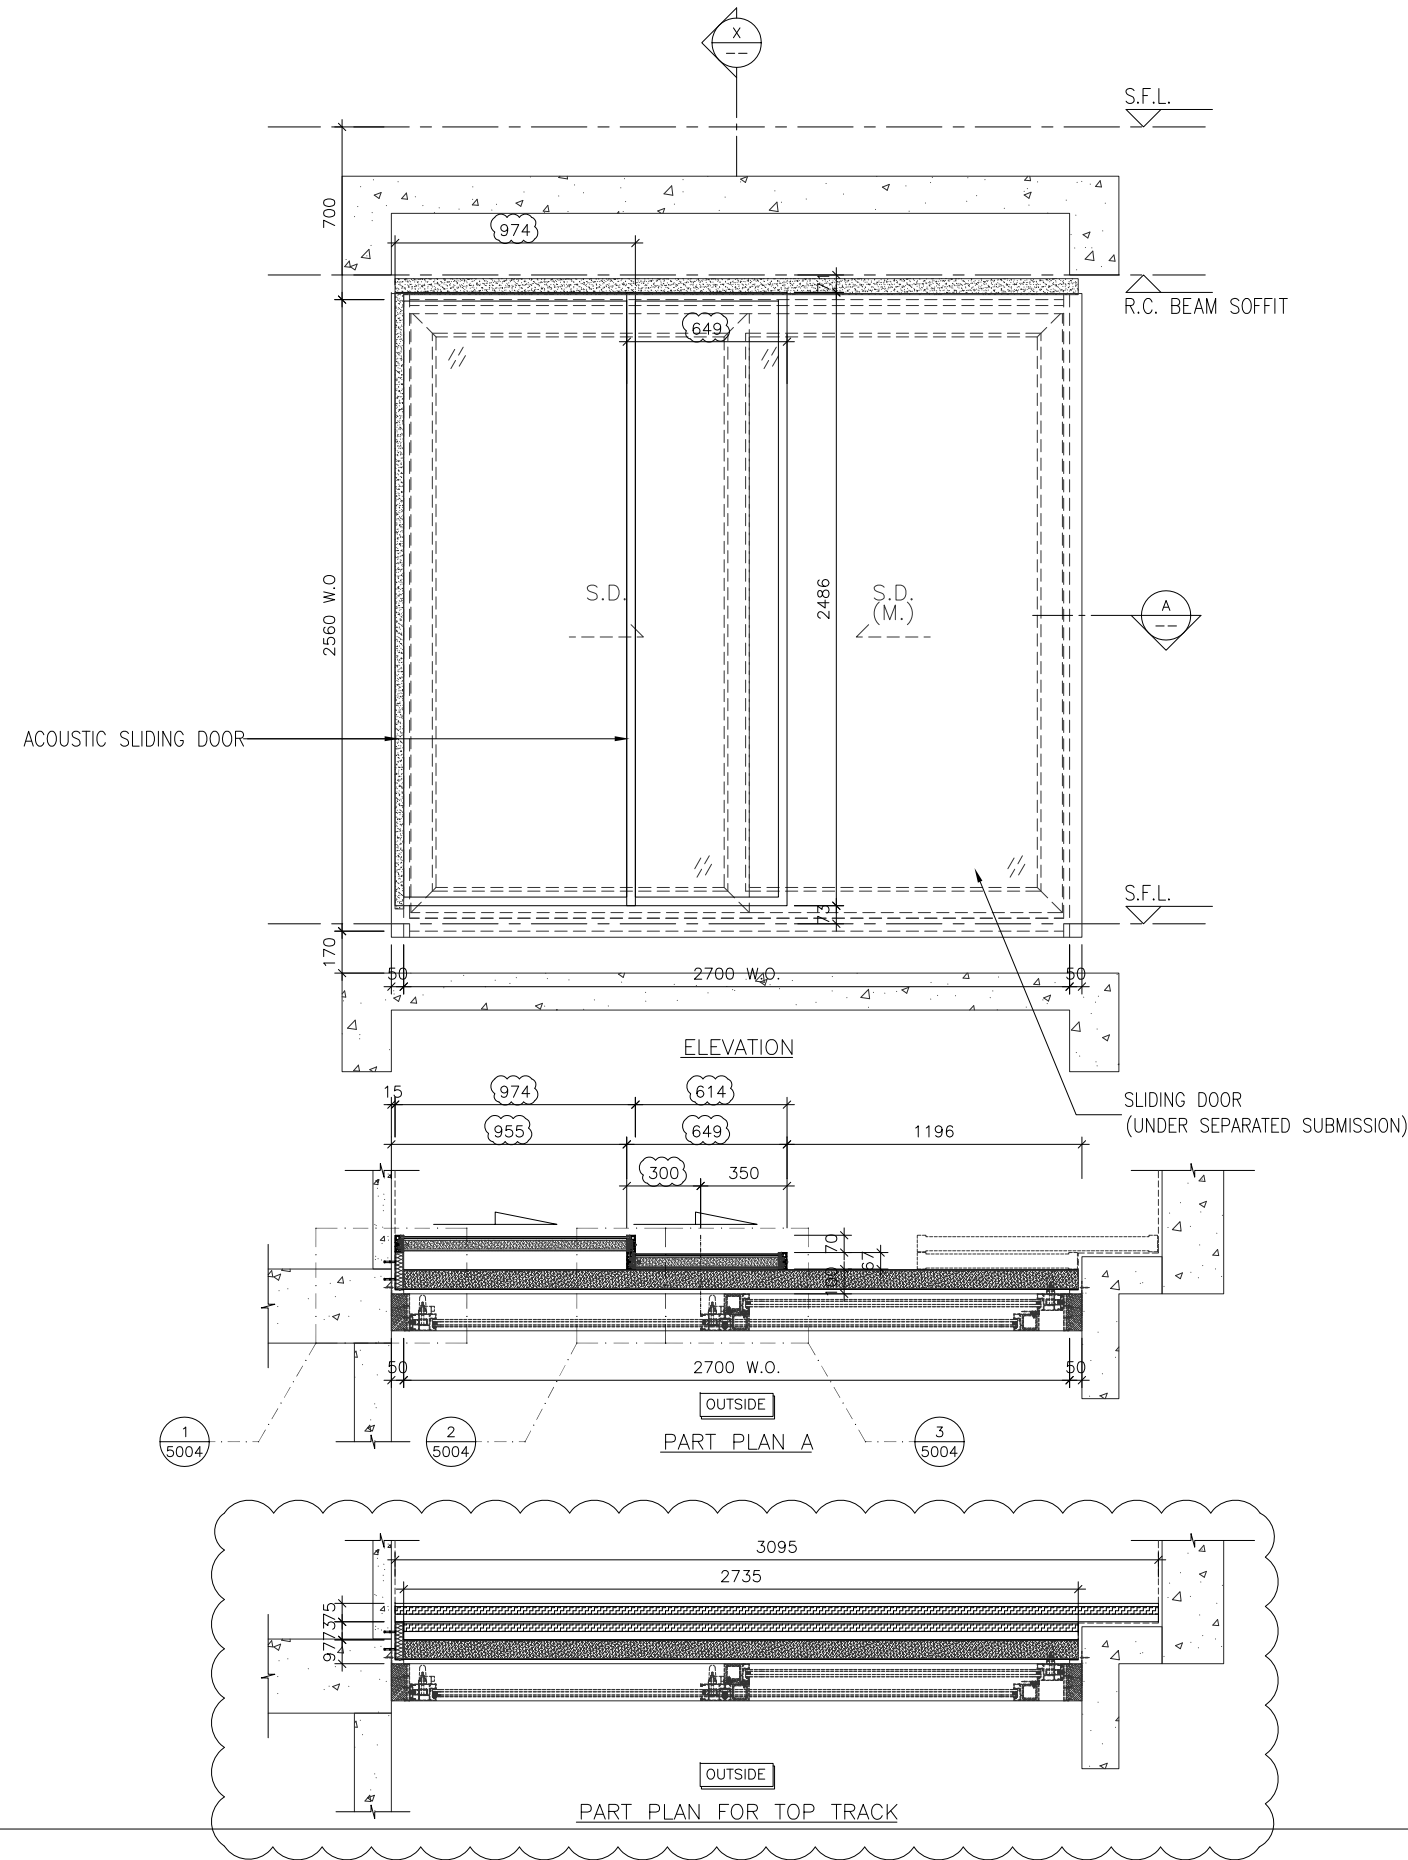

B.D. REF :

CLIENT :

ARCHITECT :
AGC DESIGN LTD
 101, 102, 103,1000

MAIN CONTRACTOR :
Gammon

STRUCTURAL ENGINEER :
ARUP

FACADE CONSULTANT:
MEINHARDT

NOTE :
 1. ALL DIMENSIONS ARE IN mm.
 2. ALL ELEVATIONS ARE VIEWED FROM OUTSIDE.
 3. ALL DIMENSIONS TO BE VERIFIED ON SITE BEFORE FABRICATION.

LEGEND :
 (X1) --- DETAIL MARK NO.
 (X001) --- REFER SHEET NO.
 1. F.F.L. --- FINISHED FLOOR LEVEL
 2. S.F.L. --- STRUCTURAL FLOOR LEVEL
 3. (R) --- REVERSED DETAIL

B	13-11-2020	REVISION SUBJECT TO COMMENTS	MN
A	24-08-2020	REVISION SUBJECT TO COMMENTS	MN
NO.	DATE	REVISED	BY

JOB NO. : J-852
 PROJECT :
 PROPOSED RESIDENTIAL DEVELOPMENT
 AT 139 - 147 ARGYLE STREET,
 NKIL 6005, 6035 R.P., 6036 R.P.,
 6037 R.P. & 6038 R.P.

TITLE :
 PART ELEVATION, PLAN & SECTION
 FOR ACOUSTIC SLIDING DOOR




DATE : 20-Jul-20 SCALE : 1:30
 DRAWN BY : LHR CHECKED BY : DW

美特鋁質有限公司
MIDI ALUMINIUM FABRICATOR LTD.
 Units 6-8, Sunray Industrial Centre, 1/F
 610 Cha Kwo Ling Road, Kowloon
 Tel:23489211-4 Fax:(852)27727666

WINDOW MARK	W1 T1C
LOCATION	1/F~21/F LIV./DIN. AT TOWER 1 FLAT C
SECTION	-
GLAZING	-
QUANTITY	18
REMARKS	NSR: T1-03/TESTED CASE: W110B

DWG NO. : J852-SD-ASD-4103 REV. : B

ELEVATION

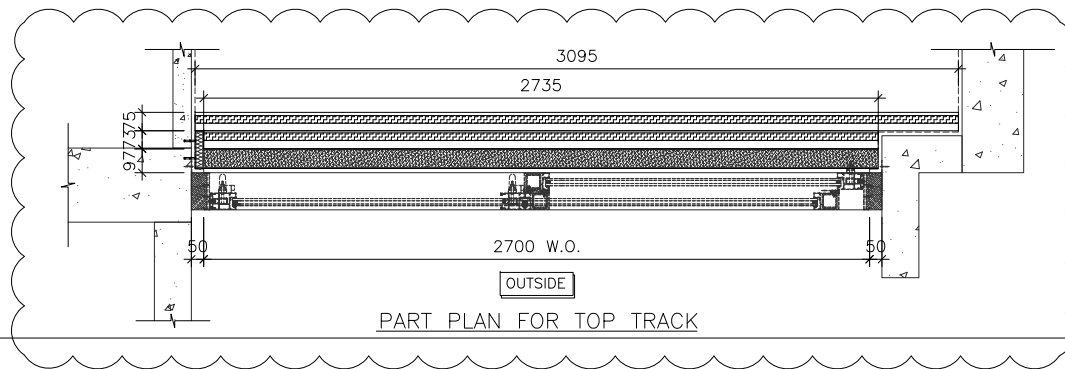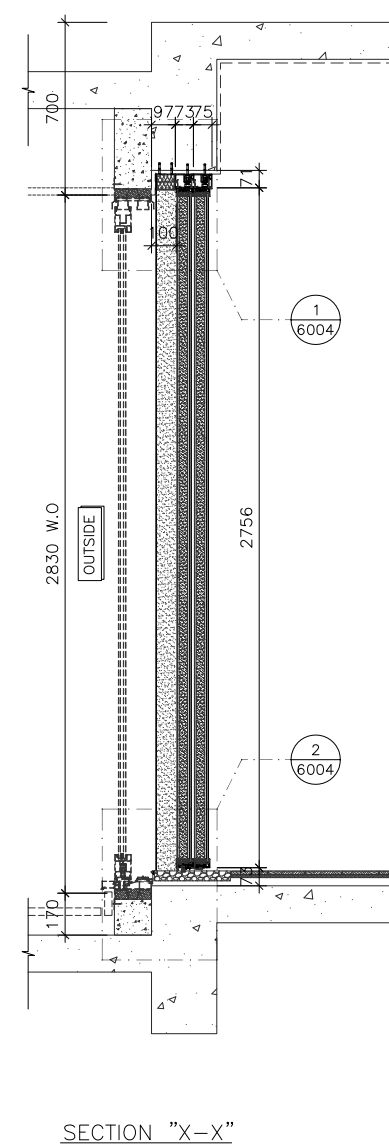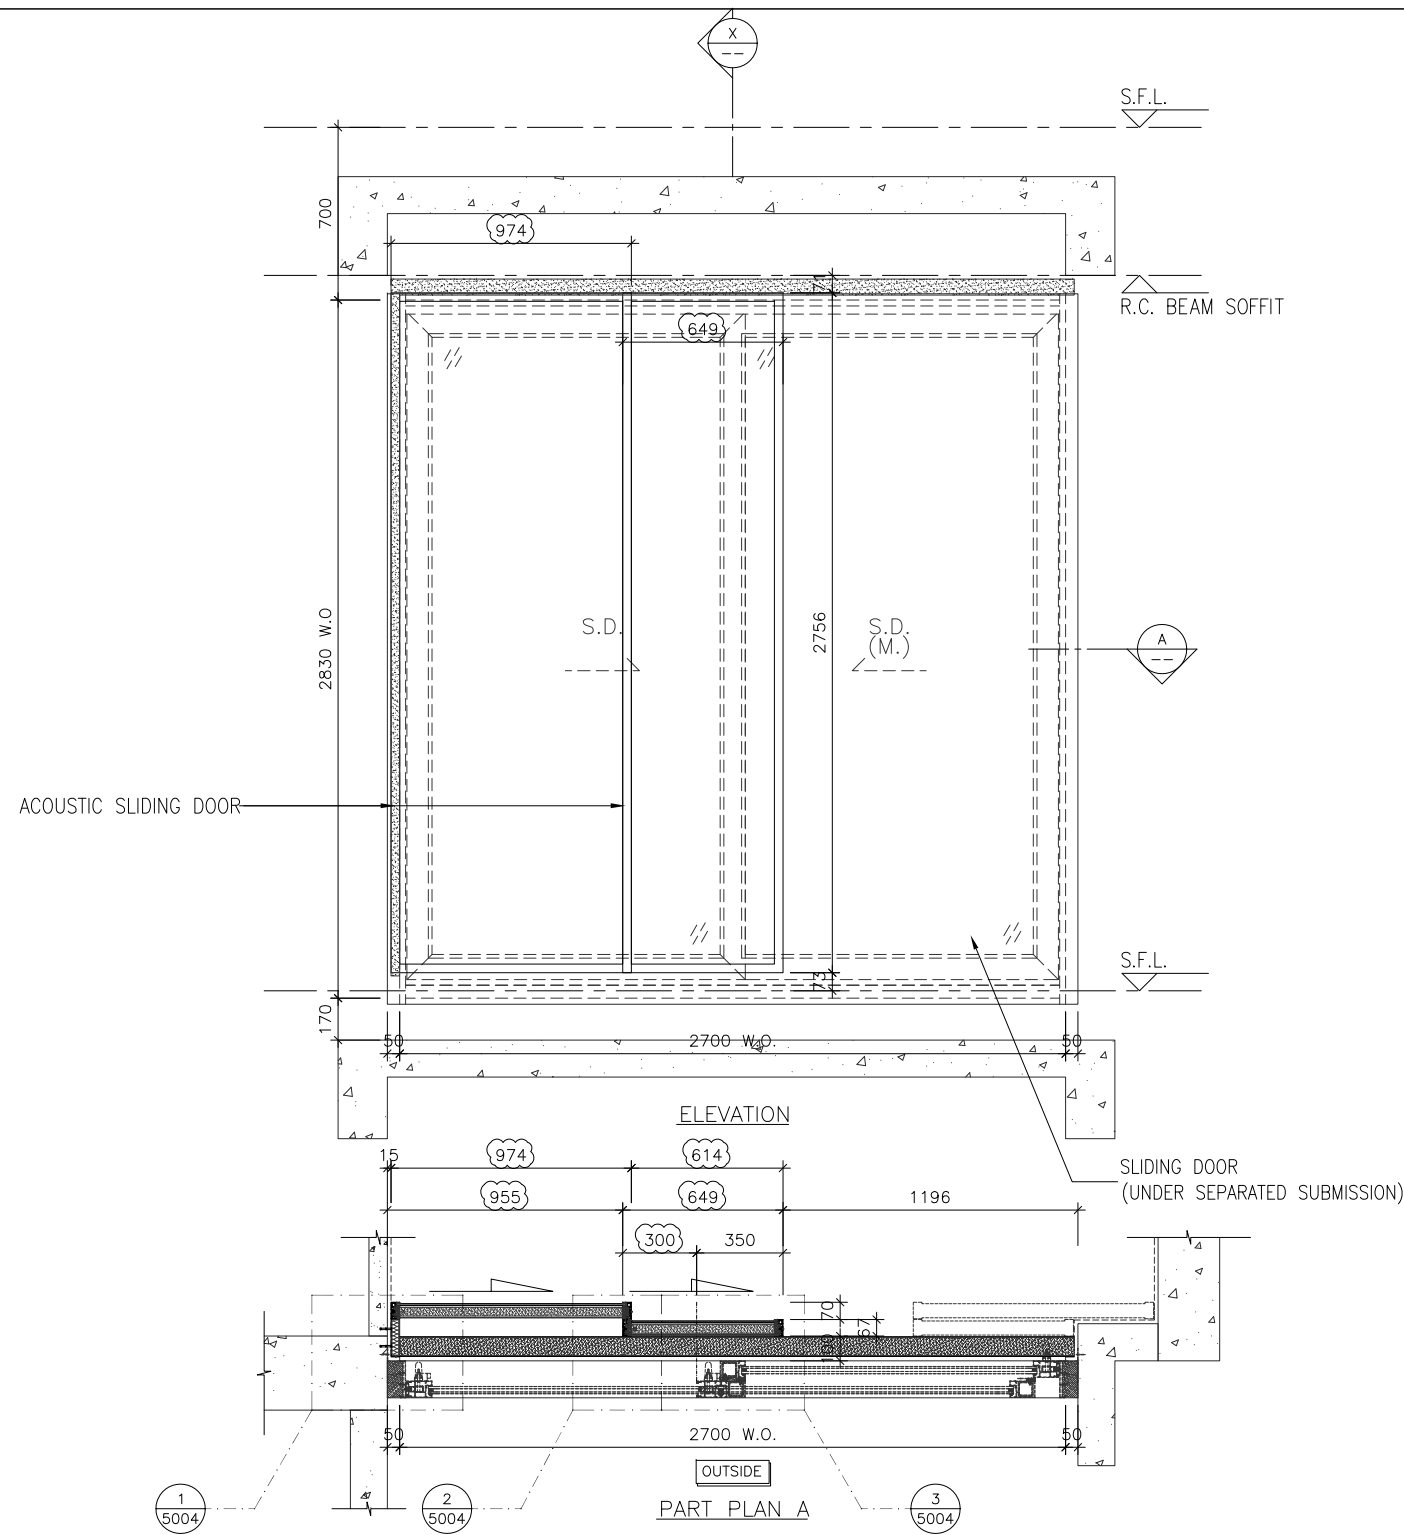

WINDOW MARK	22W1 T1C & 23W1 T1C
LOCATION	22/F~23/F LIV./DIN. AT TOWER 1 FLAT C
SECTION	-
GLAZING	-
QUANTITY	2
REMARKS	NSR: T1-03/TESTED CASE: W110A

B.D. REF :

CLIENT :

ARCHITECT :
AGC DESIGN LTD

MAIN CONTRACTOR :
Gammon

STRUCTURAL ENGINEER :
ARUP

FACADE CONSULTANT:
MEINHARDT

NOTE :
1. ALL DIMENSIONS ARE IN mm.
2. ALL ELEVATIONS ARE VIEWED FROM OUTSIDE.
3. ALL DIMENSIONS TO BE VERIFIED ON SITE BEFORE FABRICATION.

LEGEND :
 (X1) --- DETAIL MARK NO.
 (X001) --- REFER SHEET NO.
 1. F.F.L. --- FINISHED FLOOR LEVEL
 2. S.F.L. --- STRUCTURAL FLOOR LEVEL
 3. (R) --- REVERSED DETAIL

B	13-11-2020	REVISION SUBJECT TO COMMENTS	MN
A	24-08-2020	REVISION SUBJECT TO COMMENTS	MN
NO.	DATE	REVISED	BY


JOB NO. : J-852
 PROJECT : PROPOSED RESIDENTIAL DEVELOPMENT AT 139 - 147 ARGYLE STREET, NKIL 6005, 6035 R.P., 6036 R.P., 6037 R.P. & 6038 R.P.

TITLE : PART ELEVATION, PLAN & SECTION FOR ACOUSTIC SLIDING DOOR


DATE : 20-Jul-20 SCALE : 1:30
 DRAWN BY : LHR CHECKED BY : DW

美特鋁質有限公司
MIDI ALUMINIUM FABRICATOR LTD.
 Units 6-8, Sunray Industrial Centre, 1/F
 610 Cha Kwo Ling Road, Kowloon
 Tel:23489211-4 Fax:(852)2727666
 DWG NO. : J852-SD-ASD-4103A REV. : B


ELEVATION

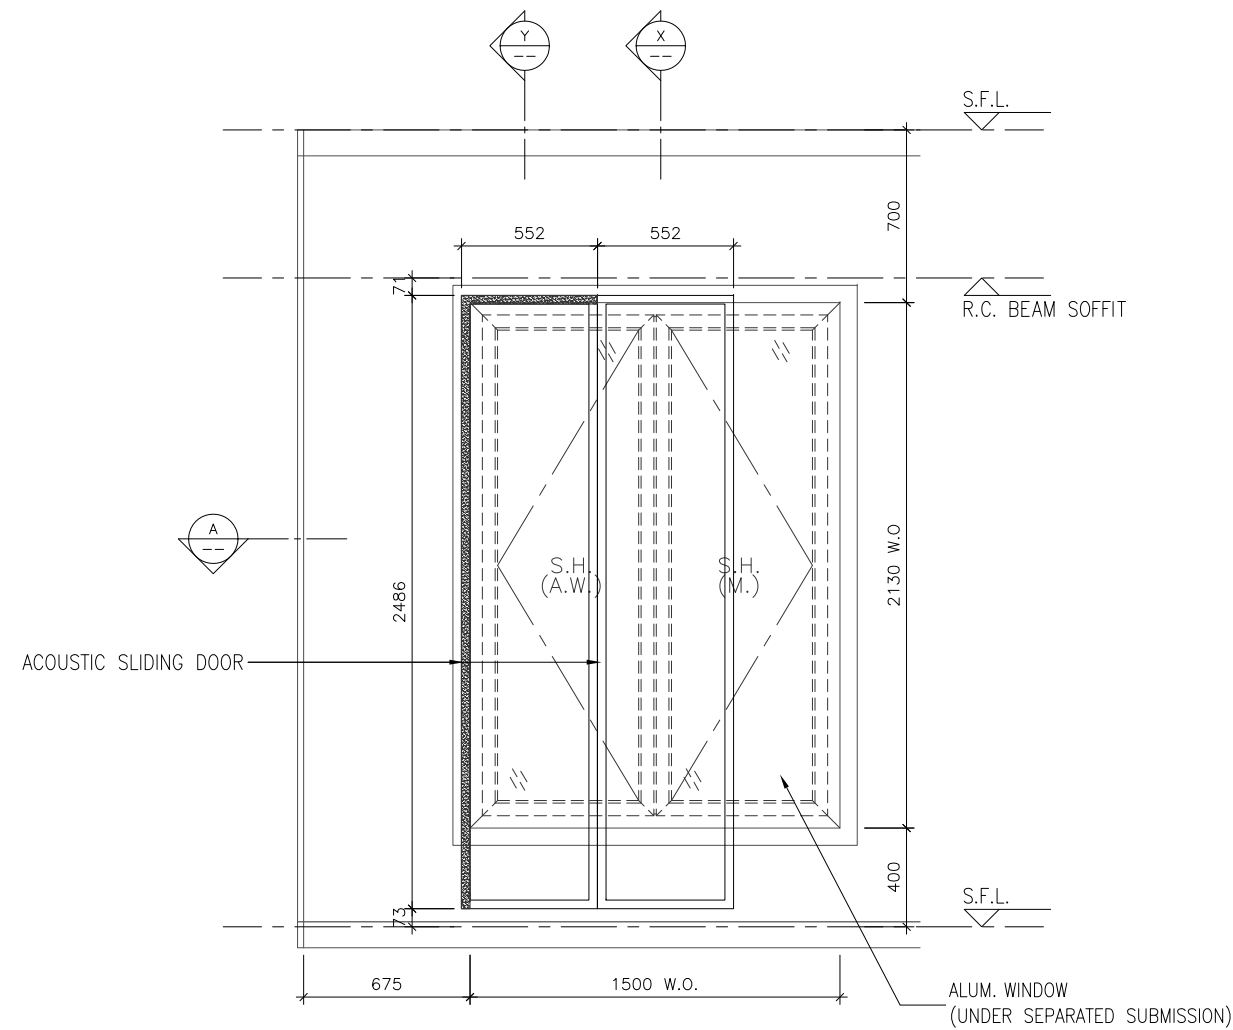


ELEVATION

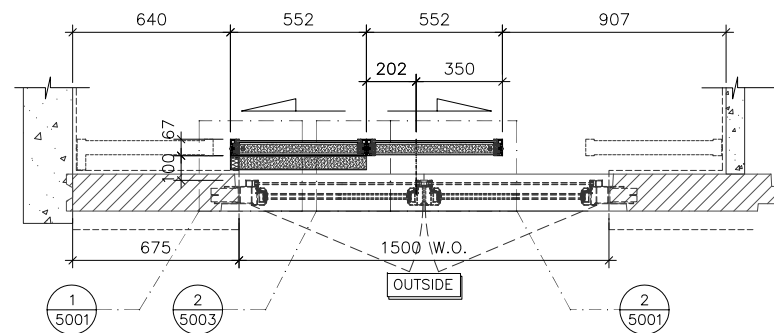


PART PLAN A

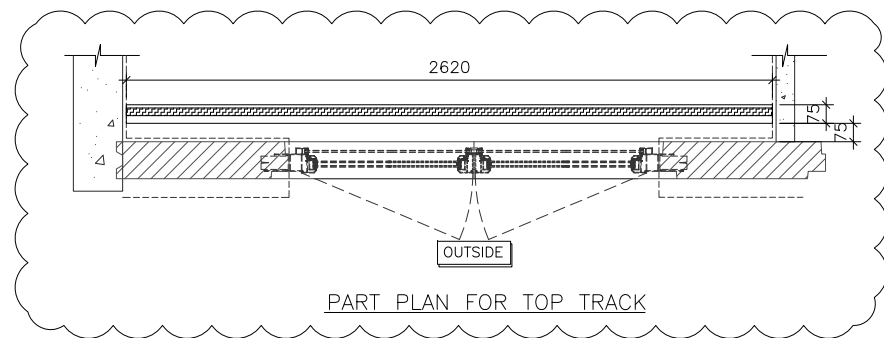

PART PLAN FOR TOP TRACK

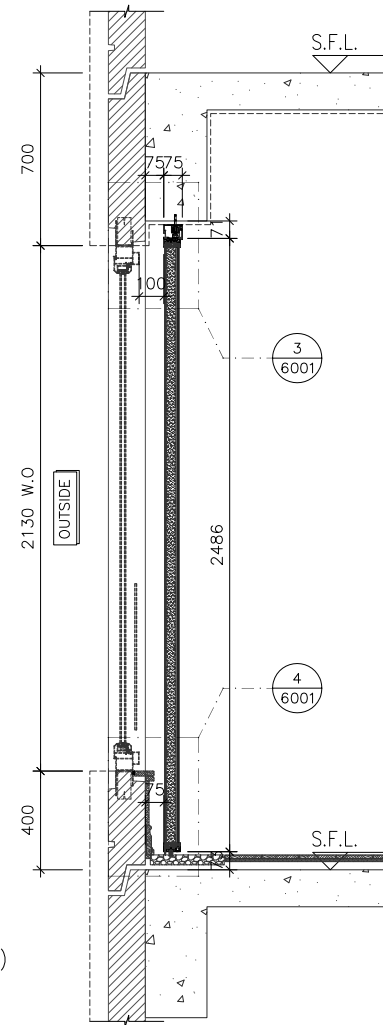

SECTION "X-X"

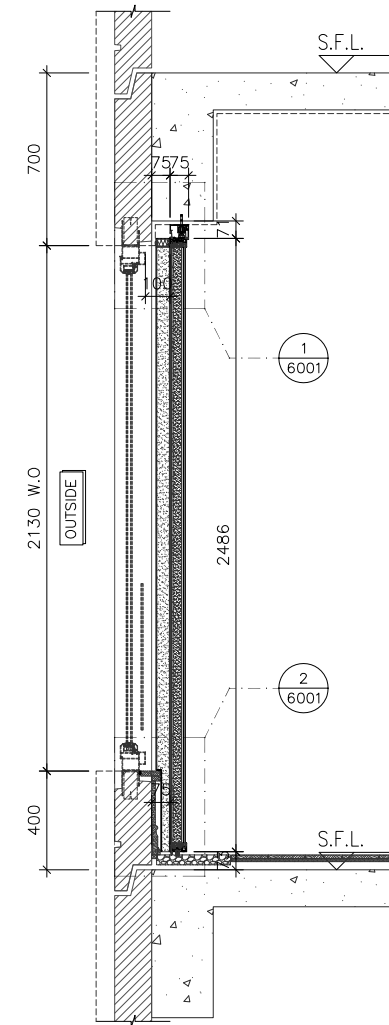

SECTION "Y-Y"

WINDOW MARK	W9 T1A
LOCATION	2/F-21/F B.R.2 AT TOWER 1 FLAT A
SECTION	-
GLAZING	-
QUANTITY	17
REMARKS	NSR: T1-04/TESTED CASE: W107B

B.D. REF :

CLIENT :

ARCHITECT :
AGC DESIGN LTD

MAIN CONTRACTOR :
Gammon

STRUCTURAL ENGINEER :
ARUP

FACADE CONSULTANT:
MEINHARDT

NOTE :
1. ALL DIMENSIONS ARE IN mm.
2. ALL ELEVATIONS ARE VIEWED FROM OUTSIDE.
3. ALL DIMENSIONS TO BE VERIFIED ON SITE BEFORE FABRICATION.

LEGEND :
X1 --- DETAIL MARK NO.
X001 --- REFER SHEET NO.

1. F.F.L. --- FINISHED FLOOR LEVEL
2. S.F.L. --- STRUCTURAL FLOOR LEVEL
3. (R) --- REVERSED DETAIL

B	13-11-2020	REVISION SUBJECT TO COMMENTS	MN
A	24-08-2020	REVISION SUBJECT TO COMMENTS	MN
NO.	DATE	REVISED	BY

JOB NO. : J-852
PROJECT : PROPOSED RESIDENTIAL DEVELOPMENT AT 139 - 147 ARGYLE STREET, NKIL 6005, 6035 R.P., 6036 R.P., 6037 R.P. & 6038 R.P.





TITLE : PART ELEVATION, PLAN & SECTION FOR ACOUSTIC SLIDING DOOR

DATE : 20-Jul-20 SCALE : 1:30
DRAWN BY : LHR CHECKED BY : DW

美特鋁質有限公司
MIDI ALUMINIUM FABRICATOR LTD.
Units 6-8, Sunray Industrial Centre, 1/F
610 Cha Kwo Ling Road, Kowloon
Tel:23489211-4 Fax:(852)27727666

DWG NO. : J852-SD-ASD-4104 REV. : B

ELEVATION

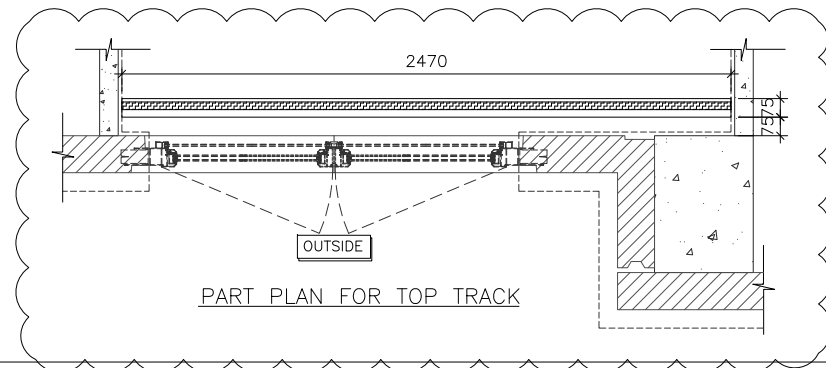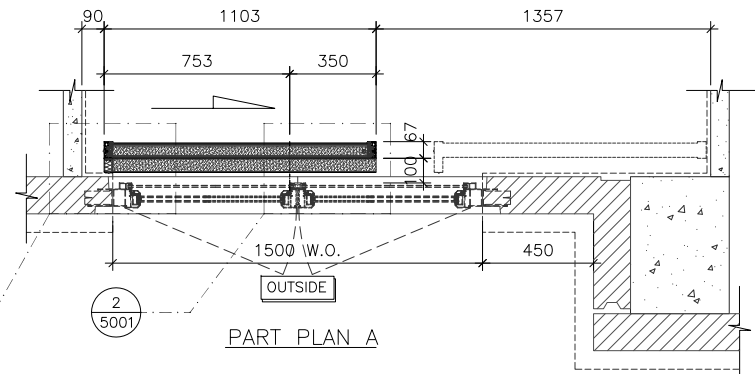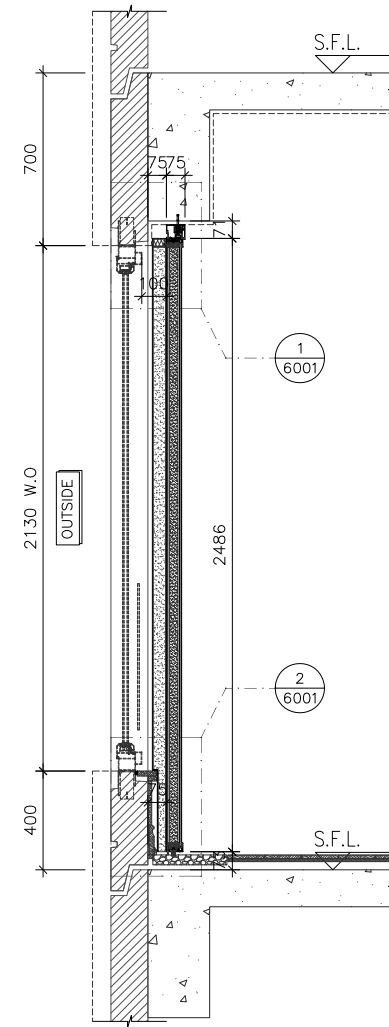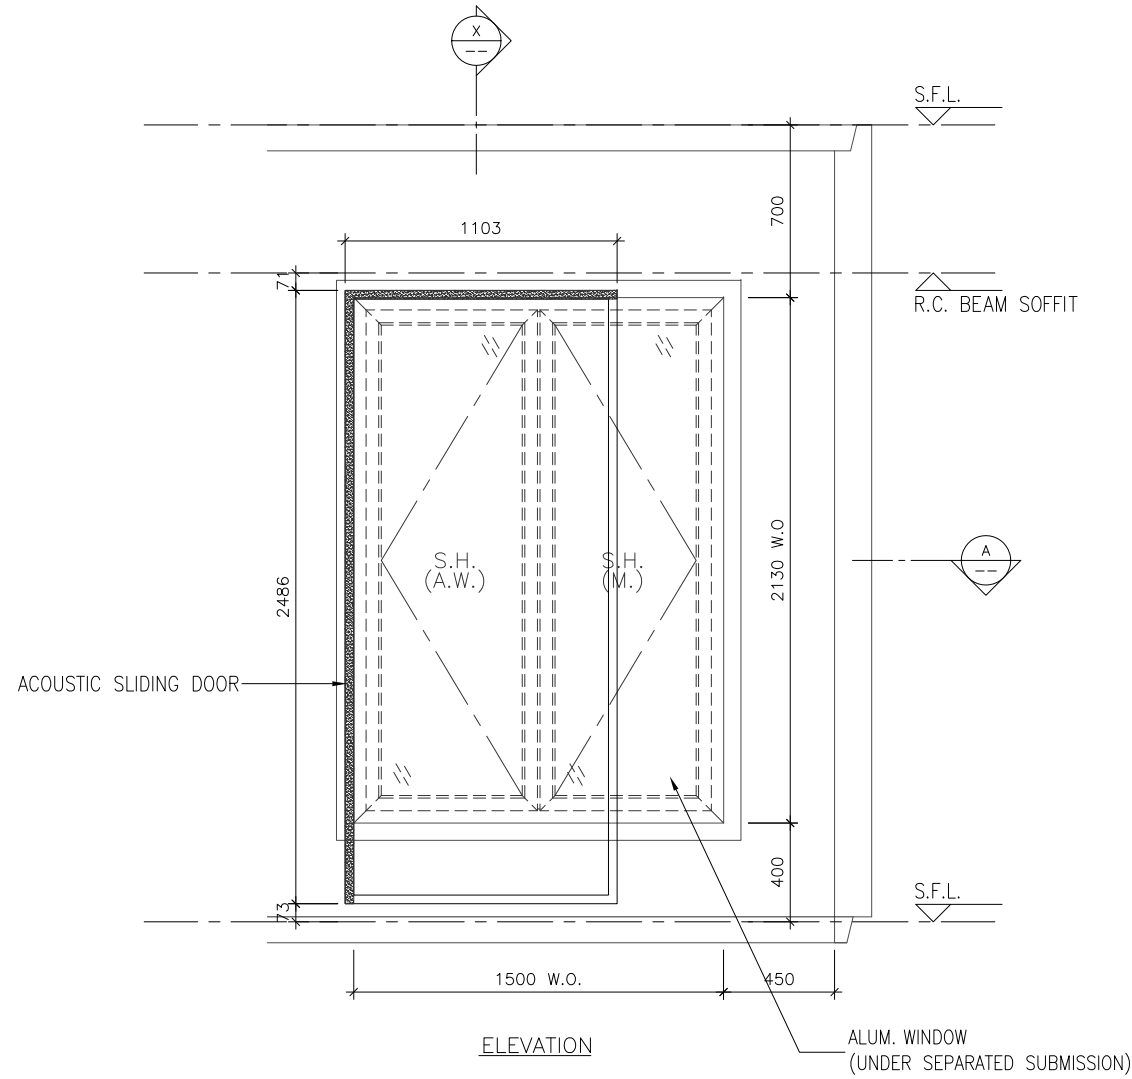

WINDOW MARK	W8 T1A
LOCATION	2/F-21/F B.R.1 AT TOWER 1 FLAT A
SECTION	-
GLAZING	-
QUANTITY	17
REMARKS	NSR: T1-05/TESTED CASE: W107B

B.D. REF :

CLIENT :

ARCHITECT :
AGC DESIGN LTD

MAIN CONTRACTOR :
Gammon

STRUCTURAL ENGINEER :
ARUP

FACADE CONSULTANT:
MEINHARDT

NOTE :
1. ALL DIMENSIONS ARE IN mm.
2. ALL ELEVATIONS ARE VIEWED FROM OUTSIDE.
3. ALL DIMENSIONS TO BE VERIFIED ON SITE BEFORE FABRICATION.

LEGEND :
x1 --- DETAIL MARK NO.
x001 --- REFER SHEET NO.
1. F.F.L. -- FINISHED FLOOR LEVEL
2. S.F.L. -- STRUCTURAL FLOOR LEVEL
3. (R) -- REVERSED DETAIL

B	13-11-2020	REVISION SUBJECT TO COMMENTS	MN
A	24-08-2020	REVISION SUBJECT TO COMMENTS	MN
NO.	DATE	REVISED	BY

JOB NO. : J-852
PROJECT : PROPOSED RESIDENTIAL DEVELOPMENT AT 139 - 147 ARGYLE STREET, NKIL 6005, 6035 R.P., 6036 R.P., 6037 R.P. & 6038 R.P.





TITLE : PART ELEVATION, PLAN & SECTION FOR ACOUSTIC SLIDING DOOR

DATE : 20-Jul-20 SCALE : 1:30
DRAWN BY : LHR CHECKED BY : DW

美特鋁質有限公司
MIDI ALUMINIUM FABRICATOR LTD.
Units 6-8, Sunray Industrial Centre, 1/F
610 Cha Kwo Ling Road, Kowloon
Tel:23489211-4 Fax:(852)2727666

DWG NO. : J852-SD-ASD-4105 REV. : B

ELEVATION

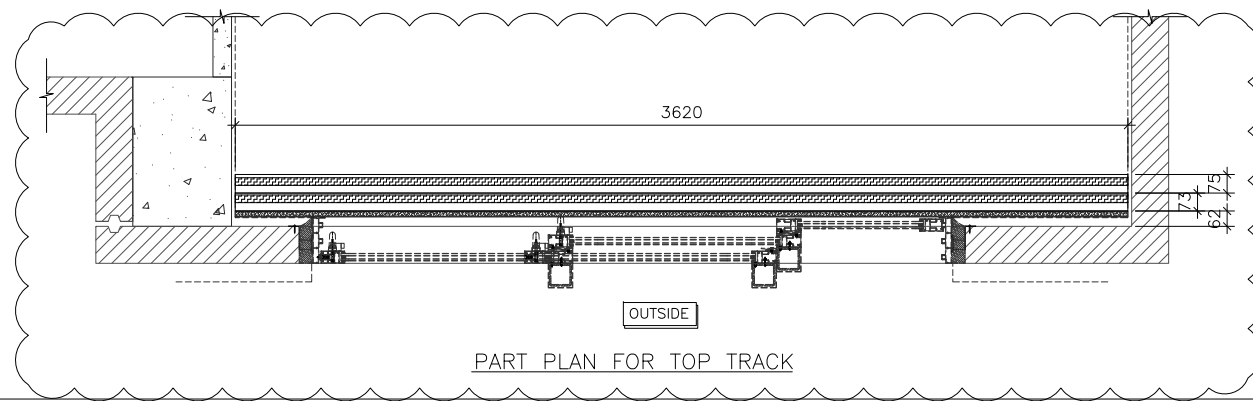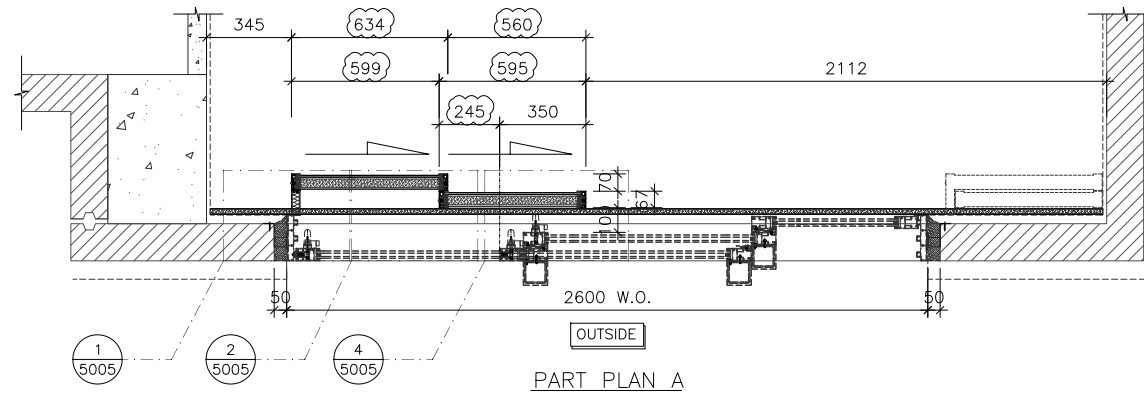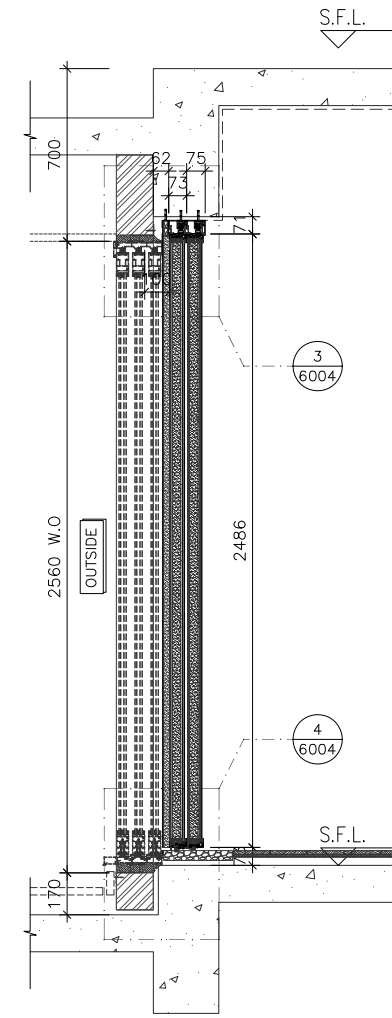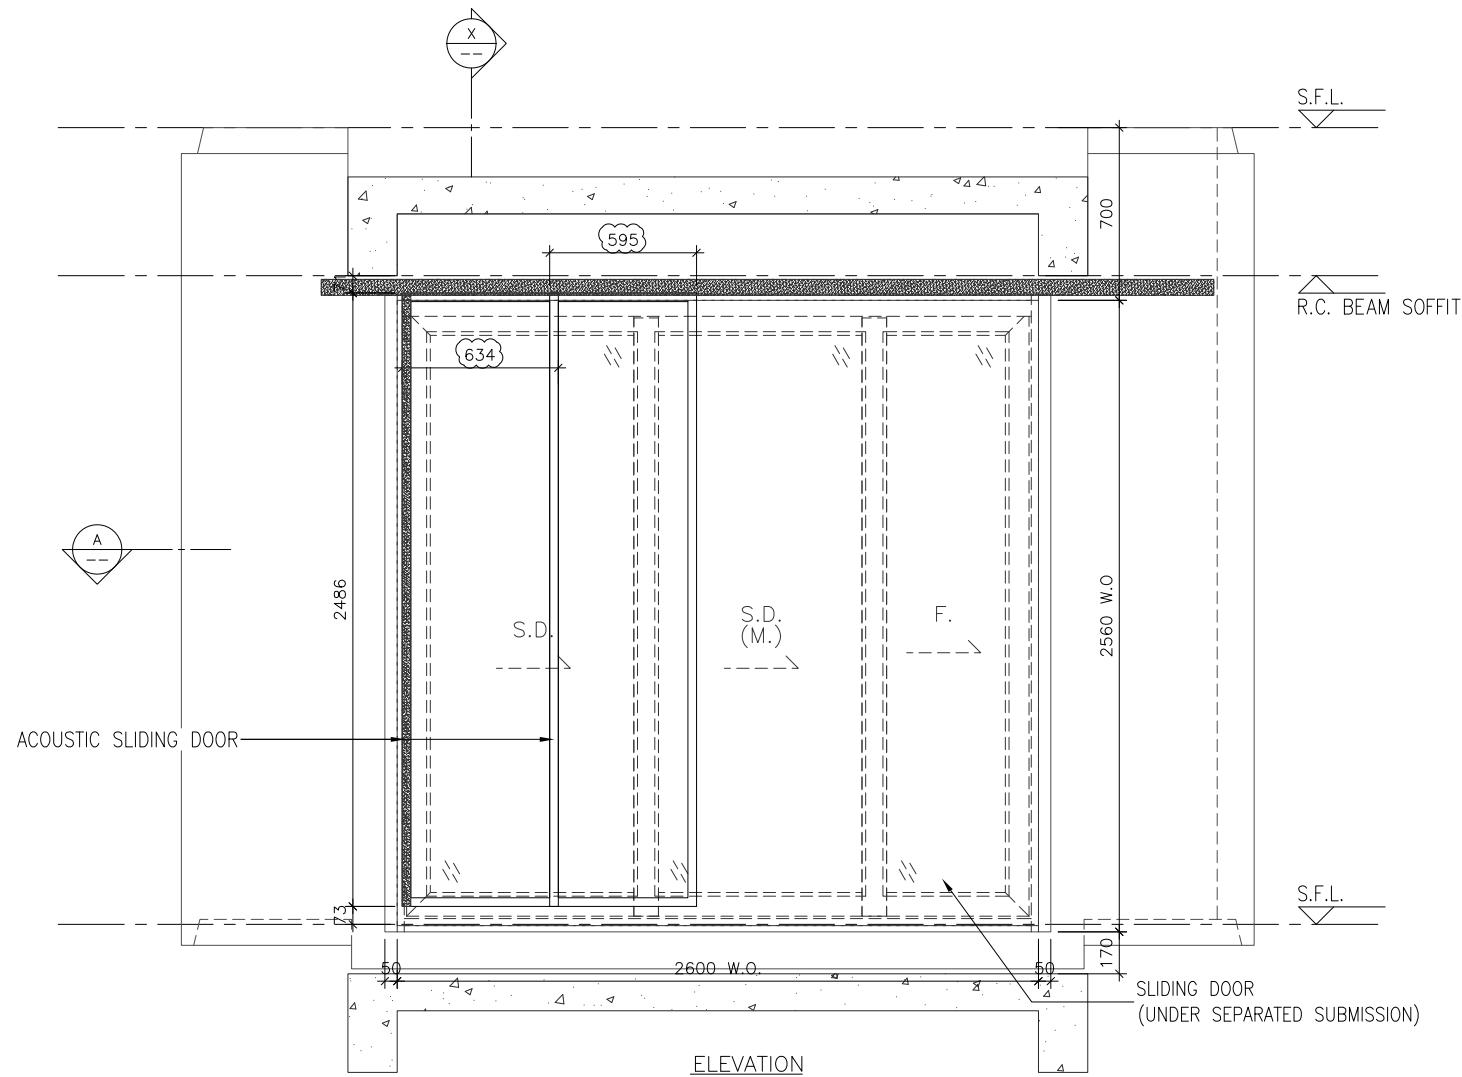

WINDOW MARK	W7 T1A
LOCATION	1/F~21/F ENSUITE AT TOWER 1 FLAT A
SECTION	-
GLAZING	-
QUANTITY	18
REMARKS	NSR: T1-06/TESTED CASE: W103C

B.D. REF :

CLIENT :

ARCHITECT :
AGC DESIGN LTD

MAIN CONTRACTOR :
Gammon

STRUCTURAL ENGINEER :
ARUP

FACADE CONSULTANT:
MEINHARDT

- NOTE :
1. ALL DIMENSIONS ARE IN mm.
 2. ALL ELEVATIONS ARE VIEWED FROM OUTSIDE.
 3. ALL DIMENSIONS TO BE VERIFIED ON SITE BEFORE FABRICATION.

- LEGEND :
- (X1) — DETAIL MARK NO.
 - (X001) — REFER SHEET NO.

1. F.F.L. -- FINISHED FLOOR LEVEL
2. S.F.L. -- STRUCTURAL FLOOR LEVEL
3. (R) -- REVERSED DETAIL

B	13-11-2020	REVISION SUBJECT TO COMMENTS	MN
A	24-08-2020	REVISION SUBJECT TO COMMENTS	MN
NO.	DATE	REVISED	BY

JOB NO. : J-852
PROJECT : PROPOSED RESIDENTIAL DEVELOPMENT AT 139 - 147 ARGYLE STREET, NKIL 6005, 6035 R.P., 6036 R.P., 6037 R.P. & 6038 R.P.



TITLE : PART ELEVATION, PLAN & SECTION FOR ACOUSTIC SLIDING DOOR

DATE : 20-Jul-20 SCALE : 1:30
DRAWN BY : LHR CHECKED BY : DW

美特鋁質有限公司
MIDI ALUMINIUM FABRICATOR LTD.
Units 6-8, Sunray Industrial Centre, 1/F
610 Cha Kwo Ling Road, Kowloon
Tel:23489211-4 Fax:(852)2727666


DWG NO. : J852-SD-ASD-4106 REV. : B

ELEVATION

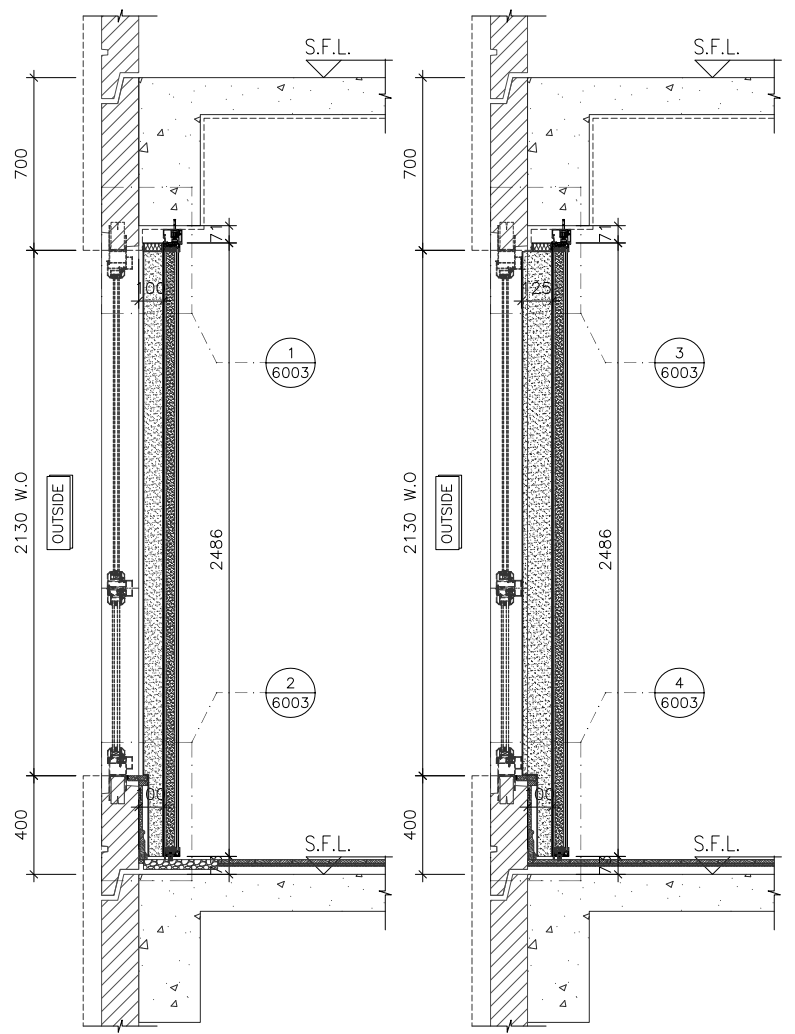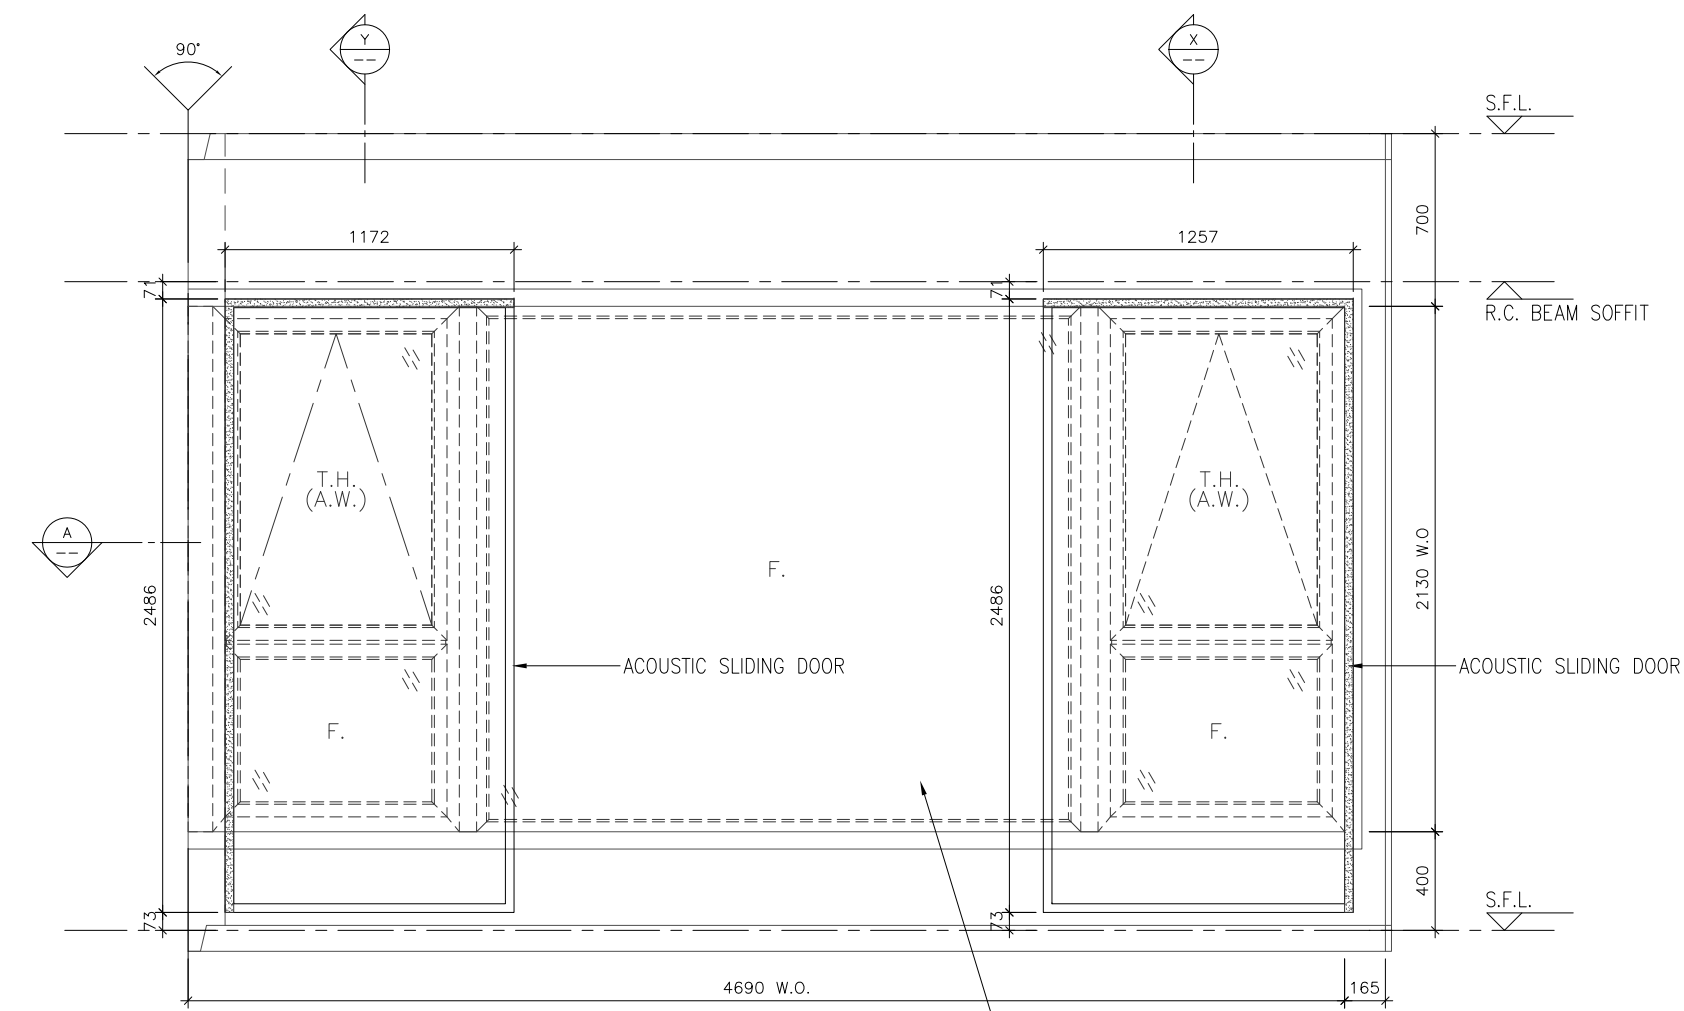


SECTION "X-X"

SECTION "Y-Y"

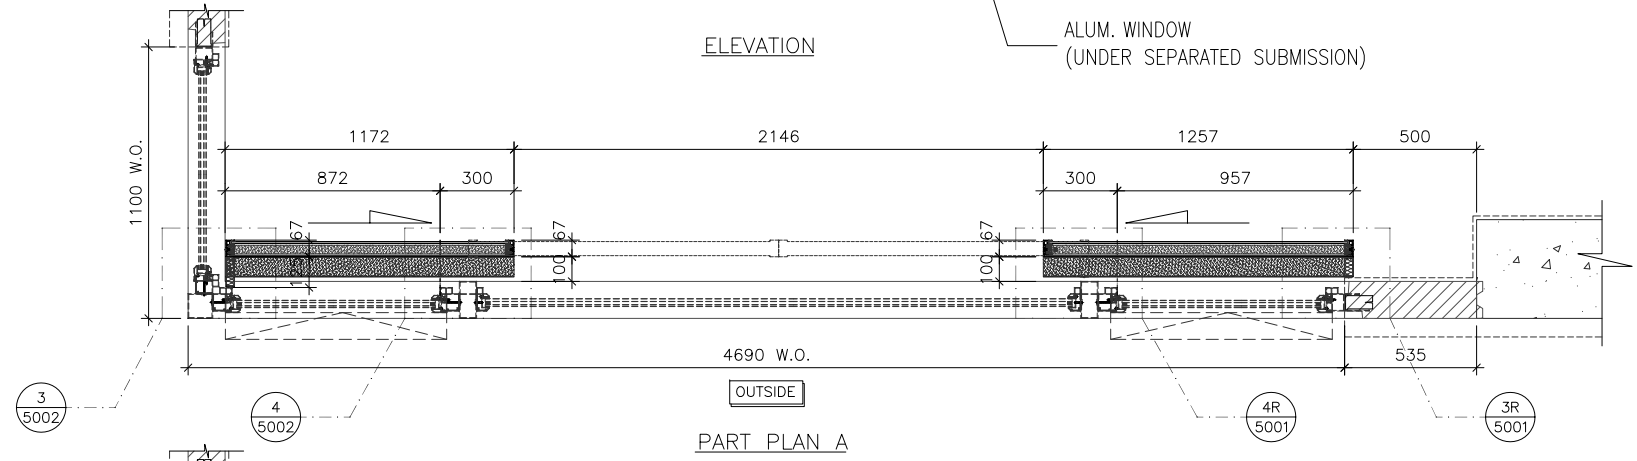

PART PLAN A

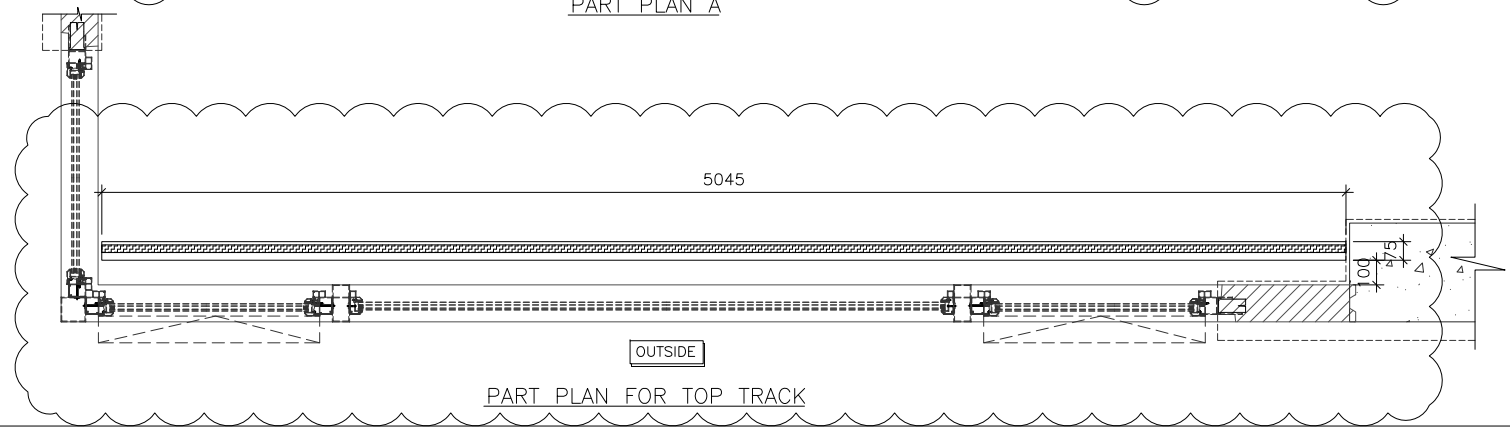

PART PLAN FOR TOP TRACK

WINDOW MARK

W3
T1A

LOCATION 1/F-21/F MASTER ENSUITE AT TOWER 1 FLAT A

SECTION -

GLAZING -

QUANTITY 18

REMARKS NSR: T1-07/TESTED CASE: W101

B.D. REF :

CLIENT :

ARCHITECT :

AGC
DESIGN LTD

MAIN CONTRACTOR :

Gammon

STRUCTURAL ENGINEER :

ARUP

FAÇADE CONSULTANT:

MEINHARDT

NOTE :

1. ALL DIMENSIONS ARE IN mm.
2. ALL ELEVATIONS ARE VIEWED FROM OUTSIDE.
3. ALL DIMENSIONS TO BE VERIFIED ON SITE BEFORE FABRICATION.

LEGEND :

- x1 --- DETAIL MARK NO.
- x001 --- REFER SHEET NO.

1. F.F.L. -- FINISHED FLOOR LEVEL
2. S.F.L. -- STRUCTURAL FLOOR LEVEL
3. (R) -- REVERSED DETAIL

NO.	DATE	REVISED	BY
B	13-11-2020	REVISION SUBJECT TO COMMENTS	MN
A	24-08-2020	REVISION SUBJECT TO COMMENTS	MN

JOB NO. : J-852

PROJECT :
PROPOSED RESIDENTIAL DEVELOPMENT
AT 139 - 147 ARGYLE STREET,
NKIL 6005, 6035 R.P., 6036 R.P.,
6037 R.P. & 6038 R.P.

TITLE :
PART ELEVATION, PLAN & SECTION
FOR ACOUSTIC SLIDING DOOR





DATE : 20-Jul-20 SCALE : 1:30

DRAWN BY : LHR CHECKED BY : DW

美特鋁質有限公司
MIDI ALUMINIUM FABRICATOR LTD.
Units 6-8, Sunray Industrial Centre, 1/F
610 Cha Kwo Ling Road, Kowloon
Tel:23489211-4 Fax:(852)27727666

DWG NO. : J852-SD-ASD-4107 REV. : B

ELEVATION

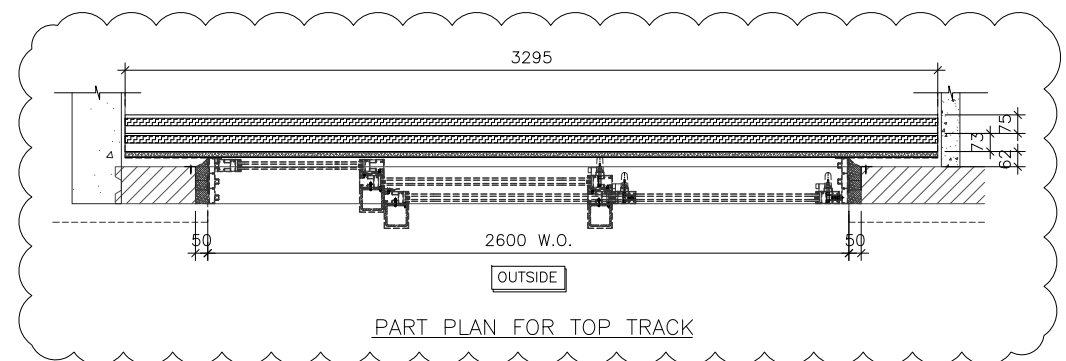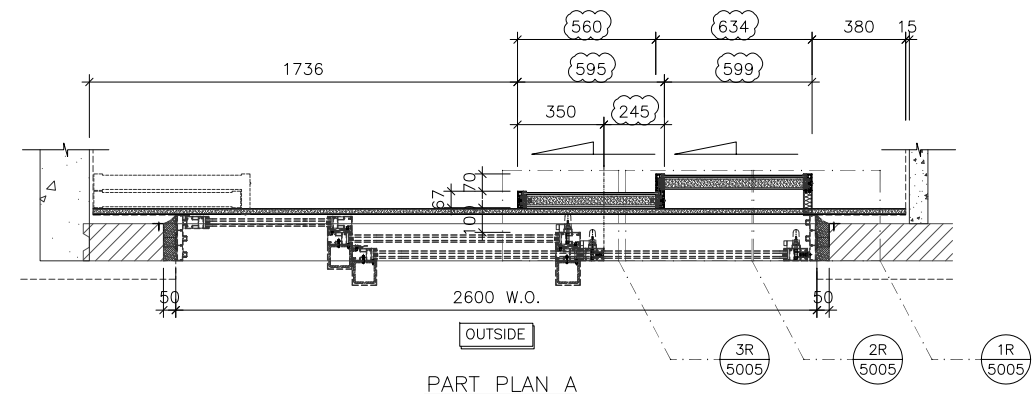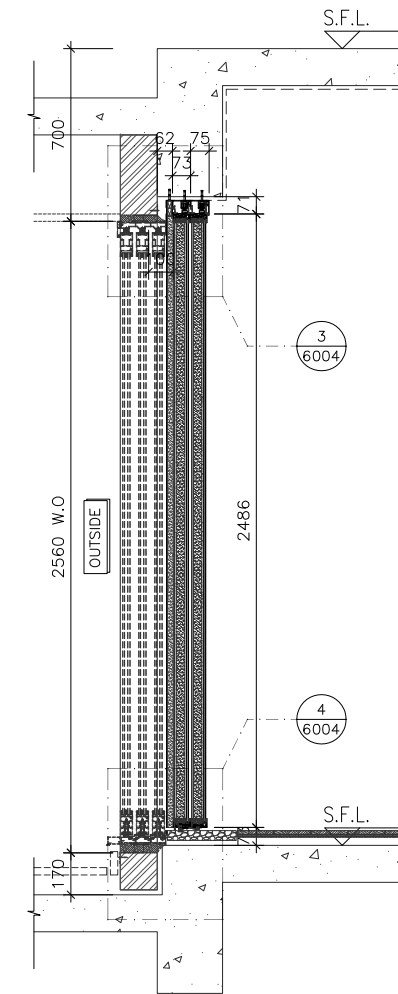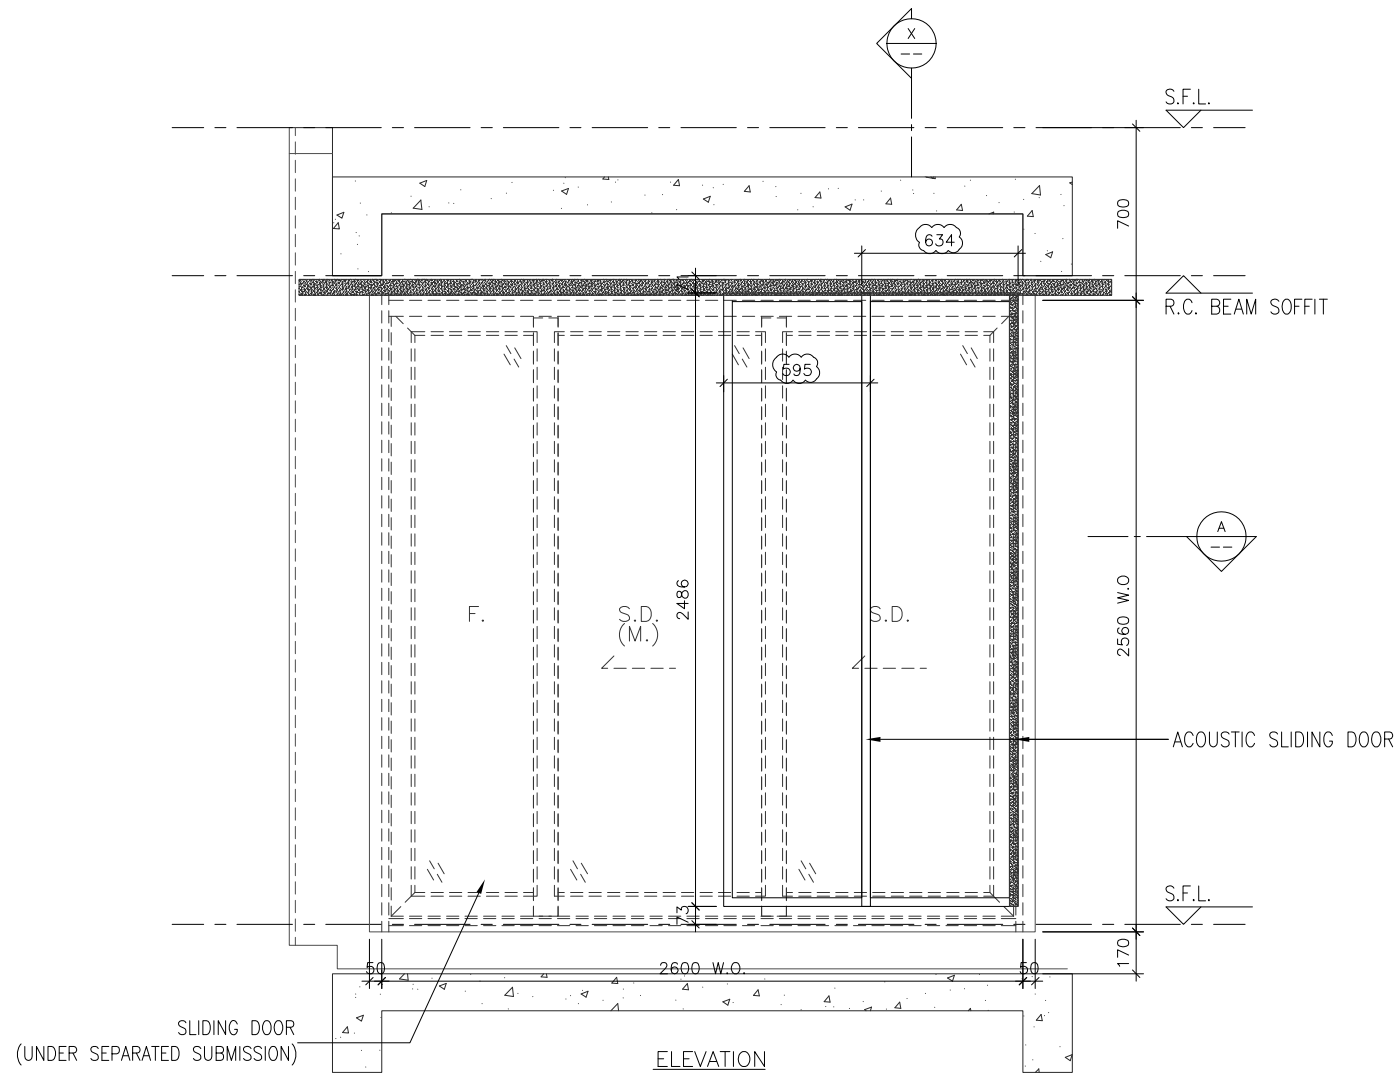

B.D. REF :

CLIENT :

ARCHITECT :
AGC DESIGN LTD

MAIN CONTRACTOR :
Gammon

STRUCTURAL ENGINEER :
ARUP

FACADE CONSULTANT:
MEINHARDT

NOTE :

1. ALL DIMENSIONS ARE IN mm.
2. ALL ELEVATIONS ARE VIEWED FROM OUTSIDE.
3. ALL DIMENSIONS TO BE VERIFIED ON SITE BEFORE FABRICATION.

LEGEND :

(X1) --- DETAIL MARK NO.
 (X001) --- REFER SHEET NO.

1. F.F.L. --- FINISHED FLOOR LEVEL
2. S.F.L. --- STRUCTURAL FLOOR LEVEL
3. (R) --- REVERSED DETAIL

NO.	DATE	REVISION	BY
B	13-11-2020	REVISION SUBJECT TO COMMENTS	MN
A	24-08-2020	REVISION SUBJECT TO COMMENTS	MN

JOB NO. : J-852

PROJECT :
 PROPOSED RESIDENTIAL DEVELOPMENT
 AT 139 - 147 ARGYLE STREET,
 NKIL 6005, 6035 R.P., 6036 R.P.,
 6037 R.P. & 6038 R.P.

TITLE :
 PART ELEVATION, PLAN & SECTION
 FOR ACOUSTIC SLIDING DOOR

DATE : 20-Jul-20 SCALE : 1:30



DRAWN BY : LHR CHECKED BY : DW

美特鋁質有限公司
MIDI ALUMINIUM FABRICATOR LTD.
 Units 6-8, Sunray Industrial Centre, 1/F
 610 Cha Kwo Ling Road, Kowloon
 Tel:23489211-4 Fax:(852)27727666

WINDOW MARK	W6 T1B
LOCATION	2/F~21/F ENSUITE AT TOWER 1 FLAT B
SECTION	-
GLAZING	-
QUANTITY	17
REMARKS	NSR: T1-13/TESTED CASE: W103B

DWG NO. : J852-SD-ASD-4108 REV. : B

ELEVATION

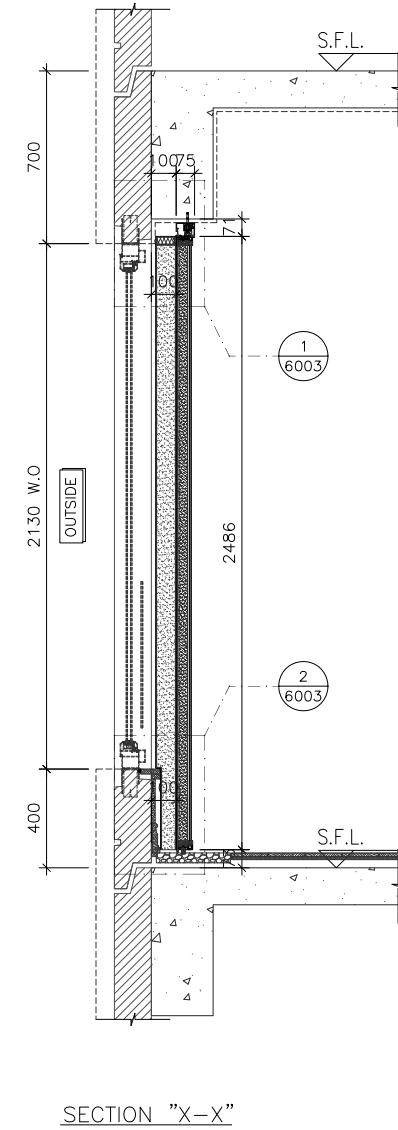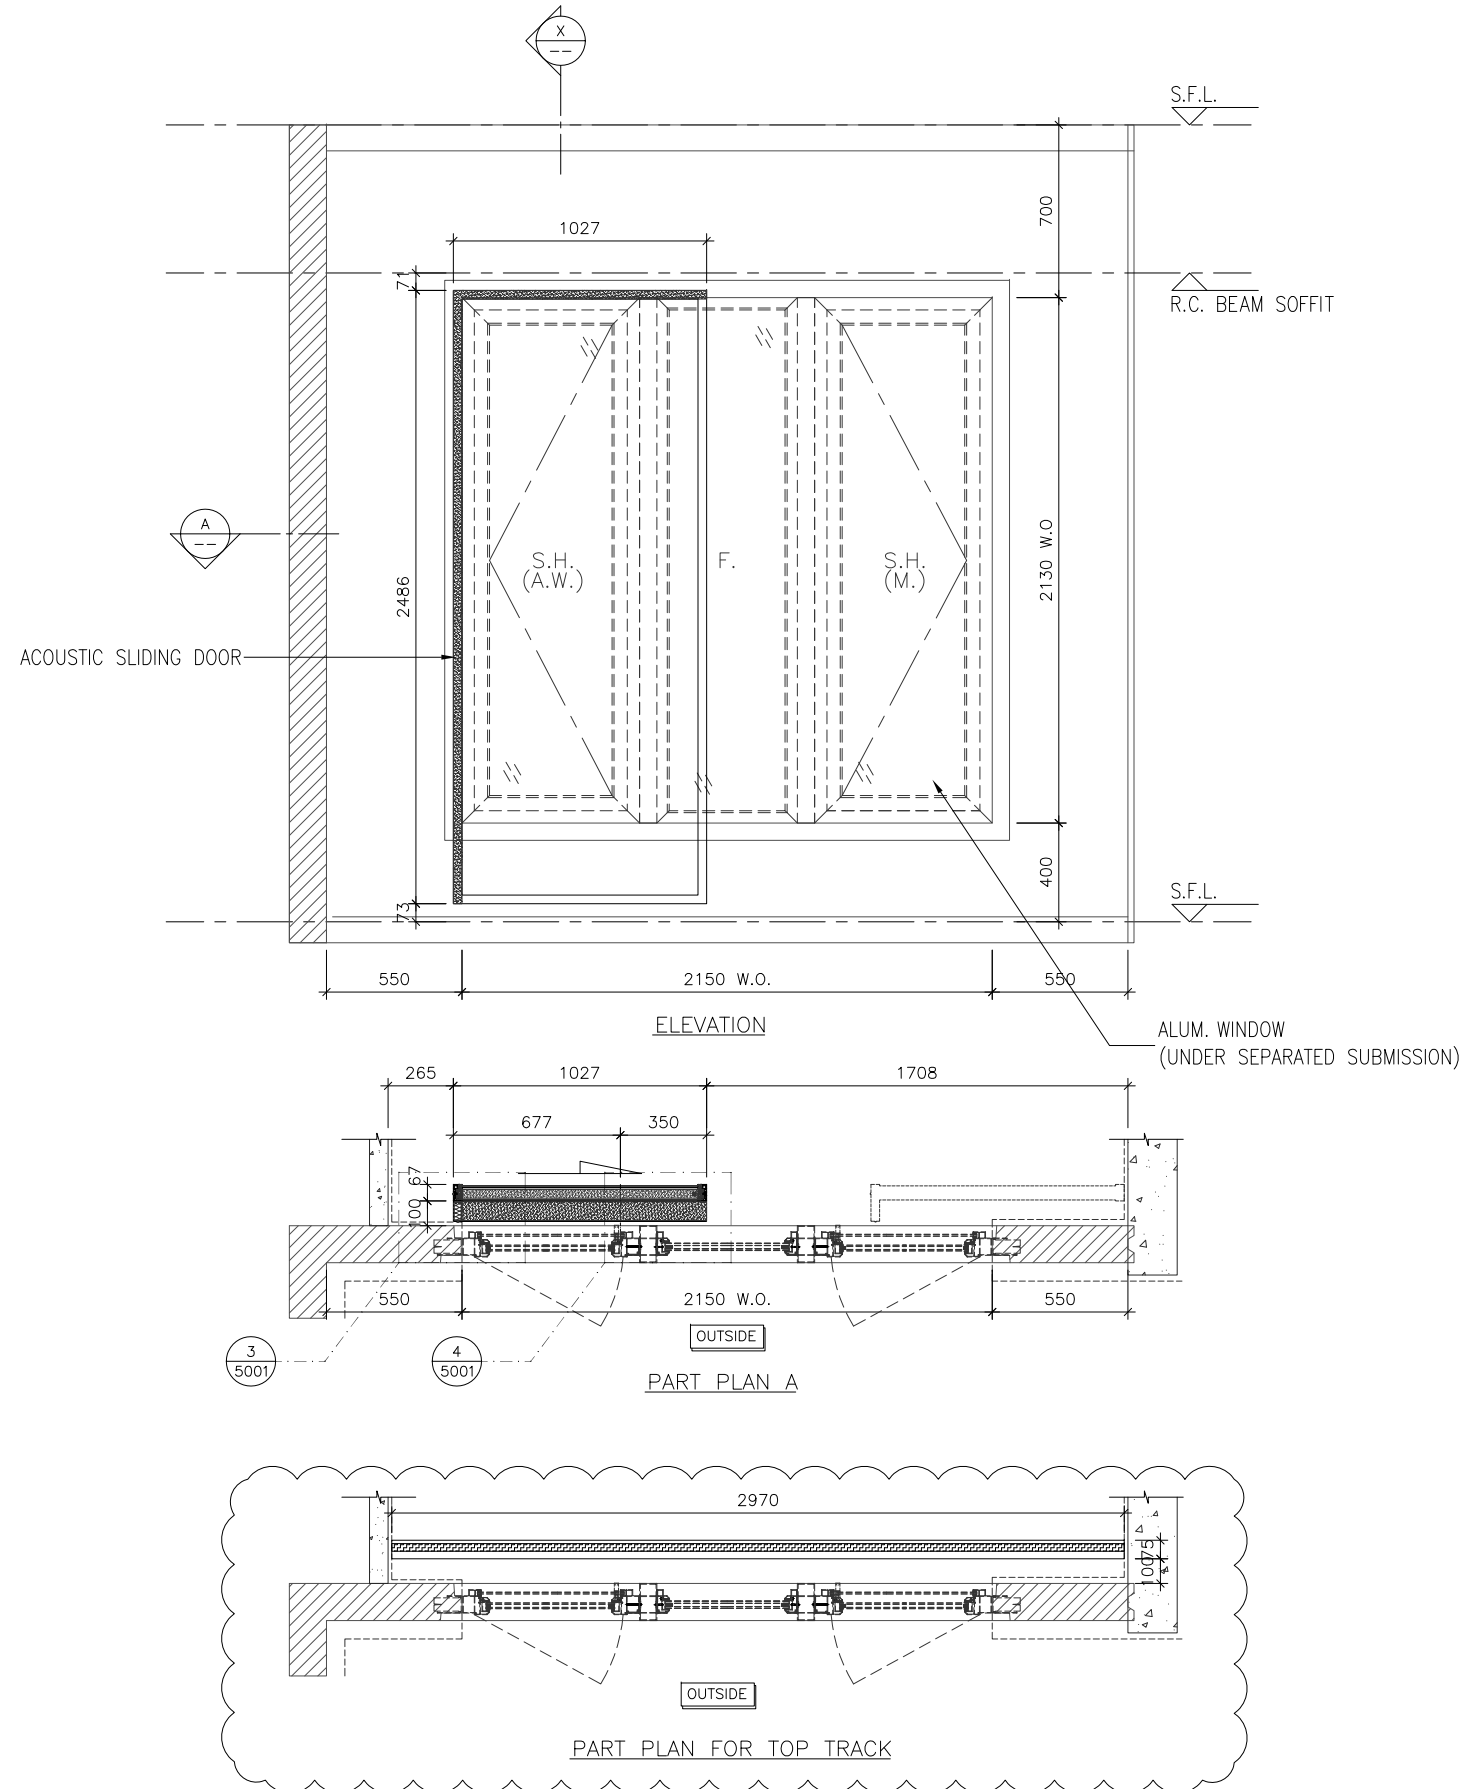

B.D. REF :

CLIENT :

ARCHITECT :
AGC DESIGN LTD
 100, 101, 102,1000

MAIN CONTRACTOR :
Gammon

STRUCTURAL ENGINEER :
ARUP

FACADE CONSULTANT:
MEINHARDT

NOTE :

1. ALL DIMENSIONS ARE IN mm.
2. ALL ELEVATIONS ARE VIEWED FROM OUTSIDE.
3. ALL DIMENSIONS TO BE VERIFIED ON SITE BEFORE FABRICATION.

LEGEND :

(X1) -- DETAIL MARK NO.
 (X001) -- REFER SHEET NO.

1. F.F.L. -- FINISHED FLOOR LEVEL
2. S.F.L. -- STRUCTURAL FLOOR LEVEL
3. (R) -- REVERSED DETAIL

NO.	DATE	REVISION	BY
B	13-11-2020	REVISION SUBJECT TO COMMENTS	MN
A	24-08-2020	REVISION SUBJECT TO COMMENTS	MN

JOB NO. : J-852

PROJECT :
 PROPOSED RESIDENTIAL DEVELOPMENT
 AT 139 - 147 ARGYLE STREET,
 NKIL 6005, 6035 R.P., 6036 R.P.,
 6037 R.P. & 6038 R.P.

TITLE :
 PART ELEVATION, PLAN & SECTION
 FOR ACOUSTIC SLIDING DOOR

DATE : 20-Jul-20 SCALE : 1:30






DRAWN BY : LHR CHECKED BY : DW

美特鋁質有限公司
MIDI ALUMINIUM FABRICATOR LTD.
 Units 6-8, Sunray Industrial Centre, 1/F
 610 Cha Kwo Ling Road, Kowloon
 Tel:23489211-4 Fax:(852)2727666

WINDOW MARK	W7 T1B
LOCATION	2/F-21/F B.R.1. AT TOWER 1 FLAT B
SECTION	-
GLAZING	-
QUANTITY	17
REMARKS	NSR: T1-14/TESTED CASE: W107A

DWG NO. : J852-SD-ASD-4109 REV. : B

ELEVATION

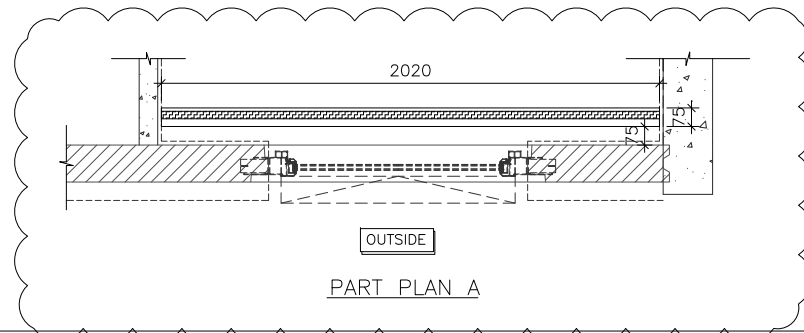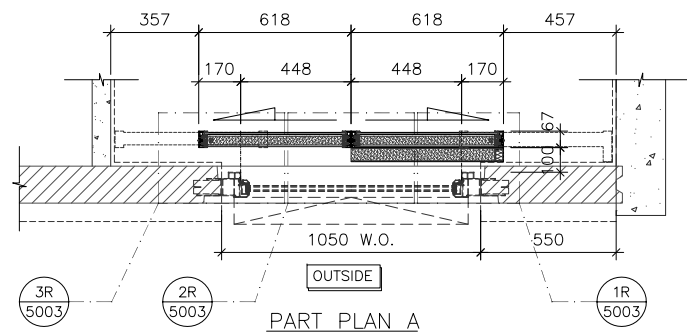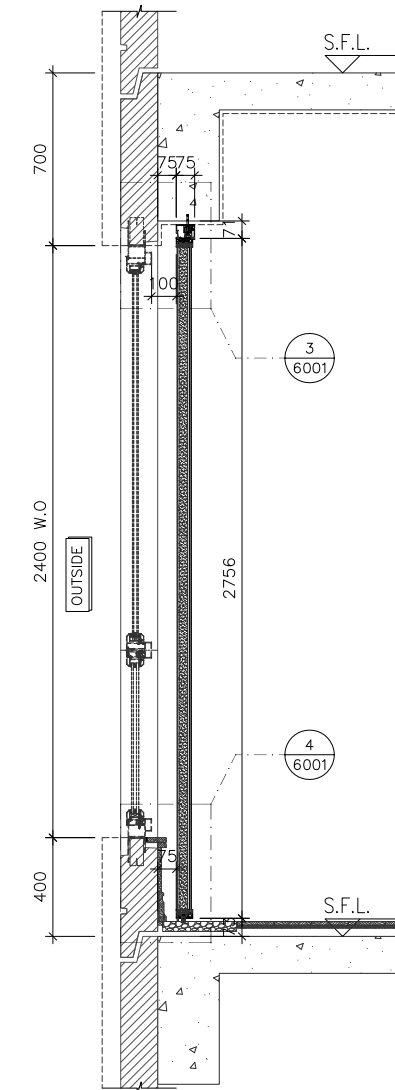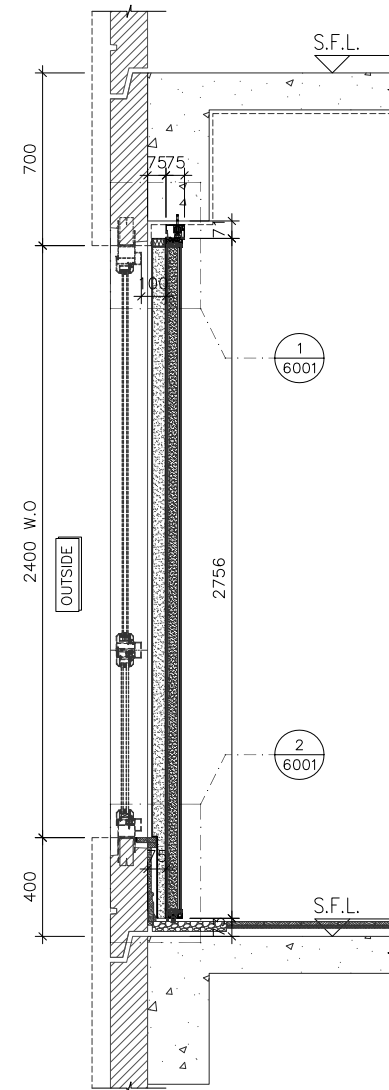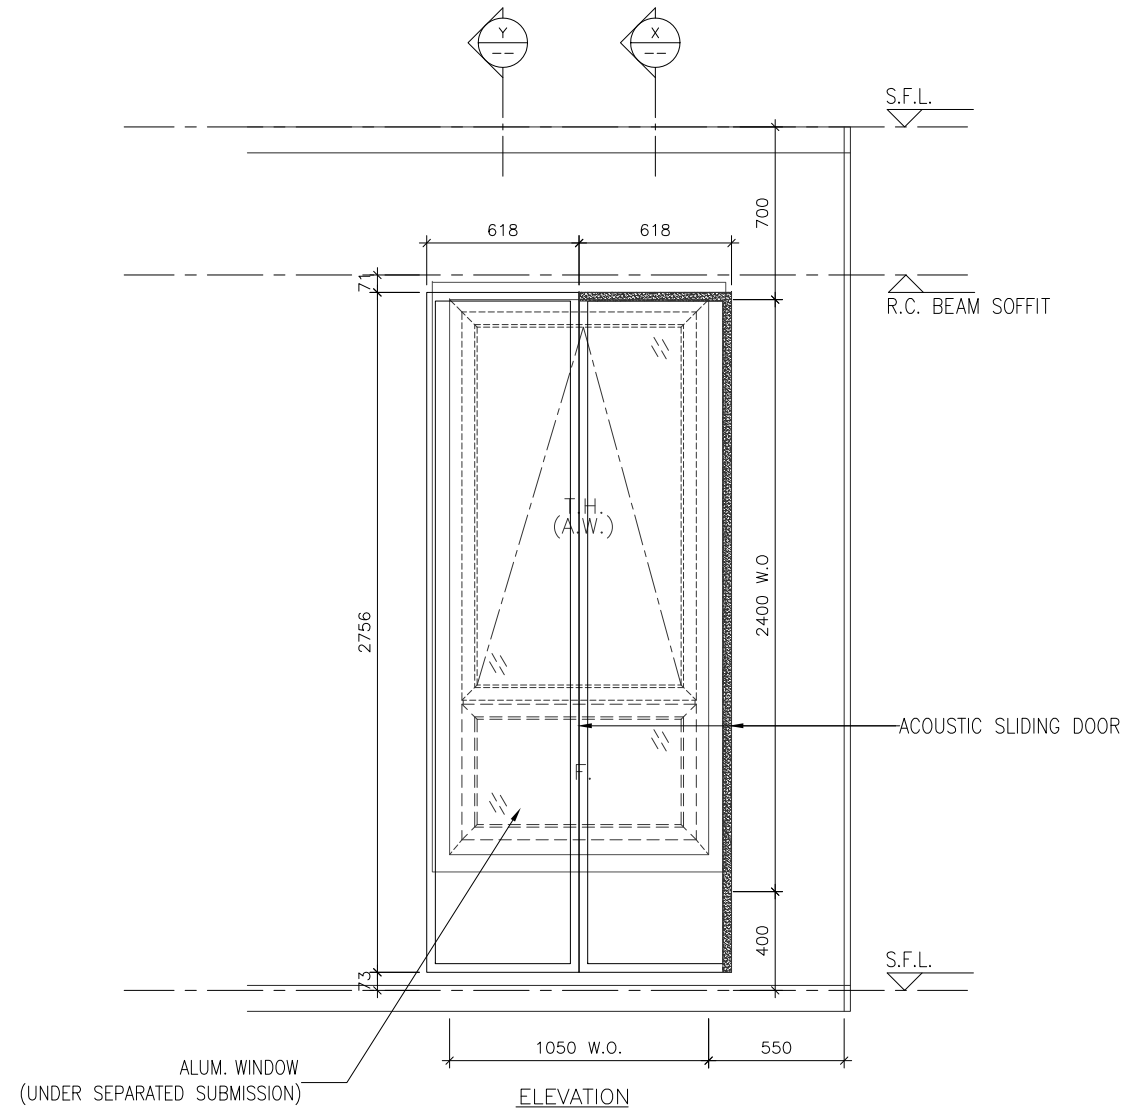

WINDOW MARK	22W13 T1A & 23W13 T1A
LOCATION	22/F & 23/F EN.3 AT TOWER 1 FLAT A
SECTION	-
GLAZING	-
QUANTITY	2
REMARKS	NSR: T1-12/TESTED CASE: W109

B.D. REF :

CLIENT :

ARCHITECT :
AGC DESIGN LTD
101, 102, 103,1000

MAIN CONTRACTOR :
Gammon

STRUCTURAL ENGINEER :
ARUP

FAÇADE CONSULTANT:
MEINHARDT

NOTE :
1. ALL DIMENSIONS ARE IN mm.
2. ALL ELEVATIONS ARE VIEWED FROM OUTSIDE.
3. ALL DIMENSIONS TO BE VERIFIED ON SITE BEFORE FABRICATION.

LEGEND :
X1 -- DETAIL MARK NO.
X001 -- REFER SHEET NO.
1. F.F.L. -- FINISHED FLOOR LEVEL
2. S.F.L. -- STRUCTURAL FLOOR LEVEL
3. (R) -- REVERSED DETAIL


B	13-11-2020	REVISION SUBJECT TO COMMENTS	MN
A	24-08-2020	REVISION SUBJECT TO COMMENTS	MN
NO.	DATE	REVISED	BY

JOB NO. : J-852
PROJECT : PROPOSED RESIDENTIAL DEVELOPMENT AT 139 - 147 ARGYLE STREET, NKIL 6005, 6035 R.P., 6036 R.P., 6037 R.P. & 6038 R.P.
TITLE : PART ELEVATION, PLAN & SECTION FOR ACOUSTIC SLIDING DOOR


DATE : 20-Jul-20 SCALE : 1:30
DRAWN BY : LHR CHECKED BY : DW

美特鋁質有限公司
MIDI ALUMINIUM FABRICATOR LTD.
Units 6-8, Sunray Industrial Centre, 1/F
610 Cha Kwo Ling Road, Kowloon
Tel:23489211-4 Fax:(852)2727666
DWG NO. : J852-SD-ASD-4109A REV. : B


ELEVATION

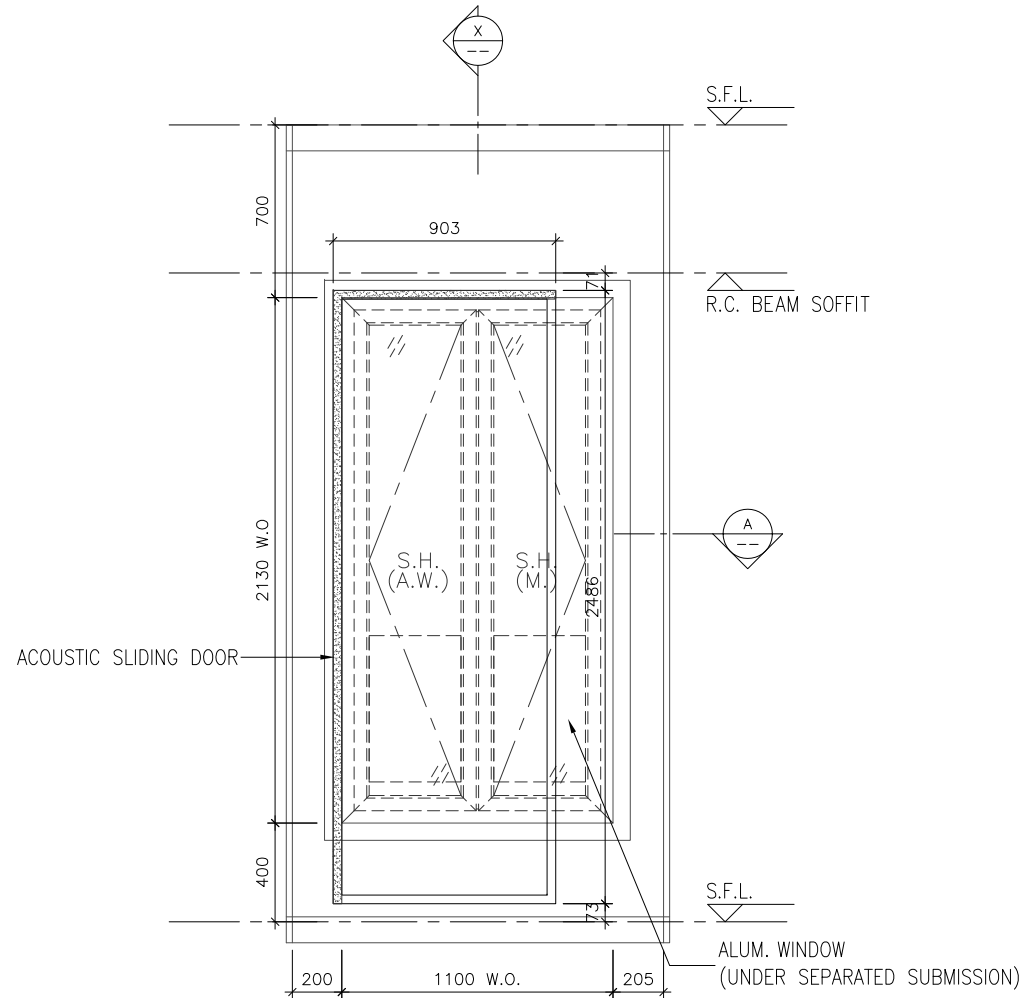


ELEVATION

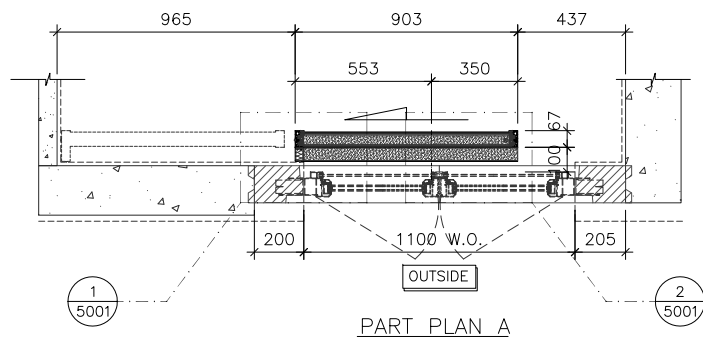

PART PLAN A

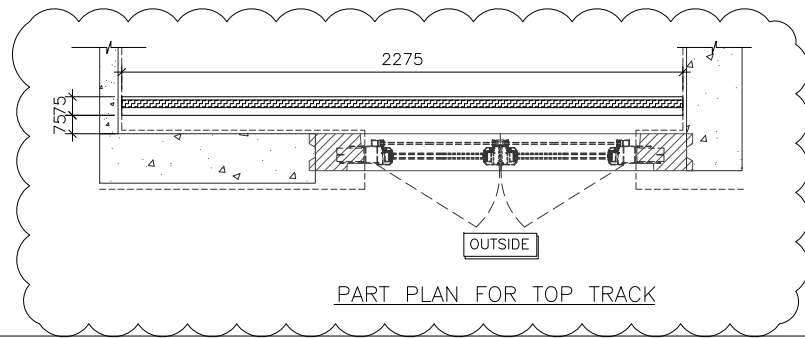

PART PLAN FOR TOP TRACK

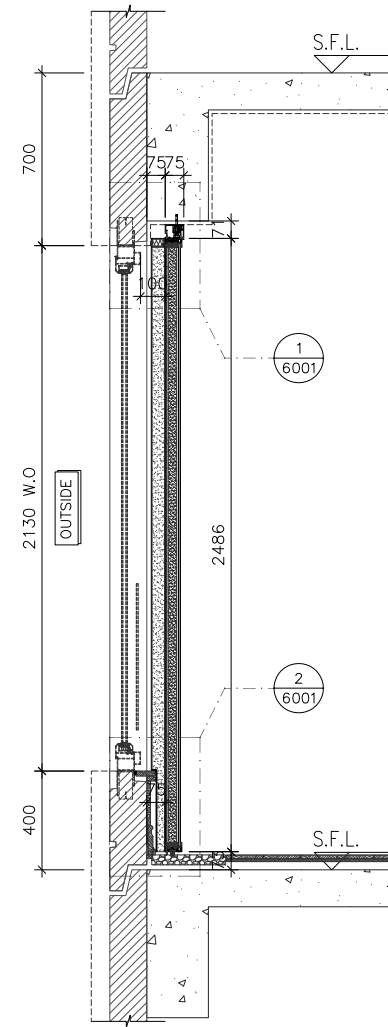

SECTION "X-X"

WINDOW MARK	W5 T2C
LOCATION	2/F-21/F B.R.2 AT TOWER 2 FLAT C
SECTION	-
GLAZING	-
QUANTITY	17
REMARKS	NSR: T2-01/TESTED CASE: W108B

B.D. REF :

CLIENT :

ARCHITECT :
AGC DESIGN LTD
101, 102, 103,1000

MAIN CONTRACTOR :
Gammon

STRUCTURAL ENGINEER :
ARUP

FACADE CONSULTANT:
MEINHARDT

NOTE :
1. ALL DIMENSIONS ARE IN mm.
2. ALL ELEVATIONS ARE VIEWED FROM OUTSIDE.
3. ALL DIMENSIONS TO BE VERIFIED ON SITE BEFORE FABRICATION.

LEGEND :
X1 --- DETAIL MARK NO.
X001 --- REFER SHEET NO.
1. F.F.L. --- FINISHED FLOOR LEVEL
2. S.F.L. --- STRUCTURAL FLOOR LEVEL
3. (R) --- REVERSED DETAIL

B	13-11-2020	REVISION SUBJECT TO COMMENTS	MN
A	24-08-2020	REVISION SUBJECT TO COMMENTS	MN
NO.	DATE	REVISED	BY

JOB NO. : J-852
PROJECT : PROPOSED RESIDENTIAL DEVELOPMENT AT 139 - 147 ARGYLE STREET, NKIL 6005, 6035 R.P., 6036 R.P., 6037 R.P. & 6038 R.P.



TITLE : PART ELEVATION, PLAN & SECTION FOR ACOUSTIC SLIDING DOOR

DATE : 20-Jul-20 SCALE : 1:30
DRAWN BY : LHR CHECKED BY : DW


美特鋁質有限公司
MIDI ALUMINIUM FABRICATOR LTD.
Units 6-8, Sunray Industrial Centre, 1/F
610 Cha Kwo Ling Road, Kowloon
Tel:23489211-4 Fax:(852)27727666

DWG NO. : J852-SD-ASD-4201 REV. : B


ELEVATION

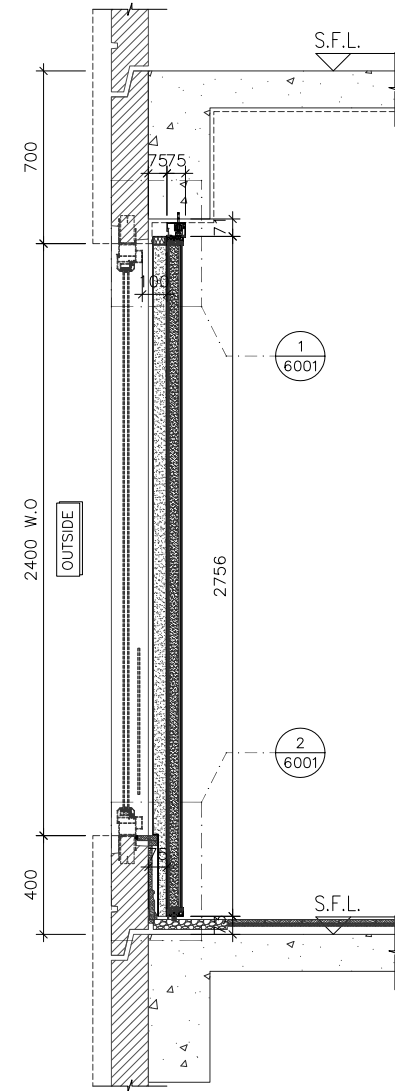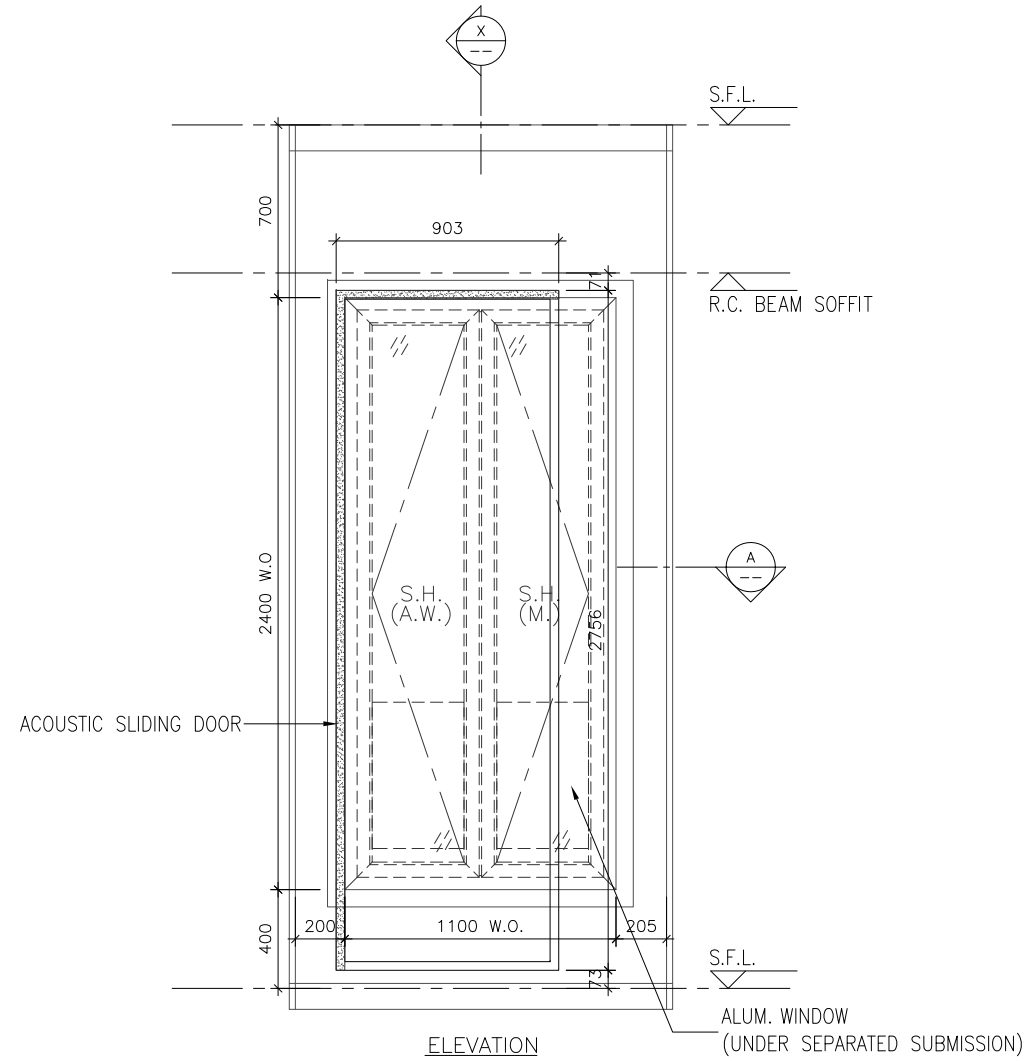

SECTION "X-X"

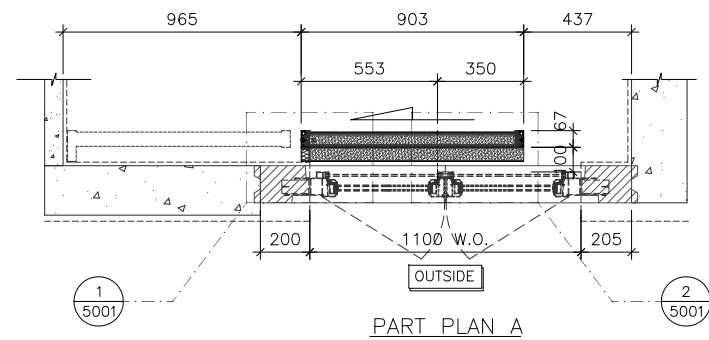

PART PLAN A

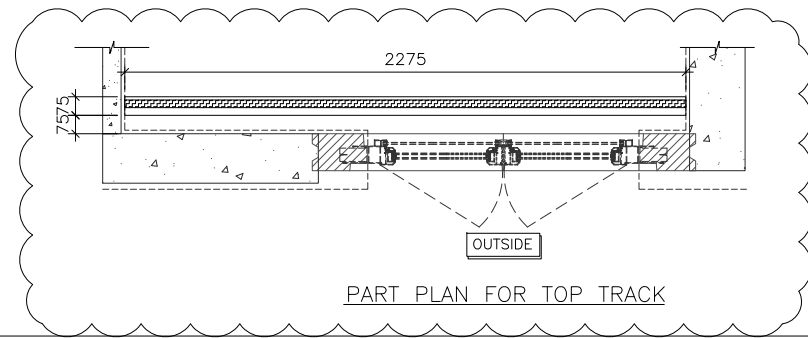

PART PLAN FOR TOP TRACK

WINDOW MARK	22W5 T2C & 23W5 T2C
LOCATION	22/F~23/F B.R.2 AT TOWER 2 FLAT C
SECTION	-
GLAZING	-
QUANTITY	2
REMARKS	NSR: T2-01/TESTED CASE: W108A

B.D. REF :

CLIENT :

ARCHITECT :



MAIN CONTRACTOR :



STRUCTURAL ENGINEER :



FACADE CONSULTANT:



NOTE :

1. ALL DIMENSIONS ARE IN mm.
2. ALL ELEVATIONS ARE VIEWED FROM OUTSIDE.
3. ALL DIMENSIONS TO BE VERIFIED ON SITE BEFORE FABRICATION.

LEGEND :

- x1 --- DETAIL MARK NO.
- x001 --- REFER SHEET NO.

1. F.F.L. --- FINISHED FLOOR LEVEL
2. S.F.L. --- STRUCTURAL FLOOR LEVEL
3. (R) --- REVERSED DETAIL

B	13-11-2020	REVISION SUBJECT TO COMMENTS	MN
A	24-08-2020	REVISION SUBJECT TO COMMENTS	MN
NO.	DATE	REVISED	BY

JOB NO. : J-852

PROJECT :
PROPOSED RESIDENTIAL DEVELOPMENT
AT 139 - 147 ARGYLE STREET,
NKIL 6005, 6035 R.P., 6036 R.P.,
6037 R.P. & 6038 R.P.

TITLE :
PART ELEVATION, PLAN & SECTION
FOR ACOUSTIC SLIDING DOOR



DATE : 20-Jul-20 SCALE : 1:30

DRAWN BY : LHR CHECKED BY : DW



美特鋁質有限公司
MIDI ALUMINIUM FABRICATOR LTD.
Units 6-8, Sunray Industrial Centre, 1/F
610 Cha Kwo Ling Road, Kowloon
Tel:23489211-4 Fax:(852)2727666

DWG NO. : J852-SD-ASD-4201A REV. : B

ELEVATION

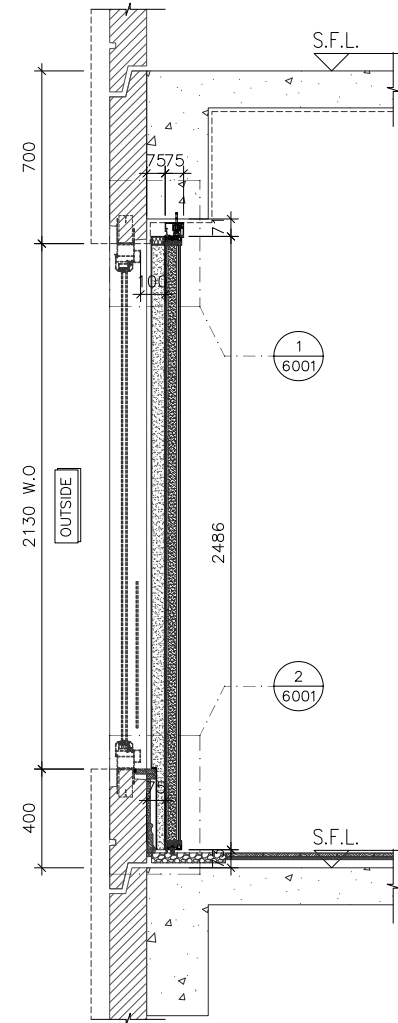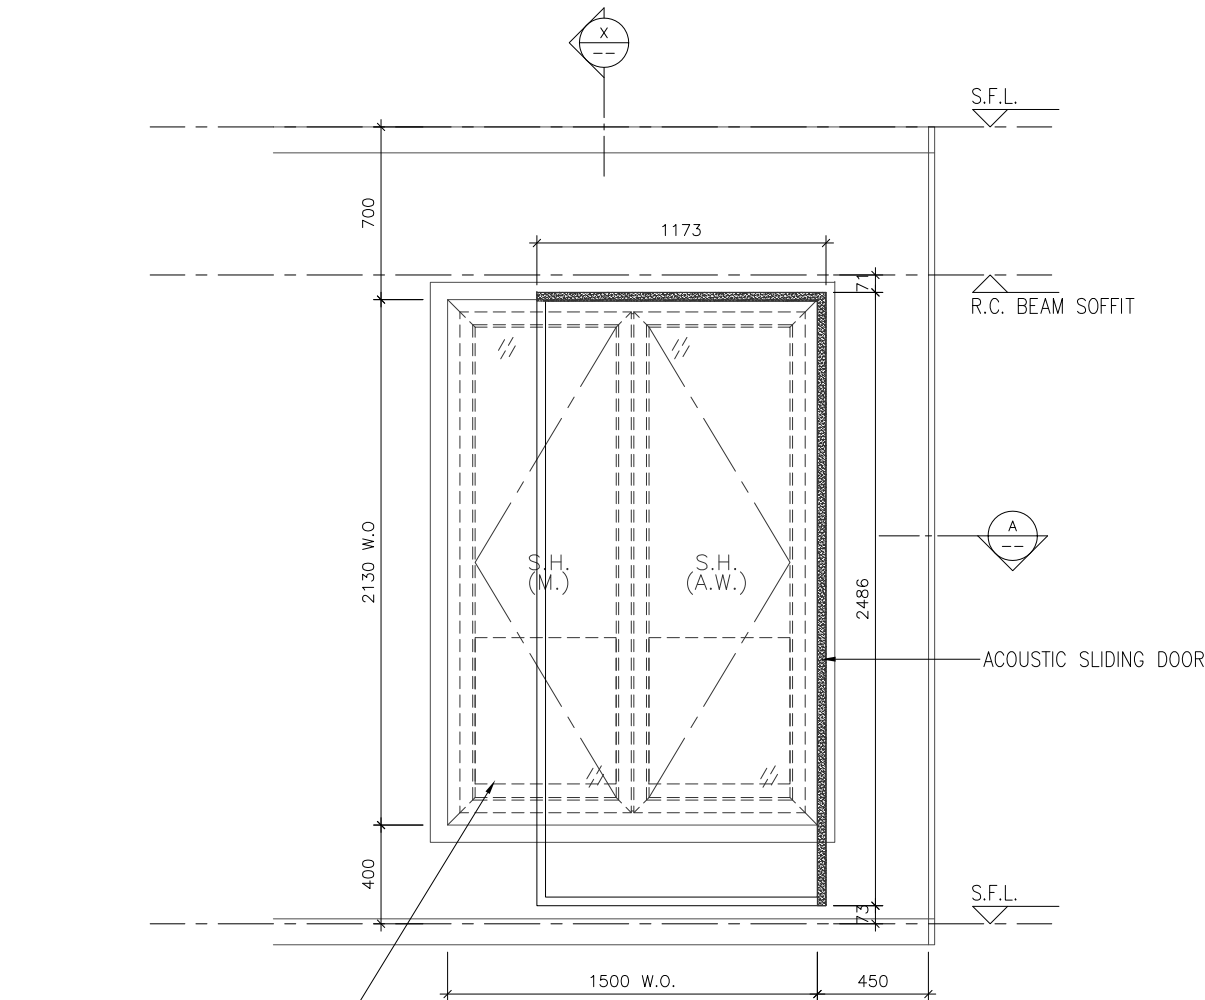

SECTION "X-X"

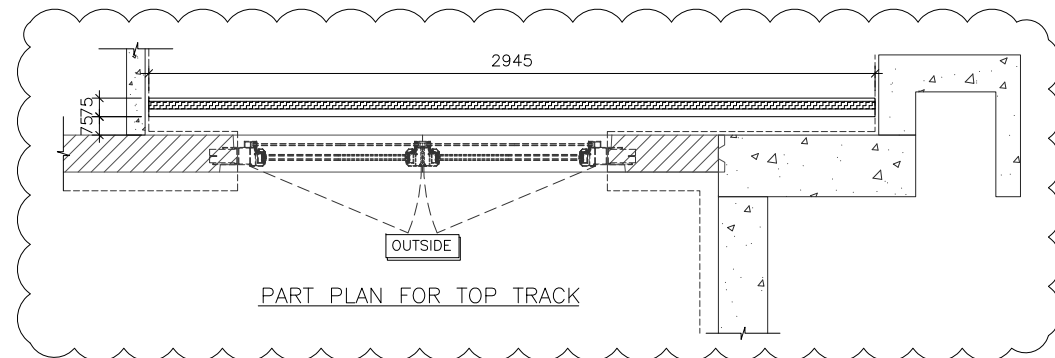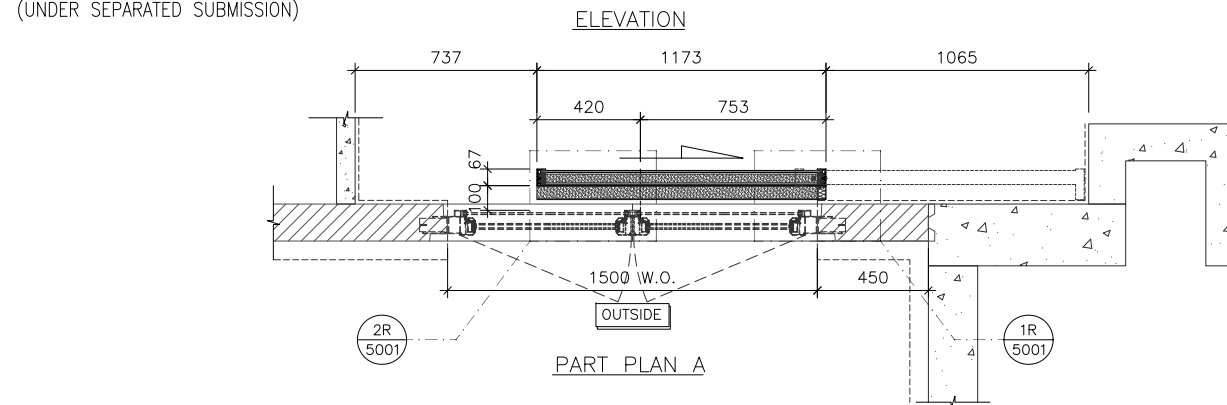

WINDOW MARK	W3 T2C
LOCATION	1/F-21/F M.B.R.1 AT TOWER 2 FLAT C
SECTION	-
GLAZING	-
QUANTITY	18
REMARKS	NSR: T2-02/TESTED CASE: W107D

B.D. REF :

CLIENT :

ARCHITECT :
AGC DESIGN LTD
101, 102, 103,1000

MAIN CONTRACTOR :
Gammon

STRUCTURAL ENGINEER :
ARUP

FACADE CONSULTANT:
MEINHARDT

NOTE :
1. ALL DIMENSIONS ARE IN mm.
2. ALL ELEVATIONS ARE VIEWED FROM OUTSIDE.
3. ALL DIMENSIONS TO BE VERIFIED ON SITE BEFORE FABRICATION.

LEGEND :
X1 - DETAIL MARK NO.
X001 - REFER SHEET NO.
1. F.F.L. -- FINISHED FLOOR LEVEL
2. S.F.L. -- STRUCTURAL FLOOR LEVEL
3. (R) -- REVERSED DETAIL

B	13-11-2020	REVISION SUBJECT TO COMMENTS	MN
A	24-08-2020	REVISION SUBJECT TO COMMENTS	MN
NO.	DATE	REVISED	BY

JOB NO. : J-852
PROJECT : PROPOSED RESIDENTIAL DEVELOPMENT AT 139 - 147 ARGYLE STREET, NKIL 6005, 6035 R.P., 6036 R.P., 6037 R.P. & 6038 R.P.





TITLE : PART ELEVATION, PLAN & SECTION FOR ACOUSTIC SLIDING DOOR

DATE : 20-Jul-20 SCALE : 1:30
DRAWN BY : LHR CHECKED BY : DW

美特鋁質有限公司
MIDI ALUMINIUM FABRICATOR LTD.
Units 6-8, Sunray Industrial Centre, 1/F
610 Cha Kwo Ling Road, Kowloon
Tel:23489211-4 Fax:(852)27727666

DWG NO. : J852-SD-ASD-4202 REV. : B

ELEVATION

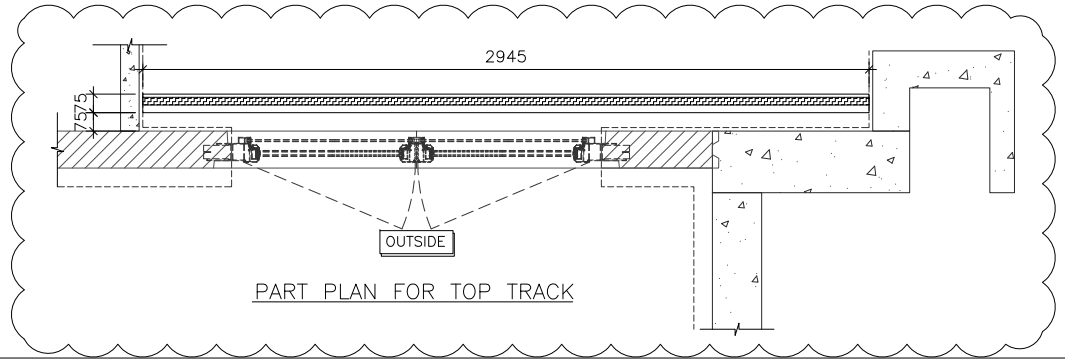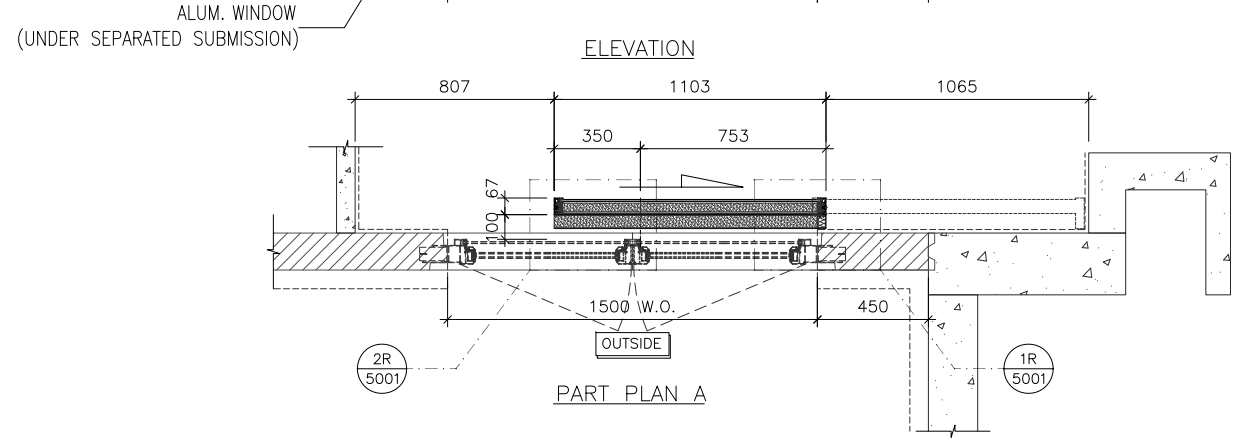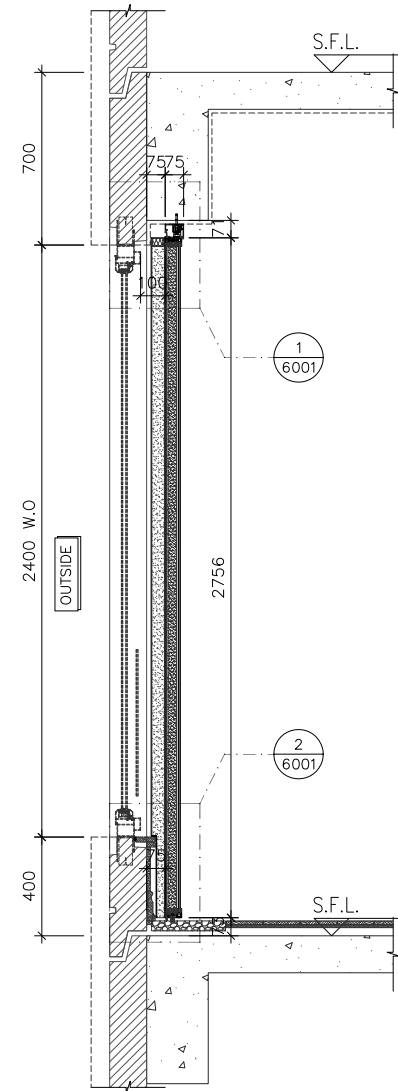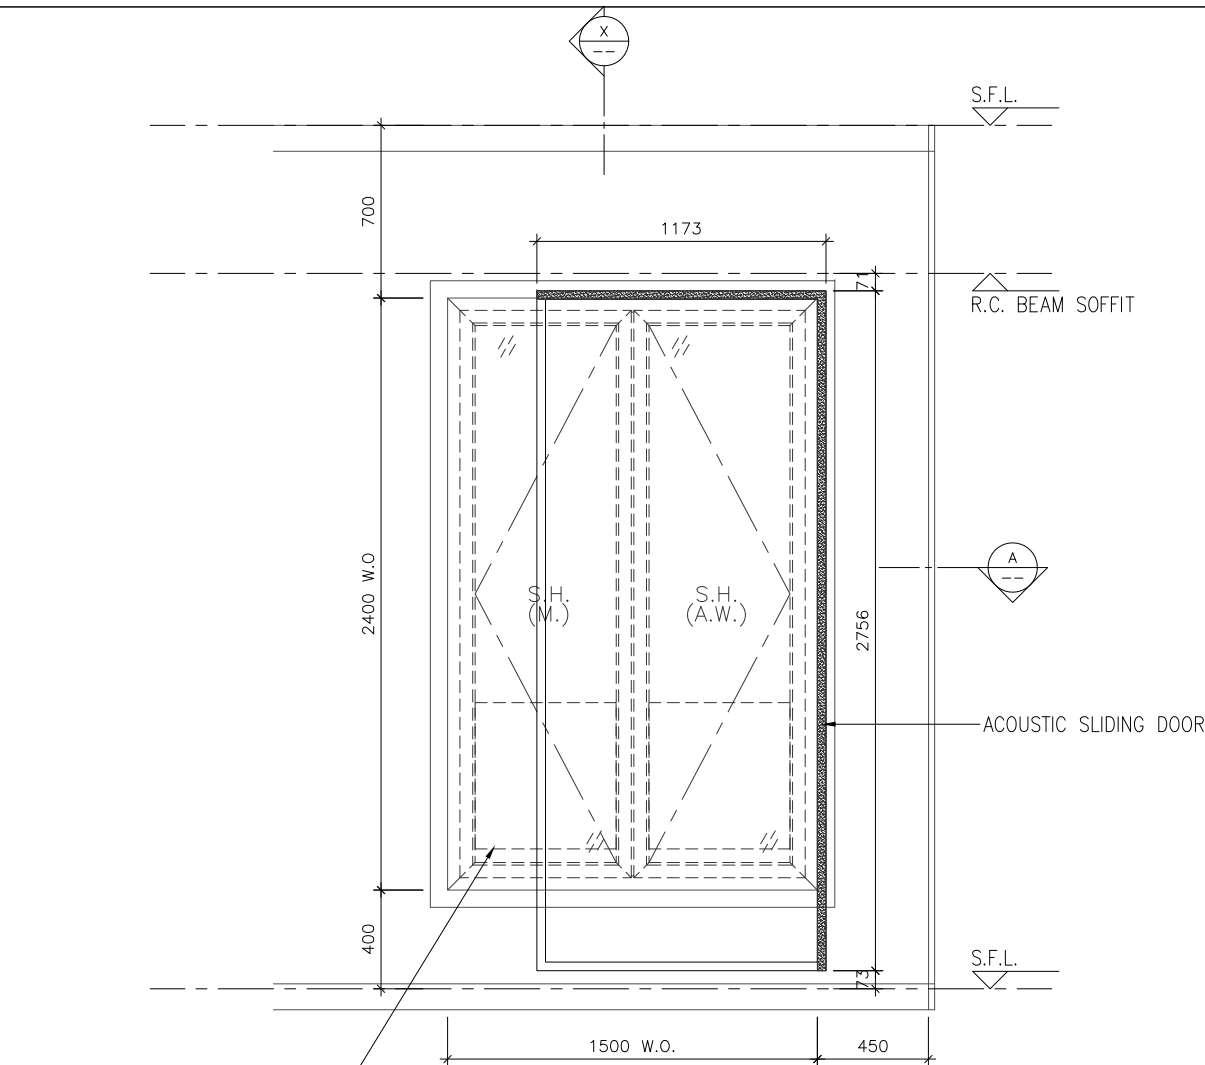

WINDOW MARK	22W3 T2C & 23W3 T2C
LOCATION	22/F~23/F M.B.R.1 AT TOWER 2 FLAT C
SECTION	-
GLAZING	-
QUANTITY	2
REMARKS	NSR: T2-02/TESTED CASE: W107C

B.D. REF :

CLIENT :

ARCHITECT :

AGC DESIGN LTD

MAIN CONTRACTOR :

Gammon

STRUCTURAL ENGINEER :

ARUP

FACADE CONSULTANT:

MEINHARDT

NOTE :

1. ALL DIMENSIONS ARE IN mm.
2. ALL ELEVATIONS ARE VIEWED FROM OUTSIDE.
3. ALL DIMENSIONS TO BE VERIFIED ON SITE BEFORE FABRICATION.

LEGEND :

(X1) — DETAIL MARK NO.
(X001) — REFER SHEET NO.

1. F.F.L. -- FINISHED FLOOR LEVEL
2. S.F.L. -- STRUCTURAL FLOOR LEVEL
3. (R) -- REVERSED DETAIL

B	13-11-2020	REVISION SUBJECT TO COMMENTS	MN
A	24-08-2020	REVISION SUBJECT TO COMMENTS	MN
NO.	DATE	REVISED	BY

JOB NO. : J-852

PROJECT :

PROPOSED RESIDENTIAL DEVELOPMENT
AT 139 - 147 ARGYLE STREET,
NKIL 6005, 6035 R.P., 6036 R.P.,
6037 R.P. & 6038 R.P.

TITLE :




PART ELEVATION, PLAN & SECTION
FOR ACOUSTIC SLIDING DOOR

DATE : 20-Jul-20	SCALE : 1:30
DRAWN BY : LHR	CHECKED BY : DW

美特鋁質有限公司
MIDI ALUMINIUM FABRICATOR LTD.
Units 6-8, Sunray Industrial Centre, 1/F
610 Cha Kwo Ling Road, Kowloon
Tel:23489211-4 Fax:(852)2727666

DWG NO. : J852-SD-ASD-4202A REV. : B

ELEVATION

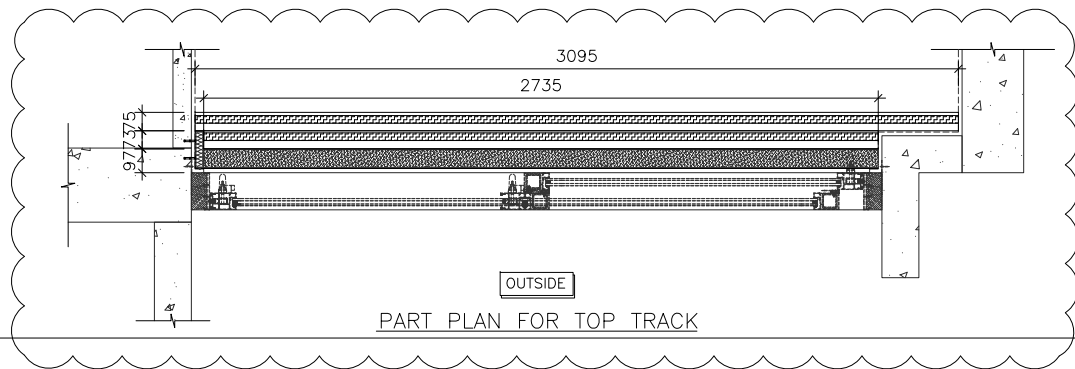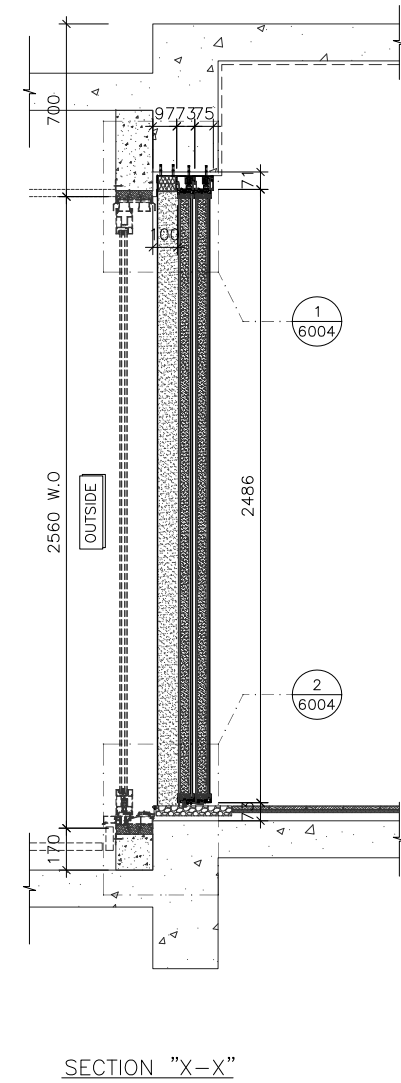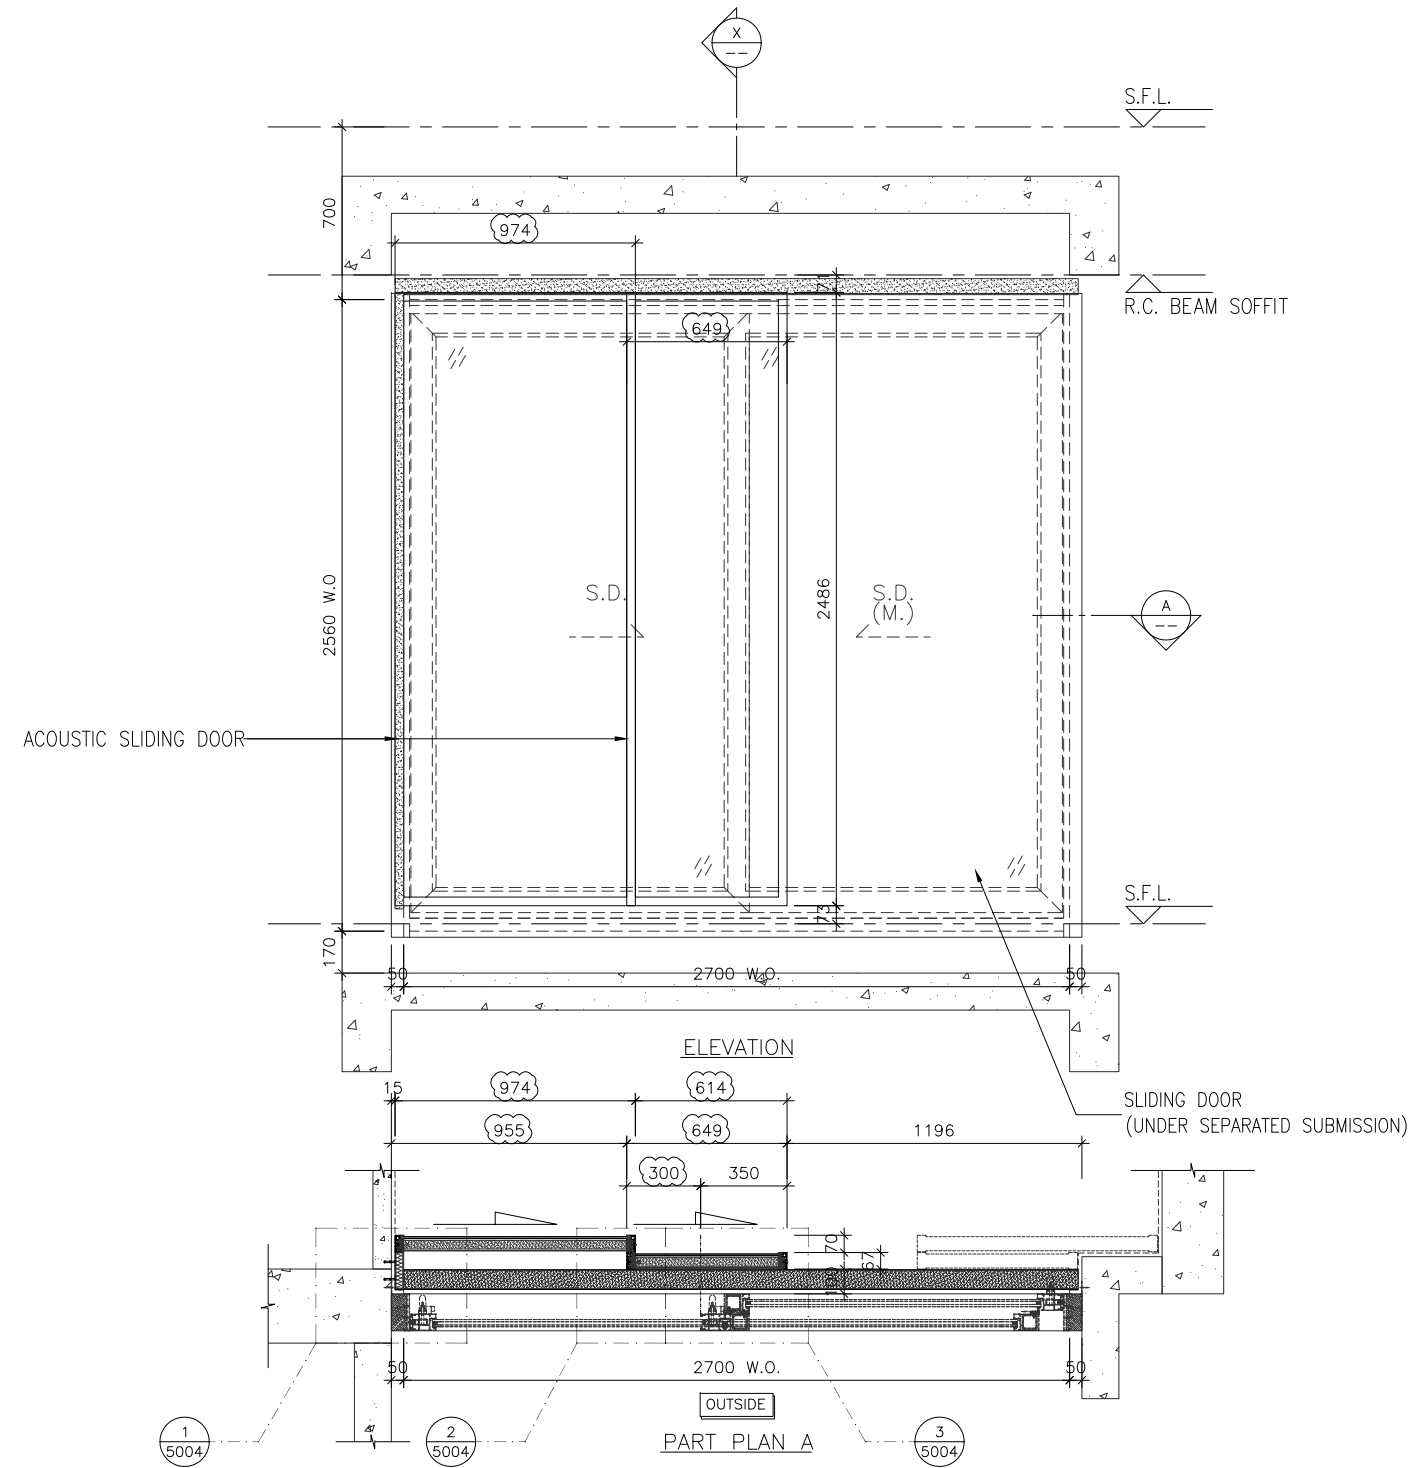

WINDOW MARK	W1 T2C
LOCATION	1/F~21/F LIV./DIN. AT TOWER 2 FLAT C
SECTION	-
GLAZING	-
QUANTITY	18
REMARKS	NSR: T2-03/TESTED CASE: W110B

B.D. REF :

CLIENT :

ARCHITECT :
AGC DESIGN LTD
 101, 102, 103,1000

MAIN CONTRACTOR :
Gammon

STRUCTURAL ENGINEER :
ARUP

FACADE CONSULTANT:
MEINHARDT

NOTE :
 1. ALL DIMENSIONS ARE IN mm.
 2. ALL ELEVATIONS ARE VIEWED FROM OUTSIDE.
 3. ALL DIMENSIONS TO BE VERIFIED ON SITE BEFORE FABRICATION.

LEGEND :
 (X1) --- DETAIL MARK NO.
 (X001) --- REFER SHEET NO.
 1. F.F.L. --- FINISHED FLOOR LEVEL
 2. S.F.L. --- STRUCTURAL FLOOR LEVEL
 3. (R) --- REVERSED DETAIL

B	13-11-2020	REVISION SUBJECT TO COMMENTS	MN
A	24-08-2020	REVISION SUBJECT TO COMMENTS	MN
NO.	DATE	REVISED	BY

JOB NO. : J-852
 PROJECT :
 PROPOSED RESIDENTIAL DEVELOPMENT
 AT 139 - 147 ARGYLE STREET,
 NKIL 6005, 6035 R.P., 6036 R.P.,
 6037 R.P. & 6038 R.P.





TITLE :
 PART ELEVATION, PLAN & SECTION
 FOR ACOUSTIC SLIDING DOOR

DATE : 20-Jul-20 SCALE : 1:30
 DRAWN BY : LHR CHECKED BY : DW

美特鋁質有限公司
MIDI ALUMINIUM FABRICATOR LTD.
 Units 6-8, Sunray Industrial Centre, 1/F
 610 Cha Kwo Ling Road, Kowloon
 Tel:23489211-4 Fax:(852)27727666

DWG NO. : J852-SD-ASD-4203 REV. : B

ELEVATION

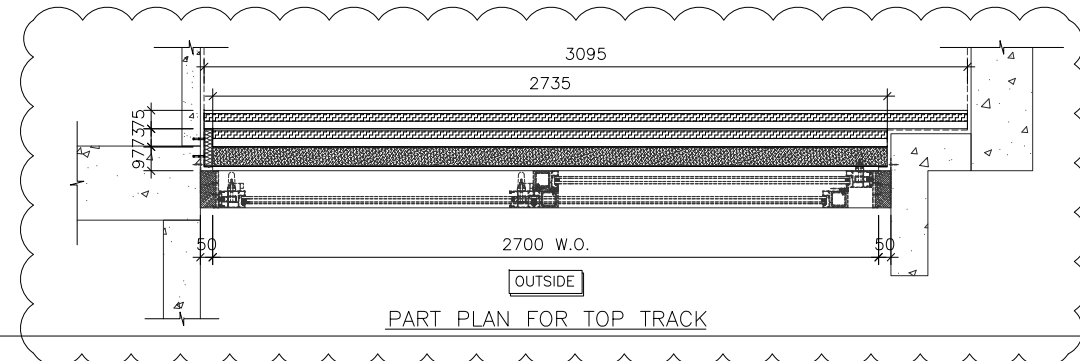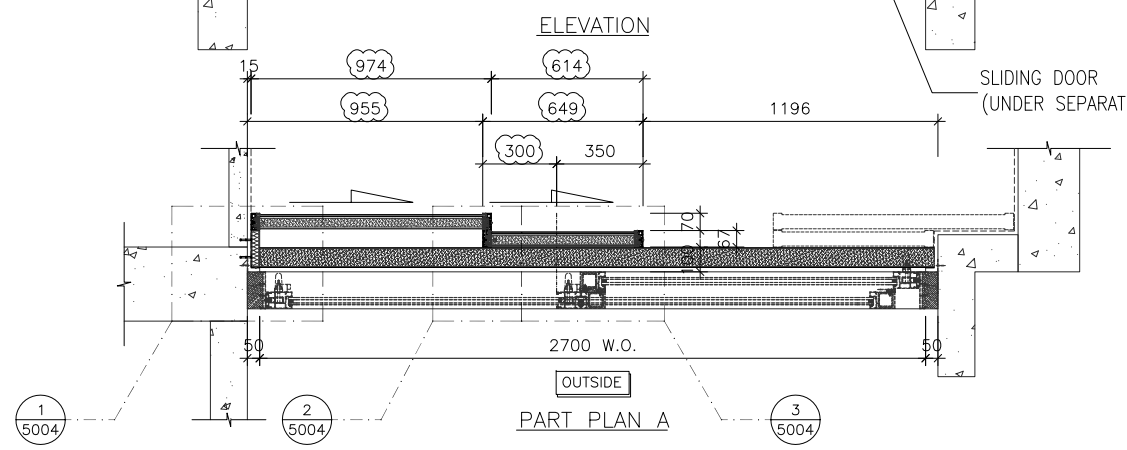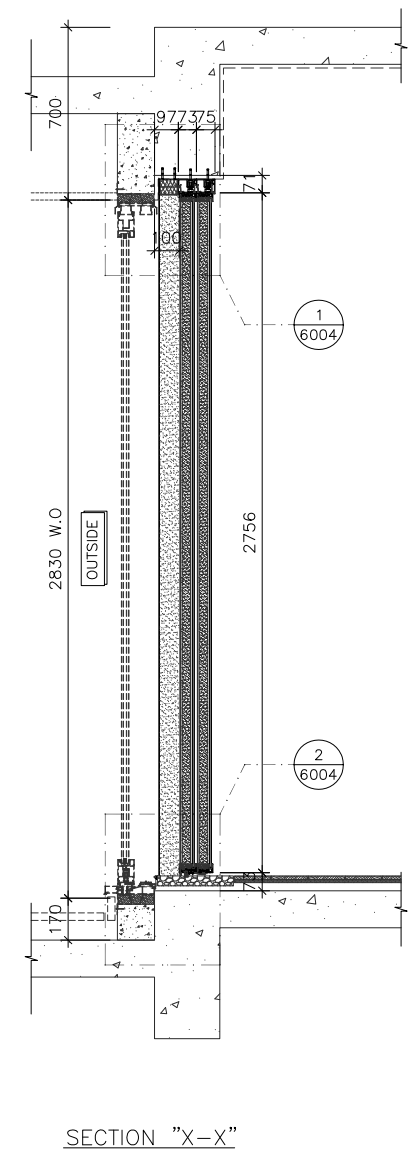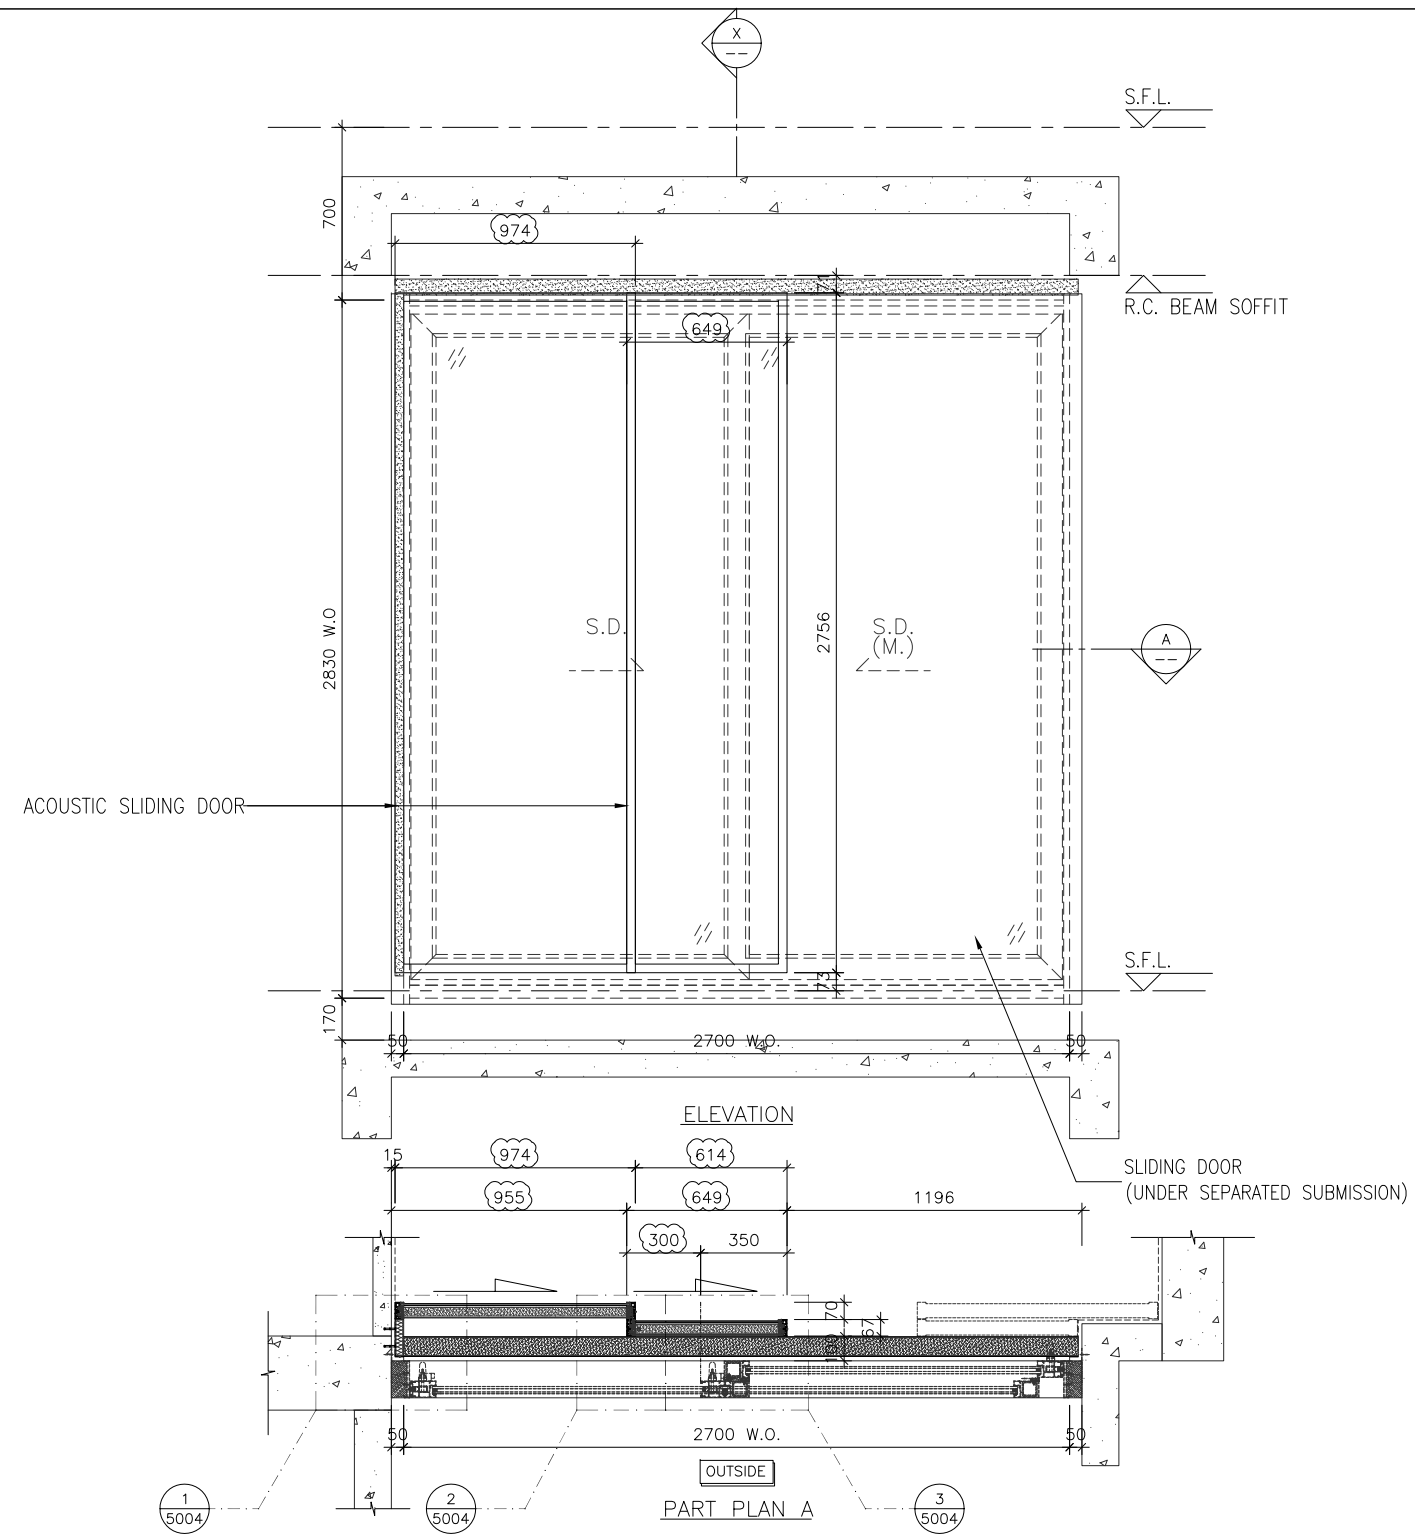

WINDOW MARK	22W1 T2C & 23W1 T2C
LOCATION	22/F~23/F LIV./DIN. AT TOWER 2 FLAT C
SECTION	-
GLAZING	-
QUANTITY	2
REMARKS	NSR: T2-03/TESTED CASE: W110A

B.D. REF :

CLIENT :

ARCHITECT :
AGC DESIGN LTD
 101, 102, 103,1000

NOTE :

1. ALL DIMENSIONS ARE IN mm.
2. ALL ELEVATIONS ARE VIEWED FROM OUTSIDE.
3. ALL DIMENSIONS TO BE VERIFIED ON SITE BEFORE FABRICATION.

LEGEND :

(X1) --- DETAIL MARK NO.
 (X001) --- REFER SHEET NO.

1. F.F.L. --- FINISHED FLOOR LEVEL
2. S.F.L. --- STRUCTURAL FLOOR LEVEL
3. (R) --- REVERSED DETAIL

B	13-11-2020	REVISION SUBJECT TO COMMENTS	MN
A	24-08-2020	REVISION SUBJECT TO COMMENTS	MN
NO.	DATE	REVISED	BY

JOB NO. : J-852

PROJECT :
 PROPOSED RESIDENTIAL DEVELOPMENT
 AT 139 - 147 ARGYLE STREET,
 NKIL 6005, 6035 R.P., 6036 R.P.,
 6037 R.P. & 6038 R.P.

TITLE :
 PART ELEVATION, PLAN & SECTION
 FOR ACOUSTIC SLIDING DOOR


DATE : 20-Jul-20 SCALE : 1:30

DRAWN BY : LHR CHECKED BY : DW


美特鋁質有限公司
MIDI ALUMINIUM FABRICATOR LTD.
 Units 6-8, Sunray Industrial Centre, 1/F
 610 Cha Kwo Ling Road, Kowloon
 Tel:23489211-4 Fax:(852)2727666

DWG NO. : J852-SD-ASD-4203A REV. : B


ELEVATION

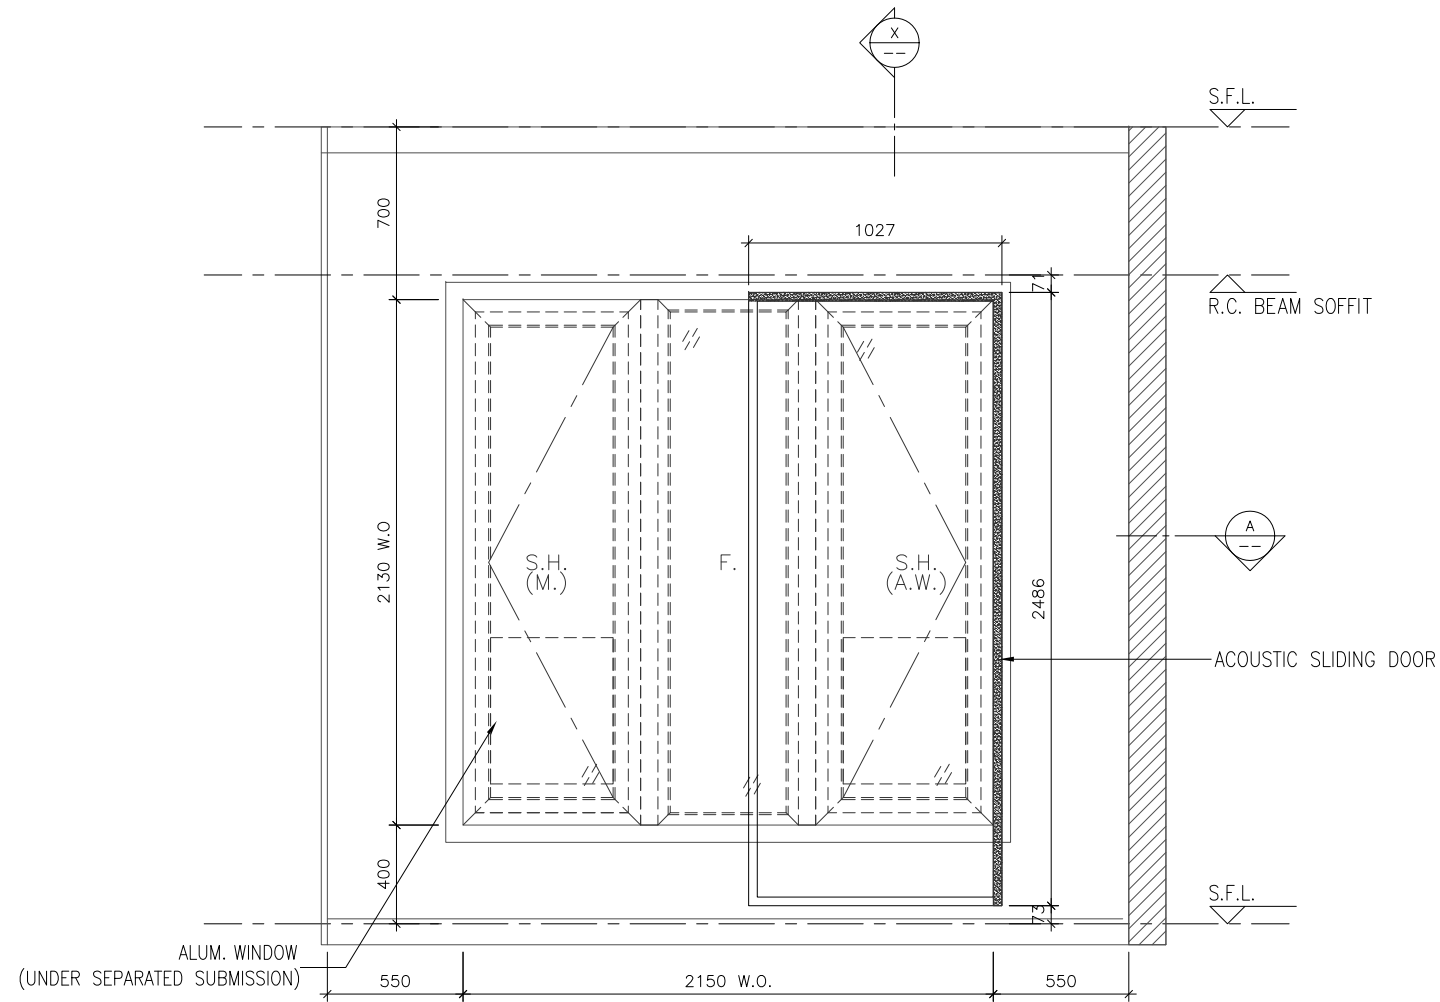


ELEVATION

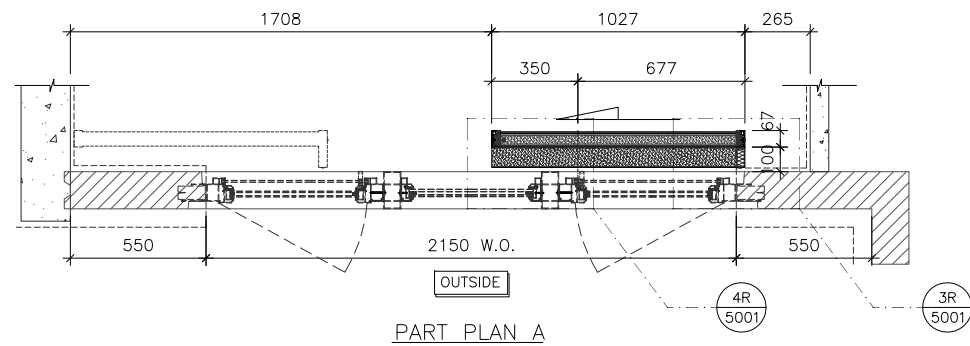

PART PLAN A

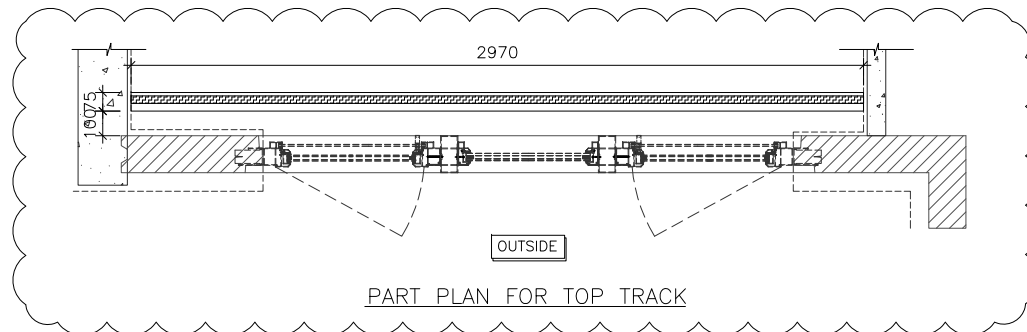

PART PLAN FOR TOP TRACK

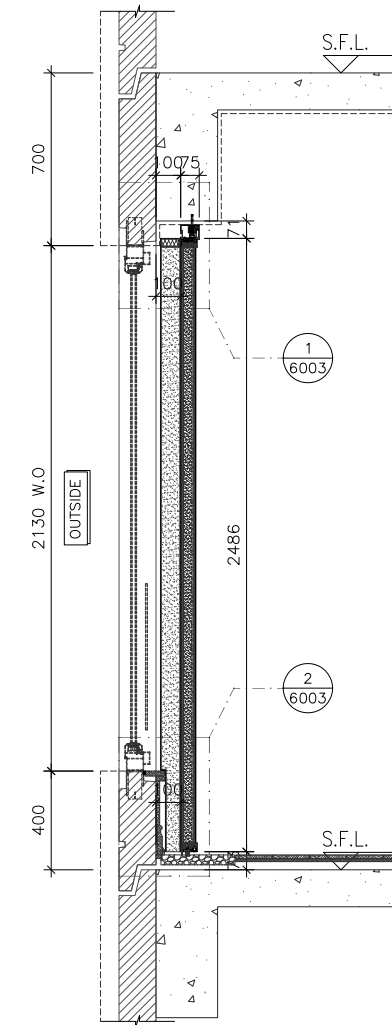

SECTION "X-X"

B.D. REF :

CLIENT :

ARCHITECT :
AGC DESIGN LTD
 101, 102, 103,1000

MAIN CONTRACTOR :
Gammon

STRUCTURAL ENGINEER :
ARUP

FAÇADE CONSULTANT:
MEINHARDT

NOTE :
 1. ALL DIMENSIONS ARE IN mm.
 2. ALL ELEVATIONS ARE VIEWED FROM OUTSIDE.
 3. ALL DIMENSIONS TO BE VERIFIED ON SITE BEFORE FABRICATION.

LEGEND :
 X1 --- DETAIL MARK NO.
 X001 --- REFER SHEET NO.

1. F.F.L. -- FINISHED FLOOR LEVEL
 2. S.F.L. -- STRUCTURAL FLOOR LEVEL
 3. (R) -- REVERSED DETAIL

NO.	DATE	REVISION	BY
B	13-11-2020	REVISION SUBJECT TO COMMENTS	MN
A	24-08-2020	REVISION SUBJECT TO COMMENTS	MN

JOB NO. : J-852
 PROJECT :
 PROPOSED RESIDENTIAL DEVELOPMENT
 AT 139 - 147 ARGYLE STREET,
 NKIL 6005, 6035 R.P., 6036 R.P.,
 6037 R.P. & 6038 R.P.

TITLE :
 PART ELEVATION, PLAN & SECTION
 FOR ACOUSTIC SLIDING DOOR

DATE : 20-Jul-20 SCALE : 1:30

DRAWN BY : LHR CHECKED BY : DW

美特鋁質有限公司
MIDI ALUMINIUM FABRICATOR LTD.
 Units 6-8, Sunray Industrial Centre, 1/F
 610 Cha Kwo Ling Road, Kowloon
 Tel:23489211-4 Fax:(852)2727666

DWG NO. : J852-SD-ASD-4204 REV. : B

WINDOW MARK
 W7
 T2B

LOCATION 3/F-21/F B.R.1. AT TOWER 2 FLAT B



SECTION -

GLAZING -


QUANTITY 16

REMARKS NSR: T2-04/TESTED CASE: W107A


ELEVATION

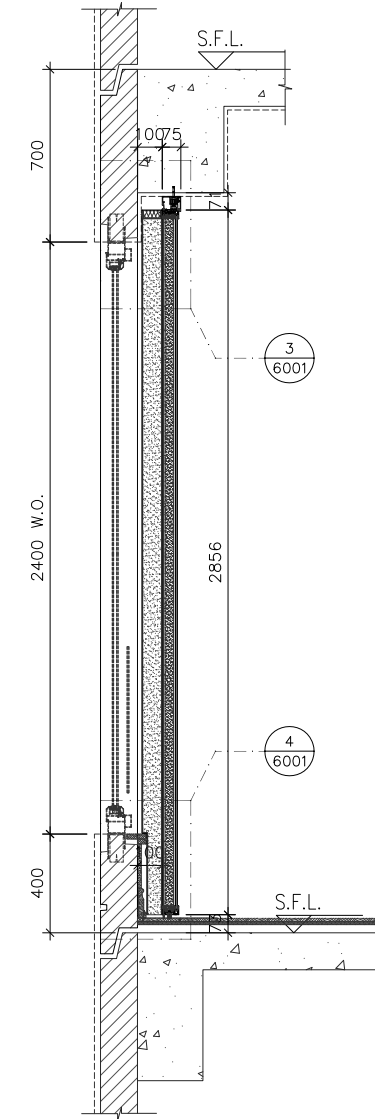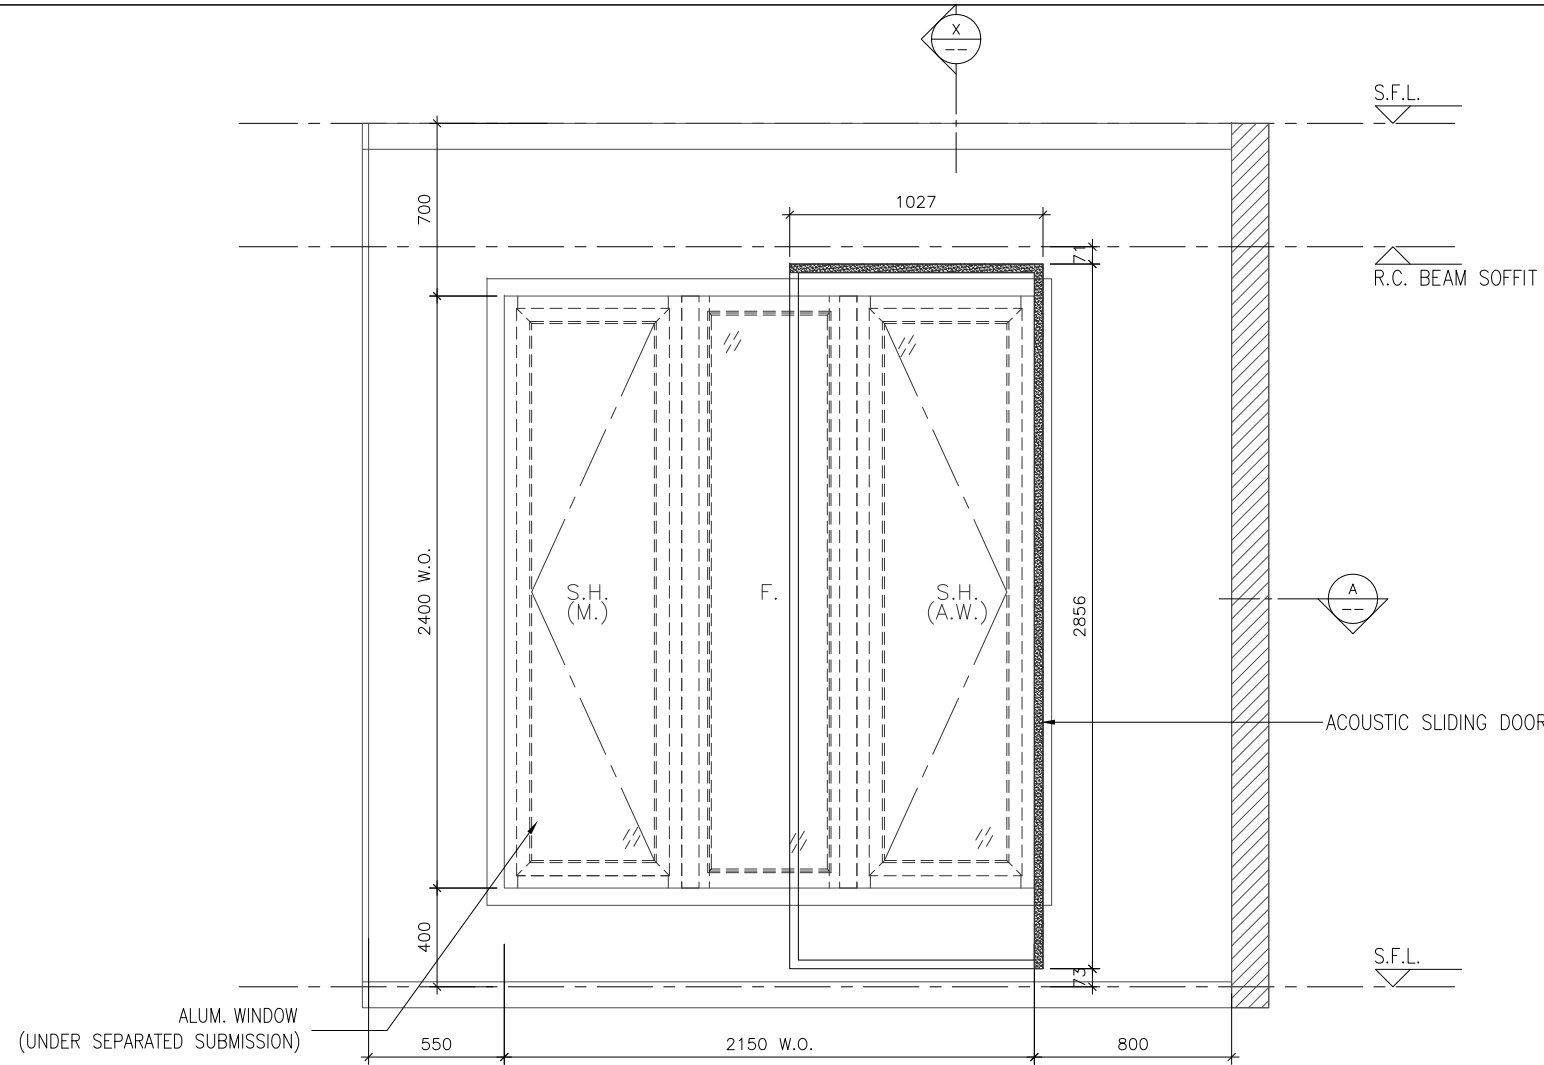

SECTION "X-X"

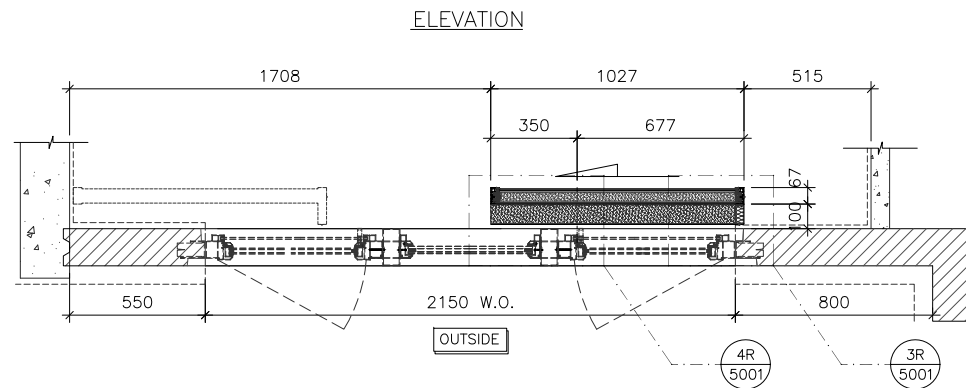

PART PLAN A

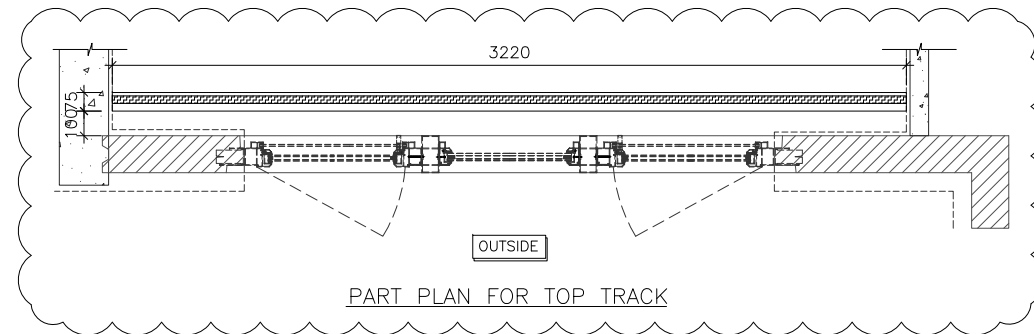

PART PLAN FOR TOP TRACK

WINDOW MARK	
LOCATION	22/F B.R.1. AT TOWER 2 FLAT B
SECTION	-
GLAZING	-
QUANTITY	1
REMARKS	NSR: T2-04/TESTED CASE: W107A

B.D. REF :

CLIENT :

ARCHITECT :
AGC DESIGN LTD
 180, 181, 182,1000

MAIN CONTRACTOR :
Gammon

STRUCTURAL ENGINEER :
ARUP

FACADE CONSULTANT:
MEINHARDT

NOTE :
 1. ALL DIMENSIONS ARE IN mm.
 2. ALL ELEVATIONS ARE VIEWED FROM OUTSIDE.
 3. ALL DIMENSIONS TO BE VERIFIED ON SITE BEFORE FABRICATION.

LEGEND :
 (X1) --- DETAIL MARK NO.
 (X001) --- REFER SHEET NO.

1. F.F.L. -- FINISHED FLOOR LEVEL
 2. S.F.L. -- STRUCTURAL FLOOR LEVEL
 3. (R) -- REVERSED DETAIL

B	13-11-2020	REVISION SUBJECT TO COMMENTS	MN
A	24-08-2020	REVISION SUBJECT TO COMMENTS	MN
NO.	DATE	REVISED	BY





JOB NO. : J-852
 PROJECT : PROPOSED RESIDENTIAL DEVELOPMENT AT 139 - 147 ARGYLE STREET, NKIL 6005, 6035 R.P., 6036 R.P., 6037 R.P. & 6038 R.P.

TITLE : PART ELEVATION, PLAN & SECTION FOR ACOUSTIC SLIDING DOOR

DATE : 20-Jul-20 SCALE : 1:30
 DRAWN BY : LHR CHECKED BY : DW

美特鋁質有限公司
MIDI ALUMINIUM FABRICATOR LTD.
 Units 6-8, Sunray Industrial Centre, 1/F
 610 Cha Kwo Ling Road, Kowloon
 Tel:23489211-4 Fax:(852)2727666
 DWG NO. : J852-SD-ASD-4204A REV. : B

ELEVATION

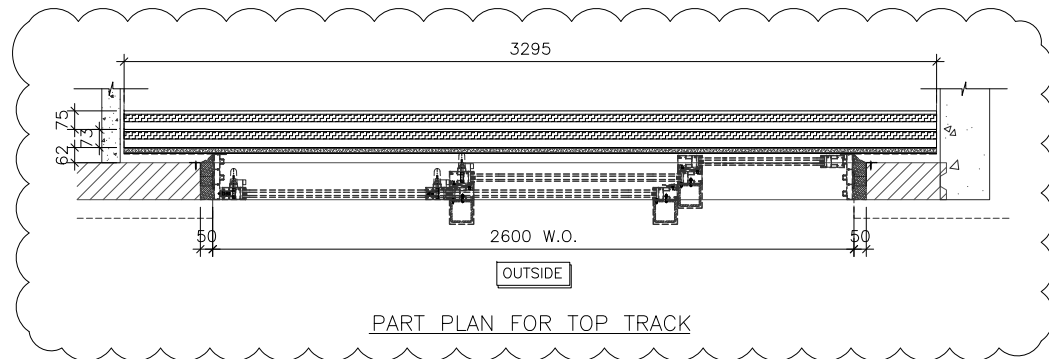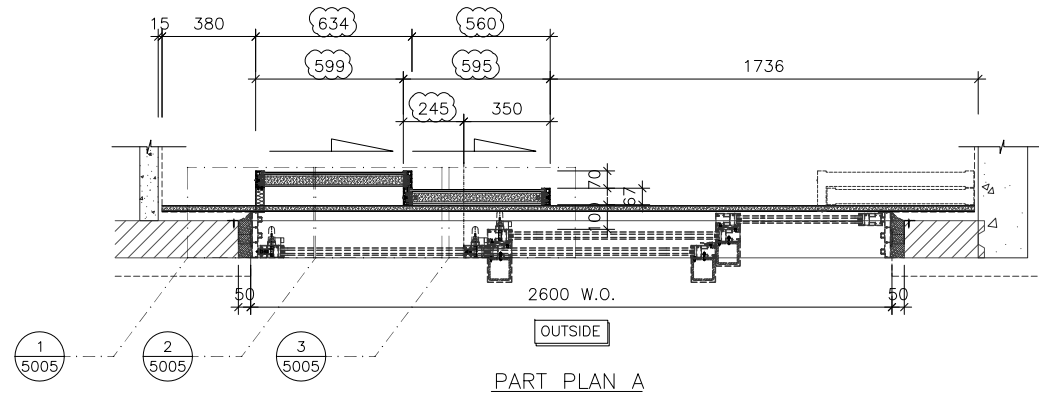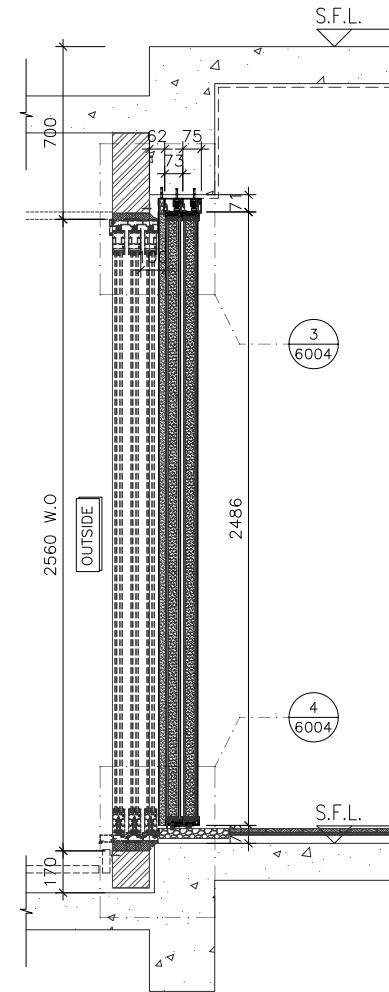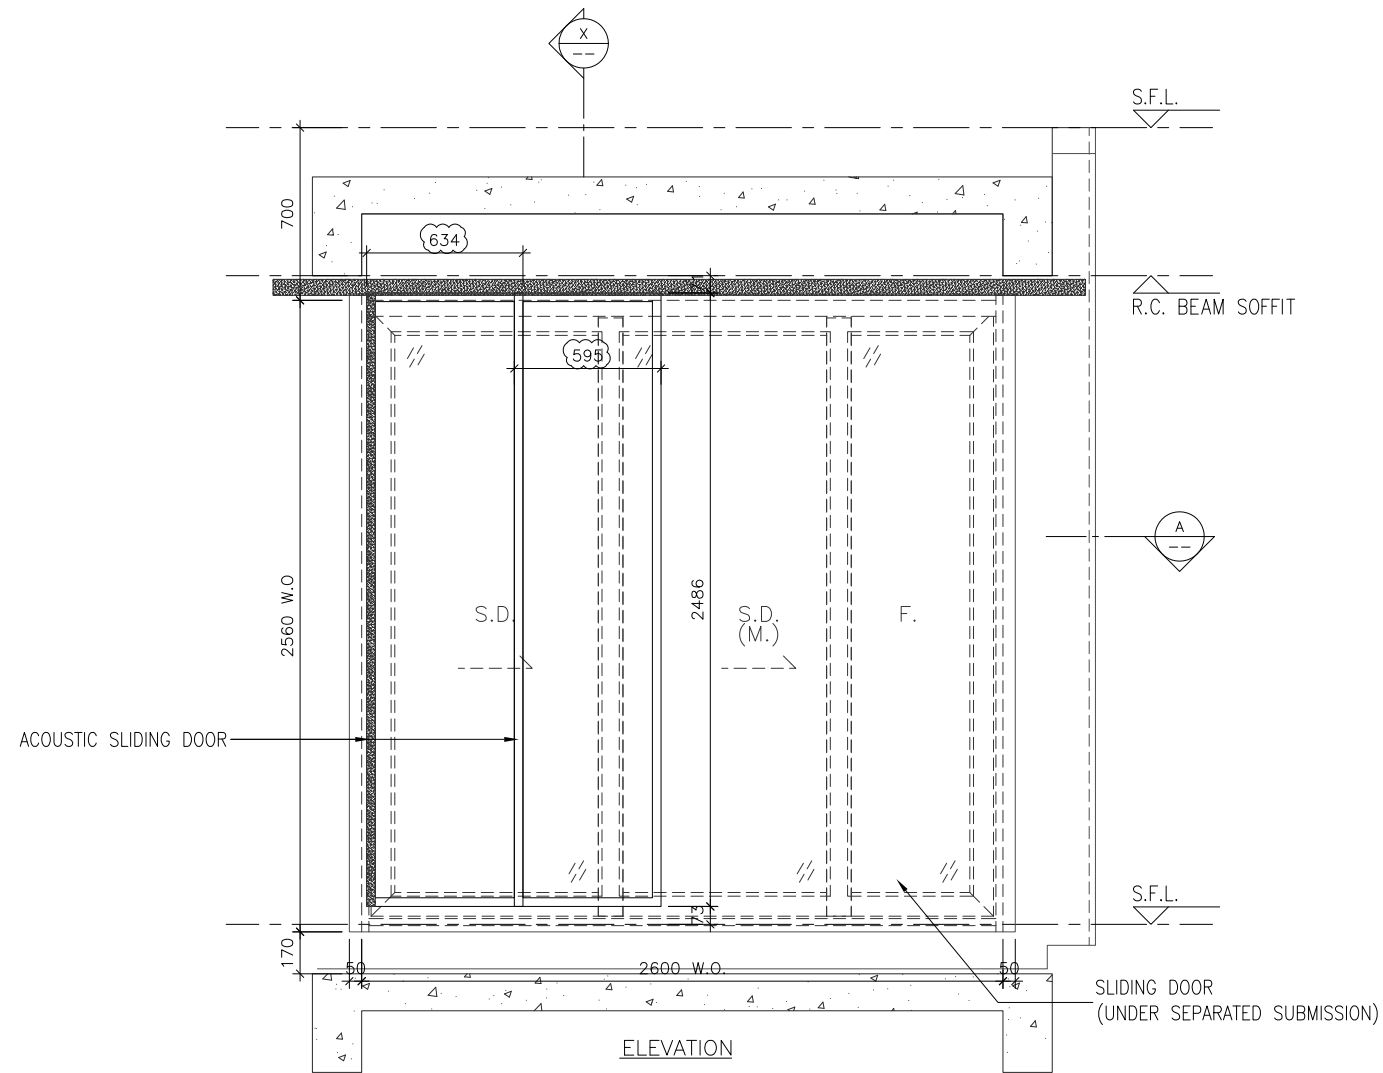

WINDOW MARK	W6 T2B
LOCATION	2/F~21/F ENSUITE AT TOWER 2 FLAT B
SECTION	-
GLAZING	-
QUANTITY	17
REMARKS	NSR: T2-05/TESTED CASE: W103A

B.D. REF :

CLIENT :

ARCHITECT :
AGC DESIGN LTD

MAIN CONTRACTOR :
Gammon

STRUCTURAL ENGINEER :
ARUP

FACADE CONSULTANT:
MEINHARDT

NOTE :
1. ALL DIMENSIONS ARE IN mm.
2. ALL ELEVATIONS ARE VIEWED FROM OUTSIDE.
3. ALL DIMENSIONS TO BE VERIFIED ON SITE BEFORE FABRICATION.

LEGEND :
 (X1) --- DETAIL MARK NO.
 (X001) --- REFER SHEET NO.
 1. F.F.L. --- FINISHED FLOOR LEVEL
 2. S.F.L. --- STRUCTURAL FLOOR LEVEL
 3. (R) --- REVERSED DETAIL

B	13-11-2020	REVISION SUBJECT TO COMMENTS	MN
A	24-08-2020	REVISION SUBJECT TO COMMENTS	MN
NO.	DATE	REVISED	BY





JOB NO. : J-852
 PROJECT :
 PROPOSED RESIDENTIAL DEVELOPMENT
 AT 139 - 147 ARGYLE STREET,
 NKIL 6005, 6035 R.P., 6036 R.P.,
 6037 R.P. & 6038 R.P.

TITLE :
 PART ELEVATION, PLAN & SECTION
 FOR ACOUSTIC SLIDING DOOR

DATE : 20-Jul-20 SCALE : 1:30
 DRAWN BY : LHR CHECKED BY : DW

美特鋁質有限公司
MIDI ALUMINIUM FABRICATOR LTD.
 Units 6-8, Sunray Industrial Centre, 1/F
 610 Cha Kwo Ling Road, Kowloon
 Tel:23489211-4 Fax:(852)27727666
 DWG NO. : J852-SD-ASD-4205 REV. : B

ELEVATION

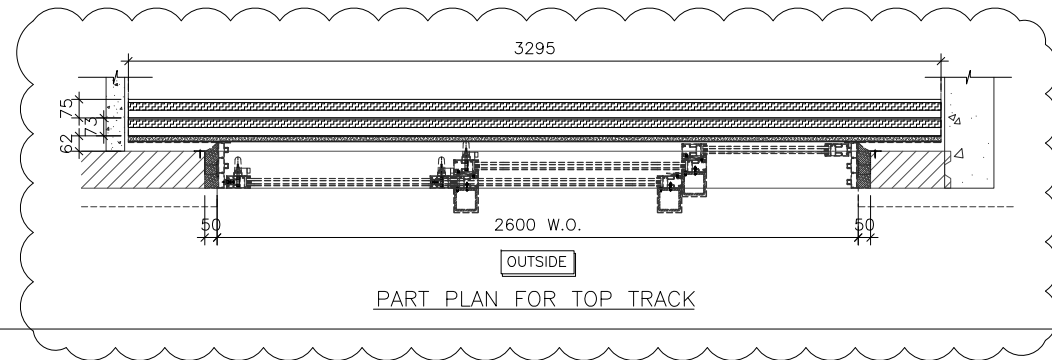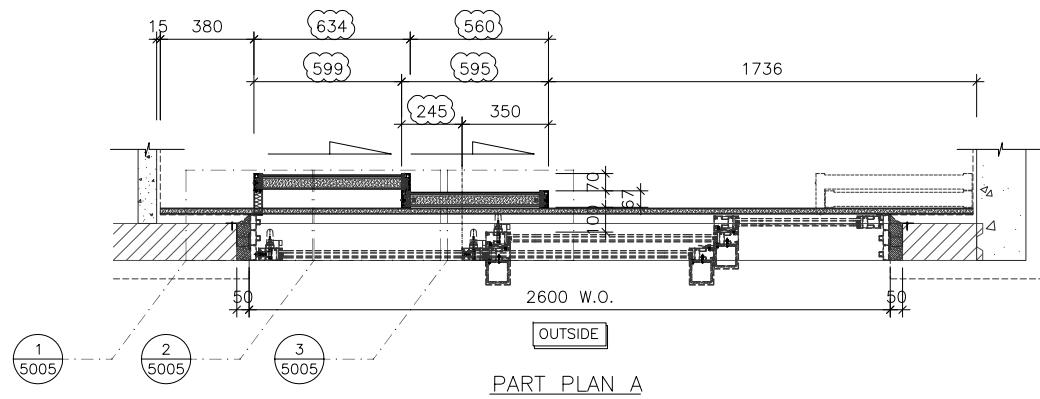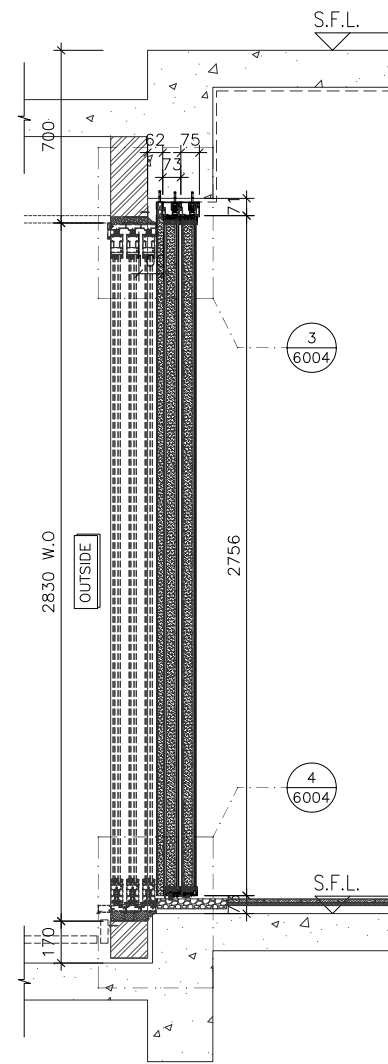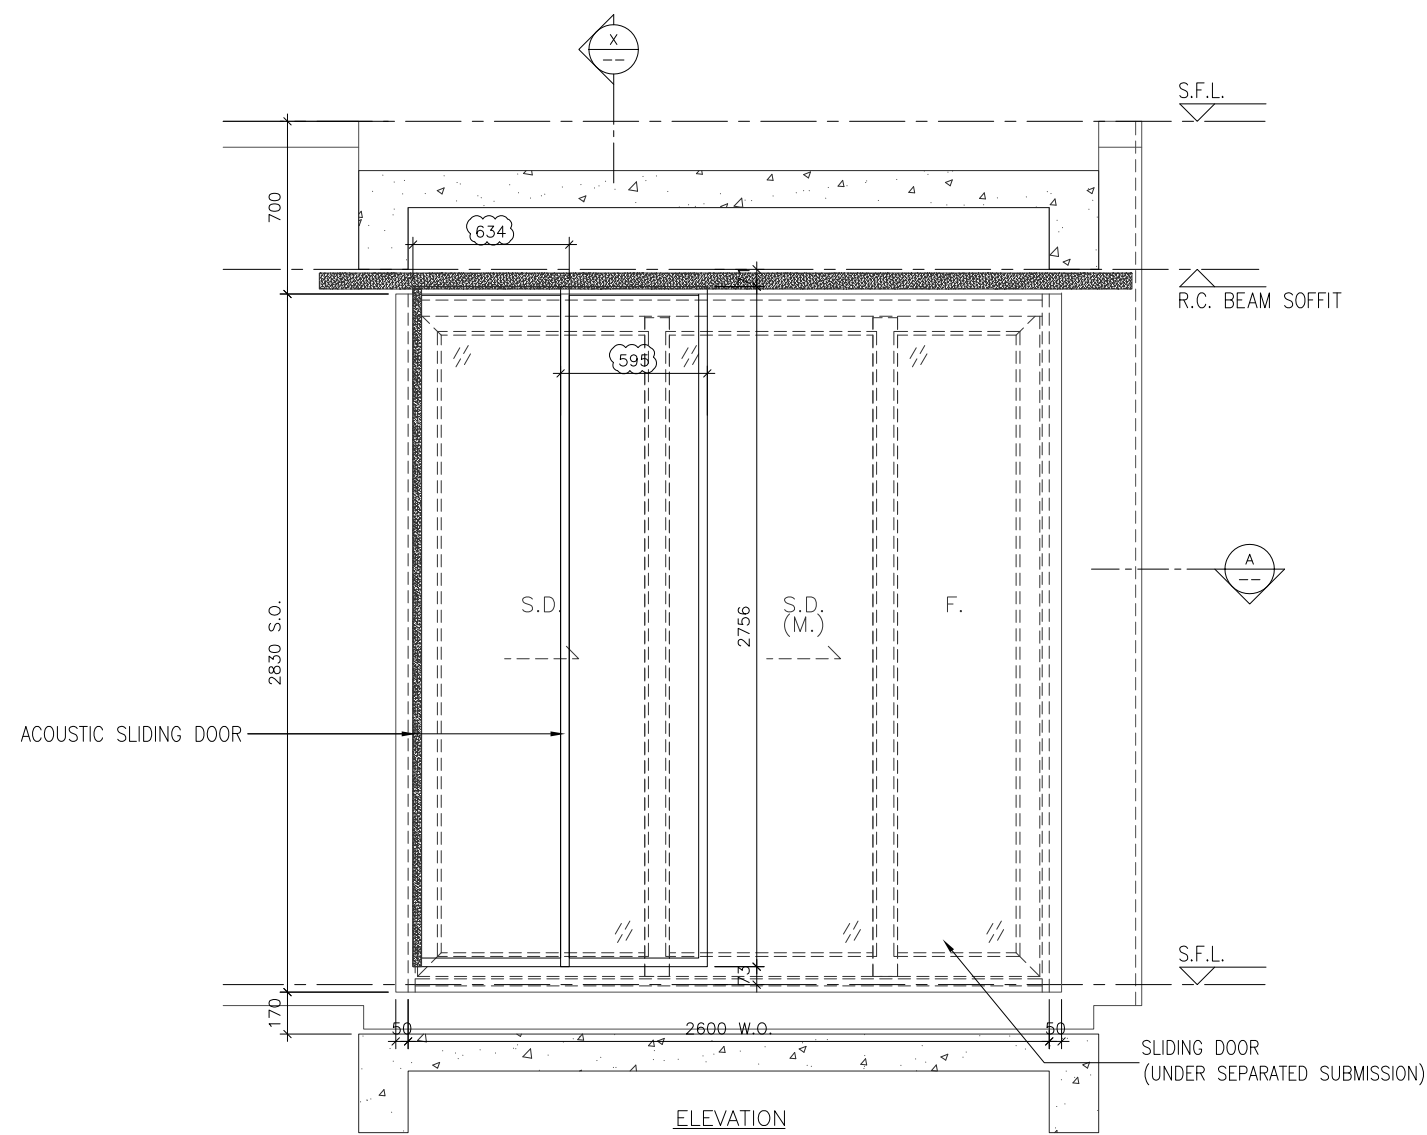

WINDOW MARK	22W6 T2B
LOCATION	22/F ENSUITE AT TOWER 2 FLAT B
SECTION	-
GLAZING	-
QUANTITY	1
REMARKS	NSR: T2-05/TESTED CASE: W103A

B.D. REF :

CLIENT :

ARCHITECT :
AGC DESIGN LTD
101, 102, 103,1000

MAIN CONTRACTOR :
Gammon

STRUCTURAL ENGINEER :
ARUP

FACADE CONSULTANT:
MEINHARDT

NOTE :
1. ALL DIMENSIONS ARE IN mm.
2. ALL ELEVATIONS ARE VIEWED FROM OUTSIDE.
3. ALL DIMENSIONS TO BE VERIFIED ON SITE BEFORE FABRICATION.

LEGEND :
X1 -- DETAIL MARK NO.
X001 -- REFER SHEET NO.

1. F.F.L. -- FINISHED FLOOR LEVEL
2. S.F.L. -- STRUCTURAL FLOOR LEVEL
3. (R) -- REVERSED DETAIL

B	13-11-2020	REVISION SUBJECT TO COMMENTS	MN
A	24-08-2020	REVISION SUBJECT TO COMMENTS	MN
NO.	DATE	REVISED	BY

JOB NO. : J-852
PROJECT : PROPOSED RESIDENTIAL DEVELOPMENT AT 139 - 147 ARGYLE STREET, NKIL 6005, 6035 R.P., 6036 R.P., 6037 R.P. & 6038 R.P.

TITLE : PART ELEVATION, PLAN & SECTION FOR ACOUSTIC SLIDING DOOR

DATE : 20-Jul-20 SCALE : 1:30



DRAWN BY : LHR CHECKED BY : DW

美特鋁質有限公司
MIDI ALUMINIUM FABRICATOR LTD.
Units 6-8, Sunray Industrial Centre, 1/F
610 Cha Kwo Ling Road, Kowloon
Tel:23489211-4 Fax:(852)27727666

DWG NO. : J852-SD-ASD-4205A REV. : B

ELEVATION

ACOUSTIC SLIDING DOOR

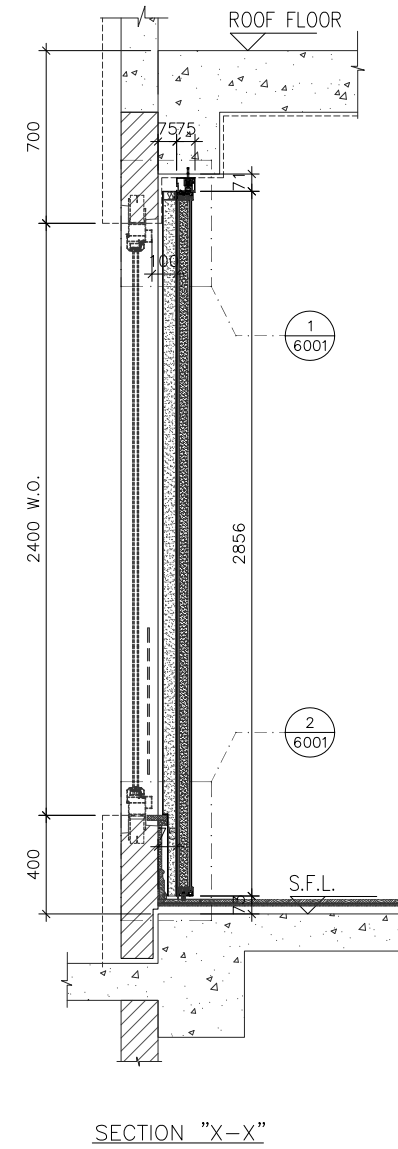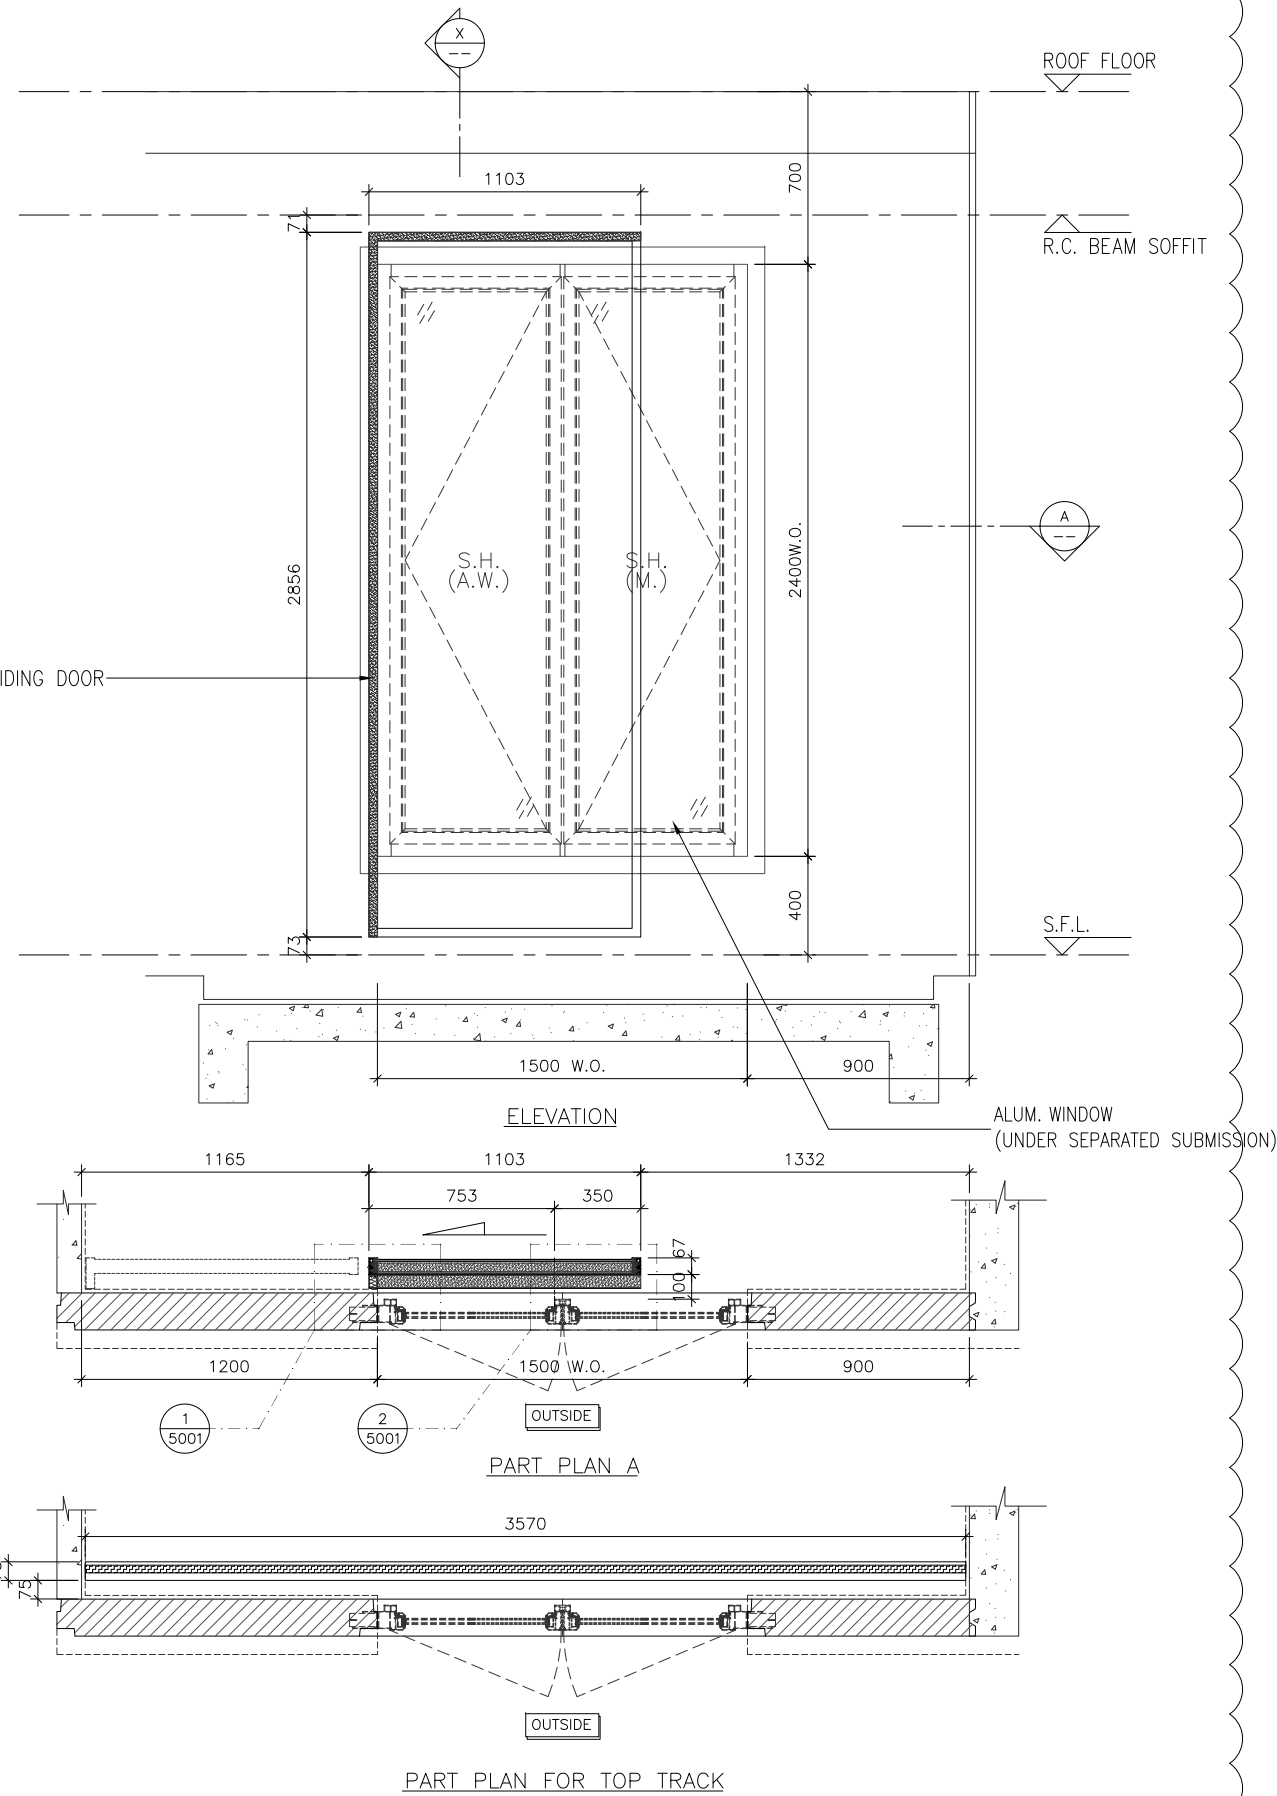

B.D. REF :

CLIENT :

ARCHITECT :
AGC DESIGN LTD
 101, 102, 103,1000

MAIN CONTRACTOR :
Gammon

STRUCTURAL ENGINEER :
ARUP

FAÇADE CONSULTANT:
MEINHARDT

NOTE :
 1. ALL DIMENSIONS ARE IN mm.
 2. ALL ELEVATIONS ARE VIEWED FROM OUTSIDE.
 3. ALL DIMENSIONS TO BE VERIFIED ON SITE BEFORE FABRICATION.

LEGEND :
 (X1) --- DETAIL MARK NO.
 (X001) --- REFER SHEET NO.

1. F.F.L. --- FINISHED FLOOR LEVEL
 2. S.F.L. --- STRUCTURAL FLOOR LEVEL
 3. (R) --- REVERSED DETAIL

NO.	DATE	REVISION	BY
B	13-11-2020	REVISION SUBJECT TO COMMENTS	MN
A	24-08-2020	REVISION SUBJECT TO COMMENTS	MN

JOB NO. : J-852
 PROJECT :
 PROPOSED RESIDENTIAL DEVELOPMENT
 AT 139 - 147 ARGYLE STREET,
 NKIL 6005, 6035 R.P., 6036 R.P.,
 6037 R.P. & 6038 R.P.

TITLE :
 PART ELEVATION, PLAN & SECTION
 FOR ACOUSTIC SLIDING DOOR

DATE : 20-Jul-20 SCALE : 1:30





DRAWN BY : LHR CHECKED BY : DW

美特鋁質有限公司
MIDI ALUMINIUM FABRICATOR LTD.
 Units 6-8, Sunray Industrial Centre, 1/F
 610 Cha Kwo Ling Road, Kowloon
 Tel:23489211-4 Fax:(852)2727666

DWG NO. : J852-SD-ASD-4205B REV. : B

WINDOW MARK	23WA T2A
LOCATION	23/F EN.4 AT TOWER 2 FLAT A
SECTION	-
GLAZING	-
QUANTITY	1
REMARKS	NSR: T2-04/TESTED CASE: W107A

ELEVATION

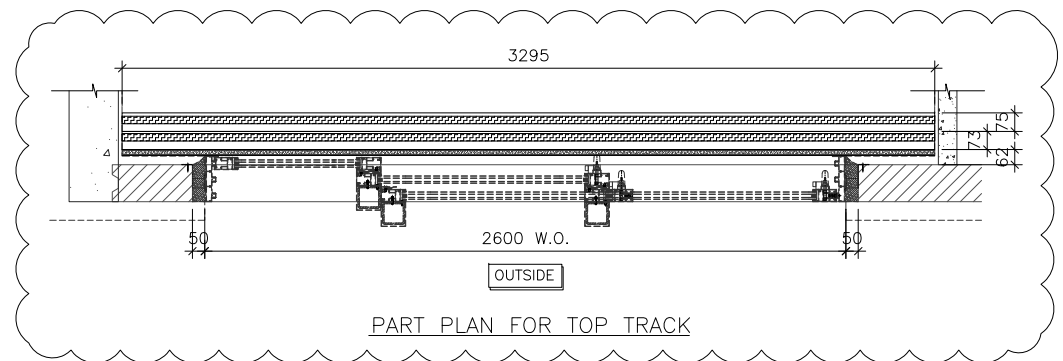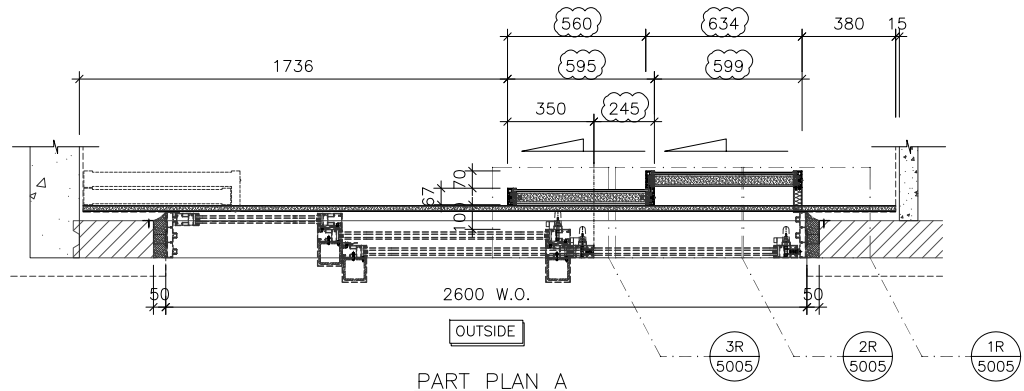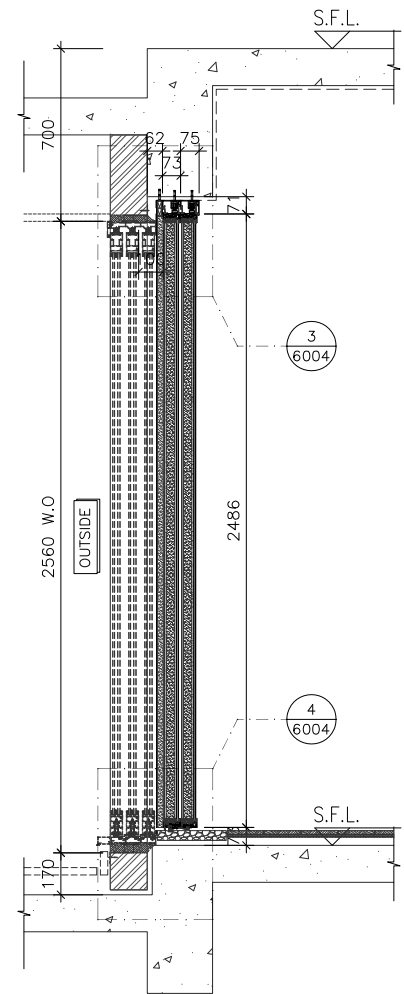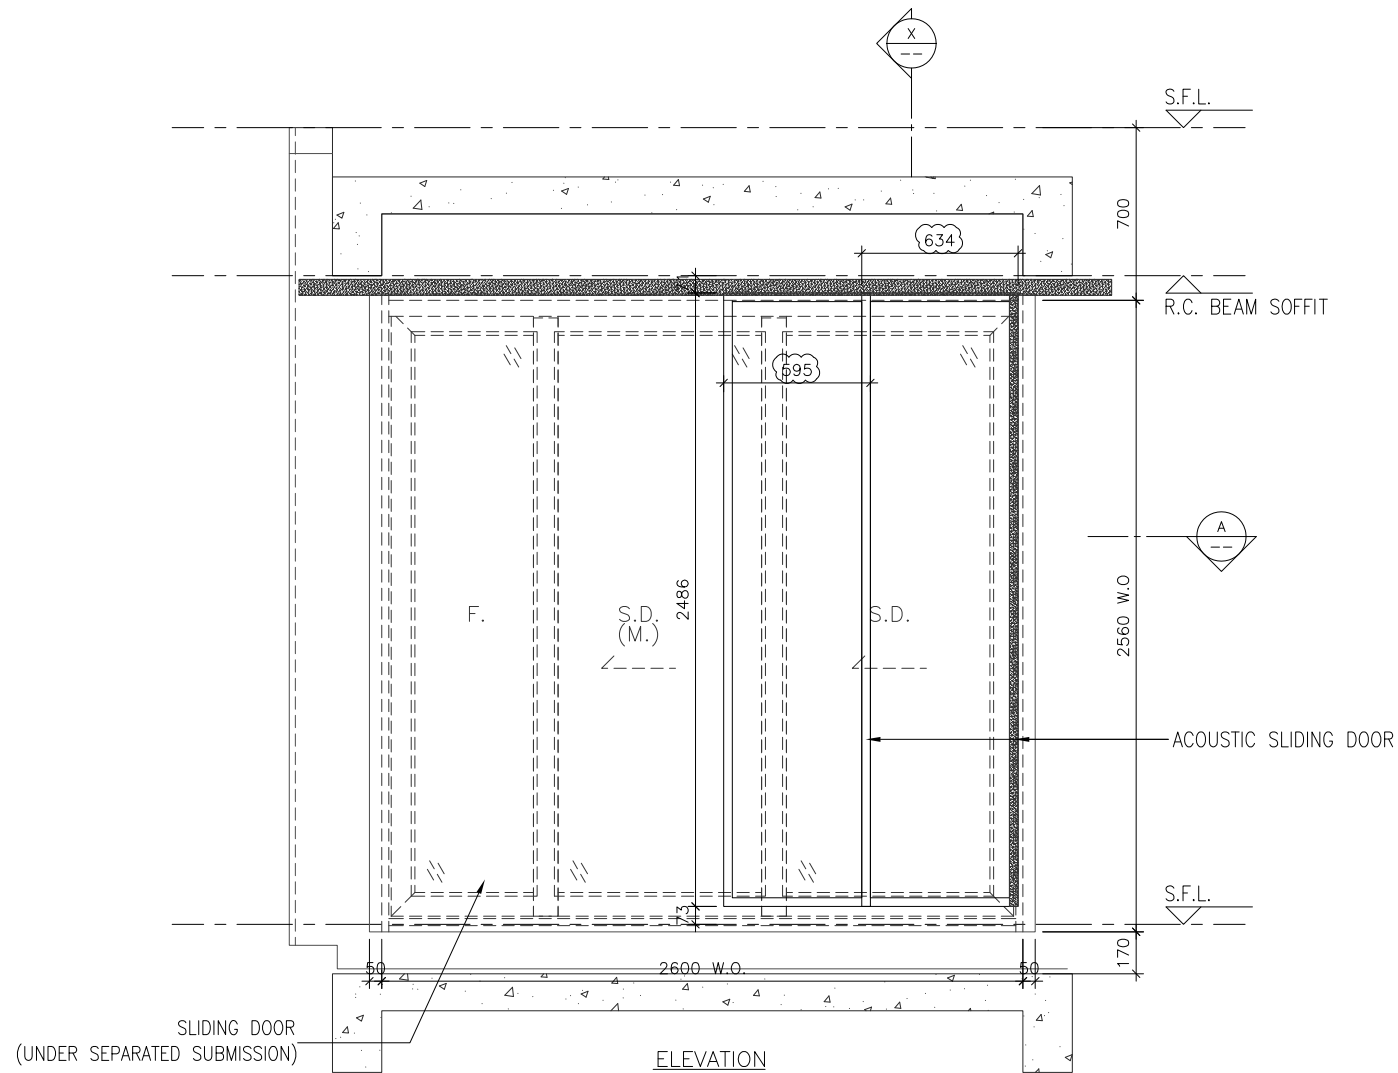

WINDOW MARK	W6 T2A
LOCATION	3/F~21/F ENSUITE AT TOWER 2 FLAT A
SECTION	-
GLAZING	-
QUANTITY	16
REMARKS	NSR: T2-12/TESTED CASE: W103B

B.D. REF :

CLIENT :

ARCHITECT :
AGC DESIGN LTD

MAIN CONTRACTOR :
Gammon

STRUCTURAL ENGINEER :
ARUP

FACADE CONSULTANT:
MEINHARDT

NOTE :
1. ALL DIMENSIONS ARE IN mm.
2. ALL ELEVATIONS ARE VIEWED FROM OUTSIDE.
3. ALL DIMENSIONS TO BE VERIFIED ON SITE BEFORE FABRICATION.

LEGEND :
 (X1) --- DETAIL MARK NO.
 (X001) --- REFER SHEET NO.
 1. F.F.L. --- FINISHED FLOOR LEVEL
 2. S.F.L. --- STRUCTURAL FLOOR LEVEL
 3. (R) --- REVERSED DETAIL

B	13-11-2020	REVISION SUBJECT TO COMMENTS	MN
A	24-08-2020	REVISION SUBJECT TO COMMENTS	MN
NO.	DATE	REVISED	BY

JOB NO. : J-852
 PROJECT : PROPOSED RESIDENTIAL DEVELOPMENT AT 139 - 147 ARGYLE STREET, NKIL 6005, 6035 R.P., 6036 R.P., 6037 R.P. & 6038 R.P.

TITLE : PART ELEVATION, PLAN & SECTION FOR ACOUSTIC SLIDING DOOR





DATE : 20-Jul-20 SCALE : 1:30

DRAWN BY : LHR CHECKED BY : DW

美特鋁質有限公司
MIDI ALUMINIUM FABRICATOR LTD.
 Units 6-8, Sunray Industrial Centre, 1/F
 610 Cha Kwo Ling Road, Kowloon
 Tel:23489211-4 Fax:(852)27727666

DWG NO. : J852-SD-ASD-4206 REV. : B

ELEVATION

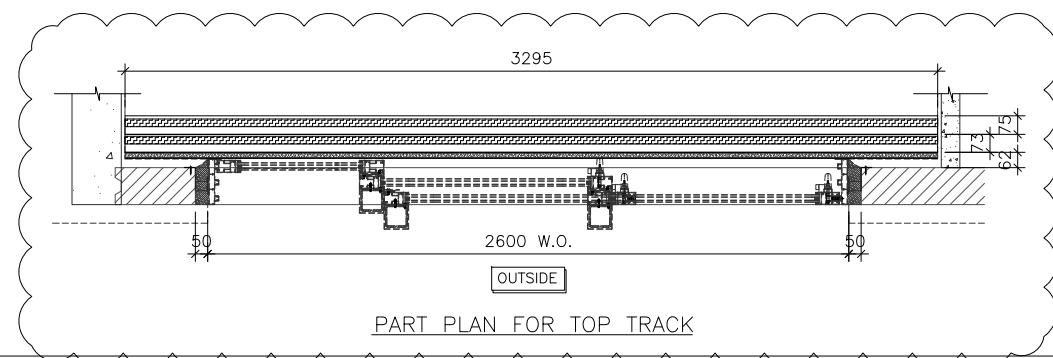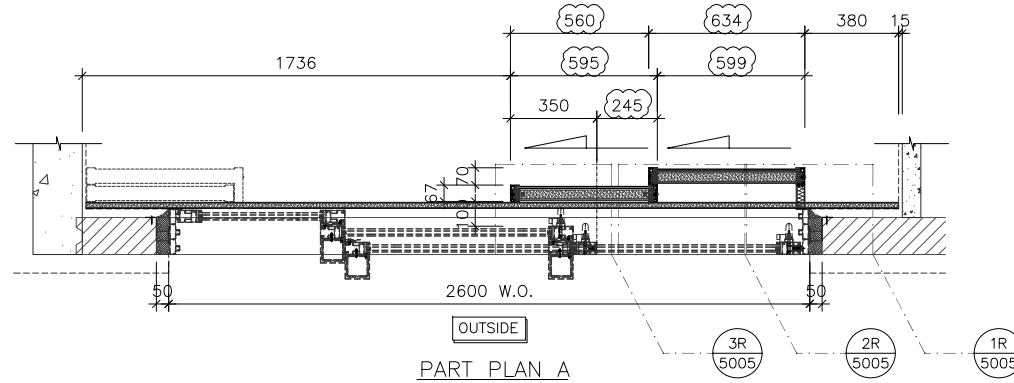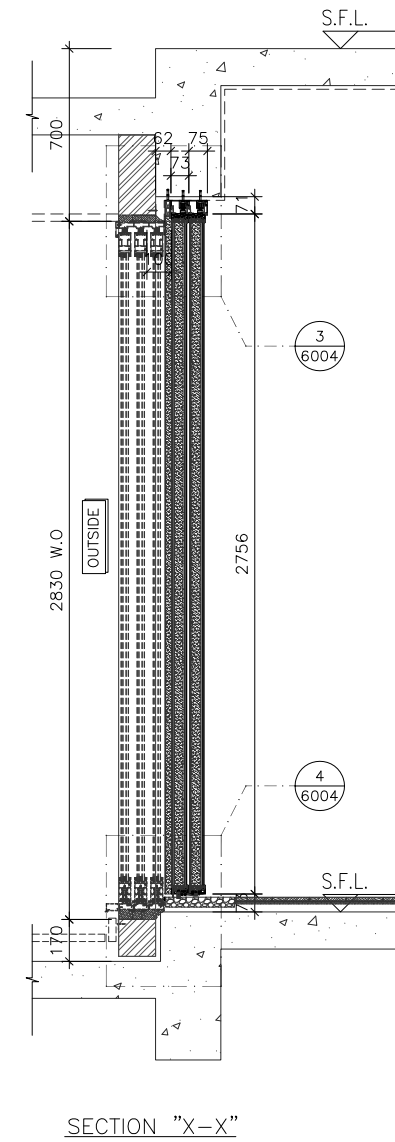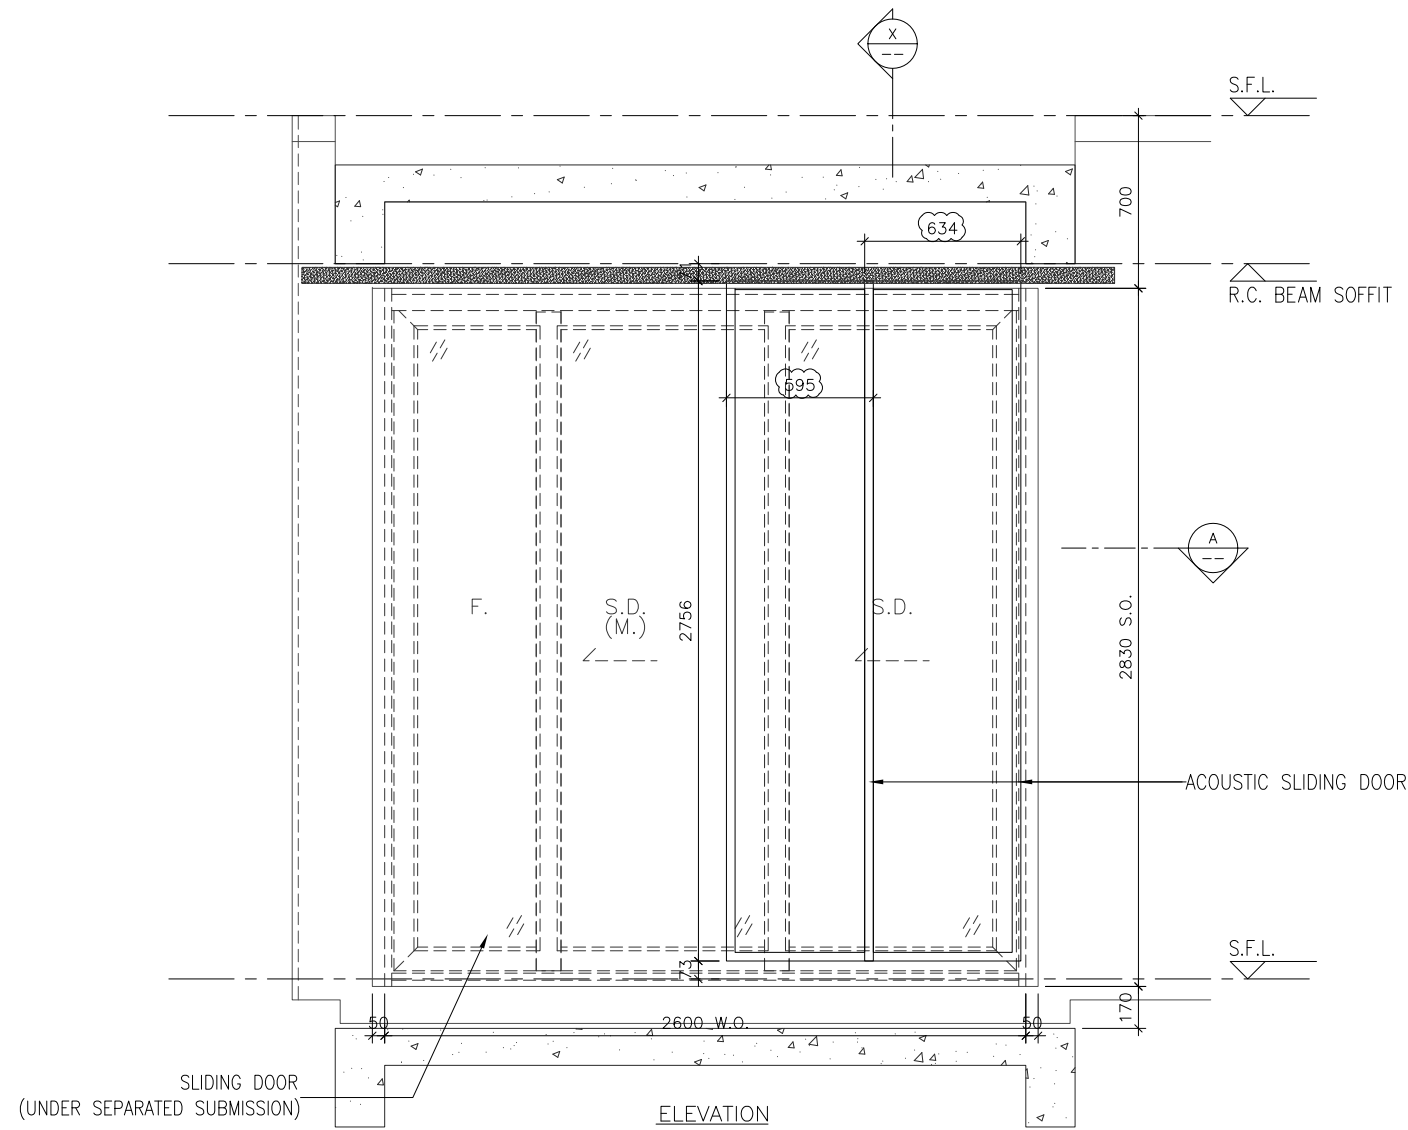

WINDOW MARK	22WB T2A
LOCATION	22/F ENSUITE AT TOWER 2 FLAT A
SECTION	-
GLAZING	-
QUANTITY	1
REMARKS	NSR: T2-12/TESTED CASE: W103A

B.D. REF :

CLIENT :

ARCHITECT :
AGC DESIGN LTD

MAIN CONTRACTOR :
Gammon

STRUCTURAL ENGINEER :
ARUP

FACADE CONSULTANT:
MEINHARDT

- NOTE :
1. ALL DIMENSIONS ARE IN mm.
 2. ALL ELEVATIONS ARE VIEWED FROM OUTSIDE.
 3. ALL DIMENSIONS TO BE VERIFIED ON SITE BEFORE FABRICATION.

- LEGEND :
- (X1) --- DETAIL MARK NO.
 - (X001) --- REFER SHEET NO.

1. F.F.L. -- FINISHED FLOOR LEVEL
2. S.F.L. -- STRUCTURAL FLOOR LEVEL
3. (R) -- REVERSED DETAIL

B	13-11-2020	REVISION SUBJECT TO COMMENTS	MN
A	24-08-2020	REVISION SUBJECT TO COMMENTS	MN
NO.	DATE	REVISED	BY


JOB NO. : J-852
PROJECT :
PROPOSED RESIDENTIAL DEVELOPMENT
AT 139 - 147 ARGYLE STREET,
NKIL 6005, 6035 R.P., 6036 R.P.,
6037 R.P. & 6038 R.P.

TITLE :
PART ELEVATION, PLAN & SECTION
FOR ACOUSTIC SLIDING DOOR

DATE : 20-Jul-20 SCALE : 1:30
DRAWN BY : LHR CHECKED BY : DW

美特鋁質有限公司
MIDI ALUMINIUM FABRICATOR LTD.
Units 6-8, Sunray Industrial Centre, 1/F
610 Cha Kwo Ling Road, Kowloon
Tel:23489211-4 Fax:(852)2727666
DWG NO. : J852-SD-ASD-4206A REV. : B

ELEVATION

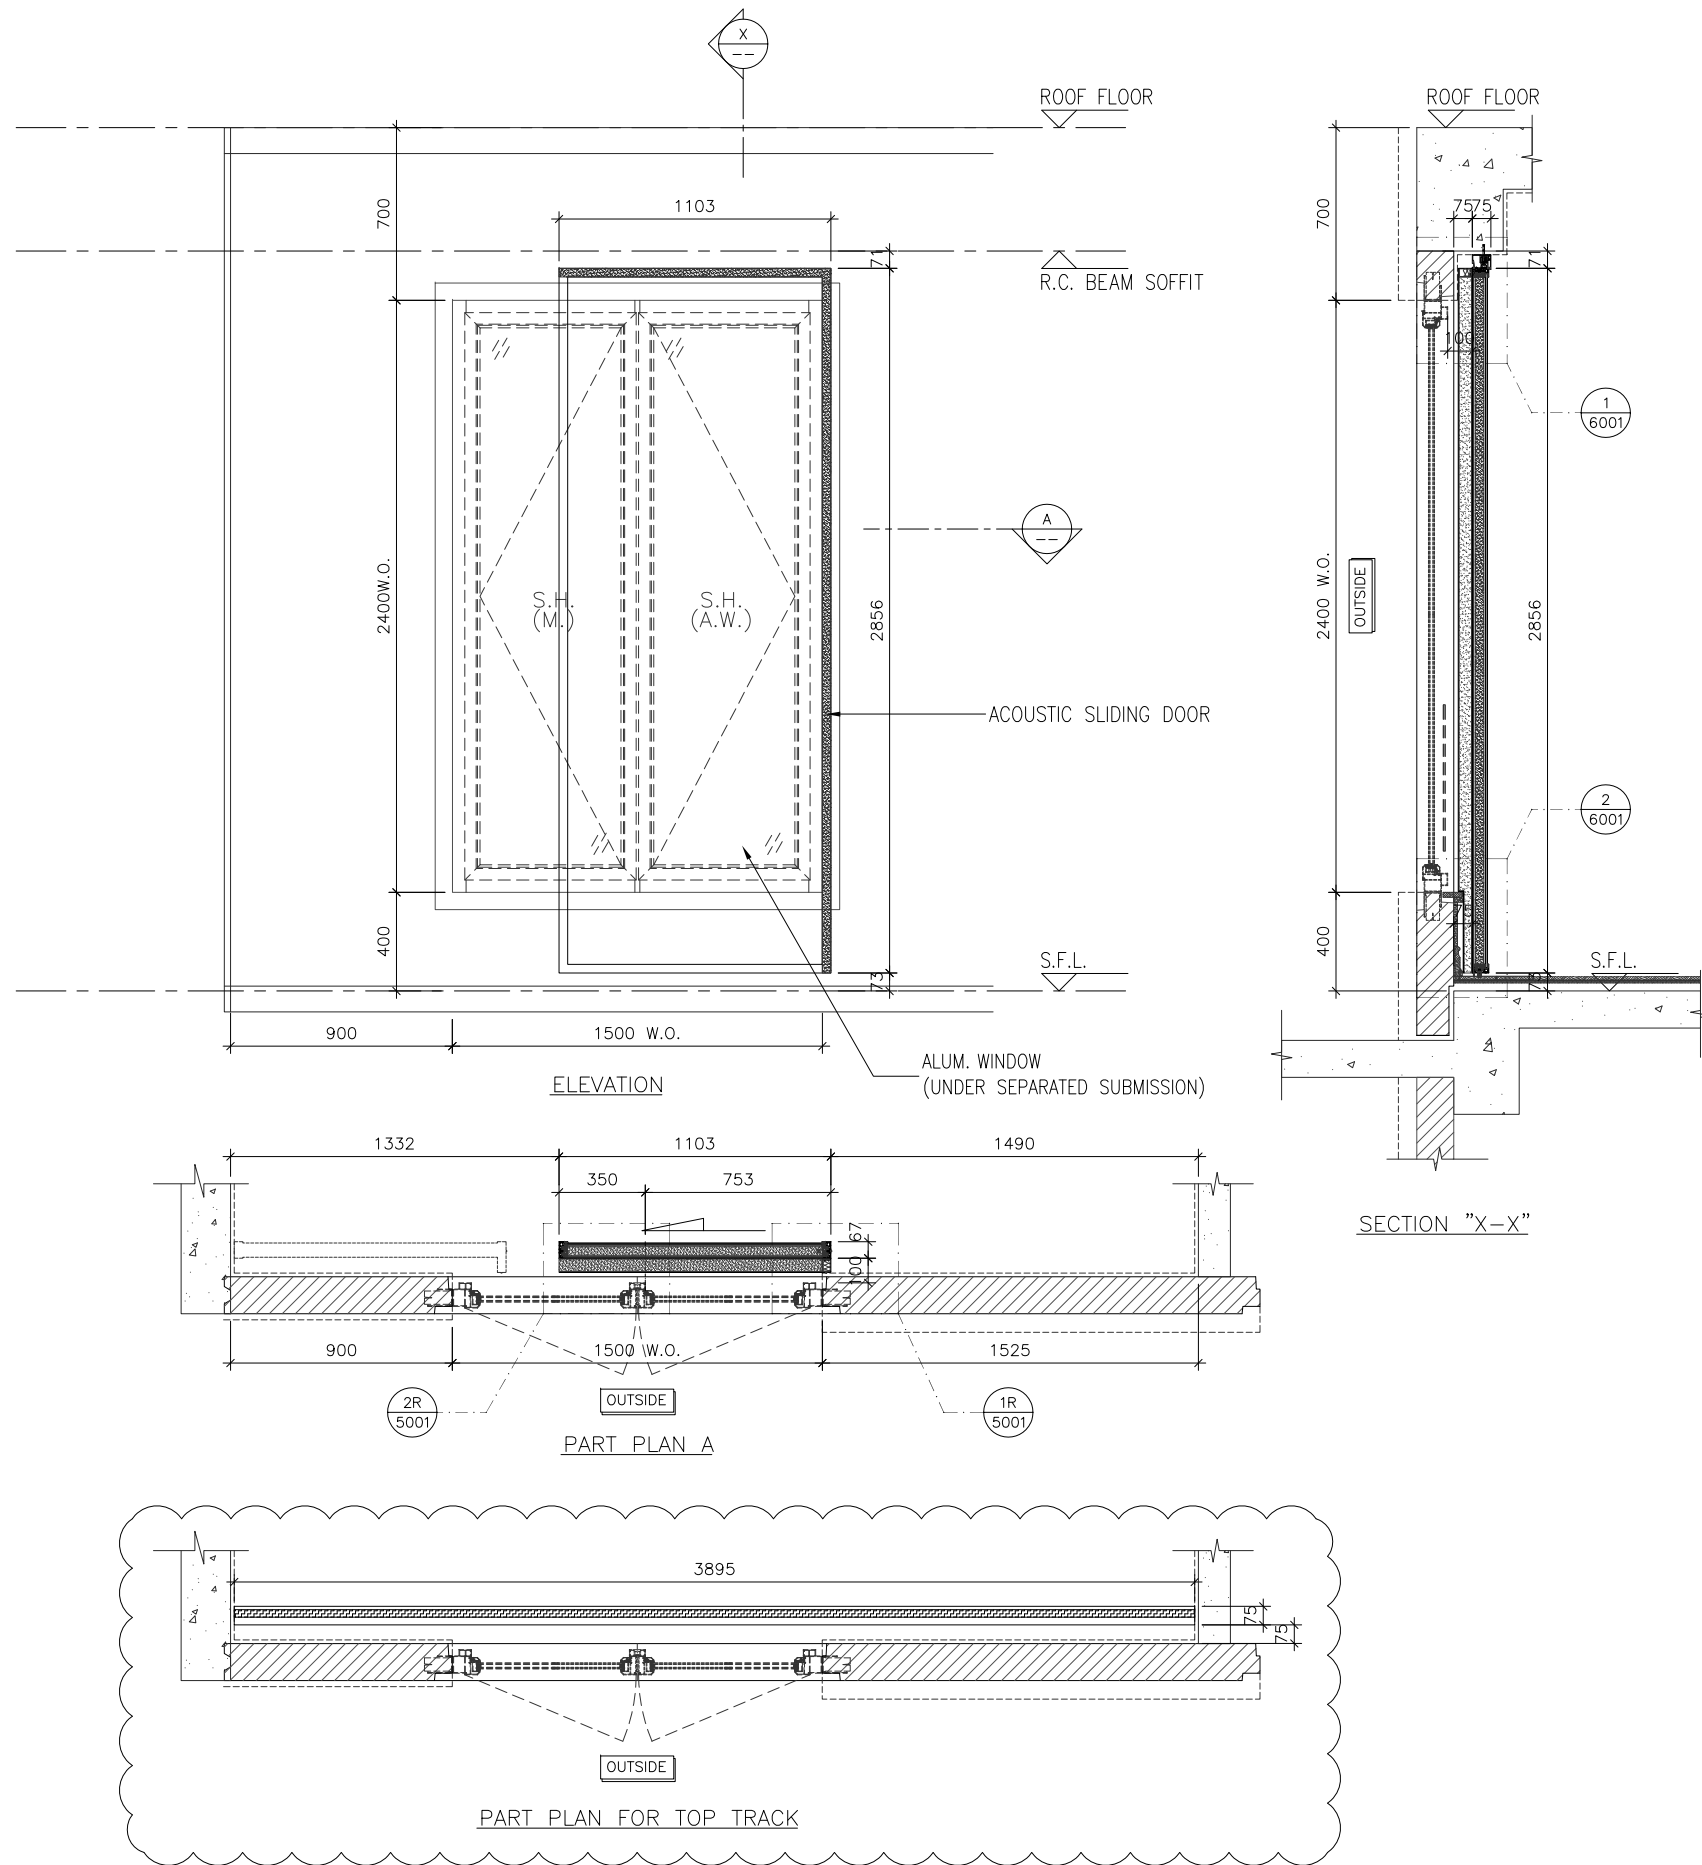

WINDOW MARK	23WS T2A
LOCATION	23/F M.EN AT TOWER 2 FLAT A
SECTION	-
GLAZING	-
QUANTITY	1
REMARKS	NSR: T2-12/TESTED CASE: W107A

B.D. REF :

CLIENT :

ARCHITECT :
AGC DESIGN LTD
 100, 101, 102,1000

MAIN CONTRACTOR :
Gammon

STRUCTURAL ENGINEER :
ARUP

FACADE CONSULTANT:
MEINHARDT

NOTE :
 1. ALL DIMENSIONS ARE IN mm.
 2. ALL ELEVATIONS ARE VIEWED FROM OUTSIDE.
 3. ALL DIMENSIONS TO BE VERIFIED ON SITE BEFORE FABRICATION.

LEGEND :
 X1 -- DETAIL MARK NO.
 X001 -- REFER SHEET NO.
 1. F.F.L. -- FINISHED FLOOR LEVEL
 2. S.F.L. -- STRUCTURAL FLOOR LEVEL
 3. (R) -- REVERSED DETAIL

B	13-11-2020	REVISION SUBJECT TO COMMENTS	MN
A	24-08-2020	REVISION SUBJECT TO COMMENTS	MN
NO.	DATE	REVISED	BY





JOB NO. : J-852
 PROJECT :
 PROPOSED RESIDENTIAL DEVELOPMENT
 AT 139 - 147 ARGYLE STREET,
 NKIL 6005, 6035 R.P., 6036 R.P.,
 6037 R.P. & 6038 R.P.

TITLE :
 PART ELEVATION, PLAN & SECTION
 FOR ACOUSTIC SLIDING DOOR

DATE : 20-Jul-20 SCALE : 1:30
 DRAWN BY : LHR CHECKED BY : DW

美特鋁質有限公司
MIDI ALUMINIUM FABRICATOR LTD.
 Units 6-8, Sunray Industrial Centre, 1/F
 610 Cha Kwo Ling Road, Kowloon
 Tel:23489211-4 Fax:(852)2727666
 DWG NO. : J852-SD-ASD-4206B REV. : B

ELEVATION

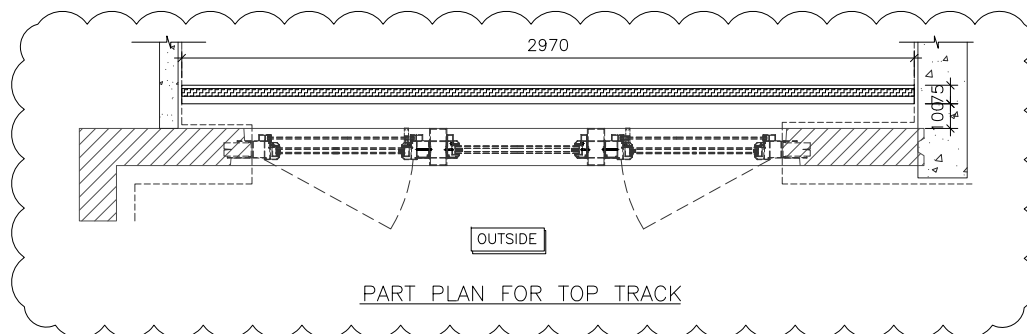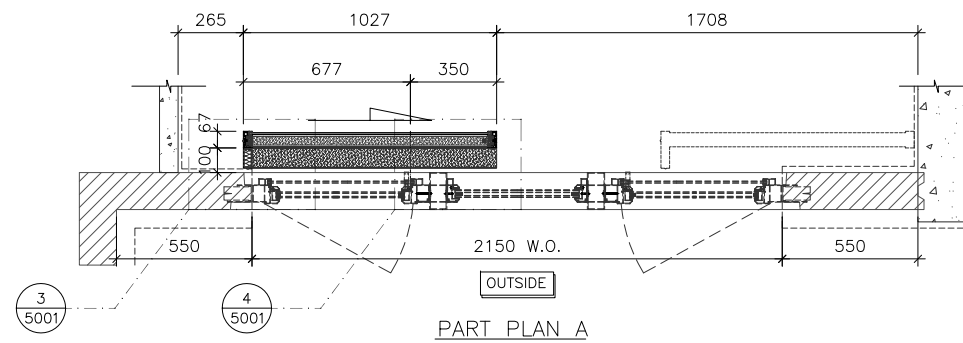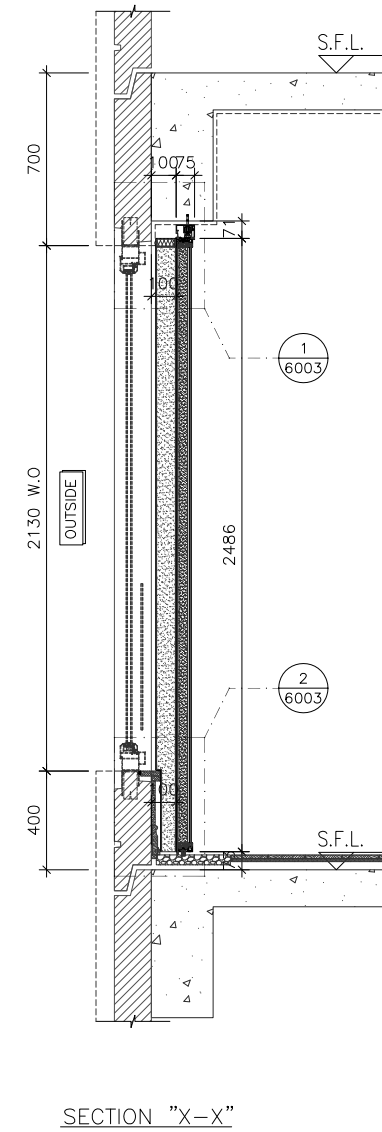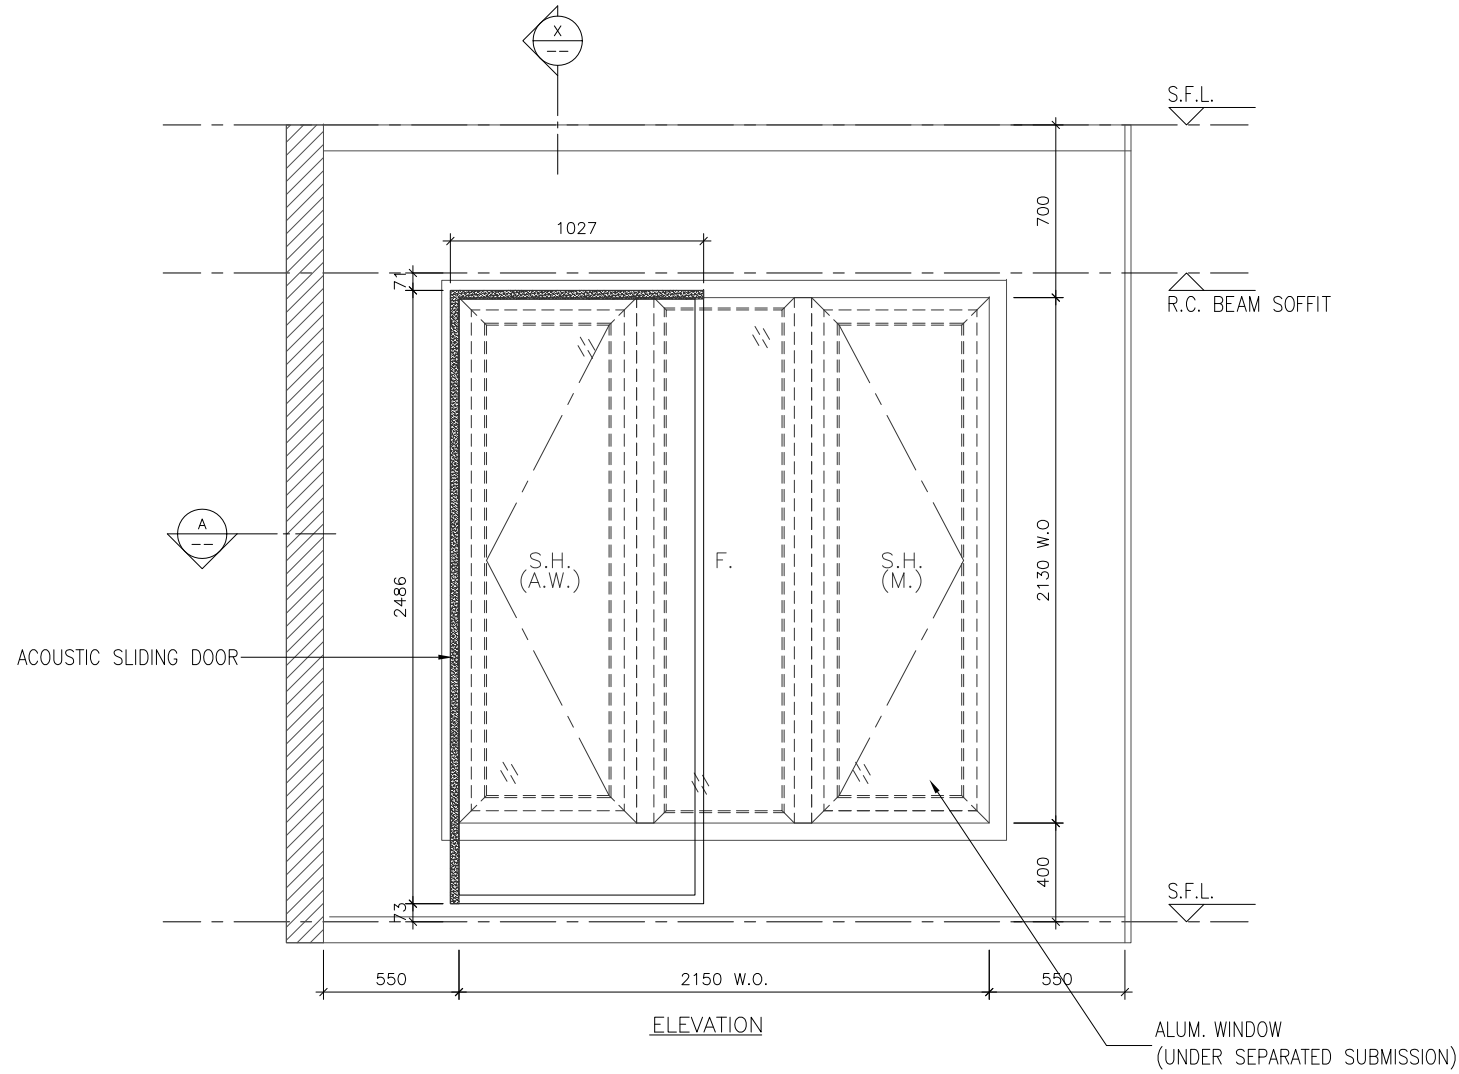

WINDOW MARK	W7 T2A
LOCATION	3/F-21/F B.R.1. AT TOWER 2 FLAT A
SECTION	-
GLAZING	-
QUANTITY	16
REMARKS	NSR: T2-13/TESTED CASE: W107A

B.D. REF :

CLIENT :

ARCHITECT :
AGC DESIGN LTD
100, 101, 102,1000

MAIN CONTRACTOR :
Gammon

STRUCTURAL ENGINEER :
ARUP

FAÇADE CONSULTANT:
MEINHARDT

NOTE :
1. ALL DIMENSIONS ARE IN mm.
2. ALL ELEVATIONS ARE VIEWED FROM OUTSIDE.
3. ALL DIMENSIONS TO BE VERIFIED ON SITE BEFORE FABRICATION.

LEGEND :
X1 -- DETAIL MARK NO.
X001 -- REFER SHEET NO.
1. F.F.L. -- FINISHED FLOOR LEVEL
2. S.F.L. -- STRUCTURAL FLOOR LEVEL
3. (R) -- REVERSED DETAIL

B	13-11-2020	REVISION SUBJECT TO COMMENTS	MN
A	24-08-2020	REVISION SUBJECT TO COMMENTS	MN
NO.	DATE	REVISED	BY

JOB NO. : J-852
PROJECT : PROPOSED RESIDENTIAL DEVELOPMENT AT 139 - 147 ARGYLE STREET, NKIL 6005, 6035 R.P., 6036 R.P., 6037 R.P. & 6038 R.P.


TITLE : PART ELEVATION, PLAN & SECTION FOR ACOUSTIC SLIDING DOOR

DATE : 20-Jul-20 SCALE : 1:30
DRAWN BY : LHR CHECKED BY : DW


美特鋁質有限公司
MIDI ALUMINIUM FABRICATOR LTD.
Units 6-8, Sunray Industrial Centre, 1/F
610 Cha Kwo Ling Road, Kowloon
Tel:23489211-4 Fax:(852)2727666

DWG NO. : J852-SD-ASD-4207 REV. : B


ELEVATION

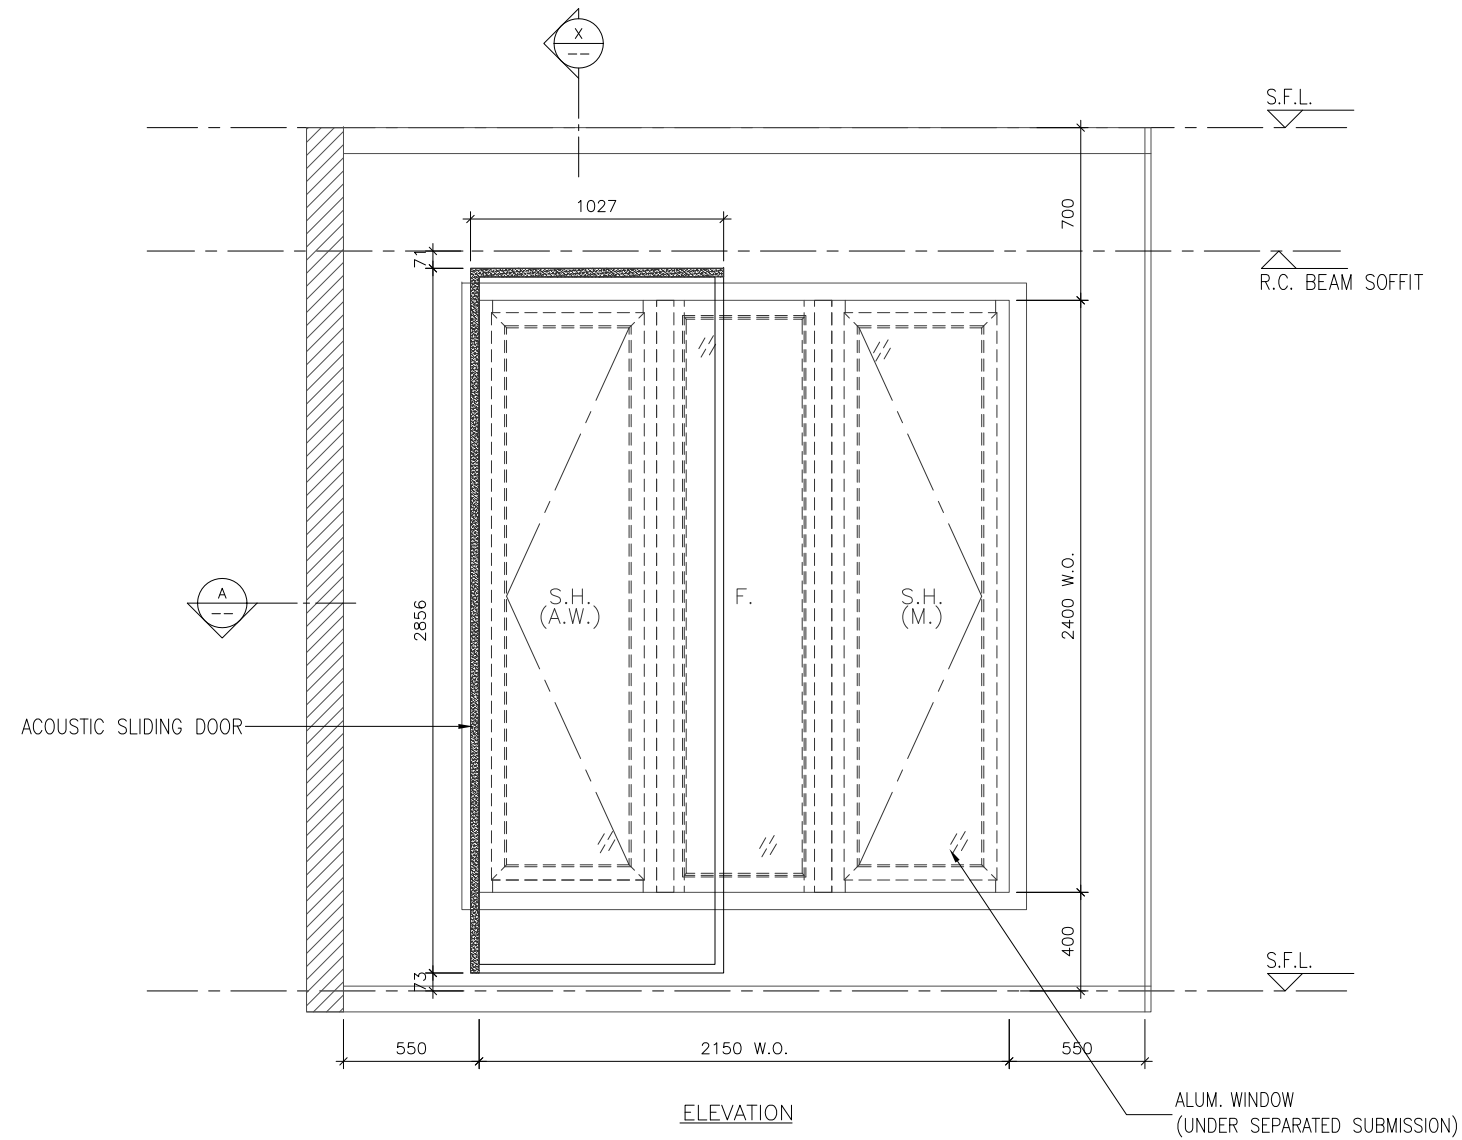


ELEVATION

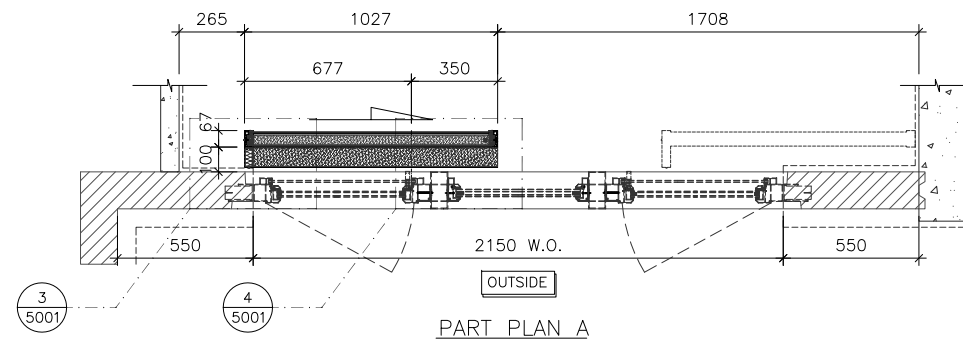

PART PLAN A

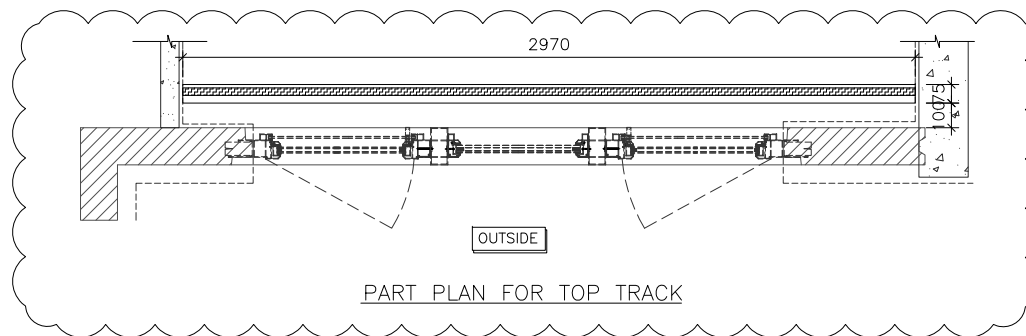

PART PLAN FOR TOP TRACK

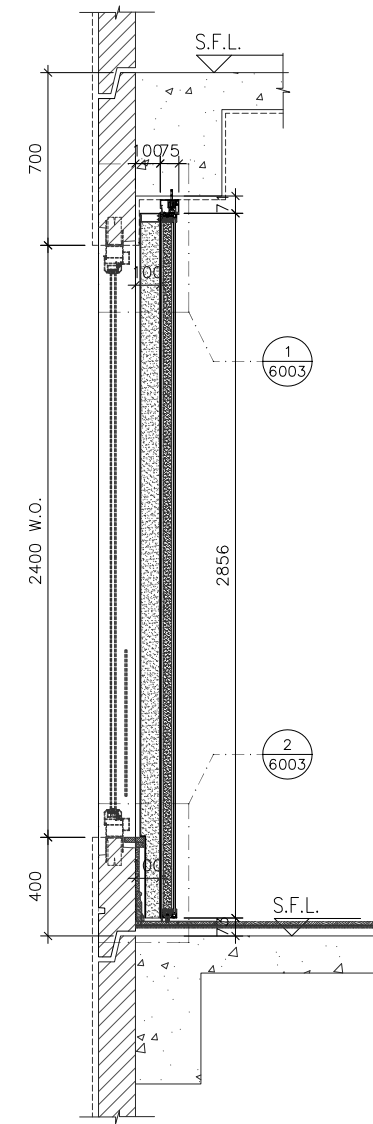

SECTION "X-X"

B.D. REF :

CLIENT :

ARCHITECT :
AGC DESIGN LTD
 181, 182, 183,1000

MAIN CONTRACTOR :
Gammon

STRUCTURAL ENGINEER :
ARUP

FACADE CONSULTANT:
MEINHARDT

NOTE :
 1. ALL DIMENSIONS ARE IN mm.
 2. ALL ELEVATIONS ARE VIEWED FROM OUTSIDE.
 3. ALL DIMENSIONS TO BE VERIFIED ON SITE BEFORE FABRICATION.

LEGEND :
 (X1) --- DETAIL MARK NO.
 (X001) --- REFER SHEET NO.

1. F.F.L. --- FINISHED FLOOR LEVEL
 2. S.F.L. --- STRUCTURAL FLOOR LEVEL
 3. (R) --- REVERSED DETAIL

NO.	DATE	REVISION	BY
B	13-11-2020	REVISION SUBJECT TO COMMENTS	MN
A	24-08-2020	REVISION SUBJECT TO COMMENTS	MN

JOB NO. : J-852
 PROJECT :
 PROPOSED RESIDENTIAL DEVELOPMENT
 AT 139 - 147 ARGYLE STREET,
 NKIL 6005, 6035 R.P., 6036 R.P.,
 6037 R.P. & 6038 R.P.

TITLE :
 PART ELEVATION, PLAN & SECTION
 FOR ACOUSTIC SLIDING DOOR

DATE : 20-Jul-20 SCALE : 1:30



DRAWN BY : LHR CHECKED BY : DW

美特鋁質有限公司
MIDI ALUMINIUM FABRICATOR LTD.
 Units 6-8, Sunray Industrial Centre, 1/F
 610 Cha Kwo Ling Road, Kowloon
 Tel:23489211-4 Fax:(852)2727666


DWG NO. : J852-SD-ASD-4207A REV. : B

WINDOW MARK	
LOCATION	22/F B.R.1. AT TOWER 2 FLAT A
SECTION	-
GLAZING	-
QUANTITY	1
REMARKS	NSR: T2-13/TESTED CASE: W107A


ELEVATION

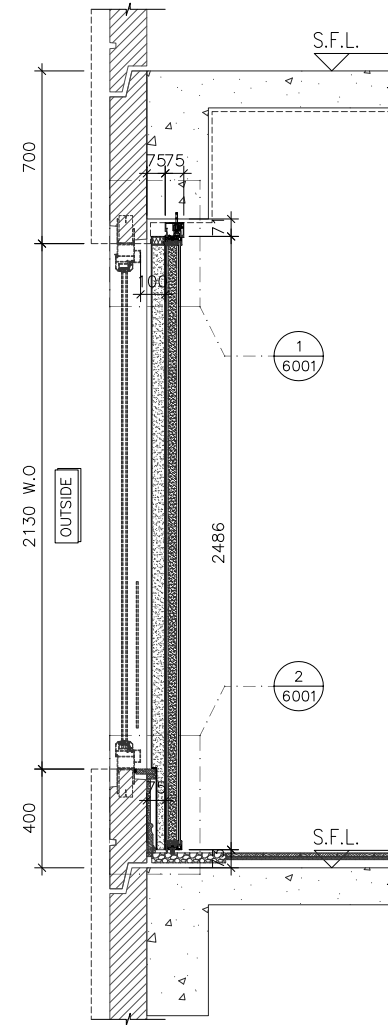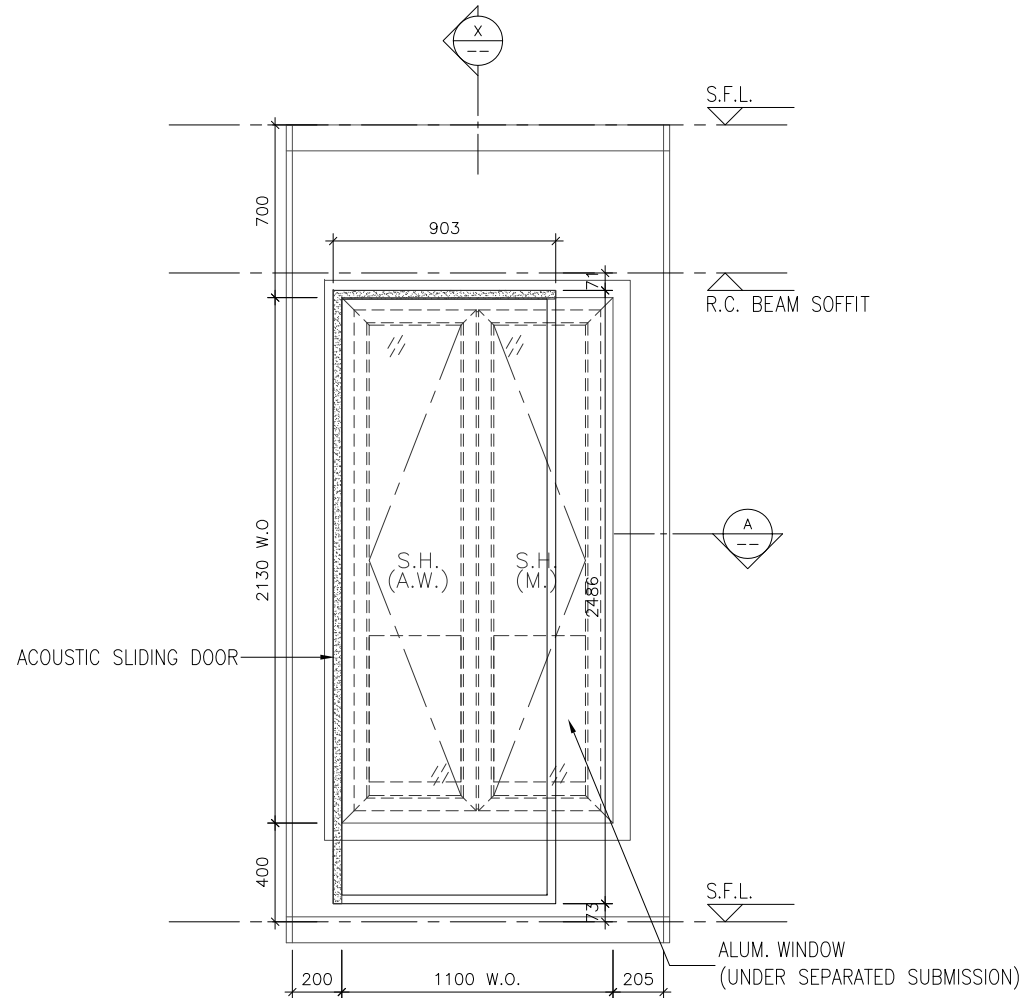

SECTION "X-X"

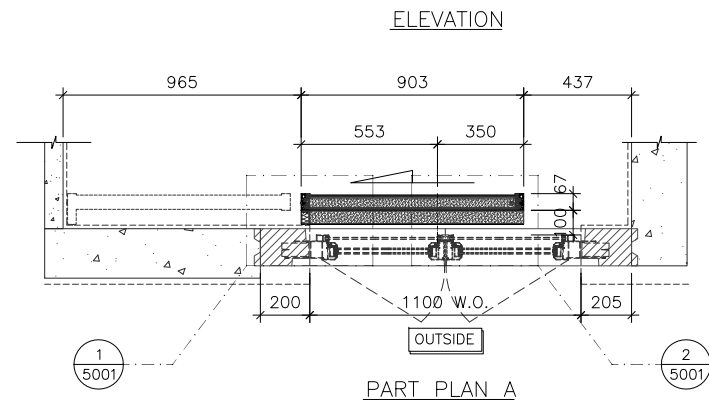

PART PLAN A

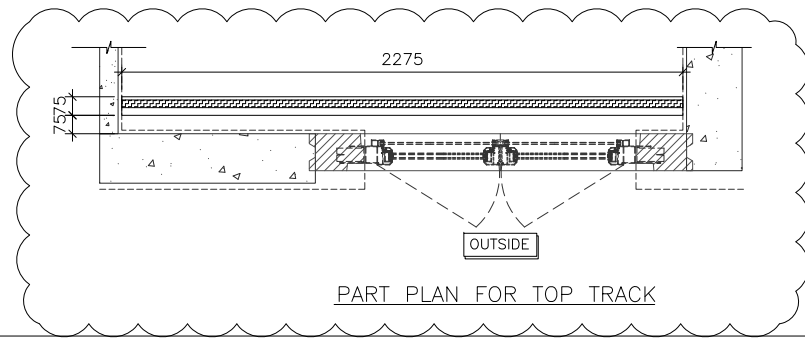

PART PLAN FOR TOP TRACK

WINDOW MARK



LOCATION 2/F-21/F B.R.2 AT TOWER 3 FLAT C

SECTION -

GLAZING -

QUANTITY 17

REMARKS NSR: T3-01/TESTED CASE: W108B

B.D. REF :

CLIENT :

ARCHITECT :

AGC
DESIGN LTD

MAIN CONTRACTOR :

Gammon

STRUCTURAL ENGINEER :

ARUP

FACADE CONSULTANT:

MEINHARDT

NOTE :

1. ALL DIMENSIONS ARE IN mm.
2. ALL ELEVATIONS ARE VIEWED FROM OUTSIDE.
3. ALL DIMENSIONS TO BE VERIFIED ON SITE BEFORE FABRICATION.

LEGEND :

- (X1) --- DETAIL MARK NO.
- (X001) --- REFER SHEET NO.

1. F.F.L. --- FINISHED FLOOR LEVEL
2. S.F.L. --- STRUCTURAL FLOOR LEVEL
3. (R) --- REVERSED DETAIL

NO.	DATE	REVISED	BY
B	13-11-2020	REVISION SUBJECT TO COMMENTS	MN
A	24-08-2020	REVISION SUBJECT TO COMMENTS	MN

JOB NO. : J-852

PROJECT :
PROPOSED RESIDENTIAL DEVELOPMENT
AT 139 - 147 ARGYLE STREET,
NKIL 6005, 6035 R.P., 6036 R.P.,
6037 R.P. & 6038 R.P.

TITLE :
PART ELEVATION, PLAN & SECTION
FOR ACOUSTIC SLIDING DOOR



DATE : 20-Jul-20 SCALE : 1:30

DRAWN BY : LHR CHECKED BY : DW


美特鋁質有限公司
MIDI ALUMINIUM FABRICATOR LTD.
Units 6-8, Sunray Industrial Centre, 1/F
610 Cha Kwo Ling Road, Kowloon
Tel:23489211-4 Fax:(852)27727666

DWG NO. : J852-SD-ASD-4301 REV. : B


ELEVATION

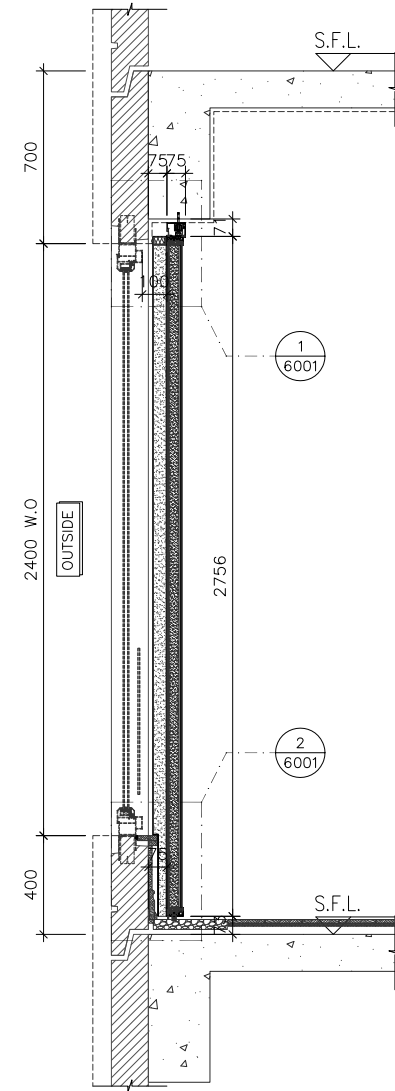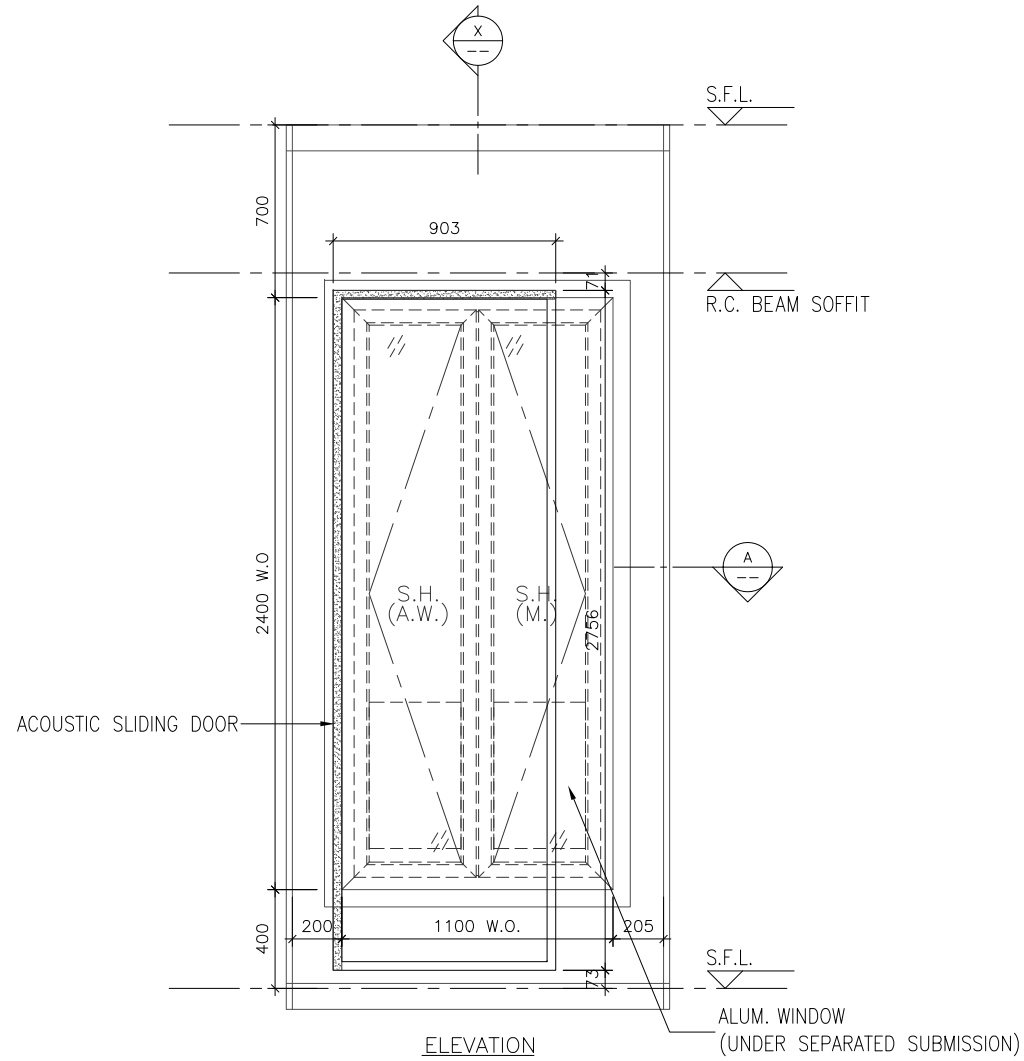

SECTION "X-X"

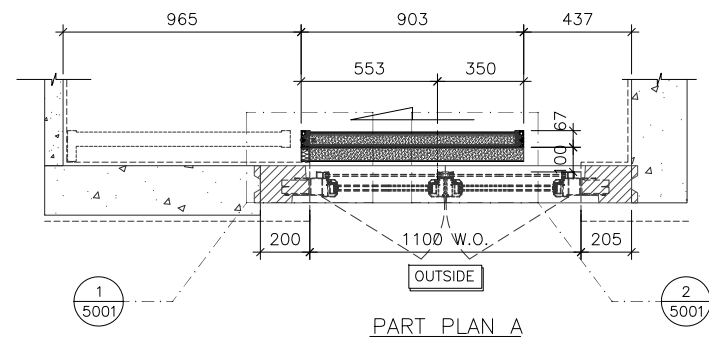

PART PLAN A

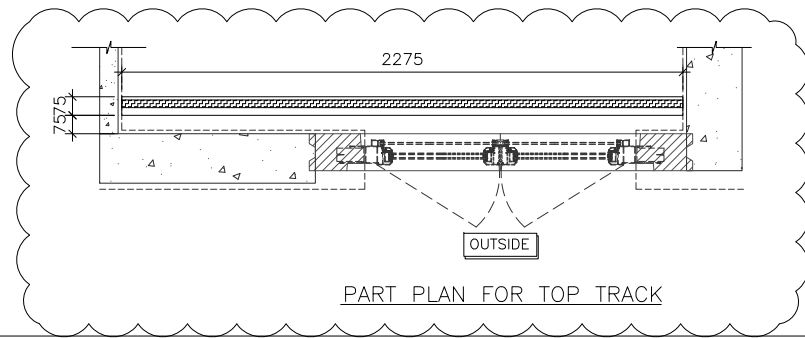

PART PLAN FOR TOP TRACK

WINDOW MARK	22W5 T3C & 23W5 T3C
LOCATION	22/F~23/F B.R.2 AT TOWER 3 FLAT C
SECTION	-
GLAZING	-
QUANTITY	2
REMARKS	NSR: T3-01/TESTED CASE: W108A

B.D. REF :

CLIENT :

ARCHITECT :



MAIN CONTRACTOR :



STRUCTURAL ENGINEER :



FACADE CONSULTANT:



NOTE :

1. ALL DIMENSIONS ARE IN mm.
2. ALL ELEVATIONS ARE VIEWED FROM OUTSIDE.
3. ALL DIMENSIONS TO BE VERIFIED ON SITE BEFORE FABRICATION.

LEGEND :

- x1 --- DETAIL MARK NO.
- x001 --- REFER SHEET NO.

1. F.F.L. --- FINISHED FLOOR LEVEL
2. S.F.L. --- STRUCTURAL FLOOR LEVEL
3. (R) --- REVERSED DETAIL

B	13-11-2020	REVISION SUBJECT TO COMMENTS	MN
A	24-08-2020	REVISION SUBJECT TO COMMENTS	MN
NO.	DATE	REVISED	BY

JOB NO. : J-852

PROJECT :
PROPOSED RESIDENTIAL DEVELOPMENT
AT 139 - 147 ARGYLE STREET,
NKIL 6005, 6035 R.P., 6036 R.P.,
6037 R.P. & 6038 R.P.

TITLE :
PART ELEVATION, PLAN & SECTION
FOR ACOUSTIC SLIDING DOOR



DATE : 20-Jul-20 SCALE : 1:30

DRAWN BY : LHR CHECKED BY : DW



美特鋁質有限公司
MIDI ALUMINIUM FABRICATOR LTD.
Units 6-8, Sunray Industrial Centre, 1/F
610 Cha Kwo Ling Road, Kowloon
Tel:23489211-4 Fax:(852)2727666

DWG NO. : J852-SD-ASD-4301A REV. : B

ELEVATION

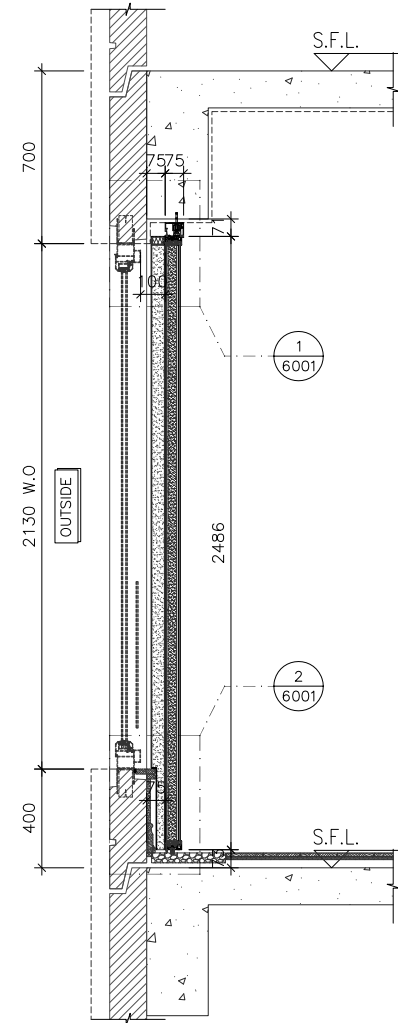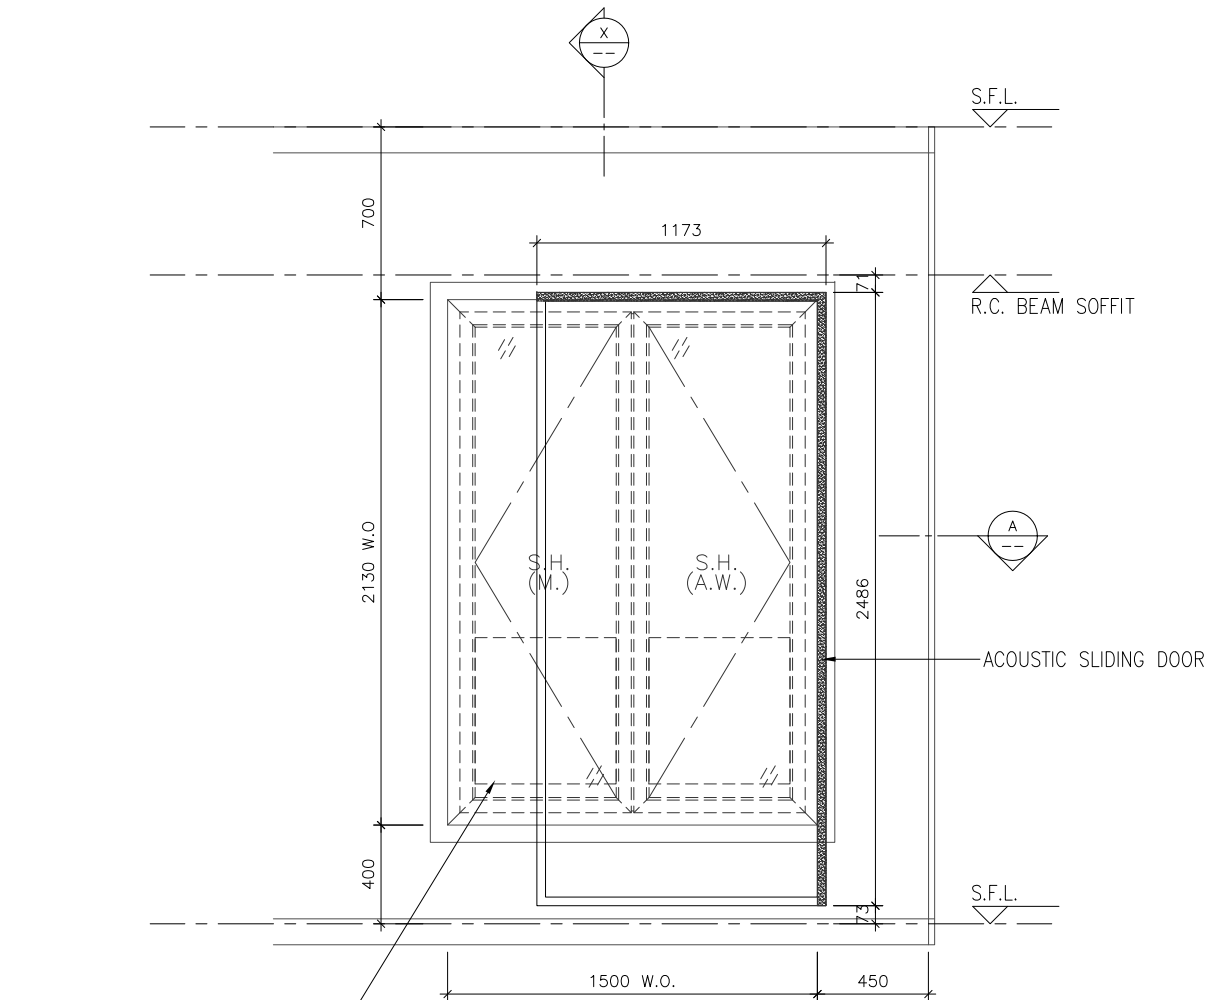

SECTION "X-X"

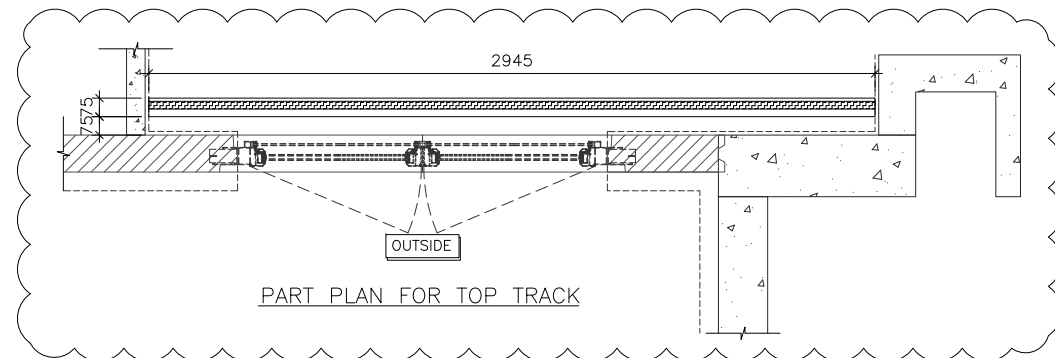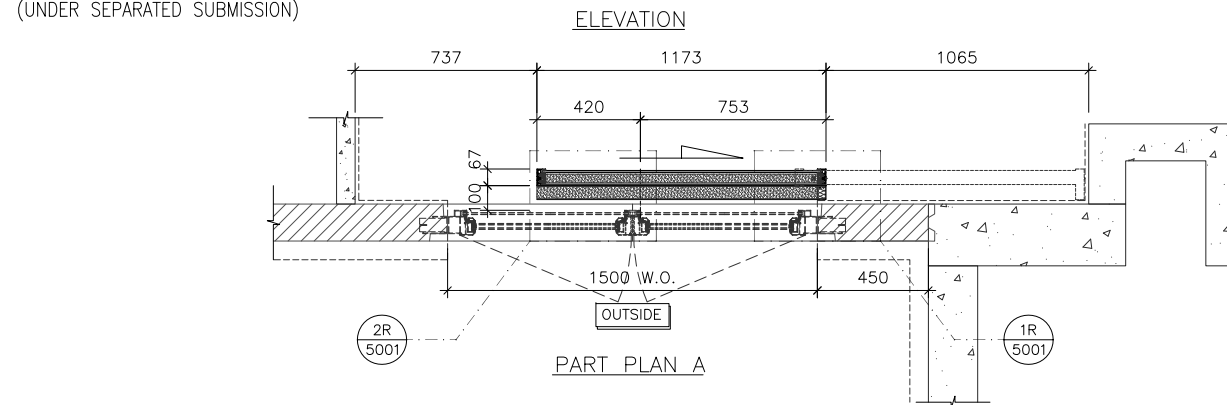

WINDOW MARK	W3 T3C
LOCATION	2/F-21/F M.B.R.1 AT TOWER 3 FLAT C
SECTION	-
GLAZING	-
QUANTITY	17
REMARKS	NSR: T3-02/TESTED CASE: W107D

B.D. REF :

CLIENT :

ARCHITECT :
AGC DESIGN LTD
AGC DESIGN LTD
101, 102, 103,1000

MAIN CONTRACTOR :
Gammon

STRUCTURAL ENGINEER :
ARUP

FACADE CONSULTANT:
MEINHARDT

NOTE :
1. ALL DIMENSIONS ARE IN mm.
2. ALL ELEVATIONS ARE VIEWED FROM OUTSIDE.
3. ALL DIMENSIONS TO BE VERIFIED ON SITE BEFORE FABRICATION.

LEGEND :
X1 - DETAIL MARK NO.
X001 - REFER SHEET NO.
1. F.F.L. -- FINISHED FLOOR LEVEL
2. S.F.L. -- STRUCTURAL FLOOR LEVEL
3. (R) -- REVERSED DETAIL

B	13-11-2020	REVISION SUBJECT TO COMMENTS	MN
A	24-08-2020	REVISION SUBJECT TO COMMENTS	MN
NO.	DATE	REVISED	BY

JOB NO. : J-852
PROJECT : PROPOSED RESIDENTIAL DEVELOPMENT AT 139 - 147 ARGYLE STREET, NKIL 6005, 6035 R.P., 6036 R.P., 6037 R.P. & 6038 R.P.



TITLE : PART ELEVATION, PLAN & SECTION FOR ACOUSTIC SLIDING DOOR

DATE : 20-Jul-20 SCALE : 1:30
DRAWN BY : LHR CHECKED BY : DW



美特鋁質有限公司
MIDI ALUMINIUM FABRICATOR LTD.
Units 6-8, Sunray Industrial Centre, 1/F
610 Cha Kwo Ling Road, Kowloon
Tel:23489211-4 Fax:(852)27727666

DWG NO. : J852-SD-ASD-4302 REV. : B

ELEVATION

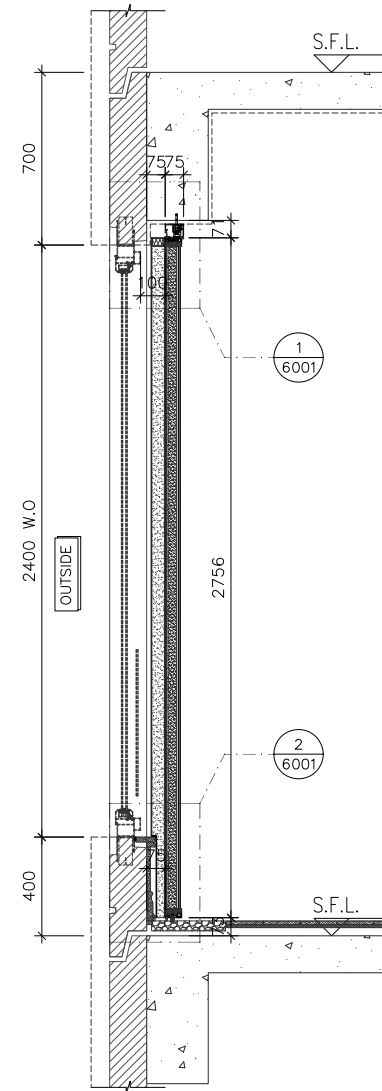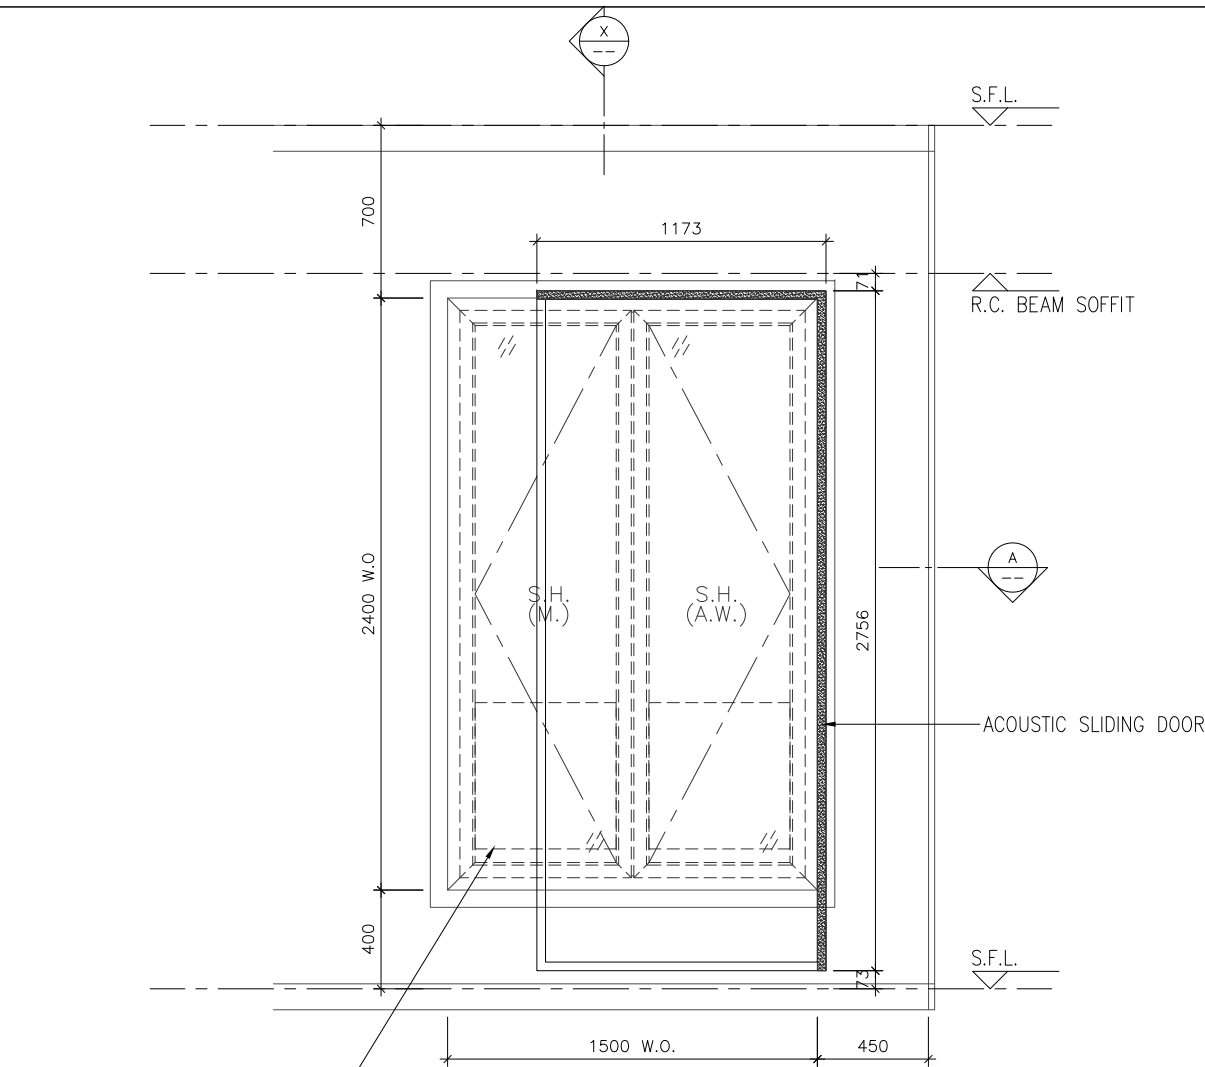

ALUM. WINDOW
(UNDER SEPARATED SUBMISSION)

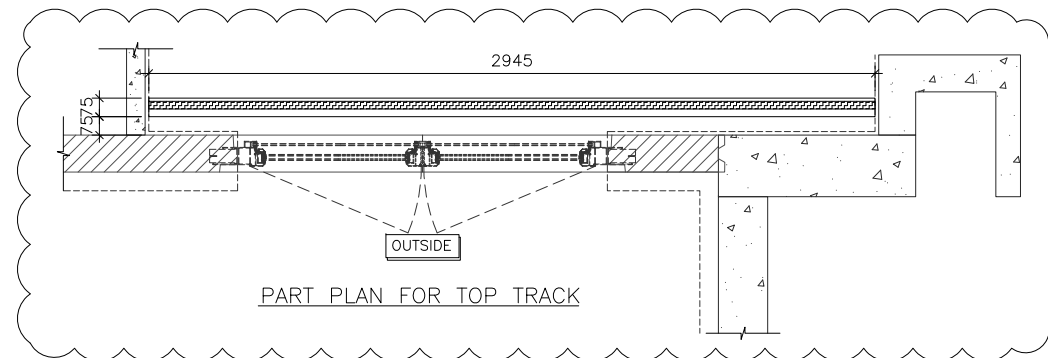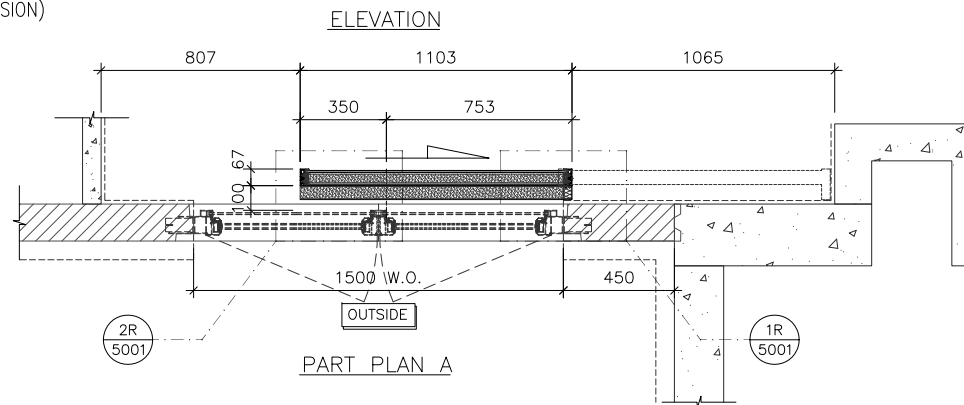

SECTION "X-X"

WINDOW MARK	22W3/T3C & 23W3/T3C
LOCATION	22/F~23/F M.B.R.1 AT TOWER 3 FLAT C
SECTION	-
GLAZING	-
QUANTITY	2
REMARKS	NSR: T3-02/TESTED CASE: W107C

B.D. REF :

CLIENT :

ARCHITECT :
AGC DESIGN LTD
101, 102, 103,1000

MAIN CONTRACTOR :
Gammon

STRUCTURAL ENGINEER :
ARUP

FACADE CONSULTANT:
MEINHARDT

NOTE :
1. ALL DIMENSIONS ARE IN mm.
2. ALL ELEVATIONS ARE VIEWED FROM OUTSIDE.
3. ALL DIMENSIONS TO BE VERIFIED ON SITE BEFORE FABRICATION.

LEGEND :
X1 --- DETAIL MARK NO.
X001 --- REFER SHEET NO.
1. F.F.L. --- FINISHED FLOOR LEVEL
2. S.F.L. --- STRUCTURAL FLOOR LEVEL
3. (R) --- REVERSED DETAIL

B	13-11-2020	REVISION SUBJECT TO COMMENTS	MN
A	24-08-2020	REVISION SUBJECT TO COMMENTS	MN
NO.	DATE	REVISED	BY




JOB NO. : J-852
PROJECT : PROPOSED RESIDENTIAL DEVELOPMENT AT 139 - 147 ARGYLE STREET, NKIL 6005, 6035 R.P., 6036 R.P., 6037 R.P. & 6038 R.P.

TITLE : PART ELEVATION, PLAN & SECTION FOR ACOUSTIC SLIDING DOOR

DATE : 20-Jul-20 SCALE : 1:30
DRAWN BY : LHR CHECKED BY : DW

美特鋁質有限公司
MIDI ALUMINIUM FABRICATOR LTD.
Units 6-8, Sunray Industrial Centre, 1/F
610 Cha Kwo Ling Road, Kowloon
Tel:23489211-4 Fax:(852)27727666
DWG NO. : J852-SD-ASD-4302A REV. : B

ELEVATION

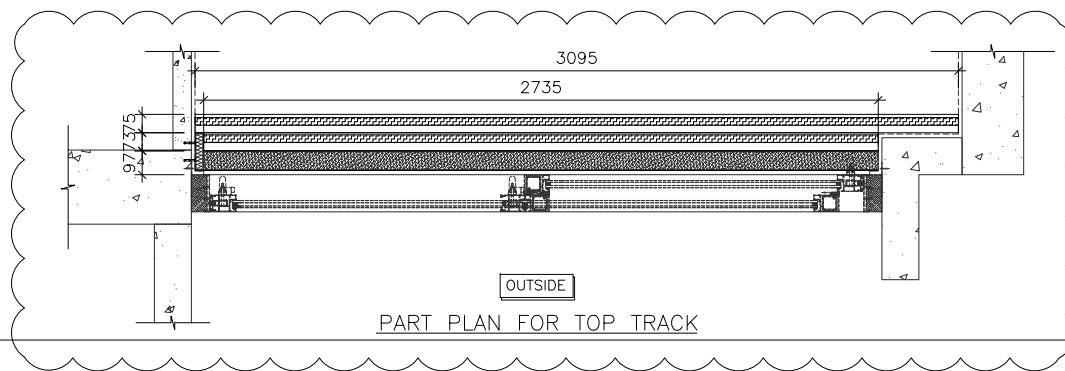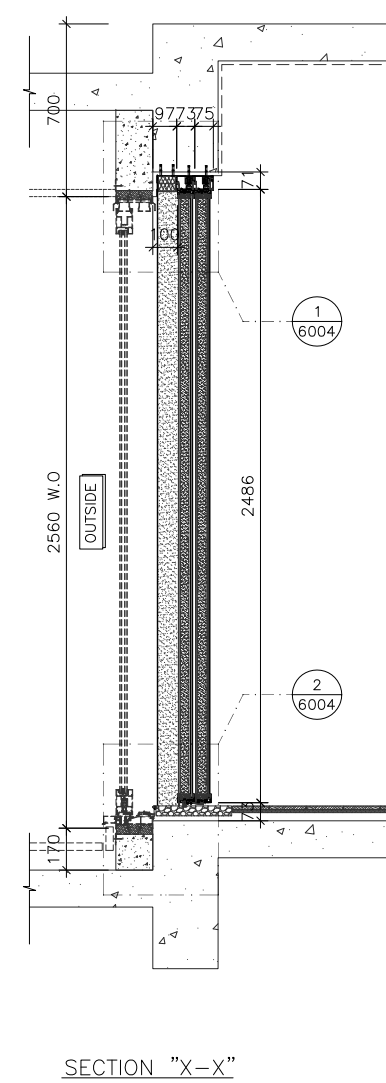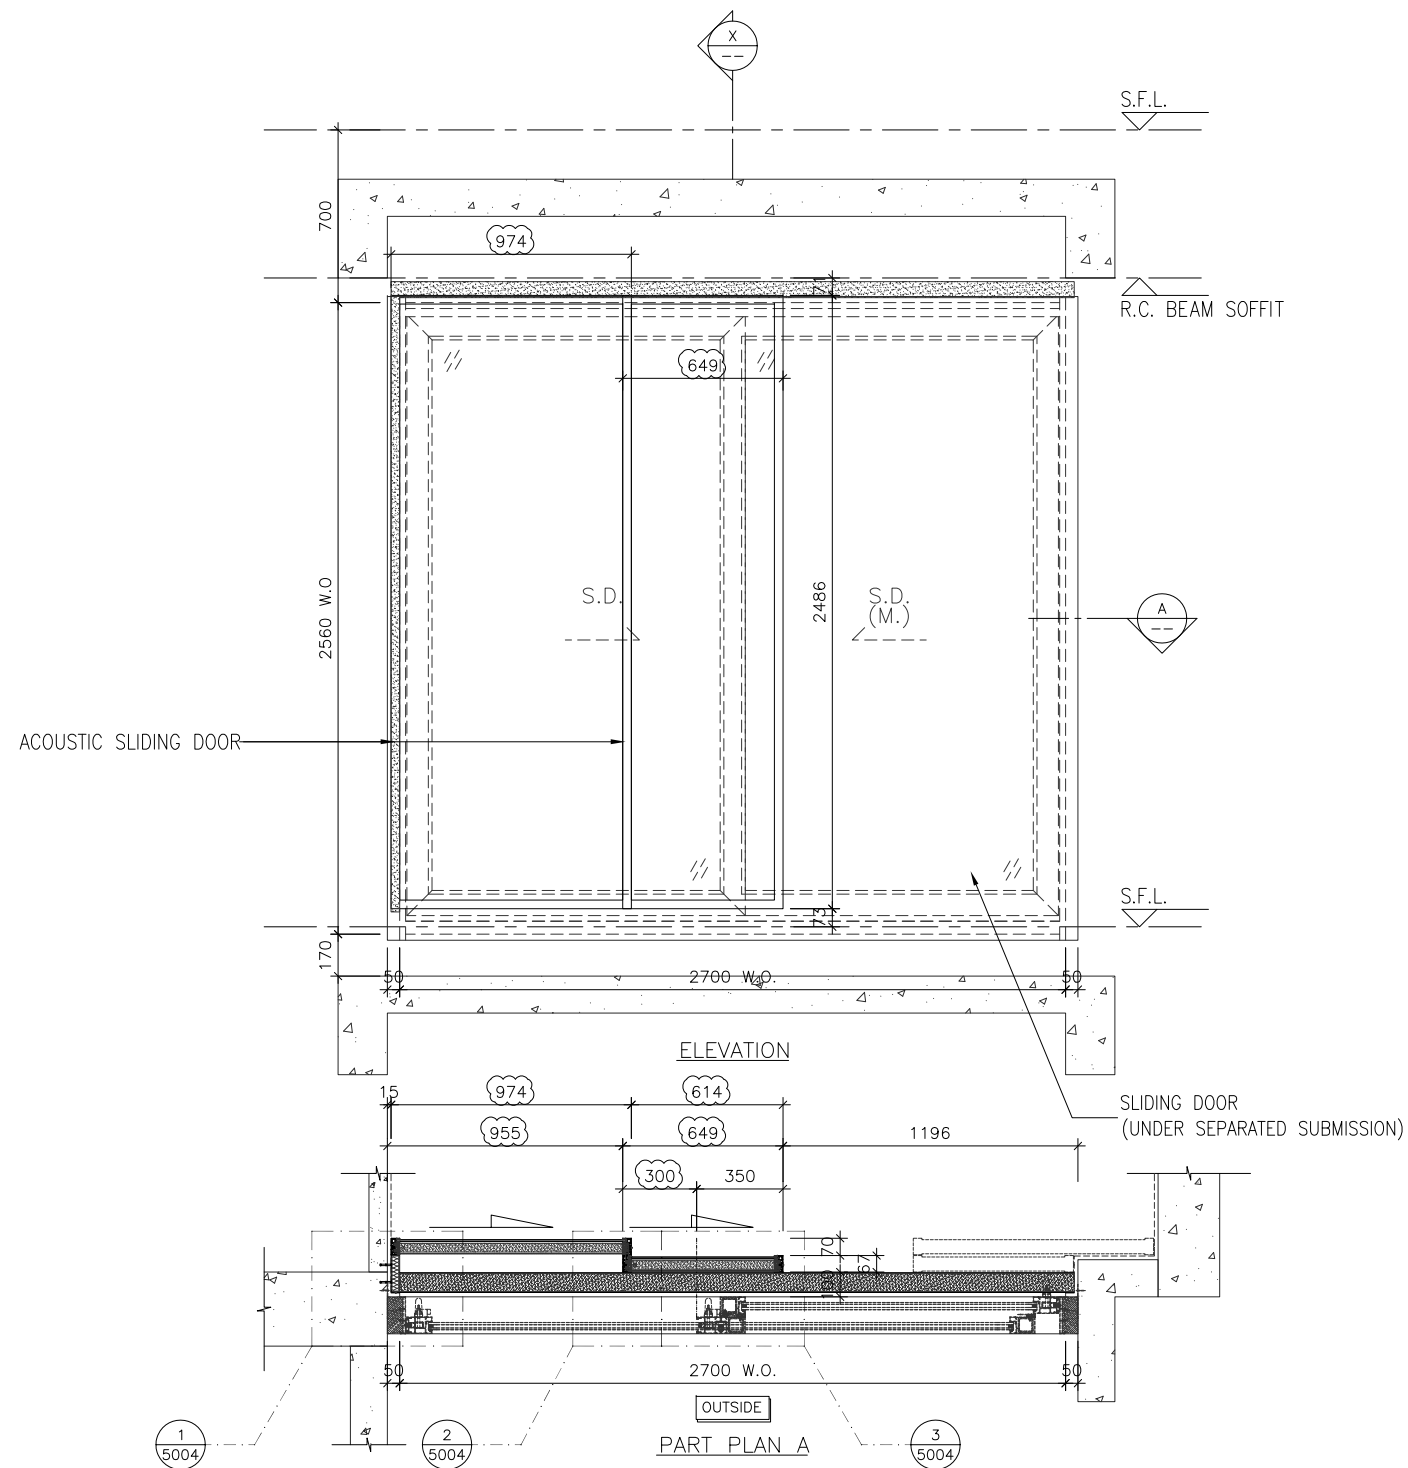

WINDOW MARK	W1 T3C
LOCATION	1/F~21/F LIV./DIN. AT TOWER 3 FLAT C
SECTION	
GLAZING	
QUANTITY	18
REMARKS	NSR: T3-03/TESTED CASE: W110B

B.D. REF :

CLIENT :

ARCHITECT :
AGC DESIGN LTD
 101, 102, 103,1000

MAIN CONTRACTOR :
Gammon

STRUCTURAL ENGINEER :
ARUP

FACADE CONSULTANT:
MEINHARDT

- NOTE :
1. ALL DIMENSIONS ARE IN mm.
 2. ALL ELEVATIONS ARE VIEWED FROM OUTSIDE.
 3. ALL DIMENSIONS TO BE VERIFIED ON SITE BEFORE FABRICATION.
- LEGEND :
- x1 --- DETAIL MARK NO.
 - x001 --- REFER SHEET NO.
1. F.F.L. --- FINISHED FLOOR LEVEL
 2. S.F.L. --- STRUCTURAL FLOOR LEVEL
 3. (A) --- REVERSED DETAIL

B	13-11-2020	REVISION SUBJECT TO COMMENTS	MN
A	24-08-2020	REVISION SUBJECT TO COMMENTS	MN
NO.	DATE	REVISED	BY

JOB NO. : J-852
 PROJECT : PROPOSED RESIDENTIAL DEVELOPMENT AT 139 - 147 ARGYLE STREET, NKIL 6005, 6035 R.P., 6036 R.P., 6037 R.P. & 6038 R.P.



TITLE : PART ELEVATION, PLAN & SECTION FOR ACOUSTIC SLIDING DOOR

DATE : 20-Jul-20 SCALE : 1:30
 DRAWN BY : LHR CHECKED BY : DW



美特鋁質有限公司
MIDI ALUMINIUM FABRICATOR LTD.
 Units 6-8, Sunray Industrial Centre, 1/F
 610 Cha Kwo Ling Road, Kowloon
 Tel:23489211-4 Fax:(852)27727666

DWG NO. : J852-SD-ASD-4303 REV. : B

ELEVATION

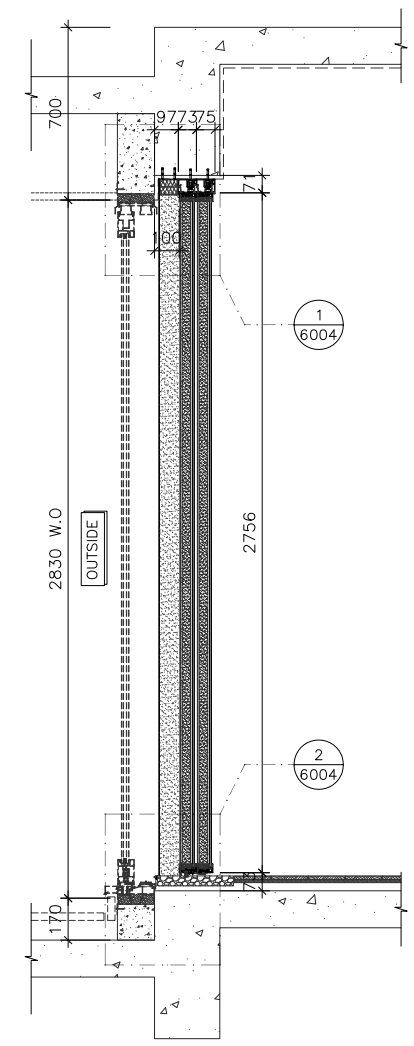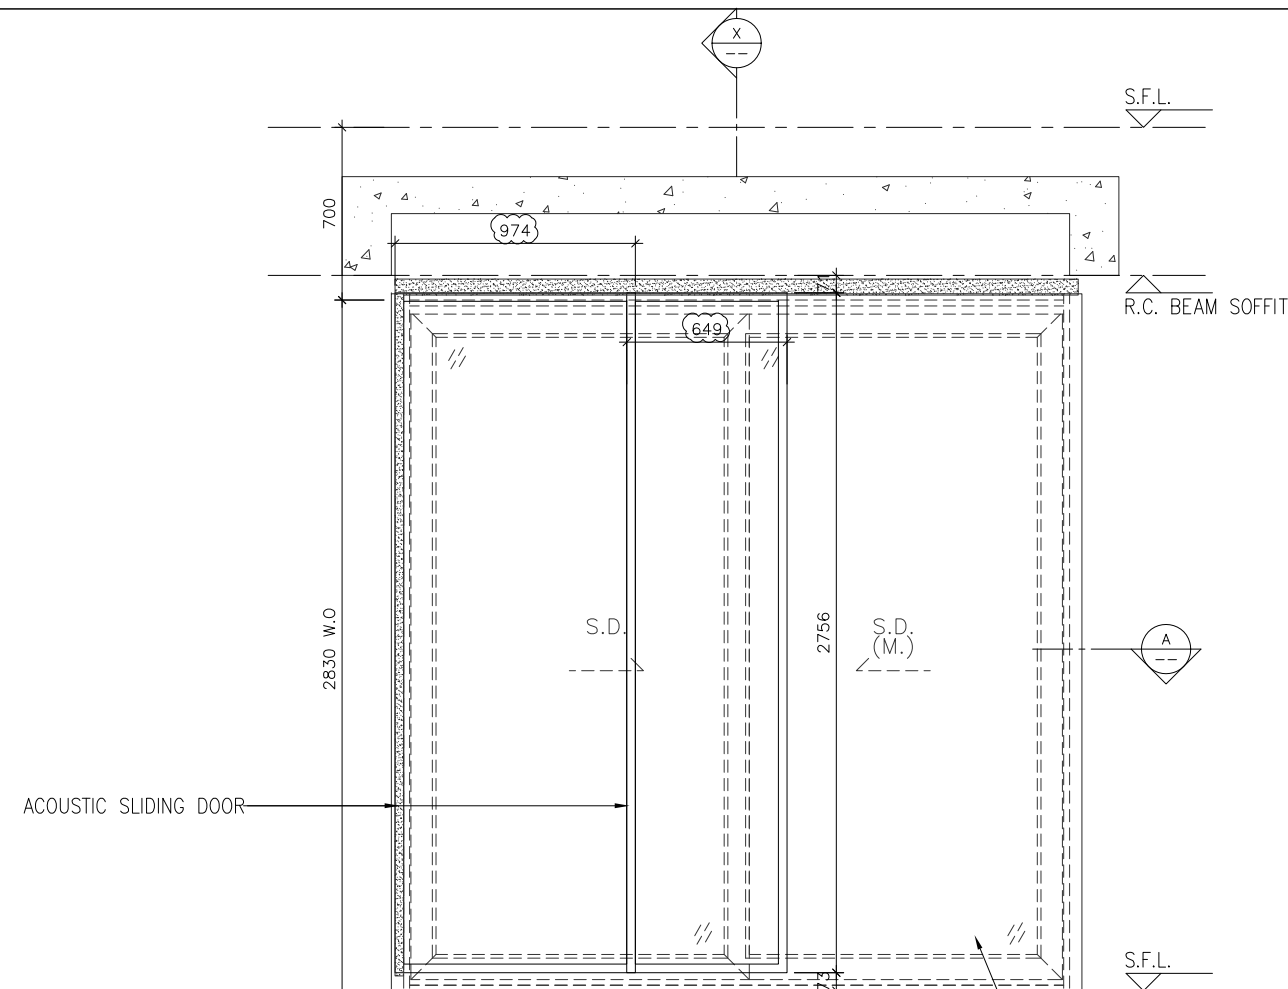

SECTION "X-X"

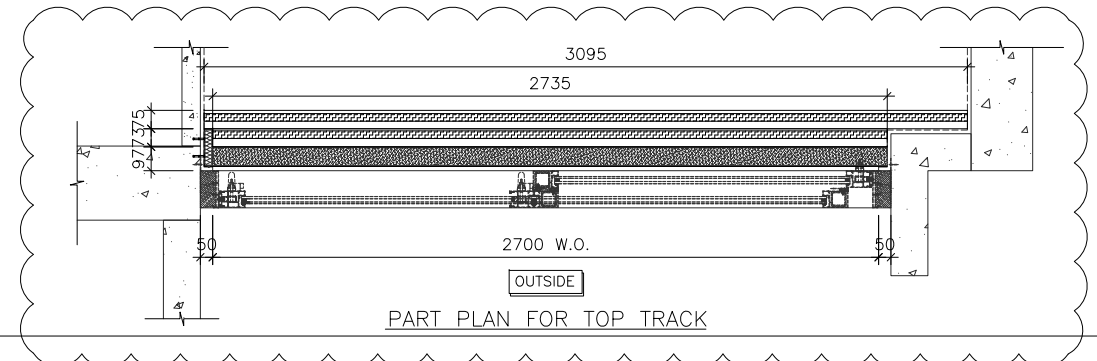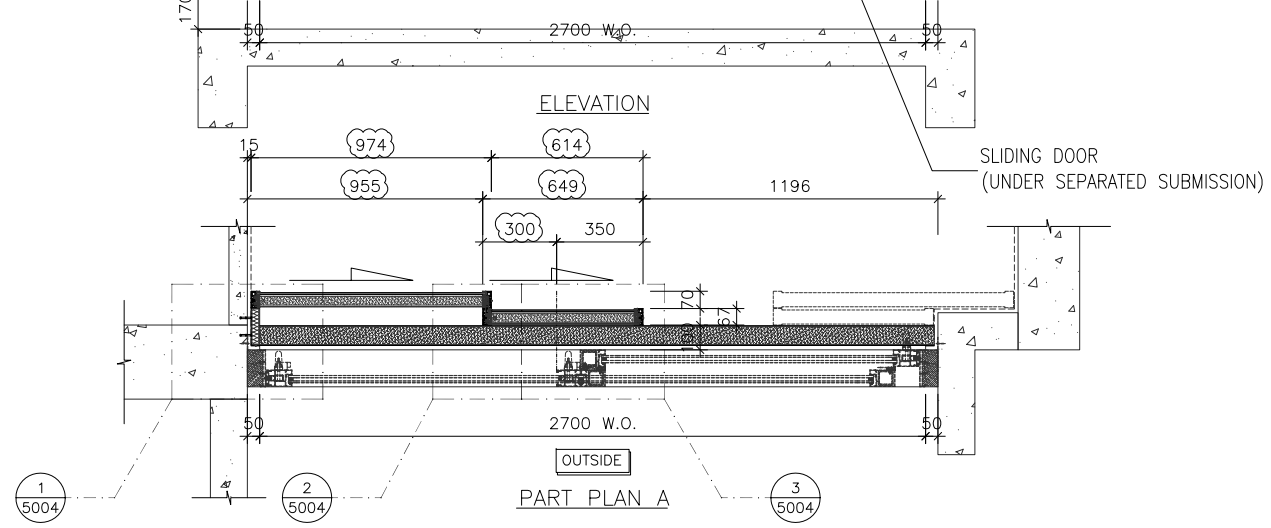

WINDOW MARK

LOCATION 22/F~23/F LIV./DIN. AT TOWER 3 FLAT C

SECTION -

GLAZING -

QUANTITY 2

REMARKS NSR: T3-03/TESTED CASE: W110A

B.D. REF :

CLIENT :

ARCHITECT :
AGC DESIGN LTD
101, 102, 103,1000

MAIN CONTRACTOR :
Gammon

STRUCTURAL ENGINEER :
ARUP

FACADE CONSULTANT:
MEINHARDT

NOTE :
1. ALL DIMENSIONS ARE IN mm.
2. ALL ELEVATIONS ARE VIEWED FROM OUTSIDE.
3. ALL DIMENSIONS TO BE VERIFIED ON SITE BEFORE FABRICATION.

LEGEND :
x1 --- DETAIL MARK NO.
x001 --- REFER SHEET NO.

1. F.F.L. --- FINISHED FLOOR LEVEL
2. S.F.L. --- STRUCTURAL FLOOR LEVEL
3. (R) --- REVERSED DETAIL

B	13-11-2020	REVISION SUBJECT TO COMMENTS	MN
A	24-08-2020	REVISION SUBJECT TO COMMENTS	MN
NO.	DATE	REVISED	BY

JOB NO. : J-852
PROJECT : PROPOSED RESIDENTIAL DEVELOPMENT AT 139 - 147 ARGYLE STREET, NKIL 6005, 6035 R.P., 6036 R.P., 6037 R.P. & 6038 R.P.

TITLE : PART ELEVATION, PLAN & SECTION FOR ACOUSTIC SLIDING DOOR


DATE : 20-Jul-20 SCALE : 1:30

DRAWN BY : LHR CHECKED BY : DW


美特鋁質有限公司
MIDI ALUMINIUM FABRICATOR LTD.
Units 6-8, Sunray Industrial Centre, 1/F
610 Cha Kwo Ling Road, Kowloon
Tel:23489211-4 Fax:(852)2727666

DWG NO. : J852-SD-ASD-4303A REV. : B


ELEVATION

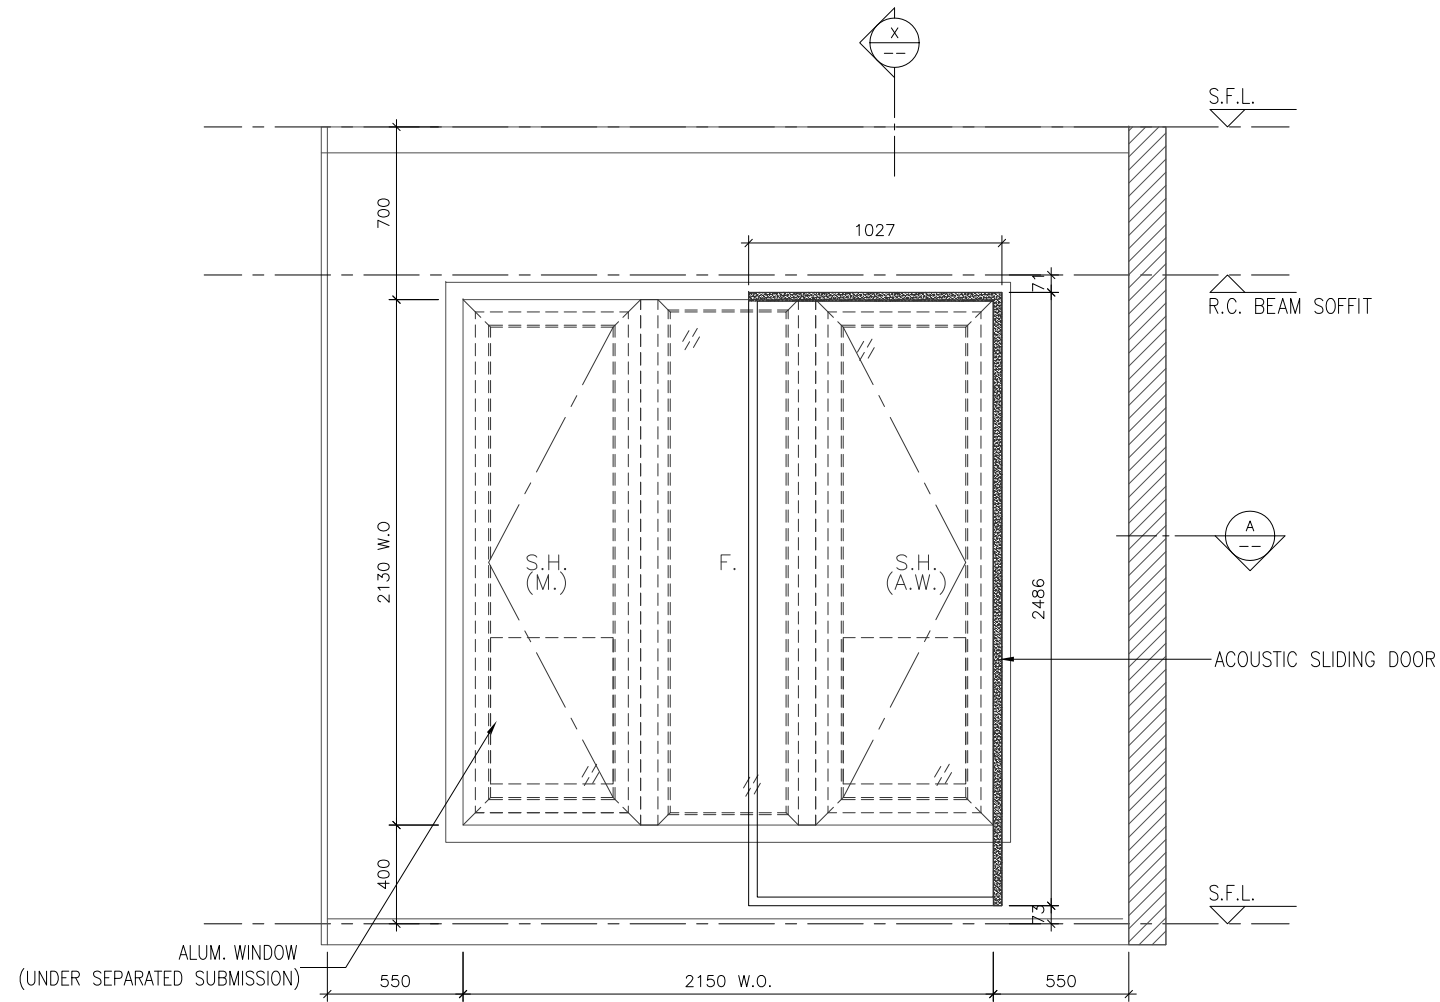


ELEVATION

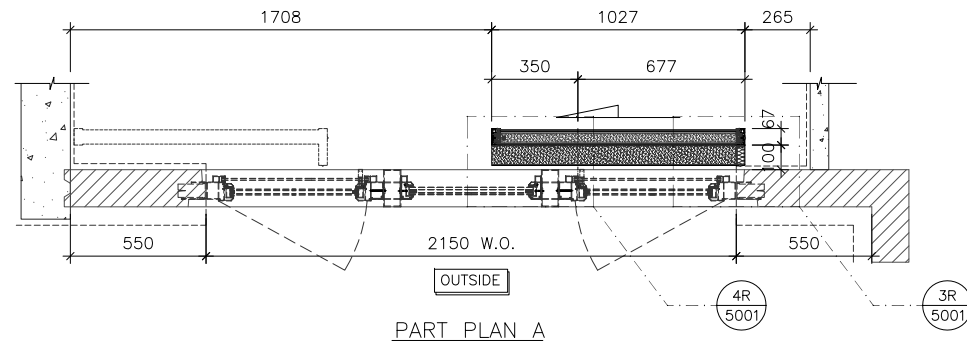

PART PLAN A

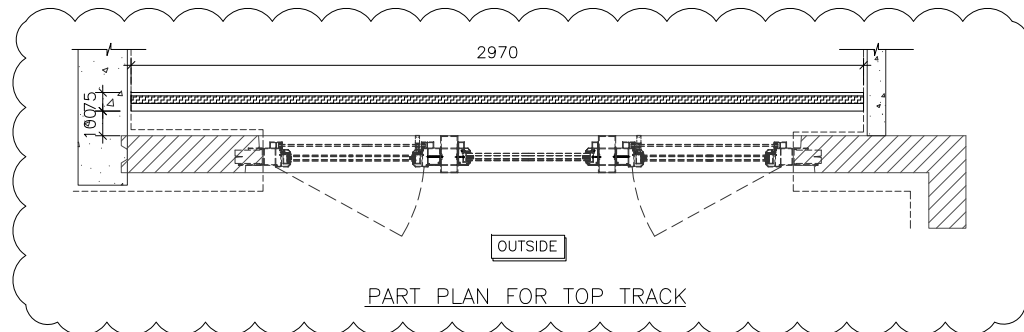

PART PLAN FOR TOP TRACK

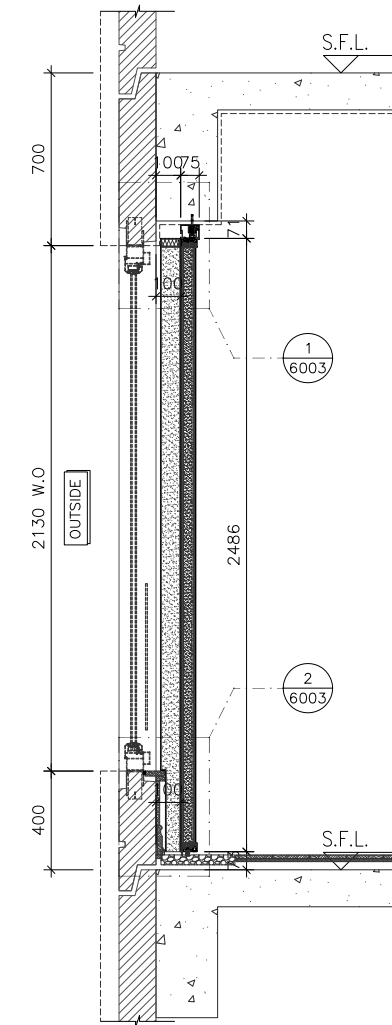

SECTION "X-X"

B.D. REF :

CLIENT :

ARCHITECT :

AGC
DESIGN LTD

MAIN CONTRACTOR :

Gammon

STRUCTURAL ENGINEER :

ARUP

FACADE CONSULTANT:

MEINHARDT

NOTE :

1. ALL DIMENSIONS ARE IN mm.
2. ALL ELEVATIONS ARE VIEWED FROM OUTSIDE.
3. ALL DIMENSIONS TO BE VERIFIED ON SITE BEFORE FABRICATION.

LEGEND :

- x1 — DETAIL MARK NO.
- x001 — REFER SHEET NO.

1. F.F.L. -- FINISHED FLOOR LEVEL
2. S.F.L. -- STRUCTURAL FLOOR LEVEL
3. (R) -- REVERSED DETAIL

NO.	DATE	REVISED	BY
B	13-11-2020	REVISION SUBJECT TO COMMENTS	MN
A	24-08-2020	REVISION SUBJECT TO COMMENTS	MN

JOB NO. : J-852

PROJECT :
PROPOSED RESIDENTIAL DEVELOPMENT
AT 139 - 147 ARGYLE STREET,
NKIL 6005, 6035 R.P., 6036 R.P.,
6037 R.P. & 6038 R.P.

TITLE :
PART ELEVATION, PLAN & SECTION
FOR ACOUSTIC SLIDING DOOR

DATE : 20-Jul-20 SCALE : 1:30

DRAWN BY : LHR CHECKED BY : DW

美特鋁質有限公司
MIDI ALUMINIUM FABRICATOR LTD.
Units 6-8, Sunray Industrial Centre, 1/F
610 Cha Kwo Ling Road, Kowloon
Tel:23489211-4 Fax:(852)2727666

DWG NO. : J852-SD-ASD-4304 REV. : B

WINDOW MARK

W7
T3B

LOCATION 3/F-21/F B.R.1. AT TOWER 3 FLAT B


SECTION -

GLAZING -


QUANTITY 16

REMARKS NSR: T3-04/TESTED CASE: W107A


ELEVATION

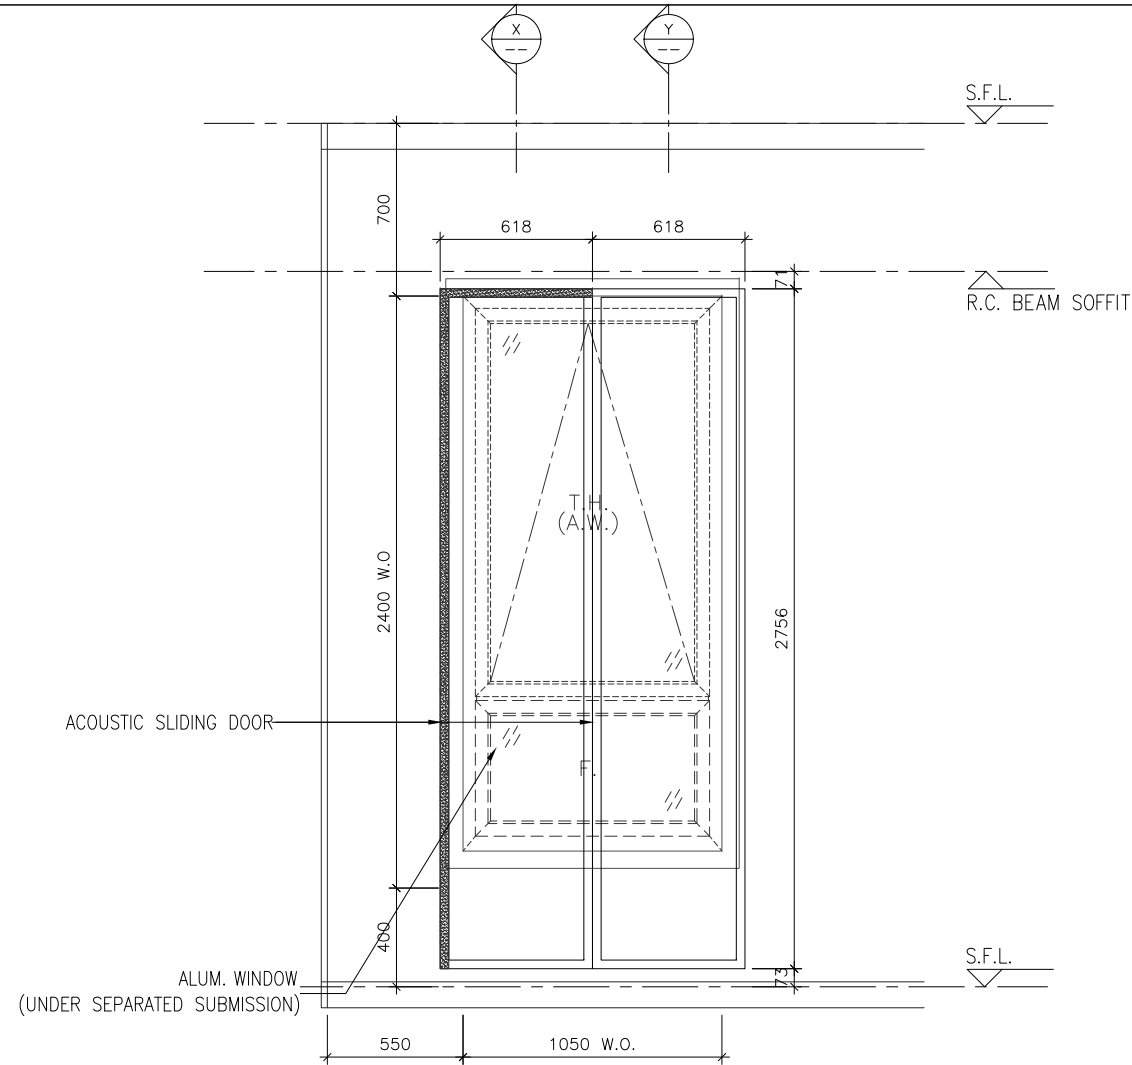


ELEVATION

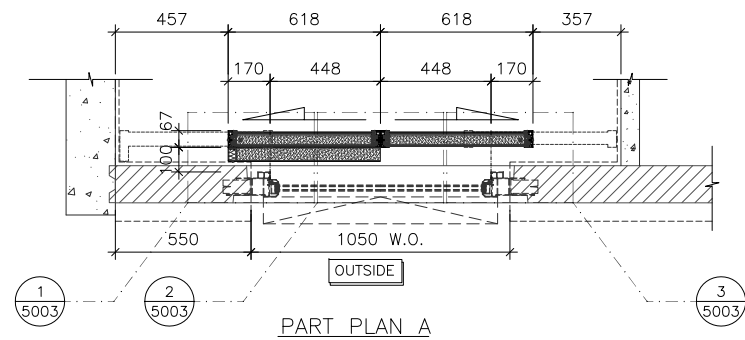


PART PLAN A

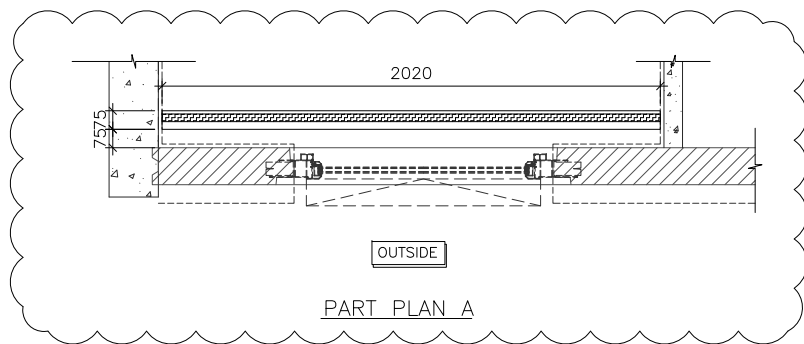

PART PLAN A

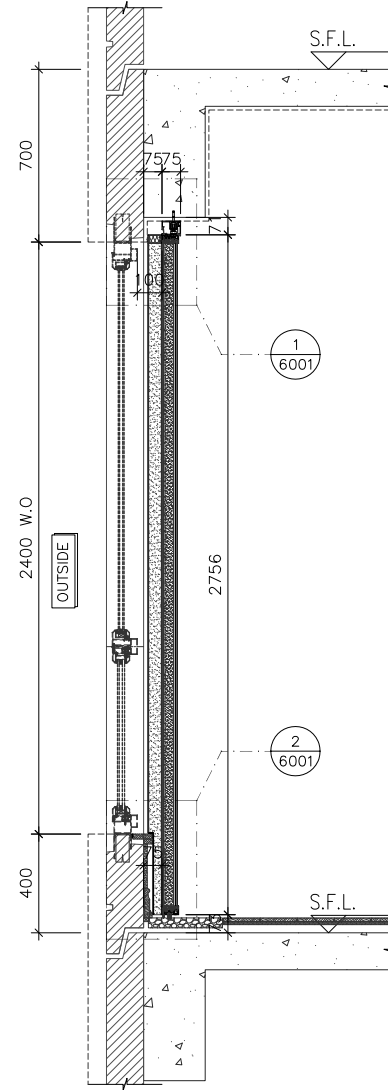

SECTION "X-X"

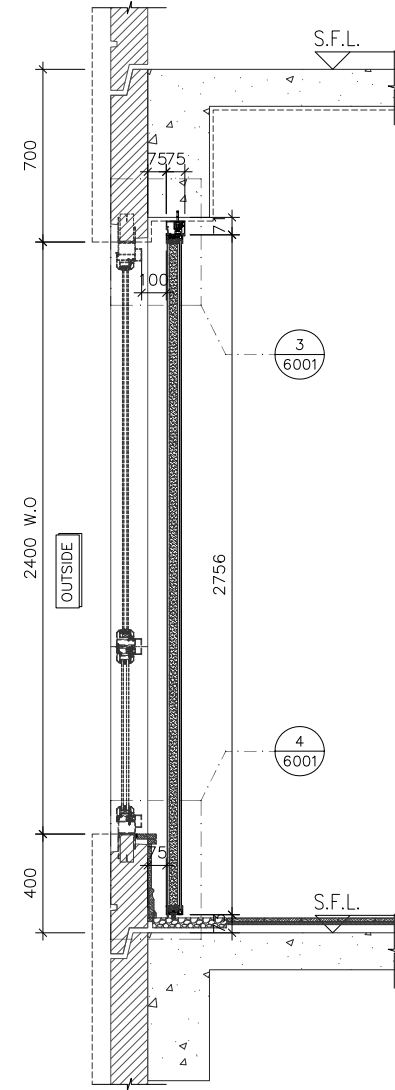

SECTION "Y-Y"

B.D. REF :

CLIENT :

ARCHITECT :
AGC DESIGN LTD

MAIN CONTRACTOR :
Gammon

STRUCTURAL ENGINEER :
ARUP

FACADE CONSULTANT:
MEINHARDT

NOTE :
1. ALL DIMENSIONS ARE IN mm.
2. ALL ELEVATIONS ARE VIEWED FROM OUTSIDE.
3. ALL DIMENSIONS TO BE VERIFIED ON SITE BEFORE FABRICATION.

LEGEND :
x1 — DETAIL MARK NO.
x001 — REFER SHEET NO.

1. F.F.L. -- FINISHED FLOOR LEVEL
2. S.F.L. -- STRUCTURAL FLOOR LEVEL
3. (R) -- REVERSED DETAIL

NO.	DATE	REVISED	BY
B	13-11-2020	REVISION SUBJECT TO COMMENTS	MN
A	24-08-2020	REVISION SUBJECT TO COMMENTS	MN

JOB NO. : J-852

PROJECT :
PROPOSED RESIDENTIAL DEVELOPMENT
AT 139 - 147 ARGYLE STREET,
NKIL 6005, 6035 R.P., 6036 R.P.,
6037 R.P. & 6038 R.P.

TITLE :
PART ELEVATION, PLAN & SECTION
FOR ACOUSTIC SLIDING DOOR

DATE : 20-Jul-20 SCALE : 1:30



DRAWN BY : LHR CHECKED BY : DW

美特鋁質有限公司
MIDI ALUMINIUM FABRICATOR LTD.
Units 6-8, Sunray Industrial Centre, 1/F
610 Cha Kwo Ling Road, Kowloon
Tel:23489211-4 Fax:(852)2727666


DWG NO. : J852-SD-ASD-4304A REV. : B

WINDOW MARK	22W13 & 23W13 T3A & T3A
LOCATION	22/F & 23/F EN.3 AT TOWER 3 FLAT A
SECTION	-
GLAZING	-
QUANTITY	2
REMARKS	NSR: T3-04/TESTED CASE: W109


ELEVATION

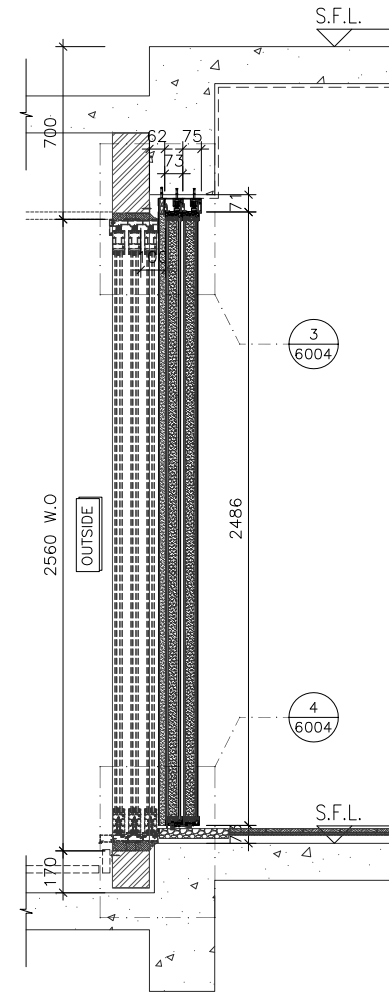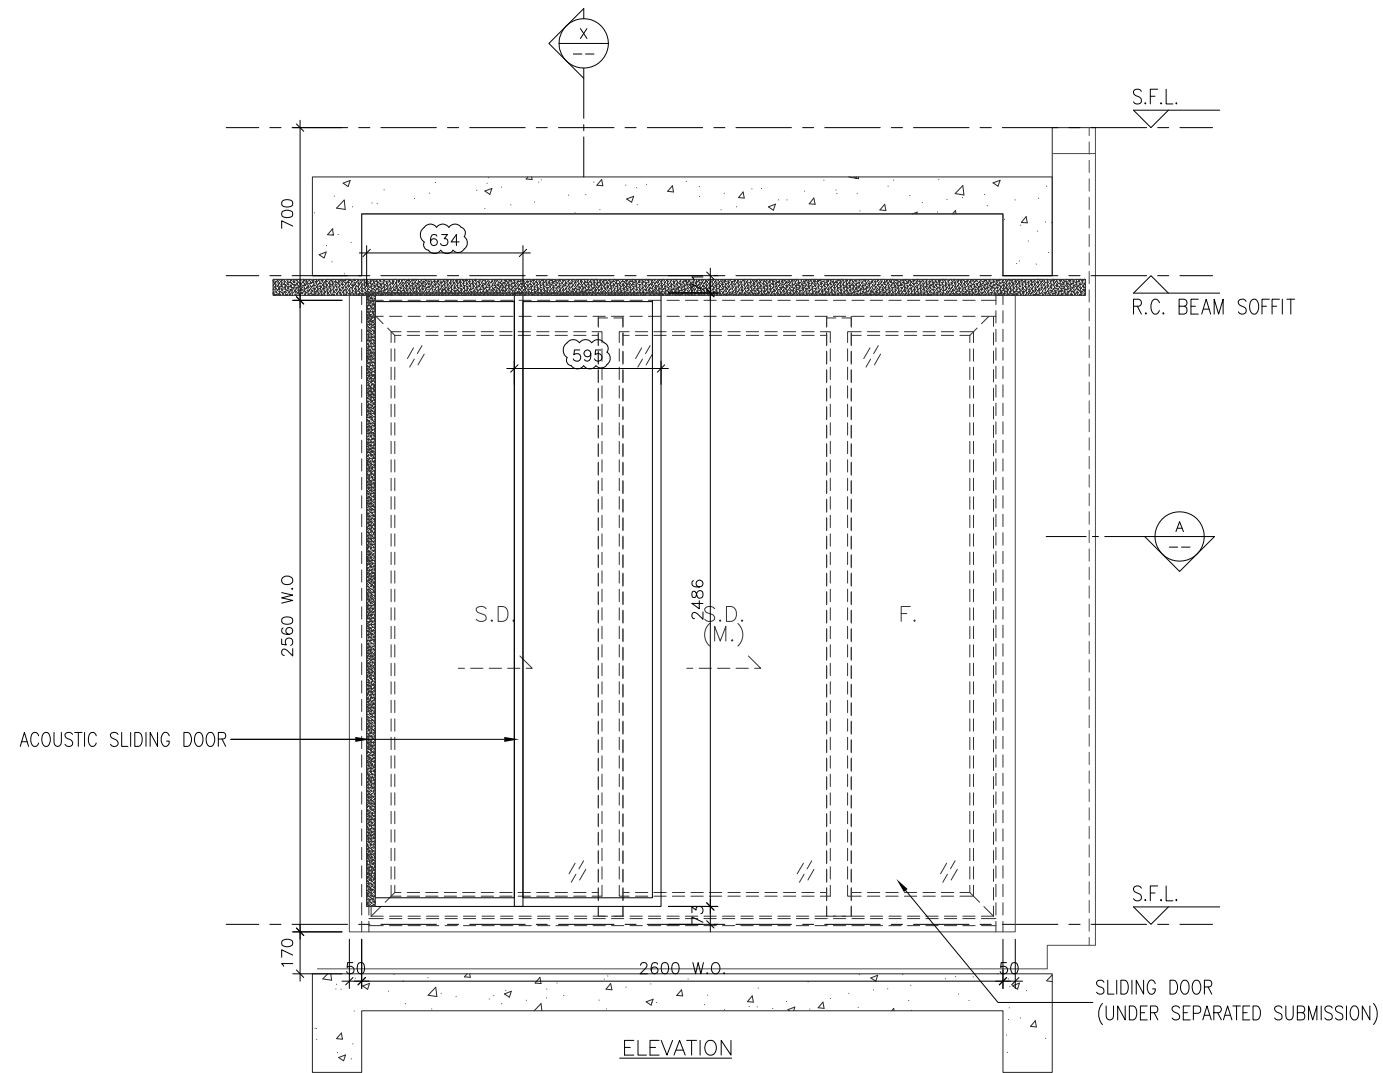

SECTION "X-X"

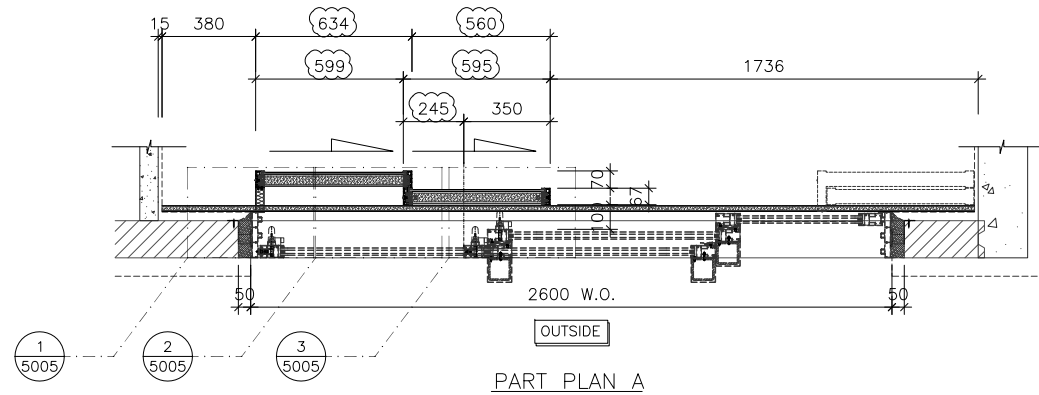

PART PLAN A

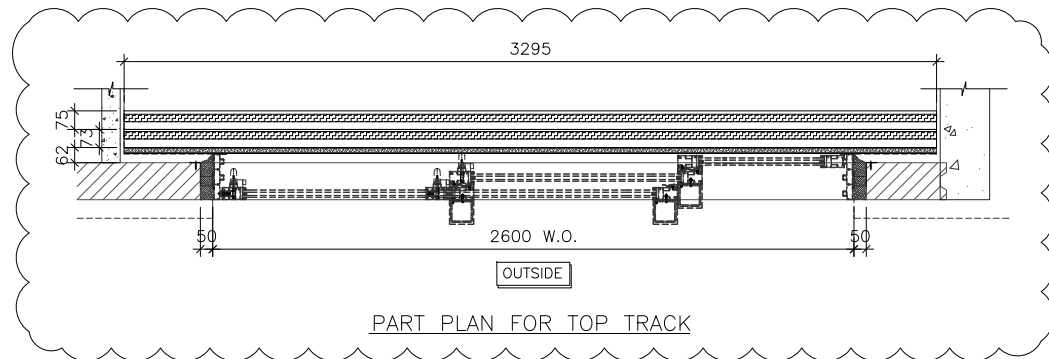

PART PLAN FOR TOP TRACK

WINDOW MARK
W6
T3B

LOCATION 3/F~21/F ENSUITE AT TOWER 3 FLAT B

SECTION -

GLAZING -

QUANTITY 16

REMARKS NSR: T3-05/TESTED CASE: W103A

B.D. REF :

CLIENT :

ARCHITECT :

AGC
DESIGN LTD

MAIN CONTRACTOR :

Gammon

STRUCTURAL ENGINEER :

ARUP

FACADE CONSULTANT:

MEINHARDT

NOTE :

1. ALL DIMENSIONS ARE IN mm.
2. ALL ELEVATIONS ARE VIEWED FROM OUTSIDE.
3. ALL DIMENSIONS TO BE VERIFIED ON SITE BEFORE FABRICATION.

LEGEND :

- (X1) --- DETAIL MARK NO.
- (X001) --- REFER SHEET NO.

1. F.F.L. -- FINISHED FLOOR LEVEL
2. S.F.L. -- STRUCTURAL FLOOR LEVEL
3. (R) -- REVERSED DETAIL

NO.	DATE	REVISION	BY
B	13-11-2020	REVISION SUBJECT TO COMMENTS	MN
A	24-08-2020	REVISION SUBJECT TO COMMENTS	MN

JOB NO. : J-852

PROJECT :
PROPOSED RESIDENTIAL DEVELOPMENT
AT 139 - 147 ARGYLE STREET,
NKIL 6005, 6035 R.P., 6036 R.P.,
6037 R.P. & 6038 R.P.

TITLE :
PART ELEVATION, PLAN & SECTION
FOR ACOUSTIC SLIDING DOOR






DATE : 20-Jul-20 SCALE : 1:30

DRAWN BY : LHR CHECKED BY : DW

美特鋁質有限公司
MIDI ALUMINIUM FABRICATOR LTD.
Units 6-8, Sunray Industrial Centre, 1/F
610 Cha Kwo Ling Road, Kowloon
Tel:23489211-4 Fax:(852)27727666

DWG NO. : J852-SD-ASD-4305 REV. : B

ELEVATION

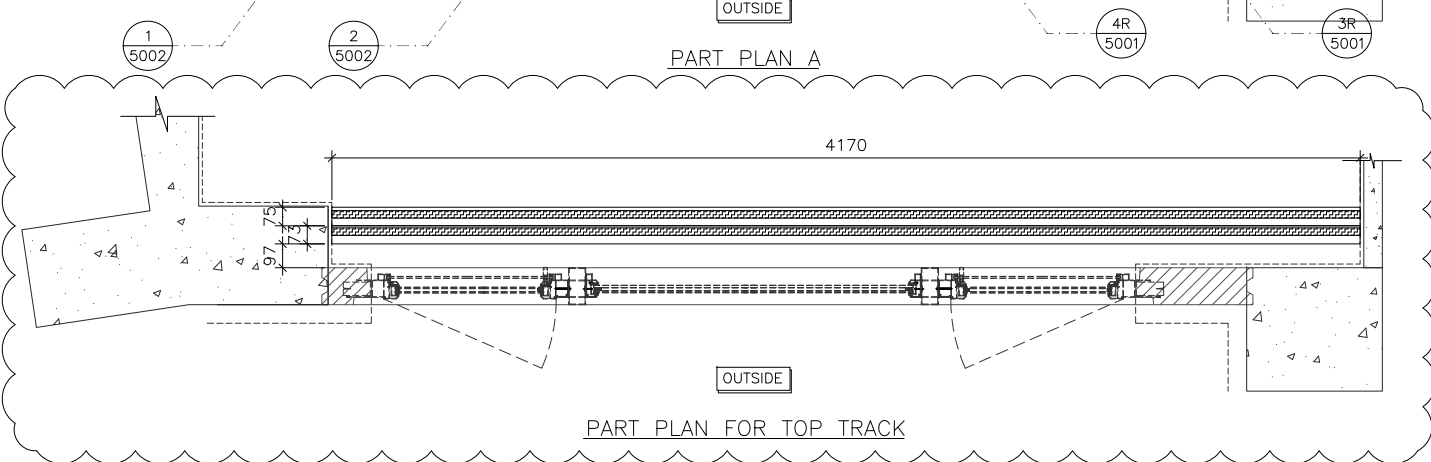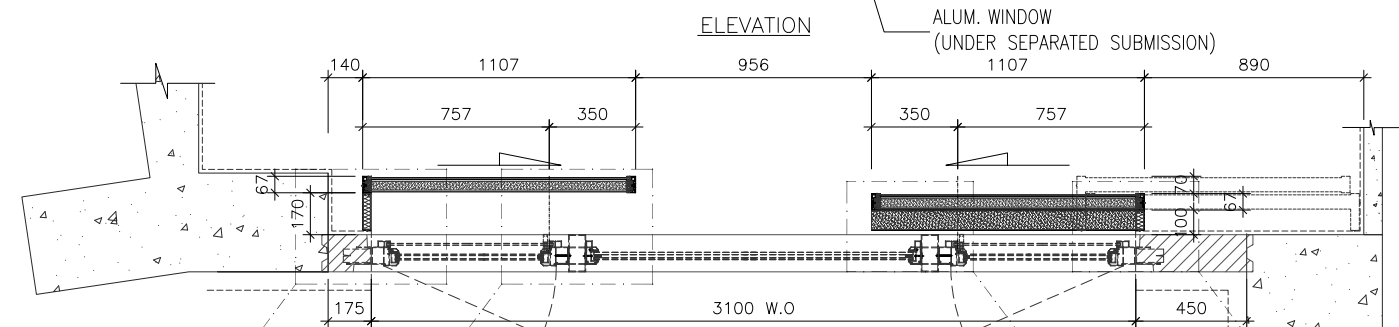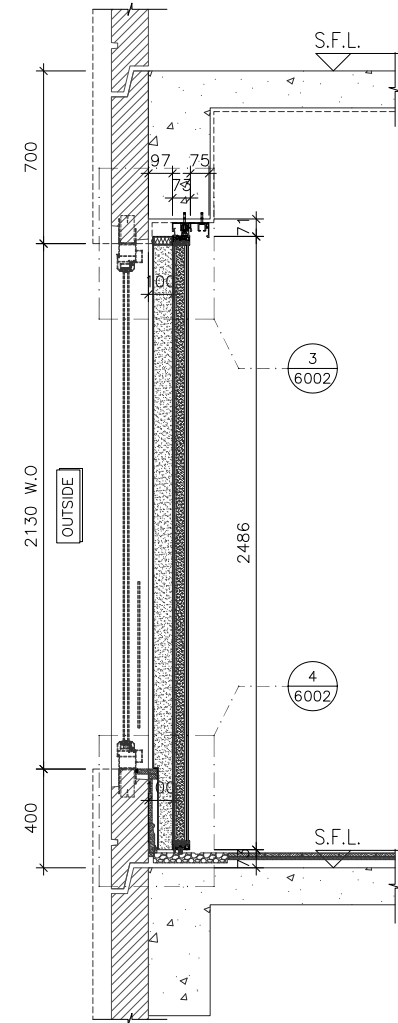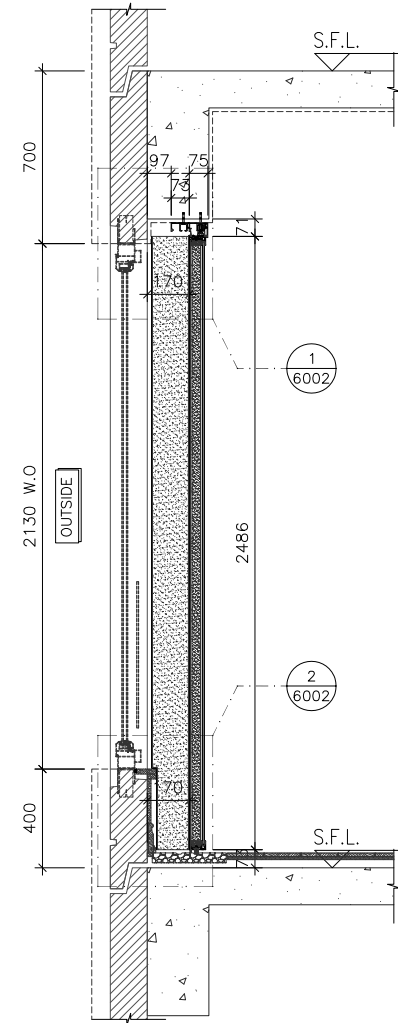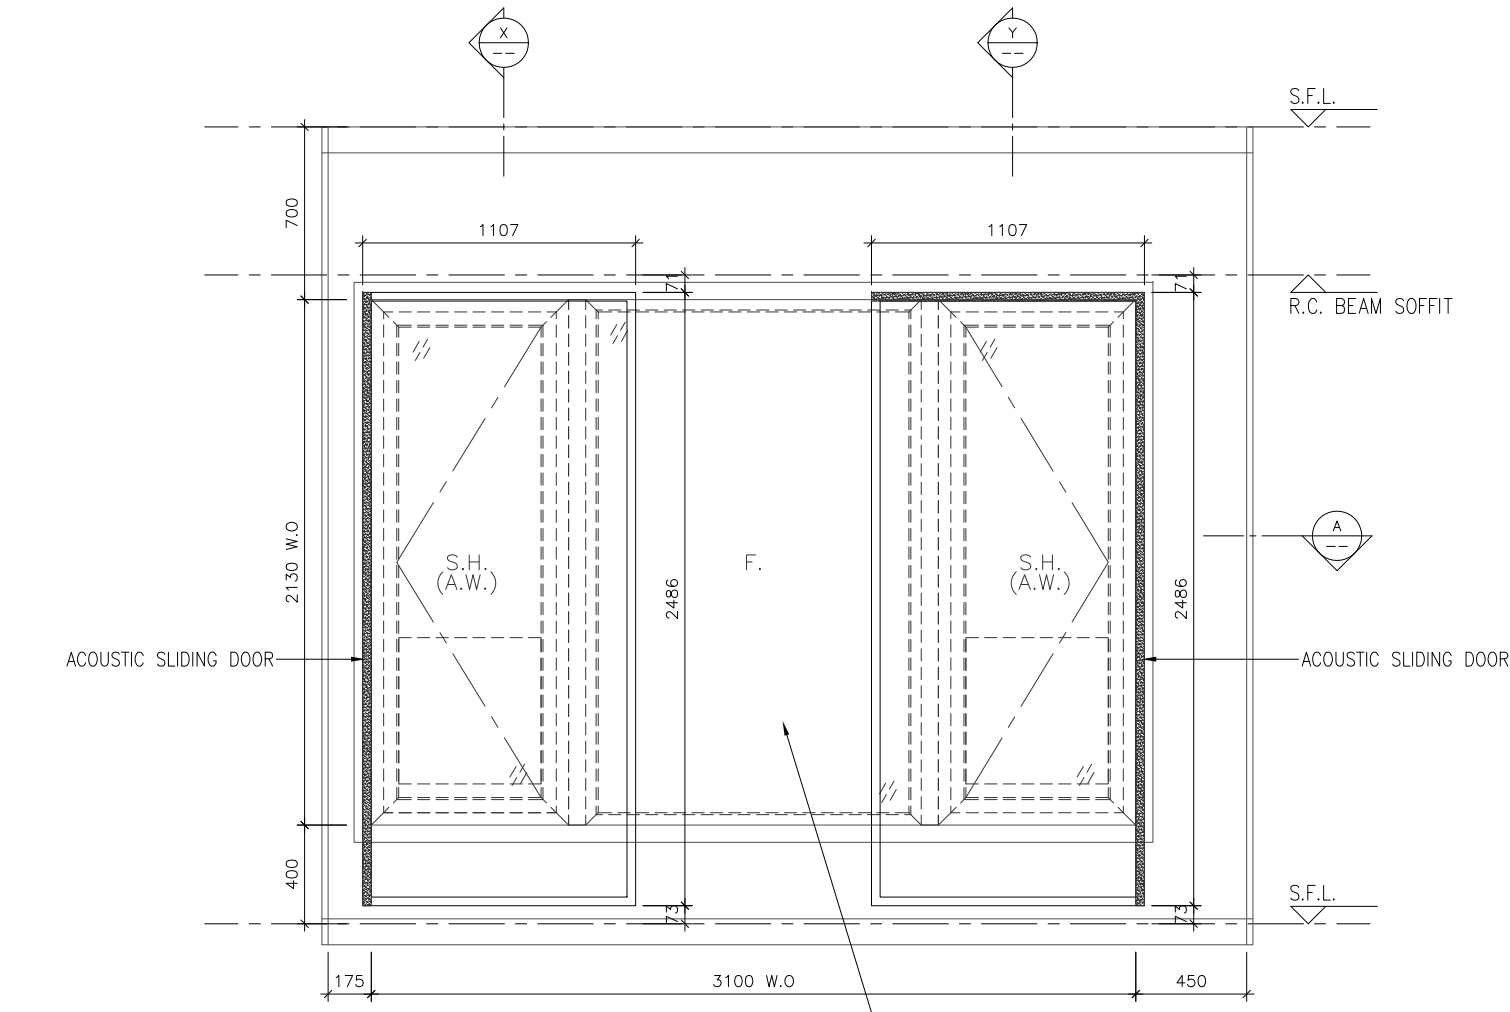

WINDOW MARK	W3 T3B
LOCATION	1/F MASTER ENSUITE AT TOWER 3 FLAT B
SECTION	-
GLAZING	-
QUANTITY	1
REMARKS	NSR: T3-06/TESTED CASE: W105

B.D. REF :

CLIENT :

ARCHITECT :
AGC DESIGN LTD

MAIN CONTRACTOR :
Gammon

STRUCTURAL ENGINEER :
ARUP

FACADE CONSULTANT:
MEINHARDT

NOTE :
1. ALL DIMENSIONS ARE IN mm.
2. ALL ELEVATIONS ARE VIEWED FROM OUTSIDE.
3. ALL DIMENSIONS TO BE VERIFIED ON SITE BEFORE FABRICATION.

LEGEND :
X1 - DETAIL MARK NO.
X001 - REFER SHEET NO.

1. F.F.L. -- FINISHED FLOOR LEVEL
2. S.F.L. -- STRUCTURAL FLOOR LEVEL
3. (R) -- REVERSED DETAIL

NO.	DATE	REVISED	BY
B	13-11-2020	REVISION SUBJECT TO COMMENTS	MN
A	24-08-2020	REVISION SUBJECT TO COMMENTS	MN

JOB NO. : J-852
PROJECT :
PROPOSED RESIDENTIAL DEVELOPMENT
AT 139 - 147 ARGYLE STREET,
NKIL 6005, 6035 R.P., 6036 R.P.,
6037 R.P. & 6038 R.P.

TITLE :
PART ELEVATION, PLAN & SECTION
FOR ACOUSTIC SLIDING DOOR






DATE : 20-Jul-20 SCALE : 1:30

DRAWN BY : LHR CHECKED BY : DW

美特鋁質有限公司
MIDI ALUMINIUM FABRICATOR LTD.
Units 6-8, Sunray Industrial Centre, 1/F
610 Cha Kwo Ling Road, Kowloon
Tel:23489211-4 Fax:(852)2727666

DWG NO. : J852-SD-ASD-4306 REV. : B

ELEVATION

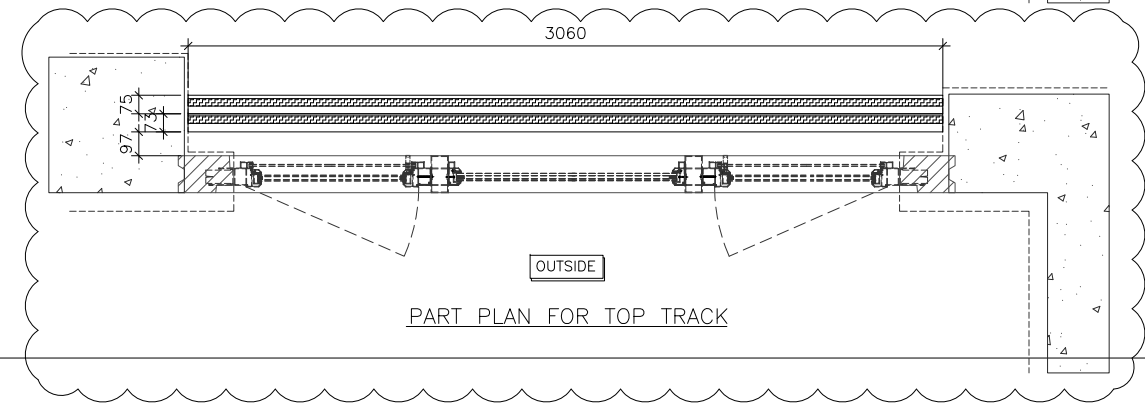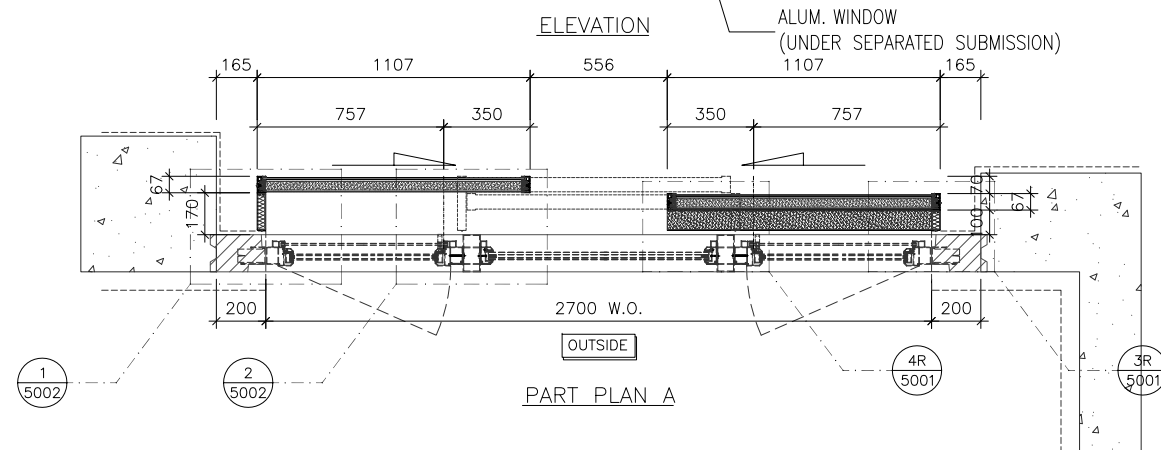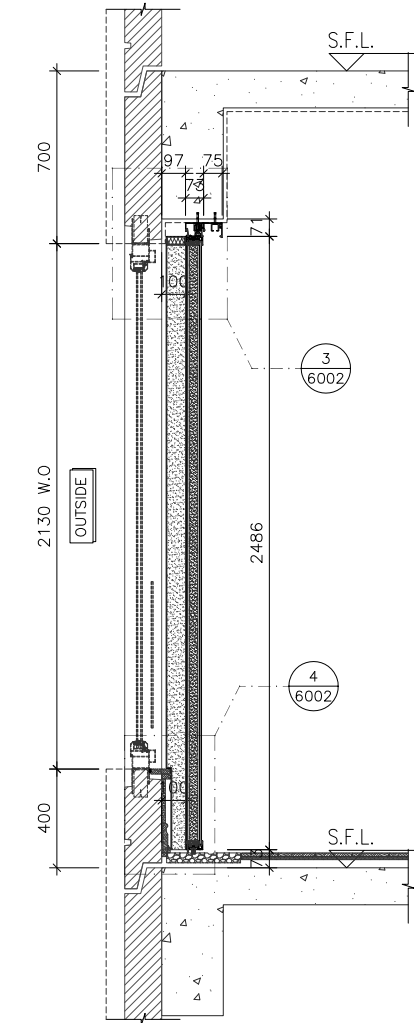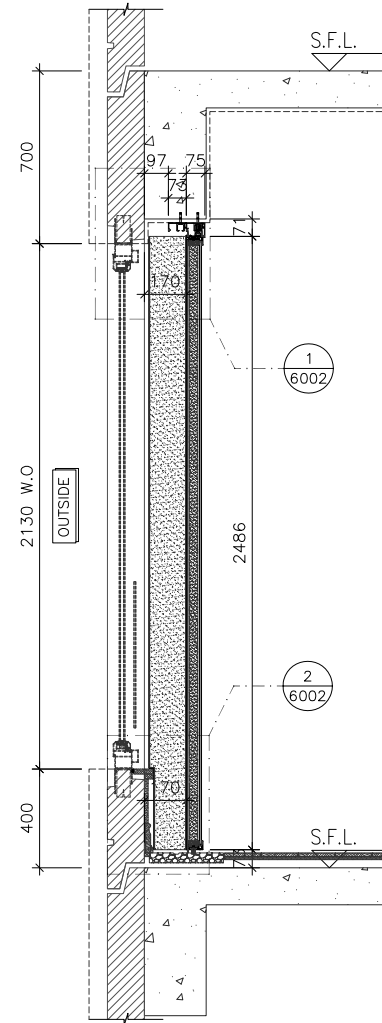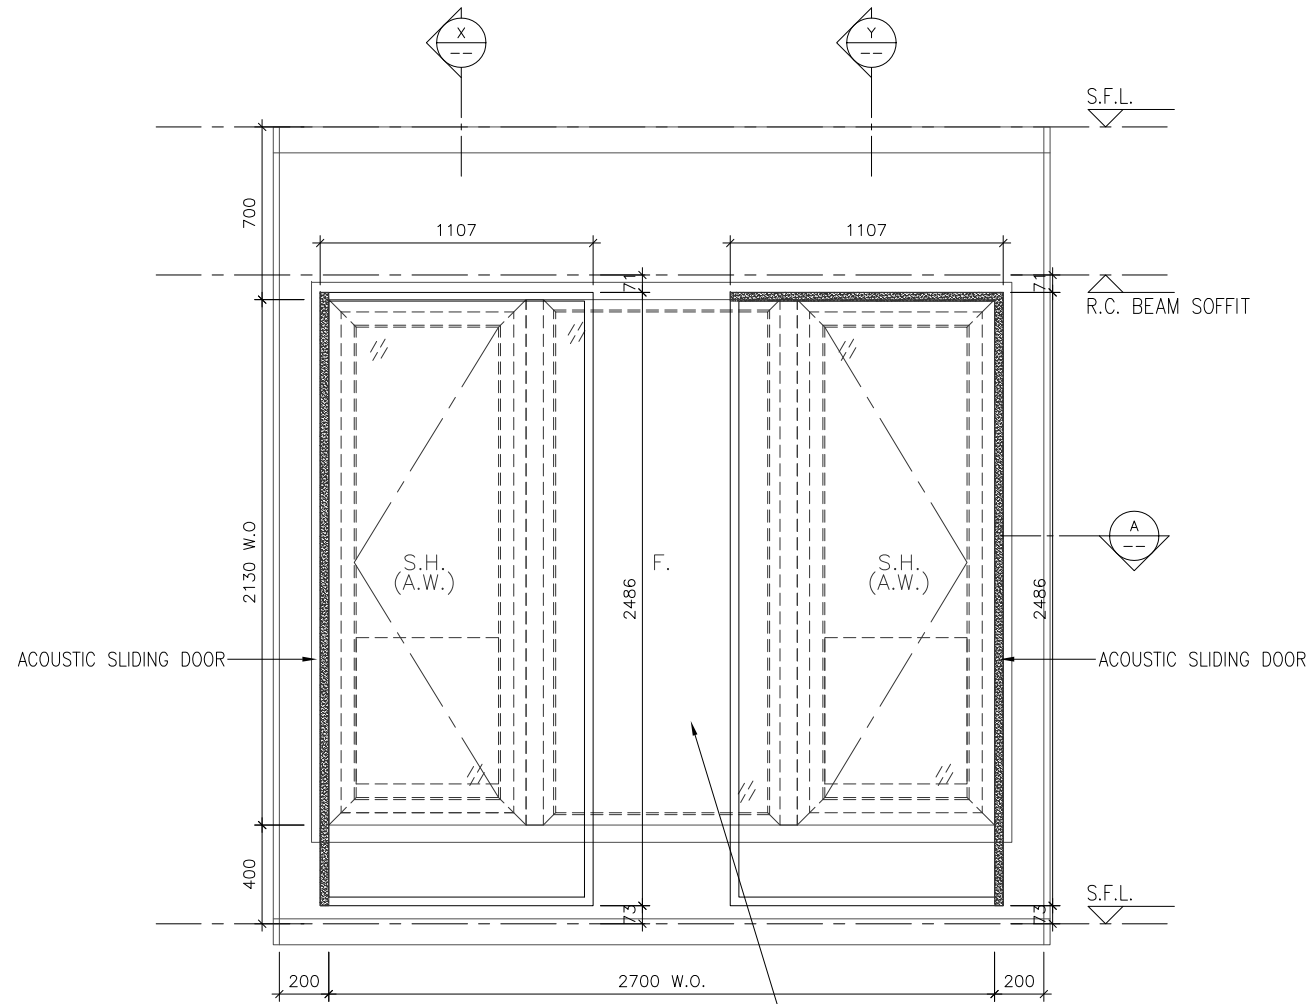

WINDOW MARK	W2 T3B
LOCATION	1/F LIV./DIN. AT TOWER 3 FLAT B
SECTION	-
GLAZING	-
QUANTITY	1
REMARKS	NSR: T3-07&08/TESTED CASE: W102

B.D. REF :

CLIENT :

ARCHITECT :
AGC DESIGN LTD


STRUCTURAL ENGINEER :
ARUP

FACADE CONSULTANT:
MEINHARDT

NOTE :
 1. ALL DIMENSIONS ARE IN mm.
 2. ALL ELEVATIONS ARE VIEWED FROM OUTSIDE.
 3. ALL DIMENSIONS TO BE VERIFIED ON SITE BEFORE FABRICATION.

LEGEND :
 X1 --- DETAIL MARK NO.
 X001 --- REFER SHEET NO.

1. F.F.L. -- FINISHED FLOOR LEVEL
 2. S.F.L. -- STRUCTURAL FLOOR LEVEL
 3. (R) -- REVERSED DETAIL

B	13-11-2020	REVISION SUBJECT TO COMMENTS	MN
A	24-08-2020	REVISION SUBJECT TO COMMENTS	MN
NO.	DATE	REVISED	BY

JOB NO. : J-852

PROJECT :
 PROPOSED RESIDENTIAL DEVELOPMENT
 AT 139 - 147 ARGYLE STREET,
 NKIL 6005, 6035 R.P., 6036 R.P.,
 6037 R.P. & 6038 R.P.

TITLE :
 PART ELEVATION, PLAN & SECTION
 FOR ACOUSTIC SLIDING DOOR






DATE : 20-Jul-20 SCALE : 1:30

DRAWN BY : LHR CHECKED BY : DW

美特鋁質有限公司
MIDI ALUMINIUM FABRICATOR LTD.
 Units 6-8, Sunray Industrial Centre, 1/F
 610 Cha Kwo Ling Road, Kowloon
 Tel:23489211-4 Fax:(852)27727666

DWG NO. : J852-SD-ASD-4307 REV. : B

ELEVATION

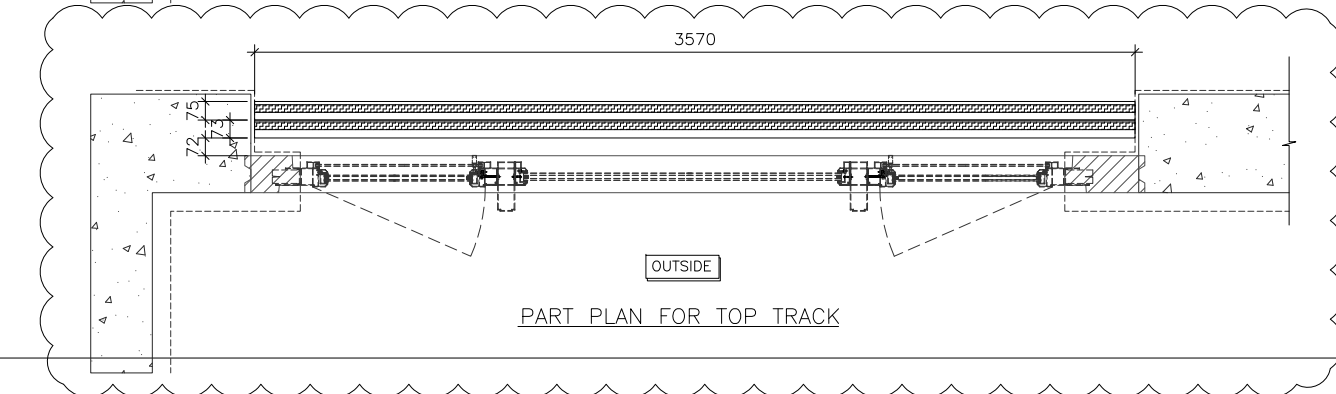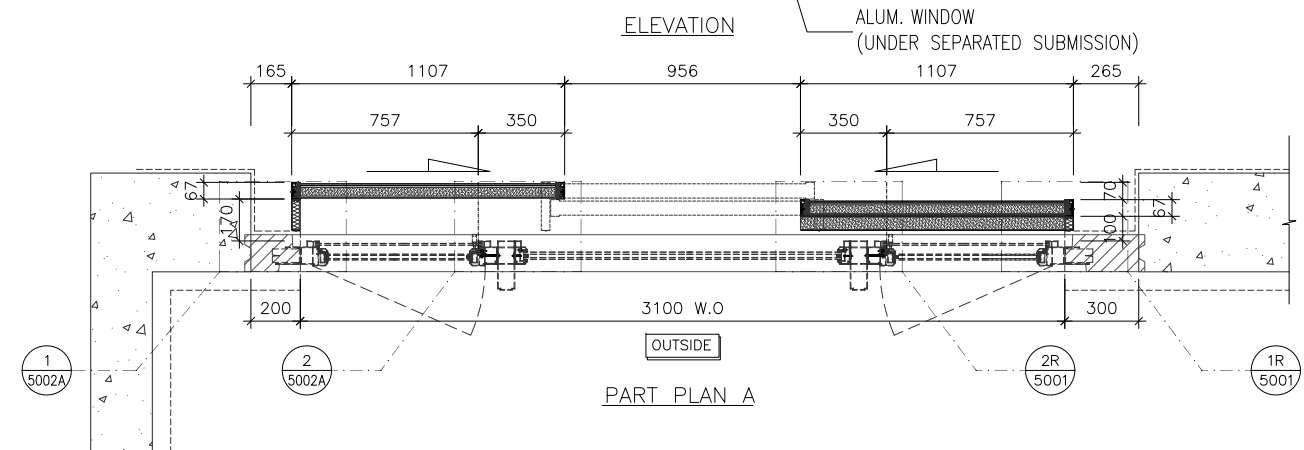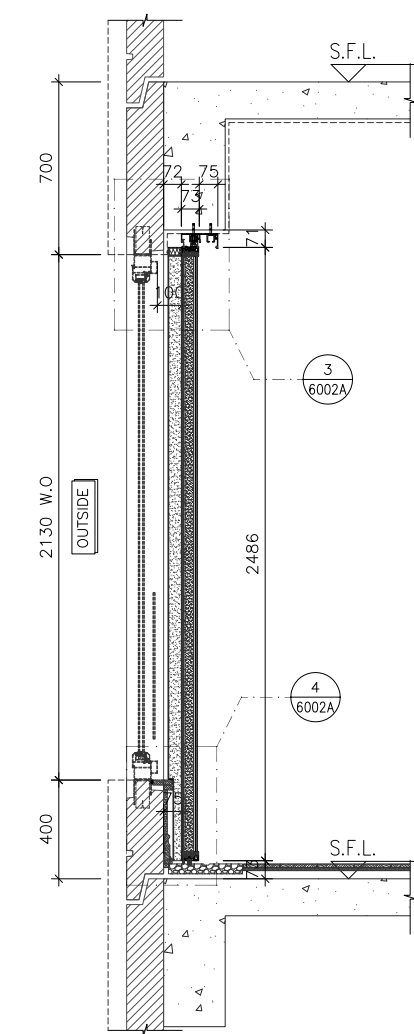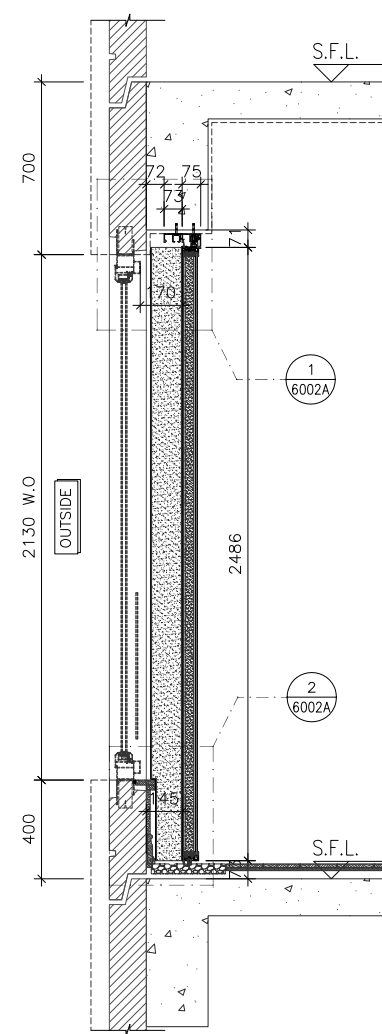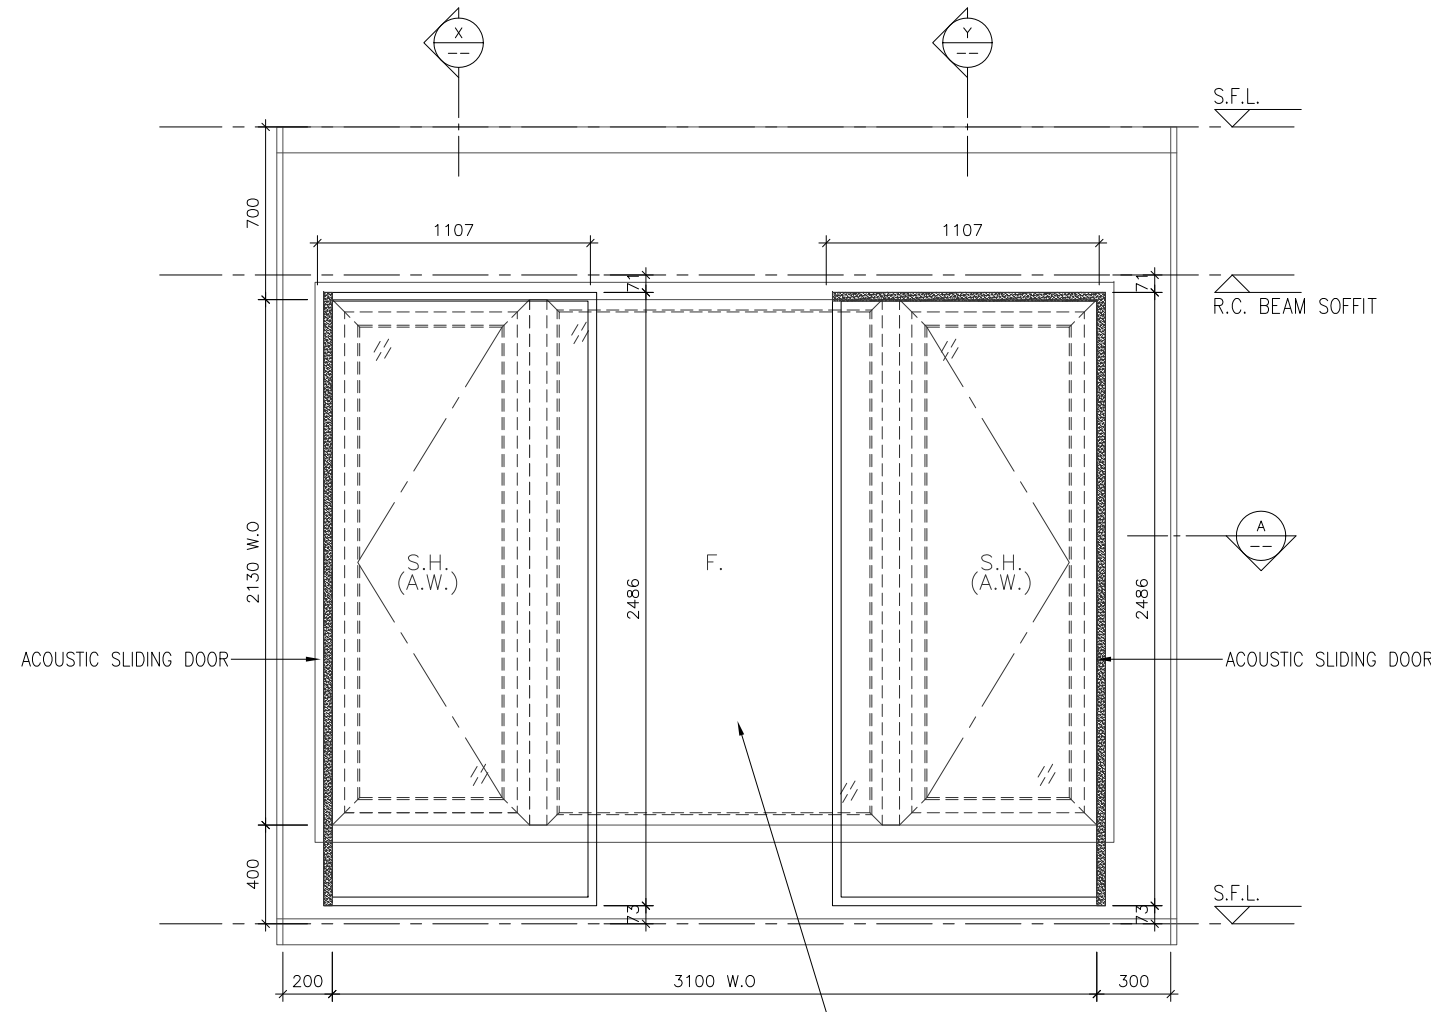

WINDOW MARK



LOCATION 1/F-5/F LIV./DIN. AT TOWER 3 FLAT A
 SECTION -
 GLAZING -
 QUANTITY 4
 REMARKS NSR: T3-09&10/TESTED CASE: W102

B.D. REF :

CLIENT :

ARCHITECT :
AGC DESIGN LTD


MAIN CONTRACTOR :
Gammon

STRUCTURAL ENGINEER :
ARUP

FACADE CONSULTANT:
MEINHARDT

NOTE :
 1. ALL DIMENSIONS ARE IN mm.
 2. ALL ELEVATIONS ARE VIEWED FROM OUTSIDE.
 3. ALL DIMENSIONS TO BE VERIFIED ON SITE BEFORE FABRICATION.

LEGEND :
 (X1) — DETAIL MARK NO.
 (X001) — REFER SHEET NO.
 1. F.F.L. — FINISHED FLOOR LEVEL
 2. S.F.L. — STRUCTURAL FLOOR LEVEL
 3. (R) — REVERSED DETAIL

NO.	DATE	REVISION	BY
B	13-11-2020	REVISION SUBJECT TO COMMENTS	MN
A	24-08-2020	REVISION SUBJECT TO COMMENTS	MN





JOB NO. : J-852
 PROJECT :
 PROPOSED RESIDENTIAL DEVELOPMENT
 AT 139 - 147 ARGYLE STREET,
 NKIL 6005, 6035 R.P., 6036 R.P.,
 6037 R.P. & 6038 R.P.
 TITLE :
 PART ELEVATION, PLAN & SECTION
 FOR ACOUSTIC SLIDING DOOR

DATE : 20-Jul-20 SCALE : 1:30
 DRAWN BY : LHR CHECKED BY : DW

美特鋁質有限公司
MIDI ALUMINIUM FABRICATOR LTD.
 Units 6-8, Sunray Industrial Centre, 1/F
 610 Cha Kwo Ling Road, Kowloon
 Tel:23489211-4 Fax:(852)2727666

DWG NO. : J852-SD-ASD-4308 REV. : B

ELEVATION

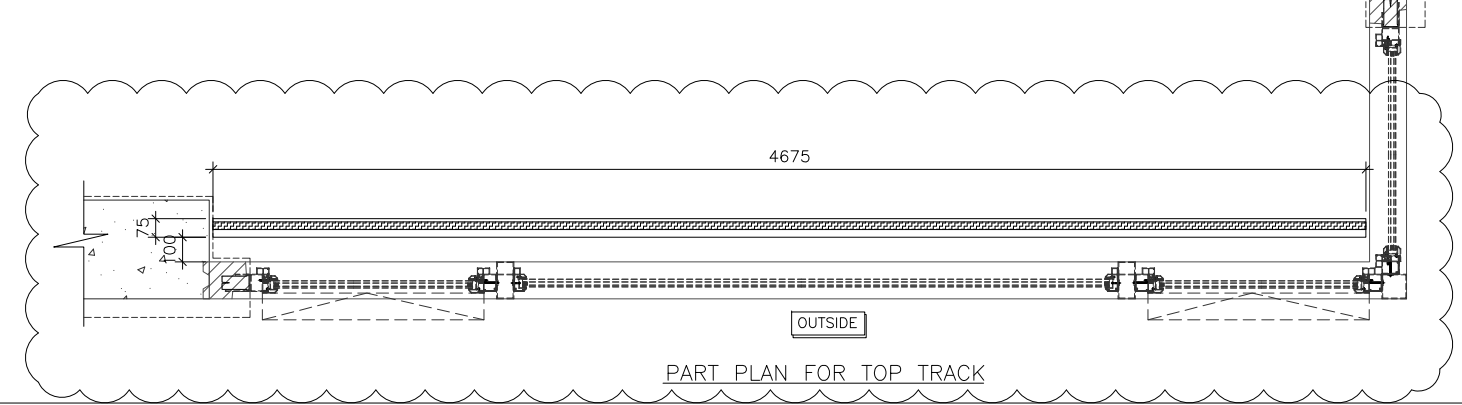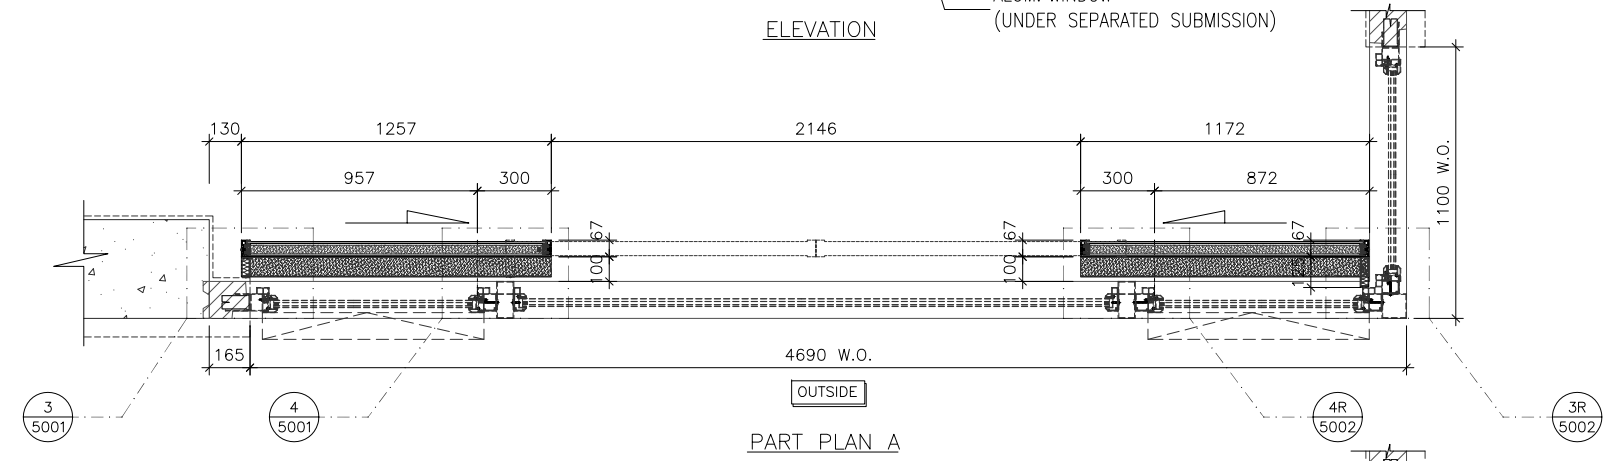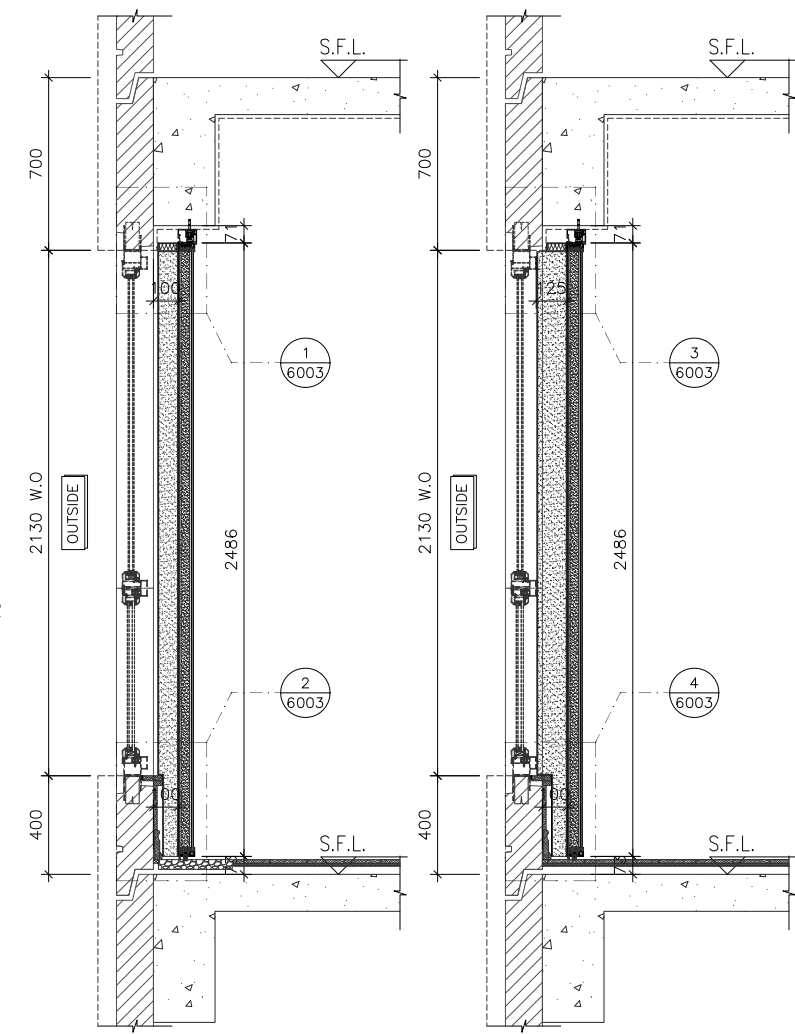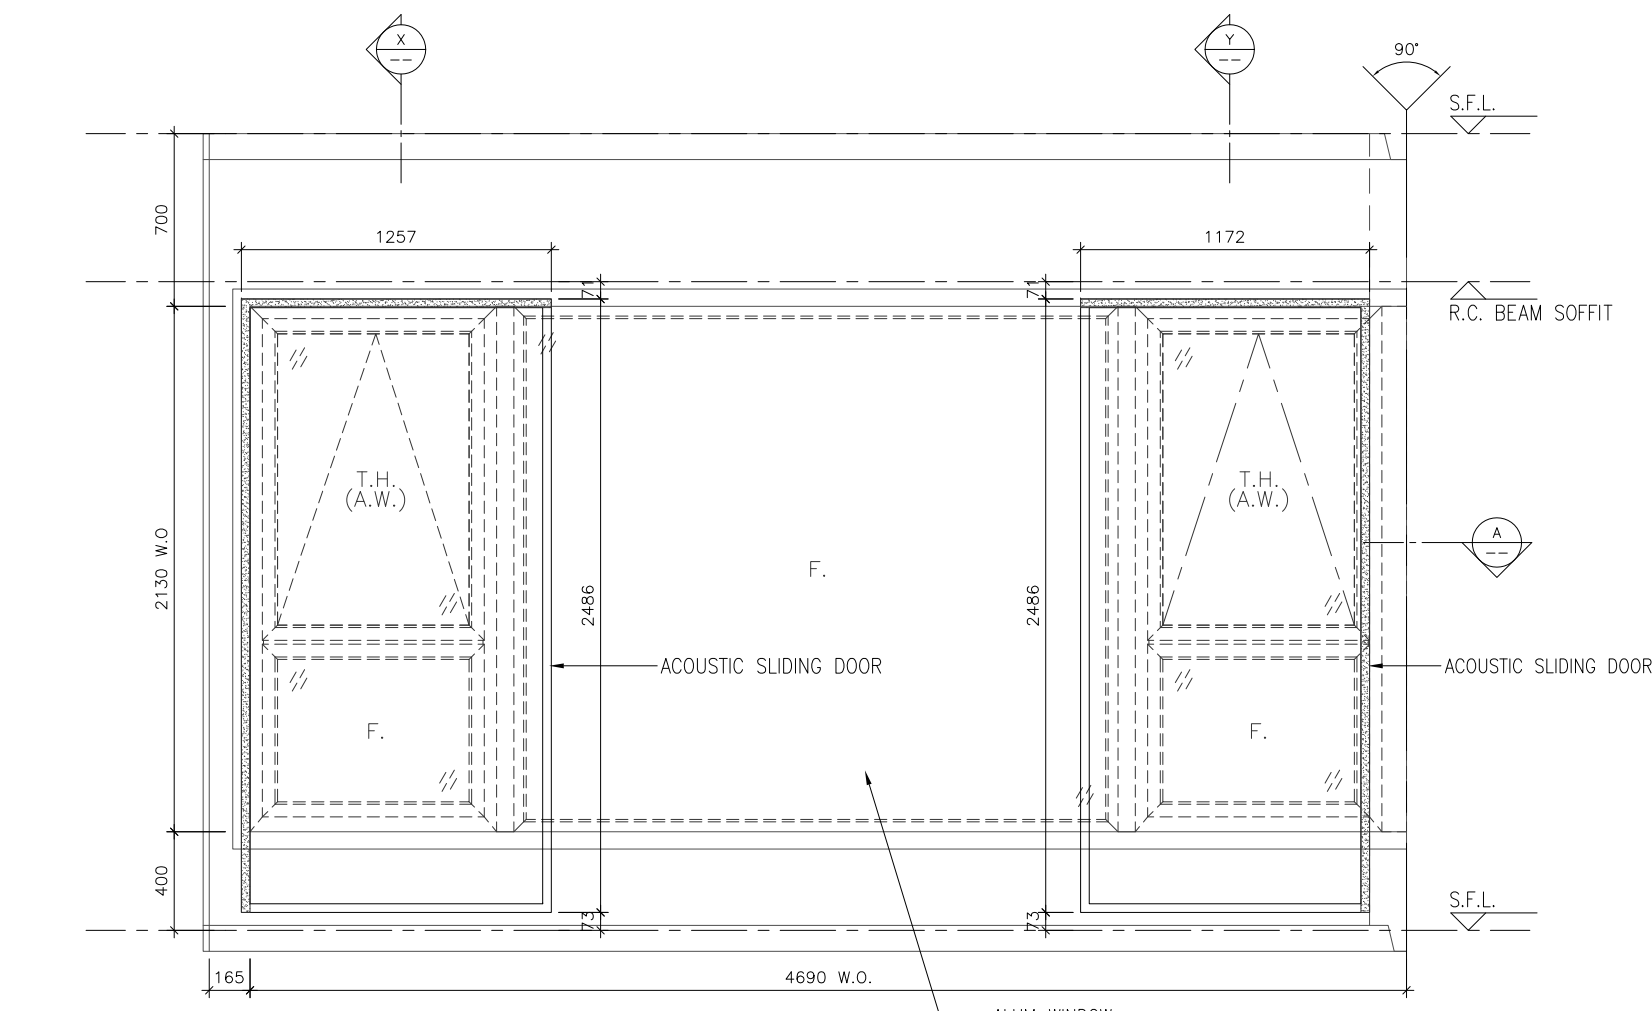

WINDOW MARK	W3 T3A
LOCATION	1/F-5/F MASTER ENSUITE AT TOWER 3 FLAT A
SECTION	-
GLAZING	-
QUANTITY	4
REMARKS	NSR: T3-11/TESTED CASE: W101

B.D. REF :

CLIENT :

ARCHITECT :
AGC DESIGN LTD

MAIN CONTRACTOR :
Gammon

STRUCTURAL ENGINEER :
ARUP

FACADE CONSULTANT:
MEINHARDT

- NOTE :
- ALL DIMENSIONS ARE IN mm.
 - ALL ELEVATIONS ARE VIEWED FROM OUTSIDE.
 - ALL DIMENSIONS TO BE VERIFIED ON SITE BEFORE FABRICATION.
- LEGEND :
- x1 - DETAIL MARK NO.
 - x001 - REFER SHEET NO.
 - 1. F.F.L. -- FINISHED FLOOR LEVEL
 - 2. S.F.L. -- STRUCTURAL FLOOR LEVEL
 - 3. (R) -- REVERSED DETAIL

NO.	DATE	REVISION	BY
B	13-11-2020	REVISION SUBJECT TO COMMENTS	MN
A	24-08-2020	REVISION SUBJECT TO COMMENTS	MN

JOB NO. : J-852

PROJECT :
PROPOSED RESIDENTIAL DEVELOPMENT
AT 139 - 147 ARGYLE STREET,
NKIL 6005, 6035 R.P., 6036 R.P.,
6037 R.P. & 6038 R.P.





TITLE :
PART ELEVATION, PLAN & SECTION
FOR ACOUSTIC SLIDING DOOR

DATE : 20-Jul-20	SCALE : 1:30
DRAWN BY : LHR	CHECKED BY : DW

美特鋁質有限公司
MIDI ALUMINIUM FABRICATOR LTD.
Units 6-8, Sunray Industrial Centre, 1/F
610 Cha Kwo Ling Road, Kowloon
Tel:23489211-4 Fax:(852)2727666

DWG NO. : J852-SD-ASD-4309 REV. : B

ELEVATION

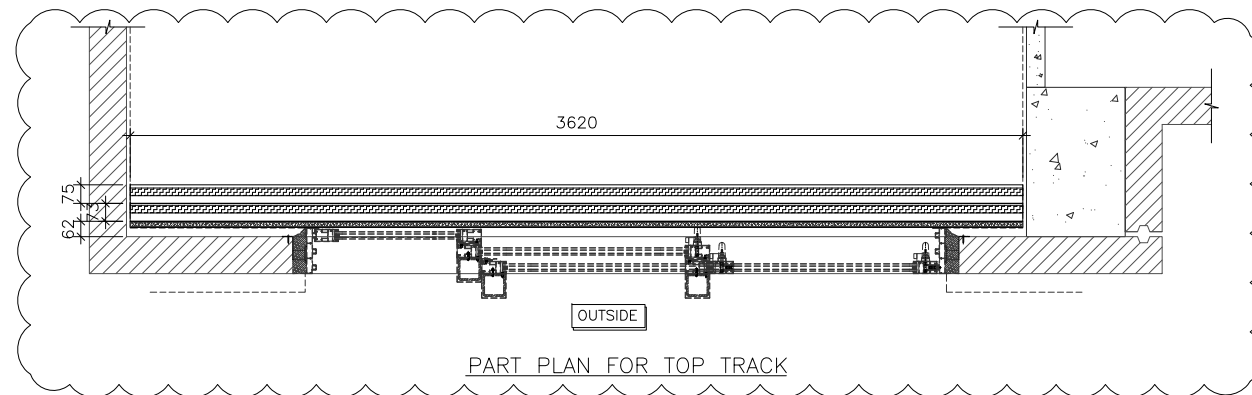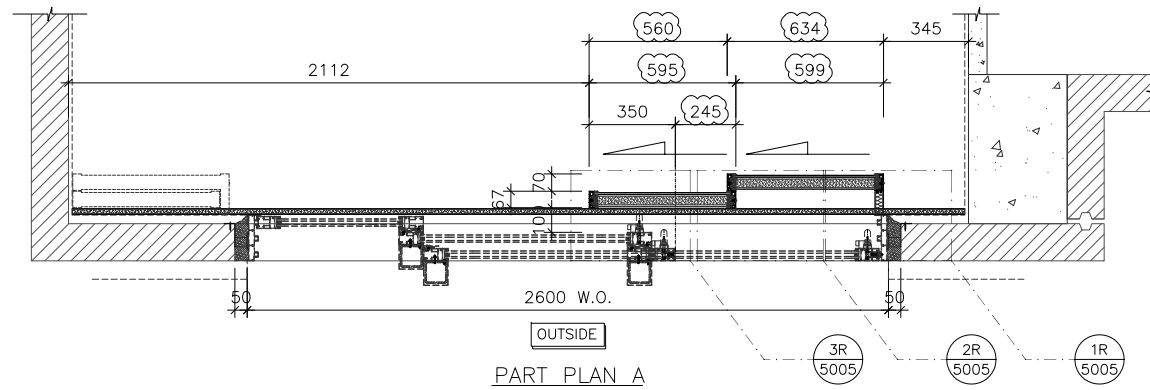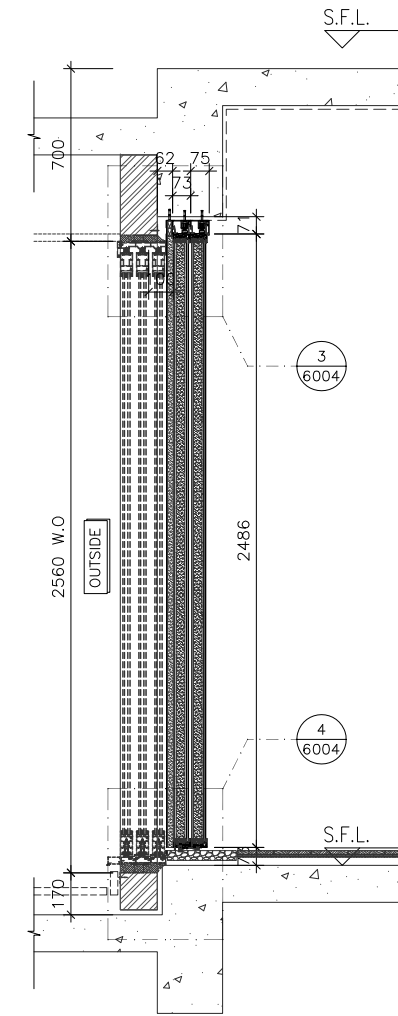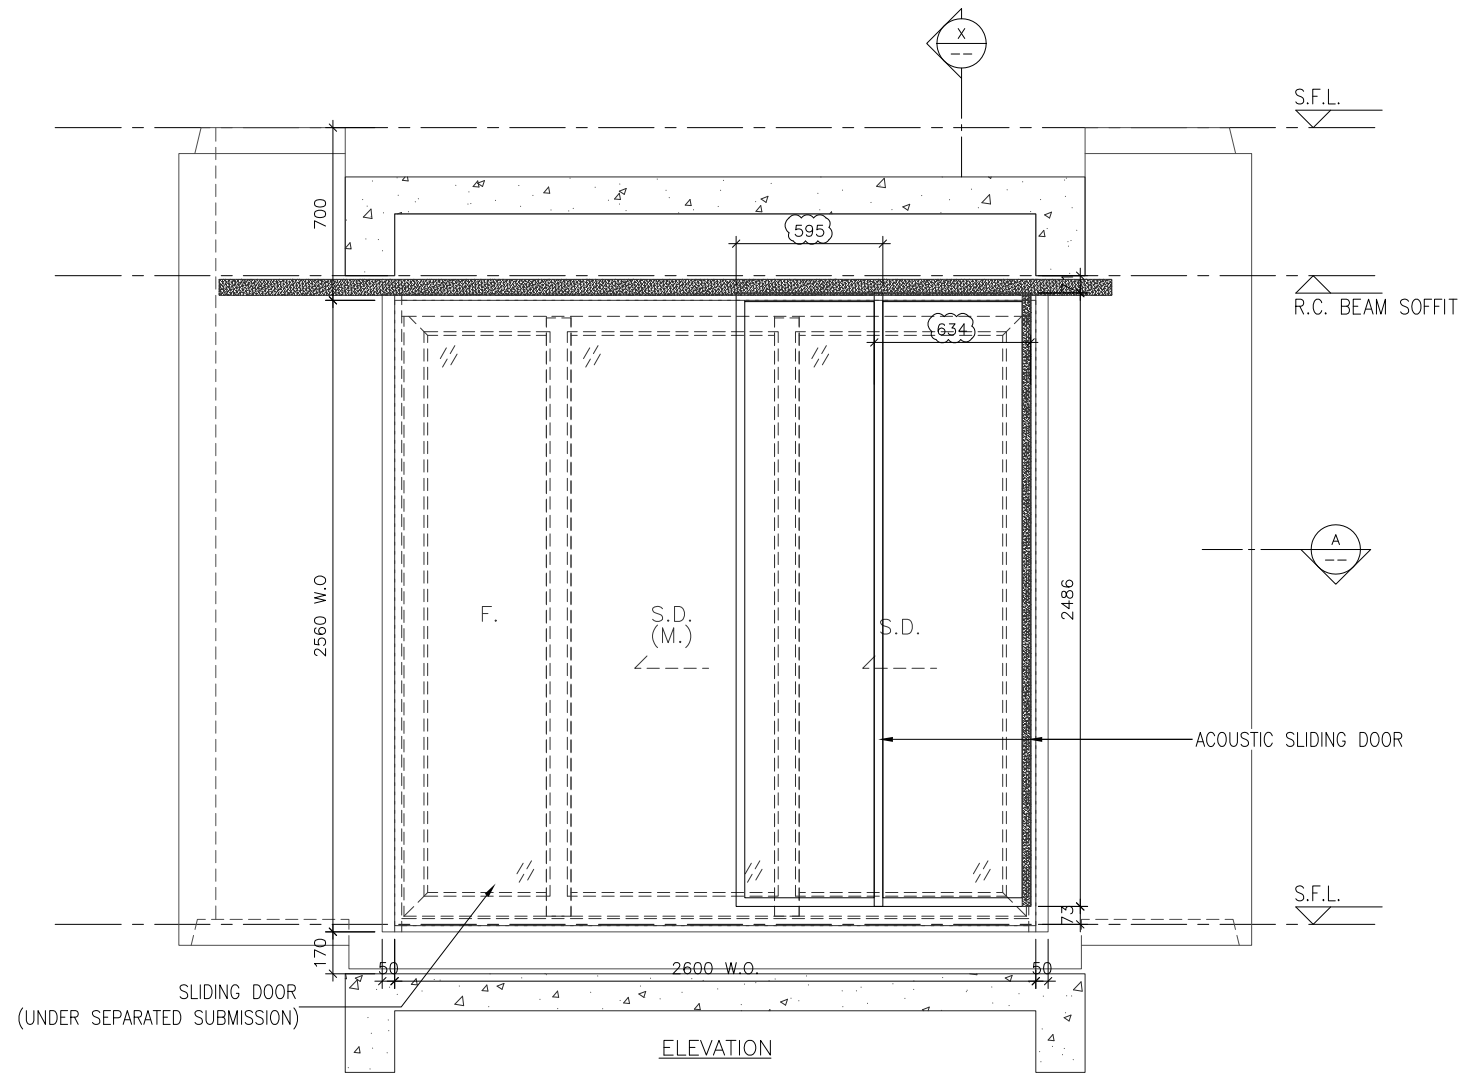

WINDOW MARK	W7 T3A
LOCATION	1/F~21/F ENSUITE AT TOWER 3 FLAT A
SECTION	-
GLAZING	-
QUANTITY	18
REMARKS	NSR: T3-12/TESTED CASE: W103B

B.D. REF :

CLIENT :

ARCHITECT :
AGC DESIGN LTD

MAIN CONTRACTOR :
Gammon

STRUCTURAL ENGINEER :
ARUP

FACADE CONSULTANT:
MEINHARDT

NOTE :
1. ALL DIMENSIONS ARE IN mm.
2. ALL ELEVATIONS ARE VIEWED FROM OUTSIDE.
3. ALL DIMENSIONS TO BE VERIFIED ON SITE BEFORE FABRICATION.

LEGEND :
X1 — DETAIL MARK NO.
X001 — REFER SHEET NO.

1. F.F.L. -- FINISHED FLOOR LEVEL
2. S.F.L. -- STRUCTURAL FLOOR LEVEL
3. (R) -- REVERSED DETAIL

B	13-11-2020	REVISION SUBJECT TO COMMENTS	MIN
A	24-08-2020	REVISION SUBJECT TO COMMENTS	MIN
NO.	DATE	REVISED	BY

JOB NO. : J-852
PROJECT : PROPOSED RESIDENTIAL DEVELOPMENT AT 139 - 147 ARGYLE STREET, NKIL 6005, 6035 R.P., 6036 R.P., 6037 R.P. & 6038 R.P.



TITLE : PART ELEVATION, PLAN & SECTION FOR ACOUSTIC SLIDING DOOR

DATE : 20-Jul-20 SCALE : 1:30
DRAWN BY : LHR CHECKED BY : DW


美特鋁質有限公司
MIDI ALUMINIUM FABRICATOR LTD.
Units 6-8, Sunray Industrial Centre, 1/F
610 Cha Kwo Ling Road, Kowloon
Tel:23489211-4 Fax:(852)2727666

DWG NO. : J852-SD-ASD-4310 REV. : B


ELEVATION

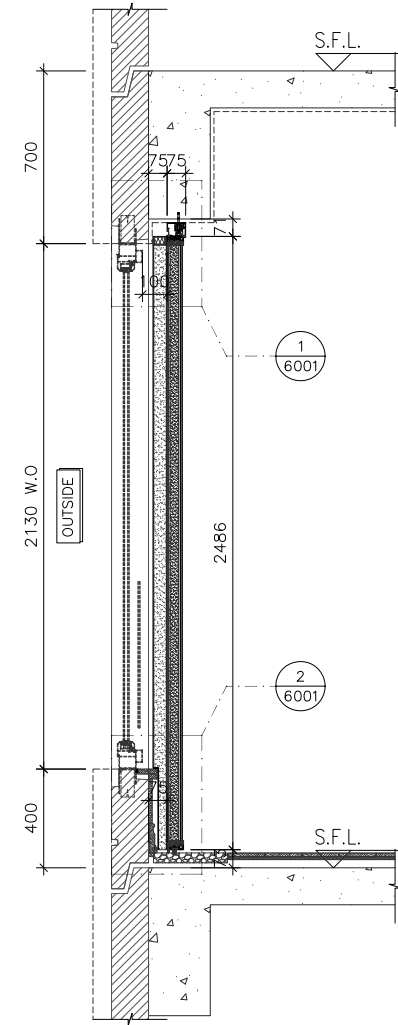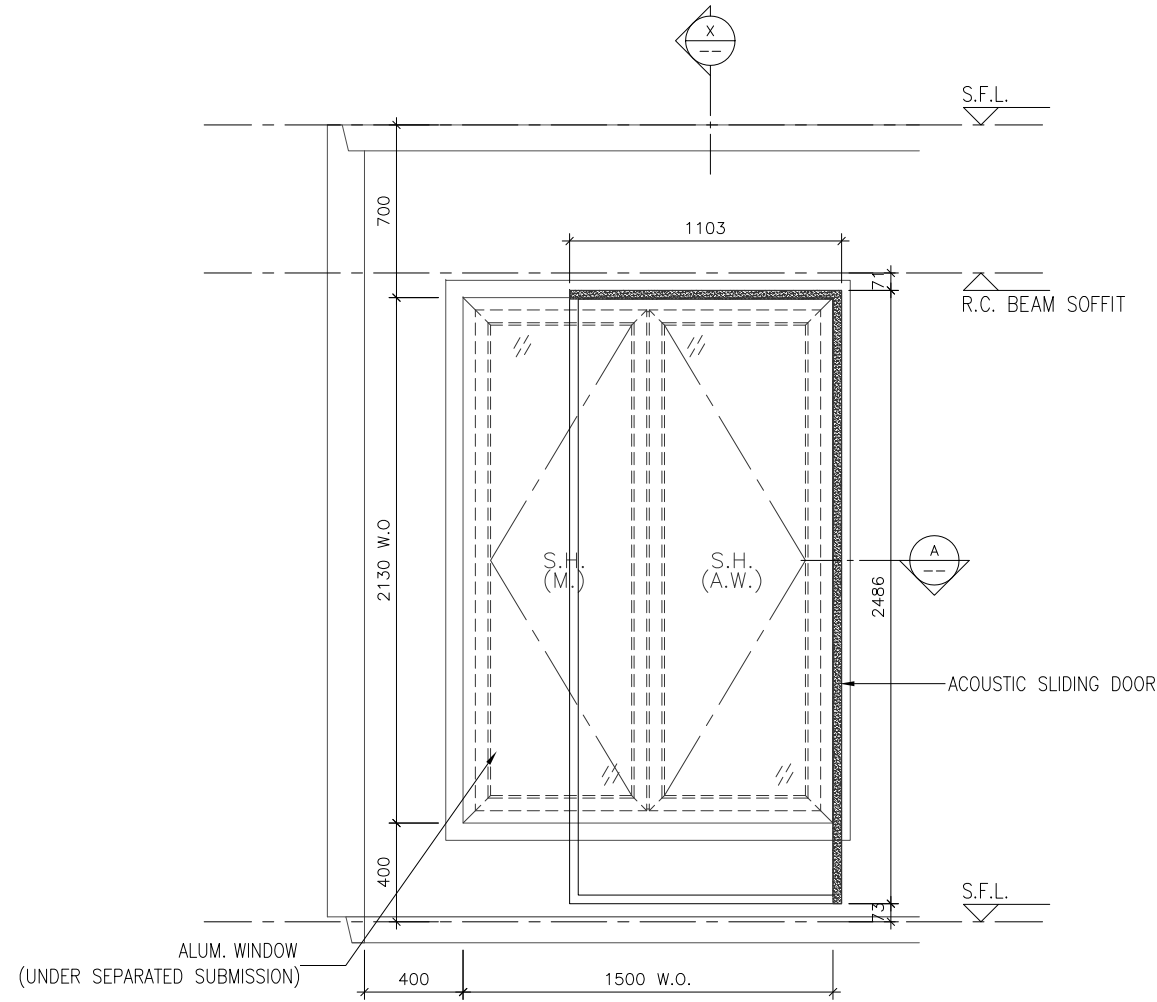

SECTION "X-X"

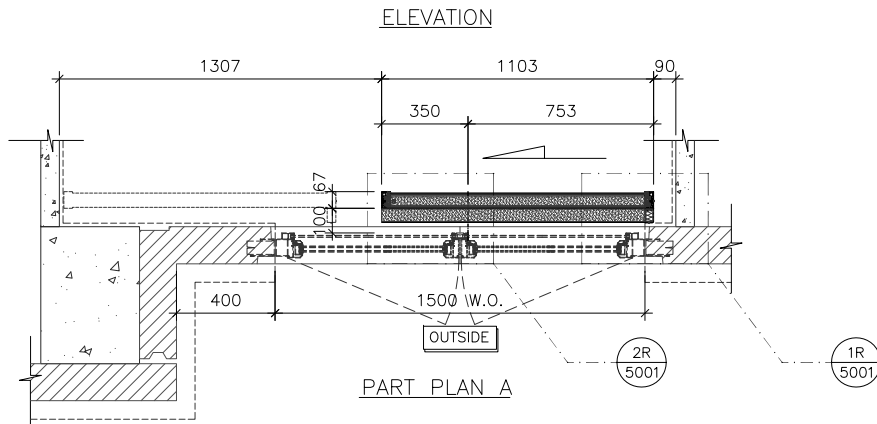

PART PLAN A

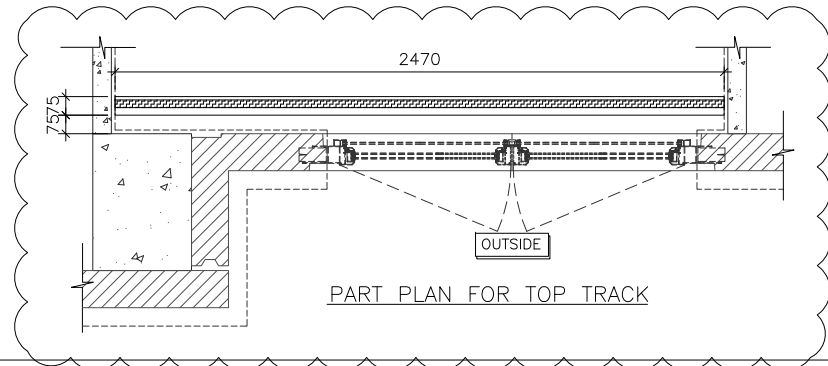

PART PLAN FOR TOP TRACK

WINDOW MARK
W8
T3A

LOCATION 2/F-21/F B.R.1 AT TOWER 3 FLAT A
SECTION -
GLAZING -
QUANTITY 17
REMARKS NSR: T3-13/TESTED CASE: W107A

B.D. REF :

CLIENT :

ARCHITECT :
AGC DESIGN LTD
101, 102, 103,1000

MAIN CONTRACTOR :
Gammon

STRUCTURAL ENGINEER :
ARUP

FACADE CONSULTANT:
MEINHARDT

NOTE :
1. ALL DIMENSIONS ARE IN mm.
2. ALL ELEVATIONS ARE VIEWED FROM OUTSIDE.
3. ALL DIMENSIONS TO BE VERIFIED ON SITE BEFORE FABRICATION.

LEGEND :
X1 — DETAIL MARK NO.
X001 — REFER SHEET NO.

1. F.F.L. -- FINISHED FLOOR LEVEL
2. S.F.L. -- STRUCTURAL FLOOR LEVEL
3. (R) -- REVERSED DETAIL

NO.	DATE	REVISED	BY
B	13-11-2020	REVISION SUBJECT TO COMMENTS	MN
A	24-08-2020	REVISION SUBJECT TO COMMENTS	MN

JOB NO. : J-852
PROJECT : PROPOSED RESIDENTIAL DEVELOPMENT AT 139 - 147 ARGYLE STREET, NKIL 6005, 6035 R.P., 6036 R.P., 6037 R.P. & 6038 R.P.


TITLE : PART ELEVATION, PLAN & SECTION FOR ACOUSTIC SLIDING DOOR

DATE : 20-Jul-20 SCALE : 1:30
DRAWN BY : LHR CHECKED BY : DW


美特鋁質有限公司
MIDI ALUMINIUM FABRICATOR LTD.
Units 6-8, Sunray Industrial Centre, 1/F
610 Cha Kwo Ling Road, Kowloon
Tel:23489211-4 Fax:(852)2727666

DWG NO. : J852-SD-ASD-4311 REV. : B


ELEVATION

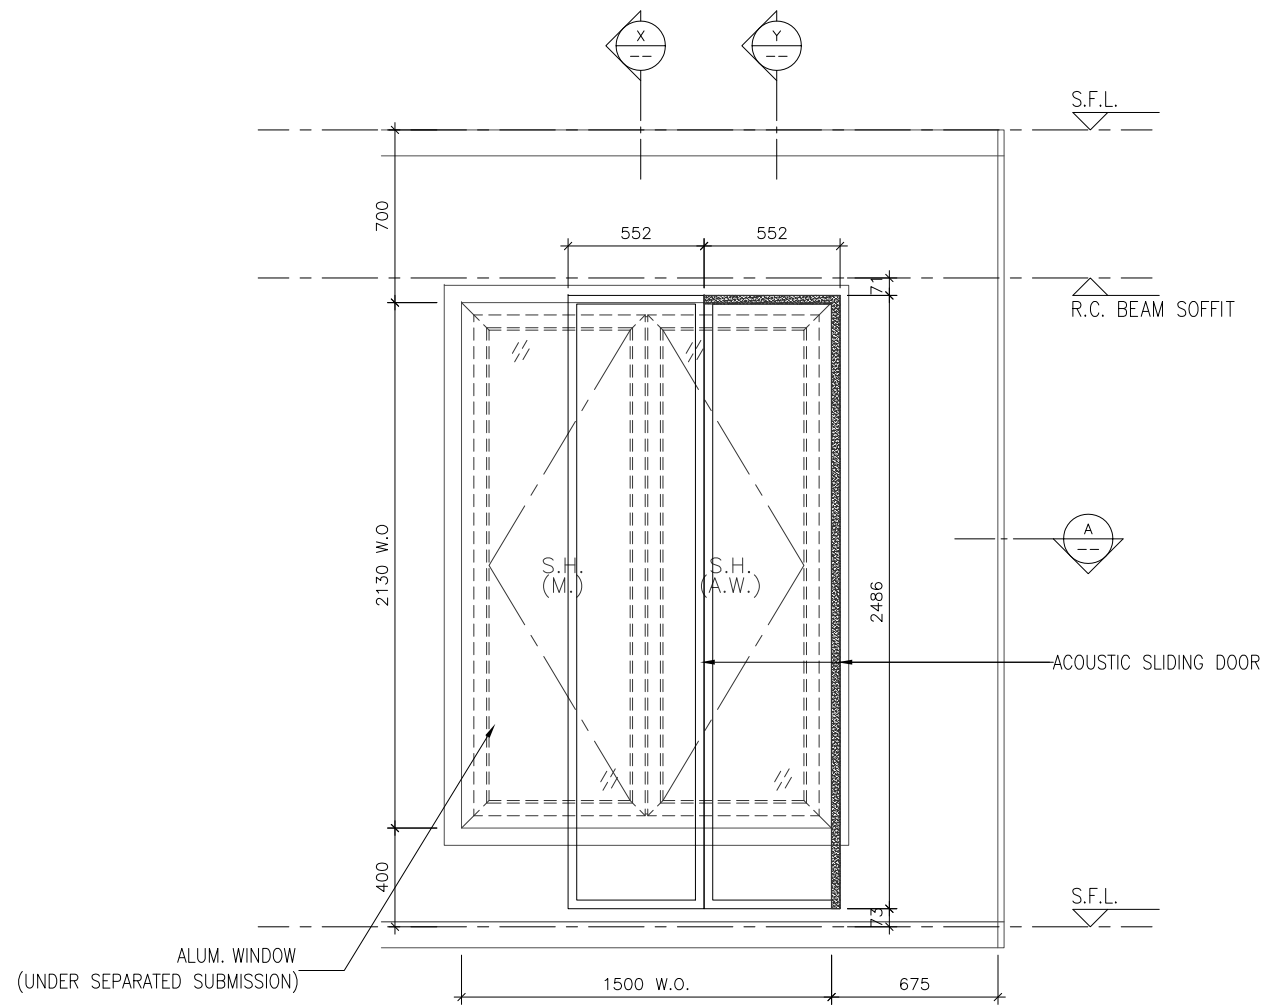


ELEVATION

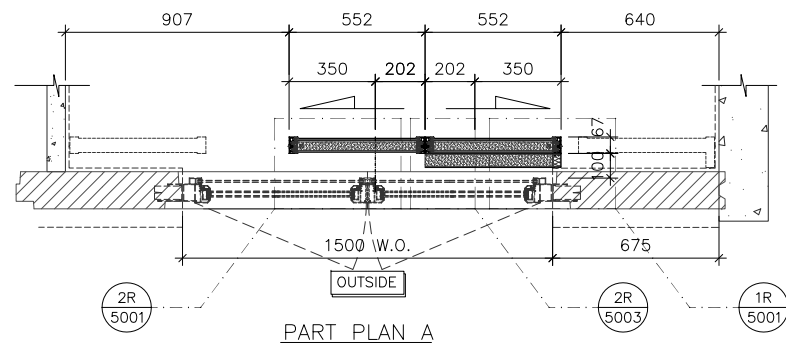


PART PLAN A

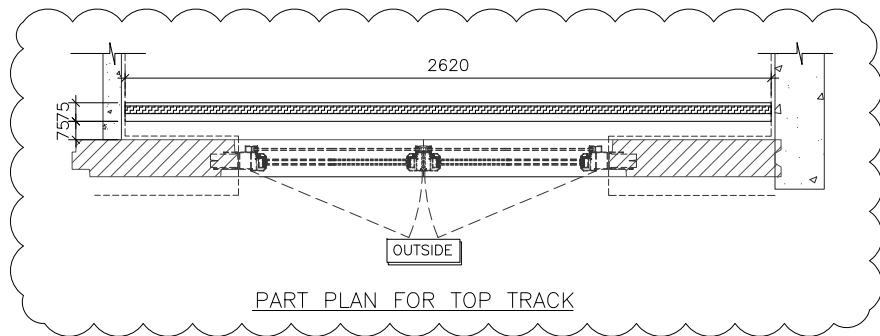

PART PLAN FOR TOP TRACK

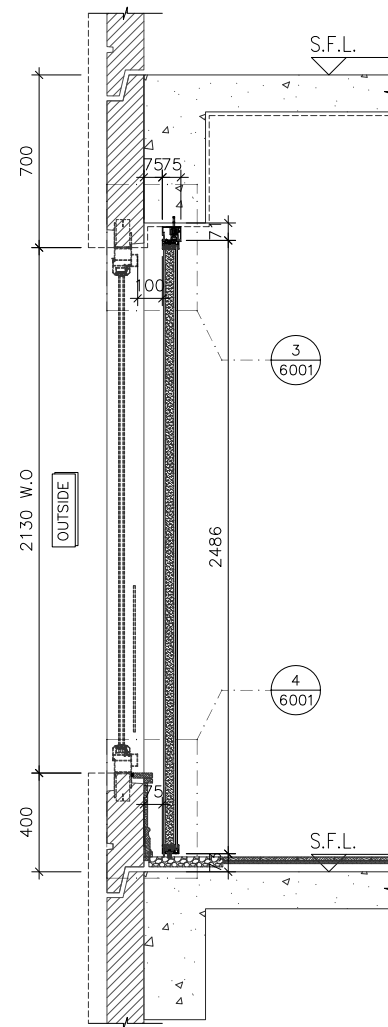

SECTION "X-X"

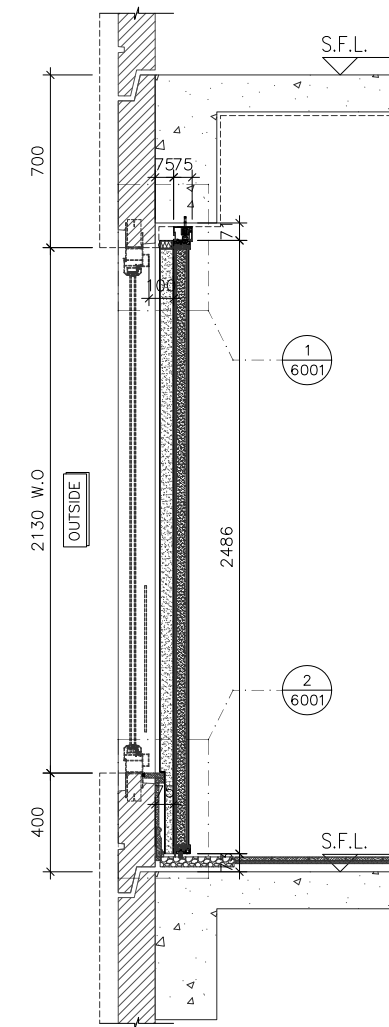

SECTION "Y-Y"

B.D. REF :

CLIENT :

ARCHITECT :
AGC DESIGN LTD
 180, 182, 184,1000

MAIN CONTRACTOR :
Gammon

STRUCTURAL ENGINEER :
ARUP

FAÇADE CONSULTANT:
MEINHARDT

NOTE :
 1. ALL DIMENSIONS ARE IN mm.
 2. ALL ELEVATIONS ARE VIEWED FROM OUTSIDE.
 3. ALL DIMENSIONS TO BE VERIFIED ON SITE BEFORE FABRICATION.

LEGEND :
 X1 — DETAIL MARK NO.
 X001 — REFER SHEET NO.

1. F.F.L. -- FINISHED FLOOR LEVEL
 2. S.F.L. -- STRUCTURAL FLOOR LEVEL
 3. (R) -- REVERSED DETAIL

B	13-11-2020	REVISION SUBJECT TO COMMENTS	MN
A	24-08-2020	REVISION SUBJECT TO COMMENTS	MN
NO.	DATE	REVISED	BY

JOB NO. : J-852
 PROJECT :
 PROPOSED RESIDENTIAL DEVELOPMENT
 AT 139 - 147 ARGYLE STREET,
 NKIL 6005, 6035 R.P., 6036 R.P.,
 6037 R.P. & 6038 R.P.

TITLE :
 PART ELEVATION, PLAN & SECTION
 FOR ACOUSTIC SLIDING DOOR


DATE : 20-Jul-20 SCALE : 1:30

DRAWN BY : LHR CHECKED BY : DW


美特鋁質有限公司
MIDI ALUMINIUM FABRICATOR LTD.
 Units 6-8, Sunray Industrial Centre, 1/F
 610 Cha Kwo Ling Road, Kowloon
 Tel:23489211-4 Fax:(852)2727666

DWG NO. : J852-SD-ASD-4312 REV. : B


WINDOW MARK	W9 T3A
LOCATION	2/F-21/F B.R.2 AT TOWER 3 FLAT A
SECTION	-
GLAZING	-
QUANTITY	17
REMARKS	NSR: T3-14/TESTED CASE: W107A

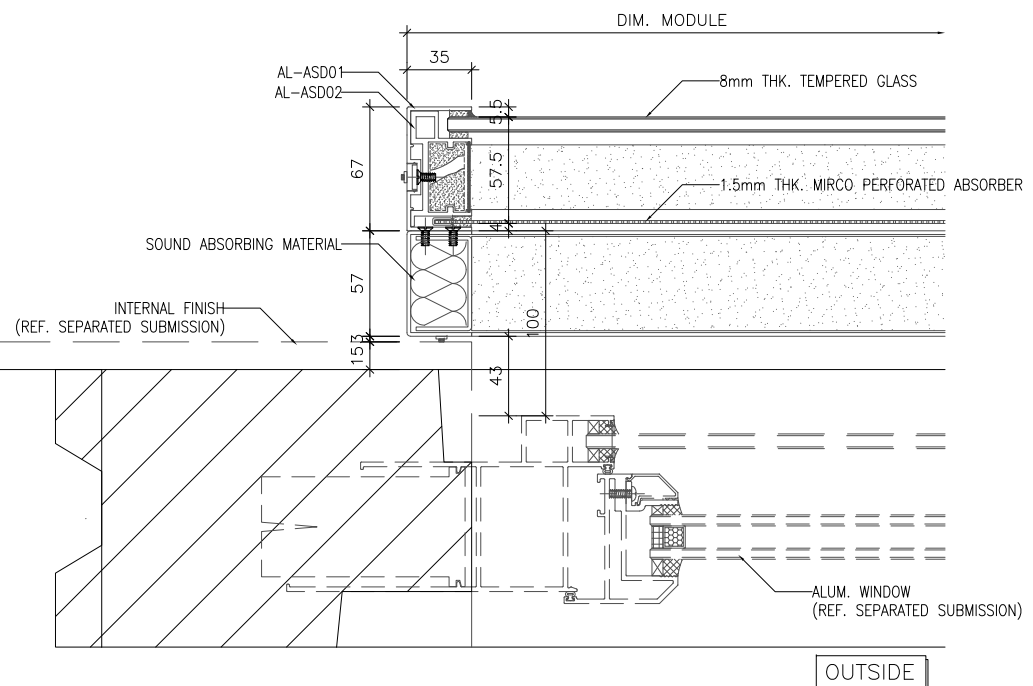


1 HORIZONTAL DETAIL
5001

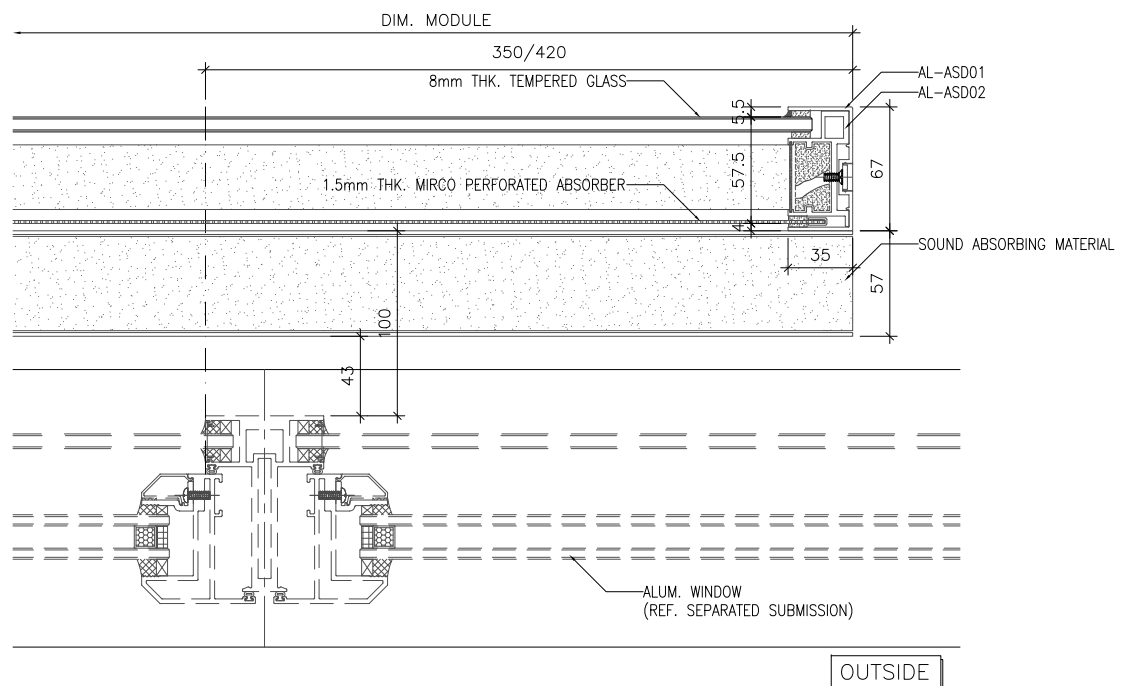

2 HORIZONTAL DETAIL
5001

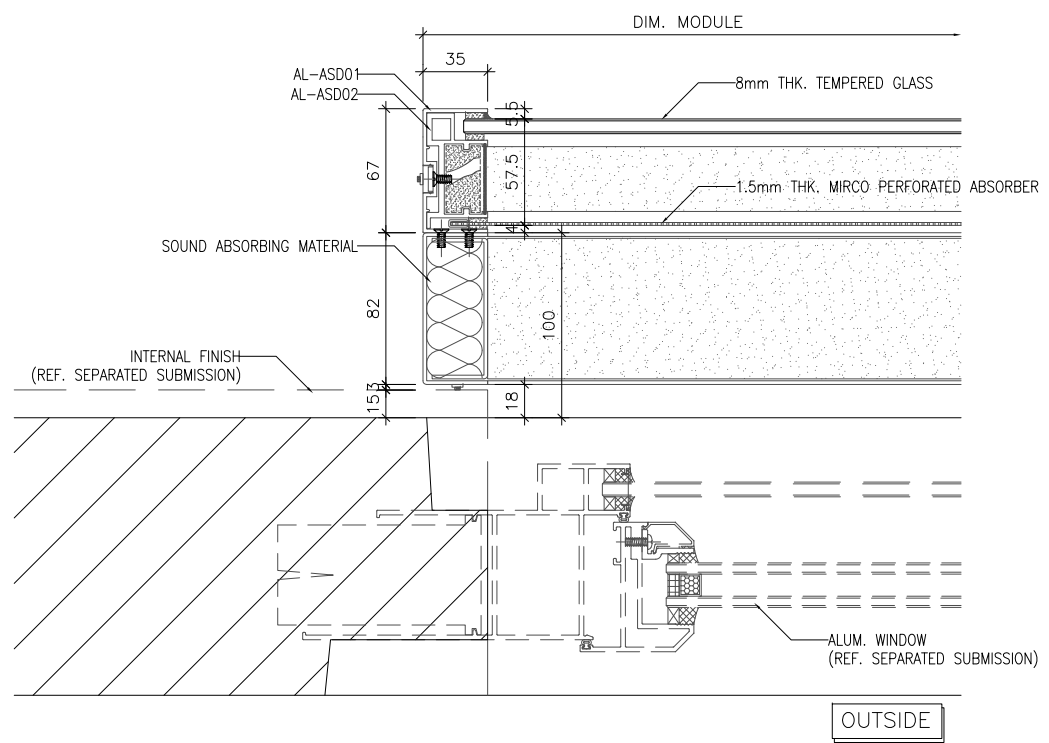

3 HORIZONTAL DETAIL
5001

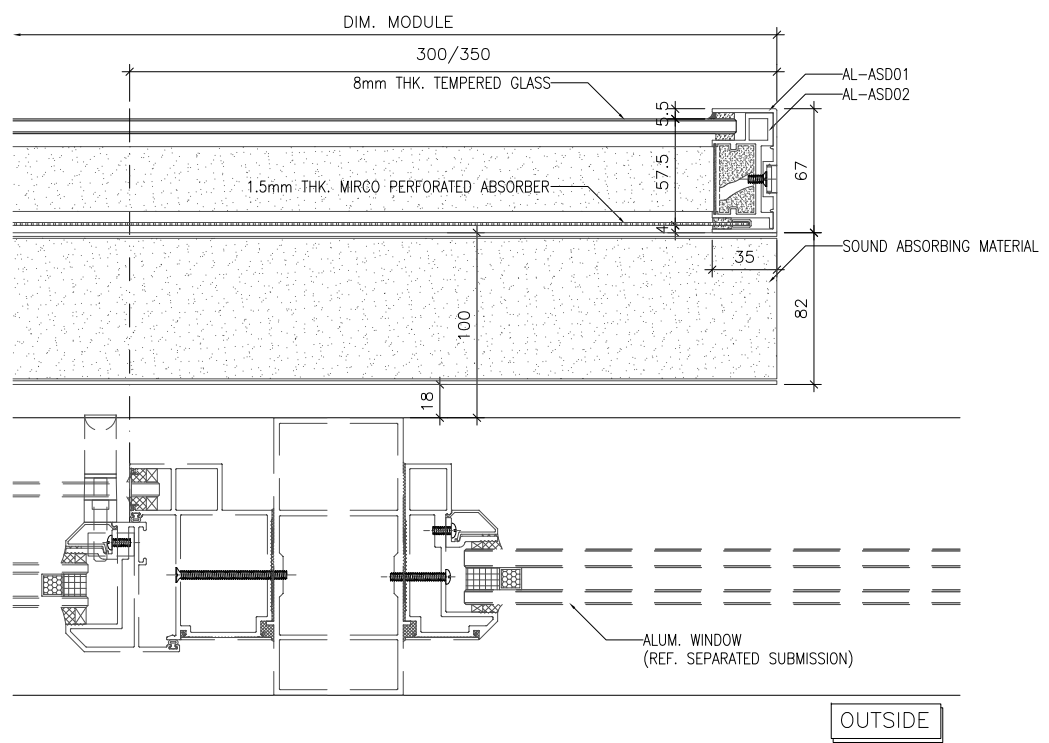

4 HORIZONTAL DETAIL
5001

B.D. REF :

CLIENT :

ARCHITECT :
AGC DESIGN LTD
110, 112, 114,1000

MAIN CONTRACTOR :
Gammon

STRUCTURAL ENGINEER :
ARUP

FAÇADE CONSULTANT:
MEINHARDT

NOTE :


1. ALL DIMENSIONS ARE IN mm.
2. ALL ELEVATIONS ARE VIEWED FROM OUTSIDE.
3. ALL DIMENSIONS TO BE VERIFIED ON SITE BEFORE FABRICATION.

LEGEND :


x1 — DETAIL MARK NO.
x001 — REFER SHEET NO.

1. F.F.L. -- FINISHED FLOOR LEVEL
2. S.F.L. -- STRUCTURAL FLOOR LEVEL
3. (R) -- REVERSED DETAIL


NO.	DATE	REVISED	BY
JOB NO. : J-852			
PROJECT : PROPOSED RESIDENTIAL DEVELOPMENT AT 139 - 147 ARGYLE STREET, NKIL 6005, 6035 R.P., 6036 R.P., 6037 R.P. & 6038 R.P.			
TITLE : TYPICAL DETAILS FOR ACOUSTIC SLIDING DOOR			
DATE : 17-Jul-20		SCALE : 1:4	
DRAWN BY : LHR		CHECKED BY : DW	
美特鋁質有限公司 MIDI ALUMINIUM FABRICATOR LTD. Units 6-8, Sunray Industrial Centre, 1/F 610 Cha Kwo Ling Road, Kowloon Tel:23489211-4 Fax:(852)2727666			
DWG NO. : J852-SD-ASD-5001			REV. : -

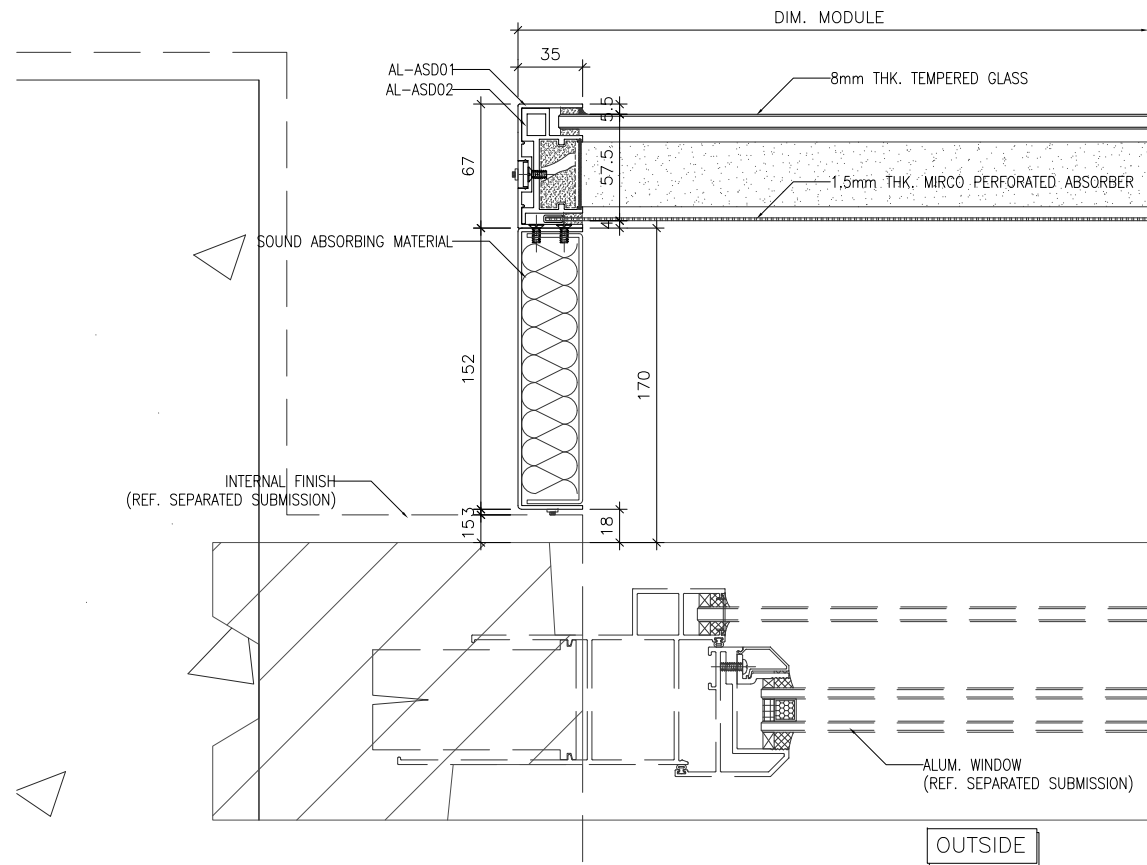


1 HORIZONTAL DETAIL
5002

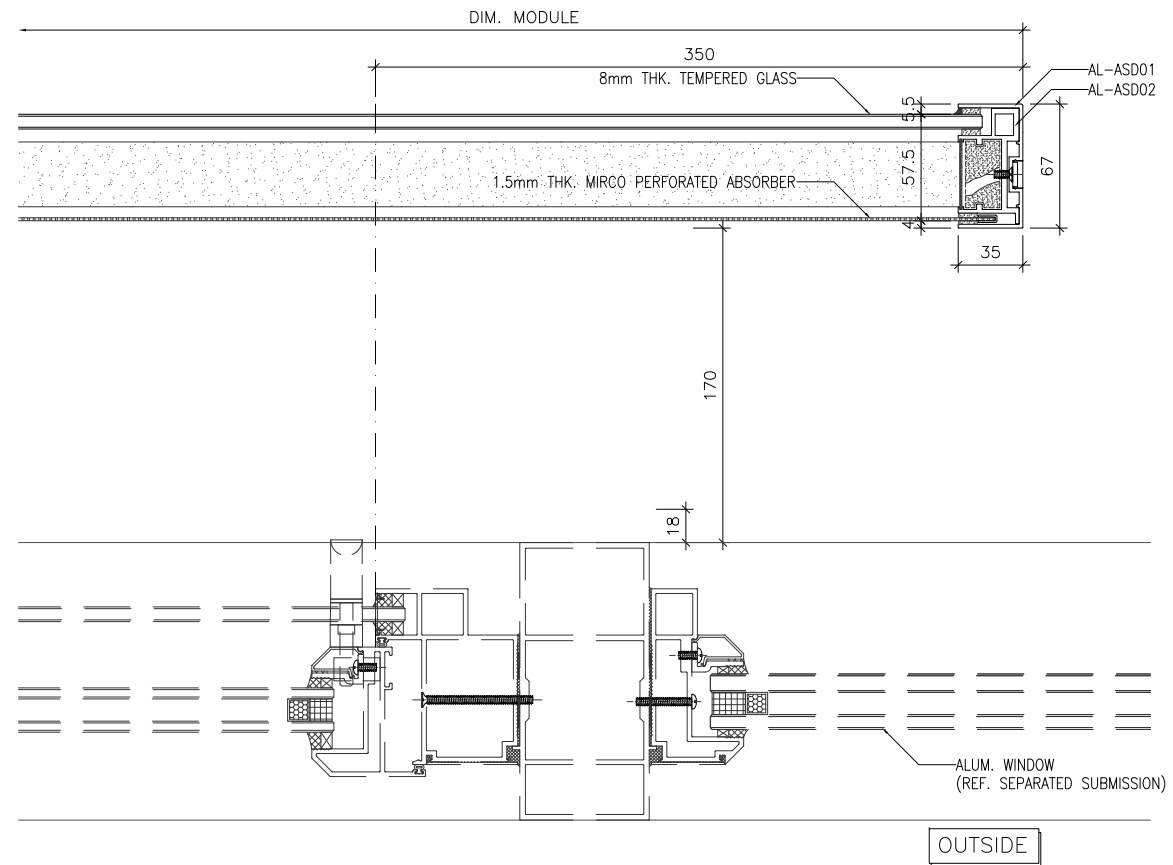

2 HORIZONTAL DETAIL
5002

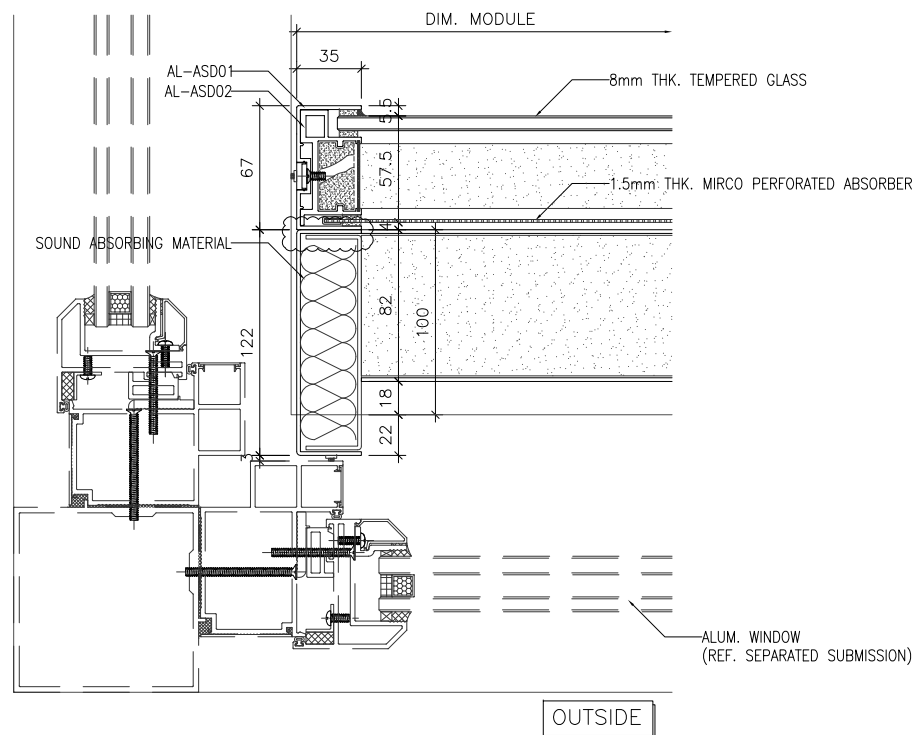

3 HORIZONTAL DETAIL
5002

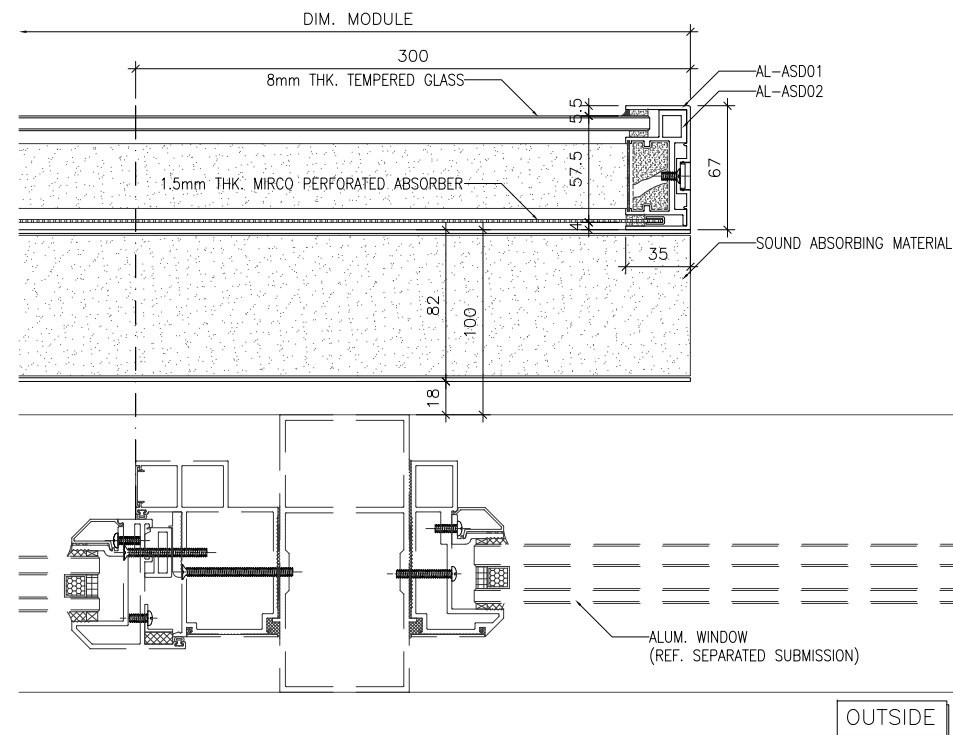

4 HORIZONTAL DETAIL
5002

B.D. REF :

CLIENT :

ARCHITECT :
AGC DESIGN LTD

MAIN CONTRACTOR :
Gammon

STRUCTURAL ENGINEER :
ARUP

FAÇADE CONSULTANT:
MEINHARDT

NOTE :

1. ALL DIMENSIONS ARE IN mm.
2. ALL ELEVATIONS ARE VIEWED FROM OUTSIDE.
3. ALL DIMENSIONS TO BE VERIFIED ON SITE BEFORE FABRICATION.

LEGEND :

- x1 — DETAIL MARK NO.
- x001 — REFER SHEET NO.

1. F.F.L. -- FINISHED FLOOR LEVEL
2. S.F.L. -- STRUCTURAL FLOOR LEVEL
3. (R) -- REVERSED DETAIL

B	13-11-2020	REVISION SUBJECT TO COMMENTS	MN
NO.	DATE	REVISED	BY

JOB NO. : J-852
PROJECT : PROPOSED RESIDENTIAL DEVELOPMENT AT 139 - 147 ARGYLE STREET, NKIL 6005, 6035 R.P., 6036 R.P., 6037 R.P. & 6038 R.P.


TITLE : TYPICAL DETAILS FOR ACOUSTIC SLIDING DOOR

DATE : 17-Jul-20 SCALE : 1:4


DRAWN BY : LHR CHECKED BY : DW

美特鋁質有限公司
MIDI ALUMINIUM FABRICATOR LTD.
Units 6-8, Sunray Industrial Centre, 1/F
610 Cha Kwo Ling Road, Kowloon
Tel:23489211-4 Fax:(852)2727666

DWG NO. : J852-SD-ASD-5002 REV. : B

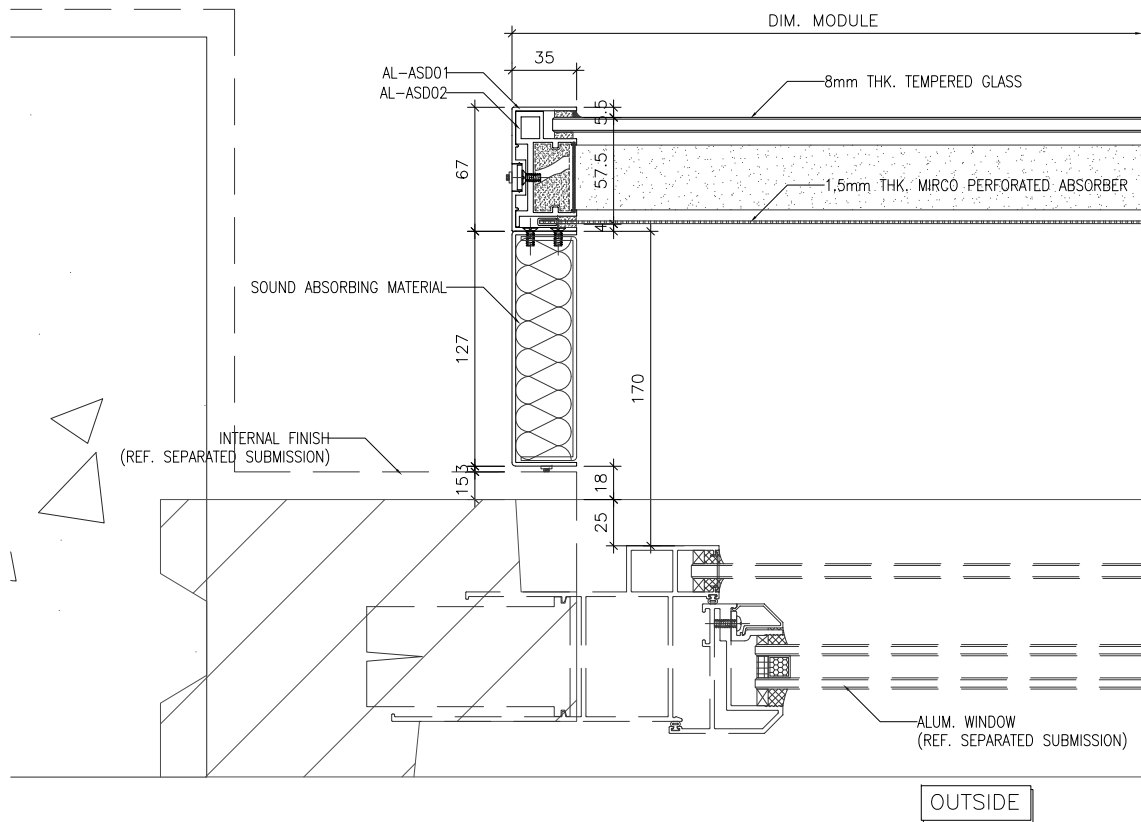

1 HORIZONTAL DETAIL
5002A

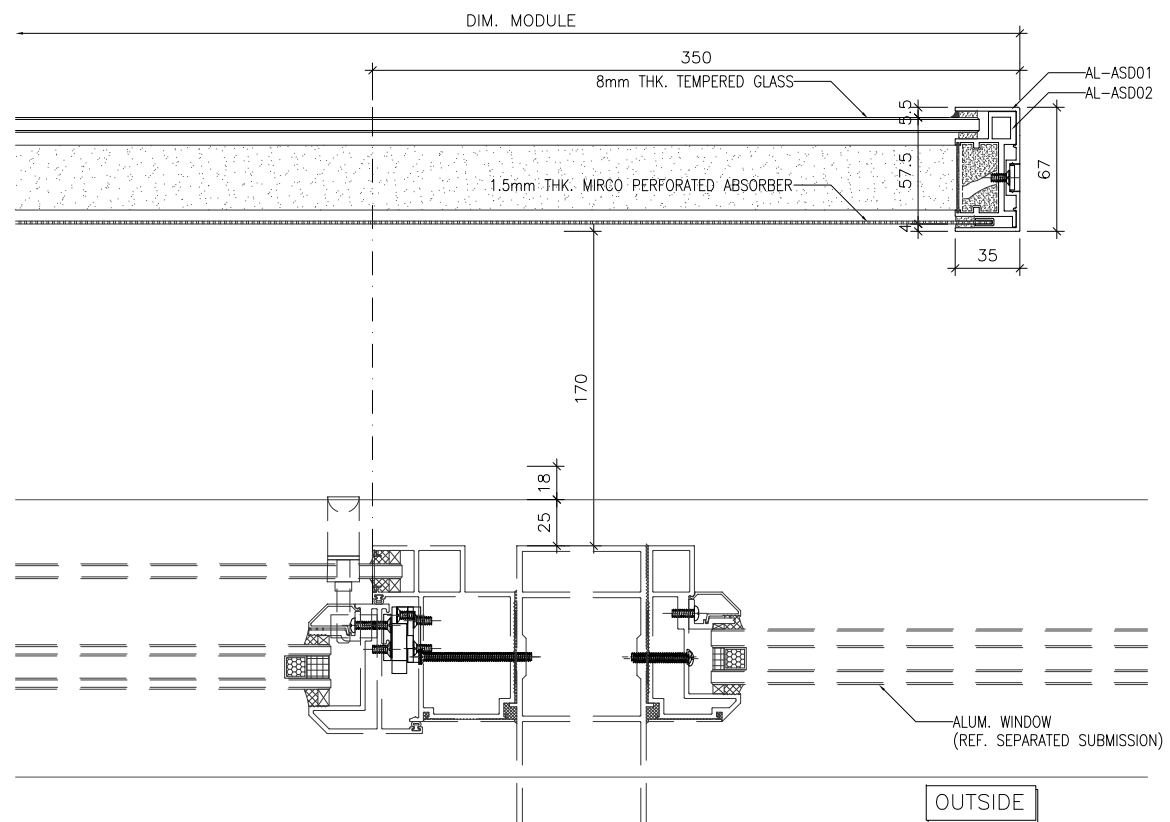

2 HORIZONTAL DETAIL
5002A

B.D. REF :

CLIENT :

ARCHITECT :
AGC DESIGN LTD
AGC DESIGN LTD
110, 112, 114,1000

MAIN CONTRACTOR :
Gammon

STRUCTURAL ENGINEER :
ARUP

FACADE CONSULTANT:
MEINHARDT

NOTE :
1. ALL DIMENSIONS ARE IN mm.
2. ALL ELEVATIONS ARE VIEWED FROM OUTSIDE.
3. ALL DIMENSIONS TO BE VERIFIED ON SITE BEFORE FABRICATION.

LEGEND :
x1 — DETAIL MARK NO.
x001 — REFER SHEET NO.
1. F.F.L. -- FINISHED FLOOR LEVEL
2. S.F.L. -- STRUCTURAL FLOOR LEVEL
3. (R) -- REVERSED DETAIL

NO.	DATE	REVISED	BY


JOB NO. : J-852
PROJECT : PROPOSED RESIDENTIAL DEVELOPMENT AT 139 - 147 ARGYLE STREET, NKIL 6005, 6035 R.P., 6036 R.P., 6037 R.P. & 6038 R.P.

TITLE : TYPICAL DETAILS FOR ACOUSTIC SLIDING DOOR


DATE : 17-Jul-20 SCALE : 1:4
DRAWN BY : LHR CHECKED BY : DW

美特鋁質有限公司
MIDI ALUMINIUM FABRICATOR LTD.
Units 6-8, Sunray Industrial Centre, 1/F
610 Cha Kwo Ling Road, Kowloon
Tel:23489211-4 Fax:(852)2727666


DWG NO. : J852-SD-ASD-5002A REV. : B

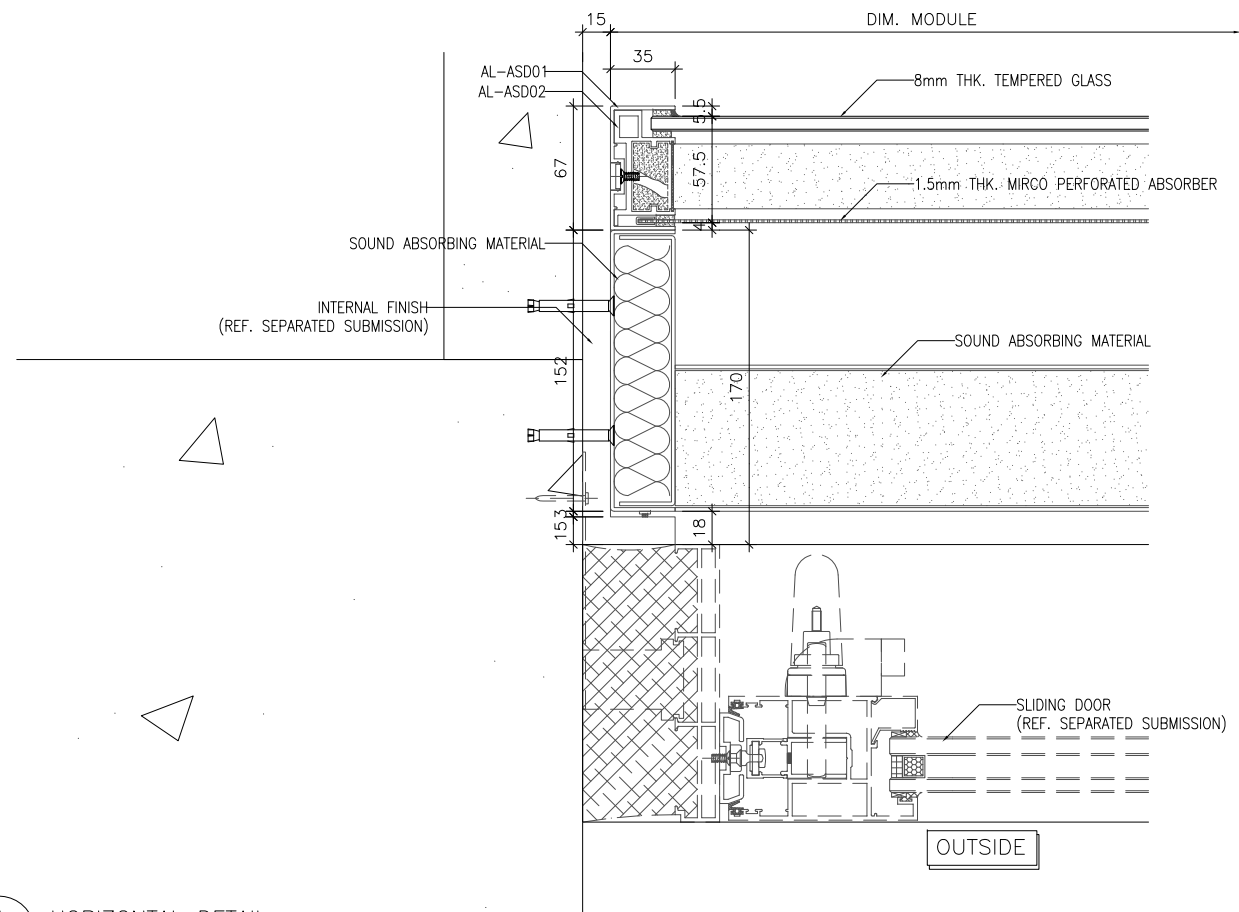

1 HORIZONTAL DETAIL
5004

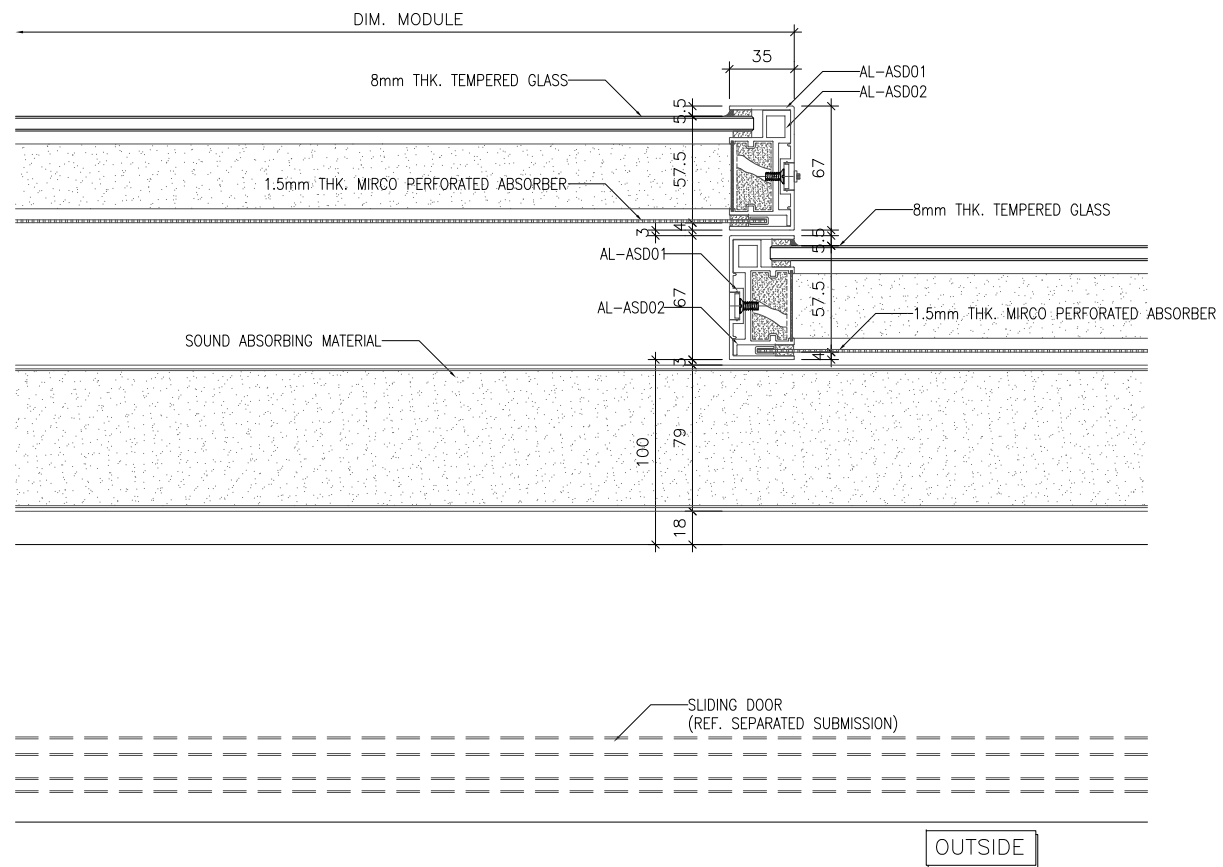

2 HORIZONTAL DETAIL
5004

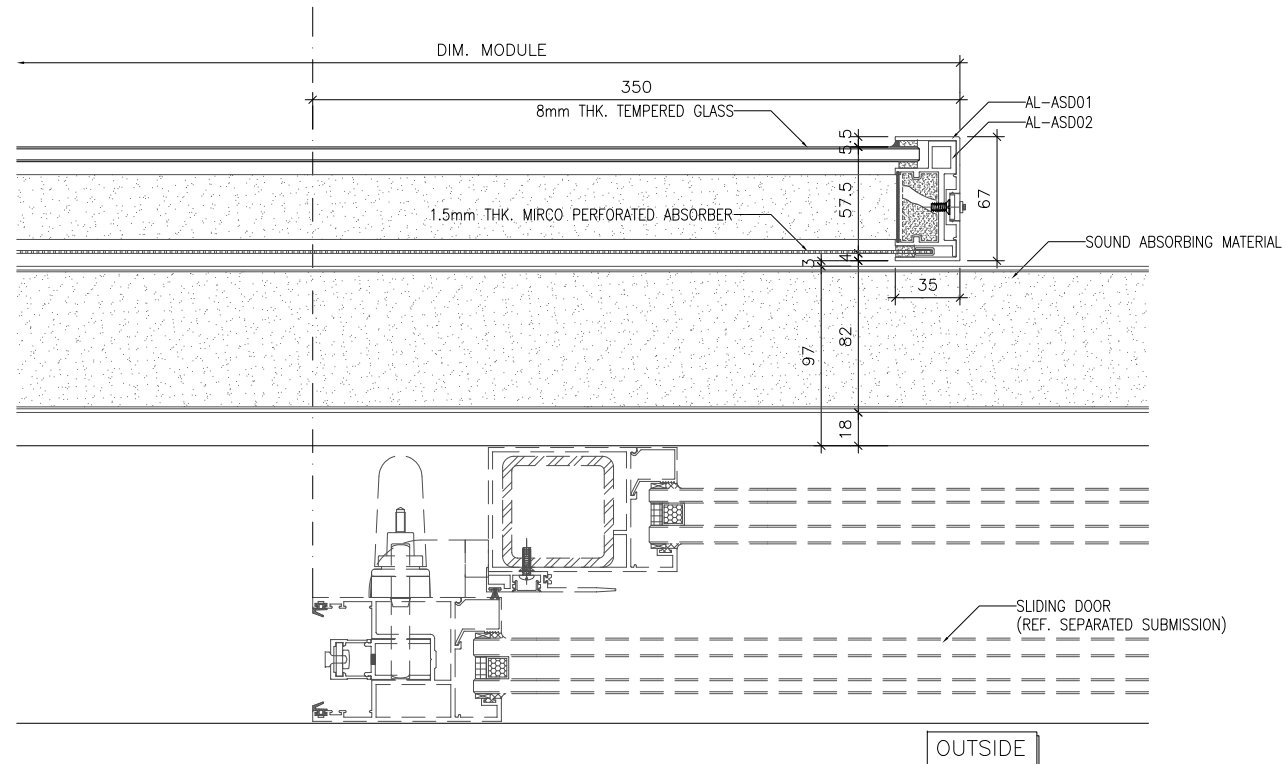

3 HORIZONTAL DETAIL
5004

B.D. REF :

CLIENT :

ARCHITECT :

AGC
DESIGN LTD

MAIN CONTRACTOR :

Gammon

STRUCTURAL ENGINEER :

ARUP

FACADE CONSULTANT:

MEINHARDT

NOTE :

- ALL DIMENSIONS ARE IN mm.
- ALL ELEVATIONS ARE VIEWED FROM OUTSIDE.
- ALL DIMENSIONS TO BE VERIFIED ON SITE BEFORE FABRICATION.

LEGEND :

x1 — DETAIL MARK NO.
x001 — REFER SHEET NO.

- F.F.L. — FINISHED FLOOR LEVEL
- S.F.L. — STRUCTURAL FLOOR LEVEL
- (R) — REVERSED DETAIL

NO.	DATE	REVISED	BY
JOB NO. : J-852			
PROJECT : PROPOSED RESIDENTIAL DEVELOPMENT AT 139 - 147 ARGYLE STREET, NKIL 6005, 6035 R.P., 6036 R.P., 6037 R.P. & 6038 R.P.			
TITLE : TYPICAL DETAILS FOR ACOUSTIC SLIDING DOOR			
DATE : 17-Jul-20		SCALE : 1:4	
DRAWN BY : LHR		CHECKED BY : DW	
<p>MIDI ALUMINIUM FABRICATOR LTD. Units 6-8, Sunray Industrial Centre, 1/F 610 Cha Kwo Ling Road, Kowloon Tel:23489211-4 Fax:(852)2727666</p>			
DWG NO. : J852-SD-ASD-5004			REV. : -

B.D. REF :

CLIENT :

ARCHITECT :
AGC DESIGN LTD

MAIN CONTRACTOR :
Gammon

STRUCTURAL ENGINEER :
ARUP

FAÇADE CONSULTANT:
MEINHARDT

NOTE :
 1. ALL DIMENSIONS ARE IN mm.
 2. ALL ELEVATIONS ARE VIEWED FROM OUTSIDE.
 3. ALL DIMENSIONS TO BE VERIFIED ON SITE BEFORE FABRICATION.

LEGEND :
 (X1) — DETAIL MARK NO.
 (X001) — REFER SHEET NO.
 1. F.F.L. — FINISHED FLOOR LEVEL
 2. S.F.L. — STRUCTURAL FLOOR LEVEL
 3. (R) — REVERSED DETAIL

NO.	DATE	REVISED	BY
-----	------	---------	----

JOB NO. : J-852
 PROJECT : PROPOSED RESIDENTIAL DEVELOPMENT
 AT 139 - 147 ARGYLE STREET,
 NKIL 6005, 6035 R.P., 6036 R.P.,
 6037 R.P. & 6038 R.P.


TITLE : TYPICAL DETAILS
 FOR ACOUSTIC SLIDING DOOR

DATE : 17-Jul-20 SCALE : 1:4


DRAWN BY : LHR CHECKED BY : DW

美特鋁質有限公司
MIDI ALUMINIUM FABRICATOR LTD.
 Units 6-8, Sunray Industrial Centre, 1/F
 610 Cha Kwo Ling Road, Kowloon
 Tel: 23489211-4 Fax: (852) 27727666


DWG NO. : J852-SD-ASD-5005 REV. : -

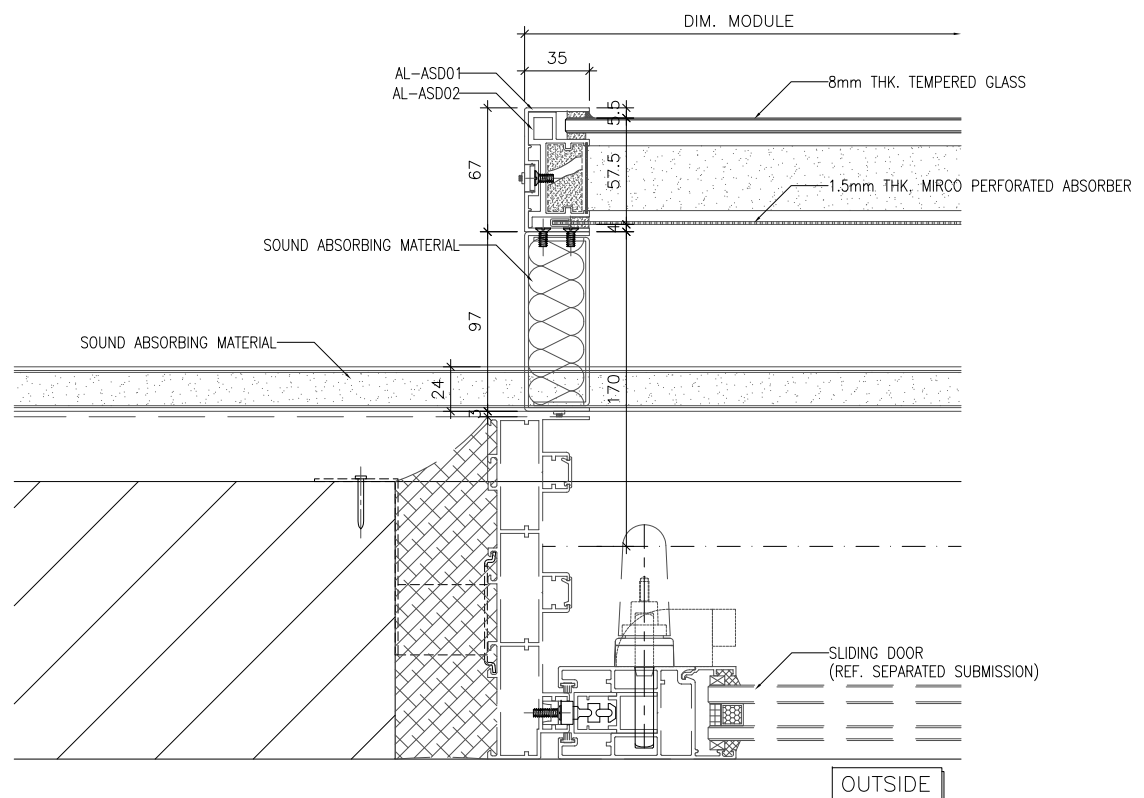


1 HORIZONTAL DETAIL
 5005

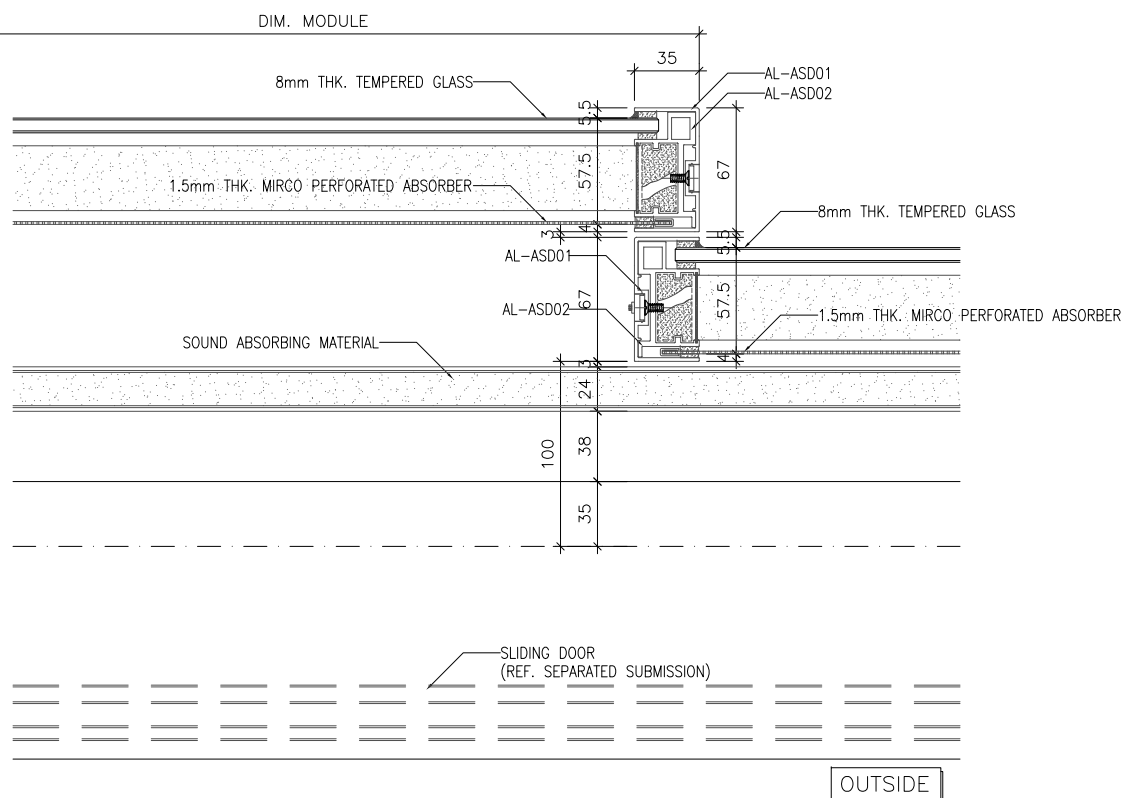


2 HORIZONTAL DETAIL
 5005

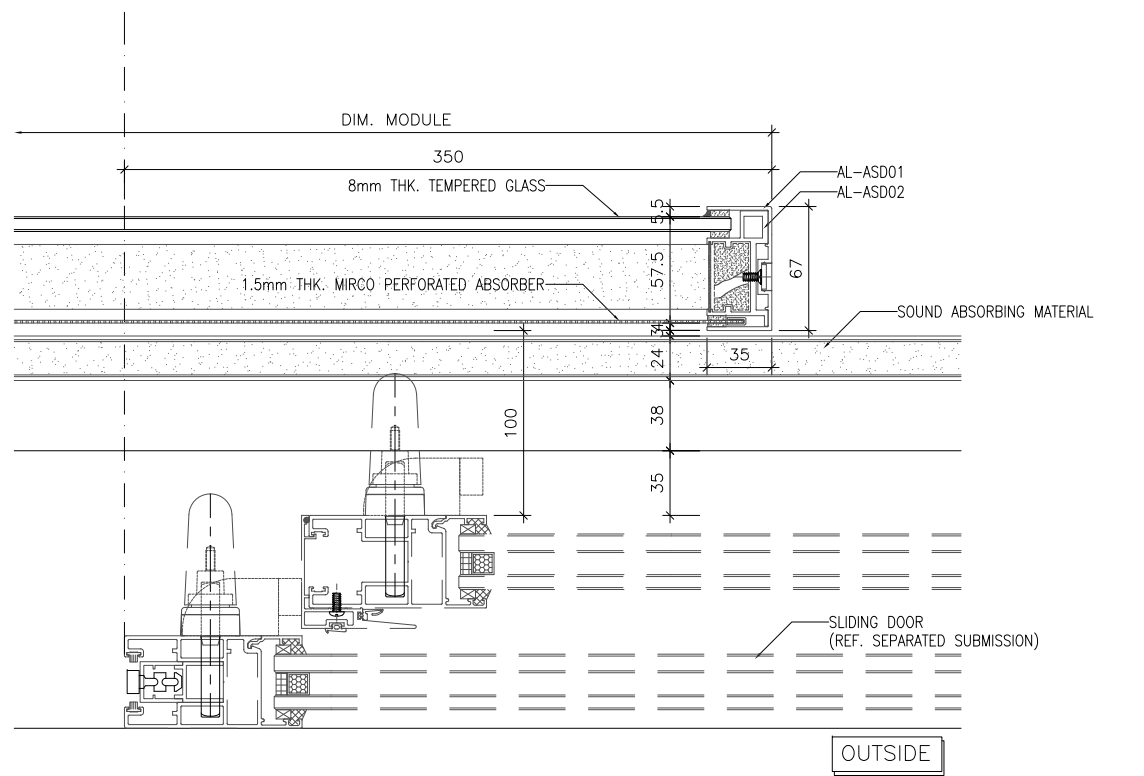


3 HORIZONTAL DETAIL
 5005

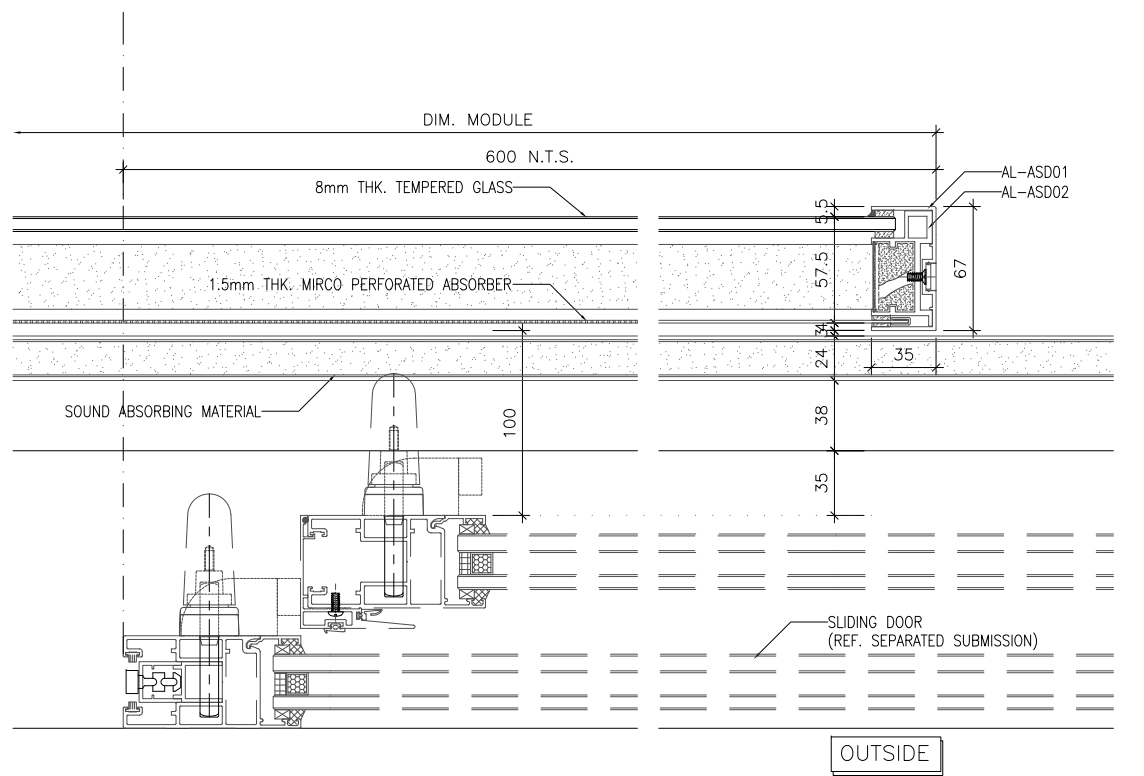


4 HORIZONTAL DETAIL
 5005

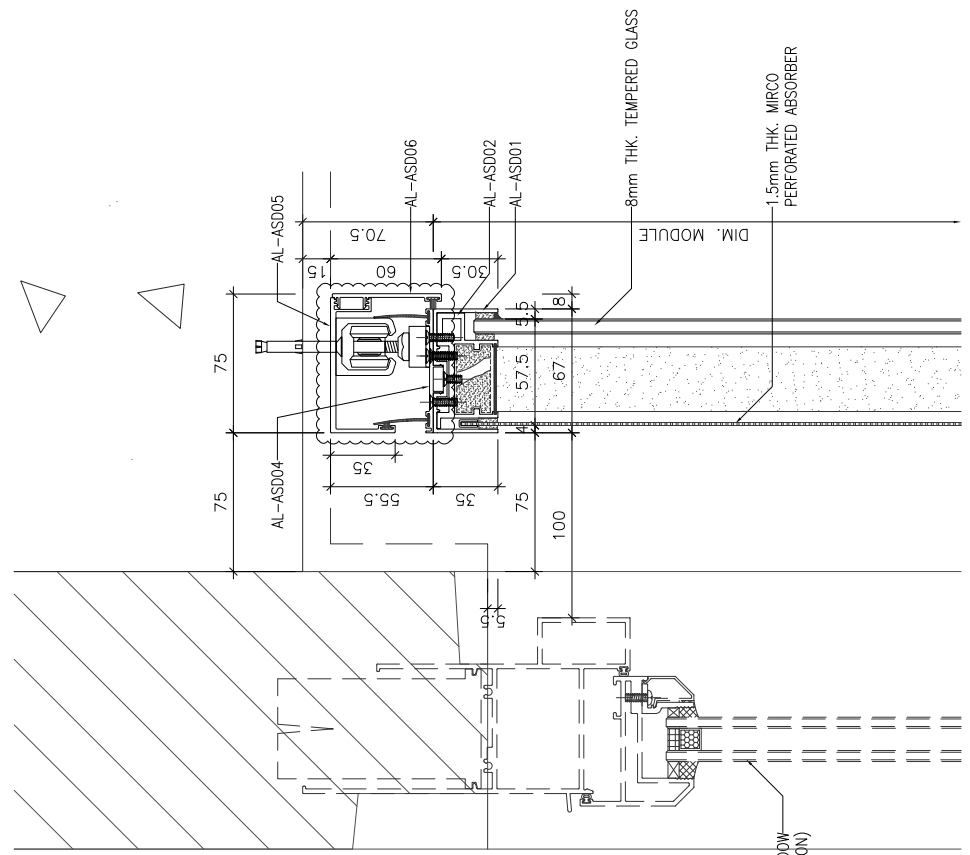


1 VERTICAL DETAIL
6001

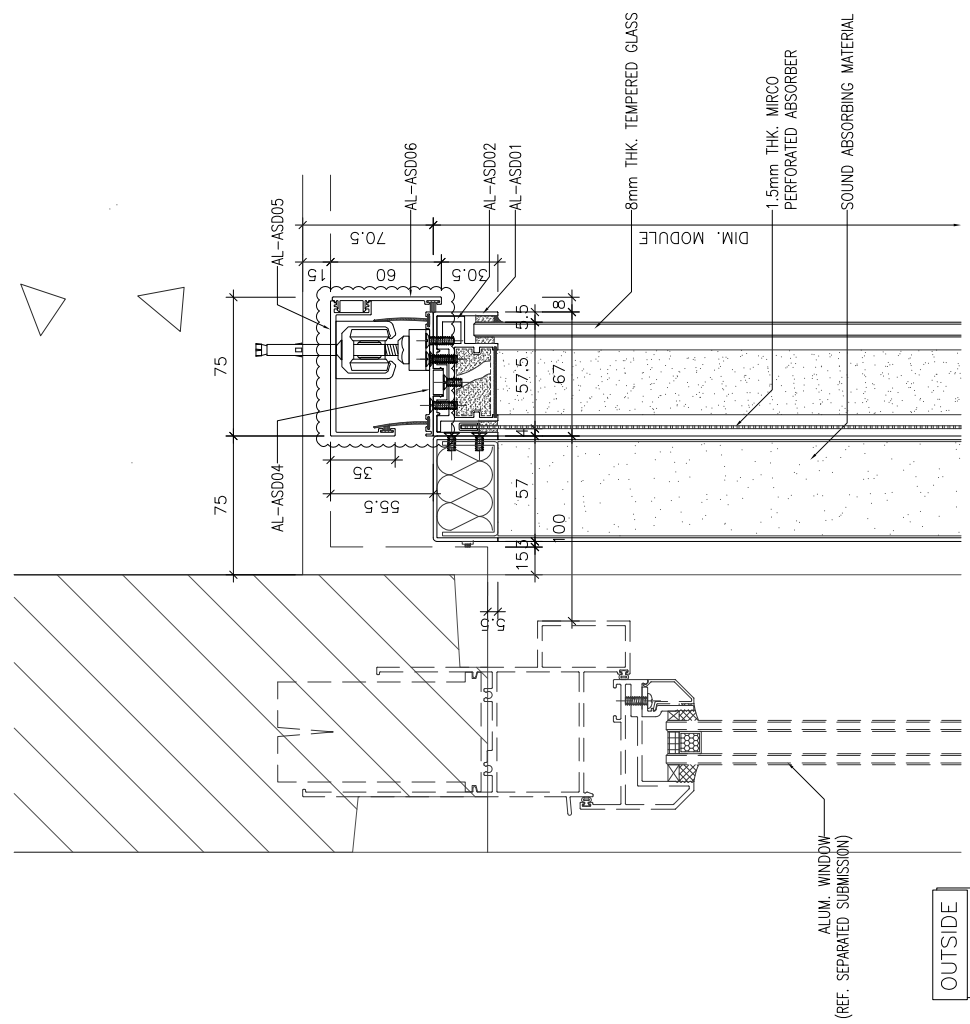

2 VERTICAL DETAIL
6001

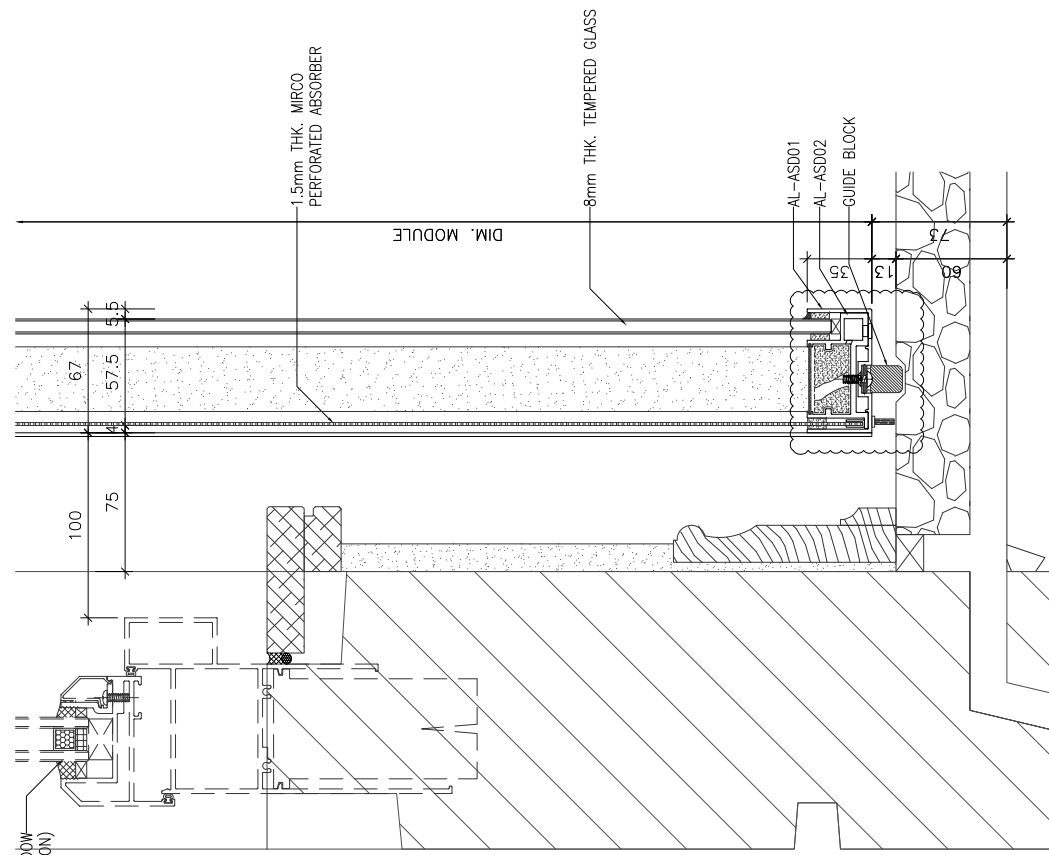

3 VERTICAL DETAIL
6001

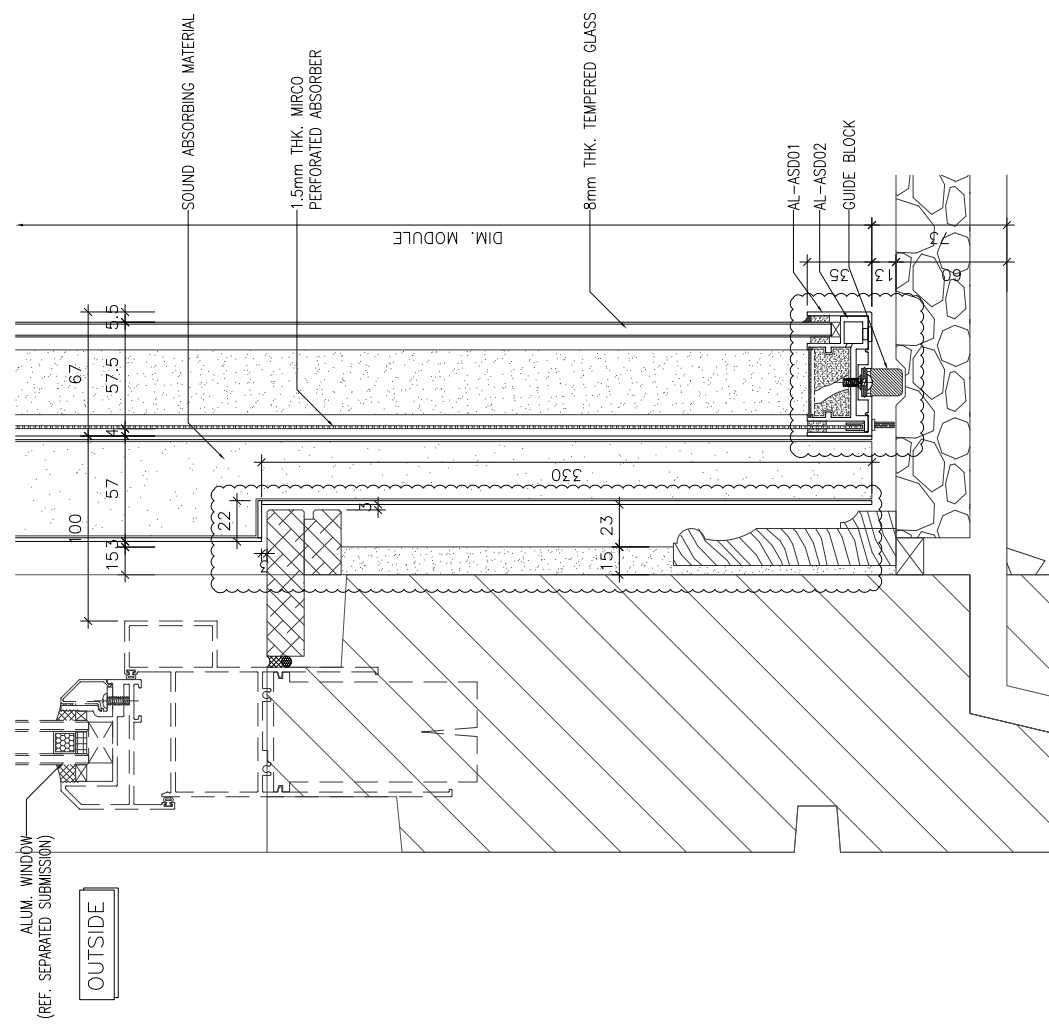

4 VERTICAL DETAIL
6001

B.D. REF :

CLIENT :

ARCHITECT :
AGC DESIGN LTD
 10/F, 102, Queen Mary, 225, Hing Fong Street, Hong Kong
 Tel: (852) 2771 1818, Fax: (852) 2771 1513, Email: agc@agc.com.hk

MAIN CONTRACTOR :
Gammon

STRUCTURAL ENGINEER :
ARUP

FACADE CONSULTANT:
MEINHARDT

NOTE :
 1. ALL DIMENSIONS ARE IN mm.
 2. ALL ELEVATIONS ARE VIEWED FROM OUTSIDE.
 3. ALL DIMENSIONS TO BE VERIFIED ON SITE BEFORE FABRICATION.

LEGEND :
 x1 --- DETAIL MARK NO.
 X001 --- REFER SHEET NO.

1. F.F.L. --- FINISHED FLOOR LEVEL
 2. S.F.L. --- STRUCTURAL FLOOR LEVEL
 3. (A) --- REVERSED DETAIL

NO.	DATE	REVISION SUBJECT TO COMMENTS	BY
B	13-11-2020	REVISION SUBJECT TO COMMENTS	MM

JOB NO. : J-852

PROJECT :
 PROPOSED RESIDENTIAL DEVELOPMENT
 AT 139 - 147 ARGYLE STREET,
 NKIL 6005, 6035 R.P., 6036 R.P.,
 6037 R.P. & 6038 R.P.


TITLE :
 TYPICAL DETAILS
 FOR ACOUSTIC SLIDING DOOR

DATE : 17-Jul-20 SCALE : 1:4


DRAWN BY : LHR CHECKED BY : DW

美特鋁質有限公司
MIDI ALUMINIUM FABRICATOR LTD.
 Units 6-8, Sunray Industrial Centre, 1/F
 610 Cha Kwo Ling Road, Kowloon
 Tel:23489211-4 Fax:(852)27727666


DWG NO. : J852-SD-ASD-6001 REV. : B

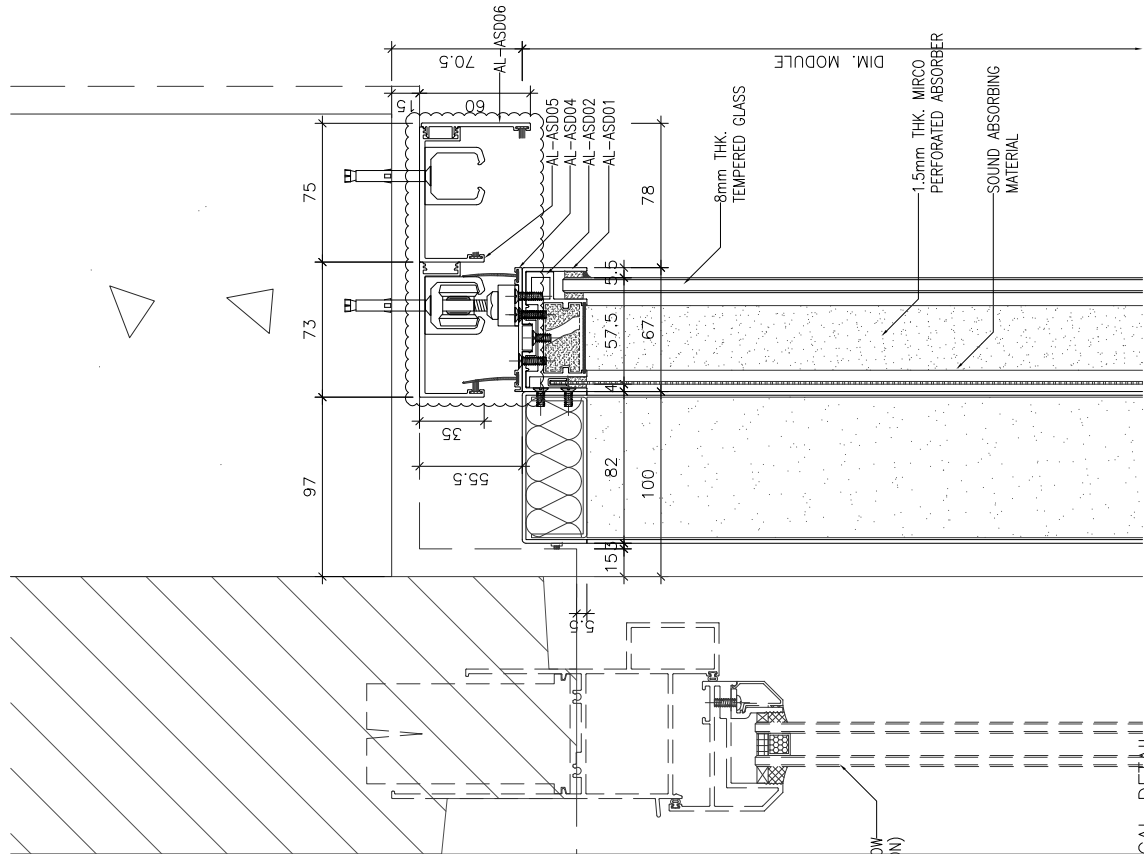


3 VERTICAL DETAIL
6002

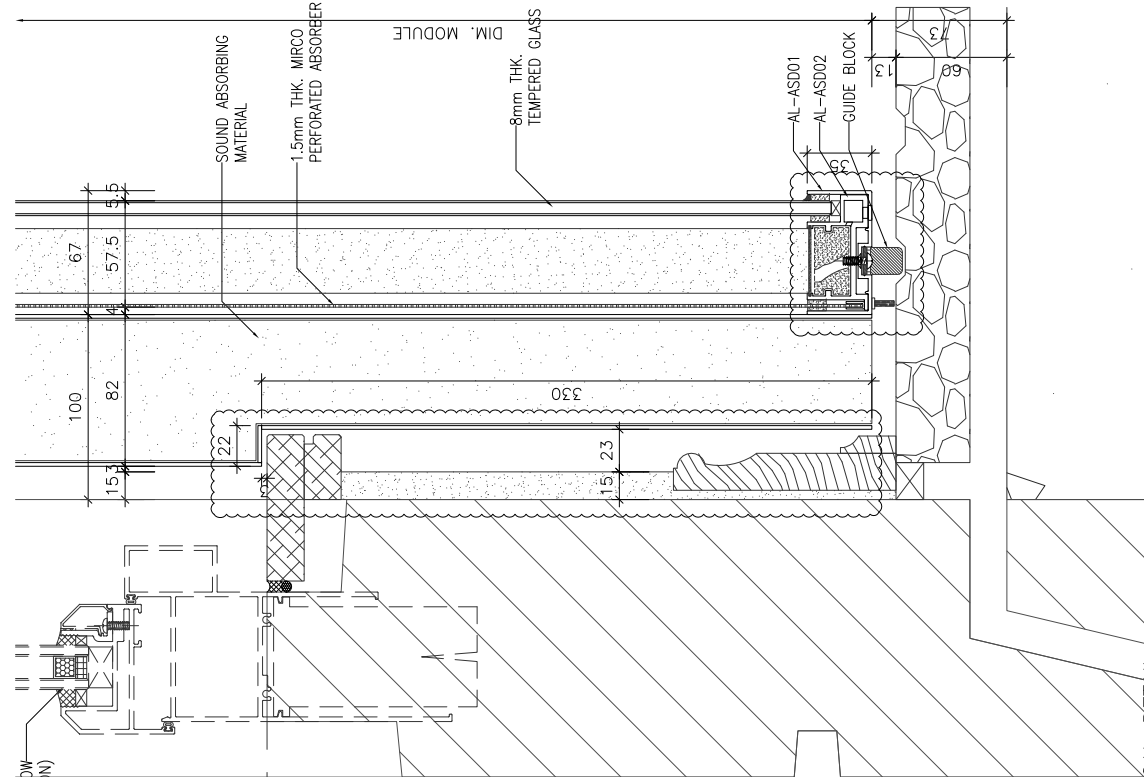

4 VERTICAL DETAIL
6002

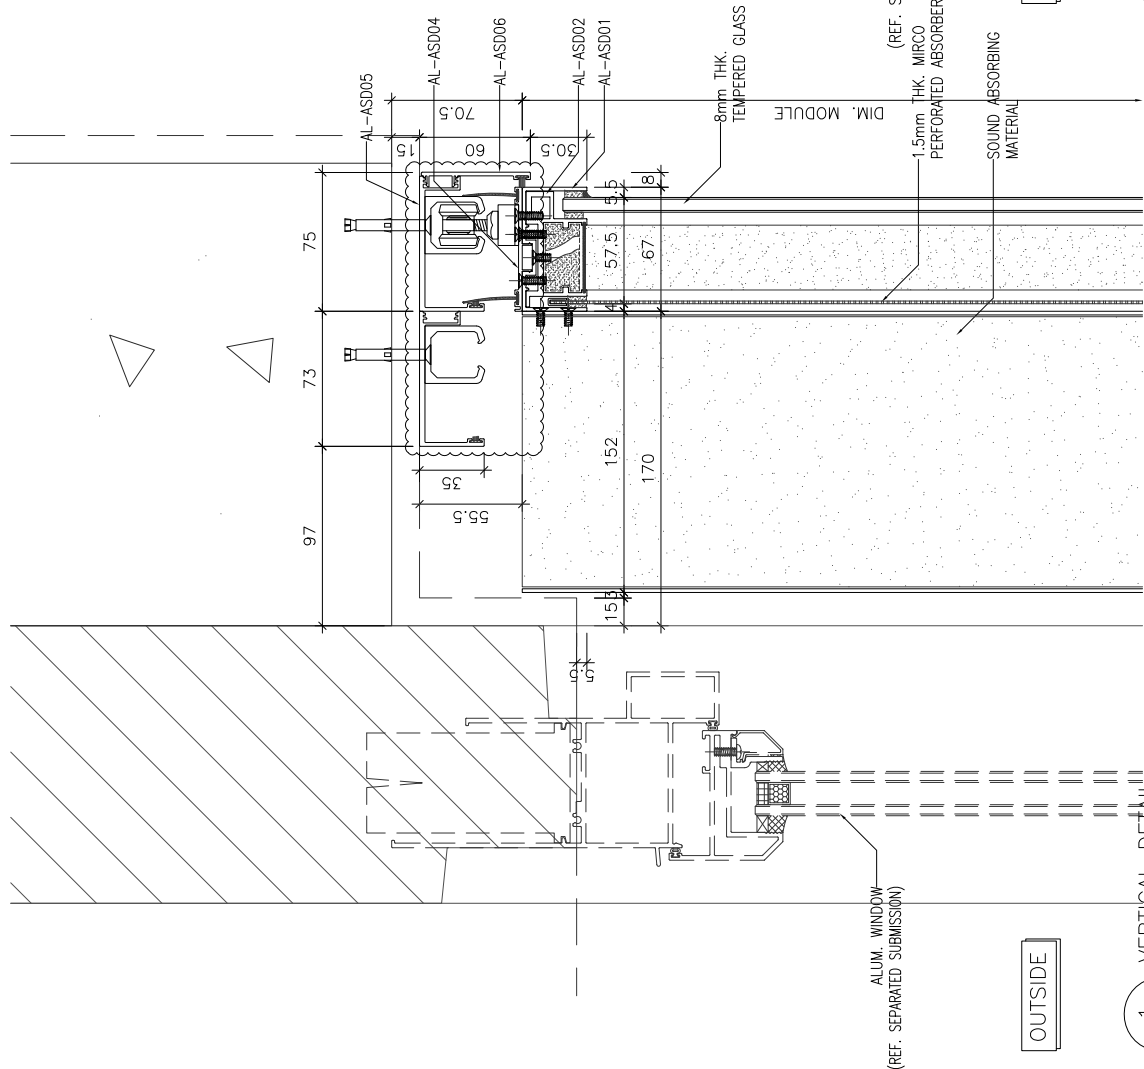

1 VERTICAL DETAIL
6002

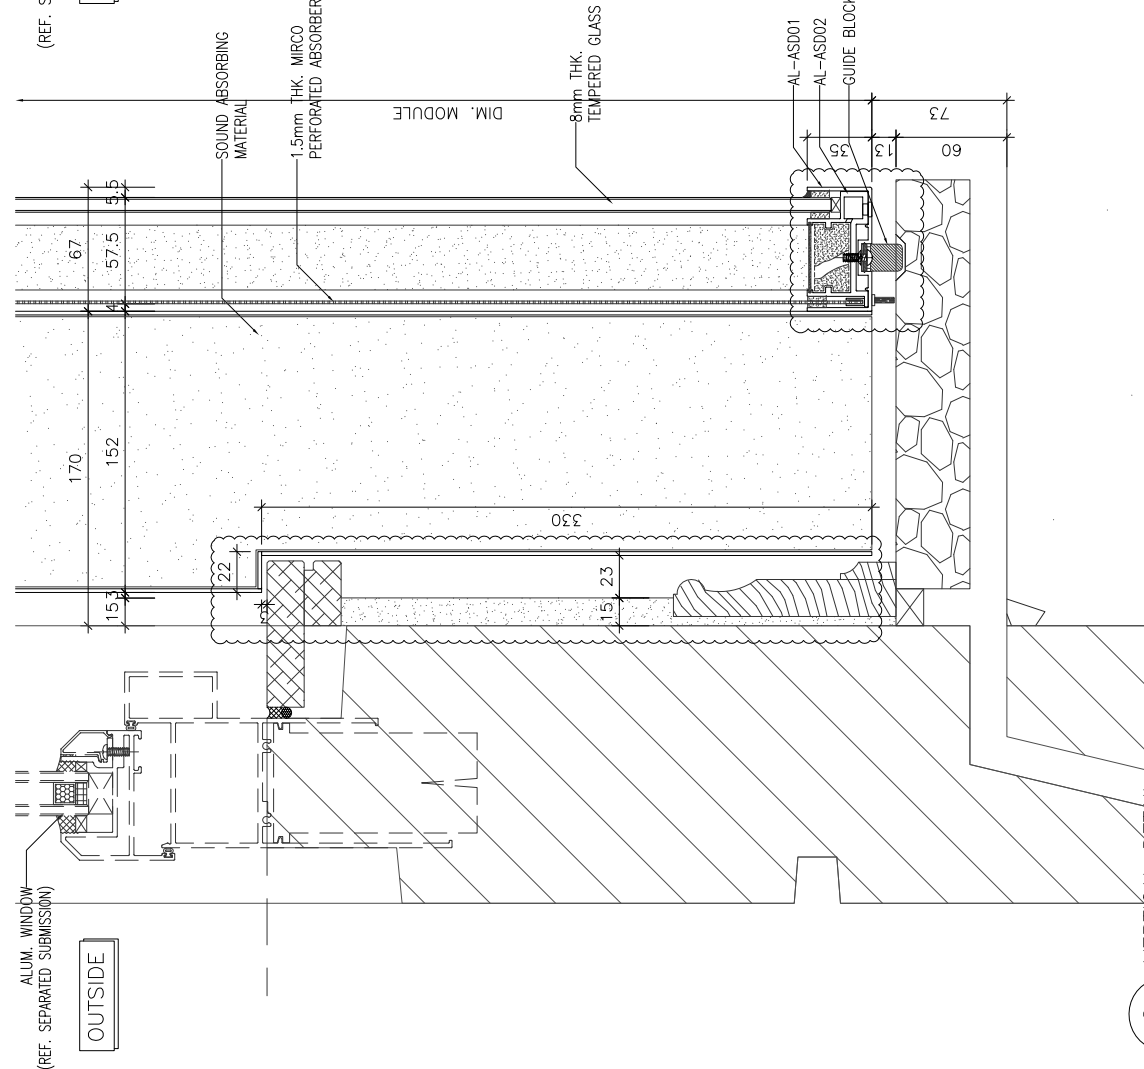

2 VERTICAL DETAIL
6002

B.D. REF :

CLIENT :

ARCHITECT :
AGC DESIGN LTD

MAIN CONTRACTOR :
Gammon

STRUCTURAL ENGINEER :
ARUP

FACADE CONSULTANT:
MEINHARDT

NOTE :
1. ALL DIMENSIONS ARE IN mm.
2. ALL ELEVATIONS ARE VIEWED FROM OUTSIDE.
3. ALL DIMENSIONS TO BE VERIFIED ON SITE BEFORE FABRICATION.

LEGEND :
X1 --- DETAIL MARK NO.
X001 --- REFER SHEET NO.
1. F.F.L. --- FINISHED FLOOR LEVEL
2. S.F.L. --- STRUCTURAL FLOOR LEVEL
3. (R) --- REVERSED DETAIL

NO.	DATE	REVISION	COMMENTS	BY
B	13-11-2020		REVISION SUBJECT TO COMMENTS	MN


JOB NO. : J-852
PROJECT : PROPOSED RESIDENTIAL DEVELOPMENT AT 139 - 147 ARGYLE STREET, NKIL 6005, 6035 R.P., 6036 R.P., 6037 R.P. & 6038 R.P.

TITLE : TYPICAL DETAILS FOR ACOUSTIC SLIDING DOOR

DATE : 17-Jul-20 SCALE : 1:4
DRAWN BY : LHR CHECKED BY : DW

美特铝质有限公司
MIDI ALUMINIUM FABRICATOR LTD.
Units 6-8, Sunray Industrial Centre, 1/F
610 Cha Kwo Ling Road, Kowloon
Tel:23489211-4 Fax:(852)2727666


DWG NO. : J852-SD-ASD-6002 REV. : B

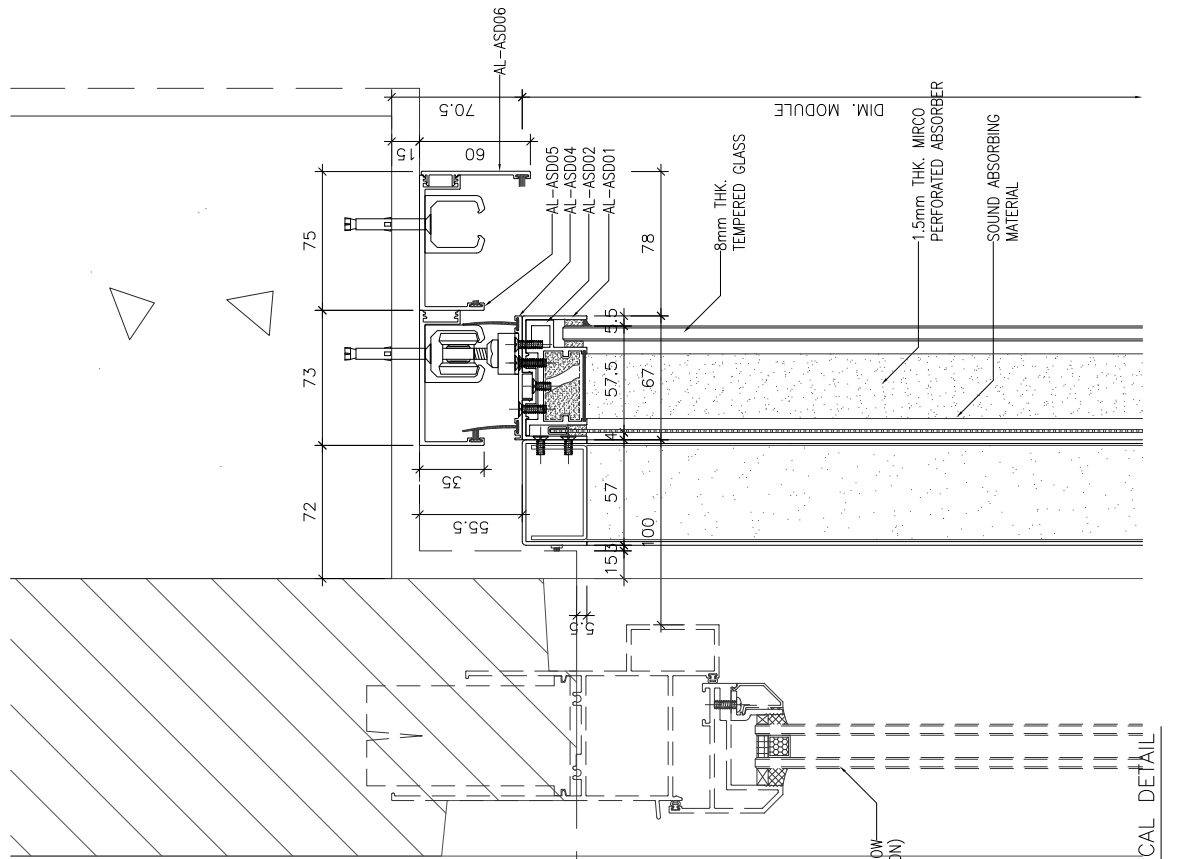

ALUM. WINDOW
(REF. SEPARATED SUBMISSION)

OUTSIDE


3 VERTICAL DETAIL
6002A

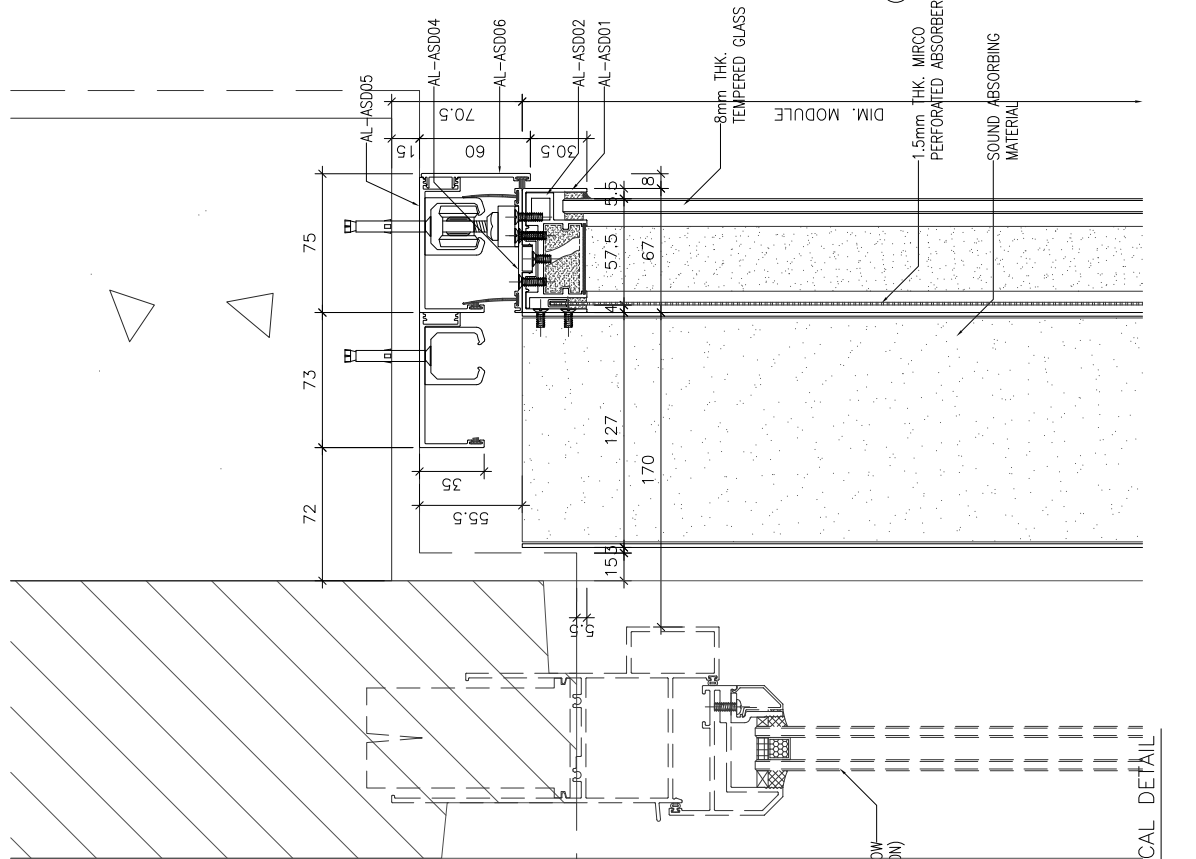

ALUM. WINDOW
(REF. SEPARATED SUBMISSION)

OUTSIDE


1 VERTICAL DETAIL
6002A

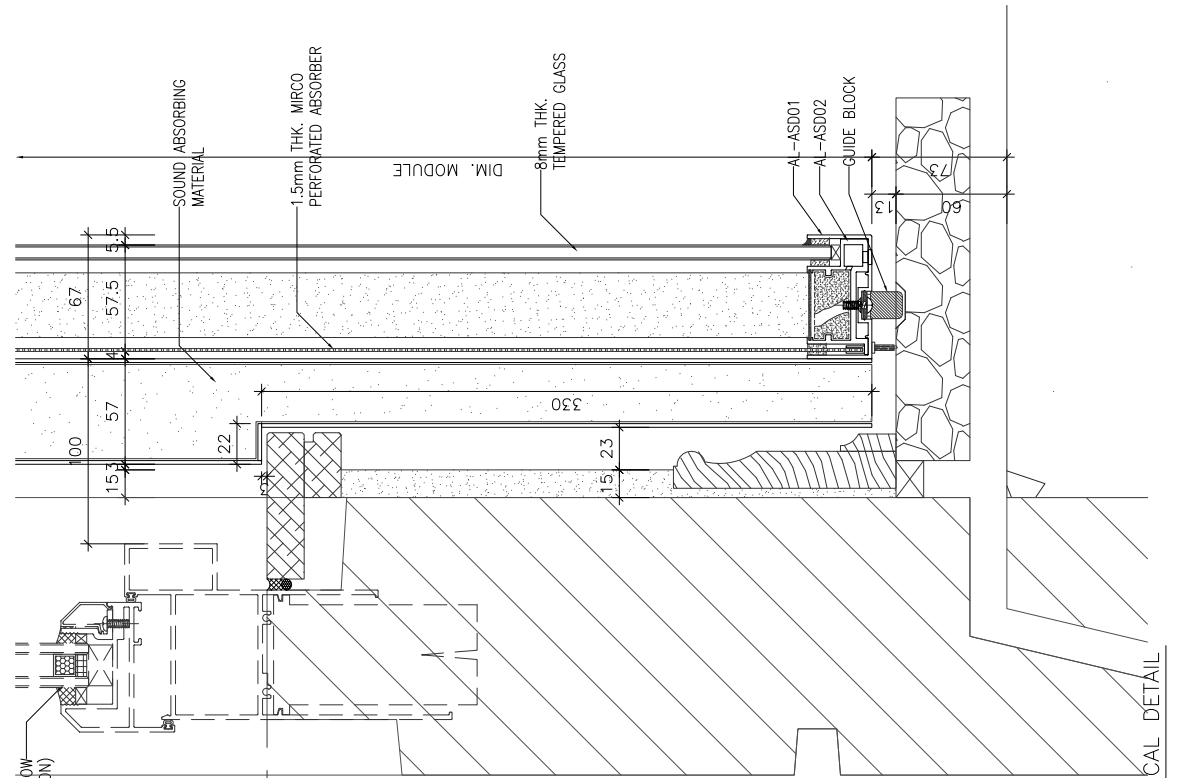

ALUM. WINDOW
(REF. SEPARATED SUBMISSION)

OUTSIDE

4 VERTICAL DETAIL
6002A

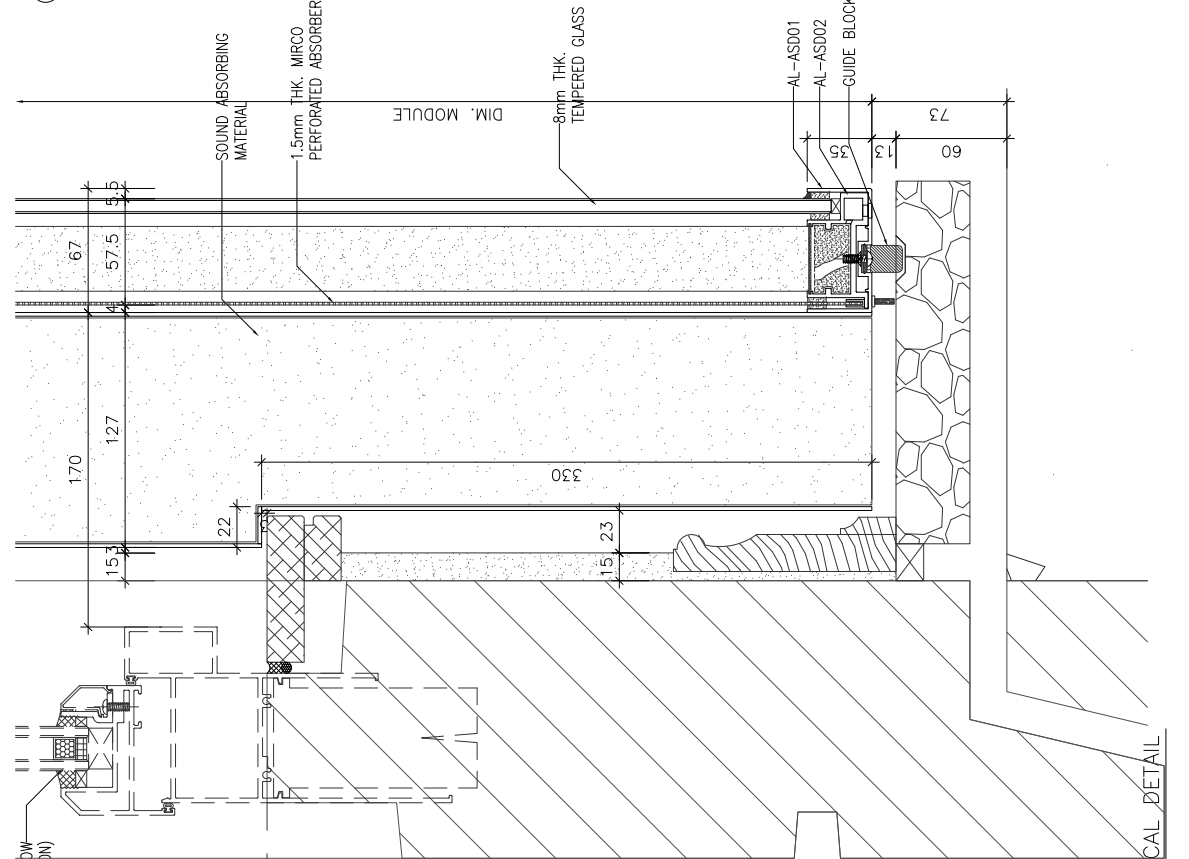

ALUM. WINDOW
(REF. SEPARATED SUBMISSION)

OUTSIDE

2 VERTICAL DETAIL
6002A

B.D. REF :

CLIENT :

ARCHITECT :

AGC
DESIGN LTD
AGC DESIGN LTD
180, 182, 184,1000

MAIN CONTRACTOR :

Gammon

STRUCTURAL ENGINEER :

ARUP

FAÇADE CONSULTANT:

MEINHARDT

NOTE :

1. ALL DIMENSIONS ARE IN mm.
2. ALL ELEVATIONS ARE VIEWED FROM OUTSIDE.
3. ALL DIMENSIONS TO BE VERIFIED ON SITE BEFORE FABRICATION.

LEGEND :

- (X1) --- DETAIL MARK NO.
- (X001) --- REFER SHEET NO.

1. F.F.L. --- FINISHED FLOOR LEVEL
2. S.F.L. --- STRUCTURAL FLOOR LEVEL
3. (R) --- REVERSED DETAIL

NO.	DATE	REVISED	BY

JOB NO. : J-852

PROJECT :
PROPOSED RESIDENTIAL DEVELOPMENT
AT 139 - 147 ARGYLE STREET,
NKIL 6005, 6035 R.P., 6036 R.P.,
6037 R.P. & 6038 R.P.


TITLE :
TYPICAL DETAILS
FOR ACOUSTIC SLIDING DOOR

DATE : 17-Jul-20 SCALE : 1:4


DRAWN BY : LHR CHECKED BY : DW

美特鋁質有限公司
MIDI ALUMINIUM FABRICATOR LTD.
Units 6-8, Sunray Industrial Centre, 1/F
610 Cha Kwo Ling Road, Kowloon
Tel:23489211-4 Fax:(852)2727666

DWG NO. : J852-SD-ASD-6002A REV. : B

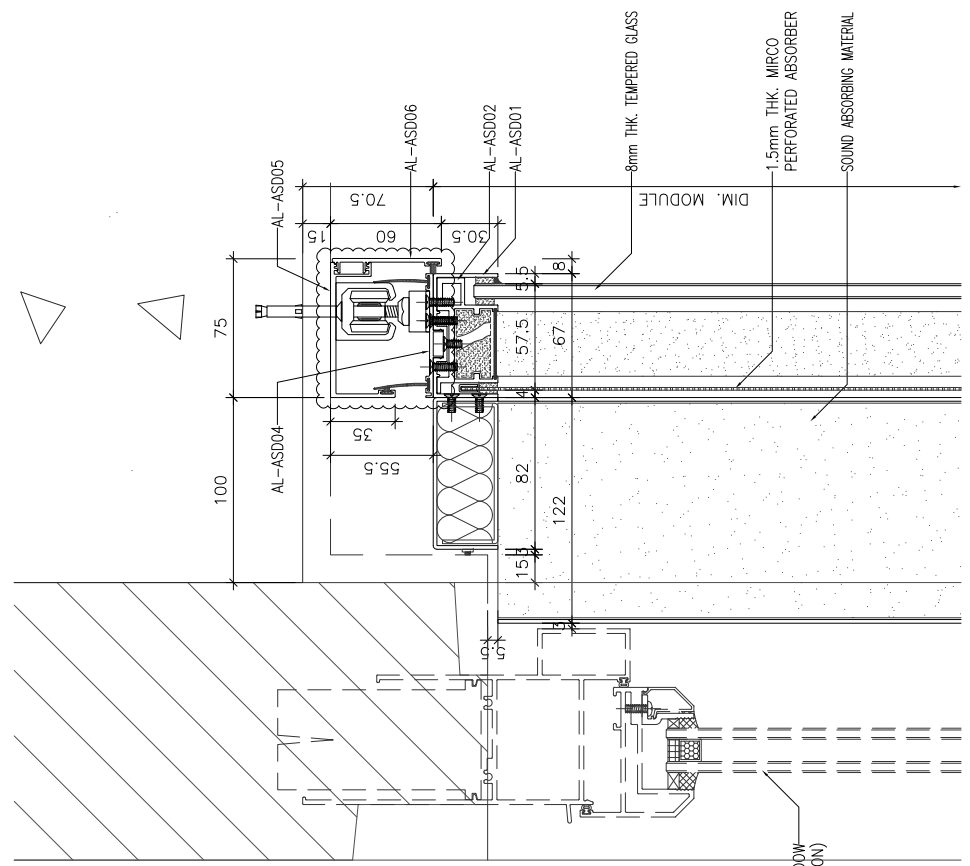


OUTSIDE

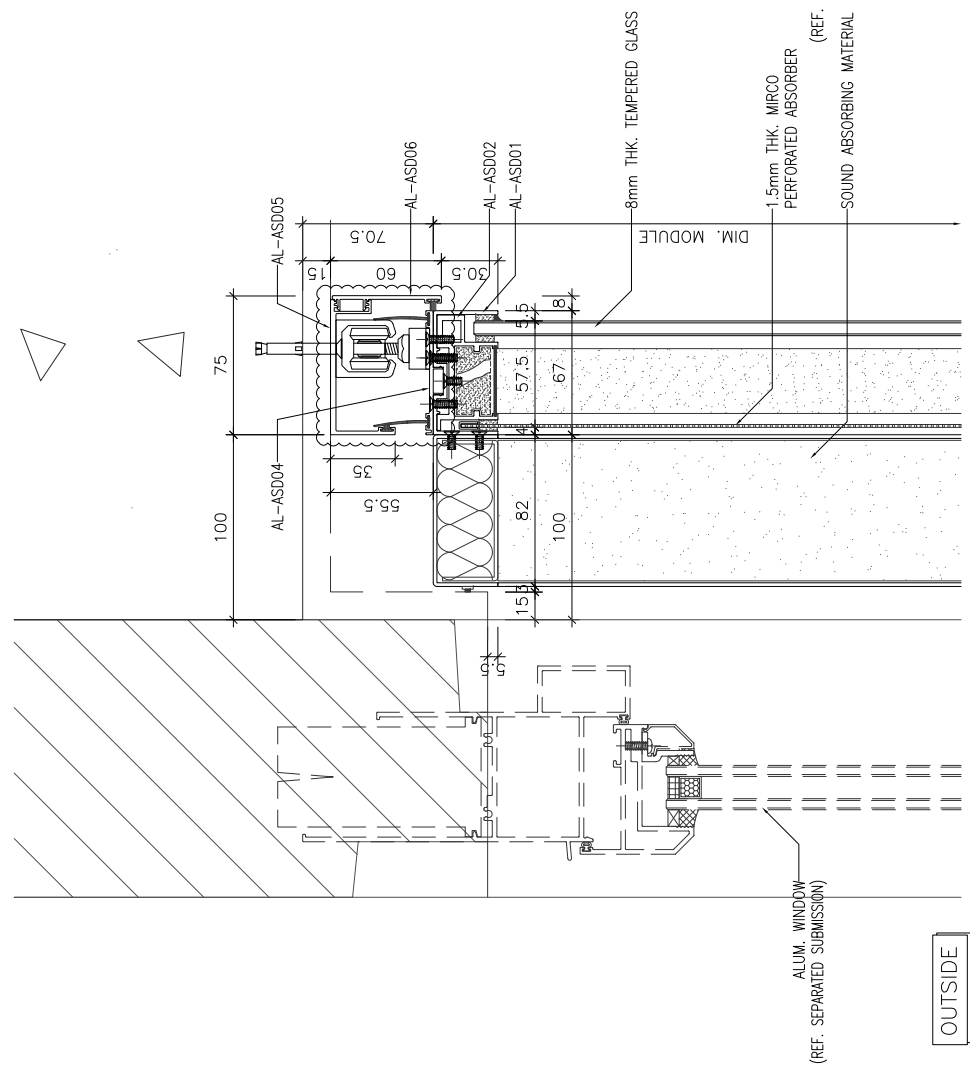


OUTSIDE

1 VERTICAL DETAIL
6003

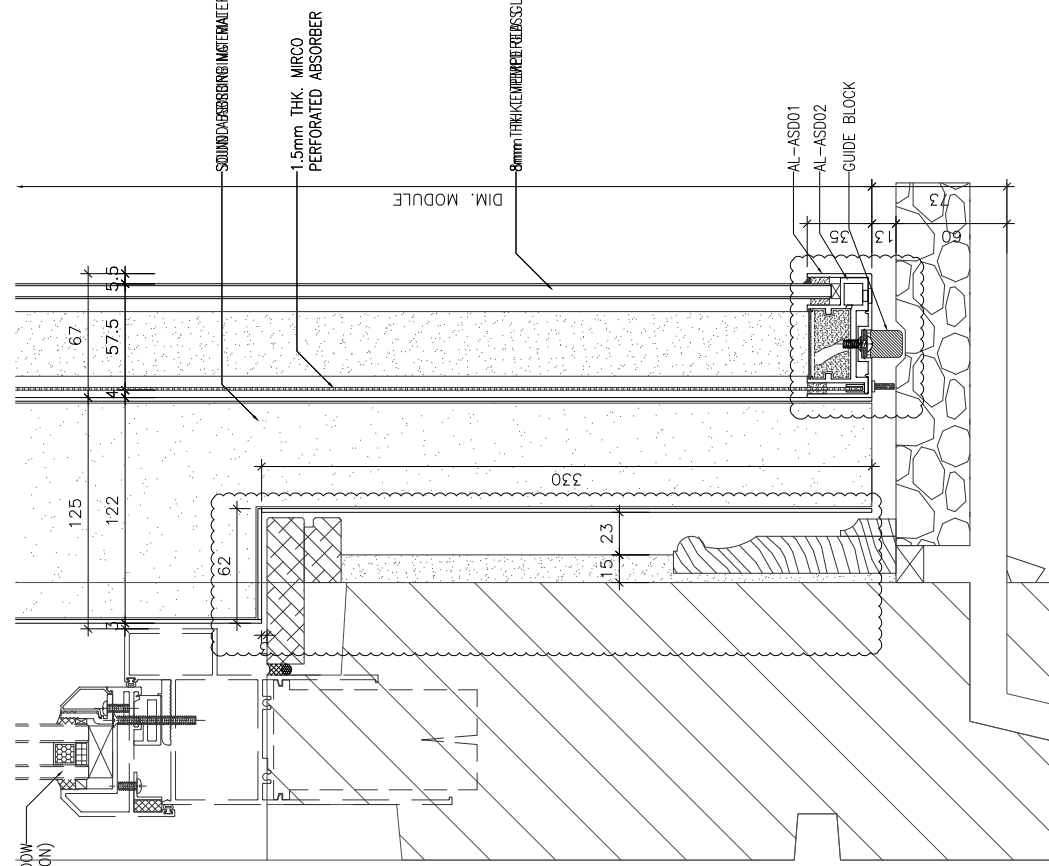

OUTSIDE

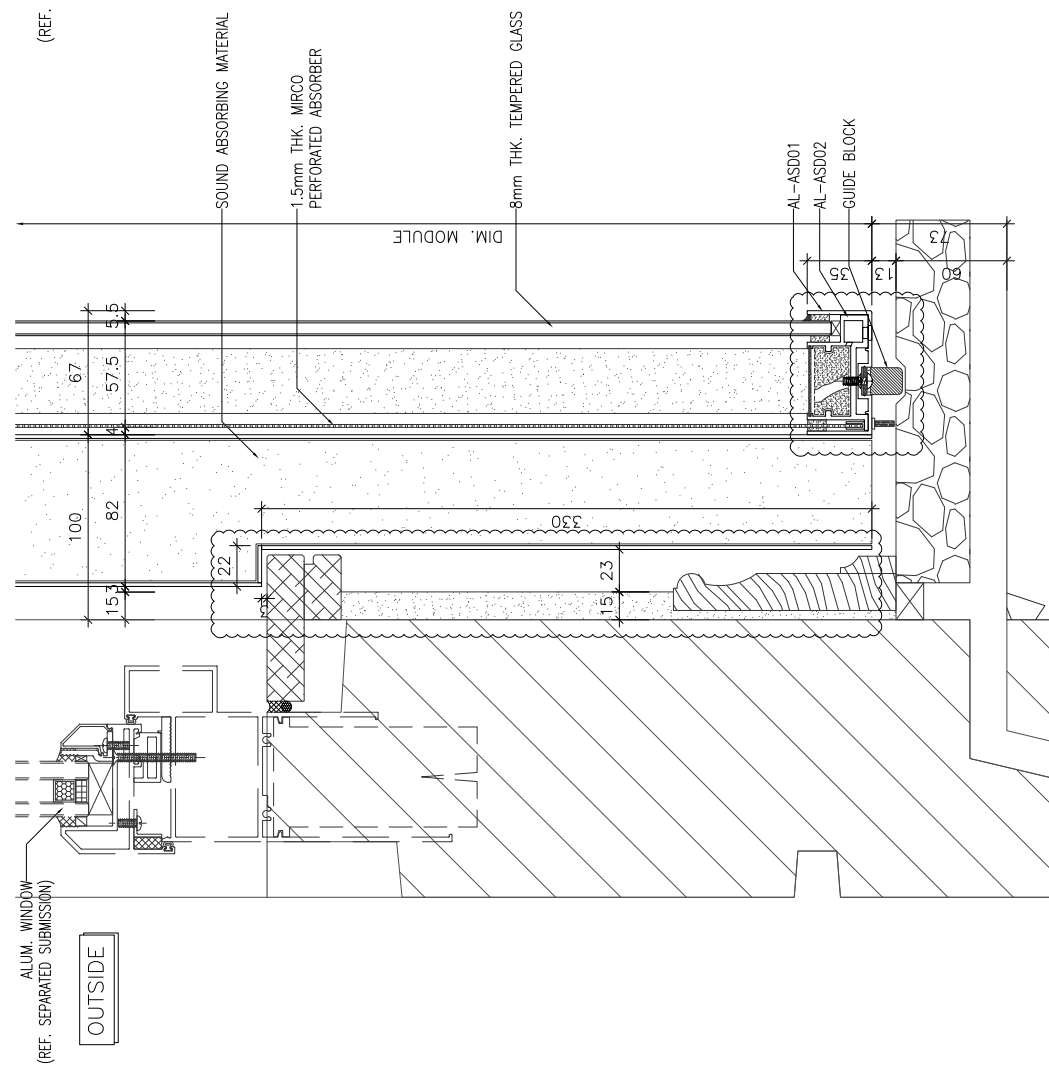

OUTSIDE

3 VERTICAL DETAIL
6003

4 VERTICAL DETAIL
6003

B.D. REF :
CLIENT :

ARCHITECT :
AGC DESIGN LTD

MAIN CONTRACTOR :
Gammon

STRUCTURAL ENGINEER :
ARUP

FACADE CONSULTANT:
MEINHARDT

NOTE :
1. ALL DIMENSIONS ARE IN mm.
2. ALL ELEVATIONS ARE VIEWED FROM OUTSIDE.
3. ALL DIMENSIONS TO BE VERIFIED ON SITE BEFORE FABRICATION.

LEGEND :
X1 --- DETAIL MARK NO.
X001 --- REFER SHEET NO.

1. F.F.L. --- FINISHED FLOOR LEVEL
2. S.F.L. --- STRUCTURAL FLOOR LEVEL
3. (R) --- REVERSED DETAIL

NO.	DATE	REVISION SUBJECT TO COMMENTS	BY
B	13-11-2020	REVISION SUBJECT TO COMMENTS	MIN

JOB NO. : J-852
PROJECT : PROPOSED RESIDENTIAL DEVELOPMENT AT 139 - 147 ARGYLE STREET, NKIL 6005, 6035 R.P., 6036 R.P., 6037 R.P. & 6038 R.P.

TITLE : TYPICAL DETAILS FOR ACOUSTIC SLIDING DOOR

DATE : 17-Jul-20 SCALE : 1:4

DRAWN BY : LHR CHECKED BY : DW

美特鋁質有限公司
MIDI ALUMINIUM FABRICATOR LTD.
Units 6-8, Sunray Industrial Centre, 1/F
610 Cha Kwo Ling Road, Kowloon
Tel:23489211-4 Fax:(852)2727666

DWG NO. : J852-SD-ASD-6003 REV. : B

