



工程指示 / 要求簡箋(E.I.)

工程指示編號：EI / 3175 / 21

修改版次：C

以此為準
2021.04.28

工程編號：J - 852

工程名稱：亞皆老街中電

工程項目：佛沙窗 地盤用玻璃 B.M. 大貨 (T1-T3) (1-21/F) (2992 件)

暫停生產

收件人：Maggie

發件人：Ant Yeung

日期：28/04/2021

要求提供 / 確認 事項：

() 初步鋁料 B.M. () 加工拆圖，然後生產 () 尺寸表

() 正式鋁料 B.M. () 技術上資料 / 指示 () 報價

內容：

C 版：業主要求廁所玻璃更改為磨沙玻璃，玻璃厚度需重新計算。請暫停生產廁所位置的玻璃。

B 版：本司和判頭也已同意確認包箱方法，無位置暫存，必須是分座分層。大玻璃獨立包，廚廁分開包

B 版：GL04 全部暫停 (安全欄河玻璃仔)

A 版：已修改 BM 上 GL03 (D21010040) 玻璃的 Low-E 編號

請按 BM 訂購 T1-T3: 1-21/F 佛沙窗玻璃 (共 2,992 件) (T1: 1,067 件, T2: 953 件, T3: 972 件) 直送地盤。

包裝要分座分層。* T3 優先出貨

GL01a-01: D21010039 (2390x2070) (共:35 件- 分 T1, T3) 為大玻璃 (未能入沙機) 須另外分箱包裝。

IGU 膠用 DC983 結構膠

玻璃要做熱浸。 Low-E: SEE0-83T.

請留意玻璃加工時不要固定的鋼化及熱浸標籤。玻璃出貨時需加上"可移除" 標籤。

單片：標籤在室外面 (注明半鋼化/ 鋼化); IGU: 標籤在室內外面 (注明半鋼化/ 鋼化)

附：6 頁 BM + 13 頁位置圖

以上項目為：

原合約工程包

原合約工程加 / 減賬

新工程報價

原因：-

分發東莞各部門：

() 生產技術總監口連附件 () 技術部 口連附件 () 生產部 口連附件 () 機械設計部口連附件

() 採購部 口連附件 () 生產統籌部口連附件 () 小羅&清 口連附件

() 質檢部 口連附件 () 會計部 口連附件 () 報關組 口連附件 () 其他 楊榮輝 口連附件

分發其他分判：

(v) 水洪 口連附件

分發香港各部門：

() 行政部口連附件 () 會計部口連附件 () 統籌部口連附件 () 工程地盤科文口連附件 祥哥

() 採購部口連附件 () QS 部 口連附件 () 維修部口連附件 () 其他 口連附件

傳遞編號：

發件人簽署：

HK / 21

項目經理簽署：

E2 375 C

 美特鋁質 有限公司 MIDI Aluminium Fabricator Ltd.		工程號:	J852	計算:	sde	日期:	2021.02.20	送呈:	
		地盤名稱:		核對:		日期:		副本:	
地盤用玻璃B.M.表		項目類別:	佛沙窗-T1-(1F~21F)	批准:		日期:		A/C Code:	
BM編號:		修改版次:	C	總計玻璃面積 (平方米):		951.34			

序號	修改內容	玻璃圖號	顏色與類型	厚度 (mm)	玻璃尺寸		數量 (塊)	總面積 (平方米)	使用位置	加工圖參考
					寬度 (W mm)	高度 (H mm)				
1		GL03-01	6mm THK. LOW IRON LOW E HS+12mm AIR GAP+6mm THK. LOW IRON TEMPERED I.G.U. (D21010040) LOW E : SEE0-83T	24.0	601.0	1931.0	108	125.34	見位置圖	GL03-01
2		GL03-02			801.0	1216.0	72	125.00	見位置圖	GL03-02
3	C暫停	GL03-03			801.0	1261.0	36	36.36	見位置圖	GL03-03
4		GL03-04			596.0	1931.0	142	163.42	見位置圖	GL03-04
5		GL03-05			346.0	1226.0	36	15.27	見位置圖	GL03-05
6		GL03-06			396.0	1931.0	34	26.00	見位置圖	GL03-06
7	C暫停	GL03-07			321.0	1261.0	18	7.29	見位置圖	GL03-07
8	C暫停	GL03-08			246.0	1261.0	18	5.58	見位置圖	GL03-08
9		GL03-09			521.0	1931.0	34	34.21	見位置圖	GL03-09
					合計:		498	538.47		
10		GL01-01	8mm THK. LOW IRON LOW E HS+12mm AIR GAP+10mm THK. LOW IRON TEMPERED I.G.U. (D20120140) LOW E: D20120140	30.0	1296.0	2066.0	36	96.39	見位置圖	GL01-01
11		GL01-02			896.0	2066.0	18	33.32	見位置圖	GL01-02
12		GL01-03			813.0	618.0	72	36.18	見位置圖	GL01-03
13	C暫停	GL01-04			813.0	468.0	36	13.70	見位置圖	GL01-04
14	C暫停	GL01-05			333.0	468.0	18	2.81	見位置圖	GL01-05
15	C暫停	GL01-06			258.0	468.0	18	2.17	見位置圖	GL01-06
16		GL01-07			506.0	2066.0	17	17.77	見位置圖	GL01-07
					合計:		215	202.33		






 美特鋁質 有限公司 MIDI Aluminium Fabricator Ltd.		工程號:	J852	計算:	sde	日期:	2021.02.20	送呈:		
		地盤名稱:		核對:		日期:		副本:		
地盤用玻璃B.M.表		項目類別:	佛沙窗-T1-(1F~21F)	批准:		日期:		A/C Code:		
BM編號:		修改版次:	C	總計玻璃面積 (平方米):		951.34				
序號	修改內容	玻璃圖號	顏色與類型	厚度 (mm)	玻璃尺寸		數量 (塊)	總面積 (平方米)	使用位置	加工圖參考
					寬度 (W mm)	高度 (H mm)				
17		GL01a-01	8mm THK. LOW IRON LOW E HS+9mm AIR GAP+12mm THK. LOW IRON TEMPERED I.G.U. (D21010039) LOW E:SEE0-83T	29.0	2390.0	2070.0	18	89.05	見位置圖	GL01a-01
						合計:	18	89.05		
18		GL04-01	10mm THK. TEMPERED GLASS (PROTECTIVE BARRIER)	10.0	666.0	593.0	108	42.65	見位置圖	GL04-01
19		GL04-02			586.0	593.0	34	11.81	見位置圖	GL04-02
20		GL04-03			461.0	593.0	34	9.29	見位置圖	GL04-03
21		GL04-04			661.0	593.0	142	55.66	見位置圖	GL04-04
22		GL04-05			311.0	368.0	18	2.06	見位置圖	GL04-05
						合計:	336	121.48		
						总合计:	1067	951.34		
加工注意事項:		1).本表中之所有玻璃顏色待定。								
		2).本表中所有玻璃對角線尺寸偏差要求不超過負2mm。								
		3).本表中玻璃要求粗磨邊處理並倒棱角，而所有玻璃之入爐方向需保持一致。								
		4).本表中所有玻璃成品均需做雙面保護，用透明靜電膠紙加四周一寸FK白膠紙做雙面加固保護處理。								
		5).本表中所有玻璃成品均需注明室內外及其玻璃編號，以便識別。								

 美特鋁質 有限公司 MIDI Aluminium Fabricator Ltd.		工程號:	J852	計算:	sde	日期:	2021.02.20	送呈:		
		地盤名稱:		核對:		日期:		副本:		
地盤用玻璃B.M.表		項目類別:	佛沙窗-T2-(1F~21F)	批准:		日期:		A/C Code:		
BM編號:		修改版次:	C	總計玻璃面積 (平方米):		716.39		T2		
序號	修改內容	玻璃圖號	顏色與類型	厚度 (mm)	玻璃尺寸		數量 (塊)	總面積 (平方米)	使用位置	加工圖參考
					寬度 (W mm)	高度 (H mm)				
1		GL03-01	6mm THK. LOW IRON LOW E HS+12mm AIR GAP+6mm THK. LOW IRON TEMPERED I.G.U. (D21010040) LOW E : SEE0-83T	24.0	601.0	1931.0	144	167.12	見位置圖	GL03-01
2		GL03-04			596.0	1931.0	72	82.86	見位置圖	GL03-04
3		GL03-05			346.0	1226.0	36	15.27	見位置圖	GL03-05
4		GL03-06			396.0	1931.0	34	26.00	見位置圖	GL03-06
5	C暫停	GL03-07			321.0	1261.0	36	14.57	見位置圖	GL03-07
6	C暫停	GL03-08			246.0	1261.0	36	11.17	見位置圖	GL03-08
7		GL03-09			521.0	1931.0	69	69.42	見位置圖	GL03-09
						合计:	427	386.41		
8		GL01-01	8mm THK. LOW IRON LOW E HS+12mm AIR GAP+10mm THK. LOW IRON TEMPERED I.G.U. (D20120140) LOW E: D20120140	30.0	1296.0	2066.0	36	96.39	見位置圖	GL01-01
9	B-修改尺寸	GL01-02			896.0	2066.0	36	66.64	見位置圖	GL01-02
10	C暫停	GL01-05			333.0	468.0	36	5.61	見位置圖	GL01-05
11	C暫停	GL01-06			258.0	468.0	36	4.35	見位置圖	GL01-06
12	B-修改尺寸	GL01-07			506.0	2066.0	34	35.54	見位置圖	GL01-07
						合计:	178	208.53		

		工程號:	J852	計算:	sde	日期:	2021.02.20	送呈:		
		地盤名稱:		核對:		日期:		副本:		
地盤用玻璃B.M.表		項目類別:	佛沙窗-T2-(1F~21F)	批准:		日期:		A/C Code:		
BM編號:		修改版次:	C	總計玻璃面積(平方米):	716.39					
序號	修改內容	玻璃圖號	顏色與類型	厚度 (mm)	玻璃尺寸		數量 (塊)	總面積 (平方米)	使用位置	加工圖參考
					寬度(W mm)	高度(H mm)				
13		GL04-01	10mm THK. TEMPERED GLASS (PROTECTIVE BARRIER)	10.0	666.0	593.0	144	56.87	見位置圖	GL04-01
14		GL04-02			586.0	593.0	68	23.63	見位置圖	GL04-02
15		GL04-03			461.0	593.0	34	9.29	見位置圖	GL04-03
16		GL04-04			661.0	593.0	72	28.22	見位置圖	GL04-04
17		GL04-05			311.0	368.0	30	3.43	見位置圖	GL04-05
					合計:		348	121.45		
					总合计:		953	716.39		
加工注意事項:		1).本表中之所有玻璃顏色待定。								
		2).本表中所有玻璃對角線尺寸偏差要求不超過負2mm。								
		3).本表中玻璃要求粗磨邊處理並倒棱角，而所有玻璃之入爐方向需保持一致。								
		4).本表中所有玻璃成品均需做雙面保護，用透明靜電膠紙加四周一寸FK白膠紙做雙面加固保護處理。								
		5).本表中所有玻璃成品均需注明室內外及其玻璃編號，以便識別。								

 美特鋁質 有限公司 MIDI Aluminium Fabricator Ltd.		工程號:	J852	計算:	sde	日期:	2021.02.20	送呈:		
		地盤名稱:		核對:		日期:		副本:		
地盤用玻璃B.M.表		項目類別:	佛沙窗-T3-(1F~3F, 6F~21F)			日期:		A/C Code:		
BM編號:		修改版次:	C	總計玻璃面積 (平方米):		895.88				
序號	修改內容	玻璃圖號	顏色與類型	厚度 (mm)	玻璃尺寸		數量 (塊)	總面積 (平方米)	使用位置	加工圖參考
					寬度 (W mm)	高度 (H mm)				
1		GL03-01	6mm THK. LOW IRON LOW E HS+12mm AIR GAP+6mm THK. LOW IRON TEMPERED I.G.U. (D21010040) LOW E : SEE0-83T	24.0	601.0	1931.0	102	118.37	見位置圖	GL03-01
2		GL03-02			801.0	1216.0	51	125.00	見位置圖	GL03-02
3	C暫停	GL03-03			801.0	1261.0	34	34.34	見位置圖	GL03-03
4		GL03-04			596.0	1931.0	134	153.91	見位置圖	GL03-04
5		GL03-05			346.0	1226.0	34	14.42	見位置圖	GL03-05
6		GL03-06			396.0	1931.0	32	24.27	見位置圖	GL03-06
7	C暫停	GL03-07			321.0	1261.0	17	6.88	見位置圖	GL03-07
8	C暫停	GL03-08			246.0	1261.0	17	5.27	見位置圖	GL03-08
9		GL03-09			521.0	1931.0	32	32.19	見位置圖	GL03-09
					合計:		452	514.66		
10		GL01-01	8mm THK. LOW IRON LOW E HS+12mm AIR GAP+10mm THK. LOW IRON TEMPERED I.G.U. (D20120140) LOW E: D20120140	30.0	1296.0	2066.0	34	91.04	見位置圖	GL01-01
11		GL01-02			896.0	2066.0	17	31.47	見位置圖	GL01-02
12		GL01-03			813.0	618.0	51	25.62	見位置圖	GL01-03
13	C暫停	GL01-04			813.0	468.0	34	12.94	見位置圖	GL01-04
14	C暫停	GL01-05			333.0	468.0	17	2.65	見位置圖	GL01-05
15	C暫停	GL01-06			258.0	468.0	17	2.05	見位置圖	GL01-06
16		GL01-07			506.0	2066.0	16	16.73	見位置圖	GL01-07
					合計:		186	182.49		

 美特鋁質 有限公司 MIDI Aluminium Fabricator Ltd.		工程號:	J852	計算:	sde	日期:	2021.02.20	送呈:		
		地盤名稱:		核對:		日期:		副本:		
地盤用玻璃B.M.表		項目類別:	佛沙窗-T3-(1F~3F, 6F~21F)			日期:		A/C Code:		
BM編號:		修改版次:	C	總計玻璃面積 (平方米):		895.88				
序號	修改內容	玻璃圖號	顏色與類型	厚度 (mm)	玻璃尺寸		數量 (塊)	總面積 (平方米)	使用位置	加工圖參考
					寬度 (W mm)	高度 (H mm)				
17		GL01a-01	8mm THK. LOW IRON LOW E HS+9mm AIR GAP+12mm THK. LOW IRON TEMPERED I.G.U. (D21010039) LOW E:SEE0-83T	29.0	2390.0	2070.0	17	84.10	見位置圖	GL01a-01
						合計:	17	84.10		
18		GL04-01	10mm THK. TEMPERED GLASS (PROTECTIVE BARRIER)	10.0	666.0	593.0	102	40.28	見位置圖	GL04-01
19		GL04-02			586.0	593.0	32	11.12	見位置圖	GL04-02
20	B製作	GL04-03			461.0	593.0	32	8.75	見位置圖	GL04-03
21		GL04-04			661.0	593.0	134	52.52	見位置圖	GL04-04
22		GL04-05			311.0	368.0	17	1.95	見位置圖	GL04-05
						合計:	317	114.62		
						总合计:	972	895.88		
加工注意事項:		1).本表中之所有玻璃顏色待定。								
		2).本表中所有玻璃對角線尺寸偏差要求不超過負2mm。								
		3).本表中玻璃要求粗磨邊處理並倒棱角，而所有玻璃之入爐方向需保持一致。								
		4).本表中所有玻璃成品均需做雙面保護，用透明靜電膠紙加四周一寸FK白膠紙做雙面加固保護處理。								
		5).本表中所有玻璃成品均需注明室內外及其玻璃編號，以便識別。								

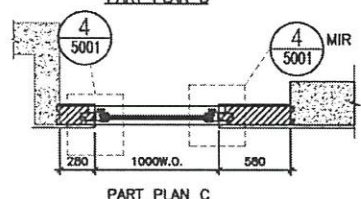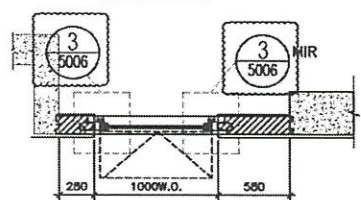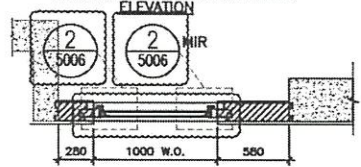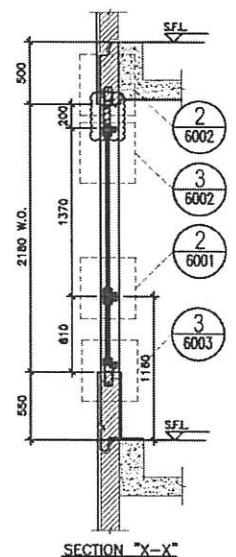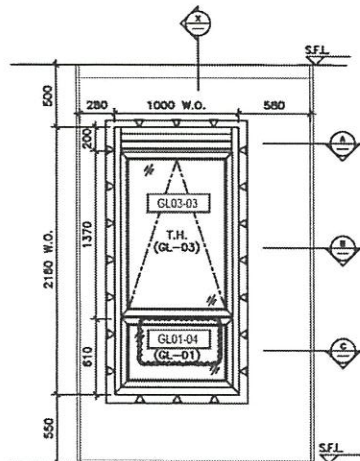

ELEVATION

(T1) W4/T1A

TYPE B		
OPENABLE WINDOW DIMENSION	(WIDTH) =	1000
	(HEIGHT) =	1370
FIXED WINDOW DIMENSION	(WIDTH) =	1000
	(HEIGHT) =	610
NUMBER OF OPENABLE AREA WINDOW	=	1
GLAZING AREA		
OPENABLE	WIDTH = 1000-111.5-111.5	= 777 mm
	HEIGHT = 1370-69.5-66.5	= 1234 mm
FIXED	WIDTH = 1000-111.5-111.5	= 777 mm
	HEIGHT = 610-66.5-111.5	= 432 mm
TOTAL	= ((777x1234)+(777x432))/1000000	= 1.294182 m ²
OPENABLE AREA		
	WIDTH = 1000-77-77	= 846 mm
	HEIGHT = 1370-32-32	= 1306 mm
TOTAL	= (846x1306)/1000000	= 1.104376 m ²

PROVIDED	
GLAZING AREA	1.294 m ²
OPENABLE AREA	1.105 m ²

B.D. REF :

CLIENT :

ARCHITECT :
AGC
BESTER LTD

MAIN CONTRACTOR :
Gammon

STRUCTURAL ENGINEER :
ARUP

FAÇADE CONSULTANT:
MENHARDT

NOTE :

- ALL DIMENSIONS ARE IN mm.
- ALL ELEVATIONS ARE VIEWED FROM OUTSIDE.
- ALL DIMENSIONS TO BE VERIFIED ON SITE BEFORE FABRICATION.

LEGEND :

(M) DETAIL MARK NO. REFER SHEET NO.

- F.F.L. — FINISHED FLOOR LEVEL
- S.F.L. — STRUCTURAL FLOOR LEVEL
- (⊖) — REVERSED DETAIL
- (⊕) — FINISH LOCATION
- △ — FINISH LOC LOCATION
- GLASS LEGEND

GL01 — 6mm+12mm AR CAP+10mm THK LGU.
GL01a — 6mm+9mm AR CAP+12mm THK LGU.
GL03 — 6mm+12mm AR CAP+6mm THK LGU.
GL04 — 10mm THK TEMPERED GLASS (PIONEER BRAND)
GL05 — 6mm+12mm AR CAP+8mm THK LGU.

E	24/01/2020	REVISION SUBJECT TO APPROVEMENT	SH
B	28/01/2020	REVISION SUBJECT TO APPROVEMENT	SH
C	22/04/2020	REVISION SUBJECT TO APPROVEMENT	SH
B	05/05/2020	REVISION SUBJECT TO APPROVEMENT	SH
A	24/01/2020	REVISION SUBJECT TO APPROVEMENT	SH
REV	DATE	REVISION	BY

JOB NO. : J-852

PROJECT : PROPOSED RESIDENTIAL DEVELOPMENT AT 139 - 147 ARGYLE STREET, NO.1 6005, 6035 R.P., 6036 R.P., 6037 R.P. & 6038 R.P.

TITLE : WINDOW SCHEDULE FOR ALUM. WINDOW






DATE : 05-Dec-19 SCALE : 1:40

DRAWN BY : MN CHECKED BY : DW

英特鋁質有限公司
MIDI ALUMINIUM PRODUCTS LTD.
Units G-8, Sunny Industrial Centre, 1/F
610 Chee Koo Ling Road, Kowloon
Tel: 23489211-4 Fax: 234772888

DWG NO. : J852-SD-PW-4105 REV. : E

WINDOW MARK	W4/T1A
LOCATION	1/F-20/F M.B. AT TOWER 1 FLAT A
SECTION	70mm ALUM. SECTION
GLAZING	GL-01, GL-03
QUANTITY	17
REMARKS	FAÇADE (PF-15)

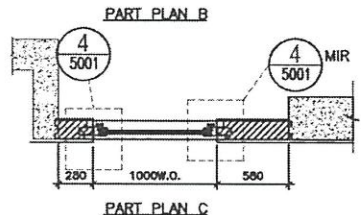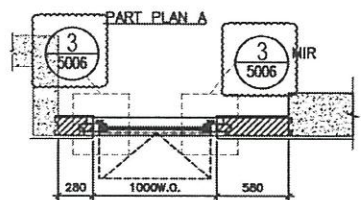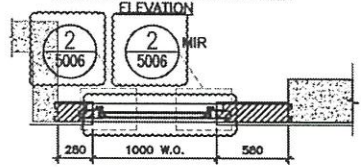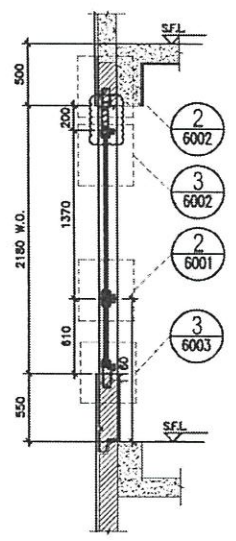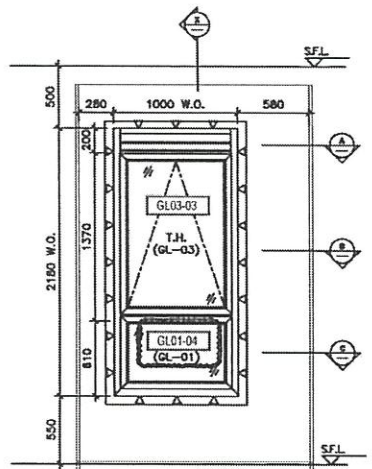

SECTION "X-X"

ELEVATION

TYPE B

OPENABLE WINDOW DIMENSION	(WIDTH) =	1000
	(HEIGHT) =	1370
FIXED WINDOW DIMENSION	(WIDTH) =	1000
	(HEIGHT) =	610
NUMBER OF OPENABLE AREA WINDOW	=	1

GLAZING AREA

OPENABLE	WIDTH = 1000-111.5-111.5	=	777 mm
	HEIGHT = 1370-66.5-66.5	=	1234 mm
FIXED	WIDTH = 1000-111.5-111.5	=	777 mm
	HEIGHT = 610-66.5-111.5	=	432 mm
TOTAL	= ((777x1234)-(777x432)) 1000000	=	1.29482 m ²

OPENABLE AREA

WIDTH = 1000-77-77	=	846 mm
HEIGHT = 1370-32-32	=	1306 mm
TOTAL = (846x1306)x1/1000000	=	1.104876 m ²

(T1) W4/T1A

PROVIDED	
GLAZING AREA	1.294 m ²
OPENABLE AREA	1.105 m ²

WINDOW MARK	W4/T1A
LOCATION	21/F M.B. AT TOWER 1 FLAT A
SECTION	70mm ALUM. SECTION
GLAZING	GL-01, GL-03
QUANTITY	1
REMARKS	FACADE (PF-15)

B.D. REF :

CLIENT :

ARCHITECT : **AGC DESIGN LTD**

MAIN CONTRACTOR : **Gammon**

STRUCTURAL ENGINEER : **ARUP**

FAÇADE CONSULTANT : **MENHARDT**

NOTE :

- ALL DIMENSIONS ARE IN mm.
- ALL ELEVATIONS ARE VIEWED FROM OUTSIDE.
- ALL DIMENSIONS TO BE VERIFIED ON SITE BEFORE FABRICATION.

LEGEND :

- 21/5006 — DETAIL MARK NO. REFER SHEET NO.
- F.F.L — FINISHED FLOOR LEVEL
- S.F.L — STRUCTURAL FLOOR LEVEL
- (2) — REVERSED DETAIL
- △ — FIXING LOCATION
- ▲ — FIXING LUG LOCATION

GLASS LEGEND

- GL01 — 6mm+12mm AIR GAP+10mm THK L.G.U.
- GL01a — 6mm+9mm AIR GAP+12mm THK L.G.U.
- GL03 — 6mm+12mm AIR GAP+6mm THK L.G.U.
- GL04 — 10mm BK TEMPERED GLASS (PROSECURE OWNER)
- GL05 — 6mm+12mm AIR GAP+6mm THK L.G.U.

B	24/04/2020	REVISION SUBJECT TO APPROVALMENT	PHD
A	26/04/2020	REVISION SUBJECT TO APPROVALMENT	PHD
REV	DATE	REVISION	BY

JOB NO. : J-852

PROJECT : PROPOSED RESIDENTIAL DEVELOPMENT AT 139 - 147 ARMYLIE STREET, NGOL 6005, 6035 R.P., 6036 R.P., 6037 R.P. & 6038 R.P.






TITLE : WINDOW SCHEDULE FOR ALUM. WINDOW

DATE : 22-Apr-20 SCALE : 1:40

DRAWN BY : MN CHECKED BY : DW

英特銘有限公司
MIDI ASSOCIATED FABRICATIONS LTD.
Units 5-8, Sunny Industrial Centre, 1/F
610 Che Koo Ling Road, Kowloon
Tel: 23488211-4 Fax: (852) 27727688

DWG NO. : J052-SD-PW-4105A REV. : B

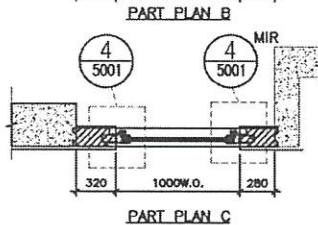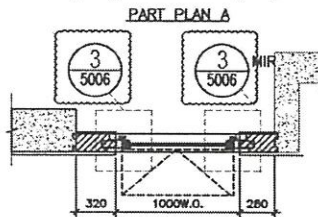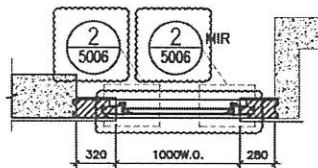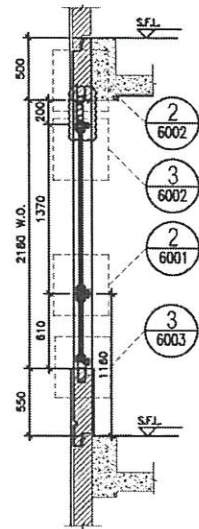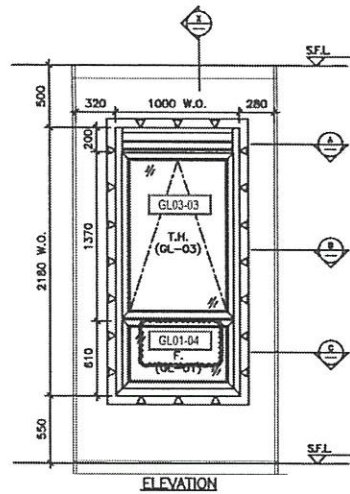

SECTION "X-X"

ELEVATION

ELEVATION

PART PLAN A

PART PLAN B

PART PLAN C

TYPE B

OPENABLE WINDOW DIMENSION	(WIDTH) =	1000
	(HEIGHT) =	1370
FIXED WINDOW DIMENSION	(WIDTH) =	1000
	(HEIGHT) =	610
NUMBER OF OPENABLE AREA WINDOW	=	1

GLAZING AREA

OPENABLE	WIDTH = 1000-111.5-111.5	=	777 mm
	HEIGHT = 1370-69.5-66.5	=	1234 mm
FIXED	WIDTH = 1000-111.5-111.5	=	777 mm
	HEIGHT = 610-66.5-111.5	=	432 mm

TOTAL = ((777x1234)+(777x432))/1000000 = 1.294482 m²

OPENABLE AREA

WIDTH = 1000-77-77	=	846 mm
HEIGHT = 1370-82-82	=	1206 mm
TOTAL = (846x1206)/1000000	=	1.104876 m ²

PROVIDED	
GLAZING AREA	1.294 m ²
OPENABLE AREA	1.105 m ²

B.D. REF :

CLIENT :

ARCHITECT :
AGC DESIGN LTD

MAIN CONTRACTOR :
Gammon

STRUCTURAL ENGINEER :
ARUP

FACADE CONSULTANT:
MEINHARDT

NOTE :
1. ALL DIMENSIONS ARE IN mm.
2. ALL ELEVATIONS ARE VIEWED FROM OUTSIDE.
3. ALL DIMENSIONS TO BE VERIFIED ON SITE BEFORE FABRICATION.

LEGEND :

① — DETAIL MARK NO.
② — REFER SHEET NO.

1. F.F.L. — FINISHED FLOOR LEVEL
2. S.F.L. — STRUCTURAL FLOOR LEVEL
3. ⊕ — REVERSED DETAIL
4. A — FINING LOCATION
5. Δ — FINING LUG LOCATION
6. GLASS LEGEND
GL01 — 8mm+12mm AIR GAP+10mm THK. L.G.U.
GL02 — 8mm+8mm AIR GAP+12mm THK. L.G.U.
GL03 — 8mm+12mm AIR GAP+8mm THK. L.G.U.
GL04 — 10mm THK. TOWERS GLASS (PROVIDE DRAWER)
GL05 — 8mm+12mm AIR GAP+8mm THK. L.G.U.

C	24/02/2020	REVISION SUBJECT TO APPROVALMENT	Rev
B	20/02/2020	REVISION SUBJECT TO APPROVALMENT	Rev
C	22/04/2020	REVISION SUBJECT TO APPROVALMENT	Rev
B	02/02/2020	REVISION SUBJECT TO APPROVALMENT	Rev
A	24/02/2020	REVISION SUBJECT TO APPROVALMENT	Rev
NO.	DATE	REVISION	BY

JOB NO. : J-852
PROJECT : PROPOSED RESIDENTIAL DEVELOPMENT AT 139 - 147 ARCYLE STREET, NKHL 6005, 6035 R.P., 6036 R.P., 6037 R.P. & 6038 R.P.

TITLE : WINDOW SCHEDULE FOR ALUM. WINDOW

DATE : 05-Dec-19 SCALE : 1:40






DRAWN BY : MIN CHECKED BY : DW

美特铝业有限公司
M.T.D. ALUMINIUM ENGINEERING CO., LTD.
Units 6-8, Saury Industrial Centre, 1/F
610 Che Kwo Ling Road, Kowloon
Tel: 23489211-4 Fax: (852) 27272668

DWG NO. : J852-SD-PW-4106 REV. : E

① W5/T1A

WINDOW MARK	W5/T1A
LOCATION	1/F-20/F EN.B. AT TOWER 1 FLAT A
SECTION	70mm ALUM. SECTION
GLAZING	GL-01, GL-03
QUANTITY	17
REMARKS	FACADE (PF-16)

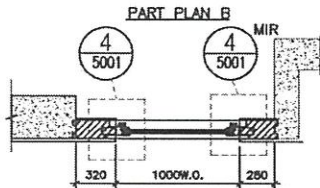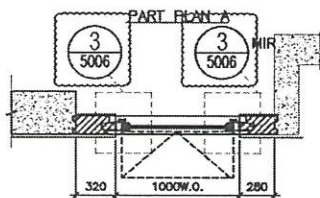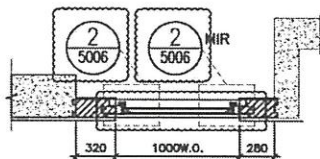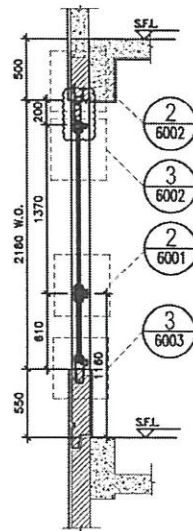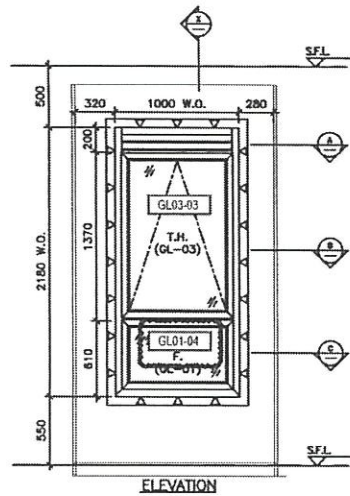

(T1) W5/T1A

TYPE B	
OPENABLE WINDOW DIMENSION	(WIDTH) = 1000 (HEIGHT) = 1370
FIXED WINDOW DIMENSION	(WIDTH) = 1000 (HEIGHT) = 610
NUMBER OF OPENABLE AREA WINDOW	= 1
GLAZING AREA	
OPENABLE	WIDTH = 1000-111.5-111.5 = 777 mm HEIGHT = 1370-69.5-66.5 = 1234 mm
FIXED	WIDTH = 1000-111.5-111.5 = 777 mm HEIGHT = 610-66.5-111.5 = 432 mm
TOTAL	= ((777x1234)+(777x432))/1000000 = 1.294852 m ²
OPENABLE AREA	
WIDTH	= 1000-77-77 = 846 mm
HEIGHT	= 1370-32-32 = 1306 mm
TOTAL	= (846x1306)/1000000 = 1.104876 m ²

PROVIDED	
GLAZING AREA	1.294 m ²
OPENABLE AREA	1.105 m ²

B.D. REF :

CLIENT :

ARCHITECT :
AGC DESIGN LTD

MAIN CONTRACTOR :
Gammon

STRUCTURAL ENGINEER :
ARUP

FAÇADE CONSULTANT :
MEINHARDT

NOTE:
1. ALL DIMENSIONS ARE IN mm.
2. ALL ELEVATIONS ARE VIEWED FROM OUTSIDE.
3. ALL DIMENSIONS TO BE VERIFIED ON SITE BEFORE FABRICATION.

LEGEND:

 1. F.F.L. — FINISHED FLOOR LEVEL
 2. S.F.L. — STRUCTURAL FLOOR LEVEL
 3. — REVERSED DETAIL
 4. — FIXING LOCATION
 5. — FIXING LUG LOCATION
 6. GLASS LEGEND
 GL01 — 8mm+12mm AIR GAP+10mm THK L.G.L.
 GL02 — 8mm+9mm AIR GAP+12mm THK L.G.L.
 GL03 — 8mm+12mm AIR GAP+8mm THK L.G.L.
 GL04 — 10mm THK TEMPERED GLASS (PROTECTIVE SHIELD)
 GL05 — 8mm+12mm AIR GAP+8mm THK L.G.L.

B	24/04/2020	REVISION SUBJECT TO APPROVALMENT	mm
A	20/04/2020	REVISION SUBJECT TO APPROVALMENT	mm
01	01/04/2020	ISSUE	mm

JOB NO. : J-852
 PROJECT : PROPOSED RESIDENTIAL DEVELOPMENT AT 130 - 147 ARGYLE STREET, NKIL 6005, 6035 R.P., 6036 R.P., 6037 R.P. & 6038 R.P.

TITLE : WINDOW SCHEDULE FOR ALUM. WINDOW

DATE : 22-Apr-20 SCALE : 1:40




DRAWN BY : MN CHECKED BY : DW

英特鋁質有限公司
 METAL ALUMINUM FABRICATOR LTD.
 Units 5-8, Sunny Industrial Centre, 1/F
 810 Che Kwo Ling Road, Kowloon
 Tel: 23488211-4 Fax: (852) 27272688

ELEVATION

WINDOW MARK	
LOCATION	21/F EN.B. AT TOWER 1 FLAT A
SECTION	70mm ALUM. SECTION
GLAZING	GL-01, GL-03
QUANTITY	1
REMARKS	FAÇADE (PF-16)

DWG NO. : J852-SD-PW-4106A REV. : B

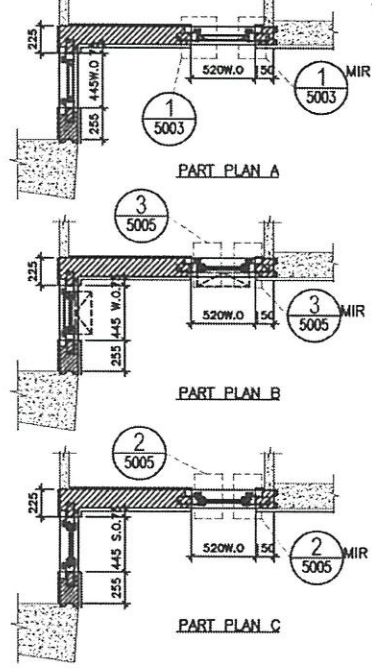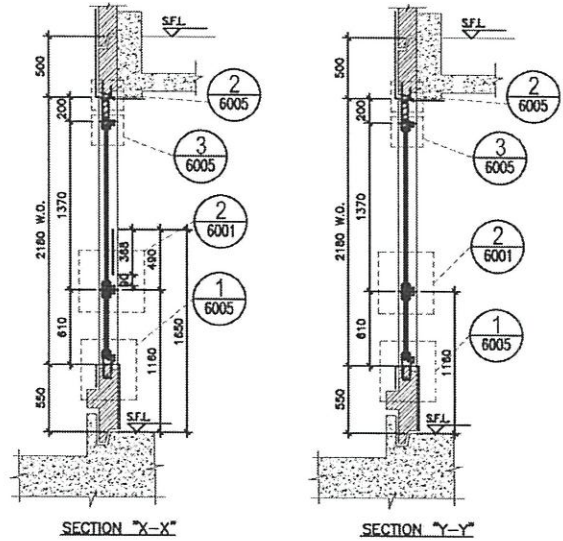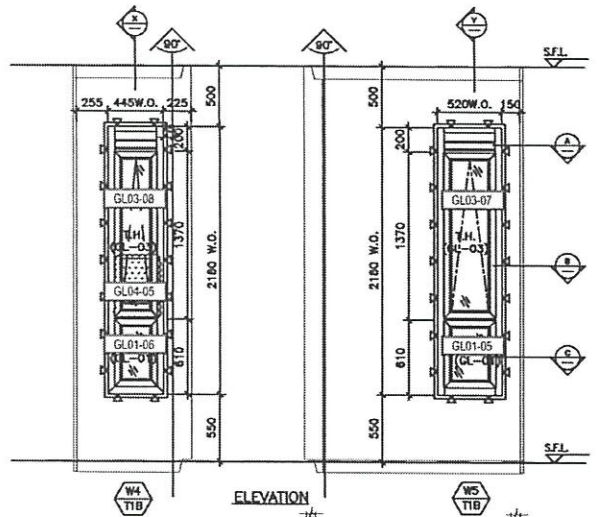

ELEVATION

W5/T1B
W4/T1B

T1

TYPE B		OPENABLE WINDOW DIMENSION	
WIDTH	= 420	WIDTH	= 445
HEIGHT	= 1370	HEIGHT	= 1370
FIXED WINDOW DIMENSION		FIXED WINDOW DIMENSION	
WIDTH	= 520	WIDTH	= 445
HEIGHT	= 610	HEIGHT	= 610
NUMBER OF OPENABLE AREA WINDOW	= 3	NUMBER OF OPENABLE AREA WINDOW	= 3
GLAZING AREA		GLAZING AREA	


PROVIDED		
GLAZING AREA	0.395	m ²
OPENABLE AREA	0.478	m ²

PROVIDED		
GLAZING AREA	0.295	m ²
OPENABLE AREA	0.380	m ²

WINDOW MARK	W5/T1B / W4/T1B
LOCATION	1/F M.B. & EN.B. AT TOWER 1 FLAT B
SECTION	70mm ALUM. SECTION
GLAZING	GL-01, GL-03
QUANTITY	1 / 1
REMARKS	FACADE (PF-37)

B.D. REF :

CLIENT :

ARCHITECT : AGC HESTER LTD

MAIN CONTRACTOR : Gammon

STRUCTURAL ENGINEER : ARUP

FAÇADE CONSULTANT : MENHARDT

NOTE :

- ALL DIMENSIONS ARE IN mm.
- ALL ELEVATIONS ARE VIEWED FROM OUTSIDE.
- ALL DIMENSIONS TO BE VERIFIED ON SITE BEFORE FABRICATION.

LEGEND :

① - DETAIL MARK NO.
② - REFER SHEET NO.

- F.F.L. - FINISHED FLOOR LEVEL
- S.F.L. - STRUCTURAL FLOOR LEVEL
- ⊖ - REVERSED DETAIL
- ⊕ - FINISH LOCATION
- △ - FINISH LOC LOCATION

GLASS LEGEND :

GL01 - 6mm+12mm AIR GAP+10mm THK L.G.U.
 GL02 - 6mm+10mm AIR GAP+12mm THK L.G.U.
 GL03 - 6mm+12mm AIR GAP+6mm THK L.G.U.
 GL04 - 10mm THK REINFORCED GLASS (TENSILE ARMED)
 GL05 - 6mm+12mm AIR GAP+6mm THK L.G.U.

B	03/04/2020	REVISION SUBJECT TO AMENDMENT	Rev
C	17/04/2020	REVISION SUBJECT TO AMENDMENT	Rev
D	24/04/2020	REVISION SUBJECT TO AMENDMENT	Rev
A	28/04/2020	REVISION SUBJECT TO AMENDMENT	Rev
Rev	DATE	REVISION	BY

JOB NO. : J-852

PROJECT : PROPOSED RESIDENTIAL DEVELOPMENT AT 130 - 147 ARVILLE STREET, NGOL 6005, 6035 R.P., 6036 R.P., 6037 R.P. & 6038 R.P.

TITLE : WINDOW SCHEDULE FOR ALUM. WINDOW



DATE : 22-Apr-20 SCALE : 1:40

DRAWN BY : MN CHECKED BY : DW

英特銘實有限公司
 MIDDI ARCHITECTURE & INTERIOR DESIGN
 Units 5-8, Sunny Industrial Centre, 1/F
 610 Chee Koo Ling Road, Kowloon
 Tel: 23488211-4 Fax: (852) 27727008

DWG NO. : J052-SD-PW-4112A REV. : D

ELEVATION

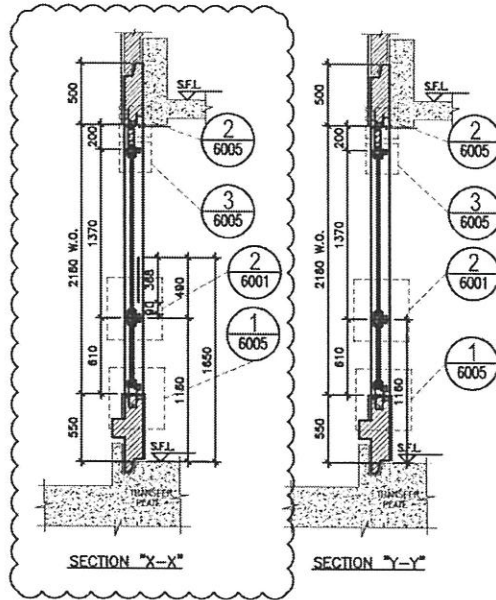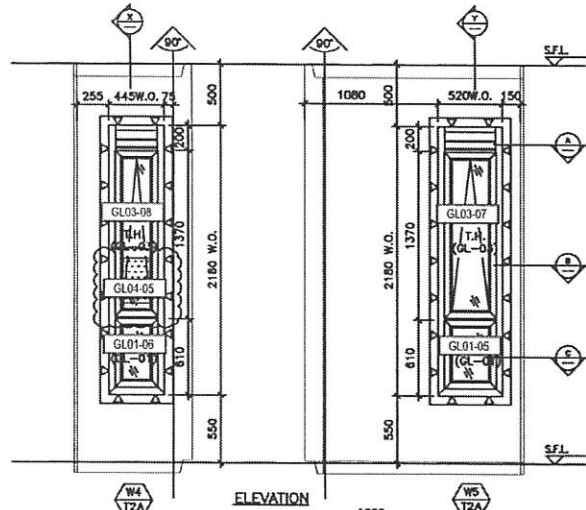

TYPE B
OPENABLE WINDOW DIMENSION

FIXED WINDOW DIMENSION

NUMBER OF OPENABLE AREA WINDOW

GLAZING AREA

OPENABLE

WIDTH = 520-111.5-111.5

HEIGHT = 1370-69.5-66.5

FIXED

WIDTH = 520-111.5-111.5

HEIGHT = 610-66.5-111.5

TOTAL = (520*1370)+(520*610)=1000000

OPENABLE AREA

WIDTH = 520-77.77

HEIGHT = 1370-32.32

TOTAL = (386*1306)=1000000

(WIDTH)	= 420
(HEIGHT)	= 1370
(WIDTH)	= 420
(HEIGHT)	= 610
	= 1

TYPE B
OPENABLE WINDOW DIMENSION

FIXED WINDOW DIMENSION

NUMBER OF OPENABLE AREA WINDOW

GLAZING AREA

OPENABLE

WIDTH = 445-111.5-111.5

HEIGHT = 1370-69.5-66.5

FIXED

WIDTH = 445-111.5-111.5

HEIGHT = 610-66.5-111.5

TOTAL = (445*1370)+(445*610)=1000000

OPENABLE AREA

WIDTH = 445-77.77


HEIGHT = 1370-32.32

TOTAL = (246*1306)=1000000

(WIDTH)	= 445
(HEIGHT)	= 1370
(WIDTH)	= 445
(HEIGHT)	= 610
	= 1

PROVIDED	
GLAZING AREA	0.495 m ²
OPENABLE AREA	0.478 m ²

PROVIDED	
GLAZING AREA	0.370 m ²
OPENABLE AREA	0.380 m ²

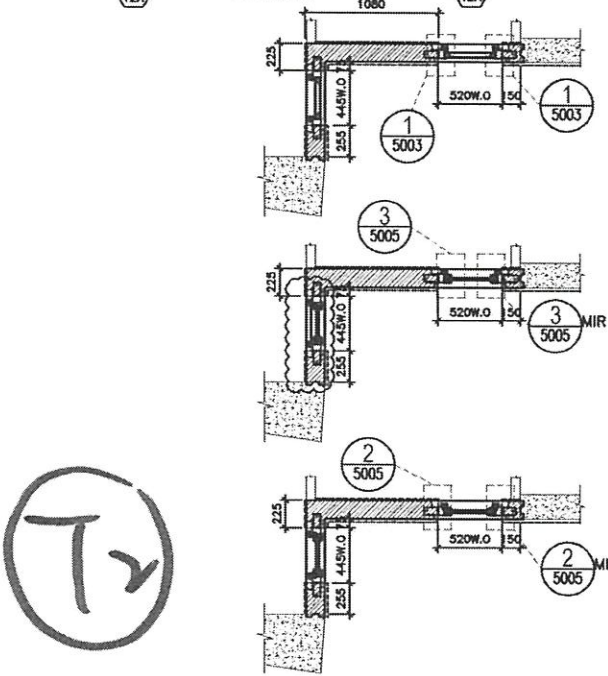

W4/T2A
W5/T2A

WINDOW MARK	W4/T2A / W5/T2A
LOCATION	1/F M.B. & EN.B. AT TOWER 2 FLAT A
SECTION	70mm ALUM. SECTION
GLAZING	GL-01, GL-03
QUANTITY	1 / 1
REMARKS	FACADE (PF-35)

B.D. REF :

CLIENT :

ARCHITECT :
AGC DESIGN LTD

MAIN CONTRACTOR :
Gammon

STRUCTURAL ENGINEER :
ARUP

FAÇADE CONSULTANT :
MEINHARDT

NOTE :
1. ALL DIMENSIONS ARE IN mm.
2. ALL ELEVATIONS ARE VIEWED FROM OUTSIDE.
3. ALL DIMENSIONS TO BE VERIFIED ON SITE BEFORE FABRICATION.

LEGEND :
① DETAIL MARK NO.
② REFER SHEET NO.

1. F.F.L.—FINISHED FLOOR LEVEL
2. S.F.L.—STRUCTURAL FLOOR LEVEL
3. Ⓡ—REVERSED DETAIL
4. ▲—FIXING LOCATION
5. △—FIXING LUG LOCATION
6. GLASS LEGEND
GL01—8mm+12mm AIR GAP+10mm TRK. L.G.L.
GL02a—8mm+8mm AIR GAP+10mm TRK. L.G.L.
GL03—8mm+12mm AIR GAP+8mm TRK. L.G.L.
GL04—10mm TRK. TEMPERED GLASS (INDICATE INVERT)
GL05—8mm+12mm AIR GAP+8mm TRK. L.G.L.

F	16/04/2020	REVISION SUBJECT TO APPROVAL	mm
E	24/04/2020	REVISION SUBJECT TO APPROVAL	mm
D	26/04/2020	REVISION SUBJECT TO APPROVAL	mm
C	27/04/2020	REVISION SUBJECT TO APPROVAL	mm
B	03/04/2020	REVISION SUBJECT TO APPROVAL	mm
A	24/04/2020	REVISION SUBJECT TO APPROVAL	mm
REV	DATE	REVISION	BY

JOB NO. : J-852

PROJECT :
PROPOSED RESIDENTIAL DEVELOPMENT
AT 130 - 147 ARDYLE STREET,
NKL 6005, 6035 R.P., 6036 R.P.,
6037 R.P. & 6038 R.P.





TITLE : WINDOW SCHEDULE FOR ALUM. WINDOW

DATE : 05-Dec-19 SCALE : 1:40

DRAWN BY : MN CHECKED BY : DW

英特銘有限公司
MIDI
Units 6-8, Sunny Industrial Centre, 1/F
810 Che Koo Ling Road, Kowloon
Tel: 23488211-4 Fax: 8522727886

DWG NO. : J852-SD-PW-4208 REV. : F

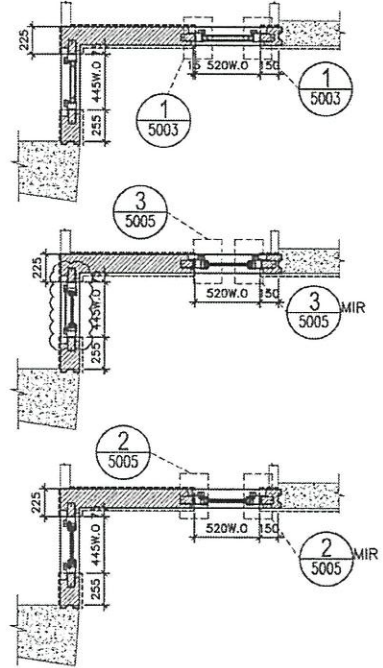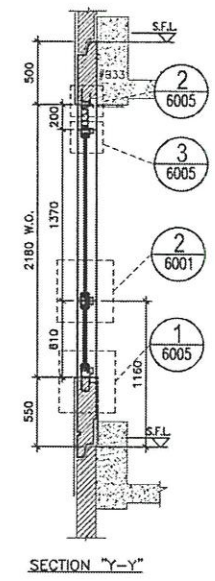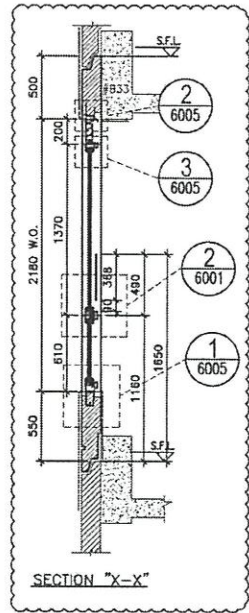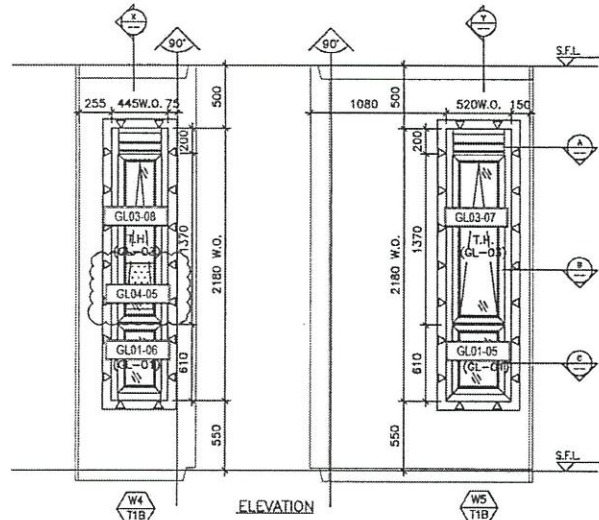

T2

W4/T2A
W5/T2A

TYPE B
OPENABLE WINDOW DIMENSION

FIXED WINDOW DIMENSION

NUMBER OF OPENABLE AREA WINDOW

GLAZING AREA

OPENABLE

WIDTH = 520-111.5-111.5

HEIGHT = 1370-69.5-66.5

FIXED

WIDTH = 520-111.5-111.5

HEIGHT = 610-66.5-111.5

TOTAL = (520x1124)+(297x1322) 1000000

OPENABLE AREA

WIDTH = 520-77-77

HEIGHT = 1370-32-32

TOTAL = (566x1306)x1 1000000

(WIDTH)	520
(HEIGHT)	1370
(WIDTH)	520
(HEIGHT)	610

NUMBER OF OPENABLE AREA WINDOW = 1













TYPE B
OPENABLE WINDOW DIMENSION

FIXED WINDOW DIMENSION

NUMBER OF OPENABLE AREA WINDOW

GLAZING AREA

OPENABLE

WIDTH = 445-111.5-111.5

HEIGHT = 1370-69.5-64.5

FIXED

WIDTH = 445-111.5-111.5

HEIGHT = 610-66.5-111.5

TOTAL = (222x1234)+(222x432)x1 600000

OPENABLE AREA

WIDTH = 445-77-77

HEIGHT = 1370-32-32

TOTAL = (291x1306)x1 1000000

(WIDTH)	445
(HEIGHT)	1370
(WIDTH)	445
(HEIGHT)	610

NUMBER OF OPENABLE AREA WINDOW = 1










B.D. REF :

CLIENT :

ARCHITECT :
AGC
REGISTERED ARCHITECTS

MAIN CONTRACTOR :
Gammon

STRUCTURAL ENGINEER :
ARUP

FACADE CONSULTANT :
MEINHARDT

NOTE:
1. ALL DIMENSIONS ARE IN mm.
2. ALL ELEVATIONS ARE VIEWED FROM OUTSIDE.
3. ALL DIMENSIONS TO BE VERIFIED ON SITE BEFORE FABRICATION.

LEGEND:
X1 - DETAIL MARK NO.
X2001 - REFER SHEET NO.

1. F.F.L. - FINISHED FLOOR LEVEL
2. S.F.L. - STRUCTURAL FLOOR LEVEL
3. (R) - REVERSED DETAIL
4. ▲ - FIXING LOCATION
5. △ - FIXING LUG LOCATION
6. GLASS LEGEND
GLD1 - 6mm+12mm AIR GAP+10mm THK. I.G.U.
GLD1a - 8mm+8mm AIR GAP+10mm THK. I.G.U.
GLD3 - 6mm+12mm AIR GAP+6mm THK. I.G.U.
GLD4 - 10mm THK. TEMPERED GLASS (PROTECTIVE BARRER)
GLD5 - 8mm+12mm AIR GAP+8mm THK. I.G.U.

C	18/09/2020	REVISION SUBJECT TO ARCH/COMMENT	DMW
B	24/09/2020	REVISION SUBJECT TO ARCH/COMMENT	DMW
A	29/09/2020	REVISION SUBJECT TO ARCH/COMMENT	DMW
REV.	DATE	REVISION	BY

JOB NO. : J-852
PROJECT : PROPOSED RESIDENTIAL DEVELOPMENT AT 139 - 147 ARGYLE STREET, NKIL 6005, 6035 R.P., 6036 R.P., 6037 R.P. & 6038 R.P.




TITLE : WINDOW SCHEDULE FOR ALUM. WINDOW

DATE : 05-Dec-19 SCALE : 1:40
DRAWN BY : MH CHECKED BY : DW

美特铝貿有限公司
MIDI ALUMINIUM FABRICATOR LTD.
Units 6-8, Sunny Industrial Centre, 1/F
610 Cha Kwo Ling Road, Kowloon
Tel: 23489211-4 Fax: (852) 2727666
DWG NO. : J852-SD-PW-4208A REV. : C

ELEVATION

WINDOW MARK	W4/T2A / W5/T2A
LOCATION	2/F-21/F M.B. & EN.B. AT TOWER 2 FLAT A
SECTION	70mm ALUM. SECTION
GLAZING	GL-01, GL-03
QUANTITY	17 / 17
REMARKS	FACADE (PF-35)

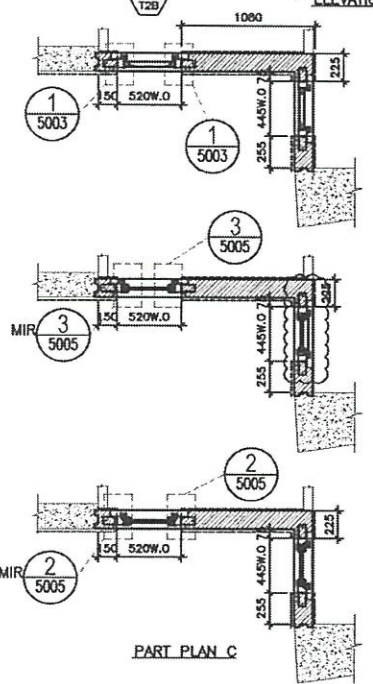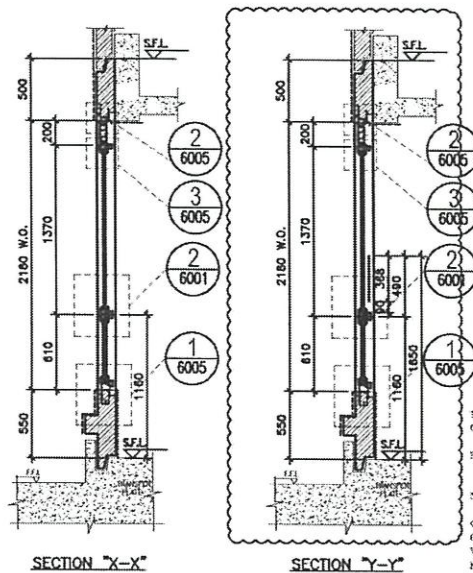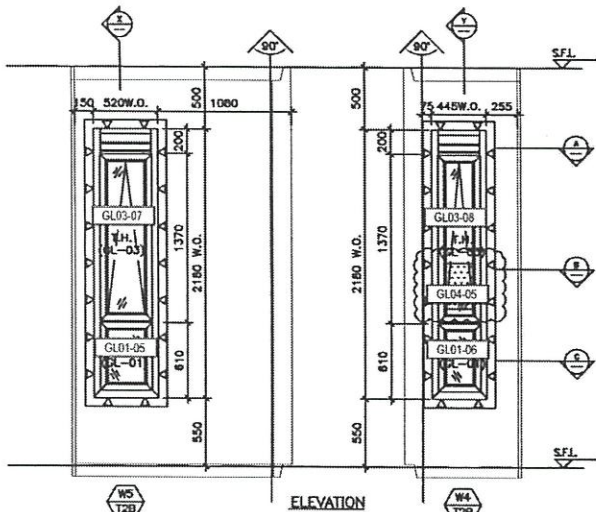

W5/T2B
W4/T2B
T2

TYPE B
OPERABLE WINDOW DIMENSION
FIXED WINDOW DIMENSION
NUMBER OF OPERABLE AREA WINDOW
GLAZING AREA
OPERABLE
WIDTH = 520-111.5-111.5
HEIGHT = 1370-60.5-66.5
FIXED
WIDTH = 520-111.5-111.5
HEIGHT = 610-66.5-111.5

WIDTH	=	520
HEIGHT	=	1370
WIDTH	=	520
HEIGHT	=	610
	=	1

PROVIDED	
GLAZING AREA	0.495 m ²
OPERABLE AREA	0.478 m ²

TYPE B
OPERABLE WINDOW DIMENSION
FIXED WINDOW DIMENSION
NUMBER OF OPERABLE AREA WINDOW
GLAZING AREA
OPERABLE
WIDTH = 445-111.5-111.5
HEIGHT = 1370-60.5-66.5
FIXED
WIDTH = 445-111.5-111.5
HEIGHT = 610-66.5-111.5

WIDTH	=	445
HEIGHT	=	1370
WIDTH	=	445
HEIGHT	=	610
	=	1

PROVIDED	
GLAZING AREA	0.370 m ²
OPERABLE AREA	0.380 m ²

B.D. REF :

CLIENT :

ARCHITECT :
AGC
DESIGNERS

M&M CONTRACTOR :
Gammon

STRUCTURAL ENGINEER :
ARUP

FAÇADE CONSULTANT :
MEINHARDT

NOTE :
1. ALL DIMENSIONS ARE IN mm.
2. ALL ELEVATIONS ARE VIEWED FROM OUTSIDE.
3. ALL DIMENSIONS TO BE CHECKED ON SITE BEFORE FABRICATION.


LEGEND :
① DETAIL MARK NO.
② REFER SHEET NO.
1. F.F.L.—FINISHED FLOOR LEVEL
2. S.F.L.—STRUCTURAL FLOOR LEVEL
3. (R)—REVERSED DETAIL.

F	16/04/2020	REVISION SUBJECT TO APPROVALMENT	Rev
E	24/04/2020	REVISION SUBJECT TO APPROVALMENT	Rev
B	28/04/2020	REVISION SUBJECT TO APPROVALMENT	Rev
C	27/04/2020	REVISION SUBJECT TO APPROVALMENT	Rev
B	02/04/2020	REVISION SUBJECT TO APPROVALMENT	Rev
A	24/04/2020	REVISION SUBJECT TO APPROVALMENT	Rev
REV	DATE	REVISION	BY



JOB NO. : J-B52
PROJECT : PROPOSED RESIDENTIAL DEVELOPMENT AT 138 - 147 ARGYLE STREET, HKL 6005, 6035 R.P., 6036 R.P., 6037 R.P. & 6038 R.P.
TITLE : WINDOW SCHEDULE FOR ALUM. WINDOW
DATE : 05-Dec-19 SCALE : 1:40
DRAWN BY : MH CHECKED BY : DW
英特鋁質有限公司
MIDI
Units 6-8, Sunny Industrial Centre, 1/F
610 Chee Koo Ling Road, Kowloon
Tel: 23482211-4 Fax: (852) 27772666
DWG NO. : J852-SD-PW-4209 REV. : F

WINDOW MARK	W5 / W4 T2B / T2B
LOCATION	1/F M.B. & EN.B. AT TOWER 2 FLAT B
SECTION	70mm ALUM. SECTION
GLAZING	GL-01, GL-03
QUANTITY	1 / 1
REMARKS	'FAÇADE' (PF-36)

ELEVATION

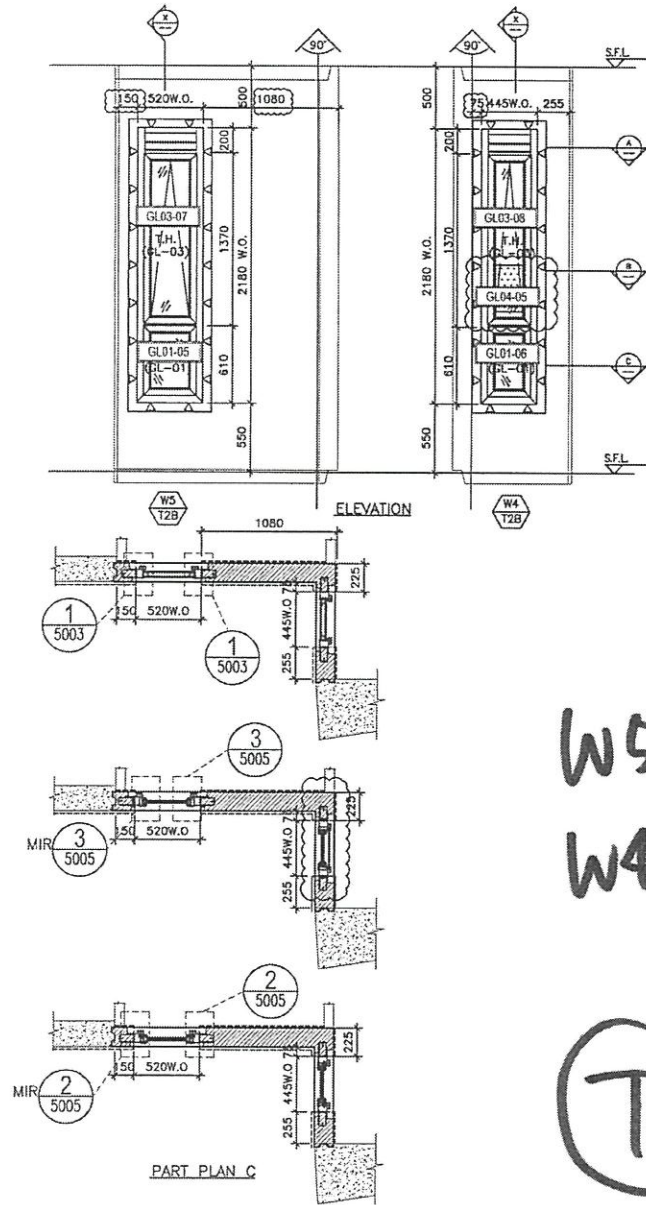

W5/T2B
W4/T2B
T2

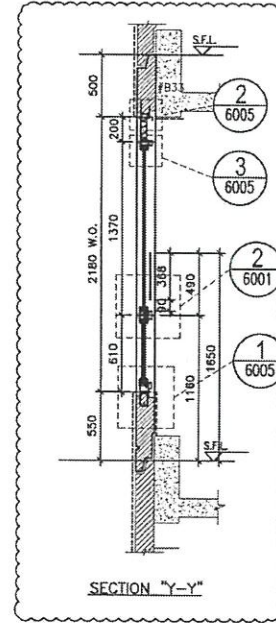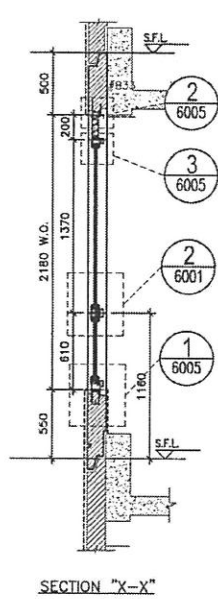

TYPE B
OPENABLE WINDOW DIMENSION

(WIDTH)	=	570
(HEIGHT)	=	1370

FIXED WINDOW DIMENSION

(WIDTH)	=	570
(HEIGHT)	=	432

NUMBER OF OPENABLE AREA WINDOW

GLAZING AREA		
OPENABLE		
WIDTH	=	520-111.5-111.5
HEIGHT	=	1370-69.5-66.5
FIXED		
WIDTH	=	520-111.5-111.5
HEIGHT	=	410-66.5-111.5
TOTAL	=	(4297x1234)+(297x452)=1800000
OPENABLE AREA		
WIDTH	=	520-77-77
HEIGHT	=	1370-32-32
TOTAL	=	(366x1306)x11000000

PROVIDED

GLAZING AREA	0.495	m ²
OPENABLE AREA	0.478	m ²

TYPE B
OPENABLE WINDOW DIMENSION

(WIDTH)	=	415
(HEIGHT)	=	1370

FIXED WINDOW DIMENSION

(WIDTH)	=	415
(HEIGHT)	=	432

NUMBER OF OPENABLE AREA WINDOW

GLAZING AREA		
OPENABLE		
WIDTH	=	415-111.5-111.5
HEIGHT	=	1370-69.5-66.5
FIXED		
WIDTH	=	415-111.5-111.5
HEIGHT	=	610-66.5-111.5
TOTAL	=	(222x1234)+(222x452)=1000000
OPENABLE AREA		
WIDTH	=	415-77-77
HEIGHT	=	1370-32-32
TOTAL	=	(291x1306)x11000000

PROVIDED

GLAZING AREA	0.370	m ²
OPENABLE AREA	0.380	m ²

B.D. REF :

CLIENT :

ARCHITECT :
AGC DESIGN LTD
MAIN CONTRACTOR :
Gammon
STRUCTURAL ENGINEER :
ARUP
FACADE CONSULTANT:
MEINHARDT

NOTE:
1. ALL DIMENSIONS ARE IN mm.
2. ALL ELEVATIONS ARE VIEWED FROM OUTSIDE.
3. ALL DIMENSIONS TO BE VERIFIED ON SITE BEFORE FABRICATION.

LEGEND:
X1 - DETAIL MARK NO.
X201 - REFER SHEET NO.

1. F.F.L. --- FINISHED FLOOR LEVEL
2. S.F.L. --- STRUCTURAL FLOOR LEVEL
3. (R) --- REVERSED DETAIL

C	18/09/2020	REVISION SUBJECT TO APPROVALMENT	Rev
B	24/05/2020	REVISION SUBJECT TO APPROVALMENT	Rev
A	24/05/2020	REVISION SUBJECT TO APPROVALMENT	Rev
NO.	DATE	REVISION	BY

JOB NO. : J-852
PROJECT : PROPOSED RESIDENTIAL DEVELOPMENT
AT 139 - 147 ARGYLE STREET,
NKIL 6005, 6035 R.P., 6036 R.P.,
6037 R.P. & 6038 R.P.


TITLE : WINDOW SCHEDULE FOR ALUM. WINDOW

DATE : 05-Dec-19 SCALE : 1:40
DRAWN BY : MN CHECKED BY : DW


美特鋁質有限公司
MIDI ALUMINIUM FABRICATOR LTD.
Units 6-8, Sunny Industrial Centre, 1/F
610 Che Kwo Ling Road, Kowloon
Tel: 2348211-4 Fax: (852) 2727666

WINDOW MARK	W5 / W4 T2B / T2B
LOCATION	2/F-21/F M.B. & EN.B. AT TOWER 2 FLAT B
SECTION	70mm ALUM. SECTION
GLAZING	GL-01, GL-03
QUANTITY	17 / 17
REMARKS	FACADE (PF-36)


DWG NO. : J852-S0-FW-4208A REV. : C

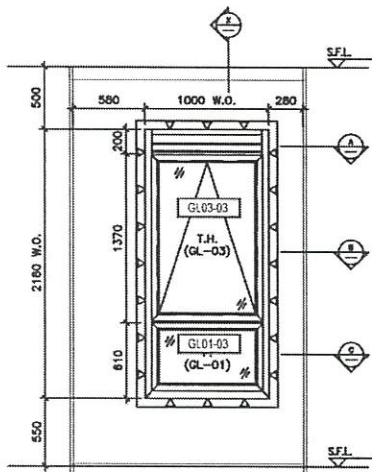




ELEVATION (FOR 1F-20F)

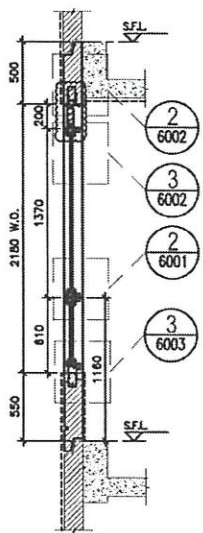

SECTION "X-X" (FOR 1F-20F)

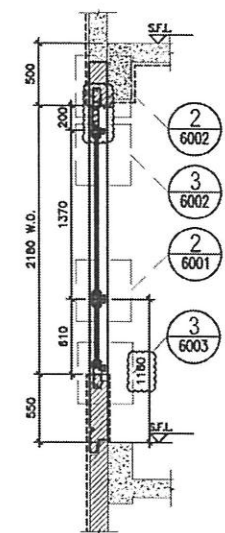

SECTION "X-X" (FOR 21F)

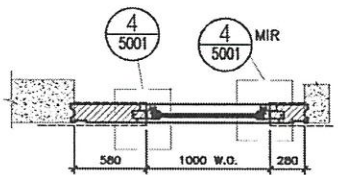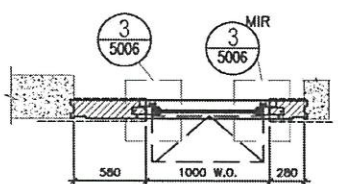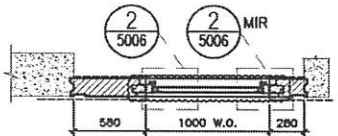

W4/T3A

(T3)

TYPE 3	
OPENABLE WINDOW DIMENSION	(WIDTH) = 1000
	(HEIGHT) = 1370
FIXED WINDOW DIMENSION	(WIDTH) = 1000
	(HEIGHT) = 810
NUMBER OF OPENABLE AREA WINDOW	1
GLAZING AREA	
OPENABLE	WIDTH = 1000-333.4-111.5 = 555.1
	HEIGHT = 1370-69.5-66.1 = 1234.4
FIXED	WIDTH = 1000-111.5-111.5 = 777.0
	HEIGHT = 810-66.5-111.5 = 632.0
TOTAL =	$(555.1 \times 1234.4) + (777.0 \times 632.0) = 1,294.7 \text{ m}^2$
OPENABLE AREA	
WIDTH = 1000-111.5	= 888.5
HEIGHT = 1370-111.5	= 1258.5
TOTAL =	$(888.5 \times 1258.5) = 1,105.7 \text{ m}^2$

PROVIDED	
GLAZING AREA	1.294 m ²
OPENABLE AREA	1.105 m ²

B.D. REF :

CLIENT :

ARCHITECT : **AGC DESIGN LTD**

MAIN CONTRACTOR : **Gammon**

STRUCTURAL ENGINEER : **ARUP**

FAÇADE CONSULTANT : **MEINHARDT**

NOTE :

- ALL DIMENSIONS ARE IN mm.
- ALL ELEVATIONS ARE VIEWED FROM OUTSIDE.
- ALL DIMENSIONS TO BE VERIFIED ON SITE BEFORE FABRICATION.

LEGEND :

ST. DETAIL MARK NO. REFER SHEET NO.

- F.F.L. — FINISHED FLOOR LEVEL
- S.F.L. — STRUCTURAL FLOOR LEVEL
- ⊖ — REVERSED DETAIL
- ▲ — FORMING LOCATION
- △ — FORMING LUG LOCATION
- CLASS LEGEND


JOB NO. : J-852

PROJECT : PROPOSED RESIDENTIAL DEVELOPMENT AT 139 - 147 ARCYLE STREET, HKL 6005, 6035 R.P., 6036 R.P., 6037 R.P. & 6038 R.P.

TITLE : WINDOW SCHEDULE FOR ALUM. WINDOW







DATE : 05-Dec-19 SCALE : 1:40

DRAWN BY : MN CHECKED BY : DW

英特鋁質有限公司
 Units 6-8, Sanyo Industrial Centre, 1/F
 610 Che Kwo Ling Road, Kowloon
 Tel: 23488211-4 Fax: (852) 2727888

DWG NO. : J852-SD-PW-4305 REV. : E

WINDOW MARK	W4/T3A
LOCATION	1/F-21/F M.B. AT TOWER 3 FLAT A
SECTION	70mm ALUM. SECTION
GLAZING	GL-01, GL-03
QUANTITY	18
REMARKS	FAÇADE (PF-13)

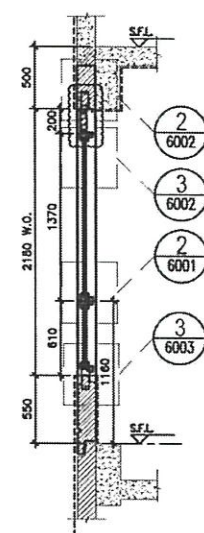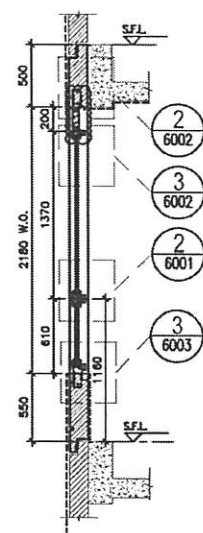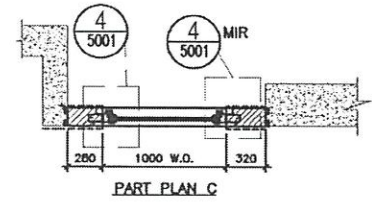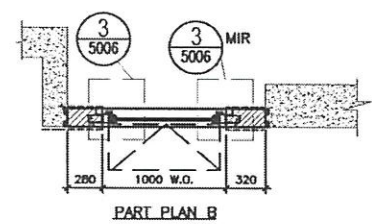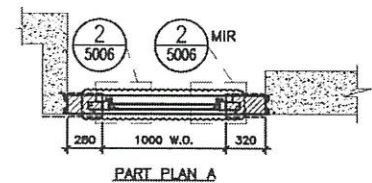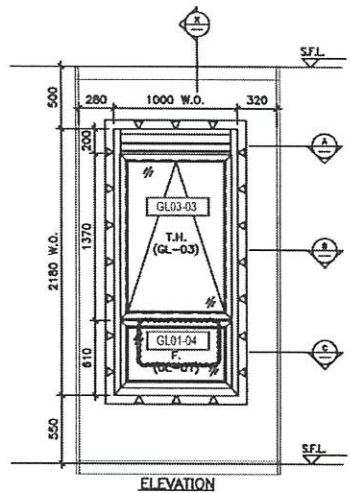

SECTION "X-X"(FOR 1F-20F)

SECTION "X-X"(FOR 21F)

TYPE B		
OPENABLE WINDOW DIMENSION	(WIDTH) =	1000
	(HEIGHT) =	1200
FIXED WINDOW DIMENSION	(WIDTH) =	1000
	(HEIGHT) =	430
NUMBER OF OPENABLE AREA WINDOW		1
GLAZING AREA		
OPENABLE	WIDTH = 1000-111.1-111.1	= 777.8 mm
	HEIGHT = 1270-69.2-69.2	= 1131.6 mm
FIXED	WIDTH = 1000-111.1-111.1	= 777.8 mm
	HEIGHT = 419-68.5-111.1	= 239.2 mm
TOTAL	= (777.8*1131.6)+(777.8*239.2)	= 1,294,417.6 mm ²
OPENABLE AREA		
WIDTH = 1000-111.1		= 888.9 mm
HEIGHT = 1270-120.2		= 1149.8 mm
TOTAL	= (888.9*1149.8)	= 1,021,977.6 mm ²

(T3)
W5/T3A

PROVIDED	
GLAZING AREA	1.294 m ²
OPENABLE AREA	1.105 m ²

ELEVATION

WINDOW MARK	W5/T3A
LOCATION	1/F-21/F EN.B. AT TOWER 3 FLAT A
SECTION	70mm ALUM. SECTION
GLAZING	GL-01, GL-03
QUANTITY	1B
REMARKS	FACADE (PF-14)

B.D. REF :

CLIENT :

ARCHITECT : **AGC DESIGN LTD**

MAIN CONTRACTOR : **Gammon**

STRUCTURAL ENGINEER : **ARUP**

FACADE CONSULTANT : **MEINHARDT**

NOTE :

- ALL DIMENSIONS ARE IN mm.
- ALL ELEVATIONS ARE VIEWED FROM OUTSIDE.
- ALL DIMENSIONS TO BE VERIFIED ON SITE BEFORE FABRICATION.

LEGEND :

① — DETAIL MARK NO.
② — REFER SHEET NO.

- F.F.L. — FINISHED FLOOR LEVEL
- S.F.L. — STRUCTURAL FLOOR LEVEL
- ⊖ — REVERSED DETAIL
- △ — FIXING LOCATION
- ▲ — FIXING LUG LOCATION

GLASS LEGEND

GL01 — 8mm+12mm AIR GAP+10mm THK. LGLU
 GL01e — 8mm+12mm AIR GAP+12mm THK. LGLU
 GL02 — 10mm THK. TEMPERED GLASS (PINNED GLASS)
 GL03 — 8mm+12mm AIR GAP+6mm THK. LGLU
 GL04 — 10mm THK. TEMPERED GLASS (PINNED GLASS)
 GL05 — 8mm+12mm AIR GAP+8mm THK. LGLU

01	ISSUE	BY

JOB NO. : J-852

PROJECT : PROPOSED RESIDENTIAL DEVELOPMENT AT 130 - 147 ARGYLE STREET, HKOL 6005, 6035 R.P., 6036 R.P., 6037 R.P. & 6038 R.P.



TITLE : WINDOW SCHEDULE FOR ALUM. WINDOW

DATE : 05-Dec-19 SCALE : 1:40


DRAWN BY : MN CHECKED BY : DW

英特鋁質有限公司
 Units 6-8, Sunny Industrial Centre, 1/F
 810 Che Koo Ling Road, Kowloon
 Tel: 23480211-4 Fax: (852) 2772888

DWG NO. : J852-SD-PW-4306 REV. : E

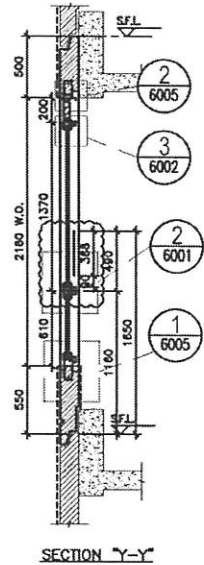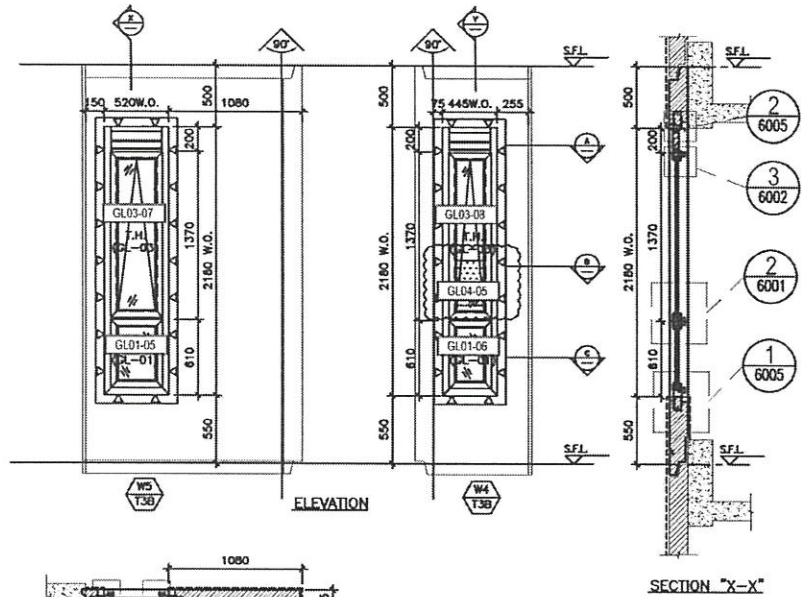

ELEVATION

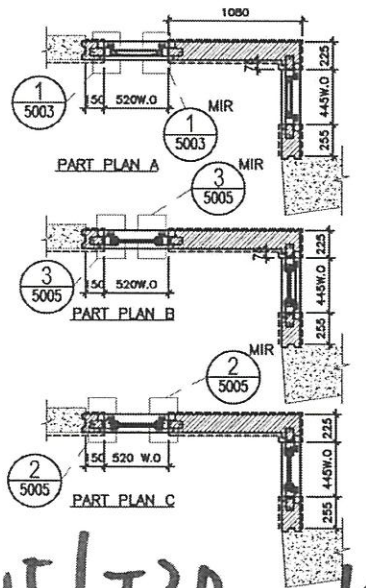

W5/T3B - W4/T3B (T3)

TYPE B
OPENABLE WINDOW DIMENSION
FIXED WINDOW DIMENSION

NUMBER OF OPENABLE AREA WINDOW

GLAZING AREA
OPENABLE
WIDTH = 520-111.5-111.5 = 297 mm
HEIGHT = 1370-69.5-68.5 = 1234 mm
FIXED
WIDTH = 520-111.5-111.5 = 297 mm
HEIGHT = 610-66.5-111.5 = 432 mm
TOTAL = (297*1234)+(297*432)=1000000

OPENABLE AREA

WIDTH	= 520
HEIGHT	= 1370
WIDTH	= 520
HEIGHT	= 610

PROVIDED	
GLAZING AREA	0.495 m ²
OPENABLE AREA	0.478 m ²

TYPE B
OPENABLE WINDOW DIMENSION
FIXED WINDOW DIMENSION

NUMBER OF OPENABLE AREA WINDOW

GLAZING AREA
OPENABLE
WIDTH = 445-111.5-111.5 = 222 mm
HEIGHT = 1370-69.5-68.5 = 1234 mm
FIXED
WIDTH = 445-111.5-111.5 = 222 mm
HEIGHT = 610-66.5-111.5 = 432 mm
TOTAL = (222*1234)+(222*432)=1000000

WIDTH	= 445
HEIGHT	= 1370
WIDTH	= 445
HEIGHT	= 610

PROVIDED	
GLAZING AREA	0.370 m ²
OPENABLE AREA	0.380 m ²

B.D. REF :

CLIENT :

ARCHITECT :
AGC DESIGN LTD
MAIN CONTRACTOR :
Gammon
STRUCTURAL ENGINEER :
ARUP
FACADE CONSULTANT:
MEINHARDT

NOTE:
1. ALL DIMENSIONS ARE IN mm.
2. ALL ELEVATIONS ARE VIEWED FROM OUTSIDE.
3. ALL DIMENSIONS TO BE VERIFIED ON SITE BEFORE FABRICATION.

LEGEND:
① - DETAIL MARK NO.
② - REFER SHEET NO.
1. F.F.L. - FINISHED FLOOR LEVEL
2. S.F.L. - STRUCTURAL FLOOR LEVEL
3. ⊕ - REVERSED DETAIL
4. △ - FIXING LOCATION
5. ⊙ - FIXING LUG LOCATION
6. CLASS LEGEND
GL01 - 8mm+12mm AIR GAP+10mm THK L.G.L.L.
GL01a - 8mm+12mm AIR GAP+12mm THK L.G.L.L.
GL02 - 10mm THK TEMPERED GLASS (PANEL GLASS)
GL03 - 6mm+12mm AIR GAP+6mm THK L.G.L.L.
GL04 - 10mm THK TEMPERED GLASS (PIONEER WINDOW)
GL05 - 8mm+12mm AIR GAP+8mm THK L.G.L.L.

NA	DATE	ISSUED	BY


JOB NO. : J-852
PROJECT :
PROPOSED RESIDENTIAL DEVELOPMENT
AT 130 - 147 ARGYLE STREET,
NO. 6005, 6035 R.P., 6036 R.P.,
6037 R.P. & 6038 R.P.

TITLE :
WINDOW SCHEDULE FOR
ALUM. WINDOW

DATE : 05-Dec-10 SCALE : 1:40
DRAWN BY : MN CHECKED BY : DW

美特铝业有限公司
Units 6-8, Sanyee Industrial Centre, 1/F
610 Che Kwo Ling Road, Kowloon
Tel: 23488211-4 Fax: (852) 27727888
DWG NO. : J852-SD-PW-4312 REV. : F

WINDOW MARK	W5/T3B / W4/T3B
LOCATION	1/F-21/F M.B. & EN.B. AT TOWER 3 FLAT B
SECTION	70mm ALUM. SECTION
GLAZING	GL-01, GL-03
QUANTITY	1B / 18
REMARKS	FACADE (PF-34)

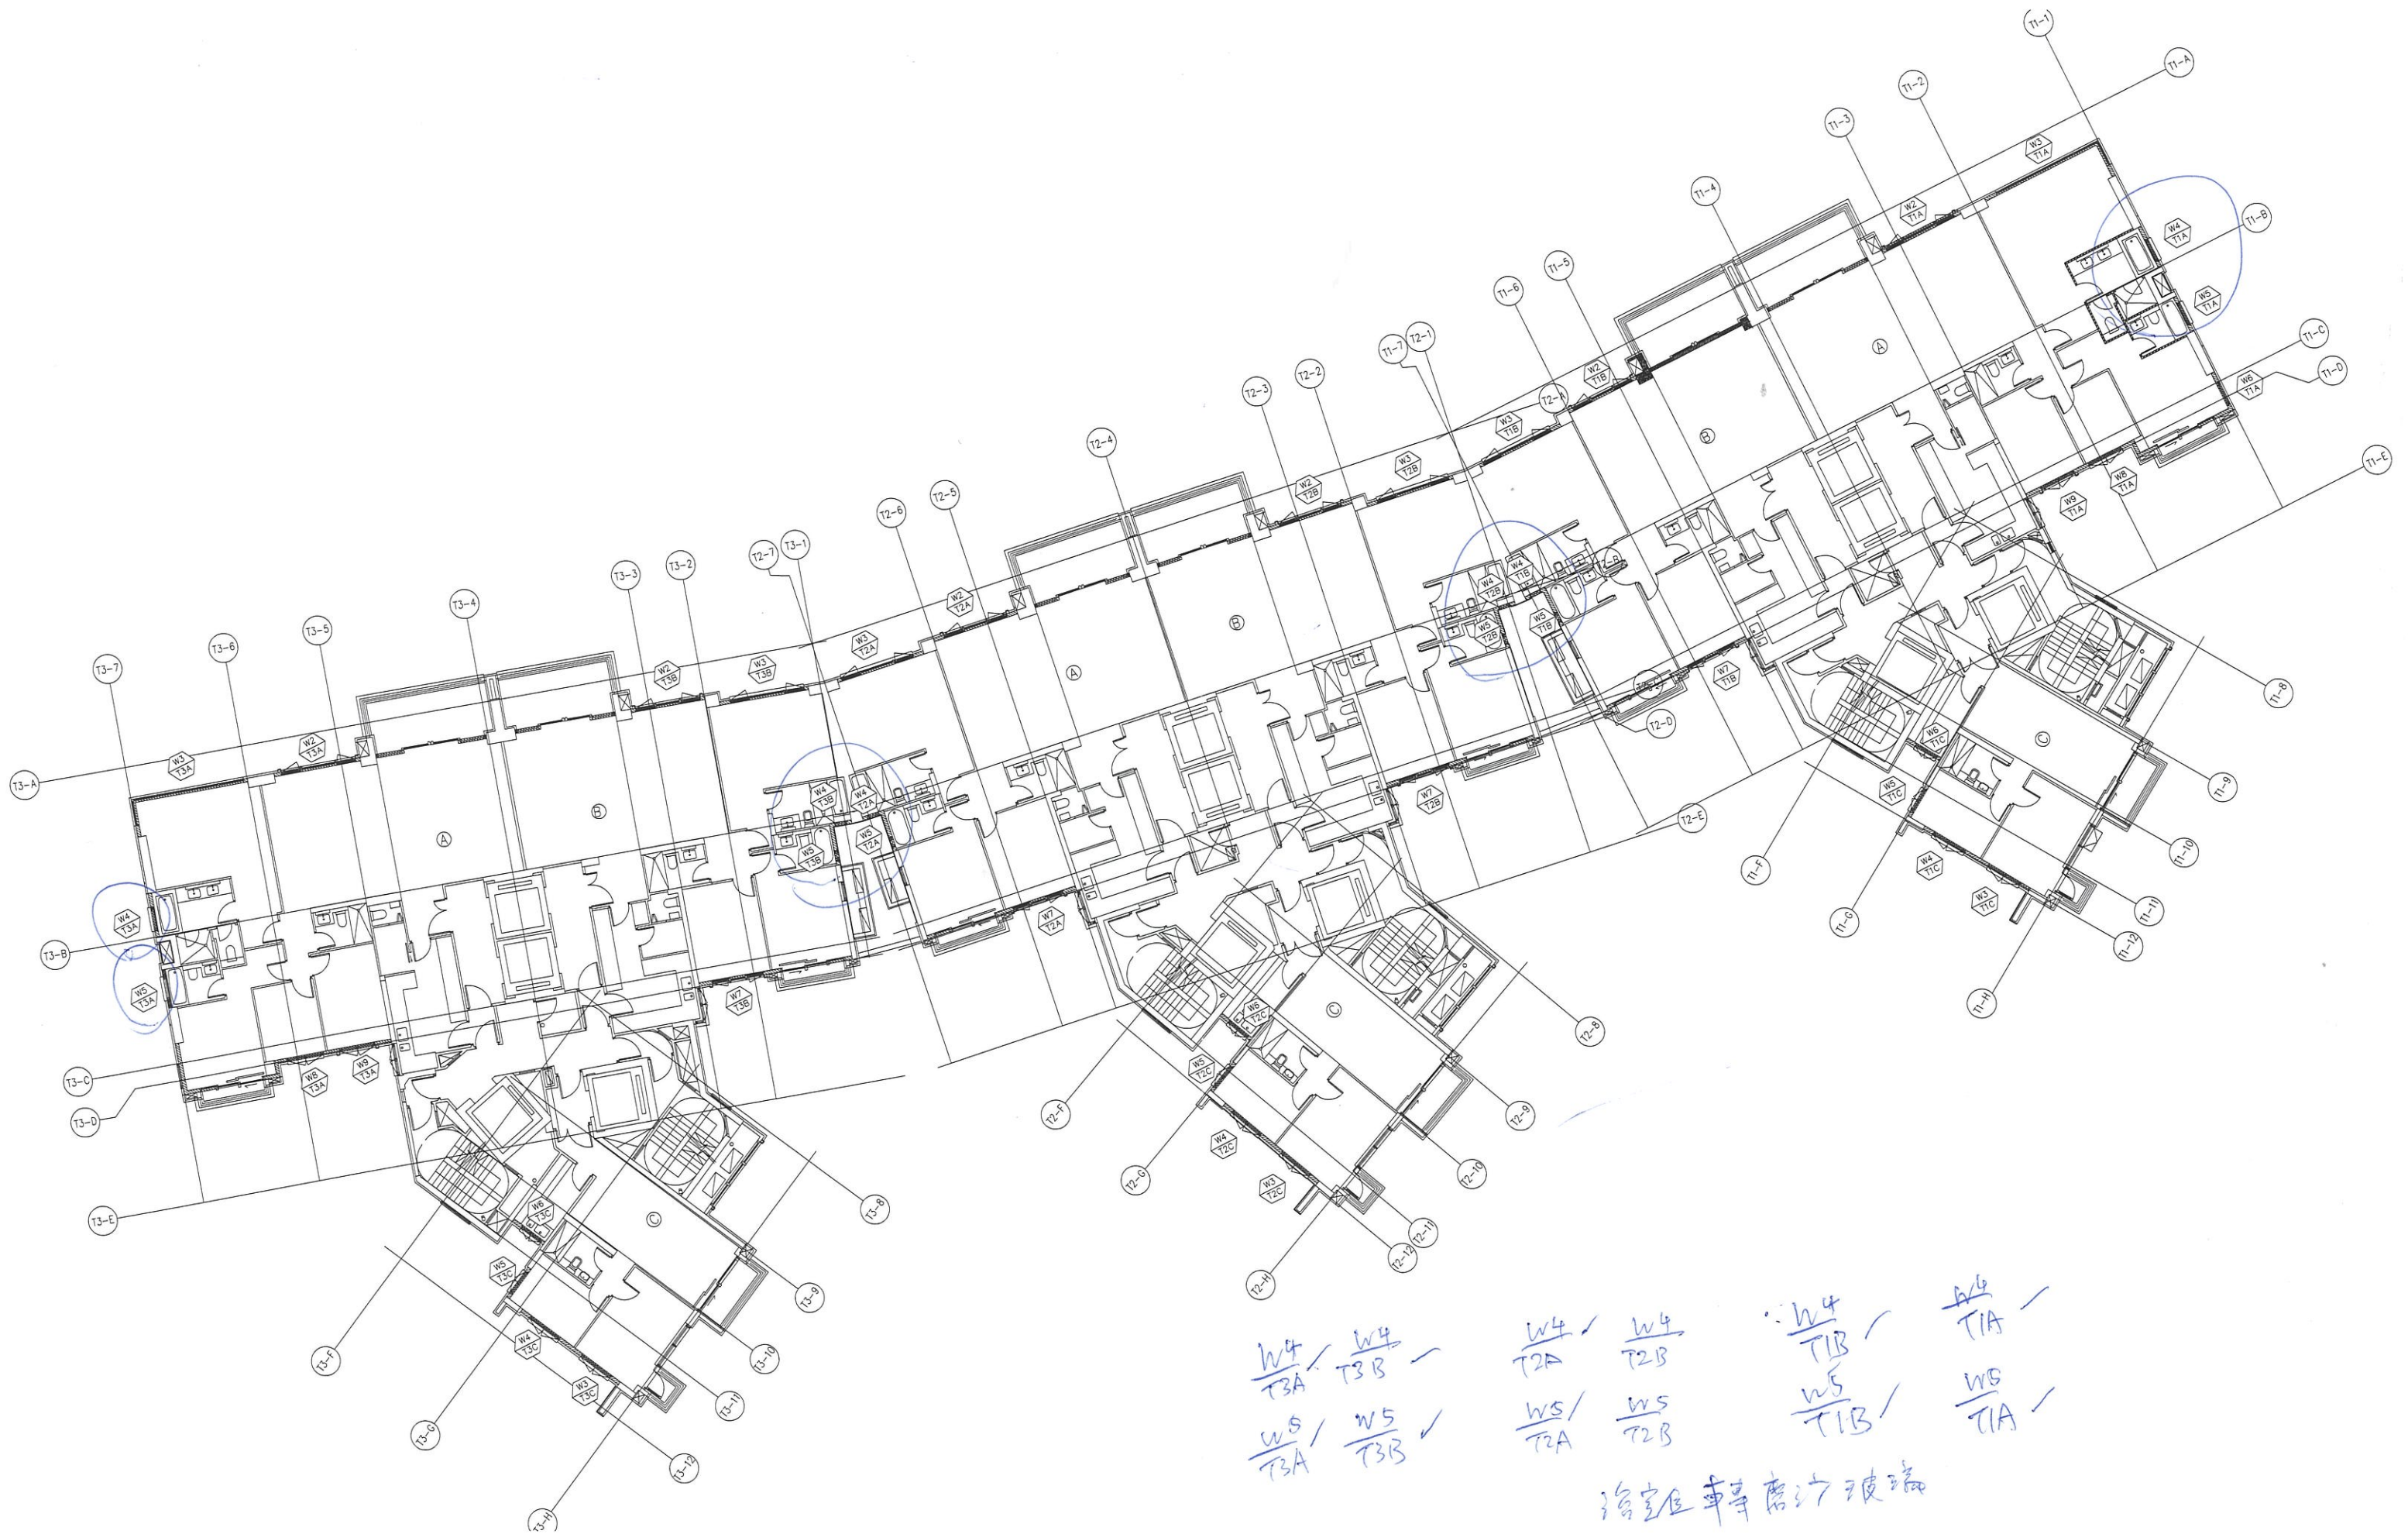

$\frac{W4}{T3A}$ ✓ $\frac{W4}{T3B}$ ✓
 $\frac{W5}{T3A}$ ✓ $\frac{W5}{T3B}$ ✓

$\frac{W4}{T2A}$ ✓ $\frac{W4}{T2B}$ ✓
 $\frac{W5}{T2A}$ ✓ $\frac{W5}{T2B}$ ✓

$\frac{W4}{T1B}$ ✓ $\frac{W4}{T1A}$ ✓
 $\frac{W5}{T1B}$ ✓ $\frac{W5}{T1A}$ ✓

洽詢車庫磨沙玻璃