

工程指示 / 要求簡箋(E.I.)

工程指示編號：EI / 3182/21 修改版次：-
 工程編號：J - 852 工程名稱：亞皆老街中電
 工程項目：後裝窗 地盤用玻璃 B.M. 大貨 (T1-T3) (1-21/F) (1287 件)
 收件人：Maggie 發件人：Ant Yeung 日期：1 /03/2021

□要求提供 / □確認 事項：

- () 初步鋁料 B.M. () 加工拆圖，然後生產 () 尺寸表
- () 正式鋁料 B.M. () 技術上資料 / 指示 () 報價
- () 配件 B.M. () 樣辦或貨品說明書 () 分判合約
- () 其他：_____

設計箱數, 箱的結構

請按 BM 訂購 T1-T3 (1-21/F) 後裝窗玻璃 (共 1,287 件) (T1: 437 件, T2: 455 件, T3: 395 件)直送地盤.

包裝要分座分層.* T3 優先出貨

IGU 膠用 DC983 結構膠

玻璃要做熱浸. Low-E: SEE0-83T.

請留意玻璃加工時不要固定的鋼化及熱浸標籤. 玻璃出貨時需加上"可移除" 標籤.

IGU: 標籤在室內外面 (注明半鋼化/ 鋼化) 精確 = GL01-T1-011, GL01-T2-009, GL01-T3-001

請在 2021.04.30 前完成上列要求. 需要人員包箱, 因玻璃尺寸太大不能用沙盤上機,

附: 6 頁 BM+6 頁參考 BM+33 頁派位圖+3 頁加工圖 +1 頁包箱要求 留用電 kkk

以上項目為:

- 原合約工程包 原合約工程加 / 減賬 新工程報價

原因 :- _____

分發東莞各部門：

- () 生產技術總監口連附件 () 技術部 口連附件 () 生產部 口連附件 () 機械設計部口連附件
- () 採購部 口連附件 () 生產統籌部口連附件 () 小羅&清 口連附件
- () 質檢部 口連附件 () 會計部 口連附件 () 報關組 口連附件 () 其他 楊榮輝 口連附件

分發其他分判：

- (v) 水洪 口連附件

分發香港各部門：

- () 行政部口連附件 () 會計部口連附件 () 統籌部口連附件 () 工程部地盤科文口連附件 祥哥
- () 採購部口連附件 () QS 部 口連附件 () 維修部口連附件 () 其他 _____ 口連附件

傳遞編號：

HK / 21

發件人簽署：

項目經理簽署：

Handwritten signature



報價單號碼：J852-02

報價單

謹致：美特鋁質有限公司

地盤名稱：J852 亞皆老街聖佐治大廈

報價日期：18-03-2021

工程內容：


玻璃種類	數量	單位	單價(港元)
8mm+12mm+10mm 中空玻璃	1	平方米	
8mm+9mm+12mm 中空玻璃	1	平方米	
6mm+12mm+6mm 中空玻璃	1	平方米	
死牆 10mm 玻璃	1	平方米	
護欄 10mm 安全玻璃	1	件	



備註：

- 不包竹棚、金屬棚架、高空車、吊船等等高空工作及吊運所需要的物料提供和使用費用。
- 包玻璃膠、膠粒
- 玻璃大貨箱頭要分樓層包裝
- 1193x2279、2380x2060、2090x2030、1290x2330 需要按尺寸獨立箱頭包裝

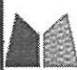



 美特鋁質有限公司 MIDI Aluminium Fabricator Ltd.	工程號:	J852	計算:	Ivan	日期:	2021/2/24	送呈:	
	地盤名稱:		核對:		日期:		副本:	<訂購用>
地盤用玻璃B.M.表	項目類別:	T1后裝窗及趟門玻璃 (1F~21F)			日期:		A/C Code:	
BM編號:	修改版次:	A-2021.03.12	總計玻璃面積 (平方米):	685.92				


序號	修改內容	玻璃圖號	顏色與類型	厚度 (mm)	玻璃尺寸		數量 (塊)	總面積 (平方米)	使用位置	加工圖參考	
					寬度 (W mm)	高度 (H mm)					
1	A-搭位12mm	GL03-T1-001	6SEE0-837 6mm+12mm AIR GAP+6mm THK. I.G.U. D 21010040	24.0	506.0	1226.0	36	22.33	T1后裝窗	GL03-T1-001	
2	A-搭位12mm	GL03-T1-002			531.0	1226.0	18	11.72	T1后裝窗	GL03-T1-002	
3	A-搭位12mm	GL03-T1-003			521.0	1226.0	18	11.50	T1后裝窗	GL03-T1-003	
4	A-搭位12mm	GL03-T1-004			571.0	1201.0	18	12.34	T1后裝窗	GL03-T1-004	
					合計:		90	57.89			
1	A-搭位18mm	GL01-T1-001	8SEE0-837 8mm+12mm AIR GAP+10mm THK. I.G.U. D 20120140	30.0	1133.0	418.0	18	8.52	T1后裝窗	GL01-T1-001	
2	A-搭位18mm	GL01-T1-002			1173.0	203.0	18	4.29	T1后裝窗	GL01-T1-002	
3	A-修改尺寸	GL01-T1-003			346.0	1599.5	18	9.96	T1后裝窗	GL01-T1-003	
4	A-搭位18mm	GL01-T1-004			942.5	2419.0	36	82.08	T1四趟趟門	GL01-T1-004	
5	A-搭位18mm	GL01-T1-005			1020.0	2268.0	36	83.28	T1四趟趟門	GL01-T1-005	
6	A-搭位18mm	GL01-T1-006			861.5	2285.0	36	70.87	T1三趟趟門	GL01-T1-006	
7	A-搭位18mm	GL01-T1-007			861.5	2285.0	36	70.87	T1三趟趟門	GL01-T1-007	
8	A-搭位18mm	GL01-T1-008			517.0	2285.0	36	42.53	T1三趟趟門	GL01-T1-008	
9	A-搭位18mm	GL01-T1-009			830.0	2419.0	36	72.28	T1四趟趟門	GL01-T1-009	
10	A-搭位18mm	GL01-T1-010			920.0	2268.0	36	75.12	T1四趟趟門	GL01-T1-010	
11	A-搭位18mm	GL01-T1-011						36	99.21	T1兩趟趟門	GL01-T1-011
12	A-搭位18mm	GL01-T1-012				460.0	2416.0	1	1.11	T1FD門	GL01-T1-012
13	A-搭位18mm	GL01-T1-013				1110.0	2416.0	1	2.68	T1FD門	GL01-T1-013
					合計:		344	622.80			

 美特鋁質 有限公司 MIDI Aluminium Fabricator Ltd.		工程號:	J852	計算:	Ivan	日期:	2021/2/24	送呈:		
		地盤名稱:		核對:		日期:	(TI)	副本:	<訂購用>	
地盤用玻璃B.M.表		項目類別:	T1后裝窗及趟門玻璃 (1F~21F)			日期:		A/C Code:		
BM編號:		修改版次:	A-2021.03.12	總計玻璃面積 (平方米):	685.92					
序號	修改內容	玻璃圖號	顏色與類型	厚度 (mm)	玻璃尺寸		數量 (塊)	總面積 (平方米)	使用位置	加工圖參考
					寬度 (W mm)	高度 (H mm)				
1	A-搭位14mm	GL05-T1-001	6mm+12mm AIR GAP+8mm THK.	26	697.0	2303.0	2	3.21	T1FD門	GL01-T1-001
2	A-搭位14mm	GL05-T1-002	I.G.U.	26	878.0	2303.0	1	2.02	T1FD門	GL01-T1-002
			D>1010041			合計:	3	5.23		
			6SEE0-83T			總合計:	437	685.92		
加工注意事項:		1).本表中之所有玻璃顏色待定。								
		2).本表中所有玻璃對角線尺寸偏差要求不超過負2mm。								
		3).本表中玻璃要求粗磨邊處理並倒棱角，而所有玻璃之入爐方向需保持一致。								
		4).本表中所有玻璃成品均需做雙面保護，用透明靜電膠紙加四周一寸FK白膠紙做雙面加固保護處理。								
		5).本表中所有玻璃成品均需注明室內外及其玻璃編號，以便識別。								

 美特鋁質 有限公司 MIDI Aluminium Fabricator Ltd.		工程號: J852	計算: Ivan	日期: 2021/2/24	送呈:						
地盤名稱:		核對:	日期:	<div style="border: 1px solid black; border-radius: 50%; width: 40px; height: 40px; display: flex; align-items: center; justify-content: center; margin: 0 auto;">T2</div> 副本: <訂購用>							
地盤用玻璃B.M.表		項目類別: T2后裝窗及趟門玻璃 (1F~21F)	日期:	A/C Code:							
BM編號:	修改版次: A-2021.03.12	總計玻璃面積 (平方米):	659.06								
序號	修改內容	玻璃圖號	顏色與類型	厚度 (mm)	玻璃尺寸		數量 (塊)	總面積 (平方米)	使用位置	加工圖參考	
					寬度 (W mm)	高度 (H mm)					
1	A-搭位12mm	GL03-T2-001	6SEE0-83T	24.0	571.0	1201.0	18	12.34	T2后裝窗	GL03-T2-001	
2	A-搭位12mm	GL03-T2-002	6mm+12mm AIR GAP+6mm THK. I.G.U.		531.0	1226.0	36	23.44	T2后裝窗	GL03-T2-002	
3	A-搭位12mm	GL03-T2-003	D>1010040		521.0	1226.0	36	22.99	T2后裝窗	GL03-T2-003	
					合計:		90	58.77			
1	A-搭位18mm	GL01-T2-001	8SEE0-83T	30.0	1173.0	203.0	36	8.57	T2后裝窗	GL01-T2-001	
2	A-修改尺寸	GL01-T2-002			140.0	1599.5	18	4.03	T2后裝窗	GL01-T2-002	
3	A-修改尺寸	GL01-T2-003			252.0	1599.5	18	7.26	T2后裝窗	GL01-T2-003	
4	A-搭位18mm	GL01-T2-004			8mm+12mm AIR GAP+10mm THK. I.G.U.	805.0	2419.0	72	140.21	T2四趟趟門/梗	GL01-T2-004
5	A-搭位18mm	GL01-T2-005			895.0	2268.0	72	146.15	T2四趟趟門/生	GL01-T2-005	
6	A-搭位18mm	GL01-T2-006			517.0	2285.0	36	42.53	T2三趟趟門/梗	GL01-T2-006	
7	A-搭位18mm	GL01-T2-007			D>10100740	861.5	2285.0	36	70.87	T2三趟趟門/生	GL01-T2-007
8	A-搭位18mm	GL01-T2-008			861.5	2285.0	36	70.87	T2三趟趟門/生	GL01-T2-008	
9	A-搭位18mm	GL01-T2-009			<div style="color: blue; font-weight: bold;">矯終箱 →</div>	1204.0	2289.0	36	99.21	T2兩趟趟門/生	GL01-T2-009
10	A-搭位18mm	GL01-T2-010				1110.0	2416.0	2	5.36	T2FD門	GL01-T2-010
					合計:		362	595.05			
1	A-搭位14mm	GL05-T2-001	6mm+12mm AIR GAP+8mm THK. I.G.U.	26	697.0	2303.0	2	3.21	T2FD門	GL05-T2-001	
	A-搭位14mm	GL05-T2-002		26	878.0	2303.0	1	2.02	T2FD門	GL05-T2-002	
					合計:		3	5.23			
					6SEE0-83T		總合計:	455	659.06		

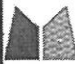
 美特鋁質 有限公司 MIDI Aluminium Fabricator Ltd.		工程號:	J852	計算:	Ivan	日期:	2021/2/24	送呈:		
		地盤名稱:		核對:		日期:		副本:	<訂購用>	
地盤用玻璃B.M.表		項目類別:	T2后裝窗及趟門玻璃 (1F~21F)			日期:		A/C Code:		
BM編號:		修改版次:	A-2021.03.12	總計玻璃面積 (平方米):	659.06					
序號	修改內容	玻璃圖號	顏色與類型	厚度 (mm)	玻璃尺寸		數量 (塊)	總面積 (平方米)	使用位置	加工圖參考
					寬度 (W mm)	高度 (H mm)				
加工注意事項:		1).本表中之所有玻璃顏色待定。								
		2).本表中所有玻璃對角線尺寸偏差要求不超過負2mm。								
		3).本表中玻璃要求粗磨邊處理並倒棱角，而所有玻璃之入爐方向需保持一致。								
		4).本表中所有玻璃成品均需做雙面保護，用透明靜電膠紙加四周一寸PK白膠紙做雙面加固保護處理。								
		5).本表中所有玻璃成品均需注明室內外及其玻璃編號，以便識別。								

 美特鋁質 有限公司 MIDI Aluminium Fabricator Ltd.		工程號: J852	計算: Ivan	日期: 2021/2/24	送呈:					
地盤名稱:		核對:	日期:	 副本: <訂購用>						
地盤用玻璃B.M.表		項目類別: T3后裝窗及趟門玻璃 (1F~3F, 6F~21F)	日期:	A/C Code:						
BM編號:	修改版次: A-2021.03.12	總計玻璃面積 (平方米):	615.86							
序號	修改內容	玻璃圖號	顏色與類型	厚度 (mm)	玻璃尺寸		數量 (塊)	總面積 (平方米)	使用位置	加工圖參考
					寬度 (W mm)	高度 (H mm)				
1	A-搭位12mm	GL03-T3-001	6SEE0-83T 6mm+12mm AIR GAP+6mm THK. I.G.U. D>1010040	24.0	506.0	1226.0	34	21.09	T3后裝窗/生	GL03-T3-001
2	A-搭位12mm	GL03-T3-002			518.5	1226.0	17	10.81	T3后裝窗/生	GL03-T3-002
3	A-搭位12mm	GL03-T3-003			508.5	1226.0	17	10.60	T3后裝窗/生	GL03-T3-003
4	A-搭位12mm	GL03-T3-004			571.0	1201.0	17	11.66	T3后裝窗/生	GL03-T3-004
					合計:		85	54.15		
1	A-搭位18mm	GL01-T3-001	8SEE0-83T 8mm+12mm AIR GAP+10mm THK. I.G.U. D>1010140 W6/T3A 6 W7/T3A改為防火門	30.0	1133.0	203.0	17	3.91	T3后裝窗/梗	GL01-T3-001
2	A-搭位18mm	GL01-T3-002			1145.0	203.0	17	3.95	T3后裝窗/梗	GL01-T3-002
3	A-修改尺寸	GL01-T3-003			249.0	1599.5	17	6.77	T3后裝窗/梗	GL01-T3-003
4	A-搭位18mm	GL01-T3-004			942.5	2419.0	34	77.52	T3四趟趟門/梗	GL01-T3-004
5	A-搭位18mm	GL01-T3-005			1020.0	2268.0	34	78.65	T3四趟趟門/生	GL01-T3-005
6	A-搭位18mm	GL01-T3-006			517.0	2285.0	16	18.90	T3三趟趟門/梗	W7/T3A改為防火門
7	A-搭位18mm	GL01-T3-007			861.5	2285.0	34	66.93	T3三趟趟門/生	GL01-T3-007
8	A-搭位18mm	GL01-T3-008			861.5	2285.0	34	66.93	T3三趟趟門/生	GL01-T3-008
9	A-搭位18mm	GL01-T3-009			830.0	2419.0	34	68.26	T3四趟趟門/梗	GL01-T3-009
10	A-搭位18mm	GL01-T3-010			920.0	2268.0	34	70.94	T3四趟趟門/生	GL01-T3-010
11	A-搭位18mm	GL01-T3-011			1204.0	2289.0	34	93.70	T3兩趟趟門/生	GL01-T3-011
12	A-搭位18mm	GL01-T3-012					1	1.11	T1FD門	GL01-T3-011
13	A-搭位18mm	GL01-T3-013					1	2.68	T1FD門	GL01-T3-011
					合計:		307	556.47		

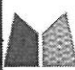 美特鋁質 有限公司 MIDI Aluminium Fabricator Ltd.		工程號:	J852	計算:	Ivan	日期:	2021/2/24	送呈:		
地盤名稱:		核對:		日期:				副本:	<訂購用>	
地盤用玻璃B.M.表		項目類別:		T3后裝窗及趟門玻璃 (1F~3F, 6F~21F)		日期:		A/C Code:		
BM編號:		修改版次:		A-2021.03.12		總計玻璃面積 (平方米):		615.86		
序號	修改內容	玻璃圖號	顏色與類型	厚度 (mm)	玻璃尺寸		數量 (塊)	總面積 (平方米)	使用位置	加工圖參考
					寬度 (W mm)	高度 (H mm)				
1	A-搭位14mm	GL05-T3-001	6mm+12mm AIR GAP+8mm THK.	26	697.0	2303.0	2	3.21	T1FD門	GL05-T3-001
2	A-搭位14mm	GL05-T3-002	I.G.U.	26	878.0	2303.0	1	2.02	T1FD門	GL05-T3-002
			DY1010041			合計:	3	5.23		
			6SEE0-83T			总合计:	395	615.86		
加工注意事項:		1).本表中之所有玻璃顏色待定。								
		2).本表中所有玻璃對角線尺寸偏差要求不超過負2mm。								
		3).本表中玻璃要求粗磨邊處理並倒稜角，而所有玻璃之入爐方向需保持一致。								
		4).本表中所有玻璃成品均需做雙面保護，用透明靜電膠紙加四周一寸FK白膠紙做雙面加固保護處理。								
		5).本表中所有玻璃成品均需注明室內外及其玻璃編號，以便識別。								

EG-DWG4



 美特鋁質 有限公司 MIDI Aluminium Fabricator Ltd.	類別		物料號		圖號	GL01-01~08
	制圖	van	2020-09-04		數量	—
修改					位置	后裝鋁窗及門用
日期						

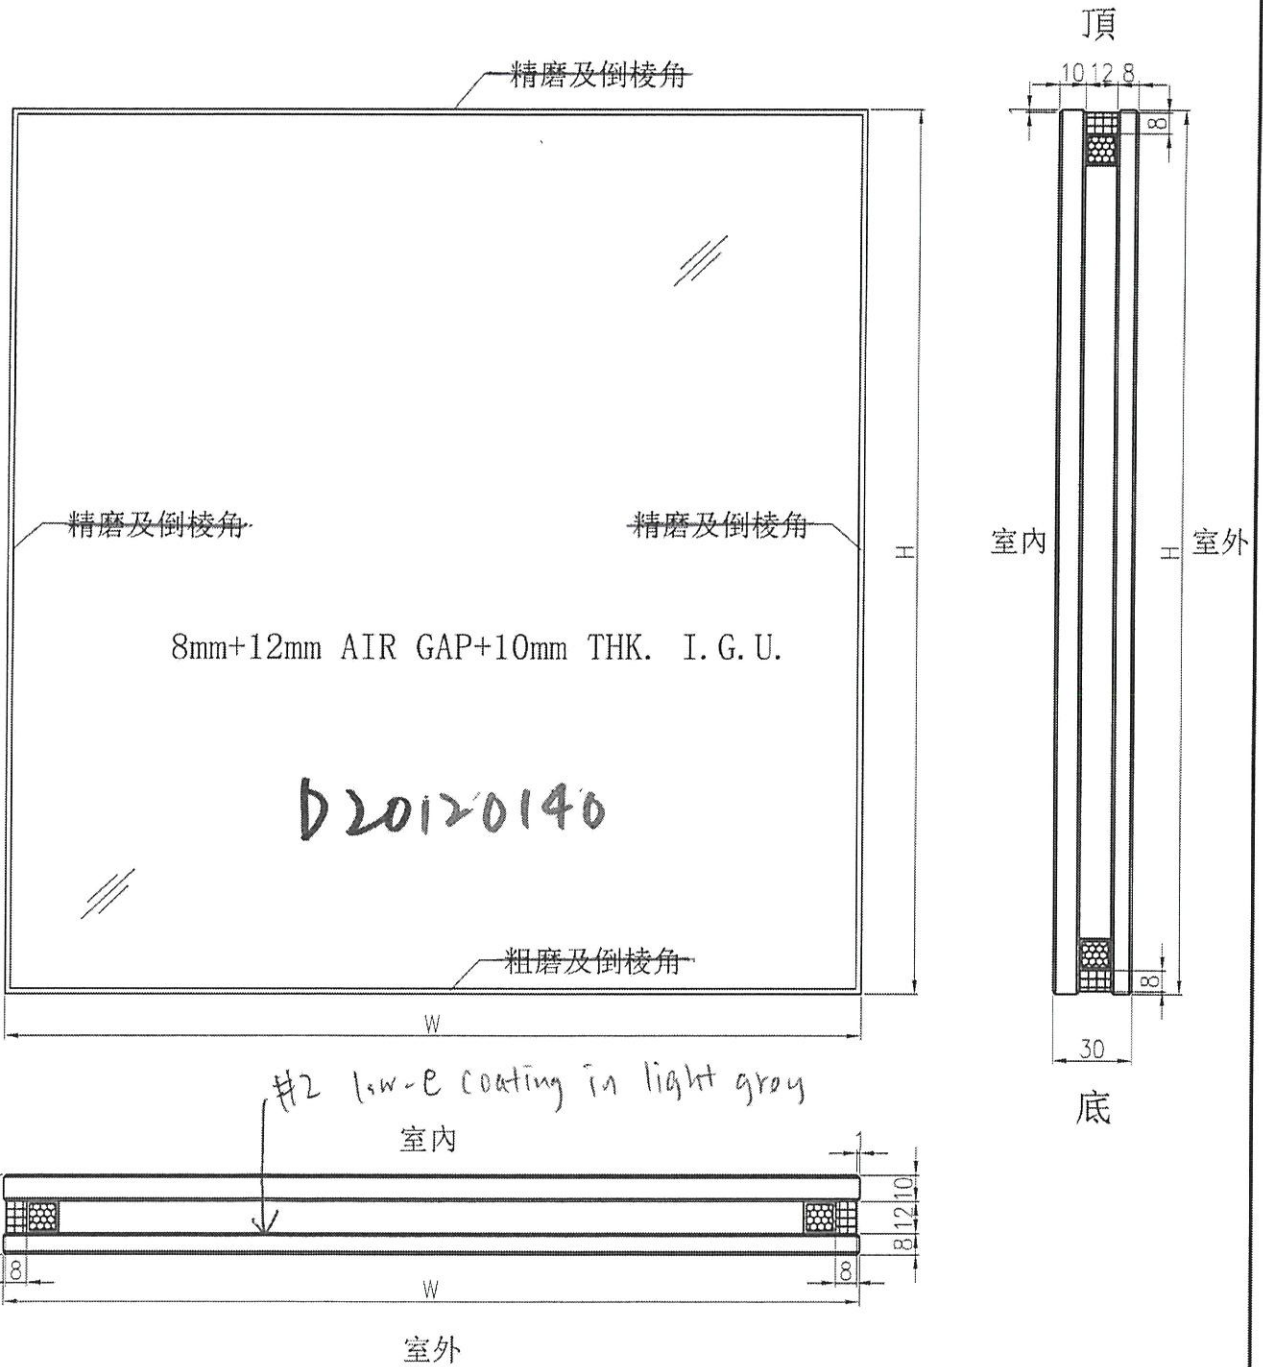

工程號	J-852	地盤	—	附 件
名稱	玻璃加工圖		採用	
材料	8mm+12mm AIR GAP+10mm THK. I.G.U.		地盤	
顏色	—		工廠	


EG-DWG4

 美特鋁質 有限公司 MIDI Aluminium Fabricator Ltd.	類別	物料號	圖號	GL03-01~10	
	制圖	van	2020-09-04	數量	—
修改		復核		位置	后裝鋁窗及門用
日期		批准			

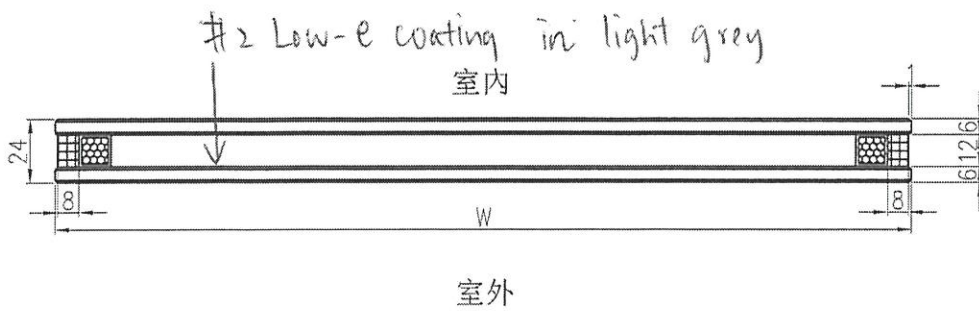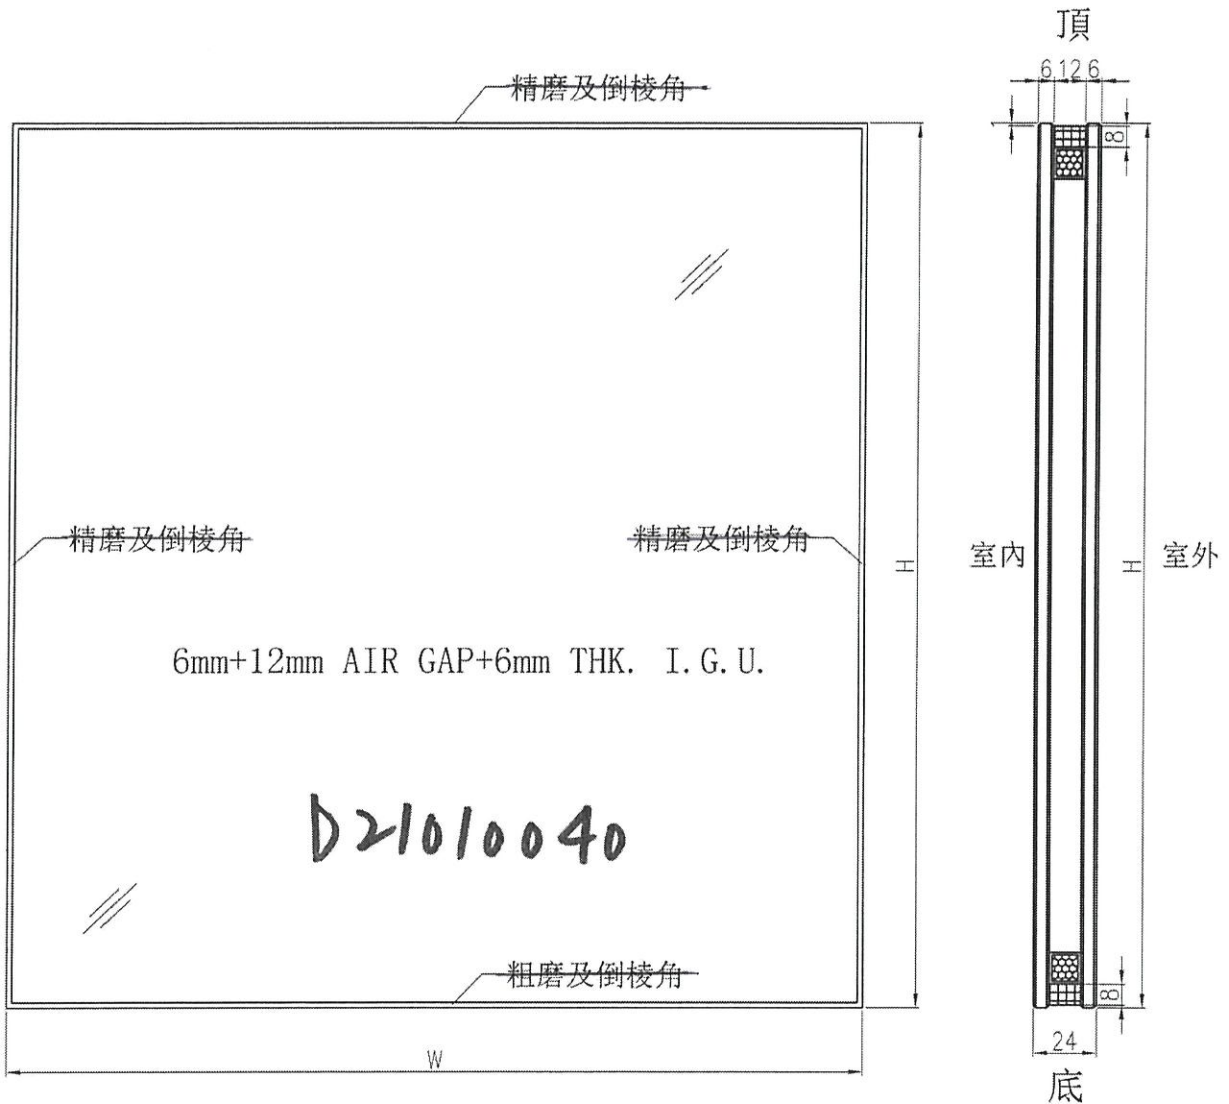


工程號	J-852	地盤	—	附件
名稱	玻璃加工圖		採用	
材料	6mm+12mm AIR GAP+6mm THK. I.G.U.		地盤	
顏色	—		工廠	


 美特鋁質有限公司 MIDI Aluminium Fabricator Ltd.	類別		物料號	
	制圖	ivan	2020-09-04	圖號 GL05-01~02
修改				數量 一
日期				位置 后裝鋁窗及鋁門用

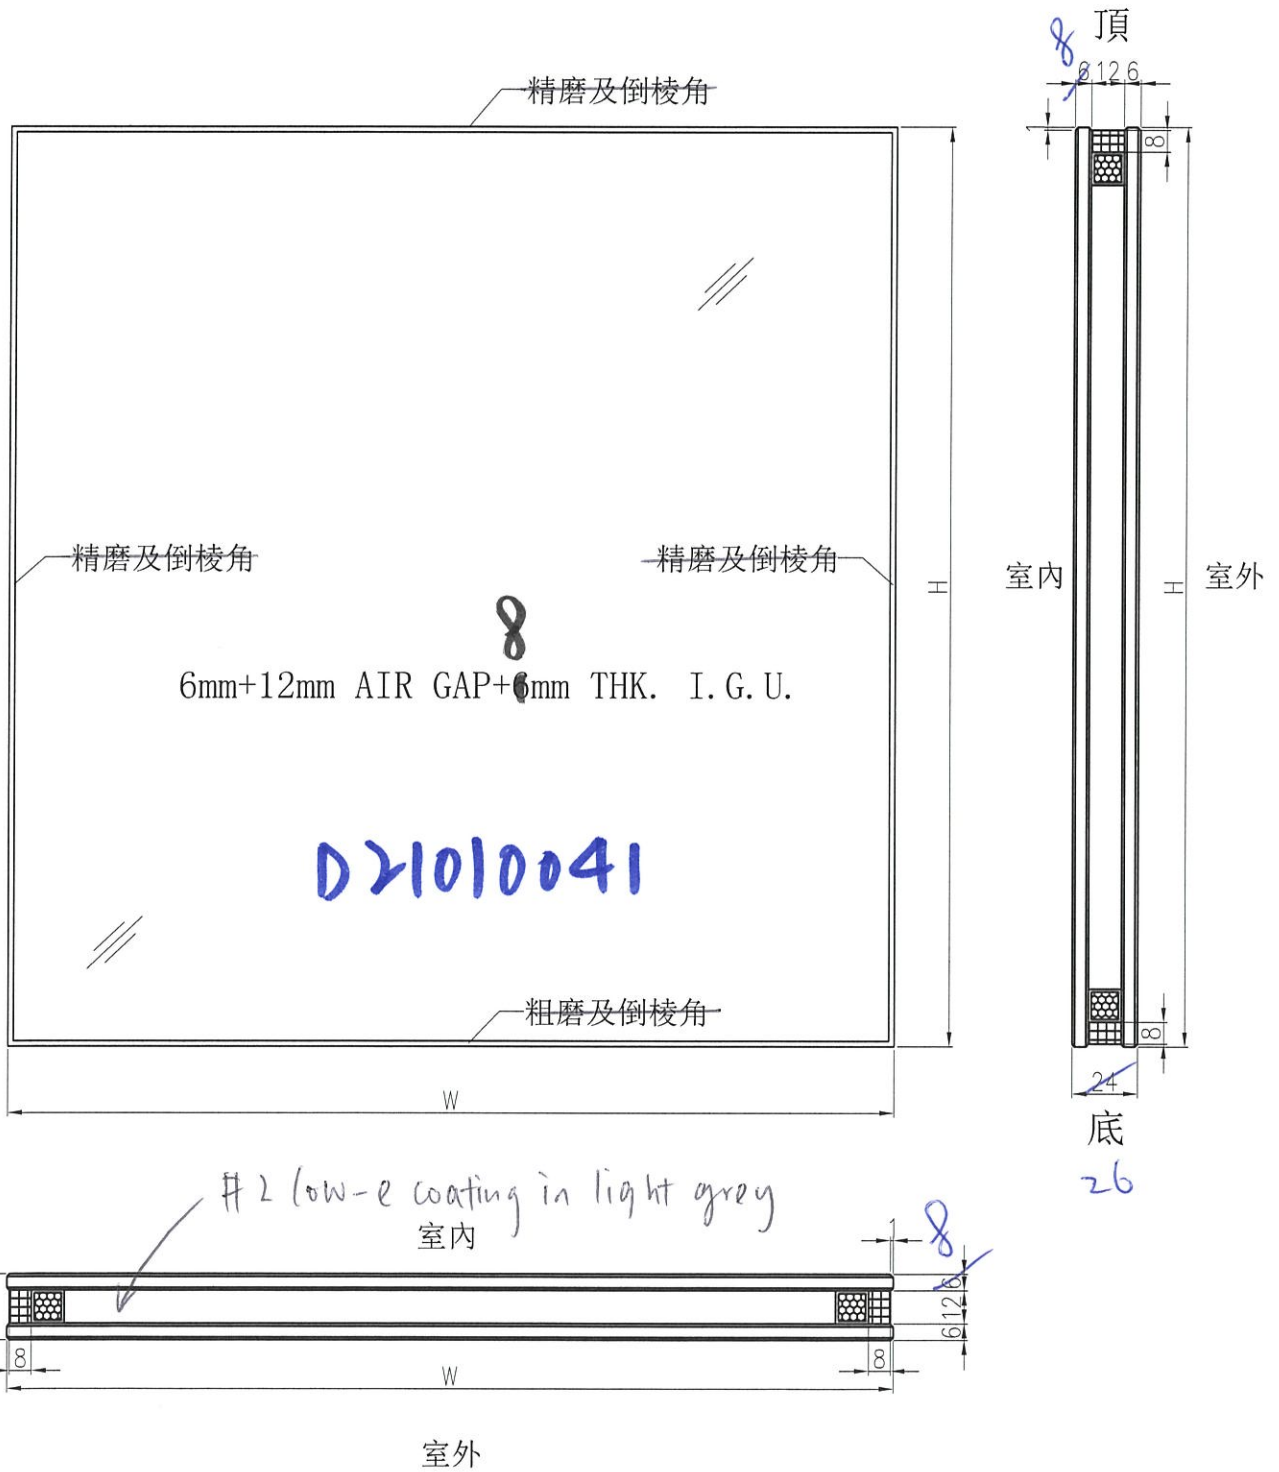

工程號	J-852	地盤	—	附 件
名稱	玻璃加工圖		採用	
材料	6mm+12mm AIR GAP+6mm THK. I.G.U.		地盤	
顏色	—	工廠	✓	

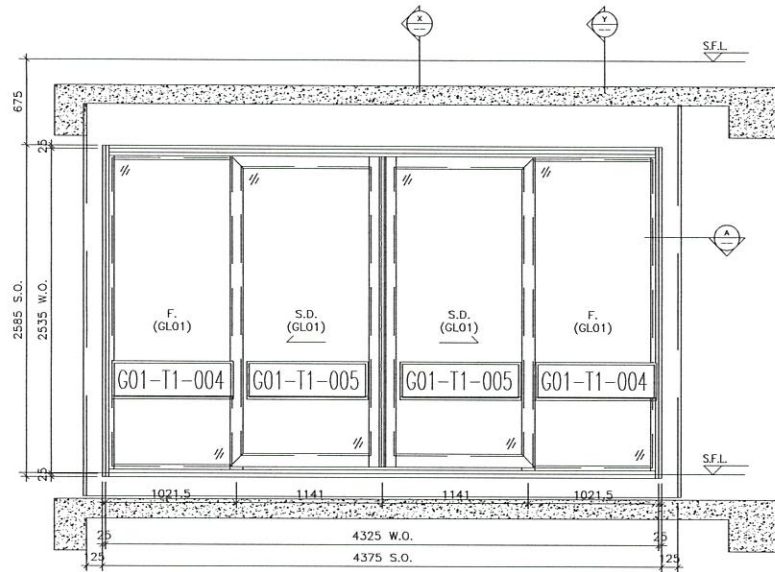


ELEVATION

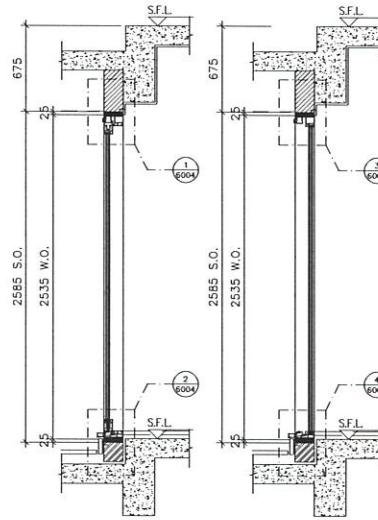


SECTION "X-X"

SECTION "Y-Y"

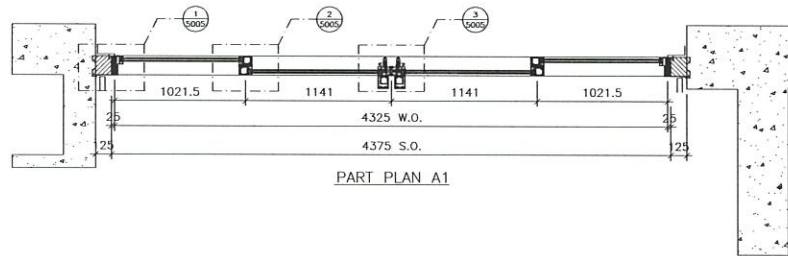

PART PLAN A1

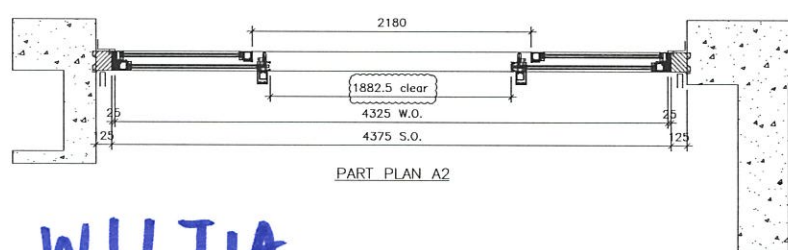

PART PLAN A2

W1/T1A

TYPE I		
SLIDING DOOR DIMENSION	(WIDTH)	= 1141
	(HEIGHT)	= 2535
FIXED WINDOW DIMENSION	(WIDTH)	= 1021.5
	(HEIGHT)	= 2535
NUMBER OF OPENABLE AREA WINDOW		= 2
GLAZING AREA		
SLIDING DOOR		
WIDTH	= 1141-106-51	= 982 mm
HEIGHT	= 2535-151-152	= 2232 mm
FIXED		
WIDTH	= 1021.5-51-63.8	= 906.7 mm
HEIGHT	= 2535-86.8-65	= 2387.2 mm
TOTAL	= (984x2232)x2+(906.7x2387.2)x2	= 8714.2700 m ²
OPENABLE AREA		
WIDTH	= (1141x2+1021.5x2)-(1141+52.8+24)+(1141+52+16.5+24)	= 1882.5 mm
HEIGHT	= 2535-86.8-65	= 2387.2 mm
TOTAL	= (1882.5x2387.2)x2	= 4486.74 m ²

PROVIDED	
GLAZING AREA	8.714 m ²
OPENABLE AREA	4.486 m ²

B.D. REF :

CLIENT :

ARCHITECT :
AGC DESIGN LTD

MAIN CONTRACTOR :
Gammon

STRUCTURAL ENGINEER :
ARUP

FAÇADE CONSULTANT :
MEINHARDT

NOTE :
1. ALL DIMENSIONS ARE IN mm.
2. ALL ELEVATIONS ARE VIEWED FROM OUTSIDE.
3. ALL DIMENSIONS TO BE VERIFIED ON SITE BEFORE FABRICATION.

LEGEND :
X1 - DETAIL MARK NO.
X004 - REFER SHEET NO.

1. F.F.L. -- FINISHED FLOOR LEVEL
2. S.F.L. -- STRUCTURAL FLOOR LEVEL
3. (R) -- REVERSED DETAIL
4. ▲ -- FIXING LOCATION
5. △ -- FIXING LUG LOCATION
6. GLASS LEGEND

GL01 -- 8mm+12mm AIR GAP+10mm THK. I.G.U.
GL02 -- 10mm THK. TEMPERED GLASS (SPANDREL GLASS)
GL03 -- 6mm+12mm AIR GAP+6mm THK. I.G.U.
GL04 -- 10mm THK. TEMPERED GLASS (PROTECTIVE BARRIER)
GL05 -- 6mm+12mm AIR GAP+8mm THK. I.G.U.

B	16/10/2020	REVISION SUBJECT TO APPROVAL	ivw
A	21/04/2020	REVISION SUBJECT TO APPROVAL	ivw
NO.	DATE	REVISION	BY

JOB NO. : J-852
PROJECT : PROPOSED RESIDENTIAL DEVELOPMENT AT 139 - 147 ARGYLE STREET, NKIL 6005, 6035 R.P., 6036 R.P., 6037 R.P. & 6038 R.P.

TITLE : WINDOW SCHEDULE FOR IN-SITU ALUM. WINDOW


DATE : 05-FEB-20 SCALE : 1:100
DRAWN BY : MN CHECKED BY : DW

美特鋁質有限公司
MIDI ALUMINIUM FABRICATOR LTD.
Units 5-8, Sunray Industrial Centre, 1/F
610 Cha Kwo Ling Road, Kowloon
Tel:23489211-4 Fax:(852)2727666



ELEVATION

WINDOW MARK	w1 T1A
LOCATION	1/F~21/F LIV./DIN. AT TOWER 1 FLAT A
SECTION	67mm ALUM. SECTION
GLAZING	GL01
QUANTITY	18
REMARKS	FAÇADE (PF-43)


DWG NO. : J852-SD-IW-4101 REV. : B

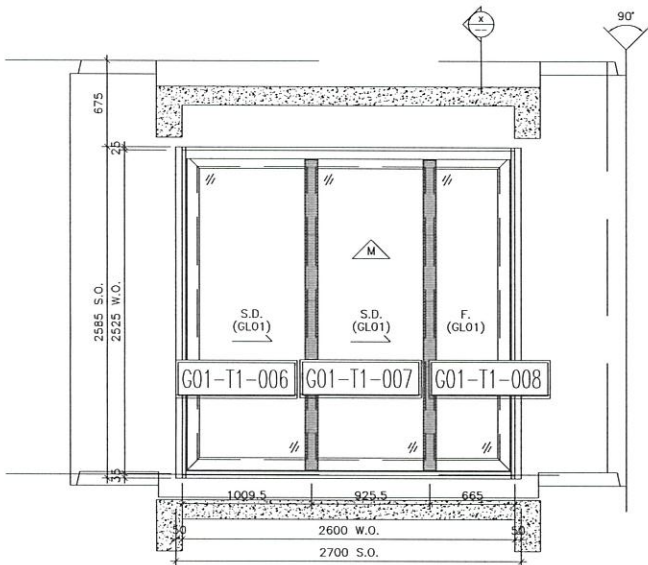


ELEVATION

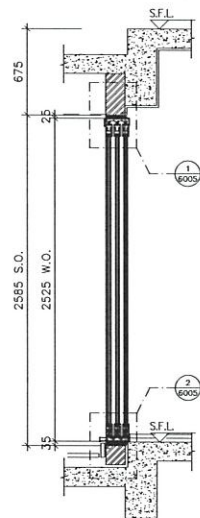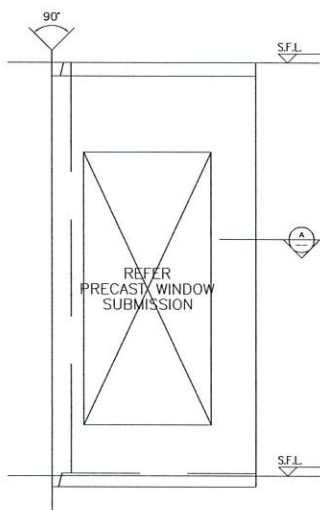

SECTION "X-X"

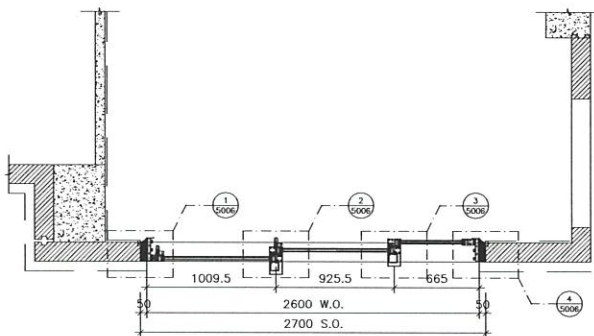

PART PLAN A1

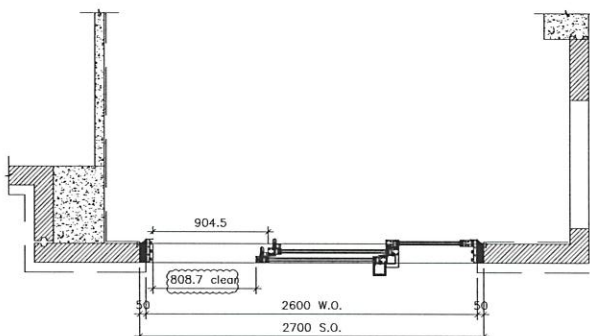

PART PLAN A2


PROVIDED	
GLAZING AREA	2.958 m ²
OPERABLE AREA	1.096 m ²

W7/T1A

ELEVATION

WINDOW MARK	W7/T1A
LOCATION	1/F~21/F ENSUITE AT TOWER 1 FLAT A
SECTION	50mm ALUM. SECTION
GLAZING	GL01
QUANTITY	18
REMARKS	FAÇADE (PF-24)

B.D. REF :

CLIENT :

ARCHITECT :
AGC DESIGN LTD

MAIN CONTRACTOR :
Gammon

STRUCTURAL ENGINEER :
ARUP

FAÇADE CONSULTANT :
MEINHARDT

NOTE :
1. ALL DIMENSIONS ARE IN mm.
2. ALL ELEVATIONS ARE VIEWED FROM OUTSIDE.
3. ALL DIMENSIONS TO BE VERIFIED ON SITE BEFORE FABRICATION.

LEGEND :
 (X1) DETAIL MARK NO.
 (X001) REFER SHEET NO.
 1. F.F.L. -- FINISHED FLOOR LEVEL
 2. S.F.L. -- STRUCTURAL FLOOR LEVEL
 3. (Z) -- REVERSED DETAIL
 4. ▲ -- FIXING LOCATION
 5. △ -- FIXING LUG LOCATION
 6. GLASS LEGEND
 GL01 -- 8mm+12mm AIR GAP+10mm THK. I.G.U.
 GL02 -- 10mm THK. TEMPERED GLASS (SPANDREL GLASS)
 GL03 -- 6mm+12mm AIR GAP+6mm THK. I.G.U.
 GL04 -- 10mm THK. TEMPERED GLASS (PROJECTIVE BARRIER)
 GL05 -- 6mm+12mm AIR GAP+8mm THK. I.G.U.

B	16/10/2020	REVISION SUBJECT TO ARCH.COMMENT	REV
A	21/04/2020	REVISION SUBJECT TO ARCH.COMMENT	REV

JOB NO. : J-852
 PROJECT : PROPOSED RESIDENTIAL DEVELOPMENT AT 139 - 147 ARGYLE STREET, NKIL 6005, 6035 R.P., 6036 R.P., 6037 R.P. & 6038 R.P.

TITLE : WINDOW SCHEDULE FOR IN-SITU ALUM. WINDOW

DATE : 05-FEB-20 SCALE : 1:100
 DRAWN BY : MN CHECKED BY : DW

美特鋁質有限公司
 MIDITE ALUMINIUM FABRICATOR LTD.
 Units 6-8, Sunray Industrial Centre, 1/F,
 610 Cha Kwo Ling Road, Kowloon
 Tel:23489211-4 Fax:(852)27727666
 DWG NO. : J852-SD-IW-4102 REV. : B

B.D. REF :

CLIENT :

ARCHITECT :
AGC DESIGN LTD

MAIN CONTRACTOR :
Gammon

STRUCTURAL ENGINEER :
ARUP

FAÇADE CONSULTANT:
MEIN-HARDT

NOTE :-
 1. ALL DIMENSIONS ARE IN mm.
 2. ALL ELEVATIONS ARE VIEWED FROM OUTSIDE.
 3. ALL DIMENSIONS TO BE VERIFIED ON SITE BEFORE FABRICATION.

LEGEND :-
 (X1) — DETAIL MARK NO.
 (X001) — REFER SHEET NO.

1. F.F.L. — FINISHED FLOOR LEVEL
2. S.F.L. — STRUCTURAL FLOOR LEVEL
3. (Z) — REVERSED DETAIL
4. ▲ — FIXING LOCATION
5. △ — FIXING LUG LOCATION
6. GLASS LEGEND
 GLO1 — 8mm+12mm AIR GAP+10mm THK. I.G.U.
 GLO2 — 10mm THK. TEMPERED GLASS (SPANDREL GLASS)
 GLO3 — 6mm+12mm AIR GAP+6mm THK. I.G.U.
 GLO4 — 10mm THK. TEMPERED GLASS (PROTECTIVE BARRIER)
 GLO5 — 6mm+12mm AIR GAP+8mm THK. I.G.U.

NO.	DATE	REVISION SUBJECT TO AMENDMENT	BY
A	21/04/2020	REVISION SUBJECT TO AMENDMENT	

JOB NO. : J-852

PROJECT :
 PROPOSED RESIDENTIAL DEVELOPMENT
 AT 139 - 147 ARGYLE STREET,
 NKIL 6005, 6035 R.P., 6036 R.P.,
 6037 R.P. & 6038 R.P.


TITLE :
 WINDOW SCHEDULE FOR
 IN-SITU ALUM. WINDOW

DATE : 05-FEB-20 SCALE : 1:100


DRAWN BY : MN CHECKED BY : DW

美特鋁質有限公司
MIDI ALUMINIUM FABRICATOR LTD.
 Units 6-8, Sunray Industrial Centre, 1/F
 610 Cha Kwo Ling Road, Kowloon
 Tel:23489211-4 Fax:(852)2727666

DWG NO. : J852-SD-IW-4103 REV. : A

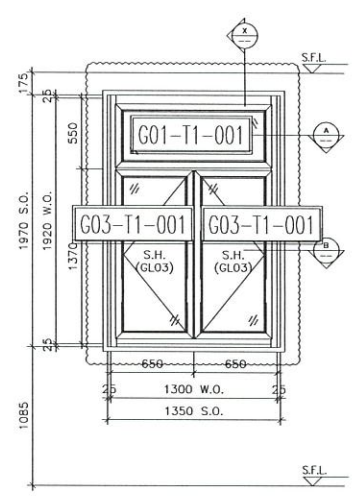


ELEVATION

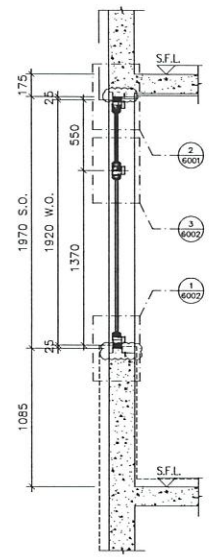


SECTION "X-X"

12
 P5
 48.5 + 3
 83.5 + 3 91.5
 125 54.5
 57.5
 86.5
 89.5 16
 1223

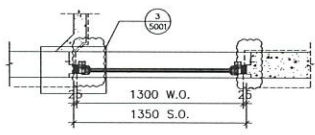

PART PLAN A

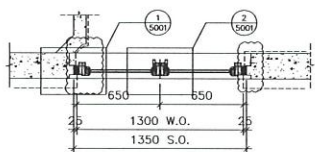

PART PLAN B



PROVIDED	
GLAZING AREA	1.564 m ²
OPERABLE AREA	1.401 m ²


W10/T1A

ELEVATION


WINDOW MARK	W10/T1A
LOCATION	1/F~21/F KIT. AT TOWER 1 FLAT A
SECTION	70mm ALUM. SECTION
GLAZING	GLO1, GLO3
QUANTITY	18
REMARKS	

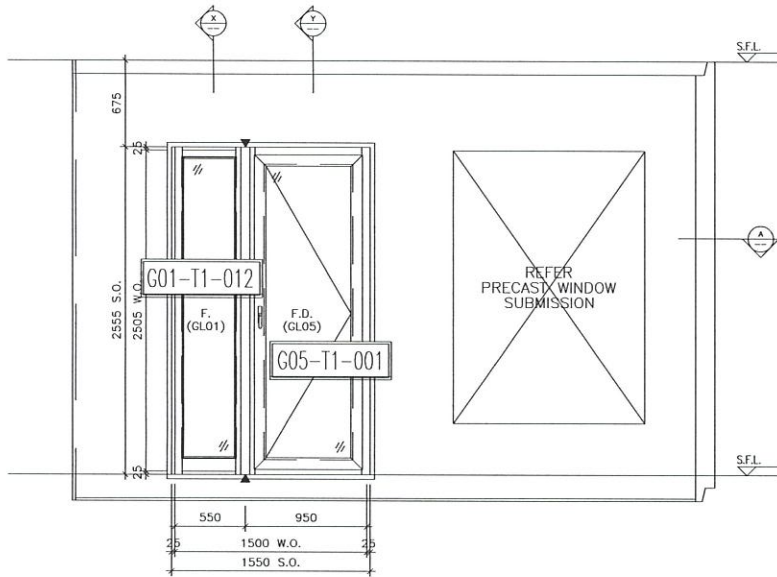


ELEVATION

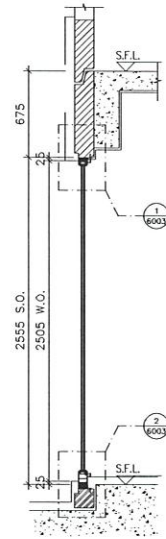


SECTION "X-X"

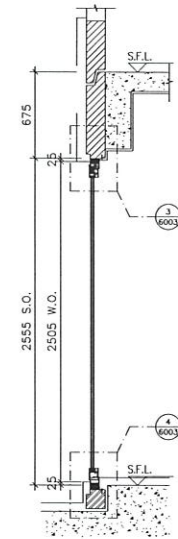

SECTION "Y-Y"

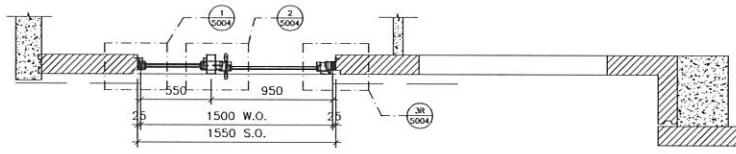

PART PLAN A1

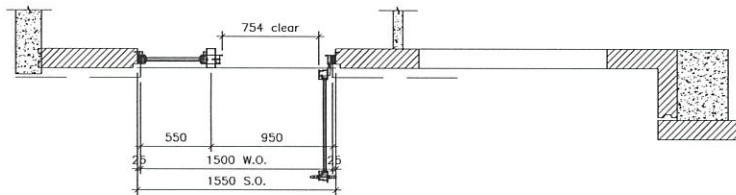

PART PLAN A2

W9/T1A

TYPE				
FRENCH DOOR DIMENSION	(WIDTH) =	910		
	(HEIGHT) =	2300		
FIXED WINDOW DIMENSION	(WIDTH) =	550		
	(HEIGHT) =	2300		
NUMBER OF OPENABLE AREA WINDOW			3	
GLAZING AREA				
FRENCH DOOR				
WIDTH	=	910-125-125-35	=	665 mm
HEIGHT	=	(2300+25)+125-1000	=	3400 mm
FIXED				
WIDTH	=	330-83-67	=	398 mm
HEIGHT	=	(2300+25)+40-1000	=	1470 mm
TOTAL	=	(665x3400)+(398x1470)	=	337948 mm ²
OPENABLE AREA				
WIDTH	=	910-35-33-100	=	754 mm
HEIGHT	=	(2300+25)+57-1110	=	1763 mm
TOTAL	=	(754x1763)	=	1327702 mm ²

PROVIDED	
GLAZING AREA	1.527 m ²
OPENABLE AREA	1.028 m ²

B.D. REF :

CLIENT :

ARCHITECT :
AGC DESIGN LTD

MAIN CONTRACTOR :
Gammon

STRUCTURAL ENGINEER :
ARUP

FAÇADE CONSULTANT:
MEINHARDT

NOTE :
1. ALL DIMENSIONS ARE IN mm.
2. ALL ELEVATIONS ARE VIEWED FROM OUTSIDE.
3. ALL DIMENSIONS TO BE VERIFIED ON SITE BEFORE FABRICATION.

LEGEND :
x1 --- DETAIL MARK NO.
x001 --- REFER SHEET NO.

- F.F.L. --- FINISHED FLOOR LEVEL
- S.F.L. --- STRUCTURAL FLOOR LEVEL
- (2) --- REVERSED DETAIL
- ▲ --- FIXING LOCATION
- △ --- FIXING LUG LOCATION
- GLASS LEGEND
GL01 --- 8mm+12mm AIR GAP+10mm THK. I.G.U.
GL02 --- 10mm THK. TEMPERED GLASS (SPANDREL GLASS)
GL03 --- 6mm+12mm AIR GAP+6mm THK. I.G.U.
GL04 --- 10mm THK. TEMPERED GLASS (PROTECTIVE BARRIER)
GL05 --- 6mm+12mm AIR GAP+8mm THK. I.G.U.

NO.	DATE	REVISION	BY
D	16/10/2020	REVISION SUBJECT TO APPROVEMENT	hwt
C	26/08/2020	REVISION SUBJECT TO APPROVEMENT	hwt
B	29/01/2020	REVISION SUBJECT TO APPROVEMENT	hwt
A	21/04/2020	REVISION SUBJECT TO APPROVEMENT	hwt

JOB NO. : J-852
PROJECT : PROPOSED RESIDENTIAL DEVELOPMENT AT 139 - 147 ARGYLE STREET, NKIL 6005, 6035 R.P., 6036 R.P., 6037 R.P. & 6038 R.P.

TITLE : WINDOW SCHEDULE FOR IN-SITU ALUM. WINDOW

DATE : 05-FEB-20 SCALE : 1:100


DRAWN BY : MN CHECKED BY : DW

美特鋁質有限公司
MIDI ALUMINIUM FABRICATOR LTD.
Units 6-8, Sunray Industrial Centre, 1/F
610 Cha Kwo Ling Road, Kowloon
Tel:23489211-4 Fax:(852)27727666


DWG NO. : J852-SD-IW-4104 REV. : D

ELEVATION


WINDOW MARK	WS T1A
LOCATION	1/F B.R.2 AT TOWER 1 FLAT A
SECTION	70mm ALUM. SECTION
GLAZING	GL01, GL05
QUANTITY	1
REMARKS	FAÇADE (PF-23)

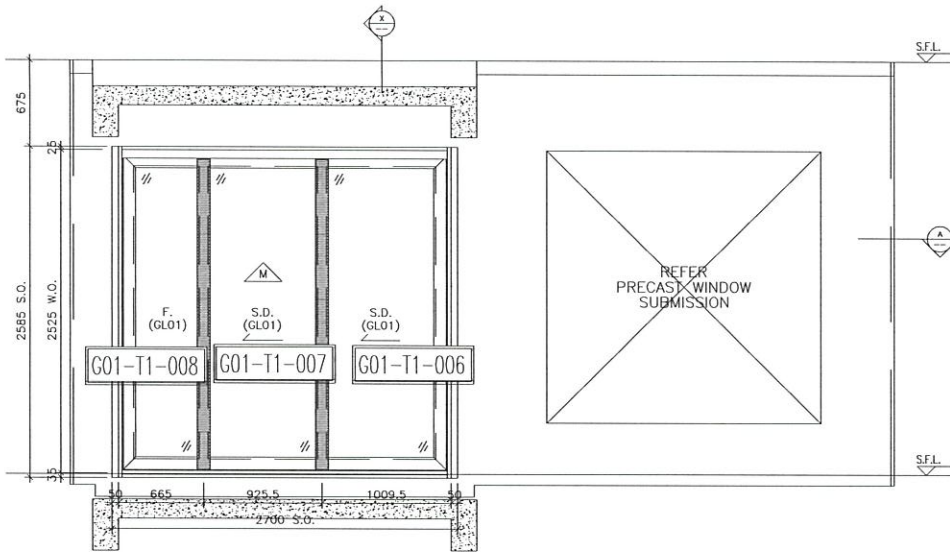


ELEVATION

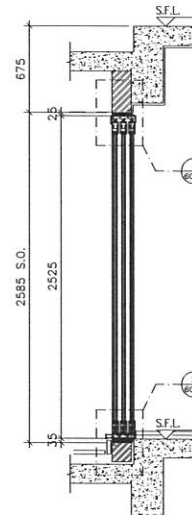

SECTION "X-X"

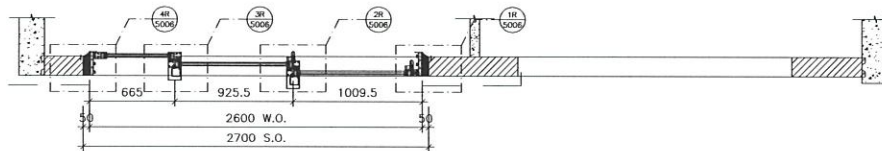

PART PLAN A1

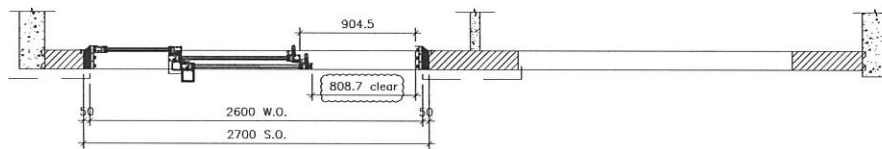

PART PLAN A2

w6/T1B

TYPE	PROVIDED	REQUIRED
GLAZING DOOR PANEL DIMENSION	(S608)T	1300
GLAZING DOOR PANEL DIMENSION	(S608)B	2100
FIXED WINDOW DIMENSION	(S608)T	665
FIXED WINDOW DIMENSION	(S608)B	1100
NUMBER OF OPENABLE AREA WINDOW		
GLAZING AREA		
GLAZING DOOR A	WIDTH = 1009.5-154.2-50	825.3 mm
HEIGHT = (2525-5)-142.2-100		2317.8 mm
GLAZING DOOR B	WIDTH = 225.5-50-75	100.0 mm
HEIGHT = (2100-5)-142.2-100		1812.8 mm
FIXED	WIDTH = 665-75-134.2	455.3 mm
HEIGHT = (2525-5)-142.2-100		2277.8 mm
TOTAL		27100.0 mm ²
OPENABLE AREA		
WIDTH = 1009.5-154.2-50		808.3 mm
HEIGHT = (2525-5)-45.2-100		1374.8 mm
TOTAL		1109.0 mm ²

PROVIDED	
GLAZING AREA	2.958 m ²
OPENABLE AREA	1.095 m ²

B.D. REF :

CLIENT :

ARCHITECT :
AGC DESIGN LTD

MAIN CONTRACTOR :
Gammon

STRUCTURAL ENGINEER :
ARUP

FACADE CONSULTANT:
MEINHARDT

NOTE:
1. ALL DIMENSIONS ARE IN mm.
2. ALL ELEVATIONS ARE VIEWED FROM OUTSIDE.
3. ALL DIMENSIONS TO BE VERIFIED ON SITE BEFORE FABRICATION.

LEGEND:
X1 - DETAIL MARK NO.
X001 - REFER SHEET NO.

- F.F.L. -- FINISHED FLOOR LEVEL
- S.F.L. -- STRUCTURAL FLOOR LEVEL
- ⊕ -- REVERSED DETAIL
- ▲ -- FIXING LOCATION
- △ -- FIXING LUG LOCATION
- GLASS LEGEND

- GL01 -- 8mm+12mm AIR GAP+10mm THK. I.G.U.
- GL02 -- 10mm THK. TEMPERED GLASS (SPANDREL GLASS)
- GL03 -- 6mm+12mm AIR GAP+6mm THK. I.G.U.
- GL04 -- 10mm THK. TEMPERED GLASS (PROTECTIVE BARRIER)
- GL05 -- 6mm+12mm AIR GAP+8mm THK. I.G.U.

NO.	DATE	REVISION	BY
B	16/10/2020	REVISION SUBJECT TO ARCH COMMENT	hwt
A	21/04/2020	REVISION SUBJECT TO ARCH COMMENT	hwt

JOB NO. : J-B52
PROJECT : PROPOSED RESIDENTIAL DEVELOPMENT AT 139 - 147 ARGYLE STREET, NKIL 6005, 6035 R.P., 6036 R.P., 6037 R.P. & 6038 R.P.

TITLE : WINDOW SCHEDULE FOR IN-SITU ALUM. WINDOW

DATE : 05-FEB-20 SCALE : 1:100
DRAWN BY : MN CHECKED BY : DW

美特鋁質有限公司
MIDI ALUMINIUM FABRICATOR LTD.
Units 6-8, Sunray Industrial Centre, 1/F
610 Cha Kwo Ling Road, Kowloon
Tel: 23489211-4 Fax: (852) 27727666
DWG NO. : J852-SD-IW-4105 REV. : B

ELEVATION

WINDOW MARK	W6/T1B
LOCATION	2/F~21/F ENSUITE & B.R.1 AT TOWER 1 FLAT B
SECTION	50mm ALUM. SECTION
GLAZING	GL01
QUANTITY	17
REMARKS	FACADE (PF-22)

B.D. REF :

CLIENT :

ARCHITECT :
AGC DESIGN LTD

MAIN CONTRACTOR :
Gammon

STRUCTURAL ENGINEER :
ARUP

FACADE CONSULTANT:
MEINHARDT

NOTE :
 1. ALL DIMENSIONS ARE IN mm.
 2. ALL ELEVATIONS ARE VIEWED FROM OUTSIDE.
 3. ALL DIMENSIONS TO BE VERIFIED ON SITE BEFORE FABRICATION.

LEGEND :
 (X1) DETAIL MARK NO.
 (X001) REFER SHEET NO.

1. F.F.L. -- FINISHED FLOOR LEVEL
 2. S.F.L. -- STRUCTURAL FLOOR LEVEL
 3. (⊕) -- REVERSED DETAIL
 4. ▲ -- FIXING LOCATION
 5. △ -- FIXING LUG LOCATION
 6. GLASS LEGEND

GL01 -- 8mm+12mm AIR GAP+10mm THK. I.G.U.
 GL02 -- 10mm THK. TEMPERED GLASS (SPANDREL GLASS)
 GL03 -- 6mm+12mm AIR GAP+6mm THK. I.G.U.
 GL04 -- 10mm THK. TEMPERED GLASS (PROJECTIVE BARRIER)
 GL05 -- 6mm+12mm AIR GAP+8mm THK. I.G.U.

B	16/10/2020	REVISION SUBJECT TO ARCH/COMMENT	ISSUED
A	21/04/2020	REVISION SUBJECT TO ARCH/COMMENT	ISSUED

JOB NO. : J-852

PROJECT :
 PROPOSED RESIDENTIAL DEVELOPMENT
 AT 139 - 147 ARGYLE STREET,
 NKIL 6005, 6035 R.P., 6036 R.P.,
 6037 R.P. & 6038 R.P.





TITLE :
 WINDOW SCHEDULE FOR
 IN-SITU ALUM. WINDOW

DATE : 05-FEB-20 SCALE : 1:100

DRAWN BY : MN CHECKED BY : DW

美特鋁質有限公司
 MIDIT ALUMINIUM FABRICATOR LTD.
 Units 6-8, Sunroy Industrial Centre, 1/F
 610 Cha Kwo Ling Road, Kowloon
 Tel:23489211-4 Fax:(852)27727666

DWG NO. : J852-SD-IW-4106 REV. : B

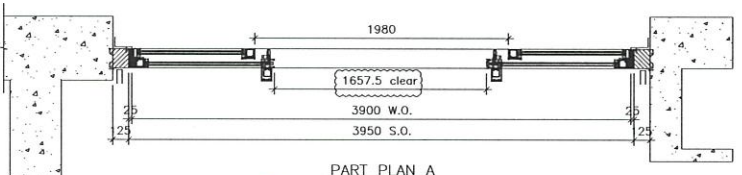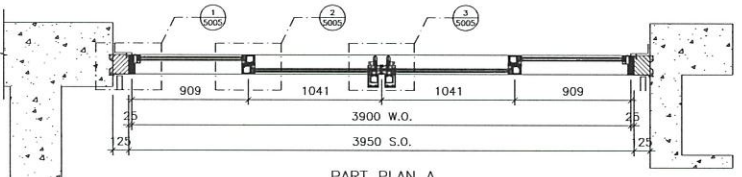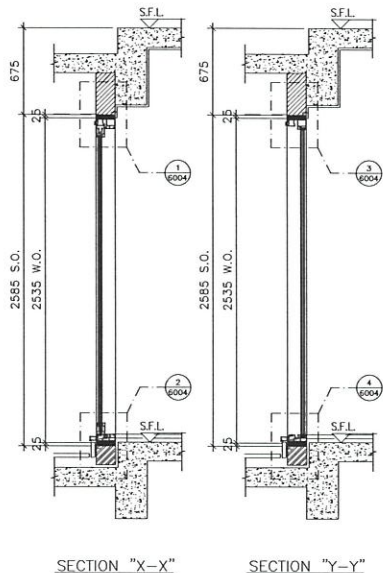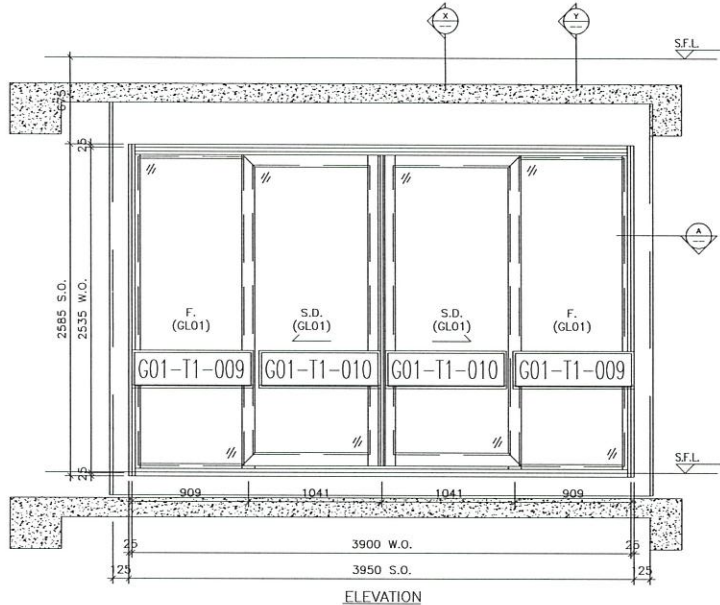

WI/T1B

TYPE I SLIDING DOOR DIMENSION	(WIDTH)	=	1041
	(HEIGHT)	=	2435
FIXED WINDOW DIMENSION	(WIDTH)	=	909
	(HEIGHT)	=	2535
NUMBER OF OPENABLE AREA WINDOW		=	2
GLAZING AREA SLIDING DOOR			
WIDTH	= 1041-106-51	=	934.5 mm
HEIGHT	= 2435-151-152	=	2283.8 mm
FIXED WINDOW			
WIDTH	= 909-51-63.8	=	855.2 mm
HEIGHT	= 2535-86.8-65	=	2448.2 mm

PROVIDED	
GLAZING AREA	7.732 m ²
OPENABLE AREA	3.950 m ²


ELEVATION

ELEVATION


PART PLAN A

PART PLAN A


WINDOW MARK	W1/T1B
LOCATION	1/F~21/F LIV./DIN. AT TOWER 1 FLAT B
SECTION	67mm ALUM. SECTION
GLAZING	GL01
QUANTITY	18
REMARKS	FACADE (PF-42)

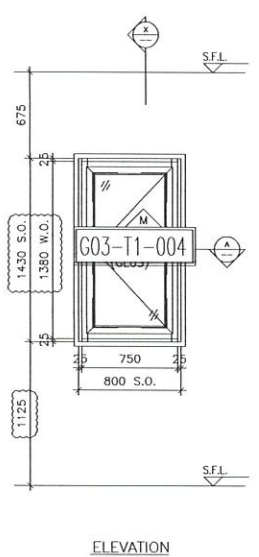


ELEVATION

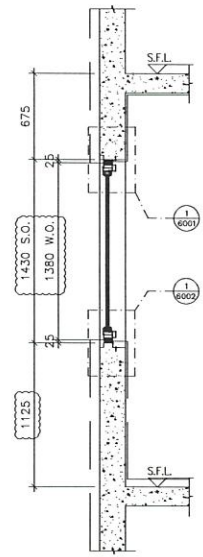

SECTION "X-X"

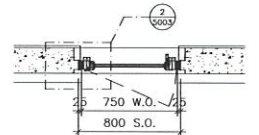

PART PLAN A1

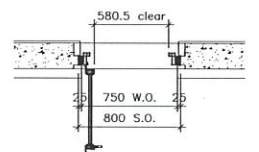

PART PLAN A2

SYSTEM	
OPENABLE WINDOW DIMENSION (WIDTH)	750
(HEIGHT)	1380
NUMBER OF OPENABLE AREA WINDOW	0
GLAZING AREA	
OPENABLE	

PROVIDED	
GLAZING AREA	0.644 m²
OPENABLE AREA	0 m²

W9/T1B

PART PLAN A2

ELEVATION

WINDOW MARK	WS T1B
LOCATION	1/F~21/F ENSUITE AT TOWER 1 FLAT B
SECTION	70mm ALUM. SECTION
GLAZING	GL03
QUANTITY	18
REMARKS	

B.D. REF :

CLIENT :

ARCHITECT :
AGC DESIGN LTD

MAIN CONTRACTOR :
Gammon

STRUCTURAL ENGINEER :
ARUP

FAÇADE CONSULTANT:
MEINHARDT

NOTE :
1. ALL DIMENSIONS ARE IN mm.
2. ALL ELEVATIONS ARE VIEWED FROM OUTSIDE.
3. ALL DIMENSIONS TO BE VERIFIED ON SITE BEFORE FABRICATION.

LEGEND :
 (X1) DETAIL MARK NO.
 (X001) REFER SHEET NO.

- F.F.L. -- FINISHED FLOOR LEVEL
- S.F.L. -- STRUCTURAL FLOOR LEVEL
- (R) -- REVERSED DETAIL
- ▲ -- FIXING LOCATION
- △ -- FIXING LUG LOCATION
- GLASS LEGEND
 GL01 -- 8mm+12mm AIR GAP+10mm THK. I.G.U.
 GL02 -- 10mm THK. TEMPERED GLASS (SPANDREL GLASS)
 GL03 -- 6mm+12mm AIR GAP+6mm THK. I.G.U.
 GL04 -- 10mm THK. TEMPERED GLASS (PROTECTIVE ENVELOPE)
 GL05 -- 6mm+12mm AIR GAP+9mm THK. I.G.U.





C	16/10/2020	REVISION SUBJECT TO APPROVAL	ivan
B	29/07/2020	REVISION SUBJECT TO APPROVAL	ivan
A	21/04/2020	REVISION SUBJECT TO APPROVAL	ivan
NO.	DATE	REVISION	BY

JOB NO. : J-852
 PROJECT :
 PROPOSED RESIDENTIAL DEVELOPMENT
 AT 139 - 147 ARGYLE STREET,
 NKIL 6005, 6035 R.P., 6036 R.P.,
 6037 R.P. & 6038 R.P.

TITLE :
 WINDOW SCHEDULE FOR
 IN-SITU ALUM. WINDOW

DATE : 05-FEB-20 SCALE : 1:100
 DRAWN BY : MN CHECKED BY : DW

美特鋁質有限公司
 MIDI ALUMINIUM FABRICATOR LTD.
 Units 6-8, Sunray Industrial Centre, 1/F,
 610 Cha Kwo Ling Road, Kowloon
 Tel:23489211-4 Fax:(852)2727666
 DWG NO. : J852-SD-IW-4108 REV. : C

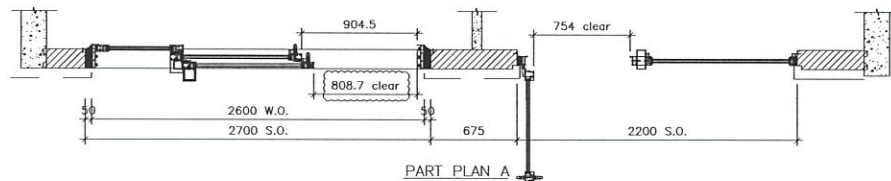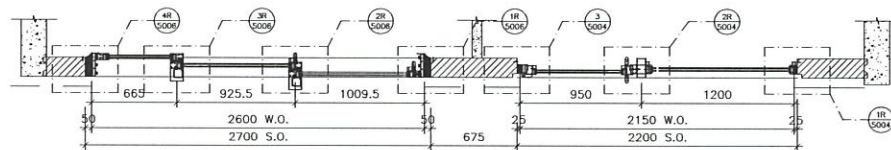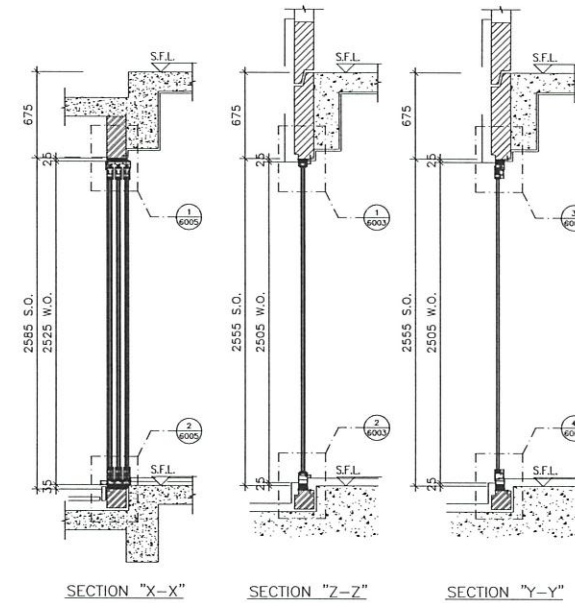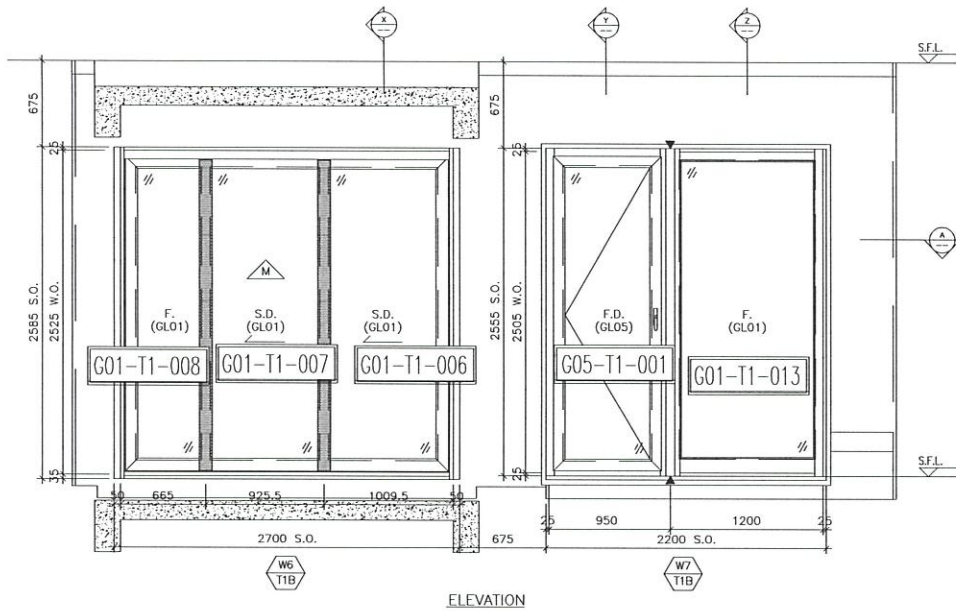

TYPE 1		TYPE V	

W6/T1B - W7/T1B

	PROVIDED	PROVIDED
GLAZING AREA	2.958 m ²	2.496 m ²
OPENABLE AREA	1.096 m ²	1.028 m ²

ELEVATION

WINDOW MARK	W6/T1B / W7/T1B
LOCATION	1/F ENSUITE & B.R.1 AT TOWER 1 FLAT B
SECTION	50mm & 70mm ALUM. SECTION
GLAZING	GL01, GLO5
QUANTITY	1 / 1
REMARKS	FAÇADE (PF-22)

B.D. REF :

CLIENT :

ARCHITECT :
AGC DESIGN LTD
 110, 112, 114,1000

MAIN CONTRACTOR :
Gammon

STRUCTURAL ENGINEER :
ARUP

FAÇADE CONSULTANT :
MEINHARDT

NOTE :
 1. ALL DIMENSIONS ARE IN mm.
 2. ALL ELEVATIONS ARE VIEWED FROM OUTSIDE.
 3. ALL DIMENSIONS TO BE VERIFIED ON SITE BEFORE FABRICATION.

LEGEND :
 (X1) DETAIL MARK NO.
 (X001) REFER SHEET NO.

1. F.F.L. -- FINISHED FLOOR LEVEL
 2. S.F.L. -- STRUCTURAL FLOOR LEVEL
 3. (R) -- REVERSED DETAIL
 4. ▲ -- FIXING LOCATION
 5. △ -- FIXING LUG LOCATION
 6. GLASS LEGEND
 GL01 -- 8mm+12mm AIR GAP+10mm THK. I.G.U.
 GL02 -- 10mm THK. TEMPERED GLASS (SPANDREL GLASS)
 GL03 -- 6mm+12mm AIR GAP+6mm THK. I.G.U.
 GL04 -- 10mm THK. TEMPERED GLASS (PROTECTIVE BARRIER)
 GL05 -- 6mm+12mm AIR GAP+6mm THK. I.G.U.

C	16/10/2020	REVISION SUBJECT TO APPROVEMENT	WAT
B	21/07/2020	REVISION SUBJECT TO APPROVEMENT	WAT
A	21/04/2020	REVISION SUBJECT TO APPROVEMENT	WAT

NO. DATE REVISION BY

JOB NO. : J-852

PROJECT :
 PROPOSED RESIDENTIAL DEVELOPMENT
 AT 139 - 147 ARGYLE STREET,
 NKIL 6005, 6035 R.P., 6036 R.P.,
 6037 R.P. & 6038 R.P.


TITLE :
 WINDOW SCHEDULE FOR
 IN-SITU ALUM. WINDOW

DATE : 05-FEB-20 SCALE : 1:100


DRAWN BY : MN CHECKED BY : DW

美特鋁質有限公司
 MIDALUMINIUM FABRICATOR LTD.
 Units 6-B, Sunray Industrial Centre, 1/F
 610 Cha Kwo Ling Road, Kowloon
 Tel:23489211-4 Fax:(852)27272666

DWG NO. : J852-SD-IW-4109 REV. : C

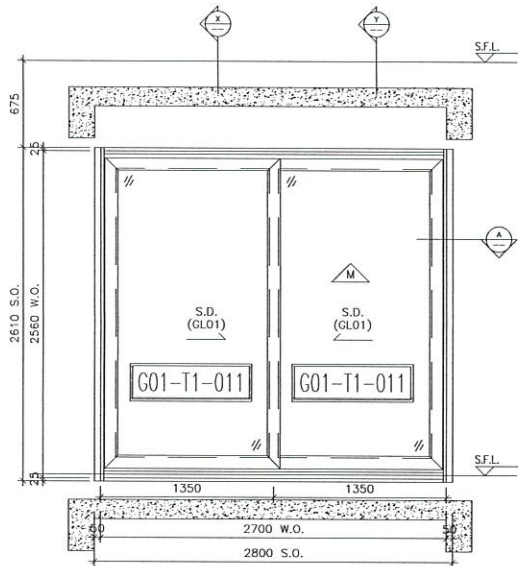


ELEVATION

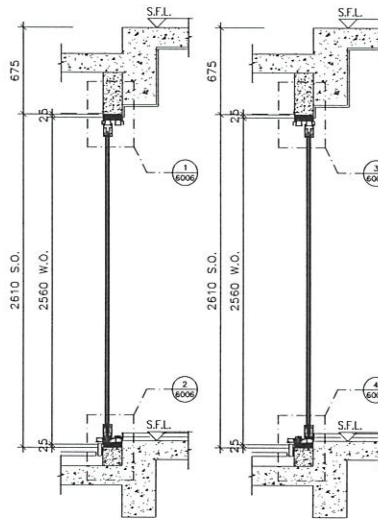


SECTION "X-X"

SECTION "Y-Y"

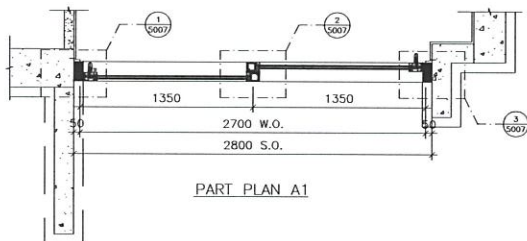

PART PLAN A1

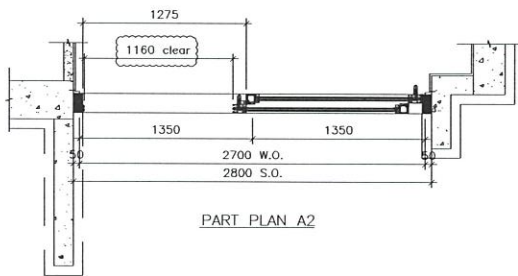

PART PLAN A2

WILTIC

TYPE	
SLIDING DOOR (A) DIMENSION	(WIDTH) = 1350 (HEIGHT) = 2560
SLIDING DOOR (B) DIMENSION	(WIDTH) = 1350 (HEIGHT) = 2560
NUMBER OF OPENABLE AREA WINDOW = 2	
GLAZING AREA	
SLIDING DOOR A	
WIDTH = 1350-135-21	= 1168 mm
HEIGHT = 2560-151-156	= 2253 mm
SLIDING DOOR B (MAINTENANCE)	
WIDTH = 1350-131-51	= 1168 mm
HEIGHT = 2560-151-156	= 2253 mm

PROVIDED	
GLAZING AREA	5.263 m ²
OPENABLE AREA	1.581 m ²

B.D. REF :

CLIENT :

ARCHITECT :
AGC DESIGN LTD

MAIN CONTRACTOR :
Gammon

STRUCTURAL ENGINEER :
ARUP

FACADE CONSULTANT:
MEINHARDT

NOTE :
1. ALL DIMENSIONS ARE IN mm.
2. ALL ELEVATIONS ARE VIEWED FROM OUTSIDE.
3. ALL DIMENSIONS TO BE VERIFIED ON SITE BEFORE FABRICATION.

LEGEND :
 (X1) DETAIL MARK NO.
 (X001) REFER SHEET NO.

- F.F.L. -- FINISHED FLOOR LEVEL
- S.F.L. -- STRUCTURAL FLOOR LEVEL
- (R) -- REVERSED DETAIL
- ▲ -- FIXING LOCATION
- △ -- FIXING LUG LOCATION
- GLASS LEGEND

- GL01 -- 8mm+12mm AIR GAP+10mm THK. I.G.U.
- GL02 -- 10mm THK. TEMPERED GLASS (SPINDREL GLASS)
- GL03 -- 6mm+12mm AIR GAP+6mm THK. I.G.U.
- GL04 -- 10mm THK. TEMPERED GLASS (PROTECTIVE BARRIER)
- GL05 -- 6mm+12mm AIR GAP+8mm THK. I.G.U.

NO	DATE	REVISION	BY
C	16/10/2020	REVISION SUBJECT TO APPROVEMENT	ivw
B	29/07/2020	REVISION SUBJECT TO APPROVEMENT	ivw
A	21/04/2020	REVISION SUBJECT TO APPROVEMENT	ivw

JOB NO. : J-852
 PROJECT : PROPOSED RESIDENTIAL DEVELOPMENT
 AT 139 - 147 ARGYLE STREET,
 NKIL 6005, 6035 R.P., 6036 R.P.,
 6037 R.P. & 6038 R.P.

TITLE : WINDOW SCHEDULE FOR
 IN-SITU ALUM. WINDOW


DATE : 05-FEB-20 SCALE : 1:100

DRAWN BY : MN CHECKED BY : DW


美特鋁質有限公司
MIDI ALUMINIUM FABRICATOR LTD.
 Units 6-B, Sunray Industrial Centre, 1/F
 610 Cha Kwo Ling Road, Kowloon
 Tel:23489211-4 Fax:(852)2727666
 DWG NO. : J852-SD-IW-4110 REV. : C

ELEVATION


WINDOW MARK	w1 T1C
LOCATION	1/F~21/F LIV./DIN. AT TOWER 1 FLAT C
SECTION	67mm ALUM. SECTION
GLAZING	GL01
QUANTITY	18
REMARKS	

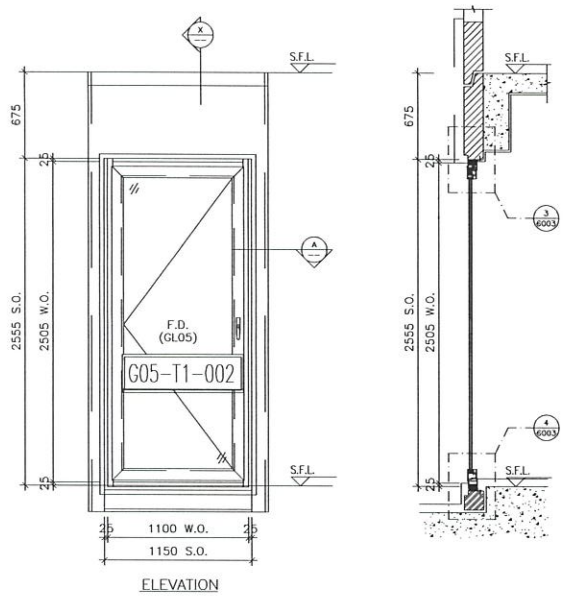

ELEVATION

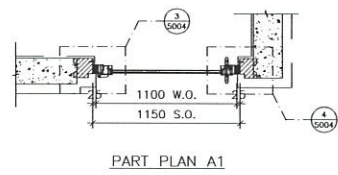

PART PLAN A1

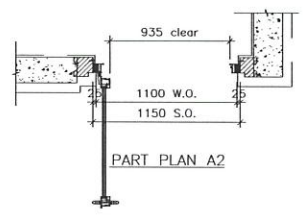

PART PLAN A2

TYPE		FRENCH DOOR DIMENSION	
(WIDTH)	1100	(HEIGHT)	2307
NUMBER OF OPENABLE AREA WINDOW		1	
GLAZING AREA		FRENCH DOOR	
WIDTH	1100+125+125		2370 mm
HEIGHT	2307+125+100		2532 mm
TOTAL	(1100+125) x (2307+125)		1,933,875 mm ²
OPENABLE AREA			
WIDTH	1100+100+100		1300 mm
HEIGHT	2307+100+100		2507 mm
TOTAL	(1100+100) x (2307+100)		1,274,400 mm ²

W5/T1C

PROVIDED		
GLAZING AREA	1.934	m ²
OPENABLE AREA	1.274	m ²

WINDOW MARK	W5/T1C
LOCATION	1/F B.R.2 AT TOWER 1 FLAT C
SECTION	70mm ALUM. SECTION
GLAZING	GL05
QUANTITY	1
REMARKS	FACADE (PF-32)

B.D. REF :

CLIENT :

ARCHITECT :
AGC DESIGN LTD

MAIN CONTRACTOR :
Gammon

STRUCTURAL ENGINEER :
ARUP

FACADE CONSULTANT:
MEINHARDT

NOTE:
 1. ALL DIMENSIONS ARE IN mm.
 2. ALL ELEVATIONS ARE VIEWED FROM OUTSIDE.
 3. ALL DIMENSIONS TO BE VERIFIED ON SITE BEFORE FABRICATION.

LEGEND:
 (X) --- DETAIL MARK NO.
 (X001) --- REFER SHEET NO.

- F.F.L. --- FINISHED FLOOR LEVEL
- S.F.L. --- STRUCTURAL FLOOR LEVEL
- (2) --- REVERSED DETAIL
- ▲ --- FIXING LOCATION
- △ --- FIXING LUG LOCATION
- GLASS LEGEND
 GL01 --- 8mm+12mm AIR GAP+10mm THK. I.G.U.
 GL02 --- 10mm THK. TEMPERED GLASS (SPANDREL GLASS)
 GL03 --- 6mm+12mm AIR GAP+6mm THK. I.G.U.
 GL04 --- 10mm THK. TEMPERED GLASS (PROTECTIVE BARBER)
 GL05 --- 6mm+12mm AIR GAP+8mm THK. I.G.U.

C	16/10/2020	REVISION SUBJECT TO APPROVAL	REV
B	29/07/2020	REVISION SUBJECT TO APPROVAL	REV
A	21/04/2020	REVISION SUBJECT TO APPROVAL	REV
NO.	DATE	REVISION	BY

JOB NO. : J-852
 PROJECT :
 PROPOSED RESIDENTIAL DEVELOPMENT
 AT 139 - 147 ARGYLE STREET,
 NKIL 6005, 6035 R.P., 6036 R.P.,
 6037 R.P. & 6038 R.P.

TITLE :
 WINDOW SCHEDULE FOR
 IN-SITU ALUM. WINDOW

DATE : 05-FEB-20 SCALE : 1:100
 DRAWN BY : MN CHECKED BY : DW

美特铝质有限公司
 MIDI ALUMINIUM FABRICATOR LTD.
 Units 6-8, Sunray Industrial Centre, 1/F
 610 Cha Kwo Ling Road, Kowloon
 Tel:23489211-4 Fax:(852)27727666
 DWG NO. : J852-SD-IW-4111 REV. : C

B.D. REF :

CLIENT :

ARCHITECT :
AGC DESIGN LTD

MAIN CONTRACTOR :
Gammon

STRUCTURAL ENGINEER :
ARUP

FAÇADE CONSULTANT:
MEINHARDT

NOTE:
 1. ALL DIMENSIONS ARE IN mm.
 2. ALL ELEVATIONS ARE VIEWED FROM OUTSIDE.
 3. ALL DIMENSIONS TO BE VERIFIED ON SITE BEFORE FABRICATION.

LEGEND:
 (X) DETAIL MARK NO.
 (X001) REFER SHEET NO.

- F.F.L. -- FINISHED FLOOR LEVEL
- S.F.L. -- STRUCTURAL FLOOR LEVEL
- (R) -- REVERSED DETAIL
- ▲ -- FIXING LOCATION
- △ -- FIXING LUG LOCATION

6. GLASS LEGEND
 GL01 -- 8mm+12mm AIR GAP+10mm THK. I.G.U.
 GL02 -- 10mm THK. TEMPERED GLASS (SPANDREL GLASS)
 GL03 -- 6mm+12mm AIR GAP+6mm THK. I.G.U.
 GL04 -- 10mm THK. TEMPERED GLASS (PROTECTIVE BARRIER)
 GL05 -- 6mm+12mm AIR GAP+8mm THK. I.G.U.


B	16/10/2020	REVISION SUBJECT TO APPROVAL	ivan
A	21/04/2020	REVISION SUBJECT TO APPROVAL	ivan
NO.	DATE	REVISION	BY

JOB NO. : J-852
 PROJECT :
 PROPOSED RESIDENTIAL DEVELOPMENT
 AT 139 - 147 ARGYLE STREET,
 NKIL 6005, 6035 R.P., 6036 R.P.,
 6037 R.P. & 6038 R.P.


TITLE : WINDOW SCHEDULE FOR IN-SITU ALUM. WINDOW

DATE : 05-FEB-20 SCALE : 1:100
 DRAWN BY : MN CHECKED BY : DW

美特鋁質有限公司
 MIDI ALUMINIUM FABRICATOR LTD.
 Units 6-8, Sunray Industrial Centre, 1/F,
 610 Cha Kwo Ling Road, Kowloon
 Tel:23489211-4 Fax:(852)27727666
 DWG NO. : J852-SD-IW-4201 REV. : B

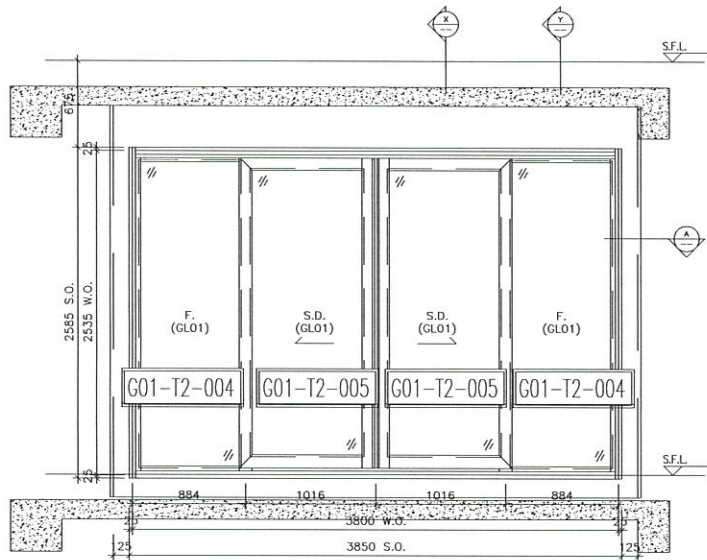


ELEVATION

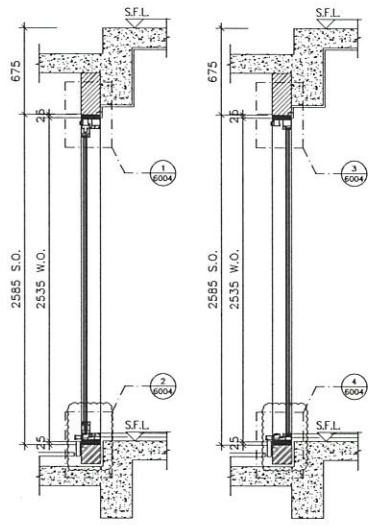


SECTION "X-X"

SECTION "Y-Y"

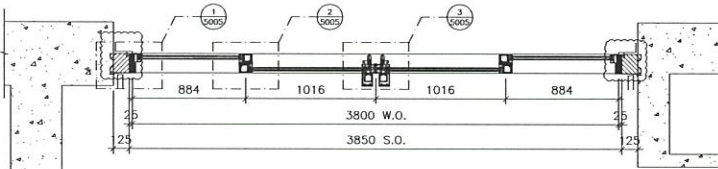

PART PLAN A

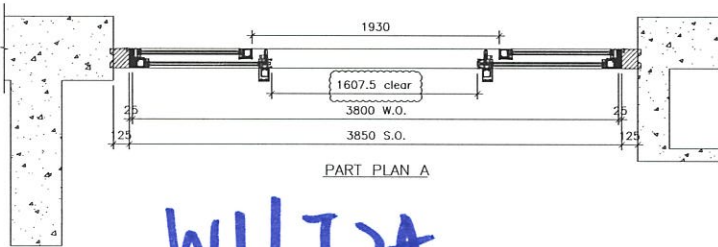

PART PLAN A





W1/T2A

TYPE I			
SLIDING DOOR DIMENSION	(WIDTH)	=	1616
	(HEIGHT)	=	2535
FIXED WINDOW DIMENSION	(WIDTH)	=	884
	(HEIGHT)	=	2535
NUMBER OF OPENABLE AREA WINDOW		=	2
GLAZING AREA			
SLIDING DOOR	WIDTH = 1016-106-51	=	859 mm
	HEIGHT = 2535-151-152	=	2232 mm
FIXED	WIDTH = 884-51-63-8	=	769.2 mm
	HEIGHT = 2535-86.8-65	=	2387.2 mm
TOTAL	= ((859x2232)x2)+(769.2x2387.2)x2	=	7.4008909 m ²
OPENABLE AREA	WIDTH = (1916x2+884x2)-((3916+52.8+24)+(1016+52+16.5+24))	=	1607.5 mm
	HEIGHT = 2535-86.8-65	=	2383.2 mm
TOTAL	= (1607.5x2383.2)x2	=	3.830994 m ²

	PROVIDED	
GLAZING AREA	7.501	m ²
OPENABLE AREA	3.831	m ²

ELEVATION

WINDOW MARK	W1/T2A
LOCATION	1/F~21/F LIV./DIN. AT TOWER 2 FLAT A
SECTION	67mm ALUM. SECTION
GLAZING	GL01
QUANTITY	18
REMARKS	FAÇADE (PF-40)

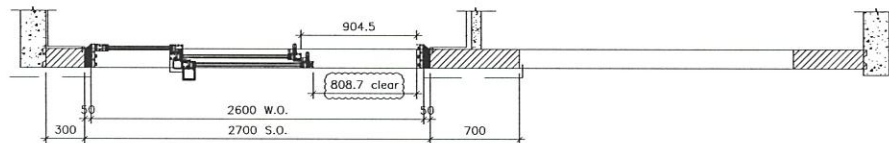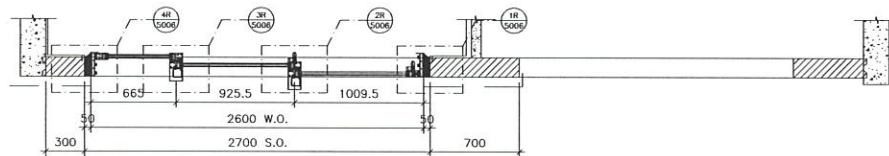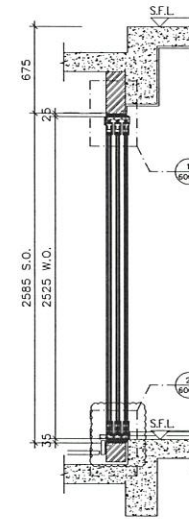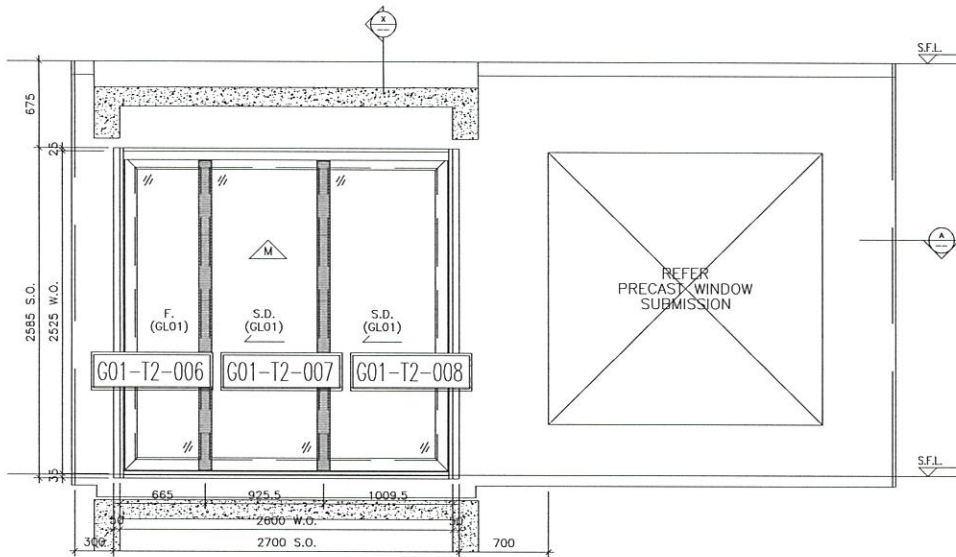

W7/T2A

TYPE 1	

PROVIDED	
GLAZING AREA	2.958 m ²
OPERABLE AREA	1.096 m ²

B.D. REF :

CLIENT :

ARCHITECT :
AGC DESIGN LTD

MAIN CONTRACTOR :
Gammon

STRUCTURAL ENGINEER :
ARUP

FAÇADE CONSULTANT:
MEINHARDT

NOTE:
 1. ALL DIMENSIONS ARE IN mm.
 2. ALL ELEVATIONS ARE VIEWED FROM OUTSIDE.
 3. ALL DIMENSIONS TO BE VERIFIED ON SITE BEFORE FABRICATION.

LEGEND:
 (X1) DETAIL MARK NO.
 (X001) REFER SHEET NO.

- F.F.L. -- FINISHED FLOOR LEVEL
- S.F.L. -- STRUCTURAL FLOOR LEVEL
- (20) -- REVERSED DETAIL
- ▲ -- FIXING LOCATION
- △ -- FIXING LUG LOCATION
- GLASS LEGEND

- GL01 -- 8mm+12mm AIR GAP+10mm THK. I.G.U.
- GL02 -- 10mm THK. TEMPERED GLASS (SPANDREL GLASS)
- GL03 -- 6mm+12mm AIR GAP+6mm THK. I.G.U.
- GL04 -- 10mm THK. TEMPERED GLASS (PROTECTIVE BARRIER)
- GL05 -- 6mm+12mm AIR GAP+8mm THK. I.G.U.

NO.	DATE	REVISION	BY
B	16/10/2020	REVISION SUBJECT TO ARCH/COMMITMENT	lva
A	21/04/2020	REVISION SUBJECT TO ARCH/COMMITMENT	lva

JOB NO. : J-852
 PROJECT : PROPOSED RESIDENTIAL DEVELOPMENT AT 139 - 147 ARGYLE STREET, NKIL 6005, 6035 R.P., 6036 R.P., 6037 R.P. & 6038 R.P.

TITLE : WINDOW SCHEDULE FOR IN-SITU ALUM. WINDOW

DATE : 05-FEB-20 SCALE : 1:100

DRAWN BY : MN CHECKED BY : DW

美特鋁質有限公司
 MIDITE ALUMINIUM FABRICATOR LTD.
 Units 6-8, Sunray Industrial Centre, 1/F
 610 Cha Kwo Ling Road, Kowloon
 Tel:23489211-4 Fax:(852)27727666

DWG NO. : J852-SD-IW-4202 REV. : B

ELEVATION

ELEVATION

SECTION "X-X"

PART PLAN A

PART PLAN A

WINDOW MARK	W7/T2A
LOCATION	2/F~21/F ENSUITE & B.R.1 AT TOWER 2 FLAT A
SECTION	50mm ALUM. SECTION
GLAZING	GL01
QUANTITY	17
REMARKS	FAÇADE (PF-20)

B.D. REF :

CLIENT :

ARCHITECT :
AGC DESIGN LTD

MAIN CONTRACTOR :
Gammon

STRUCTURAL ENGINEER :
ARUP

FAÇADE CONSULTANT:
MEINHARDT

NOTE :
 1. ALL DIMENSIONS ARE IN mm.
 2. ALL ELEVATIONS ARE VIEWED FROM OUTSIDE.
 3. ALL DIMENSIONS TO BE VERIFIED ON SITE BEFORE FABRICATION.

LEGEND :
 (X1) DETAIL MARK NO.
 (X001) REFER SHEET NO.

1. F.F.L. --- FINISHED FLOOR LEVEL
2. S.F.L. --- STRUCTURAL FLOOR LEVEL
3. (⊖) --- REVERSED DETAIL
4. ▲ --- FIXING LOCATION
5. △ --- FIXING LUG LOCATION
6. GLASS LEGEND

- GL01 --- 8mm+12mm AIR GAP+10mm THK. I.G.U.
- GL02 --- 10mm THK. TEMPERED GLASS (SPANDREL GLASS)
- GL03 --- 6mm+12mm AIR GAP+6mm THK. I.G.U.
- GL04 --- 10mm THK. TEMPERED GLASS (PROTECTIVE BARRIER)
- GL05 --- 6mm+12mm AIR GAP+8mm THK. I.G.U.

NO.	DATE	REVISION	SUBJECT TO ARCH/COMMENT	ISSUED BY
B	29/01/2020	REVISION	SUBJECT TO ARCH/COMMENT	ISSUED BY
A	21/04/2020	REVISION	SUBJECT TO ARCH/COMMENT	ISSUED BY

JOB NO. : J-B52

PROJECT :
 PROPOSED RESIDENTIAL DEVELOPMENT
 AT 139 - 147 ARGYLE STREET,
 NKIL 6005, 6035 R.P., 6036 R.P.,
 6037 R.P. & 6038 R.P.




TITLE :
 WINDOW SCHEDULE FOR
 IN-SITU ALUM. WINDOW

DATE : 05-FEB-20 SCALE : 1:100

DRAWN BY : MN CHECKED BY : DW


美特鋁質有限公司
 MIDTI ALUMINIUM FABRICATOR LTD.
 Units 6-8, Sunray Industrial Centre, 1/F
 610 Cha Kwo Ling Road, Kowloon
 Tel:23489211-4 Fax:(852)27727666

DWG NO. : J852-SD-IW-4203 REV. : B

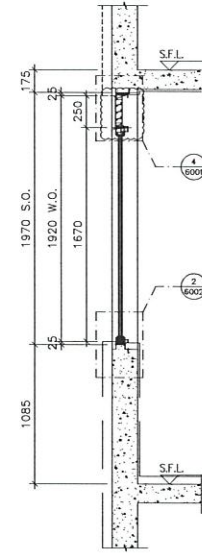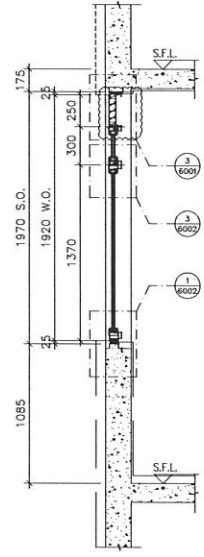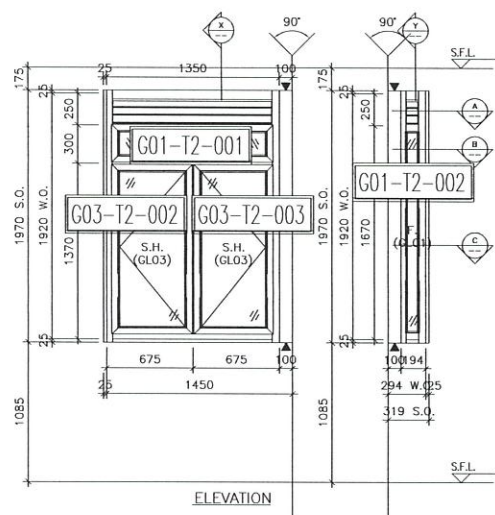

SECTION "X-X"

SECTION "Y-Y"

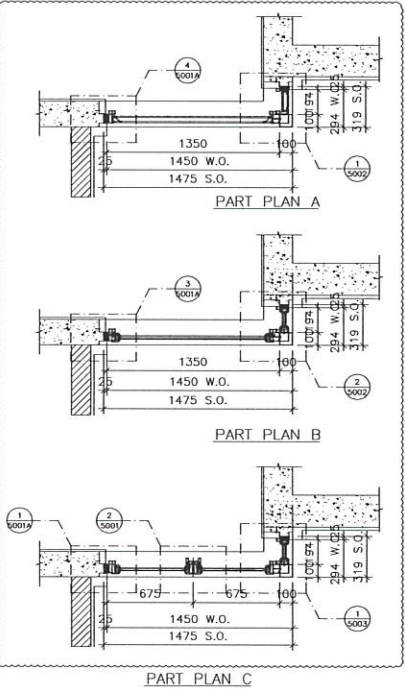

ELEVATION





ELEVATION

W8/T2A


PROVIDED	
GLAZING AREA	1.570 m ²
OPENABLE AREA	1.464 m ²

WINDOW MARK	WS T2A
LOCATION	1/F~21/F KIT. AT TOWER 2 FLAT A
SECTION	50mm ALUM. SECTION
GLAZING	GL01, GL03
QUANTITY	18
REMARKS	

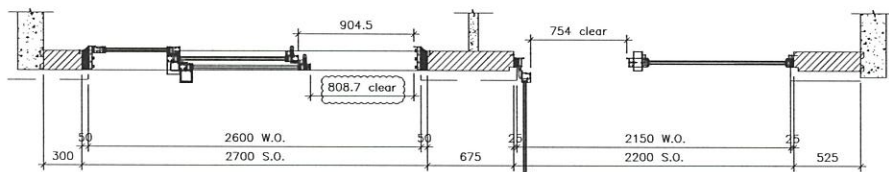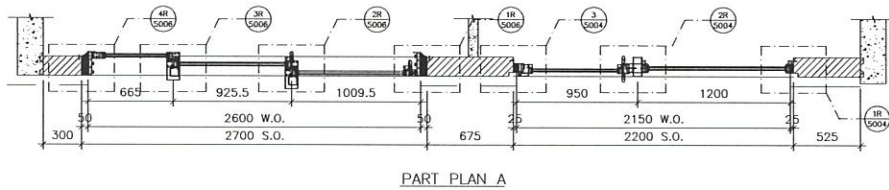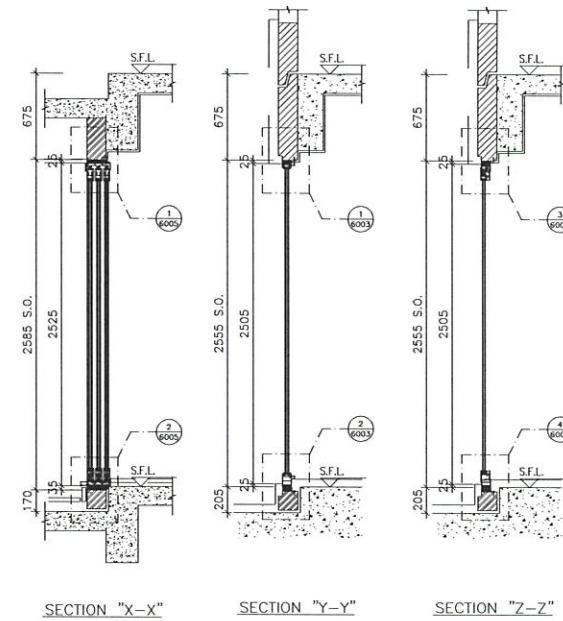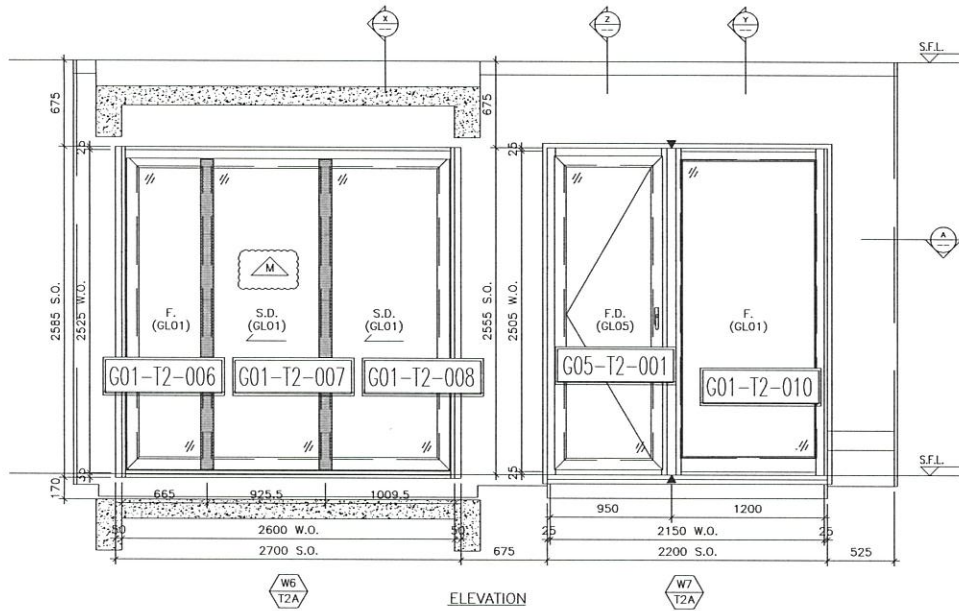


TYPE	W6/T2A	W7/T2A
FRENCH DOOR DIMENSION (WIDTH)	950	950
FRENCH DOOR DIMENSION (HEIGHT)	2505	2505
FIXED WINDOW DIMENSION (WIDTH)	1200	1200
FIXED WINDOW DIMENSION (HEIGHT)	2505	2505
NUMBER OF OPENABLE AREA WINDOW	1	1
GLAZING AREA		
FRENCH DOOR		
WIDTH = 950-125-125-35	665 mm	
HEIGHT = 2505-25-125-1000	1405 mm	
FIXED		
WIDTH = 1200-85-67	1048 mm	
HEIGHT = 2505-25-40-1000	1495 mm	
TOTAL = 0665x1405+(1048x1495)x1000000	2,495,828.8 mm ²	
OPENABLE AREA		
WIDTH = 906-33-33-108	754 mm	
HEIGHT = 2505-25-37-1110	1363 mm	
TOTAL = 0754x1363+1000000	1,028,000 mm ²	

W6/T2A	PROVIDED	W7/T2A	PROVIDED
GLAZING AREA	2.958 m ²	GLAZING AREA	2.496 m ²
OPENABLE AREA	1.096 m ²	OPENABLE AREA	1.028 m ²

W6/T2A	PROVIDED	W7/T2A	PROVIDED
GLAZING AREA	2.958 m ²	GLAZING AREA	2.496 m ²
OPENABLE AREA	1.096 m ²	OPENABLE AREA	1.028 m ²

B.D. REF :

CLIENT :

ARCHITECT : AGC DESIGN LTD

MAIN CONTRACTOR : Gammon

STRUCTURAL ENGINEER : ARUP

FAÇADE CONSULTANT : MEINHARDT

NOTE :

- ALL DIMENSIONS ARE IN mm.
- ALL ELEVATIONS ARE VIEWED FROM OUTSIDE.
- ALL DIMENSIONS TO BE VERIFIED ON SITE BEFORE FABRICATION.

LEGEND :

X1 - DETAIL MARK NO.
 6001 - REFER SHEET NO.

- F.F.L. --- FINISHED FLOOR LEVEL
- S.F.L. --- STRUCTURAL FLOOR LEVEL
- (N) --- REVERSED DETAIL
- ▲ --- FIXING LOCATION
- △ --- FIXING LUG LOCATION
- GLASS LEGEND
 - GL01 --- 8mm+12mm AIR GAP+10mm THK. I.G.U.
 - GL02 --- 10mm THK. TEMPERED GLASS (SPANDREL GLASS)
 - GL03 --- 6mm+12mm AIR GAP+6mm THK. I.G.U.
 - GL04 --- 10mm THK. TEMPERED GLASS (PROTECTIVE BARRIER)
 - GL05 --- 6mm+12mm AIR GAP+8mm THK. I.G.U.

NO.	DATE	REVISED	BY
C	16/01/2020	REVISION SUBJECT TO APPROVAL	
B	29/01/2020	REVISION SUBJECT TO APPROVAL	
A	21/04/2020	REVISION SUBJECT TO APPROVAL	

JOB NO. : J-852

PROJECT : PROPOSED RESIDENTIAL DEVELOPMENT AT 139 - 147 ARGYLE STREET, NKIL 6005, 6035 R.P., 6036 R.P., 6037 R.P. & 6038 R.P.

TITLE : WINDOW SCHEDULE FOR IN-SITU ALUM. WINDOW

DATE : 05-FEB-20 SCALE : 1:100

DRAWN BY : MN CHECKED BY : DW

美特鋁質有限公司
 MIDT ALUMINIUM FABRICATOR LTD.
 Units 6-8, Sunray Industrial Centre, 1/F,
 610 Cho Kwo Ling Road, Kowloon
 Tel:23489211-4 Fax:(852)2727666

DWG NO. : J852-SD-IW-4204 REV. : C

ELEVATION

ELEVATION

SECTION "X-X"

SECTION "Y-Y"

SECTION "Z-Z"


PART PLAN A

PART PLAN A


W6/T2A - W7/T2A

WINDOW MARK	W6/T2A / W7/T2A
LOCATION	1/F ENSUITE & B.R.1 AT TOWER 2 FLAT A
SECTION	50mm & 70mm ALUM. SECTION
GLAZING	GL01, GL05
QUANTITY	1 / 1
REMARKS	FAÇADE (PF-20)

ELEVATION

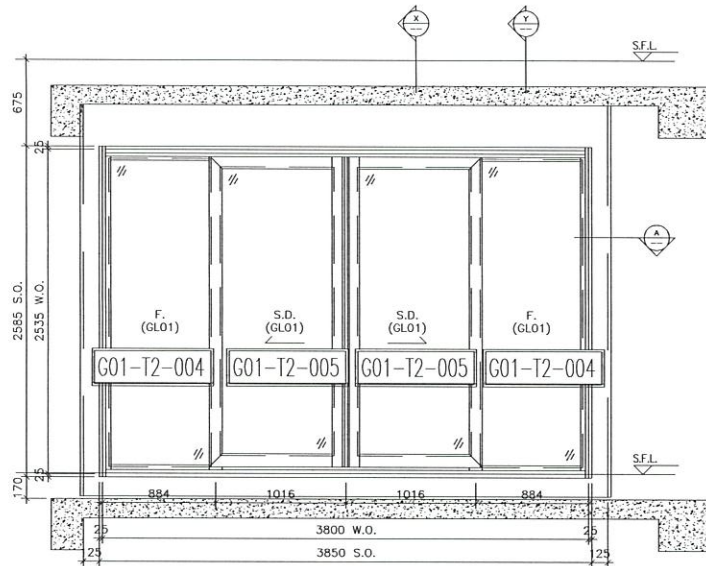


ELEVATION

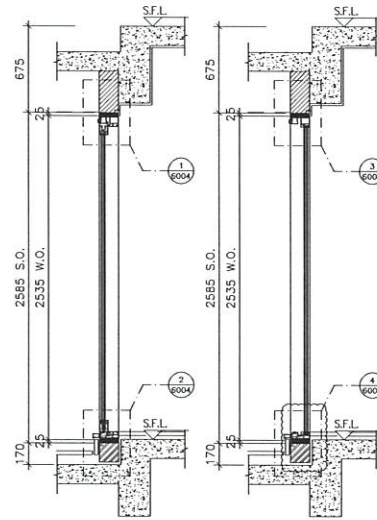


SECTION "X-X"

SECTION "Y-Y"

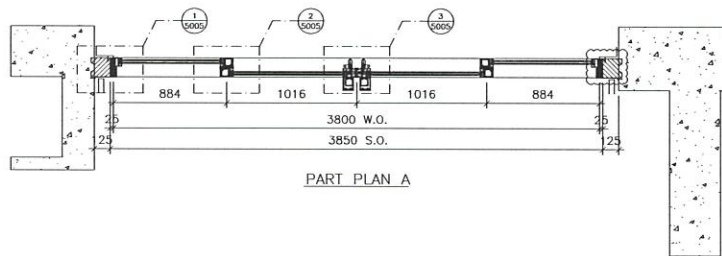

PART PLAN A

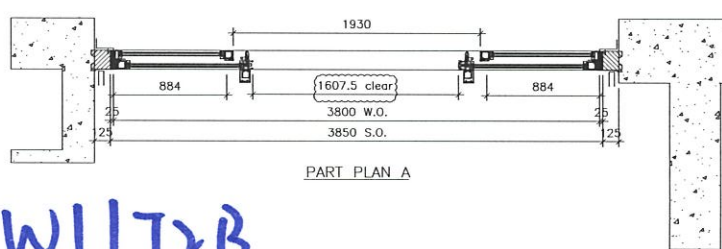

PART PLAN A

W1/T2/B

TYPE I SLIDING DOOR DIMENSION	(WIDTH)	=	1016
	(HEIGHT)	=	2535
FIXED WINDOW DIMENSION	(WIDTH)	=	884
	(HEIGHT)	=	2535
NUMBER OF OPENABLE AREA WINDOW		=	2
GLAZING AREA SLIDING DOOR			
WIDTH	=	1016-106-51	= 859 mm
HEIGHT	=	2535-151-152	= 2232 mm
FIXED WINDOW			
WIDTH	=	884-51-61.8	= 769.2 mm
HEIGHT	=	2535-86.8-65	= 2383.2 mm
TOTAL	=	(859x2232)x2+(769x2383.2)x2	= 10000990
			= 7.4008909 m ²
OPENABLE AREA			
WIDTH	=	(1016x2+884x2)-(1016+52.8+24)+(1016+52+16.5+24)	= 1607.2 mm
HEIGHT	=	2535-86.8-65	= 2383.2 mm
TOTAL	=	(1607.2x2383.2)	= 10000990
			= 3.830994 m ²

PROVIDED	
GLAZING AREA	7.501 m ²
OPENABLE AREA	3.831 m ²

B.D. REF :

CLIENT :

ARCHITECT :
AGC DESIGN LTD

MAIN CONTRACTOR :
Gammon

STRUCTURAL ENGINEER :
ARUP

FACADE CONSULTANT:
MEINHARDT

NOTE:
 1. ALL DIMENSIONS ARE IN mm.
 2. ALL ELEVATIONS ARE VIEWED FROM OUTSIDE.
 3. ALL DIMENSIONS TO BE VERIFIED ON SITE BEFORE FABRICATION.

LEGEND:
 X1 --- DETAIL MARK NO.
 X004 --- REFER SHEET NO.
 1. F.F.L --- FINISHED FLOOR LEVEL
 2. S.F.L --- STRUCTURAL FLOOR LEVEL
 3. (R) --- REVERSED DETAIL
 4. ▲ --- FIXING LOCATION
 5. △ --- FIXING LUG LOCATION
 6. GLASS LEGEND
 GL01 --- 8mm+12mm AIR GAP+10mm THK. I.G.U.
 GL02 --- 10mm THK. TEMPERED GLASS (SPANDREL GLASS)
 GL03 --- 6mm+12mm AIR GAP+6mm THK. I.G.U.
 GL04 --- 10mm THK. TEMPERED GLASS (PROTECTIVE BARRIER)
 GL05 --- 6mm+12mm AIR GAP+8mm THK. I.G.U.

B	19/10/2020	REVISION SUBJECT TO APPROVAL	WZ
A	21/04/2020	REVISION SUBJECT TO APPROVAL	WZ

JOB NO. : J-852
 PROJECT :
 PROPOSED RESIDENTIAL DEVELOPMENT
 AT 139 - 147 ARGYLE STREET,
 NKIL 6005, 6035 R.P., 6036 R.P.,
 6037 R.P. & 6038 R.P.


TITLE : WINDOW SCHEDULE FOR IN-SITU ALUM. WINDOW

DATE : 05-FEB-20 SCALE : 1:100
 DRAWN BY : MN CHECKED BY : DW


美特鋁質有限公司
 MIDII ALUMINIUM FABRICATOR LTD.
 Units 6-8, Sunray Industrial Centre, 1/F,
 610 Cha Kwo Ling Road, Kowloon
 Tel:23489211-4 Fax:(852)27727666

WINDOW MARK	W1/T2/B
LOCATION	1/F~21/F LIV./DIN. AT TOWER 2 FLAT B
SECTION	67mm ALUM. SECTION
GLAZING	GL01
QUANTITY	18
REMARKS	FACADE (PF-41)


DWG NO. : J852-SD-W-4205 REV. : B

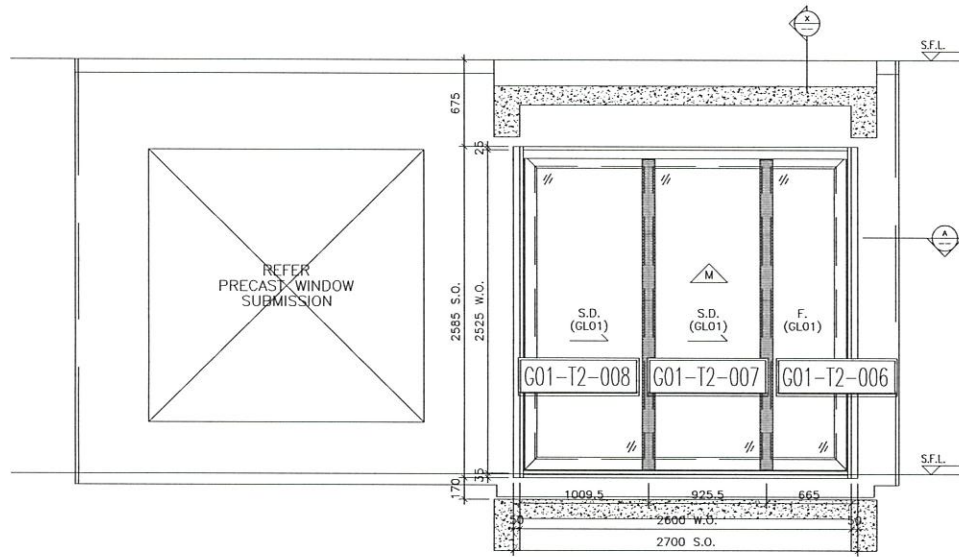


ELEVATION

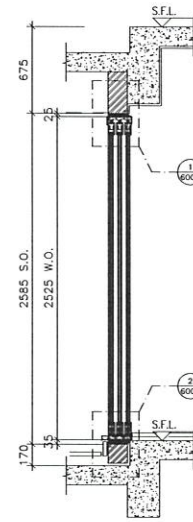

SECTION "X-X"

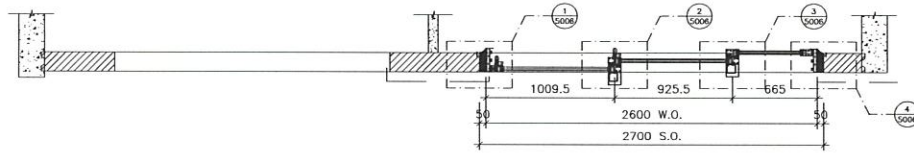

PART PLAN A

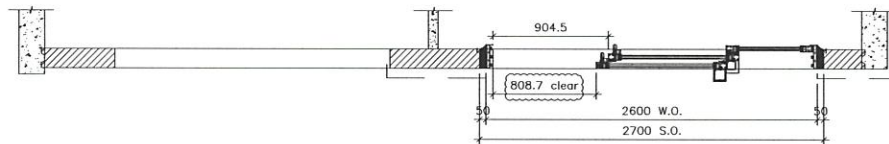

PART PLAN A

W6/T2B


PROVIDED	
GLAZING AREA	2.958 m ²
OPENABLE AREA	1.095 m ²

B.D. REF :

CLIENT :

ARCHITECT :
AGC DESIGN LTD

MAIN CONTRACTOR :
Gammon

STRUCTURAL ENGINEER :
ARUP

FACADE CONSULTANT:
MEINHARDT

NOTE:
 1. ALL DIMENSIONS ARE IN mm.
 2. ALL ELEVATIONS ARE VIEWED FROM OUTSIDE.
 3. ALL DIMENSIONS TO BE VERIFIED ON SITE BEFORE FABRICATION.

LEGEND:
 X1 - DETAIL MARK NO.
 X001 - REFER SHEET NO.

1. F.F.L. --- FINISHED FLOOR LEVEL.
 2. S.F.L. --- STRUCTURAL FLOOR LEVEL.
 3. (R) --- REVERSED DETAIL.
 4. ▲ --- FIXING LOCATION.
 5. △ --- FIXING LUG LOCATION.
 6. GLASS LEGEND
 GLO1 --- 8mm+12mm AIR GAP+10mm THK. I.G.U.
 GLO2 --- 10mm THK. TEMPERED GLASS (SPANDREL GLASS)
 GLO3 --- 6mm+12mm AIR GAP+6mm THK. I.G.U.
 GLO4 --- 10mm THK. TEMPERED GLASS (PROTECTIVE BARRIER)
 GLO5 --- 6mm+12mm AIR GAP+8mm THK. I.G.U.

NO.	DATE	REVISION SUBJECT TO AMENDMENT	REMOVED	BY
A	21/04/2020	REVISION SUBJECT TO AMENDMENT		

JOB NO. : J-852

PROJECT :
 PROPOSED RESIDENTIAL DEVELOPMENT
 AT 139 - 147 ARGYLE STREET,
 NKIL 6005, 6035 R.P., 6036 R.P.,
 6037 R.P. & 6038 R.P.

TITLE : WINDOW SCHEDULE FOR IN-SITU ALUM. WINDOW

DATE : 05-FEB-20 SCALE : 1:100



DRAWN BY : MN CHECKED BY : DW

美特鋁質有限公司
 MIDII ALUMINIUM FABRICATOR LTD.
 Units 6-8, Sunray Industrial Centre, 1/F
 610 Cha Kwo Ling Road, Kowloon
 Tel:23489211-4 Fax:(852)27276666


DWG NO. : J852-SD-IW-4206 REV. : A

ELEVATION


WINDOW MARK	W6/T2B
LOCATION	2/F~21/F B.R.2 & B.R.3 AT TOWER 2 FLAT B
SECTION	50mm ALUM. SECTION
GLAZING	GLO1
QUANTITY	17
REMARKS	FACADE (PF-21)

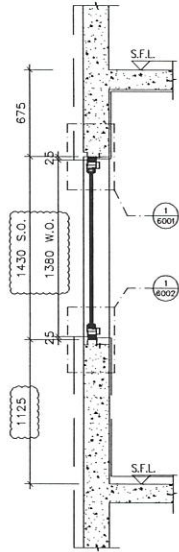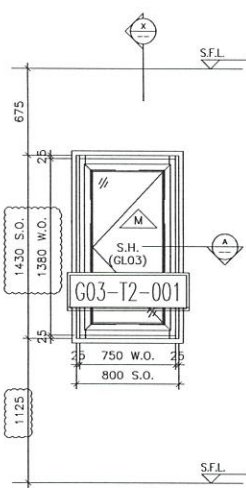

ELEVATION

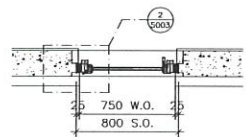

PART PLAN A1

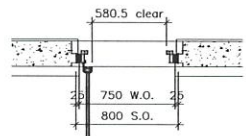

PART PLAN A2

TYPE	
OPENABLE WINDOW DIMENSION	(WIDTH) - 750 (HEIGHT) - 1380
NUMBER OF OPENABLE AREA WINDOW	2
GLAZING AREA	

PROVIDED		
GLAZING AREA	0.644	m ²
OPENABLE AREA	0	m ²

W9/T2B

ELEVATION

WINDOW MARK	W9/T2B
LOCATION	1/F~21/F ENSUITE AT TOWER 2 FLAT B
SECTION	70mm ALUM. SECTION
GLAZING	GL03
QUANTITY	18
REMARKS	

B.D. REF :

CLIENT :

ARCHITECT :
AGC DESIGN LTD

MAIN CONTRACTOR :
Gammon

STRUCTURAL ENGINEER :
ARUP

FACADE CONSULTANT:
MEINHARDT

NOTE:
1. ALL DIMENSIONS ARE IN mm.
2. ALL ELEVATIONS ARE VIEWED FROM OUTSIDE.
3. ALL DIMENSIONS TO BE VERIFIED ON SITE BEFORE FABRICATION.

LEGEND :
① - DETAIL MARK NO.
X001 - REFER SHEET NO.

- F.F.L. -- FINISHED FLOOR LEVEL
- S.F.L. -- STRUCTURAL FLOOR LEVEL
- (∅) -- REVERSED DETAIL
- ▲ -- FIXING LOCATION
- △ -- FIXING LUG LOCATION

6. GLASS LEGEND
GL01 -- 8mm+12mm AIR GAP+10mm THK. I.G.U.
GL02 -- 10mm THK. TEMPERED GLASS (SPANDREL GLASS)
GL03 -- 6mm+12mm AIR GAP+6mm THK. I.G.U.
GL04 -- 10mm THK. TEMPERED GLASS (PROTECTIVE BARRIER)
GL05 -- 6mm+12mm AIR GAP+8mm THK. I.G.U.

C	18/10/2020	REVISION SUBJECT TO ARCH/COMMIT	W9
B	29/01/2020	REVISION SUBJECT TO ARCH/COMMIT	W9
A	21/04/2020	REVISION SUBJECT TO ARCH/COMMIT	W9
NO.	DATE	REVISION	BY

JOB NO. : J-852
PROJECT :
PROPOSED RESIDENTIAL DEVELOPMENT
AT 139 - 147 ARGYLE STREET,
NKIL 6005, 6035 R.P., 6036 R.P.,
6037 R.P. & 6038 R.P.




TITLE :
WINDOW SCHEDULE FOR
IN-SITU ALUM. WINDOW

DATE : 05-FEB-20 SCALE : 1:100

DRAWN BY : MN CHECKED BY : DW

美特銘質有限公司
MIDI ALUMINIUM FABRICATOR LTD.
Units 6-8, Sunray Industrial Centre, 1/F
610 Cha Kwo Ling Road, Kowloon
Tel:23489211-4 Fax:(852)2727666

DWG NO. : J852-SD-IW-4207 REV. : C

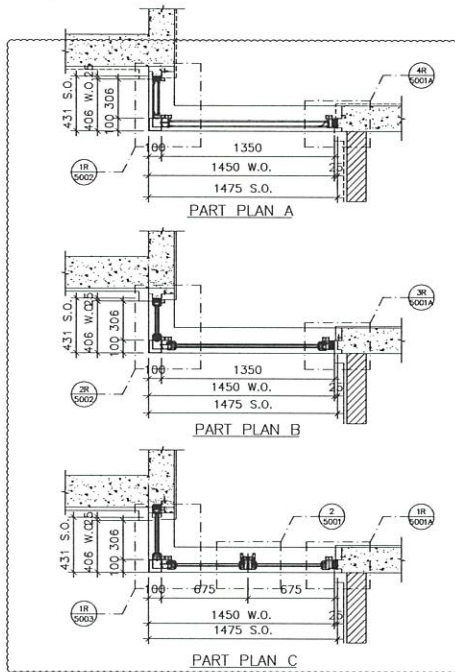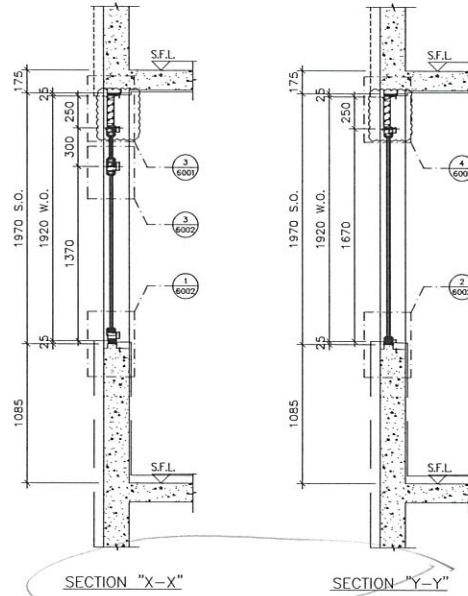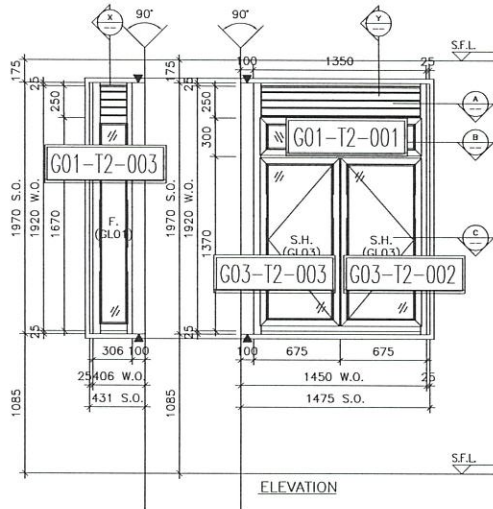

W8/T2B


PROVIDED	
GLAZING AREA	1.745 m ²
OPENABLE AREA	1.464 m ²

B.D. REF :

CLIENT :

ARCHITECT :
AGC DESIGN LTD

MAIN CONTRACTOR :
Gammon

STRUCTURAL ENGINEER :
ARUP

FACADE CONSULTANT:
MEINHARDT

NOTE:
1. ALL DIMENSIONS ARE IN mm.
2. ALL ELEVATIONS ARE VIEWED FROM OUTSIDE.
3. ALL DIMENSIONS TO BE VERIFIED ON SITE BEFORE FABRICATION.

- LEGEND :
- (X1) DETAIL MARK NO.
 - (X001) REFER SHEET NO.
 - 1. F.F.L. -- FINISHED FLOOR LEVEL
 - 2. S.F.L. -- STRUCTURAL FLOOR LEVEL
 - 3. (Z) -- REVERSED DETAIL
 - 4. ▲ -- FIXING LOCATION
 - 5. △ -- FIXING LUG LOCATION
 - 6. GLASS LEGEND

- GL01 -- 8mm+12mm AIR GAP+10mm THK. I.G.U.
- GL02 -- 10mm THK. TEMPERED GLASS (SPANDREL GLASS)
- GL03 -- 6mm+12mm AIR GAP+6mm THK. I.G.U.
- GL04 -- 10mm THK. TEMPERED GLASS (PROTECTIVE BARRIER)
- GL05 -- 6mm+12mm AIR GAP+8mm THK. I.G.U.

NO.	DATE	REVISION	REVISION SUBJECT TO	APPROVED BY
B	29/07/2020		REVISION SUBJECT TO ANCHORMENT	
A	21/04/2020		REVISION SUBJECT TO ANCHORMENT	

JOB NO. : J-852
PROJECT : PROPOSED RESIDENTIAL DEVELOPMENT AT 139 - 147 ARGYLE STREET, NKIL 6005, 6035 R.P., 6036 R.P., 6037 R.P. & 6038 R.P.

TITLE : WINDOW SCHEDULE FOR IN-SITU ALUM. WINDOW

DATE : 05-FEB-20 SCALE : 1:100

DRAWN BY : MN CHECKED BY : DW





美特鋁質有限公司
MIDI ALUMINIUM FABRICATOR LTD.
Units 6-8, Sunroy Industrial Centre, 1/F
610 Cha Kwo Ling Road, Kowloon
Tel:23489211-4 Fax:(852)27727666

DWG NO. : J852-SD-W-4208 REV. : B

ELEVATION

WINDOW MARK	W8/T2B
LOCATION	1/F~21/F KIT. AT TOWER 2 FLAT B
SECTION	50mm ALUM. SECTION
GLAZING	GL01, GL03
QUANTITY	18
REMARKS	

ELEVATION

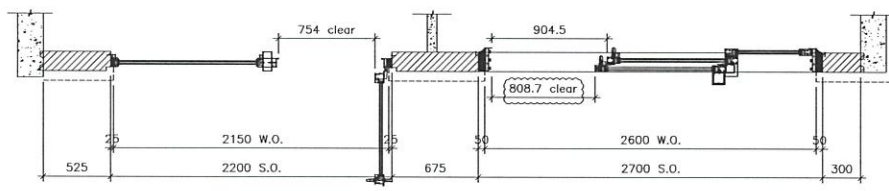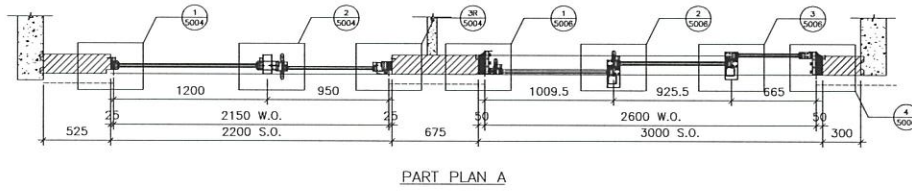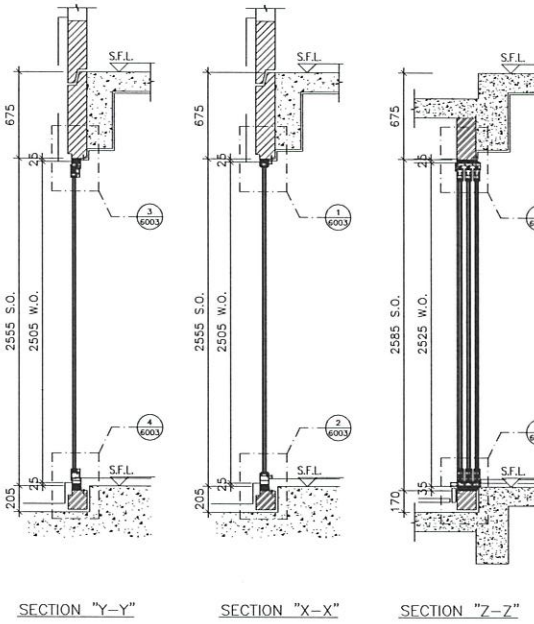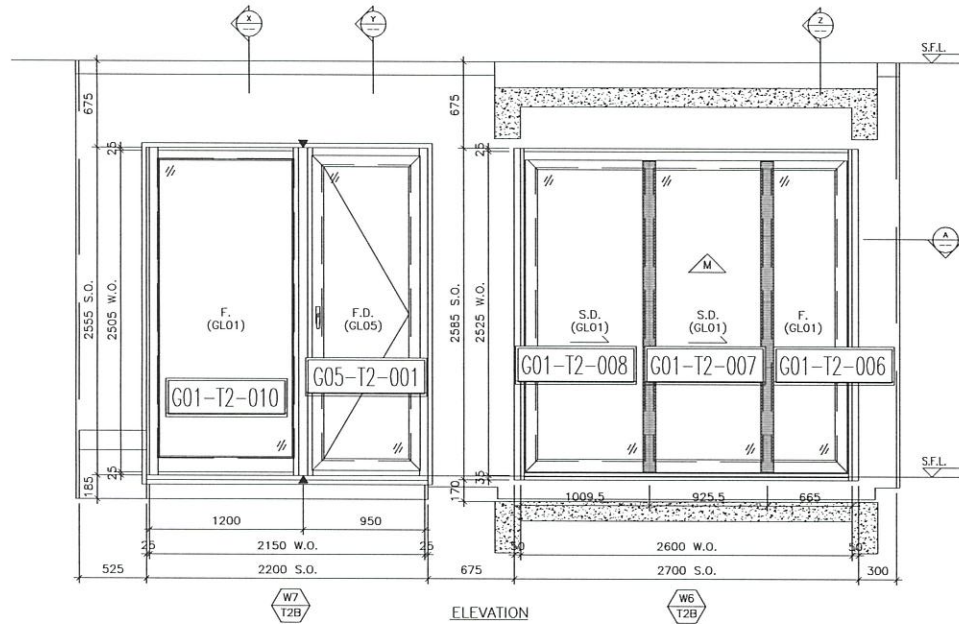



W6/T2B	PROVIDED	GLAZING AREA	OPENABLE AREA
		2.958 m ²	1.095 m ²

W7/T2B	PROVIDED	GLAZING AREA	OPENABLE AREA
		2.496 m ²	1.028 m ²

B.D. REF :

CLIENT :

ARCHITECT :
AGC DESIGN LTD

MAIN CONTRACTOR :
Gammon

STRUCTURAL ENGINEER :
ARUP

FACADE CONSULTANT:
MEINHARDT

NOTE:
1. ALL DIMENSIONS ARE IN mm.
2. ALL ELEVATIONS ARE VIEWED FROM OUTSIDE.
3. ALL DIMENSIONS TO BE VERIFIED ON SITE BEFORE FABRICATION.

LEGEND:
X1 - DETAIL MARK NO.
X2001 - REFER SHEET NO.

1. F.F.L. --- FINISHED FLOOR LEVEL
2. S.F.L. --- STRUCTURAL FLOOR LEVEL
3. (Z) --- REVERSED DETAIL
4. ▲ --- FIXING LOCATION
5. △ --- FIXING LUG LOCATION
6. GLASS LEGEND
GL01 --- 8mm+12mm AIR GAP+10mm THK. L.G.U.
GL02 --- 10mm THK. TEMPERED GLASS (SPANDREL GLASS)
GL03 --- 6mm+12mm AIR GAP+6mm THK. L.G.U.
GL04 --- 10mm THK. TEMPERED GLASS (PROTECTIVE BARRIER)
GL05 --- 6mm+12mm AIR GAP+8mm THK. L.G.U.

NO.	DATE	REVISION	BY
C	16/10/2020	REVISION SUBJECT TO APPROVAL COMMENT	
B	29/07/2020	REVISION SUBJECT TO APPROVAL COMMENT	
A	21/04/2020	REVISION SUBJECT TO APPROVAL COMMENT	

JOB NO. : J-852
PROJECT : PROPOSED RESIDENTIAL DEVELOPMENT AT 139 - 147 ARGYLE STREET, NKIL 6005, 6035 R.P., 6036 R.P., 6037 R.P. & 6038 R.P.


TITLE : WINDOW SCHEDULE FOR IN-SITU ALUM. WINDOW

DATE : 05-FEB-20 SCALE : 1:100
DRAWN BY : MN CHECKED BY : DW


美特鋁質有限公司
ALUMINUM FABRICATOR LTD.
Units 6-8, Sunray Industrial Centre, 1/F
610 Cho Kwo Ling Road, Kowloon
Tel:23489211-4 Fax:(852)27272666
DWG NO. : J852-SD-IW-4209 REV. : C

W6/T2B - W7/T2B


WINDOW MARK	W6/T2B / W7/T2B
LOCATION	1/F ENSUITE & B.R.1 AT TOWER 2 FLAT B
SECTION	50mm & 70mm ALUM. SECTION
GLAZING	GL01, GL05
QUANTITY	1 / 1
REMARKS	FACADE (PF-21)

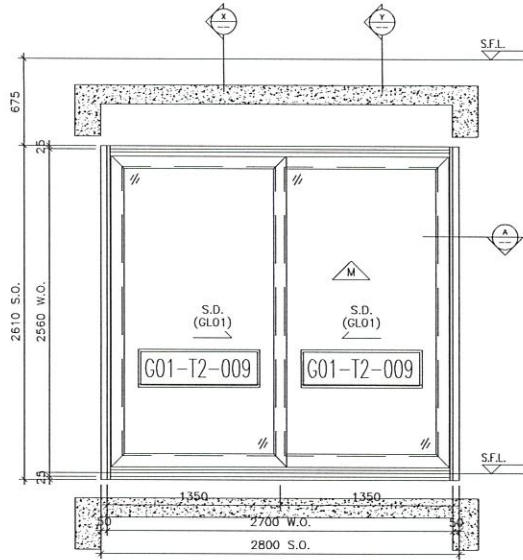


ELEVATION

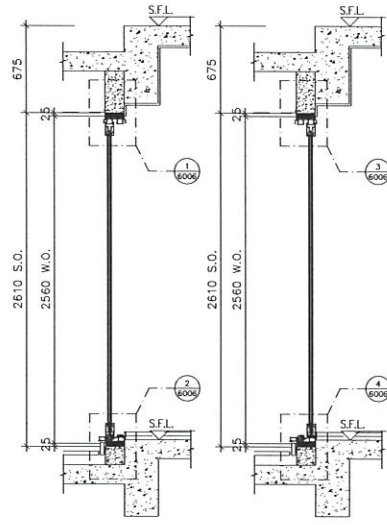

SECTION "X-X" SECTION "Y-Y"

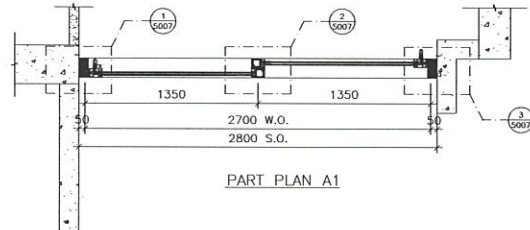

PART PLAN A1

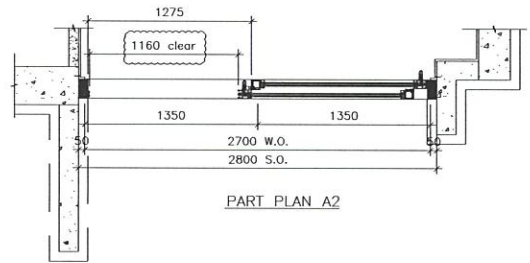

PART PLAN A2

W1/T2C

TYPE O	
SLIDING DOOR (A) DIMENSION	(WIDTH) = 1350
	(HEIGHT) = 2560
SLIDING DOOR (B) DIMENSION	(WIDTH) = 1350
	(HEIGHT) = 2560
NUMBER OF OPENABLE AREA WINDOW = 1	
GLAZING AREA	
SLIDING DOOR A	1168 mm
WIDTH = 1350-131-51	= 1168 mm
HEIGHT = 2560-151-156	= 2253 mm
SLIDING DOOR B (MAINTANCE)	1168 mm
WIDTH = 1350-131-51	= 1168 mm
HEIGHT = 2560-151-156	= 2253 mm
TOTAL = (1168x2253)+(1168x2253)	= 5.263000 m ²
OPENABLE AREA	
WIDTH = 1350-51-102-37	= 1197 mm
HEIGHT = 2560-308-37-1110	= 1581 mm
TOTAL = (1197x1581)	= 1.881000 m ²

PROVIDED	
GLAZING AREA	5.263 m ²
OPENABLE AREA	1.581 m ²

ELEVATION

WINDOW MARK	W1/T2C
LOCATION	1/F~21/F LIV./DIN. AT TOWER 2 FLAT C
SECTION	67mm ALUM. SECTION
GLAZING	GL01
QUANTITY	18
REMARKS	FACADE (PF-49)

B.D. REF :

CLIENT :

ARCHITECT :
AGC DESIGN LTD

MAIN CONTRACTOR :
Gammon

STRUCTURAL ENGINEER :
ARUP

FACADE CONSULTANT:
MEINHARDT

NOTE:

1. ALL DIMENSIONS ARE IN mm.
2. ALL ELEVATIONS ARE VIEWED FROM OUTSIDE.
3. ALL DIMENSIONS TO BE VERIFIED ON SITE BEFORE FABRICATION.

LEGEND:

(X1) DETAIL MARK NO.
(X001) REFER SHEET NO.

1. F.F.L. --- FINISHED FLOOR LEVEL
2. S.F.L. --- STRUCTURAL FLOOR LEVEL
3. (Z) --- REVERSED DETAIL
4. ▲ --- FIXING LOCATION
5. △ --- FIXING LUG LOCATION
6. GLASS LEGEND

GL01 --- 8mm+12mm AIR GAP+10mm THK. I.G.U.
GL02 --- 10mm THK. TEMPERED GLASS (SPANDREL GLASS)
GL03 --- 6mm+12mm AIR GAP+6mm THK. I.G.U.
GL04 --- 10mm THK. TEMPERED GLASS (PROTECTIVE BARRIER)
GL05 --- 6mm+12mm AIR GAP+8mm THK. I.G.U.

C	16/10/2020	REVISION SUBJECT TO APPROVEMENT	WORK
B	29/07/2020	REVISION SUBJECT TO APPROVEMENT	WORK
A	21/04/2020	REVISION SUBJECT TO APPROVEMENT	WORK
NO.	DATE	REVISION	BY

JOB NO. : J-852

PROJECT :
PROPOSED RESIDENTIAL DEVELOPMENT
AT 139 - 147 ARGYLE STREET,
NKIL 6005, 6035 R.P., 6036 R.P.,
6037 R.P. & 6038 R.P.




TITLE : WINDOW SCHEDULE FOR IN-SITU ALUM. WINDOW

DATE : 05-FEB-20 SCALE : 1:100

DRAWN BY : MN CHECKED BY : DW

美特銘質有限公司
MIDI ALUMINIUM FABRICATOR LTD.
Units 6-8, Sunray Industrial Centre, 1/F
610 Cha Kwo Ling Road, Kowloon
Tel:23489211-4 Fax:(852)27727666

DWG NO. : J852-SD-IW-4210 REV. : C

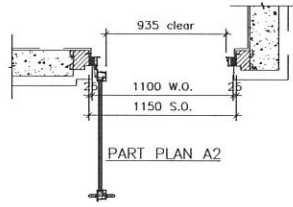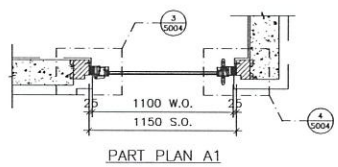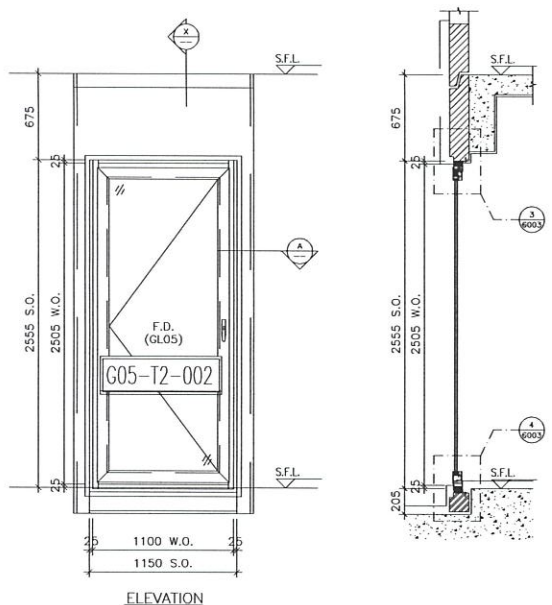


PROVIDED		
GLAZING AREA	1.194	m ²
OPENABLE AREA	1.274	m ²

W5/T2C

ELEVATION

WINDOW MARK	W5/T2C
LOCATION	1/F B.R.2 AT TOWER 2 FLAT C
SECTION	70mm ALUM. SECTION
GLAZING	GL05
QUANTITY	1
REMARKS	FAÇADE (PF-29)

B.D. REF :

CLIENT :

ARCHITECT :
AGC DESIGN LTD

MAIN CONTRACTOR :
Gammon

STRUCTURAL ENGINEER :
ARUP

FAÇADE CONSULTANT:
MEINHARDT

NOTE:
 1. ALL DIMENSIONS ARE IN mm.
 2. ALL ELEVATIONS ARE VIEWED FROM OUTSIDE.
 3. ALL DIMENSIONS TO BE VERIFIED ON SITE BEFORE FABRICATION.

LEGEND:
 X1 - DETAIL MARK NO.
 X001 - REFER SHEET NO.

1. F.F.L. -- FINISHED FLOOR LEVEL
 2. S.F.L. -- STRUCTURAL FLOOR LEVEL
 3. (2) -- REVERSED DETAIL
 4. ▲ -- FIXING LOCATION
 5. △ -- FIXING LUG LOCATION
 6. GLASS LEGEND
 GL01 -- 8mm+12mm AIR GAP+10mm THK. I.G.U.
 GL02 -- 10mm THK. TEMPERED GLASS (SPANDREL GLASS)
 GL03 -- 6mm+12mm AIR GAP+6mm THK. I.G.U.
 GL04 -- 10mm THK. TEMPERED GLASS (PROTECTIVE BARRIER)
 GL05 -- 6mm+12mm AIR GAP+8mm THK. I.G.U.

NO.	DATE	REVISION	BY
D	04/02/2021	REVISION SUBJECT TO ARCH COMMENT	WSP
C	16/10/2020	REVISION SUBJECT TO ARCH COMMENT	WSP
B	29/07/2020	REVISION SUBJECT TO ARCH COMMENT	WSP
A	21/04/2020	REVISION SUBJECT TO ARCH COMMENT	WSP

JOB NO. : J-852

PROJECT :
 PROPOSED RESIDENTIAL DEVELOPMENT
 AT 139 - 147 ARCYLE STREET,
 NKIL 6005, 6035 R.P., 6036 R.P.,
 6037 R.P. & 6038 R.P.

TITLE :
 WINDOW SCHEDULE FOR
 IN-SITU ALUM. WINDOW

DATE : 05-FEB-20 SCALE : 1:100

DRAWN BY : MN CHECKED BY : DW

美特鋁質有限公司
 MIDI ALUMINIUM FABRICATOR LTD.
 Units 5-B, Sunray Industrial Centre, 1/F
 610 Cha Kwo Ling Road, Kowloon
 Tel:23489211-4 Fax:(852)27272666

DWG NO. : J852-SD-IW-4211 REV. : D

B.D. REF :

CLIENT :

ARCHITECT :
AGC DESIGN LTD

MAIN CONTRACTOR :
Gammon

STRUCTURAL ENGINEER :
ARUP

FACADE CONSULTANT:
MEINHARDT

NOTE:
 1. ALL DIMENSIONS ARE IN mm.
 2. ALL ELEVATIONS ARE VIEWED FROM OUTSIDE.
 3. ALL DIMENSIONS TO BE VERIFIED ON SITE BEFORE FABRICATION.

LEGEND:
 (X1) DETAIL MARK NO.
 (X001) REFER SHEET NO.

1. F.F.L. --- FINISHED FLOOR LEVEL
 2. S.F.L. --- STRUCTURAL FLOOR LEVEL
 3. (R) --- REVERSED DETAIL
 4. ▲ --- FIXING LOCATION
 5. △ --- FIXING LUG LOCATION
 6. GLASS LEGEND

GL01 --- 8mm+12mm AIR GAP+10mm THK. I.G.U.
 GL02 --- 10mm THK. TEMPERED GLASS (SPANDREL GLASS)
 GL03 --- 6mm+12mm AIR GAP+6mm THK. I.G.U.
 GL04 --- 10mm THK. TEMPERED GLASS (PROTECTIVE BARRIER)
 GL05 --- 6mm+12mm AIR GAP+8mm THK. I.G.U.

B	16/10/2020	REVISION SUBJECT TO ARCH COMMENT	W
A	21/04/2020	REVISION SUBJECT TO ARCH COMMENT	W
NO	DATE	REMARK	BY

JOB NO. : J-852

PROJECT :
 PROPOSED RESIDENTIAL DEVELOPMENT
 AT 139 - 147 ARGYLE STREET,
 NKIL 6005, 6035 R.P., 6036 R.P.,
 6037 R.P. & 6038 R.P.


TITLE :
 WINDOW SCHEDULE FOR
 IN-SITU ALUM. WINDOW

DATE : 05-FEB-20 SCALE : 1:100


DRAWN BY : MN CHECKED BY : DW

美特鋁質有限公司
 MIDI ALUMINIUM FABRICATOR LTD.
 Units 6-8, Sunray Industrial Centre, 1/F
 610 Che Kwo Ling Road, Kowloon
 Tel:23489211-4 Fax:(852)27272666

DWG NO. : J852-SD-IW-4301 REV. : B

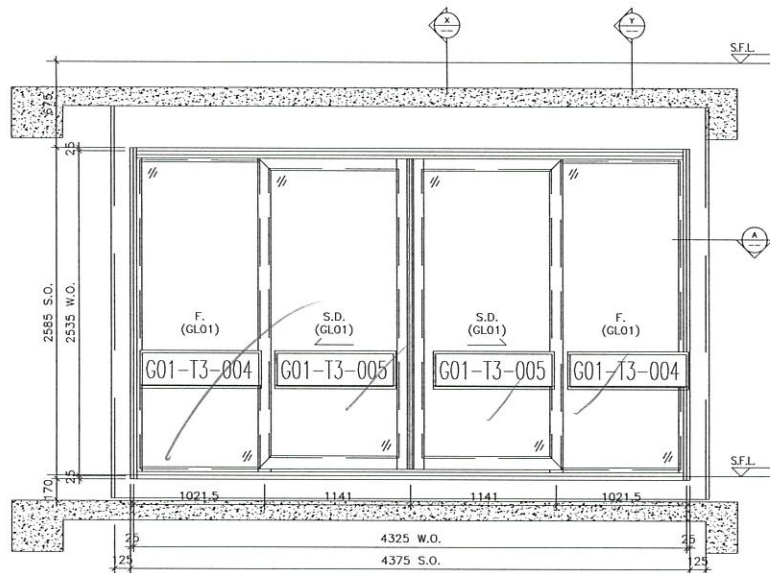


ELEVATION

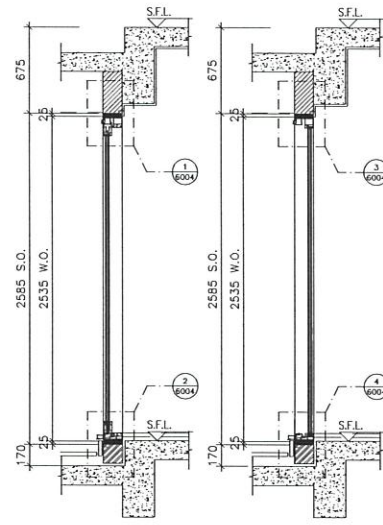


SECTION "X-X"

SECTION "Y-Y"

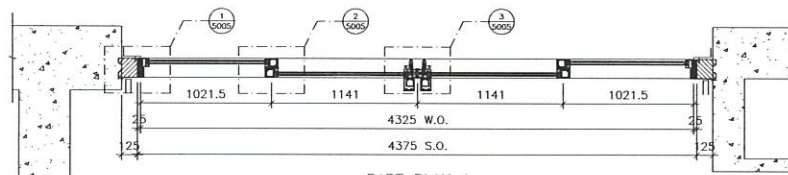

PART PLAN A

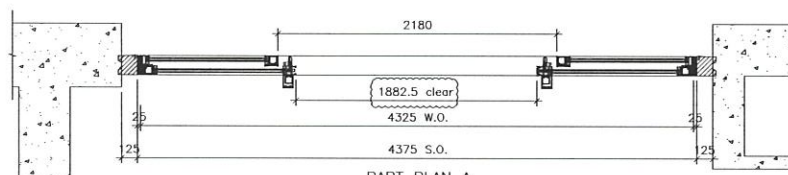

PART PLAN A


W1/T3A

TYPE I		
SLIDING DOOR DIMENSION	(WIDTH)	= 1141
	(HEIGHT)	= 2535
FIXED WINDOW DIMENSION	(WIDTH)	= 1021.5
	(HEIGHT)	= 2535
NUMBER OF OPENABLE AREA WINDOW		= 2
GLAZING AREA		
SLIDING DOOR	WIDTH = 1141.196-51	= 984 mm
	HEIGHT = 2535-151-152	= 2232 mm
FIXED WINDOW	WIDTH = 1021.5-51-63.8	= 906.7 mm
	HEIGHT = 2535-86.8-65	= 2387.2 mm
TOTAL	= ((984+2232)x2)+(906.7+2387.2)x2	= 8714.2708 m ²
OPENABLE AREA		
WIDTH	= (1141x2)+(1021.5x2)-(1141+52+8+24)+(1141+52+16+5+24)	= 3882.5 mm
HEIGHT	= 2535-86.8-65	= 2387.2 mm
TOTAL	= (3882.5x2387.2)	= 4.486374 m ²


PROVIDED	
GLAZING AREA	8.714 m ²
OPENABLE AREA	4.486 m ²

ELEVATION


WINDOW MARK	W1/T3A
LOCATION	1/F~21/F LIV./DIN. AT TOWER 3 FLAT A
SECTION	67mm ALUM. SECTION
GLAZING	GL01
QUANTITY	18
REMARKS	FACADE (PF-38)

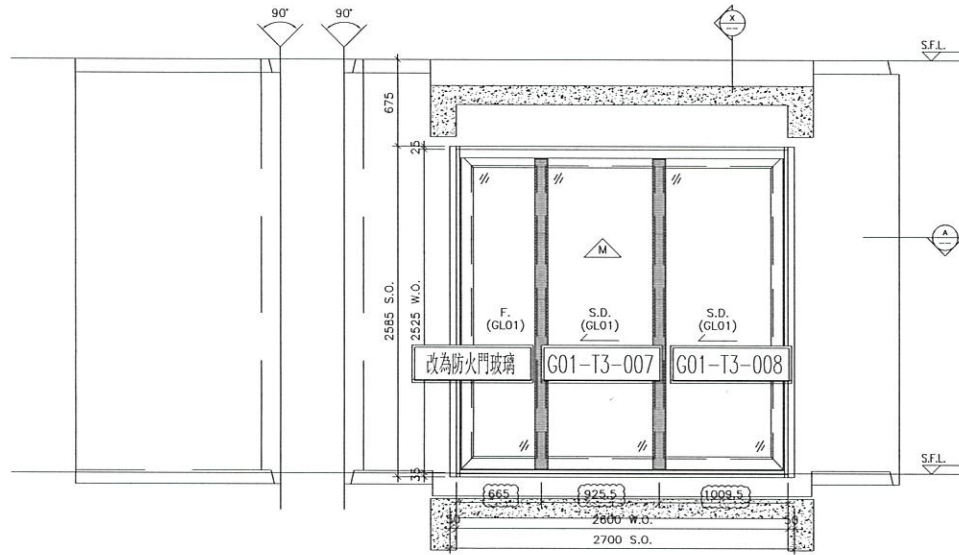


ELEVATION

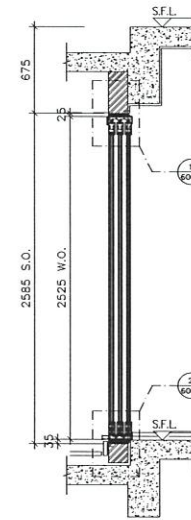

SECTION "X-X"

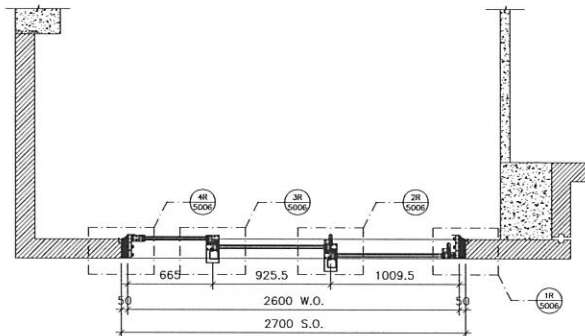

PART PLAN A

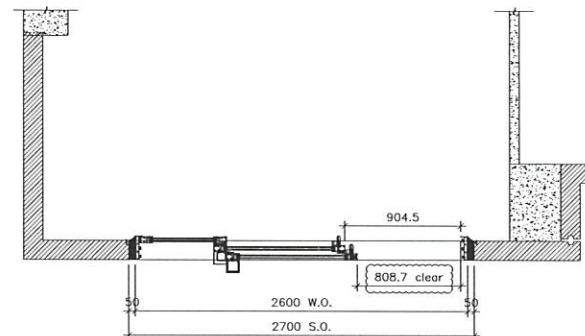

PART PLAN A


PROVIDED	
GLAZING AREA	2.958 m ²
OPENABLE AREA	1.096 m ²

W7/T3A

ELEVATION

WINDOW MARK	W7/T3A
LOCATION	1/F~21/F ENSUITE AT TOWER 3 FLAT A
SECTION	50mm ALUM. SECTION
GLAZING	GL01
QUANTITY	18
REMARKS	FACADE (PF-17)

B.D. REF :

CLIENT :

ARCHITECT :
AGC DESIGN LTD

MAIN CONTRACTOR :
Gammon

STRUCTURAL ENGINEER :
ARUP

FACADE CONSULTANT:
MEINHARDT

NOTE:
 1. ALL DIMENSIONS ARE IN mm.
 2. ALL ELEVATIONS ARE VIEWED FROM OUTSIDE.
 3. ALL DIMENSIONS TO BE VERIFIED ON SITE BEFORE FABRICATION.

LEGEND:
 X1 --- DETAIL MARK NO.
 X001 --- REFER SHEET NO.
 1. F.F.L. --- FINISHED FLOOR LEVEL
 2. S.F.L. --- STRUCTURAL FLOOR LEVEL
 3. (2) --- REVERSED DETAIL
 4. ▲ --- FIXING LOCATION
 5. △ --- FIXING LUG LOCATION
 6. GLASS LEGEND
 GL01 --- 8mm+12mm AIR GAP+10mm THK. I.G.U.
 GL02 --- 10mm THK. TEMPERED GLASS (SPANDREL GLASS)
 GL03 --- 6mm+12mm AIR GAP+6mm THK. I.G.U.
 GL04 --- 10mm THK. TEMPERED GLASS (PROTECTIVE BARRIER)
 GL05 --- 6mm+12mm AIR GAP+8mm THK. I.G.U.


NO.	DATE	REVISED	BY
B	16/10/2020	REVISION SUBJECT TO APPROVALMENT	
A	21/04/2020	REVISION SUBJECT TO APPROVALMENT	

JOB NO. : J-852
 PROJECT :
 PROPOSED RESIDENTIAL DEVELOPMENT
 AT 139 - 147 ARGYLE STREET,
 NKIL 6005, 6035 R.P., 6036 R.P.,
 6037 R.P. & 6038 R.P.


TITLE :
 WINDOW SCHEDULE FOR
 IN-SITU ALUM. WINDOW

DATE : 05-FEB-20 SCALE : 1:100
 DRAWN BY : MN CHECKED BY : DW

美特鋁質有限公司
 MIDY ALUMINIUM FABRICATOR LTD.
 Units 6-8, Sunray Industrial Centre, 1/F,
 610 Cha Kwo Ling Road, Kowloon
 Tel:23489211-4 Fax:(852)27272666
 DWG NO. : J852-SD-IW-4302 REV. : B

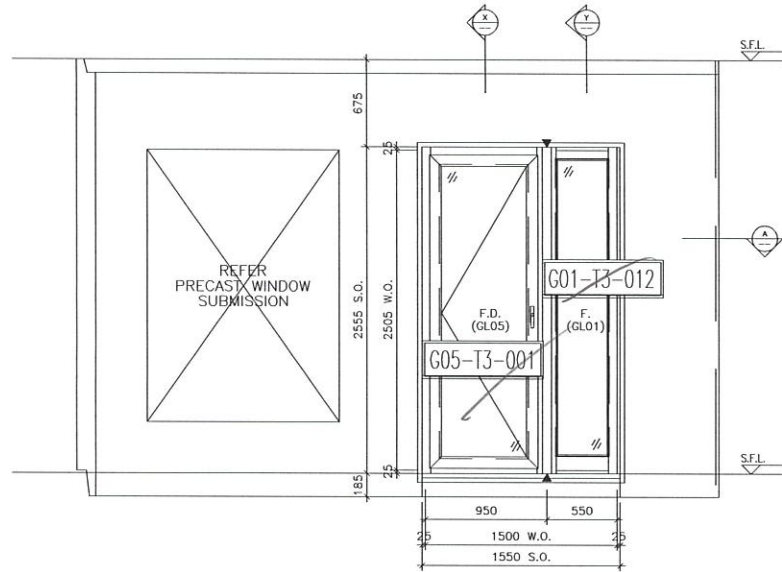


ELEVATION

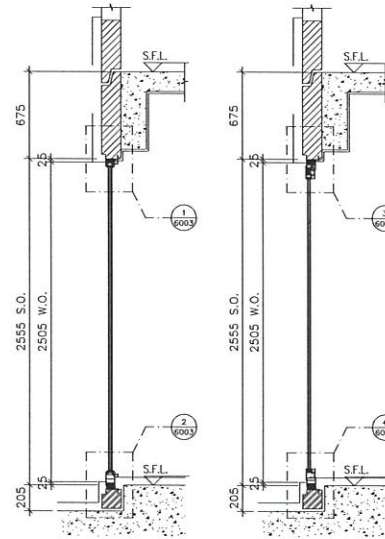


SECTION "Y-Y"

SECTION "X-X"

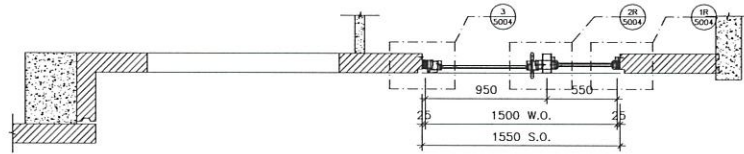

PART PLAN A1

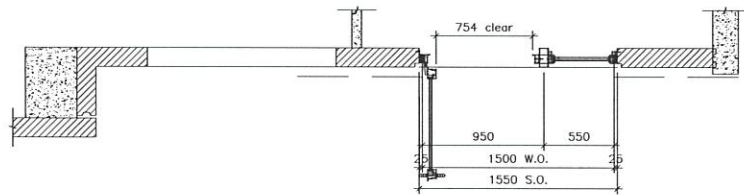

PART PLAN A2

W9/T3A

TYPE N	
FRENCH DOOR DIMENSION	(WIDTH) = 950 (HEIGHT) = 2300
FIXED WINDOW DIMENSION	(WIDTH) = 2500 (HEIGHT) = 2300
NUMBER OF OPENABLE AREA WINDOW	1
GLAZING AREA	
FRENCH DOOR	
WIDTH = 900-125-125-55	= 605 mm
HEIGHT = (2550+250-125-1000)	= 1405 mm
FIXED	
WIDTH = 250-85-87	= 578 mm
HEIGHT = (2505-250-40-1000)	= 1490 mm
TOTAL = (605x1405)+(578x1490)x1000/1000	= 132754.8 mm ²
OPENABLE AREA	
WIDTH = 900-85-53-106	= 754 mm
HEIGHT = (2550-250-50-1110)	= 1165 mm
TOTAL = (754x1165)x1000/1000	= 102770.2 mm ²

PROVIDED	
GLAZING AREA	1.527 m ²
OPENABLE AREA	1.028 m ²

B.D. REF :

CLIENT :

ARCHITECT :
AGC DESIGN LTD

MAIN CONTRACTOR :
Gammon

STRUCTURAL ENGINEER :
ARUP

FAÇADE CONSULTANT:
MEINHARDT

NOTE :
1. ALL DIMENSIONS ARE IN mm.
2. ALL ELEVATIONS ARE VIEWED FROM OUTSIDE.
3. ALL DIMENSIONS TO BE VERIFIED ON SITE BEFORE FABRICATION.

LEGEND :
 (X1) — DETAIL MARK NO.
 (X001) — REFER SHEET NO.
 1. F.F.L. — FINISHED FLOOR LEVEL
 2. S.F.L. — STRUCTURAL FLOOR LEVEL
 3. (Z) — REVERSED DETAIL
 4. ▲ — FIXING LOCATION
 5. △ — FIXING LUG LOCATION
 6. GLASS LEGEND
 GL01 — 8mm+12mm AIR GAP+10mm THK. I.G.U.
 GL02 — 10mm THK. TEMPERED GLASS (SPANDREL GLASS)
 GL03 — 6mm+12mm AIR GAP+6mm THK. I.G.U.
 GL04 — 10mm THK. TEMPERED GLASS (PROTECTIVE BARRIER)
 GL05 — 6mm+12mm AIR GAP+8mm THK. I.G.U.

NO.	DATE	REVISION	BY
C	16/10/2020	REVISION SUBJECT TO APPROVEMENT	MN
B	29/07/2020	REVISION SUBJECT TO APPROVEMENT	MN
A	21/04/2020	REVISION SUBJECT TO APPROVEMENT	MN

JOB NO. : J-852
 PROJECT : PROPOSED RESIDENTIAL DEVELOPMENT AT 139 - 147 ARGYLE STREET, NKIL 6005, 6035 R.P., 6036 R.P., 6037 R.P. & 6038 R.P.

TITLE : WINDOW SCHEDULE FOR IN-SITU ALUM. WINDOW


DATE : 05-FEB-20 SCALE : 1:100
 DRAWN BY : MN CHECKED BY : DW

美特鋁質有限公司
 MIDITE ALUMINIUM FABRICATOR LTD.
 Units 6-8, Sunray Industrial Centre, 1/F
 610 Cha Kwo Ling Road, Kowloon
 Tel:23489211-4 Fax:(852)27727666


DWG NO. : J852-SD-IW-4304 REV. : C

ELEVATION


WINDOW MARK	W9/T3A
LOCATION	1/F B.R.2 AT TOWER 1 FLAT A
SECTION	70mm ALUM. SECTION
GLAZING	GL01, GL05
QUANTITY	1
REMARKS	FAÇADE (PF-18)

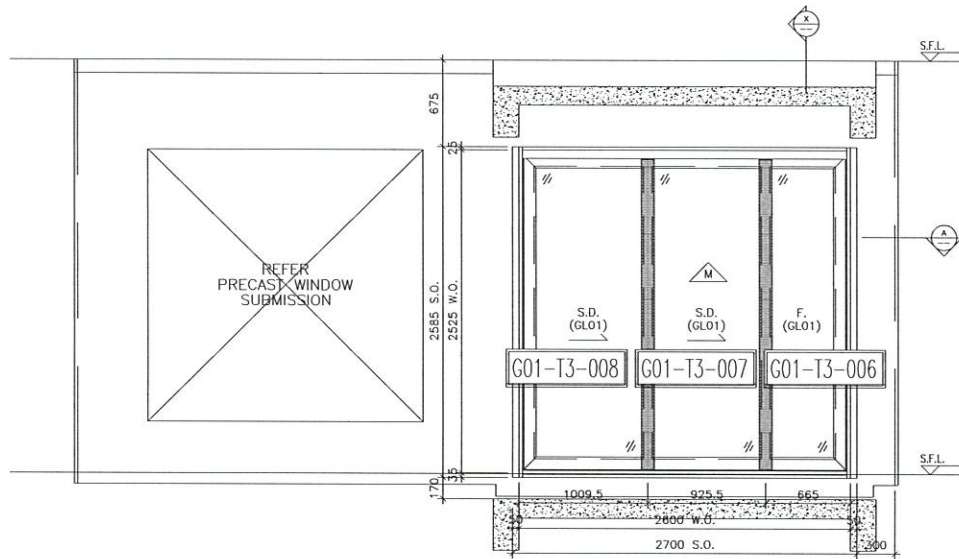


ELEVATION

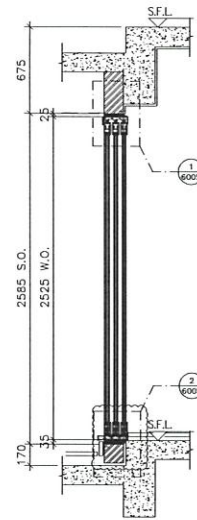

SECTION "X-X"

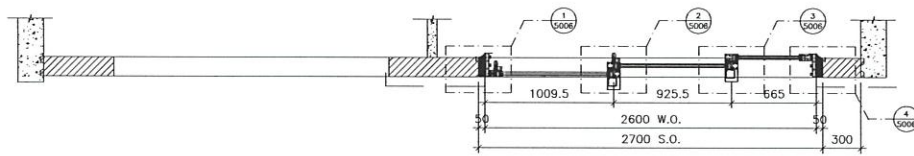

PART PLAN A

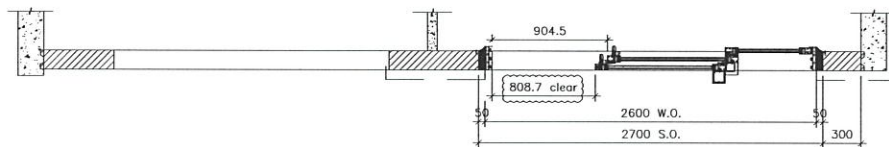

PART PLAN A

w6/T3B

TYPE 3		

PROVIDED	
GLAZING AREA	2.958 m ²
OPENABLE AREA	1.096 m ²

B.D. REF :

CLIENT :

ARCHITECT :
AGC DESIGN LTD

MAIN CONTRACTOR :
Gammon

STRUCTURAL ENGINEER :
ARUP

FACADE CONSULTANT:
MEINHARDT

NOTE:
 1. ALL DIMENSIONS ARE IN mm.
 2. ALL ELEVATIONS ARE VIEWED FROM OUTSIDE.
 3. ALL DIMENSIONS TO BE VERIFIED ON SITE BEFORE FABRICATION.

- LEGEND :
- ⊗ -- DETAIL MARK NO.
 - ⊙ -- REFER SHEET NO.
 - 1. F.F.L. -- FINISHED FLOOR LEVEL
 - 2. S.F.L. -- STRUCTURAL FLOOR LEVEL
 - 3. (R) -- REVERSED DETAIL
 - 4. ▲ -- FIXING LOCATION
 - 5. △ -- FIXING LUG LOCATION
 - 6. GLASS LEGEND

- GL01 -- 8mm+12mm AIR GAP+10mm THK. I.G.U.
- GL02 -- 10mm THK. TEMPERED GLASS (SPANDREL GLASS)
- GL03 -- 6mm+12mm AIR GAP+6mm THK. I.G.U.
- GL04 -- 10mm THK. TEMPERED GLASS (PROTECTIVE BARRIER)
- GL05 -- 6mm+12mm AIR GAP+8mm THK. I.G.U.

B	16/10/2020	REVISION SUBJECT TO ARCH/COMMENT	W
A	21/04/2020	REVISION SUBJECT TO ARCH/COMMENT	W

JOB NO. : J-852
 PROJECT :
 PROPOSED RESIDENTIAL DEVELOPMENT
 AT 139 - 147 ARGYLE STREET,
 NKIL 6005, 6035 R.P., 6036 R.P.,
 6037 R.P. & 6038 R.P.

TITLE : WINDOW SCHEDULE FOR IN-SITU ALUM. WINDOW


DATE : 05-FEB-20 SCALE : 1:100
 DRAWN BY : MN CHECKED BY : DW

美特鋁質有限公司
 MIDII ALUMINIUM FABRICATOR LTD.
 Units 6-8, Sunray Industrial Centre, 1/F,
 610 Cha Kwo Ling Road, Kowloon
 Tel:23489211-4 Fax:(852)2727666


DWG NO. : J852-SD-W-4305 REV. : B

ELEVATION

WINDOW MARK	W6/T3B
LOCATION	2/F~21/F B.R.1 & ENSUITE AT TOWER 3 FLAT B
SECTION	50mm ALUM. SECTION
GLAZING	GL01
QUANTITY	17
REMARKS	FACADE (PF-19)

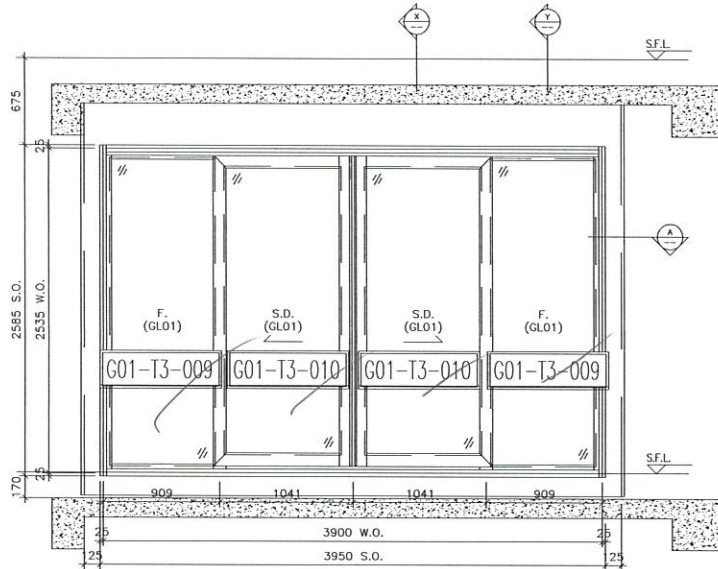


ELEVATION

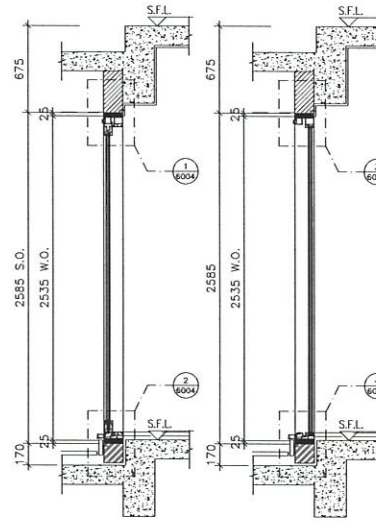


SECTION "X-X"

SECTION "Y-Y"

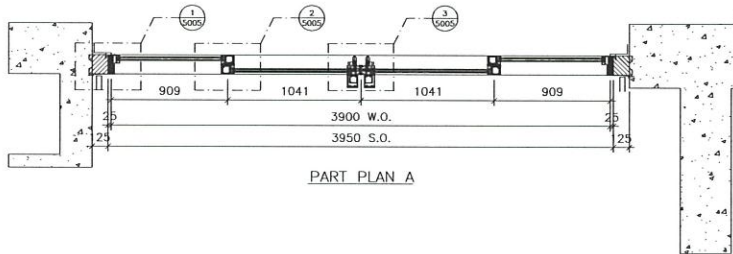

PART PLAN A

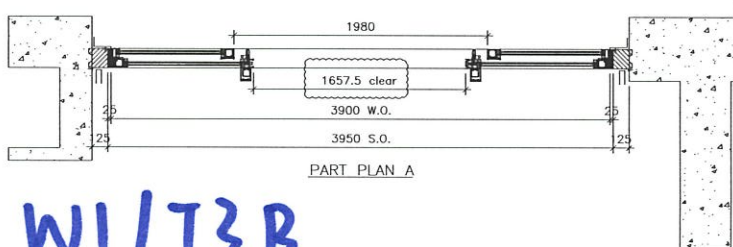

PART PLAN A

W1/T3B

TYPE I		
SLIDING DOOR DIMENSION	(WIDTH)	= 1041
	(HEIGHT)	= 2535
FIXED WINDOW DIMENSION	(WIDTH)	= 909
	(HEIGHT)	= 2535
NUMBER OF OPENABLE AREA WINDOW		= 2
GLAZING AREA		
SLIDING DOOR		
WIDTH	= 1041-106-51	= 884 mm
HEIGHT	= 2535-151-152	= 2232 mm
FIXED		
WIDTH	= 909-51-61.8	= 794.2 mm
HEIGHT	= 2535-86.8-65	= 2383.2 mm
TOTAL	= (884x2232)x2+(794.2x2383.2)x2=1000999	= 77816400 mm ²
OPENABLE AREA		
WIDTH	= (1041x2+909x2)-(1041+52+8+24)+(1041+52+16.5+24)	= 1657.5 mm
HEIGHT	= 2535-86.8-65	= 2383.2 mm
TOTAL	= (1657.5x2383.2)x2=1000999	= 3950154 mm ²

PROVIDED	
GLAZING AREA	7.732 m ²
OPENABLE AREA	3.950 m ²

B.D. REF :

CLIENT :

ARCHITECT :
AGC DESIGN LTD

MAIN CONTRACTOR :
Gammon

STRUCTURAL ENGINEER :
ARUP

FAÇADE CONSULTANT :
MEINHARDT

NOTE :
 1. ALL DIMENSIONS ARE IN mm.
 2. ALL ELEVATIONS ARE VIEWED FROM OUTSIDE.
 3. ALL DIMENSIONS TO BE VERIFIED ON SITE BEFORE FABRICATION.

LEGEND :
 X1 --- DETAIL MARK NO.
 X001 --- REFER SHEET NO.

- F.F.L. --- FINISHED FLOOR LEVEL
- S.F.L. --- STRUCTURAL FLOOR LEVEL
- (/R) --- REVERSED DETAIL
- ▲ --- FIXING LOCATION
- △ --- FIXING LUG LOCATION

6. GLASS LEGEND
 GL01 --- 8mm+12mm AIR GAP+10mm THK. I.G.U.
 GL02 --- 10mm THK. TEMPERED GLASS (SPANDREL GLASS)
 GL03 --- 6mm+12mm AIR GAP+6mm THK. I.G.U.
 GL04 --- 10mm THK. TEMPERED GLASS (PROTECTIVE BARRIER)
 GL05 --- 6mm+12mm AIR GAP+8mm THK. I.G.U.

NO.	DATE	REVISION SUBJECT TO ARCH/COMMITMENT	BY
B	16/10/2020	REVISION SUBJECT TO ARCH/COMMITMENT	Yvan
A	21/04/2020	REVISION SUBJECT TO ARCH/COMMITMENT	Yvan

JOB NO. : J-852
 PROJECT :
 PROPOSED RESIDENTIAL DEVELOPMENT
 AT 139 - 147 ARGYLE STREET,
 NKIL 6005, 6035 R.P., 6036 R.P.,
 6037 R.P. & 6038 R.P.




TITLE :
 WINDOW SCHEDULE FOR
 IN-SITU ALUM. WINDOW

DATE : 05-FEB-20 SCALE : 1:100
 DRAWN BY : MN CHECKED BY : DW




美特鋁質有限公司
 MIDI ALUMINIUM FABRICATOR LTD.
 Units 5-8, Sunray Industrial Centre, 1/F
 610 Cha Kwo Ling Road, Kowloon
 Tel:23489211-4 Fax:(852)27727666
 DWG NO. : J852-SD-IW-4306 REV. : B

ELEVATION

WINDOW MARK	W1/T3B
LOCATION	1/F~21/F LIV./DIN. AT TOWER 3 FLAT B
SECTION	67mm ALUM. SECTION
GLAZING	GL01
QUANTITY	18
REMARKS	FAÇADE (PF-39)

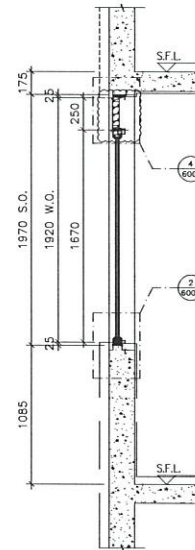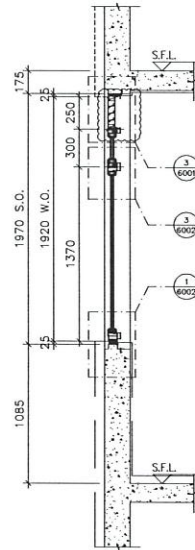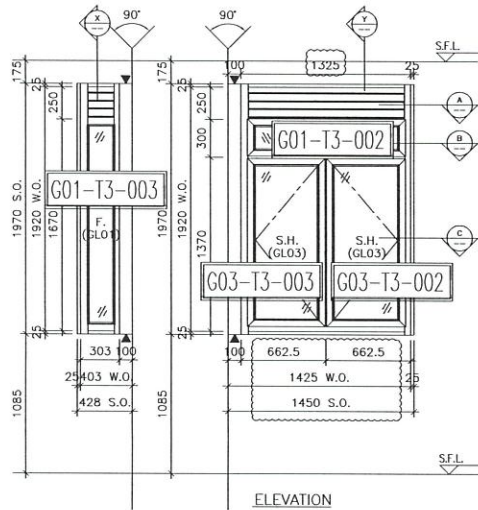

ELEVATION

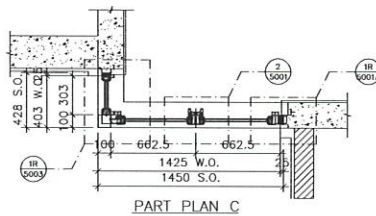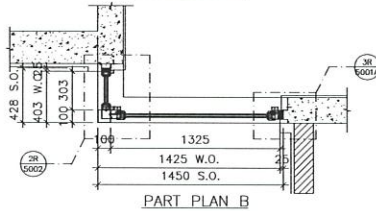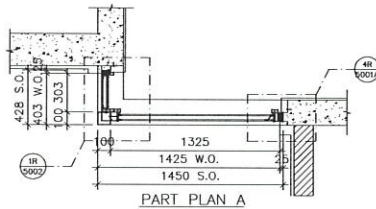

SECTION "X-X"

SECTION "Y-Y"

ELEVATION

PART PLAN A

PART PLAN B

PART PLAN C

W8/T3B


PROVIDED	
GLAZING AREA	1.706 m ²
OPENABLE AREA	1.432 m ²

B.D. REF :

CLIENT :

ARCHITECT :
AGC DESIGN LTD

MAIN CONTRACTOR :
Gammon

STRUCTURAL ENGINEER :
ARUP

FAÇADE CONSULTANT:
MEINHARDT

NOTE:
1. ALL DIMENSIONS ARE IN mm.
2. ALL ELEVATIONS ARE VIEWED FROM OUTSIDE.
3. ALL DIMENSIONS TO BE VERIFIED ON SITE BEFORE FABRICATION.

LEGEND:
X1 - DETAIL MARK NO.
X001 - REFER SHEET NO.
1. F.F.L. -- FINISHED FLOOR LEVEL
2. S.F.L. -- STRUCTURAL FLOOR LEVEL
3. (2) -- REVERSED DETAIL
4. ▲ -- FIXING LOCATION
5. △ -- FIXING LUG LOCATION
6. GLASS LEGEND
GL01 -- 8mm+12mm AIR GAP+10mm THK. I.G.U.
GL02 -- 10mm THK. TEMPERED GLASS (SPANDREL GLASS)
GL03 -- 6mm+12mm AIR GAP+6mm THK. I.G.U.
GL04 -- 10mm THK. TEMPERED GLASS (PROTECTIVE BARRIER)
GL05 -- 6mm+12mm AIR GAP+8mm THK. I.G.U.

NO.	DATE	REVISION	BY
B	29/07/2020	REVISION SUBJECT TO APPROVALMENT	MAN
A	21/04/2020	REVISION SUBJECT TO APPROVALMENT	MAN

JOB NO. : J-852
PROJECT :
PROPOSED RESIDENTIAL DEVELOPMENT
AT 139 - 147 ARCYLE STREET,
NKIL 6005, 6035 R.P., 6036 R.P.,
6037 R.P. & 6038 R.P.

TITLE : WINDOW SCHEDULE FOR IN-SITU ALUM. WINDOW

DATE : 05-FEB-20 SCALE : 1:100


DRAWN BY : MN CHECKED BY : DW

美特鋁質有限公司
MIDI ALUMINIUM FABRICATOR LTD.
Units 6-8, Sunray Industrial Centre, 1/7
610 Cha Kwo Ling Road, Kowloon
Tel:23489211-4 Fax:(852)27727666


DWG NO. : J852-SD-IW-4307 REV. : B

WINDOW MARK	W8/T3B
LOCATION	1/F~21/F KIT. AT TOWER 3 FLAT B
SECTION	50mm ALUM. SECTION
GLAZING	GL01, GL03
QUANTITY	18
REMARKS	


ELEVATION

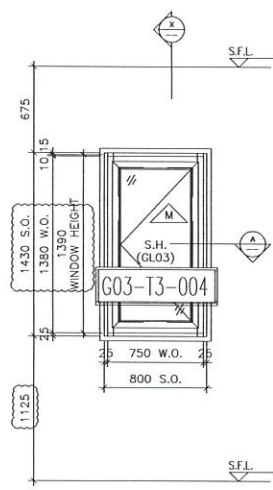


ELEVATION

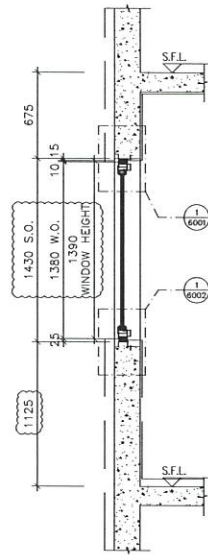

SECTION "X-X"

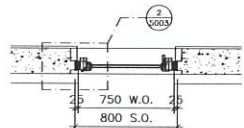

PART PLAN A1

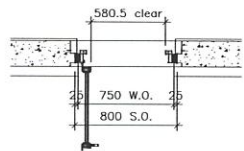

PART PLAN A2

ITEM	
OPENABLE WINDOW DIMENSION (WIDTH)	750
(HEIGHT)	1380
NUMBER OF OPENABLE AREA WINDOW	
1	
GLAZING AREA	
OPENABLE	

PROVIDED		
GLAZING AREA	0.644	m ²
OPENABLE AREA	0	m ²

W9/T3B

WINDOW MARK	W9 T3B
LOCATION	1/F~21/F ENSUITE AT TOWER 3 FLAT B
SECTION	70mm ALUM. SECTION
GLAZING	GL03
QUANTITY	18
REMARKS	

B.D. REF :

CLIENT :

ARCHITECT :
AGC DESIGN LTD

MAIN CONTRACTOR :
Gammon

STRUCTURAL ENGINEER :
ARUP

FAÇADE CONSULTANT:
MEINHARDT

NOTE :
1. ALL DIMENSIONS ARE IN mm.
2. ALL ELEVATIONS ARE VIEWED FROM OUTSIDE.
3. ALL DIMENSIONS TO BE VERIFIED ON SITE BEFORE FABRICATION.

LEGEND :
x1 - DETAIL MARK NO.
x001 - REFER SHEET NO.

- F.F.L. --- FINISHED FLOOR LEVEL
- S.F.L. --- STRUCTURAL FLOOR LEVEL
- (2) --- REVERSED DETAIL
- ▲ --- FIXING LOCATION
- △ --- FIXING LUG LOCATION
- GLASS LEGEND

- GL01 --- 8mm+12mm AIR GAP+10mm THK. I.G.U.
- GL02 --- 10mm THK. TEMPERED GLASS (SPANDREL GLASS)
- GL03 --- 6mm+12mm AIR GAP+6mm THK. I.G.U.
- GL04 --- 10mm THK. TEMPERED GLASS (PROTECTIVE BARRIER)
- GL05 --- 6mm+12mm AIR GAP+8mm THK. I.G.U.

C	DATE	REVISION SUBJECT TO APPROVAL	BY
B	16/10/2020	REVISION SUBJECT TO APPROVAL	ivan
A	29/07/2020	REVISION SUBJECT TO APPROVAL	ivan
	21/04/2020	REVISION SUBJECT TO APPROVAL	ivan





JOB NO. : J-852
PROJECT :
PROPOSED RESIDENTIAL DEVELOPMENT
AT 139 - 147 ARGYLE STREET,
NKIL 6005, 6035 R.P., 6036 R.P.,
6037 R.P. & 6038 R.P.

TITLE :
WINDOW SCHEDULE FOR
IN-SITU ALUM. WINDOW

DATE : 05-FEB-20 SCALE : 1:100
DRAWN BY : MN CHECKED BY : DW

美特鋁質有限公司
MIDI ALUMINIUM FABRICATOR LTD.
Units 6-8, Sunray Industrial Centre, 1/F
610 Cha Kwo Ling Road, Kowloon
Tel:23489211-4 Fax:(852)2727666

DWG NO. : J852-SD-IW-4308 REV. : C

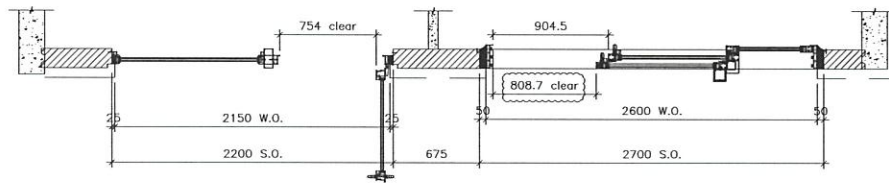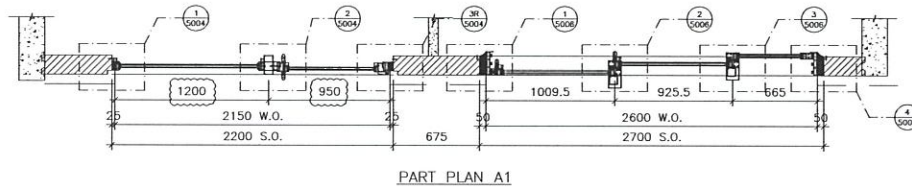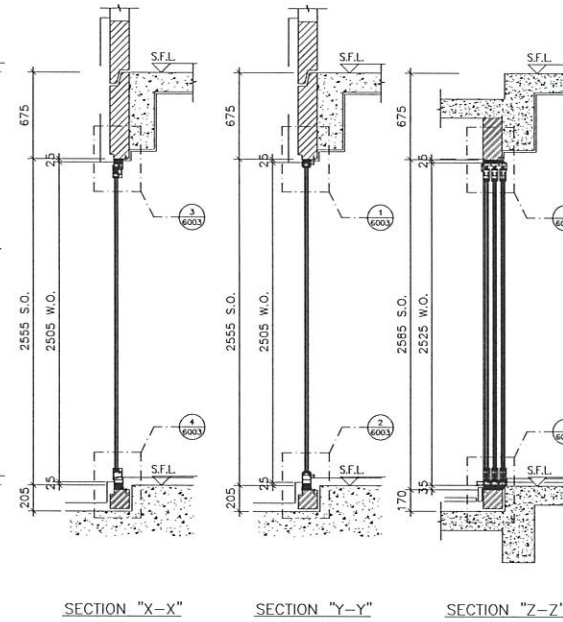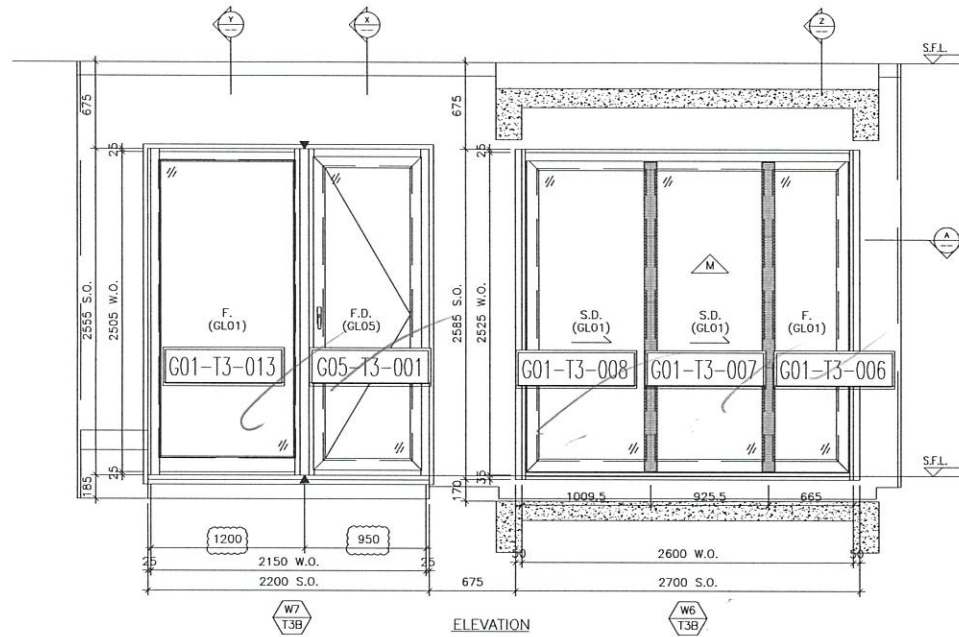

TYPE 2

SLIDING DOOR (A) DIMENSION	(WIDTH)	2200
SLIDING DOOR (A) DIMENSION	(HEIGHT)	2505
FIXED WINDOW DIMENSION	(WIDTH)	2700
FIXED WINDOW DIMENSION	(HEIGHT)	675

NUMBER OF OPENABLE AREA WINDOW

GLAZING AREA	2.958
OPENABLE AREA	1.096

TYPE N

FRENCH DOOR DIMENSION	(WIDTH)	835
FRENCH DOOR DIMENSION	(HEIGHT)	2300
FIXED WINDOW DIMENSION	(WIDTH)	1200
FIXED WINDOW DIMENSION	(HEIGHT)	2300

NUMBER OF OPENABLE AREA WINDOW

GLAZING AREA	2.496
OPENABLE AREA	1.028

PROVIDED	
GLAZING AREA	2.958 m ²
OPENABLE AREA	1.096 m ²

PROVIDED	
GLAZING AREA	2.496 m ²
OPENABLE AREA	1.028 m ²

ELEVATION

ELEVATION

PART PLAN A1

PART PLAN A2

W6/T3B - W7/T3B

WINDOW MARK	W6/T3B / W7/T3B
LOCATION	1/F B.R.1 & ENSUITE AT TOWER 3 FLAT B
SECTION	50mm & 70mm ALUM. SECTION
GLAZING	GL01, GL05
QUANTITY	1 / 1
REMARKS	FACADE (PF-19)

B.D. REF :

CLIENT :

ARCHITECT :
AGC DESIGN LTD

MAIN CONTRACTOR :
Gammon

STRUCTURAL ENGINEER :
ARUP

FACADE CONSULTANT :
MEINHARDT

NOTE :
1. ALL DIMENSIONS ARE IN mm.
2. ALL ELEVATIONS ARE VIEWED FROM OUTSIDE.
3. ALL DIMENSIONS TO BE VERIFIED ON SITE BEFORE FABRICATION.

LEGEND :
X1 - DETAIL MARK NO.
X001 - REFER SHEET NO.

1. F.F.L. --- FINISHED FLOOR LEVEL
2. S.F.L. --- STRUCTURAL FLOOR LEVEL
3. (R) --- REVERSED DETAIL
4. ▲ --- FIXING LOCATION
5. △ --- FIXING LUG LOCATION
6. GLASS LEGEND
GL01 --- 8mm+12mm AIR GAP+10mm THK. I.G.U.
GL02 --- 10mm THK. TEMPERED GLASS (SPANDREL GLASS)
GL03 --- 6mm+12mm AIR GAP+6mm THK. I.G.U.
GL04 --- 10mm THK. TEMPERED GLASS (PROTECTIVE BARRIER)
GL05 --- 6mm+12mm AIR GAP+8mm THK. I.G.U.

C	16/10/2020	REVISION SUBJECT TO APPROVAL	MAN
B	29/07/2020	REVISION SUBJECT TO APPROVAL	MAN
A	21/04/2020	REVISION SUBJECT TO APPROVAL	MAN
NO.	DATE	REVISION	BY

JOB NO. : J-852


PROJECT :
PROPOSED RESIDENTIAL DEVELOPMENT
AT 139 - 147 ARGYLE STREET,
NKIL 6005, 6035 R.P., 6036 R.P.,
6037 R.P. & 6038 R.P.

TITLE :
WINDOW SCHEDULE FOR
IN-SITU ALUM. WINDOW


DATE : 05-FEB-20	SCALE : 1:100
DRAWN BY : MN	CHECKED BY : DW

MIDI 美特鋁質有限公司
Units 6-8, Sunray Industrial Centre, 1/F
610 Cha Kwo Ling Road, Kowloon
Tel:23489211-4 Fax:(852)27727666

DWG NO. : J852-S0-1W-4309 REV. : C

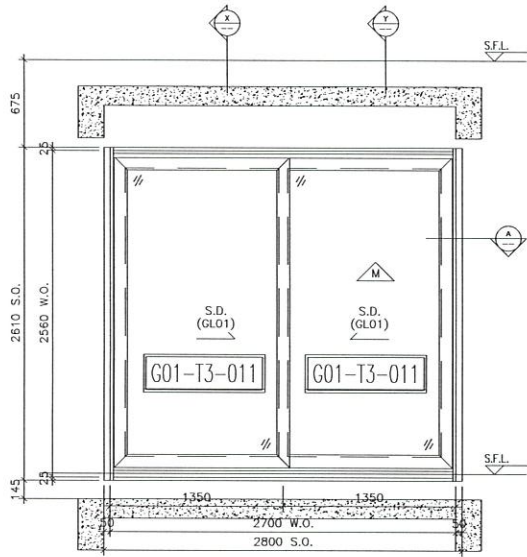


ELEVATION

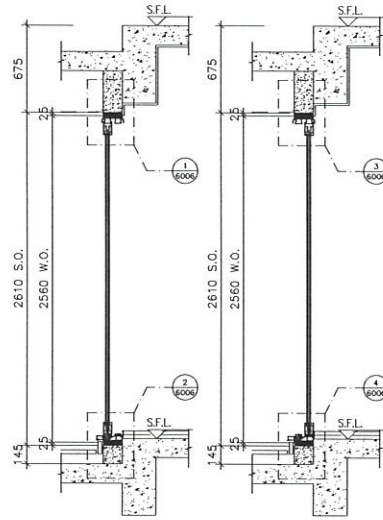


SECTION "X-X"

SECTION "Y-Y"

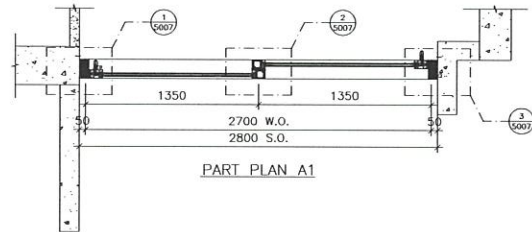

PART PLAN A1

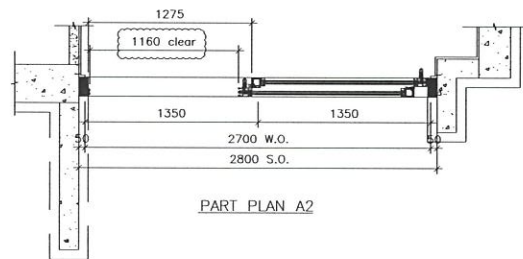

PART PLAN A2

W1/T3C

TYPE 0	
SLIDING DOOR (A) DIMENSION	(WIDTH) = 1350
	(HEIGHT) = 2610
SLIDING DOOR (B) DIMENSION	(WIDTH) = 1350
	(HEIGHT) = 2610
NUMBER OF OPENABLE AREA WINDOW = 2	
GLAZING AREA	
SLIDING DOOR A	
WIDTH = 1350-131-51	= 1168 mm
HEIGHT = 2560-131-156	= 2253 mm
SLIDING DOOR B (CLEARANCE)	
WIDTH = 1350-131-51	= 1168 mm
HEIGHT = 2560-131-156	= 2253 mm
TOTAL = (1168x2253)+(1168x2253)	= 5.263000 m ²
OPENABLE AREA	
WIDTH = 1350-131-102-97	= 1160 mm
HEIGHT = 2560-130-57-1110	= 1581 mm
TOTAL = (1160x1581)	= 1.839180 m ²

PROVIDED	
GLAZING AREA	5.263 m ²
OPENABLE AREA	1.581 m ²

B.D. REF :

CLIENT :

ARCHITECT :
AGC DESIGN LTD

MAIN CONTRACTOR :
Gammon

STRUCTURAL ENGINEER :
ARUP

FAÇADE CONSULTANT:
MEINHARDT

NOTE:
 1. ALL DIMENSIONS ARE IN mm.
 2. ALL ELEVATIONS ARE VIEWED FROM OUTSIDE.
 3. ALL DIMENSIONS TO BE VERIFIED ON SITE BEFORE FABRICATION.

LEGEND:
 (X1) -- DETAIL MARK NO.
 (X001) -- REFER SHEET NO.
 1. F.F.L. -- FINISHED FLOOR LEVEL
 2. S.F.L. -- STRUCTURAL FLOOR LEVEL
 3. (⊗) -- REVERSED DETAIL

C	16/10/2020	REVISION SUBJECT TO APPROVALMENT	ivan
B	29/07/2020	REVISION SUBJECT TO APPROVALMENT	ivan
A	21/04/2020	REVISION SUBJECT TO APPROVALMENT	ivan
NO.	DATE	REVISION	BY

JOB NO. : J-852
 PROJECT : PROPOSED RESIDENTIAL DEVELOPMENT AT 139 - 147 ARGYLE STREET, NKIL 6005, 6035 R.P., 6036 R.P., 6037 R.P. & 6038 R.P.

TITLE : WINDOW SCHEDULE FOR IN-SITU ALUM. WINDOW


DATE : 05-FEB-20 SCALE : 1:100
 DRAWN BY : MN CHECKED BY : DW

美特鋁質有限公司
MIDI ALUMINIUM FABRICATOR LTD.
 Units 6-8, Sunray Industrial Centre, 1/F
 610 Cha Kwo Ling Road, Kowloon
 Tel:23489211-4 Fax:(852)27727666


ELEVATION

WINDOW MARK	w1/T3C
LOCATION	1/F~21/F LIV./DIN. AT TOWER 3 FLAT C
SECTION	67mm ALUM. SECTION
GLAZING	GLO1
QUANTITY	18
REMARKS	FAÇADE (PF-49)


DWG NO. : J852-SD-IW-4310 REV. : C

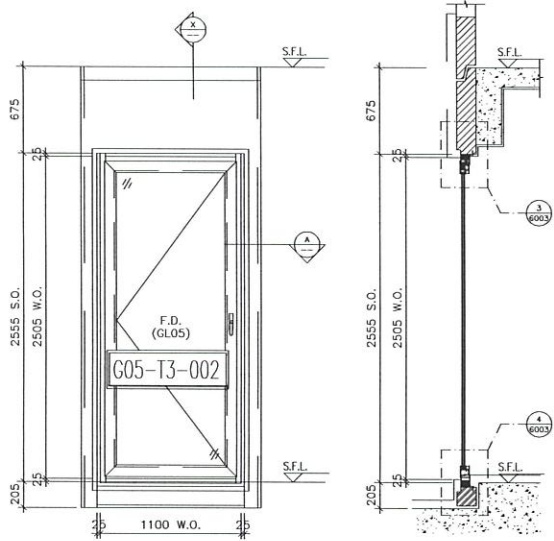

ELEVATION

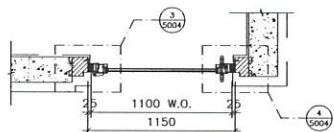

PART PLAN A1

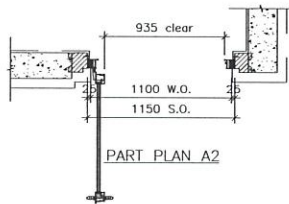

PART PLAN A2

TYPES	
FRANCE DOOR DIMENSION	(TOTAL) = 1100 (HEIGHT) = 2505
NUMBER OF OPENABLE AREA WINDOW	1
GLAZING AREA	
FRANCE WINDOW	
WIDTH = 1100-1150	810 mm
HEIGHT = 2505-2555	1405 mm
TOTAL = 1100x1405	1545.5 m
OPENABLE AREA	
WIDTH = 1100-1150	915 mm
HEIGHT = 2505-2555	1255 mm
TOTAL = 1100x1255	1380.5 m

PROVIDED	
GLAZING AREA	1.194 m ²
OPENABLE AREA	1.274 m ²

W5/T3C

ELEVATION

WINDOW MARK	WS/T3C
LOCATION	1/F B.R.2 AT TOWER 3 FLAT C
SECTION	70mm ALUM. SECTION
GLAZING	GLO5
QUANTITY	1
REMARKS	FAÇADE (PF-26)

B.D. REF :

CLIENT :

ARCHITECT :
AGC DESIGN LTD

MAIN CONTRACTOR :
Gammon

STRUCTURAL ENGINEER :
ARUP

FAÇADE CONSULTANT:
MEINHARDT

NOTE:
1. ALL DIMENSIONS ARE IN mm.
2. ALL ELEVATIONS ARE VIEWED FROM OUTSIDE.
3. ALL DIMENSIONS TO BE VERIFIED ON SITE BEFORE FABRICATION.

LEGEND:
 (X1) --- DETAIL MARK NO.
 (X001) --- REFER SHEET NO.
 1. F.F.L. --- FINISHED FLOOR LEVEL
 2. S.F.L. --- STRUCTURAL FLOOR LEVEL
 3. (R) --- REVERSED DETAIL

NO.	DATE	REVISION	REVISION SUBJECT TO ARCH/COMMENT	ISSUED BY
D	04/02/2021	REVISION SUBJECT TO ARCH/COMMENT		
C	16/10/2020	REVISION SUBJECT TO ARCH/COMMENT		
B	29/01/2020	REVISION SUBJECT TO ARCH/COMMENT		
A	21/04/2020	REVISION SUBJECT TO ARCH/COMMENT		

JOB NO. : J-852
 PROJECT :
 PROPOSED RESIDENTIAL DEVELOPMENT
 AT 139 - 147 ARGYLE STREET,
 NKIL 6005, 6035 R.P., 6036 R.P.,
 6037 R.P. & 6038 R.P.

TITLE : WINDOW SCHEDULE FOR IN-SITU ALUM. WINDOW

DATE : 05-FEB-20 SCALE : 1:100
 DRAWN BY : MN CHECKED BY : DW

美特鋁質有限公司
MIDI ALUMINIUM FABRICATOR LTD.
 Units 6-8, Sunray Industrial Centre, 1/F
 610 Cho Kwo Ling Road, Kowloon
 Tel:23489211-4 Fax:(852)2727666

DWG NO. : J852-SD-IW-4311 REV. : D

 美特鋁質 有限公司 MIDI Aluminium Fabricator Ltd.		工程號:	J852	計算:	sde	日期:	01/03/2021	送呈:		
		地盤名稱:		核對:		日期:		副本:	參考用	
地盤用玻璃B.M.表		項目類別:	T1后裝窗及FD門及趟門玻璃 (1F-21F)			日期:		A/C Code:		
BM編號:		修改版次:	A (2021-03-12)	總計玻璃面積 (平方米):		685.92				
序號	修改內容	玻璃圖號	顏色與類型	厚度 (mm)	玻璃尺寸		數量 (塊)	總面積 (平方米)	使用位置	加工圖參考
					寬度 (W mm)	高度 (H mm)				
1		GL03-T1-001	6mm+12mm AIR GAP+6mm THK. I.G.U.	24.0	506.0	1226.0	36	22.33	T1后裝窗	GL03-T1-001
2		GL03-T1-002			531.0	1226.0	18	11.72	T1后裝窗	GL03-T1-002
3		GL03-T1-003			521.0	1226.0	18	11.50	T1后裝窗	GL03-T1-003
4		GL03-T1-004			571.0	1201.0	18	12.34	T1后裝窗	GL03-T1-004
					合計:		90	57.89		
1		GL01-T1-001	8mm+12mm AIR GAP+10mm THK. I.G.U.	30.0	1133.0	418.0	18	8.52	T1后裝窗	GL01-T1-001
2		GL01-T1-002			1173.0	203.0	18	4.29	T1后裝窗	GL01-T1-002
3		GL01-T1-003			346.0	1599.0	18	9.96	T1后裝窗	GL01-T1-003
4		GL01-T1-004			942.5	2419.0	36	82.08	T1四趟趟門	GL01-T1-004
5		GL01-T1-005			1020.0	2268.0	36	83.28	T1四趟趟門	GL01-T1-005
6		GL01-T1-006			861.5	2285.0	36	70.87	T1三趟趟門	GL01-T1-006
7		GL01-T1-007			861.5	2285.0	36	70.87	T1三趟趟門	GL01-T1-007
8		GL01-T1-008			517.0	2285.0	36	42.53	T1三趟趟門	GL01-T1-008
9		GL01-T1-009			830.0	2419.0	36	72.28	T1四趟趟門	GL01-T1-009
10		GL01-T1-010			920.0	2268.0	36	75.12	T1四趟趟門	GL01-T1-010
11		GL01-T1-011			1204.0	2289.0	36	99.21	T1兩趟趟門	GL01-T1-011
12		GL01-T1-012			460.0	2416.0	1	1.11	T1FD門	GL01-T1-012
13		GL01-T1-013					1110.0	2416.0	1	2.68

 美特鋁質 有限公司 MIDI Aluminium Fabricator Ltd.		工程號:	J852	計算:	sde	日期:	01/03/2021	送呈:		
		地盤名稱:		核對:		日期:		副本:	參考用	
地盤用玻璃B.M.表		項目類別:	T1后裝窗及FD門及趟門玻璃 (1F-21F)			日期:		A/C Code:		
BM編號:		修改版次:	A (2021-03-12)	總計玻璃面積 (平方米):		685.92				
序號	修改內容	玻璃圖號	顏色與類型	厚度 (mm)	玻璃尺寸		數量 (塊)	總面積 (平方米)	使用位置	加工圖參考
					寬度 (W mm)	高度 (H mm)				
						合計:	344	622.79		
1		GL05-T1-001	6mm+12mm AIR GAP+8mm THK.		697.0	2303.0	2	3.21	T1FD門	GL01-T1-001
2		GL05-T1-002	I.G.U.		878.0	2303.0	1	2.02	T1FD門	GL01-T1-002
						合計:	3	5.23		
						总合计:	437	685.92		
加工注意事項:		1).本表中之所有玻璃顏色待定。								
		2).本表中所有玻璃對角線尺寸偏差要求不超過負2mm。								
		3).本表中玻璃要求粗磨邊處理並倒棱角，而所有玻璃之入爐方向需保持一致。								
		4).本表中所有玻璃成品均需做雙面保護，用透明靜電膠紙加四周一寸FK白膠紙做雙面加固保護處理。								
		5).本表中所有玻璃成品均需注明室內外及其玻璃編號，以便識別。								

 美特鋁質 有限公司 MIDI Aluminium Fabricator Ltd.		工程號:	J852	計算:	sde	日期:	01/03/2021	送呈:		
		地盤名稱:		核對:		日期:		副本:	參考用	
地盤用玻璃B.M.表		項目類別:	T2后裝窗及FD門及趟門玻璃 (1F-21F)			日期:		A/C Code:		
BM編號:		修改版次:	A (2021-03-12)	總計玻璃面積 (平方米):		659.06				
序號	修改內容	玻璃圖號	顏色與類型	厚度 (mm)	玻璃尺寸		數量 (塊)	總面積 (平方米)	使用位置	加工圖參考
					寬度 (W mm)	高度 (H mm)				
1		GL03-T2-001	6mm+12mm AIR GAP+6mm THK. I.G.U.	24.0	571.0	1201.0	18	12.34	T2后裝窗	GL03-T2-001
2		GL03-T2-002			531.0	1226.0	36	23.44	T2后裝窗	GL03-T2-002
3		GL03-T2-003			521.0	1226.0	36	22.99	T2后裝窗	GL03-T2-003
						合計:	90	58.77		
1		GL01-T2-001	8mm+12mm AIR GAP+10mm THK. I.G.U.	30.0	1173.0	203.0	36	8.57	T2后裝窗	GL01-T2-001
2		GL01-T2-002			140.0	1599.0	18	4.03	T2后裝窗	GL01-T2-002
3		GL01-T2-003			252.0	1599.0	18	7.25	T2后裝窗	GL01-T2-003
4		GL01-T2-004			805.0	2419.0	72	140.21	T2四趟趟門/梗	GL01-T2-004
5		GL01-T2-005			895.0	2268.0	72	146.15	T2四趟趟門/生	GL01-T2-005
6		GL01-T2-006			517.0	2285.0	36	42.53	T2三趟趟門/梗	GL01-T2-006
7		GL01-T2-007			861.5	2285.0	36	70.87	T2三趟趟門/生	GL01-T2-007
8		GL01-T2-008			861.5	2285.0	36	70.87	T2三趟趟門/生	GL01-T2-008
9		GL01-T2-009			1204.0	2289.0	36	99.21	T2兩趟趟門/生	GL01-T2-009
10		GL01-T2-010					1110.0	2416.0	2	5.36
						合計:	362	595.05		
1		GL05-T2-001	6mm+12mm AIR GAP+8mm THK. I.G.U.		697.0	2303.0	2	3.21	T2FD門	GL05-T2-001
		GL05-T2-002			878.0	2303.0	1	2.02	T2FD門	GL05-T2-002
						合計:	3	5.23		
						总合计:	455	659.06		

 美特鋁質 有限公司 MIDI Aluminium Fabricator Ltd.		工程號:	J852	計算:	sdc	日期:	01/03/2021	送呈:		
		地盤名稱:		核對:		日期:		副本:	參考用	
地盤用玻璃B.M.表		項目類別:	T2后裝窗及FD門及趟門玻璃 (1F-21F)			日期:		A/C Code:		
BM編號:		修改版次:	A (2021-03-12)	總計玻璃面積 (平方米):		659.06				
序號	修改內容	玻璃圖號	顏色與類型	厚度 (mm)	玻璃尺寸		數量 (塊)	總面積 (平方米)	使用位置	加工圖參考
					寬度 (W mm)	高度 (H mm)				
加工注意事項:		1).本表中之所有玻璃顏色待定。								
		2).本表中所有玻璃對角線尺寸偏差要求不超過負2mm。								
		3).本表中玻璃要求粗磨邊處理並倒棱角，而所有玻璃之入爐方向需保持一致。								
		4).本表中所有玻璃成品均需做雙面保護，用透明靜電膠紙加四周一寸FK白膠紙做雙面加固保護處理。								
		5).本表中所有玻璃成品均需注明室內外及其玻璃編號，以便識別。								

 美特鋁質 有限公司 MIDI Aluminium Fabricator Ltd.		工程號:	J852	計算:	sde	日期:	01/03/2021	送呈:		
		地盤名稱:		核對:		日期:		副本:	參考用	
地盤用玻璃B.M.表		項目類別:	T3后裝窗及FD門及趟門玻璃 (1F-3F, 6F-21F)			日期:		A/C Code:		
BM編號:		修改版次:	A (2021-03-12)	總計玻璃面積 (平方米):		615.86				
序號	修改內容	玻璃圖號	顏色與類型	厚度 (mm)	玻璃尺寸		數量 (塊)	總面積 (平方米)	使用位置	加工圖參考
					寬度 (W mm)	高度 (H mm)				
1		GL03-T3-001	6mm+12mm AIR GAP+6mm THK. I.G.U.	24.0	506.0	1226.0	34	21.09	T3后裝窗/生	GL03-T3-001
2		GL03-T3-002			518.5	1226.0	17	10.81	T3后裝窗/生	GL03-T3-002
3		GL03-T3-003			508.5	1226.0	17	10.60	T3后裝窗/生	GL03-T3-003
4		GL03-T3-004			571.0	1201.0	17	11.66	T3后裝窗/生	GL03-T3-004
					合計:		85	54.15		
1		GL01-T3-001	8mm+12mm AIR GAP+10mm THK. I.G.U.	30.0	1133.0	203.0	17	3.91	T3后裝窗/梗	GL01-T3-001
2		GL01-T3-002			1145.0	203.0	17	3.95	T3后裝窗/梗	GL01-T3-002
3		GL01-T3-003			249.0	1599.0	17	6.77	T3后裝窗/梗	GL01-T3-003
4		GL01-T3-004			942.5	2419.0	34	77.52	T3四趟趟門/梗	GL01-T3-004
5		GL01-T3-005			1020.0	2268.0	34	78.65	T3四趟趟門/生	GL01-T3-005
6		GL01-T3-006			517.0	2285.0	16	18.90	T3三趟趟門/梗	W7/T3A改為防火門
7		GL01-T3-007			861.5	2285.0	34	66.93	T3三趟趟門/生	GL01-T3-007
8		GL01-T3-008			861.5	2285.0	34	66.93	T3三趟趟門/生	GL01-T3-008
9		GL01-T3-009			830.0	2419.0	34	68.26	T3四趟趟門/梗	GL01-T3-009
10		GL01-T3-010			920.0	2268.0	34	70.94	T3四趟趟門/生	GL01-T3-010
11		GL01-T3-011			1204.0	2289.0	34	93.70	T3兩趟趟門/生	GL01-T3-011
12		GL01-T3-012			460.0	2416.0	1	1.11	T1FD門	GL01-T3-011
13		GL01-T3-013			1110.0	2416.0	1	2.68	T1FD門	GL01-T3-011

 美特鋁質 有限公司 MIDI Aluminium Fabricator Ltd.		工程號:	J852	計算:	sde	日期:	01/03/2021	送呈:		
		地盤名稱:		核對:		日期:		副本:	參考用	
地盤用玻璃B.M.表		項目類別:	T3后裝窗及FD門及趟門玻璃 (1F-3F, 6F-21F)			日期:		A/C Code:		
BM編號:		修改版次:	A (2021-03-12)	總計玻璃面積 (平方米):		615.86				
序號	修改內容	玻璃圖號	顏色與類型	厚度 (mm)	玻璃尺寸		數量 (塊)	總面積 (平方米)	使用位置	加工圖參考
					寬度 (W mm)	高度 (H mm)				
						合計:	307	556.47		
1		GL05-T3-001	6mm+12mm AIR GAP+8mm THK.		697.0	2303.0	2	3.21	T1FD門	GL05-T3-001
2		GL05-T3-002	I.G.U.		878.0	2303.0	1	2.02	T1FD門	GL05-T3-002
						合計:	3	5.23		
						总合计:	395	615.86		
加工注意事項:		1).本表中之所有玻璃顏色待定。								
		2).本表中所有玻璃對角線尺寸偏差要求不超過負2mm。								
		3).本表中玻璃要求粗磨邊處理並倒棱角，而所有玻璃之入爐方向需保持一致。								
		4).本表中所有玻璃成品均需做雙面保護，用透明靜電膠紙加四周一寸FK白膠紙做雙面加固保護處理。								
		5).本表中所有玻璃成品均需注明室內外及其玻璃編號，以便識別。								

包箱要求

T52

*① 大玻璃玻璃 ← (優先鑄出) T52

✓ $\frac{1204}{2390} W \times \frac{2070}{2289} H$ 此尺寸均開包。

*② 行底台層包箱

*③ 所有 GL04 10mm 的單片
此單 (小件欄均玻璃)
按尺寸包裝。

*④ T3 優先, T1, T2 同步

*⑤ $2^2/F$ $2^3/F$ 優先

*⑥ 廁所玻璃優先