美特鋁質有限公司
MIDI ALUMINIUM FABRICATOR LTD.

工程指示 / 要求簡箋 ENGINEER INSTRUCTIONS(E.I.)

工程指示編號:	EI- 6717	**修改版本:**	-
	HK-1997		
工程編號:	J 853	**工程名稱:**	延坪道 (第2期)
收件人:	生統	**發件人:**	Joe Chan
工程項目:	佛沙窗廠用背板生產.	**日期:**	07/09/2023

☐ 原合約工程包	☐ 原合約工程加 / 減賬 QT-	☐ 新工程報價 QT-

信件批核號碼/圖紙參考編號:	**批核模具圖紙編號:**
客戶指示附件:	**管理內部批簽署:**

☐ 初步鋁料 B.M.	☐ 加工拆圖，然後生產	☐ 尺寸表
☐ 正式鋁料 B.M.	☐ 技術上資料／指示	☐ 報價
☐ 配件 B.M.	☐ 樣辦或貨品說明書	☐ 分判合約
☑ 其他:		

內容: 請按附件資料，生產背板.
(用於 J853 第二期之佛沙窗).

完成上列要求日期: 30/9/2023

國內

☐ 生產技術總監	☐ 連附件	☐ 技術部	☐ 連附件	☐ 生產部	☐ 連附件
☐ 採購部	☐ 連附件	☑ 生產統籌部	☑ 連附件	☐ 報關組	☐ 連附件
☐ 質檢部	☐ 連附件	☐ 會計部	☐ 連附件	☐ 機械設計部	☐ 連附件
☐ 香港辦	☐ 連附件	☐ 其他:			

香港

☐ 行政部	☐ 連附件	☐ 會計部	☐ 連附件	☐ 統籌部	☐ 連附件	☐ 工程部	☐ 連附件
☐ 採購部	☐ 連附件	☐ QS部	☐ 連附件	☐ 地盤管理	☐ 連附件	☐ 維修部	☐ 連附件

*發件人簽署:	JC.	*組別成員批核簽署:	P.P. JC.
傳遞編號:	HK1997/23	項目經理簽署:	

美特鋁質有限公司
MIDI Aluminium Fabricator Ltd.

QF005/8

圖則登記表
DRAWING REGISTER

工程名稱 Project Title:	延坪道二期 佛沙窗（百葉用）背板
工程編號 Project No:	J-853

接收日期 Receiving Date (適用於客戶圖則)

年										
月										
日										

分發予 Distributed To

	年	23								
	月	9								
	日	6								

發出日期 Issued Date

圖則編號 Drg. No.	圖則名稱 Drawing Title		修訂編號 Revision No.
BK-101	百葉用背板	1	-
BK-102	百葉用背板	2	-
BK-103	百葉用背板	3	-
BK-201	百葉用背板	4	-
BK-202	百葉用背板	5	-
BK-203	百葉用背板	6	-
BK-204	百葉用背板	7	-
BK-205	百葉用背板	8	-
BK-206	百葉用背板	9	-
BK-207	百葉用背板	10	-
J853-SD-HPW-2004	背板位置圖	11	-
J853-SD-HPW-2006	背板位置圖	12	-
J853-SD-HPW-2007	背板位置圖	13	-
J853-SD-HPW-2008	背板位置圖	14	-
J853-SD-HPW-2009	背板位置圖	15	-
J853-SD-HPW-2010	背板位置圖	16	-
J853-SD-HPW-2011	背板位置圖	17	-
J853-SD-HPW-2011a	背板位置圖	18	-
J853-SD-HPW-2012	背板位置圖	19	-
J853-SD-HPW-2012a	背板位置圖	20	-
J853-SD-HPW-2013	背板位置圖	21	-
J853-SD-HPW-2014	背板位置圖	22	-
J853-SD-HPW-2016a	背板位置圖	23	-
J853-SD-HPW-2017	背板位置圖	24	-

美特鋁質 有限公司 MIDI Aluminium Fabricator Ltd.	工程號:	J-853	計算:	劉龍浩	日期:	2022.09.04	送呈:	胡哥
	地盤名稱:	延平道 2期屋仔	核對:	謝永林	日期:	2022.09.07	副本:	
廠用鋁背板B.M.表	項目類別:	佛沙窗百葉背板	批准:		日期:		A/C Code:	
	修改版次:	-	總V.F.:	6.84		總重量:	27.82	


序號	修改內容	鋁板圖號	鋁板名稱	顏色	實用	後備	總數	總重量	單件展開面積㎡	總展開面積㎡	單件V.F. ㎡	總V.F. ㎡	房號	窗號	樓層	備註
1		BK-101	3mm厚鋁板	EC-DG-D334232-ZD1(閃粉古銅)	1		1	1.665	0.205	0.205	0.410	0.410	HB1	WB.18B	1/F	
2		BK-101	3mm厚鋁板	EC-DG-D334232-ZD1(閃粉古銅)	1		1	1.665	0.205	0.205	0.410	0.410	HC2	WD.19D1	1/F	
3		BK-101	3mm厚鋁板	EC-DG-D334232-ZD1(閃粉古銅)	1		1	1.665	0.205	0.205	0.410	0.410	HC1	WG.14G	1/F	
4		BK-101	3mm厚鋁板	EC-DG-D334232-ZD1(閃粉古銅)	1		1	1.665	0.205	0.205	0.410	0.410	HC3	WD.19D	1/F	
5		BK-102	3mm厚鋁板	EC-DG-D334232-ZD1(閃粉古銅)	1		1	1.275	0.157	0.157	0.314	0.314	HB2,	WB.18aB	1/F	
6		BK-102	3mm厚鋁板	EC-DG-D334232-ZD1(閃粉古銅)	2		2	2.549	0.157	0.314	0.314	0.627	HD2&HD3	WD.19aD1	1/F	
7		BK-102	3mm厚鋁板	EC-DG-D334232-ZD1(閃粉古銅)	1		1	1.275	0.157	0.157	0.314	0.314	HB3,	WC.18C	1/F	
8		BK-102	3mm厚鋁板	EC-DG-D334232-ZD1(閃粉古銅)	1		1	1.275	0.157	0.157	0.314	0.314	HD1	WE.11E1	1/F	
9		BK-103	3mm厚鋁板	EC-DG-D334232-ZD1(閃粉古銅)	1		1	3.058	0.376	0.376	0.752	0.752	HD1	WE.07E1	G/F	
10		BK-201	3mm厚鋁板	EC-DG-D334232-ZD1(閃粉古銅)	1		1	1.146	0.141	0.141	0.282	0.282	HC3	LD.03D	2/F	
11		BK-201	3mm厚鋁板	EC-DG-D334232-ZD1(閃粉古銅)	1		1	1.146	0.141	0.141	0.282	0.282	HC2	LD.03D1	2/F	
12		BK-202	3mm厚鋁板	EC-DG-D334232-ZD1(閃粉古銅)	1		1	0.866	0.106	0.106	0.213	0.213	HB3	LC.01C	1/F	
13		BK-203	3mm厚鋁板	EC-DG-D334232-ZD1(閃粉古銅)	1		1	1.228	0.151	0.151	0.302	0.302	HD1	LE.02E1	1/F	
14		BK-203	3mm厚鋁板	EC-DG-D334232-ZD1(閃粉古銅)	1		1	1.228	0.151	0.151	0.302	0.302	HD1	LE.03E1	2/F	
15		BK-204	3mm厚鋁板	EC-DG-D334232-ZD1(閃粉古銅)	2		2	1.867	0.115	0.230	0.230	0.459	HB1,HB2	LB.01B	2/F	
16		BK-205	3mm厚鋁板	EC-DG-D334232-ZD1(閃粉古銅)	2		2	1.556	0.096	0.191	0.191	0.383	HB1,HB2	LB.02B	1/F	
17		BK-206	3mm厚鋁板	EC-DG-D334232-ZD1(閃粉古銅)	1		1	1.433	0.176	0.176	0.352	0.352	HB3	LC.03C	2/F	
18		BK-207	3mm厚鋁板	EC-DG-D334232-ZD1(閃粉古銅)	2		2	1.256	0.077	0.154	0.154	0.309	HD2&HD3	LD.03aD1	2/F	
				統計:			22	27.818		3.422		6.843				


EG-DWG3

美特鋁質 有限公司
MIDI Aluminium Fabricator Ltd.

工程號	J853	地盤	錦上路/延平道

序號	物料編號	數量	L	M	x	N	圖號	窗號	Facade
1	BK-101	1	665	211.0	x	3	J853-SD-HPW-2004	WB.18B	HB1
2	BK-101	1	665	211.0	x	3	J853-SD-HPW-2011	WD.19D1	HC2
3	BK-101	1	665	211.0	x	3	J853-SD-HPW-2017	WG.14G	HC1
4	BK-101	1	665	211.0	x	3	J853-SD-HPW-2011	WD.19D	HC3
	合計:	4							

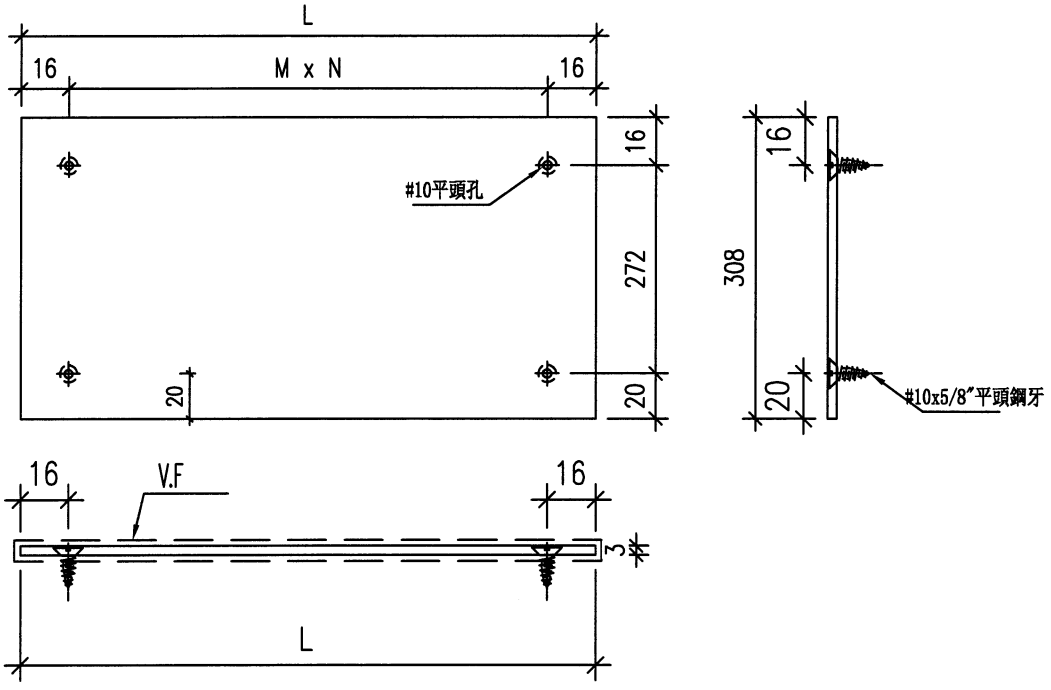

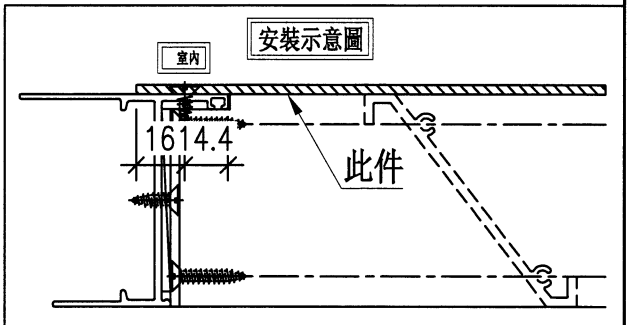


名稱	百頁鋁背板	制圖	劉龍浩	2023.09.04	修改			
材料	3mm鋁板	復核	謝永林	2023.09.07	日期			
顏色	EC-DG-D334232-ZD1(閃粉古銅)	批准			圖號	BK-101		


EG-DWG3

美特鋁質 有限公司
MIDI Aluminium Fabricator Ltd.

工程號	J853	地盤	錦上路/延平道

序號	物料編號	數量	L	M	x	N	圖號	窗號	Facade
1	BK-102	1	585	276.5	x	2	J853-SD-HPW-2004	WB.18aB	HB2,
2	BK-102	2	585	276.5	x	2	J853-SD-HPW-2011a	WD.19aD1	HD2&HD3
3	BK-102	1	585	276.5	x	2	J853-SD-HPW-2008	WC.18C	HB3,
4	BK-102	1	585	276.5	x	2	J853-SD-HPW-2014	WE.11E1	HD1
	合計:	5							

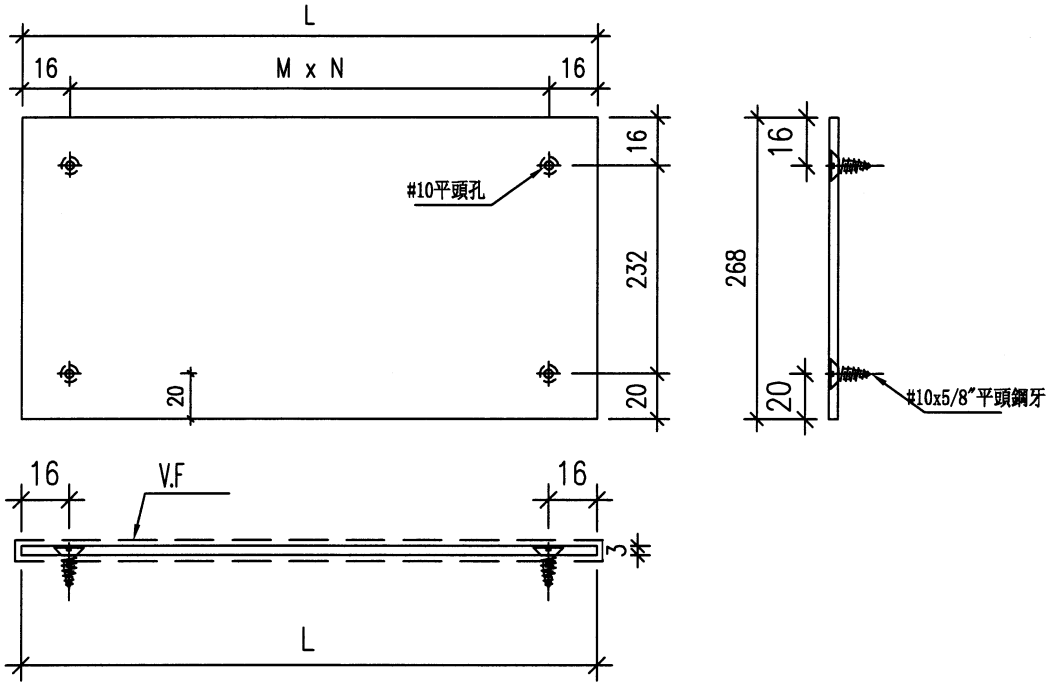

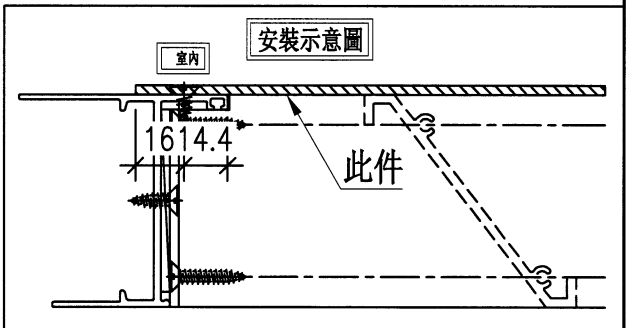


名稱	百頁鋁背板	制圖	劉龍浩	2023.09.04	修改			
材料	3mm鋁板	復核	謝永林	2023.09.07	日期			
顏色	EC-DG-D334232-ZD1(閃粉古銅)	批准			圖號	BK-102		


EG-DWG3

美特鋁質 有限公司
MIDI Aluminium Fabricator Ltd.

工程號	J853	地盤	錦上路/延平道

序號	物料編號	數量	L	M	x	N	圖號	窗號	Facade
1	BK-103	1	585	276.5	x	2	J853-SD-HPW-2013	WE.07E1	HD1
	合計：	1							

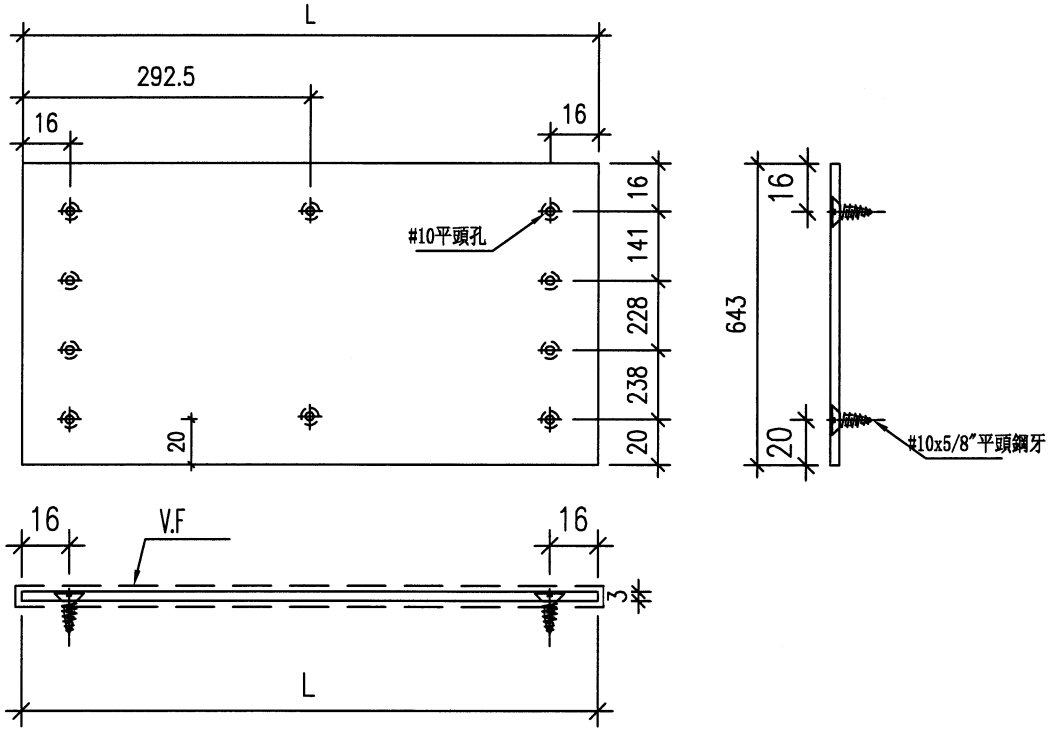

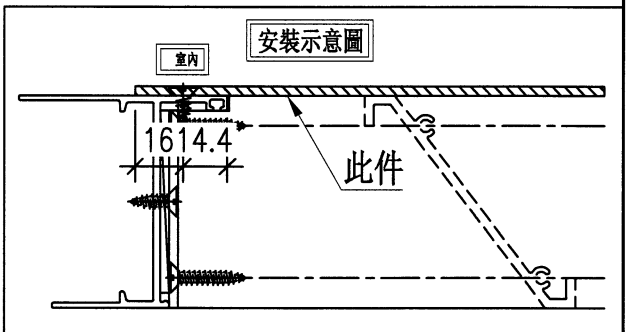


名稱	百頁鋁背板	制圖	劉龍浩	2023.09.04	修改			
材料	3mm鋁板	復核	謝永林	2023.09.07	日期			
顏色	EC-DG-D334232-ZD1(閃粉古銅)	批准			圖號	BK-103		


EG－DWG3

美特鋁質 有限公司
MIDI Aluminium Fabricator Ltd.

工程號	J853	地盤	錦上路/延平道

序號	物料編號	數量	L	M	x	N	圖號	窗號	Facade
1	BK-201	1	665	211.0	x	3	J853-SD-HPW-2012	LD.03D	HC3
2	BK-201	1	665	211.0	x	3	J853-SD-HPW-2012	LD.03D1	HC2
	合計:	2							

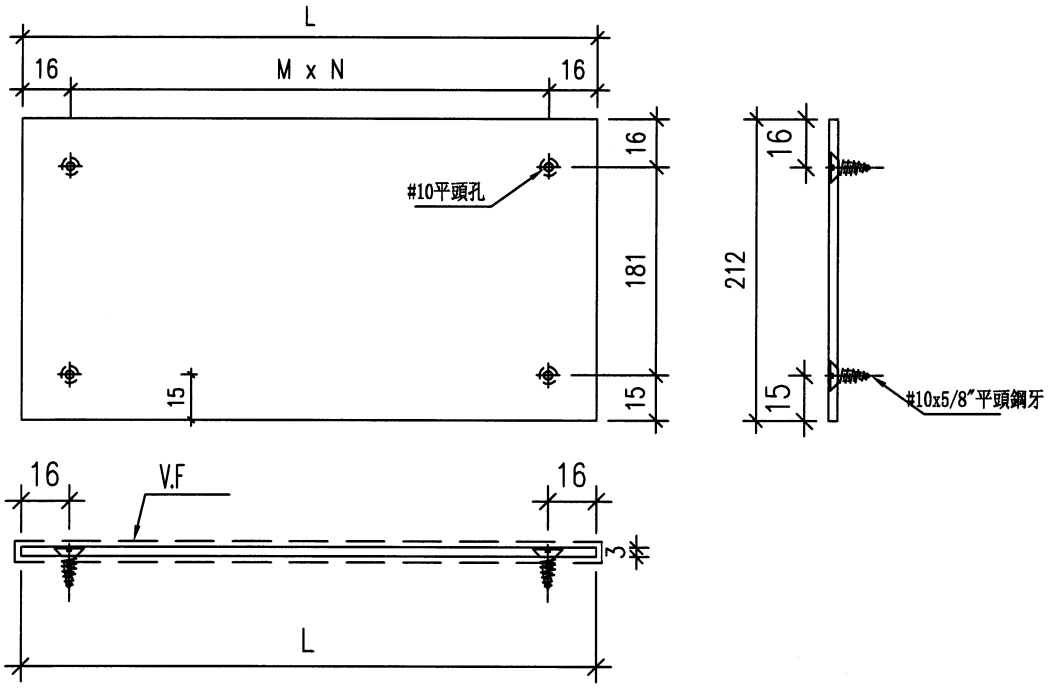

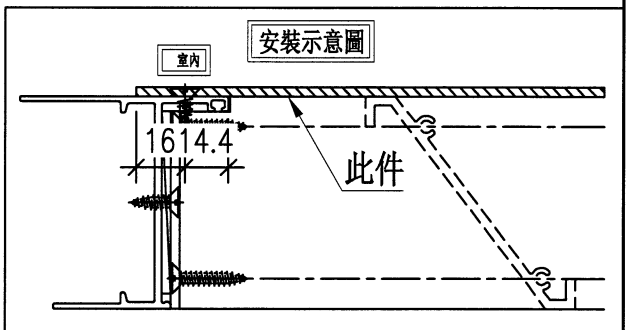


名稱	百頁鋁背板	制圖	劉龍浩	2023.09.04	修改			
材料	3mm鋁板	復核	謝永林	2023.09.07	日期			
顏色	EC-DG-D334232-ZD1(閃粉古銅)	批准			圖號	BK-201		


EG-DWG3

美特鋁質 有限公司
MIDI Aluminium Fabricator Ltd.

工程號	J853	地盤	錦上路/延平道

序號	物料編號	數量	L	M	x	N	圖號	窗號	Facade
1	BK-202	1	585	276.5	x	2	J853-SD-HPW-2009	LC.01C	HB3
	合計:	1							

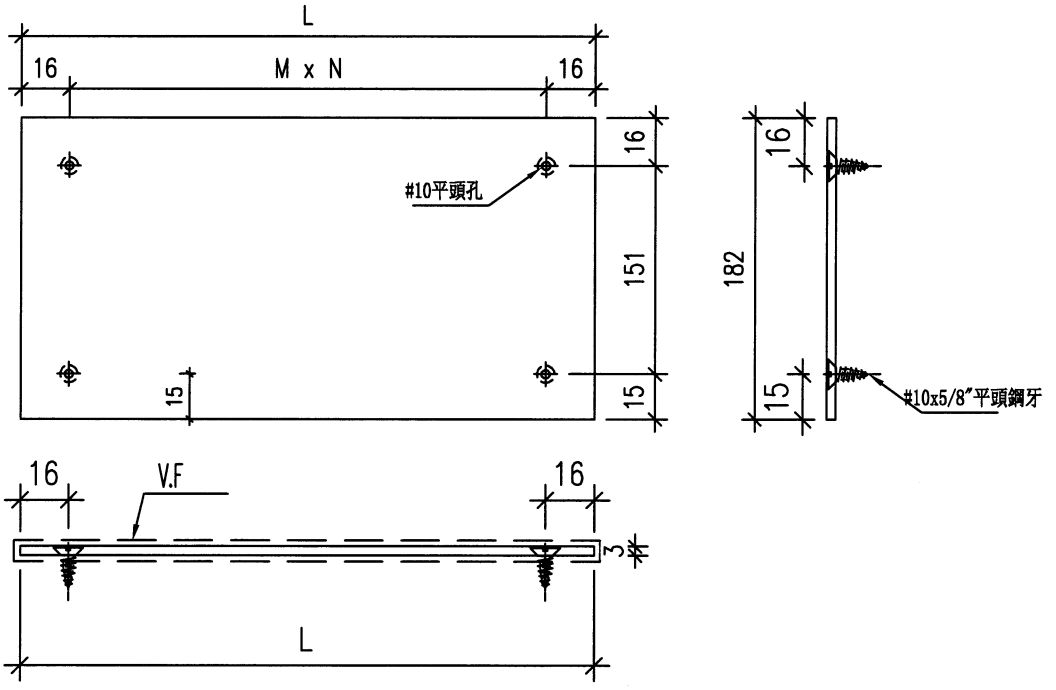

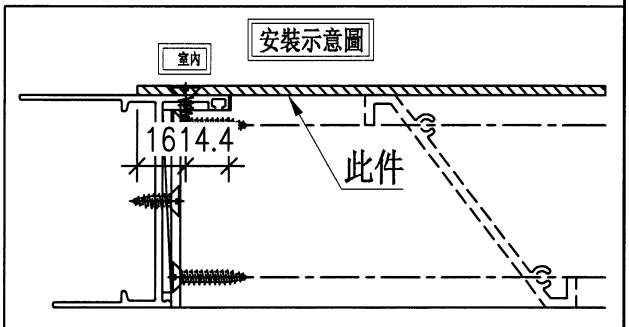


名稱	百頁鋁背板	制圖	劉龍浩	2023.09.04	修改			
材料	3mm鋁板	復核	謝永林	2023.09.07	日期			
顏色	EC-DG-D334232-ZD1(閃粉古銅)	批准			圖號	BK-202		


EG-DWG3

美特鋁質 有限公司
MIDI Aluminium Fabricator Ltd.

工程號	J853	地盤	錦上路/延平道

序號	物料編號	數量	L	M	x	N	圖號	窗號	Facade
1	BK-203	1	830	266.0	x	3	J853-SD-HPW-2016a	LE.02E1	HD1
2	BK-203	1	830	266.0	x	3	J853-SD-HPW-2016a	LE.03E1	HD1
	合計:	2							

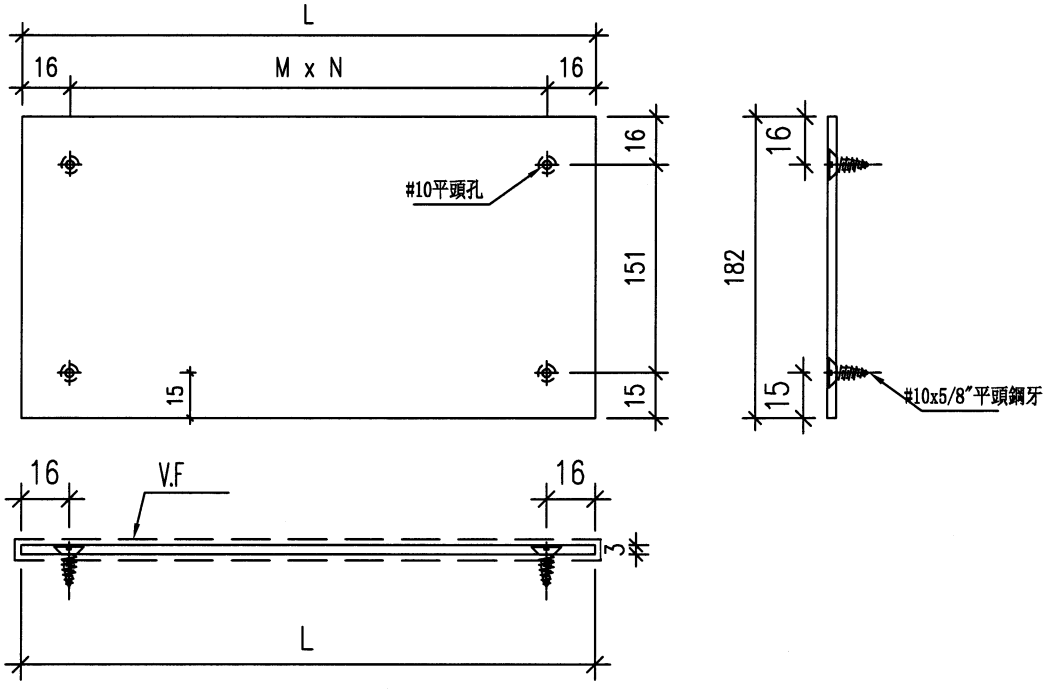

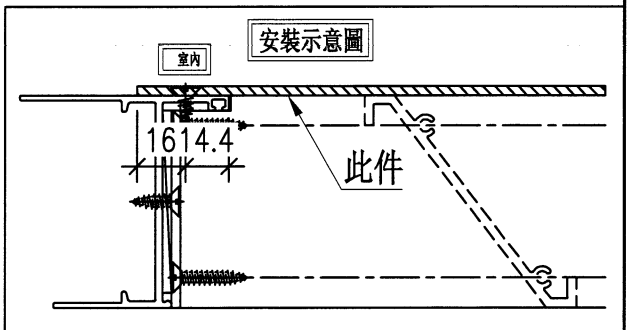


名稱	百頁鋁背板	制圖	劉龍浩	2023.09.04	修改			
材料	3mm鋁板	復核	謝永林	2023.09.07	日期			
顏色	EC-DG-D334232-ZD1(閃粉古銅)	批准			圖號	BK-203		


EG-DWG3

美特鋁質 有限公司
MIDI Aluminium Fabricator Ltd.

工程號	J853	地盤	錦上路/延平道

序號	物料編號	數量	L	M	x	N	圖號	窗號	Facade
1	BK-204	2	870	279.3	x	3	J853-SD-HPW-2006	LB.01B	HB1,HB2
	合計:	2							

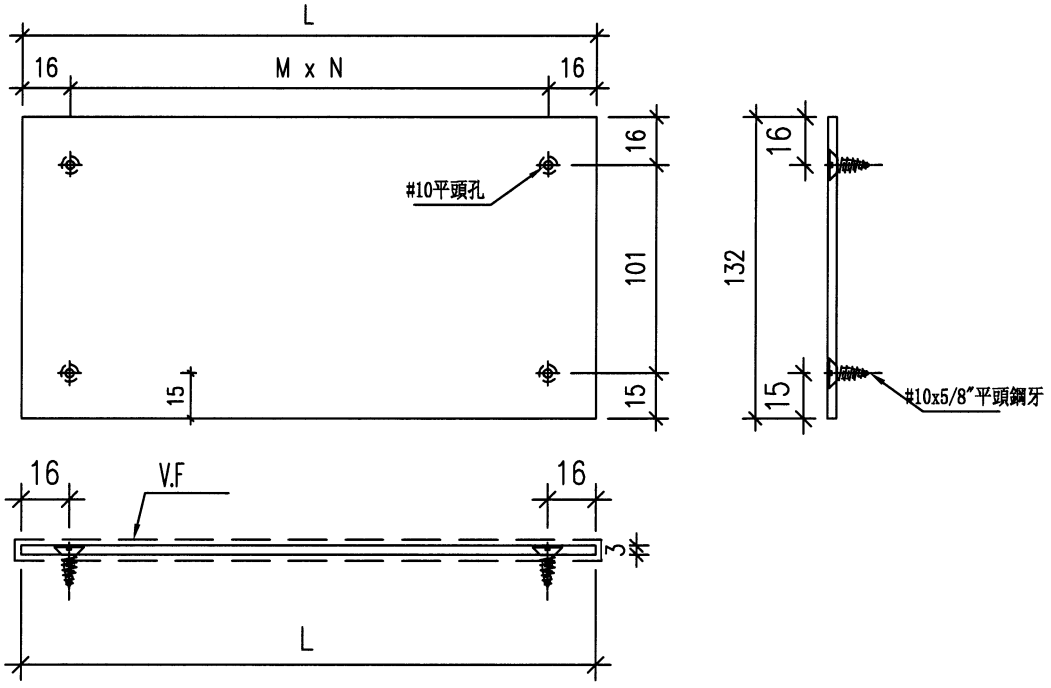

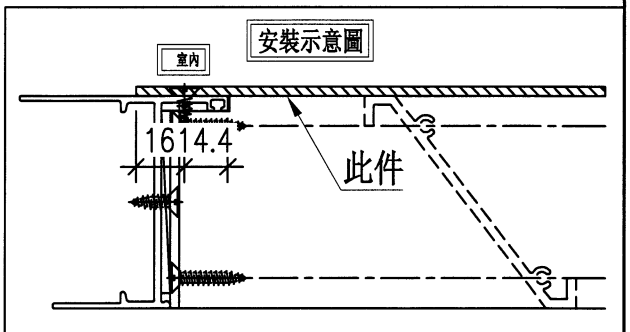


名稱	百頁鋁背板	制圖	劉龍浩	2023.09.04	修改			
材料	3mm鋁板	復核	謝永林	2023.09.07	日期			
顏色	EC-DG-D334232-ZD1(閃粉古銅)	批准			圖號	BK-204		


EG-DWG3

美特鋁質 有限公司
MIDI Aluminium Fabricator Ltd.

工程號	J853	地盤	錦上路/延平道

序號	物料編號	數量	L	M	x	N	圖號	窗號	Facade
1	BK-205	2	725	231.0	x	3	J853-SD-HPW-2007	LB.02B	HB1,HB2
	合計:	2							

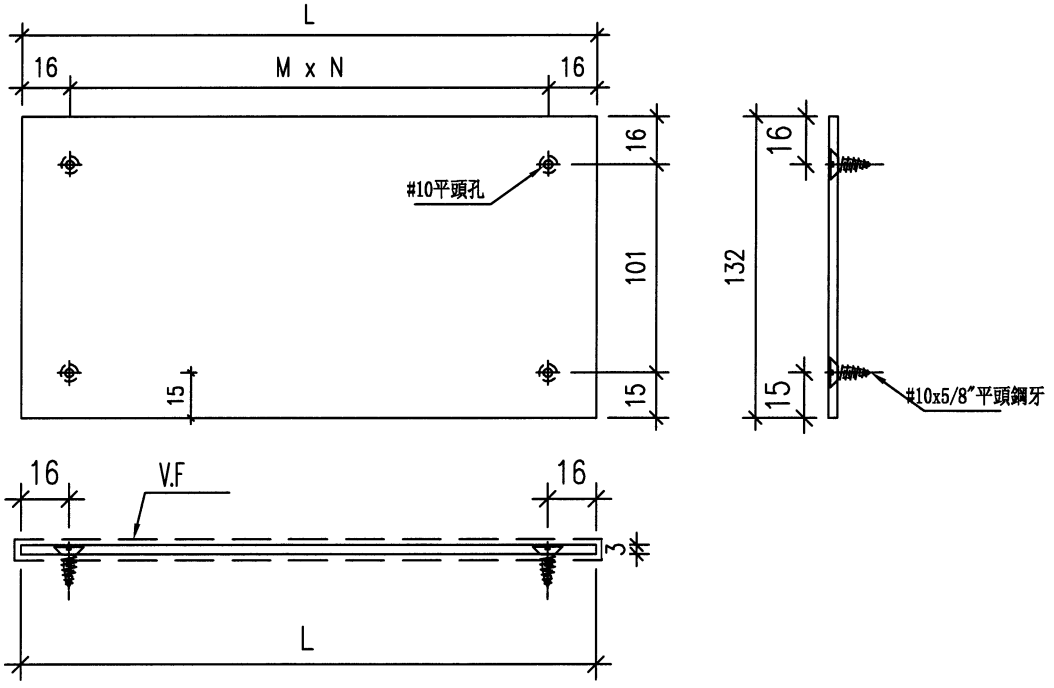

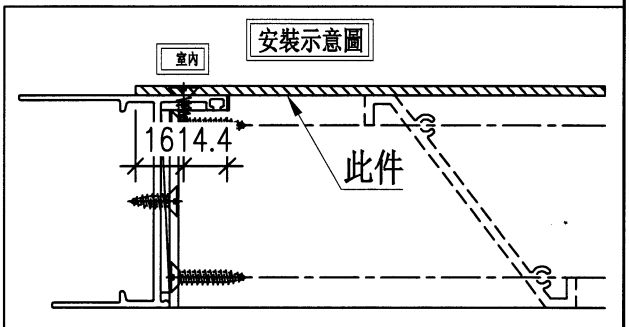


名稱	百頁鋁背板	制圖	劉龍浩	2023.09.04	修改			
材料	3mm鋁板	復核	謝永林	2023.09.07	日期			
顏色	EC-DG-D334232-ZD1(閃粉古銅)	批准			圖號	BK-205		


EG-DWG3

美特鋁質 有限公司
MIDI Aluminium Fabricator Ltd.

工程號	J853	地盤	錦上路/延平道

序號	物料編號	數量	L	M	x	N	圖號	窗號	Facade
1	BK-206	1	1335	260.6	x	5	J853-SD-HPW-2010	LC.03C	HB3
	合計:	1							

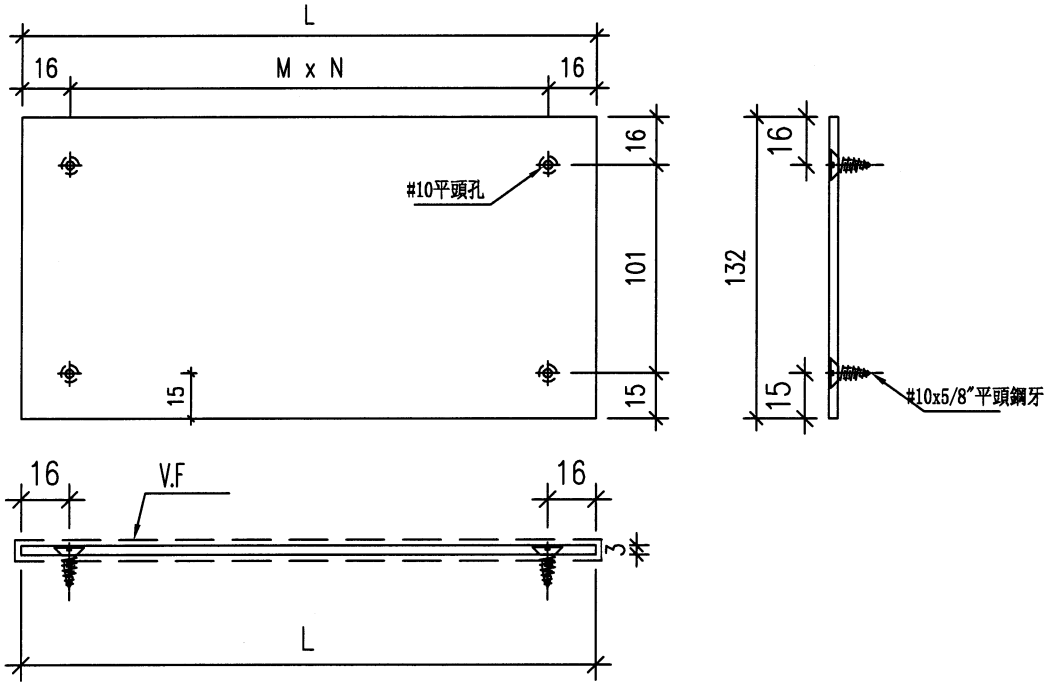

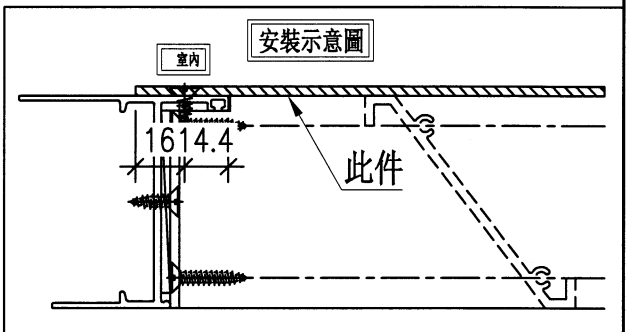


名稱	百頁鋁背板	制圖	劉龍浩	2023.09.04	修改			
材料	3mm鋁板	復核	謝永林	2023.09.07	日期			
顏色	EC-DG-D334232-ZD1(閃粉古銅)	批准			圖號	BK-206		


EG-DWG3

美特鋁質 有限公司
MIDI Aluminium Fabricator Ltd.

工程號	J853	地盤	錦上路/延平道


序號	物料編號	數量	L	M	x	N	圖號	窗號	Facade
1	BK-207	2	585	276.5	x	2	J853-SD-HPW-2012a	LD.03aD1	HD2&HD3
	合計:	2							

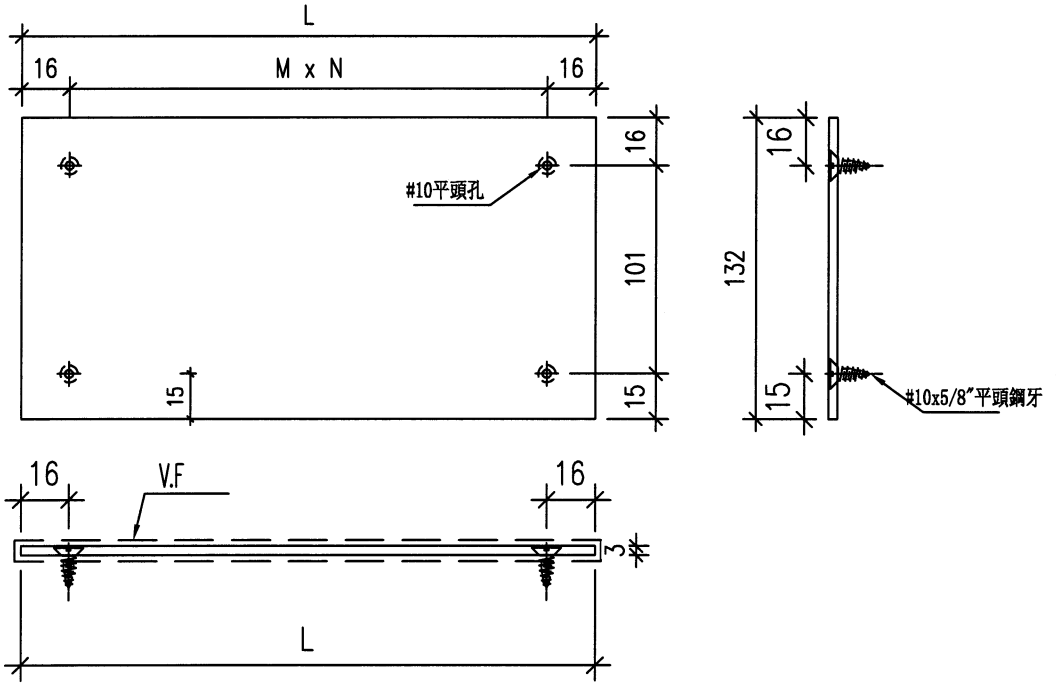

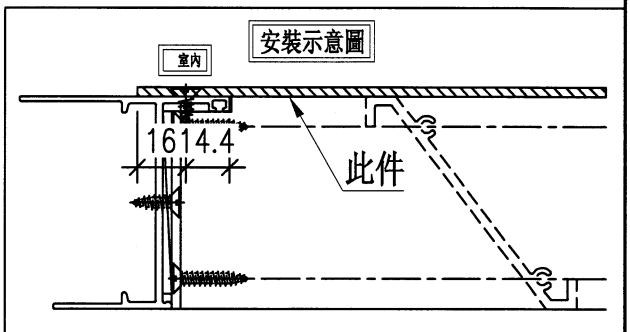


名稱	百頁鋁背板	制圖	劉龍浩	2023.09.04	修改			
材料	3mm鋁板	復核	謝永林	2023.09.07	日期			
顏色	EC-DG-D334232-ZD1(閃粉古銅)	批准			圖號	BK-207		


ELEVATION
(VIEWED FROM THE OUTSIDE)

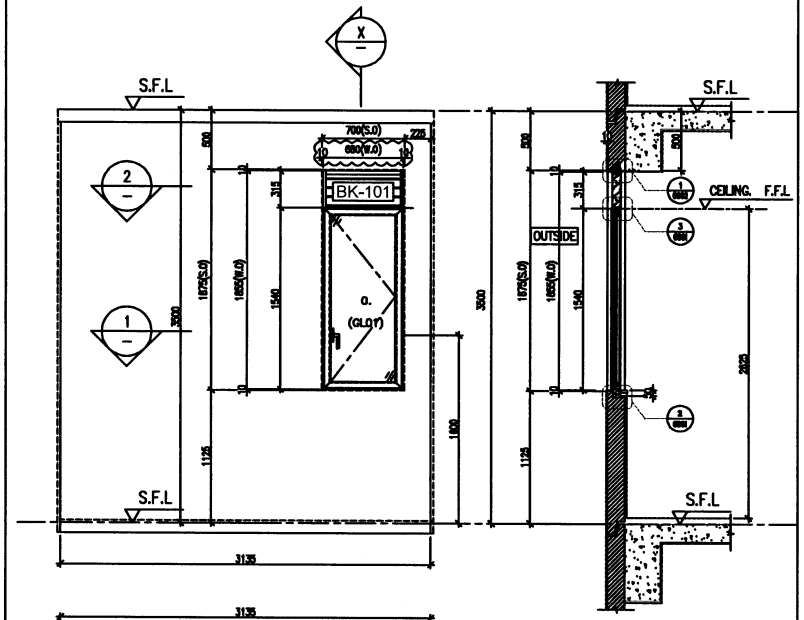


X PART SECTION

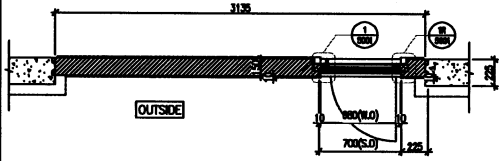


1 PART PLAN

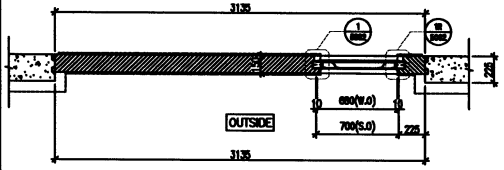


2 PART PLAN

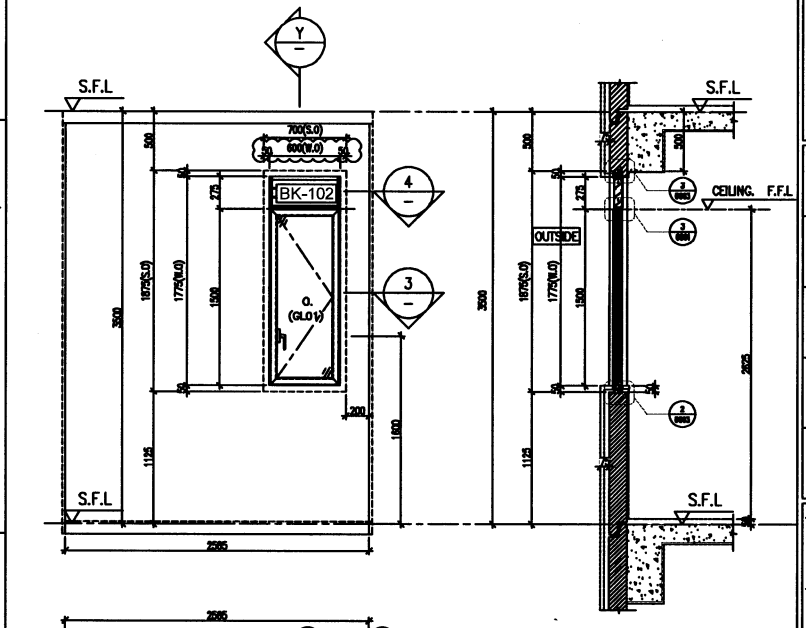

Y PART SECTION

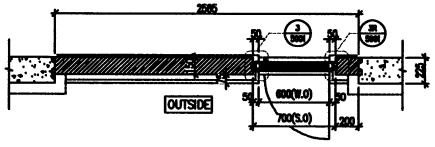

3 PART PLAN

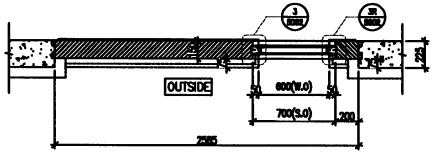

4 PART PLAN

PROVIDED		
GLAZING AREA	0.769	m^2
OPENABLE AREA	0.835	m^2
FREE AREA	50.1	%

WINDOW MARK	HB1 B	HB2 B
LOCATION	HOUSE TYPE B – 1/F EN. BATH 4	HOUSE TYPE B – 1/F EN. BATH 4
SECTION	70mm ALUM. SECTION AL1	70mm ALUM. SECTION AL1
GLAZING	GL01	GL01
QUANTITY	1 No.	1 No.
REMARKS	HOUSE NO. HB1	HOUSE NO. HB2

B.D. REF :

CLIENT :
SHIMAO GROUP HOLDINGS LIMITED

ARCHITECT : WONG TUNG & PARTNERS LIMITED

MAIN CONTRACTOR :
協興建築有限公司
HIP HING CONSTRUCTION CO LTD

STRUCTURAL ENGINEER :
C M WONG & ASSOCIATES LTD
黃志明建築工程師有限公司

FACADE CONSULTANT:
MEINHARDT

NOTE :
1. ALL DIMENSIONS ARE IN mm.
2. ALL ELEVATIONS ARE VIEWED FROM OUTSIDE.
3. ALL DIMENSIONS TO BE VERIFIED ON SITE BEFORE FABRICATION.

LEGEND :
- XX / DWG — DETAIL MARK NO. / REFER SHEET NO.
1. F.F.L. — FINISHED FLOOR LEVEL
2. S.F.L. — STRUCTURAL FLOOR LEVEL
3. (R) — REVERSED DETAIL
4. ▲ — FIXING LOCATION
5. △ — FIXING LUG LOCATION
6. GLASS LEGEND
GL01 — 10mm+12mm AIR GAP+10mm THK. I.G.U.
7. AL1
— PVF2 COATED ALUMINUM SPRAY TRIWAR (4 COAT SYSTEM) CODE: EC-DG-0334232 COLOR : ODYY 07/083 METALLIC

C	12/05/2023	GENERAL REVISED	
B	27/04/2023	GENERAL REVISED	
A	08/03/2023	GENERAL REVISED	
NO.	DATE	REMARK	BY

JOB NO. : J-853

PROJECT :
PROPOSED RESIDENTIAL DEVELOPMENT AT N.K.I.L. 6542 YIN PING ROAD KOWLOON

TITLE :
PRECAST ALUM. WINDOW & LOUVRE SCHEDULE FOR HOUSE TYPE B (1)


DATE : 12-FEB-23 | SCALE : 1:40 (A3)

DRAWN BY : Aming | CHECKED BY :


美特鋁製有限公司
MIDI ALUMINIUM FABRICATION LTD.
Units 6-8, Sunray Industrial Centre, 1/F
610 Cha Kwo Ling Road, Kowloon
Tel:23489211-4 Fax:(852)27727066

DWG NO. : J853-SD-HPW-2004 | REV. : C

ELEVATION
(VIEWED FROM THE OUTSIDE)

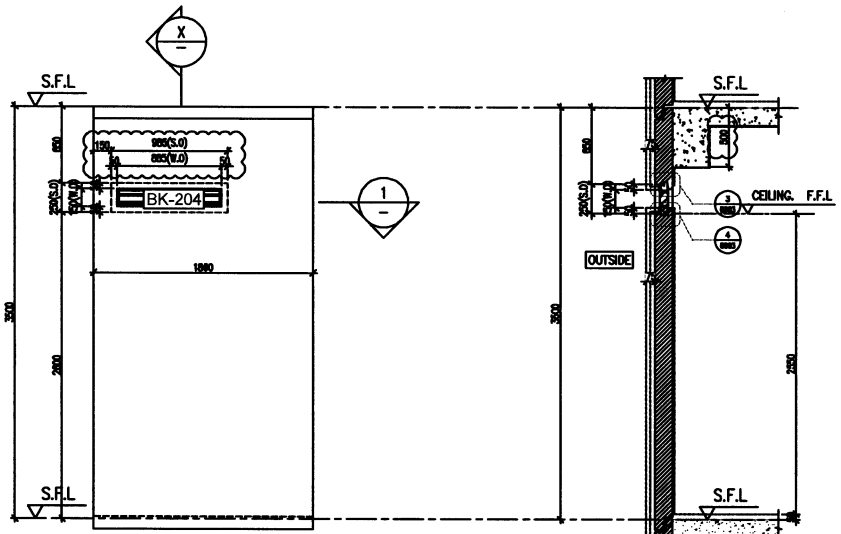

X PART SECTION

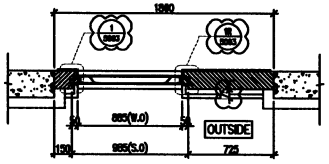

1 PART PLAN

PROVIDED		
GLAZING AREA	0	m^2
OPENABLE AREA	0	m^2
FREE AREA	50.1	%

WINDOW MARK	LG.01 B
LOCATION	HOUSE TYPE B – 2/F M.BATH
SECTION	70mm ALUM. SECTION AL1
GLAZING	–
QUANTITY	2 Nos
REMARKS	HOUSE NO. HB1, HB2

B.D. REF :

CLIENT :
SHIMAO GROUP HOLDINGS LIMITED

ARCHITECT : WONG TUNG & PARTNERS LIMITED

MAIN CONTRACTOR :
協興建築有限公司
HIP HING CONSTRUCTION CO LTD

STRUCTURAL ENGINEER :
C M WONG & ASSOCIATES LTD
黃志明建築工程師有限公司

FACADE CONSULTANT:
MEINHARDT

NOTE :
1. ALL DIMENSIONS ARE IN mm.
2. ALL ELEVATIONS ARE VIEWED FROM OUTSIDE.
3. ALL DIMENSIONS TO BE VERIFIED ON SITE BEFORE FABRICATION.

LEGEND :
- X / — DETAIL MARK NO.
- — / 0000 REFER SHEET NO.

1. F.F.L. — FINISHED FLOOR LEVEL
2. S.F.L. — STRUCTURAL FLOOR LEVEL
3. (R) — REVERSED DETAIL
4. ▲ — FIXING LOCATION
5. △ — FIXING LUG LOCATION
6. GLASS LEGEND
   GL01 — 10mm+12mm AIR GAP+10mm THK. LG.U.
7. AL1
   — PVF2 COATED ALUMINUM SPRAY TRIWAR (4 COAT SYSTEM) CODE: EC-DO-0334232 COLOR : ODYY 07/083 METALLIC

NO.	DATE	REMARKS	BY
C	12/06/2023	GENERAL REVISED	
B	27/04/2023	GENERAL REVISED	
A	08/03/2023	GENERAL REVISED	

JOB NO. : J-853

PROJECT :
PROPOSED RESIDENTIAL DEVELOPMENT AT N.K.I.L. 6542 YIN PING ROAD KOWLOON

TITLE :
PRECAST ALUM. WINDOW & LOUVRE SCHEDULE FOR HOUSE TYPE B (3)


DATE : 12-FEB-23 | SCALE : 1:40

DRAWN BY : | CHECKED BY :


美特鋁質有限公司
MIDI ALUMINIUM FABRICATION LTD.
Units 6-8, Sunray Industrial Centre, 1/F
610 Cha Kwo Ling Road, Kowloon
Tel:23409211-4 Fax:(852)27727666

DWG NO. : J853-SD-HPW-2006 | REV. : C

ELEVATION
(VIEWED FROM THE OUTSIDE)

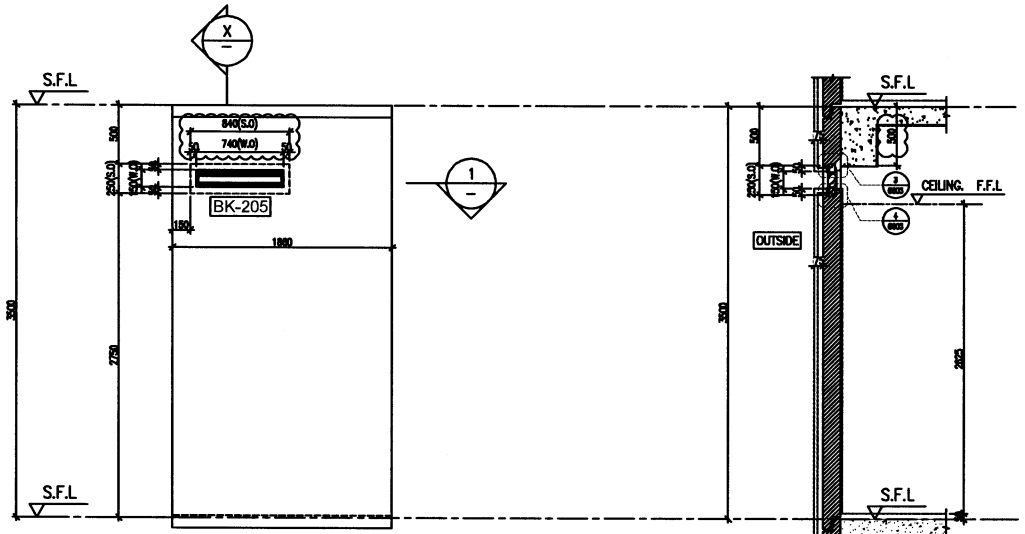

X — PART SECTION

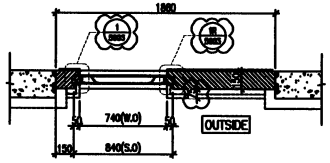

1 — PART PLAN

PROVIDED		
GLAZING AREA	0	m^2
OPENABLE AREA	0	m^2
FREE AREA	50.1	%

WINDOW MARK	GL02 / B
LOCATION	HOUSE TYPE B – 1/F EN. BATH 5
SECTION	70mm ALUM. SECTION AL1
GLAZING	GL01
QUANTITY	2 Nos
REMARKS	HOUSE NO. HB1, HB2

B.D. REF :

CLIENT :
SHIMAO GROUP HOLDINGS LIMITED

ARCHITECT : WONG TUNG & PARTNERS LIMITED

MAIN CONTRACTOR :
協興建築有限公司
HIP HING CONSTRUCTION CO LTD

STRUCTURAL ENGINEER :
C M WONG & ASSOCIATES LTD
黃志明建築工程師有限公司

FACADE CONSULTANT:
MEINHARDT

NOTE :
1. ALL DIMENSIONS ARE IN mm.
2. ALL ELEVATIONS ARE VIEWED FROM OUTSIDE.
3. ALL DIMENSIONS TO BE VERIFIED ON SITE BEFORE FABRICATION.

LEGEND :
- X1 / XXXX — DETAIL MARK NO. / REFER SHEET NO.
1. F.F.L. — FINISHED FLOOR LEVEL
2. S.F.L. — STRUCTURAL FLOOR LEVEL
3. R — REVERSED DETAIL
4. ▲ — FIXING LOCATION
5. △ — FIXING LUG LOCATION
6. GLASS LEGEND
GL01 — 10mm+12mm AIR GAP+10mm THK. L.G.U.
7. AL1
— PVF2 COATED ALUMINUM SPRAY TRINAR (4 COAT SYSTEM) CODE: EC-09-0334232 COLOR : 00YY 07/093 METALLIC

NO.	DATE	REMARKS	BY
C	12/06/2023	GENERAL REVISED	
B	27/04/2023	GENERAL REVISED	
A	08/03/2023	GENERAL REVISED	

JOB NO. : J-853

PROJECT :
PROPOSED RESIDENTIAL DEVELOPMENT AT N.K.I.L. 6542 YIN PING ROAD KOWLOON


TITLE :
PRECAST ALUM. WINDOW & LOUVRE SCHEDULE FOR HOUSE TYPE B (4)

DATE : 12-FEB-23 | SCALE : 1:40

DRAWN BY : | CHECKED BY :

美特鋁質有限公司
MIDI ALUMINIUM FABRICATORS LTD.
Units 6-8, Sunray Industrial Centre, 1/F
610 Cha Kwo Ling Road, Kowloon
Tel:23489211-4 Fax:(852)27727008

DWG NO. : J853-SD-HPW-2007 | REV. : C

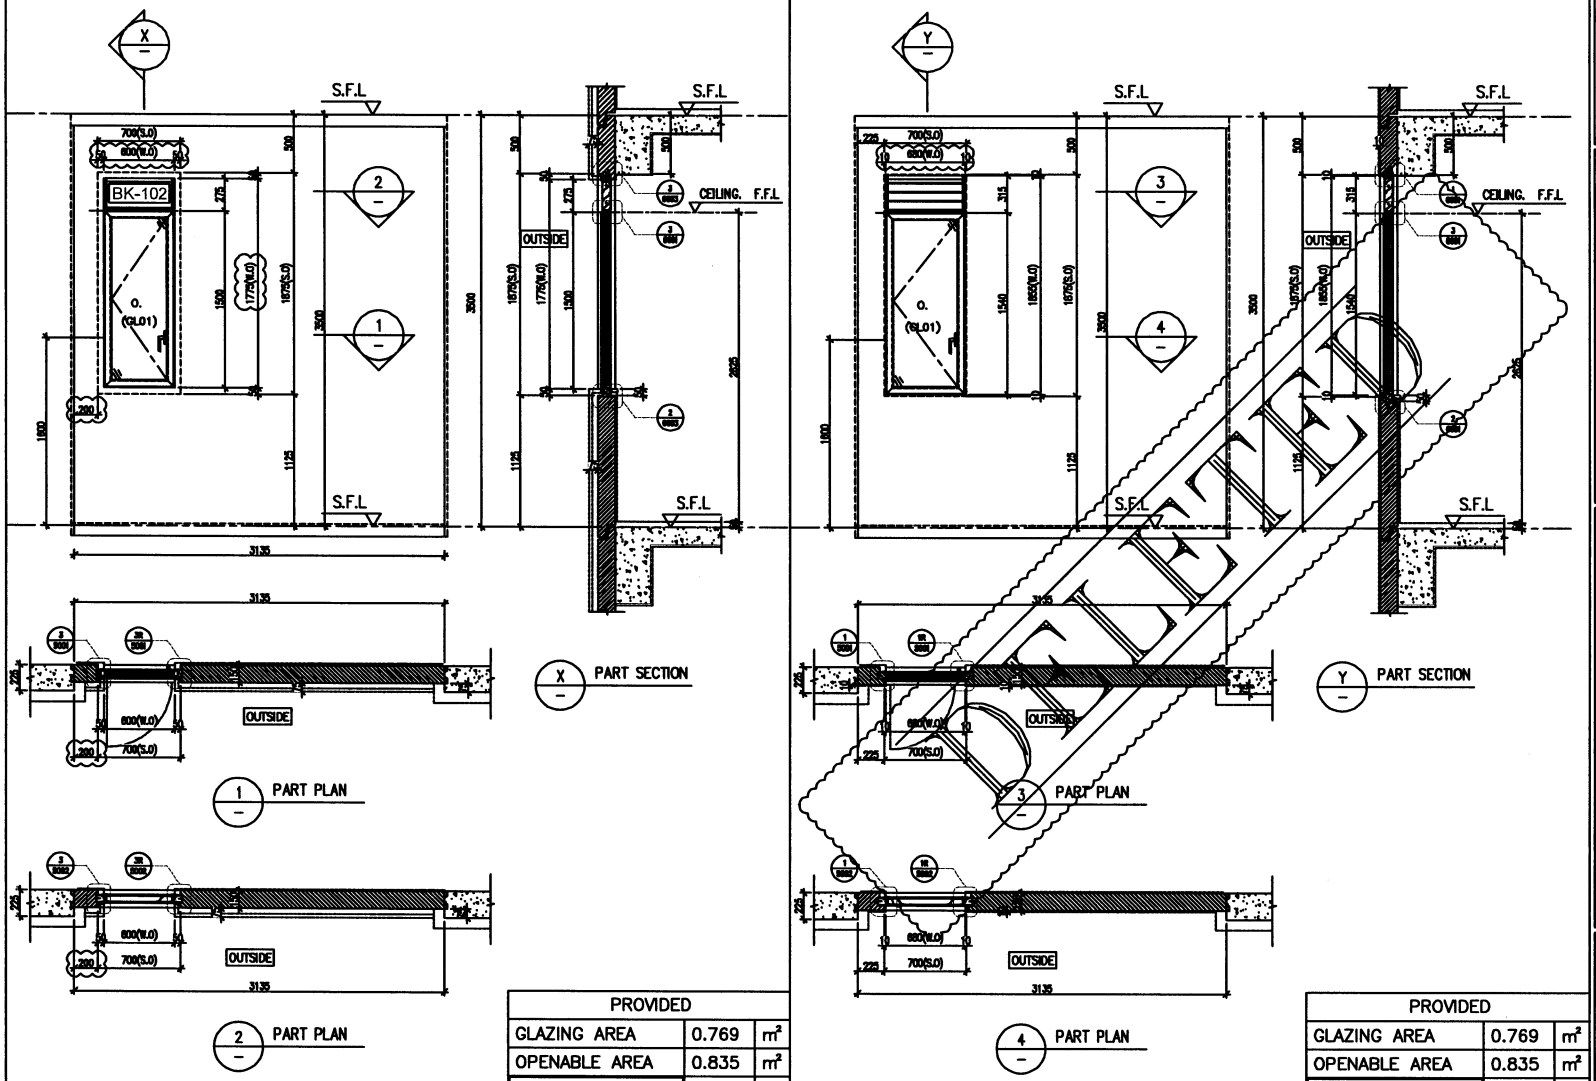

PROVIDED		
GLAZING AREA	0.769	m²
OPENABLE AREA	0.835	m²
FREE AREA	50.1	%

PROVIDED		
GLAZING AREA	0.769	m²
OPENABLE AREA	0.835	m²
FREE AREA	50.1	%

WINDOW MARK	WC.1B C	WC.1BA C
LOCATION	HOUSE TYPE C – 1/F EN. BATH 3	HOUSE TYPE C – 1/F EN. BATH 3
SECTION	70mm ALUM. SECTION AL1	70mm ALUM. SECTION
GLAZING	GL01	GL01
QUANTITY	1 No.	3 Nos
REMARKS	HOUSE NO. HB3	HOUSE NO. HB6, HB7 & HB8

B.D. REF :

CLIENT :
SHIMAO GROUP HOLDINGS LIMITED

ARCHITECT : WONG TUNG & PARTNERS LIMITED ARCHITECTS & ENGINEERS

MAIN CONTRACTOR :
協興建築有限公司
HIP HING CONSTRUCTION CO LTD

STRUCTURAL ENGINEER :
CMA C M WONG & ASSOCIATES LTD 黃志明建築工程師有限公司

FACADE CONSULTANT:
MEINHARDT

NOTE :
1. ALL DIMENSIONS ARE IN mm.
2. ALL ELEVATIONS ARE VIEWED FROM OUTSIDE.
3. ALL DIMENSIONS TO BE VERIFIED ON SITE BEFORE FABRICATION.

LEGEND :
- DETAIL MARK NO.
- REFER SHEET NO.
1. F.F.L. —FINISHED FLOOR LEVEL
2. S.F.L. —STRUCTURAL FLOOR LEVEL
3. —REVERSED DETAIL
4. —FIXING LOCATION
5. —FIXING LUG LOCATION
6. GLASS LEGEND
GL01 — 10mm+12mm AIR GAP+10mm THK. I.G.U.
7. AL1
—PVF2 COATED ALUMINUM SPRAY TRIMAR (4 COAT SYSTEM) CODE: EC-00-0334232 COLOR : ODYY 07/093 METALLIC

NO.	DATE	REMARKS	BY
D	29/06/2023	GENERAL REVISED	
C	12/06/2023	GENERAL REVISED	
B	27/04/2023	GENERAL REVISED	
A	08/03/2023	GENERAL REVISED	

JOB NO. : J-853

PROJECT :
PROPOSED RESIDENTIAL DEVELOPMENT AT N.K.I.L. 6542 YIN PING ROAD KOWLOON

TITLE :
PRECAST ALUM. WINDOW & LOUVRE SCHEDULE FOR HOUSE TYPE C (1)


DATE : 12-FEB-23 | SCALE : 1:40 (A3)


DRAWN BY : Asing | CHECKED BY :


美特組貿有限公司 MIDI
Units 6-8, Sunray Industrial Centre, 1/F
610 Cha Kwo Ling Road, Kowloon
Tel:23489211-4 Fax:(852)27727666

DWG NO. : J853-SD-HPW-2008 | REV. : D


ELEVATION
(VIEWED FROM THE OUTSIDE)

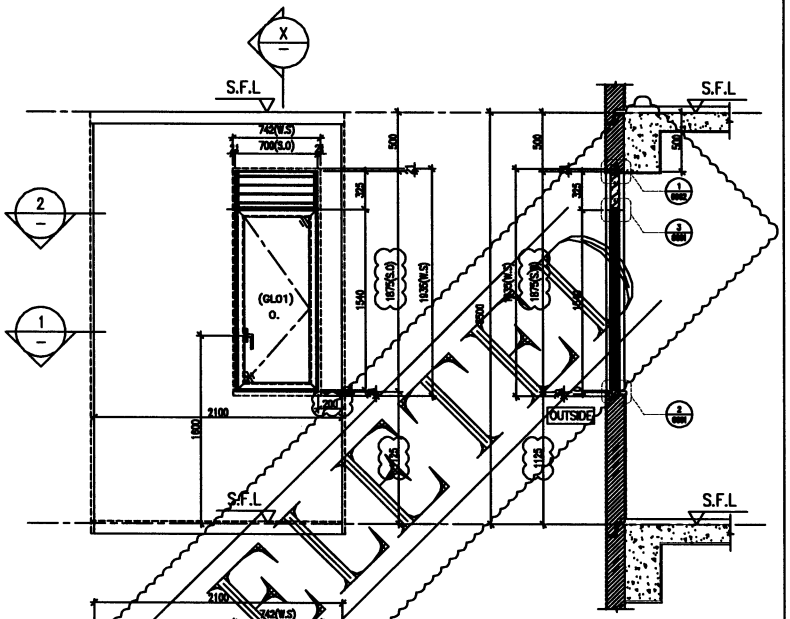


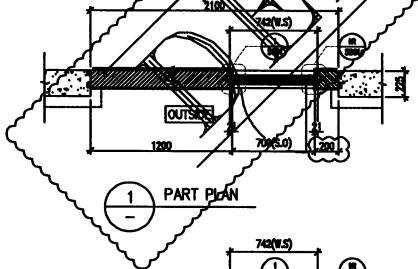

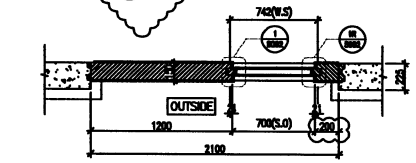

PROVIDED		
GLAZING AREA	0.769	m^2
OPENABLE AREA	0.835	m^2
FREE AREA	50.1	%

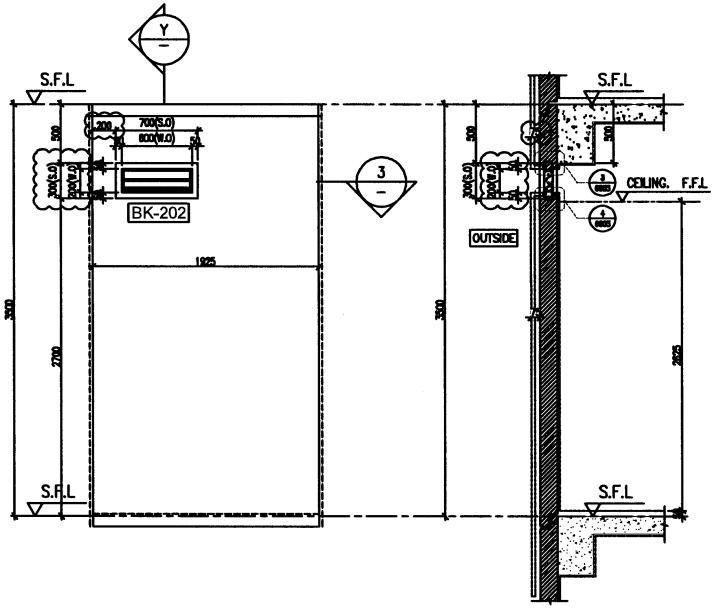

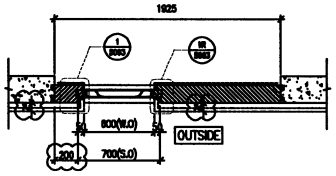

PROVIDED		
GLAZING AREA	–	m^2
OPENABLE AREA	–	m^2
FREE AREA	50.1	%

WINDOW MARK	WC.23 / C	I.C.01 / C
LOCATION	HOUSE TYPE C – 2/F EN. BATH 2	HOUSE TYPE C – 1/F EN. BATH 5 & WALK-IN CLOSET
SECTION	70mm ALUM. SECTION AL1	70mm ALUM. SECTION AL1
GLAZING	GL01	–
QUANTITY	5 Nos	1 No.
REMARKS	HOUSE NO. HB3 , HB5, HB6, HB7 & HB8	HOUSE NO. HB3

B.D. REF :

CLIENT :
SHIMAO GROUP HOLDINGS LIMITED

ARCHITECT : WONG TUNG & PARTNERS LIMITED

MAIN CONTRACTOR :
協興建築有限公司
HIP HING CONSTRUCTION CO LTD

STRUCTURAL ENGINEER :
C M WONG & ASSOCIATES LTD
黃志明建築工程師有限公司

FACADE CONSULTANT:
MEINHARDT

NOTE :
1. ALL DIMENSIONS ARE IN mm.
2. ALL ELEVATIONS ARE VIEWED FROM OUTSIDE.
3. ALL DIMENSIONS TO BE VERIFIED ON SITE BEFORE FABRICATION.

LEGEND :
- XY / XXXX — DETAIL MARK NO. / REFER SHEET NO.
1. F.F.L. — FINISHED FLOOR LEVEL
2. S.F.L. — STRUCTURAL FLOOR LEVEL
3. Ⓡ — REVERSED DETAIL
4. ▲ — FIXING LOCATION
5. △ — FIXING LUG LOCATION
6. GLASS LEGEND
GL01 — 10mm+12mm AIR GAP+10mm THK. L.G.U.
7. AL1
— PVF2 COATED ALUMINUM SPRAY TRINAR (4 COAT SYSTEM) CODE: EC-00-0334232 COLOR : 00YY 07/083 METALLIC

NO.	DATE	REMARKS	BY
D	29/06/2023	GENERAL REVISED	
C	12/06/2023	GENERAL REVISED	
B	27/04/2023	GENERAL REVISED	
A	06/03/2023	GENERAL REVISED	

JOB NO. : J-853

PROJECT :
PROPOSED RESIDENTIAL DEVELOPMENT AT N.K.I.L. 6542 YIN PING ROAD KOWLOON

TITLE :
PRECAST ALUM. WINDOW & LOUVRE SCHEDULE FOR HOUSE TYPE C (2)


DATE : 12-FEB-23 | SCALE : 1:40 (A3)

DRAWN BY : Asing | CHECKED BY :


美特鋁質有限公司
MIDI ALUMINIUM FABRICATION LTD.
Units 6-8, Sunray Industrial Centre, 1/F
610 Cha Kwo Ling Road, Kowloon
Tel:23489211-4 Fax:(852)27727066

DWG NO. : J853-SD-HPW-2009 | REV. : D

ELEVATION
(VIEWED FROM THE OUTSIDE)

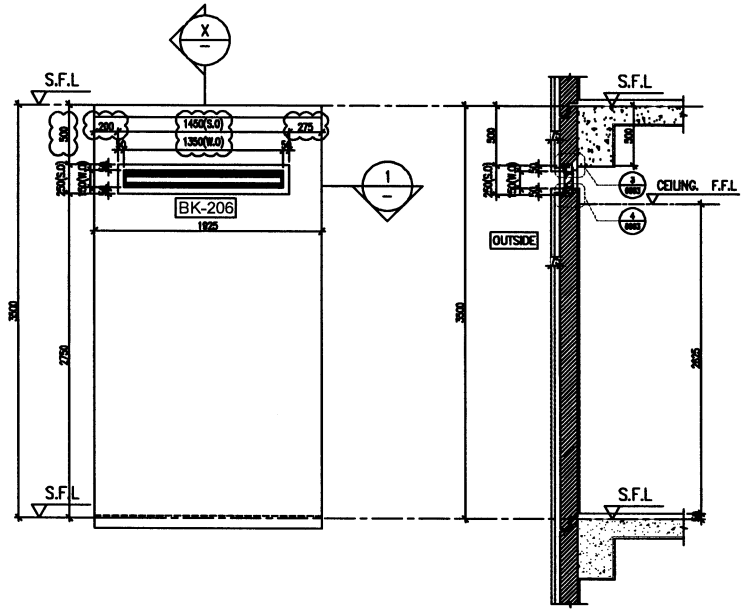


X PART SECTION

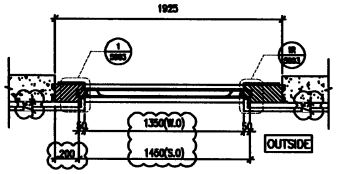


1 PART PLAN

PROVIDED		
GLAZING AREA	–	m^2
OPENABLE AREA	–	m^2
FREE AREA	50.1	%

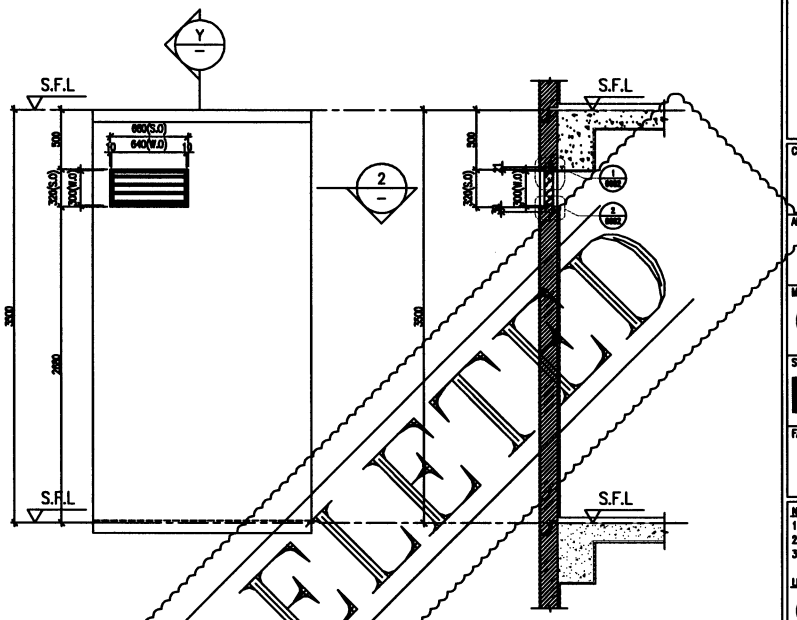

Y PART SECTION

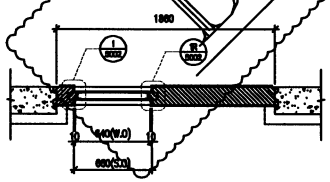

2 PART PLAN

PROVIDED		
GLAZING AREA	0	m^2
OPENABLE AREA	0	m^2
FREE AREA	50.1	%

WINDOW MARK	LC.03 C	LC.02 C
LOCATION	HOUSE TYPE C – 2/F MASTER BATHROOM	HOUSE TYPE C – 1/F WALK-IN CLOSET
SECTION	70mm ALUM. SECTION AL1	70mm ALUM. SECTION AL1
GLAZING	–	–
QUANTITY	1 No.	5 Nos
REMARKS	HOUSE NO. HB3	HOUSE NO. HB3 , HB5, HB6, HB7 & HB8

B.D. REF :

CLIENT :
SHIMAO GROUP HOLDINGS LIMITED

ARCHITECT :
WONG TUNG & PARTNERS LIMITED
ARCHITECTS & PLANNERS

MAIN CONTRACTOR :
協興建築有限公司
HIP HING CONSTRUCTION CO LTD

STRUCTURAL ENGINEER :
C M WONG & ASSOCIATES LTD
黃志明建築工程師有限公司

FACADE CONSULTANT:
MEINHARDT

NOTE :
1. ALL DIMENSIONS ARE IN mm.
2. ALL ELEVATIONS ARE VIEWED FROM OUTSIDE.
3. ALL DIMENSIONS TO BE VERIFIED ON SITE BEFORE FABRICATION.

LEGEND :
X1 / 2005 — DETAIL MARK NO. / REFER SHEET NO.
1. F.F.L. — FINISHED FLOOR LEVEL
2. S.F.L. — STRUCTURAL FLOOR LEVEL
3. (R) — REVERSED DETAIL
4. ▲ — FIXING LOCATION
5. △ — FIXING LUG LOCATION
6. GLASS LEGEND
GL01 — 10mm+12mm AIR GAP+10mm THK. I.G.U.
7. AL1
— PVF2 COATED ALUMINUM SPRAY TRIWAR (4 COAT SYSTEM) CODE: EC-DB-0334232 COLOR : ODYY 07/083 METALLIC

NO.	DATE	REMARKS	BY
D	29/05/2023	GENERAL REVISED	
C	12/05/2023	GENERAL REVISED	
B	27/04/2023	GENERAL REVISED	
A	08/03/2023	GENERAL REVISED	

JOB NO. : J-853

PROJECT :
PROPOSED RESIDENTIAL DEVELOPMENT AT N.K.I.L. 6542 YIN PING ROAD KOWLOON

TITLE :
PRECAST ALUM. WINDOW & LOUVRE SCHEDULE FOR HOUSE TYPE C (3)


DATE : 12-FEB-23 | SCALE : 1:40

DRAWN BY : | CHECKED BY :


美特鋁製有限公司
MIDI ALUMINIUM FABRICATION LTD.
Units 6-8, Sunray Industrial Centre, 1/F
610 Cha Kwo Ling Road, Kowloon
Tel:23498211-4 Fax:(852)27727698

DWG NO. : J853-SD-HPW-2010 | REV. : D


ELEVATION
(VIEWED FROM THE OUTSIDE)

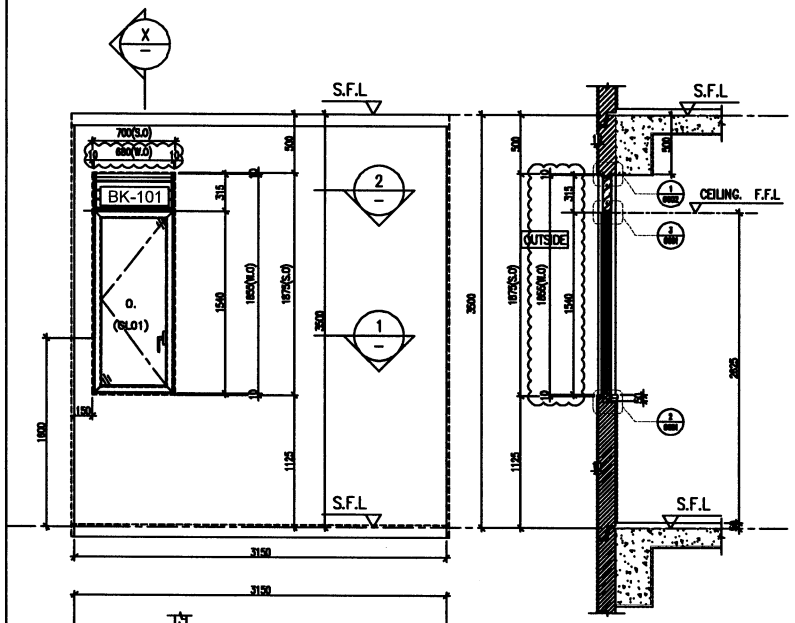

X PART SECTION

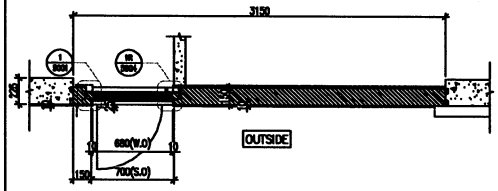


1 PART PLAN

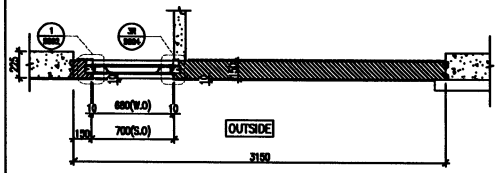


2 PART PLAN


PROVIDED		
GLAZING AREA	0.77	m^2
OPENABLE AREA	0.835	m^2
FREE AREA	50.1	%

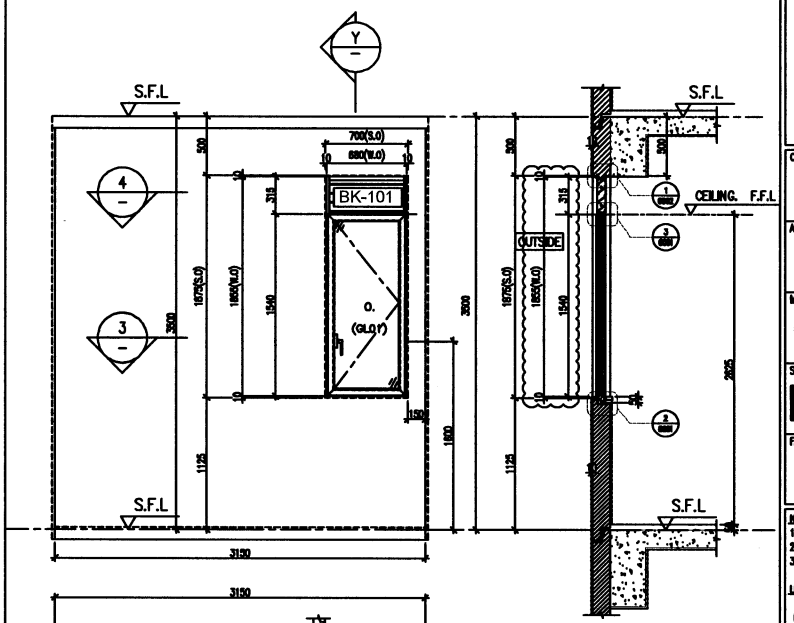

Y PART SECTION

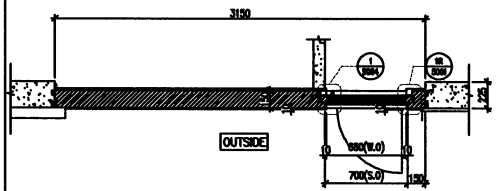

3 PART PLAN

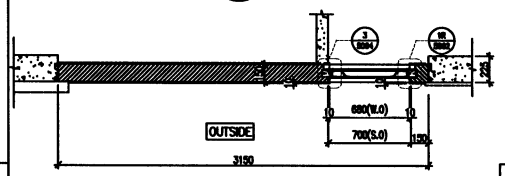

4 PART PLAN

PROVIDED		
GLAZING AREA	0.77	m^2
OPENABLE AREA	0.835	m^2
FREE AREA	50.1	%

WINDOW MARK	NO.1@ D	NO.1@ D1
LOCATION	HOUSE TYPE D – 1/F EN. BATH 4	HOUSE TYPE D1 – 1/F EN. BATH 4
SECTION	70mm ALUM. SECTION AL1	70mm ALUM. SECTION AL1
GLAZING	GL01	GL01
QUANTITY	1 No.	1 No.
REMARKS	HOUSE NO. HC3	HOUSE NO. HC2

B.D. REF :

CLIENT :
SHIMAO GROUP HOLDINGS LIMITED

ARCHITECT :
WONG TUNG & PARTNERS LIMITED
ARCHITECTS & PLANNERS

MAIN CONTRACTOR :
協興建築有限公司
HIP HING CONSTRUCTION CO LTD

STRUCTURAL ENGINEER :
C M WONG & ASSOCIATES LTD
黃志明建築工程師有限公司

FACADE CONSULTANT:
MEINHARDT

NOTE :
1. ALL DIMENSIONS ARE IN mm.
2. ALL ELEVATIONS ARE VIEWED FROM OUTSIDE.
3. ALL DIMENSIONS TO BE VERIFIED ON SITE BEFORE FABRICATION.

LEGEND :
- XX / DWG — DETAIL MARK NO. / REFER SHEET NO.
1. F.F.L. — FINISHED FLOOR LEVEL
2. S.F.L. — STRUCTURAL FLOOR LEVEL
3. (R) — REVERSED DETAIL
4. ▲ — FIXING LOCATION
5. △ — FIXING LUG LOCATION
6. GLASS LEGEND
GL01 — 10mm+12mm AIR GAP+10mm THK. I.G.U.
7. AL1
— PVF2 COATED ALUMINIUM SPRAY TRIWAR (4 COAT SYSTEM) CODE: SC-DO-0334232 COLOR : ODYY 07/083 METALLIC

D	28/06/2023	GENERAL REVISED	
C	17/07/2023	GENERAL REVISED	
B	18/06/2023	GENERAL REVISED	
A	27/04/2023	GENERAL REVISED	
No.	DATE	REMARK	BY

JOB NO. : J-853

PROJECT :
PROPOSED RESIDENTIAL DEVELOPMENT AT N.K.I.L. 6542 YIN PING ROAD KOWLOON

TITLE :
PRECAST ALUM. WINDOW & LOUVRE SCHEDULE FOR HOUSE TYPE D / D1 (1)


DATE : 12-FEB-23 | SCALE : 1:40 (A3)

DRAWN BY : Aaing | CHECKED BY :


美特鋁製有限公司
MIDI ALUMINIUM FABRICATION LTD.
Units 6-8, Sunray Industrial Centre, 1/F
610 Cha Kwo Ling Road, Kowloon
Tel:23480211-4 Fax:(852)27727066

DWG NO. : J853-SD-HPW-2011 | REV. : D


ELEVATION
(VIEWED FROM THE OUTSIDE)

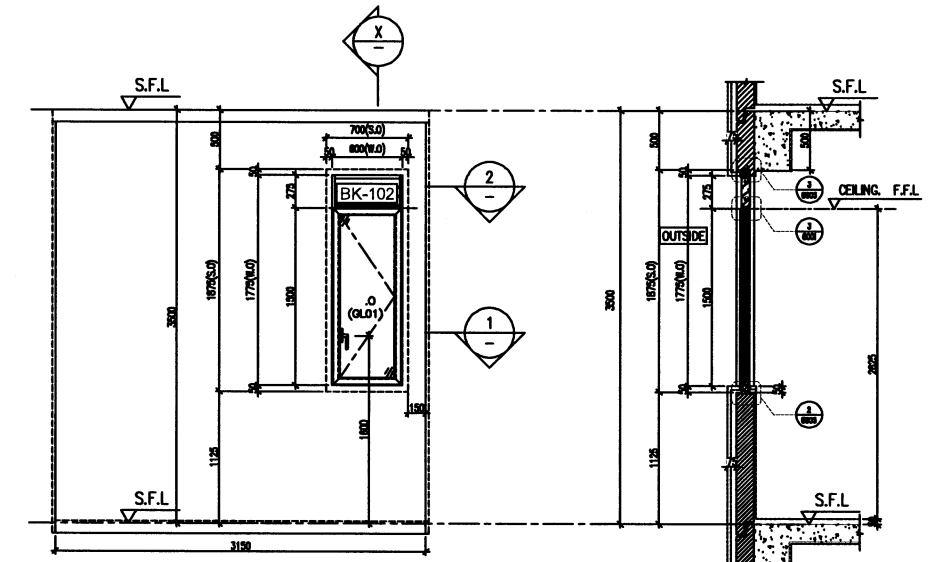

X PART SECTION

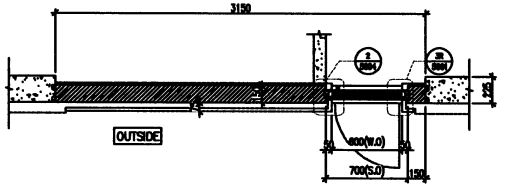

1 PART PLAN

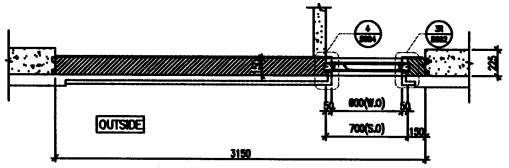

2 PART PLAN

PROVIDED		
GLAZING AREA	0.77	m^2
OPENABLE AREA	0.835	m^2
FREE AREA	50.1	%

WINDOW MARK	HD.1(b) D1
LOCATION	HOUSE TYPE D1 – 1/F EN. BATH 4
SECTION	70mm ALUM. SECTION
GLAZING	GL01
QUANTITY	2 Nos.
REMARKS	HOUSE NO. HD2 & HD3

B.D. REF :

CLIENT :
SHIMAO GROUP HOLDINGS LIMITED

ARCHITECT : WONG TUNG & PARTNERS LIMITED

MAIN CONTRACTOR :
協興建築有限公司
HIP HING CONSTRUCTION CO LTD

STRUCTURAL ENGINEER :
C M WONG & ASSOCIATES LTD
黃志明建築工程師有限公司

FACADE CONSULTANT:
MEINHARDT

NOTE :
1. ALL DIMENSIONS ARE IN mm.
2. ALL ELEVATIONS ARE VIEWED FROM OUTSIDE.
3. ALL DIMENSIONS TO BE VERIFIED ON SITE BEFORE FABRICATION.

LEGEND :
- DETAIL MARK NO.
- REFER SHEET NO.
1. F.F.L. — FINISHED FLOOR LEVEL
2. S.F.L. — STRUCTURAL FLOOR LEVEL
3. (R) — REVERSED DETAIL
4. ▲ — FIXING LOCATION
5. △ — FIXING LUG LOCATION
6. GLASS LEGEND
   GL01 — 10mm+12mm AIR GAP+10mm THK. I.G.U.
7. ALI
   — PVF2 COATED ALUMINUM SPRAY TRIWAR (4 COAT SYSTEM) CODE: EC-DG-D334232 COLOR : ODYY 07/083 METALLIC

NO.	DATE	REVISED	BY
A	17/07/2023	GENERAL REVISED	

JOB NO. : J-853

PROJECT :
PROPOSED RESIDENTIAL DEVELOPMENT AT N.K.I.L. 6542 YIN PING ROAD KOWLOON

TITLE :
PRECAST ALUM. WINDOW & LOUVRE SCHEDULE FOR HOUSE TYPE D1 (2)


DATE : 12-FEB-23 | SCALE : 1:40 (A3)

DRAWN BY : Aaing | CHECKED BY :


美特鋁質有限公司
MIDI ALUMINIUM FABRICATION LTD.
Units 6-8, Sunray Industrial Centre, 1/F
610 Cha Kwo Ling Road, Kowloon
Tel:23489211-4 Fax:(852)27727688

DWG NO. : J853-SD-HPW-2011a | REV. : A

ELEVATION
(VIEWED FROM THE OUTSIDE)

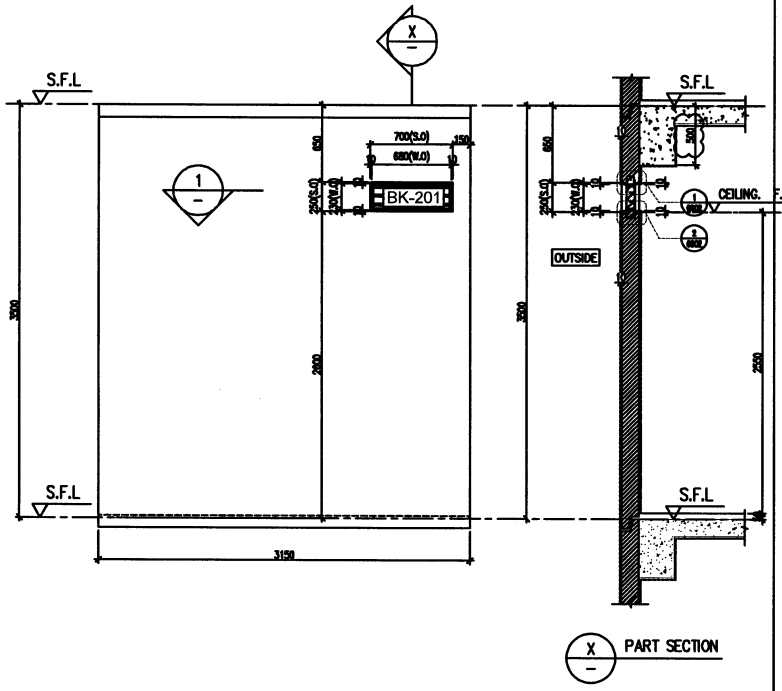


X — PART SECTION

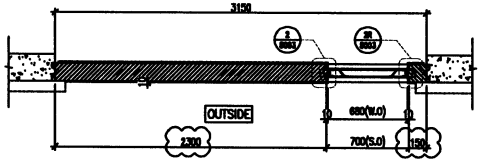


1 — PART PLAN

PROVIDED		
GLAZING AREA	–	m²
OPENABLE AREA	–	m²
FREE AREA	50.1	%

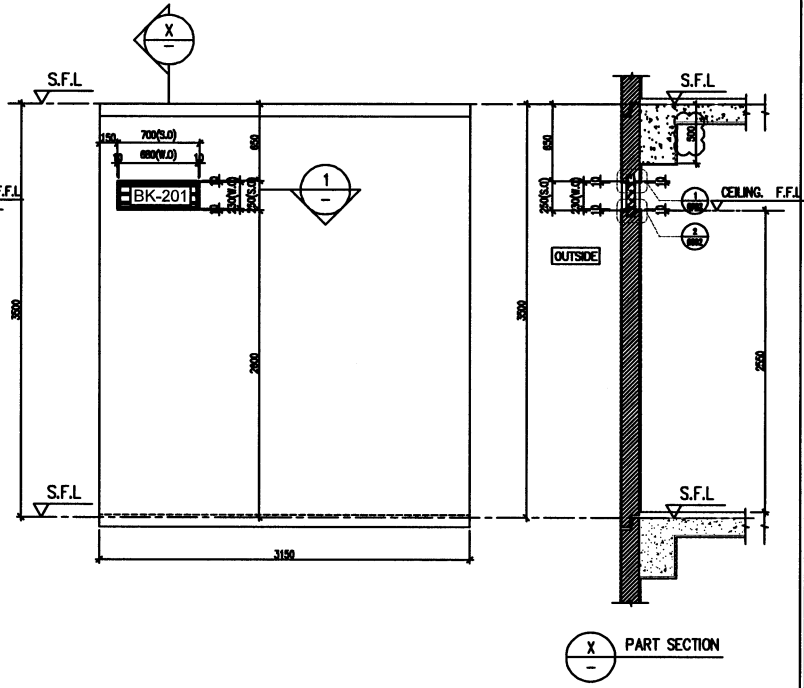

X — PART SECTION

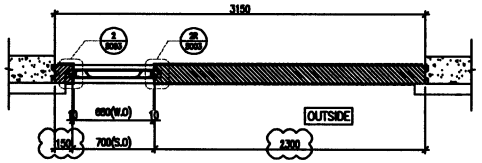

1 — PART PLAN

PROVIDED		
GLAZING AREA	–	m²
OPENABLE AREA	–	m²
FREE AREA	50.1	%

WINDOW MARK	D (D.03)	D1 (D.03)
LOCATION	HOUSE TYPE D – 2/F MASTER BATHROOM	HOUSE TYPE D1 – 2/F MASTER BATHROOM
SECTION	70mm ALUM. SECTION AL1	70mm ALUM. SECTION AL1
GLAZING	–	–
QUANTITY	1 No.	1 No.
REMARKS	HOUSE NO. HC3	HOUSE NO. HC2

B.D. REF :

CLIENT :
SHIMAO GROUP HOLDINGS LIMITED

ARCHITECT : WONG TUNG & PARTNERS LIMITED

MAIN CONTRACTOR :
協興建築有限公司
HIP HING CONSTRUCTION CO LTD

STRUCTURAL ENGINEER :
C M WONG & ASSOCIATES LTD
黃志明建築工程師有限公司

FACADE CONSULTANT:
MEINHARDT

NOTE :
1. ALL DIMENSIONS ARE IN mm.
2. ALL ELEVATIONS ARE VIEWED FROM OUTSIDE.
3. ALL DIMENSIONS TO BE VERIFIED ON SITE BEFORE FABRICATION.

LEGEND :
- DETAIL MARK NO.
- REFER SHEET NO.
1. F.F.L. — FINISHED FLOOR LEVEL
2. S.F.L. — STRUCTURAL FLOOR LEVEL
3. (R) — REVERSED DETAIL
4. ▲ ▲ — FIXING LOCATION
5. △ △ — FIXING LUG LOCATION
6. GLASS LEGEND
GL01 — 10mm+12mm AIR GAP+10mm THK. I.G.U.
7. AL1
— PVF2 COATED ALUMINUM SPRAY TRIMAR (4 COAT SYSTEM) CODE: EC-DG-0334332 COLOR : 00YY 07/083 METALLIC

E	29/08/2023	GENERAL REVISED	
D	17/07/2023	GENERAL REVISED	
C	12/06/2023	GENERAL REVISED	
B	27/04/2023	GENERAL REVISED	
A	08/03/2023	GENERAL REVISED	
No.	DATE	REMARK	BY

JOB NO. : J-853

PROJECT :
PROPOSED RESIDENTIAL DEVELOPMENT AT N.K.I.L. 6542 YIN PING ROAD KOWLOON

TITLE :
PRECAST ALUM. WINDOW & LOUVRE SCHEDULE FOR HOUSE TYPE D / D1 (3)


DATE : 12-FEB-23 | SCALE : 1:40

DRAWN BY : | CHECKED BY :


美特鋁質有限公司
MIDI ALUMINIUM FABRICATION LTD.
Units 6-8, Sunray Industrial Centre, 1/F
610 Cha Kwo Ling Road, Kowloon
Tel:23488211-4 Fax:(852)27727666

DWG NO. : J853-SD-HPW-2012 | REV. : E

ELEVATION
(VIEWED FROM THE OUTSIDE)

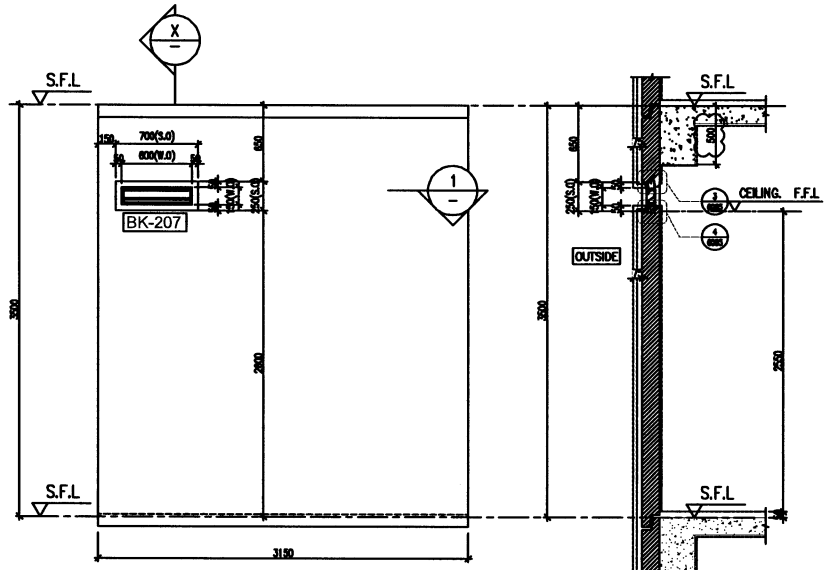

X PART SECTION

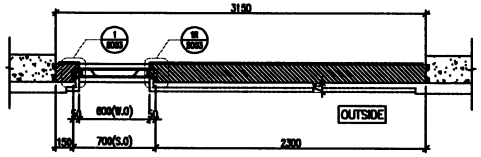

1 PART PLAN

PROVIDED		
GLAZING AREA	–	m^2
OPENABLE AREA	–	m^2
FREE AREA	50.1	%

WINDOW MARK	D1
LOCATION	HOUSE TYPE D1 – 2/F MASTER BATHROOM
SECTION	70mm ALUM. SECTION AL1
GLAZING	–
QUANTITY	2 Nos.
REMARKS	HOUSE NO. HD2 & HD3

B.D. REF :

CLIENT :
SHIMAO GROUP HOLDINGS LIMITED

ARCHITECT :
WONG TUNG & PARTNERS LIMITED

MAIN CONTRACTOR :
協興建築有限公司
HIP HING CONSTRUCTION CO LTD

STRUCTURAL ENGINEER :
C M WONG & ASSOCIATES LTD
黃志明建築工程師有限公司

FACADE CONSULTANT:
MEINHARDT

NOTE :
1. ALL DIMENSIONS ARE IN mm.
2. ALL ELEVATIONS ARE VIEWED FROM OUTSIDE.
3. ALL DIMENSIONS TO BE VERIFIED ON SITE BEFORE FABRICATION.

LEGEND :
- XX / XXXX — DETAIL MARK NO. / REFER SHEET NO.
1. F.F.L. — FINISHED FLOOR LEVEL
2. S.F.L. — STRUCTURAL FLOOR LEVEL
3. (R) — REVERSED DETAIL
4. ▲ — FIXING LOCATION
5. △ — FIXING LUG LOCATION
6. GLASS LEGEND
   GL01 — 10mm+12mm AIR GAP+10mm THK. I.G.U.
7. AL1
—PVF2 COATED ALUMINUM SPRAY TRIMAR (4 COAT SYSTEM) CODE: EC-DO-D334232 COLOR : ODYY 07/083 METALLIC

A	17/07/2023	GENERAL REVISED	
mk	date	remarks	by

JOB NO. : J-853

PROJECT :
PROPOSED RESIDENTIAL DEVELOPMENT AT N.K.I.L. 6542 YIN PING ROAD KOWLOON

TITLE :
PRECAST ALUM. WINDOW & LOUVRE SCHEDULE FOR HOUSE TYPE D1 (4)


DATE : 12-FEB-23 | SCALE : 1:40

DRAWN BY : | CHECKED BY :


美特鋁質有限公司
MIDI ALUMINIUM FABRICATION LTD.
Units 6-8, Sunray Industrial Centre, 1/F
610 Che Kee Ling Road, Kowloon
Tel:23488211-4 Fax:(852)27727066

DWG NO. : J853-SD-HPW-2012a | REV. : A

ELEVATION
(VIEWED FROM THE OUTSIDE)

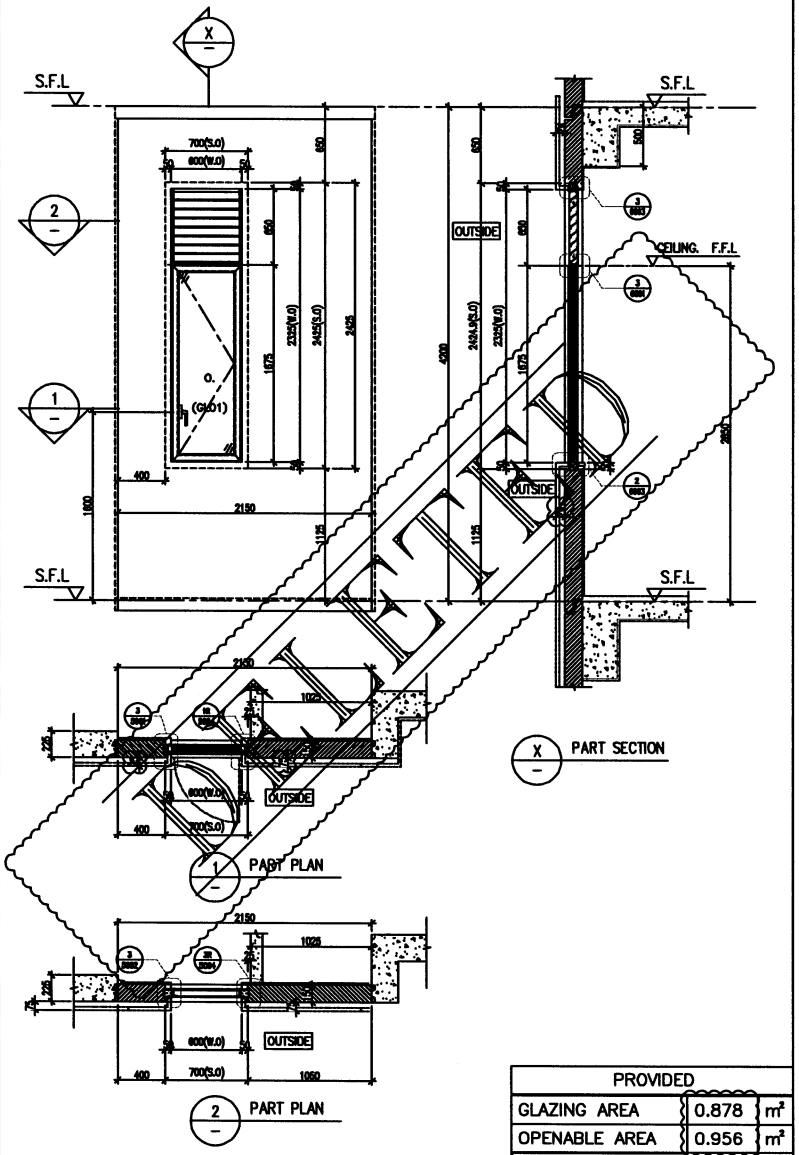

PROVIDED		
GLAZING AREA	0.878	m^2
OPENABLE AREA	0.956	m^2
FREE AREA	50.1	%

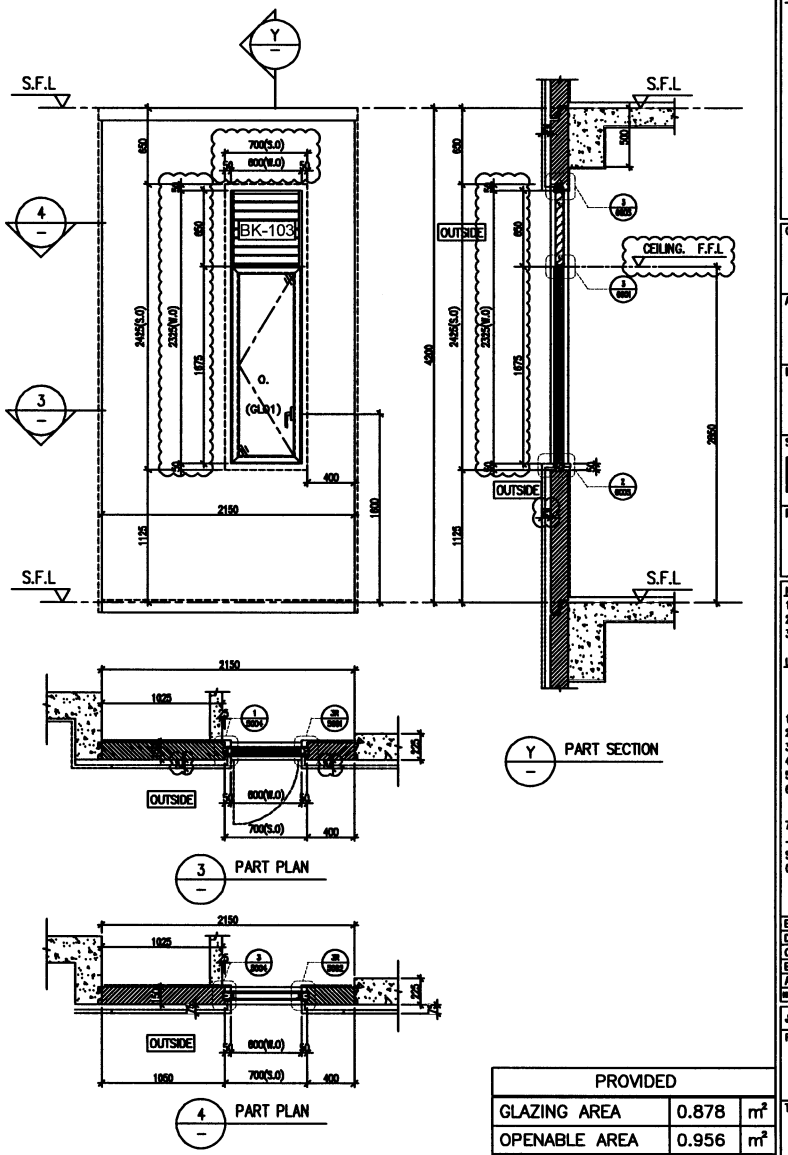

PROVIDED		
GLAZING AREA	0.878	m^2
OPENABLE AREA	0.956	m^2
FREE AREA	50.1	%

WINDOW MARK	WE.07 E	WE.07 E1
LOCATION	HOUSE TYPE E – G/F LAV.	HOUSE TYPE E1 – G/F LAV.
SECTION	70mm ALUM. SECTION AL1	70mm ALUM. SECTION AL1
GLAZING	GL01	GL01
QUANTITY	2 Nos	1 No.
REMARKS	HOUSE NO. HC6, HD7	HOUSE NO. HD1

B.D. REF :

CLIENT :
SHIMAO GROUP HOLDINGS LIMITED

ARCHITECT : WONG TUNG & PARTNERS LIMITED

MAIN CONTRACTOR :
協興建築有限公司
HIP HING CONSTRUCTION CO LTD

STRUCTURAL ENGINEER :
C M WONG & ASSOCIATES LTD
黃志明建築工程師有限公司

FACADE CONSULTANT:
MEINHARDT

NOTE :
1. ALL DIMENSIONS ARE IN mm.
2. ALL ELEVATIONS ARE VIEWED FROM OUTSIDE.
3. ALL DIMENSIONS TO BE VERIFIED ON SITE BEFORE FABRICATION.

LEGEND :
- DETAIL MARK NO.
- REFER SHEET NO.
1. F.F.L. — FINISHED FLOOR LEVEL
2. S.F.L. — STRUCTURAL FLOOR LEVEL
3. — REVERSED DETAIL
4. — FIXING LOCATION
5. — FIXING LUG LOCATION
6. GLASS LEGEND
GL01 — 10mm+12mm AIR GAP+10mm THK. I.G.U.
7. AL1
— PVF2 COATED ALUMINIUM SPRAY FINISH (4 COAT SYSTEM) CODE: EC-00-0334232 COLOR : GOYY 07/083 METALLIC

E	29/08/2023	GENERAL REVISED	
D	17/07/2023	GENERAL REVISED	
C	12/06/2023	GENERAL REVISED	
B	27/04/2023	GENERAL REVISED	
A	08/03/2023	GENERAL REVISED	
NO.	DATE	REMARK	BY

JOB NO. : J-853

PROJECT :
PROPOSED RESIDENTIAL DEVELOPMENT AT N.K.I.L. 6542 YIN PING ROAD KOWLOON

TITLE :
PRECAST ALUM. WINDOW & LOUVRE SCHEDULE FOR HOUSE TYPE E / E1 (1)


DATE : 12-FEB-23 | SCALE : 1:40 (A3)

DRAWN BY : Asing | CHECKED BY :


美特鋁質有限公司
MIDI ALUMINIUM FABRICATORS LTD.
Units 6-8, Sunray Industrial Centre, 1/F
610 Cha Kwo Ling Road, Kowloon
Tel:23480211-4 Fax:(852)27727666

DWG NO. : J853-SD-HPW-2013 | REV. : E

ELEVATION
(VIEWED FROM THE OUTSIDE)

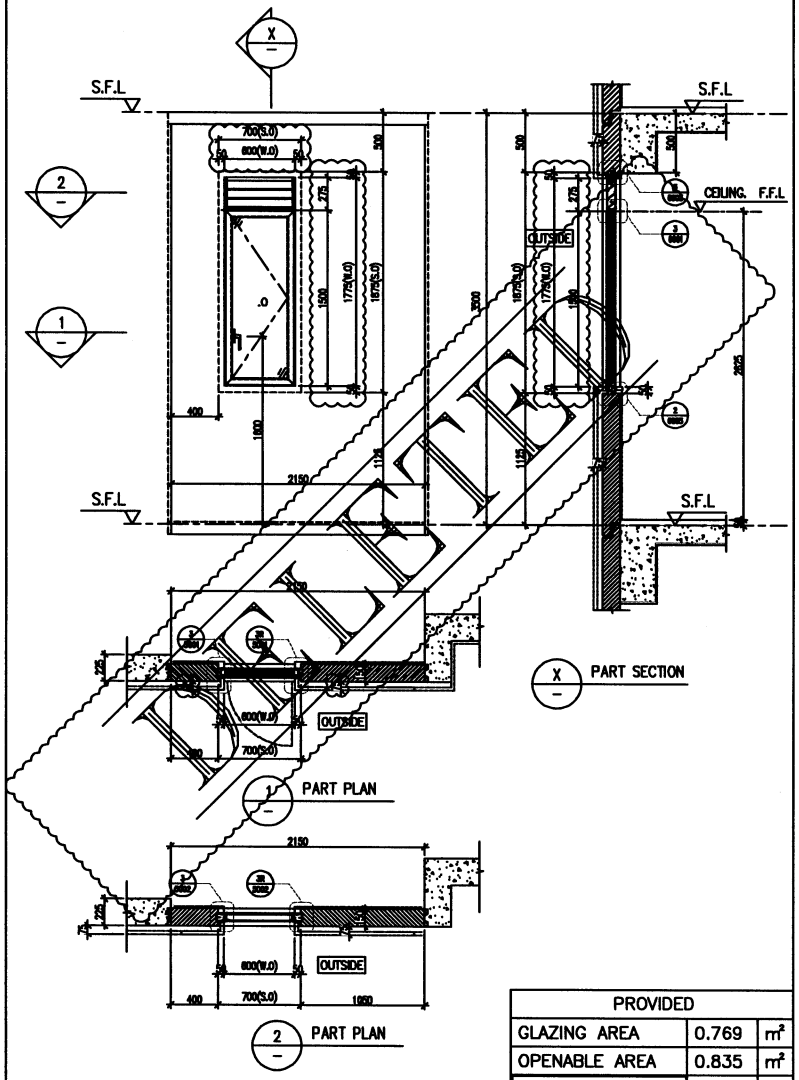

PROVIDED		
GLAZING AREA	0.769	m^2
OPENABLE AREA	0.835	m^2
FREE AREA	50.1	%

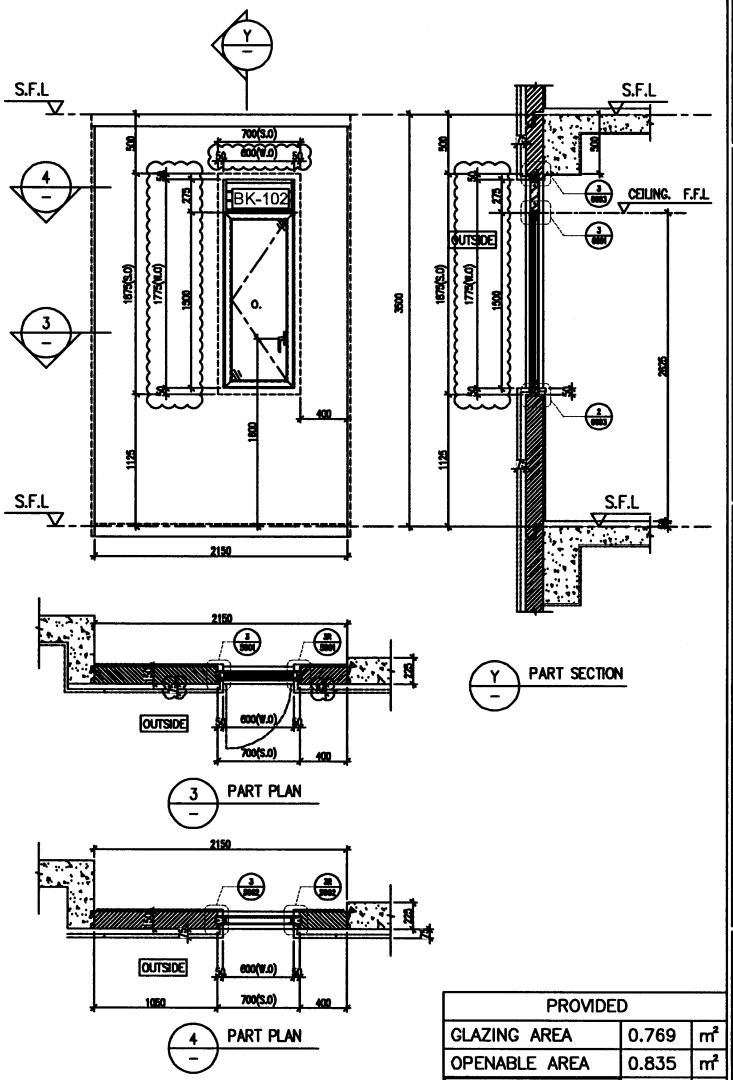

PROVIDED		
GLAZING AREA	0.769	m^2
OPENABLE AREA	0.835	m^2
FREE AREA	50.1	%

WINDOW MARK	WE.11 E	WE.11 E1
LOCATION	HOUSE TYPE E – 1/F EN. BATH 3	HOUSE TYPE E1 – 1/F EN. BATH 3
SECTION	70mm ALUM. SECTION AL1	70mm ALUM. SECTION AL1
GLAZING	GL01	GL01
QUANTITY	2 Nos	1 No.
REMARKS	HOUSE NO. HC6, HD7	HOUSE NO. HD1

B.D. REF :

CLIENT :
SHIMAO GROUP HOLDINGS LIMITED

ARCHITECT :
WONG TUNG & PARTNERS LIMITED
ARCHITECTS & PLANNERS

MAIN CONTRACTOR :
協興建築有限公司
HIP HING CONSTRUCTION CO LTD

STRUCTURAL ENGINEER :
C M WONG & ASSOCIATES LTD
黃志明建築工程師有限公司

FACADE CONSULTANT:
MEINHARDT

NOTE :
1. ALL DIMENSIONS ARE IN mm.
2. ALL ELEVATIONS ARE VIEWED FROM OUTSIDE.
3. ALL DIMENSIONS TO BE VERIFIED ON SITE BEFORE FABRICATION.

LEGEND :
- XX / XXXX — DETAIL MARK NO. / REFER SHEET NO.
1. F.F.L. — FINISHED FLOOR LEVEL
2. S.F.L. — STRUCTURAL FLOOR LEVEL
3. (XX) — REVERSED DETAIL
4. ▲ — FIXING LOCATION
5. △ — FIXING LUG LOCATION
6. GLASS LEGEND
GL01 — 10mm+12mm AIR GAP+10mm THK. LG.U.
7. AL1
— PVF2 COATED ALUMINIUM SPRAY TRIWAR (4 COAT SYSTEM) CODE: EC-09-0334232 COLOR : 00YY 07/083 METALLIC

NO.	DATE	REMARKS	BY
E	29/08/2023	GENERAL REVISED	
D	17/07/2023	GENERAL REVISED	
C	12/06/2023	GENERAL REVISED	
B	27/04/2023	GENERAL REVISED	
A	08/03/2023	GENERAL REVISED	

JOB NO. : J-853

PROJECT :
PROPOSED RESIDENTIAL DEVELOPMENT AT N.K.I.L. 6542 YIN PING ROAD KOWLOON

TITLE :
PRECAST ALUM. WINDOW & LOUVRE SCHEDULE FOR HOUSE TYPE E / E1 (2)


DATE : 12-FEB-23 | SCALE : 1:40 (A3)

DRAWN BY : Asing | CHECKED BY :


美特鋁質有限公司
MIDI ALUMINIUM FABRICATION LTD.
Units 6-8, Sunray Industrial Centre, 1/F
610 Che Kwe Ling Road, Kowloon
Tel:23489211-4 Fax:(852)27727666

DWG NO. : J853-SD-HPW-2014 | REV. : E

ELEVATION
(VIEWED FROM
THE OUTSIDE)

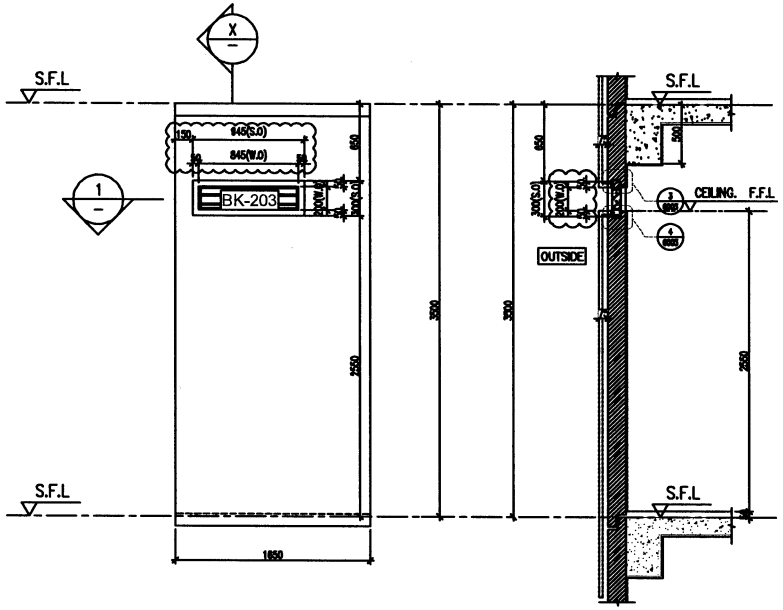


X PART SECTION

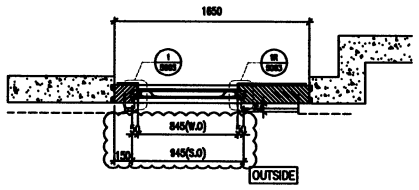


1 PART PLAN

PROVIDED		
GLAZING AREA	–	m^2
OPENABLE AREA	–	m^2
FREE AREA	50.1	%

WINDOW MARK	E.02 / E1
LOCATION	HOUSE TYPE E1 – 1/F EN. BATH 4
SECTION	70mm ALUM. SECTION AL1
GLAZING	–
QUANTITY	1 No
REMARKS	HOUSE NO. HD1

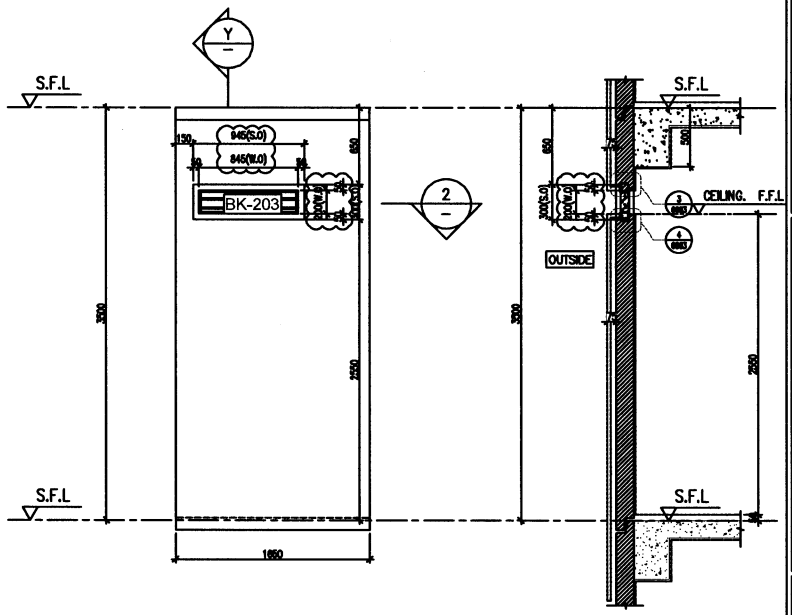

Y PART SECTION

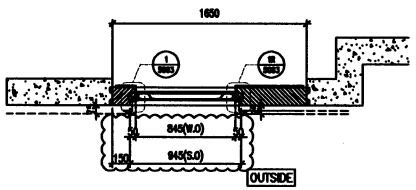

2 PART PLAN

PROVIDED		
GLAZING AREA	–	m^2
OPENABLE AREA	–	m^2
FREE AREA	50.1	%

WINDOW MARK	E.03 / E1
LOCATION	HOUSE TYPE E1 – 2/F MASTER BATHROOM
SECTION	70mm ALUM. SECTION AL1
GLAZING	GLO1
QUANTITY	1 No
REMARKS	HOUSE NO. HD1

B.D. REF :

CLIENT :
SHIMAO GROUP
HOLDINGS LIMITED

ARCHITECT : WONG TUNG & PARTNERS LIMITED

MAIN CONTRACTOR :
協興建築有限公司
HIP HING CONSTRUCTION CO LTD

STRUCTURAL ENGINEER :
C M WONG & ASSOCIATES LTD
黃志明建築工程師有限公司

FACADE CONSULTANT:
MEINHARDT

NOTE :
1. ALL DIMENSIONS ARE IN mm.
2. ALL ELEVATIONS ARE VIEWED FROM OUTSIDE.
3. ALL DIMENSIONS TO BE VERIFIED ON SITE BEFORE FABRICATION.

LEGEND :
- XX / XXXX — DETAIL MARK NO. / REFER SHEET NO.
1. F.F.L. — FINISHED FLOOR LEVEL
2. S.F.L. — STRUCTURAL FLOOR LEVEL
3. (R) — REVERSED DETAIL
4. ▲ — FIXING LOCATION
5. △ — FIXING LUG LOCATION
6. GLASS LEGEND
GLO1 — 10mm+12mm AIR GAP+10mm THK. I.G.U.
7. AL1
— PVF2 COATED ALUMINUM SPRAY TRIWAR (4 COAT SYSTEM) CODE: EC-00-0334232 COLOR : COYY 07/083 METALLIC

NO.	DATE	REMARKS	BY
A	17/07/2023	GENERAL REVISED	

JOB NO. : J-853

PROJECT :
PROPOSED RESIDENTIAL
DEVELOPMENT AT N.K.I.L. 6542
YIN PING ROAD
KOWLOON

TITLE :
PRECAST ALUM. WINDOW & LOUVRE SCHEDULE
FOR HOUSE TYPE E1
(5)


DATE : 12-FEB-23 | SCALE : 1:40

DRAWN BY : | CHECKED BY :


美特鋁質有限公司
MIDI ALUMINIUM FABRICATORS LTD.
Units 6-8, Sunray Industrial Centre, 1/F
610 Che Kwo Ling Road, Kowloon
Tel:23489211-4 Fax:(852)27727696

DWG NO. : J853-SD-HPW-2016a | REV. : A


ELEVATION
(VIEWED FROM THE OUTSIDE)

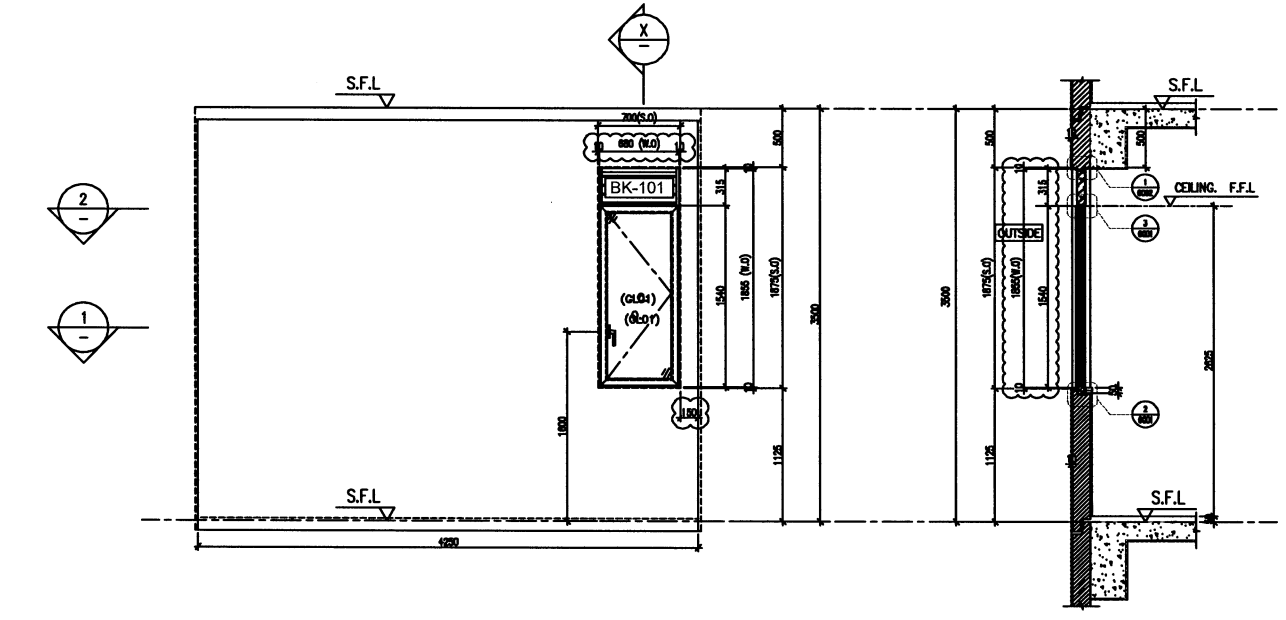

X — PART SECTION

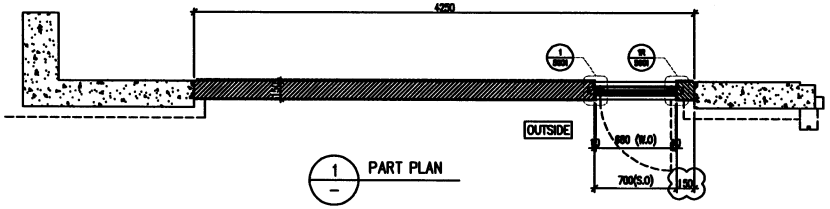

1 — PART PLAN

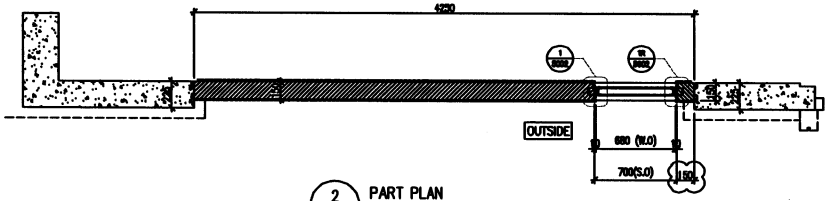

2 — PART PLAN

PROVIDED		
GLAZING AREA	0.769	m^2
OPENABLE AREA	0.835	m^2
FREE AREA	50.1	%

WINDOW MARK	WC-14 G
LOCATION	HOUSE TYPE G – 1/F EN. BATH 3
SECTION	70mm ALUM. SECTION ALT
GLAZING	GLO1
QUANTITY	1 No
REMARKS	HOUSE NO. HC1

B.D. REF :

CLIENT :
SHIMAO GROUP HOLDINGS LIMITED

ARCHITECT : WONG TUNG & PARTNERS LIMITED

MAIN CONTRACTOR :
協興建築有限公司
HIP HING CONSTRUCTION CO LTD

STRUCTURAL ENGINEER :
C M WONG & ASSOCIATES LTD
黃志明建築工程師有限公司

FACADE CONSULTANT:
MEINHARDT

NOTE :
1. ALL DIMENSIONS ARE IN mm.
2. ALL ELEVATIONS ARE VIEWED FROM OUTSIDE.
3. ALL DIMENSIONS TO BE VERIFIED ON SITE BEFORE FABRICATION.

LEGEND :
- XX / XXXX — DETAIL MARK NO. / REFER SHEET NO.
1. F.F.L. — FINISHED FLOOR LEVEL
2. S.F.L. — STRUCTURAL FLOOR LEVEL
3. (R) — REVERSED DETAIL
4. ▲ — FIXING LOCATION
5. △ — FIXING LUG LOCATION
6. GLASS LEGEND
GLO1 — 10mm+12mm AIR GAP+10mm THK. I.G.U.
7. ALT
— PVF2 COATED ALUMINIUM SPRAY TRIWAR (4 COAT SYSTEM) CODE: EC-D9-0334232 COLOR : ODYY 07/083 METALLIC

NO.	DATE	REMARKS	BY
C	12/05/2023	GENERAL REVISED	
B	27/04/2023	GENERAL REVISED	
A	08/03/2023	GENERAL REVISED	

JOB NO. : J-853

PROJECT :
PROPOSED RESIDENTIAL DEVELOPMENT AT N.K.I.L. 6542 YIN PING ROAD KOWLOON

TITLE :
PRECAST ALUM. WINDOW & LOUVRE SCHEDULE FOR HOUSE TYPE G (1)

DATE : 12-FEB-23 | SCALE : 1:40 (A3)

DRAWN BY : Asing | CHECKED BY :

美特鋁製有限公司
MIDI ALUMINIUM FABRICATION LTD.
Units 6-8, Sunray Industrial Centre, 1/F
610 Cha Kwo Ling Road, Kowloon
Tel:23489211-4 Fax:(852)27727666

DWG NO. : J853-SD-HPW-2017 | REV. : C