美特鋁質有限公司
MIDI ALUMINIUM FABRICATOR LTD.

工程指示 / 要求簡箋 ENGINEER INSTRUCTIONS(E.I.)

工程指示編號:	EI- 4318C	**修改版本:**	C
	HK- 1953		
工程編號:	J 853	**工程名稱:**	大窩坪 (延坪道)
收件人:	生統	**發件人:**	Lai Sik Hung
工程項目:	幕牆單元件用鋁碼 補件 (修訂C:因EI4949內的8a版更新圖紙調整數量)	**日期:**	08/11/2022

☐ 原合約工程包	☐ 原合約工程加 / 減賬 QT-	☐ 新工程報價 QT-

信件批核號碼/圖紙參考編號:	**批核模具圖紙編號:**
客戶指示附件:	**管理內部批簽署:**

☐ 初步鋁料 B.M.	☐ 加工拆圖，然後生產	☐ 尺寸表
☐ 正式鋁料 B.M.	☐ 技術上資料／指示	☐ 報價
☐ 配件 B.M.	☐ 樣辦或貨品說明書	☐ 分判合約
☐ 其他:		

內容: 修訂C : 因EI4949內的8a版更新圖紙調整數量

幕牆單元件用鋁碼 補件

完成上列要求日期: 15/11/2022

國內

☐ 生產技術總監	☐ 連附件	☑ 技術部	☑ 連附件	☐ 生產部	☐ 連附件
☐ 採購部	☐ 連附件	☑ 生產統籌部	☑ 連附件	☐ 報關組	☐ 連附件
☐ 質檢部	☐ 連附件	☐ 會計部	☐ 連附件	☐ 機械設計部	☐ 連附件
☑ 香港辦	☑ 連附件	☐ 其他:			

☐ 行政部	☐ 連附件	☐ 會計部	☐ 連附件	☐ 統籌部	☐ 連附件	☐ 工程部	☐ 連附件
☐ 採購部	☐ 連附件	☐ QS部	☐ 連附件	☐ 地盤管理	☐ 連附件	☐ 維修部	☐ 連附件

*發件人簽署：	*組別成員批核簽署： 9/11 2022
傳遞編號：	項目經理簽署：

圖則登記表
DRAWING REGISTER

工程名稱 Project Title: **延坪道**
地台碼拆圖

工程編號 Project No: **J-853**

分發予 Distributed To

接收日期 Receiving Date (適用於客戶圖則)

年										
月										
日										

年	22	22	22							
月	1	2	9							
日	17	24	8							

圖則編號 Drg. No.	圖則名稱 Drawing Title		修訂編號 Revision No.								
853-BT01	墻邊鋁碼	1	-	A	-						
853-BT01(1)	墻邊鋁碼(數據表)	2	-	-	A						
853-BT01a	墻邊鋁碼	3	-	A	B						
853-BT02	墻邊鋁碼	4	-	A	-						
853-BT02(1)	墻邊鋁碼(數據表)	5	-	-	A						
853-BT02a	墻邊鋁碼	6	-	A	B						
853-BT03	墻邊鋁碼	7	-	A	-						
853-BT03(1)	墻邊鋁碼(數據表)	8	-	-	A						
853-BT03a	墻邊鋁碼	9	-	A	B						
853-BT04	墻邊鋁碼	10	-	A	-						
853-BT05	墻邊鋁碼	11	-	A	-						
853-BT06	墻邊鋁碼	12	-	A	-						
853-BT06a	墻邊鋁碼	13	-	A	-						
853-BT07	墻邊鋁碼	14	-	A	-						
853-BT08	墻邊鋁碼	15	-	A	B						
853-BT09	墻邊鋁碼	16	-	A	-						
853-BT10	墻邊鋁碼	17	-	A	-						
853-BT11	墻邊鋁碼	18	-	A	-						
853-PL01	單元安裝凹碼	19	-	A	B						
853-PL01R	單元安裝凹碼	20	-	A	B						
853-PL04	單元安裝凹碼	21	-	A	-						
853-PL04R	單元安裝凹碼	22	-	A	-						
853-PL02/853-PL03	介子（48）/介子（60）	23	-	-	A						

圖則登記表
DRAWING REGISTER

接收日期 Receiving Date（適用於客戶圖則）

工程名稱 Project Title:	延坪道 地台碼拆圖	年										
		月										
工程編號 Project No:	J-853	日										

分發予 Distributed To

		年	22	22	22							
		月	1	2	9							
		日	17	24	8							

圖則編號 Drg. No.	圖則名稱 Drawing Title		修訂編號 Revision No.									
J853-SD-CW-4101	位置圖	24	-	-	A							
J853-SD-CW-4102	位置圖	25	-	-	A							
J853-SD-CW-4103	位置圖	26	-	-	A							
J853-SD-CW-4104	位置圖	27	-	-	A							
J853-SD-CW-4105	位置圖	28	-	-	A							
J853-SD-CW-4106	位置圖	29	-	-	A							
J853-SD-CW-4201	位置圖	30	-	-	A							
J853-SD-CW-4202	位置圖	31	-	-	A							
J853-SD-CW-4203	位置圖	32	-	-	A							
J853-SD-CW-4204	位置圖	33	-	-	A							
J853-SD-CW-4205	位置圖	34	-	-	A							
J853-SD-CW-4206	位置圖	35	-	-	A							
J853-SD-CW-4301	位置圖	36	-	-	A							
J853-SD-CW-4302	位置圖	37	-	-	A							
J853-SD-CW-4303	位置圖	38	-	-	A							
J853-SD-CW-4304	位置圖	39	-	-	A							
J853-SD-CW-4305	位置圖	40	-	-	A							
J853-SD-CW-4306	位置圖	41	-	-	A							
J853-SD-CW-4501	位置圖	42	-	-	A							
J853-SD-CW-4502	位置圖	43	-	-	A							
J853-SD-CW-4503	位置圖	44	-	-	A							
J853-SD-CW-4504	位置圖	45	-	-	A							
J853-SD-CW-4505	位置圖	46	-	-	A							
J853-SD-CW-4506	位置圖	47	-	-	A							
J853-SD-CW-4507	位置圖	48	-	-	A							

圖則登記表
DRAWING REGISTER

												接收日期 Receiving Date（適用於客戶圖則）									
工程名稱 Project Title:	延坪道										年										
	地台碼拆圖										月										
工程編號 Project No:	J-853										日										
分發予 Distributed To																					
											年	22	22	22							
											月	1	2	9							
											日	17	24	8							
圖則編號 Drg. No.	圖則名稱 Drawing Title											修訂編號 Revision No.									
J853-SD-CW-4508	位置圖										49	-	-	A							
J853-SD-CW-4509	位置圖										50	-	-	A							
J853-SD-CW-4510	位置圖										51	-	-	A							
J853-SD-CW-4601	位置圖										52	-	-	A							
J853-SD-CW-4602	位置圖										53	-	-	A							
J853-SD-CW-4603	位置圖										54	-	-	A							
J853-SD-CW-4604	位置圖										55	-	-	A							
J853-SD-CW-4605	位置圖										56	-	-	A							
J853-SD-CW-4606	位置圖										57	-	-	A							
J853-SD-CW-4607	位置圖										58	-	-	A							
J853-SD-CW-4608	位置圖										59	-	-	A							
J853-SD-CW-4609	位置圖										60	-	-	A							
853-BT08a	墻邊鋁碼										61	-	新增								

EG-DWG4

美特鋁質 有限公司 MIDI Aluminium Fabricator Ltd.				類別		物料號		
				制圖	陳俊賢	2021.10.29	圖號	853-BT01(1)
修改	A			復核	謝永林	2021.12.21	數量	–
日期	2022.9.8			批准	胡哥		位置	

A版依據EI4439修改數量

使用位置	數量	層數	總數	樓層
T1CW-A-1	3	16	48	5F-22F
	2	1	2	23F
T1CW-B-1	3	15	45	6F-22F
	2	1	2	23F
	1	1	1	5F
T1CW-A-2	3	16	48	5F-22F
	2	1	2	23F
	4	1	4	25F
T1CW-B-2	1	2	2	23F-25F
T1CW-A-4	1	16	16	5F-22F
T1CW-B-3	6	16	96	5F-22F
	1	6	6	23F
	1	8	8	25F
T1CW-A-5	4	1	4	23F
	4	1	4	25F
T1CW-B-4	4	1	4	23F
	4	1	4	25F
T1CW-A-6	3	1	3	23F
	5	1	5	25F
T2CW-A-1	1	9	9	17F-26F
T2CW-A-2	1	17	17	5F-23F
T2CW-A-3	3	9	27	5F-15F
	2	1	2	16F
T2CW-A-4	1	7	7	17F-23F
	2	2	4	25F-26F
T2CW-A-5	1	7	7	17F-23F
T2CW-C-1	3	19	57	5F-26F
T2CW-B-1	2	19	38	5F-26F
T2CW-C-2	2	19	38	5F-26F
T2CW-B-2	3	19	57	5F-26F
T2CW-A-7	2	1	2	25F
	2	1	2	26F
T2CW-A-8	3	1	3	26F
T3CW-A-1	1	7	7	17F-23F
T3CW-A-2	1	9	9	17F-26F
T3CW-A-3	1	17	17	5F-23F
T3CW-A-4	3	9	27	5F-15F
	2	1	2	16F
T3CW-A-5	1	7	7	17F-23F
	2	2	4	25F-26F
T3CW-C-1	3	19	57	5F-26F
T3CW-C-2	2	19	38	5F-26F
T3CW-B-1	2	19	38	5F-26F
T3CW-B-2	3	19	57	5F-26F

使用位置	數量	層數	總數	樓層
T3CW-A-7	2	1	2	25F
	2	1	2	26F
T3CW-A-8	3	1	3	26F
T5CW-A-1	1	7	7	17F-23F
T5CW-C-1	3	4	12	10F-15F
T5CW-A-2	3	9	27	5F-15F
	2	1	2	16F
T5CW-A-3	1	7	7	17F-23F
T5CW-A-5	1	19	19	5F-26F
T5CW-B-1	1	4	4	11F-16F
T5CW-A-6	1	7	7	17F-23F
	2	2	4	25F-26F
T5CW-B-2	2	9	18	16F-23F, 26F
	1	1	1	25F
T5CW-B-3	3	8	24	17F-25F
	2	1	2	26F
T5CW-D-2	3	5	15	10F-16F
T5CW-B-4	3	7	21	17F-23F
T5CW-F-2	3	14	42	10F-26F
T5CW-E-1	3	14	42	10F-26F
T5CW-A-7	3	1	3	26F
T5CW-B-5	1	1	1	25F
	2	1	2	26F
T5CW-A-8	3	1	3	25F
	3	1	3	26F
T6CW-A-1	1	19	19	5F-26F
T6CW-A-2	1	19	19	5F-26F
T6CW-A-3	2	19	38	5F-26F
T6CW-B-1	2	19	38	5F-26F
T6CW-B-2	3	19	57	5F-26F
T7CW-A-4	2	17	34	7F-26F
T7CW-A-5	3	17	51	7F-26F
T7CW-B-4	3	15	45	7F-23F
T6CW-C-2	3	14	42	10F-26F
T6CW-D-2	1	14	14	10F-26F
T7CW-B-6	1	17	17	7F-26F
T7CW-B-7	3	13	39	9F-23F
	3	1	3	8F
T7CW-B-8	8	1	8	25F
	9	1	9	26F
合計:	1543			

工程號	J853	地盤	延坪道	附件	拆圖見:853-BT01
名稱	墻邊鋁碼(數據表)	採用			
材料	X85996	地盤	✓		
顏色	鉻化	工廠			

A


EG-DWG4


美特鋁質 有限公司 MIDI Aluminium Fabricator Ltd.				類別		物料號		
				制圖	陳俊賢	2021.10.29	圖號	853-BT01a
修改	A	B		復核	謝永林	2021.12.21	數量	–
日期	2022.2.24	2022.9.8		批准	胡哥		位置	

B版依據EI4439修改數量


原EI4318，依據型材料辦牙位尺寸微調

使用位置	數量	層數	總數	樓層
T1CW-A-2	3	1	3	5F
T1CW-A-5	4	1	4	23F
T1CW-B-4	4	1	4	23F
T2CW-A-7	2	1	2	25F
T3CW-A-7	2	1	2	25F
T5CW-A-8	3	1	3	25F
T7CW-A-7	3	1	3	8F
T7CW-B-8	8	1	8	8F
合計:	29			

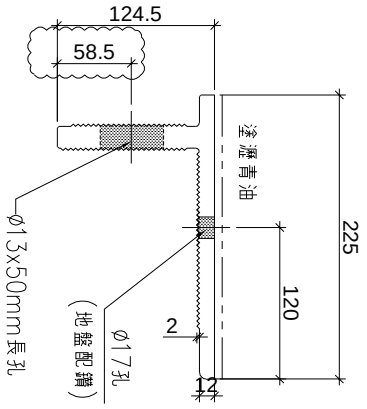


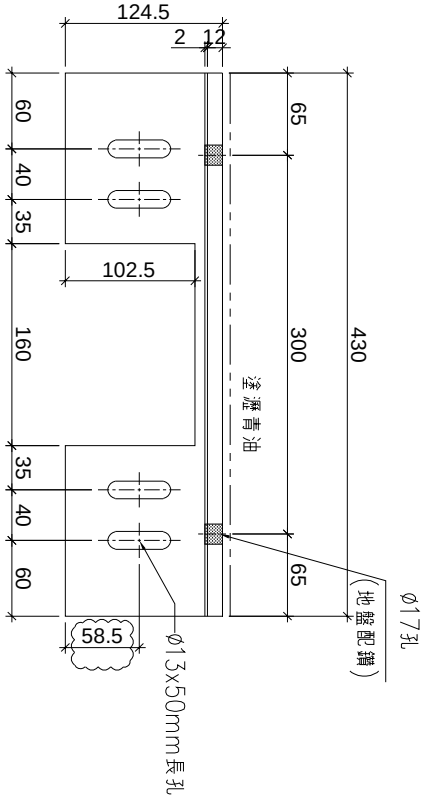

室外

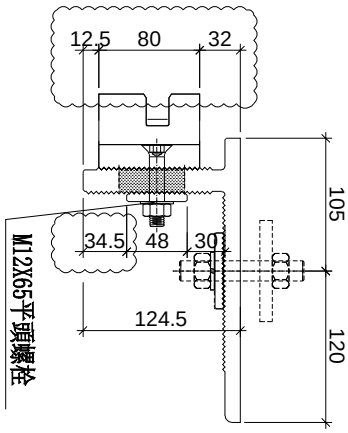

組裝示意圖

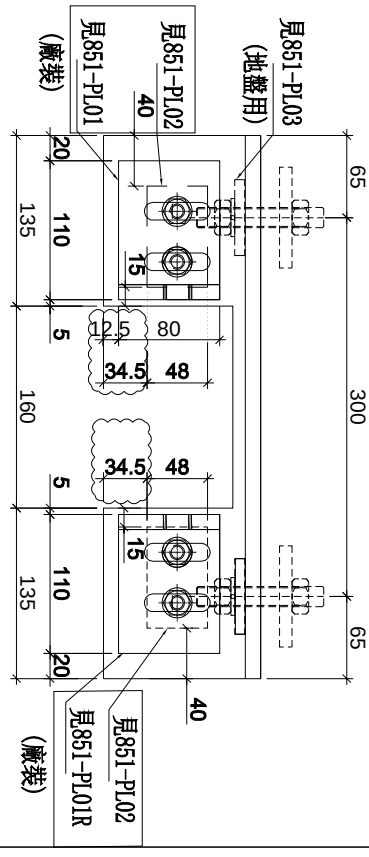

工程號	J853	地盤	延坪道		
名稱	牆邊鋁碼		採用	附件	
材料	X85996		地盤	✓	
顏色	塗灑青油＋鉻化		工廠		

EG-DWG4

美特鋁質 有限公司 MIDI Aluminium Fabricator Ltd.				類別		物料號		
				制圖	陳俊賢	2021.10.29	圖號	853-BT02(1)
修改				復核	謝永林	2021.12.21	數量	–
日期				批准	胡哥		位置	

A版依據EI4439修改數量

使用位置	數量	層數	總數	樓層
T1CW-A-1	2	16	32	5F-22F
	1	1	1	23F
T1CW-B-1	2	15	30	6F-22F
	1	1	1	23F
	4	1	4	5F
T1CW-A-2	1	18	18	5F-25F
T1CW-A-3	1	16	16	5F-22F
T1CW-A-4	1	16	16	5F-22F
T1CW-B-2	1	18	18	5F-25F
T1CW-B-3	2	16	32	5F-22F
	1	19	19	5F-25F, 22F
T1CW-A-5	2	1	2	25F
T1CW-B-4	2	1	2	25F
T1CW-A-6	4	1	4	23F
	1	1	1	25F
T2CW-A-1	1	19	19	5F-26F
T2CW-A-2	1	17	17	5F-23F
T2CW-A-3	1	9	9	5F-15F
	2	1	2	16F
T2CW-A-4	1	7	7	17F-23F
	1	2	2	25F-26F
T2CW-D-1	1	10	10	5F-16F
T2CW-A-5	1	7	7	17F-23F
T2CW-C-1	1	19	19	5F-26F
T2CW-B-1	1	19	19	5F-26F
T2CW-C-2	1	19	19	5F-26F
T2CW-B-2	1	19	19	5F-26F
T2CW-A-6	1	9	9	6F-16F
	1	1	1	5F
T2CW-A-7	1	1	1	25F
	1	1	1	26F
T2CW-A-8	1	1	1	26F
T3CW-D-1	1	10	10	5F-16F
T3CW-A-1	1	7	7	17F-23F
T3CW-A-2	1	19	19	5F-26F
T3CW-A-3	1	17	17	5F-23F
T3CW-A-4	1	9	9	5F-15F
	2	1	2	16F
T3CW-A-5	1	7	7	17F-23F
	1	2	2	25F-26F
T3CW-C-1	1	19	19	5F-26F
T3CW-C-2	1	19	19	5F-26F
T3CW-B-1	1	19	19	5F-26F
T3CW-B-2	1	19	19	5F-26F
T3CW-A-6	1	9	9	6F-16F
	1	1	1	5F
T3CW-A-7	1	1	1	25F
	1	1	1	26F

使用位置	數量	層數	總數	樓層
T3CW-A-8	1	1	1	26F
T5CW-A-1	1	17	17	5F-23F
T5CW-C-1	1	4	4	10F-15F
T5CW-A-2	1	9	9	5F-15F
	2	1	2	16F
T5CW-A-3	1	7	7	17F-23F
T5CW-A-5	1	19	19	5F-26F
T5CW-B-1	1	10	10	5F-16F
	1	4	4	11F-16F
T5CW-A-6	1	7	7	17F-23F
	1	2	2	25F-26F
T5CW-C-2	1	4	4	10F-15F
T5CW-B-2	1	10	10	16F-26F
T5CW-D-1	1	12	12	10F-23F
T5CW-B-3	2	9	18	17F-26F
T5CW-D-2	1	5	5	10F-16F
T5CW-B-4	1	7	7	17F-23F
T5CW-F-1	1	14	14	10F-26F
T5CW-F-2	1	14	14	10F-26F
T5CW-E-1	1	14	14	10F-26F
T5CW-A-7	1	1	1	26F
T5CW-B-5	3	1	3	25F
	2	1	2	26F
T5CW-A-8	1	1	1	25F
	1	1	1	26F
T6CW-A-1	1	19	19	5F-26F
T6CW-A-2	1	19	19	5F-26F
T6CW-A-3	1	19	19	5F-26F
T6CW-B-1	1	19	19	5F-26F
T6CW-B-2	1	19	19	5F-26F
T7CW-A-4	1	17	17	7F-26F
T7CW-A-5	1	17	17	7F-26F
T7CW-B-3	1	15	15	7F-23F
T7CW-B-4	1	15	15	7F-23F
T7CW-B-5	1	16	16	7F-25F
T6CW-C-1	1	14	14	10F-26F
T6CW-C-2	1	14	14	10F-26F
T6CW-D-1	1	14	14	10F-26F
T6CW-D-2	1	14	14	10F-26F
T7CW-B-6	1	17	17	7F-26F
T7CW-B-7	1	13	13	9F-23F
	1	1	1	8F
T7CW-B-8	1	1	1	25F
	1	1	1	26F
合計:			970	

工程號	J853	地盤	延坪道		
名稱	墻邊鋁碼(數據表)	採用		附件	拆圖見:853-BT02
材料	X85996	地盤	✓		
顏色	鉻化	工廠			


A


EG-DWG4


使用位置	數量	層數	總數	樓層
T1CW-B-1	1	1	1	5F
T1CW-A-2	1	1	1	5F
T1CW-B-3	1	2	2	5F,22F
T1CW-A-5	1	1	1	23F
T1CW-B-4	1	1	1	23F
T1CW-A-6	2	1	2	23F
T2CW-A-6	1	1	1	5F
T2CW-A-7	1	1	1	25F
T3CW-A-6	1	1	1	5F
T3CW-A-7	1	1	1	25F
T5CW-B-5	1	1	1	25F
T5CW-A-8	1	1	1	25F
T7CW-A-7	1	1	1	8F
T7CW-B-8	1	1	1	25F
合計:			16	


B

組裝示意圖

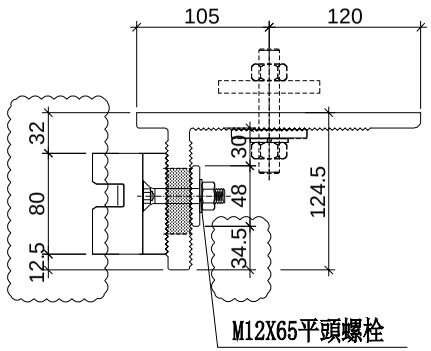

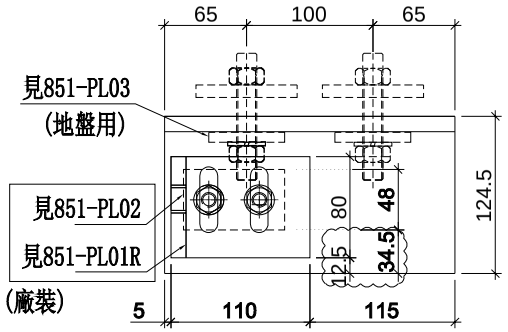

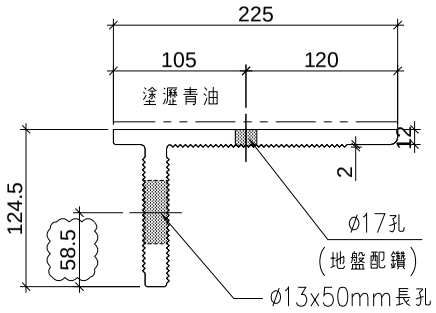

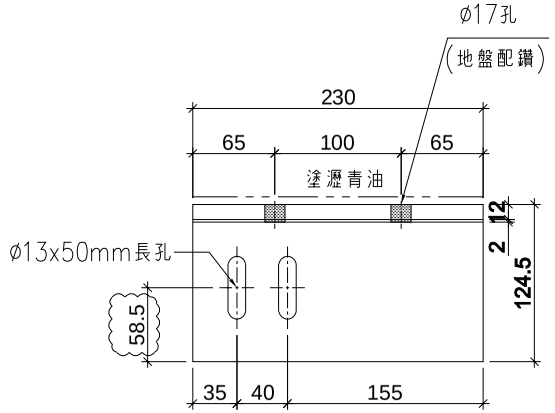

室外

修改	日期	說明
A	2022.2.24	B版依據EI4439修改數量
B	2022.9.8	原EI4318，依據型材料辦 牙位尺寸微調

美特鋁質有限公司
MIDI Aluminium Fabricator Ltd.

類別		物料號	
制圖	陳俊賢	2021.10.29	圖號 853-BT02a
復核	謝永林	2021.12.21	數量 –
批准	胡哥		位置

工程號	J853	地盤	延坪道	附件	
名稱	牆邊鋁碼			採用	地盤 ✓
材料	X85996				工廠
顏色	塗瀝青油＋鉻化				

EG-DWG4

美特鋁質 有限公司 MIDI Aluminium Fabricator Ltd.				類別		物料號		
				制圖	陳俊賢	2021.10.29	圖號	853-BT03(1)
修改	A			復核	謝永林	2021.12.21	數量	–
日期	2022.9.8			批准	胡哥		位置	

A版依據EI4439修改數量

使用位置	數量	層數	總數	樓層
T1CW-A-1	2	16	32	5F-22F
	1	1	1	23F
T1CW-B-1	2	15	30	6F-22F
	1	1	1	23F
	4	1	4	5F
T1CW-A-2	1	18	18	5F-25F
T1CW-A-3	1	16	16	5F-22F
T1CW-A-4	1	16	16	5F-22F
T1CW-B-2	1	18	18	5F-25F
T1CW-B-3	2	16	32	5F-22F
	1	19	19	5F-25F, 22F
T1CW-A-5	1	1	1	23F
	1	1	1	25F
T1CW-B-4	1	1	1	23F
	1	1	1	25F
T1CW-A-6	4	1	4	23F
	1	1	1	25F
T2CW-A-1	1	19	19	5F-26F
T2CW-A-2	1	17	17	5F-23F
T2CW-A-3	1	9	9	5F-15F
	2	1	2	16F
T2CW-A-4	1	7	7	17F-23F
	1	2	2	25F-26F
T2CW-C-1	1	19	19	5F-26F
T2CW-B-1	1	19	19	5F-26F
T2CW-C-2	1	19	19	5F-26F
T2CW-B-2	1	19	19	5F-26F
T2CW-A-6	1	9	9	6F-16F
	1	1	1	5F
T2CW-A-7	1	1	1	25F
	1	1	1	26F
T2CW-A-8	1	1	1	26F
T3CW-A-2	1	19	19	5F-26F
T3CW-A-3	1	17	17	5F-23F
T3CW-A-4	1	9	9	5F-15F
	2	1	2	16F
T3CW-A-5	1	7	7	17F-23F
	1	2	2	25F-26F
T3CW-C-1	1	19	19	5F-26F
T3CW-C-2	1	19	19	5F-26F
T3CW-B-1	1	19	19	5F-26F
T3CW-B-2	1	19	19	5F-26F
T3CW-A-6	1	9	9	6F-16F
	1	1	1	5F
T3CW-A-7	1	1	1	25F
	1	1	1	26F
T3CW-A-8	1	1	1	26F
T5CW-A-1	1	17	17	5F-23F

使用位置	數量	層數	總數	樓層
T5CW-C-1	1	4	4	10F-15F
T5CW-A-2	1	9	9	5F-15F
	2	1	2	16F
T5CW-A-3	1	7	7	17F-23F
T5CW-A-5	1	19	19	5F-26F
T5CW-B-1	1	10	10	5F-16F
	1	4	4	11F-16F
T5CW-A-6	1	7	7	17F-23F
	1	2	2	25F-26F
T5CW-C-2	1	4	4	10F-15F
T5CW-B-2	1	10	10	16F-26F
T5CW-D-1	1	12	12	10F-23F
T5CW-B-3	2	9	18	17F-26F
T5CW-D-2	1	5	5	10F-16F
T5CW-B-4	1	7	7	17F-23F
T5CW-F-1	1	14	14	10F-26F
T5CW-F-2	1	14	14	10F-26F
T5CW-E-1	1	14	14	10F-26F
T5CW-A-7	1	1	1	26F
T5CW-B-5	3	1	3	25F
	2	1	2	26F
T5CW-A-8	1	1	1	25F
	1	1	1	26F
T6CW-A-1	1	19	19	5F-26F
T6CW-A-2	1	19	19	5F-26F
T6CW-A-3	1	19	19	5F-26F
T6CW-B-1	1	19	19	5F-26F
T6CW-B-2	1	19	19	5F-26F
T7CW-A-4	1	17	17	7F-26F
T7CW-A-5	1	17	17	7F-26F
T7CW-B-3	1	15	15	7F-23F
T7CW-B-4	1	15	15	7F-23F
T7CW-B-5	1	16	16	7F-25F
T6CW-C-1	1	14	14	10F-26F
T6CW-C-2	1	14	14	10F-26F
T6CW-D-1	1	14	14	10F-26F
T6CW-D-2	1	14	14	10F-26F
T7CW-B-6	1	17	17	7F-26F
T7CW-B-7	1	13	13	9F-23F
	1	1	1	8F
T7CW-B-8	1	1	1	25F
	1	1	1	26F
合計:			936	


工程號	J853	地盤	延坪道	附件	拆圖見:853-BT03
名稱	牆邊鋁碼(數據表)	採用			
材料	X85996	地盤	✓		
顏色	鉻化	工廠			

A


EG-DWG4


使用位置	數量	層數	總數	樓層
T1CW-B-1	1	1	1	5F
T1CW-A-2	1	1	1	5F
T1CW-B-3	1	2	2	5F,22F
T1CW-A-5	1	1	1	23F
T1CW-B-4	1	1	1	23F
T1CW-A-6	2	1	2	23F
T2CW-A-6	1	1	1	5F
T2CW-A-7	1	1	1	25F
T3CW-A-6	1	1	1	5F
T3CW-A-7	1	1	1	25F
T5CW-B-5	1	1	1	25F
T5CW-A-8	1	1	1	25F
T7CW-A-7	1	1	1	8F
T7CW-B-8	1	1	1	25F
合計:			16	


B

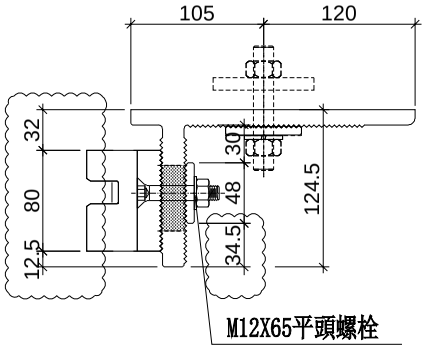

組裝示意圖

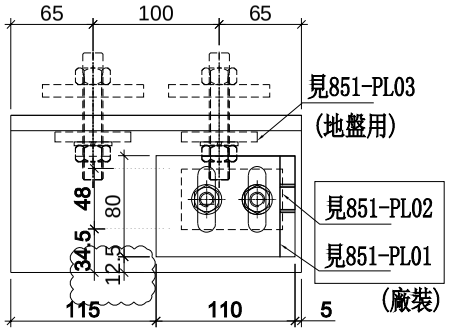

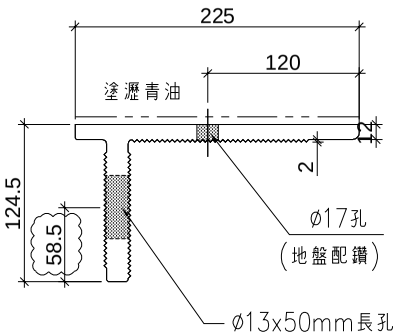

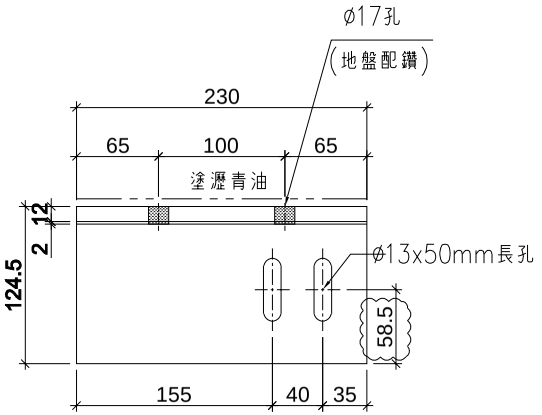

室外

B版依據EI4439修改數量

原EI4318，依據型材料辦
牙位尺寸微調

修改	A	B	
日期	2022.2.24	2022.9.8	

美特鋁質有限公司
MIDI Aluminium Fabricator Ltd.

類別	物料號	圖號	853-BT03a
制圖	2021.10.29	數量	-
復核	2021.12.21	位置	
批准	陳俊賢 謝永林 胡哥		

工程號	J853	地盤	延坪道	附件
名稱	牆邊鋁碼			採用
材料	X85996			地盤
顏色	塗澀青油+銘化			工廠


EG-DWG4


美特鋁質有限公司
MIDI Aluminium Fabricator Ltd.


修改	日期	物料號	圖號	853-BT08
A	2022.2.24	2021.10.29	數量	–
B	2022.9.8	2021.12.21	位置	

類別			
制圖	陳俊賢		
復核	謝永林		
批准	胡哥		

組裝示意圖

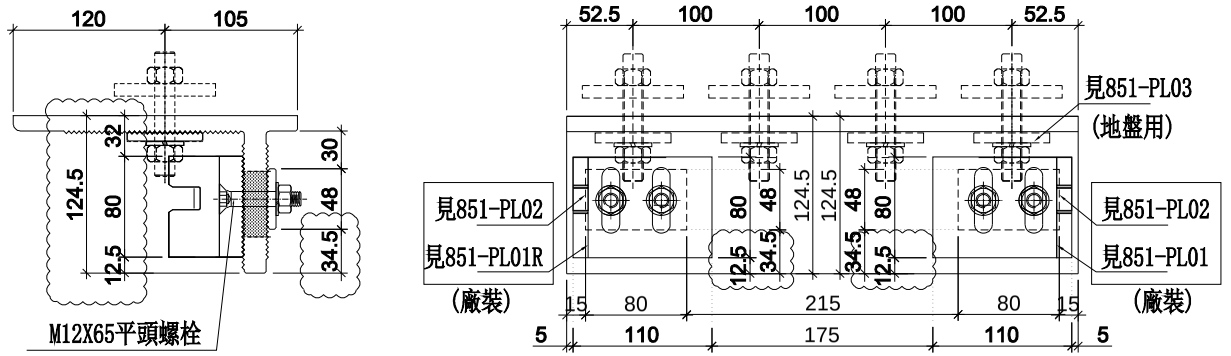

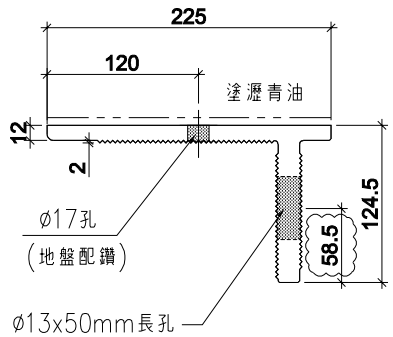

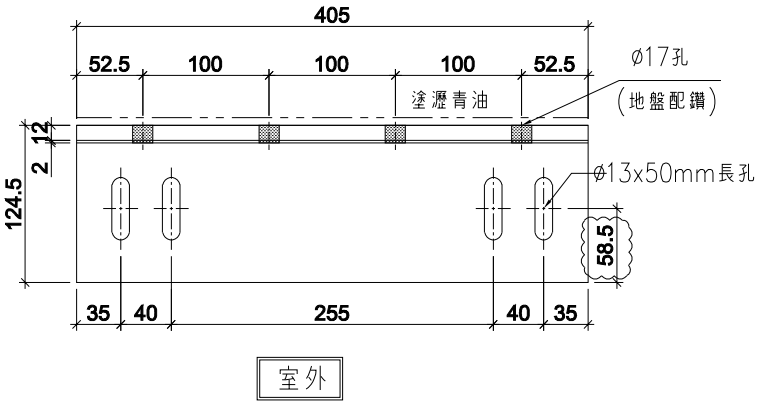

室外

原EI4318，依據型材料辦
牙位尺寸微調

B

使用位置	數量	層數	總數	樓層
T5CW-A-4	1	10	10	5F-16F


工程號	J853	地盤	延坪道	附件
名稱	牆邊鋁碼		採用	
材料	X85996		地盤	✓
顏色	塗澆青油＋鉻化		工廠	


EG-DWG4

美特鋁質 有限公司 MIDI Aluminium Fabricator Ltd.				類別		物料號		
				制圖	陳俊賢	2021.10.29	圖號	853-PL01
修改	A	B		復核	謝永林	2021.12.21	數量	–
日期	2022.2.24	2022.9.8		批准	胡哥		位置	

B版依據EI4439修改數量

原EI4318，依據型材料辦
牙位尺寸微調

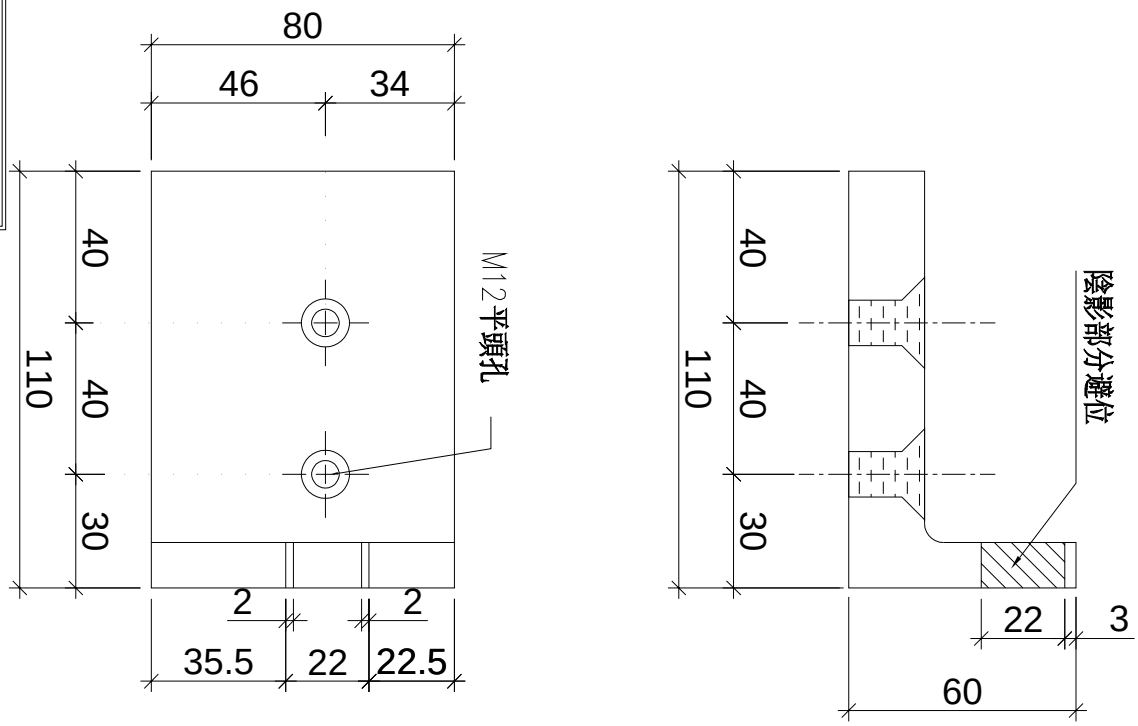

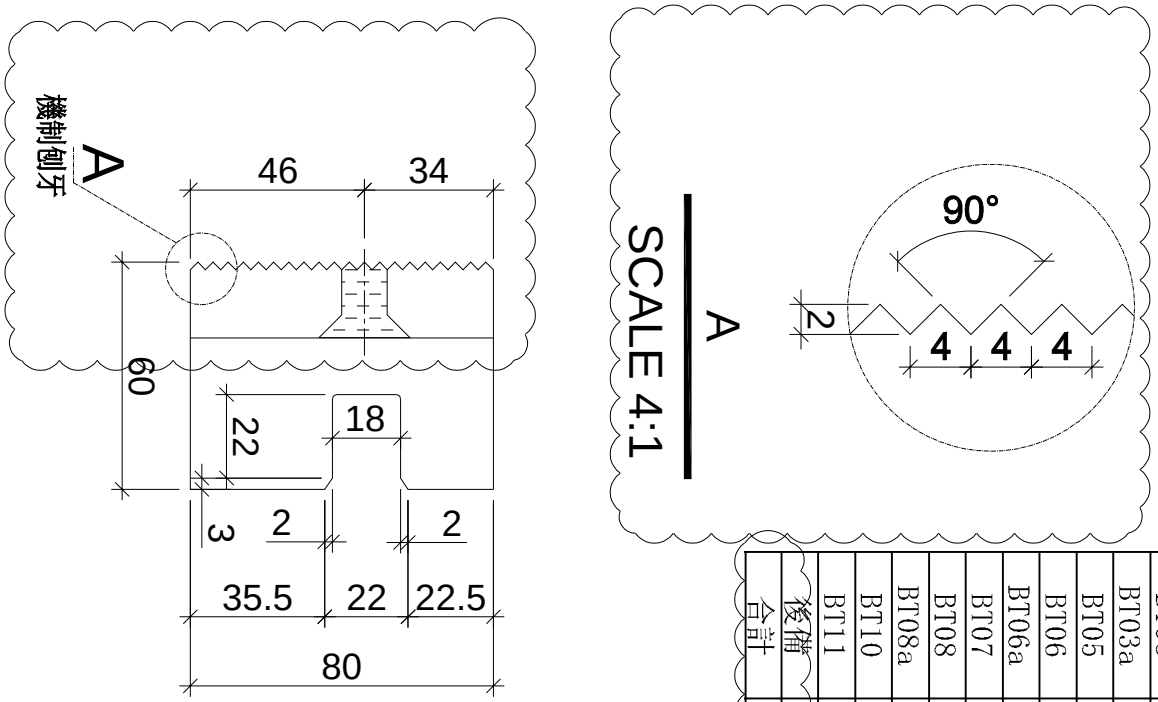

使用位置	數量
BT01	1543
BT01a	29
BT03	936
BT03a	16
BT05	80
BT06	20
BT06a	2
BT07	34
BT08	10
BT08a	1
BT10	2
BT11	1
後備	10
合計	2684


工程號	J853	地盤	延坪道	附件	
名稱	單元安裝凹碼	採用			
材料	X85997	地盤			
顏色	鋁化	工廠	✓		


EG-DWG4


美特鋁質 有限公司 MIDI Aluminium Fabricator Ltd.				類別		物料號		
				制圖	陳俊賢	2021.10.29	圖號	853-PL01R
修改	A	B		復核	謝永林	2021.12.21	數量	–
日期	2022.2.24	2022.9.8		批准	胡哥		位置	


B版依據EI4439修改數量

原EI4318，依據型材料辦
牙位尺寸微調

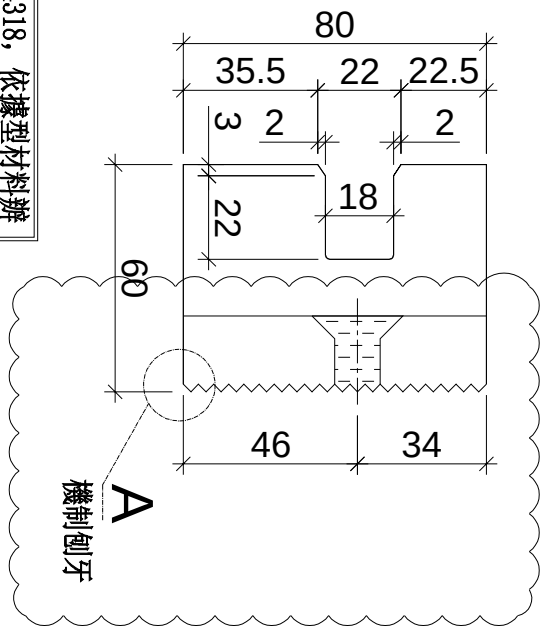

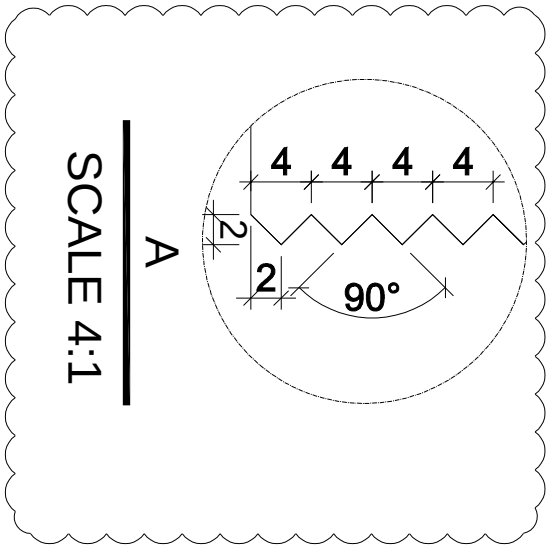

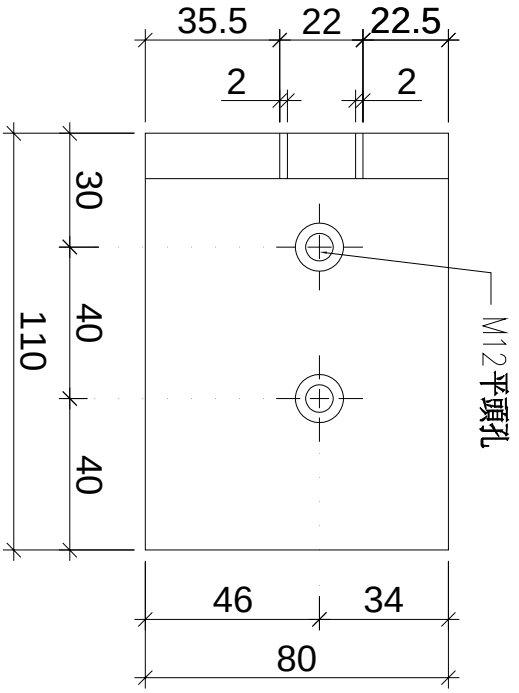

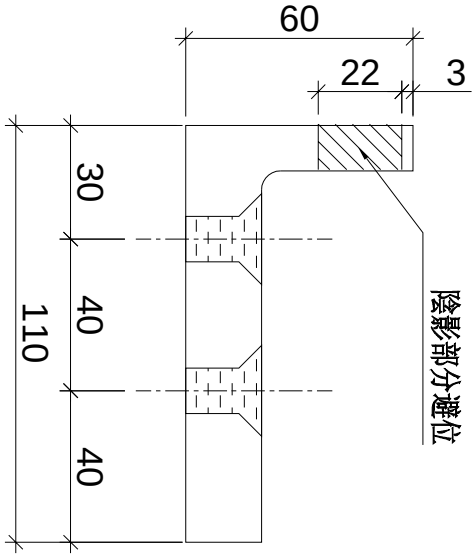

使用位置	數量
BT01	1543
BT01a	29
BT02	970
BT02a	16
BT04	46
BT06	20
BT06a	2
BT07	34
BT08	10
BT08a	1
BT10	2
BT11	1
後備	10
合計	2684

工程號	J853	地盤	延坪道	附件	
名稱	單元安裝凹碼	採用			
材料	X85997	地盤			
顏色	鉻化	工廠	✓		

EG-DWG4

美特鋁質 有限公司 MIDI Aluminium Fabricator Ltd.				類別		物料號		
				制圖	陳俊賢	2021.10.29	圖號	853-PL02/853-PL03
修改	A			復核	謝永林	2021.12.21	數量	–
日期	2022.9.8			批准	胡哥		位置	


圖號	使用位置	數量
853-PL02	BT01	3086
	BT01a	58
	BT02	970
	BT02a	16
	BT03	936
	BT03a	16
	BT04	46
	BT05	80
	BT06	40
	BT06a	4
	BT07	68
	BT08	20
	BT08a	2
	BT09	2
	BT10	4
	BT11	2
後備:		29
合計:		5370


工廠用

A版依據EI4439修改數量

地盤用

圖號	使用位置	數量
853-PL03	BT01	3086
	BT01a	58
	BT02	1940
	BT02a	32
	BT03	1872
	BT03a	32
	BT04	92
	BT05	160
	BT06	40
	BT06a	4
	BT07	68
	BT08	44
	BT09	2
	BT10	4
	BT11	2
後備:		64
合計:		7500

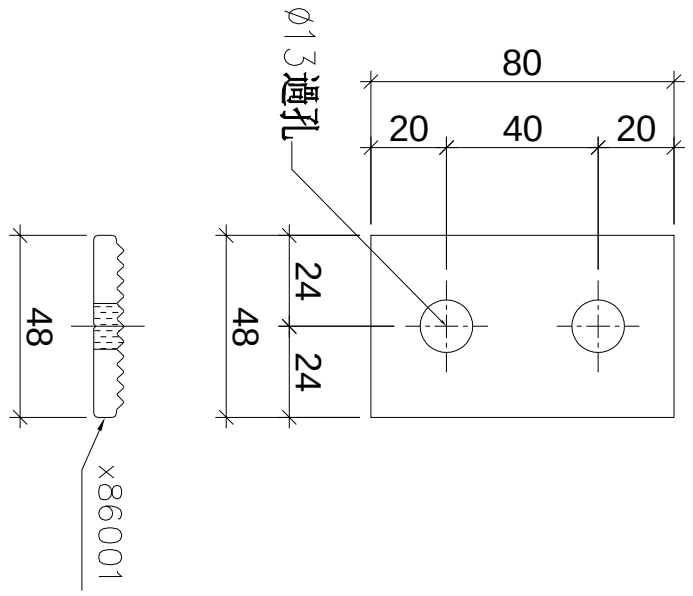


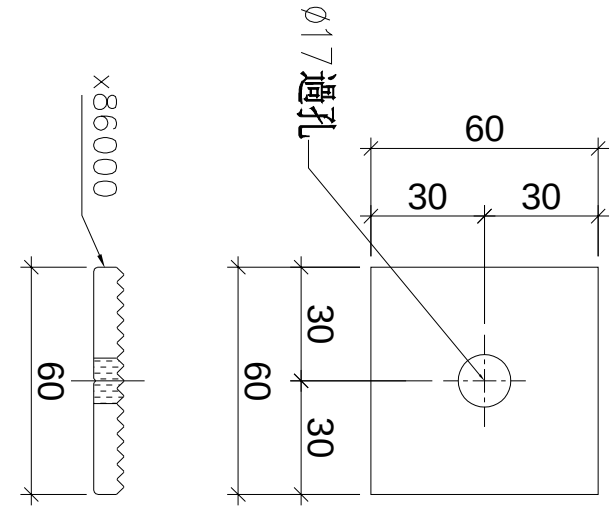


工程號	J853	地盤	延坪道		
名稱	介子（48）/介子（60）		採用		附件
材料	X86001/X86000		地盤	✓	
顏色	鉻化		工廠	✓	

LEGEND :


R.S. = RESTRAINT SOCKET

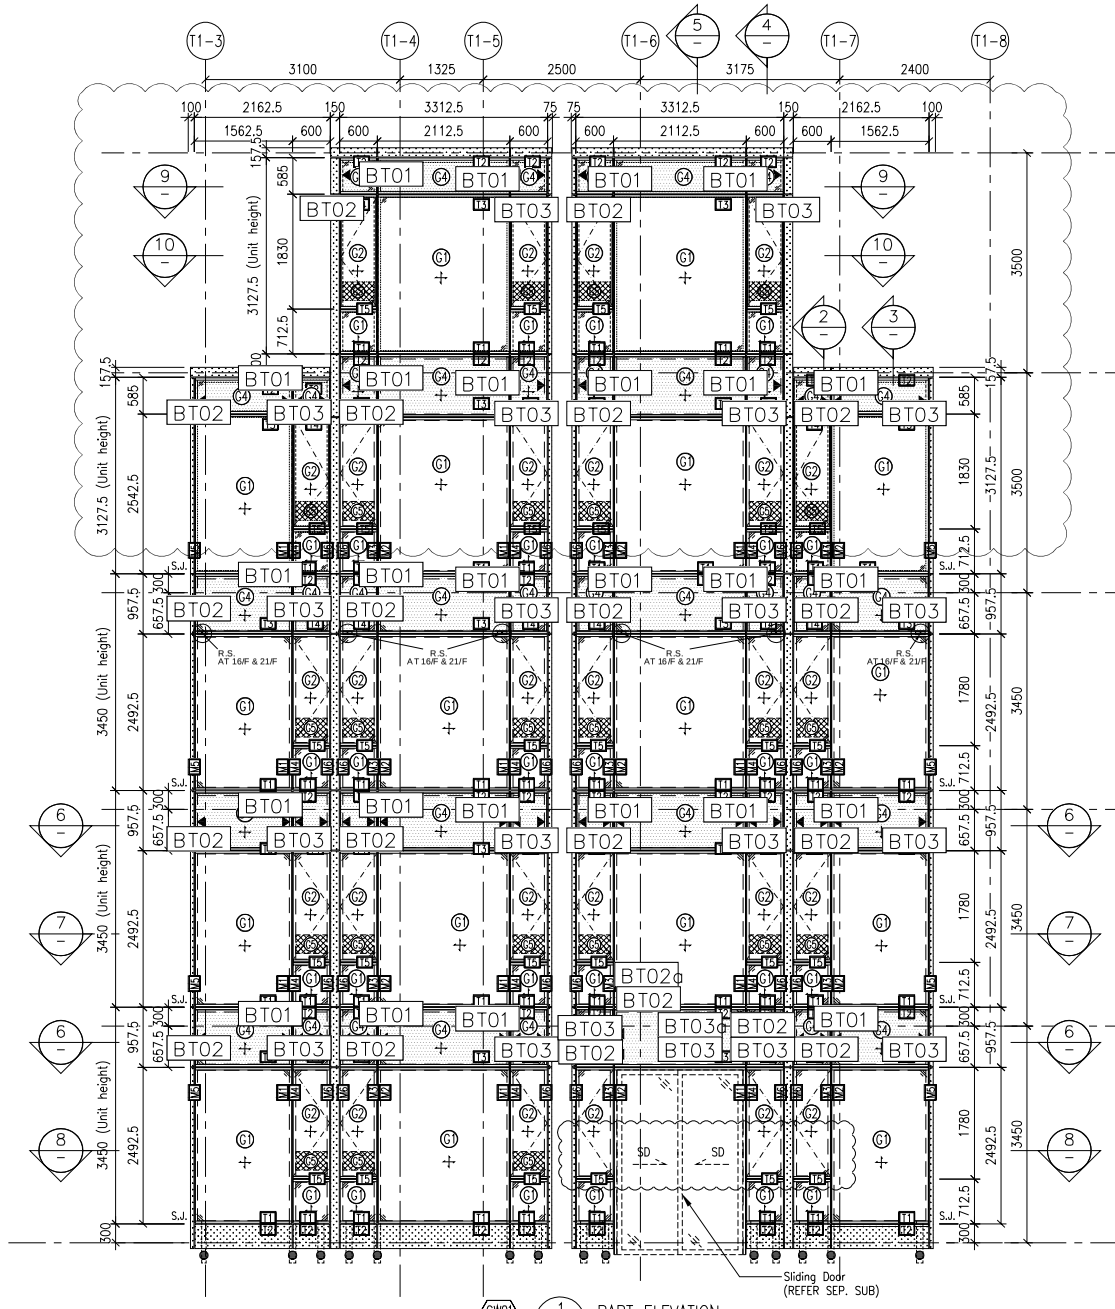

1 — PART ELEVATION FOR CURTAIN WALL

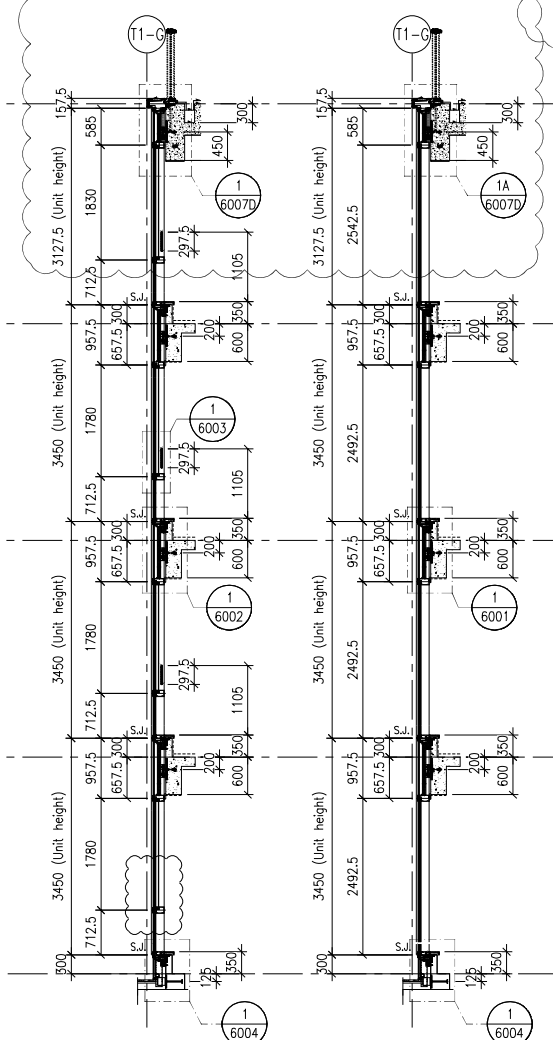


2 — TYPICAL SECTION FOR CURTAIN WALL

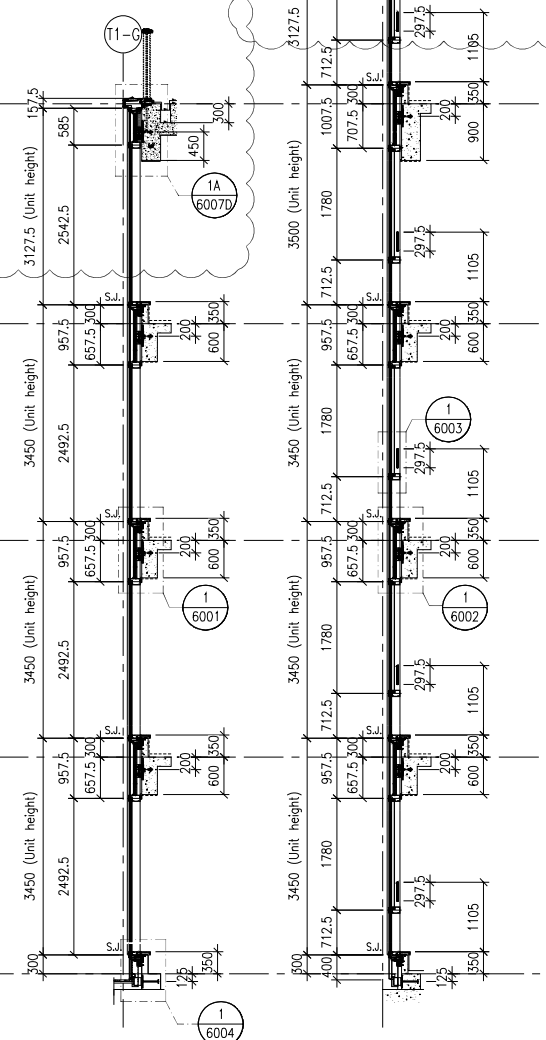

3 — TYPICAL SECTION FOR CURTAIN WALL


4 — TYPICAL SECTION FOR CURTAIN WALL

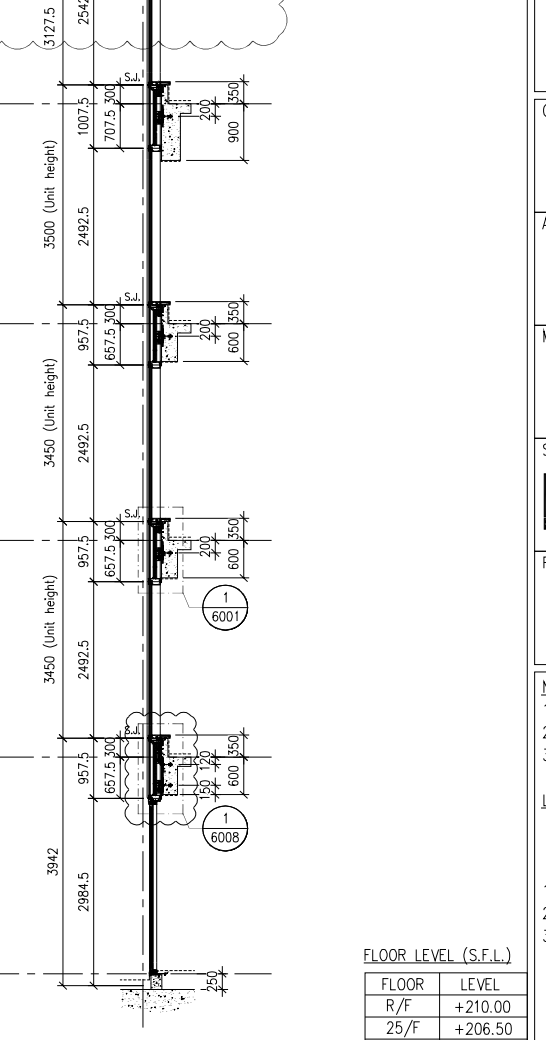


5 — TYPICAL SECTION FOR CURTAIN WALL

T1CW-A-1


T1CW-B-1

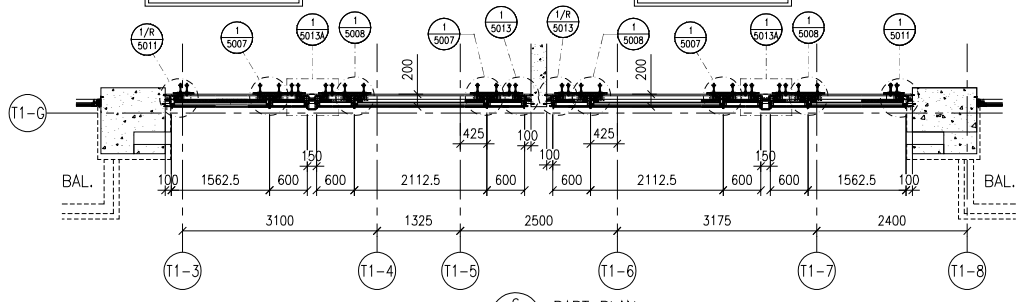


6 — PART PLAN FOR CURTAIN WALL

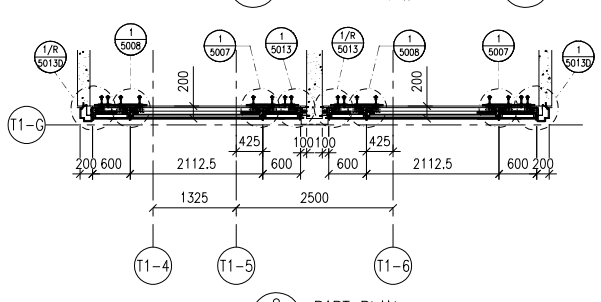


9 — PART PLAN FOR CURTAIN WALL

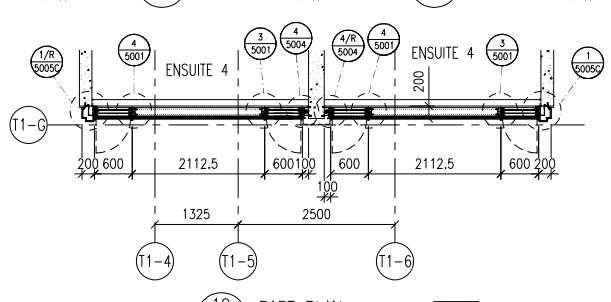

10 — PART PLAN FOR CURTAIN WALL

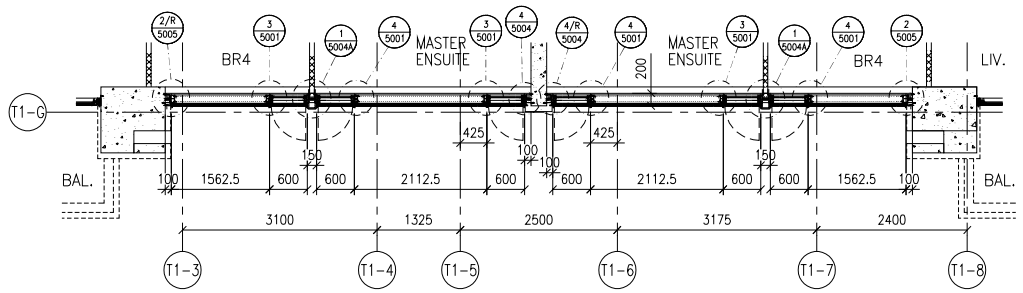

7 — PART PLAN FOR CURTAIN WALL

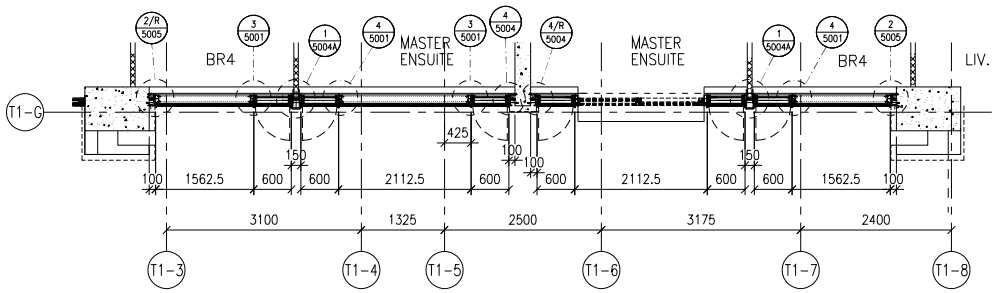

8 — PART PLAN FOR CURTAIN WALL

FLOOR LEVEL (S.F.L.)

FLOOR	LEVEL
R/F	+210.00
25/F	+206.50
23/F	+203.00
22/F	+199.50
21/F	+196.05
20/F	+192.60
19/F	+189.15
18/F	+185.70
17/F	+182.25
16/F	+178.80
15/F	+175.35
12/F	+171.90
11/F	+168.45
10/F	+165.00
9/F	+161.55
8/F	+158.10
7/F	+154.65
6/F	+151.20
5/F	+147.75

LEGEND:

- STONE CLADDING (BY OTHERS)
- G01+ – 10mm HEAT STRENGTHENED GLASS (OUTER) + 12mm AIR SPACE +12mm THK. TEMPERED CLEAR GLASS (INNER)
- G02+ – 10mm HEAT STRENGTHENED GLASS (OUTER) + 12mm AIR SPACE +10mm THK. TEMPERED CLEAR GLASS (INNER)
- G04+ – 12mm THK. HEAT STRENGTHENED GLASS & 2mm THK. ALUM. BACKPAN (SPANDREL GLASS)
- G05 – 12mm THK. CLEAR TEMPERED GLASS (INTERNAL PROTECTIVE BARRIER)
- 3mm THK. ALUM. CLADDING
- S.J. – STACK JOINT (WIND LOAD)
- AE01 – ALUM. EXTRUSION DIE NO.
- ▲ – SUPPORT POINT (WIND LOAD + DEAD LOAD)
- ● – SUPPORT POINT (WIND LOAD)

B.D. REF :

CLIENT :

SHIMAO GROUP HOLDINGS LIMITED

ARCHITECT :

WONG TUNG & PARTNERS LIMITED
ARCHITECTS & PLANNERS

MAIN CONTRACTOR :

協興建築有限公司
HIP HING CONSTRUCTION CO LTD

STRUCTURAL ENGINEER :

CMA C M WONG & ASSOCIATES LTD
黃志明建築工程師有限公司

FACADE CONSULTANT:

MEINHARDT

NOTE :

1. ALL DIMENSIONS ARE IN mm.
2. ALL ELEVATIONS ARE VIEWED FROM OUTSIDE.
3. ALL DIMENSIONS TO BE VERIFIED ON SITE BEFORE FABRICATION.

LEGEND :

X1 / X001 — DETAIL MARK NO. / REFER SHEET NO.

1. F.F.L. -- FINISHED FLOOR LEVEL
2. S.F.L. -- STRUCTURAL FLOOR LEVEL
3. /R -- HANDED DETAIL

NO.	DATE	REVISED	BY
A	02-10-2021	REVISION SUBJECT TO ARCH. COMMENT	

JOB NO. : J-853

PROJECT :

PROPOSED RESIDENTIAL DEVELOPMENT AT N.K.I.L. 6542 YIN PING ROAD KOWLOON

TITLE :

PART ELEVATION OF CURTAIN WALL AT TOWER 1

DATE : 18-MAR-21 | SCALE : 1:60 (A1)


DRAWN BY : LHR | CHECKED BY : –

美特鋁質有限公司
MIDI ALUMINIUM FABRICATOR LTD.
Units 6-8, Sunray Industrial Centre, 1/F
610 Cha Kwo Ling Road, Kowloon
Tel:23489211-4 Fax:(852)27727666

DWG NO. : J853-BD-CW-4101 | REV. : A


LEGEND :

R.S. = RESTRAINT SOCKET

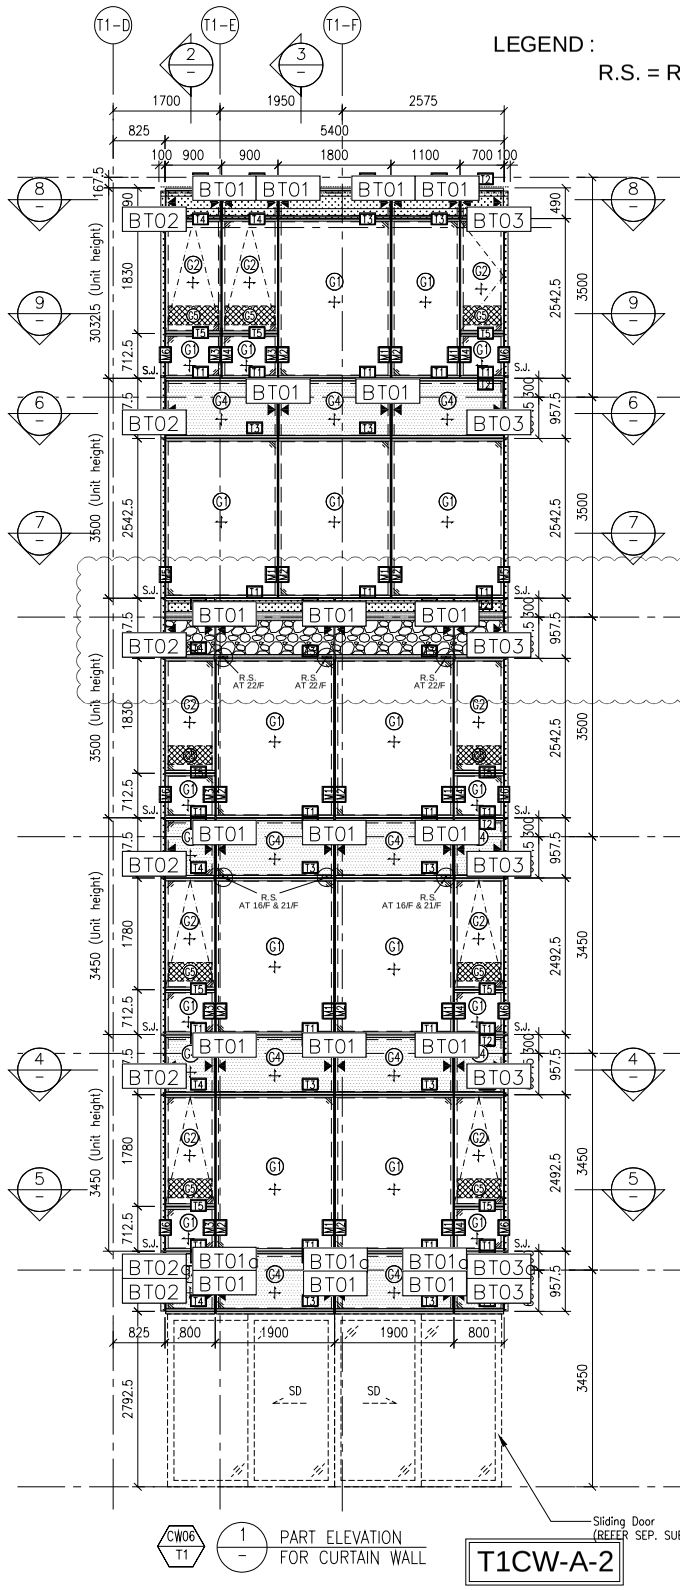


CW06 T1 — 1 — PART ELEVATION FOR CURTAIN WALL

T1CW-A-2

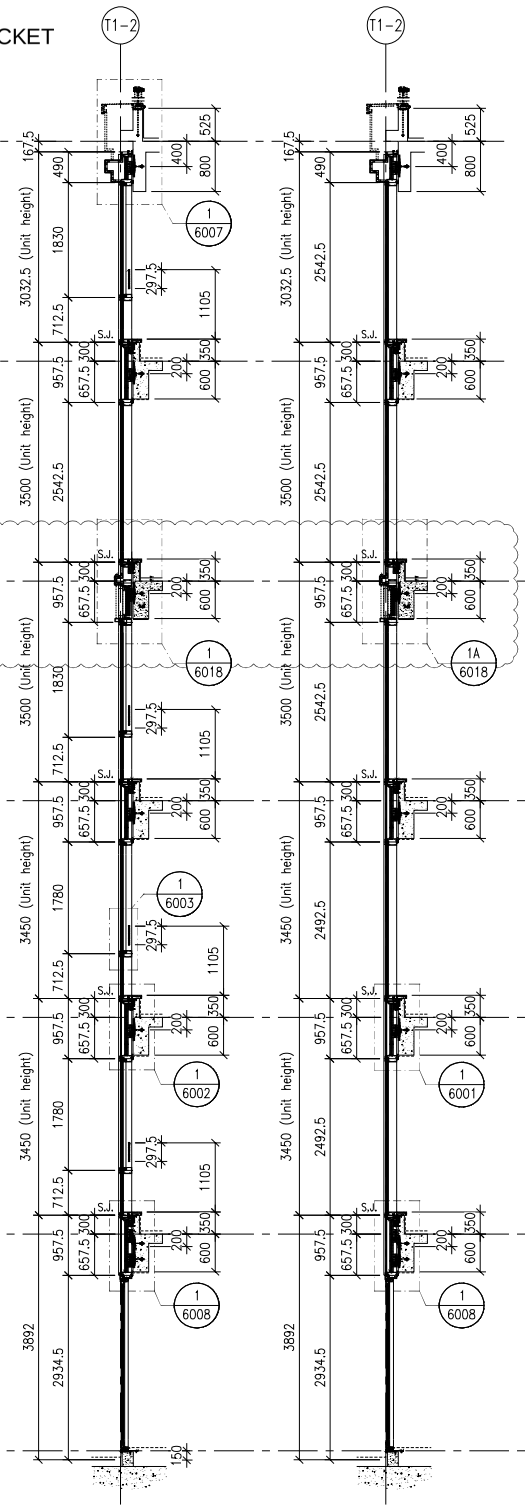


2 — TYPICAL SECTION FOR CURTAIN WALL

3 — TYPICAL SECTION FOR CURTAIN WALL

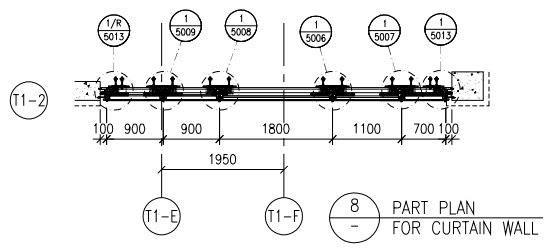


8 — PART PLAN FOR CURTAIN WALL

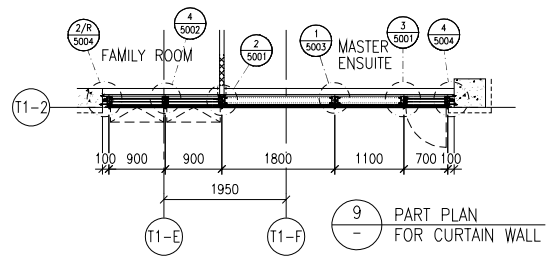


9 — PART PLAN FOR CURTAIN WALL

4 — PART PLAN FOR CURTAIN WALL

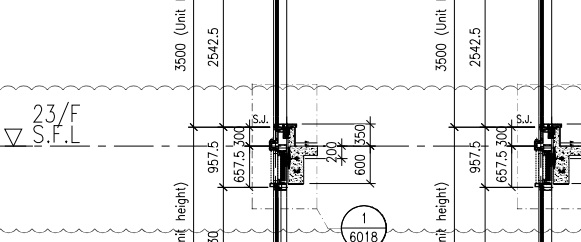


6 — PART PLAN FOR CURTAIN WALL

5 — PART PLAN FOR CURTAIN WALL

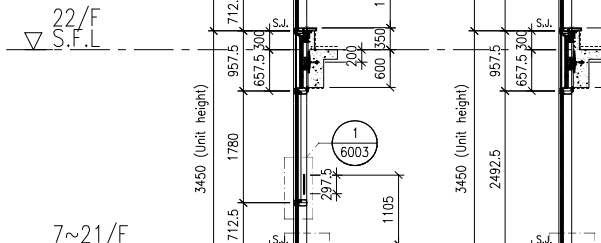

7 — PART PLAN FOR CURTAIN WALL

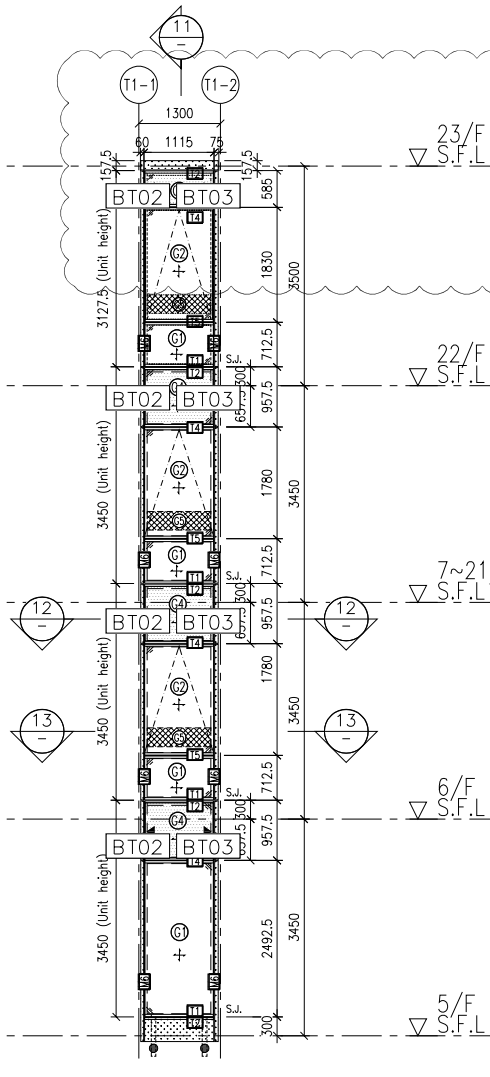


CW04 T1 — 10 — PART ELEVATION FOR CURTAIN WALL

T1CW-A-3

12 — PART PLAN FOR CURTAIN WALL

13 — PART PLAN FOR CURTAIN WALL

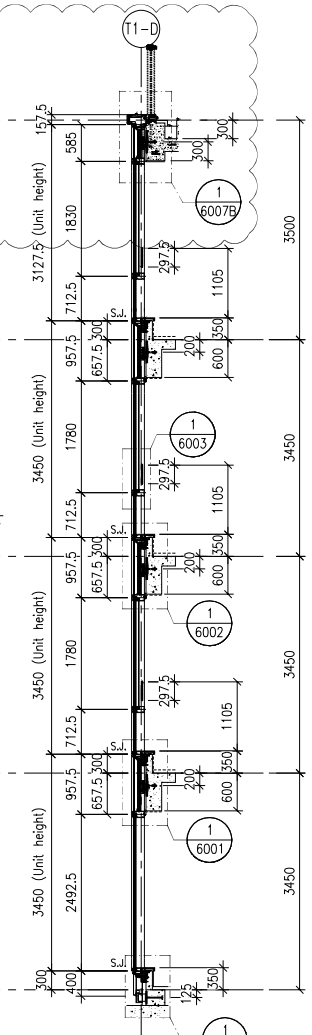

11 — TYPICAL SECTION FOR CURTAIN WALL

FLOOR LEVEL (S.F.L.)

FLOOR	LEVEL
ROOF	+210.00
25/F	+206.50
23/F	+203.00
22/F	+199.50
21/F	+196.05
20/F	+192.60
19/F	+189.15
18/F	+185.70
17/F	+182.25
16/F	+178.80
15/F	+175.35
12/F	+171.90
11/F	+168.45
10/F	+165.00
9/F	+161.55
8/F	+158.10
7/F	+154.65
6/F	+151.20
5/F	+147.75

- STONE CLADDING (BY OTHERS)

LEGEND:

- G1 — 10mm HEAT STRENGTHENED GLASS (OUTER) + 12mm AIR SPACE +12mm THK. TEMPERED CLEAR GLASS (INNER)
- G2 — 10mm HEAT STRENGTHENED GLASS (OUTER) + 12mm AIR SPACE +10mm THK. TEMPERED CLEAR GLASS (INNER)
- G4 — 12mm THK. HEAT STRENGTHENED GLASS & 2mm THK. ALUM. BACKPAN (SPANDREL GLASS)
- G5 — 12mm THK. CLEAR TEMPERED GLASS (INTERNAL PROTECTIVE BARRIER)
- 3mm THK. ALUM. CLADDING
- S.J. — STACK JOINT (WIND LOAD)
- AE01 — ALUM. EXTRUSION DIE NO.
- ▲ — SUPPORT POINT (WIND LOAD + DEAD LOAD)
- ● — SUPPORT POINT (WIND LOAD)

B.D. REF :

CLIENT :

SHIMAO GROUP HOLDINGS LIMITED

ARCHITECT : WONG TUNG & PARTNERS LIMITED ARCHITECTS & PLANNERS

MAIN CONTRACTOR : 協興建築有限公司 HIP HING CONSTRUCTION CO LTD

STRUCTURAL ENGINEER : C M WONG & ASSOCIATES LTD 黃志明建築工程師有限公司

FACADE CONSULTANT: MEINHARDT

NOTE :

1. ALL DIMENSIONS ARE IN mm.
2. ALL ELEVATIONS ARE VIEWED FROM OUTSIDE.
3. ALL DIMENSIONS TO BE VERIFIED ON SITE BEFORE FABRICATION.

LEGEND :

- X1 / X001 — DETAIL MARK NO. / REFER SHEET NO.

1. F.F.L. -- FINISHED FLOOR LEVEL
2. S.F.L. -- STRUCTURAL FLOOR LEVEL
3. /R -- REVERSED DETAIL

NO.	DATE	REVISED	BY
A	02-10-2021	REVISION SUBJECT TO ARCH. COMMENT	

JOB NO. : J-853

PROJECT :
PROPOSED RESIDENTIAL DEVELOPMENT AT N.K.I.L. 6542 YIN PING ROAD KOWLOON

TITLE :
PART ELEVATION FOR CURTAIN WALL AT TOWER 1


DATE : 18-MAR-21	SCALE : 1:60 (A1)
DRAWN BY : LHR	CHECKED BY :

美特鋁質有限公司 MIDI ALUMINIUM FABRICATOR LTD.
Units 6-8, Sunray Industrial Centre, 1/F
610 Cha Kwo Ling Road, Kowloon
Tel:23489211-4 Fax:(852)27727666

DWG NO. : J853-SD-CW-4102 | REV. : A

LEGEND :


R.S. = RESTRAINT SOCKET

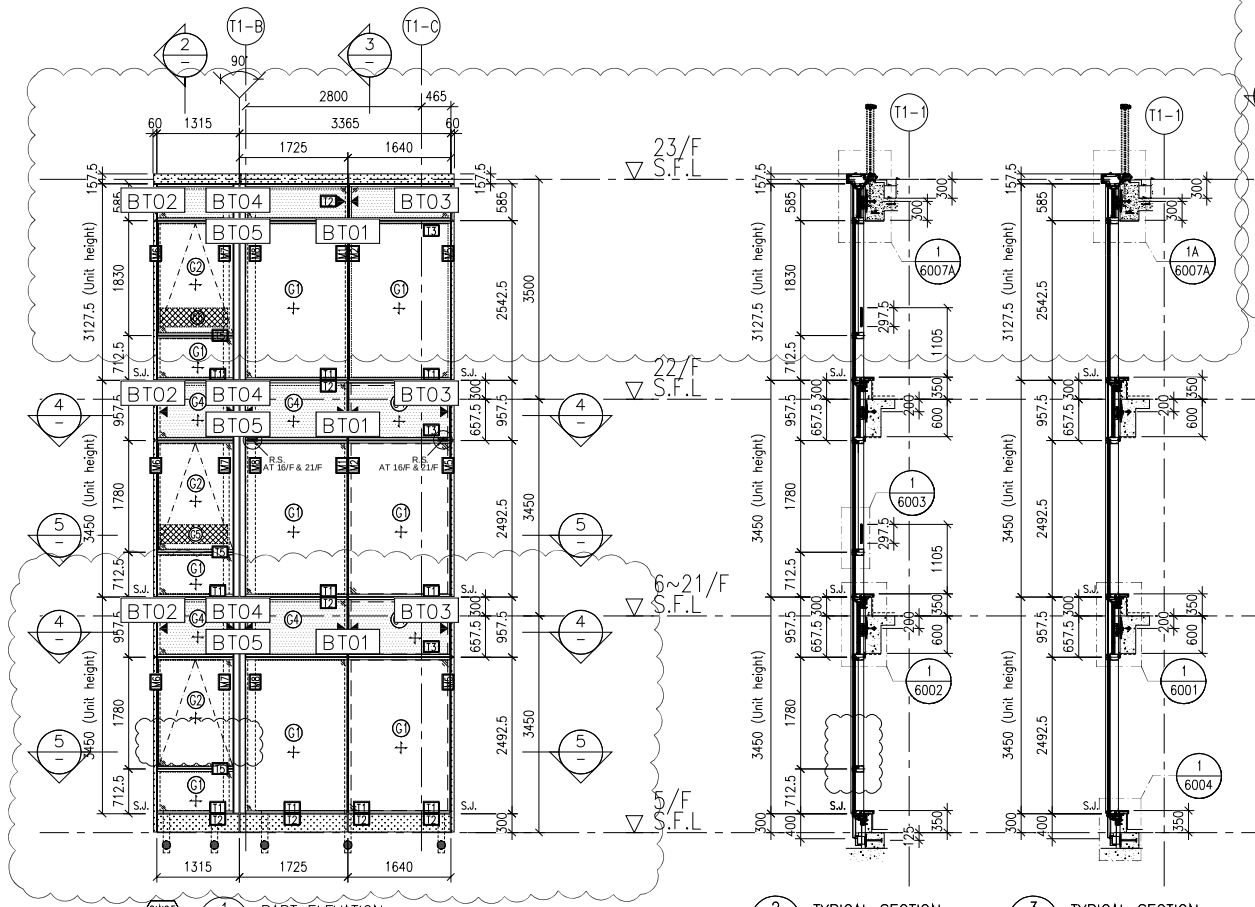

CW05 T1 — 1 — PART ELEVATION FOR CURTAIN WALL

2 — TYPICAL SECTION FOR CURTAIN WALL

3 — TYPICAL SECTION FOR CURTAIN WALL

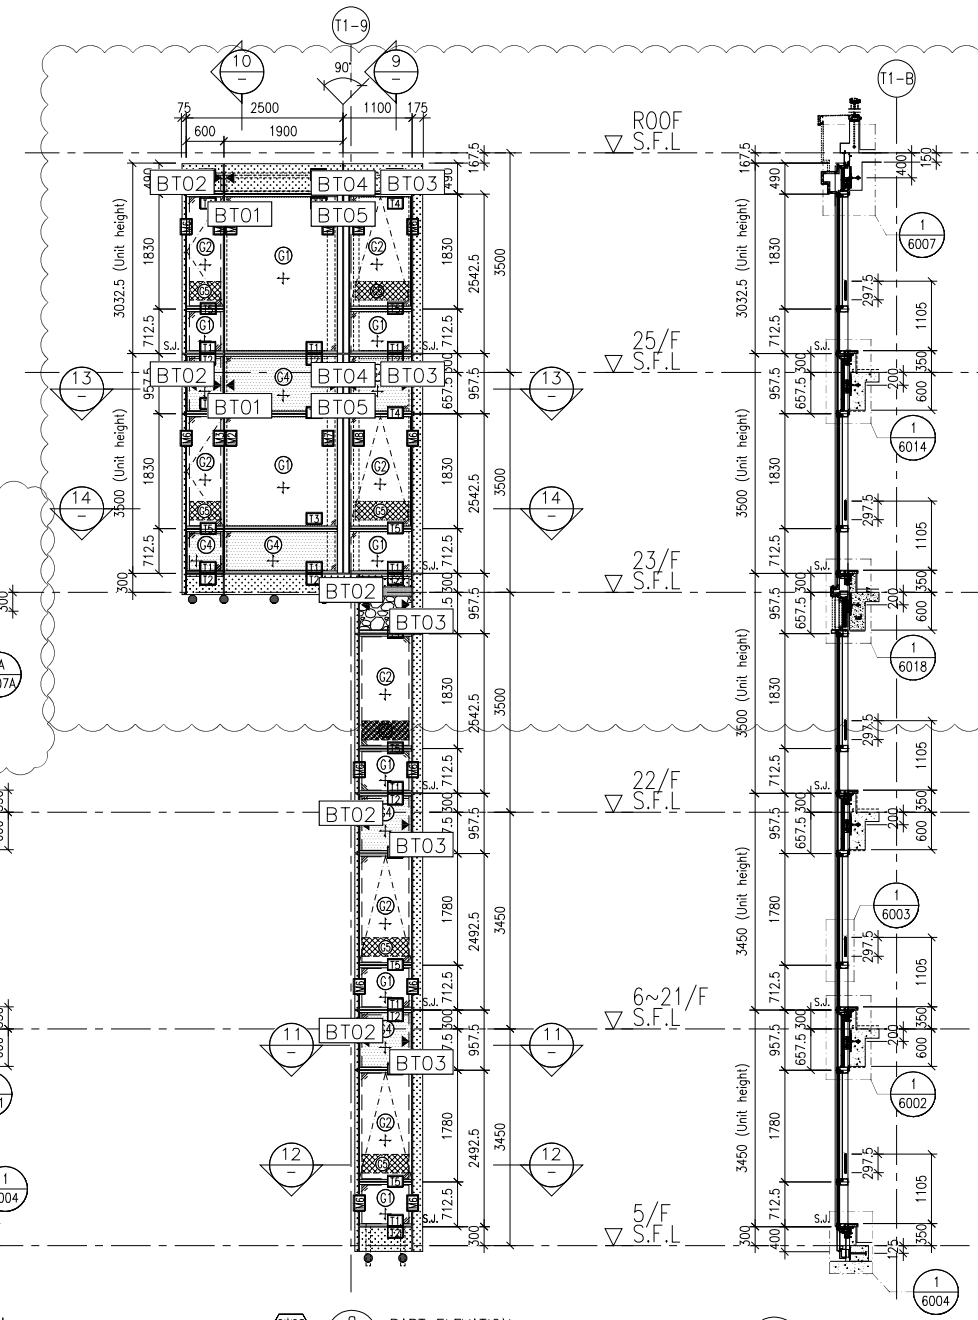


CW08 T1 — 8 — PART ELEVATION FOR CURTAIN WALL


9 — TYPICAL SECTION FOR CURTAIN WALL

10 — TYPICAL SECTION FOR CURTAIN WALL

T1CW-A-4

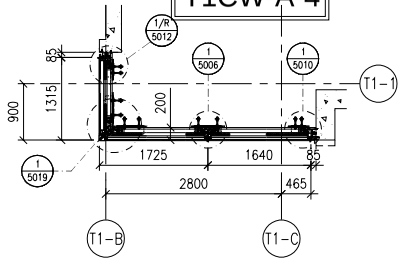


4 — PART PLAN FOR CURTAIN WALL

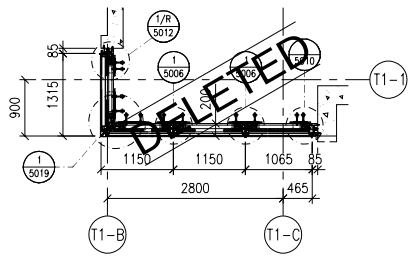


6 — PART PLAN FOR CURTAIN WALL


T1CW-B-2

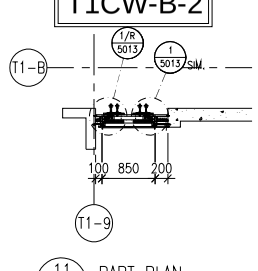


11 — PART PLAN FOR CURTAIN WALL

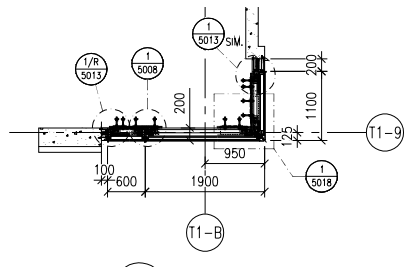


13 — PART PLAN FOR CURTAIN WALL

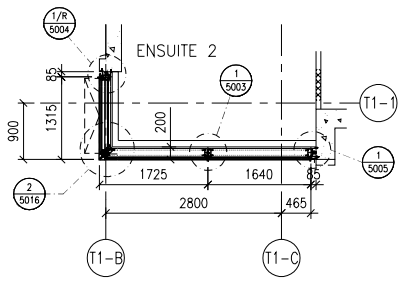


5 — PART PLAN FOR CURTAIN WALL

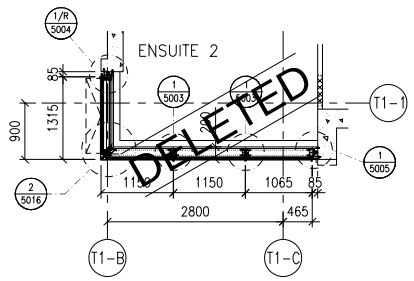

7 — PART PLAN FOR CURTAIN WALL

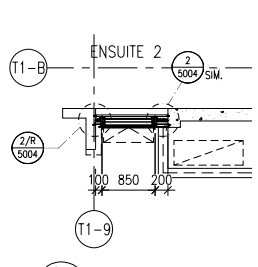

12 — PART PLAN FOR CURTAIN WALL

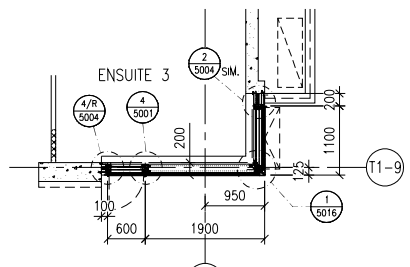

14 — PART PLAN FOR CURTAIN WALL

FLOOR LEVEL (S.F.L.)

FLOOR	LEVEL
ROOF	+210.00
25/F	+206.50
23/F	+203.00
22/F	+199.50
21/F	+196.05
20/F	+192.60
19/F	+189.15
18/F	+185.70
17/F	+182.25
16/F	+178.80
15/F	+175.35
12/F	+171.90
11/F	+168.45
10/F	+165.00
9/F	+161.55
8/F	+158.10
7/F	+154.65
6/F	+151.20
5/F	+147.75

- STONE CLADDING (BY OTHERS)

LEGEND:

- G1+ — 10mm HEAT STRENGTHENED GLASS (OUTER) + 12mm AIR SPACE +12mm THK. TEMPERED CLEAR GLASS (INNER)
- G2+ — 10mm HEAT STRENGTHENED GLASS (OUTER) + 12mm AIR SPACE +10mm THK. TEMPERED CLEAR GLASS (INNER)
- G4+ — 12mm THK. HEAT STRENGTHENED GLASS & 2mm THK. ALUM. BACKPAN (SPANDREL GLASS)
- 12mm THK. CLEAR TEMPERED GLASS (INTERNAL PROTECTIVE BARRIER)
- 3mm THK. ALUM. CLADDING
- S.J. — STACK JOINT (WIND LOAD)
- AE01 — ALUM. EXTRUSION DIE NO.
- ▲ — SUPPORT POINT (WIND LOAD + DEAD LOAD)
- ● — SUPPORT POINT (WIND LOAD)

B.D. REF :

CLIENT :

SHIMAO GROUP HOLDINGS LIMITED

ARCHITECT : WONG TUNG & PARTNERS LIMITED ARCHITECTS & PLANNERS

MAIN CONTRACTOR : 協興建築有限公司 HIP HING CONSTRUCTION CO LTD

STRUCTURAL ENGINEER : C M WONG & ASSOCIATES LTD 黃志明建築工程師有限公司

FACADE CONSULTANT: MEINHARDT

NOTE :
1. ALL DIMENSIONS ARE IN mm.
2. ALL ELEVATIONS ARE VIEWED FROM OUTSIDE.
3. ALL DIMENSIONS TO BE VERIFIED ON SITE BEFORE FABRICATION.

LEGEND :

X1 / X001 — DETAIL MARK NO. / REFER SHEET NO.

1. F.F.L. -- FINISHED FLOOR LEVEL
2. S.F.L. -- STRUCTURAL FLOOR LEVEL
3. /R -- REVERSED DETAIL

NO.	DATE	REVISED	BY
A	02-10-2021	REVISION SUBJECT TO ARCH. COMMENT	

JOB NO. : J-853

PROJECT :
PROPOSED RESIDENTIAL DEVELOPMENT AT N.K.I.L. 6542 YIN PING ROAD KOWLOON

TITLE :
PART ELEVATION FOR CURTAIN WALL AT TOWER 1

DATE : 18-MAR-21 | SCALE : 1:60 (A1)

DRAWN BY : LHR | CHECKED BY :

美特鋁質有限公司 MIDI ALUMINIUM FABRICATOR LTD.
Units 6-8, Sunray Industrial Centre, 1/F
610 Cha Kwo Ling Road, Kowloon
Tel:23489211-4 Fax:(852)27727666

DWG NO. : J853-SD-CW-4103 | REV. : A

LEGEND :

R.S. = RESTRAINT SOCKET

1 PART ELEVATION FOR CURTAIN WALL

2 TYPICAL SECTION FOR CURTAIN WALL

3 TYPICAL SECTION FOR CURTAIN WALL

4 TYPICAL SECTION FOR CURTAIN WALL

5 PART PLAN FOR CURTAIN WALL

6 PART PLAN FOR CURTAIN WALL

7 PART PLAN FOR CURTAIN WALL

8 PART PLAN FOR CURTAIN WALL

9 PART PLAN FOR CURTAIN WALL

10 PART PLAN FOR CURTAIN WALL

11 TYPICAL SECTION FOR CURTAIN WALL

T1CW-B-3

FLOOR LEVEL (S.F.L.)

FLOOR	LEVEL
ROOF	+210.00
25/F	+206.50
23/F	+203.00
22/F	+199.50
21/F	+196.05
20/F	+192.60
19/F	+189.15
18/F	+185.70
17/F	+182.25
16/F	+178.80
15/F	+175.35
12/F	+171.90
11/F	+168.45
10/F	+165.00
9/F	+161.55
8/F	+158.10
7/F	+154.65
6/F	+151.20
5/F	+147.75

- STONE CLADDING (BY OTHERS)

LEGEND:

- G1+ – 10mm HEAT STRENGTHENED GLASS (OUTER) + 12mm AIR SPACE +12mm THK. TEMPERED CLEAR GLASS (INNER)
- G2+ – 10mm HEAT STRENGTHENED GLASS (OUTER) + 12mm AIR SPACE +10mm THK. TEMPERED CLEAR GLASS (INNER)
- G4+ – 12mm THK. HEAT STRENGTHENED GLASS & 2mm THK. ALUM. BACKPAN (SPANDREL GLASS)
- G10 – 12mm THK. CLEAR TEMPERED GLASS (INTERNAL PROTECTIVE BARRIER)
- – 3mm THK. ALUM. CLADDING
- S.J. – STACK JOINT (WIND LOAD)
- AE01 – ALUM. EXTRUSION DIE NO.
- ▲ – SUPPORT POINT (WIND LOAD + DEAD LOAD)
- ● – SUPPORT POINT (WIND LOAD)

B.D. REF :

CLIENT :

SHIMAO GROUP HOLDINGS LIMITED

ARCHITECT :

WONG TUNG & PARTNERS LIMITED
ARCHITECTS & PLANNERS

MAIN CONTRACTOR :

協興建築有限公司
HIP HING CONSTRUCTION CO LTD

STRUCTURAL ENGINEER :

C M WONG & ASSOCIATES LTD
黃志明建築工程師有限公司

FACADE CONSULTANT:

MEINHARDT

NOTE :

1. ALL DIMENSIONS ARE IN mm.
2. ALL ELEVATIONS ARE VIEWED FROM OUTSIDE.
3. ALL DIMENSIONS TO BE VERIFIED ON SITE BEFORE FABRICATION.

LEGEND :

X1 — DETAIL MARK NO.
X001 — REFER SHEET NO.

1. F.F.L. --FINISHED FLOOR LEVEL
2. S.F.L. --STRUCTURAL FLOOR LEVEL
3. (/R) --REVERSED DETAIL

NO.	DATE	REVISED	BY
A	02-10-2021	REVISION SUBJECT TO ARCH. COMMENT	

JOB NO. : J-853

PROJECT :

PROPOSED RESIDENTIAL DEVELOPMENT AT N.K.I.L. 6542 YIN PING ROAD KOWLOON

TITLE :


PART ELEVATION FOR CURTAIN WALL AT TOWER 1

DATE : 18-MAR-21 | SCALE : 1:60 (A1)

DRAWN BY : LHR | CHECKED BY :


美特鋁質有限公司
MIDI ALUMINIUM FABRICATOR LTD.
Units 6-8, Sunray Industrial Centre, 1/F
610 Cha Kwo Ling Road, Kowloon
Tel:23489211-4 Fax:(852)27727666

DWG NO. : J853-SD-CW-4104 | REV. : A

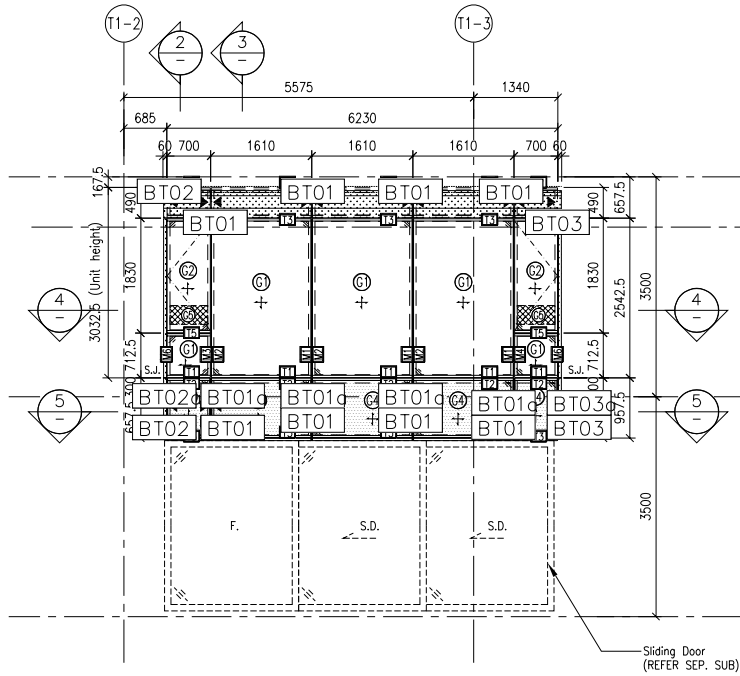


CW02 / T1 — 1 / – PART ELEVATION FOR CURTAIN WALL

T1CW-A-5

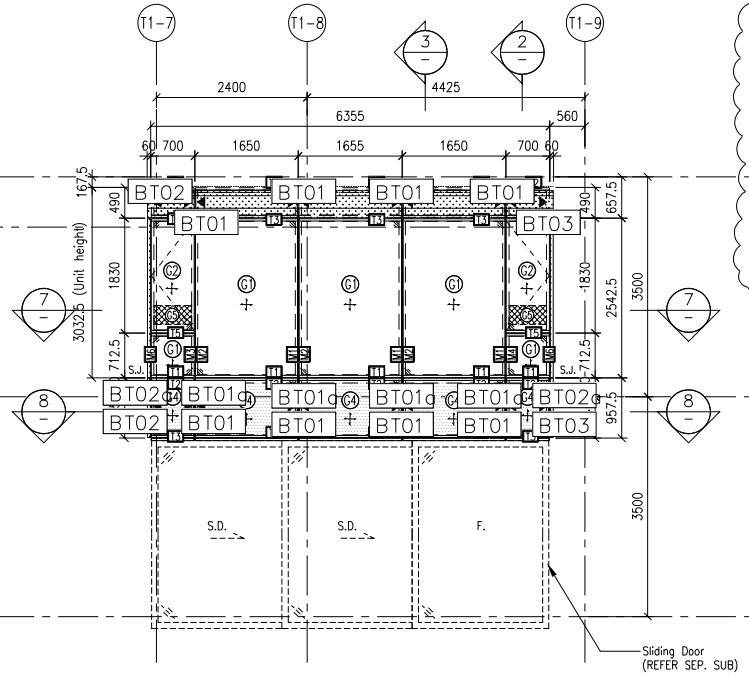


CW03 / T1 — 6 / – PART ELEVATION FOR CURTAIN WALL

T1CW-B-4

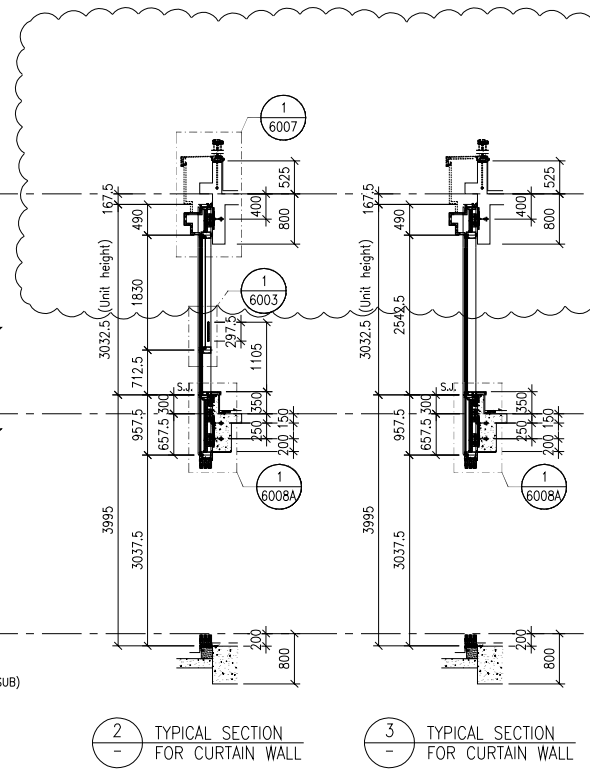


2 / – TYPICAL SECTION FOR CURTAIN WALL


3 / – TYPICAL SECTION FOR CURTAIN WALL

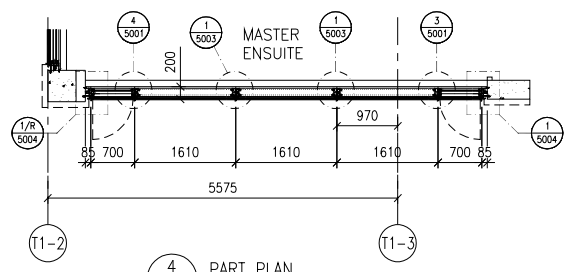


4 / – PART PLAN FOR CURTAIN WALL

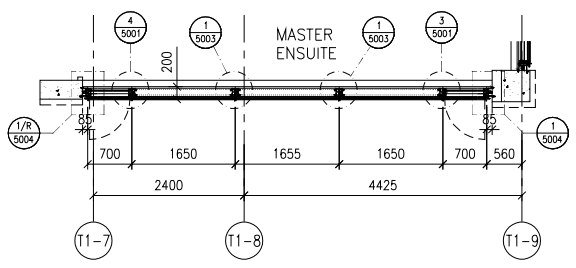

7 / – PART PLAN FOR CURTAIN WALL

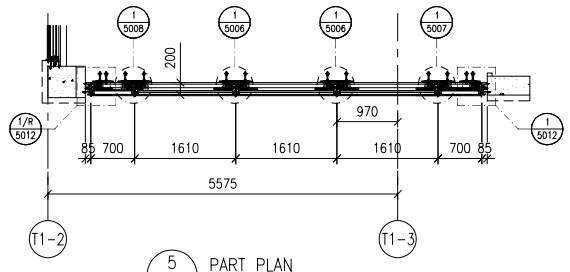

5 / – PART PLAN FOR CURTAIN WALL

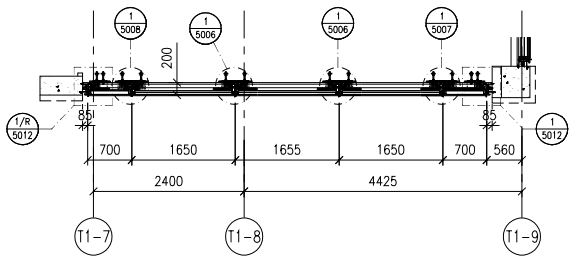

8 / – PART PLAN FOR CURTAIN WALL

FLOOR LEVEL (S.F.L.)

FLOOR	LEVEL
ROOF	+210.00
25/F	+206.50
23/F	+203.00

LEGEND:

- 01 – 10mm HEAT STRENGTHENED GLASS (OUTER) + 12mm AIR SPACE +12mm THK. TEMPERED CLEAR GLASS (INNER)
- 02 – 10mm HEAT STRENGTHENED GLASS (OUTER) + 12mm AIR SPACE +10mm THK. TEMPERED CLEAR GLASS (INNER)
- 04 – 12mm THK. HEAT STRENGTHENED GLASS & 2mm THK. ALUM. BACKPAN (SPANDREL GLASS)
- 05 – 12mm THK. CLEAR TEMPERED GLASS (INTERNAL PROTECTIVE BARRIER)
- – 3mm THK. ALUM. CLADDING
- S.J. – STACK JOINT (WIND LOAD)
- AE01 – ALUM. EXTRUSION DIE NO.
- ▲ – SUPPORT POINT (WIND LOAD + DEAD LOAD)
- ● – SUPPORT POINT (WIND LOAD)

B.D. REF :

CLIENT :

SHIMAO GROUP HOLDINGS LIMITED

ARCHITECT :

WONG TUNG & PARTNERS LIMITED
ARCHITECTS & PLANNERS

MAIN CONTRACTOR :

協興建築有限公司
HIP HING CONSTRUCTION CO LTD

STRUCTURAL ENGINEER :

C M WONG & ASSOCIATES LTD
黃志明建築工程師有限公司

FACADE CONSULTANT:

MEINHARDT

NOTE :

1. ALL DIMENSIONS ARE IN mm.
2. ALL ELEVATIONS ARE VIEWED FROM OUTSIDE.
3. ALL DIMENSIONS TO BE VERIFIED ON SITE BEFORE FABRICATION.

LEGEND :

X1 — DETAIL MARK NO.
X001 — REFER SHEET NO.

1. F.F.L. -- FINISHED FLOOR LEVEL
2. S.F.L. -- STRUCTURAL FLOOR LEVEL
3. /R -- REVERSED DETAIL

NO.	DATE	REVISED	BY

JOB NO. : J-853

PROJECT :

PROPOSED RESIDENTIAL DEVELOPMENT AT N.K.I.L. 6542 YIN PING ROAD KOWLOON


TITLE :

PART ELEVATION FOR CURTAIN WALL AT TOWER 1


DATE : 02-OCT-21	SCALE : 1:60 (A1)
DRAWN BY : LHR	CHECKED BY :

美特鋁質有限公司
MIDI ALUMINIUM FABRICATOR LTD.
Units 6-8, Sunray Industrial Centre, 1/F
610 Cha Kwo Ling Road, Kowloon
Tel:23489211-4 Fax:(852)27727666


DWG NO. : J853-SD-CW-4105 | REV. : A

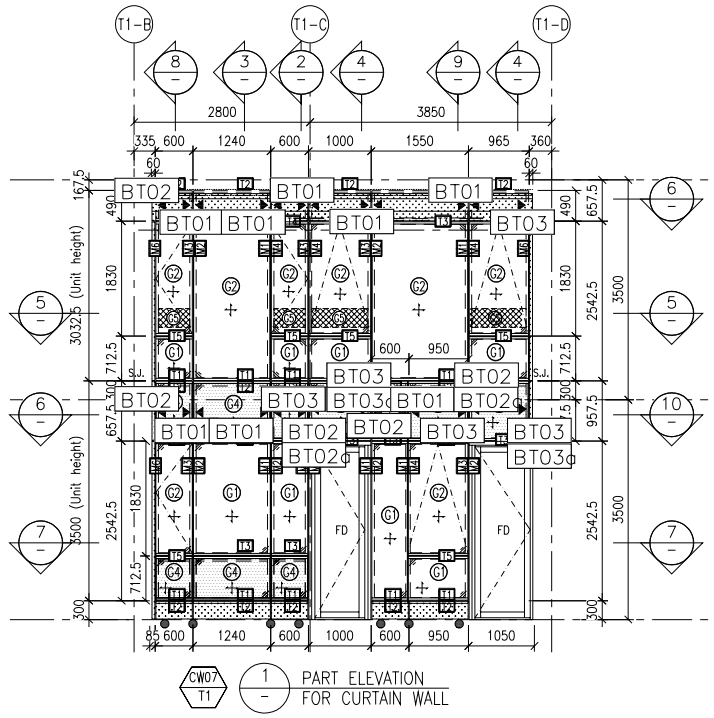


CW07 T1 — 1 — PART ELEVATION FOR CURTAIN WALL

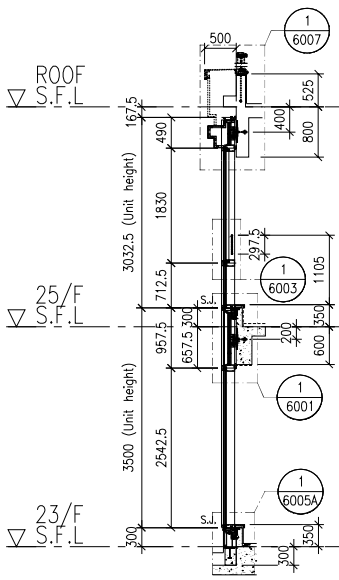


2 — TYPICAL SECTION FOR CURTAIN WALL

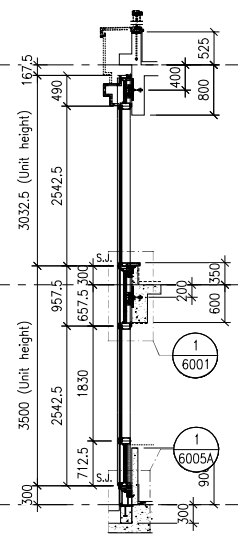


3 — TYPICAL SECTION FOR CURTAIN WALL

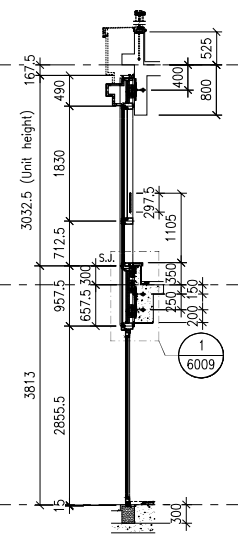


4 — TYPICAL SECTION FOR CURTAIN WALL

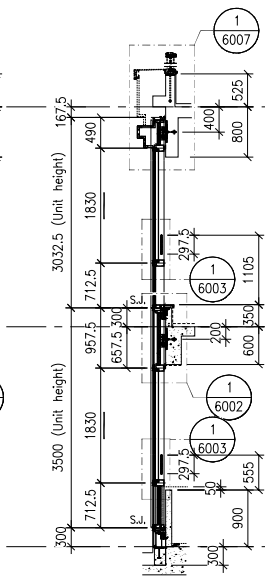

8 — TYPICAL SECTION FOR CURTAIN WALL

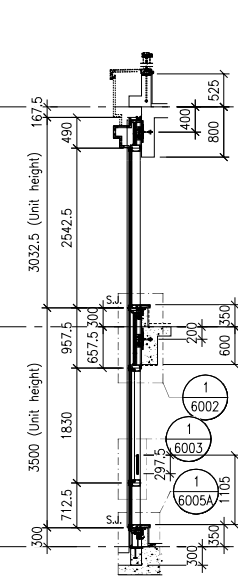


9 — TYPICAL SECTION FOR CURTAIN WALL

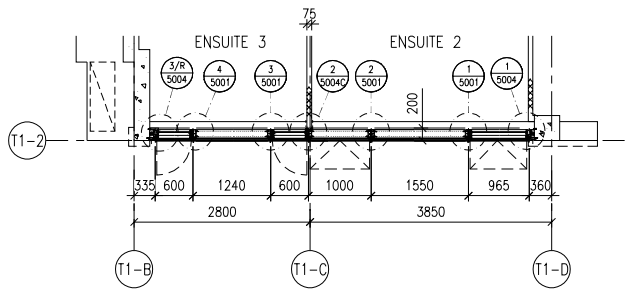


5 — PART PLAN FOR CURTAIN WALL


T1CW-A-6

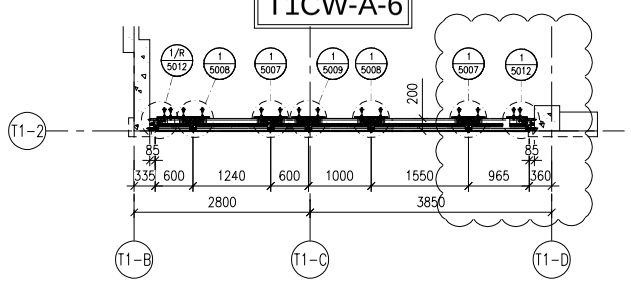

6 — PART PLAN FOR CURTAIN WALL

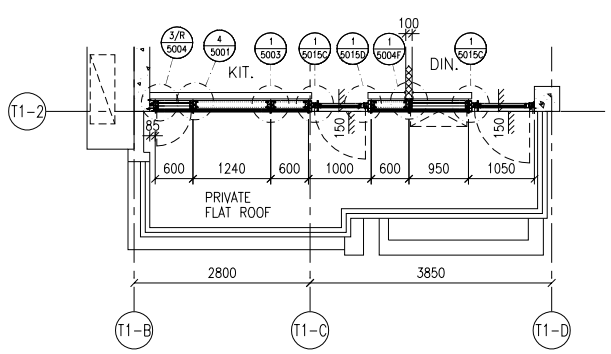

7 — PART PLAN FOR CURTAIN WALL

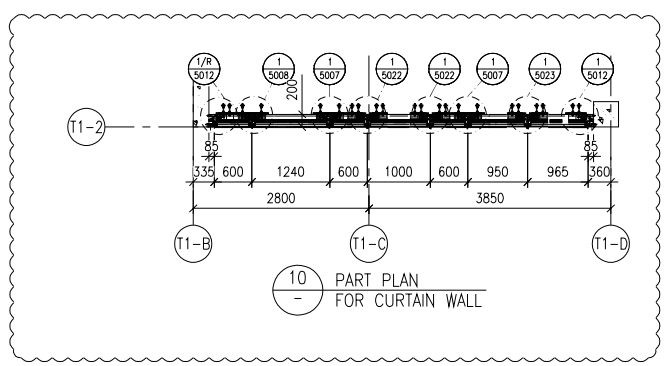

10 — PART PLAN FOR CURTAIN WALL

FLOOR LEVEL (S.F.L.)

FLOOR	LEVEL
ROOF	+210.00
25/F	+206.50
23/F	+203.00

LEGEND:

- G1 — 10mm HEAT STRENGTHENED GLASS (OUTER) + 12mm AIR SPACE +12mm THK. TEMPERED CLEAR GLASS (INNER)
- G2 — 10mm HEAT STRENGTHENED GLASS (OUTER) + 12mm AIR SPACE +10mm THK. TEMPERED CLEAR GLASS (INNER)
- G4 — 12mm THK. HEAT STRENGTHENED GLASS & 2mm THK. ALUM. BACKPAN (SPANDREL GLASS)
- G3 — 12mm THK. CLEAR TEMPERED GLASS (INTERNAL PROTECTIVE BARRIER)
- 3mm THK. ALUM. CLADDING
- S.J. — STACK JOINT (WIND LOAD)
- AE01 — ALUM. EXTRUSION DIE NO.
- ▲ — SUPPORT POINT (WIND LOAD + DEAD LOAD)
- ● — SUPPORT POINT (WIND LOAD)

B.D. REF :

CLIENT :

SHIMAO GROUP HOLDINGS LIMITED

ARCHITECT : WONG TUNG & PARTNERS LIMITED ARCHITECTS & PLANNERS

MAIN CONTRACTOR : 協興建築有限公司 HIP HING CONSTRUCTION CO LTD

STRUCTURAL ENGINEER : C M WONG & ASSOCIATES LTD 黃志明建築工程師有限公司

FACADE CONSULTANT: MEINHARDT

NOTE :
1. ALL DIMENSIONS ARE IN mm.
2. ALL ELEVATIONS ARE VIEWED FROM OUTSIDE.
3. ALL DIMENSIONS TO BE VERIFIED ON SITE BEFORE FABRICATION.

LEGEND :
- X1 / X001 — DETAIL MARK NO. / REFER SHEET NO.
1. F.F.L. -- FINISHED FLOOR LEVEL
2. S.F.L. -- STRUCTURAL FLOOR LEVEL
3. /R -- REVERSED DETAIL

NO.	DATE	REVISED	BY

JOB NO. : J-853


PROJECT :
PROPOSED RESIDENTIAL DEVELOPMENT AT N.K.I.L. 6542 YIN PING ROAD KOWLOON


TITLE :
PART ELEVATION FOR CURTAIN WALL AT TOWER 1

DATE : 02-OCT-21	SCALE : 1:60 (A1)
DRAWN BY : LHR	CHECKED BY :

美特鋁質有限公司 MIDI ALUMINIUM FABRICATOR LTD.
Units 6-8, Sunray Industrial Centre, 1/F
610 Cha Kwo Ling Road, Kowloon
Tel:23489211-4 Fax:(852)27727666

DWG NO. : J853-SD-CW-4106 | REV. : A

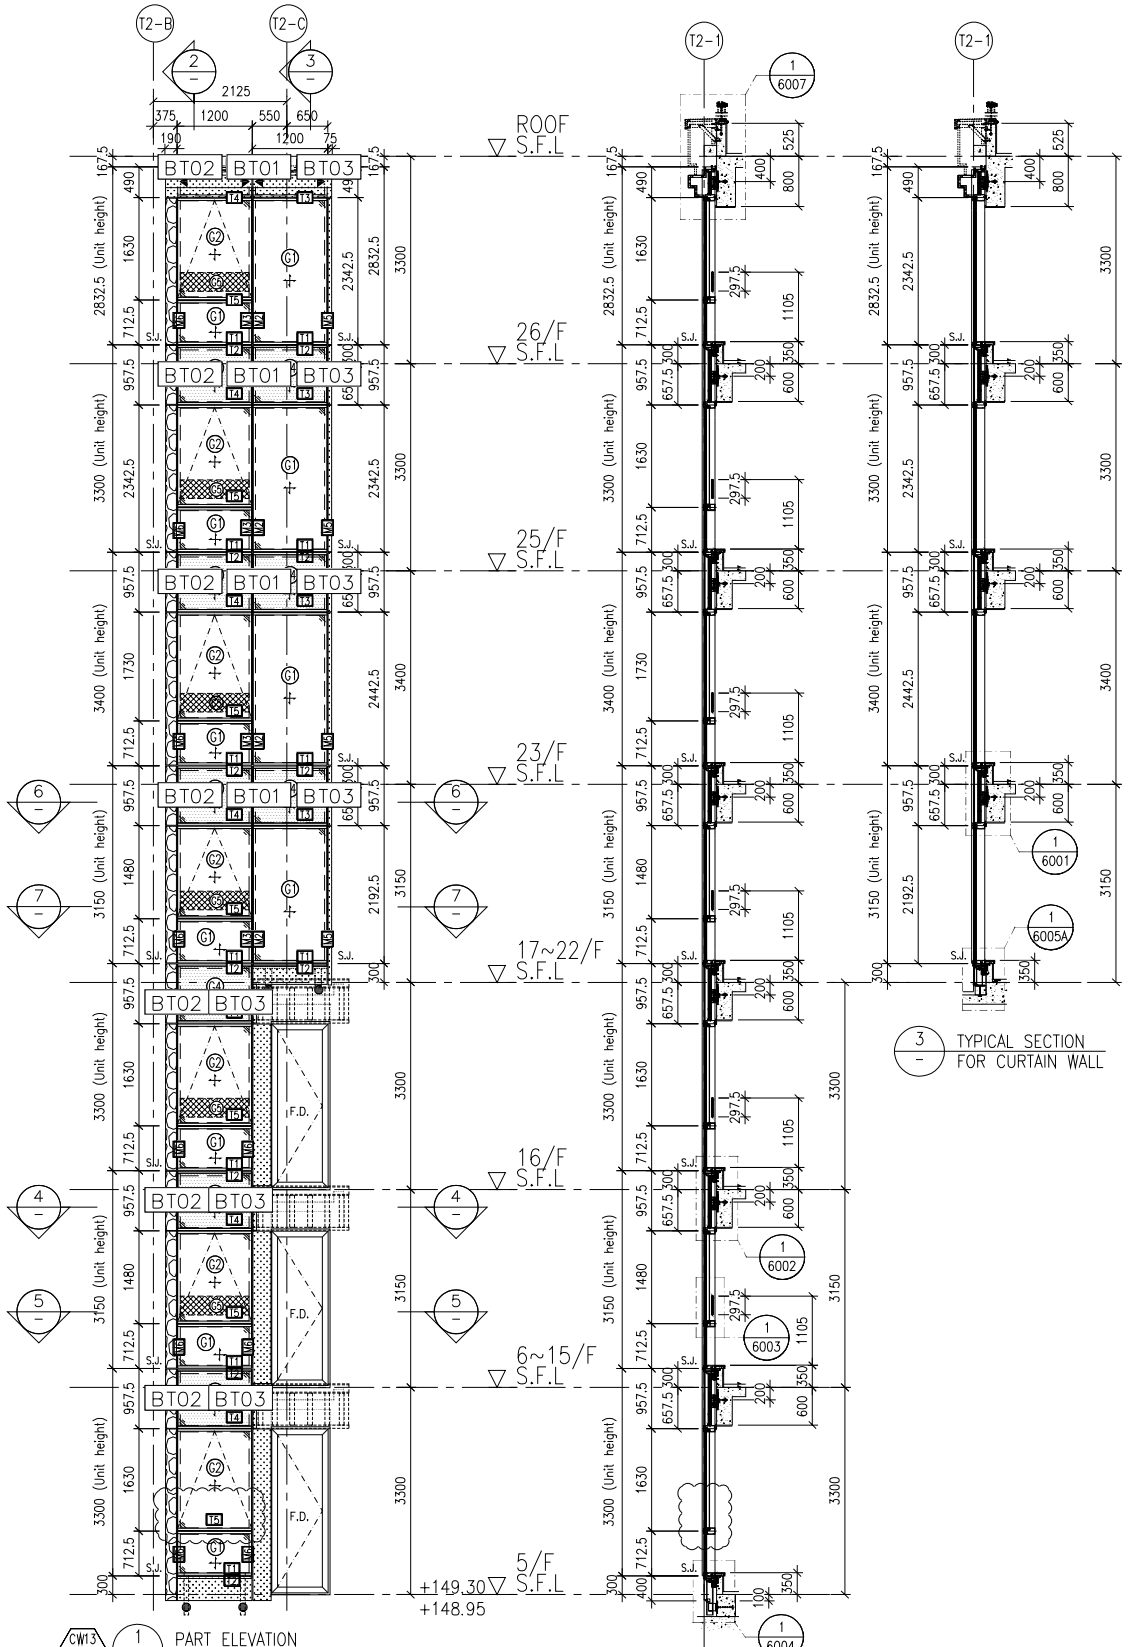

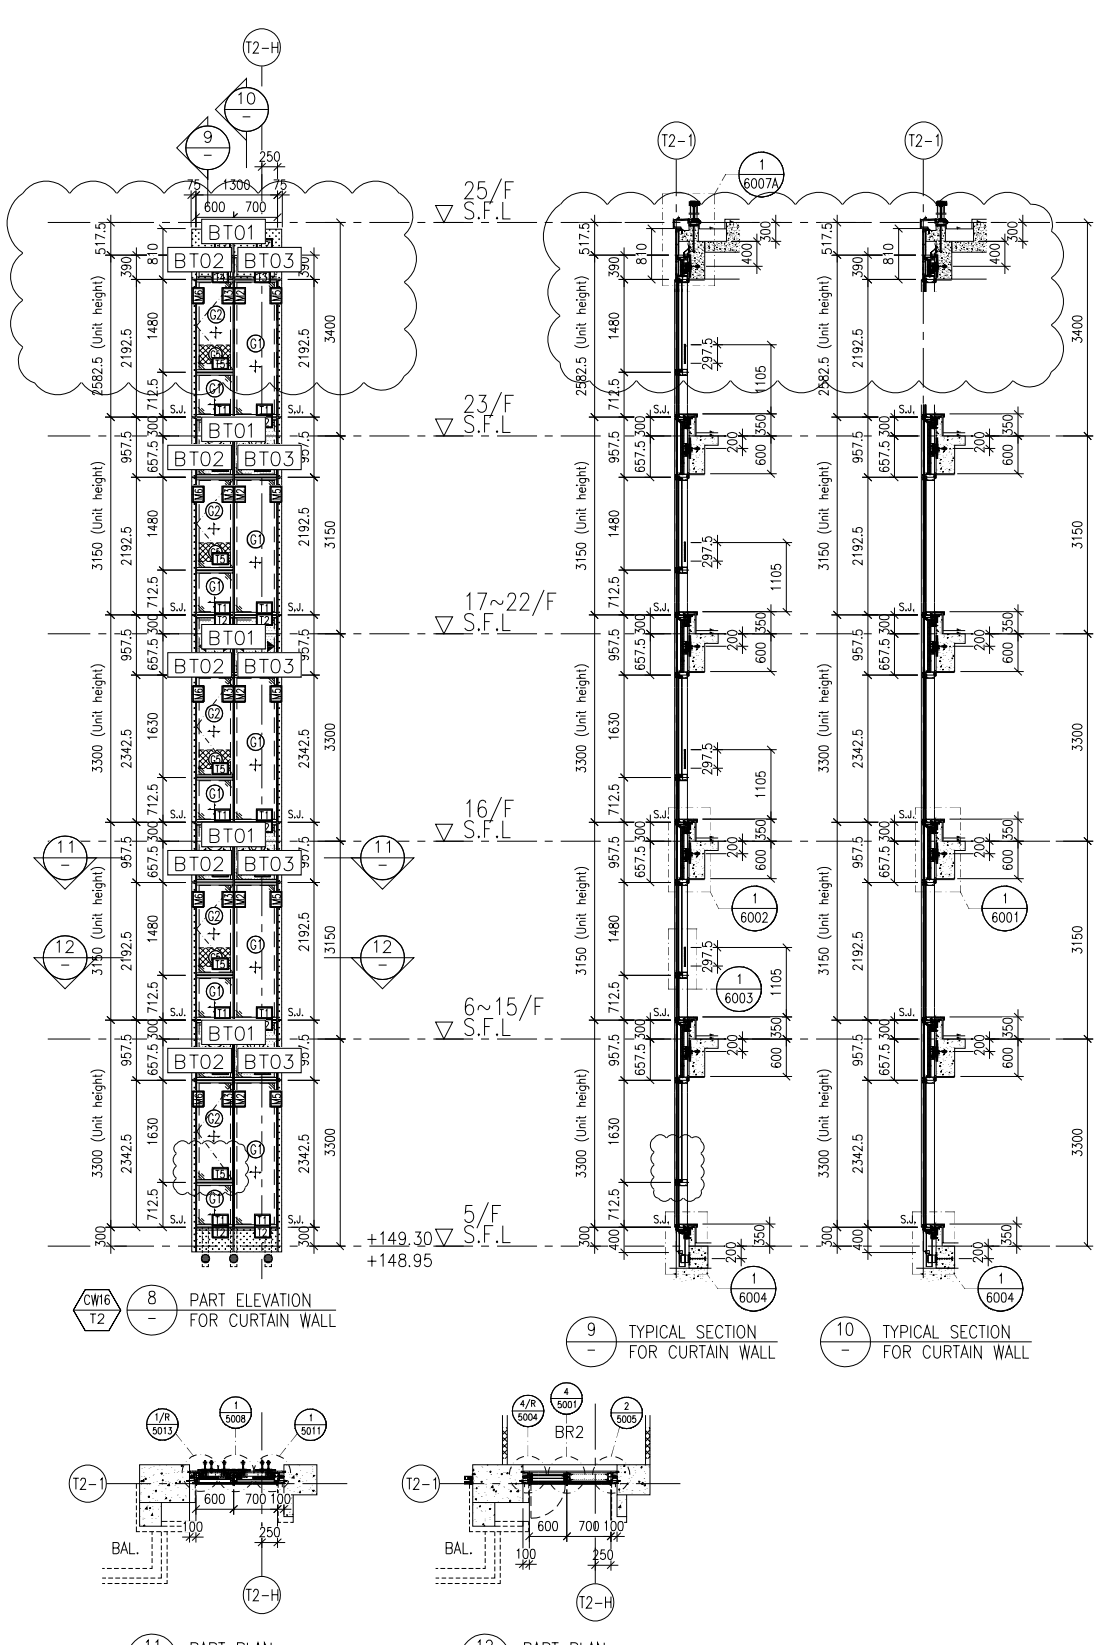

T2CW-A-2

T2 FLOOR LEVEL (S.F.L)

FLOOR	LEVEL
R/F	+210.00
26/F	+206.70
25/F	+203.40
23/F	+200.00
22/F	+196.85
21/F	+193.70
20/F	+190.55
19/F	+187.40
18/F	+184.25
17/F	+181.10
16/F	+177.80
15/F	+174.65
12/F	+171.50
11/F	+168.35
10/F	+165.20
9/F	+162.05
8/F	+158.90
7/F	+155.75
6/F	+152.60
5/F	+149.30

LEGEND:

- G1+ – 10mm HEAT STRENGTHENED GLASS (OUTER) + 12mm AIR SPACE +12mm THK. TEMPERED CLEAR GLASS (INNER)
- G2+ – 10mm HEAT STRENGTHENED GLASS (OUTER) + 12mm AIR SPACE +10mm THK. TEMPERED CLEAR GLASS (INNER)
- P4+ – 12mm THK. HEAT STRENGTHENED GLASS & 2mm THK. ALUM. BACKPAN (SPANDREL GLASS)
- G3 – 12mm THK. CLEAR TEMPERED GLASS (INTERNAL PROTECTIVE BARRIER)
- 3mm THK. ALUM. CLADDING
- S.J. – STACK JOINT (WIND LOAD)
- AE01 – ALUM. EXTRUSION DIE NO.
- ▲ – SUPPORT POINT (WIND LOAD + DEAD LOAD)
- ● – SUPPORT POINT (WIND LOAD)

B.D. REF :

CLIENT :

SHIMAO GROUP HOLDINGS LIMITED

ARCHITECT : WONG TUNG & PARTNERS LIMITED ARCHITECTS & PLANNERS

MAIN CONTRACTOR : 協興建築有限公司 HIP HING CONSTRUCTION CO LTD

STRUCTURAL ENGINEER : C M WONG & ASSOCIATES LTD 黃志明建築工程師有限公司

FACADE CONSULTANT: MEINHARDT

NOTE :

1. ALL DIMENSIONS ARE IN mm.
2. ALL ELEVATIONS ARE VIEWED FROM OUTSIDE.
3. ALL DIMENSIONS TO BE VERIFIED ON SITE BEFORE FABRICATION.

LEGEND :

X1 / X001 — DETAIL MARK NO. / REFER SHEET NO.

1. F.F.L. --FINISHED FLOOR LEVEL
2. S.F.L. --STRUCTURAL FLOOR LEVEL
3. /R --REVERSED DETAIL

NO.	DATE	REVISED	BY
A	05-10-2021	REVISION SUBJECT TO ARCH. COMMENT	

JOB NO. : J-853

PROJECT :
PROPOSED RESIDENTIAL DEVELOPMENT AT N.K.I.L. 6542 YIN PING ROAD KOWLOON

TITLE :
PART ELEVATION FOR CURTAIN WALL AT TOWER 2


DATE : 26-MAR-21	SCALE : 1:60 (A1)
DRAWN BY : LHR	CHECKED BY :

美特鋁質有限公司 MIDI ALUMINIUM FABRICATOR LTD.
Units 6-8, Sunray Industrial Centre, 1/F
610 Cha Kwo Ling Road, Kowloon
Tel:23489211-4 Fax:(852)27727666


DWG NO. : J853-SD-CW-4201 | REV. : A

LEGEND :

R.S. = RESTRAINT SOCKET

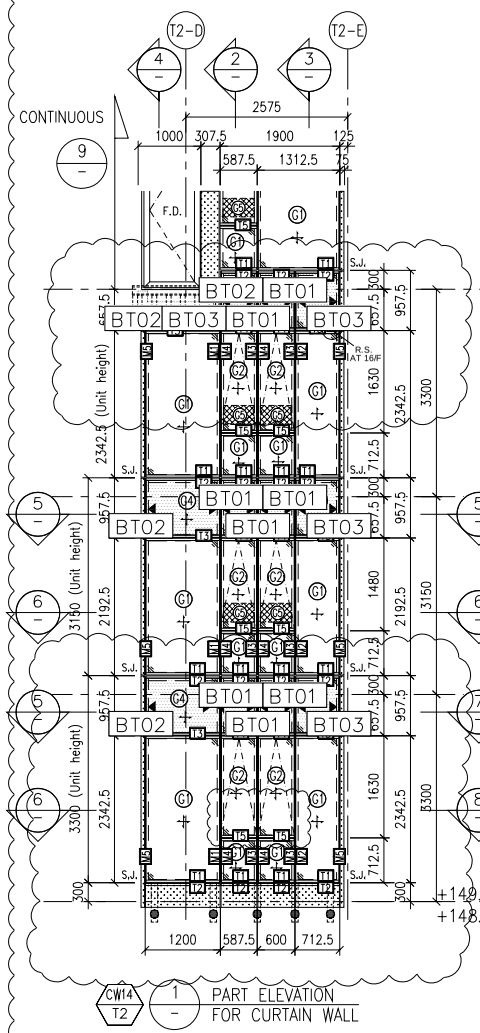


CW14 T2 — 1 — PART ELEVATION FOR CURTAIN WALL

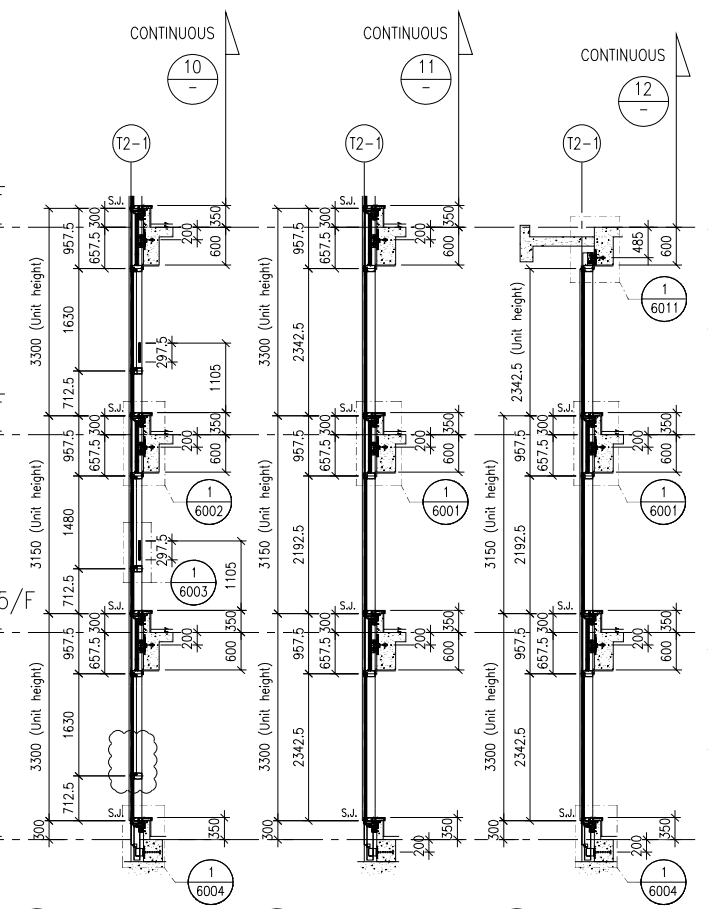


2 — TYPICAL SECTION FOR CURTAIN WALL

3 — TYPICAL SECTION FOR CURTAIN WALL

4 — TYPICAL SECTION FOR CURTAIN WALL

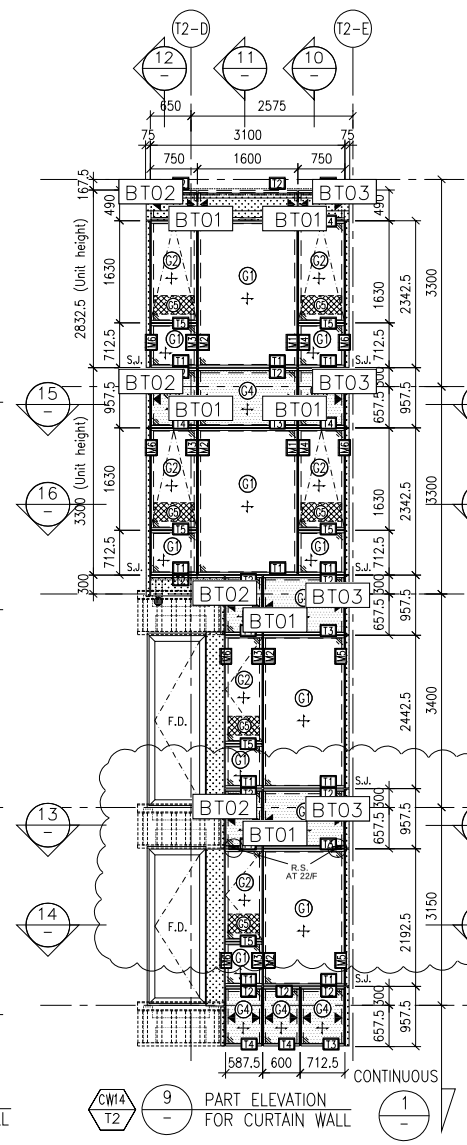

CW14 T2 — 9 — PART ELEVATION FOR CURTAIN WALL

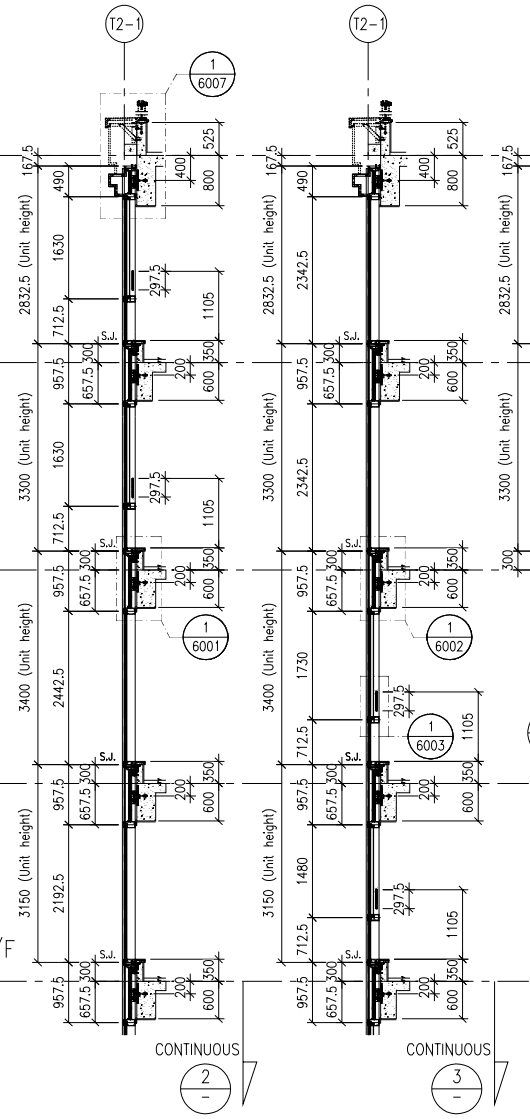


12 — TYPICAL SECTION FOR CURTAIN WALL


10 — TYPICAL SECTION FOR CURTAIN WALL

11 — TYPICAL SECTION FOR CURTAIN WALL


T2CW-A-3

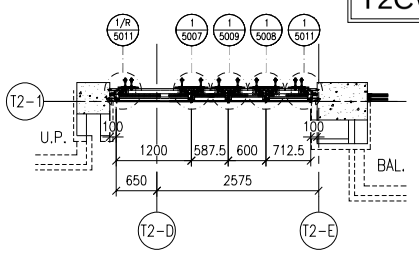


5 — PART PLAN FOR CURTAIN WALL

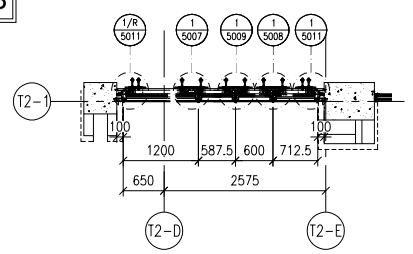

7 — PART PLAN FOR CURTAIN WALL

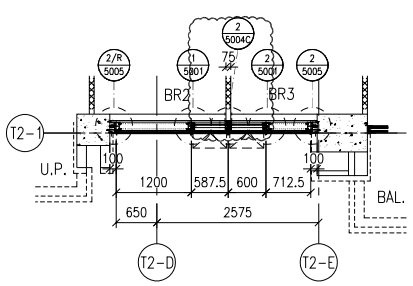


6 — PART PLAN FOR CURTAIN WALL

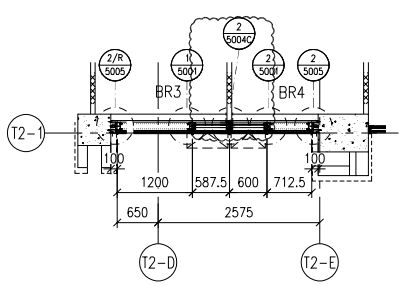


8 — PART PLAN FOR CURTAIN WALL


T2CW-A-4

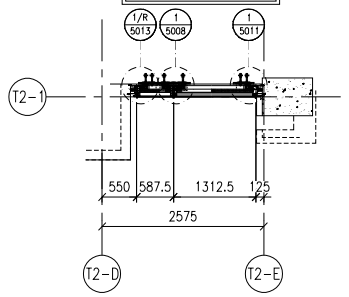


13 — PART PLAN FOR CURTAIN WALL

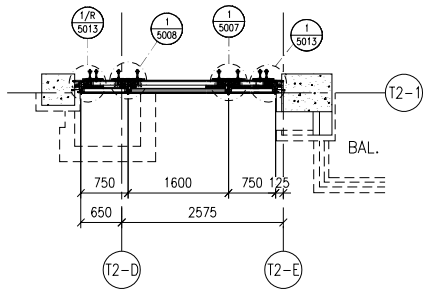

15 — PART PLAN FOR CURTAIN WALL

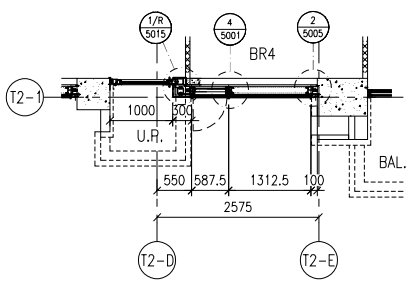

14 — PART PLAN FOR CURTAIN WALL

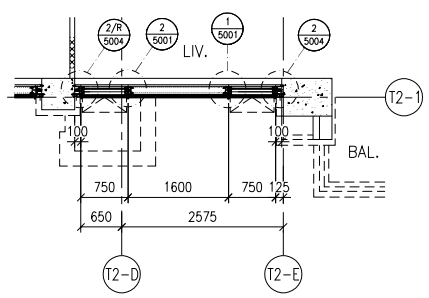

16 — PART PLAN FOR CURTAIN WALL

T2 FLOOR LEVEL (S.F.L)

FLOOR	LEVEL
R/F	+210.00
26/F	+206.70
25/F	+203.40
23/F	+200.00
22/F	+196.85
21/F	+193.70
20/F	+190.55
19/F	+187.40
18/F	+184.25
17/F	+181.10
16/F	+177.80
15/F	+174.65
12/F	+171.50
11/F	+168.35
10/F	+165.20
9/F	+162.05
8/F	+158.90
7/F	+155.75
6/F	+152.60
5/F	+149.30

LEGEND:

- G1 — 10mm HEAT STRENGTHENED GLASS (OUTER) + 12mm AIR SPACE +12mm THK. TEMPERED CLEAR GLASS (INNER)
- G2 — 10mm HEAT STRENGTHENED GLASS (OUTER) + 12mm AIR SPACE +10mm THK. TEMPERED CLEAR GLASS (INNER)
- G4 — 12mm THK. HEAT STRENGTHENED GLASS & 2mm THK. ALUM. BACKPAN (SPANDREL GLASS)
- G5 — 12mm THK. CLEAR TEMPERED GLASS (INTERNAL PROTECTIVE BARRIER)
- 3mm THK. ALUM. CLADDING
- S.J. — STACK JOINT (WIND LOAD)
- AE01 — ALUM. EXTRUSION DIE NO.
- ▲ — SUPPORT POINT (WIND LOAD + DEAD LOAD)
- ● — SUPPORT POINT (WIND LOAD)

B.D. REF :

CLIENT :

SHIMAO GROUP HOLDINGS LIMITED

ARCHITECT : WONG TUNG & PARTNERS LIMITED ARCHITECTS & PLANNERS

MAIN CONTRACTOR : 協興建築有限公司 HIP HING CONSTRUCTION CO LTD

STRUCTURAL ENGINEER : C M WONG & ASSOCIATES LTD 黃志明建築工程師有限公司

FACADE CONSULTANT: MEINHARDT

NOTE :

1. ALL DIMENSIONS ARE IN mm.
2. ALL ELEVATIONS ARE VIEWED FROM OUTSIDE.
3. ALL DIMENSIONS TO BE VERIFIED ON SITE BEFORE FABRICATION.

LEGEND :

X1 / X001 — DETAIL MARK NO. / REFER SHEET NO.

1. F.F.L. -- FINISHED FLOOR LEVEL
2. S.F.L. -- STRUCTURAL FLOOR LEVEL
3. /R -- REVERSED DETAIL

NO.	DATE	REVISED	BY
A	05-10-2021	REVISION SUBJECT TO ARCH. COMMENT	

JOB NO. : J-853

PROJECT :
PROPOSED RESIDENTIAL DEVELOPMENT AT N.K.I.L. 6542
YIN PING ROAD
KOWLOON

TITLE :
PART ELEVATION FOR CURTAIN WALL AT TOWER 2

DATE : 26-MAR-21 | SCALE : 1:60 (A1)


DRAWN BY : LHR | CHECKED BY :


美特鋁質有限公司 MIDI ALUMINIUM FABRICATOR LTD.
Units 6-8, Sunray Industrial Centre, 1/F
610 Cha Kwo Ling Road, Kowloon
Tel:23489211-4 Fax:(852)27727666


DWG NO. : J853-SD-CW-4202 | REV. : A


LEGEND :

R.S. = RESTRAINT SOCKET

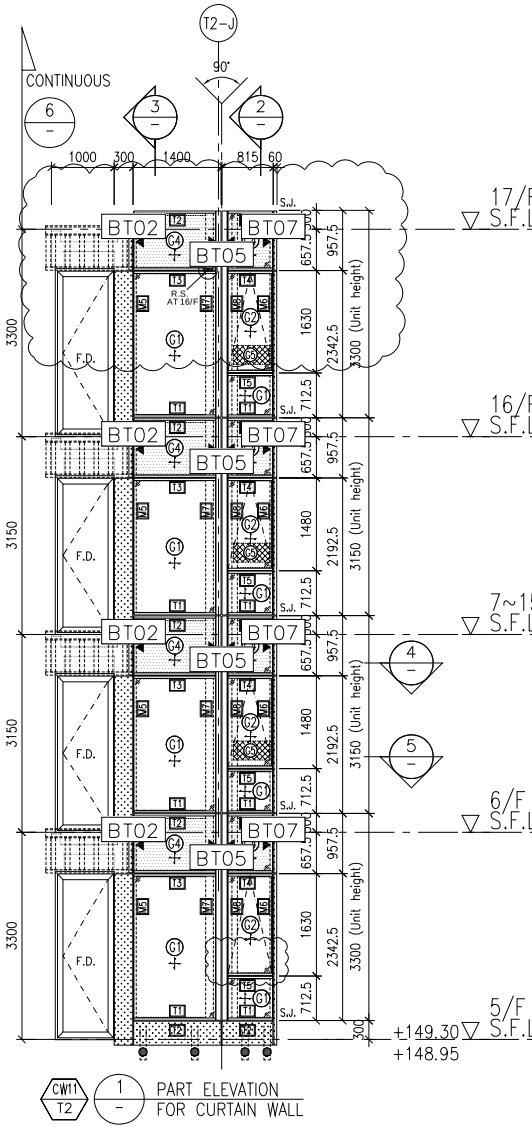


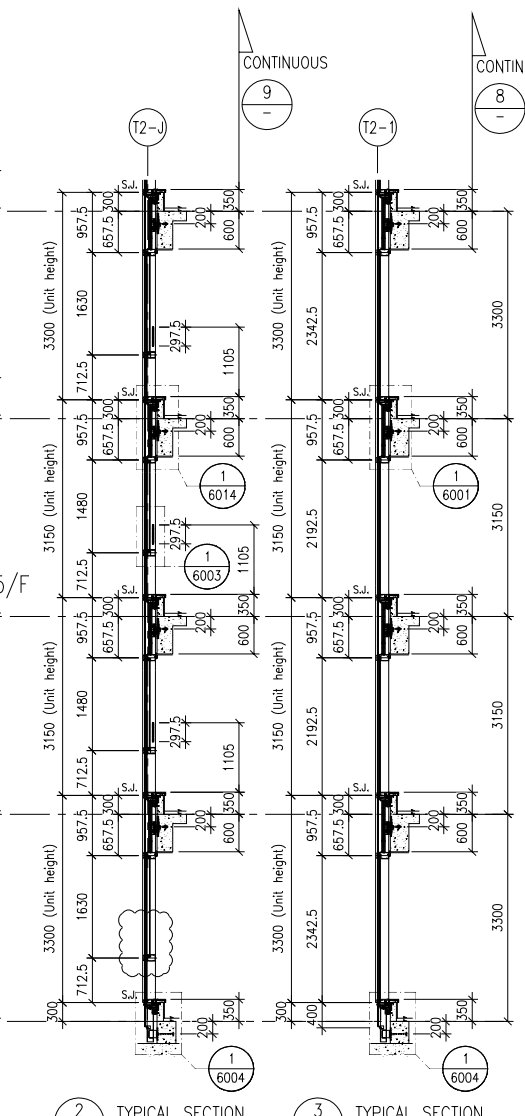

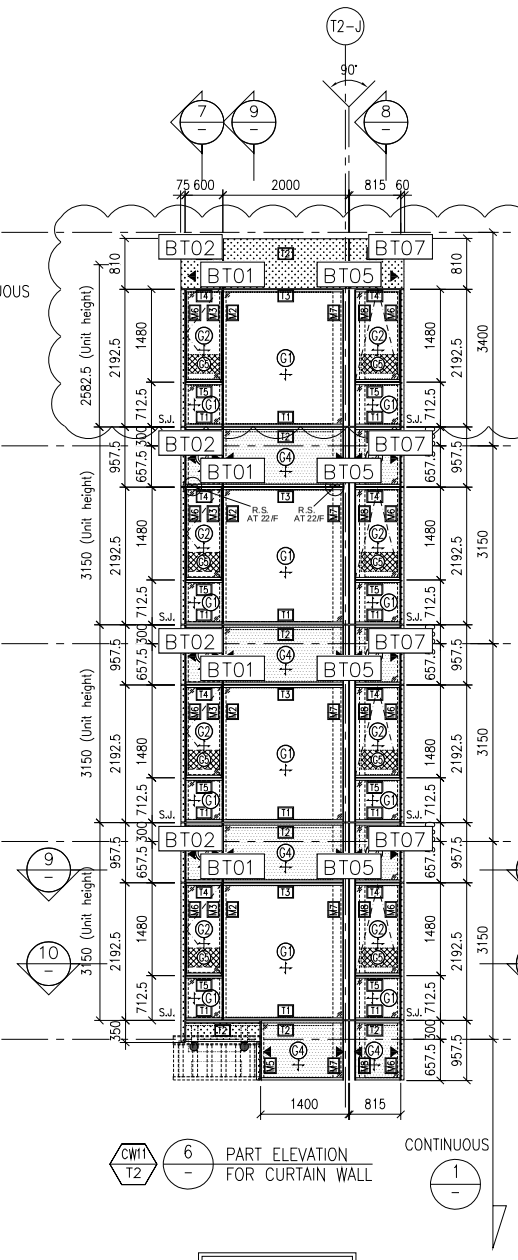


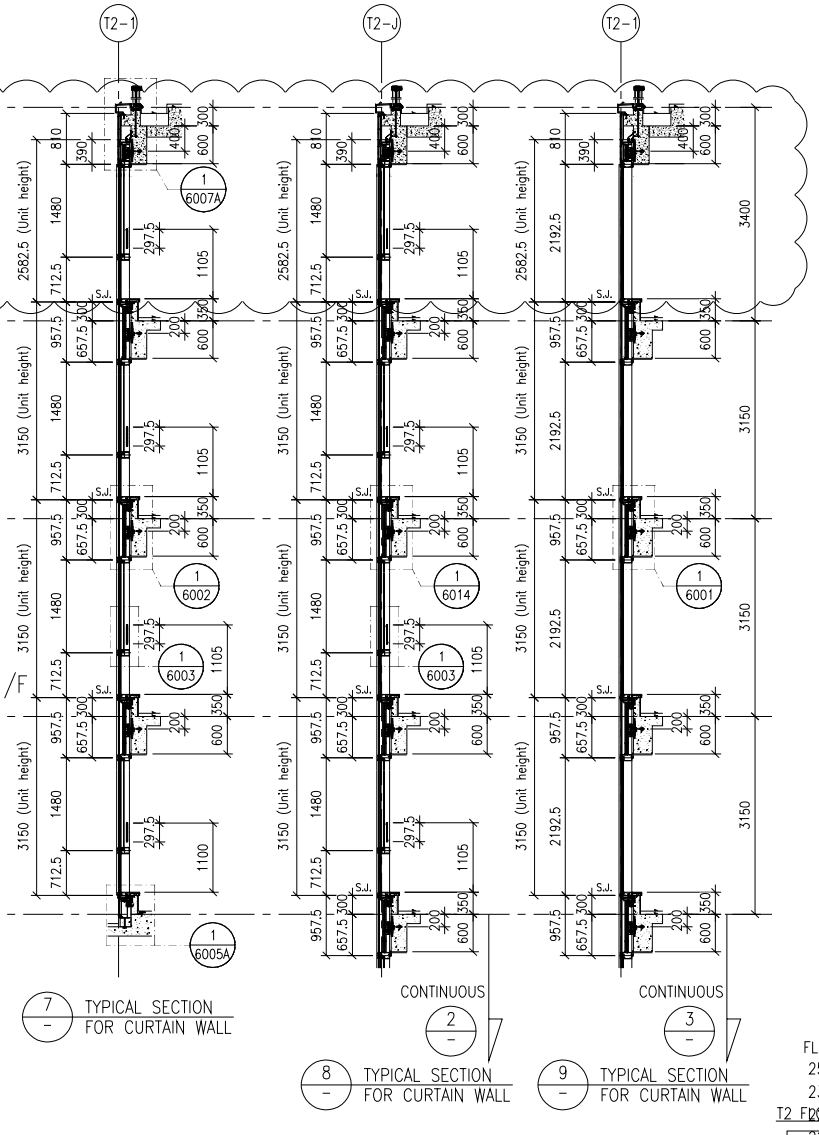


T2CW-A-5

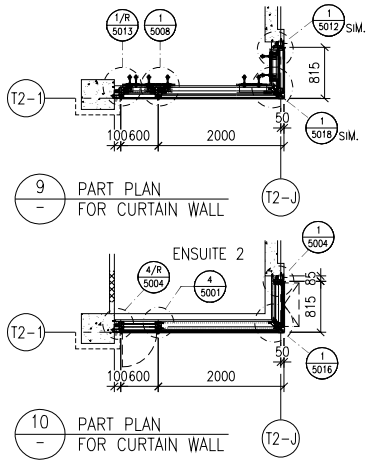

T2CW-D-1

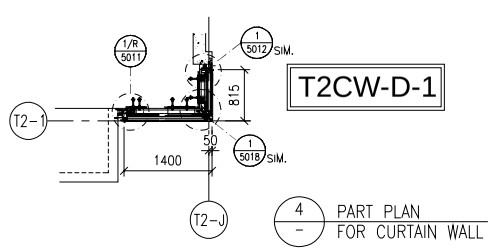

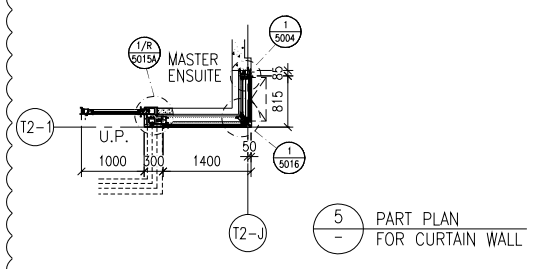

FLOOR	T2 FLOOR LEVEL (S.F.L)
25/F	
23/F	
22/F	LEVEL
21/F	+203.40
20/F	+200.00
19/F	+196.85
18/F	+193.70
17/F	+190.55
16/F	+187.40
15/F	+184.25
12/F	+181.10
11/F	+177.80
10/F	+174.65
9/F	+171.50
8/F	+168.35
7/F	+165.20
6/F	+162.05
5/F	+158.90
	+155.75
	+152.60
	+149.30

LEGEND:

- G1+ – 10mm HEAT STRENGTHENED GLASS (OUTER) + 12mm AIR SPACE +12mm THK. TEMPERED CLEAR GLASS (INNER)
- G2+ – 10mm HEAT STRENGTHENED GLASS (OUTER) + 12mm AIR SPACE +10mm THK. TEMPERED CLEAR GLASS (INNER)
- G4+ – 12mm THK. HEAT STRENGTHENED GLASS & 2mm THK. ALUM. BACKPAN (SPANDREL GLASS)
- G5 – 12mm THK. CLEAR TEMPERED GLASS (INTERNAL PROTECTIVE BARRIER)
- 3mm THK. ALUM. CLADDING
- S.J. – STACK JOINT (WIND LOAD)
- AE01 – ALUM. EXTRUSION DIE NO.
- ▲ – SUPPORT POINT (WIND LOAD + DEAD LOAD)
- ● – SUPPORT POINT (WIND LOAD)

B.D. REF :

CLIENT :

SHIMAO GROUP HOLDINGS LIMITED

ARCHITECT :

WONG TUNG & PARTNERS LIMITED
ARCHITECTS & PLANNERS

MAIN CONTRACTOR :

協興建築有限公司
HIP HING CONSTRUCTION CO LTD

STRUCTURAL ENGINEER :

C M WONG & ASSOCIATES LTD
黃志明建築工程師有限公司

FACADE CONSULTANT:

MEINHARDT

NOTE :

1. ALL DIMENSIONS ARE IN mm.
2. ALL ELEVATIONS ARE VIEWED FROM OUTSIDE.
3. ALL DIMENSIONS TO BE VERIFIED ON SITE BEFORE FABRICATION.

LEGEND :

X1 — DETAIL MARK NO.
X001 — REFER SHEET NO.

1. F.F.L. -- FINISHED FLOOR LEVEL
2. S.F.L. -- STRUCTURAL FLOOR LEVEL
3. /R -- HANDED DETAIL

NO.	DATE	REVISED	BY
A	05-10-2021	REVISION SUBJECT TO ARCH. COMMENT	

JOB NO. : J-853

PROJECT :

PROPOSED RESIDENTIAL DEVELOPMENT AT N.K.I.L. 6542 YIN PING ROAD KOWLOON

TITLE :

PART ELEVATION OF CURTAIN WALL AT TOWER 2

DATE : 26-MAR-21 | SCALE : 1:60 (A1)


DRAWN BY : LHR | CHECKED BY : –

美特鋁質有限公司
MIDI ALUMINIUM FABRICATOR LTD.
Units 6-8, Sunray Industrial Centre, 1/F
610 Cha Kwo Ling Road, Kowloon
Tel:23489211-4 Fax:(852)27727666

DWG NO. : J853-BD-CW-4203 | REV. : A

LEGEND :

R.S. = RESTRAINT SOCKET

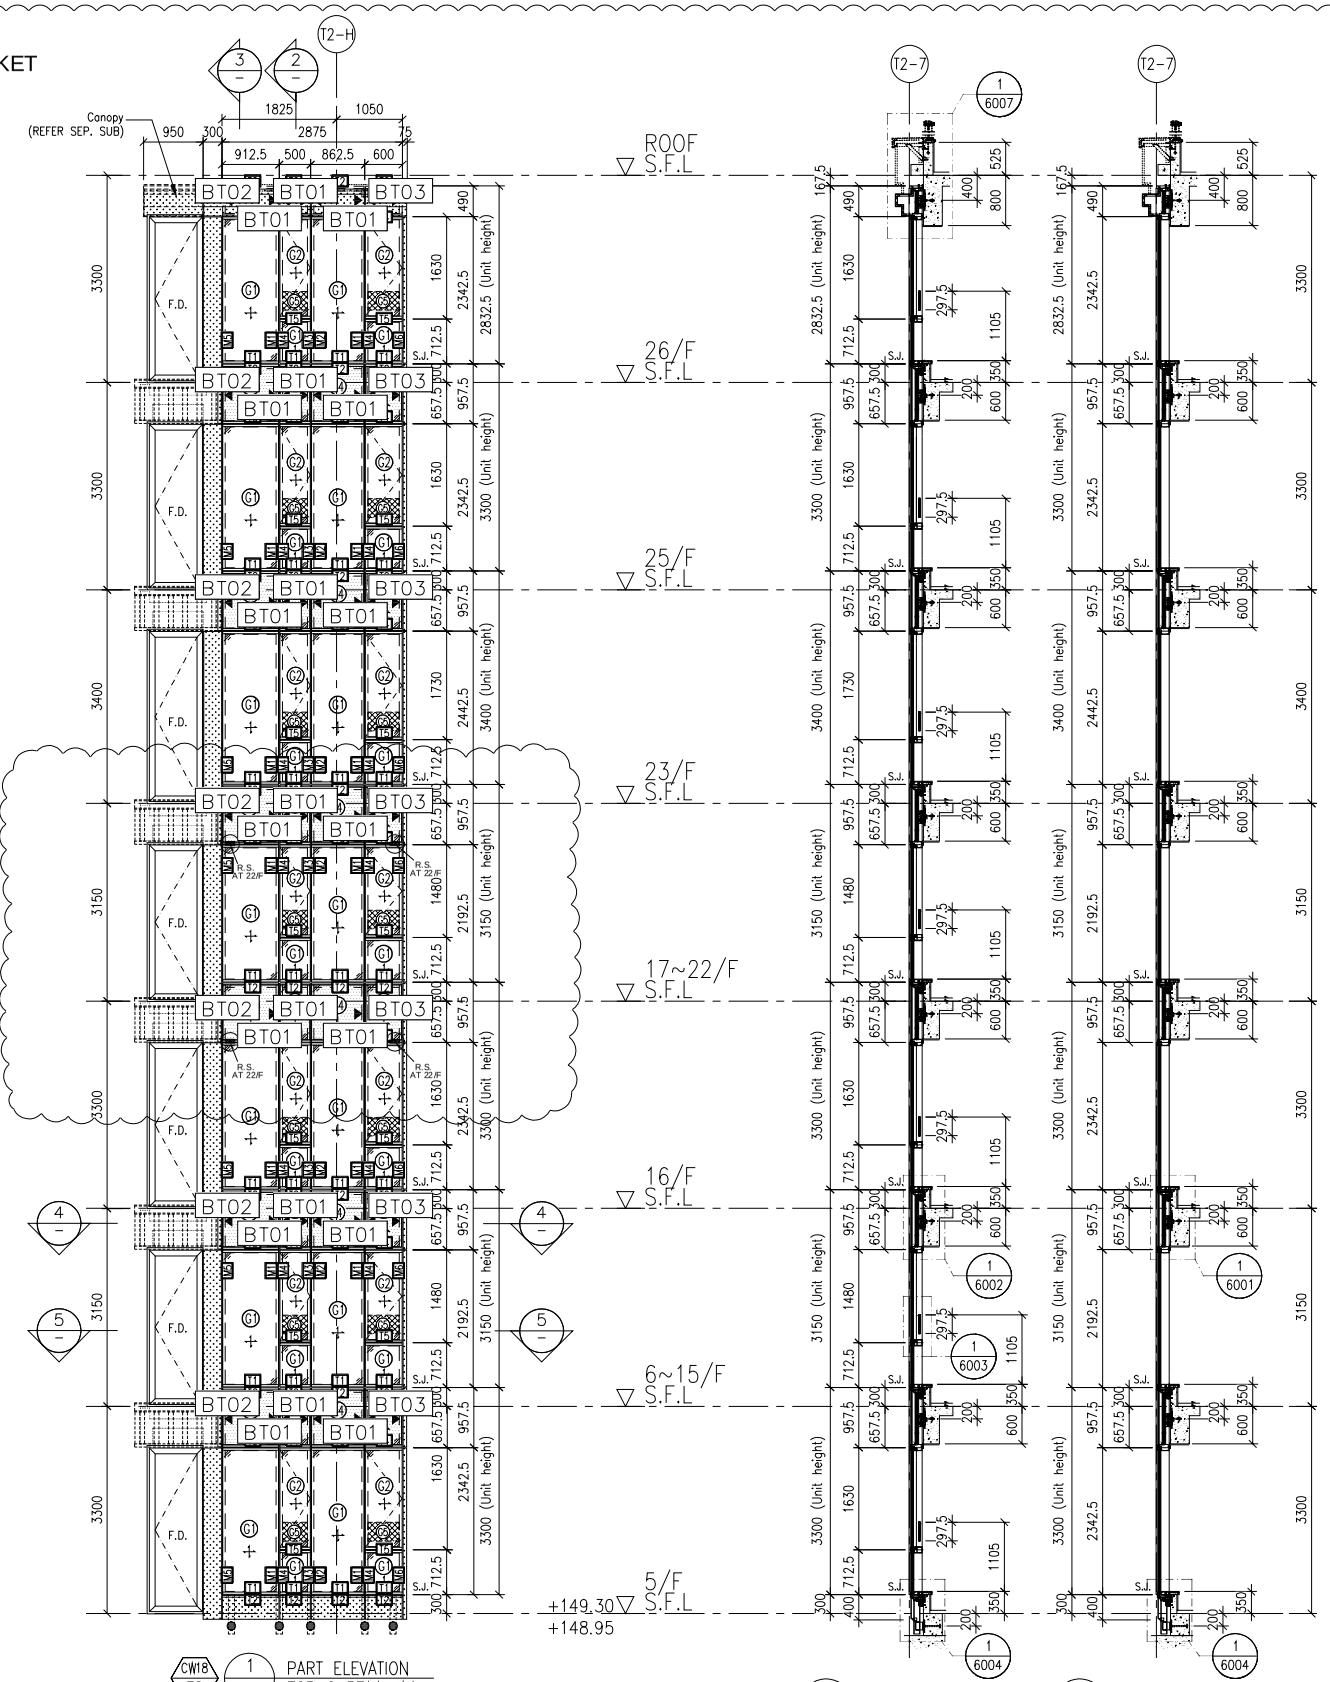


CW18 / T2 — 1 — PART ELEVATION FOR CURTAIN WALL


2 — TYPICAL SECTION FOR CURTAIN WALL

3 — TYPICAL SECTION FOR CURTAIN WALL

T2CW-C-1

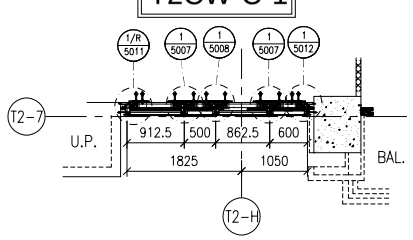

4 — PART PLAN FOR CURTAIN WALL

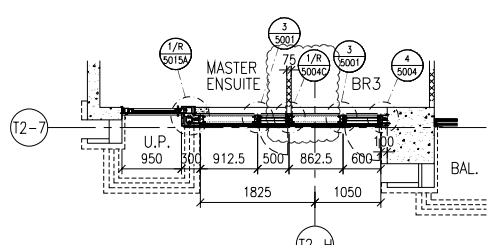

5 — PART PLAN FOR CURTAIN WALL

FLOOR LEVEL (S.F.L.)

FLOOR	LEVEL
ROOF	+210.00
26/F	+206.70
25/F	+203.40
23/F	+200.00
22/F	+196.85
21/F	+193.70
20/F	+190.55
19/F	+187.40
18/F	+184.25
17/F	+181.10
16/F	+177.80
15/F	+174.65
12/F	+171.50
11/F	+168.35
10/F	+165.20
9/F	+162.05
8/F	+158.90
7/F	+155.75
6/F	+152.60
5/F	+149.30

LEGEND:

- G1+ – 10mm HEAT STRENGTHENED GLASS (OUTER) + 12mm AIR SPACE +12mm THK. TEMPERED CLEAR GLASS (INNER)
- G2+ – 10mm HEAT STRENGTHENED GLASS (OUTER) + 12mm AIR SPACE +10mm THK. TEMPERED CLEAR GLASS (INNER)
- G4+ – 12mm THK. HEAT STRENGTHENED GLASS & 2mm THK. ALUM. BACKPAN (SPANDREL GLASS)
- G10 – 12mm THK. CLEAR TEMPERED GLASS (INTERNAL PROTECTIVE BARRIER)
- – 3mm THK. ALUM. CLADDING
- S.J. – STACK JOINT (WIND LOAD)
- AE01 – ALUM. EXTRUSION DIE NO.
- ▲ – SUPPORT POINT (WIND LOAD + DEAD LOAD)
- ● – SUPPORT POINT (WIND LOAD)

B.D. REF :

CLIENT :

SHIMAO GROUP HOLDINGS LIMITED

ARCHITECT :

WONG TUNG & PARTNERS LIMITED
ARCHITECTS & PLANNERS

MAIN CONTRACTOR :

協興建築有限公司
HIP HING CONSTRUCTION CO LTD

STRUCTURAL ENGINEER :

C M WONG & ASSOCIATES LTD
黃志明建築工程師有限公司

FACADE CONSULTANT:

MEINHARDT

NOTE :

1. ALL DIMENSIONS ARE IN mm.
2. ALL ELEVATIONS ARE VIEWED FROM OUTSIDE.
3. ALL DIMENSIONS TO BE VERIFIED ON SITE BEFORE FABRICATION.

LEGEND :

X1 / X001 — DETAIL MARK NO. / REFER SHEET NO.

1. F.F.L. -- FINISHED FLOOR LEVEL
2. S.F.L. -- STRUCTURAL FLOOR LEVEL
3. /R -- REVERSED DETAIL

NO.	DATE	REVISED	BY
A	05-10-2021	REVISION SUBJECT TO ARCH. COMMENT	

JOB NO. : J-853

PROJECT :

PROPOSED RESIDENTIAL DEVELOPMENT AT N.K.I.L. 6542 YIN PING ROAD KOWLOON

TITLE :

PART ELEVATION FOR CURTAIN WALL AT TOWER 2

DATE : 26-MAR-21 | SCALE : 1:60 (A1)

DRAWN BY : LHR | CHECKED BY :

美特鋁質有限公司
MIDI ALUMINIUM FABRICATOR LTD.
Units 6-8, Sunray Industrial Centre, 1/F
610 Cha Kwo Ling Road, Kowloon
Tel:23489211-4 Fax:(852)27727666

DWG NO. : J853-SD-CW-4204 | REV. : A

LEGEND :

R.S. = RESTRAINT SOCKET

1 — PART ELEVATION FOR CURTAIN WALL

2 — TYPICAL SECTION FOR CURTAIN WALL

3 — TYPICAL SECTION FOR CURTAIN WALL

4 — PART PLAN FOR CURTAIN WALL

5 — PART PLAN FOR CURTAIN WALL

6 — PART PLAN FOR CURTAIN WALL

7 — PART PLAN FOR CURTAIN WALL

FLOOR LEVEL (S.F.L.)

FLOOR	LEVEL
ROOF	+210.00
26/F	+206.70
25/F	+203.40
23/F	+200.00
22/F	+196.85
21/F	+193.70
20/F	+190.55
19/F	+187.40
18/F	+184.25
17/F	+181.10
16/F	+177.80
15/F	+174.65
12/F	+171.50
11/F	+168.35
10/F	+165.20
9/F	+162.05
8/F	+158.90
7/F	+155.75
6/F	+152.60
5/F	+149.30

LEGEND:

- G1 — 10mm HEAT STRENGTHENED GLASS (OUTER) + 12mm AIR SPACE +12mm THK. TEMPERED CLEAR GLASS (INNER)
- G2 — 10mm HEAT STRENGTHENED GLASS (OUTER) + 12mm AIR SPACE +10mm THK. TEMPERED CLEAR GLASS (INNER)
- G4 — 12mm THK. HEAT STRENGTHENED GLASS & 2mm THK. ALUM. BACKPAN (SPANDREL GLASS)
- G5 — 12mm THK. CLEAR TEMPERED GLASS (INTERNAL PROTECTIVE BARRIER)
- 3mm THK. ALUM. CLADDING
- S.J. — STACK JOINT (WIND LOAD)
- AE01 — ALUM. EXTRUSION DIE NO.
- ▲ — SUPPORT POINT (WIND LOAD + DEAD LOAD)
- ● — SUPPORT POINT (WIND LOAD)

B.D. REF :

CLIENT :

SHIMAO GROUP HOLDINGS LIMITED

ARCHITECT : WONG TUNG & PARTNERS LIMITED ARCHITECTS & PLANNERS

MAIN CONTRACTOR : 協興建築有限公司 HIP HING CONSTRUCTION CO LTD

STRUCTURAL ENGINEER : C M WONG & ASSOCIATES LTD 黃志明建築工程師有限公司

FACADE CONSULTANT: MEINHARDT

NOTE :

1. ALL DIMENSIONS ARE IN mm.
2. ALL ELEVATIONS ARE VIEWED FROM OUTSIDE.
3. ALL DIMENSIONS TO BE VERIFIED ON SITE BEFORE FABRICATION.

LEGEND :

X1 — DETAIL MARK NO.
X001 — REFER SHEET NO.

1. F.F.L. -- FINISHED FLOOR LEVEL
2. S.F.L. -- STRUCTURAL FLOOR LEVEL
3. /R -- REVERSED DETAIL

NO.	DATE	REVISED	BY

JOB NO. : J-853

PROJECT :
PROPOSED RESIDENTIAL DEVELOPMENT AT N.K.I.L. 6542 YIN PING ROAD KOWLOON

TITLE :
PART ELEVATION FOR CURTAIN WALL AT TOWER 2

DATE : 22-OCT-21 | SCALE : 1:60 (A1)


DRAWN BY : LHR | CHECKED BY :

美特鋁質有限公司 MIDI ALUMINIUM FABRICATOR LTD.
Units 6-8, Sunray Industrial Centre, 1/F
610 Cha Kwo Ling Road, Kowloon
Tel:23489211-4 Fax:(852)27727666

DWG NO. : J853-SD-CW-4204A | REV. : A


LEGEND :

R.S. = RESTRAINT SOCKET

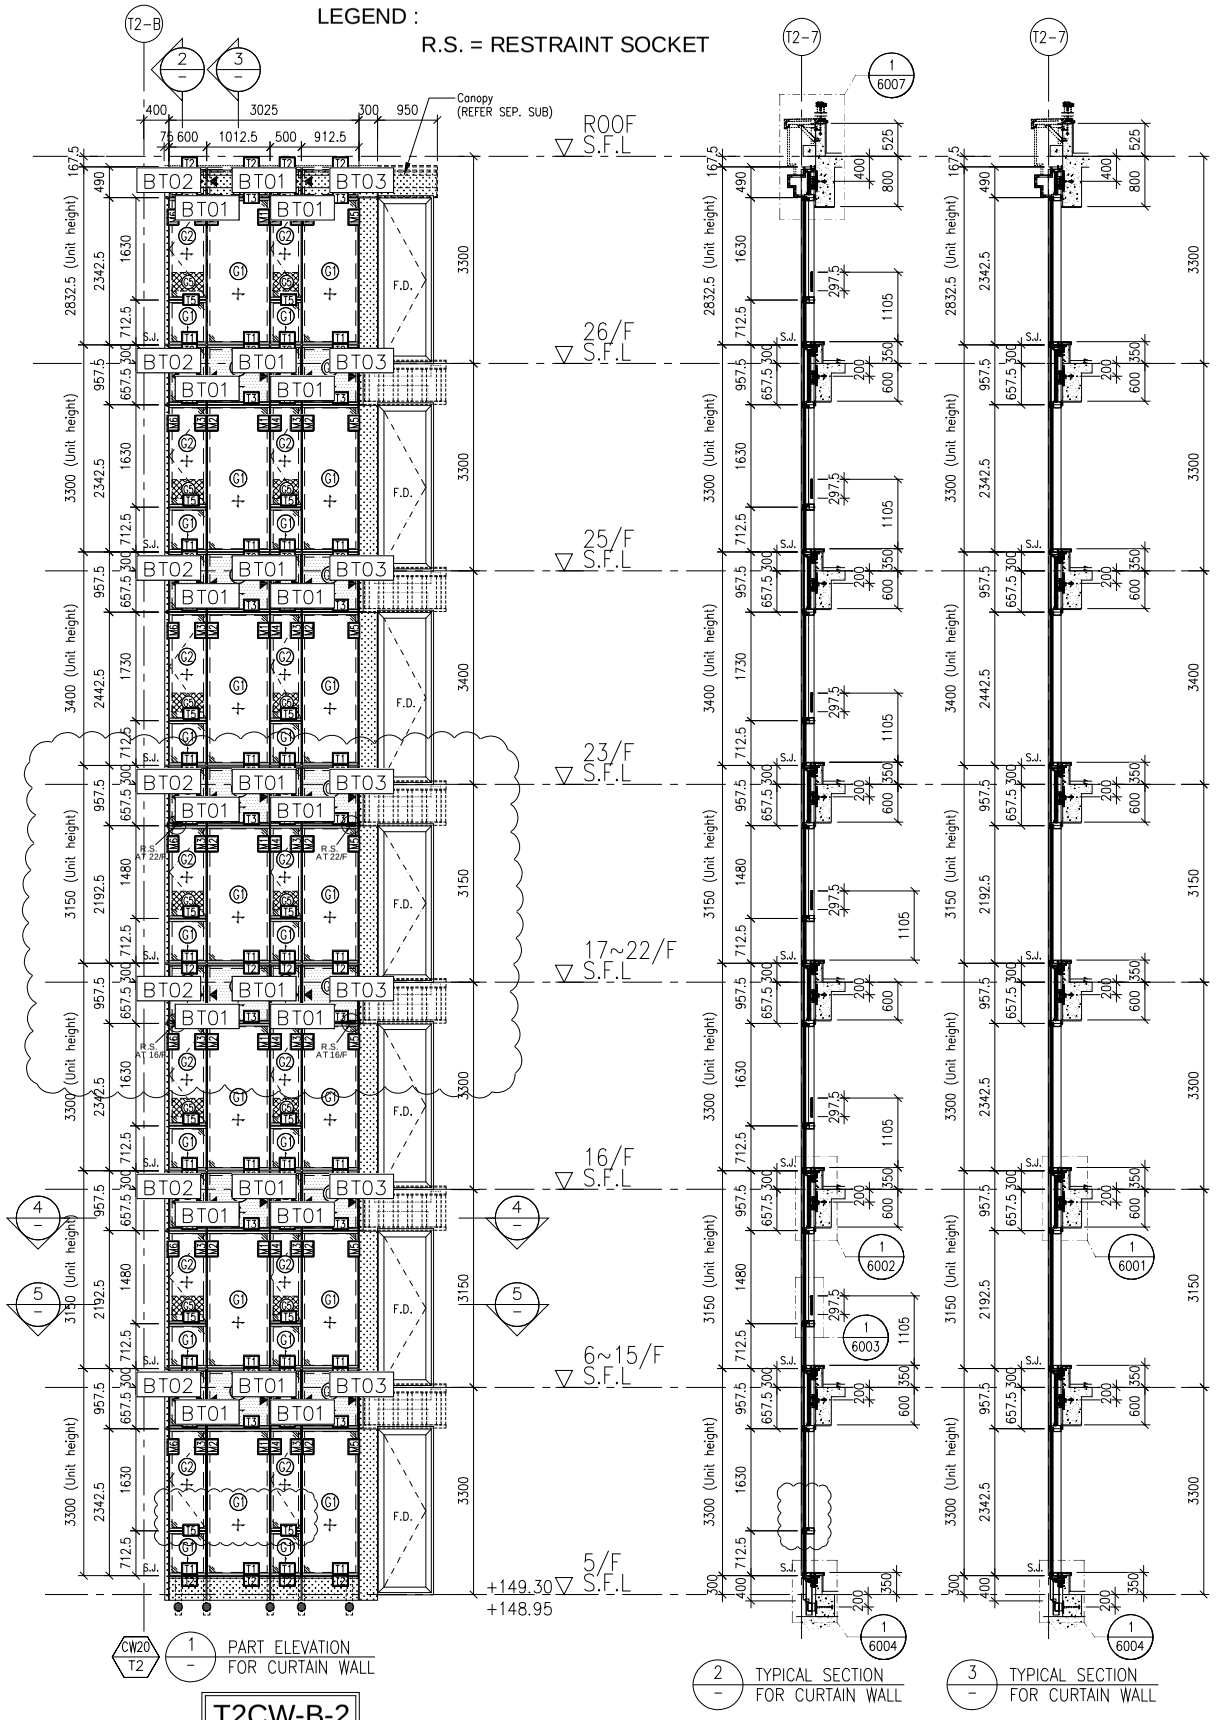


CW20 T2 — 1 — PART ELEVATION FOR CURTAIN WALL

T2CW-B-2

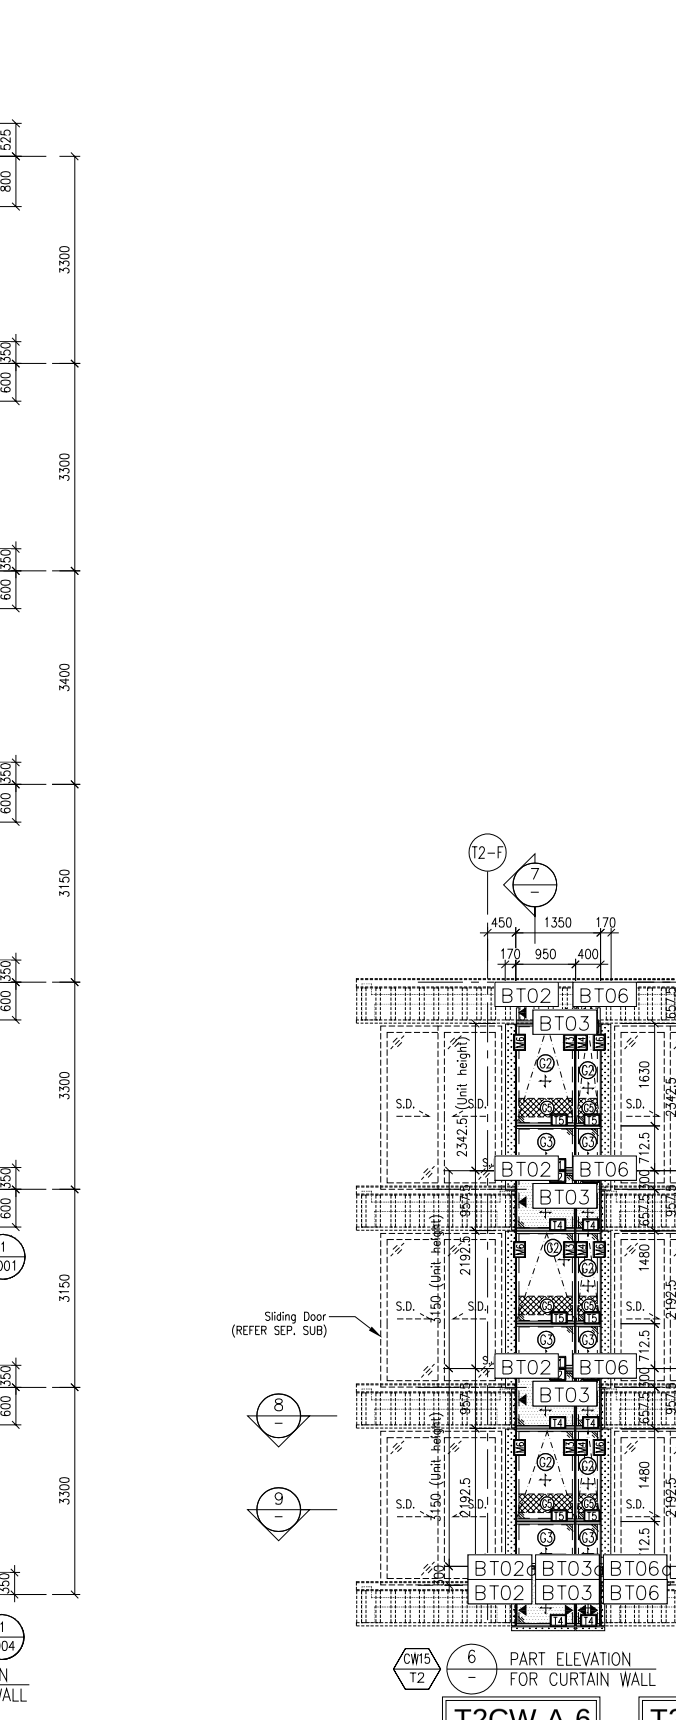


2 — TYPICAL SECTION FOR CURTAIN WALL


3 — TYPICAL SECTION FOR CURTAIN WALL

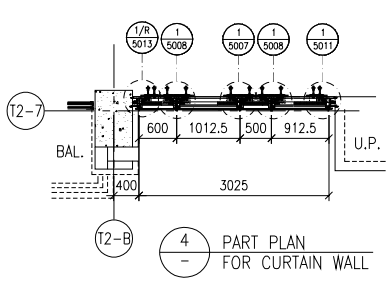

4 — PART PLAN FOR CURTAIN WALL

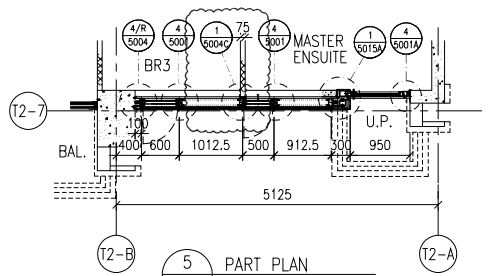

5 — PART PLAN FOR CURTAIN WALL

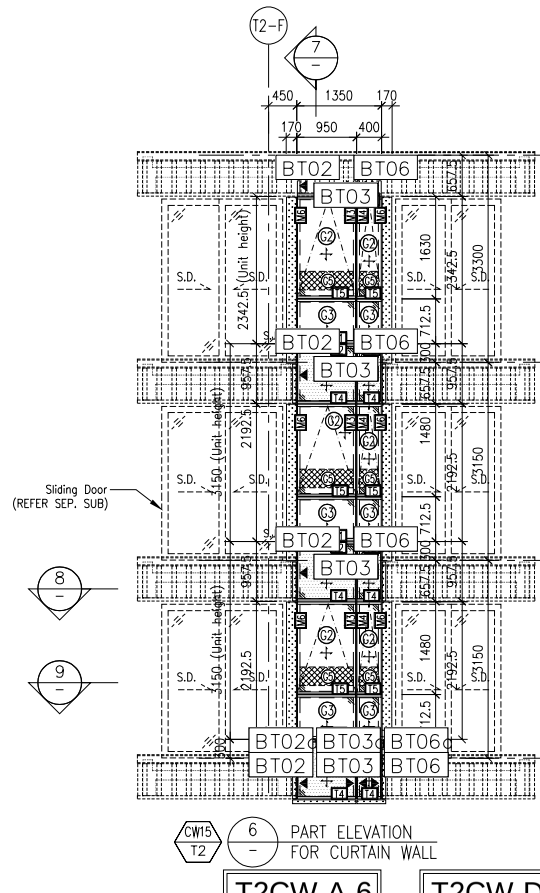


CW15 T2 — 6 — PART ELEVATION FOR CURTAIN WALL


T2CW-A-6

T2CW-D-2

7 — TYPICAL SECTION FOR CURTAIN WALL

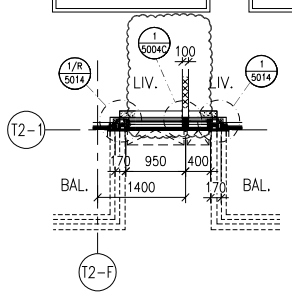

9 — PART PLAN FOR CURTAIN WALL

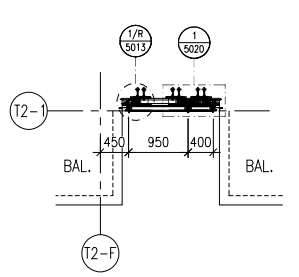

8 — PART PLAN FOR CURTAIN WALL

LEGEND:

- 3mm THK. ALUM. CLADDING
- S.J. — STACK JOINT (WIND LOAD)
- AE01 — ALUM. EXTRUSION DIE NO.
- ▲ — SUPPORT POINT (WIND LOAD + DEAD LOAD)
- ● — SUPPORT POINT (WIND LOAD)

FLOOR LEVEL (S.F.L.)

FLOOR	LEVEL
ROOF	+210.00
26/F	+206.70
25/F	+203.40
23/F	+200.00
22/F	+196.85
21/F	+193.70
20/F	+190.55
19/F	+187.40
18/F	+184.25
17/F	+181.10
16/F	+177.80
15/F	+174.65
12/F	+171.50
11/F	+168.35
10/F	+165.20
9/F	+162.05
8/F	+158.90
7/F	+155.75
6/F	+152.60
5/F	+149.30

B.D. REF :

CLIENT :

SHIMAO GROUP HOLDINGS LIMITED

ARCHITECT :

WONG TUNG & PARTNERS LIMITED
ARCHITECTS & PLANNERS

MAIN CONTRACTOR :

協興建築有限公司
HIP HING CONSTRUCTION CO LTD

STRUCTURAL ENGINEER :

C M WONG & ASSOCIATES LTD
黃志明建築工程師有限公司

FACADE CONSULTANT:

MEINHARDT

NOTE :

1. ALL DIMENSIONS ARE IN mm.
2. ALL ELEVATIONS ARE VIEWED FROM OUTSIDE.
3. ALL DIMENSIONS TO BE VERIFIED ON SITE BEFORE FABRICATION.

LEGEND :

X1 / X001 — DETAIL MARK NO. / REFER SHEET NO.

1. F.F.L. --FINISHED FLOOR LEVEL
2. S.F.L. --STRUCTURAL FLOOR LEVEL
3. /R --REVERSED DETAIL

NO.	DATE	REVISED	BY
A	05-10-2021	REVISION SUBJECT TO ARCH. COMMENT	

JOB NO. : J-853

PROJECT :

PROPOSED RESIDENTIAL DEVELOPMENT AT N.K.I.L. 6542 YIN PING ROAD KOWLOON

TITLE :


PART ELEVATION FOR CURTAIN WALL AT TOWER 2

DATE : 26-MAR-21 | SCALE : 1:60 (A1)

DRAWN BY : LHR | CHECKED BY :

美特鋁質有限公司
MIDI ALUMINIUM FABRICATOR LTD.
Units 6-8, Sunray Industrial Centre, 1/F
610 Cha Kwo Ling Road, Kowloon
Tel:23489211-4 Fax:(852)27727666

DWG NO. : J853-SD-CW-4205 | REV. : A

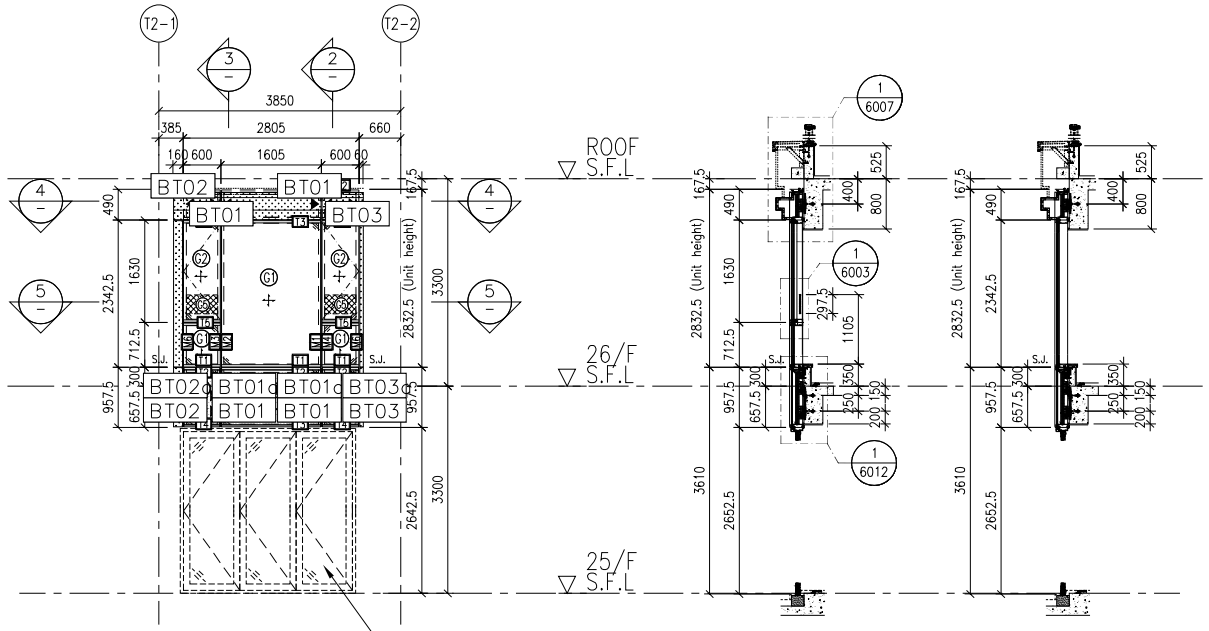


CW12 / T2 — 1 / – PART ELEVATION FOR CURTAIN WALL


2 / – TYPICAL SECTION FOR CURTAIN WALL

3 / – TYPICAL SECTION FOR CURTAIN WALL


T2CW-A-7

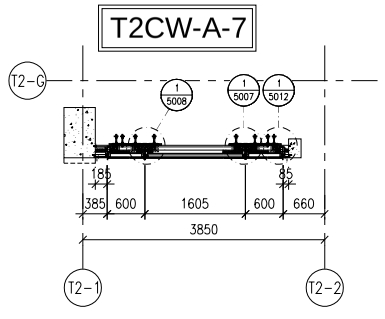


4 / – PART PLAN FOR CURTAIN WALL

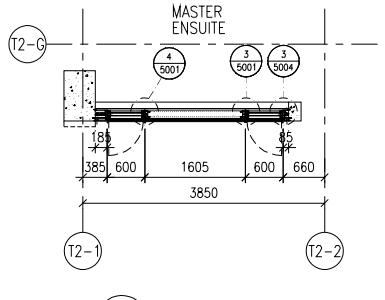


5 / – PART PLAN FOR CURTAIN WALL

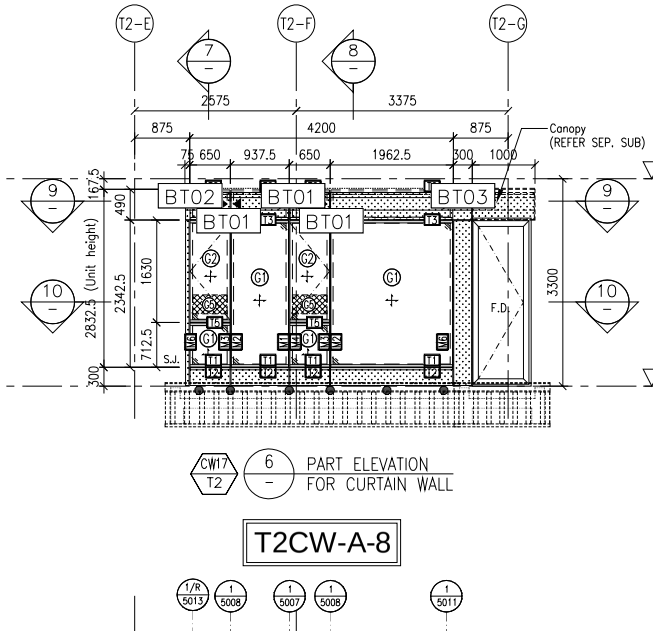

CW17 / T2 — 6 / – PART ELEVATION FOR CURTAIN WALL

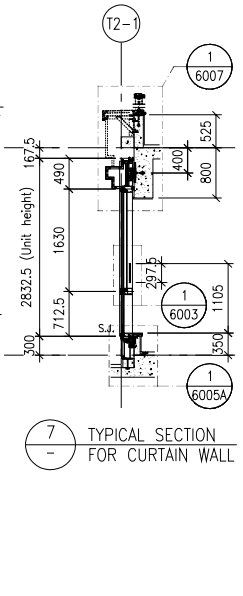


7 / – TYPICAL SECTION FOR CURTAIN WALL

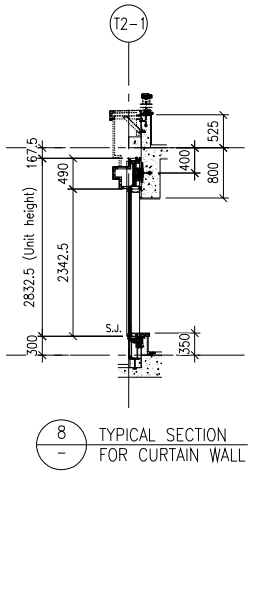


8 / – TYPICAL SECTION FOR CURTAIN WALL

T2CW-A-8

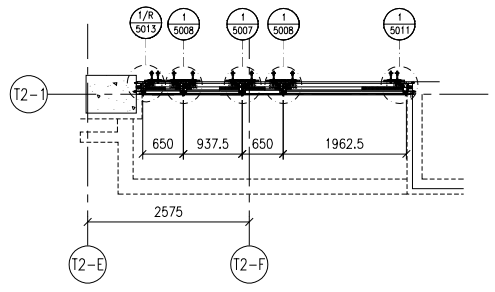

9 / – PART PLAN FOR CURTAIN WALL

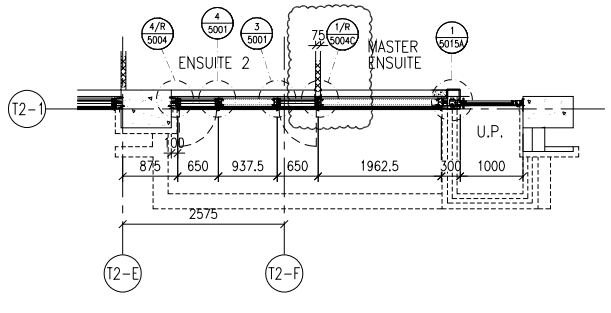

10 / – PART PLAN FOR CURTAIN WALL

FLOOR LEVEL (S.F.L.)

FLOOR	LEVEL
ROOF	+210.00
26/F	+206.70
25/F	+203.40

LEGEND:

- G1+ – 10mm HEAT STRENGTHENED GLASS (OUTER) + 12mm AIR SPACE +12mm THK. TEMPERED CLEAR GLASS (INNER)
- G2+ – 10mm HEAT STRENGTHENED GLASS (OUTER) + 12mm AIR SPACE +10mm THK. TEMPERED CLEAR GLASS (INNER)
- G4+ – 12mm THK. HEAT STRENGTHENED GLASS & 2mm THK. ALUM. BACKPAN (SPANDREL GLASS)
- G5 – 12mm THK. CLEAR TEMPERED GLASS (INTERNAL PROTECTIVE BARRIER)
- 3mm THK. ALUM. CLADDING
- S.J. – STACK JOINT (WIND LOAD)
- AE01 – ALUM. EXTRUSION DIE NO.
- ▲ – SUPPORT POINT (WIND LOAD + DEAD LOAD)
- ● – SUPPORT POINT (WIND LOAD)

B.D. REF :

CLIENT :

SHIMAO GROUP HOLDINGS LIMITED

ARCHITECT : WONG TUNG & PARTNERS LIMITED ARCHITECTS & PLANNERS

MAIN CONTRACTOR : 協興建築有限公司 HIP HING CONSTRUCTION CO LTD

STRUCTURAL ENGINEER : C M WONG & ASSOCIATES LTD 黃志明建築工程師有限公司

FACADE CONSULTANT: MEINHARDT

NOTE :
1. ALL DIMENSIONS ARE IN mm.
2. ALL ELEVATIONS ARE VIEWED FROM OUTSIDE.
3. ALL DIMENSIONS TO BE VERIFIED ON SITE BEFORE FABRICATION.

LEGEND :
- X1 / X001 — DETAIL MARK NO. / REFER SHEET NO.
1. F.F.L. -- FINISHED FLOOR LEVEL
2. S.F.L. -- STRUCTURAL FLOOR LEVEL
3. /R -- REVERSED DETAIL

NO.	DATE	REVISED	BY

JOB NO. : J-853

PROJECT :
PROPOSED RESIDENTIAL DEVELOPMENT AT N.K.I.L. 6542 YIN PING ROAD KOWLOON

TITLE :
PART ELEVATION FOR CURTAIN WALL AT TOWER 2


DATE : 05-OCT-21 | SCALE : 1:60 (A1)

DRAWN BY : LHR | CHECKED BY :

美特鋁質有限公司 MIDI ALUMINIUM FABRICATOR LTD.
Units 6-8, Sunray Industrial Centre, 1/F
610 Cha Kwo Ling Road, Kowloon
Tel:23489211-4 Fax:(852)27727666

DWG NO. : J853-SD-CW-4206 | REV. : A

LEGEND :
R.S. = RESTRAINT SOCKET

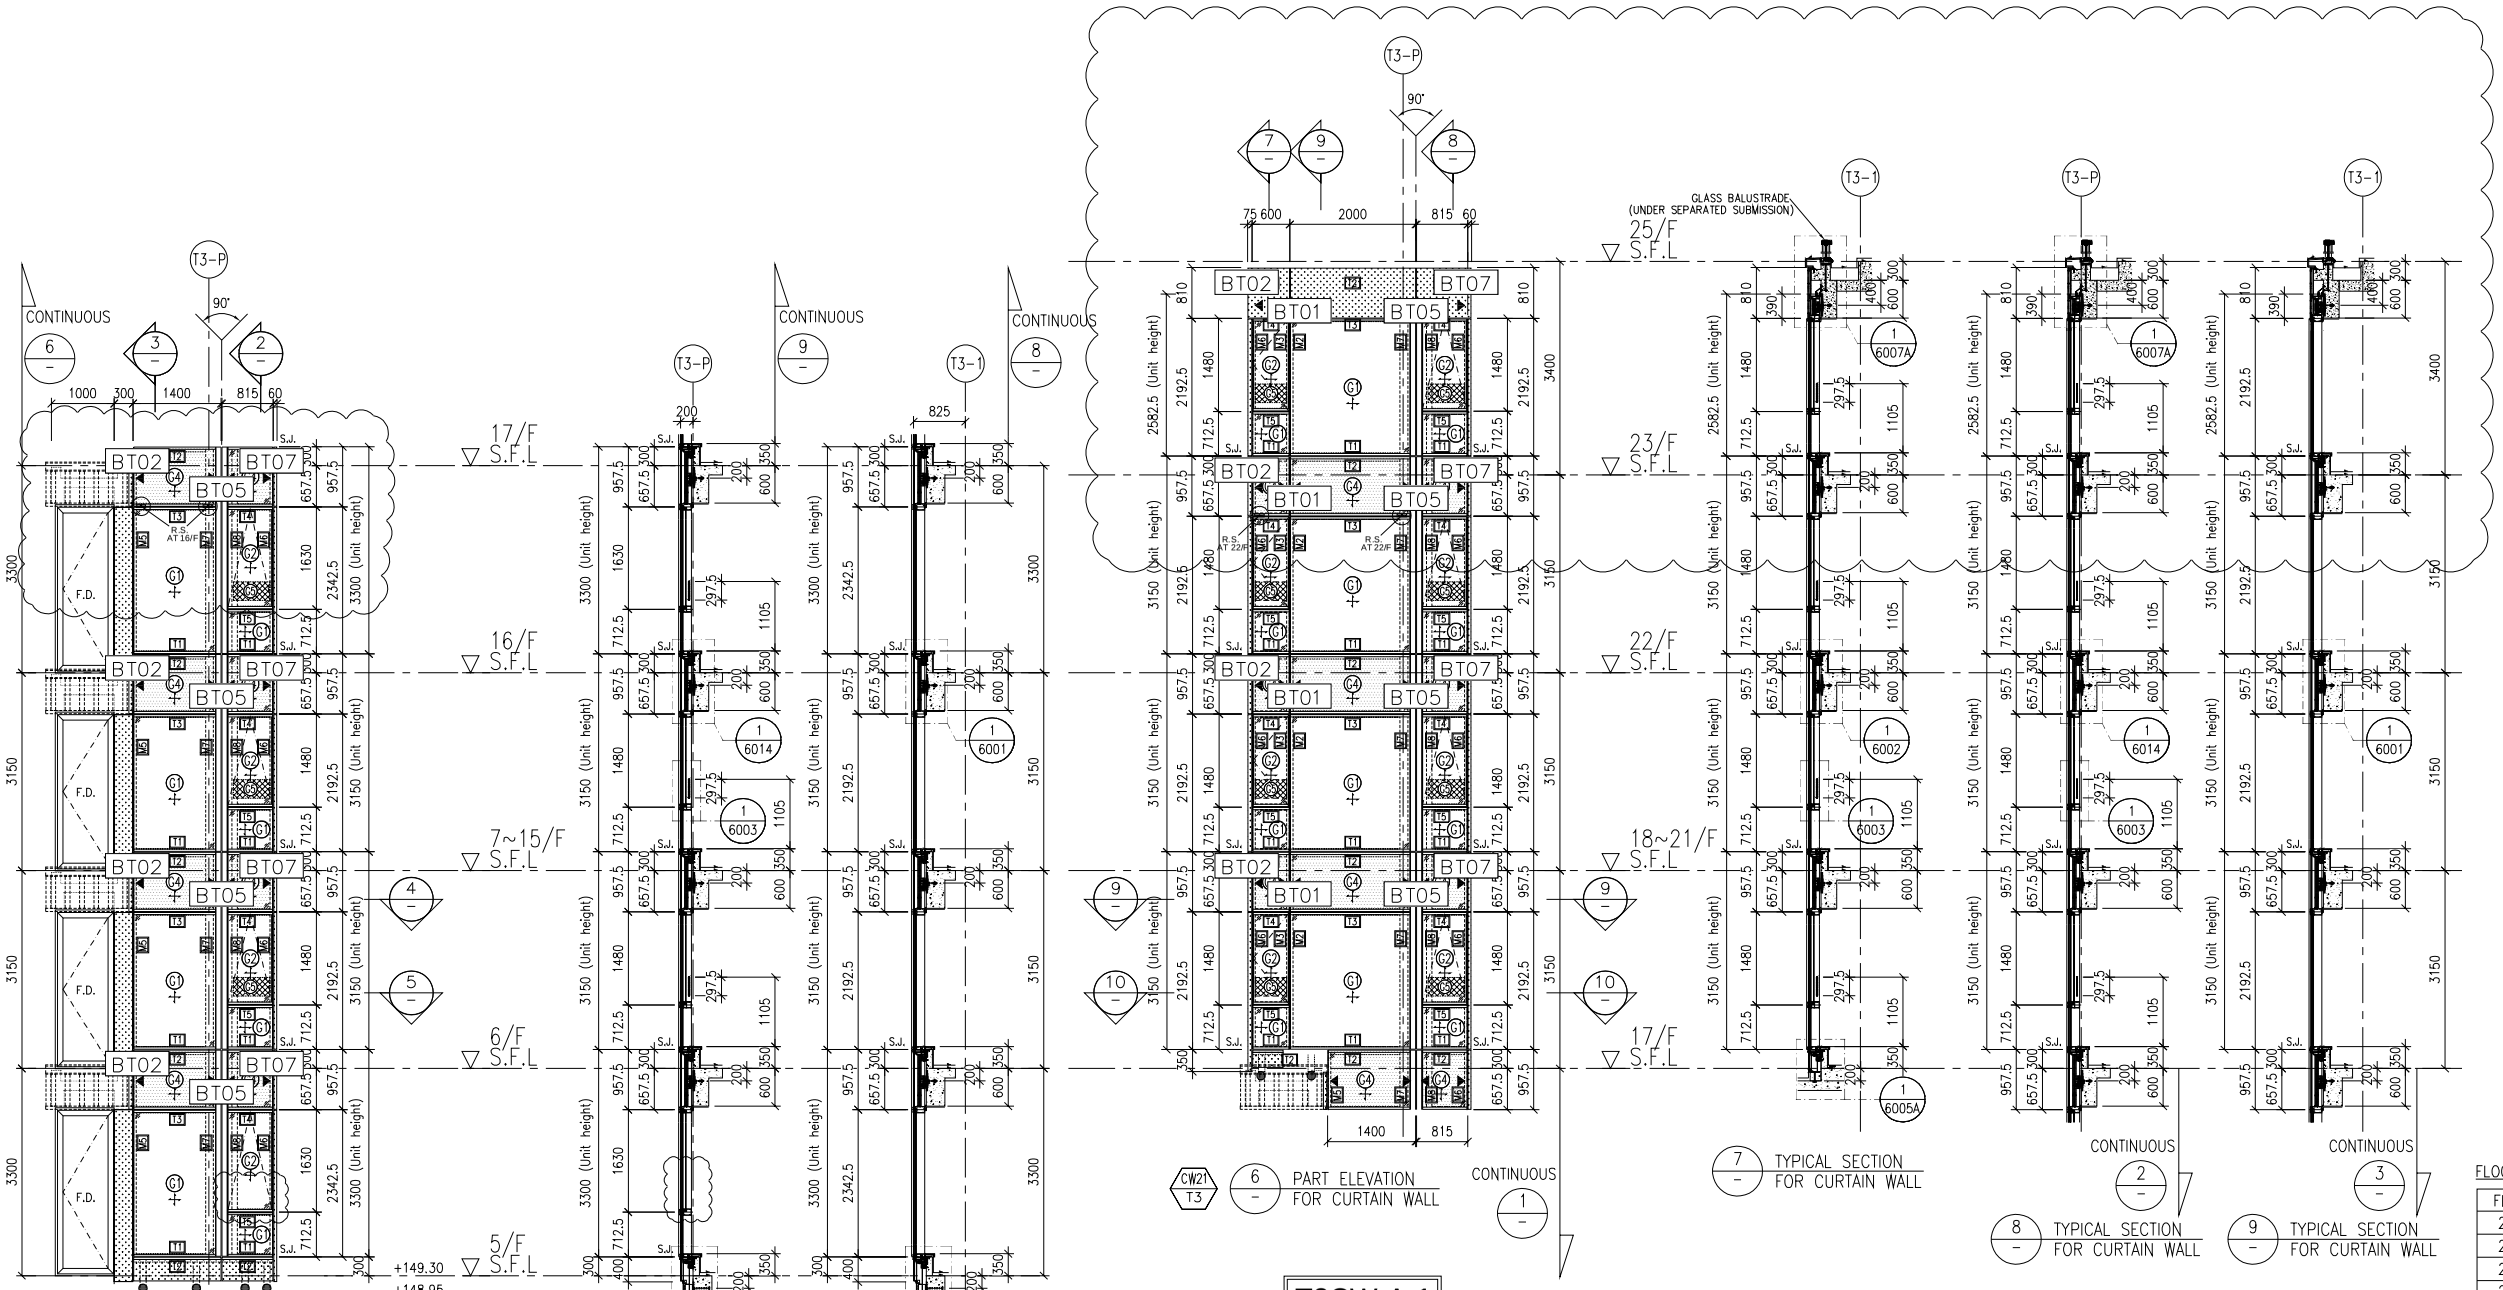

1 / – PART ELEVATION FOR CURTAIN WALL

2 / – TYPICAL SECTION FOR CURTAIN WALL

3 / – TYPICAL SECTION FOR CURTAIN WALL

4 / – PART PLAN FOR CURTAIN WALL

5 / – PART PLAN FOR CURTAIN WALL

6 / – PART ELEVATION FOR CURTAIN WALL

7 / – TYPICAL SECTION FOR CURTAIN WALL

8 / – TYPICAL SECTION FOR CURTAIN WALL

9 / – PART PLAN FOR CURTAIN WALL

10 / – PART PLAN FOR CURTAIN WALL

FLOOR LEVEL (S.F.L.)

FLOOR	LEVEL
25/F	+203.40
23/F	+200.00
22/F	+196.85
21/F	+193.70
20/F	+190.55
19/F	+187.40
18/F	+184.25
17/F	+181.10
16/F	+177.80
15/F	+174.65
12/F	+171.50
11/F	+168.35
10/F	+165.20
9/F	+162.05
8/F	+158.90
7/F	+155.75
6/F	+152.60
5/F	+149.30

LEGEND:
- G1+ – 10mm HEAT STRENGTHENED GLASS (OUTER) + 12mm AIR SPACE +12mm THK. TEMPERED CLEAR GLASS (INNER)
- G2+ – 10mm HEAT STRENGTHENED GLASS (OUTER) + 12mm AIR SPACE +10mm THK. TEMPERED CLEAR GLASS (INNER)
- G4+ – 12mm THK. HEAT STRENGTHENED GLASS & 2mm THK. ALUM. BACKPAN (SPANDREL GLASS)
- G5 – 12mm THK. CLEAR TEMPERED GLASS (INTERNAL PROTECTIVE BARRIER)
- 3mm THK. ALUM. CLADDING
- S.J. – STACK JOINT (WIND LOAD)
- AE01 – ALUM. EXTRUSION DIE NO.
- ▲ – SUPPORT POINT (WIND LOAD + DEAD LOAD)
- ● – SUPPORT POINT (WIND LOAD)

B.D. REF :

CLIENT :
SHIMAO GROUP HOLDINGS LIMITED

ARCHITECT :
WONG TUNG & PARTNERS LIMITED
ARCHITECTS & PLANNERS

MAIN CONTRACTOR :
協興建築有限公司
HIP HING CONSTRUCTION CO LTD

STRUCTURAL ENGINEER :
C M WONG & ASSOCIATES LTD
黃志明建築工程師有限公司

FACADE CONSULTANT:
MEINHARDT

NOTE :
1. ALL DIMENSIONS ARE IN mm.
2. ALL ELEVATIONS ARE VIEWED FROM OUTSIDE.
3. ALL DIMENSIONS TO BE VERIFIED ON SITE BEFORE FABRICATION.

LEGEND :
X1 / X001 — DETAIL MARK NO. / REFER SHEET NO.
1. F.F.L. --FINISHED FLOOR LEVEL
2. S.F.L. --STRUCTURAL FLOOR LEVEL
3. /R --REVERSED DETAIL

NO.	DATE	REVISED	BY
A	05-10-2021	REVISION SUBJECT TO ARCH. COMMENT	

JOB NO. : J-853

PROJECT :
PROPOSED RESIDENTIAL DEVELOPMENT AT N.K.I.L. 6542 YIN PING ROAD KOWLOON

TITLE :
PART ELEVATION FOR CURTAIN WALL AT TOWER 3


DATE : 26-MAR-21 | SCALE : 1:60 (A1)

DRAWN BY : LHR | CHECKED BY :

美特鋁質有限公司
MIDI ALUMINIUM FABRICATOR LTD.
Units 6-8, Sunray Industrial Centre, 1/F
610 Cha Kwo Ling Road, Kowloon
Tel:23489211-4 Fax:(852)27727666

DWG NO. : J853-SD-CW-4301 | REV. : A

LEGEND :
R.S. = RESTRAINT SOCKET

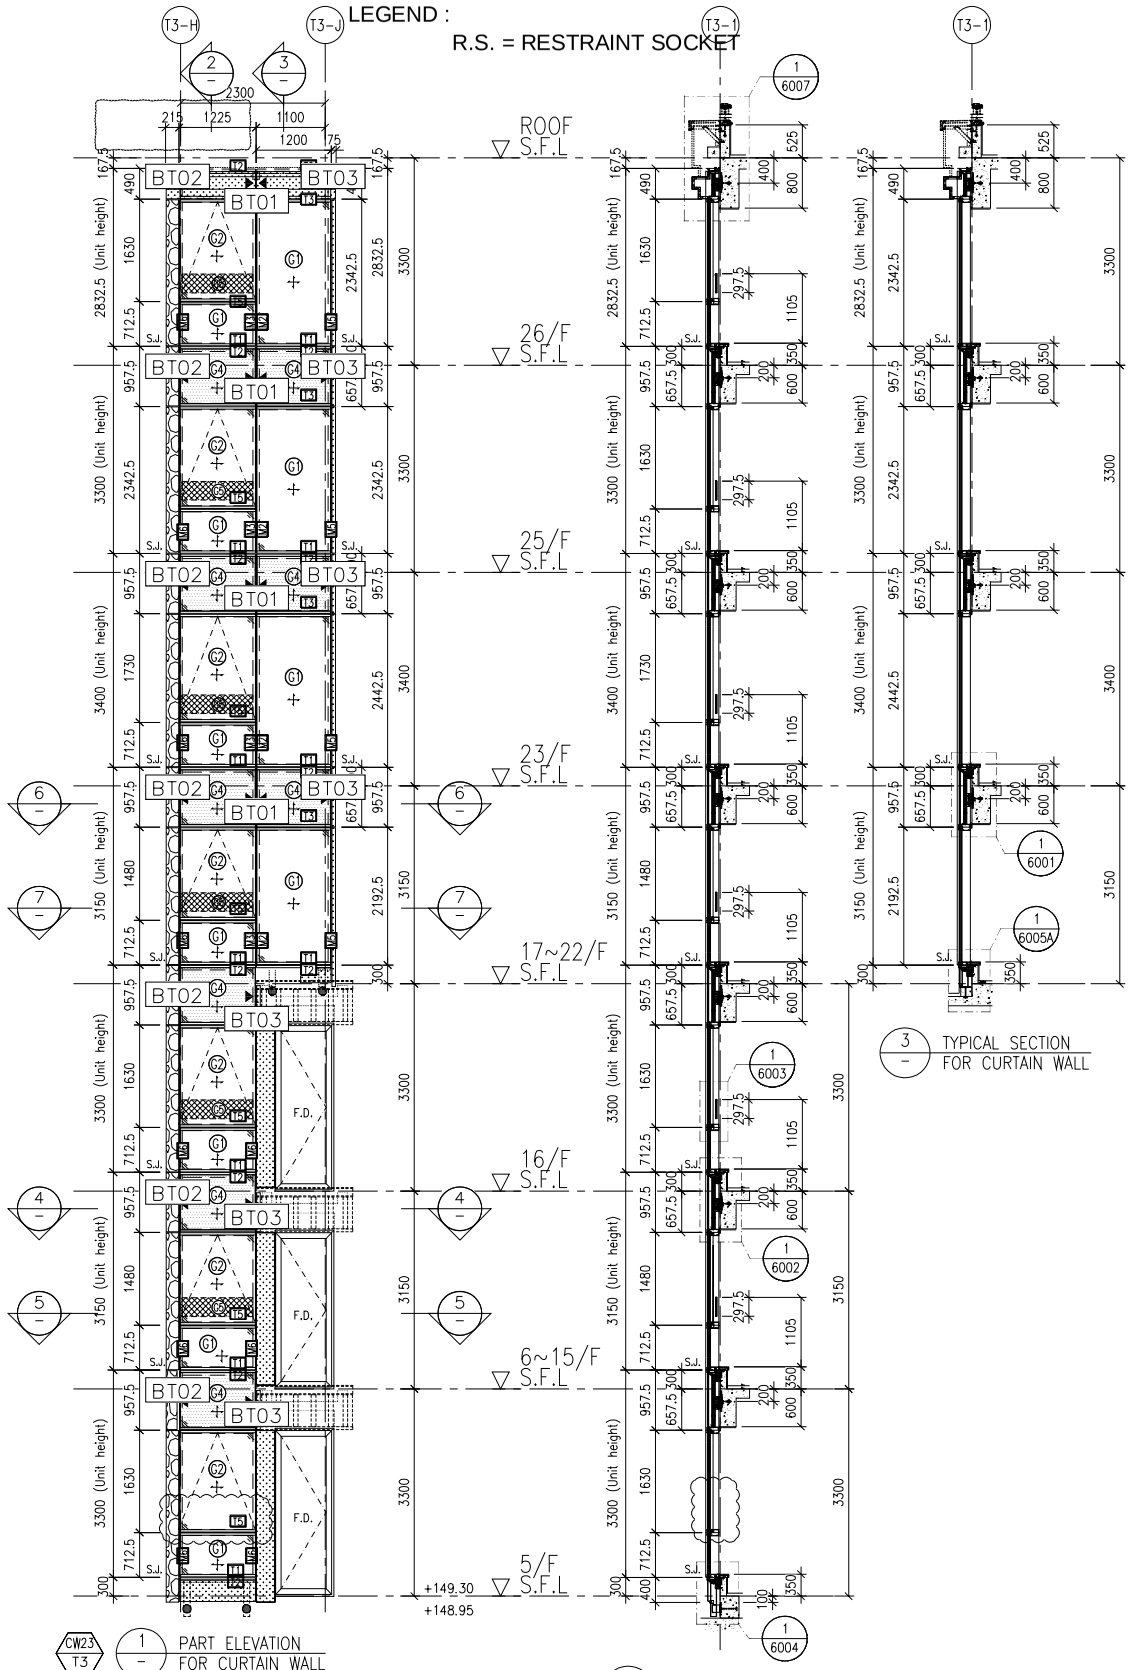


CW23 T3 — 1 — PART ELEVATION FOR CURTAIN WALL

T3CW-A-2

2 — TYPICAL SECTION FOR CURTAIN WALL


3 — TYPICAL SECTION FOR CURTAIN WALL

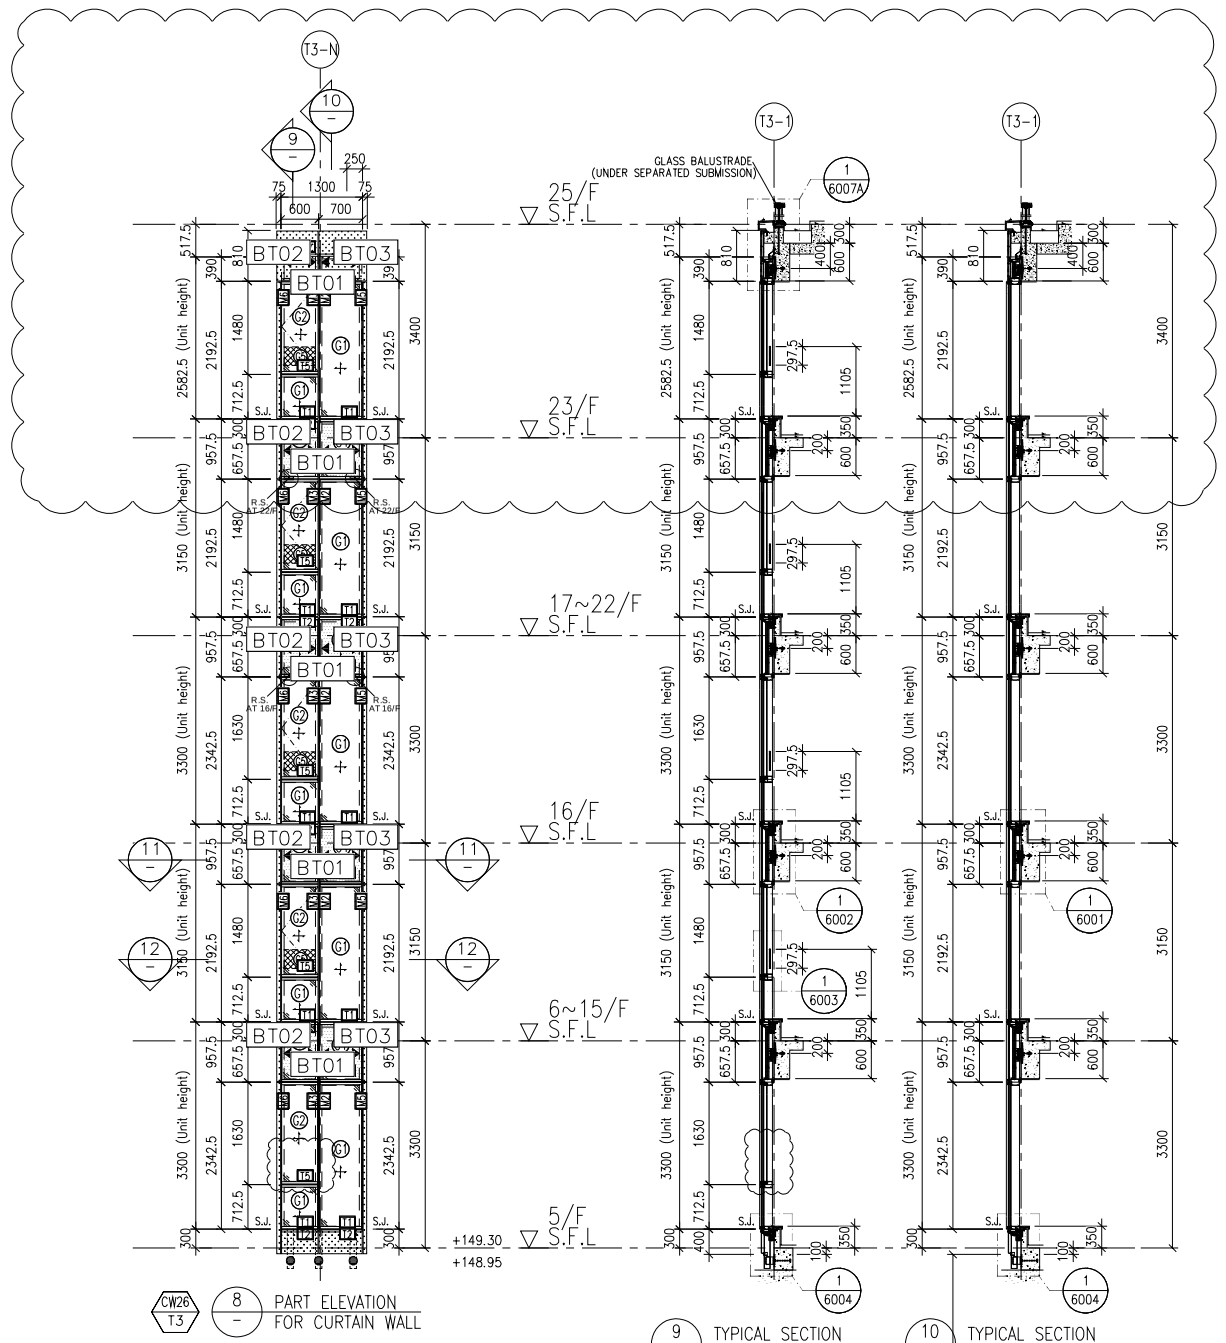


CW26 T3 — 8 — PART ELEVATION FOR CURTAIN WALL

9 — TYPICAL SECTION FOR CURTAIN WALL

10 — TYPICAL SECTION FOR CURTAIN WALL

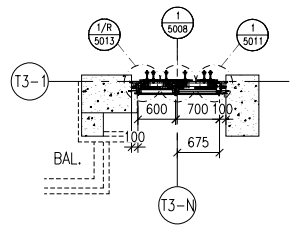


11 — PART PLAN FOR CURTAIN WALL

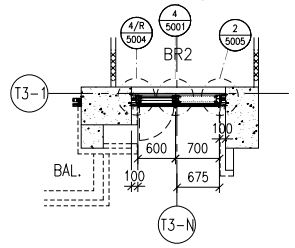

12 — PART PLAN FOR CURTAIN WALL

T3CW-A-3

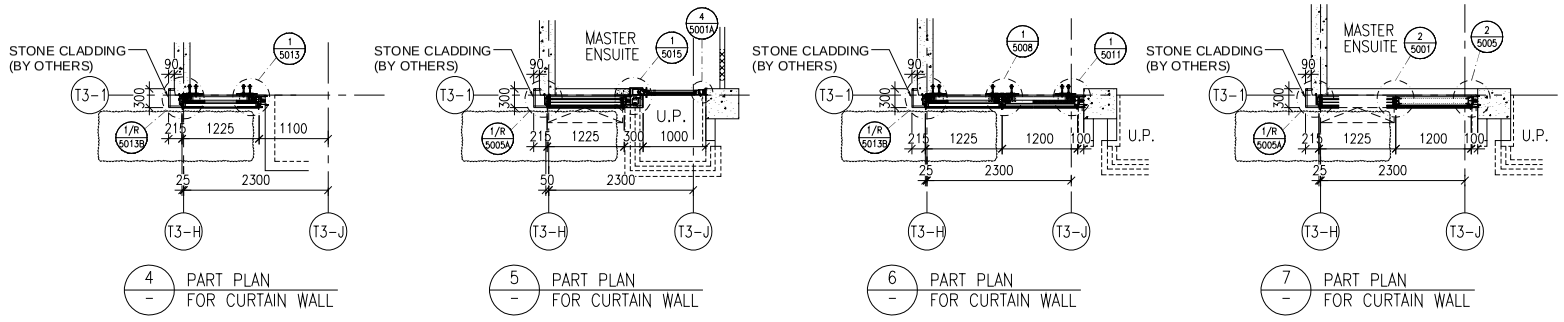

4 — PART PLAN FOR CURTAIN WALL

5 — PART PLAN FOR CURTAIN WALL

6 — PART PLAN FOR CURTAIN WALL

7 — PART PLAN FOR CURTAIN WALL

T2 FLOOR LEVEL (S.F.L.)

FLOOR	LEVEL
R/F	+210.00
26/F	+206.70
25/F	+203.40
23/F	+200.00
22/F	+196.85
21/F	+193.70
20/F	+190.55
19/F	+187.40
18/F	+184.25
17/F	+181.10
16/F	+177.80
15/F	+174.65
12/F	+171.50
11/F	+168.35
10/F	+165.20
9/F	+162.05
8/F	+158.90
7/F	+155.75
6/F	+152.60
5/F	+149.30

LEGEND:

- G1+ — 10mm HEAT STRENGTHENED GLASS (OUTER) + 12mm AIR SPACE +12mm THK. TEMPERED CLEAR GLASS (INNER)
- G2+ — 10mm HEAT STRENGTHENED GLASS (OUTER) + 12mm AIR SPACE +10mm THK. TEMPERED CLEAR GLASS (INNER)
- G4+ — 12mm THK. HEAT STRENGTHENED GLASS & 2mm THK. ALUM. BACKPAN (SPANDREL GLASS)
- G5 — 12mm THK. CLEAR TEMPERED GLASS (INTERNAL PROTECTIVE BARRIER)
- 3mm THK. ALUM. CLADDING
- S.J. — STACK JOINT (WIND LOAD)
- AE01 — ALUM. EXTRUSION DIE NO.
- ▲ — SUPPORT POINT (WIND LOAD + DEAD LOAD)
- ● — SUPPORT POINT (WIND LOAD)

12864

B.D. REF :

CLIENT :
SHIMAO GROUP HOLDINGS LIMITED

ARCHITECT :
WONG TUNG & PARTNERS LIMITED
ARCHITECTS & PLANNERS

MAIN CONTRACTOR :
協興建築有限公司
HIP HING CONSTRUCTION CO LTD

STRUCTURAL ENGINEER :
C M WONG & ASSOCIATES LTD
黃志明建築工程師有限公司

FACADE CONSULTANT:
MEINHARDT

NOTE :
1. ALL DIMENSIONS ARE IN mm.
2. ALL ELEVATIONS ARE VIEWED FROM OUTSIDE.
3. ALL DIMENSIONS TO BE VERIFIED ON SITE BEFORE FABRICATION.

LEGEND :
- X1 / X001 — DETAIL MARK NO. / REFER SHEET NO.
1. F.F.L. --FINISHED FLOOR LEVEL
2. S.F.L. --STRUCTURAL FLOOR LEVEL
3. /R --REVERSED DETAIL

NO.	DATE	REVISED	BY
A	05-10-2021	REVISION SUBJECT TO ARCH. COMMENT	

JOB NO. : J-853

PROJECT :
PROPOSED RESIDENTIAL DEVELOPMENT AT N.K.I.L. 6542 YIN PING ROAD KOWLOON

TITLE :
PART ELEVATION FOR CURTAIN WALL AT TOWER 3


DATE : 26-MAR-21 | SCALE : 1:60 (A1)

DRAWN BY : LHR | CHECKED BY :

美特鋁製有限公司
MIDI ALUMINIUM FABRICATOR LTD.
Units 6-8, Sunray Industrial Centre, 1/F
610 Cha Kwo Ling Road, Kowloon
Tel:23489211-4 Fax:(852)27727666

DWG NO. : J853-SD-CW-4302 | REV. : A

LEGEND :
R.S. = RESTRAINT SOCKET

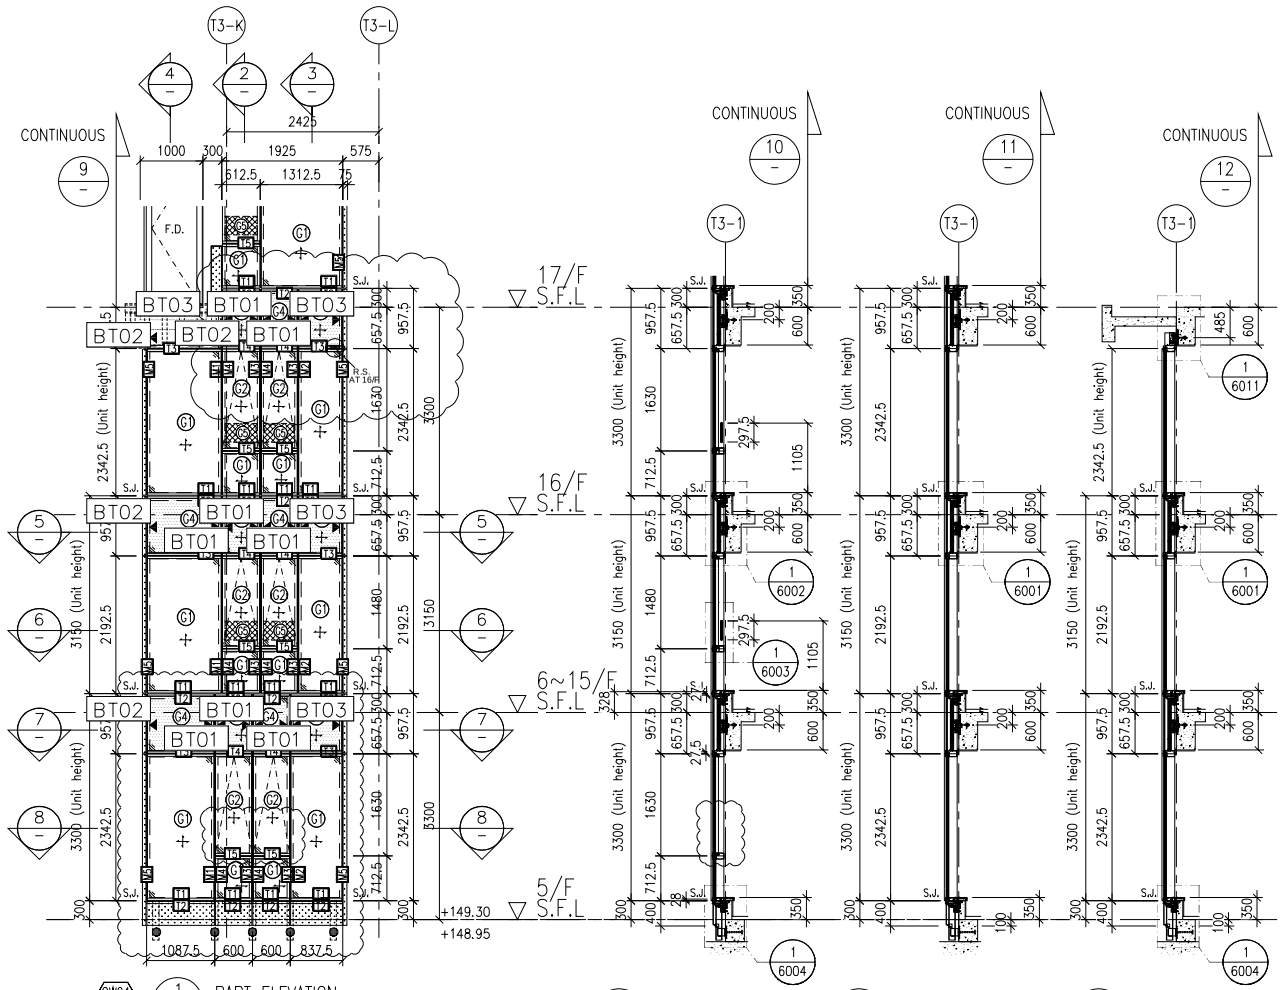


CW24 / T3 — 1 / – PART ELEVATION FOR CURTAIN WALL

2 / – TYPICAL SECTION FOR CURTAIN WALL


3 / – TYPICAL SECTION FOR CURTAIN WALL

4 / – TYPICAL SECTION FOR CURTAIN WALL


T3CW-A-4

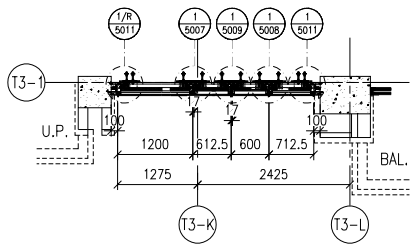


5 / – PART PLAN FOR CURTAIN WALL

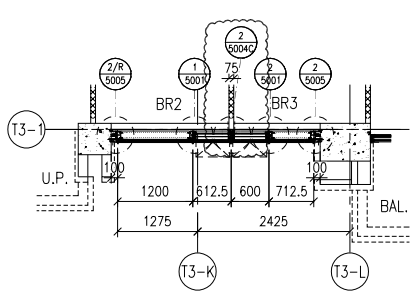


6 / – PART PLAN FOR CURTAIN WALL

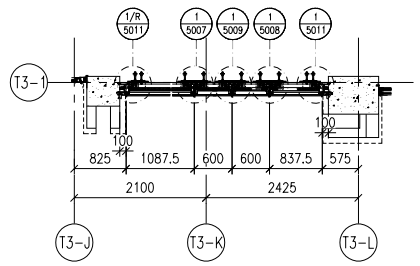


7 / – PART PLAN FOR CURTAIN WALL

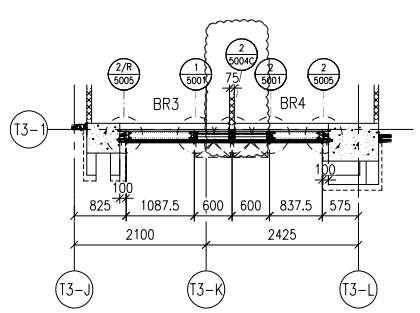


8 / – PART PLAN FOR CURTAIN WALL

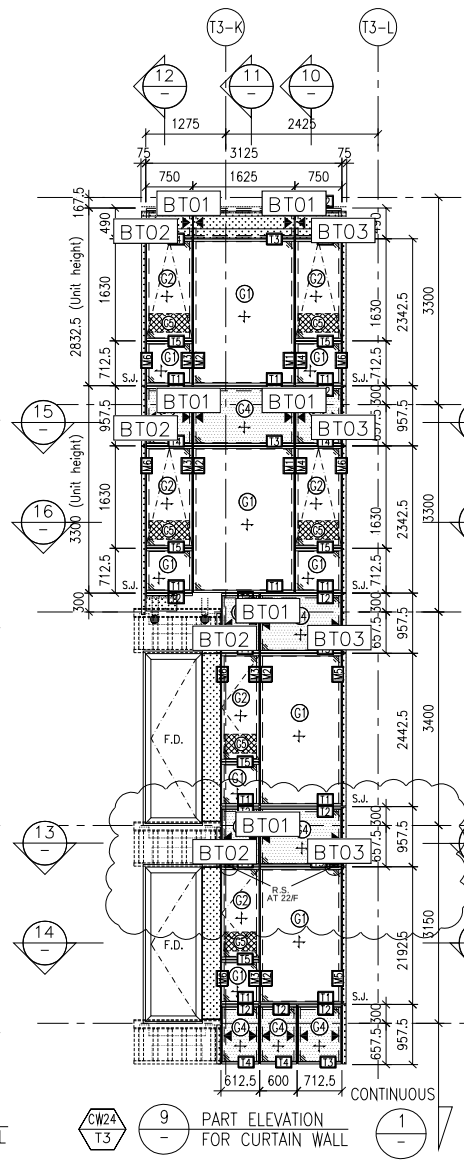


CW24 / T3 — 9 / – PART ELEVATION FOR CURTAIN WALL

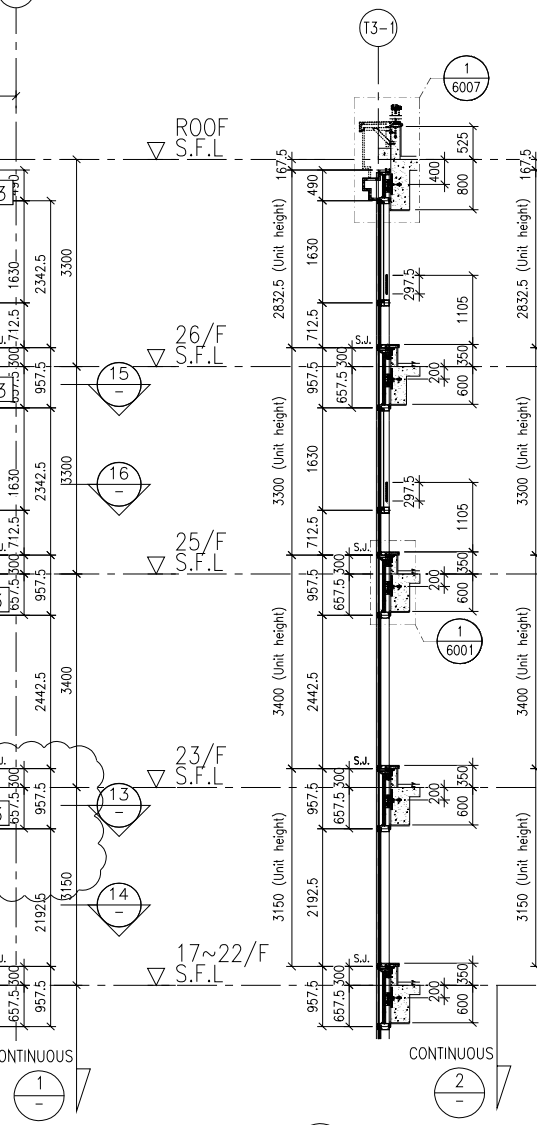

10 / – TYPICAL SECTION FOR CURTAIN WALL

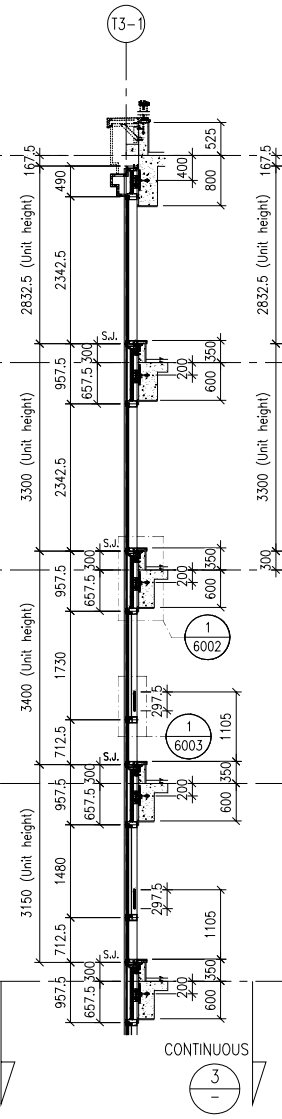


11 / – TYPICAL SECTION FOR CURTAIN WALL

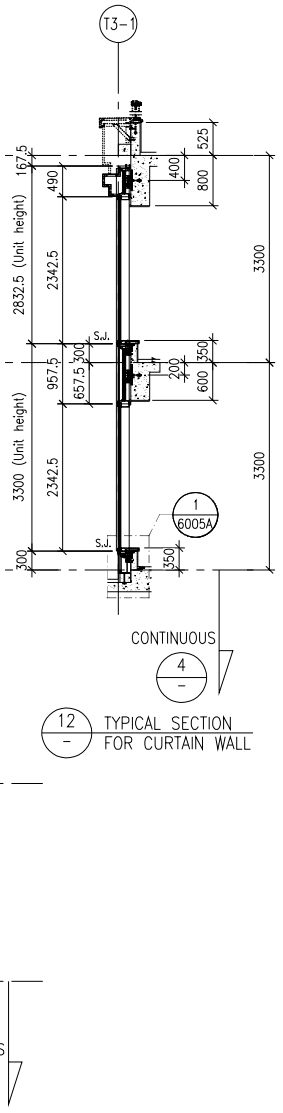


12 / – TYPICAL SECTION FOR CURTAIN WALL


T3CW-A-5

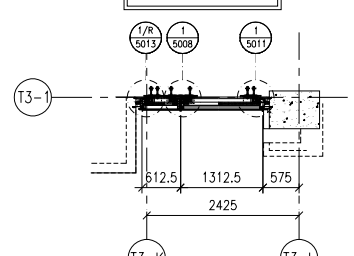


13 / – PART PLAN FOR CURTAIN WALL

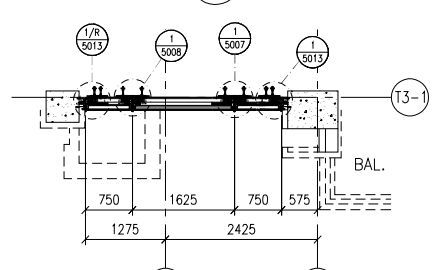

15 / – PART PLAN FOR CURTAIN WALL

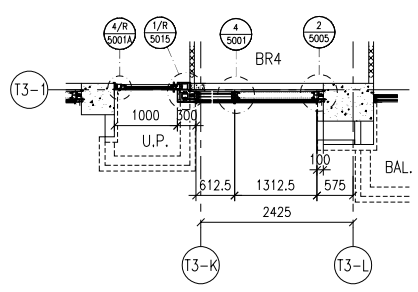

14 / – PART PLAN FOR CURTAIN WALL

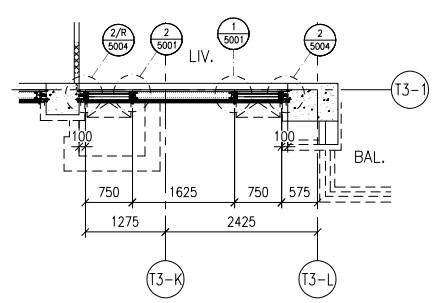

16 / – PART PLAN FOR CURTAIN WALL

T2 FLOOR LEVEL (S.F.L.)

FLOOR	LEVEL
R/F	+210.00
26/F	+206.70
25/F	+203.40
23/F	+200.00
22/F	+196.85
21/F	+193.70
20/F	+190.55
19/F	+187.40
18/F	+184.25
17/F	+181.10
16/F	+177.80
15/F	+174.65
12/F	+171.50
11/F	+168.35
10/F	+165.20
9/F	+162.05
8/F	+158.90
7/F	+155.75
6/F	+152.60
5/F	+149.30

LEGEND:
- G1 – 10mm HEAT STRENGTHENED GLASS (OUTER) + 12mm AIR SPACE +12mm THK. TEMPERED CLEAR GLASS (INNER)
- G2 – 10mm HEAT STRENGTHENED GLASS (OUTER) + 12mm AIR SPACE +10mm THK. TEMPERED CLEAR GLASS (INNER)
- G4 – 12mm THK. HEAT STRENGTHENED GLASS & 2mm THK. ALUM. BACKPAN (SPANDREL GLASS)
- G5 – 12mm THK. CLEAR TEMPERED GLASS (INTERNAL PROTECTIVE BARRIER)
- 3mm THK. ALUM. CLADDING
- S.J. – STACK JOINT (WIND LOAD)
- AE01 – ALUM. EXTRUSION DIE NO.
- ▲ – SUPPORT POINT (WIND LOAD + DEAD LOAD)
- ● – SUPPORT POINT (WIND LOAD)

B.D. REF :

CLIENT :
SHIMAO GROUP HOLDINGS LIMITED

ARCHITECT :
WONG TUNG & PARTNERS LIMITED
ARCHITECTS & PLANNERS

MAIN CONTRACTOR :
協興建築有限公司
HIP HING CONSTRUCTION CO LTD

STRUCTURAL ENGINEER :
C M WONG & ASSOCIATES LTD
黃志明建築工程師有限公司

FACADE CONSULTANT:
MEINHARDT

NOTE :
1. ALL DIMENSIONS ARE IN mm.
2. ALL ELEVATIONS ARE VIEWED FROM OUTSIDE.
3. ALL DIMENSIONS TO BE VERIFIED ON SITE BEFORE FABRICATION.

LEGEND :
X1 / X001 — DETAIL MARK NO. / REFER SHEET NO.
1. F.F.L. -- FINISHED FLOOR LEVEL
2. S.F.L. -- STRUCTURAL FLOOR LEVEL
3. /R -- REVERSED DETAIL

NO.	DATE	REVISED	BY
A	05-10-2021	REVISION SUBJECT TO ARCH. COMMENT	

JOB NO. : J-853

PROJECT :
PROPOSED RESIDENTIAL DEVELOPMENT AT N.K.I.L. 6542 YIN PING ROAD KOWLOON

TITLE :
PART ELEVATION FOR CURTAIN WALL AT TOWER 3

DATE : 26-MAR-21 | SCALE : 1:60 (A1)


DRAWN BY : LHR | CHECKED BY :

美特鋁質有限公司
MIDI ALUMINIUM FABRICATOR LTD.
Units 6-8, Sunray Industrial Centre, 1/F
610 Cha Kwo Ling Road, Kowloon
Tel:23489211-4 Fax:(852)27727666

DWG NO. : J853-SD-CW-4303 | REV. : A

LEGEND :

R.S. = RESTRAINT SOCKET

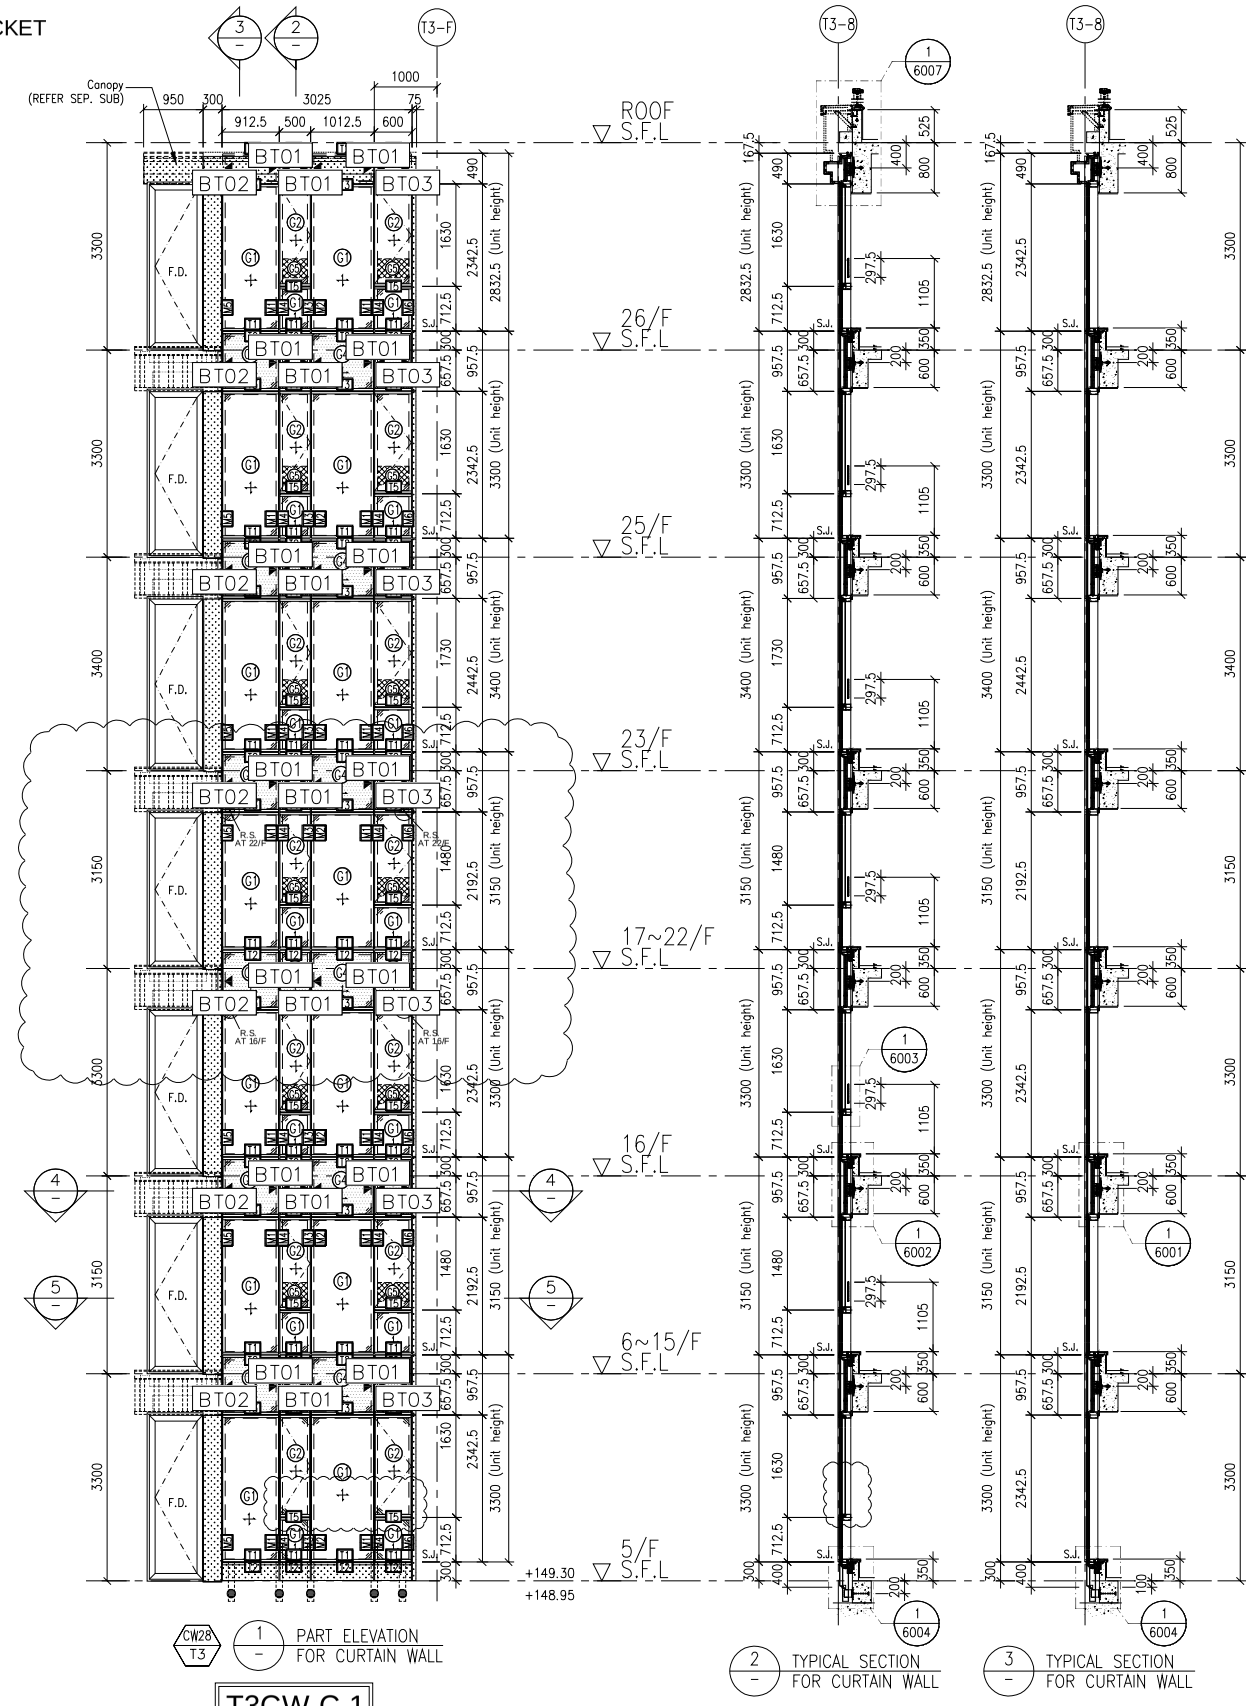


CW28 T3 — 1 — PART ELEVATION FOR CURTAIN WALL


T3CW-C-1

2 — TYPICAL SECTION FOR CURTAIN WALL

3 — TYPICAL SECTION FOR CURTAIN WALL

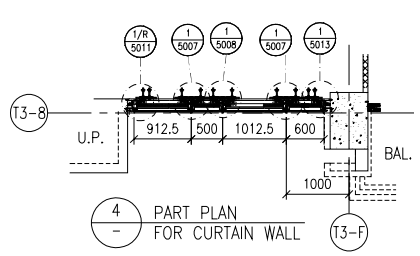

4 — PART PLAN FOR CURTAIN WALL

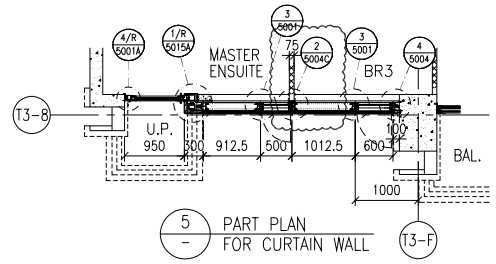

5 — PART PLAN FOR CURTAIN WALL

FLOOR LEVEL (S.F.L.)

FLOOR	LEVEL
ROOF	+210.00
26/F	+206.70
25/F	+203.40
23/F	+200.00
22/F	+196.85
21/F	+193.70
20/F	+190.55
19/F	+187.40
18/F	+184.25
17/F	+181.10
16/F	+177.80
15/F	+174.65
12/F	+171.50
11/F	+168.35
10/F	+165.20
9/F	+162.05
8/F	+158.90
7/F	+155.75
6/F	+152.60
5/F	+149.30

LEGEND:

- G1 — 10mm HEAT STRENGTHENED GLASS (OUTER) + 12mm AIR SPACE +12mm THK. TEMPERED CLEAR GLASS (INNER)
- G2 — 10mm HEAT STRENGTHENED GLASS (OUTER) + 12mm AIR SPACE +10mm THK. TEMPERED CLEAR GLASS (INNER)
- G4 — 12mm THK. HEAT STRENGTHENED GLASS & 2mm THK. ALUM. BACKPAN (SPANDREL GLASS)
- G5 — 12mm THK. CLEAR TEMPERED GLASS (INTERNAL PROTECTIVE BARRIER)
- 3mm THK. ALUM. CLADDING
- S.J. — STACK JOINT (WIND LOAD)
- AE01 — ALUM. EXTRUSION DIE NO.
- ▲ — SUPPORT POINT (WIND LOAD + DEAD LOAD)
- ● — SUPPORT POINT (WIND LOAD)

B.D. REF :

CLIENT :

SHIMAO GROUP HOLDINGS LIMITED

ARCHITECT :

WONG TUNG & PARTNERS LIMITED
ARCHITECTS & PLANNERS

MAIN CONTRACTOR :

協興建築有限公司
HIP HING CONSTRUCTION CO LTD

STRUCTURAL ENGINEER :

C M WONG & ASSOCIATES LTD
黃志明建築工程師有限公司

FACADE CONSULTANT:

MEINHARDT

NOTE :

1. ALL DIMENSIONS ARE IN mm.
2. ALL ELEVATIONS ARE VIEWED FROM OUTSIDE.
3. ALL DIMENSIONS TO BE VERIFIED ON SITE BEFORE FABRICATION.

LEGEND :

X1 — DETAIL MARK NO.
X001 — REFER SHEET NO.

1. F.F.L. --FINISHED FLOOR LEVEL
2. S.F.L. --STRUCTURAL FLOOR LEVEL
3. /R --REVERSED DETAIL

NO.	DATE	REVISED	BY
A	05-10-2021	REVISION SUBJECT TO ARCH. COMMENT	

JOB NO. : J-853

PROJECT :

PROPOSED RESIDENTIAL DEVELOPMENT AT N.K.I.L. 6542 YIN PING ROAD KOWLOON

TITLE :

PART ELEVATION FOR CURTAIN WALL AT TOWER 3

DATE : 26-MAR-21 | SCALE : 1:60 (A1)


DRAWN BY : LHR | CHECKED BY :

美特鋁質有限公司
MIDI ALUMINIUM FABRICATOR LTD.
Units 6-8, Sunray Industrial Centre, 1/F
610 Cha Kwo Ling Road, Kowloon
Tel:23489211-4 Fax:(852)27727666

DWG NO. : J853-SD-CW-4304 | REV. : A

LEGEND :

R.S. = RESTRAINT SOCKET

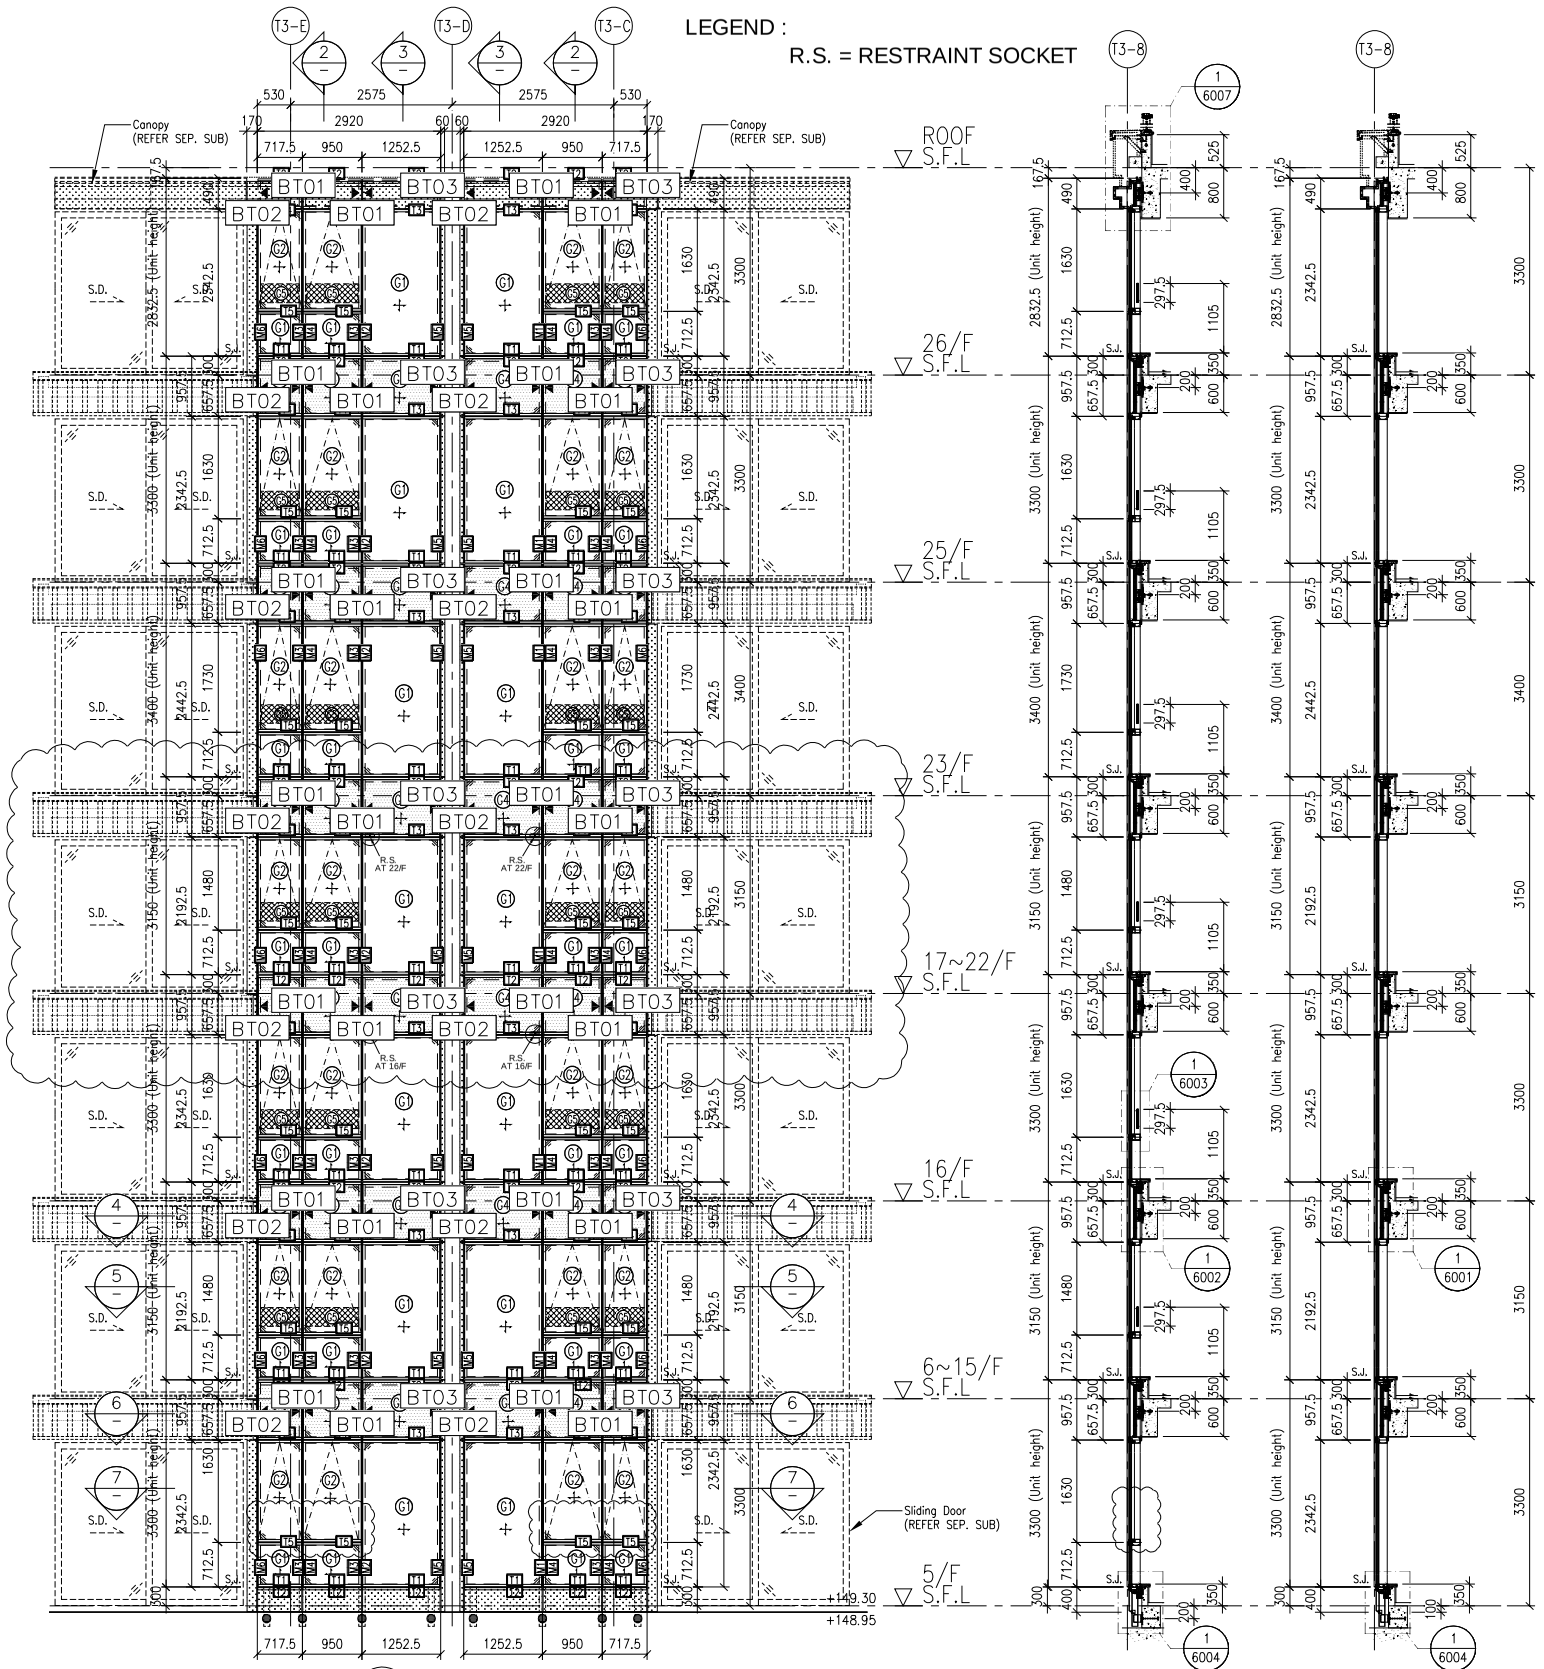


1 PART ELEVATION FOR CURTAIN WALL

2 TYPICAL SECTION FOR CURTAIN WALL


3 TYPICAL SECTION FOR CURTAIN WALL

T3CW-C-2


T3CW-B-1

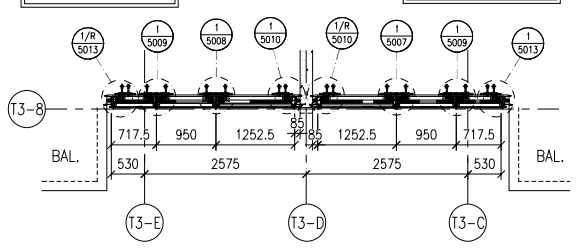


4 PART PLAN FOR CURTAIN WALL

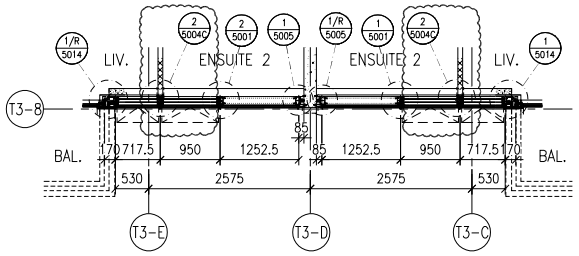

5 PART PLAN FOR CURTAIN WALL

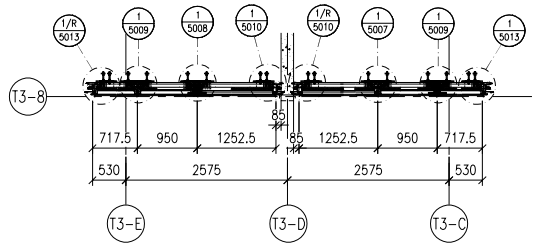

6 PART PLAN FOR CURTAIN WALL

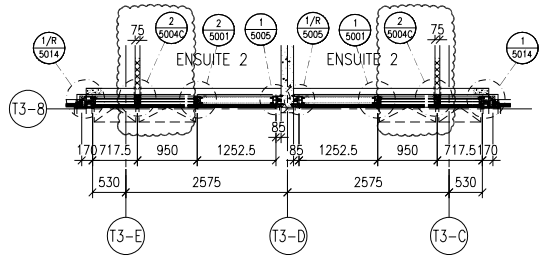

7 PART PLAN FOR CURTAIN WALL

FLOOR LEVEL (S.F.L.)

FLOOR	LEVEL
ROOF	+210.00
26/F	+206.70
25/F	+203.40
23/F	+200.00
22/F	+196.85
21/F	+193.70
20/F	+190.55
19/F	+187.40
18/F	+184.25
17/F	+181.10
16/F	+177.80
15/F	+174.65
12/F	+171.50
11/F	+168.35
10/F	+165.20
9/F	+162.05
8/F	+158.90
7/F	+155.75
6/F	+152.60
5/F	+149.30

LEGEND:

- G1+ – 10mm HEAT STRENGTHENED GLASS (OUTER) + 12mm AIR SPACE +12mm THK. TEMPERED CLEAR GLASS (INNER)
- G2+ – 10mm HEAT STRENGTHENED GLASS (OUTER) + 12mm AIR SPACE +10mm THK. TEMPERED CLEAR GLASS (INNER)
- CA+ – 12mm THK. HEAT STRENGTHENED GLASS & 2mm THK. ALUM. BACKPAN (SPANDREL GLASS)
- G3 – 12mm THK. CLEAR TEMPERED GLASS (INTERNAL PROTECTIVE BARRIER)
- 3mm THK. ALUM. CLADDING
- S.J. – STACK JOINT (WIND LOAD)
- AE01 – ALUM. EXTRUSION DIE NO.
- ▲ – SUPPORT POINT (WIND LOAD + DEAD LOAD)
- ● – SUPPORT POINT (WIND LOAD)

B.D. REF :

CLIENT :

SHIMAO GROUP HOLDINGS LIMITED

ARCHITECT :

WONG TUNG & PARTNERS LIMITED
ARCHITECTS & PLANNERS

MAIN CONTRACTOR :

協興建築有限公司
HIP HING CONSTRUCTION CO LTD

STRUCTURAL ENGINEER :

C M WONG & ASSOCIATES LTD
黃志明建築工程師有限公司

FACADE CONSULTANT:

MEINHARDT

NOTE :

1. ALL DIMENSIONS ARE IN mm.
2. ALL ELEVATIONS ARE VIEWED FROM OUTSIDE.
3. ALL DIMENSIONS TO BE VERIFIED ON SITE BEFORE FABRICATION.

LEGEND :

- X1 / X001 – DETAIL MARK NO. / REFER SHEET NO.

1. F.F.L. --FINISHED FLOOR LEVEL
2. S.F.L. --STRUCTURAL FLOOR LEVEL
3. /R --REVERSED DETAIL

NO.	DATE	REVISED	BY
A	05-10-2021	REVISION SUBJECT TO ARCH. COMMENT	

JOB NO. : J-853

PROJECT :

PROPOSED RESIDENTIAL DEVELOPMENT AT N.K.I.L. 6542 YIN PING ROAD KOWLOON

TITLE :

PART ELEVATION FOR CURTAIN WALL AT TOWER 3

DATE : 23-OCT-21 | SCALE : 1:60 (A1)


DRAWN BY : LHR | CHECKED BY :

美特鋁質有限公司
MIDI ALUMINIUM FABRICATOR LTD.
Units 6-8, Sunray Industrial Centre, 1/F
610 Cha Kwo Ling Road, Kowloon
Tel:23489211-4 Fax:(852)27727666

DWG NO. : J853-SD-CW-4304A | REV. : A

LEGEND :

R.S. = RESTRAINT SOCKET

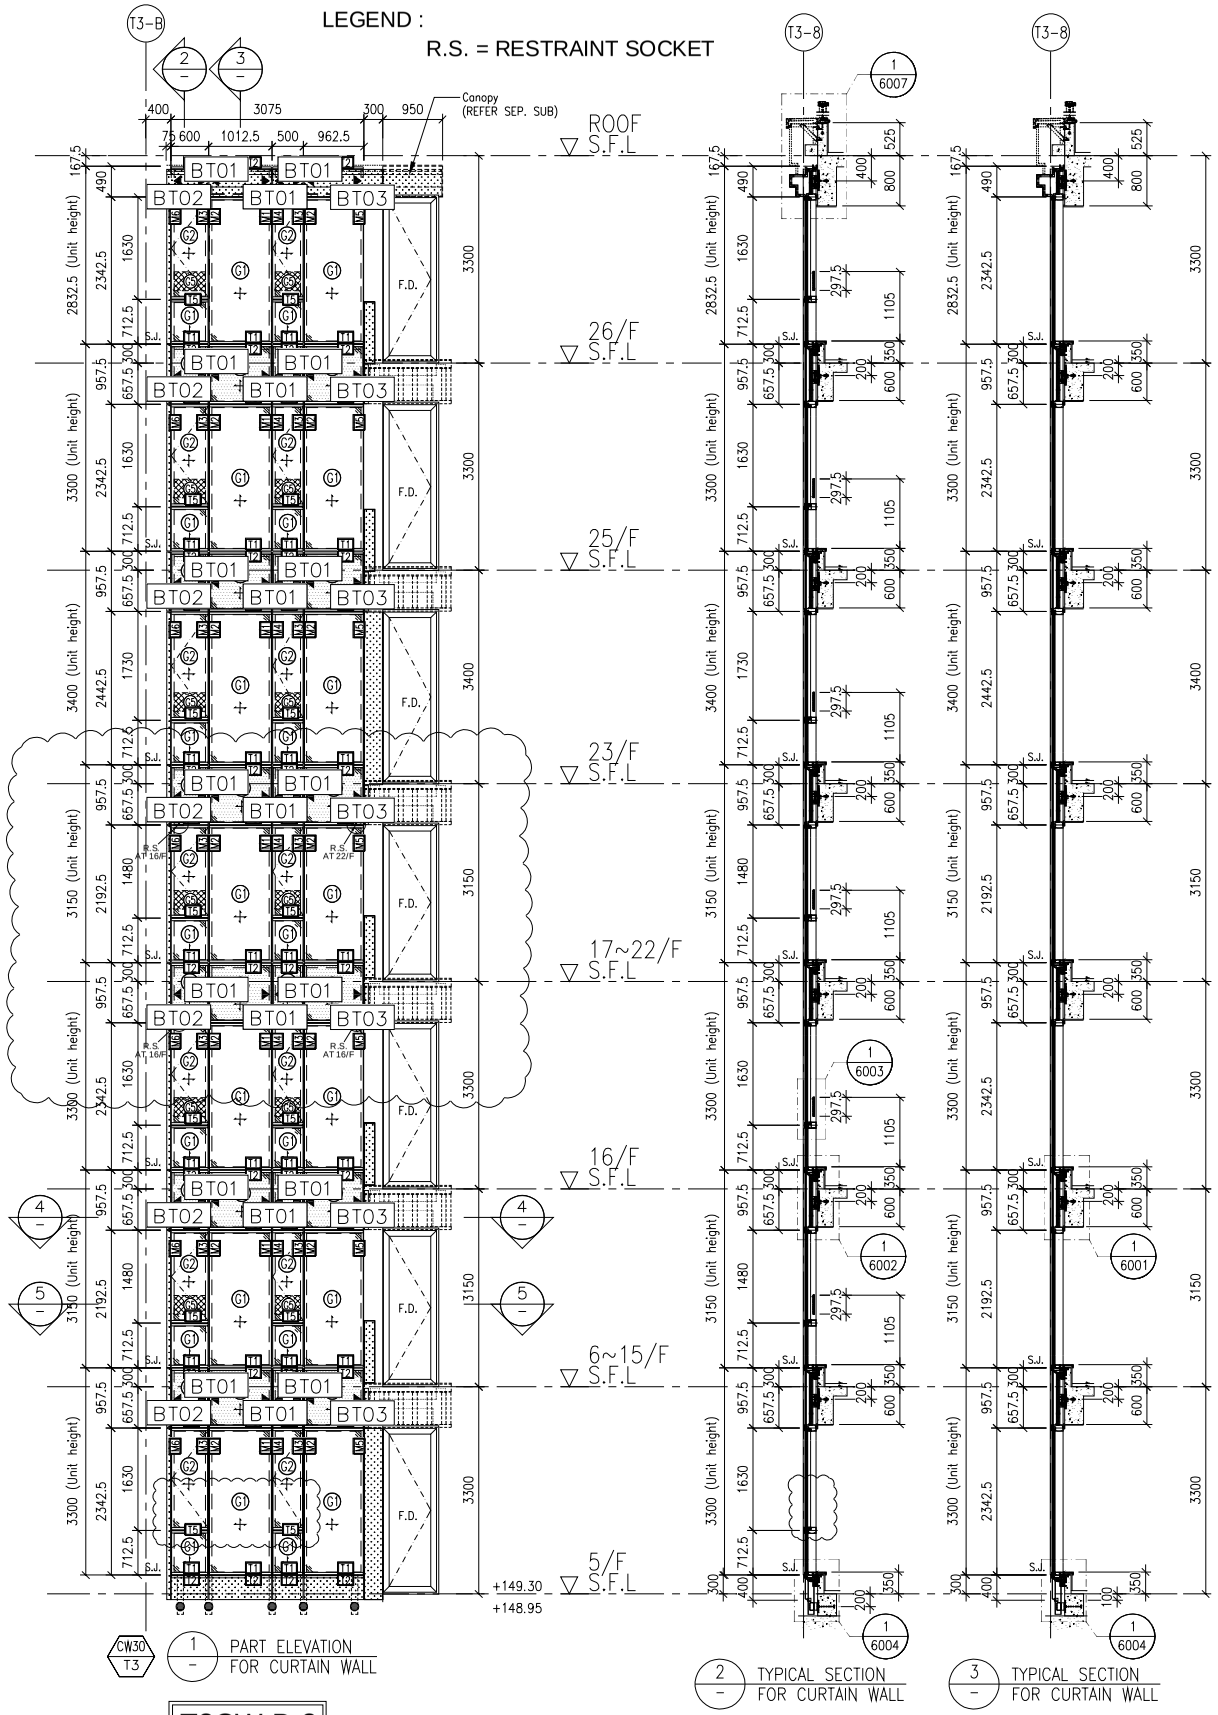


CW30 / T3 — 1 — PART ELEVATION FOR CURTAIN WALL


2 — TYPICAL SECTION FOR CURTAIN WALL

3 — TYPICAL SECTION FOR CURTAIN WALL

T3CW-B-2

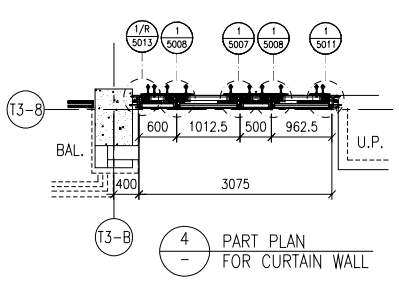


4 — PART PLAN FOR CURTAIN WALL

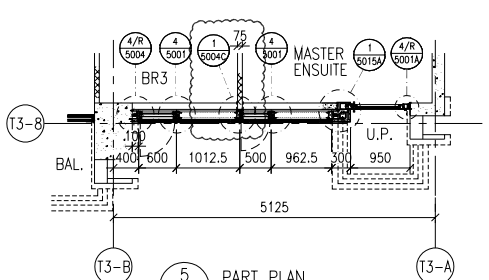


5 — PART PLAN FOR CURTAIN WALL

6 — PART ELEVATION FOR CURTAIN WALL


T3CW-A-6 | T3CW-D-2

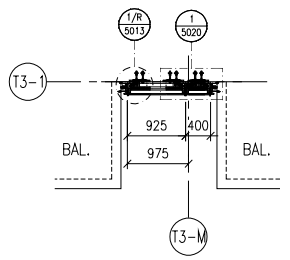

8 — PART PLAN FOR CURTAIN WALL

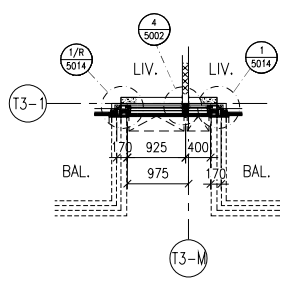

9 — PART PLAN FOR CURTAIN WALL

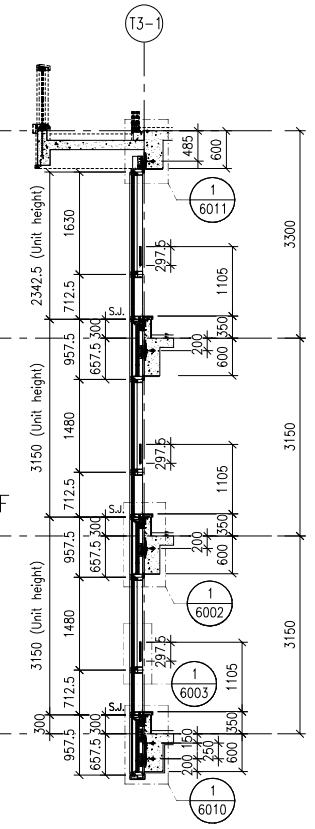

7 — TYPICAL SECTION FOR CURTAIN WALL

FLOOR LEVEL (S.F.L.)

FLOOR	LEVEL
ROOF	+210.00
26/F	+206.70
25/F	+203.40
23/F	+200.00
22/F	+196.85
21/F	+193.70
20/F	+190.55
19/F	+187.40
18/F	+184.25
17/F	+181.10
16/F	+177.80
15/F	+174.65
12/F	+171.50
11/F	+168.35
10/F	+165.20
9/F	+162.05
8/F	+158.90
7/F	+155.75
6/F	+152.60
5/F	+149.30

LEGEND:

- G1+ — 10mm HEAT STRENGTHENED GLASS (OUTER) + 12mm AIR SPACE +12mm THK. TEMPERED CLEAR GLASS (INNER)
- G2+ — 10mm HEAT STRENGTHENED GLASS (OUTER) + 12mm AIR SPACE +10mm THK. TEMPERED CLEAR GLASS (INNER)
- G4+ — 12mm THK. HEAT STRENGTHENED GLASS & 2mm THK. ALUM. BACKPAN (SPANDREL GLASS)
- G5 — 12mm THK. CLEAR TEMPERED GLASS (INTERNAL PROTECTIVE BARRIER)
- 3mm THK. ALUM. CLADDING
- S.J. — STACK JOINT (WIND LOAD)
- AE01 — ALUM. EXTRUSION DIE NO.
- ▲ — SUPPORT POINT (WIND LOAD + DEAD LOAD)
- ● — SUPPORT POINT (WIND LOAD)

B.D. REF :

CLIENT :

SHIMAO GROUP HOLDINGS LIMITED

ARCHITECT : WONG TUNG & PARTNERS LIMITED ARCHITECTS & PLANNERS

MAIN CONTRACTOR : 協興建築有限公司 HIP HING CONSTRUCTION CO LTD

STRUCTURAL ENGINEER : C M WONG & ASSOCIATES LTD 黃志明建築工程師有限公司

FACADE CONSULTANT: MEINHARDT

NOTE :

1. ALL DIMENSIONS ARE IN mm.
2. ALL ELEVATIONS ARE VIEWED FROM OUTSIDE.
3. ALL DIMENSIONS TO BE VERIFIED ON SITE BEFORE FABRICATION.

LEGEND :

- X1 / X001 — DETAIL MARK NO. / REFER SHEET NO.

1. F.F.L. -- FINISHED FLOOR LEVEL
2. S.F.L. -- STRUCTURAL FLOOR LEVEL
3. /R -- REVERSED DETAIL

NO.	DATE	REVISED	BY

JOB NO. : J-853

PROJECT :
PROPOSED RESIDENTIAL DEVELOPMENT AT N.K.I.L. 6542 YIN PING ROAD KOWLOON


TITLE :
PART ELEVATION FOR CURTAIN WALL AT TOWER 3

DATE : 05-OCT-21 | SCALE : 1:60 (A1)


DRAWN BY : LHR | CHECKED BY :

美特鋁質有限公司 MIDI ALUMINIUM FABRICATOR LTD.
Units 6-8, Sunray Industrial Centre, 1/F
610 Cha Kwo Ling Road, Kowloon
Tel:23489211-4 Fax:(852)27727666

DWG NO. : J853-SD-CW-4305 | REV. : A

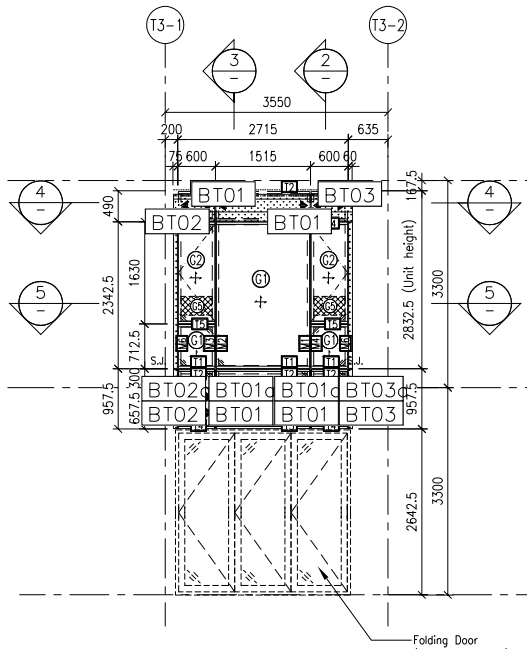


CW22 T3 — 1 — PART ELEVATION FOR CURTAIN WALL

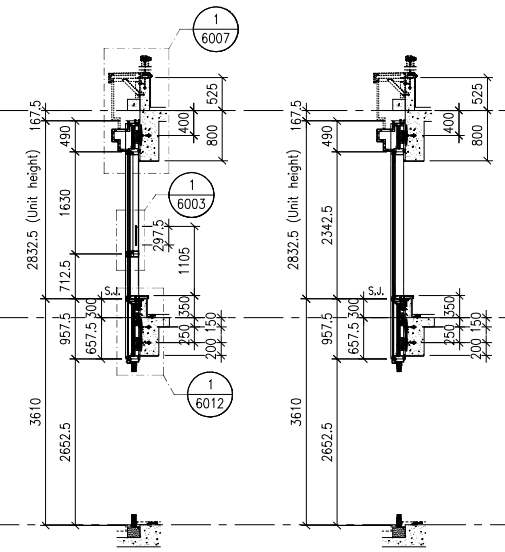


2 — TYPICAL SECTION FOR CURTAIN WALL

3 — TYPICAL SECTION FOR CURTAIN WALL


T3CW-A-7

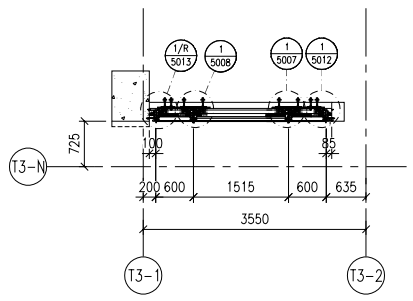


4 — PART PLAN FOR CURTAIN WALL

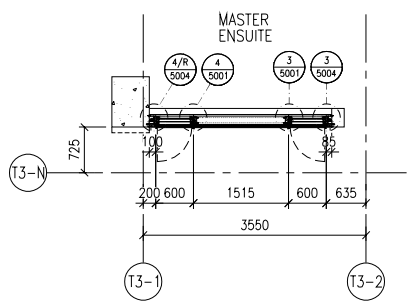


5 — PART PLAN FOR CURTAIN WALL

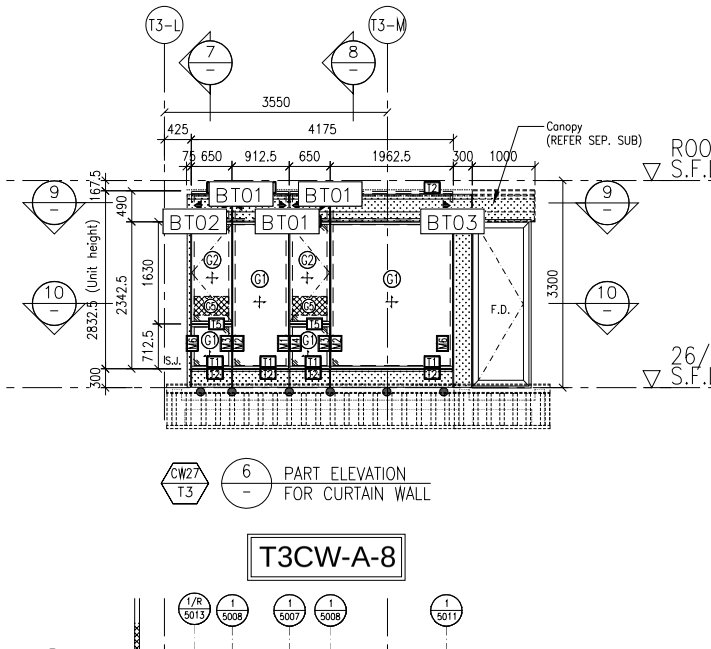

CW27 T3 — 6 — PART ELEVATION FOR CURTAIN WALL

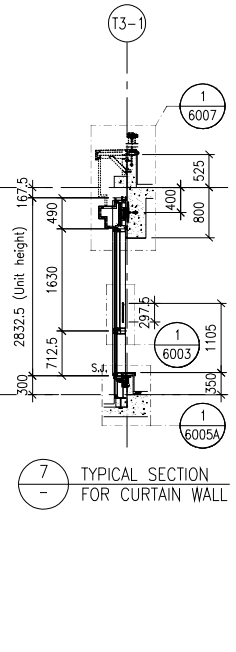


7 — TYPICAL SECTION FOR CURTAIN WALL

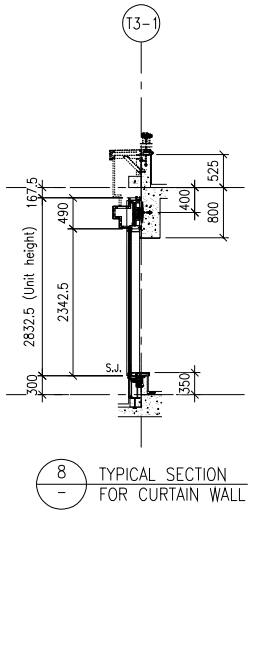


8 — TYPICAL SECTION FOR CURTAIN WALL

T3CW-A-8

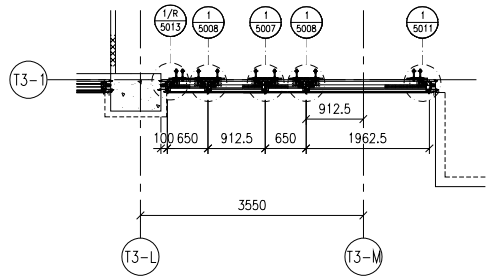

9 — PART PLAN FOR CURTAIN WALL

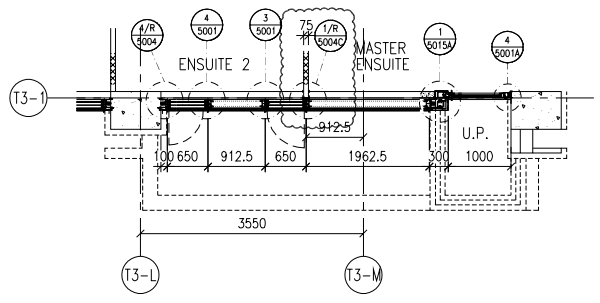

10 — PART PLAN FOR CURTAIN WALL

FLOOR LEVEL (S.F.L.)

FLOOR	LEVEL
ROOF	+210.00
26/F	+206.70
25/F	+203.40

LEGEND:

- C1 — 10mm HEAT STRENGTHENED GLASS (OUTER) + 12mm AIR SPACE +12mm THK. TEMPERED CLEAR GLASS (INNER)
- C2 — 10mm HEAT STRENGTHENED GLASS (OUTER) + 12mm AIR SPACE +10mm THK. TEMPERED CLEAR GLASS (INNER)
- C4 — 12mm THK. HEAT STRENGTHENED GLASS & 2mm THK. ALUM. BACKPAN (SPANDREL GLASS)
- C5 — 12mm THK. CLEAR TEMPERED GLASS (INTERNAL PROTECTIVE BARRIER)
- 3mm THK. ALUM. CLADDING
- S.J. — STACK JOINT (WIND LOAD)
- AE01 — ALUM. EXTRUSION DIE NO.
- ▲ — SUPPORT POINT (WIND LOAD + DEAD LOAD)
- ● — SUPPORT POINT (WIND LOAD)

B.D. REF :

CLIENT :

SHIMAO GROUP HOLDINGS LIMITED

ARCHITECT :

WONG TUNG & PARTNERS LIMITED
ARCHITECTS & PLANNERS

MAIN CONTRACTOR :

協興建築有限公司
HIP HING CONSTRUCTION CO LTD

STRUCTURAL ENGINEER :

C M WONG & ASSOCIATES LTD
黃志明建築工程師有限公司

FACADE CONSULTANT:

MEINHARDT

NOTE :

1. ALL DIMENSIONS ARE IN mm.
2. ALL ELEVATIONS ARE VIEWED FROM OUTSIDE.
3. ALL DIMENSIONS TO BE VERIFIED ON SITE BEFORE FABRICATION.

LEGEND :

X1 / X001 — DETAIL MARK NO. / REFER SHEET NO.

1. F.F.L. -- FINISHED FLOOR LEVEL
2. S.F.L. -- STRUCTURAL FLOOR LEVEL
3. (/R) -- REVERSED DETAIL

NO.	DATE	REVISED	BY

JOB NO. : J-853

PROJECT :
PROPOSED RESIDENTIAL DEVELOPMENT AT N.K.I.L. 6542 YIN PING ROAD KOWLOON


TITLE :
PART ELEVATION FOR CURTAIN WALL AT TOWER 3

DATE : 05-OCT-21	SCALE : 1:60 (A1)
DRAWN BY : LHR	CHECKED BY :


美特鋁質有限公司
MIDI ALUMINIUM FABRICATOR LTD.
Units 6-8, Sunray Industrial Centre, 1/F
610 Cha Kwo Ling Road, Kowloon
Tel:23489211-4 Fax:(852)27727666

DWG NO. : J853-SD-CW-4306 | REV. : A

LEGEND :
R.S. = RESTRAINT SOCKET

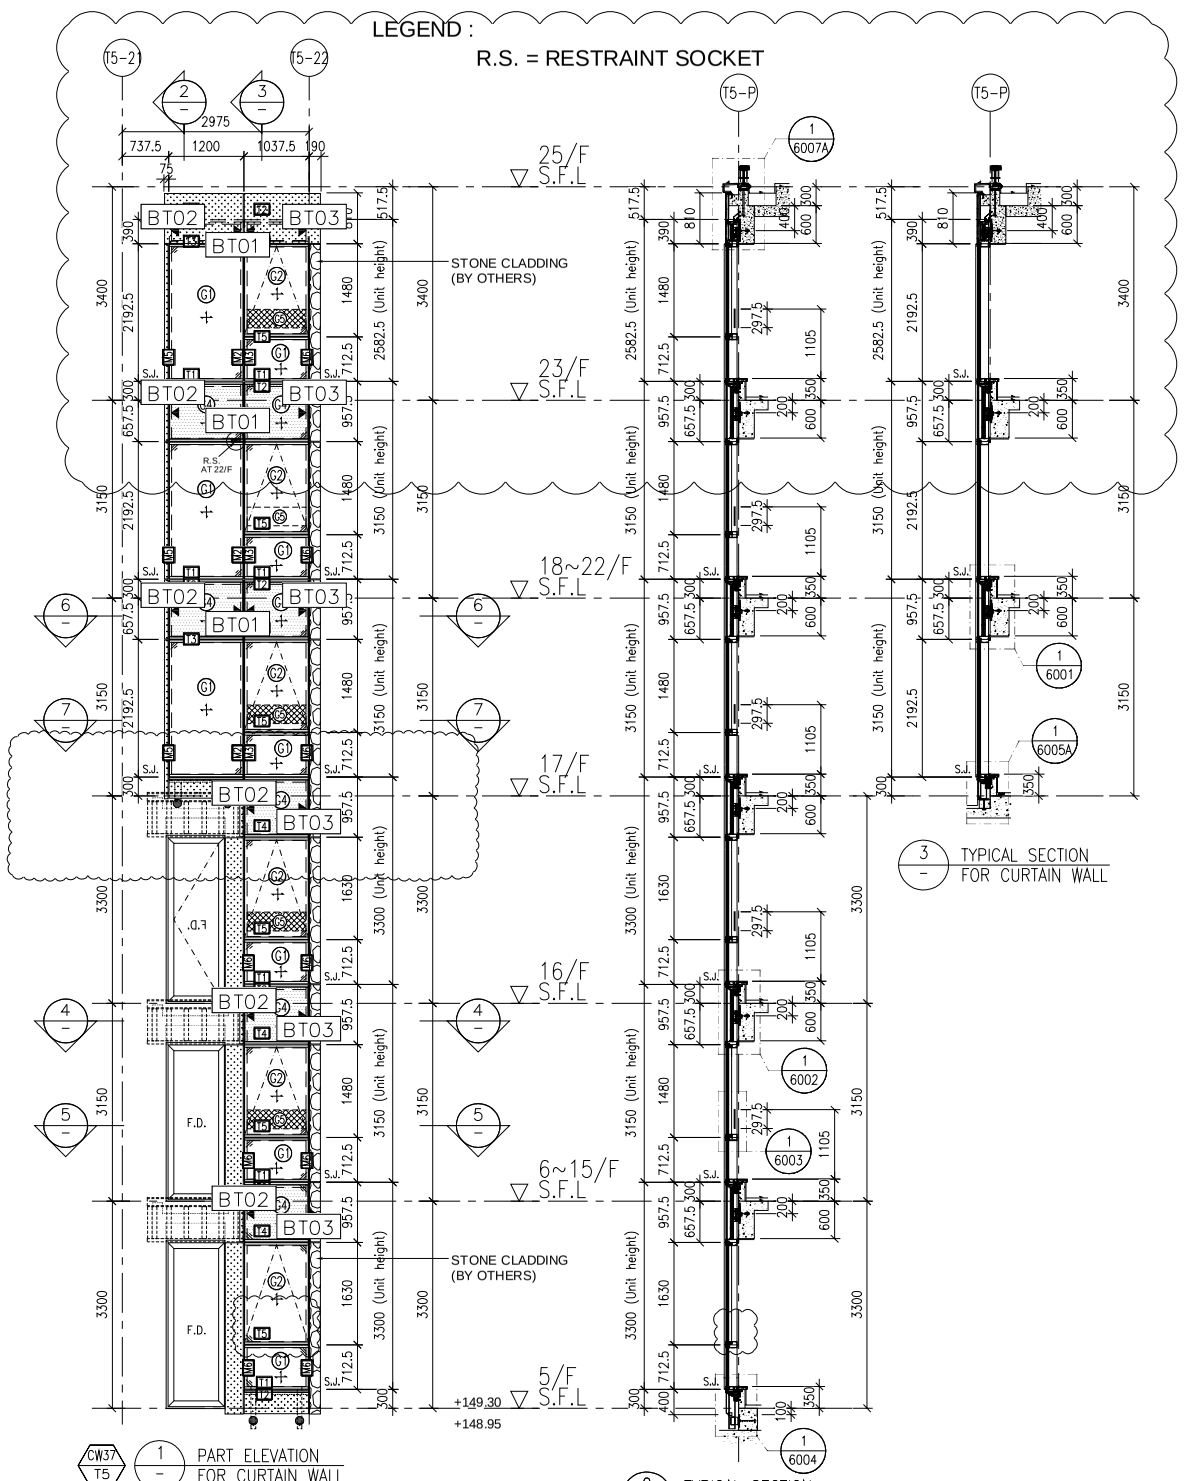

3 TYPICAL SECTION FOR CURTAIN WALL

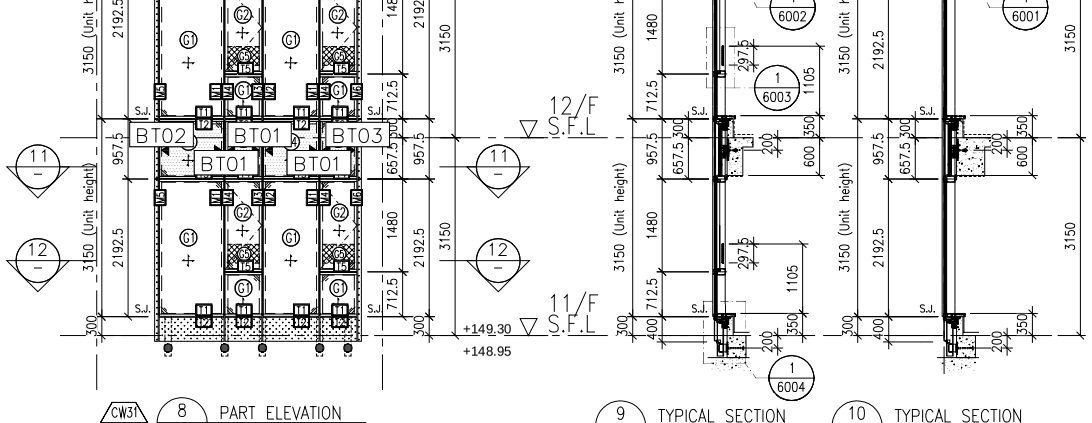


9 TYPICAL SECTION FOR CURTAIN WALL


10 TYPICAL SECTION FOR CURTAIN WALL

CW37 T5 1 PART ELEVATION FOR CURTAIN WALL


T5CW-A-1

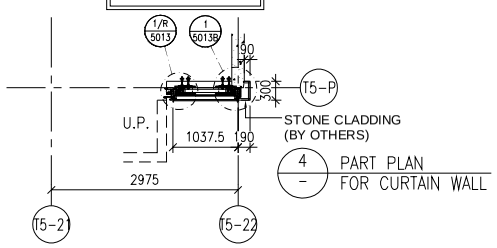


4 PART PLAN FOR CURTAIN WALL

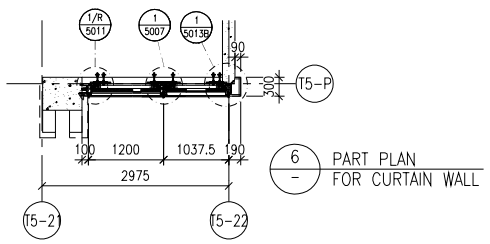

6 PART PLAN FOR CURTAIN WALL

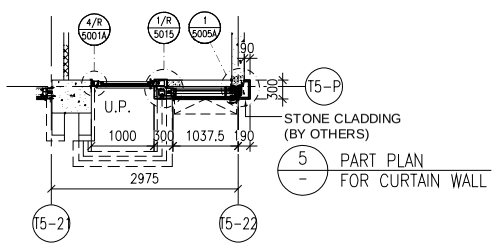

5 PART PLAN FOR CURTAIN WALL

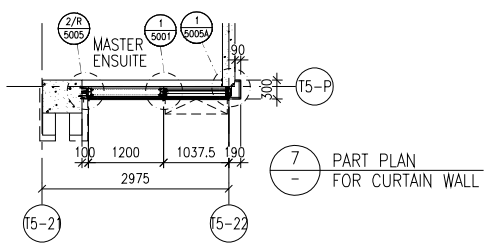


7 PART PLAN FOR CURTAIN WALL


2 TYPICAL SECTION FOR CURTAIN WALL

CW31 T5 8 PART ELEVATION FOR CURTAIN WALL

T5CW-C-1

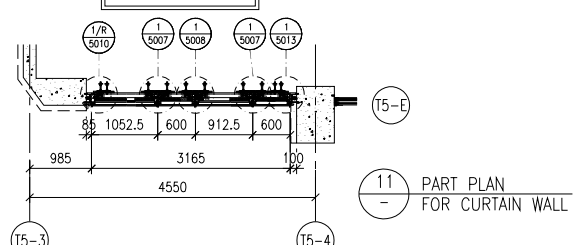

11 PART PLAN FOR CURTAIN WALL

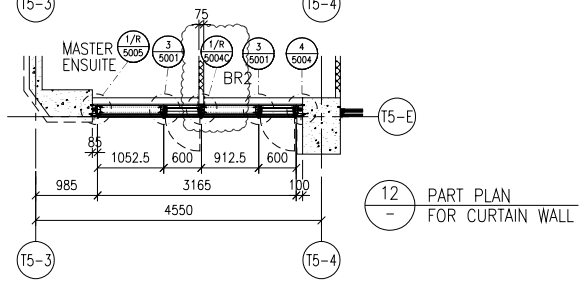

12 PART PLAN FOR CURTAIN WALL

FLOOR LEVEL (S.F.L.)

FLOOR	LEVEL
25/F	+203.40
23/F	+200.00
22/F	+196.85
21/F	+193.70
20/F	+190.55
19/F	+187.40
18/F	+184.25
17/F	+181.10
16/F	+177.80
15/F	+174.65
12/F	+171.50
11/F	+168.35
10/F	+165.20
9/F	+162.05
8/F	+158.90
7/F	+155.75
6/F	+152.60
5/F	+149.30

LEGEND:
- C1+ – 10mm HEAT STRENGTHENED GLASS (OUTER) + 12mm AIR SPACE +12mm THK. TEMPERED CLEAR GLASS (INNER)
- C2+ – 10mm HEAT STRENGTHENED GLASS (OUTER) + 12mm AIR SPACE +10mm THK. TEMPERED CLEAR GLASS (INNER)
- C4+ – 12mm THK. HEAT STRENGTHENED GLASS & 2mm THK. ALUM. BACKPAN (SPANDREL GLASS)
- C5 – 12mm THK. CLEAR TEMPERED GLASS (INTERNAL PROTECTIVE BARRIER)
- 3mm THK. ALUM. CLADDING
- S.J. – STACK JOINT (WIND LOAD)
- AE01 – ALUM. EXTRUSION DIE NO.
- ▲ – SUPPORT POINT (WIND LOAD + DEAD LOAD)
- ● – SUPPORT POINT (WIND LOAD)

B.D. REF :

CLIENT :
SHIMAO GROUP HOLDINGS LIMITED

ARCHITECT :
WONG TUNG & PARTNERS LIMITED
ARCHITECTS & PLANNERS

MAIN CONTRACTOR :
協興建築有限公司
HIP HING CONSTRUCTION CO LTD

STRUCTURAL ENGINEER :
C M WONG & ASSOCIATES LTD
黃志明建築工程師有限公司

FACADE CONSULTANT:
MEINHARDT

NOTE :
1. ALL DIMENSIONS ARE IN mm.
2. ALL ELEVATIONS ARE VIEWED FROM OUTSIDE.
3. ALL DIMENSIONS TO BE VERIFIED ON SITE BEFORE FABRICATION.

LEGEND :
- X1 / X001 – DETAIL MARK NO. / REFER SHEET NO.

1. F.F.L. --FINISHED FLOOR LEVEL
2. S.F.L. --STRUCTURAL FLOOR LEVEL
3. (/R) --REVERSED DETAIL

NO.	DATE	REVISED	BY
A	06-10-2021	REVISION SUBJECT TO ARCH. COMMENT	

JOB NO. : J-853

PROJECT :
PROPOSED RESIDENTIAL DEVELOPMENT AT N.K.I.L. 6542 YIN PING ROAD KOWLOON

TITLE :
PART ELEVATION FOR CURTAIN WALL AT TOWER 5


DATE : 31-MAR-21 | SCALE : 1:60 (A1)


DRAWN BY : LHR | CHECKED BY :

美特鋁質有限公司
MIDI ALUMINIUM FABRICATOR LTD.
Units 6-8, Sunray Industrial Centre, 1/F
610 Cha Kwo Ling Road, Kowloon
Tel:23489211-4 Fax:(852)27727666


DWG NO. : J853-SD-CW-4501 | REV. : A

LEGEND :
R.S. = RESTRAINT SOCKET

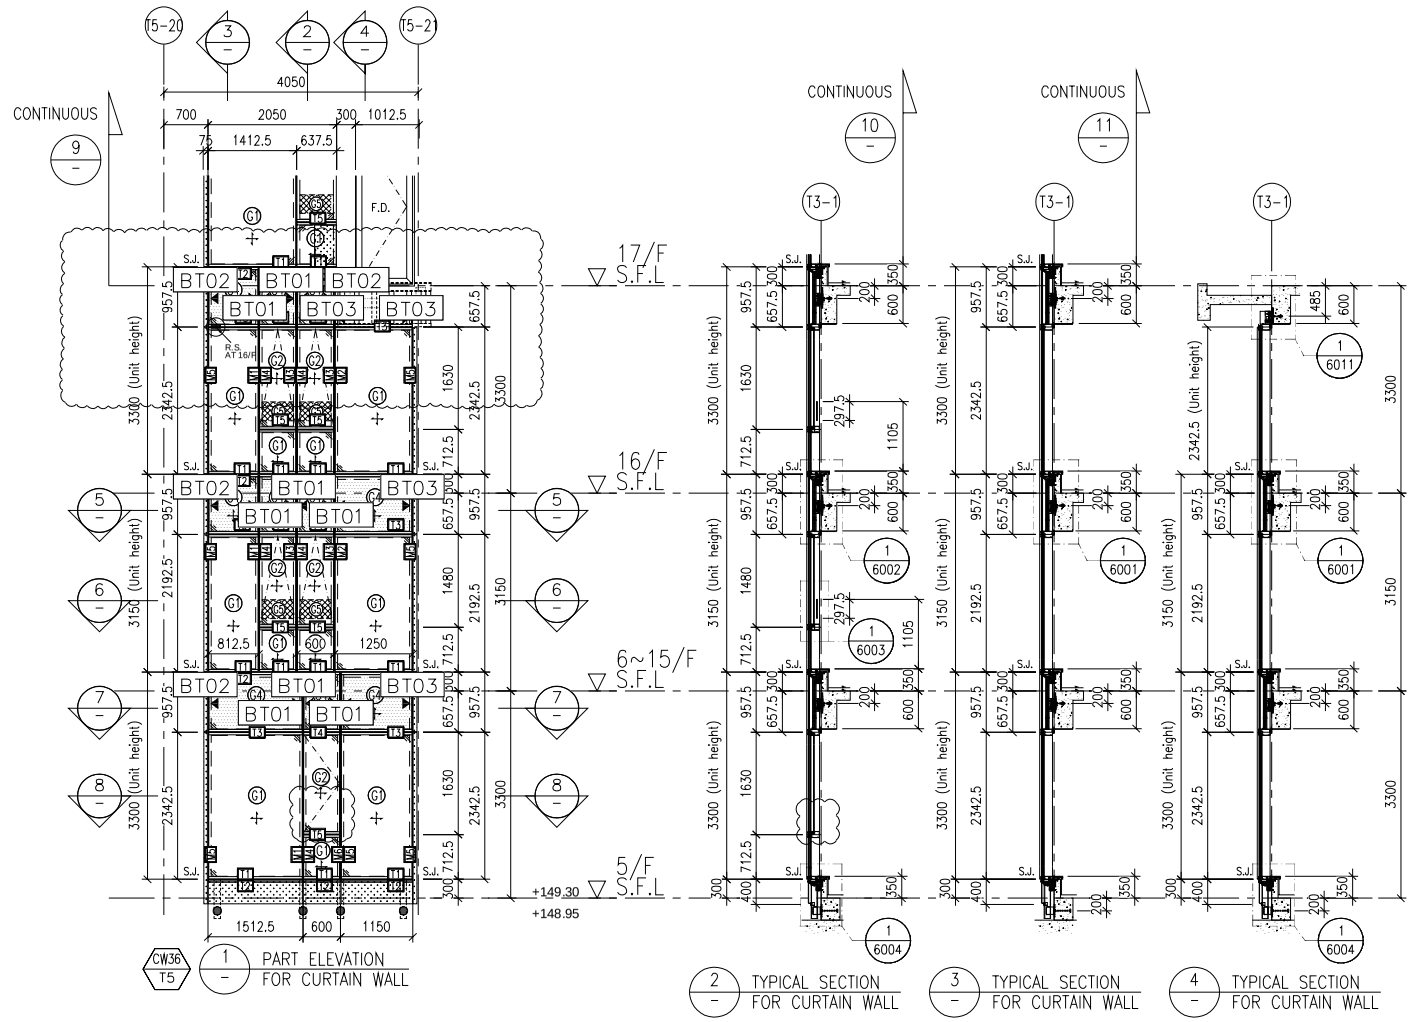


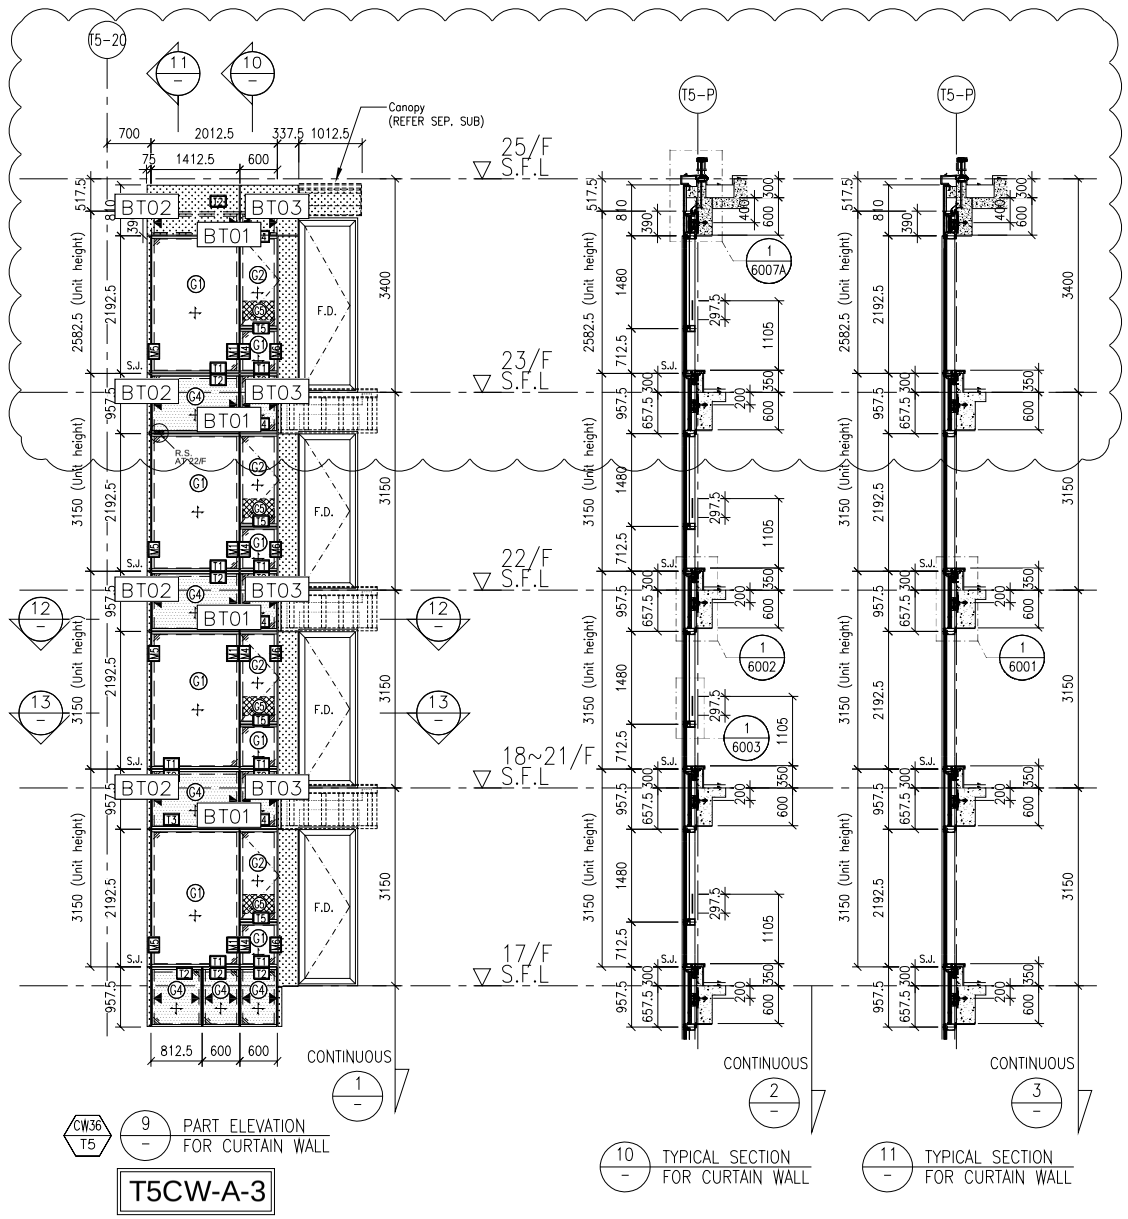

T5CW-A-2

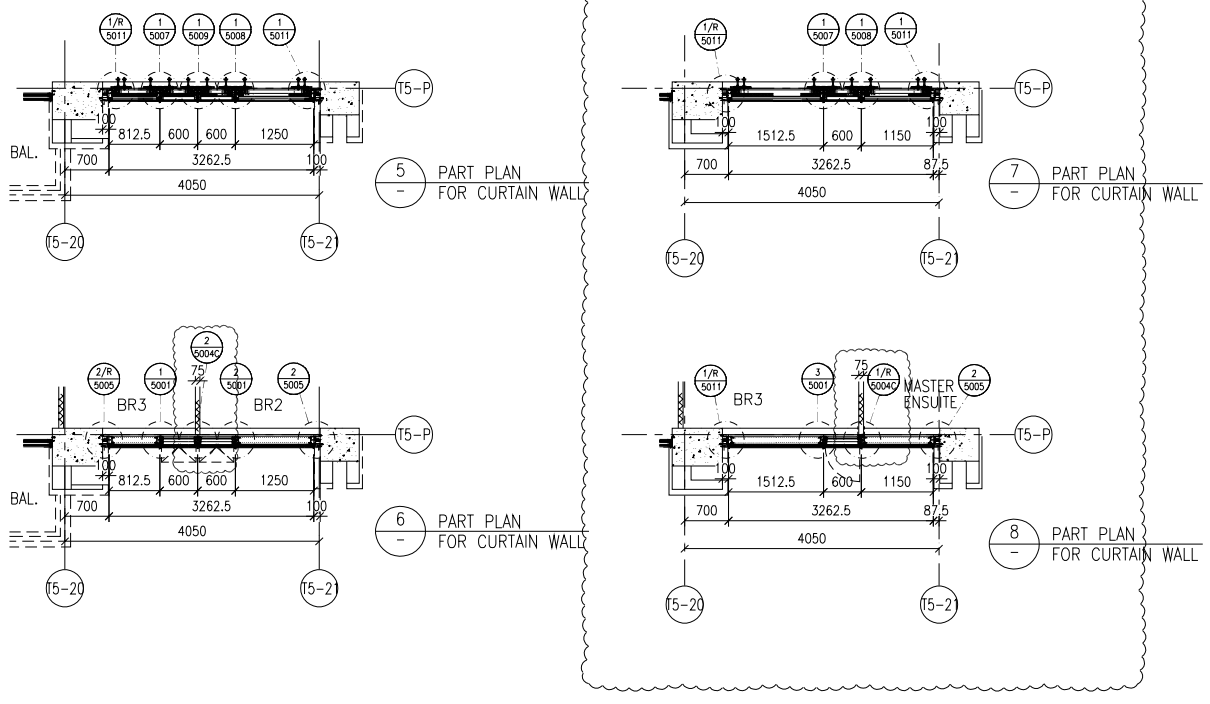

T5CW-A-3

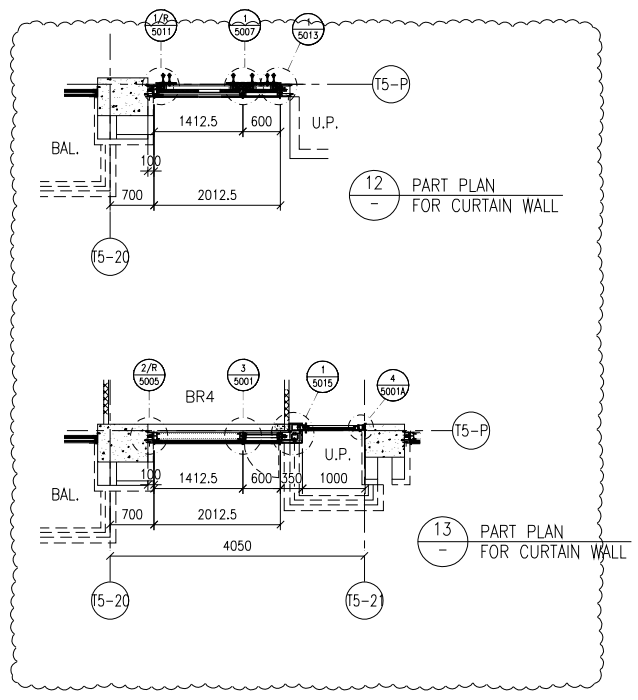

FLOOR LEVEL (S.F.L.)

FLOOR	LEVEL
25/F	+203.40
23/F	+200.00
22/F	+196.85
21/F	+193.70
20/F	+190.55
19/F	+187.40
18/F	+184.25
17/F	+181.10
16/F	+177.80
15/F	+174.65
12/F	+171.50
11/F	+168.35
10/F	+165.20
9/F	+162.05
8/F	+158.90
7/F	+155.75
6/F	+152.60
5/F	+149.30

LEGEND:
- G1 – 10mm HEAT STRENGTHENED GLASS (OUTER) + 12mm AIR SPACE +12mm THK. TEMPERED CLEAR GLASS (INNER)
- G2 – 10mm HEAT STRENGTHENED GLASS (OUTER) + 12mm AIR SPACE +10mm THK. TEMPERED CLEAR GLASS (INNER)
- G4 – 12mm THK. HEAT STRENGTHENED GLASS & 2mm THK. ALUM. BACKPAN (SPANDREL GLASS)
- 12mm THK. CLEAR TEMPERED GLASS (INTERNAL PROTECTIVE BARRIER)
- 3mm THK. ALUM. CLADDING
- S.J. – STACK JOINT (WIND LOAD)
- AE01 – ALUM. EXTRUSION DIE NO.
- ▲ – SUPPORT POINT (WIND LOAD + DEAD LOAD)
- ● – SUPPORT POINT (WIND LOAD)

B.D. REF :

CLIENT :
SHIMAO GROUP HOLDINGS LIMITED

ARCHITECT :
WONG TUNG & PARTNERS LIMITED
ARCHITECTS & PLANNERS

MAIN CONTRACTOR :
協興建築有限公司
HIP HING CONSTRUCTION CO LTD

STRUCTURAL ENGINEER :
C M WONG & ASSOCIATES LTD
黃志明建築工程師有限公司

FACADE CONSULTANT:
MEINHARDT

NOTE :
1. ALL DIMENSIONS ARE IN mm.
2. ALL ELEVATIONS ARE VIEWED FROM OUTSIDE.
3. ALL DIMENSIONS TO BE VERIFIED ON SITE BEFORE FABRICATION.

LEGEND :
- X1 / X001 — DETAIL MARK NO. / REFER SHEET NO.
1. F.F.L. -- FINISHED FLOOR LEVEL
2. S.F.L. -- STRUCTURAL FLOOR LEVEL
3. /R -- REVERSED DETAIL

NO.	DATE	REVISED	BY
A	06-10-2021	REVISION SUBJECT TO ARCH. COMMENT	

JOB NO. : J-853

PROJECT :
PROPOSED RESIDENTIAL DEVELOPMENT AT N.K.I.L. 6542
YIN PING ROAD
KOWLOON

TITLE :
PART ELEVATION FOR CURTAIN WALL AT TOWER 5


DATE : 31-MAR-21 | SCALE : 1:60 (A1)

DRAWN BY : LHR | CHECKED BY :

美特鋁質有限公司
MIDI ALUMINIUM FABRICATOR LTD.
Units 6-8, Sunray Industrial Centre, 1/F
610 Cha Kwo Ling Road, Kowloon
Tel:23489211-4 Fax:(852)27727666

DWG NO. : J853-SD-CW-4502 | REV. : A


LEGEND :
R.S. = RESTRAINT SOCKET

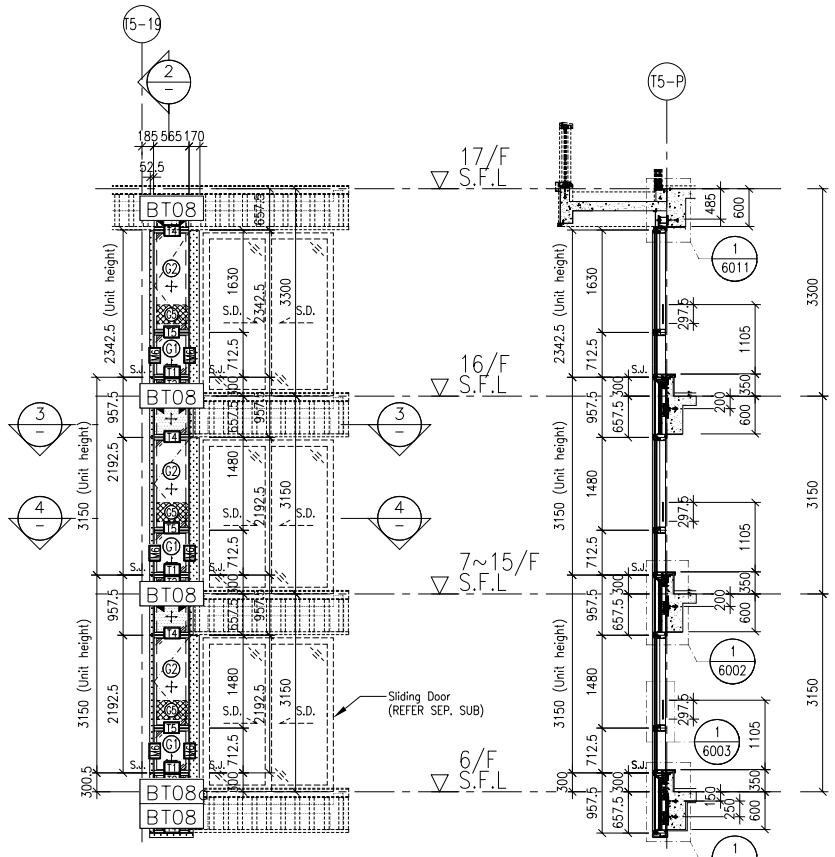


CW35 T5 1/- PART ELEVATION FOR CURTAIN WALL

2/- TYPICAL SECTION FOR CURTAIN WALL


T5CW-A-4

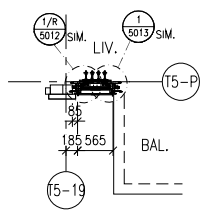


3/- PART PLAN FOR CURTAIN WALL

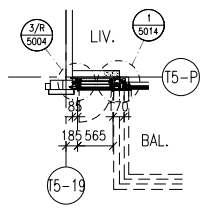

4/- PART PLAN FOR CURTAIN WALL

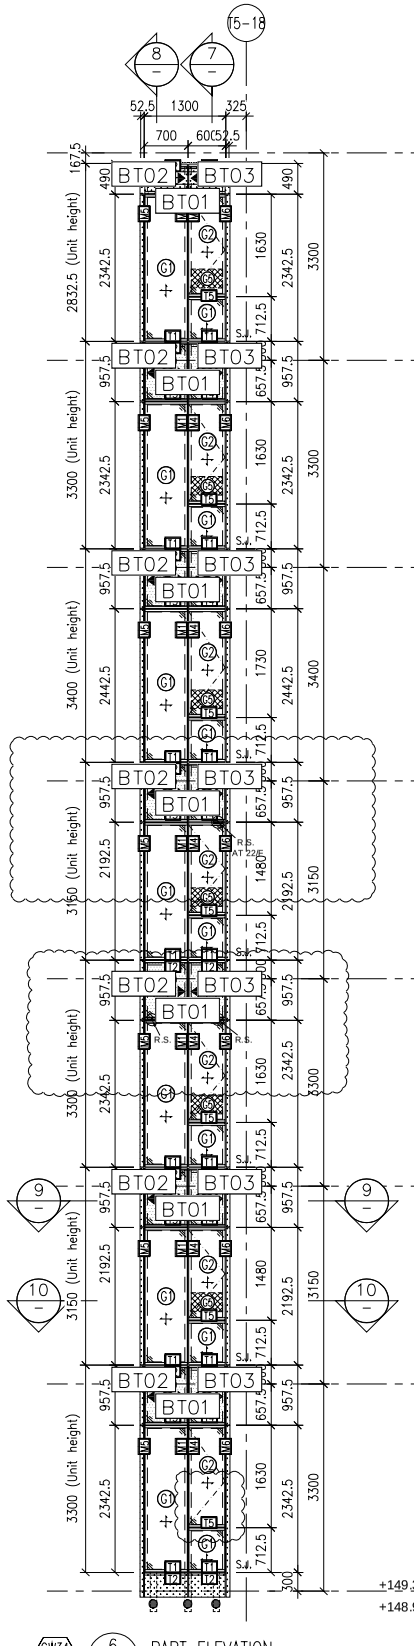


CW34 T5 6/- PART ELEVATION FOR CURTAIN WALL

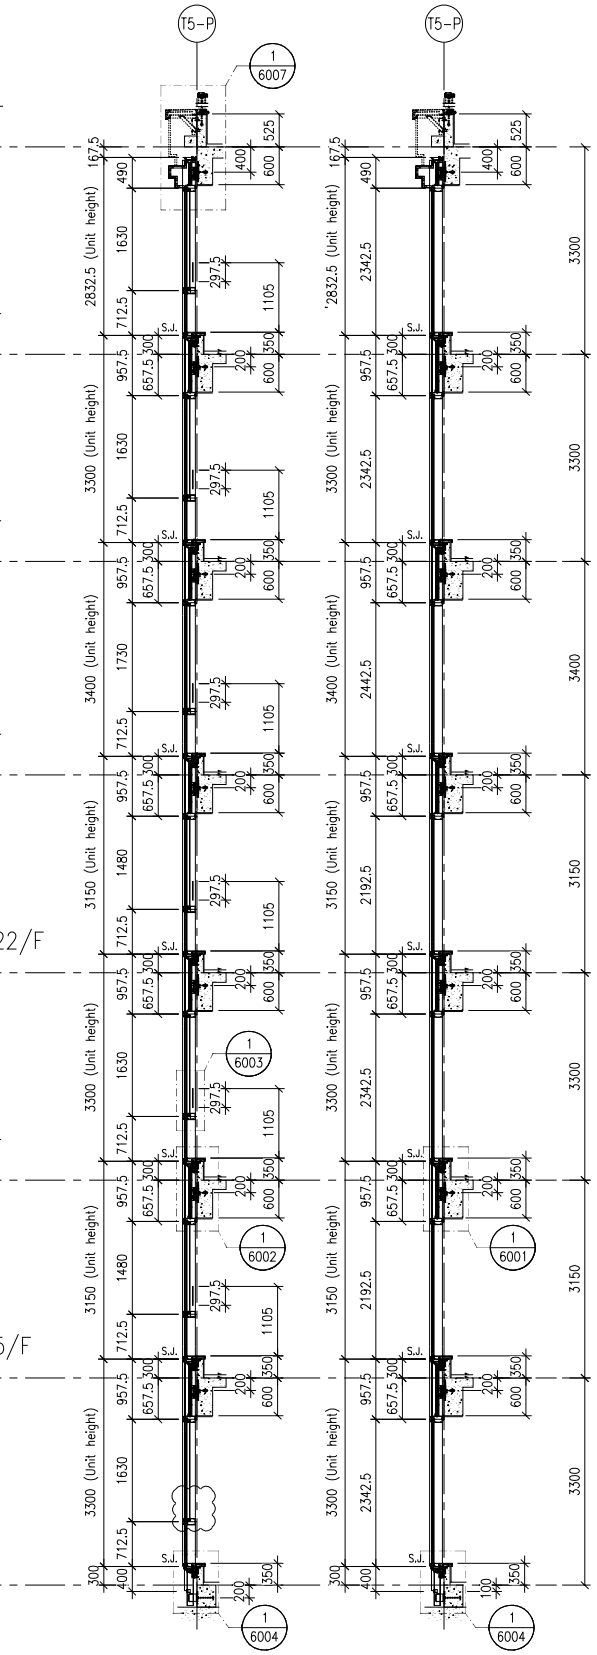


7/- TYPICAL SECTION FOR CURTAIN WALL

8/- TYPICAL SECTION FOR CURTAIN WALL

T5CW-A-5

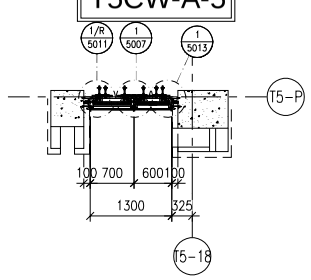

9/- PART PLAN FOR CURTAIN WALL

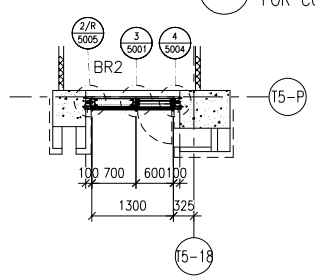

10/- PART PLAN FOR CURTAIN WALL

FLOOR LEVEL (S.F.L.)

FLOOR	LEVEL
ROOF	+210.00
26/F	+206.70
25/F	+203.40
23/F	+200.00
22/F	+196.85
21/F	+193.70
20/F	+190.55
19/F	+187.40
18/F	+184.25
17/F	+181.10
16/F	+177.80
15/F	+174.65
12/F	+171.50
11/F	+168.35
10/F	+165.20
9/F	+162.05
8/F	+158.90
7/F	+155.75
6/F	+152.60
5/F	+149.30

LEGEND:
- G+ – 10mm HEAT STRENGTHENED GLASS (OUTER) + 12mm AIR SPACE +12mm THK. TEMPERED CLEAR GLASS (INNER)
- M+ – 10mm HEAT STRENGTHENED GLASS (OUTER) + 12mm AIR SPACE +10mm THK. TEMPERED CLEAR GLASS (INNER)
- P+ – 12mm THK. HEAT STRENGTHENED GLASS & 2mm THK. ALUM. BACKPAN (SPANDREL GLASS)
- G – 12mm THK. CLEAR TEMPERED GLASS (INTERNAL PROTECTIVE BARRIER)
- 3mm THK. ALUM. CLADDING
- S.J. – STACK JOINT (WIND LOAD)
- AE01 – ALUM. EXTRUSION DIE NO.
- ▲ – SUPPORT POINT (WIND LOAD + DEAD LOAD)
- ● – SUPPORT POINT (WIND LOAD)

B.D. REF :

CLIENT :
SHIMAO GROUP HOLDINGS LIMITED

ARCHITECT :
WONG TUNG & PARTNERS LIMITED
ARCHITECTS & PLANNERS

MAIN CONTRACTOR :
協興建築有限公司
HIP HING CONSTRUCTION CO LTD

STRUCTURAL ENGINEER :
C M WONG & ASSOCIATES LTD
黃志明建築工程師有限公司

FACADE CONSULTANT:
MEINHARDT

NOTE :
1. ALL DIMENSIONS ARE IN mm.
2. ALL ELEVATIONS ARE VIEWED FROM OUTSIDE.
3. ALL DIMENSIONS TO BE VERIFIED ON SITE BEFORE FABRICATION.

LEGEND :
- X1 / X001 – DETAIL MARK NO. / REFER SHEET NO.
1. F.F.L. --FINISHED FLOOR LEVEL
2. S.F.L. --STRUCTURAL FLOOR LEVEL
3. (/R) --REVERSED DETAIL

NO.	DATE	REVISED	BY
A	06-10-2021	REVISION SUBJECT TO ARCH. COMMENT	

JOB NO. : J-853

PROJECT :
PROPOSED RESIDENTIAL DEVELOPMENT AT N.K.I.L. 6542
YIN PING ROAD
KOWLOON

TITLE :
PART ELEVATION FOR CURTAIN WALL AT TOWER 5

DATE : 31-MAR-21 | SCALE : 1:60 (A1)

DRAWN BY : LHR | CHECKED BY :

美特鋁質有限公司
MIDI ALUMINIUM FABRICATOR LTD.
Units 6-8, Sunray Industrial Centre, 1/F
610 Cha Kwo Ling Road, Kowloon
Tel:23489211-4 Fax:(852)27727666

DWG NO. : J853-SD-CW-4503 | REV. : A

LEGEND :
R.S. = RESTRAINT SOCKET

CW33 / T5 — 1 / – PART ELEVATION FOR CURTAIN WALL

2 / – TYPICAL SECTION FOR CURTAIN WALL

3 / – TYPICAL SECTION FOR CURTAIN WALL

4 / – TYPICAL SECTION FOR CURTAIN WALL

T5CW-B-1

5 / – PART PLAN FOR CURTAIN WALL

6 / – PART PLAN FOR CURTAIN WALL

7 / – PART PLAN FOR CURTAIN WALL

8 / – PART PLAN FOR CURTAIN WALL

CW33 / T5 — 9 / – PART ELEVATION FOR CURTAIN WALL

10 / – TYPICAL SECTION FOR CURTAIN WALL

11 / – TYPICAL SECTION FOR CURTAIN WALL

T5CW-A-6

12 / – PART PLAN FOR CURTAIN WALL

13 / – PART PLAN FOR CURTAIN WALL

14 / – PART PLAN FOR CURTAIN WALL

15 / – PART PLAN FOR CURTAIN WALL

FLOOR LEVEL (S.F.L.)

FLOOR	LEVEL
ROOF	+210.00
26/F	+206.70
25/F	+203.40
23/F	+200.00
22/F	+196.85
21/F	+193.70
20/F	+190.55
19/F	+187.40
18/F	+184.25
17/F	+181.10
16/F	+177.80
15/F	+174.65
12/F	+171.50
11/F	+168.35
10/F	+165.20
9/F	+162.05
8/F	+158.90
7/F	+155.75
6/F	+152.60
5/F	+149.30

LEGEND:
- G1+ – 10mm HEAT STRENGTHENED GLASS (OUTER) + 12mm AIR SPACE +12mm THK. TEMPERED CLEAR GLASS (INNER)
- G2+ – 10mm HEAT STRENGTHENED GLASS (OUTER) + 12mm AIR SPACE +10mm THK. TEMPERED CLEAR GLASS (INNER)
- P2+ – 12mm THK. HEAT STRENGTHENED GLASS & 2mm THK. ALUM. BACKPAN (SPANDREL GLASS)
- – 12mm THK. CLEAR TEMPERED GLASS (INTERNAL PROTECTIVE BARRIER)
- – 3mm THK. ALUM. CLADDING
- S.J. – STACK JOINT (WIND LOAD)
- AE01 – ALUM. EXTRUSION DIE NO.
- ▲ – SUPPORT POINT (WIND LOAD + DEAD LOAD)
- ● – SUPPORT POINT (WIND LOAD)

B.D. REF :

CLIENT :
SHIMAO GROUP HOLDINGS LIMITED

ARCHITECT :
WONG TUNG & PARTNERS LIMITED
ARCHITECTS & PLANNERS

MAIN CONTRACTOR :
協興建築有限公司
HIP HING CONSTRUCTION CO LTD

STRUCTURAL ENGINEER :
C M WONG & ASSOCIATES LTD
黃志明建築工程師有限公司

FACADE CONSULTANT:
MEINHARDT

NOTE :
1. ALL DIMENSIONS ARE IN mm.
2. ALL ELEVATIONS ARE VIEWED FROM OUTSIDE.
3. ALL DIMENSIONS TO BE VERIFIED ON SITE BEFORE FABRICATION.

LEGEND :
- X1 / X001 — DETAIL MARK NO. / REFER SHEET NO.
1. F.F.L. --FINISHED FLOOR LEVEL
2. S.F.L. --STRUCTURAL FLOOR LEVEL
3. /R --REVERSED DETAIL

NO.	DATE	REVISED	BY
A	06-10-2021	REVISION SUBJECT TO ARCH. COMMENT	

JOB NO. : J-853

PROJECT :
PROPOSED RESIDENTIAL DEVELOPMENT AT N.K.I.L. 6542
YIN PING ROAD
KOWLOON

TITLE :
PART ELEVATION FOR CURTAIN WALL AT TOWER 5


DATE : 01-APR-21 | SCALE : 1:60 (A1)

DRAWN BY : LHR | CHECKED BY :

美特鋁質有限公司
MIDI ALUMINIUM FABRICATOR LTD.
Units 6-8, Sunray Industrial Centre, 1/F
610 Cha Kwo Ling Road, Kowloon
Tel:23489211-4 Fax:(852)27727666


DWG NO. : J853-SD-CW-4504 | REV. : A

LEGEND :
R.S. = RESTRAINT SOCKET

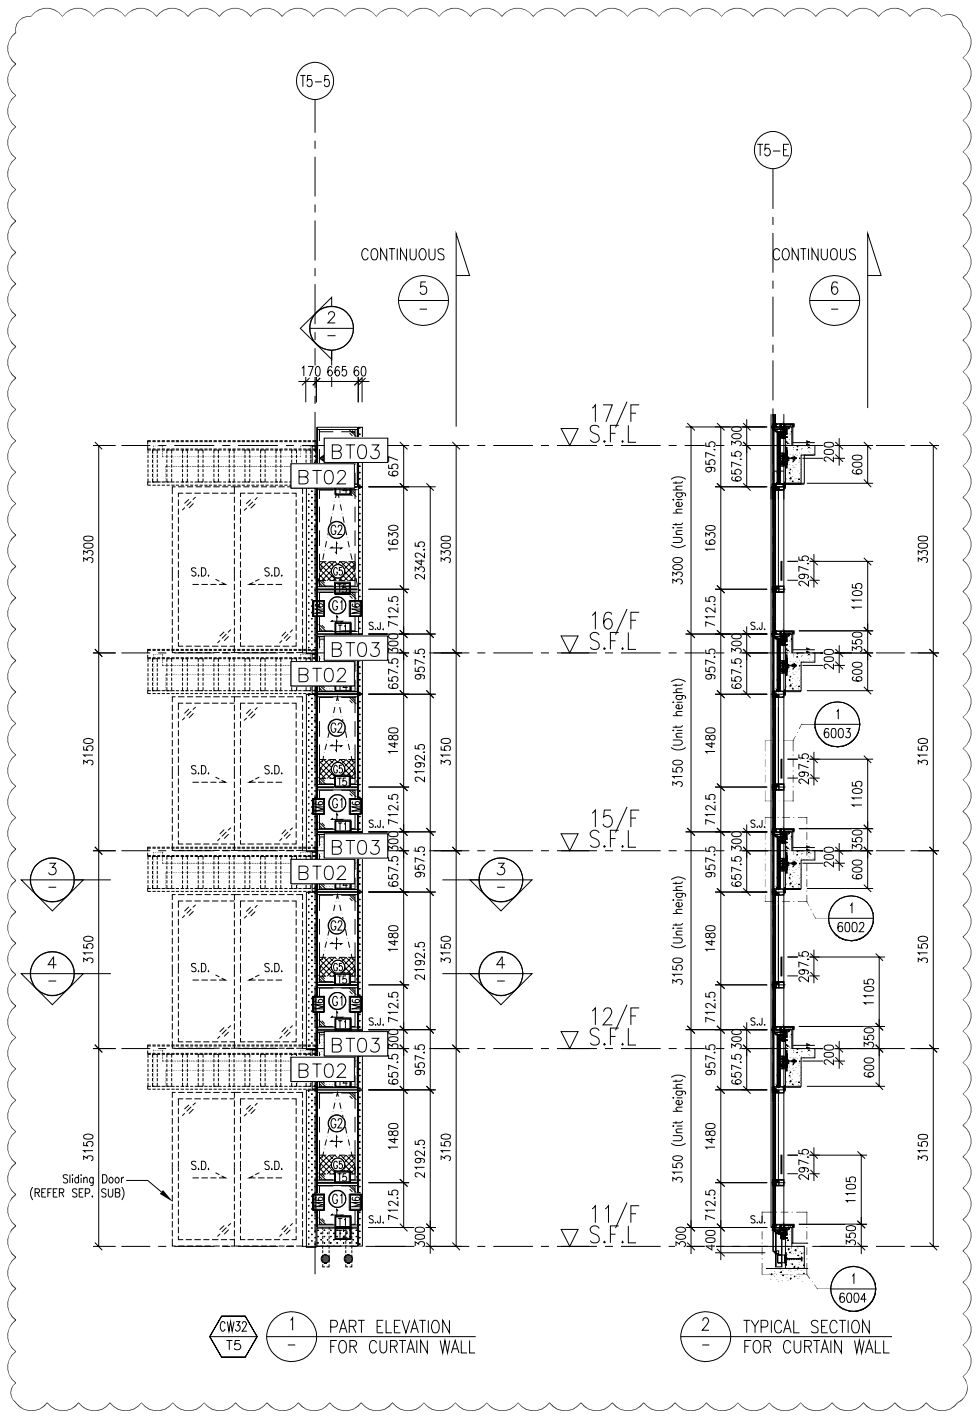


CW32 T5 — 1 — PART ELEVATION FOR CURTAIN WALL

2 — TYPICAL SECTION FOR CURTAIN WALL

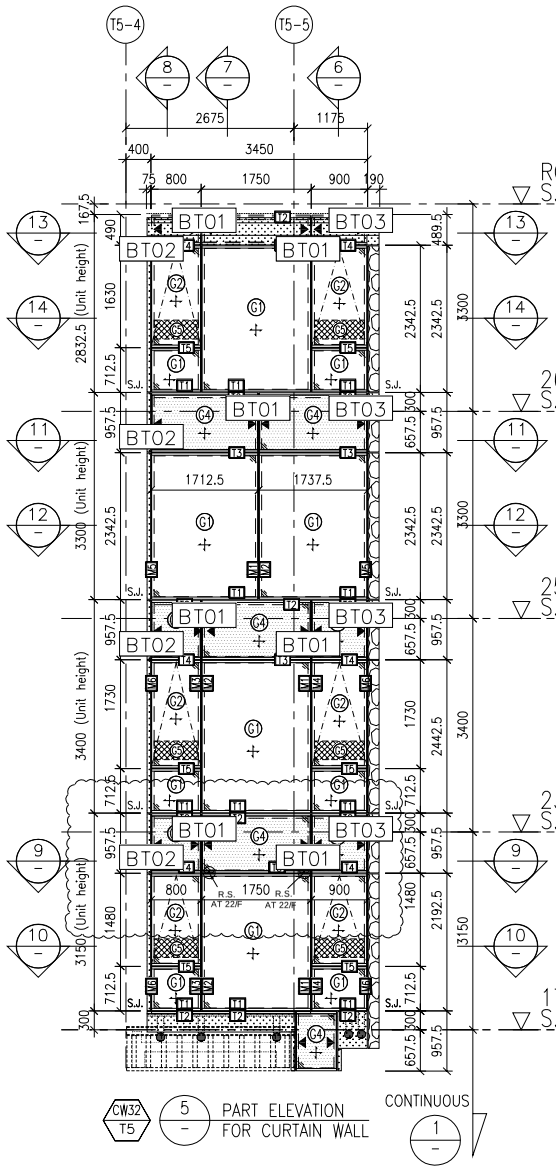


CW32 T5 — 5 — PART ELEVATION FOR CURTAIN WALL

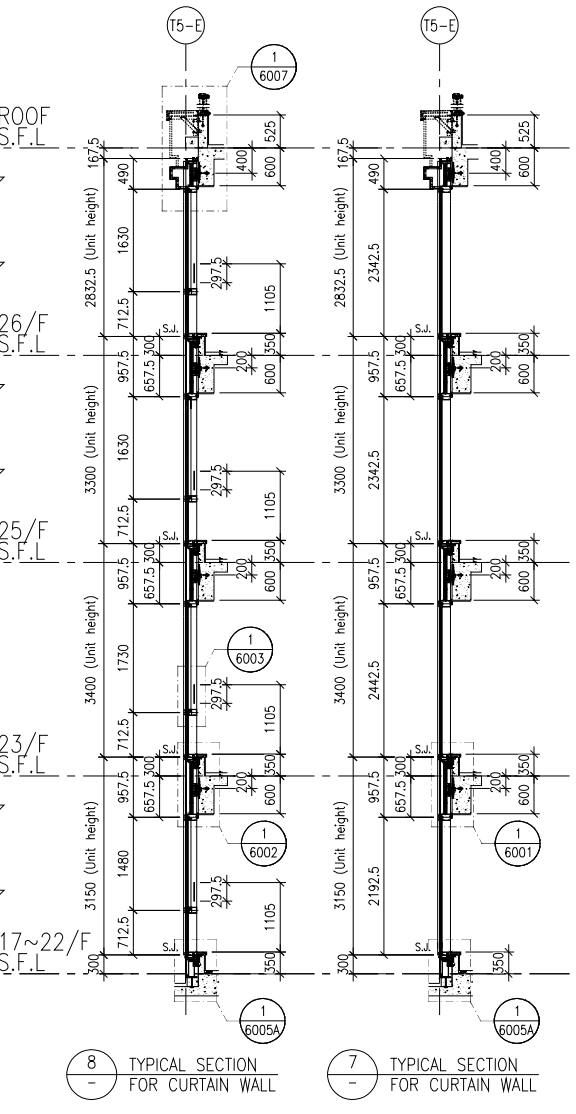


8 — TYPICAL SECTION FOR CURTAIN WALL


7 — TYPICAL SECTION FOR CURTAIN WALL

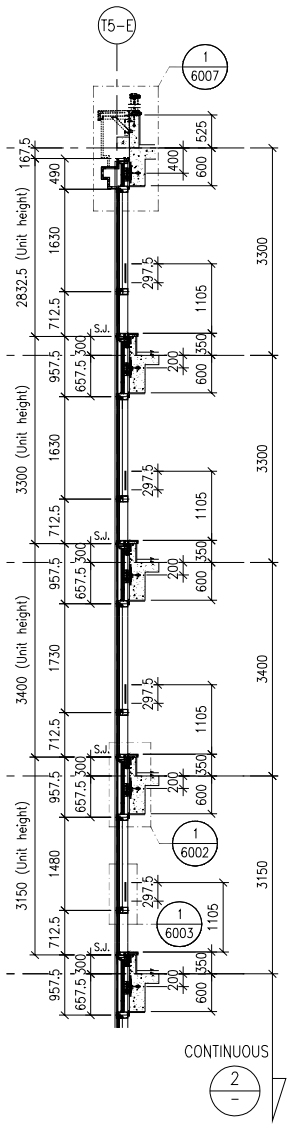


6 — TYPICAL SECTION FOR CURTAIN WALL

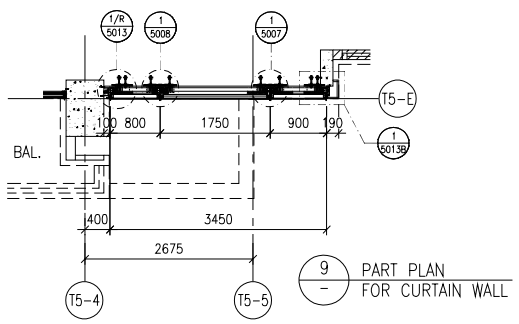


9 — PART PLAN FOR CURTAIN WALL

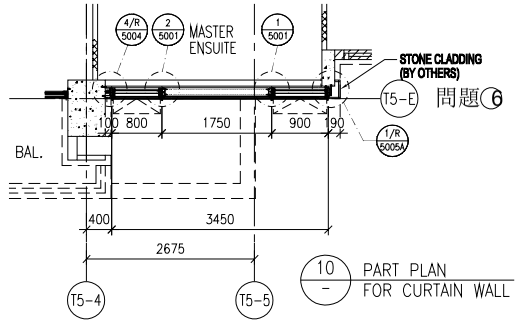


10 — PART PLAN FOR CURTAIN WALL

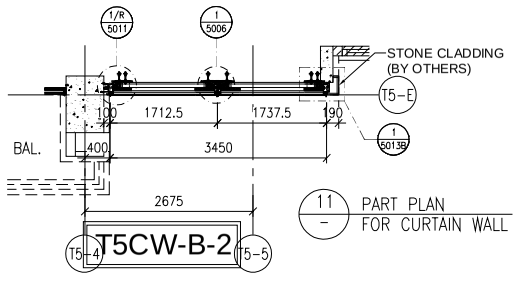

11 — PART PLAN FOR CURTAIN WALL

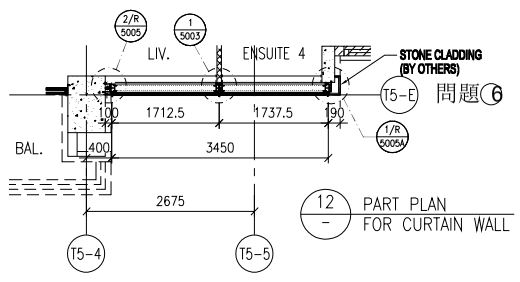


12 — PART PLAN FOR CURTAIN WALL

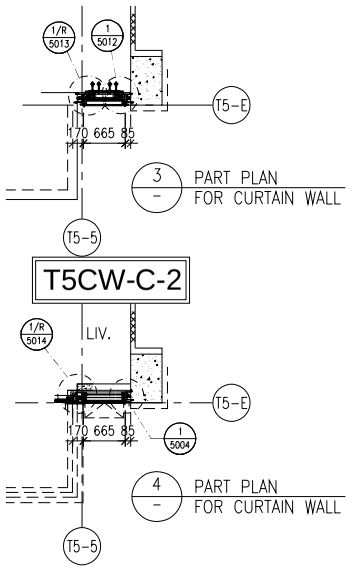


3 — PART PLAN FOR CURTAIN WALL

4 — PART PLAN FOR CURTAIN WALL

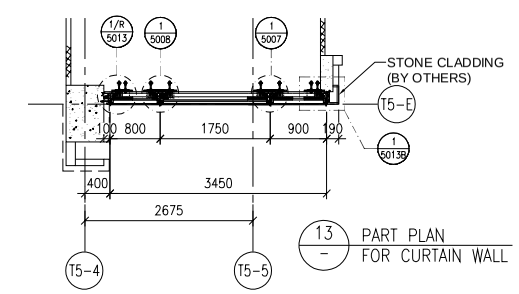

13 — PART PLAN FOR CURTAIN WALL

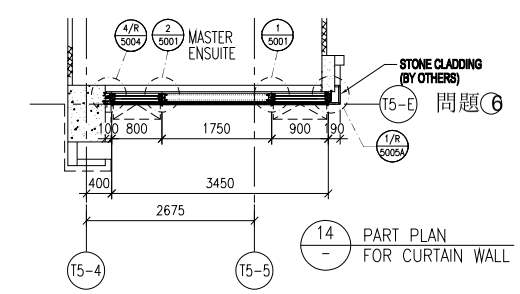

14 — PART PLAN FOR CURTAIN WALL

FLOOR LEVEL (S.F.L.)

FLOOR	LEVEL
ROOF	+210.00
26/F	+206.70
25/F	+203.40
23/F	+200.00
22/F	+196.85
21/F	+193.70
20/F	+190.55
19/F	+187.40
18/F	+184.25
17/F	+181.10
16/F	+177.80
15/F	+174.65
12/F	+171.50
11/F	+168.35

LEGEND:
- G1+ — 10mm HEAT STRENGTHENED GLASS (OUTER) + 12mm AIR SPACE +12mm THK. TEMPERED CLEAR GLASS (INNER)
- G2+ — 10mm HEAT STRENGTHENED GLASS (OUTER) + 12mm AIR SPACE +10mm THK. TEMPERED CLEAR GLASS (INNER)
- G4+ — 12mm THK. HEAT STRENGTHENED GLASS & 2mm THK. ALUM. BACKPAN (SPANDREL GLASS)
- G5 — 12mm THK. CLEAR TEMPERED GLASS (INTERNAL PROTECTIVE BARRIER)
- 3mm THK. ALUM. CLADDING
- S.J. — STACK JOINT (WIND LOAD)
- AE01 — ALUM. EXTRUSION DIE NO.
- ▲ — SUPPORT POINT (WIND LOAD + DEAD LOAD)
- ● — SUPPORT POINT (WIND LOAD)

B.D. REF :

CLIENT :
SHIMAO GROUP HOLDINGS LIMITED

ARCHITECT :
WONG TUNG & PARTNERS LIMITED
ARCHITECTS & PLANNERS

MAIN CONTRACTOR :
協興建築有限公司
HIP HING CONSTRUCTION CO LTD

STRUCTURAL ENGINEER :
C M WONG & ASSOCIATES LTD
黃志明建築工程師有限公司

FACADE CONSULTANT:
MEINHARDT

NOTE :
1. ALL DIMENSIONS ARE IN mm.
2. ALL ELEVATIONS ARE VIEWED FROM OUTSIDE.
3. ALL DIMENSIONS TO BE VERIFIED ON SITE BEFORE FABRICATION.

LEGEND :
X1 / X001 — DETAIL MARK NO. / REFER SHEET NO.

1. F.F.L. -- FINISHED FLOOR LEVEL
2. S.F.L. -- STRUCTURAL FLOOR LEVEL
3. /R -- REVERSED DETAIL

NO.	DATE	REVISED	BY
A	06-10-2021	REVISION SUBJECT TO ARCH. COMMENT	

JOB NO. : J-853

PROJECT :
PROPOSED RESIDENTIAL DEVELOPMENT AT N.K.I.L. 6542 YIN PING ROAD KOWLOON

TITLE :
PART ELEVATION FOR CURTAIN WALL AT TOWER 5


DATE : 01-APR-21 | SCALE : 1:60 (A1)

DRAWN BY : LHR | CHECKED BY :

美特鋁質有限公司
MIDI ALUMINIUM FABRICATOR LTD.
Units 6-8, Sunray Industrial Centre, 1/F
610 Cha Kwo Ling Road, Kowloon
Tel:23489211-4 Fax:(852)27727666

DWG NO. : J853-SD-CW-4505 | REV. : A


LEGEND :
R.S. = RESTRAINT SOCKET

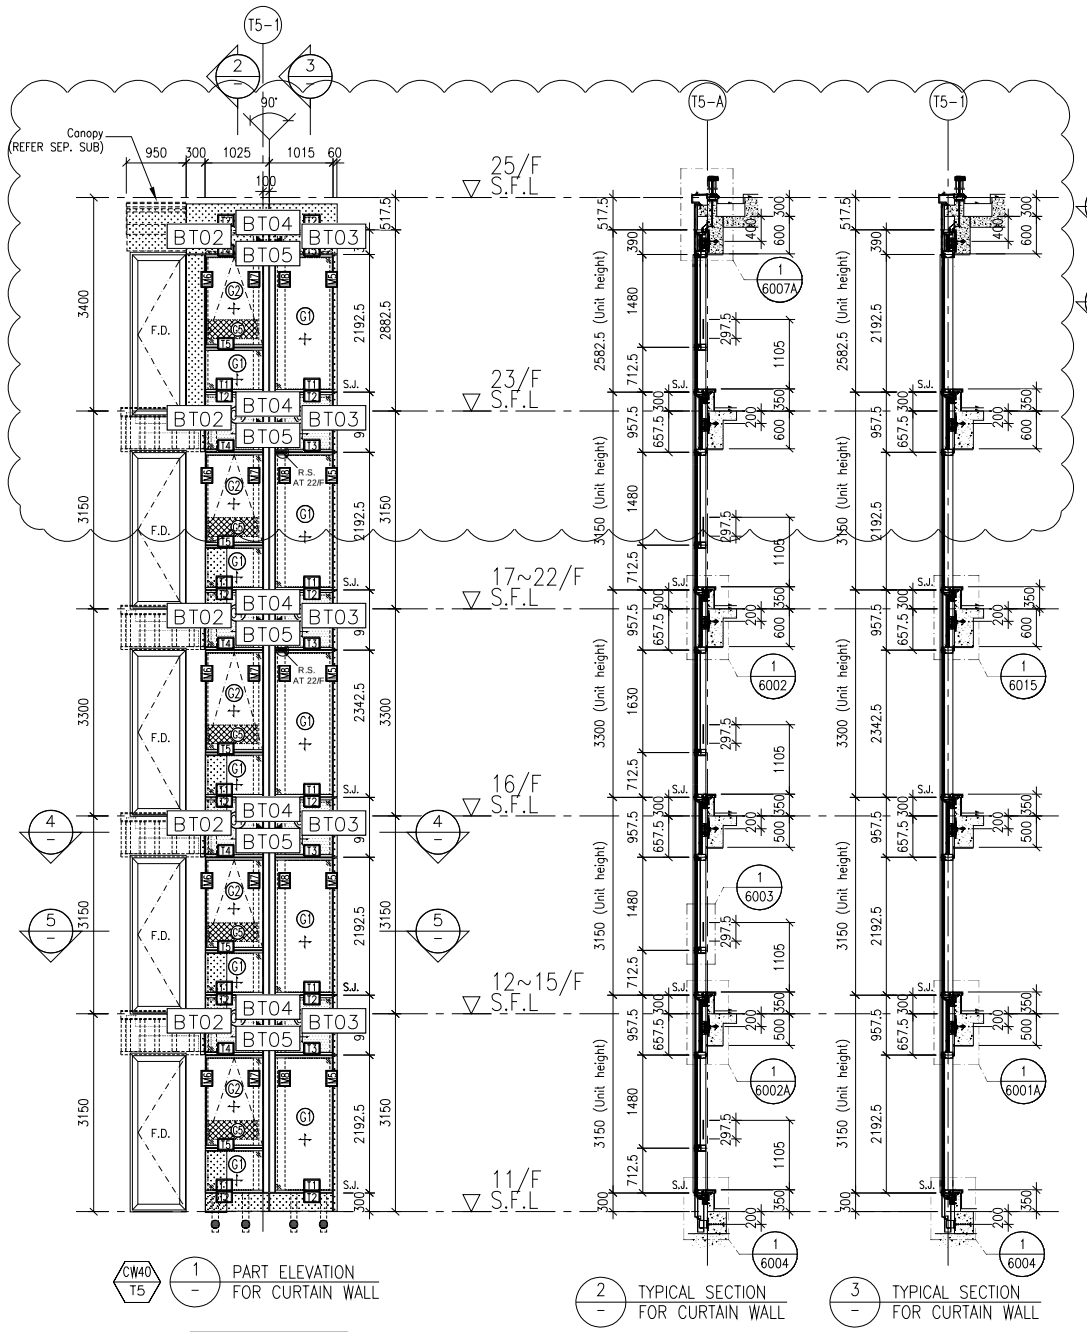


CW40 T5 — 1 — PART ELEVATION FOR CURTAIN WALL

2 — TYPICAL SECTION FOR CURTAIN WALL

3 — TYPICAL SECTION FOR CURTAIN WALL

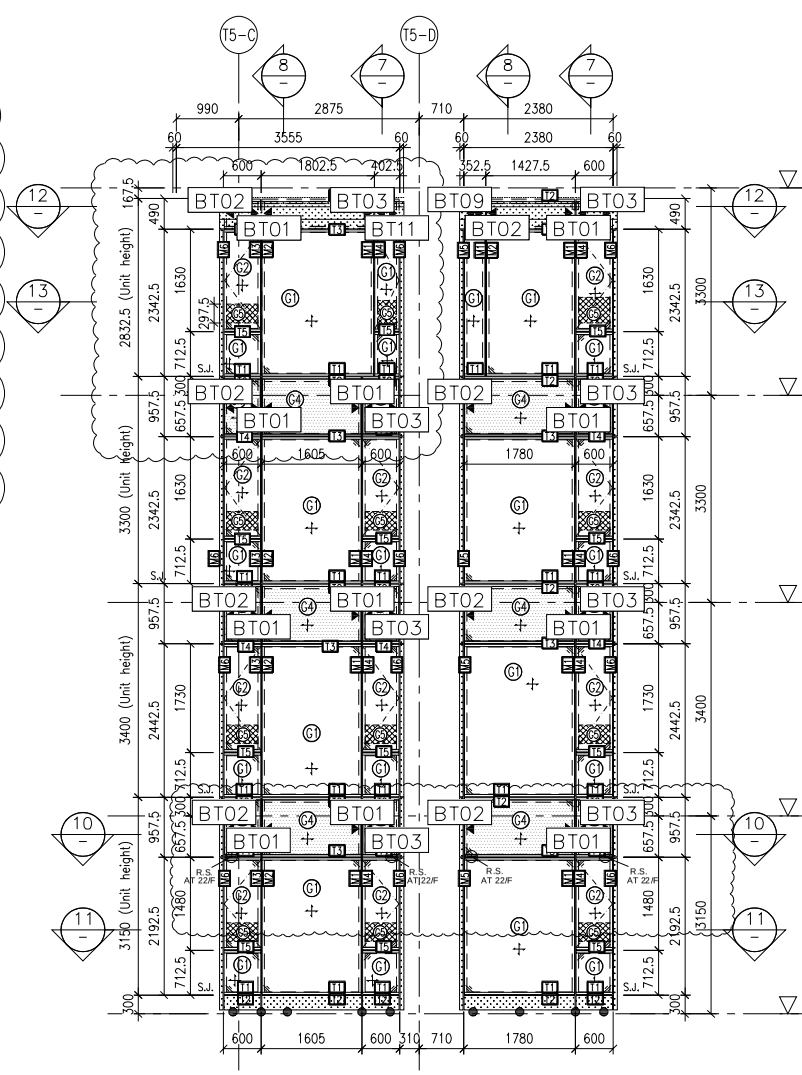


CW41 T5 — 6 — PART ELEVATION FOR CURTAIN WALL

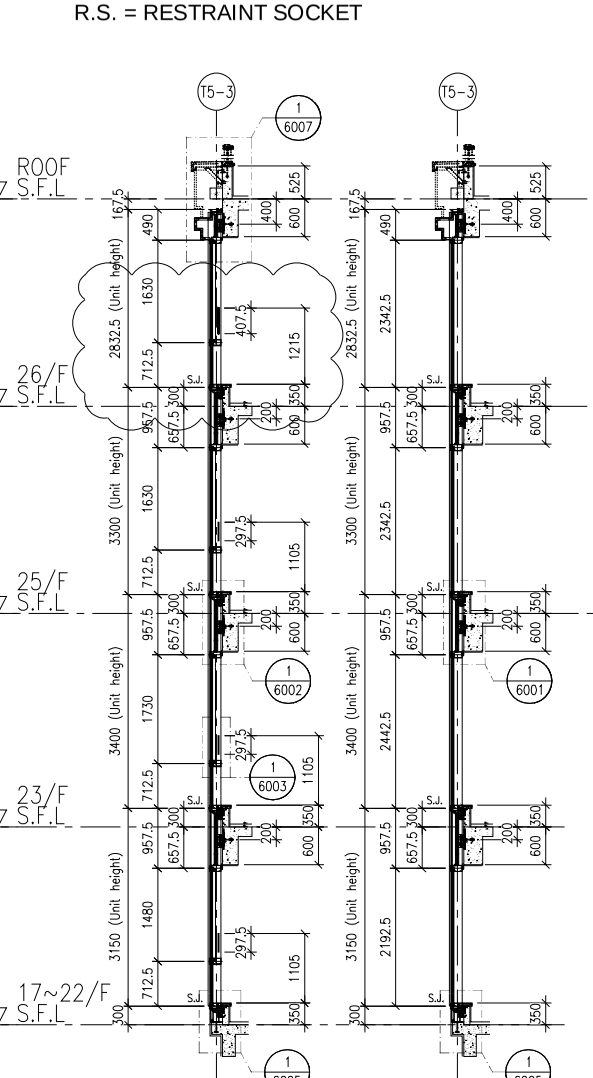


7 — TYPICAL SECTION FOR CURTAIN WALL

8 — TYPICAL SECTION FOR CURTAIN WALL


T5CW-D-1

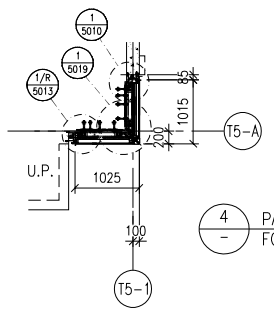

4 — PART PLAN FOR CURTAIN WALL

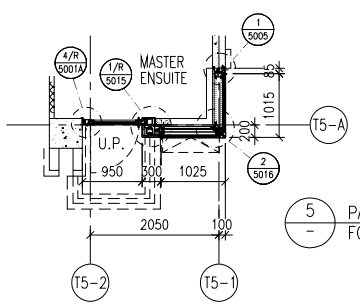


5 — PART PLAN FOR CURTAIN WALL

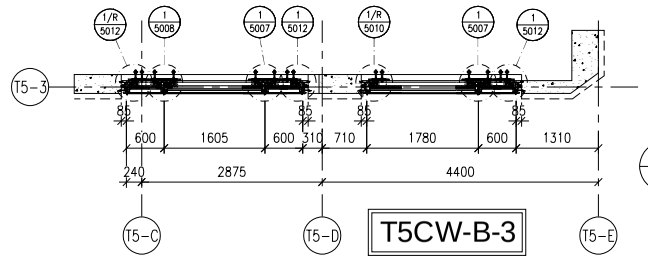


10 — PART PLAN FOR CURTAIN WALL


T5CW-B-3

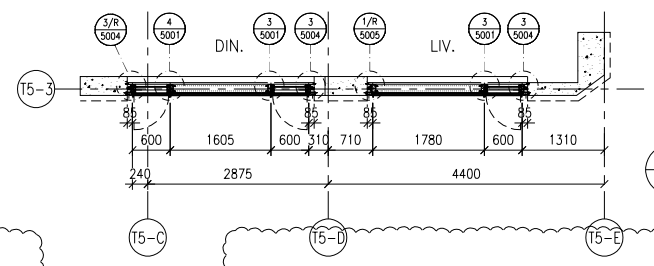

11 — PART PLAN FOR CURTAIN WALL

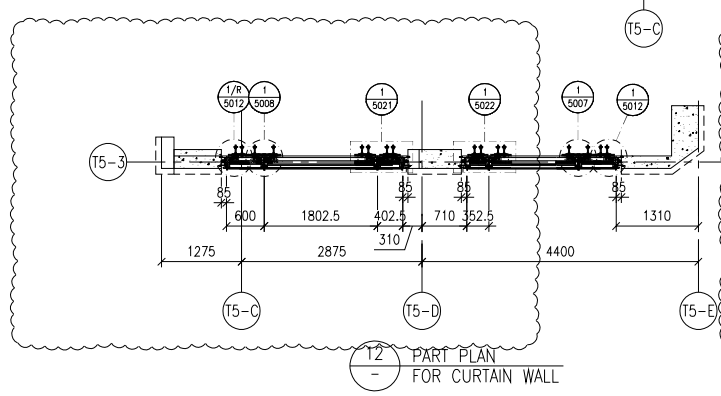

12 — PART PLAN FOR CURTAIN WALL

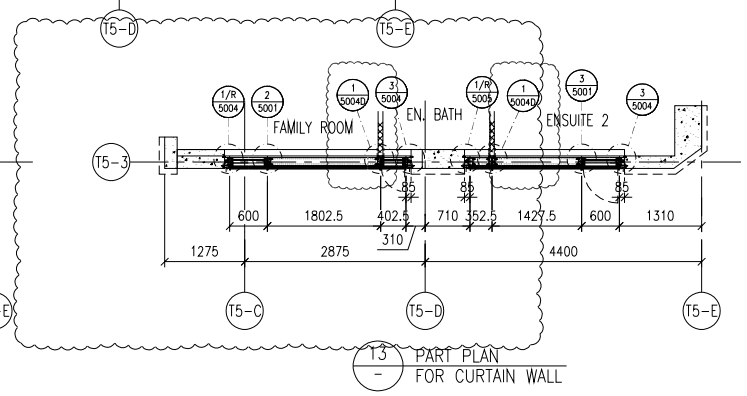

13 — PART PLAN FOR CURTAIN WALL

FLOOR LEVEL (S.F.L.)

FLOOR	LEVEL
ROOF	+210.00
26/F	+206.70
25/F	+203.40
23/F	+200.00
22/F	+196.85
21/F	+193.70
20/F	+190.55
19/F	+187.40
18/F	+184.25
17/F	+181.10
16/F	+177.80
15/F	+174.65
12/F	+171.50
11/F	+168.35

LEGEND:
- 10mm HEAT STRENGTHENED GLASS (OUTER) + 12mm AIR SPACE +12mm THK. TEMPERED CLEAR GLASS (INNER)
- 10mm HEAT STRENGTHENED GLASS (OUTER) + 12mm AIR SPACE +10mm THK. TEMPERED CLEAR GLASS (INNER)
- 12mm THK. HEAT STRENGTHENED GLASS & 2mm THK. ALUM. BACKPAN (SPANDREL GLASS)
- 12mm THK. CLEAR TEMPERED GLASS (INTERNAL PROTECTIVE BARRIER)
- 3mm THK. ALUM. CLADDING
- S.J. — STACK JOINT (WIND LOAD)
- AE01 — ALUM. EXTRUSION DIE NO.
- ▲ — SUPPORT POINT (WIND LOAD + DEAD LOAD)
- ● — SUPPORT POINT (WIND LOAD)

B.D. REF :

CLIENT :
SHIMAO GROUP HOLDINGS LIMITED

ARCHITECT :
WONG TUNG & PARTNERS LIMITED
ARCHITECTS & PLANNERS

MAIN CONTRACTOR :
協興建築有限公司
HIP HING CONSTRUCTION CO LTD

STRUCTURAL ENGINEER :
C M WONG & ASSOCIATES LTD
黃志明建築工程師有限公司

FACADE CONSULTANT:
MEINHARDT

NOTE :
1. ALL DIMENSIONS ARE IN mm.
2. ALL ELEVATIONS ARE VIEWED FROM OUTSIDE.
3. ALL DIMENSIONS TO BE VERIFIED ON SITE BEFORE FABRICATION.

LEGEND :
- X1 / X001 — DETAIL MARK NO. / REFER SHEET NO.
1. F.F.L. -- FINISHED FLOOR LEVEL
2. S.F.L. -- STRUCTURAL FLOOR LEVEL
3. /R -- REVERSED DETAIL

NO.	DATE	REVISED	BY
A	06-10-2021	REVISION SUBJECT TO ARCH. COMMENT	

JOB NO. : J-853

PROJECT :
PROPOSED RESIDENTIAL DEVELOPMENT AT N.K.I.L. 6542 YIN PING ROAD KOWLOON

TITLE :
PART ELEVATION FOR CURTAIN WALL AT TOWER 5

DATE : 05-APR-21 | SCALE : 1:60 (A1)


DRAWN BY : LHR | CHECKED BY :

美特鋁質有限公司
MIDI ALUMINIUM FABRICATOR LTD.
Units 6-8, Sunray Industrial Centre, 1/F
610 Cha Kwo Ling Road, Kowloon
Tel:23489211-4 Fax:(852)27727666

DWG NO. : J853-SD-CW-4506 | REV. : A

LEGEND :


R.S. = RESTRAINT SOCKET

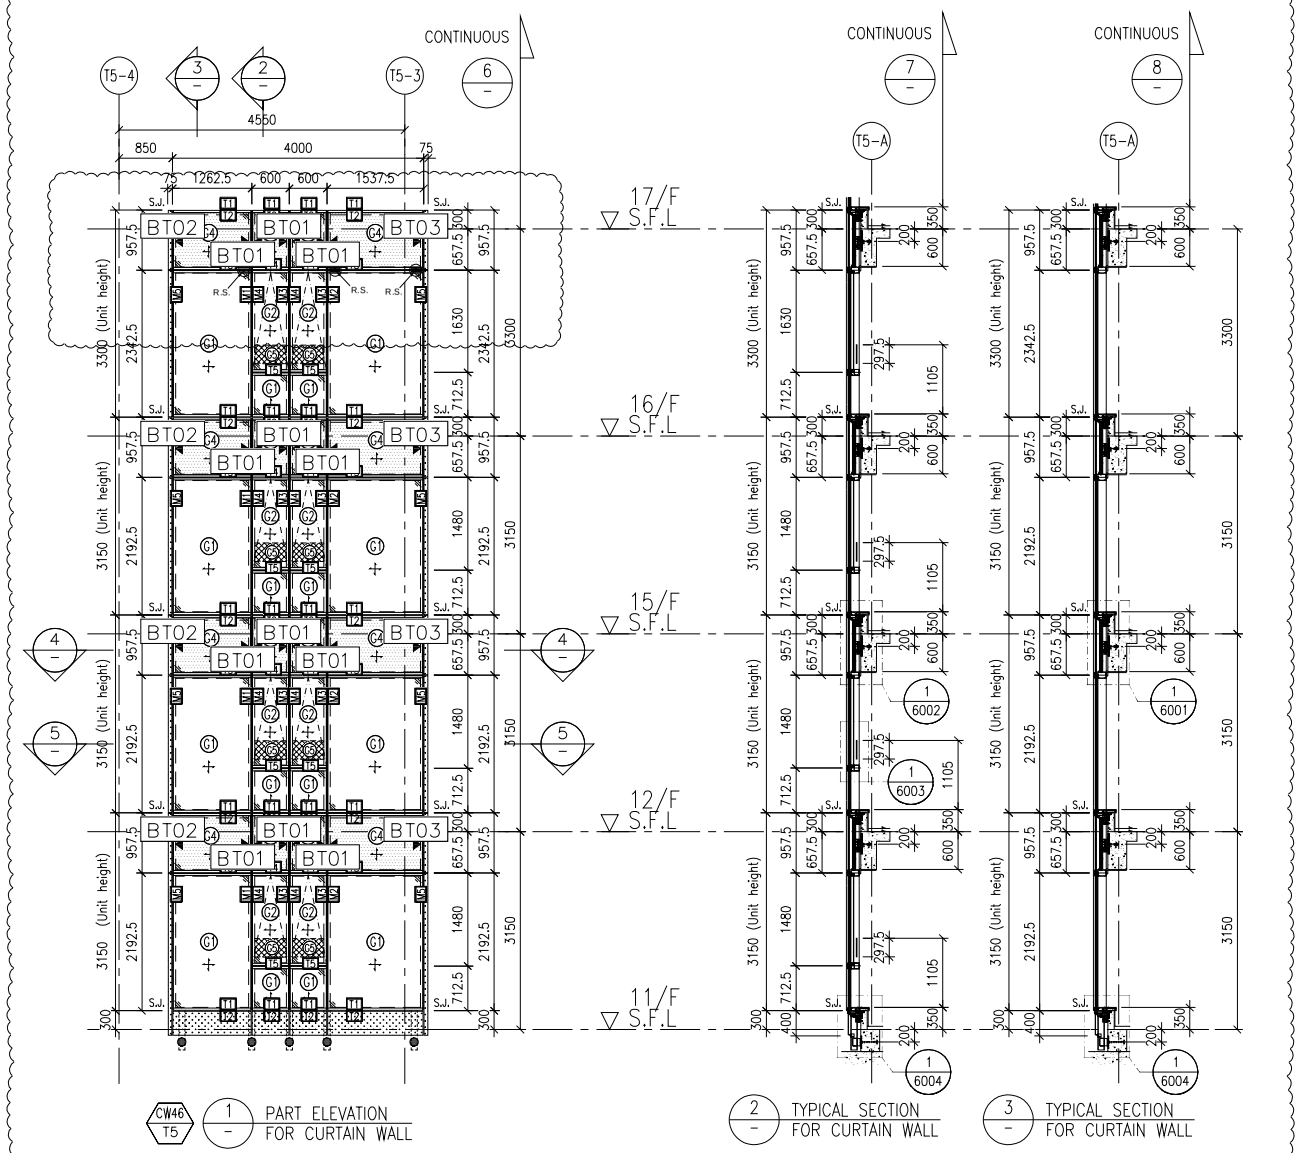

CW46 T5 — 1 — PART ELEVATION FOR CURTAIN WALL

2 — TYPICAL SECTION FOR CURTAIN WALL

3 — TYPICAL SECTION FOR CURTAIN WALL

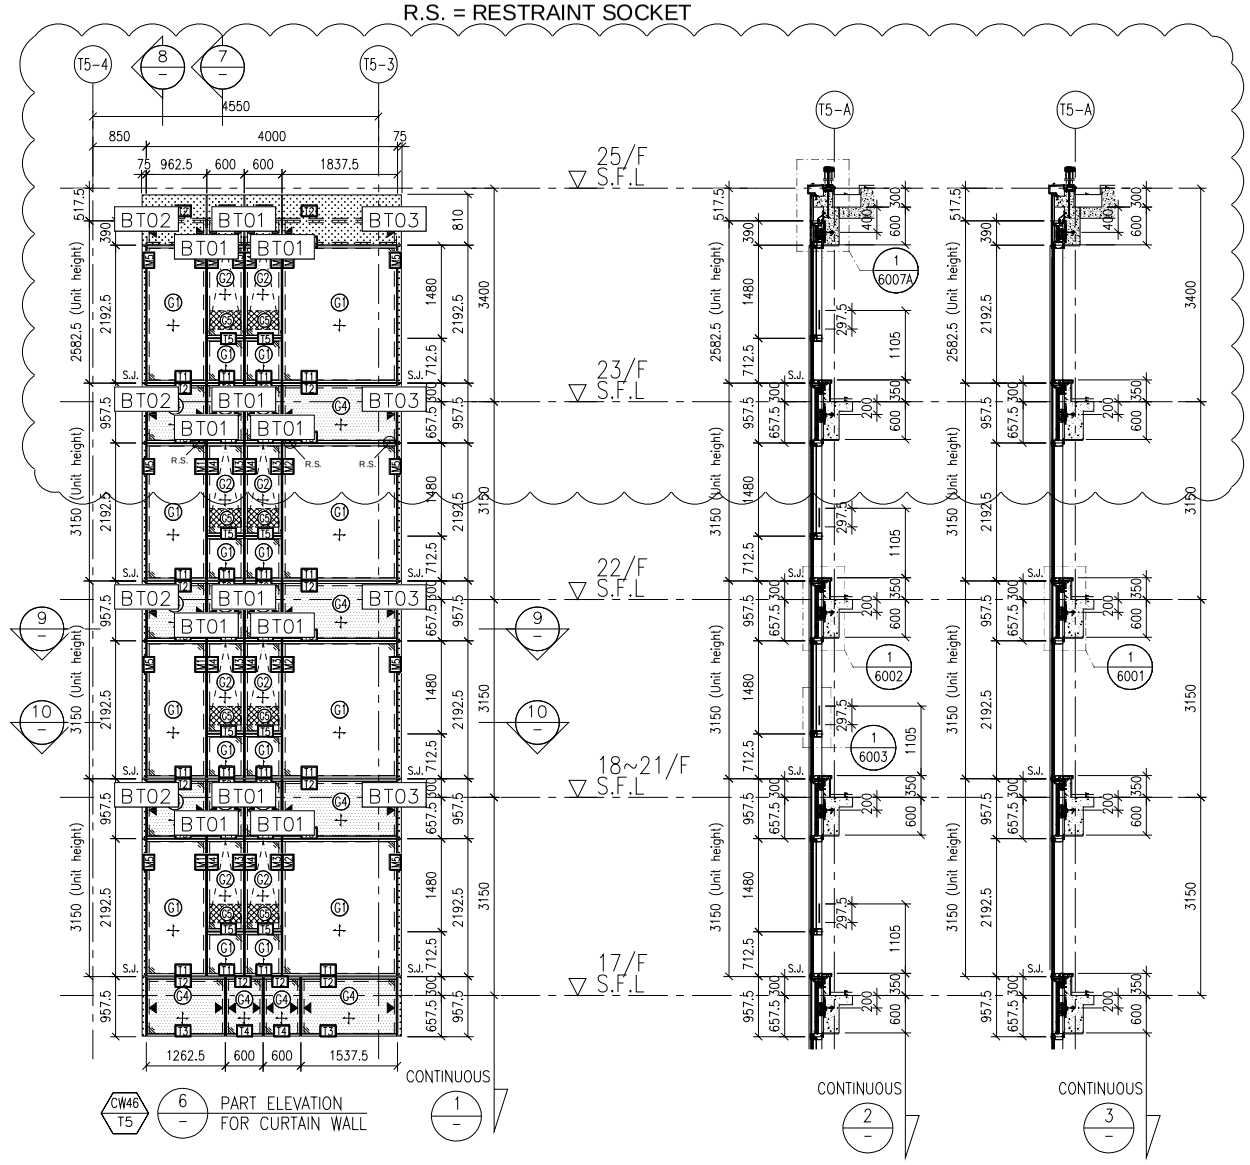


CW46 T5 — 6 — PART ELEVATION FOR CURTAIN WALL

T5CW-B-4


7 — TYPICAL SECTION FOR CURTAIN WALL

8 — TYPICAL SECTION FOR CURTAIN WALL

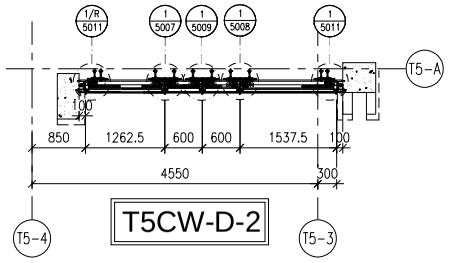


T5CW-D-2


4 — PART PLAN FOR CURTAIN WALL

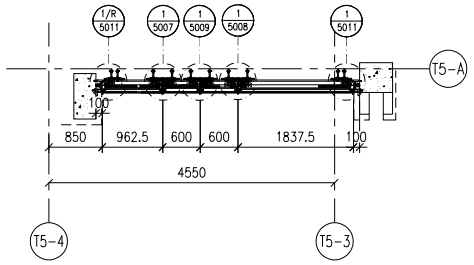

9 — PART PLAN FOR CURTAIN WALL

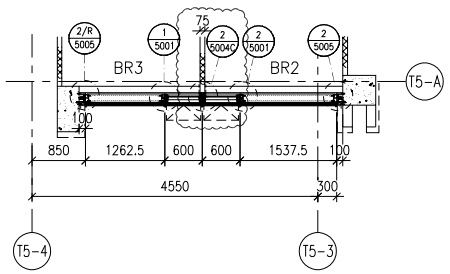

5 — PART PLAN FOR CURTAIN WALL

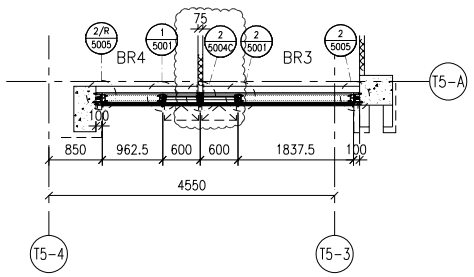

10 — PART PLAN FOR CURTAIN WALL

FLOOR LEVEL (S.F.L.)

FLOOR	LEVEL
25/F	+203.40
23/F	+200.00
22/F	+196.85
21/F	+193.70
20/F	+190.55
19/F	+187.40
18/F	+184.25
17/F	+181.10
16/F	+177.80
15/F	+174.65
12/F	+171.50
11/F	+168.35

LEGEND:

- G1 — 10mm HEAT STRENGTHENED GLASS (OUTER) + 12mm AIR SPACE +12mm THK. TEMPERED CLEAR GLASS (INNER)
- G2 — 10mm HEAT STRENGTHENED GLASS (OUTER) + 12mm AIR SPACE +10mm THK. TEMPERED CLEAR GLASS (INNER)
- G4 — 12mm THK. HEAT STRENGTHENED GLASS & 2mm THK. ALUM. BACKPAN (SPANDREL GLASS)
- G5 — 12mm THK. CLEAR TEMPERED GLASS (INTERNAL PROTECTIVE BARRIER)
- 3mm THK. ALUM. CLADDING
- S.J. — STACK JOINT (WIND LOAD)
- AE01 — ALUM. EXTRUSION DIE NO.
- ▲ — SUPPORT POINT (WIND LOAD + DEAD LOAD)
- ● — SUPPORT POINT (WIND LOAD)

B.D. REF :

CLIENT :

SHIMAO GROUP HOLDINGS LIMITED

ARCHITECT :

WONG TUNG & PARTNERS LIMITED
ARCHITECTS & PLANNERS

MAIN CONTRACTOR :

協興建築有限公司
HIP HING CONSTRUCTION CO LTD

STRUCTURAL ENGINEER :

C M WONG & ASSOCIATES LTD
黃志明建築工程師有限公司

FACADE CONSULTANT:

MEINHARDT

NOTE :

1. ALL DIMENSIONS ARE IN mm.
2. ALL ELEVATIONS ARE VIEWED FROM OUTSIDE.
3. ALL DIMENSIONS TO BE VERIFIED ON SITE BEFORE FABRICATION.

LEGEND :

X1 / X001 — DETAIL MARK NO. / REFER SHEET NO.

1. F.F.L. -- FINISHED FLOOR LEVEL
2. S.F.L. -- STRUCTURAL FLOOR LEVEL
3. /R -- REVERSED DETAIL

NO.	DATE	REVISED	BY
A	06-10-2021	REVISION SUBJECT TO ARCH. COMMENT	

JOB NO. : J-853

PROJECT :

PROPOSED RESIDENTIAL DEVELOPMENT AT N.K.I.L. 6542 YIN PING ROAD KOWLOON

TITLE :

PART ELEVATION FOR CURTAIN WALL AT TOWER 5

DATE : 05-APR-21 | SCALE : 1:60 (A1)


DRAWN BY : LHR | CHECKED BY :

美特鋁質有限公司
MIDI ALUMINIUM FABRICATOR LTD.
Units 6-8, Sunray Industrial Centre, 1/F
610 Cha Kwo Ling Road, Kowloon
Tel:23489211-4 Fax:(852)27727666

DWG NO. : J853-SD-CW-4507 | REV. : A

LEGEND :

R.S. = RESTRAINT SOCKET

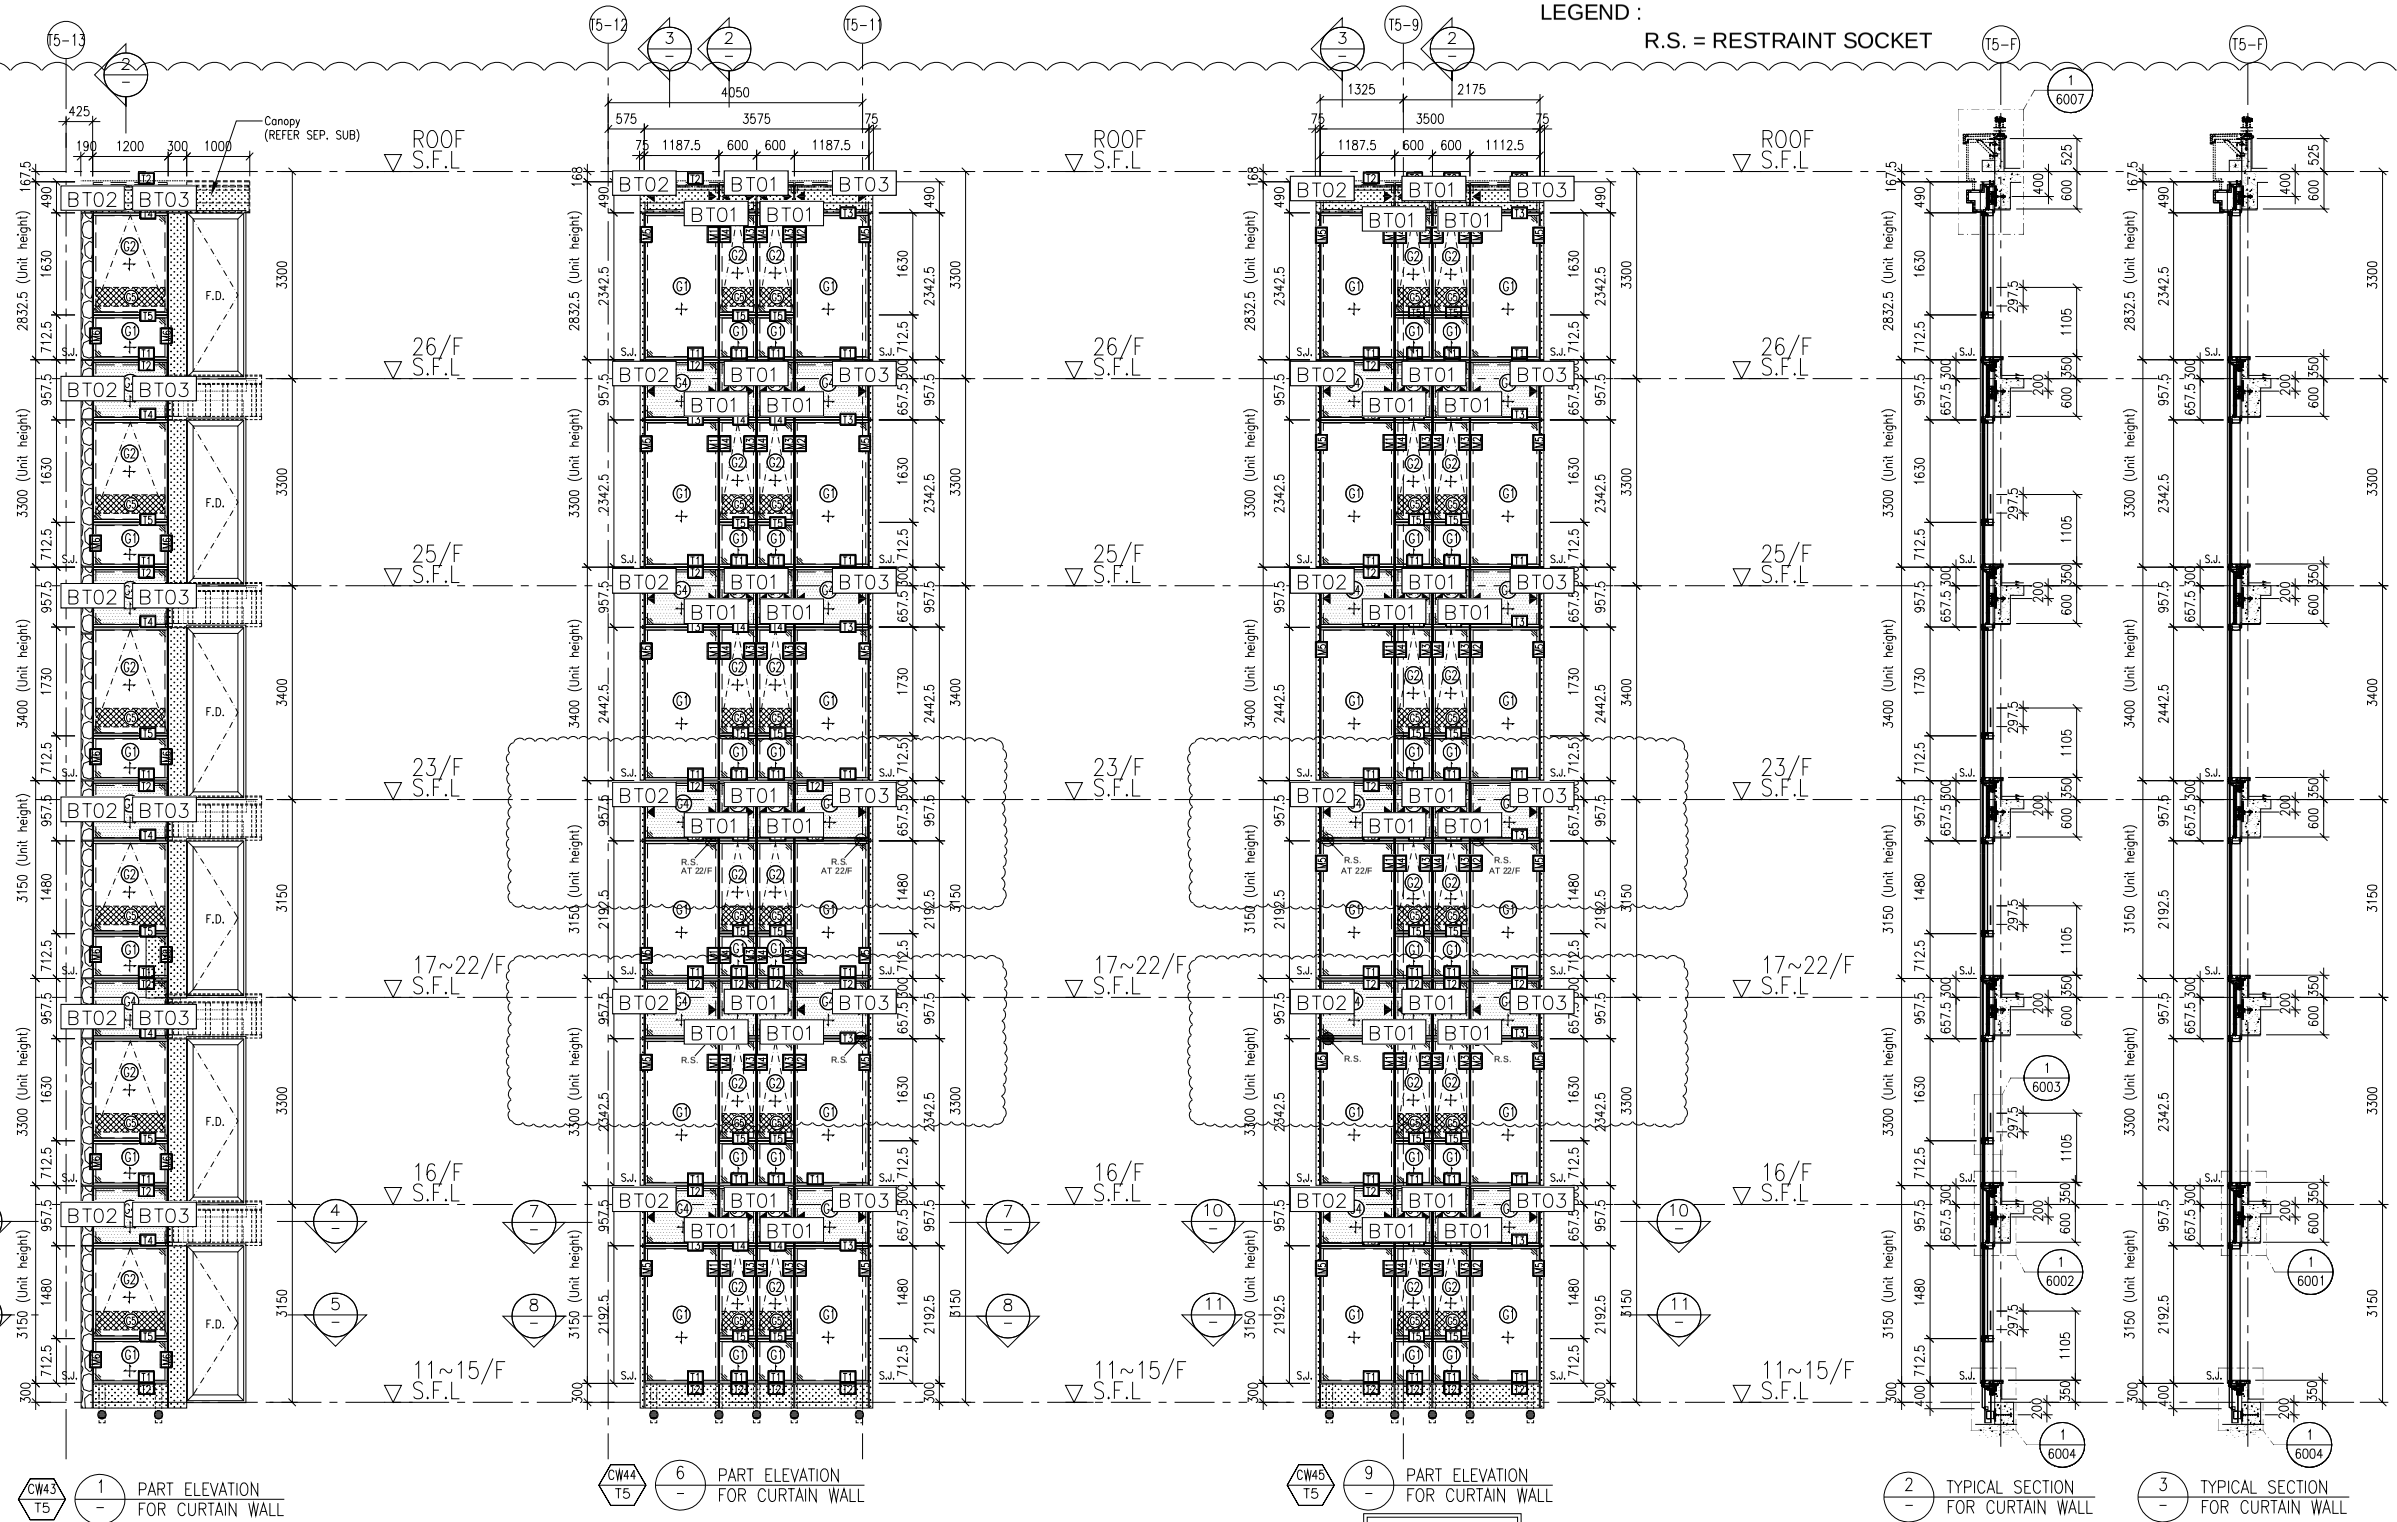

CW43 T5 — 1 — PART ELEVATION FOR CURTAIN WALL


CW44 T5 — 6 — PART ELEVATION FOR CURTAIN WALL

CW45 T5 — 9 — PART ELEVATION FOR CURTAIN WALL

2 — TYPICAL SECTION FOR CURTAIN WALL


3 — TYPICAL SECTION FOR CURTAIN WALL

T5CW-E-1

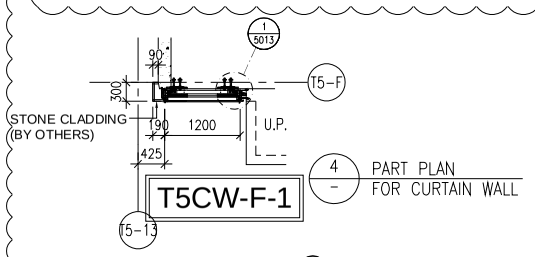


4 — PART PLAN FOR CURTAIN WALL

T5CW-F-1

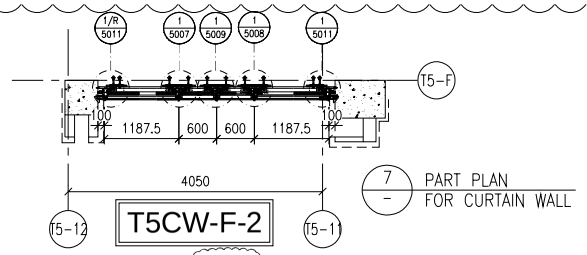


7 — PART PLAN FOR CURTAIN WALL


T5CW-F-2

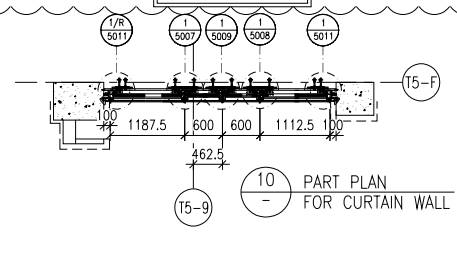


10 — PART PLAN FOR CURTAIN WALL

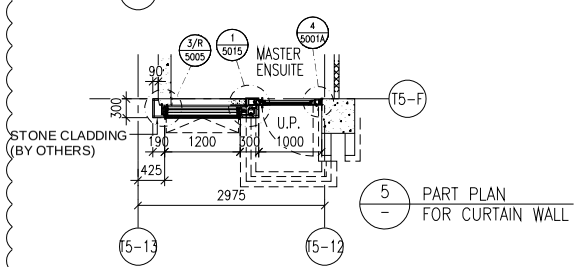

5 — PART PLAN FOR CURTAIN WALL

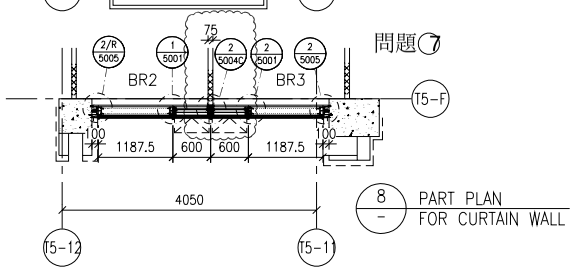

8 — PART PLAN FOR CURTAIN WALL

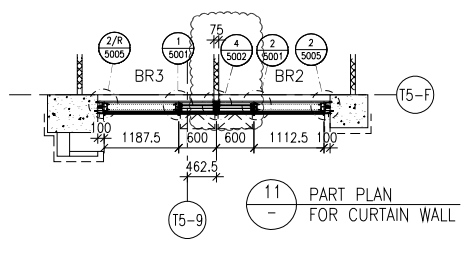

11 — PART PLAN FOR CURTAIN WALL

FLOOR LEVEL (S.F.L.)

FLOOR	LEVEL
ROOF	+210.00
26/F	+206.70
25/F	+203.40
23/F	+200.00
22/F	+196.85
21/F	+193.70
20/F	+190.55
19/F	+187.40
18/F	+184.25
17/F	+181.10
16/F	+177.80
15/F	+174.65
12/F	+171.50
11/F	+168.35

LEGEND:

- C1 — 10mm HEAT STRENGTHENED GLASS (OUTER) + 12mm AIR SPACE +12mm THK. TEMPERED CLEAR GLASS (INNER)
- C2 — 10mm HEAT STRENGTHENED GLASS (OUTER) + 12mm AIR SPACE +10mm THK. TEMPERED CLEAR GLASS (INNER)
- C4 — 12mm THK. HEAT STRENGTHENED GLASS & 2mm THK. ALUM. BACKPAN (SPANDREL GLASS)
- C5 — 12mm THK. CLEAR TEMPERED GLASS (INTERNAL PROTECTIVE BARRIER)
- 3mm THK. ALUM. CLADDING
- S.J. — STACK JOINT (WIND LOAD)
- AE01 — ALUM. EXTRUSION DIE NO.
- ▲ — SUPPORT POINT (WIND LOAD + DEAD LOAD)
- ● — SUPPORT POINT (WIND LOAD)

B.D. REF :

CLIENT :

SHIMAO GROUP HOLDINGS LIMITED

ARCHITECT :

WONG TUNG & PARTNERS LIMITED
ARCHITECTS & PLANNERS

MAIN CONTRACTOR :

協興建築有限公司
HIP HING CONSTRUCTION CO LTD

STRUCTURAL ENGINEER :

C M WONG & ASSOCIATES LTD
黃志明建築工程師有限公司

FACADE CONSULTANT:

MEINHARDT

NOTE :

1. ALL DIMENSIONS ARE IN mm.
2. ALL ELEVATIONS ARE VIEWED FROM OUTSIDE.
3. ALL DIMENSIONS TO BE VERIFIED ON SITE BEFORE FABRICATION.

LEGEND :

X1 / X001 — DETAIL MARK NO. / REFER SHEET NO.

1. F.F.L. --FINISHED FLOOR LEVEL
2. S.F.L. --STRUCTURAL FLOOR LEVEL
3. (/R) --REVERSED DETAIL

NO.	DATE	REVISED	BY
A	06-10-2021	REVISION SUBJECT TO ARCH. COMMENT	

JOB NO. : J-853

PROJECT :

PROPOSED RESIDENTIAL DEVELOPMENT AT N.K.I.L. 6542 YIN PING ROAD KOWLOON

TITLE :


PART ELEVATION FOR CURTAIN WALL AT TOWER 5

DATE : 05-APR-21 | SCALE : 1:60 (A1)

DRAWN BY : LHR | CHECKED BY :

美特鋁質有限公司
MIDI ALUMINIUM FABRICATOR LTD.
Units 6-8, Sunray Industrial Centre, 1/F
610 Cha Kwo Ling Road, Kowloon
Tel:23489211-4 Fax:(852)27727666


DWG NO. : J853-SD-CW-4508 | REV. : A

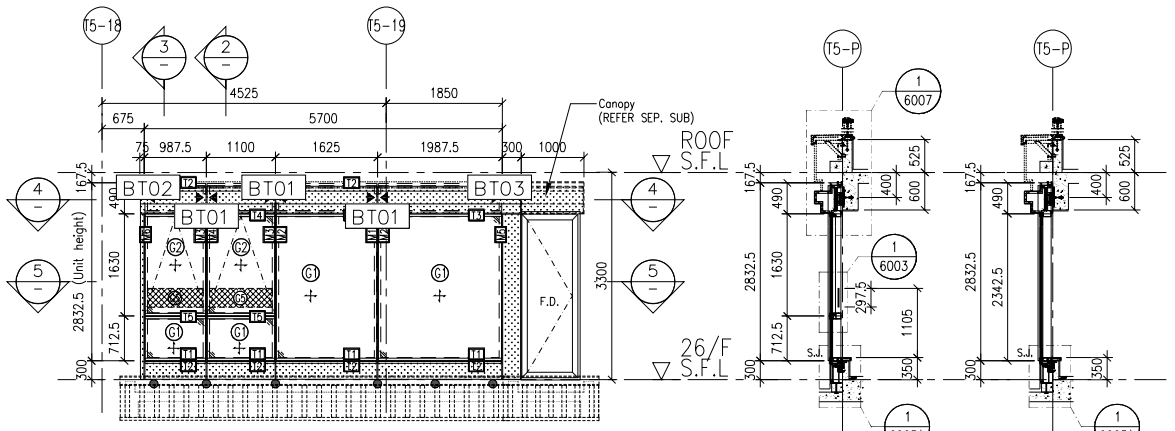


CW39 T5 — 1 — PART ELEVATION FOR CURTAIN WALL

2 — TYPICAL SECTION FOR CURTAIN WALL


3 — TYPICAL SECTION FOR CURTAIN WALL

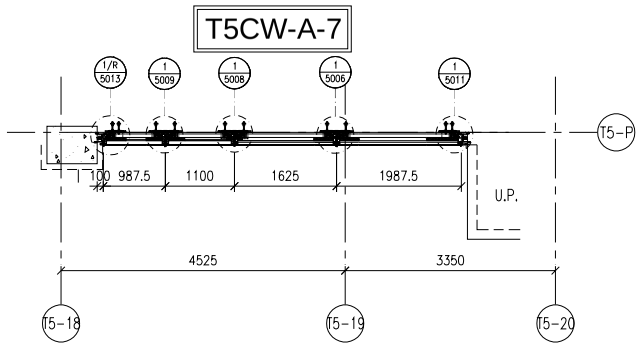

4 — PART PLAN FOR CURTAIN WALL

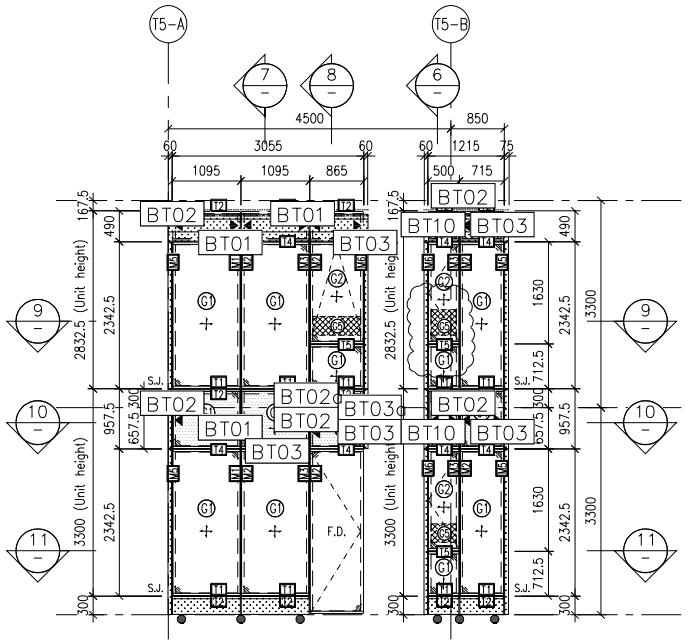


CW42 T5 — 5 — PART ELEVATION FOR CURTAIN WALL

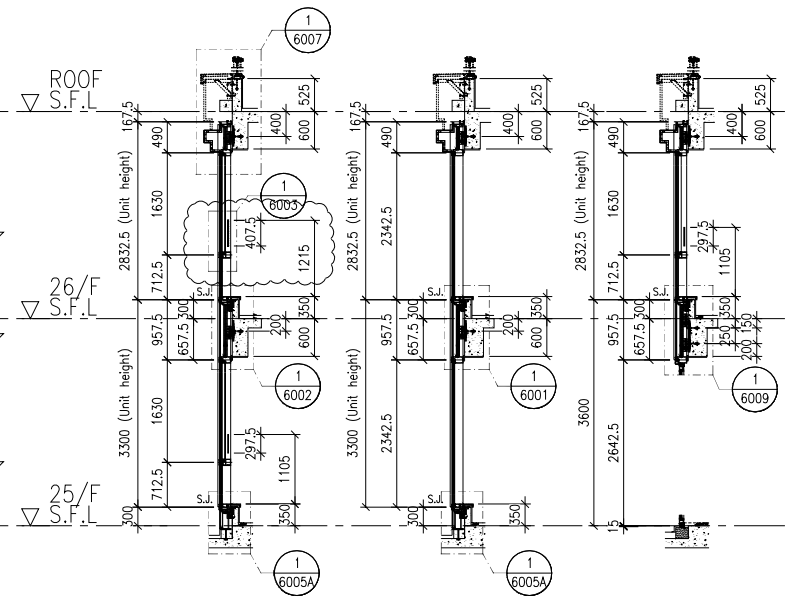

6 — TYPICAL SECTION FOR CURTAIN WALL


7 — TYPICAL SECTION FOR CURTAIN WALL

8 — TYPICAL SECTION FOR CURTAIN WALL

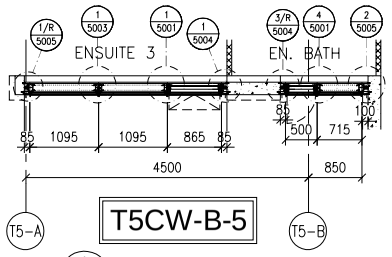


T5CW-B-5


9 — PART PLAN FOR CURTAIN WALL

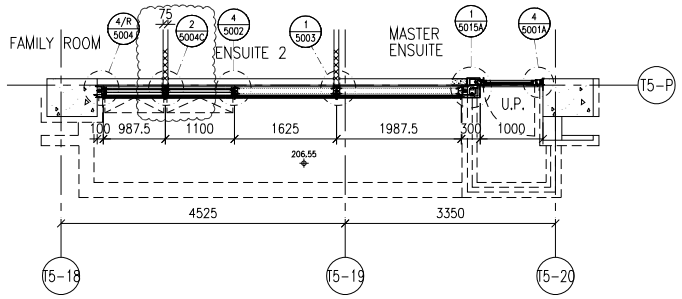

5 — PART PLAN FOR CURTAIN WALL

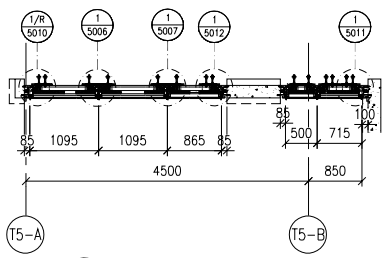

10 — PART PLAN FOR CURTAIN WALL

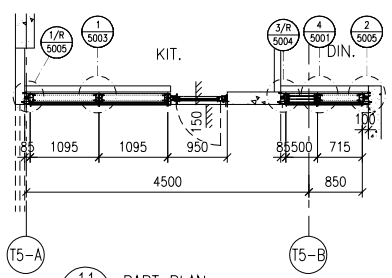

11 — PART PLAN FOR CURTAIN WALL

FLOOR LEVEL (S.F.L.)

FLOOR	LEVEL
ROOF	+210.00
26/F	+206.70
25/F	+203.40

LEGEND:

- G1 — 10mm HEAT STRENGTHENED GLASS (OUTER) + 12mm AIR SPACE +12mm THK. TEMPERED CLEAR GLASS (INNER)
- G2 — 10mm HEAT STRENGTHENED GLASS (OUTER) + 12mm AIR SPACE +10mm THK. TEMPERED CLEAR GLASS (INNER)
- G4 — 12mm THK. HEAT STRENGTHENED GLASS & 2mm THK. ALUM. BACKPAN (SPANDREL GLASS)
- G5 — 12mm THK. CLEAR TEMPERED GLASS (INTERNAL PROTECTIVE BARRIER)
- 3mm THK. ALUM. CLADDING
- S.J. — STACK JOINT (WIND LOAD)
- AF01 — ALUM. EXTRUSION DIE NO.
- ▲ — SUPPORT POINT (WIND LOAD + DEAD LOAD)
- ● — SUPPORT POINT (WIND LOAD)

B.D. REF :

CLIENT :

SHIMAO GROUP HOLDINGS LIMITED

ARCHITECT : WONG TUNG & PARTNERS LIMITED ARCHITECTS & PLANNERS

MAIN CONTRACTOR : 協興建築有限公司 HIP HING CONSTRUCTION CO LTD

STRUCTURAL ENGINEER : C M WONG & ASSOCIATES LTD 黃志明建築工程師有限公司

FACADE CONSULTANT: MEINHARDT

NOTE :
1. ALL DIMENSIONS ARE IN mm.
2. ALL ELEVATIONS ARE VIEWED FROM OUTSIDE.
3. ALL DIMENSIONS TO BE VERIFIED ON SITE BEFORE FABRICATION.

LEGEND :
- X1 / X001 — DETAIL MARK NO. / REFER SHEET NO.
1. F.F.L. -- FINISHED FLOOR LEVEL
2. S.F.L. -- STRUCTURAL FLOOR LEVEL
3. /R -- REVERSED DETAIL

NO.	DATE	REVISED	BY

JOB NO. : J-853

PROJECT :
PROPOSED RESIDENTIAL DEVELOPMENT AT N.K.I.L. 6542 YIN PING ROAD KOWLOON


TITLE :
PART ELEVATION FOR CURTAIN WALL AT TOWER 5

DATE : 06-OCT-21 | SCALE : 1:60 (A1)

DRAWN BY : LHR | CHECKED BY :

美特鋁質有限公司 MIDI ALUMINIUM FABRICATOR LTD.
Units 6-8, Sunray Industrial Centre, 1/F
610 Cha Kwo Ling Road, Kowloon
Tel:23489211-4 Fax:(852)27727666

DWG NO. : J853-SD-CW-4509 | REV. : A

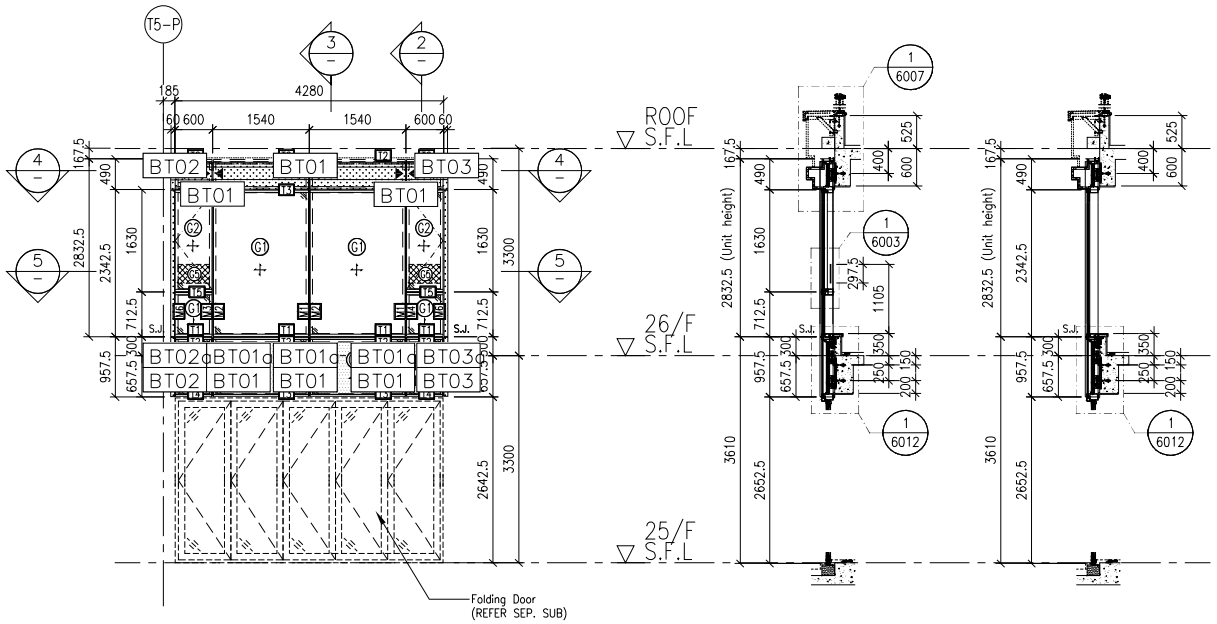


CW47 / T5 — 1 / – PART ELEVATION FOR CURTAIN WALL


2 / – TYPICAL SECTION FOR CURTAIN WALL

3 / – TYPICAL SECTION FOR CURTAIN WALL

T5CW-A-8

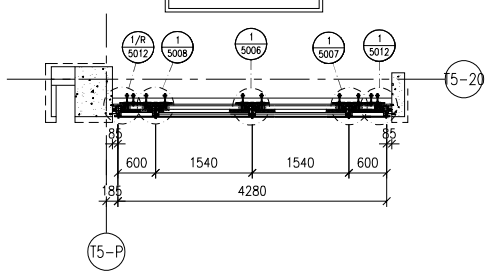

4 / – PART PLAN FOR CURTAIN WALL

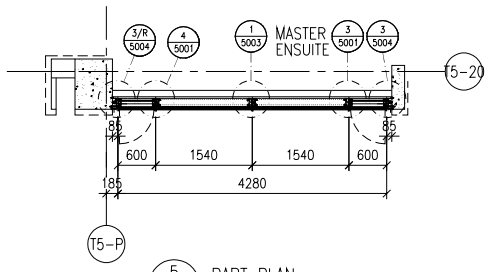

5 / – PART PLAN FOR CURTAIN WALL

FLOOR LEVEL (S.F.L.)

FLOOR	LEVEL
ROOF	+210.00
26/F	+206.70
25/F	+203.40

LEGEND:

- G1 – 10mm HEAT STRENGTHENED GLASS (OUTER) + 12mm AIR SPACE +12mm THK. TEMPERED CLEAR GLASS (INNER)
- G2 – 10mm HEAT STRENGTHENED GLASS (OUTER) + 12mm AIR SPACE +10mm THK. TEMPERED CLEAR GLASS (INNER)
- G3 – 12mm THK. HEAT STRENGTHENED GLASS & 2mm THK. ALUM. BACKPAN (SPANDREL GLASS)
- G4 – 12mm THK. CLEAR TEMPERED GLASS (INTERNAL PROTECTIVE BARRIER)
- 3mm THK. ALUM. CLADDING
- S.J. – STACK JOINT (WIND LOAD)
- AE01 – ALUM. EXTRUSION DIE NO.
- ▲ – SUPPORT POINT (WIND LOAD + DEAD LOAD)
- ● – SUPPORT POINT (WIND LOAD)

B.D. REF :

CLIENT :
SHIMAO GROUP HOLDINGS LIMITED

ARCHITECT :
WONG TUNG & PARTNERS LIMITED
ARCHITECTS & PLANNERS

MAIN CONTRACTOR :
協興建築有限公司
HIP HING CONSTRUCTION CO LTD

STRUCTURAL ENGINEER :
C M WONG & ASSOCIATES LTD
黃志明建築工程師有限公司

FACADE CONSULTANT:
MEINHARDT

NOTE :
1. ALL DIMENSIONS ARE IN mm.
2. ALL ELEVATIONS ARE VIEWED FROM OUTSIDE.
3. ALL DIMENSIONS TO BE VERIFIED ON SITE BEFORE FABRICATION.

LEGEND :
- X1 / X001 — DETAIL MARK NO. / REFER SHEET NO.

1. F.F.L. --FINISHED FLOOR LEVEL
2. S.F.L. --STRUCTURAL FLOOR LEVEL
3. /R --REVERSED DETAIL

NO.	DATE	REVISED	BY

JOB NO. : J-853

PROJECT :
PROPOSED RESIDENTIAL DEVELOPMENT AT N.K.I.L. 6542 YIN PING ROAD KOWLOON

TITLE :
PART ELEVATION FOR CURTAIN WALL AT TOWER 5

DATE : 06-OCT-21 | SCALE : 1:60 (A1)


DRAWN BY : LHR | CHECKED BY :

美特鋁質有限公司
MIDI ALUMINIUM FABRICATOR LTD.
Units 6-8, Sunray Industrial Centre, 1/F
610 Cha Kwo Ling Road, Kowloon
Tel:23489211-4 Fax:(852)27727666

DWG NO. : J853-SD-CW-4510 | REV. : A

LEGEND :

R.S. = RESTRAINT SOCKET

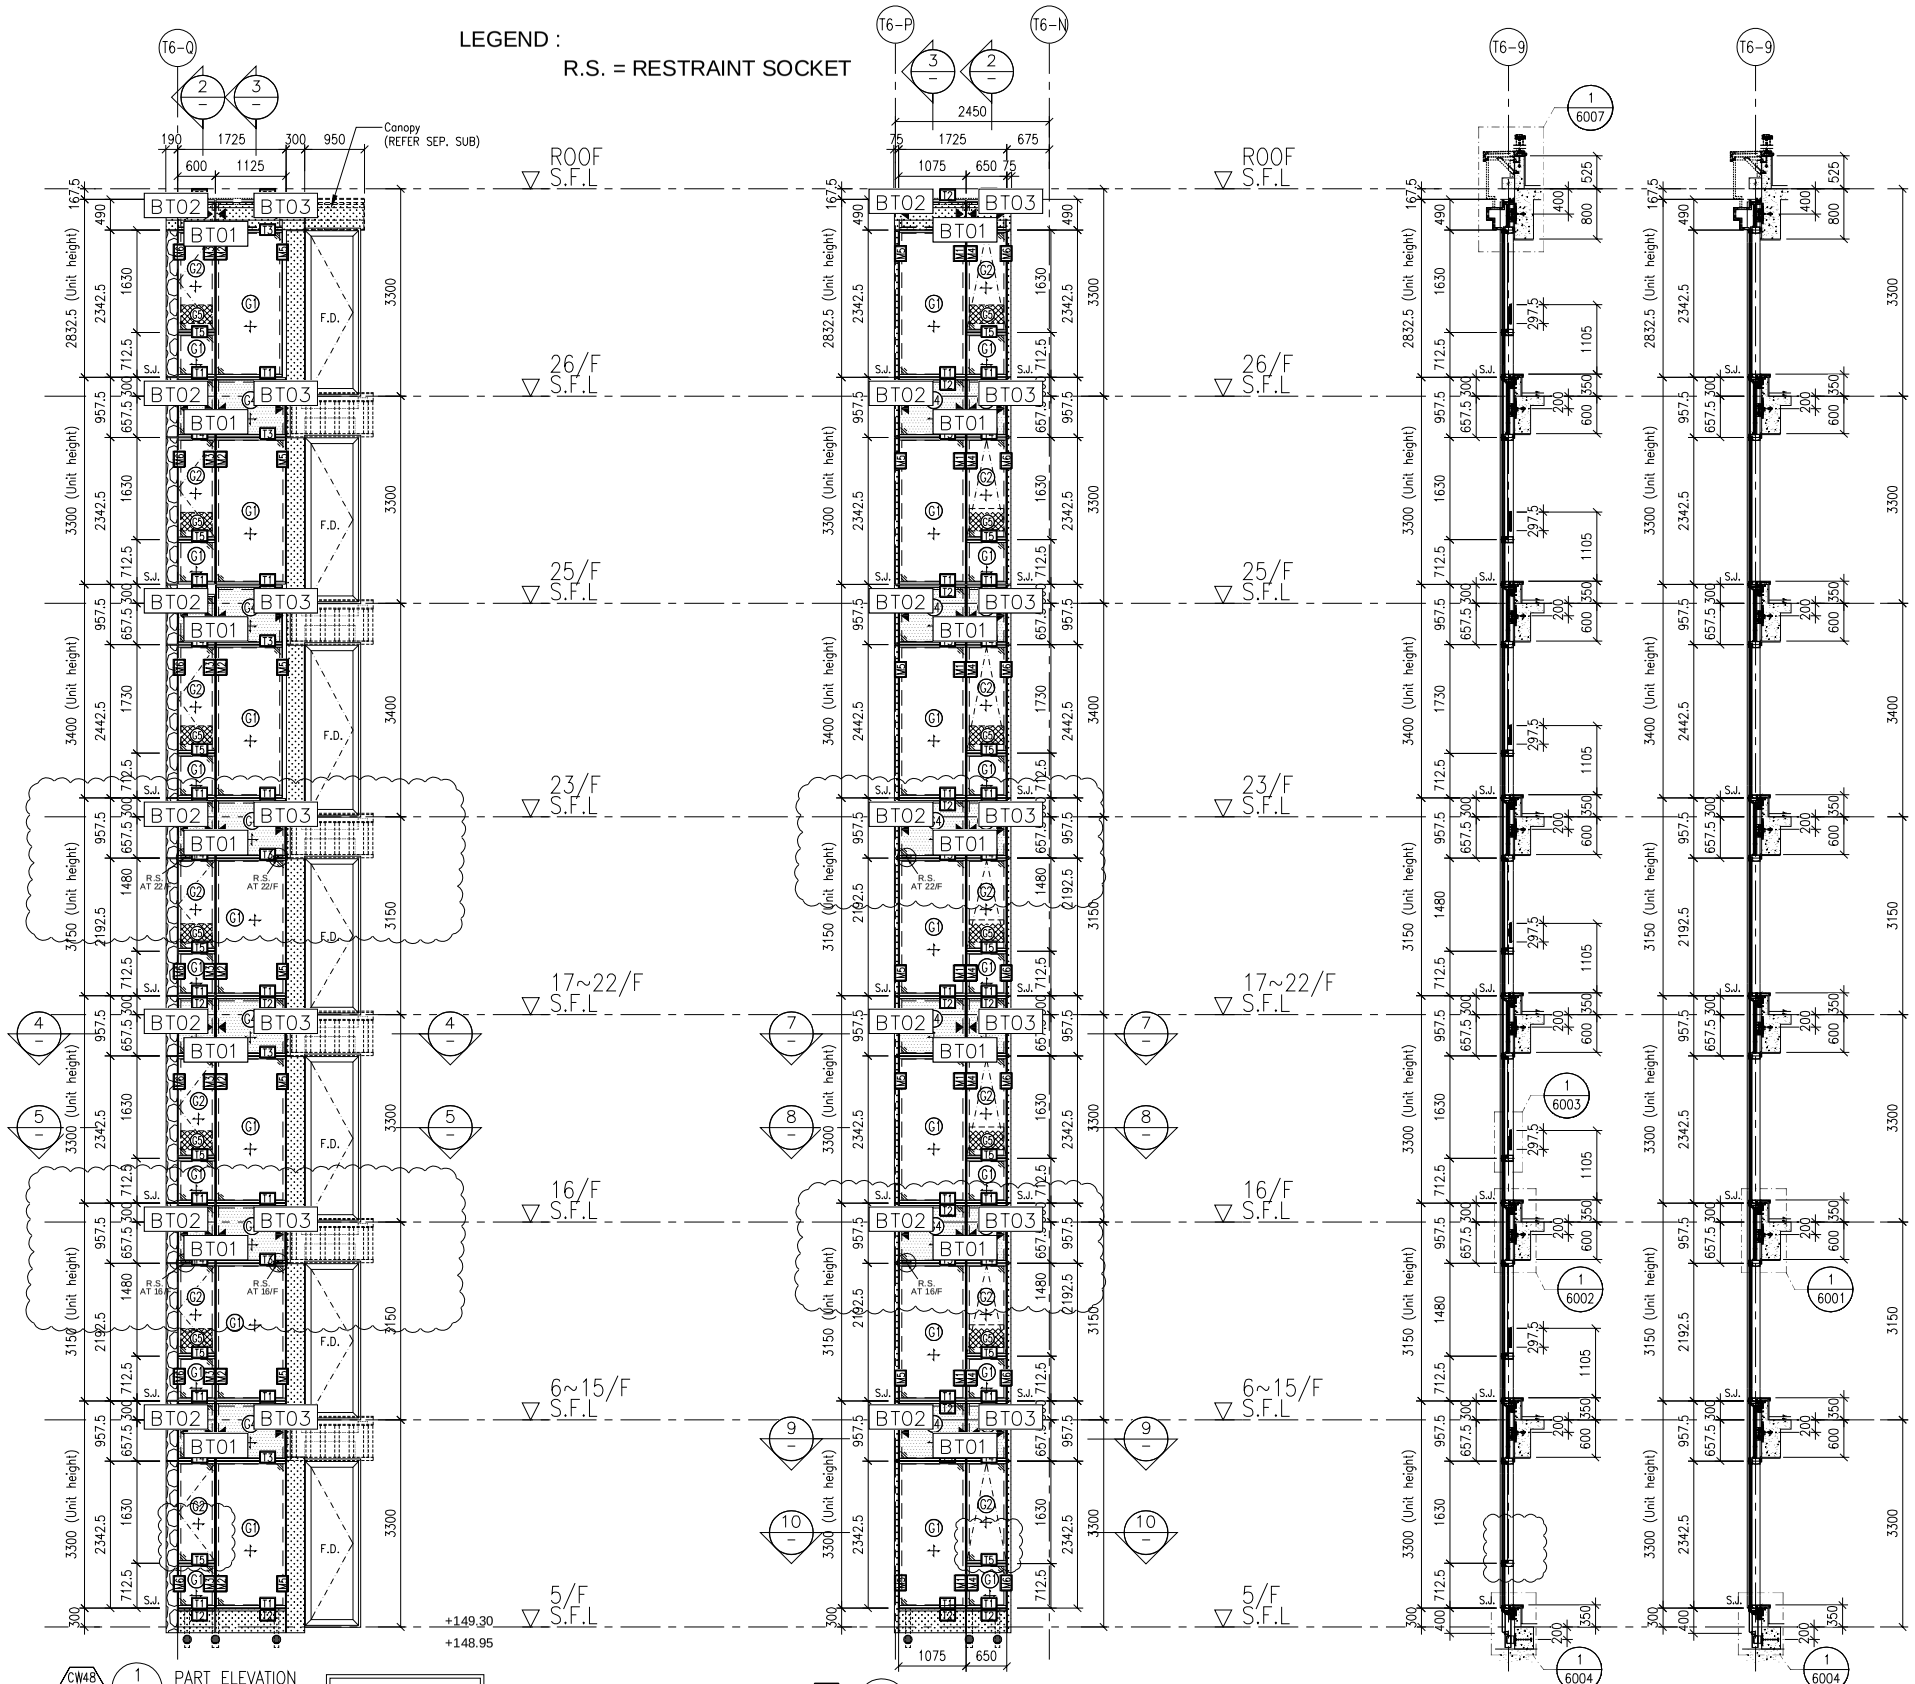


CW48 T67 1 – PART ELEVATION FOR CURTAIN WALL **T6CW-A-1**

CW49 T67 6 – PART ELEVATION FOR CURTAIN WALL **T6CW-A-2**


2 – TYPICAL SECTION FOR CURTAIN WALL

3 – TYPICAL SECTION FOR CURTAIN WALL

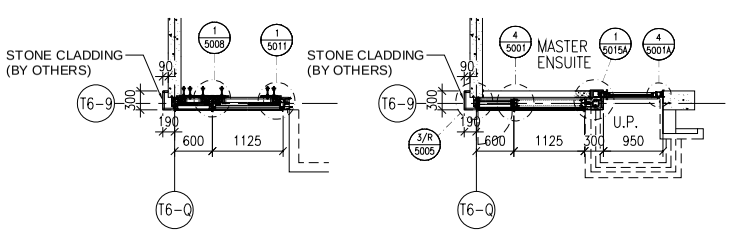


4 – PART PLAN FOR CURTAIN WALL


5 – PART PLAN FOR CURTAIN WALL

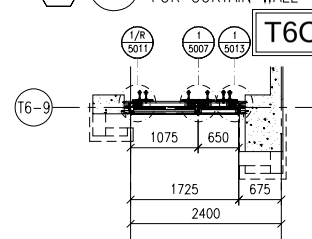

7 – PART PLAN FOR CURTAIN WALL

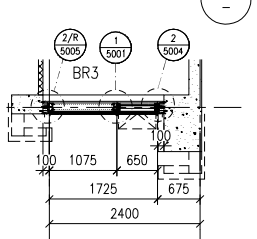

8 – PART PLAN FOR CURTAIN WALL

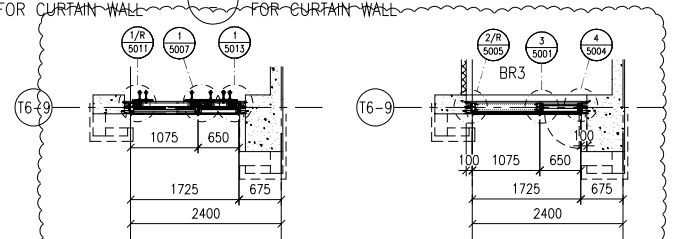

9 – PART PLAN FOR CURTAIN WALL

10 – PART PLAN FOR CURTAIN WALL

FLOOR LEVEL (S.F.L.)

FLOOR	LEVEL
ROOF	+210.00
26/F	+206.70
25/F	+203.40
23/F	+200.00
22/F	+196.85
21/F	+193.70
20/F	+190.55
19/F	+187.40
18/F	+184.25
17/F	+181.10
16/F	+177.80
15/F	+174.65
12/F	+171.50
11/F	+168.35
10/F	+165.20
9/F	+162.05
8/F	+158.90
7/F	+155.75
6/F	+152.60
5/F	+149.30

LEGEND:

- G1+ – 10mm HEAT STRENGTHENED GLASS (OUTER) + 12mm AIR SPACE +12mm THK. TEMPERED CLEAR GLASS (INNER)
- G2+ – 10mm HEAT STRENGTHENED GLASS (OUTER) + 12mm AIR SPACE +10mm THK. TEMPERED CLEAR GLASS (INNER)
- G4+ – 12mm THK. HEAT STRENGTHENED GLASS & 2mm THK. ALUM. BACKPAN (SPANDREL GLASS)
- G5 – 12mm THK. CLEAR TEMPERED GLASS (INTERNAL PROTECTIVE BARRIER)
- 3mm THK. ALUM. CLADDING
- S.J. – STACK JOINT (WIND LOAD)
- AE01 – ALUM. EXTRUSION DIE NO.
- ▲ – SUPPORT POINT (WIND LOAD + DEAD LOAD)
- ● – SUPPORT POINT (WIND LOAD)

B.D. REF :

CLIENT :

SHIMAO GROUP HOLDINGS LIMITED

ARCHITECT :

WONG TUNG & PARTNERS LIMITED
ARCHITECTS & PLANNERS

MAIN CONTRACTOR :

協興建築有限公司
HIP HING CONSTRUCTION CO LTD

STRUCTURAL ENGINEER :

C M WONG & ASSOCIATES LTD
黃志明建築工程師有限公司

FACADE CONSULTANT:

MEINHARDT

NOTE :

1. ALL DIMENSIONS ARE IN mm.
2. ALL ELEVATIONS ARE VIEWED FROM OUTSIDE.
3. ALL DIMENSIONS TO BE VERIFIED ON SITE BEFORE FABRICATION.

LEGEND :

X1 / X001 – DETAIL MARK NO. / REFER SHEET NO.

1. F.F.L. --FINISHED FLOOR LEVEL
2. S.F.L. --STRUCTURAL FLOOR LEVEL
3. /R --REVERSED DETAIL

NO.	DATE	REVISED	BY
A	09-10-2021	REVISION SUBJECT TO ARCH. COMMENT	

JOB NO. : J-853

PROJECT :

PROPOSED RESIDENTIAL DEVELOPMENT AT N.K.I.L. 6542 YIN PING ROAD KOWLOON

TITLE :

PART ELEVATION FOR CURTAIN WALL AT TOWER 6 & 7

DATE : 12-APR-21 | SCALE : 1:60 (A1)


DRAWN BY : LHR | CHECKED BY :

美特鋁質有限公司
MIDI ALUMINIUM FABRICATOR LTD.
Units 6-8, Sunray Industrial Centre, 1/F
610 Cha Kwo Ling Road, Kowloon
Tel:23489211-4 Fax:(852)27727666

DWG NO. : J853-SD-CW-4601 | REV. : A

LEGEND :


R.S. = RESTRAINT SOCKET

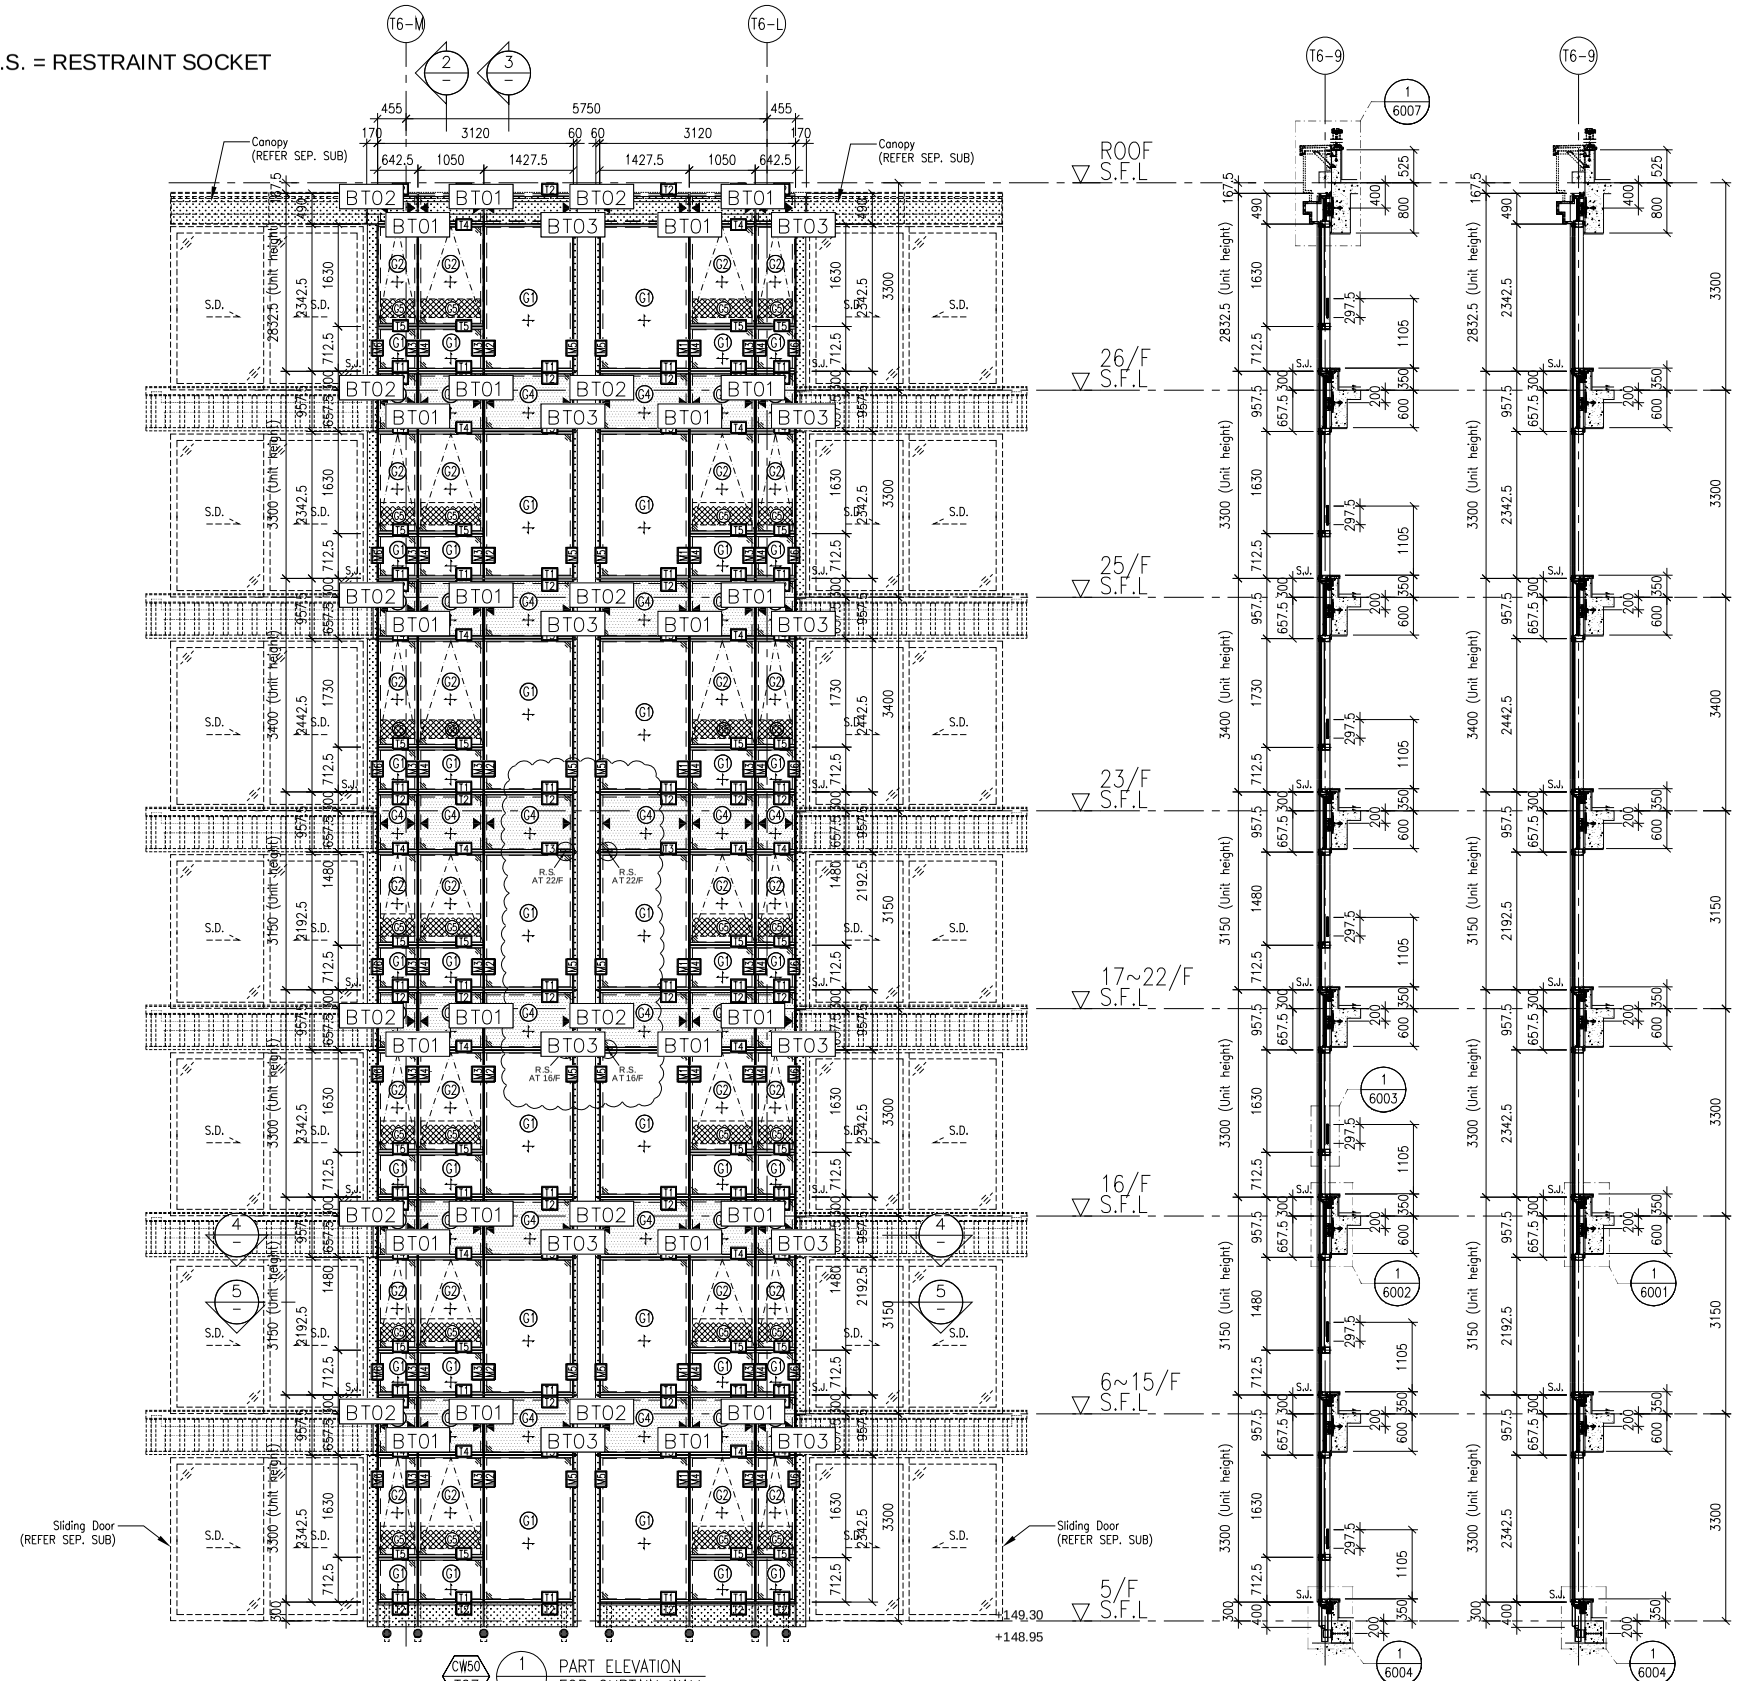


CW50 T67 1 – PART ELEVATION FOR CURTAIN WALL

T6CW-A-3

T6CW-B-1

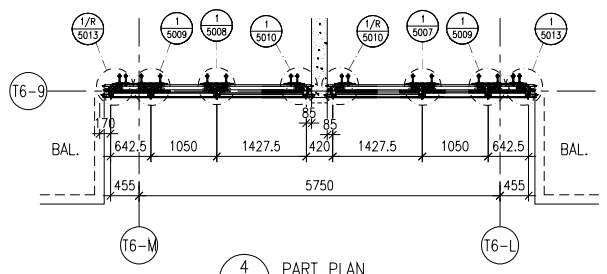

4 – PART PLAN FOR CURTAIN WALL

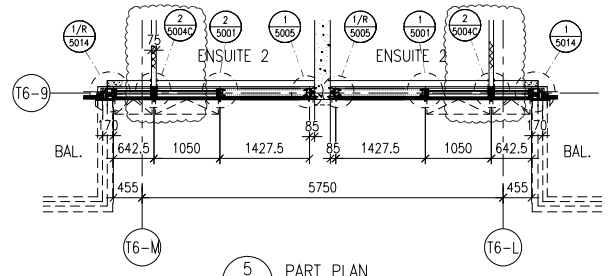

5 – PART PLAN FOR CURTAIN WALL

2 – TYPICAL SECTION FOR CURTAIN WALL

3 – TYPICAL SECTION FOR CURTAIN WALL

FLOOR LEVEL (S.F.L.)

FLOOR	LEVEL
ROOF	+210.00
26/F	+206.70
25/F	+203.40
23/F	+200.00
22/F	+196.85
21/F	+193.70
20/F	+190.55
19/F	+187.40
18/F	+184.25
17/F	+181.10
16/F	+177.80
15/F	+174.65
12/F	+171.50
11/F	+168.35
10/F	+165.20
9/F	+162.05
8/F	+158.90
7/F	+155.75
6/F	+152.60
5/F	+149.30

LEGEND:

- G1+ – 10mm HEAT STRENGTHENED GLASS (OUTER) + 12mm AIR SPACE +12mm THK. TEMPERED CLEAR GLASS (INNER)
- G2+ – 10mm HEAT STRENGTHENED GLASS (OUTER) + 12mm AIR SPACE +10mm THK. TEMPERED CLEAR GLASS (INNER)
- G4+ – 12mm THK. HEAT STRENGTHENED GLASS & 2mm THK. ALUM. BACKPAN (SPANDREL GLASS)
- G5 – 12mm THK. CLEAR TEMPERED GLASS (INTERNAL PROTECTIVE BARRIER)
- 3mm THK. ALUM. CLADDING
- S.J. – STACK JOINT (WIND LOAD)
- AE01 – ALUM. EXTRUSION DIE NO.
- ▲ – SUPPORT POINT (WIND LOAD + DEAD LOAD)
- ● – SUPPORT POINT (WIND LOAD)

B.D. REF :

CLIENT :

SHIMAO GROUP HOLDINGS LIMITED

ARCHITECT : WONG TUNG & PARTNERS LIMITED ARCHITECTS & PLANNERS

MAIN CONTRACTOR : 協興建築有限公司 HIP HING CONSTRUCTION CO LTD

STRUCTURAL ENGINEER : C M WONG & ASSOCIATES LTD 黃志明建築工程師有限公司

FACADE CONSULTANT: MEINHARDT

NOTE :

1. ALL DIMENSIONS ARE IN mm.
2. ALL ELEVATIONS ARE VIEWED FROM OUTSIDE.
3. ALL DIMENSIONS TO BE VERIFIED ON SITE BEFORE FABRICATION.

LEGEND :

X1 / X001 — DETAIL MARK NO. / REFER SHEET NO.

1. F.F.L. --FINISHED FLOOR LEVEL
2. S.F.L. --STRUCTURAL FLOOR LEVEL
3. /R --REVERSED DETAIL

NO.	DATE	REVISED	BY
A	09-10-2021	REVISION SUBJECT TO ARCH. COMMENT	

JOB NO. : J-853

PROJECT :

PROPOSED RESIDENTIAL DEVELOPMENT AT N.K.I.L. 6542 YIN PING ROAD KOWLOON


TITLE :

PART ELEVATION FOR CURTAIN WALL AT TOWER 6 & 7

DATE : 12-APR-21	SCALE : 1:60 (A1)
DRAWN BY : LHR	CHECKED BY :

美特鋁質有限公司 MIDI ALUMINIUM FABRICATOR LTD.
Units 6-8, Sunray Industrial Centre, 1/F
610 Cha Kwo Ling Road, Kowloon
Tel:23489211-4 Fax:(852)27727666

DWG NO. : J853-SD-CW-4602 REV. : A

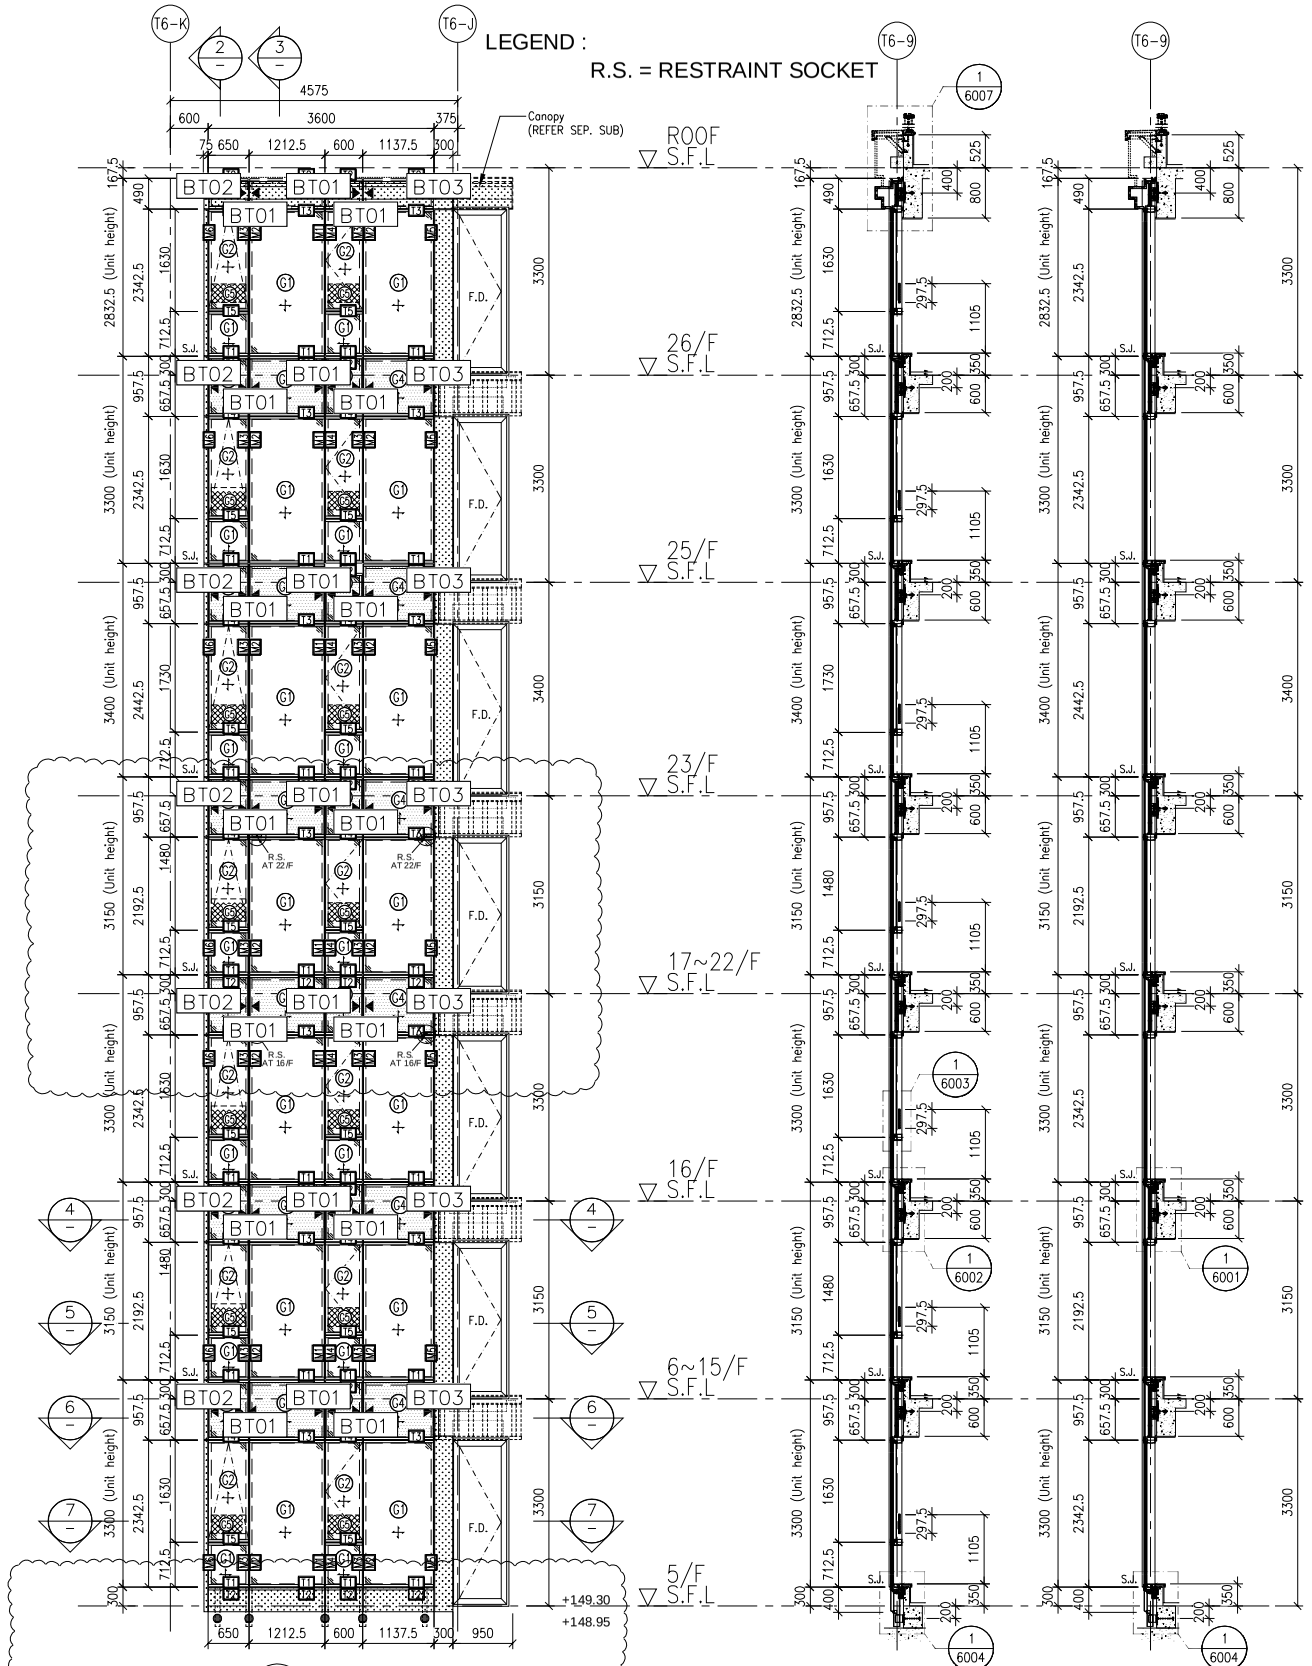


1 PART ELEVATION FOR CURTAIN WALL (CW51 / T67)


T6CW-B-2

2 TYPICAL SECTION FOR CURTAIN WALL


3 TYPICAL SECTION FOR CURTAIN WALL

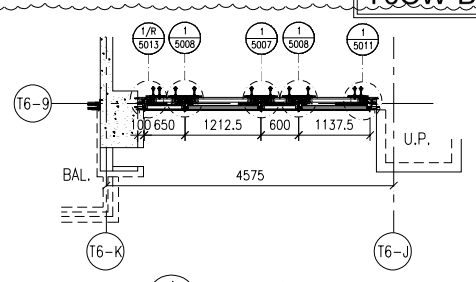


4 PART PLAN FOR CURTAIN WALL

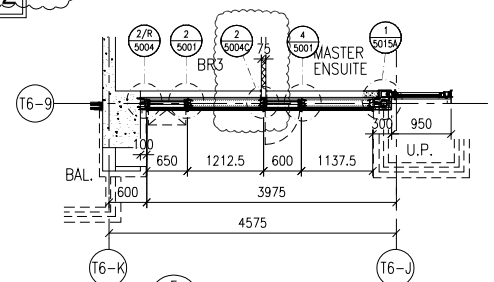

5 PART PLAN FOR CURTAIN WALL

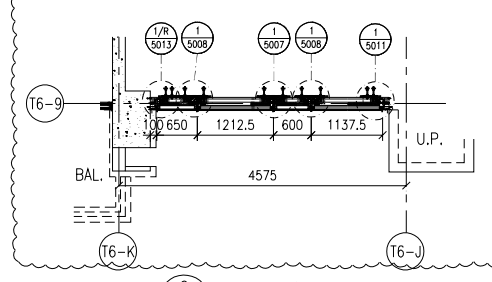

6 PART PLAN FOR CURTAIN WALL

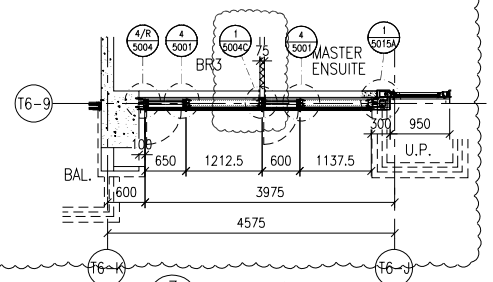

7 PART PLAN FOR CURTAIN WALL

FLOOR LEVEL (S.F.L.)

FLOOR	LEVEL
ROOF	+210.00
26/F	+206.70
25/F	+203.40
23/F	+200.00
22/F	+196.85
21/F	+193.70
20/F	+190.55
19/F	+187.40
18/F	+184.25
17/F	+181.10
16/F	+177.80
15/F	+174.65
12/F	+171.50
11/F	+168.35
10/F	+165.20
9/F	+162.05
8/F	+158.90
7/F	+155.75
6/F	+152.60
5/F	+149.30

LEGEND:

- G1 – 10mm HEAT STRENGTHENED GLASS (OUTER) + 12mm AIR SPACE +12mm THK. TEMPERED CLEAR GLASS (INNER)
- G2 – 10mm HEAT STRENGTHENED GLASS (OUTER) + 12mm AIR SPACE +10mm THK. TEMPERED CLEAR GLASS (INNER)
- G4 – 12mm THK. HEAT STRENGTHENED GLASS & 2mm THK. ALUM. BACKPAN (SPANDREL GLASS)
- G5 – 12mm THK. CLEAR TEMPERED GLASS (INTERNAL PROTECTIVE BARRIER)
- 3mm THK. ALUM. CLADDING
- S.J. – STACK JOINT (WIND LOAD)
- AE01 – ALUM. EXTRUSION DIE NO.
- ▲ – SUPPORT POINT (WIND LOAD + DEAD LOAD)
- ● – SUPPORT POINT (WIND LOAD)

B.D. REF :

CLIENT :
SHIMAO GROUP HOLDINGS LIMITED

ARCHITECT :
WONG TUNG & PARTNERS LIMITED
ARCHITECTS & PLANNERS

MAIN CONTRACTOR :
協興建築有限公司
HIP HING CONSTRUCTION CO LTD

STRUCTURAL ENGINEER :
C M WONG & ASSOCIATES LTD
黃志明建築工程師有限公司

FACADE CONSULTANT:
MEINHARDT

NOTE :
1. ALL DIMENSIONS ARE IN mm.
2. ALL ELEVATIONS ARE VIEWED FROM OUTSIDE.
3. ALL DIMENSIONS TO BE VERIFIED ON SITE BEFORE FABRICATION.

LEGEND :
X1 / X001 — DETAIL MARK NO. / REFER SHEET NO.
1. F.F.L. -- FINISHED FLOOR LEVEL
2. S.F.L. -- STRUCTURAL FLOOR LEVEL
3. /R -- REVERSED DETAIL

NO.	DATE	REVISED	BY

JOB NO. : J-853

PROJECT :
PROPOSED RESIDENTIAL DEVELOPMENT AT N.K.I.L. 6542
YIN PING ROAD
KOWLOON

TITLE :
PART ELEVATION FOR CURTAIN WALL AT TOWER 6 & 7

DATE : 24-OCT-21 | SCALE : 1:60 (A1)


DRAWN BY : LHR | CHECKED BY :

美特鋁質有限公司
MIDI ALUMINIUM FABRICATOR LTD.
Units 6-8, Sunray Industrial Centre, 1/F
610 Cha Kwo Ling Road, Kowloon
Tel:23489211-4 Fax:(852)27727666

DWG NO. : J853-SD-CW-4602A | REV. : A

LEGEND :

R.S. = RESTRAINT SOCKET

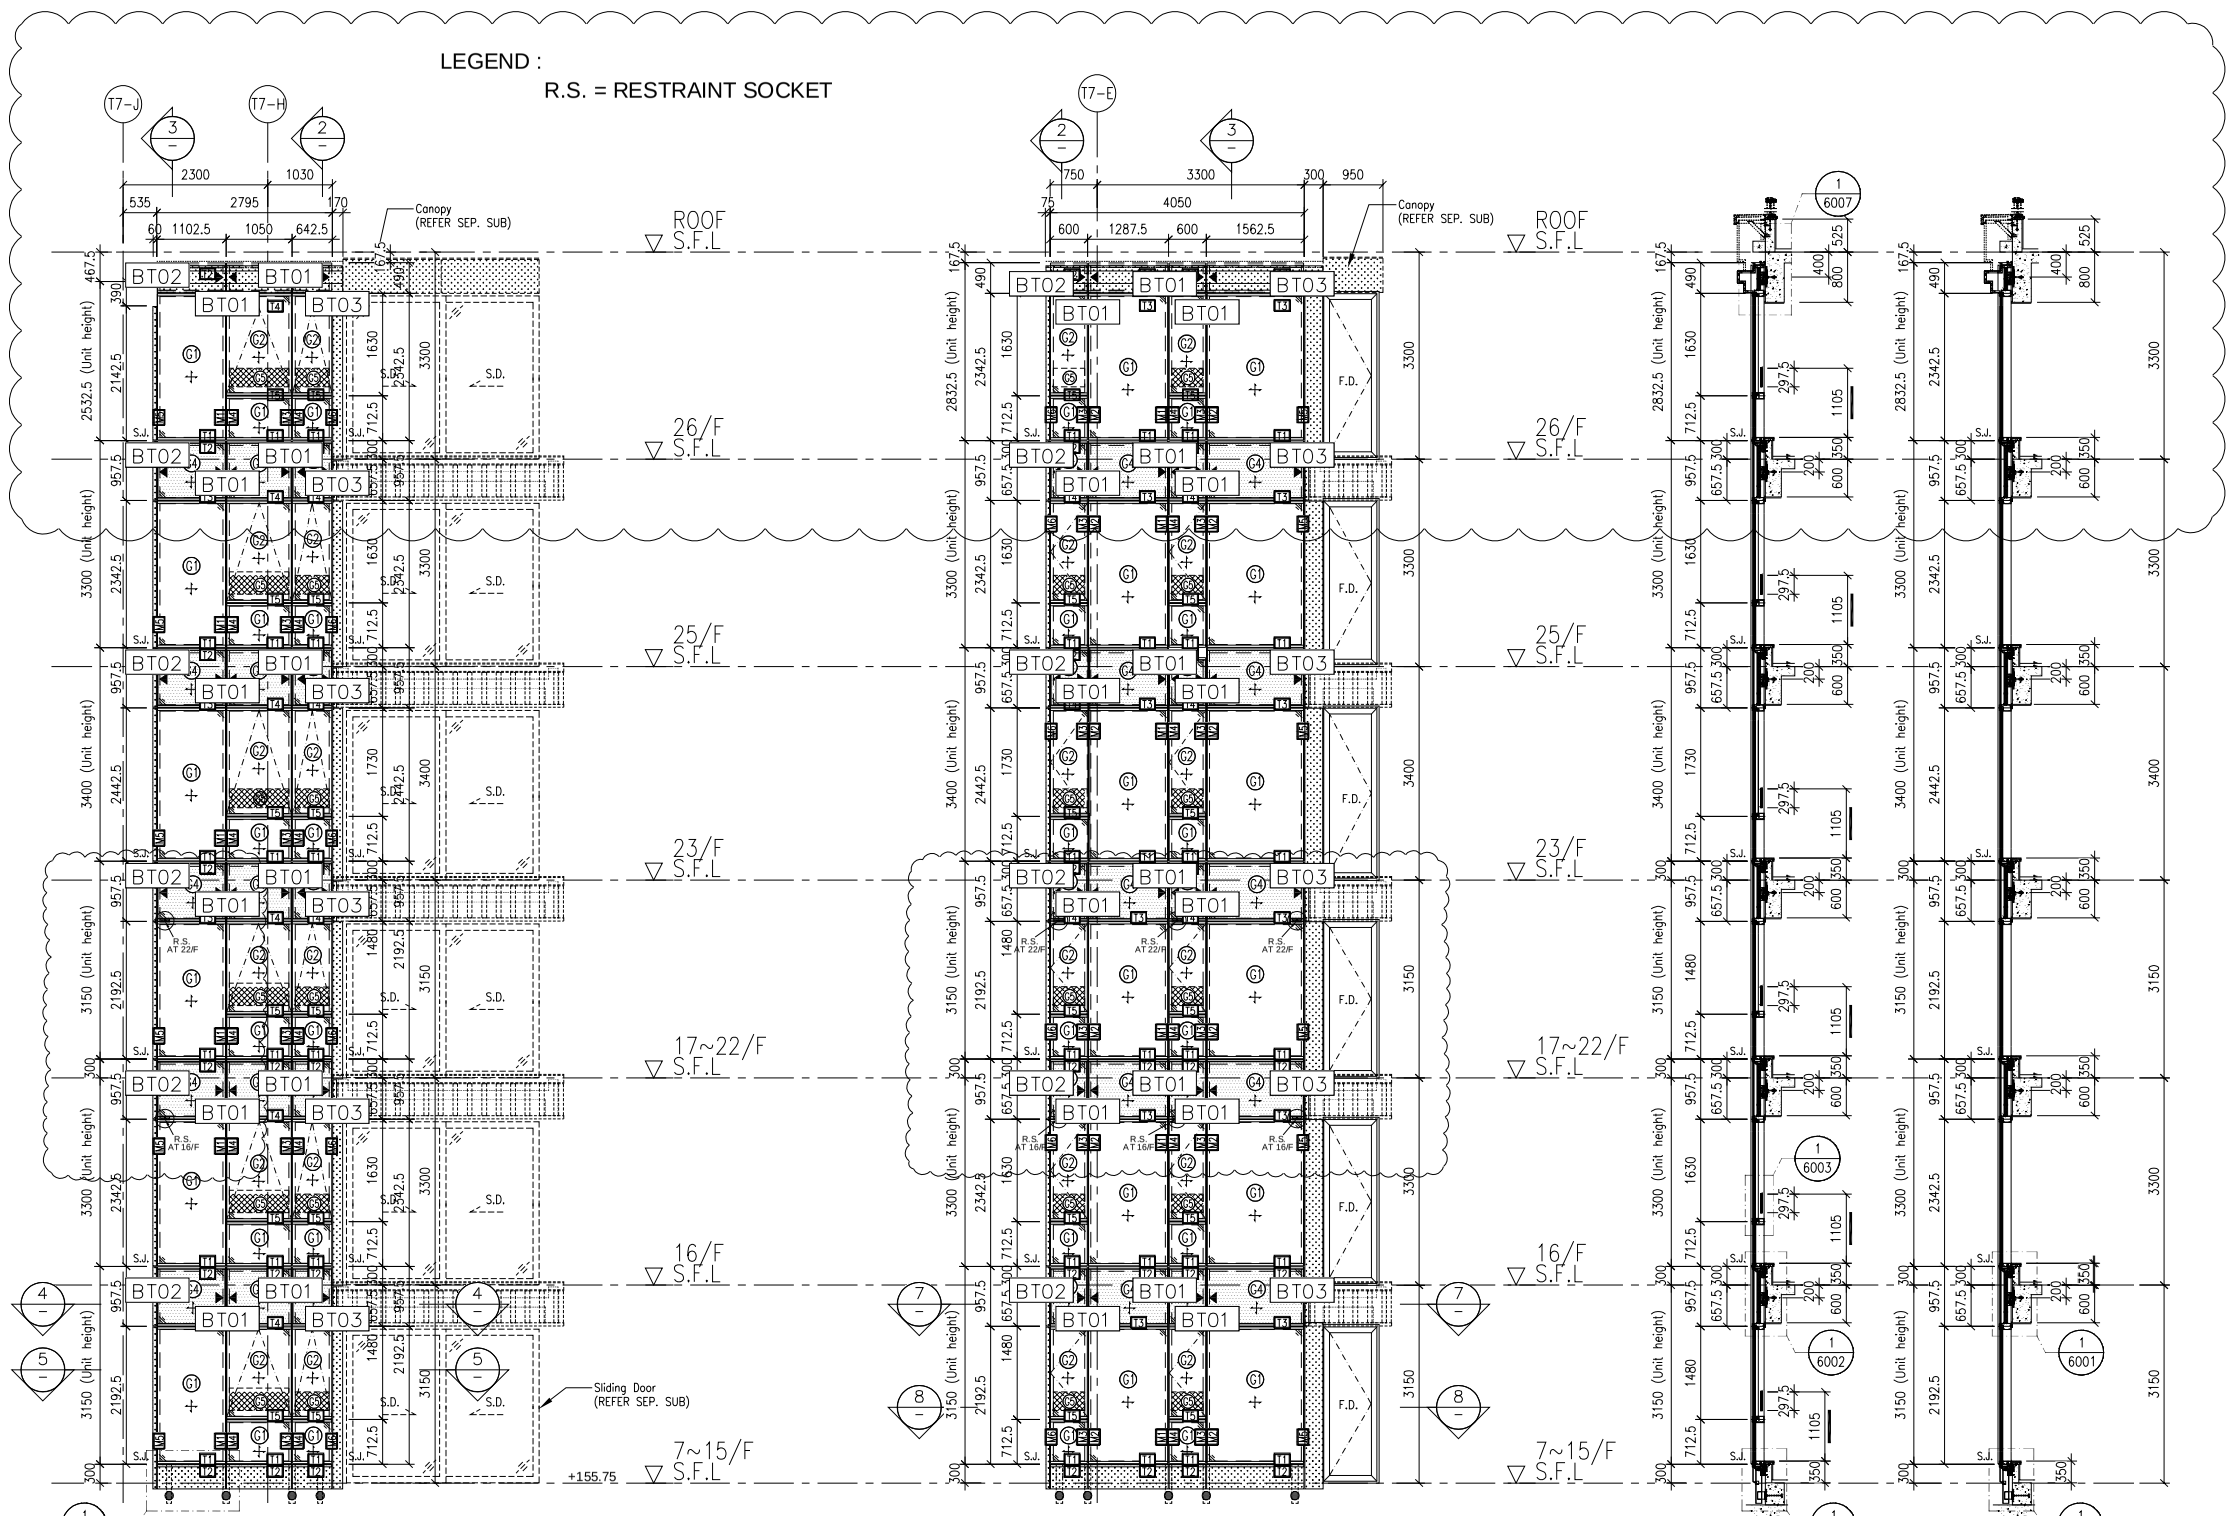

1 / 6017 CW52 T6.7 — 1 / – PART ELEVATION FOR CURTAIN WALL

CW53 T6.7 — 6 / – PART ELEVATION FOR CURTAIN WALL


2 / – TYPICAL SECTION FOR CURTAIN WALL

3 / – TYPICAL SECTION FOR CURTAIN WALL


FLOOR LEVEL (S.F.L.)

FLOOR	LEVEL
ROOF	+210.00
26/F	+206.70
25/F	+203.40
23/F	+200.00
22/F	+196.85
21/F	+193.70
20/F	+190.55
19/F	+187.40
18/F	+184.25
17/F	+181.10
16/F	+177.80
15/F	+174.65
12/F	+171.50
11/F	+168.35
10/F	+165.20
9/F	+162.05
8/F	+158.90
7/F	+155.75

T7CW-A-4

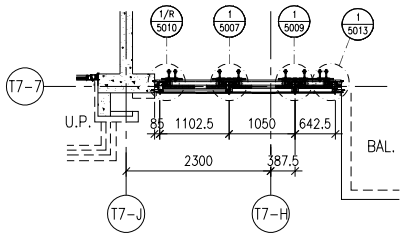


4 / – PART PLAN FOR CURTAIN WALL

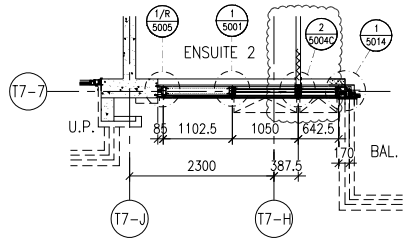


5 / – PART PLAN FOR CURTAIN WALL

T7CW-A-5

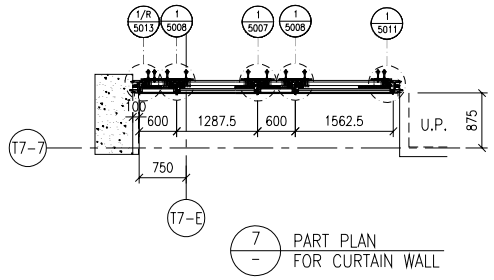

7 / – PART PLAN FOR CURTAIN WALL

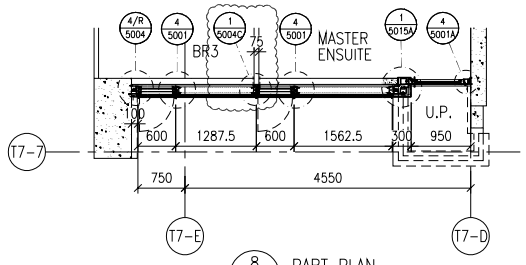

8 / – PART PLAN FOR CURTAIN WALL

LEGEND:

- G1 – 10mm HEAT STRENGTHENED GLASS (OUTER) + 12mm AIR SPACE +12mm THK. TEMPERED CLEAR GLASS (INNER)
- G2 – 10mm HEAT STRENGTHENED GLASS (OUTER) + 12mm AIR SPACE +10mm THK. TEMPERED CLEAR GLASS (INNER)
- G4 – 12mm THK. HEAT STRENGTHENED GLASS & 2mm THK. ALUM. BACKPAN (SPANDREL GLASS)
- 12mm THK. CLEAR TEMPERED GLASS (INTERNAL PROTECTIVE BARRIER)
- 3mm THK. ALUM. CLADDING
- S.J. – STACK JOINT (WIND LOAD)
- AE01 – ALUM. EXTRUSION DIE NO.
- ▲ – SUPPORT POINT (WIND LOAD + DEAD LOAD)
- ● – SUPPORT POINT (WIND LOAD)

B.D. REF :

CLIENT :

SHIMAO GROUP HOLDINGS LIMITED

ARCHITECT :

WONG TUNG & PARTNERS LIMITED
ARCHITECTS & PLANNERS

MAIN CONTRACTOR :

協興建築有限公司
HIP HING CONSTRUCTION CO LTD

STRUCTURAL ENGINEER :

C M WONG & ASSOCIATES LTD
黃志明建築工程師有限公司

FACADE CONSULTANT:

MEINHARDT

NOTE :

1. ALL DIMENSIONS ARE IN mm.
2. ALL ELEVATIONS ARE VIEWED FROM OUTSIDE.
3. ALL DIMENSIONS TO BE VERIFIED ON SITE BEFORE FABRICATION.

LEGEND :

X1 / X001 — DETAIL MARK NO. / REFER SHEET NO.

1. F.F.L. -- FINISHED FLOOR LEVEL
2. S.F.L. -- STRUCTURAL FLOOR LEVEL
3. /R -- REVERSED DETAIL

NO.	DATE	REVISED	BY
A	09-10-2021	REVISION SUBJECT TO ARCH. COMMENT	

JOB NO. : J-853

PROJECT :

PROPOSED RESIDENTIAL DEVELOPMENT AT N.K.I.L. 6542 YIN PING ROAD KOWLOON

TITLE :

PART ELEVATION FOR CURTAIN WALL AT TOWER 6 & 7

DATE : 12-APR-21 | SCALE : 1:60 (A1)


DRAWN BY : LHR | CHECKED BY :

美特鋁質有限公司
MIDI ALUMINIUM FABRICATOR LTD.
Units 6-8, Sunray Industrial Centre, 1/F
610 Cha Kwo Ling Road, Kowloon
Tel:23489211-4 Fax:(852)27727666

DWG NO. : J853-SD-CW-4603 | REV. : A


LEGEND :

R.S. = RESTRAINT SOCKET

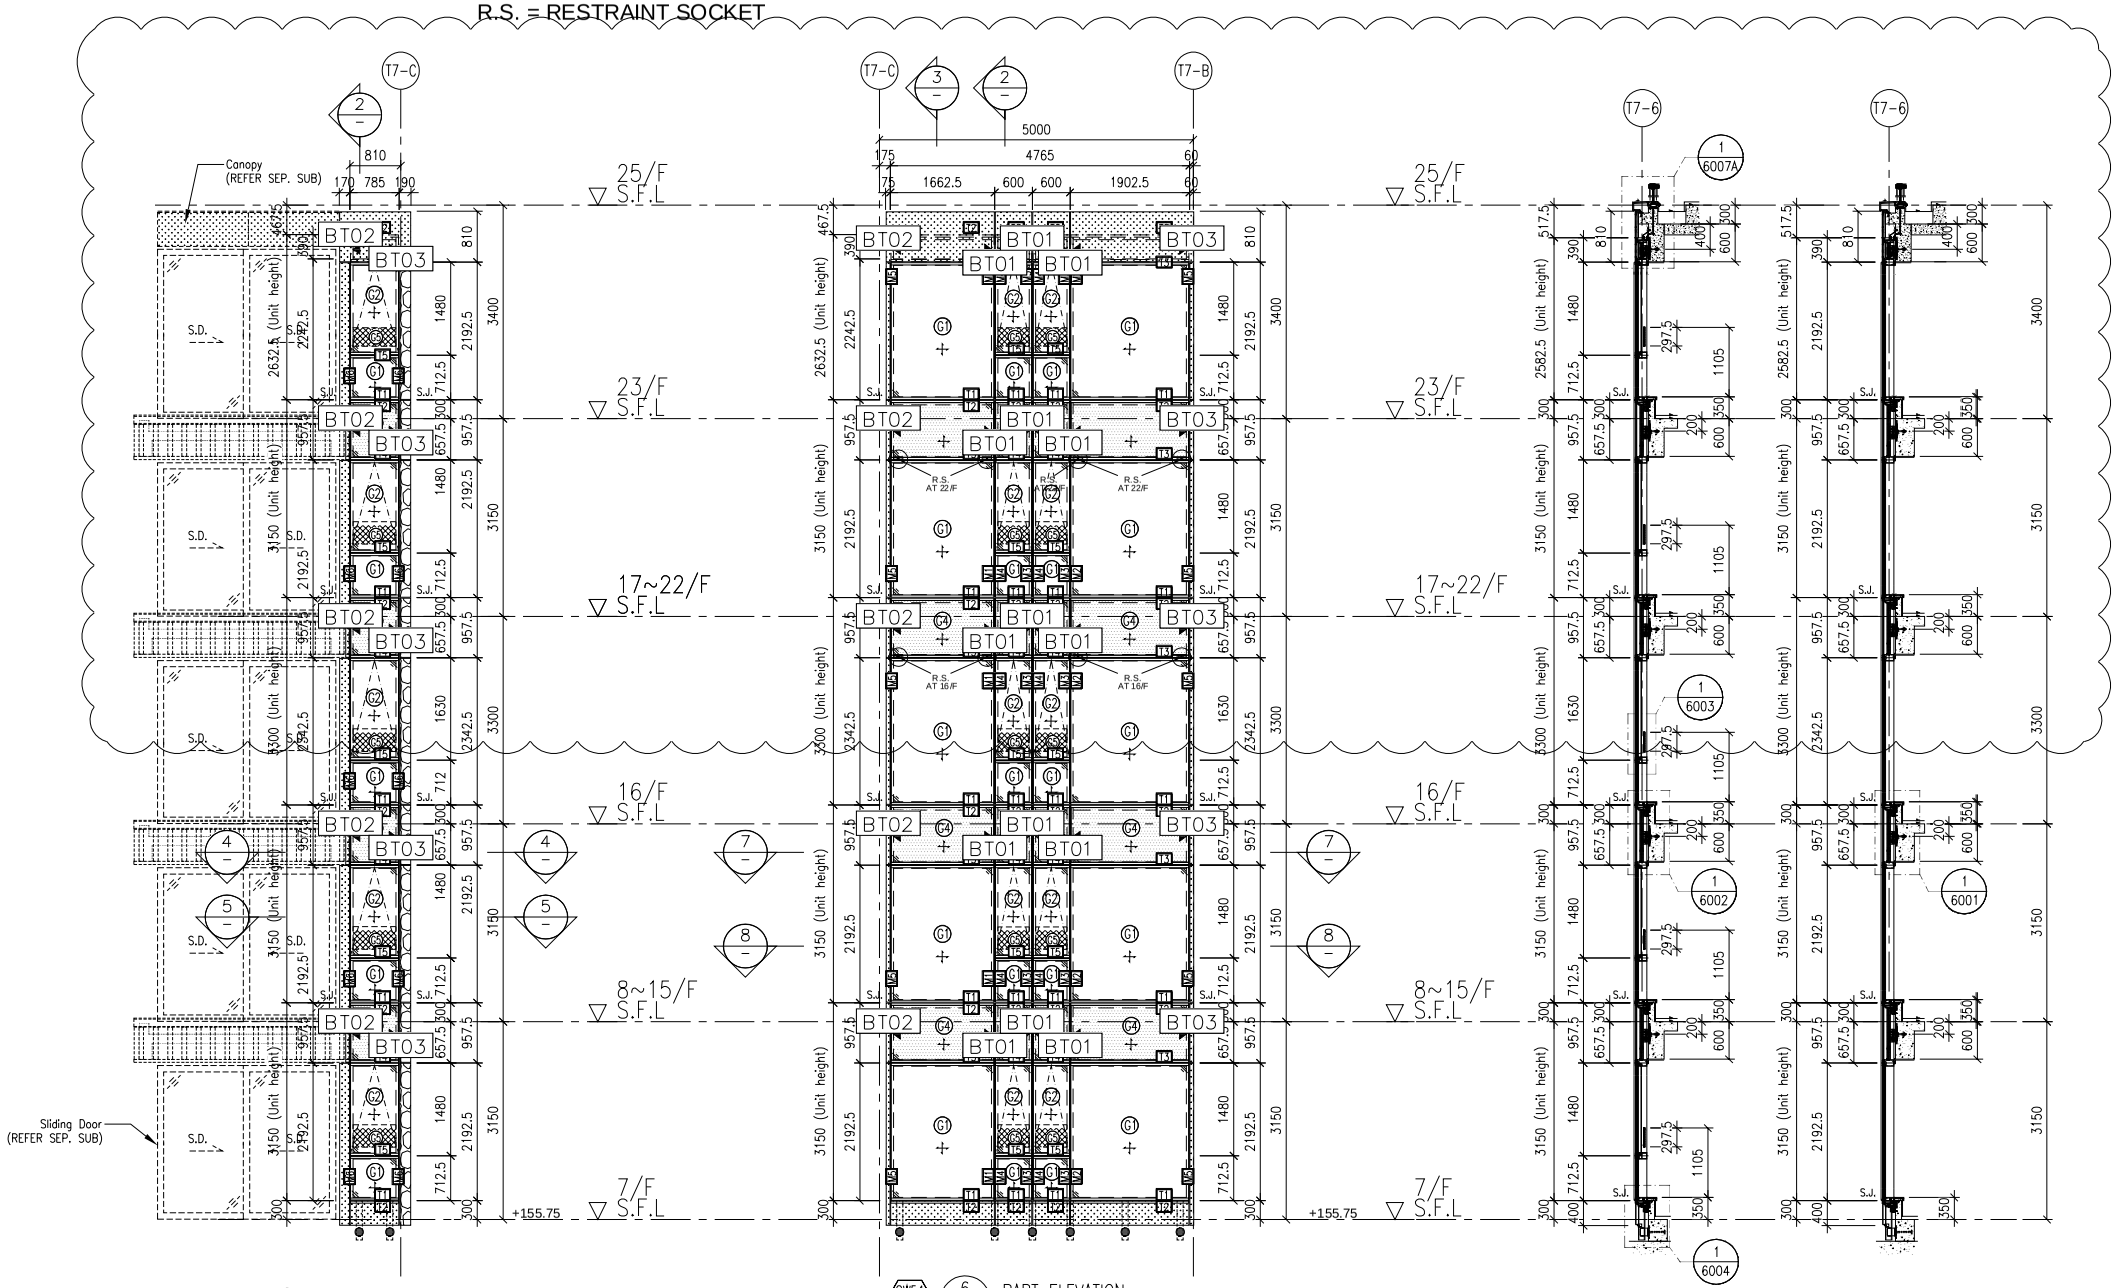


1 PART ELEVATION FOR CURTAIN WALL

T7CW-B-3

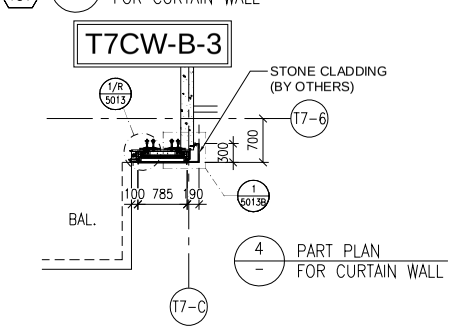


4 PART PLAN FOR CURTAIN WALL

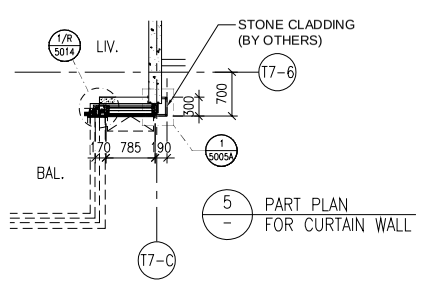


5 PART PLAN FOR CURTAIN WALL

6 PART ELEVATION FOR CURTAIN WALL

T7CW-B-4

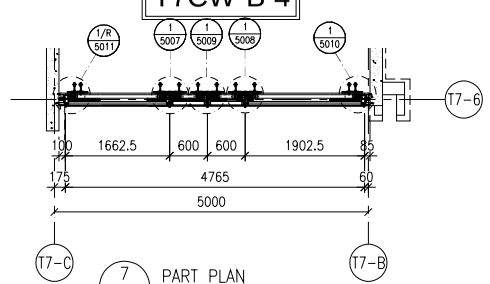

7 PART PLAN FOR CURTAIN WALL

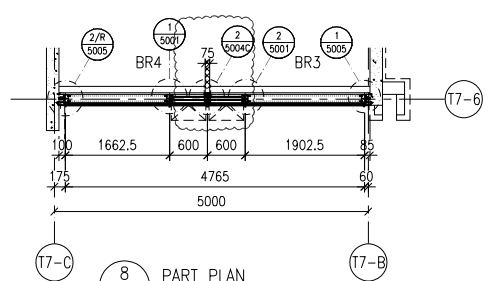

8 PART PLAN FOR CURTAIN WALL

2 TYPICAL SECTION FOR CURTAIN WALL

3 TYPICAL SECTION FOR CURTAIN WALL

FLOOR LEVEL (S.F.L.)

FLOOR	LEVEL
25/F	+203.40
23/F	+200.00
22/F	+196.85
21/F	+193.70
20/F	+190.55
19/F	+187.40
18/F	+184.25
17/F	+181.10
16/F	+177.80
15/F	+174.65
12/F	+171.50
11/F	+168.35
10/F	+165.20
9/F	+162.05
8/F	+158.90
7/F	+155.75

LEGEND:

- G1 – 10mm HEAT STRENGTHENED GLASS (OUTER) + 12mm AIR SPACE +12mm THK. TEMPERED CLEAR GLASS (INNER)
- G2 – 10mm HEAT STRENGTHENED GLASS (OUTER) + 12mm AIR SPACE +10mm THK. TEMPERED CLEAR GLASS (INNER)
- G4 – 12mm THK. HEAT STRENGTHENED GLASS & 2mm THK. ALUM. BACKPAN (SPANDREL GLASS)
- G5 – 12mm THK. CLEAR TEMPERED GLASS (INTERNAL PROTECTIVE BARRIER)
- 3mm THK. ALUM. CLADDING
- S.J. – STACK JOINT (WIND LOAD)
- AE01 – ALUM. EXTRUSION DIE NO.
- ▲ – SUPPORT POINT (WIND LOAD + DEAD LOAD)
- ● – SUPPORT POINT (WIND LOAD)

B.D. REF :

CLIENT :

SHIMAO GROUP HOLDINGS LIMITED

ARCHITECT :

WONG TUNG & PARTNERS LIMITED
ARCHITECTS & PLANNERS

MAIN CONTRACTOR :

協興建築有限公司
HIP HING CONSTRUCTION CO LTD

STRUCTURAL ENGINEER :

C M WONG & ASSOCIATES LTD
黃志明建築工程師有限公司

FACADE CONSULTANT:

MEINHARDT

NOTE :

1. ALL DIMENSIONS ARE IN mm.
2. ALL ELEVATIONS ARE VIEWED FROM OUTSIDE.
3. ALL DIMENSIONS TO BE VERIFIED ON SITE BEFORE FABRICATION.

LEGEND :

X1 / X001 — DETAIL MARK NO. / REFER SHEET NO.

1. F.F.L. -- FINISHED FLOOR LEVEL
2. S.F.L. -- STRUCTURAL FLOOR LEVEL
3. /R -- REVERSED DETAIL

NO.	DATE	REVISED	BY
A	09-10-2021	REVISION SUBJECT TO ARCH. COMMENT	

JOB NO. : J-853

PROJECT :

PROPOSED RESIDENTIAL DEVELOPMENT AT N.K.I.L. 6542 YIN PING ROAD KOWLOON

TITLE :

PART ELEVATION FOR CURTAIN WALL AT TOWER 6 & 7

DATE : 12-APR-21 | SCALE : 1:60 (A1)


DRAWN BY : LHR | CHECKED BY :

美特鋁質有限公司
MIDI ALUMINIUM FABRICATOR LTD.
Units 6-8, Sunray Industrial Centre, 1/F
610 Cha Kwo Ling Road, Kowloon
Tel:23489211-4 Fax:(852)27727666

DWG NO. : J853-SD-CW-4604 | REV. : A

LEGEND :

R.S. = RESTRAINT SOCKET

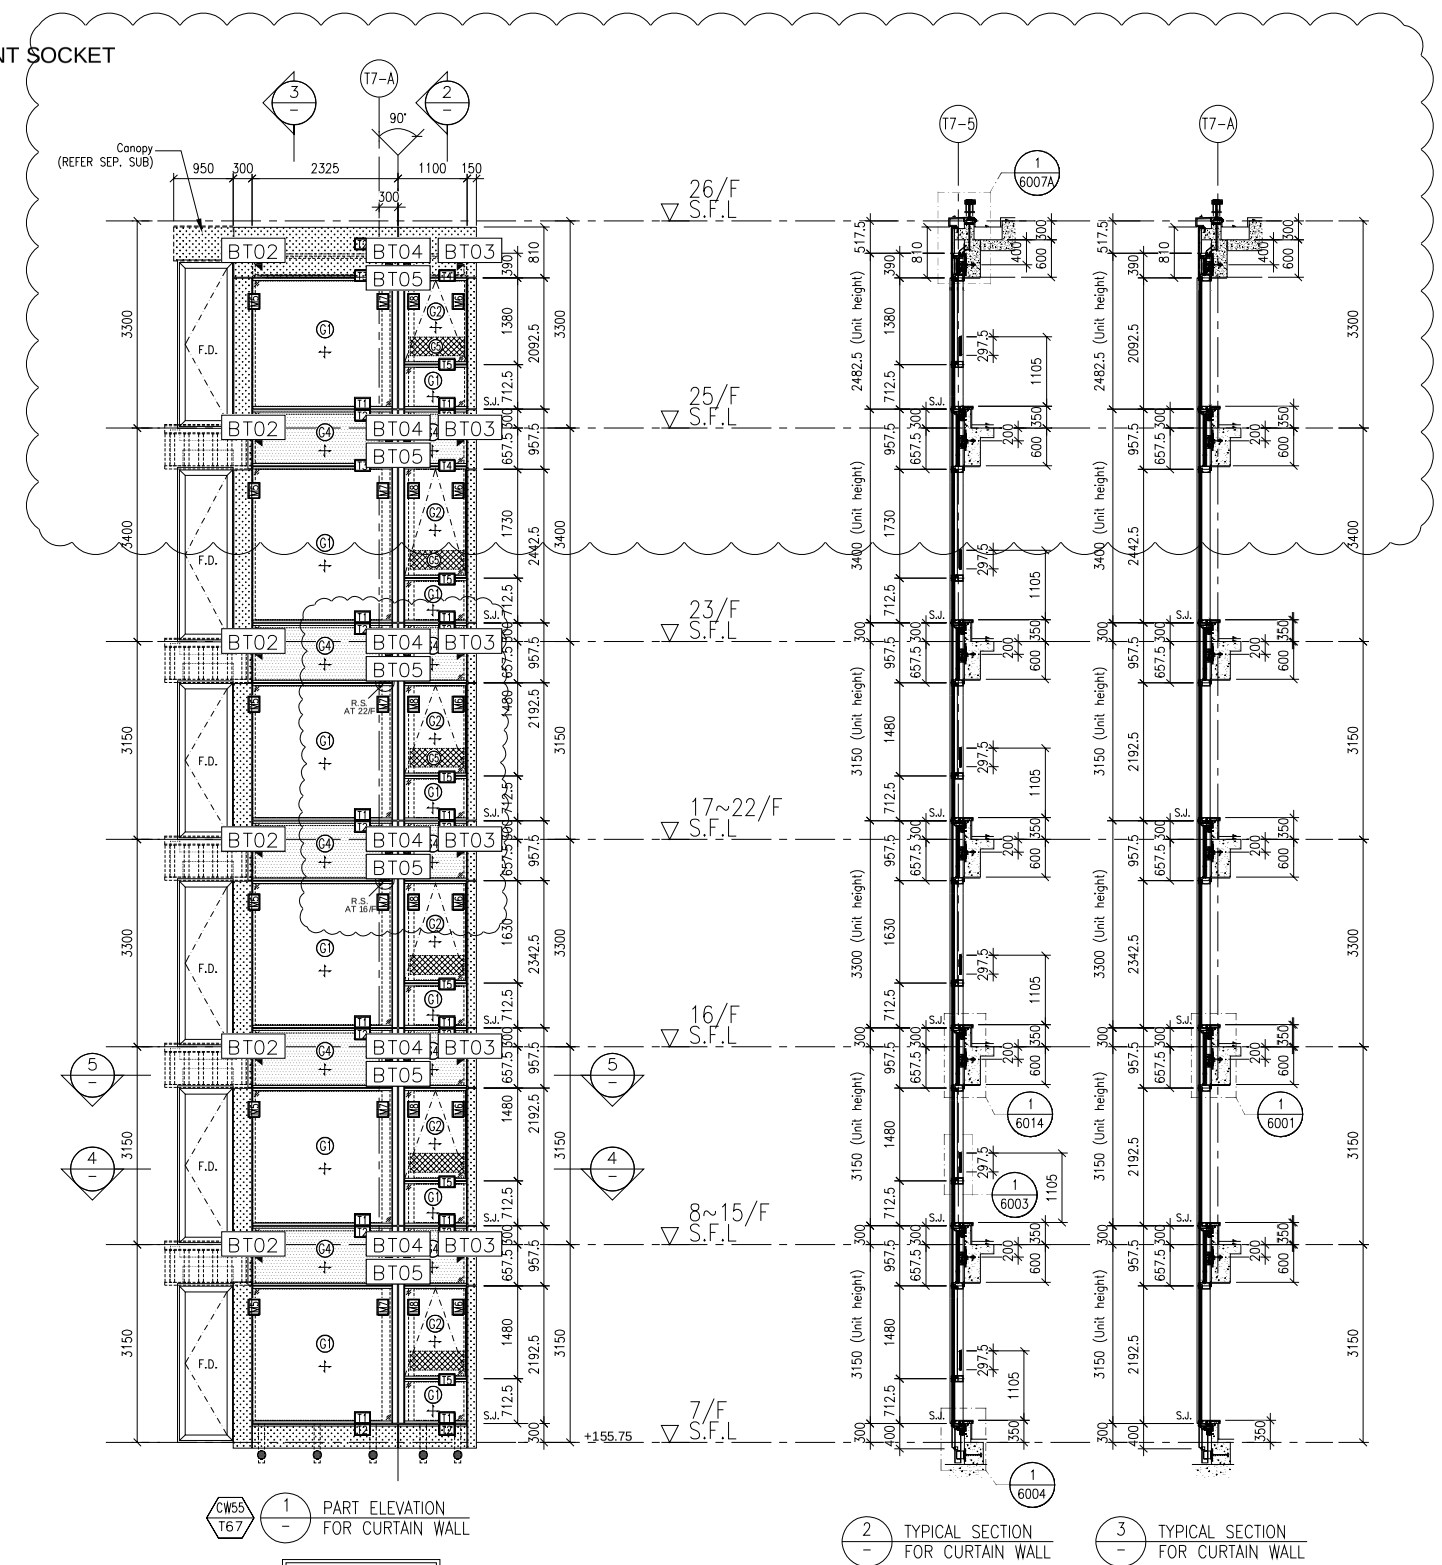


CW55 T67 1 – PART ELEVATION FOR CURTAIN WALL


2 – TYPICAL SECTION FOR CURTAIN WALL

3 – TYPICAL SECTION FOR CURTAIN WALL

T7CW-B-5

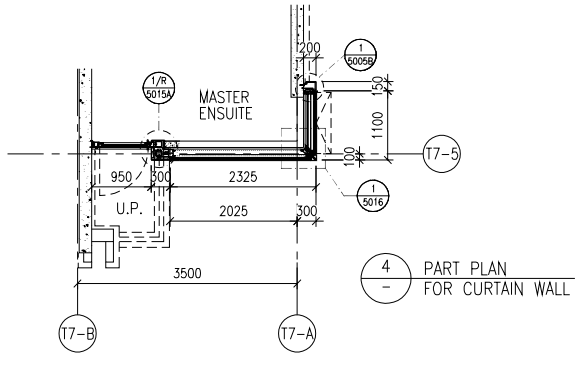

4 – PART PLAN FOR CURTAIN WALL

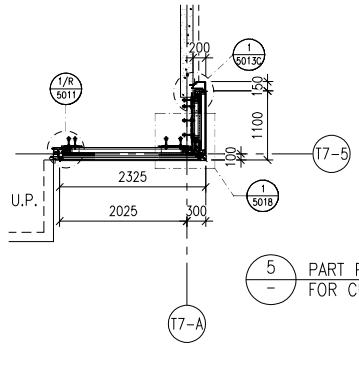

5 – PART PLAN FOR CURTAIN WALL

FLOOR LEVEL (S.F.L.)

FLOOR	LEVEL
26/F	+206.70
25/F	+203.40
23/F	+200.00
22/F	+196.85
21/F	+193.70
20/F	+190.55
19/F	+187.40
18/F	+184.25
17/F	+181.10
16/F	+177.80
15/F	+174.65
12/F	+171.50
11/F	+168.35
10/F	+165.20
9/F	+162.05
8/F	+158.90
7/F	+155.75

LEGEND:

- G1+ – 10mm HEAT STRENGTHENED GLASS (OUTER) + 12mm AIR SPACE +12mm THK. TEMPERED CLEAR GLASS (INNER)
- G2+ – 10mm HEAT STRENGTHENED GLASS (OUTER) + 12mm AIR SPACE +10mm THK. TEMPERED CLEAR GLASS (INNER)
- G4+ – 12mm THK. HEAT STRENGTHENED GLASS & 2mm THK. ALUM. BACKPAN (SPANDREL GLASS)
- G5 – 12mm THK. CLEAR TEMPERED GLASS (INTERNAL PROTECTIVE BARRIER)
- 3mm THK. ALUM. CLADDING
- S.J. – STACK JOINT (WIND LOAD)
- AE01 – ALUM. EXTRUSION DIE NO.
- ▲ – SUPPORT POINT (WIND LOAD + DEAD LOAD)
- ● – SUPPORT POINT (WIND LOAD)

B.D. REF :

CLIENT :

SHIMAO GROUP HOLDINGS LIMITED

ARCHITECT :

WONG TUNG & PARTNERS LIMITED
ARCHITECTS & PLANNERS

MAIN CONTRACTOR :

協興建築有限公司
HIP HING CONSTRUCTION CO LTD

STRUCTURAL ENGINEER :

C M WONG & ASSOCIATES LTD
黃志明建築工程師有限公司

FACADE CONSULTANT:

MEINHARDT

NOTE :

1. ALL DIMENSIONS ARE IN mm.
2. ALL ELEVATIONS ARE VIEWED FROM OUTSIDE.
3. ALL DIMENSIONS TO BE VERIFIED ON SITE BEFORE FABRICATION.

LEGEND :

X1 / X001 – DETAIL MARK NO. / REFER SHEET NO.

1. F.F.L. --FINISHED FLOOR LEVEL
2. S.F.L. --STRUCTURAL FLOOR LEVEL
3. /R --REVERSED DETAIL

NO.	DATE	REVISED	BY
A	09-10-2021	REVISION SUBJECT TO ARCH. COMMENT	

JOB NO. : J-853

PROJECT :

PROPOSED RESIDENTIAL DEVELOPMENT AT N.K.I.L. 6542 YIN PING ROAD KOWLOON

TITLE :

PART ELEVATION FOR CURTAIN WALL AT TOWER 6 & 7

DATE : 12-APR-21 | SCALE : 1:60 (A1)


DRAWN BY : LHR | CHECKED BY :

美特鋁質有限公司
MIDI ALUMINIUM FABRICATOR LTD.
Units 6-8, Sunray Industrial Centre, 1/F
610 Cha Kwo Ling Road, Kowloon
Tel:23489211-4 Fax:(852)27727666

DWG NO. : J853-SD-CW-4605 | REV. : A

LEGEND :

R.S. = RESTRAINT SOCKET

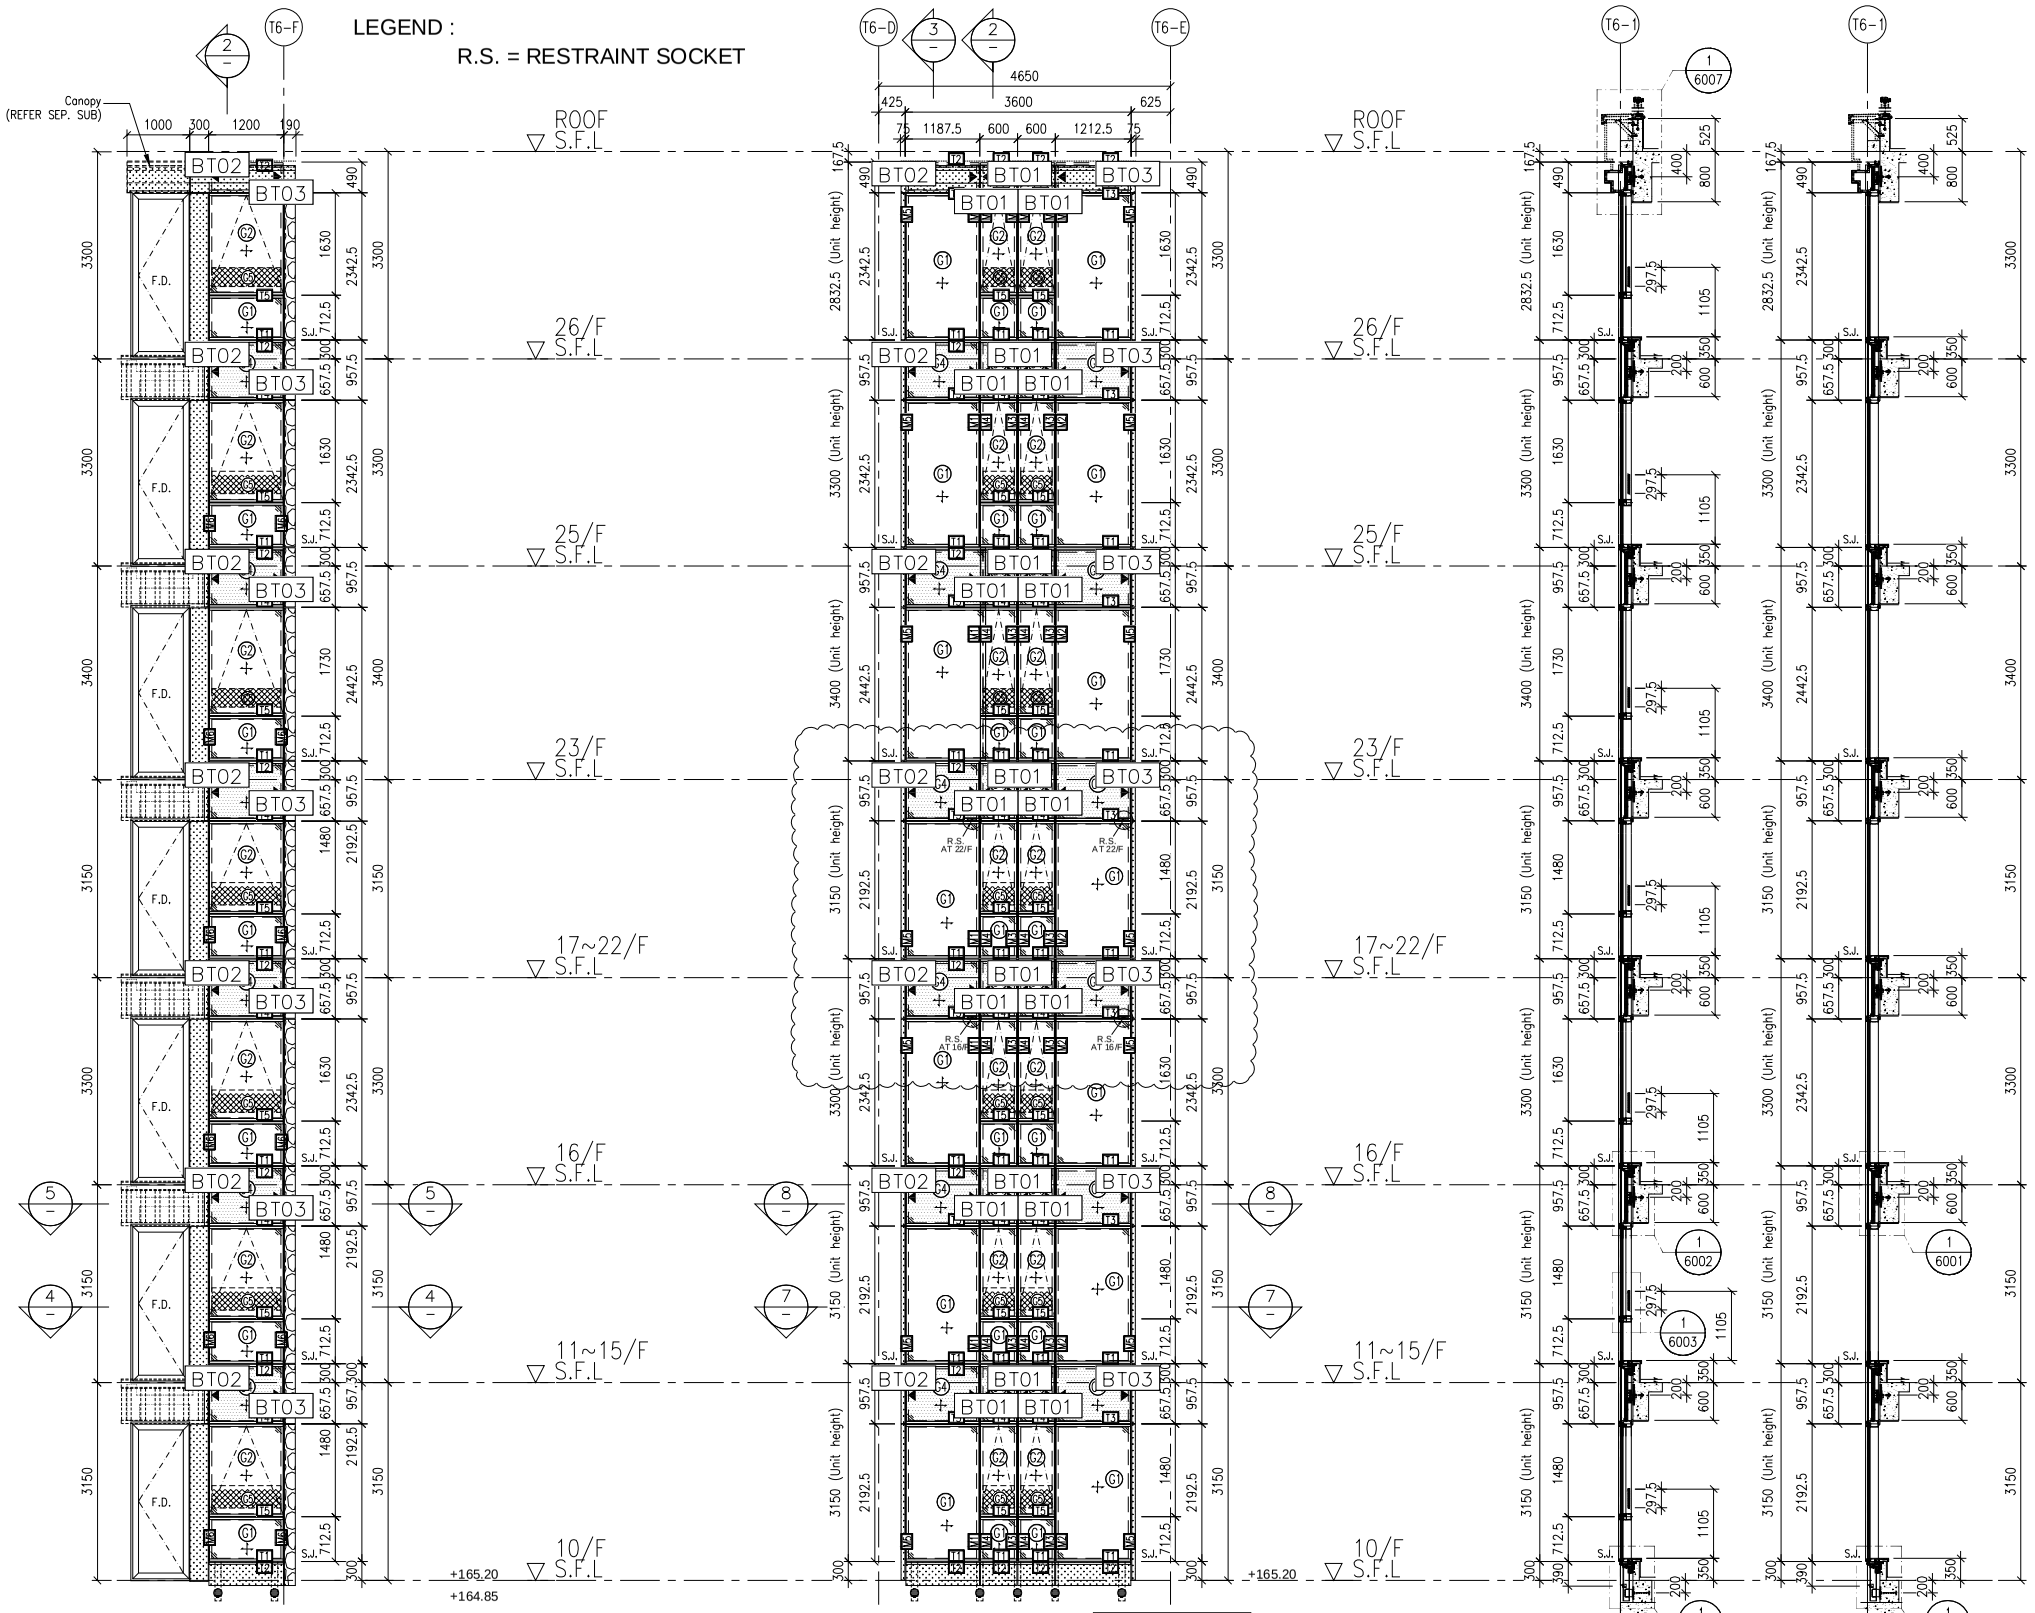

CW62 T67 1 – PART ELEVATION FOR CURTAIN WALL


T6CW-C-1

CW61 T67 6 – PART ELEVATION FOR CURTAIN WALL

T6CW-C-2


2 – TYPICAL SECTION FOR CURTAIN WALL

3 – TYPICAL SECTION FOR CURTAIN WALL

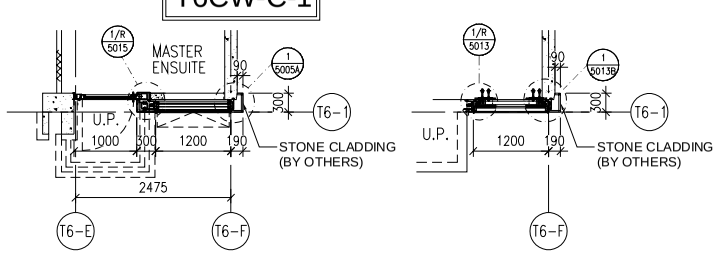


4 – PART PLAN FOR CURTAIN WALL

5 – PART PLAN FOR CURTAIN WALL

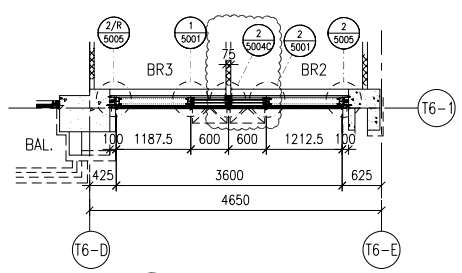

7 – PART PLAN FOR CURTAIN WALL

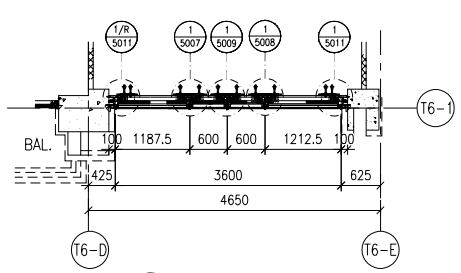

8 – PART PLAN FOR CURTAIN WALL

FLOOR LEVEL (S.F.L.)

FLOOR	LEVEL
ROOF	+210.00
26/F	+206.70
25/F	+203.40
23/F	+200.00
22/F	+196.85
21/F	+193.70
20/F	+190.55
19/F	+187.40
18/F	+184.25
17/F	+181.10
16/F	+177.80
15/F	+174.65
12/F	+171.50
11/F	+168.35
10/F	+165.20

LEGEND:

- G1+ – 10mm HEAT STRENGTHENED GLASS (OUTER) + 12mm AIR SPACE +12mm THK. TEMPERED CLEAR GLASS (INNER)
- G2+ – 10mm HEAT STRENGTHENED GLASS (OUTER) + 12mm AIR SPACE +10mm THK. TEMPERED CLEAR GLASS (INNER)
- G4+ – 12mm THK. HEAT STRENGTHENED GLASS & 2mm THK. ALUM. BACKPAN (SPANDREL GLASS)
- G6 – 12mm THK. CLEAR TEMPERED GLASS (INTERNAL PROTECTIVE BARRIER)
- 3mm THK. ALUM. CLADDING
- S.J. – STACK JOINT (WIND LOAD)
- AE01 – ALUM. EXTRUSION DIE NO.
- ▲ – SUPPORT POINT (WIND LOAD + DEAD LOAD)
- ● – SUPPORT POINT (WIND LOAD)

B.D. REF :

CLIENT :

SHIMAO GROUP HOLDINGS LIMITED

ARCHITECT : WONG TUNG & PARTNERS LIMITED ARCHITECTS & PLANNERS

MAIN CONTRACTOR : 協興建築有限公司 HIP HING CONSTRUCTION CO LTD

STRUCTURAL ENGINEER : C M WONG & ASSOCIATES LTD 黃志明建築工程師有限公司

FACADE CONSULTANT: MEINHARDT

NOTE :

1. ALL DIMENSIONS ARE IN mm.
2. ALL ELEVATIONS ARE VIEWED FROM OUTSIDE.
3. ALL DIMENSIONS TO BE VERIFIED ON SITE BEFORE FABRICATION.

LEGEND :

X1 / X001 – DETAIL MARK NO. / REFER SHEET NO.

1. F.F.L. -- FINISHED FLOOR LEVEL
2. S.F.L. -- STRUCTURAL FLOOR LEVEL
3. /R -- REVERSED DETAIL

NO.	DATE	REVISED	BY
A	09-10-2021	REVISION SUBJECT TO ARCH. COMMENT	

JOB NO. : J-853

PROJECT :

PROPOSED RESIDENTIAL DEVELOPMENT AT N.K.I.L. 6542 YIN PING ROAD KOWLOON

TITLE :

PART ELEVATION FOR CURTAIN WALL AT TOWER 6 & 7

DATE : 13-APR-21 | SCALE : 1:60 (A1)


DRAWN BY : LHR | CHECKED BY :


美特鋁質有限公司 MIDI ALUMINIUM FABRICATOR LTD.
Units 6-8, Sunray Industrial Centre, 1/F
610 Cha Kwo Ling Road, Kowloon
Tel:23489211-4 Fax:(852)27727666

DWG NO. : J853-SD-CW-4606 | REV. : A


LEGEND :

R.S. = RESTRAINT SOCKET

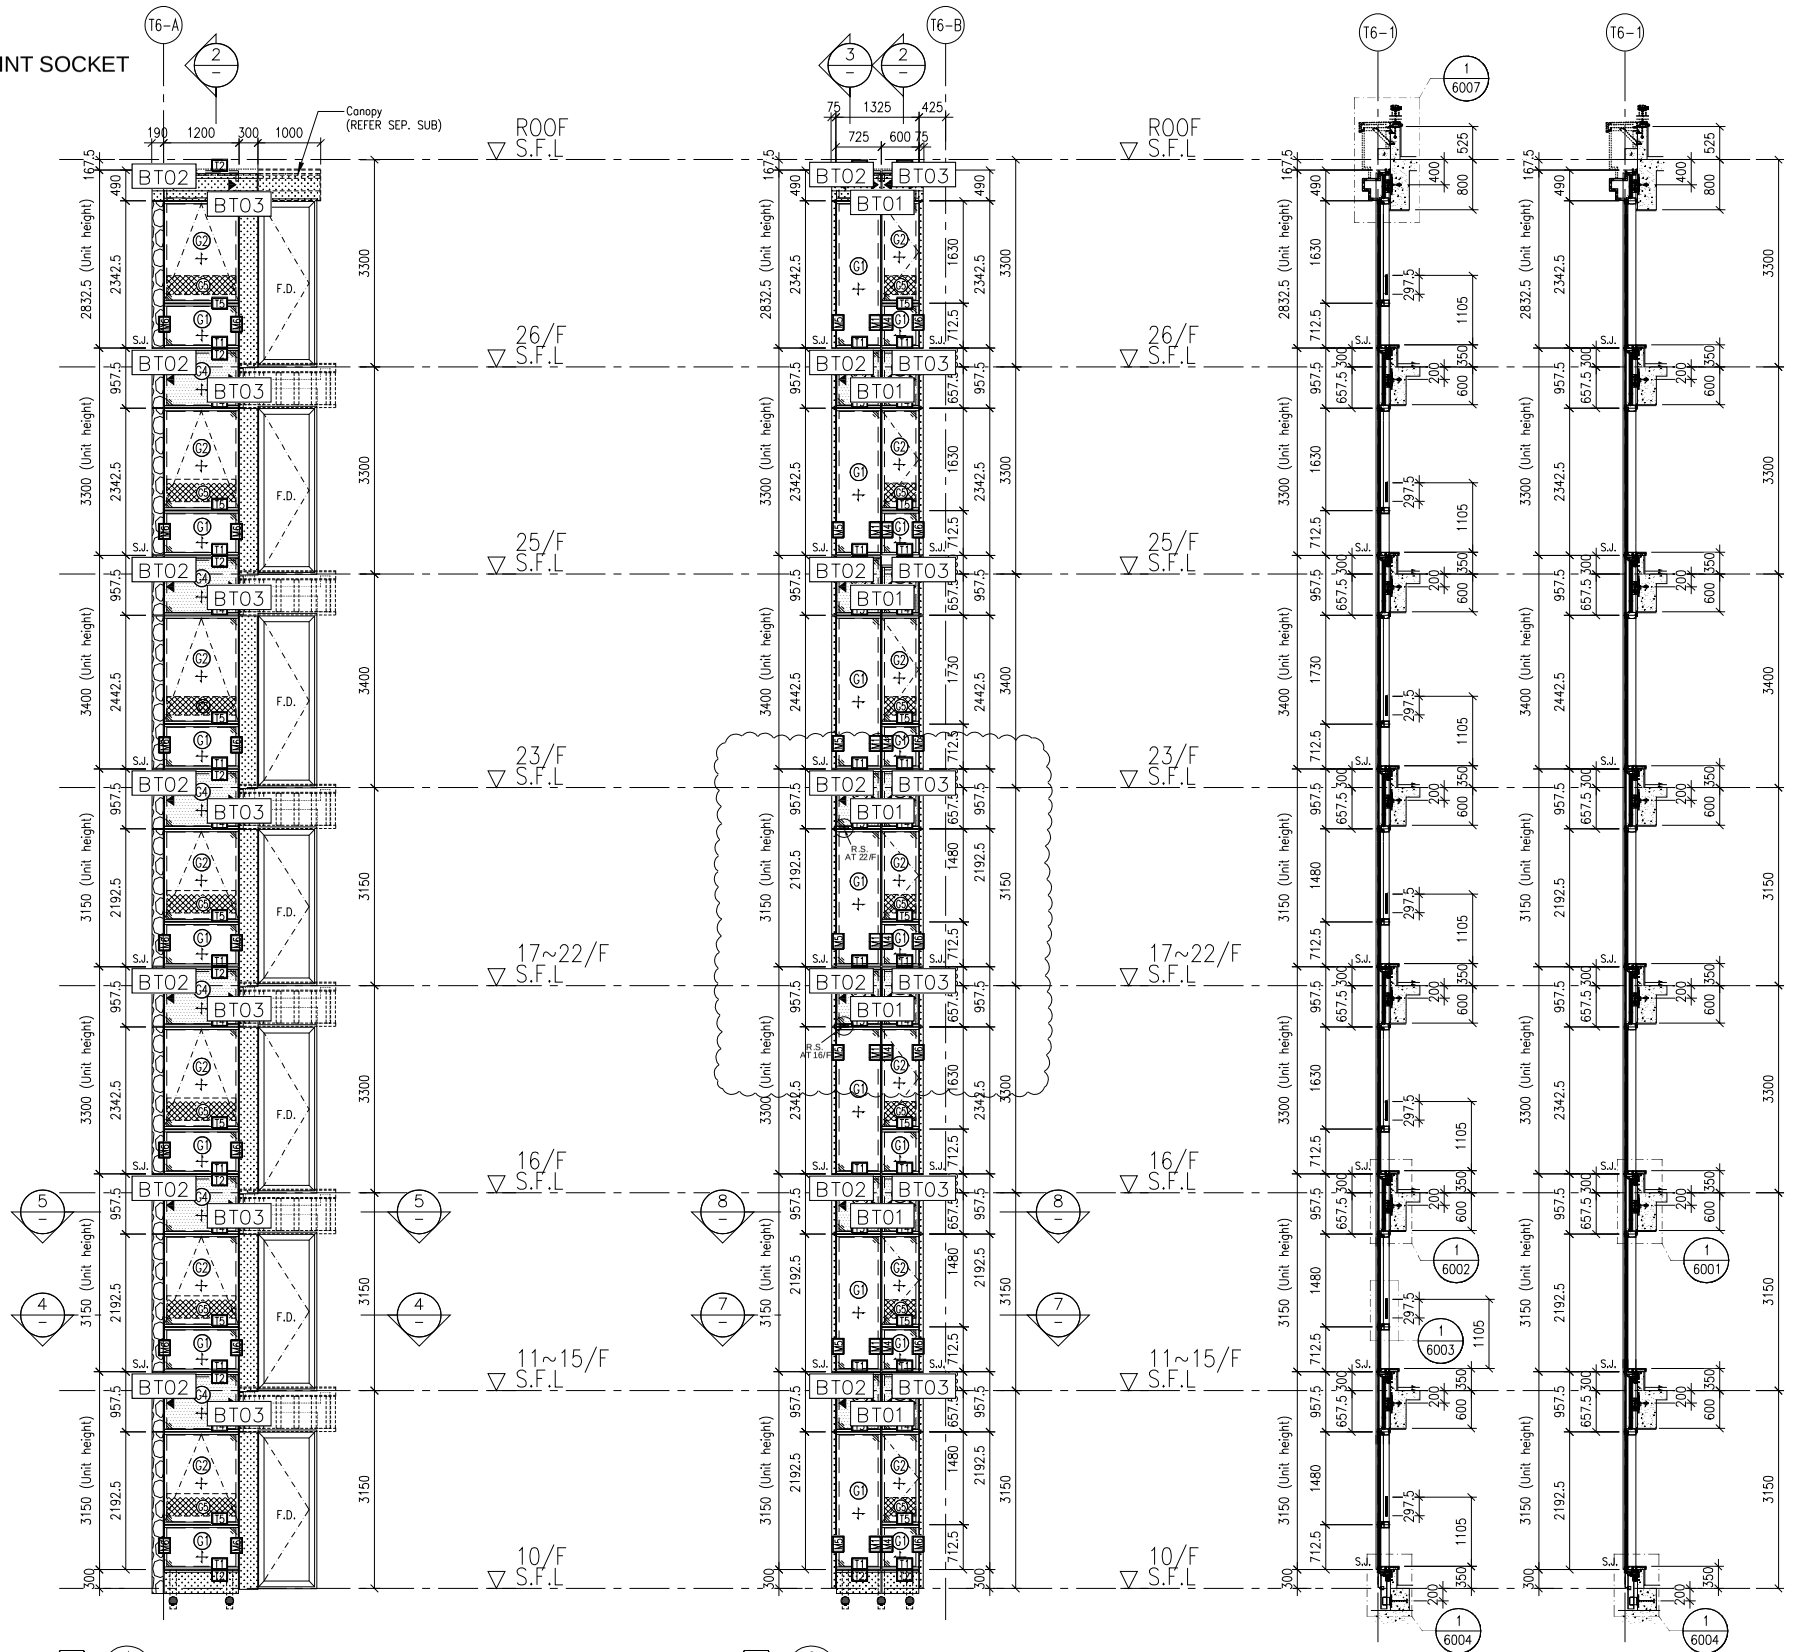


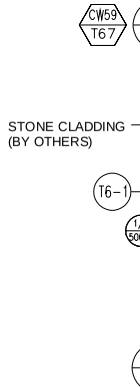


T6CW-D-1

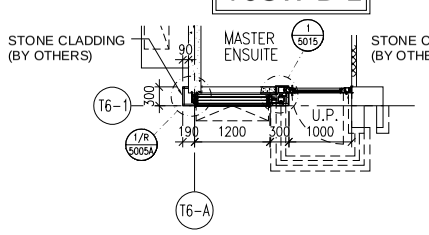


4 PART PLAN FOR CURTAIN WALL

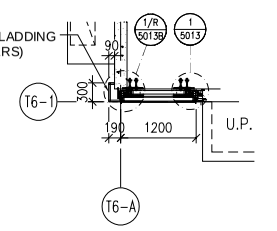


5 PART PLAN FOR CURTAIN WALL

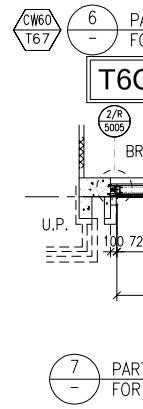

T6CW-D-2

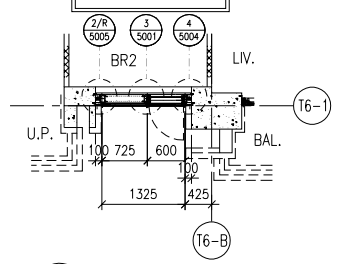

7 PART PLAN FOR CURTAIN WALL

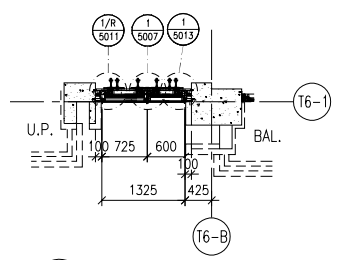

8 PART PLAN FOR CURTAIN WALL

2 TYPICAL SECTION FOR CURTAIN WALL

3 TYPICAL SECTION FOR CURTAIN WALL

FLOOR LEVEL (S.F.L.)

FLOOR	LEVEL
ROOF	+210.00
26/F	+206.70
25/F	+203.40
23/F	+200.00
22/F	+196.85
21/F	+193.70
20/F	+190.55
19/F	+187.40
18/F	+184.25
17/F	+181.10
16/F	+177.80
15/F	+174.65
12/F	+171.50
11/F	+168.35
10/F	+165.20

LEGEND:

- 01 – 10mm HEAT STRENGTHENED GLASS (OUTER) + 12mm AIR SPACE +12mm THK. TEMPERED CLEAR GLASS (INNER)
- 02 – 10mm HEAT STRENGTHENED GLASS (OUTER) + 12mm AIR SPACE +10mm THK. TEMPERED CLEAR GLASS (INNER)
- 04 – 12mm THK. HEAT STRENGTHENED GLASS & 2mm THK. ALUM. BACKPAN (SPANDREL GLASS)
- 05 – 12mm THK. CLEAR TEMPERED GLASS (INTERNAL PROTECTIVE BARRIER)
- 3mm THK. ALUM. CLADDING
- S.J. – STACK JOINT (WIND LOAD)
- AE01 – ALUM. EXTRUSION DIE NO.
- ▲ – SUPPORT POINT (WIND LOAD + DEAD LOAD)
- ● – SUPPORT POINT (WIND LOAD)

B.D. REF :

CLIENT :

SHIMAO GROUP HOLDINGS LIMITED

ARCHITECT :

WONG TUNG & PARTNERS LIMITED
ARCHITECTS & PLANNERS

MAIN CONTRACTOR :

協興建築有限公司
HIP HING CONSTRUCTION CO LTD

STRUCTURAL ENGINEER :

C M WONG & ASSOCIATES LTD
黃志明建築工程師有限公司

FACADE CONSULTANT:

MEINHARDT

NOTE :

1. ALL DIMENSIONS ARE IN mm.
2. ALL ELEVATIONS ARE VIEWED FROM OUTSIDE.
3. ALL DIMENSIONS TO BE VERIFIED ON SITE BEFORE FABRICATION.

LEGEND :

X1 – DETAIL MARK NO.
X001 – REFER SHEET NO.

1. F.F.L. --FINISHED FLOOR LEVEL
2. S.F.L. --STRUCTURAL FLOOR LEVEL
3. /R --REVERSED DETAIL

NO.	DATE	REVISED	BY
A	09-10-2021	REVISION SUBJECT TO ARCH. COMMENT	

JOB NO. : J-853

PROJECT :

PROPOSED RESIDENTIAL DEVELOPMENT AT N.K.I.L. 6542 YIN PING ROAD KOWLOON

TITLE :


PART ELEVATION FOR CURTAIN WALL AT TOWER 6 & 7

DATE : 13-APR-21 | SCALE : 1:60 (A1)

DRAWN BY : LHR | CHECKED BY :

美特鋁質有限公司
MIDI ALUMINIUM FABRICATOR LTD.
Units 6-8, Sunray Industrial Centre, 1/F
610 Cha Kwo Ling Road, Kowloon
Tel:23489211-4 Fax:(852)27727666

DWG NO. : J853-SD-CW-4607 | REV. : A

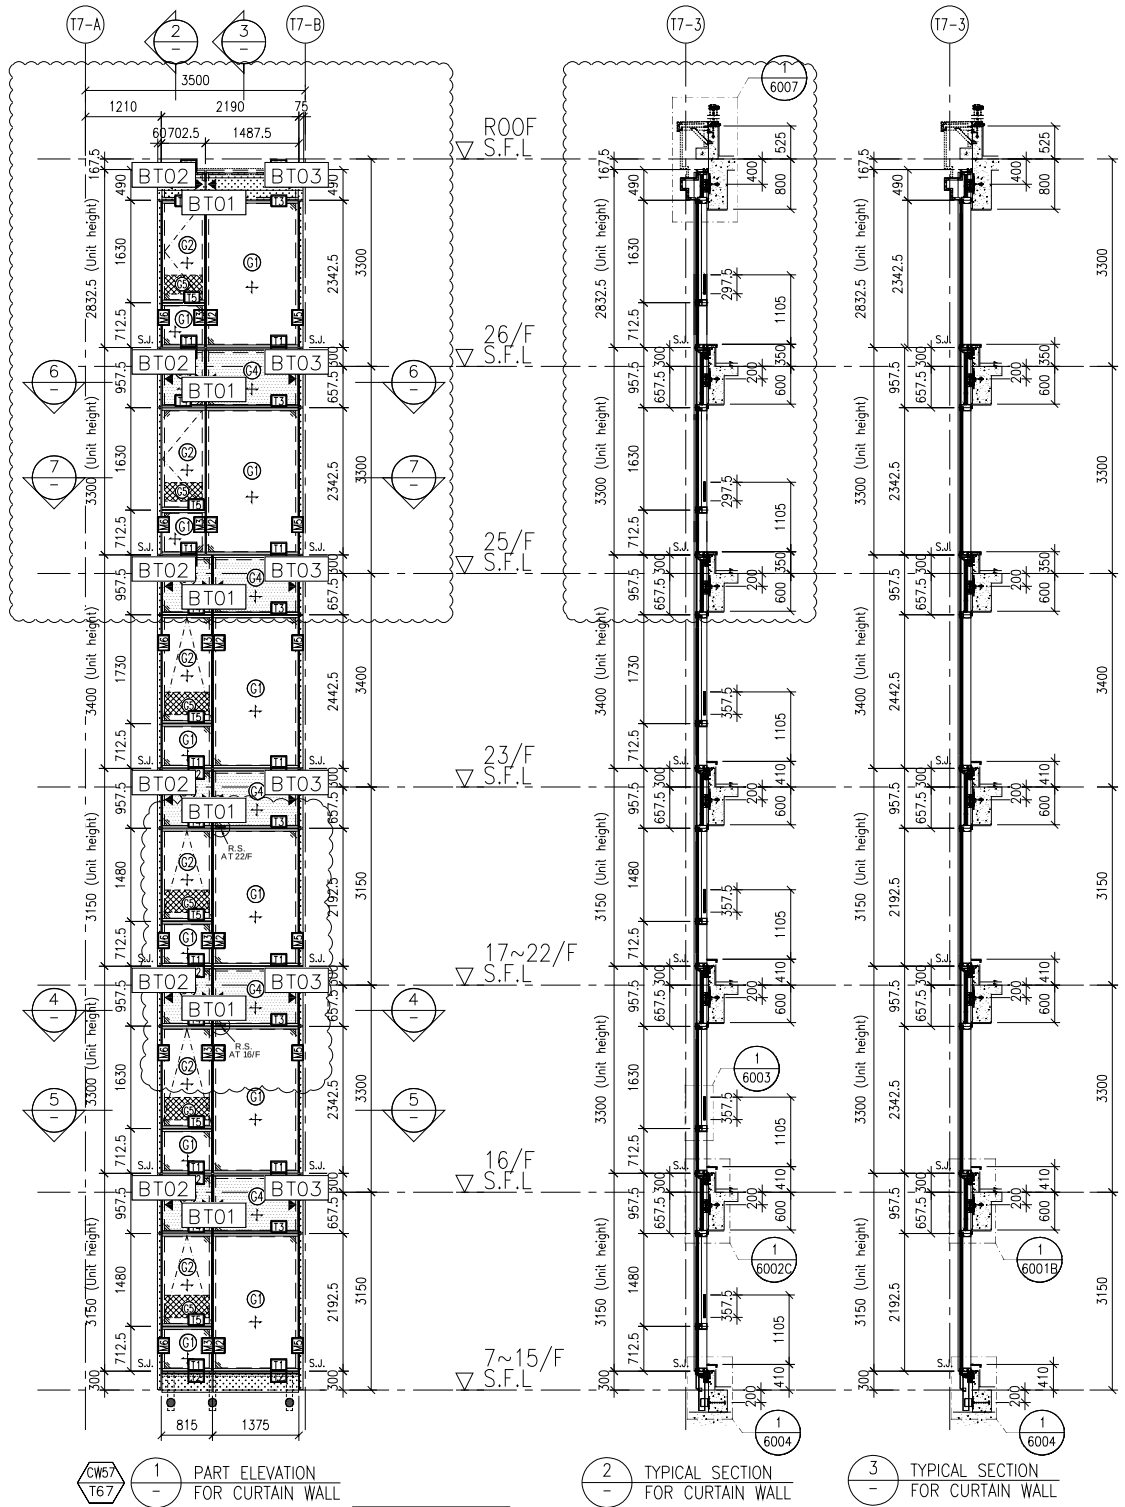


CW57 T6-7 1 – PART ELEVATION FOR CURTAIN WALL


2 – TYPICAL SECTION FOR CURTAIN WALL

3 – TYPICAL SECTION FOR CURTAIN WALL


T7CW-B-6

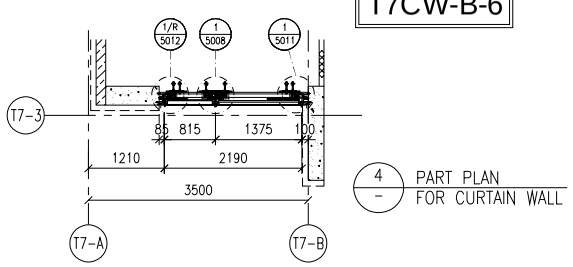


4 – PART PLAN FOR CURTAIN WALL

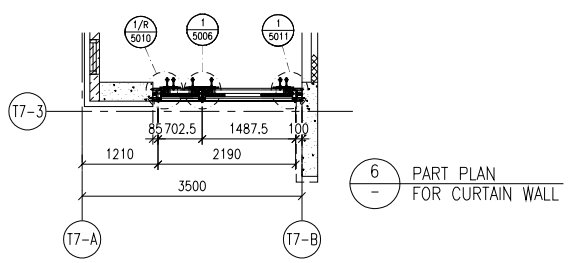


6 – PART PLAN FOR CURTAIN WALL

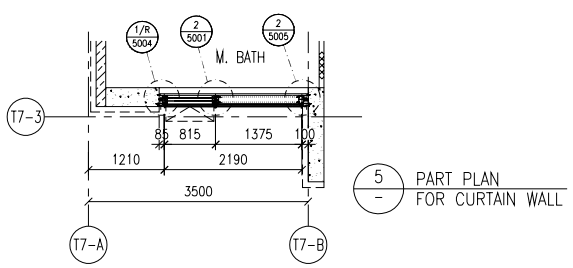

5 – PART PLAN FOR CURTAIN WALL

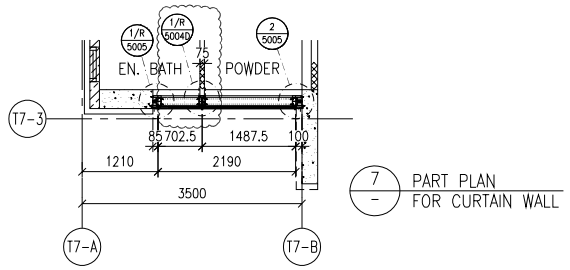

7 – PART PLAN FOR CURTAIN WALL

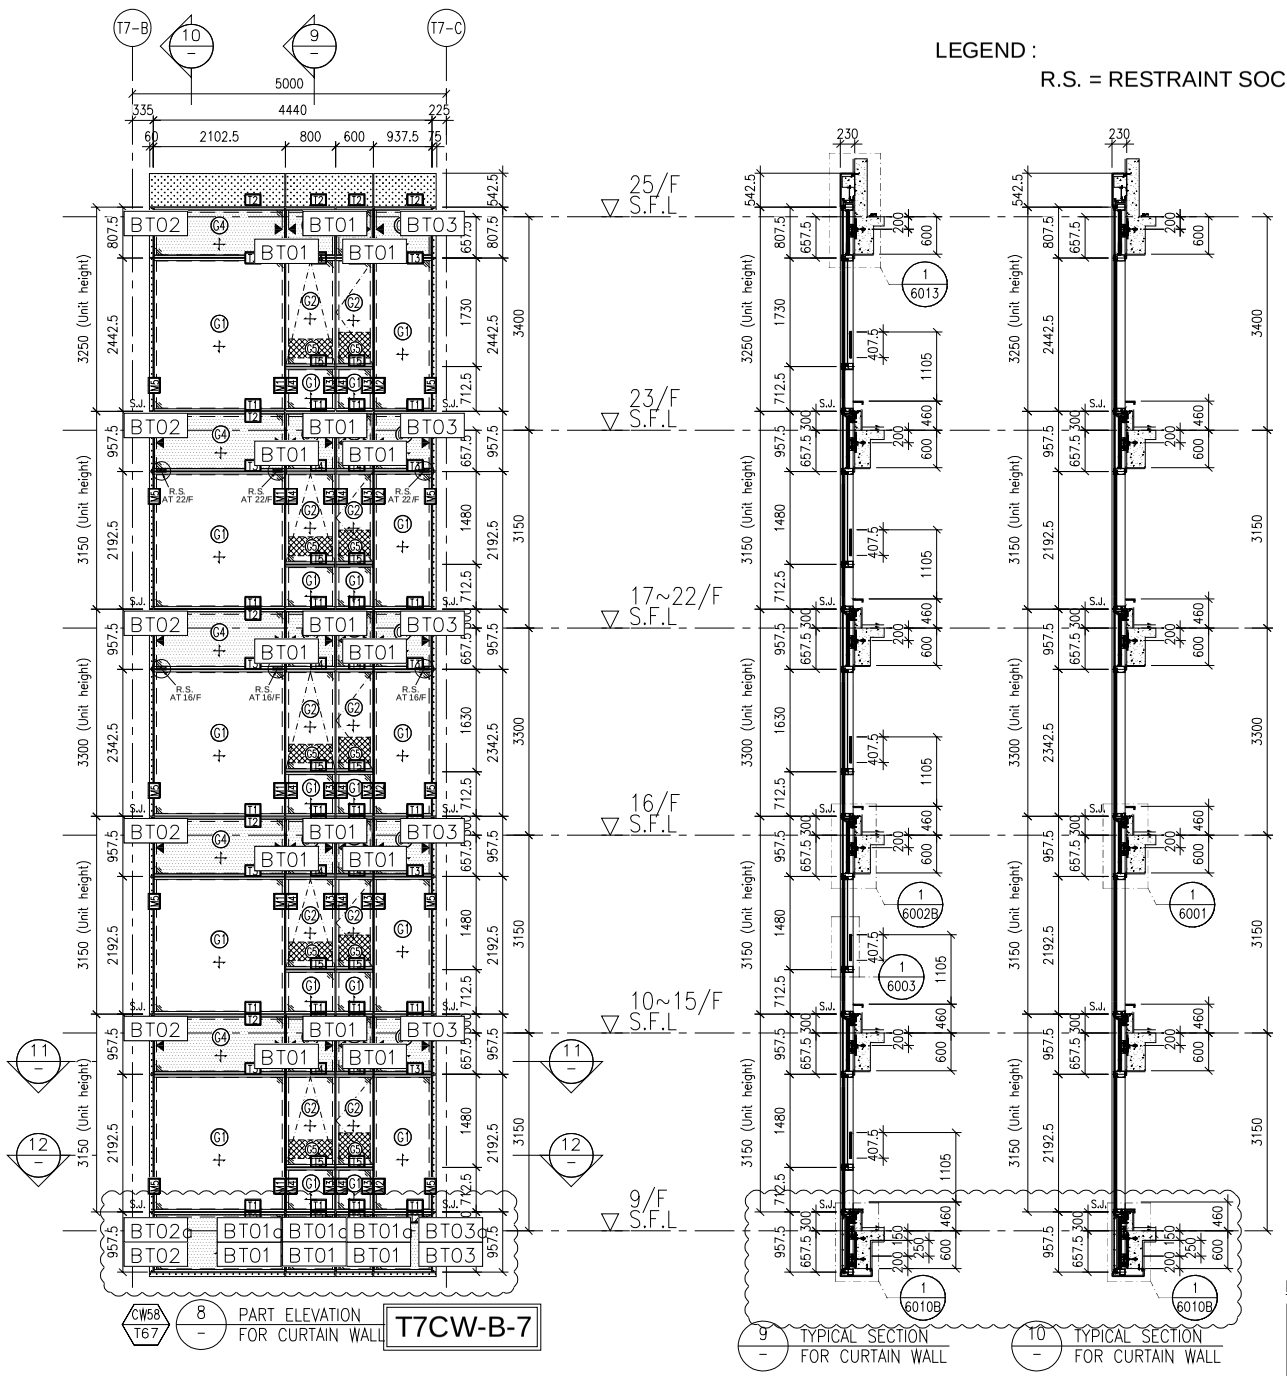


CW58 T6-7 8 – PART ELEVATION FOR CURTAIN WALL


T7CW-B-7

9 – TYPICAL SECTION FOR CURTAIN WALL

10 – TYPICAL SECTION FOR CURTAIN WALL

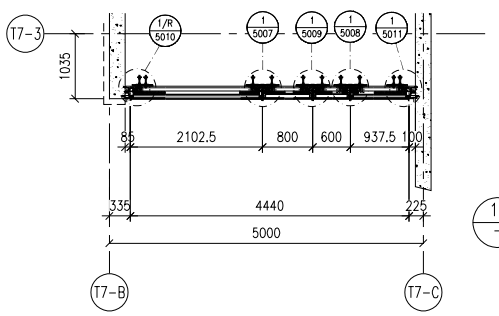

11 – PART PLAN FOR CURTAIN WALL

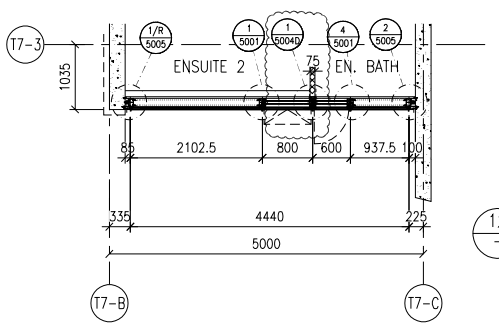

12 – PART PLAN FOR CURTAIN WALL

LEGEND :

R.S. = RESTRAINT SOCKET

FLOOR LEVEL (S.F.L.)

FLOOR	LEVEL
25/F	+203.40
23/F	+200.00
22/F	+196.85
21/F	+193.70
20/F	+190.55
19/F	+187.40
18/F	+184.25
17/F	+181.10
16/F	+177.80
15/F	+174.65
12/F	+171.50
11/F	+168.35
10/F	+165.20
9/F	+162.05
8/F	+158.90
7/F	+155.75

LEGEND:

- G1+ – 10mm HEAT STRENGTHENED GLASS (OUTER) + 12mm AIR SPACE +12mm THK. TEMPERED CLEAR GLASS (INNER)
- G2+ – 10mm HEAT STRENGTHENED GLASS (OUTER) + 12mm AIR SPACE +10mm THK. TEMPERED CLEAR GLASS (INNER)
- G4+ – 12mm THK. HEAT STRENGTHENED GLASS & 2mm THK. ALUM. BACKPAN (SPANDREL GLASS)
- G5 – 12mm THK. CLEAR TEMPERED GLASS (INTERNAL PROTECTIVE BARRIER)
- 3mm THK. ALUM. CLADDING
- S.J. – STACK JOINT (WIND LOAD)
- AE01 – ALUM. EXTRUSION DIE NO.
- ▲ – SUPPORT POINT (WIND LOAD + DEAD LOAD)
- ● – SUPPORT POINT (WIND LOAD)

B.D. REF :

CLIENT :

SHIMAO GROUP HOLDINGS LIMITED

ARCHITECT :

WONG TUNG & PARTNERS LIMITED
ARCHITECTS & PLANNERS

MAIN CONTRACTOR :

協興建築有限公司
HIP HING CONSTRUCTION CO LTD

STRUCTURAL ENGINEER :

C M WONG & ASSOCIATES LTD
黃志明建築工程師有限公司

FACADE CONSULTANT:

MEINHARDT

NOTE :

1. ALL DIMENSIONS ARE IN mm.
2. ALL ELEVATIONS ARE VIEWED FROM OUTSIDE.
3. ALL DIMENSIONS TO BE VERIFIED ON SITE BEFORE FABRICATION.

LEGEND :

X1 / X001 — DETAIL MARK NO. / REFER SHEET NO.

1. F.F.L. --FINISHED FLOOR LEVEL
2. S.F.L. --STRUCTURAL FLOOR LEVEL
3. (/R) --REVERSED DETAIL

NO.	DATE	REVISED	BY
A	09-10-2021	REVISION SUBJECT TO ARCH. COMMENT	

JOB NO. : J-853

PROJECT :

PROPOSED RESIDENTIAL DEVELOPMENT AT N.K.I.L. 6542 YIN PING ROAD KOWLOON

TITLE :


PART ELEVATION FOR CURTAIN WALL AT TOWER 6 & 7

DATE : 13-APR-21 | SCALE : 1:60 (A1)

DRAWN BY : LHR | CHECKED BY :

美特鋁質有限公司
MIDI ALUMINIUM FABRICATOR LTD.
Units 6-8, Sunray Industrial Centre, 1/F
610 Cha Kwo Ling Road, Kowloon
Tel:23489211-4 Fax:(852)27727666

DWG NO. : J853-SD-CW-4608 | REV. : A

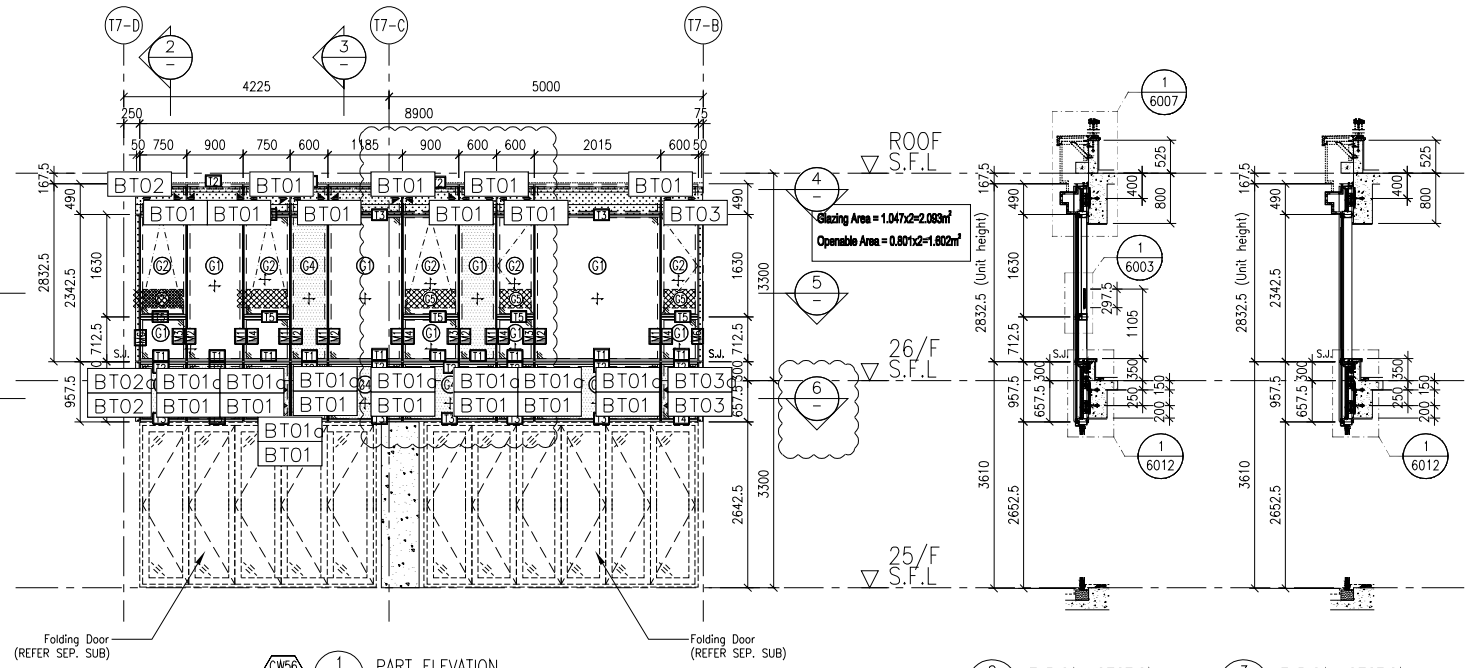


CW56 T67 — 1 — PART ELEVATION FOR CURTAIN WALL


2 — TYPICAL SECTION FOR CURTAIN WALL

3 — TYPICAL SECTION FOR CURTAIN WALL


T7CW-B-8

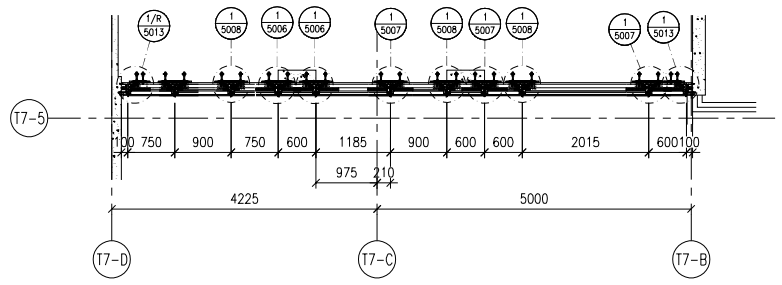

4 — PART PLAN FOR CURTAIN WALL

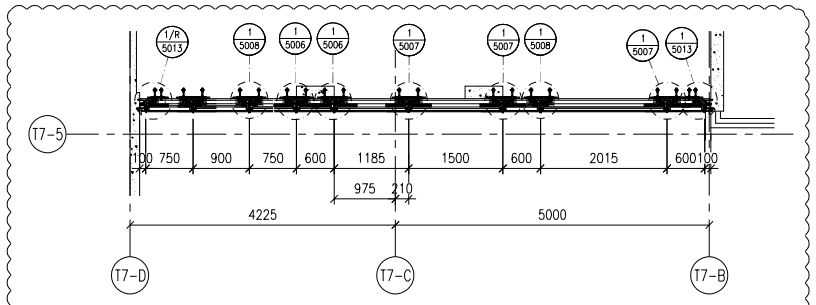

6 — PART PLAN FOR CURTAIN WALL

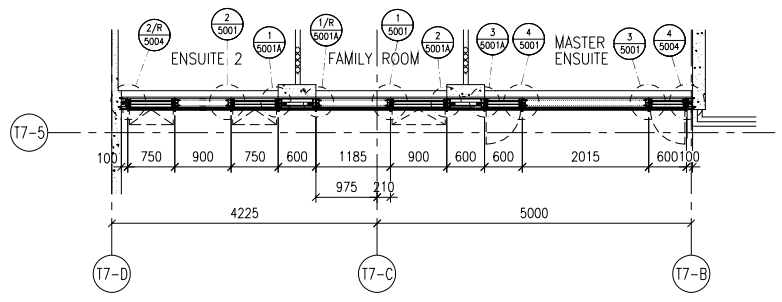

5 — PART PLAN FOR CURTAIN WALL

LEGEND:

- G1 — 10mm HEAT STRENGTHENED GLASS (OUTER) + 12mm AIR SPACE +12mm THK. TEMPERED CLEAR GLASS (INNER)
- G2 — 10mm HEAT STRENGTHENED GLASS (OUTER) + 12mm AIR SPACE +10mm THK. TEMPERED CLEAR GLASS (INNER)
- G4 — 12mm THK. HEAT STRENGTHENED GLASS & 2mm THK. ALUM. BACKPAN (SPANDREL GLASS)
- 12mm THK. CLEAR TEMPERED GLASS (INTERNAL PROTECTIVE BARRIER)
- 3mm THK. ALUM. CLADDING
- S.J. — STACK JOINT (WIND LOAD)
- AE01 — ALUM. EXTRUSION DIE NO.
- ▲ — SUPPORT POINT (WIND LOAD + DEAD LOAD)
- ● — SUPPORT POINT (WIND LOAD)

B.D. REF :

CLIENT :

SHIMAO GROUP HOLDINGS LIMITED

ARCHITECT :

WONG TUNG & PARTNERS LIMITED
ARCHITECTS & PLANNERS

MAIN CONTRACTOR :

協興建築有限公司
HIP HING CONSTRUCTION CO LTD

STRUCTURAL ENGINEER :

C M WONG & ASSOCIATES LTD
黃志明建築工程師有限公司

FACADE CONSULTANT:

MEINHARDT

NOTE :

1. ALL DIMENSIONS ARE IN mm.
2. ALL ELEVATIONS ARE VIEWED FROM OUTSIDE.
3. ALL DIMENSIONS TO BE VERIFIED ON SITE BEFORE FABRICATION.

LEGEND :

- X1 / X001 — DETAIL MARK NO. / REFER SHEET NO.

1. F.F.L. -- FINISHED FLOOR LEVEL
2. S.F.L. -- STRUCTURAL FLOOR LEVEL
3. (/R) -- REVERSED DETAIL

NO.	DATE	REVISED	BY

JOB NO. : J-853

PROJECT :
PROPOSED RESIDENTIAL DEVELOPMENT AT N.K.I.L. 6542 YIN PING ROAD KOWLOON

TITLE :
PART ELEVATION FOR CURTAIN WALL AT TOWER 6 & 7

DATE : 09-OCT-21 | SCALE : 1:60 (A1)

DRAWN BY : LHR | CHECKED BY :

美特鋁質有限公司
MIDI ALUMINIUM FABRICATOR LTD.
Units 6-8, Sunray Industrial Centre, 1/F
610 Cha Kwo Ling Road, Kowloon
Tel:23489211-4 Fax:(852)27727666


DWG NO. : J853-SD-CW-4609 | REV. : A


EG-DWG4


美特鋁質 有限公司 MIDI Aluminium Fabricator Ltd.				類別		物料號		
				制圖	陳俊賢	2022.9.7	圖號	853-BT08a
修改	新增			復核	謝永林	2022.9.8	數量	–
日期	2022.9.8			批准	胡哥		位置	

使用位置	數量	層數	總數	樓層
T5CW-A-4	1	1	1	5F


原EI4318，依據型材料辦
牙位尺寸微調

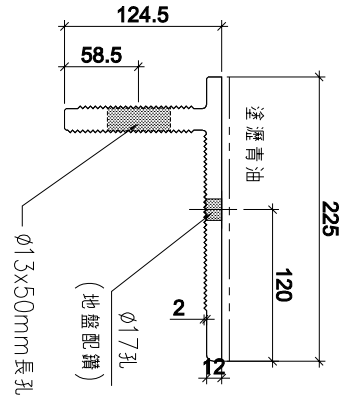

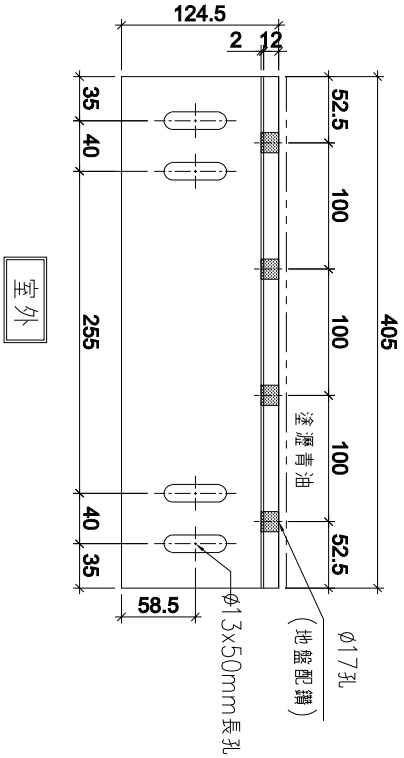

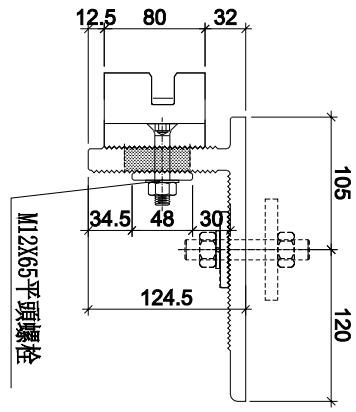

組裝示意圖

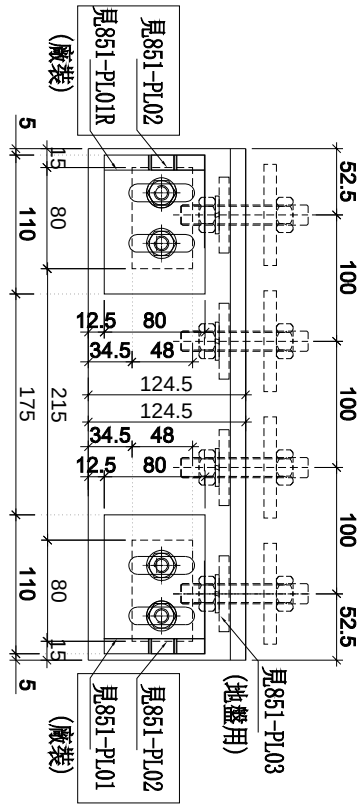

工程號	J853	地盤	延坪道			附件
名稱	墻邊鋁碼			採用		
材料	X85996			地盤	✓	
顏色	塗澀青油＋鉻化			工廠		