



工程指示 / 要求簡箋(E.I.)

工程指示編號：EI/ 4353 / 22

修改版次：B

工程編號：J-853

工程名稱：大窩坪(廷坪路)

工程項目：T2 露台欄河地盤用鐵件

收件人：Maggie Lor

發件人：大明

日期：22/03/2022

要求提供 / 確認 事項：

- | | | |
|------------------------------------|-------------------------------------|-------------------------------|
| <input type="checkbox"/> 初步鋁料 B.M. | <input type="checkbox"/> 加工拆圖，然後生產 | <input type="checkbox"/> 尺寸表 |
| <input type="checkbox"/> 正式鋁料 B.M. | <input type="checkbox"/> 技術上資料 / 指示 | <input type="checkbox"/> 報 |
| <input type="checkbox"/> 配件 B.M. | <input type="checkbox"/> 樣辦或貨品說明書 | <input type="checkbox"/> 分判合約 |
| <input type="checkbox"/> 其他：_____ | | |

內容：

煩請依附件資料

修改鐵件編號：21-M01-GMU02 M5 平頭過孔尺寸

新增編號：21-M01-GMU02R

請在 15/03/2022 前完成上列要求。

按地盤進度，分層出貨

附有關圖紙 / 文件：附 B.M 表 4 頁,圖紙 7 頁

以上項目為:

- 原合約工程包 原合約工程加 / 減賬 新工程報價

原因：-

分發東莞各部門：

- ()生產技術總監 連附件 ()技術部 連附件 ()生產部 連附件 ()機械設計部 連附件
 ()採購部 連附件 ()生產統籌部 連附件
 ()質檢部 連附件 ()會計部 連附件 ()報關組 連附件 ()其他 _____ 連附件

分發香港各部門：

- ()行政部 連附件 ()會計部 連附件 ()統籌部 連附件 ()工程地盤科文 連附件 畫人
 ()採購部 連附件 ()QS 部 連附件 ()維修部 連附件 ()其他 _____ 連附件

傳遞編號：

發件人簽署：

項目經理簽署：



美特鋁質有限公司
MADI Aluminum Fabricator Ltd.

工程號：
1853

地點名稱：
錦上路延平道

計算：
核對：

CIM

日期：
日期：

27/11/2022

送呈：
副本：

BM編號：

項目類別：

T2欄河JUP,BAI地盤用鋼件

修改：

總重量(Kg):

32219.7

序號	修改標示	配件圖號	物料編號	配件名稱	顏色	實用	後備	總數	單位	單件重量	總重量	備註
									件	KG		
1		21-M01-GMU01	21-M01-GMU01	80*20*1183mm鋼巴	熱浸鋅	301	16	317	件	14.858	4710.138	
2	B	21-M01-GMU02	21-M01-GMU02	80*20*1183mm鋼巴	熱浸鋅	62	3	65	件	14.858	965.801	減少
3	B	21-M01-GMU02R	21-M01-GMU02R	80*20*1183mm鋼巴	熱浸鋅	62	3	65	件	14.858	965.801	新增
4			21-M01-GTR01	80*10*935mm鋼巴	熱浸鋅	9	0	9	件	5.872	52.846	
5			22-M01-GTR01	80*10*320mm鋼巴	熱浸鋅	7	0	7	件	5.872	41.103	
6		21-M01-GTR01	23-M01-GTR01	80*10*910mm鋼巴	熱浸鋅	18	0	18	件	5.715	102.866	
7			24-M01-GTR01	80*10*570mm鋼巴	熱浸鋅	19	0	19	件	5.715	108.581	
8			25-M01-GTR01	80*10*320mm鋼巴	熱浸鋅	9	0	9	件	2.010	18.086	
9		21-M01-GTR02	21-M01-GTR02	80*10*1330mm鋼巴	熱浸鋅	9	0	9	件	8.352	75.172	
10			23-M01-GTR02	80*10*1280mm鋼巴	熱浸鋅	18	0	18	件	8.038	144.691	
11		21-M01-GTR03	31-M01-GTR03	80*10*228mm鋼巴	熱浸鋅	9	0	9	件	8.038	72.346	
12			22-M01-GTR03	80*10*935mm鋼巴	熱浸鋅	7	0	7	件	5.872	41.103	
13			23-M01-GTR03	80*10*455mm鋼巴	熱浸鋅	18	0	18	件	2.857	51.433	
14		22-M01-GTR03	24-M01-GTR03	80*10*910mm鋼巴	熱浸鋅	19	0	19	件	5.715	108.581	
15			25-M01-GTR03	80*10*935mm鋼巴	熱浸鋅	9	0	9	件	5.872	52.846	
16			22-M01-GTR02	80*10*1280mm鋼巴	熱浸鋅	7	1	8	件	8.038	64.307	
17		22-M01-GTR02	24-M01-GTR02	80*10*1280mm鋼巴	熱浸鋅	18	1	19	件	8.038	152.730	
18			25-M01-GTR02	80*10*1330mm鋼巴	熱浸鋅	9	1	10	件	8.352	83.524	
19			21-N01-GTR01	40*40*4mm角鋼	熱浸鋅	9	0	9	件	2.483	22.343	
20		21-N01-GTR01	23-N01-GTR01	40*40*4mm角鋼	熱浸鋅	18	0	18	件	2.422	43.596	
21			24-N01-GTR01	40*40*4mm角鋼	熱浸鋅	19	0	19	件	1.599	30.372	
22		22-N01-GTR01	22-N01-GTR01	40*40*4mm角鋼	熱浸鋅	7	0	7	件	0.993	6.951	
23			25-N01-GTR01	40*40*4mm角鋼	熱浸鋅	9	0	9	件	0.993	8.937	
24			21-N01-GTR02	40*40*4mm角鋼	熱浸鋅	9	0	9	件	3.657	32.915	
25			22-N01-GTR02	40*40*4mm角鋼	熱浸鋅	7	0	7	件	3.536	24.753	



美特紹實有限公司
MIDI Aluminium Fabricator Ltd.

工程號： 1853
地盤名稱： 錦上路延平道

計算： CIM
核對：

日期： 27/11/2022
日期：

送呈：
副本：

BM編號： 項目類別： T2鵝河,UP,BAL地盤用鋼件 修改： 總重量(KG): 32219.7

序號	修改標示	配件圖號	物料編號	配件名稱	顏色	實用	後備	總數	單位	單件重量	總重量	備註
									件	KG		
26		31-N01-GTR02	23-N01-GTR02	40*40*4mm角鋼	熱浸鋅	18	0	18	件	3.536	63.650	
27			24-N01-GTR02	40*40*4mm角鋼	熱浸鋅	19	0	19	件	3.536	67.186	
28			25-N01-GTR02	40*40*4mm角鋼	熱浸鋅	9	0	9	件	3.657	32.915	
29		21-N01-GTR03	21-N01-GTR03	40*40*4mm角鋼	熱浸鋅	9	0	9	件	0.775	6.975	
30			22-N01-GTR03	40*40*4mm角鋼	熱浸鋅	7	0	7	件	2.483	17.378	
31			23N01-GTR03	40*40*4mm角鋼	熱浸鋅	18	0	18	件	0.775	13.951	
32		22-N01-GTR03	24-N01-GTR03	40*40*4mm角鋼	熱浸鋅	19	1	20	件	2.483	49.651	
33			25-N01-GTR03	40*40*4mm角鋼	熱浸鋅	9	1	10	件	1.320	13.200	
34			21-P01-GTR01	125*75*8mm角鋼	熱浸鋅	9	0	9	件	12.802	115.218	
35		21-P01-GTR01	23-P01-GTR01	125*75*8mm角鋼	熱浸鋅	18	0	18	件	12.488	224.788	
36			24-P01-GTR01	125*75*8mm角鋼	熱浸鋅	19	0	19	件	8.221	156.197	
37			22-P01-GTR01	125*75*8mm角鋼	熱浸鋅	7	0	7	件	5.083	35.582	
38		22-P01-GTR01	25-P01-GTR01	125*75*8mm角鋼	熱浸鋅	9	0	9	件	5.083	45.748	
39			21-P01-GTR02	125*75*8mm角鋼	熱浸鋅	9	0	9	件	18.827	169.439	
40			22-P01-GTR02	125*75*8mm角鋼	熱浸鋅	7	0	7	件	18.199	127.393	
41		21-P01-GTR02	23-P01-GTR02	125*75*8mm角鋼	熱浸鋅	18	0	18	件	18.199	327.581	
42			24-P01-GTR02	125*75*8mm角鋼	熱浸鋅	19	0	19	件	18.199	345.780	
43			25-P01-GTR03	125*75*8mm角鋼	熱浸鋅	9	0	9	件	18.827	169.439	
44		21-P01-GTR03	21-P01-GTR03	125*75*8mm角鋼	熱浸鋅	9	0	9	件	3.954	35.582	
45			22-P01-GTR03	125*75*8mm角鋼	熱浸鋅	7	0	7	件	12.802	89.614	
46			23-P01-GTR03	125*75*8mm角鋼	熱浸鋅	18	0	18	件	6.778	121.996	
47		22-P01-GTR03	24-P01-GTR03	125*75*8mm角鋼	熱浸鋅	19	0	19	件	12.488	237.277	
48			25-P01-GTR03	125*75*8mm角鋼	熱浸鋅	9	0	9	件	12.802	115.218	
49		21-BA01-GMU01	21-BA01-GMU01	100*40*1029mm鋼巴	熱浸鋅	154	8	162	件	32.311	5234.317	
50		21-BA01-GMU02	21-BA01-GMU02	100*40*1029mm鋼巴	熱浸鋅	192	9	201	件	32.311	6494.431	



美特鋁有限公司
MADI Aluminum Fabricator Ltd.

工程號：
1853

地盤名稱：
錦上路延平道

計算：
核對：

CIM

日期：
日期：

27/1/2022

送呈：
副本：

BM編號：

項目類別：


T2欄河,JP,BAL地盤用鋼件

修改：

總重量(Kg):

32219.7

序號	修改標示	配件圖號	物料編號	配件名稱	顏色	實用	後備	總數	單位	單件重量	總重量	備註
									件	KG	KG	
51		22-BA01-GMU03	22-BA01-GMU03	100*40*1029mm鋼巴	熱浸鋅	54	3	57	件	32.311	1841.704	
52		21-BA01-GTR01	21-BA01-GTR01	100*15鋼巴	熱浸鋅	9	0	9	件	7.866	70.791	
53			22-BA01-GTR01	100*15鋼巴	熱浸鋅	8	0	8	件	7.866	62.926	
54		21-BA01-GTR01	23-BA01-GTR01	100*15鋼巴	熱浸鋅	18	0	18	件	6.983	125.686	
55			25-BA01-GTR01	100*15鋼巴	熱浸鋅	9	0	9	件	7.866	70.791	
56		24-BA01-GTR01	24-BA01-GTR02	100*15鋼巴	熱浸鋅	19	0	19	件	2.567	48.772	
57		21-BA01-GTR02	21-BA01-GTR02	100*15鋼巴	熱浸鋅	9	0	9	件	26.906	242.153	
58			25-BA01-GTR02	100*15鋼巴	熱浸鋅	9	0	9	件	25.728	231.555	
59		22-BA01-GTR02	22-BA01-GTR02	100*15鋼巴	熱浸鋅	8	0	8	件	71.651	573.207	
60		23-BA01-GTR02	23-BA01-GTR02	100*15鋼巴	熱浸鋅	18	0	18	件	39.505	711.092	
61			24-BA01-GTR02	100*15鋼巴	熱浸鋅	19	0	19	件	39.505	750.597	
62		21-BA01-GTR03	21-BA01-GTR03	100*15鋼巴	熱浸鋅	9	0	9	件	16.874	151.862	
63			22-BA01-GTR03	100*15鋼巴	熱浸鋅	8	0	8	件	6.983	55.861	
64		21-BA01-GTR03	24-BA01-GTR02	100*15鋼巴	熱浸鋅	19	0	19	件	13.341	253.480	
65			25-BA01-GTR03	100*15鋼巴	熱浸鋅	9	0	9	件	6.983	62.843	
66		23-BA01-GTR01	23-BA01-GTR01	100*15鋼巴	熱浸鋅	18	0	18	件	2.273	40.906	
67	A	21-BB01-GTR01	21-BB01-GTR01	125*75*8mm角鋼	熱浸鋅	9	0	9	件	9.413	84.719	
68	A		22-BB01-GTR01	125*75*8mm角鋼	熱浸鋅	8	0	8	件	8.472	67.775	
69	A	21-BB01-GTR01	23-BB01-GTR01	125*75*8mm角鋼	熱浸鋅	18	0	18	件	16.818	302.730	
70	A		25-BB01-GTR01	125*75*8mm角鋼	熱浸鋅	9	0	9	件	19.015	171.133	
71	A	24-BB01-GTR01	24-BB01-GTR01	125*75*8mm角鋼	熱浸鋅	19	0	19	件	3.765	71.541	
72	A	21-BB01-GTR02	21-BB01-GTR02	125*75*8mm角鋼	熱浸鋅	9	0	9	件	30.750	276.750	
73	A		25-BB01-GTR02	125*75*8mm角鋼	熱浸鋅	9	0	9	件	29.495	265.454	
74	A	22-BB01-GTR02	22-BB01-GTR02	125*75*8mm角鋼	熱浸鋅	8	0	8	件	78.444	627.550	
75	A		23-BB01-GTR02	125*75*8mm角鋼	熱浸鋅	18	0	18	件	44.180	795.231	

		美特鋁質有限公司		MDDI Aluminium Fabricator Ltd		工程號： J833		計算： CIM		日期： 27/1/2022		送呈：		副本：											
BM編號：		修改標示		配件圖號		物料編號		配件名稱		顏色		實用		後備		總數		單位		單件重量		總重量		備註	
項目類別：		地盤名稱：		T2攔河;UP,BAL地盤用鋼件		地盤名稱：		錦上路/延平道		核對：		日期：		修改：		總重量(kg):		32219.7							
76		A				24-BB01-GTR02		125*75*8mm角鋼		熱浸粹		19		0		19		件		44.180		839.411			
77		A				21-BB01-GTR03		125*75*8mm角鋼		熱浸粹		9		0		9		件		19.015		171.133			
78		A				22-BB01-GTR03		125*75*8mm角鋼		熱浸粹		8		0		8		件		8.472		67.775			
79		A				24-BB01-GTR03		125*75*8mm角鋼		熱浸粹		19		0		19		件		15.249		289.740			
80		A				25-BB01-GTR03		125*75*8mm角鋼		熱浸粹		9		0		9		件		8.472		76.247			
81		A				23-BB01-GTR03		125*75*8mm角鋼		熱浸粹		18		0		18		件		3.765		67.775			
82						XX-01		50*50*5角鐵		熱浸粹		25		1		26		件		11.300		293.800			
83		A				GS01-AK02		50*50*5角鐵		熱浸粹		434		2		436		件		0.377		164.372			
												總計		2269				件				32219.7			



美特铝质有限公司

MIDI Aluminium Fabricator Ltd.


工程號

J-853



地盤

錦上路/延平道

序號	物料編號	數量	使用位置	樓層
01	21-M01-GMU02	9	UP-4201	T3/(6/F-16/F)
02	21-M01-GMU02	7	UP-4202	T3/(17F-23/F)
03	21-M01-GMU02	18	UP-4203	T3/(6/F-26/F)
04	21-M01-GMU02	19	UP-4204	T3/(6/F-26/F)
05	21-M01-GMU02	9	UP-4205	T3/(6/F-16/F)
		62		

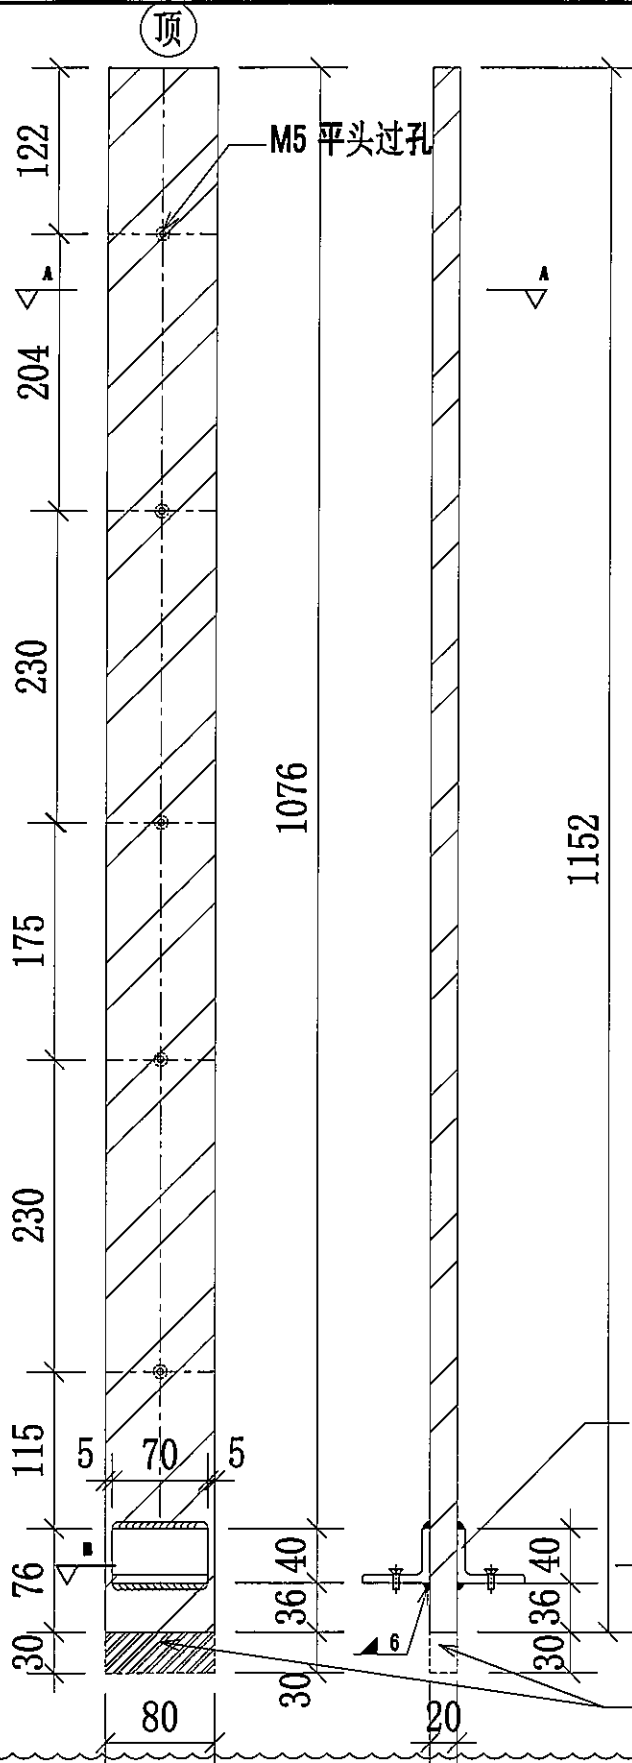

地盤用

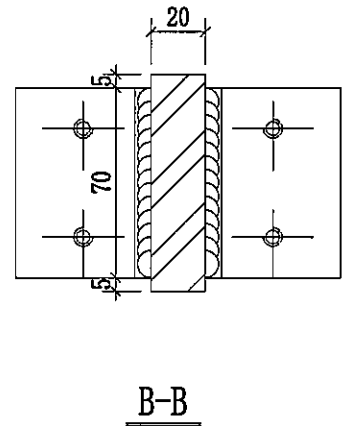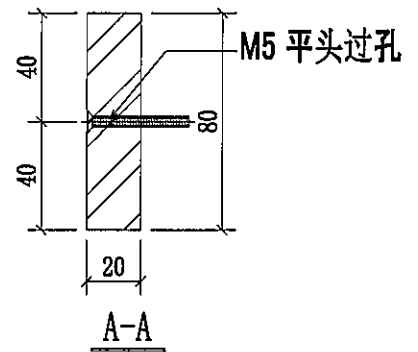


名稱	擱河UP鋼企料	制圖	CJM	2022.01.18	修改	A	
材料	80x20mm 鍍鋅鋼巴(材質: SJ275)	復核	SHUI	2022.01.19	日期	2022.03.18	
顏色		批准			圖號	21-M01-GMU02	





美特铝质有限公司
MIDI Aluminium Fabricator Ltd.

序號	物料編號	數量	使用位置	樓層
01	21-M01-GMU02R	9	UP-4201	T3/(6/F-16/F)
02	21-M01-GMU02R	7	UP-4202	T3/(17F-23/F)
03	21-M01-GMU02R	18	UP-4203	T3/(6/F-26/F)
04	21-M01-GMU02R	19	UP-4204	T3/(6/F-26/F)
05	21-M01-GMU02R	9	UP-4205	T3/(6/F-16/F)
		62		

工程號 J-853 地盤 錦上路/延平道

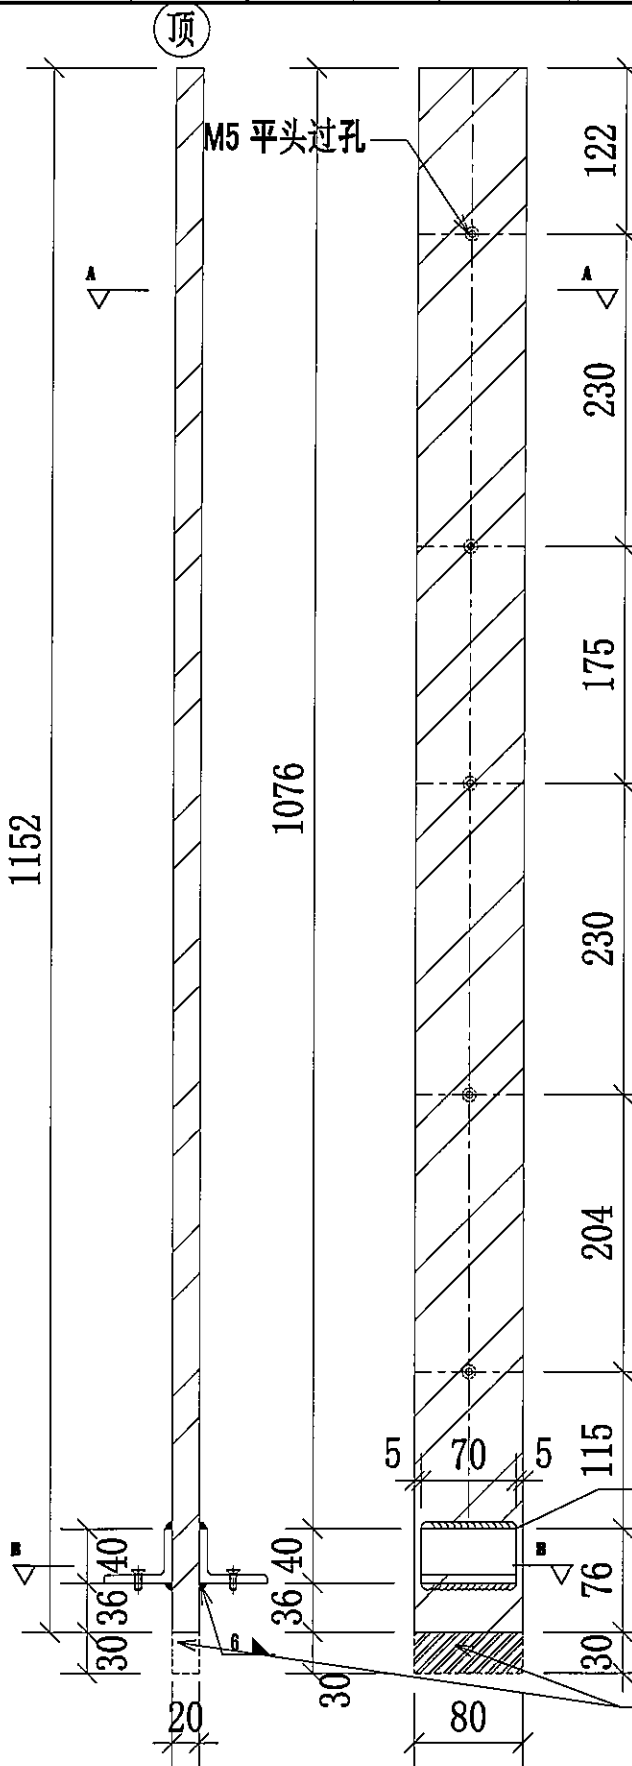

地盤用

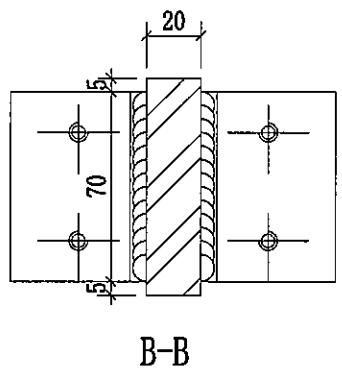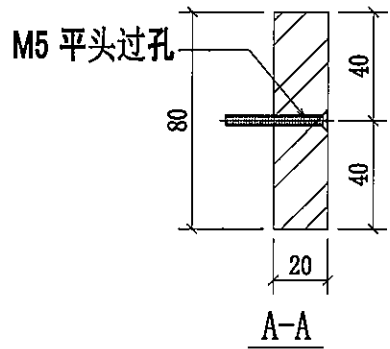

新增圖

名稱	擬河UP 鋁企料	制圖	CJM	2022.01.18	修改		
材料	80x20mm 鍍鋅鋼巴 (材質: SJ275)	復核	SHUI	2022.01.19	日期		
顏色		批準			圖號	21-M01-GMU02R	

BL 4353 B

J853-SD-UP-4201



1400 T2 FLAT A

6/F-16/F=9


發貨時：一個完整露臺的鋼件
鋁材，打包成一扎，同時出貨
到地盤。

1 TYPICAL PART PLAN FOR
4201 T2 FLAT A U.P. 6/F-16/F
(OMITTED 13, 14)


編號:	數量:	總數量:
21-M01-GMU01	4	36
21-M01-GMU02	1	9
21-M01-GMU02R	1	9
21-M01-GTR01	1	9
21-M01-GTR02	1	9
21-M01-GTR03	1	9
21-N01-GTR01	1	9
21-N01-GTR02	1	9
21-N01-GTR03	1	9
21-P01-GTR01	1	9
21-P01-GTR02	1	9
21-P01-GTR03	1	9
		135

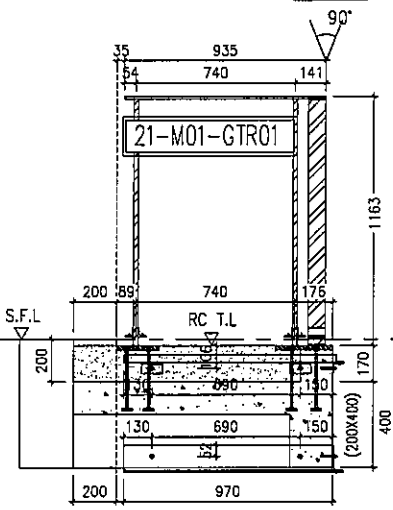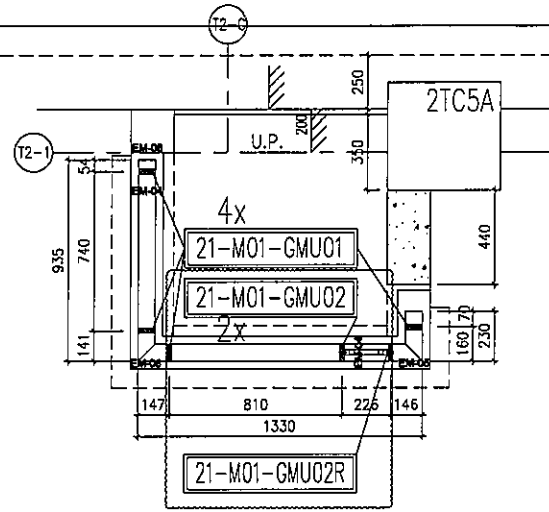


36 STEEL FRAME ONLY FOR
4201 T2 FLAT A U/P @ 6/F-25/F

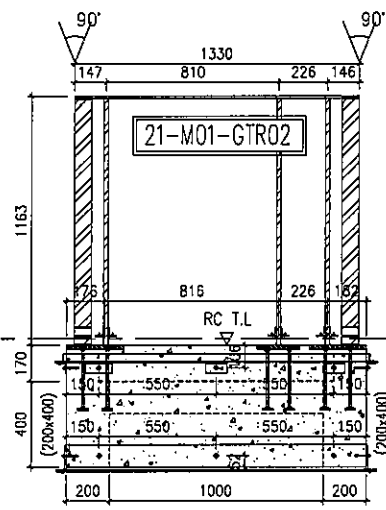


38 STEEL FRAME ONLY FOR
4201 T2 FLAT A U/P @ 6/F-25/F

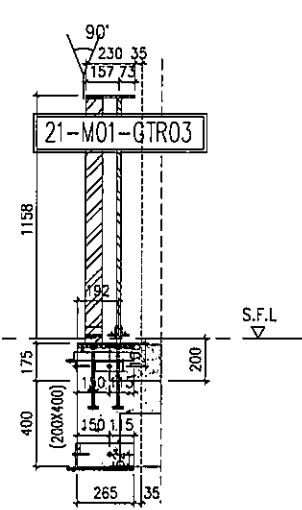

39 STEEL FRAME ONLY FOR
4201 T2 FLAT A U/P @ 6/F-25/F

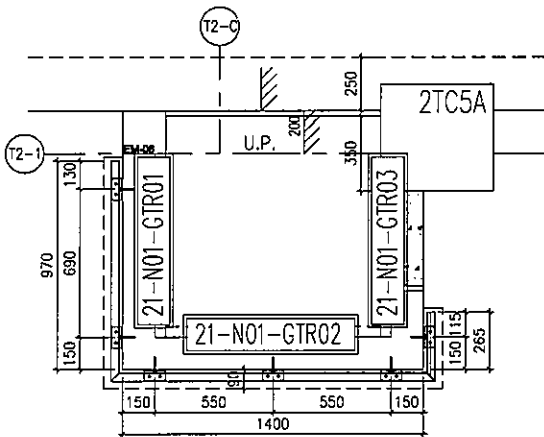

40x40x4-鋼件位置圖

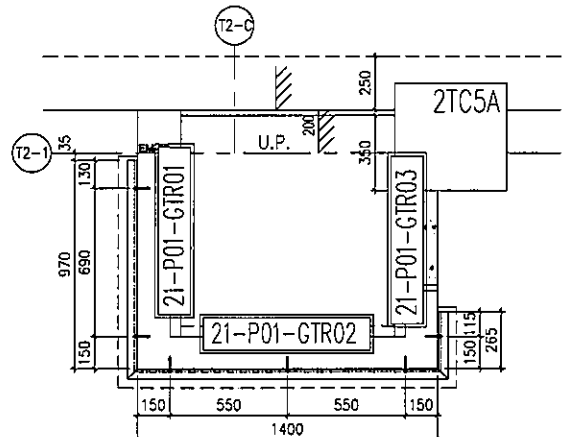

125x50x8-鋼件位置圖

UP4201-鋼件位置圖

<p>美特銘有限公司 M&T (HONG KONG) LIMITED 910 Chee Kwoi Road, Kowloon, H.K. Tel: (852) 27727565</p>	<p>DATE: 08-MAR-21</p> <p>SCALE: 1:50(A1)</p> <p>CHECKED BY: [Signature]</p>	<p>JOB NO.: J-853</p> <p>PROJECT: PROPOSED RESIDENTIAL DEVELOPMENT AT N.K.I.L. 6542 YIN PING ROAD KOWLOON</p> <p>TITLE: PART ELEVATION OF ALUM. BALUSTRADE AT TOWER 2</p>	<p>REV. NO. 1: 1. F.I.L. - FINISHED FLOOR LEVEL</p> <p>REV. NO. 2: S.F.L. - STRUCTURE FLOOR LEVEL</p> <p>REV. NO. 3: R.F.S. - REFERENCE DETAIL</p>	<p>NOTE: ALL DIMENSIONS ARE IN mm</p> <p>1. ALL DIMENSIONS ARE TAKEN FROM OUTSIDE UNLESS SPECIFIED OTHERWISE.</p> <p>2. ALL DIMENSIONS TO BE TAKEN ON SITE BEFORE FABRICATION.</p> <p>LEGEND:</p> <p>○ DETAIL MARK NO.</p> <p>○ REFER SHEET NO.</p>	<p>STRUCTURAL ENGINEER:</p> <p> M&T (HONG KONG) LIMITED</p>	<p>ARCHITECT:</p> <p> M&T (HONG KONG) LIMITED</p>	<p>CLIENT:</p>	<p>DATE:</p>


編號:	數量:	總數量:
24-M01-GMU01	5	95
24-M01-GMU02	1	19
24-M01-GMU02R	1	19
24-M01-GTR01	1	19
24-M01-GTR02	1	19
24-M01-GTR03	1	19
24-N01-GTR01	1	19
24-N01-GTR02	1	19
24-N01-GTR03	1	19
24-P01-GTR01	1	19
24-P01-GTR02	1	19
24-P01-GTR03	1	19
		304



J853-SD-UP-4204

1350 T2 FLAT C


5/F-26/F=19

發貨時：一個完整露臺的鋼件
鋁材，打包成一扎，同時出貨
到地盤。


1 TYPICAL PART PLAN FOR
4204 T2 FLAT C U.P. 5/F-26/F
(OMITTED 13, 14, 24)

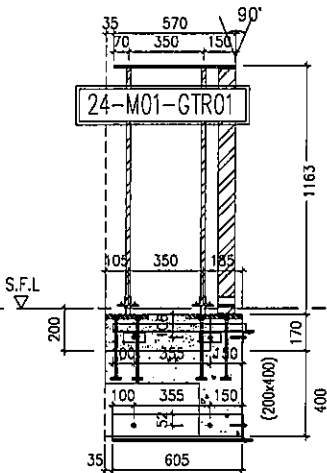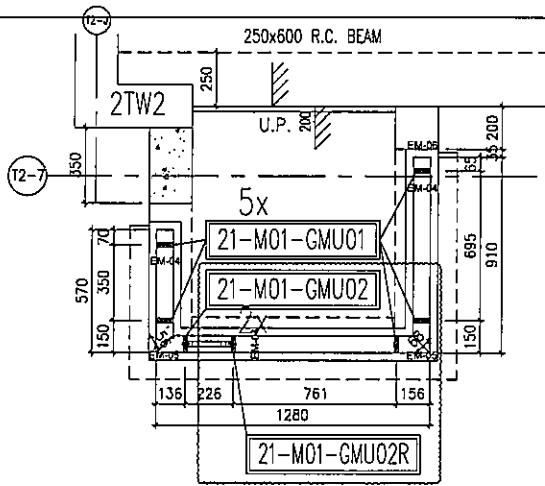


STEEL FRAME ONLY FOR
T2 FLAT C U/P 5/F-26/F

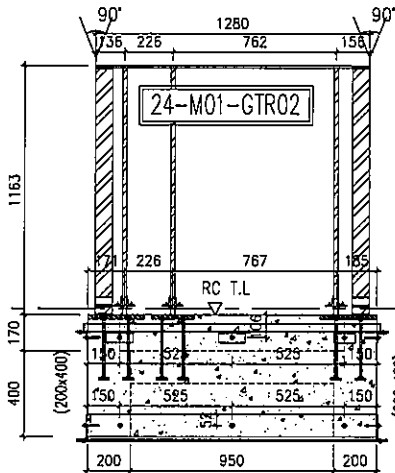


STEEL FRAME ONLY FOR
T2 FLAT C U/P 5/F-26/F

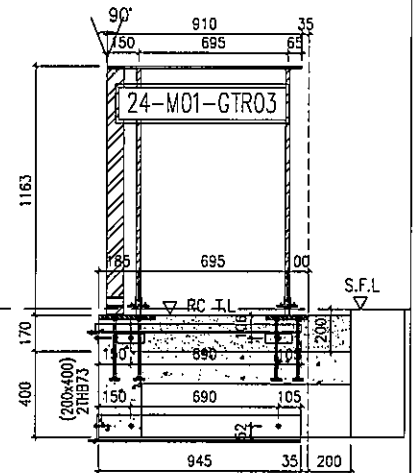

STEEL FRAME ONLY FOR
T2 FLAT C U/P 5/F-26/F

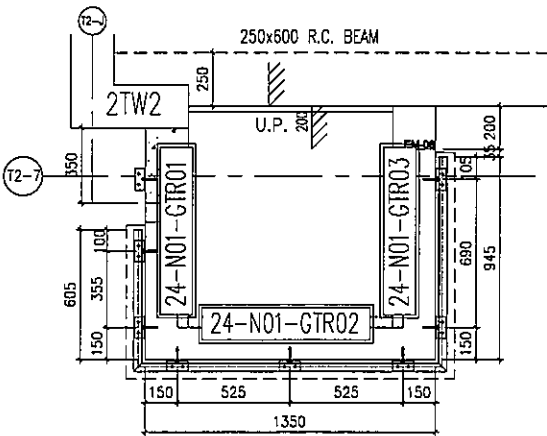

40x40x4-鋼件位置圖

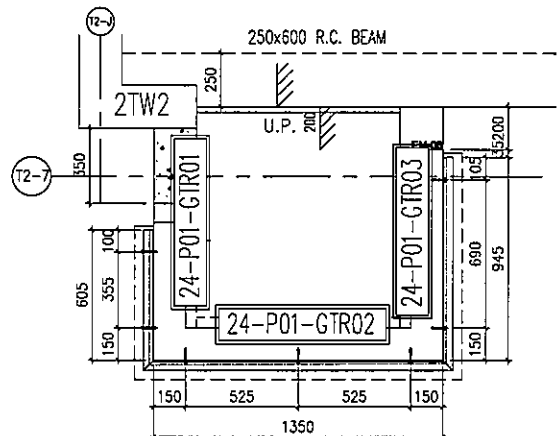

125x50x8-鋼件位置圖

UP4204-鋼件位置圖

DATE: 08-14-21	SCALE: 1:50(A1)
DRAWN BY: CLM	CHECKED BY:
PROJECT: PROPOSED RESIDENTIAL DEVELOPMENT AT N.K.L.L. 6542 YIN PING ROAD KOWLOON TITLE: PART ELEVATION OF ALUM. BALUSTRADE AT TOWER 2 JOB NO.: J-853 DWG NO.: J853-SD-UP-4204	


--	---

---	------------------	-------

