美特鋁質有限公司
MIDI ALUMINIUM FABRICATOR LTD.

工程指示 / 要求簡箋 ENGINEER INSTRUCTIONS(E.I.)

工程指示編號:	**EI-** 5446	**修改版本:**	-
	HK- 2198		
工程編號:	J 853	**工程名稱:**	NKIL6542
收件人:	生統	**發件人:**	BEARLAM
工程項目:	T1-T7工地窗後裝百頁背板，拆加工圖	**日期:**	08/12/2022

☐ 原合約工程包	☐ 原合約工程加 / 減賬 QT-	☐ 新工程報價 QT-

信件批核號碼/圖紙參考編號:	**批核模具圖紙編號:**
客戶指示附件:	**管理內部批簽署:**

☐ 初步鋁料 B.M.	☐ 加工拆圖，然後生產	☐ 尺寸表
☐ 正式鋁料 B.M.	☐ 技術上資料／指示	☐ 報價
☐ 配件 B.M.	☐ 樣辦或貨品說明書	☐ 分判合約
☐ 其他:		

內容: 現附上T1-T7 的工地窗後裝百頁背板資料，請根據相關資料盡快安排拆加工圖

完成上列要求日期: 09/12/2022

國內

☐ 生產技術總監	☐ 連附件	☐ 技術部	☐ 連附件	☐ 生產部	☐ 連附件
☐ 採購部	☐ 連附件	☑ 生產統籌部	☑ 連附件	☐ 報關組	☐ 連附件
☐ 質檢部	☐ 連附件	☐ 會計部	☐ 連附件	☐ 機械設計部	☐ 連附件
☑ 香港辦	☑ 連附件	☐ 其他:			

香港

☐ 行政部	☐ 連附件	☐ 會計部	☐ 連附件	☐ 統籌部	☐ 連附件	☐ 工程部	☐ 連附件
☐ 採購部	☐ 連附件	☐ QS部	☐ 連附件	☐ 地盤管理	☐ 連附件	☐ 維修部	☐ 連附件

*發件人簽署： Bear Lam	*組別成員批核簽署：
傳遞編號：	項目經理簽署：

ELEVATION

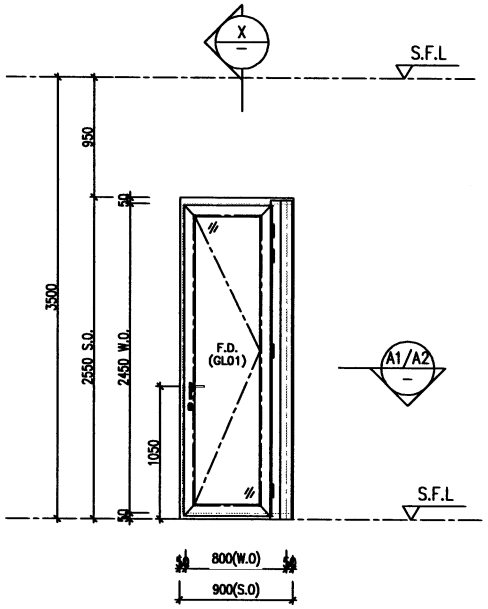

ELEVATION

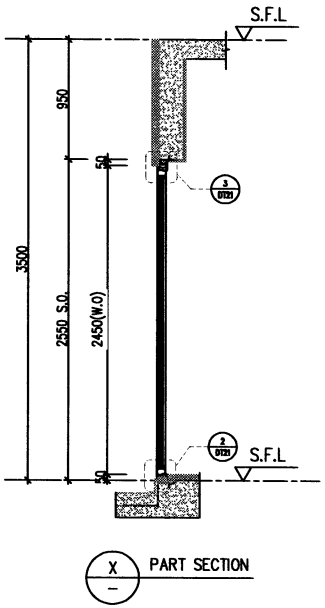

X PART SECTION

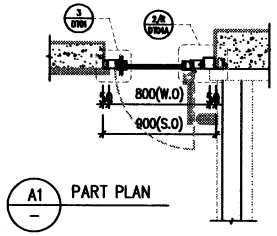

A1 PART PLAN

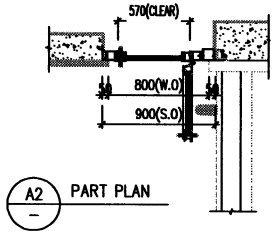

A2 PART PLAN

PROVIDED		
GLAZING AREA	0.530	m^2
OPENABLE AREA	0.720	m^2
FREE AREA	–	%

WINDOW MARK	M114A T1
LOCATION	23F UNIT A DIN. ROOM
SECTION	70mm ALUM. SECTION
GLAZING	GL01
QUANTITY	1 Nos.
REMARKS	SITE IN SITU

T:\Jobs\J-853\2. Outgoing\Black plate opening of Windows Louvre\Black Plate of T1 In-Situ Window.dwg

B.D. REF :

CLIENT :
SHIMAO GROUP HOLDINGS LIMITED

ARCHITECT :
WONG TUNG & PARTNERS LIMITED
ARCHITECTS & PLANNERS

MAIN CONTRACTOR :
協興建築有限公司
HIP HING CONSTRUCTION CO LTD

STRUCTURAL ENGINEER :
C M WONG & ASSOCIATES LTD
Consulting Engineers

SITE IN SITU CONSULTANT:
MEINHARDT

NOTE :
1. ALL DIMENSIONS ARE IN mm.
2. ALL ELEVATIONS ARE VIEWED FROM OUTSIDE.
3. ALL DIMENSIONS TO BE VERIFIED ON SITE BEFORE FABRICATION.

LEGEND :
X1 — DETAIL MARK NO.
(SHEET) — REFER SHEET NO.
1. F.F.L. — FINISHED FLOOR LEVEL
2. S.F.L. — STRUCTURAL FLOOR LEVEL
3. (R) — REVERSED DETAIL
4. ▲ — FIXING LOCATION
5. △ — FIXING LUG LOCATION
6. GLASS LEGEND
GL01 — 10mm+12mm AIR GAP+10mm THK. I.G.U.
GL05 — 10mm+12mm AIR GAP+10mm THK. I.G.U.
GL06 — 10mm+12mm AIR GAP+12mm THK. I.G.U.
PD01 — 10mm T.P+12mm AIR GAP+8mm T.P
GL07 — 10mm+12mm AIR GAP+12mm THK. I.G.U.
GL08 — 10mm+12mm AIR GAP+10mm THK. I.G.U.

NO.	DATE	REMARK	BY
A	04/08/2022	REVISION SUBJECT TO ARCH.COMMENT	

JOB NO. : J-853

PROJECT :
PROPOSED RESIDENTIAL DEVELOPMENT AT N.K.I.L. 6542 YIN PING ROAD KOWLOON

TITLE :
WINDOW SCHEDULE FOR TOWER 1 ALUM. WINDOW

DATE : 03-APR-21 | SCALE : 1:40

DRAWN BY : | CHECKED BY :

美特鋁質有限公司
MIDI ALUMINIUM FABRICATOR LTD.
Units 6-8, Sunray Industrial Centre, 1/F
610 Cha Kwo Ling Road, Kowloon
Tel:23489211-4 Fax:(852)27727666

DWG NO. : J853-SD-IW-SC111a | REV. : A

ELEVATION

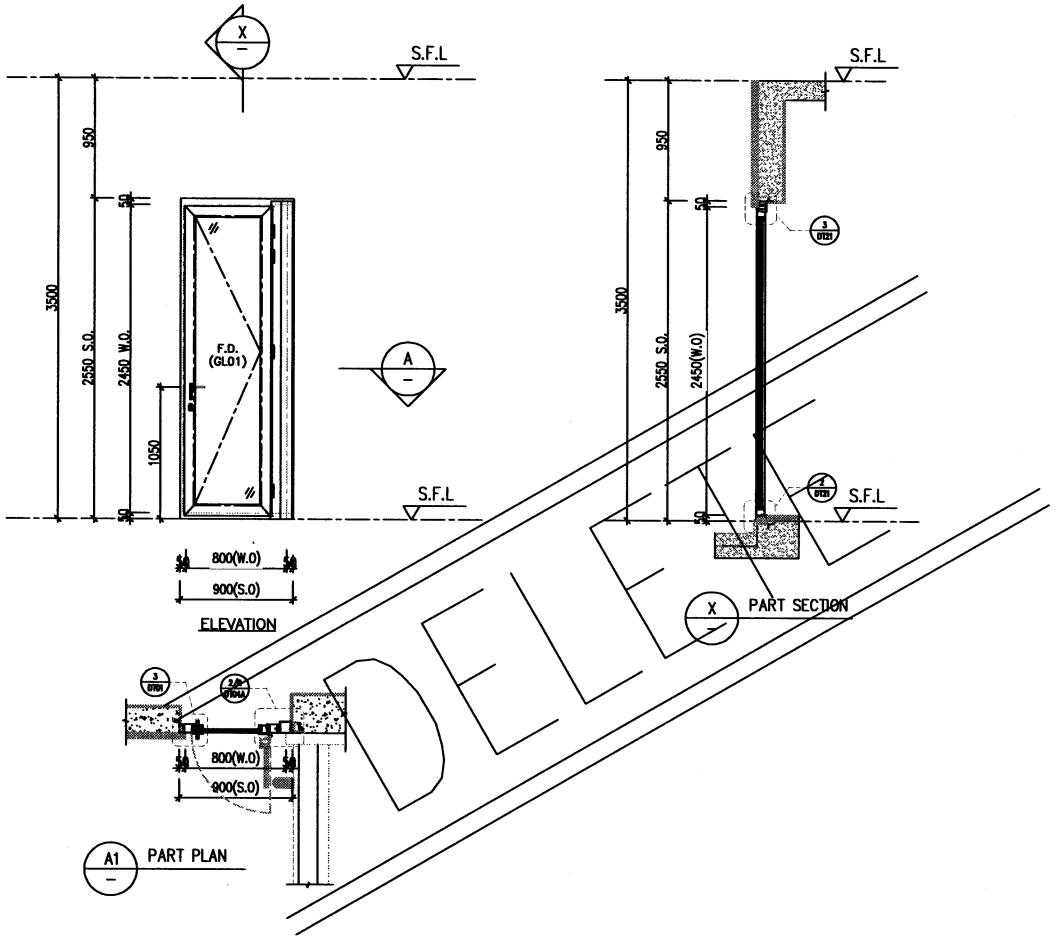

PROVIDED		
GLAZING AREA	0.530	m^2
OPENABLE AREA	0.720	m^2
FREE AREA	–	%

WINDOW MARK	W11R T1
LOCATION	25F UNIT B M.BATH
SECTION	70mm ALUM. SECTION
GLAZING	GL01
QUANTITY	1 Nos.
REMARKS	SITE IN SITU

T:\Jobs\J-853\2. Outgoing\Black plate opening of Windows Louvre\Black Plate of T1 In-Situ Window.dwg

B.D. REF :

CLIENT :
SHIMAO GROUP HOLDINGS LIMITED

ARCHITECT :
WONG TUNG & PARTNERS LIMITED
ARCHITECTS & PLANNERS

MAIN CONTRACTOR :
協興建築有限公司
HIP HING CONSTRUCTION CO LTD

STRUCTURAL ENGINEER :
C M WONG & ASSOCIATES LTD
Consulting Engineers

SITE IN SITU CONSULTANT:
MEINHARDT

NOTE :
1. ALL DIMENSIONS ARE IN mm.
2. ALL ELEVATIONS ARE VIEWED FROM OUTSIDE.
3. ALL DIMENSIONS TO BE VERIFIED ON SITE BEFORE FABRICATION.

LEGEND :
X1 / 3DT01 — DETAIL MARK NO. / REFER SHEET NO.
1. F.F.L. — FINISHED FLOOR LEVEL
2. S.F.L. — STRUCTURAL FLOOR LEVEL
3. (R) — REVERSED DETAIL
4. ▲ — FIXING LOCATION
5. △ — FIXING LUG LOCATION
6. GLASS LEGEND
GL01 — 10mm+12mm AIR GAP+10mm THK. I.G.U.
GL05 — 10mm+12mm AIR GAP+10mm THK. I.G.U.
GL06 — 10mm+12mm AIR GAP+12mm THK. I.G.U.
PD01 — 10mm T.P+12mm AIR GAP+8mm T.P
GL07 — 10mm+12mm AIR GAP+12mm THK. I.G.U.
GL08 — 10mm+12mm AIR GAP+10mm THK. I.G.U.

NO.	DATE	REMARK	BY
C	08/09/2022	REVISION SUBJECT TO ARCHITECT'S COMMENT	LHS
B	24/12/2021	REVISION SUBJECT TO ARCHITECT'S COMMENT	LHS
A	28/08/2021	REVISION SUBJECT TO ARCHITECT'S COMMENT	LHS

JOB NO. : J-853

PROJECT :
PROPOSED RESIDENTIAL DEVELOPMENT AT N.K.I.L. 6542 YIN PING ROAD KOWLOON

TITLE :
WINDOW SCHEDULE FOR TOWER 1 ALUM. WINDOW

DATE : 03-APR-21 | SCALE : 1:40

DRAWN BY : | CHECKED BY :

美特鋁製有限公司
MIDI ALUMINIUM FABRICATOR LTD.
Units 6-8, Sueray Industrial Centre, 1/F
610 Cha Kwo Ling Road, Kowloon
Tel:23489211-4 Fax:(852)27727666

DWG NO. : J853-SD-IW-SC111 | REV. : C

ELEVATION

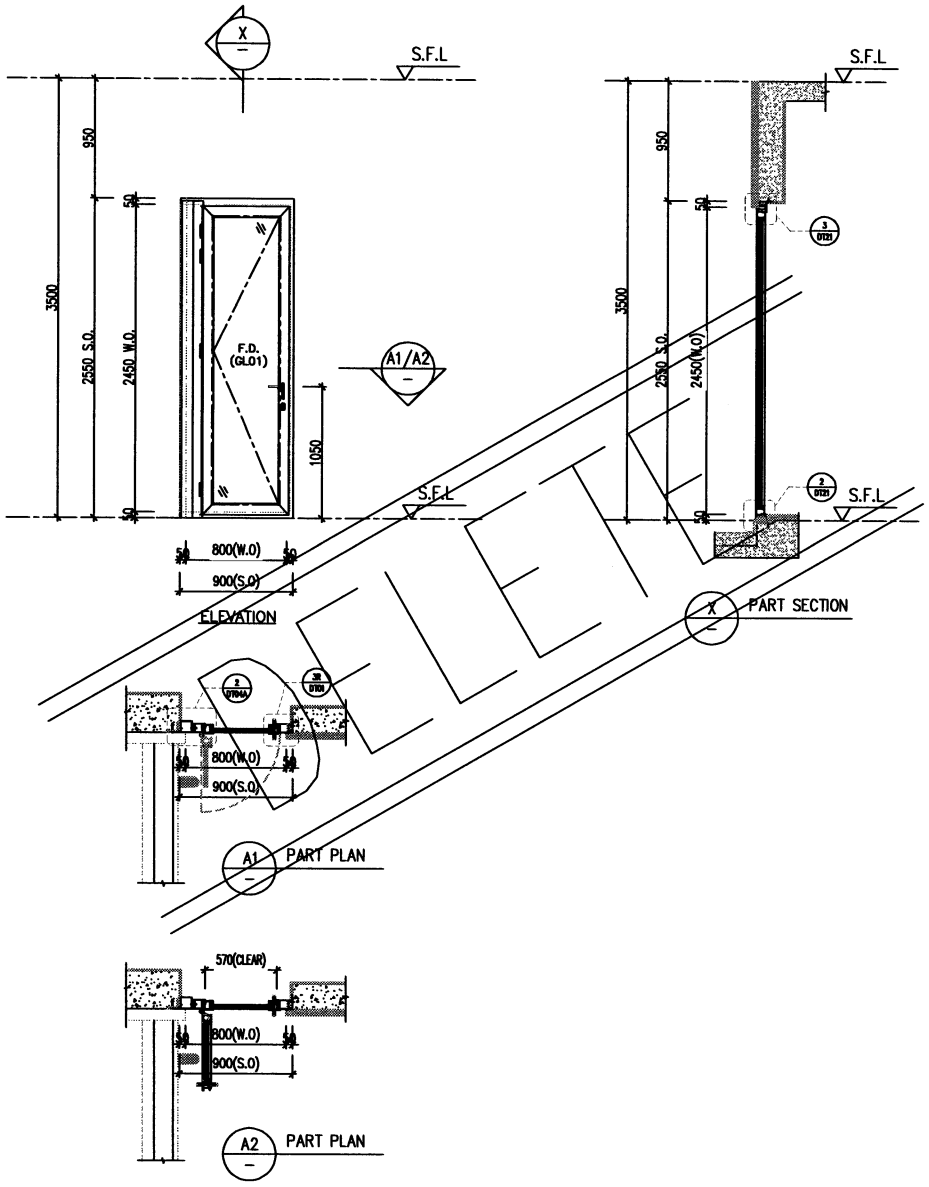

PROVIDED		
GLAZING AREA	0.530	m^2
OPENABLE AREA	0.720	m^2
FREE AREA	–	%

WINDOW MARK	W11L T1
LOCATION	25F UNIT A M.BATH
SECTION	70mm ALUM. SECTION
GLAZING	GL01
QUANTITY	1 Nos.
REMARKS	SITE IN SITU

T:\Jobs\J-853\2. Outgoing\Black plate opening of Windows Louvre\Black Plate of T1 In-Situ Window.dwg

B.D. REF :

CLIENT :
SHIMAO GROUP HOLDINGS LIMITED

ARCHITECT :
WONG TUNG & PARTNERS LIMITED
ARCHITECTS & PLANNERS

MAIN CONTRACTOR :
協興建築有限公司
HIP HING CONSTRUCTION CO LTD

STRUCTURAL ENGINEER :
C M WONG & ASSOCIATES LTD
Consulting Engineers

SITE IN SITU CONSULTANT:
MEINHARDT

NOTE :
1. ALL DIMENSIONS ARE IN mm.
2. ALL ELEVATIONS ARE VIEWED FROM OUTSIDE.
3. ALL DIMENSIONS TO BE VERIFIED ON SITE BEFORE FABRICATION.

LEGEND :
X1 / 2001 — DETAIL MARK NO. / REFER SHEET NO.
1. F.F.L. — FINISHED FLOOR LEVEL
2. S.F.L. — STRUCTURAL FLOOR LEVEL
3. (R) — REVERSED DETAIL
4. ▲ — FIXING LOCATION
5. △ — FIXING LUG LOCATION
6. GLASS LEGEND
GL01 — 10mm+12mm AIR GAP+10mm THK. LG.U.
GL05 — 10mm+12mm AIR GAP+10mm THK. LG.U.
GL06 — 10mm+12mm AIR GAP+12mm THK. LG.U.
PD01 — 10mm T.P+12mm AIR GAP+8mm T.P
GL07 — 10mm+12mm AIR GAP+12mm THK. LG.U.
GL08 — 10mm+12mm AIR GAP+10mm THK. LG.U.

NO.	DATE	REMARK	BY
C	08/08/2022	REVISION SUBJECT TO AMENDMENT	LHS
B	24/12/2021	REVISION SUBJECT TO AMENDMENT	LHS
A	28/08/2021	REVISION SUBJECT TO AMENDMENT	WSH

JOB NO. : J-853

PROJECT :
PROPOSED RESIDENTIAL DEVELOPMENT AT N.K.I.L. 6542 YIN PING ROAD KOWLOON

TITLE :
WINDOW SCHEDULE FOR TOWER 1 ALUM. WINDOW

DATE : 03-APR-21 | SCALE : 1:40

DRAWN BY : | CHECKED BY :

美特鋁製有限公司
MIDI ALUMINIUM FABRICATOR LTD.
Units 6-8, Sunray Industrial Centre, 1/F
610 Cha Kwo Ling Road, Kowloon
Tel:23488211-4 Fax:(852)27727666

DWG NO. : J853-SD-IW-SC110 | REV. : C

ELEVATION

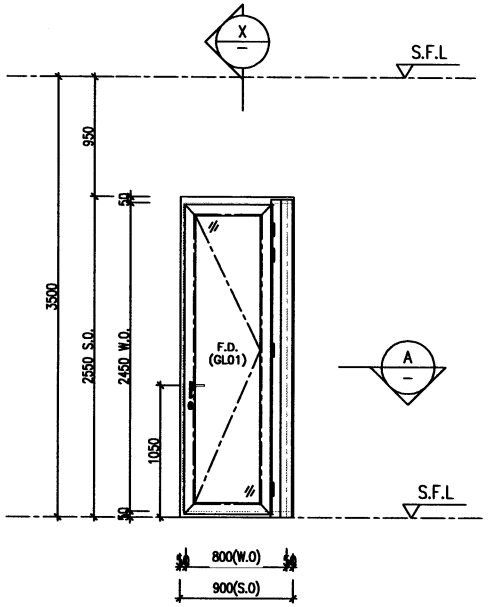

ELEVATION

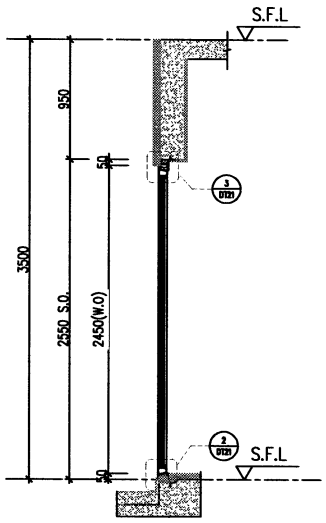

X PART SECTION

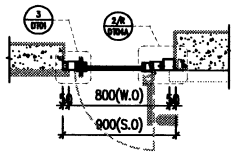

A PART PLAN

PROVIDED		
GLAZING AREA	0.530	m^2
OPENABLE AREA	0.720	m^2
FREE AREA	–	%

WINDOW MARK	M15R T1
LOCATION	23F UNIT A KITCHEN
SECTION	70mm ALUM. SECTION
GLAZING	GL01
QUANTITY	1 Nos.
REMARKS	SITE IN SITU

T:\Jobs\J-853\2. Outgoing\Black plate opening of Windows Louvre\Black Plate of T1 In-Situ Window.dwg

B.D. REF :

CLIENT :
SHIMAO GROUP HOLDINGS LIMITED

ARCHITECT :
WONG TUNG & PARTNERS LIMITED
ARCHITECTS & PLANNERS

MAIN CONTRACTOR :
協興建築有限公司
HIP HING CONSTRUCTION CO LTD

STRUCTURAL ENGINEER :
C M WONG & ASSOCIATES LTD
Consulting Engineers

SITE IN SITU CONSULTANT:
MEINHARDT

NOTE :
1. ALL DIMENSIONS ARE IN mm.
2. ALL ELEVATIONS ARE VIEWED FROM OUTSIDE.
3. ALL DIMENSIONS TO BE VERIFIED ON SITE BEFORE FABRICATION.

LEGEND :
X1 — DETAIL MARK NO.
2001 — REFER SHEET NO.

1. F.F.L. — FINISHED FLOOR LEVEL
2. S.F.L. — STRUCTURAL FLOOR LEVEL
3. (R) — REVERSED DETAIL
4. ▲ — FIXING LOCATION
5. △ — FIXING LUG LOCATION
6. GLASS LEGEND
   GL01 — 10mm+12mm AIR GAP+10mm THK. LG.U.
   GL05 — 10mm+12mm AIR GAP+10mm THK. LG.U.
   GL06 — 10mm+12mm AIR GAP+12mm THK. LG.U.
   PD01 — 10mm T.P+12mm AIR GAP+8mm T.P
   GL07 — 10mm+12mm AIR GAP+12mm THK. LG.U.
   GL08 — 10mm+12mm AIR GAP+10mm THK. LG.U.

NO.	DATE	REVISED	BY
A	04/08/2022	REVISION SUBJECT TO AMENDMENT	

JOB NO. : J-853

PROJECT :
PROPOSED RESIDENTIAL DEVELOPMENT AT N.K.I.L. 6542 YIN PING ROAD KOWLOON

TITLE :
WINDOW SCHEDULE FOR TOWER 1 ALUM. WINDOW

DATE : 03-APR-21 | SCALE : 1:40

DRAWN BY : | CHECKED BY :

美特鋁製有限公司
MIDI ALUMINIUM FABRICATOR LTD.
Units 6-8, Sunray Industrial Centre, 1/F
610 Cha Kwo Ling Road, Kowloon
Tel:23489211-4 Fax:(852)27727666

DWG NO. : J853-SD-IW-SC111b | REV. : A

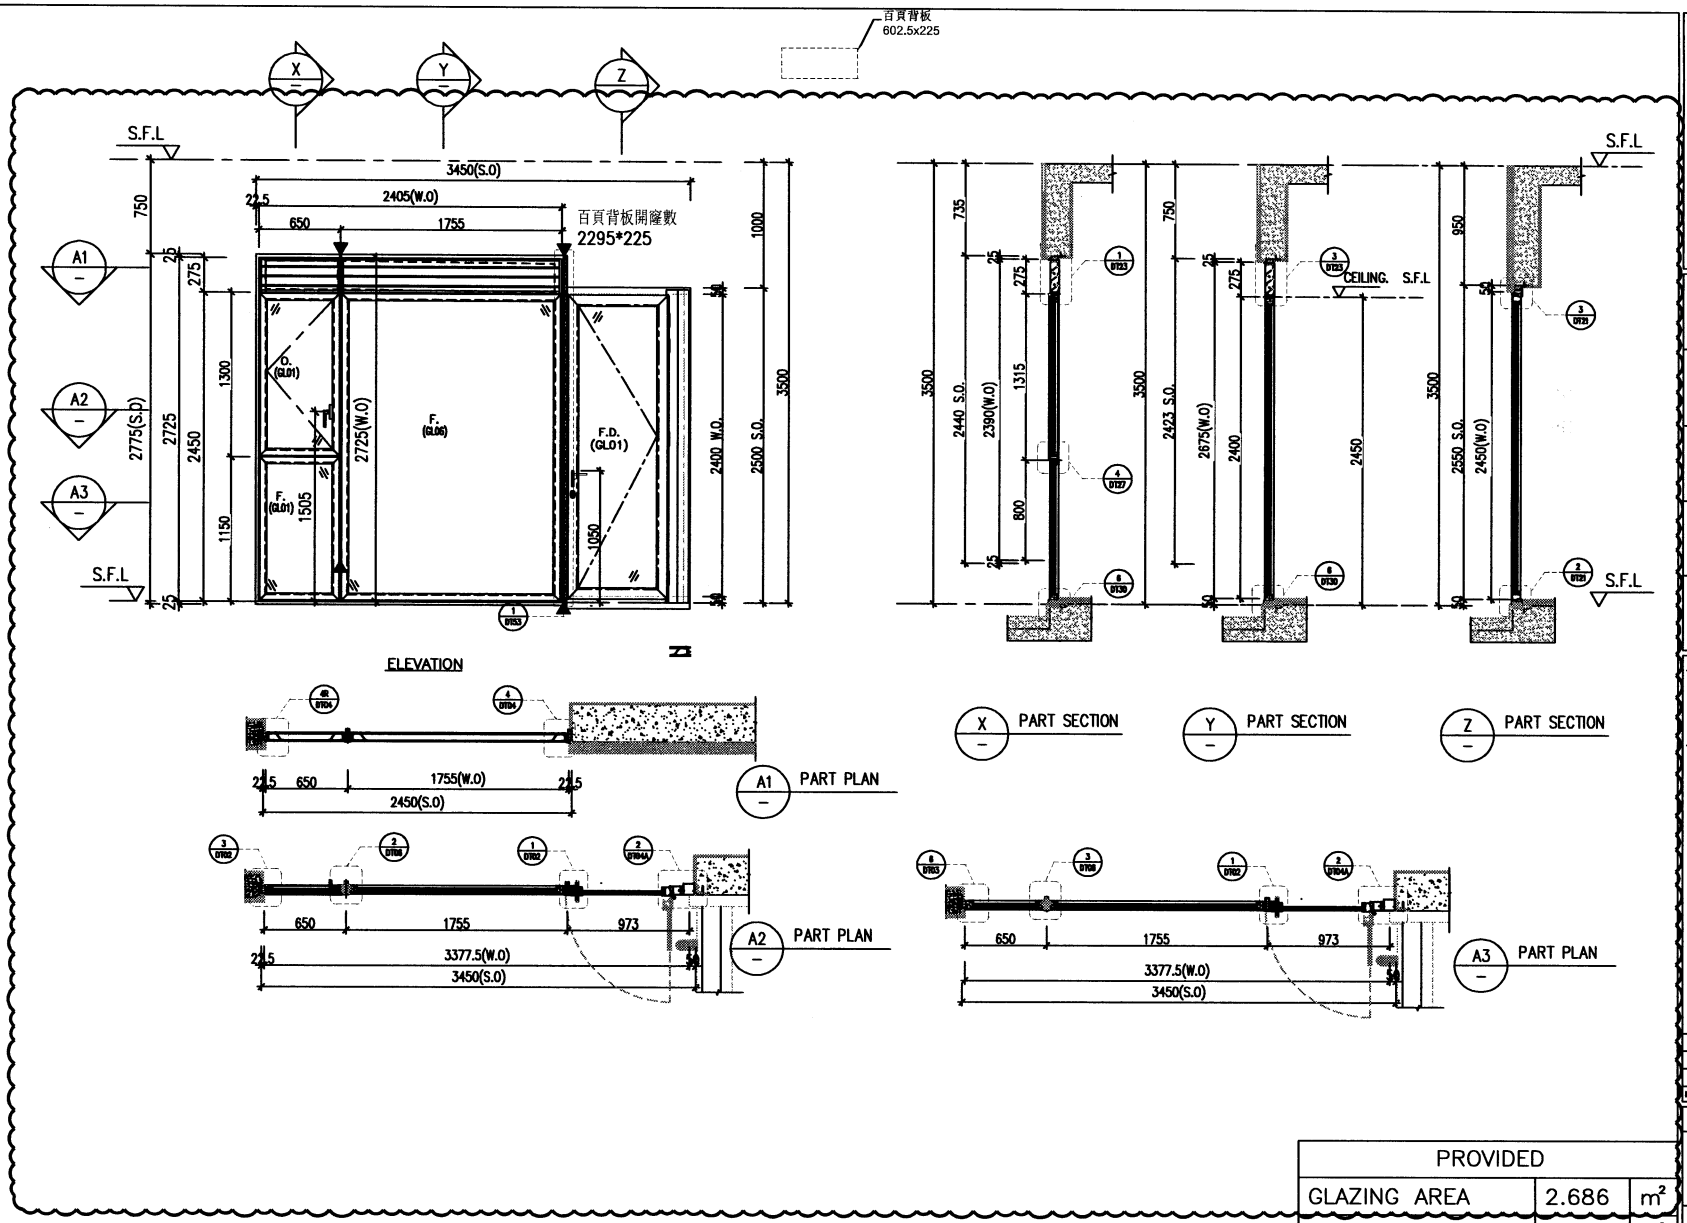

ELEVATION

PROVIDED		
GLAZING AREA	2.686	m^2
OPENABLE AREA	0.444	m^2
FREE AREA	60.5	%

WINDOW MARK	W16 T1 / W11R T1
LOCATION	25F UNIT B M.BATH
SECTION	70mm ALUM. SECTION
GLAZING	GL06
QUANTITY	1 Nos.
REMARKS	SITE IN SITU

T:\Jobs\J-853\2. Outgoing\Black plate opening of Windows Louvre\Black Plate of T1 In-Situ Window.dwg

B.D. REF :

CLIENT :
SHIMAO GROUP HOLDINGS LIMITED

ARCHITECT :
WONG TUNG & PARTNERS LIMITED
ARCHITECTS & PLANNERS

MAIN CONTRACTOR :
協興建築有限公司
HIP HING CONSTRUCTION CO LTD

STRUCTURAL ENGINEER :
C M WONG & ASSOCIATES LTD
Consulting Engineers

SITE IN SITU CONSULTANT:
MEINHARDT

NOTE :
1. ALL DIMENSIONS ARE IN mm.
2. ALL ELEVATIONS ARE VIEWED FROM OUTSIDE.
3. ALL DIMENSIONS TO BE VERIFIED ON SITE BEFORE FABRICATION.

LEGEND :
- X1 / 2#001 — DETAIL MARK NO. / REFER SHEET NO.
1. F.F.L. — FINISHED FLOOR LEVEL
2. S.F.L. — STRUCTURAL FLOOR LEVEL
3. (R) — REVERSED DETAIL
4. ▲ — FIXING LOCATION
5. △ — FIXING LUG LOCATION
6. GLASS LEGEND
   - GL01 — 10mm+12mm AIR GAP+10mm THK. LG.U.
   - GL05 — 10mm+12mm AIR GAP+10mm THK. LG.U.
   - GL06 — 10mm+12mm AIR GAP+12mm THK. LG.U.
   - PD01 — 10mm T.P+12mm AIR GAP+8mm T.P
   - GL07 — 10mm+12mm AIR GAP+12mm THK. LG.U.
   - GL08 — 10mm+12mm AIR GAP+10mm THK. LG.U.

NO.	DATE	ISSUED	BY
C	08/08/2022	REVISION SUBJECT TO ARCH.COMMENT	LHS
B	24/12/2021	REVISION SUBJECT TO ARCH.COMMENT	LHS
A	28/08/2021	REVISION SUBJECT TO ARCH.COMMENT	WSH

JOB NO. : J-853

PROJECT :
PROPOSED RESIDENTIAL DEVELOPMENT AT N.K.I.L. 6542 YIN PING ROAD KOWLOON

TITLE :
WINDOW SCHEDULE FOR TOWER 1 ALUM. WINDOW

DATE : 03-APR-21 | SCALE : 1:40

DRAWN BY : | CHECKED BY :

美特鋁製有限公司
MIDI ALUMINIUM FABRICATOR LTD.
Units 6-8, Sunray Industrial Centre, 1/F
610 Cha Kwo Ling Road, Kowloon
Tel:23489211-4 Fax:(852)27727666

DWG NO. : J853-SD-IW-SC109 | REV. : C

ELEVATION

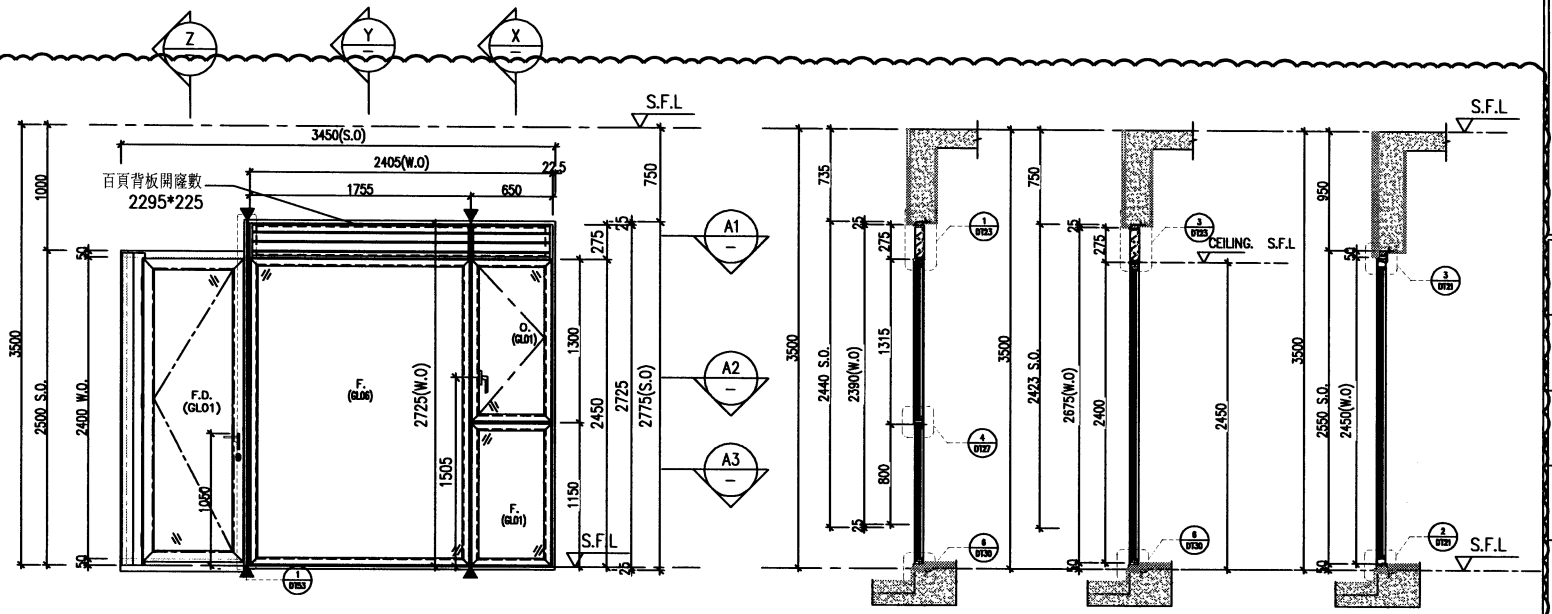

ELEVATION

X PART SECTION

Y PART SECTION

Z PART SECTION

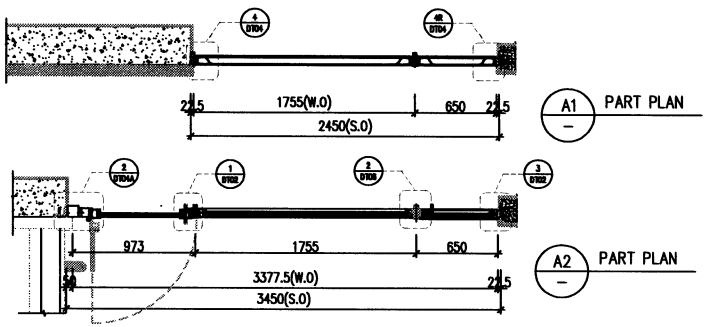

A1 PART PLAN

A2 PART PLAN

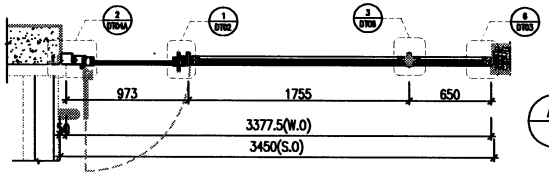

A3 PART PLAN

PROVIDED		
GLAZING AREA	2.686	m^2
OPENABLE AREA	0.444	m^2
FREE AREA	60.5	%

WINDOW MARK	W15 T1 W111L T1
LOCATION	25F UNIT A M.BATH
SECTION	70mm ALUM. SECTION
GLAZING	GL06
QUANTITY	1 Nos.
REMARKS	SITE IN SITU

T:\Jobs\J-853\2. Outgoing\Black plate opening of Windows Louvre\Black Plate of T1 In-Situ Window.dwg

B.D. REF :

CLIENT :
SHIMAO GROUP HOLDINGS LIMITED

ARCHITECT :
WONG TUNG & PARTNERS LIMITED
ARCHITECTS & PLANNERS

MAIN CONTRACTOR :
協興建築有限公司
HIP HING CONSTRUCTION CO LTD

STRUCTURAL ENGINEER :
C M WONG & ASSOCIATES LTD
Consulting Engineers

SITE IN SITU CONSULTANT:
MEINHARDT

NOTE :
1. ALL DIMENSIONS ARE IN mm.
2. ALL ELEVATIONS ARE VIEWED FROM OUTSIDE.
3. ALL DIMENSIONS TO BE VERIFIED ON SITE BEFORE FABRICATION.

LEGEND :
- X1 / 3D01 — DETAIL MARK NO. / REFER SHEET NO.
1. F.F.L. — FINISHED FLOOR LEVEL
2. S.F.L. — STRUCTURAL FLOOR LEVEL
3. (P) — REVERSED DETAIL
4. ▲ — FIXING LOCATION
5. △ — FIXING LUG LOCATION
6. GLASS LEGEND
GL01 — 10mm+12mm AIR GAP+10mm THK. LG.U.
GL05 — 10mm+12mm AIR GAP+10mm THK. LG.U.
GL06 — 10mm+12mm AIR GAP+12mm THK. LG.U.
PD01 — 10mm T.P+12mm AIR GAP+8mm T.P
GL07 — 10mm+12mm AIR GAP+12mm THK. LG.U.
GL08 — 10mm+12mm AIR GAP+10mm THK. LG.U.

NO.	DATE	REMARK	BY
C	08/08/2022	REVISION SUBJECT TO ARCH.COMMENT	LHR
B	24/12/2021	REVISION SUBJECT TO ARCH.COMMENT	LHR
A	28/08/2021	REVISION SUBJECT TO ARCH.COMMENT	WSH

JOB NO. : J-853

PROJECT :
PROPOSED RESIDENTIAL DEVELOPMENT AT N.K.I.L. 6542 YIN PING ROAD KOWLOON

TITLE :
WINDOW SCHEDULE FOR TOWER 1 ALUM. WINDOW

DATE : 03-APR-21 | SCALE : 1:40

DRAWN BY : | CHECKED BY :

美特鋁製有限公司
MIDI ALUMINIUM FABRICATOR LTD.
Units 6-8, Sunray Industrial Centre, 1/F
610 Cha Kwo Ling Road, Kowloon
Tel:23489211-4 Fax:(852)27727666

DWG NO. : J853-SD-IW-SC108 | REV. : C

ELEVATION

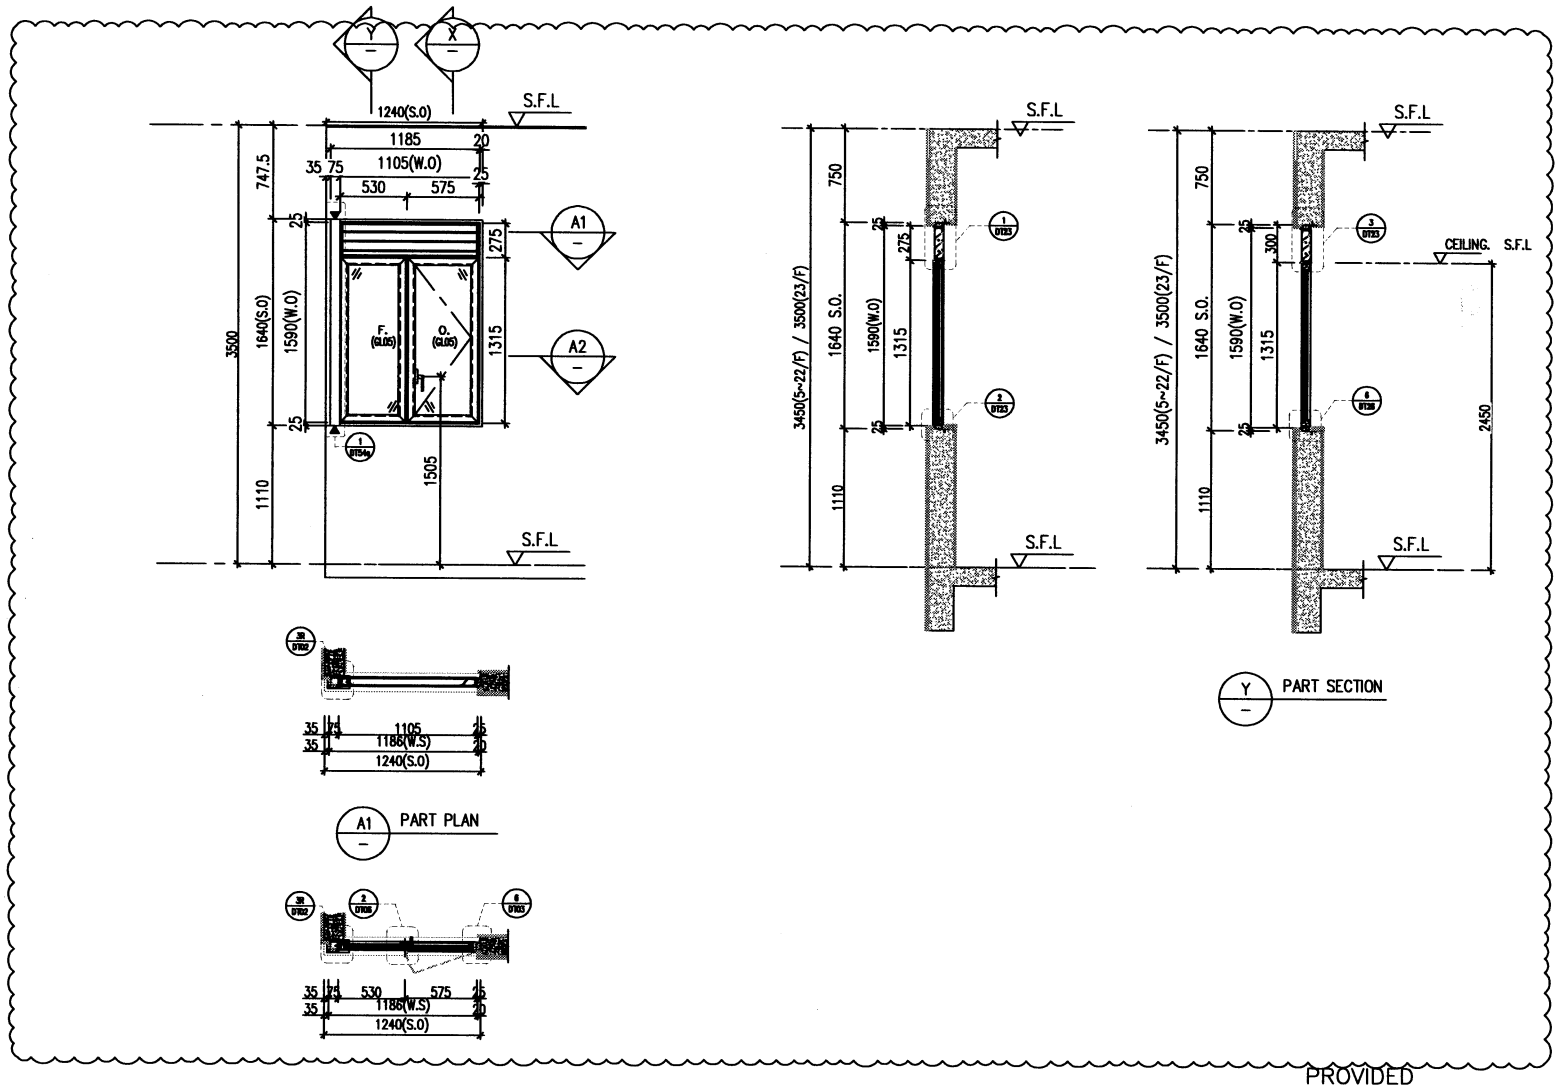

Y PART SECTION

A1 PART PLAN

A2 PART PLAN

PROVIDED

PROVIDED		
GLAZING AREA	1.815	m^2
OPENABLE AREA	1.372	m^2
FREE AREA	60.5	%

WINDOW MARK	W11 / T1
LOCATION	25F UNIT A EN.BATH
SECTION	70mm ALUM. SECTION
GLAZING	GL05
QUANTITY	1Nos.
REMARKS	SITE IN SITU

T:\Jobs\J-853\2. Outgoing\Black plate opening of Windows Louvre\Black Plate of T1 In-Situ Window.dwg

R.D. REF :

CLIENT :
SHIMAO GROUP HOLDINGS LIMITED

ARCHITECT :
WONG TUNG & PARTNERS LIMITED
ARCHITECTS & PLANNERS

MAIN CONTRACTOR :
協興建築有限公司
HIP HING CONSTRUCTION CO LTD

STRUCTURAL ENGINEER :
C M WONG & ASSOCIATES LTD
Consulting Engineers

SITE IN SITU CONSULTANT:
MEINHARDT

NOTE :
1. ALL DIMENSIONS ARE IN mm.
2. ALL ELEVATIONS ARE VIEWED FROM OUTSIDE.
3. ALL DIMENSIONS TO BE VERIFIED ON SITE BEFORE FABRICATION.

LEGEND :
- DETAIL MARK NO. / REFER SHEET NO.
1. F.F.L. — FINISHED FLOOR LEVEL
2. S.F.L. — STRUCTURAL FLOOR LEVEL
3. — REVERSED DETAIL
4. ▲ — FIXING LOCATION
5. △ — FIXING LUG LOCATION
6. GLASS LEGEND
   - GL01 — 10mm+12mm AIR GAP+10mm THK. LG.U.
   - GL05 — 10mm+12mm AIR GAP+10mm THK. LG.U.
   - GL06 — 10mm+12mm AIR GAP+12mm THK. LG.U.
   - PD01 — 10mm T.P+12mm AIR GAP+8mm T.P
   - GL07 — 10mm+12mm AIR GAP+12mm THK. LG.U.
   - GL08 — 10mm+12mm AIR GAP+10mm THK. LG.U.

NO.	DATE	REMARKS	BY
C	08/08/2022	REVISION SUBJECT TO ARCH.COMMENT	LHK
B	24/12/2021	REVISION SUBJECT TO ARCH.COMMENT	LHK
A	20/08/2021	REVISION SUBJECT TO ARCH.COMMENT	WBK

JOB NO. : J-853

PROJECT :
PROPOSED RESIDENTIAL DEVELOPMENT AT N.K.I.L. 6542 YIN PING ROAD KOWLOON

TITLE :
WINDOW SCHEDULE FOR TOWER 1 ALUM. WINDOW

DATE : 03-APR-21 | SCALE : 1:40

DRAWN BY : | CHECKED BY :

美特鋁製有限公司
MIDI ALUMINIUM FABRICATOR LTD.
Units 6-8, Sunray Industrial Centre, 1/F
610 Cha Kwo Ling Road, Kowloon
Tel:23489211-4 Fax:(852)27727666

DWG NO. : J853-SD-IW-SC107 | REV. : C

ELEVATION

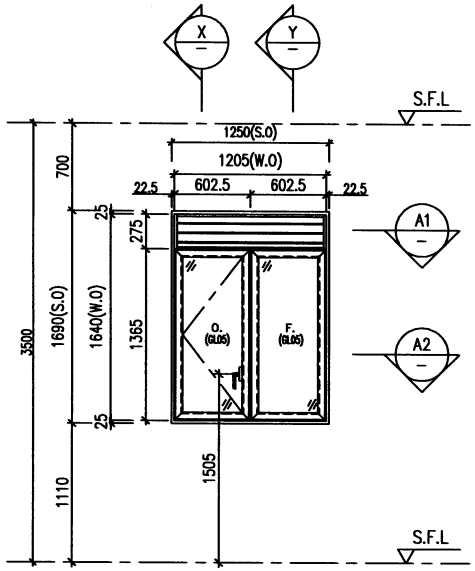

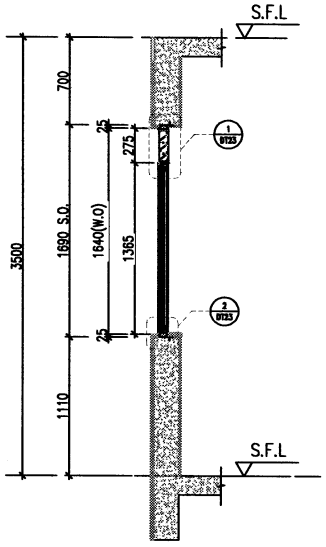

X PART SECTION

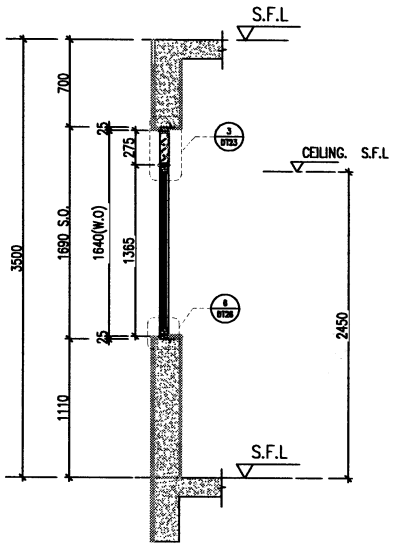

Y PART SECTION

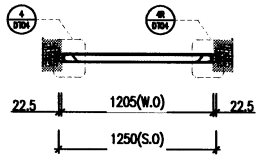

A1 PART PLAN

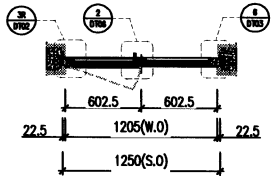

A2 PART PLAN

PROVIDED		
GLAZING AREA	1.196	m^2
OPENABLE AREA	0.667	m^2
FREE AREA	60.5	%

WINDOW MARK	WD6 T1
LOCATION	25/F UNIT B ENSUITE.BATH
SECTION	70mm ALUM. SECTION
GLAZING	GL05
QUANTITY	1 Nos.
REMARKS	SITE IN SITU

T:\Jobs\J-853\2. Outgoing\Black plate opening of Windows Louvre\Black Plate of T1 In-Situ Window.dwg

B.D. REF :

CLIENT :
SHIMAO GROUP HOLDINGS LIMITED

ARCHITECT :
WONG TUNG & PARTNERS LIMITED
ARCHITECTS & PLANNERS

MAIN CONTRACTOR :
協興建築有限公司
HIP HING CONSTRUCTION CO LTD

STRUCTURAL ENGINEER :
C M WONG & ASSOCIATES LTD
Consulting Engineers

SITE IN SITU CONSULTANT:
MEINHARDT

NOTE :
1. ALL DIMENSIONS ARE IN mm.
2. ALL ELEVATIONS ARE VIEWED FROM OUTSIDE.
3. ALL DIMENSIONS TO BE VERIFIED ON SITE BEFORE FABRICATION.

LEGEND :
- X1 / J853 — DETAIL MARK NO. / REFER SHEET NO.
1. F.F.L. — FINISHED FLOOR LEVEL
2. S.F.L. — STRUCTURAL FLOOR LEVEL
3. (R) — REVERSED DETAIL
4. ▲ — FIXING LOCATION
5. △ — FIXING LUG LOCATION
6. GLASS LEGEND
   - GL01 — 10mm+12mm AIR GAP+10mm THK. LG.U.
   - GL05 — 10mm+12mm AIR GAP+10mm THK. LG.U.
   - GL06 — 10mm+12mm AIR GAP+12mm THK. LG.U.
   - PD01 — 10mm T.P+12mm AIR GAP+8mm T.P
   - GL07 — 10mm+12mm AIR GAP+12mm THK. LG.U.
   - GL08 — 10mm+12mm AIR GAP+10mm THK. LG.U.

NO.	DATE	REMARK	BY
C	08/08/2022	REVISION SUBJECT TO ARCH.COMMENT	LHK
B	24/12/2021	REVISION SUBJECT TO ARCH.COMMENT	LHK
A	28/08/2021	REVISION SUBJECT TO ARCH.COMMENT	WSH

JOB NO. : J-853

PROJECT :
PROPOSED RESIDENTIAL DEVELOPMENT AT N.K.I.L. 6542 YIN PING ROAD KOWLOON

TITLE :
WINDOW SCHEDULE FOR TOWER 1 ALUM. WINDOW

DATE : 03-APR-21 | SCALE : 1:40

DRAWN BY : | CHECKED BY :

美特鋁製有限公司
MIDI ALUMINIUM FABRICATOR LTD.
Units 6-8, Sunray Industrial Centre, 1/F
610 Cha Kwo Ling Road, Kowloon
Tel:23489211-4 Fax:(852)27727666

DWG NO. : J853-SD-IW-SC106 | REV. : C

ELEVATION

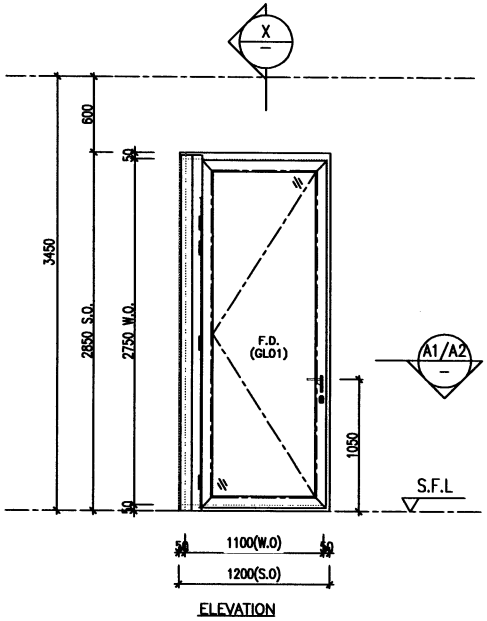

ELEVATION

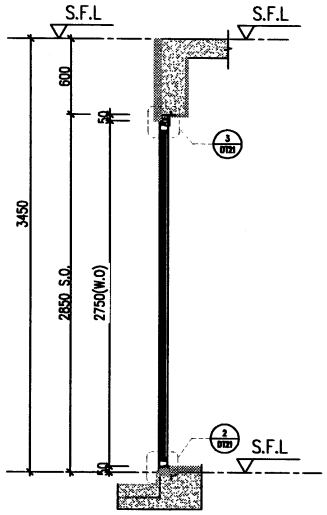

X PART SECTION

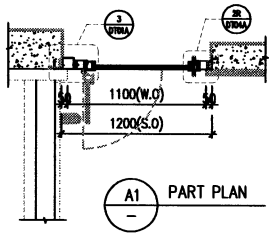

A1 PART PLAN

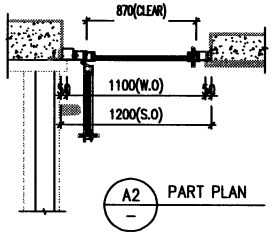

A2 PART PLAN

PROVIDED		
GLAZING AREA	1.503	m^2
OPENABLE AREA	1.788	m^2
FREE AREA	–	%

WINDOW MARK	W19 / T1
LOCATION	6F~22F UNIT A LIVING
SECTION	70mm ALUM. SECTION
GLAZING	GL01
QUANTITY	15 Nos.
REMARKS	SITE IN SITU

T:\Jobs\J-853\2. Outgoing\Black plate opening of Windows Louvre\Black Plate of T1 In-Situ Window.dwg

B.D. REF :

CLIENT :
SHIMAO GROUP HOLDINGS LIMITED

ARCHITECT :
WONG TUNG & PARTNERS LIMITED
ARCHITECTS & PLANNERS

MAIN CONTRACTOR :
協興建築有限公司
HIP HING CONSTRUCTION CO LTD

STRUCTURAL ENGINEER :
C M WONG & ASSOCIATES LTD
Consulting Engineers

SITE IN SITU CONSULTANT:
MEINHARDT

NOTE :
1. ALL DIMENSIONS ARE IN mm.
2. ALL ELEVATIONS ARE VIEWED FROM OUTSIDE.
3. ALL DIMENSIONS TO BE VERIFIED ON SITE BEFORE FABRICATION.

LEGEND :
X1 / J853 — DETAIL MARK NO. / REFER SHEET NO.
1. F.F.L. — FINISHED FLOOR LEVEL
2. S.F.L. — STRUCTURAL FLOOR LEVEL
3. (R) — REVERSED DETAIL
4. ▲ — FIXING LOCATION
5. △ — FIXING LUG LOCATION
6. GLASS LEGEND
GL01 — 10mm+12mm AIR GAP+10mm THK. LG.U.
GL05 — 10mm+12mm AIR GAP+10mm THK. LG.U.
GL06 — 10mm+12mm AIR GAP+12mm THK. LG.U.
PD01 — 10mm T.P+12mm AIR GAP+8mm T.P
GL07 — 10mm+12mm AIR GAP+12mm THK. LG.U.
GL08 — 10mm+12mm AIR GAP+10mm THK. LG.U.

NO.	DATE	REMARK	BY
C	24/12/2021	REVISION SUBJECT TO ARCH.COMMENT	LHS
B	24/12/2021	REVISION SUBJECT TO ARCH.COMMENT	LHS
A	28/08/2021	REVISION SUBJECT TO ARCH.COMMENT	WSH

JOB NO. : J-853

PROJECT :
PROPOSED RESIDENTIAL DEVELOPMENT AT N.K.I.L. 6542 YIN PING ROAD KOWLOON

TITLE :
WINDOW SCHEDULE FOR TOWER 1 ALUM. WINDOW

DATE : 03-APR-21 | SCALE : 1:40

DRAWN BY : | CHECKED BY :

美特鋁製有限公司
MIDI ALUMINIUM FABRICATOR LTD.
Units 6-8, Sunray Industrial Centre, 1/F
610 Cha Kwo Ling Road, Kowloon
Tel:23489211-4 Fax:(852)27727666

DWG NO. : J853-SD-IW-SC105 | REV. : C

ELEVATION

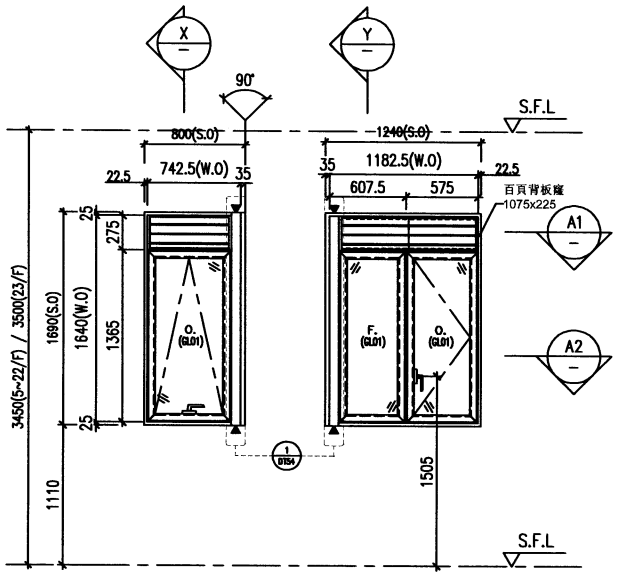

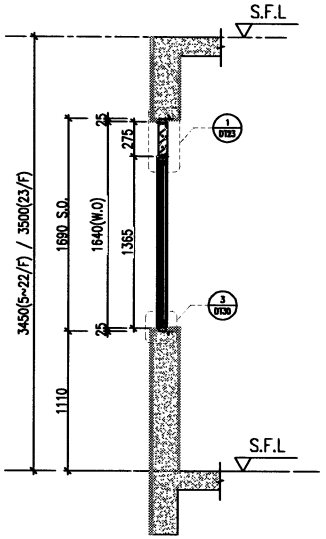

X PART SECTION

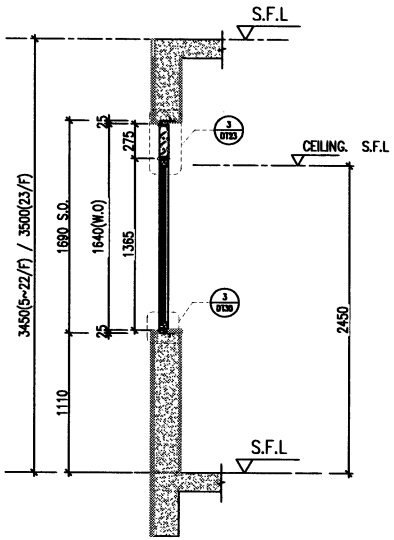

Y PART SECTION

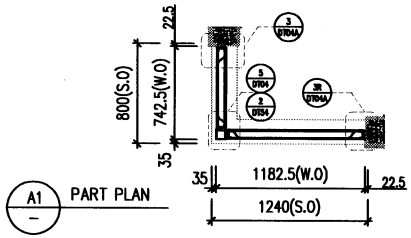

A1 PART PLAN

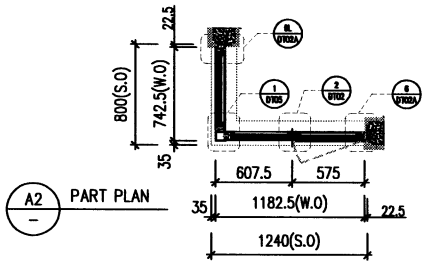

A2 PART PLAN

PROVIDED

PROVIDED		
GLAZING AREA	1.803	m^2
OPENABLE AREA	1.372	m^2
FREE AREA	60.5	%

WINDOW MARK	W13 T1	W13 T1
LOCATION	5F~22F UNIT A KITCHEN	23F UNIT A STO.
SECTION	70mm ALUM. SECTION	70mm ALUM. SECTION
GLAZING	GL01	GL01
QUANTITY	16Nos.	1 Nos.
REMARKS	SITE IN SITU	SITE IN SITU

T:\Jobs\J-853\2. Outgoing\Black plate opening of Windows Louvre\Black Plate of T1 In-Situ Window.dwg

B.D. REF :

CLIENT :
SHIMAO GROUP HOLDINGS LIMITED

ARCHITECT :
WONG TUNG & PARTNERS LIMITED
ARCHITECTS & PLANNERS

MAIN CONTRACTOR :
協興建築有限公司
HIP HING CONSTRUCTION CO LTD

STRUCTURAL ENGINEER :
C M WONG & ASSOCIATES LTD
Consulting Engineers

SITE IN SITU CONSULTANT:
MEINHARDT

NOTE :
1. ALL DIMENSIONS ARE IN mm.
2. ALL ELEVATIONS ARE VIEWED FROM OUTSIDE.
3. ALL DIMENSIONS TO BE VERIFIED ON SITE BEFORE FABRICATION.

LEGEND :
- X1 / 3001 — DETAIL MARK NO. / REFER SHEET NO.
1. F.F.L. — FINISHED FLOOR LEVEL
2. S.F.L. — STRUCTURAL FLOOR LEVEL
3. — REVERSED DETAIL
4. — FIXING LOCATION
5. — FIXING LUG LOCATION
6. GLASS LEGEND
   - GL01 — 10mm+12mm AIR GAP+10mm THK. LG.U.
   - GL05 — 10mm+12mm AIR GAP+10mm THK. LG.U.
   - GL06 — 10mm+12mm AIR GAP+12mm THK. LG.U.
   - PD01 — 10mm T.P+12mm AIR GAP+8mm T.P
   - GL07 — 10mm+12mm AIR GAP+12mm THK. LG.U.
   - GL08 — 10mm+12mm AIR GAP+10mm THK. LG.U.

NO.	DATE	REMARK	BY
D	10/10/2022	REVISION SUBJECT TO ARCH.COMMENT	LHS
C	08/08/2022	REVISION SUBJECT TO ARCH.COMMENT	LHS
B	24/12/2021	REVISION SUBJECT TO ARCH.COMMENT	LHS
A	20/08/2021	REVISION SUBJECT TO ARCH.COMMENT	WSH

JOB NO. : J-853

PROJECT :
PROPOSED RESIDENTIAL DEVELOPMENT AT N.K.I.L. 6542 YIN PING ROAD KOWLOON

TITLE :
WINDOW SCHEDULE FOR TOWER 1 ALUM. WINDOW

DATE : 03-APR-21 | SCALE : 1:40

DRAWN BY : | CHECKED BY :

美特鋁製有限公司
MIDI ALUMINIUM FABRICATOR LTD.
Units 6-8, Sunray Industrial Centre, 1/F
610 Cha Kwo Ling Road, Kowloon
Tel:23489211-4 Fax:(852)27727666

DWG NO. : J853-SD-IW-SC103 | REV. : D

ELEVATION

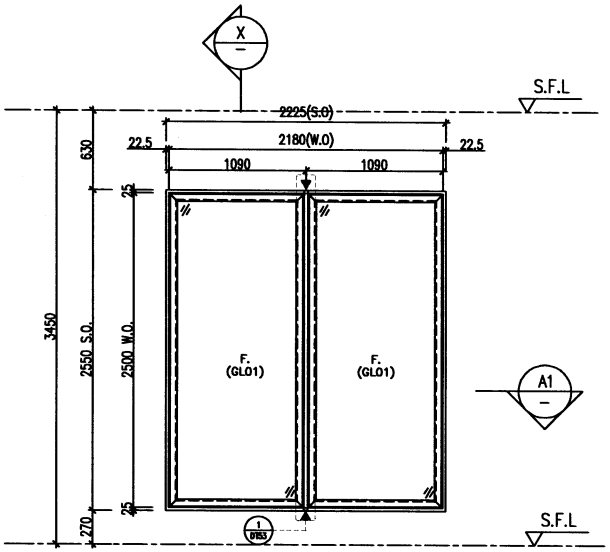

ELEVATION

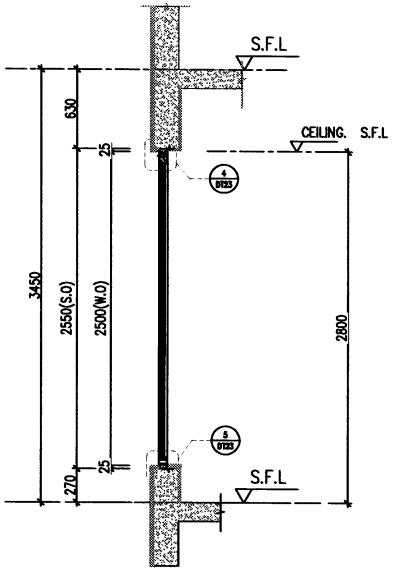

X — PART SECTION

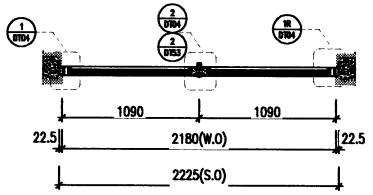

A1 — PART PLAN

PROVIDED		
GLAZING AREA	2.888	m^2
OPENABLE AREA	–	m^2
FREE AREA	–	%

WINDOW MARK	W12 / T1
LOCATION	5F UNIT A ENSUITE 3
SECTION	70mm ALUM. SECTION
GLAZING	GL01
QUANTITY	1 Nos.
REMARKS	SITE IN SITU

T:\Jobs\J-853\2. Outgoing\Black plate opening of Windows Louvre\Black Plate of T1 In-Situ Window.dwg

B.D. REF :

CLIENT :
SHIMAO GROUP HOLDINGS LIMITED

ARCHITECT :
WONG TUNG & PARTNERS LIMITED
ARCHITECTS & PLANNERS

MAIN CONTRACTOR :
協興建築有限公司
HIP HING CONSTRUCTION CO LTD

STRUCTURAL ENGINEER :
C M WONG & ASSOCIATES LTD
Consulting Engineers

SITE IN SITU CONSULTANT:
MEINHARDT

NOTE :
1. ALL DIMENSIONS ARE IN mm.
2. ALL ELEVATIONS ARE VIEWED FROM OUTSIDE.
3. ALL DIMENSIONS TO BE VERIFIED ON SITE BEFORE FABRICATION.

LEGEND :
X1 / J853 — DETAIL MARK NO. / REFER SHEET NO.
1. F.F.L. — FINISHED FLOOR LEVEL
2. S.F.L. — STRUCTURAL FLOOR LEVEL
3. (R) — REVERSED DETAIL
4. ▲ — FIXING LOCATION
5. △ — FIXING LUG LOCATION
6. GLASS LEGEND
GL01 — 10mm+12mm AIR GAP+10mm THK. LG.U.
GL05 — 10mm+12mm AIR GAP+10mm THK. LG.U.
GL06 — 10mm+12mm AIR GAP+12mm THK. LG.U.
PD01 — 10mm T.P+12mm AIR GAP+8mm T.P
GL07 — 10mm+12mm AIR GAP+12mm THK. LG.U.
GL08 — 10mm+12mm AIR GAP+10mm THK. LG.U.

NO.	DATE	REMARKS	BY
B	24/12/2021	REVISION SUBJECT TO ARCH.COMMENT	LHK
A	28/08/2021	REVISION SUBJECT TO ARCH.COMMENT	LHK

JOB NO. : J-853

PROJECT :
PROPOSED RESIDENTIAL DEVELOPMENT AT N.K.I.L. 6542 YIN PING ROAD KOWLOON

TITLE :
WINDOW SCHEDULE FOR TOWER 1 ALUM. WINDOW

DATE : 03-APR-21 | SCALE : 1:40

DRAWN BY : | CHECKED BY :

美特鋁製有限公司
MIDI ALUMINIUM FABRICATOR LTD.
Units 6-8, Sunray Industrial Centre, 1/F
610 Cha Kwo Ling Road, Kowloon
Tel:23489211-4 Fax:(852)27727666

DWG NO. : J853-SD-IW-SC104 | REV. : B

ELEVATION

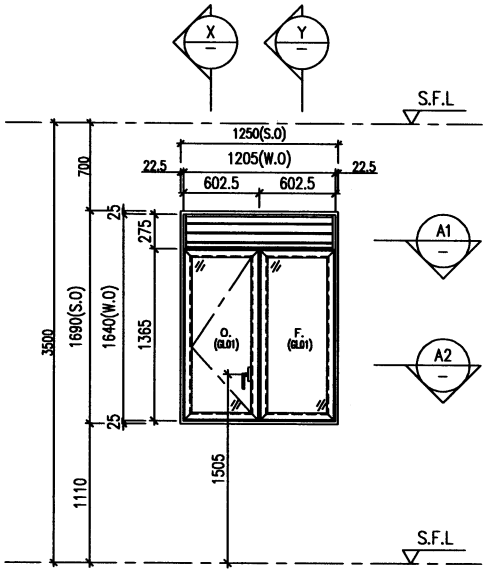

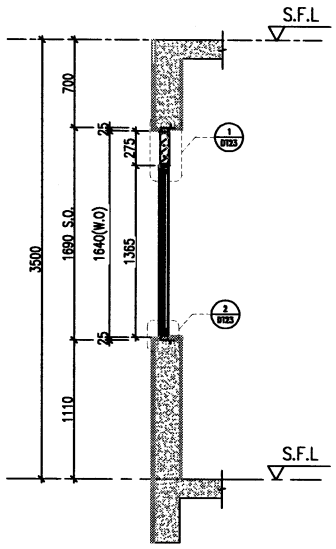

X PART SECTION

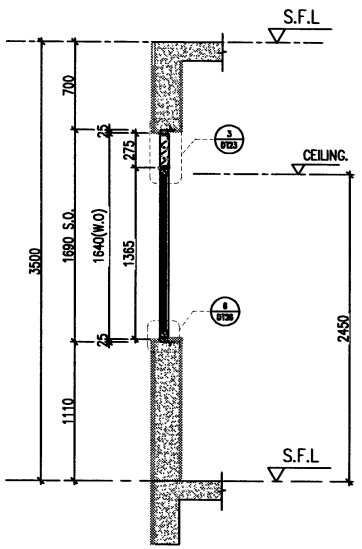

Y PART SECTION

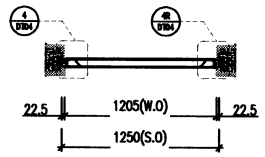

A1 PART PLAN

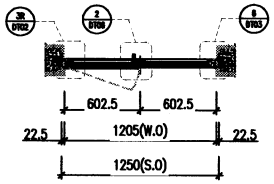

A2 PART PLAN

PROVIDED		
GLAZING AREA	1.196	m^2
OPENABLE AREA	0.667	m^2
FREE AREA	60.5	%

WINDOW MARK	W10 T1
LOCATION	23F UNIT B STO.
SECTION	70mm ALUM. SECTION
GLAZING	GL01
QUANTITY	1 Nos.
REMARKS	SITE IN SITU

T:\Jobs\J-853\2. Outgoing\Black plate opening of Windows Louvre\Black Plate of T1 In-Situ Window.dwg

B.D. REF :

CLIENT :
SHIMAO GROUP HOLDINGS LIMITED

ARCHITECT : WONG TUNG & PARTNERS LIMITED ARCHITECTS & PLANNERS

MAIN CONTRACTOR :
協興建築有限公司
HIP HING CONSTRUCTION CO LTD

STRUCTURAL ENGINEER :
C M WONG & ASSOCIATES LTD
Consulting Engineers

SITE IN SITU CONSULTANT:
MEINHARDT

NOTE :
1. ALL DIMENSIONS ARE IN mm.
2. ALL ELEVATIONS ARE VIEWED FROM OUTSIDE.
3. ALL DIMENSIONS TO BE VERIFIED ON SITE BEFORE FABRICATION.

LEGEND :
- X1 / 3001 — DETAIL MARK NO. / REFER SHEET NO.
1. F.F.L. — FINISHED FLOOR LEVEL
2. S.F.L. — STRUCTURAL FLOOR LEVEL
3. (N) — REVERSED DETAIL
4. ▲ — FIXING LOCATION
5. △ — FIXING LUG LOCATION
6. GLASS LEGEND
   - GL01 — 10mm+12mm AIR GAP+10mm THK. I.G.U.
   - GL05 — 10mm+12mm AIR GAP+10mm THK. I.G.U.
   - GL06 — 10mm+12mm AIR GAP+12mm THK. I.G.U.
   - PD01 — 10mm T.P.+12mm AIR GAP+8mm T.P
   - GL07 — 10mm+12mm AIR GAP+12mm THK. I.G.U.
   - GL08 — 10mm+12mm AIR GAP+10mm THK. I.G.U.

NO.	DATE	REMARK	BY
B	24/12/2021	REVISION SUBJECT TO ARCH.COMMENT	LHS
A	28/09/2021	REVISION SUBJECT TO ARCH.COMMENT	HSW

JOB NO. : J-853

PROJECT :
PROPOSED RESIDENTIAL DEVELOPMENT AT N.K.I.L. 6542 YIN PING ROAD KOWLOON

TITLE :
WINDOW SCHEDULE FOR TOWER 1 ALUM. WINDOW

DATE : 03-APR-21 | SCALE : 1:40

DRAWN BY : | CHECKED BY :

美特鋁製有限公司
MIDI ALUMINIUM FABRICATOR LTD.
Units 6-8, Sunray Industrial Centre, 1/F
610 Cha Kwo Ling Road, Kowloon
Tel:23489211-4 Fax:(852)27727666

DWG NO. : J853-SD-IW-SC102 | REV. : B

ELEVATION

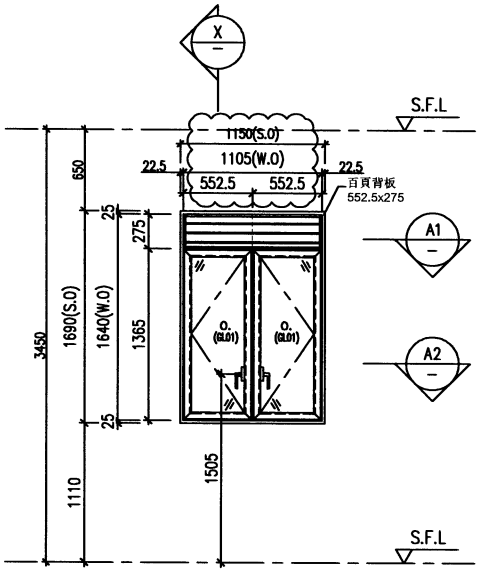

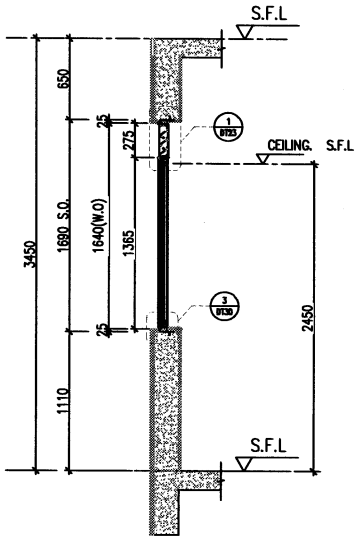

X PART SECTION

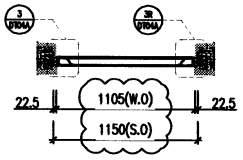

A1 PART PLAN

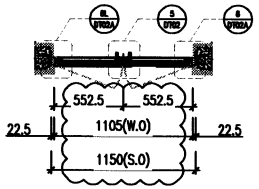

A2 PART PLAN

PROVIDED		
GLAZING AREA	1.059	m^2
OPENABLE AREA	1.232	m^2
FREE AREA	60.5	%

WINDOW MARK	W03 T1
LOCATION	5F~22F UNIT B KITCHEN
SECTION	70mm ALUM. SECTION
GLAZING	GL01
QUANTITY	16 Nos.
REMARKS	SITE IN SITU

B.D. REF :

CLIENT :
SHIMAO GROUP HOLDINGS LIMITED

ARCHITECT : WONG TUNG & PARTNERS LIMITED ARCHITECTS & PLANNERS

MAIN CONTRACTOR :
協興建築有限公司
HIP HING CONSTRUCTION CO LTD

STRUCTURAL ENGINEER :
C M WONG & ASSOCIATES LTD
Consulting Engineers

SITE IN SITU CONSULTANT:
MEINHARDT

NOTE :
1. ALL DIMENSIONS ARE IN mm.
2. ALL ELEVATIONS ARE VIEWED FROM OUTSIDE.
3. ALL DIMENSIONS TO BE VERIFIED ON SITE BEFORE FABRICATION.

LEGEND :
- X1 / 3001 — DETAIL MARK NO. / REFER SHEET NO.
1. F.F.L. — FINISHED FLOOR LEVEL
2. S.F.L. — STRUCTURAL FLOOR LEVEL
3. (R) — REVERSED DETAIL
4. ▲ — FIXING LOCATION
5. △ — FIXING LUG LOCATION
6. GLASS LEGEND
   - GL01 — 10mm+12mm AIR GAP+10mm THK. LG.U.
   - GL05 — 10mm+12mm AIR GAP+10mm THK. LG.U.
   - GL06 — 10mm+12mm AIR GAP+12mm THK. LG.U.
   - PD01 — 10mm T.P+12mm AIR GAP+8mm T.P
   - GL07 — 10mm+12mm AIR GAP+12mm THK. LG.U.
   - GL08 — 10mm+12mm AIR GAP+10mm THK. LG.U.

NO.	DATE	REMARK	BY
E	10/10/2022	REVISION SUBJECT TO ARCH.COMMENT	LHS
D	15/07/2022	REVISION SUBJECT TO ARCH.COMMENT	LHS
B	24/12/2021	REVISION SUBJECT TO ARCH.COMMENT	LHS
A	28/09/2021	REVISION SUBJECT TO ARCH.COMMENT	HSH

JOB NO. : J-853

PROJECT :
PROPOSED RESIDENTIAL DEVELOPMENT AT N.K.I.L. 6542 YIN PING ROAD KOWLOON

TITLE :
WINDOW SCHEDULE FOR TOWER 1 ALUM. WINDOW

DATE : 03-APR-21 | SCALE : 1:40

DRAWN BY : | CHECKED BY :

美特鋁製有限公司
MIDI ALUMINIUM FABRICATOR LTD.
Units 6-8, Sunrey Industrial Centre, 1/F
610 Cha Kwo Ling Road, Kowloon
Tel:23489211-4 Fax:(852)27727666

DWG NO. : J853-SD-IW-SC101 | REV. : E

T:\Jobs\J-853\2. Outgoing\Black plate opening of Windows Louvre\Black Plate of T1 In-Situ Window.dwg

ELEVATION

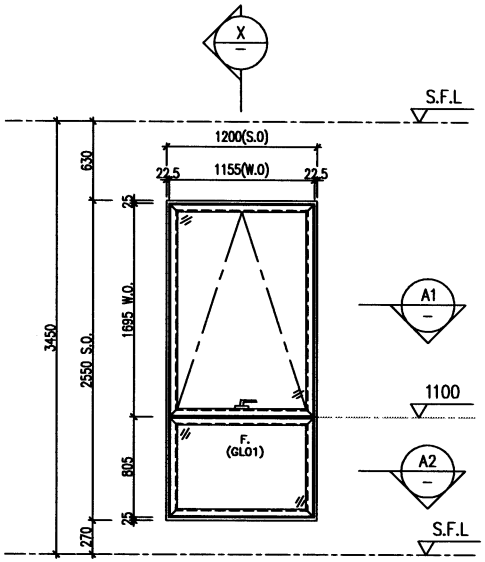

ELEVATION

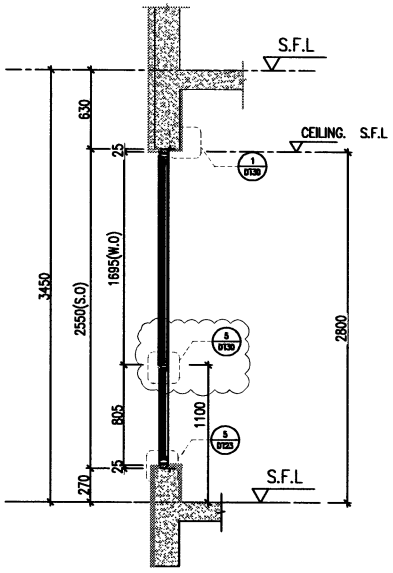

X — PART SECTION

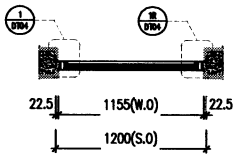

A1 — PART PLAN

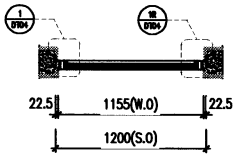

A1 — PART PLAN

PROVIDED		
GLAZING AREA	1.603	m^2
OPENABLE AREA	–	m^2
FREE AREA	–	%

WINDOW MARK	W27 / T1
LOCATION	5F UNIT A LIVING ROOM
SECTION	70mm ALUM. SECTION
GLAZING	–
QUANTITY	1 Nos.
REMARKS	SITE IN SITU

T:\Jobs\J-853\2. Outgoing\Black plate opening of Windows Louvre\Black Plate of T1 In-Situ Window.dwg

B.D. REF :

CLIENT :
SHIMAO GROUP HOLDINGS LIMITED

ARCHITECT : WONG TUNG & PARTNERS LIMITED ARCHITECTS & PLANNERS

MAIN CONTRACTOR :
協興建築有限公司
HIP HING CONSTRUCTION CO LTD

STRUCTURAL ENGINEER :
C M WONG & ASSOCIATES LTD
Consulting Engineers

SITE IN SITU CONSULTANT:
MEINHARDT

NOTE :
1. ALL DIMENSIONS ARE IN mm.
2. ALL ELEVATIONS ARE VIEWED FROM OUTSIDE.
3. ALL DIMENSIONS TO BE VERIFIED ON SITE BEFORE FABRICATION.

LEGEND :
X1 — DETAIL MARK NO.
W001 — REFER SHEET NO.
1. F.F.L. — FINISHED FLOOR LEVEL
2. S.F.L. — STRUCTURAL FLOOR LEVEL
3. (R) — REVERSED DETAIL
4. ▲ — FIXING LOCATION
5. △ — FIXING LUG LOCATION
6. GLASS LEGEND
GL01 — 10mm+12mm AIR GAP+10mm THK. I.G.U.
GL05 — 10mm+12mm AIR GAP+10mm THK. I.G.U.
GL06 — 10mm+12mm AIR GAP+12mm THK. I.G.U.
PD01 — 10mm T.P+12mm AIR GAP+8mm T.P
GL07 — 10mm+12mm AIR GAP+12mm THK. I.G.U.
GL08 — 10mm+12mm AIR GAP+10mm THK. I.G.U.

NO.	DATE	REVISED	BY
A	04/08/2022	REVISION SUBJECT TO ARCH.COMMENT	LHS

JOB NO. : J-853

PROJECT :
PROPOSED RESIDENTIAL DEVELOPMENT AT N.K.I.L. 6542 YIN PING ROAD KOWLOON

TITLE :
WINDOW SCHEDULE FOR TOWER 1 ALUM. WINDOW

DATE : 03-APR-21 | SCALE : 1:40

DRAWN BY : | CHECKED BY :

美特鋁質有限公司
MIDI ALUMINIUM FABRICATOR LTD.
Units 6-8, Sunray Industrial Centre, 1/F
610 Cha Kwo Ling Road, Kowloon
Tel:23489211-4 Fax:(852)27727666

DWG NO. : J853-SD-IW-SC127 | REV. : A

ELEVATION

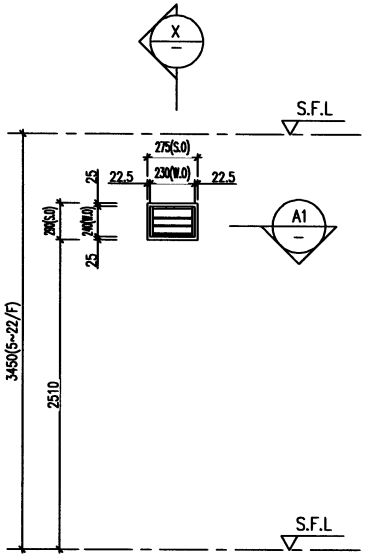

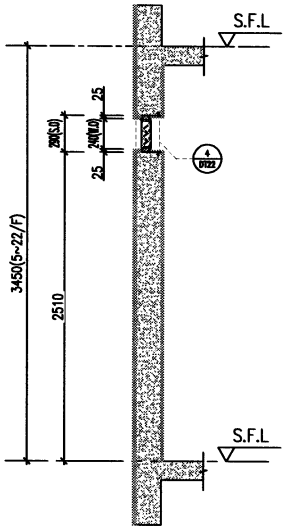

X PART SECTION

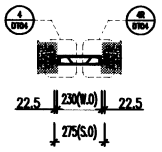

A1 PART PLAN

PROVIDED		
GLAZING AREA	–	m^2
OPENABLE AREA	–	m^2
FREE AREA	54.86	%

WINDOW MARK	L13 / T1
LOCATION	5/F~22/F UNIT A ENSUITE 2 / EN. BATH
SECTION	70mm ALUM. SECTION
GLAZING	–
QUANTITY	16 Nos.
REMARKS	SITE IN SITU

T:\Jobs\J-853\2. Outgoing\Black plate opening of Windows Louvre\Black Plate of T1 In-Situ Window.dwg

B.D. REF :

CLIENT :
SHIMAO GROUP HOLDINGS LIMITED

ARCHITECT :
WONG TUNG & PARTNERS LIMITED
ARCHITECTS & PLANNERS

MAIN CONTRACTOR :
協興建築有限公司
HIP HING CONSTRUCTION CO LTD

STRUCTURAL ENGINEER :
C M WONG & ASSOCIATES LTD
Consulting Engineers

SITE IN SITU CONSULTANT:
MEINHARDT

NOTE :
1. ALL DIMENSIONS ARE IN mm.
2. ALL ELEVATIONS ARE VIEWED FROM OUTSIDE.
3. ALL DIMENSIONS TO BE VERIFIED ON SITE BEFORE FABRICATION.

LEGEND :
X1 / WD01 — DETAIL MARK NO. / REFER SHEET NO.
1. F.F.L. — FINISHED FLOOR LEVEL
2. S.F.L. — STRUCTURAL FLOOR LEVEL
3. (75) — REVERSED DETAIL
4. ▲ — FIXING LOCATION
5. △ — FIXING LUG LOCATION
6. GLASS LEGEND
GL01 — 10mm+12mm AIR GAP+10mm THK. LG.U.
GL05 — 10mm+12mm AIR GAP+10mm THK. LG.U.
GL06 — 10mm+12mm AIR GAP+12mm THK. LG.U.
PD01 — 10mm T.P+12mm AIR GAP+8mm T.P
GL07 — 10mm+12mm AIR GAP+12mm THK. LG.U.
GL08 — 10mm+12mm AIR GAP+10mm THK. LG.U.

NO.	DATE	REVISED	BY

JOB NO. : J-853

PROJECT :
PROPOSED RESIDENTIAL DEVELOPMENT AT N.K.I.L. 6542 YIN PING ROAD KOWLOON

TITLE :
WINDOW SCHEDULE FOR TOWER 1 ALUM. WINDOW

DATE : 03-APR-21 | SCALE : 1:40

DRAWN BY : | CHECKED BY :

美特鋁質有限公司
MIDI ALUMINIUM FABRICATOR LTD.
Units 6-8, Sunray Industrial Centre, 1/F
610 Cha Kwo Ling Road, Kowloon
Tel:23489211-4 Fax:(852)27727666

DWG NO. : J853-SD-W-SC125 | REV. : B

ELEVATION

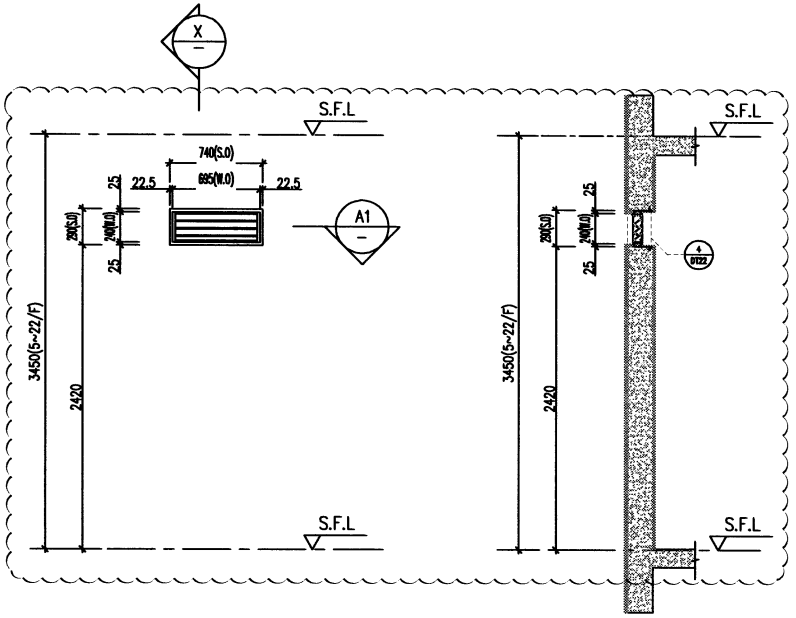

X — PART SECTION

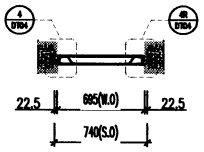

A1 — PART PLAN

PROVIDED		
GLAZING AREA	–	m^2
OPENABLE AREA	–	m^2
FREE AREA	54.86	%

WINDOW MARK	L14 / T1
LOCATION	5/F~22/F AT STAIR CAST 1
SECTION	70mm ALUM. SECTION
GLAZING	–
QUANTITY	16 Nos.
REMARKS	SITE IN SITU

T:\Jobs\J-853\2. Outgoing\Black plate opening of Windows Louvre\Black Plate of T1 In-Situ Window.dwg

B.D. REF :

CLIENT :
SHIMAO GROUP HOLDINGS LIMITED

ARCHITECT : WONG TUNG & PARTNERS LIMITED ARCHITECTS & PLANNERS

MAIN CONTRACTOR :
協興建築有限公司
HIP HING CONSTRUCTION CO LTD

STRUCTURAL ENGINEER :
C M WONG & ASSOCIATES LTD
Consulting Engineers

SITE IN SITU CONSULTANT:
MEINHARDT

NOTE :
1. ALL DIMENSIONS ARE IN mm.
2. ALL ELEVATIONS ARE VIEWED FROM OUTSIDE.
3. ALL DIMENSIONS TO BE VERIFIED ON SITE BEFORE FABRICATION.

LEGEND :
X1 / W001 — DETAIL MARK NO. / REFER SHEET NO.
1. F.F.L. — FINISHED FLOOR LEVEL
2. S.F.L. — STRUCTURAL FLOOR LEVEL
3. (R) — REVERSED DETAIL
4. ▲ — FIXING LOCATION
5. △ — FIXING LUG LOCATION
6. GLASS LEGEND
GL01 — 10mm+12mm AIR GAP+10mm THK. LG.U.
GL05 — 10mm+12mm AIR GAP+10mm THK. LG.U.
GL06 — 10mm+12mm AIR GAP+12mm THK. LG.U.
PD01 — 10mm T.P+12mm AIR GAP+8mm T.P
GL07 — 10mm+12mm AIR GAP+12mm THK. LG.U.
GL08 — 10mm+12mm AIR GAP+10mm THK. LG.U.

NO.	DATE	REMARK	BY
E	28/09/2022	REVISION SUBJECT TO ARCHCOMMENT	LHS
D	04/08/2022	REVISION SUBJECT TO ARCHCOMMENT	LHS

JOB NO. : J-853

PROJECT :
PROPOSED RESIDENTIAL DEVELOPMENT AT N.K.I.L. 6542 YIN PING ROAD KOWLOON

TITLE :
WINDOW SCHEDULE FOR TOWER 1 ALUM. WINDOW

DATE : 03-APR-21 | SCALE : 1:40

DRAWN BY : | CHECKED BY :

美特鋁製有限公司
MIDI ALUMINIUM FABRICATOR LTD.
Units 6-8, Sunray Industrial Centre, 1/F
610 Cha Kwo Ling Road, Kowloon
Tel:23489211-4 Fax:(852)27727666

DWG NO. : J853-SD-IW-SC126 | REV. : D

ELEVATION

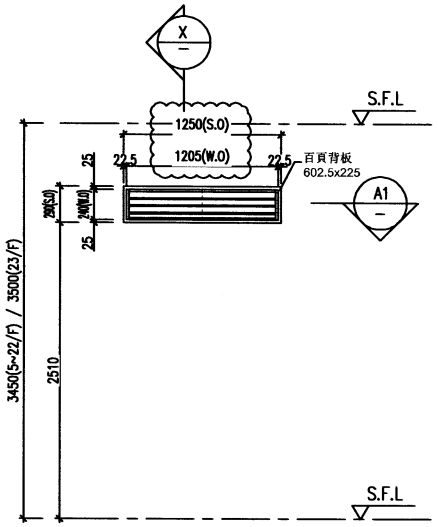

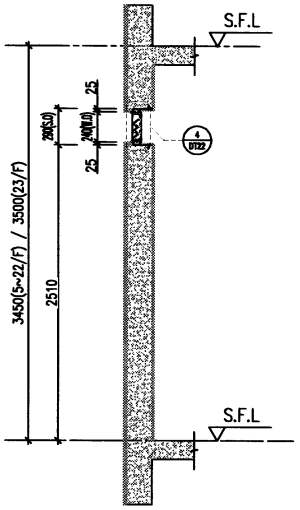

X — PART SECTION

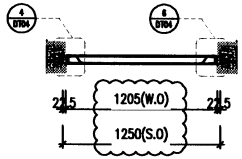

A1 — PART PLAN

PROVIDED		
GLAZING AREA	–	m^2
OPENABLE AREA	–	m^2
FREE AREA	54.86	%

WINDOW MARK	L12 / T1
LOCATION	5F~22F UNIT A KIT.
SECTION	70mm ALUM. SECTION
GLAZING	–
QUANTITY	17 No.
REMARKS	SITE IN SITU

T:\Jobs\J-853\2. Outgoing\Black plate opening of Windows Louvre\Black Plate of T1 In-Situ Window.dwg

B.D. REF :

CLIENT :
SHIMAO GROUP HOLDINGS LIMITED

ARCHITECT : WONG TUNG & PARTNERS LIMITED ARCHITECTS & PLANNERS

MAIN CONTRACTOR :
協興建築有限公司
HIP HING CONSTRUCTION CO LTD

STRUCTURAL ENGINEER :
C M WONG & ASSOCIATES LTD
Consulting Engineers

SITE IN SITU CONSULTANT:
MEINHARDT

NOTE :
1. ALL DIMENSIONS ARE IN mm.
2. ALL ELEVATIONS ARE VIEWED FROM OUTSIDE.
3. ALL DIMENSIONS TO BE VERIFIED ON SITE BEFORE FABRICATION.

LEGEND :
X1 / H001 — DETAIL MARK NO. / REFER SHEET NO.
1. F.F.L. — FINISHED FLOOR LEVEL
2. S.F.L. — STRUCTURAL FLOOR LEVEL
3. (R) — REVERSED DETAIL
4. ▲ — FIXING LOCATION
5. △ — FIXING LUG LOCATION
6. GLASS LEGEND
GL01 — 10mm+12mm AIR GAP+10mm THK. LG.U.
GL05 — 10mm+12mm AIR GAP+10mm THK. LG.U.
GL06 — 10mm+12mm AIR GAP+12mm THK. LG.U.
PD01 — 10mm T.P+12mm AIR GAP+8mm T.P
GL07 — 10mm+12mm AIR GAP+12mm THK. LG.U.
GL08 — 10mm+12mm AIR GAP+10mm THK. LG.U.

NO.	DATE	REMARK	BY
D	15/07/2022	REVISION SUBJECT TO ARCH.COMMENT	LHS
B	25/12/2021	REVISION SUBJECT TO ARCH.COMMENT	LHS
A	26/08/2021	REVISION SUBJECT TO ARCH.COMMENT	WSK

JOB NO. : J-853

PROJECT :
PROPOSED RESIDENTIAL DEVELOPMENT AT N.K.I.L. 6542 YIN PING ROAD KOWLOON

TITLE :
WINDOW SCHEDULE FOR TOWER 1 ALUM. WINDOW

DATE : 03-APR-21 | SCALE : 1:40

DRAWN BY : | CHECKED BY :

美特鋁製有限公司
MIDI ALUMINIUM FABRICATION LTD.
Units 6-8, Sunray Industrial Centre, 1/F
610 Cha Kwo Ling Road, Kowloon
Tel:23488211-4 Fax:(852)27727666

DWG NO. : J853-SD-IW-SC124 | REV. : D

ELEVATION

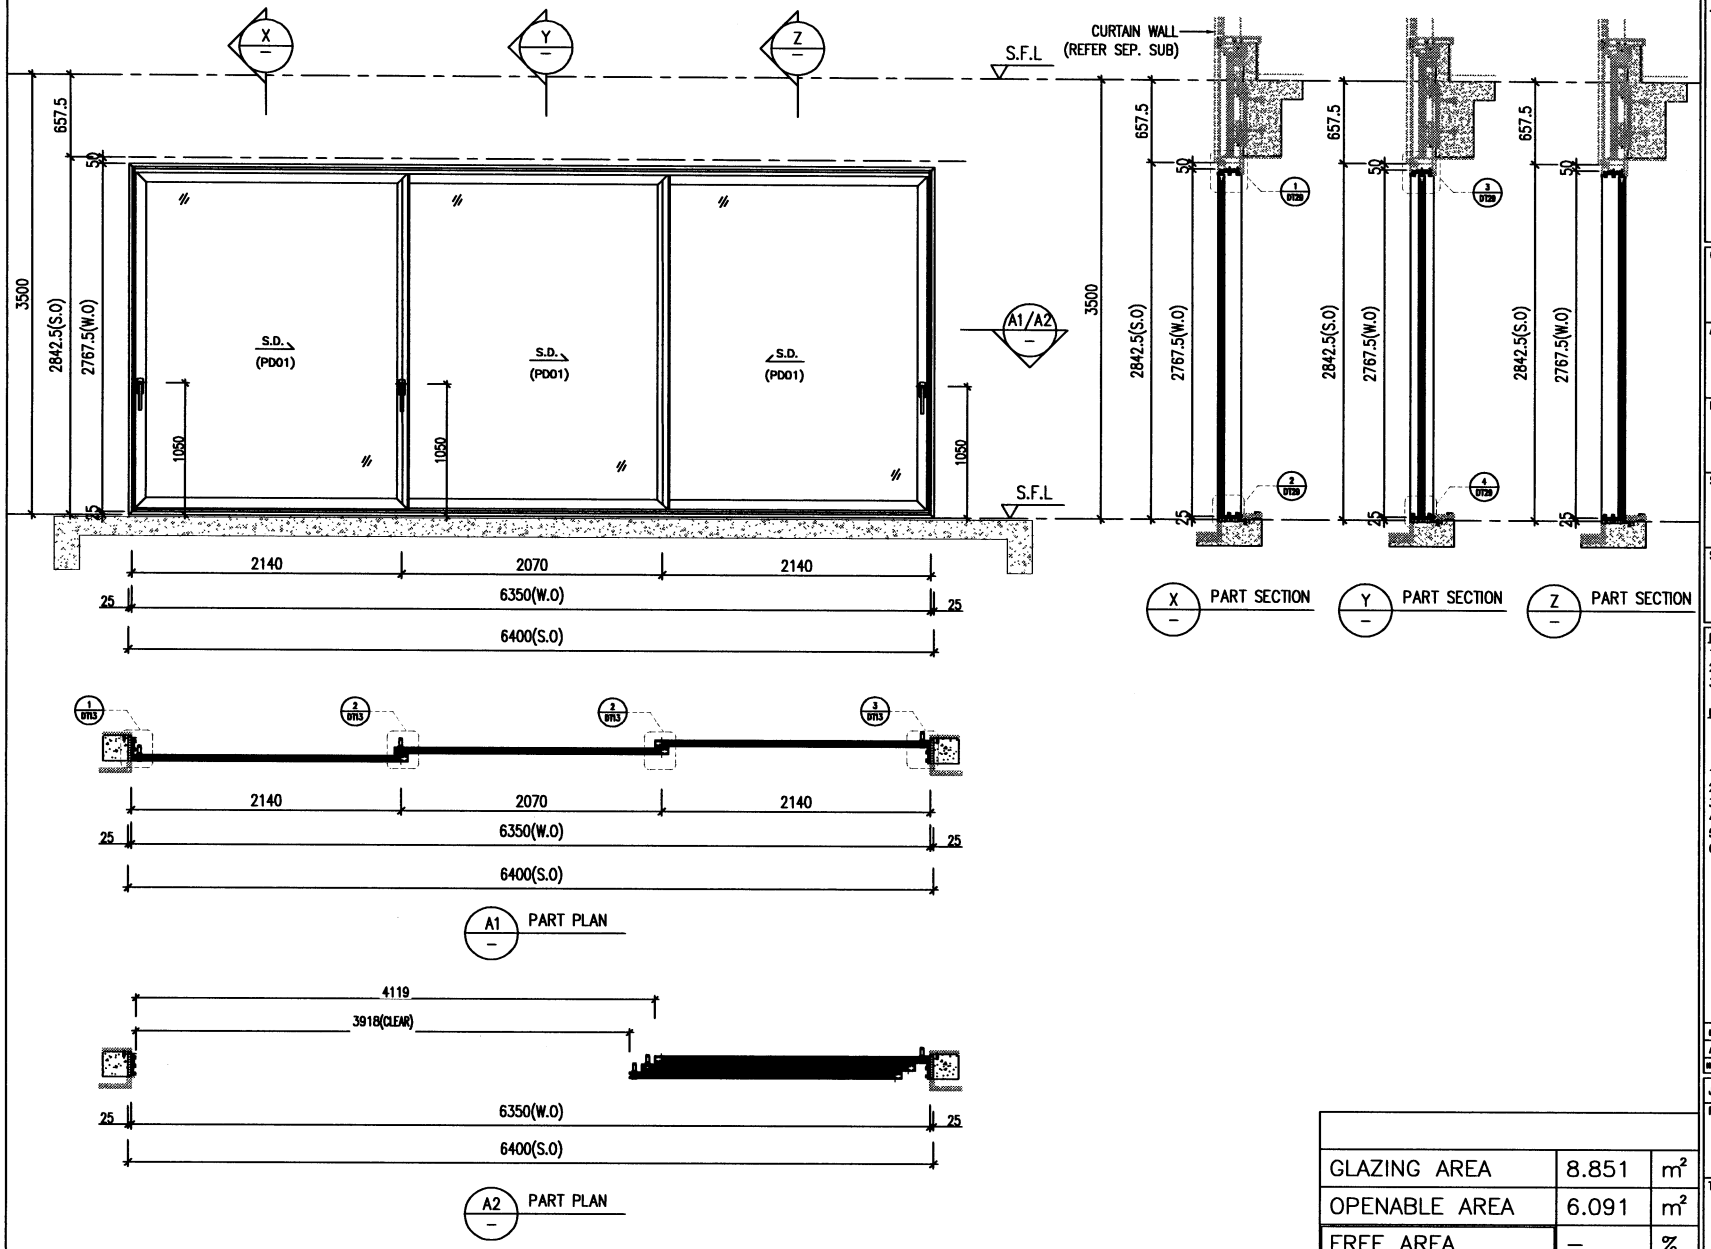

WINDOW MARK	W208 T1
LOCATION	23F UNIT A LIV.
SECTION	50mm ALUM. SECTION
GLAZING	PD01
QUANTITY	1 Nos.
REMARKS	SITE IN SITU

GLAZING AREA	8.851	m^2
OPENABLE AREA	6.091	m^2
FREE AREA	–	%

B.D. REF :

CLIENT :
SHIMAO GROUP HOLDINGS LIMITED

ARCHITECT :
WONG TUNG & PARTNERS LIMITED
ARCHITECTS & PLANNERS

MAIN CONTRACTOR :
協興建築有限公司
HIP HING CONSTRUCTION CO LTD

STRUCTURAL ENGINEER :
C M WONG & ASSOCIATES LTD
Consulting Engineers

SITE IN SITU CONSULTANT:
MEINHARDT

NOTE :
1. ALL DIMENSIONS ARE IN mm.
2. ALL ELEVATIONS ARE VIEWED FROM OUTSIDE.
3. ALL DIMENSIONS TO BE VERIFIED ON SITE BEFORE FABRICATION.

LEGEND :
X1 — DETAIL MARK NO.
(W001) — REFER SHEET NO.
1. F.F.L. — FINISHED FLOOR LEVEL
2. S.F.L. — STRUCTURAL FLOOR LEVEL
3. (R) — REVERSED DETAIL
4. ▲ — FIXING LOCATION
5. △ — FIXING LUG LOCATION
6. GLASS LEGEND
GL01 — 10mm+12mm AIR GAP+10mm THK. I.G.U.
GL05 — 10mm+12mm AIR GAP+10mm THK. I.G.U.
GL06 — 10mm+12mm AIR GAP+12mm THK. I.G.U.
PD01 — 10mm T.P+12mm AIR GAP+8mm T.P
GL07 — 10mm+12mm AIR GAP+12mm THK. I.G.U.
GL08 — 10mm+12mm AIR GAP+10mm THK. I.G.U.

NO.	DATE	REMARKS	BY
B	25/12/2021	REVISION SUBJECT TO ARCH.COMMENT	LHS
A	26/08/2021	REVISION SUBJECT TO ARCH.COMMENT	LHS

JOB NO. : J-853

PROJECT :
PROPOSED RESIDENTIAL DEVELOPMENT AT N.K.I.L. 6542 YIN PING ROAD KOWLOON

TITLE :
WINDOW SCHEDULE FOR TOWER 1 ALUM. WINDOW

DATE : 03-APR-21 | SCALE : 1:40

DRAWN BY : | CHECKED BY :

美特鋁製有限公司
MIDI ALUMINIUM FABRICATOR LTD.
Units 6-8, Sunray Industrial Centre, 1/F
610 Cha Kwo Ling Road, Kowloon
Tel:23489211-4 Fax:(852)27727666

DWG NO. : J853-SD-IW-SC121 | REV. : B

T:\Jobs\J-853\2. Outgoing\Black plate opening of Windows Louvre\Black Plate of T1 In-Situ Window.dwg

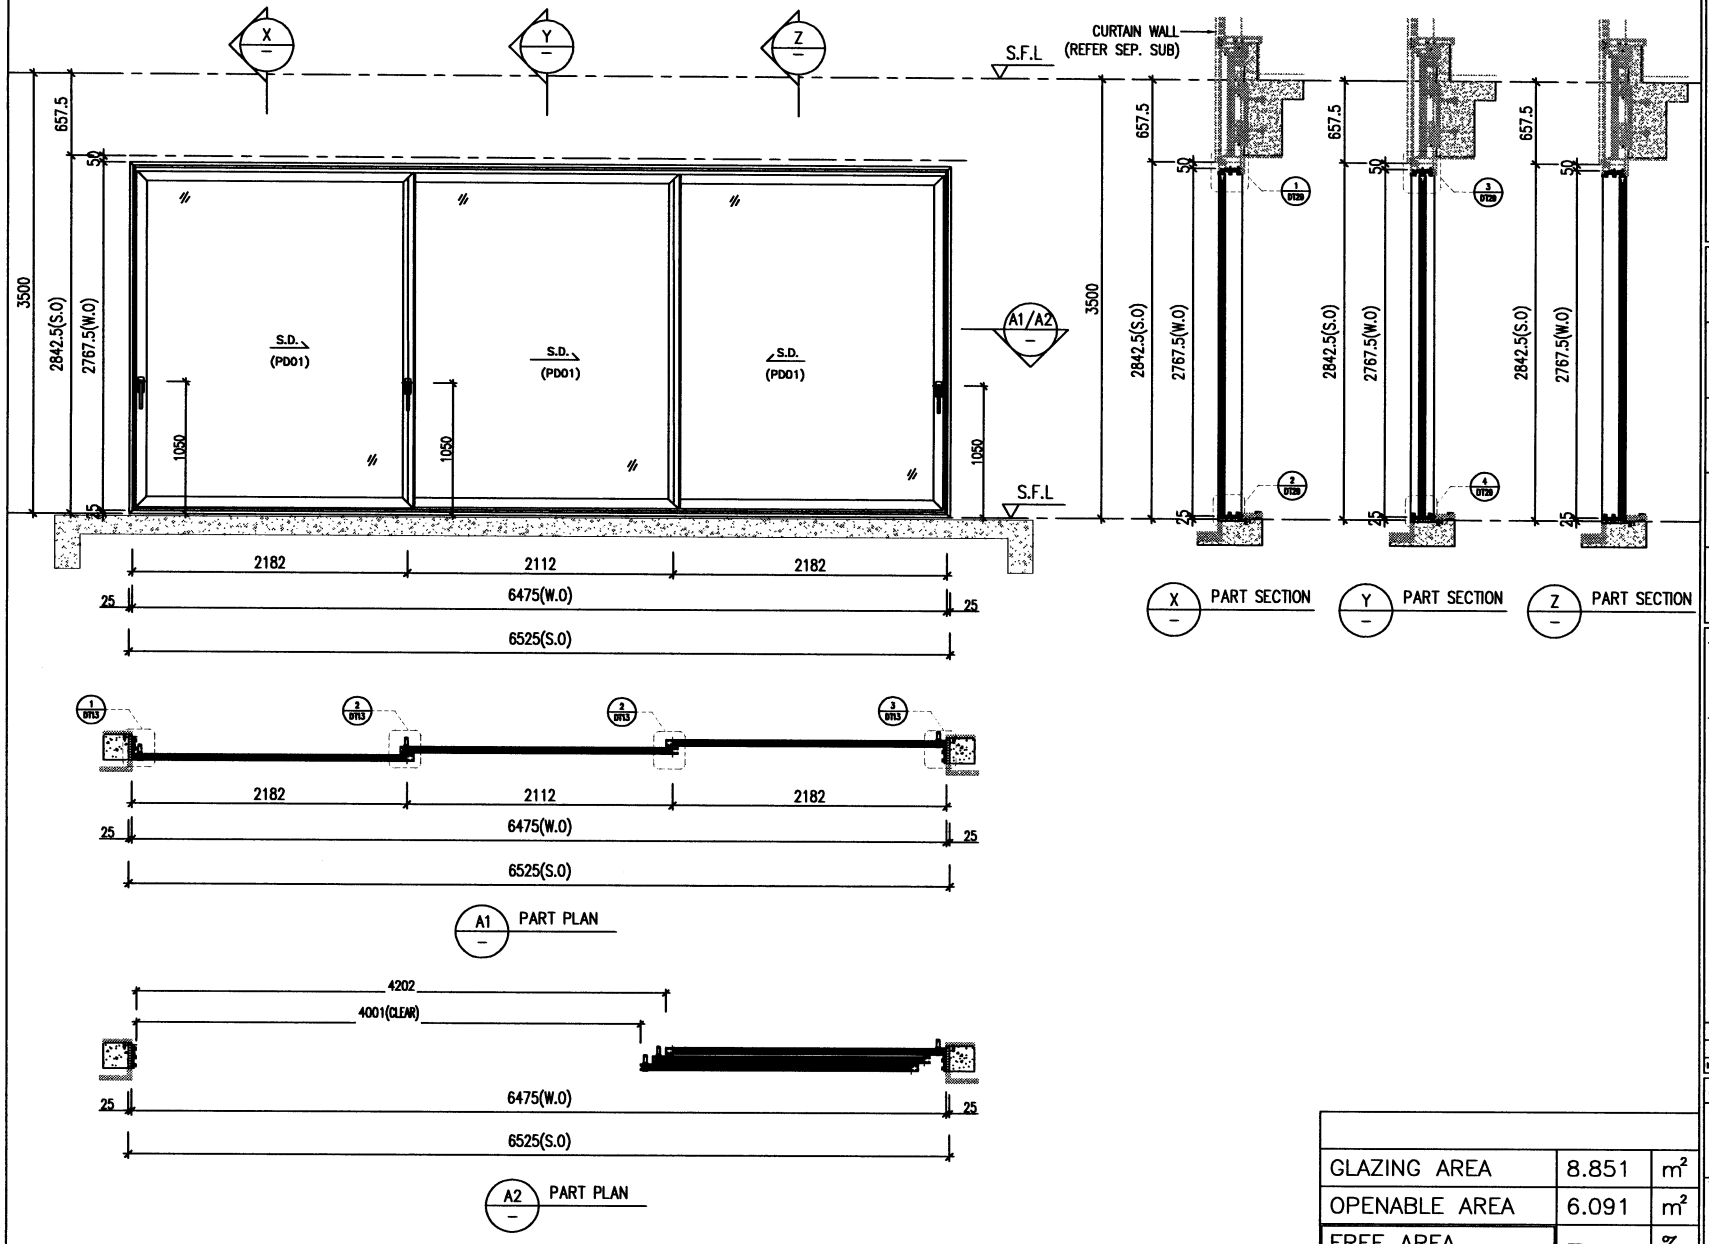

ELEVATION

WINDOW MARK	W209 T1
LOCATION	23F UNIT B LIV.
SECTION	50mm ALUM. SECTION
GLAZING	PD01
QUANTITY	1 Nos.
REMARKS	SITE IN SITU

GLAZING AREA	8.851	m^2
OPENABLE AREA	6.091	m^2
FREE AREA	–	%

B.D. REF :

CLIENT :
SHIMAO GROUP HOLDINGS LIMITED

ARCHITECT : WONG TUNG & PARTNERS LIMITED ARCHITECTS & PLANNERS

MAIN CONTRACTOR :
協興建築有限公司
HIP HING CONSTRUCTION CO LTD

STRUCTURAL ENGINEER :
C M WONG & ASSOCIATES LTD
Consulting Engineers

SITE IN SITU CONSULTANT:
MEINHARDT

NOTE :
1. ALL DIMENSIONS ARE IN mm.
2. ALL ELEVATIONS ARE VIEWED FROM OUTSIDE.
3. ALL DIMENSIONS TO BE VERIFIED ON SITE BEFORE FABRICATION.

LEGEND :
X1 / 2001 — DETAIL MARK NO. / REFER SHEET NO.
1. F.F.L. — FINISHED FLOOR LEVEL
2. S.F.L. — STRUCTURAL FLOOR LEVEL
3. — REVERSED DETAIL
4. — FIXING LOCATION
5. — FIXING LUG LOCATION
6. GLASS LEGEND
GL01 — 10mm+12mm AIR GAP+10mm THK. I.G.U.
GL05 — 10mm+12mm AIR GAP+10mm THK. I.G.U.
GL06 — 10mm+12mm AIR GAP+12mm THK. I.G.U.
PD01 — 10mm T.P+12mm AIR GAP+8mm T.P
GL07 — 10mm+12mm AIR GAP+12mm THK. I.G.U.
GL08 — 10mm+12mm AIR GAP+10mm THK. I.G.U.

NO.	DATE	REMARKS	BY
B	29/12/2021	REVISION SUBJECT TO ARCHITECT	LAM
A	26/08/2021	REVISION SUBJECT TO ARCHITECT	WAH

JOB NO. : J-853

PROJECT :
PROPOSED RESIDENTIAL DEVELOPMENT AT N.K.I.L. 6542 YIN PING ROAD KOWLOON

TITLE :
WINDOW SCHEDULE FOR TOWER 1 ALUM. WINDOW

DATE : 03-APR-21 | SCALE : 1:40

DRAWN BY : | CHECKED BY :

美特鋁實有限公司
MIDI ALUMINIUM FABRICATOR LTD.
Units 6-8, Sunray Industrial Centre, 1/F
610 Cha Kwo Ling Road, Kowloon
Tel:23489211-4 Fax:(852)27727666

DWG NO. : J853-SD-W-SC122 | REV. : B

T:\Jobs\J-853\2. Outgoing\Black plate opening of Windows Louvre\Black Plate of T1 In-Situ Window.dwg

ELEVATION

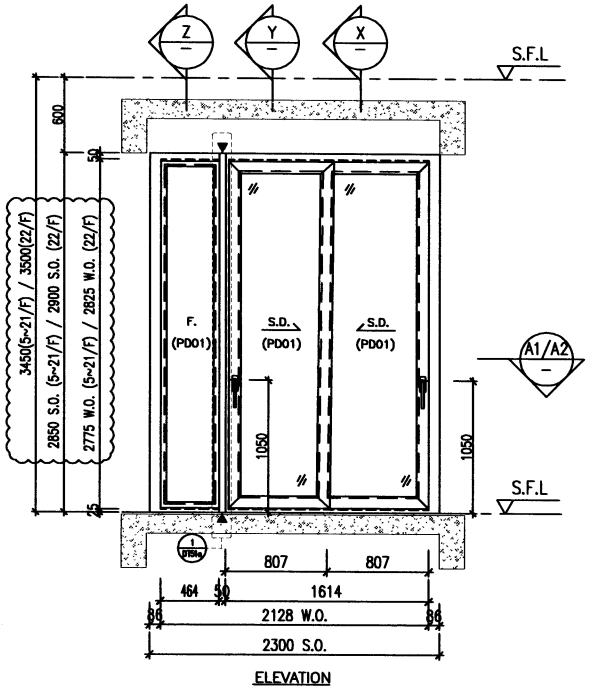

ELEVATION

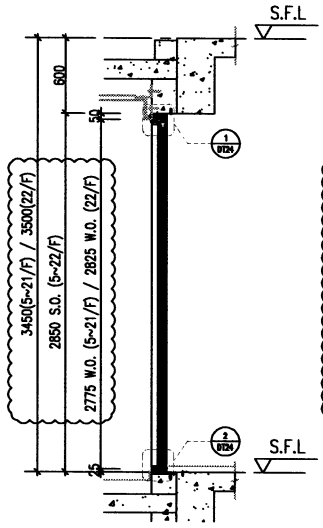

X PART SECTION

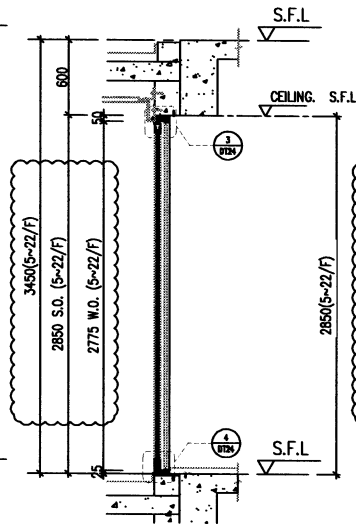

Y PART SECTION

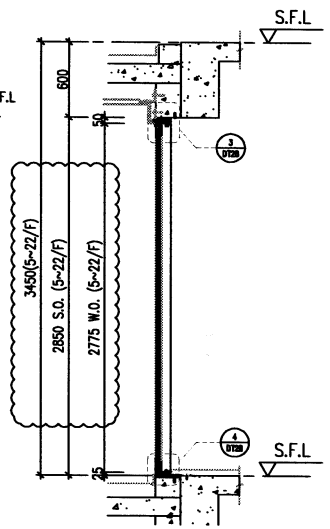

Z PART SECTION

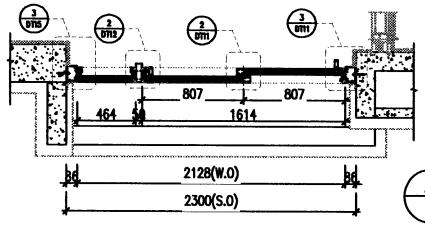

A1 PART PLAN

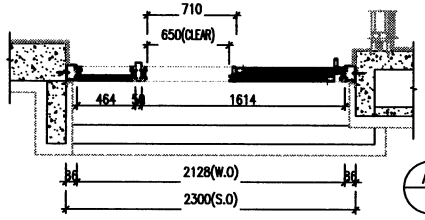

A2 PART PLAN

22F	PROVIDED		
	GLAZING AREA	2.490	m^2
	OPENABLE AREA	1.057	m^2
	FREE AREA	–	%

5F~21F	PROVIDED		
	GLAZING AREA	2.409	m^2
	OPENABLE AREA	1.025	m^2
	FREE AREA	–	%

WINDOW MARK	W207 T1	W207A T1
LOCATION	5/F~21/F UNIT B EN.2	22/F UNIT B EN.2
SECTION	150mm ALUM. SECTION	150mm ALUM. SECTION
GLAZING	PD01	PD01
QUANTITY	15 Nos.	1 No.
REMARKS	SITE IN SITU	SITE IN SITU

T:\Jobs\J-853\2. Outgoing\Black plate opening of Windows Louvre\Black Plate of T1 In-Situ Window.dwg

B.D. REF :

CLIENT :
SHIMAO GROUP HOLDINGS LIMITED

ARCHITECT : WONG TUNG & PARTNERS LIMITED ARCHITECTS & PLANNERS

MAIN CONTRACTOR :
協興建築有限公司
HIP HING CONSTRUCTION CO LTD

STRUCTURAL ENGINEER :
C M WONG & ASSOCIATES LTD
Consulting Engineers

SITE IN SITU CONSULTANT:
MEINHARDT

NOTE :
1. ALL DIMENSIONS ARE IN mm.
2. ALL ELEVATIONS ARE VIEWED FROM OUTSIDE.
3. ALL DIMENSIONS TO BE VERIFIED ON SITE BEFORE FABRICATION.

LEGEND :
X1 — DETAIL MARK NO.
W001 — REFER SHEET NO.

1. F.F.L. — FINISHED FLOOR LEVEL
2. S.F.L. — STRUCTURAL FLOOR LEVEL
3. R — REVERSED DETAIL
4. ▲ — FIXING LOCATION
5. △ — FIXING LUG LOCATION
6. GLASS LEGEND
   GL01 — 10mm+12mm AIR GAP+10mm THK. LG.U.
   GL05 — 10mm+12mm AIR GAP+10mm THK. LG.U.
   GL06 — 10mm+12mm AIR GAP+12mm THK. LG.U.
   PD01 — 10mm T.P+12mm AIR GAP+8mm T.P
   GL07 — 10mm+12mm AIR GAP+12mm THK. LG.U.
   GL08 — 10mm+12mm AIR GAP+10mm THK. LG.U.

NO.	DATE	REMARKS	BY
D	15/07/2022	REVISION SUBJECT TO ARCH.COMMENT	LHS
C	08/06/2022	REVISION SUBJECT TO ARCH.COMMENT	LHS
B	25/12/2021	REVISION SUBJECT TO ARCH.COMMENT	LHS
A	25/06/2021	REVISION SUBJECT TO ARCH.COMMENT	WSK

JOB NO. : J-853

PROJECT :
PROPOSED RESIDENTIAL DEVELOPMENT AT N.K.I.L. 6542 YIN PING ROAD KOWLOON

TITLE :
WINDOW SCHEDULE FOR TOWER 1 ALUM. WINDOW

DATE : 03-APR-21 | SCALE : 1:40

DRAWN BY : | CHECKED BY :

美特鋁質有限公司
MIDI ALUMINIUM FABRICATOR LTD.
Units 6-8, Sunray Industrial Centre, 1/F
810 Cha Kwo Ling Road, Kowloon
Tel:23488211-4 Fax:(852)27727666

DWG NO. : J853-SD-IW-SC120 | REV. : D

ELEVATION

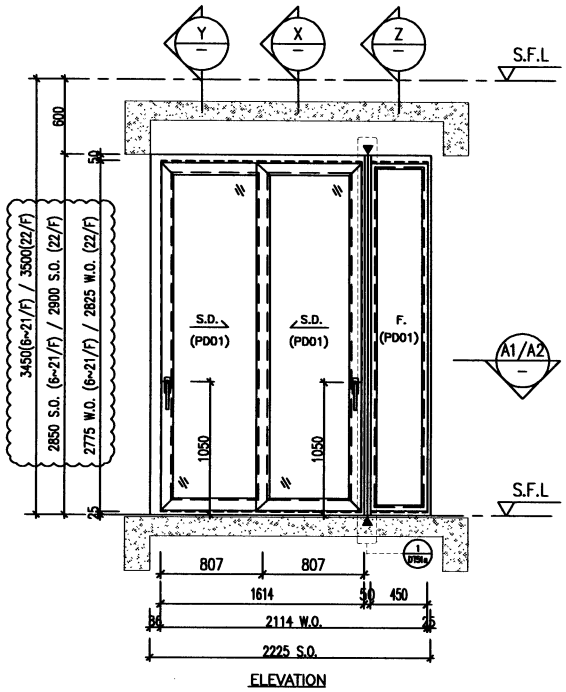

ELEVATION

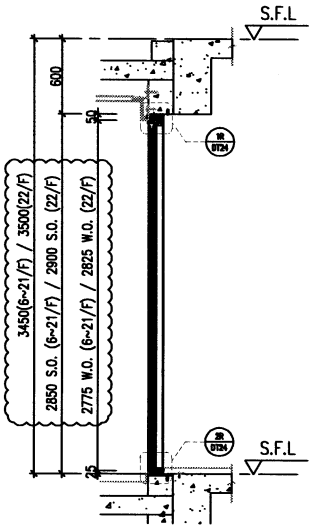

X PART SECTION

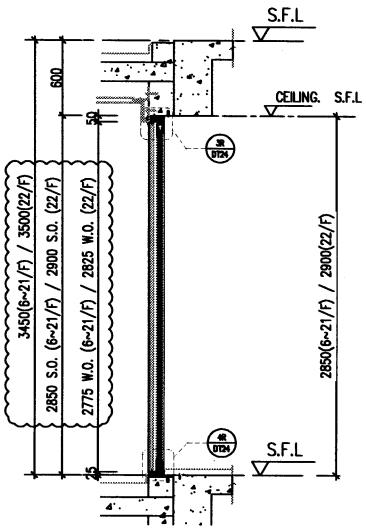

Y PART SECTION

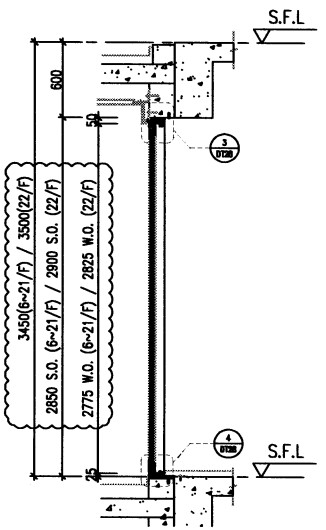

Z PART SECTION

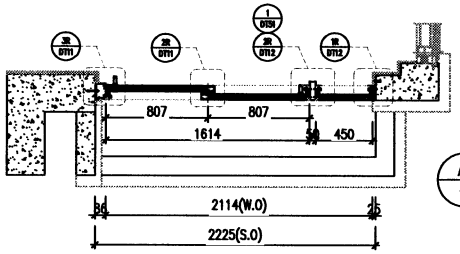

A1 PART PLAN

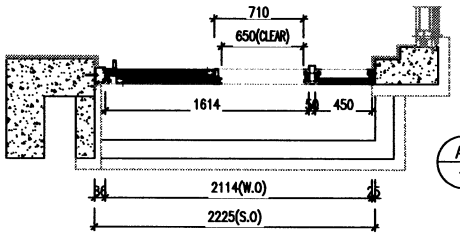

A2 PART PLAN

22F

PROVIDED		
GLAZING AREA	2.490	m^2
OPENABLE AREA	1.057	m^2
FREE AREA	–	%

5F~21F

PROVIDED		
GLAZING AREA	2.409	m^2
OPENABLE AREA	1.025	m^2
FREE AREA	–	%

WINDOW MARK	WZ06 T1	WZ06 T1
LOCATION	6/F~21/F UNIT A EN.3	22/F UNIT A EN.3
SECTION	150mm ALUM. SECTION	150mm ALUM. SECTION
GLAZING	PD01	PD01
QUANTITY	14 Nos.	1 No.
REMARKS	SITE IN SITU	SITE IN SITU

T:\Jobs\J-853\2. Outgoing\Black plate opening of Windows Louvre\Black Plate of T1 In-Situ Window.dwg

B.D. REF :

CLIENT :
SHIMAO GROUP HOLDINGS LIMITED

ARCHITECT :
WONG TUNG & PARTNERS LIMITED
ARCHITECTS & PLANNERS

MAIN CONTRACTOR :
協興建築有限公司
HIP HING CONSTRUCTION CO LTD

STRUCTURAL ENGINEER :
C M WONG & ASSOCIATES LTD
Consulting Engineers

SITE IN SITU CONSULTANT:
MEINHARDT

NOTE :
1. ALL DIMENSIONS ARE IN mm.
2. ALL ELEVATIONS ARE VIEWED FROM OUTSIDE.
3. ALL DIMENSIONS TO BE VERIFIED ON SITE BEFORE FABRICATION.

LEGEND :
X1 / 3DD1 — DETAIL MARK NO. / REFER SHEET NO.
1. F.F.L. — FINISHED FLOOR LEVEL
2. S.F.L. — STRUCTURAL FLOOR LEVEL
3. (R) — REVERSED DETAIL
4. ▲ — FIXING LOCATION
5. △ — FIXING LUG LOCATION
6. GLASS LEGEND
GL01 — 10mm+12mm AIR GAP+10mm THK. L.G.U.
GL05 — 10mm+12mm AIR GAP+10mm THK. L.G.U.
GL06 — 10mm+12mm AIR GAP+12mm THK. L.G.U.
PD01 — 10mm T.P+12mm AIR GAP+8mm T.P
GL07 — 10mm+12mm AIR GAP+12mm THK. L.G.U.
GL08 — 10mm+12mm AIR GAP+10mm THK. L.G.U.

NO.	DATE	REMARKS	BY
D	15/07/2022	REVISION SUBJECT TO ARCH.COMMENT	LHK
C	08/06/2022	REVISION SUBJECT TO ARCH.COMMENT	LHK
B	25/12/2021	REVISION SUBJECT TO ARCH.COMMENT	LHK
A	26/08/2021	REVISION SUBJECT TO ARCH.COMMENT	WSH

JOB NO. : J-853

PROJECT :
PROPOSED RESIDENTIAL DEVELOPMENT AT N.K.I.L. 6542 YIN PING ROAD KOWLOON

TITLE :
WINDOW SCHEDULE FOR TOWER 1 ALUM. WINDOW

DATE : 03-APR-21 | SCALE : 1:40

DRAWN BY : | CHECKED BY :

美特鋁製有限公司
MIDI ALUMINIUM FABRICATOR LTD.
Units 6-8, Sunray Industrial Centre, 1/F
610 Cho Kwo Ling Road, Kowloon
Tel:23489211-4 Fax:(852)27727666

DWG NO. : J853-SD-W-SC119 | REV. : D

ELEVATION

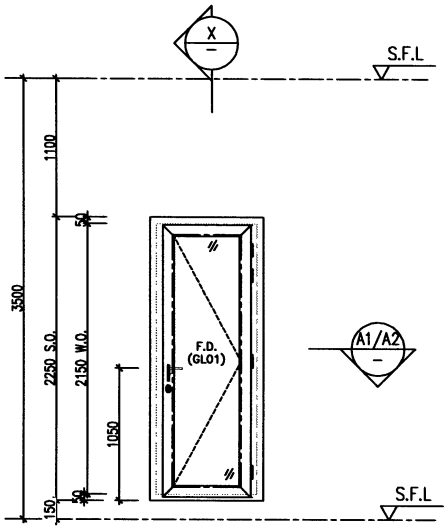

ELEVATION

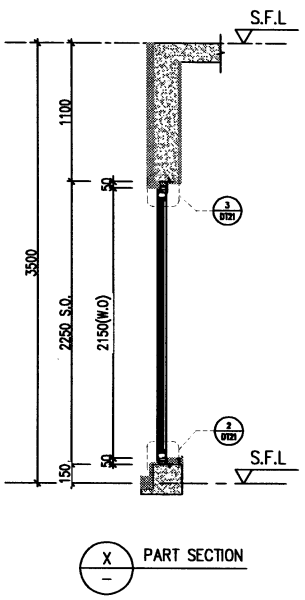

X PART SECTION

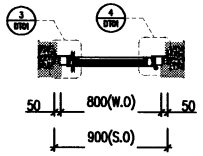

A1 PART PLAN

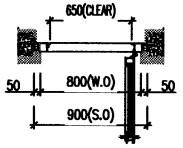

A2 PART PLAN

PROVIDED		
GLAZING AREA	0.547	m^2
OPENABLE AREA	0.723	m^2
FREE AREA	–	%

WINDOW MARK	W13/T1
LOCATION	25/F UNIT A STAIRCASE
SECTION	70mm ALUM. SECTION
GLAZING	GL01
QUANTITY	1 Nos.
REMARKS	SITE IN SITU

T:\Jobs\J-853\2. Outgoing\Black plate opening of Windows Louvre\Black Plate of T1 In-Situ Window.dwg

B.D. REF :

CLIENT :
SHIMAO GROUP HOLDINGS LIMITED

ARCHITECT :
WONG TUNG & PARTNERS LIMITED
ARCHITECTS & PLANNERS

MAIN CONTRACTOR :
協興建築有限公司
HIP HING CONSTRUCTION CO LTD

STRUCTURAL ENGINEER :
C M WONG & ASSOCIATES LTD
Consulting Engineers

SITE IN SITU CONSULTANT:
MEINHARDT

NOTE :
1. ALL DIMENSIONS ARE IN mm.
2. ALL ELEVATIONS ARE VIEWED FROM OUTSIDE.
3. ALL DIMENSIONS TO BE VERIFIED ON SITE BEFORE FABRICATION.

LEGEND :
X1 / 3DD01 — DETAIL MARK NO. / REFER SHEET NO.
1. F.F.L. — FINISHED FLOOR LEVEL
2. S.F.L. — STRUCTURAL FLOOR LEVEL
3. /R — REVERSED DETAIL
4. ▲ — FIXING LOCATION
5. △ — FIXING LUG LOCATION
6. GLASS LEGEND
GL01 — 10mm+12mm AIR GAP+10mm THK. L.G.U.
GL05 — 10mm+12mm AIR GAP+10mm THK. L.G.U.
GL06 — 10mm+12mm AIR GAP+12mm THK. L.G.U.
PD01 — 10mm T.P+12mm AIR GAP+8mm T.P
GL07 — 10mm+12mm AIR GAP+12mm THK. L.G.U.
GL08 — 10mm+12mm AIR GAP+10mm THK. L.G.U.

NO.	DATE	REMARKS	BY
B	29/12/2021	REVISION SUBJECT TO ARCHITECT	LHS
A	26/08/2021	REVISION SUBJECT TO ARCHITECT	WSH

JOB NO. : J-853

PROJECT :
PROPOSED RESIDENTIAL DEVELOPMENT AT N.K.I.L. 6542 YIN PING ROAD KOWLOON

TITLE :
WINDOW SCHEDULE FOR TOWER 1 ALUM. WINDOW

DATE : 03-APR-21 | SCALE : 1:40

DRAWN BY : | CHECKED BY :

美特鋁實有限公司
MIDI ALUMINIUM FABRICATOR LTD.
Units 6-8, Sunray Industrial Centre, 1/F
610 Cha Kwo Ling Road, Kowloon
Tel:23489211-4 Fax:(852)27727668

DWG NO. : J853-SD-W-SC118 | REV. : B

ELEVATION

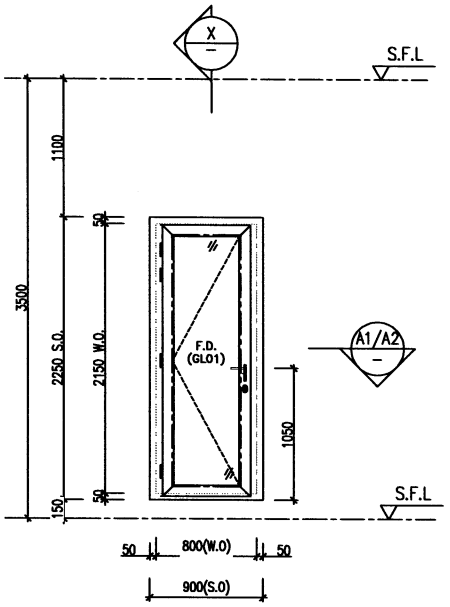

ELEVATION

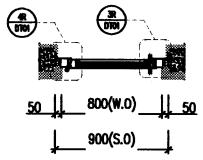

A1 PART PLAN

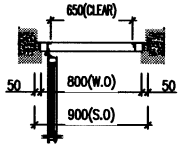

A2 PART PLAN

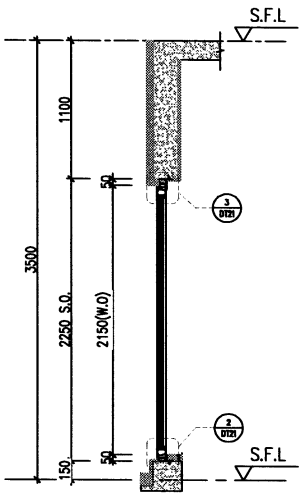

X PART SECTION

PROVIDED		
GLAZING AREA	0.547	m^2
OPENABLE AREA	0.723	m^2
FREE AREA	–	%

WINDOW MARK	W113. T1
LOCATION	25/F UNIT B STAIRCASE
SECTION	70mm ALUM. SECTION
GLAZING	GL01
QUANTITY	1 No.
REMARKS	SITE IN SITU

T:\Jobs\J-853\2. Outgoing\Black plate opening of Windows Louvre\Black Plate of T1 In-Situ Window.dwg

B.D. REF :

CLIENT :
SHIMAO GROUP HOLDINGS LIMITED

ARCHITECT :
WONG TUNG & PARTNERS LIMITED
ARCHITECTS & PLANNERS

MAIN CONTRACTOR :
協興建築有限公司
HIP HING CONSTRUCTION CO LTD

STRUCTURAL ENGINEER :
C M WONG & ASSOCIATES LTD
Consulting Engineers

SITE IN SITU CONSULTANT:
MEINHARDT

NOTE :
1. ALL DIMENSIONS ARE IN mm.
2. ALL ELEVATIONS ARE VIEWED FROM OUTSIDE.
3. ALL DIMENSIONS TO BE VERIFIED ON SITE BEFORE FABRICATION.

LEGEND :
X1 — DETAIL MARK NO.
3001 — REFER SHEET NO.
1. F.F.L. — FINISHED FLOOR LEVEL
2. S.F.L. — STRUCTURAL FLOOR LEVEL
3. — REVERSED DETAIL
4. ▲ — FIXING LOCATION
5. △ — FIXING LUG LOCATION
6. GLASS LEGEND
GL01 — 10mm+12mm AIR GAP+10mm THK. I.G.U.
GL05 — 10mm+12mm AIR GAP+10mm THK. I.G.U.
GL06 — 10mm+12mm AIR GAP+12mm THK. I.G.U.
PD01 — 10mm T.P+12mm AIR GAP+8mm T.P
GL07 — 10mm+12mm AIR GAP+12mm THK. I.G.U.
GL08 — 10mm+12mm AIR GAP+10mm THK. I.G.U.

NO.	DATE	REMARKS	BY
B	29/12/2021	REVISION SUBJECT TO ARCHITECT	LHS
A	29/09/2021	REVISION SUBJECT TO ARCHITECT	YSH

JOB NO. : J-853

PROJECT :
PROPOSED RESIDENTIAL DEVELOPMENT AT N.K.I.L. 6542 YIN PING ROAD KOWLOON

TITLE :
WINDOW SCHEDULE FOR TOWER 1 ALUM. WINDOW

DATE : 03-APR-21 | SCALE : 1:40

DRAWN BY : | CHECKED BY :

美特鋁質有限公司
MIDI ALUMINIUM FABRICATOR LTD.
Units 6-8, Sunray Industrial Centre, 1/F
610 Cha Kwo Ling Road, Kowloon
Tel:23489211-4 Fax:(852)27727666

DWG NO. : J853-SD-W-SC117 | REV. : B

ELEVATION

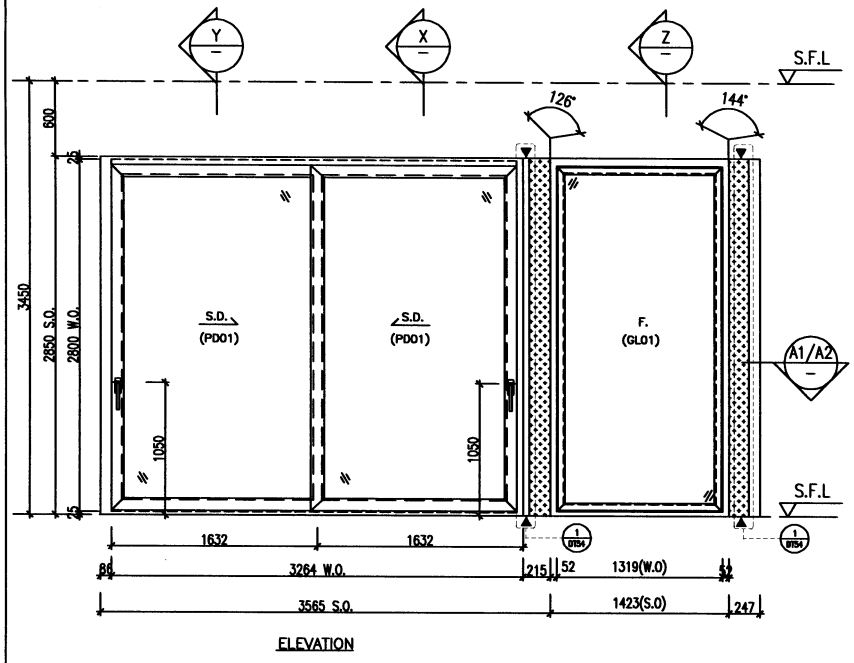

ELEVATION

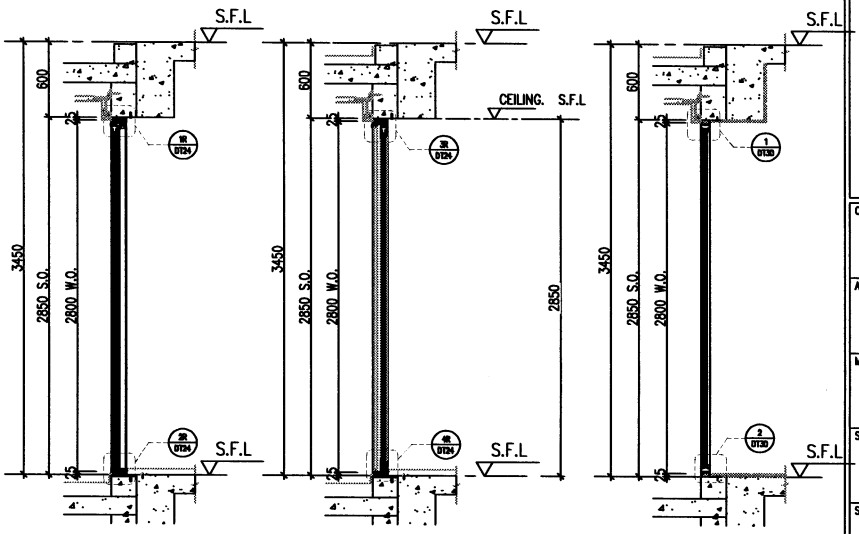

X PART SECTION

Y PART SECTION

Z PART SECTION

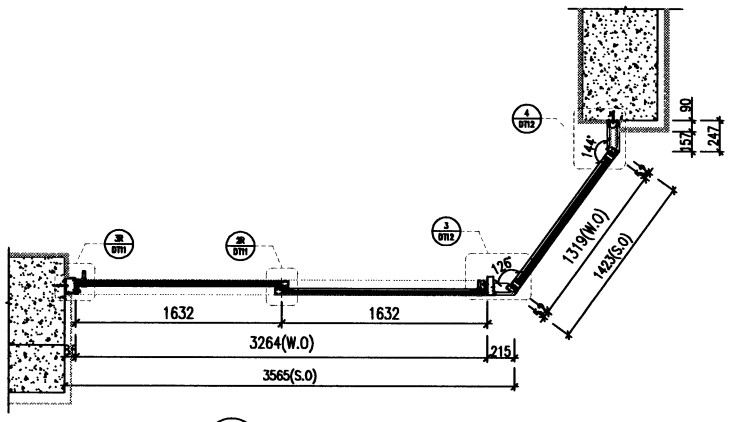

A1 PART PLAN

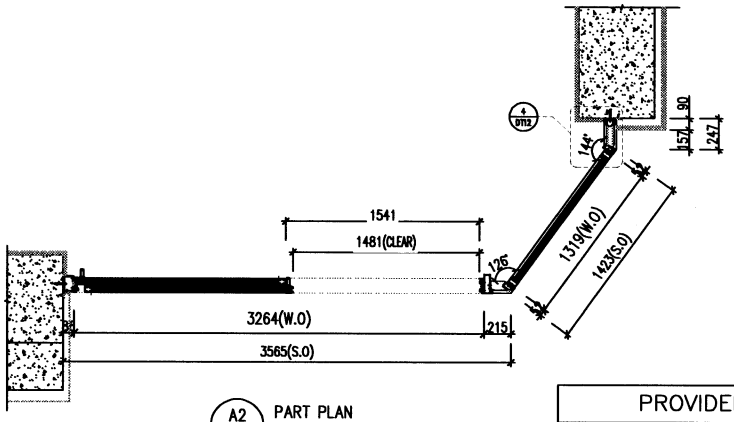

A2 PART PLAN

PROVIDED		
GLAZING AREA	6.187	m^2
OPENABLE AREA	2.336	m^2
FREE AREA	–	%

WINDOW MARK	W203 T1
LOCATION	5F UNIT B LIV.
SECTION	50mm ALUM. SECTION
GLAZING	PD01
QUANTITY	1 Nos.
REMARKS	SITE IN SITU

T:\Jobs\J-853\2. Outgoing\Black plate opening of Windows Louvre\Black Plate of T1 In-Situ Window.dwg

B.D. REF :

CLIENT :
SHIMAO GROUP HOLDINGS LIMITED

ARCHITECT :
WONG TUNG & PARTNERS LIMITED
ARCHITECTS & PLANNERS

MAIN CONTRACTOR :
協興建築有限公司
HIP HING CONSTRUCTION CO LTD

STRUCTURAL ENGINEER :
C M WONG & ASSOCIATES LTD
Consulting Engineers

SITE IN SITU CONSULTANT:
MEINHARDT

NOTE :
1. ALL DIMENSIONS ARE IN mm.
2. ALL ELEVATIONS ARE VIEWED FROM OUTSIDE.
3. ALL DIMENSIONS TO BE VERIFIED ON SITE BEFORE FABRICATION.

LEGEND :
X1 / W001 — DETAIL MARK NO. / REFER SHEET NO.
1. F.F.L. — FINISHED FLOOR LEVEL
2. S.F.L. — STRUCTURAL FLOOR LEVEL
3. Ⓡ — REVERSED DETAIL
4. ▲ — FIXING LOCATION
5. △ — FIXING LUG LOCATION
6. GLASS LEGEND
GL01 — 10mm+12mm AIR GAP+10mm THK. LG.U.
GL05 — 10mm+12mm AIR GAP+10mm THK. LG.U.
GL06 — 10mm+12mm AIR GAP+12mm THK. LG.U.
PD01 — 10mm T.P+12mm AIR GAP+8mm T.P
GL07 — 10mm+12mm AIR GAP+12mm THK. LG.U.
GL08 — 10mm+12mm AIR GAP+10mm THK. LG.U.

NO.	DATE	REMARKS	BY
C	08/08/2022	REVISION SUBJECT TO ARCH.COMMENT	LHK
B	25/12/2021	REVISION SUBJECT TO ARCH.COMMENT	LHK
A	26/08/2021	REVISION SUBJECT TO ARCH.COMMENT	WSH

JOB NO. : J-853

PROJECT :
PROPOSED RESIDENTIAL DEVELOPMENT AT N.K.I.L. 6542 YIN PING ROAD KOWLOON

TITLE :
WINDOW SCHEDULE FOR TOWER 1 ALUM. WINDOW

DATE : 03-APR-21 | SCALE : 1:40

DRAWN BY : | CHECKED BY :

美特鋁製有限公司
MIDI ALUMINIUM FABRICATOR LTD.
Units 6-8, Sunray Industrial Centre, 1/F
610 Cho Kwo Ling Road, Kowloon
Tel:23489211-4 Fax:(852)27727666

DWG NO. : J853-SD-W-SC115 | REV. : C

ELEVATION

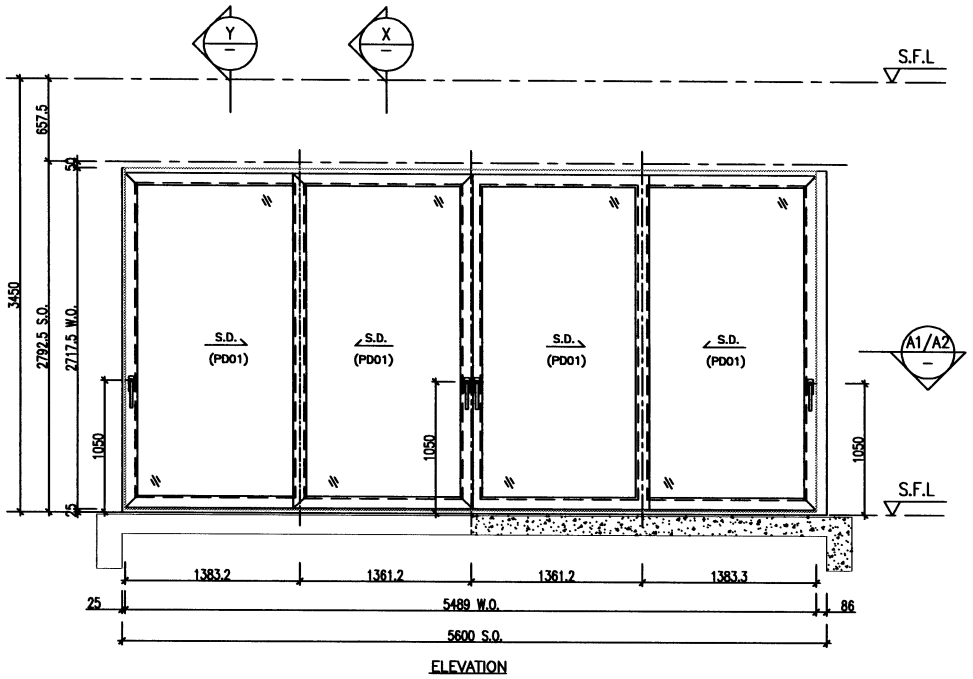

ELEVATION

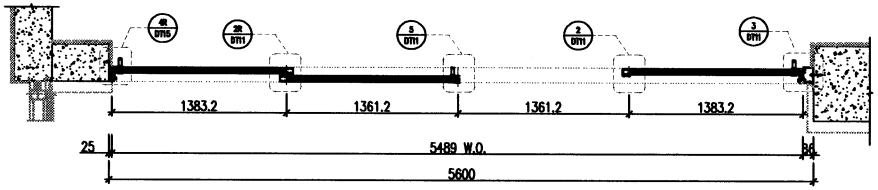

A1 PART PLAN

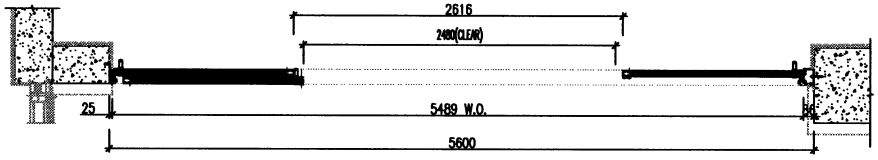

A2 PART PLAN

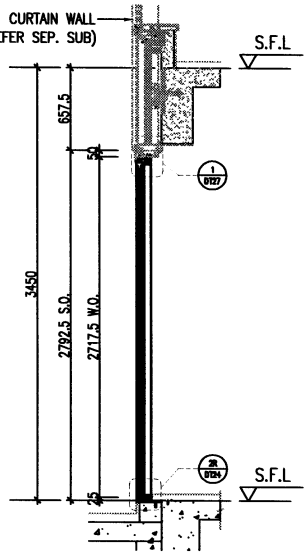

X PART SECTION

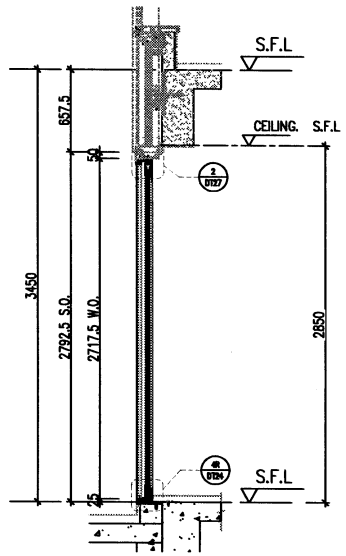

Y PART SECTION

PROVIDED		
GLAZING AREA	6.802	m^2
OPENABLE AREA	3.732	m^2
FREE AREA	–	%

WINDOW MARK	W205 T1
LOCATION	5F UNIT A LIV.
SECTION	50mm ALUM. SECTION
GLAZING	PD01
QUANTITY	1 Nos.
REMARKS	SITE IN SITU

T:\Jobs\J-853\2. Outgoing\Black plate opening of Windows Louvre\Black Plate of T1 In-Situ Window.dwg

B.D. REF :

CLIENT :
SHIMAO GROUP HOLDINGS LIMITED

ARCHITECT : WONG TUNG & PARTNERS LIMITED ARCHITECTS & PLANNERS

MAIN CONTRACTOR :
協興建築有限公司
HIP HING CONSTRUCTION CO LTD

STRUCTURAL ENGINEER :
C M WONG & ASSOCIATES LTD
Consulting Engineers

SITE IN SITU CONSULTANT:
MEINHARDT

NOTE :
1. ALL DIMENSIONS ARE IN mm.
2. ALL ELEVATIONS ARE VIEWED FROM OUTSIDE.
3. ALL DIMENSIONS TO BE VERIFIED ON SITE BEFORE FABRICATION.

LEGEND :
X1 / W001 — DETAIL MARK NO. / REFER SHEET NO.
1. F.F.L. — FINISHED FLOOR LEVEL
2. S.F.L. — STRUCTURAL FLOOR LEVEL
3. (/R) — REVERSED DETAIL
4. ▲ — FIXING LOCATION
5. △ — FIXING LUG LOCATION
6. GLASS LEGEND
GL01 — 10mm+12mm AIR GAP+10mm THK. I.G.U.
GL05 — 10mm+12mm AIR GAP+10mm THK. I.G.U.
GL06 — 10mm+12mm AIR GAP+12mm THK. I.G.U.
PD01 — 10mm T.P+12mm AIR GAP+8mm T.P
GL07 — 10mm+12mm AIR GAP+12mm THK. I.G.U.
GL08 — 10mm+12mm AIR GAP+10mm THK. I.G.U.

NO.	DATE	REVISED	BY
B	25/12/2021	REVISION SUBJECT TO AMENDMENT	LHK
A	28/06/2021	REVISION SUBJECT TO AMENDMENT	WSH

JOB NO. : J-853

PROJECT :
PROPOSED RESIDENTIAL DEVELOPMENT AT N.K.I.L. 6542 YIN PING ROAD KOWLOON

TITLE :
WINDOW SCHEDULE FOR TOWER 1 ALUM. WINDOW

DATE : 03-APR-21 | SCALE : 1:40

DRAWN BY : | CHECKED BY :

美特鋁製有限公司
MIDI ALUMINIUM FABRICATOR LTD.
Units 6-8, Sunray Industrial Centre, 1/F
610 Cha Kwo Ling Road, Kowloon
Tel:23489211-4 Fax:(852)27727666

DWG NO. : J853-SD-IW-SC116 | REV. : B

ELEVATION

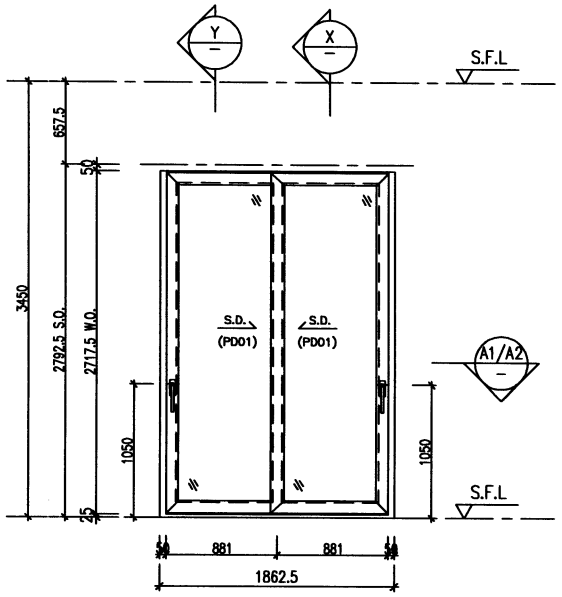

ELEVATION

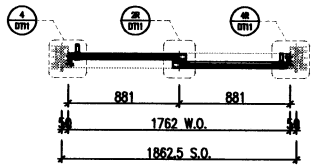

A1 PART PLAN

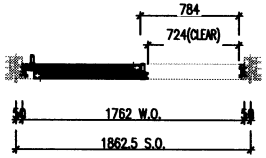

A2 PART PLAN

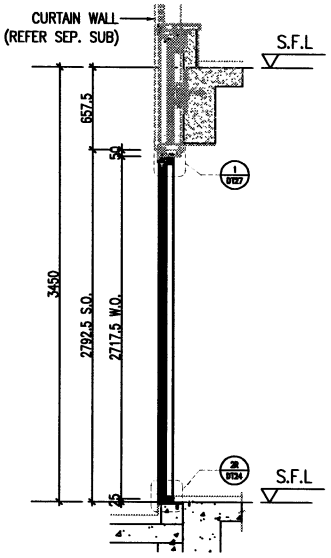

X PART SECTION

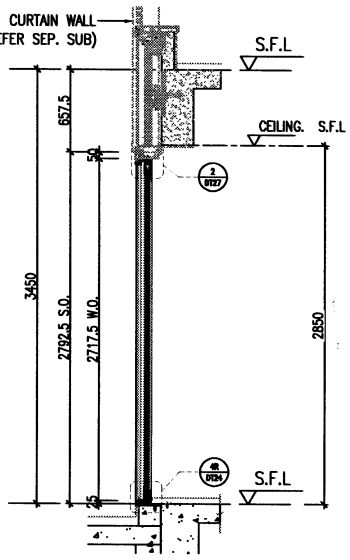

Y PART SECTION

WINDOW MARK	W204 T1
LOCATION	5F UNIT B M.EN.
SECTION	50mm ALUM. SECTION
GLAZING	PD01
QUANTITY	1 Nos.
REMARKS	SITE IN SITU

GLAZING AREA	1.220	m^2
OPENABLE AREA	0.694	m^2
FREE AREA	–	%

B.D. REF :

CLIENT :
SHIMAO GROUP HOLDINGS LIMITED

ARCHITECT :
WONG TUNG & PARTNERS LIMITED
ARCHITECTS & PLANNERS

MAIN CONTRACTOR :
協興建築有限公司
HIP HING CONSTRUCTION CO LTD

STRUCTURAL ENGINEER :
C M WONG & ASSOCIATES LTD
Consulting Engineers

SITE IN SITU CONSULTANT:
MEINHARDT

NOTE :
1. ALL DIMENSIONS ARE IN mm.
2. ALL ELEVATIONS ARE VIEWED FROM OUTSIDE.
3. ALL DIMENSIONS TO BE VERIFIED ON SITE BEFORE FABRICATION.

LEGEND :
X1 — DETAIL MARK NO.
W001 — REFER SHEET NO.
1. F.F.L. — FINISHED FLOOR LEVEL
2. S.F.L. — STRUCTURAL FLOOR LEVEL
3. — REVERSED DETAIL
4. ▲ — FIXING LOCATION
5. △ — FIXING LUG LOCATION
6. GLASS LEGEND
GL01 — 10mm+12mm AIR GAP+10mm THK. L.G.U.
GL05 — 10mm+12mm AIR GAP+10mm THK. L.G.U.
GL06 — 10mm+12mm AIR GAP+12mm THK. L.G.U.
PD01 — 10mm T.P+12mm AIR GAP+8mm T.P
GL07 — 10mm+12mm AIR GAP+12mm THK. L.G.U.
GL08 — 10mm+12mm AIR GAP+10mm THK. L.G.U.

NO.	DATE	REVISED	BY
B	24/12/2021	REVISION SUBJECT TO ARCH.COMMENT	LHC
A	26/08/2021	REVISION SUBJECT TO ARCH.COMMENT	WSH

JOB NO. : J-853

PROJECT :
PROPOSED RESIDENTIAL DEVELOPMENT AT N.K.I.L. 6542 YIN PING ROAD KOWLOON

TITLE :
WINDOW SCHEDULE FOR TOWER 1 ALUM. WINDOW

DATE : 03-APR-21 | SCALE : 1:40

DRAWN BY : | CHECKED BY :

美特鋁製有限公司
MIDI ALUMINIUM FABRICATOR LTD.
Units 6-8, Sunray Industrial Centre, 1/F
610 Cha Kwo Ling Road, Kowloon
Tel:23489211-4 Fax:(852)27727666

DWG NO. : J853-SD-IW-SC114 | REV. : B

T:\Jobs\J-853\2. Outgoing\Black plate opening of Windows Louvre\Black Plate of T1 In-Situ Window.dwg

ELEVATION

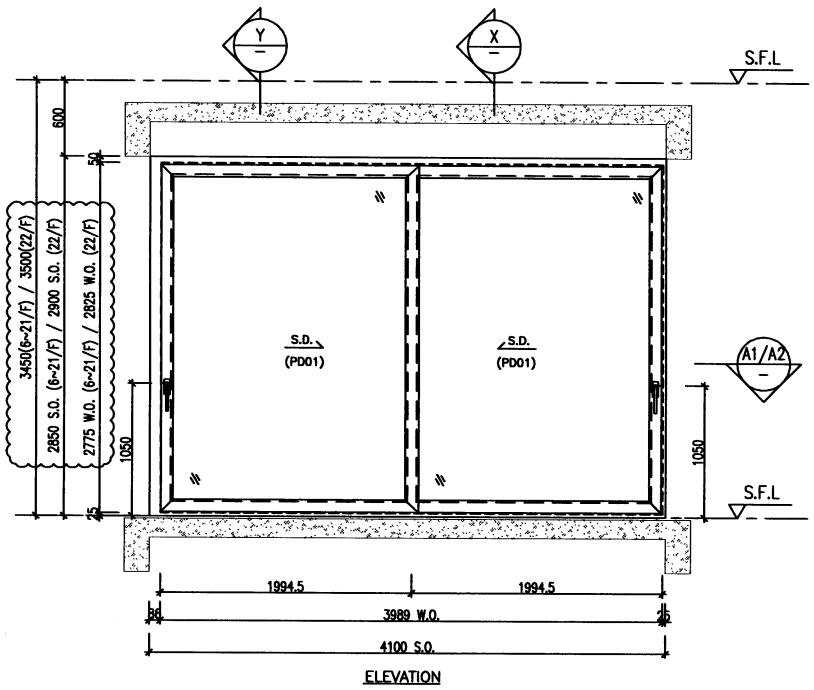

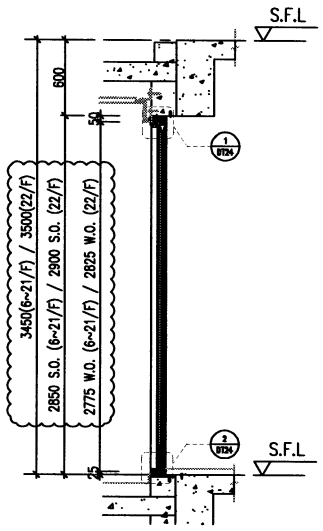

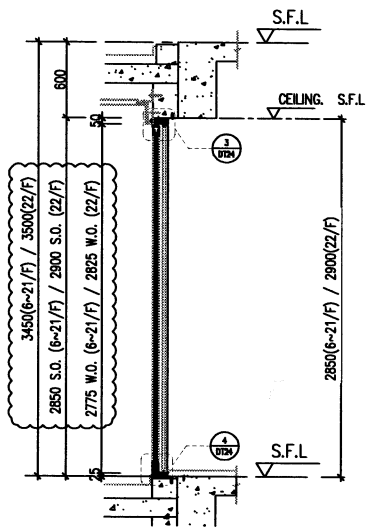

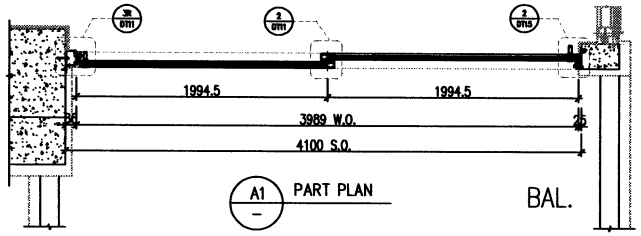

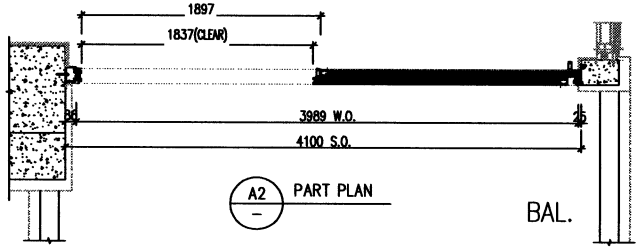

	PROVIDED		
22F	GLAZING AREA	5.513	m^2
	OPENABLE AREA	2.953	m^2
	FREE AREA	–	%

	PROVIDED		
5F~21F	GLAZING AREA	5.331	m^2
	OPENABLE AREA	2.861	m^2
	FREE AREA	–	%

WINDOW MARK	W202 T1	W202A T1
LOCATION	6/F~21/F UNIT B LIVING	22/F UNIT B LIVING
SECTION	50mm ALUM. SECTION	50mm ALUM. SECTION
GLAZING	PD01	PD01
QUANTITY	14 Nos.	1 No.
REMARKS	SITE IN SITU	SITE IN SITU

T:\Jobs\J-853\2. Outgoing\Black plate opening of Windows Louvre\Block Plate of T1 In-Situ Window.dwg

B.D. REF :

CLIENT :
SHIMAO GROUP HOLDINGS LIMITED

ARCHITECT :
WONG TUNG & PARTNERS LIMITED
ARCHITECTS & PLANNERS

MAIN CONTRACTOR :
協興建築有限公司
HIP HING CONSTRUCTION CO LTD

STRUCTURAL ENGINEER :
C M WONG & ASSOCIATES LTD
Consulting Engineers

SITE IN SITU CONSULTANT:
MEINHARDT

NOTE :
1. ALL DIMENSIONS ARE IN mm.
2. ALL ELEVATIONS ARE VIEWED FROM OUTSIDE.
3. ALL DIMENSIONS TO BE VERIFIED ON SITE BEFORE FABRICATION.

LEGEND :
X1 — DETAIL MARK NO.
W001 — REFER SHEET NO.
1. F.F.L. — FINISHED FLOOR LEVEL
2. S.F.L. — STRUCTURAL FLOOR LEVEL
3. — REVERSED DETAIL
4. ▲ — FIXING LOCATION
5. △ — FIXING LUG LOCATION
6. GLASS LEGEND
GL01 — 10mm+12mm AIR GAP+10mm THK. L.G.U.
GL05 — 10mm+12mm AIR GAP+10mm THK. L.G.U.
GL06 — 10mm+12mm AIR GAP+12mm THK. L.G.U.
PD01 — 10mm T.P+12mm AIR GAP+8mm T.P
GL07 — 10mm+12mm AIR GAP+12mm THK. L.G.U.
GL08 — 10mm+12mm AIR GAP+10mm THK. L.G.U.

NO.	DATE	REMARK	BY
D	15/07/2022	REVISION SUBJECT TO ARCHITECT	LHS
C	08/06/2022	REVISION SUBJECT TO ARCHITECT	LHS
B	24/12/2021	REVISION SUBJECT TO ARCHITECT	LHS
A	28/09/2021	REVISION SUBJECT TO ARCHITECT	WSH

JOB NO. : J-853

PROJECT :
PROPOSED RESIDENTIAL DEVELOPMENT AT N.K.I.L. 6542 YIN PING ROAD KOWLOON

TITLE :
WINDOW SCHEDULE FOR TOWER 1 ALUM. WINDOW

DATE : 03-APR-21 | SCALE : 1:40

DRAWN BY : | CHECKED BY :

美特鋁質有限公司
MIDI ALUMINIUM FABRICATOR LTD.
Units 6-8, Sunray Industrial Centre, 1/F
610 Cha Kwo Ling Road, Kowloon
Tel:23489211-4 Fax:(852)27727666

DWG NO. : J853-SD-W-SC113 | REV. : D

ELEVATION

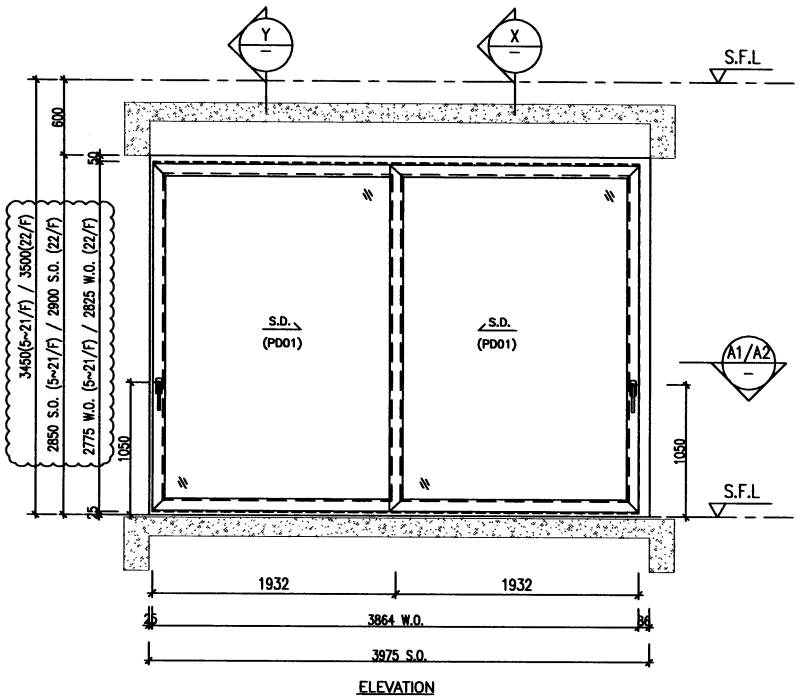

ELEVATION

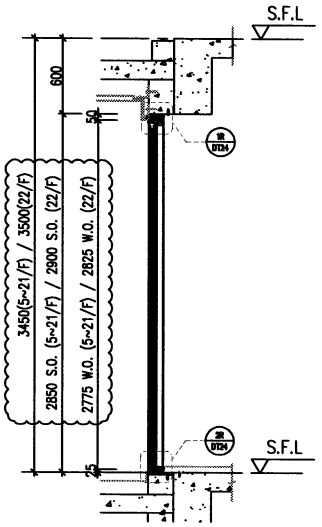

X PART SECTION

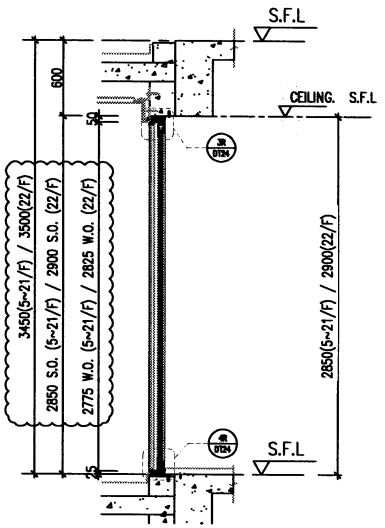

Y PART SECTION

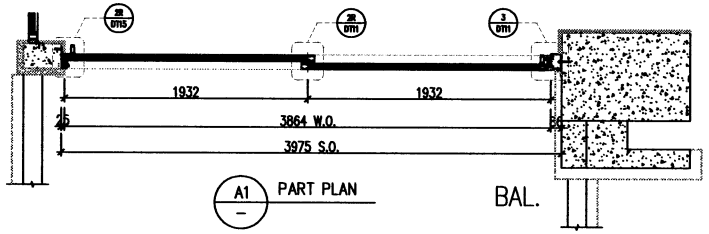

A1 PART PLAN

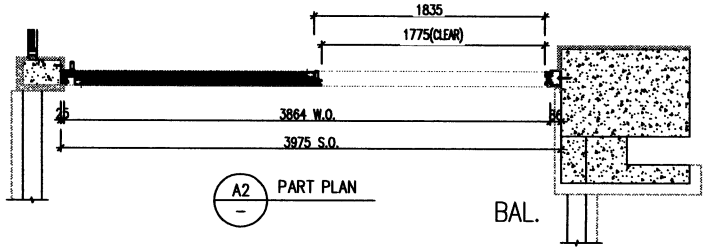

A2 PART PLAN

WINDOW MARK	W201 T1	W201a T1
LOCATION	5/F~21/F UNIT A LIVING	22/F UNIT A LIVING
SECTION	50mm ALUM. SECTION	50mm ALUM. SECTION
GLAZING	PD01	PD01
QUANTITY	15 Nos.	1 No.
REMARKS	SITE IN SITU	SITE IN SITU

22F	PROVIDED		
	GLAZING AREA	5.323	m^2
	OPENABLE AREA	2.853	m^2
	FREE AREA	–	%

5F~21F	PROVIDED		
	GLAZING AREA	5.148	m^2
	OPENABLE AREA	2.764	m^2
	FREE AREA	–	%

B.D. REF :

CLIENT :
SHIMAO GROUP HOLDINGS LIMITED

ARCHITECT :
WONG TUNG & PARTNERS LIMITED
ARCHITECTS & PLANNERS

MAIN CONTRACTOR :
協興建築有限公司
HIP HING CONSTRUCTION CO LTD

STRUCTURAL ENGINEER :
C M WONG & ASSOCIATES LTD
Consulting Engineers

MEINHARDT

NOTE :
1. ALL DIMENSIONS ARE IN mm.
2. ALL ELEVATIONS ARE VIEWED FROM OUTSIDE.
3. ALL DIMENSIONS TO BE VERIFIED ON SITE BEFORE FABRICATION.

LEGEND :
X1 / 3DS1 — DETAIL MARK NO. / REFER SHEET NO.
1. F.F.L. — FINISHED FLOOR LEVEL
2. S.F.L. — STRUCTURAL FLOOR LEVEL
3. (R) — REVERSED DETAIL
4. ▲ — FIXING LOCATION
5. △ — FIXING LUG LOCATION
6. GLASS LEGEND
GL01 — 10mm+12mm AIR GAP+10mm THK. LG.U.
GL05 — 10mm+12mm AIR GAP+10mm THK. LG.U.
GL06 — 10mm+12mm AIR GAP+12mm THK. LG.U.
PD01 — 10mm T.P+12mm AIR GAP+8mm T.P
GL07 — 10mm+12mm AIR GAP+12mm THK. LG.U.
GL08 — 10mm+12mm AIR GAP+10mm THK. LG.U.

NO.	DATE	REMARKS	BY
D	15/07/2022	REVISION SUBJECT TO ARCHITECT	LHK
C	08/06/2022	REVISION SUBJECT TO ARCHITECT	LHK
B	24/12/2021	REVISION SUBJECT TO ARCHITECT	LHK
A	26/09/2021	REVISION SUBJECT TO ARCHITECT	WSH

JOB NO. : J-853

PROJECT :
PROPOSED RESIDENTIAL DEVELOPMENT AT N.K.I.L. 6542 YIN PING ROAD KOWLOON

TITLE :
WINDOW SCHEDULE FOR TOWER 1 ALUM. WINDOW

DATE : 03-APR-21 | SCALE : 1:40

DRAWN BY : | CHECKED BY :

美特鋁製有限公司
MIDI ALUMINIUM FABRICATOR LTD.
Units 6-8, Sunray Industrial Centre, 1/F
610 Cho Kwo Ling Road, Kowloon
Tel:23489211-4 Fax:(852)27727666

DWG NO. : J853-SD-IW-SC112 | REV. : D

T:\Jobs\J-853\2. Outgoing\Black plate opening of Windows Louvre\Black Plate of T1 In-Situ Window.dwg

ELEVATION

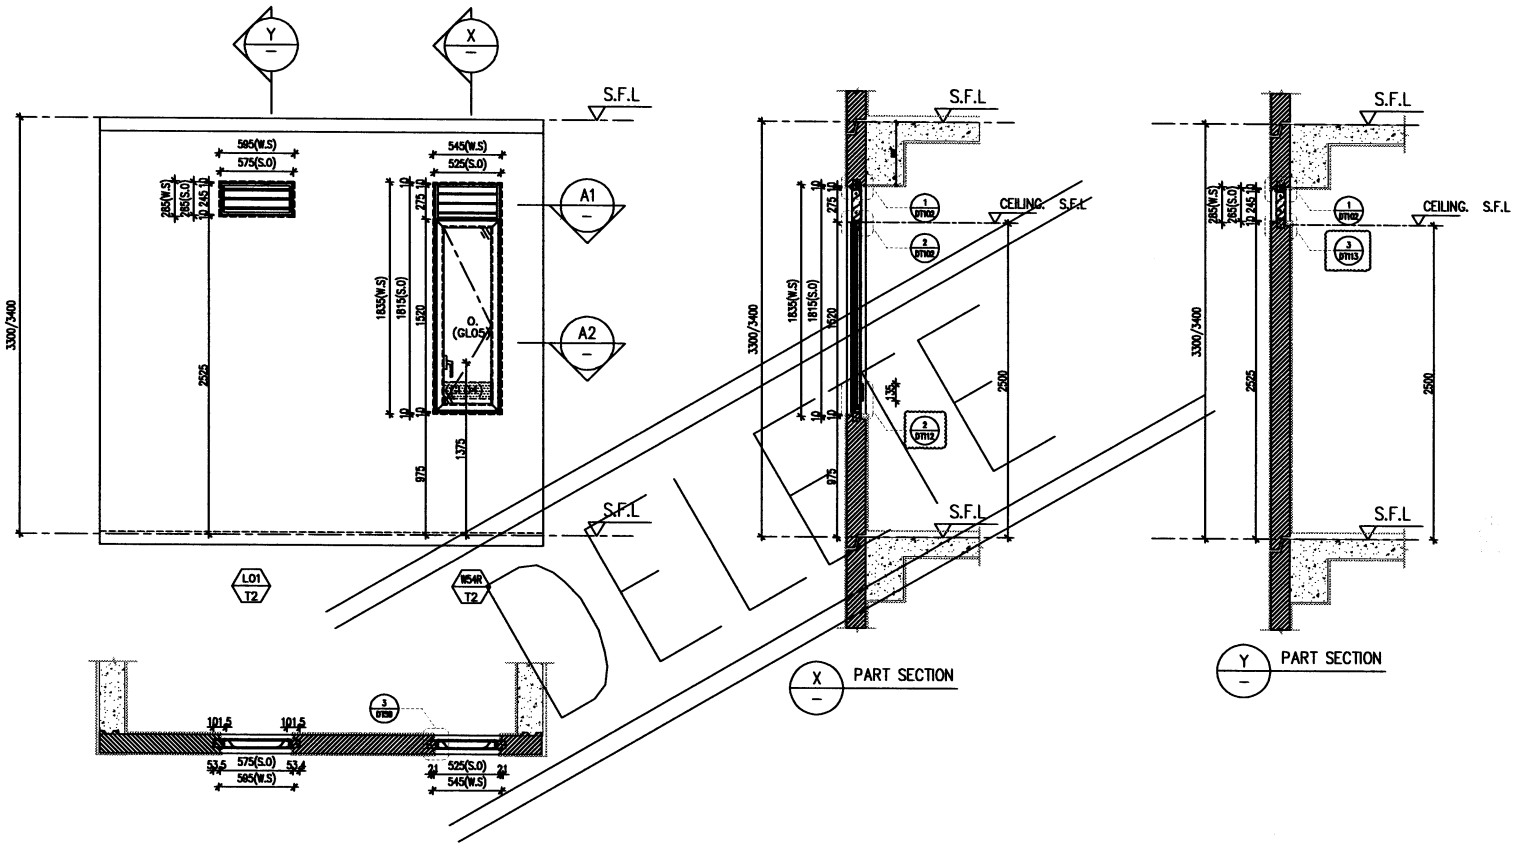

DELETE

PROVIDED		
GLAZING AREA	–	m^2
OPENABLE AREA	–	m^2
FREE AREA	55.4	%

L01 T2

PROVIDED		
GLAZING AREA	0.516	m^2
OPENABLE AREA	0.567	m^2
FREE AREA	60.7	%

W54R T2

WINDOW MARK	W54R T2
LOCATION	23&25F FLAT B MASTER BATH
SECTION	70mm ALUM. SECTION
GLAZING	GL05
QUANTITY	2Nos
REMARKS	FACADE(T2-01-04A/25F; T2-01-04B/23F)

T:\Jobs\J-853\2. Outgoing\Black plate opening of Windows Louvre\Black Plate of T2 Precat Window.dwg

B.D. REF :

CLIENT :
SHIMAO GROUP HOLDINGS LIMITED

ARCHITECT :
WONG TUNG & PARTNERS LIMITED
ARCHITECTS & PLANNERS

MAIN CONTRACTOR :
協興建築有限公司
HIP HING CONSTRUCTION CO LTD

STRUCTURAL ENGINEER :
CMA C M WONG & ASSOCIATES LTD
黃志明建築工程師有限公司

FACADE CONSULTANT:
MEINHARDT

NOTE :
1. ALL DIMENSIONS ARE IN mm.
2. ALL ELEVATIONS ARE VIEWED FROM OUTSIDE.
3. ALL DIMENSIONS TO BE VERIFIED ON SITE BEFORE FABRICATION.

LEGEND :
X1 — DETAIL MARK NO.
XD01 — REFER SHEET NO.
1. F.F.L. — FINISHED FLOOR LEVEL
2. S.F.L. — STRUCTURAL FLOOR LEVEL
3. R — REVERSED DETAIL
4. ▲ — FIXING LOCATION
5. △ — FIXING LUG LOCATION
6. GLASS LEGEND
GL01 — 10mm+12mm AIR GAP+10mm THK. I.G.U.
GL04 — 12mm THK. CLEAR TEMPERED GLASS
GL05 — 10mm+12mm AIR GAP+10mm THK. I.G.U.
GL06 — 10mm+12mm AIR GAP+12mm THK. I.G.U.
PD01 — 10mm T.P+12mm AIR GAP+8mm T.P
GL07 — 10mm+12mm AIR GAP+12mm THK. I.G.U.
GL08 — 10mm+12mm AIR GAP+10mm THK. I.G.U.

NO.	DATE	REMARK	BY
H	30/06/2022	GENERAL REVISION	edo
G	22/10/2021	REVISION SUBJECT TO ARCH.COMMENT	edo

JOB NO. : J-853

PROJECT :
PROPOSED RESIDENTIAL DEVELOPMENT AT N.K.I.L. 6542 YIN PING ROAD KOWLOON

TITLE :
WINDOW SCHEDULE FOR TOWER 2 ALUM. WINDOW

DATE : 03-APR-21 | SCALE : 1:40

DRAWN BY : | CHECKED BY :

美特鋁製有限公司
MIDI ALUMINIUM FABRICATOR LTD.
Units 6-8, Sunray Industrial Centre, 1/F
610 Cha Kwo Ling Road, Kowloon
Tel:23488211-4 Fax:(852)27727666

DWG NO. : J853-SD-PW-SC204b | REV. : H

ELEVATION

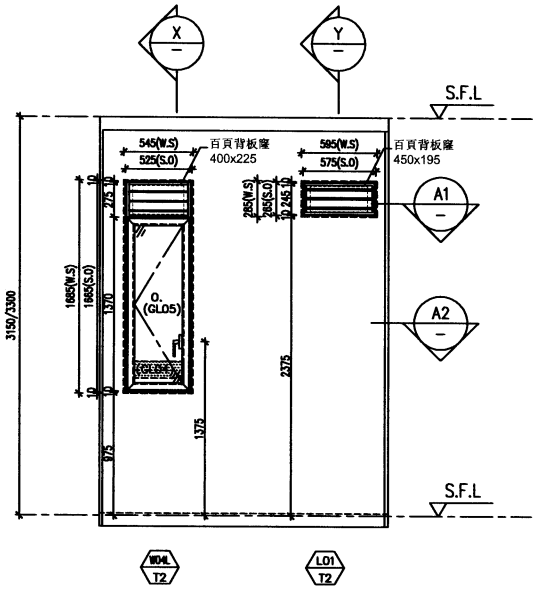

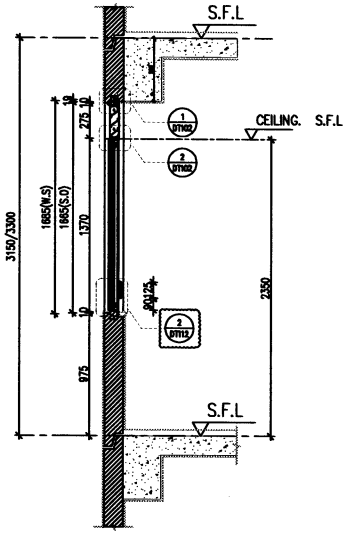

X PART SECTION

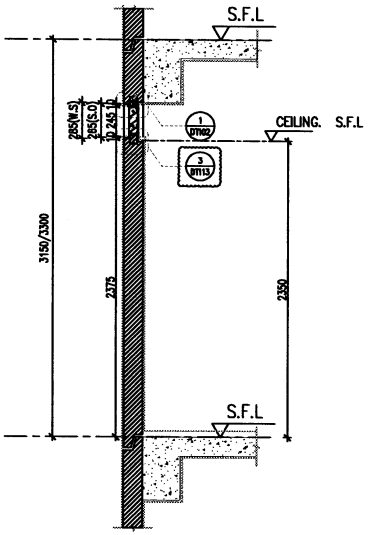

Y PART SECTION

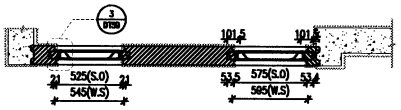

A1 PART PLAN

A2 PART PLAN

L01 T2

PROVIDED		
GLAZING AREA	–	m^2
OPENABLE AREA	–	m^2
FREE AREA	55.4	%

W04L T2

PROVIDED		
GLAZING AREA	0.460	m^2
OPENABLE AREA	0.503	m^2
FREE AREA	60.7	%

WINDOW MARK	W04L T2 & L01 T2
LOCATION	6F~16F&17F~22F&26F FLAT C MASTER BATH
SECTION	70mm ALUM. SECTION
GLAZING	GL05
QUANTITY	16 Nos / 16 Nos
REMARKS	FACADE(T2-01-05/6~15F&17F~22F; T2-01-05A/16F&26F)

T:\Jobs\J-853\2. Outgoing\Black plate opening of Windows Louvre\Black Plate of T2 Precat Window.dwg

B.D. REF :

CLIENT :
SHIMAO GROUP HOLDINGS LIMITED

ARCHITECT :
WONG TUNG & PARTNERS LIMITED
ARCHITECTS & PLANNERS

MAIN CONTRACTOR :
協興建築有限公司
HIP HING CONSTRUCTION CO LTD

STRUCTURAL ENGINEER :
C M WONG & ASSOCIATES LTD
黃志明建築工程師有限公司

FACADE CONSULTANT:
MEINHARDT

NOTE :
1. ALL DIMENSIONS ARE IN mm.
2. ALL ELEVATIONS ARE VIEWED FROM OUTSIDE.
3. ALL DIMENSIONS TO BE VERIFIED ON SITE BEFORE FABRICATION.

LEGEND :
- X1 / X001 — DETAIL MARK NO. / REFER SHEET NO.
1. F.F.L. — FINISHED FLOOR LEVEL
2. S.F.L. — STRUCTURAL FLOOR LEVEL
3. (R) — REVERSED DETAIL
4. ▲ — FIXING LOCATION
5. △ — FIXING LUG LOCATION
6. GLASS LEGEND
   - GL01 — 10mm+12mm AIR GAP+10mm THK. I.G.U.
   - GL04 — 12mm THK. CLEAR TEMPERED GLASS
   - GL05 — 10mm+12mm AIR GAP+10mm THK. I.G.U.
   - GL06 — 10mm+12mm AIR GAP+12mm THK. I.G.U.
   - PD01 — 10mm T.P+12mm AIR GAP+8mm T.P
   - GL07 — 10mm+12mm AIR GAP+12mm THK. I.G.U.
   - GL08 — 10mm+12mm AIR GAP+10mm THK. I.G.U.

NO.	DATE	REMARK	BY
H	30/08/2022	GENERAL REVISION	mdc
G	22/10/2021	REVISION SUBJECT TO ARCH.COMMENT	mdc
A	08/08/2021	REVISION SUBJECT TO ARCH.COMMENT	mdc

JOB NO. : J-853

PROJECT :
PROPOSED RESIDENTIAL DEVELOPMENT AT N.K.I.L. 6542 YIN PING ROAD KOWLOON

TITLE :
WINDOW SCHEDULE FOR TOWER 2 ALUM. WINDOW

DATE : 03-APR-21 | SCALE : 1:40

DRAWN BY : | CHECKED BY :

美特鋁實有限公司
MIDI ALUMINIUM FABRICATOR LTD.
Units 6-8, Sunray Industrial Centre, 1/F
610 Cha Kwo Ling Road, Kowloon
Tel:23489211-4 Fax:(852)27727666

DWG NO. : J853-SD-PW-SC205a | REV. : H

ELEVATION

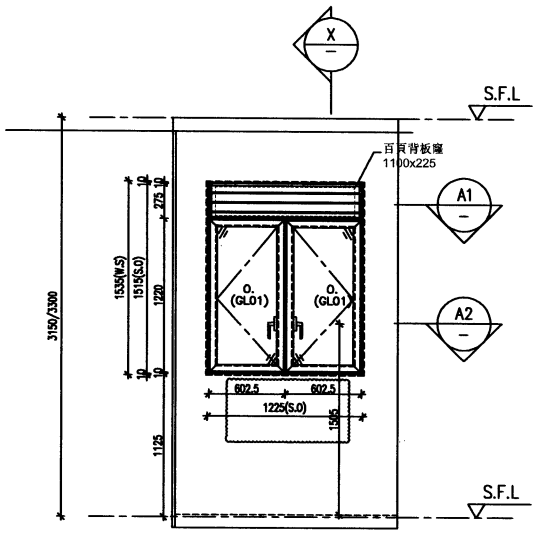

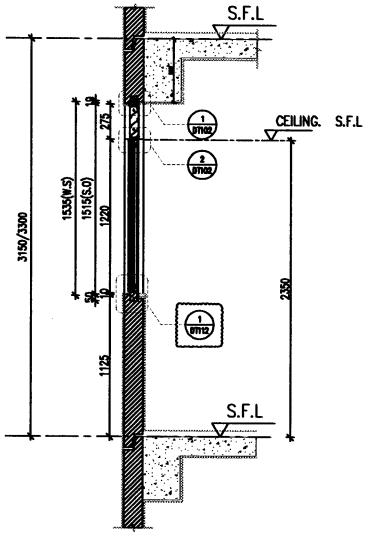

X — PART SECTION

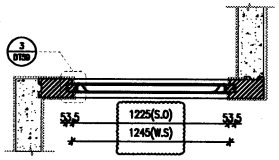

A1 — PART PLAN

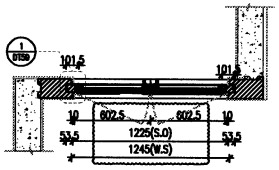

A2 — PART PLAN

W13 / T2

PROVIDED		
GLAZING AREA	1.028	m^2
OPENABLE AREA	1.216	m^2
FREE AREA	60.7	%

WINDOW MARK	W13 / T2
LOCATION	6F~22F&26F FLAT C KITCHEN
SECTION	70mm ALUM. SECTION
GLAZING	GL01
QUANTITY	16 Nos.
REMARKS	FACADE (T2-01-06/6~15F&17F~22F; T2-01-06A/16F&26F)

B.D. REF :

CLIENT :
SHIMAO GROUP HOLDINGS LIMITED

ARCHITECT :
WONG TUNG & PARTNERS LIMITED
ARCHITECTS & PLANNERS

MAIN CONTRACTOR :
協興建築有限公司
HIP HING CONSTRUCTION CO LTD

STRUCTURAL ENGINEER :
C M WONG & ASSOCIATES LTD
黃志明建築工程師有限公司

FACADE CONSULTANT:
MEINHARDT

NOTE :
1. ALL DIMENSIONS ARE IN mm.
2. ALL ELEVATIONS ARE VIEWED FROM OUTSIDE.
3. ALL DIMENSIONS TO BE VERIFIED ON SITE BEFORE FABRICATION.

LEGEND :
X1 / X001 — DETAIL MARK NO. / REFER SHEET NO.
1. F.F.L. — FINISHED FLOOR LEVEL
2. S.F.L. — STRUCTURAL FLOOR LEVEL
3. ⓡ — REVERSED DETAIL
4. ▲ — FIXING LOCATION
5. △ — FIXING LUG LOCATION
6. GLASS LEGEND
GL01 — 10mm+12mm AIR GAP+10mm THK. I.G.U.
GL04 — 12mm THK. CLEAR TEMPERED GLASS
GL05 — 10mm+12mm AIR GAP+10mm THK. I.G.U.
GL06 — 10mm+12mm AIR GAP+12mm THK. I.G.U.
PD01 — 10mm T.P+12mm AIR GAP+8mm T.P
GL07 — 10mm+12mm AIR GAP+12mm THK. I.G.U.
GL08 — 10mm+12mm AIR GAP+10mm THK. I.G.U.

H	29/05/2022	GENERAL REVISION	hdc
G	22/10/2021	REVISION SUBJECT TO ARCH.COMMENT	hdc
A	08/09/2021	REVISION SUBJECT TO ARCH.COMMENT	hdc
NO.	DATE	REMARK	BY

JOB NO. : J-853

PROJECT :
PROPOSED RESIDENTIAL DEVELOPMENT AT N.K.I.L. 6542 YIN PING ROAD KOWLOON

TITLE :
WINDOW SCHEDULE FOR TOWER 2 ALUM. WINDOW

DATE : 03-APR-21 | SCALE : 1:40

DRAWN BY : | CHECKED BY :

美特鋁質有限公司
MIDI ALUMINIUM FABRICATION LTD.
Units 6-8, Sunray Industrial Centre, 1/F
610 Cha Kwo Ling Road, Kowloon
Tel:23488211-4 Fax:(852)27727666

DWG NO. : J853-SD-PW-SC206 | REV. : H

T:\Jobs\J-853\2. Outgoing\Black plate opening of Windows Louvre\Black Plate of T2 Precat Window.dwg

ELEVATION

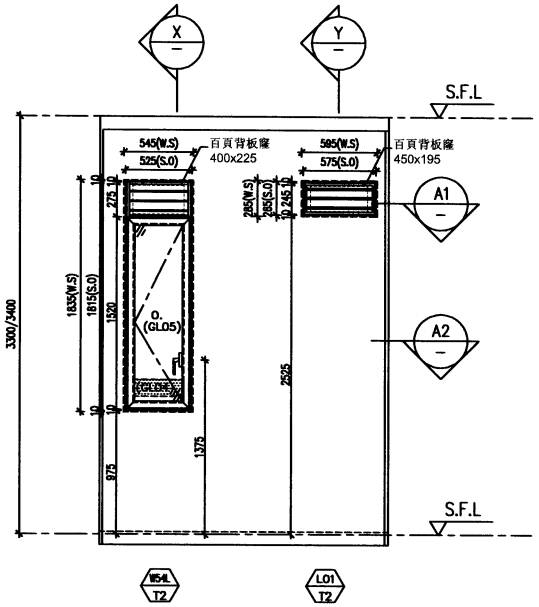

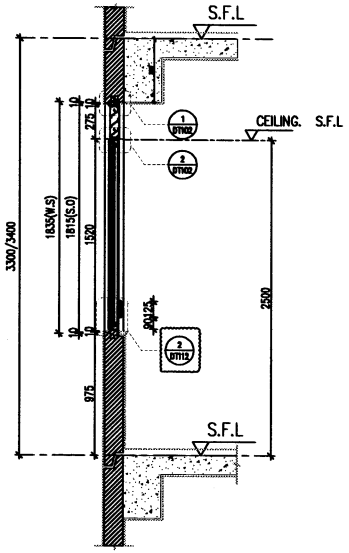

X PART SECTION

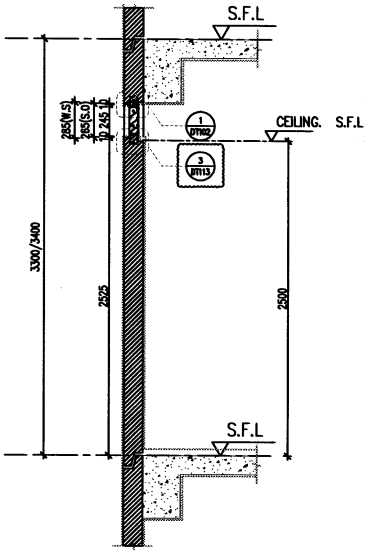

Y PART SECTION

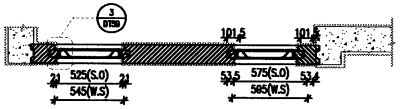

A1 PART PLAN

A2 PART PLAN

PROVIDED		
GLAZING AREA	–	m^2
OPENABLE AREA	–	m^2
FREE AREA	55.4	%

L01 T2

PROVIDED		
GLAZING AREA	0.516	m^2
OPENABLE AREA	0.567	m^2
FREE AREA	60.7	%

W54L T2

WINDOW MARK	W54L T2 & L01 T2
LOCATION	23F&25F FLAT C MASTER BATH
SECTION	70mm ALUM. SECTION
GLAZING	GL05
QUANTITY	2 Nos / 2 Nos
REMARKS	FACADE(T2-01-05A/25F; T2-01-05B/23F)

T:\Jobs\J-853\2. Outgoing\Black plate opening of Windows Louvre\Black Plate of T2 Precat Window.dwg

B.D. REF :

CLIENT :
SHIMAO GROUP HOLDINGS LIMITED

ARCHITECT :
WONG TUNG & PARTNERS LIMITED
ARCHITECTS & PLANNERS

MAIN CONTRACTOR :
協興建築有限公司
HIP HING CONSTRUCTION CO LTD

STRUCTURAL ENGINEER :
C M WONG & ASSOCIATES LTD
黃志明建築工程師有限公司

FACADE CONSULTANT:
MEINHARDT

NOTE :
1. ALL DIMENSIONS ARE IN mm.
2. ALL ELEVATIONS ARE VIEWED FROM OUTSIDE.
3. ALL DIMENSIONS TO BE VERIFIED ON SITE BEFORE FABRICATION.

LEGEND :
- X1 / 3DT01 — DETAIL MARK NO. / REFER SHEET NO.
1. F.F.L. — FINISHED FLOOR LEVEL
2. S.F.L. — STRUCTURAL FLOOR LEVEL
3. — REVERSED DETAIL
4. ▲ — FIXING LOCATION
5. △ — FIXING LUG LOCATION
6. GLASS LEGEND
   - GL01 — 10mm+12mm AIR GAP+10mm THK. I.G.U.
   - GL04 — 12mm THK. CLEAR TEMPERED GLASS
   - GL05 — 10mm+12mm AIR GAP+10mm THK. I.G.U.
   - GL06 — 10mm+12mm AIR GAP+12mm THK. I.G.U.
   - PD01 — 10mm T.P+12mm AIR GAP+8mm T.P
   - GL07 — 10mm+12mm AIR GAP+12mm THK. I.G.U.
   - GL08 — 10mm+12mm AIR GAP+10mm THK. I.G.U.

NO.	DATE	REMARK	BY
H	30/08/2022	GENERAL REVISION	bala
G	22/10/2021	REVISION SUBJECT TO ARCH.COMMENT	bala
A	08/08/2021	REVISION SUBJECT TO ARCH.COMMENT	bala

JOB NO. : J-853

PROJECT :
PROPOSED RESIDENTIAL DEVELOPMENT AT N.K.I.L. 6542
YIN PING ROAD
KOWLOON

TITLE :
WINDOW SCHEDULE FOR TOWER 2 ALUM. WINDOW

DATE : 03-APR-21 | SCALE : 1:40

DRAWN BY : | CHECKED BY :

美特鋁質有限公司
MIDI ALUMINIUM FABRICATOR LTD.
Units 6-8, Sunray Industrial Centre, 1/F
610 Cha Kwo Ling Road, Kowloon
Tel:23489211-4 Fax:(852)27727666

DWG NO. : J853-SD-PW-SC205b | REV. : H

ELEVATION

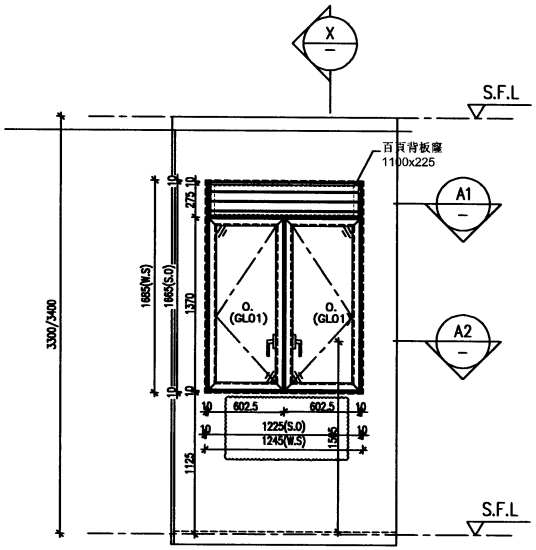

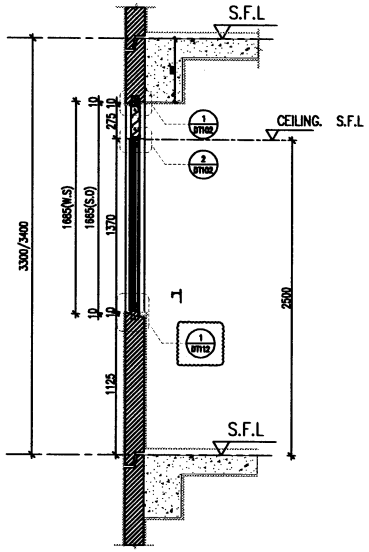

X PART SECTION

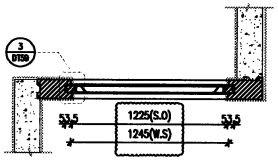

A1 PART PLAN

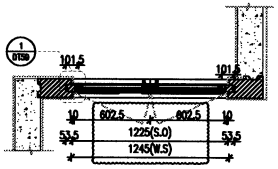

A2 PART PLAN

W63 T2

PROVIDED		
GLAZING AREA	1.170	m^2
OPENABLE AREA	1.375	m^2
FREE AREA	60.7	%

WINDOW MARK	W63 T2
LOCATION	5F&23F&25F FLAT C KITCHEN
SECTION	70mm ALUM. SECTION
GLAZING	GL01
QUANTITY	3 Nos.
REMARKS	FACADE (T2-01-06A/5F&25F; T2-01-06B/23F)

T:\Jobs\J-853\2. Outgoing\Black plate opening of Windows Louvre\Black Plate of T2 Precat Window.dwg

B.D. REF :

CLIENT :
SHIMAO GROUP HOLDINGS LIMITED

ARCHITECT :
WONG TUNG & PARTNERS LIMITED
ARCHITECTS & PLANNERS

MAIN CONTRACTOR :
協興建築有限公司
HIP HING CONSTRUCTION CO LTD

STRUCTURAL ENGINEER :
C M WONG & ASSOCIATES LTD
黃志明建築工程師有限公司

FACADE CONSULTANT:
MEINHARDT

NOTE :
1. ALL DIMENSIONS ARE IN mm.
2. ALL ELEVATIONS ARE VIEWED FROM OUTSIDE.
3. ALL DIMENSIONS TO BE VERIFIED ON SITE BEFORE FABRICATION.

LEGEND :
- DETAIL MARK NO.
- REFER SHEET NO.
1. F.F.L. — FINISHED FLOOR LEVEL
2. S.F.L. — STRUCTURAL FLOOR LEVEL
3. — REVERSED DETAIL
4. — FIXING LOCATION
5. — FIXING LUG LOCATION
6. GLASS LEGEND
GL01 — 10mm+12mm AIR GAP+10mm THK. I.G.U.
GL04 — 12mm THK. CLEAR TEMPERED GLASS
GL05 — 10mm+12mm AIR GAP+10mm THK. I.G.U.
GL06 — 10mm+12mm AIR GAP+12mm THK. I.G.U.
PD01 — 10mm T.P+12mm AIR GAP+8mm T.P
GL07 — 10mm+12mm AIR GAP+12mm THK. I.G.U.
GL08 — 10mm+12mm AIR GAP+10mm THK. I.G.U.

NO.	DATE	REMARK	BY
I	30/08/2022	GENERAL REVISION	wlo
H	29/08/2022	REVISION SUBJECT TO ARCH.COMMENT	wlo
G	22/10/2021	REVISION SUBJECT TO ARCH.COMMENT	wlo

JOB NO. : J-853

PROJECT :
PROPOSED RESIDENTIAL DEVELOPMENT AT N.K.I.L. 6542 YIN PING ROAD KOWLOON

TITLE :
WINDOW SCHEDULE FOR TOWER 2 ALUM. WINDOW

DATE : 03-APR-21 | SCALE : 1:40

DRAWN BY : | CHECKED BY :

美特鋁製有限公司
MIDI ALUMINIUM FABRICATOR LTD.
Units 6-8, Sunray Industrial Centre, 1/F
610 Cha Kwo Ling Road, Kowloon
Tel:23489211-4 Fax:(852)27727666

DWG NO. : J853-SD-PW-SC206a | REV. : I

ELEVATION

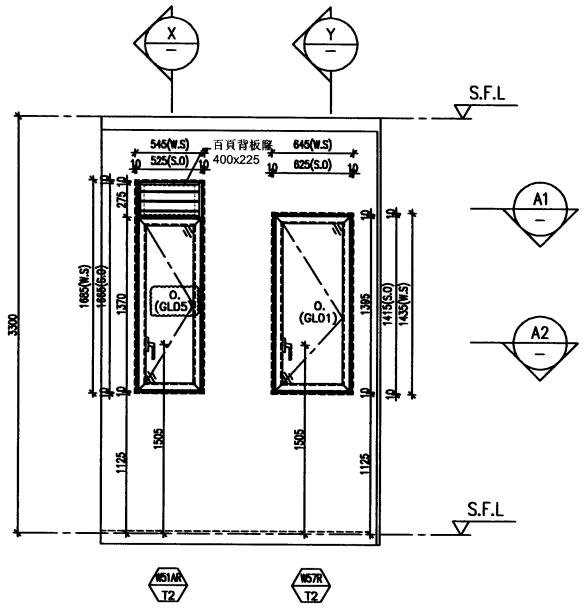

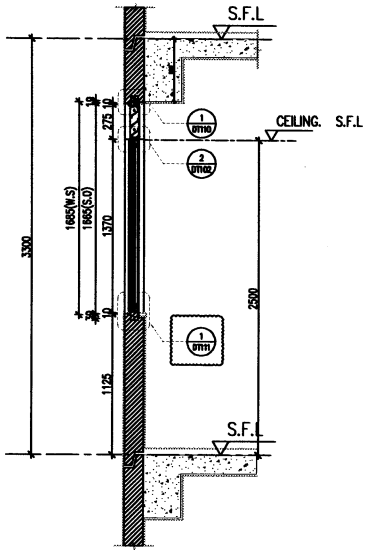

X PART SECTION

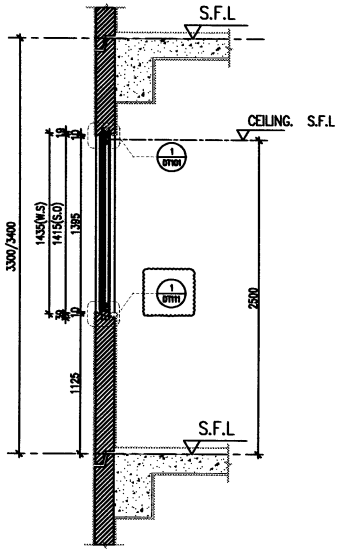

Y PART SECTION

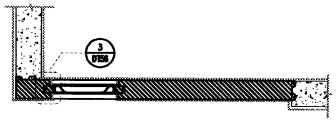

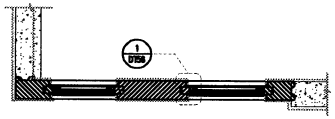

A1 PART PLAN

A2 PART PLAN

	PROVIDED		
GLAZING AREA	0.594	m^2
OPENABLE AREA	0.698	m^2
FREE AREA	–	%

W57R T2

	PROVIDED		
GLAZING AREA	0.458	m^2
OPENABLE AREA	0.554	m^2
FREE AREA	60.7	%

W51AR T2

WINDOW MARK	W57R T2 & W51AR T2
LOCATION	5F&25F FLAT C LAV. / UTILITY
SECTION	70mm ALUM. SECTION
GLAZING	GL01/W57R , GL05/W51AR
QUANTITY	2 Nos.
REMARKS	FACADE (T2-01-07A/5F&25F)

T:\Jobs\J-853\2. Outgoing\Black plate opening of Windows Louvre\Black Plate of T2 Precat Window.dwg

B.D. REF :

CLIENT :
SHIMAO GROUP HOLDINGS LIMITED

ARCHITECT :
WONG TUNG & PARTNERS LIMITED
ARCHITECTS & PLANNERS

MAIN CONTRACTOR :
協興建築有限公司
HIP HING CONSTRUCTION CO LTD

STRUCTURAL ENGINEER :
CMA C M WONG & ASSOCIATES LTD
黃志明建築工程師有限公司

FACADE CONSULTANT:
MEINHARDT

NOTE :
1. ALL DIMENSIONS ARE IN mm.
2. ALL ELEVATIONS ARE VIEWED FROM OUTSIDE.
3. ALL DIMENSIONS TO BE VERIFIED ON SITE BEFORE FABRICATION.

LEGEND :
X1 / 2D01 — DETAIL MARK NO. / REFER SHEET NO.
1. F.F.L. — FINISHED FLOOR LEVEL
2. S.F.L. — STRUCTURAL FLOOR LEVEL
3. R — REVERSED DETAIL
4. ▲ — FIXING LOCATION
5. △ — FIXING LUG LOCATION
6. GLASS LEGEND
GL01 — 10mm+12mm AIR GAP+10mm THK. I.G.U.
GL04 — 12mm THK. CLEAR TEMPERED GLASS
GL05 — 10mm+12mm AIR GAP+10mm THK. I.G.U.
GL06 — 10mm+12mm AIR GAP+12mm THK. I.G.U.
PD01 — 10mm T.P+12mm AIR GAP+8mm T.P
GL07 — 10mm+12mm AIR GAP+12mm THK. I.G.U.
GL08 — 10mm+12mm AIR GAP+10mm THK. I.G.U.

NO.	DATE	REMARK	BY
H	29/09/2022	GENERAL REVISION	ada
G	22/10/2021	REVISION SUBJECT TO ARCH.COMMENT	ada
A	08/09/2021	REVISION SUBJECT TO ARCH.COMMENT	ada

JOB NO. : J-853

PROJECT :
PROPOSED RESIDENTIAL DEVELOPMENT AT N.K.I.L. 6542 YIN PING ROAD KOWLOON

TITLE :
WINDOW SCHEDULE FOR TOWER 2 ALUM. WINDOW

DATE : 03-APR-21 | SCALE : 1:40

DRAWN BY : | CHECKED BY :

美特鋁質有限公司
MIDI ALUMINIUM FABRICATOR LTD.
Units 6-8, Sunray Industrial Centre, 1/F
610 Cha Kwo Ling Road, Kowloon
Tel:23488211-4 Fax:(852)27727666

DWG NO. : J853-SD-PW-SC207a | REV. : H

ELEVATION

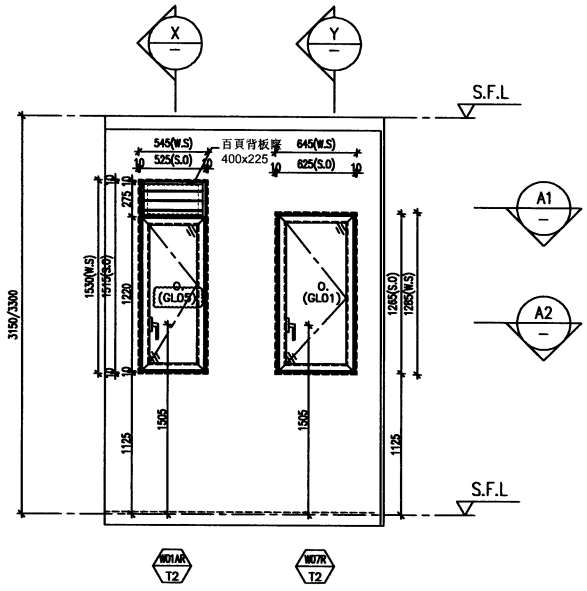

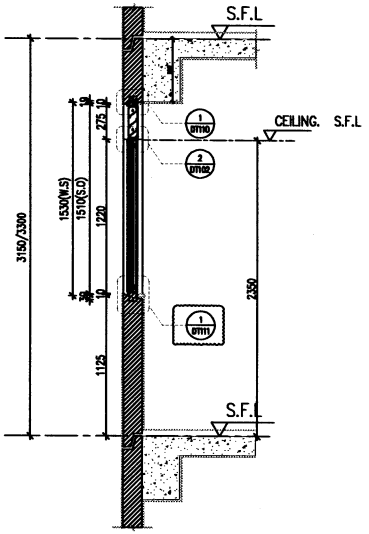

X PART SECTION

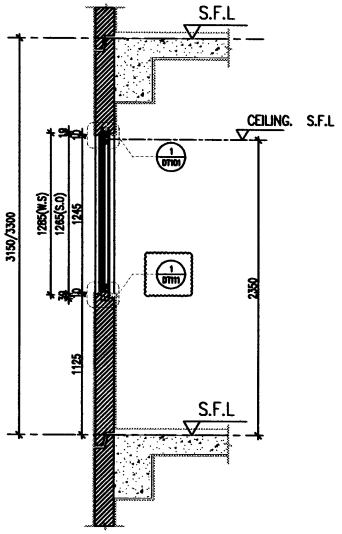

Y PART SECTION

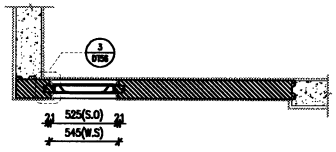

A1 PART PLAN

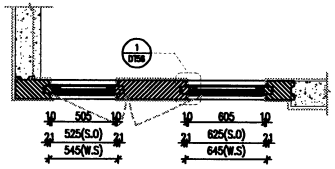

A2 PART PLAN

W07R T2	PROVIDED		
GLAZING AREA	0.523	m^2
OPENABLE AREA	0.618	m^2
FREE AREA	–	%

W01AR T2	PROVIDED		
GLAZING AREA	0.402	m^2
OPENABLE AREA	0.490	m^2
FREE AREA	60.7	%

WINDOW MARK	W07R T2 & W01AR T2
LOCATION	6F~15F&17F~22F FLAT C LAV. / UTILITY
SECTION	70mm ALUM. SECTION
GLAZING	GL01/W07R , GL05/W01AR
QUANTITY	14 Nos.
REMARKS	FACADE (T2-01-07/6~15F&17F~22F)

T:\Jobs\J-853\2. Outgoing\Black plate opening of Windows Louvre\Black Plate of T2 Precat Window.dwg

B.D. REF :

CLIENT :
SHIMAO GROUP HOLDINGS LIMITED

ARCHITECT :
WONG TUNG & PARTNERS LIMITED ARCHITECTS & PLANNERS

MAIN CONTRACTOR :
協興建築有限公司 HIP HING CONSTRUCTION CO LTD

STRUCTURAL ENGINEER :
C M WONG & ASSOCIATES LTD 黃志明建築工程師有限公司

FACADE CONSULTANT:
MEINHARDT

NOTE :
1. ALL DIMENSIONS ARE IN mm.
2. ALL ELEVATIONS ARE VIEWED FROM OUTSIDE.
3. ALL DIMENSIONS TO BE VERIFIED ON SITE BEFORE FABRICATION.

LEGEND :
- X1 / X001 — DETAIL MARK NO. / REFER SHEET NO.
1. F.F.L. — FINISHED FLOOR LEVEL
2. S.F.L. — STRUCTURAL FLOOR LEVEL
3. Ⓡ — REVERSED DETAIL
4. ▲ — FIXING LOCATION
5. △ — FIXING LUG LOCATION
6. GLASS LEGEND
   - GL01 — 10mm+12mm AIR GAP+10mm THK. I.G.U.
   - GL04 — 12mm THK. CLEAR TEMPERED GLASS
   - GL05 — 10mm+12mm AIR GAP+10mm THK. I.G.U.
   - GL06 — 10mm+12mm AIR GAP+12mm THK. I.G.U.
   - PD01 — 10mm T.P+12mm AIR GAP+8mm T.P
   - GL07 — 10mm+12mm AIR GAP+12mm THK. I.G.U.
   - GL08 — 10mm+12mm AIR GAP+10mm THK. I.G.U.

NO.	DATE	REMARK	BY
H	28/05/2022	GENERAL REVISION	kelo
G	22/10/2021	REVISION SUBJECT TO ARCH.COMMENT	kelo
A	08/09/2021	REVISION SUBJECT TO ARCH.COMMENT	kelo

JOB NO. : J-853

PROJECT :
PROPOSED RESIDENTIAL DEVELOPMENT AT N.K.I.L. 6542 YIN PING ROAD KOWLOON

TITLE :
WINDOW SCHEDULE FOR TOWER 2 ALUM. WINDOW

DATE : 03-APR-21 | SCALE : 1:40

DRAWN BY : | CHECKED BY :

美特鋁製有限公司 MIDI ALUMINIUM FABRICATION LTD.
Units 6-8, Sunray Industrial Centre, 1/F
610 Cha Kwo Ling Road, Kowloon
Tel:23488211-4 Fax:(852)27727666

DWG NO. : J853-SD-PW-SC207 | REV. : H

ELEVATION

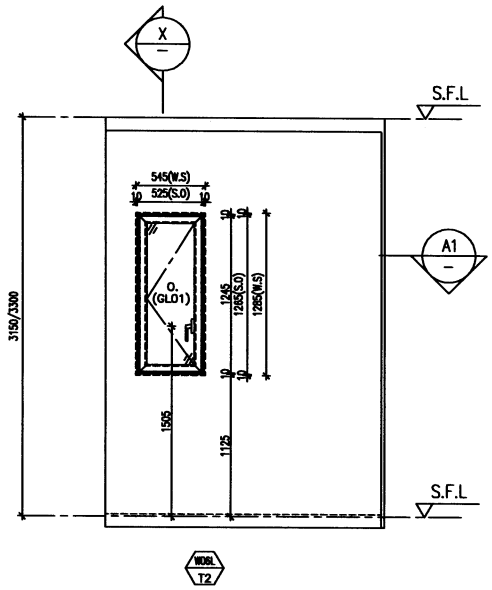

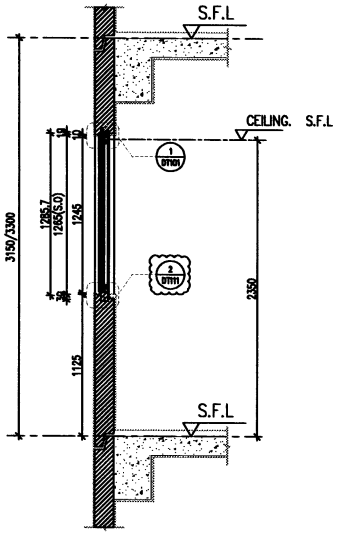

X PART SECTION

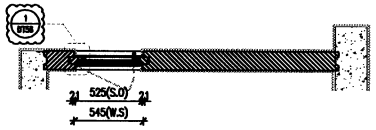

A1 PART PLAN

PROVIDED		
GLAZING AREA	0.412	m^2
OPENABLE AREA	0.502	m^2
FREE AREA	60.7	%

WINDOW MARK	W08L T2
LOCATION	6F~16F FLAT D UTILITY
SECTION	70mm ALUM. SECTION
GLAZING	GL01
QUANTITY	9 Nos.
REMARKS	FACADE (T2-01-08/6~15F; T2-01-08A/16F)

T:\Jobs\J-853\2. Outgoing\Black plate opening of Windows Louvre\Black Plate of T2 Precat Window.dwg

B.D. REF :

CLIENT :
SHIMAO GROUP
HOLDINGS LIMITED

ARCHITECT : WONG TUNG & PARTNERS LIMITED ARCHITECTS & PLANNERS

MAIN CONTRACTOR :
協興建築有限公司
HIP HING CONSTRUCTION CO LTD

STRUCTURAL ENGINEER :
CMA C M WONG & ASSOCIATES LTD
黃志明建築工程師有限公司

FACADE CONSULTANT: MEINHARDT

NOTE :
1. ALL DIMENSIONS ARE IN mm.
2. ALL ELEVATIONS ARE VIEWED FROM OUTSIDE.
3. ALL DIMENSIONS TO BE VERIFIED ON SITE BEFORE FABRICATION.

LEGEND :
- X1 / X001 — DETAIL MARK NO. / REFER SHEET NO.
1. F.F.L. — FINISHED FLOOR LEVEL
2. S.F.L. — STRUCTURAL FLOOR LEVEL
3. R — REVERSED DETAIL
4. ▲ — FIXING LOCATION
5. △ — FIXING LUG LOCATION
6. GLASS LEGEND
   - GL01 — 10mm+12mm AIR GAP+10mm THK. I.G.U.
   - GL04 — 12mm THK. CLEAR TEMPERED GLASS
   - GL05 — 10mm+12mm AIR GAP+10mm THK. I.G.U.
   - GL06 — 10mm+12mm AIR GAP+12mm THK. I.G.U.
   - PD01 — 10mm T.P+12mm AIR GAP+8mm T.P
   - GL07 — 10mm+12mm AIR GAP+12mm THK. I.G.U.
   - GL08 — 10mm+12mm AIR GAP+10mm THK. I.G.U.

NO.	DATE	REMARK	BY
I	29/08/2022	GENERAL REVISION	mds
H	25/05/2022	REVISION SUBJECT TO ARCH.COMMENT	mds
G	22/10/2021	REVISION SUBJECT TO ARCH.COMMENT	mds
A	08/08/2021	REVISION SUBJECT TO ARCH.COMMENT	mds

JOB NO. : J-853

PROJECT :
PROPOSED RESIDENTIAL DEVELOPMENT AT N.K.I.L. 6542 YIN PING ROAD KOWLOON

TITLE :
WINDOW SCHEDULE FOR TOWER 2 ALUM. WINDOW

DATE : 03-APR-21 | SCALE : 1:40

DRAWN BY : | CHECKED BY :

美特鋁質有限公司
MIDI ALUMINIUM FABRICATORS LTD.
Units 6-8, Sunray Industrial Centre, 1/F
610 Cha Kwo Ling Road, Kowloon
Tel:23489211-4 Fax:(852)27727666

DWG NO. : J853-SD-PW-SC208 | REV. : H

ELEVATION

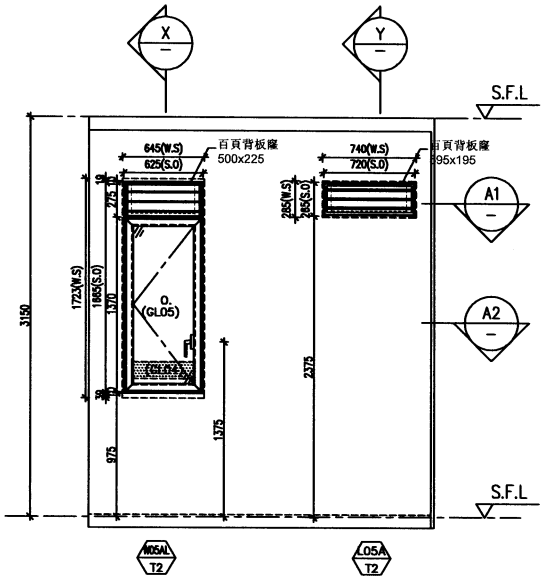

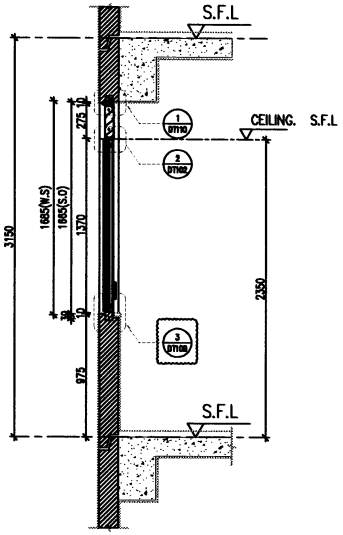

X PART SECTION

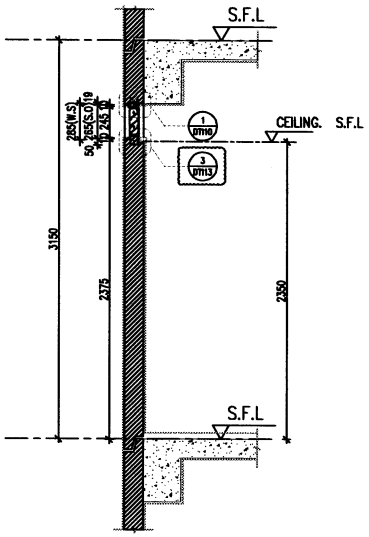

Y PART SECTION

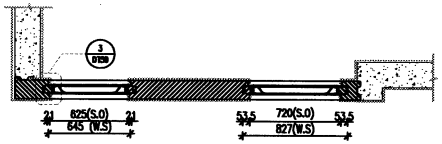

A1 PART PLAN

A2 PART PLAN

L05A T2	PROVIDED		
GLAZING AREA	–	m^2
OPENABLE AREA	–	m^2
FREE AREA	55.4	%

W05AL T2	PROVIDED		
GLAZING AREA	0.581	m^2
OPENABLE AREA	0.617	m^2
FREE AREA	60.7	%

WINDOW MARK	W05AL T2 & L05A T2
LOCATION	17F~22F FLAT A MASTER BATH
SECTION	70mm ALUM. SECTION
GLAZING	GL05
QUANTITY	6 Nos / 6 Nos
REMARKS	FACADE(T2-01-09/17F~22F)

B.D. REF :

CLIENT :
SHIMAO GROUP HOLDINGS LIMITED

ARCHITECT :
WONG TUNG & PARTNERS LIMITED
ARCHITECTS & PLANNERS

MAIN CONTRACTOR :
協興建築有限公司
HIP HING CONSTRUCTION CO LTD

STRUCTURAL ENGINEER :
C M WONG & ASSOCIATES LTD
黃志明建築工程師有限公司

FACADE CONSULTANT:
MEINHARDT

NOTE :
1. ALL DIMENSIONS ARE IN mm.
2. ALL ELEVATIONS ARE VIEWED FROM OUTSIDE.
3. ALL DIMENSIONS TO BE VERIFIED ON SITE BEFORE FABRICATION.

LEGEND :
- X1 / XD01 — DETAIL MARK NO. / REFER SHEET NO.
1. F.F.L. — FINISHED FLOOR LEVEL
2. S.F.L. — STRUCTURAL FLOOR LEVEL
3. (R) — REVERSED DETAIL
4. ▲ — FIXING LOCATION
5. △ — FIXING LUG LOCATION
6. GLASS LEGEND
   - GL01 — 10mm+12mm AIR GAP+10mm THK. L.G.U.
   - GL04 — 12mm THK. CLEAR TEMPERED GLASS
   - GL05 — 10mm+12mm AIR GAP+10mm THK. L.G.U.
   - GL06 — 10mm+12mm AIR GAP+12mm THK. L.G.U.
   - PD01 — 10mm T.P+12mm AIR GAP+6mm T.P
   - GL07 — 10mm+12mm AIR GAP+12mm THK. L.G.U.
   - GL08 — 10mm+12mm AIR GAP+10mm THK. L.G.U.

NO.	DATE	REMARK	BY
H	29/08/2022	GENERAL REVISION	ada
G	22/10/2021	REVISION SUBJECT TO ARCH.COMMENT	ada
A	08/08/2021	REVISION SUBJECT TO ARCH.COMMENT	ada

JOB NO. : J-853

PROJECT :
PROPOSED RESIDENTIAL DEVELOPMENT AT N.K.I.L. 6542 YIN PING ROAD KOWLOON

TITLE :
WINDOW SCHEDULE FOR TOWER 2 ALUM. WINDOW

DATE : 03-APR-21 | SCALE : 1:40

DRAWN BY : | CHECKED BY :

美特鋁質有限公司
MIDI ALUMINIUM FABRICATION LTD.
Units 6-8, Sunray Industrial Centre, 1/F
610 Cha Kwo Ling Road, Kowloon
Tel:23489211-4 Fax:(852)27727666

DWG NO. : J853-SD-PW-SC209a | REV. : H

T:\Jobs\J-853\2. Outgoing\Black plate opening of Windows Louvre\Black Plate of T2 Precat Window.dwg

ELEVATION

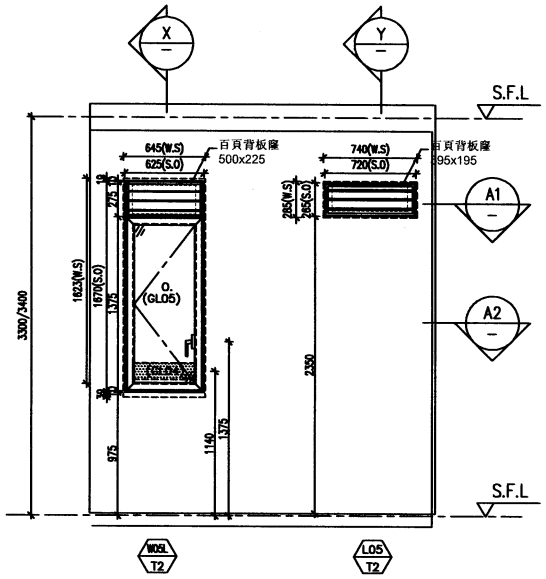

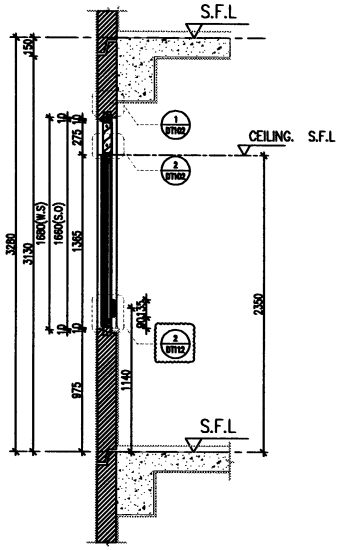

X PART SECTION

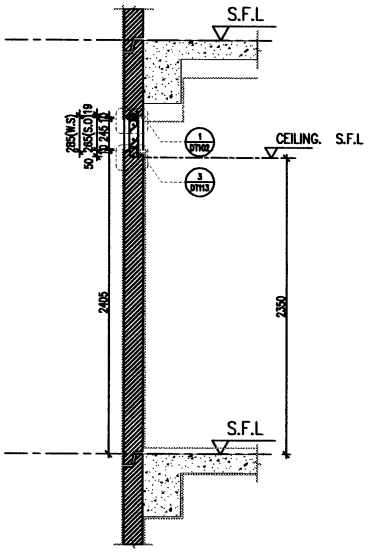

Y PART SECTION

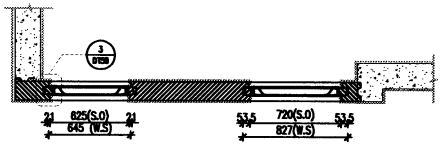

A1 PART PLAN

A2 PART PLAN

L05 T2

PROVIDED		
GLAZING AREA	–	m^2
OPENABLE AREA	–	m^2
FREE AREA	55.4	%

W05L T2

PROVIDED		
GLAZING AREA	0.584	m^2
OPENABLE AREA	0.620	m^2
FREE AREA	60.7	%

WINDOW MARK	W05L T2 & L05 T2
LOCATION	23F&26F FLAT A MASTER BATH
SECTION	70mm ALUM. SECTION
GLAZING	GL05
QUANTITY	2 Nos / 2 Nos
REMARKS	FACADE(T2-01-09B/23F)

T:\Jobs\J-853\2. Outgoing\Black plate opening of Windows Louvre\Black Plate of T2 Precat Window.dwg

B.D. REF :

CLIENT :
SHIMAO GROUP HOLDINGS LIMITED

ARCHITECT :
WONG TUNG & PARTNERS LIMITED
ARCHITECTS & PLANNERS

MAIN CONTRACTOR :
協興建築有限公司
HIP HING CONSTRUCTION CO LTD

STRUCTURAL ENGINEER :
C M WONG & ASSOCIATES LTD
黃志明建築工程師有限公司

FACADE CONSULTANT:
MEINHARDT

NOTE :
1. ALL DIMENSIONS ARE IN mm.
2. ALL ELEVATIONS ARE VIEWED FROM OUTSIDE.
3. ALL DIMENSIONS TO BE VERIFIED ON SITE BEFORE FABRICATION.

LEGEND :
X1 — DETAIL MARK NO.
X001 — REFER SHEET NO.
1. F.F.L. — FINISHED FLOOR LEVEL
2. S.F.L. — STRUCTURAL FLOOR LEVEL
3. — REVERSED DETAIL
4. ▲ — FIXING LOCATION
5. △ — FIXING LUG LOCATION
6. GLASS LEGEND
GL01 — 10mm+12mm AIR GAP+10mm THK. I.G.U.
GL04 — 12mm THK. CLEAR TEMPERED GLASS
GL05 — 10mm+12mm AIR GAP+10mm THK. I.G.U.
GL06 — 10mm+12mm AIR GAP+12mm THK. I.G.U.
PD01 — 10mm T.P+12mm AIR GAP+8mm T.P
GL07 — 10mm+12mm AIR GAP+12mm THK. I.G.U.
GL08 — 10mm+12mm AIR GAP+10mm THK. I.G.U.

NO.	DATE	REMARK	BY
H	29/03/2022	GENERAL REVISION	mlo
G	22/10/2021	REVISION SUBJECT TO ARCH.COMMENT	mlo
A	08/09/2021	REVISION SUBJECT TO ARCH.COMMENT	mlo

JOB NO. : J-853

PROJECT :
PROPOSED RESIDENTIAL DEVELOPMENT AT N.K.I.L. 6542 YIN PING ROAD KOWLOON

TITLE :
WINDOW SCHEDULE FOR TOWER 2 ALUM. WINDOW

DATE : 03-APR-21 | SCALE : 1:40

DRAWN BY : | CHECKED BY :

美特鋁製有限公司
MIDI ALUMINIUM FABRICATION LTD.
Units 6-8, Sunray Industrial Centre, 1/F
610 Cha Kwo Ling Road, Kowloon
Tel:23488211-4 Fax:(852)27727666

DWG NO. : J853-SD-PW-SC209 | REV. : H

ELEVATION

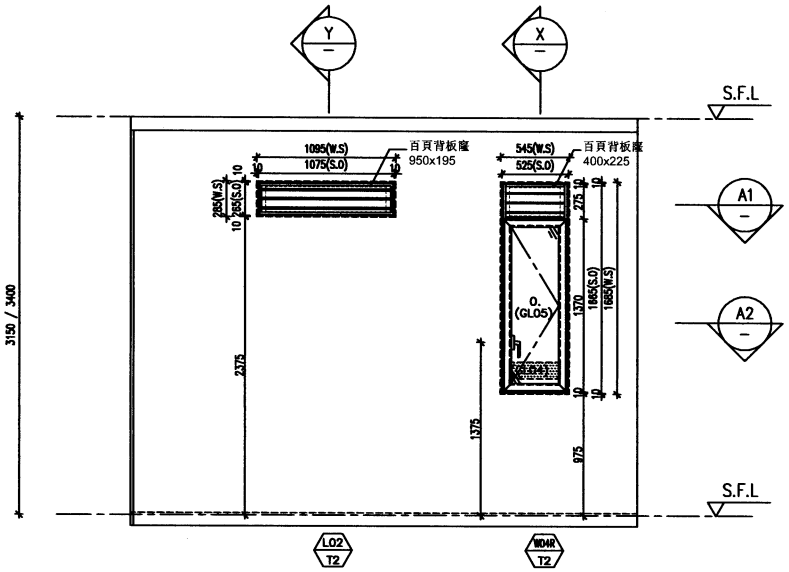

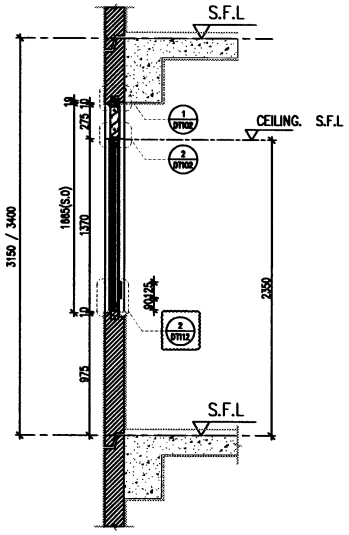

X PART SECTION

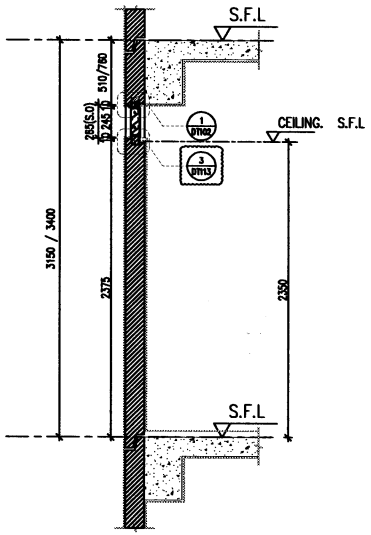

Y PART SECTION

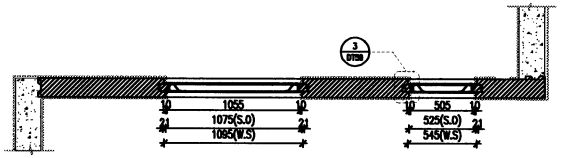

A1 PART PLAN

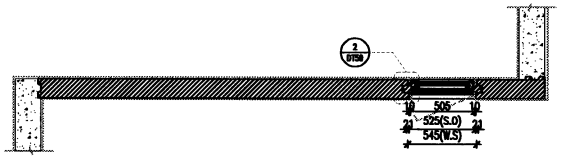

A2 PART PLAN

LO2 T2

PROVIDED		
GLAZING AREA	–	m^2
OPENABLE AREA	–	m^2
FREE AREA	55.4	%

W04R T2

PROVIDED		
GLAZING AREA	0.460	m^2
OPENABLE AREA	0.503	m^2
FREE AREA	60.7	%

WINDOW MARK	W04R T2 & LO2 T2
LOCATION	17F~23F FLAT A ENSUITE 2 EN. BATH
SECTION	70mm ALUM. SECTION
GLAZING	GL05
QUANTITY	7 Nos / 7 Nos.
REMARKS	FACADE (T2-01-10/17F~22F & T2-01-10B/23F)

T:\Jobs\J-853\2. Outgoing\Black plate opening of Windows Louvre\Black Plate of T2 Precat Window.dwg

B.D. REF :

CLIENT :
SHIMAO GROUP HOLDINGS LIMITED

ARCHITECT :
WONG TUNG & PARTNERS LIMITED
ARCHITECTS & PLANNERS

MAIN CONTRACTOR :
協興建築有限公司
HIP HING CONSTRUCTION CO LTD

STRUCTURAL ENGINEER :
CMA C M WONG & ASSOCIATES LTD
黃志明建築工程師有限公司

FACADE CONSULTANT:
MEINHARDT

NOTE :
1. ALL DIMENSIONS ARE IN mm.
2. ALL ELEVATIONS ARE VIEWED FROM OUTSIDE.
3. ALL DIMENSIONS TO BE VERIFIED ON SITE BEFORE FABRICATION.

LEGEND :
- X1 / XXX1 — DETAIL MARK NO. / REFER SHEET NO.
1. F.F.L. — FINISHED FLOOR LEVEL
2. S.F.L. — STRUCTURAL FLOOR LEVEL
3. (R) — REVERSED DETAIL
4. ▲ — FIXING LOCATION
5. △ — FIXING LUG LOCATION
6. GLASS LEGEND
   - GL01 — 10mm+12mm AIR GAP+10mm THK. L.G.U.
   - GL04 — 12mm THK. CLEAR TEMPERED GLASS
   - GL05 — 10mm+12mm AIR GAP+10mm THK. L.G.U.
   - GL06 — 10mm+12mm AIR GAP+12mm THK. L.G.U.
   - PD01 — 10mm T.P+12mm AIR GAP+8mm T.P
   - GL07 — 10mm+12mm AIR GAP+12mm THK. L.G.U.
   - GL08 — 10mm+12mm AIR GAP+10mm THK. L.G.U.

NO.	DATE	REMARK	BY
H	28/08/2022	GENERAL REVISION	ada
G	22/10/2021	REVISION SUBJECT TO ARCH.COMMENT	ada
A	05/08/2021	REVISION SUBJECT TO ARCH.COMMENT	ada

JOB NO. : J-853

PROJECT :
PROPOSED RESIDENTIAL DEVELOPMENT AT N.K.I.L. 6542 YIN PING ROAD KOWLOON

TITLE :
WINDOW SCHEDULE FOR TOWER 2 ALUM. WINDOW

DATE : 03-APR-21 | SCALE : 1:40

DRAWN BY : | CHECKED BY :

美特鋁質有限公司
MIDI ALUMINIUM FABRICATOR LTD.
Units 6-8, Sunray Industrial Centre, 1/F
610 Cha Kwo Ling Road, Kowloon
Tel:23489211-4 Fax:(852)27727686

DWG NO. : J853-SD-PW-SC210 | REV. : H

ELEVATION

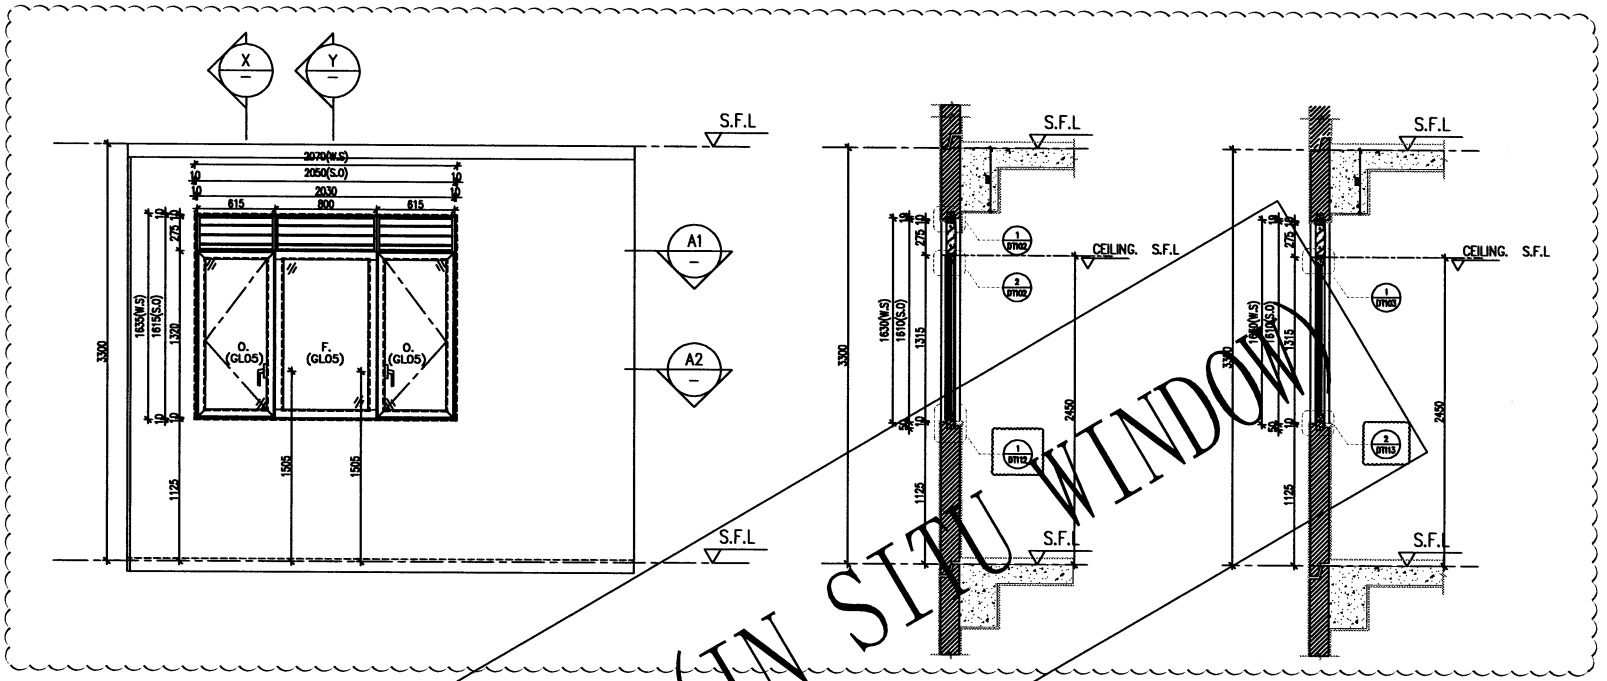

X PART SECTION

Y PART SECTION

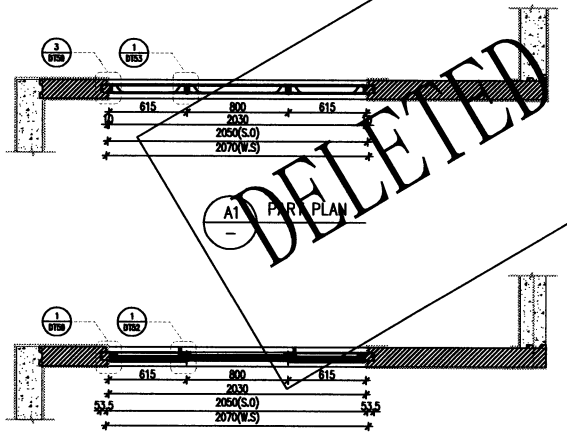

A1 PART PLAN

A2 PART PLAN

DELETED (IN SITU WINDOW)

PROVIDED		
GLAZING AREA	1.852	m^2
OPENABLE AREA	1.237	m^2
FREE AREA	60.7	%

W20 T2

WINDOW MARK	W20 T2
LOCATION	25F FLAT A KITCHEN
SECTION	70mm ALUM. SECTION
GLAZING	GL05
QUANTITY	1 Nos
REMARKS	FACADE (T2-01-10A/25F)

B.D. REF :

CLIENT :
SHIMAO GROUP HOLDINGS LIMITED

ARCHITECT :
WONG TUNG & PARTNERS LIMITED
ARCHITECTS & PLANNERS

MAIN CONTRACTOR :
協興建築有限公司
HIP HING CONSTRUCTION CO LTD

STRUCTURAL ENGINEER :
C M WONG & ASSOCIATES LTD
黃志明建築工程師有限公司

FACADE CONSULTANT:
MEINHARDT

NOTE :
1. ALL DIMENSIONS ARE IN mm.
2. ALL ELEVATIONS ARE VIEWED FROM OUTSIDE.
3. ALL DIMENSIONS TO BE VERIFIED ON SITE BEFORE FABRICATION.

LEGEND :
X1 / XDE1 — DETAIL MARK NO. / REFER SHEET NO.
1. F.F.L. — FINISHED FLOOR LEVEL
2. S.F.L. — STRUCTURAL FLOOR LEVEL
3. (R) — REVERSED DETAIL
4. ▲ — FIXING LOCATION
5. △ — FIXING LUG LOCATION
6. GLASS LEGEND
GL01 — 10mm+12mm AIR GAP+10mm THK. I.G.U.
GL04 — 12mm THK. CLEAR TEMPERED GLASS
GL05 — 10mm+12mm AIR GAP+10mm THK. I.G.U.
GL06 — 10mm+12mm AIR GAP+12mm THK. I.G.U.
PD01 — 10mm T.P+12mm AIR GAP+8mm T.P
GL07 — 10mm+12mm AIR GAP+12mm THK. I.G.U.
GL08 — 10mm+12mm AIR GAP+10mm THK. I.G.U.

NO.	DATE	REMARK	BY
H	28/05/2022	GENERAL REVISION	wds
G	22/10/2021	REVISION SUBJECT TO ARCH.COMMENT	wds
A	08/05/2021	REVISION SUBJECT TO ARCH.COMMENT	wds

JOB NO. : J-853

PROJECT :
PROPOSED RESIDENTIAL DEVELOPMENT AT N.K.I.L. 6542 YIN PING ROAD KOWLOON

TITLE :
WINDOW SCHEDULE FOR TOWER 2 ALUM. WINDOW

DATE : 03-APR-21 | SCALE : 1:40

DRAWN BY : | CHECKED BY :

美特鋁製有限公司
MIDI ALUMINIUM FABRICATOR LTD.
Units 6-8, Sunray Industrial Centre, 1/F
610 Cha Kwo Ling Road, Kowloon
Tel:23489211-4 Fax:(852)27727666

DWG NO. : J853-SD-PW-SC211 | REV. : H

T:\Jobs\J-853\2. Outgoing\Black plate opening of Windows Louvre\Black Plate of T2 Precat Window.dwg

ELEVATION

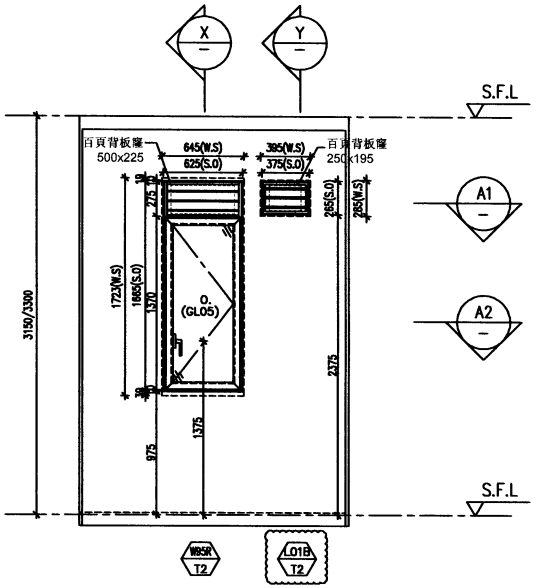

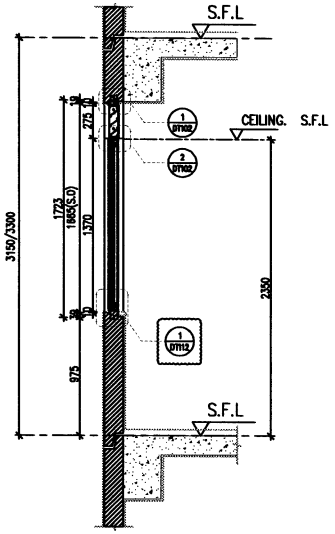

X PART SECTION

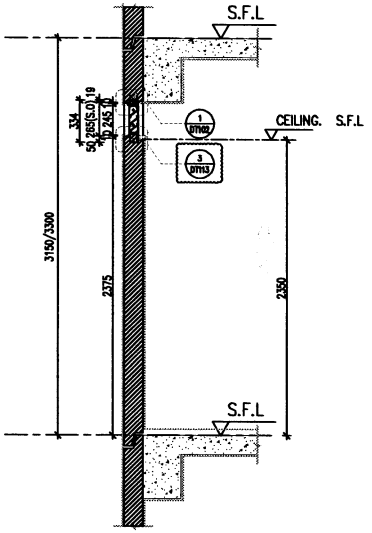

Y PART SECTION

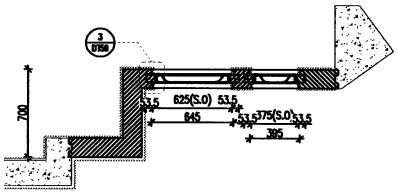

A1 PART PLAN

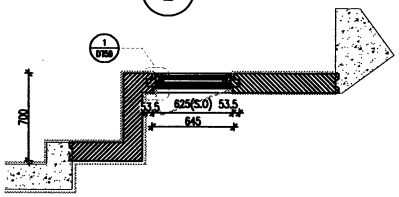

A2 PART PLAN

L01B T2

PROVIDED		
GLAZING AREA	–	m^2
OPENABLE AREA	–	m^2
FREE AREA	55.4	%

W95R T2

PROVIDED		
GLAZING AREA	0.584	m^2
OPENABLE AREA	0.686	m^2
FREE AREA	60.7	%

WINDOW MARK	W95R T2 & L01B T2
LOCATION	5F FLAT A MASTER BATH
SECTION	70mm ALUM. SECTION
GLAZING	GL05
QUANTITY	1 Nos / 1 Nos.
REMARKS	FACADE (T2-02-01A/5F)

T:\Jobs\J-853\2. Outgoing\Black plate opening of Windows Louvre\Black Plate of T2 Precat Window.dwg

B.D. REF :

CLIENT :
SHIMAO GROUP HOLDINGS LIMITED

ARCHITECT :
WONG TUNG & PARTNERS LIMITED
ARCHITECTS & PLANNERS

MAIN CONTRACTOR :
協興建築有限公司
HIP HING CONSTRUCTION CO LTD

STRUCTURAL ENGINEER :
C M WONG & ASSOCIATES LTD
黃志明建築工程師有限公司

FACADE CONSULTANT:
MEINHARDT

NOTE :
1. ALL DIMENSIONS ARE IN mm.
2. ALL ELEVATIONS ARE VIEWED FROM OUTSIDE.
3. ALL DIMENSIONS TO BE VERIFIED ON SITE BEFORE FABRICATION.

LEGEND :
X1 / 2001 — DETAIL MARK NO. / REFER SHEET NO.
1. F.F.L. — FINISHED FLOOR LEVEL
2. S.F.L. — STRUCTURAL FLOOR LEVEL
3. (R) — REVERSED DETAIL
4. ▲ — FIXING LOCATION
5. △ — FIXING LUG LOCATION
6. GLASS LEGEND
GL01 — 10mm+12mm AIR GAP+10mm THK. I.G.U.
GL04 — 12mm THK. CLEAR TEMPERED GLASS
GL05 — 10mm+12mm AIR GAP+10mm THK. I.G.U.
GL06 — 10mm+12mm AIR GAP+12mm THK. I.G.U.
PD01 — 10mm T.P+12mm AIR GAP+8mm T.P
GL07 — 10mm+12mm AIR GAP+12mm THK. I.G.U.
GL08 — 10mm+12mm AIR GAP+10mm THK. I.G.U.

NO.	DATE	REVISED	BY
H	29/08/2022	GENERAL REVISION	ada
G	21/10/2021	REVISION SUBJECT TO ARCH.COMMENT	ada
A	06/08/2021	REVISION SUBJECT TO ARCH.COMMENT	ada

JOB NO. : J-853

PROJECT :
PROPOSED RESIDENTIAL DEVELOPMENT AT N.K.I.L. 6542 YIN PING ROAD KOWLOON

TITLE :
WINDOW SCHEDULE FOR TOWER 2 ALUM. WINDOW

DATE : 03-APR-21 | SCALE : 1:40

DRAWN BY : | CHECKED BY :

美特鋁質有限公司
MIDI ALUMINIUM FABRICATOR LTD.
Units 6-8, Sunray Industrial Centre, 1/F
610 Cha Kwo Ling Road, Kowloon
Tel:23489211-4 Fax:(852)27727666

DWG NO. : J853-SD-PW-SC212 | REV. : H

ELEVATION

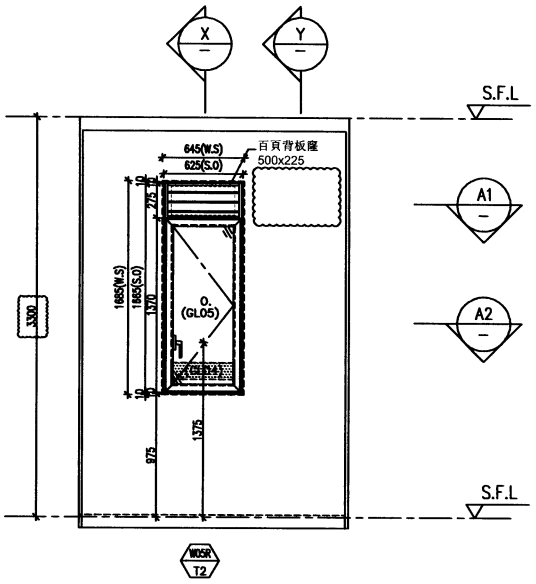

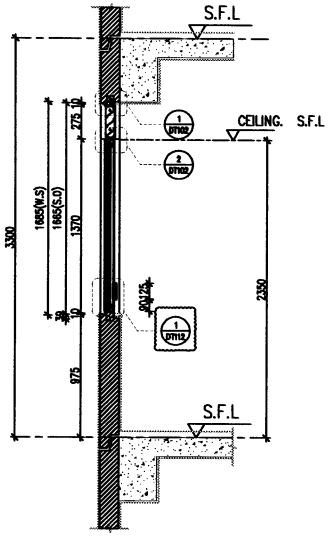

X PART SECTION

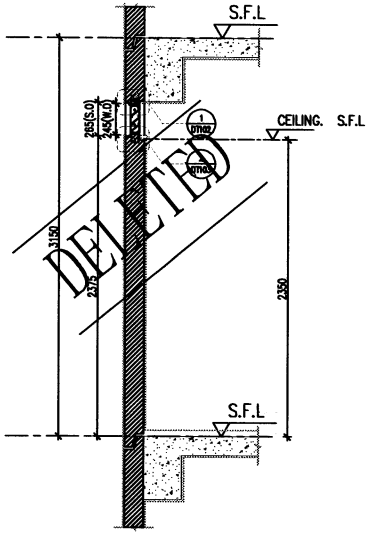

Y PART SECTION

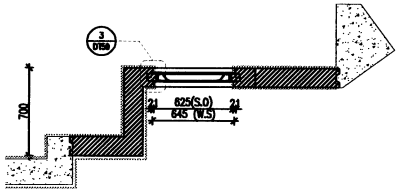

A1 PART PLAN

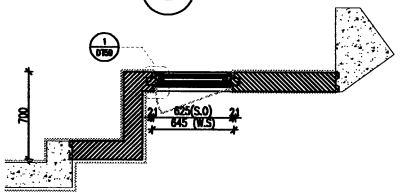

A2 PART PLAN

L01 T2

PROVIDED		
GLAZING AREA	–	m^2
OPENABLE AREA	–	m^2
FREE AREA	55.4	%

DELETED

W05R T2

PROVIDED		
GLAZING AREA	0.584	m^2
OPENABLE AREA	0.620	m^2
FREE AREA	60.7	%

WINDOW MARK	W05R T2
LOCATION	16F FLAT D MASTER BATH
SECTION	70mm ALUM. SECTION
GLAZING	GL05
QUANTITY	1 Nos
REMARKS	FACADE (T2-02-01B/16F)

B.D. REF :

CLIENT :
SHIMAO GROUP HOLDINGS LIMITED

ARCHITECT :
WONG TUNG & PARTNERS LIMITED
ARCHITECTS & PLANNERS

MAIN CONTRACTOR :
協興建築有限公司
HIP HING CONSTRUCTION CO LTD

STRUCTURAL ENGINEER :
C M WONG & ASSOCIATES LTD
黃志明建築工程師有限公司

FACADE CONSULTANT:
MEINHARDT

NOTE :
1. ALL DIMENSIONS ARE IN mm.
2. ALL ELEVATIONS ARE VIEWED FROM OUTSIDE.
3. ALL DIMENSIONS TO BE VERIFIED ON SITE BEFORE FABRICATION.

LEGEND :
- X1 / 2DS1 — DETAIL MARK NO. / REFER SHEET NO.
1. F.F.L. — FINISHED FLOOR LEVEL
2. S.F.L. — STRUCTURAL FLOOR LEVEL
3. (70) — REVERSED DETAIL
4. ▲ — FIXING LOCATION
5. △ — FIXING LUG LOCATION
6. GLASS LEGEND
   - GL01 — 10mm+12mm AIR GAP+10mm THK. L.G.U.
   - GL04 — 12mm THK. CLEAR TEMPERED GLASS
   - GL05 — 10mm+12mm AIR GAP+10mm THK. L.G.U.
   - GL06 — 10mm+12mm AIR GAP+12mm THK. L.G.U.
   - PD01 — 10mm T.P+12mm AIR GAP+8mm T.P
   - GL07 — 10mm+12mm AIR GAP+12mm THK. L.G.U.
   - GL08 — 10mm+12mm AIR GAP+10mm THK. L.G.U.

NO.	DATE	REVISED	BY

JOB NO. : J-853

PROJECT :
PROPOSED RESIDENTIAL DEVELOPMENT AT N.K.I.L. 6542 YIN PING ROAD KOWLOON

TITLE :
WINDOW SCHEDULE FOR TOWER 2 ALUM. WINDOW

DATE : 03-APR-21 | SCALE : 1:40

DRAWN BY : | CHECKED BY :

美特鋁製有限公司
MIDI ALUMINIUM FABRICATORS LTD.
Units 6-8, Sunray Industrial Centre, 1/F
610 Cha Kwo Ling Road, Kowloon
Tel:23489211-4 Fax:(852)27727666

DWG NO. : J853-SD-PW-SC212b | REV. : –

T:\Jobs\J-853\2. Outgoing\Black plate opening of Windows Louvre\Black Plate of T2 Precat Window.dwg

ELEVATION

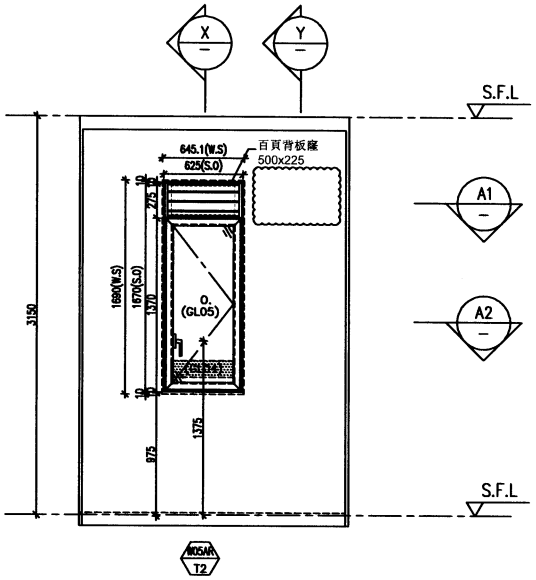

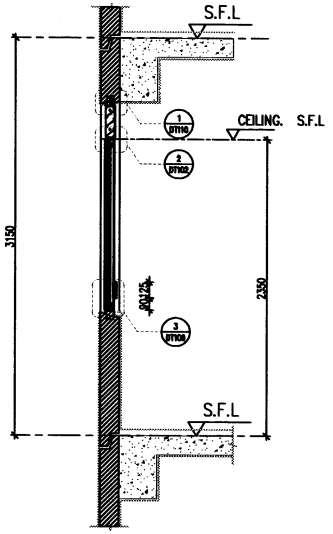

X PART SECTION

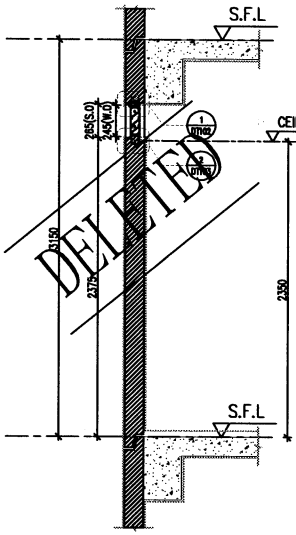

Y PART SECTION

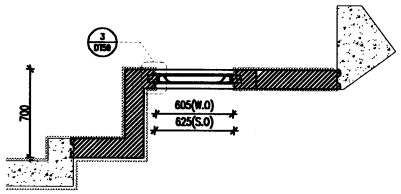

A1 PART PLAN

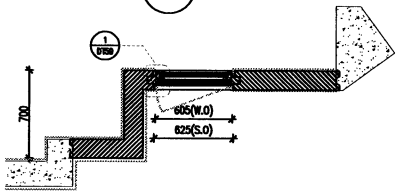

A2 PART PLAN

L01 T2

PROVIDED		
GLAZING AREA	–	m^2
OPENABLE AREA	–	m^2
FREE AREA	55.4	%

DELETED

W05AR T2

PROVIDED		
GLAZING AREA	0.581	m^2
OPENABLE AREA	0.620	m^2
FREE AREA	60.7	%

WINDOW MARK	W05AR T2
LOCATION	6F~15F FLAT D MASTER BATH
SECTION	70mm ALUM. SECTION
GLAZING	GL05
QUANTITY	8 Nos
REMARKS	FACADE (T2-02-01/6F~15F)

T:\Jobs\J-853\2. Outgoing\Black plate opening of Windows Louvre\Black Plate of T2 Precat Window.dwg

B.D. REF :

CLIENT :
SHIMAO GROUP HOLDINGS LIMITED

ARCHITECT :
WONG TUNG & PARTNERS LIMITED
ARCHITECTS & PLANNERS

MAIN CONTRACTOR :
協興建築有限公司
HIP HING CONSTRUCTION CO LTD

STRUCTURAL ENGINEER :
C M WONG & ASSOCIATES LTD
黃志明建築工程師有限公司

FACADE CONSULTANT:
MEINHARDT

NOTE :
1. ALL DIMENSIONS ARE IN mm.
2. ALL ELEVATIONS ARE VIEWED FROM OUTSIDE.
3. ALL DIMENSIONS TO BE VERIFIED ON SITE BEFORE FABRICATION.

LEGEND :
X1 — DETAIL MARK NO.
XD01 — REFER SHEET NO.
1. F.F.L. — FINISHED FLOOR LEVEL
2. S.F.L. — STRUCTURAL FLOOR LEVEL
3. (R) — REVERSED DETAIL
4. ▲ — FIXING LOCATION
5. △ — FIXING LUG LOCATION
6. GLASS LEGEND
GL01 — 10mm+12mm AIR GAP+10mm THK. LG.U.
GL04 — 12mm THK. CLEAR TEMPERED GLASS
GL05 — 10mm+12mm AIR GAP+10mm THK. LG.U.
GL06 — 10mm+12mm AIR GAP+12mm THK. LG.U.
PD01 — 10mm T.P+12mm AIR GAP+8mm T.P
GL07 — 10mm+12mm AIR GAP+12mm THK. LG.U.
GL08 — 10mm+12mm AIR GAP+10mm THK. LG.U.

NO.	DATE	REMARK	BY
H	29/08/2022	GENERAL REVISION	
G	22/10/2021	REVISION SUBJECT TO ARCH.COMMENT	

JOB NO. : J-853

PROJECT :
PROPOSED RESIDENTIAL DEVELOPMENT AT N.K.I.L. 6542 YIN PING ROAD KOWLOON

TITLE :
WINDOW SCHEDULE FOR TOWER 2 ALUM. WINDOW

DATE : 03-APR-21 | SCALE : 1:40

DRAWN BY : | CHECKED BY :

美特鋁質有限公司
MIDI ALUMINIUM FABRICATOR LTD.
Units 6-8, Sunray Industrial Centre, 1/F
610 Cho Kwo Ling Road, Kowloon
Tel:23488211-4 Fax:(852)27727666

DWG NO. : J853-SD-PW-SC212a | REV. : H

ELEVATION

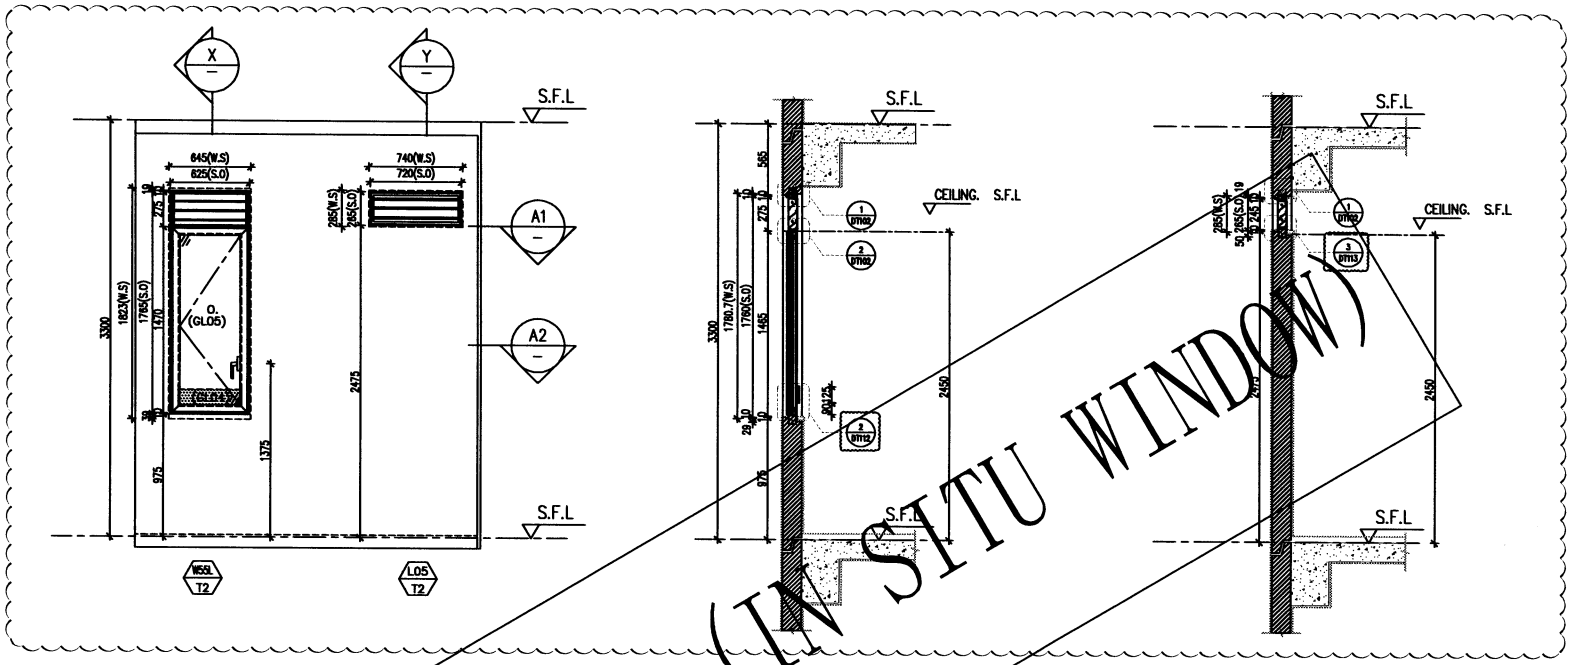

DELETED (IN SITU WINDOW)

X PART SECTION

Y PART SECTION

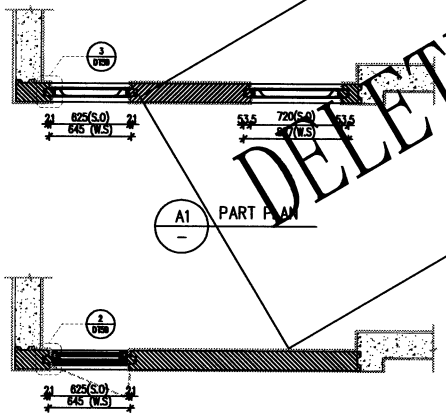

A1 PART PLAN

A2 PART PLAN

W05L T2	PROVIDED		
GLAZING AREA	—	m^2
OPENABLE AREA	—	m^2
FREE AREA	55.4	%

W05L T2	PROVIDED		
GLAZING AREA	0.584	m^2
OPENABLE AREA	0.620	m^2
FREE AREA	60.7	%

WINDOW MARK	W05L T2 & L05 T2
LOCATION	25F FLAT A ENSUITE 4 BATH
SECTION	70mm ALUM. SECTION
GLAZING	GL05
QUANTITY	1 Nos / 1 Nos
REMARKS	(T2-01-09A-25F)

T:\Jobs\J-853\2. Outgoing\Black plate opening of Windows Louvre\Black Plate of T2 Precat Window.dwg

B.D. REF :

CLIENT :
SHIMAO GROUP HOLDINGS LIMITED

ARCHITECT :
WONG TUNG & PARTNERS LIMITED
ARCHITECTS & PLANNERS

MAIN CONTRACTOR :
協興建築有限公司
HIP HING CONSTRUCTION CO LTD

STRUCTURAL ENGINEER :
C M WONG & ASSOCIATES LTD
黃志明建築工程師有限公司

FACADE CONSULTANT:
MEINHARDT

NOTE :
1. ALL DIMENSIONS ARE IN mm.
2. ALL ELEVATIONS ARE VIEWED FROM OUTSIDE.
3. ALL DIMENSIONS TO BE VERIFIED ON SITE BEFORE FABRICATION.

LEGEND :
- X1 / XXX1 — DETAIL MARK NO. / REFER SHEET NO.
1. F.F.L. — FINISHED FLOOR LEVEL
2. S.F.L. — STRUCTURAL FLOOR LEVEL
3. (R) — REVERSED DETAIL
4. ▲ — FIXING LOCATION
5. △ — FIXING LUG LOCATION
6. GLASS LEGEND
   - GL01 — 10mm+12mm AIR GAP+10mm THK. I.G.U.
   - GL04 — 12mm THK. CLEAR TEMPERED GLASS
   - GL05 — 10mm+12mm AIR GAP+10mm THK. I.G.U.
   - GL06 — 10mm+12mm AIR GAP+12mm THK. I.G.U.
   - PD01 — 10mm T.P+12mm AIR GAP+8mm T.P
   - GL07 — 10mm+12mm AIR GAP+12mm THK. I.G.U.
   - GL08 — 10mm+12mm AIR GAP+10mm THK. I.G.U.

NO.	DATE	REVISED	BY

JOB NO. : J-853

PROJECT :
PROPOSED RESIDENTIAL DEVELOPMENT AT N.K.I.L. 6542 YIN PING ROAD KOWLOON

TITLE :
WINDOW SCHEDULE FOR TOWER 2 ALUM. WINDOW

DATE : 20 JUL 2022 | SCALE : 1:40

DRAWN BY : | CHECKED BY :

美特鋁製有限公司
MIDI ALUMINIUM FABRICATOR LTD.
Units 6-8, Sunray Industrial Centre, 1/F
610 Cha Kwo Ling Road, Kowloon
Tel:23489211-4 Fax:(852)27727666

DWG NO. : J853-SD-PW-SC2098 REV. : —

ELEVATION

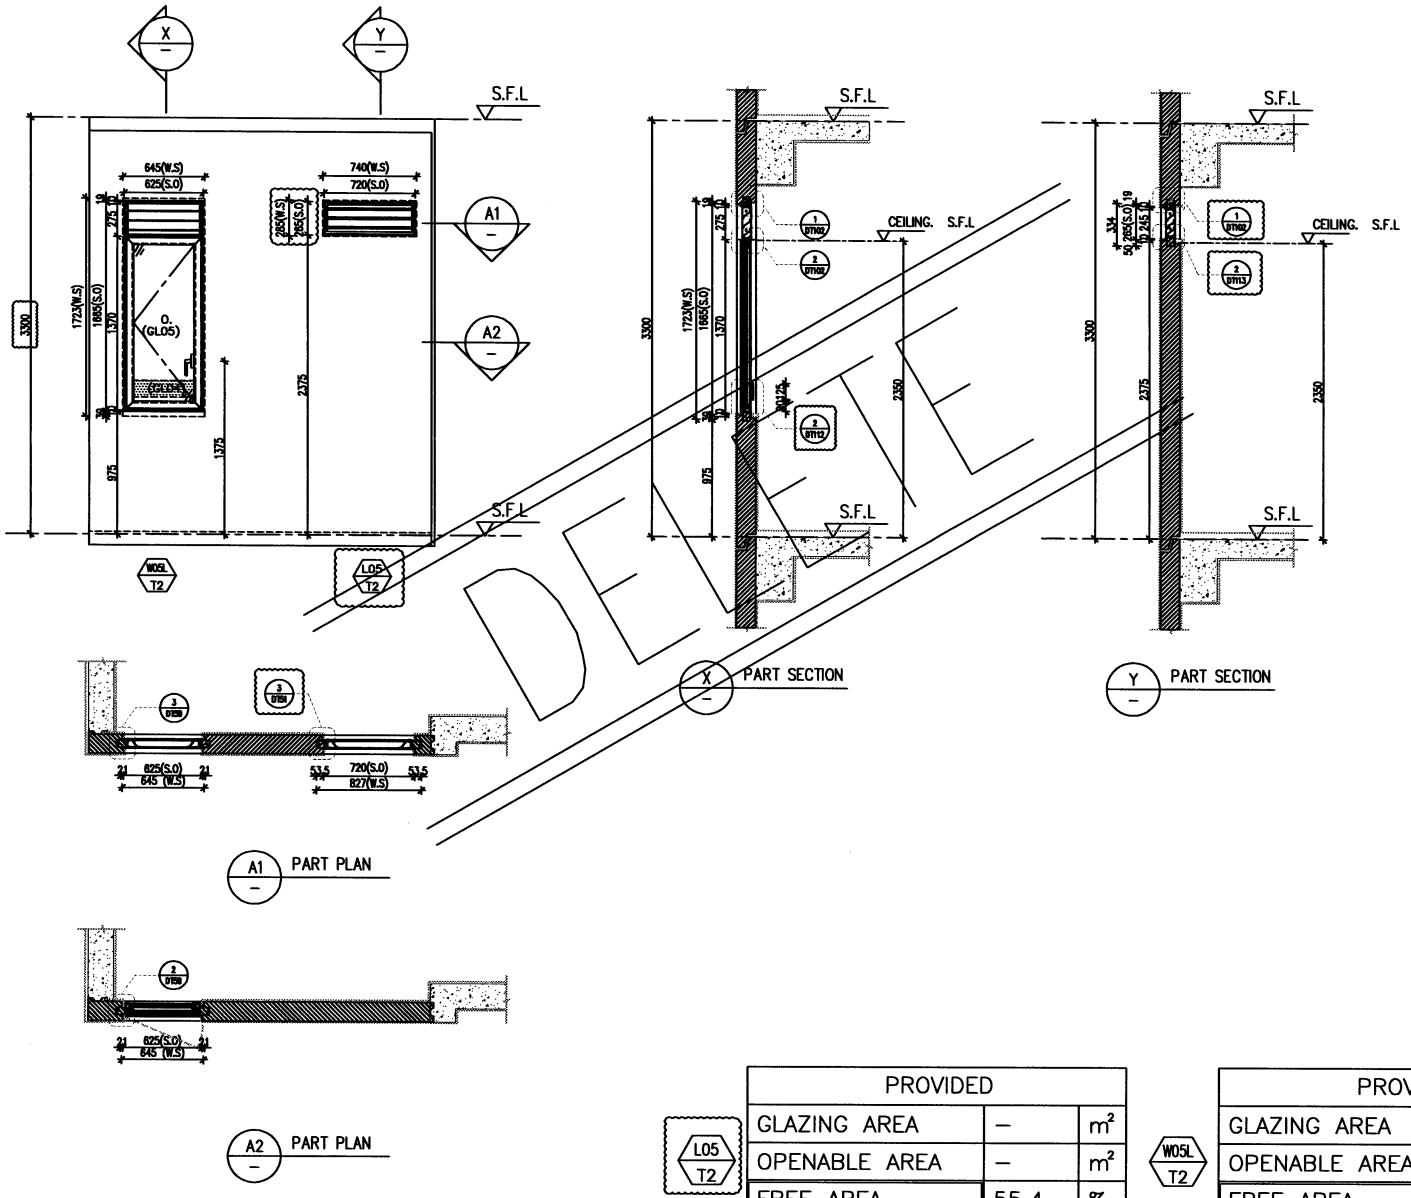

PROVIDED		
GLAZING AREA	–	m^2
OPENABLE AREA	–	m^2
FREE AREA	55.4	%

L05 T2

PROVIDED		
GLAZING AREA	0.584	m^2
OPENABLE AREA	0.620	m^2
FREE AREA	60.7	%

W05L T2

LOCATION	2–26 F FLAT A ENSUITE 3 EN. BATH
SECTION	70mm ALUM. SECTION
GLAZING	GL05
QUANTITY	1 Nos / 1 Nos.
REMARKS	FACADE (T2–01–10B/2–26F)

T:\Jobs\J-853\2. Outgoing\Black plate opening of Windows Louvre\Black Plate of T2 Precat Window.dwg

B.D. REF :

CLIENT :
SHIMAO GROUP HOLDINGS LIMITED

ARCHITECT :
WONG TUNG & PARTNERS LIMITED
ARCHITECTS & PLANNERS

MAIN CONTRACTOR :
協興建築有限公司
HIP HING CONSTRUCTION CO LTD

STRUCTURAL ENGINEER :
C M WONG & ASSOCIATES LTD
黃志明建築工程師有限公司

FACADE CONSULTANT:
MEINHARDT

NOTE :
1. ALL DIMENSIONS ARE IN mm.
2. ALL ELEVATIONS ARE VIEWED FROM OUTSIDE.
3. ALL DIMENSIONS TO BE VERIFIED ON SITE BEFORE FABRICATION.

LEGEND :
- X1 / XXX1 — DETAIL MARK NO. / REFER SHEET NO.
1. F.F.L. — FINISHED FLOOR LEVEL
2. S.F.L. — STRUCTURAL FLOOR LEVEL
3. (R) — REVERSED DETAIL
4. ▲ — FIXING LOCATION
5. △ — FIXING LUG LOCATION
6. GLASS LEGEND
   - GL01 — 10mm+12mm AIR GAP+10mm THK. I.G.U.
   - GL04 — 12mm THK. CLEAR TEMPERED GLASS
   - GL05 — 10mm+12mm AIR GAP+10mm THK. I.G.U.
   - GL06 — 10mm+12mm AIR GAP+12mm THK. I.G.U.
   - PD01 — 10mm T.P+12mm AIR GAP+8mm T.P
   - GL07 — 10mm+12mm AIR GAP+12mm THK. I.G.U.
   - GL08 — 10mm+12mm AIR GAP+10mm THK. I.G.U.

NO.	DATE	REVISED	BY

JOB NO. : J–853

PROJECT :
PROPOSED RESIDENTIAL DEVELOPMENT AT N.K.I.L. 6542 YIN PING ROAD KOWLOON

TITLE :
WINDOW SCHEDULE FOR TOWER 2 ALUM. WINDOW

DATE : 03–APR–21 | SCALE : 1:40

DRAWN BY : | CHECKED BY :

美特鋁質有限公司
MIDI ALUMINIUM FABRICATOR LTD.
Units 6–8, Sunray Industrial Centre, 1/F
610 Cha Kwo Ling Road, Kowloon
Tel:23489211–4 Fax:(852)27727666

DWG NO. : J853–SD–PW–SC210a | REV. : –

ELEVATION

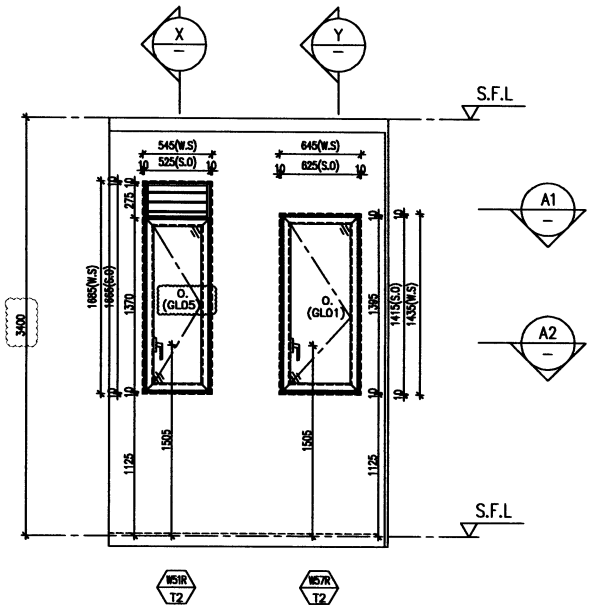

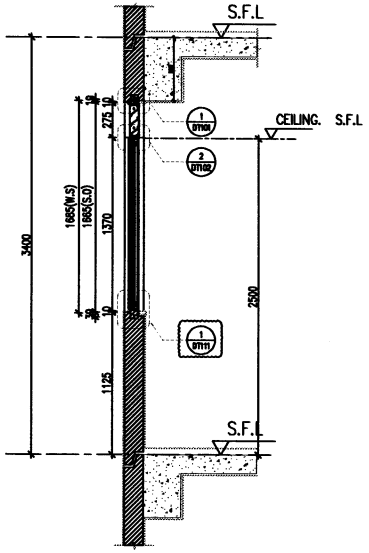

X PART SECTION

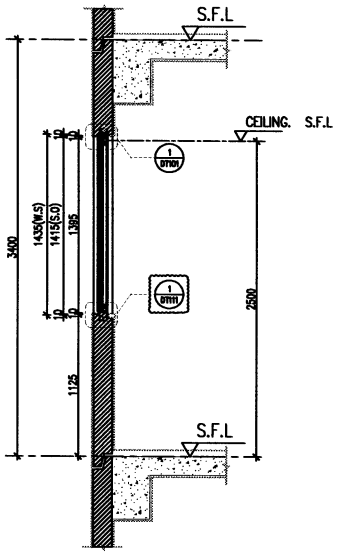

Y PART SECTION

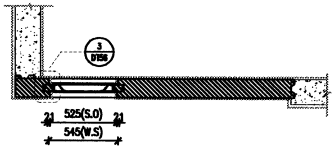

A1 PART PLAN

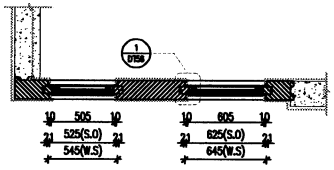

A2 PART PLAN

PROVIDED		
GLAZING AREA	0.594	m^2
OPENABLE AREA	0.698	m^2
FREE AREA	—	%

W57R T2

PROVIDED		
GLAZING AREA	0.460	m^2
OPENABLE AREA	0.557	m^2
FREE AREA	60.7	%

W51R T2

WINDOW MARK	W57R T2 & W51R T2
LOCATION	23F FLAT C LAV. / UTILITY
SECTION	70mm ALUM. SECTION
GLAZING	GL01/W57R , GL05/W51R
QUANTITY	1 Nos.
REMARKS	FACADE (T2-01-07B/23F)

T:\Jobs\J-853\2. Outgoing\Black plate opening of Windows Louvre\Black Plate of T2 Precat Window.dwg

B.D. REF :

CLIENT :
SHIMAO GROUP HOLDINGS LIMITED

ARCHITECT :
WONG TUNG & PARTNERS LIMITED
ARCHITECTS & PLANNERS

MAIN CONTRACTOR :
協興建築有限公司
HIP HING CONSTRUCTION CO LTD

STRUCTURAL ENGINEER :
CMA C M WONG & ASSOCIATES LTD
黃志明建築工程師有限公司

FACADE CONSULTANT:
MEINHARDT

NOTE :
1. ALL DIMENSIONS ARE IN mm.
2. ALL ELEVATIONS ARE VIEWED FROM OUTSIDE.
3. ALL DIMENSIONS TO BE VERIFIED ON SITE BEFORE FABRICATION.

LEGEND :
- X1 / X001 — DETAIL MARK NO. / REFER SHEET NO.
1. F.F.L. — FINISHED FLOOR LEVEL
2. S.F.L. — STRUCTURAL FLOOR LEVEL
3. (75) — REVERSED DETAIL
4. ▲ — FIXING LOCATION
5. △ — FIXING LUG LOCATION
6. GLASS LEGEND
   - GL01 — 10mm+12mm AIR GAP+10mm THK. I.G.U.
   - GL04 — 12mm THK. CLEAR TEMPERED GLASS
   - GL05 — 10mm+12mm AIR GAP+10mm THK. I.G.U.
   - GL06 — 10mm+12mm AIR GAP+12mm THK. I.G.U.
   - PD01 — 10mm T.P+12mm AIR GAP+8mm T.P
   - GL07 — 10mm+12mm AIR GAP+12mm THK. I.G.U.
   - GL08 — 10mm+12mm AIR GAP+10mm THK. I.G.U.

NO.	DATE	REMARK	BY
H	29/08/2022	GENERAL REVISION	bda

JOB NO. : J-853

PROJECT :
PROPOSED RESIDENTIAL DEVELOPMENT AT N.K.I.L. 6542 YIN PING ROAD KOWLOON

TITLE :
WINDOW SCHEDULE FOR TOWER 2 ALUM. WINDOW

DATE : 03-APR-21 | SCALE : 1:40

DRAWN BY : | CHECKED BY :

美特鋁質有限公司
MIDI ALUMINIUM FABRICATOR LTD.
Units 6-8, Sunray Industrial Centre, 1/F
610 Cha Kwo Ling Road, Kowloon
Tel:23489211-4 Fax:(852)27727666

DWG NO. : J853-SD-PW-SC207c | REV. : —

ELEVATION

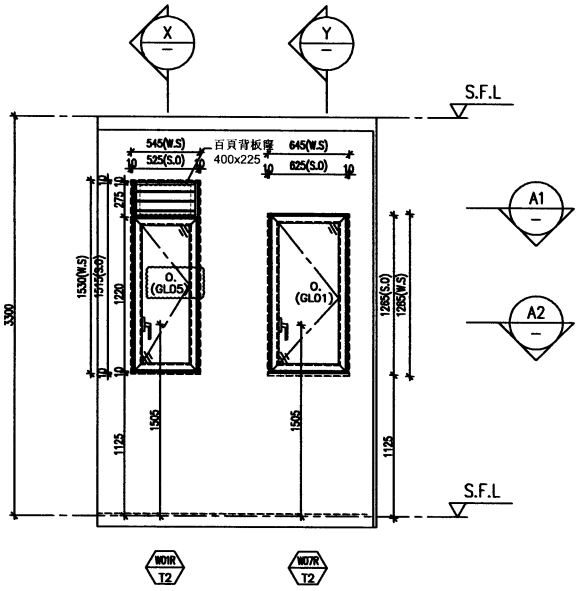

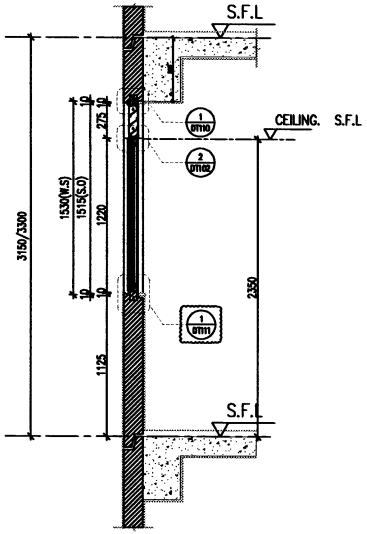

X PART SECTION

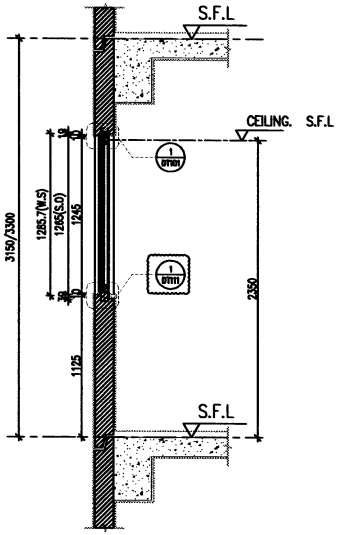

Y PART SECTION

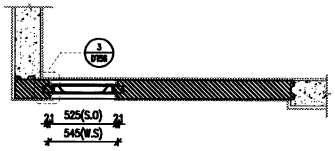

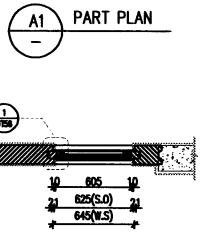

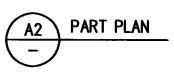

W07R T2	PROVIDED		
GLAZING AREA	0.523	m^2
OPENABLE AREA	0.618	m^2
FREE AREA	–	%

W01R T2	PROVIDED		
GLAZING AREA	0.404	m^2
OPENABLE AREA	0.492	m^2
FREE AREA	60.7	%

WINDOW MARK	W07R T2 & W01R T2
LOCATION	16F&26F FLAT C LAV. / UTILITY
SECTION	70mm ALUM. SECTION
GLAZING	GL01/W07R , GL05/W01R
QUANTITY	2 Nos.
REMARKS	FACADE (T2-01-07A/16F&26F)

T:\Jobs\J-853\2. Outgoing\Black plate opening of Windows Louvre\Black Plate of T2 Precat Window.dwg

B.D. REF :

CLIENT :
SHIMAO GROUP HOLDINGS LIMITED

ARCHITECT :
WONG TUNG & PARTNERS LIMITED
ARCHITECTS & PLANNERS

MAIN CONTRACTOR :
協興建築有限公司
HIP HING CONSTRUCTION CO LTD

STRUCTURAL ENGINEER :
CMA C M WONG & ASSOCIATES LTD
黃志明建築工程師有限公司

FACADE CONSULTANT:
MEINHARDT

NOTE :
1. ALL DIMENSIONS ARE IN mm.
2. ALL ELEVATIONS ARE VIEWED FROM OUTSIDE.
3. ALL DIMENSIONS TO BE VERIFIED ON SITE BEFORE FABRICATION.

LEGEND :
- X1 / X001 — DETAIL MARK NO. / REFER SHEET NO.
1. F.F.L. — FINISHED FLOOR LEVEL
2. S.F.L. — STRUCTURAL FLOOR LEVEL
3. R — REVERSED DETAIL
4. ▲ — FIXING LOCATION
5. △ — FIXING LUG LOCATION
6. GLASS LEGEND
   - GL01 — 10mm+12mm AIR GAP+10mm THK. I.G.U.
   - GL04 — 12mm THK. CLEAR TEMPERED GLASS
   - GL05 — 10mm+12mm AIR GAP+10mm THK. I.G.U.
   - GL06 — 10mm+12mm AIR GAP+12mm THK. I.G.U.
   - PD01 — 10mm T.P+12mm AIR GAP+8mm T.P
   - GL07 — 10mm+12mm AIR GAP+12mm THK. I.G.U.
   - GL08 — 10mm+12mm AIR GAP+10mm THK. I.G.U.

NO.	DATE	REMARK	BY
H	29/08/2022	GENERAL REVISION	edo

JOB NO. : J-853

PROJECT :
PROPOSED RESIDENTIAL DEVELOPMENT AT N.K.I.L. 6542 YIN PING ROAD KOWLOON

TITLE :
WINDOW SCHEDULE FOR TOWER 2 ALUM. WINDOW

DATE : 03-APR-21 | SCALE : 1:40

DRAWN BY : | CHECKED BY :

美特鋁質有限公司
MIDI ALUMINIUM FABRICATION LTD.
Units 6-8, Sunray Industrial Centre, 1/F
610 Cha Kwo Ling Road, Kowloon
Tel:23489211-4 Fax:(852)27727666

DWG NO. : J853-SD-PW-SC207b | REV. : –

ELEVATION

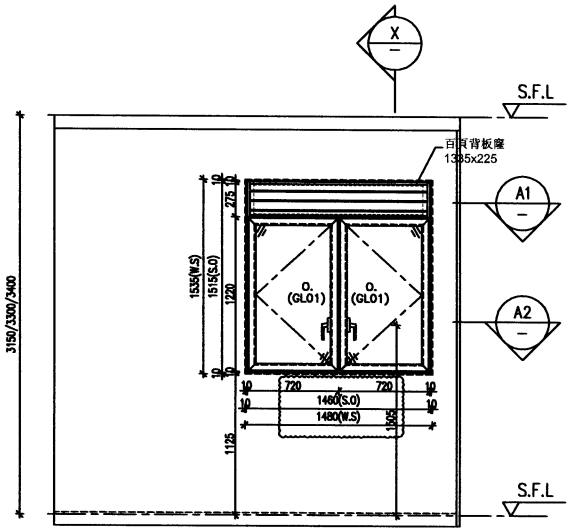

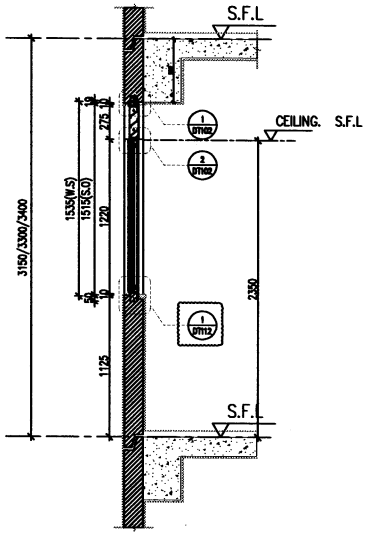

X PART SECTION

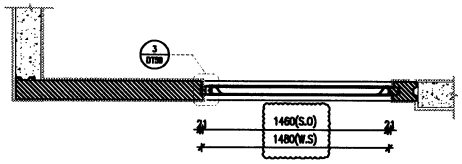

A1 PART PLAN

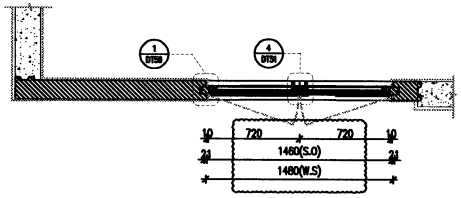

A2 PART PLAN

PROVIDED		
GLAZING AREA	1.285	m^2
OPENABLE AREA	1.486	m^2
FREE AREA	60.7	%

WINDOW MARK	W10 / T2
LOCATION	16F&26F FLAT B KITCHEN
SECTION	70mm ALUM. SECTION
GLAZING	GL01
QUANTITY	2 Nos.
REMARKS	FACADE (T2-01-03A/16F&26F)

B.D. REF :

CLIENT :
SHIMAO GROUP HOLDINGS LIMITED

ARCHITECT :
WONG TUNG & PARTNERS LIMITED
ARCHITECTS & PLANNERS

MAIN CONTRACTOR :
協興建築有限公司
HIP HING CONSTRUCTION CO LTD

STRUCTURAL ENGINEER :
CMA C M WONG & ASSOCIATES LTD
黃志明建築工程師有限公司

FACADE CONSULTANT:
MEINHARDT

NOTE :
1. ALL DIMENSIONS ARE IN mm.
2. ALL ELEVATIONS ARE VIEWED FROM OUTSIDE.
3. ALL DIMENSIONS TO BE VERIFIED ON SITE BEFORE FABRICATION.

LEGEND :
X1 / X001 — DETAIL MARK NO. / REFER SHEET NO.
1. F.F.L. — FINISHED FLOOR LEVEL
2. S.F.L. — STRUCTURAL FLOOR LEVEL
3. (R) — REVERSED DETAIL
4. ▲ — FIXING LOCATION
5. △ — FIXING LUG LOCATION
6. GLASS LEGEND
GL01 — 10mm+12mm AIR GAP+10mm THK. I.G.U.
GL04 — 12mm THK. CLEAR TEMPERED GLASS
GL05 — 10mm+12mm AIR GAP+10mm THK. I.G.U.
GL06 — 10mm+12mm AIR GAP+12mm THK. I.G.U.
PD01 — 10mm T.P+12mm AIR GAP+8mm T.P
GL07 — 10mm+12mm AIR GAP+12mm THK. I.G.U.
GL08 — 10mm+12mm AIR GAP+10mm THK. I.G.U.

NO.	DATE	REMARK	BY
A	30/06/2022	GENERAL REVISION	

JOB NO. : J-853

PROJECT :
PROPOSED RESIDENTIAL DEVELOPMENT AT N.K.I.L. 6542 YIN PING ROAD KOWLOON

TITLE :
WINDOW SCHEDULE FOR TOWER 2 ALUM. WINDOW

DATE : 03-APR-21 | SCALE : 1:40

DRAWN BY : | CHECKED BY :

美特鋁質有限公司
MIDI ALUMINIUM FABRICATOR LTD.
Units 6-8, Sunray Industrial Centre, 1/F
610 Cha Kwo Ling Road, Kowloon
Tel:23489211-4 Fax:(852)27727666

DWG NO. : J853-SD-PW-SC203b | REV. : -

T:\Jobs\J-853\2. Outgoing\Black plate opening of Windows Louvre\Black Plate of T2 Precat Window.dwg

ELEVATION

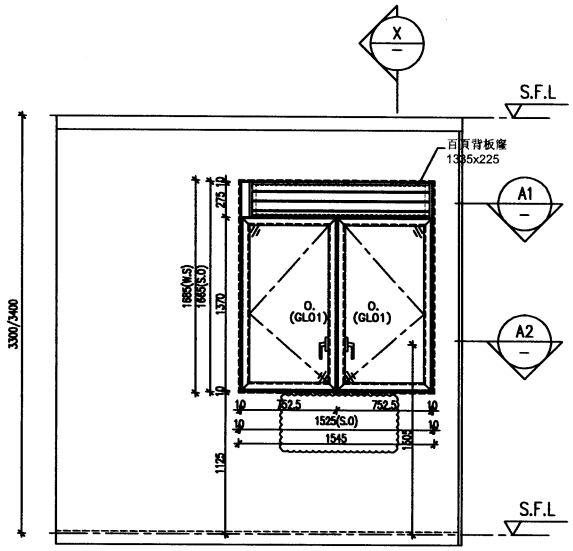

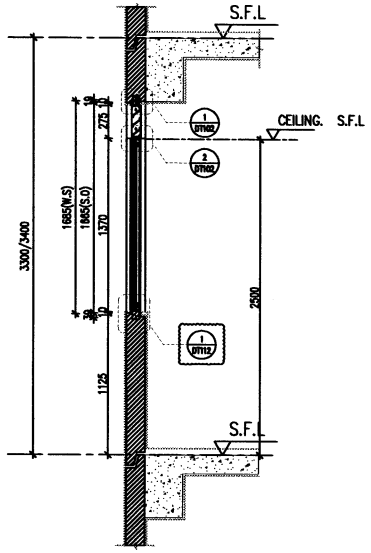

X PART SECTION

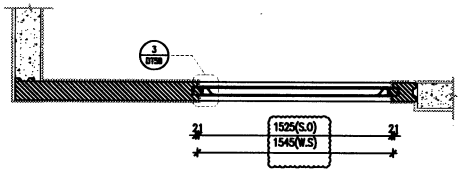

A1 PART PLAN

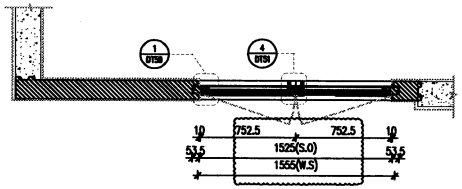

A2 PART PLAN

PROVIDED		
GLAZING AREA	1.461	m^2
OPENABLE AREA	1.680	m^2
FREE AREA	60.7	%

WINDOW MARK	W60 T2
LOCATION	23F FLAT B KITCHEN
SECTION	70mm ALUM. SECTION
GLAZING	GL01
QUANTITY	1 No.
REMARKS	FACADE (T2-01-03B/23F)

T:\Jobs\J-853\2. Outgoing\Black plate opening of Windows Louvre\Black Plate of T2 Precat Window.dwg

B.D. REF :

CLIENT :
SHIMAO GROUP HOLDINGS LIMITED

ARCHITECT :
WONG TUNG & PARTNERS LIMITED
ARCHITECTS & PLANNERS

MAIN CONTRACTOR :
協興建築有限公司
HIP HING CONSTRUCTION CO LTD

STRUCTURAL ENGINEER :
C M WONG & ASSOCIATES LTD
黃志明建築工程師有限公司

FACADE CONSULTANT:
MEINHARDT

NOTE :
1. ALL DIMENSIONS ARE IN mm.
2. ALL ELEVATIONS ARE VIEWED FROM OUTSIDE.
3. ALL DIMENSIONS TO BE VERIFIED ON SITE BEFORE FABRICATION.

LEGEND :
X1 / XD01 — DETAIL MARK NO. / REFER SHEET NO.
1. F.F.L. — FINISHED FLOOR LEVEL
2. S.F.L. — STRUCTURAL FLOOR LEVEL
3. — REVERSED DETAIL
4. ▲ — FIXING LOCATION
5. △ — FIXING LUG LOCATION
6. GLASS LEGEND
GL01 — 10mm+12mm AIR GAP+10mm THK. L.G.U.
GL04 — 12mm THK. CLEAR TEMPERED GLASS
GL05 — 10mm+12mm AIR GAP+10mm THK. L.G.U.
GL06 — 10mm+12mm AIR GAP+12mm THK. L.G.U.
PD01 — 10mm T.P+12mm AIR GAP+8mm T.P
GL07 — 10mm+12mm AIR GAP+12mm THK. L.G.U.
GL08 — 10mm+12mm AIR GAP+10mm THK. L.G.U.

NO.	DATE	REMARK	BY
A	30/08/2022	GENERAL REVISION	ada

JOB NO. : J-853

PROJECT :
PROPOSED RESIDENTIAL DEVELOPMENT AT N.K.I.L. 6542 YIN PING ROAD KOWLOON

TITLE :
WINDOW SCHEDULE FOR TOWER 2 ALUM. WINDOW

DATE : 03-APR-21 | SCALE : 1:40

DRAWN BY : | CHECKED BY :

美特鋁實有限公司
MIDI ALUMINIUM FABRICATOR LTD.
Units 6-8, Sunray Industrial Centre, 1/F
610 Cha Kwo Ling Road, Kowloon
Tel:23489211-4 Fax:(852)27727666

DWG NO. : J853-SD-PW-SC203c | REV. : -

ELEVATION

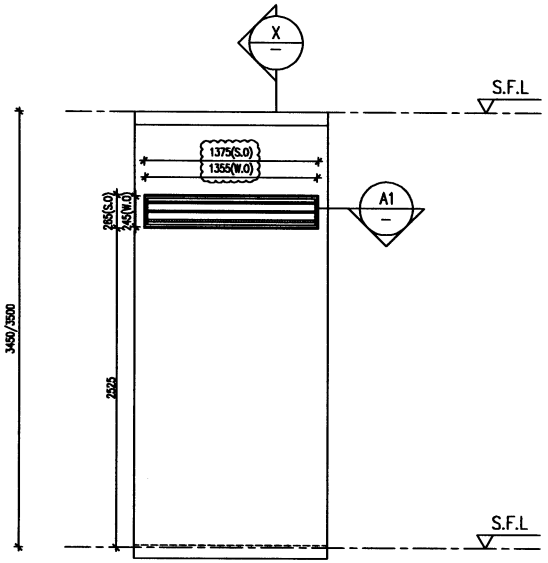

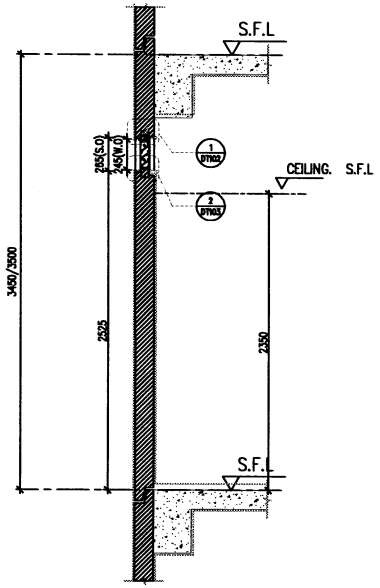

X PART SECTION

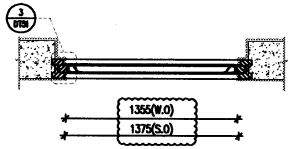

A1 PART PLAN

PROVIDED		
GLAZING AREA	0	m^2
OPENABLE AREA	0	m^2
FREE AREA	55.4	%

WINDOW MARK	L05 / T1
LOCATION	5F–25F COMMON STAIRCASE
SECTION	70mm ALUM. LOUVER
GLAZING	–
QUANTITY	18 Nos.
REMARKS	FACADE (T1–02–01/5F–21F; T1–02–02/22F & 23F)

T:\Jobs\J-853\2. Outgoing\Black plate opening of Windows Louvre\Black Plate of T2 Precat Window.dwg

B.D. REF :

CLIENT :
SHIMAO GROUP HOLDINGS LIMITED

ARCHITECT :
WONG TUNG & PARTNERS LIMITED
ARCHITECTS & PLANNERS

MAIN CONTRACTOR :
協興建築有限公司
HIP HING CONSTRUCTION CO LTD

STRUCTURAL ENGINEER :
C M WONG & ASSOCIATES LTD
黃志明建築工程師有限公司

FACADE CONSULTANT:
MEINHARDT

NOTE :
1. ALL DIMENSIONS ARE IN mm.
2. ALL ELEVATIONS ARE VIEWED FROM OUTSIDE.
3. ALL DIMENSIONS TO BE VERIFIED ON SITE BEFORE FABRICATION.

LEGEND :
X1 / XDW1 — DETAIL MARK NO. / REFER SHEET NO.
1. F.F.L. — FINISHED FLOOR LEVEL
2. S.F.L. — STRUCTURAL FLOOR LEVEL
3. Ⓡ — REVERSED DETAIL
4. ▲ — FIXING LOCATION
5. △ — FIXING LUG LOCATION
6. GLASS LEGEND
GL01 — 10mm+12mm AIR GAP+10mm THK. I.G.U.
GL04 — 12mm THK. CLEAR TEMPERED GLASS
GL05 — 10mm+12mm AIR GAP+10mm THK. I.G.U.
GL06 — 10mm+12mm AIR GAP+12mm THK. I.G.U.
PD01 — 10mm T.P+12mm AIR GAP+8mm T.P
GL07 — 10mm+12mm AIR GAP+12mm THK. I.G.U.
GL08 — 10mm+12mm AIR GAP+10mm THK. I.G.U.

NO.	DATE	REVISED	BY

JOB NO. : J–853

PROJECT :
PROPOSED RESIDENTIAL DEVELOPMENT AT N.K.I.L. 6542
YIN PING ROAD
KOWLOON

TITLE :
WINDOW SCHEDULE FOR TOWER 1 ALUM. WINDOW

DATE : 03–APR–21 | SCALE : 1:40

DRAWN BY : | CHECKED BY :

美特鋁製有限公司
MIDI ALUMINIUM FABRICATOR LTD.
Units 6–8, Sunray Industrial Centre, 1/F
610 Cha Kwo Ling Road, Kowloon
Tel:23489211–4 Fax:(852)27727666

DWG NO. : J853–SD–PW–SC101 | REV. : –

ELEVATION

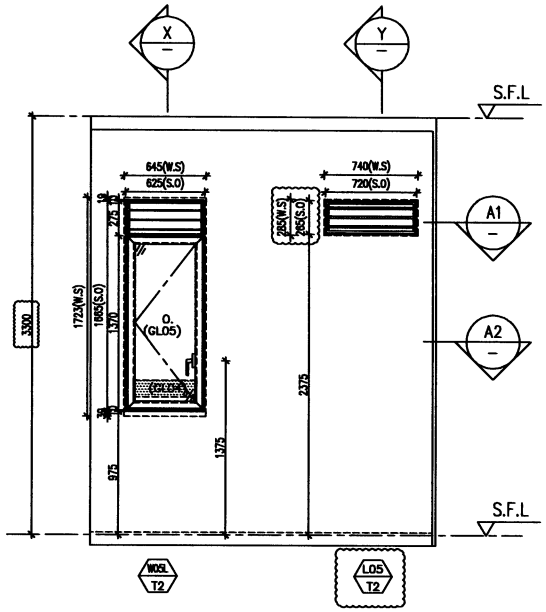

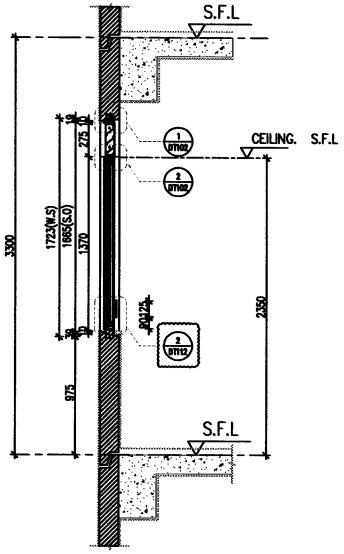

X PART SECTION

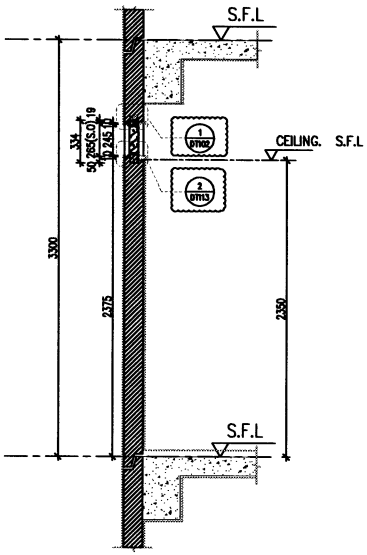

Y PART SECTION

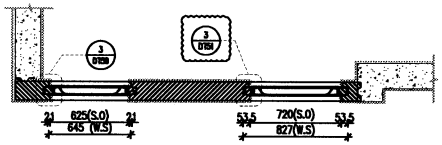

A1 PART PLAN

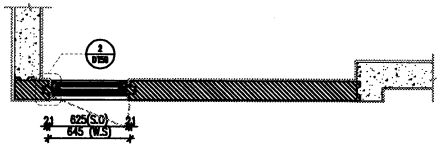

A2 PART PLAN

L05 T2	PROVIDED		
GLAZING AREA	–	m^2
OPENABLE AREA	–	m^2
FREE AREA	55.4	%

W05L T2	PROVIDED		
GLAZING AREA	0.584	m^2
OPENABLE AREA	0.620	m^2
FREE AREA	60.7	%

WINDOW MARK	W05L T2 & L05 T2
LOCATION	16F FLAT A MASTER BATH
SECTION	70mm ALUM. SECTION
GLAZING	GL05
QUANTITY	1 Nos / 1 Nos
REMARKS	FACADE(T2-01-01A/16F)

T:\Jobs\J-853\2. Outgoing\Black plate opening of Windows Louvre\Black Plate of T2 Precat Window.dwg

B.D. REF :

CLIENT :
SHIMAO GROUP HOLDINGS LIMITED

ARCHITECT :
WONG TUNG & PARTNERS LIMITED
ARCHITECTS & PLANNERS

MAIN CONTRACTOR :
協興建築有限公司
HIP HING CONSTRUCTION CO LTD

STRUCTURAL ENGINEER :
C M WONG & ASSOCIATES LTD
黃志明建築工程師有限公司

FACADE CONSULTANT:
MEINHARDT

NOTE :
1. ALL DIMENSIONS ARE IN mm.
2. ALL ELEVATIONS ARE VIEWED FROM OUTSIDE.
3. ALL DIMENSIONS TO BE VERIFIED ON SITE BEFORE FABRICATION.

LEGEND :
X1 / X001 — DETAIL MARK NO. / REFER SHEET NO.
1. F.F.L. — FINISHED FLOOR LEVEL
2. S.F.L. — STRUCTURAL FLOOR LEVEL
3. — REVERSED DETAIL
4. — FIXING LOCATION
5. — FIXING LUG LOCATION
6. GLASS LEGEND
GL01 — 10mm+12mm AIR GAP+10mm THK. I.G.U.
GL04 — 12mm THK. CLEAR TEMPERED GLASS
GL05 — 10mm+12mm AIR GAP+10mm THK. I.G.U.
GL06 — 10mm+12mm AIR GAP+12mm THK. I.G.U.
PD01 — 10mm T.P+12mm AIR GAP+8mm T.P
GL07 — 10mm+12mm AIR GAP+12mm THK. I.G.U.
GL08 — 10mm+12mm AIR GAP+10mm THK. I.G.U.

NO.	DATE	REVISED	BY
A	30/09/2022	GENERAL REVISION	mlm

JOB NO. : J-853

PROJECT :
PROPOSED RESIDENTIAL DEVELOPMENT AT N.K.I.L. 6542 YIN PING ROAD KOWLOON

TITLE :
WINDOW SCHEDULE FOR TOWER 2 ALUM. WINDOW

DATE : 03-APR-21 | SCALE : 1:40

DRAWN BY : | CHECKED BY :

美特鋁製有限公司
MIDI ALUMINIUM FABRICATOR LTD.
Units 6-8, Sunray Industrial Centre, 1/F
610 Cha Kwo Ling Road, Kowloon
Tel:23488211-4 Fax:(852)27727666

DWG NO. : J853-SD-PW-SC201a | REV. : –

ELEVATION

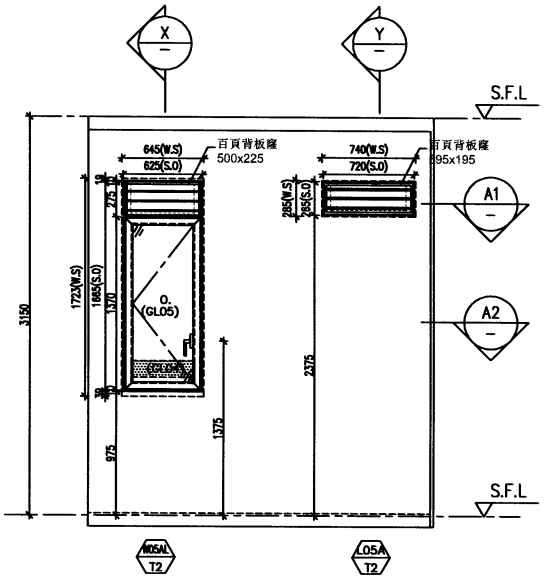

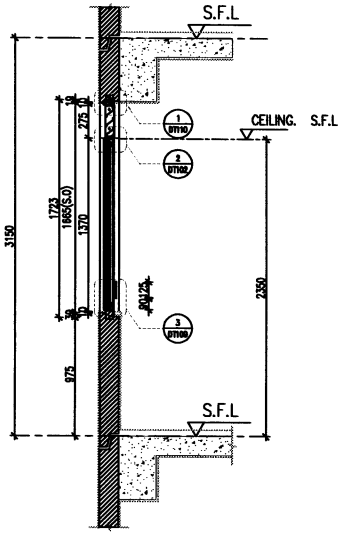

X PART SECTION

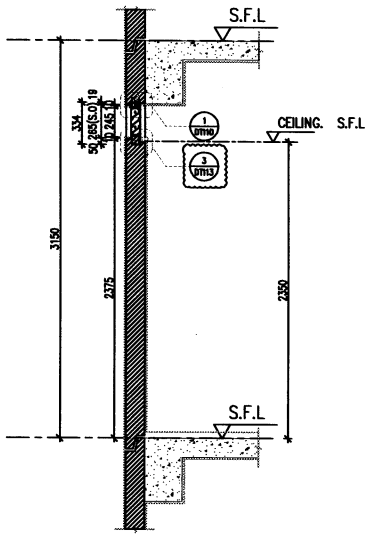

Y PART SECTION

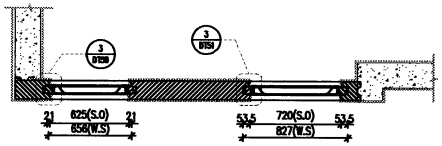

A1 PART PLAN

A2 PART PLAN

PROVIDED		
GLAZING AREA	–	m^2
OPENABLE AREA	–	m^2
FREE AREA	55.4	%

L05A T2

PROVIDED		
GLAZING AREA	0.581	m^2
OPENABLE AREA	0.618	m^2
FREE AREA	60.7	%

W05AL T2

WINDOW MARK	W05AL T2 & L05A T2
LOCATION	6F~15F FLAT A MASTER BATH
SECTION	70mm ALUM. SECTION
GLAZING	GL05
QUANTITY	8 Nos / 8 Nos
REMARKS	FACADE(T2-01-01/6~15F)

T:\Jobs\J-853\2. Outgoing\Black plate opening of Windows Louvre\Black Plate of T2 Precat Window.dwg

B.D. REF :

CLIENT :
SHIMAO GROUP HOLDINGS LIMITED

ARCHITECT :
WONG TUNG & PARTNERS LIMITED
ARCHITECTS & PLANNERS

MAIN CONTRACTOR :
協興建築有限公司
HIP HING CONSTRUCTION CO LTD

STRUCTURAL ENGINEER :
CMA C M WONG & ASSOCIATES LTD
黃志明建築工程師有限公司

FACADE CONSULTANT:
MEINHARDT

NOTE :
1. ALL DIMENSIONS ARE IN mm.
2. ALL ELEVATIONS ARE VIEWED FROM OUTSIDE.
3. ALL DIMENSIONS TO BE VERIFIED ON SITE BEFORE FABRICATION.

LEGEND :
- DETAIL MARK NO.
- REFER SHEET NO.

1. F.F.L. — FINISHED FLOOR LEVEL
2. S.F.L. — STRUCTURAL FLOOR LEVEL
3. — REVERSED DETAIL
4. ▲ — FIXING LOCATION
5. △ — FIXING LUG LOCATION
6. GLASS LEGEND
   - GL01 — 10mm+12mm AIR GAP+10mm THK. I.G.U.
   - GL04 — 12mm THK. CLEAR TEMPERED GLASS
   - GL05 — 10mm+12mm AIR GAP+10mm THK. I.G.U.
   - GL06 — 10mm+12mm AIR GAP+12mm THK. I.G.U.
   - PD01 — 10mm T.P+12mm AIR GAP+8mm T.P
   - GL07 — 10mm+12mm AIR GAP+12mm THK. I.G.U.
   - GL08 — 10mm+12mm AIR GAP+10mm THK. I.G.U.

NO.	DATE	REMARK	BY
H	30/08/2022	GENERAL REVISION	mlb
G	22/10/2021	REVISION SUBJECT TO ARCH.COMMENT	mlb
A	05/08/2021	REVISION SUBJECT TO ARCH.COMMENT	mlb

JOB NO. : J-853

PROJECT :
PROPOSED RESIDENTIAL DEVELOPMENT AT N.K.I.L. 6542 YIN PING ROAD KOWLOON

TITLE :
WINDOW SCHEDULE FOR TOWER 2 ALUM. WINDOW

DATE : 03-APR-21 | SCALE : 1:40

DRAWN BY : | CHECKED BY :

美特鋁製有限公司
MIDI ALUMINIUM FABRICATOR LTD.
Units 6-8, Sunray Industrial Centre, 1/F
610 Cha Kwo Ling Road, Kowloon
Tel:23489211-4 Fax:(852)27727666

DWG NO. : J853-SD-PW-SC201 | REV. : H

ELEVATION

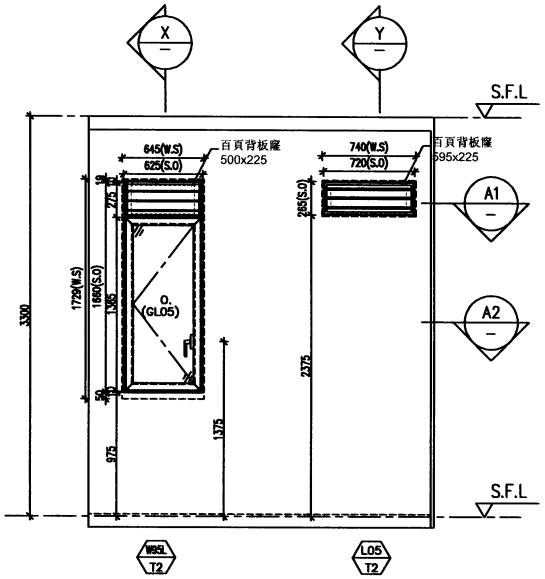

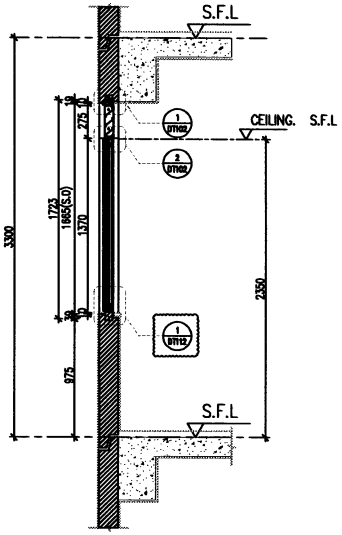

X PART SECTION

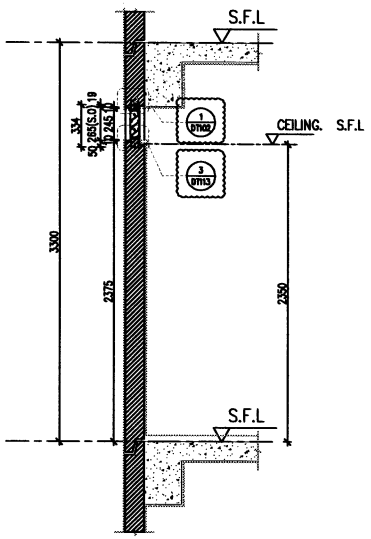

Y PART SECTION

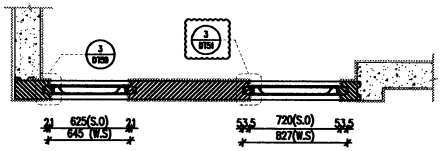

A1 PART PLAN

A2 PART PLAN

L05 T2	PROVIDED		
GLAZING AREA	–	m^2
OPENABLE AREA	–	m^2
FREE AREA	55.4	%

W05L T2	PROVIDED		
GLAZING AREA	0.584	m^2
OPENABLE AREA	0.620	m^2
FREE AREA	60.7	%

WINDOW MARK	W05L T2 & L05 T2
LOCATION	5F FLAT A MASTER BATH
SECTION	70mm ALUM. SECTION
GLAZING	GL05
QUANTITY	1 Nos / 1 Nos
REMARKS	FACADE(T2-01-01A/5F)

B.D. REF :

CLIENT :
SHIMAO GROUP HOLDINGS LIMITED

ARCHITECT :
WONG TUNG & PARTNERS LIMITED
ARCHITECTS & PLANNERS

MAIN CONTRACTOR :
協興建築有限公司
HIP HING CONSTRUCTION CO LTD

STRUCTURAL ENGINEER :
CMA C M WONG & ASSOCIATES LTD
黃志明建築工程師有限公司

FACADE CONSULTANT:
MEINHARDT

NOTE :
1. ALL DIMENSIONS ARE IN mm.
2. ALL ELEVATIONS ARE VIEWED FROM OUTSIDE.
3. ALL DIMENSIONS TO BE VERIFIED ON SITE BEFORE FABRICATION.

LEGEND :
- X1 / XDR1 — DETAIL MARK NO. / REFER SHEET NO.
1. F.F.L. — FINISHED FLOOR LEVEL
2. S.F.L. — STRUCTURAL FLOOR LEVEL
3. (R) — REVERSED DETAIL
4. ▲ — FIXING LOCATION
5. △ — FIXING LUG LOCATION
6. GLASS LEGEND
   - GL01 — 10mm+12mm AIR GAP+10mm THK. I.G.U.
   - GL04 — 12mm THK. CLEAR TEMPERED GLASS
   - GL05 — 10mm+12mm AIR GAP+10mm THK. I.G.U.
   - GL06 — 10mm+12mm AIR GAP+12mm THK. I.G.U.
   - PD01 — 10mm T.P+12mm AIR GAP+8mm T.P
   - GL07 — 10mm+12mm AIR GAP+12mm THK. I.G.U.
   - GL08 — 10mm+12mm AIR GAP+10mm THK. I.G.U.

NO.	DATE	REVISED	BY
A	30/08/2022	GENERAL REVISION	

JOB NO. : J-853

PROJECT :
PROPOSED RESIDENTIAL DEVELOPMENT AT N.K.I.L. 6542 YIN PING ROAD KOWLOON

TITLE :
WINDOW SCHEDULE FOR TOWER 2 ALUM. WINDOW

DATE : 03-APR-21 | SCALE : 1:40

DRAWN BY : | CHECKED BY :

美特鋁質有限公司
MIDI ALUMINIUM FABRICATOR LTD.
Units 6-8, Sunray Industrial Centre, 1/F
610 Cha Kwo Ling Road, Kowloon
Tel:23489211-4 Fax:(852)27727666

DWG NO. : J853-SD-PW-SC201b | REV. : -

T:\Jobs\J-853\2. Outgoing\Black plate opening of Windows Louvre\Black Plate of T2 Precat Window.dwg

ELEVATION

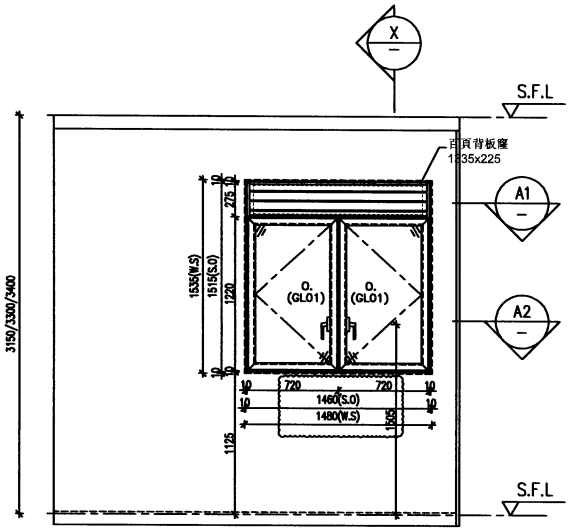

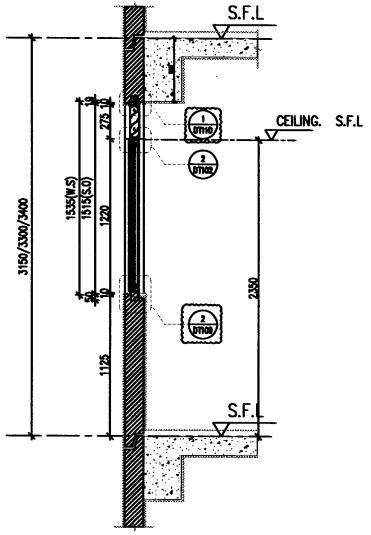

X PART SECTION

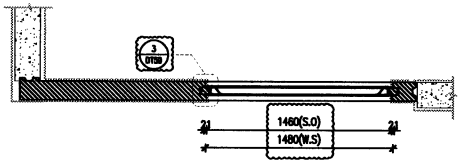

A1 PART PLAN

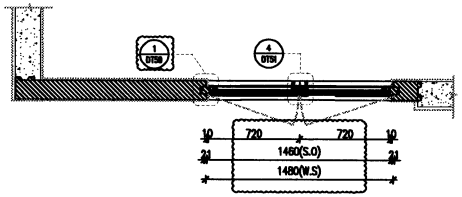

A2 PART PLAN

PROVIDED		
GLAZING AREA	1.279	m^2
OPENABLE AREA	1.480	m^2
FREE AREA	60.7	%

WINDOW MARK	W10A / T2
LOCATION	6~15F&17F~22F FLAT B KITCHEN
SECTION	70mm ALUM. SECTION
GLAZING	GLO1
QUANTITY	14 Nos.
REMARKS	FACADE (T2-01-03/6~15F&17F~22F)

T:\Jobs\J-853\2. Outgoing\Black plate opening of Windows Louvre\Black Plate of T2 Precat Window.dwg

B.D. REF :

CLIENT :
SHIMAO GROUP HOLDINGS LIMITED

ARCHITECT :
WONG TUNG & PARTNERS LIMITED
ARCHITECTS & PLANNERS

MAIN CONTRACTOR :
協興建築有限公司
HIP HING CONSTRUCTION CO LTD

STRUCTURAL ENGINEER :
CMA C M WONG & ASSOCIATES LTD
黃志明建築工程師有限公司

FACADE CONSULTANT:
MEINHARDT

NOTE :
1. ALL DIMENSIONS ARE IN mm.
2. ALL ELEVATIONS ARE VIEWED FROM OUTSIDE.
3. ALL DIMENSIONS TO BE VERIFIED ON SITE BEFORE FABRICATION.

LEGEND :
- X1 / X001 — DETAIL MARK NO. / REFER SHEET NO.
1. F.F.L. — FINISHED FLOOR LEVEL
2. S.F.L. — STRUCTURAL FLOOR LEVEL
3. (R) — REVERSED DETAIL
4. ▲ — FIXING LOCATION
5. △ — FIXING LUG LOCATION
6. GLASS LEGEND
   - GLO1 — 10mm+12mm AIR GAP+10mm THK. I.G.U.
   - GLO4 — 12mm THK. CLEAR TEMPERED GLASS
   - GLO5 — 10mm+12mm AIR GAP+10mm THK. I.G.U.
   - GLO6 — 10mm+12mm AIR GAP+12mm THK. I.G.U.
   - PDO1 — 10mm T.P+12mm AIR GAP+8mm T.P
   - GLO7 — 10mm+12mm AIR GAP+12mm THK. I.G.U.
   - GLO8 — 10mm+12mm AIR GAP+10mm THK. I.G.U.

NO.	DATE	REMARK	BY
H	30/08/2022	GENERAL REVISION	ada
G	22/10/2021	REVISION SUBJECT TO ARCH.COMMENT	ada
A	05/08/2021	REVISION SUBJECT TO ARCH.COMMENT	ada

JOB NO. : J-853

PROJECT :
PROPOSED RESIDENTIAL DEVELOPMENT AT N.K.I.L. 6542 YIN PING ROAD KOWLOON

TITLE :
WINDOW SCHEDULE FOR TOWER 2 ALUM. WINDOW

DATE : 03-APR-21 | SCALE : 1:40

DRAWN BY : | CHECKED BY :

美特鋁製有限公司
MIDI ALUMINIUM FABRICATION LTD.
Units 6-8, Sunray Industrial Centre, 1/F
610 Cha Kwo Ling Road, Kowloon
Tel:23489211-4 Fax:(852)27727666

DWG NO. : J853-SD-PW-SC203 | REV. : H

ELEVATION

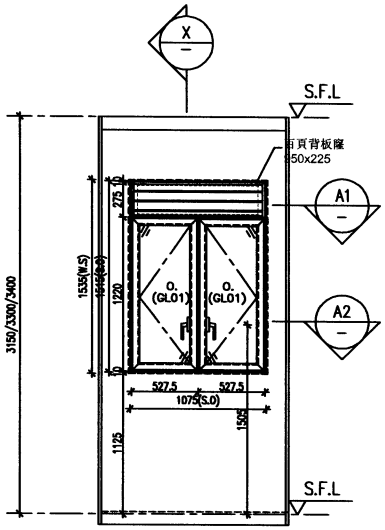

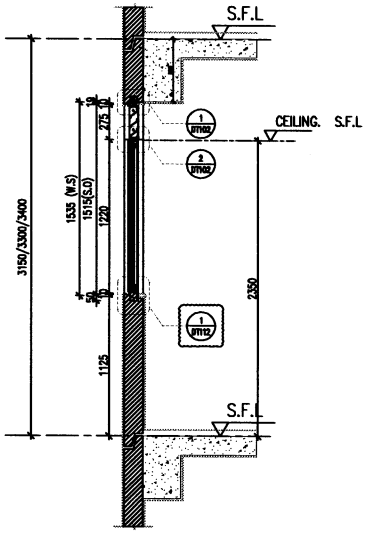

X PART SECTION

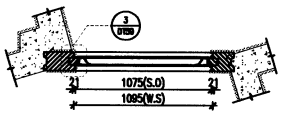

A1 PART PLAN

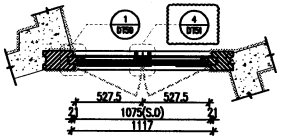

A2 PART PLAN

PROVIDED		
GLAZING AREA	0.865	m^2
OPENABLE AREA	1.044	m^2
FREE AREA	60.7	%

WINDOW MARK	W08 T2
LOCATION	5F~23F FLAT A KITCHEN
SECTION	70mm ALUM. SECTION
GLAZING	GL01
QUANTITY	17 Nos.
REMARKS	FACADE (T2-01-02/6~15F&17F~22F; T2-01-02A/5F&16F; T2-01-02B/23F)

T:\Jobs\J-853\2. Outgoing\Black plate opening of Windows Louvre\Black Plate of T2 Precat Window.dwg

B.D. REF :

CLIENT :
SHIMAO GROUP HOLDINGS LIMITED

ARCHITECT :
WONG TUNG & PARTNERS LIMITED ARCHITECTS & PLANNERS

MAIN CONTRACTOR :
協興建築有限公司 HIP HING CONSTRUCTION CO LTD

STRUCTURAL ENGINEER :
CMA C M WONG & ASSOCIATES LTD 黃志明建築工程師有限公司

FACADE CONSULTANT:
MEINHARDT

NOTE :
1. ALL DIMENSIONS ARE IN mm.
2. ALL ELEVATIONS ARE VIEWED FROM OUTSIDE.
3. ALL DIMENSIONS TO BE VERIFIED ON SITE BEFORE FABRICATION.

LEGEND :
- DETAIL MARK NO.
- REFER SHEET NO.

1. F.F.L. — FINISHED FLOOR LEVEL
2. S.F.L. — STRUCTURAL FLOOR LEVEL
3. (R) — REVERSED DETAIL
4. ▲ — FIXING LOCATION
5. △ — FIXING LUG LOCATION
6. GLASS LEGEND
   - GL01 — 10mm+12mm AIR GAP+10mm THK. I.G.U.
   - GL04 — 12mm THK. CLEAR TEMPERED GLASS
   - GL05 — 10mm+12mm AIR GAP+10mm THK. I.G.U.
   - GL06 — 10mm+12mm AIR GAP+12mm THK. I.G.U.
   - PD01 — 10mm T.P+12mm AIR GAP+8mm T.P
   - GL07 — 10mm+12mm AIR GAP+12mm THK. I.G.U.
   - GL08 — 10mm+12mm AIR GAP+10mm THK. I.G.U.

NO.	DATE	REVISED	BY
H	30/06/2022	GENERAL REVISION	ada
G	22/10/2021	REVISION SUBJECT TO ARCH.COMMENT	ada
A	08/08/2021	REVISION SUBJECT TO ARCH.COMMENT	ada

JOB NO. : J-853

PROJECT :
PROPOSED RESIDENTIAL DEVELOPMENT AT N.K.I.L. 6542 YIN PING ROAD KOWLOON

TITLE :
WINDOW SCHEDULE FOR TOWER 2 ALUM. WINDOW

DATE : 03-APR-21 | SCALE : 1:40

DRAWN BY : | CHECKED BY :

美特鋁製有限公司 MIDI ALUMINIUM FABRICATOR LTD.
Units 6-8, Sunray Industrial Centre, 1/F
610 Cha Kwo Ling Road, Kowloon
Tel:23489211-4 Fax:(852)27727666

DWG NO. : J853-SD-PW-SC202 | REV. : H

ELEVATION

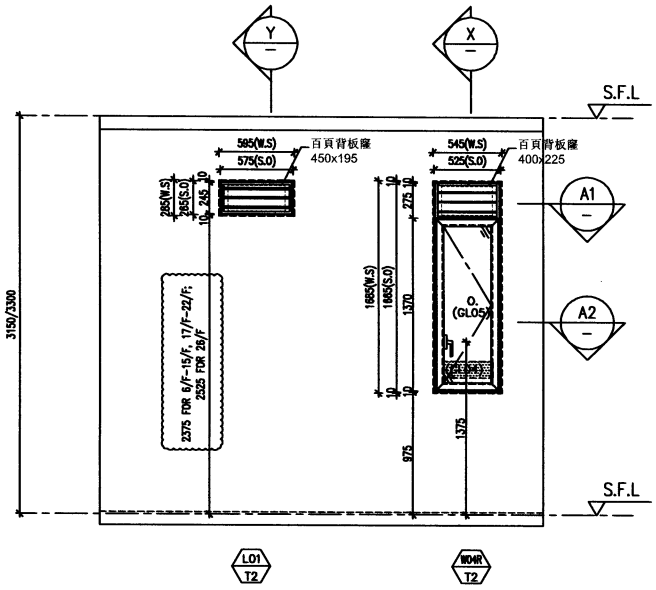

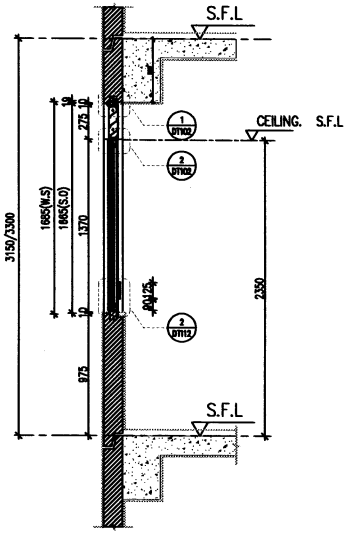

X PART SECTION

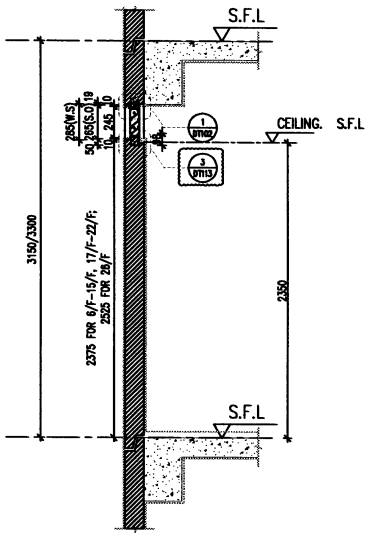

Y PART SECTION

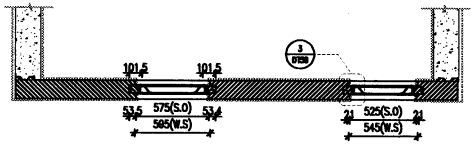

A1 PART PLAN

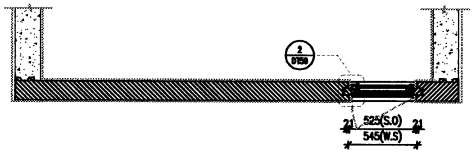

A2 PART PLAN

PROVIDED		
GLAZING AREA	–	m^2
OPENABLE AREA	–	m^2
FREE AREA	55.4	%

L01 T2

PROVIDED		
GLAZING AREA	0.460	m^2
OPENABLE AREA	0.503	m^2
FREE AREA	60.7	%

W04R T2

WINDOW MARK	W04R T2 & L01 T2
LOCATION	6F~16F FLAT B MASTER BATH
SECTION	70mm ALUM. SECTION
GLAZING	GL05
QUANTITY	10 Nos / 10 Nos
REMARKS	FACADE(T2-01-04/6~15F; T2-01-04A/16F)

T:\Jobs\J-853\2. Outgoing\Black plate opening of Windows Louvre\Black Plate of T2 Precat Window.dwg

B.D. REF :

CLIENT :
SHIMAO GROUP HOLDINGS LIMITED

ARCHITECT :
WONG TUNG & PARTNERS LIMITED
ARCHITECTS & PLANNERS

MAIN CONTRACTOR :
協興建築有限公司
HIP HING CONSTRUCTION CO LTD

STRUCTURAL ENGINEER :
C M WONG & ASSOCIATES LTD
黃志明建築工程師有限公司

FACADE CONSULTANT:
MEINHARDT

NOTE :
1. ALL DIMENSIONS ARE IN mm.
2. ALL ELEVATIONS ARE VIEWED FROM OUTSIDE.
3. ALL DIMENSIONS TO BE VERIFIED ON SITE BEFORE FABRICATION.

LEGEND :
- X1 / X001 — DETAIL MARK NO. / REFER SHEET NO.
1. F.F.L. — FINISHED FLOOR LEVEL
2. S.F.L. — STRUCTURAL FLOOR LEVEL
3. (R) — REVERSED DETAIL
4. ▲ — FIXING LOCATION
5. △ — FIXING LUG LOCATION
6. GLASS LEGEND
   - GL01 — 10mm+12mm AIR GAP+10mm THK. L.G.U.
   - GL04 — 12mm THK. CLEAR TEMPERED GLASS
   - GL05 — 10mm+12mm AIR GAP+10mm THK. L.G.U.
   - GL06 — 10mm+12mm AIR GAP+12mm THK. L.G.U.
   - PD01 — 10mm T.P+12mm AIR GAP+8mm T.P
   - GL07 — 10mm+12mm AIR GAP+12mm THK. L.G.U.
   - GL08 — 10mm+12mm AIR GAP+10mm THK. L.G.U.

NO.	DATE	REMARK	BY
I	31/08/2022	GENERAL REVISION	mlo
H	30/08/2022	GENERAL REVISION	mlo
G	22/10/2021	REVISION SUBJECT TO ARCH.COMMENT	mlo
A	05/08/2021	REVISION SUBJECT TO ARCH.COMMENT	mlo

JOB NO. : J-853

PROJECT :
PROPOSED RESIDENTIAL DEVELOPMENT AT N.K.I.L. 6542 YIN PING ROAD KOWLOON

TITLE :
WINDOW SCHEDULE FOR TOWER 2 ALUM. WINDOW

DATE : 03-APR-21 | SCALE : 1:40

DRAWN BY : | CHECKED BY :

美特鋁製有限公司
MIDI ALUMINIUM FABRICATOR LTD.
Units 6-8, Sunray Industrial Centre, 1/F
610 Cha Kwo Ling Road, Kowloon
Tel:23489211-4 Fax:(852)27727666

DWG NO. : J853-SD-PW-SC204 | REV. : I

ELEVATION

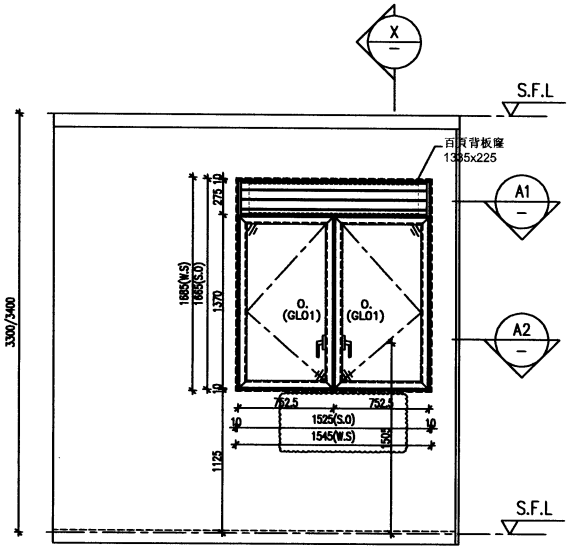

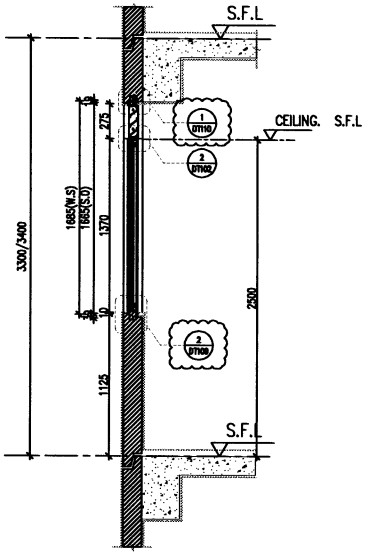

X — PART SECTION

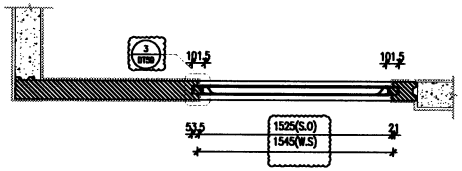

A1 — PART PLAN

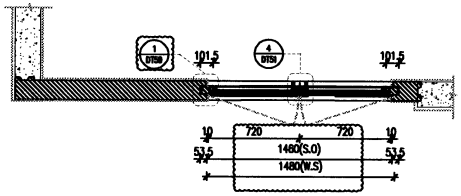

A2 — PART PLAN

PROVIDED		
GLAZING AREA	1.455	m^2
OPENABLE AREA	1.674	m^2
FREE AREA	60.7	%

WINDOW MARK	W60A / T2
LOCATION	5F&25F FLAT B KITCHEN
SECTION	70mm ALUM. SECTION
GLAZING	GLO1
QUANTITY	2 Nos.
REMARKS	FACADE (T2-01-03A/5F&25F)

B.D. REF :

CLIENT :
SHIMAO GROUP HOLDINGS LIMITED

ARCHITECT :
WONG TUNG & PARTNERS LIMITED
ARCHITECTS & PLANNERS

MAIN CONTRACTOR :
協興建築有限公司
HIP HING CONSTRUCTION CO LTD

STRUCTURAL ENGINEER :
CMA C M WONG & ASSOCIATES LTD
黃志明建築工程師有限公司

FACADE CONSULTANT:
MEINHARDT

NOTE :
1. ALL DIMENSIONS ARE IN mm.
2. ALL ELEVATIONS ARE VIEWED FROM OUTSIDE.
3. ALL DIMENSIONS TO BE VERIFIED ON SITE BEFORE FABRICATION.

LEGEND :
X1 / X001 — DETAIL MARK NO. / REFER SHEET NO.
1. F.F.L. — FINISHED FLOOR LEVEL
2. S.F.L. — STRUCTURAL FLOOR LEVEL
3. (20) — REVERSED DETAIL
4. ▲ — FIXING LOCATION
5. △ — FIXING LUG LOCATION
6. GLASS LEGEND
GL01 — 10mm+12mm AIR GAP+10mm THK. I.G.U.
GL04 — 12mm THK. CLEAR TEMPERED GLASS
GL05 — 10mm+12mm AIR GAP+10mm THK. I.G.U.
GL06 — 10mm+12mm AIR GAP+12mm THK. I.G.U.
PD01 — 10mm T.P+12mm AIR GAP+8mm T.P
GL07 — 10mm+12mm AIR GAP+12mm THK. I.G.U.
GL08 — 10mm+12mm AIR GAP+10mm THK. I.G.U.

NO.	DATE	REMARK	BY
H	30/08/2022	GENERAL REVISION	
G	22/10/2021	REVISION SUBJECT TO ARCH.COMMENT	
A	08/08/2021	REVISION SUBJECT TO ARCH.COMMENT	

JOB NO. : J-853

PROJECT :
PROPOSED RESIDENTIAL DEVELOPMENT AT N.K.I.L. 6542 YIN PING ROAD KOWLOON

TITLE :
WINDOW SCHEDULE FOR TOWER 2 ALUM. WINDOW

DATE : 03-APR-21 | SCALE : 1:40

DRAWN BY : | CHECKED BY :

美特鋁製有限公司
MIDI ALUMINIUM FABRICATOR LTD.
Units 6-8, Sunray Industrial Centre, 1/F
610 Cha Kwo Ling Road, Kowloon
Tel:23488211-4 Fax:(852)27727666

DWG NO. : J853-SD-PW-SC203e | REV. : H

T:\Jobs\J-853\2. Outgoing\Black plate opening of Windows Louvre\Black Plate of T2 Precat Window.dwg

ELEVATION

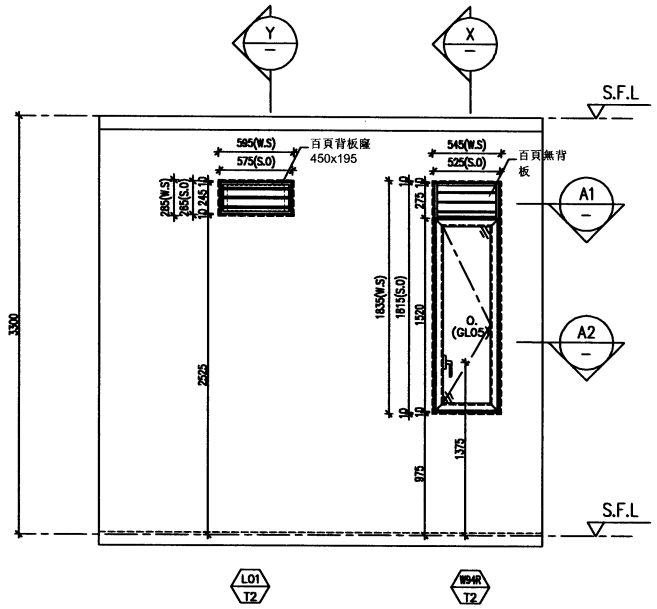

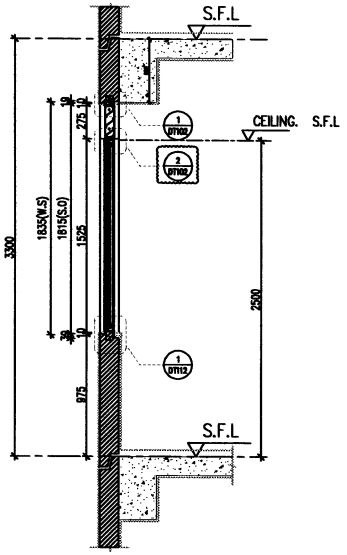

X PART SECTION

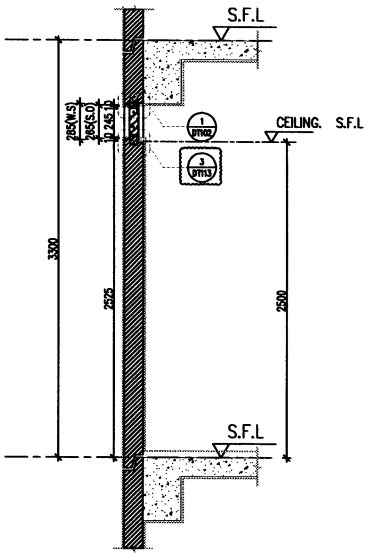

Y PART SECTION

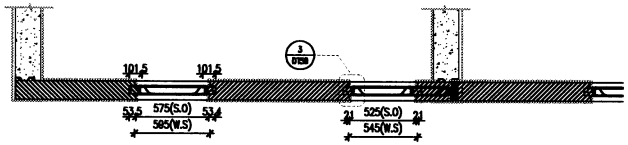

A1 PART PLAN

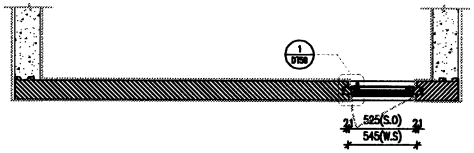

A2 PART PLAN

PROVIDED		
GLAZING AREA	–	m^2
OPENABLE AREA	–	m^2
FREE AREA	55.4	%

L01 T2

PROVIDED		
GLAZING AREA	0.516	m^2
OPENABLE AREA	0.621	m^2
FREE AREA	60.7	%

W94R T2

WINDOW MARK	W94R T2 & L01 T2
LOCATION	5F FLAT B MASTER BATH
SECTION	70mm ALUM. SECTION
GLAZING	GL05
QUANTITY	1 Nos / 1 Nos
REMARKS	FACADE(T2-01-04A/5F)

T:\Jobs\J-853\2. Outgoing\Black plate opening of Windows Louvre\Black Plate of T2 Precat Window.dwg

B.D. REF :

CLIENT :
SHIMAO GROUP HOLDINGS LIMITED

ARCHITECT :
WONG TUNG & PARTNERS LIMITED
ARCHITECTS & PLANNERS

MAIN CONTRACTOR :
協興建築有限公司
HIP HING CONSTRUCTION CO LTD

STRUCTURAL ENGINEER :
C M WONG & ASSOCIATES LTD
黃志明建築工程師有限公司

FACADE CONSULTANT:
MEINHARDT

NOTE :
1. ALL DIMENSIONS ARE IN mm.
2. ALL ELEVATIONS ARE VIEWED FROM OUTSIDE.
3. ALL DIMENSIONS TO BE VERIFIED ON SITE BEFORE FABRICATION.

LEGEND :
X1 — DETAIL MARK NO.
XD01 — REFER SHEET NO.
1. F.F.L. — FINISHED FLOOR LEVEL
2. S.F.L. — STRUCTURAL FLOOR LEVEL
3. R — REVERSED DETAIL
4. ▲ — FIXING LOCATION
5. △ — FIXING LUG LOCATION
6. GLASS LEGEND
GL01 — 10mm+12mm AIR GAP+10mm THK. I.G.U.
GL04 — 12mm THK. CLEAR TEMPERED GLASS
GL05 — 10mm+12mm AIR GAP+10mm THK. I.G.U.
GL06 — 10mm+12mm AIR GAP+12mm THK. I.G.U.
PD01 — 10mm T.P+12mm AIR GAP+8mm T.P
GL07 — 10mm+12mm AIR GAP+12mm THK. I.G.U.
GL08 — 10mm+12mm AIR GAP+10mm THK. I.G.U.

NO.	DATE	REMARK	BY
I	30/08/2022	GENERAL REVISION	ada
H	25/05/2022	REVISION SUBJECT TO ARCH.COMMENT	ada
G	22/10/2021	REVISION SUBJECT TO ARCH.COMMENT	ada

JOB NO. : J-853

PROJECT :
PROPOSED RESIDENTIAL DEVELOPMENT AT N.K.I.L. 6542 YIN PING ROAD KOWLOON

TITLE :
WINDOW SCHEDULE FOR TOWER 2 ALUM. WINDOW

DATE : 03-APR-21 | SCALE : 1:40

DRAWN BY : | CHECKED BY :

美特鋁質有限公司
MIDI ALUMINIUM FABRICATOR LTD.
Units 6-8, Sunray Industrial Centre, 1/F
610 Cha Kwo Ling Road, Kowloon
Tel:23489211-4 Fax:(852)27727666

DWG NO. : J853-SD-PW-SC204a | REV. : I

ELEVATION

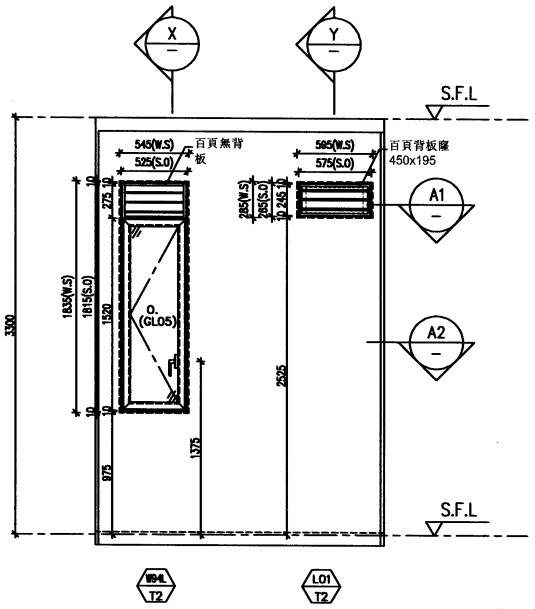

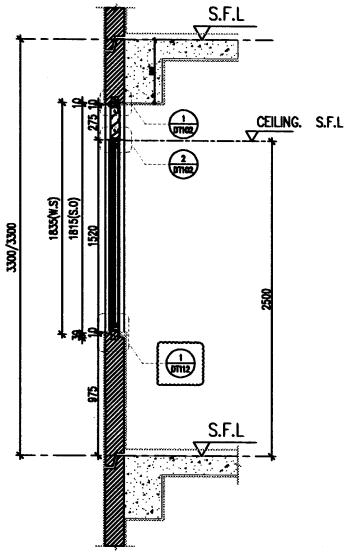

X PART SECTION

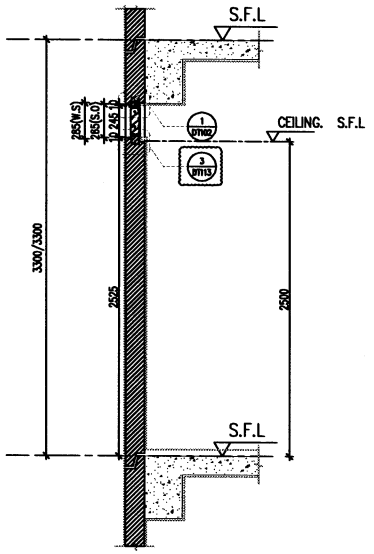

Y PART SECTION

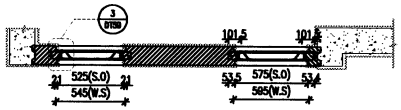

A1 PART PLAN

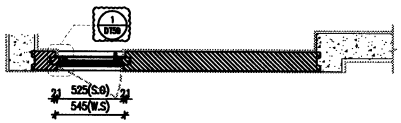

A2 PART PLAN

PROVIDED (L01 T2)		
GLAZING AREA	–	m^2
OPENABLE AREA	–	m^2
FREE AREA	55.4	%

PROVIDED (W94L T2)		
GLAZING AREA	0.516	m^2
OPENABLE AREA	0.621	m^2
FREE AREA	60.7	%

WINDOW MARK	W94L T2 & L01 T2
LOCATION	5F FLAT C MASTER BATH
SECTION	70mm ALUM. SECTION
GLAZING	GL05
QUANTITY	1Nos / 1Nos
REMARKS	FACADE(T2-01-05A/5F)

T:\Jobs\J-853\2. Outgoing\Black plate opening of Windows Louvre\Black Plate of T2 Precat Window.dwg

B.D. REF :

CLIENT :
SHIMAO GROUP HOLDINGS LIMITED

ARCHITECT :
WONG TUNG & PARTNERS LIMITED
ARCHITECTS & PLANNERS

MAIN CONTRACTOR :
協興建築有限公司
HIP HING CONSTRUCTION CO LTD

STRUCTURAL ENGINEER :
C M WONG & ASSOCIATES LTD
黃志明建築工程師有限公司

FACADE CONSULTANT:
MEINHARDT

NOTE :
1. ALL DIMENSIONS ARE IN mm.
2. ALL ELEVATIONS ARE VIEWED FROM OUTSIDE.
3. ALL DIMENSIONS TO BE VERIFIED ON SITE BEFORE FABRICATION.

LEGEND :
- X1 / XD01 — DETAIL MARK NO. / REFER SHEET NO.
1. F.F.L. — FINISHED FLOOR LEVEL
2. S.F.L. — STRUCTURAL FLOOR LEVEL
3. (75) — REVERSED DETAIL
4. ▲ — FIXING LOCATION
5. △ — FIXING LUG LOCATION
6. GLASS LEGEND
   - GL01 — 10mm+12mm AIR GAP+10mm THK. I.G.U.
   - GL04 — 12mm THK. CLEAR TEMPERED GLASS
   - GL05 — 10mm+12mm AIR GAP+10mm THK. I.G.U.
   - GL06 — 10mm+12mm AIR GAP+12mm THK. I.G.U.
   - PD01 — 10mm T.P+12mm AIR GAP+8mm T.P
   - GL07 — 10mm+12mm AIR GAP+12mm THK. I.G.U.
   - GL08 — 10mm+12mm AIR GAP+10mm THK. I.G.U.

NO.	DATE	REVISED	BY
H	30/08/2022	GENERAL REVISION	edo
G	22/10/2021	REVISION SUBJECT TO ARCH.COMMENT	edo
A	05/08/2021	REVISION SUBJECT TO ARCH.COMMENT	edo

JOB NO. : J-853

PROJECT :
PROPOSED RESIDENTIAL DEVELOPMENT AT N.K.I.L. 6542 YIN PING ROAD KOWLOON

TITLE :
WINDOW SCHEDULE FOR TOWER 2 ALUM. WINDOW

DATE : 03-APR-21 | SCALE : 1:40

DRAWN BY : | CHECKED BY :

美特鋁質有限公司
MIDI ALUMINIUM FABRICATOR LTD.
Units 6-8, Sunray Industrial Centre, 1/F
610 Cha Kwo Ling Road, Kowloon
Tel:23489211-4 Fax:(852)27727666

DWG NO. : J853-SD-PW-SC205 | REV. : H

ELEVATION

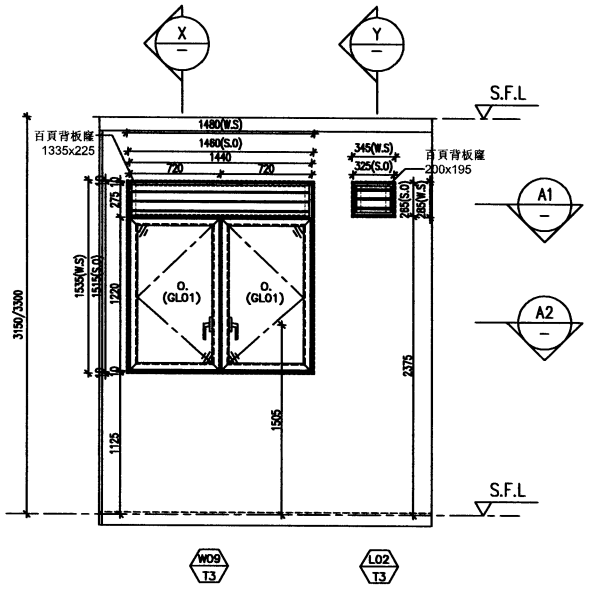

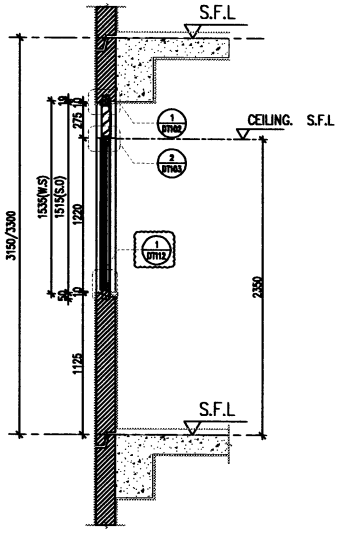

X PART SECTION

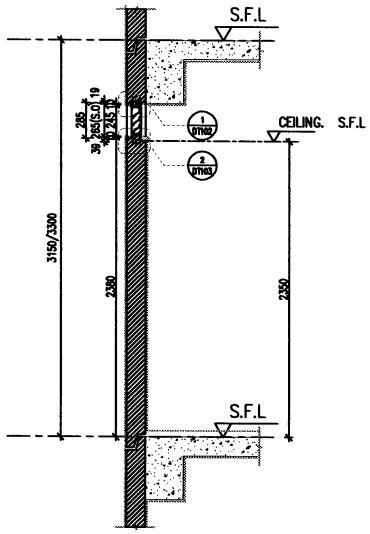

Y PART SECTION

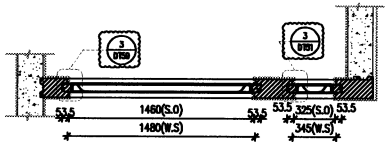

A1 PART PLAN

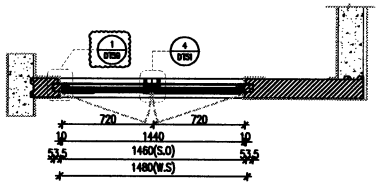

A2 PART PLAN

L02 T3	PROVIDED		
	GLAZING AREA	–	m^2
	OPENABLE AREA	–	m^2
	FREE AREA	55.4	%

WO9 T3	PROVIDED		
	GLAZING AREA	1.285	m^2
	OPENABLE AREA	1.486	m^2
	FREE AREA	60.7	%

WINDOW MARK	WO9 T3 & L02 T3
LOCATION	6F~15F&17F~22F&16F&26F FLAT B KITCHEN
SECTION	70mm ALUM. SECTION
GLAZING	GL01
QUANTITY	16 Nos.
REMARKS	FACADE (T3-01-04/6~15F&17F~22F; T3-01-04A/16F&26F)

B.D. REF :

CLIENT :
SHIMAO GROUP HOLDINGS LIMITED

ARCHITECT :
WONG TUNG & PARTNERS LIMITED
ARCHITECTS & PLANNERS

MAIN CONTRACTOR :
協興建築有限公司
HIP HING CONSTRUCTION CO LTD

STRUCTURAL ENGINEER :
C M WONG & ASSOCIATES LTD
黃志明建築工程師有限公司

FACADE CONSULTANT:
MEINHARDT

NOTE :
1. ALL DIMENSIONS ARE IN mm.
2. ALL ELEVATIONS ARE VIEWED FROM OUTSIDE.
3. ALL DIMENSIONS TO BE VERIFIED ON SITE BEFORE FABRICATION.

LEGEND :
- X1 / XD01 — DETAIL MARK NO. / REFER SHEET NO.
1. F.F.L. — FINISHED FLOOR LEVEL
2. S.F.L. — STRUCTURAL FLOOR LEVEL
3. — REVERSED DETAIL
4. ▲ — FIXING LOCATION
5. △ — FIXING LUG LOCATION
6. GLASS LEGEND
   - GL01 — 10mm+12mm AIR GAP+10mm THK. L.G.U.
   - GL04 — 12mm THK. CLEAR TEMPERED GLASS
   - GL05 — 10mm+12mm AIR GAP+10mm THK. L.G.U.
   - GL06 — 10mm+12mm AIR GAP+12mm THK. L.G.U.
   - PD01 — 10mm T.P+12mm AIR GAP+8mm T.P
   - GL07 — 10mm+12mm AIR GAP+12mm THK. L.G.U.
   - GL08 — 10mm+12mm AIR GAP+10mm THK. L.G.U.

NO.	DATE	REMARK	BY
H	30/08/2022	GENERAL REVISION	wlo
G	22/10/2021	REVISION SUBJECT TO ARCH.COMMENT	wlo
A	08/08/2021	REVISION SUBJECT TO ARCH.COMMENT	wlo

JOB NO. : J-853

PROJECT :
PROPOSED RESIDENTIAL DEVELOPMENT AT N.K.I.L. 6542 YIN PING ROAD KOWLOON

TITLE :
WINDOW SCHEDULE FOR TOWER 3 ALUM. WINDOW

DATE : 03-APR-21 | SCALE : 1:40

DRAWN BY : | CHECKED BY :

美特鋁質有限公司
MIDI ALUMINIUM FABRICATION LTD.
Units 6-8, Sunray Industrial Centre, 1/F
610 Cha Kwo Ling Road, Kowloon
Tel:23489211-4 Fax:(852)27727666

DWG NO. : J853-SD-PW-SC304 | REV. : H

ELEVATION

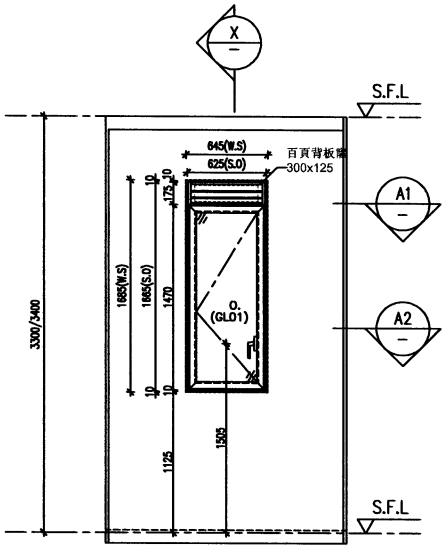

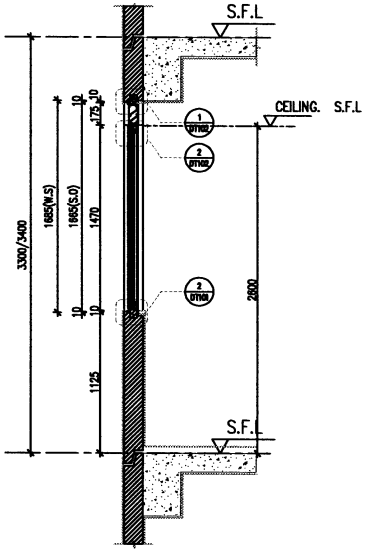

X PART SECTION

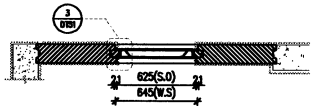

A1 PART PLAN

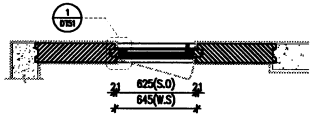

A2 PART PLAN

PROVIDED		
GLAZING AREA	0.631	m^2
OPENABLE AREA	0.739	m^2
FREE AREA	52.1	%

WINDOW MARK	W69L T3
LOCATION	5F&23F&25F FLAT B MASTER ENSUITE
SECTION	70mm ALUM. SECTION
GLAZING	GL01
QUANTITY	3 Nos.
REMARKS	FACADE (T3-01-05A/5F&25F; T3-01-05B/23F;)

B.D. REF :

CLIENT :
SHIMAO GROUP HOLDINGS LIMITED

ARCHITECT :
WONG TUNG & PARTNERS LIMITED
ARCHITECTS & PLANNERS

MAIN CONTRACTOR :
協興建築有限公司
HIP HING CONSTRUCTION CO LTD

STRUCTURAL ENGINEER :
C M WONG & ASSOCIATES LTD
黃志明建築工程師有限公司

FACADE CONSULTANT:
MEINHARDT

NOTE :
1. ALL DIMENSIONS ARE IN mm.
2. ALL ELEVATIONS ARE VIEWED FROM OUTSIDE.
3. ALL DIMENSIONS TO BE VERIFIED ON SITE BEFORE FABRICATION.

LEGEND :
X1 — DETAIL MARK NO.
3D01 — REFER SHEET NO.

1. F.F.L. — FINISHED FLOOR LEVEL
2. S.F.L. — STRUCTURAL FLOOR LEVEL
3. (R) — REVERSED DETAIL
4. ▲ — FIXING LOCATION
5. △ — FIXING LUG LOCATION
6. GLASS LEGEND
   GL01 — 10mm+12mm AIR GAP+10mm THK. L.G.U.
   GL04 — 12mm THK. CLEAR TEMPERED GLASS
   GL05 — 10mm+12mm AIR GAP+10mm THK. L.G.U.
   GL06 — 10mm+12mm AIR GAP+12mm THK. L.G.U.
   PD01 — 10mm T.P+12mm AIR GAP+8mm T.P
   GL07 — 10mm+12mm AIR GAP+12mm THK. L.G.U.
   GL08 — 10mm+12mm AIR GAP+10mm THK. L.G.U.

NO.	DATE	REVISED	BY
H	30/06/2022	GENERAL REVISION	
G	22/10/2021	REVISION SUBJECT TO ARCH.COMMENT	

JOB NO. : J-853

PROJECT :
PROPOSED RESIDENTIAL DEVELOPMENT AT N.K.I.L. 6542 YIN PING ROAD KOWLOON

TITLE :
WINDOW SCHEDULE FOR TOWER 3 ALUM. WINDOW

DATE : 03-APR-21 | SCALE : 1:40

DRAWN BY : | CHECKED BY :

美特鋁質有限公司
MIDI ALUMINIUM FABRICATOR LTD.
Units 6-8, Sunray Industrial Centre, 1/F
610 Cha Kwo Ling Road, Kowloon
Tel:23489211-4 Fax:(852)27727666

DWG NO. : J853-SD-PW-SC305a | REV. : H

ELEVATION

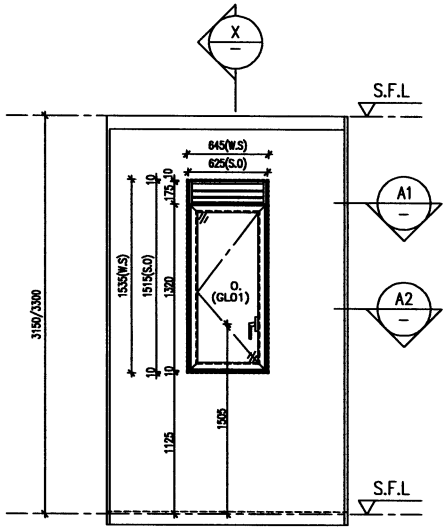

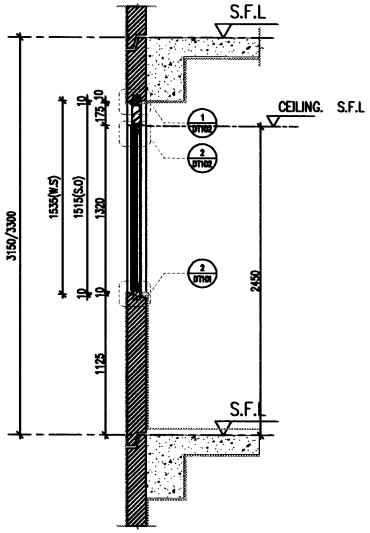

X PART SECTION

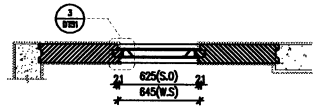

A1 PART PLAN

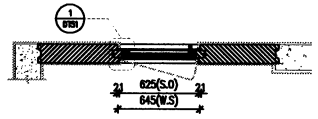

A2 PART PLAN

PROVIDED		
GLAZING AREA	0.560	m^2
OPENABLE AREA	0.660	m^2
FREE AREA	52.1	%

WINDOW MARK	W19L T3
LOCATION	6F~22F&26F FLAT B MASTER ENSUITE
SECTION	70mm ALUM. SECTION
GLAZING	GL01
QUANTITY	16 Nos
REMARKS	FACADE (T3-01-05/6~15F&17F~22F; T3-01-05A/16F&26F;)

B.D. REF :

CLIENT :
SHIMAO GROUP HOLDINGS LIMITED

ARCHITECT :
WONG TUNG & PARTNERS LIMITED
ARCHITECTS & PLANNERS

MAIN CONTRACTOR :
協興建築有限公司
HIP HING CONSTRUCTION CO LTD

STRUCTURAL ENGINEER :
C M WONG & ASSOCIATES LTD
黃志明建築工程師有限公司

FACADE CONSULTANT:
MEINHARDT

NOTE :
1. ALL DIMENSIONS ARE IN mm.
2. ALL ELEVATIONS ARE VIEWED FROM OUTSIDE.
3. ALL DIMENSIONS TO BE VERIFIED ON SITE BEFORE FABRICATION.

LEGEND :
- DETAIL MARK NO.
- REFER SHEET NO.

1. F.F.L. — FINISHED FLOOR LEVEL
2. S.F.L. — STRUCTURAL FLOOR LEVEL
3. (R) — REVERSED DETAIL
4. ▲ — FIXING LOCATION
5. △ — FIXING LUG LOCATION
6. GLASS LEGEND
   - GL01 — 10mm+12mm AIR GAP+10mm THK. I.G.U.
   - GL04 — 12mm THK. CLEAR TEMPERED GLASS
   - GL05 — 10mm+12mm AIR GAP+10mm THK. I.G.U.
   - GL06 — 10mm+12mm AIR GAP+12mm THK. I.G.U.
   - PD01 — 10mm T.P+12mm AIR GAP+8mm T.P
   - GL07 — 10mm+12mm AIR GAP+12mm THK. I.G.U.
   - GL08 — 10mm+12mm AIR GAP+10mm THK. I.G.U.

NO.	DATE	REVISED	BY
H	30/08/2022	GENERAL REVISION	ada
G	22/10/2021	REVISION SUBJECT TO ARCH.COMMENT	ada

JOB NO. : J-853

PROJECT :
PROPOSED RESIDENTIAL DEVELOPMENT AT N.K.I.L. 6542 YIN PING ROAD KOWLOON

TITLE :
WINDOW SCHEDULE FOR TOWER 3 ALUM. WINDOW

DATE : 03-APR-21 | SCALE : 1:40

DRAWN BY : | CHECKED BY :

美特鋁質有限公司
MIDI ALUMINIUM FABRICATOR LTD.
Units 6-8, Sunray Industrial Centre, 1/F
610 Cha Kwo Ling Road, Kowloon
Tel:23489211-4 Fax:(852)27727666

DWG NO. : J853-SD-PW-SC305 | REV. : H

ELEVATION

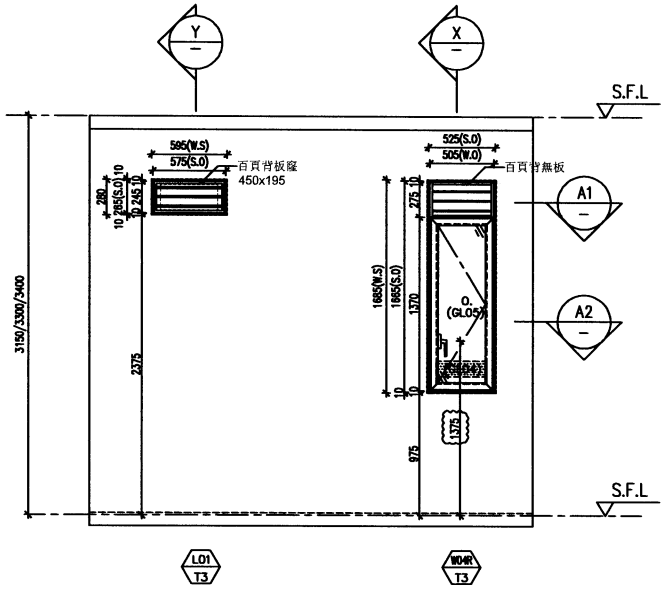

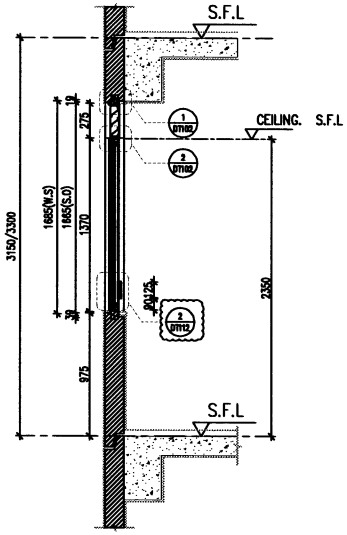

X PART SECTION

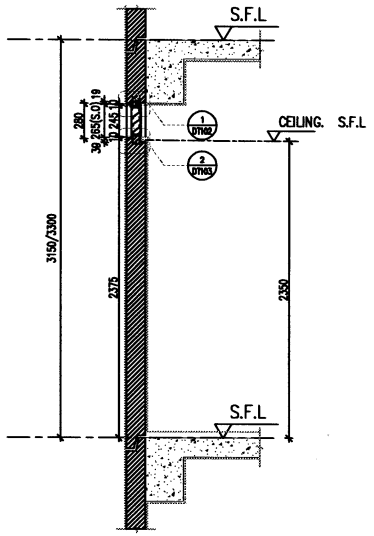

Y PART SECTION

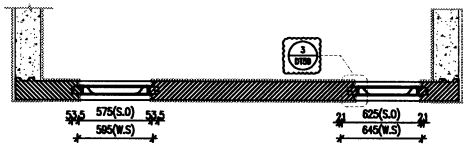

A1 PART PLAN

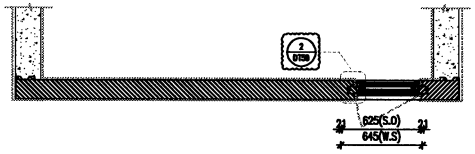

A2 PART PLAN

L01 T3	PROVIDED		
GLAZING AREA	—	m^2
OPENABLE AREA	—	m^2
FREE AREA	55.4	%

W04R T3	PROVIDED		
GLAZING AREA	0.460	m^2
OPENABLE AREA	0.503	m^2
FREE AREA	60.7	%

WINDOW MARK	W04R T3 & L01 T3
LOCATION	6F~22F&26F FLAT B MASTER BATH ROOM
SECTION	70mm ALUM. SECTION
GLAZING	GL05
QUANTITY	16 Nos / 16 Nos
REMARKS	FACADE(T3-01-06/6~15F&17F~22F; T3-01-06A/16F&26F)

B.D. REF :

CLIENT :
SHIMAO GROUP HOLDINGS LIMITED

ARCHITECT :
WONG TUNG & PARTNERS LIMITED
ARCHITECTS & PLANNERS

MAIN CONTRACTOR :
協興建築有限公司
HIP HING CONSTRUCTION CO LTD

STRUCTURAL ENGINEER :
C M WONG & ASSOCIATES LTD
黃志明建築工程師有限公司

FACADE CONSULTANT:
MEINHARDT

NOTE :
1. ALL DIMENSIONS ARE IN mm.
2. ALL ELEVATIONS ARE VIEWED FROM OUTSIDE.
3. ALL DIMENSIONS TO BE VERIFIED ON SITE BEFORE FABRICATION.

LEGEND :
X1 — DETAIL MARK NO.
X000 — REFER SHEET NO.

1. F.F.L. — FINISHED FLOOR LEVEL
2. S.F.L. — STRUCTURAL FLOOR LEVEL
3. (R) — REVERSED DETAIL
4. ▲ — FIXING LOCATION
5. △ — FIXING LUG LOCATION
6. GLASS LEGEND
GL01 — 10mm+12mm AIR GAP+10mm THK. LG.U.
GL04 — 12mm THK. CLEAR TEMPERED GLASS
GL05 — 10mm+12mm AIR GAP+10mm THK. LG.U.
GL06 — 10mm+12mm AIR GAP+12mm THK. LG.U.
PD01 — 10mm T.P+12mm AIR GAP+8mm T.P
GL07 — 10mm+12mm AIR GAP+12mm THK. LG.U.
GL08 — 10mm+12mm AIR GAP+10mm THK. LG.U.

NO.	DATE	REMARK	BY
H	30/08/2022	GENERAL REVISION	ada
G	22/10/2021	REVISION SUBJECT TO ARCH.COMMENT	ada
A	08/05/2021	REVISION SUBJECT TO ARCH.COMMENT	ada

JOB NO. : J-853

PROJECT :
PROPOSED RESIDENTIAL DEVELOPMENT AT N.K.I.L. 6542 YIN PING ROAD KOWLOON

TITLE :
WINDOW SCHEDULE FOR TOWER 3 ALUM. WINDOW

DATE : 03-APR-21 | SCALE : 1:40

DRAWN BY : | CHECKED BY :

美特鋁製有限公司
MIDI ALUMINIUM FABRICATOR LTD.
Units 6-8, Sunray Industrial Centre, 1/F
610 Cha Kwo Ling Road, Kowloon
Tel:23488211-4 Fax:(852)27727668

DWG NO. : J853-SD-PW-SC306 | REV. : H

ELEVATION

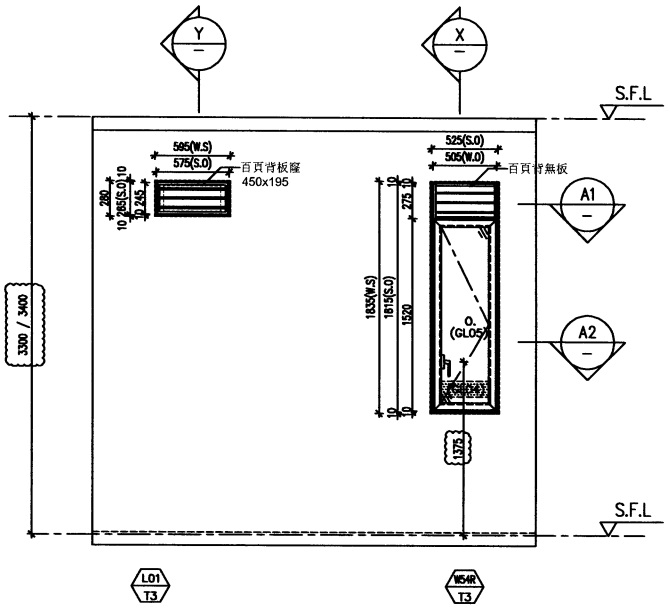

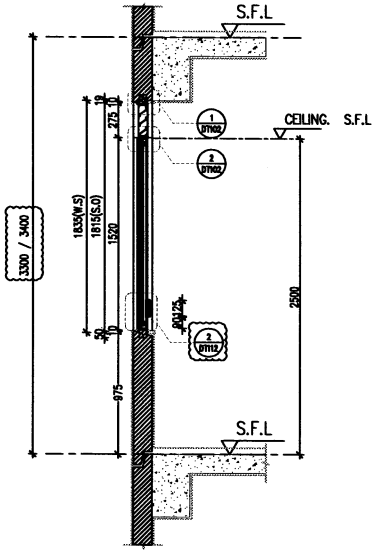

X PART SECTION

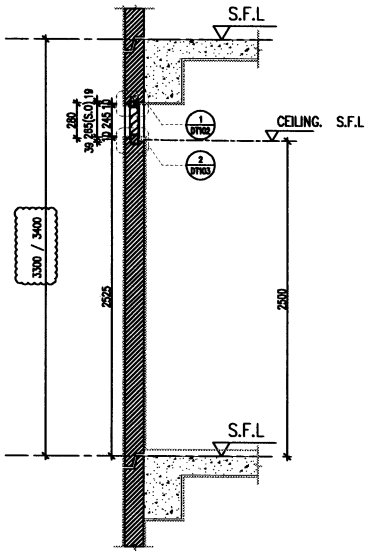

Y PART SECTION

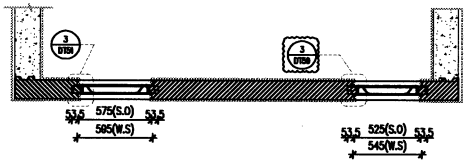

A1 PART PLAN

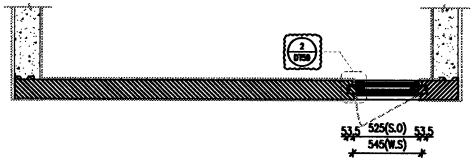

A2 PART PLAN

L01 T3	PROVIDED		
	GLAZING AREA	–	m^2
	OPENABLE AREA	–	m^2
	FREE AREA	55.4	%

W54R T3	PROVIDED		
	GLAZING AREA	0.516	m^2
	OPENABLE AREA	0.567	m^2
	FREE AREA	60.7	%

WINDOW MARK	W54R T3 & L01 T3
LOCATION	23F&25F FLAT B MASTER BATH ROOM
SECTION	70mm ALUM. SECTION
GLAZING	GL05
QUANTITY	2 Nos / 2 Nos
REMARKS	FACADE(T3-01-06A/25F; T3-01-06B/23F)

B.D. REF :

CLIENT :
SHIMAO GROUP HOLDINGS LIMITED

ARCHITECT :
WONG TUNG & PARTNERS LIMITED
ARCHITECTS & PLANNERS

MAIN CONTRACTOR :
協興建築有限公司
HIP HING CONSTRUCTION CO LTD

STRUCTURAL ENGINEER :
C M WONG & ASSOCIATES LTD
黃志明建築工程師有限公司

FACADE CONSULTANT:
MEINHARDT

NOTE :
1. ALL DIMENSIONS ARE IN mm.
2. ALL ELEVATIONS ARE VIEWED FROM OUTSIDE.
3. ALL DIMENSIONS TO BE VERIFIED ON SITE BEFORE FABRICATION.

LEGEND :
- DETAIL MARK NO.
- REFER SHEET NO.
1. F.F.L. — FINISHED FLOOR LEVEL
2. S.F.L. — STRUCTURAL FLOOR LEVEL
3. — REVERSED DETAIL
4. ▲ — FIXING LOCATION
5. △ — FIXING LUG LOCATION
6. GLASS LEGEND
   - GL01 — 10mm+12mm AIR GAP+10mm THK. LG.U.
   - GL04 — 12mm THK. CLEAR TEMPERED GLASS
   - GL05 — 10mm+12mm AIR GAP+10mm THK. LG.U.
   - GL06 — 10mm+12mm AIR GAP+12mm THK. LG.U.
   - PD01 — 10mm T.P+12mm AIR GAP+8mm T.P
   - GL07 — 10mm+12mm AIR GAP+12mm THK. LG.U.
   - GL08 — 10mm+12mm AIR GAP+10mm THK. LG.U.

NO.	DATE	REMARK	BY
G	22/10/2021	REVISION SUBJECT TO ARCH.COMMENT	edo

JOB NO. : J-853

PROJECT :
PROPOSED RESIDENTIAL DEVELOPMENT AT N.K.I.L. 6542
YIN PING ROAD
KOWLOON

TITLE :
WINDOW SCHEDULE FOR TOWER 3 ALUM. WINDOW

DATE : 03-APR-21 | SCALE : 1:40

DRAWN BY : | CHECKED BY :

美特鋁製有限公司
MIDI ALUMINIUM FABRICATOR LTD.
Units 6-8, Sunray Industrial Centre, 1/F
610 Cha Kwo Ling Road, Kowloon
Tel:23489211-4 Fax:(852)27727666

DWG NO. : J853-SD-PW-SC306b | REV. : G

ELEVATION

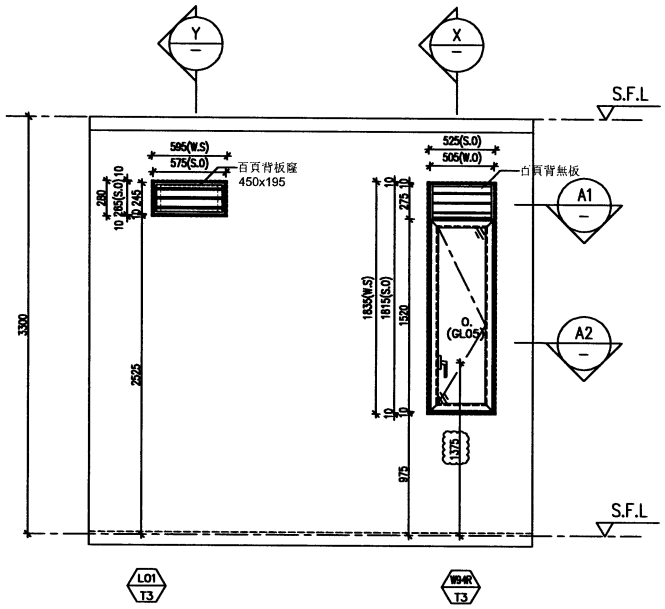

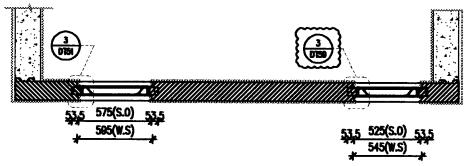

A1 PART PLAN

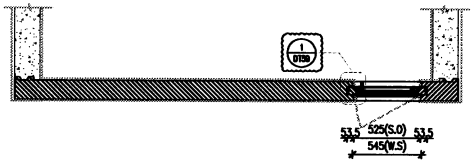

A2 PART PLAN

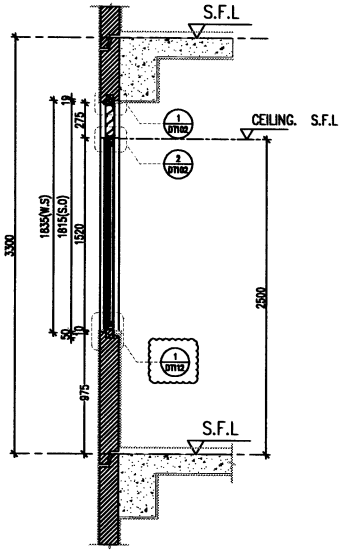

X PART SECTION

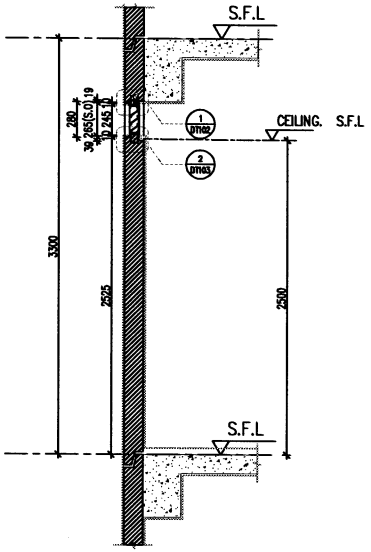

Y PART SECTION

PROVIDED		
GLAZING AREA	–	m^2
OPENABLE AREA	–	m^2
FREE AREA	55.4	%

L01 T3

PROVIDED		
GLAZING AREA	0.516	m^2
OPENABLE AREA	0.621	m^2
FREE AREA	60.7	%

W94R T3

WINDOW MARK	W94R T3 & L01 T3
LOCATION	5F FLAT B MASTER BATH ROOM
SECTION	70mm ALUM. SECTION
GLAZING	GL05
QUANTITY	1 Nos / 1 Nos
REMARKS	FACADE(T3-01-06A/5F)

B.D. REF :

CLIENT :
SHIMAO GROUP HOLDINGS LIMITED

ARCHITECT :
WONG TUNG & PARTNERS LIMITED
ARCHITECTS & PLANNERS

MAIN CONTRACTOR :
協興建築有限公司
HIP HING CONSTRUCTION CO LTD

STRUCTURAL ENGINEER :
C M WONG & ASSOCIATES LTD
黃志明建築工程師有限公司

FACADE CONSULTANT:
MEINHARDT

NOTE :
1. ALL DIMENSIONS ARE IN mm.
2. ALL ELEVATIONS ARE VIEWED FROM OUTSIDE.
3. ALL DIMENSIONS TO BE VERIFIED ON SITE BEFORE FABRICATION.

LEGEND :
- X1 / XXX1 — DETAIL MARK NO. / REFER SHEET NO.
1. F.F.L. — FINISHED FLOOR LEVEL
2. S.F.L. — STRUCTURAL FLOOR LEVEL
3. (R) — REVERSED DETAIL
4. ▲ — FIXING LOCATION
5. △ — FIXING LUG LOCATION
6. GLASS LEGEND
   - GL01 — 10mm+12mm AIR GAP+10mm THK. I.G.U.
   - GL04 — 12mm THK. CLEAR TEMPERED GLASS
   - GL05 — 10mm+12mm AIR GAP+10mm THK. I.G.U.
   - GL06 — 10mm+12mm AIR GAP+12mm THK. I.G.U.
   - PD01 — 10mm T.P+12mm AIR GAP+8mm T.P
   - GL07 — 10mm+12mm AIR GAP+12mm THK. I.G.U.
   - GL08 — 10mm+12mm AIR GAP+10mm THK. I.G.U.

NO.	DATE	REMARK	BY
H	30/08/2022	GENERAL REVISION	mlo
G	22/10/2021	REVISION SUBJECT TO ARCH.COMMENT	mlo

JOB NO. : J-853

PROJECT :
PROPOSED RESIDENTIAL DEVELOPMENT AT N.K.I.L. 6542 YIN PING ROAD KOWLOON

TITLE :
WINDOW SCHEDULE FOR TOWER 3 ALUM. WINDOW

DATE : 03-APR-21 | SCALE : 1:40

DRAWN BY : | CHECKED BY :

美特鋁製有限公司
MIDI ALUMINIUM FABRICATION LTD.
Units 6-8, Sunray Industrial Centre, 1/F
610 Cha Kwo Ling Road, Kowloon
Tel:23488211-4 Fax:(852)27727666

DWG NO. : J853-SD-PW-SC306a | REV. : H

ELEVATION

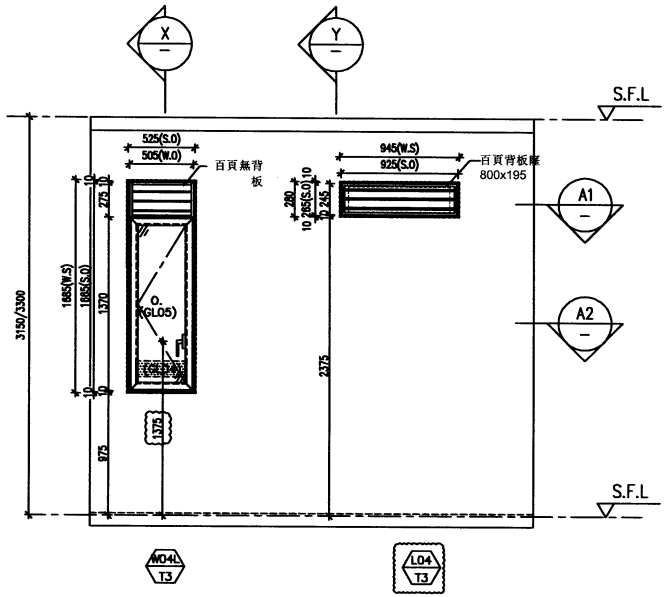

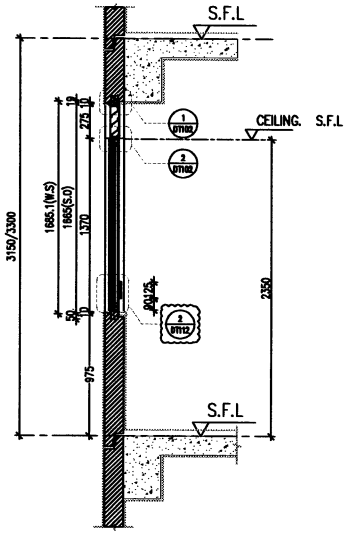

X PART SECTION

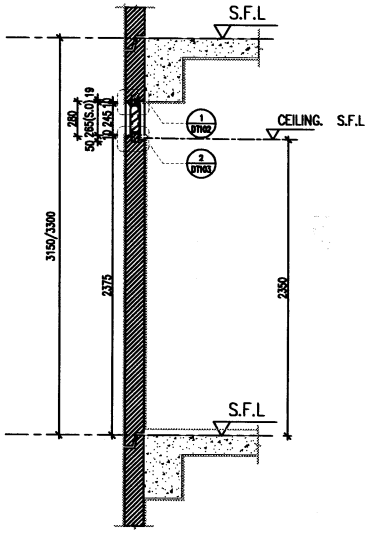

Y PART SECTION

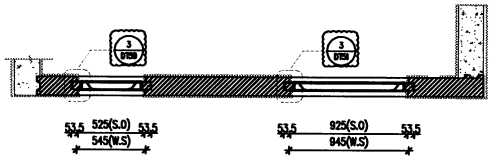

A1 PART PLAN

A2 PART PLAN

PROVIDED		
GLAZING AREA	–	m^2
OPENABLE AREA	–	m^2
FREE AREA	55.4	%

L04 T3

PROVIDED		
GLAZING AREA	0.460	m^2
OPENABLE AREA	0.503	m^2
FREE AREA	60.7	%

WO4L T3

WINDOW MARK	WO4L T3 & L04 T3
LOCATION	6F~22F&26F FLAT C MASTER BATH ROOM
SECTION	70mm ALUM. SECTION
GLAZING	GL05
QUANTITY	16 Nos / 16 Nos
REMARKS	FACADE(T3-01-07/6~15F&17F~22F; T3-01-07A/16F&26F;)

B.D. REF :

CLIENT :
SHIMAO GROUP HOLDINGS LIMITED

ARCHITECT :
WONG TUNG & PARTNERS LIMITED
ARCHITECTS & PLANNERS

MAIN CONTRACTOR :
協興建築有限公司
HIP HING CONSTRUCTION CO LTD

STRUCTURAL ENGINEER :
C M WONG & ASSOCIATES LTD
黃志明建築工程師有限公司

FACADE CONSULTANT:
MEINHARDT

NOTE :
1. ALL DIMENSIONS ARE IN mm.
2. ALL ELEVATIONS ARE VIEWED FROM OUTSIDE.
3. ALL DIMENSIONS TO BE VERIFIED ON SITE BEFORE FABRICATION.

LEGEND :
- X1 / XD01 — DETAIL MARK NO. / REFER SHEET NO.
1. F.F.L. — FINISHED FLOOR LEVEL
2. S.F.L. — STRUCTURAL FLOOR LEVEL
3. (R) — REVERSED DETAIL
4. ▲ — FIXING LOCATION
5. △ — FIXING LUG LOCATION
6. GLASS LEGEND
   - GL01 — 10mm+12mm AIR GAP+10mm THK. L.G.U.
   - GL04 — 12mm THK. CLEAR TEMPERED GLASS
   - GL05 — 10mm+12mm AIR GAP+10mm THK. L.G.U.
   - GL06 — 10mm+12mm AIR GAP+12mm THK. L.G.U.
   - PD01 — 10mm T.P+12mm AIR GAP+8mm T.P
   - GL07 — 10mm+12mm AIR GAP+12mm THK. L.G.U.
   - GL08 — 10mm+12mm AIR GAP+10mm THK. L.G.U.

NO.	DATE	REMARKS	BY
G	22/10/2021	REVISION SUBJECT TO ARCH.COMMENT	wilo
A	08/09/2021	REVISION SUBJECT TO ARCH.COMMENT	wilo

JOB NO. : J-853

PROJECT :
PROPOSED RESIDENTIAL DEVELOPMENT AT N.K.I.L. 6542 YIN PING ROAD KOWLOON

TITLE :
WINDOW SCHEDULE FOR TOWER 3 ALUM. WINDOW

DATE : 03-APR-21 | SCALE : 1:40

DRAWN BY : | CHECKED BY :

美特鋁製有限公司
MIDI ALUMINIUM FABRICATOR LTD.
Units 6-8, Sunray Industrial Centre, 1/F
610 Cha Kwo Ling Road, Kowloon
Tel:23489211-4 Fax:(852)27727666

DWG NO. : J853-SD-PW-SC307 | REV. : G

ELEVATION

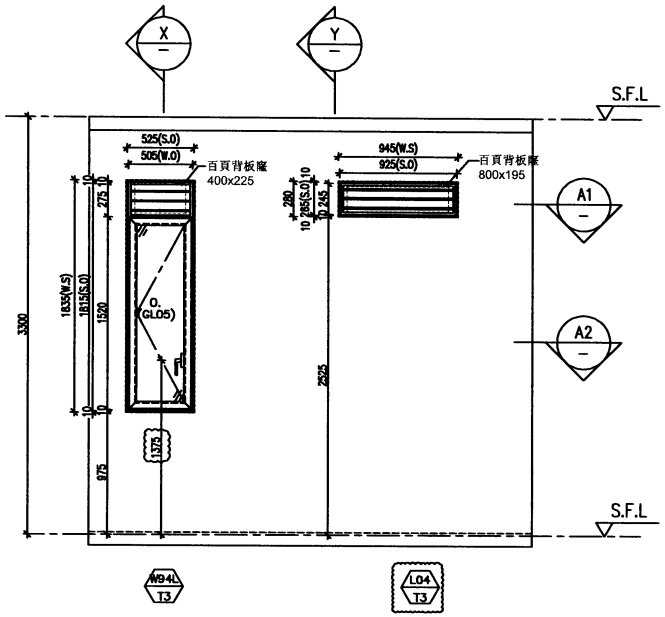

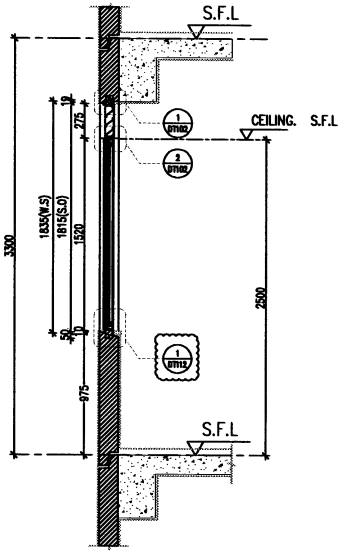

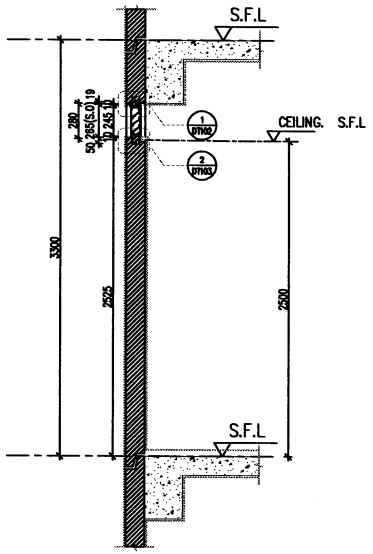

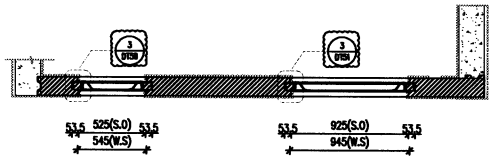

PROVIDED		
GLAZING AREA	–	m^2
OPENABLE AREA	–	m^2
FREE AREA	55.4	%

L04 T3

PROVIDED		
GLAZING AREA	0.516	m^2
OPENABLE AREA	0.621	m^2
FREE AREA	60.7	%

W94L T3

WINDOW MARK	W94L T3 & L04 T3
LOCATION	5F FLAT C MASTER BATH ROOM
SECTION	70mm ALUM. SECTION
GLAZING	GL05
QUANTITY	1 Nos / 1 Nos
REMARKS	FACADE(T3-01-07A/5F)

B.D. REF :

CLIENT :
SHIMAO GROUP HOLDINGS LIMITED

ARCHITECT :
WONG TUNG & PARTNERS LIMITED
ARCHITECTS & PLANNERS

MAIN CONTRACTOR :
協興建築有限公司
HIP HING CONSTRUCTION CO LTD

STRUCTURAL ENGINEER :
C M WONG & ASSOCIATES LTD
黃志明建築工程師有限公司

FACADE CONSULTANT:
MEINHARDT

NOTE :
1. ALL DIMENSIONS ARE IN mm.
2. ALL ELEVATIONS ARE VIEWED FROM OUTSIDE.
3. ALL DIMENSIONS TO BE VERIFIED ON SITE BEFORE FABRICATION.

LEGEND :
- X1 / XXX1 — DETAIL MARK NO. / REFER SHEET NO.
1. F.F.L. — FINISHED FLOOR LEVEL
2. S.F.L. — STRUCTURAL FLOOR LEVEL
3. (A) — REVERSED DETAIL
4. ▲ — FIXING LOCATION
5. △ — FIXING LUG LOCATION
6. GLASS LEGEND
   - GL01 — 10mm+12mm AIR GAP+10mm THK. I.G.U.
   - GL04 — 12mm THK. CLEAR TEMPERED GLASS
   - GL05 — 10mm+12mm AIR GAP+10mm THK. I.G.U.
   - GL06 — 10mm+12mm AIR GAP+12mm THK. I.G.U.
   - PD01 — 10mm T.P+12mm AIR GAP+8mm T.P
   - GL07 — 10mm+12mm AIR GAP+12mm THK. I.G.U.
   - GL08 — 10mm+12mm AIR GAP+10mm THK. I.G.U.

NO.	DATE	REMARK	BY
G	22/10/2021	REVISION SUBJECT TO ARCH.COMMENT	wilo
A	08/08/2021	REVISION SUBJECT TO ARCH.COMMENT	wilo

JOB NO. : J-853

PROJECT :
PROPOSED RESIDENTIAL DEVELOPMENT AT N.K.I.L. 6542 YIN PING ROAD KOWLOON

TITLE :
WINDOW SCHEDULE FOR TOWER 3 ALUM. WINDOW

DATE : 03-APR-21 | SCALE : 1:40

DRAWN BY : | CHECKED BY :

美特鋁質有限公司
MIDI ALUMINIUM FABRICATOR LTD.
Units 6-8, Sunray Industrial Centre, 1/F
610 Cha Kwo Ling Road, Kowloon
Tel:23489211-4 Fax:(852)27727666

DWG NO. : J853-SD-PW-SC307a | REV. : G

ELEVATION

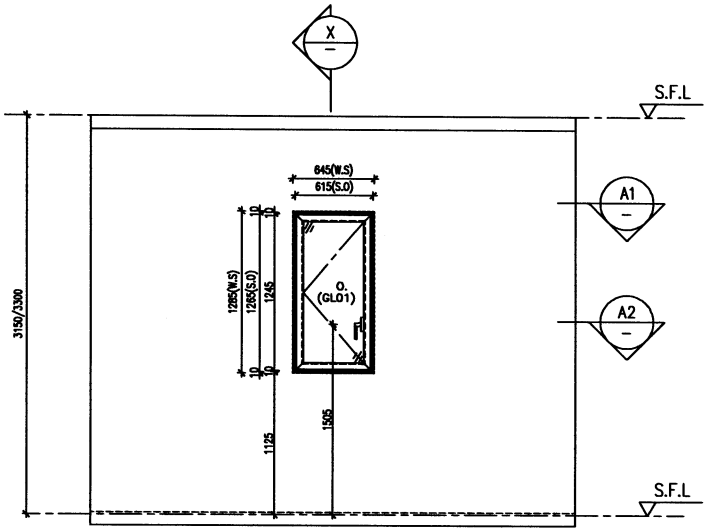

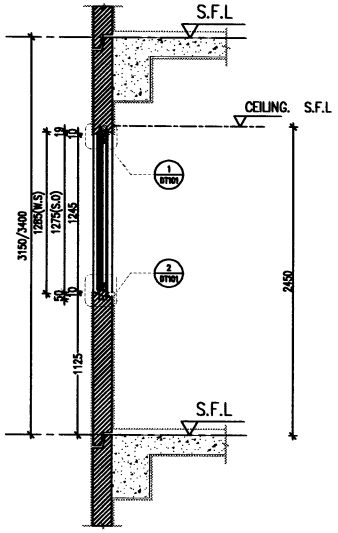

X — PART SECTION

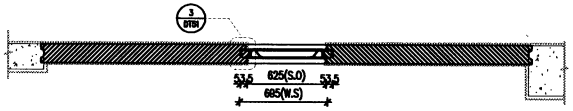

A1 — PART PLAN

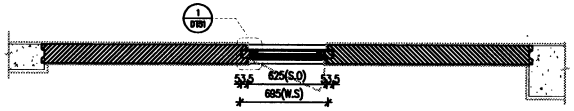

A2 — PART PLAN

PROVIDED		
GLAZING AREA	0.558	m^2
OPENABLE AREA	0.658	m^2
FREE AREA	–	%

WINDOW MARK	W29L T3
LOCATION	6F~15F & 17F~22F FLAT C MASTER ENSUITE
SECTION	70mm ALUM. SECTION
GLAZING	GL01
QUANTITY	14 Nos
REMARKS	FACADE(T3-01-08/6~15F&17F~22F)

B.D. REF :

CLIENT :
SHIMAO GROUP HOLDINGS LIMITED

ARCHITECT : WONG TUNG & PARTNERS LIMITED ARCHITECTS & PLANNERS

MAIN CONTRACTOR :
協興建築有限公司
HIP HING CONSTRUCTION CO LTD

STRUCTURAL ENGINEER :
C M WONG & ASSOCIATES LTD
黃志明建築工程師有限公司

FACADE CONSULTANT: MEINHARDT

NOTE :
1. ALL DIMENSIONS ARE IN mm.
2. ALL ELEVATIONS ARE VIEWED FROM OUTSIDE.
3. ALL DIMENSIONS TO BE VERIFIED ON SITE BEFORE FABRICATION.

LEGEND :
X1 — DETAIL MARK NO.
20001 — REFER SHEET NO.

1. F.F.L. — FINISHED FLOOR LEVEL
2. S.F.L. — STRUCTURAL FLOOR LEVEL
3. (R) — REVERSED DETAIL
4. ▲ — FIXING LOCATION
5. △ — FIXING LUG LOCATION
6. GLASS LEGEND
   GL01 — 10mm+12mm AIR GAP+10mm THK. LG.U.
   GL04 — 12mm THK. CLEAR TEMPERED GLASS
   GL05 — 10mm+12mm AIR GAP+10mm THK. LG.U.
   GL06 — 10mm+12mm AIR GAP+12mm THK. LG.U.
   PD01 — 10mm T.P+12mm AIR GAP+8mm T.P
   GL07 — 10mm+12mm AIR GAP+12mm THK. LG.U.
   GL08 — 10mm+12mm AIR GAP+10mm THK. LG.U.

NO.	DATE	REMARKS	BY
G	22/10/2021	REVISION SUBJECT TO ARCH.COMMENT	
A	08/08/2021	REVISION SUBJECT TO ARCH.COMMENT	

JOB NO. : J-853

PROJECT :
PROPOSED RESIDENTIAL DEVELOPMENT AT N.K.I.L. 6542 YIN PING ROAD KOWLOON

TITLE :
WINDOW SCHEDULE FOR TOWER 3 ALUM. WINDOW

DATE : 03-APR-21 | SCALE : 1:40

DRAWN BY : | CHECKED BY :

美特鋁製有限公司
MIDI ALUMINIUM FABRICATOR LTD.
Units 6-8, Sunray Industrial Centre, 1/F
610 Cha Kwo Ling Road, Kowloon
Tel:23489211-4 Fax:(852)27727666

DWG NO. : J853-SD-PW-SC308 | REV. : G

ELEVATION

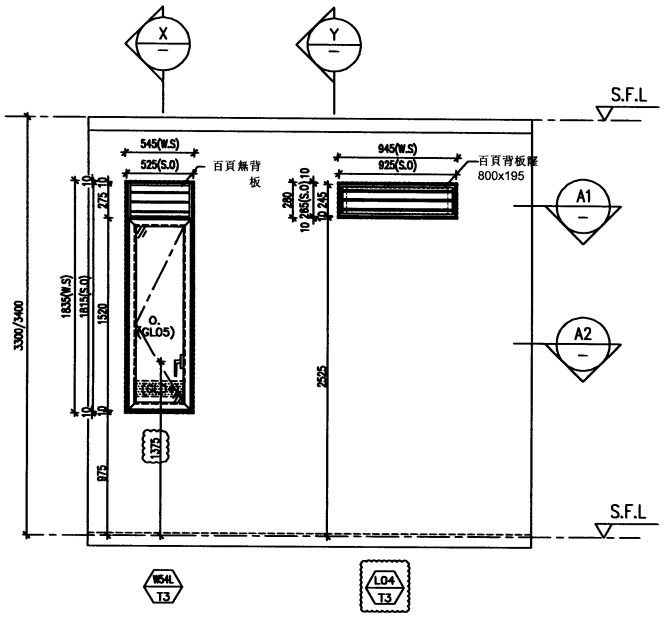

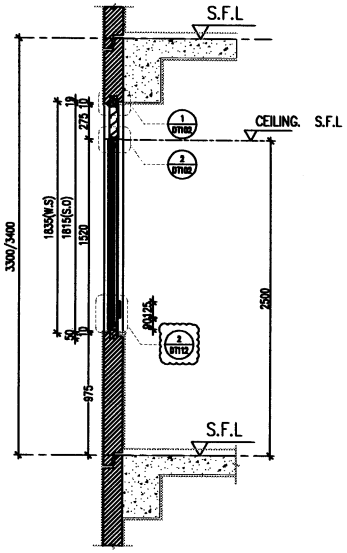

X PART SECTION

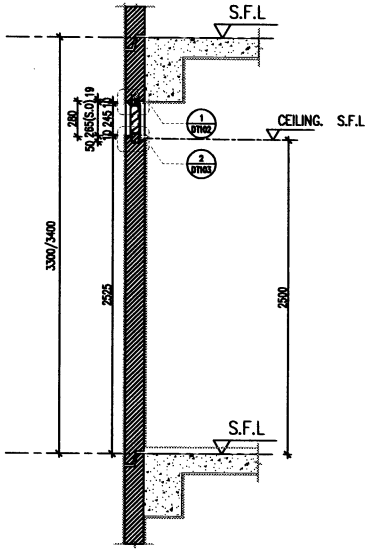

Y PART SECTION

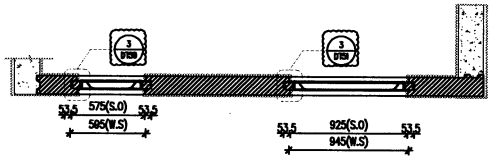

A1 PART PLAN

A2 PART PLAN

L04 T3

PROVIDED		
GLAZING AREA	–	m^2
OPENABLE AREA	–	m^2
FREE AREA	59.35	%

W54L T3

PROVIDED		
GLAZING AREA	0.516	m^2
OPENABLE AREA	0.567	m^2
FREE AREA	60.7	%

WINDOW MARK	W54L T3 & L04 T3
LOCATION	23F&25F FLAT C MASTER BATH ROOM
SECTION	70mm ALUM. SECTION
GLAZING	GL05
QUANTITY	2 Nos / 2 Nos
REMARKS	FACADE(T3-01-07A/25F; T3-01-07B/23F)

B.D. REF :

CLIENT :
SHIMAO GROUP HOLDINGS LIMITED

ARCHITECT :
WONG TUNG & PARTNERS LIMITED
ARCHITECTS & PLANNERS

MAIN CONTRACTOR :
協興建築有限公司
HIP HING CONSTRUCTION CO LTD

STRUCTURAL ENGINEER :
C M WONG & ASSOCIATES LTD
黃志明建築工程師有限公司

FACADE CONSULTANT:
MEINHARDT

NOTE :
1. ALL DIMENSIONS ARE IN mm.
2. ALL ELEVATIONS ARE VIEWED FROM OUTSIDE.
3. ALL DIMENSIONS TO BE VERIFIED ON SITE BEFORE FABRICATION.

LEGEND :
- X1 / 2001 — DETAIL MARK NO. / REFER SHEET NO.
1. F.F.L. — FINISHED FLOOR LEVEL
2. S.F.L. — STRUCTURAL FLOOR LEVEL
3. (R) — REVERSED DETAIL
4. ▲ — FIXING LOCATION
5. △ — FIXING LUG LOCATION
6. GLASS LEGEND
   - GL01 — 10mm+12mm AIR GAP+10mm THK. L.G.U.
   - GL04 — 12mm THK. CLEAR TEMPERED GLASS
   - GL05 — 10mm+12mm AIR GAP+10mm THK. L.G.U.
   - GL06 — 10mm+12mm AIR GAP+12mm THK. L.G.U.
   - PD01 — 10mm T.P+12mm AIR GAP+8mm T.P
   - GL07 — 10mm+12mm AIR GAP+12mm THK. L.G.U.
   - GL08 — 10mm+12mm AIR GAP+10mm THK. L.G.U.

NO.	DATE	REVISION SUBJECT TO ARCH.COMMENT	BY
G	22/10/2021		

JOB NO. : J-853

PROJECT :
PROPOSED RESIDENTIAL DEVELOPMENT AT N.K.I.L. 6542 YIN PING ROAD KOWLOON

TITLE :
WINDOW SCHEDULE FOR TOWER 3 ALUM. WINDOW

DATE : 03-APR-21 | SCALE : 1:40

DRAWN BY : | CHECKED BY :

美特鋁製有限公司
MIDI ALUMINIUM FABRICATOR LTD.
Units 6-8, Sunray Industrial Centre, 1/F
610 Cha Kwo Ling Road, Kowloon
Tel:23489211-4 Fax:(852)27727666

DWG NO. : J853-SD-PW-SC307b | REV. : G

ELEVATION

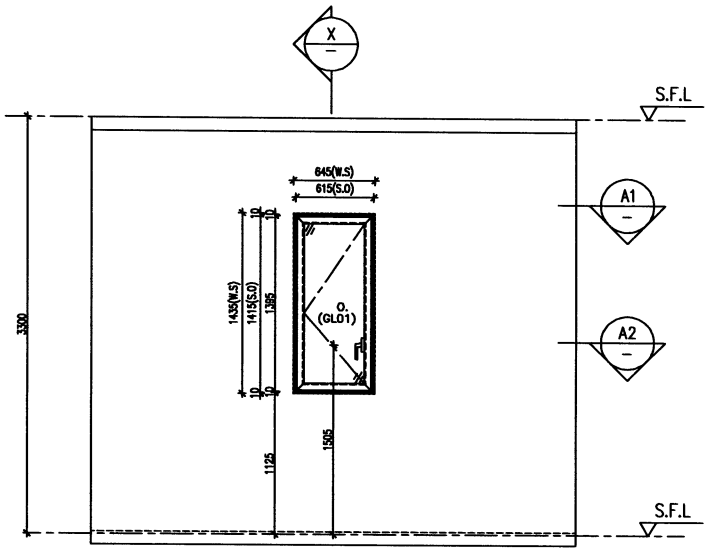

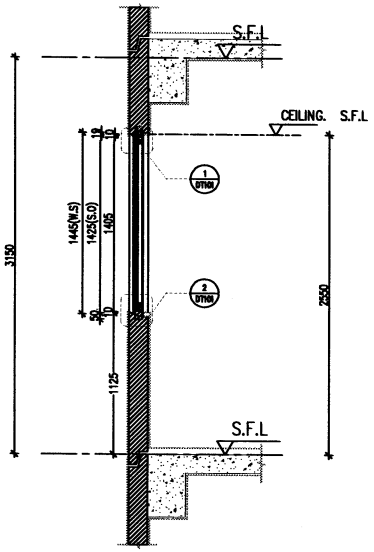

X — PART SECTION

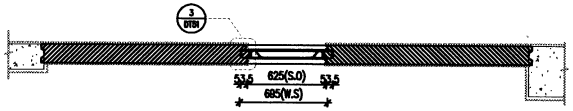

A1 — PART PLAN

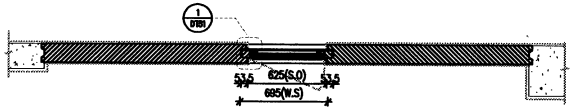

A2 — PART PLAN

PROVIDED		
GLAZING AREA	0.629	m^2
OPENABLE AREA	0.737	m^2
FREE AREA	–	%

WINDOW MARK	W79L T3
LOCATION	5F&25F FLAT C MASTER ENSUITE
SECTION	70mm ALUM. SECTION
GLAZING	GL01
QUANTITY	2 Nos
REMARKS	FACADE(T3-01-08A/5F&25F)

B.D. REF :

CLIENT :
SHIMAO GROUP HOLDINGS LIMITED

ARCHITECT :
WONG TUNG & PARTNERS LIMITED
ARCHITECTS & PLANNERS

MAIN CONTRACTOR :
協興建築有限公司
HIP HING CONSTRUCTION CO LTD

STRUCTURAL ENGINEER :
CMA C M WONG & ASSOCIATES LTD
黃志明建築工程師有限公司

FACADE CONSULTANT:
MEINHARDT

NOTE :
1. ALL DIMENSIONS ARE IN mm.
2. ALL ELEVATIONS ARE VIEWED FROM OUTSIDE.
3. ALL DIMENSIONS TO BE VERIFIED ON SITE BEFORE FABRICATION.

LEGEND :
X1 / X001 — DETAIL MARK NO. / REFER SHEET NO.
1. F.F.L. — FINISHED FLOOR LEVEL
2. S.F.L. — STRUCTURAL FLOOR LEVEL
3. (R) — REVERSED DETAIL
4. ▲ — FIXING LOCATION
5. △ — FIXING LUG LOCATION
6. GLASS LEGEND
GL01 — 10mm+12mm AIR GAP+10mm THK. I.G.U.
GL04 — 12mm THK. CLEAR TEMPERED GLASS
GL05 — 10mm+12mm AIR GAP+10mm THK. I.G.U.
GL06 — 10mm+12mm AIR GAP+12mm THK. I.G.U.
PD01 — 10mm T.P+12mm AIR GAP+8mm T.P
GL07 — 10mm+12mm AIR GAP+12mm THK. I.G.U.
GL08 — 10mm+12mm AIR GAP+10mm THK. I.G.U.

NO.	DATE	REVISED	BY
0	22/10/2021	REVISION SUBJECT TO ARCH.COMMENT	ada

JOB NO. : J-853

PROJECT :
PROPOSED RESIDENTIAL DEVELOPMENT AT N.K.I.L. 6542 YIN PING ROAD KOWLOON

TITLE :
WINDOW SCHEDULE FOR TOWER 3 ALUM. WINDOW

DATE : 03-APR-21 | SCALE : 1:40

DRAWN BY : | CHECKED BY :

美特鋁質有限公司
MIDI ALUMINIUM FABRICATOR LTD.
Units 6-8, Sunray Industrial Centre, 1/F
610 Cha Kwo Ling Road, Kowloon
Tel:23489211-4 Fax:(852)27727666

DWG NO. : J853-SD-PW-SC308a | REV. : G

ELEVATION

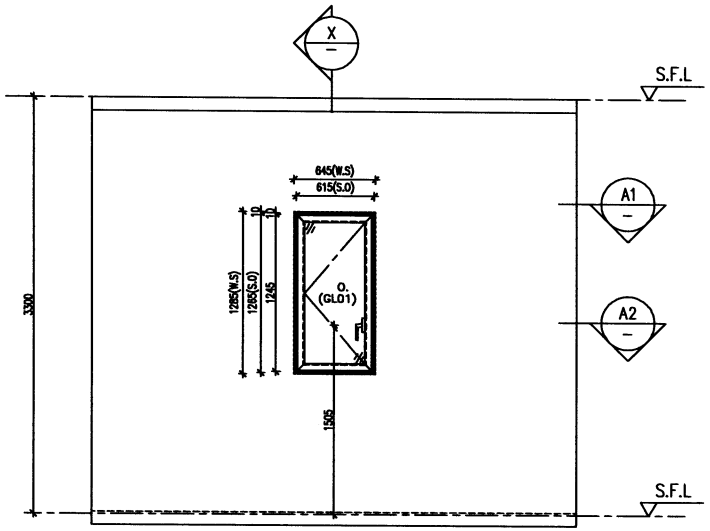

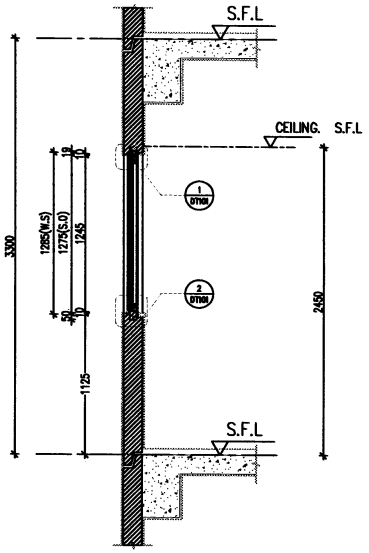

X PART SECTION

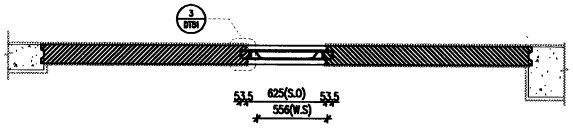

A1 PART PLAN

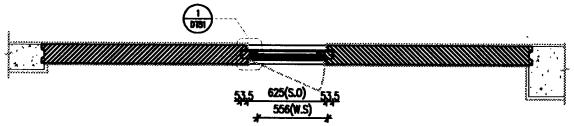

A2 PART PLAN

PROVIDED		
GLAZING AREA	0.560	m^2
OPENABLE AREA	0.660	m^2
FREE AREA	–	%

WINDOW MARK	W29L T3
LOCATION	16F & 26F FLAT C MASTER ENSUITE
SECTION	70mm ALUM. SECTION
GLAZING	GL01
QUANTITY	2 Nos
REMARKS	FACADE(T3-01-08A/16F&26F;)

B.D. REF :

CLIENT :
SHIMAO GROUP HOLDINGS LIMITED

ARCHITECT :
WONG TUNG & PARTNERS LIMITED
ARCHITECTS & PLANNERS

MAIN CONTRACTOR :
協興建築有限公司
HIP HING CONSTRUCTION CO LTD

STRUCTURAL ENGINEER :
CMA C M WONG & ASSOCIATES LTD
黃志明建築工程師有限公司

FACADE CONSULTANT:
MEINHARDT

NOTE :
1. ALL DIMENSIONS ARE IN mm.
2. ALL ELEVATIONS ARE VIEWED FROM OUTSIDE.
3. ALL DIMENSIONS TO BE VERIFIED ON SITE BEFORE FABRICATION.

LEGEND :
X1 / XXX1 — DETAIL MARK NO. / REFER SHEET NO.
1. F.F.L. — FINISHED FLOOR LEVEL
2. S.F.L. — STRUCTURAL FLOOR LEVEL
3. (R) — REVERSED DETAIL
4. ▲ — FIXING LOCATION
5. △ — FIXING LUG LOCATION
6. GLASS LEGEND
GL01 — 10mm+12mm AIR GAP+10mm THK. I.G.U.
GL04 — 12mm THK. CLEAR TEMPERED GLASS
GL05 — 10mm+12mm AIR GAP+10mm THK. I.G.U.
GL06 — 10mm+12mm AIR GAP+12mm THK. I.G.U.
PD01 — 10mm T.P+12mm AIR GAP+8mm T.P
GL07 — 10mm+12mm AIR GAP+12mm THK. I.G.U.
GL08 — 10mm+12mm AIR GAP+10mm THK. I.G.U.

NO.	DATE	REVISED	BY

JOB NO. : J-853

PROJECT :
PROPOSED RESIDENTIAL DEVELOPMENT AT N.K.I.L. 6542
YIN PING ROAD
KOWLOON

TITLE :
WINDOW SCHEDULE FOR TOWER 3 ALUM. WINDOW

DATE : 03-APR-21 | SCALE : 1:40

DRAWN BY : | CHECKED BY :

美特鋁質有限公司
MIDI ALUMINIUM FABRICATOR LTD.
Units 6-8, Sunray Industrial Centre, 1/F
610 Cha Kwo Ling Road, Kowloon
Tel:23489211-4 Fax:(852)27727666

DWG NO. : J853-SD-PW-SC308 | REV. : –

ELEVATION

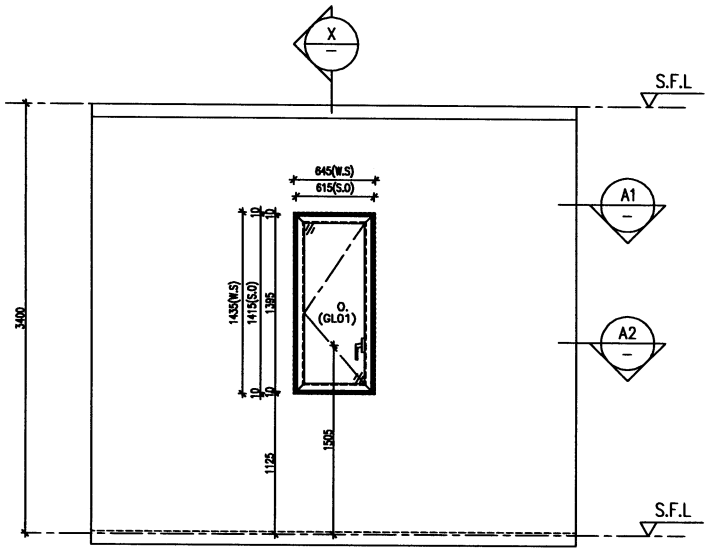

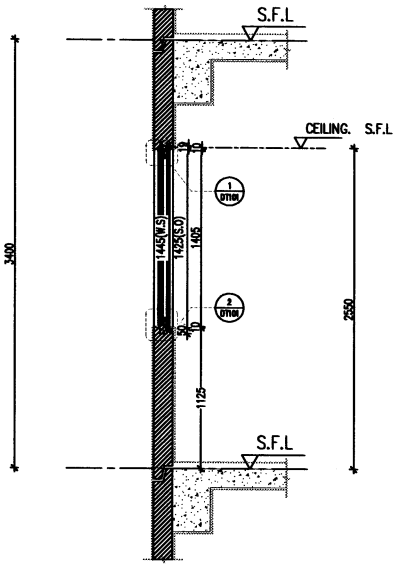

X — PART SECTION

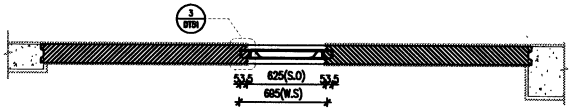

A1 — PART PLAN

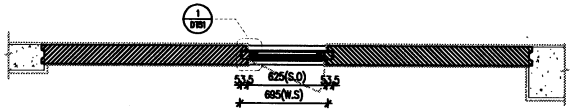

A2 — PART PLAN

PROVIDED		
GLAZING AREA	0.631	m^2
OPENABLE AREA	0.739	m^2
FREE AREA	–	%

WINDOW MARK	W79L T3
LOCATION	23F FLAT C MASTER ENSUITE
SECTION	70mm ALUM. SECTION
GLAZING	GL01
QUANTITY	1 Nos
REMARKS	FACADE(T3-01-08B/23F)

B.D. REF :

CLIENT :
SHIMAO GROUP HOLDINGS LIMITED

ARCHITECT :
WONG TUNG & PARTNERS LIMITED
ARCHITECTS & PLANNERS

MAIN CONTRACTOR :
協興建築有限公司
HIP HING CONSTRUCTION CO LTD

STRUCTURAL ENGINEER :
CMA C M WONG & ASSOCIATES LTD
黃志明建築工程師有限公司

FACADE CONSULTANT:
MEINHARDT

NOTE :
1. ALL DIMENSIONS ARE IN mm.
2. ALL ELEVATIONS ARE VIEWED FROM OUTSIDE.
3. ALL DIMENSIONS TO BE VERIFIED ON SITE BEFORE FABRICATION.

LEGEND :
X1 / X001 — DETAIL MARK NO. / REFER SHEET NO.
1. F.F.L. — FINISHED FLOOR LEVEL
2. S.F.L. — STRUCTURAL FLOOR LEVEL
3. (78) — REVERSED DETAIL
4. ▲ — FIXING LOCATION
5. △ — FIXING LUG LOCATION
6. GLASS LEGEND
GL01 — 10mm+12mm AIR GAP+10mm THK. L.G.U.
GL04 — 12mm THK. CLEAR TEMPERED GLASS
GL05 — 10mm+12mm AIR GAP+10mm THK. L.G.U.
GL06 — 10mm+12mm AIR GAP+12mm THK. L.G.U.
PD01 — 10mm T.P+12mm AIR GAP+8mm T.P
GL07 — 10mm+12mm AIR GAP+12mm THK. L.G.U.
GL08 — 10mm+12mm AIR GAP+10mm THK. L.G.U.

NO.	DATE	REVISED	BY

JOB NO. : J-853

PROJECT :
PROPOSED RESIDENTIAL DEVELOPMENT AT N.K.I.L. 6542 YIN PING ROAD KOWLOON

TITLE :
WINDOW SCHEDULE FOR TOWER 3 ALUM. WINDOW

DATE : 03-APR-21 | SCALE : 1:40

DRAWN BY : | CHECKED BY :

美特鋁製有限公司
MIDI ALUMINIUM FABRICATION LTD.
Units 6-8, Sunray Industrial Centre, 1/F
610 Cha Kwo Ling Road, Kowloon
Tel:23489211-4 Fax:(852)27727666

DWG NO. : J853-SD-PW-SC308b | REV. : –

ELEVATION

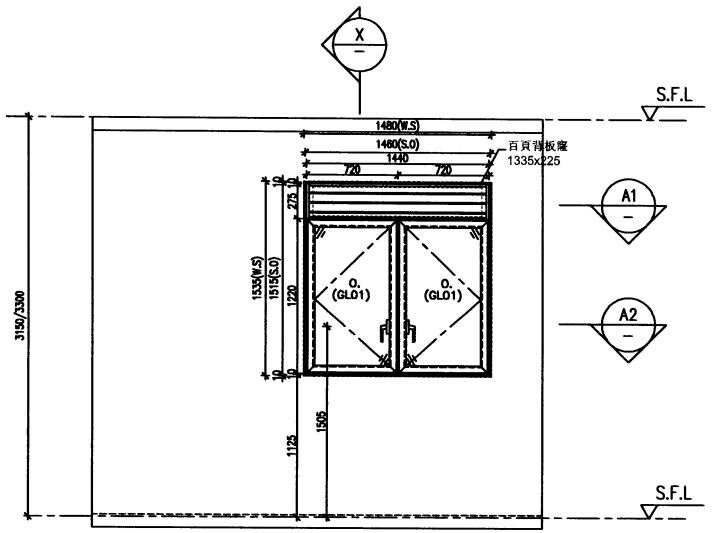

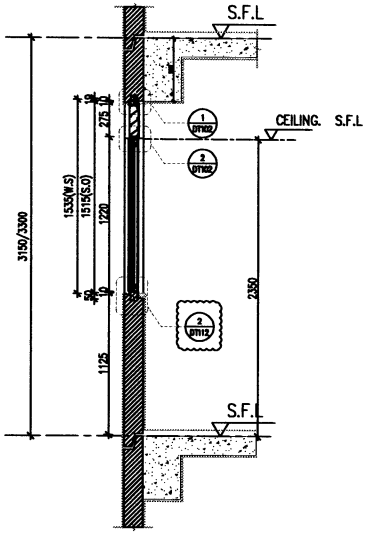

X PART SECTION

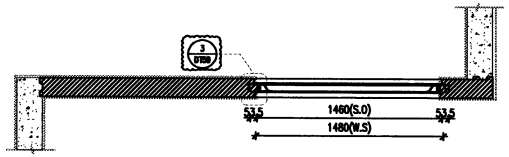

A1 PART PLAN

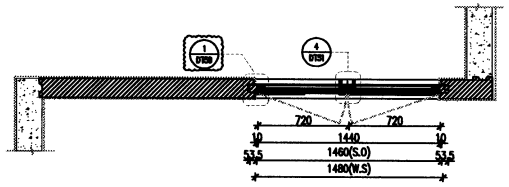

A2 PART PLAN

PROVIDED		
GLAZING AREA	1.285	m^2
OPENABLE AREA	1.486	m^2
FREE AREA	60.7	%

WINDOW MARK	W09 T3
LOCATION	16F&26F FLAT C KITCHEN
SECTION	70mm ALUM. SECTION
GLAZING	GL01
QUANTITY	2 Nos
REMARKS	FACADE(T3-01-09A/16F&26F)

B.D. REF :

CLIENT :
SHIMAO GROUP HOLDINGS LIMITED

ARCHITECT : WONG TUNG & PARTNERS LIMITED ARCHITECTS & PLANNERS

MAIN CONTRACTOR :
協興建築有限公司
HIP HING CONSTRUCTION CO LTD

STRUCTURAL ENGINEER :
C M WONG & ASSOCIATES LTD
黃志明建築工程師有限公司

FACADE CONSULTANT:
MEINHARDT

NOTE :
1. ALL DIMENSIONS ARE IN mm.
2. ALL ELEVATIONS ARE VIEWED FROM OUTSIDE.
3. ALL DIMENSIONS TO BE VERIFIED ON SITE BEFORE FABRICATION.

LEGEND :
- X1 / 20/01 — DETAIL MARK NO. / REFER SHEET NO.
1. F.F.L. — FINISHED FLOOR LEVEL
2. S.F.L. — STRUCTURAL FLOOR LEVEL
3. (R) — REVERSED DETAIL
4. ▲ — FIXING LOCATION
5. △ — FIXING LUG LOCATION
6. GLASS LEGEND
   - GL01 — 10mm+12mm AIR GAP+10mm THK. I.G.U.
   - GL04 — 12mm THK. CLEAR TEMPERED GLASS
   - GL05 — 10mm+12mm AIR GAP+10mm THK. I.G.U.
   - GL06 — 10mm+12mm AIR GAP+12mm THK. I.G.U.
   - PD01 — 10mm T.P+12mm AIR GAP+8mm T.P
   - GL07 — 10mm+12mm AIR GAP+12mm THK. I.G.U.
   - GL08 — 10mm+12mm AIR GAP+10mm THK. I.G.U.

NO.	DATE	REVISED	BY
A	30/09/2022	REVISION SUBJECT TO ARCH.COMMENT	wlo

JOB NO. : J-853

PROJECT :
PROPOSED RESIDENTIAL DEVELOPMENT AT N.K.I.L. 6542 YIN PING ROAD KOWLOON

TITLE :
WINDOW SCHEDULE FOR TOWER 3 ALUM. WINDOW

DATE : 03-APR-21 | SCALE : 1:40

DRAWN BY : | CHECKED BY :

美特鋁實有限公司
MIDI ALUMINIUM FABRICATION LTD.
Units 6-8, Sunray Industrial Centre, 1/F
610 Cha Kwo Ling Road, Kowloon
Tel:23489211-4 Fax:(852)27727666

DWG NO. : J853-SD-PW-SC3091 | REV. : A

ELEVATION

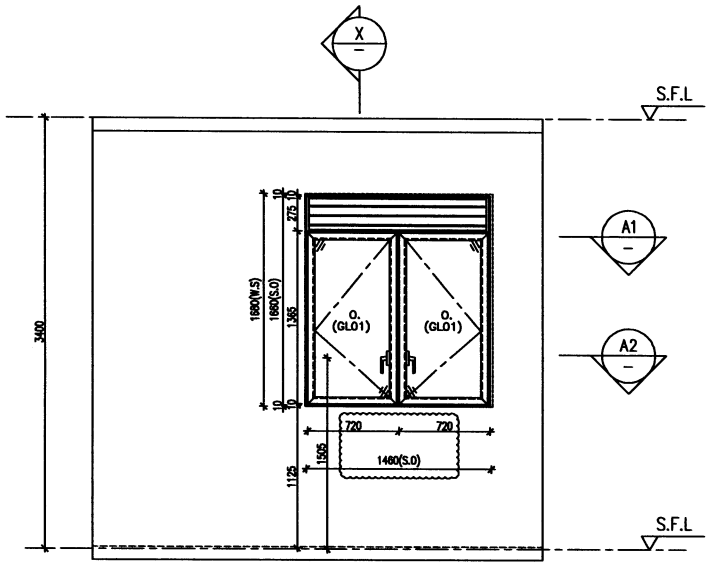

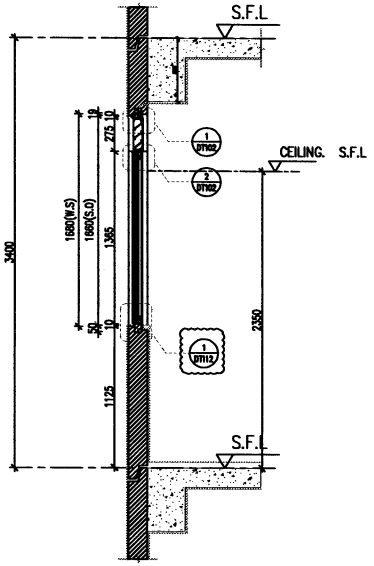

X PART SECTION

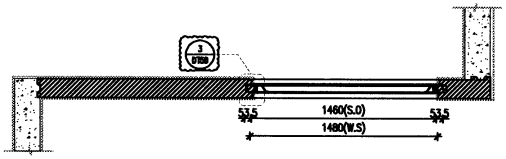

A1 PART PLAN

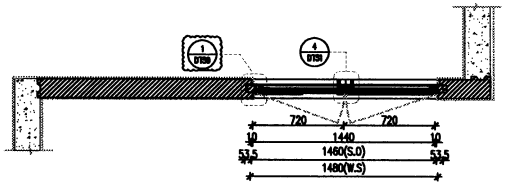

A2 PART PLAN

PROVIDED		
GLAZING AREA	1.461	m^2
OPENABLE AREA	1.680	m^2
FREE AREA	60.7	%

WINDOW MARK	W59 / T3
LOCATION	23F FLAT C KITCHEN
SECTION	70mm ALUM. SECTION
GLAZING	GL01
QUANTITY	1 Nos
REMARKS	FACADE(T3-01-09B/23F)

B.D. REF :

CLIENT :
SHIMAO GROUP HOLDINGS LIMITED

ARCHITECT :
WONG TUNG & PARTNERS LIMITED
ARCHITECTS & PLANNERS

MAIN CONTRACTOR :
協興建築有限公司
HIP HING CONSTRUCTION CO LTD

STRUCTURAL ENGINEER :
CMA C M WONG & ASSOCIATES LTD
黃志明建築工程師有限公司

FACADE CONSULTANT:
MEINHARDT

NOTE :
1. ALL DIMENSIONS ARE IN mm.
2. ALL ELEVATIONS ARE VIEWED FROM OUTSIDE.
3. ALL DIMENSIONS TO BE VERIFIED ON SITE BEFORE FABRICATION.

LEGEND :
X1 — DETAIL MARK NO.
X001 — REFER SHEET NO.
1. F.F.L. — FINISHED FLOOR LEVEL
2. S.F.L. — STRUCTURAL FLOOR LEVEL
3. R — REVERSED DETAIL
4. ▲ — FIXING LOCATION
5. △ — FIXING LUG LOCATION
6. GLASS LEGEND
GL01 — 10mm+12mm AIR GAP+10mm THK. I.G.U.
GL04 — 12mm THK. CLEAR TEMPERED GLASS
GL05 — 10mm+12mm AIR GAP+10mm THK. I.G.U.
GL06 — 10mm+12mm AIR GAP+12mm THK. I.G.U.
PD01 — 10mm T.P+12mm AIR GAP+8mm T.P
GL07 — 10mm+12mm AIR GAP+12mm THK. I.G.U.
GL08 — 10mm+12mm AIR GAP+10mm THK. I.G.U.

NO.	DATE	REVISED	BY
A	30/09/2022	REVISION SUBJECT TO ARCH.COMMENT	MDL

JOB NO. : J-853

PROJECT :
PROPOSED RESIDENTIAL DEVELOPMENT AT N.K.I.L. 6542 YIN PING ROAD KOWLOON

TITLE :
WINDOW SCHEDULE FOR TOWER 3 ALUM. WINDOW

DATE : 03-APR-21 | SCALE : 1:40

DRAWN BY : | CHECKED BY :

美特鋁製有限公司
MIDI ALUMINIUM FABRICATOR LTD.
Units 6-8, Sunray Industrial Centre, 1/F
610 Cha Kwo Ling Road, Kowloon
Tel:23489211-4 Fax:(852)27727666

DWG NO. : J853-SD-PW-SC309c | REV. : A

ELEVATION

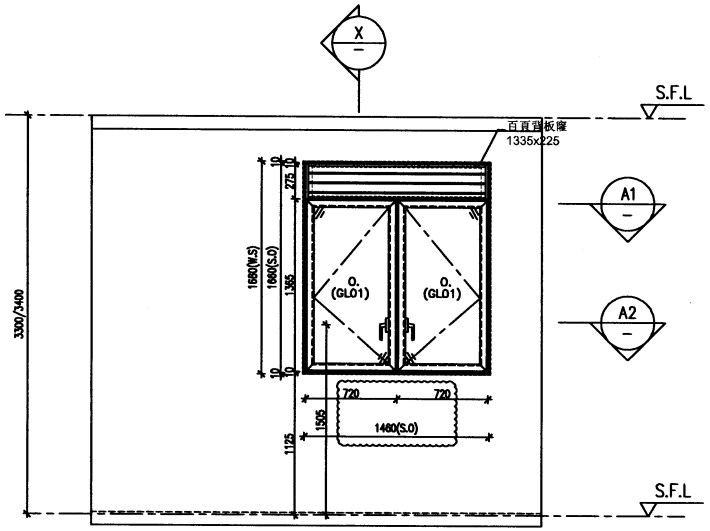

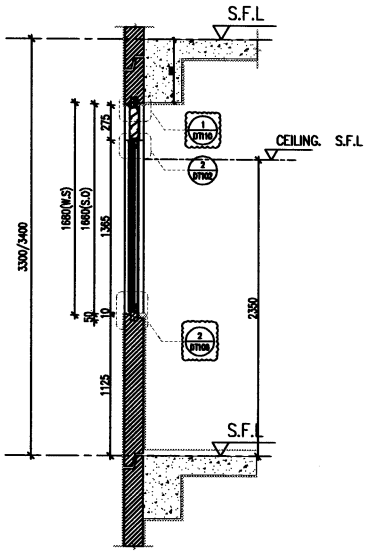

X PART SECTION

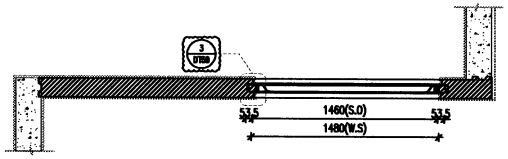

A1 PART PLAN

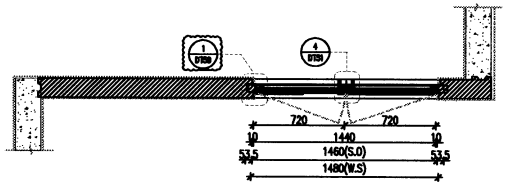

A2 PART PLAN

PROVIDED		
GLAZING AREA	1.455	m^2
OPENABLE AREA	1.674	m^2
FREE AREA	60.7	%

WINDOW MARK	W59A T3
LOCATION	5F&25F FLAT C KITCHEN
SECTION	70mm ALUM. SECTION
GLAZING	GL01
QUANTITY	2 Nos
REMARKS	FACADE(T3-01-09A/5F&25F)

B.D. REF :

CLIENT :
SHIMAO GROUP HOLDINGS LIMITED

ARCHITECT :
WONG TUNG & PARTNERS LIMITED
ARCHITECTS & PLANNERS

MAIN CONTRACTOR :
協興建築有限公司
HIP HING CONSTRUCTION CO LTD

STRUCTURAL ENGINEER :
C M WONG & ASSOCIATES LTD
黃志明建築工程師有限公司

FACADE CONSULTANT:
MEINHARDT

NOTE :
1. ALL DIMENSIONS ARE IN mm.
2. ALL ELEVATIONS ARE VIEWED FROM OUTSIDE.
3. ALL DIMENSIONS TO BE VERIFIED ON SITE BEFORE FABRICATION.

LEGEND :
X1 / 2001 — DETAIL MARK NO. / REFER SHEET NO.
1. F.F.L. — FINISHED FLOOR LEVEL
2. S.F.L. — STRUCTURAL FLOOR LEVEL
3. (R) — REVERSED DETAIL
4. ▲ — FIXING LOCATION
5. △ — FIXING LUG LOCATION
6. GLASS LEGEND
GL01 — 10mm+12mm AIR GAP+10mm THK. I.G.U.
GL04 — 12mm THK. CLEAR TEMPERED GLASS
GL05 — 10mm+12mm AIR GAP+10mm THK. I.G.U.
GL06 — 10mm+12mm AIR GAP+12mm THK. I.G.U.
PD01 — 10mm T.P+12mm AIR GAP+8mm T.P
GL07 — 10mm+12mm AIR GAP+12mm THK. I.G.U.
GL08 — 10mm+12mm AIR GAP+10mm THK. I.G.U.

NO.	DATE	REVISED	BY
0	22/10/2021	REVISION SUBJECT TO ARCH.COMMENT	mlo
A	08/09/2021	REVISION SUBJECT TO ARCH.COMMENT	mlo

JOB NO. : J-853

PROJECT :
PROPOSED RESIDENTIAL DEVELOPMENT AT N.K.I.L. 6542
YIN PING ROAD
KOWLOON

TITLE :
WINDOW SCHEDULE FOR TOWER 3 ALUM. WINDOW

DATE : 03-APR-21 | SCALE : 1:40

DRAWN BY : | CHECKED BY :

美特鋁製有限公司
MIDI ALUMINIUM FABRICATOR LTD.
Units 6-8, Sunray Industrial Centre, 1/F
610 Cha Kwo Ling Road, Kowloon
Tel:23489211-4 Fax:(852)27727666

DWG NO. : J853-SD-PW-SC309a | REV. : G

ELEVATION

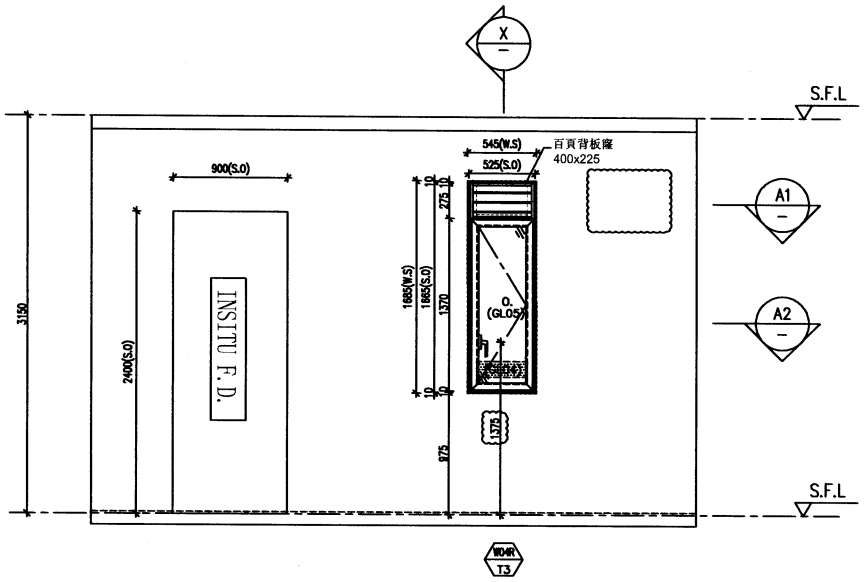

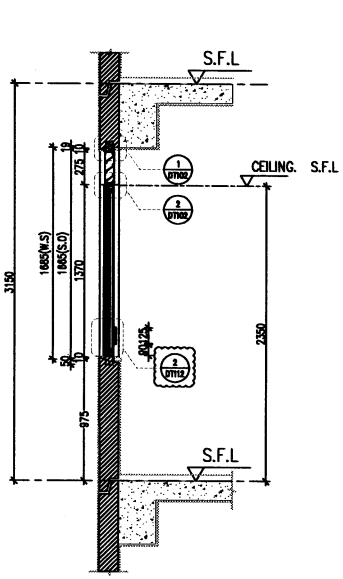

X PART SECTION

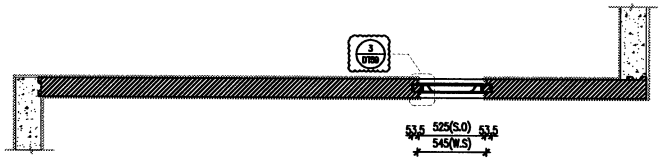

A1 PART PLAN

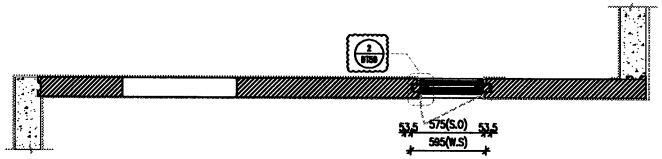

A2 PART PLAN

L01 T3

PROVIDED		
GLAZING AREA	–	m^2
OPENABLE AREA	–	m^2
FREE AREA	55.4	%

DELETED

W04R T3

PROVIDED		
GLAZING AREA	0.460	m^2
OPENABLE AREA	0.503	m^2
FREE AREA	60.7	%

WINDOW MARK	W04R T3
LOCATION	17F FLAT A ENSUITE BATH
SECTION	70mm ALUM. SECTION
GLAZING	GL05
QUANTITY	1 No.
REMARKS	FACADE(T3-01-11/17F)

B.D. REF :

CLIENT :
SHIMAO GROUP HOLDINGS LIMITED

ARCHITECT :
WONG TUNG & PARTNERS LIMITED
ARCHITECTS & PLANNERS

MAIN CONTRACTOR :
協興建築有限公司
HIP HING CONSTRUCTION CO LTD

STRUCTURAL ENGINEER :
C M WONG & ASSOCIATES LTD
黃志明建築工程師有限公司

FACADE CONSULTANT:
MEINHARDT

NOTE :
1. ALL DIMENSIONS ARE IN mm.
2. ALL ELEVATIONS ARE VIEWED FROM OUTSIDE.
3. ALL DIMENSIONS TO BE VERIFIED ON SITE BEFORE FABRICATION.

LEGEND :
- X1 / X2/Sh1 — DETAIL MARK NO. / REFER SHEET NO.
1. F.F.L. — FINISHED FLOOR LEVEL
2. S.F.L. — STRUCTURAL FLOOR LEVEL
3. (R) — REVERSED DETAIL
4. ▲ — FIXING LOCATION
5. △ — FIXING LUG LOCATION
6. GLASS LEGEND
   - GL01 — 10mm+12mm AIR GAP+10mm THK. L.G.U.
   - GL04 — 12mm THK. CLEAR TEMPERED GLASS
   - GL05 — 10mm+12mm AIR GAP+10mm THK. L.G.U.
   - GL06 — 10mm+12mm AIR GAP+12mm THK. L.G.U.
   - PD01 — 10mm T.P+12mm AIR GAP+8mm T.P
   - GL07 — 10mm+12mm AIR GAP+12mm THK. L.G.U.
   - GL08 — 10mm+12mm AIR GAP+10mm THK. L.G.U.

NO.	DATE	REVISED	BY
0	22/10/2021	REVISION SUBJECT TO ARCH.COMMENT	sdo
A	08/08/2021	REVISION SUBJECT TO ARCH.COMMENT	sdo

JOB NO. : J-853

PROJECT :
PROPOSED RESIDENTIAL DEVELOPMENT AT N.K.I.L. 6542 YIN PING ROAD KOWLOON

TITLE :
WINDOW SCHEDULE FOR TOWER 3 ALUM. WINDOW

DATE : 03-APR-21 | SCALE : 1:40

DRAWN BY : | CHECKED BY :

美特鋁製有限公司
MIDI ALUMINIUM FABRICATOR LTD.
Units 6-8, Sunray Industrial Centre, 1/F
610 Cha Kwo Ling Road, Kowloon
Tel:23489211-4 Fax:(852)27727666

DWG NO. : J853-SD-PW-SC310 | REV. : G

ELEVATION

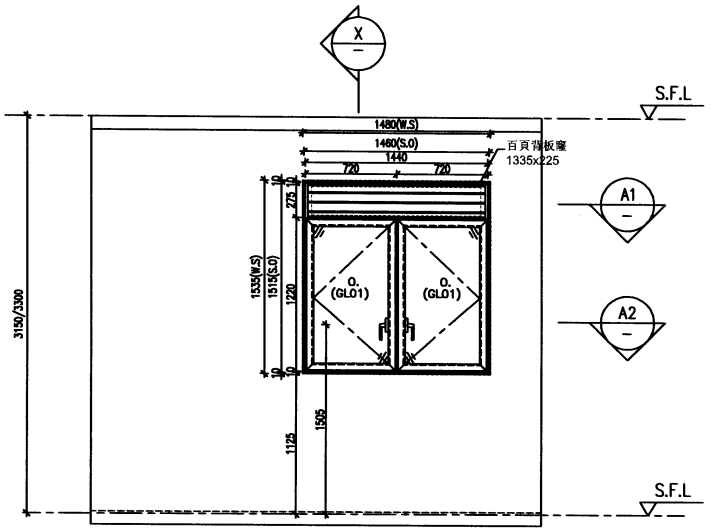

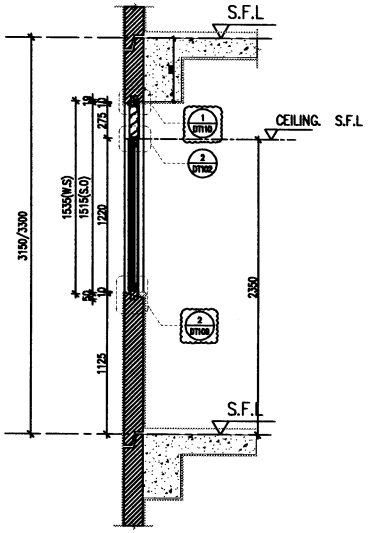

X PART SECTION

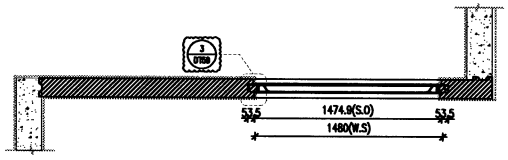

A1 PART PLAN

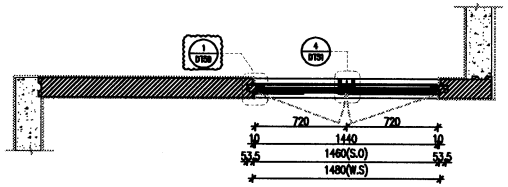

A2 PART PLAN

PROVIDED		
GLAZING AREA	1.279	m^2
OPENABLE AREA	1.480	m^2
FREE AREA	60.7	%

WINDOW MARK	W09A / T3
LOCATION	6F~15F&17F~22F FLAT C KITCHEN
SECTION	70mm ALUM. SECTION
GLAZING	GL01
QUANTITY	14 Nos
REMARKS	FACADE(T3-01-09/6~15F&17F~22F)

B.D. REF :

CLIENT :
SHIMAO GROUP HOLDINGS LIMITED

ARCHITECT :
WONG TUNG & PARTNERS LIMITED
ARCHITECTS & PLANNERS

MAIN CONTRACTOR :
協興建築有限公司
HIP HING CONSTRUCTION CO LTD

STRUCTURAL ENGINEER :
CMA C M WONG & ASSOCIATES LTD
黃志明建築工程師有限公司

FACADE CONSULTANT:
MEINHARDT

NOTE :
1. ALL DIMENSIONS ARE IN mm.
2. ALL ELEVATIONS ARE VIEWED FROM OUTSIDE.
3. ALL DIMENSIONS TO BE VERIFIED ON SITE BEFORE FABRICATION.

LEGEND :
X1 / X001 — DETAIL MARK NO. / REFER SHEET NO.
1. F.F.L. — FINISHED FLOOR LEVEL
2. S.F.L. — STRUCTURAL FLOOR LEVEL
3. (R) — REVERSED DETAIL
4. ▲ — FIXING LOCATION
5. △ — FIXING LUG LOCATION
6. GLASS LEGEND
GL01 — 10mm+12mm AIR GAP+10mm THK. I.G.U.
GL04 — 12mm THK. CLEAR TEMPERED GLASS
GL05 — 10mm+12mm AIR GAP+10mm THK. I.G.U.
GL06 — 10mm+12mm AIR GAP+12mm THK. I.G.U.
PD01 — 10mm T.P+12mm AIR GAP+8mm T.P
GL07 — 10mm+12mm AIR GAP+12mm THK. I.G.U.
GL08 — 10mm+12mm AIR GAP+10mm THK. I.G.U.

NO.	DATE	REVISED	BY
H	30/08/2022	REVISION SUBJECT TO ARCH.COMMENT	edo
G	22/10/2021	REVISION SUBJECT TO ARCH.COMMENT	edo
A	08/08/2021	REVISION SUBJECT TO ARCH.COMMENT	edo

JOB NO. : J-853

PROJECT :
PROPOSED RESIDENTIAL DEVELOPMENT AT N.K.I.L. 6542 YIN PING ROAD KOWLOON

TITLE :
WINDOW SCHEDULE FOR TOWER 3 ALUM. WINDOW

DATE : 03-APR-21 | SCALE : 1:40

DRAWN BY : | CHECKED BY :

美特鋁製有限公司
MIDI ALUMINIUM FABRICATOR LTD.
Units 6-8, Sunray Industrial Centre, 1/F
610 Cha Kwo Ling Road, Kowloon
Tel:23489211-4 Fax:(852)27727666

DWG NO. : J853-SD-PW-SC309 | REV. : H

ELEVATION

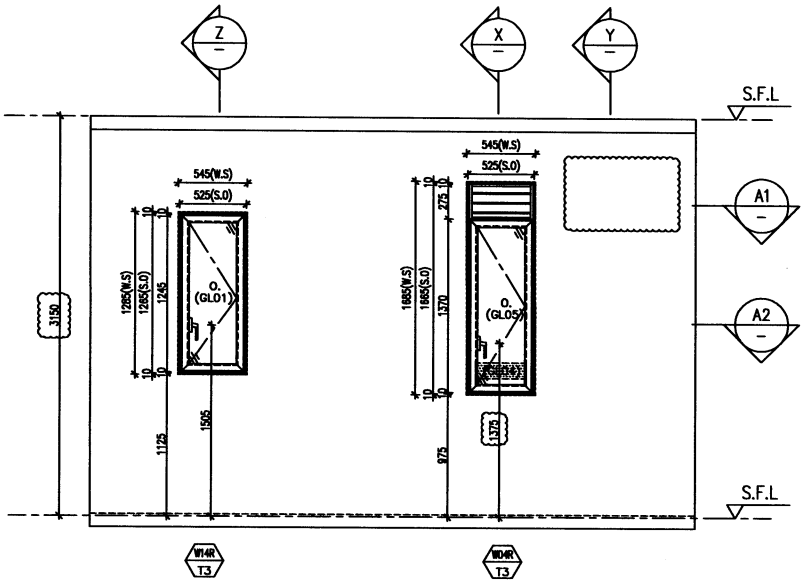

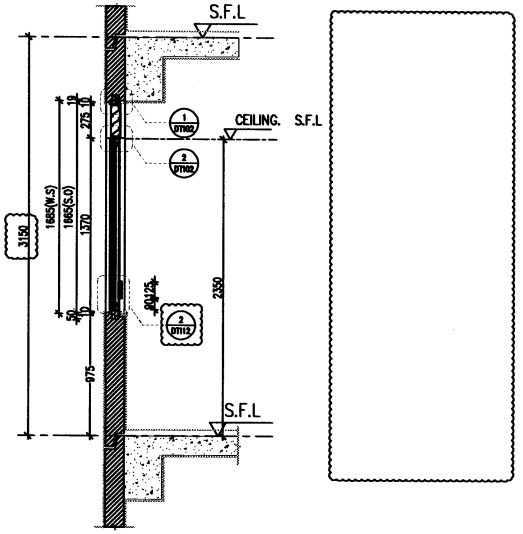

X PART SECTION

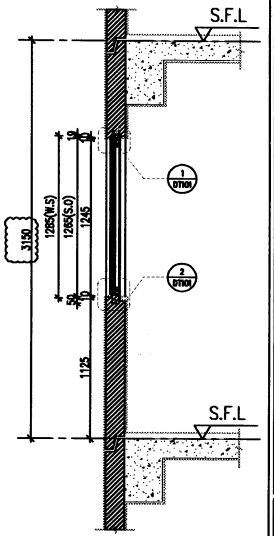

Z PART SECTION

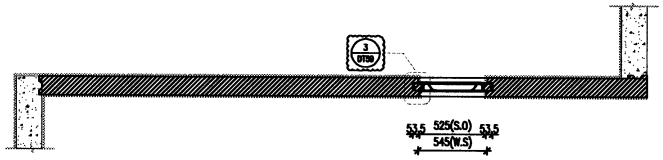

A1 PART PLAN

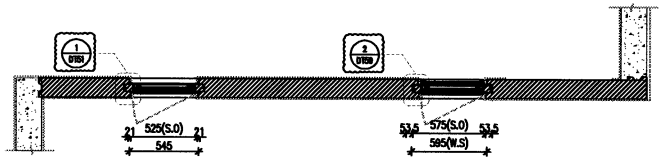

A2 PART PLAN

W14R T3	PROVIDED		
	GLAZING AREA	0.412	m^2
	OPENABLE AREA	0.502	m^2
	FREE AREA	60.7	%

L01 T3	PROVIDED		
	GLAZING AREA	–	m^2
	OPENABLE AREA	–	m^2
	FREE AREA	55.4	%

DELETED

W04R T3	PROVIDED		
	GLAZING AREA	0.460	m^2
	OPENABLE AREA	0.503	m^2
	FREE AREA	60.7	%

WINDOW MARK	W14R T3 & W04R T3
LOCATION	18F~22F FLAT A ENSUITE &BATH
SECTION	70mm ALUM. SECTION
GLAZING	GL01 & GL05
QUANTITY	5 Nos / 5 Nos / 5 Nos
REMARKS	FACADE(T3-01-10/18F~22F)

B.D. REF :

CLIENT :
SHIMAO GROUP HOLDINGS LIMITED

ARCHITECT :
WONG TUNG & PARTNERS LIMITED
ARCHITECTS & PLANNERS

MAIN CONTRACTOR :
協興建築有限公司
HIP HING CONSTRUCTION CO LTD

STRUCTURAL ENGINEER :
C M WONG & ASSOCIATES LTD
黃志明建築工程師有限公司

FACADE CONSULTANT:
MEINHARDT

NOTE :
1. ALL DIMENSIONS ARE IN mm.
2. ALL ELEVATIONS ARE VIEWED FROM OUTSIDE.
3. ALL DIMENSIONS TO BE VERIFIED ON SITE BEFORE FABRICATION.

LEGEND :
- X1 / XXX1 — DETAIL MARK NO. / REFER SHEET NO.
1. F.F.L. — FINISHED FLOOR LEVEL
2. S.F.L. — STRUCTURAL FLOOR LEVEL
3. (70) — REVERSED DETAIL
4. ▲ — FIXING LOCATION
5. △ — FIXING LUG LOCATION
6. GLASS LEGEND
   - GL01 — 10mm+12mm AIR GAP+10mm THK. L.G.U.
   - GL04 — 12mm THK. CLEAR TEMPERED GLASS
   - GL05 — 10mm+12mm AIR GAP+10mm THK. L.G.U.
   - GL06 — 10mm+12mm AIR GAP+12mm THK. L.G.U.
   - PD01 — 10mm T.P+12mm AIR GAP+8mm T.P
   - GL07 — 10mm+12mm AIR GAP+12mm THK. L.G.U.
   - GL08 — 10mm+12mm AIR GAP+10mm THK. L.G.U.

NO.	DATE	REVISED	BY
0	22/10/2021	REVISION SUBJECT TO ARCH.COMMENT	wlw
A	08/09/2021	REVISION SUBJECT TO ARCH.COMMENT	wlw

JOB NO. : J-853

PROJECT :
PROPOSED RESIDENTIAL DEVELOPMENT AT N.K.I.L. 6542 YIN PING ROAD KOWLOON

TITLE :
WINDOW SCHEDULE FOR TOWER 3 ALUM. WINDOW

DATE : 03-APR-21 | SCALE : 1:40

DRAWN BY : | CHECKED BY :

美特鋁製有限公司
MIDI ALUMINIUM FABRICATOR LTD.
Units 6-8, Sunray Industrial Centre, 1/F
610 Cha Kwo Ling Road, Kowloon
Tel:23489211-4 Fax:(852)27727666

DWG NO. : J853-SD-PW-SC311 | REV. : G

ELEVATION

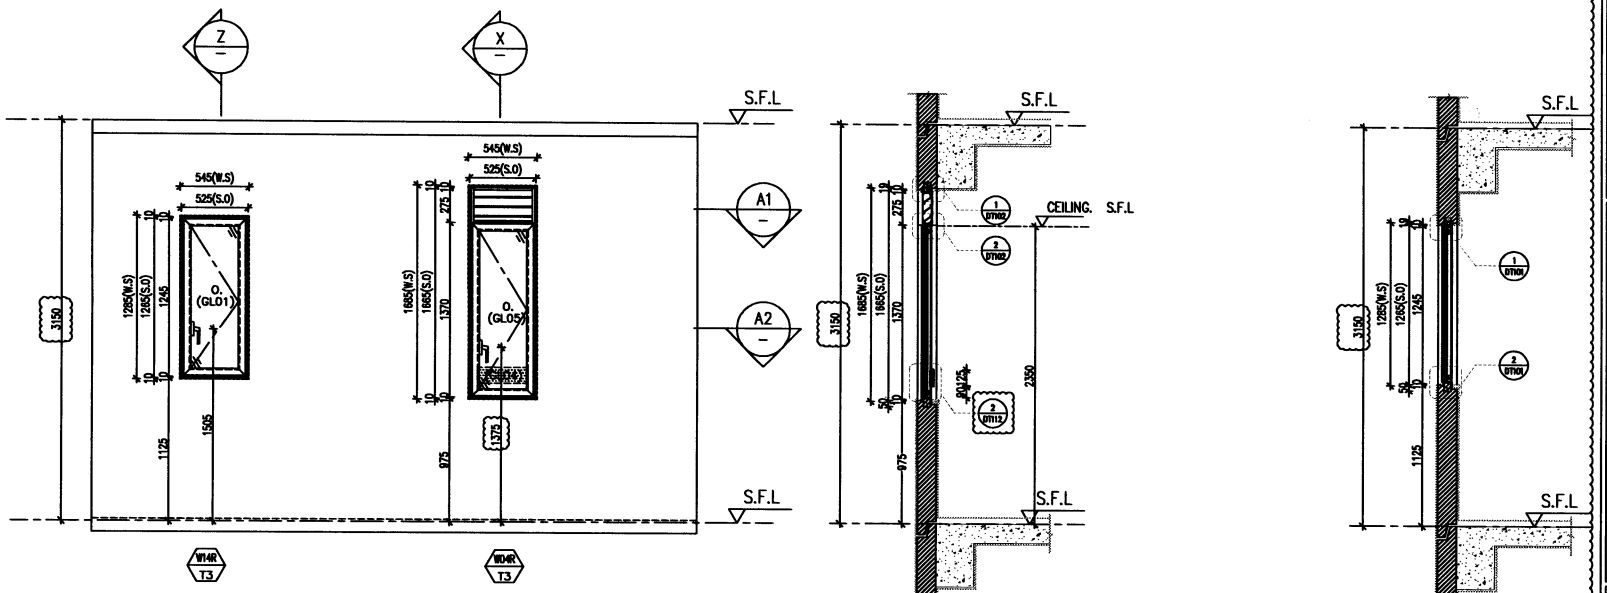

X PART SECTION

Z PART SECTION

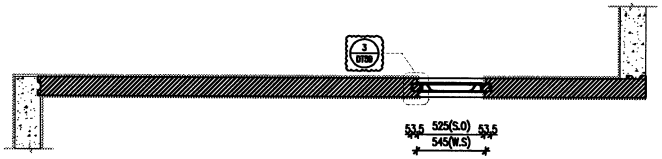

A1 PART PLAN

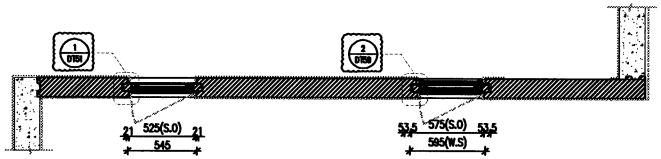

A2 PART PLAN

W14R T3	PROVIDED		
	GLAZING AREA	0.412	m^2
	OPENABLE AREA	0.502	m^2
	FREE AREA	60.7	%

W04R T3	PROVIDED		
	GLAZING AREA	0.460	m^2
	OPENABLE AREA	0.503	m^2
	FREE AREA	60.7	%

WINDOW MARK	W14R T3 & W04R T3
LOCATION	23F FLAT A ENSUITE &BATH
SECTION	70mm ALUM. SECTION
GLAZING	GL01 & GL05
QUANTITY	1 Nos / 1 Nos / 1 Nos
REMARKS	FACADE (T3-01-10B/23F)

B.D. REF :

CLIENT :
SHIMAO GROUP HOLDINGS LIMITED

ARCHITECT :
WONG TUNG & PARTNERS LIMITED
ARCHITECTS & PLANNERS

MAIN CONTRACTOR :
協興建築有限公司
HIP HING CONSTRUCTION CO LTD

STRUCTURAL ENGINEER :
C M WONG & ASSOCIATES LTD
黃志明建築工程師有限公司

FACADE CONSULTANT:
MEINHARDT

NOTE :
1. ALL DIMENSIONS ARE IN mm.
2. ALL ELEVATIONS ARE VIEWED FROM OUTSIDE.
3. ALL DIMENSIONS TO BE VERIFIED ON SITE BEFORE FABRICATION.

LEGEND :
- X1 / 3D01 — DETAIL MARK NO. / REFER SHEET NO.
1. F.F.L. — FINISHED FLOOR LEVEL
2. S.F.L. — STRUCTURAL FLOOR LEVEL
3. (R) — REVERSED DETAIL
4. ▲ — FIXING LOCATION
5. △ — FIXING LUG LOCATION
6. GLASS LEGEND
   - GL01 — 10mm+12mm AIR GAP+10mm THK. I.G.U.
   - GL04 — 12mm THK. CLEAR TEMPERED GLASS
   - GL05 — 10mm+12mm AIR GAP+10mm THK. I.G.U.
   - GL06 — 10mm+12mm AIR GAP+12mm THK. I.G.U.
   - PD01 — 10mm T.P+12mm AIR GAP+8mm T.P
   - GL07 — 10mm+12mm AIR GAP+12mm THK. I.G.U.
   - GL08 — 10mm+12mm AIR GAP+10mm THK. I.G.U.

NO.	DATE	REMARKS	BY
B	22/10/2021	REVISION SUBJECT TO ARCH.COMMENT	
A	08/08/2021	REVISION SUBJECT TO ARCH.COMMENT	

JOB NO. : J-853

PROJECT :
PROPOSED RESIDENTIAL DEVELOPMENT AT N.K.I.L. 6542 YIN PING ROAD KOWLOON

TITLE :
WINDOW SCHEDULE FOR TOWER 3 ALUM. WINDOW

DATE : 03-APR-21 | SCALE : 1:40

DRAWN BY : | CHECKED BY :

美特鋁製有限公司
MIDI ALUMINIUM FABRICATOR LTD.
Units 6-8, Sunray Industrial Centre, 1/F
610 Cha Kwo Ling Road, Kowloon
Tel:23489211-4 Fax:(852)27727668

DWG NO. : J853-SD-PW-SC311 | REV. : G

ELEVATION

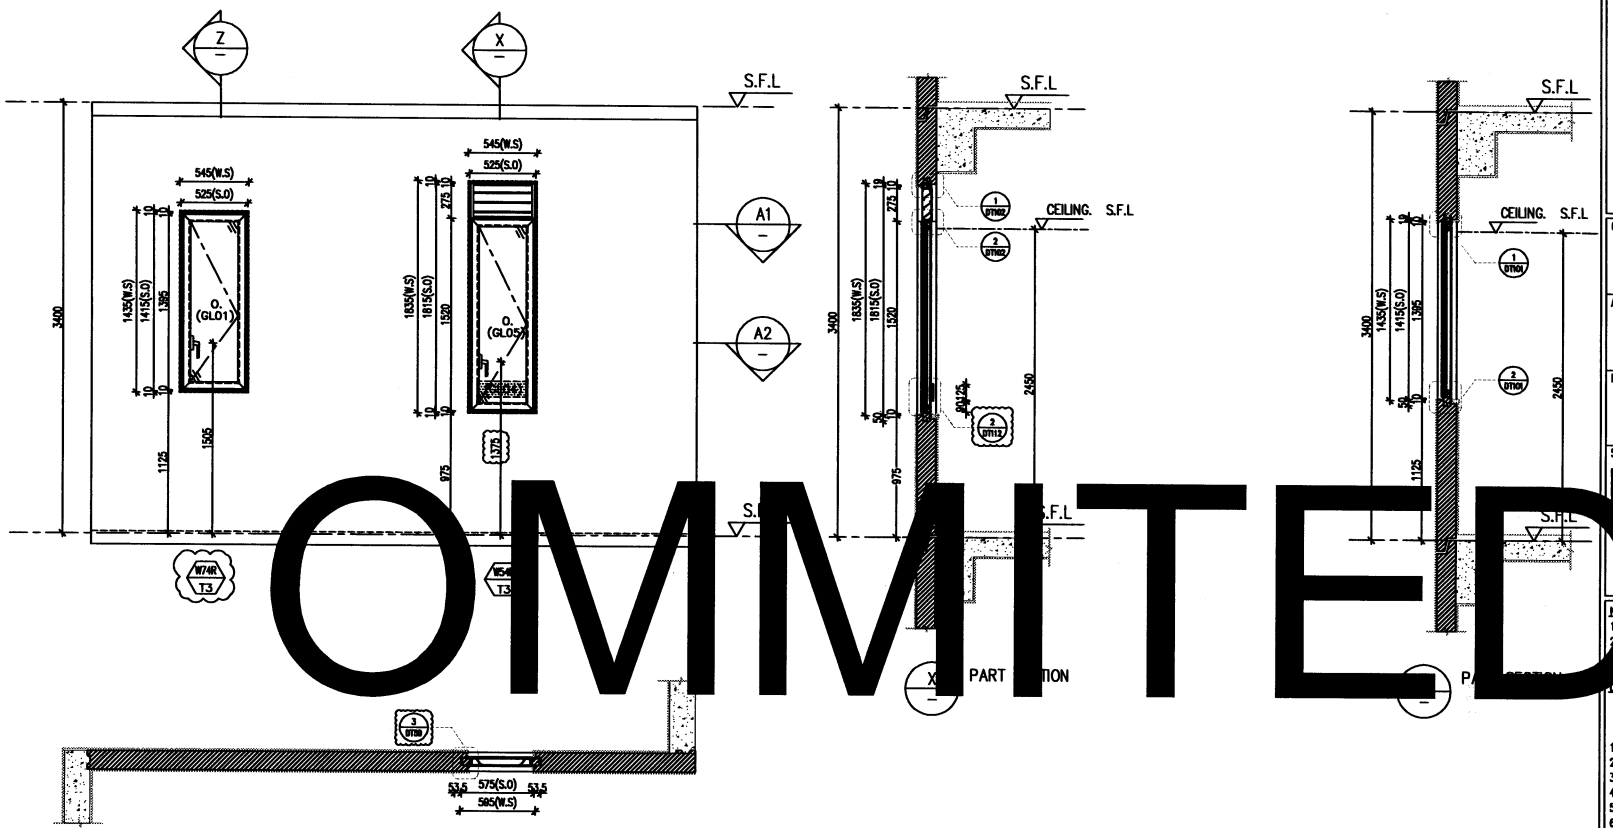

OMMITED

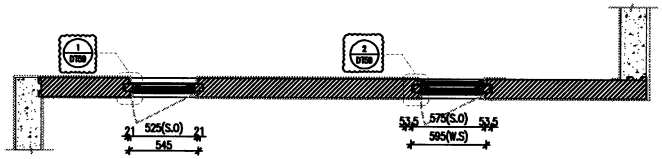

W14R T3

PROVIDED		
GLAZING AREA	0.412	m^2
OPENABLE AREA	0.502	m^2
FREE AREA	60.7	%

L01 T3

DELETED

PROVIDED		
GLAZING AREA	–	m^2
OPENABLE AREA	–	m^2
FREE AREA	55.4	%

W04R T3

PROVIDED		
GLAZING AREA	0.460	m^2
OPENABLE AREA	0.503	m^2
FREE AREA	60.7	%

WINDOW MARK	W74R T3 & W54R T3
LOCATION	23F FLAT A ENSUITE &BATH
SECTION	70mm ALUM. SECTION
GLAZING	GL01 & GL05
QUANTITY	1 No. / 1 No. / 1 No.
REMARKS	FACADE (T3-01-10B/23F)

B.D. REF :

CLIENT :
SHIMAO GROUP HOLDINGS LIMITED

ARCHITECT :
WONG TUNG & PARTNERS LIMITED
ARCHITECTS & PLANNERS

MAIN CONTRACTOR :
協興建築有限公司
HIP HING CONSTRUCTION CO LTD

STRUCTURAL ENGINEER :
C M WONG & ASSOCIATES LTD
黃志明建築工程師有限公司

E CONSULTANT:
MEINHARDT

NOTES :
1. DIMENSIONS ARE IN mm.
2. ELEVATIONS ARE VIEWED FROM OUTSIDE.
3. ALL DIMENSIONS TO BE VERIFIED ON SITE BEFORE FABRICATION.

LEGEND :
- X1 / XD01 — DETAIL MARK NO. / REFER SHEET NO.
1. F.F.L. — FINISHED FLOOR LEVEL
2. S.F.L. — STRUCTURAL FLOOR LEVEL
3. (R) — REVERSED DETAIL
4. ▲ — FIXING LOCATION
5. △ — FIXING LUG LOCATION
6. GLASS LEGEND
   - GL01 — 10mm+12mm AIR GAP+10mm THK. L.G.U.
   - GL04 — 12mm THK. CLEAR TEMPERED GLASS
   - GL05 — 10mm+12mm AIR GAP+10mm THK. L.G.U.
   - GL06 — 10mm+12mm AIR GAP+12mm THK. L.G.U.
   - PD01 — 10mm T.P+12mm AIR GAP+8mm T.P
   - GL07 — 10mm+12mm AIR GAP+12mm THK. L.G.U.
   - GL08 — 10mm+12mm AIR GAP+10mm THK. L.G.U.

NO.	DATE	REMARKS	BY
H	25/05/2022	REVISION SUBJECT TO ARCH.COMMENT	
G	22/10/2021	REVISION SUBJECT TO ARCH.COMMENT	
A	05/08/2021	REVISION SUBJECT TO ARCH.COMMENT	

JOB NO. : J-853

PROJECT :
PROPOSED RESIDENTIAL DEVELOPMENT AT N.K.I.L. 6542 YIN PING ROAD KOWLOON

TITLE :
WINDOW SCHEDULE FOR TOWER 3 ALUM. WINDOW

DATE : 03-APR-21 | SCALE : 1:40

DRAWN BY : | CHECKED BY :

美特鋁質有限公司
MIDI ALUMINIUM FABRICATOR LTD.
Units 6-8, Sunray Industrial Centre, 1/F
610 Cha Kwo Ling Road, Kowloon
Tel:23489211-4 Fax:(852)27727666

DWG NO. : J853-SD-PW-SC311d REV. : H

ELEVATION

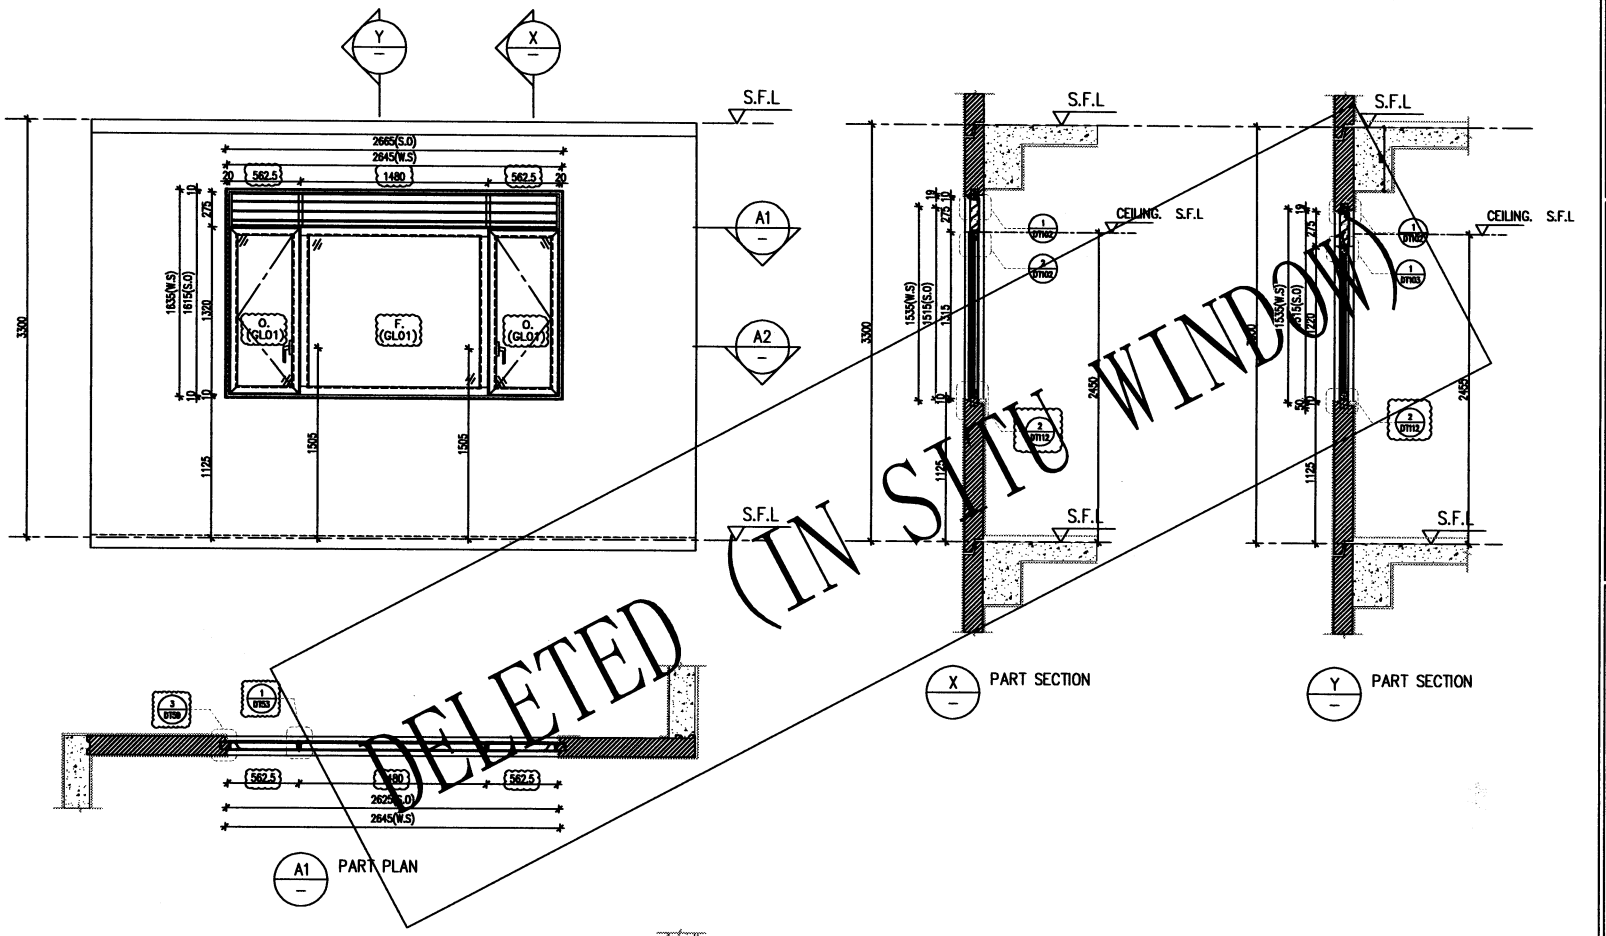

DELETED (IN SITU WINDOW)

PROVIDED		
GLAZING AREA	2.471	m^2
OPENABLE AREA	1.237	m^2
FREE AREA	60.7	%

W20 T3

WINDOW MARK	W20 T3
LOCATION	25F FLAT A KITCHEN
SECTION	70mm ALUM. SECTION
GLAZING	(GL01)
QUANTITY	1 No.
REMARKS	FACADE(T3-01-10A/25F)

B.D. REF :

CLIENT :
SHIMAO GROUP HOLDINGS LIMITED

ARCHITECT :
WONG TUNG & PARTNERS LIMITED
ARCHITECTS & PLANNERS

MAIN CONTRACTOR :
協興建築有限公司
HIP HING CONSTRUCTION CO LTD

STRUCTURAL ENGINEER :
C M WONG & ASSOCIATES LTD
黃志明建築工程師有限公司

FACADE CONSULTANT:
MEINHARDT

NOTE :
1. ALL DIMENSIONS ARE IN mm.
2. ALL ELEVATIONS ARE VIEWED FROM OUTSIDE.
3. ALL DIMENSIONS TO BE VERIFIED ON SITE BEFORE FABRICATION.

LEGEND :
- X1 / 20001 — DETAIL MARK NO. / REFER SHEET NO.
1. F.F.L. — FINISHED FLOOR LEVEL
2. S.F.L. — STRUCTURAL FLOOR LEVEL
3. (R) — REVERSED DETAIL
4. ▲ — FIXING LOCATION
5. △ — FIXING LUG LOCATION
6. GLASS LEGEND
   - GL01 — 10mm+12mm AIR GAP+10mm THK. I.G.U.
   - GL04 — 12mm THK. CLEAR TEMPERED GLASS
   - GL05 — 10mm+12mm AIR GAP+10mm THK. I.G.U.
   - GL06 — 10mm+12mm AIR GAP+12mm THK. I.G.U.
   - PD01 — 10mm T.P+12mm AIR GAP+8mm T.P
   - GL07 — 10mm+12mm AIR GAP+12mm THK. I.G.U.
   - GL08 — 10mm+12mm AIR GAP+10mm THK. I.G.U.

NO.	DATE	REMARKS	BY
G	22/10/2021	REVISION SUBJECT TO ARCH.COMMENT	ada
A	08/08/2021	REVISION SUBJECT TO ARCH.COMMENT	ada

JOB NO. : J-853

PROJECT :
PROPOSED RESIDENTIAL DEVELOPMENT AT N.K.I.L. 6542 YIN PING ROAD KOWLOON

TITLE :
WINDOW SCHEDULE FOR TOWER 3 ALUM. WINDOW

DATE : 03-APR-21 | SCALE : 1:40

DRAWN BY : | CHECKED BY :

美特鋁質有限公司
MIDI ALUMINIUM FABRICATOR LTD.
Units 6-8, Sunray Industrial Centre, 1/F
610 Cha Kwo Ling Road, Kowloon
Tel:23489211-4 Fax:(852)27727666

DWG NO. : J853-SD-PW-SC312 | REV. : G

ELEVATION

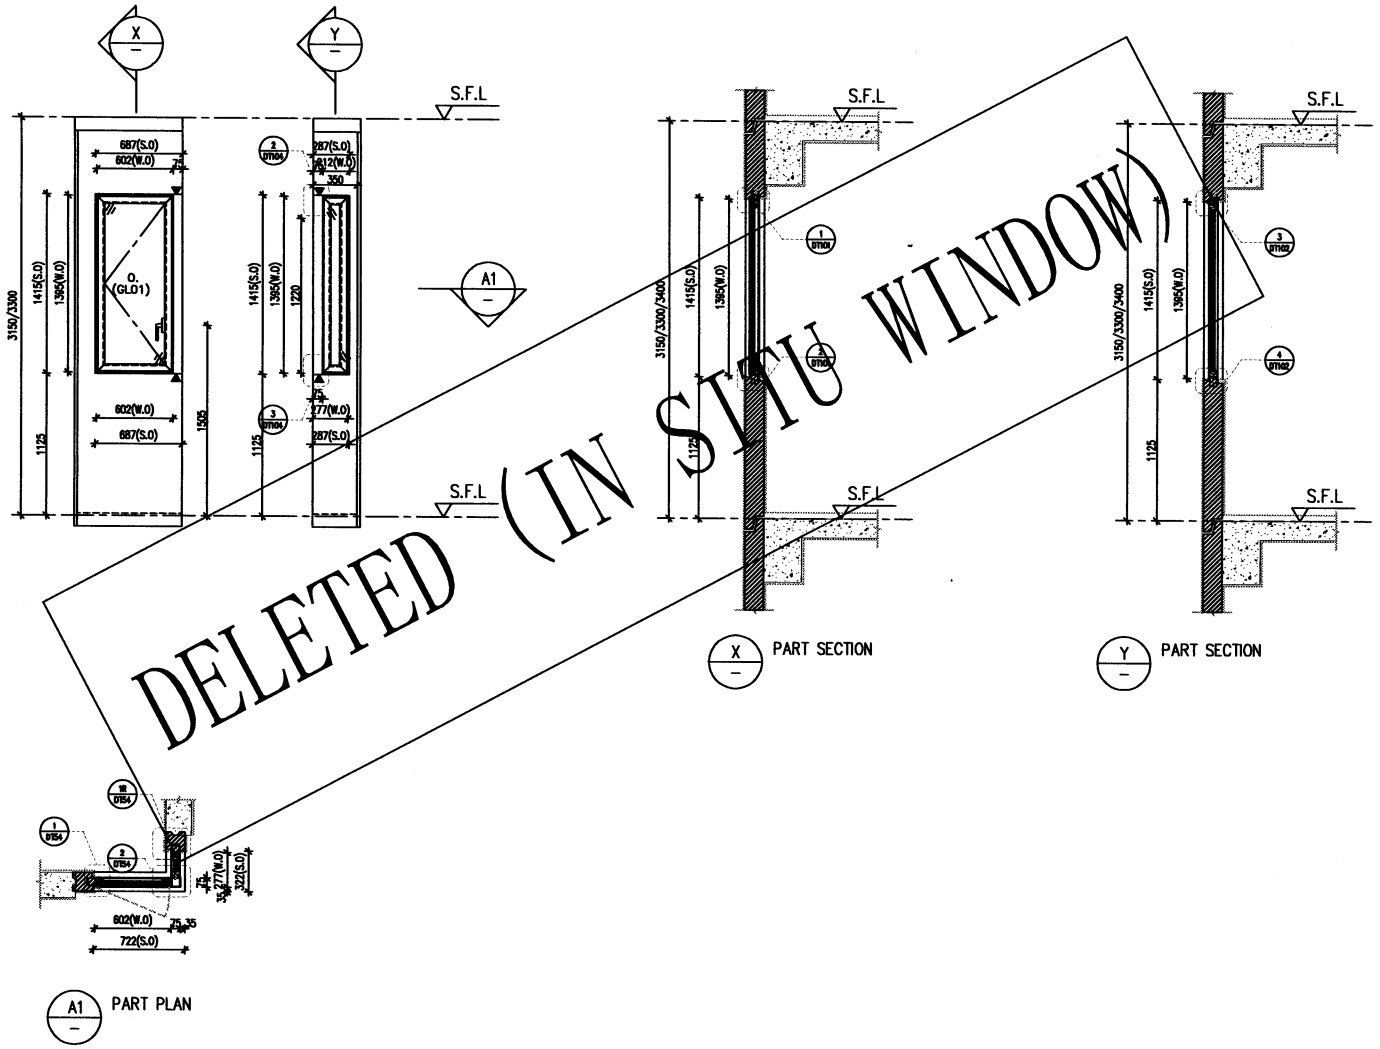

DELETED (IN SITU WINDOW)

PROVIDED		
GLAZING AREA	0.686	m^2
OPENABLE AREA	0.690	m^2
FREE AREA	60.7	%

W11 T3

WINDOW MARK	W11 T3
LOCATION	6F~16F FLAT D BEDROOM 3
SECTION	70mm ALUM. SECTION
GLAZING	GL01
QUANTITY	9 No.
REMARKS	FACADE(T3-03-05/6F~15F;T3-03-05A/16F)

B.D. REF :

CLIENT :
SHIMAO GROUP HOLDINGS LIMITED

ARCHITECT :
WONG TUNG & PARTNERS LIMITED
ARCHITECTS & PLANNERS

MAIN CONTRACTOR :
協興建築有限公司
HIP HING CONSTRUCTION CO LTD

STRUCTURAL ENGINEER :
C M WONG & ASSOCIATES LTD
黃志明建築工程師有限公司

FACADE CONSULTANT:
MEINHARDT

NOTE :
1. ALL DIMENSIONS ARE IN mm.
2. ALL ELEVATIONS ARE VIEWED FROM OUTSIDE.
3. ALL DIMENSIONS TO BE VERIFIED ON SITE BEFORE FABRICATION.

LEGEND :
X1 / X0001 — DETAIL MARK NO. / REFER SHEET NO.
1. F.F.L. — FINISHED FLOOR LEVEL
2. S.F.L. — STRUCTURAL FLOOR LEVEL
3. (R) — REVERSED DETAIL
4. ▲ — FIXING LOCATION
5. △ — FIXING LUG LOCATION
6. GLASS LEGEND
GL01 — 10mm+12mm AIR GAP+10mm THK. LG.U.
GL04 — 12mm THK. CLEAR TEMPERED GLASS
GL05 — 10mm+12mm AIR GAP+10mm THK. LG.U.
GL06 — 10mm+12mm AIR GAP+12mm THK. LG.U.
PD01 — 10mm T.P+12mm AIR GAP+8mm T.P
GL07 — 10mm+12mm AIR GAP+12mm THK. LG.U.
GL08 — 10mm+12mm AIR GAP+10mm THK. LG.U.

NO.	DATE	REVISED	BY
A	08/09/2021	REVISION SUBJECT TO ARCH.COMMENT	

JOB NO. : J-853

PROJECT :
PROPOSED RESIDENTIAL DEVELOPMENT AT N.K.I.L. 6542
YIN PING ROAD
KOWLOON

TITLE :
WINDOW SCHEDULE FOR TOWER 3 ALUM. WINDOW

DATE : 03-APR-21 | SCALE : 1:40

DRAWN BY : | CHECKED BY :

美特鋁質有限公司
MIDI ALUMINIUM FABRICATOR LTD.
Units 6-8, Sunray Industrial Centre, 1/F
610 Cha Kwo Ling Road, Kowloon
Tel:23488211-4 Fax:(852)27727666

DWG NO. : J853-SD-PW-SC313 | REV. : A

ELEVATION

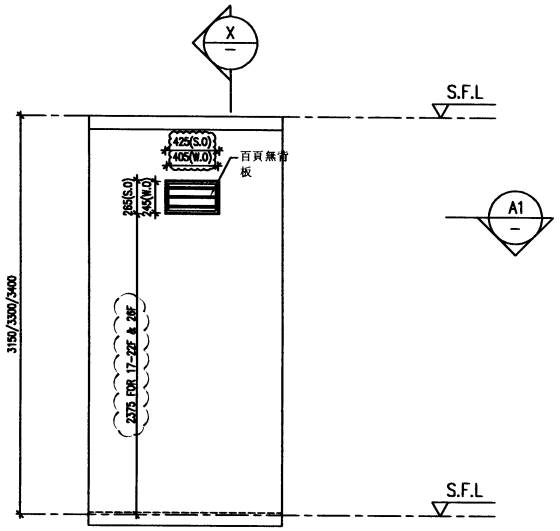

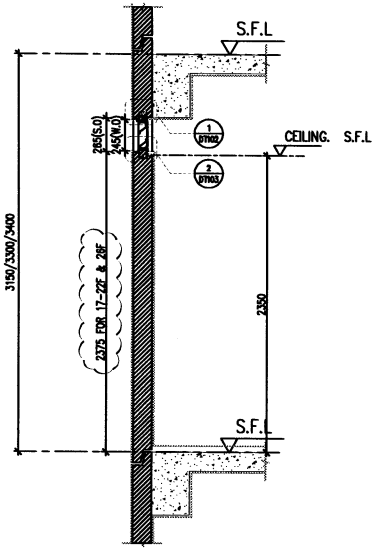

X — PART SECTION

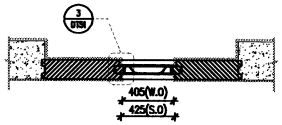

A1 — PART PLAN

WINDOW MARK	L05 / T3
LOCATION	6F–26F COMMON STAIRCASE
SECTION	70mm ALUM. LOUVER
GLAZING	–
QUANTITY	18 Nos.
REMARKS	FACADE (T3-02-05/17F~22F & T3-02-05A/26F)

PROVIDED		
GLAZING AREA	0	m^2
OPENABLE AREA	0	m^2
FREE AREA	55.4	%

B.D. REF :

CLIENT :
SHIMAO GROUP HOLDINGS LIMITED

ARCHITECT : WONG TUNG & PARTNERS LIMITED ARCHITECTS & PLANNERS

MAIN CONTRACTOR :
協興建築有限公司
HIP HING CONSTRUCTION CO LTD

STRUCTURAL ENGINEER :
C M WONG & ASSOCIATES LTD
黃志明建築工程師有限公司

FACADE CONSULTANT: MEINHARDT

NOTE :
1. ALL DIMENSIONS ARE IN mm.
2. ALL ELEVATIONS ARE VIEWED FROM OUTSIDE.
3. ALL DIMENSIONS TO BE VERIFIED ON SITE BEFORE FABRICATION.

LEGEND :
X1 / 2000 — DETAIL MARK NO. / REFER SHEET NO.
1. F.F.L. — FINISHED FLOOR LEVEL
2. S.F.L. — STRUCTURAL FLOOR LEVEL
3. (R) — REVERSED DETAIL
4. ▲ — FIXING LOCATION
5. △ — FIXING LUG LOCATION
6. GLASS LEGEND
GL01 — 10mm+12mm AIR GAP+10mm THK. LG.U.
GL04 — 12mm THK. CLEAR TEMPERED GLASS
GL05 — 10mm+12mm AIR GAP+10mm THK. LG.U.
GL06 — 10mm+12mm AIR GAP+12mm THK. LG.U.
PD01 — 10mm T.P+12mm AIR GAP+8mm T.P
GL07 — 10mm+12mm AIR GAP+12mm THK. LG.U.
GL08 — 10mm+12mm AIR GAP+10mm THK. LG.U.

NO.	DATE	REVISED	BY

JOB NO. : J-853

PROJECT :
PROPOSED RESIDENTIAL DEVELOPMENT AT N.K.I.L. 6542 YIN PING ROAD KOWLOON

TITLE :
WINDOW SCHEDULE FOR TOWER 3 ALUM. WINDOW

DATE : 03-APR-21 | SCALE : 1:40

DRAWN BY : | CHECKED BY :

美特鋁質有限公司
MIDI ALUMINIUM FABRICATOR LTD.
Units 6-8, Sunray Industrial Centre, 1/F
610 Cha Kwo Ling Road, Kowloon
Tel:23488211-4 Fax:(852)27727666

DWG NO. : J853-SD-PW-SC315 | REV. : –

ELEVATION

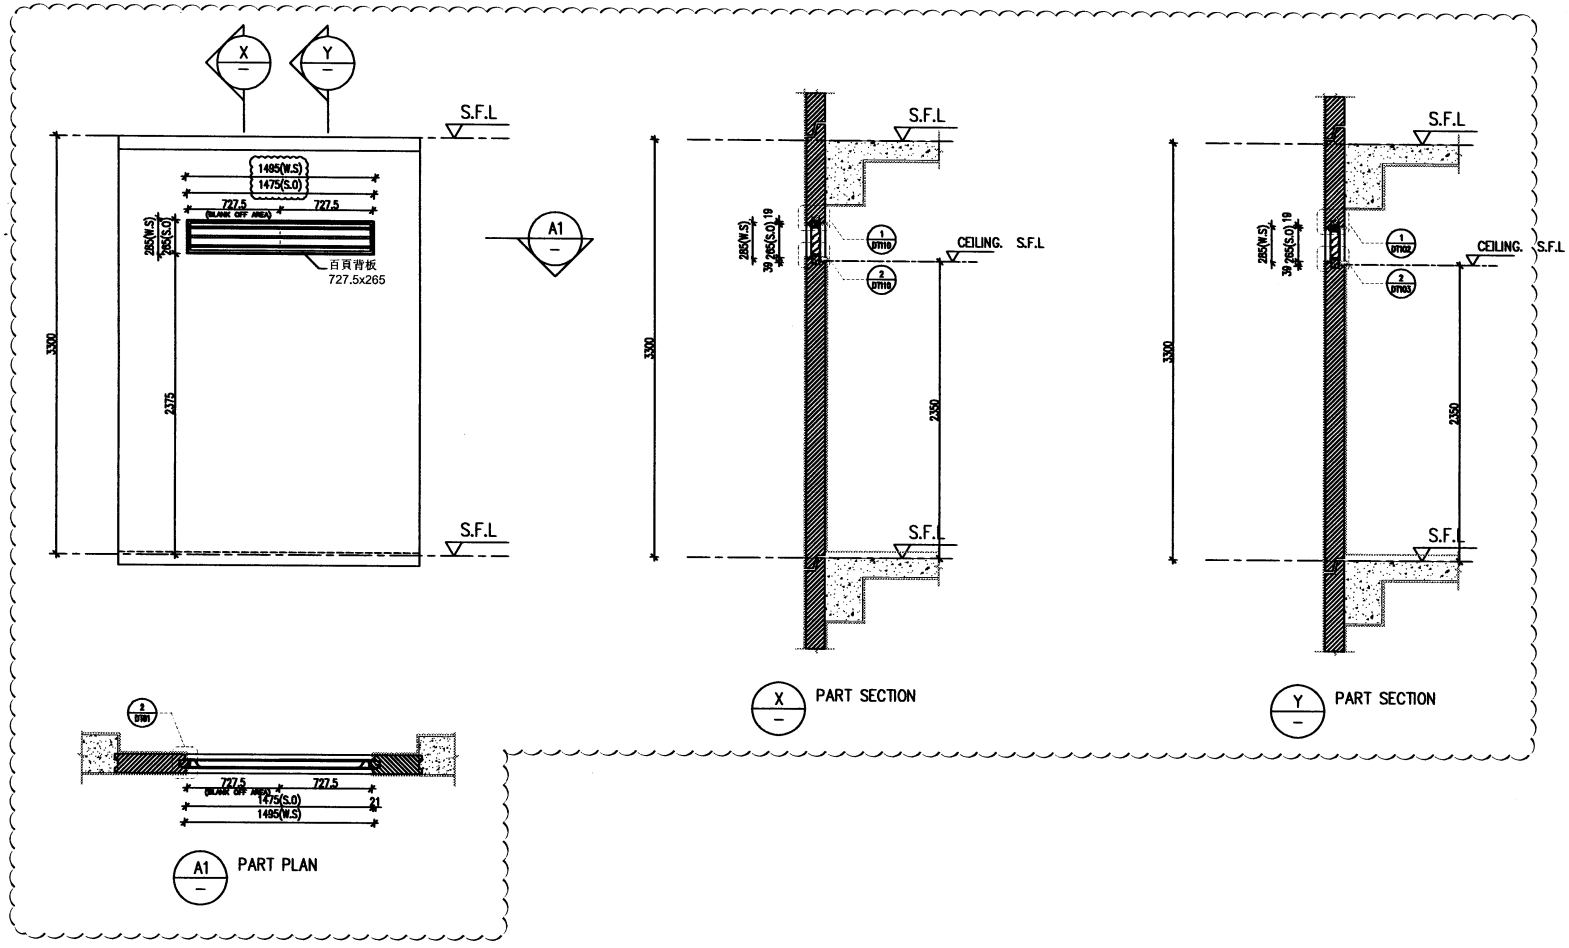

PROVIDED		
GLAZING AREA	–	m^2
OPENABLE AREA	–	m^2
FREE AREA	55.4	%

WINDOW MARK	L11 / T3
LOCATION	5F FLAT A M. BATH
SECTION	70mm ALUM. LOUVER
GLAZING	–
QUANTITY	1 No.
REMARKS	FACADE (T3-03-02A/5F)

B.D. REF :

CLIENT :
SHIMAO GROUP HOLDINGS LIMITED

ARCHITECT :
WONG TUNG & PARTNERS LIMITED
ARCHITECTS & PLANNERS

MAIN CONTRACTOR :
協興建築有限公司
HIP HING CONSTRUCTION CO LTD

STRUCTURAL ENGINEER :
CMA C M WONG & ASSOCIATES LTD
黃志明建築工程師有限公司

FACADE CONSULTANT:
MEINHARDT

NOTE :
1. ALL DIMENSIONS ARE IN mm.
2. ALL ELEVATIONS ARE VIEWED FROM OUTSIDE.
3. ALL DIMENSIONS TO BE VERIFIED ON SITE BEFORE FABRICATION.

LEGEND :
X1 / X1001 — DETAIL MARK NO. / REFER SHEET NO.
1. F.F.L. — FINISHED FLOOR LEVEL
2. S.F.L. — STRUCTURAL FLOOR LEVEL
3. (R) — REVERSED DETAIL
4. ▲ — FIXING LOCATION
5. △ — FIXING LUG LOCATION
6. GLASS LEGEND
GL01 — 10mm+12mm AIR GAP+10mm THK. LG.U.
GL04 — 12mm THK. CLEAR TEMPERED GLASS
GL05 — 10mm+12mm AIR GAP+10mm THK. LG.U.
GL06 — 10mm+12mm AIR GAP+12mm THK. LG.U.
PD01 — 10mm T.P+12mm AIR GAP+8mm T.P
GL07 — 10mm+12mm AIR GAP+12mm THK. LG.U.
GL08 — 10mm+12mm AIR GAP+10mm THK. LG.U.

NO.	DATE	REVISED	BY
A	22/08/2022	REVISION SUBJECT TO COMMENT	

JOB NO. : J-853

PROJECT :
PROPOSED RESIDENTIAL DEVELOPMENT AT N.K.I.L. 6542 YIN PING ROAD KOWLOON

TITLE :
WINDOW SCHEDULE FOR TOWER 3 ALUM. WINDOW

DATE : 03-APR-21 | SCALE : 1:40

DRAWN BY : | CHECKED BY :

美特鋁質有限公司
MIDI ALUMINIUM FABRICATOR LTD.
Units 6-8, Sunray Industrial Centre, 1/F
610 Cha Kwo Ling Road, Kowloon
Tel:23489211-4 Fax:(852)27727668

DWG NO. : J853-SD-PW-SC314 | REV. : A

ELEVATION

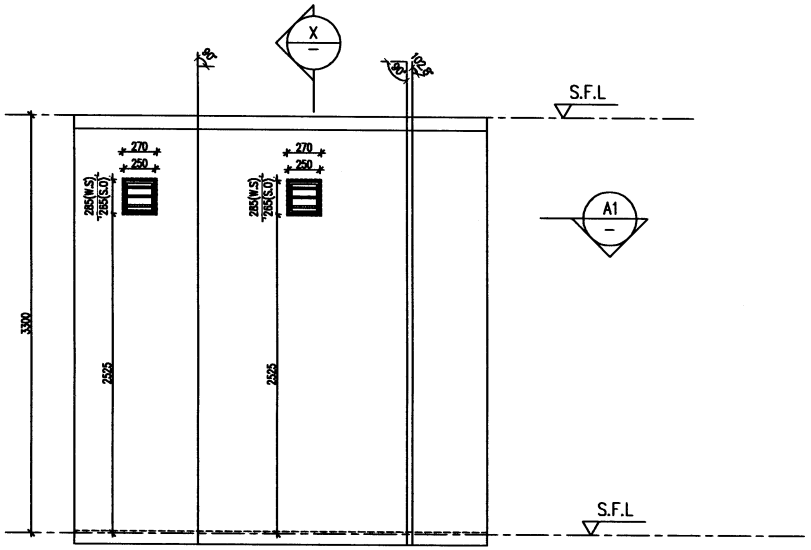

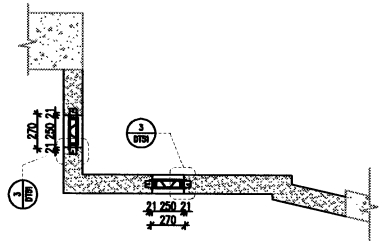

A1 PART PLAN

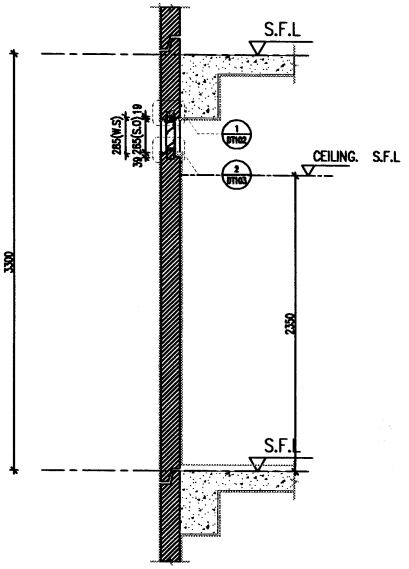

X PART SECTION

PROVIDED		
GLAZING AREA	0	m^2
OPENABLE AREA	0	m^2
FREE AREA	55.4	%

WINDOW MARK	L13 / T3
LOCATION	5F R.S.M.R.R
SECTION	70mm ALUM. LOUVER
GLAZING	–
QUANTITY	1 No. / 1 No.
REMARKS	FACADE (T3-02-01A/5F)

B.D. REF :

CLIENT :
SHIMAO GROUP HOLDINGS LIMITED

ARCHITECT :
WONG TUNG & PARTNERS LIMITED
ARCHITECTS & PLANNERS

MAIN CONTRACTOR :
協興建築有限公司
HIP HING CONSTRUCTION CO LTD

STRUCTURAL ENGINEER :
CMA C M WONG & ASSOCIATES LTD
黃志明建築工程師有限公司

FACADE CONSULTANT:
MEINHARDT

NOTE :
1. ALL DIMENSIONS ARE IN mm.
2. ALL ELEVATIONS ARE VIEWED FROM OUTSIDE.
3. ALL DIMENSIONS TO BE VERIFIED ON SITE BEFORE FABRICATION.

LEGEND :
X1 / XXX1 — DETAIL MARK NO. / REFER SHEET NO.
1. F.F.L. — FINISHED FLOOR LEVEL
2. S.F.L. — STRUCTURAL FLOOR LEVEL
3. (R) — REVERSED DETAIL
4. ▲ — FIXING LOCATION
5. △ — FIXING LUG LOCATION
6. GLASS LEGEND
GL01 — 10mm+12mm AIR GAP+10mm THK. LG.U.
GL04 — 12mm THK. CLEAR TEMPERED GLASS
GL05 — 10mm+12mm AIR GAP+10mm THK. LG.U.
GL06 — 10mm+12mm AIR GAP+12mm THK. LG.U.
PD01 — 10mm T.P+12mm AIR GAP+8mm T.P
GL07 — 10mm+12mm AIR GAP+12mm THK. LG.U.
GL08 — 10mm+12mm AIR GAP+10mm THK. LG.U.

NO.	DATE	REVISED	BY

JOB NO. : J-853

PROJECT :
PROPOSED RESIDENTIAL DEVELOPMENT AT N.K.I.L. 6542 YIN PING ROAD KOWLOON

TITLE :
WINDOW SCHEDULE FOR TOWER 3 ALUM. WINDOW

DATE : 03-APR-21 | SCALE : 1:40

DRAWN BY : | CHECKED BY :

美特鋁製有限公司
MIDI ALUMINIUM FABRICATORS LTD.
Units 6-8, Sunray Industrial Centre, 1/F
610 Cha Kwo Ling Road, Kowloon
Tel:23489211-4 Fax:(852)27727666

DWG NO. : J853-SD-PW-SC317 | REV. : –

ELEVATION

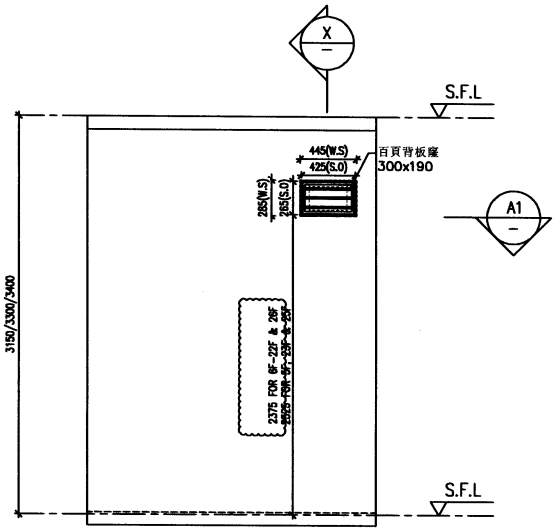

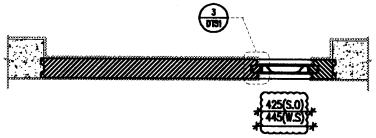

A1 PART PLAN

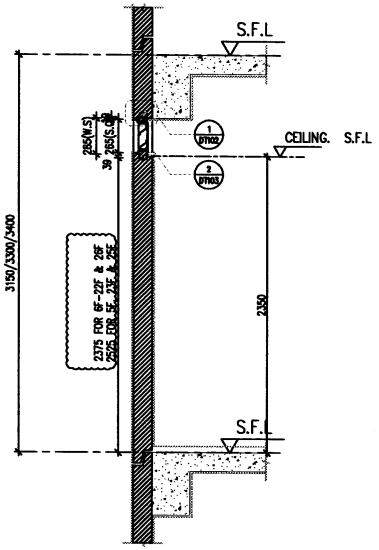

X PART SECTION

PROVIDED		
GLAZING AREA	0	m^2
OPENABLE AREA	0	m^2
FREE AREA	55.4	%

WINDOW MARK	L05 / T3
LOCATION	5F–26F FLAT B LAV.
SECTION	70mm ALUM. LOUVER
GLAZING	–
QUANTITY	19 Nos.
REMARKS	FACADE (T3–03–01/6F~15F&17F~22F & T3–03–01A/5F, 16F, 25F & 26F & T3–03–01B/23F)

B.D. REF :

CLIENT :
SHIMAO GROUP HOLDINGS LIMITED

ARCHITECT :
WONG TUNG & PARTNERS LIMITED
ARCHITECTS & PLANNERS

MAIN CONTRACTOR :
協興建築有限公司
HIP HING CONSTRUCTION CO LTD

STRUCTURAL ENGINEER :
C M WONG & ASSOCIATES LTD
黃志明建築工程師有限公司

FACADE CONSULTANT:
MEINHARDT

NOTE :
1. ALL DIMENSIONS ARE IN mm.
2. ALL ELEVATIONS ARE VIEWED FROM OUTSIDE.
3. ALL DIMENSIONS TO BE VERIFIED ON SITE BEFORE FABRICATION.

LEGEND :
X1 / X001 — DETAIL MARK NO. / REFER SHEET NO.
1. F.F.L. — FINISHED FLOOR LEVEL
2. S.F.L. — STRUCTURAL FLOOR LEVEL
3. (R) — REVERSED DETAIL
4. ▲ — FIXING LOCATION
5. △ — FIXING LUG LOCATION
6. GLASS LEGEND
GL01 — 10mm+12mm AIR GAP+10mm THK. I.G.U.
GL04 — 12mm THK. CLEAR TEMPERED GLASS
GL05 — 10mm+12mm AIR GAP+10mm THK. I.G.U.
GL06 — 10mm+12mm AIR GAP+12mm THK. I.G.U.
PD01 — 10mm T.P+12mm AIR GAP+8mm T.P
GL07 — 10mm+12mm AIR GAP+12mm THK. I.G.U.
GL08 — 10mm+12mm AIR GAP+10mm THK. I.G.U.

NO.	DATE	REVISED	BY

JOB NO. : J–853

PROJECT :
PROPOSED RESIDENTIAL DEVELOPMENT AT N.K.I.L. 6542 YIN PING ROAD KOWLOON

TITLE :
WINDOW SCHEDULE FOR TOWER 3 ALUM. WINDOW

DATE : 03–APR–21 | SCALE : 1:40

DRAWN BY : | CHECKED BY :

美特鋁質有限公司
MIDI ALUMINIUM FABRICATOR LTD.
Units 6–8, Sunray Industrial Centre, 1/F
610 Cha Kwo Ling Road, Kowloon
Tel:23488211–4 Fax:(852)27727666

DWG NO. : J853–SD–PW–SC316 | REV. : –

ELEVATION

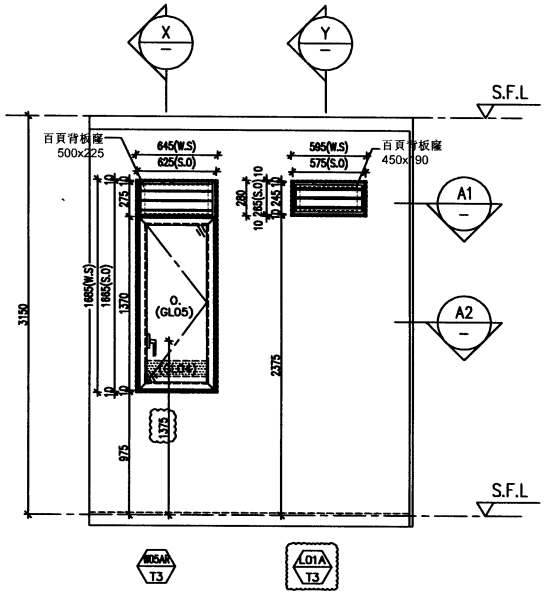

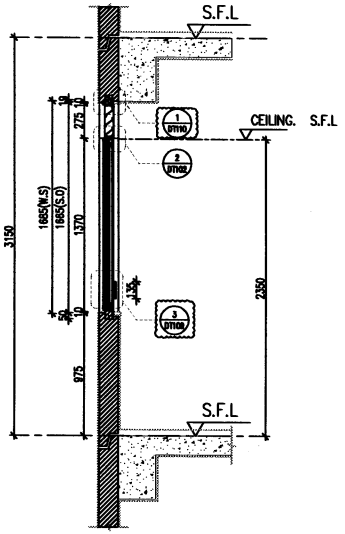

X PART SECTION

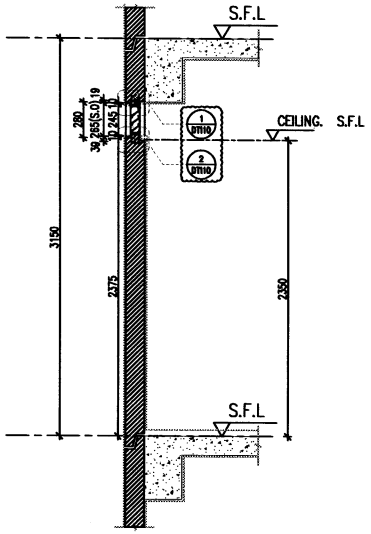

Y PART SECTION

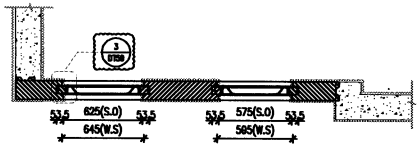

A1 PART PLAN

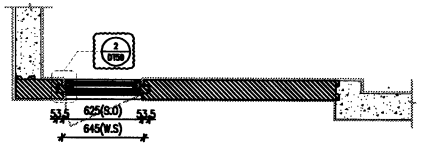

A2 PART PLAN

L01A T3	PROVIDED		
	GLAZING AREA	–	m^2
	OPENABLE AREA	–	m^2
	FREE AREA	55.4	%

W05AR T3	PROVIDED		
	GLAZING AREA	0.581	m^2
	OPENABLE AREA	0.638	m^2
	FREE AREA	60.7	%

WINDOW MARK	W05AR T3 & L01A T3
LOCATION	6F~15F&17F~22F FLAT A EN.BATH & MASTER BATH
SECTION	70mm ALUM. SECTION
GLAZING	GL05
QUANTITY	14 Nos / 14 Nos
REMARKS	FACADE(T3-01-01/6~15F&17F~22F)

B.D. REF :

CLIENT :
SHIMAO GROUP HOLDINGS LIMITED

ARCHITECT :
WONG TUNG & PARTNERS LIMITED
ARCHITECTS & PLANNERS

MAIN CONTRACTOR :
協興建築有限公司
HIP HING CONSTRUCTION CO LTD

STRUCTURAL ENGINEER :
C M WONG & ASSOCIATES LTD
黃志明建築工程師有限公司

FACADE CONSULTANT:
MEINHARDT

NOTE :
1. ALL DIMENSIONS ARE IN mm.
2. ALL ELEVATIONS ARE VIEWED FROM OUTSIDE.
3. ALL DIMENSIONS TO BE VERIFIED ON SITE BEFORE FABRICATION.

LEGEND :
- DETAIL MARK NO.
- REFER SHEET NO.

1. F.F.L. — FINISHED FLOOR LEVEL
2. S.F.L. — STRUCTURAL FLOOR LEVEL
3. — REVERSED DETAIL
4. — FIXING LOCATION
5. — FIXING LUG LOCATION
6. GLASS LEGEND
   - GL01 — 10mm+12mm AIR GAP+10mm THK. I.G.U.
   - GL04 — 12mm THK. CLEAR TEMPERED GLASS
   - GL05 — 10mm+12mm AIR GAP+10mm THK. I.G.U.
   - GL06 — 10mm+12mm AIR GAP+12mm THK. I.G.U.
   - PD01 — 10mm T.P+12mm AIR GAP+8mm T.P
   - GL07 — 10mm+12mm AIR GAP+12mm THK. I.G.U.
   - GL08 — 10mm+12mm AIR GAP+10mm THK. I.G.U.

NO.	DATE	REMARK	BY
H	30/08/2022	GENERAL REVISION	cdc
G	22/10/2021	REVISION SUBJECT TO ARCH.COMMENT	cdc
A	08/08/2021	REVISION SUBJECT TO ARCH.COMMENT	cdc

JOB NO. : J-853

PROJECT :
PROPOSED RESIDENTIAL DEVELOPMENT AT N.K.I.L. 6542 YIN PING ROAD KOWLOON

TITLE :
WINDOW SCHEDULE FOR TOWER 3 ALUM. WINDOW

DATE : 03-APR-21 | SCALE : 1:40

DRAWN BY : | CHECKED BY :

美特鋁質有限公司
MIDI ALUMINIUM FABRICATION LTD.
Units 6-8, Sunray Industrial Centre, 1/F
610 Cha Kwo Ling Road, Kowloon
Tel:23489211-4 Fax:(852)27727668

DWG NO. : J853-SD-PW-SC301 | REV. : H

ELEVATION

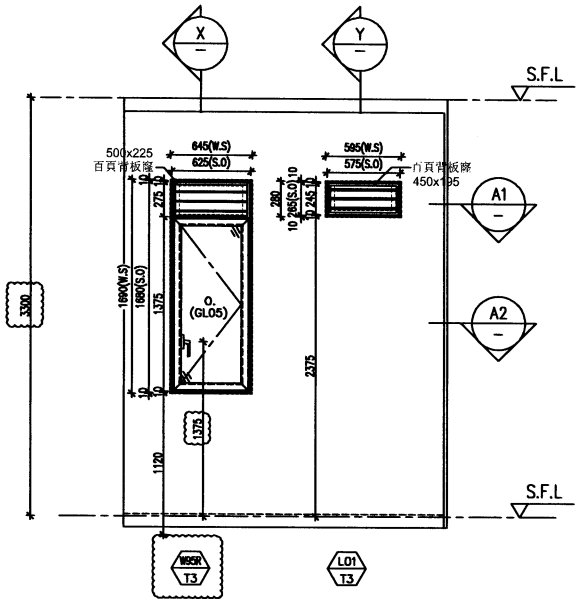

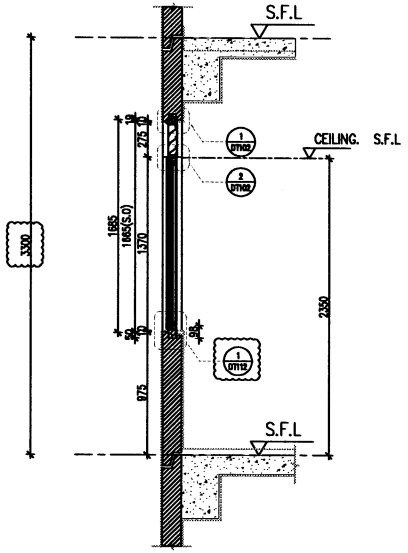

X PART SECTION

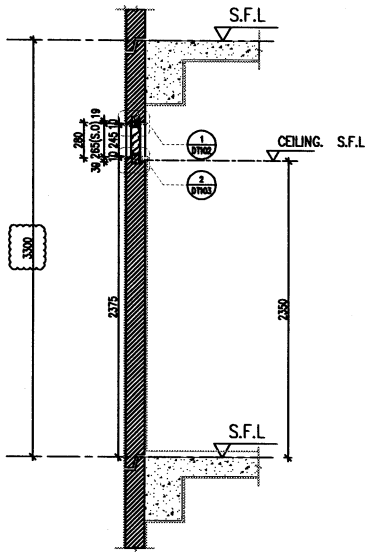

Y PART SECTION

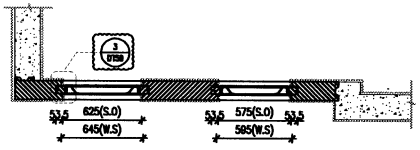

A1 PART PLAN

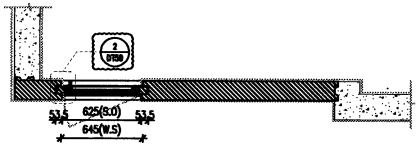

A2 PART PLAN

L01 T3	PROVIDED		
	GLAZING AREA	–	m^2
	OPENABLE AREA	–	m^2
	FREE AREA	55.4	%

W95R T3	PROVIDED		
	GLAZING AREA	0.584	m^2
	OPENABLE AREA	0.686	m^2
	FREE AREA	60.7	%

WINDOW MARK	W95R T3 & L01 T3
LOCATION	5F FLAT A EN.BATH & MASTER BATH
SECTION	70mm ALUM. SECTION
GLAZING	GL05
QUANTITY	1 No / 1 No
REMARKS	FACADE(T3-01-01A/5F)

B.D. REF :

CLIENT :
SHIMAO GROUP HOLDINGS LIMITED

ARCHITECT : WONG TUNG & PARTNERS LIMITED ARCHITECTS & PLANNERS

MAIN CONTRACTOR :
協興建築有限公司
HIP HING CONSTRUCTION CO LTD

STRUCTURAL ENGINEER :
C M WONG & ASSOCIATES LTD
黃志明建築工程師有限公司

FACADE CONSULTANT: MEINHARDT

NOTE :
1. ALL DIMENSIONS ARE IN mm.
2. ALL ELEVATIONS ARE VIEWED FROM OUTSIDE.
3. ALL DIMENSIONS TO BE VERIFIED ON SITE BEFORE FABRICATION.

LEGEND :
- DETAIL MARK NO.
- REFER SHEET NO.

1. F.F.L. — FINISHED FLOOR LEVEL
2. S.F.L. — STRUCTURAL FLOOR LEVEL
3. (R) — REVERSED DETAIL
4. ▲ — FIXING LOCATION
5. △ — FIXING LUG LOCATION
6. GLASS LEGEND
   - GL01 — 10mm+12mm AIR GAP+10mm THK. LG.U.
   - GL04 — 12mm THK. CLEAR TEMPERED GLASS
   - GL05 — 10mm+12mm AIR GAP+10mm THK. LG.U.
   - GL06 — 10mm+12mm AIR GAP+12mm THK. LG.U.
   - PD01 — 10mm T.P+12mm AIR GAP+8mm T.P
   - GL07 — 10mm+12mm AIR GAP+12mm THK. LG.U.
   - GL08 — 10mm+12mm AIR GAP+10mm THK. LG.U.

NO.	DATE	REMARK	BY
H	30/08/2022	GENERAL REVISION	mdw
G	22/10/2021	REVISION SUBJECT TO ARCH.COMMENT	mdw

JOB NO. : J-853

PROJECT :
PROPOSED RESIDENTIAL DEVELOPMENT AT N.K.I.L. 6542 YIN PING ROAD KOWLOON

TITLE :
WINDOW SCHEDULE FOR TOWER 3 ALUM. WINDOW

DATE : 03-APR-21 | SCALE : 1:40

DRAWN BY : | CHECKED BY :

美特鋁質有限公司
MIDI ALUMINIUM FABRICATOR LTD.
Units 6-8, Sunray Industrial Centre, 1/F
610 Cha Kwo Ling Road, Kowloon
Tel:23488211-4 Fax:(852)27727666

DWG NO. : J853-SD-PW-SC301a | REV. : H

ELEVATION

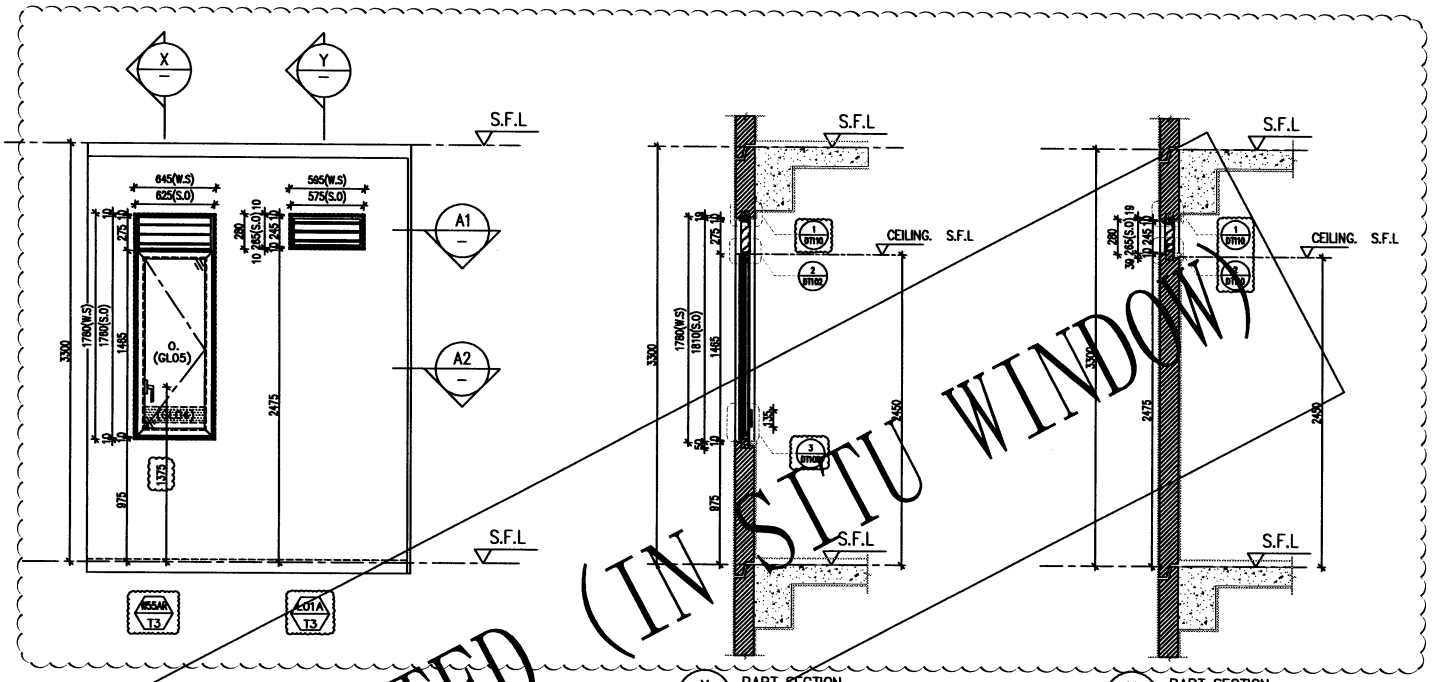

DELETED (IN STU WINDOW)

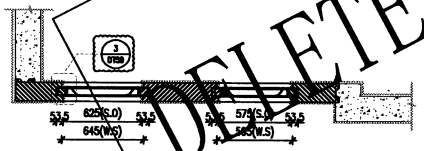

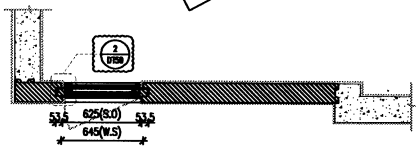

L01A T3

PROVIDED		
GLAZING AREA	–	m^2
OPENABLE AREA	–	m^2
FREE AREA	55.4	%

W55AR T3

PROVIDED		
GLAZING AREA	0.652	m^2
OPENABLE AREA	0.697	m^2
FREE AREA	60.7	%

WINDOW MARK	W55AR T3 & L01A T3
LOCATION	25F FLAT A EN.BATH & MASTER BATH
SECTION	70mm ALUM. SECTION
GLAZING	GL05
QUANTITY	1 Nos / 1 Nos
REMARKS	FACADE(T3-01-01A/25F;)

B.D. REF :

CLIENT :
SHIMAO GROUP HOLDINGS LIMITED

ARCHITECT :
WONG TUNG & PARTNERS LIMITED
ARCHITECTS & PLANNERS

MAIN CONTRACTOR :
協興建築有限公司
HIP HING CONSTRUCTION CO LTD

STRUCTURAL ENGINEER :
C M WONG & ASSOCIATES LTD
黃志明建築工程師有限公司

FACADE CONSULTANT:
MEINHARDT

NOTE :
1. ALL DIMENSIONS ARE IN mm.
2. ALL ELEVATIONS ARE VIEWED FROM OUTSIDE.
3. ALL DIMENSIONS TO BE VERIFIED ON SITE BEFORE FABRICATION.

LEGEND :
- X1 / X001 — DETAIL MARK NO. / REFER SHEET NO.
1. F.F.L. — FINISHED FLOOR LEVEL
2. S.F.L. — STRUCTURAL FLOOR LEVEL
3. R — REVERSED DETAIL
4. ▲ — FIXING LOCATION
5. △ — FIXING LUG LOCATION
6. GLASS LEGEND
   - GL01 — 10mm+12mm AIR GAP+10mm THK. LG.U.
   - GL04 — 12mm THK. CLEAR TEMPERED GLASS
   - GL05 — 10mm+12mm AIR GAP+10mm THK. LG.U.
   - GL06 — 10mm+12mm AIR GAP+12mm THK. LG.U.
   - PD01 — 10mm T.P+12mm AIR GAP+8mm T.P
   - GL07 — 10mm+12mm AIR GAP+12mm THK. LG.U.
   - GL08 — 10mm+12mm AIR GAP+10mm THK. LG.U.

NO.	DATE	REVISED	BY
H	30/08/2022	GENERAL REVISION	julia
G	22/10/2021	REVISION SUBJECT TO ARCH.COMMENT	julia

JOB NO. : J-853

PROJECT :
PROPOSED RESIDENTIAL DEVELOPMENT AT N.K.I.L. 6542 YIN PING ROAD KOWLOON

TITLE :
WINDOW SCHEDULE FOR TOWER 3 ALUM. WINDOW

DATE : 03-APR-21 | SCALE : 1:40

DRAWN BY : | CHECKED BY :

美特鋁製有限公司
MIDI ALUMINIUM FABRICATOR LTD.
Units 6-8, Sunray Industrial Centre, 1/F
610 Cha Kwo Ling Road, Kowloon
Tel:23488211-4 Fax:(852)27727666

DWG NO. : J853-SD-PW-SC301c | REV. : H

ELEVATION

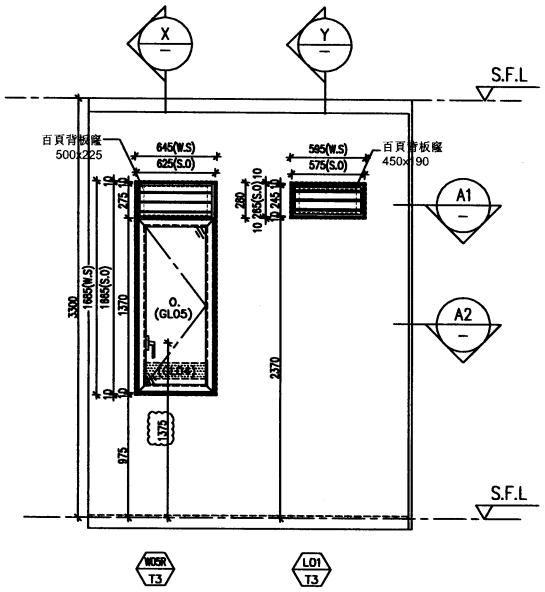

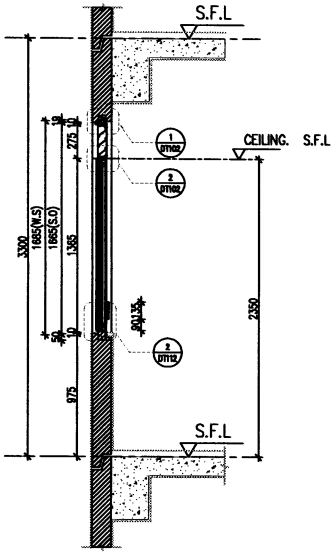

X — PART SECTION

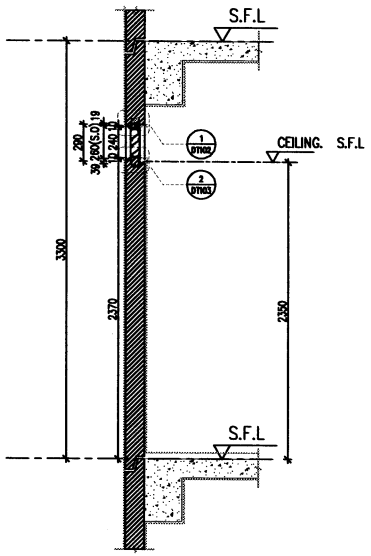

Y — PART SECTION

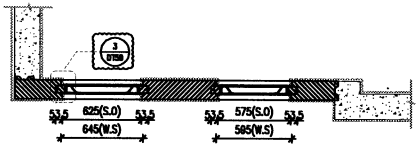

A1 — PART PLAN

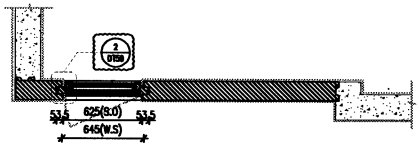

A2 — PART PLAN

L01 T3	PROVIDED		
	GLAZING AREA	–	m^2
	OPENABLE AREA	–	m^2
	FREE AREA	55.4	%

W05R T3	PROVIDED		
	GLAZING AREA	0.584	m^2
	OPENABLE AREA	0.618	m^2
	FREE AREA	60.7	%

WINDOW MARK	W05R T3 & L01 T3
LOCATION	16F&23F FLAT A EN.BATH & MASTER BATH
SECTION	70mm ALUM. SECTION
GLAZING	GL05
QUANTITY	2 Nos / 2 Nos
REMARKS	FACADE(T3-01-01A/16F;T3-01-01B/23F)

B.D. REF :

CLIENT :
SHIMAO GROUP HOLDINGS LIMITED

ARCHITECT :
WONG TUNG & PARTNERS LIMITED
ARCHITECTS & PLANNERS

MAIN CONTRACTOR :
協興建築有限公司
HIP HING CONSTRUCTION CO LTD

STRUCTURAL ENGINEER :
C M WONG & ASSOCIATES LTD
黃志明建築工程師有限公司

FACADE CONSULTANT:
MEINHARDT

NOTE :
1. ALL DIMENSIONS ARE IN mm.
2. ALL ELEVATIONS ARE VIEWED FROM OUTSIDE.
3. ALL DIMENSIONS TO BE VERIFIED ON SITE BEFORE FABRICATION.

LEGEND :
- X1 / XXX1 — DETAIL MARK NO. / REFER SHEET NO.
1. F.F.L. — FINISHED FLOOR LEVEL
2. S.F.L. — STRUCTURAL FLOOR LEVEL
3. (R) — REVERSED DETAIL
4. ▲ — FIXING LOCATION
5. △ — FIXING LUG LOCATION
6. GLASS LEGEND
   - GL01 — 10mm+12mm AIR GAP+10mm THK. I.G.U.
   - GL04 — 12mm THK. CLEAR TEMPERED GLASS
   - GL05 — 10mm+12mm AIR GAP+10mm THK. I.G.U.
   - GL06 — 10mm+12mm AIR GAP+12mm THK. I.G.U.
   - PD01 — 10mm T.P+12mm AIR GAP+8mm T.P
   - GL07 — 10mm+12mm AIR GAP+12mm THK. I.G.U.
   - GL08 — 10mm+12mm AIR GAP+10mm THK. I.G.U.

NO.	DATE	REMARKS	BY
I	31/08/2022	GENERAL REVISION	mdm
H	30/08/2022	GENERAL REVISION	mdm
G	22/10/2021	REVISION SUBJECT TO ARCH.COMMENT	mdm

JOB NO. : J-853

PROJECT :
PROPOSED RESIDENTIAL DEVELOPMENT AT N.K.I.L. 6542 YIN PING ROAD KOWLOON

TITLE :
WINDOW SCHEDULE FOR TOWER 3 ALUM. WINDOW

DATE : 03-APR-21 | SCALE : 1:40

DRAWN BY : | CHECKED BY :

美特鋁質有限公司
MIDI ALUMINIUM FABRICATION LTD.
Units 6-8, Sunray Industrial Centre, 1/F
610 Cha Kwo Ling Road, Kowloon
Tel:23488211-4 Fax:(852)27727666

DWG NO. : J853-SD-PW-SC301b | REV. : I

ELEVATION

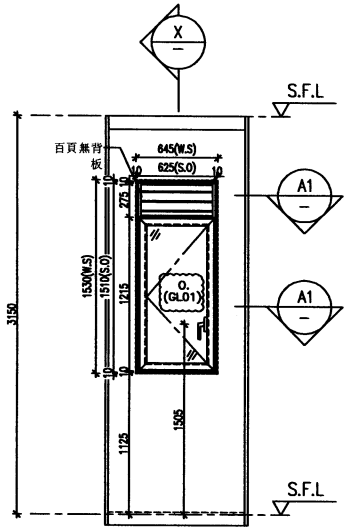

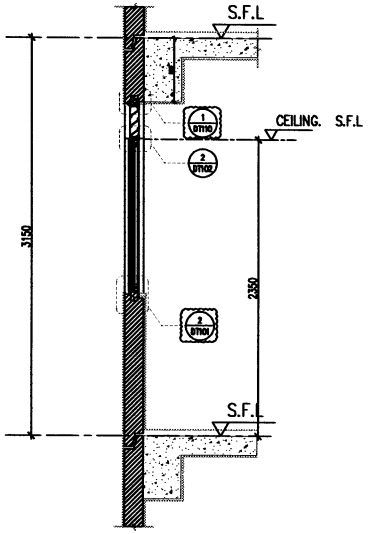

X — PART SECTION

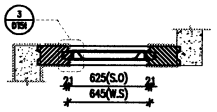

A1 — PART PLAN

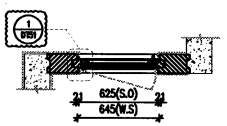

A2 — PART PLAN

PROVIDED		
GLAZING AREA	0.511	m^2
OPENABLE AREA	0.604	m^2
FREE AREA	60.7	%

WINDOW MARK	W07AL T3
LOCATION	6~15F&17F~22F FLAT B UTILITY
SECTION	70mm ALUM. SECTION
GLAZING	{GL01}
QUANTITY	14 Nos.
REMARKS	FACADE(T3-01-03/6~15F&17F~22F)

B.D. REF :

CLIENT :
SHIMAO GROUP HOLDINGS LIMITED

ARCHITECT :
WONG TUNG & PARTNERS LIMITED
ARCHITECTS & PLANNERS

MAIN CONTRACTOR :
協興建築有限公司
HIP HING CONSTRUCTION CO LTD

STRUCTURAL ENGINEER :
CMA C M WONG & ASSOCIATES LTD
黃志明建築工程師有限公司

FACADE CONSULTANT:
MEINHARDT

NOTE :
1. ALL DIMENSIONS ARE IN mm.
2. ALL ELEVATIONS ARE VIEWED FROM OUTSIDE.
3. ALL DIMENSIONS TO BE VERIFIED ON SITE BEFORE FABRICATION.

LEGEND :
X1 / X001 — DETAIL MARK NO. / REFER SHEET NO.
1. F.F.L. — FINISHED FLOOR LEVEL
2. S.F.L. — STRUCTURAL FLOOR LEVEL
3. (R) — REVERSED DETAIL
4. ▲ — FIXING LOCATION
5. △ — FIXING LUG LOCATION
6. GLASS LEGEND
GL01 — 10mm+12mm AIR GAP+10mm THK. L.G.U.
GL04 — 12mm THK. CLEAR TEMPERED GLASS
GL05 — 10mm+12mm AIR GAP+10mm THK. L.G.U.
GL06 — 10mm+12mm AIR GAP+12mm THK. L.G.U.
PD01 — 10mm T.P.+12mm AIR GAP+6mm T.P.
GL07 — 10mm+12mm AIR GAP+12mm THK. L.G.U.
GL08 — 10mm+12mm AIR GAP+10mm THK. L.G.U.

NO.	DATE	REMARK	BY
H	30/08/2022	GENERAL REVISION	
G	22/10/2021	REVISION SUBJECT TO ARCH.COMMENT	
A	08/08/2021	REVISION SUBJECT TO ARCH.COMMENT	

JOB NO. : J-853

PROJECT :
PROPOSED RESIDENTIAL DEVELOPMENT AT N.K.I.L. 6542 YIN PING ROAD KOWLOON

TITLE :
WINDOW SCHEDULE FOR TOWER 3 ALUM. WINDOW

DATE : 03-APR-21 | SCALE : 1:40

DRAWN BY : | CHECKED BY :

美特鋁質有限公司
MIDI ALUMINIUM FABRICATOR LTD.
Units 6-8, Sunray Industrial Centre, 1/F
610 Cha Kwo Ling Road, Kowloon
Tel:23489211-4 Fax:(852)27727666

DWG NO. : J853-SD-PW-SC303 | REV. : H

ELEVATION

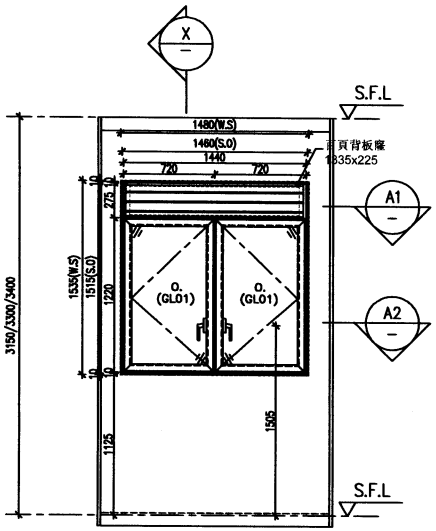

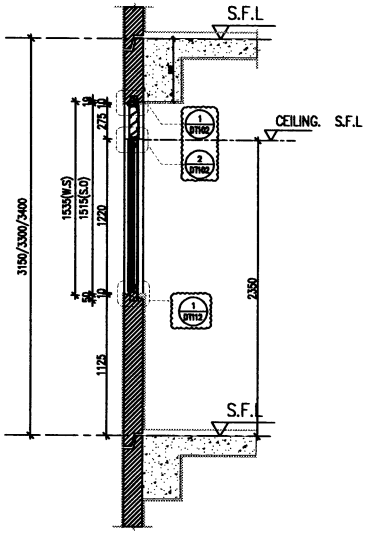

X PART SECTION

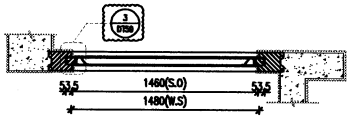

A1 PART PLAN

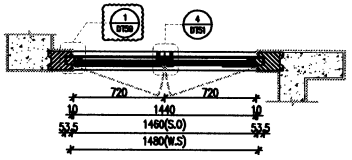

A2 PART PLAN

PROVIDED		
GLAZING AREA	1.285	m^2
OPENABLE AREA	1.486	m^2
FREE AREA	60.7	%

W09 T3

WINDOW MARK	W09 T3
LOCATION	5F~23F FLAT A KITCHEN
SECTION	70mm ALUM. SECTION
GLAZING	GL01
QUANTITY	17 Nos.
REMARKS	FACADE (T3-01-02/6~15F&17F~22F; T3-01-02A/5F&16F; T3-01-02B/23F)

B.D. REF :

CLIENT :
SHIMAO GROUP HOLDINGS LIMITED

ARCHITECT :
WONG TUNG & PARTNERS LIMITED
ARCHITECTS & PLANNERS

MAIN CONTRACTOR :
協興建築有限公司
HIP HING CONSTRUCTION CO LTD

STRUCTURAL ENGINEER :
C M WONG & ASSOCIATES LTD
黃志明建築工程師有限公司

FACADE CONSULTANT:
MEINHARDT

NOTE :
1. ALL DIMENSIONS ARE IN mm.
2. ALL ELEVATIONS ARE VIEWED FROM OUTSIDE.
3. ALL DIMENSIONS TO BE VERIFIED ON SITE BEFORE FABRICATION.

LEGEND :
- X1 / XXX1 — DETAIL MARK NO. / REFER SHEET NO.
1. F.F.L. — FINISHED FLOOR LEVEL
2. S.F.L. — STRUCTURAL FLOOR LEVEL
3. (R) — REVERSED DETAIL
4. ▲ — FIXING LOCATION
5. △ — FIXING LUG LOCATION
6. GLASS LEGEND
   - GL01 — 10mm+12mm AIR GAP+10mm THK. I.G.U.
   - GL04 — 12mm THK. CLEAR TEMPERED GLASS
   - GL05 — 10mm+12mm AIR GAP+10mm THK. I.G.U.
   - GL06 — 10mm+12mm AIR GAP+12mm THK. I.G.U.
   - PD01 — 10mm T.P+12mm AIR GAP+8mm T.P
   - GL07 — 10mm+12mm AIR GAP+12mm THK. I.G.U.
   - GL08 — 10mm+12mm AIR GAP+10mm THK. I.G.U.

NO.	DATE	REMARK	BY
H	30/08/2022	GENERAL REVISION	mlo
G	22/10/2021	REVISION SUBJECT TO ARCH.COMMENT	mlo
A	08/08/2021	REVISION SUBJECT TO ARCH.COMMENT	mlo

JOB NO. : J-853

PROJECT :
PROPOSED RESIDENTIAL DEVELOPMENT AT N.K.I.L. 6542 YIN PING ROAD KOWLOON

TITLE :
WINDOW SCHEDULE FOR TOWER 3 ALUM. WINDOW

DATE : 03-APR-21 | SCALE : 1:40

DRAWN BY : | CHECKED BY :

美特鋁質有限公司
MIDI ALUMINIUM FABRICATOR LTD.
Units 6-8, Sunray Industrial Centre, 1/F
610 Cha Kwo Ling Road, Kowloon
Tel:23488211-4 Fax:(852)27727666

DWG NO. : J853-SD-PW-SC302 | REV. : H

ELEVATION

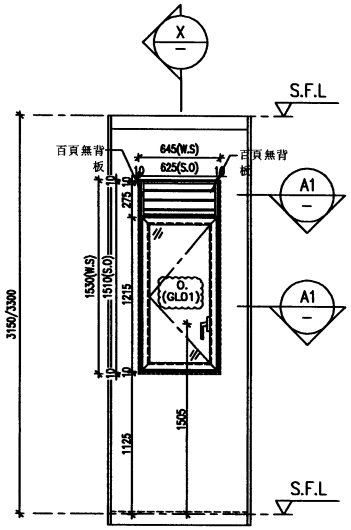

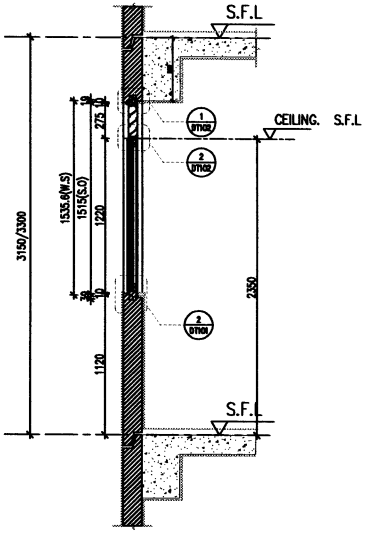

X — PART SECTION

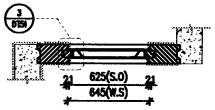

A1 — PART PLAN

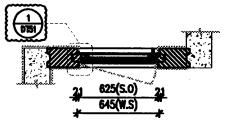

A2 — PART PLAN

PROVIDED		
GLAZING AREA	0.513	m^2
OPENABLE AREA	0.607	m^2
FREE AREA	60.7	%

WINDOW MARK	W07L T3
LOCATION	16F&26F FLAT B UTILITY
SECTION	70mm ALUM. SECTION
GLAZING	{GL01}
QUANTITY	2 Nos.
REMARKS	FACADE(T3-01-03A/16F&26F)

B.D. REF :

CLIENT :
SHIMAO GROUP HOLDINGS LIMITED

ARCHITECT :
WONG TUNG & PARTNERS LIMITED
ARCHITECTS & PLANNERS

MAIN CONTRACTOR :
協興建築有限公司
HIP HING CONSTRUCTION CO LTD

STRUCTURAL ENGINEER :
C M WONG & ASSOCIATES LTD
黃志明建築工程師有限公司

FACADE CONSULTANT:
MEINHARDT

NOTE :
1. ALL DIMENSIONS ARE IN mm.
2. ALL ELEVATIONS ARE VIEWED FROM OUTSIDE.
3. ALL DIMENSIONS TO BE VERIFIED ON SITE BEFORE FABRICATION.

LEGEND :
X1 — DETAIL MARK NO.
XD01 — REFER SHEET NO.

1. F.F.L. — FINISHED FLOOR LEVEL
2. S.F.L. — STRUCTURAL FLOOR LEVEL
3. (R) — REVERSED DETAIL
4. ▲ — FIXING LOCATION
5. △ — FIXING LUG LOCATION
6. GLASS LEGEND
   GL01 — 10mm+12mm AIR GAP+10mm THK. LG.U.
   GL04 — 12mm THK. CLEAR TEMPERED GLASS
   GL05 — 10mm+12mm AIR GAP+10mm THK. LG.U.
   GL06 — 10mm+12mm AIR GAP+12mm THK. LG.U.
   PD01 — 10mm T.P+12mm AIR GAP+8mm T.P
   GL07 — 10mm+12mm AIR GAP+12mm THK. LG.U.
   GL08 — 10mm+12mm AIR GAP+10mm THK. LG.U.

NO.	DATE	REMARK	BY
A	30/08/2022	GENERAL REVISION	edo

JOB NO. : J-853

PROJECT :
PROPOSED RESIDENTIAL DEVELOPMENT AT N.K.I.L. 6542 YIN PING ROAD KOWLOON

TITLE :
WINDOW SCHEDULE FOR TOWER 3 ALUM. WINDOW

DATE : 03-APR-21 | SCALE : 1:40

DRAWN BY : | CHECKED BY :

美特鋁質有限公司
MIDI ALUMINIUM FABRICATOR LTD.
Units 6-8, Sunray Industrial Centre, 1/F
610 Cha Kwo Ling Road, Kowloon
Tel:23488211-4 Fax:(852)27727666

DWG NO. : J853-SD-PW-SC303b | REV. : A

ELEVATION

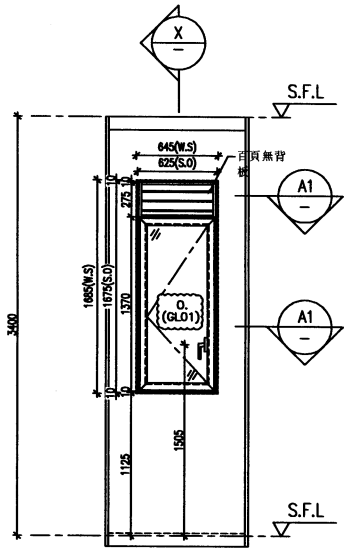

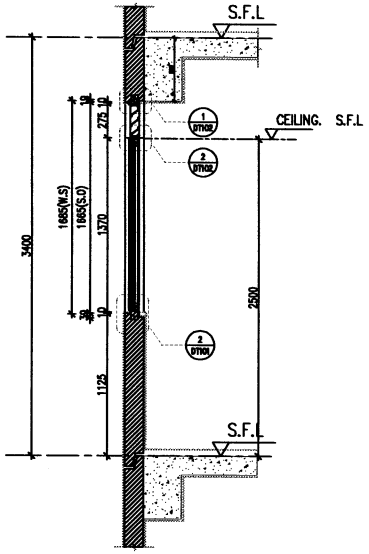

X — PART SECTION

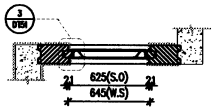

A1 — PART PLAN

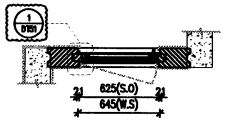

A2 — PART PLAN

PROVIDED		
GLAZING AREA	0.584	m^2
OPENABLE AREA	0.686	m^2
FREE AREA	60.7	%

WINDOW MARK	W57L T3
LOCATION	23F FLAT B UTILITY
SECTION	70mm ALUM. SECTION
GLAZING	{GL01}
QUANTITY	1 Nos.
REMARKS	FACADE(T3-01-03B/23F)

B.D. REF :

CLIENT :
SHIMAO GROUP HOLDINGS LIMITED

ARCHITECT :
WONG TUNG & PARTNERS LIMITED
ARCHITECTS & PLANNERS

MAIN CONTRACTOR :
協興建築有限公司
HIP HING CONSTRUCTION CO LTD

STRUCTURAL ENGINEER :
CMA C M WONG & ASSOCIATES LTD
黃志明建築工程師有限公司

FACADE CONSULTANT:
MEINHARDT

NOTE :
1. ALL DIMENSIONS ARE IN mm.
2. ALL ELEVATIONS ARE VIEWED FROM OUTSIDE.
3. ALL DIMENSIONS TO BE VERIFIED ON SITE BEFORE FABRICATION.

LEGEND :
- DETAIL MARK NO.
- REFER SHEET NO.

1. F.F.L. — FINISHED FLOOR LEVEL
2. S.F.L. — STRUCTURAL FLOOR LEVEL
3. (R) — REVERSED DETAIL
4. ▲ — FIXING LOCATION
5. △ — FIXING LUG LOCATION
6. GLASS LEGEND
   - GL01 — 10mm+12mm AIR GAP+10mm THK. L.G.U.
   - GL04 — 12mm THK. CLEAR TEMPERED GLASS
   - GL05 — 10mm+12mm AIR GAP+10mm THK. L.G.U.
   - GL06 — 10mm+12mm AIR GAP+12mm THK. L.G.U.
   - PD01 — 10mm T.P+12mm AIR GAP+8mm T.P
   - GL07 — 10mm+12mm AIR GAP+12mm THK. L.G.U.
   - GL08 — 10mm+12mm AIR GAP+10mm THK. L.G.U.

NO.	DATE	REMARKS	BY
H	30/08/2022	GENERAL REVISION	ada
G	22/10/2021	REVISION SUBJECT TO ARCH.COMMENT	ada

JOB NO. : J-853

PROJECT :
PROPOSED RESIDENTIAL DEVELOPMENT AT N.K.I.L. 6542 YIN PING ROAD KOWLOON

TITLE :
WINDOW SCHEDULE FOR TOWER 3 ALUM. WINDOW

DATE : 03-APR-21 | SCALE : 1:40

DRAWN BY : | CHECKED BY :

美特鋁質有限公司
MIDI ALUMINIUM FABRICATOR LTD.
Units 6-8, Sunray Industrial Centre, 1/F
610 Cha Kwo Ling Road, Kowloon
Tel:23489211-4 Fax:(852)27727666

DWG NO. : J853-SD-PW-SC303e | REV. : H

ELEVATION

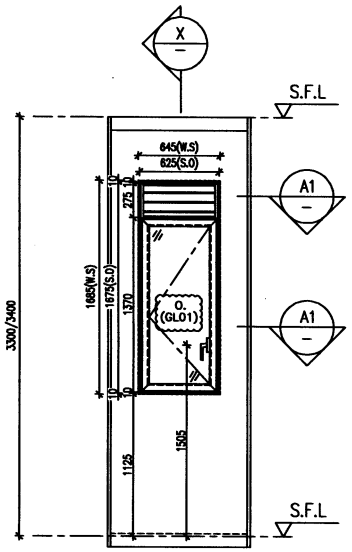

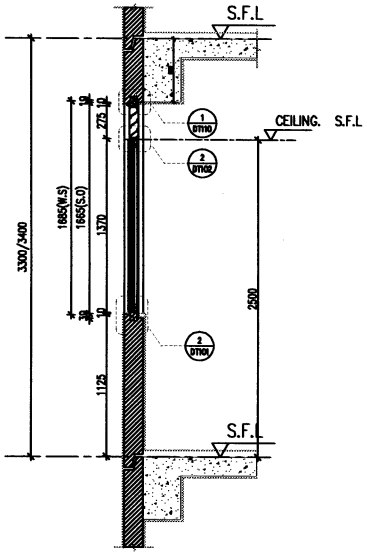

X — PART SECTION

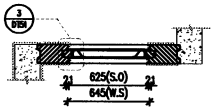

A1 — PART PLAN

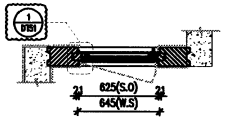

A2 — PART PLAN

PROVIDED		
GLAZING AREA	0.581	m^2
OPENABLE AREA	0.684	m^2
FREE AREA	60.7	%

WINDOW MARK	W57AL T3
LOCATION	5F&25F FLAT B UTILITY
SECTION	70mm ALUM. SECTION
GLAZING	{GL01}
QUANTITY	2 Nos.
REMARKS	FACADE(T3-01-03A/5F&25F)

B.D. REF :

CLIENT :
SHIMAO GROUP HOLDINGS LIMITED

ARCHITECT :
WONG TUNG & PARTNERS LIMITED
ARCHITECTS & PLANNERS

MAIN CONTRACTOR :
協興建築有限公司
HIP HING CONSTRUCTION CO LTD

STRUCTURAL ENGINEER :
CMA C M WONG & ASSOCIATES LTD
黃志明建築工程師有限公司

FACADE CONSULTANT:
MEINHARDT

NOTE :
1. ALL DIMENSIONS ARE IN mm.
2. ALL ELEVATIONS ARE VIEWED FROM OUTSIDE.
3. ALL DIMENSIONS TO BE VERIFIED ON SITE BEFORE FABRICATION.

LEGEND :
- DETAIL MARK NO.
- REFER SHEET NO.

1. F.F.L. — FINISHED FLOOR LEVEL
2. S.F.L. — STRUCTURAL FLOOR LEVEL
3. (R) — REVERSED DETAIL
4. ▲ — FIXING LOCATION
5. △ — FIXING LUG LOCATION
6. GLASS LEGEND
   - GL01 — 10mm+12mm AIR GAP+10mm THK. I.G.U.
   - GL04 — 12mm THK. CLEAR TEMPERED GLASS
   - GL05 — 10mm+12mm AIR GAP+10mm THK. I.G.U.
   - GL06 — 10mm+12mm AIR GAP+12mm THK. I.G.U.
   - PD01 — 10mm T.P+12mm AIR GAP+8mm T.P
   - GL07 — 10mm+12mm AIR GAP+12mm THK. I.G.U.
   - GL08 — 10mm+12mm AIR GAP+10mm THK. I.G.U.

NO.	DATE	REVISED	BY
A	30/08/2022	GENERAL REVISION	

JOB NO. : J-853

PROJECT :
PROPOSED RESIDENTIAL DEVELOPMENT AT N.K.I.L. 6542 YIN PING ROAD KOWLOON

TITLE :
WINDOW SCHEDULE FOR TOWER 3 ALUM. WINDOW

DATE : 03-APR-21 | SCALE : 1:40

DRAWN BY : | CHECKED BY :

美特鋁製有限公司
MIDI ALUMINIUM FABRICATOR LTD.
Units 6-8, Sunray Industrial Centre, 1/F
610 Cha Kwo Ling Road, Kowloon
Tel:23488211-4 Fax:(852)27727666

DWG NO. : J853-SD-PW-SC303c | REV. : A

ELEVATION

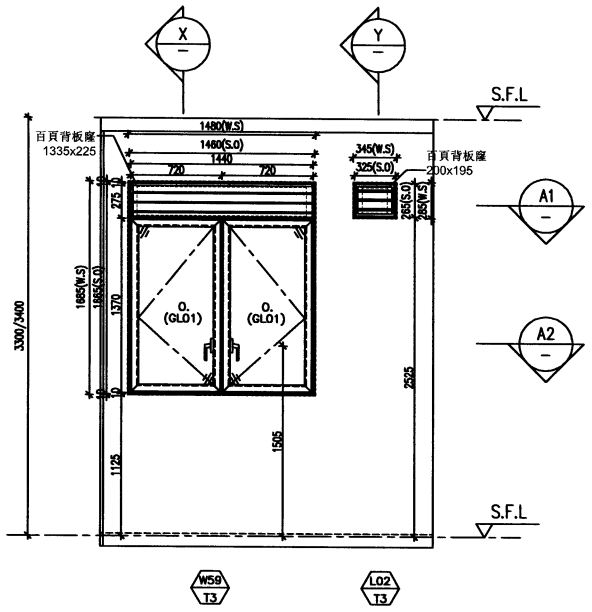

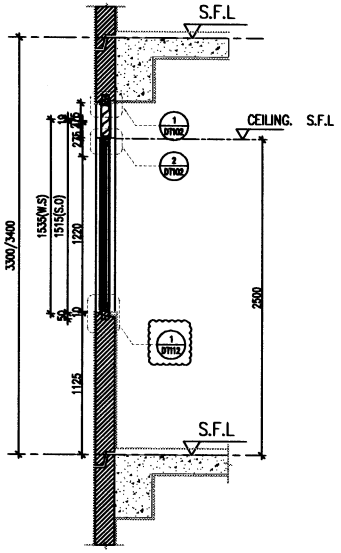

X PART SECTION

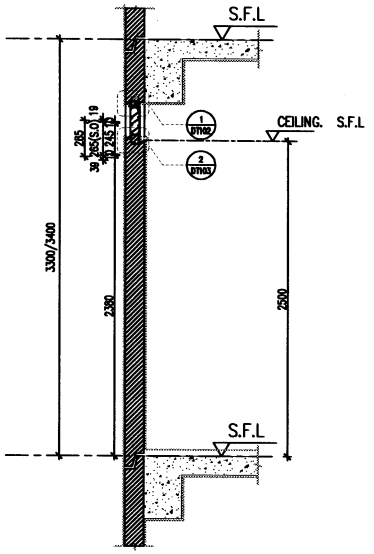

Y PART SECTION

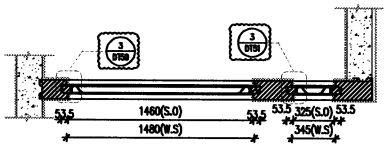

A1 PART PLAN

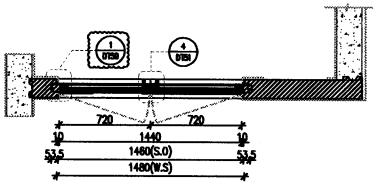

A2 PART PLAN

PROVIDED		
GLAZING AREA	–	m^2
OPENABLE AREA	–	m^2
FREE AREA	55.4	%

L02 T3

PROVIDED		
GLAZING AREA	1.461	m^2
OPENABLE AREA	1.680	m^2
FREE AREA	60.7	%

W59 T3

WINDOW MARK	W59 T3 & L02 T3
LOCATION	5F&25F&23F FLAT B KITCHEN
SECTION	70mm ALUM. SECTION
GLAZING	GL01
QUANTITY	3 Nos
REMARKS	FACADE (T3-01-04A/5F&25F; T3-01-04B/23F)

B.D. REF :

CLIENT :
SHIMAO GROUP HOLDINGS LIMITED

ARCHITECT :
WONG TUNG & PARTNERS LIMITED
ARCHITECTS & PLANNERS

MAIN CONTRACTOR :
協興建築有限公司
HIP HING CONSTRUCTION CO LTD

STRUCTURAL ENGINEER :
C M WONG & ASSOCIATES LTD
黃志明建築工程師有限公司

FACADE CONSULTANT:
MEINHARDT

NOTE :
1. ALL DIMENSIONS ARE IN mm.
2. ALL ELEVATIONS ARE VIEWED FROM OUTSIDE.
3. ALL DIMENSIONS TO BE VERIFIED ON SITE BEFORE FABRICATION.

LEGEND :
X1 — DETAIL MARK NO.
XX01 — REFER SHEET NO.
1. F.F.L. — FINISHED FLOOR LEVEL
2. S.F.L. — STRUCTURAL FLOOR LEVEL
3. R — REVERSED DETAIL
4. ▲ — FIXING LOCATION
5. △ — FIXING LUG LOCATION
6. GLASS LEGEND
GL01 — 10mm+12mm AIR GAP+10mm THK. I.G.U.
GL04 — 12mm THK. CLEAR TEMPERED GLASS
GL05 — 10mm+12mm AIR GAP+10mm THK. I.G.U.
GL06 — 10mm+12mm AIR GAP+12mm THK. I.G.U.
PD01 — 10mm T.P+12mm AIR GAP+8mm T.P
GL07 — 10mm+12mm AIR GAP+12mm THK. I.G.U.
GL08 — 10mm+12mm AIR GAP+10mm THK. I.G.U.

NO.	DATE	REMARK	BY
H	30/08/2022	GENERAL REVISION	ada
G	22/10/2021	REVISION SUBJECT TO ARCH.COMMENT	ada

JOB NO. : J-853

PROJECT :
PROPOSED RESIDENTIAL DEVELOPMENT AT N.K.I.L. 6542 YIN PING ROAD KOWLOON

TITLE :
WINDOW SCHEDULE FOR TOWER 3 ALUM. WINDOW

DATE : 03-APR-21 | SCALE : 1:40

DRAWN BY : | CHECKED BY :

美特鋁製有限公司
MIDI ALUMINIUM FABRICATION LTD.
Units 6-8, Sunray Industrial Centre, 1/F
610 Cha Kwo Ling Road, Kowloon
Tel:23489211-4 Fax:(852)27727666

DWG NO. : J853-SD-PW-SC304a | REV. : H

ELEVATION

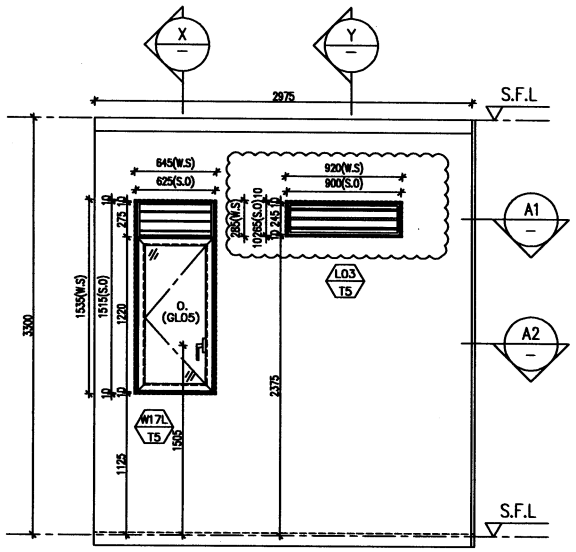

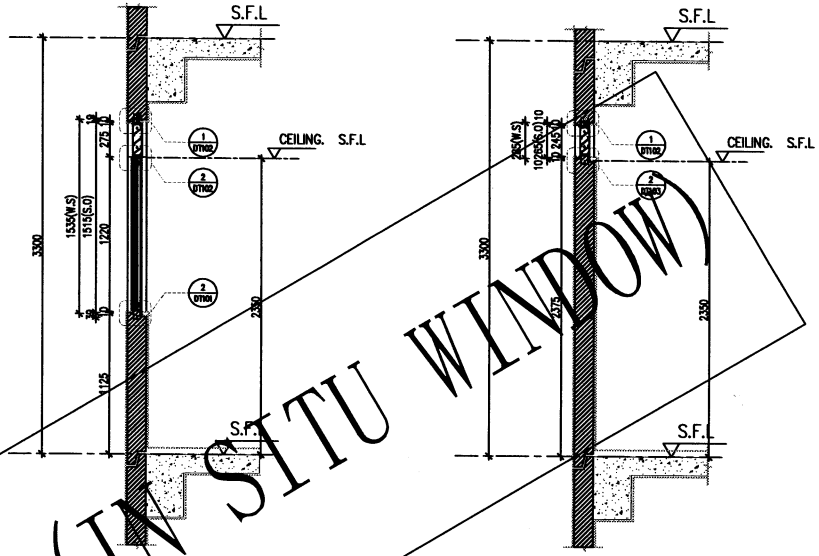

X PART SECTION

Y PART SECTION

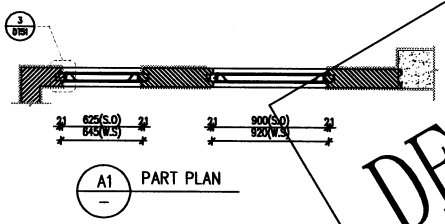

A1 PART PLAN

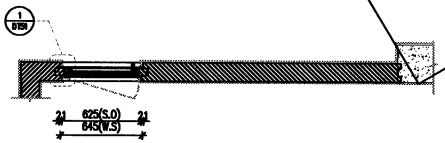

A2 PART PLAN

DELETED (IN SITU WINDOW)

PROVIDED		
GLAZING AREA	–	m^2
OPENABLE AREA	–	m^2
FREE AREA	60.8	%

LO3 T5

PROVIDED		
GLAZING AREA	0.512	m^2
OPENABLE AREA	0.590	m^2
FREE AREA	60.8	%

W17L T5

WINDOW MARK	W17L T5 LO3 T5
LOCATION	26F FLAT A LAY.UTILITY
SECTION	70mm ALUM. SECTION
GLAZING	GL05
QUANTITY	1 No.
REMARKS	FACADE (T5–02–06A)

B.D. REF :

CLIENT :
SHIMAO GROUP HOLDINGS LIMITED

ARCHITECT :
WONG TUNG & PARTNERS LIMITED
ARCHITECTS & PLANNERS

MAIN CONTRACTOR :
協興建築有限公司
HIP HING CONSTRUCTION CO LTD

STRUCTURAL ENGINEER :
C M WONG & ASSOCIATES LTD
黃志明建築工程師有限公司

FACADE CONSULTANT:
MEINHARDT

NOTE :
1. ALL DIMENSIONS ARE IN mm.
2. ALL ELEVATIONS ARE VIEWED FROM OUTSIDE.
3. ALL DIMENSIONS TO BE VERIFIED ON SITE BEFORE FABRICATION.

LEGEND :
- X1 / XD01 — DETAIL MARK NO. / REFER SHEET NO.
1. F.F.L. — FINISHED FLOOR LEVEL
2. S.F.L. — STRUCTURAL FLOOR LEVEL
3. (N) — REVERSED DETAIL
4. ▲ — FIXING LOCATION
5. △ — FIXING LUG LOCATION
6. GLASS LEGEND
   - GL01 — 10mm+12mm AIR GAP+10mm THK. L.G.U.
   - GL04 — 12mm THK. CLEAR TEMPERED GLASS
   - GL05 — 10mm+12mm AIR GAP+10mm THK. L.G.U.
   - GL06 — 10mm+12mm AIR GAP+12mm THK. L.G.U.
   - PD01 — 10mm T.P+12mm AIR GAP+8mm T.P
   - GL07 — 10mm+12mm AIR GAP+12mm THK. L.G.U.
   - GL08 — 10mm+12mm AIR GAP+10mm THK. L.G.U.

NO.	DATE	REMARK	BY
B	08/07/2022	GENERAL REVISION	mdo
A	29/07/2021	REVISION SUBJECT TO ARCH.COMMENT	mdo

JOB NO. : J–853

PROJECT :
PROPOSED RESIDENTIAL DEVELOPMENT AT N.K.I.L. 6542 YIN PING ROAD KOWLOON

TITLE :
WINDOW SCHEDULE FOR TOWER 5 ALUM. WINDOW

DATE : 03–APR–21 | SCALE : 1:40

DRAWN BY : | CHECKED BY :

美特鋁質有限公司
MIDI ALUMINIUM FABRICATION LTD.
Units 6–8, Sunray Industrial Centre, 1/F
610 Cha Kwo Ling Road, Kowloon
Tel:23488211–4 Fax:(852)27727666

DWG NO. : J853–SD–PW–SC519 | REV. : B

T:\Jobs\J-853\2. Outgoing\Black plate opening of Windows Louvre\Black Plate of T5 Precat Window.dwg

ELEVATION

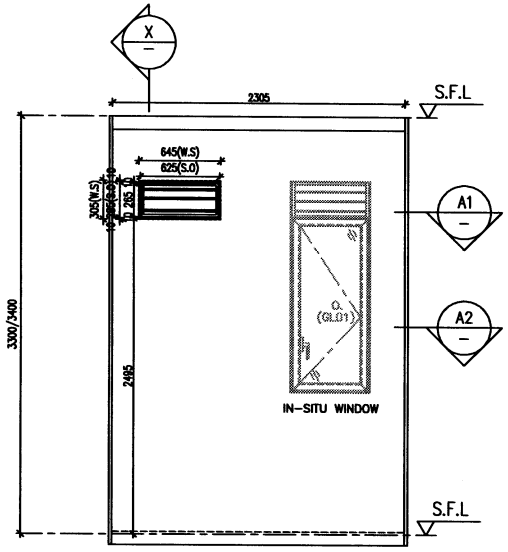

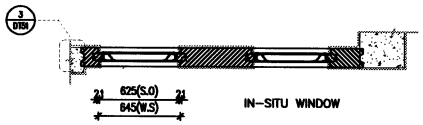

A1 PART PLAN

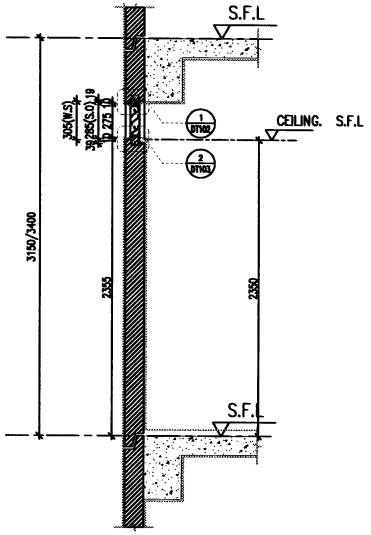

X PART SECTION

PROVIDED		
GLAZING AREA	0.585	m^2
OPENABLE AREA	0.643	m^2
FREE AREA	60.8	%

WINDOW MARK	L08A / T5
LOCATION	23F FLAT COMNON AREA STAIRCASE
SECTION	70mm ALUM. SECTION
GLAZING	GL01
QUANTITY	1 No.
REMARKS	FACADE: (T5-02-04B/23F)

T:\Jobs\J-853\2. Outgoing\Black plate opening of Windows Louvre\Black Plate of T5 Precat Window.dwg

B.D. REF :

CLIENT :
SHIMAO GROUP HOLDINGS LIMITED

ARCHITECT :
WONG TUNG & PARTNERS LIMITED
ARCHITECTS & PLANNERS

MAIN CONTRACTOR :
協興建築有限公司
HIP HING CONSTRUCTION CO LTD

STRUCTURAL ENGINEER :
C M WONG & ASSOCIATES LTD
黃志明建築工程師有限公司

FACADE CONSULTANT:
MEINHARDT

NOTE :
1. ALL DIMENSIONS ARE IN mm.
2. ALL ELEVATIONS ARE VIEWED FROM OUTSIDE.
3. ALL DIMENSIONS TO BE VERIFIED ON SITE BEFORE FABRICATION.

LEGEND :
X1 / X001 — DETAIL MARK NO. / REFER SHEET NO.
1. F.F.L. — FINISHED FLOOR LEVEL
2. S.F.L. — STRUCTURAL FLOOR LEVEL
3. (/B) — REVERSED DETAIL
4. ▲ — FIXING LOCATION
5. △ — FIXING LUG LOCATION
6. GLASS LEGEND
GL01 — 10mm+12mm AIR GAP+10mm THK. I.G.U.
GL04 — 12mm THK. CLEAR TEMPERED GLASS
GL05 — 10mm+12mm AIR GAP+10mm THK. I.G.U.
GL06 — 10mm+12mm AIR GAP+12mm THK. I.G.U.
PD01 — 10mm T.P+12mm AIR GAP+8mm T.P
GL07 — 10mm+12mm AIR GAP+12mm THK. I.G.U.
GL08 — 10mm+12mm AIR GAP+10mm THK. I.G.U.

NO.	DATE	REMARK	BY
B	08/07/2022	GENERAL REVISION	wdo
A	28/07/2021	REVISION SUBJECT TO ARCH.COMMENT	wdo

JOB NO. : J-853

PROJECT :
PROPOSED RESIDENTIAL DEVELOPMENT AT N.K.I.L. 6542 YIN PING ROAD KOWLOON

TITLE :
WINDOW SCHEDULE FOR TOWER 5 ALUM. WINDOW

DATE : 03-APR-21 | SCALE : 1:40

DRAWN BY : | CHECKED BY :

美特鋁質有限公司
MIDI ALUMINIUM FABRICATOR LTD.
Units 6-8, Sunray Industrial Centre, 1/F
610 Cha Kwo Ling Road, Kowloon
Tel:23488211-4 Fax:(852)27727666

DWG NO. : J853-SD-PW-SC517a | REV. : C

ELEVATION

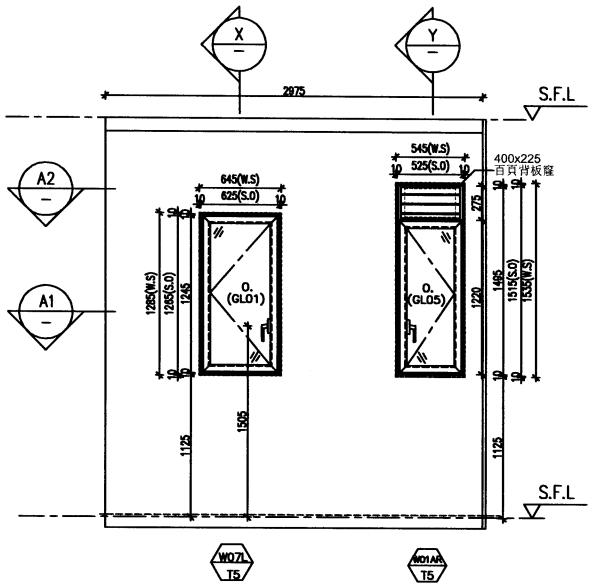

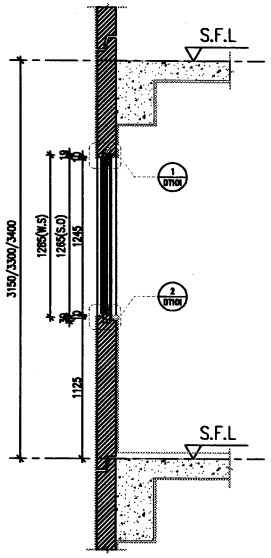

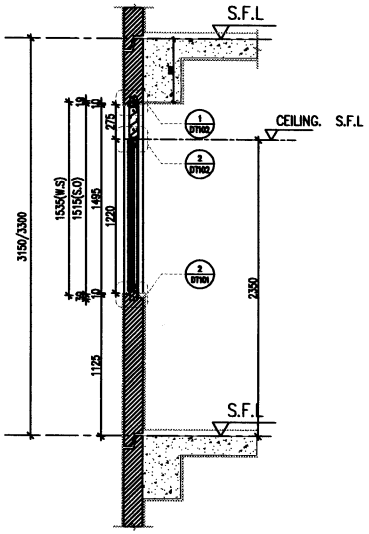

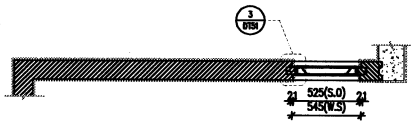

A1 PART PLAN

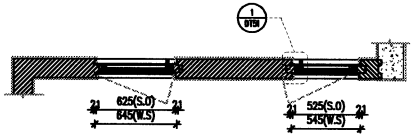

A2 PART PLAN

PROVIDED		
GLAZING AREA	0.403	m^2
OPENABLE AREA	0.479	m^2
FREE AREA	60.8	%

W01AR T5

PROVIDED		
GLAZING AREA	0.522	m^2
OPENABLE AREA	0.603	m^2
FREE AREA	–	%

W07L T5

WINDOW MARK	W07L T5 & W01AR T5
LOCATION	17~25F FLAT A LAY.UTILITY
SECTION	70mm ALUM. SECTION
GLAZING	W07L–GL01 / W01R–GL05
QUANTITY	6 Nos.
REMARKS	FACADE: (T5–02–05/17~22F)

T:\Jobs\J-853\2. Outgoing\Black plate opening of Windows Louvre\Black Plate of T5 Precat Window.dwg

B.D. REF :

CLIENT :
SHIMAO GROUP HOLDINGS LIMITED

ARCHITECT :
WONG TUNG & PARTNERS LIMITED
ARCHITECTS & PLANNERS

MAIN CONTRACTOR :
協興建築有限公司
HIP HING CONSTRUCTION CO LTD

STRUCTURAL ENGINEER :
C M WONG & ASSOCIATES LTD
黃志明建築工程師有限公司

FACADE CONSULTANT:
MEINHARDT

NOTE :
1. ALL DIMENSIONS ARE IN mm.
2. ALL ELEVATIONS ARE VIEWED FROM OUTSIDE.
3. ALL DIMENSIONS TO BE VERIFIED ON SITE BEFORE FABRICATION.

LEGEND :
- X1 / XX01 — DETAIL MARK NO. / REFER SHEET NO.
1. F.F.L. — FINISHED FLOOR LEVEL
2. S.F.L. — STRUCTURAL FLOOR LEVEL
3. (N) — REVERSED DETAIL
4. ▲ — FIXING LOCATION
5. △ — FIXING LUG LOCATION
6. GLASS LEGEND
   - GL01 — 10mm+12mm AIR GAP+10mm THK. I.G.U.
   - GL04 — 12mm THK. CLEAR TEMPERED GLASS
   - GL05 — 10mm+12mm AIR GAP+10mm THK. I.G.U.
   - GL06 — 10mm+12mm AIR GAP+12mm THK. I.G.U.
   - PD01 — 10mm T.P+12mm AIR GAP+8mm T.P
   - GL07 — 10mm+12mm AIR GAP+12mm THK. I.G.U.
   - GL08 — 10mm+12mm AIR GAP+10mm THK. I.G.U.

NO.	DATE	REVISED	BY
A	28/07/2021	REVISION SUBJECT TO ARCH.COMMENT	ada

JOB NO. : J–853

PROJECT :
PROPOSED RESIDENTIAL DEVELOPMENT AT N.K.I.L. 6542 YIN PING ROAD KOWLOON

TITLE :
WINDOW SCHEDULE FOR TOWER 5 ALUM. WINDOW

DATE : 03–APR–21 | SCALE : 1:40

DRAWN BY : | CHECKED BY :

美特鋁質有限公司
MTDI ALUMINIUM FABRICATION LTD.
Units 6–8, Sunray Industrial Centre, 1/F
610 Cha Kwo Ling Road, Kowloon
Tel:23488211–4 Fax:(852)27727666

DWG NO. : J853–SD–PW–SC518 | REV. : A

ELEVATION

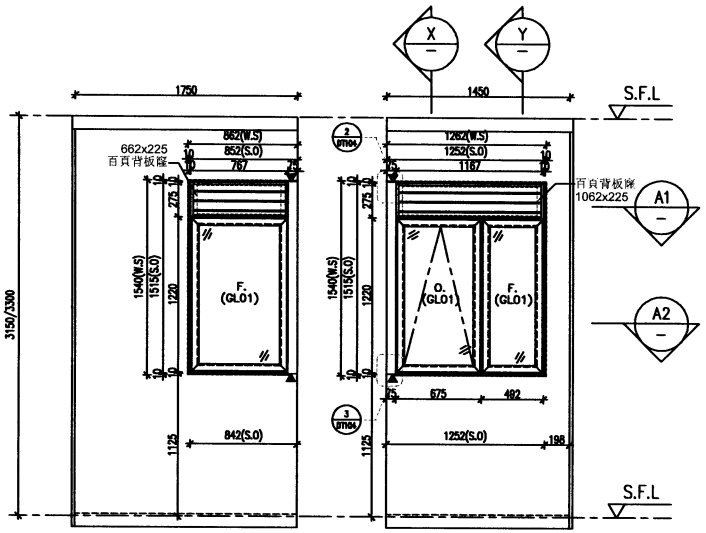

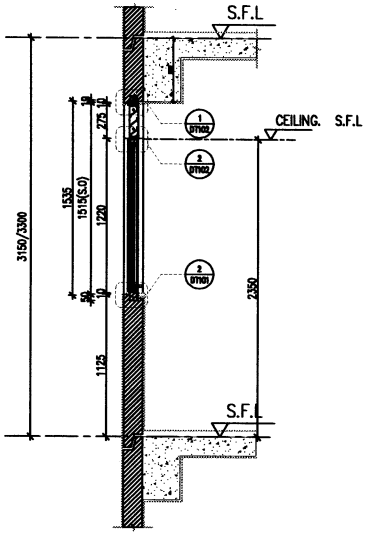

X PART SECTION

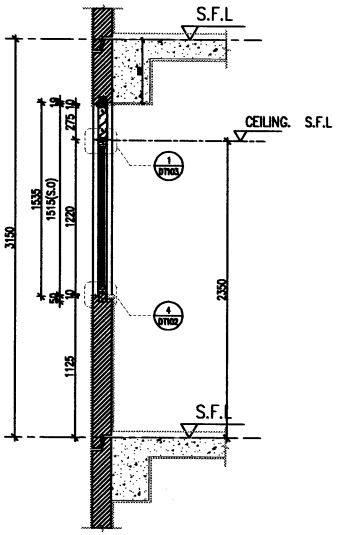

Y PART SECTION

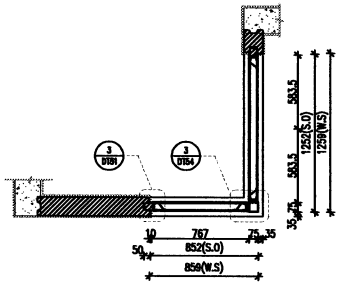

A1 PART PLAN

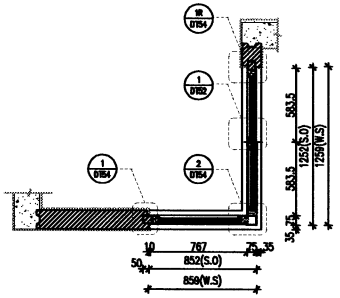

A2 PART PLAN

PROVIDED		
GLAZING AREA	1.779	m^2
OPENABLE AREA	0.675	m^2
FREE AREA	60.8	%

WINDOW MARK	W13 / T5
LOCATION	11F~16F FLAT C KITCHEN
SECTION	70mm ALUM. SECTION
GLAZING	GL01
QUANTITY	4 Nos.
REMARKS	FACADE(T5-02-03/11~15F; T5-02-03A/16F)

T:\Jobs\J-853\2. Outgoing\Black plate opening of Windows Louvre\Black Plate of T5 Precat Window.dwg

B.D. REF :

CLIENT :
SHIMAO GROUP HOLDINGS LIMITED

ARCHITECT :
WONG TUNG & PARTNERS LIMITED
ARCHITECTS & PLANNERS

MAIN CONTRACTOR :
協興建築有限公司
HIP HING CONSTRUCTION CO LTD

STRUCTURAL ENGINEER :
C M WONG & ASSOCIATES LTD
黃志明建築工程師有限公司

FACADE CONSULTANT:
MEINHARDT

NOTE :
1. ALL DIMENSIONS ARE IN mm.
2. ALL ELEVATIONS ARE VIEWED FROM OUTSIDE.
3. ALL DIMENSIONS TO BE VERIFIED ON SITE BEFORE FABRICATION.

LEGEND :
- X1 / X001 — DETAIL MARK NO. / REFER SHEET NO.
1. F.F.L. — FINISHED FLOOR LEVEL
2. S.F.L. — STRUCTURAL FLOOR LEVEL
3. (R) — REVERSED DETAIL
4. ▲ — FIXING LOCATION
5. △ — FIXING LUG LOCATION
6. GLASS LEGEND
   - GL01 — 10mm+12mm AIR GAP+10mm THK. L.G.U.
   - GL04 — 12mm THK. CLEAR TEMPERED GLASS
   - GL05 — 10mm+12mm AIR GAP+10mm THK. L.G.U.
   - GL06 — 10mm+12mm AIR GAP+12mm THK. L.G.U.
   - PD01 — 10mm T.P+12mm AIR GAP+8mm T.P
   - GL07 — 10mm+12mm AIR GAP+12mm THK. L.G.U.
   - GL08 — 10mm+12mm AIR GAP+10mm THK. L.G.U.

NO.	DATE	REMARK	BY
A	08/07/2022	GENERAL REVISION	

JOB NO. : J-853

PROJECT :
PROPOSED RESIDENTIAL DEVELOPMENT AT N.K.I.L. 6542 YIN PING ROAD KOWLOON

TITLE :
WINDOW SCHEDULE FOR TOWER 5 ALUM. WINDOW

DATE : 03-APR-21 | SCALE : 1:40

DRAWN BY : | CHECKED BY :

美特鋁製有限公司
MIDI ALUMINIUM FABRICATION LTD.
Units 6-8, Sunray Industrial Centre, 1/F
610 Cha Kwo Ling Road, Kowloon
Tel:23489211-4 Fax:(852)27727666

DWG NO. : J853-SD-PW-SC516 | REV. : A

ELEVATION

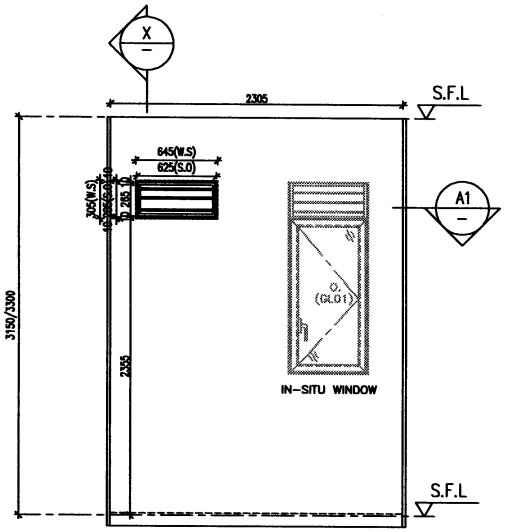

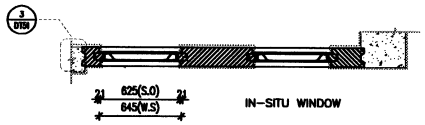

A1 PART PLAN

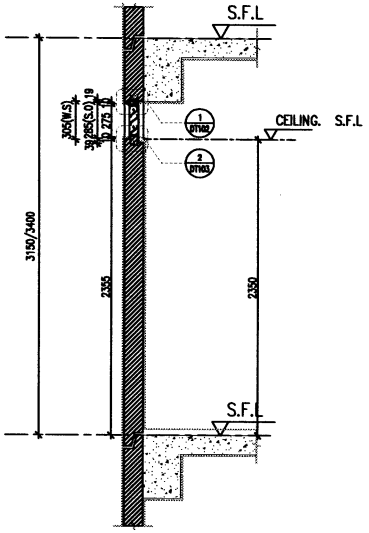

X PART SECTION

PROVIDED		
GLAZING AREA	0.514	m^2
OPENABLE AREA	0.593	m^2
FREE AREA	60.8	%

WINDOW MARK	L08A / T5
LOCATION	11F~15F & 17F~22F FLAT COMNON AREA STAIRCASE
SECTION	70mm ALUM. SECTION
GLAZING	GL01
QUANTITY	9 Nos.
REMARKS	FACADE: (T5-02-04/11~15F&17~22F)

T:\Jobs\J-853\2 Outgoing\Black plate opening of Windows Louvre\Black Plate of T5 Precat Window.dwg

B.D. REF :

CLIENT :
SHIMAO GROUP HOLDINGS LIMITED

ARCHITECT :
WONG TUNG & PARTNERS LIMITED
ARCHITECTS & PLANNERS

MAIN CONTRACTOR :
協興建築有限公司
HIP HING CONSTRUCTION CO LTD

STRUCTURAL ENGINEER :
CMA C M WONG & ASSOCIATES LTD
黃志明建築工程師有限公司

FACADE CONSULTANT:
MEINHARDT

NOTE :
1. ALL DIMENSIONS ARE IN mm.
2. ALL ELEVATIONS ARE VIEWED FROM OUTSIDE.
3. ALL DIMENSIONS TO BE VERIFIED ON SITE BEFORE FABRICATION.

LEGEND :
X1 / 2D01 — DETAIL MARK NO. / REFER SHEET NO.
1. F.F.L. — FINISHED FLOOR LEVEL
2. S.F.L. — STRUCTURAL FLOOR LEVEL
3. R — REVERSED DETAIL
4. ▲ — FIXING LOCATION
5. △ — FIXING LUG LOCATION
6. GLASS LEGEND
GL01 — 10mm+12mm AIR GAP+10mm THK. I.G.U.
GL04 — 12mm THK. CLEAR TEMPERED GLASS
GL05 — 10mm+12mm AIR GAP+10mm THK. I.G.U.
GL06 — 10mm+12mm AIR GAP+12mm THK. I.G.U.
PD01 — 10mm T.P+12mm AIR GAP+8mm T.P
GL07 — 10mm+12mm AIR GAP+12mm THK. I.G.U.
GL08 — 10mm+12mm AIR GAP+10mm THK. I.G.U.

NO.	DATE	REMARK	BY
B	08/07/2022	GENERAL REVISION	edo
A	26/07/2021	REVISION SUBJECT TO ARCH.COMMENT	edo

JOB NO. : J-853

PROJECT :
PROPOSED RESIDENTIAL DEVELOPMENT AT N.K.I.L. 6542 YIN PING ROAD KOWLOON

TITLE :
WINDOW SCHEDULE FOR TOWER 5 ALUM. WINDOW

DATE : 03-APR-21 | SCALE : 1:40

DRAWN BY : | CHECKED BY :

美特鋁製有限公司
MIDI ALUMINIUM FABRICATOR LTD.
Units 6-8, Sunray Industrial Centre, 1/F
610 Cha Kwo Ling Road, Kowloon
Tel:23489211-4 Fax:(852)27727666

DWG NO. : J853-SD-PW-SC517 | REV. : C

ELEVATION

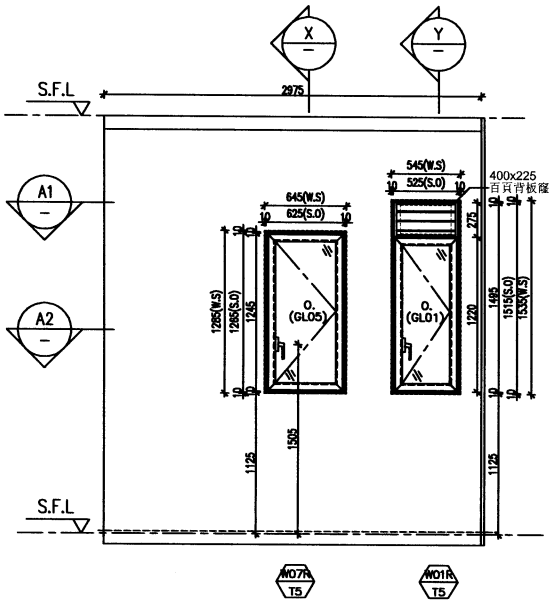

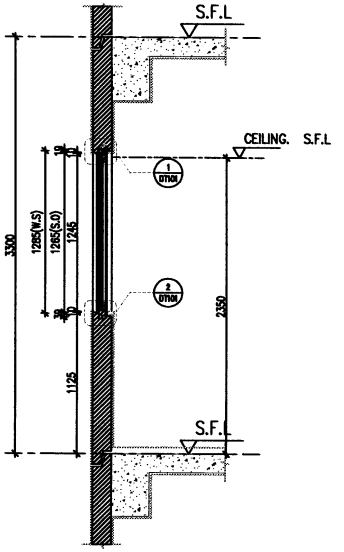

X PART SECTION

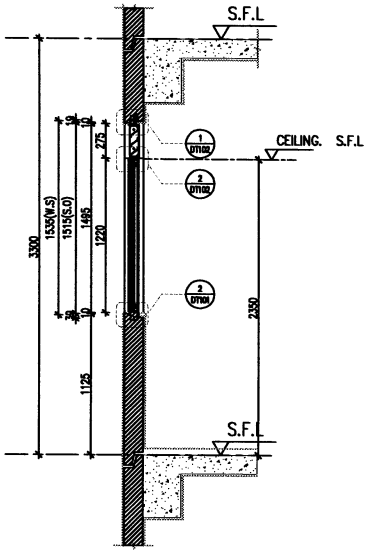

Y PART SECTION

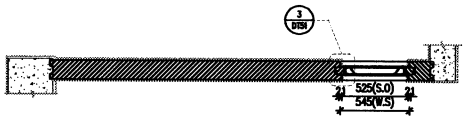

A1 PART PLAN

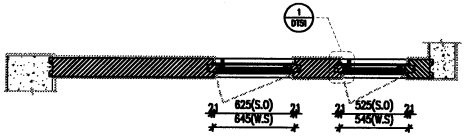

A2 PART PLAN

PROVIDED		
GLAZING AREA	0.405	m^2
OPENABLE AREA	0.481	m^2
FREE AREA	60.8	%

W01R T5

PROVIDED		
GLAZING AREA	0.523	m^2
OPENABLE AREA	0.604	m^2
FREE AREA	–	%

W07R T5

WINDOW MARK	W01R T5 & W07R T5
LOCATION	5F FLAT A DINING ROOM
SECTION	70mm ALUM. SECTION
GLAZING	W01R–GL01 / W07R–GL05
QUANTITY	1 / 1 Nos.
REMARKS	FACADE (T5–02–01A)

T:\Jobs\J-853\2. Outgoing\Black plate opening of Windows Louvre\Black Plate of T5 Precat Window.dwg

B.D. REF :

CLIENT :
SHIMAO GROUP HOLDINGS LIMITED

ARCHITECT :
WONG TUNG & PARTNERS LIMITED
ARCHITECTS & PLANNERS

MAIN CONTRACTOR :
協興建築有限公司
HIP HING CONSTRUCTION CO LTD

STRUCTURAL ENGINEER :
C M WONG & ASSOCIATES LTD
黃志明建築工程師有限公司

FACADE CONSULTANT:
MEINHARDT

NOTE :
1. ALL DIMENSIONS ARE IN mm.
2. ALL ELEVATIONS ARE VIEWED FROM OUTSIDE.
3. ALL DIMENSIONS TO BE VERIFIED ON SITE BEFORE FABRICATION.

LEGEND :
- X1 / W001 — DETAIL MARK NO. / REFER SHEET NO.
1. F.F.L. — FINISHED FLOOR LEVEL
2. S.F.L. — STRUCTURAL FLOOR LEVEL
3. R — REVERSED DETAIL
4. ▲ — FIXING LOCATION
5. △ — FIXING LUG LOCATION
6. GLASS LEGEND
   - GL01 — 10mm+12mm AIR GAP+10mm THK. I.G.U.
   - GL04 — 12mm THK. CLEAR TEMPERED GLASS
   - GL05 — 10mm+12mm AIR GAP+10mm THK. I.G.U.
   - GL06 — 10mm+12mm AIR GAP+12mm THK. I.G.U.
   - PD01 — 10mm T.P+12mm AIR GAP+8mm T.P
   - GL07 — 10mm+12mm AIR GAP+12mm THK. I.G.U.
   - GL08 — 10mm+12mm AIR GAP+10mm THK. I.G.U.

NO.	DATE	REMARKS	BY
A	28/07/2021	REVISION SUBJECT TO ARCH.COMMENT	edo

JOB NO. : J–853

PROJECT :
PROPOSED RESIDENTIAL DEVELOPMENT AT N.K.I.L. 6542 YIN PING ROAD KOWLOON

TITLE :
WINDOW SCHEDULE FOR TOWER 5 ALUM. WINDOW

DATE : 03–APR–21 | SCALE : 1:40

DRAWN BY : | CHECKED BY :

美特鋁製有限公司
MIDI ALUMINIUM FABRICATION LTD.
Units 6–8, Sunray Industrial Centre, 1/F
610 Cha Kwo Ling Road, Kowloon
Tel:23488211–4 Fax:(852)27727666

DWG NO. : J853–SD–PW–SC515 | REV. : A

ELEVATION

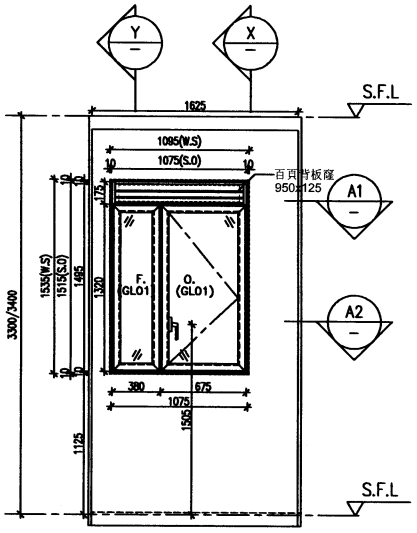

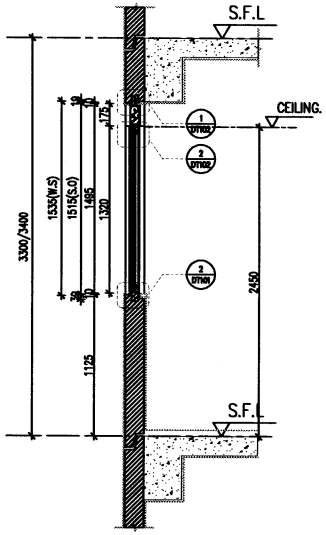

X PART SECTION

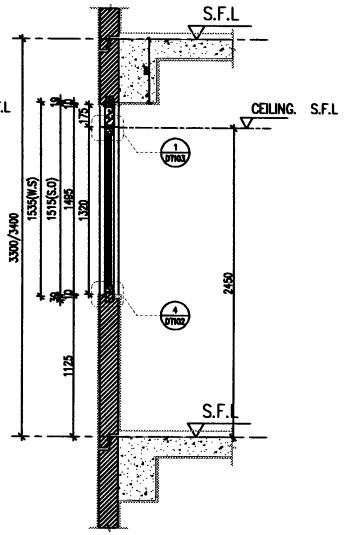

Y PART SECTION

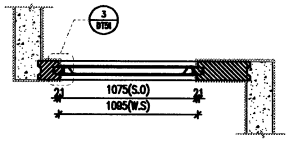

A1 PART PLAN

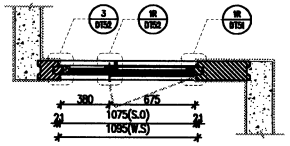

A2 PART PLAN

PROVIDED		
GLAZING AREA	0.981	m^2
OPENABLE AREA	0.735	m^2
FREE AREA	52	%

WINDOW MARK	W12 / T5
LOCATION	16F FLAT D MASTER ENSUITE & 23F FLAT B MASTER ENSUITE
SECTION	70mm ALUM. SECTION
GLAZING	GL01
QUANTITY	2 Nos.
REMARKS	FACADE: (T5-01-13A/16F; T5-01-13B/23F)

B.D. REF :

CLIENT :
SHIMAO GROUP HOLDINGS LIMITED

ARCHITECT :
WONG TUNG & PARTNERS LIMITED
ARCHITECTS & PLANNERS

MAIN CONTRACTOR :
協興建築有限公司
HIP HING CONSTRUCTION CO LTD

STRUCTURAL ENGINEER :
C M WONG & ASSOCIATES LTD
黃志明建築工程師有限公司

FACADE CONSULTANT:
MEINHARDT

NOTE :
1. ALL DIMENSIONS ARE IN mm.
2. ALL ELEVATIONS ARE VIEWED FROM OUTSIDE.
3. ALL DIMENSIONS TO BE VERIFIED ON SITE BEFORE FABRICATION.

LEGEND :
X1 / X001 — DETAIL MARK NO. / REFER SHEET NO.
1. F.F.L. — FINISHED FLOOR LEVEL
2. S.F.L. — STRUCTURAL FLOOR LEVEL
3. (R) — REVERSED DETAIL
4. ▲ — FIXING LOCATION
5. △ — FIXING LUG LOCATION
6. GLASS LEGEND
GL01 — 10mm+12mm AIR GAP+10mm THK. I.G.U.
GL04 — 12mm THK. CLEAR TEMPERED GLASS
GL05 — 10mm+12mm AIR GAP+10mm THK. I.G.U.
GL06 — 10mm+12mm AIR GAP+12mm THK. I.G.U.
PD01 — 10mm T.P+12mm AIR GAP+8mm T.P
GL07 — 10mm+12mm AIR GAP+12mm THK. I.G.U.
GL08 — 10mm+12mm AIR GAP+10mm THK. I.G.U.

NO.	DATE	REMARK	BY
A	08/07/2022	GENERAL REVISION	ada

JOB NO. : J-853

PROJECT :
PROPOSED RESIDENTIAL DEVELOPMENT AT N.K.I.L. 6542 YIN PING ROAD KOWLOON

TITLE :
WINDOW SCHEDULE FOR TOWER 5 ALUM. WINDOW

DATE : 03-APR-21 | SCALE : 1:40

DRAWN BY : | CHECKED BY :

美特鋁質有限公司
MIDI ALUMINIUM FABRICATOR LTD.
Units 6-8, Sunray Industrial Centre, 1/F
610 Cha Kwo Ling Road, Kowloon
Tel:23489211-4 Fax:(852)27727666

DWG NO. : J853-SD-PW-SC514a | REV. : A

T:\Jobs\J-853\2. Outgoing\Black plate opening of Windows Louvre\Black Plate of T5 Precat Window.dwg

ELEVATION

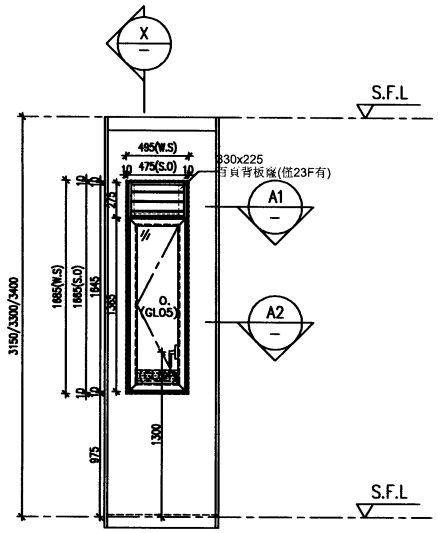

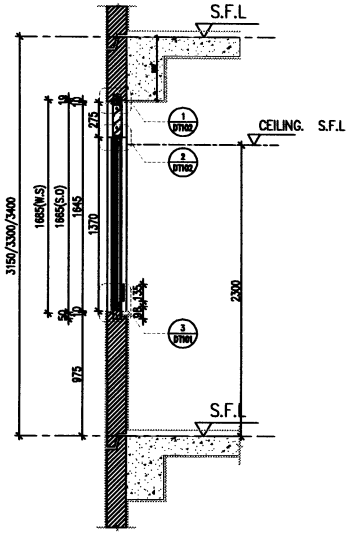

X PART SECTION

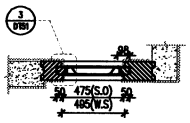

A1 PART PLAN

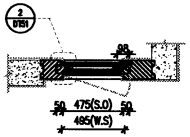

A2 PART PLAN

PROVIDED		
GLAZING AREA	0.405	m^2
OPENABLE AREA	0.481	m^2
FREE AREA	60.8	%

WINDOW MARK	W28L T5
LOCATION	11F~16F FLAT D MASTER BATH & 23F FLAT B EN. BATH
SECTION	70mm ALUM. SECTION
GLAZING	GL05
QUANTITY	5 Nos.
REMARKS	FACADE: (T5-01-12/11F~15F; T5-01-12A/16F; T5-01-12B/23F)

B.D. REF :

CLIENT :
SHIMAO GROUP HOLDINGS LIMITED

ARCHITECT : WONG TUNG & PARTNERS LIMITED ARCHITECTS & PLANNERS

MAIN CONTRACTOR :
協興建築有限公司
HIP HING CONSTRUCTION CO LTD

STRUCTURAL ENGINEER :
C M WONG & ASSOCIATES LTD
黃志明建築工程師有限公司

FACADE CONSULTANT: MEINHARDT

NOTE :
1. ALL DIMENSIONS ARE IN mm.
2. ALL ELEVATIONS ARE VIEWED FROM OUTSIDE.
3. ALL DIMENSIONS TO BE VERIFIED ON SITE BEFORE FABRICATION.

LEGEND :
X1 — DETAIL MARK NO.
XX01 — REFER SHEET NO.
1. F.F.L. — FINISHED FLOOR LEVEL
2. S.F.L. — STRUCTURAL FLOOR LEVEL
3. (R) — REVERSED DETAIL
4. ▲ — FIXING LOCATION
5. △ — FIXING LUG LOCATION
6. GLASS LEGEND
GL01 — 10mm+12mm AIR GAP+10mm THK. I.G.U.
GL04 — 12mm THK. CLEAR TEMPERED GLASS
GL05 — 10mm+12mm AIR GAP+10mm THK. I.G.U.
GL06 — 10mm+12mm AIR GAP+12mm THK. I.G.U.
PD01 — 10mm T.P+12mm AIR GAP+8mm T.P
GL07 — 10mm+12mm AIR GAP+12mm THK. I.G.U.
GL08 — 10mm+12mm AIR GAP+10mm THK. I.G.U.

NO.	DATE	REMARK	BY
A	08/07/2022	GENERAL REVISION	

JOB NO. : J-853

PROJECT :
PROPOSED RESIDENTIAL DEVELOPMENT AT N.K.I.L. 6542 YIN PING ROAD KOWLOON

TITLE :
WINDOW SCHEDULE FOR TOWER 5 ALUM. WINDOW

DATE : 03-APR-21 | SCALE : 1:40

DRAWN BY : | CHECKED BY :

美特鋁質有限公司
MIDI ALUMINIUM FABRICATOR LTD.
Units 6-8, Sunray Industrial Centre, 1/F
610 Cha Kwo Ling Road, Kowloon
Tel:23488211-4 Fax:(852)27727666

DWG NO. : J853-SD-PW-SC513a | REV. : A

T:\Jobs\J-853\2. Outgoing\Black plate opening of Windows Louvre\Black Plate of T5 Precat Window.dwg

ELEVATION

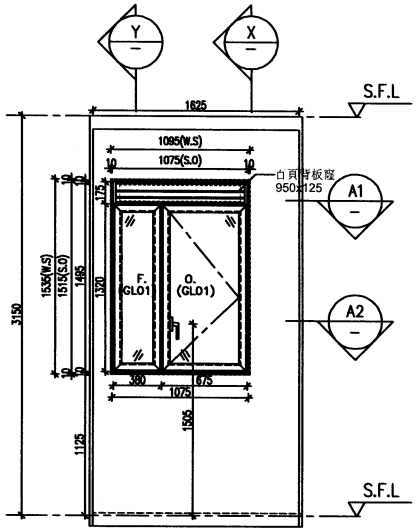

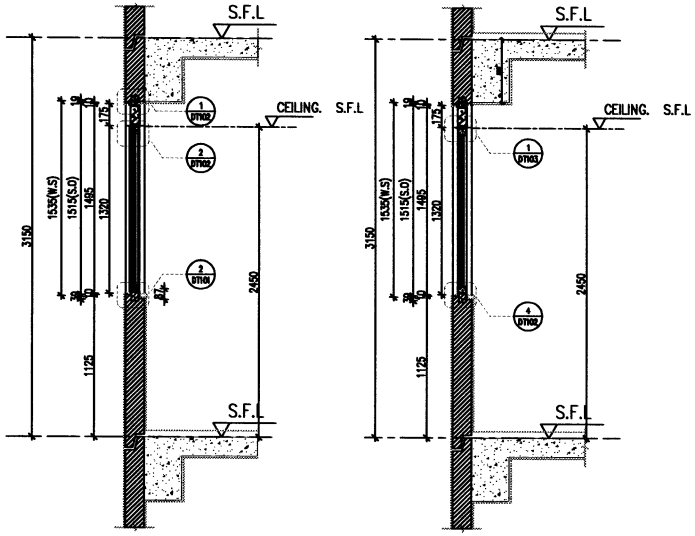

X PART SECTION

Y PART SECTION

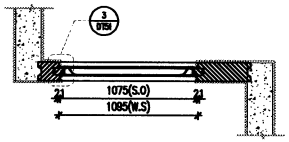

A1 PART PLAN

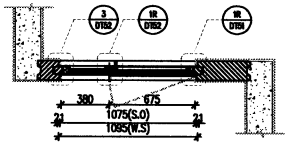

A2 PART PLAN

PROVIDED		
GLAZING AREA	0.976	m^2
OPENABLE AREA	0.732	m^2
FREE AREA	52	%

WINDOW MARK	W12A T5
LOCATION	11F~15F FLAT D MASTER ENSUITE & 17F~22F FLAT B ENSUITE 2
SECTION	70mm ALUM. SECTION
GLAZING	GL01
QUANTITY	9 Nos.
REMARKS	FACADE: (T5-01-13/11~15F&17~22F)

T:\Jobs\J-853\2. Outgoing\Black plate opening of Windows Louvre\Black Plate of T5 Precat Window.dwg

B.D. REF :

CLIENT :
SHIMAO GROUP HOLDINGS LIMITED

ARCHITECT : WONG TUNG & PARTNERS LIMITED ARCHITECTS & PLANNERS

MAIN CONTRACTOR :
協興建築有限公司
HIP HING CONSTRUCTION CO LTD

STRUCTURAL ENGINEER :
C M WONG & ASSOCIATES LTD
黃志明建築工程師有限公司

FACADE CONSULTANT: MEINHARDT

NOTE :
1. ALL DIMENSIONS ARE IN mm.
2. ALL ELEVATIONS ARE VIEWED FROM OUTSIDE.
3. ALL DIMENSIONS TO BE VERIFIED ON SITE BEFORE FABRICATION.

LEGEND :
- DETAIL MARK NO.
- REFER SHEET NO.

1. F.F.L. — FINISHED FLOOR LEVEL
2. S.F.L. — STRUCTURAL FLOOR LEVEL
3. — REVERSED DETAIL
4. — FIXING LOCATION
5. — FIXING LUG LOCATION
6. GLASS LEGEND
   - GL01 — 10mm+12mm AIR GAP+10mm THK. LG.U.
   - GL04 — 12mm THK. CLEAR TEMPERED GLASS
   - GL05 — 10mm+12mm AIR GAP+10mm THK. LG.U.
   - GL06 — 10mm+12mm AIR GAP+12mm THK. LG.U.
   - PD01 — 10mm T.P+12mm AIR GAP+8mm T.P
   - GL07 — 10mm+12mm AIR GAP+12mm THK. LG.U.
   - GL08 — 10mm+12mm AIR GAP+10mm THK. LG.U.

NO.	DATE	REMARKS	BY
B	08/07/2022	GENERAL REVISION	edo
A	26/07/2021	REVISION SUBJECT TO ARCH.COMMENT	edo

JOB NO. : J-853

PROJECT :
PROPOSED RESIDENTIAL DEVELOPMENT AT N.K.I.L. 6542 YIN PING ROAD KOWLOON

TITLE :
WINDOW SCHEDULE FOR TOWER 5 ALUM. WINDOW

DATE : 03-APR-21 | SCALE : 1:40

DRAWN BY : | CHECKED BY :

美特鋁製有限公司
MIDI ALUMINIUM FABRICATOR LTD.
Units 6-8, Sunray Industrial Centre, 1/F
610 Cha Kwo Ling Road, Kowloon
Tel:23489211-4 Fax:(852)27727666

DWG NO. : J853-SD-PW-SC514 | REV. : B

ELEVATION

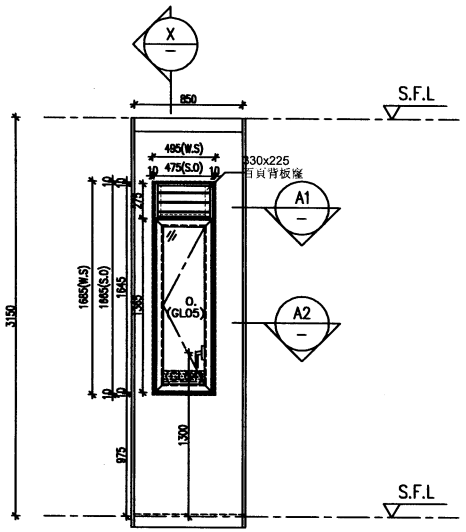

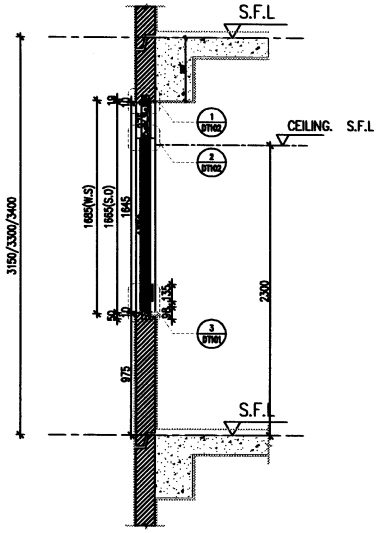

X PART SECTION

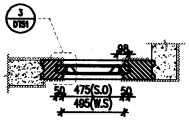

A1 PART PLAN

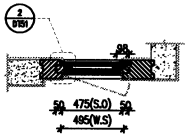

A2 PART PLAN

PROVIDED		
GLAZING AREA	0.403	m^2
OPENABLE AREA	0.479	m^2
FREE AREA	60.8	%

WINDOW MARK	W28AL T5
LOCATION	17~22F (FLAT B EN. BATH)
SECTION	70mm ALUM. SECTION
GLAZING	GL05
QUANTITY	6 Nos.
REMARKS	FACADE: (T5-01-12/17F~22F)

B.D. REF :

CLIENT :
SHIMAO GROUP HOLDINGS LIMITED

ARCHITECT :
WONG TUNG & PARTNERS LIMITED
ARCHITECTS & PLANNERS

MAIN CONTRACTOR :
協興建築有限公司
HIP HING CONSTRUCTION CO LTD

STRUCTURAL ENGINEER :
C M WONG & ASSOCIATES LTD
黃志明建築工程師有限公司

FACADE CONSULTANT:
MEINHARDT

NOTE :
1. ALL DIMENSIONS ARE IN mm.
2. ALL ELEVATIONS ARE VIEWED FROM OUTSIDE.
3. ALL DIMENSIONS TO BE VERIFIED ON SITE BEFORE FABRICATION.

LEGEND :
X1 / 1D001 — DETAIL MARK NO. / REFER SHEET NO.
1. F.F.L. — FINISHED FLOOR LEVEL
2. S.F.L. — STRUCTURAL FLOOR LEVEL
3. (R) — REVERSED DETAIL
4. ▲ — FIXING LOCATION
5. △ — FIXING LUG LOCATION
6. GLASS LEGEND
GL01 — 10mm+12mm AIR GAP+10mm THK. L.G.U.
GL04 — 12mm THK. CLEAR TEMPERED GLASS
GL05 — 10mm+12mm AIR GAP+10mm THK. L.G.U.
GL06 — 10mm+12mm AIR GAP+12mm THK. L.G.U.
PD01 — 10mm T.P+12mm AIR GAP+8mm T.P
GL07 — 10mm+12mm AIR GAP+12mm THK. L.G.U.
GL08 — 10mm+12mm AIR GAP+10mm THK. L.G.U.

NO.	DATE	REMARK	BY
B	08/07/2022	GENERAL REVISION	mdc
A	28/07/2021	REVISION SUBJECT TO ARCH.COMMENT	mdc

JOB NO. : J-853

PROJECT :
PROPOSED RESIDENTIAL DEVELOPMENT AT N.K.I.L. 6542 YIN PING ROAD KOWLOON

TITLE :
WINDOW SCHEDULE FOR TOWER 5 ALUM. WINDOW

DATE : 03-APR-21 | SCALE : 1:40

DRAWN BY : | CHECKED BY :

美特鋁質有限公司
MIDI ALUMINIUM FABRICATION LTD.
Units 6-8, Sunray Industrial Centre, 1/F
610 Cha Kwo Ling Road, Kowloon
Tel:23489211-4 Fax:(852)27727666

DWG NO. : J853-SD-PW-SC513 | REV. : B

T:\Jobs\J-853\2. Outgoing\Black plate opening of Windows Louvre\Black Plate of T5 Precat Window.dwg

ELEVATION

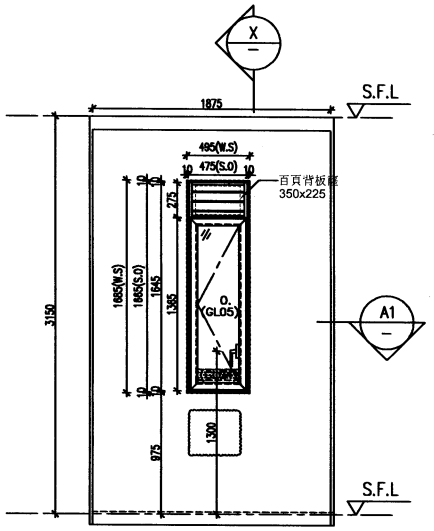

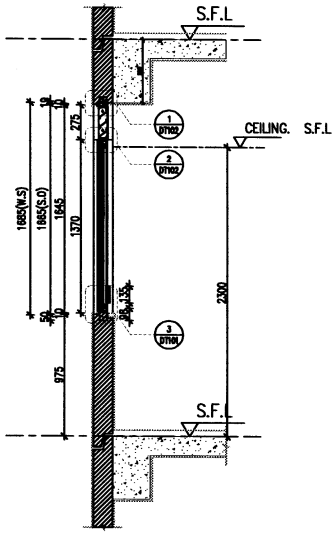

X — PART SECTION

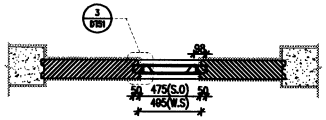

A1 — PART PLAN

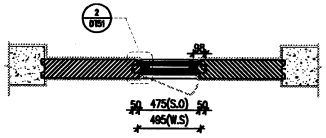

A2 — PART PLAN

PROVIDED		
GLAZING AREA	0.349	m^2
OPENABLE AREA	0.423	m^2
FREE AREA	60.8	%

WINDOW MARK	W15AL T5
LOCATION	11F~15F FLAT C MASTER BATH
SECTION	70mm ALUM. SECTION
GLAZING	GL05
QUANTITY	3 Nos.
REMARKS	FACADE(T5-01-11/11~15F)

T:\Jobs\J-853\2. Outgoing\Black plate opening of Windows Louvre\Black Plate of T5 Precat Window.dwg

B.D. REF :

CLIENT :
SHIMAO GROUP HOLDINGS LIMITED

ARCHITECT :
WONG TUNG & PARTNERS LIMITED
ARCHITECTS & PLANNERS

MAIN CONTRACTOR :
協興建築有限公司
HIP HING CONSTRUCTION CO LTD

STRUCTURAL ENGINEER :
C M WONG & ASSOCIATES LTD
黃志明建築工程師有限公司

FACADE CONSULTANT:
MEINHARDT

NOTE :
1. ALL DIMENSIONS ARE IN mm.
2. ALL ELEVATIONS ARE VIEWED FROM OUTSIDE.
3. ALL DIMENSIONS TO BE VERIFIED ON SITE BEFORE FABRICATION.

LEGEND :
X1 — DETAIL MARK NO.
X0001 — REFER SHEET NO.
1. F.F.L. — FINISHED FLOOR LEVEL
2. S.F.L. — STRUCTURAL FLOOR LEVEL
3. Ⓡ — REVERSED DETAIL
4. ▲ — FIXING LOCATION
5. △ — FIXING LUG LOCATION
6. GLASS LEGEND
GL01 — 10mm+12mm AIR GAP+10mm THK. I.G.U.
GL04 — 12mm THK. CLEAR TEMPERED GLASS
GL05 — 10mm+12mm AIR GAP+10mm THK. I.G.U.
GL06 — 10mm+12mm AIR GAP+12mm THK. I.G.U.
PD01 — 10mm T.P+12mm AIR GAP+8mm T.P
GL07 — 10mm+12mm AIR GAP+12mm THK. I.G.U.
GL08 — 10mm+12mm AIR GAP+10mm THK. I.G.U.

NO.	DATE	REMARK	BY
C	08/07/2022	GENERAL REVISION	mlo
B	28/07/2021	REVISION SUBJECT TO ARCH.COMMENT	mlo
A	14/07/2021	REVISION SUBJECT TO ARCH.COMMENT	mlo

JOB NO. : J-853

PROJECT :
PROPOSED RESIDENTIAL DEVELOPMENT AT N.K.I.L. 6542 YIN PING ROAD KOWLOON

TITLE :
WINDOW SCHEDULE FOR TOWER 5 ALUM. WINDOW

DATE : 03-APR-21 | SCALE : 1:40

DRAWN BY : | CHECKED BY :

美特鋁製有限公司
MIDI ALUMINIUM FABRICATOR LTD.
Units 6-8, Sunray Industrial Centre, 1/F
610 Cha Kwo Ling Road, Kowloon
Tel:23489211-4 Fax:(852)27727666

DWG NO. : J853-SD-PW-SC512 | REV. : C

ELEVATION

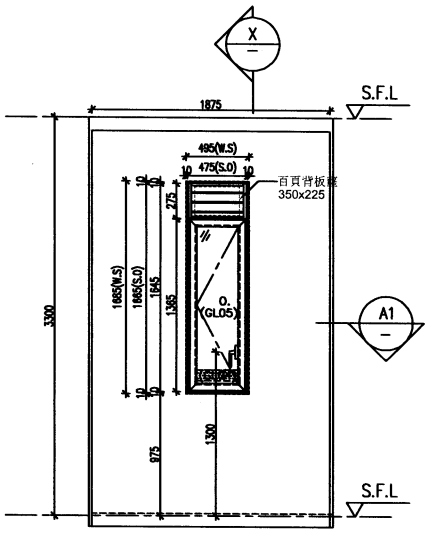

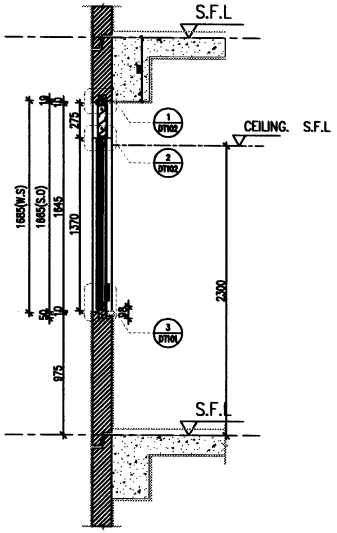

X — PART SECTION

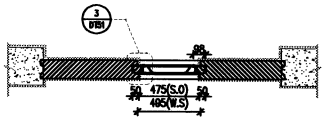

A1 — PART PLAN

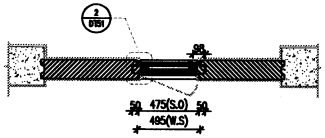

A2 — PART PLAN

PROVIDED		
GLAZING AREA	0.350	m^2
OPENABLE AREA	0.425	m^2
FREE AREA	60.8	%

WINDOW MARK	W15L / T5
LOCATION	16F FLAT C MASTER BATH
SECTION	70mm ALUM. SECTION
GLAZING	GL05
QUANTITY	1 Nos.
REMARKS	FACADE(T5-01-11A/16F)

T:\Jobs\J-853\2. Outgoing\Black plate opening of Windows Louvre\Black Plate of T5 Precat Window.dwg

B.D. REF :

CLIENT :
SHIMAO GROUP HOLDINGS LIMITED

ARCHITECT : WONG TUNG & PARTNERS LIMITED ARCHITECTS & PLANNERS

MAIN CONTRACTOR :
協興建築有限公司
HIP HING CONSTRUCTION CO LTD

STRUCTURAL ENGINEER :
C M WONG & ASSOCIATES LTD
黃志明建築工程師有限公司

FACADE CONSULTANT: MEINHARDT

NOTE :
1. ALL DIMENSIONS ARE IN mm.
2. ALL ELEVATIONS ARE VIEWED FROM OUTSIDE.
3. ALL DIMENSIONS TO BE VERIFIED ON SITE BEFORE FABRICATION.

LEGEND :
X1 / XXX1 — DETAIL MARK NO. / REFER SHEET NO.
1. F.F.L. — FINISHED FLOOR LEVEL
2. S.F.L. — STRUCTURAL FLOOR LEVEL
3. (R) — REVERSED DETAIL
4. ▲ — FIXING LOCATION
5. △ — FIXING LUG LOCATION
6. GLASS LEGEND
GL01 — 10mm+12mm AIR GAP+10mm THK. I.G.U.
GL04 — 12mm THK. CLEAR TEMPERED GLASS
GL05 — 10mm+12mm AIR GAP+10mm THK. I.G.U.
GL06 — 10mm+12mm AIR GAP+12mm THK. I.G.U.
PD01 — 10mm T.P+12mm AIR GAP+8mm T.P
GL07 — 10mm+12mm AIR GAP+12mm THK. I.G.U.
GL08 — 10mm+12mm AIR GAP+10mm THK. I.G.U.

NO.	DATE	REMARK	BY
A	08/07/2022	GENERAL REVISION	ada

JOB NO. : J-853

PROJECT :
PROPOSED RESIDENTIAL DEVELOPMENT AT N.K.I.L. 6542 YIN PING ROAD KOWLOON

TITLE :
WINDOW SCHEDULE FOR TOWER 5 ALUM. WINDOW

DATE : 03-APR-21 | SCALE : 1:40

DRAWN BY : | CHECKED BY :

美特鋁製有限公司
MIDI ALUMINIUM FABRICATION LTD.
Units 6-8, Sunray Industrial Centre, 1/F
610 Cha Kwo Ling Road, Kowloon
Tel:23488211-4 Fax:(852)27727666

DWG NO. : J853-SD-PW-SC512a | REV. : B

STONE CLADDING FINISHING

ELEVATION

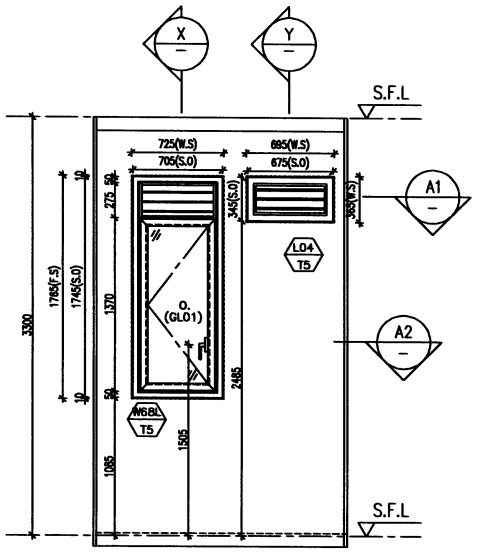

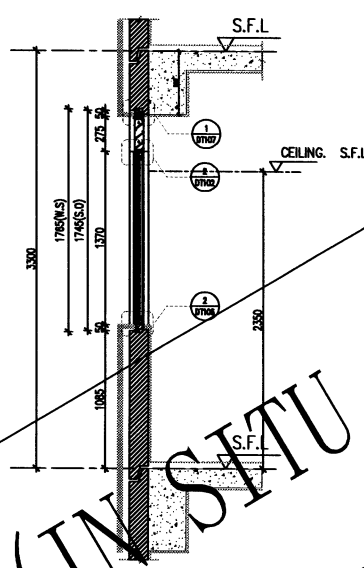

X PART SECTION

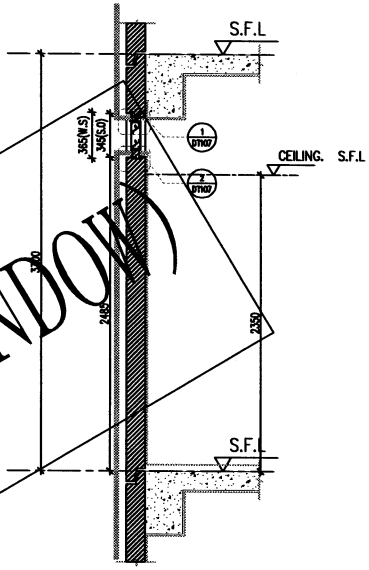

Y PART SECTION

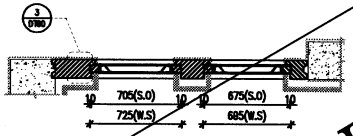

A1 PART PLAN

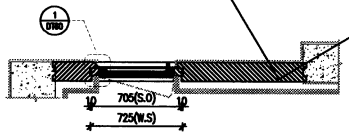

A2 PART PLAN

DELETED (IN SITU WINDOW)

PROVIDED		
GLAZING AREA	–	m^2
OPENABLE AREA	–	m^2
FREE AREA	54.4	%

L04 T5

PROVIDED		
GLAZING AREA	0.582	m^2
OPENABLE AREA	0.669	m^2
FREE AREA	60.8	%

W68L T5

WINDOW MARK	W68L T5 & L04 T5
LOCATION	25F FLAT B KITCHEN
SECTION	70mm ALUM. SECTION
GLAZING	GL01
QUANTITY	1 Nos.
REMARKS	FACADE (T5-01-10A)

B.D. REF :

CLIENT :
SHIMAO GROUP HOLDINGS LIMITED

ARCHITECT :
WONG TUNG & PARTNERS LIMITED
ARCHITECTS & PLANNERS

MAIN CONTRACTOR :
協興建築有限公司
HIP HING CONSTRUCTION CO LTD

STRUCTURAL ENGINEER :
C M WONG & ASSOCIATES LTD
黃志明建築工程師有限公司

FACADE CONSULTANT:
MEINHARDT

NOTE :
1. ALL DIMENSIONS ARE IN mm.
2. ALL ELEVATIONS ARE VIEWED FROM OUTSIDE.
3. ALL DIMENSIONS TO BE VERIFIED ON SITE BEFORE FABRICATION.

LEGEND :
X1 — DETAIL MARK NO.
X001 — REFER SHEET NO.
1. F.F.L. — FINISHED FLOOR LEVEL
2. S.F.L. — STRUCTURAL FLOOR LEVEL
3. /6 — REVERSED DETAIL
4. ▲ — FIXING LOCATION
5. △ — FIXING LUG LOCATION
6. GLASS LEGEND
GL01 — 10mm+12mm AIR GAP+10mm THK. I.G.U.
GL04 — 12mm THK. CLEAR TEMPERED GLASS
GL05 — 10mm+12mm AIR GAP+10mm THK. I.G.U.
GL06 — 10mm+12mm AIR GAP+12mm THK. I.G.U.
PD01 — 10mm T.P+12mm AIR GAP+8mm T.P
GL07 — 10mm+12mm AIR GAP+12mm THK. I.G.U.
GL08 — 10mm+12mm AIR GAP+10mm THK. I.G.U.

NO.	DATE	REMARK	BY
C	08/07/2022	GENERAL REVISION	mlo
B	29/07/2021	REVISION SUBJECT TO ARCH.COMMENT	mlo
A	14/07/2021	REVISION SUBJECT TO ARCH.COMMENT	mlo

JOB NO. : J-853

PROJECT :
PROPOSED RESIDENTIAL DEVELOPMENT AT N.K.I.L. 6542 YIN PING ROAD KOWLOON

TITLE :
WINDOW SCHEDULE FOR TOWER 5 ALUM. WINDOW

DATE : 03-APR-21 | SCALE : 1:40

DRAWN BY : | CHECKED BY :

美特鋁製有限公司
MIDI ALUMINIUM FABRICATOR LTD.
Units 6-8, Sunray Industrial Centre, 1/F
610 Cha Kwo Ling Road, Kowloon
Tel:23489211-4 Fax:(852)27727666

DWG NO. : J853-SD-PW-SC510 | REV. : C

T:\Jobs\J-853\2. Outgoing\Black plate opening of Windows Louvre\Black Plate of T5 Precat Window.dwg

ELEVATION

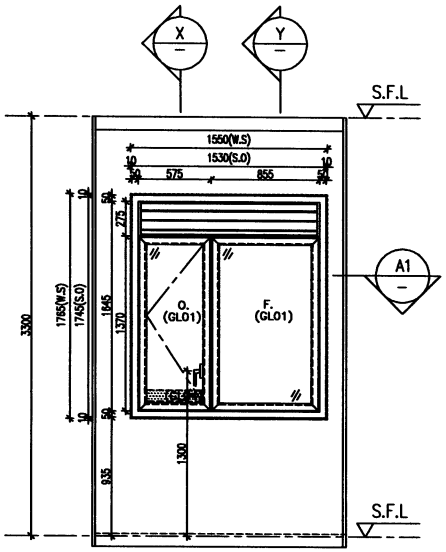

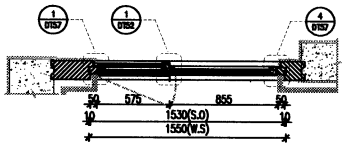

A1 PART PLAN

STONE CLADDING FINISHING

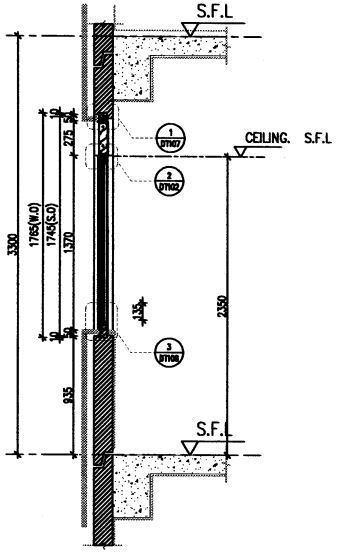

X PART SECTION

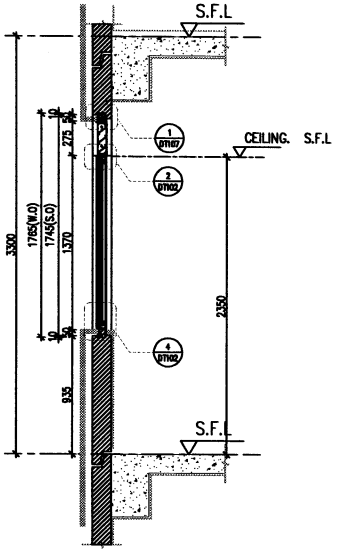

Y PART SECTION

NOTE :
1. ALL DIMENSIONS ARE IN mm.
2. ALL ELEVATIONS ARE VIEWED FROM OUTSIDE.
3. ALL DIMENSIONS TO BE VERIFIED ON SITE BEFORE FABRICATION.

LEGEND :

X1 — DETAIL MARK NO.
X0001 — REFER SHEET NO.

1. F.F.L. — FINISHED FLOOR LEVEL
2. S.F.L. — STRUCTURAL FLOOR LEVEL
3. (R) — REVERSED DETAIL
4. ▲ — FIXING LOCATION
5. △ — FIXING LUG LOCATION
6. GLASS LEGEND
   - GL01 — 10mm+12mm AIR GAP+10mm THK. I.G.U.
   - GL04 — 12mm THK. CLEAR TEMPERED GLASS
   - GL05 — 10mm+12mm AIR GAP+10mm THK. I.G.U.
   - GL06 — 10mm+12mm AIR GAP+12mm THK. I.G.U.
   - PD01 — 10mm T.P+12mm AIR GAP+8mm T.P.
   - GL07 — 10mm+12mm AIR GAP+12mm THK. I.G.U.
   - GL08 — 10mm+12mm AIR GAP+10mm THK. I.G.U.

B	08/07/2022	GENERAL REVISION	ada
A	28/07/2021	REVISION SUBJECT TO ARCH.COMMENT	ada
NO.	DATE	REMARK	BY

PROVIDED		
GLAZING AREA	1.354	m^2
OPENABLE AREA	0.580	m^2
FREE AREA	60.8	%

WINDOW MARK	W69 / T5
LOCATION	26F FLAT B (ENSUITE 3)
SECTION	70mm ALUM. SECTION
GLAZING	GL01
QUANTITY	1 Nos.
REMARKS	FACADE (T5-01-15A)

B.D. REF :

CLIENT :
SHIMAO GROUP HOLDINGS LIMITED

ARCHITECT :
WONG TUNG & PARTNERS LIMITED
ARCHITECTS & PLANNERS

MAIN CONTRACTOR :
協興建築有限公司
HIP HING CONSTRUCTION CO LTD

STRUCTURAL ENGINEER :
C M WONG & ASSOCIATES LTD
黃志明建築工程師有限公司

FACADE CONSULTANT:
MEINHARDT

JOB NO. : J-853

PROJECT :
PROPOSED RESIDENTIAL DEVELOPMENT AT N.K.I.L. 6542 YIN PING ROAD KOWLOON

TITLE :
WINDOW SCHEDULE FOR TOWER 5 ALUM. WINDOW

DATE : 03-APR-21 | SCALE : 1:40

DRAWN BY : | CHECKED BY :

美特鋁製有限公司
MIDI ALUMINIUM FABRICATION LTD.
Units 6-8, Sunray Industrial Centre, 1/F
610 Cha Kwo Ling Road, Kowloon
Tel:23489211-4 Fax:(852)27727666

DWG NO. : J853-SD-PW-SC511 | REV. : B

T:\Jobs\J-853\2. Outgoing\Black plate opening of Windows Louvre\Black Plate of T5 Precat Window.dwg

ELEVATION

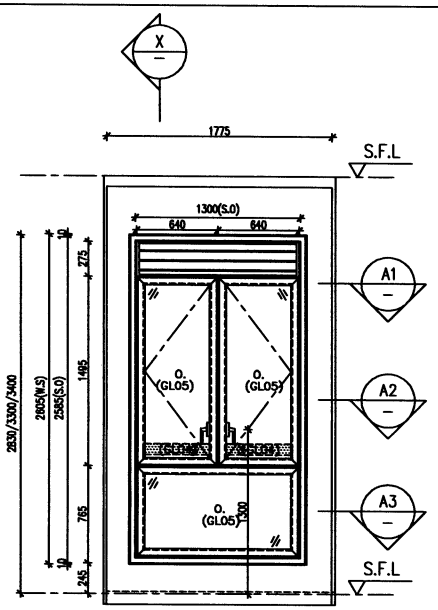

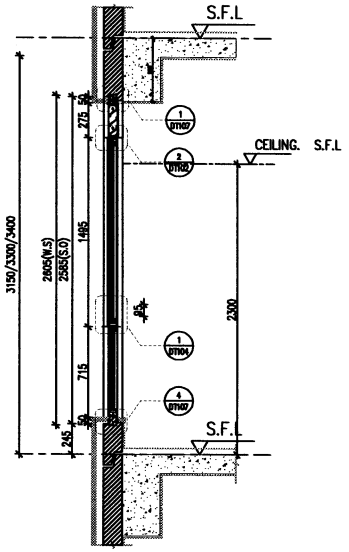

X PART SECTION

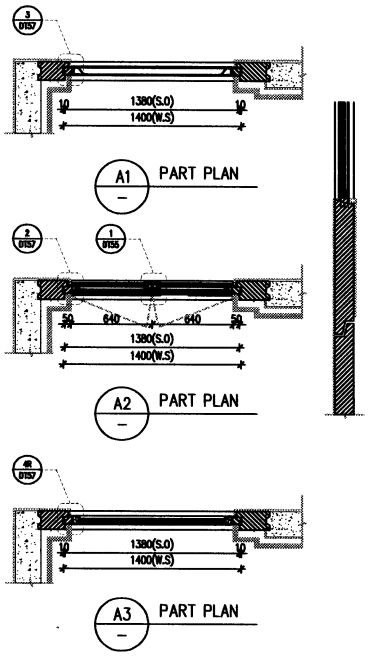

STONE CLADDING FINISHING

PROVIDED		
GLAZING AREA	1.251	m^2
OPENABLE AREA	1.427	m^2
FREE AREA	60.8	%

WINDOW MARK	W61 T5
LOCATION	25F FLAT B ENSUITE 4
SECTION	70mm ALUM. SECTION
GLAZING	GL05
QUANTITY	1 Nos.
REMARKS	FACADE(T5-01-09A/25F)

B.D. REF :

CLIENT :
SHIMAO GROUP HOLDINGS LIMITED

ARCHITECT :
WONG TUNG & PARTNERS LIMITED
ARCHITECTS & PLANNERS

MAIN CONTRACTOR :
協興建築有限公司
HIP HING CONSTRUCTION CO LTD

STRUCTURAL ENGINEER :
C M WONG & ASSOCIATES LTD
黃志明建築工程師有限公司

FACADE CONSULTANT:
MEINHARDT

NOTE :
1. ALL DIMENSIONS ARE IN mm.
2. ALL ELEVATIONS ARE VIEWED FROM OUTSIDE.
3. ALL DIMENSIONS TO BE VERIFIED ON SITE BEFORE FABRICATION.

LEGEND :
- X1 / W001 — DETAIL MARK NO. / REFER SHEET NO.
1. F.F.L. — FINISHED FLOOR LEVEL
2. S.F.L. — STRUCTURAL FLOOR LEVEL
3. (R) — REVERSED DETAIL
4. ▲ — FIXING LOCATION
5. △ — FIXING LUG LOCATION
6. GLASS LEGEND
   - GL01 — 10mm+12mm AIR GAP+10mm THK. I.G.U.
   - GL04 — 12mm THK. CLEAR TEMPERED GLASS
   - GL05 — 10mm+12mm AIR GAP+10mm THK. I.G.U.
   - GL06 — 10mm+12mm AIR GAP+12mm THK. I.G.U.
   - PD01 — 10mm T.P+12mm AIR GAP+8mm T.P
   - GL07 — 10mm+12mm AIR GAP+12mm THK. I.G.U.
   - GL08 — 10mm+12mm AIR GAP+10mm THK. I.G.U.

NO.	DATE	REMARK	BY
A	28/07/2021	REVISION SUBJECT TO ARCH.COMMENT	ada

JOB NO. : J-853

PROJECT :
PROPOSED RESIDENTIAL DEVELOPMENT AT N.K.I.L. 8542 YIN PING ROAD KOWLOON

TITLE :
WINDOW SCHEDULE FOR TOWER 5 ALUM. WINDOW

DATE : 03-APR-21 | SCALE : 1:40

DRAWN BY : | CHECKED BY :

美特鋁質有限公司
MIDI ALUMINIUM FABRICATION LTD.
Units 6-8, Sunray Industrial Centre, 1/F
610 Cha Kwo Ling Road, Kowloon
Tel:23489211-4 Fax:(852)27727666

DWG NO. : J853-SD-PW-SC509a | REV. : A

T:\Jobs\J-853\2. Outgoing\Black plate opening of Windows Louvre\Black Plate of T5 Precat Window.dwg

STONE CLADDING FINISHING

ELEVATION

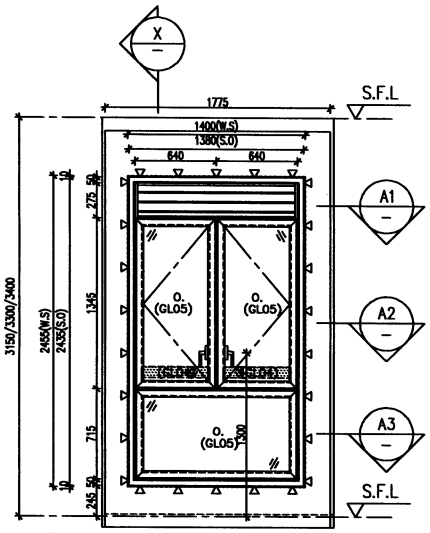

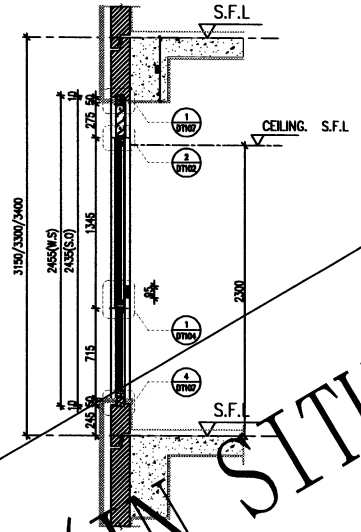

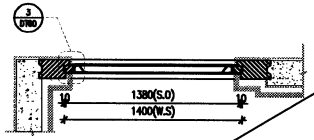

X PART SECTION

A1 PART PLAN

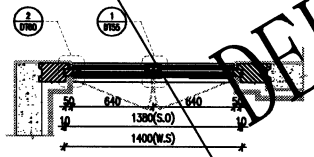

A2 PART PLAN

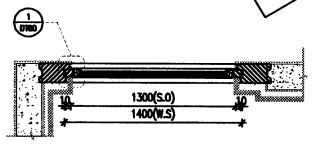

A3 PART PLAN

DELETED (IN SITU WINDOW)

PROVIDED		
GLAZING AREA	1.010	m^2
OPENABLE AREA	1.258	m^2
FREE AREA	60.8	%

WINDOW MARK	W11 / T5
LOCATION	17F~22F; 23F & 26F FLAT B MASTER BATH
SECTION	70mm ALUM. SECTION
GLAZING	GL05
QUANTITY	8 Nos.
REMARKS	FACADE(T5-01-09/17~22F; T5-01-09B/23F; T5-01-14A/26F)

B.D. REF :

CLIENT :
SHIMAO GROUP HOLDINGS LIMITED

ARCHITECT : WONG TUNG & PARTNERS LIMITED ARCHITECTS & PLANNERS

MAIN CONTRACTOR :
協興建築有限公司
HIP HING CONSTRUCTION CO LTD

STRUCTURAL ENGINEER :
C M WONG & ASSOCIATES LTD
黃志明建築工程師有限公司

FACADE CONSULTANT: MEINHARDT

NOTE :
1. ALL DIMENSIONS ARE IN mm.
2. ALL ELEVATIONS ARE VIEWED FROM OUTSIDE.
3. ALL DIMENSIONS TO BE VERIFIED ON SITE BEFORE FABRICATION.

LEGEND :
- DETAIL MARK NO.
- REFER SHEET NO.

1. F.F.L. — FINISHED FLOOR LEVEL
2. S.F.L. — STRUCTURAL FLOOR LEVEL
3. — REVERSED DETAIL
4. — FIXING LOCATION
5. — FIXING LUG LOCATION
6. GLASS LEGEND
   - GL01 — 10mm+12mm AIR GAP+10mm THK. LG.U.
   - GL04 — 12mm THK. CLEAR TEMPERED GLASS
   - GL05 — 10mm+12mm AIR GAP+10mm THK. LG.U.
   - GL06 — 10mm+12mm AIR GAP+12mm THK. LG.U.
   - PD01 — 10mm T.P+12mm AIR GAP+8mm T.P
   - GL07 — 10mm+12mm AIR GAP+12mm THK. LG.U.
   - GL08 — 10mm+12mm AIR GAP+10mm THK. LG.U.

NO.	DATE	REMARK	BY
D	15/08/2022	GENERAL REVISION	ada
C	08/07/2022	GENERAL REVISION	ada
B	29/07/2021	REVISION SUBJECT TO ARCH.COMMENT	ada
A	14/07/2021	REVISION SUBJECT TO ARCH.COMMENT	ada

JOB NO. : J-853

PROJECT :
PROPOSED RESIDENTIAL DEVELOPMENT AT N.K.I.L. 6542
YIN PING ROAD
KOWLOON

TITLE :
WINDOW SCHEDULE FOR TOWER 5 ALUM. WINDOW

DATE : 03-APR-21 | SCALE : 1:40

DRAWN BY : | CHECKED BY :

美特鋁製有限公司
MIDI ALUMINIUM FABRICATOR LTD.
Units 6-8, Sunray Industrial Centre, 1/F
610 Cha Kwo Ling Road, Kowloon
Tel:23489211-4 Fax:(852)27727666

DWG NO. : J853-SD-PW-SC509 | REV. : D

T:\Jobs\J-853\2. Outgoing\Black plate opening of Windows Louvre\Black Plate of T5 Precat Window.dwg

ELEVATION

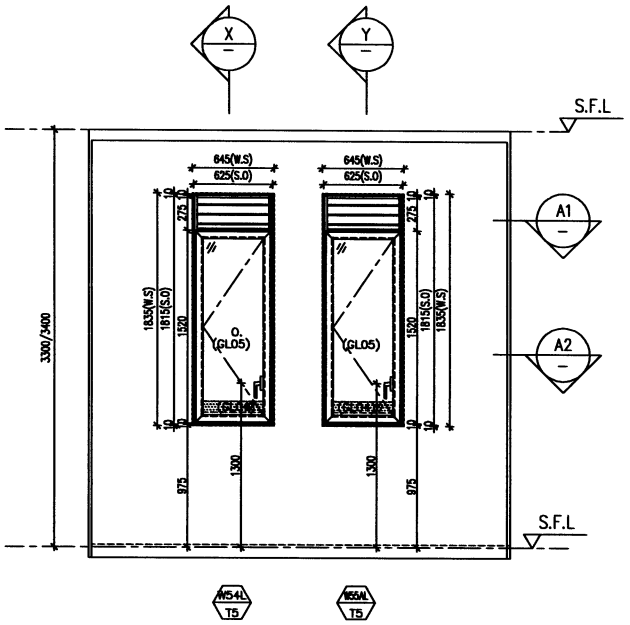

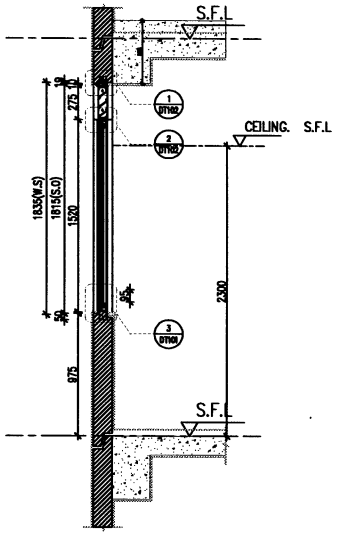

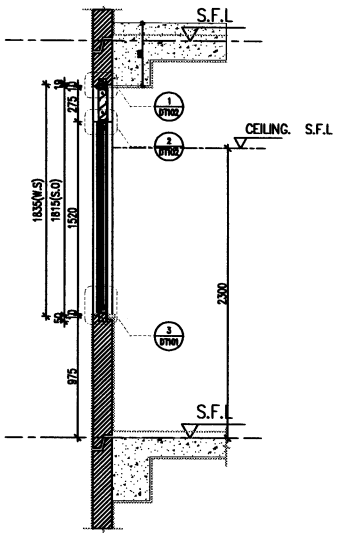

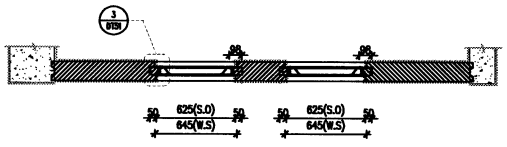

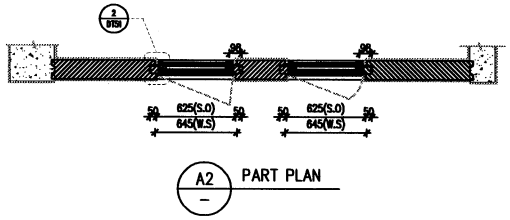

PROVIDED		
GLAZING AREA	0.581	m^2
OPENABLE AREA	0.668	m^2
FREE AREA	60.8	%

W54L T5

PROVIDED		
GLAZING AREA	0.582	m^2
OPENABLE AREA	0.669	m^2
FREE AREA	60.8	%

W54L T5

WINDOW MARK	W54L T5 & W55N T5
LOCATION	25/F FLAT F MASTER BATH
SECTION	70mm ALUM. SECTION
GLAZING	GL05
QUANTITY	1 Nos.
REMARKS	FACADE(T5-01-07A/25F)

T:\Jobs\J-853\2. Outgoing\Black plate opening of Windows Louvre\Black Plate of T5 Precat Window.dwg

B.D. REF :

CLIENT :
SHIMAO GROUP HOLDINGS LIMITED

ARCHITECT :
WONG TUNG & PARTNERS LIMITED
ARCHITECTS & PLANNERS

MAIN CONTRACTOR :
協興建築有限公司
HIP HING CONSTRUCTION CO LTD

STRUCTURAL ENGINEER :
C M WONG & ASSOCIATES LTD
黃志明建築工程師有限公司

FACADE CONSULTANT:
MEINHARDT

NOTE :
1. ALL DIMENSIONS ARE IN mm.
2. ALL ELEVATIONS ARE VIEWED FROM OUTSIDE.
3. ALL DIMENSIONS TO BE VERIFIED ON SITE BEFORE FABRICATION.

LEGEND :
X1 — DETAIL MARK NO.
X001 — REFER SHEET NO.
1. F.F.L. — FINISHED FLOOR LEVEL
2. S.F.L. — STRUCTURAL FLOOR LEVEL
3. (N) — REVERSED DETAIL
4. ▲ — FIXING LOCATION
5. △ — FIXING LUG LOCATION
6. GLASS LEGEND
GL01 — 10mm+12mm AIR GAP+10mm THK. I.G.U.
GL04 — 12mm THK. CLEAR TEMPERED GLASS
GL05 — 10mm+12mm AIR GAP+10mm THK. I.G.U.
GL06 — 10mm+12mm AIR GAP+12mm THK. I.G.U.
PD01 — 10mm T.P+12mm AIR GAP+8mm T.P
GL07 — 10mm+12mm AIR GAP+12mm THK. I.G.U.
GL08 — 10mm+12mm AIR GAP+10mm THK. I.G.U.

NO.	DATE	REMARK	BY
A	08/07/2022	GENERAL REVISION	sdo

JOB NO. : J-853

PROJECT :
PROPOSED RESIDENTIAL DEVELOPMENT AT N.K.I.L. 6542 YIN PING ROAD KOWLOON

TITLE :
WINDOW SCHEDULE FOR TOWER 5 ALUM. WINDOW

DATE : 03-APR-21 | SCALE : 1:40

DRAWN BY : | CHECKED BY :

美特鋁質有限公司
MIDI ALUMINIUM FABRICATION LTD.
Units 6-8, Sunray Industrial Centre, 1/F
610 Cha Kwo Ling Road, Kowloon
Tel:23489211-4 Fax:(852)27727666

DWG NO. : J853-SD-PW-SC507c | REV. : A

STONE CLADDING FINISHING

ELEVATION

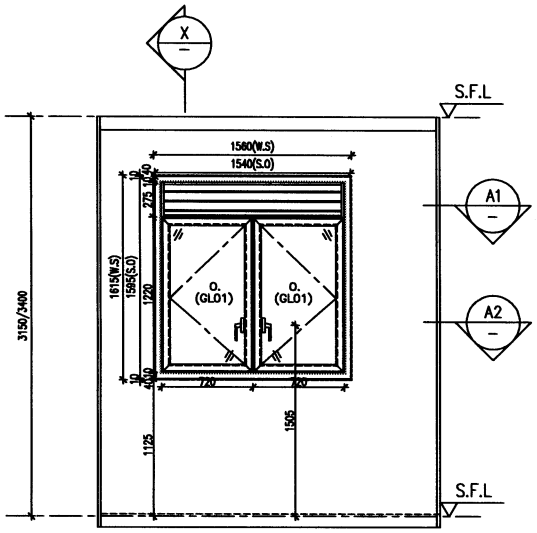

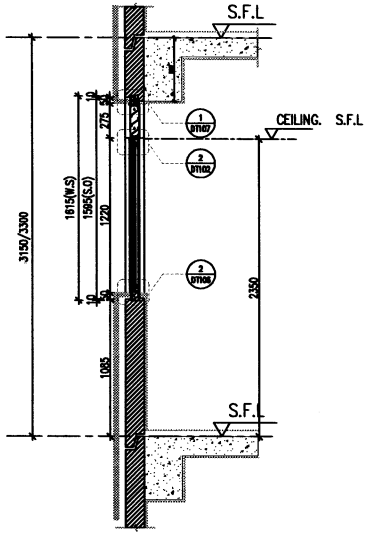

X PART SECTION

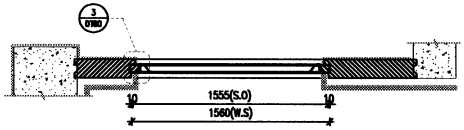

A1 PART PLAN

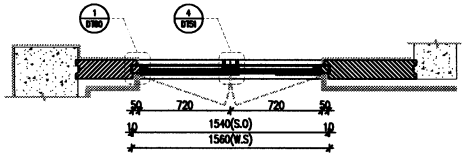

A2 PART PLAN

PROVIDED		
GLAZING AREA	1.295	m^2
OPENABLE AREA	1.461	m^2
FREE AREA	60.8	%

WINDOW MARK	W09 T5
LOCATION	17F~23F FLAT B KITCHEN
SECTION	70mm ALUM. SECTION
GLAZING	GL01
QUANTITY	7 Nos.
REMARKS	FACADE(T5-01-08/17~22F; T5-01-08B/23F)

B.D. REF :

CLIENT :
SHIMAO GROUP HOLDINGS LIMITED

ARCHITECT : WONG TUNG & PARTNERS LIMITED ARCHITECTS & PLANNERS

MAIN CONTRACTOR :
協興建築有限公司
HIP HING CONSTRUCTION CO LTD

STRUCTURAL ENGINEER :
C M WONG & ASSOCIATES LTD
黃志明建築工程師有限公司

FACADE CONSULTANT: MEINHARDT

NOTE :
1. ALL DIMENSIONS ARE IN mm.
2. ALL ELEVATIONS ARE VIEWED FROM OUTSIDE.
3. ALL DIMENSIONS TO BE VERIFIED ON SITE BEFORE FABRICATION.

LEGEND :
- X1 / 2D01 — DETAIL MARK NO. / REFER SHEET NO.
1. F.F.L. — FINISHED FLOOR LEVEL
2. S.F.L. — STRUCTURAL FLOOR LEVEL
3. R — REVERSED DETAIL
4. ▲ — FIXING LOCATION
5. △ — FIXING LUG LOCATION
6. GLASS LEGEND
   - GL01 — 10mm+12mm AIR GAP+10mm THK. I.G.U.
   - GL04 — 12mm THK. CLEAR TEMPERED GLASS
   - GL05 — 10mm+12mm AIR GAP+10mm THK. I.G.U.
   - GL06 — 10mm+12mm AIR GAP+12mm THK. I.G.U.
   - PD01 — 10mm T.P+12mm AIR GAP+8mm T.P
   - GL07 — 10mm+12mm AIR GAP+12mm THK. I.G.U.
   - GL08 — 10mm+12mm AIR GAP+10mm THK. I.G.U.

NO.	DATE	REMARK	BY
C	05/07/2022	GENERAL REVISION	mdn
B	28/07/2021	REVISION SUBJECT TO ARCH.COMMENT	mdn
A	14/07/2021	REVISION SUBJECT TO ARCH.COMMENT	mdn

JOB NO. : J-853

PROJECT :
PROPOSED RESIDENTIAL DEVELOPMENT AT N.K.I.L. 6542
YIN PING ROAD
KOWLOON

TITLE :
WINDOW SCHEDULE FOR TOWER 5 ALUM. WINDOW

DATE : 03-APR-21 | SCALE : 1:40

DRAWN BY : | CHECKED BY :

美特鋁製有限公司
MIDI ALUMINIUM FABRICATOR LTD.
Units 6-8, Sunray Industrial Centre, 1/F
610 Cha Kwo Ling Road, Kowloon
Tel:23489211-4 Fax:(852)27727666

DWG NO. : J853-SD-PW-SC508 | REV. : B

T:\Jobs\J-853\2. Outgoing\Black plate opening of Windows Louvre\Black Plate of T5 Precat Window.dwg

ELEVATION

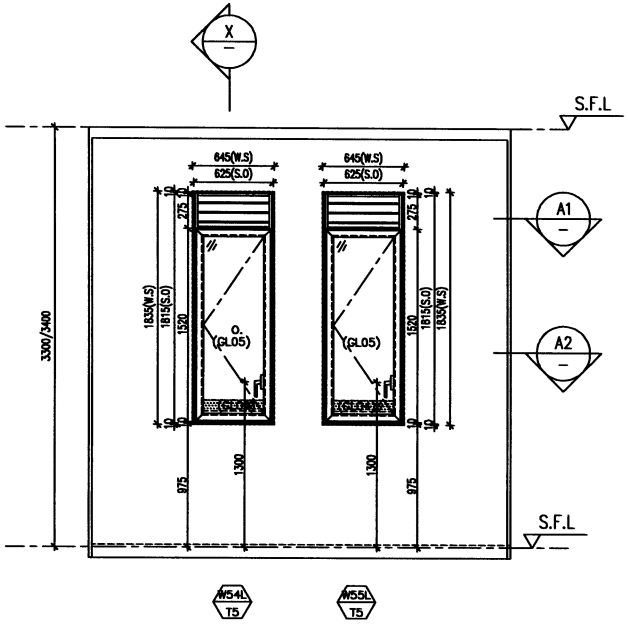

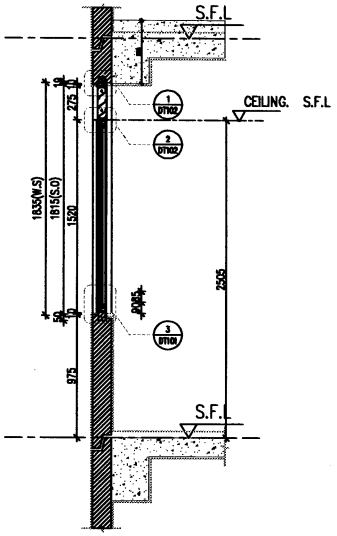

X — PART SECTION

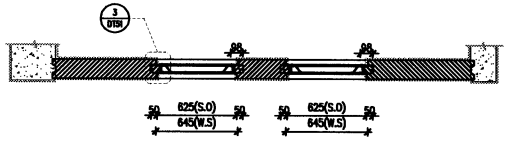

A1 — PART PLAN

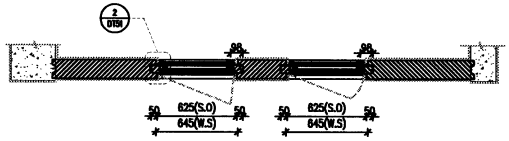

A2 — PART PLAN

PROVIDED		
GLAZING AREA	0.585	m^2
OPENABLE AREA	0.672	m^2
FREE AREA	60.8	%

W55L T5

WINDOW MARK	W54L T5 & W55L T5
LOCATION	23/F FLAT F MASTER BATH
SECTION	70mm ALUM. SECTION
GLAZING	GL05
QUANTITY	2 Nos.
REMARKS	FACADE(T5-01-07B/23F)

T:\Jobs\J-853\2. Outgoing\Black plate opening of Windows Louvre\Black Plate of T5 Precat Window.dwg

B.D. REF :

CLIENT :
SHIMAO GROUP HOLDINGS LIMITED

ARCHITECT :
WONG TUNG & PARTNERS LIMITED
ARCHITECTS & PLANNERS

MAIN CONTRACTOR :
協興建築有限公司
HIP HING CONSTRUCTION CO LTD

STRUCTURAL ENGINEER :
CMA C M WONG & ASSOCIATES LTD
黃志明建築工程師有限公司

FACADE CONSULTANT:
MEINHARDT

NOTE :
1. ALL DIMENSIONS ARE IN mm.
2. ALL ELEVATIONS ARE VIEWED FROM OUTSIDE.
3. ALL DIMENSIONS TO BE VERIFIED ON SITE BEFORE FABRICATION.

LEGEND :
X1 — DETAIL MARK NO.
XXD1 — REFER SHEET NO.
1. F.F.L. — FINISHED FLOOR LEVEL
2. S.F.L. — STRUCTURAL FLOOR LEVEL
3. (N) — REVERSED DETAIL
4. ▲ — FIXING LOCATION
5. △ — FIXING LUG LOCATION
6. GLASS LEGEND
GL01 — 10mm+12mm AIR GAP+10mm THK. I.G.U.
GL04 — 12mm THK. CLEAR TEMPERED GLASS
GL05 — 10mm+12mm AIR GAP+10mm THK. I.G.U.
GL06 — 10mm+12mm AIR GAP+12mm THK. I.G.U.
PD01 — 10mm T.P+12mm AIR GAP+8mm T.P
GL07 — 10mm+12mm AIR GAP+12mm THK. I.G.U.
GL08 — 10mm+12mm AIR GAP+10mm THK. I.G.U.

NO.	DATE	REMARK	BY
B	08/07/2022	GENERAL REVISION	mdo
A	28/07/2021	REVISION SUBJECT TO ARCH.COMMENT	mdo

JOB NO. : J-853

PROJECT :
PROPOSED RESIDENTIAL DEVELOPMENT AT N.K.I.L. 6542 YIN PING ROAD KOWLOON

TITLE :
WINDOW SCHEDULE FOR TOWER 5 ALUM. WINDOW

DATE : 03-APR-21 | SCALE : 1:40

DRAWN BY : | CHECKED BY :

美特鋁製有限公司
MIDI ALUMINIUM FABRICATOR LTD.
Units 6-8, Sunray Industrial Centre, 1/F
610 Cha Kwo Ling Road, Kowloon
Tel:23489211-4 Fax:(852)27727666

DWG NO. : J853-SD-PW-SC507b | REV. : B

ELEVATION

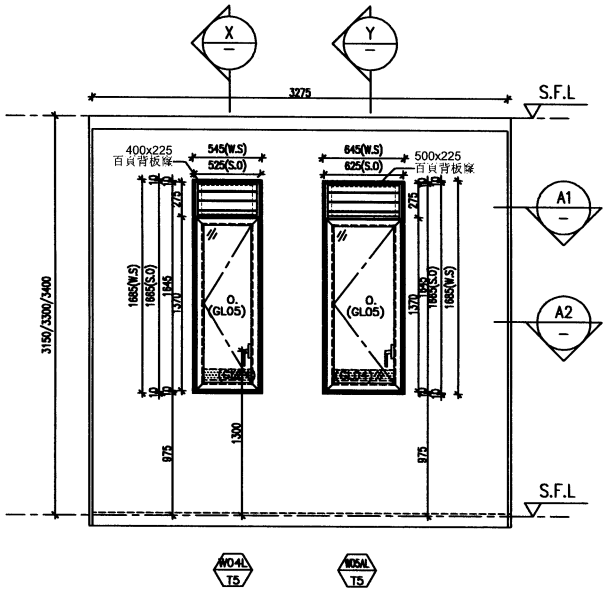

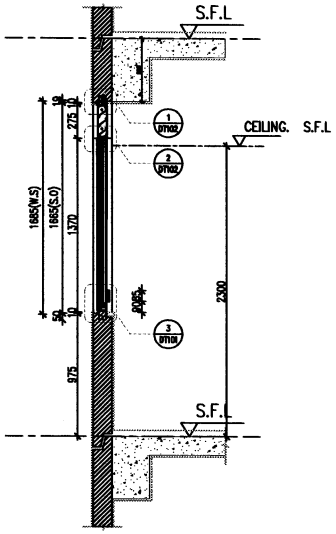

X PART SECTION

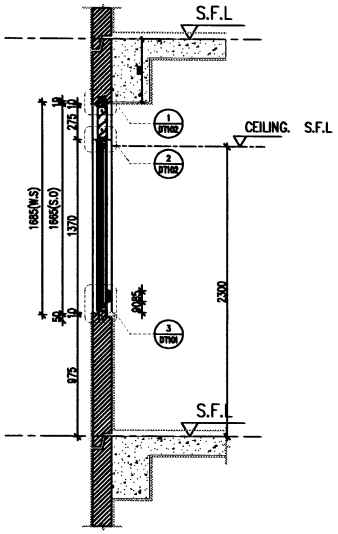

Y PART SECTION

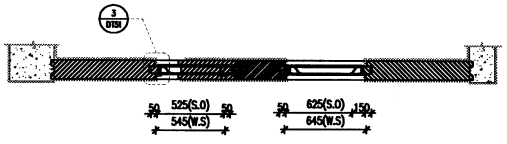

A1 PART PLAN

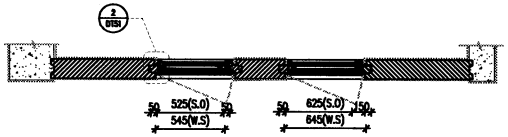

A2 PART PLAN

PROVIDED		
GLAZING AREA	0.512	m^2
OPENABLE AREA	0.590	m^2
FREE AREA	60.8	%

W05L T5

PROVIDED		
GLAZING AREA	0.511	m^2
OPENABLE AREA	0.589	m^2
FREE AREA	60.8	%

W05AL T5

WINDOW MARK	W04L T5 & W05AL T5
LOCATION	11~15F&17~22F FLAT F MASTER BATH
SECTION	70mm ALUM. SECTION
GLAZING	GL05
QUANTITY	9 Nos.
REMARKS	FACADE(T5-01-07/11~15F&17~22F)

T:\Jobs\J-853\2. Outgoing\Black plate opening of Windows Louvre\Black Plate of T5 Precat Window.dwg

B.D. REF :

CLIENT :
SHIMAO GROUP HOLDINGS LIMITED

ARCHITECT :
WONG TUNG & PARTNERS LIMITED
ARCHITECTS & PLANNERS

MAIN CONTRACTOR :
協興建築有限公司
HIP HING CONSTRUCTION CO LTD

STRUCTURAL ENGINEER :
C M WONG & ASSOCIATES LTD
黃志明建築工程師有限公司

FACADE CONSULTANT:
MEINHARDT

NOTE :
1. ALL DIMENSIONS ARE IN mm.
2. ALL ELEVATIONS ARE VIEWED FROM OUTSIDE.
3. ALL DIMENSIONS TO BE VERIFIED ON SITE BEFORE FABRICATION.

LEGEND :
- DETAIL MARK NO.
- REFER SHEET NO.
1. F.F.L. — FINISHED FLOOR LEVEL
2. S.F.L. — STRUCTURAL FLOOR LEVEL
3. — REVERSED DETAIL
4. — FIXING LOCATION
5. — FIXING LUG LOCATION
6. GLASS LEGEND
   - GL01 — 10mm+12mm AIR GAP+10mm THK. I.G.U.
   - GL04 — 12mm THK. CLEAR TEMPERED GLASS
   - GL05 — 10mm+12mm AIR GAP+10mm THK. I.G.U.
   - GL06 — 10mm+12mm AIR GAP+12mm THK. I.G.U.
   - PD01 — 10mm T.P+12mm AIR GAP+8mm T.P
   - GL07 — 10mm+12mm AIR GAP+12mm THK. I.G.U.
   - GL08 — 10mm+12mm AIR GAP+10mm THK. I.G.U.

NO.	DATE	ISSUED	BY
A	08/07/2022	GENERAL REVISION	

JOB NO. : J-853

PROJECT :
PROPOSED RESIDENTIAL DEVELOPMENT AT N.K.I.L. 6542 YIN PING ROAD KOWLOON

TITLE :
WINDOW SCHEDULE FOR TOWER 5 ALUM. WINDOW

DATE : 03-APR-21 | SCALE : 1:40

DRAWN BY : | CHECKED BY :

美特鋁製有限公司
MIDI ALUMINIUM FABRICATOR LTD.
Units 6-8, Sunray Industrial Centre, 1/F
610 Cha Kwo Ling Road, Kowloon
Tel:23489211-4 Fax:(852)27727666

DWG NO. : J853-SD-PW-SC507a | REV. : A

STONE CLADDING FINISHING

ELEVATION

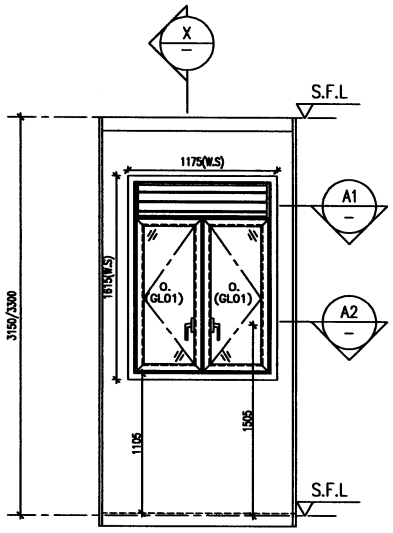

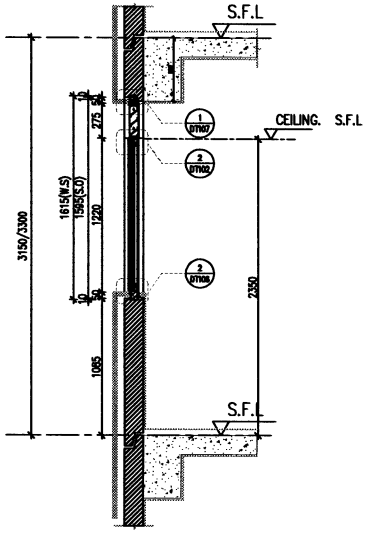

X — PART SECTION

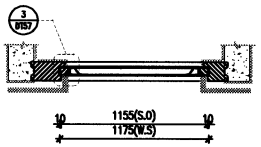

A1 — PART PLAN

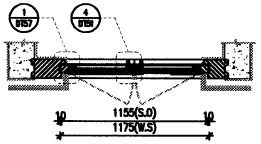

A2 — PART PLAN

PROVIDED		
GLAZING AREA	0.861	m^2
OPENABLE AREA	1.015	m^2
FREE AREA	60.8	%

WINDOW MARK	W06 / T5
LOCATION	6F~16F FLAT B KITCHEN
SECTION	70mm ALUM. SECTION
GLAZING	GL01
QUANTITY	9 Nos.
REMARKS	FACADE (T5-01-06/6~15F; T5-01-06A/16F)

T:\Jobs\J-853\2. Outgoing\Black plate opening of Windows Louvre\Black Plate of T5 Precat Window.dwg

B.D. REF :

CLIENT :
SHIMAO GROUP HOLDINGS LIMITED

ARCHITECT : WONG TUNG & PARTNERS LIMITED ARCHITECTS & PLANNERS

MAIN CONTRACTOR :
協興建築有限公司
HIP HING CONSTRUCTION CO LTD

STRUCTURAL ENGINEER :
CMA C M WONG & ASSOCIATES LTD 黃志明建築工程師有限公司

FACADE CONSULTANT:
MEINHARDT

NOTE :
1. ALL DIMENSIONS ARE IN mm.
2. ALL ELEVATIONS ARE VIEWED FROM OUTSIDE.
3. ALL DIMENSIONS TO BE VERIFIED ON SITE BEFORE FABRICATION.

LEGEND :
- X1 / X001 — DETAIL MARK NO. / REFER SHEET NO.
1. F.F.L. — FINISHED FLOOR LEVEL
2. S.F.L. — STRUCTURAL FLOOR LEVEL
3. (R) — REVERSED DETAIL
4. ▲ — FIXING LOCATION
5. △ — FIXING LUG LOCATION
6. GLASS LEGEND
   - GL01 — 10mm+12mm AIR GAP+10mm THK. I.G.U.
   - GL04 — 12mm THK. CLEAR TEMPERED GLASS
   - GL05 — 10mm+12mm AIR GAP+10mm THK. I.G.U.
   - GL06 — 10mm+12mm AIR GAP+12mm THK. I.G.U.
   - PD01 — 10mm T.P+12mm AIR GAP+8mm T.P
   - GL07 — 10mm+12mm AIR GAP+12mm THK. I.G.U.
   - GL08 — 10mm+12mm AIR GAP+10mm THK. I.G.U.

NO.	DATE	REMARK	BY
C	08/07/2022	GENERAL REVISION	ada
B	28/07/2021	REVISION SUBJECT TO ARCH.COMMENT	ada
A	14/07/2021	REVISION SUBJECT TO ARCH.COMMENT	ada

JOB NO. : J-853

PROJECT :
PROPOSED RESIDENTIAL DEVELOPMENT AT N.K.I.L. 6542 YIN PING ROAD KOWLOON

TITLE :
WINDOW SCHEDULE FOR TOWER 5 ALUM. WINDOW

DATE : 03-APR-21 | SCALE : 1:40

DRAWN BY : | CHECKED BY :

美特鋁製有限公司
MIDI ALUMINIUM FABRICATOR LTD.
Units 6-8, Sunray Industrial Centre, 1/F
610 Cha Kwo Ling Road, Kowloon
Tel:23489211-4 Fax:(852)27727666

DWG NO. : J853-SD-PW-SC506 | REV. : C

ELEVATION

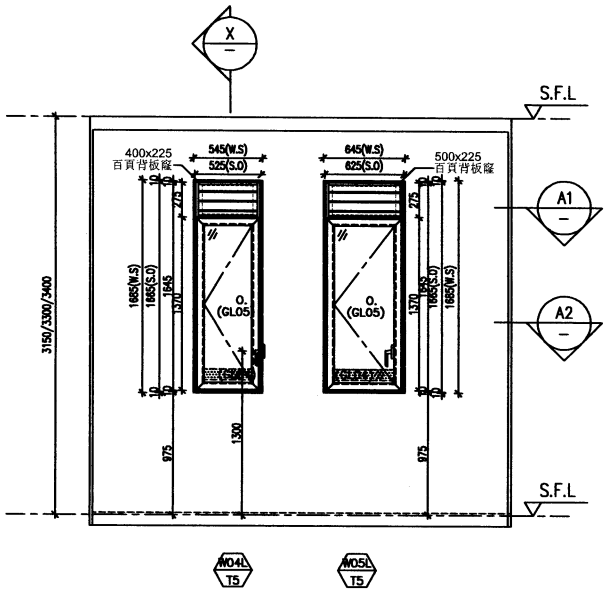

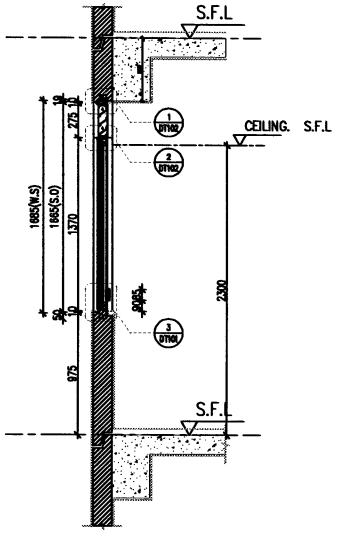

X — PART SECTION

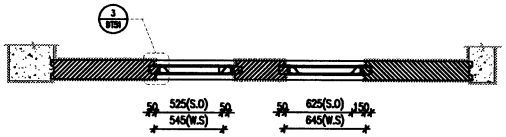

A1 — PART PLAN

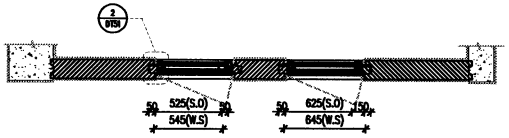

A2 — PART PLAN

PROVIDED		
GLAZING AREA	0.514	m^2
OPENABLE AREA	0.593	m^2
FREE AREA	60.8	%

WO5L T5

PROVIDED		
GLAZING AREA	0.514	m^2
OPENABLE AREA	0.593	m^2
FREE AREA	60.8	%

WO5L T5

WINDOW MARK	WO4L T5 & WO5L T5
LOCATION	16F&26F FLAT F MASTER BATH
SECTION	70mm ALUM. SECTION
GLAZING	GL05
QUANTITY	2 Nos.
REMARKS	FACADE(T5-01-07A/16F&26F)

B.D. REF :

CLIENT :
SHIMAO GROUP HOLDINGS LIMITED

ARCHITECT :
WONG TUNG & PARTNERS LIMITED
ARCHITECTS & PLANNERS

MAIN CONTRACTOR :
協興建築有限公司
HIP HING CONSTRUCTION CO LTD

STRUCTURAL ENGINEER :
C M WONG & ASSOCIATES LTD
黃志明建築工程師有限公司

FACADE CONSULTANT:
MEINHARDT

NOTE :
1. ALL DIMENSIONS ARE IN mm.
2. ALL ELEVATIONS ARE VIEWED FROM OUTSIDE.
3. ALL DIMENSIONS TO BE VERIFIED ON SITE BEFORE FABRICATION.

LEGEND :
X1 / X001 — DETAIL MARK NO. / REFER SHEET NO.
1. F.F.L. — FINISHED FLOOR LEVEL
2. S.F.L. — STRUCTURAL FLOOR LEVEL
3. (R) — REVERSED DETAIL
4. ▲ — FIXING LOCATION
5. △ — FIXING LUG LOCATION
6. GLASS LEGEND
GL01 — 10mm+12mm AIR GAP+10mm THK. L.G.U.
GL04 — 12mm THK. CLEAR TEMPERED GLASS
GL05 — 10mm+12mm AIR GAP+10mm THK. L.G.U.
GL06 — 10mm+12mm AIR GAP+12mm THK. L.G.U.
PD01 — 10mm T.P+12mm AIR GAP+6mm T.P
GL07 — 10mm+12mm AIR GAP+12mm THK. L.G.U.
GL08 — 10mm+12mm AIR GAP+10mm THK. L.G.U.

NO.	DATE	REMARK	BY
C	08/07/2022	GENERAL REVISION	mlo
B	28/07/2021	REVISION SUBJECT TO ARCH.COMMENT	mlo
A	14/07/2021	REVISION SUBJECT TO ARCH.COMMENT	mlo

JOB NO. : J-853

PROJECT :
PROPOSED RESIDENTIAL DEVELOPMENT AT N.K.I.L. 6542 YIN PING ROAD KOWLOON

TITLE :
WINDOW SCHEDULE FOR TOWER 5 ALUM. WINDOW

DATE : 03-APR-21 | SCALE : 1:40

DRAWN BY : | CHECKED BY :

美特鋁製有限公司
MIDI ALUMINIUM FABRICATOR LTD.
Units 6-8, Sunray Industrial Centre, 1/F
610 Cha Kwo Ling Road, Kowloon
Tel:23489211-4 Fax:(852)27727666

DWG NO. : J853-SD-PW-SC507 | REV. : C

T:\Jobs\J-853\2. Outgoing\Black plate opening of Windows Louvre\Black Plate of T5 Precat Window.dwg

LOUVER REQUESTED BY BS

ELEVATION

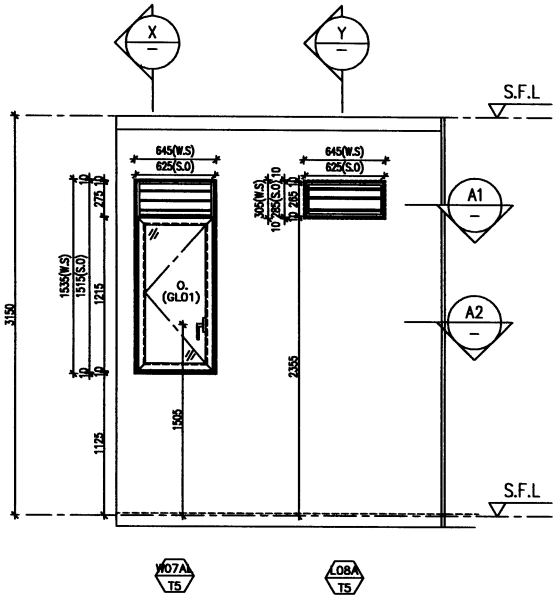

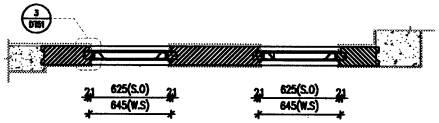

A1 PART PLAN

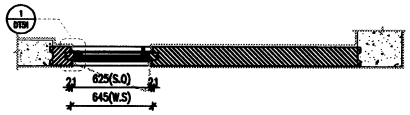

A2 PART PLAN

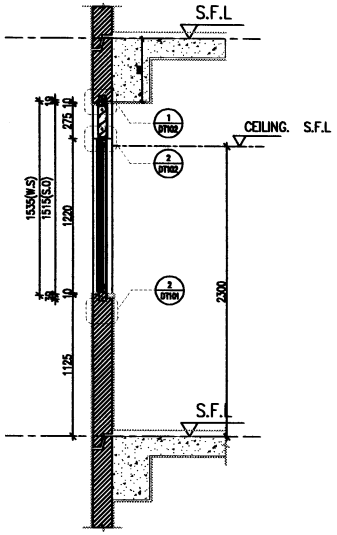

X PART SECTION

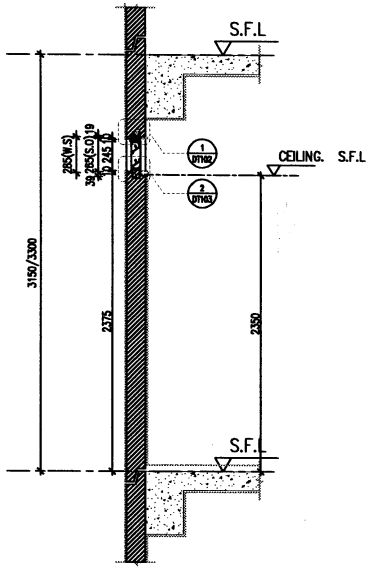

X PART SECTION

W07A T5	PROVIDED		
GLAZING AREA	0.510	m^2
OPENABLE AREA	0.587	m^2
FREE AREA	60.8	%

L08A T5	PROVIDED		
GLAZING AREA	–	m^2
OPENABLE AREA	–	m^2
FREE AREA	54.4	%

WINDOW MARK	W07A T5 & L08A T5
LOCATION	6F~15F FLAT COMMON AREA STAIRCASE
SECTION	70mm ALUM. SECTION
GLAZING	GL01
QUANTITY	8 Nos.
REMARKS	FACADE (T5-01-05/6~15F)

T:\Jobs\J-853\2. Outgoing\Black plate opening of Windows Louvre\Black Plate of T5 Precat Window.dwg

B.D. REF :

CLIENT :
SHIMAO GROUP HOLDINGS LIMITED

ARCHITECT : WONG TUNG & PARTNERS LIMITED ARCHITECTS & PLANNERS

MAIN CONTRACTOR :
協興建築有限公司
HIP HING CONSTRUCTION CO LTD

STRUCTURAL ENGINEER :
C M WONG & ASSOCIATES LTD
黃志明建築工程師有限公司

FACADE CONSULTANT: MEINHARDT

NOTE :
1. ALL DIMENSIONS ARE IN mm.
2. ALL ELEVATIONS ARE VIEWED FROM OUTSIDE.
3. ALL DIMENSIONS TO BE VERIFIED ON SITE BEFORE FABRICATION.

LEGEND :
- X1 / X001 — DETAIL MARK NO. / REFER SHEET NO.
1. F.F.L. — FINISHED FLOOR LEVEL
2. S.F.L. — STRUCTURAL FLOOR LEVEL
3. (R) — REVERSED DETAIL
4. ▲ — FIXING LOCATION
5. △ — FIXING LUG LOCATION
6. GLASS LEGEND
   - GL01 — 10mm+12mm AIR GAP+10mm THK. LG.U.
   - GL04 — 12mm THK. CLEAR TEMPERED GLASS
   - GL05 — 10mm+12mm AIR GAP+10mm THK. LG.U.
   - GL06 — 10mm+12mm AIR GAP+12mm THK. LG.U.
   - PD01 — 10mm T.P+12mm AIR GAP+6mm T.P
   - GL07 — 10mm+12mm AIR GAP+12mm THK. LG.U.
   - GL08 — 10mm+12mm AIR GAP+10mm THK. LG.U.

NO.	DATE	REMARK	BY
D	31/08/2022	GENERAL REVISION	mdc
C	08/07/2022	GENERAL REVISION	mdc
B	28/07/2021	REVISION SUBJECT TO ARCH.COMMENT	mdc
A	14/07/2021	REVISION SUBJECT TO ARCH.COMMENT	mdc

JOB NO. : J-853

PROJECT :
PROPOSED RESIDENTIAL DEVELOPMENT AT N.K.I.L. 6542 YIN PING ROAD KOWLOON

TITLE :
WINDOW SCHEDULE FOR TOWER 5 ALUM. WINDOW

DATE : 03-APR-21 | SCALE : 1:40

DRAWN BY : | CHECKED BY :

美特鋁製有限公司
MIDI ALUMINIUM FABRICATOR LTD.
Units 6-8, Sunray Industrial Centre, 1/F
610 Cha Kwo Ling Road, Kowloon
Tel:23489211-4 Fax:(852)27727666

DWG NO. : J853-SD-PW-SC505 | REV. : D

ELEVATION

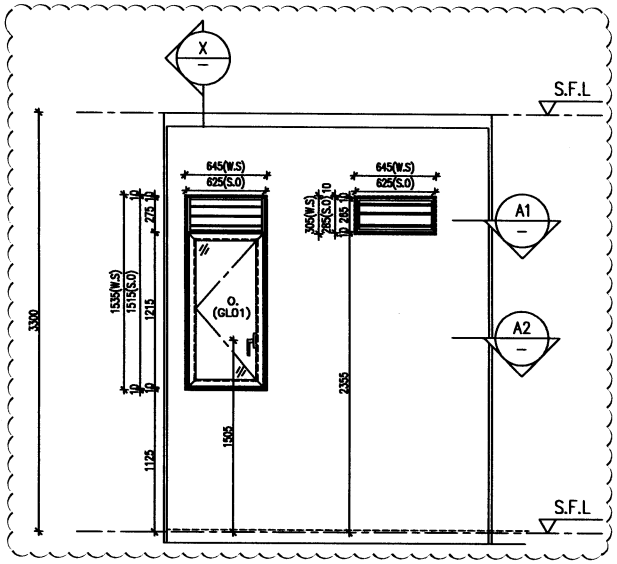

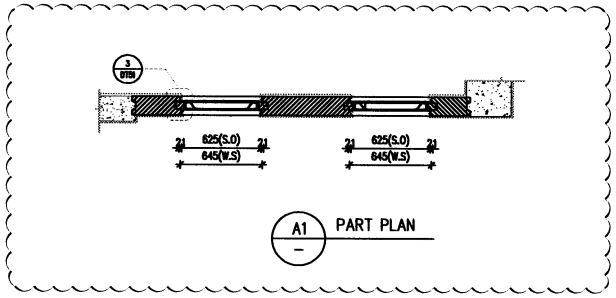

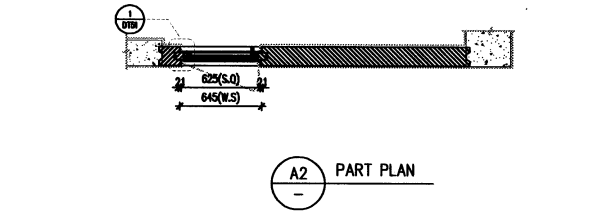

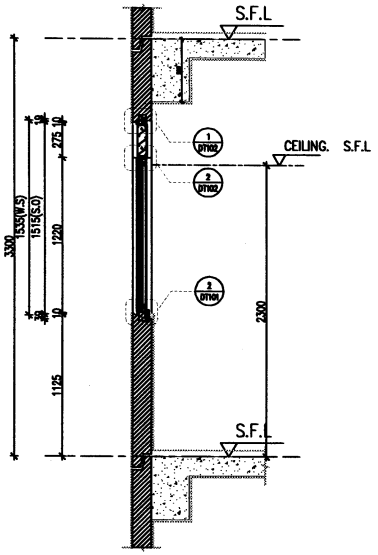

LOUVER REQUESTED BY BS

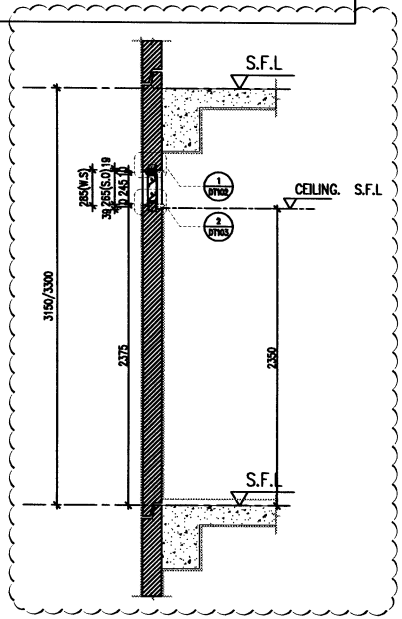

W07A T5	PROVIDED		
GLAZING AREA	0.510	m^2
OPENABLE AREA	0.587	m^2
FREE AREA	60.8	%

L08A T5	PROVIDED		
GLAZING AREA	–	m^2
OPENABLE AREA	–	m^2
FREE AREA	54.4	%

WINDOW MARK	W07A T5 & L08A T5
LOCATION	16F FLAT COMMON AREA STAIRCASE
SECTION	70mm ALUM. SECTION
GLAZING	GL01
QUANTITY	1 No.
REMARKS	FACADE (T5-01-05A/16F)

B.D. REF :

CLIENT :
SHIMAO GROUP HOLDINGS LIMITED

ARCHITECT : WONG TUNG & PARTNERS LIMITED ARCHITECTS & PLANNERS

MAIN CONTRACTOR :
協興建築有限公司
HIP HING CONSTRUCTION CO LTD

STRUCTURAL ENGINEER :
C M WONG & ASSOCIATES LTD
黃志明建築工程師有限公司

FACADE CONSULTANT:
MEINHARDT

NOTE :
1. ALL DIMENSIONS ARE IN mm.
2. ALL ELEVATIONS ARE VIEWED FROM OUTSIDE.
3. ALL DIMENSIONS TO BE VERIFIED ON SITE BEFORE FABRICATION.

LEGEND :
X1 / X001 — DETAIL MARK NO. / REFER SHEET NO.
1. F.F.L. — FINISHED FLOOR LEVEL
2. S.F.L. — STRUCTURAL FLOOR LEVEL
3. (R) — REVERSED DETAIL
4. ▲ — FIXING LOCATION
5. △ — FIXING LUG LOCATION
6. GLASS LEGEND
GL01 — 10mm+12mm AIR GAP+10mm THK. LG.U.
GL04 — 12mm THK. CLEAR TEMPERED GLASS
GL05 — 10mm+12mm AIR GAP+10mm THK. LG.U.
GL06 — 10mm+12mm AIR GAP+12mm THK. LG.U.
PD01 — 10mm T.P+12mm AIR GAP+8mm T.P
GL07 — 10mm+12mm AIR GAP+12mm THK. LG.U.
GL08 — 10mm+12mm AIR GAP+10mm THK. LG.U.

NO.	DATE	REMARKS	BY
D	31/08/2022	GENERAL REVISION	
C	08/07/2022	GENERAL REVISION	
B	28/07/2021	REVISION SUBJECT TO ARCH.COMMENT	
A	14/07/2021	REVISION SUBJECT TO ARCH.COMMENT	

JOB NO. : J-853

PROJECT :
PROPOSED RESIDENTIAL DEVELOPMENT AT N.K.I.L. 6542 YIN PING ROAD KOWLOON

TITLE :
WINDOW SCHEDULE FOR TOWER 5 ALUM. WINDOW

DATE : 03-APR-21 | SCALE : 1:40

DRAWN BY : | CHECKED BY :

美特鋁質有限公司
MIDI ALUMINIUM FABRICATOR LTD.
Units 6-8, Sunray Industrial Centre, 1/F
610 Cha Kwo Ling Road, Kowloon
Tel:23489211-4 Fax:(852)27727666

DWG NO. : J853-SD-PW-SC505a | REV. : C

T:\Jobs\J-853\2. Outgoing\Black plate opening of Windows Louvre\Black Plate of T5 Precat Window.dwg

ELEVATION

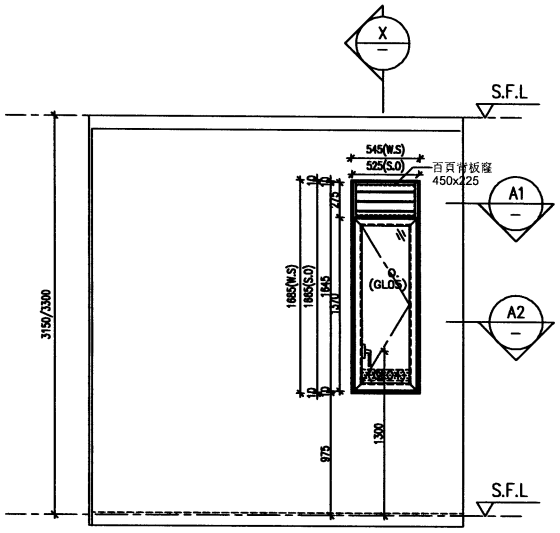

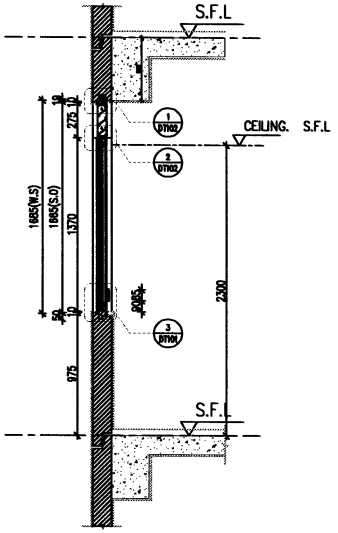

X PART SECTION

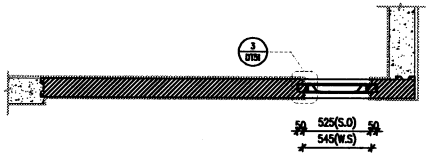

A1 PART PLAN

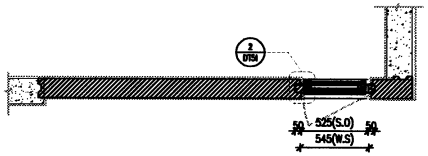

A2 PART PLAN

PROVIDED		
GLAZING AREA	0.404	m^2
OPENABLE AREA	0.480	m^2
FREE AREA	60.8	%

WINDOW MARK	W04R/T5 6/F-16/F
LOCATION	11F~16F FLAT A MASTER BATH
SECTION	70mm ALUM. SECTION
GLAZING	GL05
QUANTITY	9 Nos.
REMARKS	FACADE(T5-01-04/6~15F; T5-01-04A/16F)

B.D. REF :

CLIENT :
SHIMAO GROUP HOLDINGS LIMITED

ARCHITECT :
WONG TUNG & PARTNERS LIMITED
ARCHITECTS & PLANNERS

MAIN CONTRACTOR :
協興建築有限公司
HIP HING CONSTRUCTION CO LTD

STRUCTURAL ENGINEER :
C M WONG & ASSOCIATES LTD
黃志明建築工程師有限公司

FACADE CONSULTANT:
MEINHARDT

NOTE :
1. ALL DIMENSIONS ARE IN mm.
2. ALL ELEVATIONS ARE VIEWED FROM OUTSIDE.
3. ALL DIMENSIONS TO BE VERIFIED ON SITE BEFORE FABRICATION.

LEGEND :
X1/W04R — DETAIL MARK NO.
— REFER SHEET NO.
1. F.F.L. — FINISHED FLOOR LEVEL
2. S.F.L. — STRUCTURAL FLOOR LEVEL
3. (R) — REVERSED DETAIL
4. ▲ — FIXING LOCATION
5. △ — FIXING LUG LOCATION
6. GLASS LEGEND
GL01 — 10mm+12mm AIR GAP+10mm THK. I.G.U.
GL04 — 12mm THK. CLEAR TEMPERED GLASS
GL05 — 10mm+12mm AIR GAP+10mm THK. I.G.U.
GL06 — 10mm+12mm AIR GAP+12mm THK. I.G.U.
PD01 — 10mm T.P+12mm AIR GAP+8mm T.P
GL07 — 10mm+12mm AIR GAP+12mm THK. I.G.U.
GL08 — 10mm+12mm AIR GAP+10mm THK. I.G.U.

NO.	DATE	REVISED	BY
C	08/07/2022	GENERAL REVISION	ada
B	28/07/2021	REVISION SUBJECT TO ARCH.COMMENT	ada
A	14/07/2021	REVISION SUBJECT TO ARCH.COMMENT	ada

JOB NO. : J-853

PROJECT :
PROPOSED RESIDENTIAL DEVELOPMENT AT N.K.I.L. 6542 YIN PING ROAD KOWLOON

TITLE :
WINDOW SCHEDULE FOR TOWER 5 ALUM. WINDOW

DATE : 03-APR-21 | SCALE : 1:40

DRAWN BY : | CHECKED BY :

美特鋁質有限公司
MIDI ALUMINIUM FABRICATOR LTD.
Units 6-8, Sunray Industrial Centre, 1/F
610 Cha Kwo Ling Road, Kowloon
Tel:23489211-4 Fax:(852)27727666

DWG NO. : J853-SD-PW-SC504 | REV. : C

T:\Jobs\J-853\2. Outgoing\Black plate opening of Windows Louvre\Black Plate of T5 Precat Window.dwg

ELEVATION

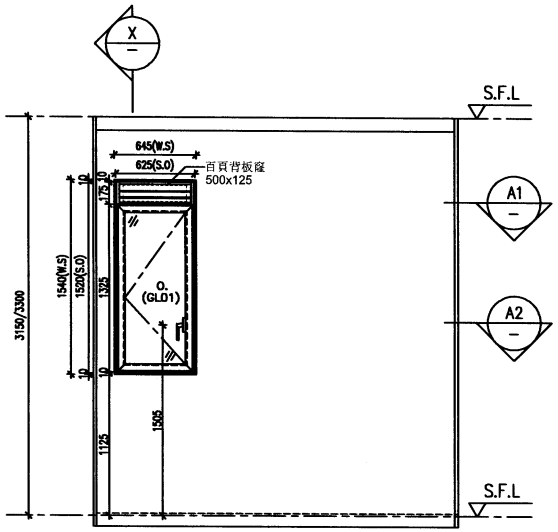

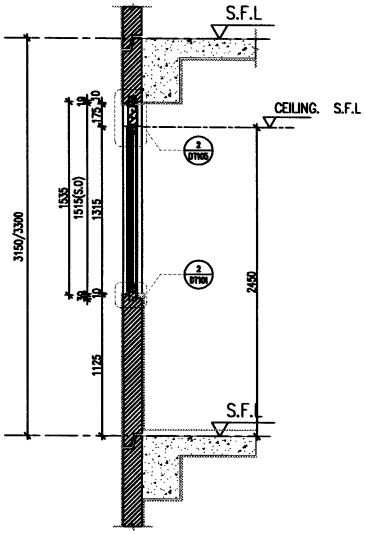

X — PART SECTION

A2 — PART PLAN

A2 — PART PLAN

PROVIDED		
GLAZING AREA	0.552	m^2
OPENABLE AREA	0.637	m^2
FREE AREA	52.1	%

WINDOW MARK	T5
LOCATION	6F~16F FLAT A DINING ROOM
SECTION	70mm ALUM. SECTION
GLAZING	GL01
QUANTITY	8 Nos.
REMARKS	FACADE (T5-01-03/6~15F)

B.D. REF :

CLIENT :
SHIMAO GROUP HOLDINGS LIMITED

ARCHITECT :
WONG TUNG & PARTNERS LIMITED
ARCHITECTS & PLANNERS

MAIN CONTRACTOR :
協興建築有限公司
HIP HING CONSTRUCTION CO LTD

STRUCTURAL ENGINEER :
C M WONG & ASSOCIATES LTD
黃志明建築工程師有限公司

FACADE CONSULTANT:
MEINHARDT

NOTE :
1. ALL DIMENSIONS ARE IN mm.
2. ALL ELEVATIONS ARE VIEWED FROM OUTSIDE.
3. ALL DIMENSIONS TO BE VERIFIED ON SITE BEFORE FABRICATION.

LEGEND :
- DETAIL MARK NO.
- REFER SHEET NO.

1. F.F.L. — FINISHED FLOOR LEVEL
2. S.F.L. — STRUCTURAL FLOOR LEVEL
3. — REVERSED DETAIL
4. — FDOING LOCATION
5. — FDOING LUG LOCATION
6. GLASS LEGEND
   - GL01 — 10mm+12mm AIR GAP+10mm THK. I.G.U.
   - GL04 — 12mm THK. CLEAR TEMPERED GLASS
   - GL05 — 10mm+12mm AIR GAP+10mm THK. I.G.U.
   - GL06 — 10mm+12mm AIR GAP+12mm THK. I.G.U.
   - PD01 — 10mm T.P+12mm AIR GAP+8mm T.P
   - GL07 — 10mm+12mm AIR GAP+12mm THK. I.G.U.
   - GL08 — 10mm+12mm AIR GAP+10mm THK. I.G.U.

NO.	DATE	REMARK	BY
C	08/07/2022	GENERAL REVISION	mlo
B	29/07/2021	REVISION SUBJECT TO ARCH.COMMENT	mlo
A	14/07/2021	REVISION SUBJECT TO ARCH.COMMENT	mlo

JOB NO. : J-853

PROJECT :
PROPOSED RESIDENTIAL DEVELOPMENT AT N.K.I.L. 6542 YIN PING ROAD KOWLOON

TITLE :
WINDOW SCHEDULE FOR TOWER 5 ALUM. WINDOW

DATE : 03-APR-21 | SCALE : 1:40

DRAWN BY : | CHECKED BY :

美特鋁製有限公司
MIDI ALUMINIUM FABRICATION LTD.
Units 6-8, Sunray Industrial Centre, 1/F
610 Cha Kwo Ling Road, Kowloon
Tel:23489211-4 Fax:(852)27727666

DWG NO. : J853-SD-PW-SC503 | REV. : C

T:\Jobs\J-853\2. Outgoing\Black plate opening of Windows Louvre\Black Plate of T5 Precat Window.dwg

ELEVATION

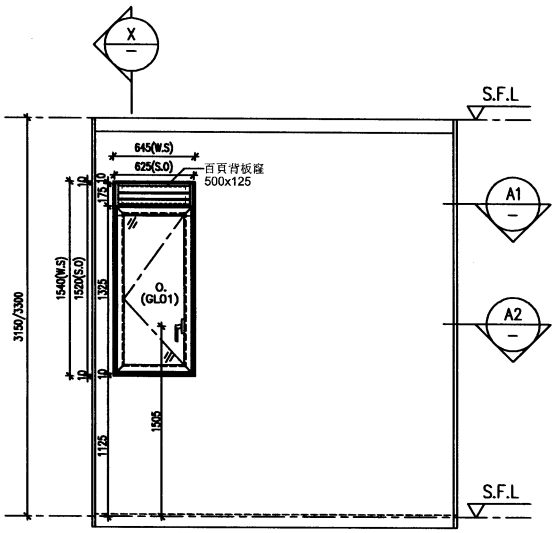

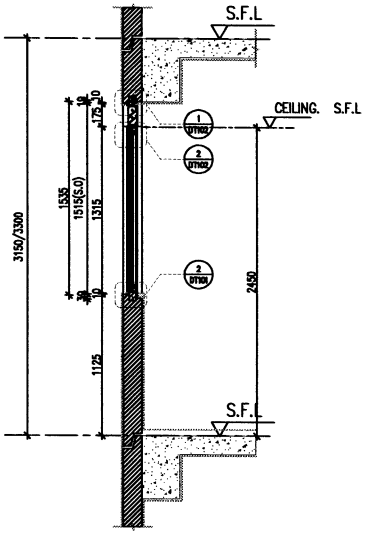

X — PART SECTION

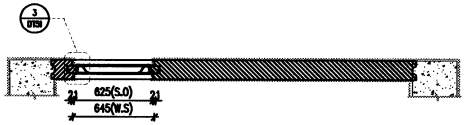

A2 — PART PLAN

A2 — PART PLAN

PROVIDED		
GLAZING AREA	0.552	m^2
OPENABLE AREA	0.637	m^2
FREE AREA	52.1	%

WINDOW MARK	W076L T5
LOCATION	16F FLAT A DINING ROOM
SECTION	70mm ALUM. SECTION
GLAZING	GL01
QUANTITY	1 Nos.
REMARKS	FACADE (T5-01-03A/16F)

B.D. REF :

CLIENT :
SHIMAO GROUP HOLDINGS LIMITED

ARCHITECT :
WONG TUNG & PARTNERS LIMITED ARCHITECTS & PLANNERS

MAIN CONTRACTOR :
協興建築有限公司 HIP HING CONSTRUCTION CO LTD

STRUCTURAL ENGINEER :
C M WONG & ASSOCIATES LTD 黃志明建築工程師有限公司

FACADE CONSULTANT:
MEINHARDT

NOTE :
1. ALL DIMENSIONS ARE IN mm.
2. ALL ELEVATIONS ARE VIEWED FROM OUTSIDE.
3. ALL DIMENSIONS TO BE VERIFIED ON SITE BEFORE FABRICATION.

LEGEND :
- X1 / XXX1 — DETAIL MARK NO. / REFER SHEET NO.
1. F.F.L. — FINISHED FLOOR LEVEL
2. S.F.L. — STRUCTURAL FLOOR LEVEL
3. (R) — REVERSED DETAIL
4. ▲ — FIXING LOCATION
5. △ — FIXING LUG LOCATION
6. GLASS LEGEND
   GL01 — 10mm+12mm AIR GAP+10mm THK. LG.U.
   GL04 — 12mm THK. CLEAR TEMPERED GLASS
   GL05 — 10mm+12mm AIR GAP+10mm THK. LG.U.
   GL06 — 10mm+12mm AIR GAP+12mm THK. LG.U.
   PD01 — 10mm T.P+12mm AIR GAP+8mm T.P
   GL07 — 10mm+12mm AIR GAP+12mm THK. LG.U.
   GL08 — 10mm+12mm AIR GAP+10mm THK. LG.U.

NO.	DATE	REMARK	BY
C	08/07/2022	GENERAL REVISION	
B	28/07/2021	REVISION SUBJECT TO ARCH.COMMENT	
A	14/07/2021	REVISION SUBJECT TO ARCH.COMMENT	

JOB NO. : J-853

PROJECT :
PROPOSED RESIDENTIAL DEVELOPMENT AT N.K.I.L. 6542 YIN PING ROAD KOWLOON

TITLE :
WINDOW SCHEDULE FOR TOWER 5 ALUM. WINDOW

DATE : 03-APR-21 | SCALE : 1:40

DRAWN BY : | CHECKED BY :

美特鋁製有限公司 MIDI ALUMINIUM FABRICATOR LTD.
Units 6-8, Sunray Industrial Centre, 1/F
610 Cha Kwo Ling Road, Kowloon
Tel:23488211-4 Fax:(852)27727666

DWG NO. : J853-SD-PW-SC503 REV. : C

T:\Jobs\J-853\2. Outgoing\Black plate opening of Windows Louvre\Black Plate of T5 Precat Window.dwg

ELEVATION

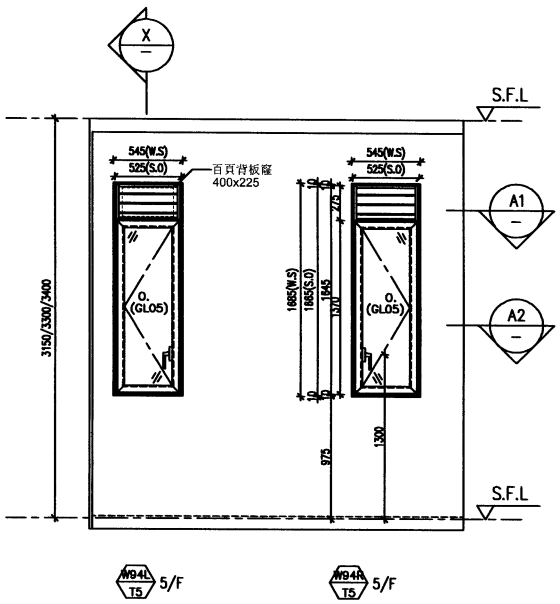

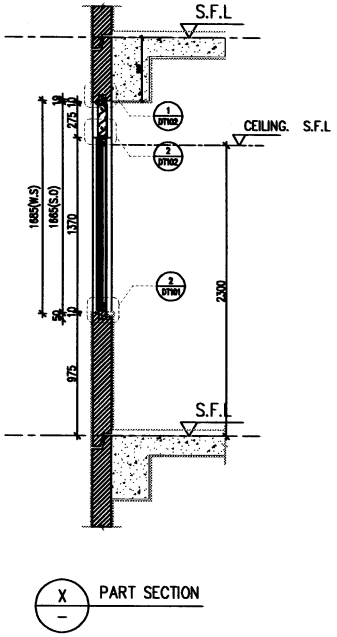

X PART SECTION

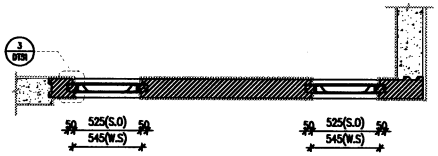

A1 PART PLAN

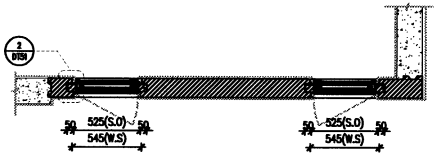

A2 PART PLAN

W94L T5 W94R T5

PROVIDED		
GLAZING AREA	0.405	m^2
OPENABLE AREA	0.481	m^2
FREE AREA	60.8	%

WINDOW MARK	W94L T5 & W94R T5
LOCATION	5F FLAT A MASTER BATH
SECTION	70mm ALUM. SECTION
GLAZING	GL05
QUANTITY	1 / 1 Nos.
REMARKS	FACADE(T5-01-02A/5F)

T:\Jobs\J-853\2. Outgoing\Black plate opening of Windows Louvre\Black Plate of T5 Precat Window.dwg

B.D. REF :

CLIENT :
SHIMAO GROUP HOLDINGS LIMITED

ARCHITECT :
WONG TUNG & PARTNERS LIMITED
ARCHITECTS & PLANNERS

MAIN CONTRACTOR :
協興建築有限公司
HIP HING CONSTRUCTION CO LTD

STRUCTURAL ENGINEER :
C M WONG & ASSOCIATES LTD
黃志明建築工程師有限公司

FACADE CONSULTANT:
MEINHARDT

NOTE :
1. ALL DIMENSIONS ARE IN mm.
2. ALL ELEVATIONS ARE VIEWED FROM OUTSIDE.
3. ALL DIMENSIONS TO BE VERIFIED ON SITE BEFORE FABRICATION.

LEGEND :
X1 / X001 — DETAIL MARK NO. / REFER SHEET NO.
1. F.F.L. — FINISHED FLOOR LEVEL
2. S.F.L. — STRUCTURAL FLOOR LEVEL
3. (R) — REVERSED DETAIL
4. ▲ — FIXING LOCATION
5. △ — FIXING LUG LOCATION
6. GLASS LEGEND
GL01 — 10mm+12mm AIR GAP+10mm THK. I.G.U.
GL04 — 12mm THK. CLEAR TEMPERED GLASS
GL05 — 10mm+12mm AIR GAP+10mm THK. I.G.U.
GL06 — 10mm+12mm AIR GAP+12mm THK. I.G.U.
PD01 — 10mm T.P+12mm AIR GAP+8mm T.P
GL07 — 10mm+12mm AIR GAP+12mm THK. I.G.U.
GL08 — 10mm+12mm AIR GAP+10mm THK. I.G.U.

NO.	DATE	REVISED	BY
A	05/07/2022	GENERAL REVISION	edo

JOB NO. : J-853

PROJECT :
PROPOSED RESIDENTIAL DEVELOPMENT AT N.K.I.L. 6542 YIN PING ROAD KOWLOON

TITLE :
WINDOW SCHEDULE FOR TOWER 5 ALUM. WINDOW

DATE : 03-APR-21 | SCALE : 1:40

DRAWN BY : | CHECKED BY :

美特鋁製有限公司
MIDI ALUMINIUM FABRICATOR LTD.
Units 6-8, Sunray Industrial Centre, 1/F
610 Cha Kwo Ling Road, Kowloon
Tel:23489211-4 Fax:(852)27727666

DWG NO. : J853-SD-PW-SC502a | REV. : A

ELEVATION

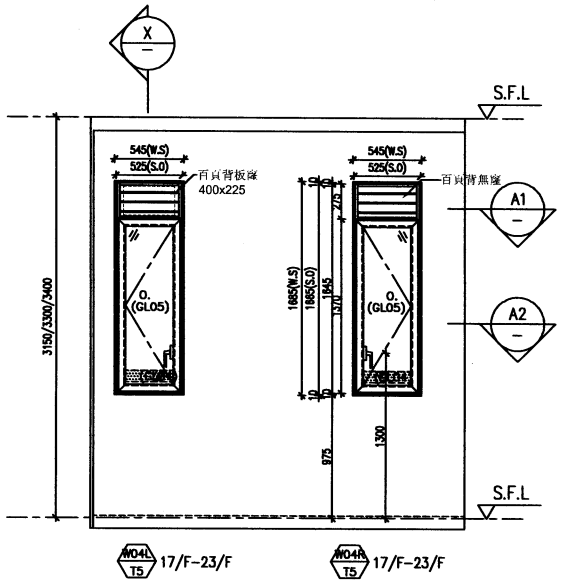

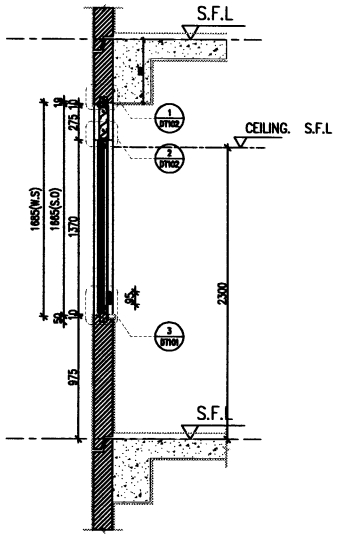

X — PART SECTION

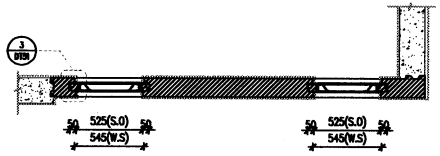

A1 — PART PLAN

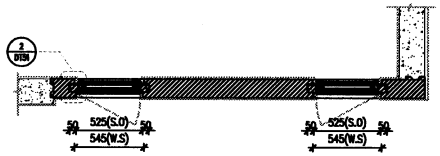

A2 — PART PLAN

W04L T5 W04R T5

PROVIDED		
GLAZING AREA	0.405	m^2
OPENABLE AREA	0.481	m^2
FREE AREA	60.8	%

WINDOW MARK	W04L T5 & W04R T5 17/F-23/F
LOCATION	17~23F FLAT A MASTER BATH
SECTION	70mm ALUM. SECTION
GLAZING	GL05
QUANTITY	7 Nos.
REMARKS	FACADE(T5-01-02/17~22F; T5-01-02B/23F)

T:\Jobs\J-853\2. Outgoing\Black plate opening of Windows Louvre\Black Plate of T5 Precat Window.dwg

B.D. REF :

CLIENT :
SHIMAO GROUP HOLDINGS LIMITED

ARCHITECT :
WONG TUNG & PARTNERS LIMITED
ARCHITECTS & PLANNERS

MAIN CONTRACTOR :
協興建築有限公司
HIP HING CONSTRUCTION CO LTD

STRUCTURAL ENGINEER :
C M WONG & ASSOCIATES LTD
黃志明建築工程師有限公司

FACADE CONSULTANT:
MEINHARDT

NOTE :
1. ALL DIMENSIONS ARE IN mm.
2. ALL ELEVATIONS ARE VIEWED FROM OUTSIDE.
3. ALL DIMENSIONS TO BE VERIFIED ON SITE BEFORE FABRICATION.

LEGEND :
X1 — DETAIL MARK NO.
XX01 — REFER SHEET NO.
1. F.F.L. — FINISHED FLOOR LEVEL
2. S.F.L. — STRUCTURAL FLOOR LEVEL
3. R — REVERSED DETAIL
4. ▲ — FIXING LOCATION
5. △ — FIXING LUG LOCATION
6. GLASS LEGEND
GL01 — 10mm+12mm AIR GAP+10mm THK. I.G.U.
GL04 — 12mm THK. CLEAR TEMPERED GLASS
GL05 — 10mm+12mm AIR GAP+10mm THK. I.G.U.
GL06 — 10mm+12mm AIR GAP+12mm THK. I.G.U.
PD01 — 10mm T.P+12mm AIR GAP+8mm T.P
GL07 — 10mm+12mm AIR GAP+12mm THK. I.G.U.
GL08 — 10mm+12mm AIR GAP+10mm THK. I.G.U.

NO.	DATE	REMARK	BY
C	08/07/2022	GENERAL REVISION	ada
B	28/07/2021	REVISION SUBJECT TO ARCH.COMMENT	ada
A	14/07/2021	REVISION SUBJECT TO ARCH.COMMENT	ada

JOB NO. : J-853

PROJECT :
PROPOSED RESIDENTIAL DEVELOPMENT AT N.K.I.L. 6542 YIN PING ROAD KOWLOON

TITLE :
WINDOW SCHEDULE FOR TOWER 5 ALUM. WINDOW

DATE : 03-APR-21 | SCALE : 1:40

DRAWN BY : | CHECKED BY :

美特鋁製有限公司
MIDI ALUMINIUM FABRICATION LTD.
Units 6-8, Sunray Industrial Centre, 1/F
610 Cha Kwo Ling Road, Kowloon
Tel:23489211-4 Fax:(852)27727666

DWG NO. : J853-SD-PW-SC502 | REV. : C

ELEVATION

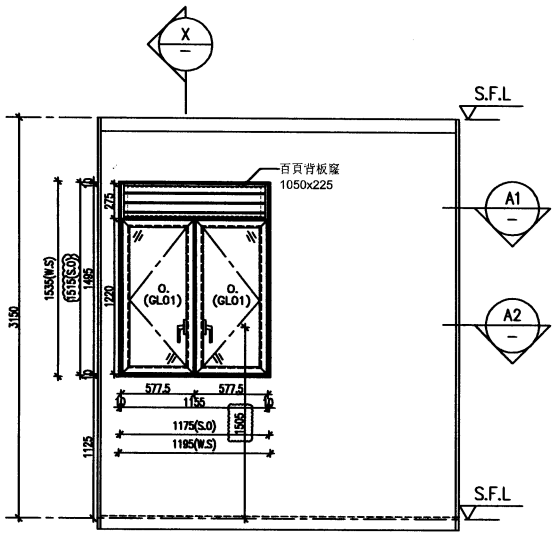

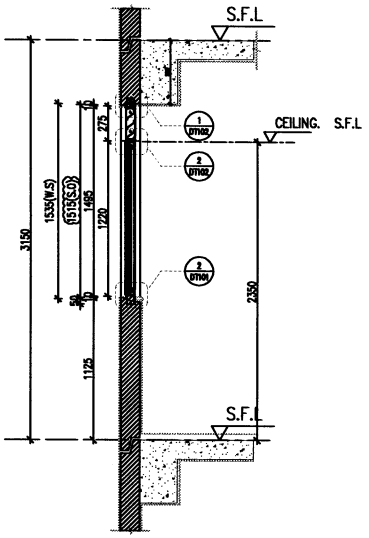

X PART SECTION

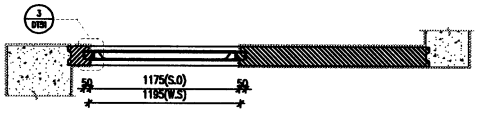

A1 PART PLAN

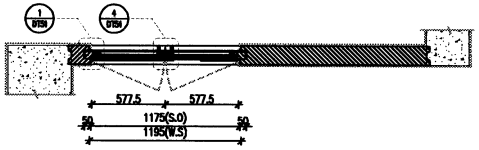

A2 PART PLAN

PROVIDED		
GLAZING AREA	0.973	m^2
OPENABLE AREA	1.131	m^2
FREE AREA	60.8	%

WINDOW MARK	W03A T5
LOCATION	17F~22F FLAT A KITCHEN
SECTION	70mm ALUM. SECTION
GLAZING	GL01
QUANTITY	6 Nos.
REMARKS	FACADE(T5-01-01/17~22F)

T:\Jobs\J-853\2. Outgoing\Black plate opening of Windows Louvre\Black Plate of T5 Precat Window.dwg

B.D. REF :

CLIENT :
SHIMAO GROUP HOLDINGS LIMITED

ARCHITECT :
WONG TUNG & PARTNERS LIMITED
ARCHITECTS & PLANNERS

MAIN CONTRACTOR :
協興建築有限公司
HIP HING CONSTRUCTION CO LTD

STRUCTURAL ENGINEER :
C M WONG & ASSOCIATES LTD
黃志明建築工程師有限公司

FACADE CONSULTANT:
MEINHARDT

NOTE :
1. ALL DIMENSIONS ARE IN mm.
2. ALL ELEVATIONS ARE VIEWED FROM OUTSIDE.
3. ALL DIMENSIONS TO BE VERIFIED ON SITE BEFORE FABRICATION.

LEGEND :
- X1 / X001 — DETAIL MARK NO. / REFER SHEET NO.
1. F.F.L. — FINISHED FLOOR LEVEL
2. S.F.L. — STRUCTURAL FLOOR LEVEL
3. — REVERSED DETAIL
4. ▲ — FIXING LOCATION
5. △ — FIXING LUG LOCATION
6. GLASS LEGEND
   - GL01 — 10mm+12mm AIR GAP+10mm THK. I.G.U.
   - GL04 — 12mm THK. CLEAR TEMPERED GLASS
   - GL05 — 10mm+12mm AIR GAP+10mm THK. I.G.U.
   - GL06 — 10mm+12mm AIR GAP+12mm THK. I.G.U.
   - PD01 — 10mm T.P+12mm AIR GAP+8mm T.P
   - GL07 — 10mm+12mm AIR GAP+12mm THK. I.G.U.
   - GL08 — 10mm+12mm AIR GAP+10mm THK. I.G.U.

NO.	DATE	REMARK	BY
B	08/07/2022	GENERAL REVISION	edo

JOB NO. : J-853

PROJECT :
PROPOSED RESIDENTIAL DEVELOPMENT AT N.K.I.L. 6542 YIN PING ROAD KOWLOON

TITLE :
WINDOW SCHEDULE FOR TOWER 5 ALUM. WINDOW

DATE : 03-APR-21 | SCALE : 1:40

DRAWN BY : | CHECKED BY :

美特鋁質有限公司
MIDI ALUMINIUM FABRICATION LTD.
Units 6-8, Sunray Industrial Centre, 1/F
610 Cha Kwo Ling Road, Kowloon
Tel:23488211-4 Fax:(852)27727666

DWG NO. : J853-SD-PW-SC501a | REV. : B

ELEVATION

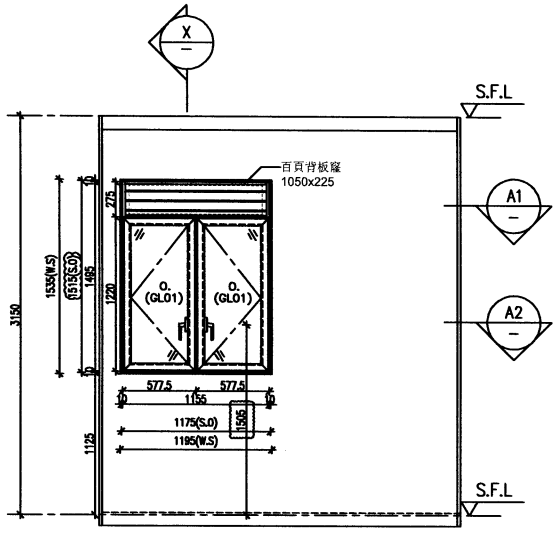

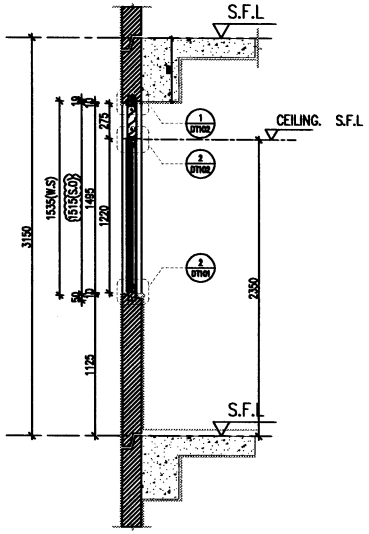

X PART SECTION

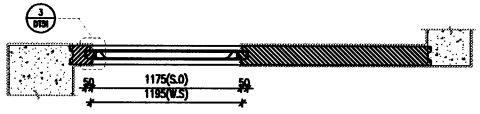

A1 PART PLAN

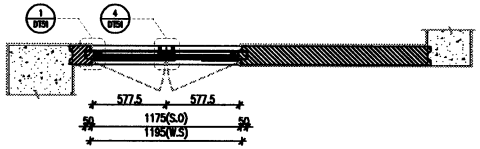

A2 PART PLAN

PROVIDED		
GLAZING AREA	0.974	m^2
OPENABLE AREA	1.132	m^2
FREE AREA	60.8	%

WINDOW MARK	W03 / T5
LOCATION	5F~15F FLAT A KITCHEN
SECTION	70mm ALUM. SECTION
GLAZING	GL01
QUANTITY	10 Nos.
REMARKS	FACADE(T5-01-01A/5F & 16F; T5-01-01B/23F; T5-01-01/6~15F)

T:\Jobs\J-853\2. Outgoing\Black plate opening of Windows Louvre\Black Plate of T5 Precat Window.dwg

B.D. REF :

CLIENT :
SHIMAO GROUP HOLDINGS LIMITED

ARCHITECT :
WONG TUNG & PARTNERS LIMITED
ARCHITECTS & PLANNERS

MAIN CONTRACTOR :
協興建築有限公司
HIP HING CONSTRUCTION CO LTD

STRUCTURAL ENGINEER :
CMA C M WONG & ASSOCIATES LTD
黃志明建築工程師有限公司

FACADE CONSULTANT:
MEINHARDT

NOTE :
1. ALL DIMENSIONS ARE IN mm.
2. ALL ELEVATIONS ARE VIEWED FROM OUTSIDE.
3. ALL DIMENSIONS TO BE VERIFIED ON SITE BEFORE FABRICATION.

LEGEND :
X1 / X001 — DETAIL MARK NO. / REFER SHEET NO.
1. F.F.L. — FINISHED FLOOR LEVEL
2. S.F.L. — STRUCTURAL FLOOR LEVEL
3. R — REVERSED DETAIL
4. ▲ — FIXING LOCATION
5. △ — FIXING LUG LOCATION
6. GLASS LEGEND
GL01 — 10mm+12mm AIR GAP+10mm THK. I.G.U.
GL04 — 12mm THK. CLEAR TEMPERED GLASS
GL05 — 10mm+12mm AIR GAP+10mm THK. I.G.U.
GL06 — 10mm+12mm AIR GAP+12mm THK. I.G.U.
PD01 — 10mm T.P+12mm AIR GAP+8mm T.P
GL07 — 10mm+12mm AIR GAP+12mm THK. I.G.U.
GL08 — 10mm+12mm AIR GAP+10mm THK. I.G.U.

NO.	DATE	REMARK	BY
D	08/07/2022	GENERAL REVISION	ada

JOB NO. : J-853

PROJECT :
PROPOSED RESIDENTIAL DEVELOPMENT AT N.K.I.L. 6542 YIN PING ROAD KOWLOON

TITLE :
WINDOW SCHEDULE FOR TOWER 5 ALUM. WINDOW

DATE : 03-APR-21 | SCALE : 1:40

DRAWN BY : | CHECKED BY :

美特鋁質有限公司
MIDI ALUMINIUM FABRICATOR LTD.
Units 6-8, Sunray Industrial Centre, 1/F
610 Cha Kwo Ling Road, Kowloon
Tel:23489211-4 Fax:(852)27727666

DWG NO. : J853-SD-PW-SC501 | REV. : D

ELEVATION

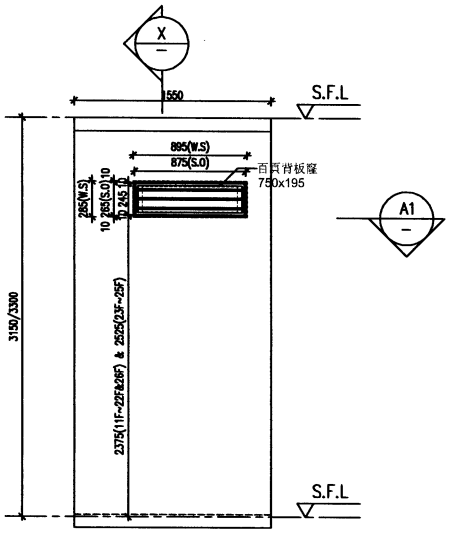

A1 PART PLAN

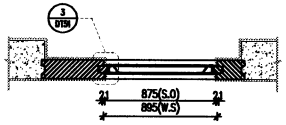

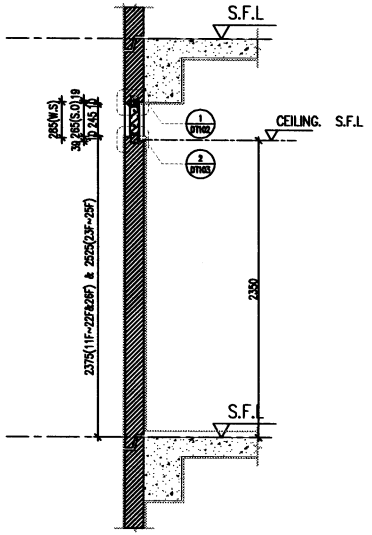

X PART SECTION

PROVIDED		
GLAZING AREA	–	m^2
OPENABLE AREA	–	m^2
FREE AREA	54.4	%

WINDOW MARK	L02 / T5
LOCATION	11F~26F FLAT F OPEN KIT.
SECTION	70mm ALUM. LOUVER
GLAZING	–
QUANTITY	13 Nos.
REMARKS	FACADE (T5–03–04/11~15F&17F~22F; T5–03–04A/16F&25F~26F; T5–03–04B/23F)

T:\Jobs\J-853\2. Outgoing\Black plate opening of Windows Louvre\Black Plate of T5 Precat Window.dwg

B.D. REF :

CLIENT :
SHIMAO GROUP HOLDINGS LIMITED

ARCHITECT :
WONG TUNG & PARTNERS LIMITED
ARCHITECTS & PLANNERS

MAIN CONTRACTOR :
協興建築有限公司
HIP HING CONSTRUCTION CO LTD

STRUCTURAL ENGINEER :
CMA C M WONG & ASSOCIATES LTD
黃志明建築工程師有限公司

FACADE CONSULTANT:
MEINHARDT

NOTE :
1. ALL DIMENSIONS ARE IN mm.
2. ALL ELEVATIONS ARE VIEWED FROM OUTSIDE.
3. ALL DIMENSIONS TO BE VERIFIED ON SITE BEFORE FABRICATION.

LEGEND :
X1 / X0001 — DETAIL MARK NO. / REFER SHEET NO.
1. F.F.L. — FINISHED FLOOR LEVEL
2. S.F.L. — STRUCTURAL FLOOR LEVEL
3. (N) — REVERSED DETAIL
4. ▲ — FIXING LOCATION
5. △ — FIXING LUG LOCATION
6. GLASS LEGEND
GL01 — 10mm+12mm AIR GAP+10mm THK. I.G.U.
GL04 — 12mm THK. CLEAR TEMPERED GLASS
GL05 — 10mm+12mm AIR GAP+10mm THK. I.G.U.
GL06 — 10mm+12mm AIR GAP+12mm THK. I.G.U.
PD01 — 10mm T.P+12mm AIR GAP+8mm T.P
GL07 — 10mm+12mm AIR GAP+12mm THK. I.G.U.
GL08 — 10mm+12mm AIR GAP+10mm THK. I.G.U.

NO.	DATE	REVISED	BY
B	05/07/2022	GENERAL REVISION	ada
A	28/07/2021	REVISION SUBJECT TO ARCH.COMMENT	

JOB NO. : J–853

PROJECT :
PROPOSED RESIDENTIAL DEVELOPMENT AT N.K.I.L. 6542 YIN PING ROAD KOWLOON

TITLE :
WINDOW SCHEDULE FOR TOWER 5 ALUM. WINDOW

DATE : 03–APR–21 | SCALE : 1:40

DRAWN BY : | CHECKED BY :

美特鋁質有限公司
MIDI ALUMINIUM FABRICATOR LTD.
Units 6–8, Sunray Industrial Centre, 1/F
610 Cha Kwo Ling Road, Kowloon
Tel:23489211–4 Fax:(852)27727666

DWG NO. : J853–SD–PW–SC522 | REV. : B

ELEVATION

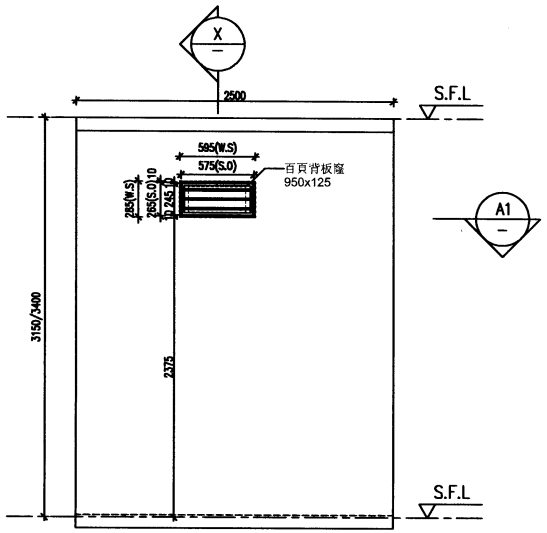

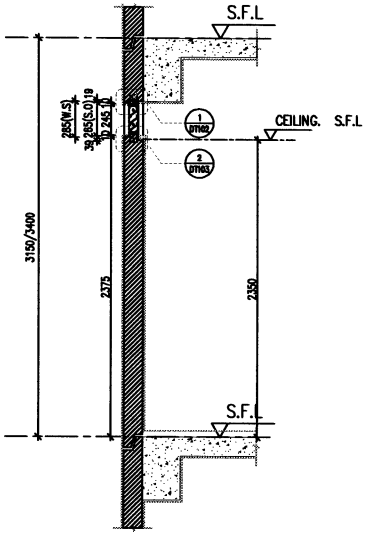

X PART SECTION

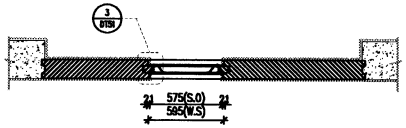

A1 PART PLAN

PROVIDED		
GLAZING AREA	–	m^2
OPENABLE AREA	–	m^2
FREE AREA	54.4	%

WINDOW MARK	L01 / T5
LOCATION	5/F; 17~25F FLAT A KITCHEN
SECTION	70mm ALUM. LOUVER
GLAZING	–
QUANTITY	9 Nos.
REMARKS	FACADE (T5–02–07/17F~22F; T5–02–07A/5F & 25F; T5–02–07B/23F)

B.D. REF :

CLIENT :
SHIMAO GROUP HOLDINGS LIMITED

ARCHITECT :
WONG TUNG & PARTNERS LIMITED
ARCHITECTS & PLANNERS

MAIN CONTRACTOR :
協興建築有限公司
HIP HING CONSTRUCTION CO LTD

STRUCTURAL ENGINEER :
C M WONG & ASSOCIATES LTD
黃志明建築工程師有限公司

FACADE CONSULTANT:
MEINHARDT

NOTE :
1. ALL DIMENSIONS ARE IN mm.
2. ALL ELEVATIONS ARE VIEWED FROM OUTSIDE.
3. ALL DIMENSIONS TO BE VERIFIED ON SITE BEFORE FABRICATION.

LEGEND :
X1 / 2D01 — DETAIL MARK NO. / REFER SHEET NO.
1. F.F.L. — FINISHED FLOOR LEVEL
2. S.F.L. — STRUCTURAL FLOOR LEVEL
3. (N) — REVERSED DETAIL
4. ▲ — FIXING LOCATION
5. △ — FIXING LUG LOCATION
6. GLASS LEGEND
GL01 — 10mm+12mm AIR GAP+10mm THK. L.G.U.
GL04 — 12mm THK. CLEAR TEMPERED GLASS
GL05 — 10mm+12mm AIR GAP+10mm THK. L.G.U.
GL06 — 10mm+12mm AIR GAP+12mm THK. L.G.U.
PD01 — 10mm T.P+12mm AIR GAP+8mm T.P
GL07 — 10mm+12mm AIR GAP+12mm THK. L.G.U.
GL08 — 10mm+12mm AIR GAP+10mm THK. L.G.U.

NO.	DATE	REMARK	BY
A	08/07/2022	GENERAL REVISION	

JOB NO. : J–853

PROJECT :
PROPOSED RESIDENTIAL DEVELOPMENT AT N.K.I.L. 6542 YIN PING ROAD KOWLOON

TITLE :
WINDOW SCHEDULE FOR TOWER 5 ALUM. WINDOW

DATE : 03–APR–21 | SCALE : 1:40

DRAWN BY : | CHECKED BY :

美特鋁製有限公司
MIDI ALUMINIUM FABRICATORS LTD.
Units 6–8, Sunray Industrial Centre, 1/F
610 Cha Kwo Ling Road, Kowloon
Tel:23489211–4 Fax:(852)27727666

DWG NO. : J853–SD–PW–SC520 | REV. : A

T:\Jobs\J-853\2. Outgoing\Black plate opening of Windows Louvre\Black Plate of T5 Precat Window.dwg

ELEVATION

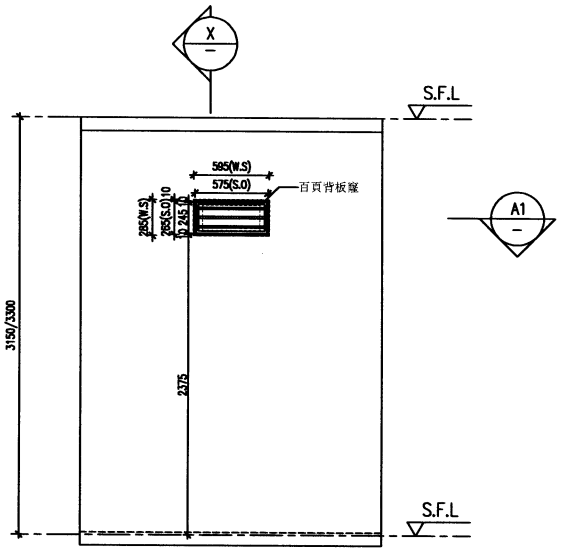

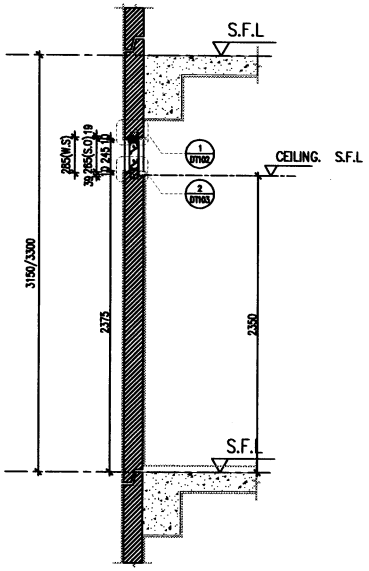

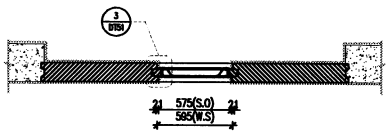

A1 PART PLAN

PROVIDED		
GLAZING AREA	–	m^2
OPENABLE AREA	–	m^2
FREE AREA	54.4	%

WINDOW MARK	L01 / T5
LOCATION	5F&25F FLAT A KITCHEN
SECTION	70mm ALUM. LOUVER
GLAZING	
QUANTITY	9 Nos.
REMARKS	FACADE (T5-03-02A/16F; T5-03-02/6F-15F)

B.D. REF :

CLIENT :
SHIMAO GROUP HOLDINGS LIMITED

ARCHITECT :
WONG TUNG & PARTNERS LIMITED
ARCHITECTS & PLANNERS

MAIN CONTRACTOR :
協興建築有限公司
HIP HING CONSTRUCTION CO LTD

STRUCTURAL ENGINEER :
CMA C M WONG & ASSOCIATES LTD
黃志明建築工程師有限公司

FACADE CONSULTANT:
MEINHARDT

NOTE :
1. ALL DIMENSIONS ARE IN mm.
2. ALL ELEVATIONS ARE VIEWED FROM OUTSIDE.
3. ALL DIMENSIONS TO BE VERIFIED ON SITE BEFORE FABRICATION.

LEGEND :
X1 / X2/S1 — DETAIL MARK NO. / REFER SHEET NO.
1. F.F.L. — FINISHED FLOOR LEVEL
2. S.F.L. — STRUCTURAL FLOOR LEVEL
3. (N) — REVERSED DETAIL
4. ▲ — FIXING LOCATION
5. △ — FIXING LUG LOCATION
6. GLASS LEGEND
GL01 — 10mm+12mm AIR GAP+10mm THK. L.G.U.
GL04 — 12mm THK. CLEAR TEMPERED GLASS
GL05 — 10mm+12mm AIR GAP+10mm THK. L.G.U.
GL06 — 10mm+12mm AIR GAP+12mm THK. L.G.U.
PD01 — 10mm T.P+12mm AIR GAP+8mm T.P
GL07 — 10mm+12mm AIR GAP+12mm THK. L.G.U.
GL08 — 10mm+12mm AIR GAP+10mm THK. L.G.U.

NO.	DATE	REMARK	BY
A	08/07/2022	GENERAL REVISION	

JOB NO. : J-853

PROJECT :
PROPOSED RESIDENTIAL DEVELOPMENT AT N.K.I.L. 6542 YIN PING ROAD KOWLOON

TITLE :
WINDOW SCHEDULE FOR TOWER 5 ALUM. WINDOW

DATE : 03-APR-21 | SCALE : 1:40

DRAWN BY : | CHECKED BY :

美特鋁製有限公司
MIDI ALUMINIUM FABRICATION LTD.
Units 6-8, Sunray Industrial Centre, 1/F
610 Cha Kwo Ling Road, Kowloon
Tel:23489211-4 Fax:(852)27727666

DWG NO. : J853-SD-PW-SC521 | REV. : A

T:\Jobs\J-853\2. Outgoing\Black plate opening of Windows Louvre\Black Plate of T5 Precat Window.dwg

ELEVATION

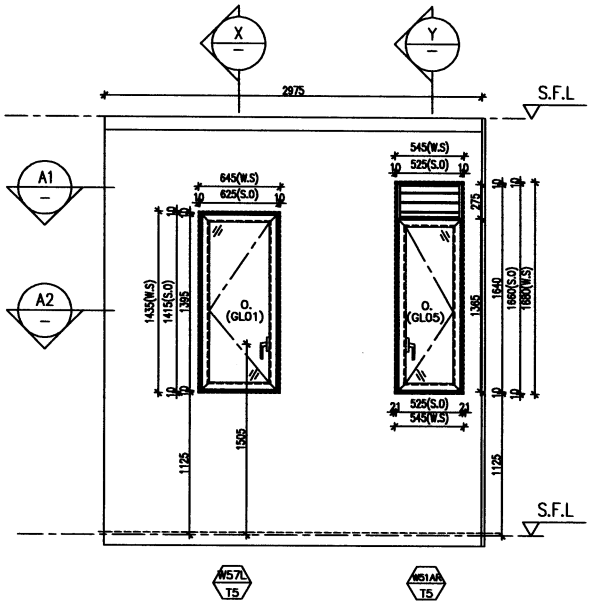

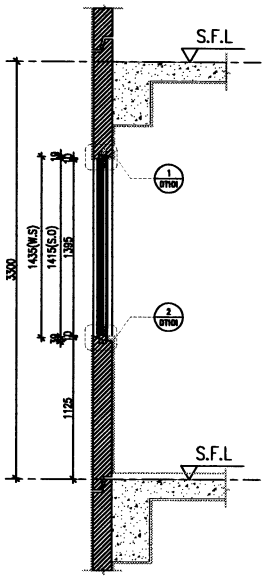

X PART SECTION

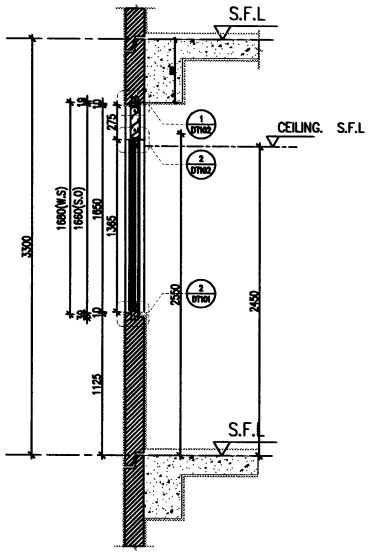

X PART SECTION

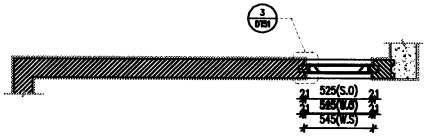

A1 PART PLAN

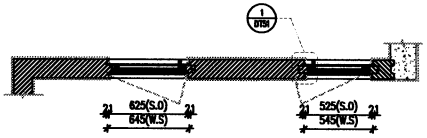

A2 PART PLAN

PROVIDED		
GLAZING AREA	0.459	m^2
OPENABLE AREA	0.543	m^2
FREE AREA	–	%

W51AR T5

PROVIDED		
GLAZING AREA	0.594	m^2
OPENABLE AREA	0.683	m^2
FREE AREA	60.8	%

W57L T5

WINDOW MARK	W57L T5 & W51AR T5
LOCATION	25F FLAT A LAY.UTILITY
SECTION	70mm ALUM. SECTION
GLAZING	W57L-GL01 /W51R-GL05
QUANTITY	1 No.
REMARKS	FACADE: (T5-02-05A/25F)

B.D. REF :

CLIENT :
SHIMAO GROUP HOLDINGS LIMITED

ARCHITECT :
WONG TUNG & PARTNERS LIMITED
ARCHITECTS & PLANNERS

MAIN CONTRACTOR :
協興建築有限公司
HIP HING CONSTRUCTION CO LTD

STRUCTURAL ENGINEER :
C M WONG & ASSOCIATES LTD
黃志明建築工程師有限公司

FACADE CONSULTANT:
MEINHARDT

NOTE :
1. ALL DIMENSIONS ARE IN mm.
2. ALL ELEVATIONS ARE VIEWED FROM OUTSIDE.
3. ALL DIMENSIONS TO BE VERIFIED ON SITE BEFORE FABRICATION.

LEGEND :
- X1 / XDG1 — DETAIL MARK NO. / REFER SHEET NO.
1. F.F.L. — FINISHED FLOOR LEVEL
2. S.F.L. — STRUCTURAL FLOOR LEVEL
3. (R) — REVERSED DETAIL
4. ▲ — FIXING LOCATION
5. △ — FIXING LUG LOCATION
6. GLASS LEGEND
GL01 — 10mm+12mm AIR GAP+10mm THK. I.G.U.
GL04 — 12mm THK. CLEAR TEMPERED GLASS
GL05 — 10mm+12mm AIR GAP+10mm THK. I.G.U.
GL06 — 10mm+12mm AIR GAP+12mm THK. I.G.U.
PD01 — 10mm T.P+12mm AIR GAP+8mm T.P
GL07 — 10mm+12mm AIR GAP+12mm THK. I.G.U.
GL08 — 10mm+12mm AIR GAP+10mm THK. I.G.U.

NO.	DATE	REVISED	BY
B	31/08/2022	GENERAL REVISION	ada
A	28/07/2021	REVISION SUBJECT TO ARCH.COMMENT	ada

JOB NO. : J-853

PROJECT :
PROPOSED RESIDENTIAL DEVELOPMENT AT N.K.I.L. 6542
YIN PING ROAD
KOWLOON

TITLE :
WINDOW SCHEDULE FOR TOWER 5 ALUM. WINDOW

DATE : 03-APR-21 | SCALE : 1:40

DRAWN BY : | CHECKED BY :

美特鋁製有限公司
MIDI ALUMINIUM FABRICATION LTD.
Units 6-8, Sunray Industrial Centre, 1/F
610 Cha Kwo Ling Road, Kowloon
Tel:23489211-4 Fax:(852)27727666

DWG NO. : J853-SD-PW-SC518a | REV. : B

T:\Jobs\J-853\2. Outgoing\Black plate opening of Windows Louvre\Black Plate of T5 Precat Window.dwg

ELEVATION

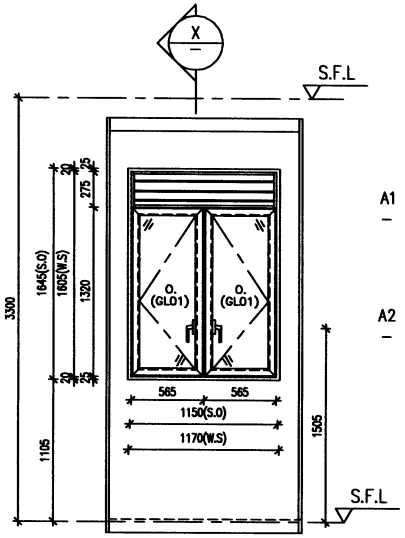

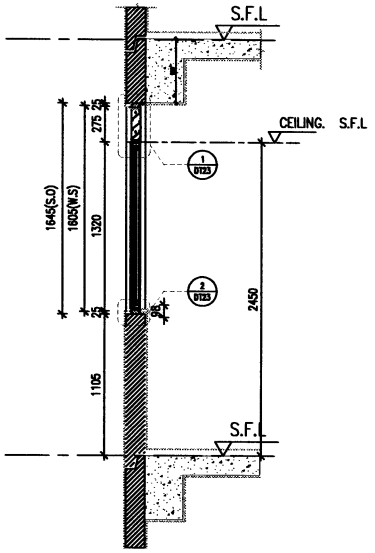

X PART SECTION

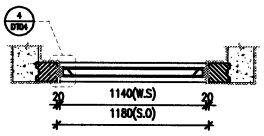

A1 PART PLAN

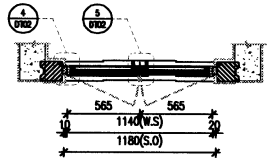

A2 PART PLAN

PROVIDED		
GLAZING AREA	0.942	m^2
OPENABLE AREA	1.125	m^2
FREE AREA	60.7	%

WINDOW MARK	W03A T7
LOCATION	25F FLAT B KITCHEN
SECTION	70mm ALUM. SECTION
GLAZING	GL01
QUANTITY	1 Nos.
REMARKS	FACADE (T7-01-04/25F)

B.D. REF :

CLIENT :
SHIMAO GROUP HOLDINGS LIMITED

ARCHITECT :
WONG TUNG & PARTNERS LIMITED
ARCHITECTS & PLANNERS

MAIN CONTRACTOR :
協興建築有限公司
HIP HING CONSTRUCTION CO LTD

STRUCTURAL ENGINEER :
C M WONG & ASSOCIATES LTD
Consulting Engineers

SITE IN SITU CONSULTANT:
MEINHARDT

NOTE :
1. ALL DIMENSIONS ARE IN mm.
2. ALL ELEVATIONS ARE VIEWED FROM OUTSIDE.
3. ALL DIMENSIONS TO BE VERIFIED ON SITE BEFORE FABRICATION.

LEGEND :
X1 — DETAIL MARK NO.
J0001 — REFER SHEET NO.

1. F.F.L. — FINISHED FLOOR LEVEL
2. S.F.L. — STRUCTURAL FLOOR LEVEL
3. (R) — REVERSED DETAIL
4. ▲ — FIXING LOCATION
5. △ — FIXING LUG LOCATION
6. GLASS LEGEND
   - GL01 — 10mm+12mm AIR GAP+10mm THK. I.G.U.
   - GL05 — 10mm+12mm AIR GAP+10mm THK. I.G.U.
   - GL06 — 10mm+12mm AIR GAP+12mm THK. I.G.U.
   - PD01 — 10mm T.P+12mm AIR GAP+8mm T.P
   - GL07 — 10mm+12mm AIR GAP+12mm THK. I.G.U.
   - GL08 — 10mm+12mm AIR GAP+10mm THK. I.G.U.

NO.	DATE	REVISED	BY

JOB NO. : J-853

PROJECT :
PROPOSED RESIDENTIAL DEVELOPMENT AT N.K.I.L. 6542 YIN PING ROAD KOWLOON

TITLE :
WINDOW SCHEDULE FOR TOWER 7 ALUM. WINDOW

DATE : 16-SEP-22 | SCALE : 1:40

DRAWN BY : JK | CHECKED BY :

美特鋁製有限公司
MIDI ALUMINIUM FABRICATOR LTD.
Units 6-8, Sunray Industrial Centre, 1/F
610 Cha Kwo Ling Road, Kowloon
Tel:23489211-4 Fax:(852)27727666

DWG NO. : J853-SD-IW-SC711 | REV. : -

ELEVATION

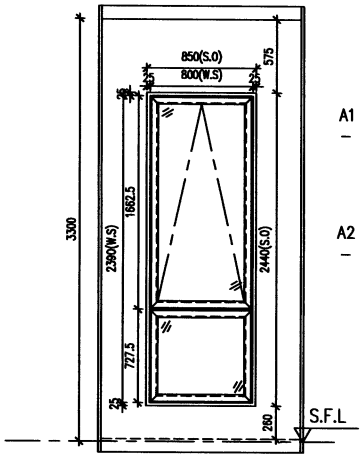

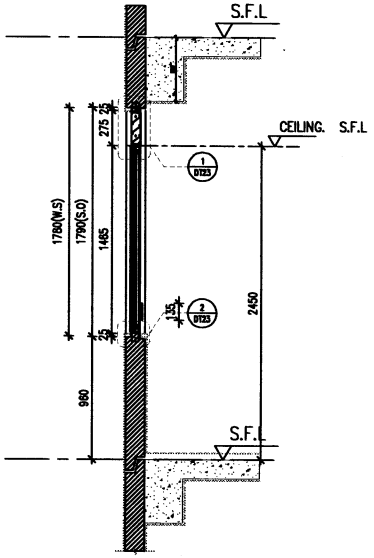

X
–
PART SECTION

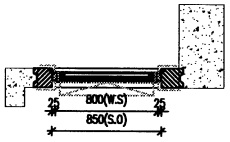

A1
–
PART PLAN

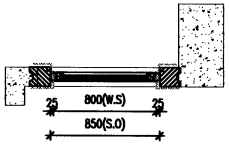

A2
–
PART PLAN

PROVIDED		
GLAZING AREA	0.513	m^2
OPENABLE AREA	0.611	m^2
FREE AREA	60.7	%

WINDOW MARK	WDSR T7
LOCATION	26F FLAT B ENSUITE 3 BATH
SECTION	70mm ALUM. SECTION
GLAZING	GL05
QUANTITY	1 Nos.
REMARKS	SITE IN-SITU

B.D. REF :

CLIENT :
SHIMAO GROUP HOLDINGS LIMITED

ARCHITECT :
WONG TUNG & PARTNERS LIMITED
ARCHITECTS & PLANNERS

MAIN CONTRACTOR :
協興建築有限公司
HIP HING CONSTRUCTION CO LTD

STRUCTURAL ENGINEER :
C M WONG & ASSOCIATES LTD
Consulting Engineers

SITE IN SITU CONSULTANT:
MEINHARDT

NOTE :
1. ALL DIMENSIONS ARE IN mm.
2. ALL ELEVATIONS ARE VIEWED FROM OUTSIDE.
3. ALL DIMENSIONS TO BE VERIFIED ON SITE BEFORE FABRICATION.

LEGEND :
X1 / XX01 — DETAIL MARK NO. / REFER SHEET NO.
1. F.F.L. — FINISHED FLOOR LEVEL
2. S.F.L. — STRUCTURAL FLOOR LEVEL
3. (R) — REVERSED DETAIL
4. ▲ — FIXING LOCATION
5. △ — FIXING LUG LOCATION
6. GLASS LEGEND
GL01 — 10mm+12mm AIR GAP+10mm THK. I.G.U.
GL05 — 10mm+12mm AIR GAP+10mm THK. I.G.U.
GL06 — 10mm+12mm AIR GAP+12mm THK. I.G.U.
PD01 — 10mm T.P+12mm AIR GAP+8mm T.P
GL07 — 10mm+12mm AIR GAP+12mm THK. I.G.U.
GL08 — 10mm+12mm AIR GAP+10mm THK. I.G.U.

NO.	DATE	REMARK	BY

JOB NO. : J-853

PROJECT :
PROPOSED RESIDENTIAL DEVELOPMENT AT N.K.I.L. 6542 YIN PING ROAD KOWLOON

TITLE :
WINDOW SCHEDULE FOR TOWER 7 ALUM. WINDOW

DATE : 16-SEP-22 | SCALE : 1:40

DRAWN BY : JK | CHECKED BY :

美特鋁質有限公司
MIDI ALUMINIUM FABRICATOR LTD.
Units 6-8, Sunray Industrial Centre, 1/F
610 Cha Kwo Ling Road, Kowloon
Tel:23489211-4 Fax:(852)27727666

DWG NO. : J853-SD-IW-SC711a | REV. : –

ELEVATION

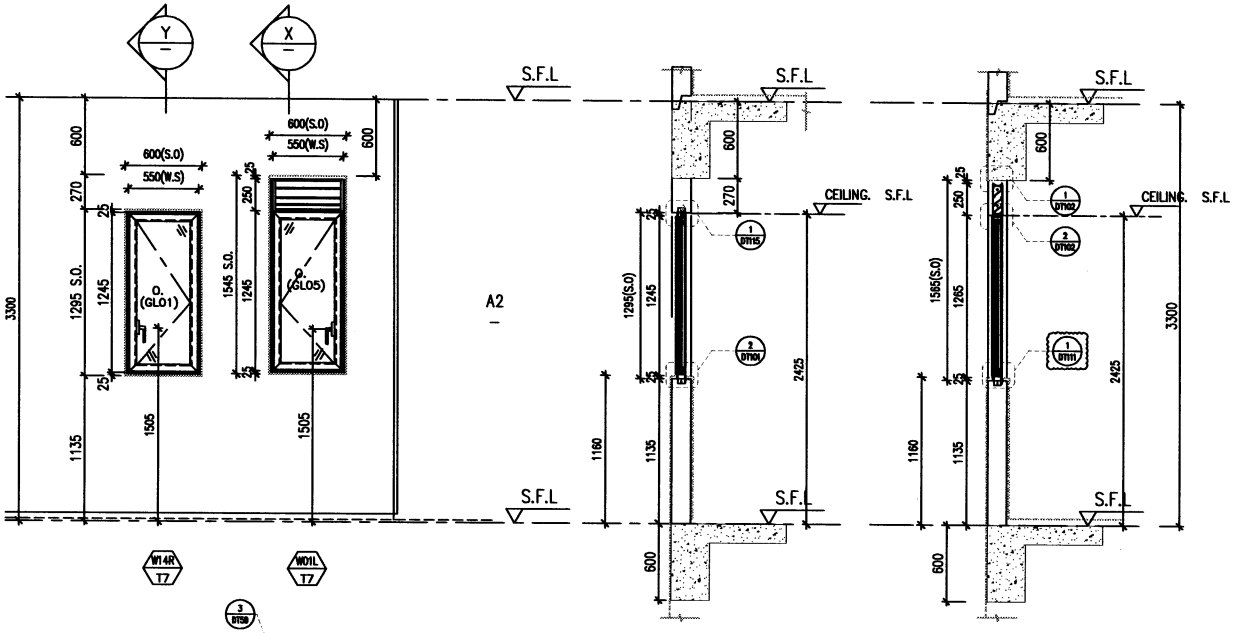

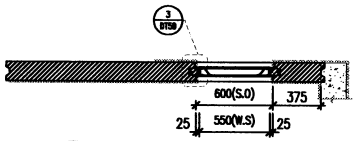

A1 PART PLAN

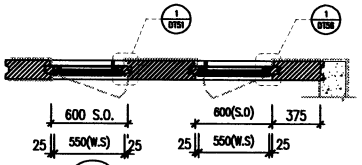

A2 PART PLAN

Y PART SECTION

X PART SECTION

PROVIDED		
GLAZING AREA	0.524	m^2
OPENABLE AREA	0.618	m^2
FREE AREA	–	%

W01R T7

PROVIDED		
GLAZING AREA	0.865	m^2
OPENABLE AREA	1.044	m^2
FREE AREA	60.7	%

W14R T7

WINDOW MARK	W01L T7, W14R T7
LOCATION	T7 25F FLAT B UTILITY & LAV
SECTION	70mm ALUM. SECTION
GLAZING	GL01
QUANTITY	1 Nos./ 1 Nos.
REMARKS	IN-SITU WINDOW

B.D. REF :

CLIENT :
SHIMAO GROUP HOLDINGS LIMITED

ARCHITECT :
WONG TUNG & PARTNERS LIMITED
ARCHITECTS & PLANNERS

MAIN CONTRACTOR :
協興建築有限公司
HIP HING CONSTRUCTION CO LTD

STRUCTURAL ENGINEER :
C M WONG & ASSOCIATES LTD
Consulting Engineers

SITE IN SITU CONSULTANT:
MEINHARDT

NOTE :
1. ALL DIMENSIONS ARE IN mm.
2. ALL ELEVATIONS ARE VIEWED FROM OUTSIDE.
3. ALL DIMENSIONS TO BE VERIFIED ON SITE BEFORE FABRICATION.

LEGEND :
X1 / 2001 — DETAIL MARK NO. / REFER SHEET NO.
1. F.F.L. — FINISHED FLOOR LEVEL
2. S.F.L. — STRUCTURAL FLOOR LEVEL
3. (R) — REVERSED DETAIL
4. ▲ — FIXING LOCATION
5. △ — FIXING LUG LOCATION
6. GLASS LEGEND
GL01 — 10mm+12mm AIR GAP+10mm THK. I.G.U.
GL05 — 10mm+12mm AIR GAP+10mm THK. I.G.U.
GL06 — 10mm+12mm AIR GAP+12mm THK. I.G.U.
PD01 — 10mm T.P+12mm AIR GAP+8mm T.P
GL07 — 10mm+12mm AIR GAP+12mm THK. I.G.U.
GL08 — 10mm+12mm AIR GAP+10mm THK. I.G.U.

NO.	DATE	REVISED	BY

JOB NO. : J-853

PROJECT :
PROPOSED RESIDENTIAL DEVELOPMENT AT N.K.I.L. 6542 YIN PING ROAD KOWLOON

TITLE :
WINDOW SCHEDULE FOR TOWER 7 ALUM. WINDOW

DATE : 03-APR-21 | SCALE : 1:40

DRAWN BY : | CHECKED BY :

美特鋁質有限公司
MIDI ALUMINIUM FABRICATOR LTD.
Units 6-8, Sunray Industrial Centre, 1/F
610 Cho Kwo Ling Road, Kowloon
Tel:23489211-4 Fax:(852)27727666

DWG NO. : J853-SD-IW-SC710 | REV. : –

ELEVATION

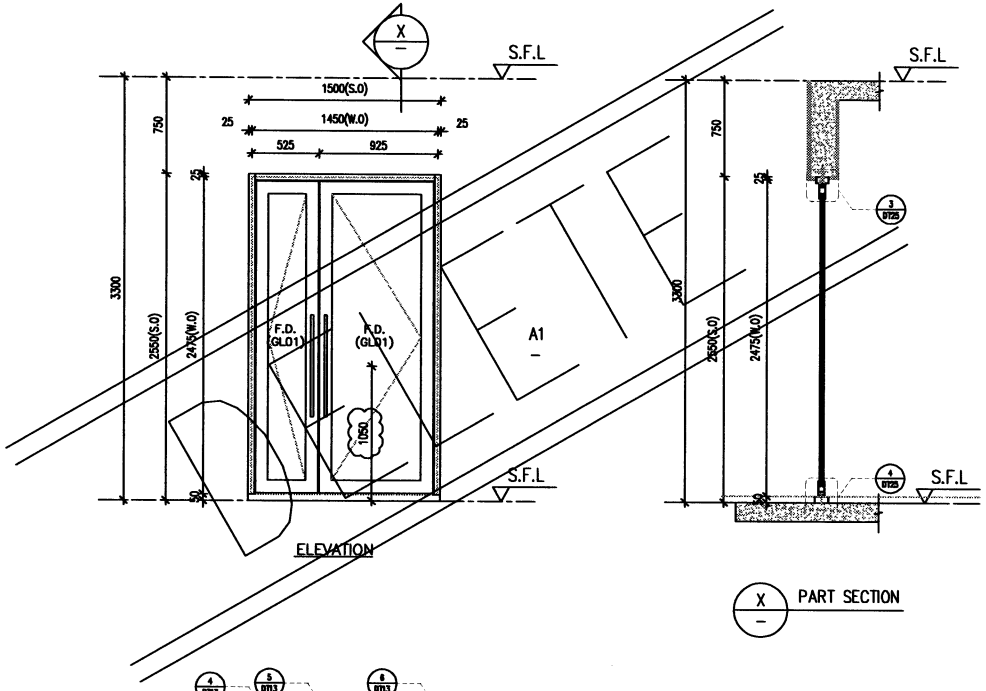

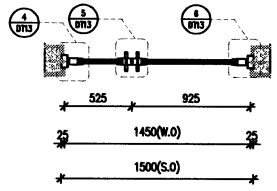

A1 PART PLAN

PROVIDED		
GLAZING AREA	1.104	m^2
OPENABLE AREA	1.82	m^2
FREE AREA	–	%

WINDOW MARK	W121 / T7
LOCATION	5F LOBBY
SECTION	52mm ALUM. SECTION
GLAZING	GL01
QUANTITY	1 Nos.
REMARKS	SITE IN SITU

B.D. REF :

CLIENT :
SHIMAO GROUP HOLDINGS LIMITED

ARCHITECT :
WONG TUNG & PARTNERS LIMITED
ARCHITECTS & PLANNERS

MAIN CONTRACTOR :
協興建築有限公司
HIP HING CONSTRUCTION CO LTD

STRUCTURAL ENGINEER :
C M WONG & ASSOCIATES LTD
Consulting Engineers

SITE IN SITU CONSULTANT:
MEINHARDT

NOTE :
1. ALL DIMENSIONS ARE IN mm.
2. ALL ELEVATIONS ARE VIEWED FROM OUTSIDE.
3. ALL DIMENSIONS TO BE VERIFIED ON SITE BEFORE FABRICATION.

LEGEND :
X1 / 2001 — DETAIL MARK NO. / REFER SHEET NO.
1. F.F.L. — FINISHED FLOOR LEVEL
2. S.F.L. — STRUCTURAL FLOOR LEVEL
3. (R) — REVERSED DETAIL
4. ▲ — FIXING LOCATION
5. △ — FIXING LUG LOCATION
6. GLASS LEGEND
GL01 — 10mm+12mm AIR GAP+10mm THK. LG.U.
GL05 — 10mm+12mm AIR GAP+10mm THK. LG.U.
GL06 — 10mm+12mm AIR GAP+12mm THK. LG.U.
PD01 — 10mm T.P+12mm AIR GAP+8mm T.P
GL07 — 10mm+12mm AIR GAP+12mm THK. LG.U.
GL08 — 10mm+12mm AIR GAP+10mm THK. LG.U.

NO.	DATE	REMARKS	BY
A	28/09/2021	REVISION SUBJECT TO ARCH.COMMENT	

JOB NO. : J-853

PROJECT :
PROPOSED RESIDENTIAL DEVELOPMENT AT N.K.I.L. 6542 YIN PING ROAD KOWLOON

TITLE :
WINDOW SCHEDULE FOR TOWER 7 ALUM. WINDOW

DATE : 03-APR-21 | SCALE : 1:40

DRAWN BY : | CHECKED BY :

美特鋁製有限公司
MIDI ALUMINIUM FABRICATOR LTD.
Units 6-8, Sunray Industrial Centre, 1/F
610 Cha Kwo Ling Road, Kowloon
Tel:23489211-4 Fax:(852)27727666

DWG NO. : J853-SD-IW-SC709 | REV. : A

ELEVATION

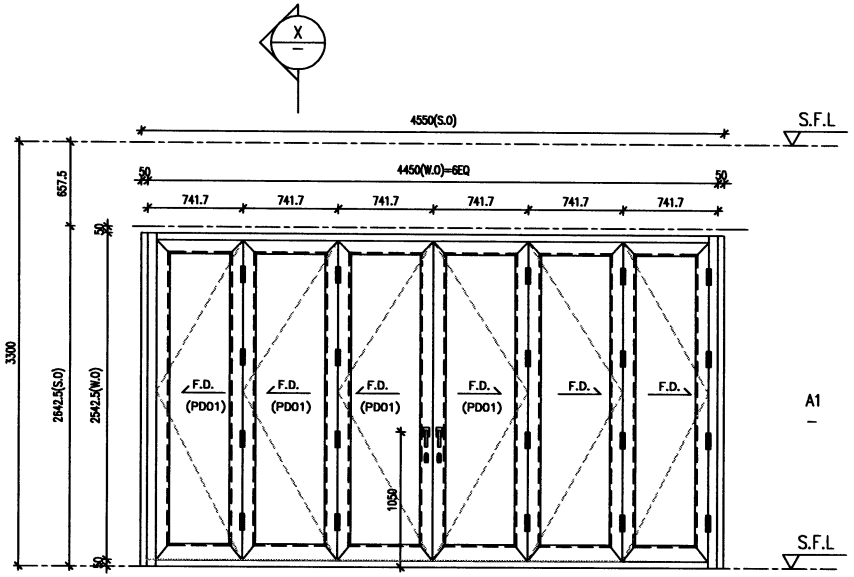

ELEVATION

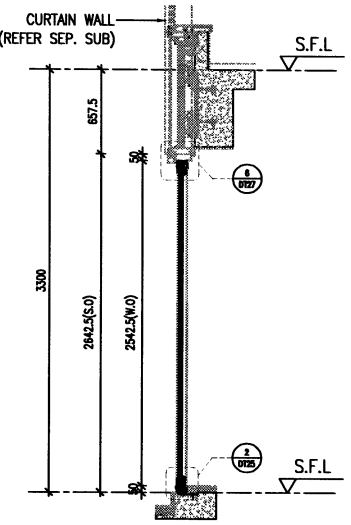

X — PART SECTION

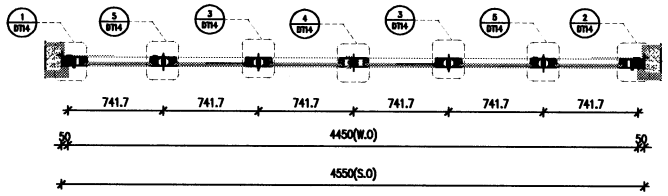

A1 — PART PLAN

PROVIDED		
GLAZING AREA	4.067	m^2
OPENABLE AREA	4.526	m^2
FREE AREA	—	%

WINDOW MARK	W302 T7
LOCATION	25F UNIT B LIVING
SECTION	70mm ALUM. SECTION
GLAZING	PD01
QUANTITY	1 Nos.
REMARKS	SITE IN SITU

B.D. REF :

CLIENT :
SHIMAO GROUP HOLDINGS LIMITED

ARCHITECT :
WONG TUNG & PARTNERS LIMITED
ARCHITECTS & PLANNERS

MAIN CONTRACTOR :
協興建築有限公司
HIP HING CONSTRUCTION CO LTD

STRUCTURAL ENGINEER :
C M WONG & ASSOCIATES LTD
Consulting Engineers

SITE IN SITU CONSULTANT:
MEINHARDT

NOTE :
1. ALL DIMENSIONS ARE IN mm.
2. ALL ELEVATIONS ARE VIEWED FROM OUTSIDE.
3. ALL DIMENSIONS TO BE VERIFIED ON SITE BEFORE FABRICATION.

LEGEND :
X1 — DETAIL MARK NO.
X0001 — REFER SHEET NO.

1. F.F.L. — FINISHED FLOOR LEVEL
2. S.F.L. — STRUCTURAL FLOOR LEVEL
3. (R) — REVERSED DETAIL
4. ▲ — FIXING LOCATION
5. △ — FIXING LUG LOCATION
6. GLASS LEGEND
   GL01 — 10mm+12mm AIR GAP+10mm THK. I.G.U.
   GL05 — 10mm+12mm AIR GAP+10mm THK. I.G.U.
   GL06 — 10mm+12mm AIR GAP+12mm THK. I.G.U.
   PD01 — 10mm T.P+12mm AIR GAP+8mm T.P
   GL07 — 10mm+12mm AIR GAP+12mm THK. I.G.U.
   GL08 — 10mm+12mm AIR GAP+10mm THK. I.G.U.

NO.	DATE	REMARK	BY
C	18/04/2022	REVISION SUBJECT TO ARCH.COMMENT	LHK
B	16/12/2021	REVISION SUBJECT TO ARCH.COMMENT	LHK
A	28/08/2021	REVISION SUBJECT TO ARCH.COMMENT	WSH

JOB NO. : J-853

PROJECT :
PROPOSED RESIDENTIAL DEVELOPMENT AT N.K.I.L. 6542 YIN PING ROAD KOWLOON

TITLE :
WINDOW SCHEDULE FOR TOWER 7 ALUM. WINDOW

DATE : 03-APR-21 | SCALE : 1:40

DRAWN BY : | CHECKED BY :

美特鋁製有限公司
MIDI ALUMINIUM FABRICATOR LTD.
Units 6-8, Sunray Industrial Centre, 1/F
610 Cha Kwo Ling Road, Kowloon
Tel:23489211-4 Fax:(852)27727666

DWG NO. : J853-SD-IW-SC708 | REV. : C

ELEVATION

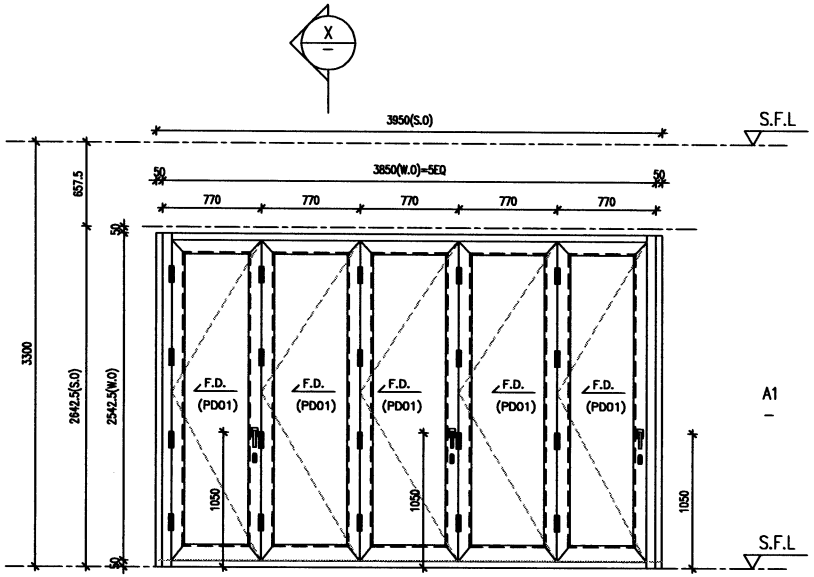

ELEVATION

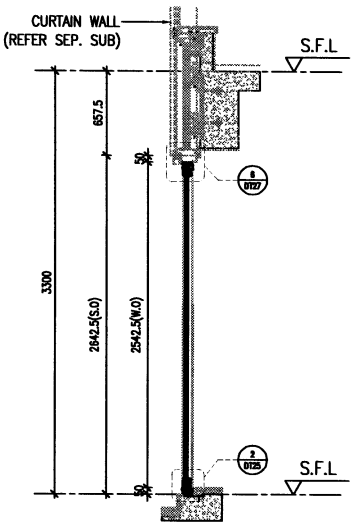

X/— PART SECTION

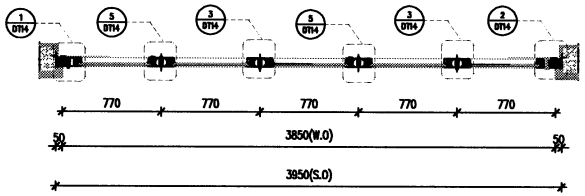

A1/— PART PLAN

PROVIDED		
GLAZING AREA	3.546	m^2
OPENABLE AREA	3.753	m^2
FREE AREA	—	%

WINDOW MARK	W301 T7
LOCATION	25F UNIT B LIVING
SECTION	70mm ALUM. SECTION
GLAZING	PD01
QUANTITY	1 Nos.
REMARKS	SITE IN SITU

B.D. REF :

CLIENT :
SHIMAO GROUP HOLDINGS LIMITED

ARCHITECT :
WONG TUNG & PARTNERS LIMITED
ARCHITECTS & PLANNERS

MAIN CONTRACTOR :
協興建築有限公司
HIP HING CONSTRUCTION CO LTD

STRUCTURAL ENGINEER :
C M WONG & ASSOCIATES LTD
Consulting Engineers

SITE IN SITU CONSULTANT:
MEINHARDT

NOTE :
1. ALL DIMENSIONS ARE IN mm.
2. ALL ELEVATIONS ARE VIEWED FROM OUTSIDE.
3. ALL DIMENSIONS TO BE VERIFIED ON SITE BEFORE FABRICATION.

LEGEND :
X1 — DETAIL MARK NO.
X001 — REFER SHEET NO.

1. F.F.L. — FINISHED FLOOR LEVEL
2. S.F.L. — STRUCTURAL FLOOR LEVEL
3. (R) — REVERSED DETAIL
4. ▲ — FIXING LOCATION
5. △ — FIXING LUG LOCATION
6. GLASS LEGEND
   - GL01 — 10mm+12mm AIR GAP+10mm THK. LG.U.
   - GL05 — 10mm+12mm AIR GAP+10mm THK. LG.U.
   - GL06 — 10mm+12mm AIR GAP+12mm THK. LG.U.
   - PD01 — 10mm T.P+12mm AIR GAP+8mm T.P
   - GL07 — 10mm+12mm AIR GAP+12mm THK. LG.U.
   - GL08 — 10mm+12mm AIR GAP+10mm THK. LG.U.

NO.	DATE	REMARKS	BY
C	18/04/2022	REVISION SUBJECT TO ARCH.COMMENT	LHS
B	16/12/2021	REVISION SUBJECT TO ARCH.COMMENT	LHS
A	28/09/2021	REVISION SUBJECT TO ARCH.COMMENT	WSM

JOB NO. : J-853

PROJECT :
PROPOSED RESIDENTIAL DEVELOPMENT AT N.K.I.L. 6542 YIN PING ROAD KOWLOON

TITLE :
WINDOW SCHEDULE FOR TOWER 7 ALUM. WINDOW

DATE : 03-APR-21 | SCALE : 1:40

DRAWN BY : | CHECKED BY :

美特鋁製有限公司
MIDI ALUMINIUM FABRICATOR LTD.
Units 6-8, Sunray Industrial Centre, 1/F
610 Cha Kwo Ling Road, Kowloon
Tel:23489211-4 Fax:(852)27727666

DWG NO. : J853-SD-IW-SC707 | REV. : C

ELEVATION

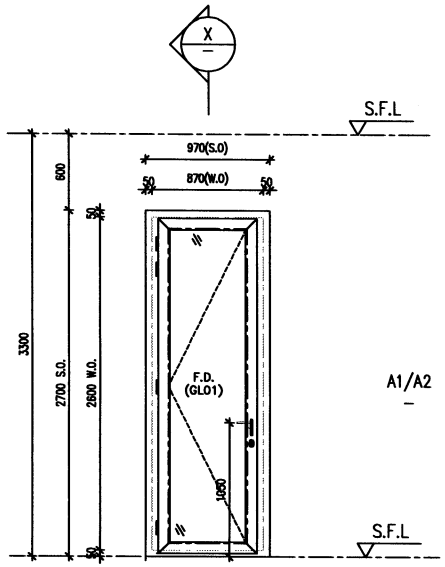

ELEVATION

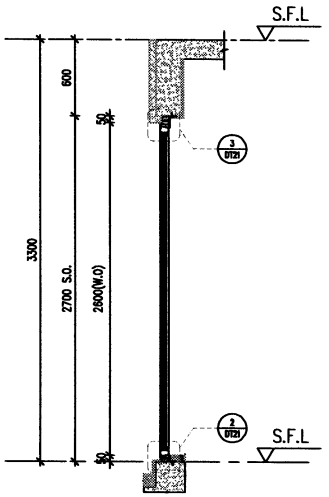

X PART SECTION

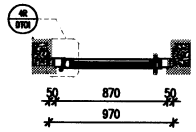

A PART PLAN

PROVIDED		
GLAZING AREA	1.072	m^2
OPENABLE AREA	1.016	m^2
FREE AREA	–	%

WINDOW MARK	W78 / T7
LOCATION	26F UNIT B ENSUITE 3
SECTION	70mm ALUM. SECTION
GLAZING	GL01
QUANTITY	1 Nos.
REMARKS	SITE IN SITU

B.D. REF :

CLIENT :
SHIMAO GROUP HOLDINGS LIMITED

ARCHITECT :
WONG TUNG & PARTNERS LIMITED
ARCHITECTS & PLANNERS

MAIN CONTRACTOR :
協興建築有限公司
HIP HING CONSTRUCTION CO LTD

STRUCTURAL ENGINEER :
C M WONG & ASSOCIATES LTD
Consulting Engineers

SITE IN SITU CONSULTANT:
MEINHARDT

NOTE :
1. ALL DIMENSIONS ARE IN mm.
2. ALL ELEVATIONS ARE VIEWED FROM OUTSIDE.
3. ALL DIMENSIONS TO BE VERIFIED ON SITE BEFORE FABRICATION.

LEGEND :
X1 / X001 — DETAIL MARK NO. / REFER SHEET NO.
1. F.F.L. — FINISHED FLOOR LEVEL
2. S.F.L. — STRUCTURAL FLOOR LEVEL
3. (78) — REVERSED DETAIL
4. ▲ — FIXING LOCATION
5. △ — FIXING LUG LOCATION
6. GLASS LEGEND
GL01 — 10mm+12mm AIR GAP+10mm THK. I.G.U.
GL05 — 10mm+12mm AIR GAP+10mm THK. I.G.U.
GL06 — 10mm+12mm AIR GAP+12mm THK. I.G.U.
PD01 — 10mm T.P+12mm AIR GAP+8mm T.P
GL07 — 10mm+12mm AIR GAP+12mm THK. I.G.U.
GL08 — 10mm+12mm AIR GAP+10mm THK. I.G.U.

NO.	DATE	REMARK	BY
C	18/04/2022	REVISION SUBJECT TO ARCH.COMMENT	LHS
B	16/12/2021	REVISION SUBJECT TO ARCH.COMMENT	LHS
A	28/08/2021	REVISION SUBJECT TO ARCH.COMMENT	WSH

JOB NO. : J-853

PROJECT :
PROPOSED RESIDENTIAL DEVELOPMENT AT N.K.I.L. 6542 YIN PING ROAD KOWLOON

TITLE :
WINDOW SCHEDULE FOR TOWER 7 ALUM. WINDOW

DATE : 03-APR-21 | SCALE : 1:40

DRAWN BY : | CHECKED BY :

美特鋁質有限公司
MIDI ALUMINIUM FABRICATOR LTD.
Units 6-8, Sunray Industrial Centre, 1/F
610 Cha Kwo Ling Road, Kowloon
Tel:23489211-4 Fax:(852)27727666

DWG NO. : J853-SD-IW-SC706 | REV. : C

ELEVATION

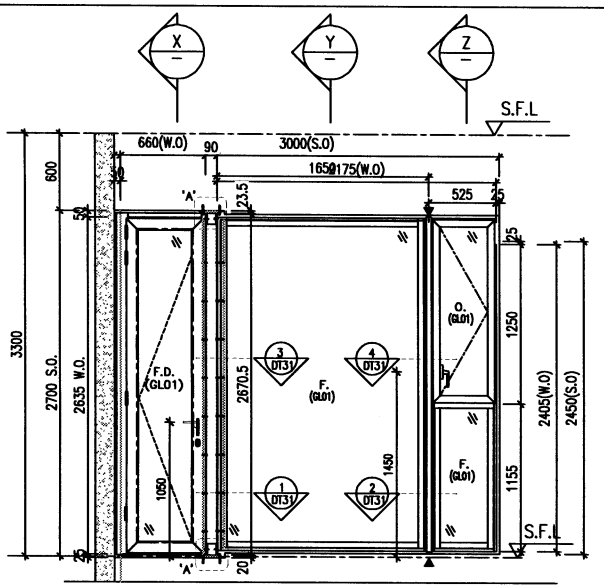

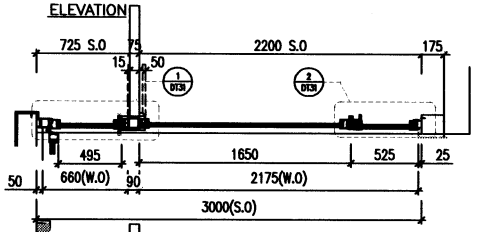

A1 PART PLAN

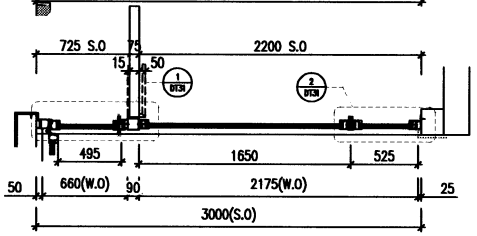

A2 PART PLAN

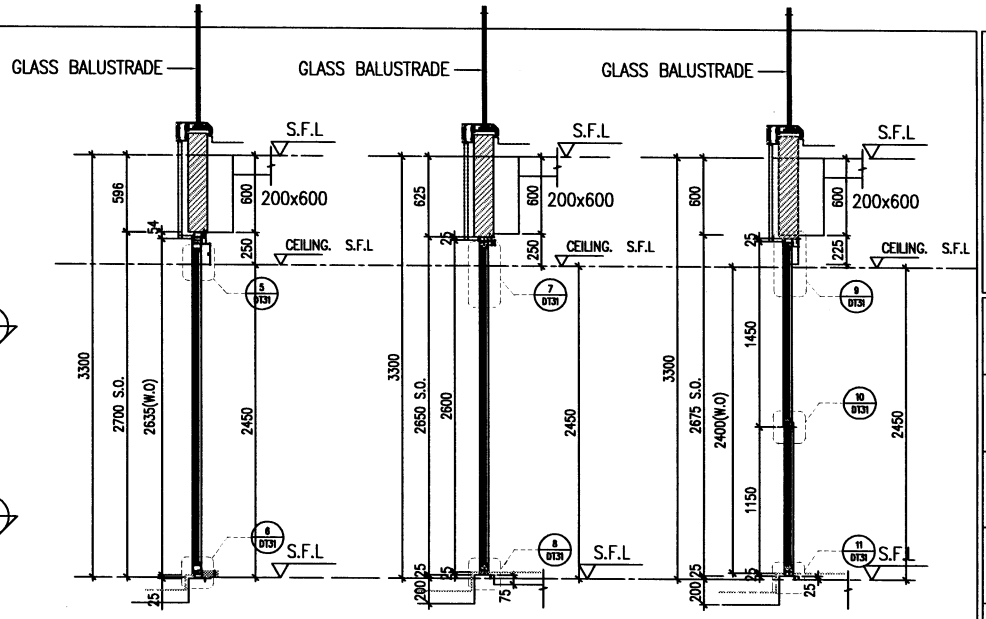

X PART SECTION

Y PART SECTION

Z PART SECTION

PROVIDED		
GLAZING AREA	2.709	m^2
OPENABLE AREA	1.504	m^2
FREE AREA	—	%

WINDOW MARK	W79 / T7
LOCATION	26F UNIT B WALK-IN CLOSET
SECTION	70mm ALUM. SECTION
GLAZING	GL01
QUANTITY	1 Nos.
REMARKS	SITE IN SITU

B.D. REF :

CLIENT :
SHIMAO GROUP HOLDINGS LIMITED

ARCHITECT :
WONG TUNG & PARTNERS LIMITED
ARCHITECTS & PLANNERS

MAIN CONTRACTOR :
協興建築有限公司
HIP HING CONSTRUCTION CO LTD

STRUCTURAL ENGINEER :
C M WONG & ASSOCIATES LTD
Consulting Engineers

SITE IN SITU CONSULTANT:
MEINHARDT

NOTE :
1. ALL DIMENSIONS ARE IN mm.
2. ALL ELEVATIONS ARE VIEWED FROM OUTSIDE.
3. ALL DIMENSIONS TO BE VERIFIED ON SITE BEFORE FABRICATION.

LEGEND :
X1 / 2001 — DETAIL MARK NO. / REFER SHEET NO.
1. F.F.L. — FINISHED FLOOR LEVEL
2. S.F.L. — STRUCTURAL FLOOR LEVEL
3. (78) — REVERSED DETAIL
4. ▲ — FIXING LOCATION
5. △ — FIXING LUG LOCATION
6. GLASS LEGEND
GL01 — 10mm+12mm AIR GAP+10mm THK. I.G.U.
GL05 — 10mm+12mm AIR GAP+10mm THK. I.G.U.
GL06 — 10mm+12mm AIR GAP+12mm THK. I.G.U.
PD01 — 10mm T.P+12mm AIR GAP+8mm T.P
GL07 — 10mm+12mm AIR GAP+12mm THK. I.G.U.
GL08 — 10mm+12mm AIR GAP+10mm THK. I.G.U.

NO.	DATE	REMARKS	BY
D	15/07/2022	REVISION SUBJECT TO ARCH.COMMENT	LHK
C	18/04/2022	REVISION SUBJECT TO ARCH.COMMENT	LHK
B	16/12/2021	REVISION SUBJECT TO ARCH.COMMENT	LHK
A	28/08/2021	REVISION SUBJECT TO ARCH.COMMENT	WAH

JOB NO. : J-853

PROJECT :
PROPOSED RESIDENTIAL DEVELOPMENT AT N.K.I.L. 6542 YIN PING ROAD KOWLOON

TITLE :
WINDOW SCHEDULE FOR TOWER 7 ALUM. WINDOW

DATE : 03-APR-21 | SCALE : 1:40

DRAWN BY : | CHECKED BY :

美特鋁製有限公司
MIDI ALUMINIUM FABRICATOR LTD.
Units 6-8, Sunray Industrial Centre, 1/F
610 Cha Kwo Ling Road, Kowloon
Tel:23489211-4 Fax:(852)27727666

DWG NO. : J853-SD-IW-SC705 | REV. : C

ELEVATION

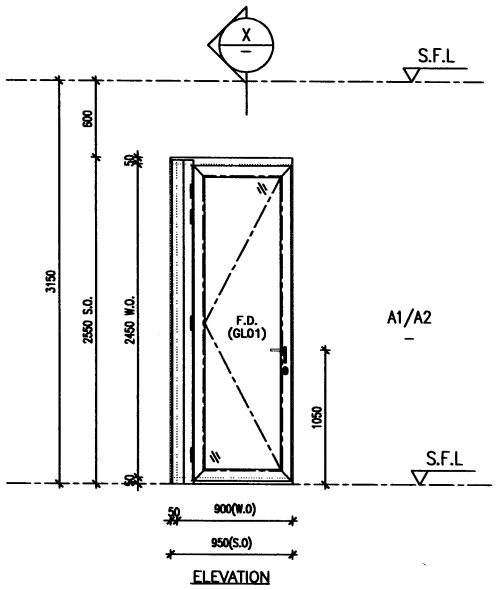

A1/A2

ELEVATION

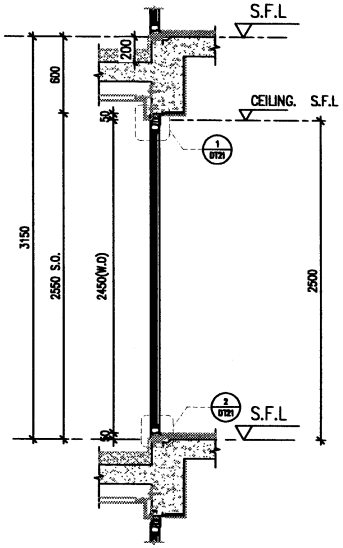

X PART SECTION

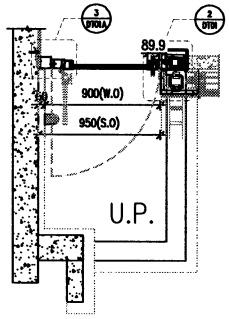

A1 PART PLAN

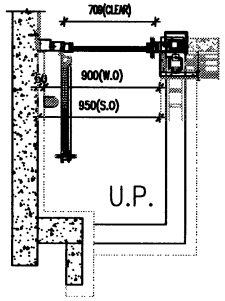

A2 PART PLAN

PROVIDED		
GLAZING AREA	0.691	m^2
OPENABLE AREA	0.889	m^2
FREE AREA	–	%

WINDOW MARK	W104L T7
LOCATION	7F~15F&17F~22F &25F UNIT B ENSUITE
SECTION	70mm ALUM. SECTION
GLAZING	GL01
QUANTITY	14 Nos.
REMARKS	SITE IN SITU

B.D. REF :

CLIENT :
SHIMAO GROUP HOLDINGS LIMITED

ARCHITECT :
WONG TUNG & PARTNERS LIMITED
ARCHITECTS & PLANNERS

MAIN CONTRACTOR :
協興建築有限公司
HIP HING CONSTRUCTION CO LTD

STRUCTURAL ENGINEER :
C M WONG & ASSOCIATES LTD
Consulting Engineers

SITE IN SITU CONSULTANT:
MEINHARDT

NOTE :
1. ALL DIMENSIONS ARE IN mm.
2. ALL ELEVATIONS ARE VIEWED FROM OUTSIDE.
3. ALL DIMENSIONS TO BE VERIFIED ON SITE BEFORE FABRICATION.

LEGEND :
X1 / XXXS1 — DETAIL MARK NO. / REFER SHEET NO.
1. F.F.L. — FINISHED FLOOR LEVEL
2. S.F.L. — STRUCTURAL FLOOR LEVEL
3. (R) — REVERSED DETAIL
4. ▲ — FIXING LOCATION
5. △ — FIXING LUG LOCATION
6. GLASS LEGEND
GL01 — 10mm+12mm AIR GAP+10mm THK. L.G.U.
GL05 — 10mm+12mm AIR GAP+10mm THK. L.G.U.
GL06 — 10mm+12mm AIR GAP+12mm THK. L.G.U.
PD01 — 10mm T.P+12mm AIR GAP+8mm T.P
GL07 — 10mm+12mm AIR GAP+12mm THK. L.G.U.
GL08 — 10mm+12mm AIR GAP+10mm THK. L.G.U.

NO.	DATE	REVISED	BY
C	18/04/2022	REVISION SUBJECT TO ARCH.COMMENT	LHK
B	16/12/2021	REVISION SUBJECT TO ARCH.COMMENT	LHK
A	28/06/2021	REVISION SUBJECT TO ARCH.COMMENT	WMH

JOB NO. : J-853

PROJECT :
PROPOSED RESIDENTIAL DEVELOPMENT AT N.K.I.L. 6542 YIN PING ROAD KOWLOON

TITLE :
WINDOW SCHEDULE FOR TOWER 7 ALUM. WINDOW

DATE : 03-APR-21 | SCALE : 1:40

DRAWN BY : | CHECKED BY :

美特鋁質有限公司
MIDI ALUMINIUM FABRICATOR LTD.
Units 6-8, Sunray Industrial Centre, 1/F
610 Cha Kwo Ling Road, Kowloon
Tel:23488211-4 Fax:(852)27727666

DWG NO. : J853-SD-IW-SC704 | REV. : C

ELEVATION

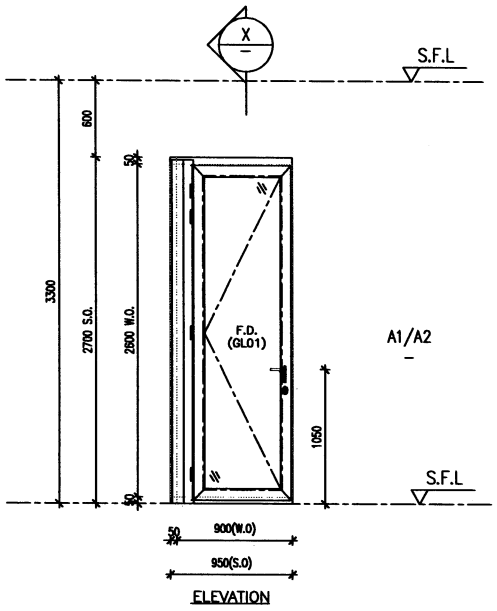

ELEVATION

A1/A2

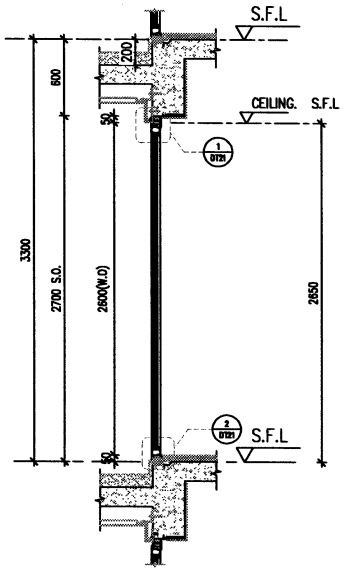

X PART SECTION

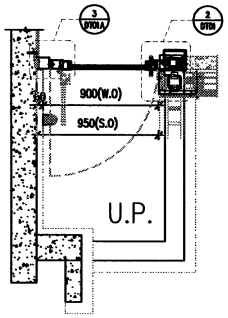

A1 PART PLAN

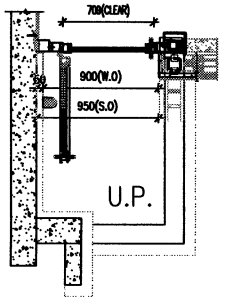

A2 PART PLAN

PROVIDED		
GLAZING AREA	0.778	m^2
OPENABLE AREA	0.995	m^2
FREE AREA	–	%

WINDOW MARK	W154L T7
LOCATION	16F UNIT B ENSUITE
SECTION	70mm ALUM. SECTION
GLAZING	GL01
QUANTITY	1Nos.
REMARKS	SITE IN SITU

B.D. REF :

CLIENT :
SHIMAO GROUP HOLDINGS LIMITED

ARCHITECT : WONG TUNG & PARTNERS LIMITED ARCHITECTS & PLANNERS

MAIN CONTRACTOR :
協興建築有限公司
HIP HING CONSTRUCTION CO LTD

STRUCTURAL ENGINEER :
C M WONG & ASSOCIATES LTD
Consulting Engineers

SITE IN SITU CONSULTANT:
MEINHARDT

NOTE :
1. ALL DIMENSIONS ARE IN mm.
2. ALL ELEVATIONS ARE VIEWED FROM OUTSIDE.
3. ALL DIMENSIONS TO BE VERIFIED ON SITE BEFORE FABRICATION.

LEGEND :
X1 / 2001 — DETAIL MARK NO. / REFER SHEET NO.
1. F.F.L. — FINISHED FLOOR LEVEL
2. S.F.L. — STRUCTURAL FLOOR LEVEL
3. (N) — REVERSED DETAIL
4. ▲ — FIXING LOCATION
5. △ — FIXING LUG LOCATION
6. GLASS LEGEND
GL01 — 10mm+12mm AIR GAP+10mm THK. I.G.U.
GL05 — 10mm+12mm AIR GAP+10mm THK. I.G.U.
GL06 — 10mm+12mm AIR GAP+12mm THK. I.G.U.
PD01 — 10mm T.P+12mm AIR GAP+8mm T.P
GL07 — 10mm+12mm AIR GAP+12mm THK. I.G.U.
GL08 — 10mm+12mm AIR GAP+10mm THK. I.G.U.

NO.	DATE	REMARK	BY
C	18/04/2022	REVISION SUBJECT TO ARCH.COMMENT	LHS
B	16/12/2021	REVISION SUBJECT TO ARCH.COMMENT	LHS

JOB NO. : J-853

PROJECT :
PROPOSED RESIDENTIAL DEVELOPMENT AT N.K.I.L. 6542 YIN PING ROAD KOWLOON

TITLE :
WINDOW SCHEDULE FOR TOWER 7 ALUM. WINDOW

DATE : 03-APR-21 | SCALE : 1:40

DRAWN BY : | CHECKED BY :

美特鋁實有限公司
MIDI ALUMINIUM FABRICATOR LTD.
Units 6-8, Sunray Industrial Centre, 1/F
610 Cha Kwo Ling Road, Kowloon
Tel:23489211-4 Fax:(852)27727666

DWG NO. : J853-SD-IW-SC704a | REV. : C

ELEVATION

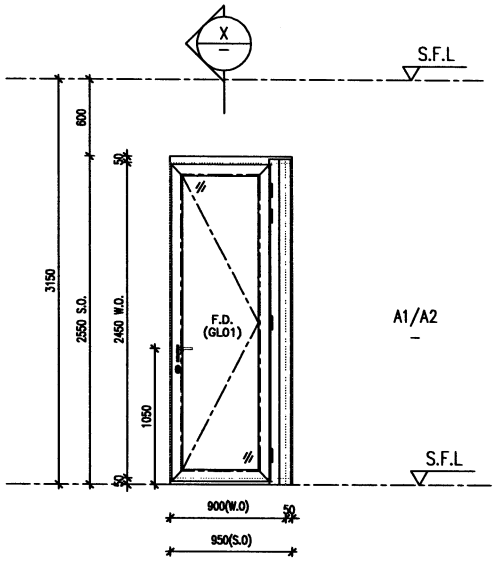

A1/A2

ELEVATION

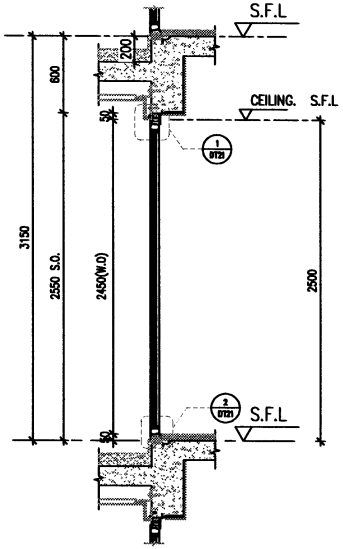

X — PART SECTION

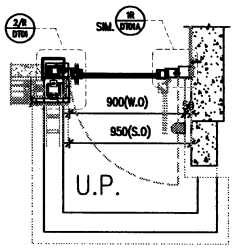

A1 — PART PLAN

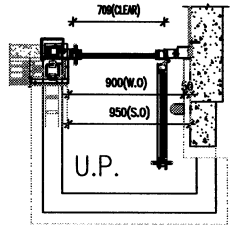

A2 — PART PLAN

PROVIDED		
GLAZING AREA	0.691	m^2
OPENABLE AREA	0.889	m^2
FREE AREA	–	%

WINDOW MARK	W01A T7
LOCATION	7F~15F&17F~22F UNIT A ENSUITE
SECTION	70mm ALUM. SECTION
GLAZING	GL01
QUANTITY	13 Nos.
REMARKS	SITE IN SITU

B.D. REF :

CLIENT :
SHIMAO GROUP HOLDINGS LIMITED

ARCHITECT :
WONG TUNG & PARTNERS LIMITED
ARCHITECTS & PLANNERS

MAIN CONTRACTOR :
協興建築有限公司
HIP HING CONSTRUCTION CO LTD

STRUCTURAL ENGINEER :
C M WONG & ASSOCIATES LTD
Consulting Engineers

SITE IN SITU CONSULTANT:
MEINHARDT

NOTE.:
1. ALL DIMENSIONS ARE IN mm.
2. ALL ELEVATIONS ARE VIEWED FROM OUTSIDE.
3. ALL DIMENSIONS TO BE VERIFIED ON SITE BEFORE FABRICATION.

LEGEND :
- X1 / X001 — DETAIL MARK NO. / REFER SHEET NO.
1. F.F.L. — FINISHED FLOOR LEVEL
2. S.F.L. — STRUCTURAL FLOOR LEVEL
3. (R) — REVERSED DETAIL
4. ▲ — FIXING LOCATION
5. △ — FIXING LUG LOCATION
6. GLASS LEGEND
   - GL01 — 10mm+12mm AIR GAP+10mm THK. I.G.U.
   - GL05 — 10mm+12mm AIR GAP+10mm THK. I.G.U.
   - GL06 — 10mm+12mm AIR GAP+12mm THK. I.G.U.
   - PD01 — 10mm T.P+12mm AIR GAP+8mm T.P
   - GL07 — 10mm+12mm AIR GAP+12mm THK. I.G.U.
   - GL08 — 10mm+12mm AIR GAP+10mm THK. I.G.U.

NO.	DATE	REMARK	BY
C	18/04/2022	REVISION SUBJECT TO AM/COMMENT	LHK
B	16/12/2021	REVISION SUBJECT TO AM/COMMENT	LHK
A	28/06/2021	REVISION SUBJECT TO AM/COMMENT	WSH

JOB NO. : J-853

PROJECT :
PROPOSED RESIDENTIAL DEVELOPMENT AT N.K.I.L. 6542 YIN PING ROAD KOWLOON

TITLE :
WINDOW SCHEDULE FOR TOWER 7 ALUM. WINDOW

DATE : 03-APR-21 | SCALE : 1:40

DRAWN BY : | CHECKED BY :

美特鋁質有限公司
MIDI ALUMINIUM FABRICATOR LTD.
Units 6-8, Sunray Industrial Centre, 1/F
610 Cha Kwo Ling Road, Kowloon
Tel:23489211-4 Fax:(852)27727686

DWG NO. : J853-SD-IW-SC703 | REV. : C

ELEVATION

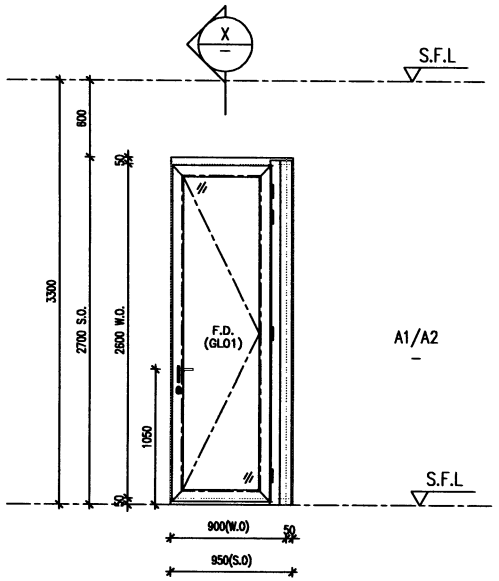

A1/A2

ELEVATION

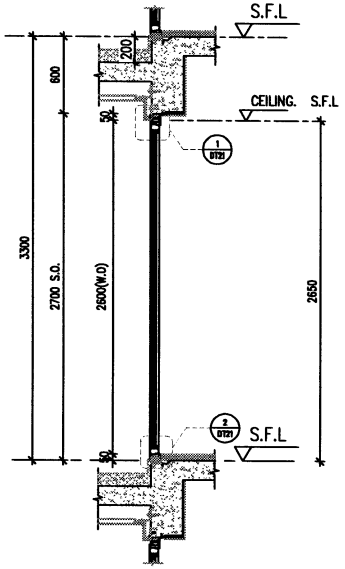

X PART SECTION

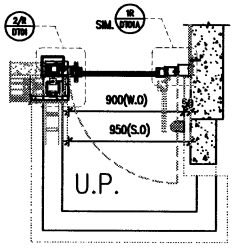

A1 PART PLAN

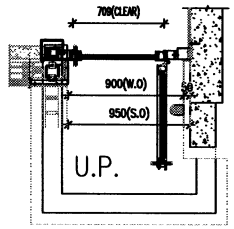

A2 PART PLAN

PROVIDED		
GLAZING AREA	0.778	m^2
OPENABLE AREA	0.995	m^2
FREE AREA	–	%

WINDOW MARK	W15IR T7
LOCATION	16F&25F~26F UNIT A ENSUITE
SECTION	70mm ALUM. SECTION
GLAZING	GL01
QUANTITY	3 Nos.
REMARKS	SITE IN SITU

B.D. REF :

CLIENT :
SHIMAO GROUP HOLDINGS LIMITED

ARCHITECT :
WONG TUNG & PARTNERS LIMITED
ARCHITECTS & PLANNERS

MAIN CONTRACTOR :
協興建築有限公司
HIP HING CONSTRUCTION CO LTD

STRUCTURAL ENGINEER :
C M WONG & ASSOCIATES LTD
Consulting Engineers

SITE IN SITU CONSULTANT:
MEINHARDT

NOTE :
1. ALL DIMENSIONS ARE IN mm.
2. ALL ELEVATIONS ARE VIEWED FROM OUTSIDE.
3. ALL DIMENSIONS TO BE VERIFIED ON SITE BEFORE FABRICATION.

LEGEND :
X1 / XXXX — DETAIL MARK NO. / REFER SHEET NO.
1. F.F.L. — FINISHED FLOOR LEVEL
2. S.F.L. — STRUCTURAL FLOOR LEVEL
3. R — REVERSED DETAIL
4. ▲ — FIXING LOCATION
5. △ — FIXING LUG LOCATION
6. GLASS LEGEND
GL01 — 10mm+12mm AIR GAP+10mm THK. L.G.U.
GL05 — 10mm+12mm AIR GAP+10mm THK. L.G.U.
GL06 — 10mm+12mm AIR GAP+12mm THK. L.G.U.
PD01 — 10mm T.P+12mm AIR GAP+8mm T.P
GL07 — 10mm+12mm AIR GAP+12mm THK. L.G.U.
GL08 — 10mm+12mm AIR GAP+10mm THK. L.G.U.

NO.	DATE	REVISED	BY
C	18/04/2022	REVISION SUBJECT TO ARCH.COMMENT	LHS
B	16/12/2021	REVISION SUBJECT TO ARCH.COMMENT	LHS

JOB NO. : J-853

PROJECT :
PROPOSED RESIDENTIAL DEVELOPMENT AT N.K.I.L. 6542 YIN PING ROAD KOWLOON

TITLE :
WINDOW SCHEDULE FOR TOWER 7 ALUM. WINDOW

DATE : 03-APR-21 | SCALE : 1:40

DRAWN BY : | CHECKED BY :

美特鋁質有限公司
MIDI ALUMINIUM FABRICATOR LTD.
Units 6-8, Sunray Industrial Centre, 1/F
610 Cha Kwo Ling Road, Kowloon
Tel:23488211-4 Fax:(852)27727666

DWG NO. : J853-SD-IW-SC703a | REV. : C

ELEVATION

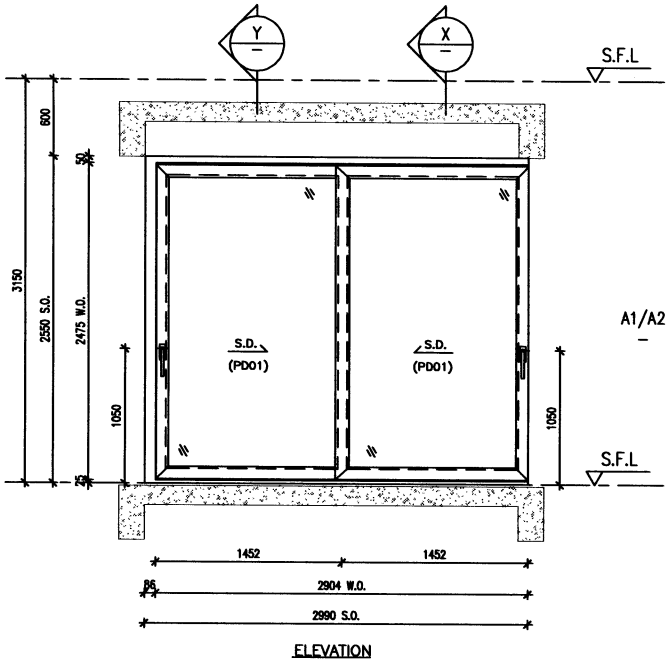

ELEVATION

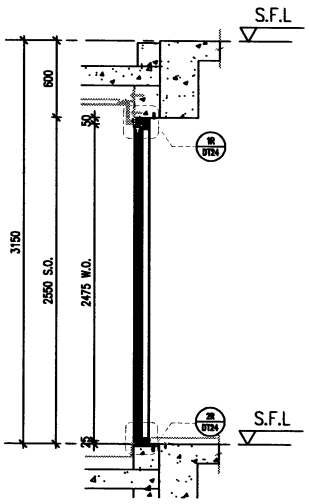

X PART SECTION

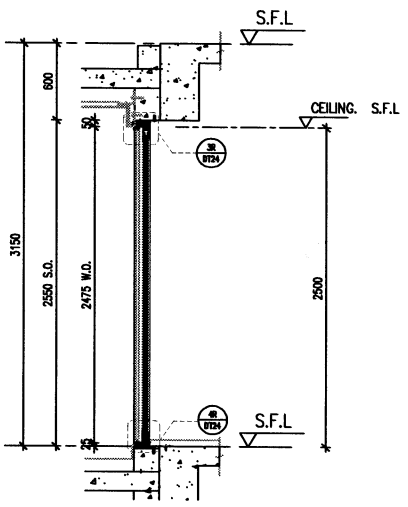

Y PART SECTION

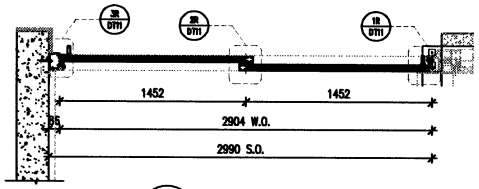

A1 PART PLAN

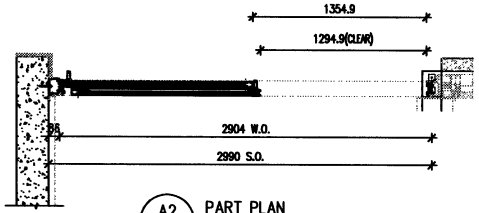

A2 PART PLAN

PROVIDED		
GLAZING AREA	2.975	m^2
OPENABLE AREA	1.626	m^2
FREE AREA	–	%

WINDOW MARK	W202 T7
LOCATION	7F~15F&17F~22F UNIT B LIVING
SECTION	50mm ALUM. SECTION
GLAZING	PD01
QUANTITY	14 Nos.
REMARKS	SITE IN SITU

B.D. REF :

CLIENT :
SHIMAO GROUP HOLDINGS LIMITED

ARCHITECT : WONG TUNG & PARTNERS LIMITED ARCHITECTS & PLANNERS

MAIN CONTRACTOR :
協興建築有限公司
HIP HING CONSTRUCTION CO LTD

STRUCTURAL ENGINEER :
C M WONG & ASSOCIATES LTD
Consulting Engineers

SITE IN SITU CONSULTANT:
MEINHARDT

NOTE :
1. ALL DIMENSIONS ARE IN mm.
2. ALL ELEVATIONS ARE VIEWED FROM OUTSIDE.
3. ALL DIMENSIONS TO BE VERIFIED ON SITE BEFORE FABRICATION.

LEGEND :
- X1 / 2D01 — DETAIL MARK NO. / REFER SHEET NO.
1. F.F.L. — FINISHED FLOOR LEVEL
2. S.F.L. — STRUCTURAL FLOOR LEVEL
3. (R) — REVERSED DETAIL
4. ▲ — FIXING LOCATION
5. △ — FIXING LUG LOCATION
6. GLASS LEGEND
   - GLD1 — 10mm+12mm AIR GAP+10mm THK. L.G.U.
   - GL05 — 10mm+12mm AIR GAP+10mm THK. L.G.U.
   - GL06 — 10mm+12mm AIR GAP+12mm THK. L.G.U.
   - PD01 — 10mm T.P+12mm AIR GAP+8mm T.P
   - GL07 — 10mm+12mm AIR GAP+12mm THK. L.G.U.
   - GL08 — 10mm+12mm AIR GAP+10mm THK. L.G.U.

NO.	DATE	REMARK	BY
C	18/04/2022	REVISION SUBJECT TO ARCH.COMMENT	LMK
B	16/12/2021	REVISION SUBJECT TO ARCH.COMMENT	LMK
A	28/08/2021	REVISION SUBJECT TO ARCH.COMMENT	KWH

JOB NO. : J-853

PROJECT :
PROPOSED RESIDENTIAL DEVELOPMENT AT N.K.I.L. 6542 YIN PING ROAD KOWLOON

TITLE :
WINDOW SCHEDULE FOR TOWER 7 ALUM. WINDOW

DATE : 03-APR-21 | SCALE : 1:40

DRAWN BY : | CHECKED BY :

美特鋁製有限公司
MIDI ALUMINIUM FABRICATOR LTD.
Units 6-8, Sunray Industrial Centre, 1/F
610 Cha Kwo Ling Road, Kowloon
Tel:23489211-4 Fax:(852)27727666

DWG NO. : J853-SD-IW-SC702 | REV. : C

ELEVATION

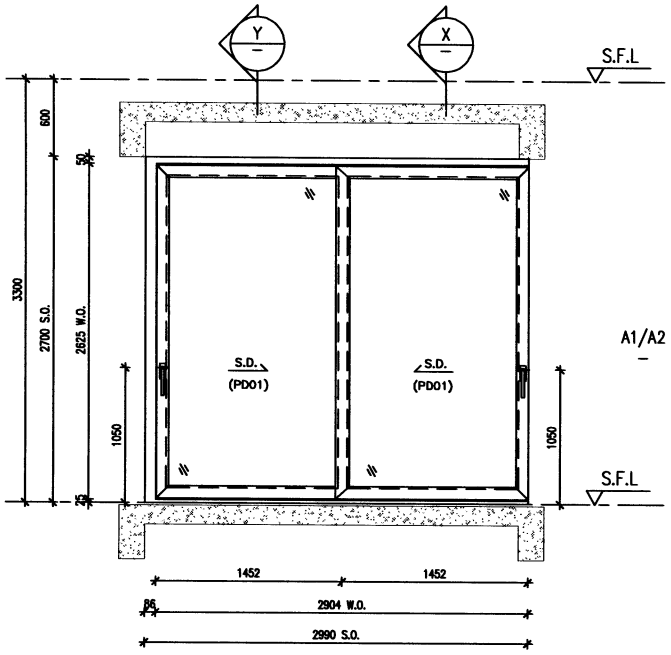

ELEVATION

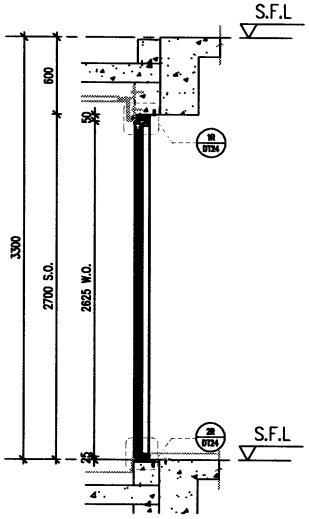

X — PART SECTION

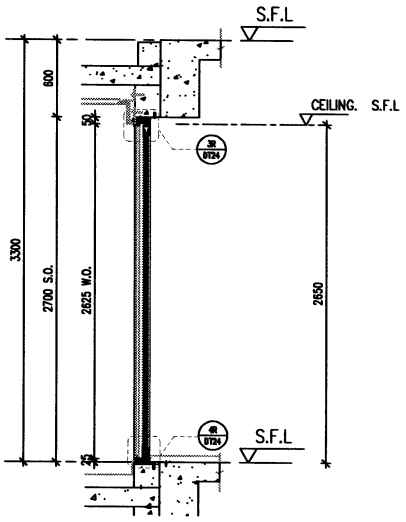

Y — PART SECTION

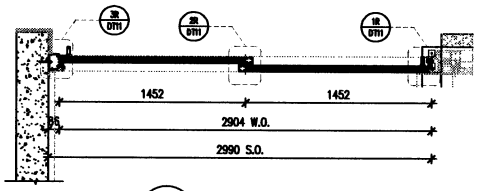

A1 — PART PLAN

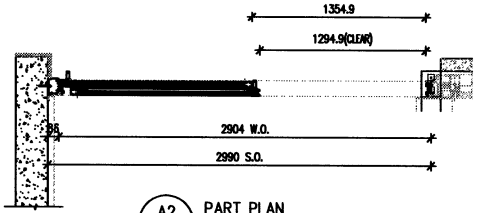

A2 — PART PLAN

PROVIDED		
GLAZING AREA	3.359	m^2
OPENABLE AREA	1.824	m^2
FREE AREA	–	%

WINDOW MARK	W252 T7
LOCATION	16F UNIT B LIVING
SECTION	50mm ALUM. SECTION
GLAZING	PD01
QUANTITY	1 Nos.
REMARKS	SITE IN SITU

B.D. REF :

CLIENT :
SHIMAO GROUP HOLDINGS LIMITED

ARCHITECT : WONG TUNG & PARTNERS LIMITED ARCHITECTS & PLANNERS

MAIN CONTRACTOR :
協興建築有限公司
HIP HING CONSTRUCTION CO LTD

STRUCTURAL ENGINEER :
C M WONG & ASSOCIATES LTD
Consulting Engineers

SITE IN SITU CONSULTANT:
MEINHARDT

NOTE :
1. ALL DIMENSIONS ARE IN mm.
2. ALL ELEVATIONS ARE VIEWED FROM OUTSIDE.
3. ALL DIMENSIONS TO BE VERIFIED ON SITE BEFORE FABRICATION.

LEGEND :
- X1 / 2D01 — DETAIL MARK NO. / REFER SHEET NO.
1. F.F.L. — FINISHED FLOOR LEVEL
2. S.F.L. — STRUCTURAL FLOOR LEVEL
3. (R) — REVERSED DETAIL
4. ▲ — FIXING LOCATION
5. △ — FIXING LUG LOCATION
6. GLASS LEGEND
   - GL01 — 10mm+12mm AIR GAP+10mm THK. L.G.U.
   - GL05 — 10mm+12mm AIR GAP+10mm THK. L.G.U.
   - GL06 — 10mm+12mm AIR GAP+12mm THK. L.G.U.
   - PD01 — 10mm T.P+12mm AIR GAP+8mm T.P
   - GL07 — 10mm+12mm AIR GAP+12mm THK. L.G.U.
   - GL08 — 10mm+12mm AIR GAP+10mm THK. L.G.U.

NO.	DATE	REMARK	BY
C	18/04/2022	REVISION SUBJECT TO ARCH.COMMENT	LHD
B	18/12/2021	REVISION SUBJECT TO ARCH.COMMENT	LHD

JOB NO. : J-853

PROJECT :
PROPOSED RESIDENTIAL DEVELOPMENT AT N.K.I.L. 6542 YIN PING ROAD KOWLOON

TITLE :
WINDOW SCHEDULE FOR TOWER 7 ALUM. WINDOW

DATE : 03-APR-21 | SCALE : 1:40

DRAWN BY : | CHECKED BY :

美特鋁製有限公司
MIDI ALUMINIUM FABRICATOR LTD.
Units 6-8, Sunray Industrial Centre, 1/F
610 Cha Kwo Ling Road, Kowloon
Tel:23489211-4 Fax:(852)27727666

DWG NO. : J853-SD-IW-SC702a | REV. : C

ELEVATION

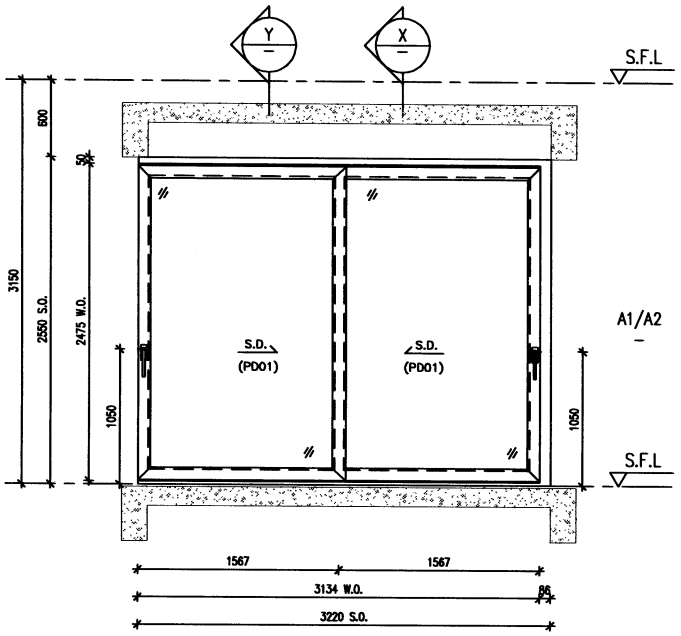

ELEVATION

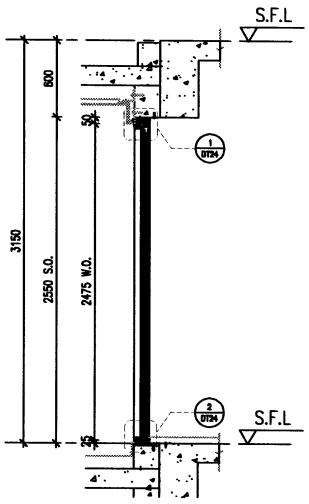

X PART SECTION

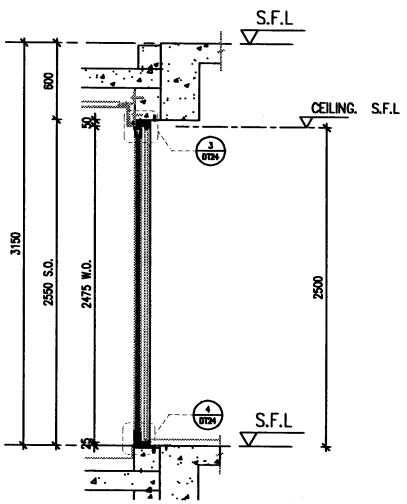

Y PART SECTION

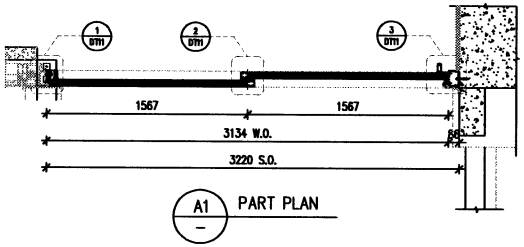

A1 PART PLAN

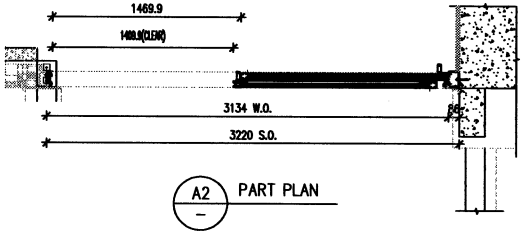

A2 PART PLAN

PROVIDED		
GLAZING AREA	3.243	m^2
OPENABLE AREA	1.773	m^2
FREE AREA	–	%

WINDOW MARK	W201 / T7
LOCATION	7F~15F&17F~22F UNIT A LIVING
SECTION	50mm ALUM. SECTION
GLAZING	PD01
QUANTITY	13 Nos.
REMARKS	SITE IN SITU

B.D. REF :

CLIENT :
SHIMAO GROUP HOLDINGS LIMITED

ARCHITECT : WONG TUNG & PARTNERS LIMITED ARCHITECTS & PLANNERS

MAIN CONTRACTOR :
協興建築有限公司
HIP HING CONSTRUCTION CO LTD

STRUCTURAL ENGINEER :
C M WONG & ASSOCIATES LTD
Consulting Engineers

SITE IN SITU CONSULTANT:
MEINHARDT

NOTE :
1. ALL DIMENSIONS ARE IN mm.
2. ALL ELEVATIONS ARE VIEWED FROM OUTSIDE.
3. ALL DIMENSIONS TO BE VERIFIED ON SITE BEFORE FABRICATION.

LEGEND :
- X1 / X2001 — DETAIL MARK NO. / REFER SHEET NO.
1. F.F.L. — FINISHED FLOOR LEVEL
2. S.F.L. — STRUCTURAL FLOOR LEVEL
3. (R) — REVERSED DETAIL
4. ▲ — FIXING LOCATION
5. △ — FIXING LUG LOCATION
6. GLASS LEGEND
   - GLD1 — 10mm+12mm AIR GAP+10mm THK. I.G.U.
   - GL05 — 10mm+12mm AIR GAP+10mm THK. I.G.U.
   - GL06 — 10mm+12mm AIR GAP+12mm THK. I.G.U.
   - PD01 — 10mm T.P+12mm AIR GAP+8mm T.P
   - GL07 — 10mm+12mm AIR GAP+12mm THK. I.G.U.
   - GL08 — 10mm+12mm AIR GAP+10mm THK. I.G.U.

NO.	DATE	REVISED	BY
C	18/04/2022	REVISION SUBJECT TO ARCH.COMMENT	LHK
B	16/12/2021	REVISION SUBJECT TO ARCH.COMMENT	LHK
A	28/08/2021	REVISION SUBJECT TO ARCH.COMMENT	WSM

JOB NO. : J-853

PROJECT :
PROPOSED RESIDENTIAL DEVELOPMENT AT N.K.I.L. 6542 YIN PING ROAD KOWLOON

TITLE :
WINDOW SCHEDULE FOR TOWER 7 ALUM. WINDOW

DATE : 03-APR-21 | SCALE : 1:40

DRAWN BY : | CHECKED BY :

美特鋁製有限公司
MIDI ALUMINIUM FABRICATOR LTD.
Units 6-8, Sunray Industrial Centre, 1/F
610 Cha Kwo Ling Road, Kowloon
Tel:23489211-4 Fax:(852)27727666

DWG NO. : J853-SD-IW-SC701 | REV. : C

ELEVATION

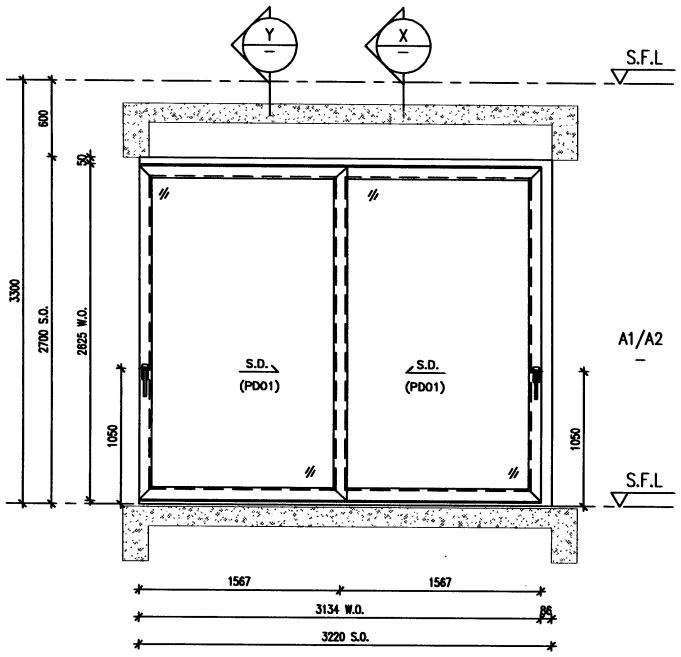

ELEVATION

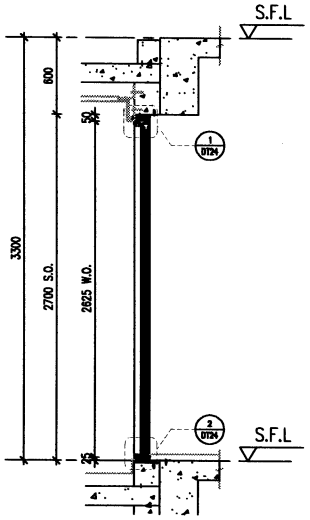

X PART SECTION

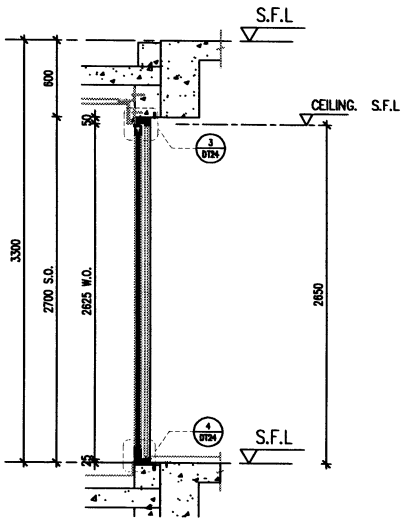

Y PART SECTION

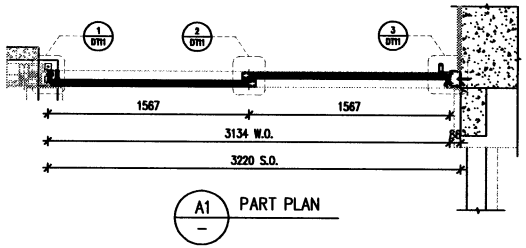

A1 PART PLAN

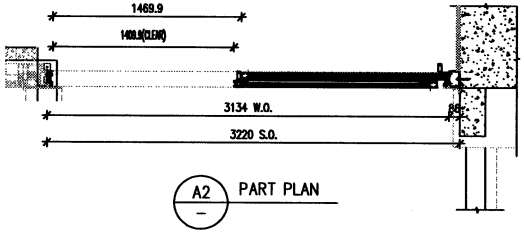

A2 PART PLAN

PROVIDED		
GLAZING AREA	3.661	m^2
OPENABLE AREA	1.985	m^2
FREE AREA	–	%

WINDOW MARK	W251 / T7
LOCATION	16F&25F~26F UNIT A LIVING
SECTION	50mm ALUM. SECTION
GLAZING	PD01
QUANTITY	3 Nos.
REMARKS	SITE IN SITU

B.D. REF :

CLIENT :
SHIMAO GROUP HOLDINGS LIMITED

ARCHITECT : WONG TUNG & PARTNERS LIMITED ARCHITECTS & PLANNERS

MAIN CONTRACTOR :
協興建築有限公司
HIP HING CONSTRUCTION CO LTD

STRUCTURAL ENGINEER :
C M WONG & ASSOCIATES LTD
Consulting Engineers

SITE IN SITU CONSULTANT:
MEINHARDT

NOTE :
1. ALL DIMENSIONS ARE IN mm.
2. ALL ELEVATIONS ARE VIEWED FROM OUTSIDE.
3. ALL DIMENSIONS TO BE VERIFIED ON SITE BEFORE FABRICATION.

LEGEND :
- X1 / 2001 — DETAIL MARK NO. / REFER SHEET NO.
1. F.F.L. — FINISHED FLOOR LEVEL
2. S.F.L. — STRUCTURAL FLOOR LEVEL
3. (R) — REVERSED DETAIL
4. ▲ — FIXING LOCATION
5. △ — FIXING LUG LOCATION
6. GLASS LEGEND
   - GL01 — 10mm+12mm AIR GAP+10mm THK. I.G.U.
   - GL05 — 10mm+12mm AIR GAP+10mm THK. I.G.U.
   - GL06 — 10mm+12mm AIR GAP+12mm THK. I.G.U.
   - PD01 — 10mm T.P+12mm AIR GAP+8mm T.P
   - GL07 — 10mm+12mm AIR GAP+12mm THK. I.G.U.
   - GL08 — 10mm+12mm AIR GAP+10mm THK. I.G.U.

NO.	DATE	REMARK	BY
C	18/04/2022	REVISION SUBJECT TO ARCH.COMMENT	LWK
B	14/12/2021	REVISION SUBJECT TO ARCH.COMMENT	LWK

JOB NO. : J-853

PROJECT :
PROPOSED RESIDENTIAL DEVELOPMENT AT N.K.I.L. 6542 YIN PING ROAD KOWLOON

TITLE :
WINDOW SCHEDULE FOR TOWER 7 ALUM. WINDOW

DATE : 03-APR-21 | SCALE : 1:40

DRAWN BY : | CHECKED BY :

美特鋁質有限公司
MIDI ALUMINIUM FABRICATOR LTD.
Units 6-8, Sunray Industrial Centre, 1/F
610 Cha Kwo Ling Road, Kowloon
Tel:23489211-4 Fax:(852)27727666

DWG NO. : J853-SD-IW-SC701a | REV. : C

ELEVATION

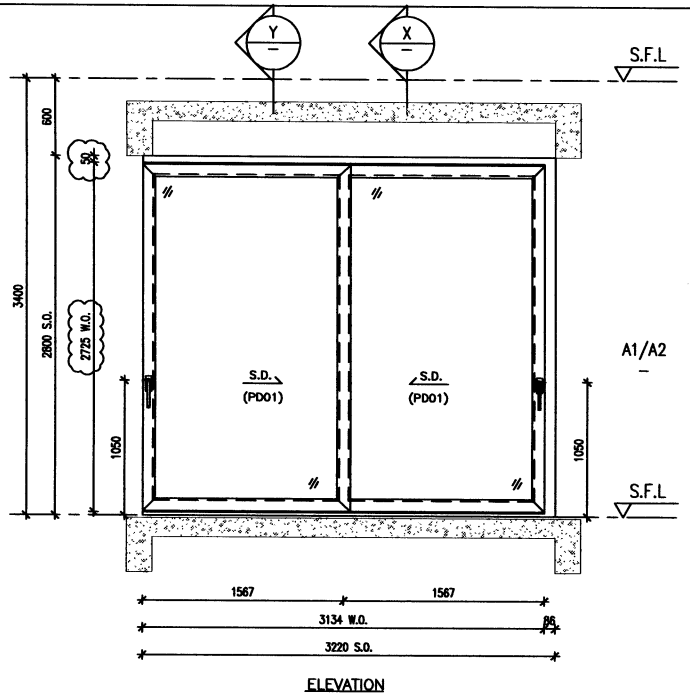

ELEVATION

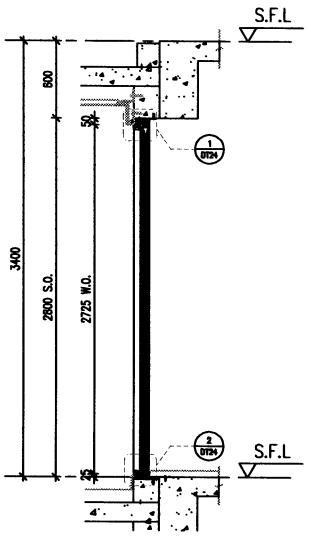

X PART SECTION

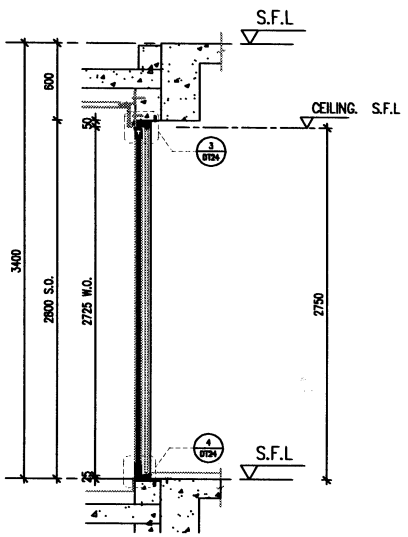

Y PART SECTION

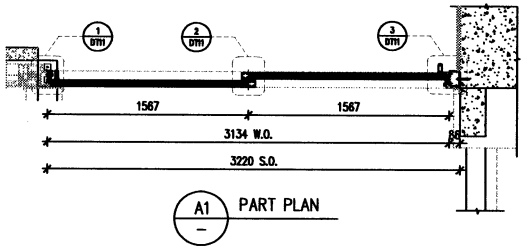

A1 PART PLAN

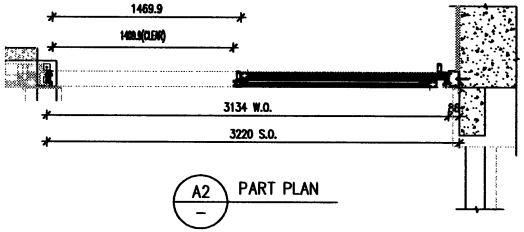

A2 PART PLAN

PROVIDED		
GLAZING AREA	3.939	m^2
OPENABLE AREA	2.127	m^2
FREE AREA	–	%

WINDOW MARK	W271 T7
LOCATION	23F UNIT A LIVING
SECTION	50mm ALUM. SECTION
GLAZING	PD01
QUANTITY	1 Nos.
REMARKS	SITE IN SITU

B.D. REF :

CLIENT :
SHIMAO GROUP HOLDINGS LIMITED

ARCHITECT :
WONG TUNG & PARTNERS LIMITED
ARCHITECTS & PLANNERS

MAIN CONTRACTOR :
協興建築有限公司
HIP HING CONSTRUCTION CO LTD

STRUCTURAL ENGINEER :
C M WONG & ASSOCIATES LTD
Consulting Engineers

SITE IN SITU CONSULTANT:
MEINHARDT

NOTE :
1. ALL DIMENSIONS ARE IN mm.
2. ALL ELEVATIONS ARE VIEWED FROM OUTSIDE.
3. ALL DIMENSIONS TO BE VERIFIED ON SITE BEFORE FABRICATION.

LEGEND :
X1 / XXDT — DETAIL MARK NO. / REFER SHEET NO.
1. F.F.L. — FINISHED FLOOR LEVEL
2. S.F.L. — STRUCTURAL FLOOR LEVEL
3. /R — REVERSED DETAIL
4. ▲ — FIXING LOCATION
5. △ — FIXING LUG LOCATION
6. GLASS LEGEND
GL01 — 10mm+12mm AIR GAP+10mm THK. L.G.U.
GL05 — 10mm+12mm AIR GAP+10mm THK. L.G.U.
GL06 — 10mm+12mm AIR GAP+12mm THK. L.G.U.
PD01 — 10mm T.P+12mm AIR GAP+8mm T.P
GL07 — 10mm+12mm AIR GAP+12mm THK. L.G.U.
GL08 — 10mm+12mm AIR GAP+10mm THK. L.G.U.

NO.	DATE	REVISED	BY
C	18/04/2022	REVISION SUBJECT TO ARCHITECT	LHS
B	16/12/2021	REVISION SUBJECT TO ARCHITECT	LHS

JOB NO. : J-853

PROJECT :
PROPOSED RESIDENTIAL DEVELOPMENT AT N.K.I.L. 6542 YIN PING ROAD KOWLOON

TITLE :
WINDOW SCHEDULE FOR TOWER 7 ALUM. WINDOW

DATE : 03-APR-21 | SCALE : 1:40

DRAWN BY : | CHECKED BY :

美特鋁質有限公司
MIDI ALUMINIUM FABRICATOR LTD.
Units 6-8, Sunray Industrial Centre, 1/F
510 Cha Kwo Ling Road, Kowloon
Tel:23489211-4 Fax:(852)27727666

DWG NO. : J853-SD-IW-SC701b | REV. : C

ELEVATION

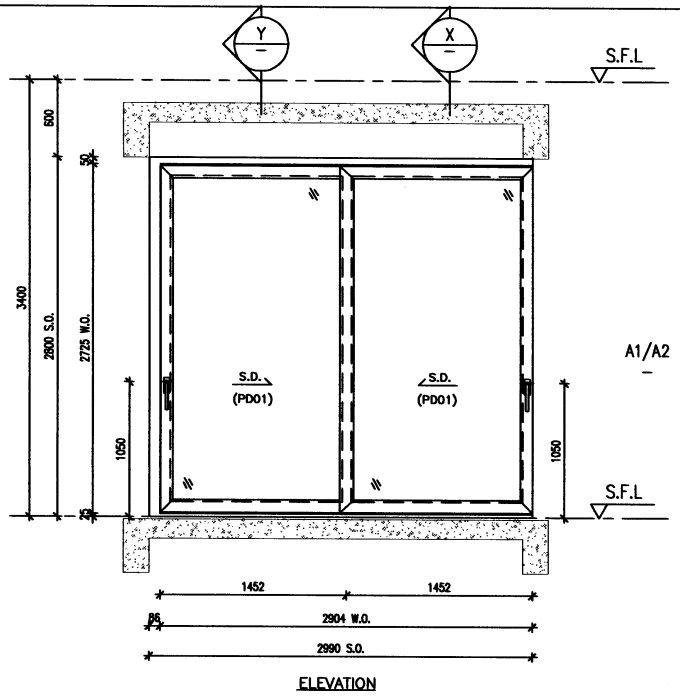

ELEVATION

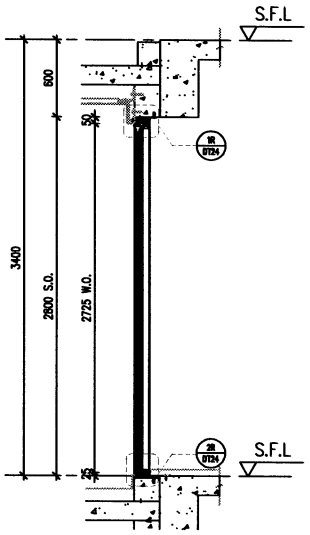

X PART SECTION

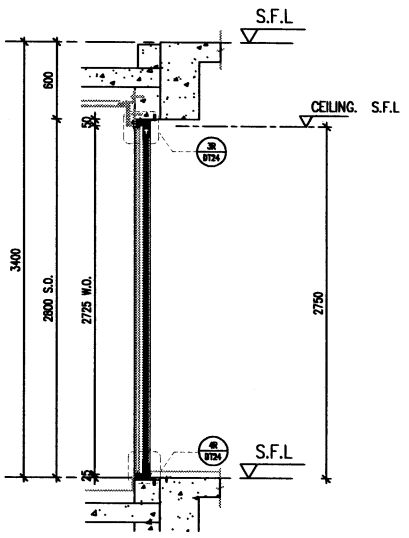

Y PART SECTION

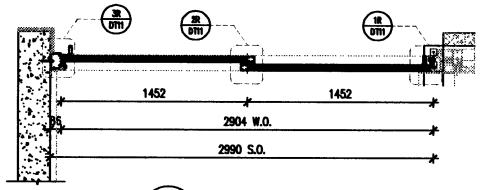

A1 PART PLAN

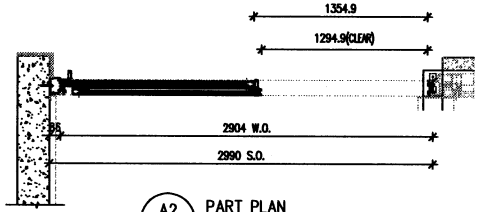

A2 PART PLAN

PROVIDED		
GLAZING AREA	3.614	m^2
OPENABLE AREA	1.954	m^2
FREE AREA	–	%

WINDOW MARK	W272 T7
LOCATION	23F UNIT B LIVING
SECTION	50mm ALUM. SECTION
GLAZING	PD01
QUANTITY	1 Nos.
REMARKS	SITE IN SITU

B.D. REF :

CLIENT :
SHIMAO GROUP HOLDINGS LIMITED

ARCHITECT :
WONG TUNG & PARTNERS LIMITED
ARCHITECTS & PLANNERS

MAIN CONTRACTOR :
協興建築有限公司
HIP HING CONSTRUCTION CO LTD

STRUCTURAL ENGINEER :
C M WONG & ASSOCIATES LTD
Consulting Engineers

SITE IN SITU CONSULTANT:
MEINHARDT

NOTE :
1. ALL DIMENSIONS ARE IN mm.
2. ALL ELEVATIONS ARE VIEWED FROM OUTSIDE.
3. ALL DIMENSIONS TO BE VERIFIED ON SITE BEFORE FABRICATION.

LEGEND :
- X1 / 22021 — DETAIL MARK NO. / REFER SHEET NO.
1. F.F.L. — FINISHED FLOOR LEVEL
2. S.F.L. — STRUCTURAL FLOOR LEVEL
3. (R) — REVERSED DETAIL
4. ▲ — FIXING LOCATION
5. △ — FIXING LUG LOCATION
6. GLASS LEGEND
   - GL01 — 10mm+12mm AIR GAP+10mm THK. I.G.U.
   - GL05 — 10mm+12mm AIR GAP+10mm THK. I.G.U.
   - GL06 — 10mm+12mm AIR GAP+12mm THK. I.G.U.
   - PD01 — 10mm T.P+12mm AIR GAP+8mm T.P
   - GL07 — 10mm+12mm AIR GAP+12mm THK. I.G.U.
   - GL08 — 10mm+12mm AIR GAP+10mm THK. I.G.U.

NO.	DATE	REMARK	BY
C	18/04/2022	REVISION SUBJECT TO ARCHITECT COMMENT	

JOB NO. : J-853

PROJECT :
PROPOSED RESIDENTIAL DEVELOPMENT AT N.K.I.L. 6542 YIN PING ROAD KOWLOON

TITLE :
WINDOW SCHEDULE FOR TOWER 7 ALUM. WINDOW

DATE : 03-APR-21 | SCALE : 1:40

DRAWN BY : | CHECKED BY :

美特鋁製有限公司
MIDI ALUMINIUM FABRICATOR LTD.
Units 6-8, Sunray Industrial Centre, 1/F
610 Cha Kwo Ling Road, Kowloon
Tel:23489211-4 Fax:(852)27727666

DWG NO. : J853-SD-IW-SC702b | REV. : C

ELEVATION

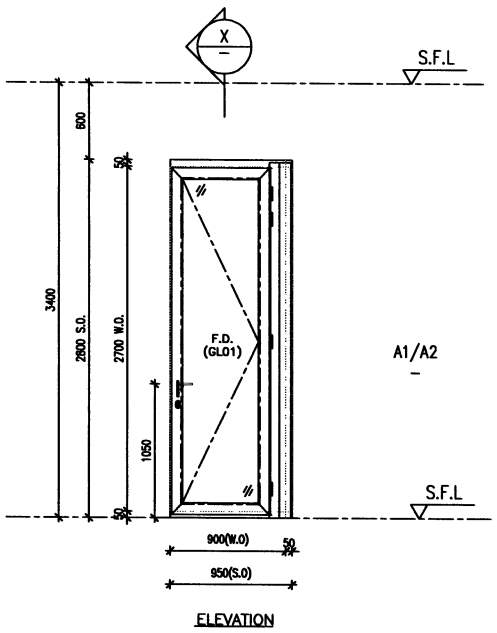

ELEVATION

A1/A2

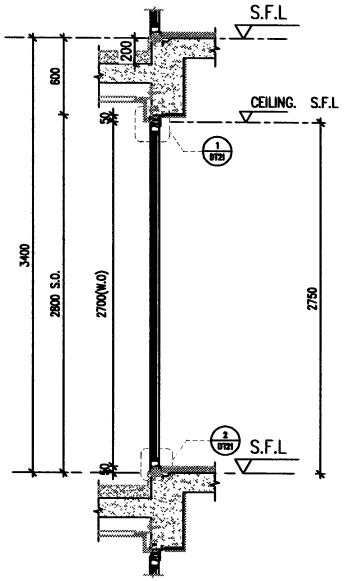

X PART SECTION

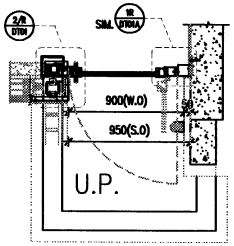

A1 PART PLAN

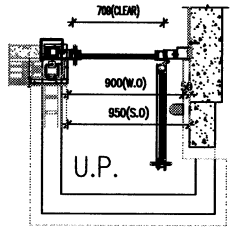

A2 PART PLAN

PROVIDED		
GLAZING AREA	0.836	m^2
OPENABLE AREA	1.066	m^2
FREE AREA	–	%

WINDOW MARK	WN71R T7
LOCATION	23F UNIT A ENSUITE
SECTION	70mm ALUM. SECTION
GLAZING	GL01
QUANTITY	1 Nos.
REMARKS	SITE IN SITU

B.D. REF :

CLIENT :
SHIMAO GROUP HOLDINGS LIMITED

ARCHITECT :
WONG TUNG & PARTNERS LIMITED
ARCHITECTS & PLANNERS

MAIN CONTRACTOR :
協興建築有限公司
HIP HING CONSTRUCTION CO LTD

STRUCTURAL ENGINEER :
C M WONG & ASSOCIATES LTD
Consulting Engineers

SITE IN SITU CONSULTANT:
MEINHARDT

NOTE :
1. ALL DIMENSIONS ARE IN mm.
2. ALL ELEVATIONS ARE VIEWED FROM OUTSIDE.
3. ALL DIMENSIONS TO BE VERIFIED ON SITE BEFORE FABRICATION.

LEGEND :
- X1 / XXXX — DETAIL MARK NO. / REFER SHEET NO.
1. F.F.L. — FINISHED FLOOR LEVEL
2. S.F.L. — STRUCTURAL FLOOR LEVEL
3. /R — REVERSED DETAIL
4. ▲ — FIXING LOCATION
5. △ — FIXING LUG LOCATION
6. GLASS LEGEND
   - GL01 — 10mm+12mm AIR GAP+10mm THK. LG.U.
   - GL05 — 10mm+12mm AIR GAP+10mm THK. LG.U.
   - GL06 — 10mm+12mm AIR GAP+12mm THK. LG.U.
   - PD01 — 10mm T.P+12mm AIR GAP+8mm T.P
   - GL07 — 10mm+12mm AIR GAP+12mm THK. LG.U.
   - GL08 — 10mm+12mm AIR GAP+10mm THK. LG.U.

NO.	DATE	REMARK	BY
C	18/04/2022	REVISION SUBJECT TO ARCH.COMMENT	LHS
B	16/12/2021	REVISION SUBJECT TO ARCH.COMMENT	LHS

JOB NO. : J-853

PROJECT :
PROPOSED RESIDENTIAL DEVELOPMENT AT N.K.I.L. 6542 YIN PING ROAD KOWLOON

TITLE :
WINDOW SCHEDULE FOR TOWER 7 ALUM. WINDOW

DATE : 03-APR-21 | SCALE : 1:40

DRAWN BY : | CHECKED BY :

美特鋁實有限公司
MIDI ALUMINIUM FABRICATOR LTD.
Units 6-8, Sunray Industrial Centre, 1/F
610 Cha Kwo Ling Road, Kowloon
Tel:23489211-4 Fax:(852)27727666

DWG NO. : J853-SD-IW-SC703b | REV. : C

ELEVATION

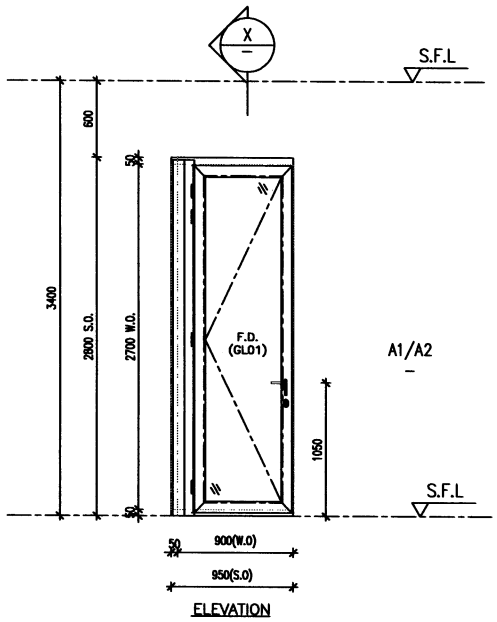

ELEVATION

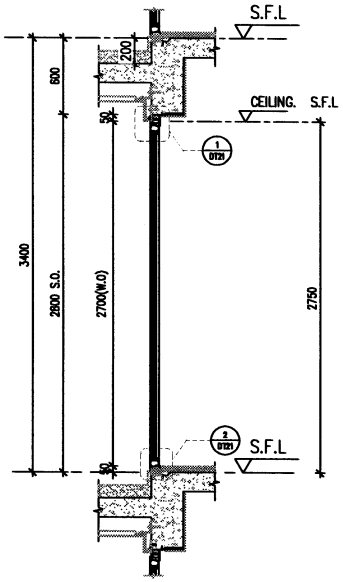

X PART SECTION

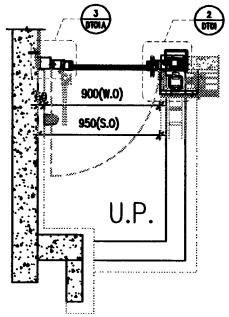

A1 PART PLAN

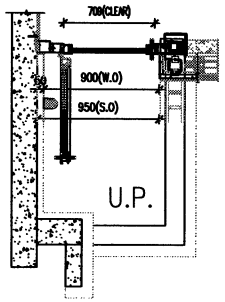

A2 PART PLAN

PROVIDED		
GLAZING AREA	0.836	m^2
OPENABLE AREA	1.066	m^2
FREE AREA	—	%

WINDOW MARK	W174L T7
LOCATION	23F UNIT B ENSUITE
SECTION	70mm ALUM. SECTION
GLAZING	GL01
QUANTITY	1 Nos.
REMARKS	SITE IN SITU

B.D. REF :

CLIENT :
SHIMAO GROUP HOLDINGS LIMITED

ARCHITECT :
WONG TUNG & PARTNERS LIMITED
ARCHITECTS & PLANNERS

MAIN CONTRACTOR :
協興建築有限公司
HIP HING CONSTRUCTION CO LTD

STRUCTURAL ENGINEER :
C M WONG & ASSOCIATES LTD
Consulting Engineers

SITE IN SITU CONSULTANT:
MEINHARDT

NOTE :
1. ALL DIMENSIONS ARE IN mm.
2. ALL ELEVATIONS ARE VIEWED FROM OUTSIDE.
3. ALL DIMENSIONS TO BE VERIFIED ON SITE BEFORE FABRICATION.

LEGEND :
X1 / 2001 — DETAIL MARK NO. / REFER SHEET NO.
1. F.F.L. — FINISHED FLOOR LEVEL
2. S.F.L. — STRUCTURAL FLOOR LEVEL
3. (R) — REVERSED DETAIL
4. ▲ — FIXING LOCATION
5. △ — FIXING LUG LOCATION
6. GLASS LEGEND
GL01 — 10mm+12mm AIR GAP+10mm THK. L.G.U.
GL05 — 10mm+12mm AIR GAP+10mm THK. L.G.U.
GL06 — 10mm+12mm AIR GAP+12mm THK. L.G.U.
PD01 — 10mm T.P+12mm AIR GAP+8mm T.P
GL07 — 10mm+12mm AIR GAP+12mm THK. L.G.U.
GL08 — 10mm+12mm AIR GAP+10mm THK. L.G.U.

NO.	DATE	REVISED	BY
C	18/04/2022	REVISION SUBJECT TO ARCH.COMMENT	LHK
B	16/12/2021	REVISION SUBJECT TO ARCH.COMMENT	LHK

JOB NO. : J-853

PROJECT :
PROPOSED RESIDENTIAL DEVELOPMENT AT N.K.I.L. 6542 YIN PING ROAD KOWLOON

TITLE :
WINDOW SCHEDULE FOR TOWER 7 ALUM. WINDOW

DATE : 03-APR-21 | SCALE : 1:40

DRAWN BY : | CHECKED BY :

美特鋁質有限公司
MIDI ALUMINIUM FABRICATOR LTD.
Units 6-8, Sunray Industrial Centre, 1/F
610 Cha Kwo Ling Road, Kowloon
Tel:23489211-4 Fax:(852)27727666

DWG NO. : J853-SD-IW-SC704b | REV. : C

ELEVATION

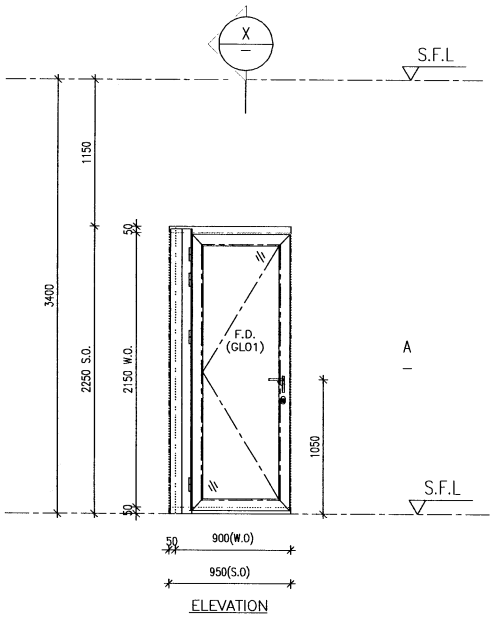

ELEVATION

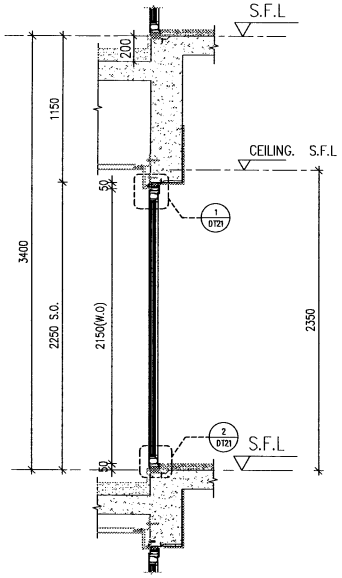

X — PART SECTION

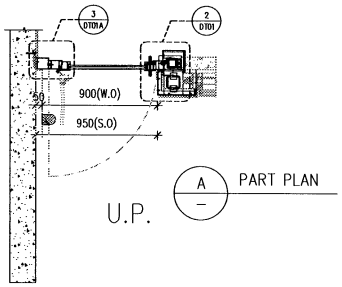

A — PART PLAN

PROVIDED		
GLAZING AREA	0.836	m^2
OPENABLE AREA	1.066	m^2
FREE AREA	—	%

WINDOW MARK	W113 / T7
LOCATION	26F UNIT B STAIR CASE
SECTION	70mm ALUM. SECTION
GLAZING	GL01
QUANTITY	1 Nos.
REMARKS	SITE IN SITU

B.D. REF :

CLIENT :
SHIMAO GROUP HOLDINGS LIMITED

ARCHITECT :
WONG TUNG & PARTNERS LIMITED
ARCHITECTS & PLANNERS

MAIN CONTRACTOR :
協興建築有限公司
HIP HING CONSTRUCTION CO LTD

STRUCTURAL ENGINEER :
C M WONG & ASSOCIATES LTD
Consulting Engineers

SITE IN SITU CONSULTANT:
MEINHARDT

NOTE :
1. ALL DIMENSIONS ARE IN mm.
2. ALL ELEVATIONS ARE VIEWED FROM OUTSIDE.
3. ALL DIMENSIONS TO BE VERIFIED ON SITE BEFORE FABRICATION.

LEGEND :
X1 / X001 — DETAIL MARK NO. / REFER SHEET NO.
1. F.F.L. — FINISHED FLOOR LEVEL
2. S.F.L. — STRUCTURAL FLOOR LEVEL
3. (/R) — REVERSED DETAIL
4. ▲ — FIXING LOCATION
5. △ — FIXING LUG LOCATION
6. GLASS LEGEND
GL01 — 10mm+12mm AIR GAP+10mm THK. I.G.U.
GL05 — 10mm+12mm AIR GAP+10mm THK. I.G.U.
GL06 — 10mm+12mm AIR GAP+12mm THK. I.G.U.
PD01 — 10mm T.P+12mm AIR GAP+8mm T.P
GL07 — 10mm+12mm AIR GAP+12mm THK. I.G.U.
GL08 — 10mm+12mm AIR GAP+10mm THK. I.G.U.

NO.	DATE	REVISED	BY
A	16/12/2021	REVISION SUBJECT TO ARCH.COMMENT	LHR

JOB NO. : J-853

PROJECT :
PROPOSED RESIDENTIAL DEVELOPMENT AT N.K.I.L. 6542 YIN PING ROAD KOWLOON

TITLE :
WINDOW SCHEDULE FOR TOWER 7 ALUM. WINDOW

DATE : 03-APR-21 | SCALE : 1:40

DRAWN BY : | CHECKED BY :

美特鋁質有限公司
MIDI ALUMINIUM FABRICATOR LTD.
Units 6-8, Sunray Industrial Centre, 1/F
610 Cha Kwo Ling Road, Kowloon
Tel:23489211-4 Fax:(852)27727666

DWG NO. : J853-SD-IW-SC704c | REV. : A

ELEVATION

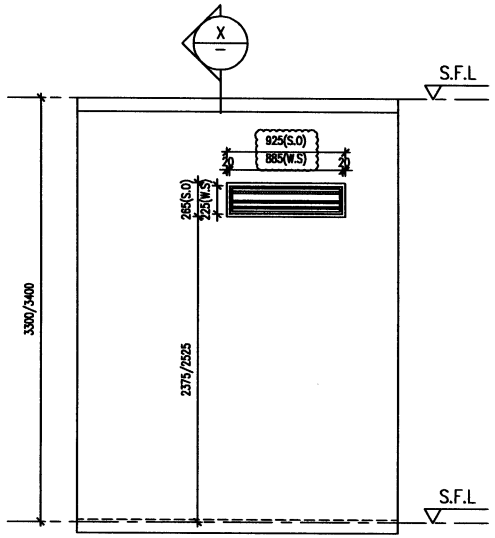

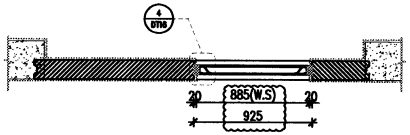

A1 PART PLAN

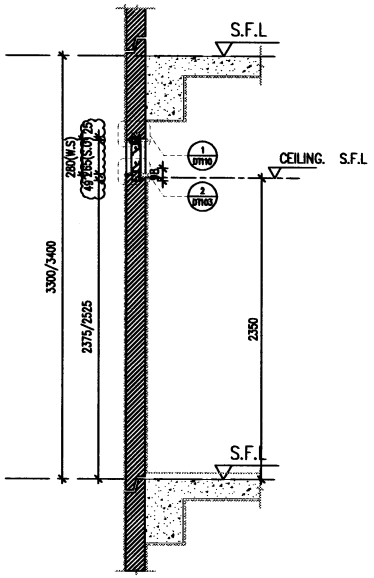

X PART SECTION

WINDOW MARK	L01 / T7
LOCATION	26F ENSUITE 3 BATH ROOM
SECTION	70mm ALUM. LOUVER
GLAZING	–
QUANTITY	1 Nos.
REMARKS	FACADE (T7–01–05A/26F)

PROVIDED		
GLAZING AREA	0	m^2
OPENABLE AREA	0	m^2
FREE AREA	56.4	%

B.D. REF :

CLIENT :
SHIMAO GROUP HOLDINGS LIMITED

ARCHITECT :
WONG TUNG & PARTNERS LIMITED
ARCHITECTS & PLANNERS

MAIN CONTRACTOR :
協興建築有限公司
HIP HING CONSTRUCTION CO LTD

STRUCTURAL ENGINEER :
C M WONG & ASSOCIATES LTD
Consulting Engineers

SITE IN SITU CONSULTANT:
MEINHARDT

NOTE :
1. ALL DIMENSIONS ARE IN mm.
2. ALL ELEVATIONS ARE VIEWED FROM OUTSIDE.
3. ALL DIMENSIONS TO BE VERIFIED ON SITE BEFORE FABRICATION.

LEGEND :
X1 / 2001 — DETAIL MARK NO. / REFER SHEET NO.
1. F.F.L. — FINISHED FLOOR LEVEL
2. S.F.L. — STRUCTURAL FLOOR LEVEL
3. (R) — REVERSED DETAIL
4. ▲ — FIXING LOCATION
5. △ — FIXING LUG LOCATION
6. GLASS LEGEND
GL01 — 10mm+12mm AIR GAP+10mm THK. I.G.U.
GL05 — 10mm+12mm AIR GAP+10mm THK. I.G.U.
GL06 — 10mm+12mm AIR GAP+12mm THK. I.G.U.
PD01 — 10mm T.P+12mm AIR GAP+8mm T.P
GL07 — 10mm+12mm AIR GAP+12mm THK. I.G.U.
GL08 — 10mm+12mm AIR GAP+10mm THK. I.G.U.

NO.	DATE	REVISED	BY

JOB NO. : J–853

PROJECT :
PROPOSED RESIDENTIAL DEVELOPMENT AT N.K.I.L. 6542 YIN PING ROAD KOWLOON

TITLE :
WINDOW SCHEDULE FOR TOWER 7 ALUM. WINDOW

DATE : 03–APR–21 | SCALE : 1:40

DRAWN BY : | CHECKED BY :

美特鋁製有限公司
MIDI ALUMINIUM FABRICATOR LTD.
Units 6–8, Sunray Industrial Centre, 1/F
610 Cha Kwo Ling Road, Kowloon
Tel:23489211–4 Fax:(852)27727666

DWG NO. : J853–SD–W–SC713 | REV. : A

ELEVATION

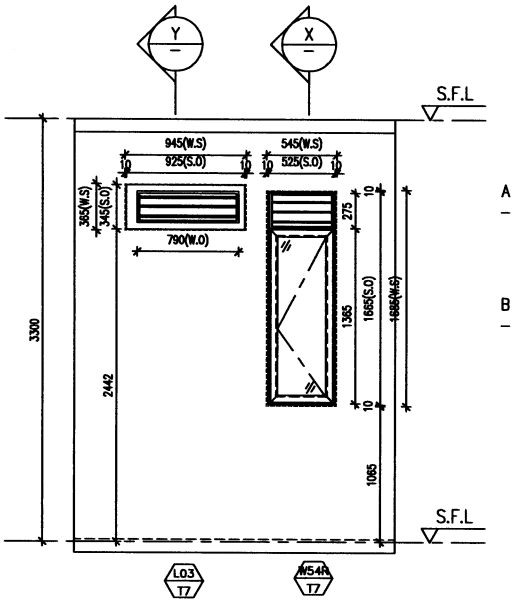

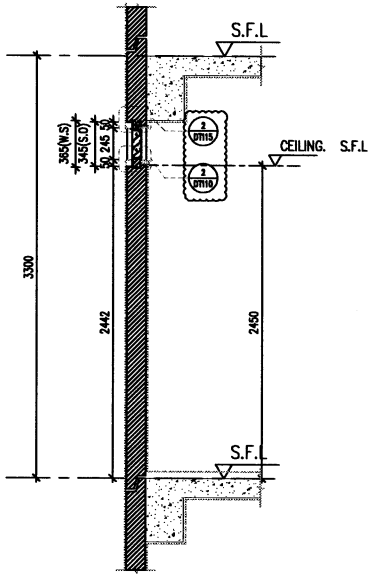

Y PART SECTION

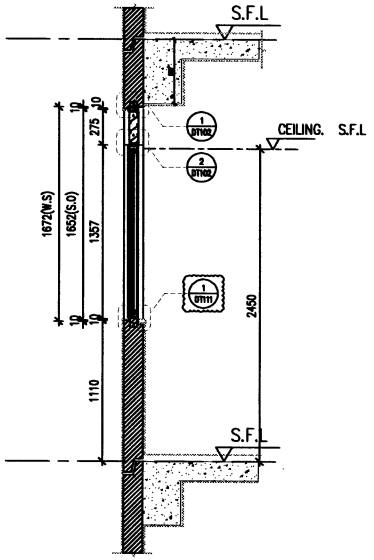

X PART SECTION

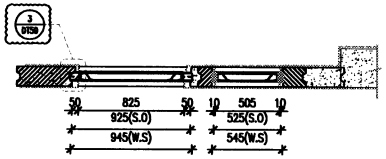

A PART PLAN

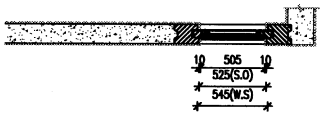

B PART PLAN

W54R T7

PROVIDED		
GLAZING AREA	–	m^2
OPENABLE AREA	–	m^2
FREE AREA	55.4	%

WINDOW MARK	W54R T7, L03 T7
LOCATION	25F FLAT B BATH RM
SECTION	70mm ALUM. SECTION
GLAZING	GL05
QUANTITY	1 No.
REMARKS	FACADE (T7-01-07A/25F)

B.D. REF :

CLIENT :
SHIMAO GROUP HOLDINGS LIMITED

ARCHITECT : WONG TUNG & PARTNERS LIMITED ARCHITECTS & PLANNERS

MAIN CONTRACTOR :
協興建築有限公司
HIP HING CONSTRUCTION CO LTD

STRUCTURAL ENGINEER :
C M WONG & ASSOCIATES LTD
Consulting Engineers

SITE IN SITU CONSULTANT:
MEINHARDT

NOTE :
1. ALL DIMENSIONS ARE IN mm.
2. ALL ELEVATIONS ARE VIEWED FROM OUTSIDE.
3. ALL DIMENSIONS TO BE VERIFIED ON SITE BEFORE FABRICATION.

LEGEND :
- X1 / X1001 — DETAIL MARK NO. / REFER SHEET NO.
1. F.F.L. — FINISHED FLOOR LEVEL
2. S.F.L. — STRUCTURAL FLOOR LEVEL
3. (R) — REVERSED DETAIL
4. ▲ — FIXING LOCATION
5. △ — FIXING LUG LOCATION
6. GLASS LEGEND
   - GL01 — 10mm+12mm AIR GAP+10mm THK. LG.U.
   - GL05 — 10mm+12mm AIR GAP+10mm THK. LG.U.
   - GL06 — 10mm+12mm AIR GAP+12mm THK. LG.U.
   - PD01 — 10mm T.P+12mm AIR GAP+8mm T.P
   - GL07 — 10mm+12mm AIR GAP+12mm THK. LG.U.
   - GL08 — 10mm+12mm AIR GAP+10mm THK. LG.U.

NO.	DATE	REVISED	BY

JOB NO. : J-853

PROJECT :
PROPOSED RESIDENTIAL DEVELOPMENT AT N.K.I.L. 6542 YIN PING ROAD KOWLOON

TITLE :
WINDOW SCHEDULE FOR TOWER 7 ALUM. WINDOW

DATE : 16-SEP-2022 | SCALE : 1:40

DRAWN BY : JK | CHECKED BY :

美特鋁製有限公司
MIDI ALUMINIUM FABRICATOR LTD.
Units 6-8, Sunroy Industrial Centre, 1/F
610 Cha Kwo Ling Road, Kowloon
Tel:23489211-4 Fax:(852)27727666

DWG NO. : J853-SD-W-SC712 | REV. : –

ELEVATION

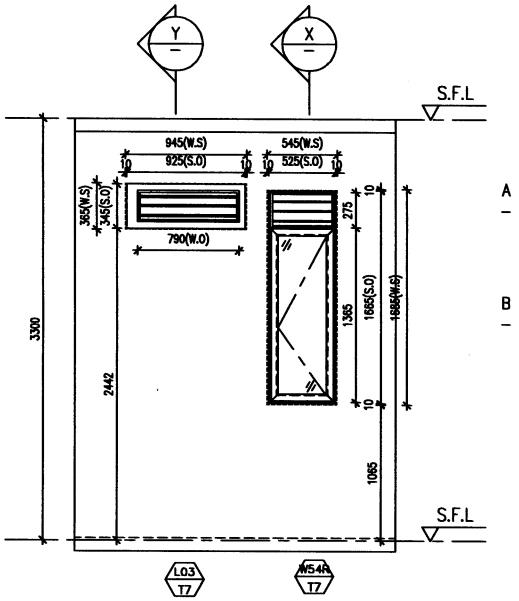

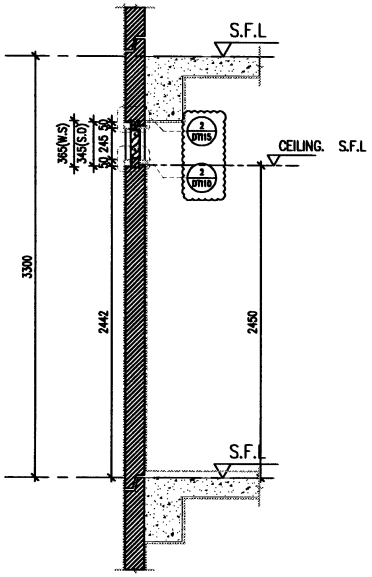

Y PART SECTION

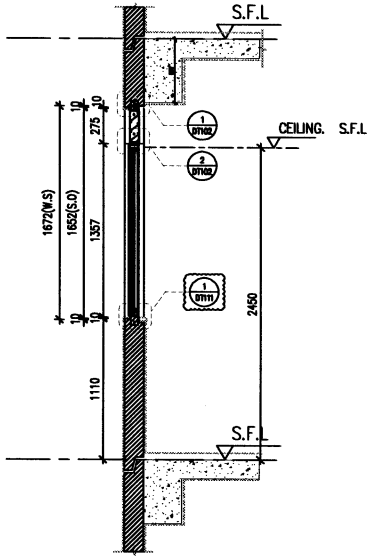

X PART SECTION

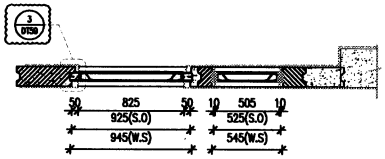

A PART PLAN

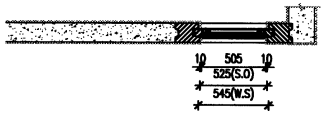

B PART PLAN

W54R T7

PROVIDED		
GLAZING AREA	–	m^2
OPENABLE AREA	–	m^2
FREE AREA	55.4	%

WINDOW MARK	W04R T7, L03 T7
LOCATION	26F FLAT B M. BATH RM
SECTION	70mm ALUM. SECTION
GLAZING	GL05
QUANTITY	1 No.
REMARKS	FACADE (T7-01-07A/26F)

B.D. REF :

CLIENT :
SHIMAO GROUP HOLDINGS LIMITED

ARCHITECT :
WONG TUNG & PARTNERS LIMITED
ARCHITECTS & PLANNERS

MAIN CONTRACTOR :
協興建築有限公司
HIP HING CONSTRUCTION CO LTD

STRUCTURAL ENGINEER :
C M WONG & ASSOCIATES LTD
Consulting Engineers

SITE IN SITU CONSULTANT:
MEINHARDT

NOTE :
1. ALL DIMENSIONS ARE IN mm.
2. ALL ELEVATIONS ARE VIEWED FROM OUTSIDE.
3. ALL DIMENSIONS TO BE VERIFIED ON SITE BEFORE FABRICATION.

LEGEND :
X1 / XXX1 — DETAIL MARK NO. / REFER SHEET NO.
1. F.F.L. — FINISHED FLOOR LEVEL
2. S.F.L. — STRUCTURAL FLOOR LEVEL
3. /R — REVERSED DETAIL
4. ▲ — FIXING LOCATION
5. △ — FIXING LUG LOCATION
6. GLASS LEGEND
GL01 — 10mm+12mm AIR GAP+10mm THK. LG.U.
GL05 — 10mm+12mm AIR GAP+10mm THK. LG.U.
GL06 — 10mm+12mm AIR GAP+12mm THK. LG.U.
PD01 — 10mm T.P+12mm AIR GAP+8mm T.P
GL07 — 10mm+12mm AIR GAP+12mm THK. LG.U.
GL08 — 10mm+12mm AIR GAP+10mm THK. LG.U.

NO.	DATE	REMARKS	BY

JOB NO. : J-853

PROJECT :
PROPOSED RESIDENTIAL DEVELOPMENT AT N.K.I.L. 6542 YIN PING ROAD KOWLOON

TITLE :
WINDOW SCHEDULE FOR TOWER 7 ALUM. WINDOW

DATE : 16-SEP-2022 | SCALE : 1:40

DRAWN BY : JK | CHECKED BY :

美特鋁製有限公司
MIDI ALUMINIUM FABRICATION LTD.
Units 6-8, Sunray Industrial Centre, 1/F
610 Cha Kwo Ling Road, Kowloon
Tel:23489211-4 Fax:(852)27727666

DWG NO. : J853-SD-W-SC712a | REV. : –

ELEVATION

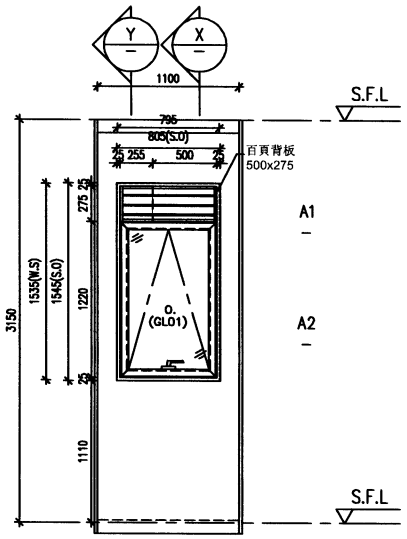

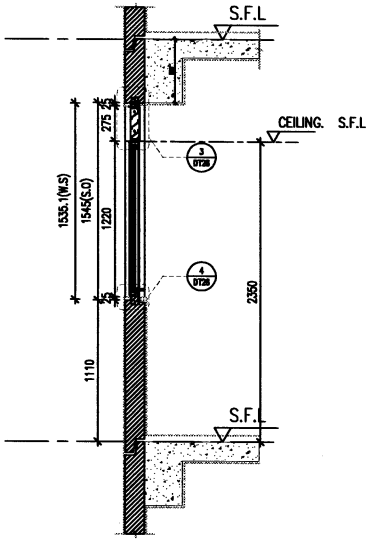

X PART SECTION

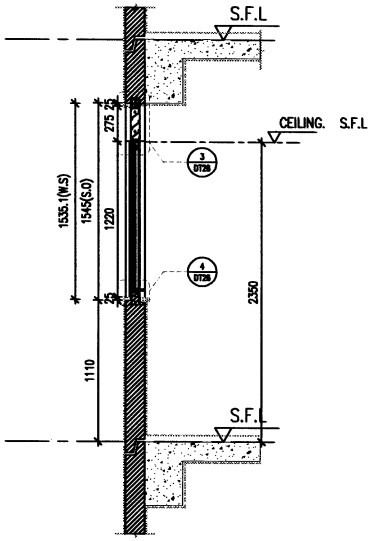

Y PART SECTION

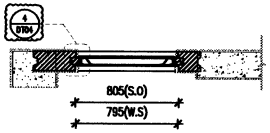

A1 PART PLAN

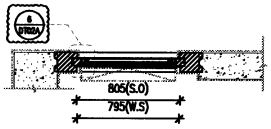

A2 PART PLAN

PROVIDED		
GLAZING AREA	0.676	m^2
OPENABLE AREA	0.778	m^2
FREE AREA	60.7	%

WINDOW MARK	W10A / T7
LOCATION	7F~15F & 17F~22F FLAT B KITCHEN
SECTION	70mm ALUM. SECTION
GLAZING	GL01
QUANTITY	~~13 Nos~~
REMARKS	FACADE(T7-01-05/7F~15F&17F~22F)

B.D. REF :

CLIENT :
SHIMAO GROUP HOLDINGS LIMITED

ARCHITECT :
WONG TUNG & PARTNERS LIMITED
ARCHITECTS & PLANNERS

MAIN CONTRACTOR :
協興建築有限公司
HIP HING CONSTRUCTION CO LTD

STRUCTURAL ENGINEER :
C M WONG & ASSOCIATES LTD
Consulting Engineers

SITE IN SITU CONSULTANT:
MEINHARDT

NOTE :
1. ALL DIMENSIONS ARE IN mm.
2. ALL ELEVATIONS ARE VIEWED FROM OUTSIDE.
3. ALL DIMENSIONS TO BE VERIFIED ON SITE BEFORE FABRICATION.

LEGEND :
- X1 / XXXS — DETAIL MARK NO. / REFER SHEET NO.
1. F.F.L. — FINISHED FLOOR LEVEL
2. S.F.L. — STRUCTURAL FLOOR LEVEL
3. (R) — REVERSED DETAIL
4. ▲ — FIXING LOCATION
5. △ — FIXING LUG LOCATION
6. GLASS LEGEND
   - GL01 — 10mm+12mm AIR GAP+10mm THK. I.G.U.
   - GL05 — 10mm+12mm AIR GAP+10mm THK. I.G.U.
   - GL06 — 10mm+12mm AIR GAP+12mm THK. I.G.U.
   - PD01 — 10mm T.P+12mm AIR GAP+8mm T.P
   - GL07 — 10mm+12mm AIR GAP+12mm THK. I.G.U.
   - GL08 — 10mm+12mm AIR GAP+10mm THK. I.G.U.

NO.	DATE	REMARKS	BY

JOB NO. : J-853

PROJECT :
PROPOSED RESIDENTIAL DEVELOPMENT AT N.K.I.L. 6542 YIN PING ROAD KOWLOON

TITLE :
WINDOW SCHEDULE FOR TOWER 7 ALUM. WINDOW

DATE : 16-09-2022 | SCALE : 1:40

DRAWN BY : | CHECKED BY :

美特鋁製有限公司
MIDI ALUMINIUM FABRICATOR LTD.
Units 6-8, Sunroy Industrial Centre, 1/F
610 Cha Kwo Ling Road, Kowloon
Tel:23489211-4 Fax:(852)27727666

DWG NO. : J853-SD-IW-711b | REV. : -

ELEVATION

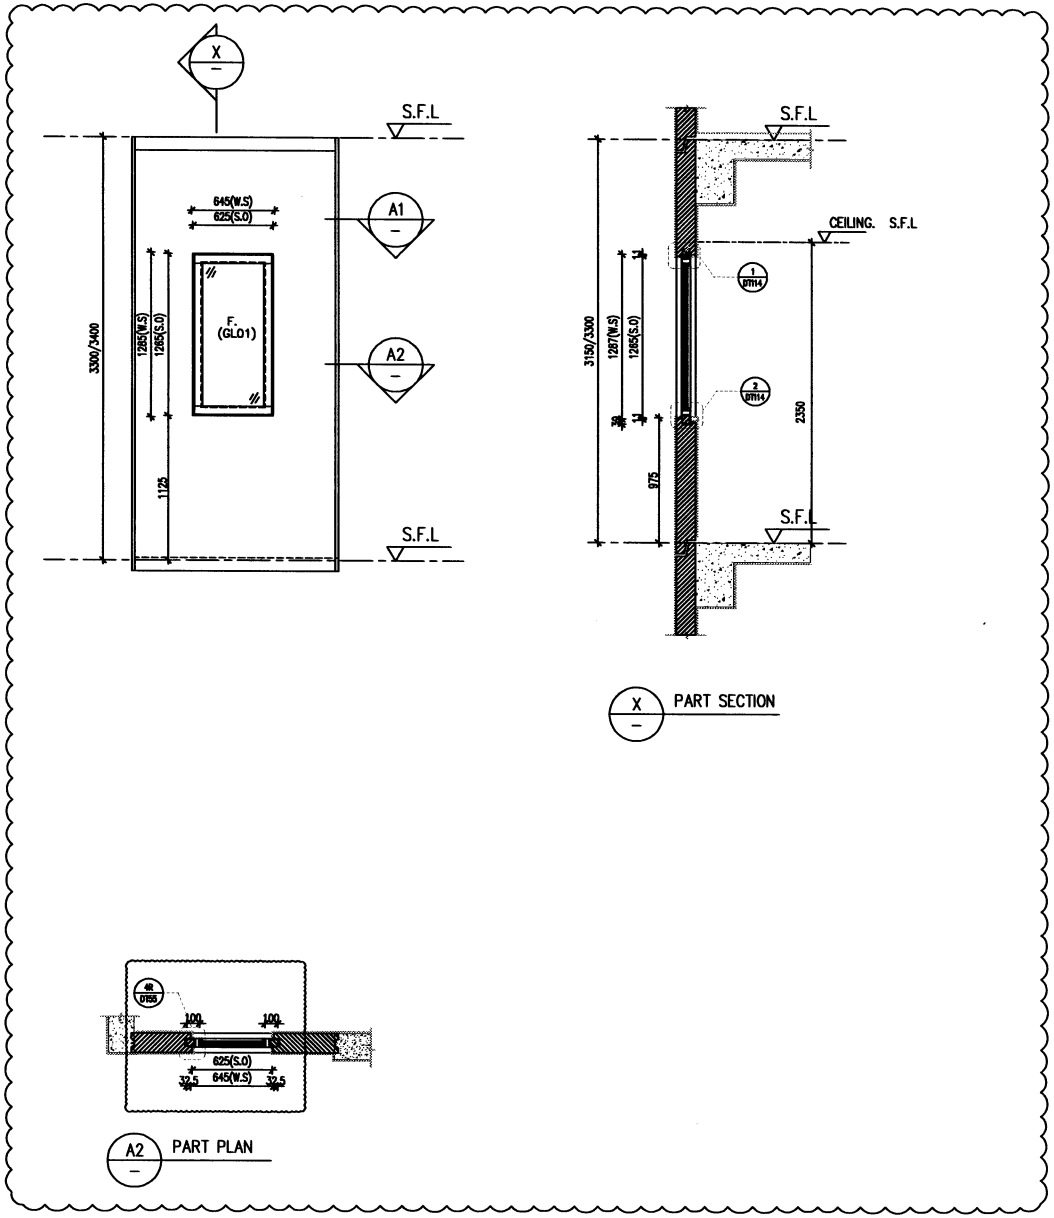

WINDOW MARK	W63 / T7
LOCATION	23F&25F FLAT A KITCHEN
SECTION	70mm ALUM. SECTION
GLAZING	GL01
QUANTITY	2 Nos.
REMARKS	FACADE (T7-01-03A/25F; T7-01-03B/23F)

PROVIDED		
GLAZING AREA	0.561	m^2
OPENABLE AREA	—	m^2
FREE AREA	60.7	%

B.D. REF :

CLIENT :
SHIMAO GROUP HOLDINGS LIMITED

ARCHITECT : WONG TUNG & PARTNERS LIMITED ARCHITECTS & PLANNERS

MAIN CONTRACTOR : 協興建築有限公司 HIP HING CONSTRUCTION CO LTD

STRUCTURAL ENGINEER : CMA C M WONG & ASSOCIATES LTD 黃志明結構工程師有限公司

FACADE CONSULTANT: MEINHARDT

NOTE :
1. ALL DIMENSIONS ARE IN mm.
2. ALL ELEVATIONS ARE VIEWED FROM OUTSIDE.
3. ALL DIMENSIONS TO BE VERIFIED ON SITE BEFORE FABRICATION.

LEGEND :
- X1 / X001 — DETAIL MARK NO. / REFER SHEET NO.
1. F.F.L. — FINISHED FLOOR LEVEL
2. S.F.L. — STRUCTURAL FLOOR LEVEL
3. (R) — REVERSED DETAIL
4. ▲ — FIXING LOCATION
5. △ — FIXING LUG LOCATION
6. GLASS LEGEND
   - GL01 — 10mm+12mm AIR GAP+10mm THK. LG.U.
   - GL04 — 12mm THK. CLEAR TEMPERED GLASS
   - GL05 — 10mm+12mm AIR GAP+10mm THK. LG.U.
   - GL06 — 10mm+12mm AIR GAP+12mm THK. LG.U.
   - GL07 — 10mm+12mm AIR GAP+12mm THK. LG.U.
   - GL08 — 10mm+12mm AIR GAP+10mm THK. LG.U.

NO.	DATE	REVISED	BY
C	07/09/2022	REVISION SUBJECT TO ARCH.COMMENT	eda
B	04/08/2022	REVISION SUBJECT TO ARCH.COMMENT	eda
A	18/10/2021	REVISION SUBJECT TO ARCH.COMMENT	eda

JOB NO. : J-853

PROJECT :
PROPOSED RESIDENTIAL DEVELOPMENT AT N.K.I.L. 6542 YIN PING ROAD KOWLOON

TITLE :
WINDOW SCHEDULE FOR TOWER 7 ALUM. WINDOW

DATE : 03-APR-21 | SCALE : 1:40

DRAWN BY : | CHECKED BY :

美特鋁製有限公司 MIDI ALUMINIUM FABRICATOR LTD.
Units 6-8, Sunray Industrial Centre, 1/F
610 Cha Kwo Ling Road, Kowloon
Tel:23489211-4 Fax:(852)27727666

DWG NO. : J853-SD-PW-SC702a | REV. : C

T:\Jobs\J-853\2, Outgoing\Black plate opening of Windows Louvre\Black Plate of T7 Precat Window.dwg

ELEVATION

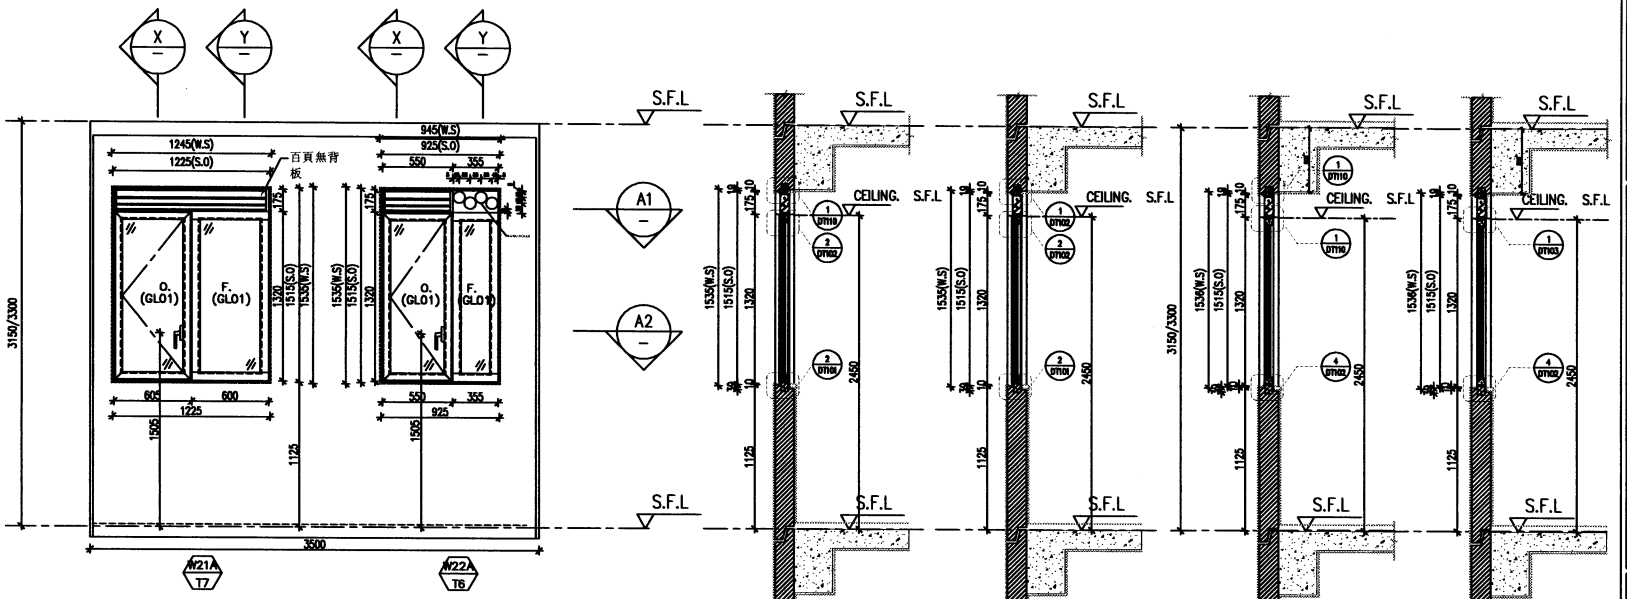

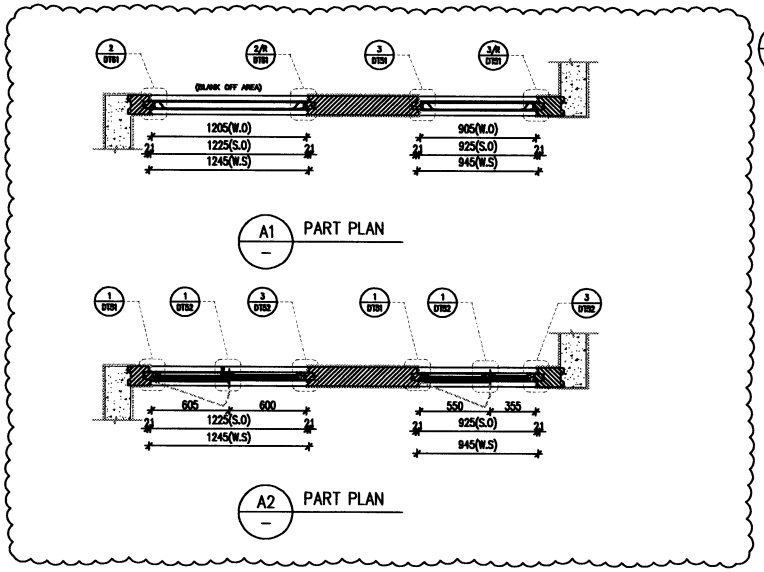

PROVIDED		
GLAZING AREA	0.797	m^2
OPENABLE AREA	0.593	m^2
FREE AREA	52.1	%

W22A T6

PROVIDED		
GLAZING AREA	1.153	m^2
OPENABLE AREA	0.661	m^2
FREE AREA	52.1	%

W21A T7

WINDOW MARK	W21A T7 & W22A T6
LOCATION	7F~22F FLAT A BEDROOM 4
SECTION	70mm ALUM. SECTION
GLAZING	GL01
QUANTITY	13 Nos / 13 NOS
REMARKS	FACADE (T7-01-01/7~15F&17F~22F)

B.D. REF :

CLIENT :
SHIMAO GROUP HOLDINGS LIMITED

ARCHITECT :
WONG TUNG & PARTNERS LIMITED
ARCHITECTS & PLANNERS

MAIN CONTRACTOR :
協興建築有限公司
HIP HING CONSTRUCTION CO LTD

STRUCTURAL ENGINEER :
C M WONG & ASSOCIATES LTD
黃志明陸榮工程師有限公司

FACADE CONSULTANT:
MEINHARDT

NOTE :
1. ALL DIMENSIONS ARE IN mm.
2. ALL ELEVATIONS ARE VIEWED FROM OUTSIDE.
3. ALL DIMENSIONS TO BE VERIFIED ON SITE BEFORE FABRICATION.

LEGEND :
- X1 / XXX1 — DETAIL MARK NO. / REFER SHEET NO.
1. F.F.L. — FINISHED FLOOR LEVEL
2. S.F.L. — STRUCTURAL FLOOR LEVEL
3. (78) — REVERSED DETAIL
4. ▲ — FIXING LOCATION
5. △ — FIXING LUG LOCATION
6. GLASS LEGEND
   - GL01 — 10mm+12mm AIR GAP+10mm THK. LG.U.
   - GL04 — 12mm THK. CLEAR TEMPERED GLASS
   - GL05 — 10mm+12mm AIR GAP+10mm THK. LG.U.
   - GL06 — 10mm+12mm AIR GAP+12mm THK. LG.U.
   - GL07 — 10mm+12mm AIR GAP+12mm THK. LG.U.
   - GL08 — 10mm+12mm AIR GAP+10mm THK. LG.U.

NO.	DATE	REMARK	BY
B	07/09/2022	REVISION SUBJECT TO ARCH.COMMENT	edw
A	04/08/2022	REVISION SUBJECT TO ARCH.COMMENT	edw

JOB NO. : J-853

PROJECT :
PROPOSED RESIDENTIAL DEVELOPMENT AT N.K.I.L. 6542 YIN PING ROAD KOWLOON

TITLE :
WINDOW SCHEDULE FOR TOWER 7 ALUM. WINDOW

DATE : 03-APR-21 | SCALE : 1:40

DRAWN BY : | CHECKED BY :

美特鋁製有限公司
MIDI ALUMINIUM FABRICATOR LTD.
Units 6-8, Sunray Industrial Centre, 1/F
610 Cha Kwo Ling Road, Kowloon
Tel:23489211-4 Fax:(852)27727666

DWG NO. : J853-SD-PW-SC702b | REV. : B

T:\Jobs\J-853\2. Outgoing\Black plate opening of Windows Louvre\Black Plate of T7 Precat Window.dwg

ELEVATION

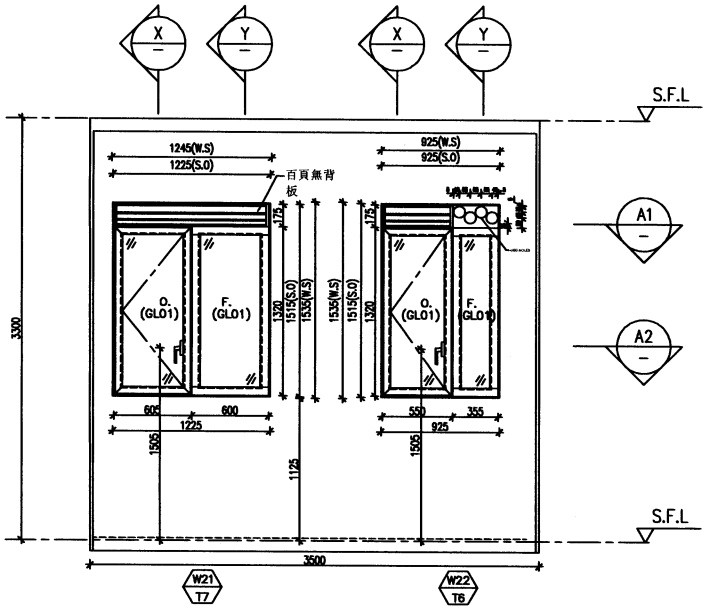

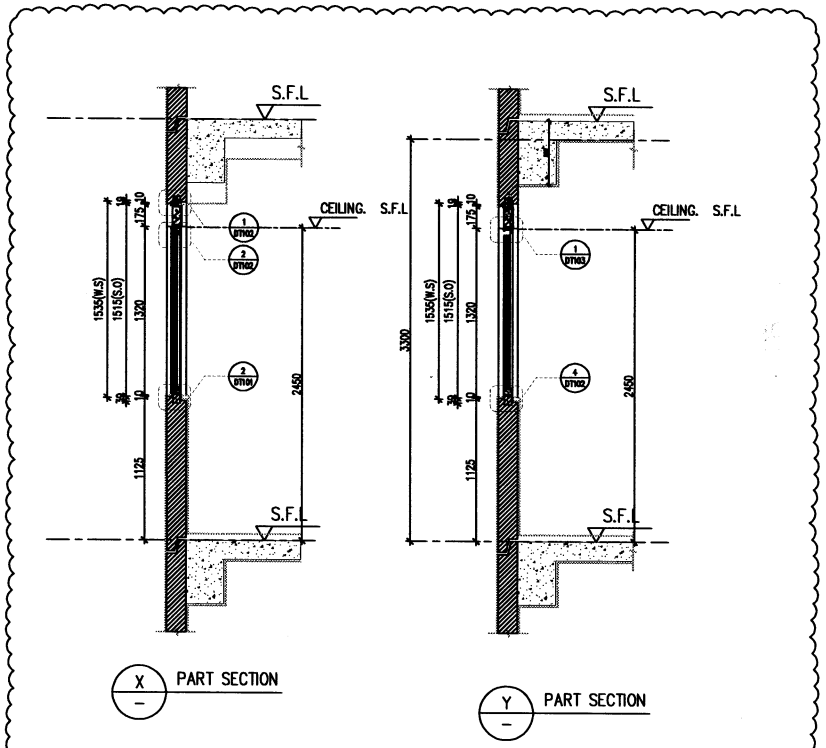

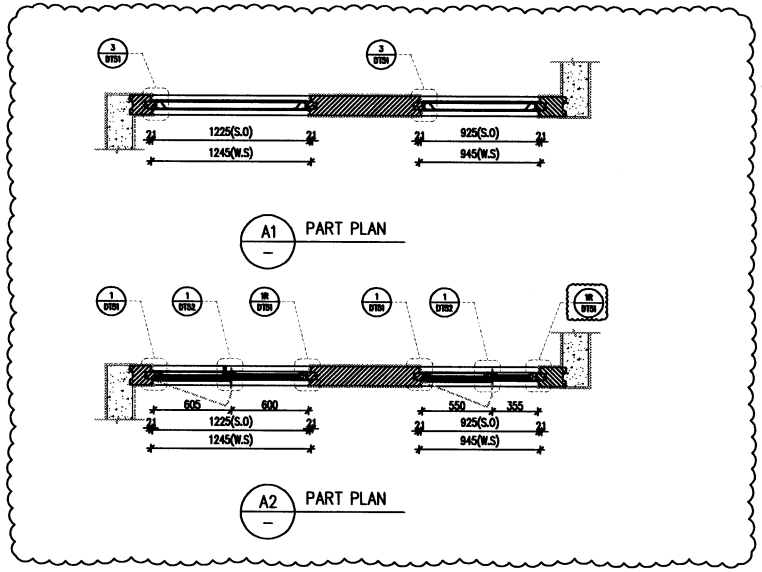

PROVIDED		
GLAZING AREA	0.801	m^2
OPENABLE AREA	0.596	m^2
FREE AREA	52.1	%

W22 T6

PROVIDED		
GLAZING AREA	1.157	m^2
OPENABLE AREA	0.664	m^2
FREE AREA	52.1	%

W21 T7

WINDOW MARK	W21 T7 & W22 T6
LOCATION	16F & 26F FLAT A BEDROOM 4
SECTION	70mm ALUM. SECTION
GLAZING	GL01
QUANTITY	2 Nos. / 2 Nos.
REMARKS	FACADE (T7-01-01A/16F & 26F)

T:\Jobs\J-853\2. Outgoing\Black plate opening of Windows Louvre\Black Plate of T7 Precat Window.dwg

B.D. REF :

CLIENT :
SHIMAO GROUP HOLDINGS LIMITED

ARCHITECT : WONG TUNG & PARTNERS LIMITED ARCHITECTS & PLANNERS

MAIN CONTRACTOR : 協興建築有限公司 HIP HING CONSTRUCTION CO LTD

STRUCTURAL ENGINEER : CMA C M WONG & ASSOCIATES LTD 黃志明結構工程師有限公司

FACADE CONSULTANT: MEINHARDT

NOTE :
1. ALL DIMENSIONS ARE IN mm.
2. ALL ELEVATIONS ARE VIEWED FROM OUTSIDE.
3. ALL DIMENSIONS TO BE VERIFIED ON SITE BEFORE FABRICATION.

LEGEND :
- X1 / X001 — DETAIL MARK NO. / REFER SHEET NO.
1. F.F.L. — FINISHED FLOOR LEVEL
2. S.F.L. — STRUCTURAL FLOOR LEVEL
3. — REVERSED DETAIL
4. ▲ — FIXING LOCATION
5. △ — FIXING LUG LOCATION
6. GLASS LEGEND
   - GL01 — 10mm+12mm AIR GAP+10mm THK. I.G.U.
   - GL04 — 12mm THK. CLEAR TEMPERED GLASS
   - GL05 — 10mm+12mm AIR GAP+10mm THK. I.G.U.
   - GL06 — 10mm+12mm AIR GAP+12mm THK. I.G.U.
   - GL07 — 10mm+12mm AIR GAP+12mm THK. I.G.U.
   - GL08 — 10mm+12mm AIR GAP+10mm THK. I.G.U.

NO.	DATE	REVISED	BY
B	07/05/2022	REVISION SUBJECT TO ARCH.COMMENT	mdm
A	04/05/2022	REVISION SUBJECT TO ARCH.COMMENT	mdm

JOB NO. : J-853

PROJECT :
PROPOSED RESIDENTIAL DEVELOPMENT AT N.K.I.L. 6542 YIN PING ROAD KOWLOON

TITLE :
WINDOW SCHEDULE FOR TOWER 7 ALUM. WINDOW

DATE : 03-APR-21 | SCALE : 1:40

DRAWN BY : | CHECKED BY :

美特鋁質有限公司 MIDI ALUMINIUM FABRICATION LTD.
Units 6-8, Sunray Industrial Centre, 1/F
610 Cha Kwo Ling Road, Kowloon
Tel:23489211-4 Fax:(852)27727666

DWG NO. : J853-SD-PW-SC702c | REV. : A

ELEVATION

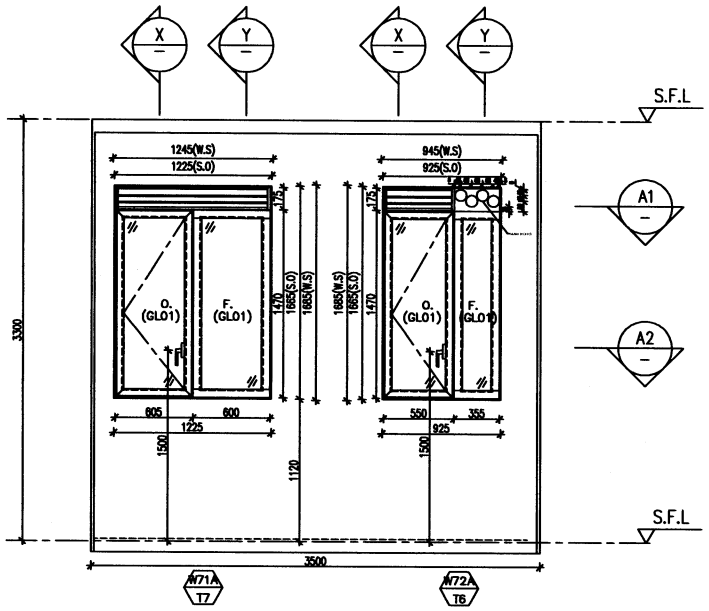

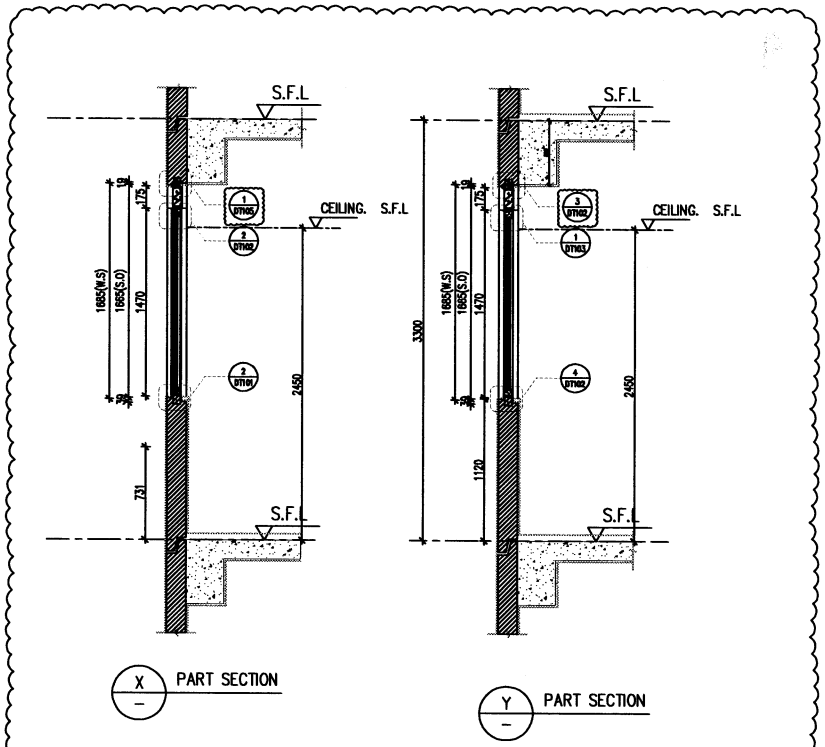

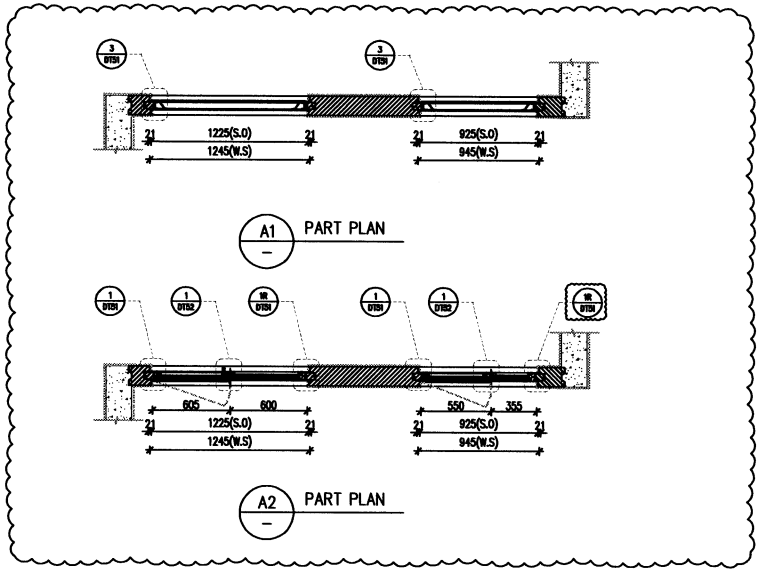

PROVIDED		
GLAZING AREA	0.899	m^2
OPENABLE AREA	0.665	m^2
FREE AREA	52.1	%

W72A T6

PROVIDED		
GLAZING AREA	1.299	m^2
OPENABLE AREA	0.742	m^2
FREE AREA	52.1	%

W71A T7

WINDOW MARK	W71A T7 & W72A T6
LOCATION	25F FLAT A BEDROOM 4
SECTION	70mm ALUM. SECTION
GLAZING	GLO1
QUANTITY	1 No. / 1 No.
REMARKS	FACADE (T7-01-01A/25F)

T:\Jobs\J-853\2. Outgoing\Black plate opening of Windows Louvre\Black Plate of T7 Precat Window.dwg

B.D. REF :

CLIENT :
SHIMAO GROUP HOLDINGS LIMITED

ARCHITECT :
WONG TUNG & PARTNERS LIMITED
ARCHITECTS & PLANNERS

MAIN CONTRACTOR :
協興建築有限公司
HIP HING CONSTRUCTION CO LTD

STRUCTURAL ENGINEER :
C M WONG & ASSOCIATES LTD
黃志明結構工程師有限公司

FACADE CONSULTANT:
MEINHARDT

NOTE :
1. ALL DIMENSIONS ARE IN mm.
2. ALL ELEVATIONS ARE VIEWED FROM OUTSIDE.
3. ALL DIMENSIONS TO BE VERIFIED ON SITE BEFORE FABRICATION.

LEGEND :
X1 — DETAIL MARK NO.
2001 — REFER SHEET NO.
1. F.F.L. — FINISHED FLOOR LEVEL
2. S.F.L. — STRUCTURAL FLOOR LEVEL
3. (R) — REVERSED DETAIL
4. ▲ — FIXING LOCATION
5. △ — FIXING LUG LOCATION
6. GLASS LEGEND
GLO1 — 10mm+12mm AIR GAP+10mm THK. I.G.U.
GLO4 — 12mm THK. CLEAR TEMPERED GLASS
GLO5 — 10mm+12mm AIR GAP+10mm THK. I.G.U.
GLO6 — 10mm+12mm AIR GAP+12mm THK. I.G.U.
GLO7 — 10mm+12mm AIR GAP+12mm THK. I.G.U.
GLO8 — 10mm+12mm AIR GAP+10mm THK. I.G.U.

NO.	DATE	REMARK	BY
B	07/09/2022	REVISION SUBJECT TO ARCH.COMMENT	sada
A	04/08/2022	REVISION SUBJECT TO ARCH.COMMENT	sada

JOB NO. : J-853

PROJECT :
PROPOSED RESIDENTIAL DEVELOPMENT AT N.K.I.L. 6542 YIN PING ROAD KOWLOON

TITLE :
WINDOW SCHEDULE FOR TOWER 7 ALUM. WINDOW

DATE : 03-APR-21 | SCALE : 1:40

DRAWN BY : | CHECKED BY :

美特鋁質有限公司
MIDI ALUMINIUM FABRICATOR LTD.
Units 6-8, Sunray Industrial Centre, 1/F
610 Cha Kwo Ling Road, Kowloon
Tel:23489211-4 Fax:(852)27727666

DWG NO. : J853-SD-PW-SC702d | REV. : B

ELEVATION

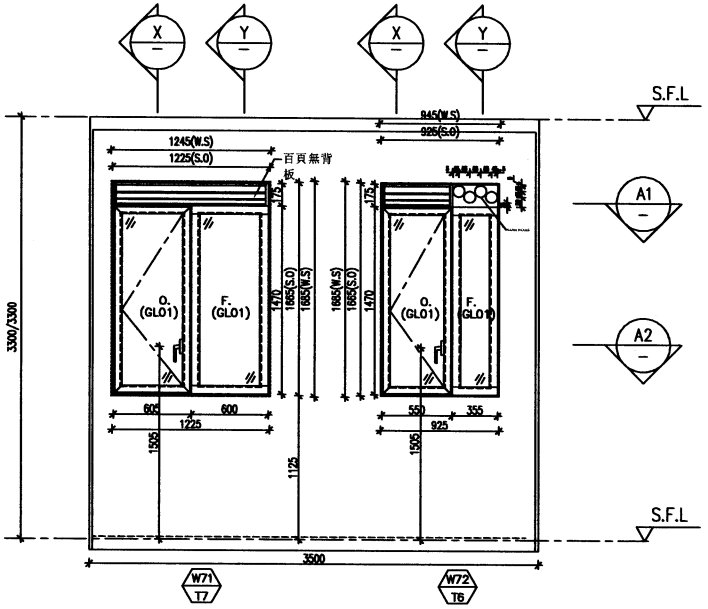

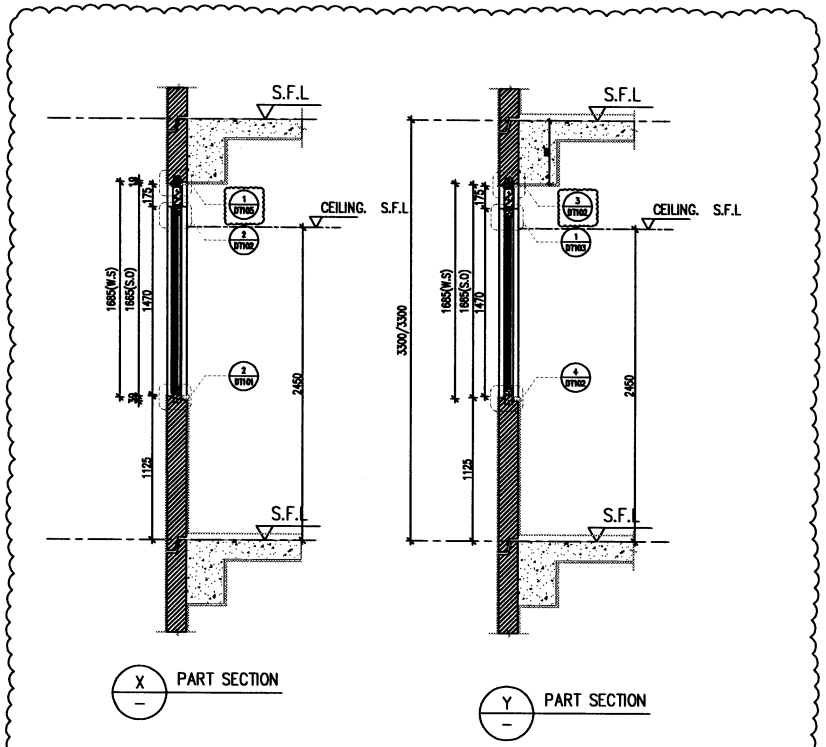

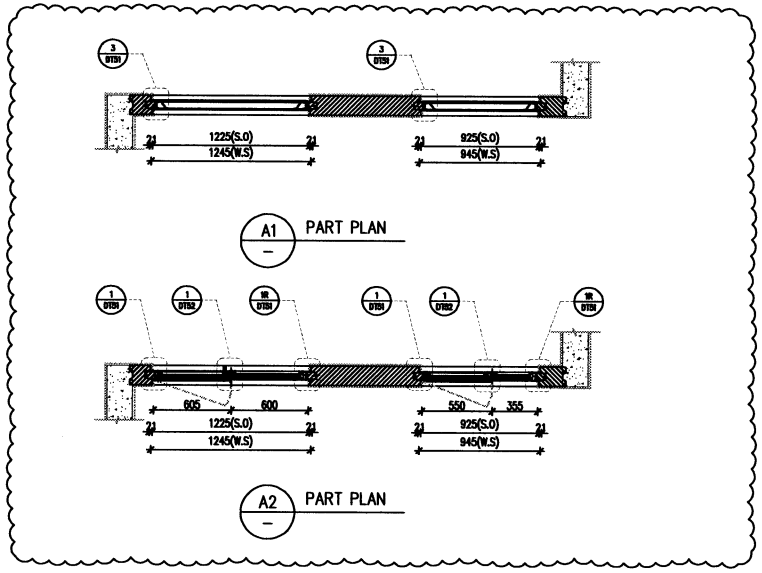

PROVIDED		
GLAZING AREA	0.901	m^2
OPENABLE AREA	0.667	m^2
FREE AREA	52.1	%

W72 T6

PROVIDED		
GLAZING AREA	1.303	m^2
OPENABLE AREA	0.744	m^2
FREE AREA	52.1	%

W71 T7

WINDOW MARK	W71 T7 & W72 T6
LOCATION	23F FLAT A BEDROOM 4
SECTION	70mm ALUM. SECTION
GLAZING	GL01
QUANTITY	1 Nos / 1 NOS
REMARKS	FACADE (T7-01-01B/23F)

T:\Jobs\J-853\2. Outgoing\Black plate opening of Windows Louvre\Black Plate of T7 Precat Window.dwg

B.D. REF :

CLIENT :
SHIMAO GROUP HOLDINGS LIMITED

ARCHITECT :
WONG TUNG & PARTNERS LIMITED
ARCHITECTS & PLANNERS

MAIN CONTRACTOR :
協興建築有限公司
HIP HING CONSTRUCTION CO LTD

STRUCTURAL ENGINEER :
C M WONG & ASSOCIATES LTD
黃志明結構工程師有限公司

FACADE CONSULTANT:
MEINHARDT

NOTE :
1. ALL DIMENSIONS ARE IN mm.
2. ALL ELEVATIONS ARE VIEWED FROM OUTSIDE.
3. ALL DIMENSIONS TO BE VERIFIED ON SITE BEFORE FABRICATION.

LEGEND :
- X1 / XSD1 — DETAIL MARK NO. / REFER SHEET NO.
1. F.F.L. — FINISHED FLOOR LEVEL
2. S.F.L. — STRUCTURAL FLOOR LEVEL
3. R — REVERSED DETAIL
4. ▲ — FIXING LOCATION
5. △ — FIXING LUG LOCATION
6. GLASS LEGEND
   - GL01 — 10mm+12mm AIR GAP+10mm THK. I.G.U.
   - GL04 — 12mm THK. CLEAR TEMPERED GLASS
   - GL05 — 10mm+12mm AIR GAP+10mm THK. I.G.U.
   - GL06 — 10mm+12mm AIR GAP+12mm THK. I.G.U.
   - GL07 — 10mm+12mm AIR GAP+12mm THK. I.G.U.
   - GL08 — 10mm+12mm AIR GAP+10mm THK. I.G.U.

NO.	DATE	REVISED	BY
B	07/09/2022	REVISION SUBJECT TO ARCH.COMMENT	mds
A	04/08/2022	REVISION SUBJECT TO ARCH.COMMENT	mds

JOB NO. : J-853

PROJECT :
PROPOSED RESIDENTIAL DEVELOPMENT AT N.K.I.L. 6542 YIN PING ROAD KOWLOON

TITLE :
WINDOW SCHEDULE FOR TOWER 7 ALUM. WINDOW

DATE : 03-APR-21 | SCALE : 1:40

DRAWN BY : | CHECKED BY :

美特鋁製有限公司
MIDI ALUMINIUM FABRICATOR LTD.
Units 6-8, Sunray Industrial Centre, 1/F
610 Cha Kwo Ling Road, Kowloon
Tel:23488211-4 Fax:(852)27727666

DWG NO. : J853-SD-PW-SC702e | REV. : A

ELEVATION

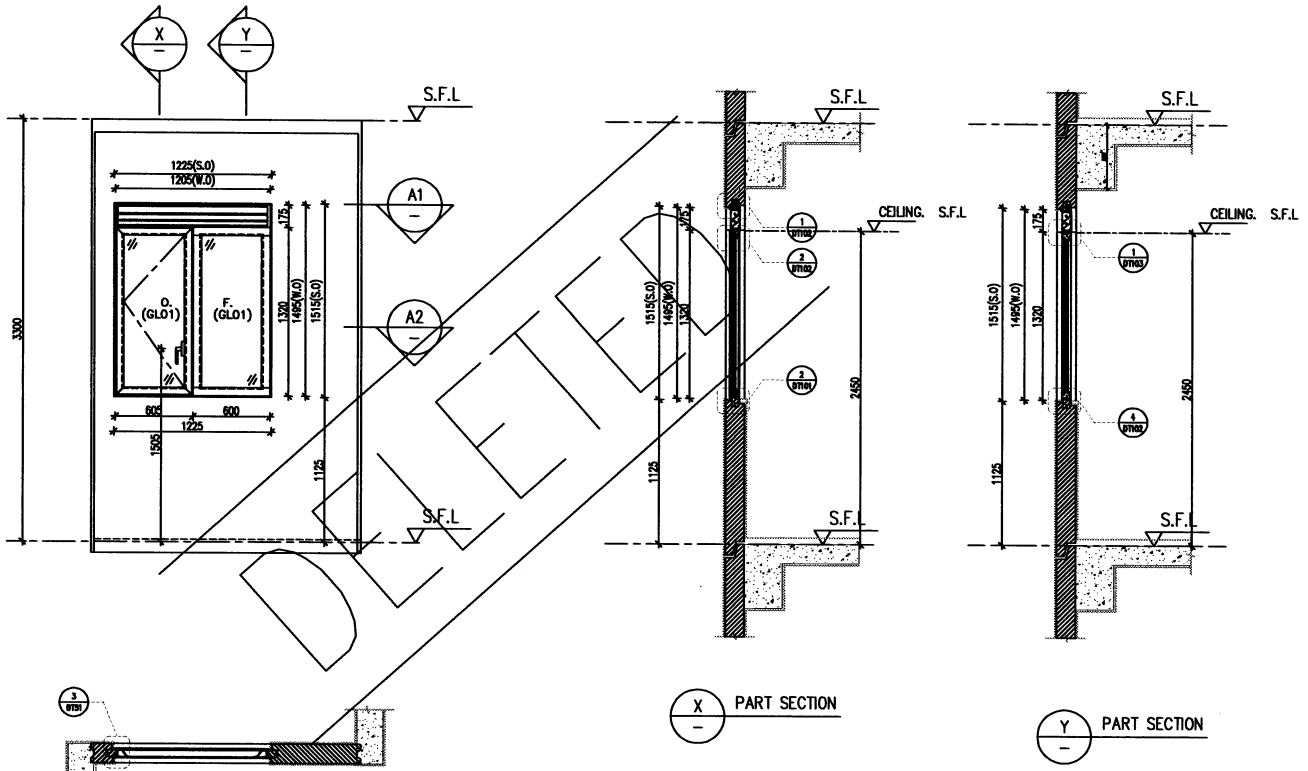

DELETED

X PART SECTION

Y PART SECTION

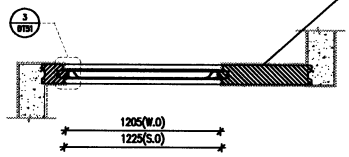

A1 PART PLAN

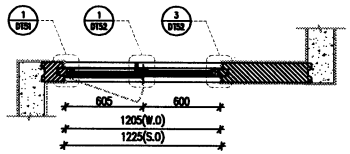

A2 PART PLAN

PROVIDED		
GLAZING AREA	1.157	m^2
OPENABLE AREA	0.664	m^2
FREE AREA	52.1	%

WINDOW MARK	W21 / T7
LOCATION	26F FLAT A BEDROOM 4
SECTION	70mm ALUM. SECTION
GLAZING	GL01
QUANTITY	1 Nos.
REMARKS	FACADE (T7-01-01A/26F)

T:\Jobs\J-853\2. Outgoing\Black plate opening of Windows Louvre\Black Plate of T7 Precat Window.dwg

B.D. REF :

CLIENT :
SHIMAO GROUP HOLDINGS LIMITED

ARCHITECT :
WONG TUNG & PARTNERS LIMITED
ARCHITECTS & PLANNERS

MAIN CONTRACTOR :
HIP HING CONSTRUCTION CO LTD

STRUCTURAL ENGINEER :
C M WONG & ASSOCIATES LTD

FACADE CONSULTANT:
MEINHARDT

NOTE :
1. ALL DIMENSIONS ARE IN mm.
2. ALL ELEVATIONS ARE VIEWED FROM OUTSIDE.
3. ALL DIMENSIONS TO BE VERIFIED ON SITE BEFORE FABRICATION.

LEGEND :
- DETAIL MARK NO. / REFER SHEET NO.
1. F.F.L. — FINISHED FLOOR LEVEL
2. S.F.L. — STRUCTURAL FLOOR LEVEL
3. (R) — REVERSED DETAIL
4. ▲ — FIXING LOCATION
5. △ — FIXING LUG LOCATION
6. GLASS LEGEND
   - GL01 — 10mm+12mm AIR GAP+10mm THK. LG.U.
   - GL04 — 12mm THK. CLEAR TEMPERED GLASS
   - GL05 — 10mm+12mm AIR GAP+10mm THK. LG.U.
   - GL06 — 10mm+12mm AIR GAP+12mm THK. LG.U.
   - GL07 — 10mm+12mm AIR GAP+12mm THK. LG.U.
   - GL08 — 10mm+12mm AIR GAP+10mm THK. LG.U.

NO.	DATE	REVISED	BY
6	18/10/2021	REVISION SUBJECT TO ARCH.COMMENT	

JOB NO. : J-853

PROJECT :
PROPOSED RESIDENTIAL DEVELOPMENT AT N.K.I.L. 6542 YIN PING ROAD KOWLOON

TITLE :
WINDOW SCHEDULE FOR TOWER 7 ALUM. WINDOW

DATE : 03-APR-21 | SCALE : 1:40

DRAWN BY : | CHECKED BY :

美特鋁製有限公司
MIDI ALUMINIUM FABRICATOR LTD.
Units 6-8, Sunray Industrial Centre, 1/F
610 Cha Kwo Ling Road, Kowloon
Tel:23489211-4 Fax:(852)27727666

DWG NO. : J853-SD-PW-SC702f | REV. : G

ELEVATION

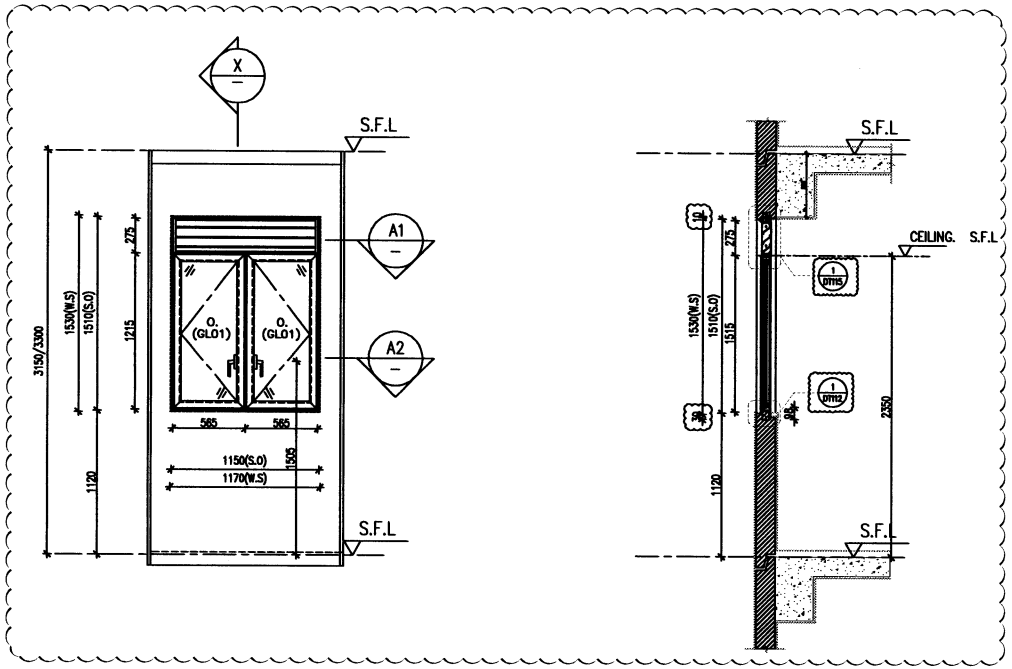

X — PART SECTION

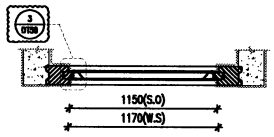

A1 — PART PLAN

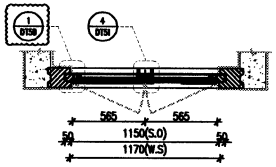

A2 — PART PLAN

PROVIDED		
GLAZING AREA	0.942	m^2
OPENABLE AREA	1.125	m^2
FREE AREA	60.7	%

WINDOW MARK	W03A T7
LOCATION	7F~15F&17F~22F FLAT B KITCHEN
SECTION	70mm ALUM. SECTION
GLAZING	GL01
QUANTITY	13 Nos.
REMARKS	FACADE (T7-01-04/7F~15F&17F~22F)

T:\Jobs\J-853\2. Outgoing\Black plate opening of Windows Louvre\Black Plate of T7 Precat Window.dwg

B.D. REF :

CLIENT :
SHIMAO GROUP HOLDINGS LIMITED

ARCHITECT : WONG TUNG & PARTNERS LIMITED ARCHITECTS & PLANNERS

MAIN CONTRACTOR :
協興建築有限公司 HIP HING CONSTRUCTION CO LTD

STRUCTURAL ENGINEER :
CMA C M WONG & ASSOCIATES LTD 黃志明建築工程師有限公司

FACADE CONSULTANT:
MEINHARDT

NOTE :
1. ALL DIMENSIONS ARE IN mm.
2. ALL ELEVATIONS ARE VIEWED FROM OUTSIDE.
3. ALL DIMENSIONS TO BE VERIFIED ON SITE BEFORE FABRICATION.

LEGEND :
X1 / 2001 — DETAIL MARK NO. / REFER SHEET NO.
1. F.F.L. — FINISHED FLOOR LEVEL
2. S.F.L. — STRUCTURAL FLOOR LEVEL
3. (R) — REVERSED DETAIL
4. ▲ — FIXING LOCATION
5. △ — FIXING LUG LOCATION
6. GLASS LEGEND
GL01 — 10mm+12mm AIR GAP+10mm THK. I.G.U.
GL04 — 12mm THK. CLEAR TEMPERED GLASS
GL05 — 10mm+12mm AIR GAP+10mm THK. I.G.U.
GL06 — 10mm+12mm AIR GAP+12mm THK. I.G.U.
GL07 — 10mm+12mm AIR GAP+12mm THK. I.G.U.
GL08 — 10mm+12mm AIR GAP+10mm THK. I.G.U.

NO.	DATE	REVISED	BY
B	07/08/2022	REVISION SUBJECT TO ARCH.COMMENT	mdc
A	20/08/2021	REVISION SUBJECT TO ARCH.COMMENT	mdc

JOB NO. : J-853

PROJECT :
PROPOSED RESIDENTIAL DEVELOPMENT AT N.K.I.L. 6542 YIN PING ROAD KOWLOON

TITLE :
WINDOW SCHEDULE FOR TOWER 7 ALUM. WINDOW

DATE : 03-APR-21 | SCALE : 1:40

DRAWN BY : | CHECKED BY :

美特鋁製有限公司 MIDI ALUMINIUM FABRICATOR LTD.
Units 6-8, Sunray Industrial Centre, 1/F
610 Cha Kwo Ling Road, Kowloon
Tel:23489211-4 Fax:(852)27727666

DWG NO. : J853-SD-PW-SC703 | REV. : B

ELEVATION

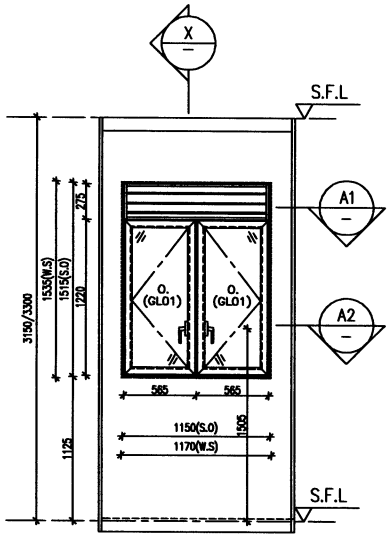

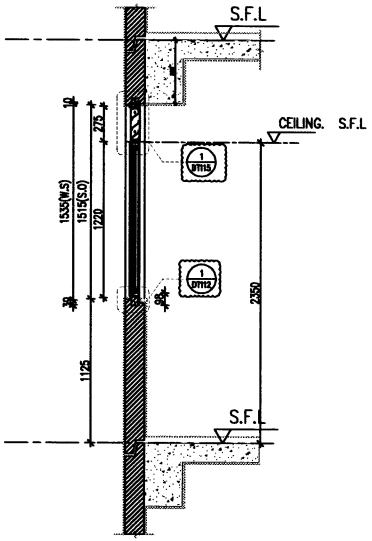

X — PART SECTION

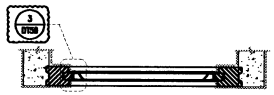

1150(S.O)
1170(W.S)

A1 — PART PLAN

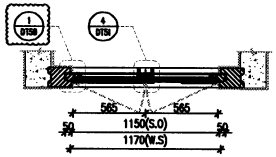

A2 — PART PLAN

PROVIDED		
GLAZING AREA	0.947	m^2
OPENABLE AREA	1.130	m^2
FREE AREA	60.7	%

WINDOW MARK	W03 / T7
LOCATION	16F & 23F FLAT B KITCHEN
SECTION	70mm ALUM. SECTION
GLAZING	GL01
QUANTITY	2 Nos.
REMARKS	FACADE (T7-01-04A/16F; T7-01-04B/23F)

T:\Jobs\J-853\2. Outgoing\Black plate opening of Windows Louvre\Black Plate of T7 Facade Window.dwg

B.D. REF :

CLIENT :
SHIMAO GROUP
HOLDINGS LIMITED

ARCHITECT :
WONG TUNG & PARTNERS LIMITED
ARCHITECTS & PLANNERS

MAIN CONTRACTOR :
協興建築有限公司
HIP HING CONSTRUCTION CO LTD

STRUCTURAL ENGINEER :
C M WONG & ASSOCIATES LTD
黃志明建築工程師有限公司

FACADE CONSULTANT:
MEINHARDT

NOTE :
1. ALL DIMENSIONS ARE IN mm.
2. ALL ELEVATIONS ARE VIEWED FROM OUTSIDE.
3. ALL DIMENSIONS TO BE VERIFIED ON SITE BEFORE FABRICATION.

LEGEND :
X1 / X001 — DETAIL MARK NO. / REFER SHEET NO.
1. F.F.L. — FINISHED FLOOR LEVEL
2. S.F.L. — STRUCTURAL FLOOR LEVEL
3. — REVERSED DETAIL
4. ▲ — FIXING LOCATION
5. △ — FIXING LUG LOCATION
6. GLASS LEGEND
GL01 — 10mm+12mm AIR GAP+10mm THK. I.G.U.
GL04 — 12mm THK. CLEAR TEMPERED GLASS
GL05 — 10mm+12mm AIR GAP+10mm THK. I.G.U.
GL06 — 10mm+12mm AIR GAP+12mm THK. I.G.U.
GL07 — 10mm+12mm AIR GAP+12mm THK. I.G.U.
GL08 — 10mm+12mm AIR GAP+10mm THK. I.G.U.

NO.	DATE	REMARK	BY
A	04/08/2022	REVISION SUBJECT TO ARCH.COMMENT	kelv

JOB NO. : J-853

PROJECT :
PROPOSED RESIDENTIAL
DEVELOPMENT AT N.K.I.L. 6542
YIN PING ROAD
KOWLOON

TITLE :
WINDOW SCHEDULE FOR
TOWER 7 ALUM. WINDOW

DATE : 03-APR-21 | SCALE : 1:40
DRAWN BY : | CHECKED BY :

美特鋁質有限公司
MIDI ALUMINIUM FABRICATOR LTD.
Units 6-8, Sunray Industrial Centre, 1/F
610 Cha Kwo Ling Road, Kowloon
Tel:23489211-4 Fax:(852)27727666

DWG NO. : J853-SD-PW-SC703a | REV. : A

ELEVATION

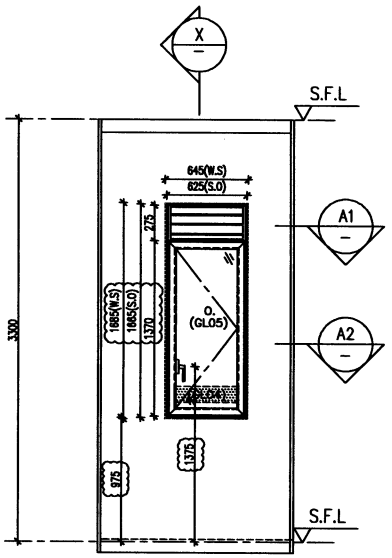

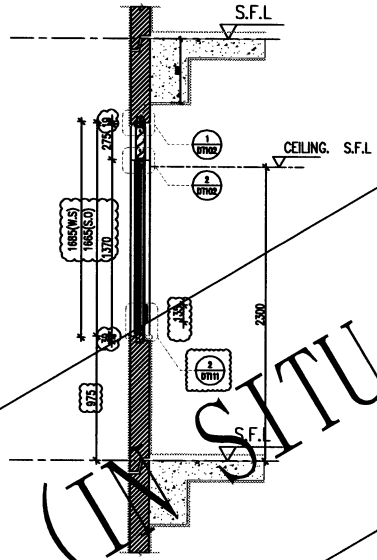

X PART SECTION

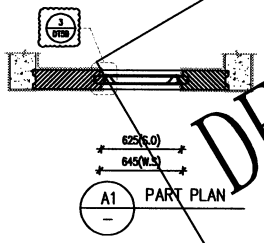

625(S.O)
645(W.S)
A1 PART PLAN

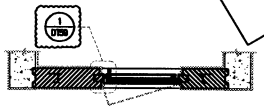

625(S.O)
645(W.S)
A2 PART PLAN

DELETED (IN SITU WINDOW)

PROVIDED		
GLAZING AREA	0.513	m^2
OPENABLE AREA	0.611	m^2
FREE AREA	60.7	%

WINDOW MARK	W05R / T7
LOCATION	26F FLAT B ENSUITE BATH
SECTION	70mm ALUM. SECTION
GLAZING	GL05
QUANTITY	1 Nos.
REMARKS	FACADE (T7-01-04A/26F)

T:\Jobs\J-853\2. Outgoing\Black plate opening of Windows Louvre\Black Plate of T7 Precat Window.dwg

B.D. REF :

CLIENT :
SHIMAO GROUP HOLDINGS LIMITED

ARCHITECT :
WONG TUNG & PARTNERS LIMITED
ARCHITECTS & PLANNERS

MAIN CONTRACTOR :
協興建築有限公司
HIP HING CONSTRUCTION CO LTD

STRUCTURAL ENGINEER :
CMA C M WONG & ASSOCIATES LTD
黃志明建築工程師有限公司

FACADE CONSULTANT:
MEINHARDT

NOTE :
1. ALL DIMENSIONS ARE IN mm.
2. ALL ELEVATIONS ARE VIEWED FROM OUTSIDE.
3. ALL DIMENSIONS TO BE VERIFIED ON SITE BEFORE FABRICATION.

LEGEND :
- XY / 2001 — DETAIL MARK NO. / REFER SHEET NO.
1. F.F.L. — FINISHED FLOOR LEVEL
2. S.F.L. — STRUCTURAL FLOOR LEVEL
3. (R) — REVERSED DETAIL
4. ▲ — FIXING LOCATION
5. △ — FIXING LUG LOCATION
6. GLASS LEGEND
   - GL01 — 10mm+12mm AIR GAP+10mm THK. LG.U.
   - GL04 — 12mm THK. CLEAR TEMPERED GLASS
   - GL05 — 10mm+12mm AIR GAP+10mm THK. LG.U.
   - GL06 — 10mm+12mm AIR GAP+12mm THK. LG.U.
   - GL07 — 10mm+12mm AIR GAP+12mm THK. LG.U.
   - GL08 — 10mm+12mm AIR GAP+10mm THK. LG.U.

NO.	DATE	REVISED	BY
A	04/08/2022	REVISION SUBJECT TO ARCH.COMMENT	mhs

JOB NO. : J-853

PROJECT :
PROPOSED RESIDENTIAL DEVELOPMENT AT N.K.I.L. 6542 YIN PING ROAD KOWLOON

TITLE :
WINDOW SCHEDULE FOR TOWER 7 ALUM. WINDOW

DATE : 03-APR-21 | SCALE : 1:40

DRAWN BY : | CHECKED BY :

美特鋁製有限公司
MIDI ALUMINIUM FABRICATOR LTD.
Units 6-8, Sunray Industrial Centre, 1/F
610 Cha Kwo Ling Road, Kowloon
Tel:23489211-4 Fax:(852)27727666

DWG NO. : J853-SD-PW-SC703b | REV. : A

ELEVATION

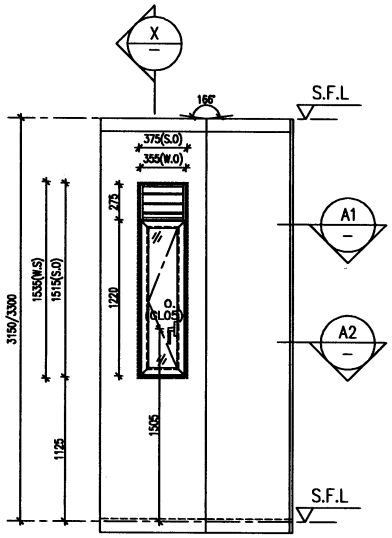

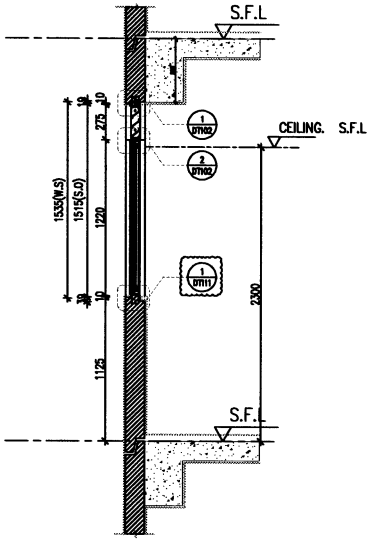

X — PART SECTION

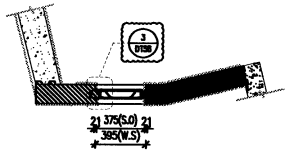

A1 — PART PLAN

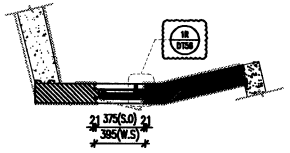

A2 — PART PLAN

PROVIDED		
GLAZING AREA	0.241	m^2
OPENABLE AREA	0.324	m^2
FREE AREA	60.7	%

WINDOW MARK	WD2L (T7)
LOCATION	7F~22F & 23F FLAT B LAV.
SECTION	70mm ALUM. SECTION
GLAZING	GL05
QUANTITY	15 Nos.
REMARKS	FACADE (T7-02-02/7~15F&17F~22F; T7-02-02A/16F; T7-02-02B/23F)

T:\Jobs\J-853\2. Outgoing\Black plate opening of Windows Louvre\Black Plate of T7 Precat Window.dwg

B.D. REF :

CLIENT :
SHIMAO GROUP HOLDINGS LIMITED

ARCHITECT :
WONG TUNG & PARTNERS LIMITED
ARCHITECTS & PLANNERS

MAIN CONTRACTOR :
協興建築有限公司
HIP HING CONSTRUCTION CO LTD

STRUCTURAL ENGINEER :
CMA C M WONG & ASSOCIATES LTD
黃志明結構工程師有限公司

FACADE CONSULTANT:
MEINHARDT

NOTE :
1. ALL DIMENSIONS ARE IN mm.
2. ALL ELEVATIONS ARE VIEWED FROM OUTSIDE.
3. ALL DIMENSIONS TO BE VERIFIED ON SITE BEFORE FABRICATION.

LEGEND :
X1 / 2001 — DETAIL MARK NO. / REFER SHEET NO.
1. F.F.L. — FINISHED FLOOR LEVEL
2. S.F.L. — STRUCTURAL FLOOR LEVEL
3. (R) — REVERSED DETAIL
4. ▲ — FIXING LOCATION
5. △ — FIXING LUG LOCATION
6. GLASS LEGEND
GL01 — 10mm+12mm AIR GAP+10mm THK. L.G.U.
GL04 — 12mm THK. CLEAR TEMPERED GLASS
GL05 — 10mm+12mm AIR GAP+10mm THK. L.G.U.
GL06 — 10mm+12mm AIR GAP+12mm THK. L.G.U.
GL07 — 10mm+12mm AIR GAP+12mm THK. L.G.U.
GL08 — 10mm+12mm AIR GAP+10mm THK. L.G.U.

NO.	DATE	REMARK	BY
B	04/08/2022	REVISION SUBJECT TO ARCH.COMMENT	mlo
A	16/10/2021	REVISION SUBJECT TO ARCH.COMMENT	mlo

JOB NO. : J-853

PROJECT :
PROPOSED RESIDENTIAL DEVELOPMENT AT N.K.I.L. 6542 YIN PING ROAD KOWLOON

TITLE :
WINDOW SCHEDULE FOR TOWER 7 ALUM. WINDOW

DATE : 03-APR-21 | SCALE : 1:40

DRAWN BY : | CHECKED BY :

美特鋁製有限公司
MIDI ALUMINIUM FABRICATOR LTD.
Units 6-8, Sunray Industrial Centre, 1/F
610 Cha Kwo Ling Road, Kowloon
Tel:23489211-4 Fax:(852)27727666

DWG NO. : J853-SD-PW-SC704 | REV. : B

ELEVATION

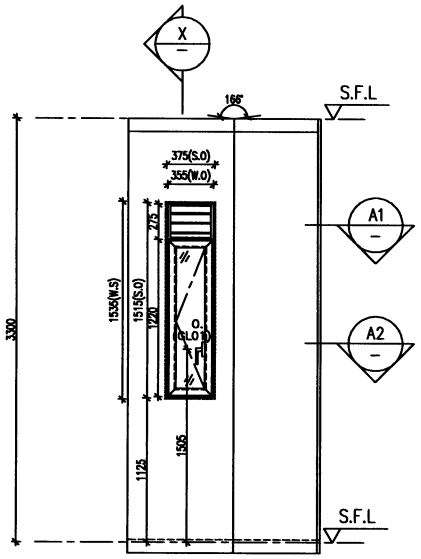

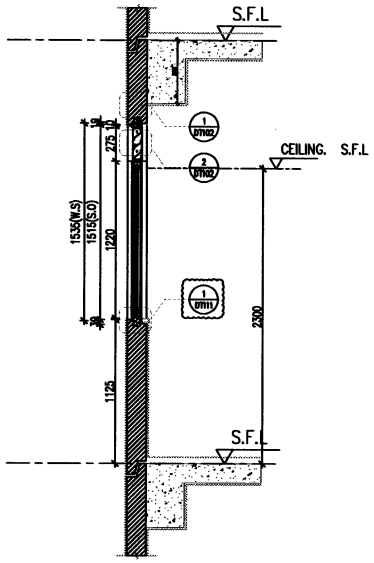

X — PART SECTION

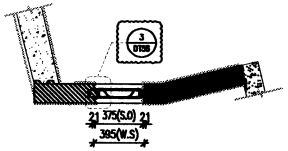

A1 — PART PLAN

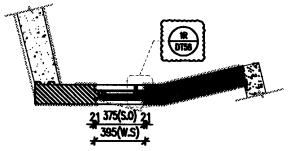

A2 — PART PLAN

PROVIDED		
GLAZING AREA	0.274	m^2
OPENABLE AREA	0.367	m^2
FREE AREA	60.7	%

WINDOW MARK	WBOL T7
LOCATION	25F FLAT B LAV.
SECTION	70mm ALUM. SECTION
GLAZING	GL01
QUANTITY	1 No.
REMARKS	FACADE (T7-02-02A/25F)

B.D. REF :

CLIENT :
SHIMAO GROUP HOLDINGS LIMITED

ARCHITECT :
WONG TUNG & PARTNERS LIMITED
ARCHITECTS & PLANNERS

MAIN CONTRACTOR :
協興建築有限公司
HIP HING CONSTRUCTION CO LTD

STRUCTURAL ENGINEER :
C M WONG & ASSOCIATES LTD
黃志明結構工程師有限公司

FACADE CONSULTANT:
MEINHARDT

NOTE :
1. ALL DIMENSIONS ARE IN mm.
2. ALL ELEVATIONS ARE VIEWED FROM OUTSIDE.
3. ALL DIMENSIONS TO BE VERIFIED ON SITE BEFORE FABRICATION.

LEGEND :
- X1 / 2DW1 — DETAIL MARK NO. / REFER SHEET NO.
1. F.F.L. — FINISHED FLOOR LEVEL
2. S.F.L. — STRUCTURAL FLOOR LEVEL
3. (R) — REVERSED DETAIL
4. ▲ — FIXING LOCATION
5. △ — FIXING LUG LOCATION
6. GLASS LEGEND
   - GLO1 — 10mm+12mm AIR GAP+10mm THK. I.G.U.
   - GLO4 — 12mm THK. CLEAR TEMPERED GLASS
   - GLO5 — 10mm+12mm AIR GAP+10mm THK. I.G.U.
   - GLO6 — 10mm+12mm AIR GAP+12mm THK. I.G.U.
   - GLO7 — 10mm+12mm AIR GAP+12mm THK. I.G.U.
   - GLO8 — 10mm+12mm AIR GAP+10mm THK. I.G.U.

NO.	DATE	REVISED	BY
A	04/08/2022	REVISION SUBJECT TO ARCH.COMMENT	

JOB NO. : J-853

PROJECT :
PROPOSED RESIDENTIAL DEVELOPMENT AT N.K.I.L. 6542 YIN PING ROAD KOWLOON

TITLE :
WINDOW SCHEDULE FOR TOWER 7 ALUM. WINDOW

DATE : 03-APR-21 | SCALE : 1:40

DRAWN BY : | CHECKED BY :

美特鋁製有限公司
MIDI ALUMINIUM FABRICATOR LTD.
Units 6-8, Sunray Industrial Centre, 1/F
610 Cha Kwo Ling Road, Kowloon
Tel:23489211-4 Fax:(852)27727666

DWG NO. : J853-SD-PW-SC704a | REV. : A

T:\Jobs\J-853\2. Outgoing\Black plate opening of Windows Louvre\Black Plate of T7 Precat Window.dwg

ELEVATION

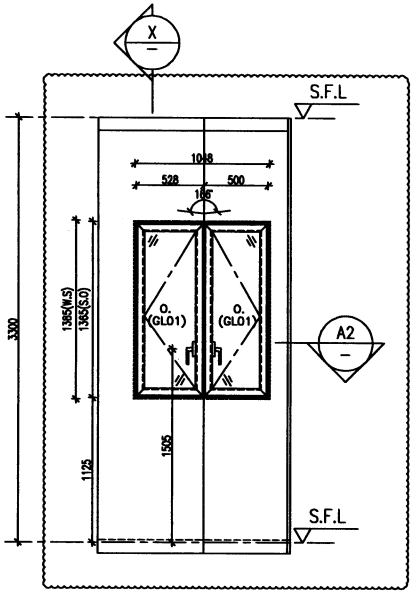

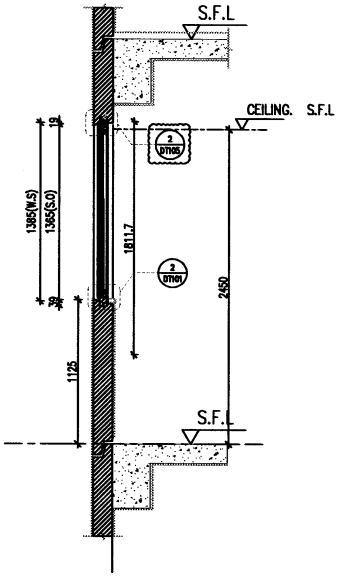

X — PART SECTION

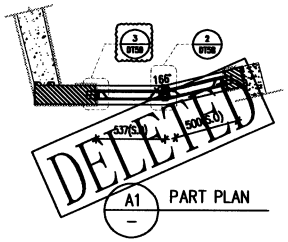

A1 — PART PLAN

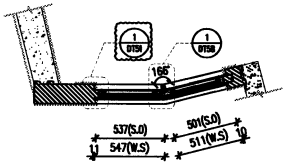

A2 — PART PLAN

PROVIDED		
GLAZING AREA	0.911	m^2
OPENABLE AREA	1.101	m^2
FREE AREA	52.1	%

WINDOW MARK	W77 / T7
LOCATION	26F FLAT B ENSUITE 3
SECTION	70mm ALUM. SECTION
GLAZING	GL05
QUANTITY	1 No.
REMARKS	FACADE (T7-02-02A)

T:\Jobs\J-853\2. Outgoing\Black plate opening of windows Louver\Black Plate of T7 Precat Window.dwg

B.D. REF :

CLIENT :
SHIMAO GROUP HOLDINGS LIMITED

ARCHITECT :
WONG TUNG & PARTNERS LIMITED
ARCHITECTS & PLANNERS

MAIN CONTRACTOR :
協興建築有限公司
HIP HING CONSTRUCTION CO LTD

STRUCTURAL ENGINEER :
CMA C M WONG & ASSOCIATES LTD
黃志明建築工程師有限公司

FACADE CONSULTANT:
MEINHARDT

NOTE :
1. ALL DIMENSIONS ARE IN mm.
2. ALL ELEVATIONS ARE VIEWED FROM OUTSIDE.
3. ALL DIMENSIONS TO BE VERIFIED ON SITE BEFORE FABRICATION.

LEGEND :
X1 — DETAIL MARK NO.
X001 — REFER SHEET NO.

1. F.F.L. — FINISHED FLOOR LEVEL
2. S.F.L. — STRUCTURAL FLOOR LEVEL
3. (R) — REVERSED DETAIL
4. ▲ — FIXING LOCATION
5. △ — FIXING LUG LOCATION
6. GLASS LEGEND
   GL01 — 10mm+12mm AIR GAP+10mm THK. I.G.U.
   GL04 — 12mm THK. CLEAR TEMPERED GLASS
   GL05 — 10mm+12mm AIR GAP+10mm THK. I.G.U.
   GL06 — 10mm+12mm AIR GAP+12mm THK. I.G.U.
   GL07 — 10mm+12mm AIR GAP+12mm THK. I.G.U.
   GL08 — 10mm+12mm AIR GAP+10mm THK. I.G.U.

NO.	DATE	REMARKS	BY
B	20/06/2022	REVISION SUBJECT TO ARCH.COMMENT	eda
A	20/06/2022	REVISION SUBJECT TO ARCH.COMMENT	eda

JOB NO. : J-853

PROJECT :
PROPOSED RESIDENTIAL DEVELOPMENT AT N.K.I.L. 6542 YIN PING ROAD KOWLOON

TITLE :
WINDOW SCHEDULE FOR TOWER 7 ALUM. WINDOW

DATE : 03-APR-21 | SCALE : 1:40

DRAWN BY : | CHECKED BY :

美特鋁製有限公司
MIDI ALUMINIUM FABRICATOR LTD.
Units 6-8, Sunray Industrial Centre, 1/F
610 Cha Kwo Ling Road, Kowloon
Tel:23489211-4 Fax:(852)27727666

DWG NO. : J853-SD-PW-SC704b | REV. : B

ELEVATION

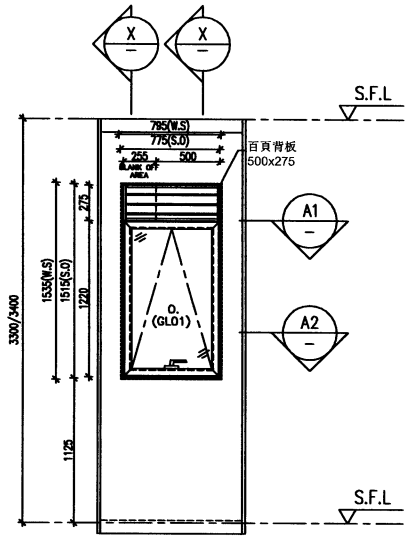

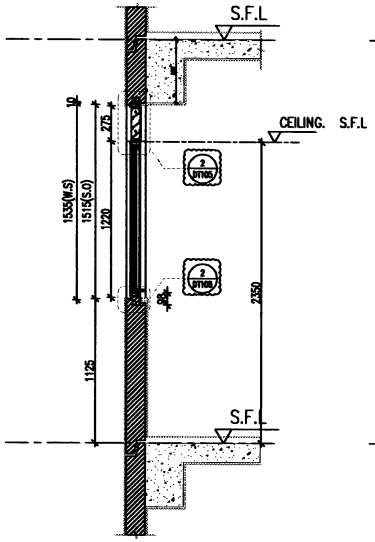

X — PART SECTION

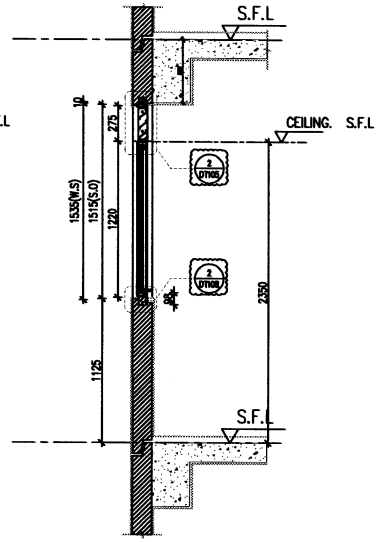

X — PART SECTION

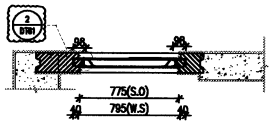

A1 — PART PLAN

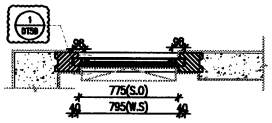

A2 — PART PLAN

PROVIDED		
GLAZING AREA	0.677	m^2
OPENABLE AREA	0.779	m^2
FREE AREA	60.7	%

WINDOW MARK	W10 / T7
LOCATION	16F, 23F FLAT B KITCHEN
SECTION	70mm ALUM. SECTION
GLAZING	GL01
QUANTITY	2 Nos.
REMARKS	FACADE(T7-01-05A/16F; T7-01-05B/23F)

T:\Jobs\J-853\2. Outgoing\Black plate opening of Windows Louvre\Black Plate of T7 Precat Window.dwg

B.D. REF :

CLIENT :
SHIMAO GROUP HOLDINGS LIMITED

ARCHITECT : WONG TUNG & PARTNERS LIMITED ARCHITECTS & PLANNERS

MAIN CONTRACTOR :
協興建築有限公司 HIP HING CONSTRUCTION CO LTD

STRUCTURAL ENGINEER :
CMA C M WONG & ASSOCIATES LTD 黃志明建築工程師有限公司

FACADE CONSULTANT: MEINHARDT

NOTE :
1. ALL DIMENSIONS ARE IN mm.
2. ALL ELEVATIONS ARE VIEWED FROM OUTSIDE.
3. ALL DIMENSIONS TO BE VERIFIED ON SITE BEFORE FABRICATION.

LEGEND :
- X1 / X0001 — DETAIL MARK NO. / REFER SHEET NO.
1. F.F.L. — FINISHED FLOOR LEVEL
2. S.F.L. — STRUCTURAL FLOOR LEVEL
3. (R) — REVERSED DETAIL
4. ▲ — FIXING LOCATION
5. △ — FIXING LUG LOCATION
6. GLASS LEGEND
   - GL01 — 10mm+12mm AIR GAP+10mm THK. I.G.U.
   - GL04 — 12mm THK. CLEAR TEMPERED GLASS
   - GL05 — 10mm+12mm AIR GAP+10mm THK. I.G.U.
   - GL06 — 10mm+12mm AIR GAP+12mm THK. I.G.U.
   - GL07 — 10mm+12mm AIR GAP+12mm THK. I.G.U.
   - GL08 — 10mm+12mm AIR GAP+10mm THK. I.G.U.

NO.	DATE	REVISED	BY
A	29/08/2022	REVISION SUBJECT TO ARCH.COMMENT	

JOB NO. : J-853

PROJECT :
PROPOSED RESIDENTIAL DEVELOPMENT AT N.K.I.L. 6542 YIN PING ROAD KOWLOON

TITLE :
WINDOW SCHEDULE FOR TOWER 7 ALUM. WINDOW

DATE : 03-APR-21 | SCALE : 1:40

DRAWN BY : | CHECKED BY :

美特鋁製有限公司 MIDI ALUMINIUM FABRICATOR LTD.
Units 6-8, Sunray Industrial Centre, 1/F
610 Cha Kwo Ling Road, Kowloon
Tel:23489211-4 Fax:(852)27727666

DWG NO. : J853-SD-PW-SC705 | REV. : A

ELEVATION

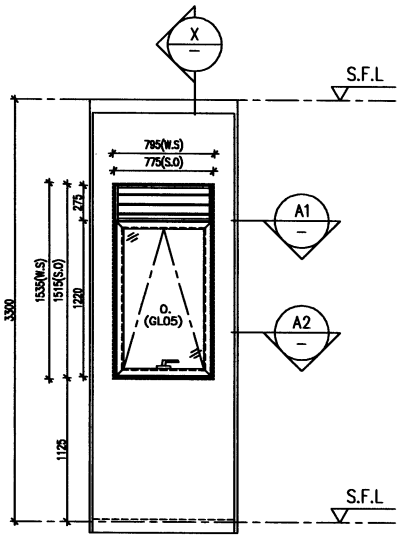

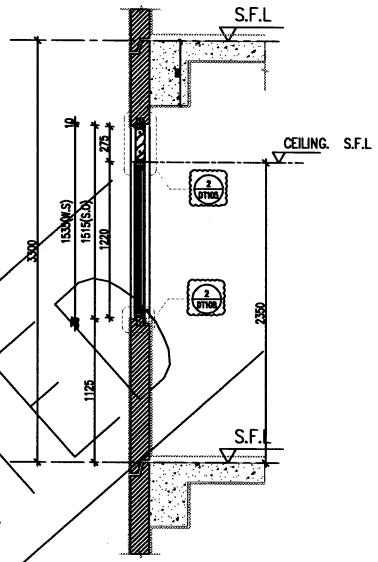

X PART SECTION

DELETE

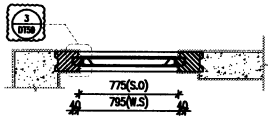

A1 PART PLAN

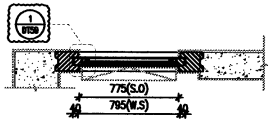

A2 PART PLAN

PROVIDED		
GLAZING AREA	0.677	m^2
OPENABLE AREA	0.779	m^2
FREE AREA	60.7	%

WINDOW MARK	W76 / T7
LOCATION	26F FLAT B EN BATH
SECTION	70mm ALUM. SECTION
GLAZING	{GL05}
QUANTITY	1 No.
REMARKS	FACADE(T7-01-05A/26F)

T:\Jobs\J-853\2. Outgoing\Black plate opening of Windows Louvre\Black Plate of T7 Precat Window.dwg

B.D. REF :

CLIENT :
SHIMAO GROUP HOLDINGS LIMITED

ARCHITECT : WONG TUNG & PARTNERS LIMITED ARCHITECTS & PLANNERS

MAIN CONTRACTOR :
協興建築有限公司
HIP HING CONSTRUCTION CO LTD

STRUCTURAL ENGINEER :
CMA C M WONG & ASSOCIATES LTD 黃志明結構工程師有限公司

FACADE CONSULTANT:
MEINHARDT

NOTE :
1. ALL DIMENSIONS ARE IN mm.
2. ALL ELEVATIONS ARE VIEWED FROM OUTSIDE.
3. ALL DIMENSIONS TO BE VERIFIED ON SITE BEFORE FABRICATION.

LEGEND :
X1 / X001 — DETAIL MARK NO. / REFER SHEET NO.
1. F.F.L. — FINISHED FLOOR LEVEL
2. S.F.L. — STRUCTURAL FLOOR LEVEL
3. (R) — REVERSED DETAIL
4. ▲ — FIXING LOCATION
5. △ — FIXING LUG LOCATION
6. GLASS LEGEND
GL01 — 10mm+12mm AIR GAP+10mm THK. I.G.U.
GL04 — 12mm THK. CLEAR TEMPERED GLASS
GL05 — 10mm+12mm AIR GAP+10mm THK. I.G.U.
GL06 — 10mm+12mm AIR GAP+12mm THK. I.G.U.
GL07 — 10mm+12mm AIR GAP+12mm THK. I.G.U.
GL08 — 10mm+12mm AIR GAP+10mm THK. I.G.U.

NO.	DATE	REMARK	BY
B	04/08/2022	REVISION SUBJECT TO ARCH.COMMENT	
A	22/06/2022	REVISION SUBJECT TO ARCH.COMMENT	

JOB NO. : J-853

PROJECT :
PROPOSED RESIDENTIAL DEVELOPMENT AT N.K.I.L. 6542 YIN PING ROAD KOWLOON

TITLE :
WINDOW SCHEDULE FOR TOWER 7 ALUM. WINDOW

DATE : 03-APR-21 | SCALE : 1:40

DRAWN BY : | CHECKED BY :

美特鋁製有限公司
MIDI ALUMINIUM FABRICATOR LTD.
Units 6-8, Sunray Industrial Centre, 1/F
610 Cha Kwo Ling Road, Kowloon
Tel:23489211-4 Fax:(852)27727666

DWG NO. : J853-SD-PW-SC705 REV. : -

ELEVATION

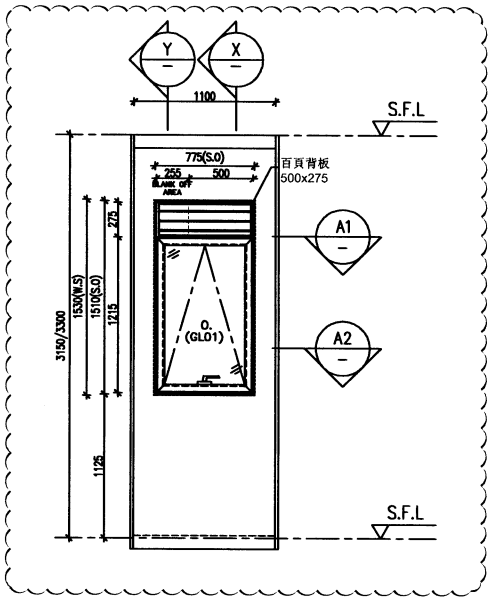

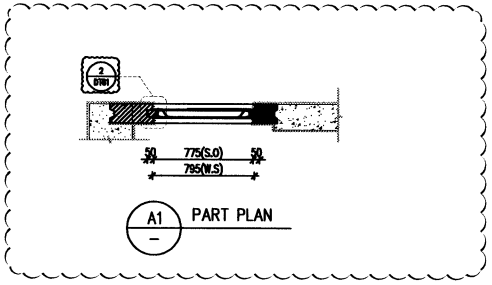

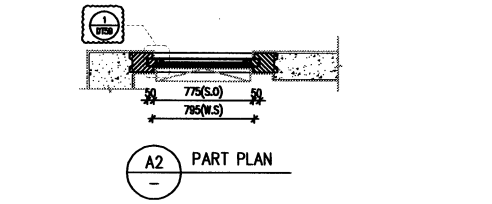

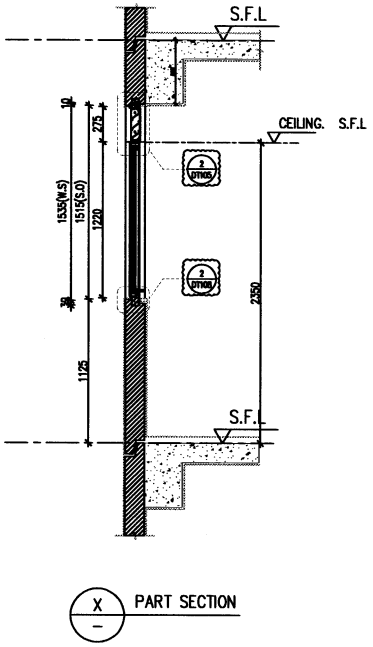

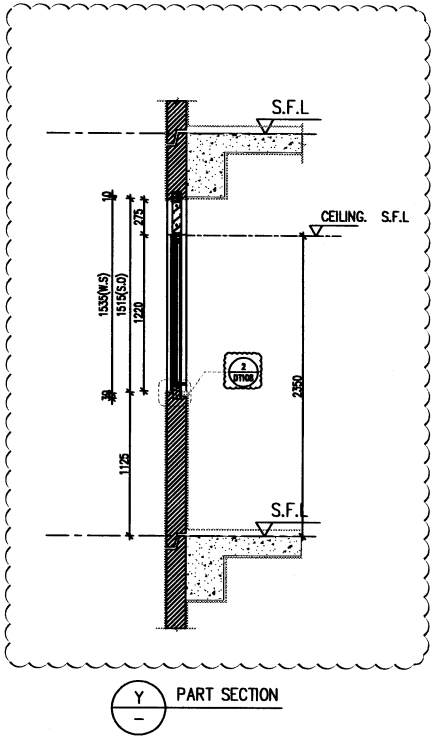

PROVIDED		
GLAZING AREA	0.676	m^2
OPENABLE AREA	0.778	m^2
FREE AREA	60.7	%

WINDOW MARK	W10A / T7
LOCATION	7F~15F & 17F~22F FLAT B KITCHEN
SECTION	70mm ALUM. SECTION
GLAZING	GL01
QUANTITY	13 Nos
REMARKS	FACADE(T7-01-05/7F~15F&17F~22F)

T:\Jobs\J-853\2. Outgoing\Black plate opening of Windows Louvre\Black Plate of T7 Precat Window.dwg

B.D. REF :

CLIENT :
SHIMAO GROUP HOLDINGS LIMITED

ARCHITECT :
WONG TUNG & PARTNERS LIMITED
ARCHITECTS & PLANNERS

MAIN CONTRACTOR :
協興建築有限公司
HIP HING CONSTRUCTION CO LTD

STRUCTURAL ENGINEER :
C M WONG & ASSOCIATES LTD
黃志明建築工程師有限公司

FACADE CONSULTANT:
MEINHARDT

NOTE :
1. ALL DIMENSIONS ARE IN mm.
2. ALL ELEVATIONS ARE VIEWED FROM OUTSIDE.
3. ALL DIMENSIONS TO BE VERIFIED ON SITE BEFORE FABRICATION.

LEGEND :
- X1 / 2001 — DETAIL MARK NO. / REFER SHEET NO.
1. F.F.L. — FINISHED FLOOR LEVEL
2. S.F.L. — STRUCTURAL FLOOR LEVEL
3. (R) — REVERSED DETAIL
4. ▲ — FIXING LOCATION
5. △ — FIXING LUG LOCATION
6. GLASS LEGEND
   - GL01 — 10mm+12mm AIR GAP+10mm THK. L.G.U.
   - GL04 — 12mm THK. CLEAR TEMPERED GLASS
   - GL05 — 10mm+12mm AIR GAP+10mm THK. L.G.U.
   - GL06 — 10mm+12mm AIR GAP+12mm THK. L.G.U.
   - GL07 — 10mm+12mm AIR GAP+12mm THK. L.G.U.
   - GL08 — 10mm+12mm AIR GAP+10mm THK. L.G.U.

NO.	DATE	REVISED	BY
C	31/08/2022	REVISION SUBJECT TO COMMENT	ada
B	04/08/2022	REVISION SUBJECT TO ARCH.COMMENT	ada
A	18/10/2021	REVISION SUBJECT TO ARCH.COMMENT	ada

JOB NO. : J-853

PROJECT :
PROPOSED RESIDENTIAL DEVELOPMENT AT N.K.I.L. 6542 YIN PING ROAD KOWLOON

TITLE :
WINDOW SCHEDULE FOR TOWER 7 ALUM. WINDOW

DATE : 03-APR-21 | SCALE : 1:40

DRAWN BY : | CHECKED BY :

美特鋁製有限公司
MIDI ALUMINIUM FABRICATOR LTD.
Units 6-8, Sunray Industrial Centre, 1/F
610 Cha Kwo Ling Road, Kowloon
Tel:23489211-4 Fax:(852)27727666

DWG NO. : J853-SD-PW-SC7054 REV. : B

ELEVATION

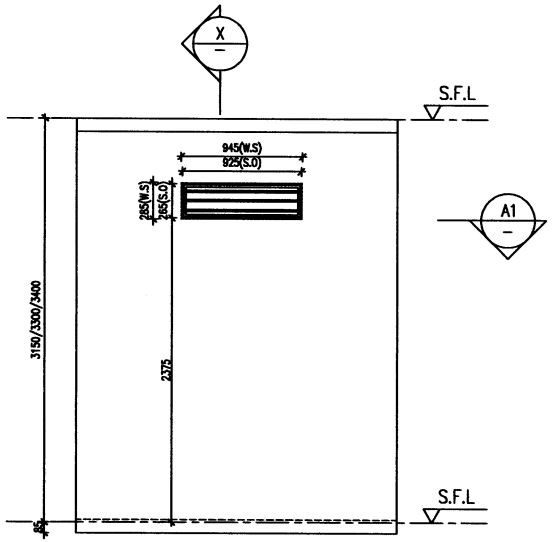

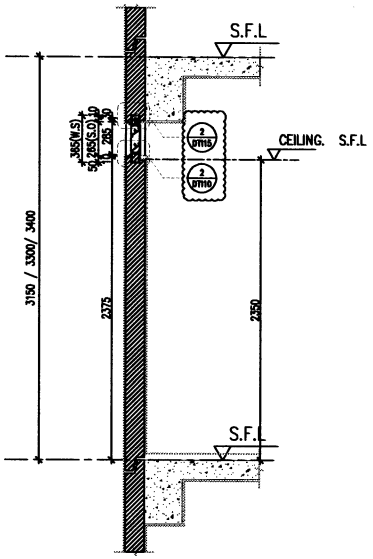

X PART SECTION

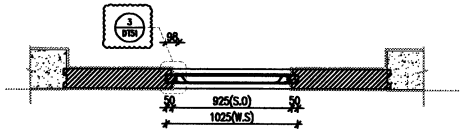

A1 PART PLAN

WINDOW MARK	L03 / T7
LOCATION	7F~23F FLAT B BATH RM
SECTION	70mm ALUM. LOUVER
GLAZING	–
QUANTITY	15 Nos.
REMARKS	FACADE (T7-03-02/7F~15F&17F~22F; T7-03-02A/16F; T7-03-02B/23F)

PROVIDED		
GLAZING AREA	0	m^2
OPENABLE AREA	0	m^2
FREE AREA	55.4	%

B.D. REF :

CLIENT :
SHIMAO GROUP HOLDINGS LIMITED

ARCHITECT :
WONG TUNG & PARTNERS LIMITED
ARCHITECTS & PLANNERS

MAIN CONTRACTOR :
協興建築有限公司
HIP HING CONSTRUCTION CO LTD

STRUCTURAL ENGINEER :
CMA C M WONG & ASSOCIATES LTD
黃志明建築工程師有限公司

FACADE CONSULTANT:
MEINHARDT

NOTE :
1. ALL DIMENSIONS ARE IN mm.
2. ALL ELEVATIONS ARE VIEWED FROM OUTSIDE.
3. ALL DIMENSIONS TO BE VERIFIED ON SITE BEFORE FABRICATION.

LEGEND :
X1 / 2DW1 — DETAIL MARK NO. / REFER SHEET NO.
1. F.F.L. — FINISHED FLOOR LEVEL
2. S.F.L. — STRUCTURAL FLOOR LEVEL
3. (R) — REVERSED DETAIL
4. ▲ — FIXING LOCATION
5. △ — FIXING LUG LOCATION
6. GLASS LEGEND
GLD1 — 10mm+12mm AIR GAP+10mm THK. I.G.U.
GLD4 — 12mm THK. CLEAR TEMPERED GLASS
GLD5 — 10mm+12mm AIR GAP+10mm THK. I.G.U.
GLD6 — 10mm+12mm AIR GAP+12mm THK. I.G.U.
GLD7 — 10mm+12mm AIR GAP+12mm THK. I.G.U.
GLD8 — 10mm+12mm AIR GAP+10mm THK. I.G.U.

NO.	DATE	REVISED	BY
6	18/10/2021	REVISION SUBJECT TO ARCH.COMMENT	mdm

JOB NO. : J-853

PROJECT :
PROPOSED RESIDENTIAL DEVELOPMENT AT N.K.I.L. 6542 YIN PING ROAD KOWLOON

TITLE :
WINDOW SCHEDULE FOR TOWER 7 ALUM. WINDOW

DATE : 03-APR-21 | SCALE : 1:40

DRAWN BY : | CHECKED BY :

美特鋁製有限公司
MIDI ALUMINIUM FABRICATOR LTD.
Units 6-8, Sunray Industrial Centre, 1/F
610 Cho Kwo Ling Road, Kowloon
Tel:2348211-4 Fax:(852)27727666

DWG NO. : J853-SD-PW-SC706 | REV. : B

ELEVATION

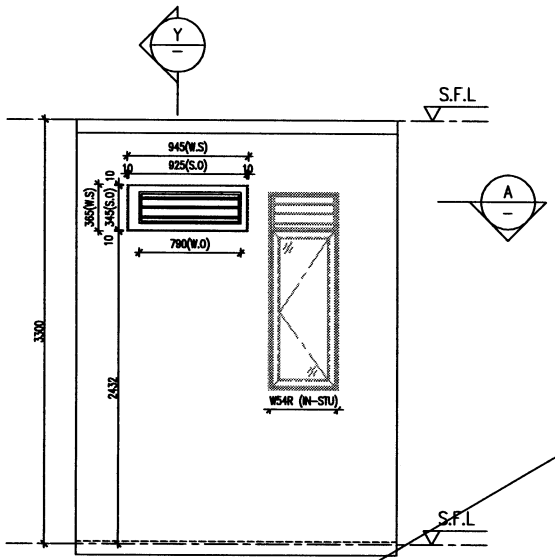

L03 T7 FACADE (T7-01-07A/25F)

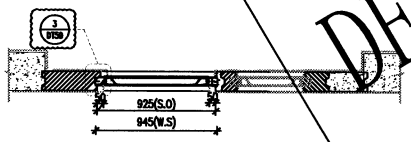

A PART PLAN

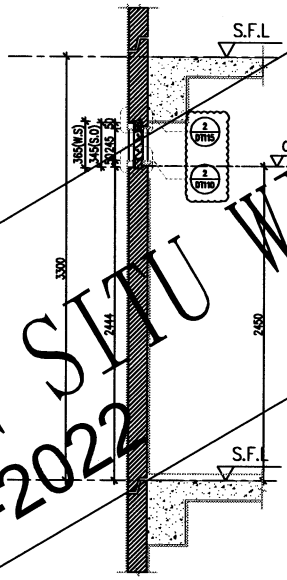

Y PART SECTION

DELETED (IN SITU WINDOW)
18-10-2022

L03 T7

PROVIDED		
GLAZING AREA	–	m^2
OPENABLE AREA	–	m^2
FREE AREA	55.4	%

WINDOW MARK	L03 T7
LOCATION	25F FLAT B BATH RM
SECTION	70mm ALUM. SECTION
GLAZING	GL05
QUANTITY	1 No.
REMARKS	FACADE (T7-01-07A/25F)

B.D. REF :

CLIENT :
SHIMAO GROUP HOLDINGS LIMITED

ARCHITECT :
WONG TUNG & PARTNERS LIMITED
ARCHITECTS & PLANNERS

MAIN CONTRACTOR :
協興建築有限公司
HIP HING CONSTRUCTION CO LTD

STRUCTURAL ENGINEER :
CMA C M WONG & ASSOCIATES LTD
黃志明結構工程師有限公司

FACADE CONSULTANT:
MEINHARDT

NOTE :
1. ALL DIMENSIONS ARE IN mm.
2. ALL ELEVATIONS ARE VIEWED FROM OUTSIDE.
3. ALL DIMENSIONS TO BE VERIFIED ON SITE BEFORE FABRICATION.

LEGEND :
X1 / XXX — DETAIL MARK NO. / REFER SHEET NO.
1. F.F.L. — FINISHED FLOOR LEVEL
2. S.F.L. — STRUCTURAL FLOOR LEVEL
3. (R) — REVERSED DETAIL
4. ▲ — FIXING LOCATION
5. △ — FIXING LUG LOCATION
6. GLASS LEGEND
GL01 — 10mm+12mm AIR GAP+10mm THK. I.G.U.
GL04 — 12mm THK. CLEAR TEMPERED GLASS
GL05 — 10mm+12mm AIR GAP+10mm THK. I.G.U.
GL06 — 10mm+12mm AIR GAP+12mm THK. I.G.U.
GL07 — 10mm+12mm AIR GAP+12mm THK. I.G.U.
GL08 — 10mm+12mm AIR GAP+10mm THK. I.G.U.

NO.	DATE	REVISED	BY
B	04/08/2022	REVISION SUBJECT TO ARCH.COMMENT	mdc
A	18/10/2021	REVISION SUBJECT TO ARCH.COMMENT	mdc

JOB NO. : J-853

PROJECT :
PROPOSED RESIDENTIAL DEVELOPMENT AT N.K.I.L. 6542 YIN PING ROAD KOWLOON

TITLE :
WINDOW SCHEDULE FOR TOWER 7 ALUM. WINDOW

DATE : 03-APR-21 | SCALE : 1:40
DRAWN BY : | CHECKED BY :

美特鋁製有限公司
MIDI ALUMINIUM FABRICATOR LTD.
Units 6-8, Sunray Industrial Centre, 1/F
610 Cha Kwo Ling Road, Kowloon
Tel:23489211-4 Fax:(852)27727666

DWG NO. : J853-SD-PW-SC707 | REV. : B

T:\Jobs\J-853\2. Outgoing\Black plate opening of Windows Louvre\Black Plate of T7 Precat Window.dwg

ELEVATION

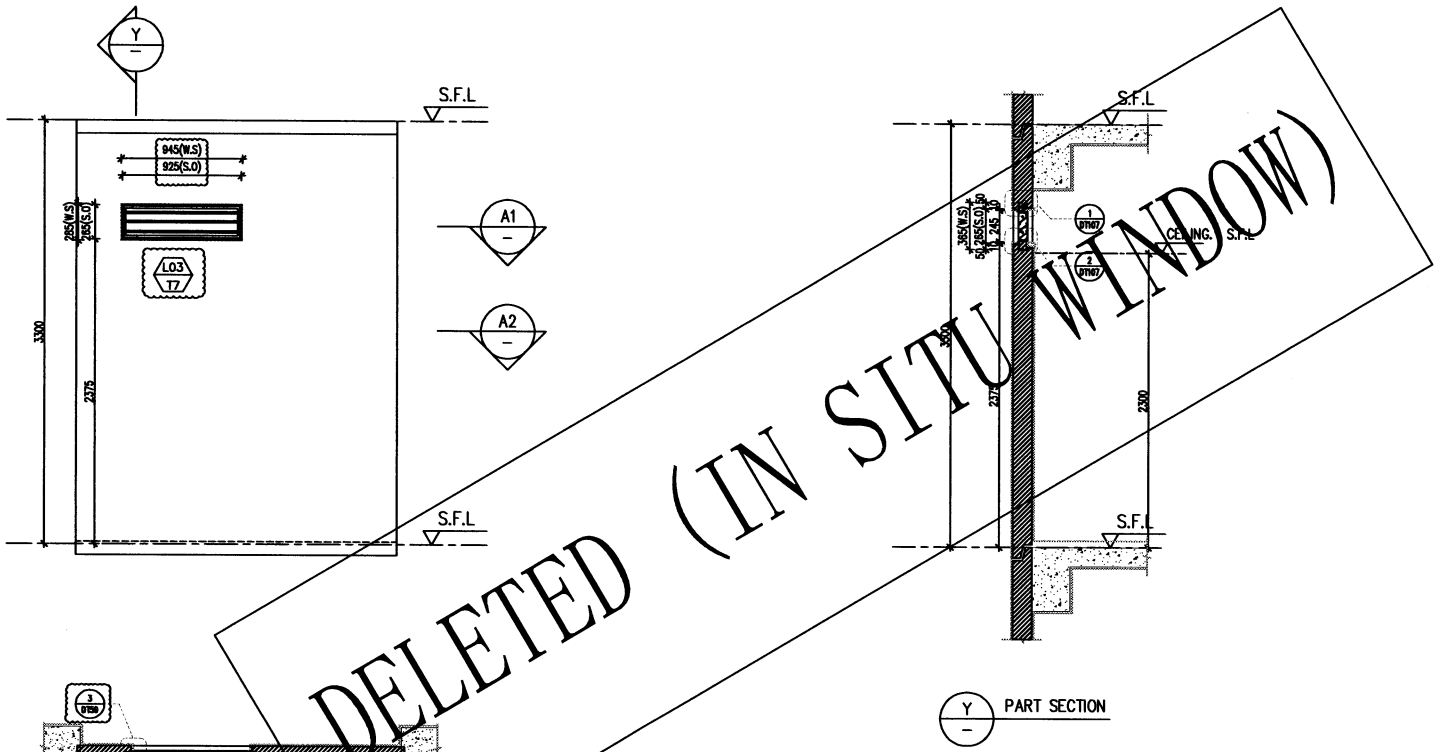

DELETED (IN SITU WINDOW)

L03 T7

PROVIDED			PROVIDED		
GLAZING AREA	–	m^2	GLAZING AREA	0.404	m^2
OPENABLE AREA	–	m^2	OPENABLE AREA	0.492	m^2
FREE AREA	55.4	%	FREE AREA	60.7	%

WDHR T7

WINDOW MARK	L04 T7
LOCATION	26F FLAT B BATH RM
SECTION	70mm ALUM. SECTION
GLAZING	GL05
QUANTITY	1 No.
REMARKS	FACADE (T7-01-07A/26F)

B.D. REF :

CLIENT :
SHIMAO GROUP HOLDINGS LIMITED

ARCHITECT :
WONG TUNG & PARTNERS LIMITED
ARCHITECTS & PLANNERS

MAIN CONTRACTOR :
協興建築有限公司
HIP HING CONSTRUCTION CO LTD

STRUCTURAL ENGINEER :
CMA C M WONG & ASSOCIATES LTD
黃志明建築工程師有限公司

FACADE CONSULTANT:
MEINHARDT

NOTE :
1. ALL DIMENSIONS ARE IN mm.
2. ALL ELEVATIONS ARE VIEWED FROM OUTSIDE.
3. ALL DIMENSIONS TO BE VERIFIED ON SITE BEFORE FABRICATION.

LEGEND :
X1 — DETAIL MARK NO.
X0001 — REFER SHEET NO.
1. F.F.L. — FINISHED FLOOR LEVEL
2. S.F.L. — STRUCTURAL FLOOR LEVEL
3. (R) — REVERSED DETAIL
4. ▲ — FIXING LOCATION
5. △ — FIXING LUG LOCATION
6. GLASS LEGEND
GL01 — 10mm+12mm AIR GAP+10mm THK. I.G.U.
GL04 — 12mm THK. CLEAR TEMPERED GLASS
GL05 — 10mm+12mm AIR GAP+10mm THK. I.G.U.
GL06 — 10mm+12mm AIR GAP+12mm THK. I.G.U.
GL07 — 10mm+12mm AIR GAP+12mm THK. I.G.U.
GL08 — 10mm+12mm AIR GAP+10mm THK. I.G.U.

NO.	DATE	REVISED	BY
B	04/08/2022	REVISION SUBJECT TO ARCH.COMMENT	sala
A	18/10/2021	REVISION SUBJECT TO ARCH.COMMENT	sala

JOB NO. : J-853

PROJECT :
PROPOSED RESIDENTIAL DEVELOPMENT AT N.K.I.L. 6542 YIN PING ROAD KOWLOON

TITLE :
WINDOW SCHEDULE FOR TOWER 7 ALUM. WINDOW

DATE : 03-APR-21 | SCALE : 1:40

DRAWN BY : | CHECKED BY :

美特鋁製有限公司
MIDI ALUMINIUM FABRICATOR LTD.
Units 6-8, Sunray Industrial Centre, 1/F
610 Cha Kwo Ling Road, Kowloon
Tel:23489211-4 Fax:(852)27727666

DWG NO. : J853-SD-PW-SC707a | REV. : B

T:\Jobs\J-853\2. Outgoing\Black plate opening of Windows Louvre\Black Plate of T7 Precat Window.dwg

ELEVATION

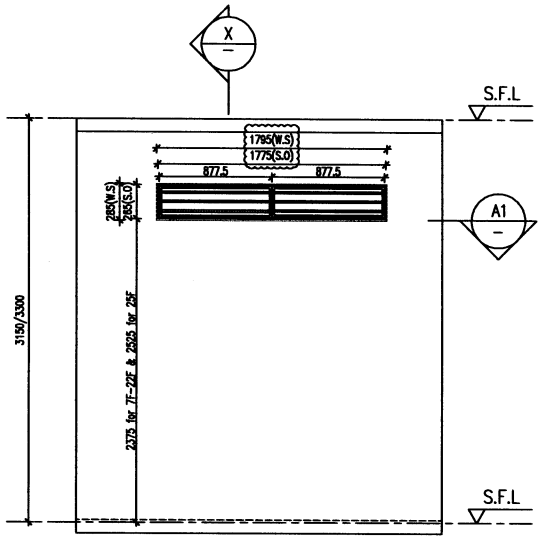

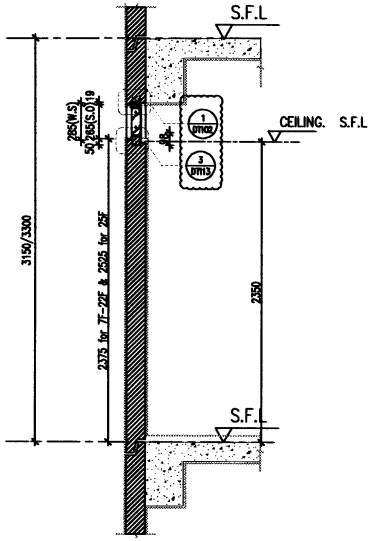

X PART SECTION

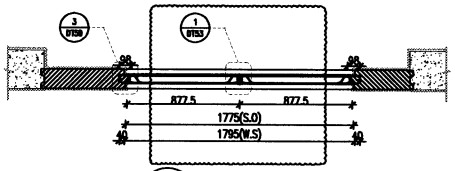

A1 PART PLAN

PROVIDED		
GLAZING AREA	–	m^2
OPENABLE AREA	–	m^2
FREE AREA	55.4	%

WINDOW MARK	L11A / T7
LOCATION	7F~15F & 17F~22F & 25F FLAT A KITCHEN
SECTION	70mm ALUM. LOUVER
GLAZING	–
QUANTITY	14 Nos.
REMARKS	FACADE (T7-01-02/7F~15F&17F~22F & T7-01-02A/25F)

T:\Jobs\J-853\2. Outgoing\Black plate opening of Windows Louvre\Black Plate of T7 Precat Window.dwg

B.D. REF :

CLIENT :
SHIMAO GROUP HOLDINGS LIMITED

ARCHITECT :
WONG TUNG & PARTNERS LIMITED
ARCHITECTS & PLANNERS

MAIN CONTRACTOR :
協興建築有限公司
HIP HING CONSTRUCTION CO LTD

STRUCTURAL ENGINEER :
C M WONG & ASSOCIATES LTD
黃志明結構工程師有限公司

FACADE CONSULTANT:
MEINHARDT

NOTE :
1. ALL DIMENSIONS ARE IN mm.
2. ALL ELEVATIONS ARE VIEWED FROM OUTSIDE.
3. ALL DIMENSIONS TO BE VERIFIED ON SITE BEFORE FABRICATION.

LEGEND :
X1 / X001 — DETAIL MARK NO. / REFER SHEET NO.
1. F.F.L. — FINISHED FLOOR LEVEL
2. S.F.L. — STRUCTURAL FLOOR LEVEL
3. (R) — REVERSED DETAIL
4. ▲ — FIXING LOCATION
5. △ — FIXING LUG LOCATION
6. GLASS LEGEND
GL01 — 10mm+12mm AIR GAP+10mm THK. L.G.U.
GL04 — 12mm THK. CLEAR TEMPERED GLASS
GL05 — 10mm+12mm AIR GAP+10mm THK. L.G.U.
GL06 — 10mm+12mm AIR GAP+12mm THK. L.G.U.
GL07 — 10mm+12mm AIR GAP+12mm THK. L.G.U.
GL08 — 10mm+12mm AIR GAP+10mm THK. L.G.U.

NO.	DATE	REVISED	BY
B	04/08/2022	REVISION SUBJECT TO ARCH.COMMENT	mdc
A	20/08/2022	REVISION SUBJECT TO ARCH.COMMENT	mdc

JOB NO. : J-853

PROJECT :
PROPOSED RESIDENTIAL DEVELOPMENT AT N.K.I.L. 6542 YIN PING ROAD KOWLOON

TITLE :
WINDOW SCHEDULE FOR TOWER 7 ALUM. WINDOW

DATE : 03-APR-21 | SCALE : 1:40

DRAWN BY : | CHECKED BY :

美特鋁製有限公司
MIDI ALUMINIUM FABRICATION LTD.
Units 6-8, Sunray Industrial Centre, 1/F
610 Cha Kwo Ling Road, Kowloon
Tel:23489211-4 Fax:(852)27727666

DWG NO. : J853-SD-PW-SC708 | REV. : B

ELEVATION

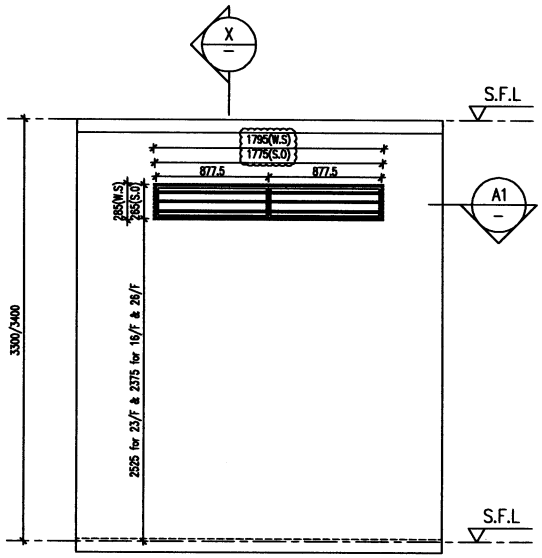

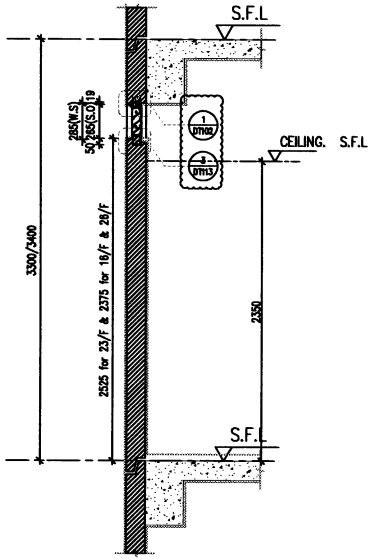

X PART SECTION

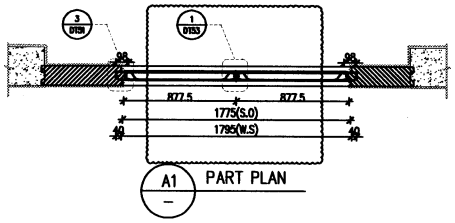

PROVIDED		
GLAZING AREA	–	m^2
OPENABLE AREA	–	m^2
FREE AREA	55.4	%

WINDOW MARK	L11 / T7
LOCATION	16F&23F&26F FLAT A KITCHEN
SECTION	70mm ALUM. LOUVER
GLAZING	–
QUANTITY	3 Nos.
REMARKS	FACADE (T7-01-02A/16F&26F, T7-01-02B/23F)

T:\Jobs\J-853\2. Outgoing\Black plate opening of Windows Louvre\Black Plate of T7 Precat Window.dwg

B.D. REF :

CLIENT :
SHIMAO GROUP HOLDINGS LIMITED

ARCHITECT :
WONG TUNG & PARTNERS LIMITED
ARCHITECTS & PLANNERS

MAIN CONTRACTOR :
協興建築有限公司
HIP HING CONSTRUCTION CO LTD

STRUCTURAL ENGINEER :
C M WONG & ASSOCIATES LTD
黃志明結構工程師有限公司

FACADE CONSULTANT:
MEINHARDT

NOTE :
1. ALL DIMENSIONS ARE IN mm.
2. ALL ELEVATIONS ARE VIEWED FROM OUTSIDE.
3. ALL DIMENSIONS TO BE VERIFIED ON SITE BEFORE FABRICATION.

LEGEND :
X1 / X001 — DETAIL MARK NO. / REFER SHEET NO.
1. F.F.L. — FINISHED FLOOR LEVEL
2. S.F.L. — STRUCTURAL FLOOR LEVEL
3. (78) — REVERSED DETAIL
4. ▲ — FIXING LOCATION
5. △ — FIXING LUG LOCATION
6. GLASS LEGEND
GL01 — 10mm+12mm AIR GAP+10mm THK. I.G.U.
GL04 — 12mm THK. CLEAR TEMPERED GLASS
GL05 — 10mm+12mm AIR GAP+10mm THK. I.G.U.
GL06 — 10mm+12mm AIR GAP+12mm THK. I.G.U.
GL07 — 10mm+12mm AIR GAP+12mm THK. I.G.U.
GL08 — 10mm+12mm AIR GAP+10mm THK. I.G.U.

NO.	DATE	REMARKS	BY
B	04/08/2022	REVISION SUBJECT TO ARCH.COMMENT	sada
A	20/06/2022	REVISION SUBJECT TO ARCH.COMMENT	sada

JOB NO. : J-853

PROJECT :
PROPOSED RESIDENTIAL DEVELOPMENT AT N.K.I.L. 6542 YIN PING ROAD KOWLOON

TITLE :
WINDOW SCHEDULE FOR TOWER 7 ALUM. WINDOW

DATE : 03-APR-21 | SCALE : 1:40

DRAWN BY : | CHECKED BY :

美特鋁製有限公司
MIDI ALUMINIUM FABRICATOR LTD.
Units 6-8, Sunray Industrial Centre, 1/F
610 Cha Kwo Ling Road, Kowloon
Tel:23489211-4 Fax:(852)27727666

DWG NO. : J853-SD-PW-SC708a | REV. : B

ELEVATION

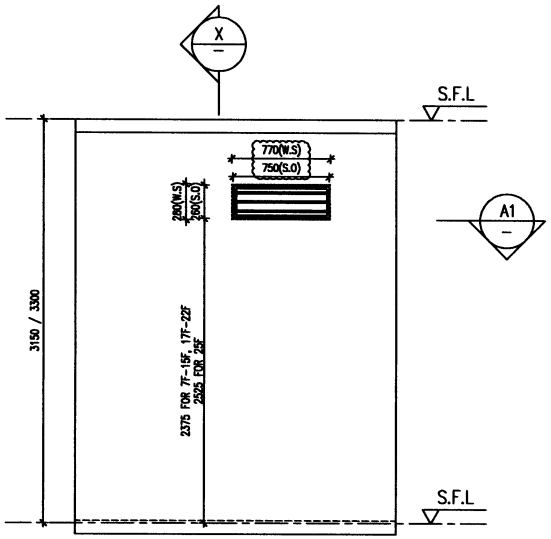

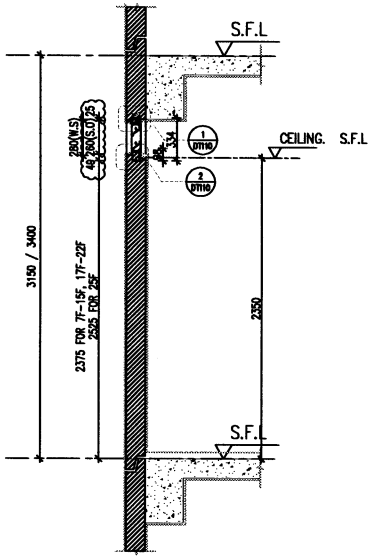

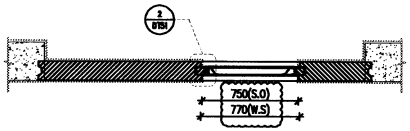

A1 PART PLAN

X PART SECTION

PROVIDED		
GLAZING AREA	0	m^2
OPENABLE AREA	0	m^2
FREE AREA	56.4	%

WINDOW MARK	LO1A / T7
LOCATION	7F~15F & 17F~22F COMMON STAIRCASE
SECTION	70mm ALUM. LOUVER
GLAZING	–
QUANTITY	14 Nos.
REMARKS	FACADE (T7-03-01/7F~15F&17F~22F; T7-03-01A/25F)

B.D. REF :

CLIENT :
SHIMAO GROUP HOLDINGS LIMITED

ARCHITECT :
WONG TUNG & PARTNERS LIMITED
ARCHITECTS & PLANNERS

MAIN CONTRACTOR :
協興建築有限公司
HIP HING CONSTRUCTION CO LTD

STRUCTURAL ENGINEER :
CMA C M WONG & ASSOCIATES LTD
黃志明建築工程師有限公司

FACADE CONSULTANT:
MEINHARDT

NOTE :
1. ALL DIMENSIONS ARE IN mm.
2. ALL ELEVATIONS ARE VIEWED FROM OUTSIDE.
3. ALL DIMENSIONS TO BE VERIFIED ON SITE BEFORE FABRICATION.

LEGEND :
XY — DETAIL MARK NO.
XXXX — REFER SHEET NO.
1. F.F.L. — FINISHED FLOOR LEVEL
2. S.F.L. — STRUCTURAL FLOOR LEVEL
3. (R) — REVERSED DETAIL
4. ▲ — FIXING LOCATION
5. △ — FIXING LUG LOCATION
6. GLASS LEGEND
GLD1 — 10mm+12mm AIR GAP+10mm THK. I.G.U.
GLD4 — 12mm THK. CLEAR TEMPERED GLASS
GLD5 — 10mm+12mm AIR GAP+10mm THK. I.G.U.
GLD6 — 10mm+12mm AIR GAP+12mm THK. I.G.U.
GLD7 — 10mm+12mm AIR GAP+12mm THK. I.G.U.
GLD8 — 10mm+12mm AIR GAP+10mm THK. I.G.U.

NO.	DATE	REMARK	BY
C	31/08/2022	REVISION SUBJECT TO ARCH.COMMENT	sala
B	04/08/2022	REVISION SUBJECT TO ARCH.COMMENT	sala
A	20/08/2022	REVISION SUBJECT TO ARCH.COMMENT	sala

JOB NO. : J-853

PROJECT :
PROPOSED RESIDENTIAL DEVELOPMENT AT N.K.I.L. 6542 YIN PING ROAD KOWLOON

TITLE :
WINDOW SCHEDULE FOR TOWER 7 ALUM. WINDOW

DATE : 03-APR-21 | SCALE : 1:40

DRAWN BY : | CHECKED BY :

美特鋁製有限公司
MIDI ALUMINIUM FABRICATOR LTD.
Units 6-8, Sunray Industrial Centre, 1/F
610 Cha Kwo Ling Road, Kowloon
Tel:23489211-4 Fax:(852)27727666

DWG NO. : J853-SD-PW-SC709 | REV. : C

T:\Jobs\J-853\2. Outgoing\Black plate opening of Windows Louvre\Black Plate of T7 Precat Window.dwg

ELEVATION

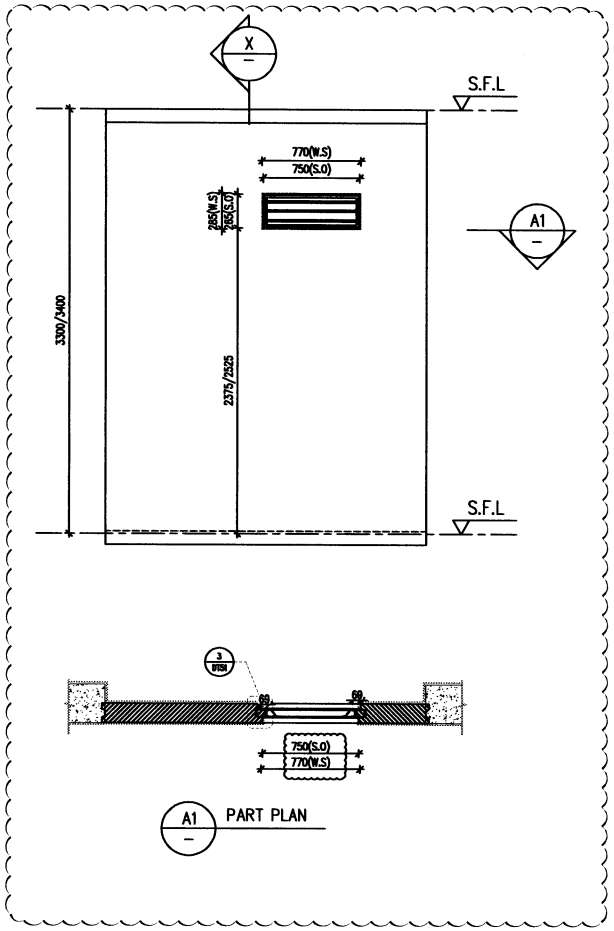

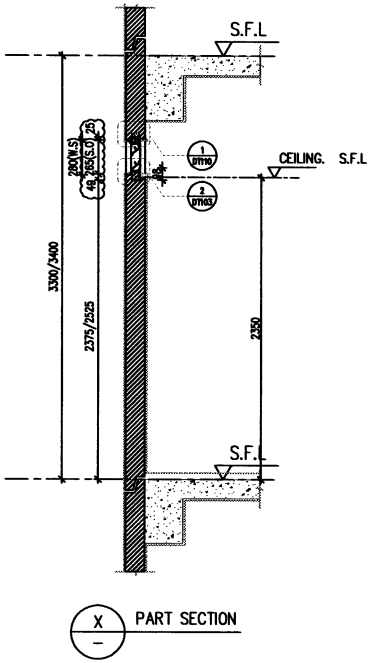

PROVIDED		
GLAZING AREA	0	m^2
OPENABLE AREA	0	m^2
FREE AREA	56.4	%

WINDOW MARK	L01 / T7
LOCATION	16F, 23F COMMON STAIRCASE
SECTION	70mm ALUM. LOUVER
GLAZING	–
QUANTITY	2 Nos.
REMARKS	FACADE (T7–03–01A/16F / T7–03–01B/23F)

T:\Jobs\J-853\2. Outgoing\Black plate opening of Windows Louvre\Black Plate of T7 Precat Window.dwg

B.D. REF :

CLIENT :
SHIMAO GROUP HOLDINGS LIMITED

ARCHITECT :
WONG TUNG & PARTNERS LIMITED
ARCHITECTS & PLANNERS

MAIN CONTRACTOR :
協興建築有限公司
HIP HING CONSTRUCTION CO LTD

STRUCTURAL ENGINEER :
C M WONG & ASSOCIATES LTD
黃志明建築工程師有限公司

FACADE CONSULTANT:
MEINHARDT

NOTE :
1. ALL DIMENSIONS ARE IN mm.
2. ALL ELEVATIONS ARE VIEWED FROM OUTSIDE.
3. ALL DIMENSIONS TO BE VERIFIED ON SITE BEFORE FABRICATION.

LEGEND :
X1 / X001 — DETAIL MARK NO. / REFER SHEET NO.
1. F.F.L. — FINISHED FLOOR LEVEL
2. S.F.L. — STRUCTURAL FLOOR LEVEL
3. (R) — REVERSED DETAIL
4. ▲ — FIXING LOCATION
5. △ — FIXING LUG LOCATION
6. GLASS LEGEND
GL01 — 10mm+12mm AIR GAP+10mm THK. I.G.U.
GL04 — 12mm THK. CLEAR TEMPERED GLASS
GL05 — 10mm+12mm AIR GAP+10mm THK. I.G.U.
GL06 — 10mm+12mm AIR GAP+12mm THK. I.G.U.
GL07 — 10mm+12mm AIR GAP+12mm THK. I.G.U.
GL08 — 10mm+12mm AIR GAP+10mm THK. I.G.U.

NO.	DATE	REMARK	BY
B	04/05/2022	REVISION SUBJECT TO ARCH.COMMENT	mdc
A	20/04/2022	REVISION SUBJECT TO ARCH.COMMENT	mdc

JOB NO. : J–853

PROJECT :
PROPOSED RESIDENTIAL DEVELOPMENT AT N.K.I.L. 6542 YIN PING ROAD KOWLOON

TITLE :
WINDOW SCHEDULE FOR TOWER 7 ALUM. WINDOW

DATE : 03–APR–21 | SCALE : 1:40
DRAWN BY : | CHECKED BY :

美特鋁製有限公司
MIDI ALUMINIUM FABRICATOR LTD.
Units 6–8, Sunray Industrial Centre, 1/F
610 Cha Kwo Ling Road, Kowloon
Tel:23489211–4 Fax:(852)27727666

DWG NO. : J853–SD–PW–SC709a | REV. : B

ELEVATION

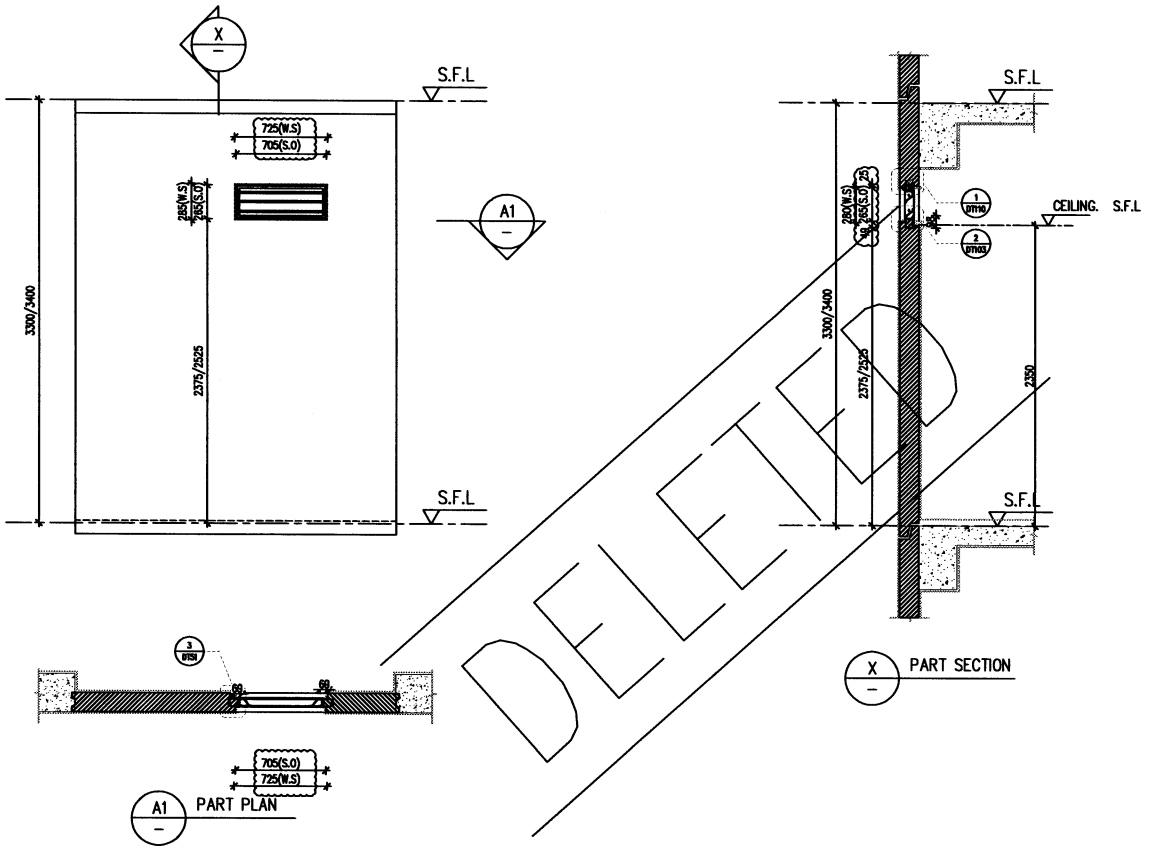

DELETE

PROVIDED		
GLAZING AREA	0	m^2
OPENABLE AREA	0	m^2
FREE AREA	56.4	%

WINDOW MARK	L01 / T7
LOCATION	26F ENSUITE 3 BATH ROOM
SECTION	70mm ALUM. LOUVER
GLAZING	–
QUANTITY	Nos.
REMARKS	FACADE (T7-01-05A/26F)

B.D. REF :

CLIENT :
SHIMAO GROUP HOLDINGS LIMITED

ARCHITECT :
WONG TUNG & PARTNERS LIMITED
ARCHITECTS & PLANNERS

MAIN CONTRACTOR :
協興建築有限公司
HIP HING CONSTRUCTION CO LTD

STRUCTURAL ENGINEER :
CMA C M WONG & ASSOCIATES LTD
黃志明建築工程師有限公司

FACADE CONSULTANT:
MEINHARDT

NOTE :
1. ALL DIMENSIONS ARE IN mm.
2. ALL ELEVATIONS ARE VIEWED FROM OUTSIDE.
3. ALL DIMENSIONS TO BE VERIFIED ON SITE BEFORE FABRICATION.

LEGEND :
- X1 / X901 — DETAIL MARK NO. / REFER SHEET NO.
1. F.F.L. — FINISHED FLOOR LEVEL
2. S.F.L. — STRUCTURAL FLOOR LEVEL
3. /R — REVERSED DETAIL
4. ▲ — FIXING LOCATION
5. △ — FIXING LUG LOCATION
6. GLASS LEGEND
   - GL01 — 10mm+12mm AIR GAP+10mm THK. I.G.U.
   - GL04 — 12mm THK. CLEAR TEMPERED GLASS
   - GL05 — 10mm+12mm AIR GAP+10mm THK. I.G.U.
   - GL06 — 10mm+12mm AIR GAP+12mm THK. I.G.U.
   - GL07 — 10mm+12mm AIR GAP+12mm THK. I.G.U.
   - GL08 — 10mm+12mm AIR GAP+10mm THK. I.G.U.

NO.	DATE	REVISED	BY
A	04/08/2022	REVISION SUBJECT TO ARCH'S COMMENT	hdb

JOB NO. : J-853

PROJECT :
PROPOSED RESIDENTIAL DEVELOPMENT AT N.K.I.L. 6542 YIN PING ROAD KOWLOON

TITLE :
WINDOW SCHEDULE FOR TOWER 7 ALUM. WINDOW

DATE : 03-APR-21 | SCALE : 1:40

DRAWN BY : | CHECKED BY :

美特鋁製有限公司
MIDI ALUMINIUM FABRICATOR LTD.
Units 6-8, Sunray Industrial Centre, 1/F
610 Cha Kwo Ling Road, Kowloon
Tel:23489211-4 Fax:(852)27727666

DWG NO. : J853-SD-PW-SC709b | REV. : A

ELEVATION

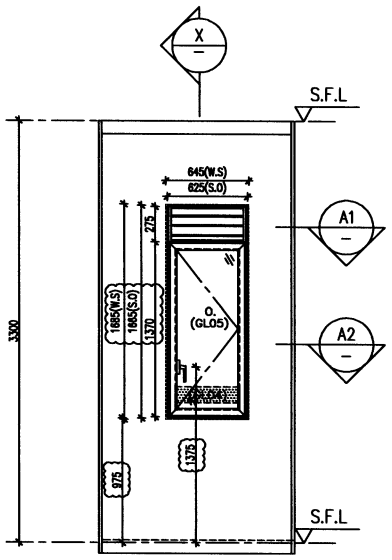

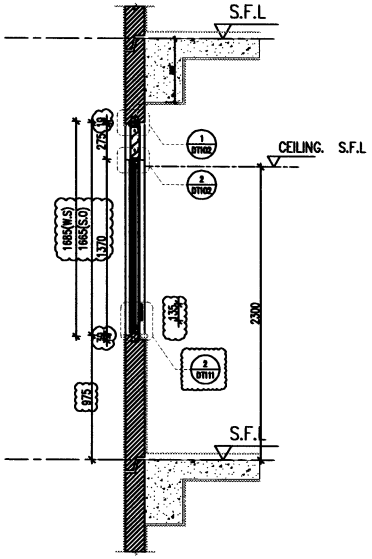

X PART SECTION

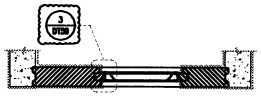

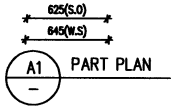

A1 PART PLAN

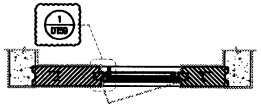

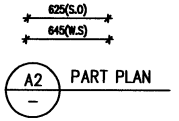

A2 PART PLAN

PROVIDED		
GLAZING AREA	0.513	m^2
OPENABLE AREA	0.611	m^2
FREE AREA	60.7	%

WINDOW MARK	W/GR/T7
LOCATION	26F COMMON STAIRCASE
SECTION	70mm ALUM. SECTION
GLAZING	GL05
QUANTITY	1 Nos.
REMARKS	FACADE (T7-01-04A/26F)

B.D. REF :

CLIENT :
SHIMAO GROUP HOLDINGS LIMITED

ARCHITECT :
WONG TUNG & PARTNERS LIMITED
ARCHITECTS & PLANNERS

MAIN CONTRACTOR :
協興建築有限公司
HIP HING CONSTRUCTION CO LTD

STRUCTURAL ENGINEER :
C M WONG & ASSOCIATES LTD
黃志明結構工程師有限公司

FACADE CONSULTANT:
MEINHARDT

NOTE :
1. ALL DIMENSIONS ARE IN mm.
2. ALL ELEVATIONS ARE VIEWED FROM OUTSIDE.
3. ALL DIMENSIONS TO BE VERIFIED ON SITE BEFORE FABRICATION.

LEGEND :
- X1 / XXXY — DETAIL MARK NO. / REFER SHEET NO.
1. F.F.L. — FINISHED FLOOR LEVEL
2. S.F.L. — STRUCTURAL FLOOR LEVEL
3. /R — REVERSED DETAIL
4. ▲ — FIXING LOCATION
5. △ — FIXING LUG LOCATION
6. GLASS LEGEND
   - GL01 — 10mm+12mm AIR GAP+10mm THK. I.G.U.
   - GL04 — 12mm THK. CLEAR TEMPERED GLASS
   - GL05 — 10mm+12mm AIR GAP+10mm THK. I.G.U.
   - GL06 — 10mm+12mm AIR GAP+12mm THK. I.G.U.
   - GL07 — 10mm+12mm AIR GAP+12mm THK. I.G.U.
   - GL08 — 10mm+12mm AIR GAP+10mm THK. I.G.U.

NO.	DATE	REVISED	BY

JOB NO. : J-853

PROJECT :
PROPOSED RESIDENTIAL DEVELOPMENT AT N.K.I.L. 6542 YIN PING ROAD KOWLOON

TITLE :
WINDOW SCHEDULE FOR TOWER 7 ALUM. WINDOW

DATE : 31-AUG-22 | SCALE : 1:40

DRAWN BY : | CHECKED BY :

美特鋁製有限公司
MIDI ALUMINIUM FABRICATOR LTD.
Units 6-8, Sunray Industrial Centre, 1/F
610 Cha Kwo Ling Road, Kowloon
Tel:23489211-4 Fax:(852)27727666

DWG NO. : J853-SD-PW-SC710 | REV. : -

T:\Jobs\J-853\2. Outgoing\Black plate opening of Windows Louvre\Black Plate of T7 Precat Window.dwg

ELEVATION

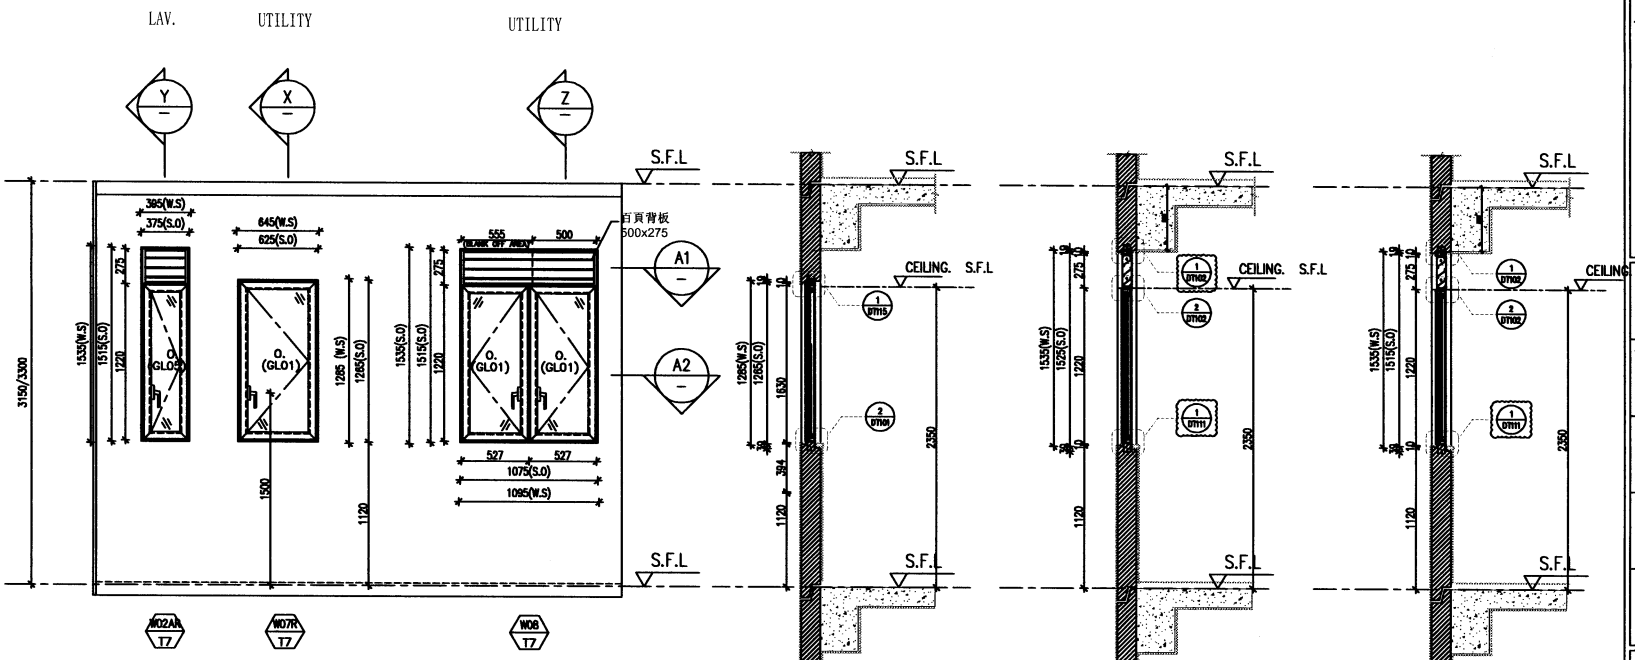

X PART SECTION

Y PART SECTION

Z PART SECTION

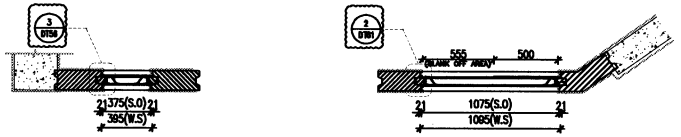

A1 PART PLAN

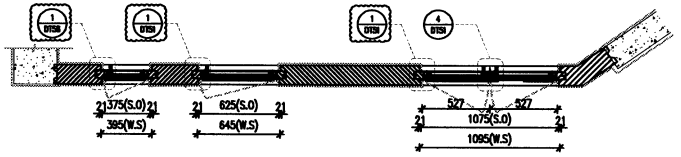

A2 PART PLAN

PROVIDED		
GLAZING AREA	0.523	m^2
OPENABLE AREA	0.618	m^2
FREE AREA	—	%

(W07R T7)

PROVIDED		
GLAZING AREA	0.240	m^2
OPENABLE AREA	0.319	m^2
FREE AREA	60.7	%

(W02AA T7)

PROVIDED		
GLAZING AREA	0.865	m^2
OPENABLE AREA	1.044	m^2
FREE AREA	60.7	%

(W08 T7)

WINDOW MARK	W02AA T7, W07R T7, W08 T7
LOCATION	7F~15F&17F~22F FLAT A UTILITY & LAV
SECTION	70mm ALUM. SECTION
GLAZING	GL01
QUANTITY	13 Nos./ 13 Nos. / 13 Nos.
REMARKS	FACADE (T7-02-01/7~15F&17F~22F)

T:\Jobs\J-853\2. Outgoing\Black plate opening of Windows Louvre\Black Plate of T7 Precat Window.dwg

B.D. REF :

CLIENT :
SHIMAO GROUP HOLDINGS LIMITED

ARCHITECT :
WONG TUNG & PARTNERS LIMITED
ARCHITECTS & PLANNERS

MAIN CONTRACTOR :
協興建築有限公司
HIP HING CONSTRUCTION CO LTD

STRUCTURAL ENGINEER :
C M WONG & ASSOCIATES LTD
黃志明結構工程師有限公司

FACADE CONSULTANT:
MEINHARDT

NOTE :
1. ALL DIMENSIONS ARE IN mm.
2. ALL ELEVATIONS ARE VIEWED FROM OUTSIDE.
3. ALL DIMENSIONS TO BE VERIFIED ON SITE BEFORE FABRICATION.

LEGEND :
- X1 / X001 — DETAIL MARK NO. / REFER SHEET NO.
1. F.F.L. — FINISHED FLOOR LEVEL
2. S.F.L. — STRUCTURAL FLOOR LEVEL
3. (N) — REVERSED DETAIL
4. ▲ — FIXING LOCATION
5. △ — FIXING LUG LOCATION
6. GLASS LEGEND
   - GL01 — 10mm+12mm AIR GAP+10mm THK. I.G.U.
   - GL04 — 12mm THK. CLEAR TEMPERED GLASS
   - GL05 — 10mm+12mm AIR GAP+10mm THK. I.G.U.
   - GL06 — 10mm+12mm AIR GAP+12mm THK. I.G.U.
   - GL07 — 10mm+12mm AIR GAP+12mm THK. I.G.U.
   - GL08 — 10mm+12mm AIR GAP+10mm THK. I.G.U.

NO.	DATE	REVISED	BY
B	31/08/2022	REVISION SUBJECT TO COMMENT	wds
A	16/10/2021	REVISION SUBJECT TO ARCH.COMMENT	wds

JOB NO. : J-853

PROJECT :
PROPOSED RESIDENTIAL DEVELOPMENT AT N.K.I.L. 6542 YIN PING ROAD KOWLOON

TITLE :
WINDOW SCHEDULE FOR TOWER 7 ALUM. WINDOW

DATE : 03-APR-21 | SCALE : 1:40

DRAWN BY : | CHECKED BY :

美特鋁製有限公司
MIDI ALUMINIUM FABRICATION LTD.
Units 6-8, Sunray Industrial Centre, 1/F
610 Cha Kwo Ling Road, Kowloon
Tel:23489211-4 Fax:(852)27727666

DWG NO. : J853-SD-PW-SC701 | REV. : B

ELEVATION

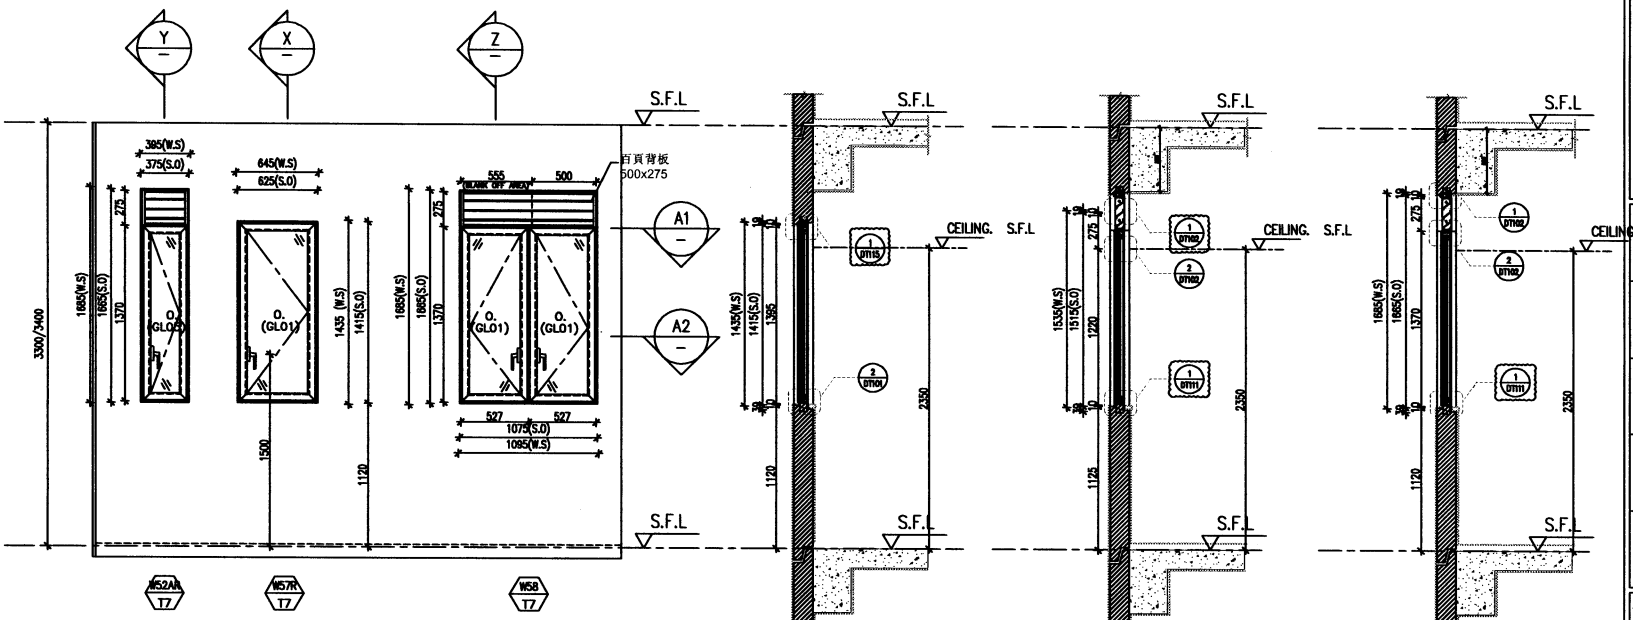

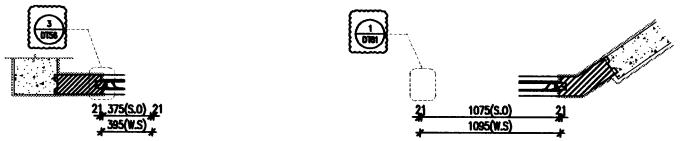

X PART SECTION

Y PART SECTION

Z PART SECTION

A1 PART PLAN

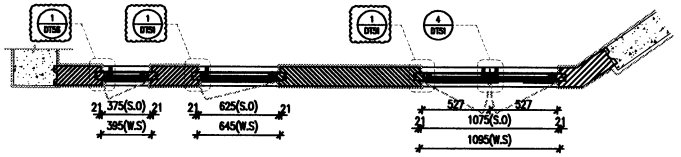

A2 PART PLAN

PROVIDED		
GLAZING AREA	0.594	m^2
OPENABLE AREA	0.697	m^2
FREE AREA	–	%

W57R T7

PROVIDED		
GLAZING AREA	0.273	m^2
OPENABLE AREA	0.361	m^2
FREE AREA	60.7	%

W52AA T7

PROVIDED		
GLAZING AREA	0.984	m^2
OPENABLE AREA	1.181	m^2
FREE AREA	60.7	%

W58 T7

WINDOW MARK	W52AA T7, W57R T7, W58 T7
LOCATION	25F FLAT A UTILITY & LAV
SECTION	70mm ALUM. SECTION
GLAZING	GL01
QUANTITY	1 No./ 1 No. / 1 No.
REMARKS	FACADE (T7-02-01A/25F)

T:\Jobs\J-853\2. Outgoing\Black plate opening of Windows Louvre\Black Plate of T7 Precat Window.dwg

B.D. REF :

CLIENT : S.F.I. SHIMAO GROUP HOLDINGS LIMITED

ARCHITECT : WONG TUNG & PARTNERS LIMITED ARCHITECTS & PLANNERS

MAIN CONTRACTOR : 協興建築有限公司 HIP HING CONSTRUCTION CO LTD

STRUCTURAL ENGINEER : C M WONG & ASSOCIATES LTD 黃志明註冊工程師有限公司

FACADE CONSULTANT: MEINHARDT

NOTE :
1. ALL DIMENSIONS ARE IN mm.
2. ALL ELEVATIONS ARE VIEWED FROM OUTSIDE.
3. ALL DIMENSIONS TO BE VERIFIED ON SITE BEFORE FABRICATION.

LEGEND :
- X1 / 2001 — DETAIL MARK NO. / REFER SHEET NO.
1. F.F.L. — FINISHED FLOOR LEVEL
2. S.F.L. — STRUCTURAL FLOOR LEVEL
3. (78) — REVERSED DETAIL
4. ▲ — FIXING LOCATION
5. △ — FIXING LUG LOCATION
6. GLASS LEGEND
   - GL01 — 10mm+12mm AIR GAP+10mm THK. I.G.U.
   - GL04 — 12mm THK. CLEAR TEMPERED GLASS
   - GL05 — 10mm+12mm AIR GAP+10mm THK. I.G.U.
   - GL06 — 10mm+12mm AIR GAP+12mm THK. I.G.U.
   - GL07 — 10mm+12mm AIR GAP+12mm THK. I.G.U.
   - GL08 — 10mm+12mm AIR GAP+10mm THK. I.G.U.

NO.	DATE	REVISED	BY
A	16/10/2021	REVISION SUBJECT TO ARCH.COMMENT	MDI

JOB NO. : J-853

PROJECT : PROPOSED RESIDENTIAL DEVELOPMENT AT N.K.I.L. 6542 YIN PING ROAD KOWLOON

TITLE : WINDOW SCHEDULE FOR TOWER 7 ALUM. WINDOW

DATE : 03-APR-21 | SCALE : 1:40

DRAWN BY : | CHECKED BY :

美特鋁質有限公司 MIDI ALUMINIUM FABRICATION LTD.
Units 6-8, Sunray Industrial Centre, 1/F
610 Cha Kwo Ling Road, Kowloon
Tel:23489211-4 Fax:(852)27727666

DWG NO. : J853-SD-PW-SC701a | REV. : B

ELEVATION

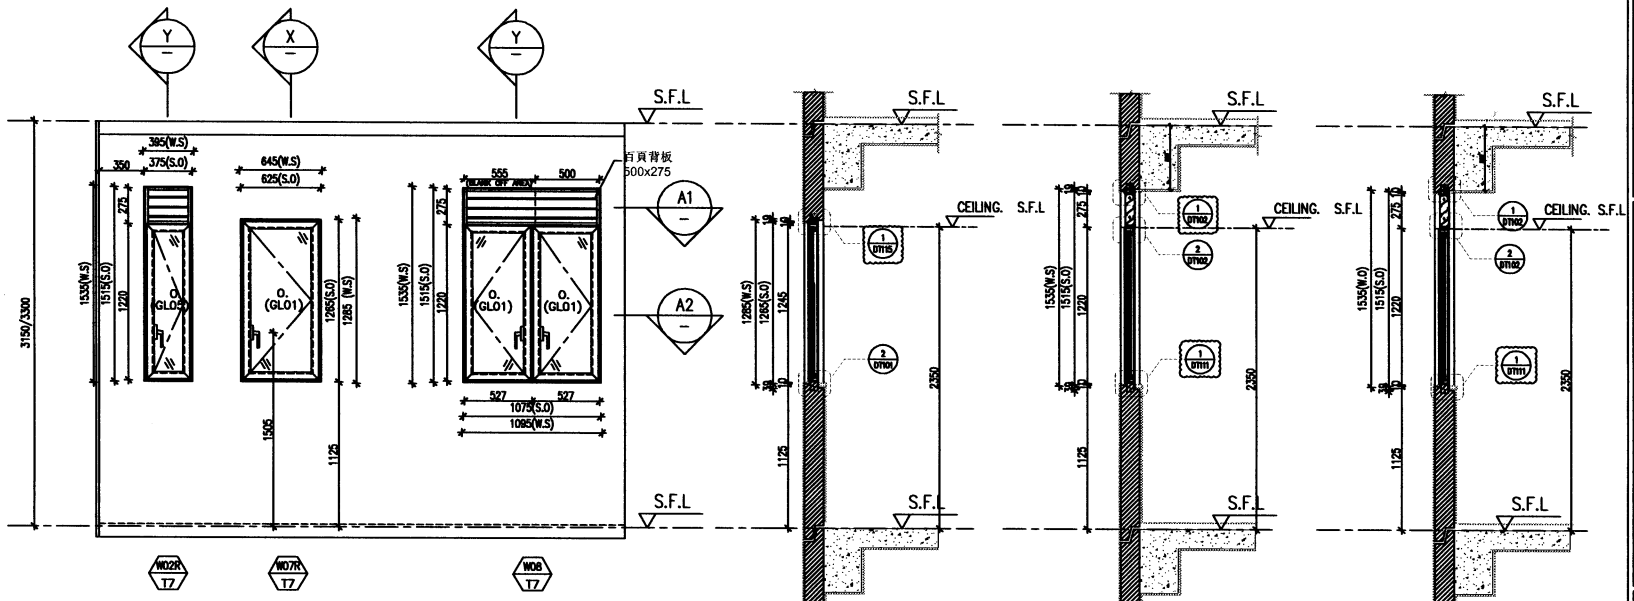

X PART SECTION

Y PART SECTION

Z PART SECTION

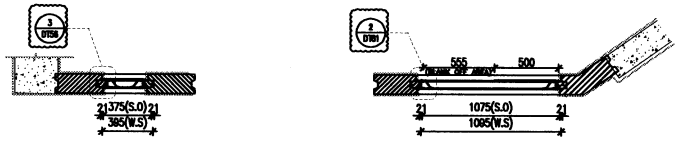

A1 PART PLAN

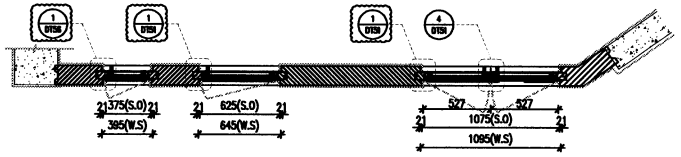

A2 PART PLAN

PROVIDED		
GLAZING AREA	0.524	m^2
OPENABLE AREA	0.618	m^2
FREE AREA	–	%

(W07R T7)

PROVIDED		
GLAZING AREA	0.241	m^2
OPENABLE AREA	0.320	m^2
FREE AREA	60.7	%

(W02R T7)

PROVIDED		
GLAZING AREA	0.865	m^2
OPENABLE AREA	1.044	m^2
FREE AREA	60.7	%

(W08 T7)

WINDOW MARK	W02R T7, W07R T7, W08 T7
LOCATION	16F&26F FLAT A UTILITY & LAV
SECTION	70mm ALUM. SECTION
GLAZING	GL01
QUANTITY	2 Nos./ 2 Nos. / 2 Nos.
REMARKS	FACADE (T7-02-01A/16F&26F)

T:\Jobs\J-853\2. Outgoing\Black plate opening of Windows Louvre\Black Plate of T7 Precat Window.dwg

B.D. REF :

CLIENT :
SHIMAO GROUP HOLDINGS LIMITED

ARCHITECT :
WONG TUNG & PARTNERS LIMITED
ARCHITECTS & PLANNERS

MAIN CONTRACTOR :
協興建築有限公司
HIP HING CONSTRUCTION CO LTD

STRUCTURAL ENGINEER :
C M WONG & ASSOCIATES LTD
黃志明結構工程師有限公司

FACADE CONSULTANT:
MEINHARDT

NOTE :
1. ALL DIMENSIONS ARE IN mm.
2. ALL ELEVATIONS ARE VIEWED FROM OUTSIDE.
3. ALL DIMENSIONS TO BE VERIFIED ON SITE BEFORE FABRICATION.

LEGEND :
- X1 / XXX1 — DETAIL MARK NO. / REFER SHEET NO.
1. F.F.L. — FINISHED FLOOR LEVEL
2. S.F.L. — STRUCTURAL FLOOR LEVEL
3. — REVERSED DETAIL
4. ▲ — FIXING LOCATION
5. △ — FIXING LUG LOCATION
6. GLASS LEGEND
   - GL01 — 10mm+12mm AIR GAP+10mm THK. LG.U.
   - GL04 — 12mm THK. CLEAR TEMPERED GLASS
   - GL05 — 10mm+12mm AIR GAP+10mm THK. LG.U.
   - GL06 — 10mm+12mm AIR GAP+12mm THK. LG.U.
   - GL07 — 10mm+12mm AIR GAP+12mm THK. LG.U.
   - GL08 — 10mm+12mm AIR GAP+10mm THK. LG.U.

NO.	DATE	REVISED	BY
A	16/10/2021	REVISION SUBJECT TO ARCH.COMMENT	kdo

JOB NO. : J-853

PROJECT :
PROPOSED RESIDENTIAL DEVELOPMENT AT N.K.I.L. 6542 YIN PING ROAD KOWLOON

TITLE :
WINDOW SCHEDULE FOR TOWER 7 ALUM. WINDOW

DATE : 03-APR-21 | SCALE : 1:40

DRAWN BY : | CHECKED BY :

美特鋁製有限公司
MIDI ALUMINIUM FABRICATOR LTD.
Units 6-8, Sunray Industrial Centre, 1/F
610 Cha Kwo Ling Road, Kowloon
Tel:23489211-4 Fax:(852)27727666

DWG NO. : J853-SD-PW-SC701b | REV. : B

ELEVATION

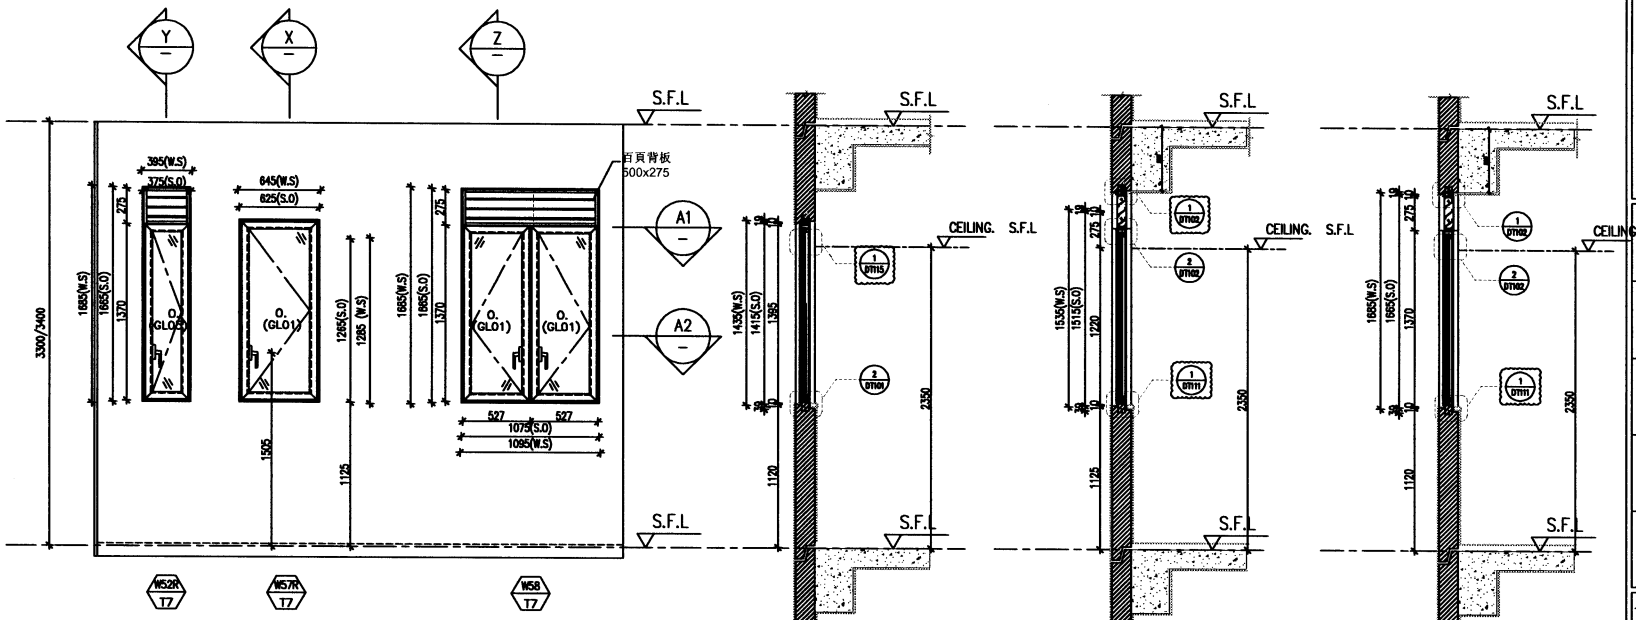

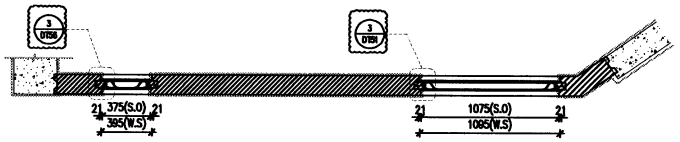

X PART SECTION

Y PART SECTION

Z PART SECTION

A1 PART PLAN

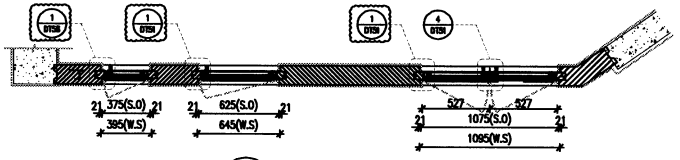

A2 PART PLAN

PROVIDED		
GLAZING AREA	0.594	m^2
OPENABLE AREA	0.697	m^2
FREE AREA	—	%

W57R T7

PROVIDED		
GLAZING AREA	0.274	m^2
OPENABLE AREA	0.362	m^2
FREE AREA	60.7	%

W52R T7

PROVIDED		
GLAZING AREA	0.984	m^2
OPENABLE AREA	1.181	m^2
FREE AREA	60.7	%

W58 T7

WINDOW MARK	W52R T7 / W57R T7 / W58 T7
LOCATION	23F FLAT A UTILITY & LAV
SECTION	70mm ALUM. SECTION
GLAZING	GL01
QUANTITY	1 Nos./ 1 Nos. / 1 Nos.
REMARKS	FACADE (T7-02-01B/23F)

B.D. REF :

CLIENT : ISHIMAO GROUP HOLDINGS LIMITED

ARCHITECT : WONG TUNG & PARTNERS LIMITED ARCHITECTS & PLANNERS

MAIN CONTRACTOR : 協興建築有限公司 HIP HING CONSTRUCTION CO LTD

STRUCTURAL ENGINEER : CMA C M WONG & ASSOCIATES LTD 黃志明建築工程師有限公司

FACADE CONSULTANT: MEINHARDT

NOTE :
1. ALL DIMENSIONS ARE IN mm.
2. ALL ELEVATIONS ARE VIEWED FROM OUTSIDE.
3. ALL DIMENSIONS TO BE VERIFIED ON SITE BEFORE FABRICATION.

LEGEND :
- X1 / X0001 — DETAIL MARK NO. / REFER SHEET NO.
1. F.F.L. — FINISHED FLOOR LEVEL
2. S.F.L. — STRUCTURAL FLOOR LEVEL
3. (R) — REVERSED DETAIL
4. ▲ — FIXING LOCATION
5. △ — FIXING LUG LOCATION
6. GLASS LEGEND
   - GL01 — 10mm+12mm AIR GAP+10mm THK. LG.U.
   - GL04 — 12mm THK. CLEAR TEMPERED GLASS
   - GL05 — 10mm+12mm AIR GAP+10mm THK. LG.U.
   - GL06 — 10mm+12mm AIR GAP+12mm THK. LG.U.
   - GL07 — 10mm+12mm AIR GAP+12mm THK. LG.U.
   - GL08 — 10mm+12mm AIR GAP+10mm THK. LG.U.

NO.	DATE	REVISED	BY
A	18/10/2021	REVISION SUBJECT TO ARCH.COMMENT	mks

JOB NO. : J-853

PROJECT : PROPOSED RESIDENTIAL DEVELOPMENT AT N.K.I.L. 6542 YIN PING ROAD KOWLOON

TITLE : WINDOW SCHEDULE FOR TOWER 7 ALUM. WINDOW

DATE : 03-APR-21 | SCALE : 1:40

DRAWN BY : | CHECKED BY :

美特鋁製有限公司 MIDI ALUMINIUM FABRICATOR LTD.
Units 6-8, Sunray Industrial Centre, 1/F
610 Cha Kwo Ling Road, Kowloon
Tel:23489211-4 Fax:(852)27727666

DWG NO. : J853-SD-PW-SC701c | REV. : B

T:\Jobs\J-853\2. Outgoing\Black plate opening of Windows Louvre\Black Plate of T7 Precat Window.dwg

ELEVATION

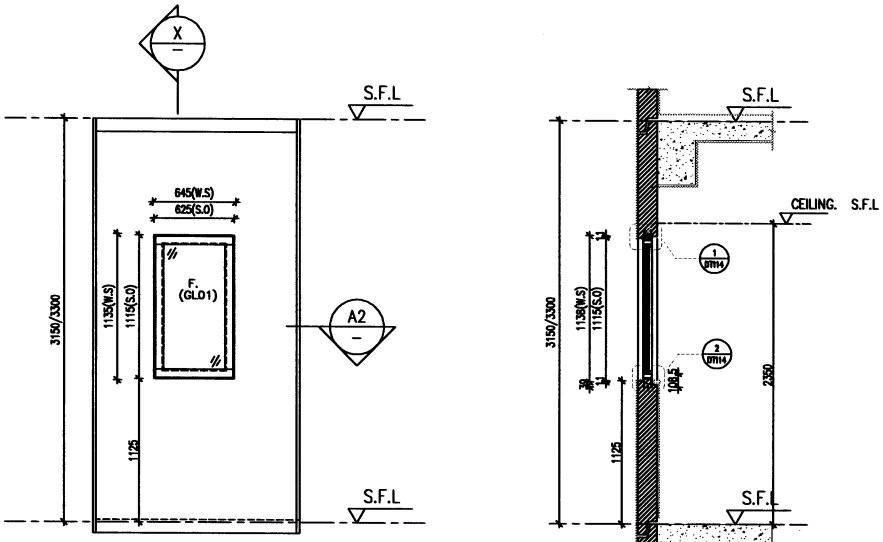

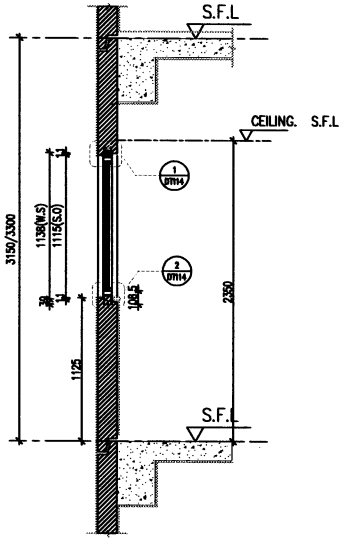

X PART SECTION

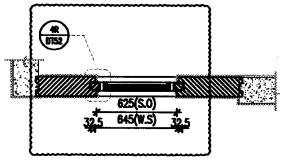

A2 PART PLAN

PROVIDED		
GLAZING AREA	0.486	m^2
OPENABLE AREA	–	m^2
FREE AREA	60.7	%

WINDOW MARK	W13 T7
LOCATION	7/F~22F&26F FLAT A KITCHEN
SECTION	70mm ALUM. SECTION
GLAZING	GL01
QUANTITY	15 Nos.
REMARKS	FACADE (T7-01-03/7~15F&17F~22F; T7-01-03A/16F&26F)

T:\Jobs\J-853\2. Outgoing\Black plate opening of Windows Louvre\Black Plate of T7 Precat Window.dwg

B.D. REF :

CLIENT :
SHIMAO GROUP HOLDINGS LIMITED

ARCHITECT :
WONG TUNG & PARTNERS LIMITED
ARCHITECTS & PLANNERS

MAIN CONTRACTOR :
協興建築有限公司
HIP HING CONSTRUCTION CO LTD

STRUCTURAL ENGINEER :
C M WONG & ASSOCIATES LTD
黃志明建築工程師有限公司

FACADE CONSULTANT:
MEINHARDT

NOTE :
1. ALL DIMENSIONS ARE IN mm.
2. ALL ELEVATIONS ARE VIEWED FROM OUTSIDE.
3. ALL DIMENSIONS TO BE VERIFIED ON SITE BEFORE FABRICATION.

LEGEND :
X1 — DETAIL MARK NO.
X901 — REFER SHEET NO.
1. F.F.L. — FINISHED FLOOR LEVEL
2. S.F.L. — STRUCTURAL FLOOR LEVEL
3. /R — REVERSED DETAIL
4. ▲ — FIXING LOCATION
5. △ — FIXING LUG LOCATION
6. GLASS LEGEND
GL01 — 10mm+12mm AIR GAP+10mm THK. I.G.U.
GL04 — 12mm THK. CLEAR TEMPERED GLASS
GL05 — 10mm+12mm AIR GAP+10mm THK. I.G.U.
GL06 — 10mm+12mm AIR GAP+12mm THK. I.G.U.
GL07 — 10mm+12mm AIR GAP+12mm THK. I.G.U.
GL08 — 10mm+12mm AIR GAP+10mm THK. I.G.U.

NO.	DATE	REMARK	BY
C	07/09/2022	REVISION SUBJECT TO ARCH.COMMENT	sala
B	04/08/2022	REVISION SUBJECT TO ARCH.COMMENT	sala
A	18/10/2021	REVISION SUBJECT TO ARCH.COMMENT	sala

JOB NO. : J-853

PROJECT :
PROPOSED RESIDENTIAL DEVELOPMENT AT N.K.I.L. 6542 YIN PING ROAD KOWLOON

TITLE :
WINDOW SCHEDULE FOR TOWER 7 ALUM. WINDOW

DATE : 03-APR-21 | SCALE : 1:40

DRAWN BY : | CHECKED BY :

美特鋁製有限公司
MIDI ALUMINIUM FABRICATOR LTD.
Units 6-8, Sunray Industrial Centre, 1/F
610 Cha Kwo Ling Road, Kowloon
Tel:23489211-4 Fax:(852)27727666

DWG NO. : J853-SD-PW-SC702 | REV. : C