



工程指示 / 要求簡箋 ENGINEER INSTRUCTIONS(E.I.)

工程指示編號:	EI-5543	修改版本:	-
	HK-2382		
工程編號:	J 853	工程名稱:	延坪道
收件人:	生統	發件人:	Lai Sik Hung
工程項目:	廠用 T1-T7 幕牆特式層單元件鋁板 大貨	日期:	28/12/2022

<input type="checkbox"/> 原合約工程包	<input type="checkbox"/> 原合約工程加 / 減脹 QT-	<input type="checkbox"/> 新工程報價 QT-
---------------------------------	--	------------------------------------

信件批核號碼/圖紙參考編號:	批核模具圖紙編號:
客戶指示附件:	管理內部批簽署:

<input type="checkbox"/> 初步鋁料 B.M.	<input type="checkbox"/> 加工拆圖, 然後生產	<input type="checkbox"/> 尺寸表
<input type="checkbox"/> 正式鋁料 B.M.	<input type="checkbox"/> 技術上資料/指示	<input type="checkbox"/> 報價
<input type="checkbox"/> 配件 B.M.	<input type="checkbox"/> 樣辦或貨品說明書	<input type="checkbox"/> 分判合約
<input type="checkbox"/> 其他:		


內容: 廠用 T1-T7 幕牆特式層單元件鋁板 大貨 需分座包裝
完成上列要求日期: 09/01/2023

國內


<input type="checkbox"/> 生產技術總監	<input type="checkbox"/> 連附件	<input checked="" type="checkbox"/> 技術部	<input checked="" type="checkbox"/> 連附件	<input type="checkbox"/> 生產部	<input type="checkbox"/> 連附件
<input type="checkbox"/> 採購部	<input type="checkbox"/> 連附件	<input checked="" type="checkbox"/> 生產統籌部	<input checked="" type="checkbox"/> 連附件	<input type="checkbox"/> 報關組	<input type="checkbox"/> 連附件
<input type="checkbox"/> 質檢部	<input type="checkbox"/> 連附件	<input type="checkbox"/> 會計部	<input type="checkbox"/> 連附件	<input type="checkbox"/> 機械設計部	<input type="checkbox"/> 連附件
<input checked="" type="checkbox"/> 香港辦	<input checked="" type="checkbox"/> 連附件	<input type="checkbox"/> 其他:			

<input type="checkbox"/> 行政部	<input type="checkbox"/> 連附件	<input type="checkbox"/> 會計部	<input type="checkbox"/> 連附件	<input type="checkbox"/> 統籌部	<input type="checkbox"/> 連附件	<input type="checkbox"/> 工程部	<input type="checkbox"/> 連附件
<input type="checkbox"/> 採購部	<input type="checkbox"/> 連附件	<input type="checkbox"/> QS部	<input type="checkbox"/> 連附件	<input type="checkbox"/> 地盤管理	<input type="checkbox"/> 連附件	<input type="checkbox"/> 維修部	<input type="checkbox"/> 連附件


*發件人簽署:		*組別成員批核簽署:	
傳遞編號:		項目經理簽署:	

	工程號: J-853	計算: HHQ	日期:	2022-12-27		送呈:胡哥
	地盤名稱: 延坪道住宅	核對: WLQ	日期:	2022-12-27		副本:
廠用鋁板B.M.表	項目類別: 幕牆	批准:	日期:			
BM編號:	修改版次:	A/C Code:	總V.F.:	176.10	總重量:	1481.10 此BM依據 資料計算


序號	修改內容	鋁板圖號	鋁板名稱	顏色	實用	後備	總數	總重量	展開面積		總V.F.		備註	
									單件展開面積	總展開面積	單件V.F.	總V.F.		
									平方米		平方米			
1		DMP-5	3mm厚鋁板	EC-DG-D334232-ZD1(閃粉古銅)	5	0	5	26.838	0.660	3.301	0.641	3.205		
2		DMP-6	3mm厚鋁板	EC-DG-D334232-ZD1(閃粉古銅)	33	0	33	204.307	0.762	25.130	0.738	24.367		
3		DMP-10	3mm厚鋁板	EC-DG-D334232-ZD1(閃粉古銅)	8	0	8	52.823	0.812	6.497	0.787	6.296		
4		DMP-12	3mm厚鋁板	EC-DG-D334232-ZD1(閃粉古銅)	6	0	6	42.088	0.863	5.177	0.836	5.014		
5		DMP-13	3mm厚鋁板	EC-DG-D334232-ZD1(閃粉古銅)	2	0	2	18.971	1.167	2.333	1.128	2.255		
6		DMP-16	3mm厚鋁板	EC-DG-D334232-ZD1(閃粉古銅)	4	0	4	28.652	0.881	3.524	0.853	3.413		
7		DMP-17	3mm厚鋁板	EC-DG-D334232-ZD1(閃粉古銅)	1	0	1	9.378	1.154	1.154	1.115	1.115		
8		DMP-18	3mm厚鋁板	EC-DG-D334232-ZD1(閃粉古銅)	6	0	6	44.559	0.913	5.481	0.884	5.306		
9		DMP-18a	3mm厚鋁板	EC-DG-D334232-ZD1(閃粉古銅)	1	0	1	10.309	1.268	1.268	1.225	1.225		
10		DMP-19	3mm厚鋁板	EC-DG-D334232-ZD1(閃粉古銅)	3	0	3	19.611	0.804	2.412	0.779	2.338		
11		DMP-20	3mm厚鋁板	EC-DG-D334232-ZD1(閃粉古銅)	1	0	1	7.838	0.964	0.964	0.933	0.933		
12		DMP-21	3mm厚鋁板	EC-DG-D334232-ZD1(閃粉古銅)	3	0	3	29.692	1.217	3.652	1.176	3.529		
13		DMP-25a	3mm厚鋁板	EC-DG-D334232-ZD1(閃粉古銅)	1	0	1	9.197	1.131	1.131	1.094	1.094		
14		DMP-25b	3mm厚鋁板	EC-DG-D334232-ZD1(閃粉古銅)	1	0	1	11.338	1.395	1.395	1.347	1.347		
15		DMP-25c	3mm厚鋁板	EC-DG-D334232-ZD1(閃粉古銅)	1	0	1	8.374	1.030	1.030	0.996	0.996		
16		DMP-26	3mm厚鋁板	EC-DG-D334232-ZD1(閃粉古銅)	4	0	4	34.647	1.065	4.262	1.030	4.121		
17		DMP-30	3mm厚鋁板	EC-DG-D334232-ZD1(閃粉古銅)	4	0	4	36.294	1.116	4.464	1.079	4.316		
18		DMP-50	3mm厚鋁板	EC-DG-D334232-ZD1(閃粉古銅)	4	0	4	44.530	1.369	5.477	1.322	5.289		
19		DMP-105	3mm厚鋁板	EC-DG-D334232-ZD1(閃粉古銅)	1	0	1	16.074	1.977	1.977	1.906	1.906		

	工程號: J-853	計算: HHQ	日期: 2022-12-27			送呈:胡哥
	地盤名稱: 延坪道住宅	核對: WLQ	日期: 2022-12-27			副本:
廠用鋁板B.M.表	項目類別: 幕牆	批准:	日期:			
BM編號:	修改版次:	A/C Code:	總V.F.:	176.10	總重量:	1481.10 此BM依據 資料計算

序號	修改內容	鋁板圖號	鋁板名稱	顏色	實用	後備	總數	總重量	展開面積		總V.F.		備註	
									單件展開面積	總展開面積	單件V.F.	總V.F.		
									平方米		平方米			
20		DMP-106	3mm厚鋁板	EC-DG-D334232-ZD1(閃粉古銅)	1	0	1	10.309	1.268	1.268	1.225	1.225		
21		DMP-113	3mm厚鋁板	EC-DG-D334232-ZD1(閃粉古銅)	1	0	1	11.956	1.471	1.471	1.419	1.419		
22		DMP-114	3mm厚鋁板	EC-DG-D334232-ZD1(閃粉古銅)	1	0	1	17.721	2.180	2.180	2.101	2.101		
23		DMP-115	3mm厚鋁板	EC-DG-D334232-ZD1(閃粉古銅)	1	0	1	11.544	1.420	1.420	1.371	1.371		
24		DMP-116	3mm厚鋁板	EC-DG-D334232-ZD1(閃粉古銅)	1	0	1	14.221	1.749	1.749	1.687	1.687		
25		DMP-121	3mm厚鋁板	EC-DG-D334232-ZD1(閃粉古銅)	3	0	3	43.527	1.785	5.354	1.721	5.163		
26		DMP-122	3mm厚鋁板	EC-DG-D334232-ZD1(閃粉古銅)	2	0	2	29.677	1.825	3.650	1.760	3.520		
27		DMP-123	3mm厚鋁板	EC-DG-D334232-ZD1(閃粉古銅)	1	0	1	14.880	1.830	1.830	1.765	1.765		
28		DMP-124	3mm厚鋁板	EC-DG-D334232-ZD1(閃粉古銅)	1	0	1	11.462	1.410	1.410	1.361	1.361		
29		DMP-126	3mm厚鋁板	EC-DG-D334232-ZD1(閃粉古銅)	1	0	1	14.015	1.724	1.724	1.663	1.663		
30		DMP-201	3mm厚鋁板	EC-DG-D334232-ZD1(閃粉古銅)	1	0	1	11.133	1.369	1.369	1.322	1.322		
31		DMP-205	3mm厚鋁板	EC-DG-D334232-ZD1(閃粉古銅)	1	0	1	14.427	1.775	1.775	1.711	1.711		
32		DMP-209	3mm厚鋁板	EC-DG-D334232-ZD1(閃粉古銅)	1	0	1	8.765	1.078	1.078	1.042	1.042		
33		DMP-210	3mm厚鋁板	EC-DG-D334232-ZD1(閃粉古銅)	1	0	1	8.353	1.027	1.027	0.994	0.994		
34		DMP-211	3mm厚鋁板	EC-DG-D334232-ZD1(閃粉古銅)	1	0	1	11.565	1.422	1.422	1.373	1.373		
35		DMP-212	3mm厚鋁板	EC-DG-D334232-ZD1(閃粉古銅)	1	0	1	11.565	1.422	1.422	1.373	1.373		
36		DMP-213	3mm厚鋁板	EC-DG-D334232-ZD1(閃粉古銅)	1	0	1	9.588	1.179	1.179	1.140	1.140		
37		DMP-214	3mm厚鋁板	EC-DG-D334232-ZD1(閃粉古銅)	1	0	1	8.765	1.078	1.078	1.042	1.042		
38		DMP-215	3mm厚鋁板	EC-DG-D334232-ZD1(閃粉古銅)	1	0	1	14.468	1.780	1.780	1.716	1.716		

	工程號: J-853	計算: HHQ	日期:	2022-12-27		送呈:胡哥
	地盤名稱: 延坪道住宅	核對: WLQ	日期:	2022-12-27		副本:
廠用鋁板B.M.表	項目類別: 幕牆	批准:	日期:			
BM編號:	修改版次:	A/C Code:	總V.F.:	176.10	總重量:	1481.10 此BM依據 資料計算

序號	修改內容	鋁板圖號	鋁板名稱	顏色	實用	後備	總數	總重量	展開面積		總V.F.		備註	
									單件展開面積	總展開面積	單件V.F.	總V.F.		
									平方米		平方米			
39		DMP-216	3mm厚鋁板	EC-DG-D334232-ZD1(閃粉古銅)	1	0	1	8.971	1.103	1.103	1.067	1.067		
40		DMP-217	3mm厚鋁板	EC-DG-D334232-ZD1(閃粉古銅)	1	0	1	17.412	2.142	2.142	2.064	2.064		
41		DMP-303	3mm厚鋁板	EC-DG-D334232-ZD1(閃粉古銅)	1	0	1	11.133	1.369	1.369	1.322	1.322		
42		DMP-308	3mm厚鋁板	EC-DG-D334232-ZD1(閃粉古銅)	1	0	1	14.633	1.800	1.800	1.736	1.736		
43		DMP-309	3mm厚鋁板	EC-DG-D334232-ZD1(閃粉古銅)	1	0	1	8.765	1.078	1.078	1.042	1.042		
44		DMP-310	3mm厚鋁板	EC-DG-D334232-ZD1(閃粉古銅)	1	0	1	9.588	1.179	1.179	1.140	1.140		
45		DMP-311	3mm厚鋁板	EC-DG-D334232-ZD1(閃粉古銅)	1	0	1	11.565	1.422	1.422	1.373	1.373		
46		DMP-312	3mm厚鋁板	EC-DG-D334232-ZD1(閃粉古銅)	1	0	1	11.565	1.422	1.422	1.373	1.373		
47		DMP-313	3mm厚鋁板	EC-DG-D334232-ZD1(閃粉古銅)	1	0	1	9.588	1.179	1.179	1.140	1.140		
48		DMP-314	3mm厚鋁板	EC-DG-D334232-ZD1(閃粉古銅)	1	0	1	9.177	1.129	1.129	1.091	1.091		
49		DMP-315	3mm厚鋁板	EC-DG-D334232-ZD1(閃粉古銅)	1	0	1	13.727	1.688	1.688	1.629	1.629		
50		DMP-316	3mm厚鋁板	EC-DG-D334232-ZD1(閃粉古銅)	1	0	1	8.765	1.078	1.078	1.042	1.042		
51		DMP-317	3mm厚鋁板	EC-DG-D334232-ZD1(閃粉古銅)	1	0	1	17.412	2.142	2.142	2.064	2.064		
52		DMP-508	3mm厚鋁板	EC-DG-D334232-ZD1(閃粉古銅)	1	0	1	7.015	0.863	0.863	0.836	0.836		
53		DMP-511	3mm厚鋁板	EC-DG-D334232-ZD1(閃粉古銅)	1	0	1	8.374	1.030	1.030	0.996	0.996		
54		DMP-513	3mm厚鋁板	EC-DG-D334232-ZD1(閃粉古銅)	1	0	1	15.662	1.926	1.926	1.857	1.857		
55		DMP-519	3mm厚鋁板	EC-DG-D334232-ZD1(閃粉古銅)	1	0	1	4.153	0.511	0.511	0.498	0.498		
56		DMP-521	3mm厚鋁板	EC-DG-D334232-ZD1(閃粉古銅)	1	0	1	13.006	1.600	1.600	1.544	1.544		
57		DMP-526	3mm厚鋁板	EC-DG-D334232-ZD1(閃粉古銅)	1	0	1	11.030	1.357	1.357	1.310	1.310		

	工程號: J-853	計算: HHQ	日期:	2022-12-27			送呈:胡哥
	地盤名稱: 延坪道住宅	核對: WLQ	日期:	2022-12-27			副本:
廠用鋁板B.M.表	項目類別: 幕牆	批准:	日期:				
BM編號:	修改版次:	A/C Code:	總V.F.:	176.10	總重量:	1481.10	此BM依據 資料計算

序號	修改內容	鋁板圖號	鋁板名稱	顏色	實用	後備	總數	總重量	展開面積		總V.F.		備註	
									單件展開面積	總展開面積	單件V.F.	總V.F.		
									平方米		平方米			
58		DMP-527	3mm厚鋁板	EC-DG-D334232-ZD1(閃粉古銅)	1	0	1	11.030	1.357	1.357	1.310	1.310		
59		DMP-528	3mm厚鋁板	EC-DG-D334232-ZD1(閃粉古銅)	1	0	1	11.030	1.357	1.357	1.310	1.310		
60		DMP-529	3mm厚鋁板	EC-DG-D334232-ZD1(閃粉古銅)	1	0	1	10.412	1.281	1.281	1.237	1.237		
61		DMP-530	3mm厚鋁板	EC-DG-D334232-ZD1(閃粉古銅)	1	0	1	14.633	1.800	1.800	1.736	1.736		
62		DMP-531	3mm厚鋁板	EC-DG-D334232-ZD1(閃粉古銅)	1	0	1	17.618	2.167	2.167	2.088	2.088		
63		DMP-532	3mm厚鋁板	EC-DG-D334232-ZD1(閃粉古銅)	1	0	1	10.268	1.263	1.263	1.220	1.220		
64		DMP-533	3mm厚鋁板	EC-DG-D334232-ZD1(閃粉古銅)	1	0	1	10.268	1.263	1.263	1.220	1.220		
65		DMP-534	3mm厚鋁板	EC-DG-D334232-ZD1(閃粉古銅)	1	0	1	7.138	0.878	0.878	0.850	0.850		
66		DMP-535	3mm厚鋁板	EC-DG-D334232-ZD1(閃粉古銅)	1	0	1	13.933	1.714	1.714	1.653	1.653		
67		DMP-536	3mm厚鋁板	EC-DG-D334232-ZD1(閃粉古銅)	1	0	1	13.933	1.714	1.714	1.653	1.653		
68		DMP-538	3mm厚鋁板	EC-DG-D334232-ZD1(閃粉古銅)	1	0	1	16.095	1.980	1.980	1.908	1.908		
69		DMP-539	3mm厚鋁板	EC-DG-D334232-ZD1(閃粉古銅)	1	0	1	4.565	0.561	0.561	0.546	0.546		
70		DMP-601	3mm厚鋁板	EC-DG-D334232-ZD1(閃粉古銅)	1	0	1	10.515	1.293	1.293	1.249	1.249		
71		DMP-602	3mm厚鋁板	EC-DG-D334232-ZD1(閃粉古銅)	1	0	1	10.103	1.243	1.243	1.201	1.201		
72		DMP-603	3mm厚鋁板	EC-DG-D334232-ZD1(閃粉古銅)	1	0	1	13.006	1.600	1.600	1.544	1.544		
73		DMP-604	3mm厚鋁板	EC-DG-D334232-ZD1(閃粉古銅)	1	0	1	13.006	1.600	1.600	1.544	1.544		
74		DMP-605	3mm厚鋁板	EC-DG-D334232-ZD1(閃粉古銅)	1	0	1	11.235	1.382	1.382	1.334	1.334		
75		DMP-606	3mm厚鋁板	EC-DG-D334232-ZD1(閃粉古銅)	1	0	1	10.618	1.306	1.306	1.261	1.261		
76		DMP-613	3mm厚鋁板	EC-DG-D334232-ZD1(閃粉古銅)	1	0	1	11.030	1.357	1.357	1.310	1.310		



美特鋁質有限公司
MIDI Aluminium Fabricator Ltd.

工程號 J-853 地盤 延坪道住宅

加工圖見：DMP-5

編號	長度	數量	N	A	M	B	分格	位置	座號	樓層
DMP-5	478	1	1 x 300	89	1 x 275	101.5	500	J853-SD-CW-4304	T3	26F
	478	1	1 x 300	89	1 x 275	101.5	500	J853-SD-CW-4305	T3	26F
	478	1	1 x 300	89	1 x 275	101.5	500	J853-SD-CW-4204	T2	26F
	478	1	1 x 300	89	1 x 275	101.5	500	J853-SD-CW-4205	T2	26F
	478	1	1 x 300	89	1 x 275	101.5	500	J853-SD-CW-4509	T5	26F
	578	1	1 x 300	139	1 x 300	139	600	J853-SD-CW-4103	T1	25F
	578	1	1 x 300	139	1 x 300	139	600	J853-SD-CW-4106	T1	25F
	578	1	1 x 300	139	1 x 300	139	600	J853-SD-CW-4205	T2	26F
	578	1	1 x 300	139	1 x 300	139	600	J853-SD-CW-4206	T2	26F
	578	1	1 x 300	139	1 x 300	139	600	J853-SD-CW-4206	T2	26F
DMP-6	578	1	1 x 300	139	1 x 300	139	600	J853-SD-CW-4206	T2	26F
	578	1	1 x 300	139	1 x 300	139	600	J853-SD-CW-4205	T2	26F
	578	1	1 x 300	139	1 x 300	139	600	J853-SD-CW-4304	T3	26F
	578	1	1 x 300	139	1 x 300	139	600	J853-SD-CW-4305	T3	26F
	578	1	1 x 300	139	1 x 300	139	600	J853-SD-CW-4306	T3	26F
	578	1	1 x 300	139	1 x 300	139	600	J853-SD-CW-4306	T3	26F
	578	1	1 x 300	139	1 x 300	139	600	J853-SD-CW-4306	T3	26F
	578	1	1 x 300	139	1 x 300	139	600	J853-SD-CW-4503	T5	26F
	578	1	1 x 300	139	1 x 300	139	600	J853-SD-CW-4504	T5	26F
	578	1	1 x 300	139	1 x 300	139	600	J853-SD-CW-4504	T5	26F
	578	1	1 x 300	139	1 x 300	139	600	J853-SD-CW-4506	T5	26F
	578	1	1 x 300	139	1 x 300	139	600	J853-SD-CW-4510	T5	26F
	578	1	1 x 300	139	1 x 300	139	600	J853-SD-CW-4506	T5	26F
	578	1	1 x 300	139	1 x 300	139	600	J853-SD-CW-4508	T5	26F
	578	1	1 x 300	139	1 x 300	139	600	J853-SD-CW-4508	T5	26F
	578	1	1 x 300	139	1 x 300	139	600	J853-SD-CW-4508	T5	26F
	578	1	1 x 300	139	1 x 300	139	600	J853-SD-CW-4508	T5	26F
	578	1	1 x 300	139	1 x 300	139	600	J853-SD-CW-4607	T6	26F
578	1	1 x 300	139	1 x 300	139	600	J853-SD-CW-4601	T6	26F	
578	1	1 x 300	139	1 x 300	139	600	J853-SD-CW-4602A	T6	26F	
578	1	1 x 300	139	1 x 300	139	600	J853-SD-CW-4606	T6	26F	
578	1	1 x 300	139	1 x 300	139	600	J853-SD-CW-4606	T6	26F	
578	1	1 x 300	139	1 x 300	139	600	J853-SD-CW-4609	T7	26F	
578	1	1 x 300	139	1 x 300	139	600	J853-SD-CW-4603	T7	26F	
578	1	1 x 300	139	1 x 300	139	600	J853-SD-CW-4603	T7	26F	
578	1	1 x 300	139	1 x 300	139	600	J853-SD-CW-4603	T7	26F	
578	1	1 x 300	139	1 x 300	139	600	J853-SD-CW-4609	T7	26F	
578	1	1 x 300	139	1 x 300	139	600	J853-SD-CW-4609	T7	26F	
578	1	1 x 300	139	1 x 300	139	600	J853-SD-CW-4609	T7	26F	
578	1	1 x 300	139	1 x 300	139	600	J853-SD-CW-4609	T7	26F	
名稱	鋁板欄		制圖	黃漢卿	2022.12.27	修改				
材料	3mm鋁/X86271		復核	王禮秋	2022.12.27	日期				
顏色	EC-DG-D334232-ZD1(閃古銅)		批准	胡哥		圖號	DMP-5-1			



美特鋁質有限公司
MIDI Aluminium Fabricator Ltd.

工程號 J-853 地盤 延坪道住宅

加工圖見：DMP-5

編號	長度	數量	N	A	M	B	分格	位置	座號	樓層
DMP-10	628	1	1 x 300	164	1 x 300	164	650	J853-SD-CW-4104	T1	25F
	628	1	1 x 300	164	1 x 300	164	650	J853-SD-CW-4104	T1	25F
	628	1	1 x 300	164	1 x 300	164	650	J853-SD-CW-4206	T2	26F
	628	1	1 x 300	164	1 x 300	164	650	J853-SD-CW-4206	T2	26F
DMP-12	678	1	1 x 300	164	1 x 300	164	650	J853-SD-CW-4306	T3	26F
	678	1	1 x 300	164	1 x 300	164	650	J853-SD-CW-4306	T3	26F
	678	1	1 x 300	164	1 x 300	164	650	J853-SD-CW-4601	T6	26F
	678	1	1 x 300	164	1 x 300	164	650	J853-SD-CW-4602A	T6	26F
DMP-13	978	2	3 x 250	114	3 x 250	114	1000	J853-SD-CW-4105	T1	25F
	978	2	3 x 250	114	3 x 250	114	1000	J853-SD-CW-4105	T1	25F
	978	1	3 x 250	114	3 x 250	114	1000	J853-SD-CW-4106	T1	25F
	978	1	3 x 250	114	3 x 250	114	1000	J853-SD-CW-4106	T1	25F
DMP-16	695.5	1	2 x 250	97.75	1 x 300	197.75	717.5	J853-SD-CW-4204A	T2	26F
	695.5	1	2 x 250	97.75	1 x 300	197.75	717.5	J853-SD-CW-4304A	T3	26F
	695.5	1	2 x 250	97.75	1 x 300	197.75	717.5	J853-SD-CW-4204A	T2	26F
	695.5	1	2 x 250	97.75	1 x 300	197.75	717.5	J853-SD-CW-4304A	T3	26F
DMP-17	965.5	1	3 x 250	107.8	3 x 250	107.75	987.5	J853-SD-CW-4509	T5	26F
	728	1	2 x 250	114	2 x 250	114	750	J853-SD-CW-4202	T2	26F
	728	1	2 x 250	114	2 x 250	114	750	J853-SD-CW-4202	T2	26F
	728	1	2 x 250	114	2 x 250	114	750	J853-SD-CW-4202	T2	26F
DMP-18	728	1	2 x 250	114	2 x 250	114	750	J853-SD-CW-4303	T3	26F
	728	1	2 x 250	114	2 x 250	114	750	J853-SD-CW-4303	T3	26F
	728	1	2 x 250	114	2 x 250	114	750	J853-SD-CW-4303	T3	26F
	728	1	2 x 250	114	2 x 250	114	750	J853-SD-CW-4303	T3	26F
DMP-18a	1078	1	3 x 300	89	3 x 275	126.5	1100	J853-SD-CW-4509	T5	26F
	620.5	1	2 x 200	110.3	2 x 200	110.25	642.5	J853-SD-CW-4602	T6	26F
	620.5	1	2 x 200	110.3	2 x 200	110.25	642.5	J853-SD-CW-4602	T6	26F
	620.5	1	2 x 200	110.3	2 x 200	110.25	642.5	J853-SD-CW-4603	T7	26F
DMP-20	778	1	2 x 300	89	2 x 275	114	800	J853-SD-CW-4505	T5	26F
	1028	1	3 x 250	139	3 x 250	139	1050	J853-SD-CW-4602	T6	26F
	1028	1	3 x 250	139	3 x 250	139	1050	J853-SD-CW-4602	T6	26F
DMP-21	1028	1	3 x 250	139	3 x 250	139	1050	J853-SD-CW-4602	T6	26F
	1028	1	3 x 250	139	3 x 250	139	1050	J853-SD-CW-4603	T7	26F
	1028	1	3 x 250	139	3 x 250	139	1050	J853-SD-CW-4603	T7	26F
DMP-25a	943	1	2 x 300	171.5	2 x 300	171.5	965	J853-SD-CW-4106	T1	25F
	1203	1	3 x 300	151.5	3 x 300	151.5	1225	J853-SD-CW-4302	T3	26F
DMP-25c	843	1	2 x 300	121.5	2 x 300	121.5	865	J853-SD-CW-4509	T5	26F

名稱	鋁板欄	制圖	黃漢卿	2022.12.27	修改	
材料	3mm鋁/X86271	復核	王禮秋	2022.12.27	日期	
顏色	EC-DG-D334232-ZD1(粉古銅)	批准	胡哥		圖號	DMP-5-2



美特鋁質 有限公司
MIDI Aluminium Fabricator Ltd.

加工圖見：DMP-5

工程號 J-853 地盤 延坪道住宅

編號	長度	數量	N	A	M	B	分格	位置	座號	樓層
DMP-26	878	1	2	x 300	139	2	x 300	J853-SD-CW-4102	T1	25F
	878	1	2	x 300	139	2	x 300	J853-SD-CW-4102	T1	25F
	878	1	2	x 300	139	2	x 300	J853-SD-CW-4505	T5	26F
DMP-30	878	1	2	x 300	139	2	x 300	J853-SD-CW-4609	T7	26F
	928	1	2	x 300	164	2	x 300	J853-SD-CW-4204A	T2	26F
	928	1	2	x 300	164	2	x 300	J853-SD-CW-4204A	T2	26F
DMP-50	928	1	2	x 300	164	2	x 300	J853-SD-CW-4304A	T3	26F
	1178	1	3	x 300	139	3	x 300	J853-SD-CW-4201	T2	26F
	1178	1	3	x 300	139	3	x 300	J853-SD-CW-4508	T5	26F
DMP-105	1178	1	3	x 300	139	3	x 300	J853-SD-CW-4607	T6	26F
	1178	1	3	x 300	139	3	x 300	J853-SD-CW-4606	T6	26F
	1178	1	3	x 300	139	3	x 300	J853-SD-CW-4102	T1	25F
DMP-106	1078	1	3	x 300	89	3	x 275	J853-SD-CW-4104	T1	25F
	1278	1	4	x 250	139	4	x 250	J853-SD-CW-4104	T1	25F
	1978	1	6	x 300	89	6	x 275	J853-SD-CW-4104	T1	25F
DMP-115	1228	1	3	x 300	164	3	x 300	J853-SD-CW-4104	T1	25F
	1553	1	4	x 300	176.5	4	x 300	J853-SD-CW-4104	T1	25F
	1588	3	5	x 250	169	5	x 250	J853-SD-CW-4105	T1	25F
DMP-122	1628	2	5	x 250	189	5	x 250	J853-SD-CW-4105	T1	25F
	1633	1	5	x 250	191.5	5	x 250	J853-SD-CW-4105	T1	25F
	1218	1	3	x 300	159	3	x 300	J853-SD-CW-4106	T1	25F
DMP-126	1528	1	4	x 300	164	4	x 300	J853-SD-CW-4106	T1	25F
	1178	1	3	x 300	139	3	x 300	J853-SD-CW-4201	T2	26F
	1578	1	4	x 300	189	4	x 300	J853-SD-CW-4202	T2	26F
DMP-209	890.5	1	2	x 300	145.3	2	x 300	J853-SD-CW-4204	T2	26F
	840.5	1	2	x 300	120.3	2	x 300	J853-SD-CW-4204	T2	26F
	1230.5	1	3	x 300	165.3	3	x 300	J853-SD-CW-4204A	T2	26F
DMP-212	1230.5	1	3	x 300	165.3	3	x 300	J853-SD-CW-4204A	T2	26F
	990.5	1	3	x 250	120.3	3	x 250	J853-SD-CW-4205	T2	26F
	890.5	1	2	x 300	145.3	2	x 300	J853-SD-CW-4205	T2	26F
DMP-215	1583	1	5	x 250	166.5	5	x 250	J853-SD-CW-4206	T2	26F
	915.5	1	2	x 300	157.8	2	x 300	J853-SD-CW-4206	T2	26F
	1940.5	1	7	x 250	95.25	7	x 250	J853-SD-CW-4206	T2	26F
DMP-303	1178	1	3	x 300	139	3	x 300	J853-SD-CW-4302	T3	26F
	1603	1	5	x 250	176.5	5	x 250	J853-SD-CW-4303	T3	26F
	890.5	1	2	x 300	145.3	2	x 300	J853-SD-CW-4304	T3	26F
DMP-310	990.5	1	3	x 250	120.3	3	x 250	J853-SD-CW-4304	T3	26F
	1230.5	1	3	x 300	165.3	3	x 300	J853-SD-CW-4304A	T3	26F
	1230.5	1	3	x 300	165.3	3	x 300	J853-SD-CW-4304A	T3	26F

名稱	鋁板欄	制圖	黃漢卿	2022.12.27	修改	
材料	3mm鋁/X86271	復核	王禮秋	2022.12.27	日期	
顏色	EC-DG-D334232-ZD1(閃古銅)	批准	胡哥		圖號	DMP-5-3



美特鋁質 有限公司
MIDI Aluminium Fabricator Ltd.


加工圖見：DMP-5

工程號 J-853 地盤 延坪道住宅



編號	長度	數量	N	A	M	B	規格	位置	座號	樓層	
DMP-313	990.5	1	3	x 250	3	x 120.25	1013	J853-SD-CW-4305	T3	26F	
DMP-314	940.5	1	2	x 300	2	x 170.25	962.5	J853-SD-CW-4305	T3	26F	
DMP-315	1493	1	4	x 300	4	x 146.5	1515	J853-SD-CW-4306	T3	26F	
DMP-316	890.5	1	2	x 300	2	x 145.25	912.5	J853-SD-CW-4306	T3	26F	
DMP-317	1940.5	1	7	x 250	7	x 95.25	1963	J853-SD-CW-4306	T3	26F	
DMP-508	678	1	2	x 250	1	x 300	189	J853-SD-CW-4503	T5	26F	
DMP-511	843	1	2	x 300	2	x 121.5	865	J853-SD-CW-4504	T5	26F	
DMP-513	1728	1	5	x 300	5	x 114	1750	J853-SD-CW-4505	T5	26F	
DMP-519	330.5	1	1	x 150	1	x 90.25	352.5	J853-SD-CW-4506	T5	26F	
DMP-521	1405.5	1	4	x 300	4	x 102.75	1428	J853-SD-CW-4506	T5	26F	
DMP-526	1165.5	1	3	x 300	3	x 132.75	1188	J853-SD-CW-4508	T5	26F	
DMP-527	1165.5	1	3	x 300	3	x 132.75	1188	J853-SD-CW-4508	T5	26F	
DMP-528	1165.5	1	3	x 300	3	x 132.75	1188	J853-SD-CW-4508	T5	26F	
DMP-529	1090.5	1	3	x 300	3	x 95.25	1113	J853-SD-CW-4508	T5	26F	
DMP-530	1603	1	5	x 250	5	x 176.5	1625	J853-SD-CW-4509	T5	26F	
DMP-531	1965.5	1	6	x 300	6	x 275	1988	J853-SD-CW-4509	T5	26F	
DMP-532	1073	1	3	x 300	3	x 275	1095	J853-SD-CW-4509	T5	26F	
DMP-533	1073	1	3	x 300	3	x 275	1095	J853-SD-CW-4509	T5	26F	
DMP-534	693	1	2	x 250	2	x 96.5	715	J853-SD-CW-4509	T5	26F	
DMP-535	1518	1	4	x 300	4	x 159	1540	J853-SD-CW-4510	T5	26F	
DMP-536	1518	1	4	x 300	4	x 159	1540	J853-SD-CW-4510	T5	26F	
DMP-538	1780.5	1	5	x 300	5	x 140.25	1803	J853-SD-CW-4506	T5	26F	
DMP-539	380.5	1	1	x 200	1	x 180	100.25	402.5	J853-SD-CW-4506	T5	26F
DMP-601	1103	1	3	x 300	3	x 101.5	1125	J853-SD-CW-4601	T6	26F	
DMP-602	1053	1	3	x 250	3	x 151.5	1075	J853-SD-CW-4601	T6	26F	
DMP-603	1405.5	1	4	x 300	4	x 102.75	1428	J853-SD-CW-4602	T6	26F	
DMP-604	1405.5	1	4	x 300	4	x 102.75	1428	J853-SD-CW-4602	T6	26F	
DMP-605	1190.5	1	3	x 300	3	x 145.25	1213	J853-SD-CW-4602A	T6	26F	
DMP-606	1115.5	1	3	x 300	3	x 107.75	1138	J853-SD-CW-4602A	T6	26F	
DMP-613	1165.5	1	3	x 300	3	x 132.75	1188	J853-SD-CW-4606	T6	26F	
DMP-614	1190.5	1	3	x 300	3	x 145.25	1213	J853-SD-CW-4606	T6	26F	
DMP-615	703	1	2	x 250	2	x 101.5	725	J853-SD-CW-4607	T6	26F	
DMP-607	1080.5	1	3	x 300	3	x 275	1103	J853-SD-CW-4603	T7	26F	
DMP-608	1265.5	1	4	x 250	4	x 132.75	1288	J853-SD-CW-4603	T7	26F	
DMP-609	1540.5	1	4	x 300	4	x 170.25	1563	J853-SD-CW-4603	T7	26F	
DMP-616	680.5	1	1	x 300	1	x 190.25	702.5	J853-SD-CW-4608	T7	26F	
DMP-618	1465.5	1	4	x 300	4	x 132.75	1488	J853-SD-CW-4608	T7	26F	
DMP-621	878	1	2	x 300	2	x 139	900	J853-SD-CW-4609	T7	26F	
DMP-622	1163	1	3	x 300	3	x 131.5	1185	J853-SD-CW-4609	T7	26F	
DMP-623	1993	1	6	x 300	6	x 96.5	2015	J853-SD-CW-4609	T7	26F	

名稱	鋁板欄	制圖	黃漢卿	2022.12.27	修改	
材料	3mm鋁/X86271	復核	王禮秋	2022.12.27	日期	
顏色	EC-DG-D334232-ZD1(粉古銅)	批准	胡哥		圖號	DMP-5-4

LEGEND :
R.S. = RESTRAINT SOCKET

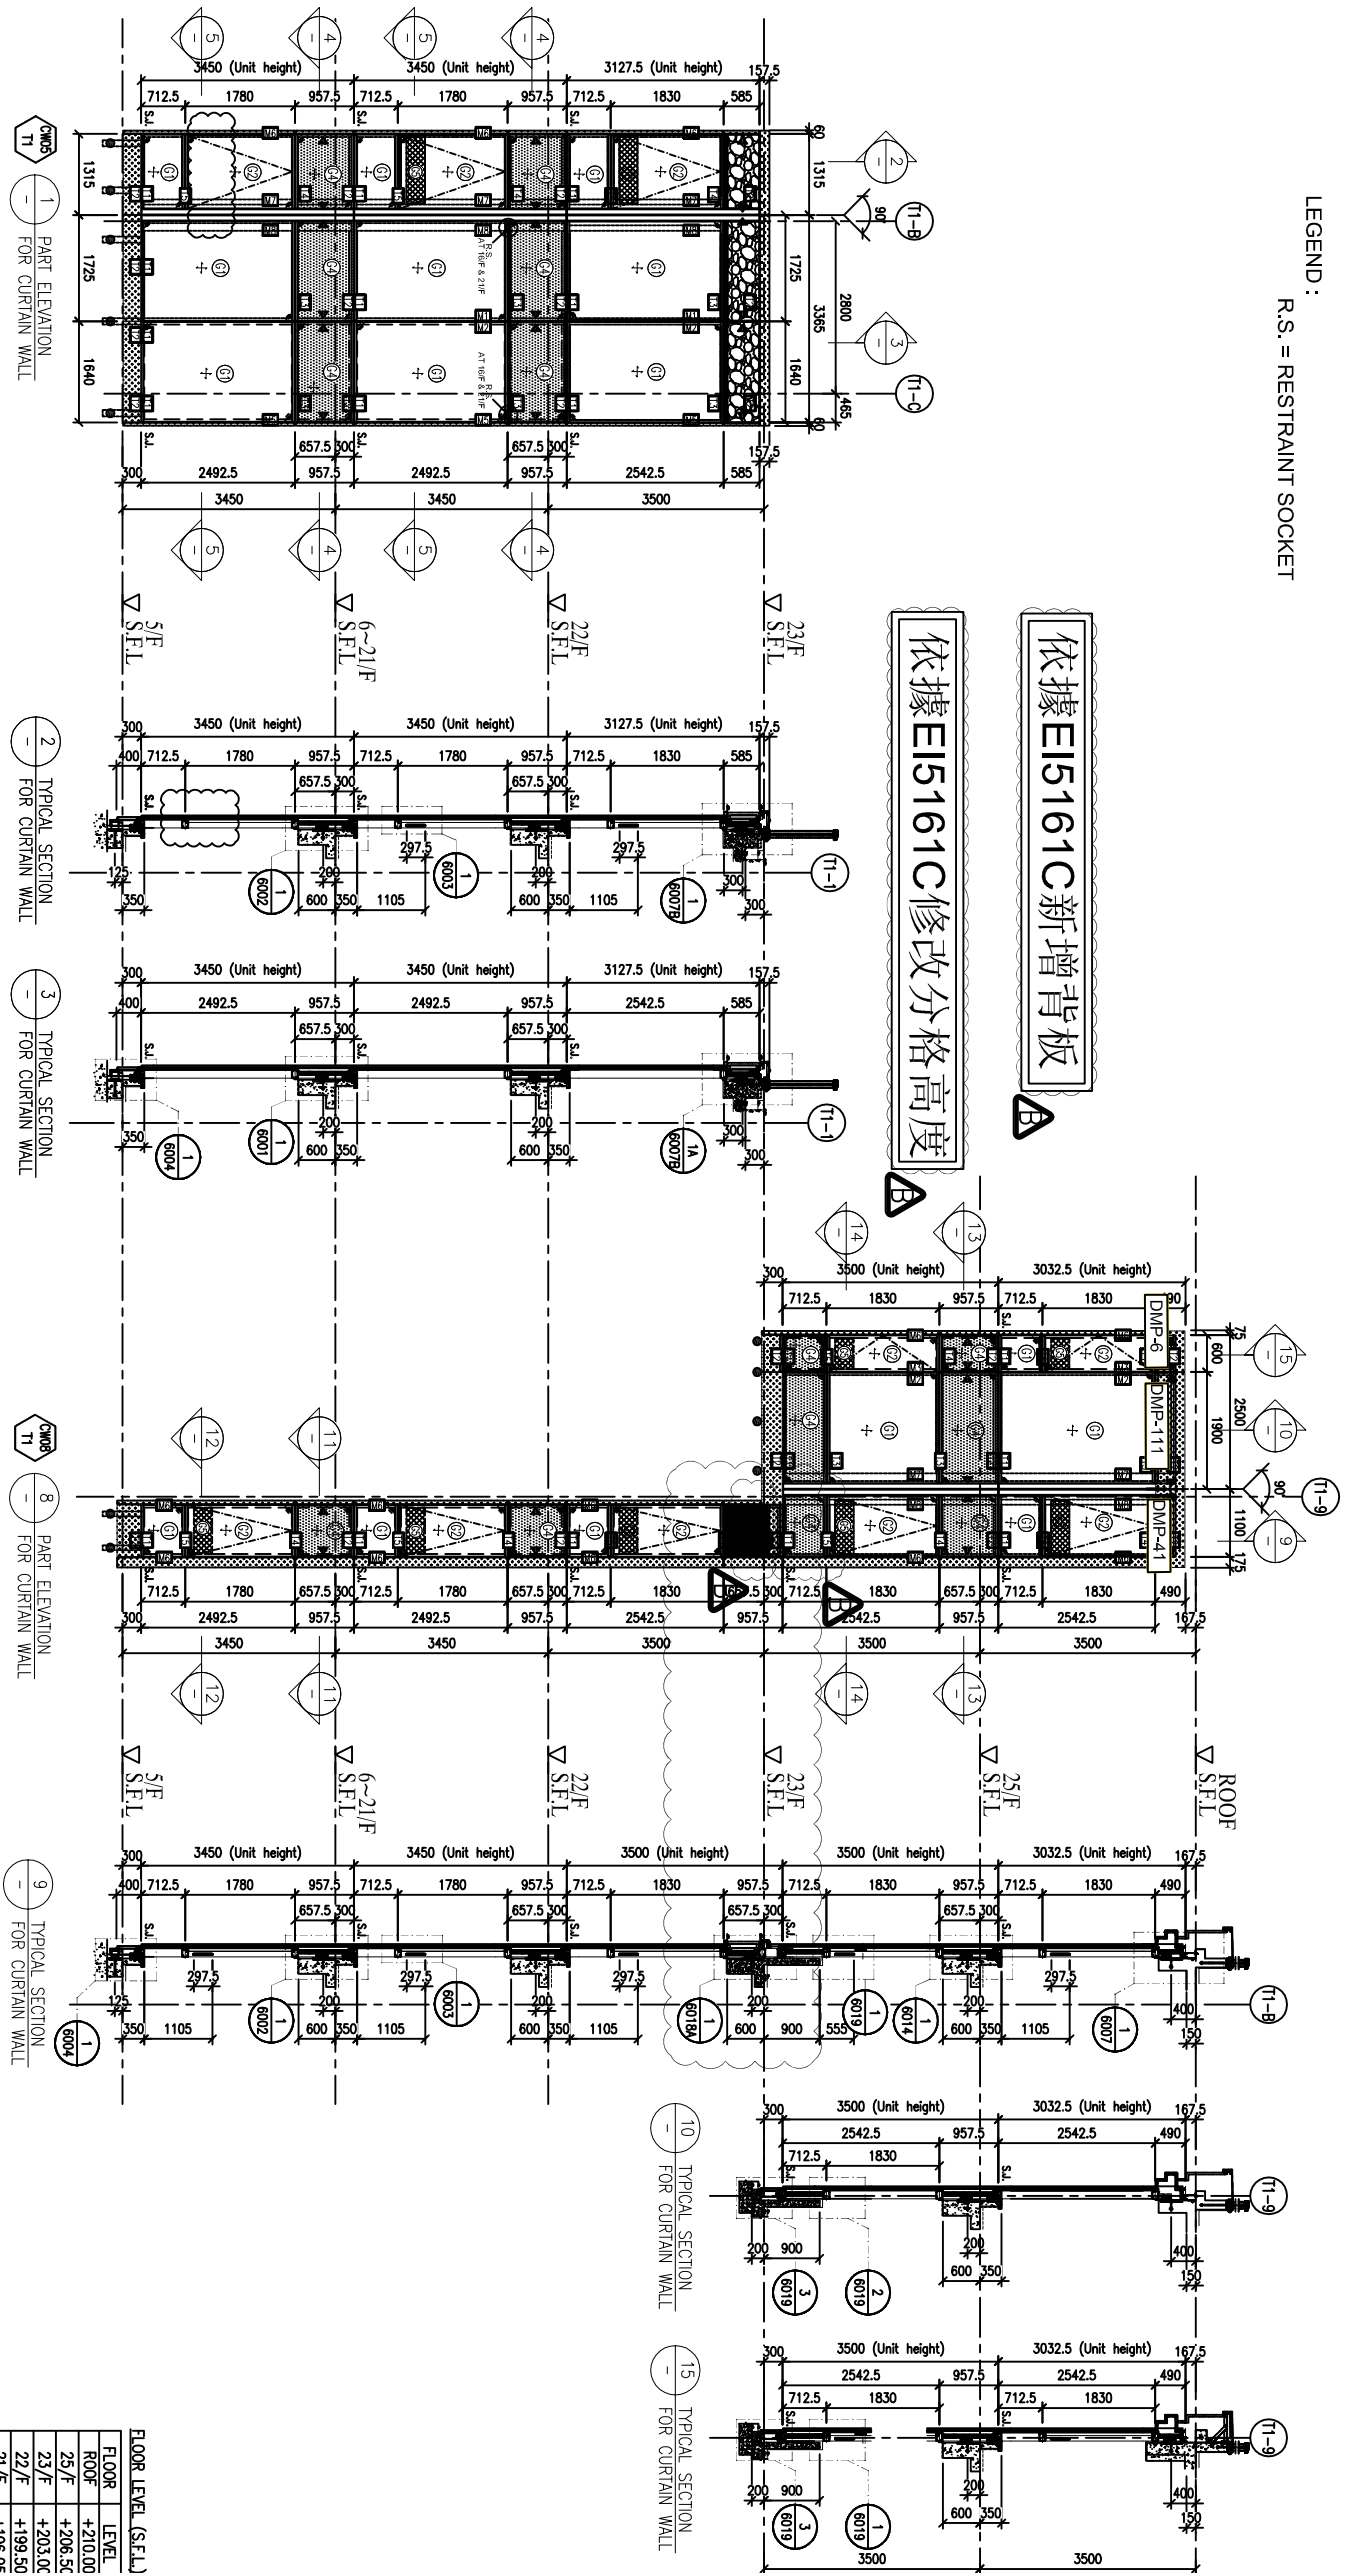

依據 EI5161C 新增背板
依據 EI5161C 修改格高度

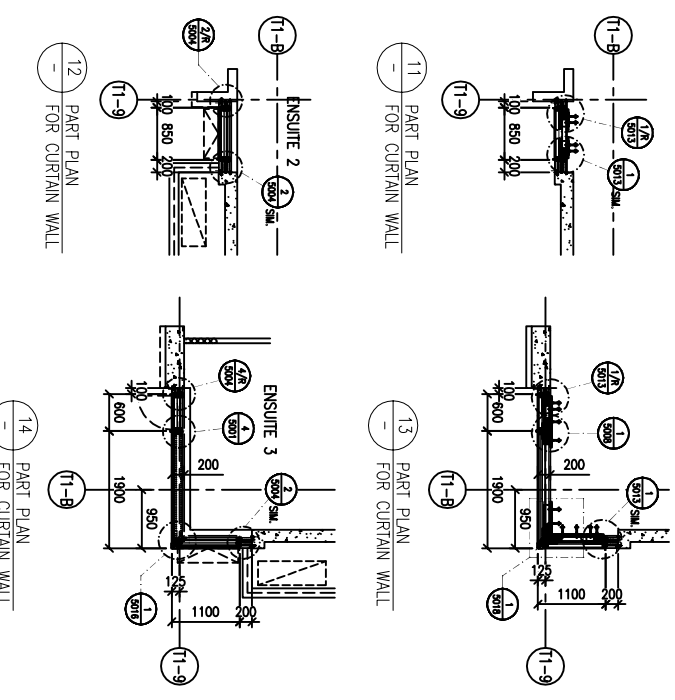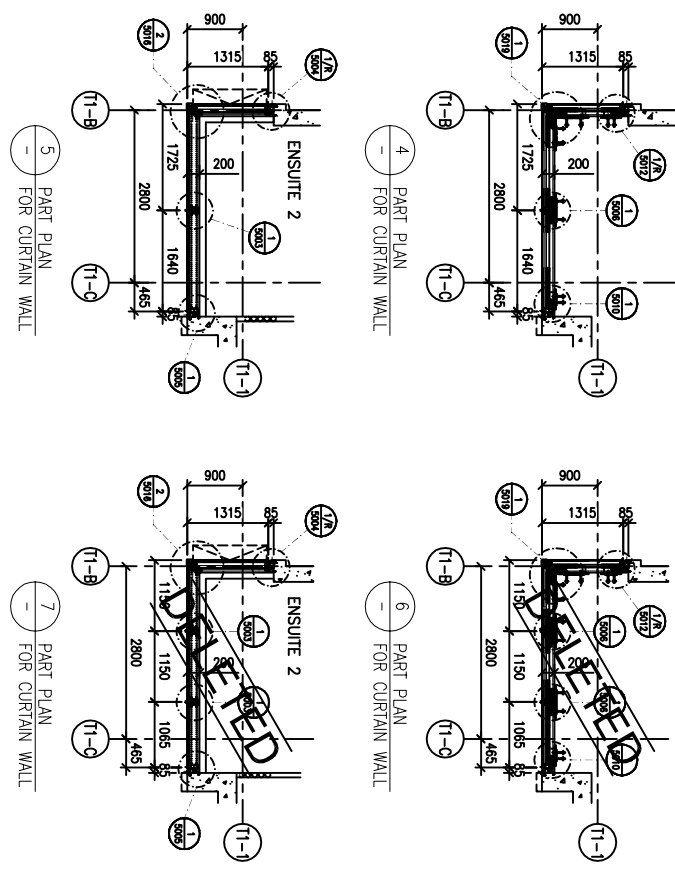

LEGEND:

- STONE CLADDING (BY OTHERS)
- 10mm HEAT STRENGTHENED GLASS (OUTER)
- 12mm HEAT STRENGTHENED GLASS (INNER)
- 10mm HEAT STRENGTHENED GLASS (OUTER) + 12mm AIR SPACE + 12mm THK. TEMPERED CLEAR GLASS (INNER)
- 10mm HEAT STRENGTHENED GLASS (INNER) + 12mm AIR SPACE + 10mm THK. TEMPERED CLEAR GLASS (INNER)
- 12mm THK. HEAT STRENGTHENED GLASS (SPANDREL GLASS)
- 2mm THK. ALUM. BACKPAN (SPANDREL GLASS) (INTERNAL PROTECTIVE BARRIER)
- 3mm THK. ALUM. CLADDING
- S.J. - STACK JOINT (WIND LOAD)
- ALUM. EXTRUSION DIE NO.
- SUPPORT POINT (WIND LOAD + DEAD LOAD)
- SUPPORT POINT (WIND LOAD)

FLOOR LEVEL (S.F.L.)

FLOOR	LEVEL
ROOF	+210.00
25/F	+206.50
23/F	+203.00
22/F	+199.50
21/F	+196.05
20/F	+192.60
19/F	+189.15
18/F	+185.70
17/F	+182.25
16/F	+178.80
15/F	+175.35
12/F	+171.90
11/F	+168.45
10/F	+165.00
9/F	+161.55
8/F	+158.10
7/F	+154.65
6/F	+151.20
5/F	+147.75

NOTE:
1. ALL DIMENSIONS ARE IN mm.
2. ALL ELEVATIONS ARE VIEWED FROM OUTSIDE.
3. ALL DIMENSIONS TO BE VERIFIED ON SITE BEFORE FABRICATION.

LEGEND:
 DETAIL MARK NO.
 REFER SHEET NO.
 1. F.F.L. -- FINISHED FLOOR LEVEL
 2. S.F.L. -- STRUCTURAL FLOOR LEVEL
 3. -- REVERSED DETAIL

B.D. REF :

CLIENT : SHIMAO GROUP HOLDINGS LIMITED

ARCHITECT : TUNG TUNG & PARTNERS LIMITED ARCHITECTS & PLANNERS

MAIN CONTRACTOR : 協興建築有限公司 HIP HING CONSTRUCTION CO LTD

STRUCTURAL ENGINEER : C M WONG & ASSOCIATES LTD 黃志明建築工程師有限公司

FAÇADE CONSULTANT: MENHARDT

PROJECT : PROPOSED RESIDENTIAL DEVELOPMENT AT N.K.I.L. 6542 YIN PING ROAD KOWLOON

JOB NO. : J-853

DATE : 02-10-2021

REVISION SUBJECT TO ARCH. COMMENT

REV. : B

TITLE : PART ELEVATION FOR CURTAIN WALL AT TOWER 1

DATE : 18-MAR-21

SCALE : 1:60 (A1)

DRAWN BY : LHR

CHECKED BY :

UNIT 6-8, Sunray Industrial Centre, 1/F
610 Che Kwo Ling Road, Kowloon
Tel: 23489211-4 Fax: (852) 27277866

REV. : B

B.D. REF :

CLIENT :
SHIMAO GROUP HOLDINGS LIMITED

ARCHITECT :
WONG TUNG & PARTNERS LIMITED ARCHITECTS & PLANNERS

MAIN CONTRACTOR :
協興建築有限公司 HIP HING CONSTRUCTION CO LTD

STRUCTURAL ENGINEER :
ICMA C M WONG & ASSOCIATES LTD 黃志明建築工程師有限公司

FAÇADE CONSULTANT :
MEINHARDT



NOTE :
 1. ALL DIMENSIONS ARE IN mm.
 2. ALL ELEVATIONS ARE VIEWED FROM OUTSIDE.
 3. ALL DIMENSIONS TO BE VERIFIED ON SITE BEFORE FABRICATION.

LEGEND :
 (X1) DETAIL MARK NO. REFER SHEET NO.
 (X00) REFER SHEET NO.
 1. F.F.L. -- FINISHED FLOOR LEVEL
 2. S.F.L. -- STRUCTURAL FLOOR LEVEL
 3. (R) -- REVERSED DETAIL

FLOOR	LEVEL (S.F.L.)
ROOF	+210.00
25/F	+206.50
22/F	+203.00
21/F	+199.05
20/F	+192.60
19/F	+189.15
18/F	+182.25
17/F	+185.70
16/F	+178.80
15/F	+175.35
12/F	+171.90
11/F	+168.45
10/F	+165.00
9/F	+161.55
8/F	+158.10
7/F	+154.65
6/F	+151.20
5/F	+147.75

JOB NO. : J-853
 PROJECT : PROPOSED RESIDENTIAL DEVELOPMENT AT N.K.I.L. 6542 YIN PING ROAD KOWLOON
 TITLE : PART ELEVATION FOR CURTAIN WALL AT TOWER 1
 DATE : 18-MAR-21 SCALE : 1:60 (A1)
 DRAWN BY : LHR CHECKED BY :
美特銘實有限公司 MIDY ARCHITECTURE ENGINEERS LTD.
 Units 6-8, Sunny Industrial Centre, 1/F
 610 Cheung Kwo Ling Road, Kowloon
 Tel: 23489211-4 Fax: (852) 27277866
 DWG NO. : JB53-SD-CW-4104 REV. : B

LEGEND :
 R.S. = RESTRAINT SOCKET

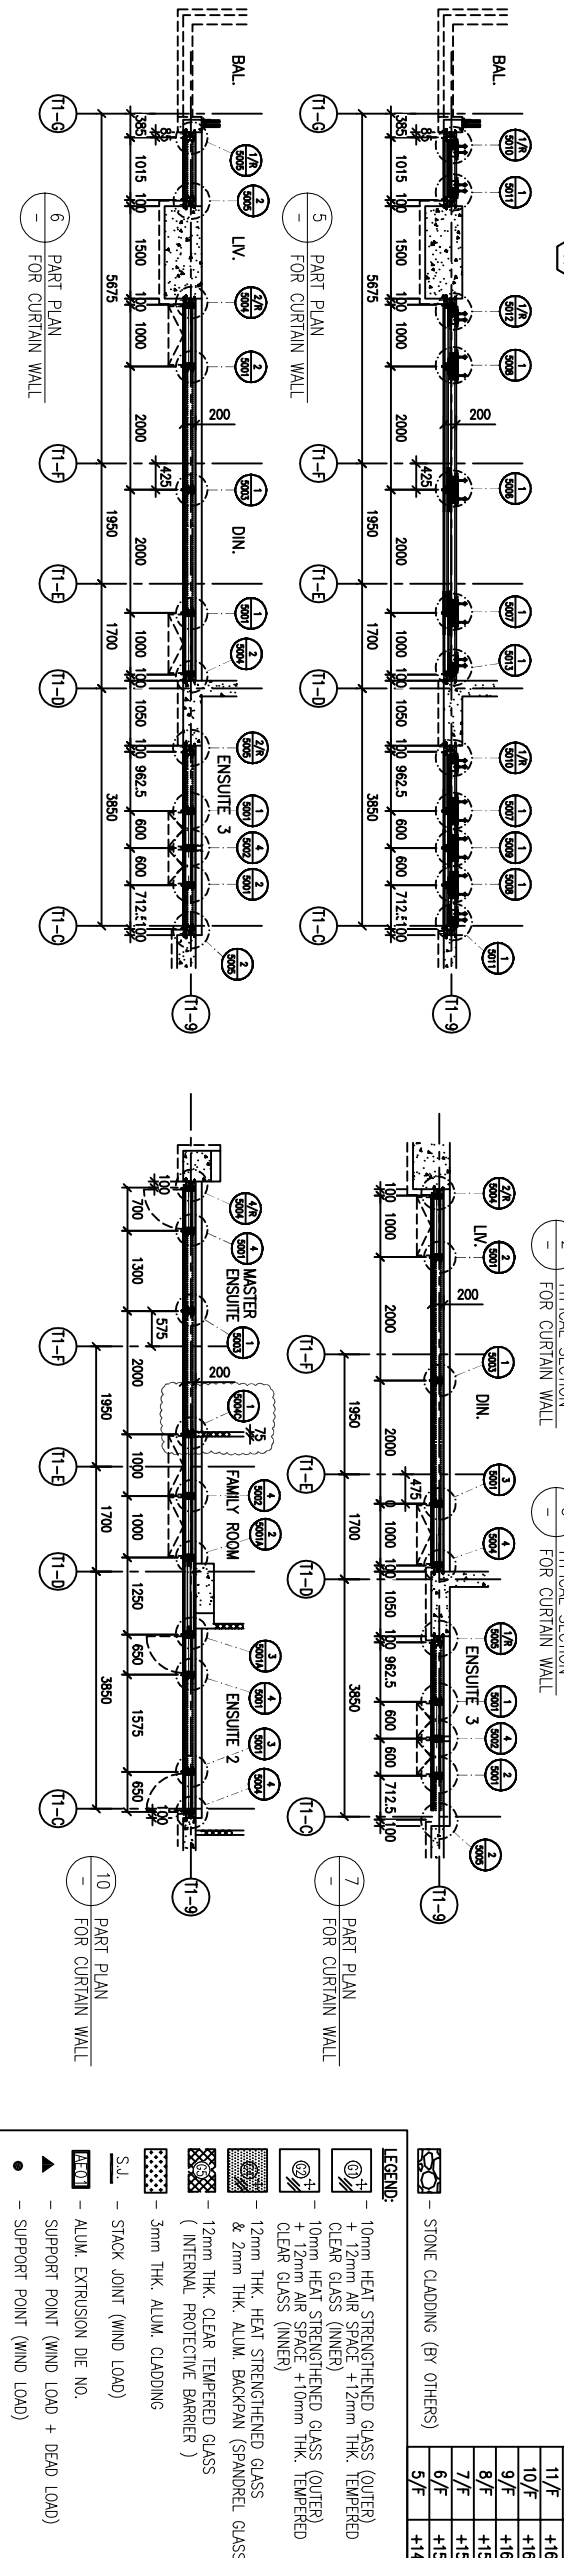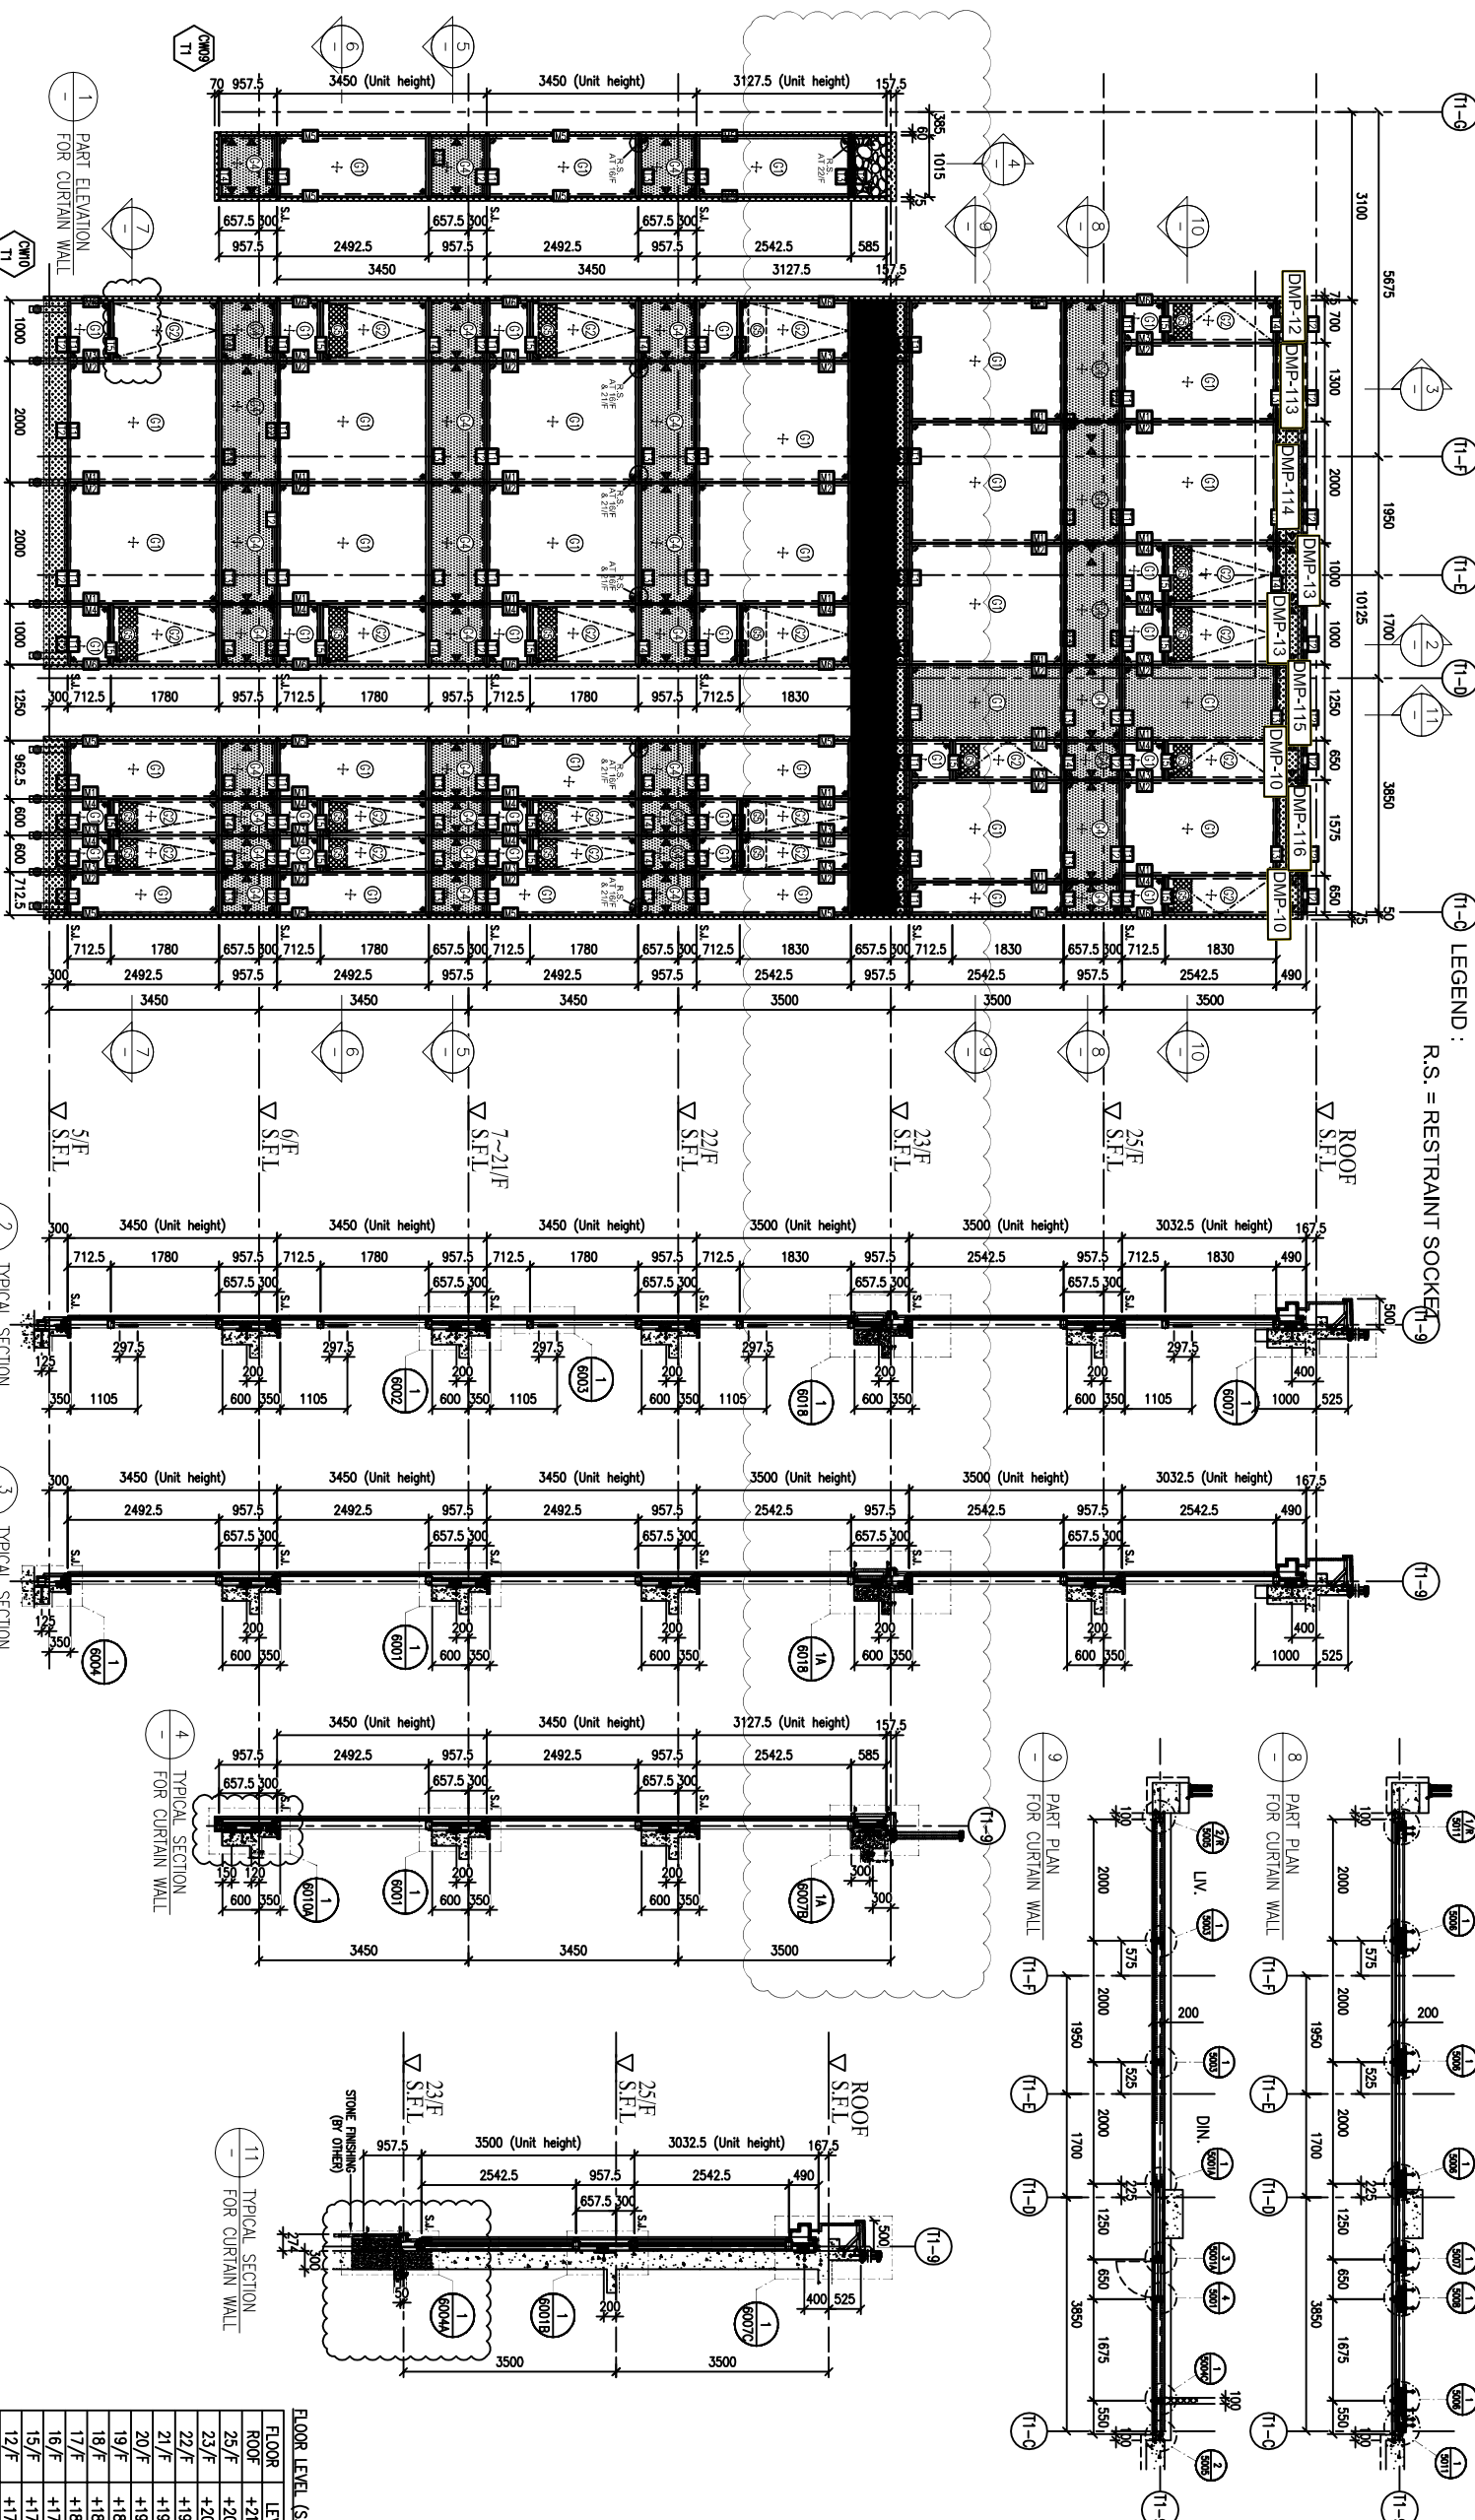

B.D. REF :

CLIENT :
SHIMAO GROUP
HOLDINGS LIMITED

ARCHITECT :
WONG TUNG & PARTNERS LIMITED
ARCHITECTS & PLANNERS



MAIN CONTRACTOR :
協興建築有限公司
HIP HING CONSTRUCTION CO LTD




STRUCTURAL ENGINEER :


ICMA C M WONG & ASSOCIATES LTD
黃志明建築工程師有限公司

FAÇADE CONSULTANT:



NOTE :
1. ALL DIMENSIONS ARE IN mm.
2. ALL ELEVATIONS ARE VIEWED FROM OUTSIDE.
3. ALL DIMENSIONS TO BE VERIFIED ON SITE BEFORE FABRICATION.

 LEGEND :
 DETAIL MARK NO.
 REFER SHEET NO.
 1. F.F.L.--FINISHED FLOOR LEVEL
 2. S.F.L.--STRUCTURAL FLOOR LEVEL
 3.  --REVERSED DETAIL

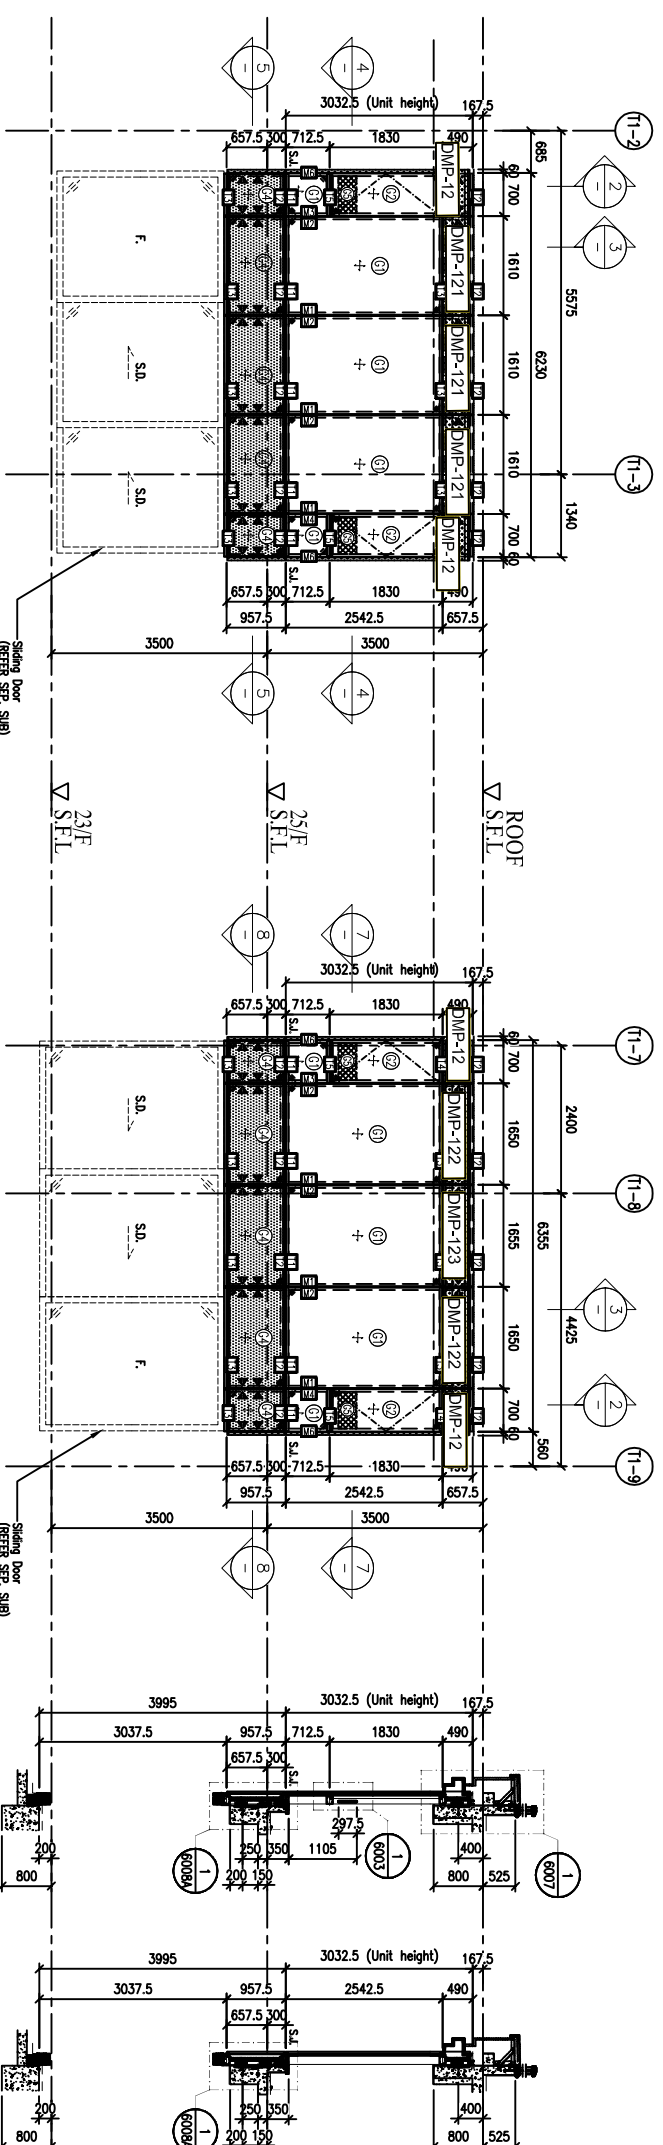


1 PART ELEVATION FOR CURTAIN WALL


6 PART ELEVATION FOR CURTAIN WALL

2 TYPICAL SECTION FOR CURTAIN WALL


3 TYPICAL SECTION FOR CURTAIN WALL

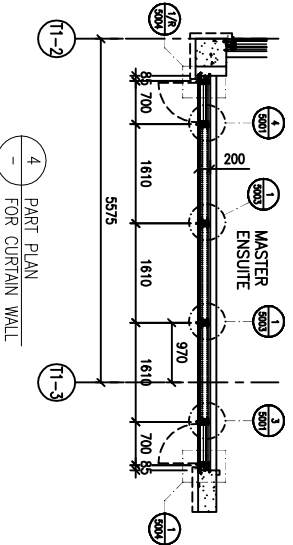


4 PART PLAN FOR CURTAIN WALL

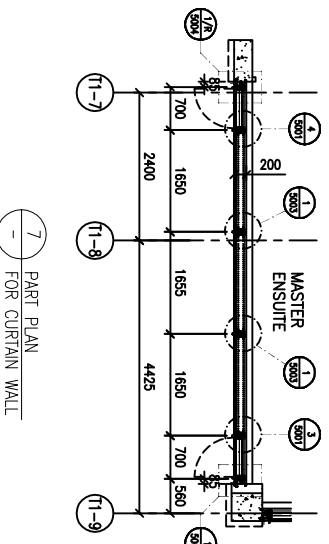

7 PART PLAN FOR CURTAIN WALL

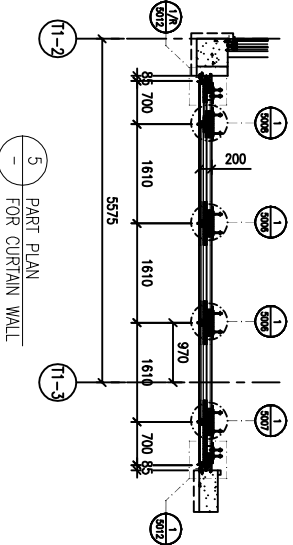


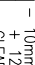
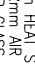
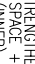
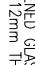
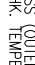

 

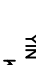
5 PART PLAN FOR CURTAIN WALL

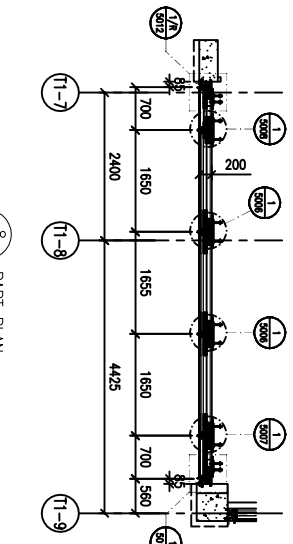

8 PART PLAN FOR CURTAIN WALL

FLOOR LEVEL (S.F.L.)	
FLOOR	LEVEL
ROOF	+210.00
25/F	+206.50
23/F	+203.00

LEGEND:

-  10mm HEAT STRENGTHENED GLASS (OUTER)
-  12mm HEAT STRENGTHENED GLASS (INNER)
-  10mm HEAT STRENGTHENED GLASS (OUTER) + 12mm AIR SPACE + 12mm THK. TEMPERED CLEAR GLASS (INNER)
-  12mm HEAT STRENGTHENED GLASS (INNER) + 12mm AIR SPACE + 10mm THK. TEMPERED CLEAR GLASS (INNER)
-  12mm THK. HEAT STRENGTHENED GLASS & 2mm THK. ALUM. BACKPAN (SPANDREL GLASS) (INTERNAL PROTECTIVE BARRIER)
-  3mm THK. ALUM. CLADDING
-  S.J. -- STACK JOINT (WIND LOAD)
-  ALUM. EXTRUSION DIE NO.
-  SUPPORT POINT (WIND LOAD + DEAD LOAD)
-  SUPPORT POINT (WIND LOAD)

TITLE :
PART ELEVATION
FOR CURTAIN WALL
AT TOWER 1

DATE : 02-OCT-21 SCALE : 1:60 (A1)

DRAWN BY : LHR CHECKED BY :

美特鋁質有限公司
MIDI Aluminium Fabricators Ltd.
Units 6-8, Sunny Industrial Centre, 1/F
610 Che Kwo Ling Road, Kowloon
Tel: 23489211-4 Fax: (852) 27277866
DWG NO. : JB53-SD-CW-4105 REV. : B

CLIENT :
SHIMAO GROUP
HOLDINGS LIMITED

ARCHITECT :
WONG TUNG & PARTNERS LIMITED
ARCHITECTS & PLANNERS



MAIN CONTRACTOR :
協興建築有限公司
HIP HING CONSTRUCTION CO LTD

STRUCTURAL ENGINEER :

ICMA C M WONG & ASSOCIATES LTD
黃志明建築工程師有限公司






FAÇADE CONSULTANT:



NOTE :
1. ALL DIMENSIONS ARE IN mm.
2. ALL ELEVATIONS ARE VIEWED FROM OUTSIDE.
3. ALL DIMENSIONS TO BE VERIFIED ON SITE BEFORE FABRICATION.

LEGEND :

- ⊗1 --- DETAIL MARK NO.
- ⊗001 --- REFER SHEET NO.
- 1. F.F.L. --- FINISHED FLOOR LEVEL
- 2. S.F.L. --- STRUCTURAL FLOOR LEVEL
- 3. ⊗R --- REVERSED DETAIL

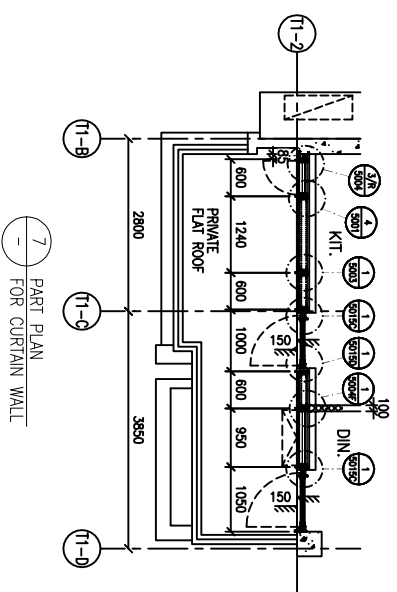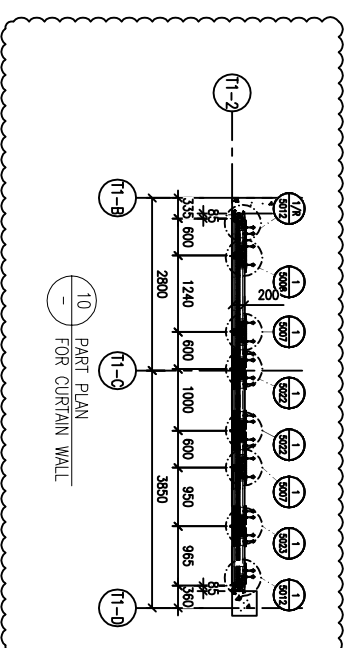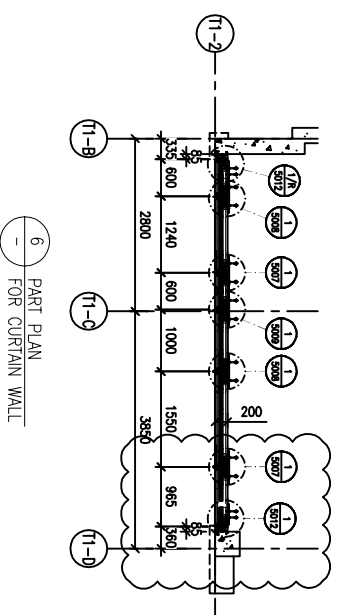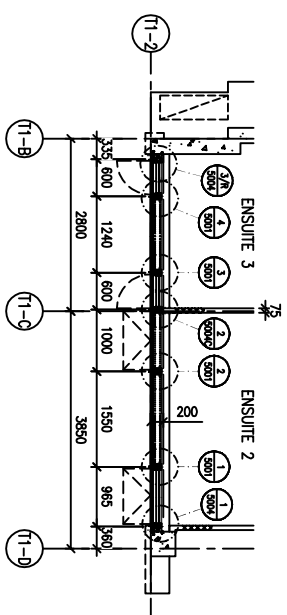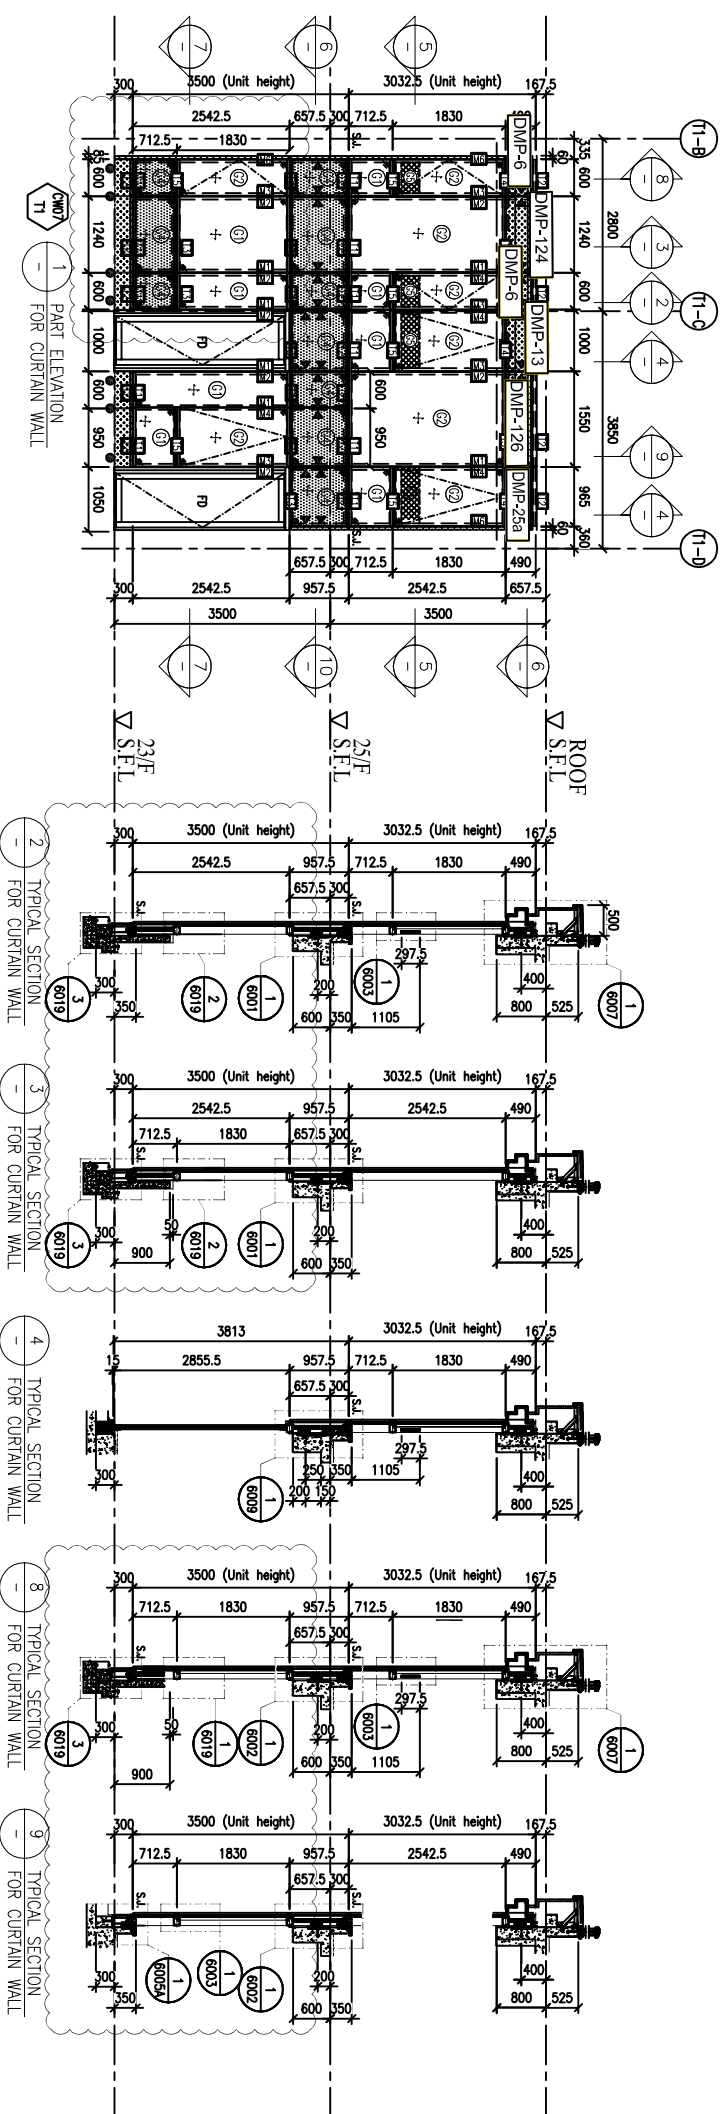

FLOOR LEVEL (S.F.L.)	
FLOOR	LEVEL
ROOF	+210.00
25/F	+206.50
23/F	+203.00

- LEGEND:
- ⊗1 --- 10mm HEAT STRENGTHENED GLASS (OUTER) + 12mm AIR SPACE + 12mm THK. TEMPERED CLEAR GLASS (INNER)
 - ⊗2 --- 10mm HEAT STRENGTHENED GLASS (OUTER) + 12mm AIR SPACE + 10mm THK. TEMPERED CLEAR GLASS (INNER)
 - ⊗3 --- 12mm THK. HEAT STRENGTHENED GLASS & 2mm THK. ALUM. BACKPAN (SPANDREL GLASS) (INTERNAL PROTECTIVE BARRIER)
 - ⊗4 --- 12mm THK. CLEAR TEMPERED GLASS
 - ⊗5 --- 3mm THK. ALUM. CLADDING
 - S.J. --- STACK JOINT (WIND LOAD)
 - ALUM --- ALUM. EXTRUSION DIE NO.
 - SUPPORT POINT (WIND LOAD + DEAD LOAD)
 - SUPPORT POINT (WIND LOAD)

DATE : 02-OCT-21	SCALE : 1:60 (A1)
DRAWN BY : LHR	CHECKED BY :
TITLE : PART ELEVATION FOR CURTAIN WALL AT TOWER 1	
PROJECT : PROPOSED RESIDENTIAL DEVELOPMENT AT N.K.I.L. 6542 YIN PING ROAD KOWLOON	
DRAWN BY : LHR CHECKED BY : DATE : 02-OCT-21 SCALE : 1:60 (A1)	
DWG NO. : JB53-SD-CW-4106	REV. : B

B.D. REF :

CLIENT :
SHIMAO GROUP HOLDINGS LIMITED

ARCHITECT :
WONG TUNG & PARTNERS LIMITED
 ARCHITECTS & ENGINEERS

MAIN CONTRACTOR :
協興建築有限公司
 HIP HING CONSTRUCTION CO LTD

STRUCTURAL ENGINEER :
ICMA
 C M WONG & ASSOCIATES LTD
 黃志明建築工程師有限公司

FAÇADE CONSULTANT:
MEINHARDT

NOTE:
 1. ALL DIMENSIONS ARE IN mm.
 2. ALL ELEVATIONS ARE VIEWED FROM OUTSIDE.
 3. ALL DIMENSIONS TO BE VERIFIED ON SITE BEFORE FABRICATION.




LEGEND:
 (X1) DETAIL MARK NO.
 (X00) REFER SHEET NO.
 1. F.F.L. -- FINISHED FLOOR LEVEL
 2. S.F.L. -- STRUCTURAL FLOOR LEVEL
 3. (R) -- REVERSED DETAIL

FLOOR	LEVEL
R/F	+210.00
26/F	+206.70
25/F	+203.40
23/F	+200.00
22/F	+196.85
21/F	+193.70
20/F	+189.55
19/F	+187.40
18/F	+184.25
17/F	+181.10
16/F	+177.80
15/F	+174.65
12/F	+171.50
11/F	+168.35
10/F	+165.20
9/F	+162.05
8/F	+158.90
7/F	+155.75
6/F	+152.60
5/F	+149.30

JOB NO. : J-853
 PROJECT : PROPOSED RESIDENTIAL DEVELOPMENT AT N.K.I.L. 6542 YIN PING ROAD KOWLOON

TITLE : PART ELEVATION FOR CURTAIN WALL AT TOWER 2



DATE : 26-MAR-21 SCALE : 1:60 (A1)
 DRAWN BY : LHR CHECKED BY :
 美特鋁質有限公司
 MIDU Aluminium Fabrication Ltd.
 Units 6-8, Sunny Industrial Centre, 1/F
 610 Cha Kwo Ling Road, Kowloon
 Tel: 23489211-4 Fax: (852) 2727866
 DWG NO. : J853-SD-CW-4201 REV. : C

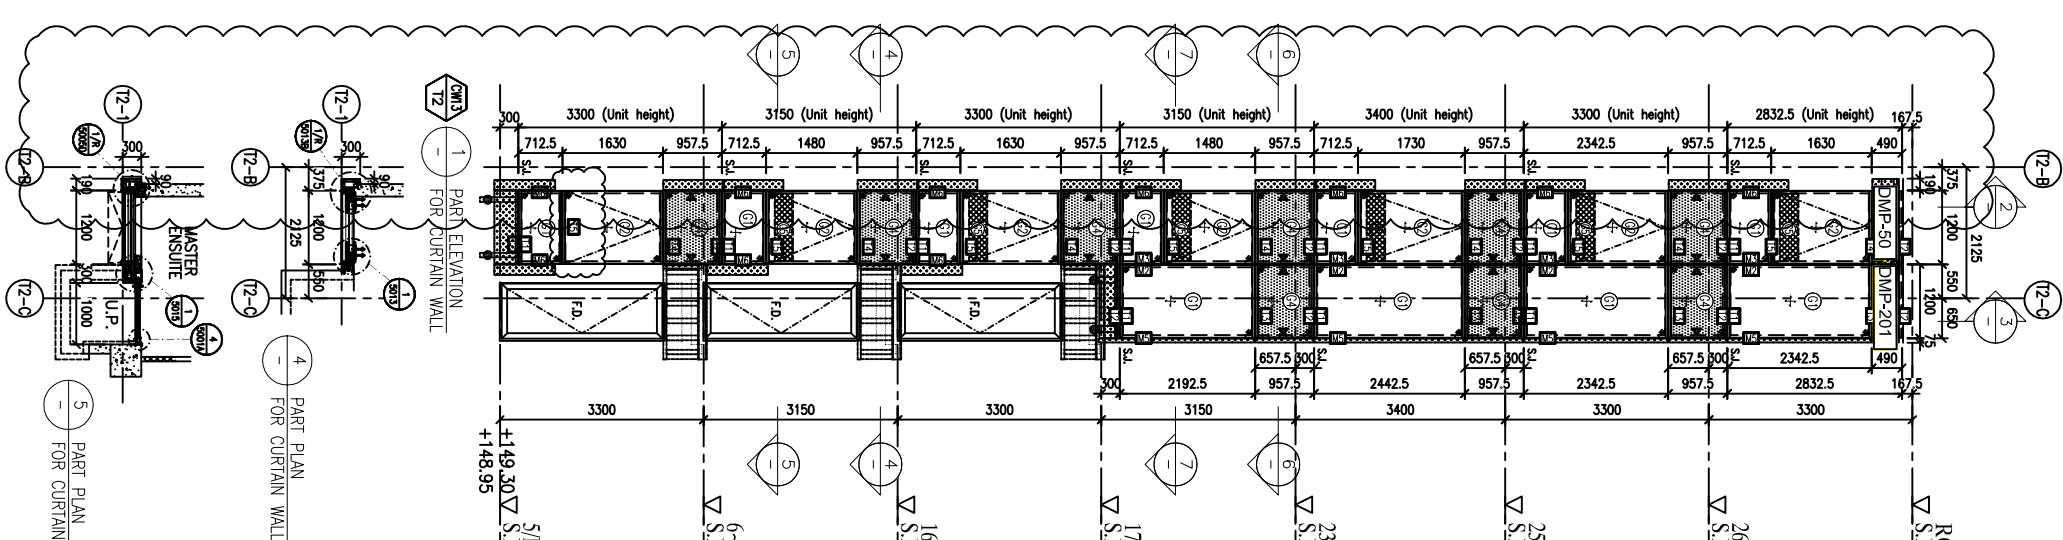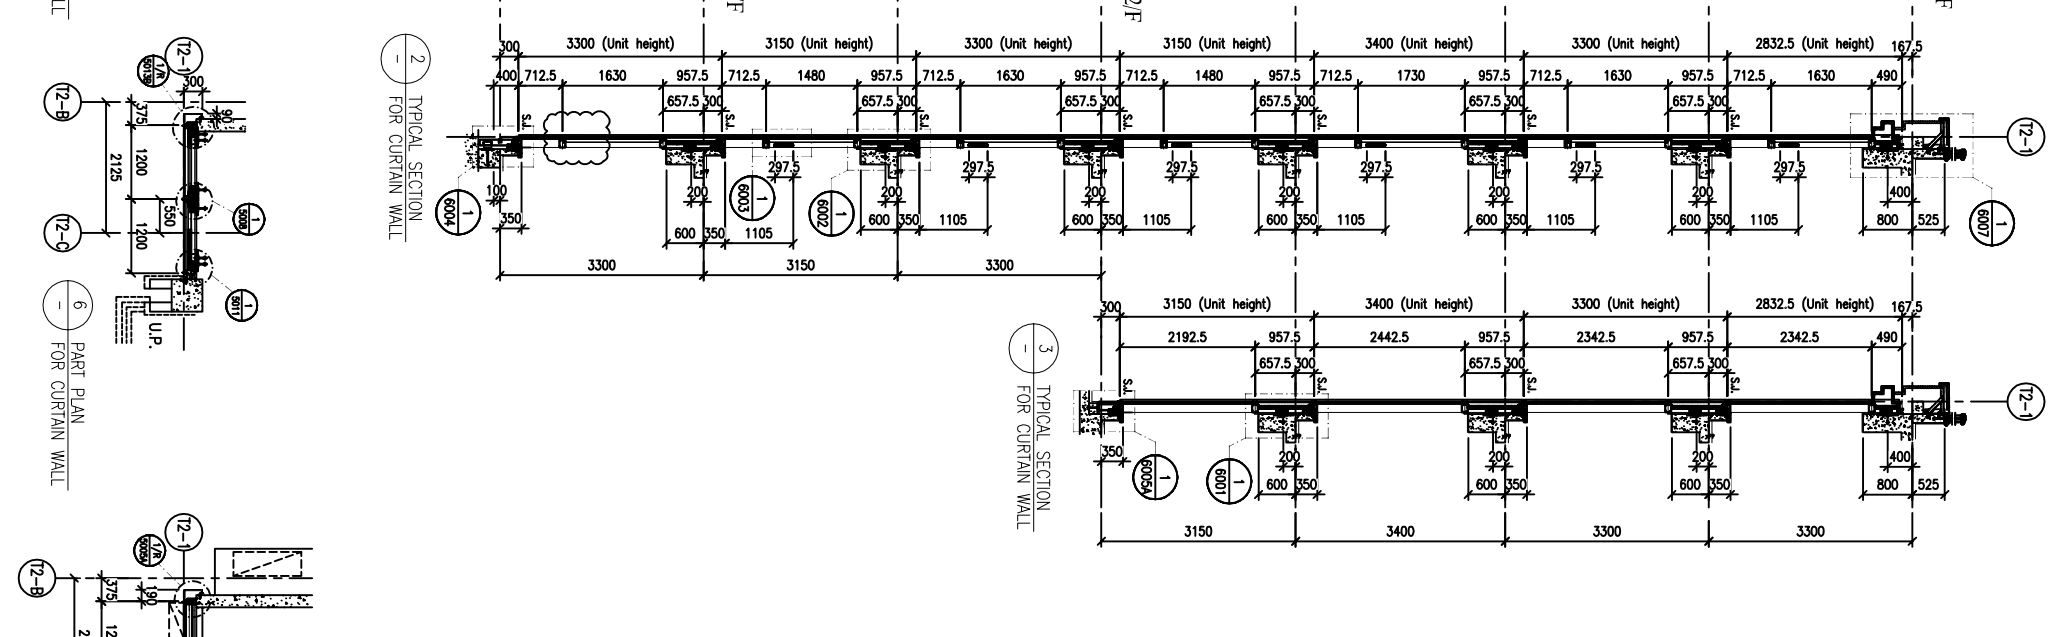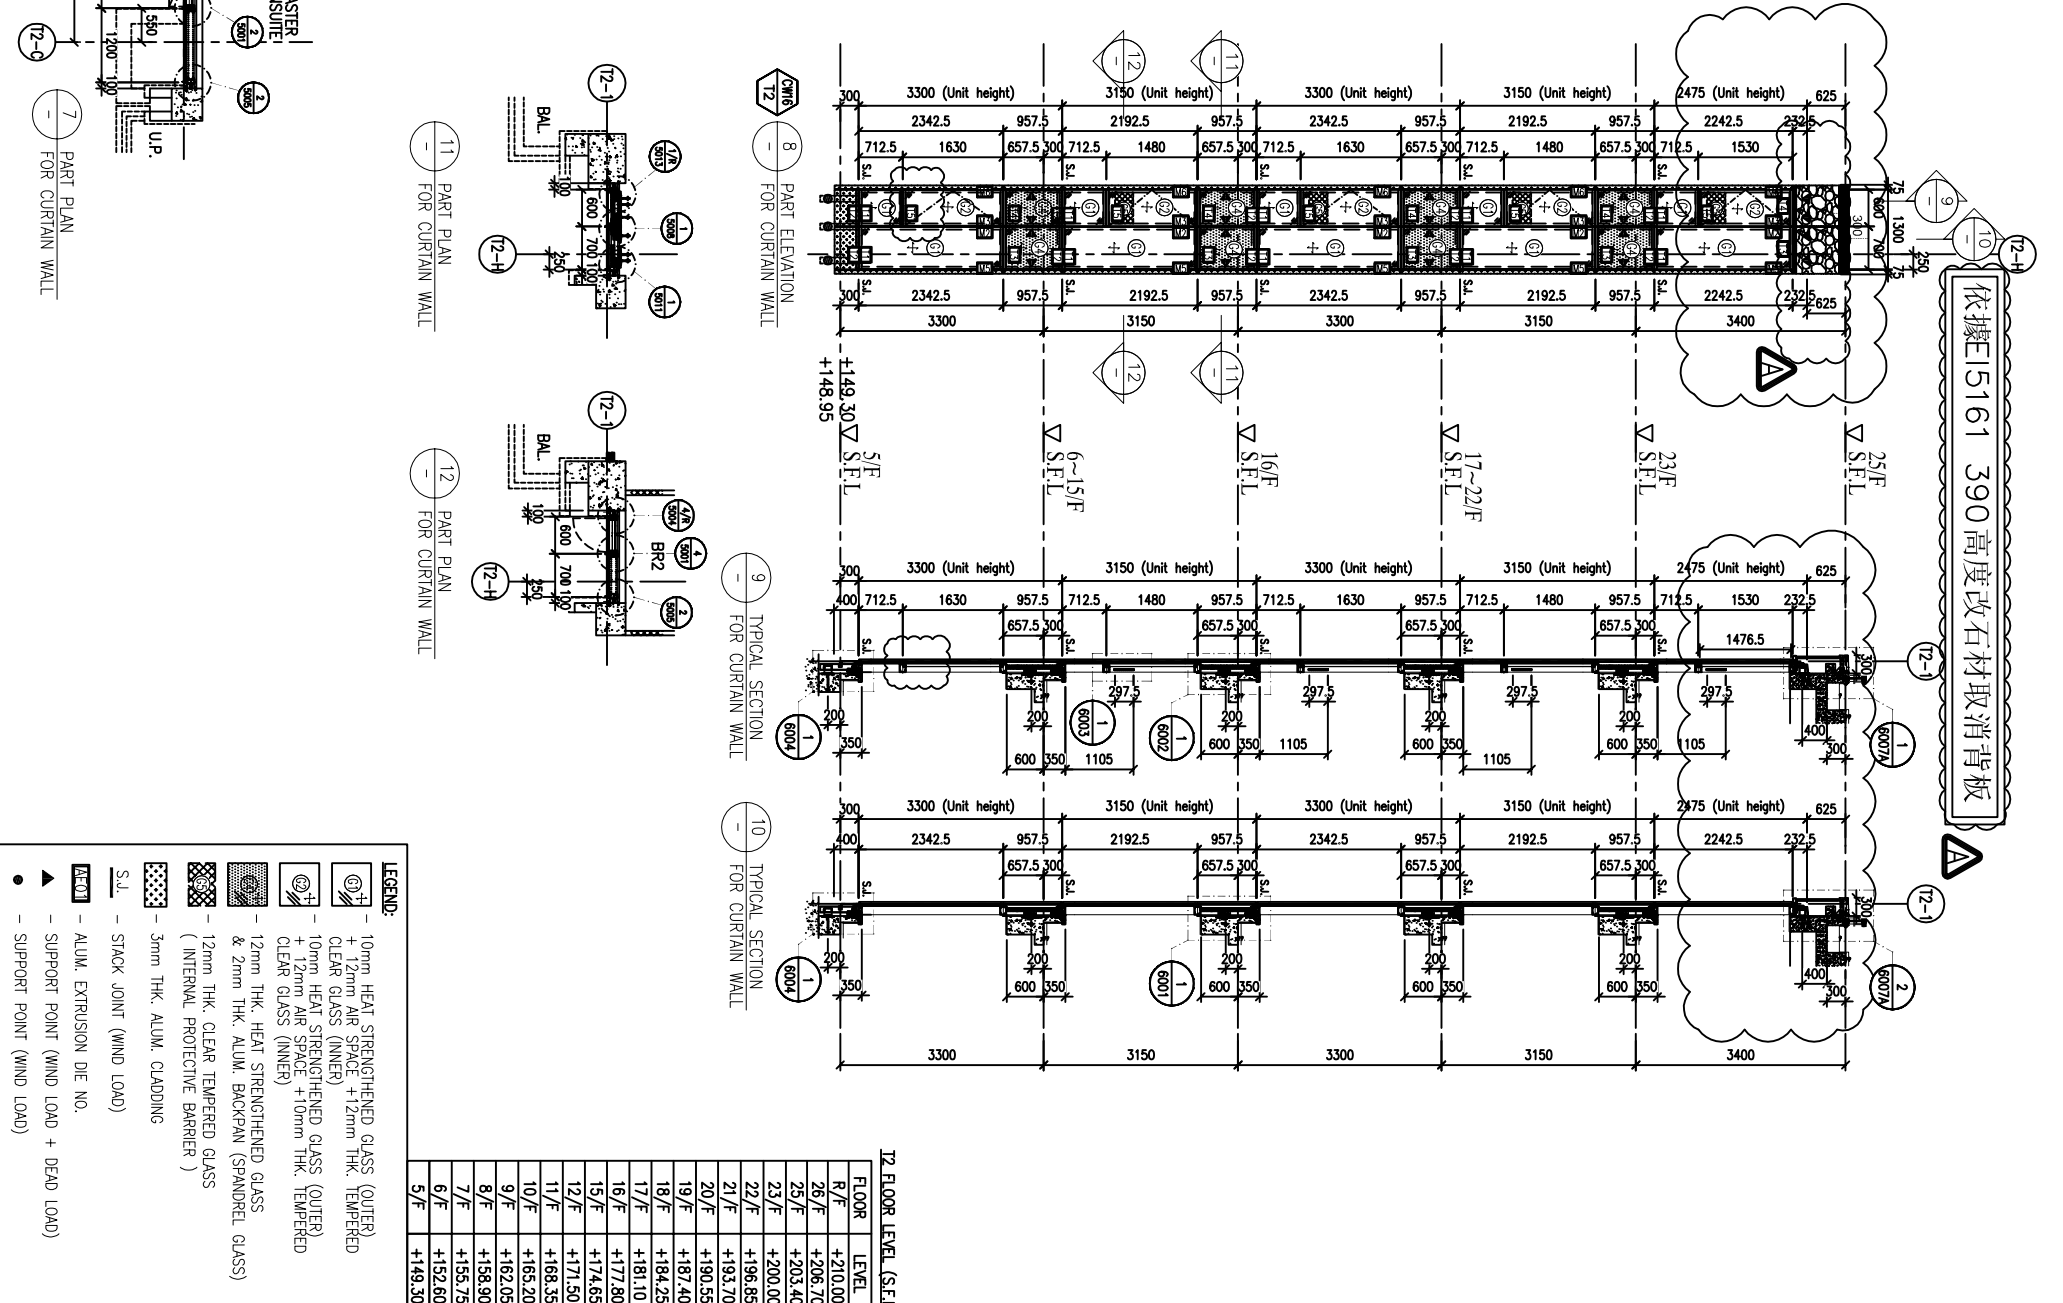

LEGEND:

- 10mm HEAT STRENGTHENED GLASS (OUTER) CLEAR GLASS (INNER)
- 12mm HEAT STRENGTHENED GLASS (OUTER) CLEAR GLASS (INNER)
- 12mm THK. HEAT STRENGTHENED GLASS & 2mm THK. ALUM. BACKPAN (SPANDREL GLASS) (INTERNAL PROTECTIVE BARRIER)
- 3mm THK. ALUM. CLADDING
- S.J. - STACK JOINT (WIND LOAD)
- ALUM. EXTRUSION DIE NO.
- SUPPORT POINT (WIND LOAD + DEAD LOAD)
- SUPPORT POINT (WIND LOAD)

LEGEND :
R.S. = RESTRAINT SOCKET

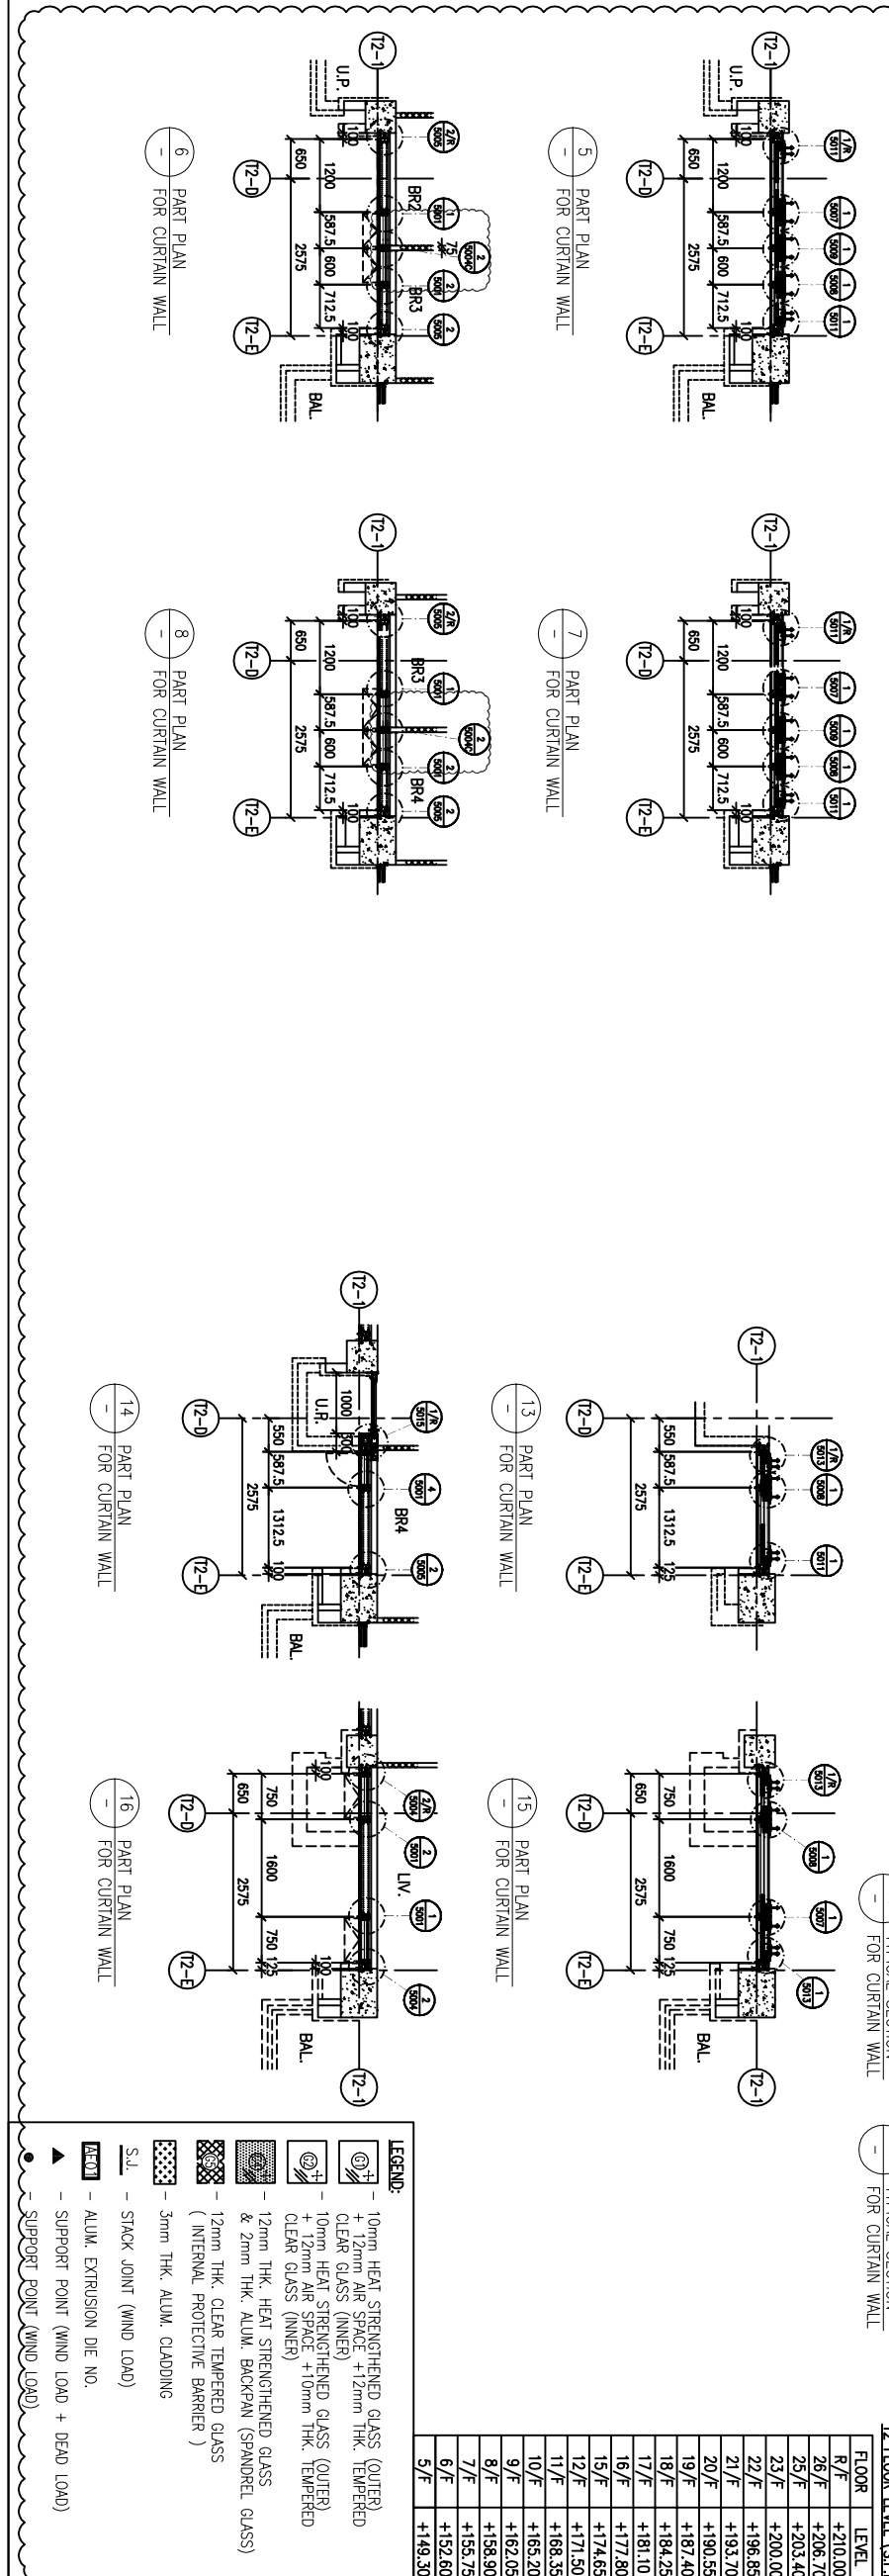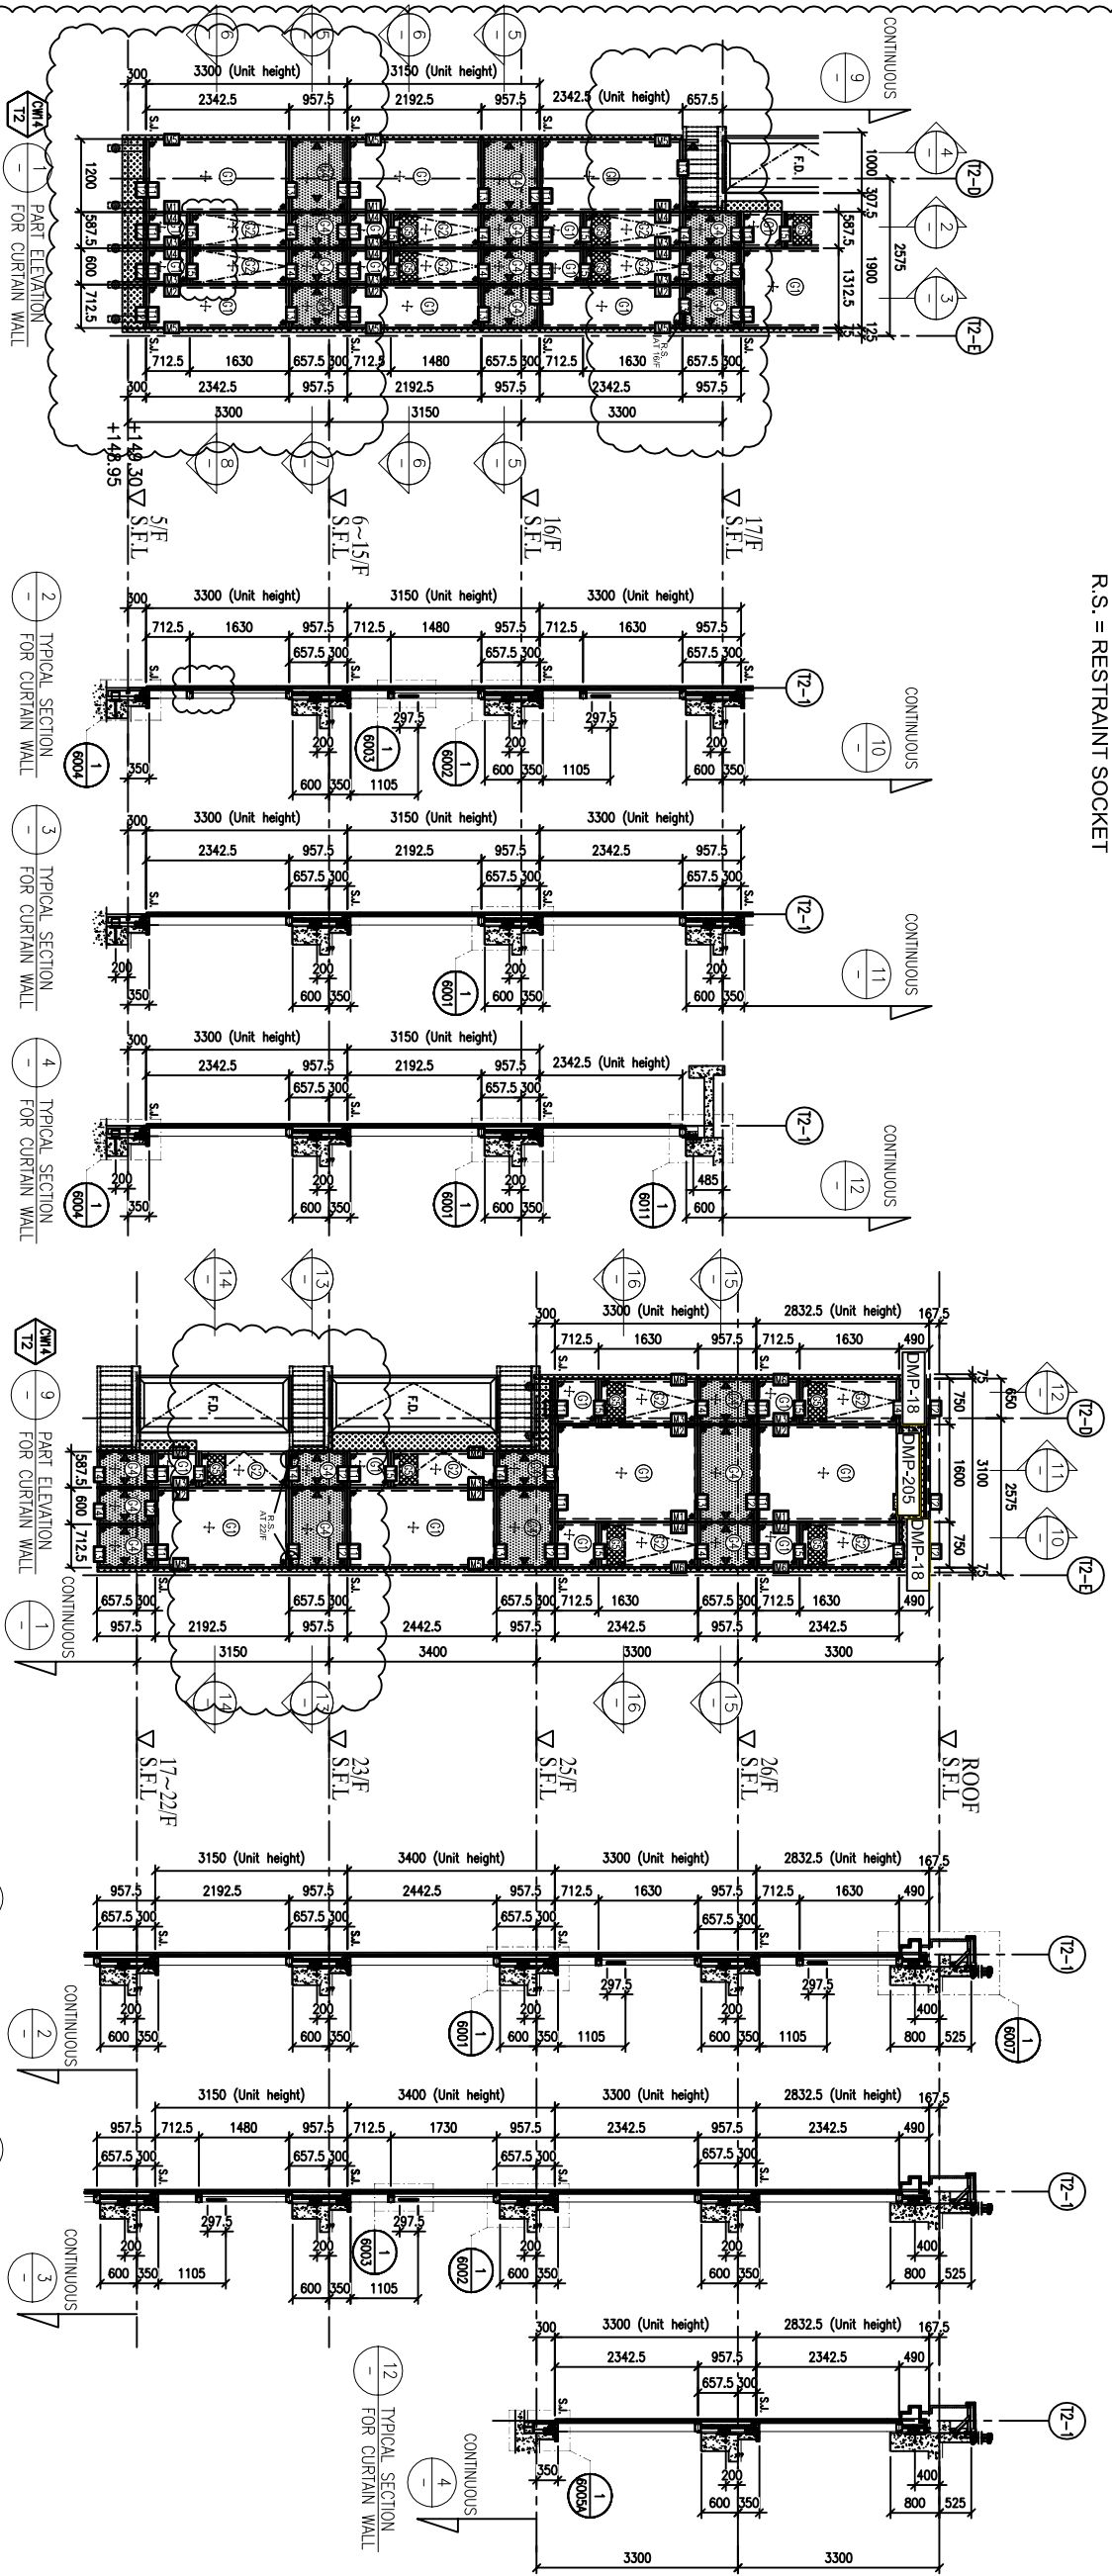


FLOOR	LEVEL
26/F	+206.70
25/F	+203.40
23/F	+200.00
22/F	+196.85
21/F	+193.70
20/F	+190.55
19/F	+187.40
18/F	+184.25
17/F	+181.10
16/F	+177.80
15/F	+174.65
12/F	+171.50
11/F	+168.35
10/F	+165.20
9/F	+162.05
8/F	+158.90
7/F	+155.75
6/F	+152.60
5/F	+149.30

- LEGEND:
- ① 10mm HEAT STRENGTHENED GLASS (OUTER)
 - ② +12mm AIR SPACE +12mm THK. TEMPERED CLEAR GLASS (INNER)
 - ③ 10mm HEAT STRENGTHENED GLASS (OUTER)
 - ④ +12mm AIR SPACE +10mm THK. TEMPERED CLEAR GLASS (INNER)
 - ⑤ 12mm THK. HEAT STRENGTHENED GLASS & 2mm THK. ALUM. BACKPAN (SPANDREL GLASS)
 - ⑥ 12mm THK. CLEAR TEMPERED GLASS (INTERNAL PROTECTIVE BARRIER)
 - ⑦ 3mm THK. ALUM. CLADDING
 - ⑧ S.J. - STACK JOINT (WIND LOAD)
 - ⑨ ALUM. EXTRUSION DIE NO.
 - ⑩ SUPPORT POINT (WIND LOAD + DEAD LOAD)
 - ⑪ SUPPORT POINT (WIND LOAD)

B.D. REF. :

CLIENT :
SHIMAO GROUP HOLDINGS LIMITED

ARCHITECT :
YONG TUNG & PARTNERS LIMITED ARCHITECTS & PLANNERS

MAIN CONTRACTOR :
協興建築有限公司 HIP HING CONSTRUCTION CO LTD

STRUCTURAL ENGINEER :
C M WONG & ASSOCIATES LTD 黃志明建築工程師有限公司



FAÇADE CONSULTANT :
MENHARDT

NOTE :
1. ALL DIMENSIONS ARE IN mm.
2. ALL ELEVATIONS ARE VIEWED FROM OUTSIDE.
3. ALL DIMENSIONS TO BE VERIFIED ON SITE BEFORE FABRICATION.

LEGEND :
⑪ DETAIL MARK NO.
⑫ REFER SHEET NO.
1. F.F.L. -- FINISHED FLOOR LEVEL
2. S.F.L. -- STRUCTURAL FLOOR LEVEL
3. R.S. -- REVERSED DETAIL

JOB NO. : J-853
PROJECT : PROPOSED RESIDENTIAL DEVELOPMENT AT N.K.L.L. 6542 YIN PING ROAD KOWLOON
TITLE : PART ELEVATION FOR CURTAIN WALL AT TOWER 2
DATE : 26-MAR-21 SCALE : 1:60 (A1)
DRAWN BY : LHR CHECKED BY :
Units 6-8, Sunray Industrial Centre, 1/F
610 Che Kwo Ling Road, Kowloon
Tel:23489211-4 Fax:(852)27277866
DWG NO. : JB53-SD-CW-4202 REV. : A

LEGEND :
R.S. = RESTRAINT SOCKET

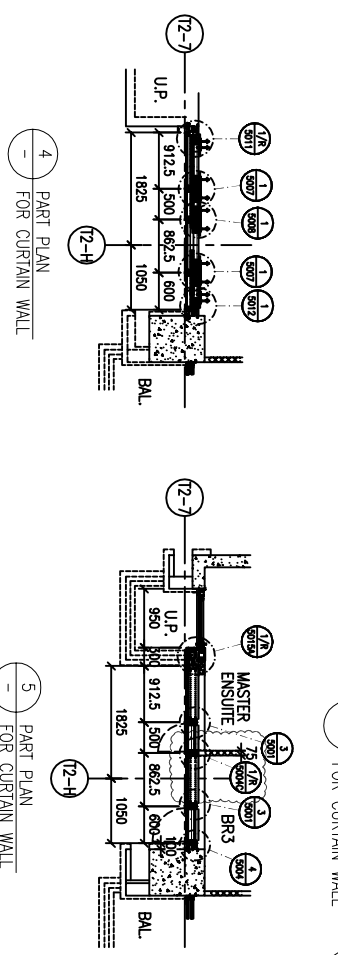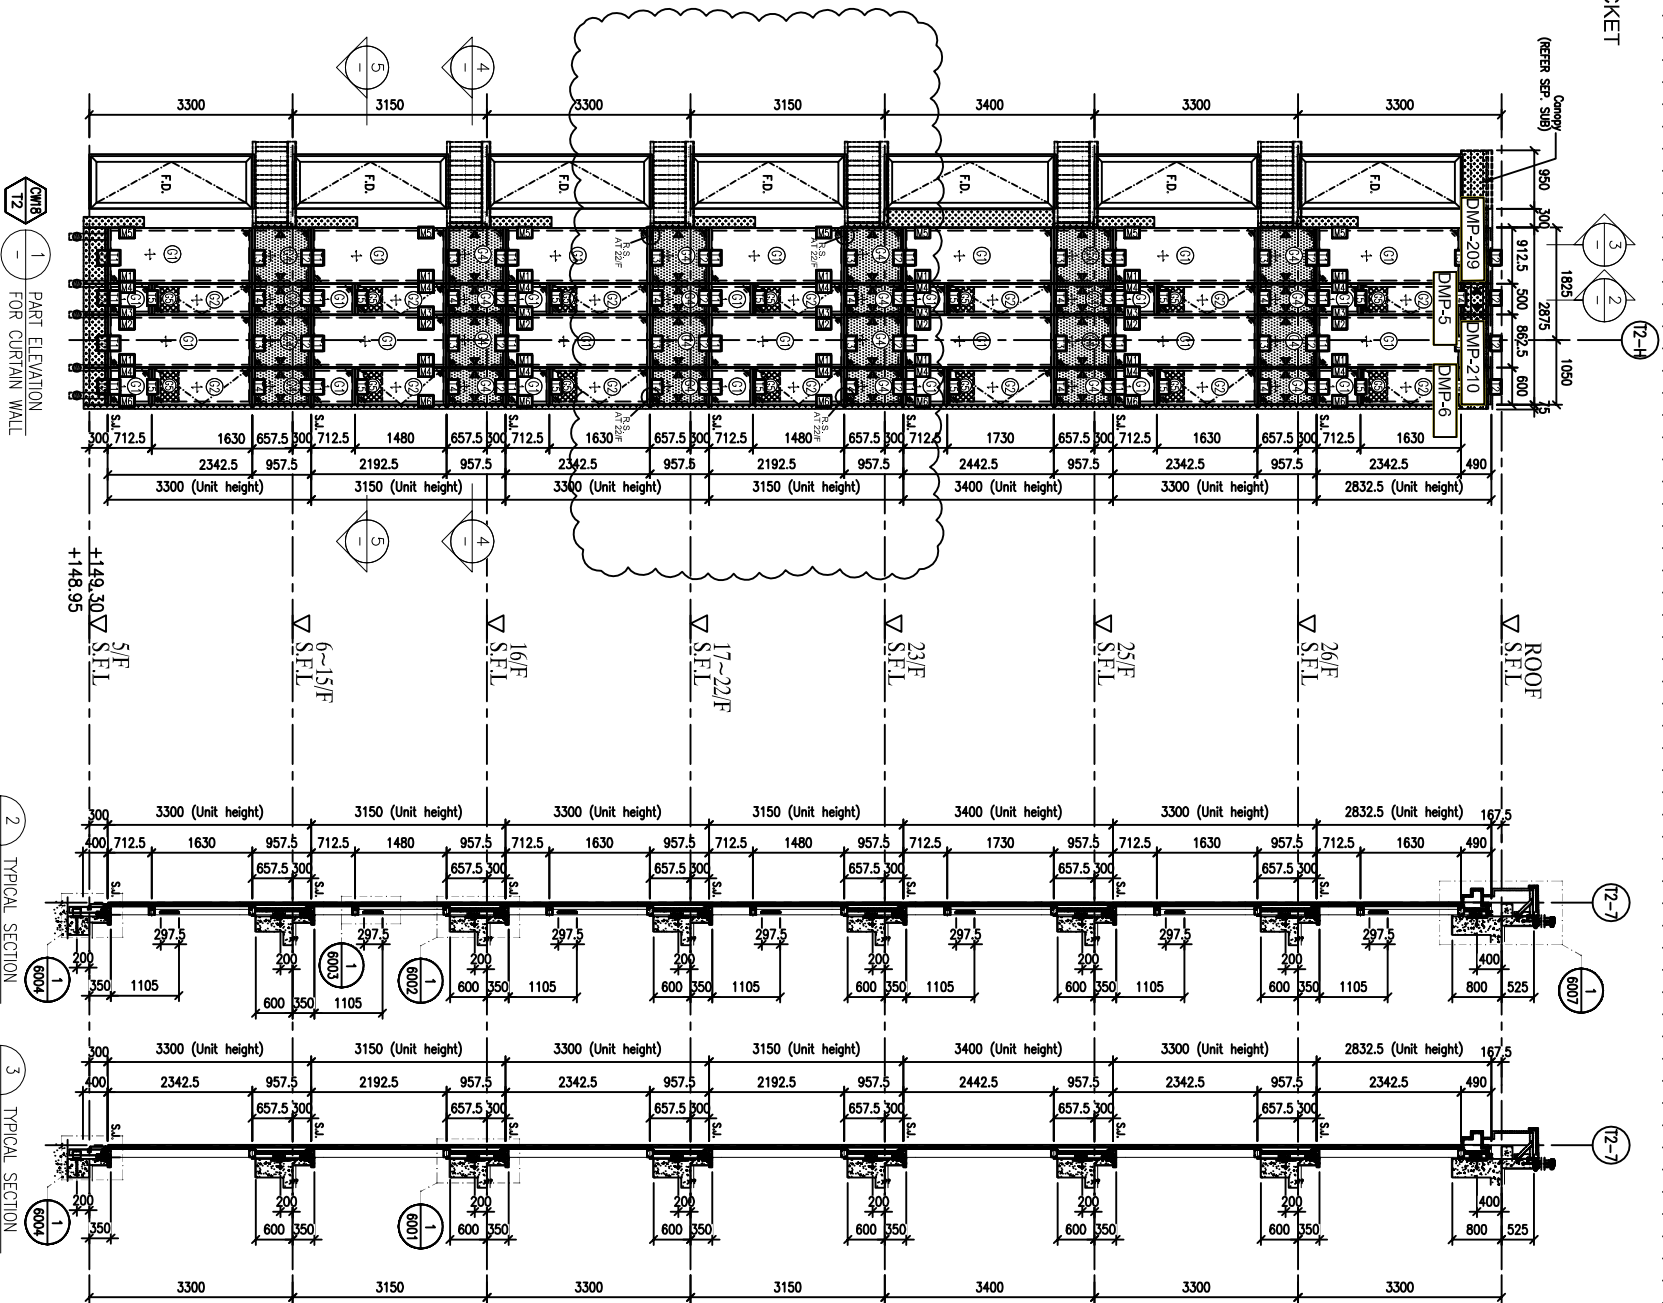

FLOOR LEVEL (S.F.L.)

FLOOR	LEVEL
ROOF	+210.00
26/F	+206.70
25/F	+203.40
23/F	+200.00
22/F	+196.85
21/F	+193.70
20/F	+189.55
19/F	+187.40
18/F	+184.25
17/F	+181.10
16/F	+177.80
15/F	+174.65
12/F	+171.50
11/F	+168.35
10/F	+165.20
9/F	+162.05
8/F	+158.90
7/F	+155.75
6/F	+152.60
5/F	+149.30

LEGEND:

- 10mm HEAT STRENGTHENED GLASS (OUTER) + 12mm AIR SPACE + 12mm THK. TEMPERED CLEAR GLASS (INNER)
- 10mm HEAT STRENGTHENED GLASS (OUTER) + 12mm AIR SPACE + 10mm THK. TEMPERED CLEAR GLASS (INNER)
- 12mm THK. HEAT STRENGTHENED GLASS & 2mm THK. ALUM. BACKPAN (SPANDREL GLASS) (INTERNAL PROTECTIVE BARRIER)
- 3mm THK. ALUM. CLADDING
- S.J. - STACK JOINT (WIND LOAD)
- ALUM. EXTRUSION DIE NO.
- SUPPORT POINT (WIND LOAD + DEAD LOAD)
- SUPPORT POINT (WIND LOAD)

NOTE:

1. ALL DIMENSIONS ARE IN mm.
2. ALL ELEVATIONS ARE VIEWED FROM OUTSIDE.
3. ALL DIMENSIONS TO BE VERIFIED ON SITE BEFORE FABRICATION.

LEGEND:

- DETAIL MARK NO.
- REFER SHEET NO.
- S.F.L. -- FINISHED FLOOR LEVEL
- S.F.L. -- STRUCTURAL FLOOR LEVEL
- REVERSED DETAIL

ARCHITECT:

WTF
WONG TUNG & PARTNERS LIMITED
ARCHITECTS & PLANNERS

STRUCTURAL ENGINEER:

ICMA
C M WONG & ASSOCIATES LTD
黃志明建築工程師有限公司

MAIN CONTRACTOR:

WTF
協興建築有限公司
HIP HING CONSTRUCTION CO LTD

CLIENT:

SHIMAO GROUP
HOLDINGS LIMITED

DATE: 26-MAR-21

SCALE: 1:60 (A1)

DRAWN BY: LHR

CHECKED BY:

TITLE:

PART ELEVATION
FOR CURTAIN WALL
AT TOWER 2

PROJECT:

PROPOSED RESIDENTIAL
DEVELOPMENT AT N.K.I.L. 6542
YIN PING ROAD
KOWLOON

JOB NO.: J-853

REVISION SUBJECT TO ARCH COMMENT

NO.	DATE	REVISION
1	08-10-2021	REVISION

REV.: A

美特銘實有限公司
MIDI Aluminium Fabricators Ltd.
Units 6-8, Sunny Industrial Centre, 1/F
610 Che Kwo Ling Road, Kowloon
Tel: 23489211-4 Fax: (852) 27277866
DWG NO.: J853-SD-CW-4204

B.D. REF :

CLIENT : SHIMAO GROUP HOLDINGS LIMITED

ARCHITECT : WONG TUNG & PARTNERS LIMITED ARCHITECTS & PLANNERS



MAIN CONTRACTOR : 協興建築有限公司 HIP HING CONSTRUCTION CO LTD

STRUCTURAL ENGINEER :

ICMA C M WONG & ASSOCIATES LTD 黃志明建築工程師有限公司

FAÇADE CONSULTANT :







NOTE : 1. ALL DIMENSIONS ARE IN mm. 2. ALL ELEVATIONS ARE VIEWED FROM OUTSIDE. 3. ALL DIMENSIONS TO BE VERIFIED ON SITE BEFORE FABRICATION.





LEGEND : (X1) DETAIL MARK NO. (X00) REFER SHEET NO. 1. F.F.L. -- FINISHED FLOOR LEVEL 2. S.F.L. -- STRUCTURAL FLOOR LEVEL 3. (R) -- REVERSED DETAIL

Table with 2 columns: FLOOR LEVEL (S.F.L.), FLOOR LEVEL. Rows include ROOF, 26/F, 25/F, 23/F, 22/F, 21/F, 20/F, 19/F, 18/F, 17/F, 16/F, 15/F, 12/F, 11/F, 10/F, 9/F, 8/F, 7/F, 6/F, 5/F with corresponding levels.



LEGEND : 10mm HEAT STRENGTHENED GLASS (OUTER) + 12mm AIR SPACE + 12mm THK. TEMPERED CLEAR GLASS (INNER) 10mm HEAT STRENGTHENED GLASS (OUTER) + 12mm AIR SPACE + 10mm THK. TEMPERED CLEAR GLASS (INNER) 12mm THK. HEAT STRENGTHENED GLASS & 2mm THK. ALUM. BACKPAN (SPANDREL GLASS) (INTERNAL PROTECTIVE BARRIER) 3mm THK. ALUM. CLADDING S.I. - STACK JOINT (WIND LOAD) ALUM. EXTRUSION DIE NO. SUPPORT POINT (WIND LOAD + DEAD LOAD) SUPPORT POINT (WIND LOAD)

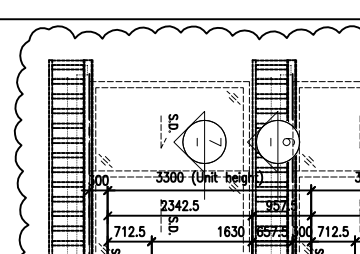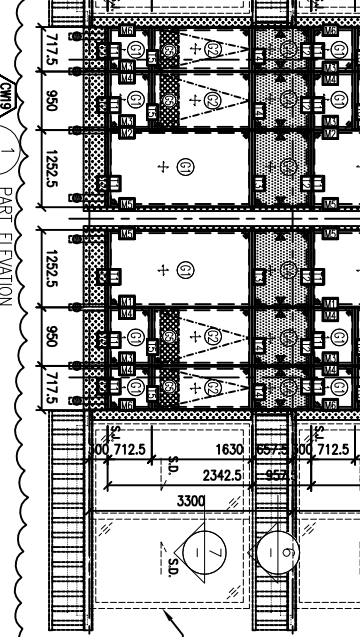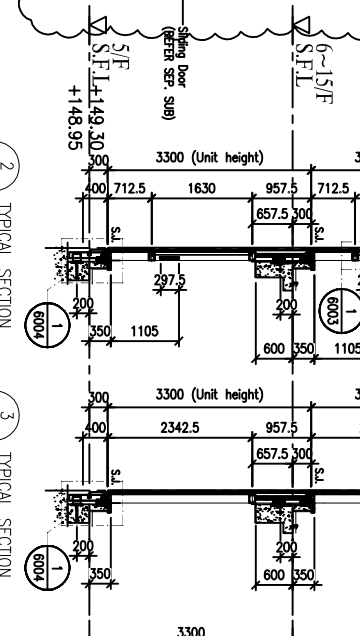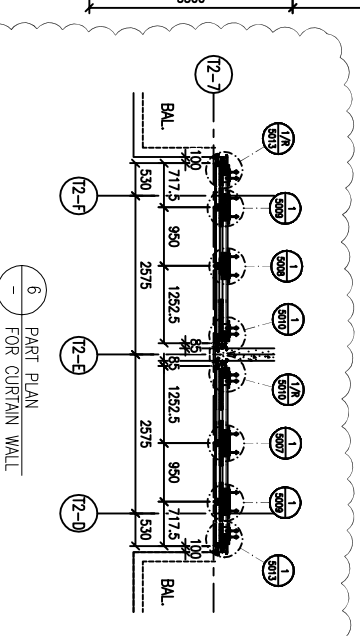

Project information including title 'PART ELEVATION FOR CURTAIN WALL AT TOWER 2', date '22-OCT-21', scale '1:60 (A1)', and company details for MIDY Aluminum Fabricator Ltd.

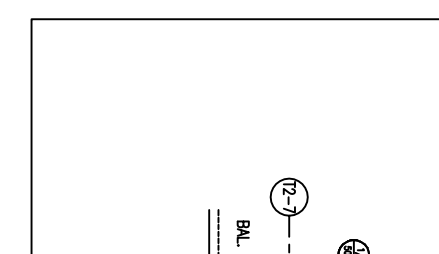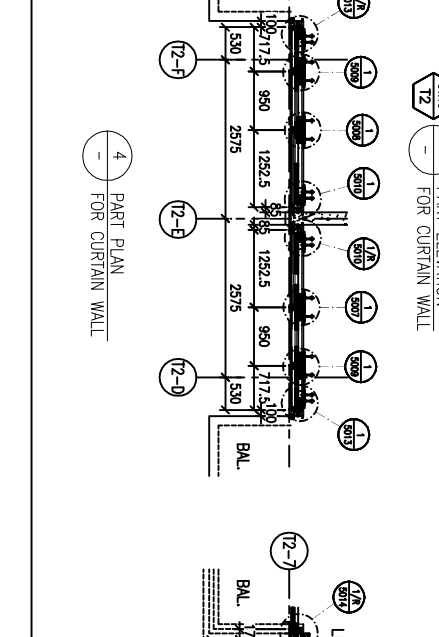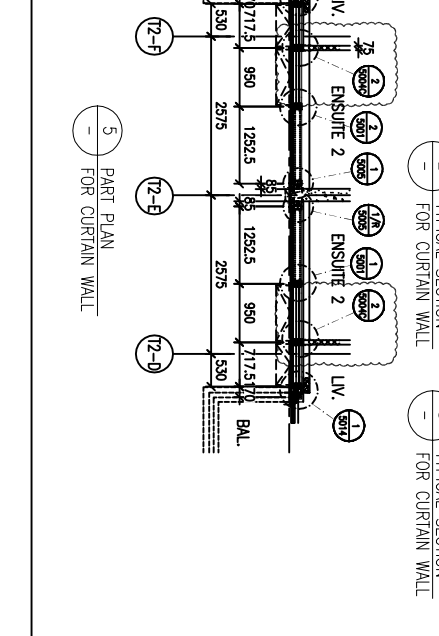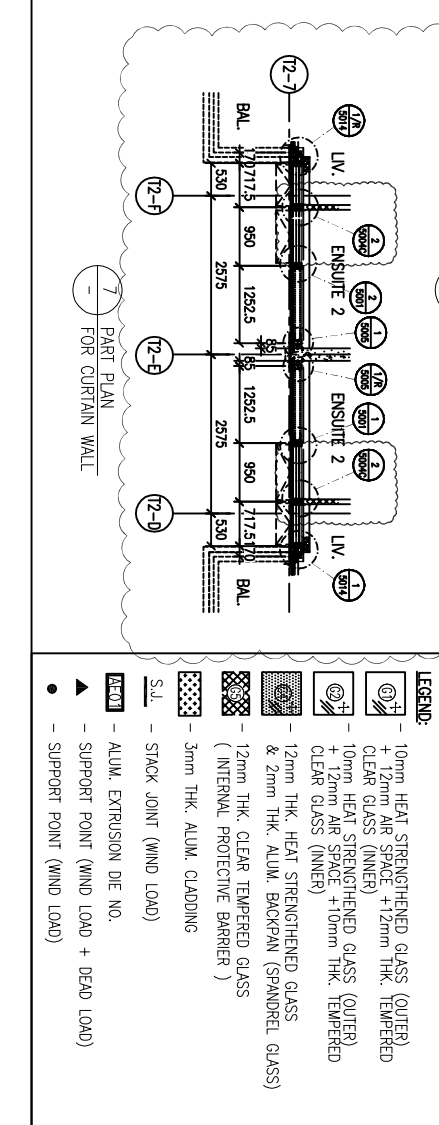



LEGEND:
R.S. = RESTRAINT SOCKET

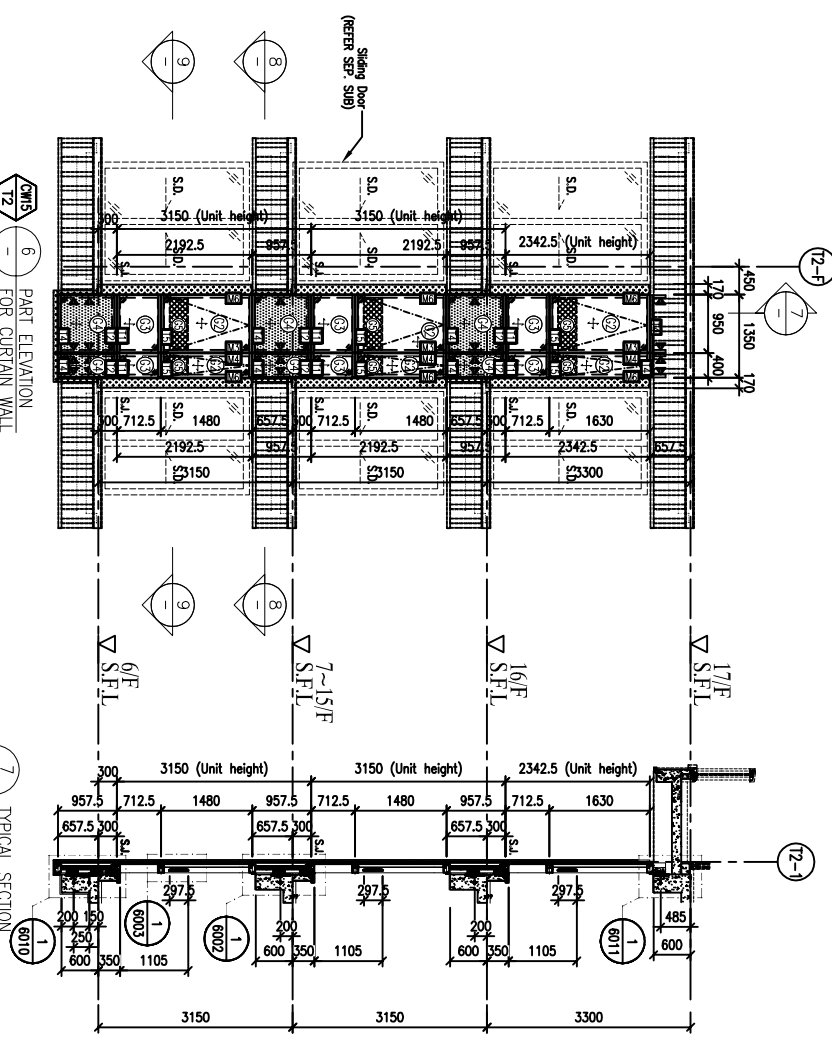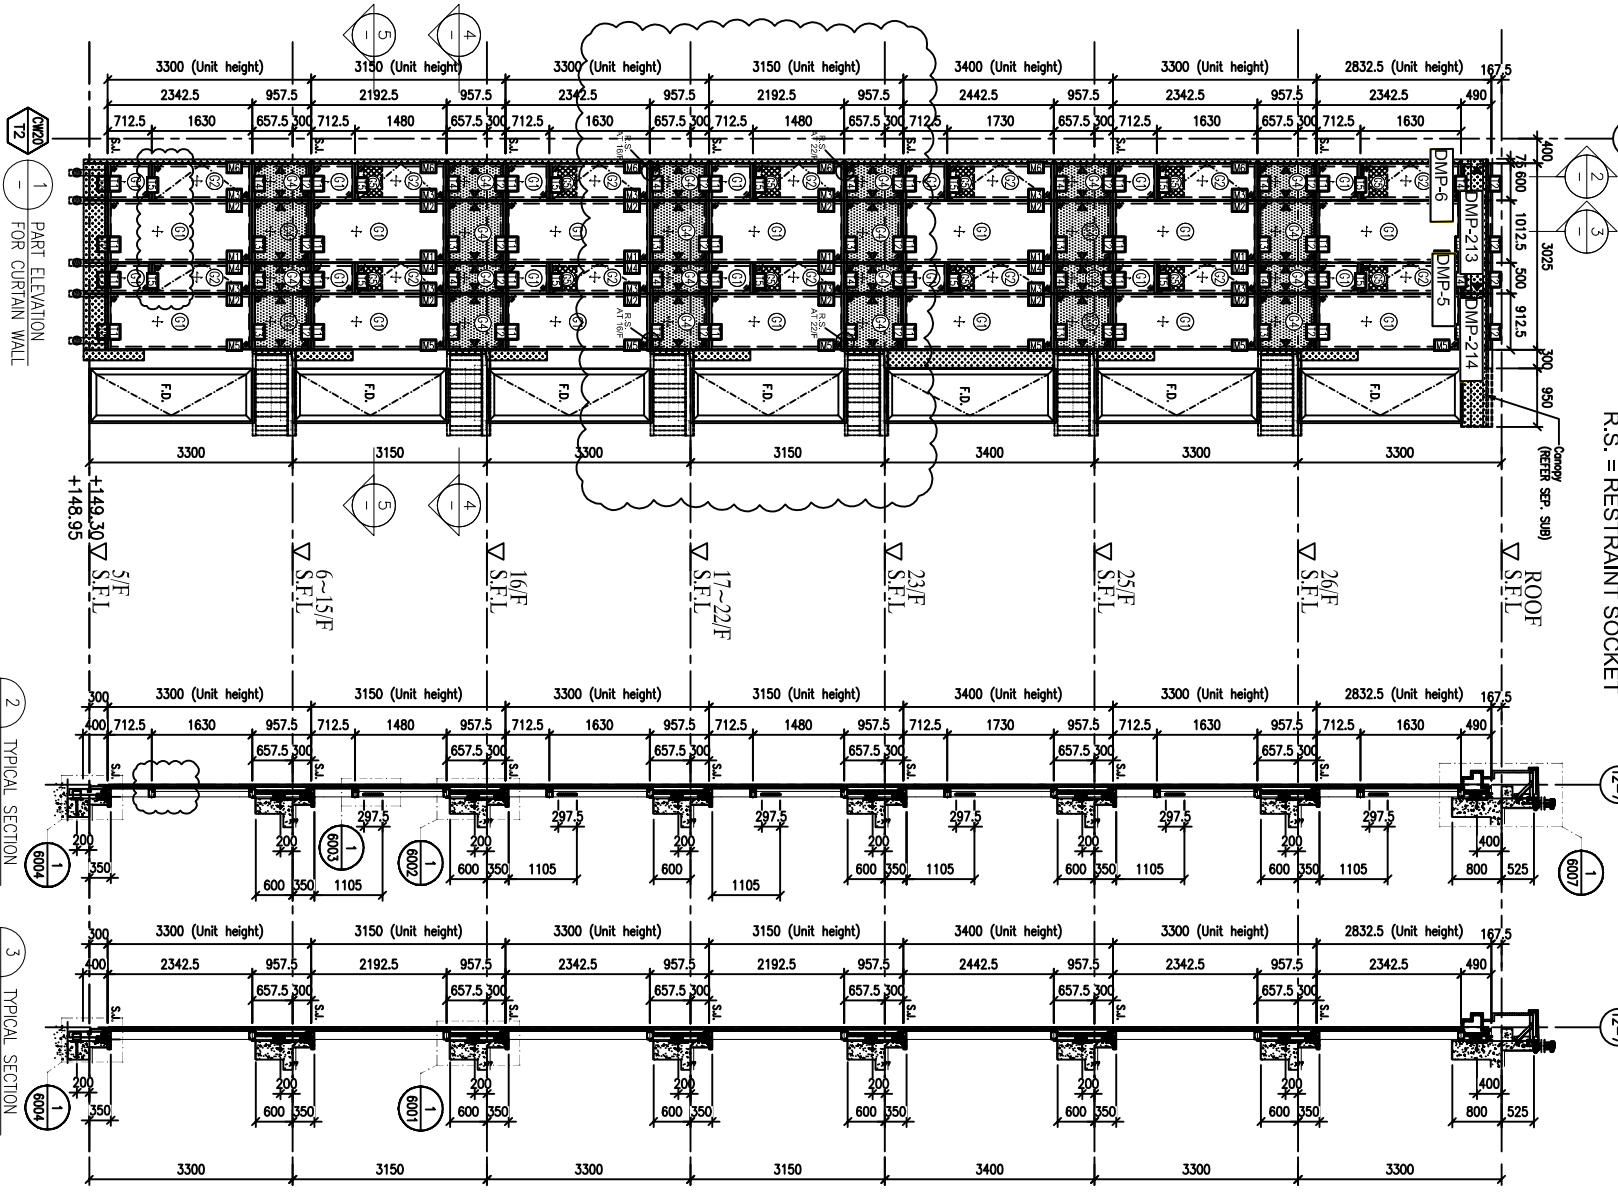

FLOOR LEVEL (S.F.L.)	LEVEL
ROOF	+210.00
26/F	+206.70
25/F	+203.40
23/F	+200.00
22/F	+196.65
21/F	+193.70
20/F	+190.55
19/F	+187.40
18/F	+184.25
17/F	+181.10
16/F	+177.80
15/F	+174.65
12/F	+171.50
11/F	+168.35
10/F	+165.20
9/F	+162.05
8/F	+158.90
7/F	+155.75
6/F	+152.60
5/F	+149.30

LEGEND:

- 10mm HEAT STRENGTHENED GLASS (OUTER) + 12mm AIR SPACE + 12mm HEAT STRENGTHENED GLASS (INNER) + 12mm HEAT STRENGTHENED GLASS (OUTER) + 12mm AIR SPACE + 10mm HEAT STRENGTHENED CLEAR GLASS (INNER)
- 12mm THK. HEAT STRENGTHENED GLASS & 2mm THK. ALUM. BACKPAN (SPANDEL GLASS) (INTERNAL PROTECTIVE BARRIER)
- 3mm THK. ALUM. CLADDING
- S.J. - STACK JOINT (WIND LOAD)
- ALUM. EXTRUSION DIE NO.
- SUPPORT POINT (WIND LOAD + DEAD LOAD)
- SUPPORT POINT (WIND LOAD)

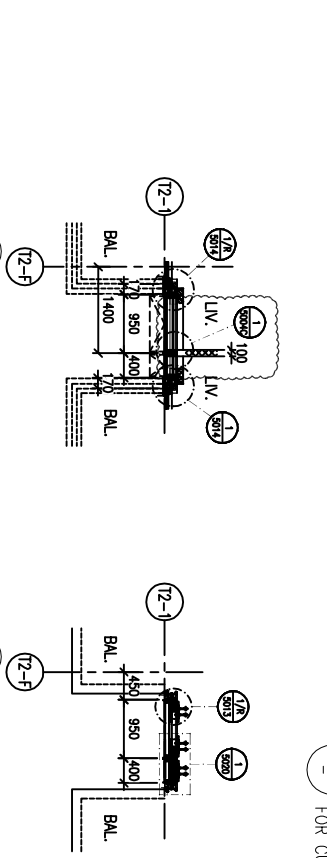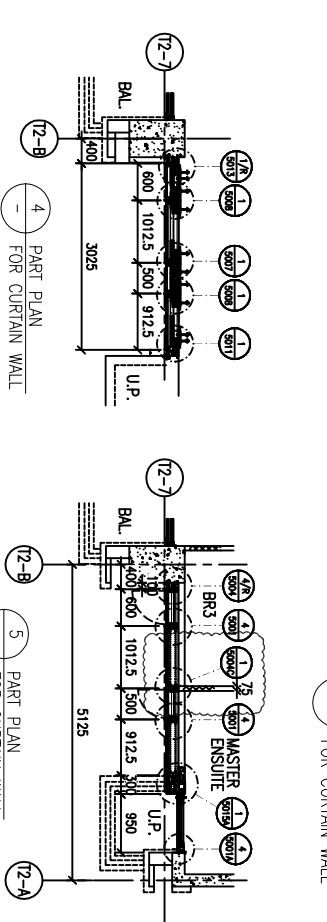

B.D. REF.:

CLIENT:
SHIMAO GROUP HOLDINGS LIMITED

ARCHITECT:
WONG TUNG & PARTNERS LIMITED
ARCHITECTS & ENGINEERS

MAIN CONTRACTOR:
協興建築有限公司
HIP HING CONSTRUCTION CO LTD

STRUCTURAL ENGINEER:
CGMA
C M WONG & ASSOCIATES LTD
黃志明建築工程師有限公司

FAÇADE CONSULTANT:
MEINWART

NOTE:
1. ALL DIMENSIONS ARE IN mm.
2. ALL ELEVATIONS ARE VIEWED FROM OUTSIDE.
3. ALL DIMENSIONS TO BE VERIFIED ON SITE BEFORE FABRICATION.

LEGEND:
 DETAIL MARK NO. REFER SHEET NO.
 F.F.L. -- FINISHED FLOOR LEVEL
 S.F.L. -- STRUCTURAL FLOOR LEVEL
 -- REVERSED DETAIL

NO.	DATE	REVISION SHEET TO ARCH. COMMENT	BY
1	05-10-2021	REVISION SHEET TO ARCH. COMMENT	BR

JOB NO.: J-853

PROJECT: PROPOSED RESIDENTIAL DEVELOPMENT AT N.K.I.L. 6542 YIN PING ROAD KOWLOON

TITLE:
PART ELEVATION FOR CURTAIN WALL AT TOWER 2

DATE: 26-MAR-21 SCALE: 1:60 (A1)

DRAWN BY: LHR CHECKED BY:

REV.: A

DMG NO.: J853-SD-CW-4205

Units 6-8, Sunray Industrial Centre, 1/F
610 Chee Kwo Ling Road, Kowloon
Tel: 23489211-4 Fax: (852) 27277866

美特銘實有限公司
MIDI ARCHITECTURE FABRICATION LTD.

B.D. REF :

CLIENT :
SHIMAO GROUP
HOLDINGS LIMITED

ARCHITECT :
WONG TUNG & PARTNERS LIMITED
ARCHITECTS & PLANNERS



MAIN CONTRACTOR :
協興建築有限公司
HIP HING CONSTRUCTION CO. LTD




STRUCTURAL ENGINEER :
ICMA
C.M. WONG & ASSOCIATES LTD
黃志明建築工程師有限公司

FAÇADE CONSULTANT:




NOTE:
1. ALL DIMENSIONS ARE IN mm.
2. ALL ELEVATIONS ARE VIEWED FROM OUTSIDE.
3. ALL DIMENSIONS TO BE VERIFIED ON SITE BEFORE FABRICATION.

LEGEND:
 -- DETAIL MARK NO.
 -- REFER SHEET NO.
 1. F.F.L. -- FINISHED FLOOR LEVEL
 2. S.F.L. -- STRUCTURAL FLOOR LEVEL
 3. -- REVERSED DETAIL

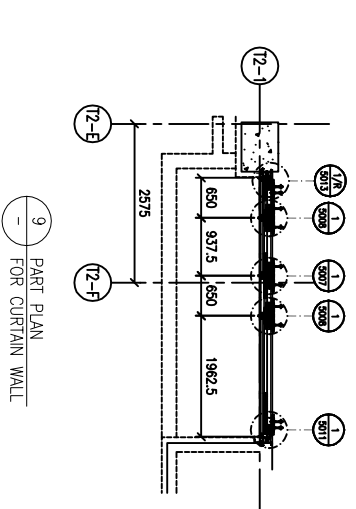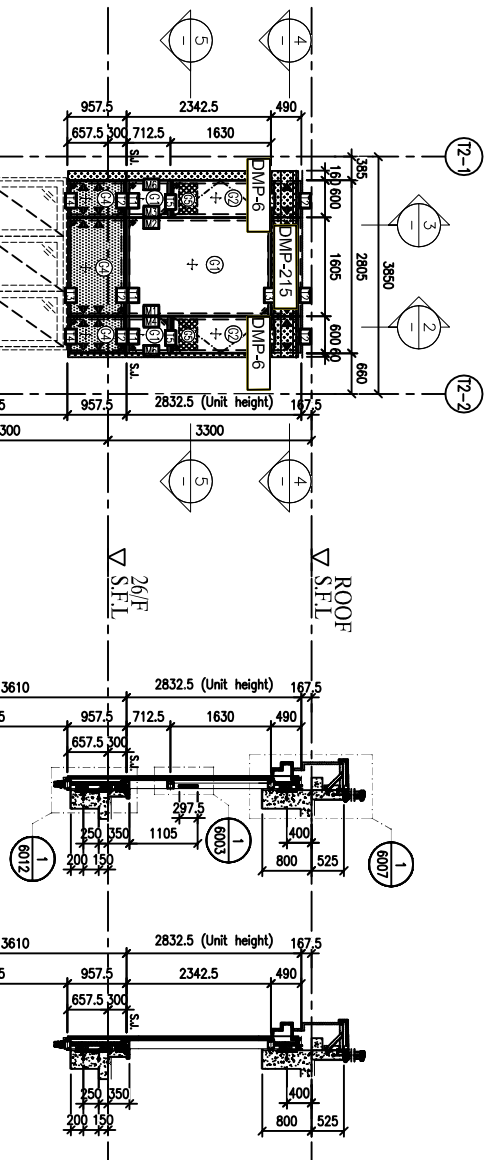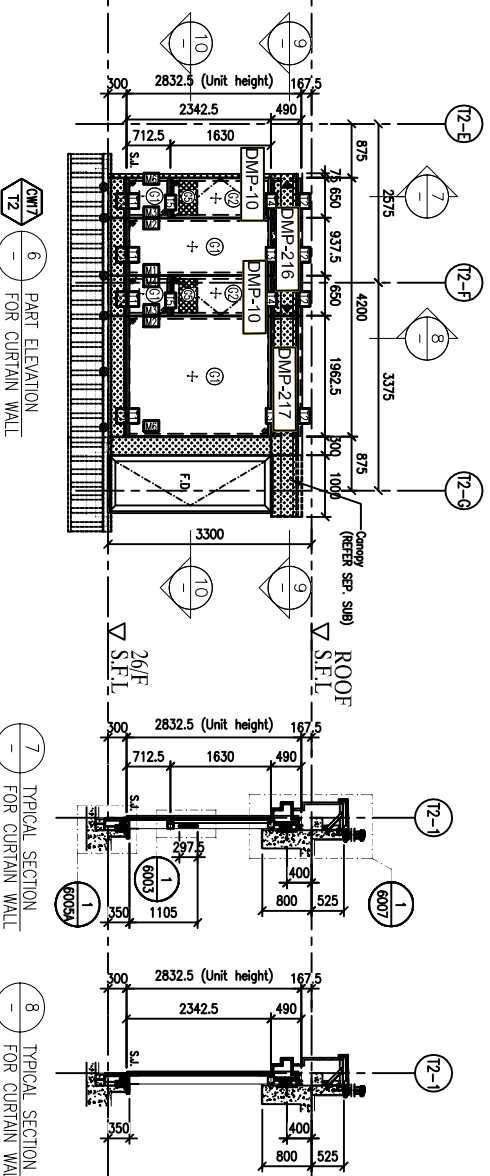


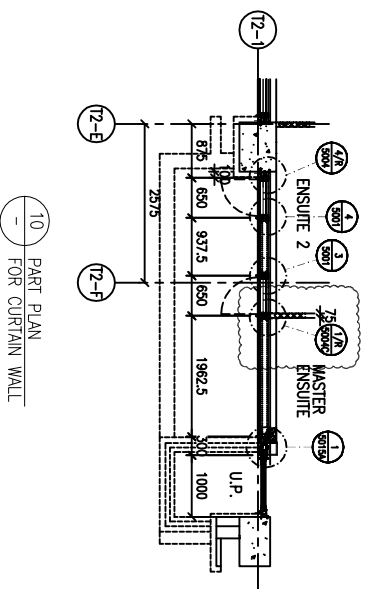


2 TYPICAL SECTION FOR CURTAIN WALL

3 TYPICAL SECTION FOR CURTAIN WALL

4 PART PLAN FOR CURTAIN WALL

5 PART PLAN FOR CURTAIN WALL

FLOOR LEVEL (S.F.L.)	
FLOOR	LEVEL
ROOF	+210.00
26/F	+206.70
25/F	+203.40

- LEGEND:
- 10mm HEAT STRENGTHENED GLASS (OUTER) + 12mm AIR SPACE + 12mm THK. TEMPERED CLEAR GLASS (INNER)
 - 10mm HEAT STRENGTHENED GLASS (INNER) + 12mm AIR SPACE + 10mm THK. TEMPERED CLEAR GLASS (INNER)
 - 12mm THK. HEAT STRENGTHENED GLASS & 2mm THK. ALUM. BACKPAN (SPANDREL GLASS) (INTERNAL PROTECTIVE BARRIER)
 - 3mm THK. ALUM. CLADDING
 - S.J. -- STACK JOINT (WIND LOAD)
 - ALUM. EXTRUSION DIE NO.
 - SUPPORT POINT (WIND LOAD + DEAD LOAD)
 - SUPPORT POINT (WIND LOAD)

DATE : 05-OCT-21	SCALE : 1:60 (A1)
DRAWN BY : LHR	CHECKED BY :
TITLE : PART ELEVATION FOR CURTAIN WALL AT TOWER 2	
PROJECT : PROPOSED RESIDENTIAL DEVELOPMENT AT N.K.I.L. 6542 YIN PING ROAD KOWLOON	
JOB NO. : J-853	
DWG NO. : JB53-SD-CW-4206	
REV. : A	

MID International Resources Ltd.
 Units 6-8, Sunny Industrial Centre, 1/F
 610 Chee Kwo Ling Road, Kowloon
 Tel: 23489211-4 Fax: (852) 27277866

B.O. REF. :

CLIENT :
SHIMAO GROUP HOLDINGS LIMITED

ARCHITECT :
YONG TUNG & PARTNERS LIMITED
 ARCHITECTS & PLANNERS

MAIN CONTRACTOR :
協興建築有限公司
 HIP HING CONSTRUCTION CO LTD

STRUCTURAL ENGINEER :
ICMA
 C M WONG & ASSOCIATES LTD
 黃志明建築工程師有限公司

FAÇADE CONSULTANT:
MEINHARDT

NOTE:
 1. ALL DIMENSIONS ARE IN mm.
 2. ALL ELEVATIONS ARE VIEWED FROM OUTSIDE.
 3. ALL DIMENSIONS TO BE VERIFIED ON SITE BEFORE FABRICATION.

LEGEND:
 (X1) DETAIL MARK NO.
 (X00) REFER SHEET NO.
 1. F.F.L. -- FINISHED FLOOR LEVEL
 2. S.F.L. -- STRUCTURAL FLOOR LEVEL
 3. (R) -- REVERSED DETAIL



FLOOR	LEVEL
R/F	+210.00
26/F	+206.70
25/F	+203.40
23/F	+200.00
22/F	+196.85
21/F	+193.70
20/F	+189.55
19/F	+187.40
18/F	+184.25
17/F	+181.10
16/F	+177.80
15/F	+174.65
12/F	+171.50
11/F	+168.35
10/F	+165.20
9/F	+162.05
8/F	+158.90
7/F	+155.75
6/F	+152.60
5/F	+149.30

JOB NO. : J-853
 PRODUCT : PROPOSED RESIDENTIAL DEVELOPMENT AT N.K.I.L. 6542 YIN PING ROAD KOWLOON

TITLE : PART ELEVATION FOR CURTAIN WALL AT TOWER 3
 DATE : 26-MAR-21
 SCALE : 1:60 (A1)
 DRAWN BY : LHR
 CHECKED BY :

美特銘實有限公司
 MIDY Aluminium Fabricator Ltd.
 Units 6-8, Sunny Industrial Centre, 1/F
 610 Che Kwo Ling Road, Kowloon
 Tel:23489211-4 Fax:(852)2727866
 DWG NO. : J853-SD-CW-4302
 REV. : C

依據E15161 390高度改石材取消背板


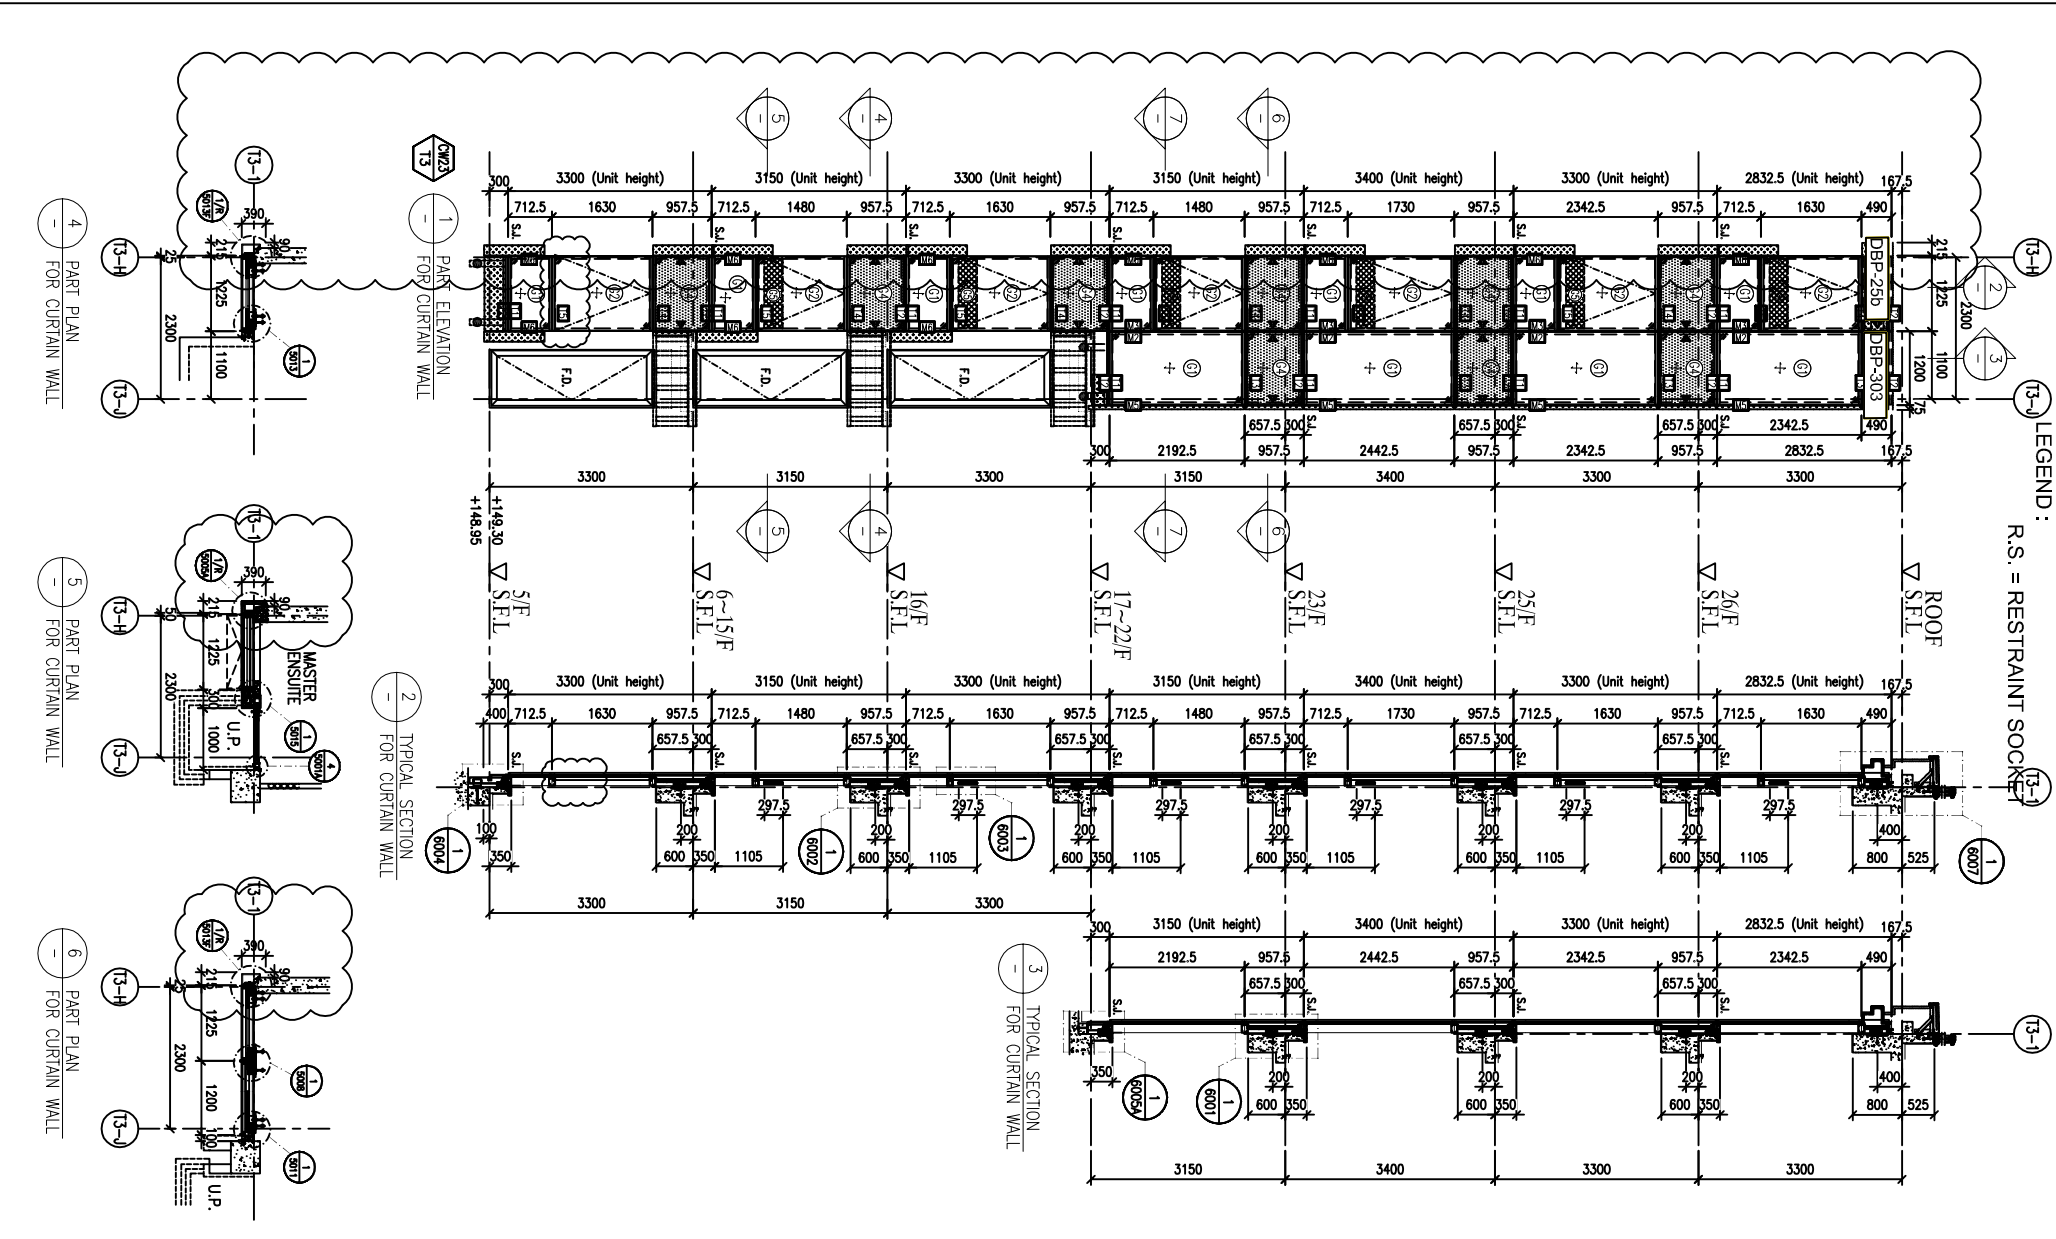
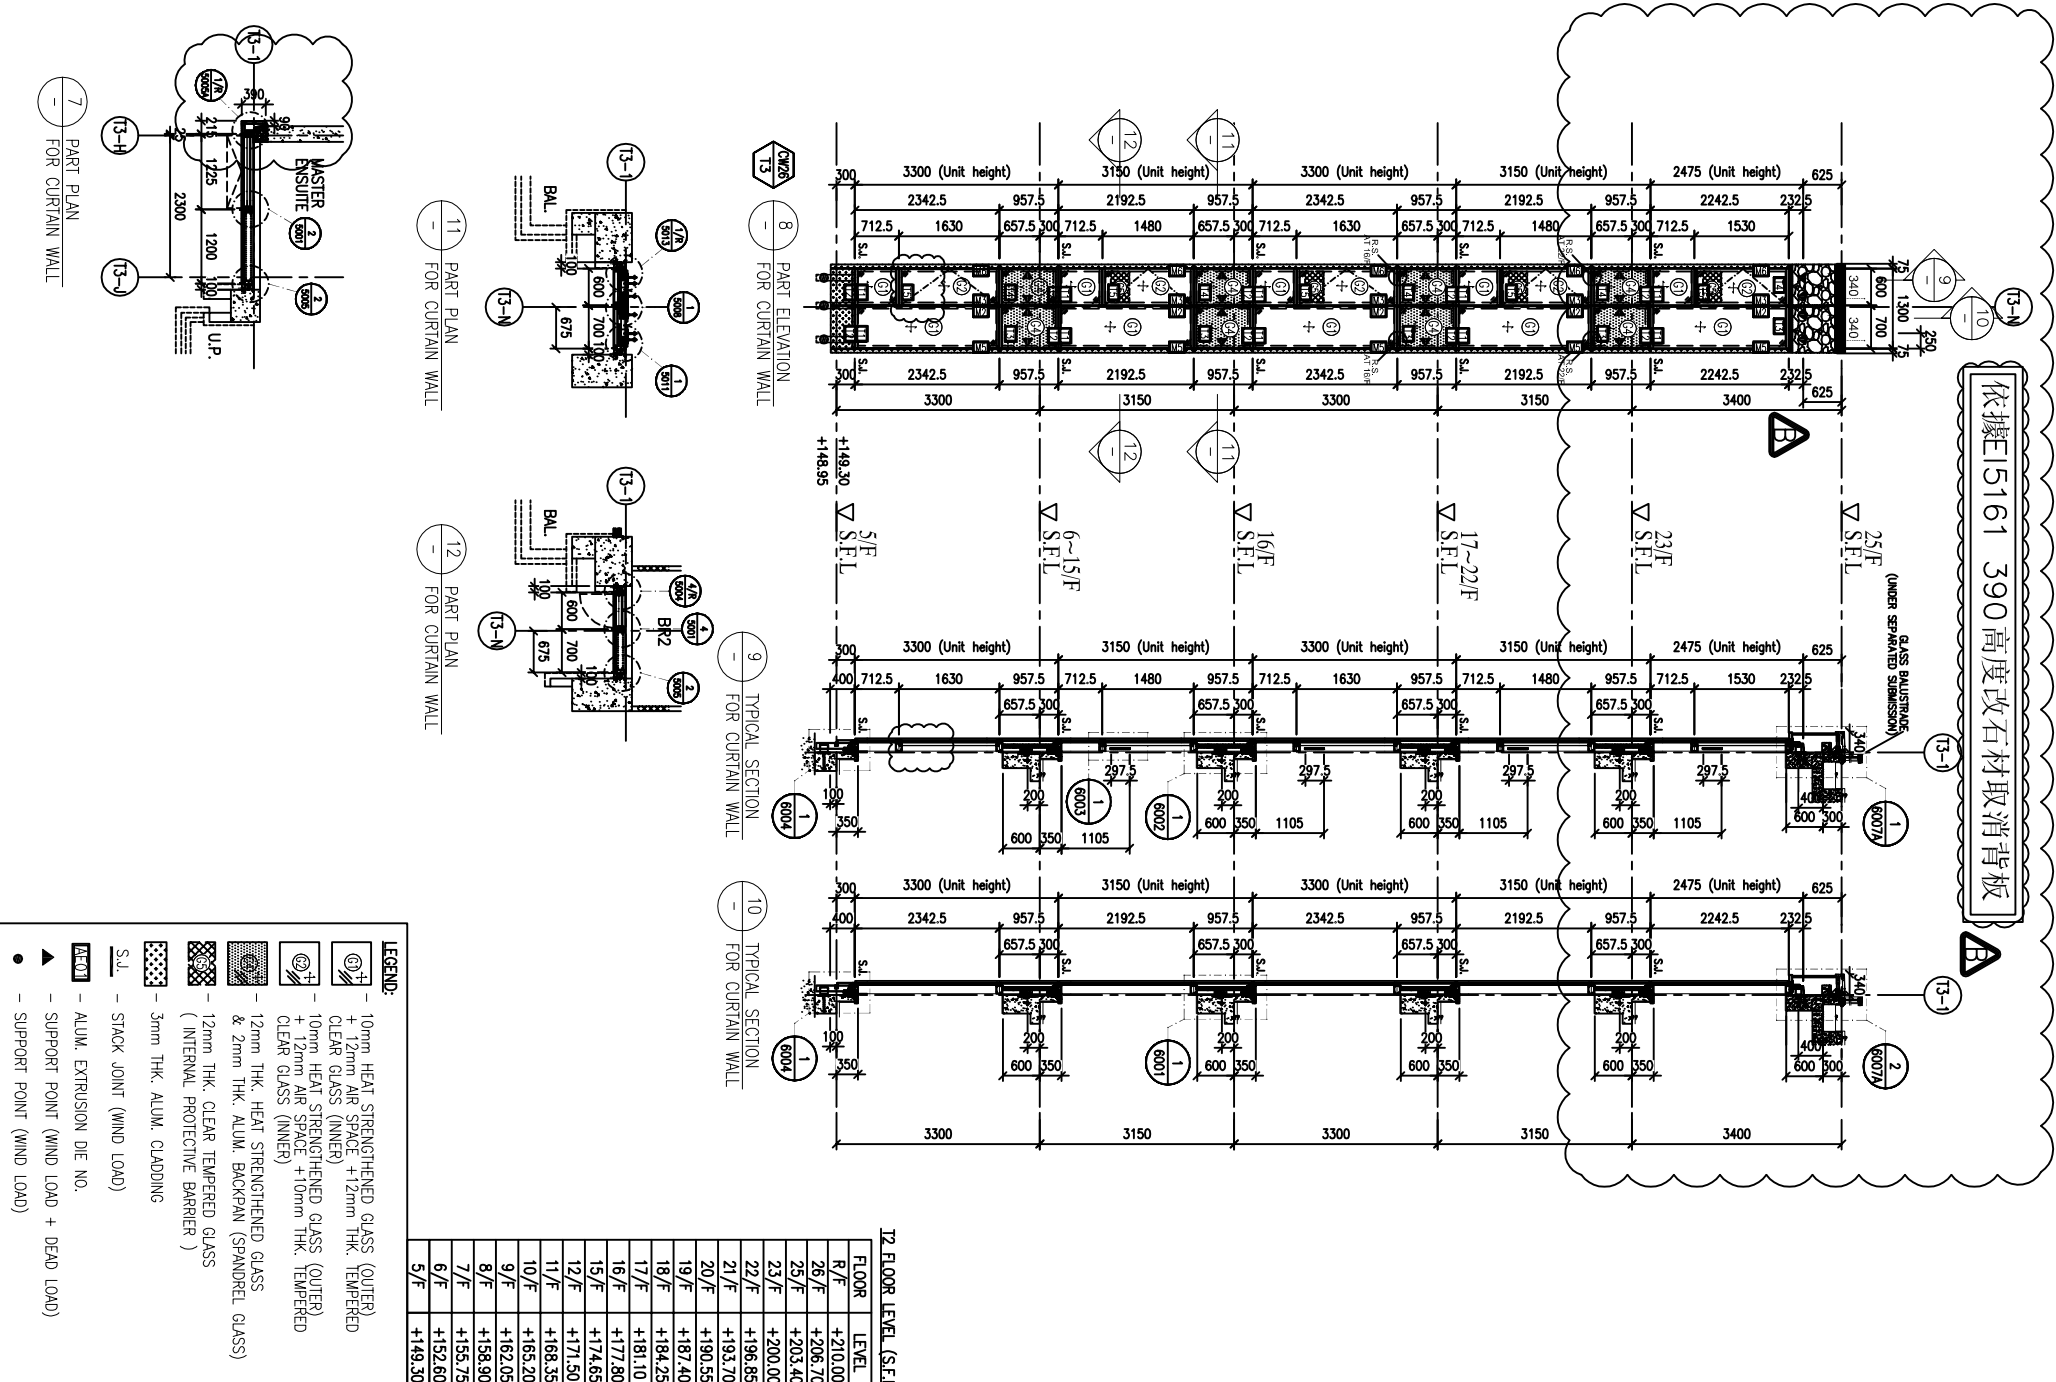


LEGEND:

- (X1) 10mm HEAT STRENGTHENED GLASS (OUTER)
- (X2) 12mm HEAT STRENGTHENED GLASS (INNER)
- (X3) 10mm HEAT STRENGTHENED GLASS (OUTER) + 12mm HEAT STRENGTHENED GLASS (INNER)
- (X4) 12mm THK. HEAT STRENGTHENED GLASS (OUTER) + 12mm THK. CLEAR TEMPERED GLASS (INNER)
- (X5) 12mm THK. HEAT STRENGTHENED GLASS & 2mm THK. ALUM. BACKPAN (SPANDREL GLASS) (INTERNAL PROTECTIVE BARRIER)
- (X6) 3mm THK. ALUM. CLADDING
- (X7) S.J. - STACK JOINT (WIND LOAD)
- (X8) ALUM. EXTRUSION DET. NO.
- (X9) SUPPORT POINT (WIND LOAD + DEAD LOAD)
- (X0) SUPPORT POINT (WIND LOAD)

LEGEND :
R.S. = RESTRAINT SOCKET

請用A3紙打印

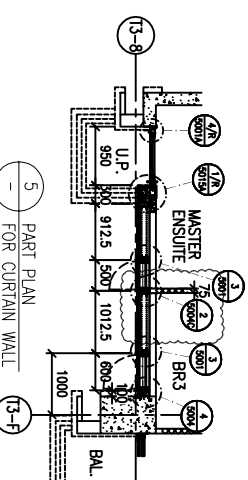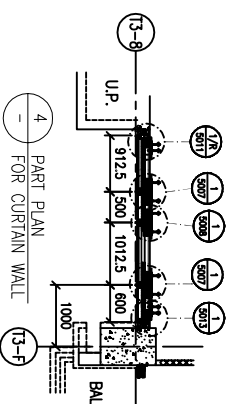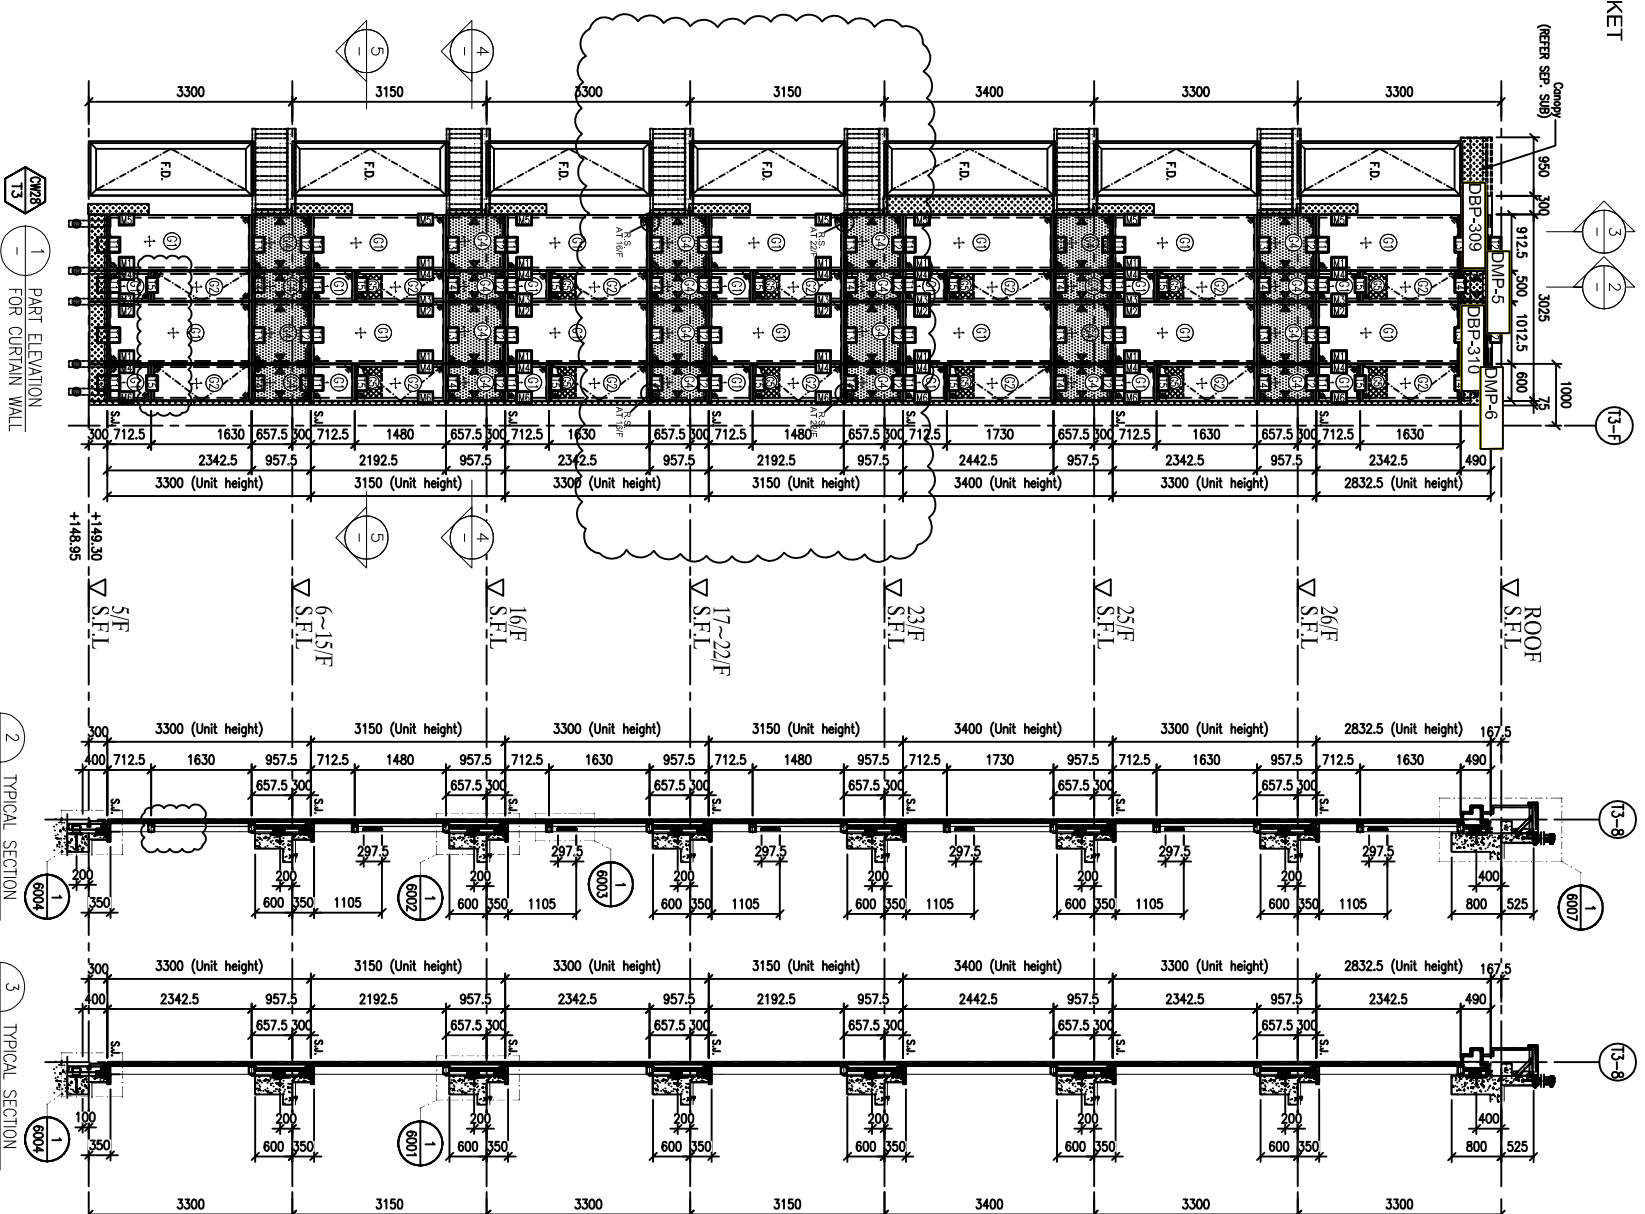

LEGEND:

- ① 10mm HEAT STRENGTHENED GLASS (OUTER) + 12mm AIR SPACE + 12mm THK. TEMPERED CLEAR GLASS (INNER)
- ② 10mm HEAT STRENGTHENED GLASS (OUTER) + 12mm AIR SPACE + 10mm THK. TEMPERED CLEAR GLASS (INNER)
- ③ 12mm THK. HEAT STRENGTHENED GLASS & 2mm THK. ALUM. BACKPAN (SPANDREL GLASS) (INTERNAL PROTECTIVE BARRIER)
- ④ 3mm THK. ALUM. CLADDING
- S.J. - STACK JOINT (WIND LOAD)
- ALUM. - ALUM. EXTRUSION DIE NO.
- ▲ - SUPPORT POINT (WIND LOAD + DEAD LOAD)
- - SUPPORT POINT (WIND LOAD)

FLOOR LEVEL (S.F.L.)	FLOOR LEVEL
ROOF	+210.00
26/F	+206.70
25/F	+203.40
23/F	+200.00
22/F	+196.85
21/F	+193.70
20/F	+190.55
19/F	+187.40
18/F	+184.25
17/F	+181.10
16/F	+177.80
15/F	+174.65
12/F	+171.50
11/F	+168.35
10/F	+165.20
9/F	+162.05
8/F	+158.90
7/F	+155.75
6/F	+152.60
5/F	+149.30

NOTE:
1. ALL DIMENSIONS ARE IN mm.
2. ALL ELEVATIONS ARE VIEWED FROM OUTSIDE.
3. ALL DIMENSIONS TO BE VERIFIED ON SITE BEFORE FABRICATION.

LEGEND:
① - DETAIL MARK NO.
② - REFER SHEET NO.
1. F.F.L. - FINISHED FLOOR LEVEL
2. S.F.L. - STRUCTURAL FLOOR LEVEL
3. Ⓡ - REVERSED DETAIL

B.D. REF :

CLIENT :
SHIMAO GROUP HOLDINGS LIMITED

ARCHITECT :
WONG TUNG & PARTNERS LIMITED ARCHITECTS & PLANNERS

MAIN CONTRACTOR :
協興建築有限公司 HIP HING CONSTRUCTION CO LTD

STRUCTURAL ENGINEER :
ICMA C M WONG & ASSOCIATES LTD
黃志明建築工程師有限公司

FAÇADE CONSULTANT:
MENHARDT

NO.	DATE	REVISION SUBJECT TO ARCH. COMMENT	REVISION	BY
1	06-10-2021			

JOB NO. : J-853
PROJECT : PROPOSED RESIDENTIAL DEVELOPMENT AT N.K.I.L. 6542 YIN PING ROAD KOWLOON

TITLE : PART ELEVATION FOR CURTAIN WALL AT TOWER 3
DATE : 26-MAR-21 SCALE : 1:60 (A1)
DRAWN BY : LHR CHECKED BY :
美特銘實有限公司
Units 6-8, Sunray Industrial Centre, 1/F
610 Che Kwo Ling Road, Kowloon
Tel:23489211-4 Fax:(852)27277866
DWG NO. : J853-SD-CW-4304 REV. : A

請用A3紙打印

B.D. REF :

CLIENT :
SHIMAO GROUP
HOLDINGS LIMITED

ARCHITECT :
WONG TUNG & PARTNERS LIMITED
ARCHITECTS & PLANNERS



MAIN CONTRACTOR :
協興建築有限公司
HIP HING CONSTRUCTION CO LTD

STRUCTURAL ENGINEER :
ICMA C M WONG & ASSOCIATES LTD
黃志明建築工程師有限公司

FAÇADE CONSULTANT:



NOTE :
1. ALL DIMENSIONS ARE IN mm.
2. ALL ELEVATIONS ARE VIEWED FROM OUTSIDE.
3. ALL DIMENSIONS TO BE VERIFIED ON SITE BEFORE FABRICATION.

LEGEND :
① - DETAIL MARK NO.
② - REFER SHEET NO.
1. F.F.L. -- FINISHED FLOOR LEVEL
2. S.F.L. -- STRUCTURAL FLOOR LEVEL
3. Ⓡ -- REVERSED DETAIL

FLOOR LEVEL (S.F.L.)	FLOOR LEVEL
ROOF	+210.00
26/F	+206.70
25/F	+203.40
23/F	+200.00
22/F	+196.85
21/F	+193.70
20/F	+189.55
19/F	+187.40
18/F	+184.25
17/F	+181.10
16/F	+177.80
15/F	+174.65
12/F	+171.50
11/F	+168.35
10/F	+165.20
9/F	+162.05
8/F	+158.90
7/F	+155.75
6/F	+152.60
5/F	+149.30

PRODUCT :
PROPOSED RESIDENTIAL
DEVELOPMENT AT N.K.I.L. 6542
YIN PING ROAD
KOWLOON


TITLE :
PART ELEVATION
FOR CURTAIN WALL
AT TOWER 3

DATE : 23-OCT-21
SCALE : 1:60 (A1)

DRAWN BY : LHR
CHECKED BY :

美特鋁質有限公司
MIDI Aluminium Fabricator Ltd.
Units 6-8, Sunny Industrial Centre, 1/F
610 Cho Kwong Road, Kowloon
Tel: 23489211-4 Fax: (852) 2727866
DWG NO. : JB53-SD-CW-4304A REV. : A

LEGEND :
R.S. = RESTRAINT SOCKET

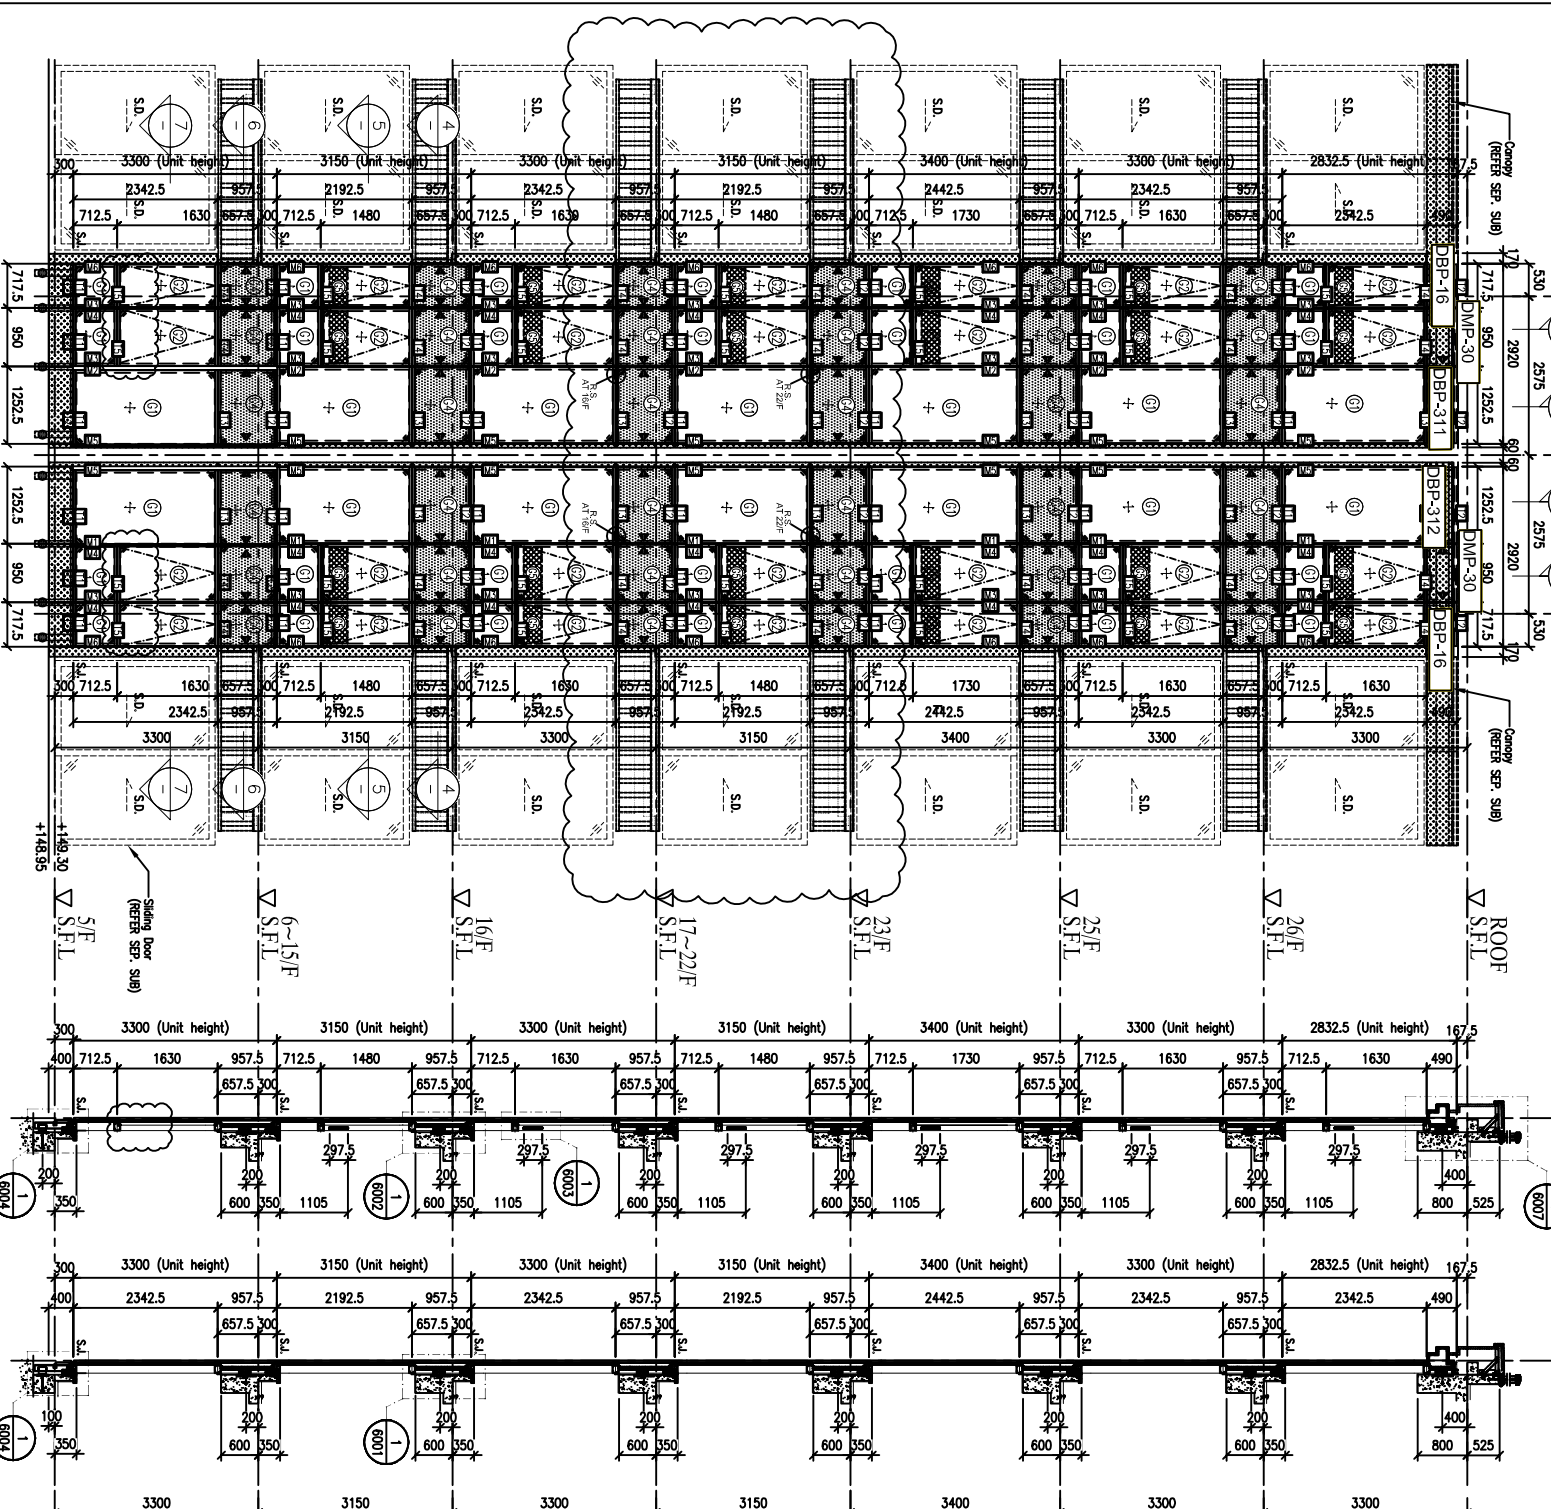

1 PART ELEVATION FOR CURTAIN WALL

2 TYPICAL SECTION FOR CURTAIN WALL

3 TYPICAL SECTION FOR CURTAIN WALL

6 PART PLAN FOR CURTAIN WALL

4 PART PLAN FOR CURTAIN WALL

5 PART PLAN FOR CURTAIN WALL






7 PART PLAN FOR CURTAIN WALL

LEGEND:

- ① - 10mm HEAT STRENGTHENED GLASS (OUTER) + 12mm AIR SPACE + 12mm THK. TEMPERED CLEAR GLASS (INNER)
- ② - 10mm HEAT STRENGTHENED GLASS (OUTER) + 12mm AIR SPACE + 10mm THK. TEMPERED CLEAR GLASS (INNER)
- ③ - 12mm THK. HEAT STRENGTHENED GLASS & 2mm THK. ALUM. BACKPAN (SPANDREL GLASS) (INTERNAL PROTECTIVE BARRIER)
- ④ - 3mm THK. ALUM. CLADDING
- S.J. - STACK JOINT (WIND LOAD)
- ALUM. - ALUM. EXTRUSION DIE NO.
- ▲ - SUPPORT POINT (WIND LOAD + DEAD LOAD)
- - SUPPORT POINT (WIND LOAD)

請用A3紙打印

LEGEND :
R.S. = RESTRAINT SOCKET

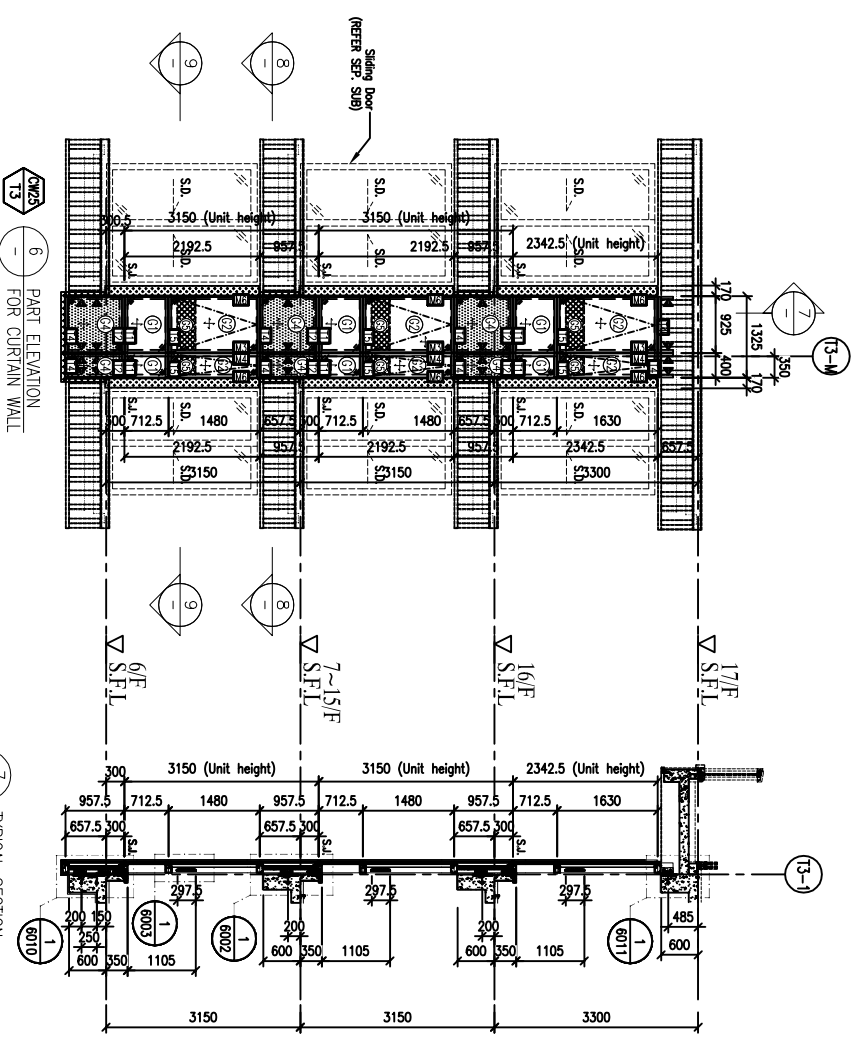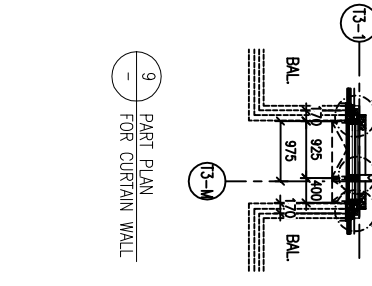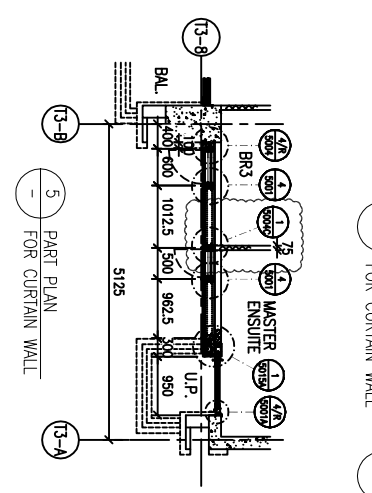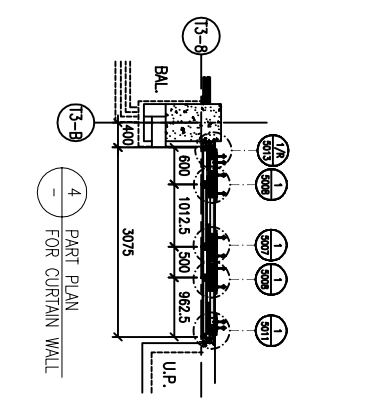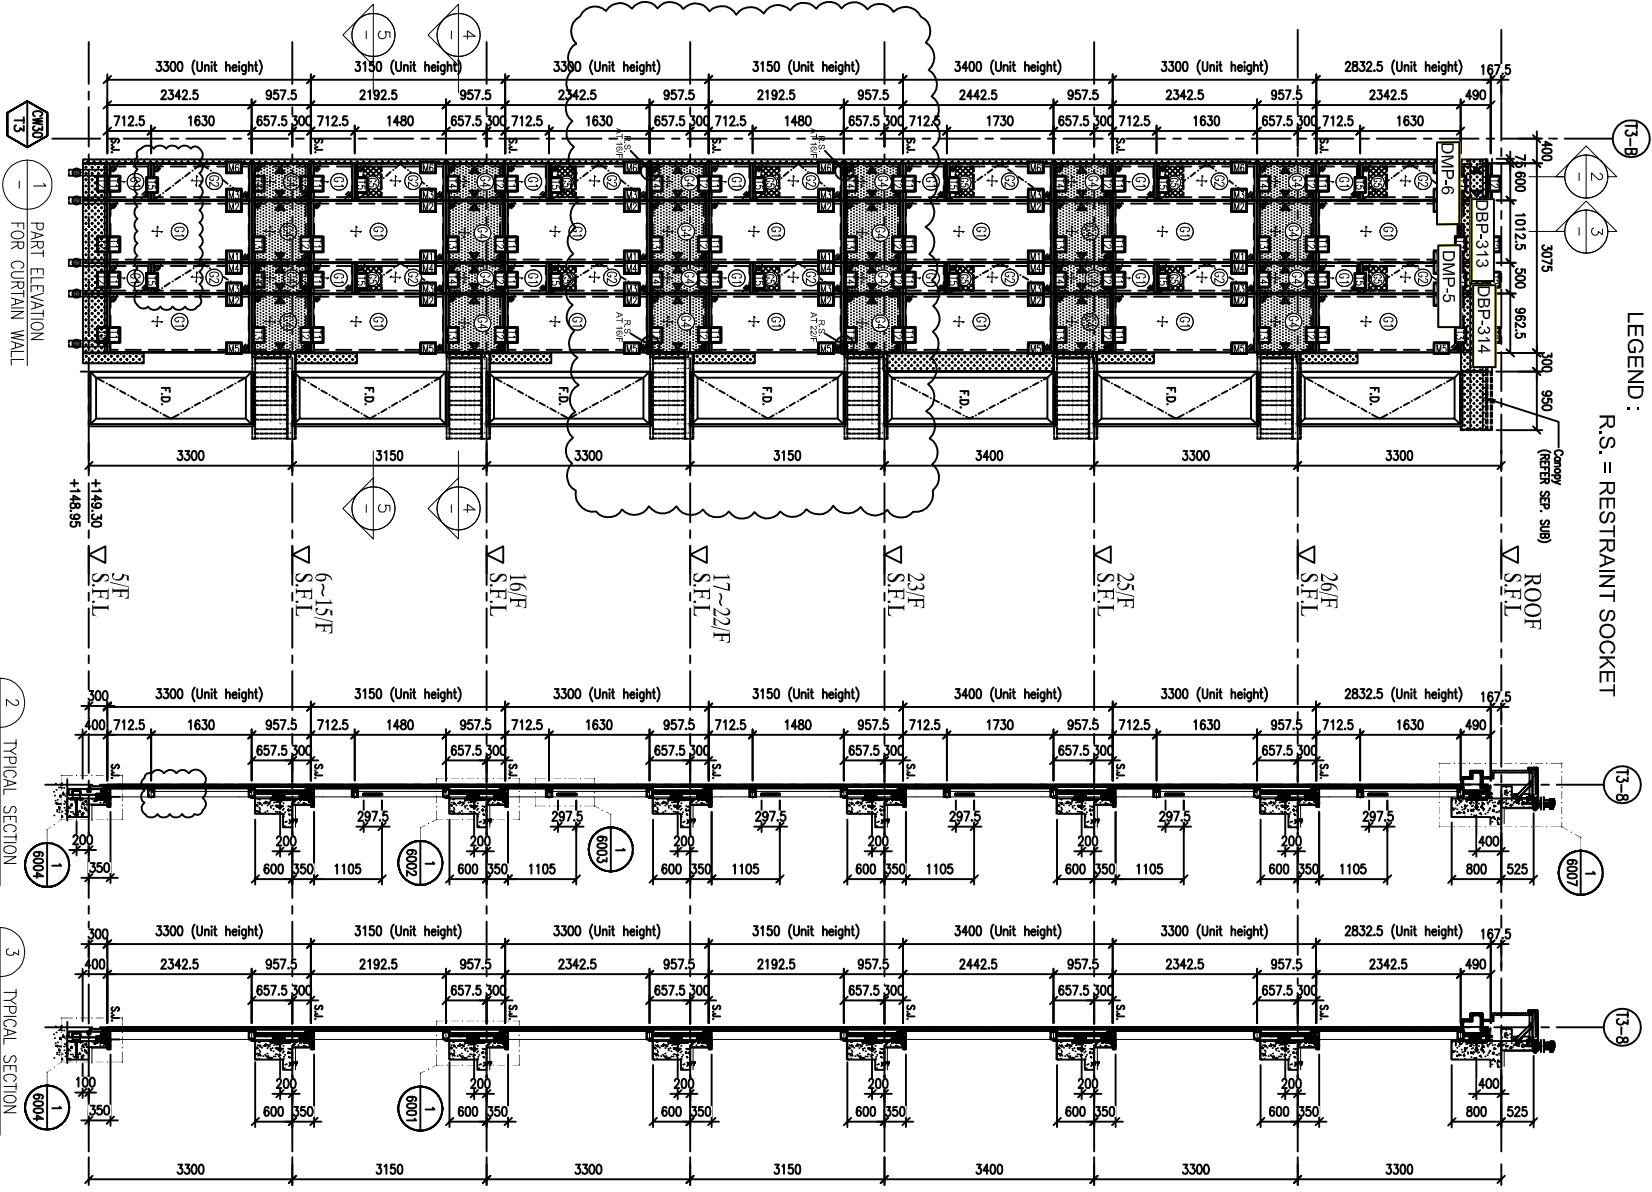

FLOOR LEVEL (S.F.L.)

FLOOR	LEVEL
ROOF	+210.00
26/F	+206.70
25/F	+203.40
23/F	+200.00
22/F	+196.85
21/F	+193.70
20/F	+190.55
19/F	+187.40
18/F	+184.25
17/F	+181.10
16/F	+177.80
15/F	+174.65
12/F	+171.50
11/F	+168.35
10/F	+165.20
9/F	+162.05
8/F	+158.90
7/F	+155.75
6/F	+152.60
5/F	+149.30

- LEGEND:**
 - ④ 12mm THK. HEAT STRENGTHENED GLASS & 2mm THK. ALUM. BACKPAN (SPANDREL GLASS)
 - ⑤ 3mm THK. ALUM. CLADDING
 - S.J. STACK JOINT (WIND LOAD)
 - ALUM. EXTRUSION DE. NO.
 - ▲ SIP-SUPPORT POINT (WIND LOAD + DEAD LOAD)
 - SIP-SUPPORT POINT (WIND LOAD)

CLIENT : SHIMAO GROUP HOLDINGS LIMITED

ARCHITECT : HONG TUNG & PARTNERS LIMITED ARCHITECTS & PLANNERS

MAIN CONTRACTOR : 協興建築有限公司 HIP HING CONSTRUCTION CO LTD

STRUCTURAL ENGINEER : ICMA C M WONG & ASSOCIATES LTD 黃志明建築工程師有限公司

FAÇADE CONSULTANT : MENHARDT

PROJECT : PROPOSED RESIDENTIAL DEVELOPMENT AT N.K.I.L. 6542 YIN PING ROAD KOWLOON

TITLE : PART ELEVATION FOR CURTAIN WALL AT TOWER 3

DATE : 05-OCT-21 **SCALE :** 1:60 (A1)





DRAWN BY : LHR **CHECKED BY :**

UNITS : 6-8, Sunny Industrial Centre, 610 Chee Kwo Ling Road, Kowloon
Tel: 23489211-4 Fax: (852) 27277866

DWG NO. : JB53-SD-CW-4305 **REV. :** A

請使用A3紙打印

LEGEND :
R.S. = RESTRAINT SOCKET

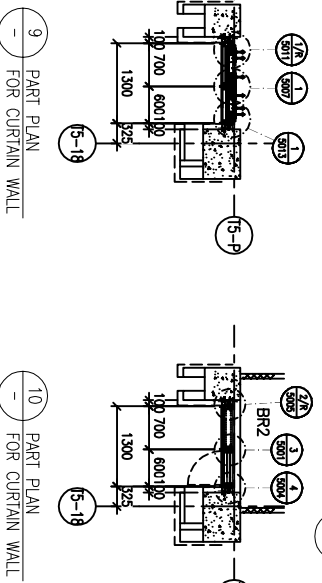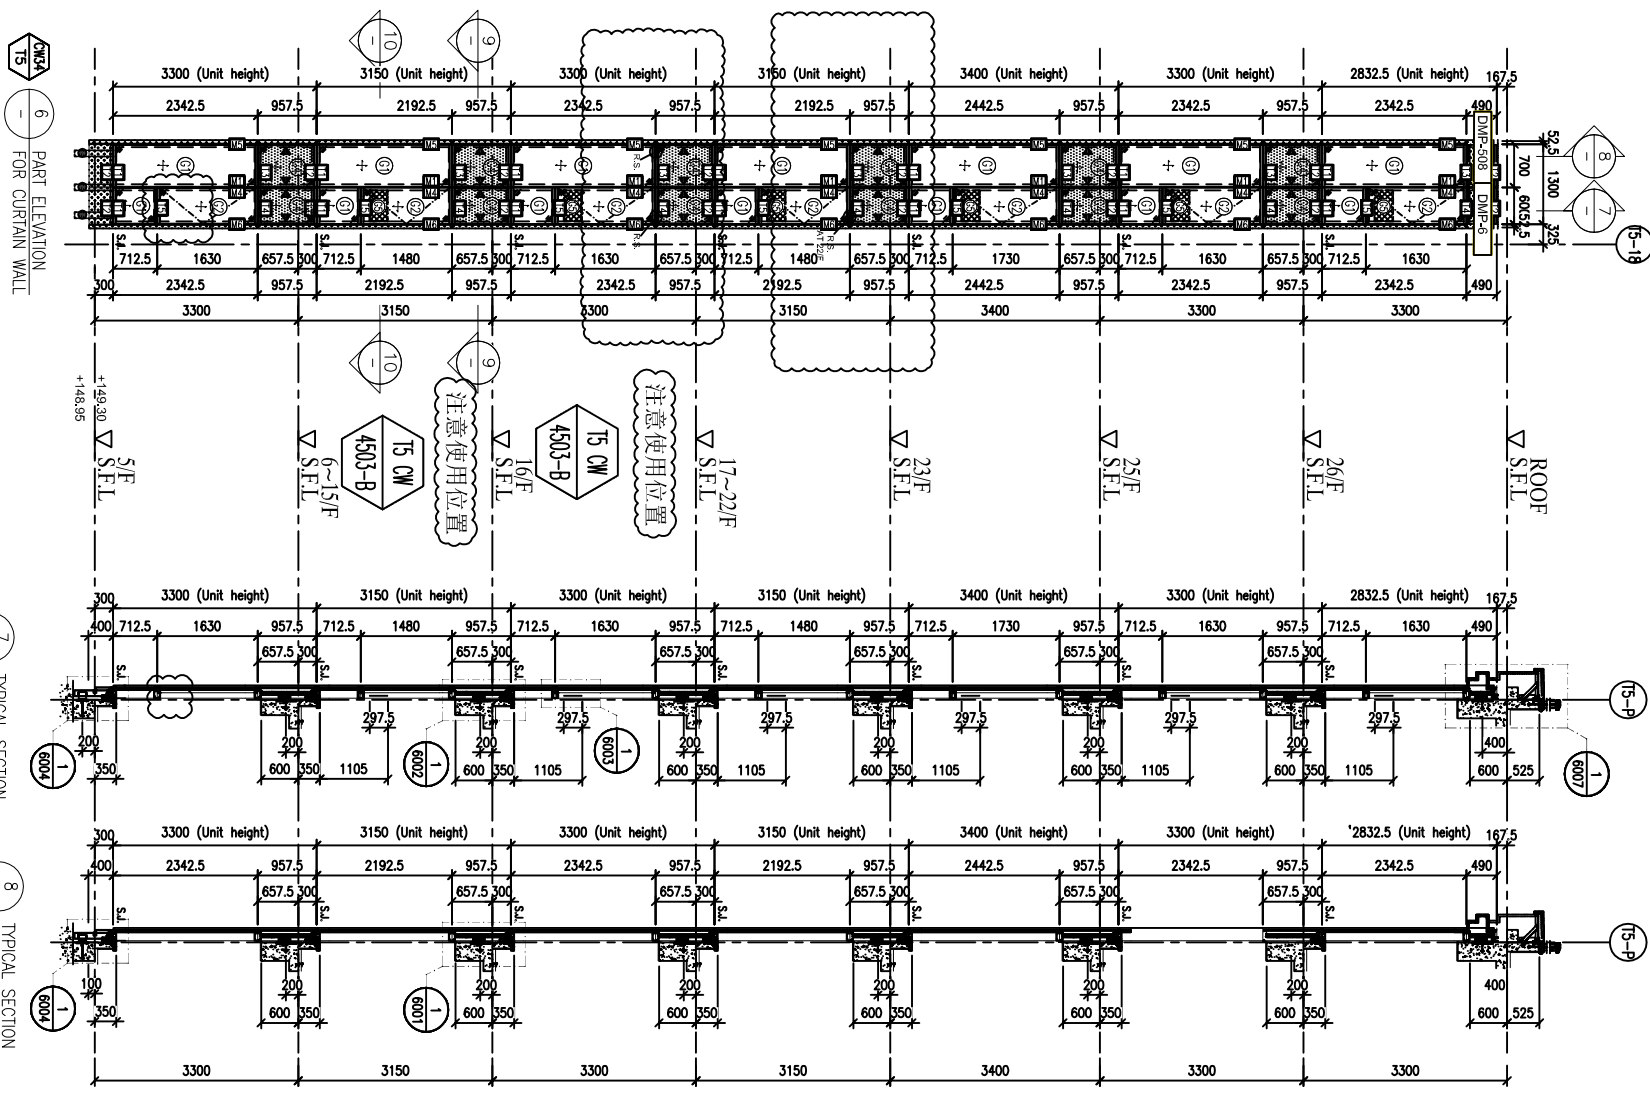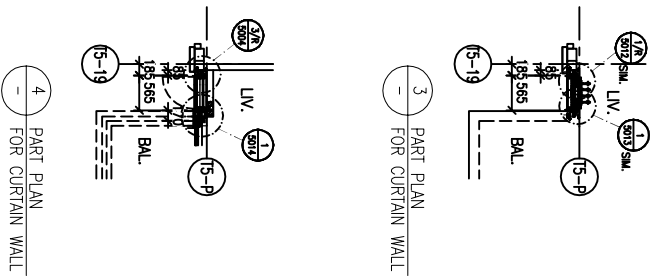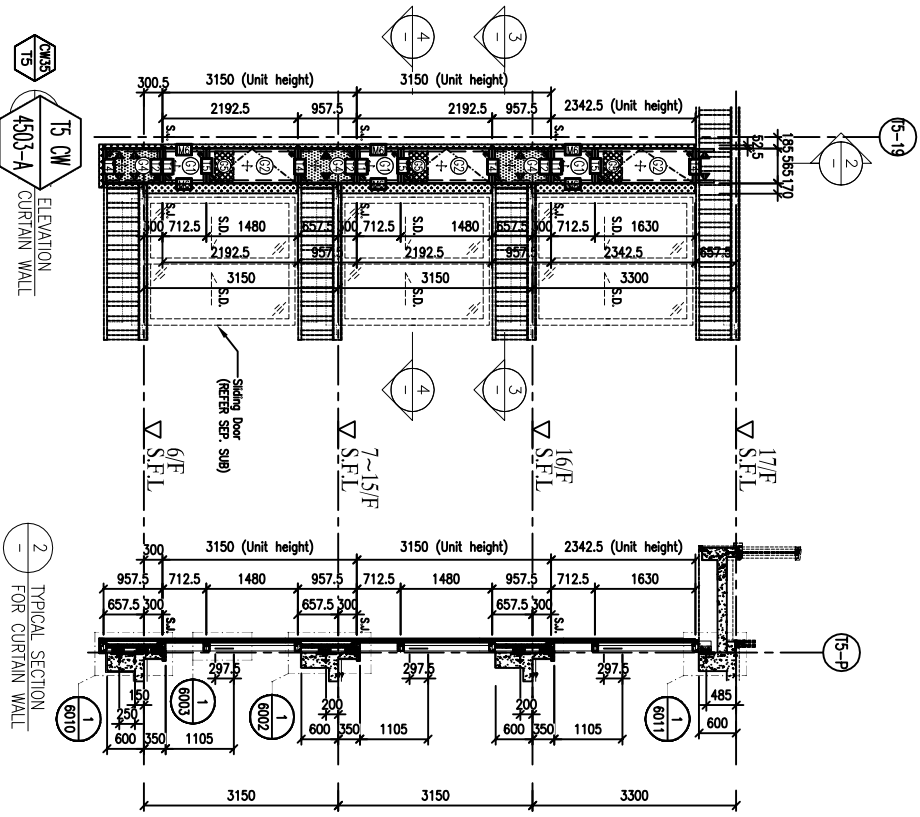

請使用A3紙打印

B.D. REF :

CLIENT :
SHIMAO GROUP HOLDINGS LIMITED

ARCHITECT :
WONG TUNG & PARTNERS LIMITED
ARCHITECTS & PLANNERS

MAIN CONTRACTOR :
協興建築有限公司
HIP HING CONSTRUCTION CO LTD

STRUCTURAL ENGINEER :
ICMA
C M WONG & ASSOCIATES LTD
黃志明建築工程師有限公司

FAÇADE CONSULTANT:
MENHARDT

NOTE :
1. ALL DIMENSIONS ARE IN mm.
2. ALL ELEVATIONS ARE VIEWED FROM OUTSIDE.
3. ALL DIMENSIONS TO BE VERIFIED ON SITE BEFORE FABRICATION.

LEGEND :
 (X1) DETAIL MARK NO.
 (X007) REFER SHEET NO.
 1. F.F.L. -- FINISHED FLOOR LEVEL
 2. S.F.L. -- STRUCTURAL FLOOR LEVEL
 3. (R) -- REVERSED DETAIL

FLOOR LEVEL (S.F.L.)	FLOOR LEVEL
ROOF	+210.00
26/F	+206.70
25/F	+203.40
23/F	+200.00
22/F	+196.85
21/F	+193.70
20/F	+190.55
19/F	+187.40
18/F	+184.25
17/F	+181.10
16/F	+177.80
15/F	+174.65
12/F	+171.50
11/F	+168.35
10/F	+165.20
9/F	+162.05
8/F	+158.90
7/F	+155.75
6/F	+152.60
5/F	+149.30

LEGEND:

- 10mm HEAT STRENGTHENED GLASS (OUTER) + 12mm AIR SPACE + 12mm THK. TEMPERED CLEAR GLASS (INNER)
- 10mm HEAT STRENGTHENED GLASS (OUTER) + 12mm AIR SPACE + 10mm THK. TEMPERED CLEAR GLASS (INNER)
- 12mm THK. HEAT STRENGTHENED GLASS & 2mm THK. ALUM. BACKPAN (SPANDREL GLASS) (INTERNAL PROTECTIVE BARRIER)
- 3mm THK. ALUM. CLADDING
- S.J. -- STACK JOINT (WIND LOAD)
- ALUM. -- ALUM. EXTRUSION DIE NO.
- SUPPORT POINT (WIND LOAD + DEAD LOAD)
- SUPPORT POINT (WIND LOAD)

JOB NO. : J-853

PROJECT : PROPOSED RESIDENTIAL DEVELOPMENT AT N.K.I.L. 6542 YIN PING ROAD KOWLOON

TITLE : PART ELEVATION FOR CURTAIN WALL AT TOWER 5

DATE : 31-MAR-21 SCALE : 1:60 (A1)


DRAWN BY : LHR CHECKED BY :

Units 6-8, Sunray Industrial Centre, 1/F
610 Che Kwo Ling Road, Kowloon
Tel: 23489211-4 Fax: (852) 27277866
DWG NO. : J853-SD-CW-4503 REV. : A

B.D. REF :

請使用A3紙打印

LEGEND :
R.S. = RESTRAINT SOCKET

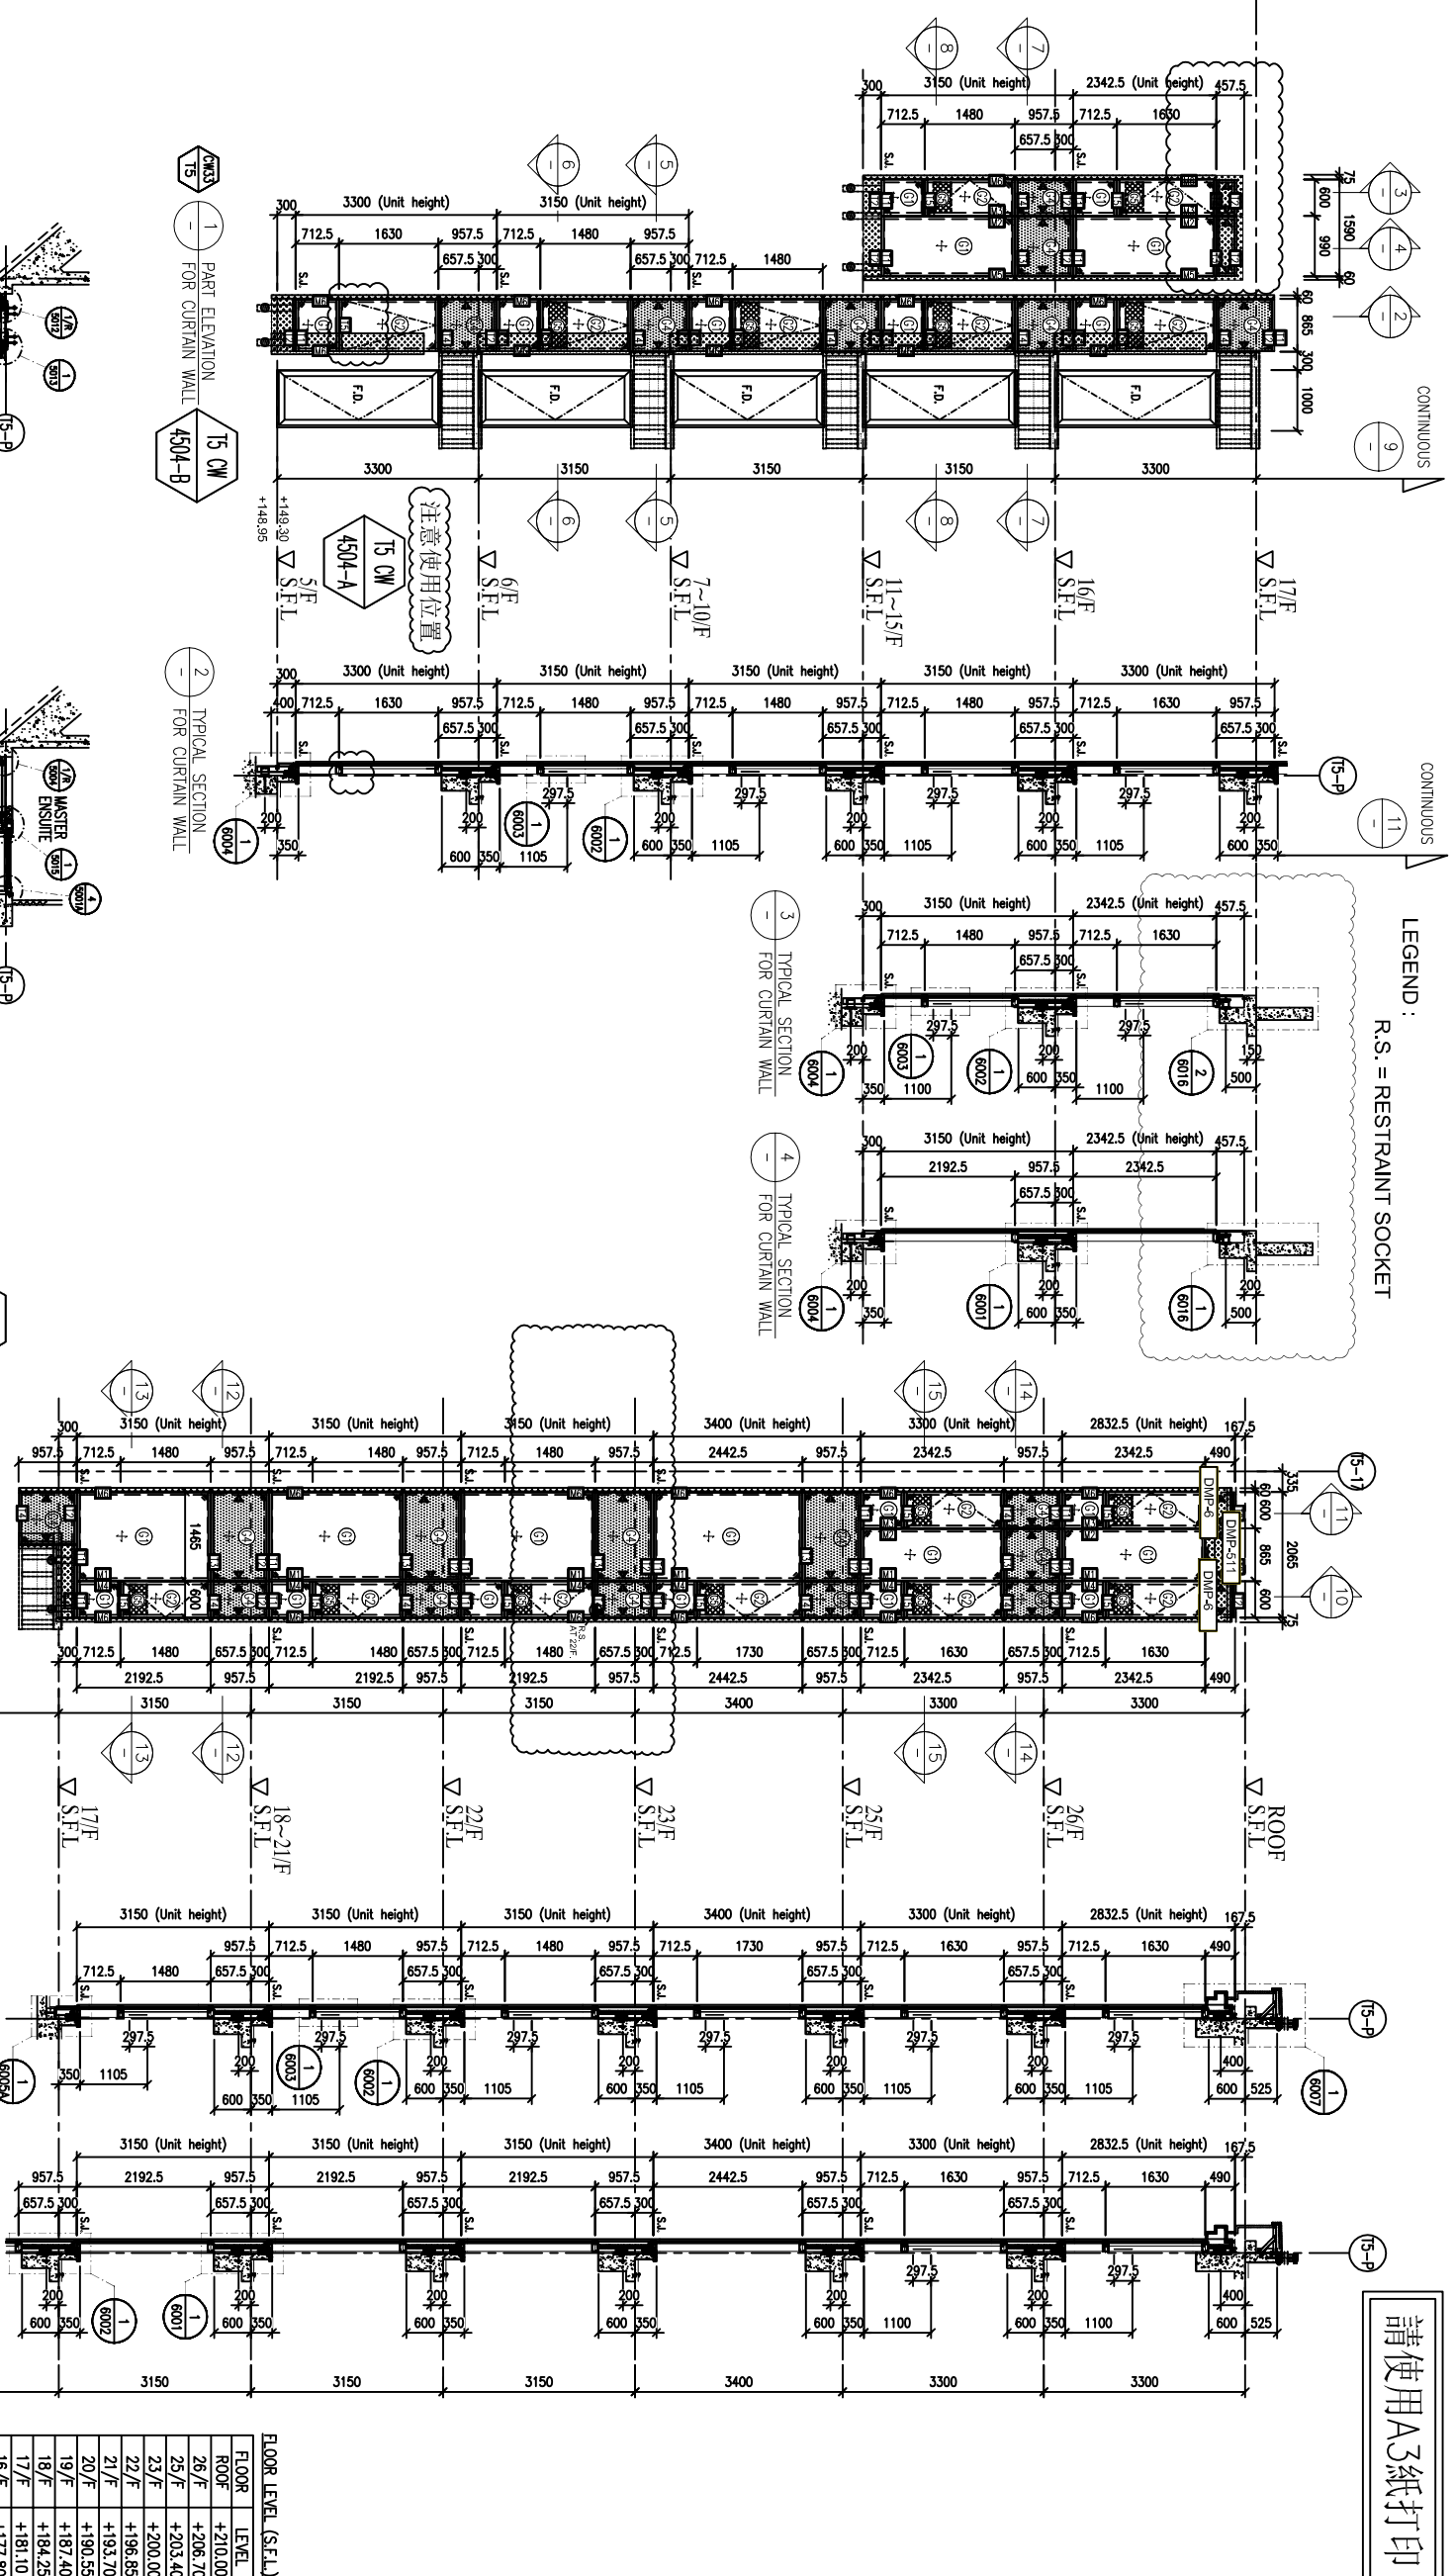

FLOOR LEVEL (S.F.L.)	FLOOR LEVEL
ROOF	+210.00
26/F	+206.70
25/F	+203.40
23/F	+200.00
22/F	+196.85
21/F	+193.70
20/F	+190.55
19/F	+187.40
18/F	+184.25
17/F	+181.10
16/F	+177.80
15/F	+174.65
12/F	+171.50
11/F	+168.35
10/F	+165.20
9/F	+162.05
8/F	+158.90
7/F	+155.75
6/F	+152.60
5/F	+149.30

LEGEND:

- ① 10mm HEAT STRENGTHENED GLASS (OUTER) + 12mm AIR SPACE + 12mm THK. TEMPERED CLEAR GLASS (INNER)
- ② 10mm HEAT STRENGTHENED GLASS (OUTER) + 12mm AIR SPACE + 10mm THK. TEMPERED CLEAR GLASS (INNER)
- ③ 12mm THK. HEAT STRENGTHENED GLASS & 2mm THK. ALUM. BACKPAN (SPANDREL GLASS) (INTERNAL PROTECTIVE BARBER)
- ④ 3mm THK. ALUM. CLADDING
- S.L. - STACK JOINT (WIND LOAD)
- ALUM. - ALUM. EXTRUSION DIE NO.
- SUPPORT POINT (WIND LOAD + DEAD LOAD)
- SUPPORT POINT (WIND LOAD)


PROJECT : PROPOSED RESIDENTIAL DEVELOPMENT AT N.K.I.L. 6542 YIN PING ROAD KOWLOON

TITLE : PART ELEVATION FOR CURTAIN WALL AT TOWER 5

DATE : 01-APR-21 SCALE : 1:60 (A1)

DRAWN BY : LHR CHECKED BY :

JOB NO. : J-853

REVISION SUBJECT TO ARCH. COMMENT

REVISION NO. DATE

NOTE :
1. ALL DIMENSIONS ARE IN mm.
2. ALL ELEVATIONS ARE VIEWED FROM OUTSIDE.
3. ALL DIMENSIONS TO BE VERIFIED ON SITE BEFORE FABRICATION.

LEGEND:
X1 - DETAIL MARK NO.
X001 - REFER SHEET NO.
1. F.F.L. - FINISHED FLOOR LEVEL
2. S.F.L. - STRUCTURAL FLOOR LEVEL
3. R - REVERSED DETAIL

ARCHITECT : **YONG TUNG & PARTNERS LIMITED**
ARCHITECTS & ENGINEERS

MAIN CONTRACTOR : **協興建築有限公司**
HIP HING CONSTRUCTION CO LTD

STRUCTURAL ENGINEER : **ICMA**
C M WONG & ASSOCIATES LTD
黃志明建築工程師有限公司





FAÇADE CONSULTANT : **MENHARDT**

CLIENT : **SHIMAO GROUP HOLDINGS LIMITED**

美特銘實有限公司
MIDI Aluminium Fabricator Ltd.
Units 6-8, Sunny Industrial Centre, 1/F
610 Cheung Kwo Ling Road, Kowloon
Tel: 23489211-4 Fax: (852) 27277866
DWG NO. : JB53-SD-CW-4504 REV. : A

B.D. REF :

LEGEND :
R.S. = RESTRAINT SOCKET

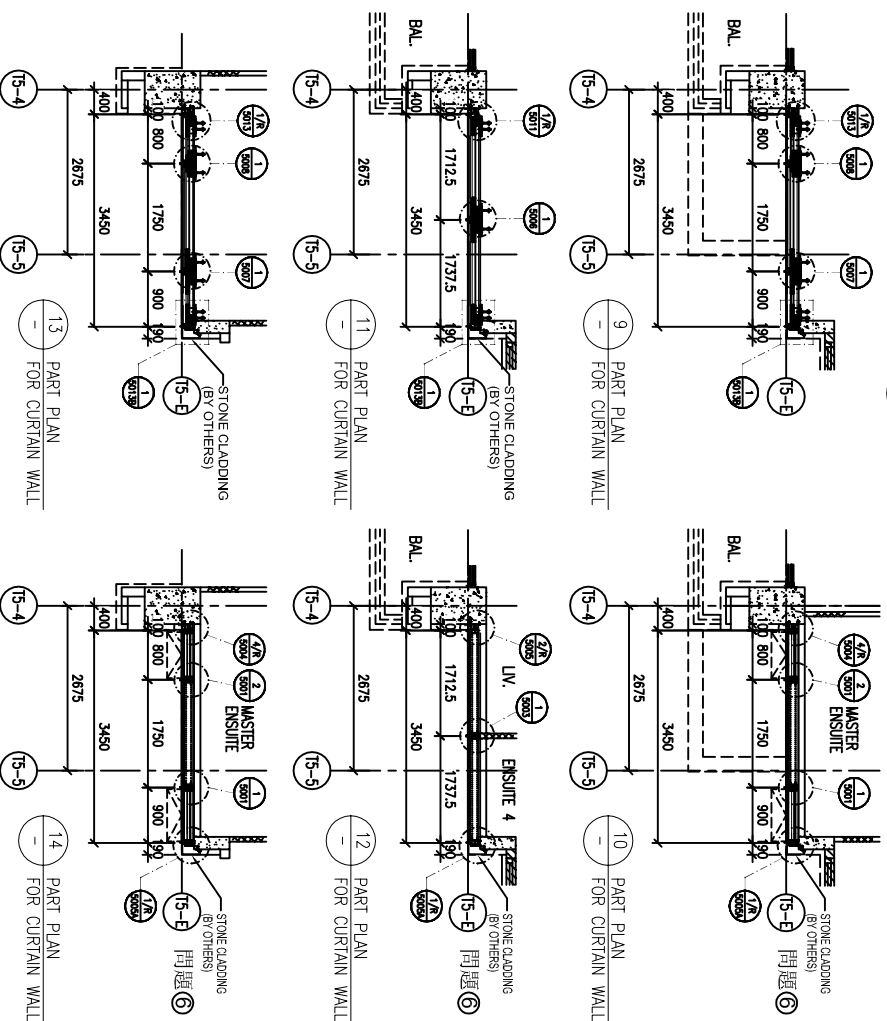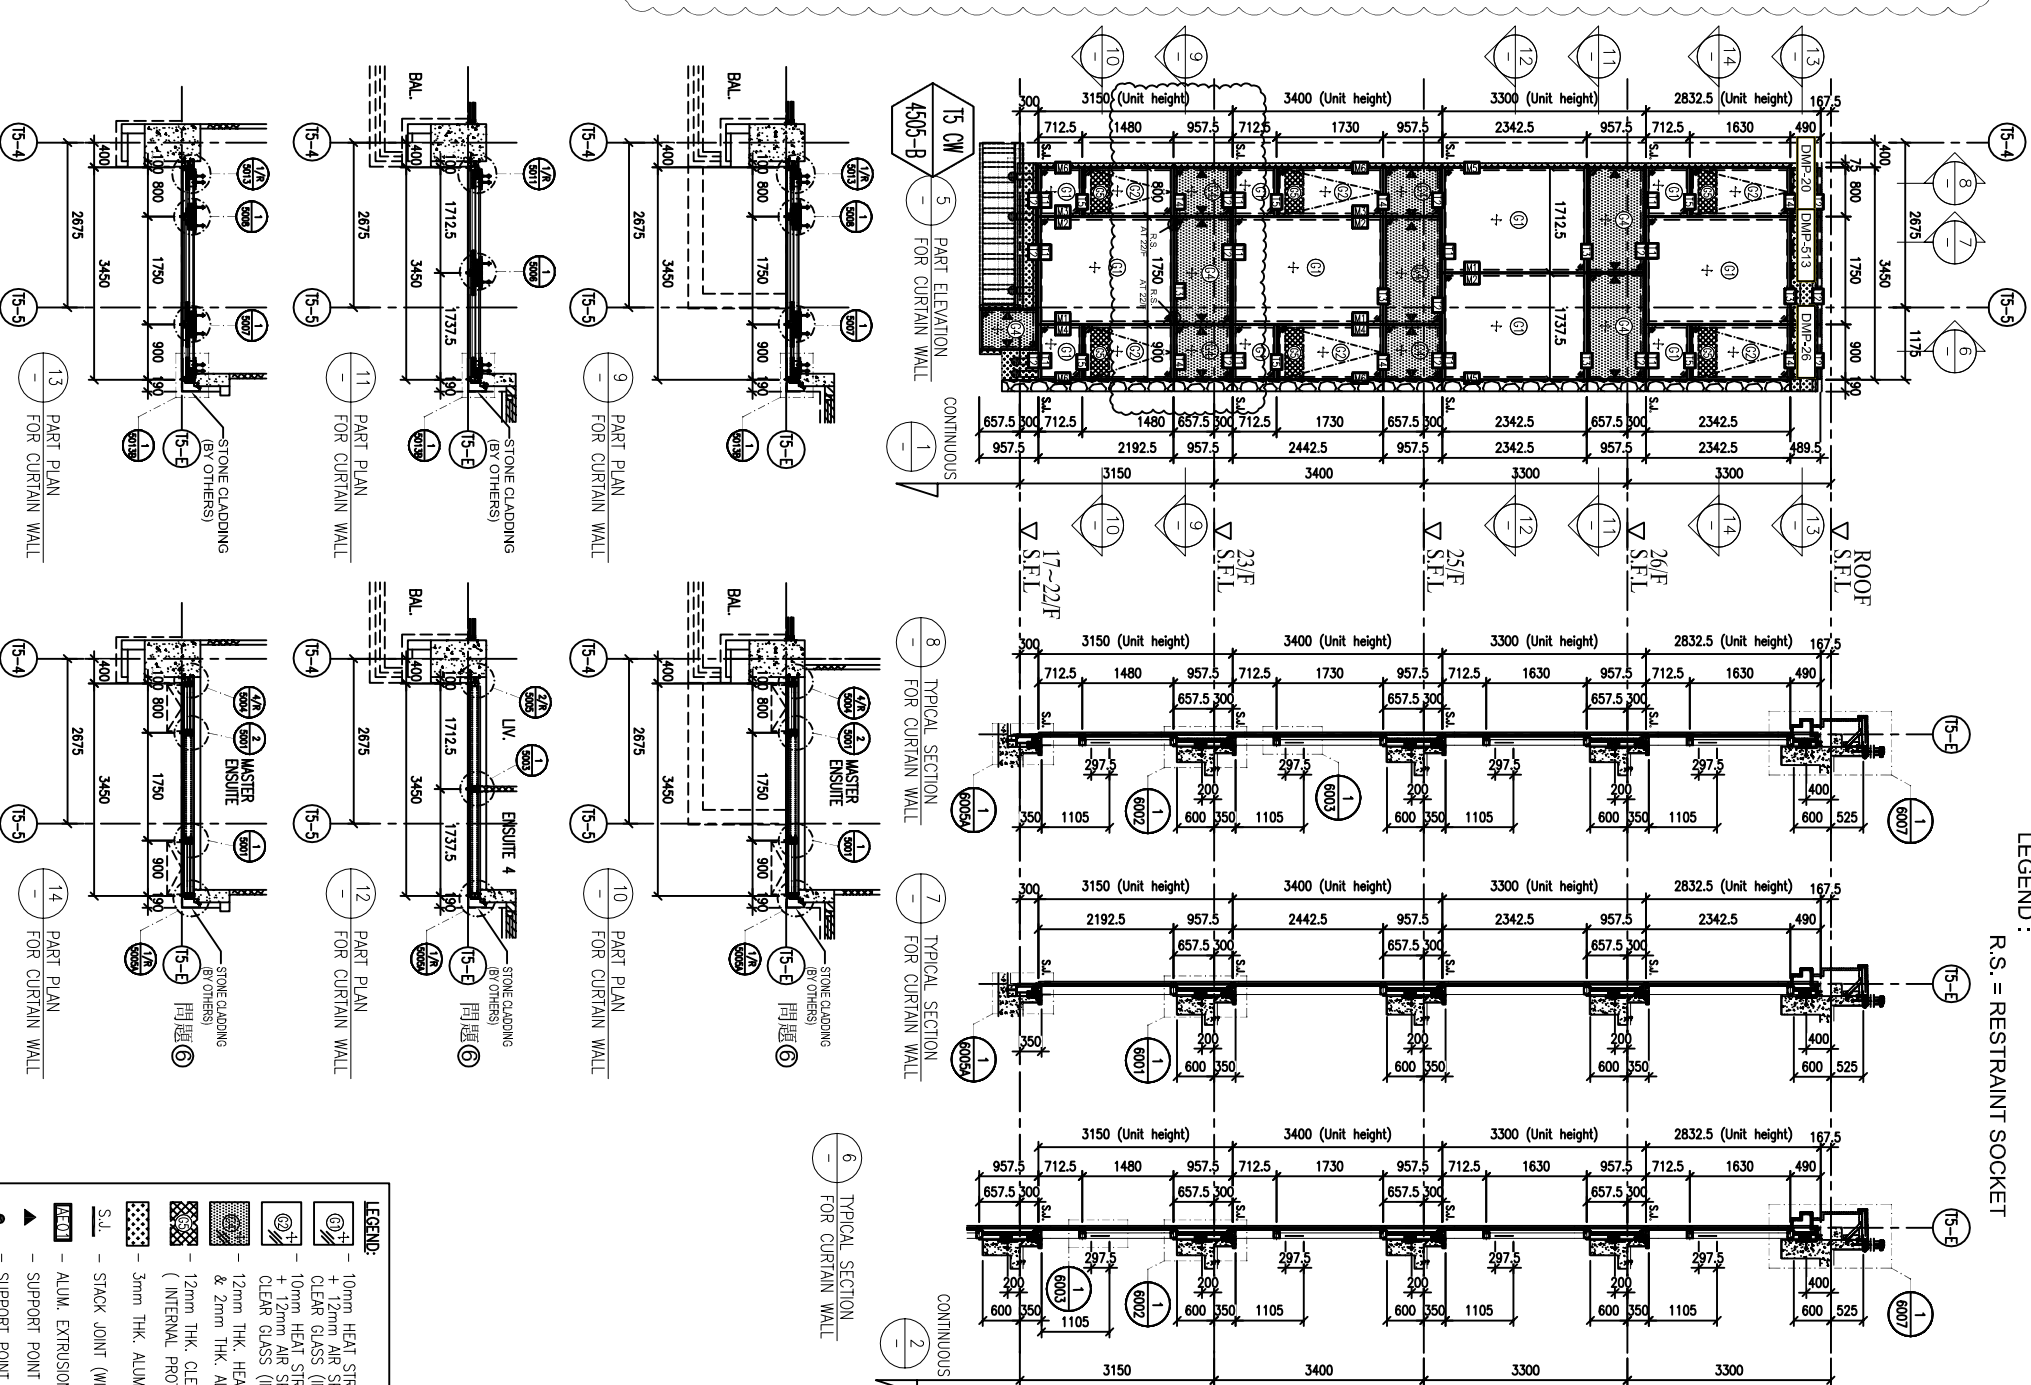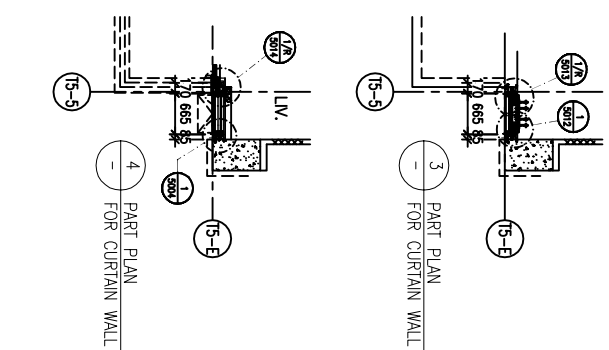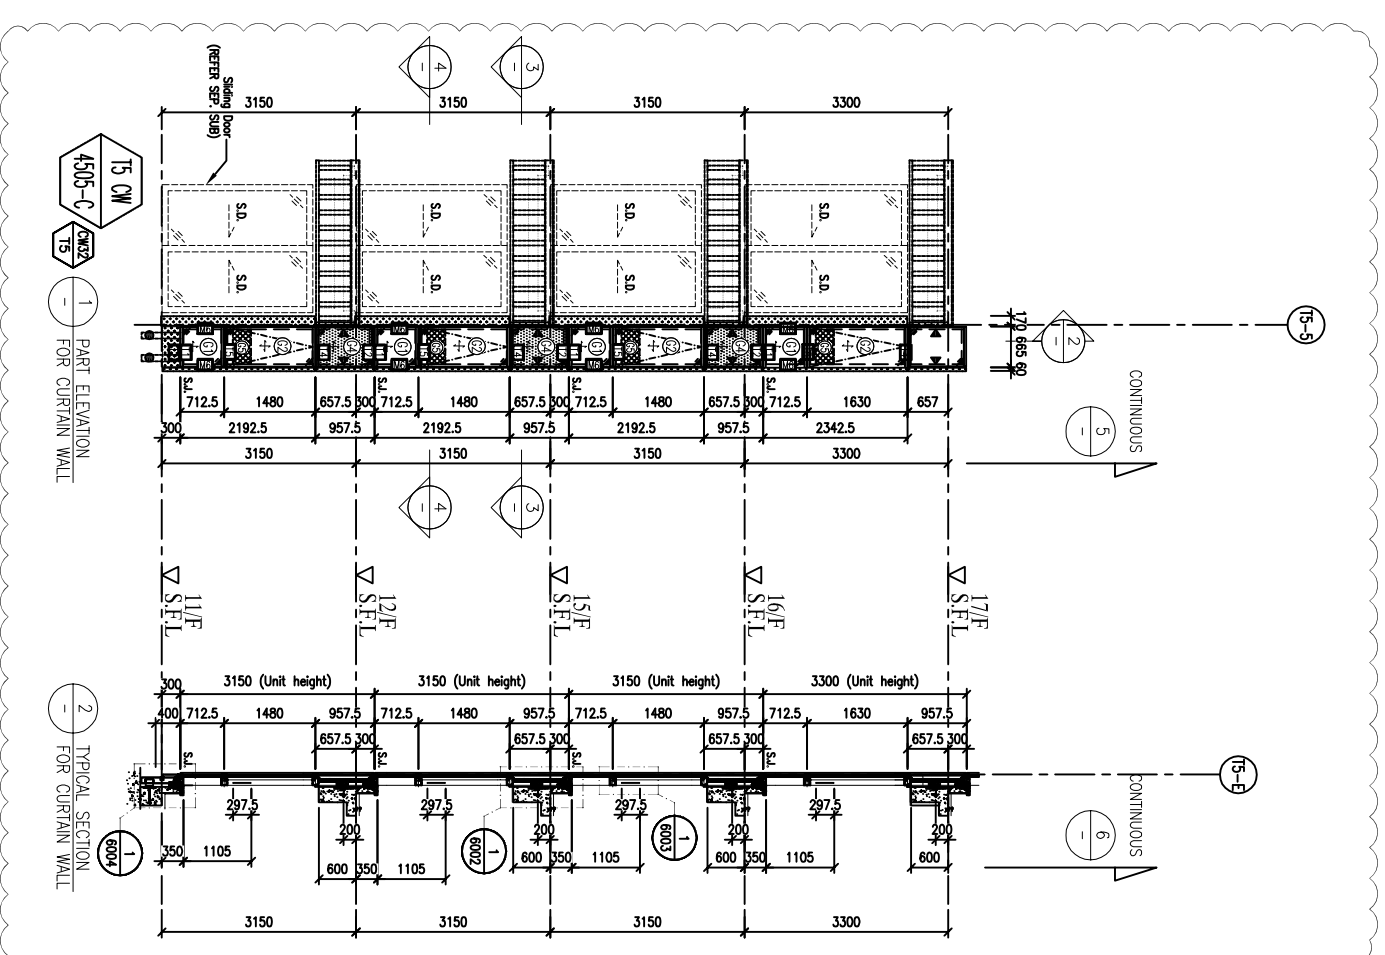

LEGEND:

- 10mm HEAT STRENGTHENED GLASS (OUTER) + 12mm AIR SPACE + 12mm THK. TEMPERED CLEAR GLASS (INNER)
- 10mm HEAT STRENGTHENED GLASS (OUTER) + 12mm AIR SPACE + 10mm THK. TEMPERED CLEAR GLASS (INNER)
- 12mm THK. HEAT STRENGTHENED GLASS & 2mm THK. ALUM. BACKPAN (SPANDREL GLASS)
- 12mm THK. CLEAR TEMPERED GLASS (INTERNAL PROTECTIVE BARRIER)
- 3mm THK. ALUM. CLADDING
- S.J. - STACK JOINT (WIND LOAD)
- ALUM. EXTRUSION DIE NO.
- SUPPORT POINT (WIND LOAD + DEAD LOAD)
- - SUPPORT POINT (WIND LOAD)

FLOOR LEVEL (S.F.L.)

FLOOR	LEVEL
ROOF	+210.00
28/F	+206.70
25/F	+203.40
23/F	+200.00
22/F	+196.85
21/F	+193.70
20/F	+190.55
19/F	+187.40
18/F	+184.25
17/F	+181.10
16/F	+177.80
15/F	+174.65
12/F	+171.50
11/F	+168.35

- NOTE:**
1. ALL DIMENSIONS ARE IN mm.
 2. ALL ELEVATIONS ARE VIEWED FROM OUTSIDE.
 3. ALL DIMENSIONS TO BE VERIFIED ON SITE BEFORE FABRICATION.
- LEGEND:**
- (X1) - DETAIL MARK NO.
 - (X001) - REFER SHEET NO.
 - 1. S.F.L. -- FINISHED FLOOR LEVEL
 - 2. S.F.L. -- STRUCTURAL FLOOR LEVEL
 - 3. (R) -- REVERSED DETAIL

MEINHARDT

FAÇADE CONSULTANT:

ICMA
C M WONG & ASSOCIATES LTD
黃志明建築工程師有限公司

STRUCTURAL ENGINEER :

HIP HING CONSTRUCTION CO LTD

MAIN CONTRACTOR :

WONG TING & PARTNERS LIMITED
ARCHITECTS & ENGINEERS

CLIENT :
SHIMAO GROUP
HOLDINGS LIMITED

美特銘實有限公司
MIDI ARCHITECTS & ENGINEERS LTD.
Units 6-8, Sunray Industrial Centre,
610 Che Kwo Ling Road, Kowloon
Tel: 23489211-4 Fax: (852) 27277866
DWG NO. : JB53-SD-CW-4505 REV. : A

DATE : 01-APR-21 SCALE : 1:60 (A1)
DRAWN BY : LHR CHECKED BY :

TITLE :
PART ELEVATION
FOR CURTAIN WALL
AT TOWER 5



PROJECT :
PROPOSED RESIDENTIAL
DEVELOPMENT AT N.K.I.L. 6542
YIN PING ROAD
KOWLOON

JOB NO. : J-853

NO.	DATE	REVISION SUBJECT TO ARCH. COMMENT	BY
1	08-10-2021	REVISION	

請使用A3紙打印

LEGEND:
R.S. = RESTRAINT SOCKET

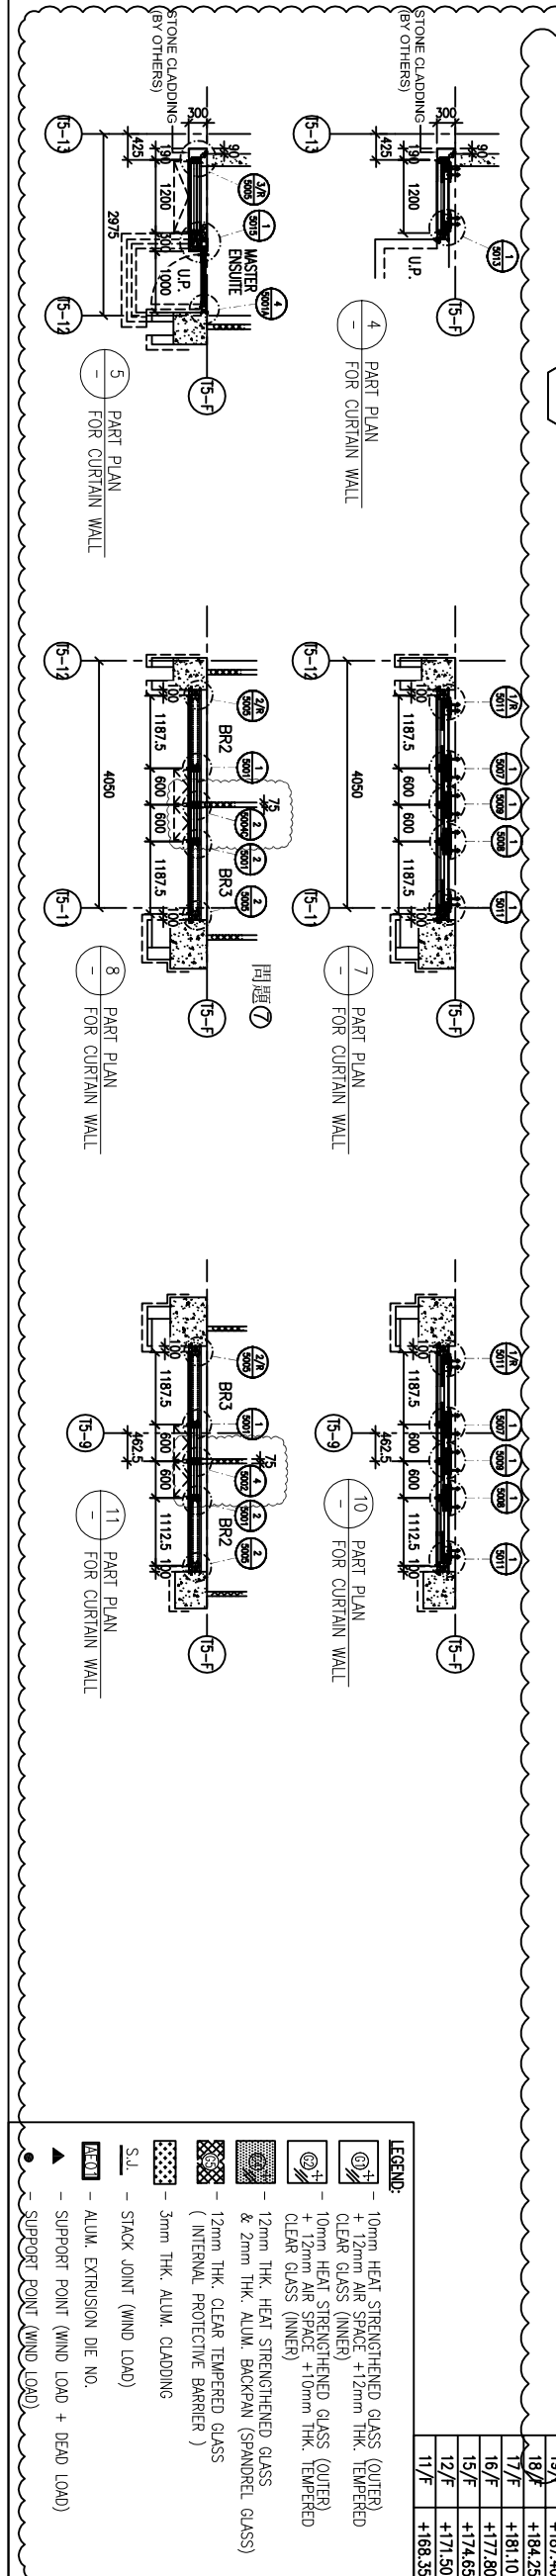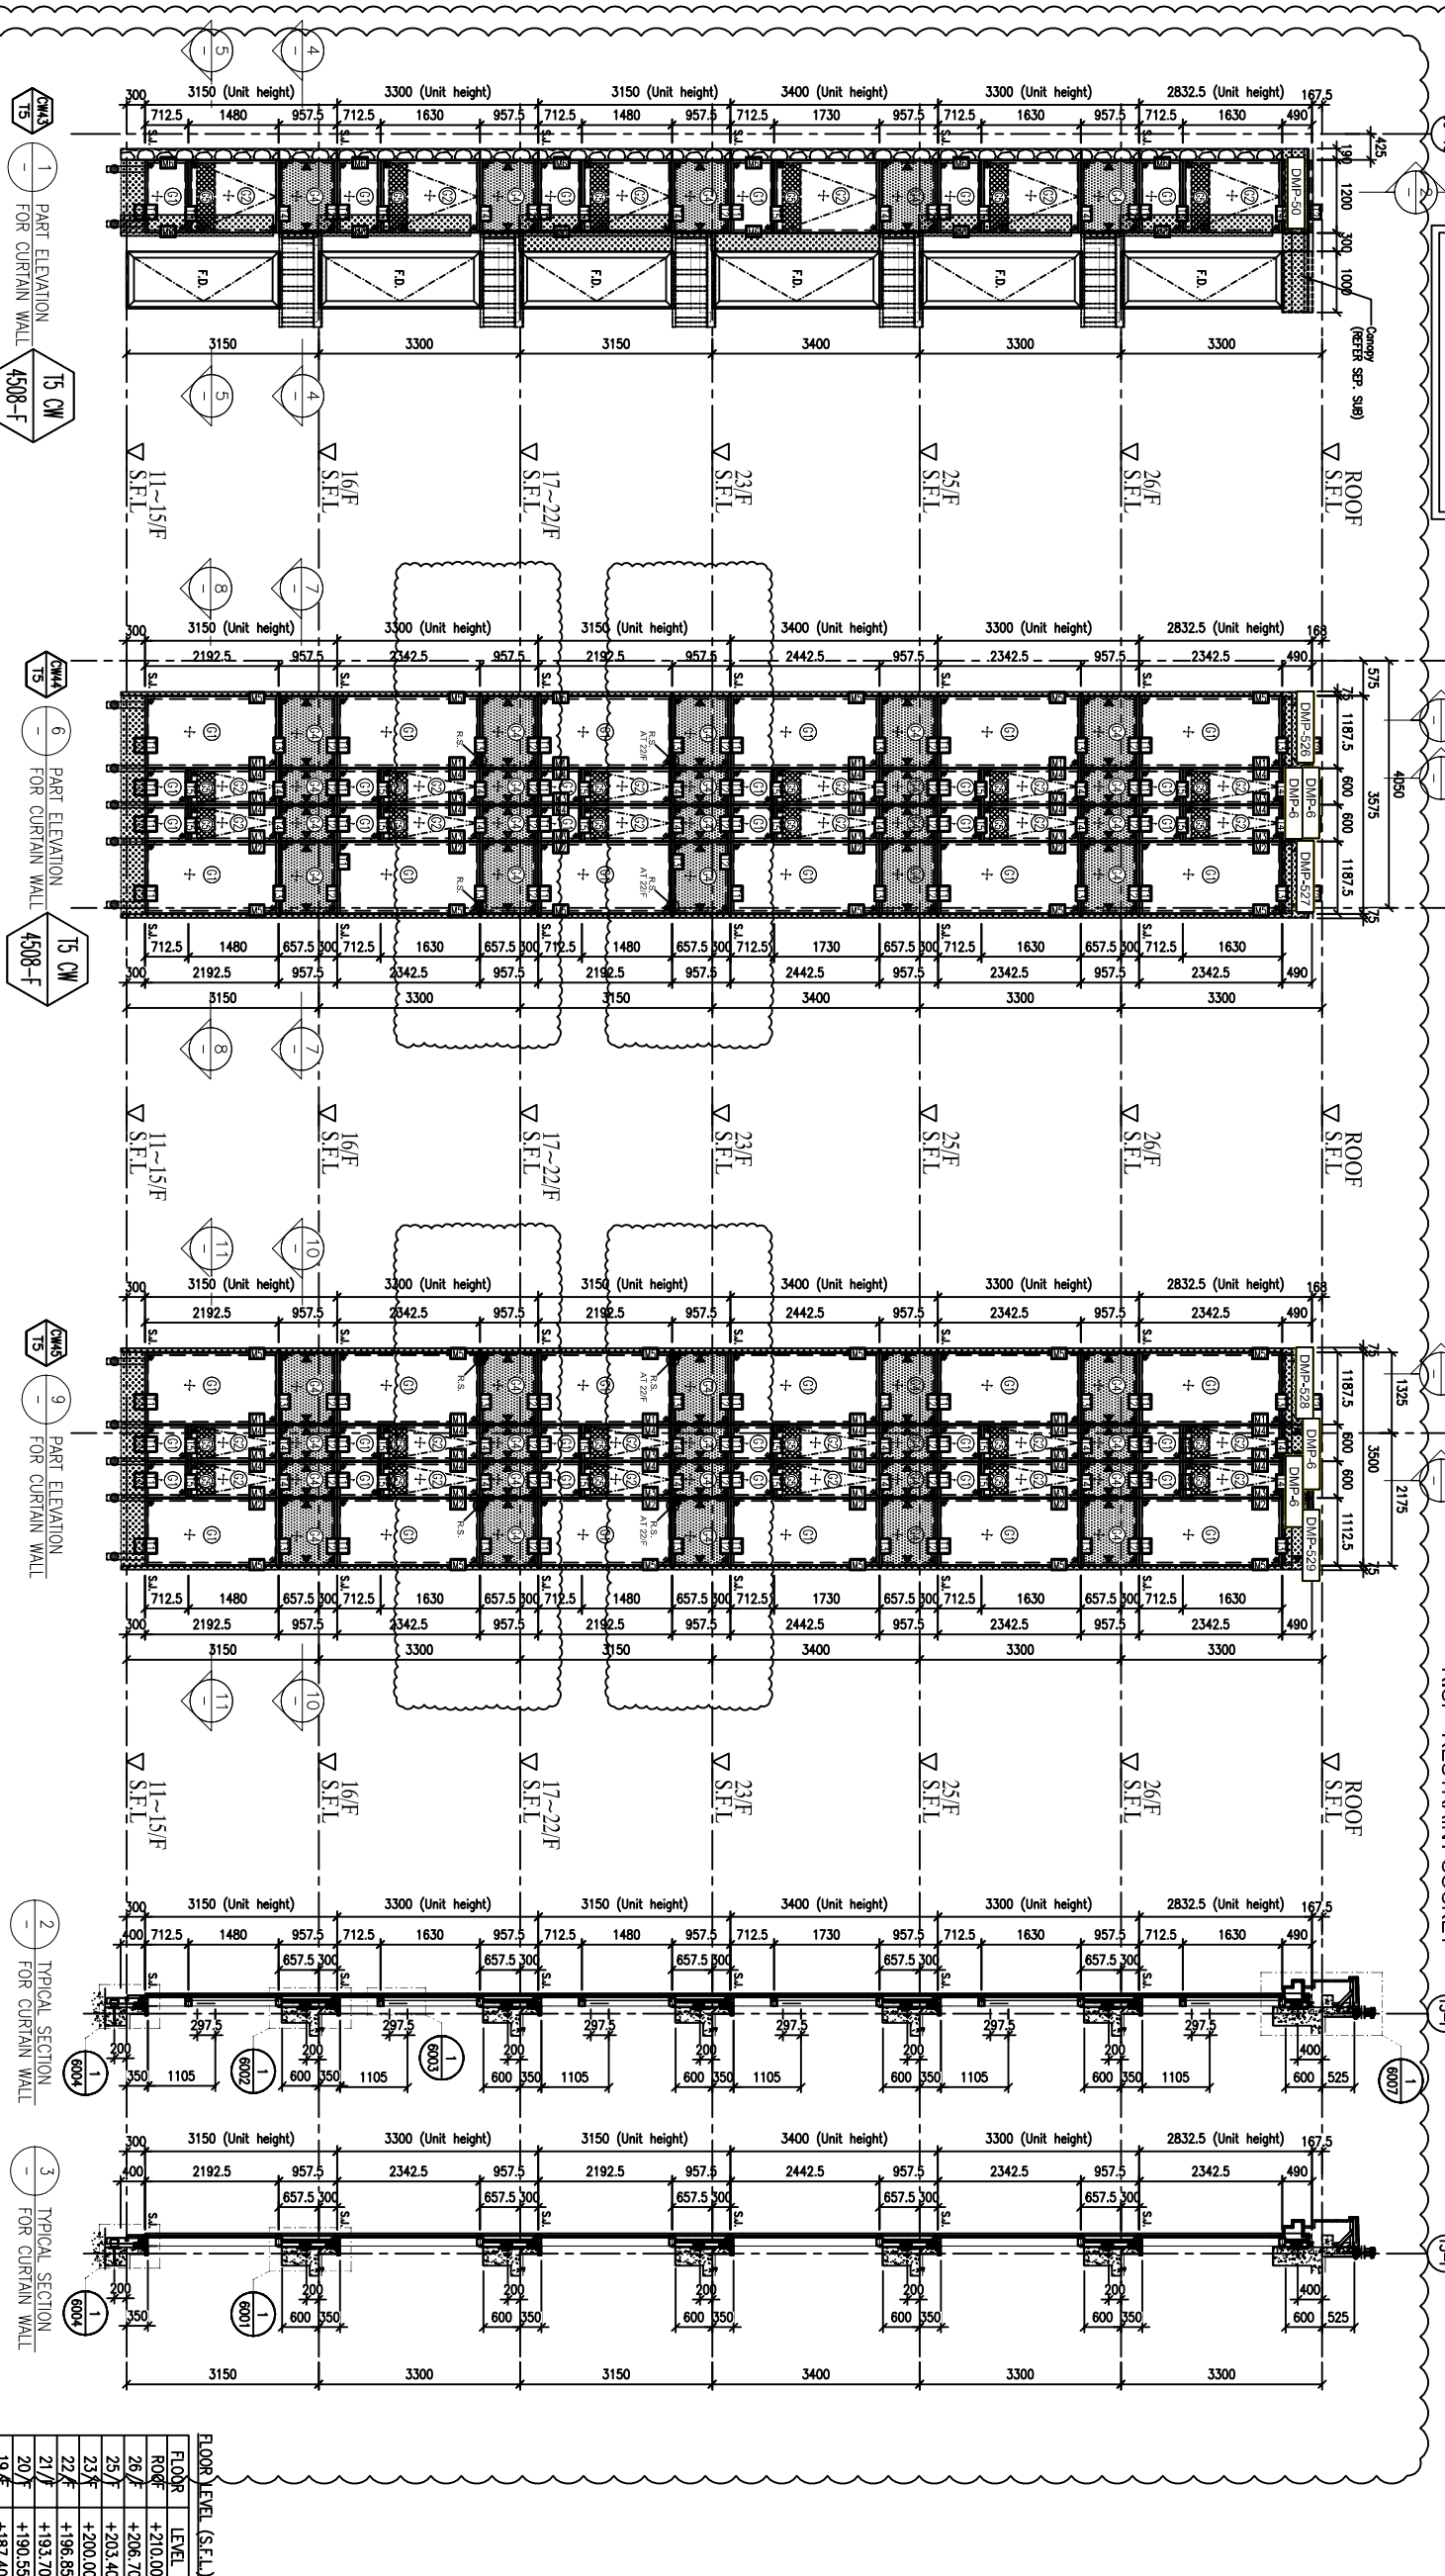

FLOOR LEVEL (S.F.L.)	FLOOR LEVEL
ROOF	+210.00
26/F	+206.70
25/F	+203.40
23/F	+200.00
22/F	+196.85
21/F	+193.70
20/F	+190.55
19/F	+187.40
18/F	+184.25
17/F	+181.10
16/F	+177.80
15/F	+174.65
12/F	+171.50
11/F	+168.35

CLIENT: SHIMAO GROUP HOLDINGS LIMITED

ARCHITECT: WONG TUNG & PARTNERS LIMITED ARCHITECTS & PLANNERS

MAIN CONTRACTOR: 協興建築有限公司 HIP HING CONSTRUCTION CO. LTD

STRUCTURAL ENGINEER: C.M. WONG & ASSOCIATES LTD 黃志明建築工程師有限公司

FAÇADE CONSULTANT: MENHARDT

DATE: 06-10-2021

JOB NO.: J-853

PROJECT: PROPOSED RESIDENTIAL DEVELOPMENT AT N.K.I.L. 6542 YIN PING ROAD KOWLOON

TITLE: PART ELEVATION FOR CURTAIN WALL AT TOWER 5

DATE: 05-APR-21

SCALE: 1:60 (A1)

DRAWN BY: LHR

CHECKED BY:

REV.: A

UNIT: Units 6-8, Sunny Industrial Centre, 1/F, 610 Che Kwo Ling Road, Kowloon

TEL: 23489211-4 Fax: (852) 27277866

DWG NO.: J853-SD-CW-4508

NOTE:

1. ALL DIMENSIONS ARE IN mm.
2. ALL ELEVATIONS ARE VIEWED FROM OUTSIDE.
3. ALL DIMENSIONS TO BE VERIFIED ON SITE BEFORE FABRICATION.

LEGEND:





(X1) DETAIL MARK NO.
(X001) REFER SHEET NO.

1. F.F.L. -- FINISHED FLOOR LEVEL
2. S.F.L. -- STRUCTURAL FLOOR LEVEL
3. (R) -- REVERSED DETAIL

LEGEND:

- 10mm HEAT STRENGTHENED GLASS (OUTER) + 12mm AIR SPACE + 12mm THK. TEMPERED CLEAR GLASS (INNER)
- 10mm HEAT STRENGTHENED GLASS (OUTER) + 12mm AIR SPACE + 10mm THK. TEMPERED CLEAR GLASS (INNER)
- 12mm THK. HEAT STRENGTHENED GLASS & 2mm THK. ALUM. BACKPAN (SPANDREL GLASS) (INTERNAL PROTECTIVE BARRIER)
- 3mm THK. ALUM. CLADDING
- S.J. -- STACK JOINT (WIND LOAD)
- ALUM. EXTRUSION DIE NO.
- SUPPORT POINT (WIND LOAD + DEAD LOAD)
- SUPPORT POINT (WIND LOAD)

請使用A3紙打印

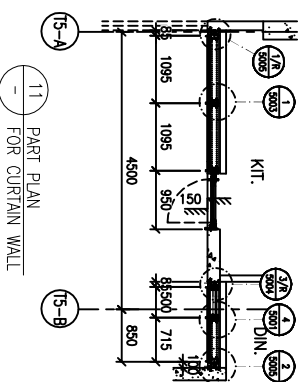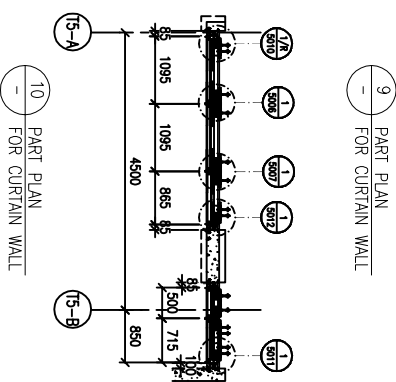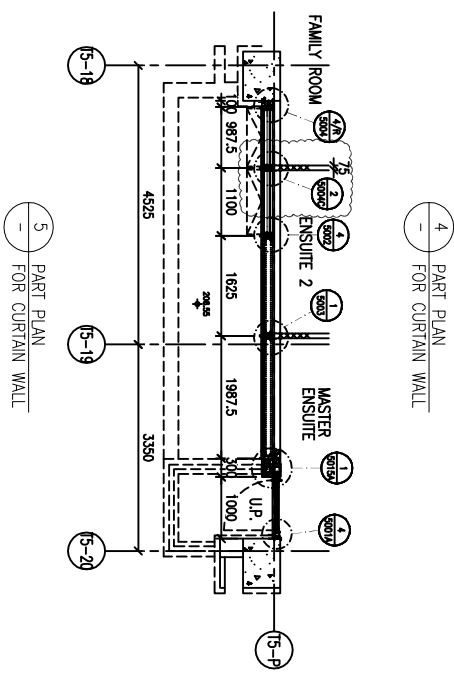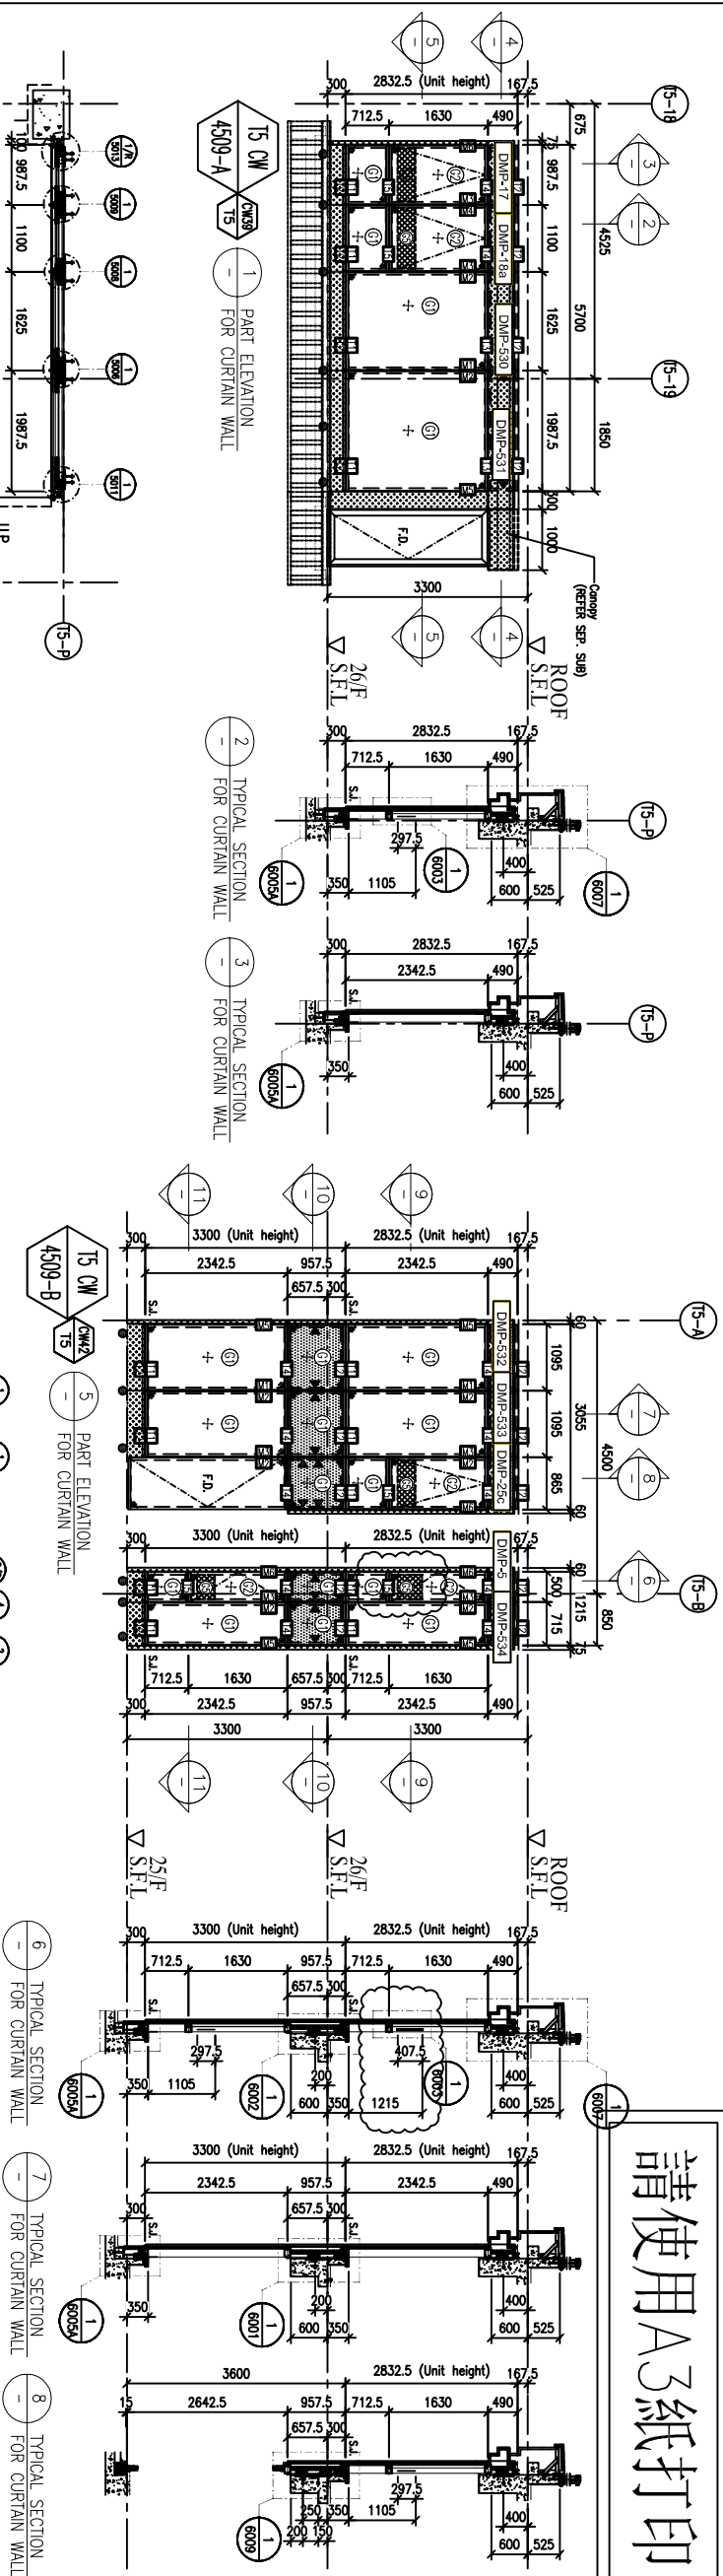

FLOOR LEVEL (S.F.L.)	
FLOOR	LEVEL
ROOF	+210.00
26/F	+206.70
25/F	+203.40

- LEGEND:**
- 10mm HEAT STRENGTHENED GLASS (OUTER) + 12mm AIR SPACE + 12mm THK. TEMPERED CLEAR GLASS (INNER)
 - 10mm HEAT STRENGTHENED GLASS (OUTER) + 12mm AIR SPACE + 10mm THK. TEMPERED CLEAR GLASS (INNER)
 - 12mm THK. HEAT STRENGTHENED GLASS & 2mm THK. ALUM. BACKPAN (SPANDREL GLASS) (INTERNAL PROTECTIVE BARRIER)
 - 3mm THK. ALUM. CLADDING
 - S.J. - STACK JOINT (WIND LOAD)
 - ALUM. EXTRUSION DIE NO.
 - SUPPORT POINT (WIND LOAD + DEAD LOAD)
 - SUPPORT POINT (WIND LOAD)

B.D. REF :

CLIENT : SHIMAO GROUP HOLDINGS LIMITED

ARCHITECT : TUNG TUNG & PARTNERS LIMITED ARCHITECTS & PLANNERS

MAIN CONTRACTOR : 協興建築有限公司 HIP HING CONSTRUCTION CO LTD

STRUCTURAL ENGINEER : C M WONG & ASSOCIATES LTD 黃志明建築工程師有限公司

FAÇADE CONSULTANT: MENHARDT

NOTE:

- ALL DIMENSIONS ARE IN mm.
- ALL ELEVATIONS ARE VIEWED FROM OUTSIDE.
- ALL DIMENSIONS TO BE VERIFIED ON SITE BEFORE FABRICATION.

LEGEND:

- XT - DETAIL MARK NO.
- 1000 - REFER SHEET NO.
- 1. F.F.L. - FINISHED FLOOR LEVEL
- 2. S.F.L. - STRUCTURAL FLOOR LEVEL
- 3. (R) - REVERSED DETAIL

TITLE : PART ELEVATION FOR CURTAIN WALL AT TOWER 5

DATE : 06-OCT-21 SCALE : 1:60 (A1)

DRAWN BY : LHR CHECKED BY :

PROJECT : PROPOSED RESIDENTIAL DEVELOPMENT AT N.K.I.L. 6542 YIN PING ROAD KOWLOON

MEASURED BY :







美特經貿有限公司
MIDI INTERNATIONAL TRADING COMPANY LTD.
Units 6-8, Sunny Industrial Centre, 1/F
610 Che Kwo Ling Road, Kowloon
Tel: 23489211-4 Fax: (852) 27277866
DWG NO. : JB53-SD-CW-4509 REV. : A

請使用A3紙打印

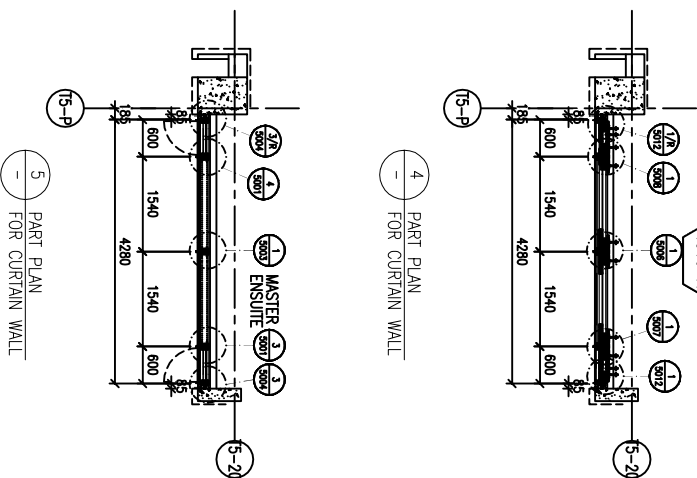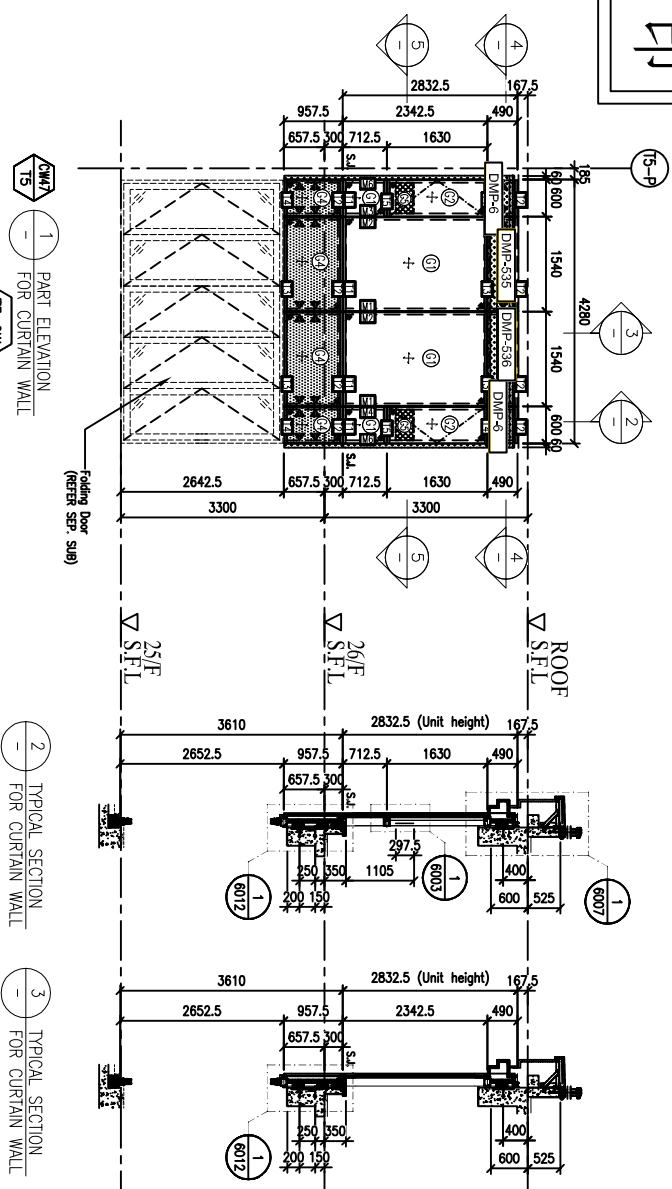

1 PART ELEVATION FOR CURTAIN WALL
2 TYPICAL SECTION FOR CURTAIN WALL
3 TYPICAL SECTION FOR CURTAIN WALL

4 PART PLAN FOR CURTAIN WALL

5 PART PLAN FOR CURTAIN WALL

FLOOR LEVEL (S.F.L.)

FLOOR	LEVEL
ROOF	+210.00
26/F	+206.70
25/F	+203.40

- LEGEND:
- 10mm HEAT STRENGTHENED GLASS (OUTER) + 12mm AIR SPACE + 12mm THK. TEMPERED CLEAR GLASS (INNER)
 - 10mm HEAT STRENGTHENED GLASS (OUTER) + 12mm AIR SPACE + 10mm THK. TEMPERED CLEAR GLASS (INNER)
 - 12mm THK. HEAT STRENGTHENED GLASS & 2mm THK. ALUM. BACKPAN (SPANDREL GLASS) (INTERNAL PROTECTIVE BARRIER)
 - 3mm THK. ALUM. CLADDING
 - S.J. - STACK JOINT (WIND LOAD)
 - ALUM. EXTRUSION DIE NO.
 - SUPPORT POINT (WIND LOAD + DEAD LOAD)
 - SUPPORT POINT (WIND LOAD)

NOTE:

- ALL DIMENSIONS ARE IN mm.
- ALL ELEVATIONS ARE VIEWED FROM OUTSIDE.
- ALL DIMENSIONS TO BE VERIFIED ON SITE BEFORE FABRICATION.

LEGEND:

- DETAIL MARK NO.
- REFER SHEET NO.
- 1. F.F.L.--FINISHED FLOOR LEVEL
- 2. S.F.L.--STRUCTURAL FLOOR LEVEL
- 3. --REVERSED DETAIL

B.D. REF :

CLIENT : SHIMAO GROUP HOLDINGS LIMITED

ARCHITECT : WONG TUNG & PARTNERS LIMITED ARCHITECTS & PLANNERS

MAIN CONTRACTOR : 協興建築有限公司 HIP HING CONSTRUCTION CO.LTD

STRUCTURAL ENGINEER : C.M.WONG & ASSOCIATES LTD 黃志明建築工程師有限公司

FAÇADE CONSULTANT: MENHARDT

JOB NO. : J-853

PROJECT : PROPOSED RESIDENTIAL DEVELOPMENT AT N.K.I.L. 6542 YIN PING ROAD KOWLOON

TITLE : PART ELEVATION FOR CURTAIN WALL AT TOWER 5

DATE : 06-OCT-21 SCALE : 1:60 (A1)

DRAWN BY : LHR CHECKED BY :

Units 6-8, Sunny Industrial Centre, 1/F
610 Chee Kwo Ling Road, Kowloon
Tel:23489211-4 Fax:(852)27277866
DWG NO. : J853-SD-CW-4510 REV. : A

B.D. REF :
請用A3紙打印

CLIENT :
SHIMAO GROUP
HOLDINGS LIMITED

ARCHITECT :
WONG TUNG & PARTNERS LIMITED
ARCHITECTS & PLANNERS

MAIN CONTRACTOR :
協興建築有限公司
HIP HING CONSTRUCTION CO LTD



STRUCTURAL ENGINEER :
C M WONG & ASSOCIATES LTD
黃志明建築工程師有限公司

FAÇADE CONSULTANT:
MENHARDT

NOTE :
1. ALL DIMENSIONS ARE IN mm.
2. ALL ELEVATIONS ARE VIEWED FROM OUTSIDE.
3. ALL DIMENSIONS TO BE VERIFIED ON SITE BEFORE FABRICATION.

LEGEND :
 DETAIL MARK NO.
 REFER SHEET NO.
 1. F.F.L. -- FINISHED FLOOR LEVEL
 2. S.F.L. -- STRUCTURAL FLOOR LEVEL
 3. -- REVERSED DETAIL

FLOOR LEVEL (S.F.L.)	LEVEL
ROOF	+210.00
26/F	+206.70
25/F	+203.40
23/F	+200.00
19/F	+187.40
18/F	+184.25
17/F	+181.10
16/F	+177.80
15/F	+174.65
12/F	+171.50
11/F	+168.35
10/F	+165.20
9/F	+162.05
8/F	+158.90
7/F	+155.75
6/F	+152.60
5/F	+149.30

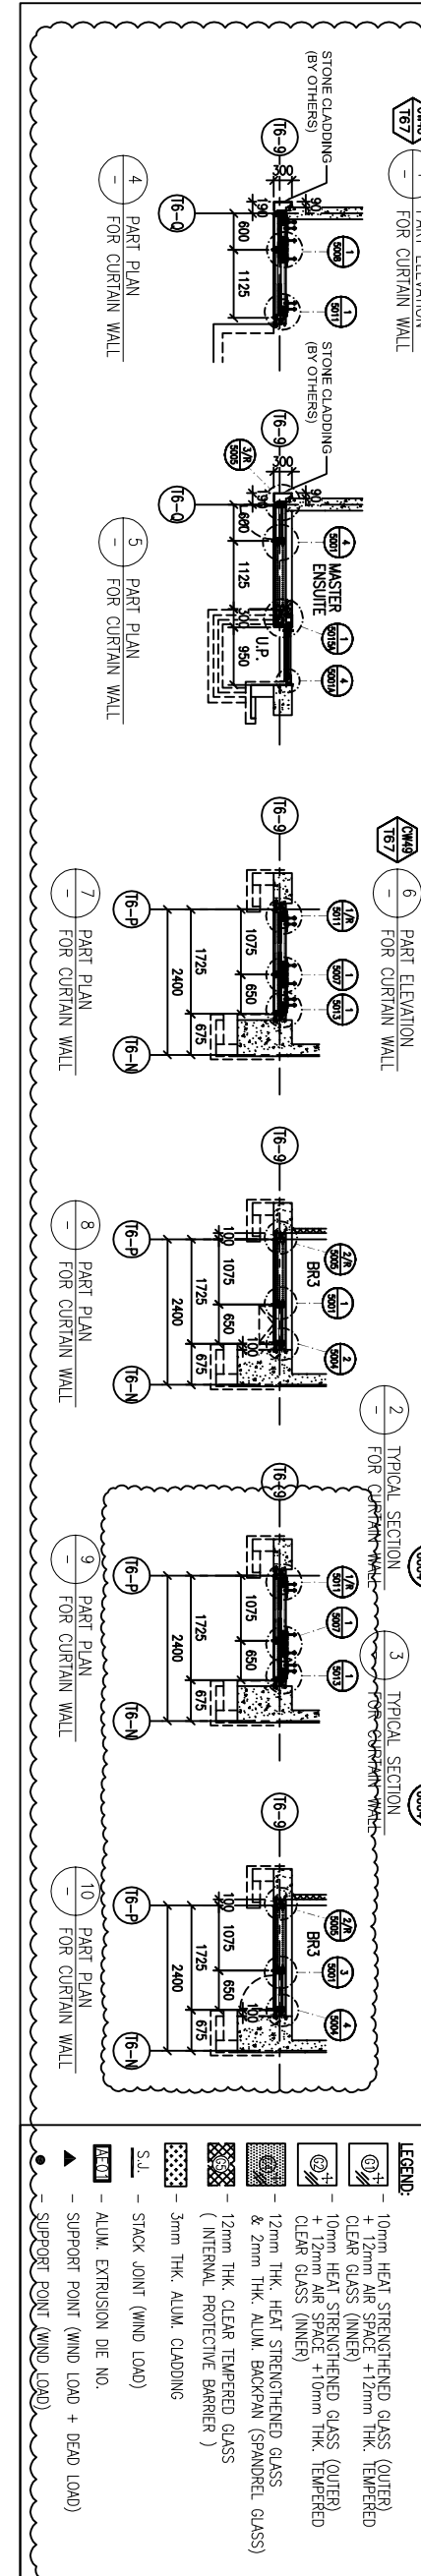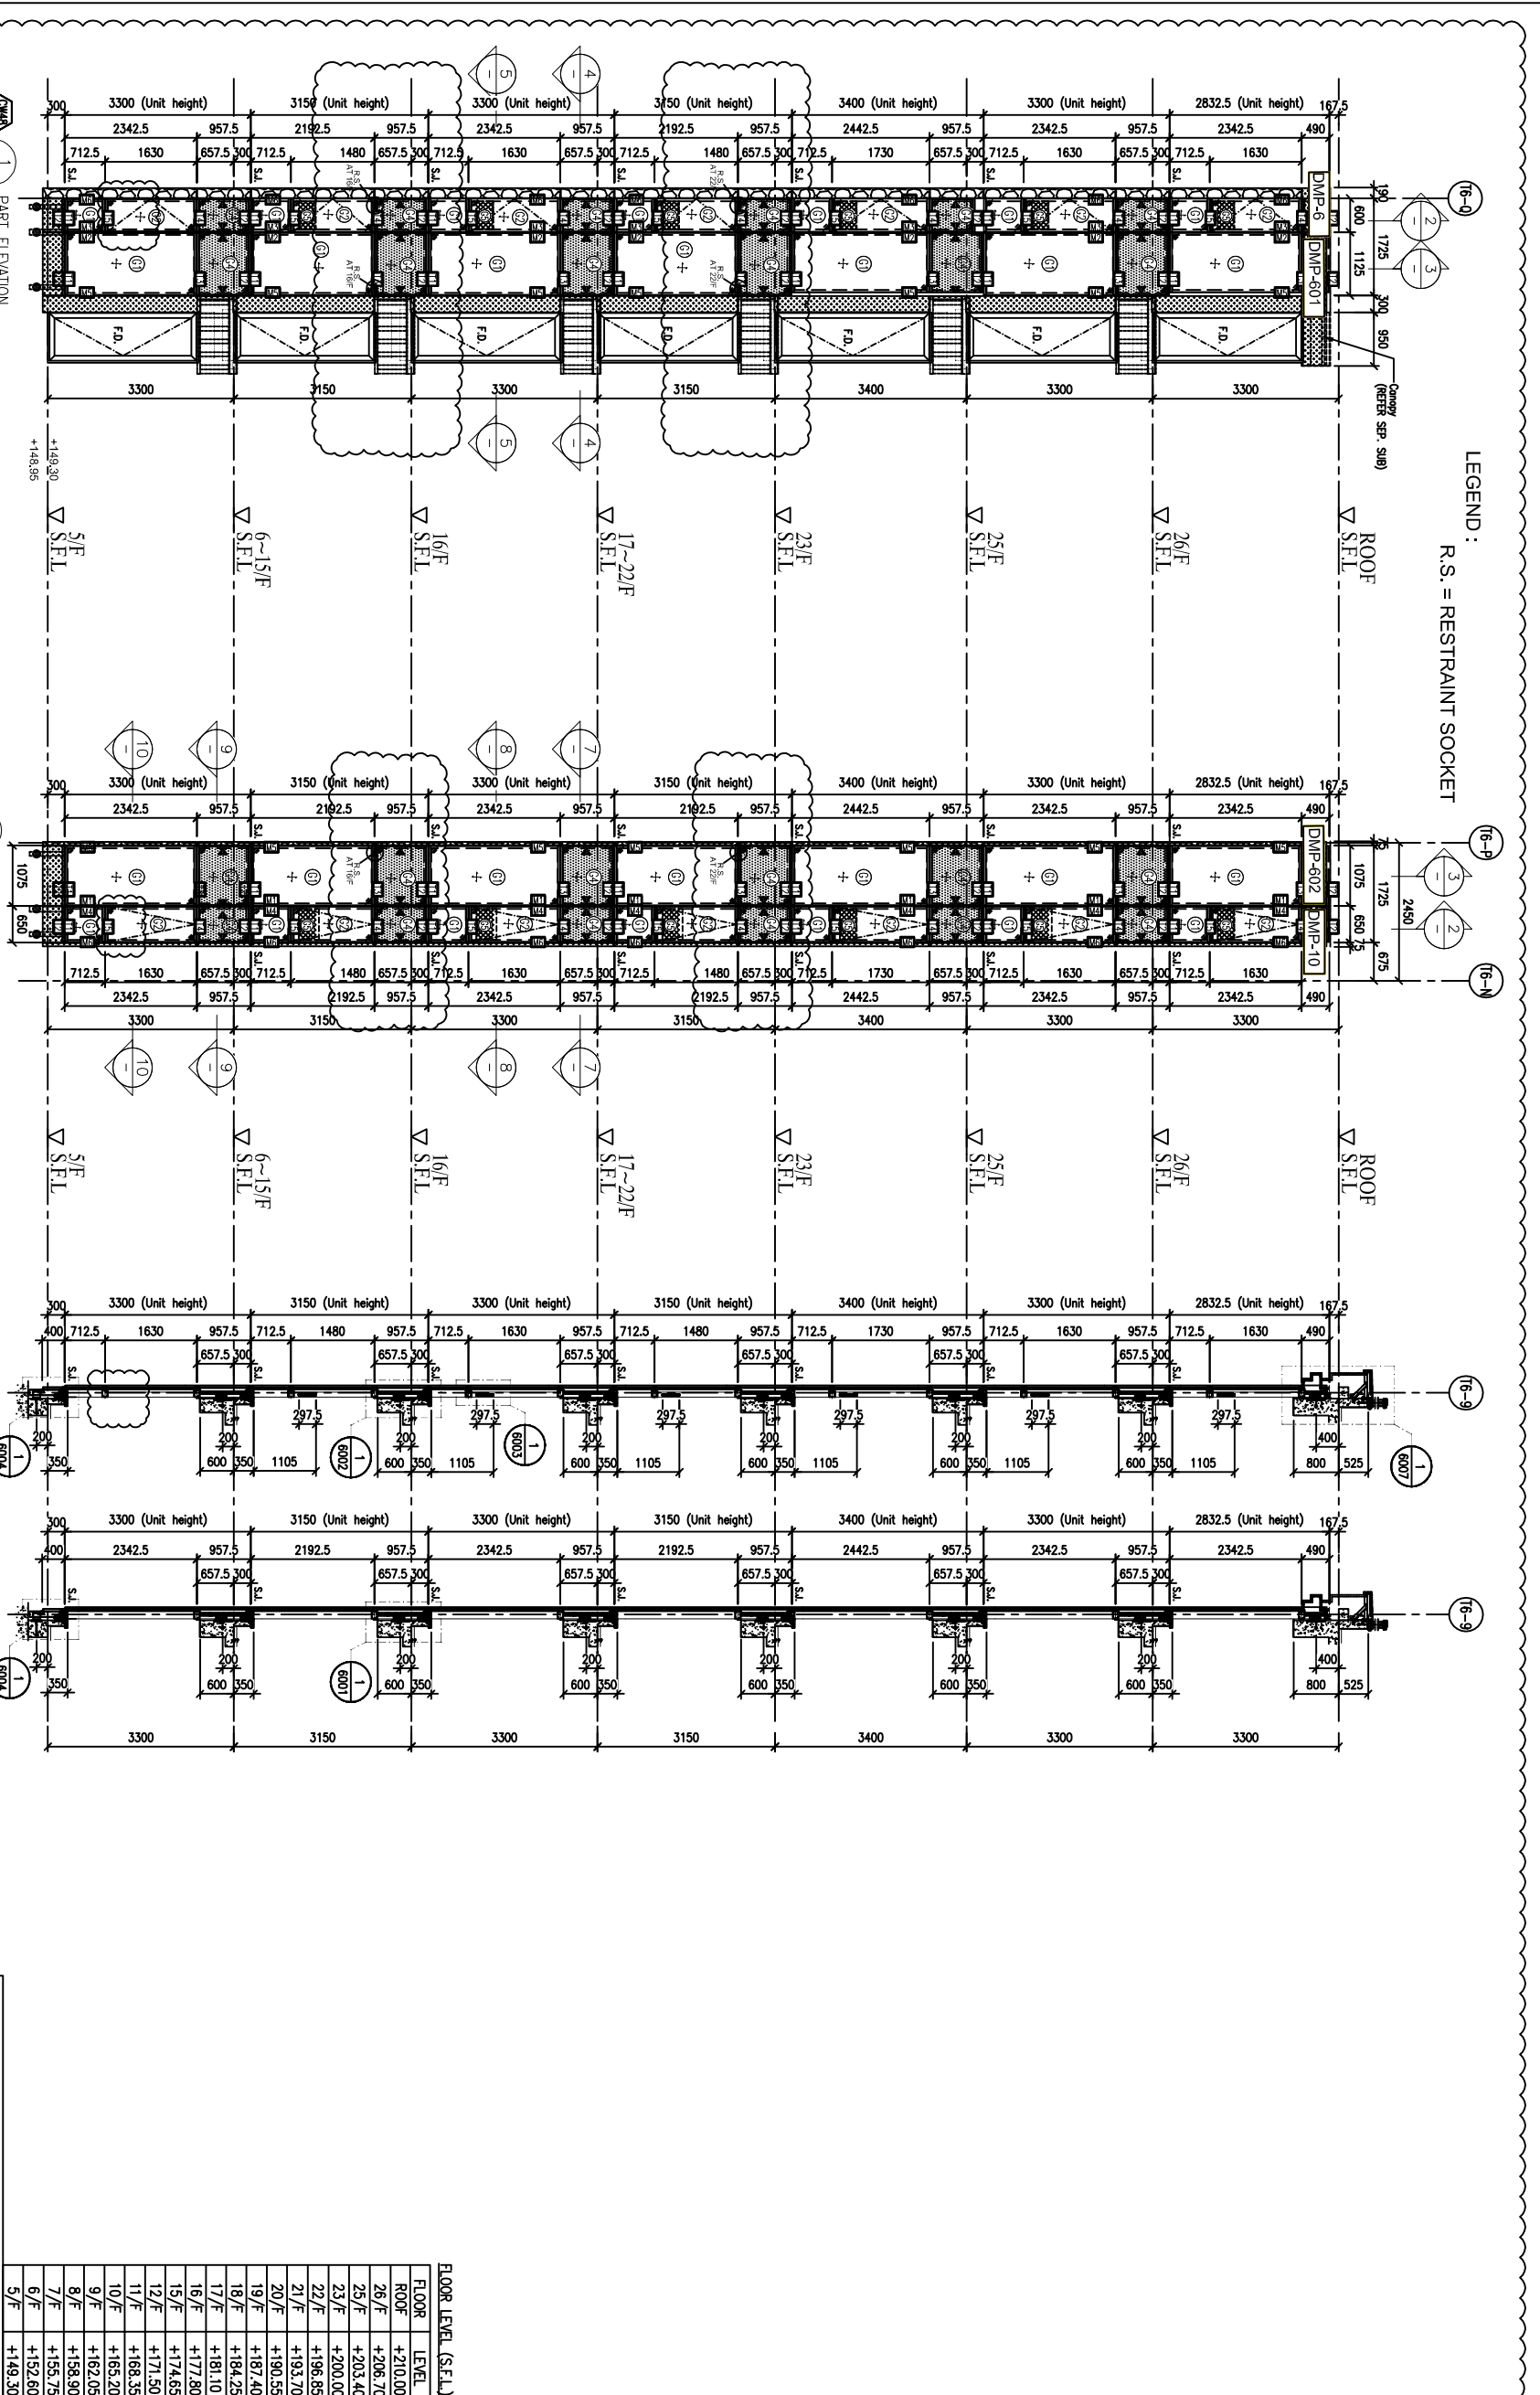

TITLE :
PART ELEVATION
FOR CURTAIN WALL
AT TOWER 6 & 7

DATE : 12-APR-21 SCALE : 1:60 (A1)

DRAWN BY : LHR CHECKED BY :

PROJECT :
PROPOSED RESIDENTIAL
DEVELOPMENT AT N.K.I.L. 6542
YIN PING ROAD
KOWLOON




JOB NO. : J-853

DATE : 08-10-2021 REVISION SUBJECT TO ARCH. COMMENT

REV. : A

Units 6-8, Sunray Industrial Centre, 1/F
610 Che Kwo Ling Road, Kowloon
Tel: 23489211-4 Fax: (852) 27277866
DWG NO. : JB53-SD-CW-4601

LEGEND :
R.S. = RESTRAINT SOCKET

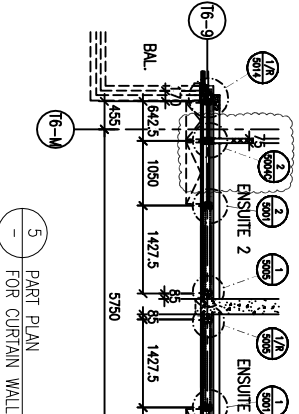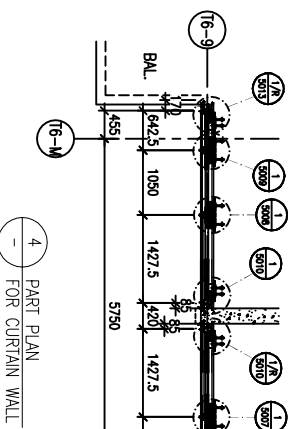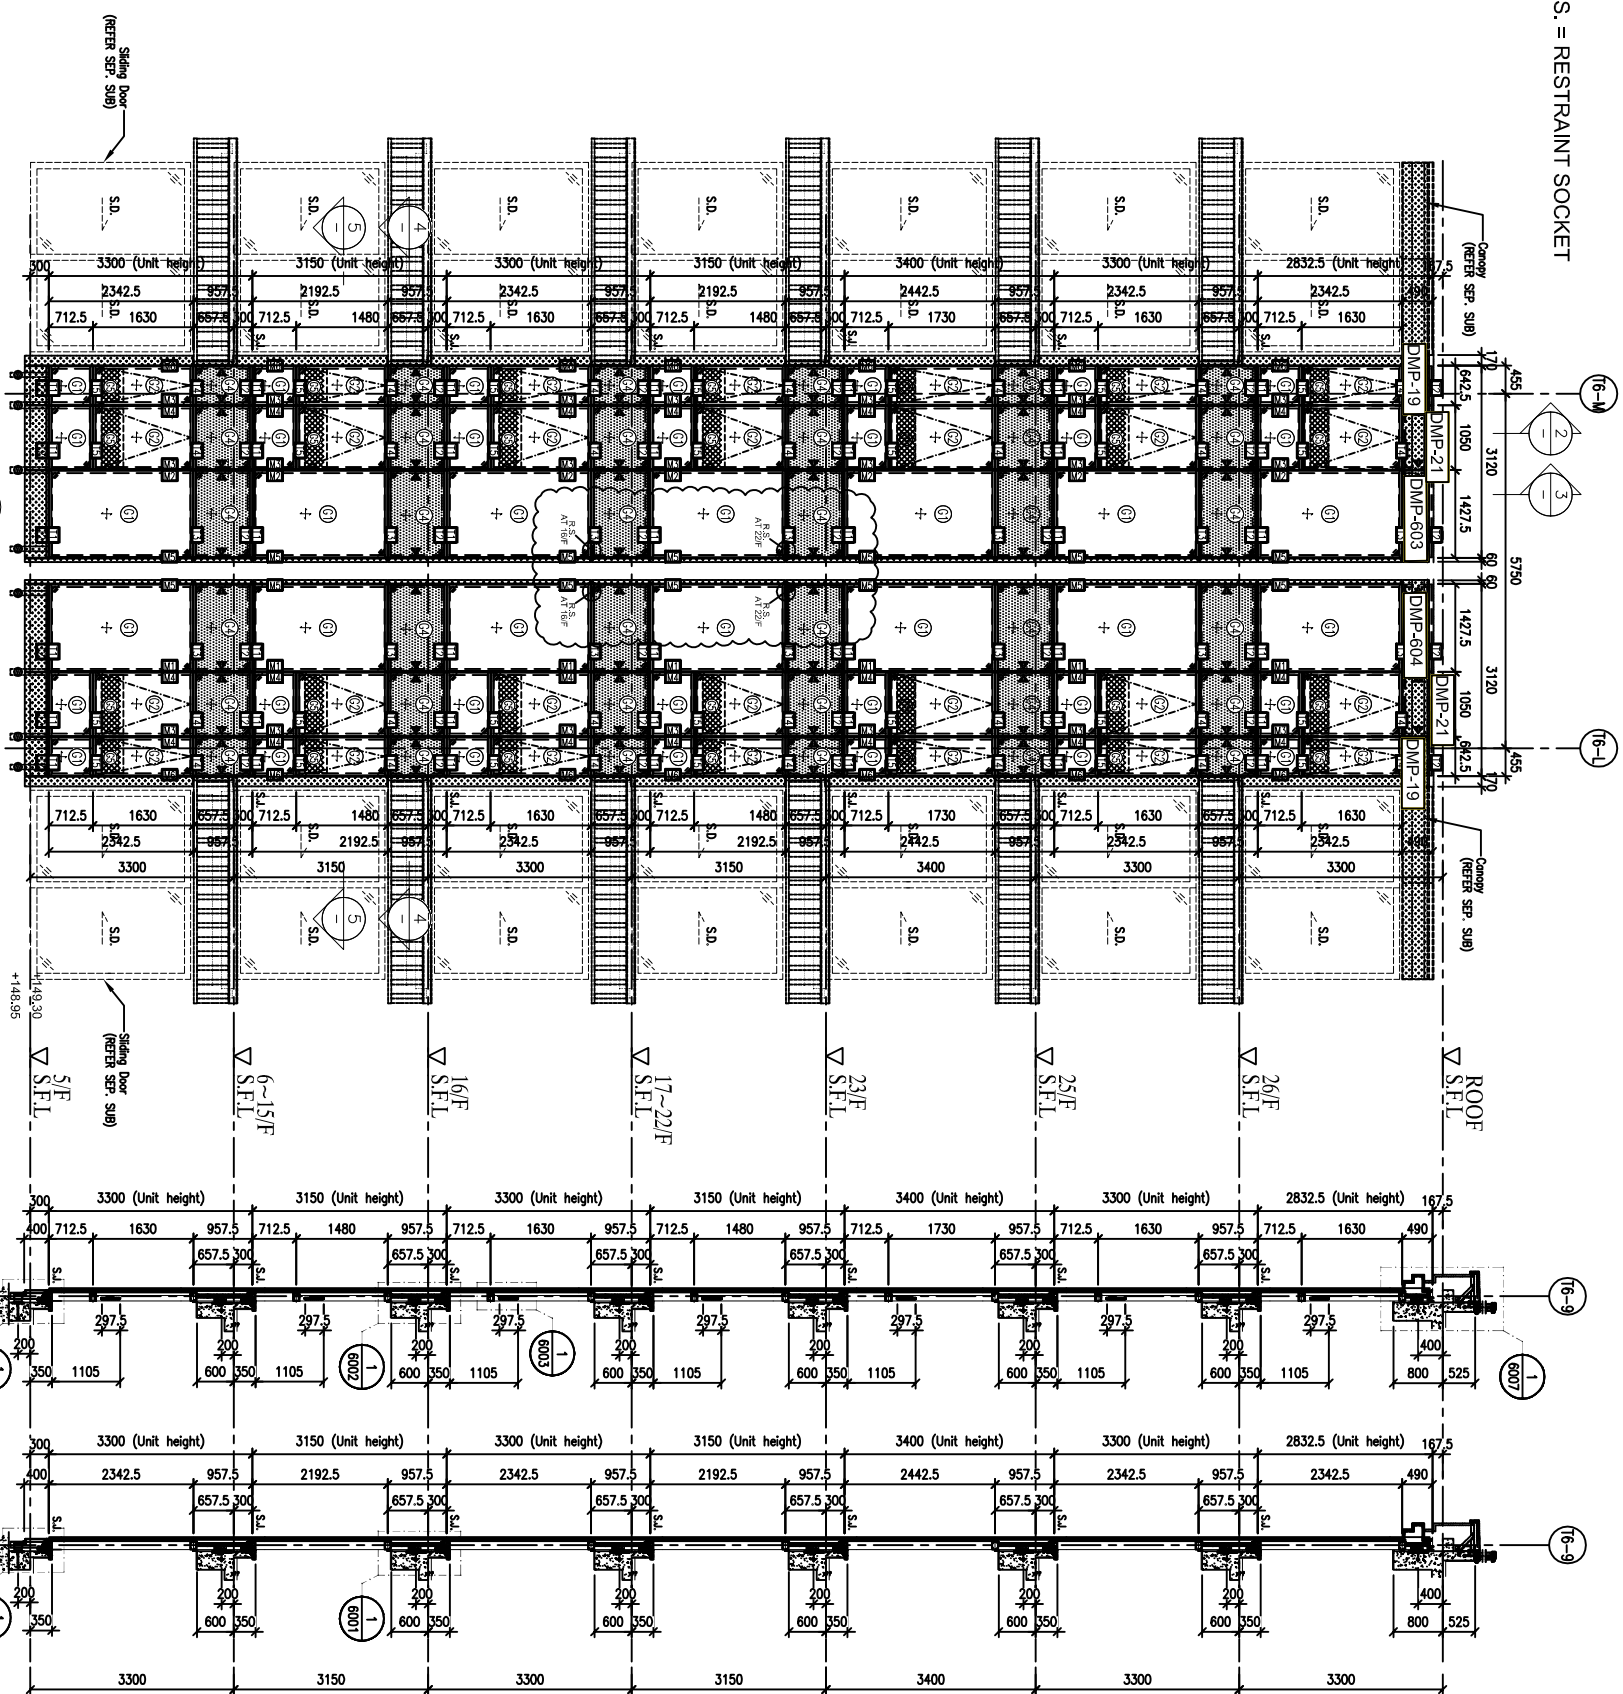

FLOOR LEVEL (S.F.L.)

FLOOR	LEVEL
ROOF	+210.00
26/F	+206.70
25/F	+203.40
23/F	+200.00
22/F	+196.85
21/F	+193.70
20/F	+190.55
19/F	+187.40
18/F	+184.25
17/F	+181.10
16/F	+177.80
15/F	+174.65
12/F	+171.50
11/F	+168.35
10/F	+165.20
9/F	+162.05
8/F	+158.90
7/F	+155.75
6/F	+152.60
5/F	+149.30

- LEGEND:
- ① 10mm HEAT STRENGTHENED GLASS (OUTER) + 12mm AIR SPACE + 12mm THK. TEMPERED CLEAR GLASS (INNER)
 - ② 10mm HEAT STRENGTHENED GLASS (OUTER) + 12mm AIR SPACE + 10mm THK. TEMPERED CLEAR GLASS (INNER)
 - ③ 12mm THK. HEAT STRENGTHENED GLASS & 2mm THK. ALUM. BACKPAN (SPANDREL GLASS) (INTERNAL PROTECTIVE BARRIER)
 - ④ 3mm THK. ALUM. CLADDING
 - S.L. - STACK JOINT (WIND LOAD)
 - ALUM. - ALUM. EXTRUSION DIE NO.
 - ▲ - SUPPORT POINT (WIND LOAD + DEAD LOAD)
 - - SUPPORT POINT (WIND LOAD)

B.D. REF :
請用A3紙打印

CLIENT :
SHIMAO GROUP HOLDINGS LIMITED

ARCHITECT :
WONG TUNG & PARTNERS LIMITED ARCHITECTS & PLANNERS

MAIN CONTRACTOR :
協興建築有限公司 HIP HING CONSTRUCTION CO LTD

STRUCTURAL ENGINEER :
ICMA C M WONG & ASSOCIATES LTD 黃志明建築工程師有限公司

FAÇADE CONSULTANT:
MEINWART

NOTE:
1. ALL DIMENSIONS ARE IN mm.
2. ALL ELEVATIONS ARE VIEWED FROM OUTSIDE.
3. ALL DIMENSIONS TO BE VERIFIED ON SITE BEFORE FABRICATION.

LEGEND:
①1 - DETAIL MARK NO.
②000 - REFER SHEET NO.
1. F.F.L. - FINISHED FLOOR LEVEL
2. S.F.L. - STRUCTURAL FLOOR LEVEL
3. Ⓜ - REVERSED DETAIL

PROJECT :
PROPOSED RESIDENTIAL DEVELOPMENT AT N.K.I.L. 6542 YIN PING ROAD KOWLOON

JOB NO. :
J-853

DATE :
08-10-2021

REVISION SHEET TO ARCH. COMMENT

NO.	DATE	REVISION
1	08-10-2021	REVISION SHEET TO ARCH. COMMENT

TITLE :
PART ELEVATION FOR CURTAIN WALL AT TOWER 6 & 7

DATE :
12-APR-21

SCALE :
1:60 (A1)

DRAWN BY :
LHR

CHECKED BY :

美特銘實有限公司
MIDI Aluminium Fabricators Ltd.
Units 6-8, Sunny Industrial Centre, 1/F
610 Che Kwo Ling Road, Kowloon
Tel:23489211-4 Fax:(852)27277866
DWG NO. :
J853-SD-CW-4602

REV. :
A

B.D. REF :
請用A3紙打印

CLIENT :
SHIMAO GROUP
HOLDINGS LIMITED


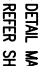
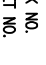

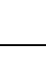
ARCHITECT :
YONG TUNG & PARTNERS LIMITED
ARCHITECTS & PLANNERS

MAIN CONTRACTOR :
協興建築有限公司
HIP HING CONSTRUCTION CO LTD

STRUCTURAL ENGINEER :
C M WONG & ASSOCIATES LTD
黃志明建築工程師有限公司

FAÇADE CONSULTANT:
MENHARDT

NOTE :
1. ALL DIMENSIONS ARE IN mm.
2. ALL ELEVATIONS ARE VIEWED FROM OUTSIDE.
3. ALL DIMENSIONS TO BE VERIFIED ON SITE BEFORE FABRICATION.


LEGEND :
 DETAIL MARK NO.
 REFER SHEET NO.
 F.F.L. -- FINISHED FLOOR LEVEL
 S.F.L. -- STRUCTURAL FLOOR LEVEL
 -- REVERSED DETAIL

NO.	DATE	REVISION SUBJECT TO ARCH. COMMENT	BY
1	08-10-2021	REVISION SUBJECT TO ARCH. COMMENT	BR

JOB NO. : J-853
 PROJECT : PROPOSED RESIDENTIAL DEVELOPMENT AT N.K.I.L. 6542 YIN PING ROAD KOWLOON
 TITLE : PART ELEVATION FOR CURTAIN WALL AT TOWER 6 & 7

DATE : 13-APR-21 SCALE : 1:60 (A1)
 DRAWN BY : LHR CHECKED BY :

美特鋁質有限公司
MIDI Aluminium Fabricator Ltd.
Units 6-8, Sunray Industrial Centre, 1/F
610 Cheung Kwong Road, Kowloon
Tel: 23489211-4 Fax: (852) 27277866
DWG NO. : J853-SD-CW-4606 REV. : A

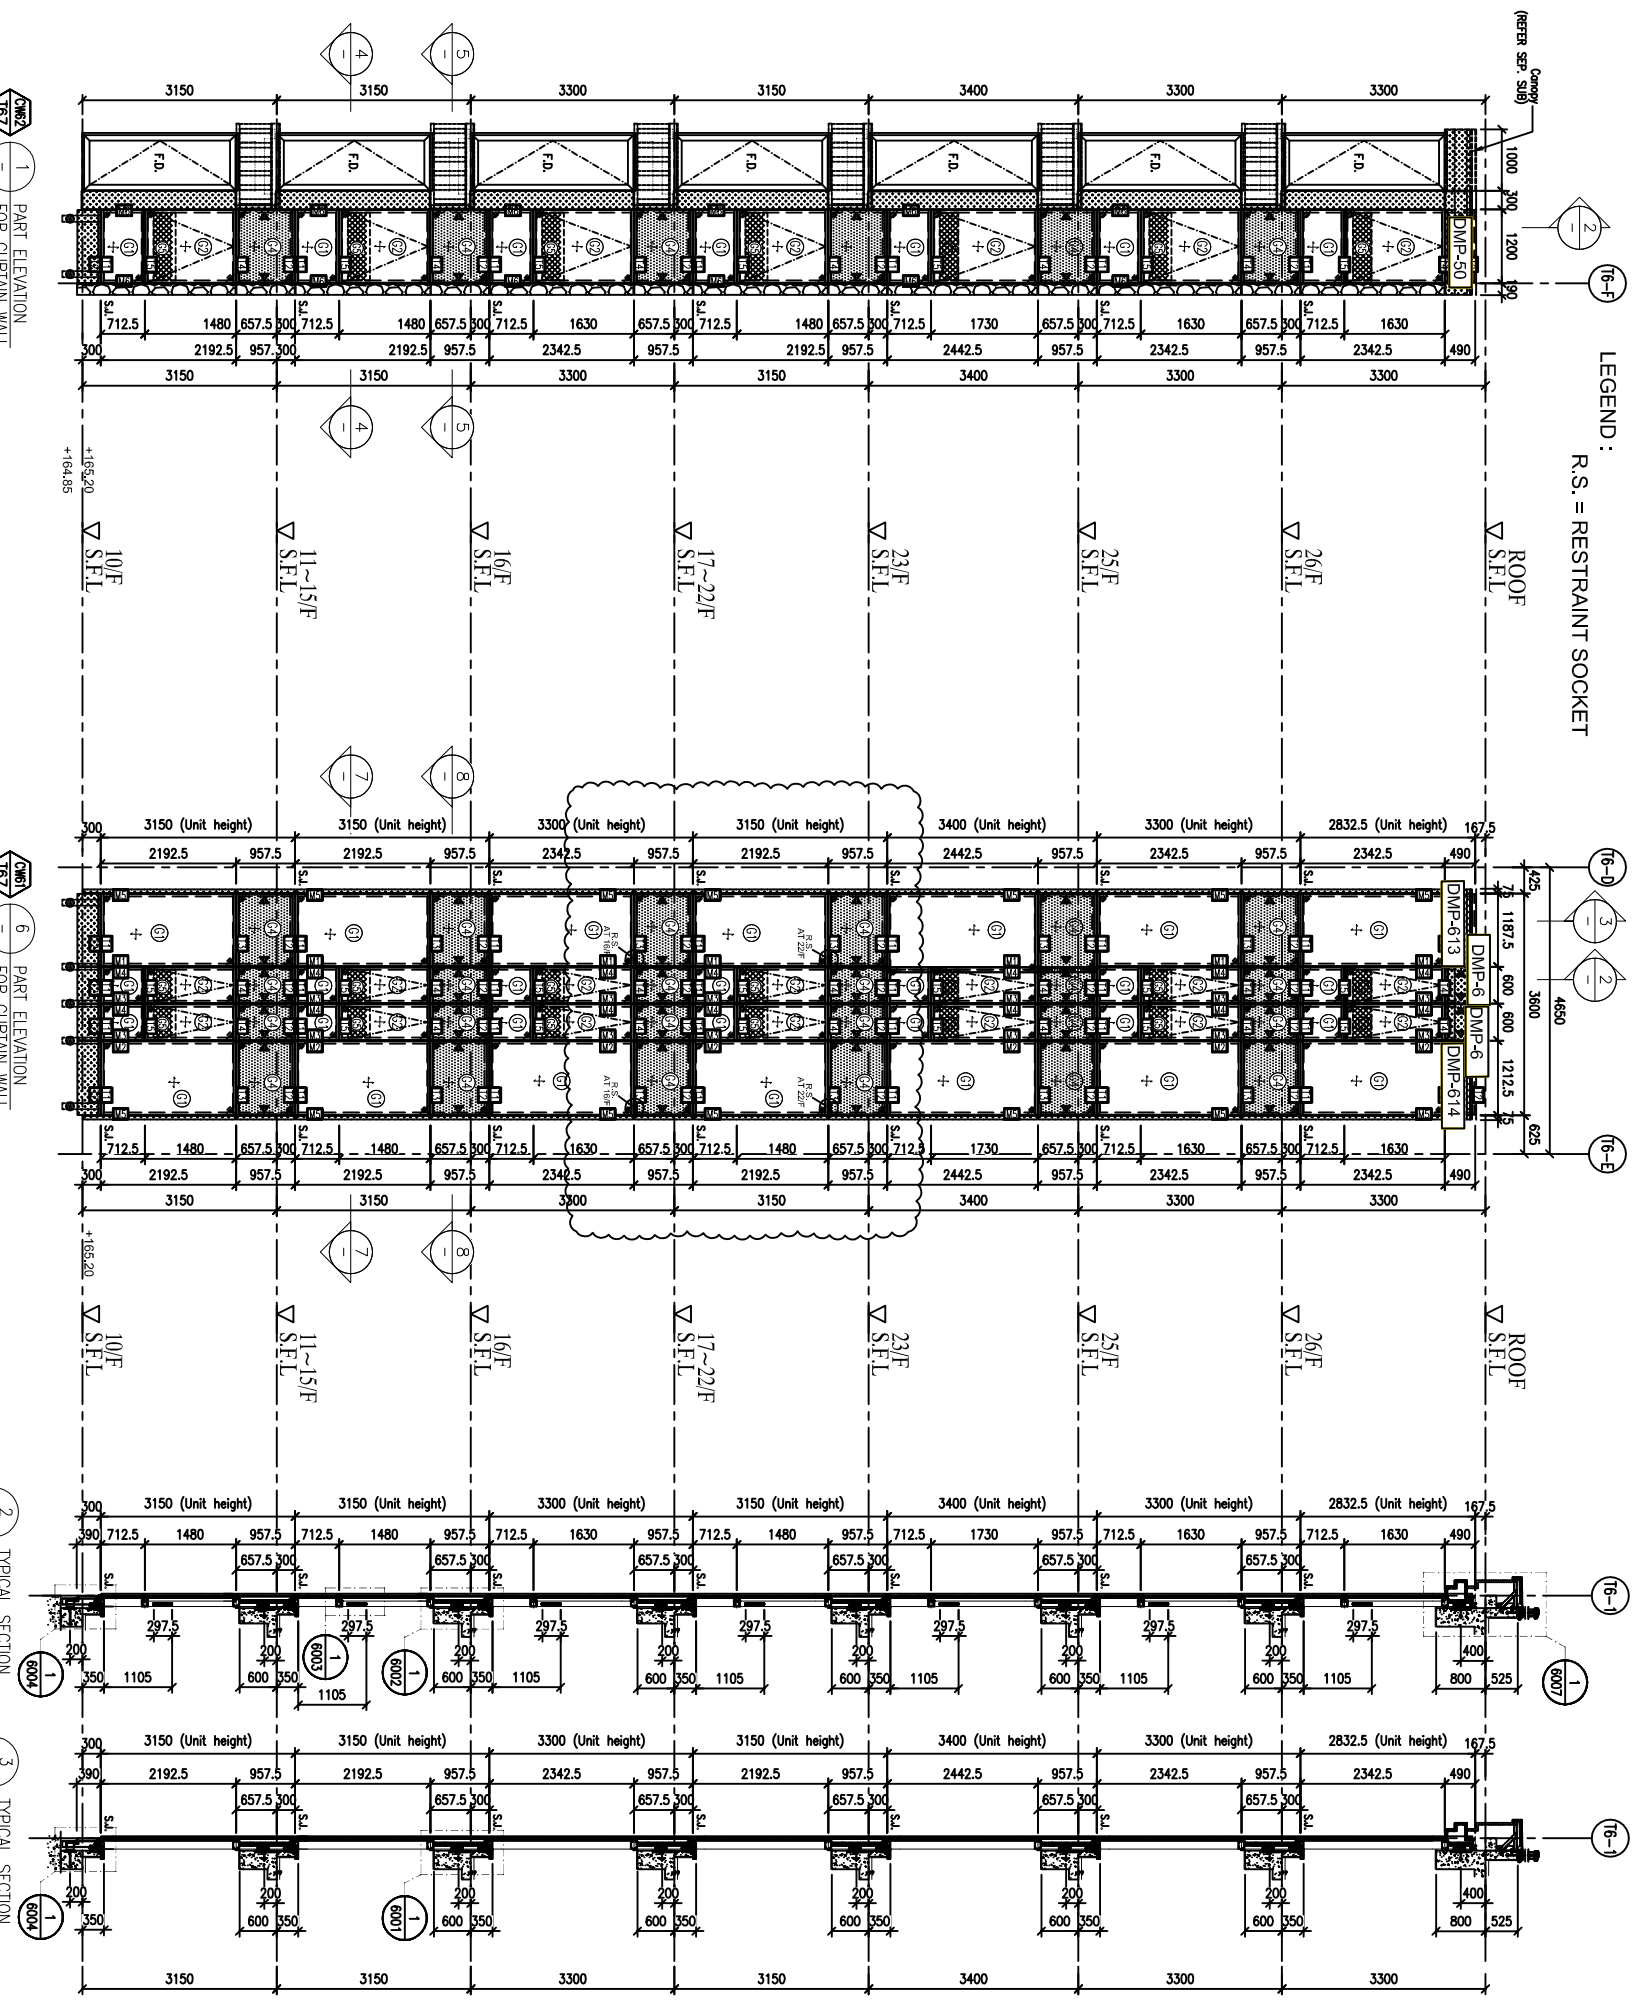

FLOOR LEVEL (S.F.L.)

FLOOR	LEVEL
ROOF	+210.00
26/F	+206.70
25/F	+203.40
23/F	+200.00
22/F	+196.85
21/F	+193.70
20/F	+190.55
19/F	+187.40
18/F	+184.25
17/F	+181.10
16/F	+177.80
15/F	+174.65
12/F	+171.50
11/F	+168.35
10/F	+165.20

LEGEND:
 10mm HEAT STRENGTHENED GLASS (OUTER)
 + 12mm AIR SPACE +12mm THK. TEMPERED CLEAR GLASS (INNER)
 10mm HEAT STRENGTHENED GLASS (OUTER)
 + 12mm AIR SPACE +10mm THK. TEMPERED CLEAR GLASS (INNER)
 12mm THK. HEAT STRENGTHENED GLASS
 & 2mm THK. ALUM. BACKPAN (SPANDREL GLASS) (INTERNAL PROTECTIVE BARRIER)
 S.J. -- STACK JOINT (WIND LOAD)
 ALUM. EXTRUSION DIE NO.
 SUPPORT POINT (WIND LOAD + DEAD LOAD)
 SUPPORT POINT (WIND LOAD)

LEGEND :
R.S. = RESTRAINT SOCKET

1 PART ELEVATION FOR CURTAIN WALL

6 PART ELEVATION FOR CURTAIN WALL

2 TYPICAL SECTION FOR CURTAIN WALL

3 TYPICAL SECTION FOR CURTAIN WALL

4 PART PLAN FOR CURTAIN WALL

5 PART PLAN FOR CURTAIN WALL

7 PART PLAN FOR CURTAIN WALL

8 PART PLAN FOR CURTAIN WALL

2 TYPICAL SECTION FOR CURTAIN WALL

3 TYPICAL SECTION FOR CURTAIN WALL


4 PART PLAN FOR CURTAIN WALL

5 PART PLAN FOR CURTAIN WALL

7 PART PLAN FOR CURTAIN WALL

8 PART PLAN FOR CURTAIN WALL

LEGEND:
R.S. = RESTRAINT SOCKET

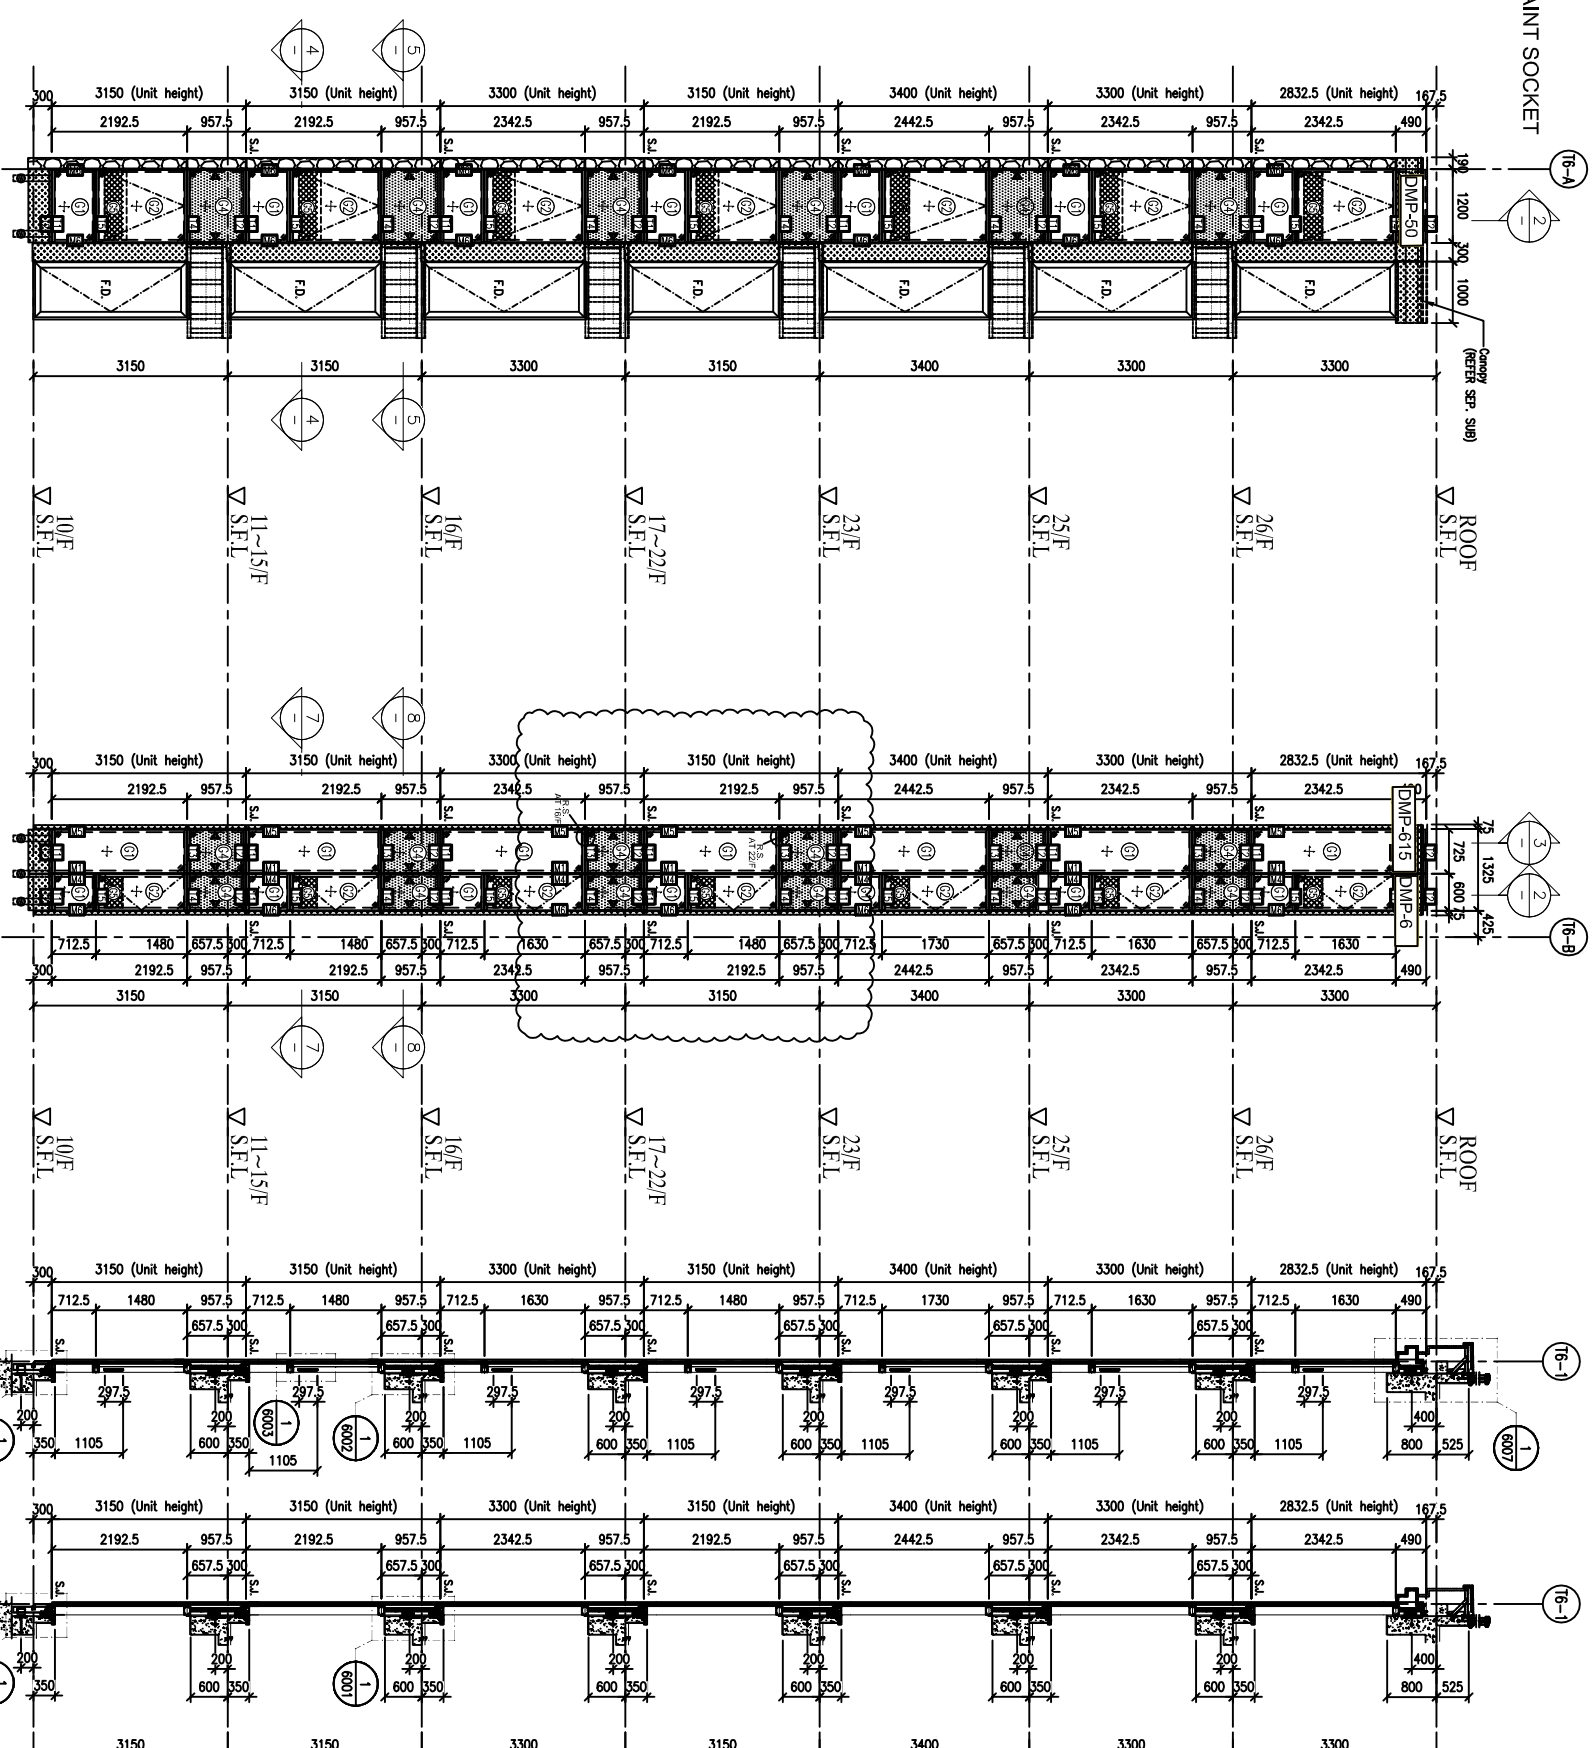

1 PART ELEVATION FOR CURTAIN WALL

6 PART ELEVATION FOR CURTAIN WALL

2 TYPICAL SECTION FOR CURTAIN WALL

3 TYPICAL SECTION FOR CURTAIN WALL

4 PART PLAN FOR CURTAIN WALL

5 PART PLAN FOR CURTAIN WALL

7 PART PLAN FOR CURTAIN WALL

8 PART PLAN FOR CURTAIN WALL

LEGEND:

- 10mm HEAT STRENGTHENED GLASS (OUTER)
- 10mm HEAT STRENGTHENED GLASS (OUTER) + 12mm AIR SPACE + 12mm THK. TEMPERED CLEAR GLASS (INNER)
- 12mm HEAT STRENGTHENED GLASS (OUTER) + 12mm AIR SPACE + 10mm THK. TEMPERED CLEAR GLASS (INNER)
- 12mm THK. HEAT STRENGTHENED GLASS & 2mm THK. ALUM. BACKPAN (SPANDREL GLASS) (INTERNAL PROTECTIVE BARRIER)
- 3mm THK. ALUM. CLADDING
- S.J. - STACK JOINT (WIND LOAD)
- ALUM. EXTRUSION DIE NO.
- SUPPORT POINT (WIND LOAD + DEAD LOAD)
- SUPPORT POINT (WIND LOAD)

FLOOR LEVEL (S.F.L.)	FLOOR LEVEL
ROOF	+210.00
26/F	+206.70
25/F	+203.40
23/F	+200.00
22/F	+196.85
21/F	+193.70
20/F	+190.55
19/F	+187.40
18/F	+184.25
17/F	+181.10
16/F	+177.80
15/F	+174.65
12/F	+171.50
11/F	+168.35
10/F	+165.20

B.D. REF :
請用A3紙打印

CLIENT :
SHIMAO GROUP HOLDINGS LIMITED

ARCHITECT :
WONG TUNG & PARTNERS LIMITED
ARCHITECTS & PLANNERS

MAIN CONTRACTOR :
協興建築有限公司
HIP HING CONSTRUCTION CO. LTD

STRUCTURAL ENGINEER :
C.M. WONG & ASSOCIATES LTD
黃志明建築工程師有限公司

FAÇADE CONSULTANT :
MENHARDT

NOTE :
1. ALL DIMENSIONS ARE IN mm.
2. ALL ELEVATIONS ARE VIEWED FROM OUTSIDE.
3. ALL DIMENSIONS TO BE VERIFIED ON SITE BEFORE FABRICATION.

LEGEND :
X1 - DETAIL MARK NO.
X001 - REFER SHEET NO.
1. F.F.L. - FINISHED FLOOR LEVEL
2. S.F.L. - STRUCTURAL FLOOR LEVEL
3. R.S. - REVERSED DETAIL



NO.	DATE	REVISION SUBJECT TO ARCH. COMMENT	BY
1	08-10-2021	REVISION SUBJECT TO ARCH. COMMENT	REVISION

JOB NO. : J-853
PROJECT : PROPOSED RESIDENTIAL DEVELOPMENT AT N.K.I.L. 6542 YIN PING ROAD KOWLOON

TITLE : PART ELEVATION FOR CURTAIN WALL AT TOWER 6 & 7
SCALE : 1:60 (A1)

DATE : 13-APR-21
DRAWN BY : LHR
CHECKED BY :
MIDI ARCHITECTURE TRANSCRIPTION LTD.
Units 6-8, Sunny Industrial Centre, 1/F
610 Che Kwo Ling Road, Kowloon
Tel: 23489211-4 Fax: (852) 27277866
DWG NO. : J853-SD-CW-4607
REV. : A

LEGEND:
R.S. = RESTRAINT SOCKET

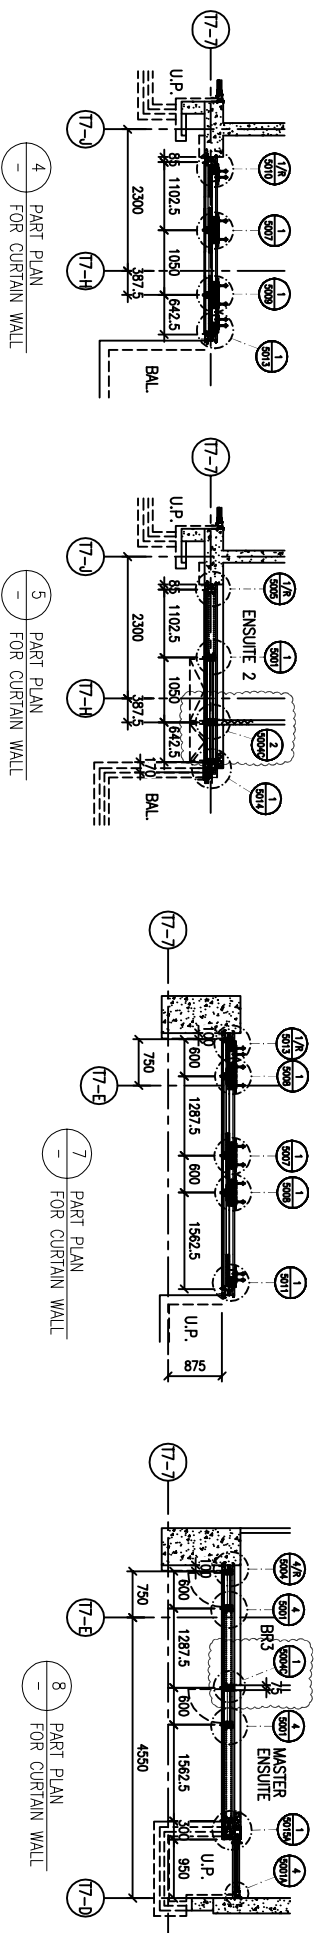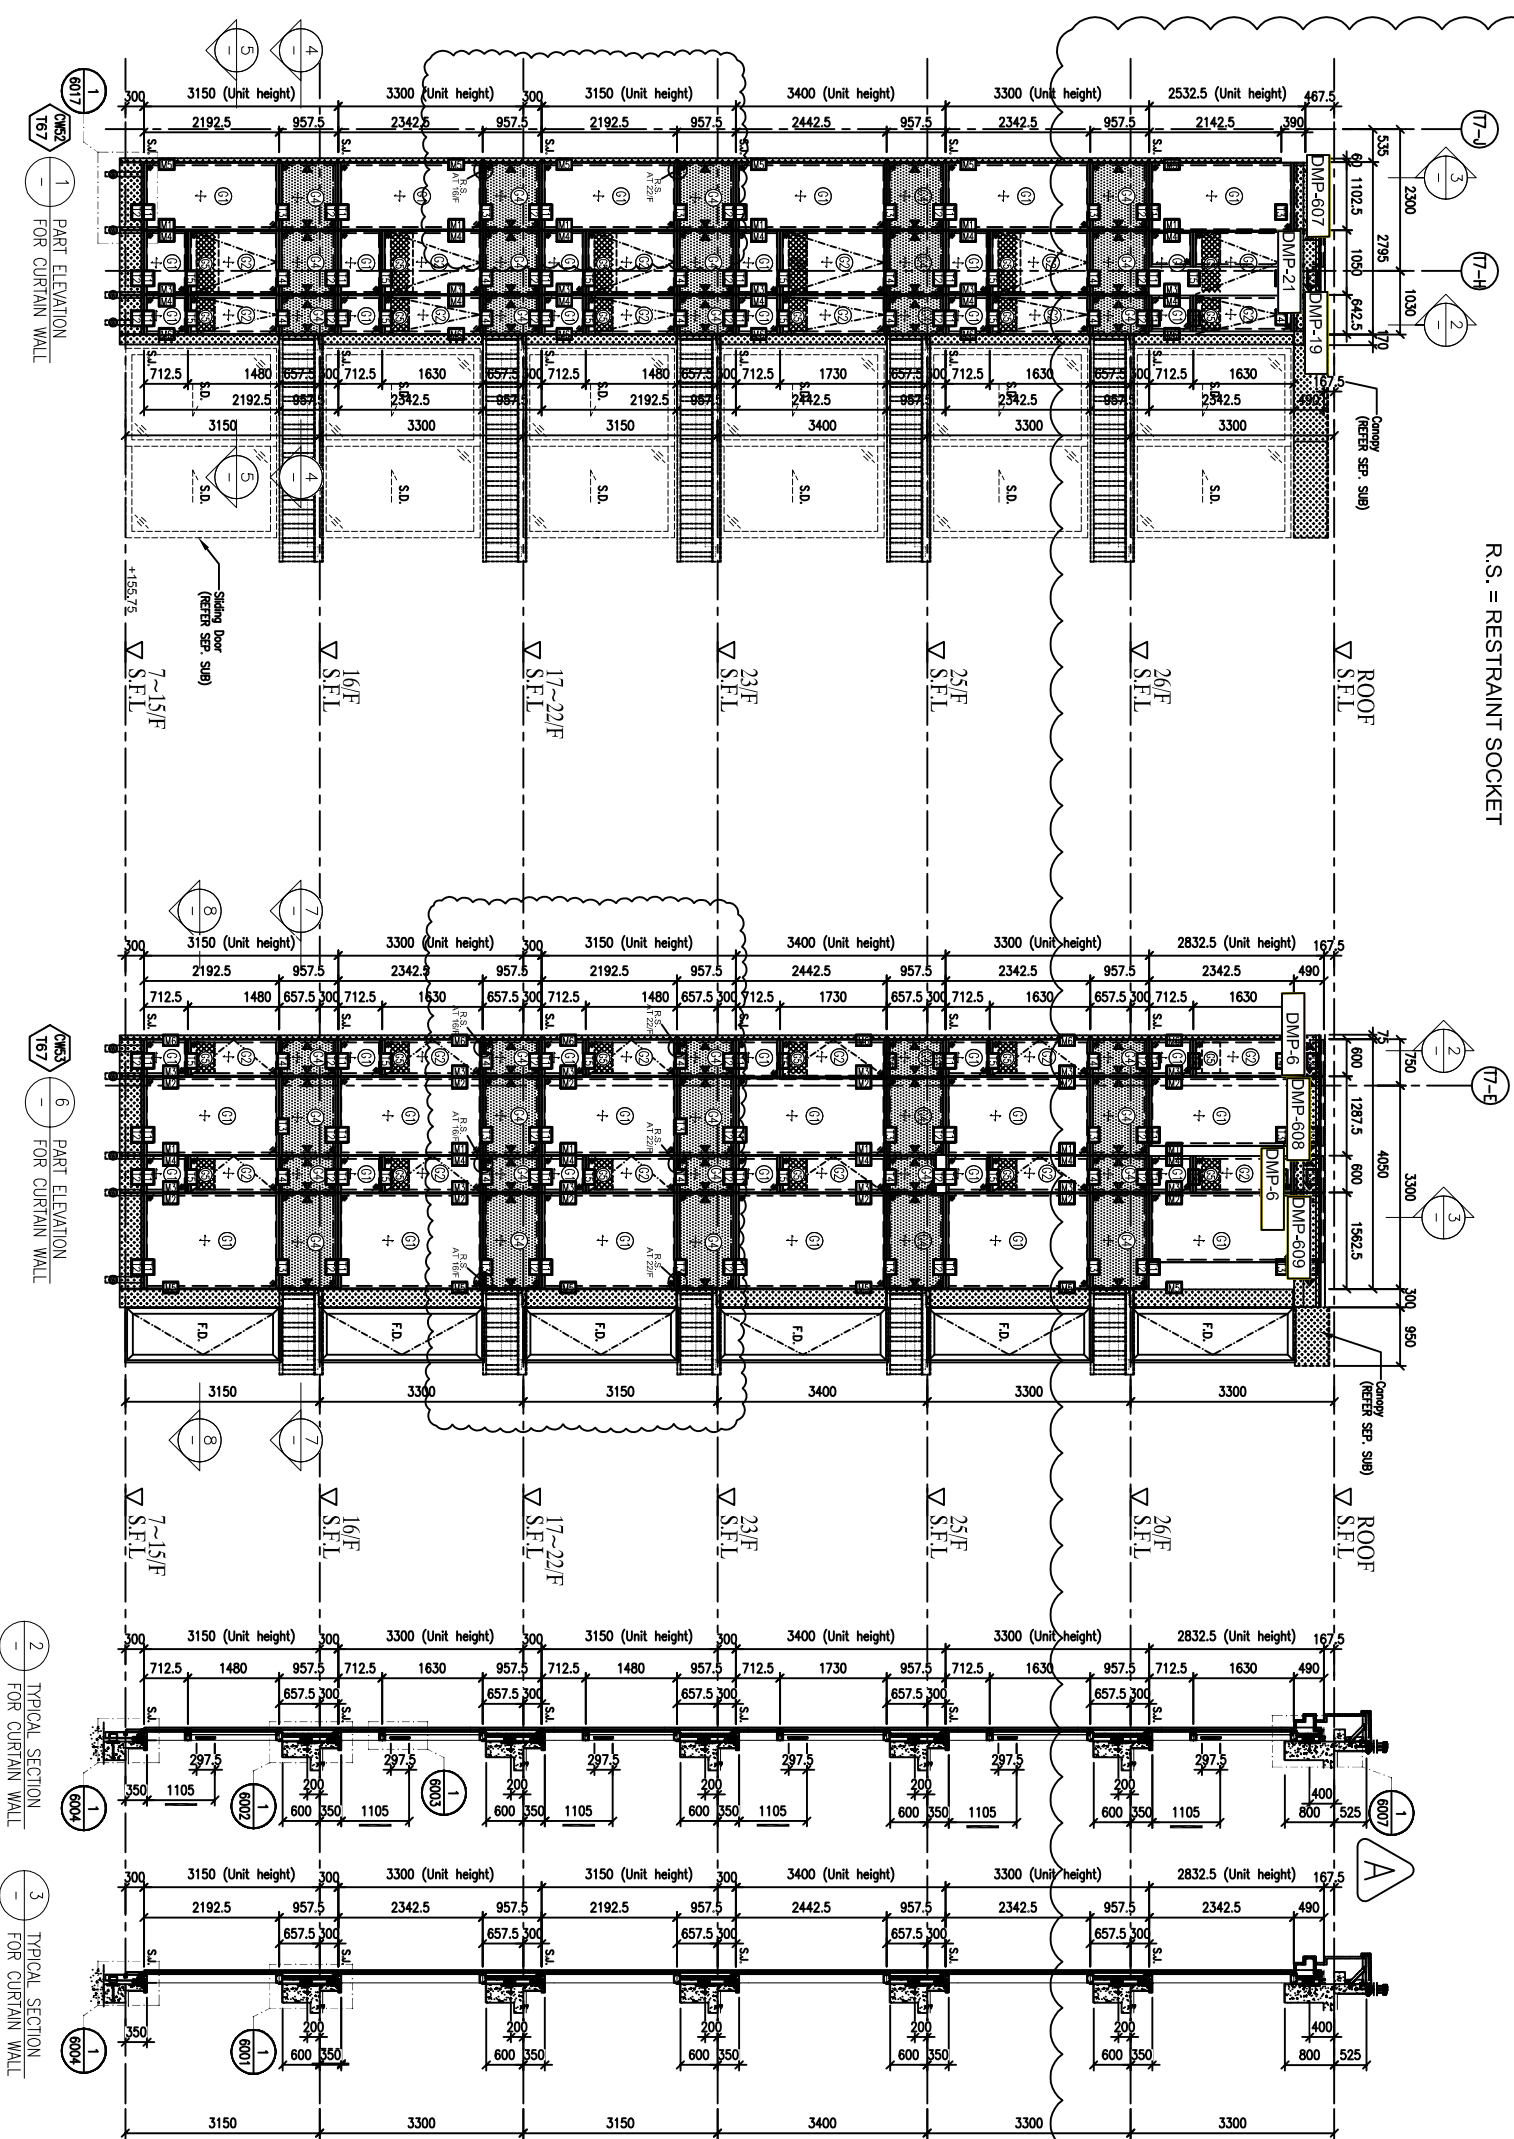

FLOOR LEVEL (S.F.L.)

FLOOR	LEVEL
ROOF	+210.00
26/F	+206.70
25/F	+203.40
23/F	+200.00
22/F	+196.85
21/F	+193.70
20/F	+190.55
19/F	+187.40
18/F	+184.25
17/F	+181.10
16/F	+177.80
15/F	+174.65
12/F	+171.50
11/F	+168.35
10/F	+165.20
9/F	+162.05
8/F	+158.90
7/F	+155.75

- LEGEND:
- ① 10mm HEAT STRENGTHENED GLASS (OUTER) + 12mm AIR SPACE + 12mm THK. TEMPERED CLEAR GLASS (INNER)
 - ② 10mm HEAT STRENGTHENED GLASS (OUTER) + 12mm AIR SPACE + 10mm THK. TEMPERED CLEAR GLASS (INNER)
 - ③ 12mm THK. HEAT STRENGTHENED GLASS & 2mm THK. ALUM. BACKPAN (SPANDREL GLASS) (INTERNAL PROTECTIVE BARRIER)
 - ④ 3mm THK. ALUM. CLADDING
 - S.J. - STACK JOINT (WIND LOAD)
 - ALUM. - ALUM. EXTRUSION DIE NO.
 - ▲ - SUPPORT POINT (WIND LOAD + DEAD LOAD)
 - - SUPPORT POINT (WIND LOAD)

B.D. REF :
請用A3紙打印

CLIENT :
SHIMAO GROUP HOLDINGS LIMITED

ARCHITECT :
WONG TUNG & PARTNERS LIMITED
ARCHITECTS & PLANNERS

MAIN CONTRACTOR :
協興建築有限公司
HIP HING CONSTRUCTION CO LTD

STRUCTURAL ENGINEER :
ICMA
C M WONG & ASSOCIATES LTD
黃志明建築工程師有限公司

FAÇADE CONSULTANT:
MEINHARDT

NOTE:
1. ALL DIMENSIONS ARE IN mm.
2. ALL ELEVATIONS ARE VIEWED FROM OUTSIDE.
3. ALL DIMENSIONS TO BE VERIFIED ON SITE BEFORE FABRICATION.

LEGEND:
①1 - DETAIL MARK NO.
①000 - REFER SHEET NO.
1. F.F.L. -- FINISHED FLOOR LEVEL
2. S.F.L. -- STRUCTURAL FLOOR LEVEL
3. R/S -- REVERSED DETAIL

JOB NO. : J-853
PROJECT : PROPOSED RESIDENTIAL DEVELOPMENT AT N.K.I.L. 6542 YIN PING ROAD KOWLOON
TITLE : PART ELEVATION FOR CURTAIN WALL AT TOWER 6 & 7
DATE : 12-APR-21 SCALE : 1:60 (A1)
DRAWN BY : LHR CHECKED BY :
MIDI 美特鋁質有限公司
Units 6-8, Sunny Industrial Centre, 1/F
610 Che Kwo Ling Road, Kowloon
Tel: 23489211-4 Fax: (852) 27277866
DWG NO. : J853-SD-CW-4603 REV. : A

B.D. REF :
請用A3紙打印

CLIENT :
SHIMAO GROUP
HOLDINGS LIMITED

ARCHITECT :
WONG TUNG & PARTNERS LIMITED
ARCHITECTS & PLANNERS



MAIN CONTRACTOR :
協興建築有限公司
HIP HING CONSTRUCTION CO LTD

STRUCTURAL ENGINEER :
ICMA C.M. WONG & ASSOCIATES LTD
黃志明建築工程師有限公司

FAÇADE CONSULTANT:



NOTE :
1. ALL DIMENSIONS ARE IN mm.
2. ALL ELEVATIONS ARE VIEWED FROM OUTSIDE.
3. ALL DIMENSIONS TO BE VERIFIED ON SITE BEFORE FABRICATION.

LEGEND :

- (X1) --- DETAIL MARK NO.
- (X001) --- REFER SHEET NO.
- 1. F.F.L. --- FINISHED FLOOR LEVEL
- 2. S.F.L. --- STRUCTURAL FLOOR LEVEL
- 3. (R) --- REVERSED DETAIL




NO.	DATE	REVISION	BY

JOB NO. : J-853
PROJECT : PROPOSED RESIDENTIAL DEVELOPMENT AT N.K.I.L. 6542 YIN PING ROAD KOWLOON

TITLE : PART ELEVATION FOR CURTAIN WALL AT TOWER 6 & 7

DATE : 09-OCT-21 SCALE : 1:60 (A1)
DRAWN BY : LHR CHECKED BY :

美特鋁質有限公司
MIDI Aluminium Fabricator Ltd.
Units 6-8, Sunny Industrial Centre, 1/F
610 Che Kwo Ling Road, Kowloon
Tel: 23489211-4 Fax: (852) 27277866
DWG NO. : JB53-SD-CW-4609 REV. : A

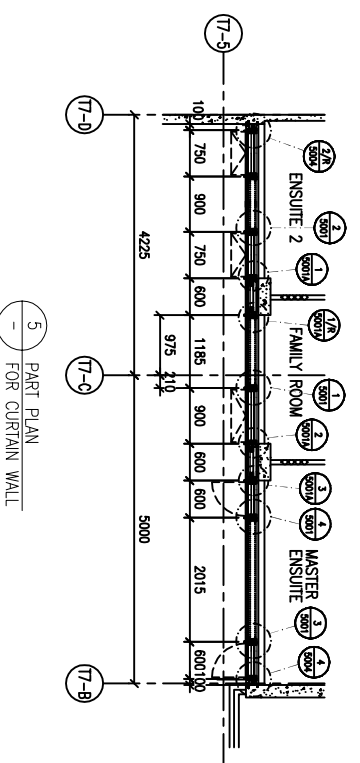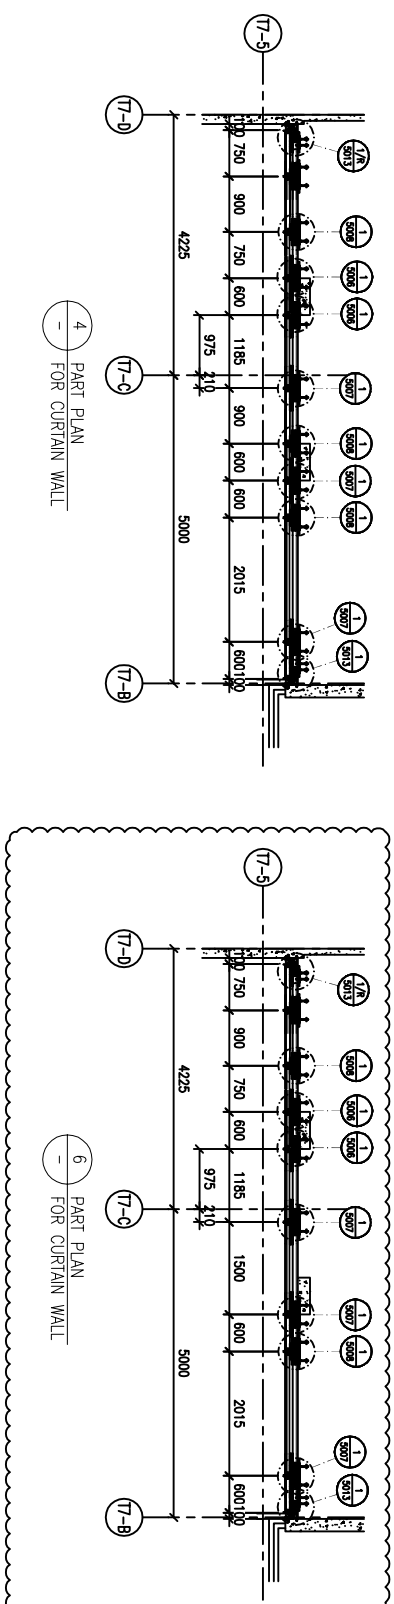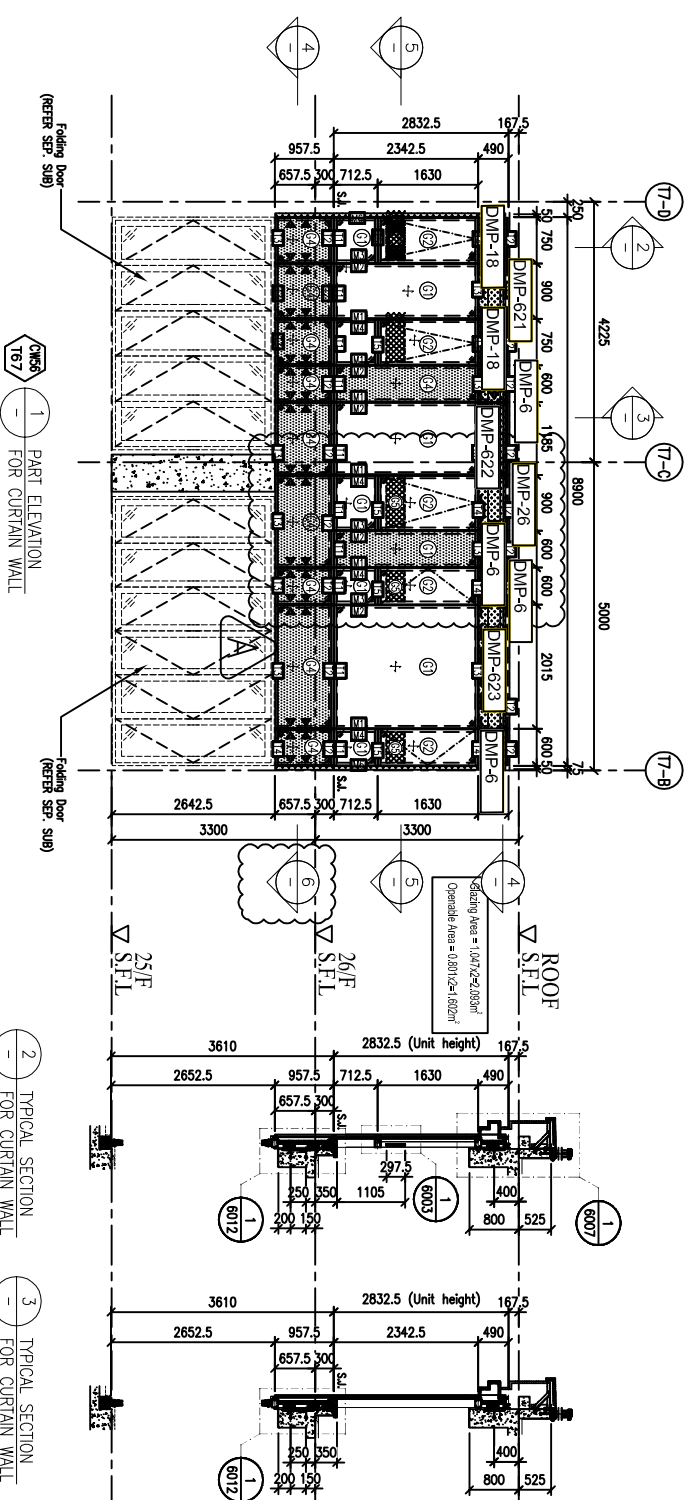

LEGEND:

	10mm HEAT STRENGTHENED GLASS (OUTER) + 12mm AIR SPACE + 12mm THK. TEMPERED CLEAR GLASS (INNER)
	10mm HEAT STRENGTHENED GLASS (OUTER) + 12mm AIR SPACE + 10mm THK. TEMPERED CLEAR GLASS (INNER)
	12mm THK. HEAT STRENGTHENED GLASS & 2mm THK. ALUM. BACKPAN (SPANDREL GLASS)
	12mm THK. CLEAR TEMPERED GLASS (INTERNAL PROTECTIVE BARRIER)
	3mm THK. ALUM. CLADDING
	S.J. --- STACK JOINT (WIND LOAD)
	ALUM. EXTRUSION (WIND LOAD)
	SUPPORT POINT (WIND LOAD + DEAD LOAD)
	SUPPORT POINT (WIND LOAD)