美特鋁質有限公司
MIDI ALUMINIUM FABRICATOR LTD.

工程指示 / 要求簡箋 ENGINEER INSTRUCTIONS(E.I.)

工程指示編號:	EI- 5570C	**修改版本:**	C
	HK- 0417		
工程編號:	J 853	**工程名稱:**	大窩坪（延坪道）
收件人:	生統	**發件人:**	Edwin Ho
工程項目:	T5、T6及T7GB欄河鋁料（C：加工圖紙更新）	**日期:**	09/03/2023

☐ 原合約工程包	☐ 原合約工程加 / 減賬 QT-	☐ 新工程報價 QT-

信件批核號碼/圖紙參考編號:	**批核模具圖紙編號:**
客戶指示附件:	**管理內部批簽署:**

☐ 初步鋁料 B.M.	☐ 加工拆圖，然後生產	☐ 尺寸表
☐ 正式鋁料 B.M.	☐ 技術上資料／指示	☐ 報價
☑ 配件 B.M.	☐ 樣辦或貨品說明書	☐ 分判合約
☐ 其他:		

內容: 煩請根據附件加工圖，生產T5、T6及T7 GB欄河鋁料。

完成上列要求日期: ASAP

國內

☐ 生產技術總監	☐ 連附件	☐ 技術部	☐ 連附件	☐ 生產部	☐ 連附件
☐ 採購部	☐ 連附件	☑ 生產統籌部	☑ 連附件	☐ 報關組	☐ 連附件
☐ 質檢部	☐ 連附件	☐ 會計部	☐ 連附件	☐ 機械設計部	☐ 連附件
☐ 香港辦	☑ 連附件	☐ 其他:			

香港

☐ 行政部	☐ 連附件	☐ 會計部	☐ 連附件	☐ 統籌部	☐ 連附件	☐ 工程部	☐ 連附件
☐ 採購部	☐ 連附件	☐ QS部	☐ 連附件	☑ 地盤管理	☑ 連附件	☐ 維修部	☐ 連附件

*發件人簽署： Edwin Ho	*組別成員批核簽署： 9/3/2023
傳遞編號：	項目經理簽署：

Tai Wo Ping.

圖則登記表
DRAWING REGISTER

工程名稱 Project Title: T5-T7, GB擴河鋁料加工

工程編號 Project No: **J-853**

接收日期 Receiving Date (適用於客戶圖則)

年										
月										
日										

分發予 Distributed To

發出日期 Issued Date

年	22	23	23						
月	12	02	03						
日	20	22	02						

圖則編號 Drg. No.	圖則名稱 Drawing Title	修訂編號 Revision No.									
	圖則登記表	1	–								
	鋁料派位表	2	–								
J853-GB-FAB2-01	86215加工圖	3	–		A						
J853-GB-FAB2-02	86215加工圖	4	–		A						
J853-GB-FAB2-02A	86215加工圖	5	–		新增						
J853-GB-FAB2-03	86215加工圖	6	–		A						
J853-GB-FAB2-03A	86215加工圖	7	–		新增						
J853-GB-FAB2-04	86215加工圖	8	–		A						
J853-GB-FAB2-05	86215加工圖	9	–		A						
J853-GB-FAB2-06	86215加工圖	10	–		A						
J853-GB-FAB2-06B	86215加工圖	11	–		新增						
J853-GB-FAB2-07	86215加工圖	12	–		A						
J853-GB-FAB2-07B	86215加工圖	13	–		新增						
J853-GB-FAB2-08	86215加工圖	14	–		A						
J853-GB-FAB2-08A	86215加工圖	15	–		新增						
J853-GB-FAB2-09	86215加工圖	16	–		A						
J853-GB-FAB2-10	86215加工圖	17	–		A						
J853-GB-FAB2-11	86215加工圖	18	–		A						
J853-GB-FAB2-12	86215加工圖	19	–		A						
J853-GB-FAB2-13	86215加工圖	20	–		A						
J853-GB-FAB2-14	86215加工圖	21	–		A						
J853-GB-FAB2-15	86215加工圖	22	–		A						
J853-GB-FAB2-16	86215加工圖	23	–		A						
J853-GB-FAB2-17	86215加工圖	24	–		A						
J853-GB-FAB2-17A	86215加工圖	25	–		新增						
J853-GB-FAB2-17B	86215加工圖	26	–		新增						
J853-GB-FAB2-18	86215加工圖	27	–		A						
J853-GB-FAB2-18A	86215加工圖	28	–		新增						
J853-GB-FAB2-18B	86215加工圖	29	–		新增						
J853-GB-FAB2-19	86215加工圖	30	–		A						
J853-GB-FAB2-19A	86215加工圖	31	–		新增						
J853-GB-FAB2-20	86215加工圖	32	–		A						
J853-GB-FAB2-20A	86215加工圖	33	–		新增						
J853-GB-FAB2-21	86215加工圖	34	–		A						
J853-GB-FAB2-22	86215加工圖	35	–		A						
J853-GB-FAB2-23	86215加工圖	36	–		A						
J853-GB-FAB2-24	86215加工圖	37	–		A						
J853-GB-FAB2-25	86215加工圖	38	–		A						
J853-GB-FAB2-26	86215加工圖	39	–		A						
J853-GB-FAB2-27	86215加工圖	40	–		A						
J853-GB-FAB2-28	86215加工圖	41	–		A						
J853-GB-FAB2-29	86215加工圖	42	–		A						
J853-GB-FAB2-30	86216加工圖	43	–	A							
J853-GB-FAB2-31	86216加工圖	44	–	A							
J853-GB-FAB2-31-1	86216加工圖	45	–	A							
J853-GB-FAB2-32	86216加工圖	46	–	A							
J853-GB-FAB2-33	86216加工圖	47	–	A							
J853-GB-FAB2-34	86216加工圖	48	–	A							
J853-GB-FAB2-35	86216加工圖	49	–	A							
J853-GB-FAB2-36	86216加工圖	50	–	A							
J853-GB-FAB2-37	86216加工圖	51	–	A							
J853-GB-FAB2-38	86216加工圖	52	–	A							
J853-GB-FAB2-39	86216加工圖	53	–	A							
J853-GB-FAB2-40	86216加工圖	54	–	A							
J853-GB-FAB2-41	86216加工圖	55	–	A							

圖則登記表
DRAWING REGISTER

工程名稱 Project Title: T5-T7, GB擴河鋁料加工

工程編號 Project No: **J-853**

接收日期 Receiving Date (適用於客戶圖則)

年										
月										
日										

分發予 Distributed To

發出日期 Issued Date

年	22	23	23						
月	12	02	03						
日	20	22	02						

圖則編號 Drg. No.	圖則名稱 Drawing Title	修訂編號 Revision No.									
J853-GB-FAB2-42	86216加工圖	56	–	A							
J853-GB-FAB2-43	86216加工圖	57	–	A							
J853-GB-FAB2-44	86216加工圖	58	–	A							
J853-GB-FAB2-45	86216加工圖	59	–	A							
J853-GB-FAB2-46	86216加工圖	60	–	A							
J853-GB-FAB2-47	86216加工圖	61	–	A							
J853-GB-FAB2-48	86216加工圖	62	–	A							
J853-GB-FAB2-49	86216加工圖	63	–	A							
J853-GB-FAB2-50	86217加工圖	64	–								
J853-GB-FAB2-51	86217加工圖	65	–	A							
J853-GB-FAB2-52	86217加工圖	66	–	A							
J853-GB-FAB2-53	86217加工圖	67	–	A							
J853-GB-FAB2-54	86217加工圖	68	–	A							
J853-GB-FAB2-55	86217加工圖	69	–	A							
J853-GB-FAB2-56	86217加工圖	70	–	A							
J853-GB-FAB2-57	86217加工圖	71	–	A							
J853-GB-FAB2-58	86217加工圖	72	–	A							
J853-GB-FAB2-59	86217加工圖	73	–	A							
J853-GB-FAB2-60	86217加工圖	74	–	A							
J853-GB-FAB2-61	86217加工圖	75	–	A							
J853-GB-FAB2-62	86217加工圖	76	–	A							
J853-GB-FAB2-63	86217加工圖	77	–	A							
J853-GB-FAB2-64	86217加工圖	78	–	A							
J853-GB-FAB2-65	86217加工圖	79	–	A							
J853-GB-FAB2-66	86217加工圖	80	–	A							
J853-GB-FAB2-67	86217加工圖	81	–	A							
J853-GB-FAB2-68	86218加工圖	82	–								
J853-GB-FAB2-69	86218加工圖	83	–								
J853-GB-FAB2-70	86218加工圖	84	–								
J853-GB-FAB2-71	86218加工圖	85	–								
J853-GB-FAB2-72	86218加工圖	86	–								
J853-GB-FAB2-73	86218加工圖	87	–								
J853-GB-FAB2-74	86218加工圖	88	–								
J853-GB-FAB2-75	86218加工圖	89	–								
J853-GB-FAB2-76	86218加工圖	90	–								
J853-GB-FAB2-77	86218加工圖	91	–								
J853-GB-FAB2-78	86218加工圖	92	–								
J853-GB-FAB2-79	86218加工圖	93	–								
J853-GB-FAB2-80	86218加工圖	94	–								
J853-GB-FAB2-81	86218加工圖	95	–								
J853-GB-FAB2-82	86218加工圖	96	–								
J853-GB-FAB2-83	86218加工圖	97	–								
J853-GB-FAB2-84	86218加工圖	98	–								
J853-GB-FAB2-85	86218加工圖	99	–								
J853-GB-FAB2-86	86218加工圖	100	–								
J853-GB-FAB2-87	86218加工圖	101	–								
J853-GB-FAB2-88	86218加工圖	102	–								
J853-GB-FAB2-89	86218加工圖	103	–								
J853-GB-FAB2-90	86218加工圖	104	–								
J853-GB-FAB2-91	86218加工圖	105	–								
J853-GB-FAB2-92	86218加工圖	106	–								
J853-GB-FAB2-93	86218加工圖	107	–								
J853-GB-FAB2-94	86218加工圖	108	–								
J853-GB-FAB2-95	86218加工圖	109	–								
J853-GB-FAB2-96	86218加工圖	110	–								

圖則登記表
DRAWING REGISTER

工程名稱 Project Title: T5-T7, GB擴河鋁料加工

工程編號 Project No: J-853

接收日期 Receiving Date (適用於客戶圖則)

年										
月										
日										

分發予 Distributed To

發出日期 Issued Date

年	22	23	23						
月	12	02	03						
日	20	22	02						

圖則編號 Drg. No.	圖則名稱 Drawing Title	修訂編號 Revision No.									
J853-GB-FAB2-97	86218加工圖	111	–								
J853-GB-FAB2-98	86218加工圖	112	–								
~~J853-GB-FAB2-99~~	~~86219加工圖~~	~~113~~	–								
~~J853-GB-FAB2-100~~	~~86219加工圖~~	~~114~~	–								
~~J853-GB-FAB2-101~~	~~86219加工圖~~	~~115~~	–								
~~J853-GB-FAB2-102~~	~~86219加工圖~~	~~116~~	–								
J853-GB-FAB2-103	86225加工圖	117	–	A							
J853-GB-FAB2-104	86225加工圖	118	–	A							
J853-GB-FAB2-105	86226加工圖	119	–	A							
J853-GB-FAB2-106	86226加工圖	120	–	A							
J853-GB-FAB2-107	86227加工圖	121	–								
J853-GB-FAB2-108	86228加工圖	122	–	A							
J853-GB-FAB2-109	86235加工圖	123	–								
J853-GB-FAB2-110	86236加工圖	124	–								
J853-GB-FAB2-111	86229加工圖	125	–								
J853-GB-FAB2-112	86229加工圖	126	–								
J853-GB-FAB2-113	86229加工圖	127	–								
J853-GB-FAB2-114	86229加工圖	128	–								
J853-GB-FAB2-115	86229加工圖	129	–								
J853-GB-FAB2-116	86229加工圖	130	–								
J853-GB-FAB2-117	86230加工圖	131	–								
J853-GB-FAB2-118	86230加工圖	132	–								
J853-GB-FAB2-119	86230加工圖	133	–								
J853-GB-FAB2-120	86230加工圖	134	–								
J853-GB-FAB2-121	86230加工圖	135	–								
J853-GB-FAB2-122	86230加工圖	136	–								
J853-GB-FAB2-123	86230加工圖	137	–								
J853-GB-FAB2-124	86230加工圖	138	–								
J853-GB-FAB2-125	86230加工圖	139	–								
J853-GB-FAB2-126	86230加工圖	140	–								
J853-GB-FAB2-127	86230加工圖	141	–								
J853-GB-FAB2-128	86230加工圖	142	–								
J853-GB-FAB2-129	86230加工圖	143	–								
J853-GB-FAB2-130	86230加工圖	144	–								
J853-GB-FAB2-131	86230加工圖	145	–								
J853-GB-FAB2-132	86230加工圖	146	–								
J853-GB-FAB2-133	86230加工圖	147	–								
J853-GB-FAB2-134	86230加工圖	148	–								
J853-GB-FAB2-135	86230加工圖	149	–								
J853-GB-FAB2-136	86230加工圖	150	–								
J853-GB-FAB2-137	86230加工圖	151	–								
J853-GB-FAB2-138	86230加工圖	152	–								
J853-GB-FAB2-139	86230加工圖	153	–								
J853-GB-FAB2-140	86230加工圖	154	–								
J853-GB-FAB2-141	86230加工圖	155	–								
J853-GB-FAB2-142	86230加工圖	156	–								
J853-GB-FAB2-143	86230加工圖	157	–								
J853-GB-FAB2-144	86230加工圖	158	–								
J853-GB-FAB2-145	86230加工圖	159	–								
J853-SD-GB-5501	位置圖	160	–		A						
J853-SD-GB-5502	位置圖	161	–		A						
J853-SD-GB-5503	位置圖	162	–		A						
J853-SD-GB-5504	位置圖	163	–		A						
J853-SD-GB-5505	位置圖	164	–		A						
J853-SD-GB-5506	位置圖	165	–		A						

圖則登記表
DRAWING REGISTER

工程名稱 Project Title:
T5-T7, GB擱河鋁料加工

工程編號 Project No: **J-853**

接收日期 Receiving Date (適用於客戶圖則)

年										
月										
日										

分發予 Distributed To

發出日期 Issued Date


年	22	23	23						
月	12	02	03						
日	20	22	02						

圖則編號 Drg. No.	圖則名稱 Drawing Title	修訂編號 Revision No.								
J853-SD-GB-5507	位置圖	166	-		A					
J853-SD-GB-5601	位置圖	167	-		A					
J853-SD-GB-5602	位置圖	168	-		A					
J853-SD-GB-5603	位置圖	169	-		A					
J853-SD-GB-5701	位置圖	170	-		A					
J853-SD-GB-5702	位置圖	171	-		A					

美特鋁質 有限公司
MIDI Aluminium Fabricator Ltd.

工程號	J853	地盤	~~錦上路~~ TUP

送工地

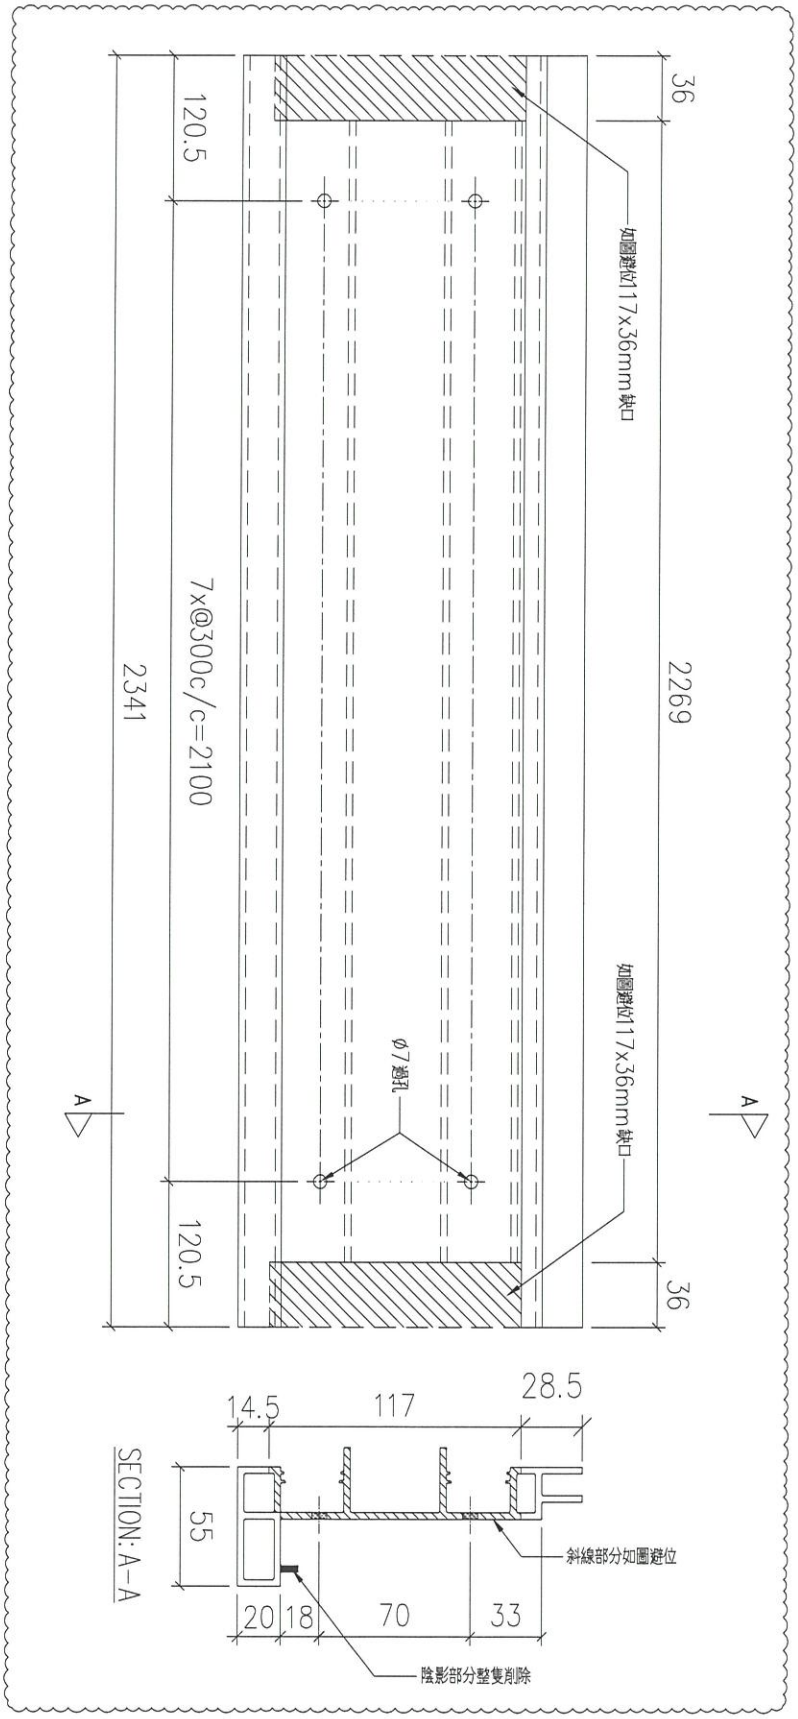


序號	物料編號	數量	安裝位置	樓層
01	T5-X86215-01	8	見派位圖	T5 FLAT A 17~25/F

名稱	扶手加工圖	制圖	LHR	2022,08,26	修改	A		
材料	X86215	復核	–	–	日期	2023.3.2		
顏色	JMQ213457(3coats)	批準			圖號	J853-GB-FAB2-01		

美特鋁質 有限公司
MIDI Aluminium Fabricator Ltd.

工程號	J853	地盤	錦上路 TWP

送工地

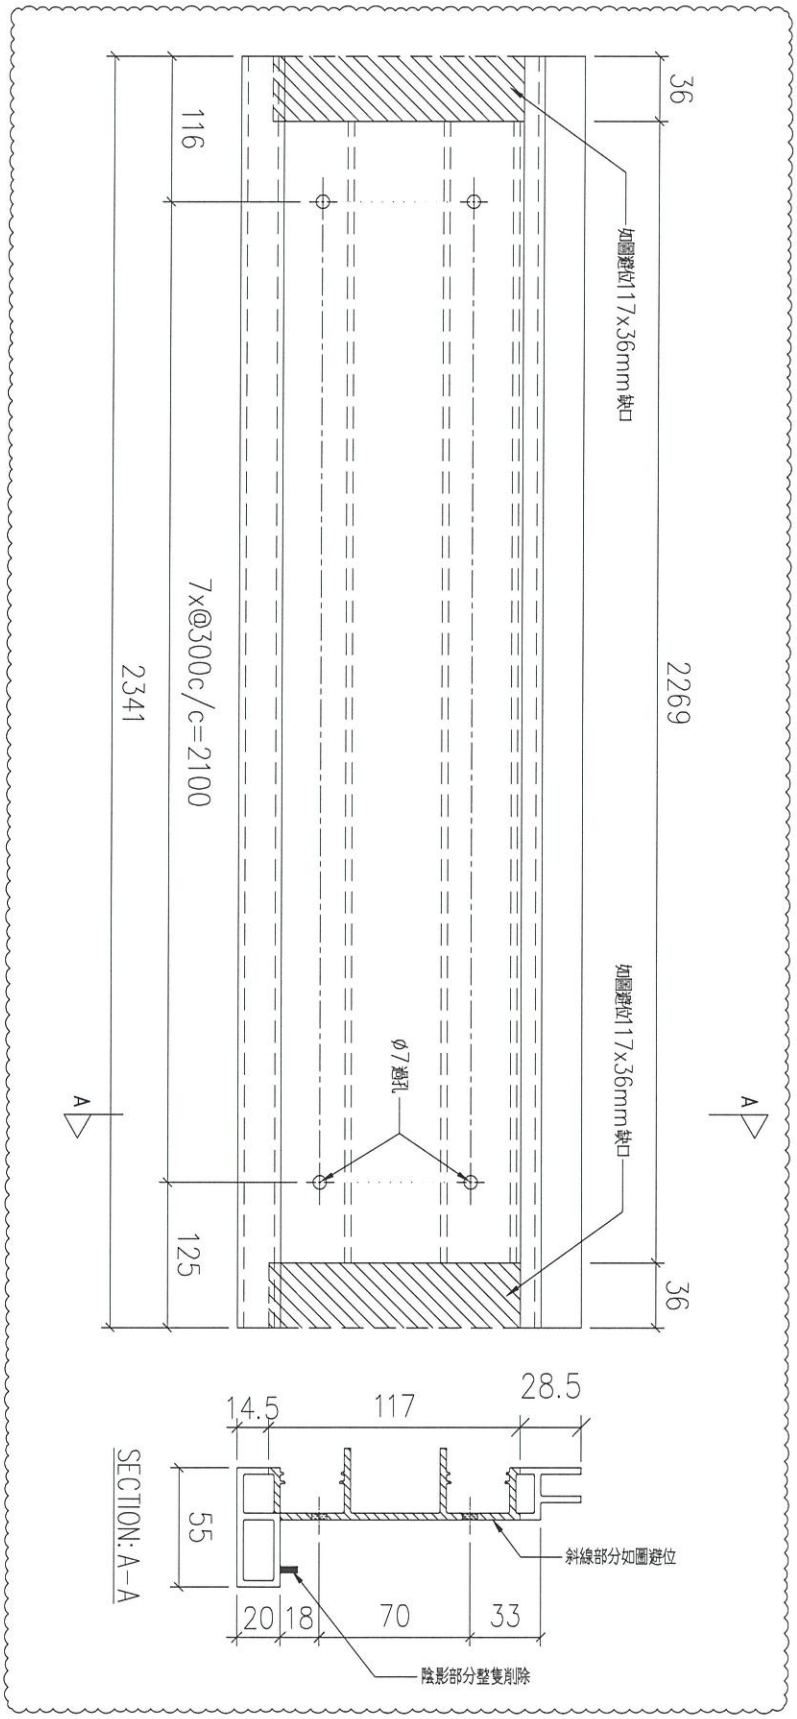

序號	物料編號	數量	安裝位置	樓層
01	T5-X86215-02	8	見派位圖	T5 FLAT A 17~25/F

名稱	扶手加工圖	制圖	LHR	2022,08,26	修改	A		
材料	X86215	復核	–	–	日期	2023.3.2		
顏色	JMQ213457(3coats)	批準			圖號	J853-GB-FAB2-02		

2

美特鋁質 有限公司
MIDI Aluminium Fabricator Ltd.

工程號	J853	地盤	~~錦上路~~ TWP

送工地

新增圖


	物料編號	數量	安裝位置	樓層
		合計: 220		
19	T6-X86215-08A	18	見派位圖	T6 FLAT B 5,6,8~26/F
18	T7-X86215-05A	17	見派位圖	T7 FLAT A 7~26/F
17	T6-X86215-05A	18	見派位圖	T6 FLAT A 5,6,8~26/F
16	T7-X86215-03A	15	見派位圖	T7 FLAT B 7~23/F
15	T6-X86215-01A	18	見派位圖	T6 FLAT A 5,6,8~26/F
14	T6-X86215-01A	18	見派位圖	T6 FLAT B 5,6,8~26/F
13	T7-X86215-01A	17	見派位圖	T7 FLAT A 7~26/F
12	T5-X86215-16A	9	見派位圖	T5 FLAT A 6~16/F
11	T5-X86215-16A	8	見派位圖	T5 FLAT A 17~25/F
10	T5-X86215-14A	4	見派位圖	T5 FLAT D 11~16/F
09	T5-X86215-12A	9	見派位圖	T5 FLAT B 6~16/F
08	T5-X86215-12B	4	見派位圖	T5 FLAT C 11~16/F
07	T5-X86215-10A	9	見派位圖	T5 FLAT B 6~16/F
06	T5-X86215-09A	9	見派位圖	T5 FLAT A 6~16/F
05	T5-X86215-09A	4	見派位圖	T5 FLAT C 11~16/F
04	T5-X86215-06A	13	見派位圖	T5 FLAT E/F 11~26/F
03	T6-X86215-03A	14	見派位圖	T6 FLAT C/D 10~26/F
02	T5-X86215-04A	8	見派位圖	T5 FLAT B 17~25/F
01	T5-X86215-02A	8	見派位圖	T5 FLAT A 17~25/F

名稱	扶手加工圖	制圖	LHR	2022,08,26	修改	–		
材料	X86215	復核	–	–	日期	–		
顏色	JMQ213457(3coats)	批準			圖號	J853-GB-FAB2-02A		

美特鋁質 有限公司
MIDI Aluminium Fabricator Ltd.

工程號	J853	地盤	錦上路 TWP

送工地

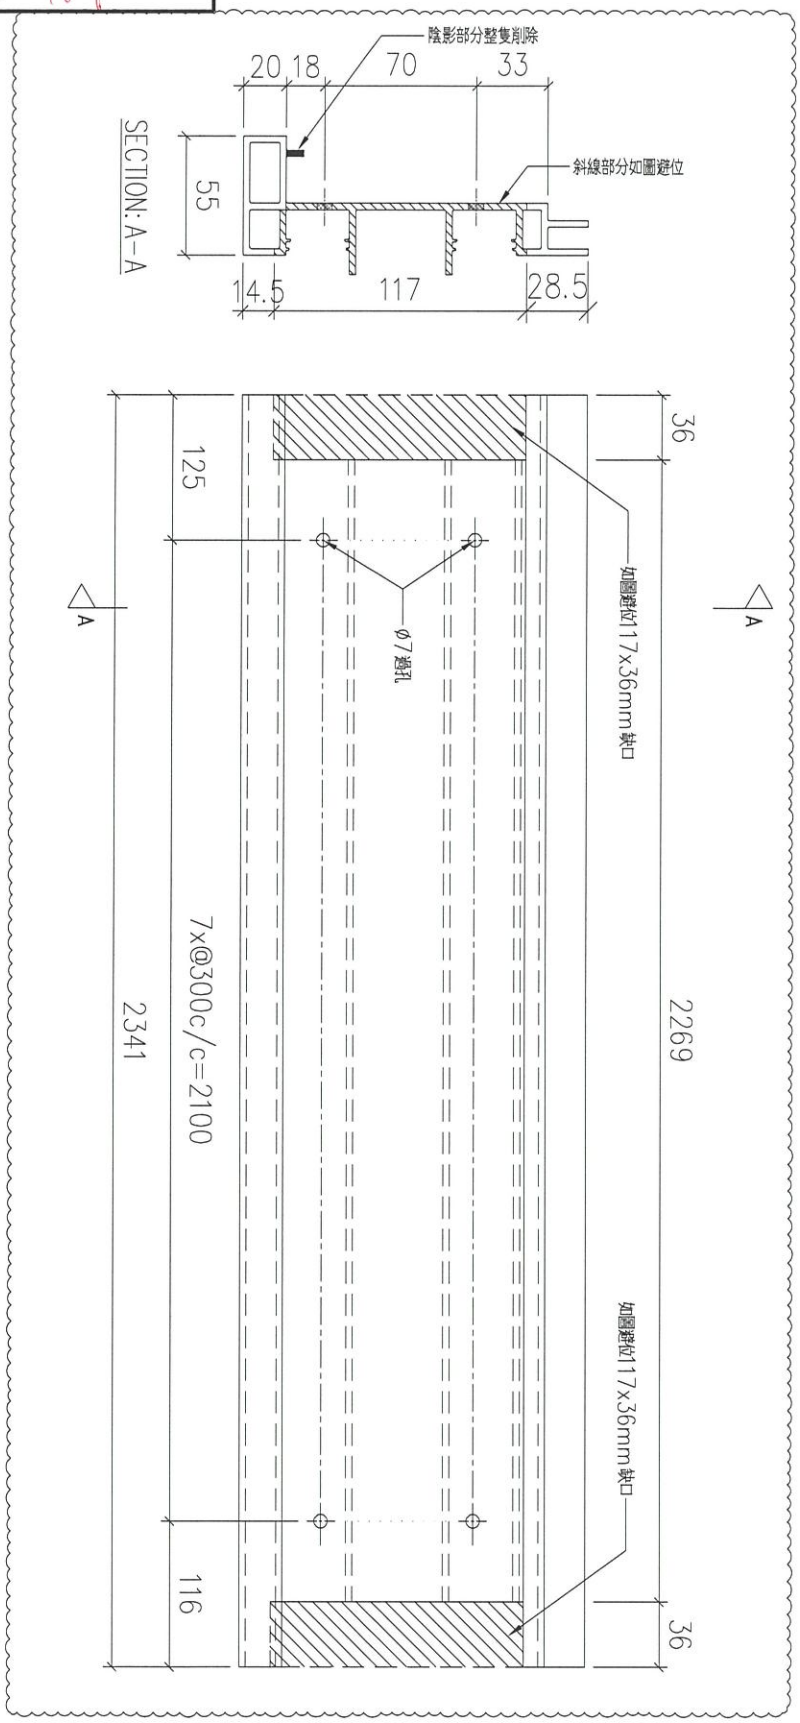

序號	物料編號	數量	安裝位置	樓層
01	T5-X86215-03	8	見派位圖	T5 FLAT A 17~25/F

名稱	扶手加工圖	制圖	LHR	2022,08,26	修改	A		
材料	X86215	復核	–	–	日期	2023.3.2		
顏色	JMQ213457(3coats)	批準			圖號	J853-GB-FAB2-03		

美特鋁質 有限公司
MIDI Aluminium Fabricator Ltd.

工程號	J853	地盤	錦上路 TWP

送工地

新增圖


序號	物料編號	數量	安裝位置	樓層
01	T5-X86215-03A	8	見派位圖	T5 FLAT A 17~25/F
02	T5-X86215-05A	8	見派位圖	T5 FLAT B 17~25/F
03	T7-X86215-06A	15	見派位圖	T7 FLAT B 7~23/F
04	T6-X86215-04A	14	見派位圖	T6 FLAT C/D 10~26/F
05	T5-X86215-07A	13	見派位圖	T5 FLAT E/F 11~26/F
06	T5-X86215-11A	9	見派位圖	T5 FLAT A 6~16/F
07	T5-X86215-13A	8	見派位圖	T5 FLAT B 17~25/F
08	T7-X86215-02A	17	見派位圖	T7 FLAT A 7~26/F
09	T6-X86215-02A	18	見派位圖	T6 FLAT B 5,6,8~26/F
10	T6-X86215-02A	18	見派位圖	T6 FLAT A 5,6,8~26/F
11	T7-X86215-04A	17	見派位圖	T7 FLAT A 7~26/F
12	T6-X86215-06A	18	見派位圖	T6 FLAT B 5,6,8~26/F
13	T6-X86215-07B	18	見派位圖	T6 FLAT A 5,6,8~26/F
14	T5-X86215-09B	4	見派位圖	T5 FLAT C 11~16/F
15	T5-X86215-09B	9	見派位圖	T5 FLAT A 6~16/F
16	T5-X86215-10B	9	見派位圖	T5 FLAT B 6~16/F
17	T5-X86215-08C	4	見派位圖	T5 FLAT D 11~16/F
	合計:	207		

名稱	扶手加工圖	制圖	LHR	2022,08,26	修改	–		
材料	X86215	復核	–	–	日期	–		
顏色	JMQ213457(3coats)	批準			圖號	J853-GB-FAB2-03A		

美特鋁質 有限公司
MIDI Aluminium Fabricator Ltd.

工程號	J853	地盤	錦上路 Tuip

送工地

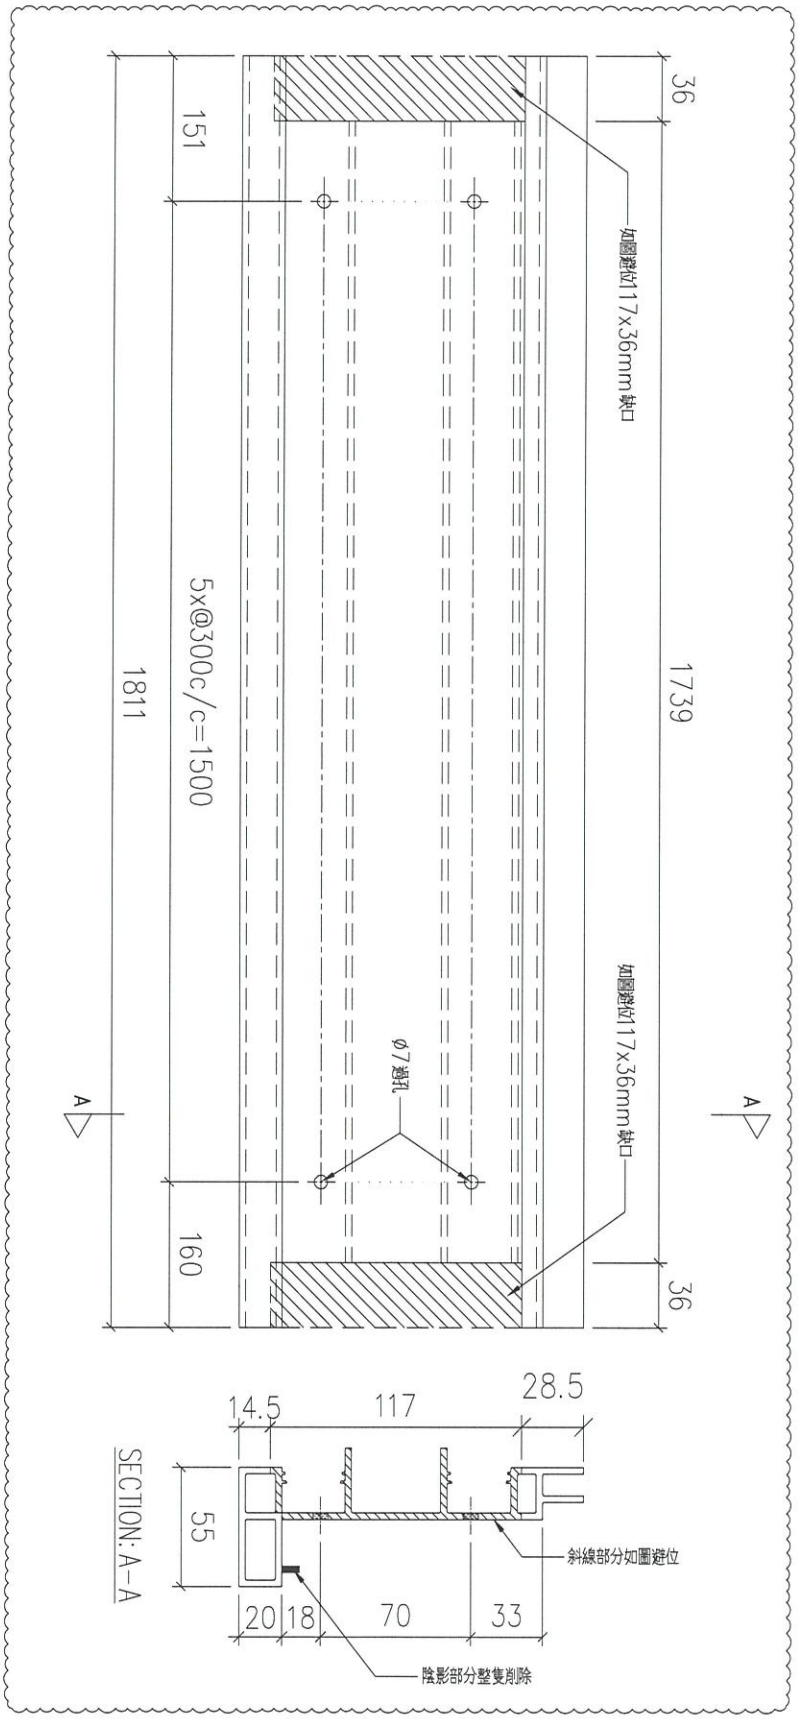


序號	物料編號	數量	安裝位置	樓層
01	T5-X86215-04	8	見派位圖	T5 FLAT B 17~25/F

名稱	扶手加工圖	制圖	LHR	2022,08,26	修改	A		
材料	X86215	復核	–	–	日期	2023.3.2		
顏色	JMQ213457(3coats)	批準			圖號	J853-GB-FAB2-04		

美特鋁質 有限公司
MIDI Aluminium Fabricator Ltd.

工程號	J853	地盤	錦上路 TWP

送工地

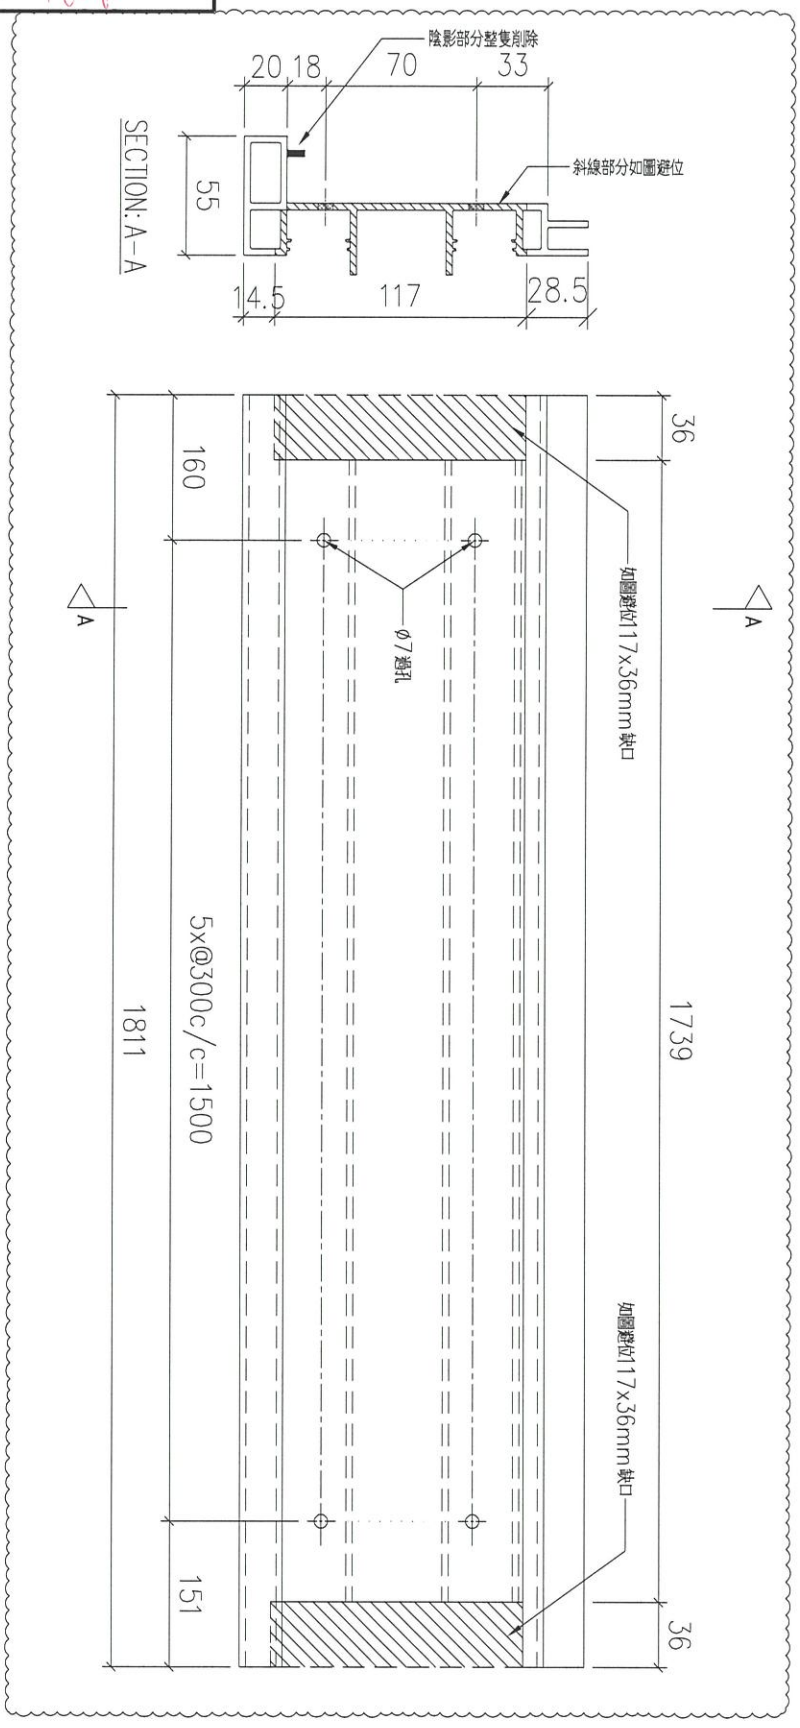


序號	物料編號	數量	安裝位置	樓層
01	T5-X86215-05	8	見派位圖	T5 FLAT B 17~25/F

名稱	扶手加工圖	制圖	LHR	2022,08,26	修改	A		
材料	X86215	復核	–	–	日期	2023.3.2		
顏色	JMQ213457(3coats)	批準			圖號	J853-GB-FAB2-05		

美特鋁質 有限公司
MIDI Aluminium Fabricator Ltd.

工程號	J853	地盤	錦上路 TWP

送工地

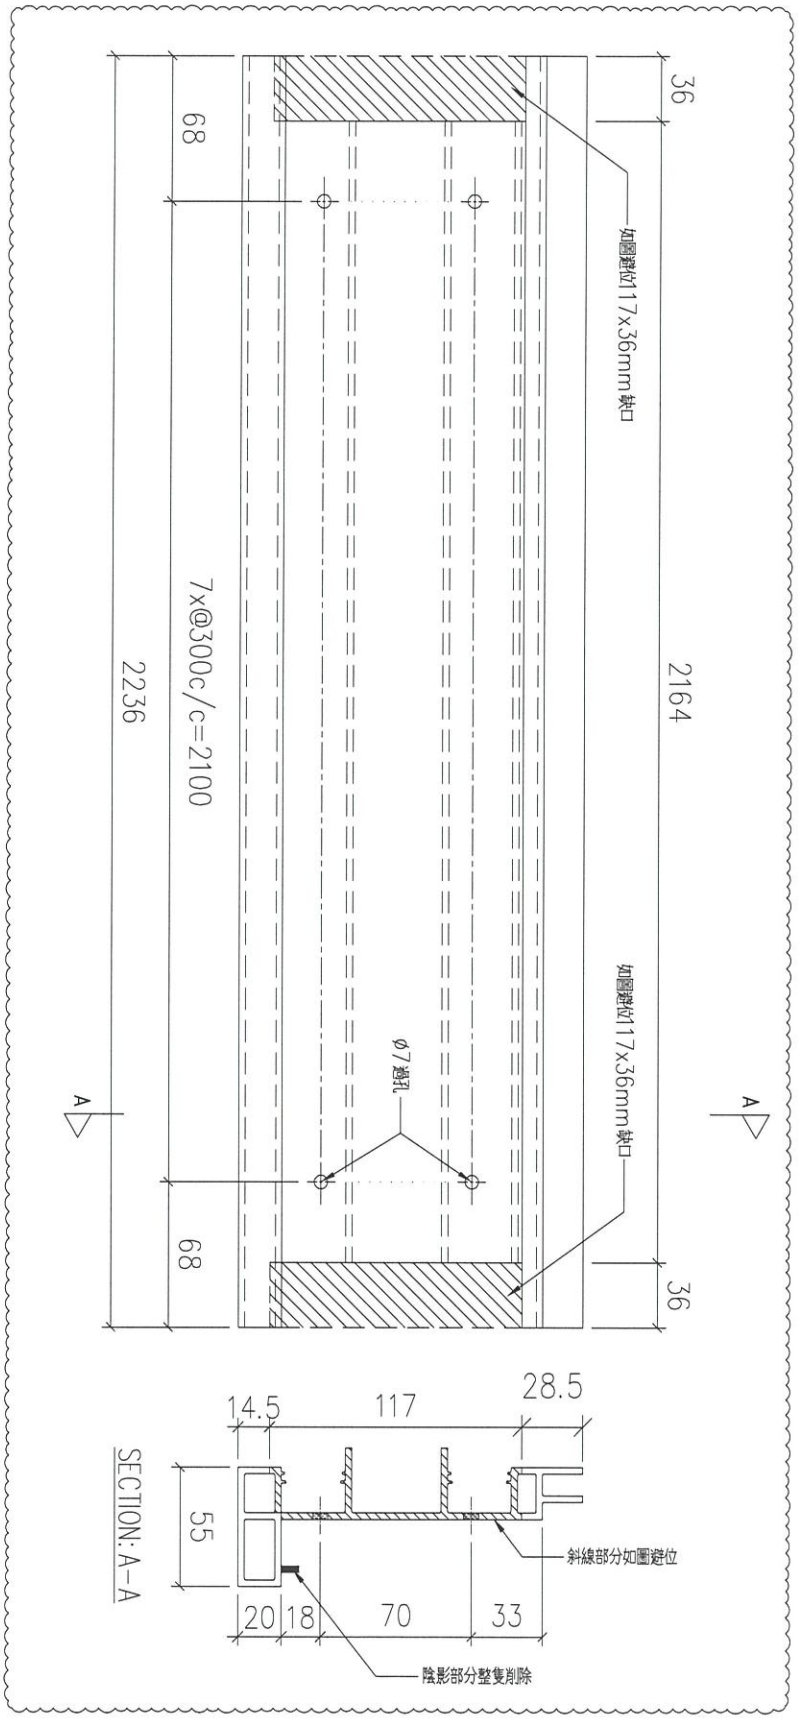

序號	物料編號	數量	安裝位置	樓層
01	T5-X86215-06	13	見派位圖	T5 FLAT E/F 11~26/F
02	T6-X86215-03	14	見派位圖	T6 FLAT C/D 10~26/F


名稱	扶手加工圖	制圖	LHR	2022,08,26	修改	A		
材料	X86215	復核	–	–	日期	2023.3.2		
顏色	JMQ213457(3coats)	批準			圖號	J853-GB-FAB2-06		


美特鋁質 有限公司
MIDI Aluminium Fabricator Ltd.

工程號	J853	地盤	~~錦上路~~ TWP

送工地

新增圖

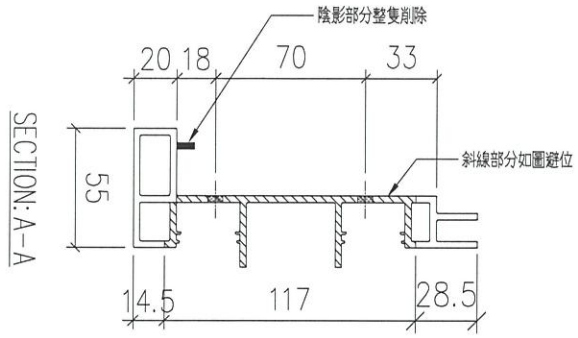


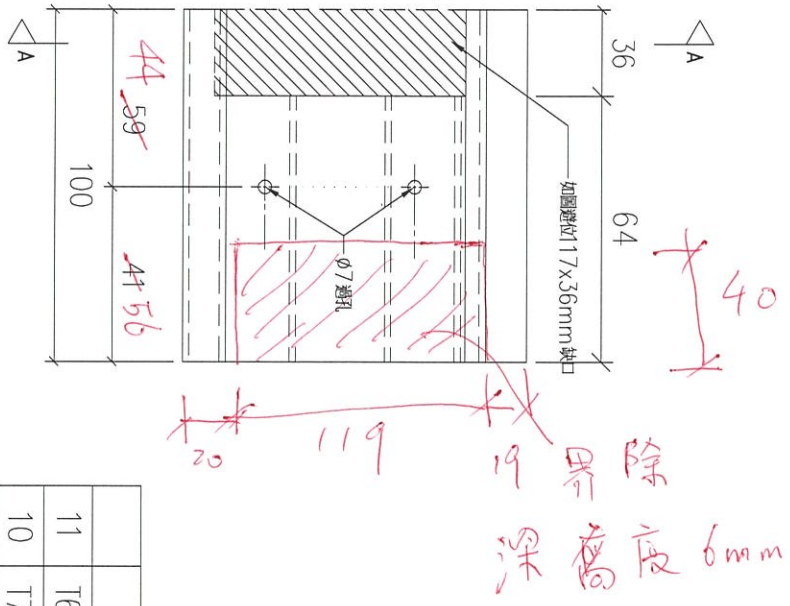

序號	物料編號	數量	安裝位置	樓層
	合計:	129		
11	T6-X86215-08B	18	見派位圖	T6 FLAT B 5,6,8~26/F
10	T7-X86215-05B	17	見派位圖	T7 FLAT A 7~26/F
09	T6-X86215-05B	18	見派位圖	T6 FLAT A 5,6,8~26/F
08	T7-X86215-03B	15	見派位圖	T7 FLAT B 7~23/F
07	T5-X86215-16B	9	見派位圖	T5 FLAT A 6~16/F
06	T5-X86215-16B	8	見派位圖	T5 FLAT A 17~25/F
05	T5-X86215-14B	4	見派位圖	T5 FLAT D 11~16/F
04	T5-X86215-12B	9	見派位圖	T5 FLAT B 6~16/F
03	T5-X86215-12B	4	見派位圖	T5 FLAT C 11~16/F
02	T6-X86215-03B	14	見派位圖	T6 FLAT C/D 10~26/F
01	T5-X86215-06B	13	見派位圖	T5 FLAT E/F 11~26/F


名稱	扶手加工圖	制圖	LHR	2022,08,26	修改	–		
材料	X86215	復核	–	–	日期	–		
顏色	JMQ213457(3coats)	批準			圖號	J853-GB-FAB2-06B		

GB
7B

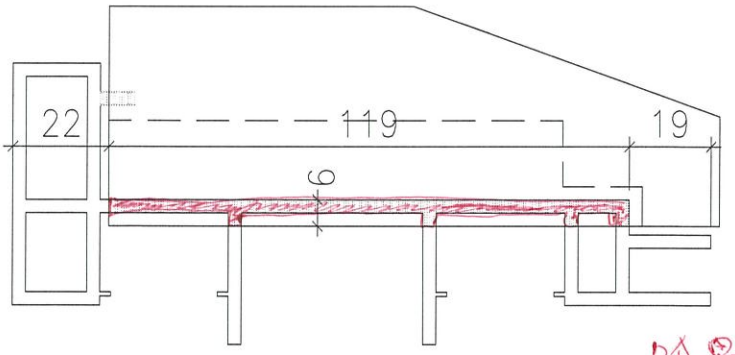

SECTION A-A

陰影部份
界除
深度6mm

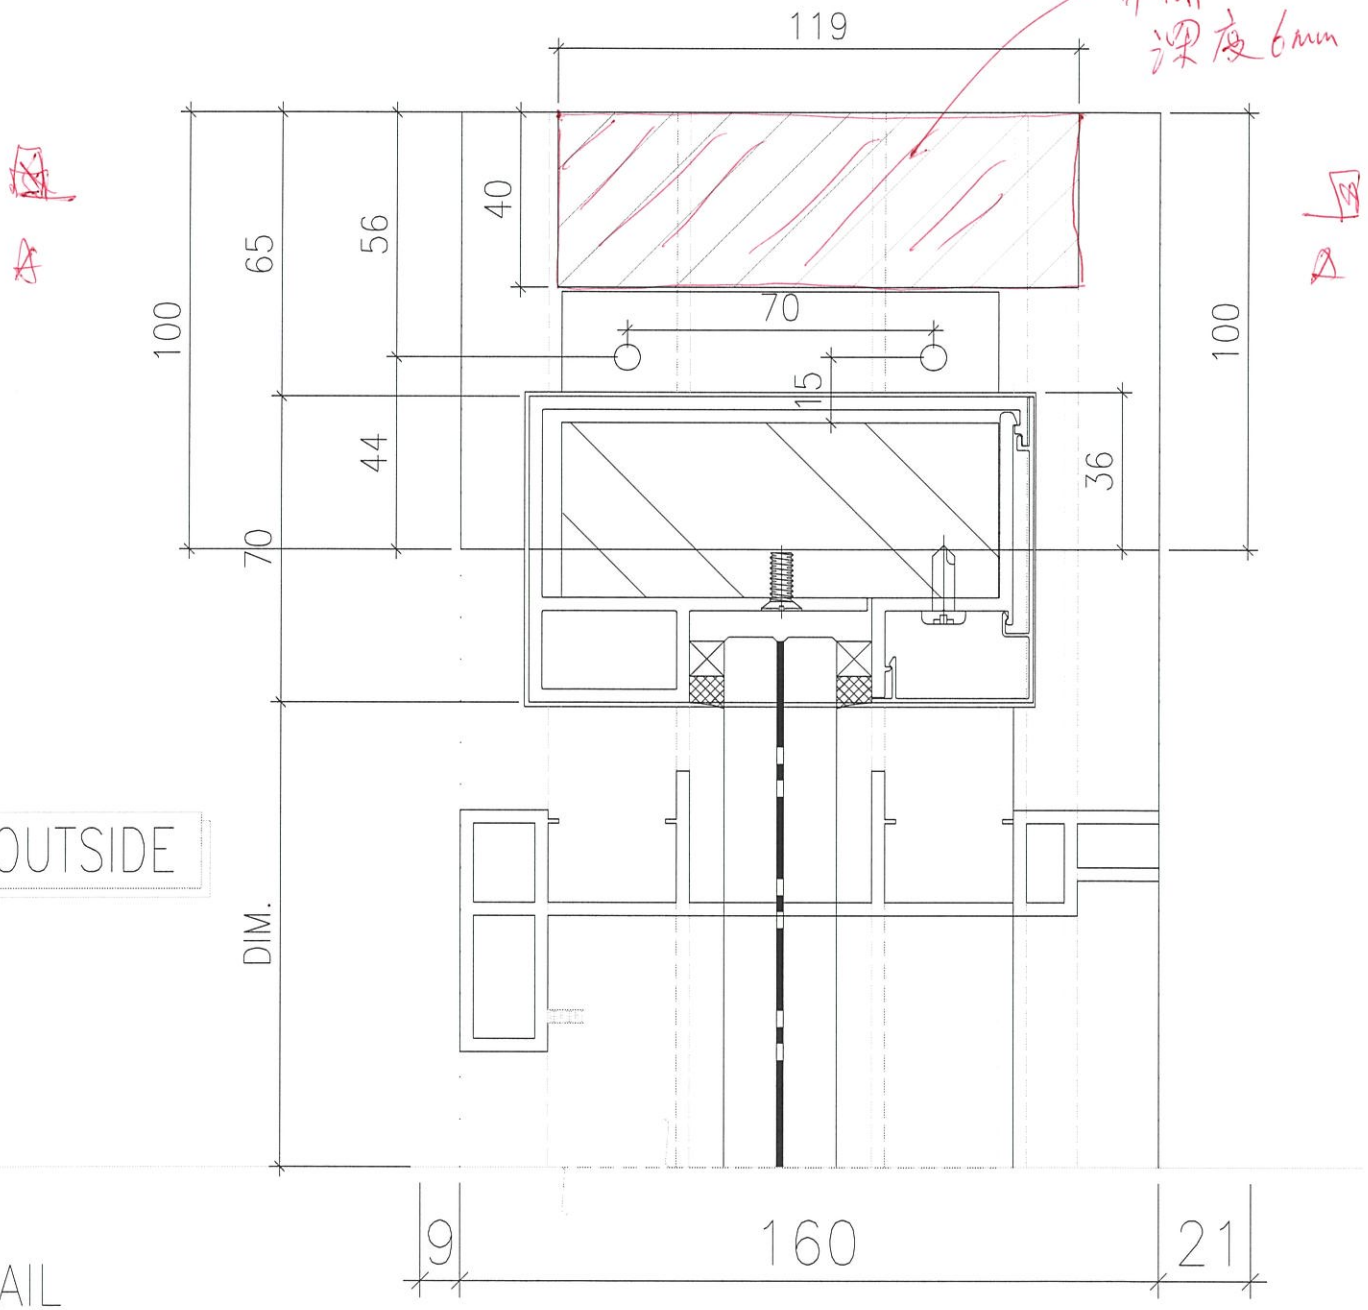


N DETAIL

ALUSTRADE AT BALCONY

送工地

美特鋁質 有限公司
MIDI Aluminium Fabricator Ltd.

工程號	J853	地盤	~~錦上路~~ TWP

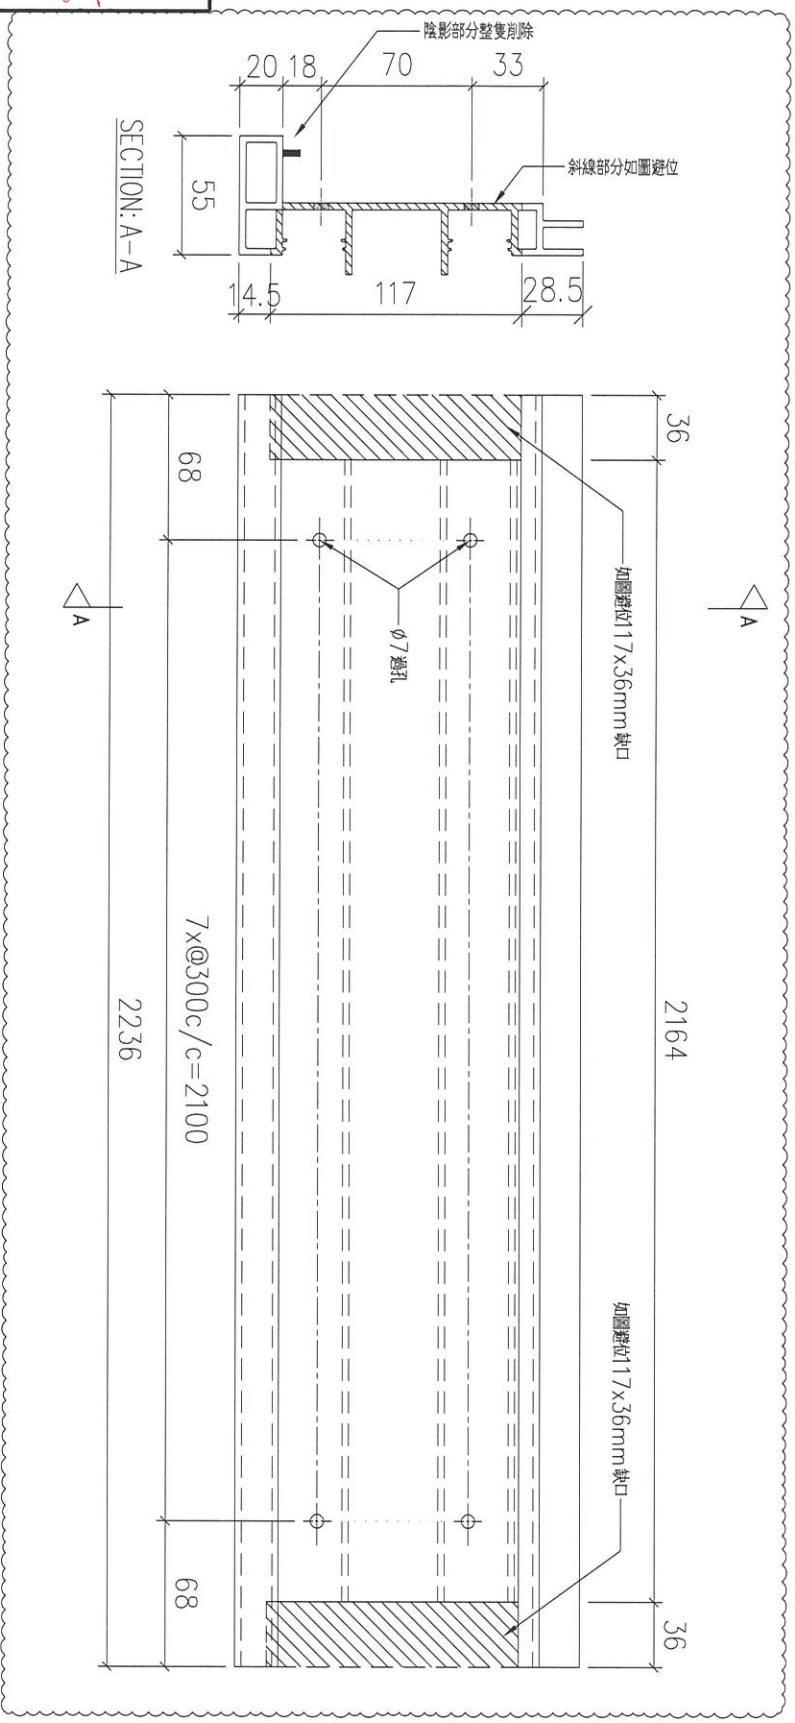

序號	物料編號	數量	安裝位置	樓層
01	T5-X86215-07	13	見派位圖	T5 FLAT E/F 11~26/F
02	T6-X86215-04	14	見派位圖	T6 FLAT C/D 10~26/F
03	T7-X86215-06	15	見派位圖	T7 FLAT B 7~23/F


名稱	扶手加工圖	制圖	LHR	2022,08,26	修改	A		
材料	X86215	復核	–	–	日期	2023.3.2		
顏色	JMQ213457(3coats)	批準			圖號	J853-GB-FAB2-07		

美特鋁質 有限公司
MIDI Aluminium Fabricator Ltd.

工程號	J853	地盤	錦上路

送工地

新增圖

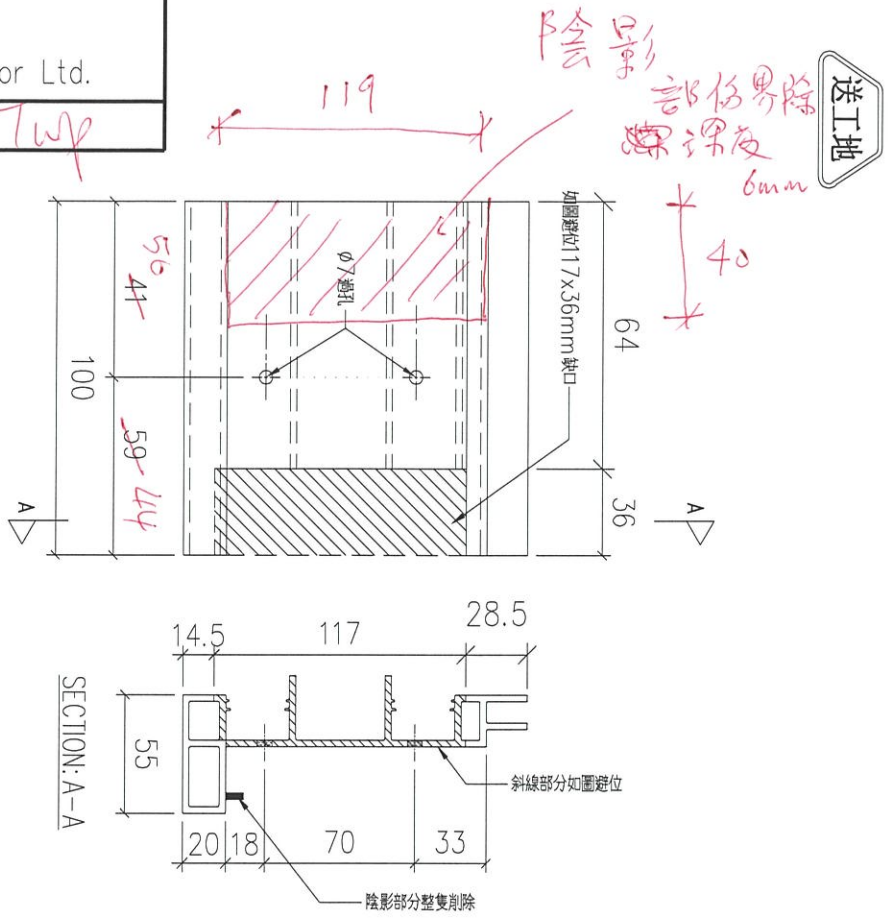


序號	物料編號	數量	安裝位置	樓層
	合計:	133		
11	T6-X86215-07A	18	見派位圖	T6 FLAT A 5,6,8~26/F
10	T6-X86215-06B	18	見派位圖	T6 FLAT B 5,6,8~26/F
09	T7-X86215-04B	17	見派位圖	T7 FLAT A 7~26/F
08	T5-X86215-15G	8	見派位圖	T5 FLAT A 17~25/F
07	T5-X86215-15C	9	見派位圖	T5 FLAT B 6~16/F
06	T5-X86215-13B	8	見派位圖	T5 FLAT B 17~25/F
05	T5-X86215-11B	9	見派位圖	T5 FLAT A 6~16/F
04	T5-X86215-08B	4	見派位圖	T5 FLAT D 11~16/F
03	T7-X86215-06B	15	見派位圖	T7 FLAT B 7~23/F
02	T6-X86215-04B	14	見派位圖	T6 FLAT C/D 10~26/F
01	T5-X86215-07B	13	見派位圖	T5 FLAT E/F 11~26/F

名稱	扶手加工圖	制圖	LHR	2022,08,26	修改	–		
材料	X86215	復核	–	–	日期	–		
顏色	JMQ213457(3coats)	批準			圖號	J853-GB-FAB2-07B		

美特鋁質 有限公司
MIDI Aluminium Fabricator Ltd.

工程號	J853	地盤	錦上路 FWP

送工地

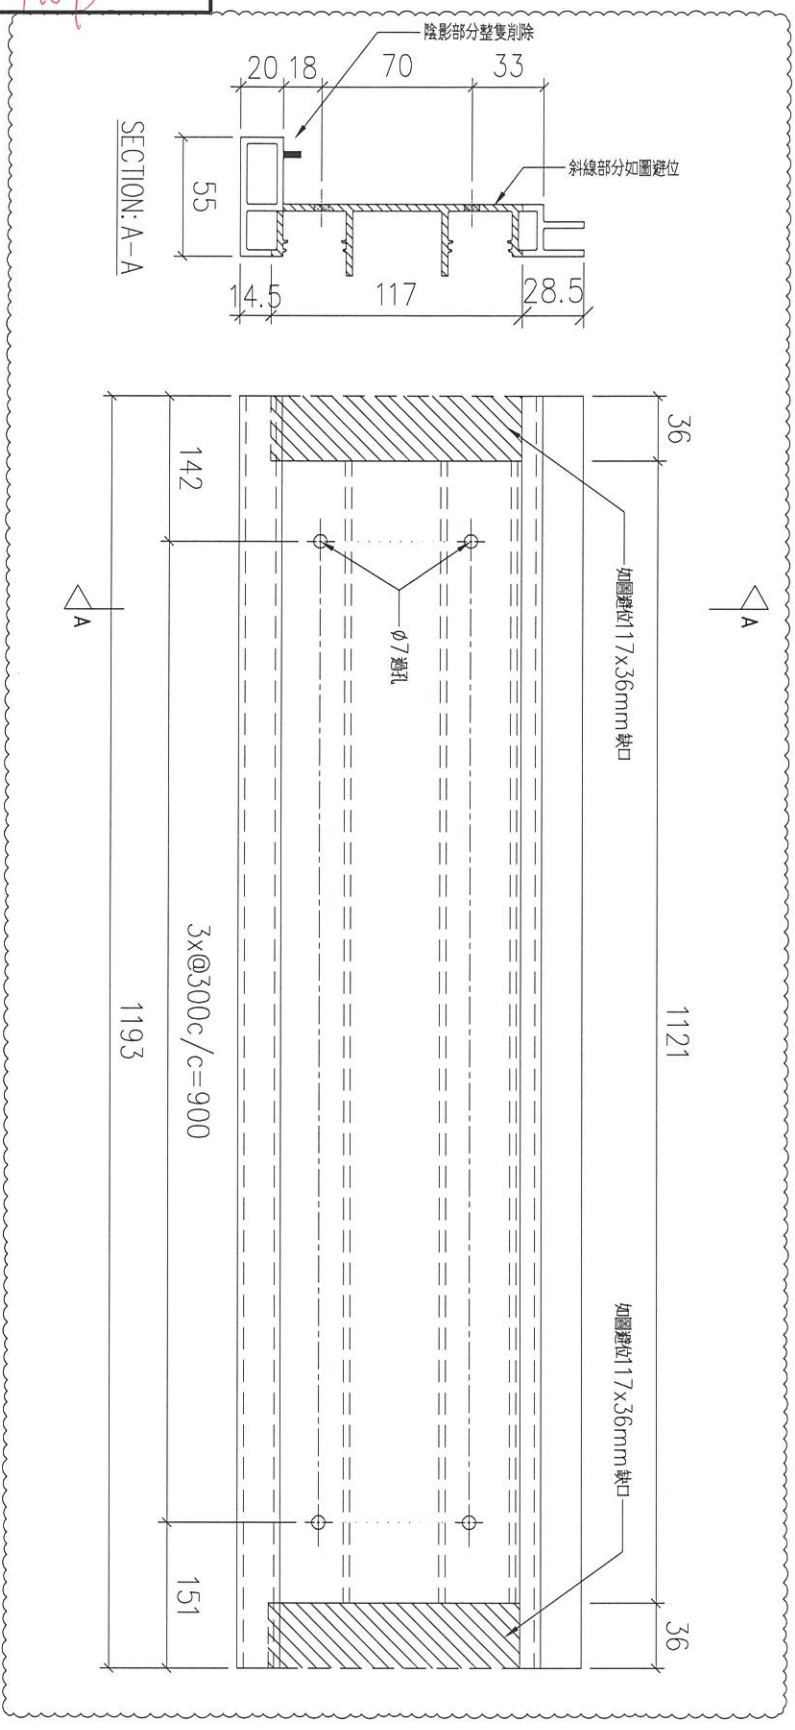

序號	物料編號	數量	安裝位置	樓層
01	T5-X86215-08	4	見派位圖	T5 FLAT D 11~16/F


名稱	扶手加工圖	制圖	LHR	2022,08,26	修改	A		
材料	X86215	復核	–	–	日期	2023.3.2		
顏色	JMQ213457(3coats)	批準			圖號	J853-GB-FAB2-08		


美特鋁質 有限公司
MIDI Aluminium Fabricator Ltd.

工程號	J853	地盤	~~錦上路~~ Twp

送工地

新增圖

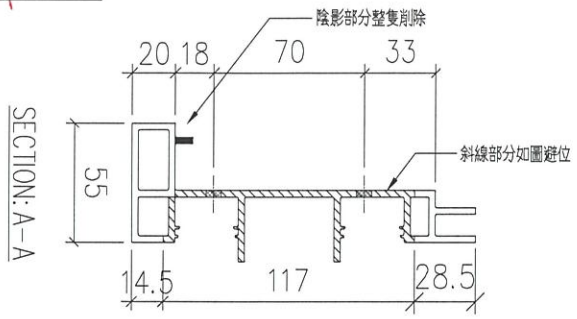

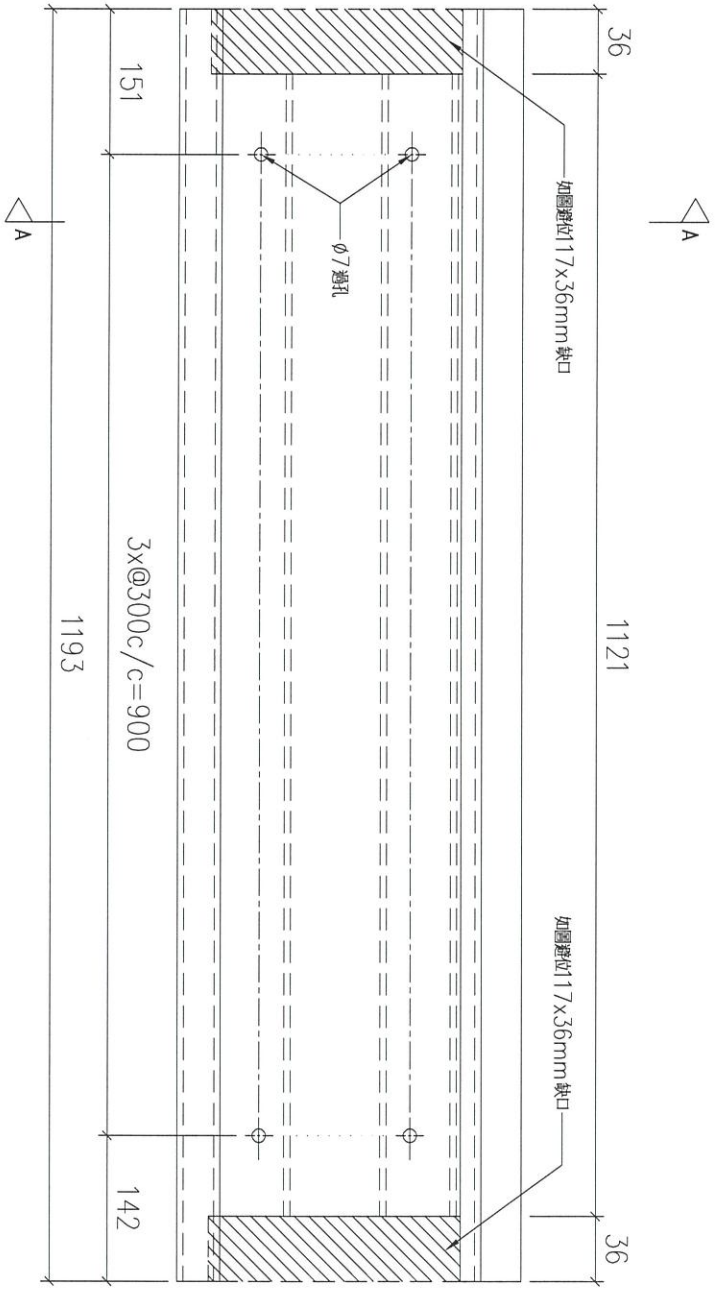


序號	物料編號	數量	安裝位置	樓層
01	T5-X86215-08A	4	見派位圖	T5 FLAT D 11~16/F

名稱	扶手加工圖	制圖	LHR	2022,08,26	修改	–		
材料	X86215	復核	–	–	日期	–		
顏色	JMQ213457(3coats)	批準			圖號	J853-GB-FAB2-08A		

美特鋁質 有限公司
MIDI Aluminium Fabricator Ltd.

工程號	J853	地盤	~~錦上路~~ TWP

送工地

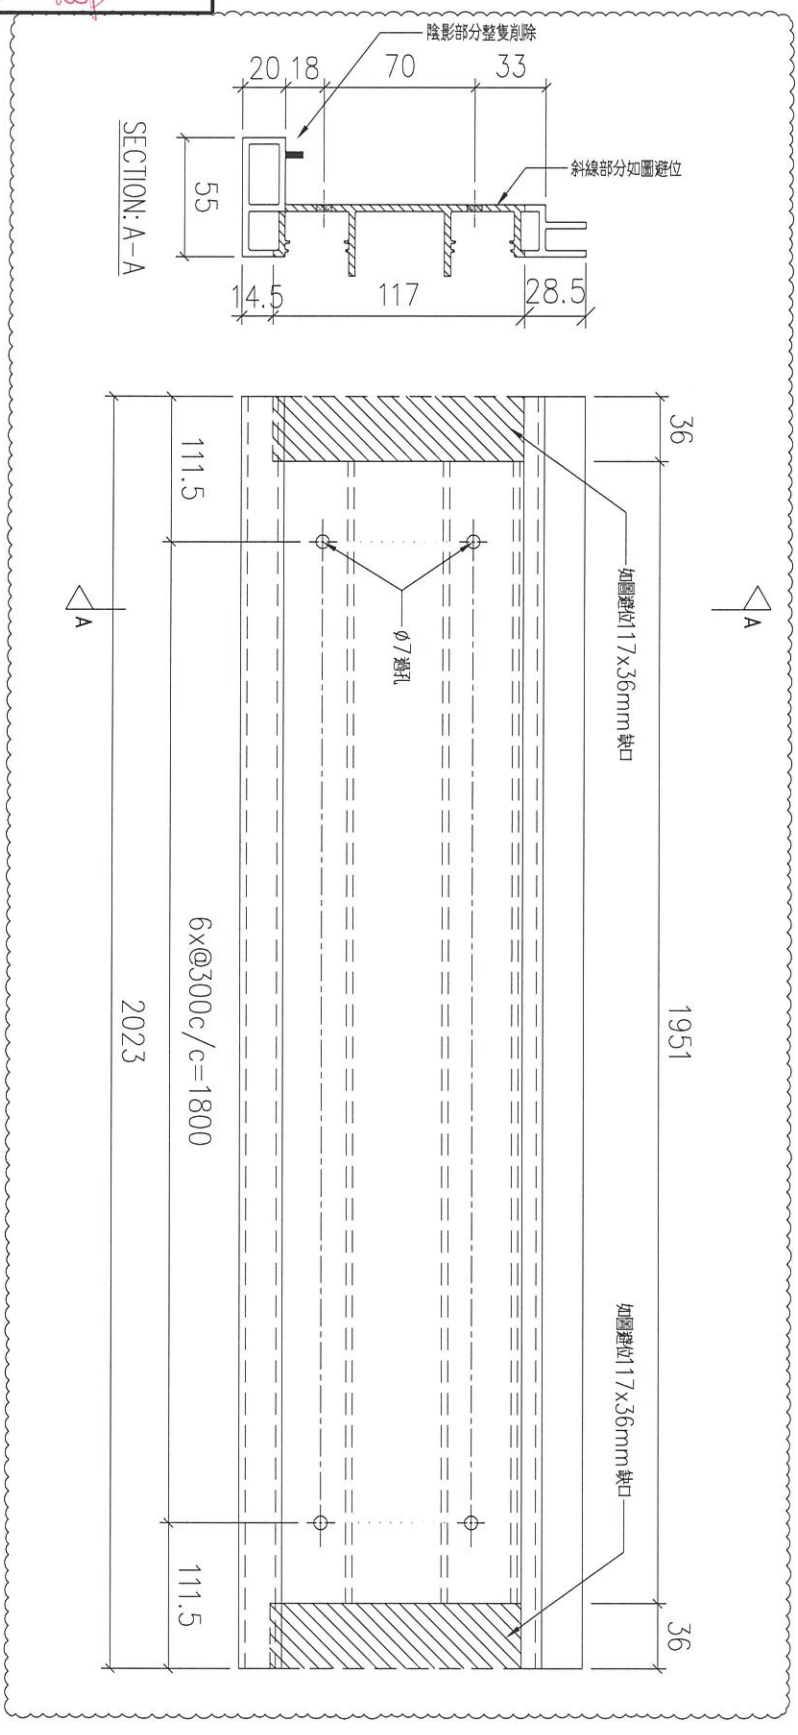


序號	物料編號	數量	安裝位置	樓層
01	T5-X86215-09	9	T5 FLAT A 6~16/F	
02	T5-X86215-09	4	見派位圖	T5 FLAT C 11~16/F

名稱	扶手加工圖	制圖	LHR	2022,08,26	修改	A		
材料	X86215	復核	–	–	日期	2023.3.2		
顏色	JMQ213457(3coats)	批準			圖號	J853-GB-FAB2-09		

美特鋁質 有限公司
MIDI Aluminium Fabricator Ltd.

工程號	J853	地盤	錦上路 TWP

送工地

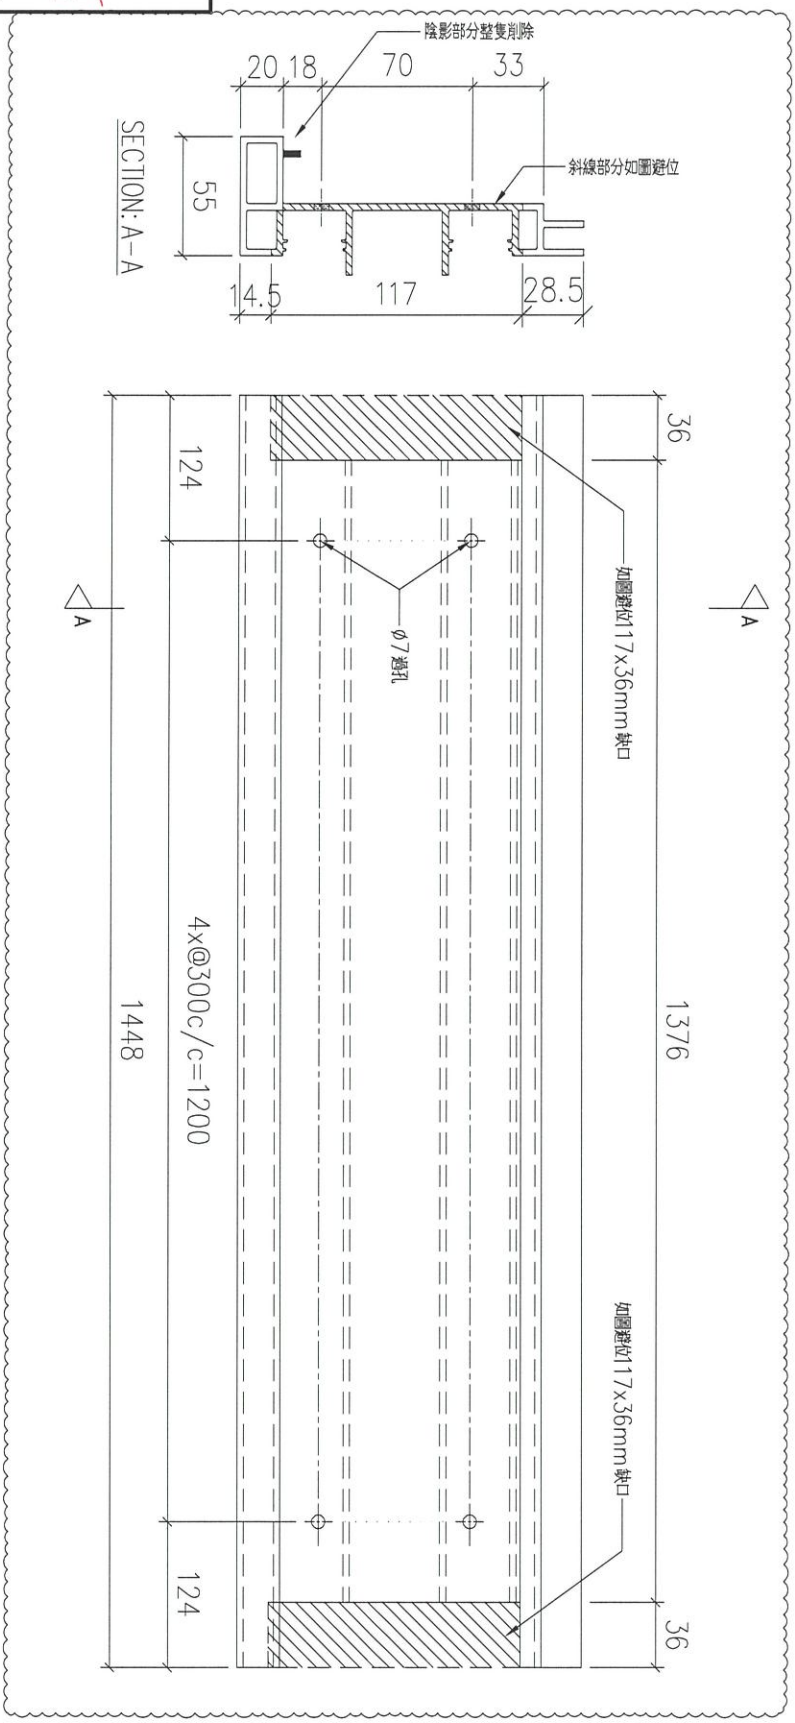


序號	物料編號	數量	安裝位置	樓層
01	T5-X86215-10	9	見派位圖	T5 FLAT B 6~16/F

名稱	扶手加工圖	制圖	LHR	2022,08,26	修改	A		
材料	X86215	復核	–	–	日期	2023.3.2		
顏色	JMQ213457(3coats)	批準			圖號	J853-GB-FAB2-10		

美特鋁質 有限公司 MIDI Aluminium Fabricator Ltd.			
工程號	J853	地盤	~~錦上路~~ TWP

送工地

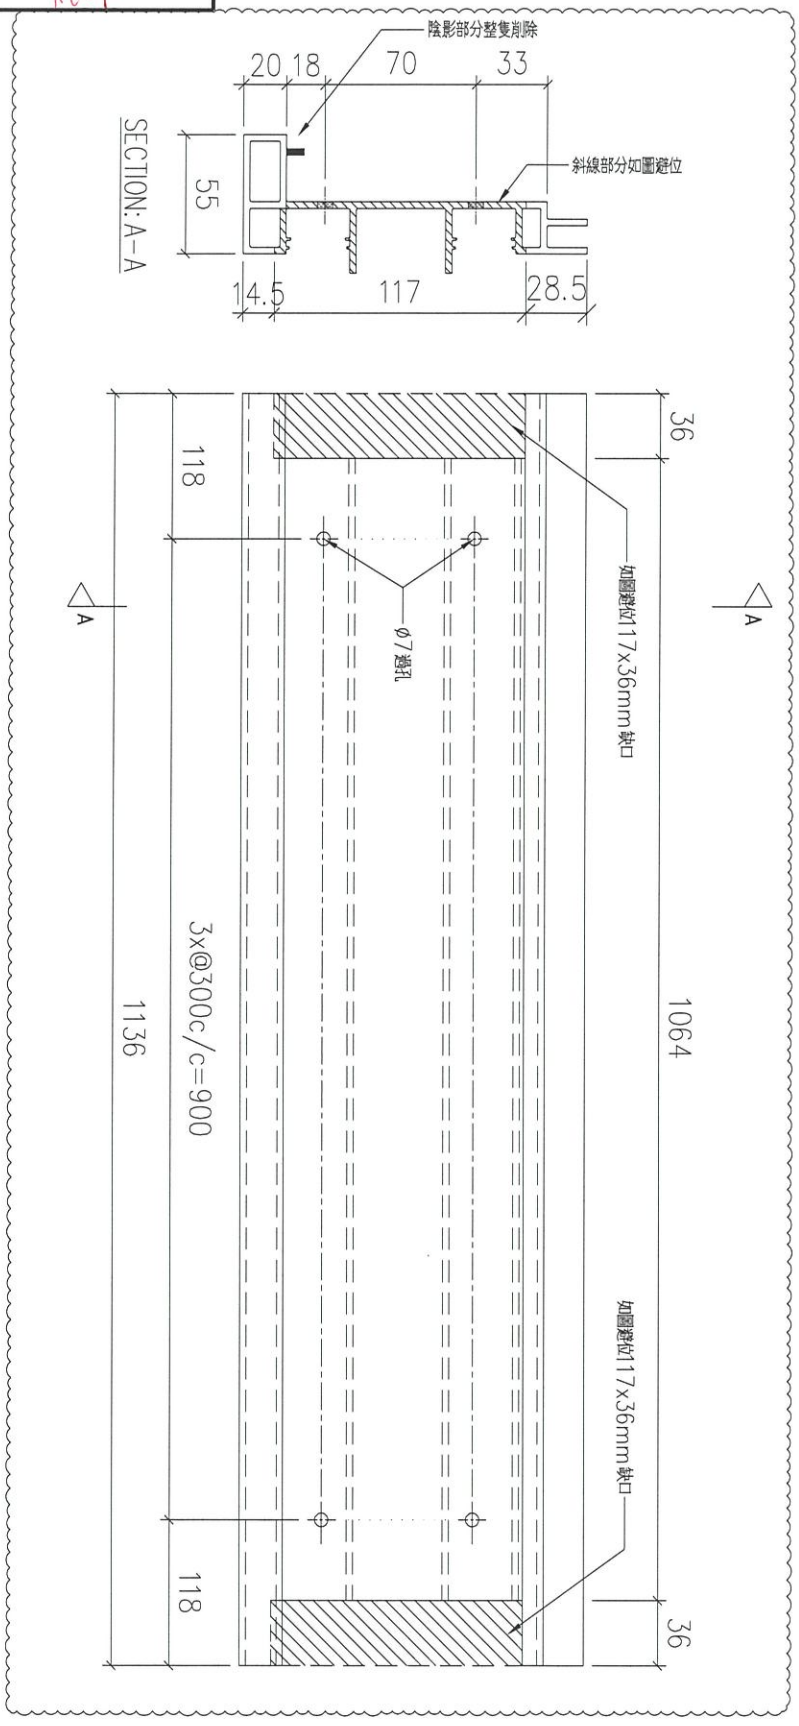


序號	物料編號	數量	安裝位置	樓層
01	T5-X86215-11	9	見派位圖	T5 FLAT A 6~16/F

名稱	扶手加工圖	制圖	LHR	2022,08,26	修改	A		
材料	X86215	復核	–	–	日期	2023.3.2		
顏色	JMQ213457(3coats)	批準			圖號	J853-GB-FAB2-11		

美特鋁質 有限公司
MIDI Aluminium Fabricator Ltd.

工程號	J853	地盤	錦上路 TWP

送工地

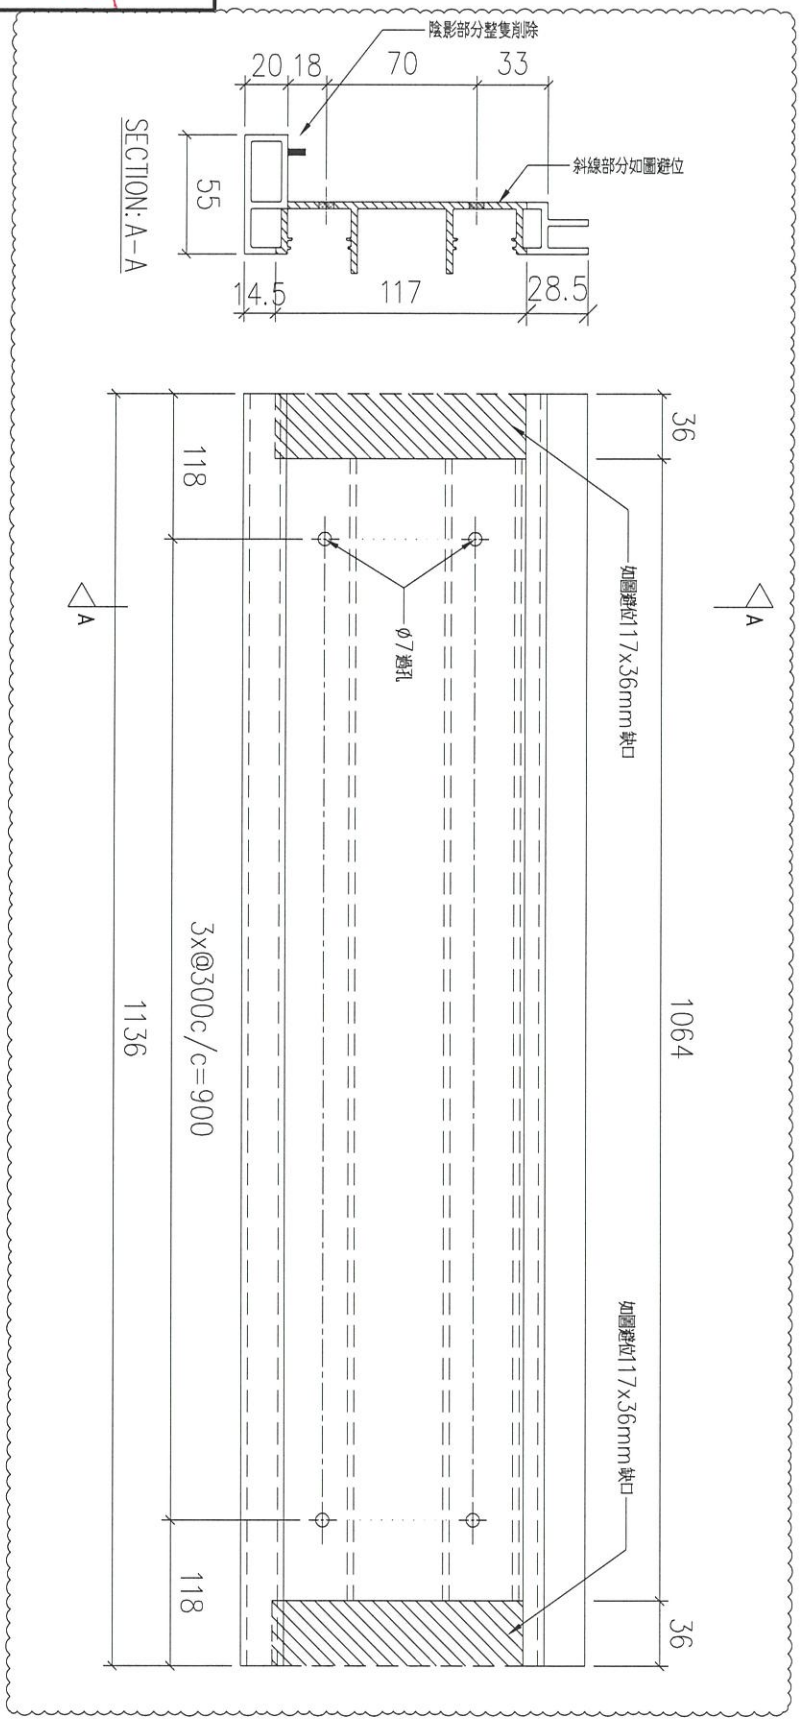


序號	物料編號	數量	安裝位置	樓層
01	T5-X86215-12	9	見派位圖	T5 FLAT B 6~16/F
02	T5-X86215-12	4	見派位圖	T5 FLAT C 11~16/F

名稱	扶手加工圖	制圖	LHR	2022,08,26	修改	A		
材料	X86215	復核	–	–	日期	2023.3.2		
顏色	JMQ213457(3coats)	批準			圖號	J853-GB-FAB2-12		

美特鋁質 有限公司
MIDI Aluminium Fabricator Ltd.

工程號	J853	地盤	錦上路 TWP

送工地

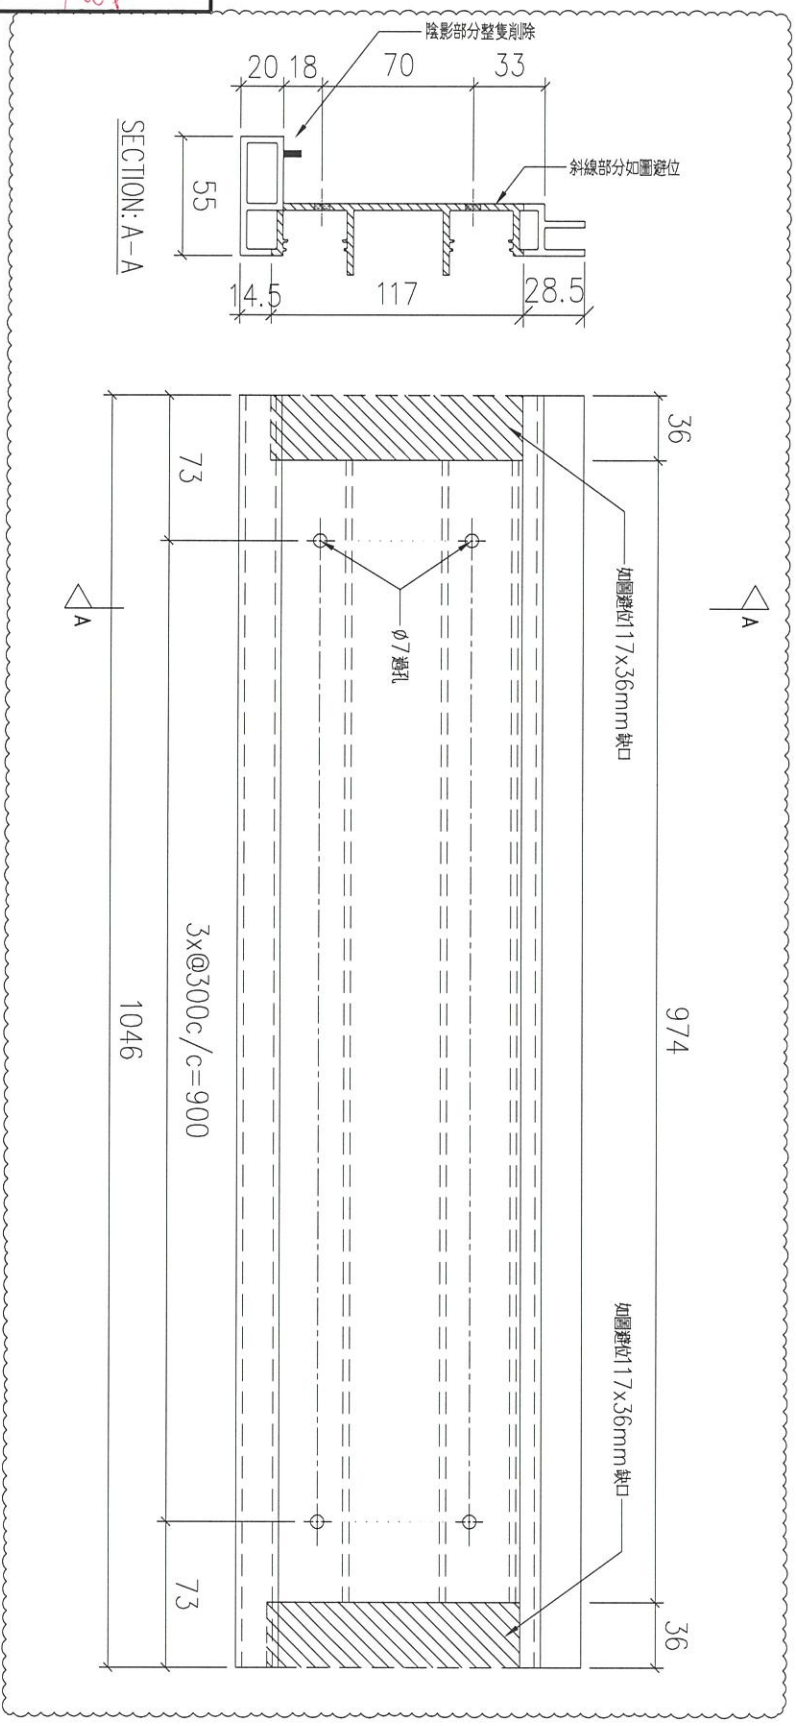


序號	物料編號	數量	安裝位置	樓層
01	T5-X86215-13	8	見派位圖	T5 FLAT B 17~25/F

名稱	扶手加工圖	制圖	LHR	2022,08,26	修改	A		
材料	X86215	復核	–	–	日期	2023.3.2		
顏色	JMQ213457(3coats)	批準			圖號	J853-GB-FAB2-13		

美特鋁質 有限公司
MIDI Aluminium Fabricator Ltd.

工程號	J853	地盤	錦上路 T1,2P

送工地

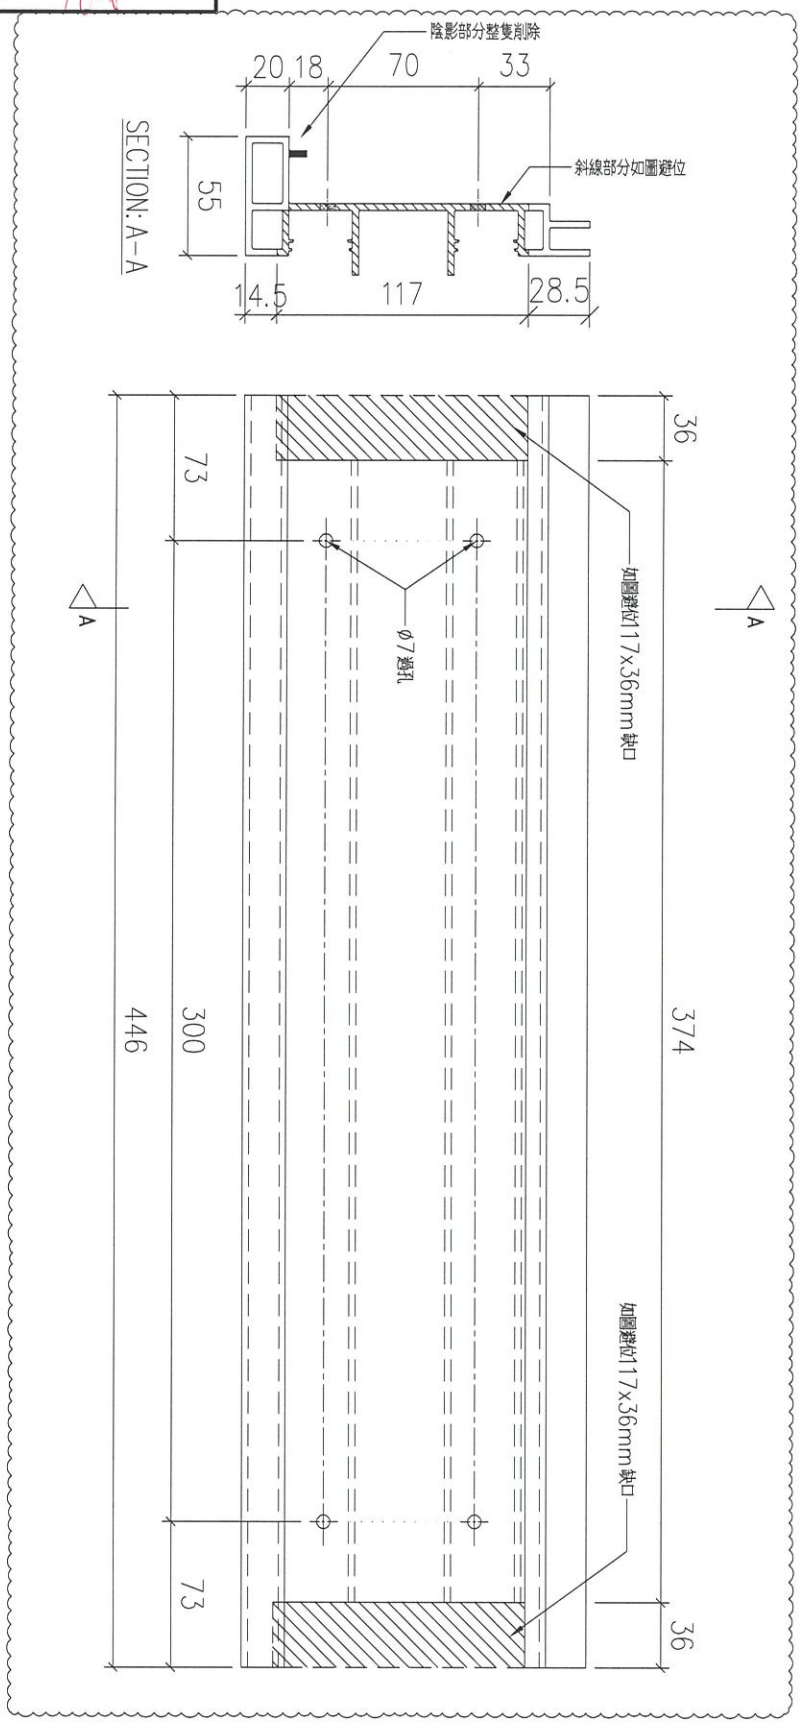


序號	物料編號	數量	安裝位置	樓層
01	T5-X86215-14	4	見派位圖	T5 FLAT D 11~16/F

名稱	扶手加工圖	制圖	LHR	2022,08,26	修改	A		
材料	X86215	復核	–	–	日期	2023.3.2		
顏色	JMQ213457(3coats)	批準			圖號	J853-GB-FAB2-14		

美特鋁質 有限公司
MIDI Aluminium Fabricator Ltd.

工程號	J853	地盤	~~錦上路~~ Tsp

送工地

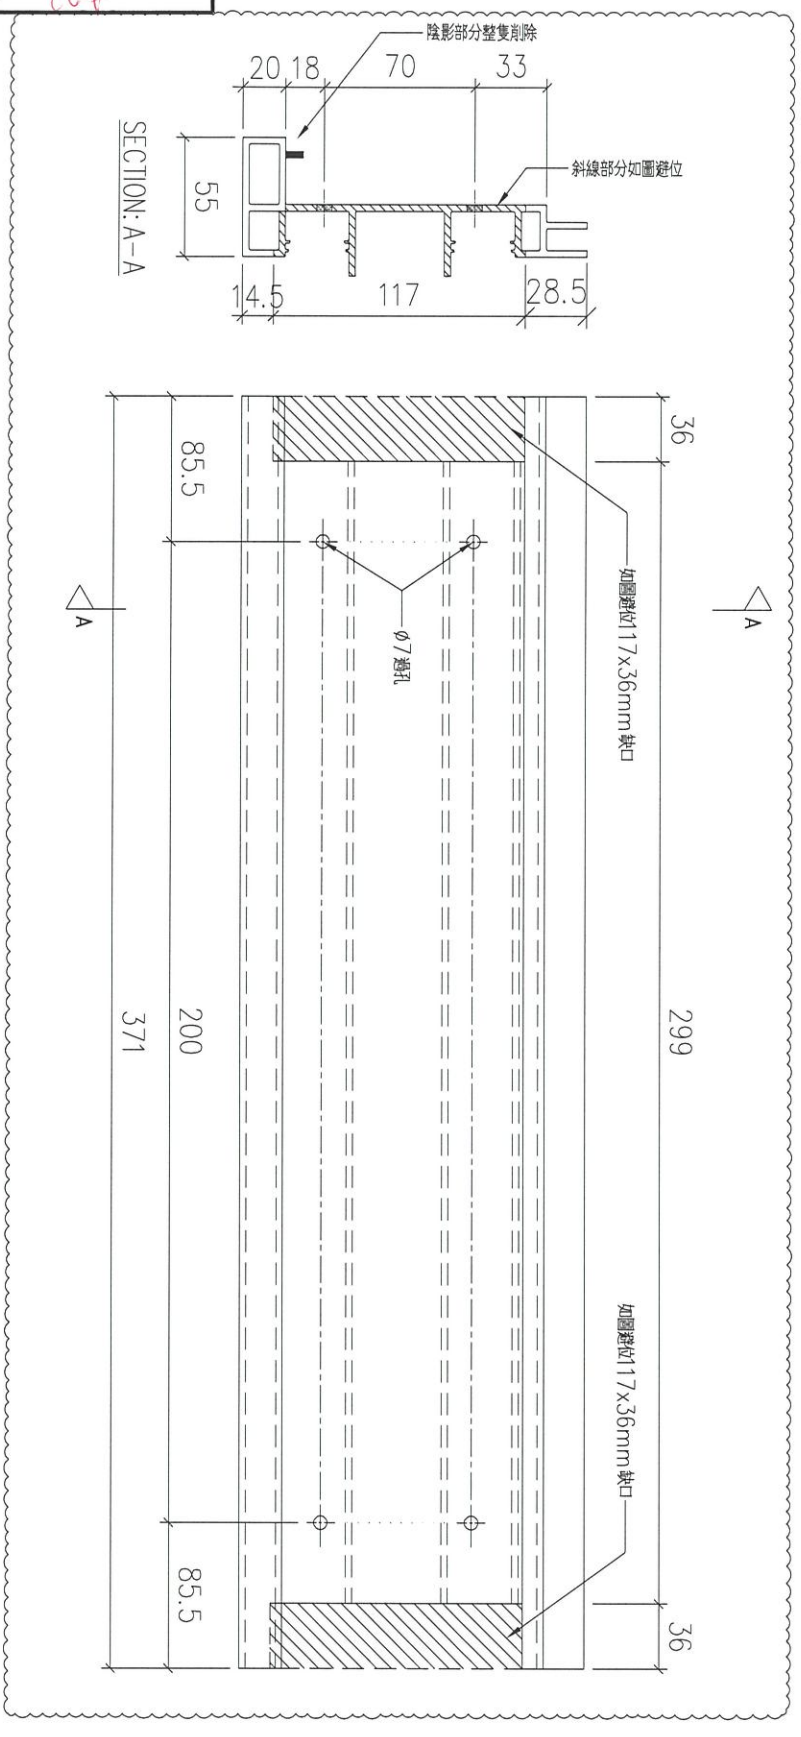

序號	物料編號	數量	安裝位置	樓層
01	T5-X86215-15	8	見派位圖	T5 FLAT A 17~25/F
02	T5-X86215-15	9	見派位圖	T5 FLAT B 6~16/F


名稱	扶手加工圖	制圖	LHR	2022,08,26	修改	A		
材料	X86215	復核	–	–	日期	2023.3.2		
顏色	JMQ213457(3coats)	批準			圖號	J853-GB-FAB2-15		

15

美特鋁質 有限公司
MIDI Aluminium Fabricator Ltd.

工程號	J853	地盤	錦上路 TWP

送工地

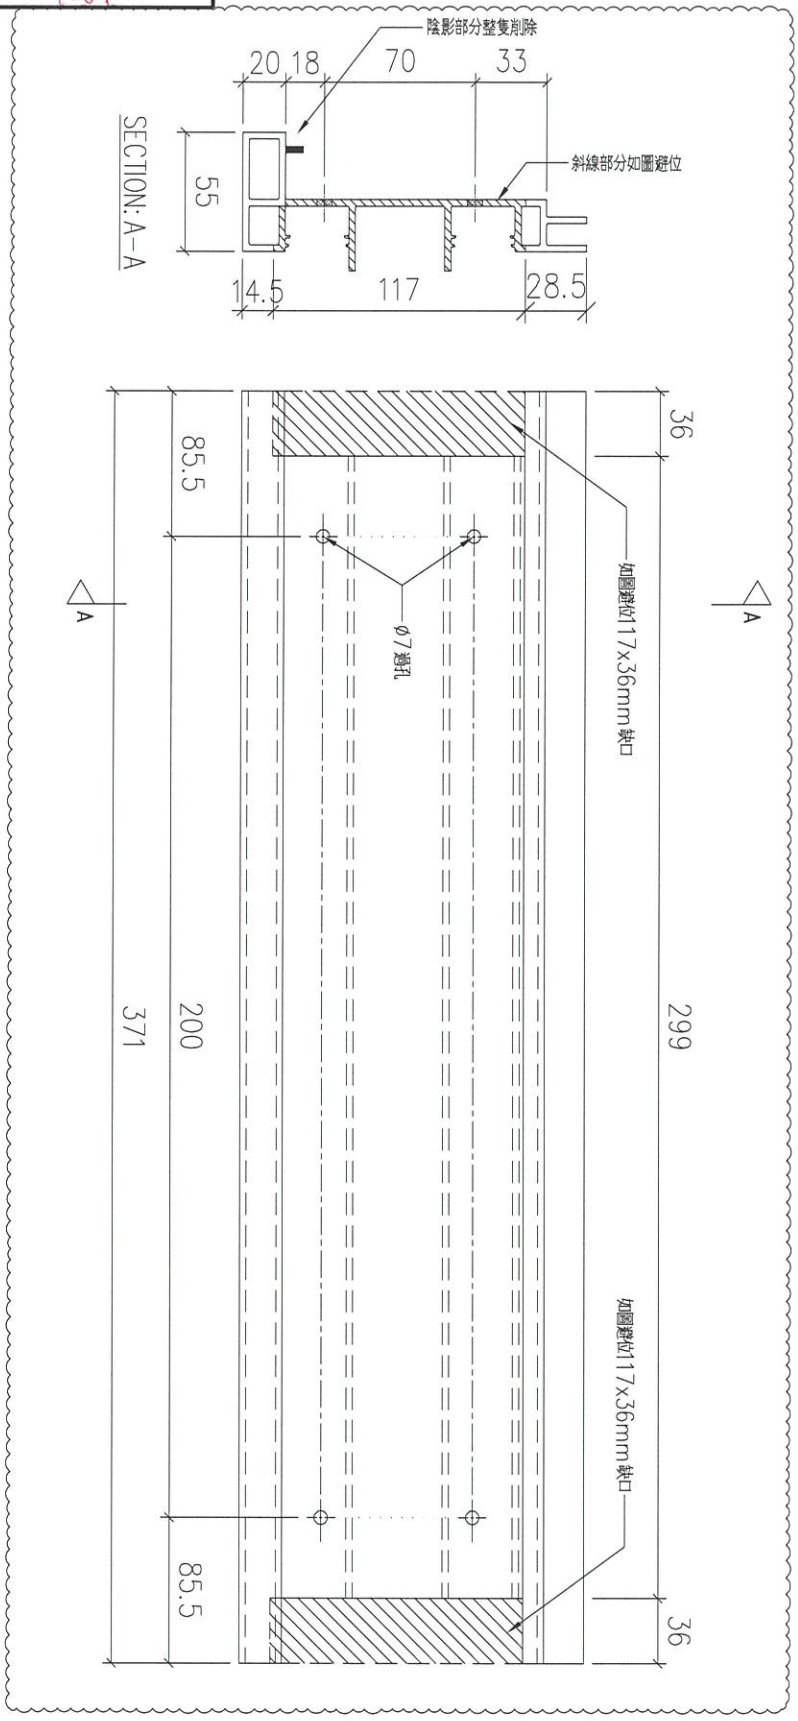


序號	物料編號	數量	安裝位置	樓層
01	T5-X86215-16	9	見派位圖	T5 FLAT A 6~16/F
02	T5-X86215-16	8	見派位圖	T5 FLAT A 17~25/F

名稱	扶手加工圖	制圖	LHR	2022,08,26	修改	A		
材料	X86215	復核	–	–	日期	2023.3.2		
顏色	JMQ213457(3coats)	批準			圖號	J853–GB–FAB2–16		

美特鋁質 有限公司
MIDI Aluminium Fabricator Ltd.

工程號	J853	地盤	錦上路 TWP

送工地

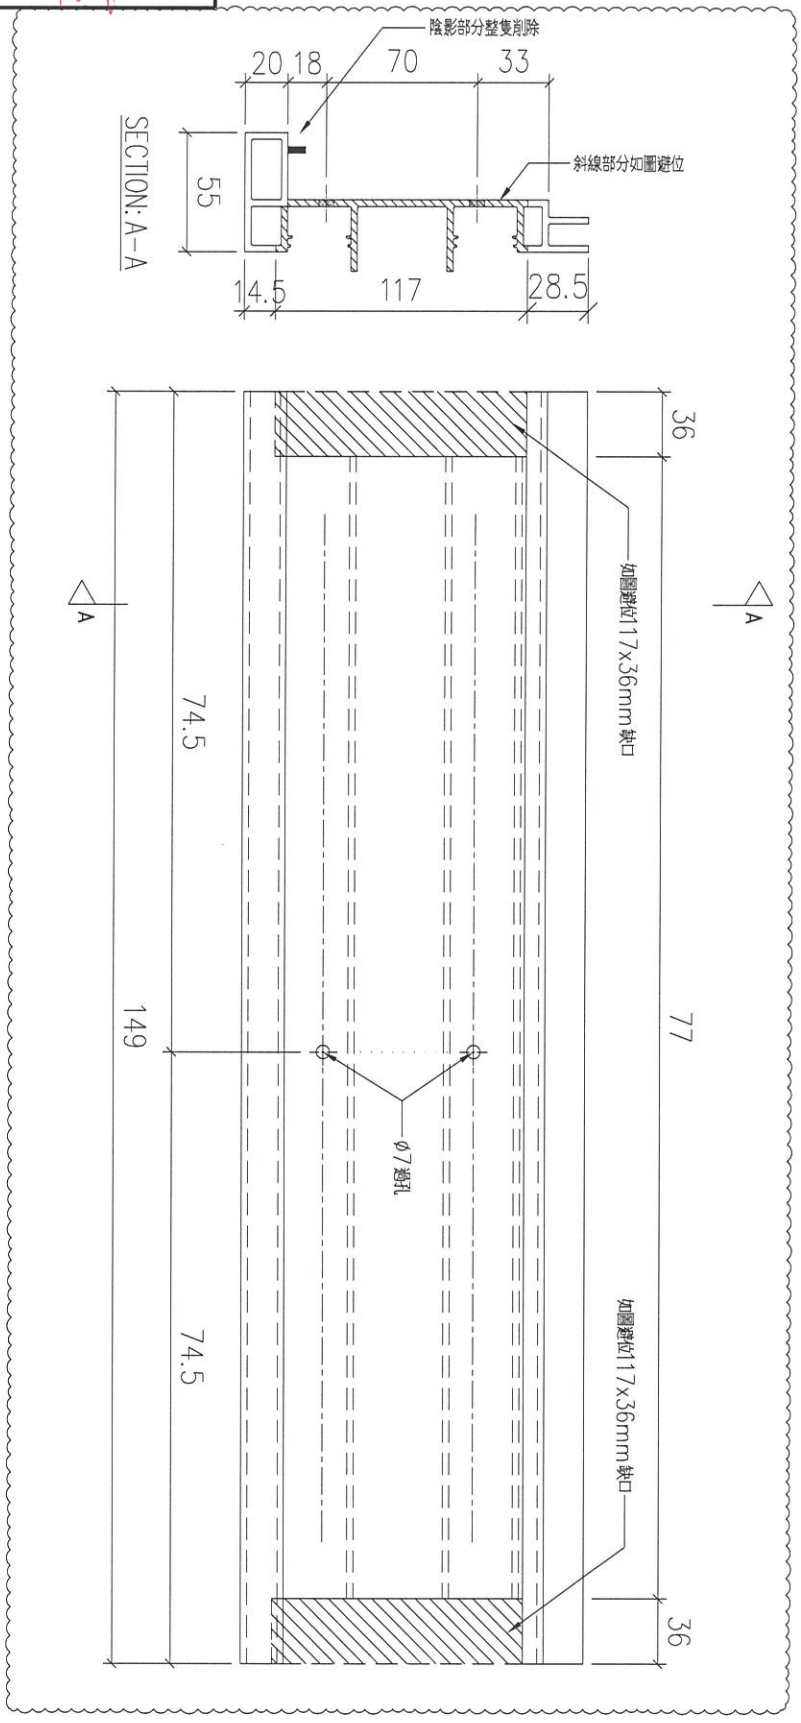

序號	物料編號	數量	安裝位置	樓層
01	T5-X86215-17	4	見派位圖	T5 FLAT C 11~16/F

名稱	扶手加工圖	制圖	LHR	2022,08,26	修改	A		
材料	X86215	復核	–	–	日期	2023.3.2		
顏色	JMQ213457(3coats)	批準			圖號	J853-GB-FAB2-17		


17

美特鋁質 有限公司
MIDI Aluminium Fabricator Ltd.

工程號	J853	地盤	錦上路 TWP

送工地

新增圖

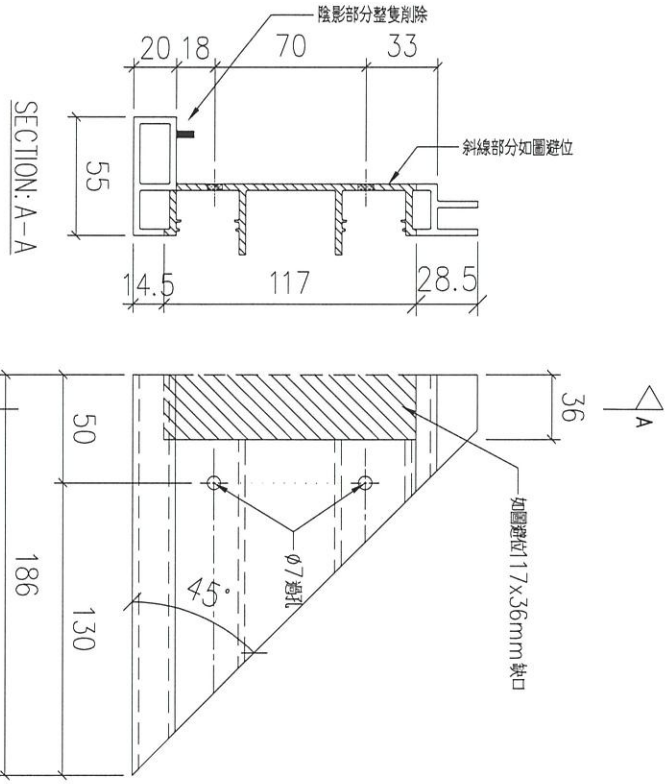


序號	物料編號	數量	安裝位置	樓層
01	T5-X86215-17A	4	見派位圖	T5 FLAT C 11~16/F

名稱	扶手加工圖	制圖	LHR	2022,08,26	修改	–		
材料	X86215	復核	–	–	日期	–		
顏色	JMQ213457(3coats)	批準			圖號	J853-GB-FAB2-17A		

美特鋁質 有限公司
MIDI Aluminium Fabricator Ltd.

工程號	J853	地盤	~~錦上路~~ TWP

送工地

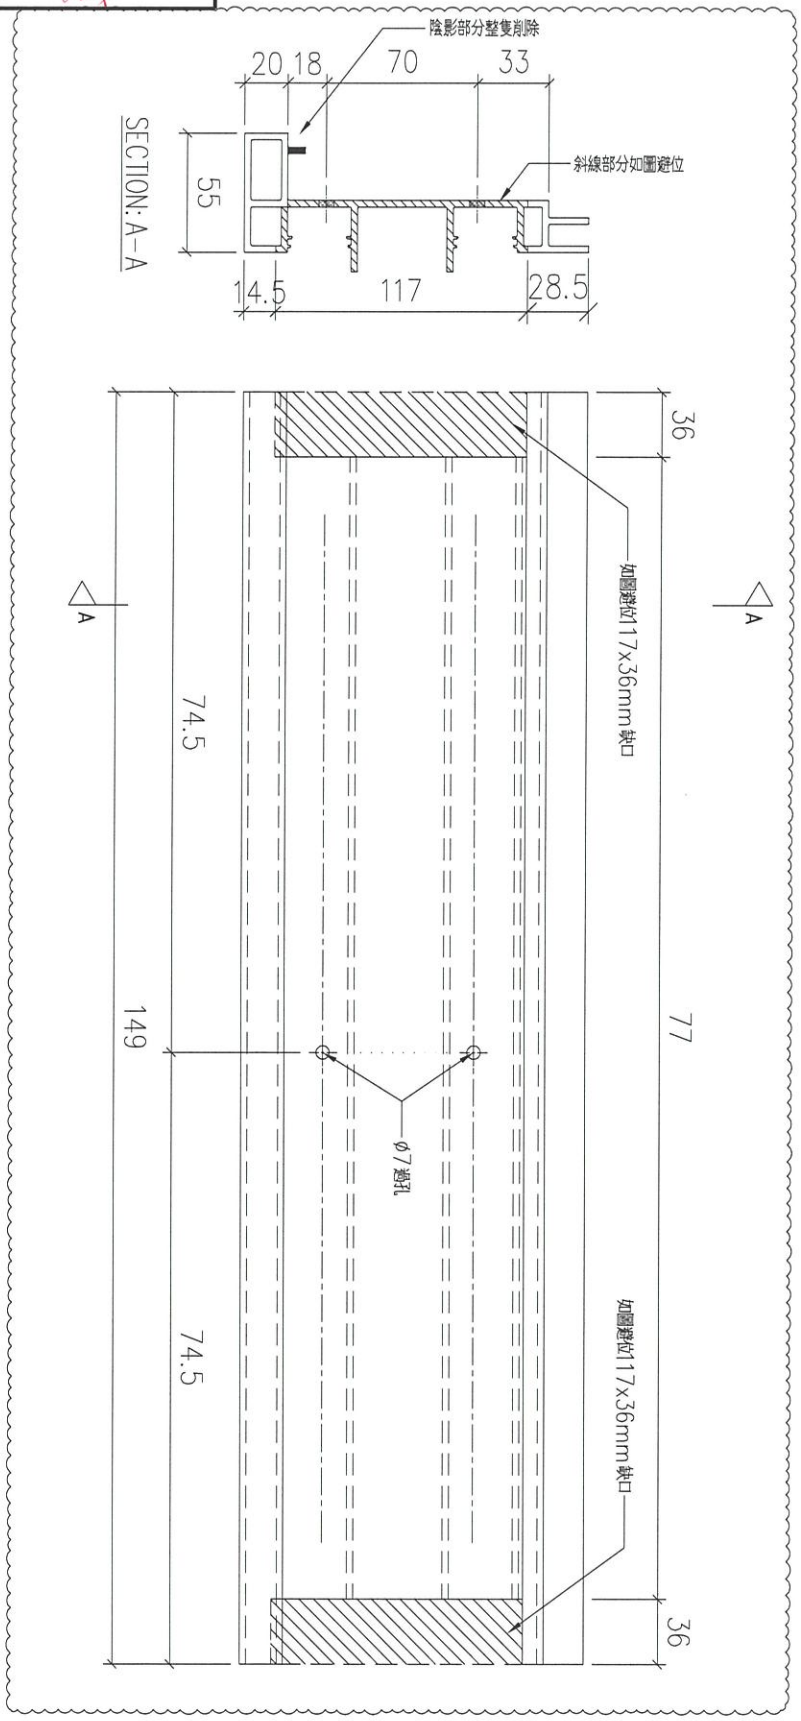

序號	物料編號	數量	安裝位置	樓層
01	T5-X86215-18	8	見派位圖	T5 FLAT B 17~25/F


名稱	扶手加工圖	制圖	LHR	2022,08,26	修改	A		
材料	X86215	復核	–	–	日期	2023.3.2		
顏色	JMQ213457(3coats)	批準			圖號	J853-GB-FAB2-18		

美特鋁質 有限公司
MIDI Aluminium Fabricator Ltd.

工程號	J853	地盤	~~錦上路~~ Twp

送工地

新增圖

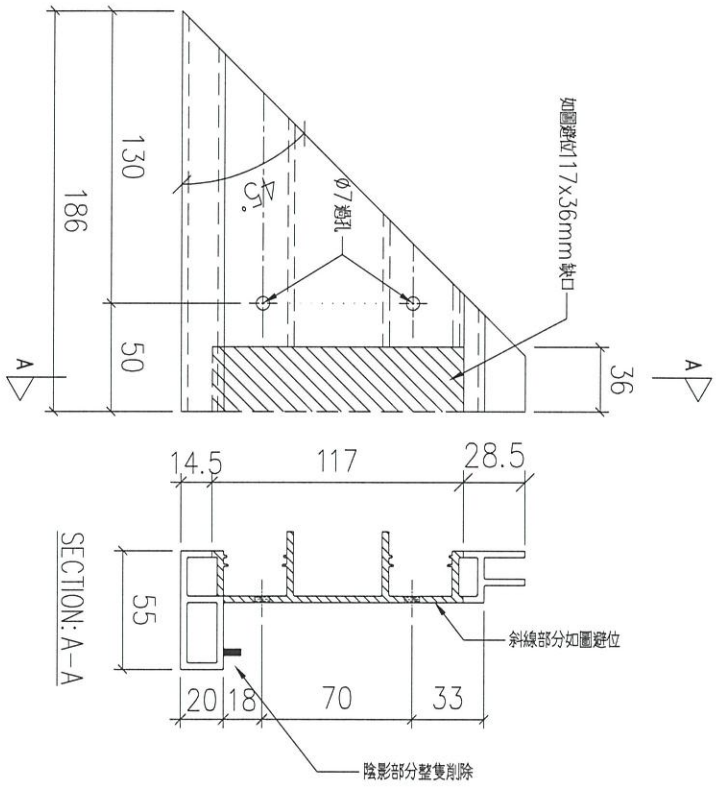


序號	物料編號	數量	安裝位置	樓層
01	T5-X86215-18A	8	見派位圖	T5 FLAT B 17~25/F

名稱	扶手加工圖	制圖	LHR	2022,08,26	修改	–		
材料	X86215	復核	–	–	日期	–		
顏色	JMQ213457(3coats)	批準			圖號	J853-GB-FAB2-18A		

美特鋁質 有限公司
MIDI Aluminium Fabricator Ltd.

工程號	J853	地盤	~~錦上路~~ Twp

送工地

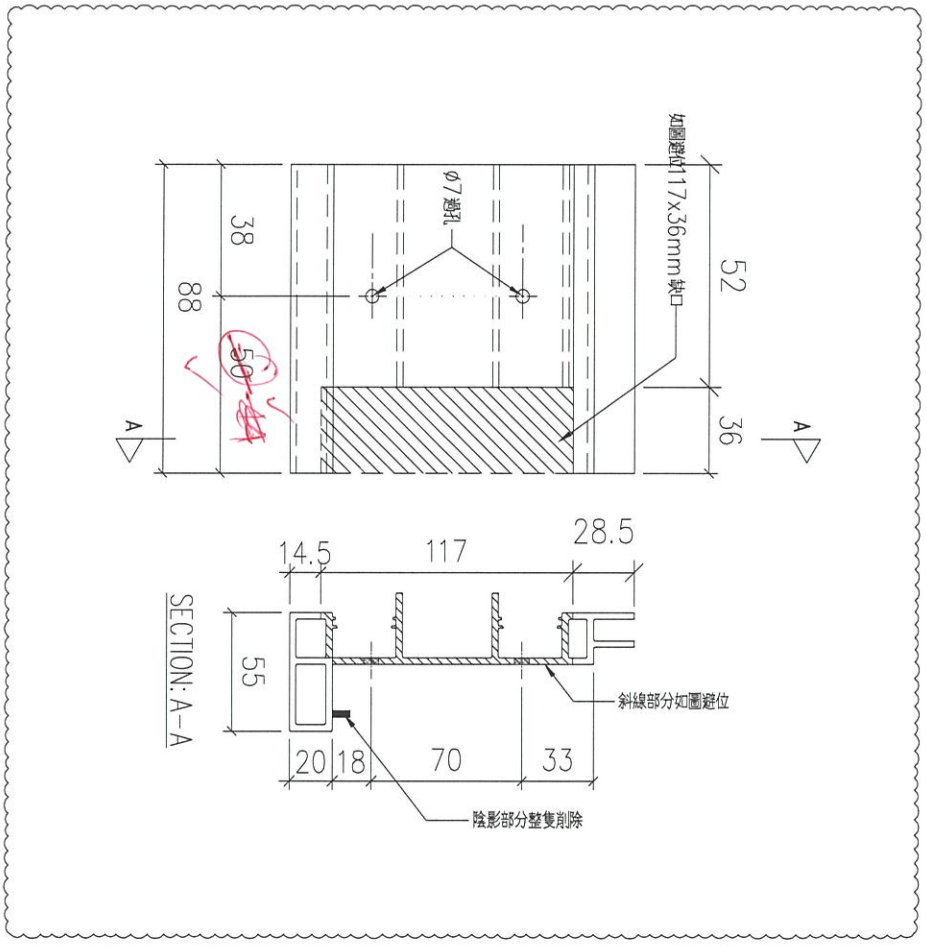

序號	物料編號	數量	安裝位置	樓層
01	T5-X86215-19	13	見派位圖	T5 FLAT E/F 11~26/F


名稱	扶手加工圖	制圖	LHR	2022,08,26	修改	A		
材料	X86215	復核	–	–	日期	2023.3.2		
顏色	JMQ213457(3coats)	批準			圖號	J853-GB-FAB2-19		

美特鋁質 有限公司
MIDI Aluminium Fabricator Ltd.

工程號	J853	地盤	~~錦上路~~ Twp

送工地

新增圖

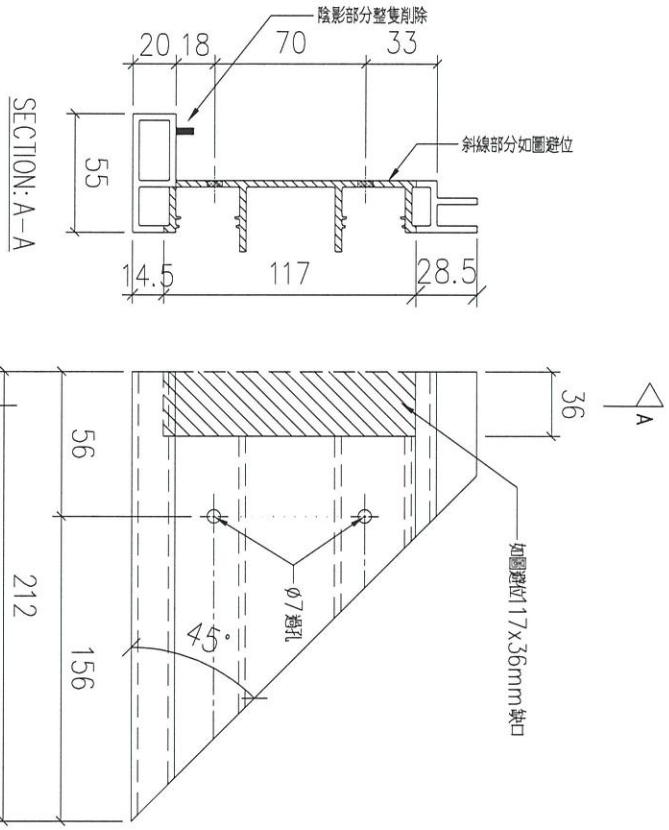


序號	物料編號	數量	安裝位置	樓層
01	T5-X86215-19A	13	見派位圖	T5 FLAT E/F 11~26/F

名稱	扶手加工圖	制圖	LHR	2022,08,26	修改	–		
材料	X86215	復核	–	–	日期	–		
顏色	JMQ213457(3coats)	批準			圖號	J853-GB-FAB2-19A		

美特鋁質 有限公司
MIDI Aluminium Fabricator Ltd.

工程號	J853	地盤	~~錦上路~~ Tuen

送工地

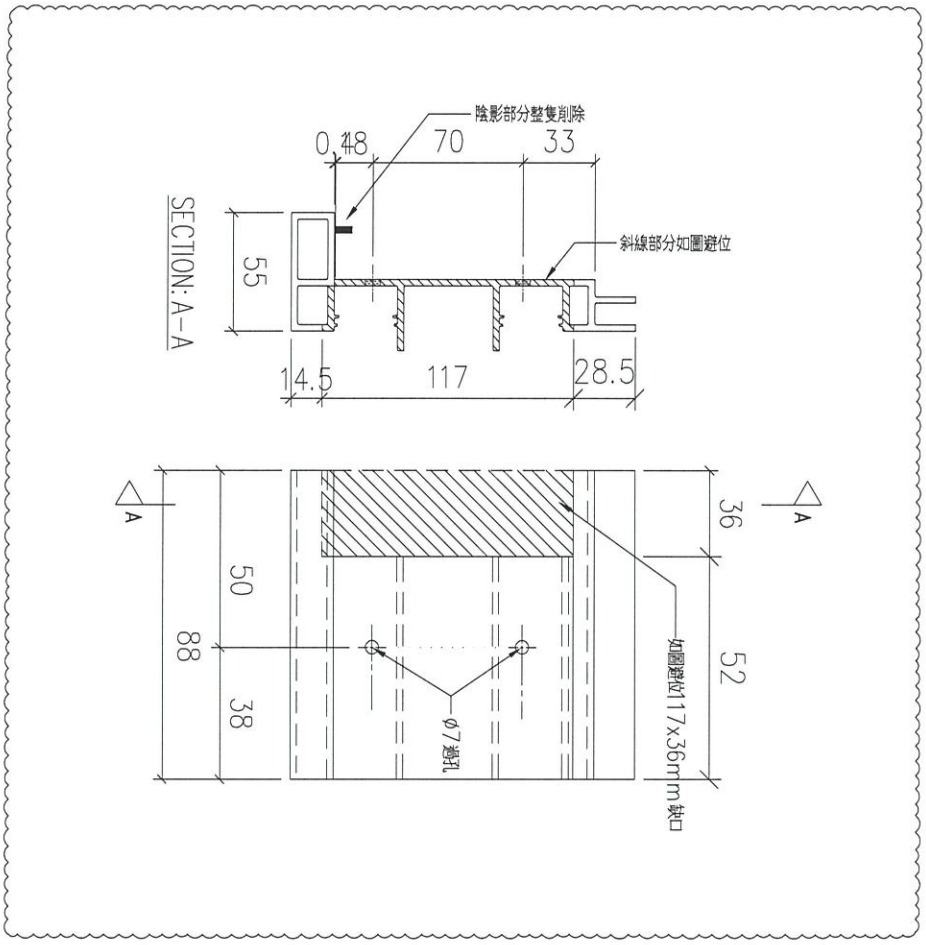

序號	物料編號	數量	安裝位置	樓層
01	T5-X86215-20	13	見派位圖	T5 FLAT E/F 11~26/F


名稱	扶手加工圖	制圖	LHR	2022,08,26	修改	A		
材料	X86215	復核	–	–	日期	2023.3.2		
顏色	JMQ213457(3coats)	批準			圖號	J853-GB-FAB2-20		

美特鋁質 有限公司
MIDI Aluminium Fabricator Ltd.

工程號	J853	地盤	錦上路 Twp

送工地

新增圖

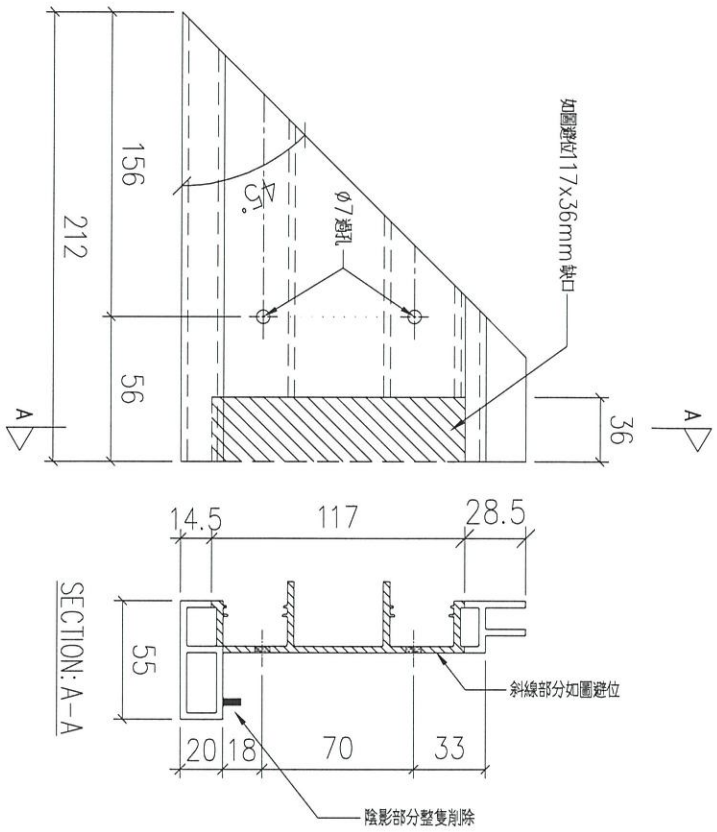


序號	物料編號	數量	安裝位置	樓層
01	T5-X86215-20A	13	見派位圖	T5 FLAT E/F 11~26/F

名稱	扶手加工圖	制圖	LHR	2022,08,26	修改	–		
材料	X86215	復核	–	–	日期	–		
顏色	JMQ213457(3coats)	批準			圖號	J853-GB-FAB2-20A		

美特鋁質 有限公司
MIDI Aluminium Fabricator Ltd.

工程號	J853	地盤	錦上路 TWP

送工地

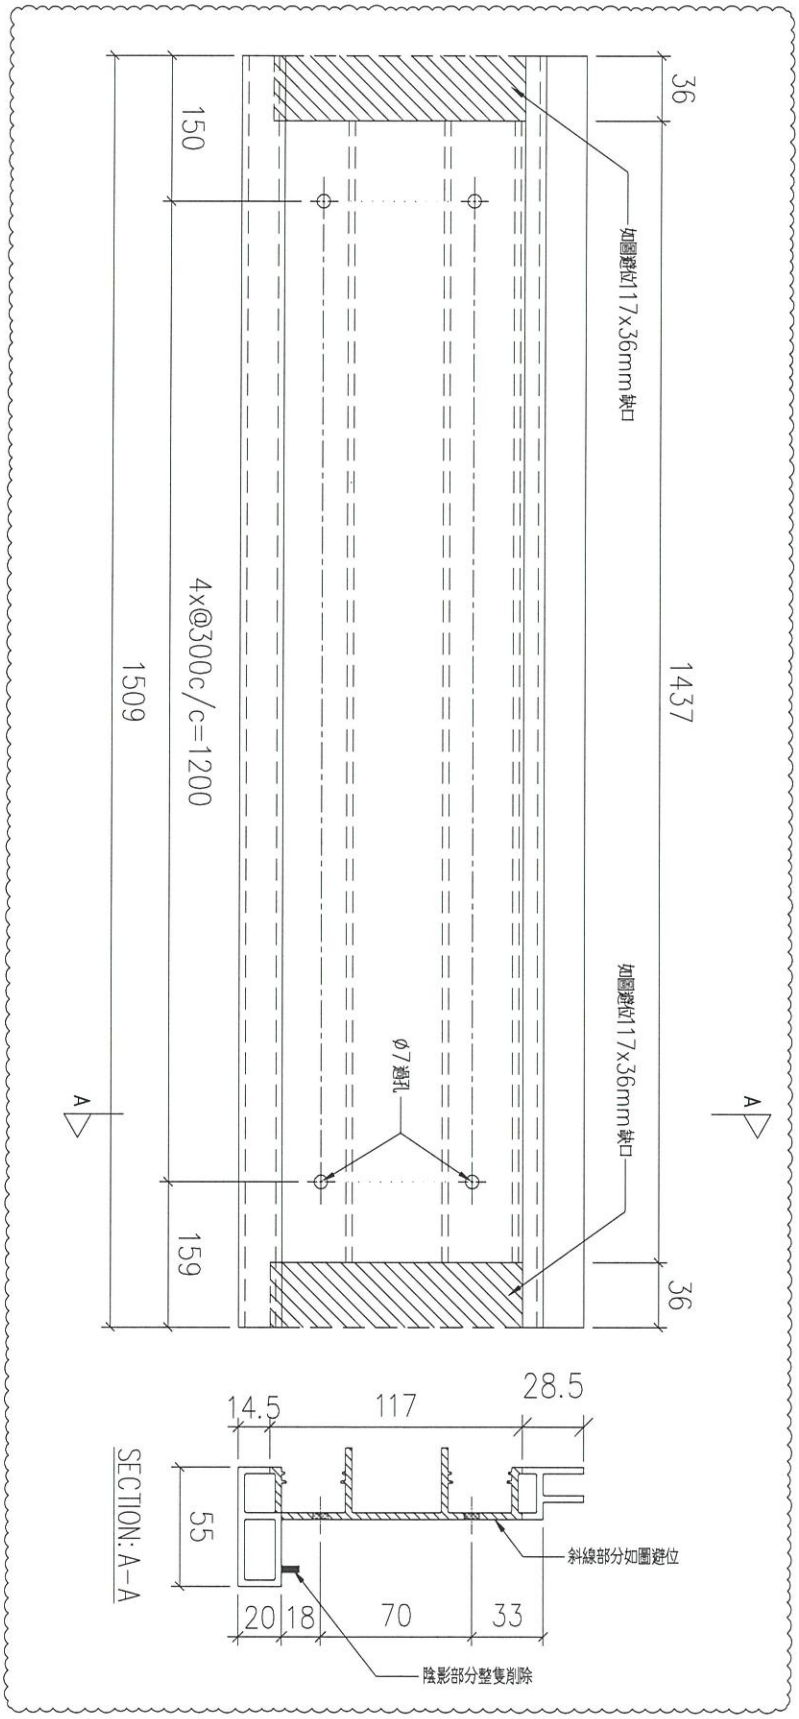


序號	物料編號	數量	安裝位置	樓層
01	T6-X86215-01	18	見派位圖	T6 FLAT A 5,6,8~26/F
02	T6-X86215-01	18	見派位圖	T6 FLAT B 5,6,8~26/F
03	T7-X86215-01	17	見派位圖	T7 FLAT A 7~26/F

名稱	扶手加工圖	制圖	LHR	2022,08,26	修改	A		
材料	X86215	復核	–	–	日期	2023.3.2		
顏色	JMQ213457(3coats)	批準			圖號	J853-GB-FAB2-21		

美特鋁質 有限公司
MIDI Aluminium Fabricator Ltd.

工程號	J853	地盤	~~錦上路~~ TKP

送工地

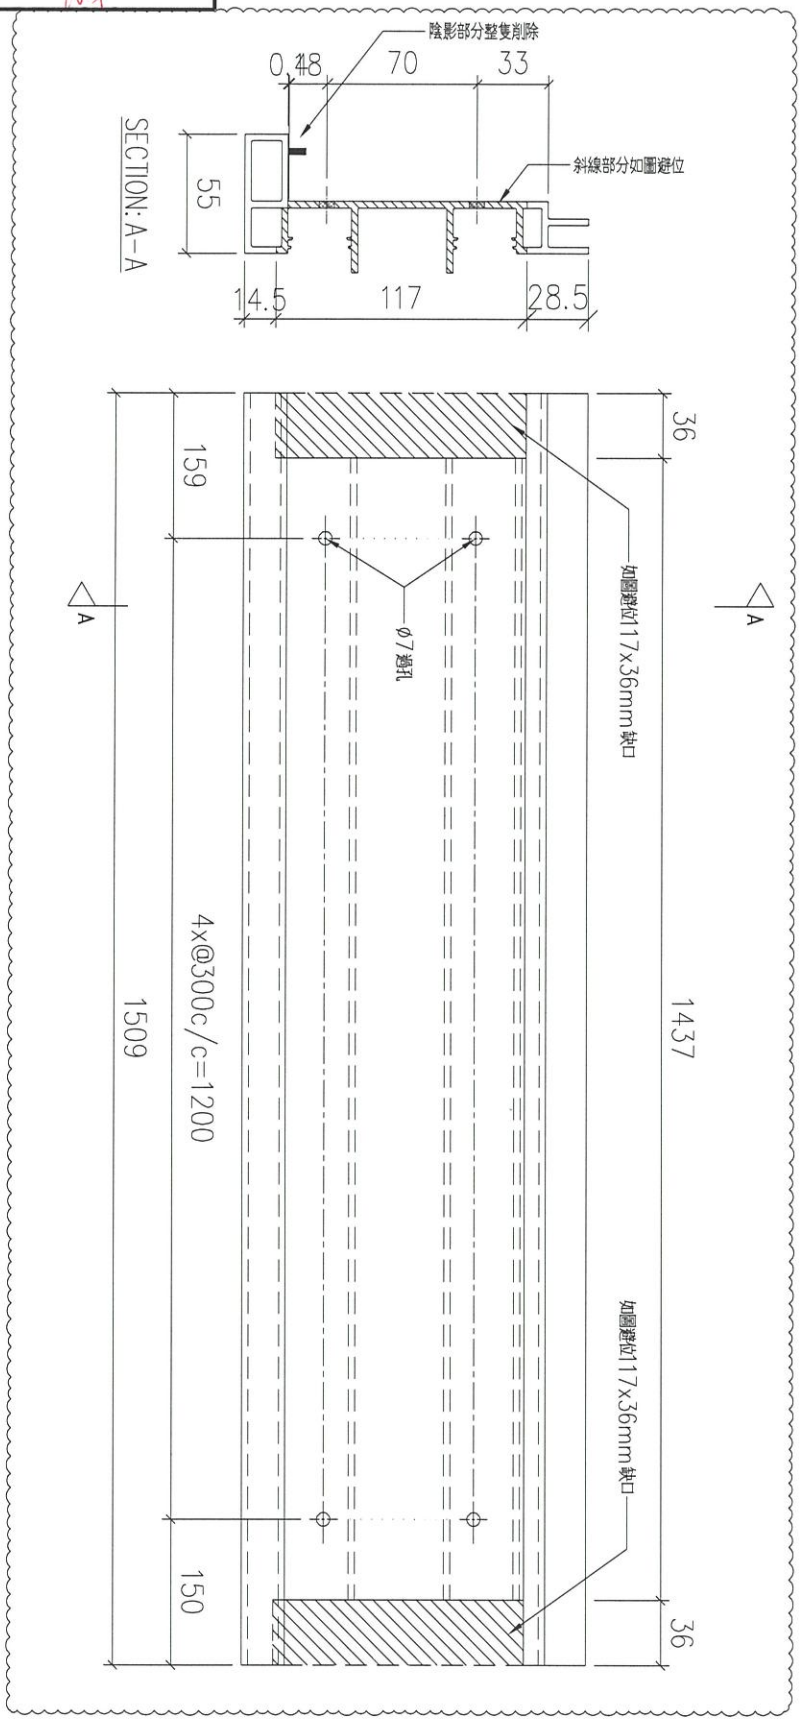

序號	物料編號	數量	安裝位置	樓層
01	T6-X86215-02	18	見派位圖	T6 FLAT A 5,6,8~26/F
02	T6-X86215-02	18	見派位圖	T6 FLAT B 5,6,8~26/F
03	T7-X86215-02	17	見派位圖	T7 FLAT A 7~26/F


名稱	扶手加工圖	制圖	LHR	2022,08,26	修改	A		
材料	X86215	復核	–	–	日期	2023.3.2		
顏色	JMQ213457(3coats)	批準			圖號	J853-GB-FAB2-22		

22

送工地

美特鋁質 有限公司
MIDI Aluminium Fabricator Ltd.

工程號	J853	地盤	錦上路

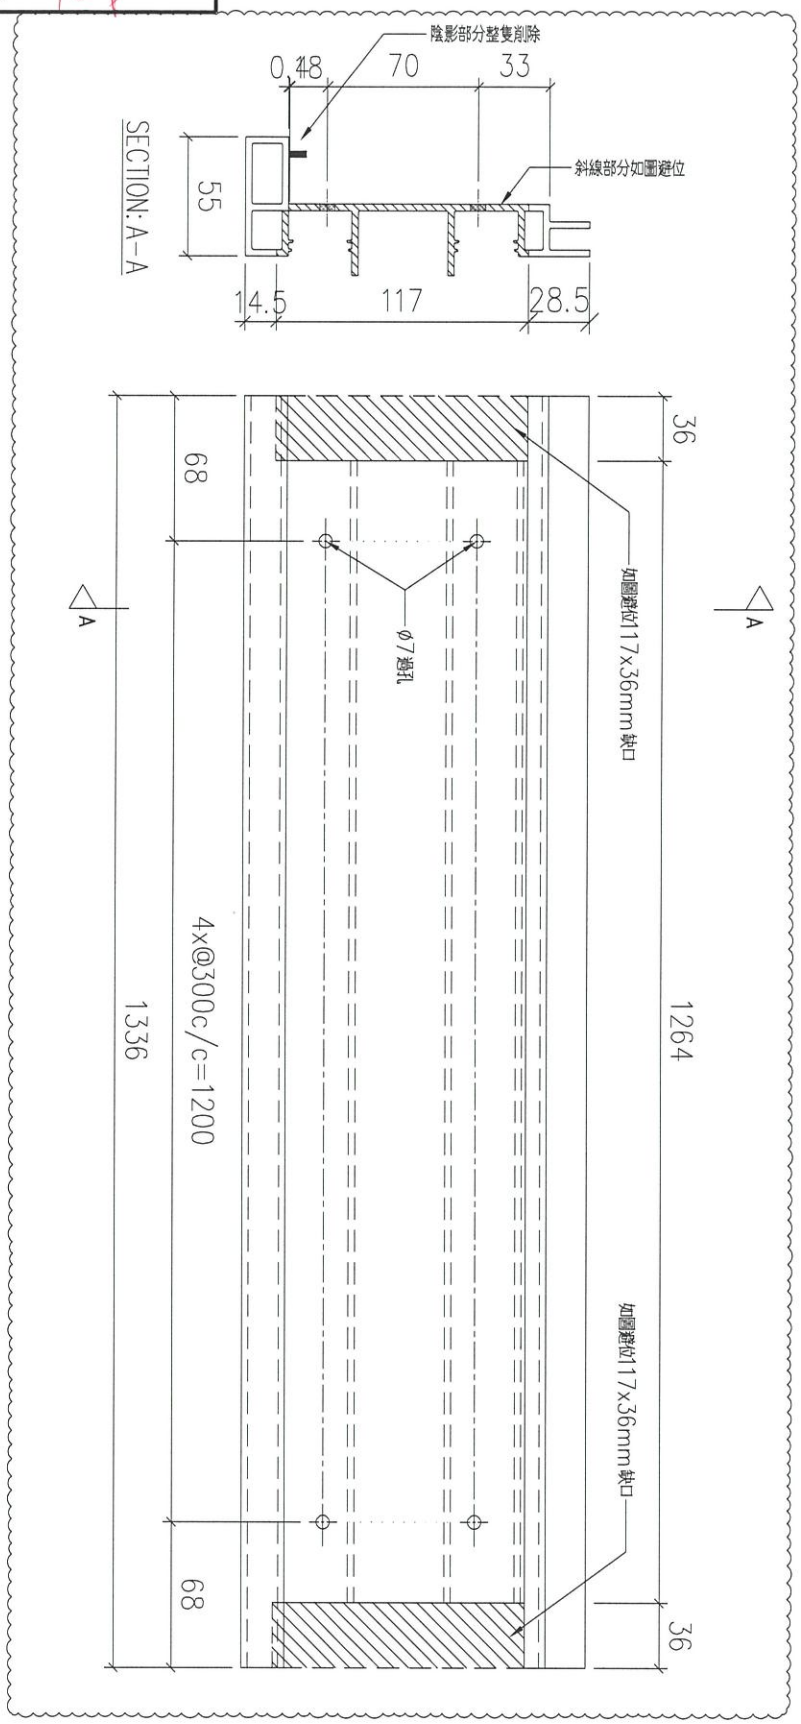


序號	物料編號	數量	安裝位置	樓層
01	T6-X86215-05	18	見派位圖	T6 FLAT A 5,6,8~26/F
02	T7-X86215-03	15	見派位圖	T7 FLAT B 7~23/F

名稱	扶手加工圖	制圖	LHR	2022,08,26	修改	A		
材料	X86215	復核	–	–	日期	2023.3.2		
顏色	JMQ213457(3coats)	批準			圖號	J853-GB-FAB2-23		

美特鋁質 有限公司 MIDI Aluminium Fabricator Ltd.			
工程號	J853	地盤	錦上路 TWP

送工地

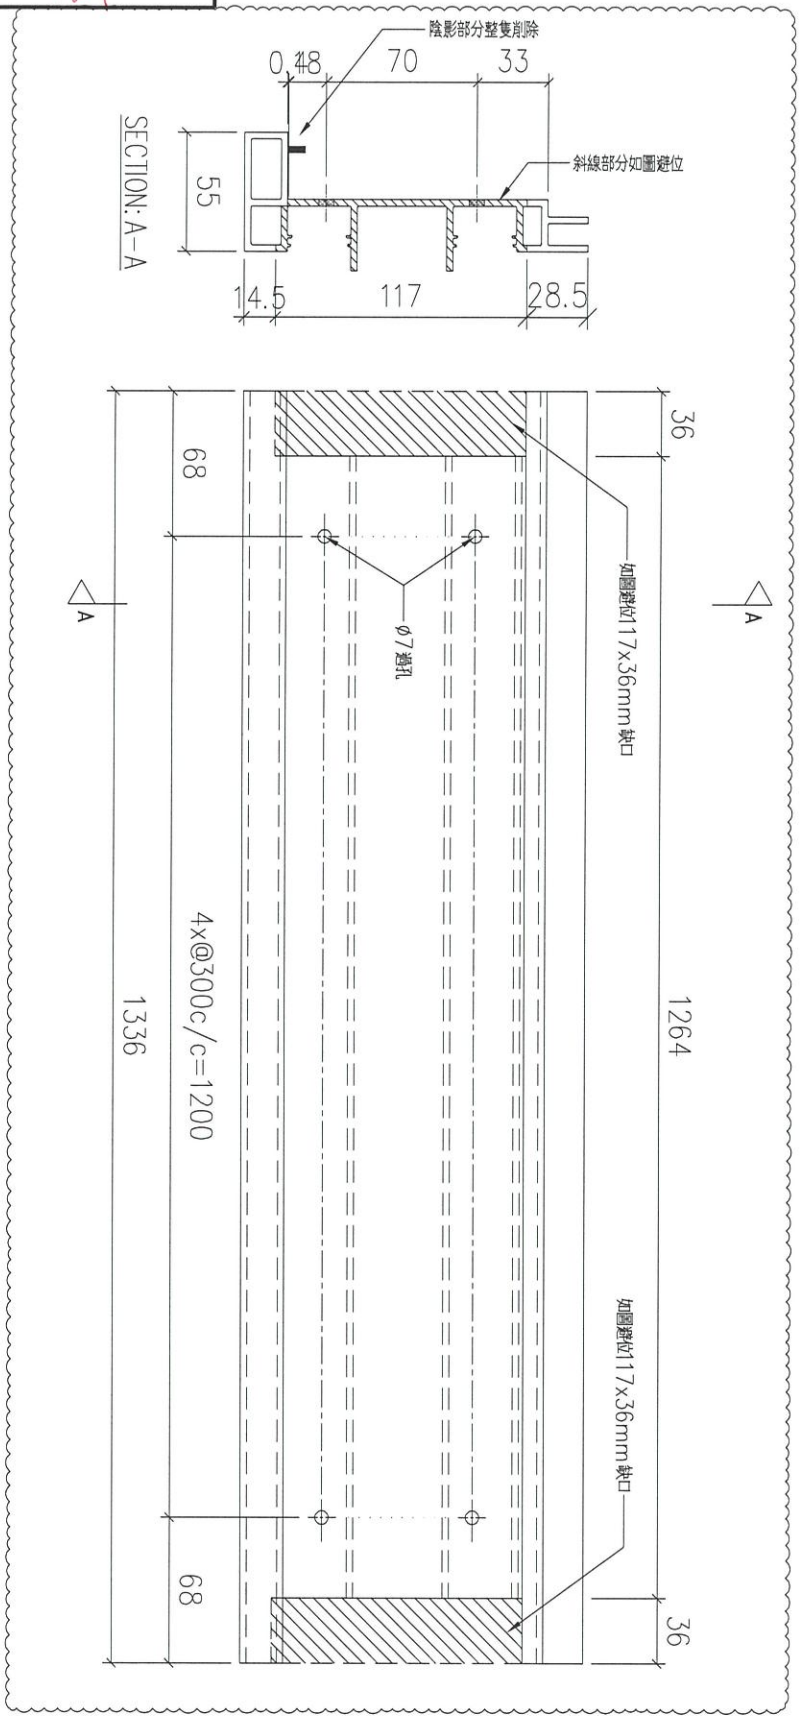


序號	物料編號	數量	安裝位置	樓層
01	T6-X86215-06	18	見派位圖	T6 FLAT B 5,6,8~26/F
02	T7-X86215-04	17	見派位圖	T7 FLAT A 7~26/F

名稱	扶手加工圖	制圖	LHR	2022,08,26	修改	A		
材料	X86215	復核	–	–	日期	2023.3.2		
顏色	JMQ213457(3coats)	批準			圖號	J853-GB-FAB2-24		

美特鋁質 有限公司
MIDI Aluminium Fabricator Ltd.

工程號	J853	地盤	~~錦上路~~ TWP

送工地

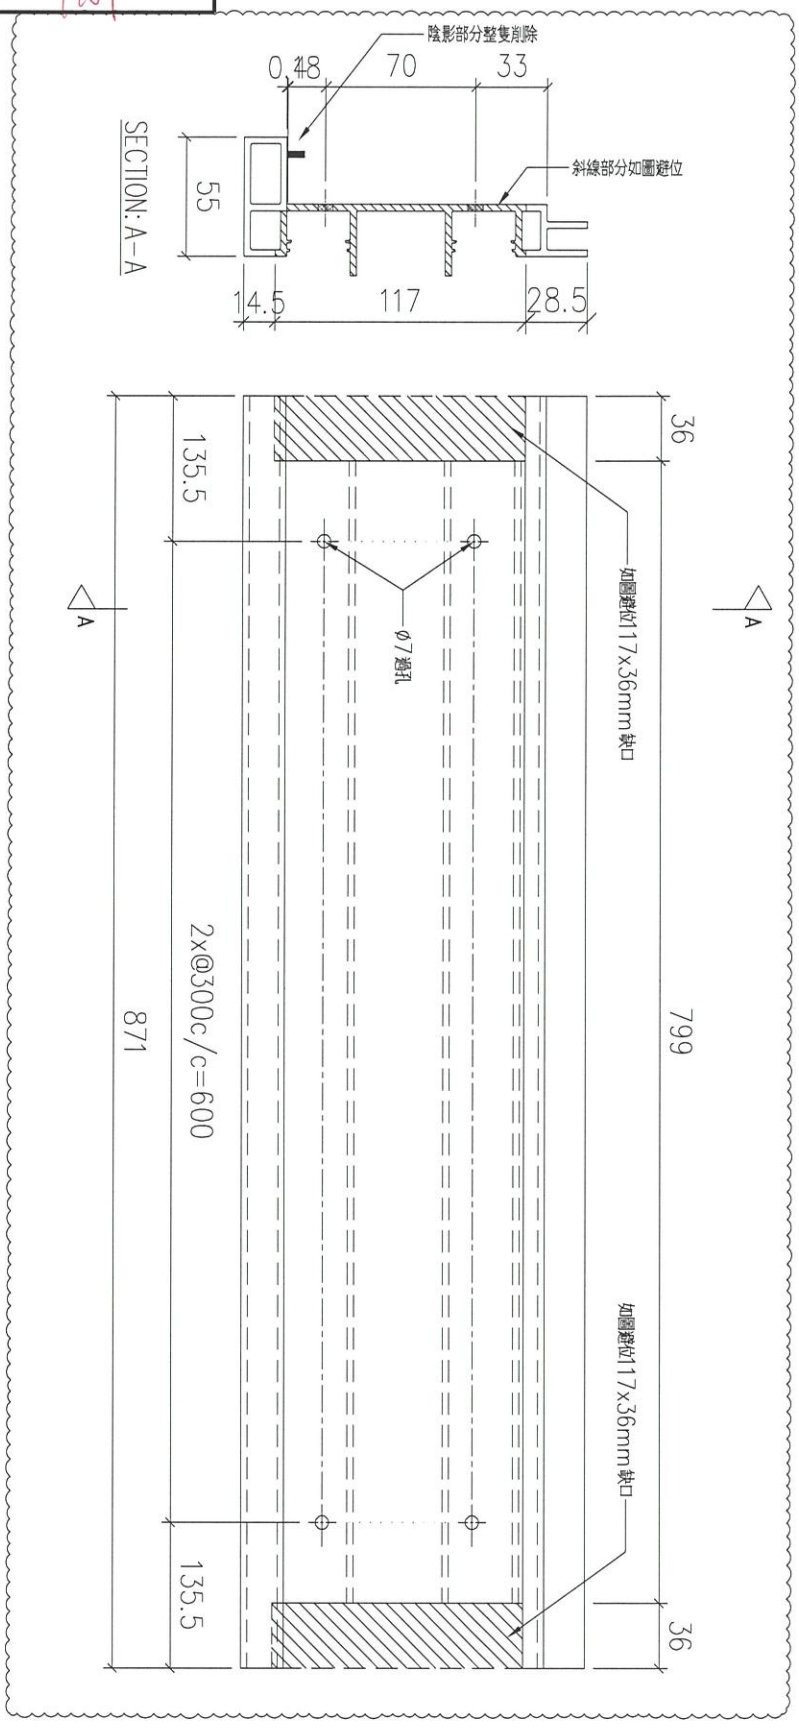

序號	物料編號	數量	安裝位置	樓層
01	T7-X86215-05	17	見派位圖	T7 FLAT A 7~26/F


名稱	扶手加工圖	制圖	LHR	2022,08,26	修改	A		
材料	X86215	復核	–	–	日期	2023.3.2		
顏色	JMQ213457(3coats)	批準			圖號	J853-GB-FAB2-25		

25

美特鋁質 有限公司
MIDI Aluminium Fabricator Ltd.

工程號	J853	地盤	錦上路

送工地

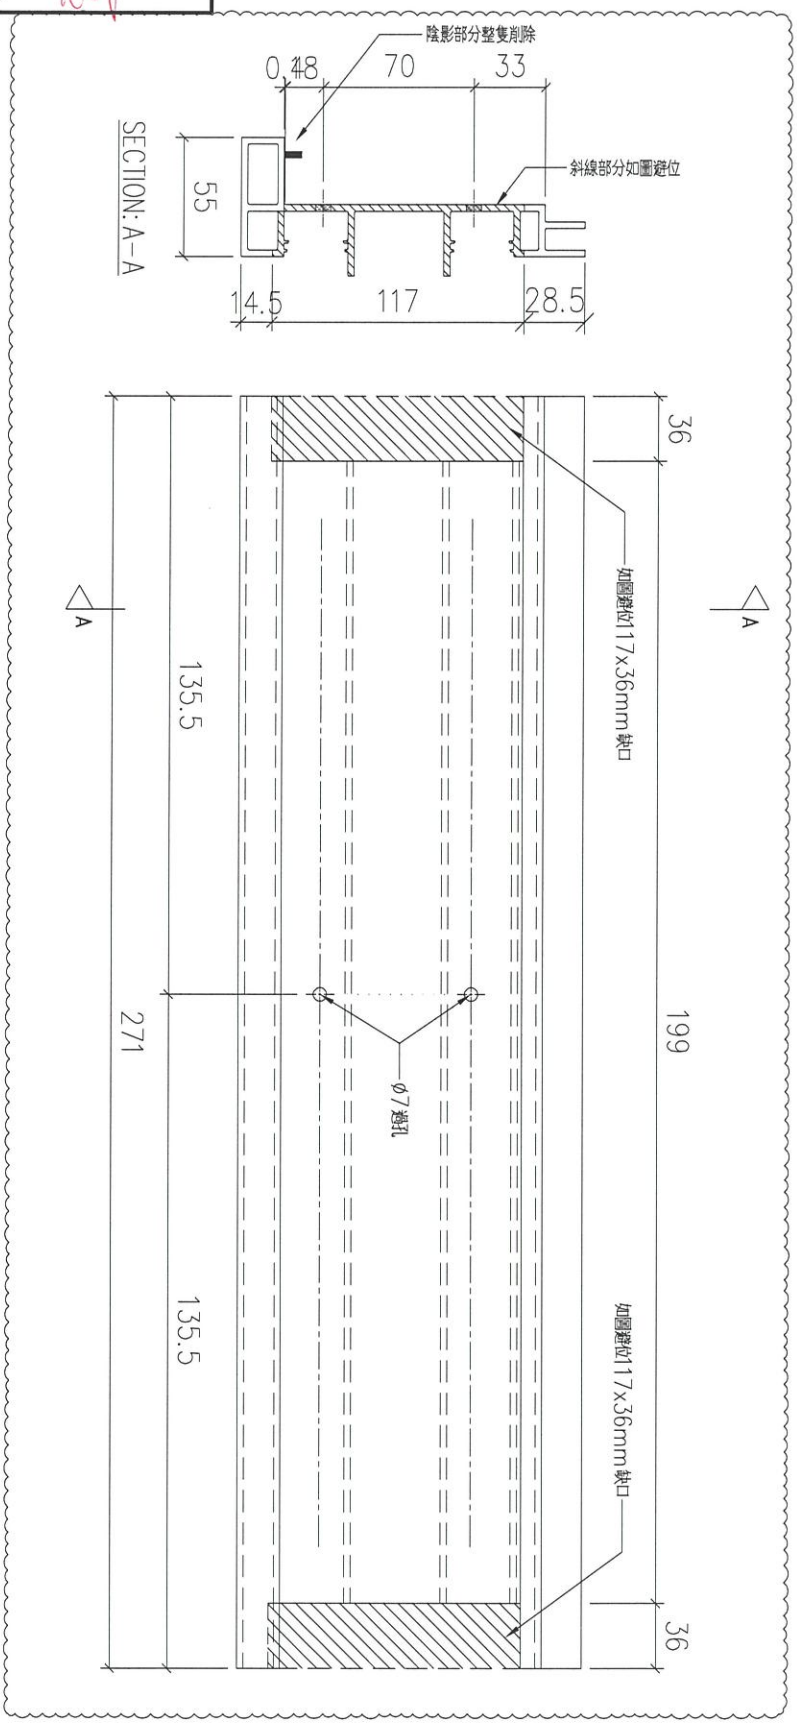


序號	物料編號	數量	安裝位置	樓層
01	T6-X86215-07	18	見派位圖	T6 FLAT A 5,6,8~26/F

名稱	扶手加工圖	制圖	LHR	2022,08,26	修改	A		
材料	X86215	復核	–	–	日期	2023.3.2		
顏色	JMQ213457(3coats)	批準			圖號	J853-GB-FAB2-26		

美特鋁質 有限公司
MIDI Aluminium Fabricator Ltd.

工程號	J853	地盤	~~錦上路~~ TIN P

送工地

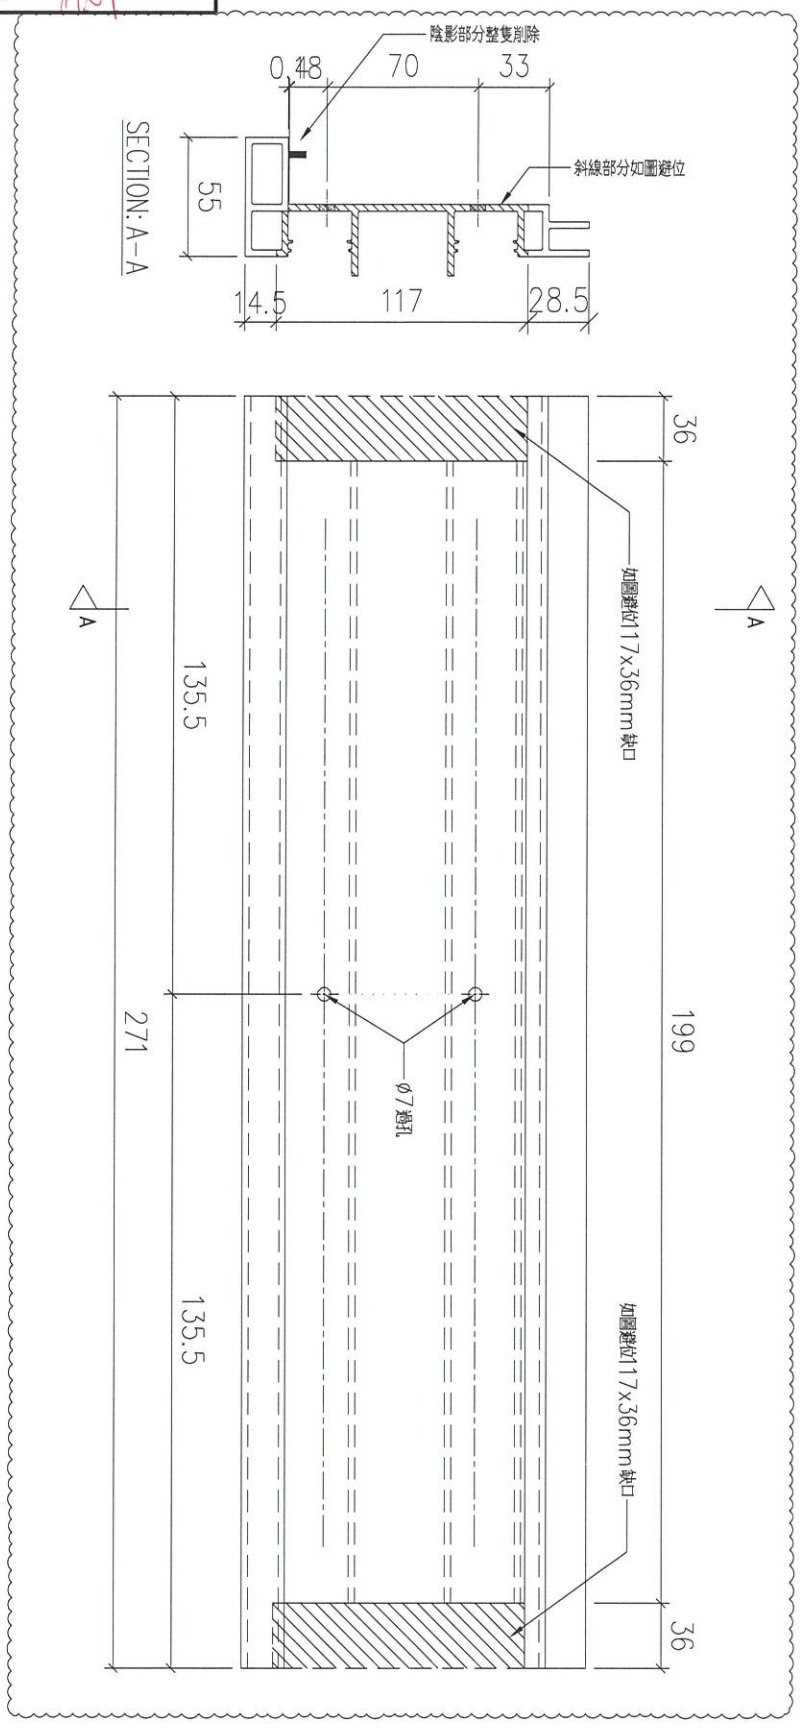


序號	物料編號	數量	安裝位置	樓層
01	T6-X86215-08	18	見派位圖	T6 FLAT B 5,6,8~26/F

名稱	扶手加工圖	制圖	LHR	2022,08,26	修改	A		
材料	X86215	復核	–	–	日期	2023.3.2		
顏色	JMQ213457(3coats)	批準			圖號	J853-GB-FAB2-27		

美特鋁質 有限公司
MIDI Aluminium Fabricator Ltd.

工程號	J853	地盤	錦上路 TWP

送工地

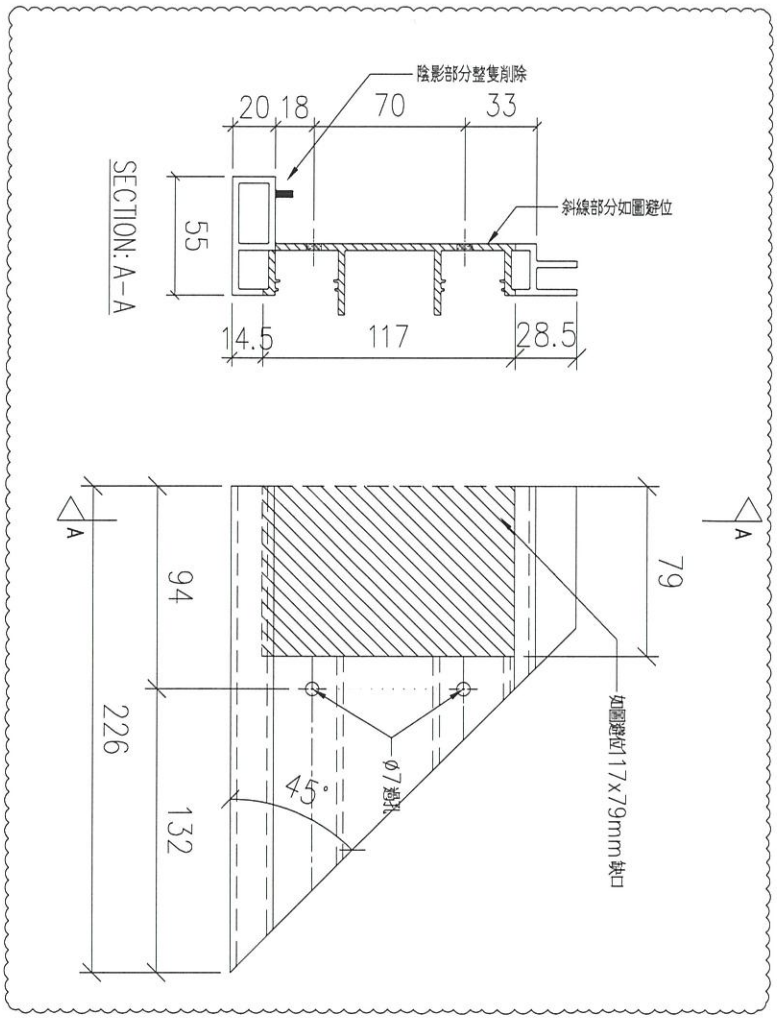


序號	物料編號	數量	安裝位置	樓層
01	T6-X86215-09	14	見派位圖	T6 FLAT C/D 10~26/F

名稱	扶手加工圖	制圖	LHR	2022,08,26	修改	A		
材料	X86215	復核	–	–	日期	2023.3.2		
顏色	JMQ213457(3coats)	批準			圖號	J853-GB-FAB2-28		

美特鋁質 有限公司
MIDI Aluminium Fabricator Ltd.

工程號	J853	地盤	~~錦上路~~ TWP

送工地

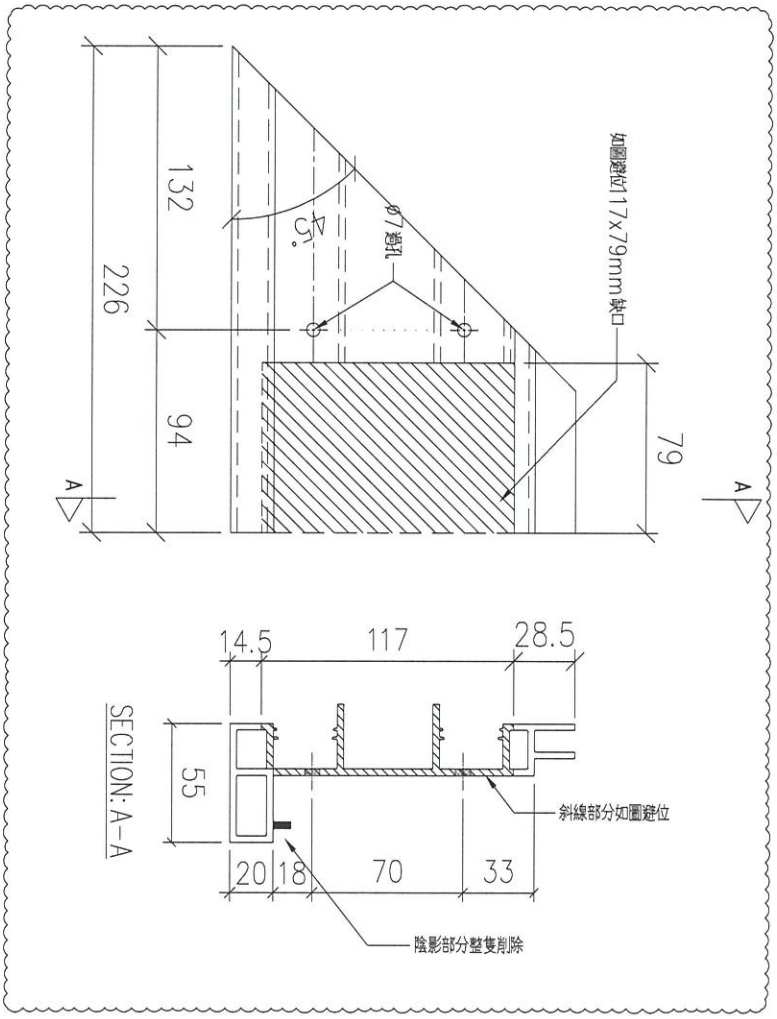

序號	物料編號	數量	安裝位置	樓層
01	T6-X86215-10	14	見派位圖	T6 FLAT C/D 10~26/F


名稱	扶手加工圖	制圖	LHR	2022,08,26	修改	A		
材料	X86215	復核	–	–	日期	2023.3.2		
顏色	JMQ213457(3coats)	批準			圖號	J853-GB-FAB2-29		

美特鋁質 有限公司
MIDI Aluminium Fabricator Ltd.

工程號	J853	地盤	~~錦上路~~ Tulip

送工地

新增圖

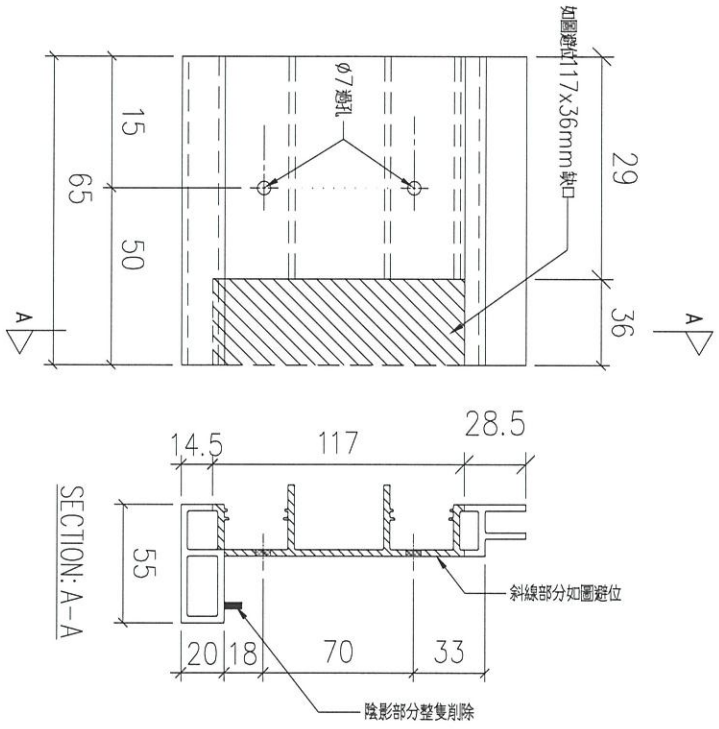

序號	物料編號	數量	安裝位置	樓層
01	T5-X86215-17B	4	見派位圖	T5 FLAT C 11~16/F


名稱	扶手加工圖	制圖	LHR	2022,08,26	修改	–		
材料	X86215	復核	–	–	日期	–		
顏色	JMQ213457(3coats)	批準			圖號	J853-GB-FAB2-17B		


美特鋁質 有限公司
MIDI Aluminium Fabricator Ltd.

工程號	J853	地盤	錦上路 T3P

送工地

新增圖

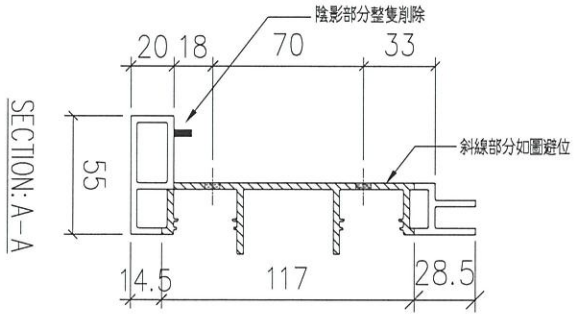

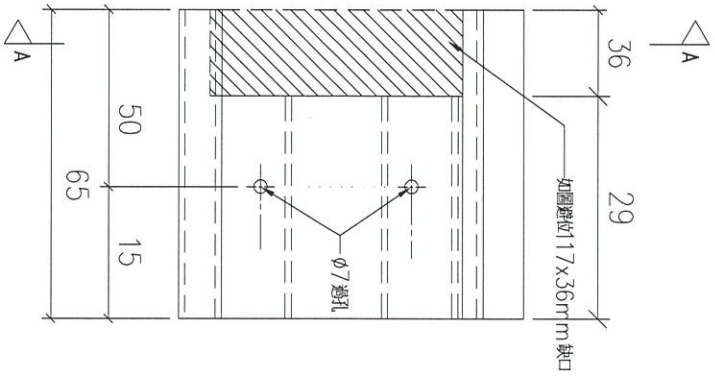



序號	物料編號	數量	安裝位置	樓層
01	T5-X86215-18B	8	見派位圖	T5 FLAT B 17~25/F

名稱	扶手加工圖	制圖	LHR	2022,08,26	修改	–		
材料	X86215	復核	–	–	日期	–		
顏色	JMQ213457(3coats)	批準			圖號	J853-GB-FAB2-18B		

40

送工地

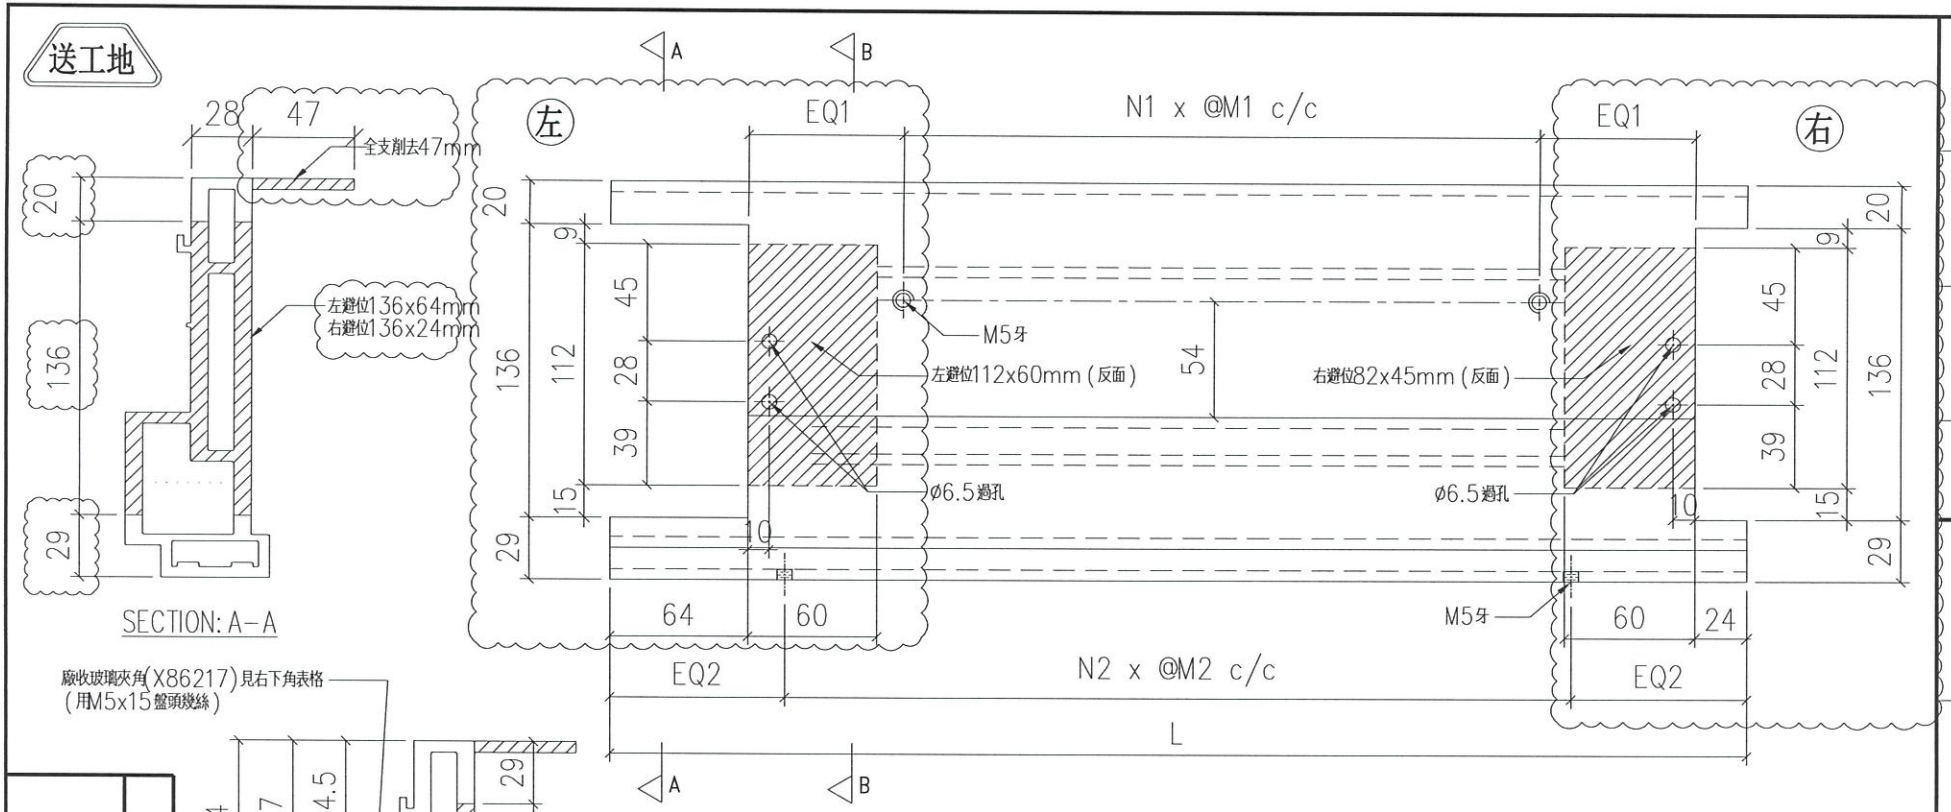

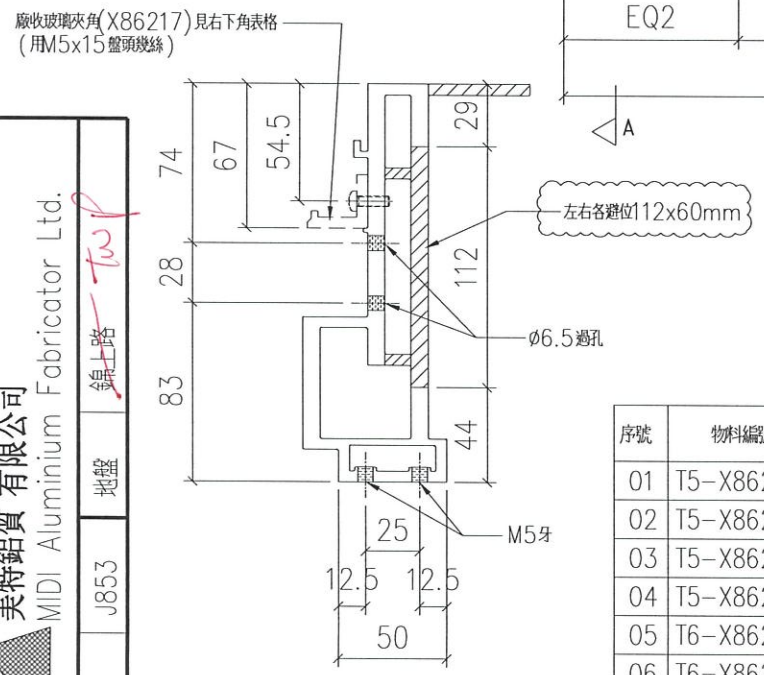

序號	物料編號	數量	L:	EQ1:	EQ2:	M1:	M2:	N1:	N2:	廠收玻璃夾角見：	使用位置	樓層
01	T5-X86216-02	8	2350	51	75	270	275	8	8	T5-X86217-01	見派位圖	T5 FLAT A 17~25/F
02	T5-X86216-03	8	2341	46.5	70.5	270	275	8	8	T5-X86217-02	見派位圖	T5 FLAT A 17~25/F
03	T5-X86216-07	8	1820	56	70	270	280	6	6	T5-X86217-05	見派位圖	T5 FLAT B 17~25/F
04	T5-X86216-10	4	1202	57	81	250	260	4	4	T5-X86217-07	見派位圖	T5 FLAT D 11~16/F
05	T6-X86216-01	18	1518	40	84	270	270	5	5	T6-X86217-01	見派位圖	T6 FLAT A 5,6,8~26/F
06	T6-X86216-01	18	1518	40	84	270	270	5	5	T6-X86217-01	見派位圖	T6 FLAT B 5,6,8~26/F
07	T7-X86216-01	17	1518	40	84	270	270	5	5	T7-X86217-01	見派位圖	T7 FLAT A 7~26/F
		81										

美特鋁質 有限公司
MIDI Aluminium Fabricator Ltd.

工程號	J853
地盤	錦上路


制圖	LHR
復核	–
批准	

修改	日期	圖號
A	2023.2.12	J853-GB-FAB2-30
2022,08,17	–	

名稱	底橫加工圖
材料	X86216
顏色	JMQ213457(3coats)

美特鋁質 有限公司
MIDI Aluminium Fabricator Ltd.

工程號	J853	地盤	~~錦上路~~ TWP

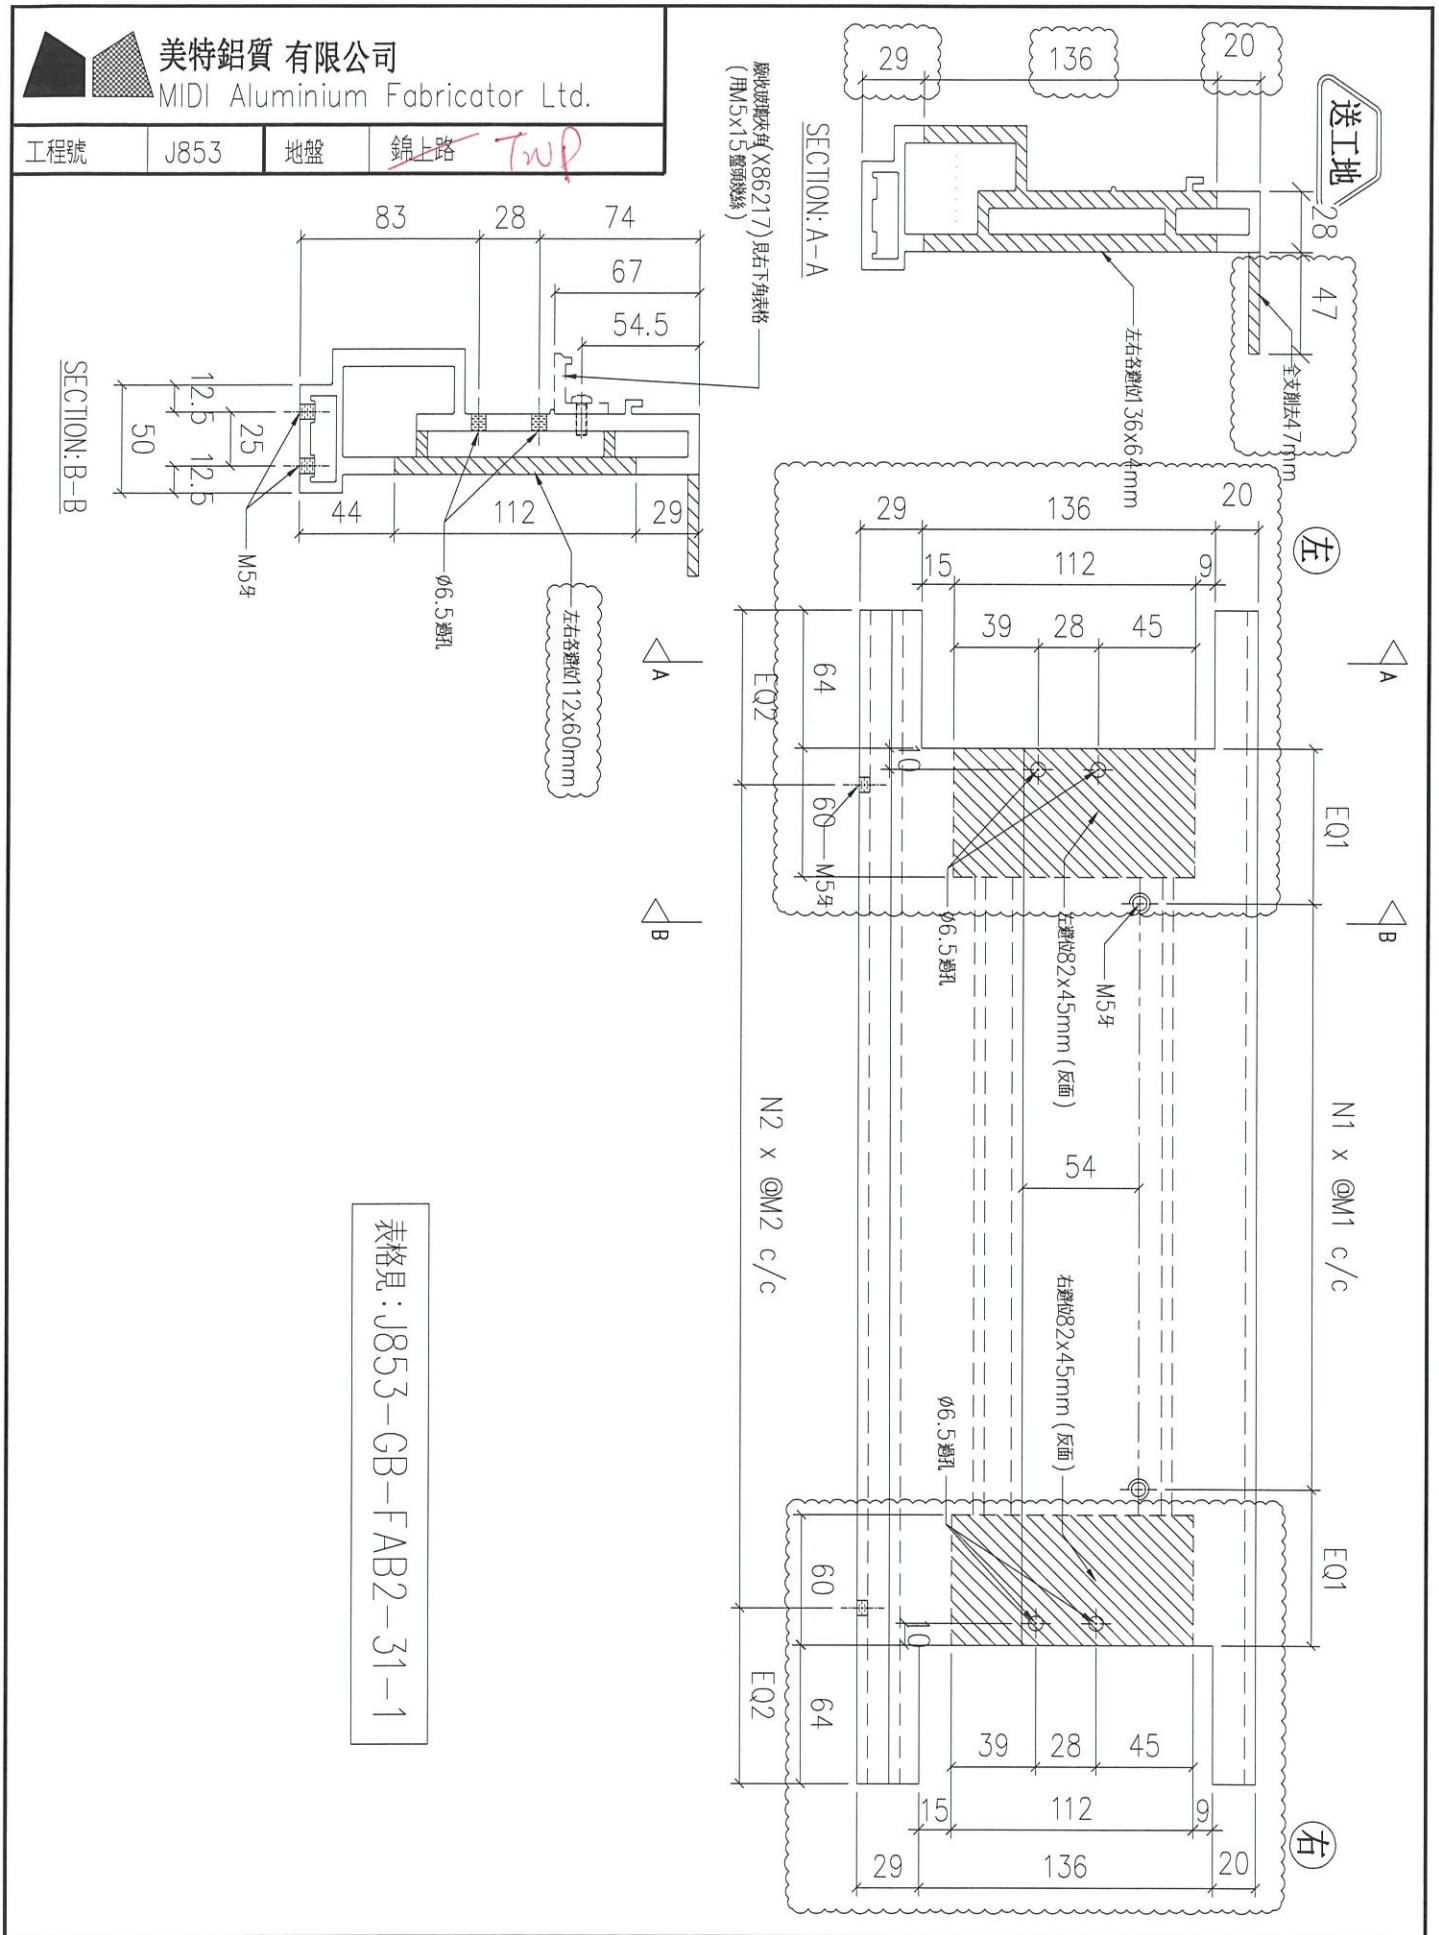

表格見：J853-GB-FAB2-31-1

名稱	底橫加工圖	制圖	LHR	2022,08,17	修改	A		
材料	X86216	復核	–	–	日期	2023.2.12		
顏色	JMQ213457(3coats)	批準			圖號	J853-GB-FAB2-31		

送工地

美特鋁質 有限公司
MIDI Aluminium Fabricator Ltd.


工程號	J853	地盤	錦上路 TWP

353

序號	物料編號	數量	L:	EQ1:	EQ2:	M1:	M2:	N1:	N2:	廢收玻璃夾角見：	使用位置	樓層
01	T5-X86216-01	8	2390	51	95	270	275	8	8	T5-X86217-01	見派位圖	T5 FLAT A 17~25/F
02	T5-X86216-04	26	2294	33	97	300	300	7	7	T5-X86217-03	見派位圖	T5 FLAT E/F 11~26/F
03	T5-X86216-05	9	2080.5	31.25	77.75	270	275	7	7	T5-X86217-04	見派位圖	T5 FLAT A 6~16/F
04	T5-X86216-05	4	2080.5	31.25	77.75	270	275	7	7	T5-X86217-04	見派位圖	T5 FLAT C 11~16/F
05	T5-X86216-06	8	1860	56	90	270	280	6	6	T5-X86217-05	見派位圖	T5 FLAT B 17~25/F
06	T5-X86216-08	9	1505.5	38.75	77.75	260	270	5	5	T5-X86217-06	見派位圖	T5 FLAT B 6~16/F
07	T5-X86216-09	4	1242	57	81	250	270	4	4	T5-X86217-07	見派位圖	T5 FLAT D 11~16/F
08	T5-X86216-11	9	1194	33	97	250	250	4	4	T5-X86217-08	見派位圖	T5 FLAT A 6~16/F
09	T5-X86216-11	9	1194	33	97	250	250	4	4	T5-X86217-08	見派位圖	T5 FLAT B 6~16/F
10	T5-X86216-11	4	1194	33	97	250	250	4	4	T5-X86217-08	見派位圖	T5 FLAT C 11~16/F
11	T5-X86216-12	8	1104	38	102	300	300	3	3	T5-X86217-09	見派位圖	T5 FLAT B 17~25/F
12	T5-X86216-13	4	504	38	102	300	300	1	1	T5-X86217-10	見派位圖	T5 FLAT D 11~16/F
13	T5-X86216-14	9	429	50.5	89.5	200	250	1	1	T5-X86217-11	見派位圖	T5 FLAT A 6~16/F
14	T5-X86216-14	16	429	50.5	89.5	200	250	1	1	T5-X86217-11	見派位圖	T5 FLAT A 17~25/F
15	T5-X86216-14	9	429	50.5	89.5	200	250	1	1	T5-X86217-11	見派位圖	T5 FLAT B 6~16/F
16	T6-X86216-02	18	1558	40	91.5	270	275	5	5	T6-X86217-01	見派位圖	T6 FLAT A 5,6,8~26/F
17	T6-X86216-02	18	1558	40	91.5	270	275	5	5	T6-X86217-01	見派位圖	T6 FLAT B 5,6,8~26/F
18	T6-X86216-03	28	2294	33	97	300	300	7	7	T6-X86217-02	見派位圖	T6 FLAT C/D 10~26/F
19	T6-X86216-04	18	1394	33	97	300	300	4	4	T6-X86217-03	見派位圖	T6 FLAT A 5,6,8~26/F
20	T6-X86216-04	18	1394	33	97	300	300	4	4	T6-X86217-03	見派位圖	T6 FLAT B 5,6,8~26/F
21	T6-X86216-05	18	329	33	97	135	135	1	1	T6-X86217-04	見派位圖	T6 FLAT A 5,6,8~26/F
22	T6-X86216-05	18	329	33	97	135	135	1	1	T6-X86217-04	見派位圖	T6 FLAT B 5,6,8~26/F
23	T7-X86216-02	17	1558	40	91.5	270	275	5	5	T7-X86217-01	見派位圖	T7 FLAT A 7~26/F
24	T7-X86216-03	15	2294	33	97	300	300	7	7	T7-X86217-02	見派位圖	T7 FLAT B 7~23/F
25	T7-X86216-04	17	1394	33	97	300	300	4	4	T7-X86217-03	見派位圖	T7 FLAT A 7~26/F
26	T7-X86216-04	15	1394	33	97	300	300	4	4	T7-X86217-03	見派位圖	T7 FLAT B 7~23/F
27	T7-X86216-05	17	929	25.5	89.5	250	250	3	3	T7-X86217-04	見派位圖	T7 FLAT A 7~26/F

名稱	底橫加工圖	制圖	LHR	2022,08,17	修改	A		
材料	X86216	復核	–	–	日期	2023.2.12		
顏色	JMQ213457(3coats)	批準			圖號	J853-GB-FAB2-31-1		

送工地

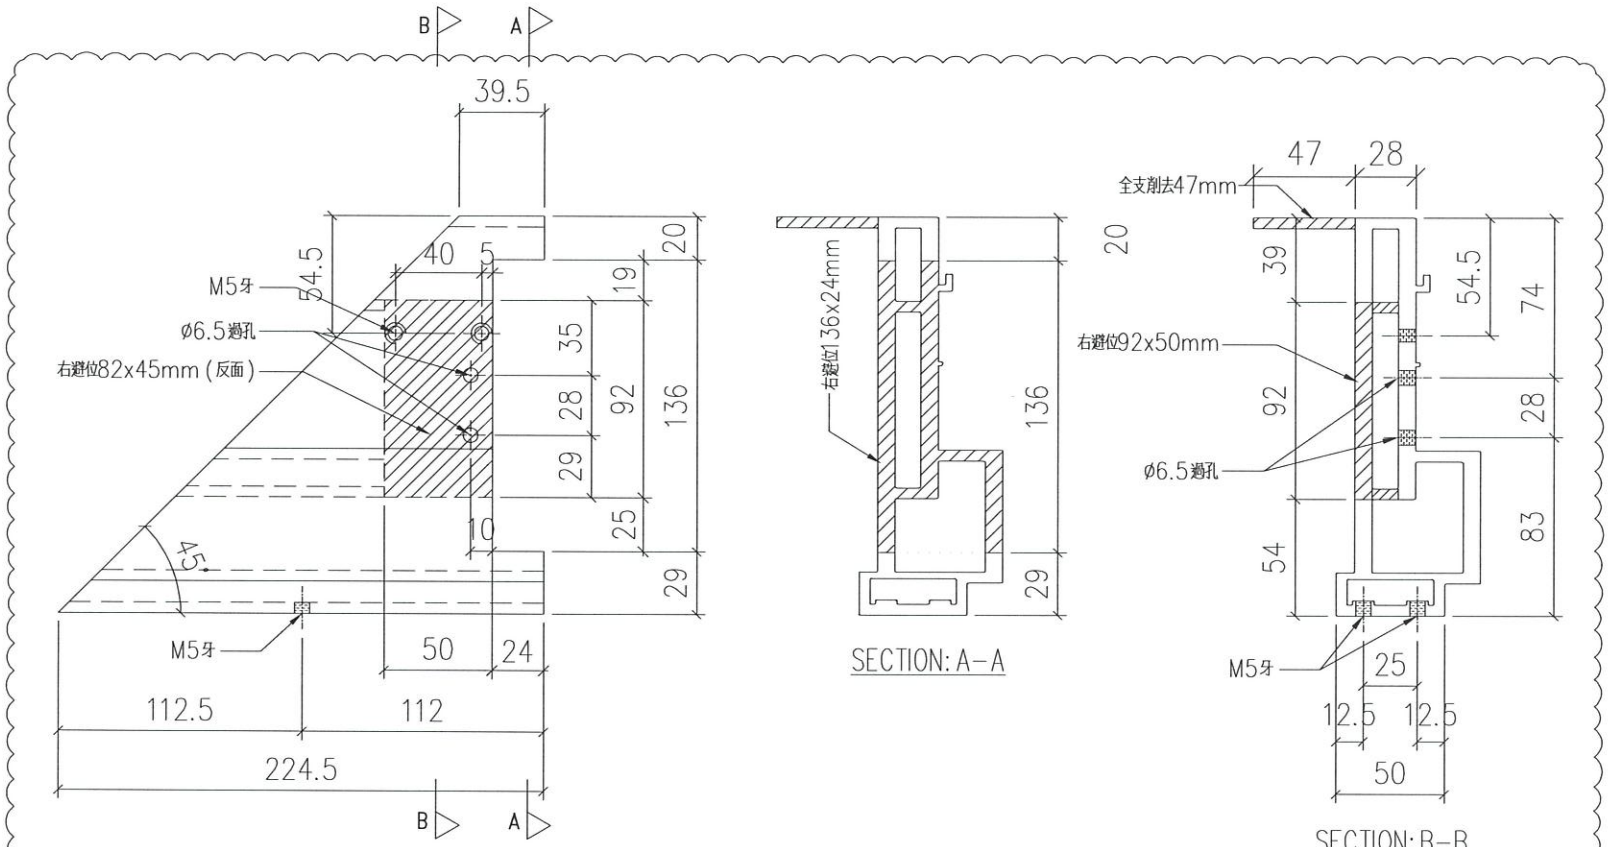

序號	物料編號	數量	使用位置	樓層
01	T5-X86216-15	34	見派位圖	T5 FLAT A 6~25/F
02	T5-X86216-15	18	見派位圖	T5 FLAT B 6~16/F
03	T5-X86216-15	8	見派位圖	T5 FLAT B 17~25/F
04	T5-X86216-15	8	見派位圖	T5 FLAT C 11~16/F
05	T5-X86216-15	4	見派位圖	T5 FLAT D 11~16/F
06	T5-X86216-15	13	見派位圖	T5 FLAT E/F 11~26/F

序號	物料編號	數量	使用位置	樓層
07	T6-X86216-15	36	見派位圖	T6 FLAT A 5,6,8~26/F
08	T6-X86216-15	36	見派位圖	T6 FLAT B 5,6,8~26/F
09	T6-X86216-15	14	見派位圖	T6 FLAT C/D 10~26/F
10	T7-X86216-15	34	見派位圖	T7 FLAT A 7~26/F
11	T7-X86216-15	15	見派位圖	T7 FLAT B 7~23/F
		220		

美特鋁質 有限公司
MIDI Aluminium Fabricator Ltd.

工程號	J853
地盤	錦上路


制圖	LHR	2022,08,17	修改	A	
復核	–	–	日期	2023.2.12	
批准			圖號	J853-GB-FAB2-32	

名稱	底橫加工圖
材料	X86216
顏色	JMQ213457(3coats)

美特鋁質 有限公司
MIDI Aluminium Fabricator Ltd.

工程號	J853	地點	錦上路 Twp

送工地

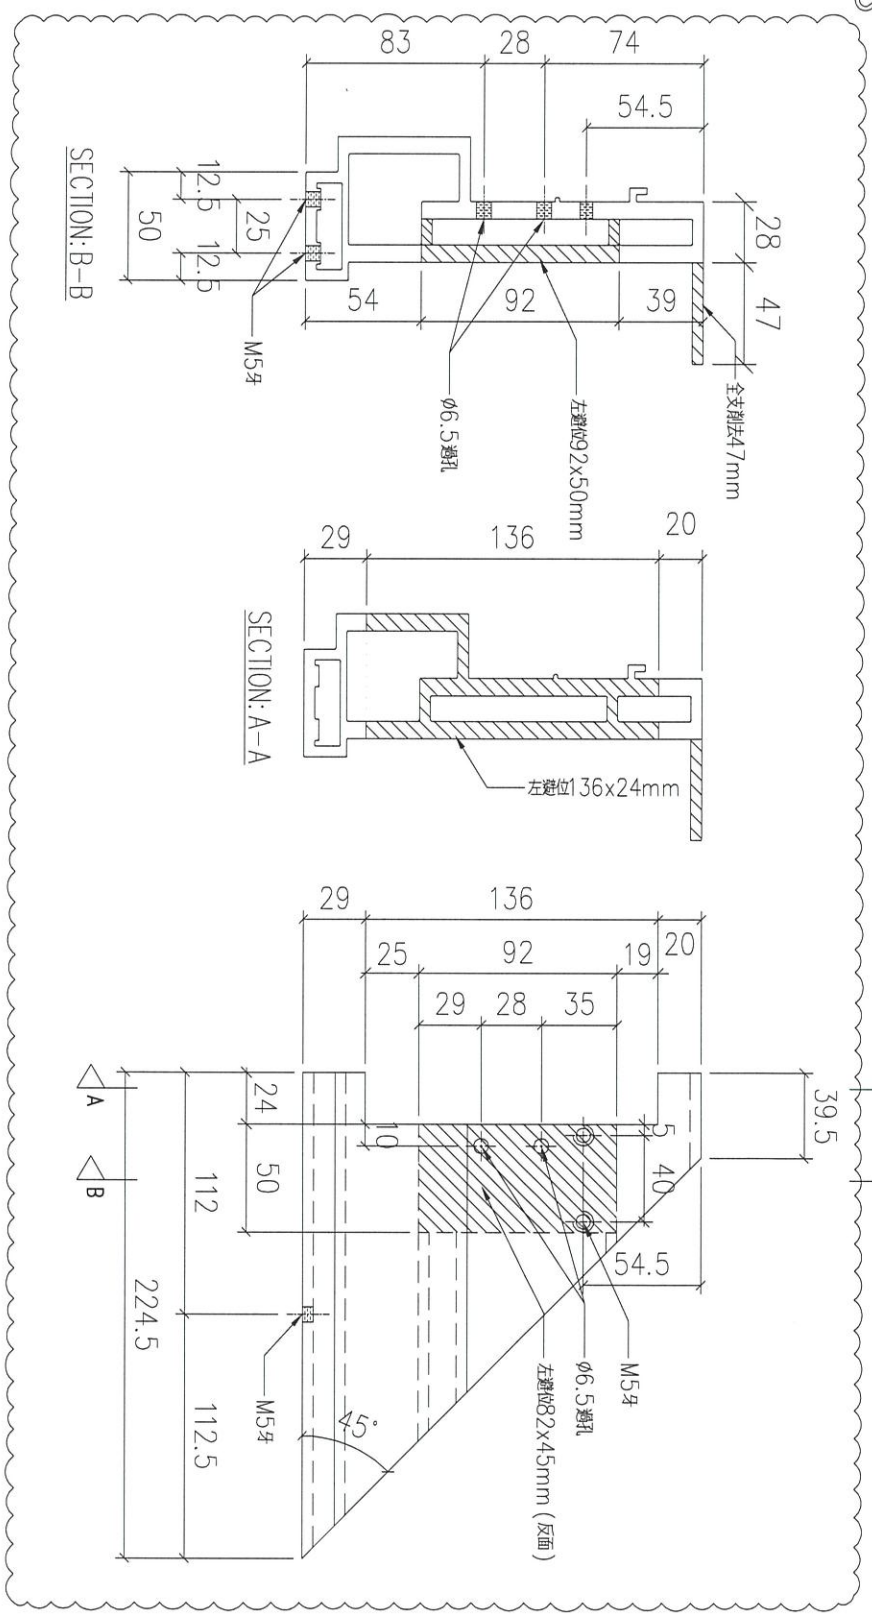

序號	物料編號	數量	使用位置	樓層
01	T5-X86216-16	34	見派位圖	T5 FLAT A 6~25/F
02	T5-X86216-16	18	見派位圖	T5 FLAT B 6~16/F
03	T5-X86216-16	16	見派位圖	T5 FLAT B 17~25/F
04	T5-X86216-16	4	見派位圖	T5 FLAT C 11~16/F
05	T5-X86216-16	4	見派位圖	T5 FLAT D 11~16/F
06	T5-X86216-16	13	見派位圖	T5 FLAT E/F 11~26/F


序號	物料編號	數量	使用位置	樓層
07	T6-X86216-16	36	見派位圖	T6 FLAT A 5,6,8~26/F
08	T6-X86216-16	36	見派位圖	T6 FLAT B 5,6,8~26/F
09	T6-X86216-16	14	見派位圖	T6 FLAT C/D 10~26/F
10	T7-X86216-16	34	見派位圖	T7 FLAT A 7~26/F
11	T7-X86216-16	15	見派位圖	T7 FLAT B 7~23/F
		224		

名稱	底橫加工圖	制圖	LHR	2022,08,17	修改	A		
材料	X86216	復核	–	–	日期	2023.2.12		
顏色	JMQ213457(3coats)	批準			圖號	J853-GB-FAB2-33		

美特鋁質 有限公司
MIDI Aluminium Fabricator Ltd.

工程號	J853	地盤	錦上路 Tup

送工地

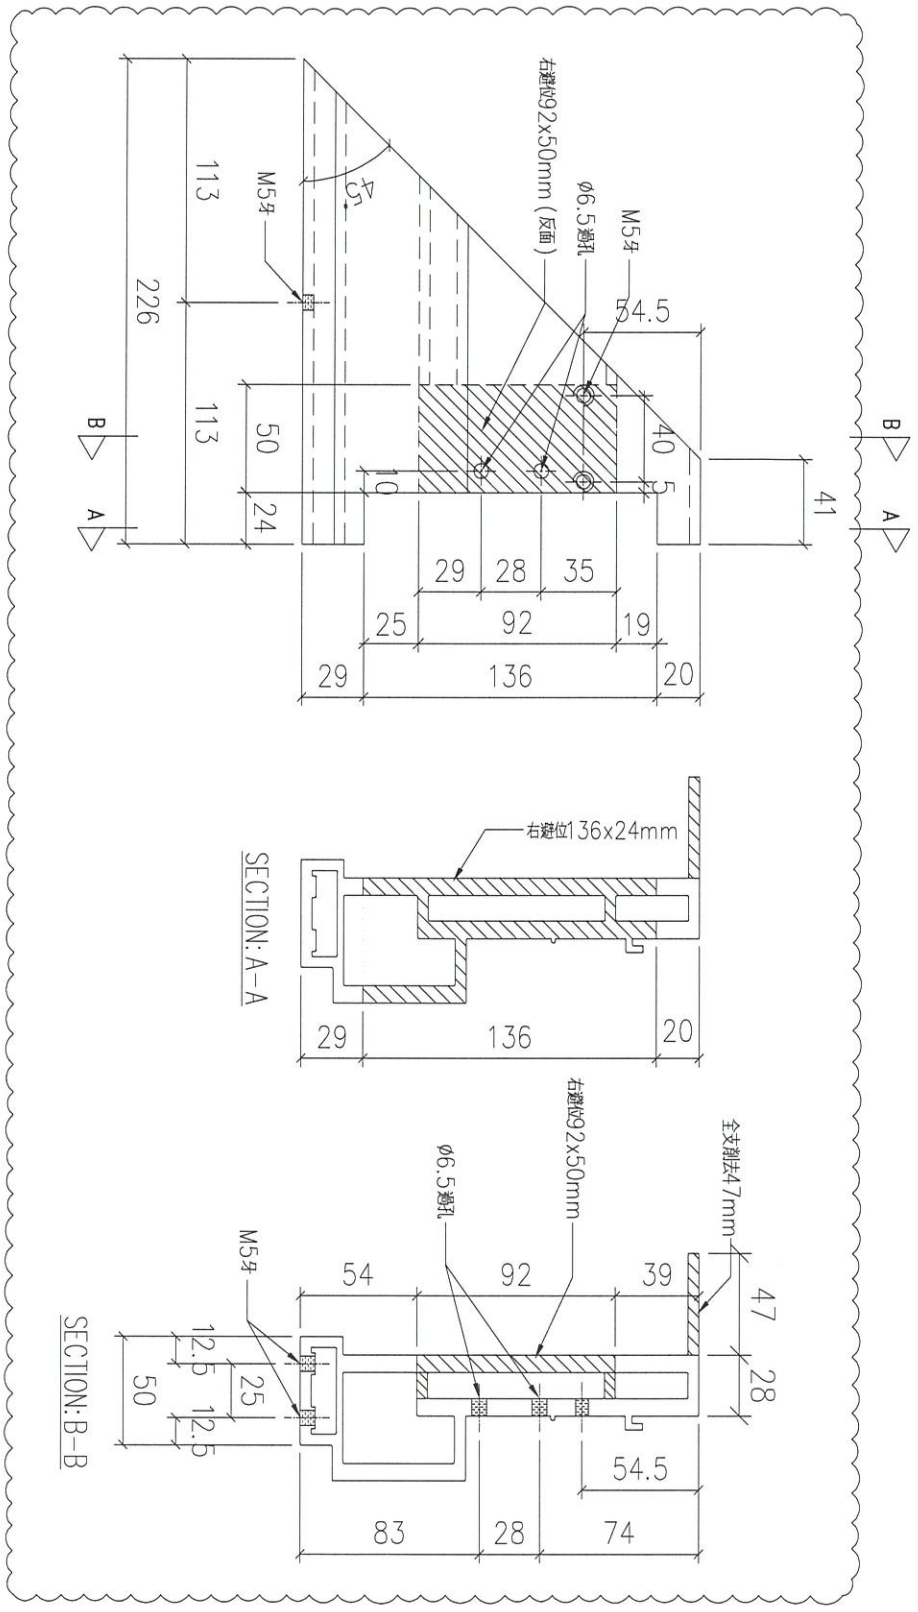


序號	物料編號	數量	使用位置	樓層
01	T5-X86216-17	13	見派位圖	T5 FLAT E/F 11~26/F

名稱	底橫加工圖	制圖	LHR	2022,08,17	修改	A		
材料	X86216	復核	–	–	日期	2023.2.12		
顏色	JMQ213457(3coats)	批準			圖號	J853-GB-FAB2-34		

美特鋁質 有限公司
MIDI Aluminium Fabricator Ltd.

工程號	J853	地盤	錦上路 TWP

送工地

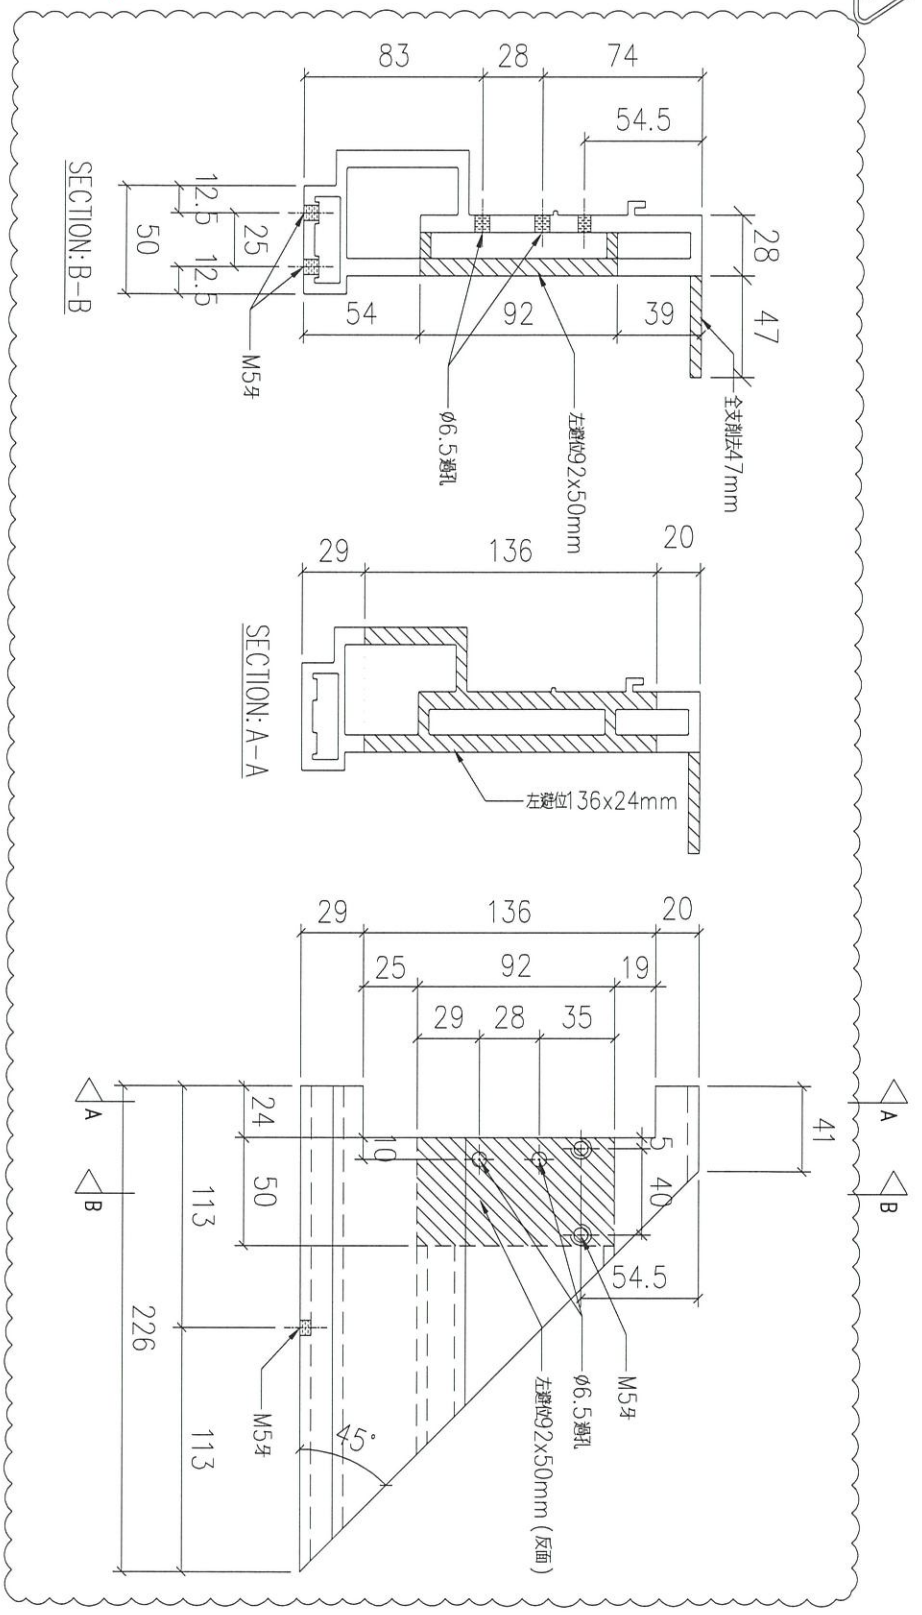


序號	物料編號	數量	使用位置	樓層
01	T5-X86216-18	13	見派位圖	T5 FLAT E/F 11~26/F

名稱	底橫加工圖	制圖	LHR	2022,08,17	修改	A		
材料	X86216	復核	–	–	日期	2023.2.12		
顏色	JMQ213457(3coats)	批準			圖號	J853-GB-FAB2-35		

美特鋁質 有限公司
MIDI Aluminium Fabricator Ltd.

工程號	J853	地盤	~~錦上路~~ TWP

送工地

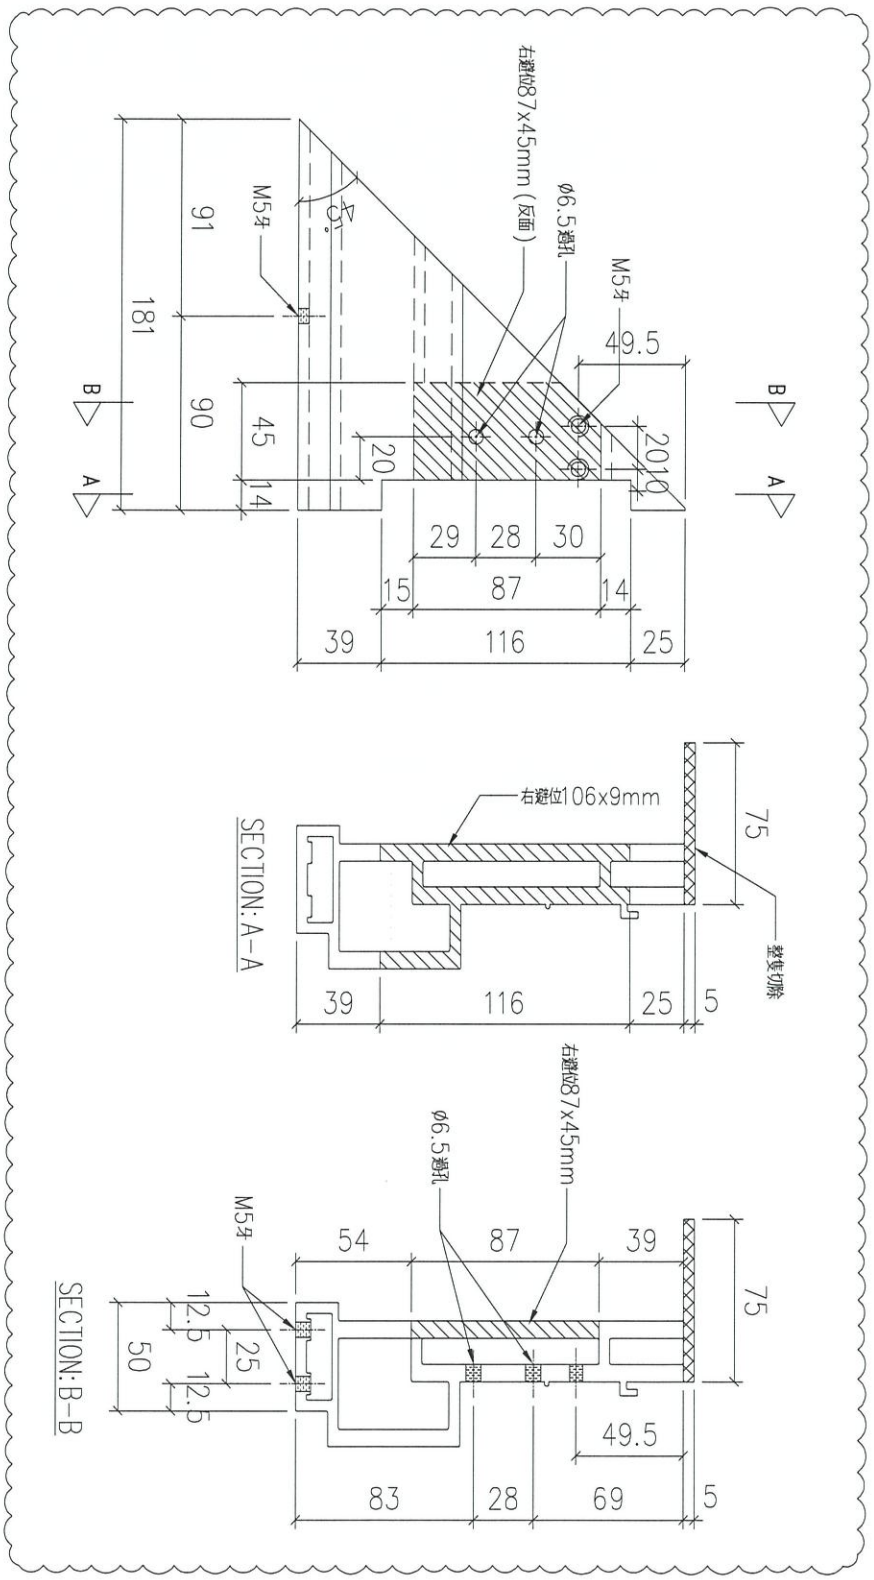


序號	物料編號	數量	使用位置	樓層
01	T5-X86216-19	8	見派位圖	T5 FLAT B 17~25/F

名稱	底橫加工圖	制圖	LHR	2022,08,17	修改	A		
材料	X86216	復核	–	–	日期	2023.2.12		
顏色	JMQ213457(3coats)	批準			圖號	J853-GB-FAB2-36		

美特鋁質 有限公司
MIDI Aluminium Fabricator Ltd.

工程號	J853	地盤	錦上路 TWP

送工地

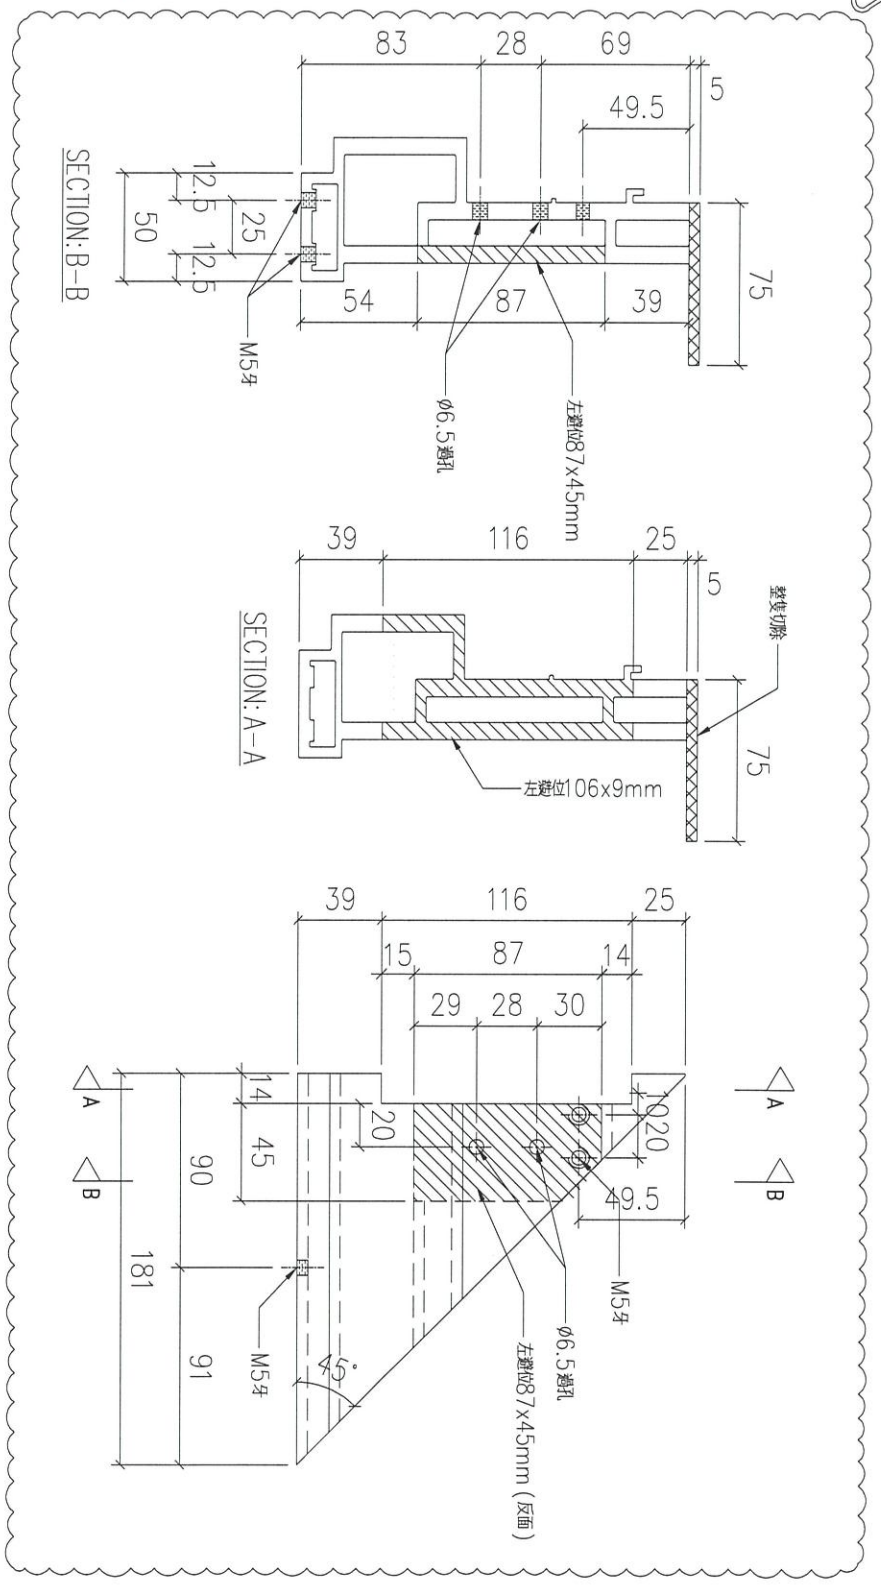


序號	物料編號	數量	使用位置	樓層
01	T5-X86216-20	4	見派位圖	T5 FLAT C 11~16/F

名稱	底橫加工圖	制圖	LHR	2022,08,17	修改	A		
材料	X86216	復核	–	–	日期	2023.2.12		
顏色	JMQ213457(3coats)	批準			圖號	J853-GB-FAB2-37		

美特鋁質 有限公司
MIDI Aluminium Fabricator Ltd.

工程號	J853	地盤	錦上路 Twp

送工地

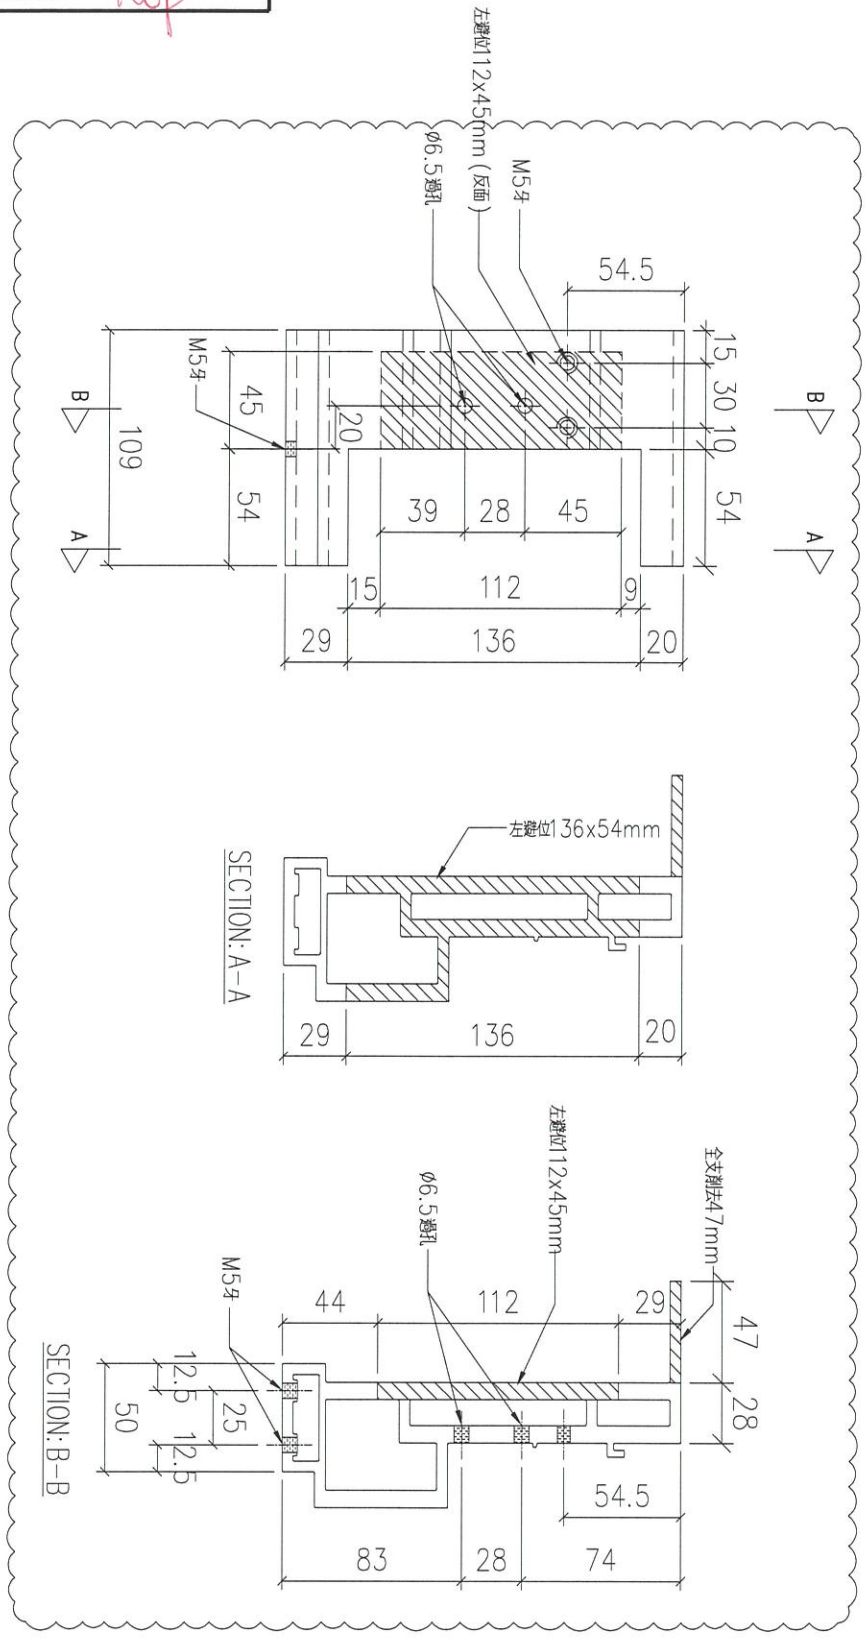


序號	物料編號	數量	使用位置	樓層
01	T5-X86216-26	13	見派位圖	T5 FLAT E/F 11~26/F

名稱	底橫加工圖	制圖	LHR	2022,08,17	修改	A		
材料	X86216	復核	–	–	日期	2023.2.12		
顏色	JMQ213457(3coats)	批準			圖號	J853-GB-FAB2-38		

美特鋁質 有限公司
MIDI Aluminium Fabricator Ltd.

工程號	J838	地盤	~~錦上路~~ TWP

送工地

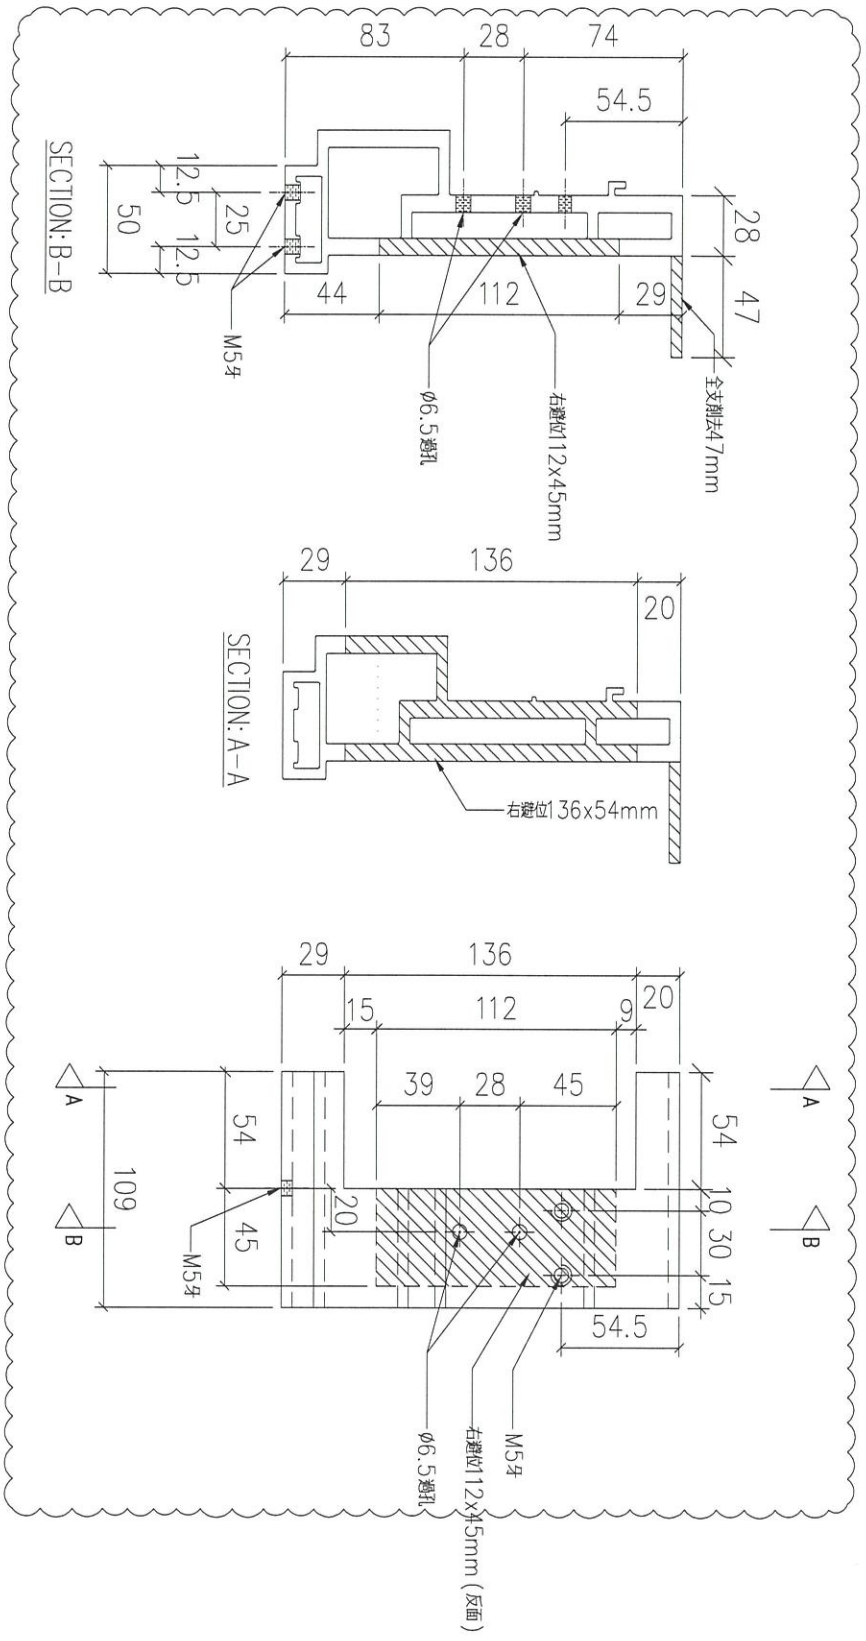


序號	物料編號	數量	使用位置	樓層
01	T5-X86216-27	13	見派位圖	T5 FLAT E/F 11~26/F

名稱	底橫加工圖	制圖	LHR	2022,08,17	修改	A		
材料	X86216	復核	–	–	日期	2023.2.12		
顏色	JMQ213457(3coats)	批準			圖號	J853-GB-FAB2-39		

美特鋁質 有限公司
MIDI Aluminium Fabricator Ltd.

工程號	J853	地盤	錦上路 Twp

送工地

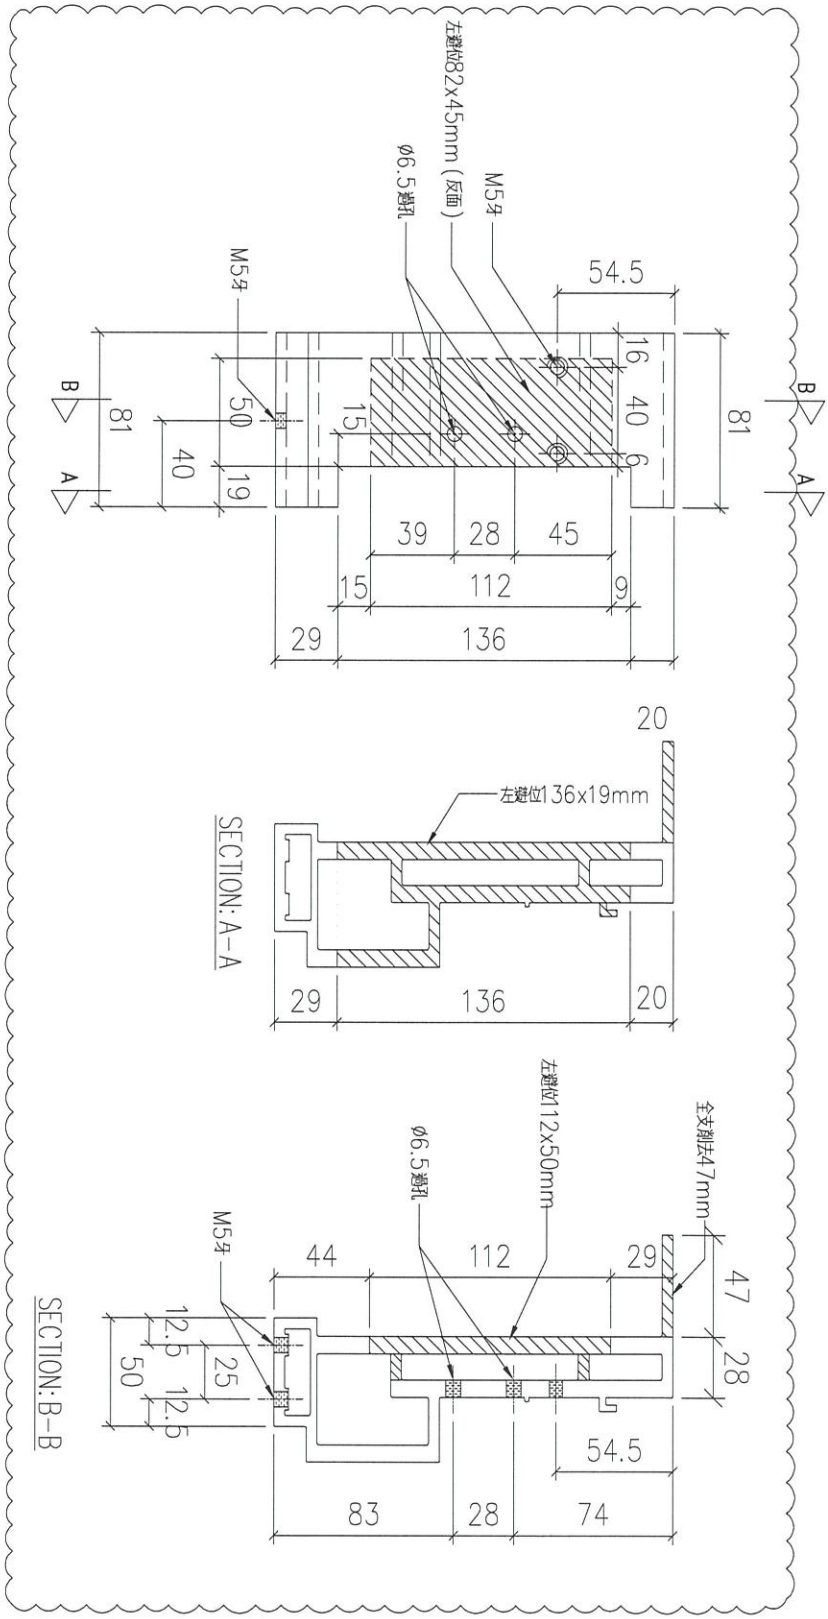


序號	物料編號	數量	使用位置	樓層
01	T5-X86216-21	17	見派位圖	T5 FLAT A 6~25/F
02	T5-X86216-21	9	見派位圖	T5 FLAT B 6~16/F
03	T5-X86216-21	8	見派位圖	T5 FLAT B 17~25/F
04	T5-X86216-21	4	見派位圖	T5 FLAT D 11~16/F
05	T5-X86216-21	13	見派位圖	T5 FLAT E/F 11~26/F
06	T6-X86216-21	18	見派位圖	T6 FLAT A 5,6,8~26/F
07	T6-X86216-21	18	見派位圖	T6 FLAT B 5,6,8~26/F
08	T6-X86216-21	14	見派位圖	T6 FLAT C/D 10~26/F
09	T7-X86216-21	17	見派位圖	T7 FLAT A 7~26/F
10	T7-X86216-21	15	見派位圖	T7 FLAT B 7~23/F
		133		

名稱	底橫加工圖	制圖	LHR	2022,08,17	修改	A		
材料	X86216	復核	–	–	日期	2023.2.12		
顏色	JMQ213457(3coats)	批準			圖號	J853-GB-FAB2-40		

美特鋁質 有限公司
MIDI Aluminium Fabricator Ltd.

工程號	J838	地盤	~~錦上路~~ TWP

送工地

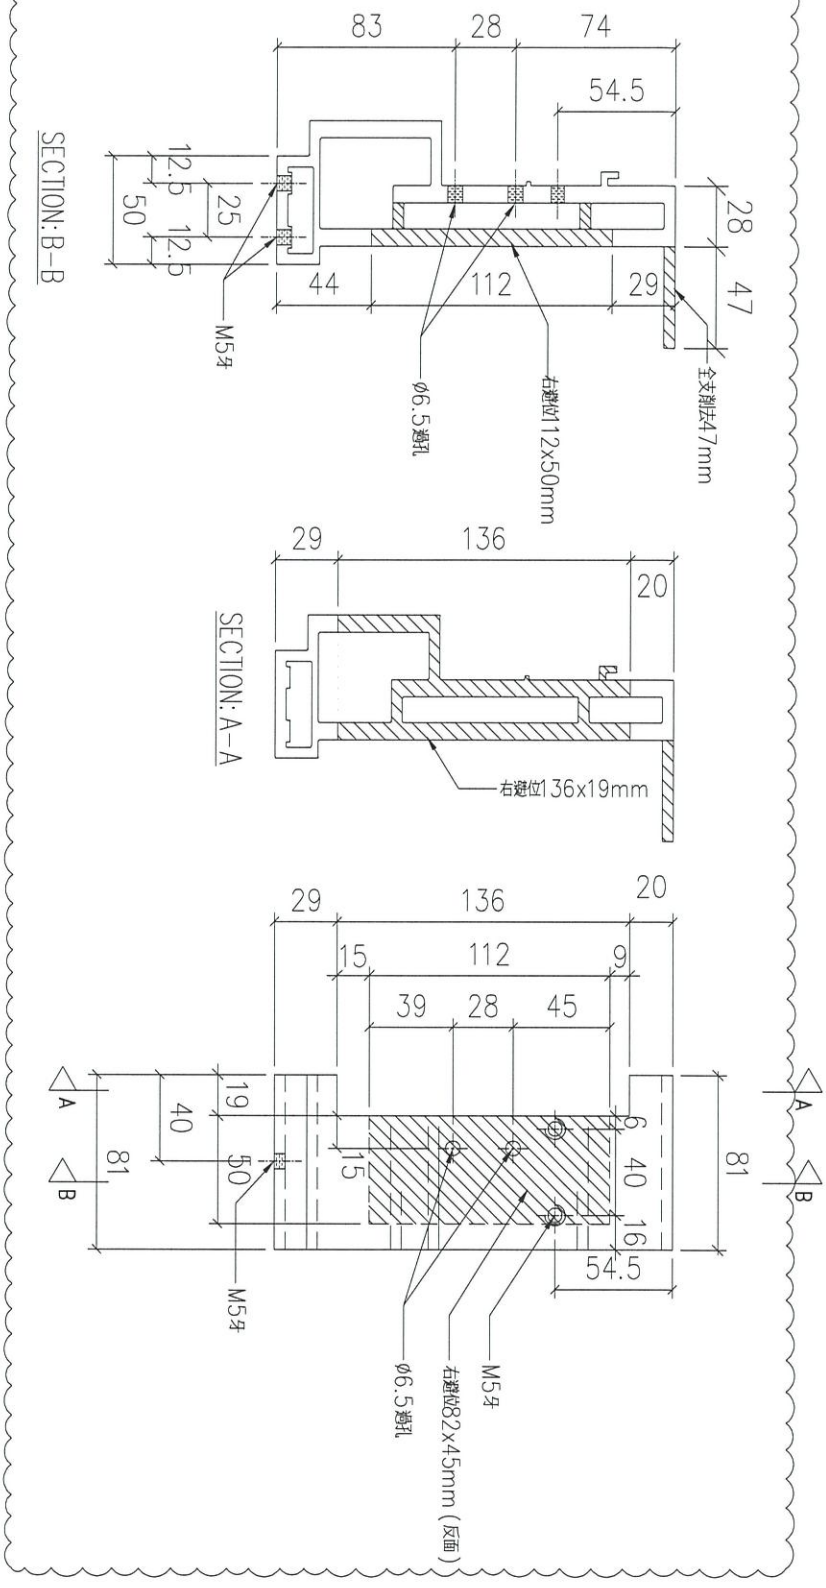


序號	物料編號	數量	使用位置	樓層
01	T5-X86216-22	17	見派位圖	T5 FLAT A 6~25/F
02	T5-X86216-22	9	見派位圖	T5 FLAT B 6~16/F
03	T5-X86216-22	4	見派位圖	T5 FLAT C 11~16/F
04	T5-X86216-22	4	見派位圖	T5 FLAT D 11~16/F
05	T5-X86216-22	13	見派位圖	T5 FLAT E/F 11~26/F
06	T6-X86216-22	18	見派位圖	T6 FLAT A 5,6,8~26/F
07	T6-X86216-22	18	見派位圖	T6 FLAT B 5,6,8~26/F
08	T6-X86216-22	14	見派位圖	T6 FLAT C/D 10~26/F
09	T7-X86216-22	17	見派位圖	T7 FLAT A 7~26/F
10	T7-X86216-22	15	見派位圖	T7 FLAT B 7~23/F
		129		

名稱	底橫加工圖	制圖	LHR	2022,08,17	修改	A		
材料	X86216	復核	–	–	日期	2023.2.12		
顏色	JMQ213457(3coats)	批準			圖號	J853-GB-FAB2-41		

美特鋁質 有限公司
MIDI Aluminium Fabricator Ltd.

工程號	J853	地盤	錦上路 TWP

送工地

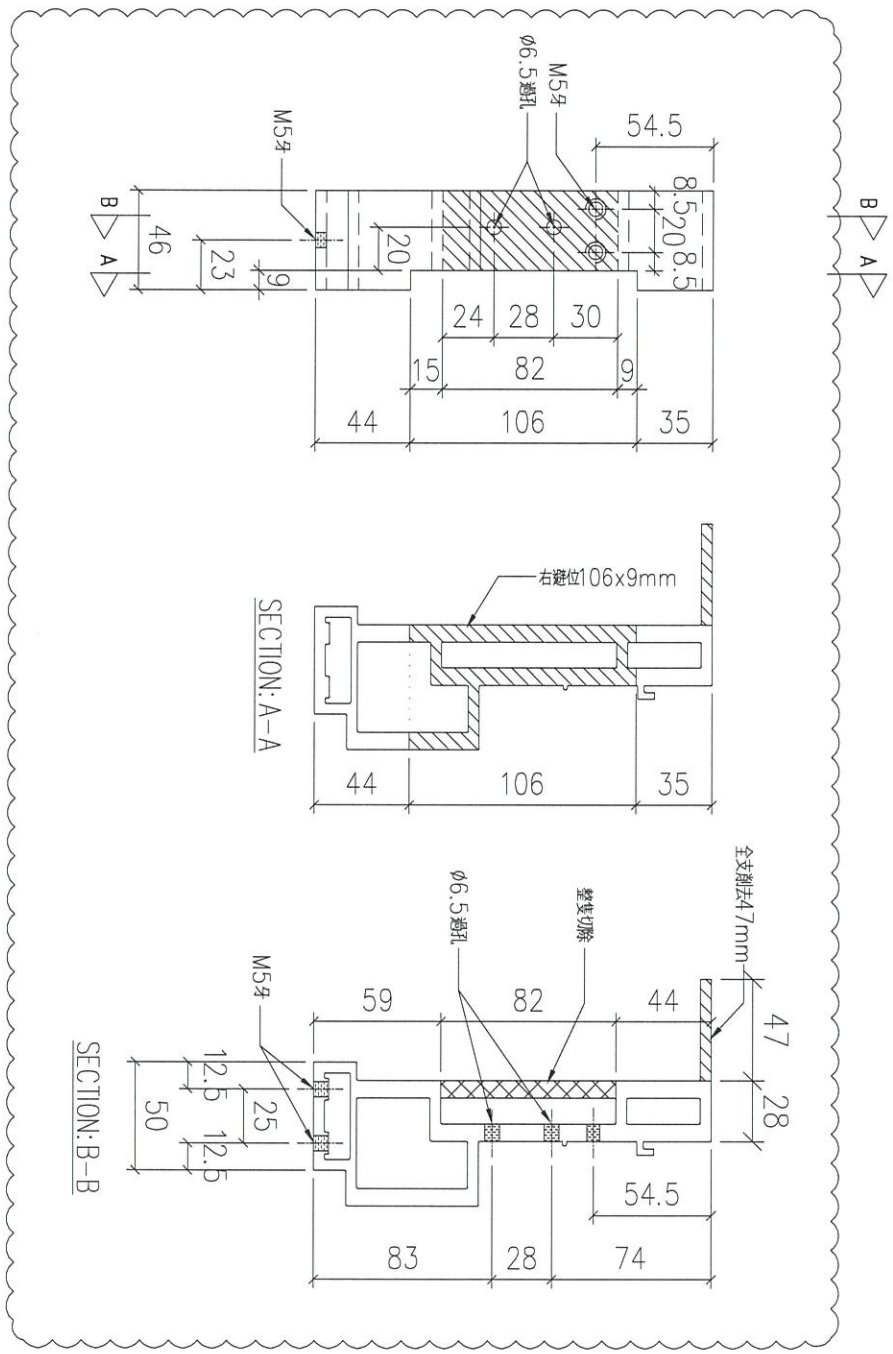


序號	物料編號	數量	使用位置	樓層
01	T5-X86216-23	4	見派位圖	T5 FLAT C 11~16/F

名稱	底橫加工圖	制圖	LHR	2022,08,17	修改	A		
材料	X86216	復核	–	–	日期	2023.2.12		
顏色	JMQ213457(3coats)	批準			圖號	J853-GB-FAB2-42		

美特鋁質 有限公司
MIDI Aluminium Fabricator Ltd.

工程號	J838	地盤	錦上路 ~~TWP~~

送工地

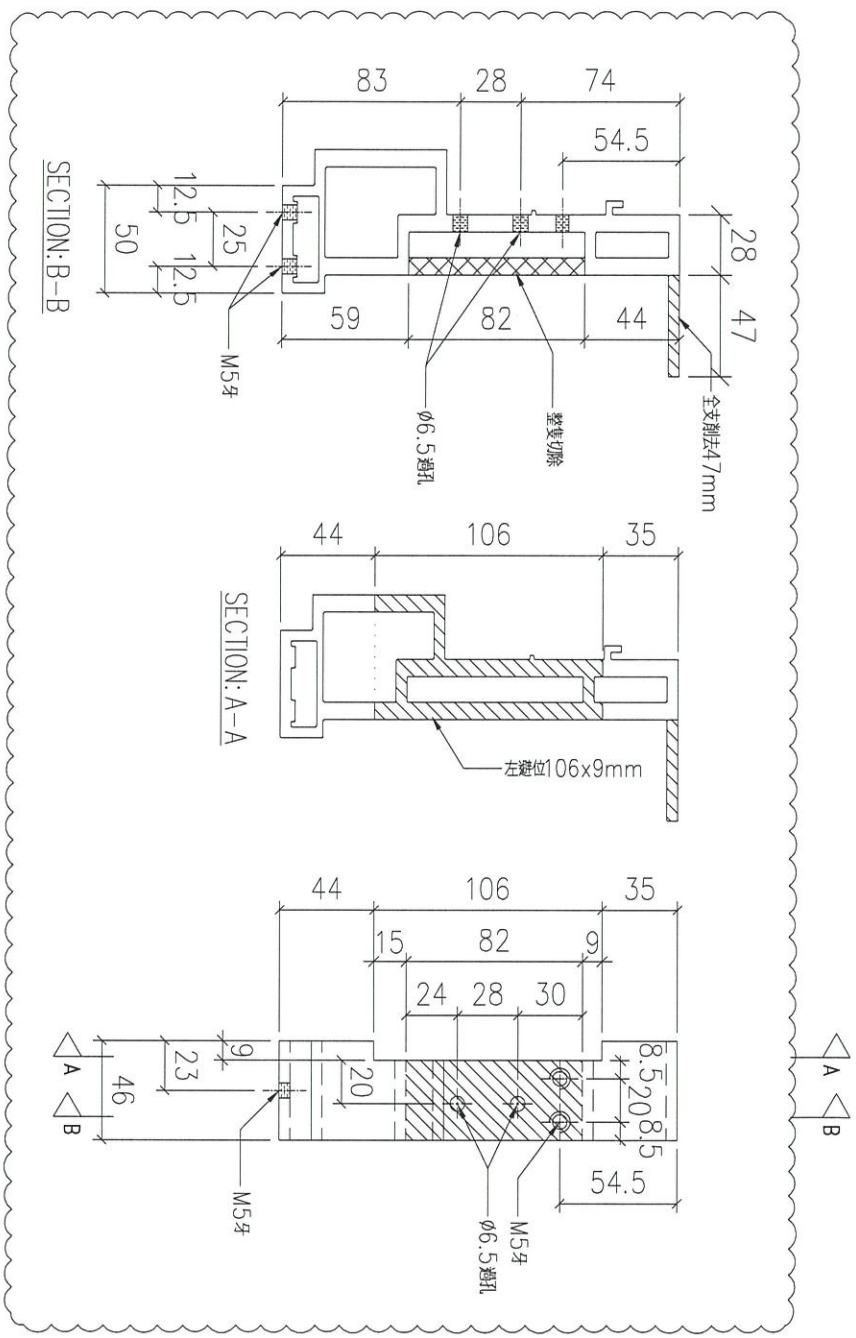


序號	物料編號	數量	使用位置	樓層
01	T5-X86216-24	8	見派位圖	T5 FLAT B 17~25/F

名稱	底橫加工圖	制圖	LHR	2022,08,17	修改	A		
材料	X86216	復核	–	–	日期	2023.2.12		
顏色	JMQ213457(3coats)	批準			圖號	J853-GB-FAB2-43		

送工地

美特鋁質 有限公司
MIDI Aluminium Fabricator Ltd.

工程號	J853	地盤	錦上路 TWP

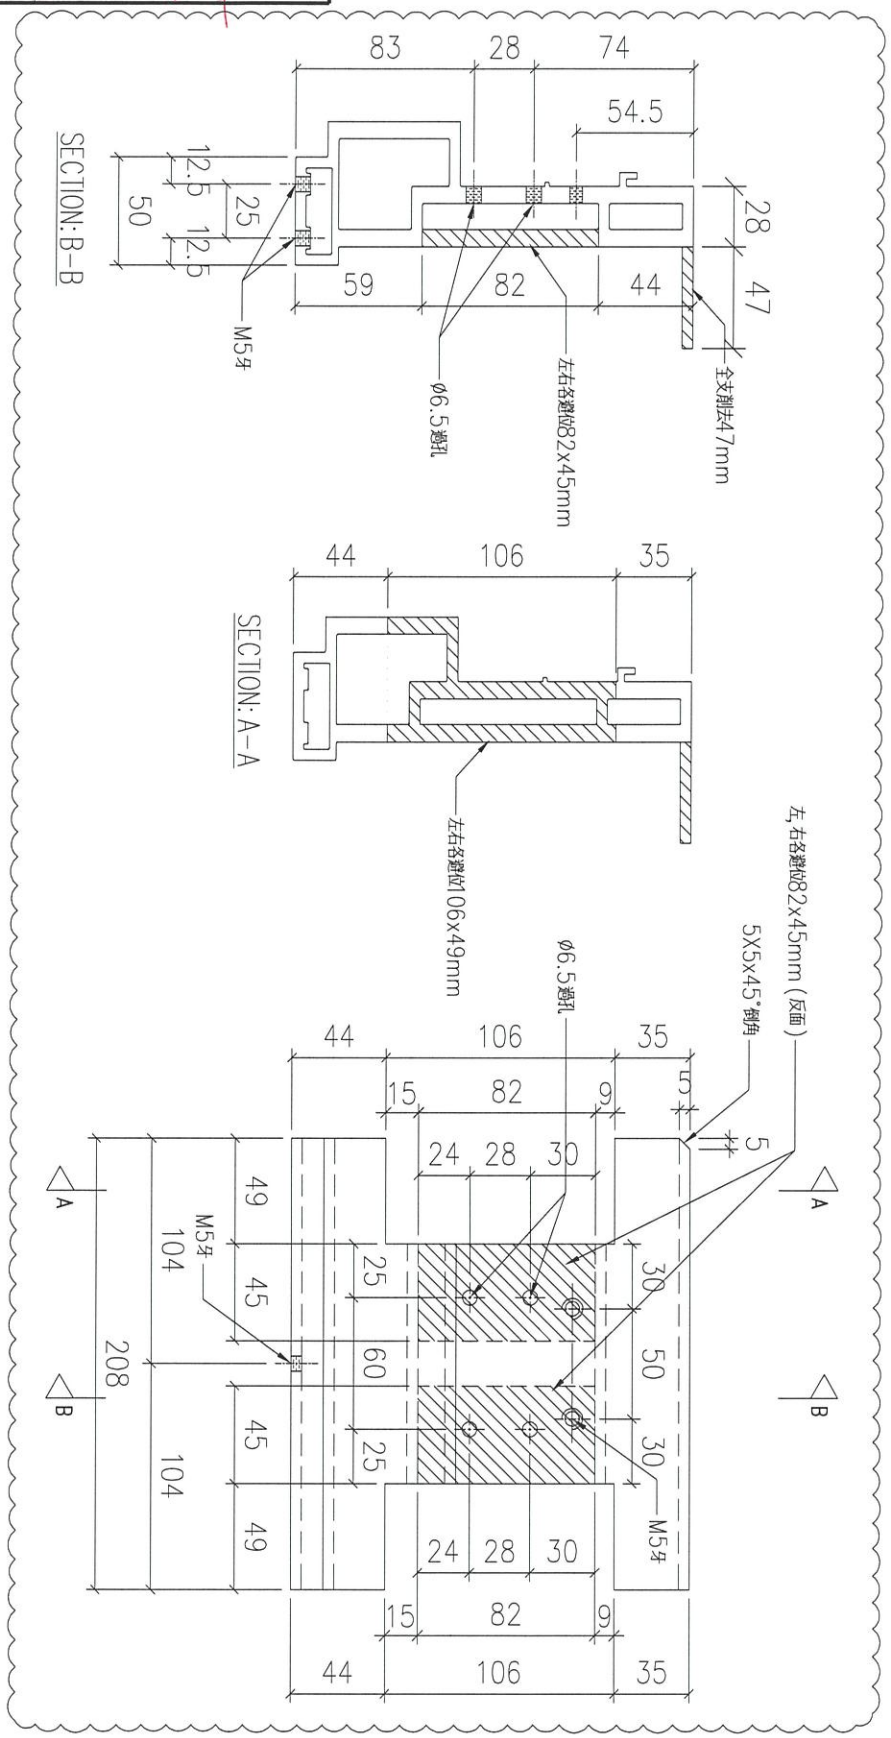


序號	物料編號	數量	使用位置	樓層
01	T5-X86216-25	8	見派位圖	T5 FLAT B 17~25/F

名稱	底橫加工圖	制圖	LHR	2022,08,17	修改	A		
材料	X86216	復核	–	–	日期	2023.2.12		
顏色	JMQ213457(3coats)	批準			圖號	J853-GB-FAB2-44		

美特鋁質 有限公司
MIDI Aluminium Fabricator Ltd.

工程號	J853	地盤	錦上路

送工地

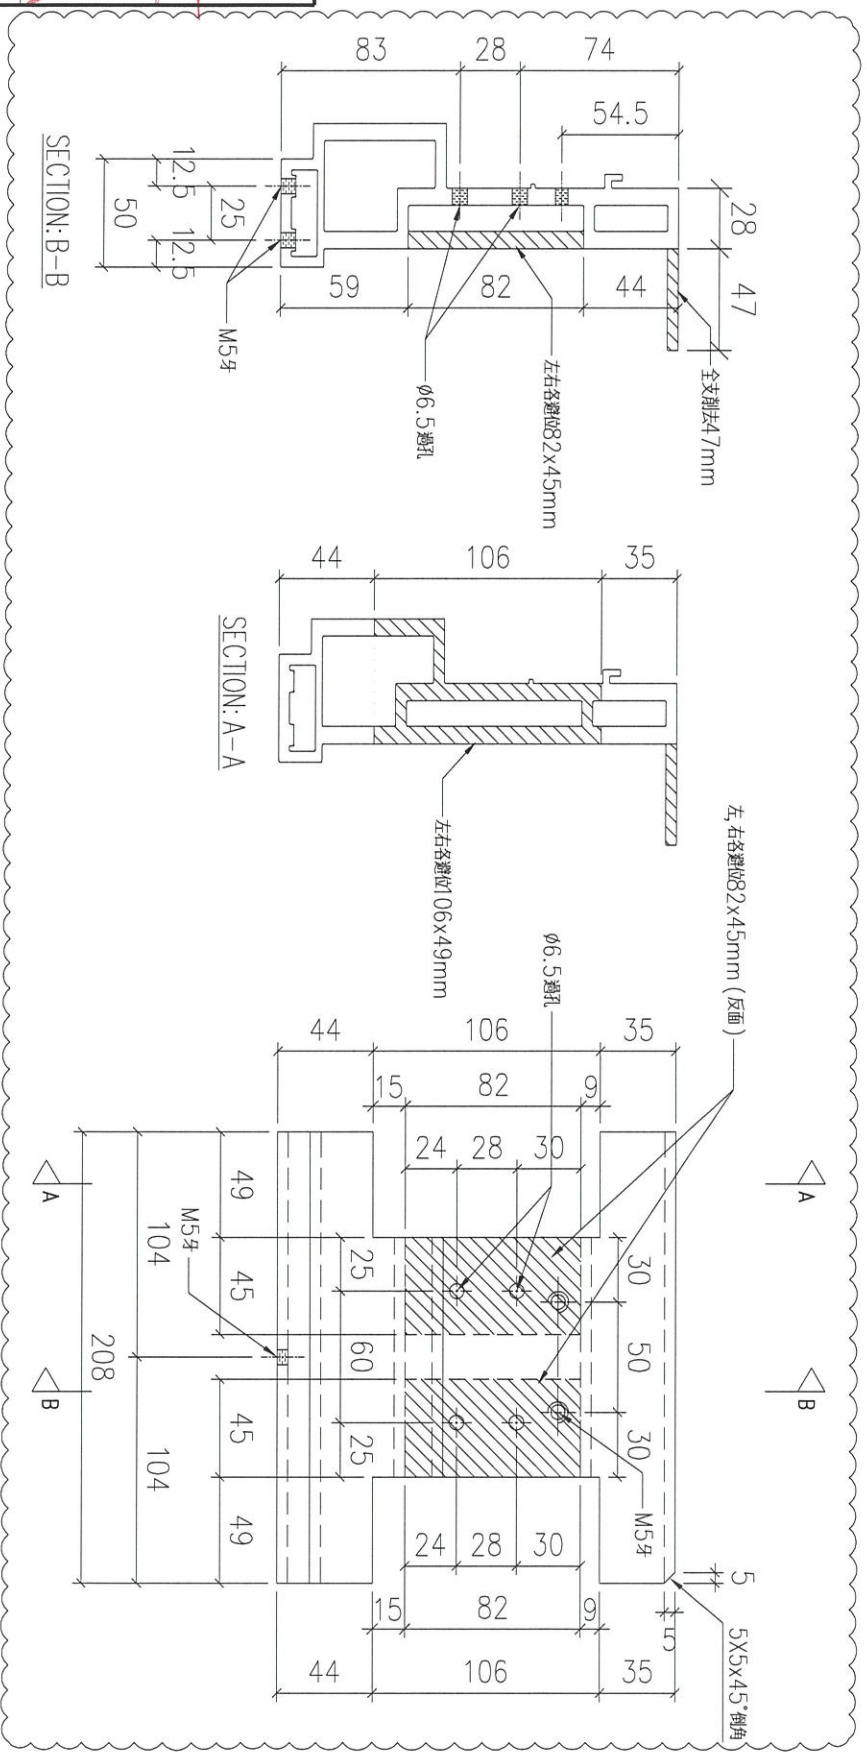


序號	物料編號	數量	使用位置	樓層
01	T5-X86216-26	4	見派位圖	T5 FLAT C 11~16/F

名稱	底橫加工圖	制圖	LHR	2022,08,17	修改	A		
材料	X86216	復核	–	–	日期	2023.2.12		
顏色	JMQ213457(3coats)	批準			圖號	J853-GB-FAB2-45		

美特鋁質 有限公司
MIDI Aluminium Fabricator Ltd.

工程號	J853	地盤	錦上路 Twp

送工地

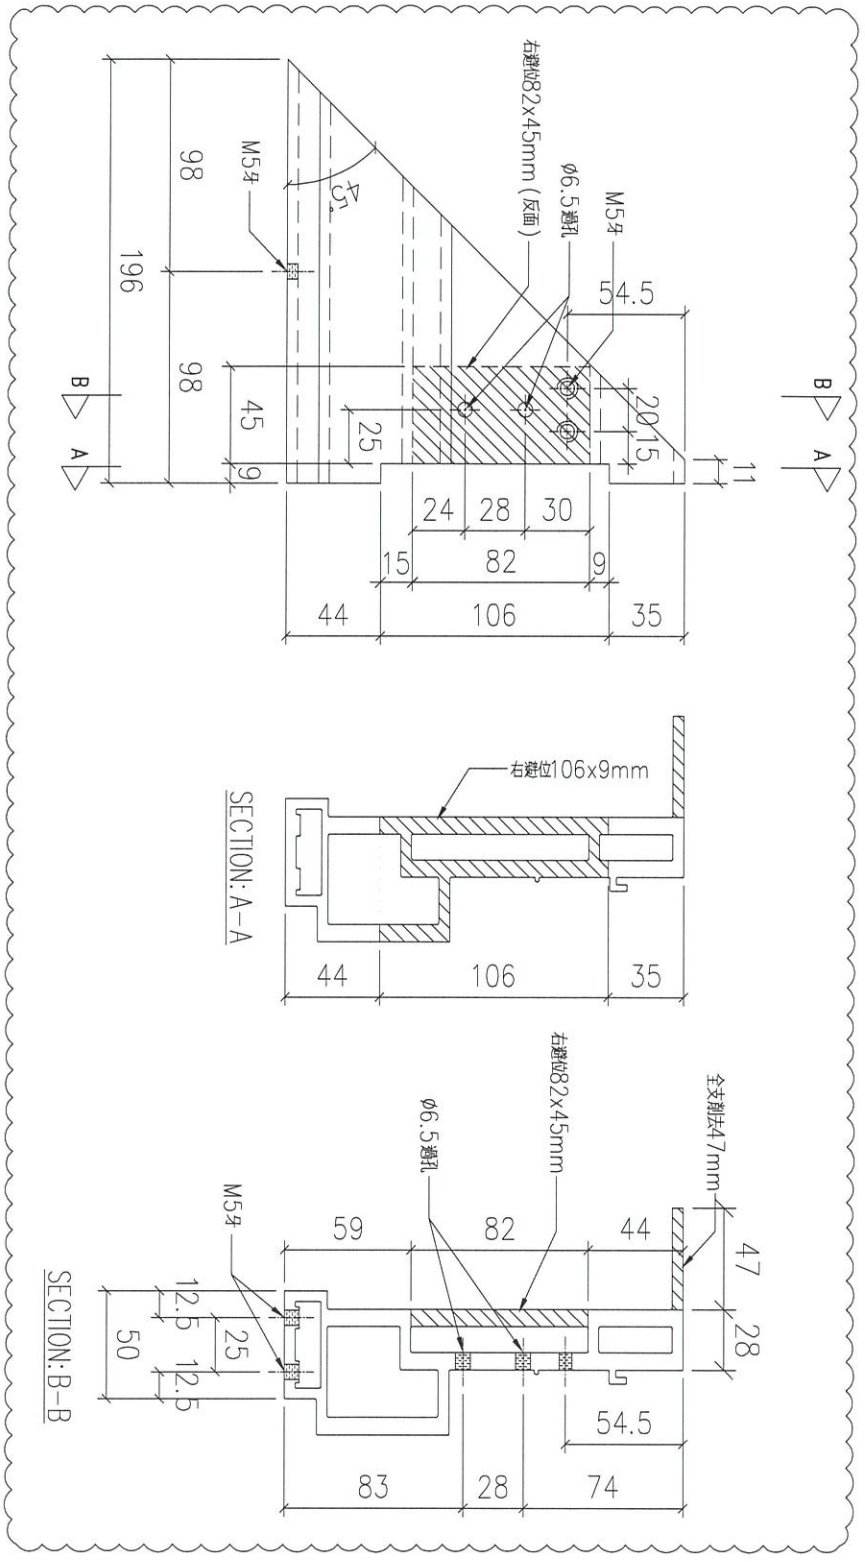


序號	物料編號	數量	使用位置	樓層
01	T6-X86216-06	14	見派位圖	T6 FLAT C/D 10~26/F

名稱	底橫加工圖	制圖	LHR	2022,08,17	修改	A		
材料	X86216	復核	–	–	日期	2023.2.12		
顏色	JMQ213457(3coats)	批準			圖號	J853-GB-FAB2-46		

美特鋁質 有限公司
MIDI Aluminium Fabricator Ltd.

工程號	J853	地盤	~~錦上路~~ Twp

送工地

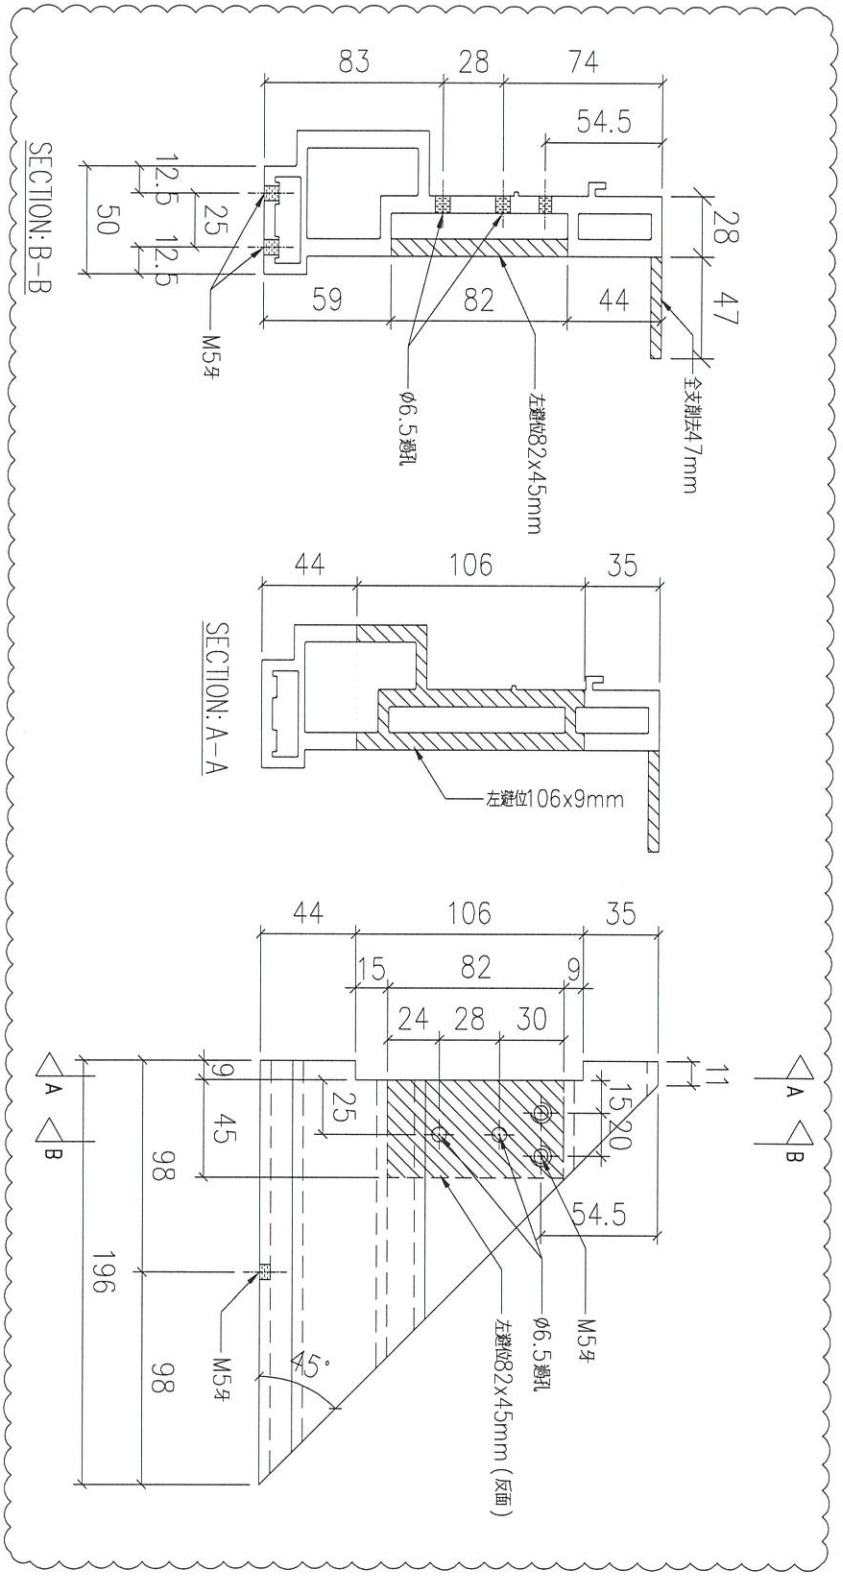


序號	物料編號	數量	使用位置	樓層
01	T6-X86216-07	14	見派位圖	T6 FLAT C/D 10~26/F

名稱	底橫加工圖	制圖	LHR	2022,08,17	修改	A		
材料	X86216	復核	–	–	日期	2023.2.12		
顏色	JMQ213457(3coats)	批準			圖號	J853-GB-FAB2-47		

美特鋁質 有限公司
MIDI Aluminium Fabricator Ltd.

工程號	J853	地盤	錦上路 TWP

送工地

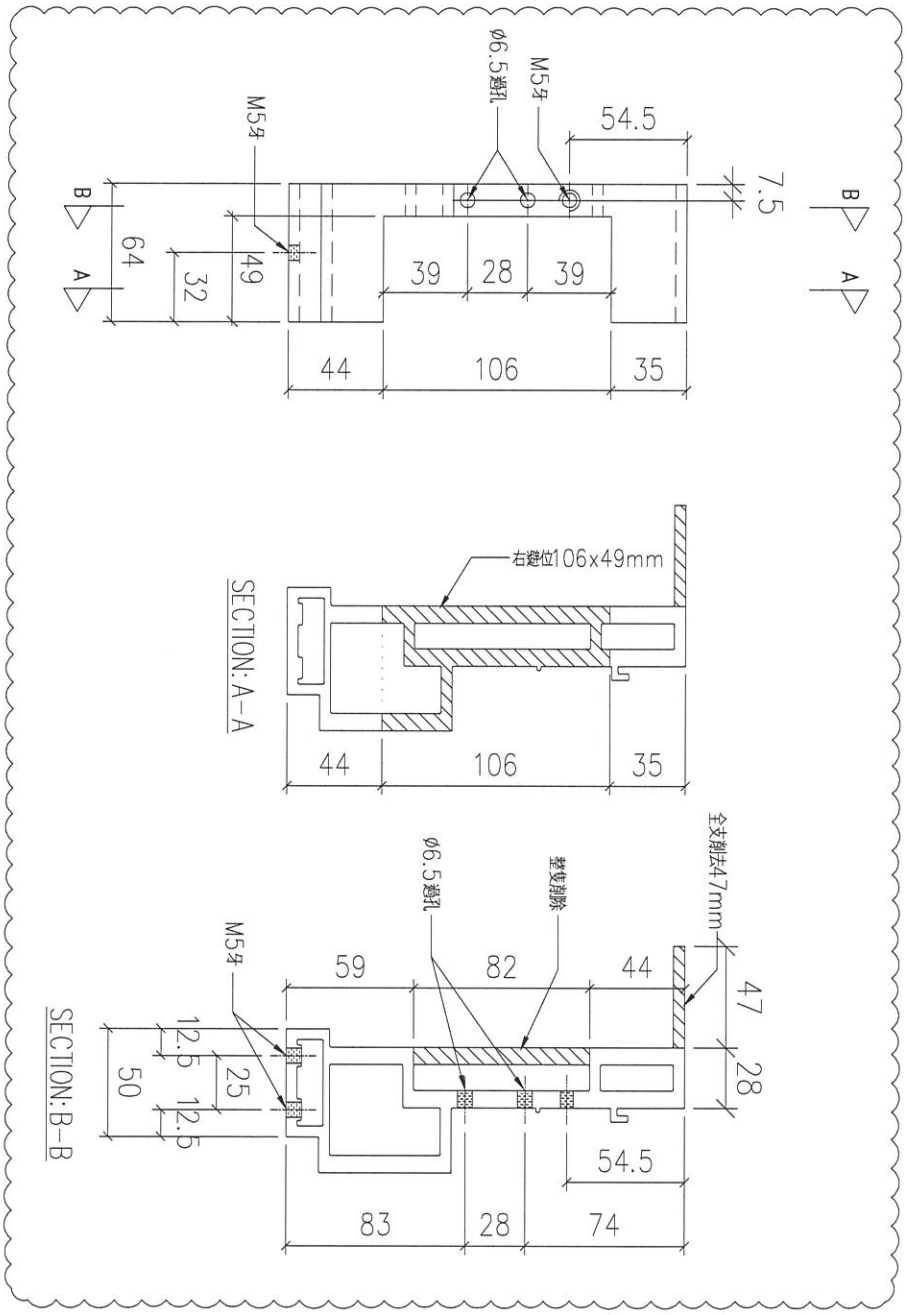


序號	物料編號	數量	使用位置	樓層
01	T6-X86216-08	14	見派位圖	T6 FLAT C/D 10~26/F

名稱	底橫加工圖	制圖	LHR	2022,08,17	修改	A		
材料	X86216	復核	–	–	日期	2023.2.12		
顏色	JMQ213457(3coats)	批準			圖號	J853-GB-FAB2-48		

美特鋁質 有限公司
MIDI Aluminium Fabricator Ltd.

工程號	J838	地盤	錦上路 TWT


送工地

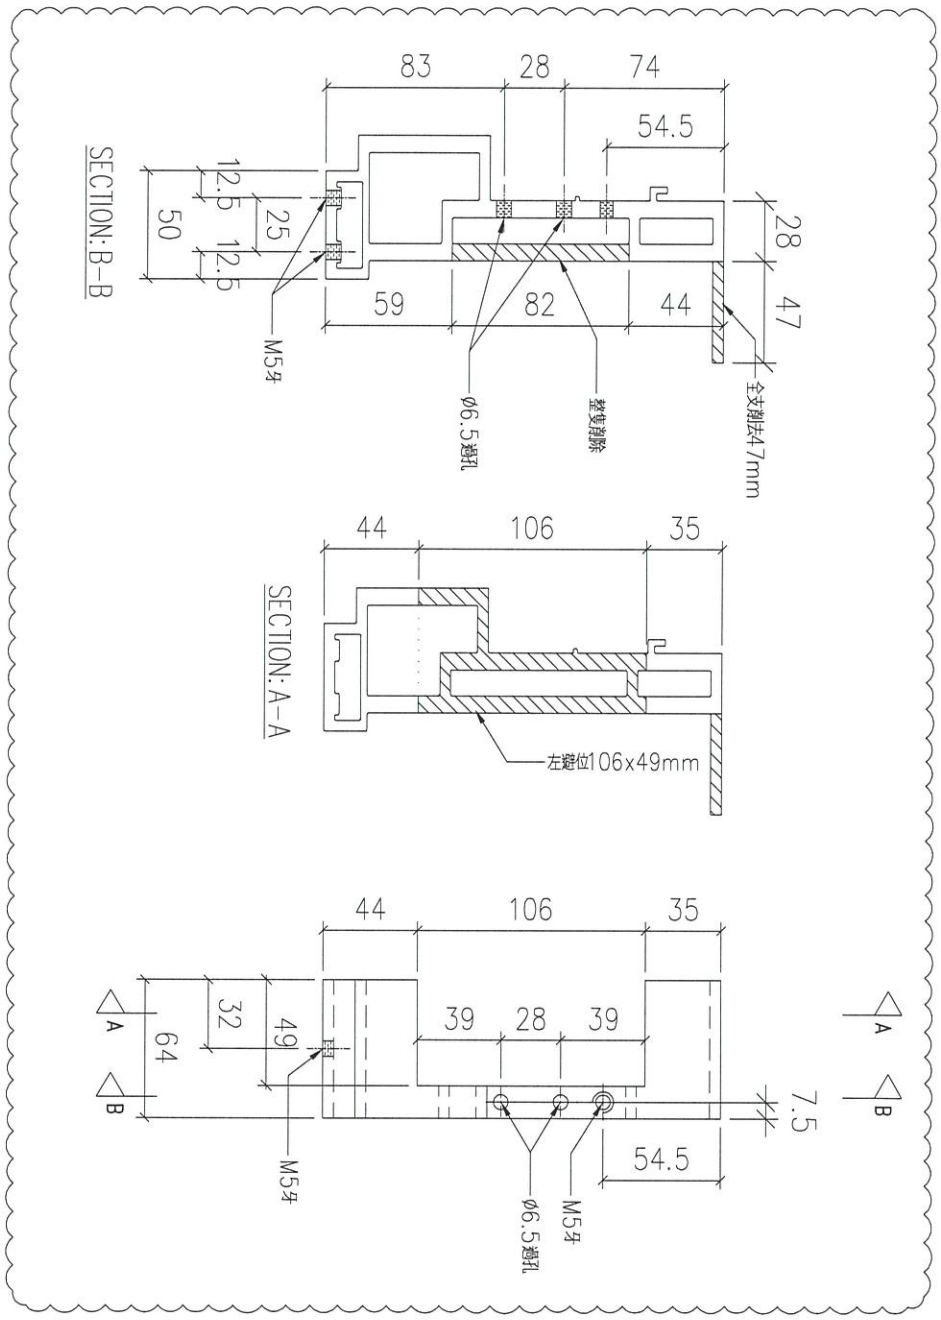


序號	物料編號	數量	使用位置	樓層
01	T6-X86216-09	14	見派位圖	T6 FLAT C/D 10~26/F

名稱	底橫加工圖	制圖	LHR	2022,08,17	修改	A		
材料	X86216	復核	–	–	日期	2023.2.12		
顏色	JMQ213457(3coats)	批準			圖號	J853-GB-FAB2-49		

工廠用

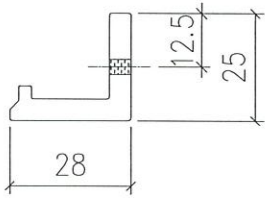

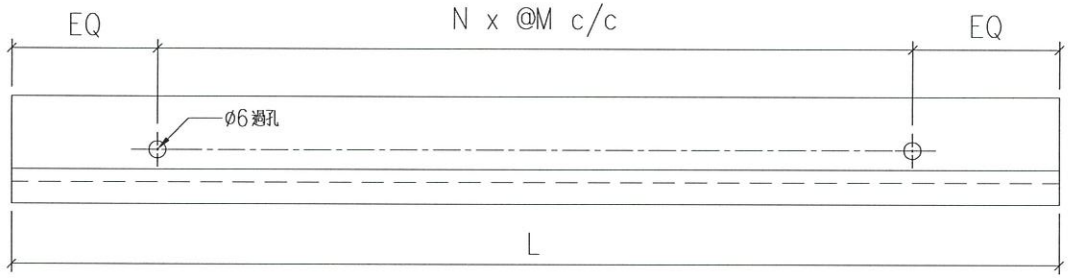

序號	物料編號	數量	L:	EQ:	M:	N:	安裝位置
01	T5-X86217-01	16	2292	66	270	8	見組裝圖
02	T5-X86217-02	8	2283	61.5	270	8	見組裝圖
03	T5-X86217-03	26	2196	48	300	7	見組裝圖
04	T5-X86217-04	13	1982	46	270	7	見組裝圖
05	T5-X86217-05	16	1762	71	270	6	見組裝圖
06	T5-X86217-06	9	1407	53.5	260	5	見組裝圖
07	T5-X86217-07	8	1144	72	250	4	見組裝圖
08	T5-X86217-08	22	1096	48	250	4	見組裝圖
09	T5-X86217-09	8	1006	53	300	3	見組裝圖
10	T5-X86217-10	4	406	53	300	1	見組裝圖
11	T5-X86217-11	34	331	65.5	200	1	見組裝圖
12	T6-X86217-01	72	1460	55	270	5	見組裝圖
13	T6-X86217-02	28	2196	48	300	7	見組裝圖
14	T6-X86217-03	36	1296	48	300	4	見組裝圖
15	T6-X86217-04	36	231	48	135	1	見組裝圖
16	T7-X86217-01	34	1460	55	270	5	見組裝圖
17	T7-X86217-02	15	2196	48	300	7	見組裝圖
18	T7-X86217-03	32	1296	48	300	4	見組裝圖
19	T7-X86217-04	17	831	40.5	250	3	見組裝圖
		442					

美特鋁質 有限公司
MIDI Aluminium Fabricator Ltd.

工程號	J853	地盤	錦上路

修改	–		
日期	–		
圖號	J853-GB-FAB2-50		
制圖	LHR	2022,08,20	
復核	–	–	
批準			
名稱	玻璃夾角		
材料	X86217		
顏色	JMQ213457(3coats)		


美特鋁質 有限公司
MIDI Aluminium Fabricator Ltd.


工程號	J853	地點	錦上路 TWP

送工地

序號	物料編號	數量	使用位置	樓層
01	T5-X86217-12	34	見派位圖	T5 FLAT A 6~25/F
02	T5-X86217-12	18	見派位圖	T5 FLAT B 6~16/F
03	T5-X86217-12	8	見派位圖	T5 FLAT B 17~25/F
04	T5-X86217-12	8	見派位圖	T5 FLAT C 11~16/F
05	T5-X86217-12	4	見派位圖	T5 FLAT D 11~16/F
06	T5-X86217-12	13	見派位圖	T5 FLAT E/F 11~26/F

序號	物料編號	數量	使用位置	樓層
07	T6-X86217-12	36	見派位圖	T6 FLAT A 5,6,8~26/F
08	T6-X86217-12	36	見派位圖	T6 FLAT B 5,6,8~26/F
09	T6-X86217-12	14	見派位圖	T6 FLAT C/D 10~26/F
10	T7-X86217-12	34	見派位圖	T7 FLAT A 7~26/F
11	T7-X86217-12	15	見派位圖	T7 FLAT B 7~23/F
		220		

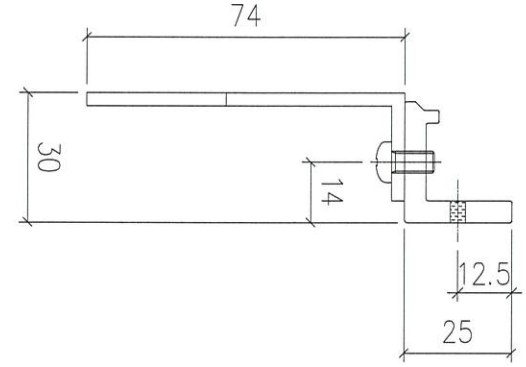

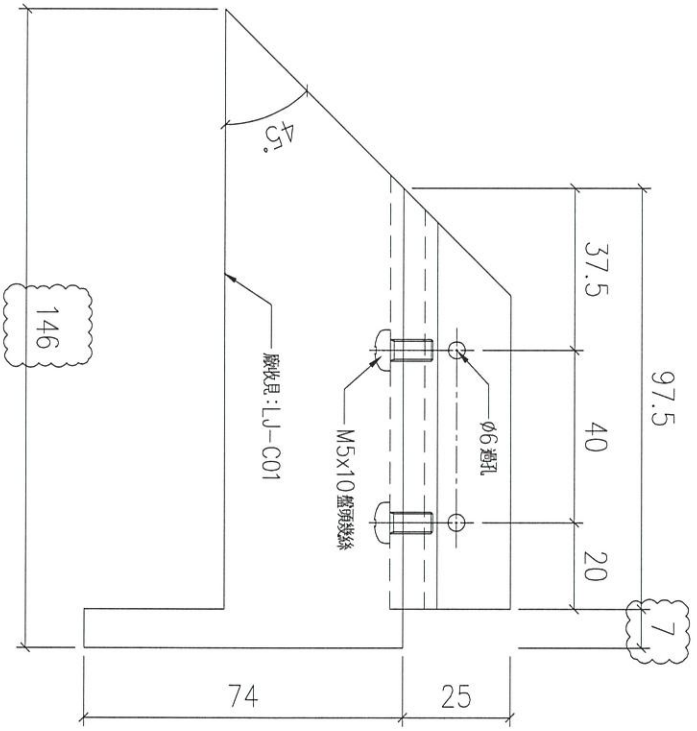

名稱	玻璃夾角	制圖	LHR	2022,08,20	修改	A		
材料	X86217	復核	–	–	日期	2023.2.12		
顏色	JMQ213457(3coats)	批準			圖號	J853-GB-FAB2-51		


美特鋁質 有限公司
MIDI Aluminium Fabricator Ltd.


工程號	J853	地盤	錦上路 ~~TWP~~

送工地

序號	物料編號	數量	使用位置	樓層
01	T5-X86217-13	34	見派位圖	T5 FLAT A 6~25/F
02	T5-X86217-13	18	見派位圖	T5 FLAT B 6~16/F
03	T5-X86217-13	16	見派位圖	T5 FLAT B 17~25/F
04	T5-X86217-13	4	見派位圖	T5 FLAT C 11~16/F
05	T5-X86217-13	4	見派位圖	T5 FLAT D 11~16/F
06	T5-X86217-13	13	見派位圖	T5 FLAT E/F 11~26/F

序號	物料編號	數量	使用位置	樓層
07	T6-X86217-13	36	見派位圖	T6 FLAT A 5,6,8~26/F
08	T6-X86217-13	36	見派位圖	T6 FLAT B 5,6,8~26/F
09	T6-X86217-13	14	見派位圖	T6 FLAT C/D 10~26/F
10	T7-X86217-13	34	見派位圖	T7 FLAT A 7~26/F
11	T7-X86217-13	15	見派位圖	T7 FLAT B 7~23/F
		224		

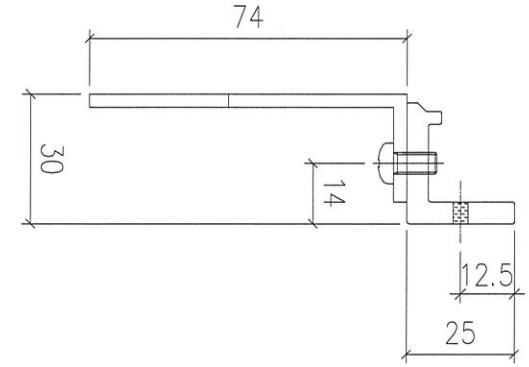

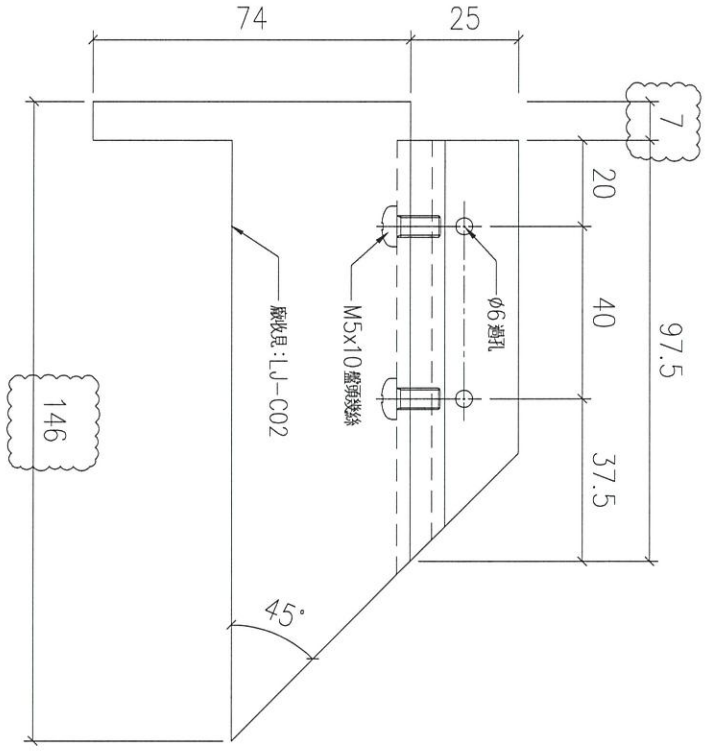



名稱	玻璃夾角	制圖	LHR	2022,08,20	修改	A		
材料	X86217	復核	–	–	日期	2023.2.21		
顏色	JMQ213457(3coats)	批準			圖號	J853-GB-FAB2-52		

美特鋁質 有限公司
MIDI Aluminium Fabricator Ltd.

工程號	J853	地盤	錦上路 TWP

送工地

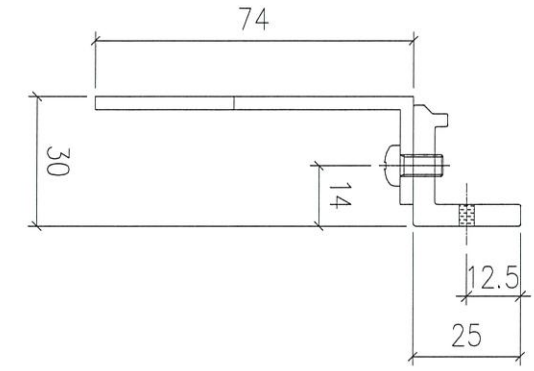

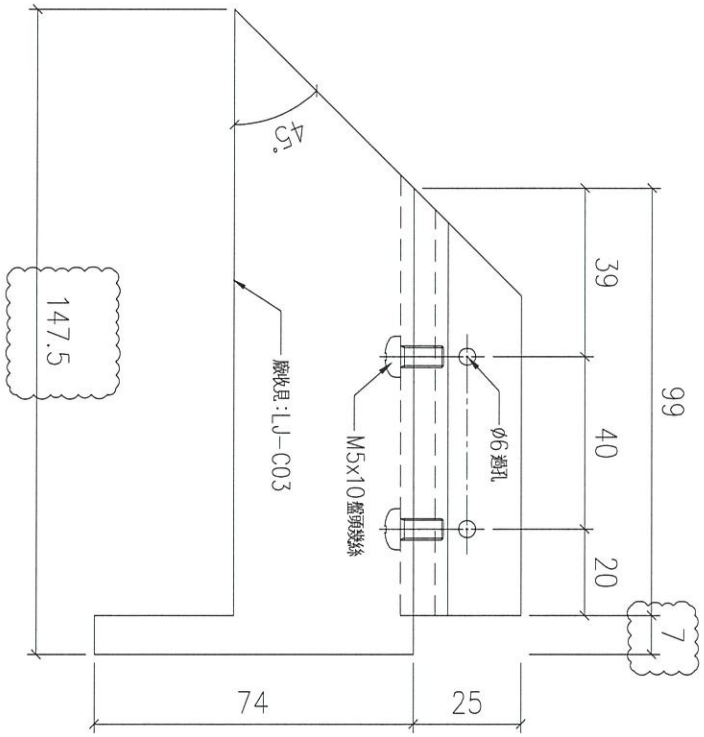


序號	物料編號	數量	使用位置	樓層
01	T5-X86217-14	13	見派位圖	T5 FLAT E/F 11~26/F


名稱	玻璃夾角	制圖	LHR	2022,08,20	修改	A		
材料	X86217	復核	–	–	日期	2023.2.21		
顏色	JMQ213457(3coats)	批準			圖號	J853-GB-FAB2-53		

美特鋁質 有限公司
MIDI Aluminium Fabricator Ltd.

工程號	J853	地盤	~~錦上路~~ Twp

送工地

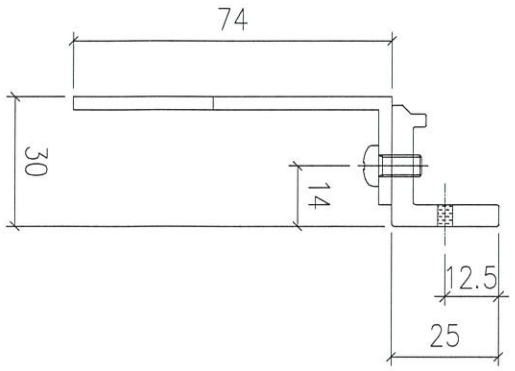

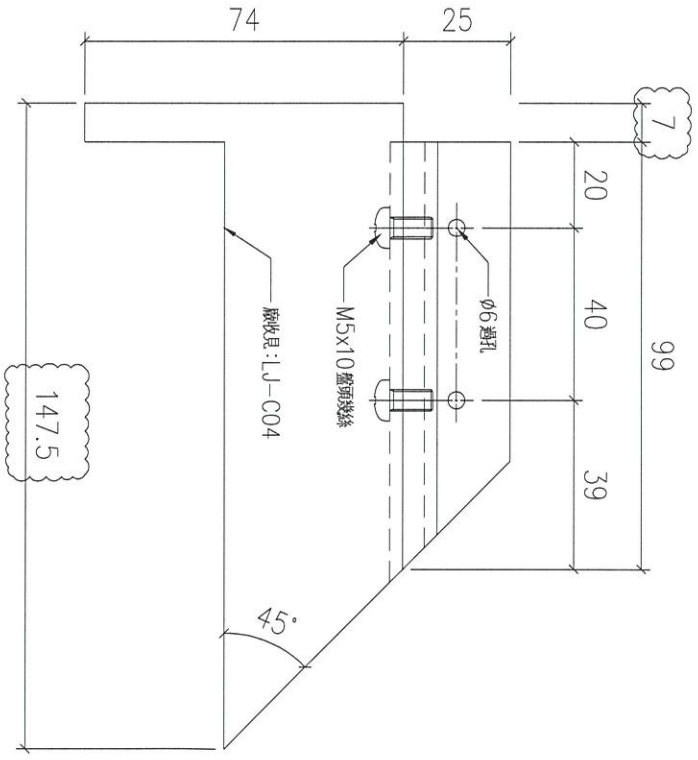


序號	物料編號	數量	使用位置	樓層
01	T5-X86217-15	13	見派位圖	T5 FLAT E/F 11~26/F


名稱	玻璃夾角	制圖	LHR	2022,08,20	修改	A		
材料	X86217	復核	–	–	日期	2023.2.21		
顏色	JMQ213457(3coats)	批準			圖號	J853-GB-FAB2-54		

美特鋁質 有限公司
MIDI Aluminium Fabricator Ltd.

工程號	J853	地盤	錦上路 TWP

送工地

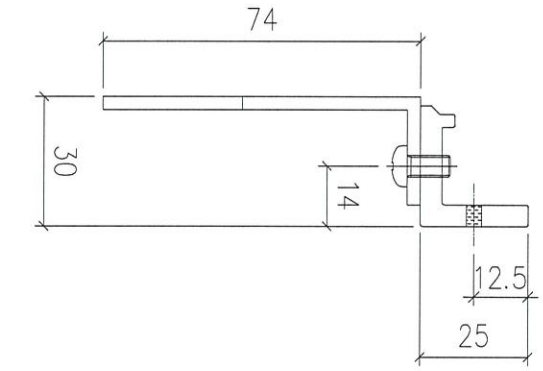

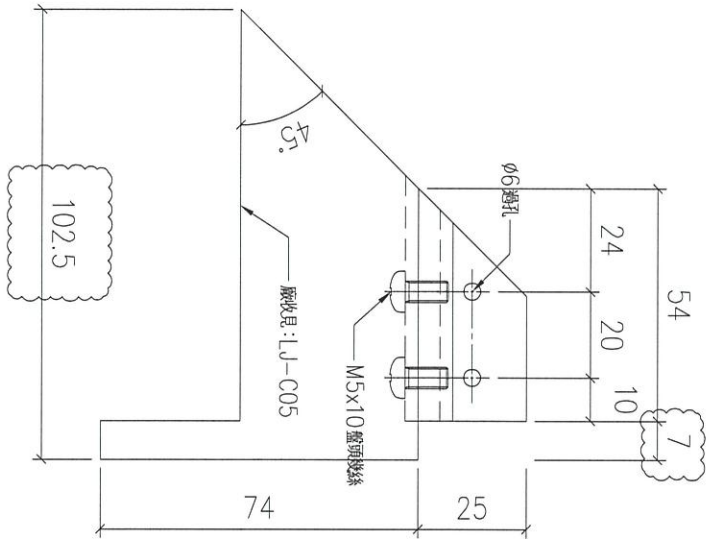


序號	物料編號	數量	使用位置	樓層
01	T5-X86217-16	8	見派位圖	T5 FLAT B 17~25/F


名稱	玻璃夾角	制圖	LHR	2022,08,20	修改	A		
材料	X86217	復核	–	–	日期	2023.2.21		
顏色	JMQ213457(3coats)	批準			圖號	J853-GB-FAB2-55		

美特鋁質 有限公司
MIDI Aluminium Fabricator Ltd.

工程號	J853	地盤	~~錦上路~~ TWP

送工地

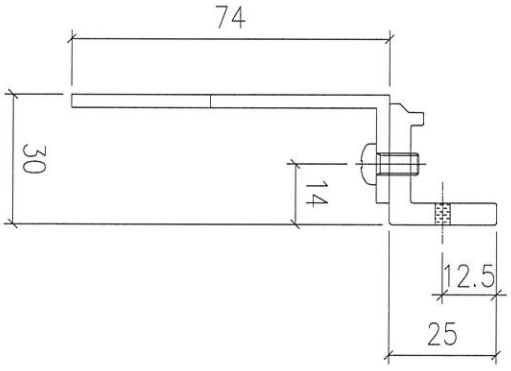

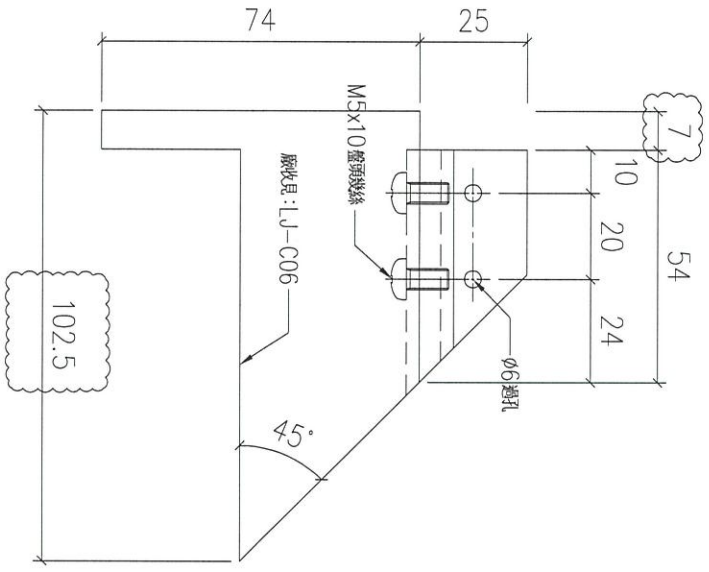


序號	物料編號	數量	使用位置	樓層
01	T5-X86217-17	4	見派位圖	T5 FLAT C 11~16/F


名稱	玻璃夾角	制圖	LHR	2022,08,20	修改	A		
材料	X86217	復核	–	–	日期	2023.2.21		
顏色	JMQ213457(3coats)	批準			圖號	J853-GB-FAB2-56		

美特鋁質 有限公司
MIDI Aluminium Fabricator Ltd.

工程號	J853	地盤	錦上路 TWP

送工地

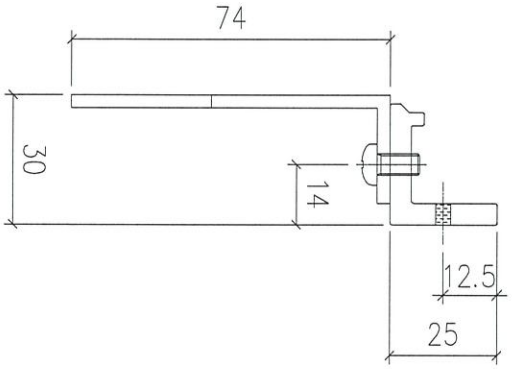

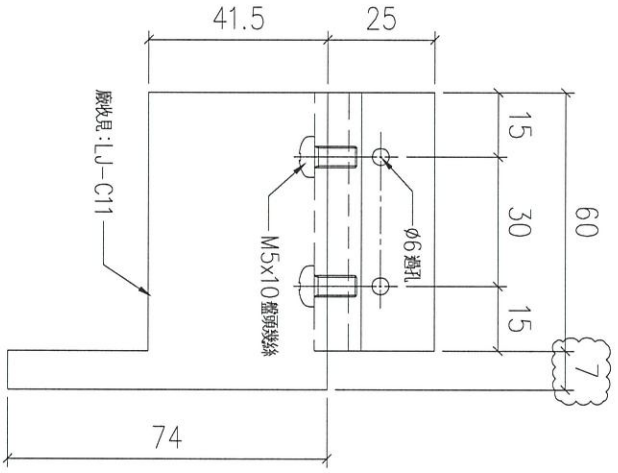


序號	物料編號	數量	使用位置	樓層
01	T5-X86217-22	13	見派位圖	T5 FLAT E/F 11~26/F


名稱	玻璃夾角	制圖	LHR	2022,08,20	修改	A		
材料	X86217	復核	–	–	日期	2023.2.21		
顏色	JMQ213457(3coats)	批準			圖號	J853-GB-FAB2-57		

美特鋁質 有限公司
MIDI Aluminium Fabricator Ltd.

工程號	J853	地盤	錦上路 ~~TWP~~

送工地

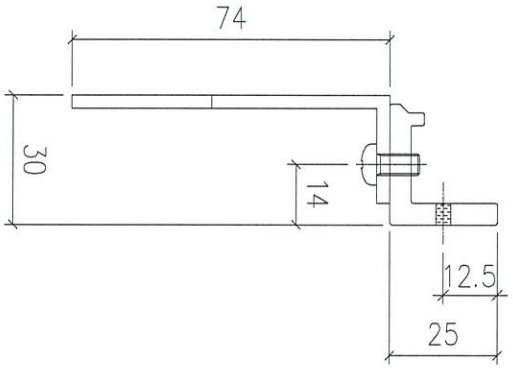

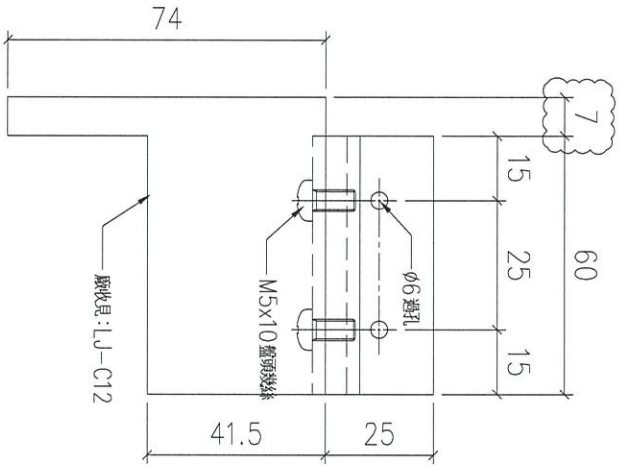


序號	物料編號	數量	使用位置	樓層
01	T5-X86217-23	13	見派位圖	T5 FLAT E/F 11~26/F


名稱	玻璃夾角	制圖	LHR	2022,08,20	修改	A		
材料	X86217	復核	–	–	日期	2023.2.21		
顏色	JMQ213457(3coats)	批準			圖號	J853-GB-FAB2-58		

美特鋁質 有限公司
MIDI Aluminium Fabricator Ltd.

工程號	J853	地盤	錦上路 TWP

送工地

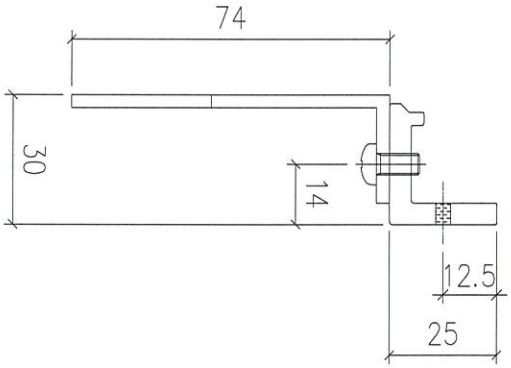

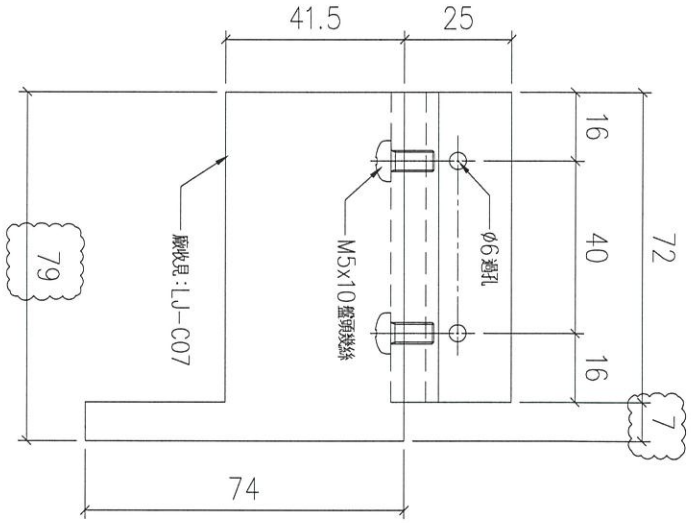


序號	物料編號	數量	使用位置	樓層
01	T5-X86217-18	17	見派位圖	T5 FLAT A 6~25/F
02	T5-X86217-18	9	見派位圖	T5 FLAT B 6~16/F
03	T5-X86217-18	8	見派位圖	T5 FLAT B 17~25/F
04	T5-X86217-18	4	見派位圖	T5 FLAT D 11~16/F
05	T5-X86217-18	13	見派位圖	T5 FLAT E/F 11~26/F
06	T6-X86217-18	18	見派位圖	T6 FLAT A 5,6,8~26/F
07	T6-X86217-18	18	見派位圖	T6 FLAT B 5,6,8~26/F
08	T6-X86217-18	14	見派位圖	T6 FLAT C/D 10~26/F
09	T7-X86217-18	17	見派位圖	T7 FLAT A 7~26/F
10	T7-X86217-18	15	見派位圖	T7 FLAT B 7~23/F
		133		


名稱	玻璃夾角	制圖	LHR	2022,08,20	修改	A		
材料	X86217	復核	–	–	日期	2023.2.21		
顏色	JMQ213457(3coats)	批準			圖號	J853-GB-FAB2-59		

美特鋁質 有限公司
MIDI Aluminium Fabricator Ltd.

工程號	J853	地盤	錦上路 TWP

送工地

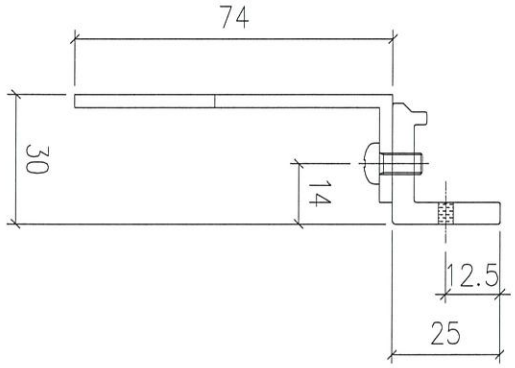

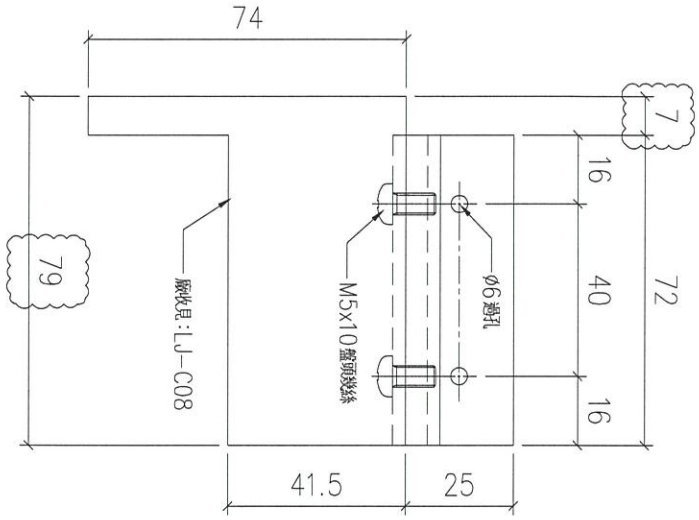


序號	物料編號	數量	使用位置	樓層
01	T5-X86217-19	17	見派位圖	T5 FLAT A 6~25/F
02	T5-X86217-19	9	見派位圖	T5 FLAT B 6~16/F
03	T5-X86217-19	4	見派位圖	T5 FLAT C 11~16/F
04	T5-X86217-19	4	見派位圖	T5 FLAT D 11~16/F
05	T5-X86217-19	13	見派位圖	T5 FLAT E/F 11~26/F
06	T6-X86217-19	18	見派位圖	T6 FLAT A 5,6,8~26/F
07	T6-X86217-19	18	見派位圖	T6 FLAT B 5,6,8~26/F
08	T6-X86217-19	14	見派位圖	T6 FLAT C/D 10~26/F
09	T7-X86217-19	17	見派位圖	T7 FLAT A 7~26/F
10	T7-X86217-19	15	見派位圖	T7 FLAT B 7~23/F
		129		

名稱	玻璃夾角	制圖	LHR	2022,08,20	修改	A		
材料	X86217	復核	–	–	日期	2023.2.21		
顏色	JMQ213457(3coats)	批準			圖號	J853-GB-FAB2-60		

美特鋁質 有限公司
MIDI Aluminium Fabricator Ltd.

工程號	J853	地盤	~~錦上路~~ Twp

送工地

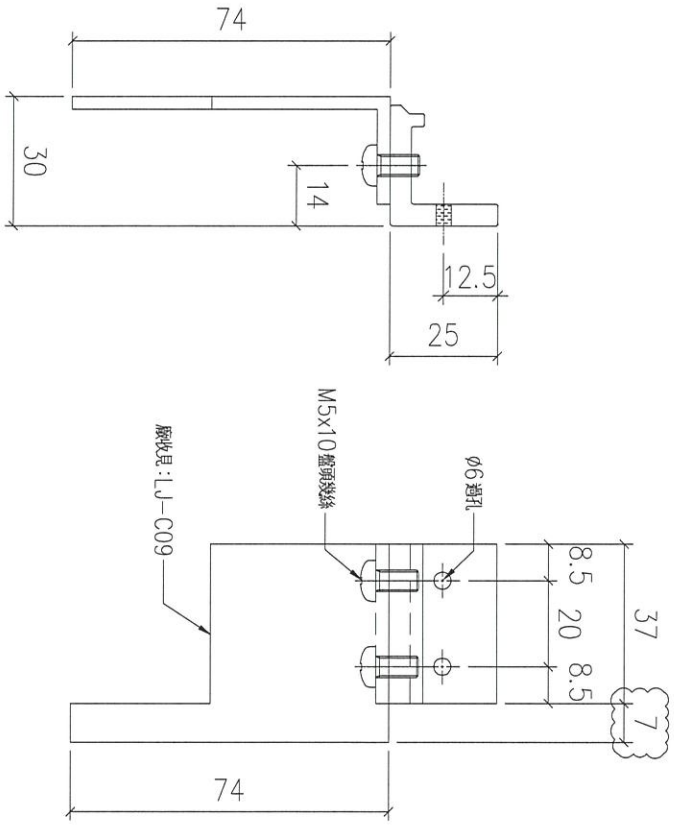


序號	物料編號	數量	使用位置	樓層
01	T5-X86217-20	4	見派位圖	T5 FLAT C 11~16/F


名稱	玻璃夾角	制圖	LHR	2022,08,20	修改	A		
材料	X86217	復核	–	–	日期	2023.2.21		
顏色	JMQ213457(3coats)	批準			圖號	J853-GB-FAB2-61		

美特鋁質 有限公司
MIDI Aluminium Fabricator Ltd.

工程號	J853	地盤	~~錦上路~~ Twp

送工地

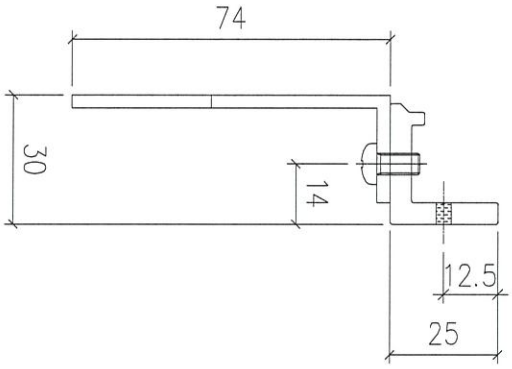

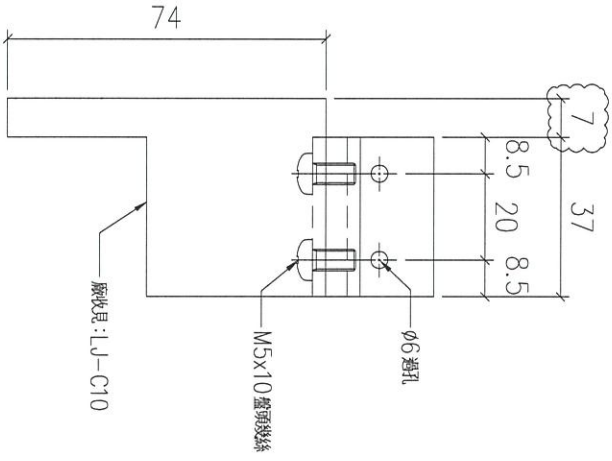


序號	物料編號	數量	使用位置	樓層
01	T5-X86217-21	8	見派位圖	T5 FLAT B 17~25/F


名稱	玻璃夾角	制圖	LHR	2022,08,20	修改	A		
材料	X86217	復核	–	–	日期	2023.2.21		
顏色	JMQ213457(3coats)	批準			圖號	J853-GB-FAB2-62		

美特鋁質 有限公司
MIDI Aluminium Fabricator Ltd.

工程號	J853	地盤	~~錦上路~~ Twp

送工地

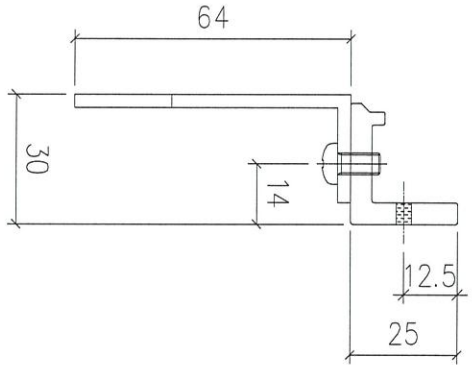

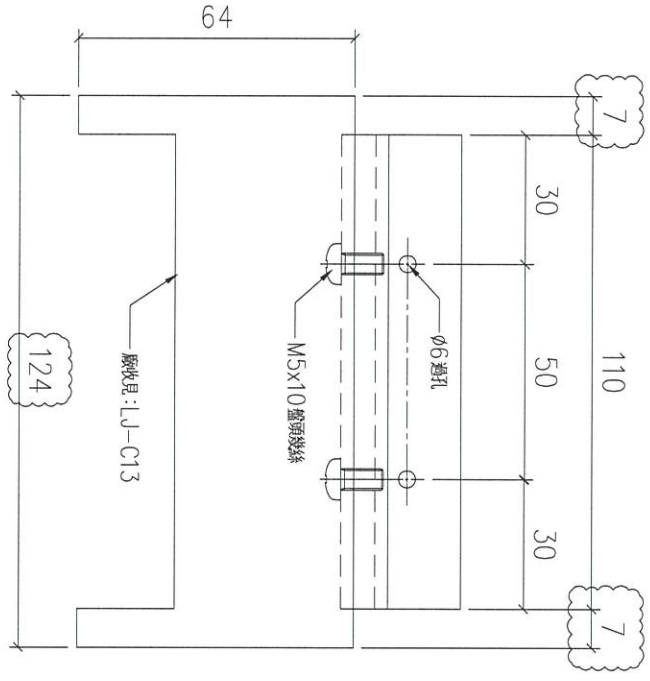


序號	物料編號	數量	使用位置	樓層
01	T5-X86217-24	8	見派位圖	T5 FLAT B 17~25/F
02	T5-X86217-24	4	見派位圖	T5 FLAT C 11~16/F


名稱	玻璃夾角	制圖	LHR	2022,08,20	修改	A		
材料	X86217	復核	–	–	日期	2023.2.21		
顏色	JMQ213457(3coats)	批準			圖號	J853-GB-FAB2-63		

美特鋁質 有限公司
MIDI Aluminium Fabricator Ltd.

工程號	J853	地盤	錦上路 T3P

送工地

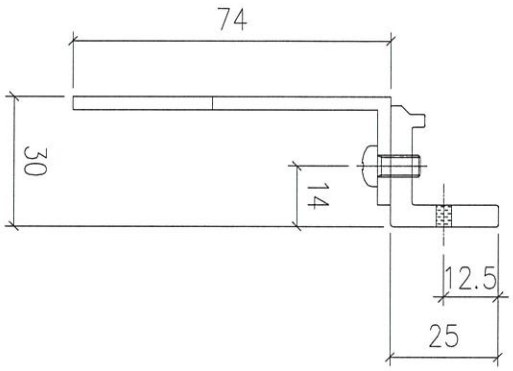

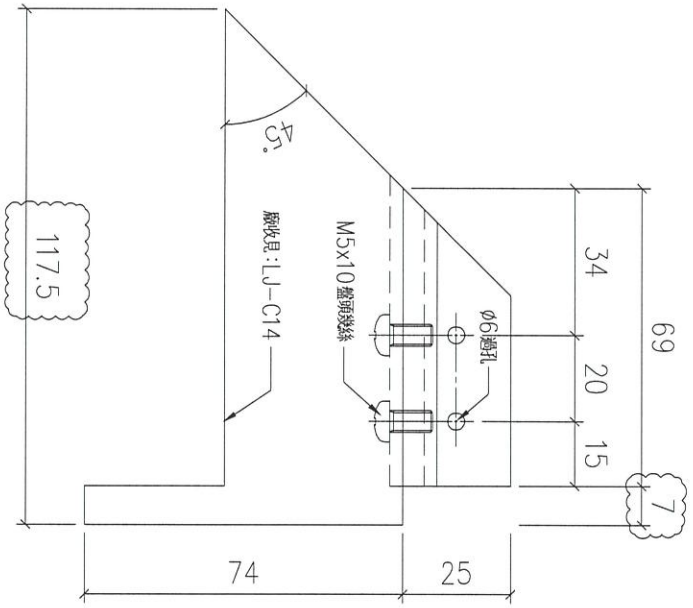


序號	物料編號	數量	使用位置	樓層
01	T6-X86217-05	14	見派位圖	T6 FLAT C/D 10~26/F


名稱	玻璃夾角	制圖	LHR	2022,08,20	修改	A		
材料	X86217	復核	–	–	日期	2023.2.21		
顏色	JMQ213457(3coats)	批準			圖號	J853-GB-FAB2-64		

美特鋁質 有限公司
MIDI Aluminium Fabricator Ltd.

工程號	J853	地盤	~~錦上路~~ TWP

送工地

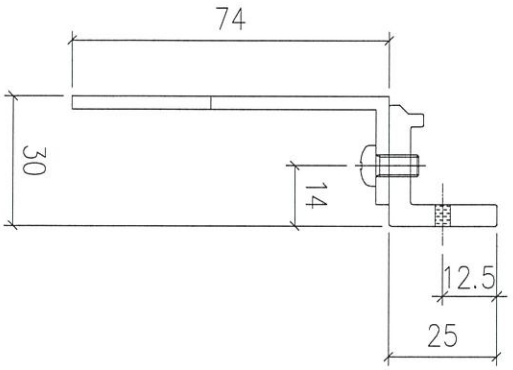

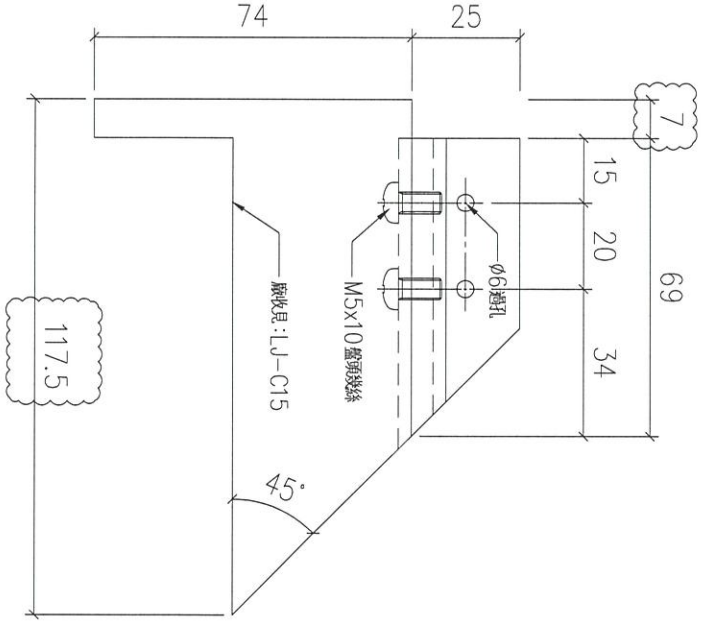


序號	物料編號	數量	使用位置	樓層
01	T6-X86217-06	14	見派位圖	T6 FLAT C/D 10~26/F

名稱	玻璃夾角	制圖	LHR	2022,08,20	修改	A		
材料	X86217	復核	–	–	日期	2023.2.21		
顏色	JMQ213457(3coats)	批準			圖號	J853-GB-FAB2-65 /		

美特鋁質 有限公司
MIDI Aluminium Fabricator Ltd.

工程號	J853	地盤	錦上路 TWP

送工地

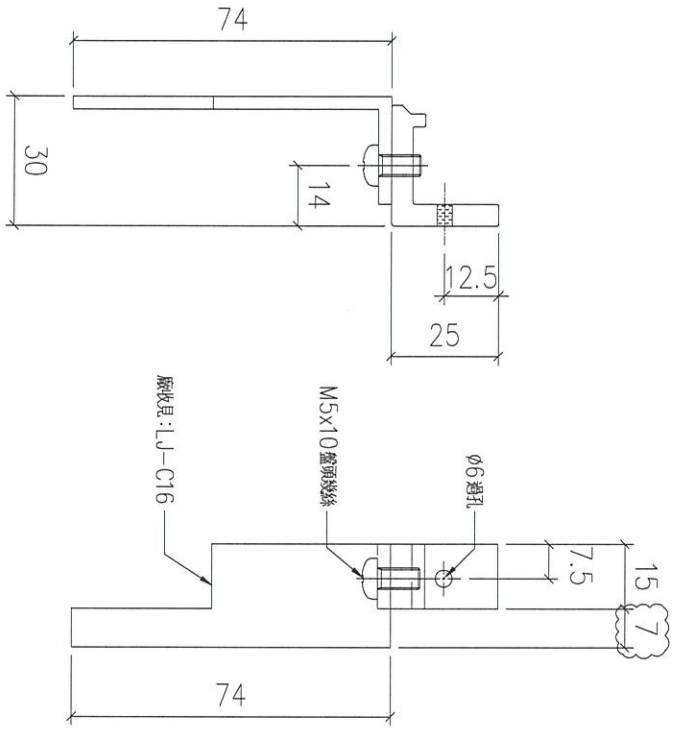


序號	物料編號	數量	使用位置	樓層
01	T6-X86217-07	14	見派位圖	T6 FLAT C/D 10~26/F


名稱	玻璃夾角	制圖	LHR	2022,08,20	修改	A		
材料	X86217	復核	–	–	日期	2023.2.21		
顏色	JMQ213457(3coats)	批準			圖號	J853-GB-FAB2-66		

美特鋁質 有限公司
MIDI Aluminium Fabricator Ltd.

工程號	J853	地盤	~~錦上路~~ Twp

送工地

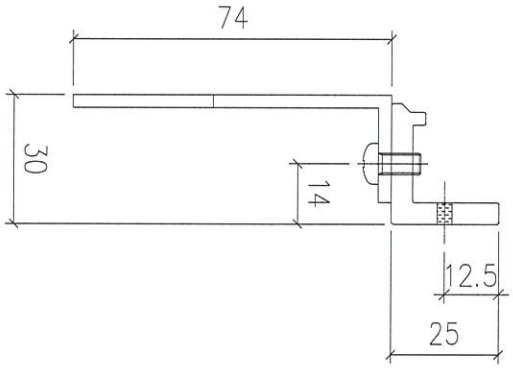

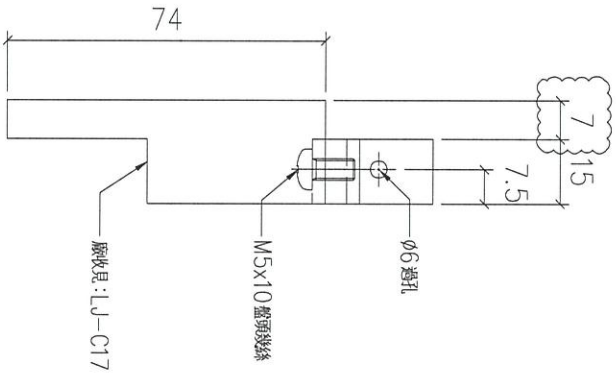


序號	物料編號	數量	使用位置	樓層
01	T6-X86217-08	14	見派位圖	T6 FLAT C/D 10~26/F


名稱	玻璃夾角	制圖	LHR	2022,08,20	修改	A		
材料	X86217	復核	–	–	日期	2023.2.21		
顏色	JMQ213457(3coats)	批準			圖號	J853-GB-FAB2-67		

美特鋁質 有限公司
MIDI Aluminium Fabricator Ltd.

工程號	J853	地盤	~~錦上路~~ Twf

送工地

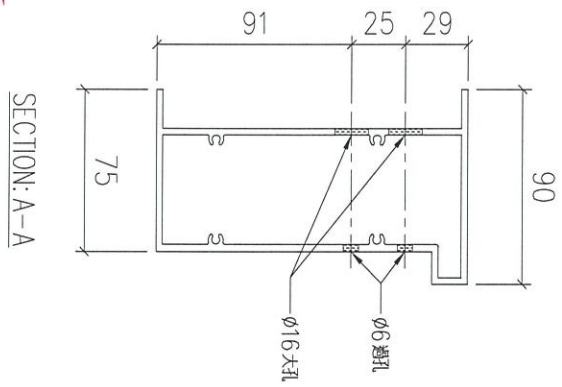

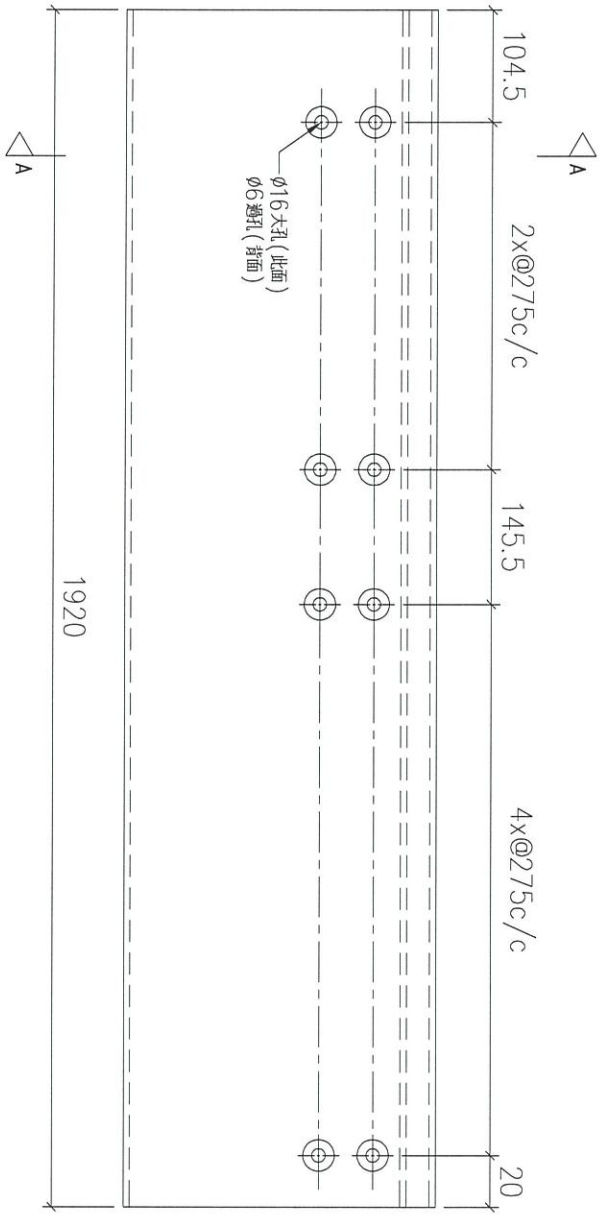


序號	物料編號	數量	安裝位置	樓層
01	T5-X86218-01	8	見派位圖	T5 FLAT A 17~25/F


名稱	底橫外飾加工圖	制圖	LHR	2022,08,23	修改	–		
材料	X86218	復核	–	–	日期	–		
顏色	JMQ213457(3coats)	批準			圖號	J853-GB-FAB2-68		

美特鋁質 有限公司
MIDI Aluminium Fabricator Ltd.

工程號	J853	地盤	錦上路 TWP

送工地

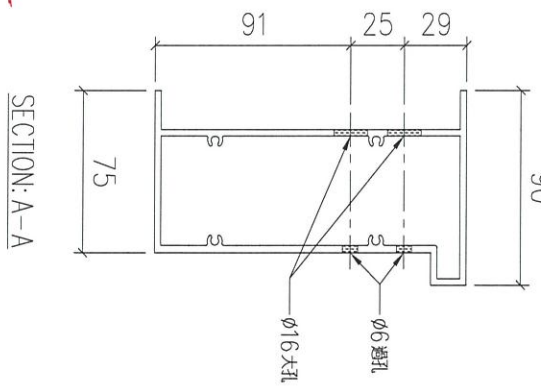

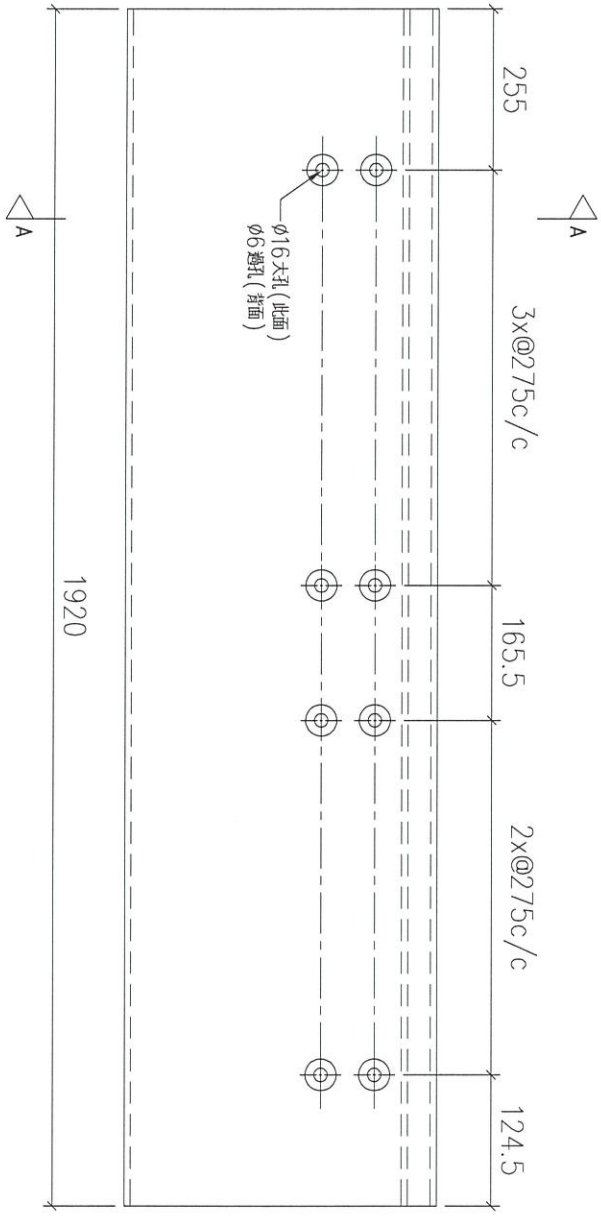


序號	物料編號	數量	安裝位置	樓層
01	T5-X86218-02	8	見派位圖	T5 FLAT A 17~25/F


名稱	底橫外飾加工圖	制圖	LHR	2022,08,23	修改	–		
材料	X86218	復核	–	–	日期	–		
顏色	JMQ213457(3coats)	批準			圖號	J853-GB-FAB2-69		


美特鋁質 有限公司
MIDI Aluminium Fabricator Ltd.

工程號	J853	地盤	錦上路 TWP

送工地

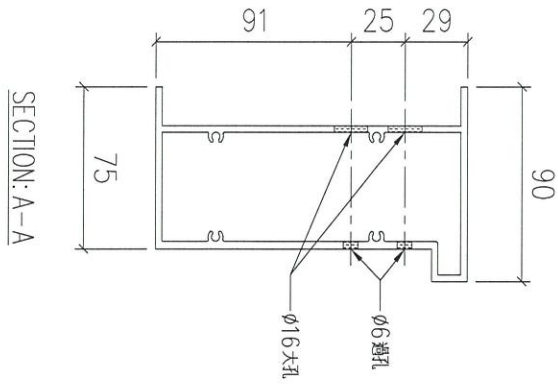

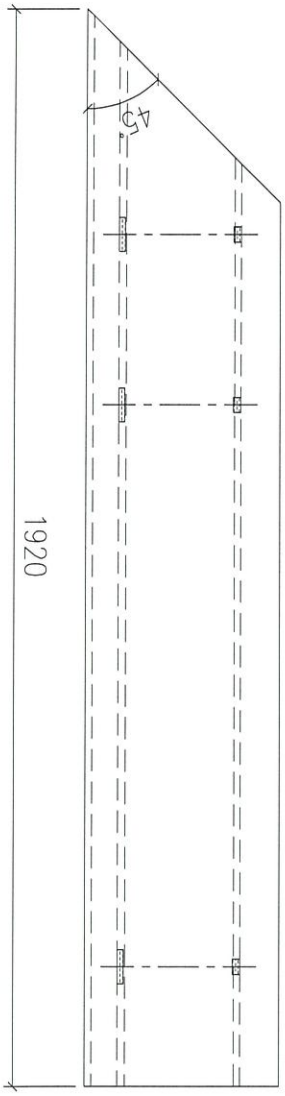

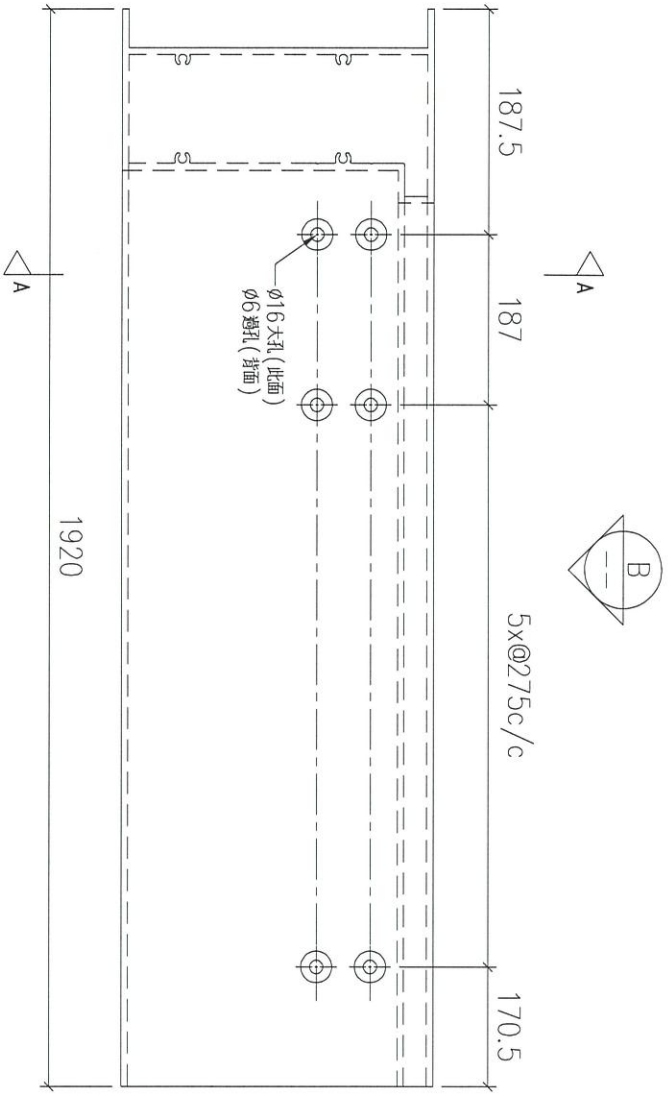


序號	物料編號	數量	安裝位置	樓層
01	T5-X86218-03	8	見派位圖	T5 FLAT A 17~25/F


名稱	底橫外飾加工圖	制圖	LHR	2022,08,23	修改	—		
材料	X86218	復核	—	—	日期	—		
顏色	JMQ213457(3coats)	批準			圖號	J853-GB-FAB2-70		


美特鋁質 有限公司
MIDI Aluminium Fabricator Ltd.

工程號	J853	地盤	~~錦上路~~ TWP

送工地

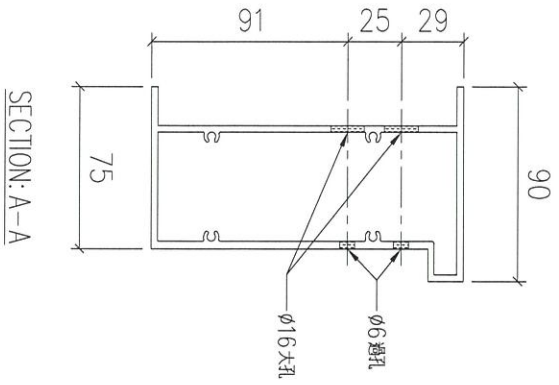

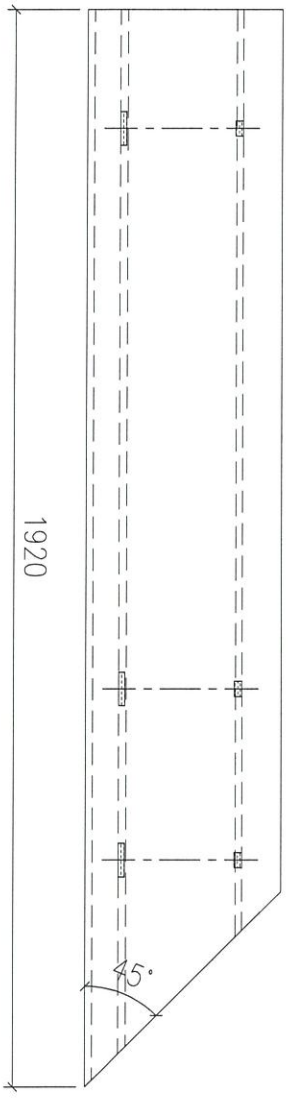

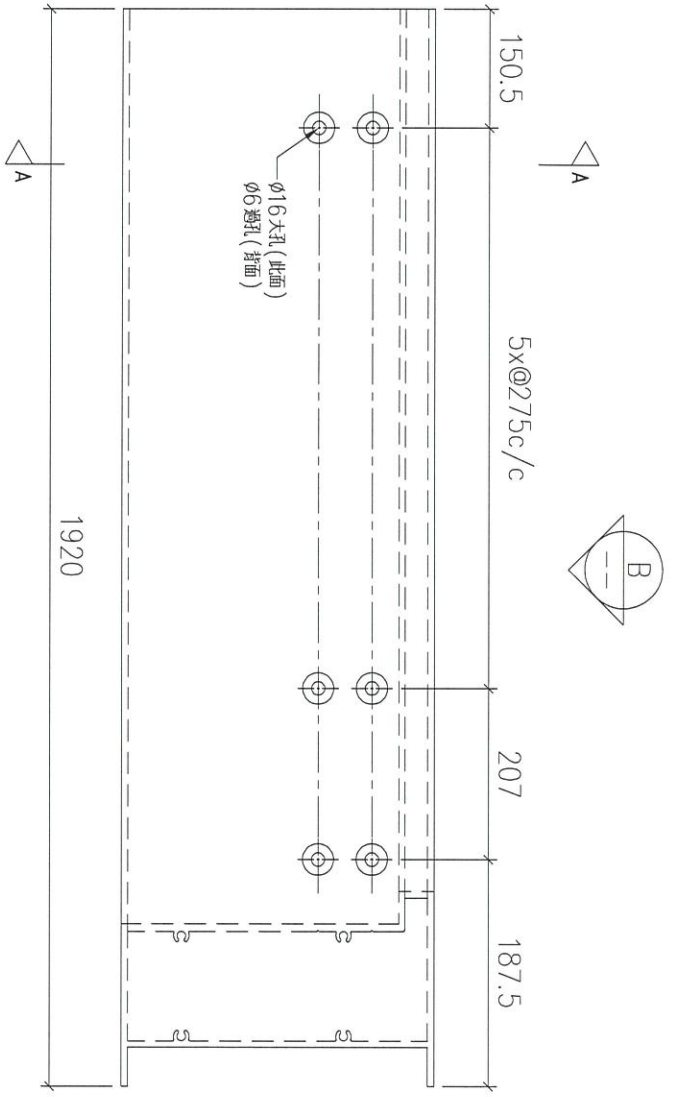


序號	物料編號	數量	安裝位置	樓層
01	T5-X86218-04	8	見派位圖	T5 FLAT A 17~25/F

名稱	底橫外飾加工圖	制圖	LHR	2022,08,23	修改	–		
材料	X86218	復核	–	–	日期	–		
顏色	JMQ213457(3coats)	批準			圖號	J853-GB-FAB2-71		


美特鋁質 有限公司
MIDI Aluminium Fabricator Ltd.

工程號	J853	地盤	錦上路 ~~TWP~~

送工地

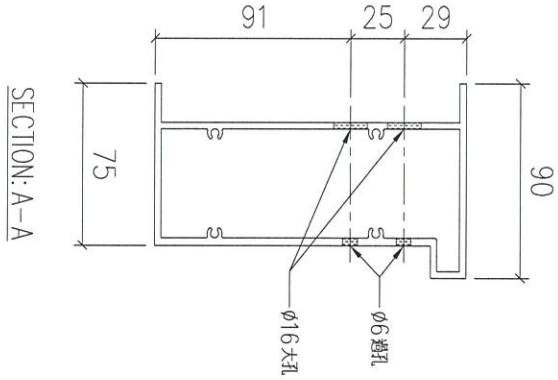

SECTION: A-A

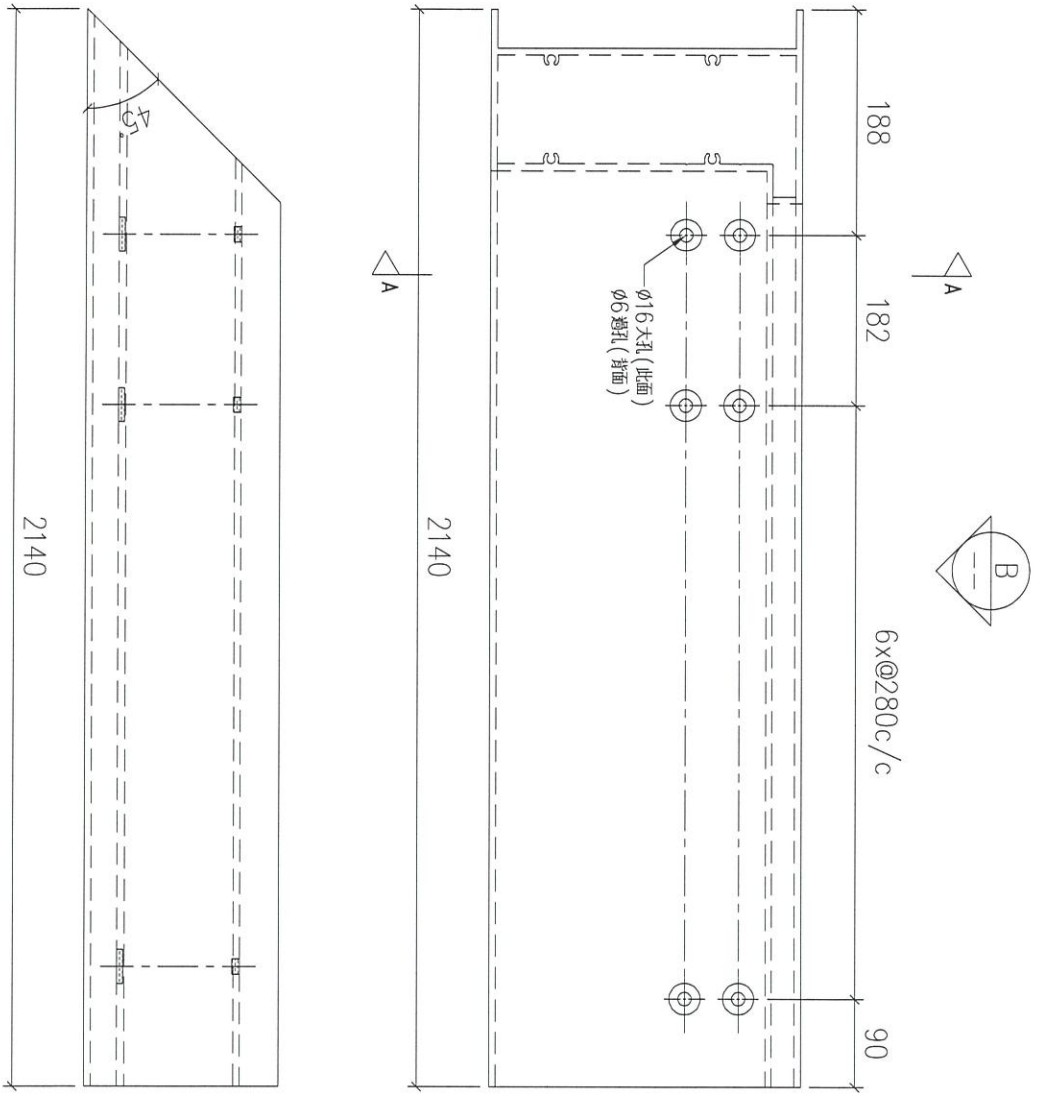

VIEW B


序號	物料編號	數量	安裝位置	樓層
01	T5-X86218-05	8	見派位圖	T5 FLAT B 17~25/F


名稱	底橫外飾加工圖	制圖	LHR	2022,08,23	修改	–		
材料	X86218	復核	–	–	日期	–		
顏色	JMQ213457(3coats)	批準			圖號	J853-GB-FAB2-72		


美特鋁質 有限公司
MIDI Aluminium Fabricator Ltd.

工程號	J853	地盤	~~錦上路~~ TWP

送工地

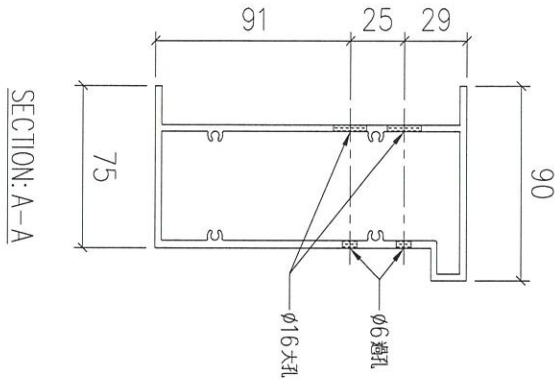

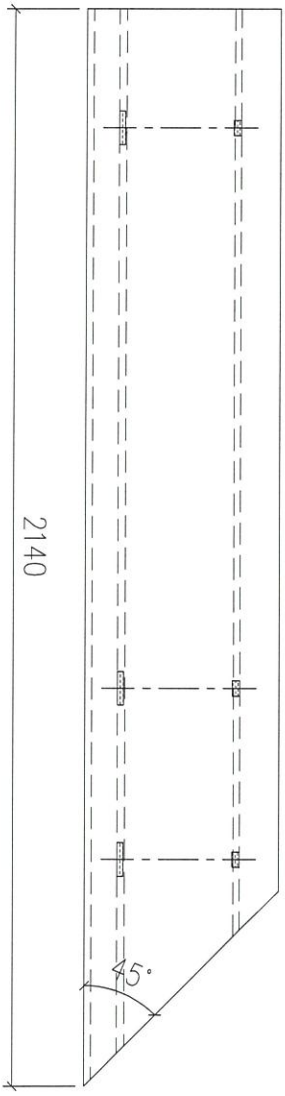

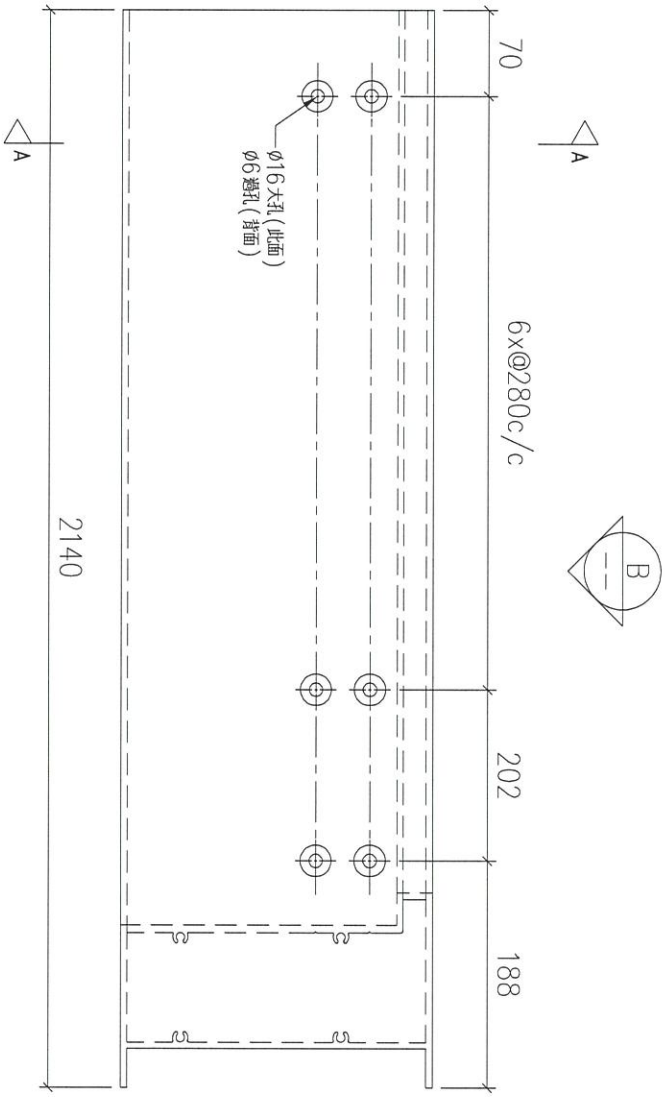


序號	物料編號	數量	安裝位置	樓層
01	T5-X86218-06	8	見派位圖	T5 FLAT B 17~25/F

名稱	底橫外飾加工圖	制圖	LHR	2022,08,23	修改	–		
材料	X86218	復核	–	–	日期	–		
顏色	JMQ213457(3coats)	批準			圖號	J853-GB-FAB2-73		


美特鋁質 有限公司
MIDI Aluminium Fabricator Ltd.

工程號	J853	地盤	~~錦上路~~ Tsp


送工地

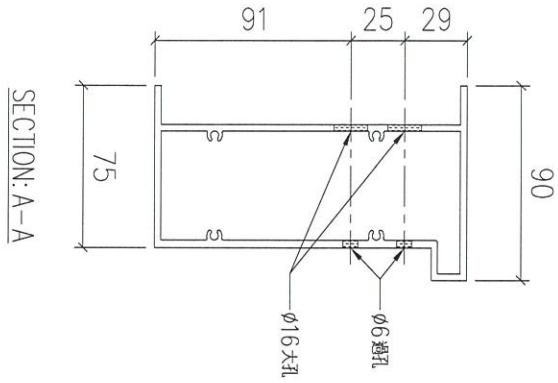

SECTION: A-A

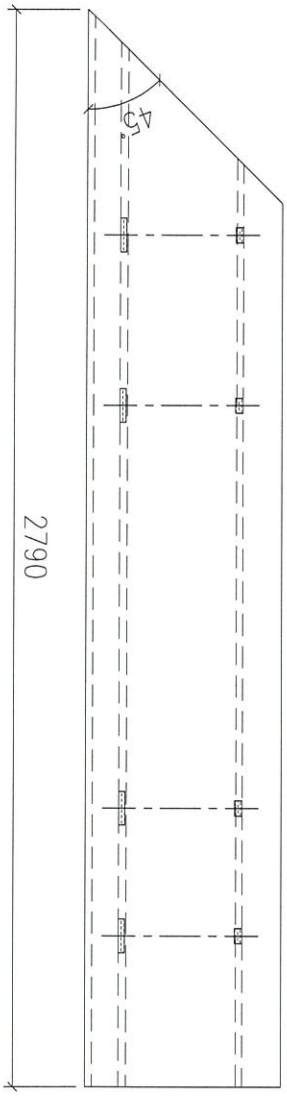

VIEW B

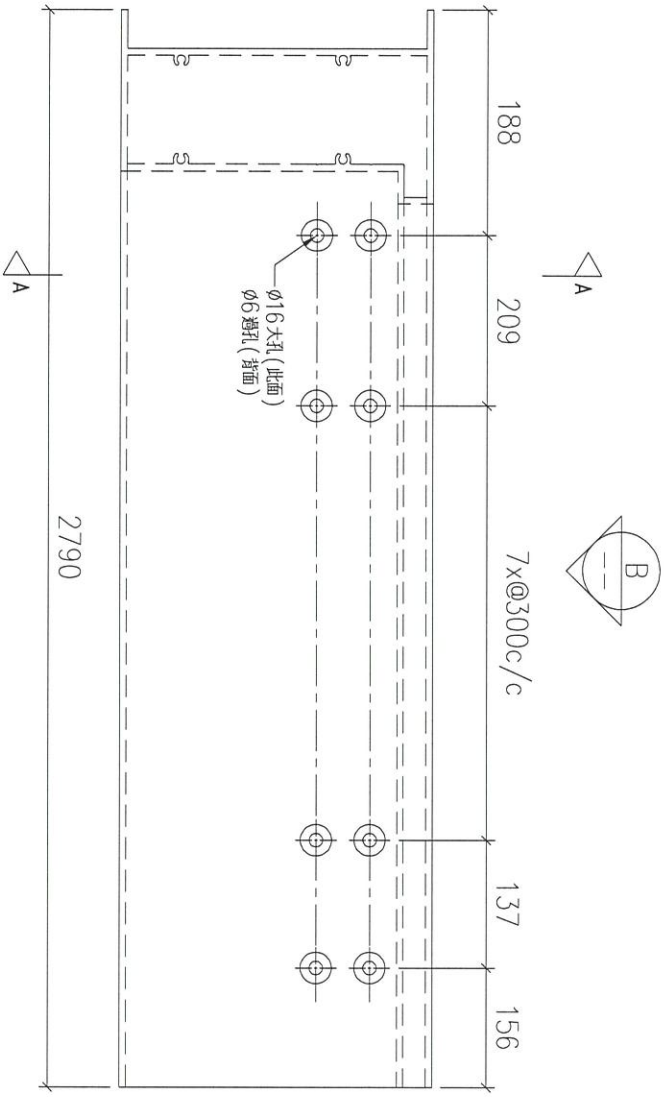


序號	物料編號	數量	安裝位置	樓層
01	T5-X86218-07	13	見派位圖	T5 FLAT E/F 11~26/F
02	T6-X86218-03	14	見派位圖	T6 FLAT C/D 10~26/F


名稱	底橫外飾加工圖	制圖	LHR	2022,08,23	修改	–		
材料	X86218	復核	–	–	日期	–		
顏色	JMQ213457(3coats)	批準			圖號	J853-GB-FAB2-74		

美特鋁質 有限公司
MIDI Aluminium Fabricator Ltd.

工程號	J853	地盤	~~錦上路~~ Twp

送工地

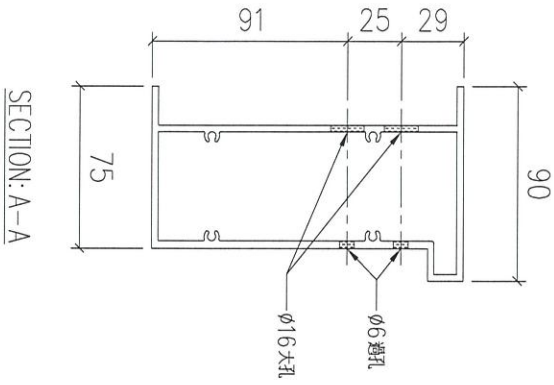

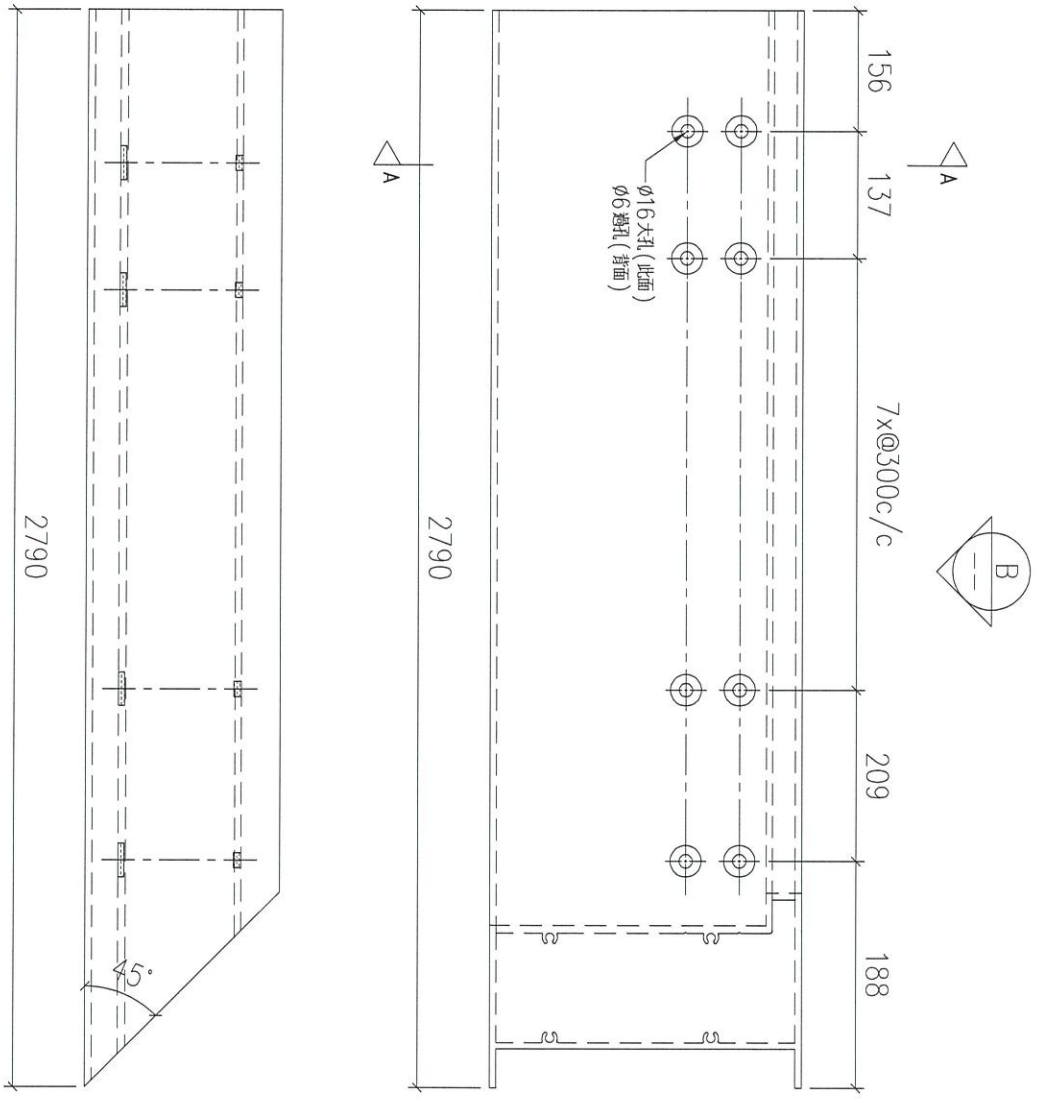


序號	物料編號	數量	安裝位置	樓層
01	T5-X86218-08	13	見派位圖	T5 FLAT E/F 11~26/F
02	T6-X86218-04	14	見派位圖	T6 FLAT C/D 10~26/F


名稱	底橫外飾加工圖	制圖	LHR	2022,08,23	修改	–		
材料	X86218	復核	–	–	日期	–		
顏色	JMQ213457(3coats)	批準			圖號	J853-GB-FAB2-75		


美特鋁質 有限公司
MIDI Aluminium Fabricator Ltd.

工程號	J853	地盤	~~錦上路~~ TWP

送工地

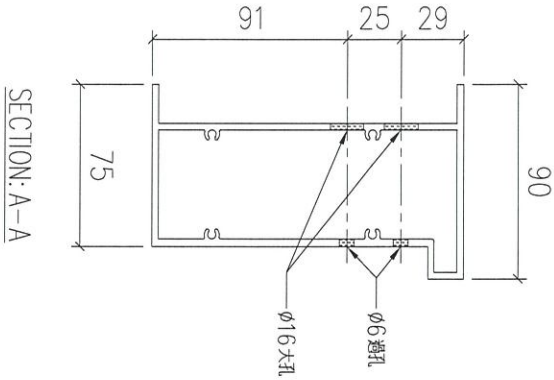

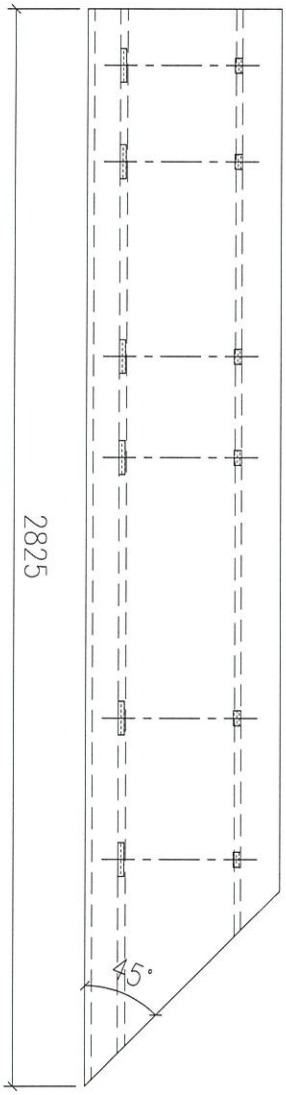

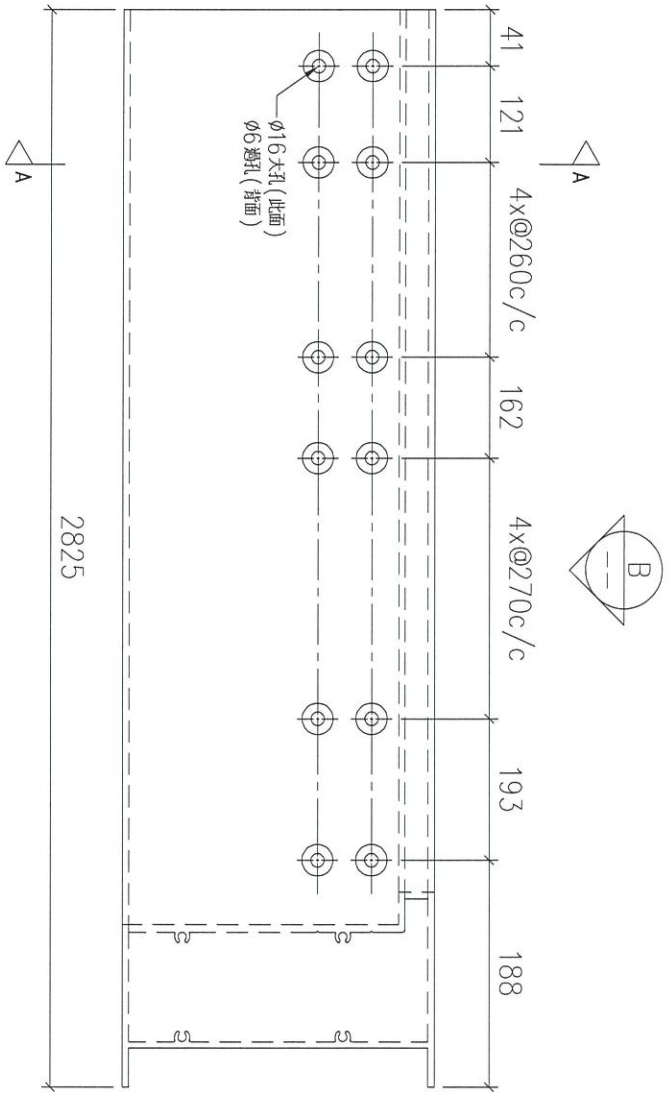


序號	物料編號	數量	安裝位置	樓層
01	T5-X86218-09	4	見派位圖	T5 FLAT D 11~16/F

名稱	底橫外飾加工圖	制圖	LHR	2022,08,23	修改	–		
材料	X86218	復核	–	–	日期	–		
顏色	JMQ213457(3coats)	批準			圖號	J853-GB-FAB2-76		


美特鋁質 有限公司
MIDI Aluminium Fabricator Ltd.


工程號	J853	地盤	~~錦上路~~ TWP

送工地

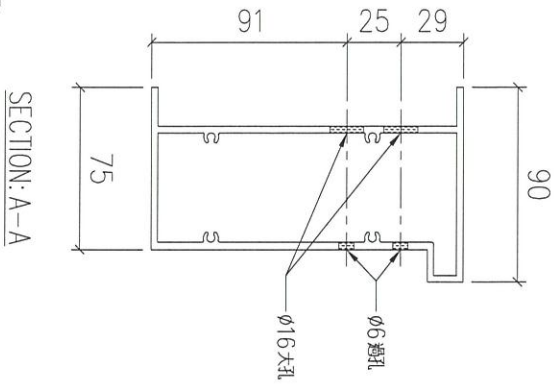

SECTION: A-A

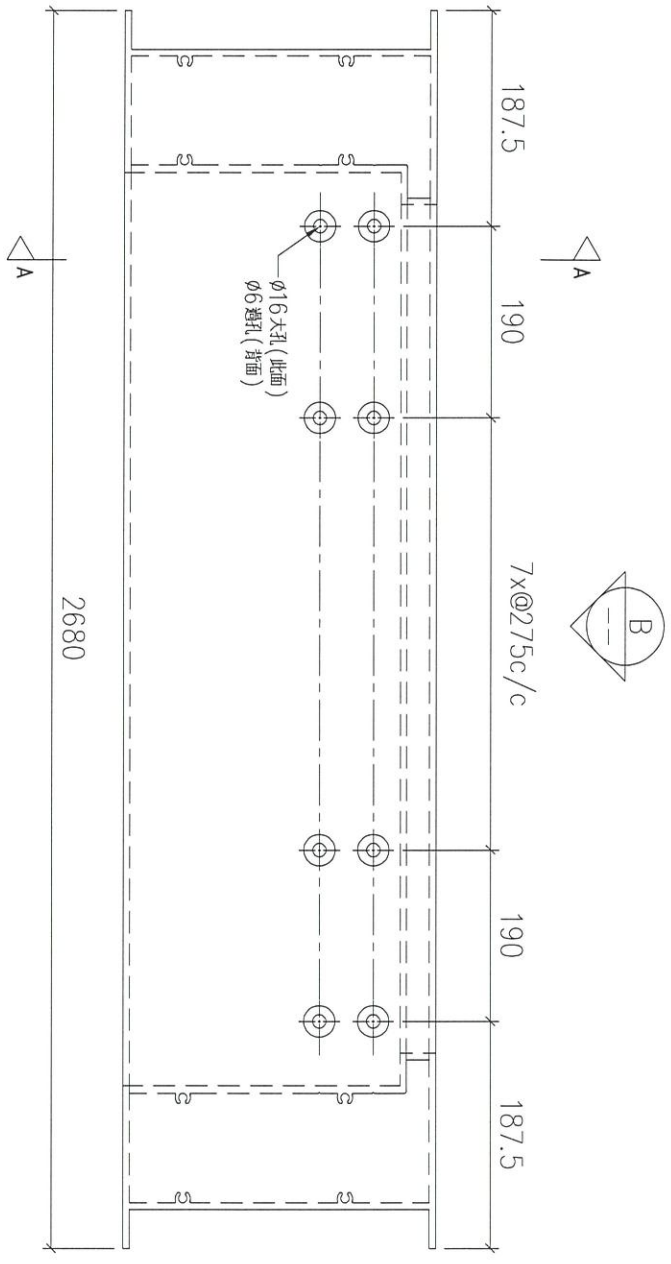

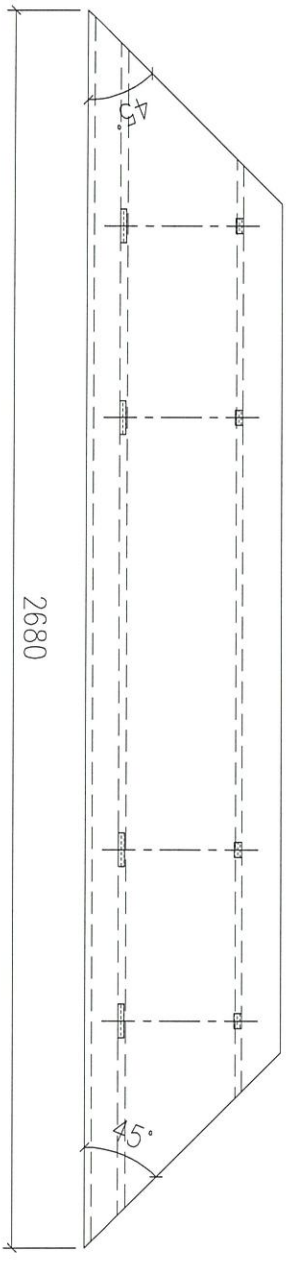

VIEW B


序號	物料編號	數量	安裝位置	樓層
01	T5-X86218-10	9	見派位圖	T5 FLAT A 6~16/F
02	T5-X86218-10	4	見派位圖	T5 FLAT C 11~16/F

名稱	底橫外飾加工圖	制圖	LHR	2022,08,23	修改	–		
材料	X86218	復核	–	–	日期	–		
顏色	JMQ213457(3coats)	批準			圖號	J853-GB-FAB2-77		


美特鋁質 有限公司
MIDI Aluminium Fabricator Ltd.

工程號	J853	地盤	錦上路 Tuen


送工地

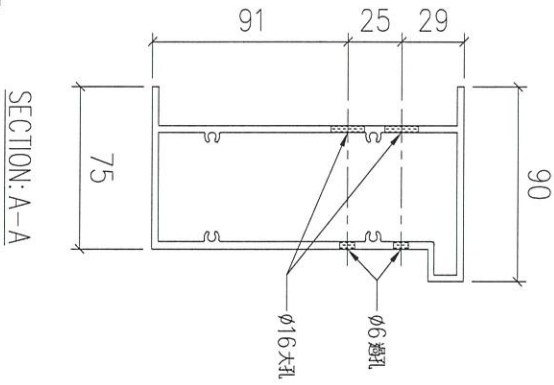

SECTION: A-A

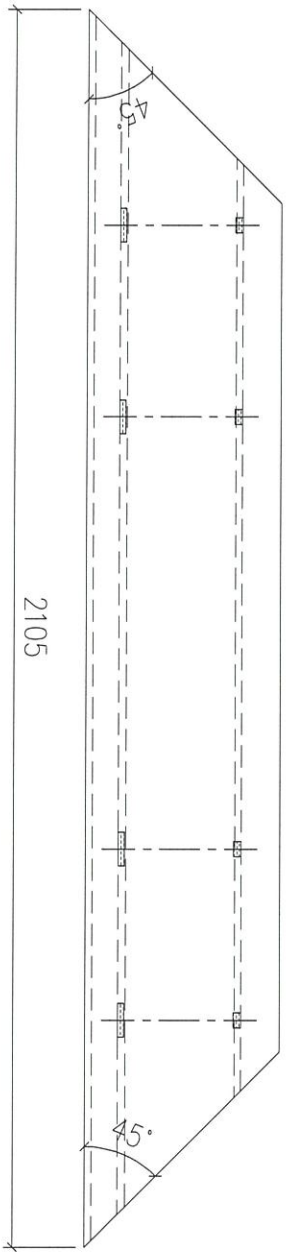

VIEW B

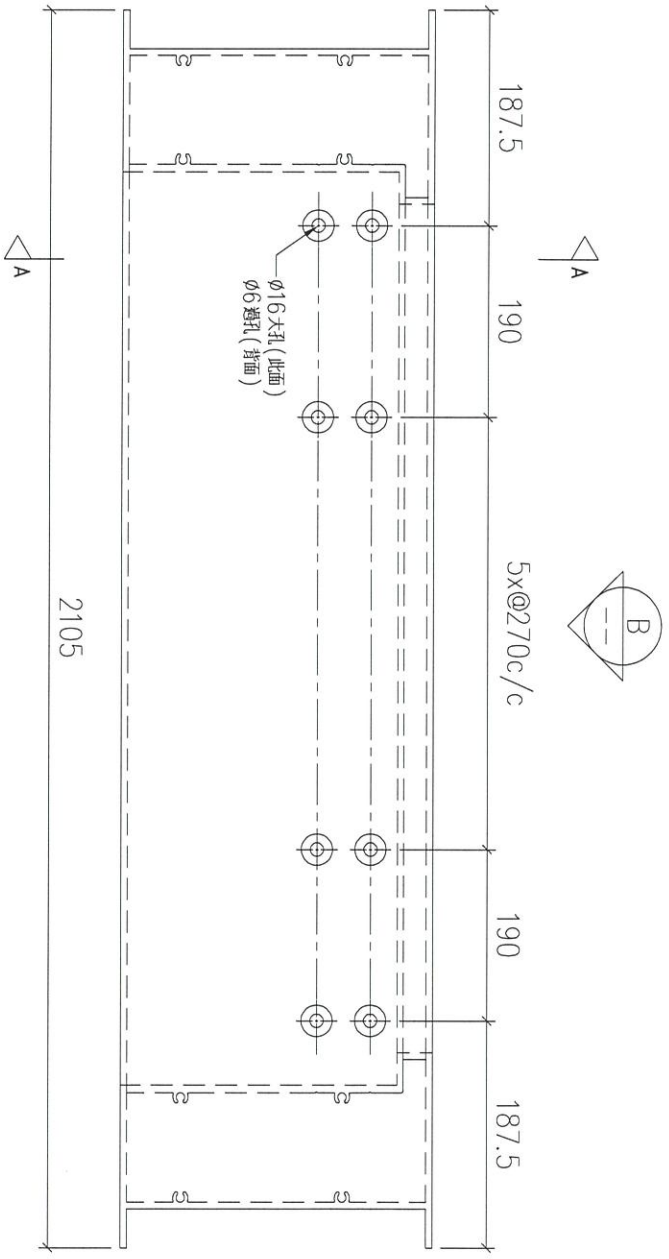


序號	物料編號	數量	安裝位置	樓層
01	T5-X86218-11	9	見派位圖	T5 FLAT B 6~16/F


名稱	底橫外飾加工圖	制圖	LHR	2022,08,23	修改	–		
材料	X86218	復核	–	–	日期	–		
顏色	JMQ213457(3coats)	批準			圖號	J853-GB-FAB2-78		


美特鋁質 有限公司
MIDI Aluminium Fabricator Ltd.

工程號	J853	地盤	錦上路 TWP

送工地

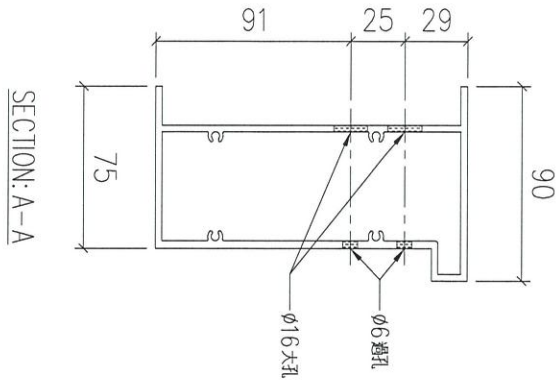

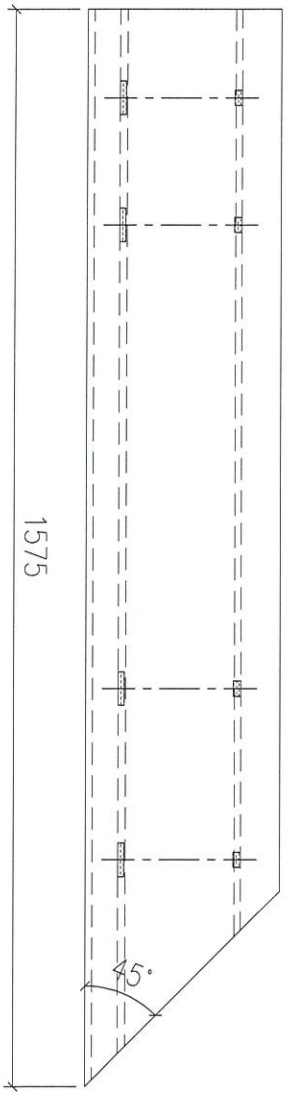

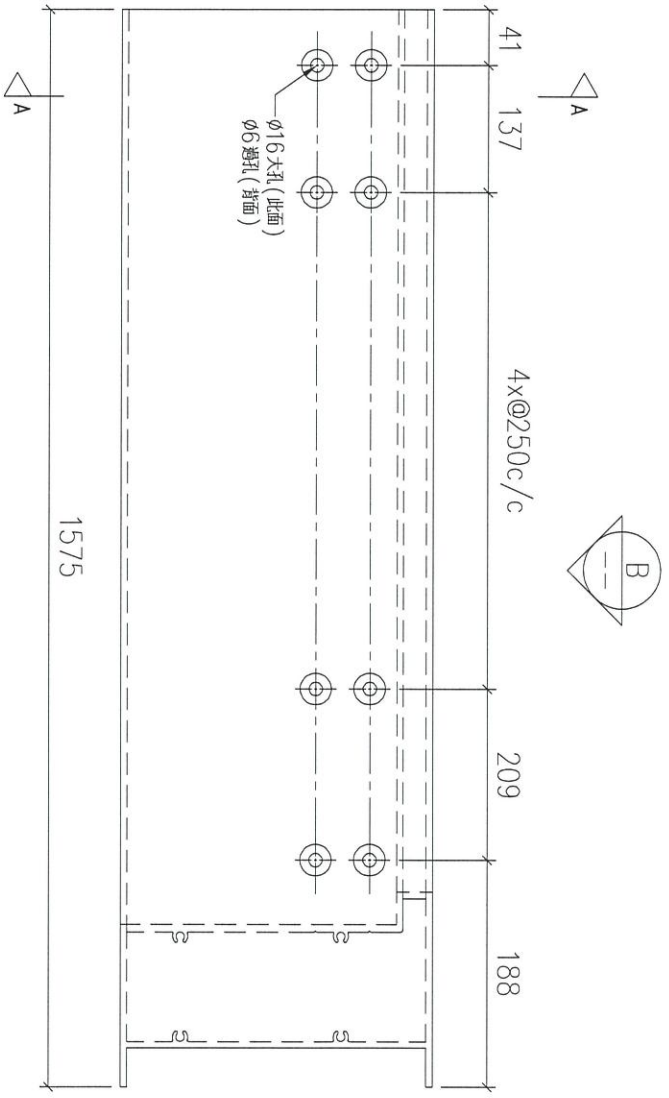


序號	物料編號	數量	安裝位置	樓層
01	T5-X86218-12	9	見派位圖	T5 FLAT A 6~16/F


名稱	底橫外飾加工圖	制圖	LHR	2022,08,23	修改	–		
材料	X86218	復核	–	–	日期	–		
顏色	JMQ213457(3coats)	批準			圖號	J853-GB-FAB2-79		


美特鋁質 有限公司
MIDI Aluminium Fabricator Ltd.

工程號	J853	地盤	錦上路 TWP

送工地

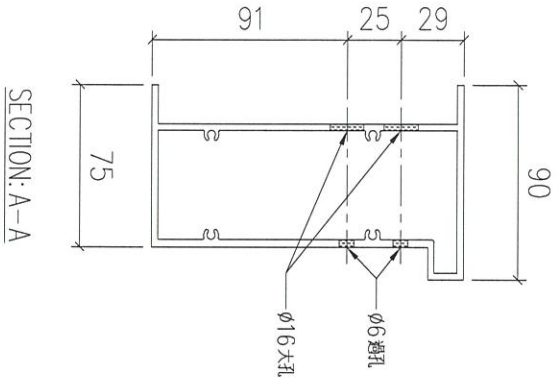

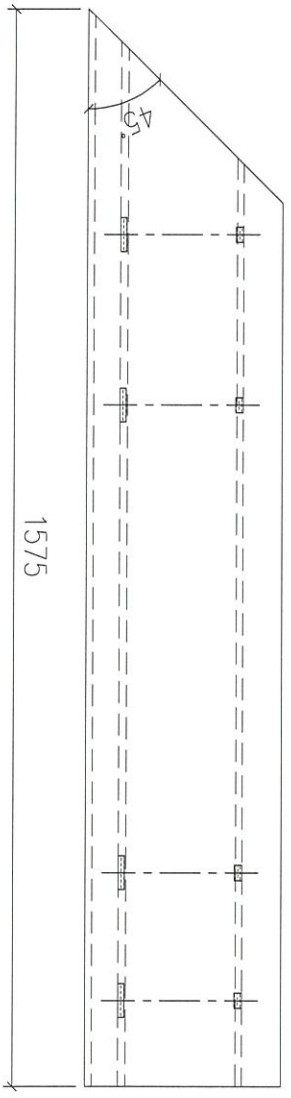

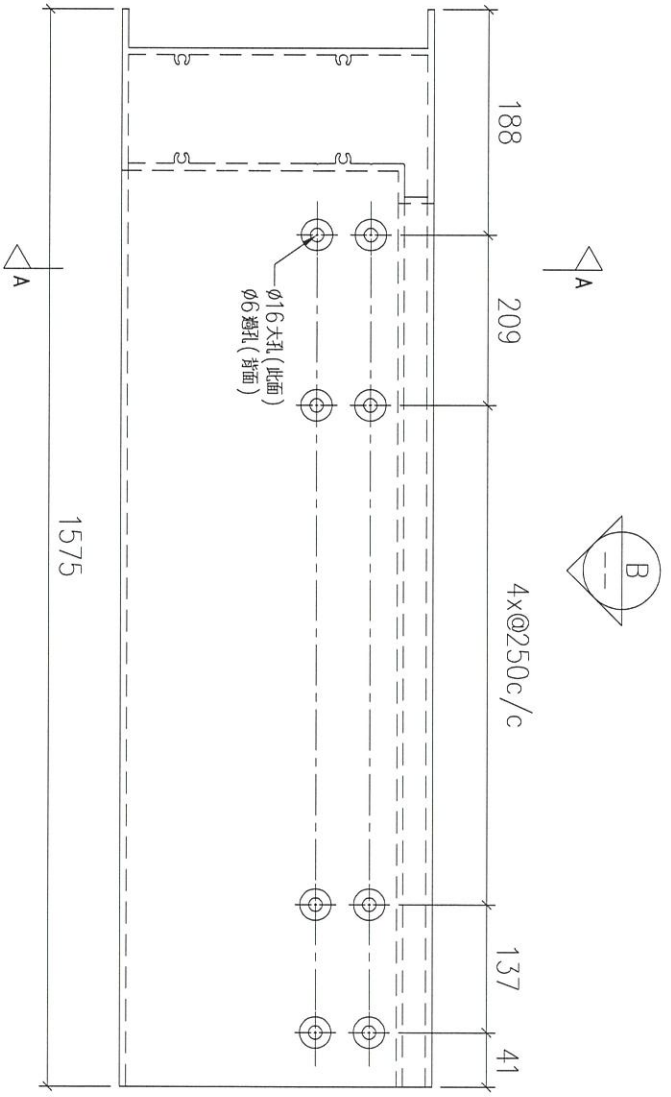


序號	物料編號	數量	安裝位置	樓層
01	T5-X86218-13	9	見派位圖	T5 FLAT B 6~16/F
02	T5-X86218-13	4	見派位圖	T5 FLAT C 11~16/F


名稱	底橫外飾加工圖	制圖	LHR	2022,08,23	修改	–		
材料	X86218	復核	–	–	日期	–		
顏色	JMQ213457(3coats)	批準			圖號	J853-GB-FAB2-80		


美特鋁質 有限公司
MIDI Aluminium Fabricator Ltd.

工程號	J853	地盤	錦上路 ~~Twp~~

送工地

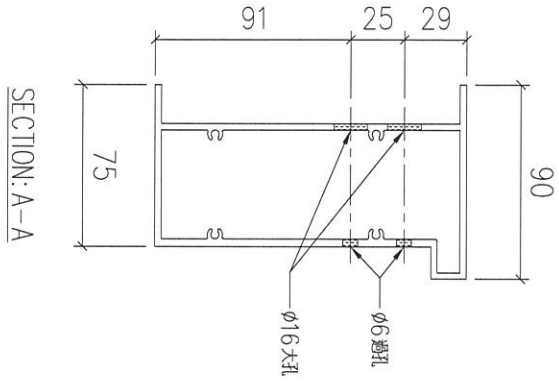

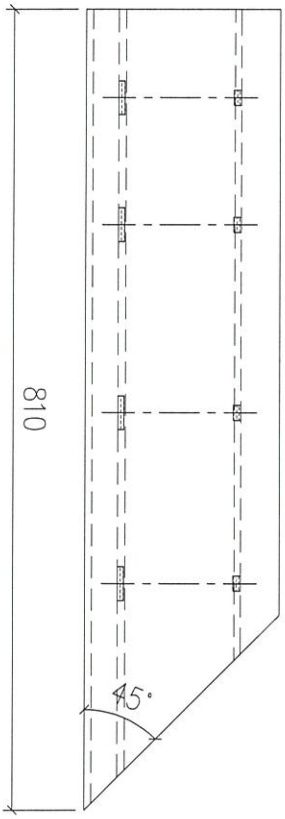

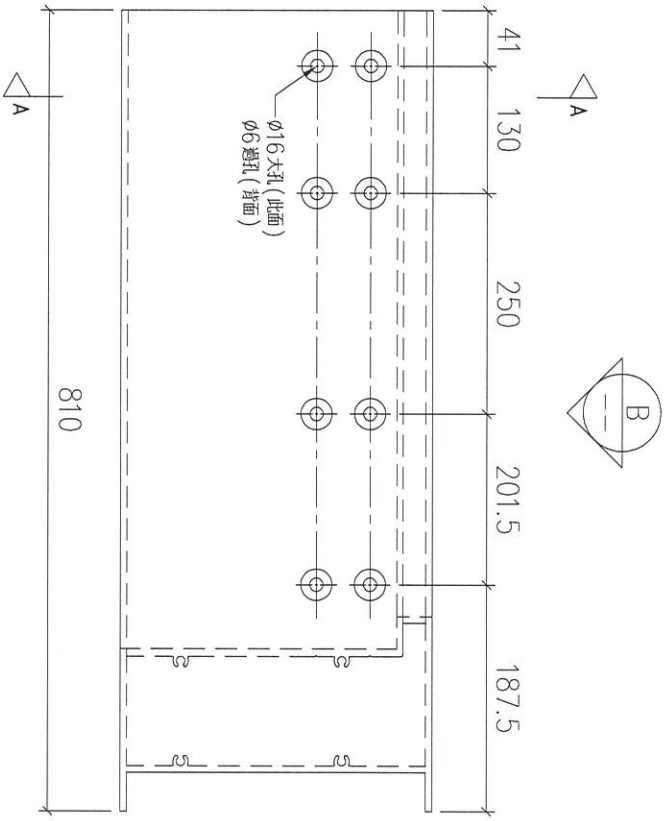


序號	物料編號	數量	安裝位置	樓層
01	T5-X86218-14	8	見派位圖	T5 FLAT A 17~25/F
02	T5-X86218-14	9	見派位圖	T5 FLAT B 6~16/F

名稱	底橫外飾加工圖	制圖	LHR	2022,08,23	修改	–		
材料	X86218	復核	–	–	日期	–		
顏色	JMQ213457(3coats)	批準			圖號	J853-GB-FAB2-81		


美特鋁質 有限公司
MIDI Aluminium Fabricator Ltd.


工程號	J853	地盤	錦上路 ~~Twp~~

送工地

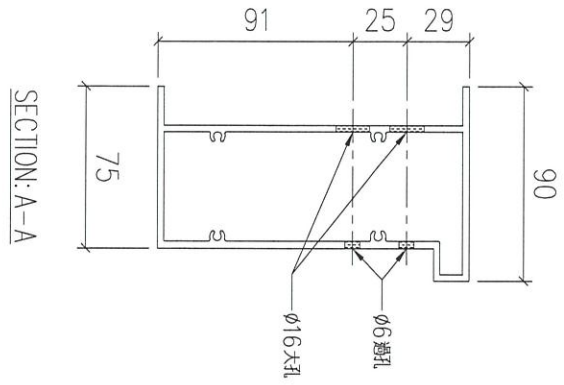

SECTION: A-A

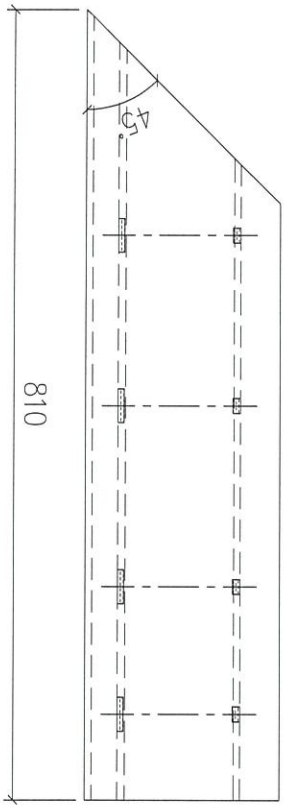

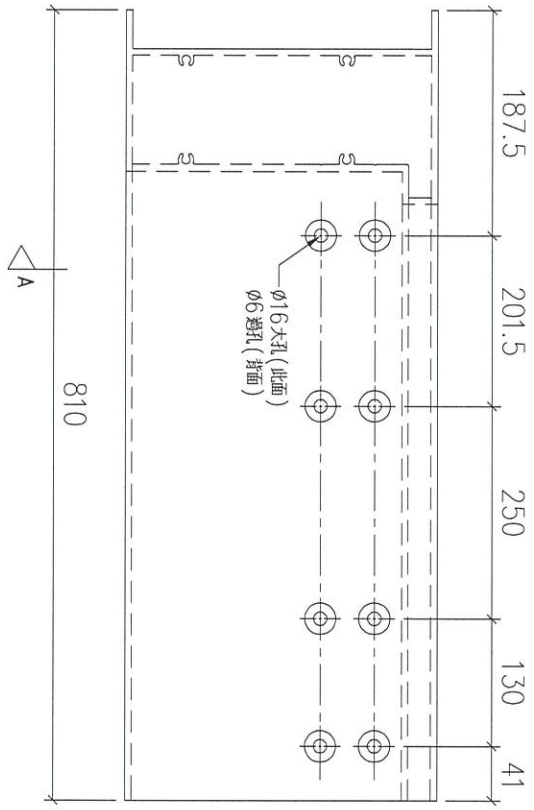


序號	物料編號	數量	安裝位置	樓層
01	T5-X86218-15	9	見派位圖	T5 FLAT A 6~16/F
02	T5-X86218-15	8	見派位圖	T5 FLAT A 17~25/F


名稱	底橫外飾加工圖	制圖	LHR	2022,08,23	修改	–		
材料	X86218	復核	–	–	日期	–		
顏色	JMQ213457(3coats)	批準			圖號	J853-GB-FAB2-82		


美特鋁質 有限公司
MIDI Aluminium Fabricator Ltd.

工程號	J853	地盤	錦上路 TWP

送工地

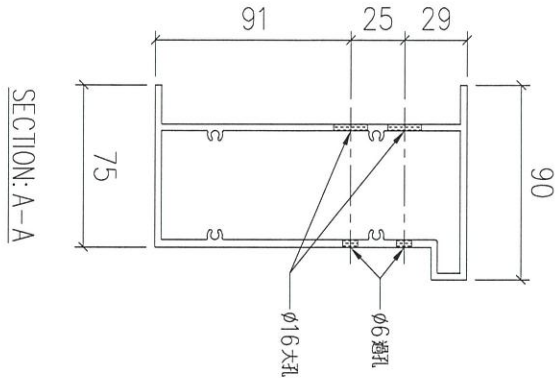

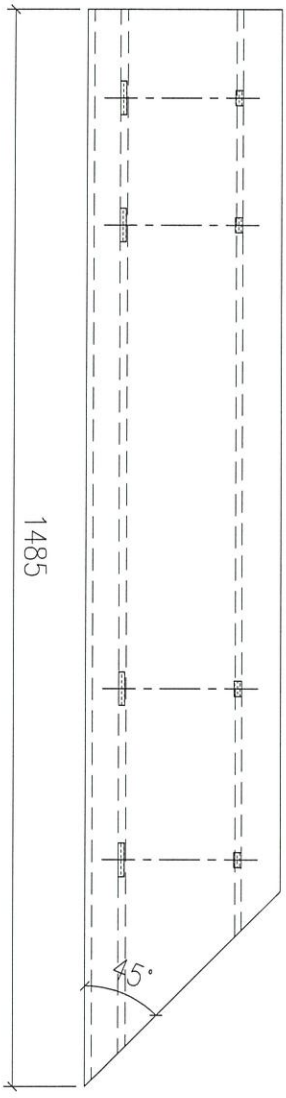

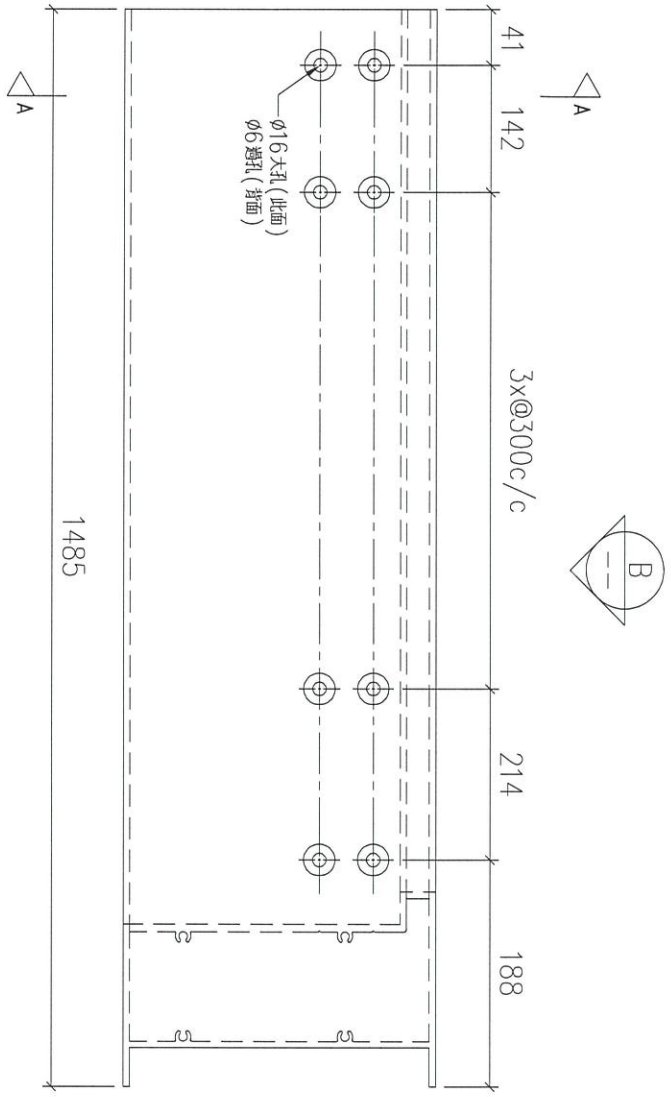


序號	物料編號	數量	安裝位置	樓層
01	T5-X86218-16	8	見派位圖	T5 FLAT B 17~25/F


名稱	底橫外飾加工圖	制圖	LHR	2022,08,23	修改	–		
材料	X86218	復核	–	–	日期	–		
顏色	JMQ213457(3coats)	批準			圖號	J853-GB-FAB2-83		


美特鋁質 有限公司
MIDI Aluminium Fabricator Ltd.

工程號	J853	地盤	錦上路 T3P

送工地

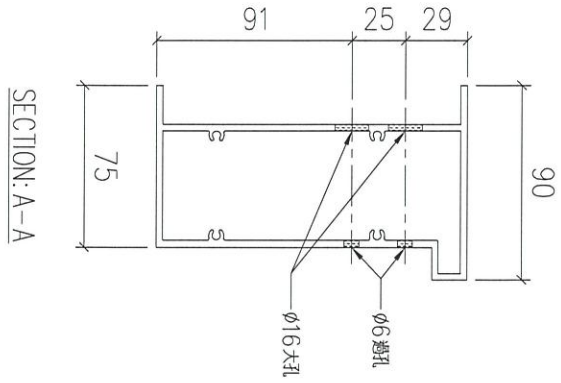

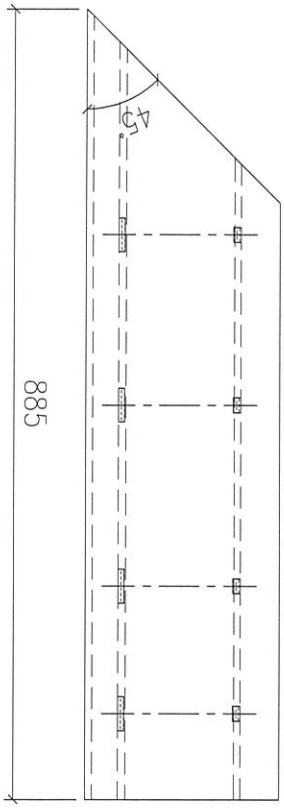

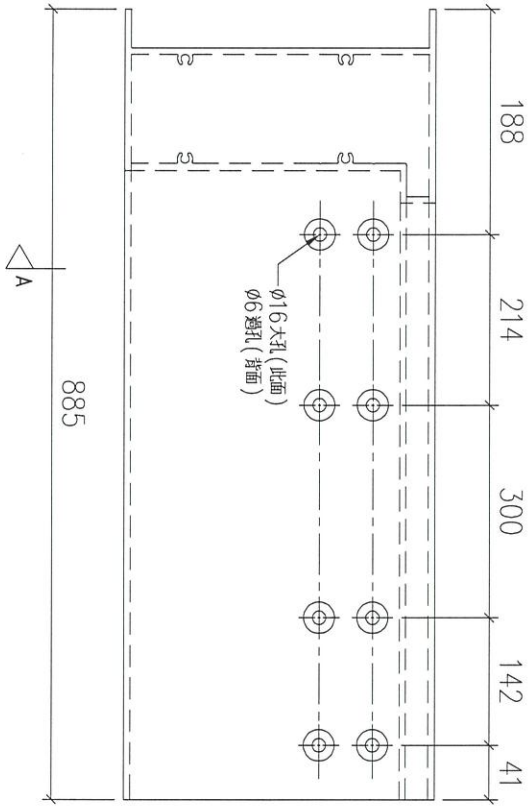


序號	物料編號	數量	安裝位置	樓層
01	T5-X86218-17	4	見派位圖	T5 FLAT D 11~16/F


名稱	底橫外飾加工圖	制圖	LHR	2022,08,23	修改	–		
材料	X86218	復核	–	–	日期	–		
顏色	JMQ213457(3coats)	批準			圖號	J853-GB-FAB2-84		


美特鋁質 有限公司
MIDI Aluminium Fabricator Ltd.

工程號	J853	地盤	~~錦上路~~ TWP

送工地

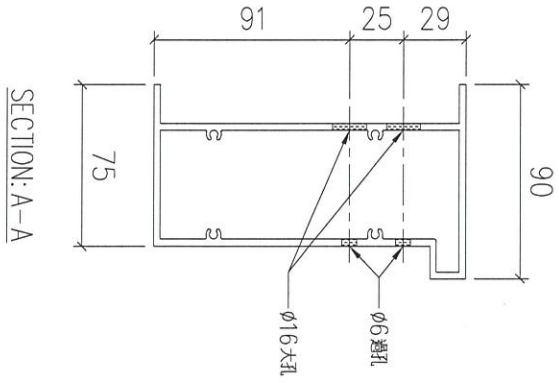

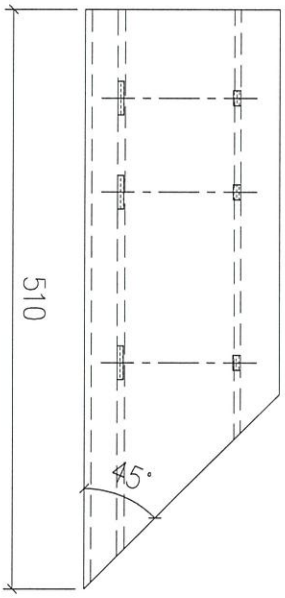

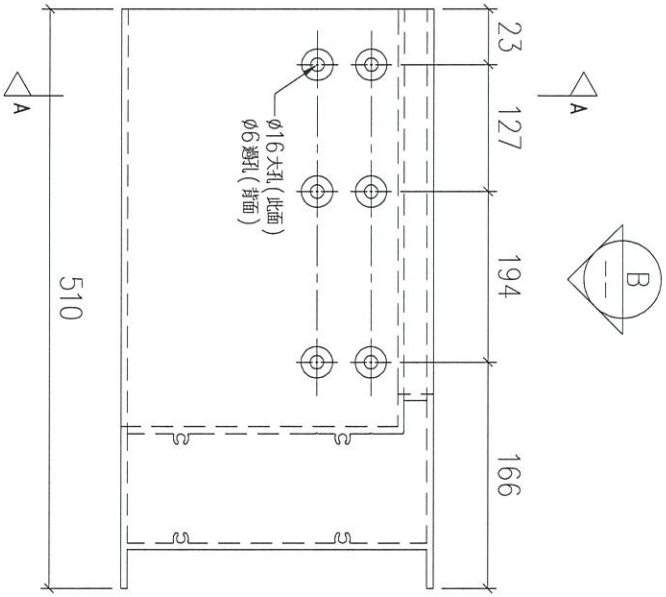


序號	物料編號	數量	安裝位置	樓層
01	T5-X86218-18	4	見派位圖	T5 FLAT C 11~16/F


名稱	底橫外飾加工圖	制圖	LHR	2022,08,23	修改	–		
材料	X86218	復核	–	–	日期	–		
顏色	JMQ213457(3coats)	批準			圖號	J853-GB-FAB2-85		


美特鋁質 有限公司
MIDI Aluminium Fabricator Ltd.

工程號	J853	地盤	錦上路 TWP

送工地

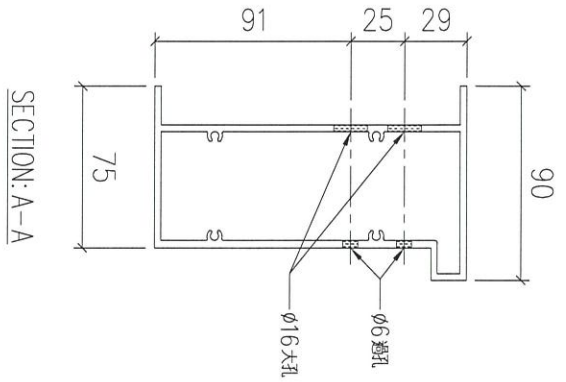

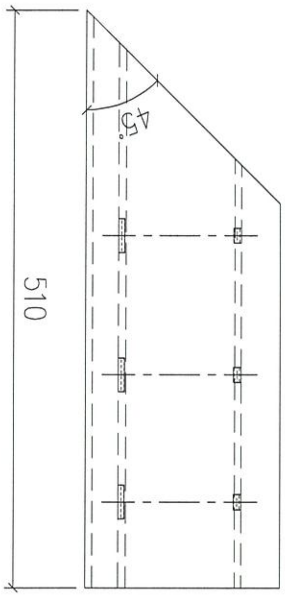

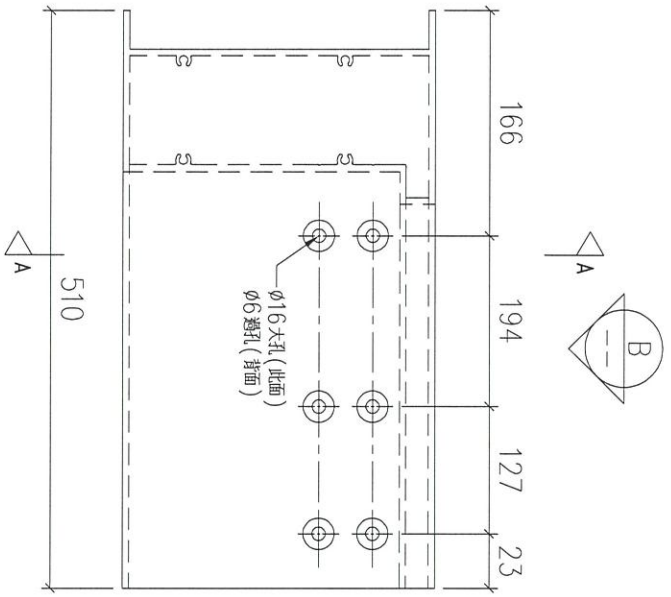


序號	物料編號	數量	安裝位置	樓層
01	T5-X86218-19	8	見派位圖	T5 FLAT B 17~25/F


名稱	底橫外飾加工圖	制圖	LHR	2022,08,23	修改	–		
材料	X86218	復核	–	–	日期	–		
顏色	JMQ213457(3coats)	批準			圖號	J853-GB-FAB2-86		


美特鋁質 有限公司
MIDI Aluminium Fabricator Ltd.

工程號	J853	地盤	錦上路 TWP

送工地

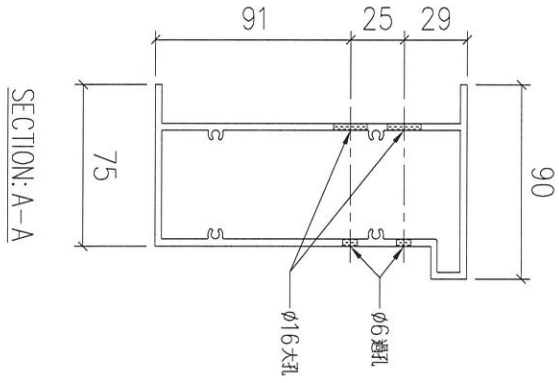

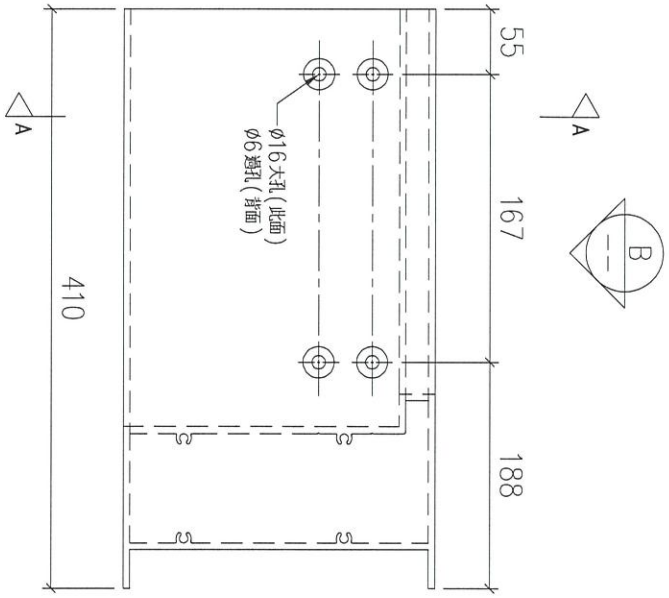

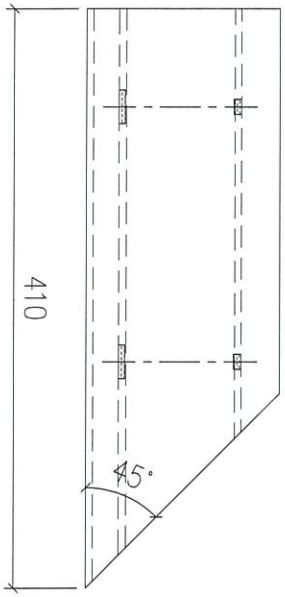


序號	物料編號	數量	安裝位置	樓層
01	T5-X86218-20	13	見派位圖	T5 FLAT E/F 11~26/F

名稱	底橫外飾加工圖	制圖	LHR	2022,08,23	修改	–		
材料	X86218	復核	–	–	日期	–		
顏色	JMQ213457(3coats)	批準			圖號	J853-GB-FAB2-87		


美特鋁質 有限公司
MIDI Aluminium Fabricator Ltd.

工程號	J853	地盤	錦上路 T3P


送工地

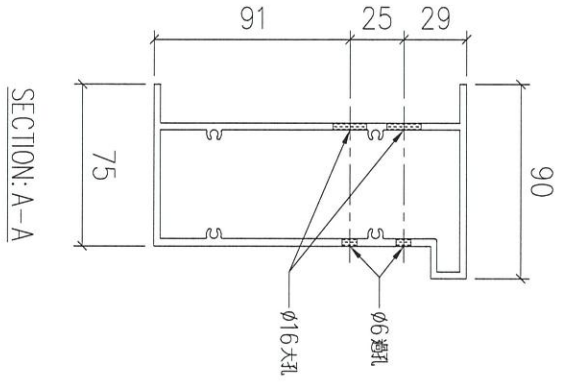

SECTION: A-A

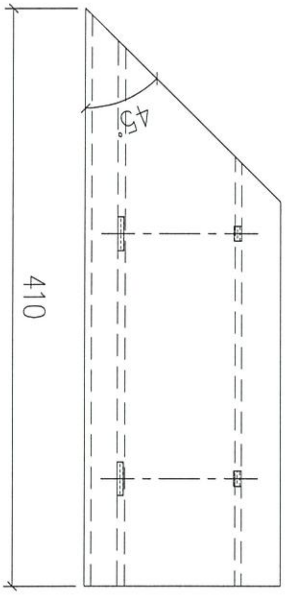

VIEW B

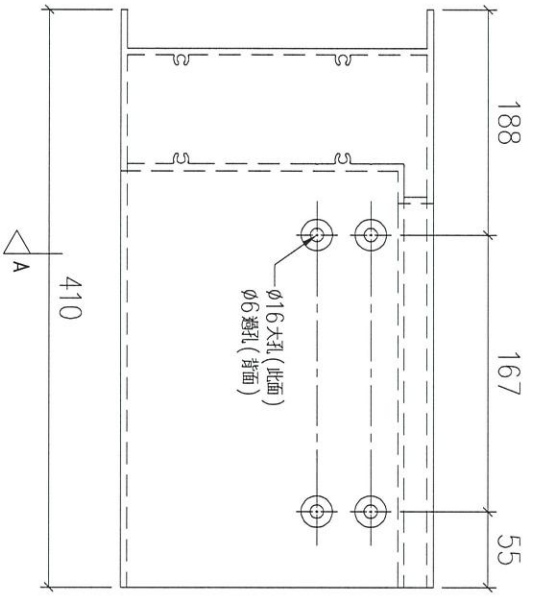


序號	物料編號	數量	安裝位置	樓層
01	T5-X86218-21	13	見派位圖	T5 FLAT E/F 11~26/F


名稱	底橫外飾加工圖	制圖	LHR	2022,08,23	修改	–		
材料	X86218	復核	–	–	日期	–		
顏色	JMQ213457(3coats)	批準			圖號	J853-GB-FAB2-88		


美特鋁質 有限公司
MIDI Aluminium Fabricator Ltd.

工程號	J853	地盤	錦上路 TWP

送工地

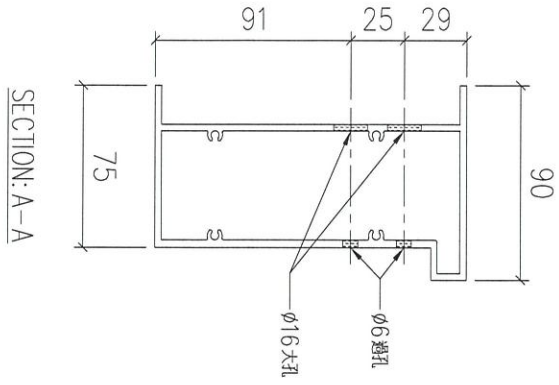

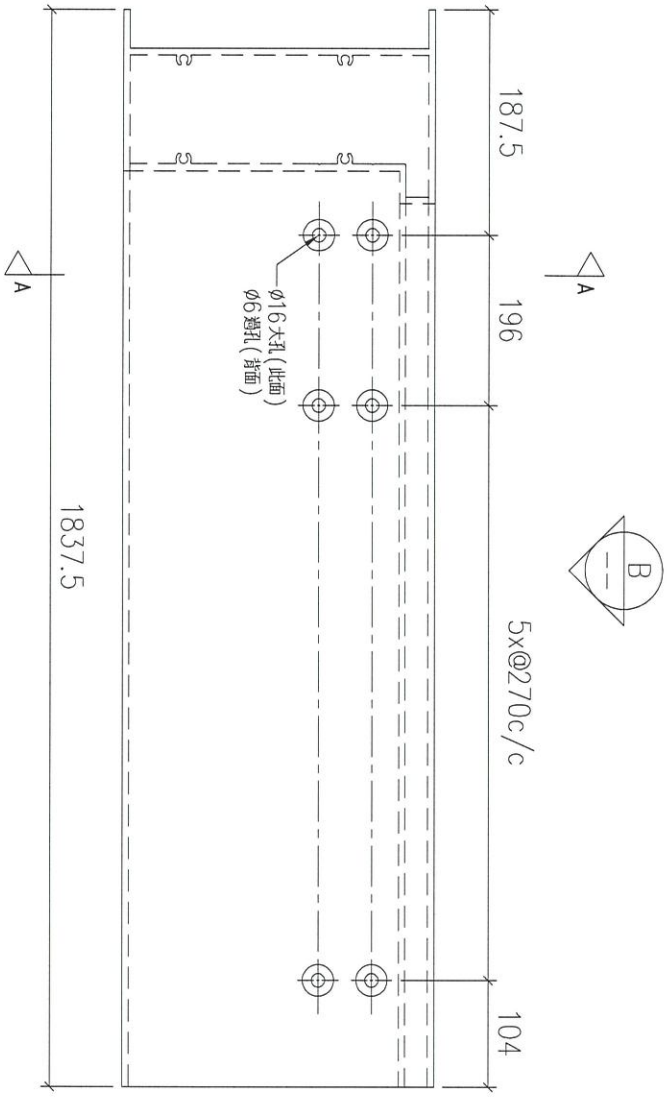

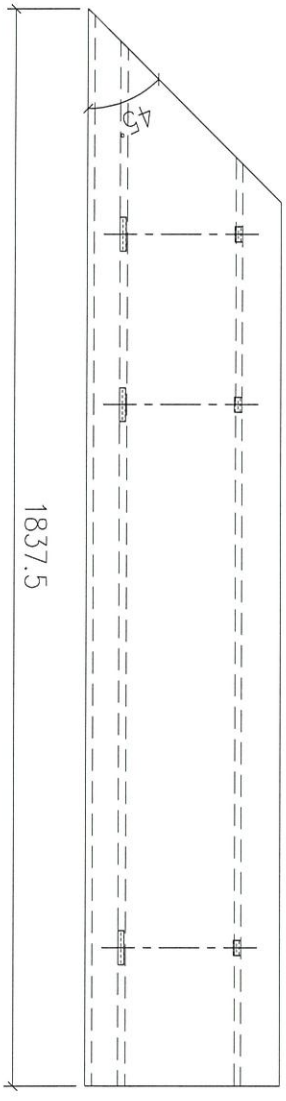


序號	物料編號	數量	安裝位置	樓層
01	T6-X86218-01	18	見派位圖	T6 FLAT A 5,6,8~26/F
02	T6-X86218-01	18	見派位圖	T6 FLAT B 5,6,8~26/F
03	T7-X86218-01	17	見派位圖	T7 FLAT A 7~26/F

名稱	底橫外飾加工圖	制圖	LHR	2022,08,23	修改	–		
材料	X86218	復核	–	–	日期	–		
顏色	JMQ213457(3coats)	批準			圖號	J853-GB-FAB2-89		


美特鋁質 有限公司
MIDI Aluminium Fabricator Ltd.

工程號	J853	地盤	錦上路 TWF


送工地

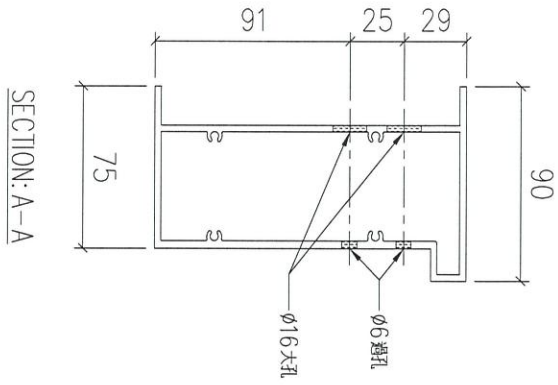

SECTION: A-A

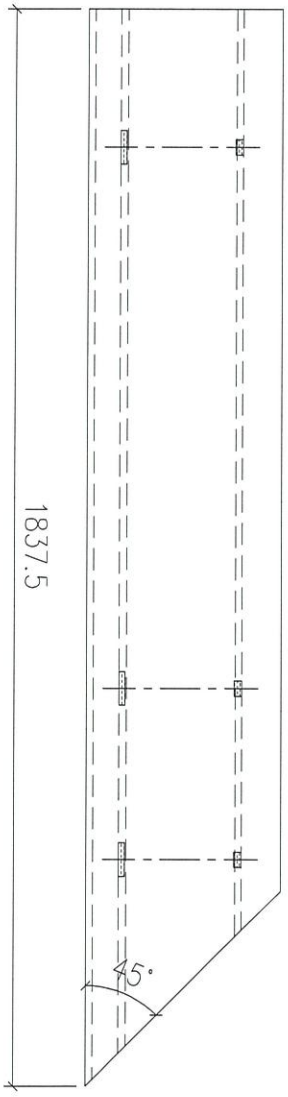

VIEW B

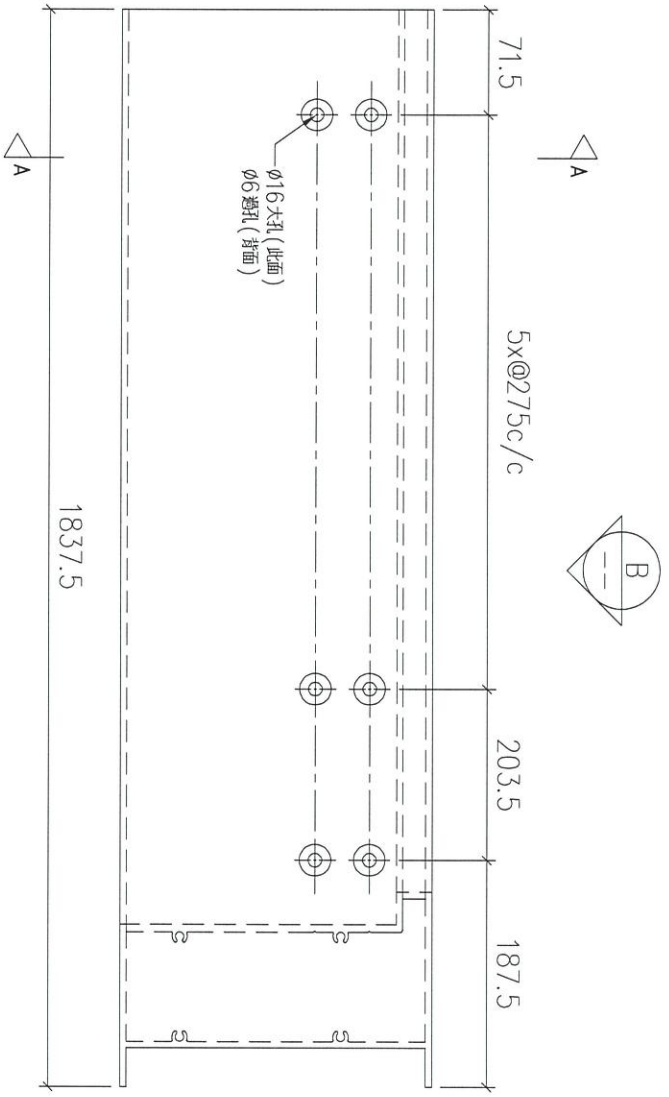


序號	物料編號	數量	安裝位置	樓層
01	T6-X86218-02	18	見派位圖	T6 FLAT A 5,6,8~26/F
02	T6-X86218-02	18	見派位圖	T6 FLAT B 5,6,8~26/F
03	T7-X86218-02	17	見派位圖	T7 FLAT A 7~26/F


名稱	底橫外飾加工圖	制圖	LHR	2022,08,23	修改	–		
材料	X86218	復核	–	–	日期	–		
顏色	JMQ213457(3coats)	批準			圖號	J853-GB-FAB2-90		


美特鋁質 有限公司
MIDI Aluminium Fabricator Ltd.

工程號	J853	地盤	錦上路 Twf

送工地

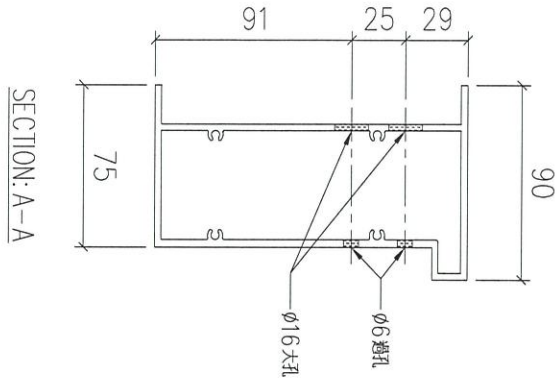

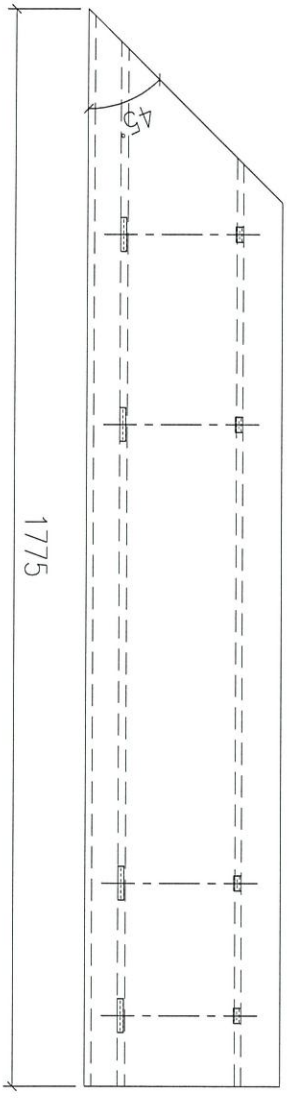

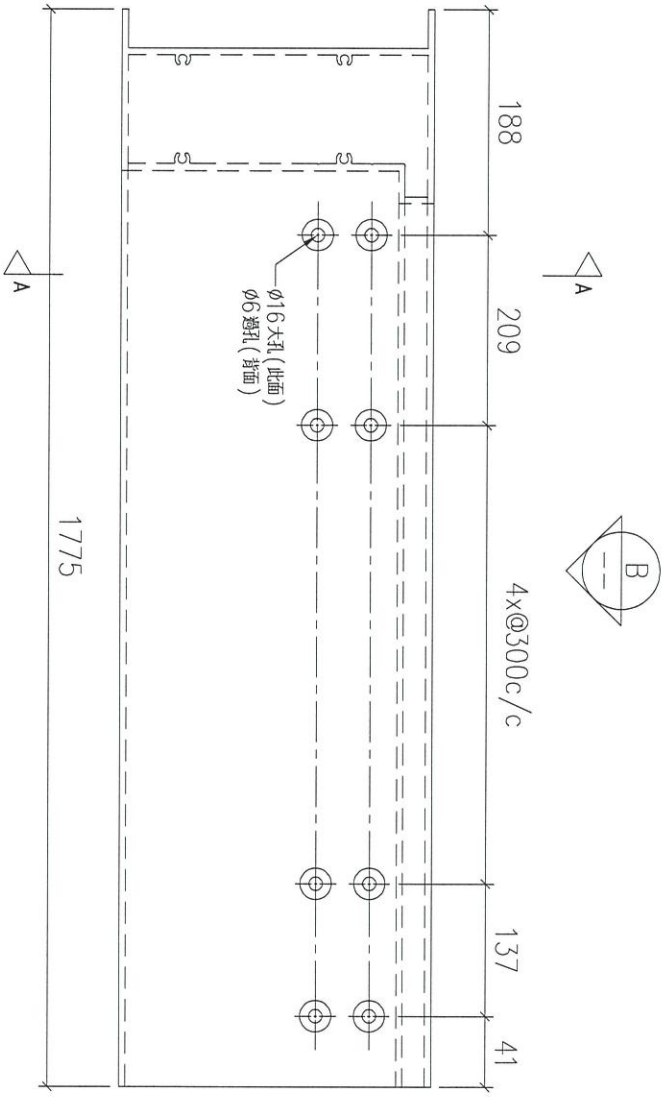


序號	物料編號	數量	安裝位置	樓層
01	T6-X86218-05	18	見派位圖	T6 FLAT A 5,6,8~26/F
02	T7-X86218-03	15	見派位圖	T7 FLAT B 7~23/F

名稱	底橫外飾加工圖	制圖	LHR	2022,08,23	修改	–		
材料	X86218	復核	–	–	日期	–		
顏色	JMQ213457(3coats)	批準			圖號	J853-GB-FAB2-91		


美特鋁質 有限公司
MIDI Aluminium Fabricator Ltd.


工程號	J853	地盤	~~錦上路~~ TWP

送工地

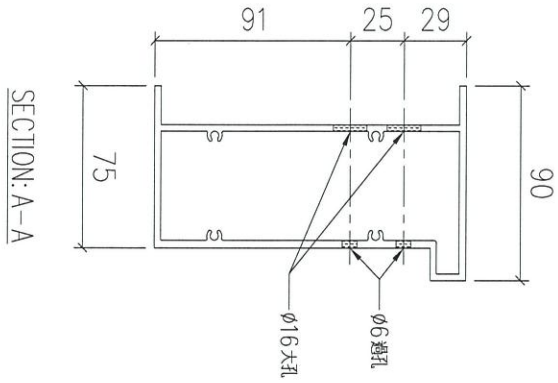

SECTION: A-A

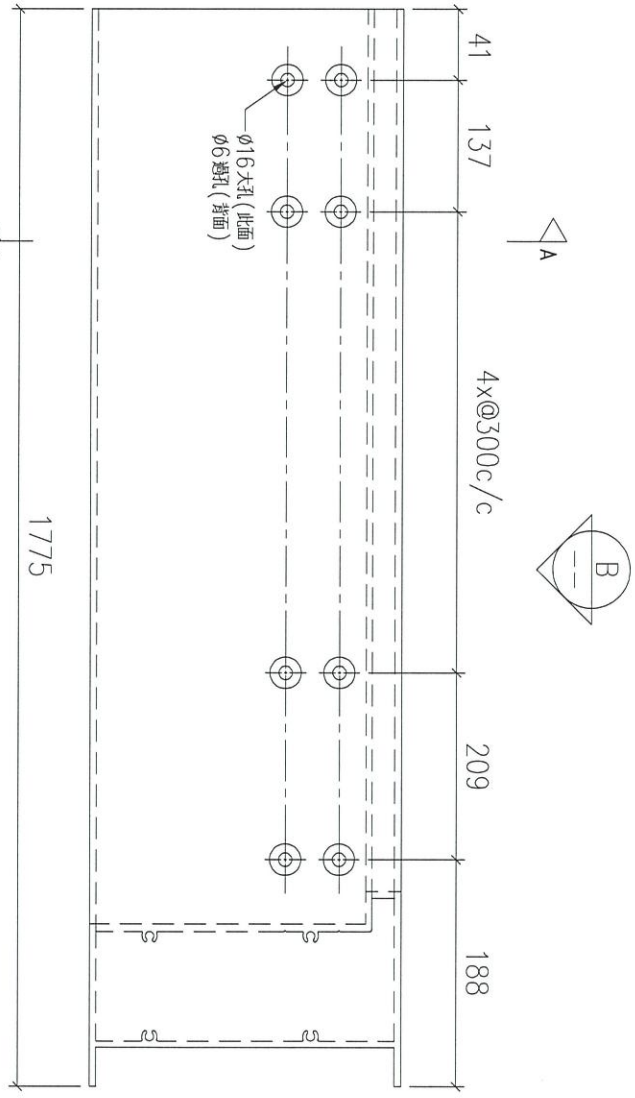

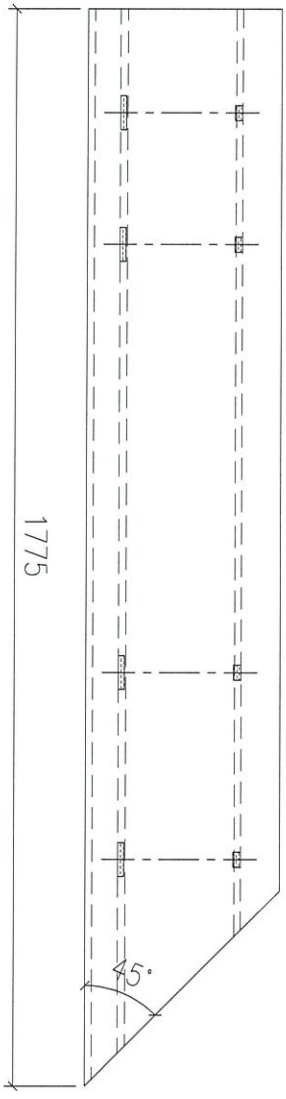

VIEW B


序號	物料編號	數量	安裝位置	樓層
01	T6-X86218-06	18	見派位圖	T6 FLAT B 5,6,8~26/F
02	T7-X86218-04	17	見派位圖	T7 FLAT A 7~26/F


名稱	底橫外飾加工圖	制圖	LHR	2022,08,23	修改	–		
材料	X86218	復核	–	–	日期	–		
顏色	JMQ213457(3coats)	批準			圖號	J853-GB-FAB2-92		


美特鋁質 有限公司
MIDI Aluminium Fabricator Ltd.

工程號	J853	地盤	~~錦上路~~ T3P

送工地

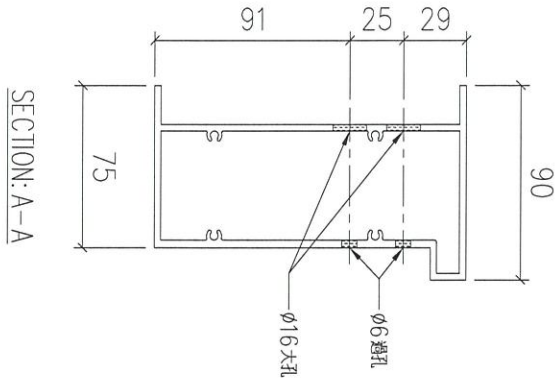

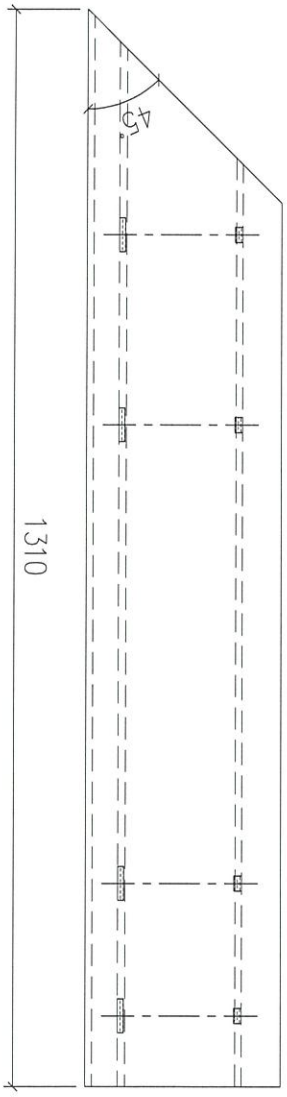

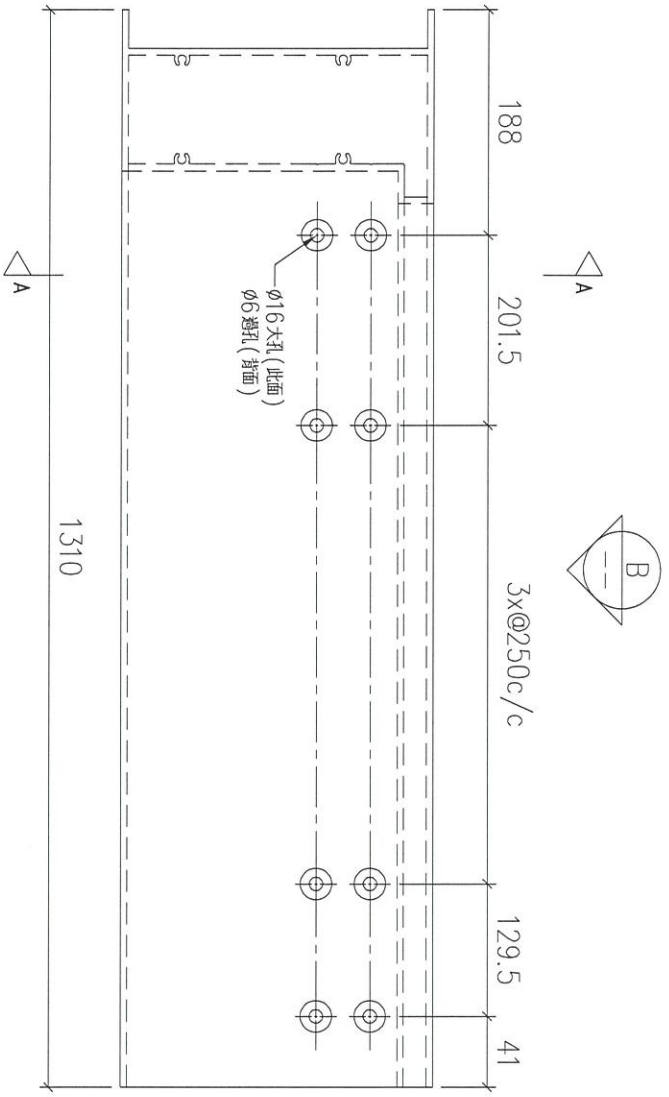


序號	物料編號	數量	安裝位置	樓層
01	T7-X86218-05	17	見派位圖	T7 FLAT A 7~26/F


名稱	底橫外飾加工圖	制圖	LHR	2022,08,23	修改	–		
材料	X86218	復核	–	–	日期	–		
顏色	JMQ213457(3coats)	批準			圖號	J853-GB-FAB2-93		


美特鋁質 有限公司
MIDI Aluminium Fabricator Ltd.

工程號	J853	地盤	錦上路 TWP

送工地

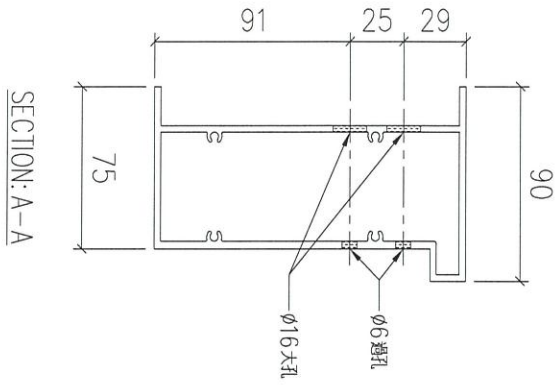

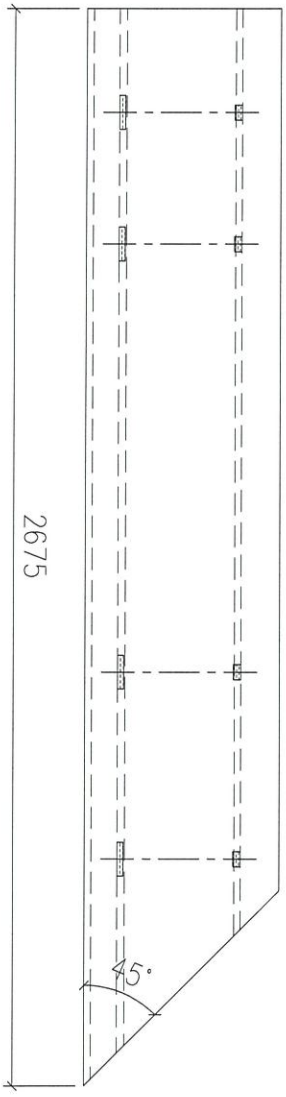

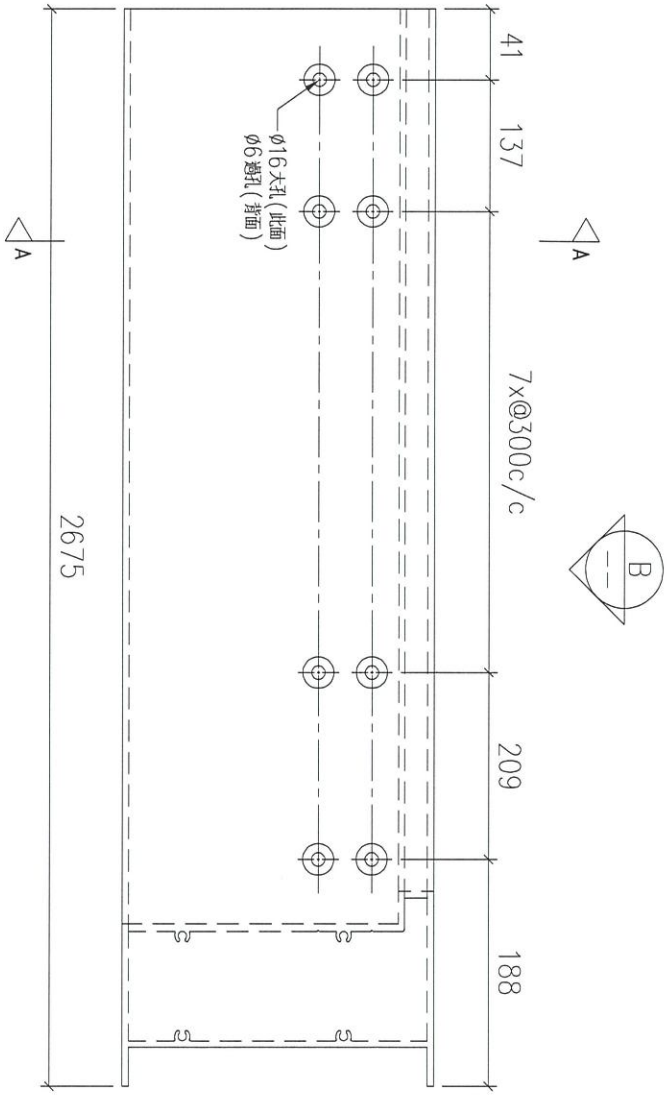


序號	物料編號	數量	安裝位置	樓層
01	T7-X86218-06	15	見派位圖	T7 FLAT B 7~23/F


名稱	底橫外飾加工圖	制圖	LHR	2022,08,23	修改	–		
材料	X86218	復核	–	–	日期	–		
顏色	JMQ213457(3coats)	批準			圖號	J853-GB-FAB2-94		


美特鋁質 有限公司
MIDI Aluminium Fabricator Ltd.

工程號	J853	地盤	錦上路 TWP

送工地

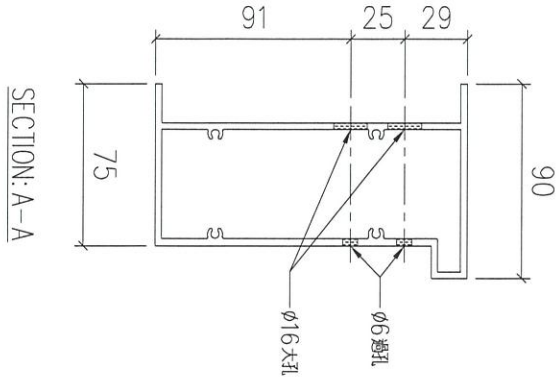

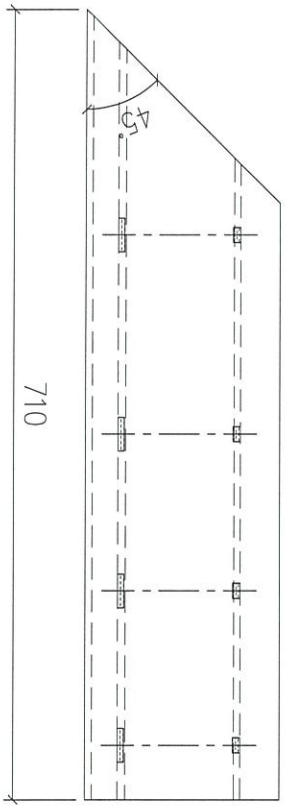

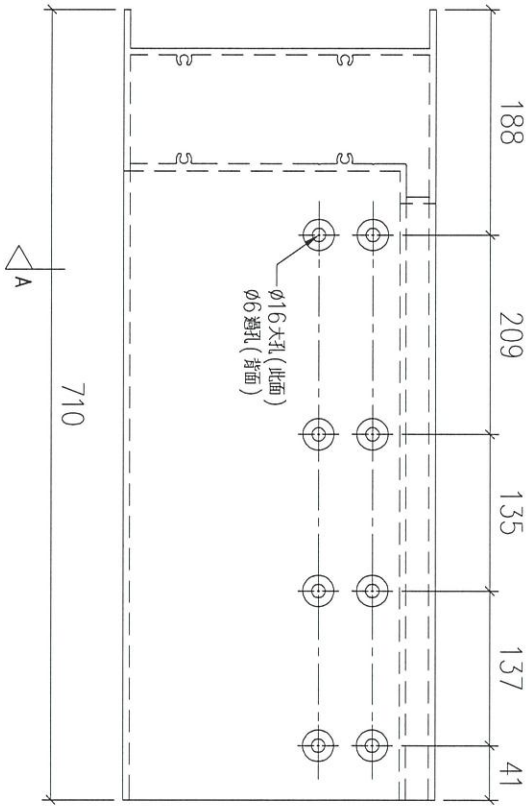


序號	物料編號	數量	安裝位置	樓層
01	T6-X86218-07	18	見派位圖	T6 FLAT B 5,6,8~26/F


名稱	底橫外飾加工圖	制圖	LHR	2022,08,23	修改	–		
材料	X86218	復核	–	–	日期	–		
顏色	JMQ213457(3coats)	批準			圖號	J853-GB-FAB2-95		


美特鋁質 有限公司
MIDI Aluminium Fabricator Ltd.

工程號	J853	地盤	~~錦上路~~ Twp

送工地

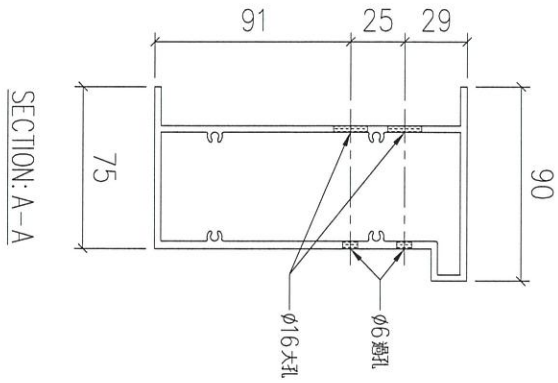

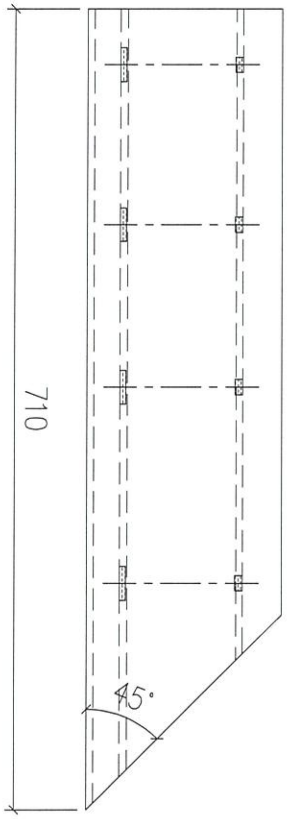

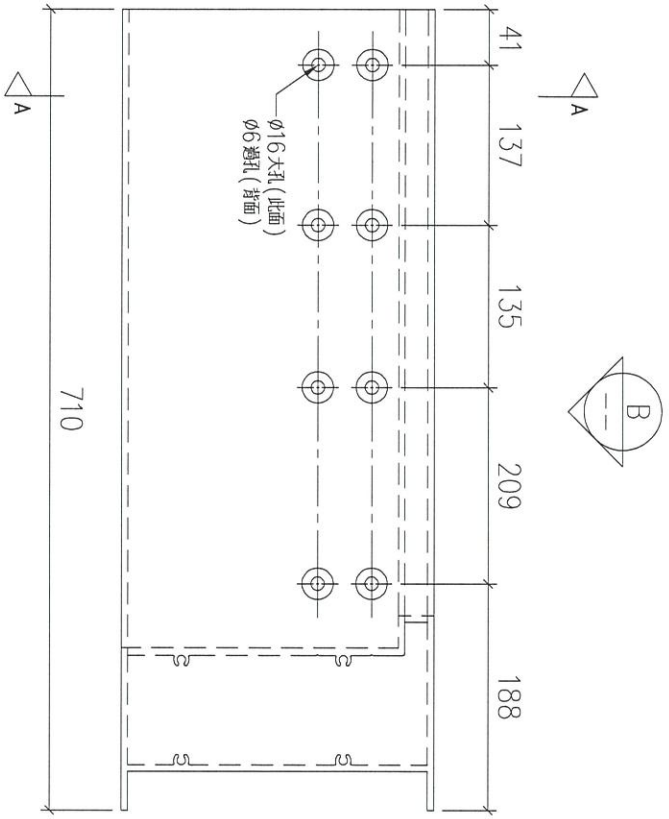


序號	物料編號	數量	安裝位置	樓層
01	T6-X86218-08	18	見派位圖	T6 FLAT A 5,6,8~26/F


名稱	底橫外飾加工圖	制圖	LHR	2022,08,23	修改	–		
材料	X86218	復核	–	–	日期	–		
顏色	JMQ213457(3coats)	批準			圖號	J853-GB-FAB2-96		


美特鋁質 有限公司
MIDI Aluminium Fabricator Ltd.


工程號	J853	地盤	錦上路 Tsuen

送工地

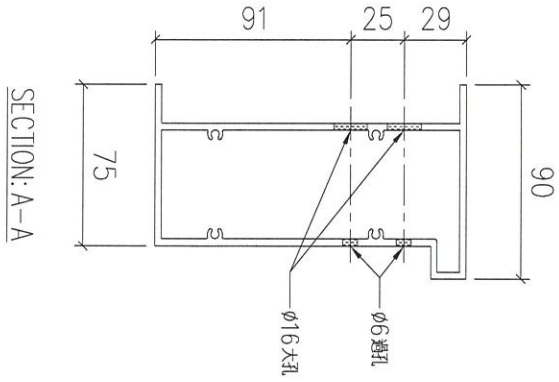

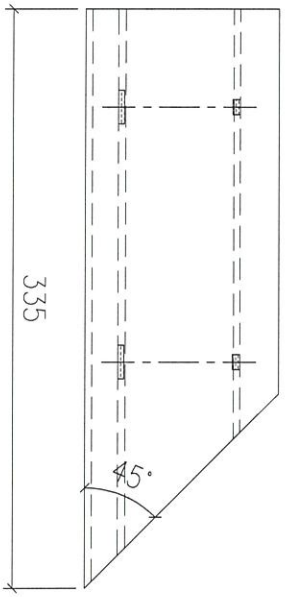

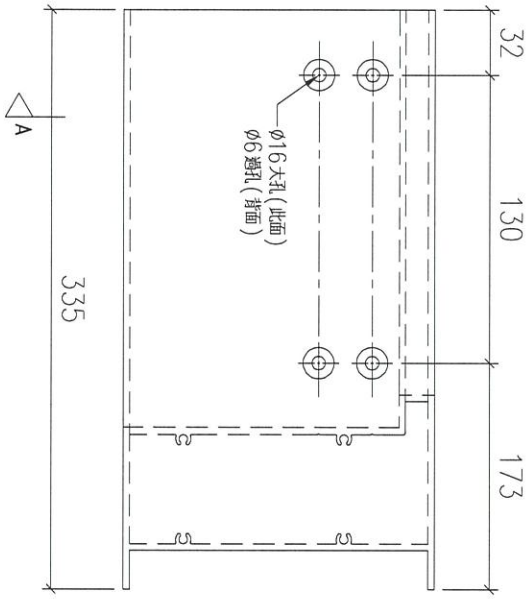

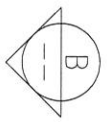


序號	物料編號	數量	安裝位置	樓層
01	T6-X86218-09	14	見派位圖	T6 FLAT C/D 10~26/F


名稱	底橫外飾加工圖	制圖	LHR	2022,08,23	修改	–		
材料	X86218	復核	–	–	日期	–		
顏色	JMQ213457(3coats)	批準			圖號	J853-GB-FAB2-97		


美特鋁質 有限公司
MIDI Aluminium Fabricator Ltd.

工程號	J853	地盤	錦上路 TWP

送工地

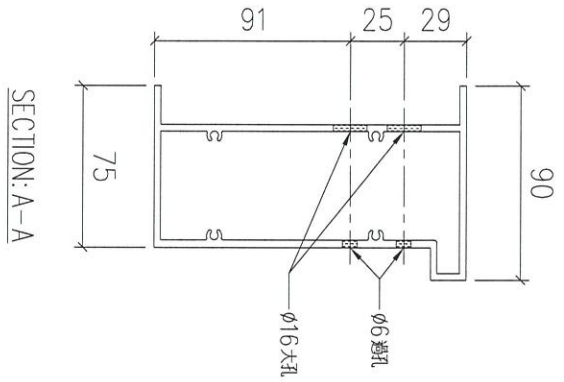

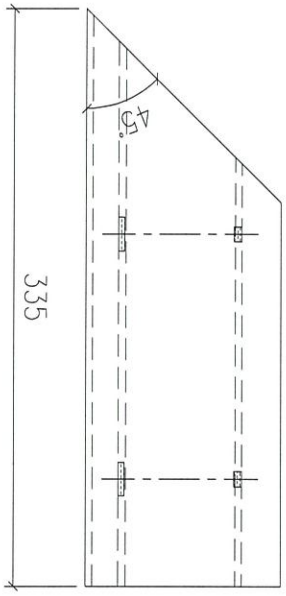


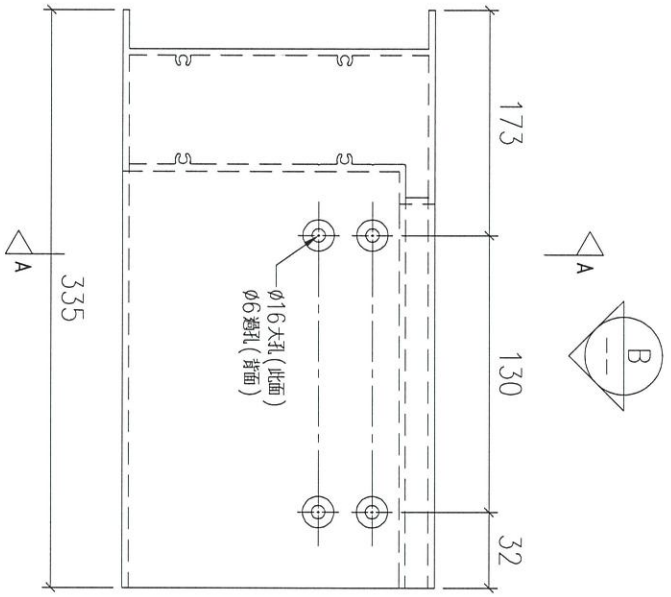


序號	物料編號	數量	安裝位置	樓層
01	T6-X86218-10	14	見派位圖	T6 FLAT C/D 10~26/F

名稱	底橫外飾加工圖	制圖	LHR	2022,08,23	修改	–		
材料	X86218	復核	–	–	日期	–		
顏色	JMQ213457(3coats)	批準			圖號	J853-GB-FAB2-98		

送工地

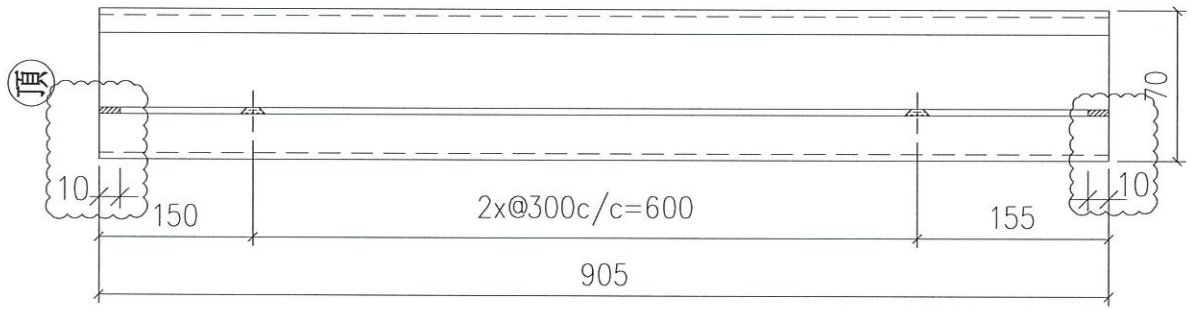

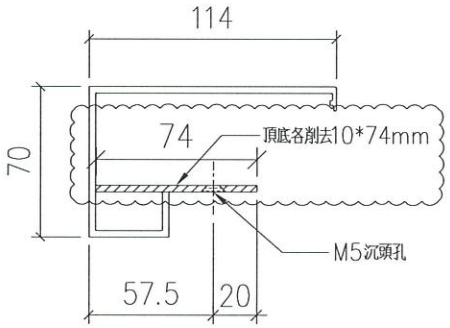


序號	物料編號	數量	安裝位置	樓層
01	T5-X86225-01	27	見派位圖	T5 FLAT A 6~16/F
02	T5-X86225-01	24	見派位圖	T5 FLAT A 17~25/F
03	T5-X86225-01	27	見派位圖	T5 FLAT B 6~16/F
04	T5-X86225-01	24	見派位圖	T5 FLAT B 17~25/F
05	T5-X86225-01	12	見派位圖	T5 FLAT C 11~16/F
06	T5-X86225-01	8	見派位圖	T5 FLAT D 11~16/F
07	T5-X86225-01	39	見派位圖	T5 FLAT E/F 11~26/F
08	T6-X86225-01	54	見派位圖	T6 FLAT A 5,6,8~26/F
09	T6-X86225-01	54	見派位圖	T6 FLAT B 5,6,8~26/F
10	T6-X86225-01	42	見派位圖	T6 FLAT C/D 10~26/F
11	T7-X86225-01	51	見派位圖	T7 FLAT A 7~26/F
12	T7-X86225-01	30	見派位圖	T7 FLAT B 7~23/F
		392		


美特鋁質 有限公司
MIDI Aluminium Fabricator Ltd.

工程號	J853	地盤	錦上路

名稱	企料加工圖	制圖	LHR	2022,08,29	修改	A	
材料	X86225	復核	—	—	日期	2023.2.21	
顏色	JMQ213457(3coats)	批准			圖號	J853-GB-FAB2-103	

送工地

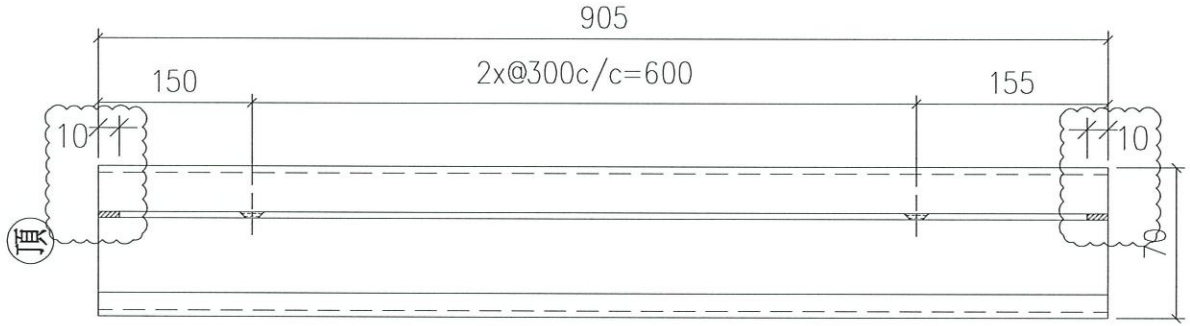

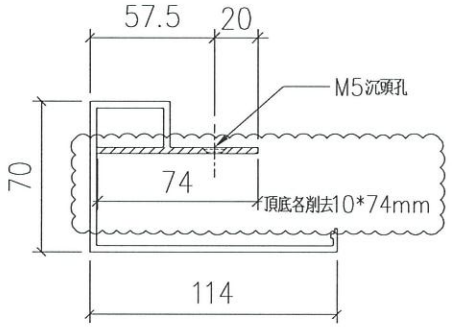


序號	物料編號	數量	安裝位置	樓層
01	T5-X86225-02	27	見派位圖	T5 FLAT A 6~16/F
02	T5-X86225-02	24	見派位圖	T5 FLAT A 17~25/F
03	T5-X86225-02	27	見派位圖	T5 FLAT B 6~16/F
04	T5-X86225-02	24	見派位圖	T5 FLAT B 17~25/F
05	T5-X86225-02	12	見派位圖	T5 FLAT C 11~16/F
06	T5-X86225-02	8	見派位圖	T5 FLAT D 11~16/F
07	T5-X86225-02	39	見派位圖	T5 FLAT E/F 11~26/F
08	T6-X86225-02	54	見派位圖	T6 FLAT A 5,6,8~26/F
09	T6-X86225-02	54	見派位圖	T6 FLAT B 5,6,8~26/F
10	T6-X86225-02	42	見派位圖	T6 FLAT C/D 10~26/F
11	T7-X86225-02	51	見派位圖	T7 FLAT A 7~26/F
12	T7-X86225-02	30	見派位圖	T7 FLAT B 7~23/F
		392		


美特鋁質 有限公司
MIDI Aluminium Fabricator Ltd.

工程號	J853	地盤	錦上路

修改	A		
日期	2023.2.21		
圖號	J853-GB-FAB2-104		
制圖	LHR	2022,08,29	
復核	-	-	
批準			
名稱	金料加工圖		
材料	X86225		
顏色	JMQ213457(3coats)		

送工地

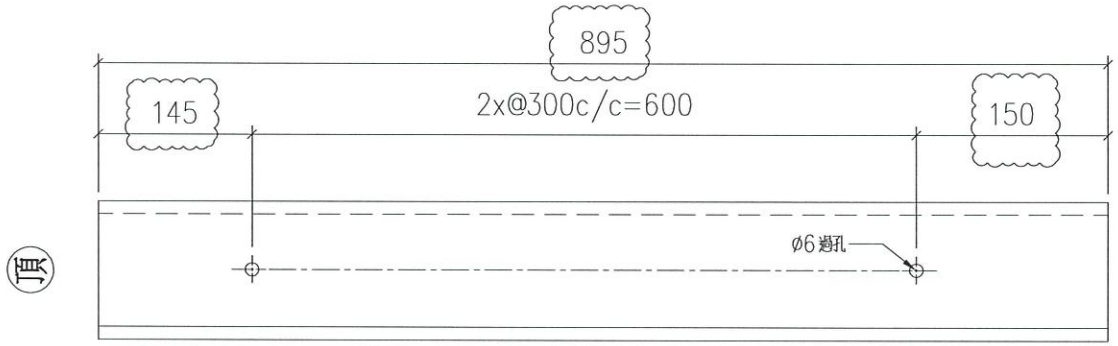

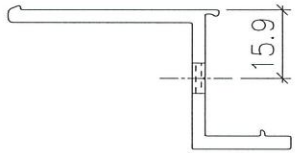


序號	物料編號	數量	安裝位置	樓層
01	T5-X86226-01	27	見派位圖	T5 FLAT A 6~16/F
02	T5-X86226-01	24	見派位圖	T5 FLAT A 17~25/F
03	T5-X86226-01	27	見派位圖	T5 FLAT B 6~16/F
04	T5-X86226-01	24	見派位圖	T5 FLAT B 17~25/F
05	T5-X86226-01	12	見派位圖	T5 FLAT C 11~16/F
06	T5-X86226-01	8	見派位圖	T5 FLAT D 11~16/F
07	T5-X86226-01	39	見派位圖	T5 FLAT E/F 11~26/F
08	T6-X86226-01	54	見派位圖	T6 FLAT A 5,6,8~26/F
09	T6-X86226-01	54	見派位圖	T6 FLAT B 5,6,8~26/F
10	T6-X86226-01	42	見派位圖	T6 FLAT C/D 10~26/F
11	T7-X86226-01	51	見派位圖	T7 FLAT A 7~26/F
12	T7-X86226-01	30	見派位圖	T7 FLAT B 7~23/F
		392		


美特鋁質 有限公司
MIDI Aluminium Fabricator Ltd.

工程號	J853	地盤	錦上路

修改	A		
日期	2023.2.21		
圖號	J853-GB-FAB2-105		
制圖	LHR	2022,08,29	
復核	—	—	
批準			
名稱	全料加工圖		
材料	X86226		
顏色	MILL		

送工地

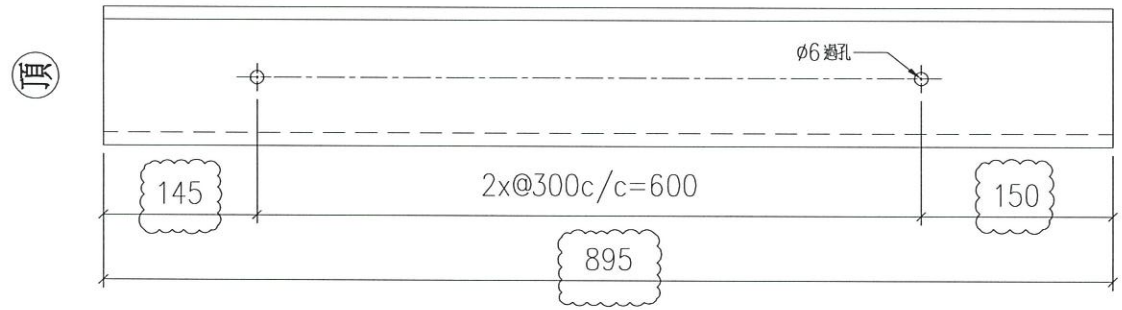

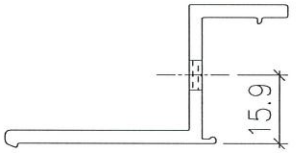

序號	物料編號	數量	安裝位置	樓層
01	T5-X86226-02	27	見派位圖	T5 FLAT A 6~16/F
02	T5-X86226-02	24	見派位圖	T5 FLAT A 17~25/F
03	T5-X86226-02	27	見派位圖	T5 FLAT B 6~16/F
04	T5-X86226-02	24	見派位圖	T5 FLAT B 17~25/F
05	T5-X86226-02	12	見派位圖	T5 FLAT C 11~16/F
06	T5-X86226-02	8	見派位圖	T5 FLAT D 11~16/F
07	T5-X86226-02	39	見派位圖	T5 FLAT E/F 11~26/F
08	T6-X86226-02	54	見派位圖	T6 FLAT A 5,6,8~26/F
09	T6-X86226-02	54	見派位圖	T6 FLAT B 5,6,8~26/F
10	T6-X86226-02	42	見派位圖	T6 FLAT C/D 10~26/F
11	T7-X86226-02	51	見派位圖	T7 FLAT A 7~26/F
12	T7-X86226-02	30	見派位圖	T7 FLAT B 7~23/F
		392		

美特鋁質 有限公司
MIDI Aluminium Fabricator Ltd.

工程號	J853	地盤	錦上路

修改	A		
日期	2023.2.21		
圖號	J853-GB-FAB2-106		
制圖	LHR	2022,08,29	修改
復核	–	–	日期
批準			圖號


名稱	金料加工圖
材料	X86226
顏色	MILL


美特鋁質 有限公司
MIDI Aluminium Fabricator Ltd.

工程號	J853	地盤	錦上路 Twp

送工地

頂

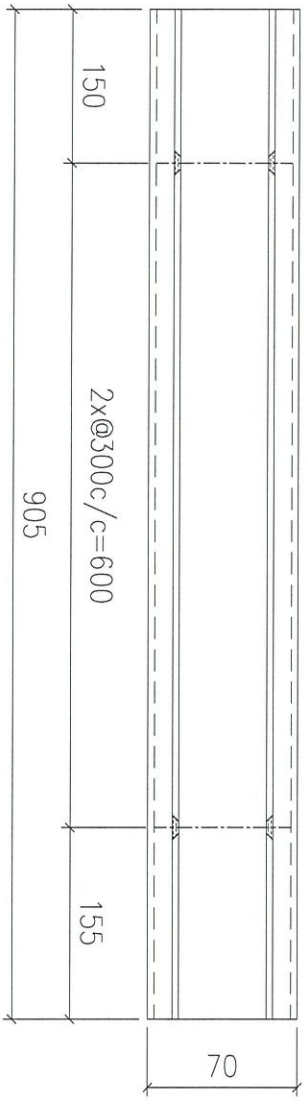

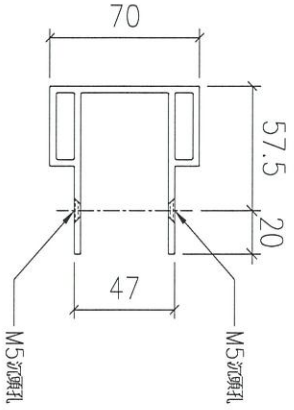

序號	物料編號	數量	安裝位置	樓層
01	T5-X86227-01	16	見派位圖	T5 FLAT A 17~25/F
02	T5-X86227-01	8	見派位圖	T5 FLAT B 17~25/F
03	T5-X86227-01	4	見派位圖	T5 FLAT D 11~16/F
04	T6-X86227-01	18	見派位圖	T6 FLAT A 5,6,8~26/F
05	T6-X86227-01	18	見派位圖	T6 FLAT B 5,6,8~26/F
06	T7-X86227-01	17	見派位圖	T7 FLAT A 7~26/F
		81		


名稱	企料加工圖	制圖	LHR	2022,08,29	修改	–		
材料	X86227	復核	–	–	日期	–		
顏色	JMQ213457(3coats)	批準			圖號	J853-GB-FAB2-107		

美特鋁質 有限公司
MIDI Aluminium Fabricator Ltd.

工程號	J853	地盤	~~錦上路~~ TUP

送工地


頂

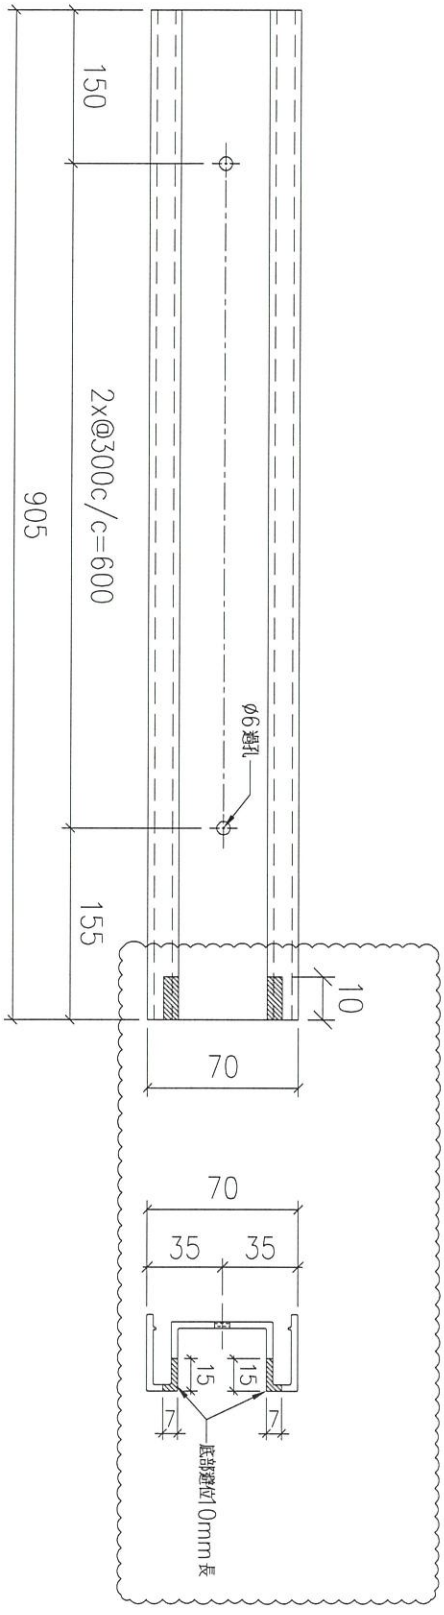


序號	物料編號	數量	安裝位置	樓層
01	T5-X86228-01	16	見派位圖	T5 FLAT A 17~25/F
02	T5-X86228-01	8	見派位圖	T5 FLAT B 17~25/F
03	T5-X86228-01	4	見派位圖	T5 FLAT D 11~16/F
04	T6-X86228-01	18	見派位圖	T6 FLAT A 5,6,8~26/F
05	T6-X86228-01	18	見派位圖	T6 FLAT B 5,6,8~26/F
06	T7-X86228-01	17	見派位圖	T7 FLAT A 7~26/F
		81		

名稱	企料加工圖	制圖	LHR	2022,08,29	修改	A		
材料	X86228	復核	–	–	日期	2023.2.21		
顏色	JMQ213457(3coats)	批準			圖號	J853-GB-FAB2-108		

送工地

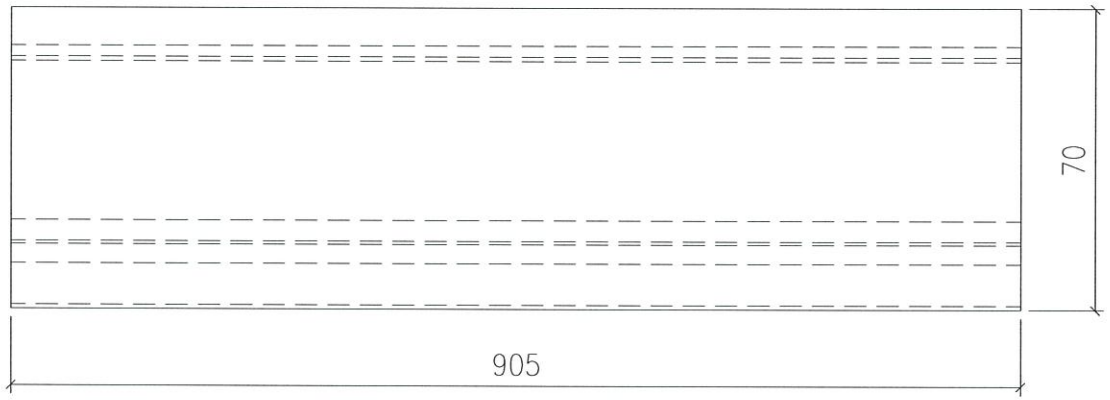

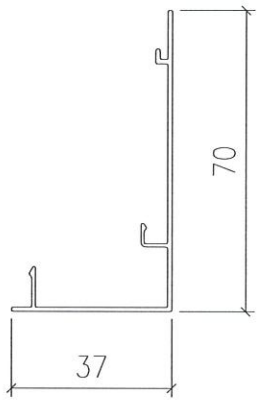

序號	物料編號	數量	安裝位置	樓層
01	T5-X86235-01	54	見派位圖	T5 FLAT A 6~16/F
02	T5-X86235-01	48	見派位圖	T5 FLAT A 17~25/F
03	T5-X86235-01	54	見派位圖	T5 FLAT B 6~16/F
04	T5-X86235-01	48	見派位圖	T5 FLAT B 17~25/F
05	T5-X86235-01	24	見派位圖	T5 FLAT C 11~16/F
06	T5-X86235-01	16	見派位圖	T5 FLAT D 11~16/F
07	T5-X86235-01	78	見派位圖	T5 FLAT E/F 11~26/F
08	T6-X86235-01	108	見派位圖	T6 FLAT A 5,6,8~26/F
09	T6-X86235-01	108	見派位圖	T6 FLAT B 5,6,8~26/F
10	T6-X86235-01	84	見派位圖	T6 FLAT C/D 10~26/F
11	T7-X86235-01	102	見派位圖	T7 FLAT A 7~26/F
12	T7-X86235-01	60	見派位圖	T7 FLAT B 7~23/F
		784		

美特鋁質 有限公司
MIDI Aluminium Fabricator Ltd.


工程號	J853	地盤	錦上路 TWP


名稱	企料扣蓋加工圖	制圖	LHR	2022,08,29	修改	—		
材料	X86235	復核	—	—	日期	—		
顏色	JMQ213457(3coats)	批準			圖號	J853-GB-FAB2-109		

美特鋁質 有限公司
MIDI Aluminium Fabricator Ltd.

工程號	J853	地盤	錦上路 Twp

送工地

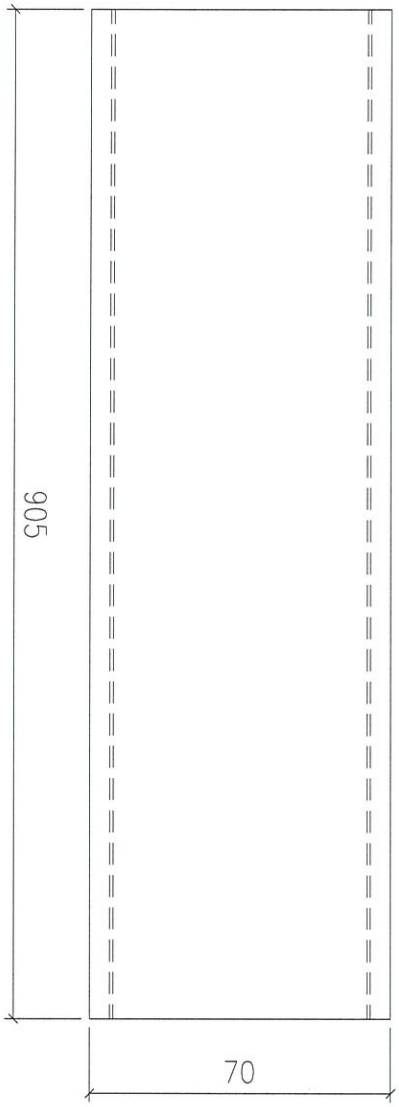


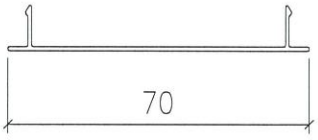

序號	物料編號	數量	安裝位置	樓層
01	T5-X86236-01	16	見派位圖	T5 FLAT A 17~25/F
02	T5-X86236-01	8	見派位圖	T5 FLAT B 17~25/F
03	T5-X86236-01	4	見派位圖	T5 FLAT D 11~16/F
04	T6-X86236-01	18	見派位圖	T6 FLAT A 5,6,8~26/F
05	T6-X86236-01	18	見派位圖	T6 FLAT B 5,6,8~26/F
06	T7-X86236-01	17	見派位圖	T7 FLAT A 7~26/F
		81		

名稱	企料扣蓋加工圖	制圖	LHR	2022,08,29	修改	–		
材料	X86236	復核	–	–	日期	–		
顏色	JMQ213457(3coats)	批準			圖號	J853-GB-FAB2-110		

送工地

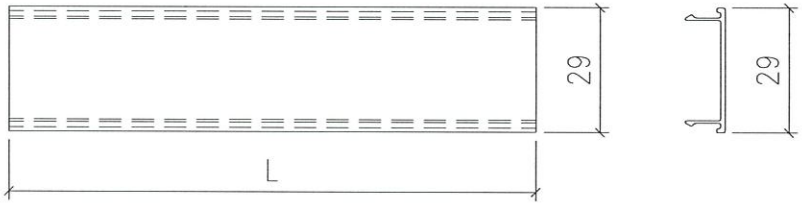


序號	物料編號	L:	數量	安裝位置	樓層
01	T5-X86229-01	2269	48	見派位圖	T5 FLAT A 17~25/F
02	T5-X86229-02	2164.5	52	見派位圖	T5 FLAT E/F 11~26/F
03	T5-X86229-03	1951	18	見派位圖	T5 FLAT A 6~16/F
04	T5-X86229-03	1951	8	見派位圖	T5 FLAT C 11~16/F
05	T5-X86229-04	1739.5	32	見派位圖	T5 FLAT B 17~25/F
06	T5-X86229-05	1376	18	見派位圖	T5 FLAT B 6~16/F
07	T5-X86229-06	1121.5	16	見派位圖	T5 FLAT D 11~16/F
08	T5-X86229-07	1064.5	18	見派位圖	T5 FLAT A 6~16/F
09	T5-X86229-07	1064.5	18	見派位圖	T5 FLAT B 6~16/F
10	T5-X86229-07	1064.5	8	見派位圖	T5 FLAT C 11~16/F
11	T5-X86229-08	974.5	16	見派位圖	T5 FLAT B 17~25/F
12	T5-X86229-09	374.5	8	見派位圖	T5 FLAT D 11~16/F
13	T5-X86229-10	299.5	18	見派位圖	T5 FLAT A 6~16/F
14	T5-X86229-10	299.5	32	見派位圖	T5 FLAT A 17~25/F
15	T5-X86229-10	299.5	18	見派位圖	T5 FLAT B 6~16/F
16	T5-X86229-11	78	16	見派位圖	T5 FLAT B 17~25/F
17	T5-X86229-11	78	8	見派位圖	T5 FLAT C 11~16/F
18	T5-X86229-12	64	36	見派位圖	T5 FLAT A 6~16/F
19	T5-X86229-12	64	32	見派位圖	T5 FLAT A 17~25/F
20	T5-X86229-12	64	36	見派位圖	T5 FLAT B 6~16/F
21	T5-X86229-12	64	16	見派位圖	T5 FLAT B 17~25/F
22	T5-X86229-12	64	8	見派位圖	T5 FLAT C 11~16/F
23	T5-X86229-12	64	16	見派位圖	T5 FLAT D 11~16/F
24	T5-X86229-12	64	52	見派位圖	T5 FLAT E/F 11~26/F
25	T5-X86229-13	52	52	見派位圖	T5 FLAT E/F 11~26/F
26	T5-X86229-14	29	16	見派位圖	T5 FLAT B 17~25/F
27	T5-X86229-14	29	8	見派位圖	T5 FLAT C 11~16/F
			624		

修改			
日期	–	–	
圖號	J853-GB-FAB2-111		
制圖	LHR	2022.08.30	
復核	–	–	
批準			
名稱	扶手扣蓋加工圖		
材料	X86229		
顏色	JMQ213457(3coats)		

美特鋁質 有限公司
MIDI Aluminium Fabricator Ltd.

工程號	J853	地盤	錦上路

送工地

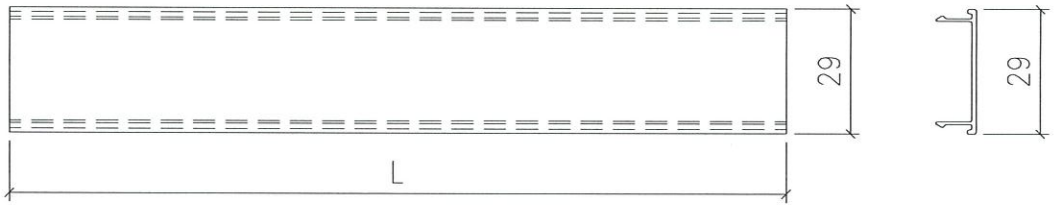

序號	物料編號	L:	數量	安裝位置	樓層
01	T6-X86229-01	2164.5	56	見派位圖	T6 FLAT C/D 10~26/F
02	T6-X86229-02	1437	72	見派位圖	T6 FLAT A 5,6,8~26/F
03	T6-X86229-02	1437	72	見派位圖	T6 FLAT B 5,6,8~26/F
04	T6-X86229-03	1264.5	36	見派位圖	T6 FLAT A 5,6,8~26/F
05	T6-X86229-03	1264.5	36	見派位圖	T6 FLAT B 5,6,8~26/F
06	T6-X86229-04	199.5	36	見派位圖	T6 FLAT A 5,6,8~26/F
07	T6-X86229-04	199.5	36	見派位圖	T6 FLAT B 5,6,8~26/F
08	T6-X86229-05	64	72	見派位圖	T6 FLAT A 5,6,8~26/F
09	T6-X86229-05	64	72	見派位圖	T6 FLAT B 5,6,8~26/F
10	T6-X86229-05	64	56	見派位圖	T6 FLAT C/D 10~26/F
11	T7-X86229-01	2164.5	30	見派位圖	T7 FLAT B 7~23/F
12	T7-X86229-02	1437	68	見派位圖	T7 FLAT A 7~26/F
13	T7-X86229-03	1264.5	34	見派位圖	T7 FLAT A 7~26/F
14	T7-X86229-03	1264.5	30	見派位圖	T7 FLAT B 7~23/F
15	T7-X86229-04	799.5	34	見派位圖	T7 FLAT A 7~26/F
16	T7-X86229-05	64	68	見派位圖	T7 FLAT A 7~26/F
17	T7-X86229-05	64	60	見派位圖	T7 FLAT B 7~23/F
			868		

美特鋁質 有限公司
MIDI Aluminium Fabricator Ltd.


工程號	J853	地盤	錦上路 Tuen

修改	—		
日期	—		
圖號	J853-GB-FAB2-112		

制圖	LHR	2022,08,30	
復核	—	—	
批準			

名稱	扶手扣蓋加工圖
材料	X86229
顏色	JMQ213457(3coats)

送工地

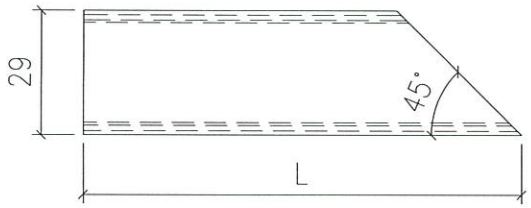

序號	物料編號	L:	數量	安裝位置	樓層
01	T5-X86229-15	173	18	見派位圖	T5 FLAT A 6~16/F
02	T5-X86229-15	173	16	見派位圖	T5 FLAT A 17~25/F
03	T5-X86229-15	173	18	見派位圖	T5 FLAT B 6~16/F
04	T5-X86229-15	173	8	見派位圖	T5 FLAT B 17~25/F
05	T5-X86229-15	173	8	見派位圖	T5 FLAT C 11~16/F
06	T5-X86229-15	173	4	見派位圖	T5 FLAT D 11~16/F
07	T5-X86229-15	173	13	見派位圖	T5 FLAT E/F 11~26/F
08	T5-X86229-17	157	13	見派位圖	T5 FLAT E/F 11~26/F
09	T5-X86229-19	130	8	見派位圖	T5 FLAT B 17~25/F
10	T5-X86229-21	96	18	見派位圖	T5 FLAT A 6~16/F
11	T5-X86229-21	96	16	見派位圖	T5 FLAT A 17~25/F
12	T5-X86229-21	96	18	見派位圖	T5 FLAT B 6~16/F
13	T5-X86229-21	96	8	見派位圖	T5 FLAT B 17~25/F
14	T5-X86229-21	96	8	見派位圖	T5 FLAT C 11~16/F
15	T5-X86229-21	96	4	見派位圖	T5 FLAT D 11~16/F
16	T5-X86229-21	96	13	見派位圖	T5 FLAT E/F 11~26/F
17	T5-X86229-23	80	13	見派位圖	T5 FLAT E/F 11~26/F
18	T5-X86229-25	53	8	見派位圖	T5 FLAT B 17~25/F
			212		

修改	-		
日期	-		
圖號	J853-GB-FAB2-113		
制圖	LHR	2022,08,30	
復核	-	-	
批準			
名稱	扶手扣蓋加工圖		
材料	X86229		
顏色	JMQ213457(3coats)		

美特鋁質 有限公司
MIDI Aluminium Fabricator Ltd.

工程號	J853	地盤	錦上路 Tuen

美特鋁質 有限公司
MIDI Aluminium Fabricator Ltd.

工程號	J853	地盤	錦上路 ~~5~~ TWP

送工地

序號	物料編號	L:	數量	安裝位置	樓層
01	T6-X86229-06	173	36	見派位圖	T6 FLAT A 5,6,8~26/F
02	T6-X86229-06	173	36	見派位圖	T6 FLAT B 5,6,8~26/F
03	T6-X86229-06	173	14	見派位圖	T6 FLAT C/D 10~26/F
04	T6-X86229-08	126	14	見派位圖	T6 FLAT C/D 10~26/F
05	T6-X86229-10	96	36	見派位圖	T6 FLAT A 5,6,8~26/F
06	T6-X86229-10	96	36	見派位圖	T6 FLAT B 5,6,8~26/F
07	T6-X86229-10	96	14	見派位圖	T6 FLAT C/D 10~26/F
08	T6-X86229-12	49	14	見派位圖	T6 FLAT C/D 10~26/F
09	T7-X86229-06	173	34	見派位圖	T7 FLAT A 7~26/F
10	T7-X86229-06	173	15	見派位圖	T7 FLAT B 7~23/F
11	T7-X86229-08	96	34	見派位圖	T7 FLAT A 7~26/F
12	T7-X86229-08	96	15	見派位圖	T7 FLAT B 7~23/F
			298		

名稱	扶手扣蓋加工圖	制圖	LHR	2022,08,30	修改	–		
材料	X86229	復核	–	–	日期	–		
顏色	JMQ213457(3coats)	批準			圖號	J853-GB-FAB2-114		

美特鋁質 有限公司
MIDI Aluminium Fabricator Ltd.

工程號	J853	地盤	~~錦上路~~ Twp

送工地

序號	物料編號	L:	數量	安裝位置	樓層
01	T5-X86229-16	173	18	見派位圖	T5 FLAT A 6~16/F
02	T5-X86229-16	173	16	見派位圖	T5 FLAT A 17~25/F
03	T5-X86229-16	173	18	見派位圖	T5 FLAT B 6~16/F
04	T5-X86229-16	173	16	見派位圖	T5 FLAT B 17~25/F
05	T5-X86229-16	173	4	見派位圖	T5 FLAT C 11~16/F
06	T5-X86229-16	173	4	見派位圖	T5 FLAT D 11~16/F
07	T5-X86229-16	173	13	見派位圖	T5 FLAT E/F 11~26/F
08	T5-X86229-18	157	13	見派位圖	T5 FLAT E/F 11~26/F
09	T5-X86229-20	130	4	見派位圖	T5 FLAT C 11~16/F
10	T5-X86229-22	96	18	見派位圖	T5 FLAT A 6~16/F
11	T5-X86229-22	96	16	見派位圖	T5 FLAT A 17~25/F
12	T5-X86229-22	96	18	見派位圖	T5 FLAT B 6~16/F
13	T5-X86229-22	96	16	見派位圖	T5 FLAT B 17~25/F
14	T5-X86229-22	96	4	見派位圖	T5 FLAT C 11~16/F
15	T5-X86229-22	96	4	見派位圖	T5 FLAT D 11~16/F
16	T5-X86229-22	96	13	見派位圖	T5 FLAT E/F 11~26/F
17	T5-X86229-24	80	13	見派位圖	T5 FLAT E/F 11~26/F
18	T5-X86229-26	53	4	見派位圖	T5 FLAT C 11~16/F
			212		

名稱	扶手扣蓋加工圖	制圖	LHR	2022,08,30	修改	–		
材料	X86229	復核	–	–	日期	–		
顏色	JMQ213457(3coats)	批準			圖號	J853-GB-FAB2-115		

美特鋁質 有限公司
MIDI Aluminium Fabricator Ltd.

工程號	J853	地盤	~~錦上路~~ TOP

送工地


序號	物料編號	L:	數量	安裝位置	樓層
01	T6-X86229-07	173	36	見派位圖	T6 FLAT A 5,6,8~26/F
02	T6-X86229-07	173	36	見派位圖	T6 FLAT B 5,6,8~26/F
03	T6-X86229-07	173	14	見派位圖	T6 FLAT C/D 10~26/F
04	T6-X86229-09	126	14	見派位圖	T6 FLAT C/D 10~26/F
05	T6-X86229-11	96	36	見派位圖	T6 FLAT A 5,6,8~26/F
06	T6-X86229-11	96	36	見派位圖	T6 FLAT B 5,6,8~26/F
07	T6-X86229-11	96	14	見派位圖	T6 FLAT C/D 10~26/F
08	T6-X86229-13	49	14	見派位圖	T6 FLAT C/D 10~26/F
09	T7-X86229-07	173	34	見派位圖	T7 FLAT A 7~26/F
10	T7-X86229-07	173	15	見派位圖	T7 FLAT B 7~23/F
11	T7-X86229-09	96	34	見派位圖	T7 FLAT A 7~26/F
12	T7-X86229-09	96	15	見派位圖	T7 FLAT B 7~23/F
			298		


名稱	扶手扣蓋加工圖	制圖	LHR	2022,08,30	修改	–		
材料	X86229	復核	–	–	日期	–		
顏色	JMQ213457(3coats)	批準			圖號	J853-GB-FAB2-116		


美特鋁質 有限公司
MIDI Aluminium Fabricator Ltd.

工程號	J853	地盤	錦上路 Twp

送工地

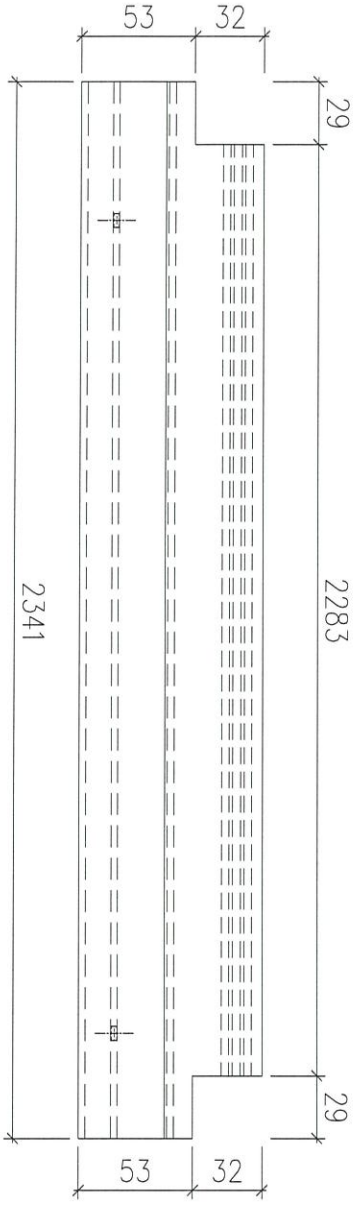

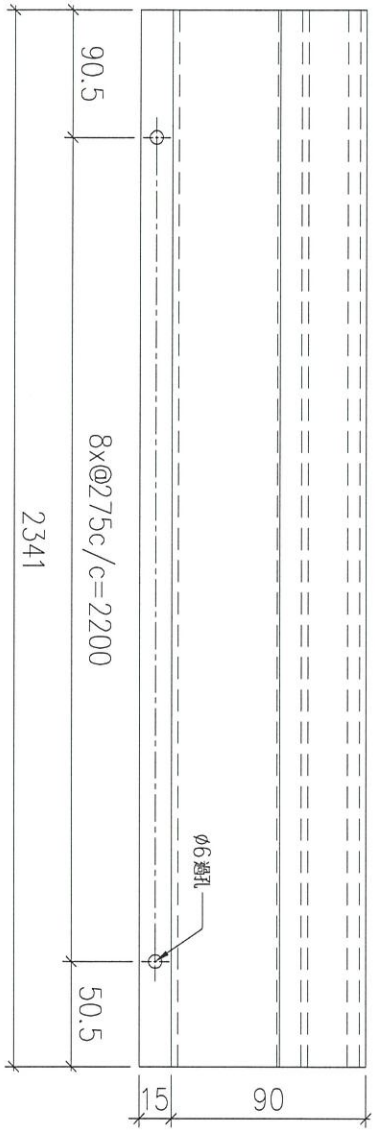

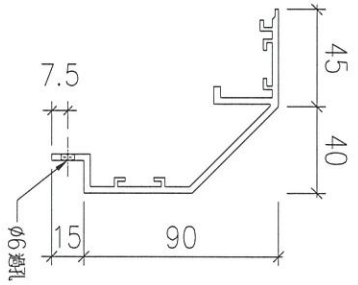


序號	物料編號	數量	安裝位置	樓層
01	T5-X86230-01	8	見派位圖	T5 FLAT A 17~25/F

名稱		制圖	LHR	2022,08,30	修改	–		
材料	X86230	復核	–	–	日期	–		
顏色	JMQ213457(3coats)	批準			圖號	J853-GB-FAB2-117		

美特鋁質 有限公司
MIDI Aluminium Fabricator Ltd.

工程號	J853	地盤	~~錦上路~~ Tw f

送工地

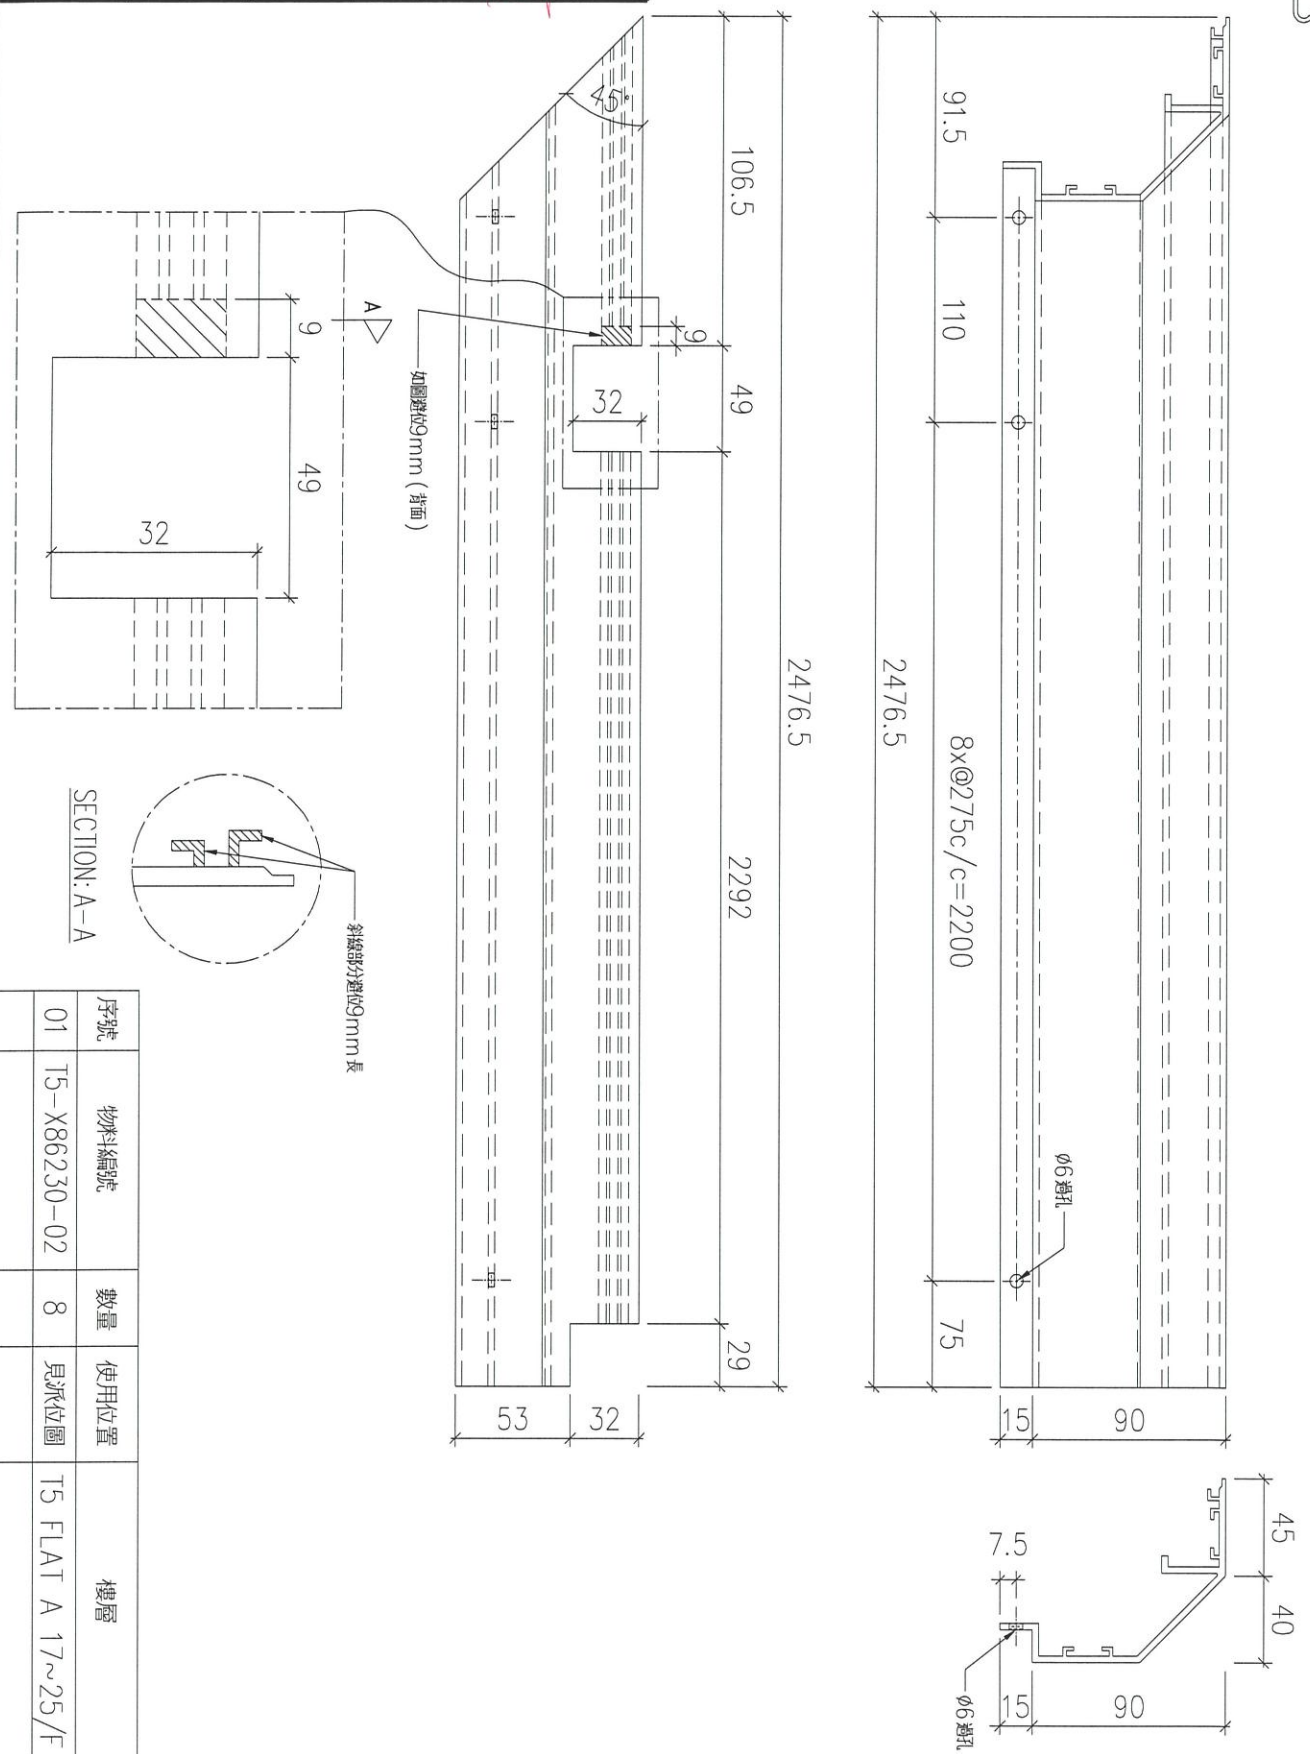

序號	物料編號	數量	使用位置	樓層
01	T5-X86230-02	8	見派位圖	T5 FLAT A 17~25/F


名稱		制圖	LHR	2022,08,30	修改	–		
材料	X86230	復核	–	–	日期	–		
顏色	JMQ213457(3coats)	批準			圖號	J853-GB-FAB2-118		


美特鋁質 有限公司
MIDI Aluminium Fabricator Ltd.


工程號	J853	地盤	~~錦上路~~ Twp


序號	物料編號	數量	使用位置	樓層
01	T5-X86230-03	8	見派位圖	T5 FLAT A 17~25/F

送工地

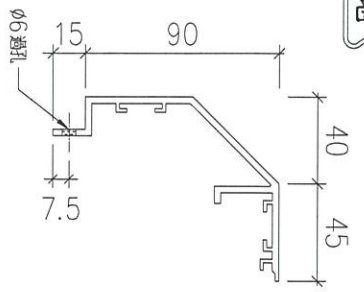


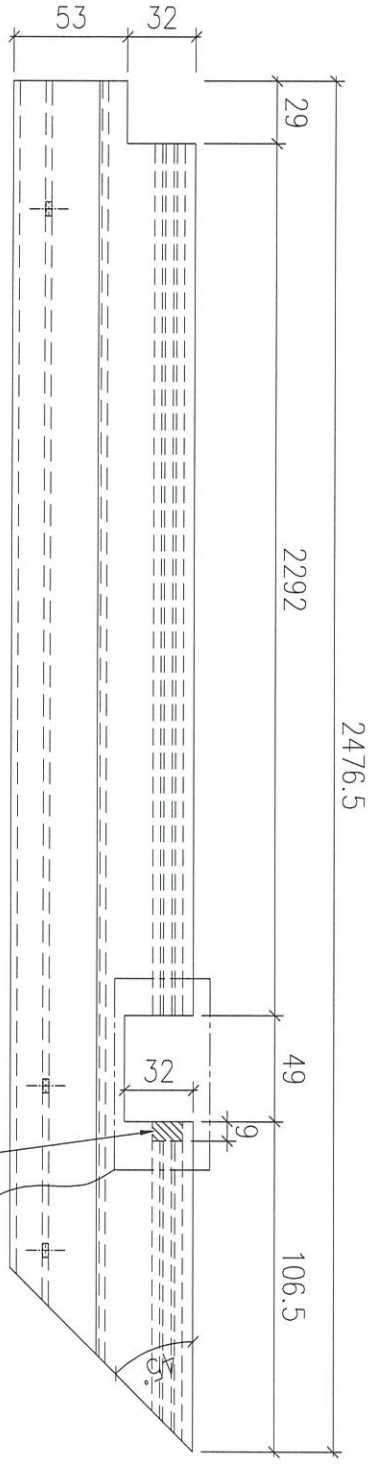

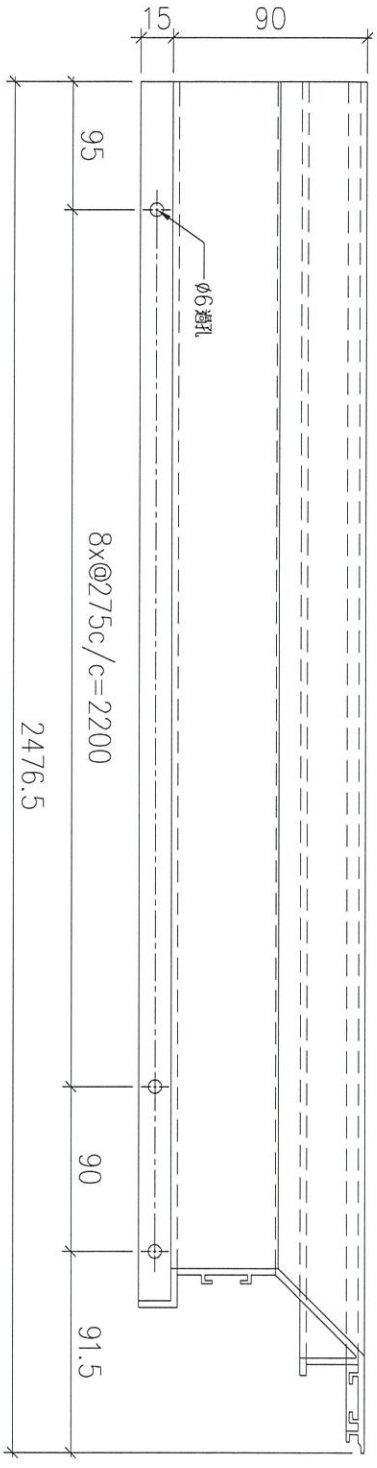

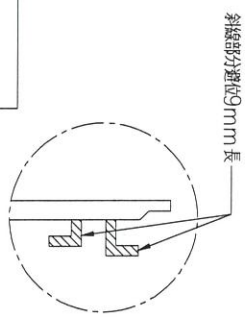

SECTION: A-A

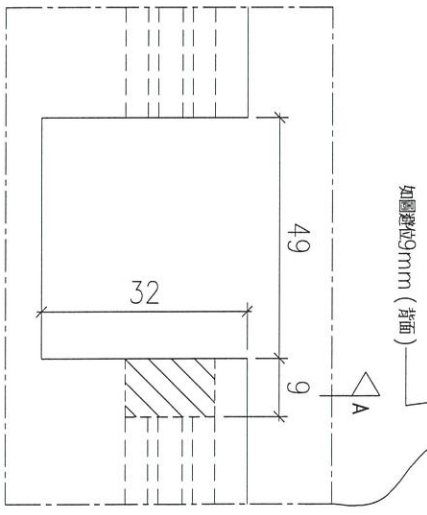


名稱		制圖	LHR	2022,08,30	修改	–		
材料	X86230	復核	–	–	日期	–		
顏色	JMQ213457(3coats)	批準			圖號	J853-GB-FAB2-119		

美特鋁質 有限公司
MIDI Aluminium Fabricator Ltd.

工程號	J853	地盤	錦上路 TWP

送工地

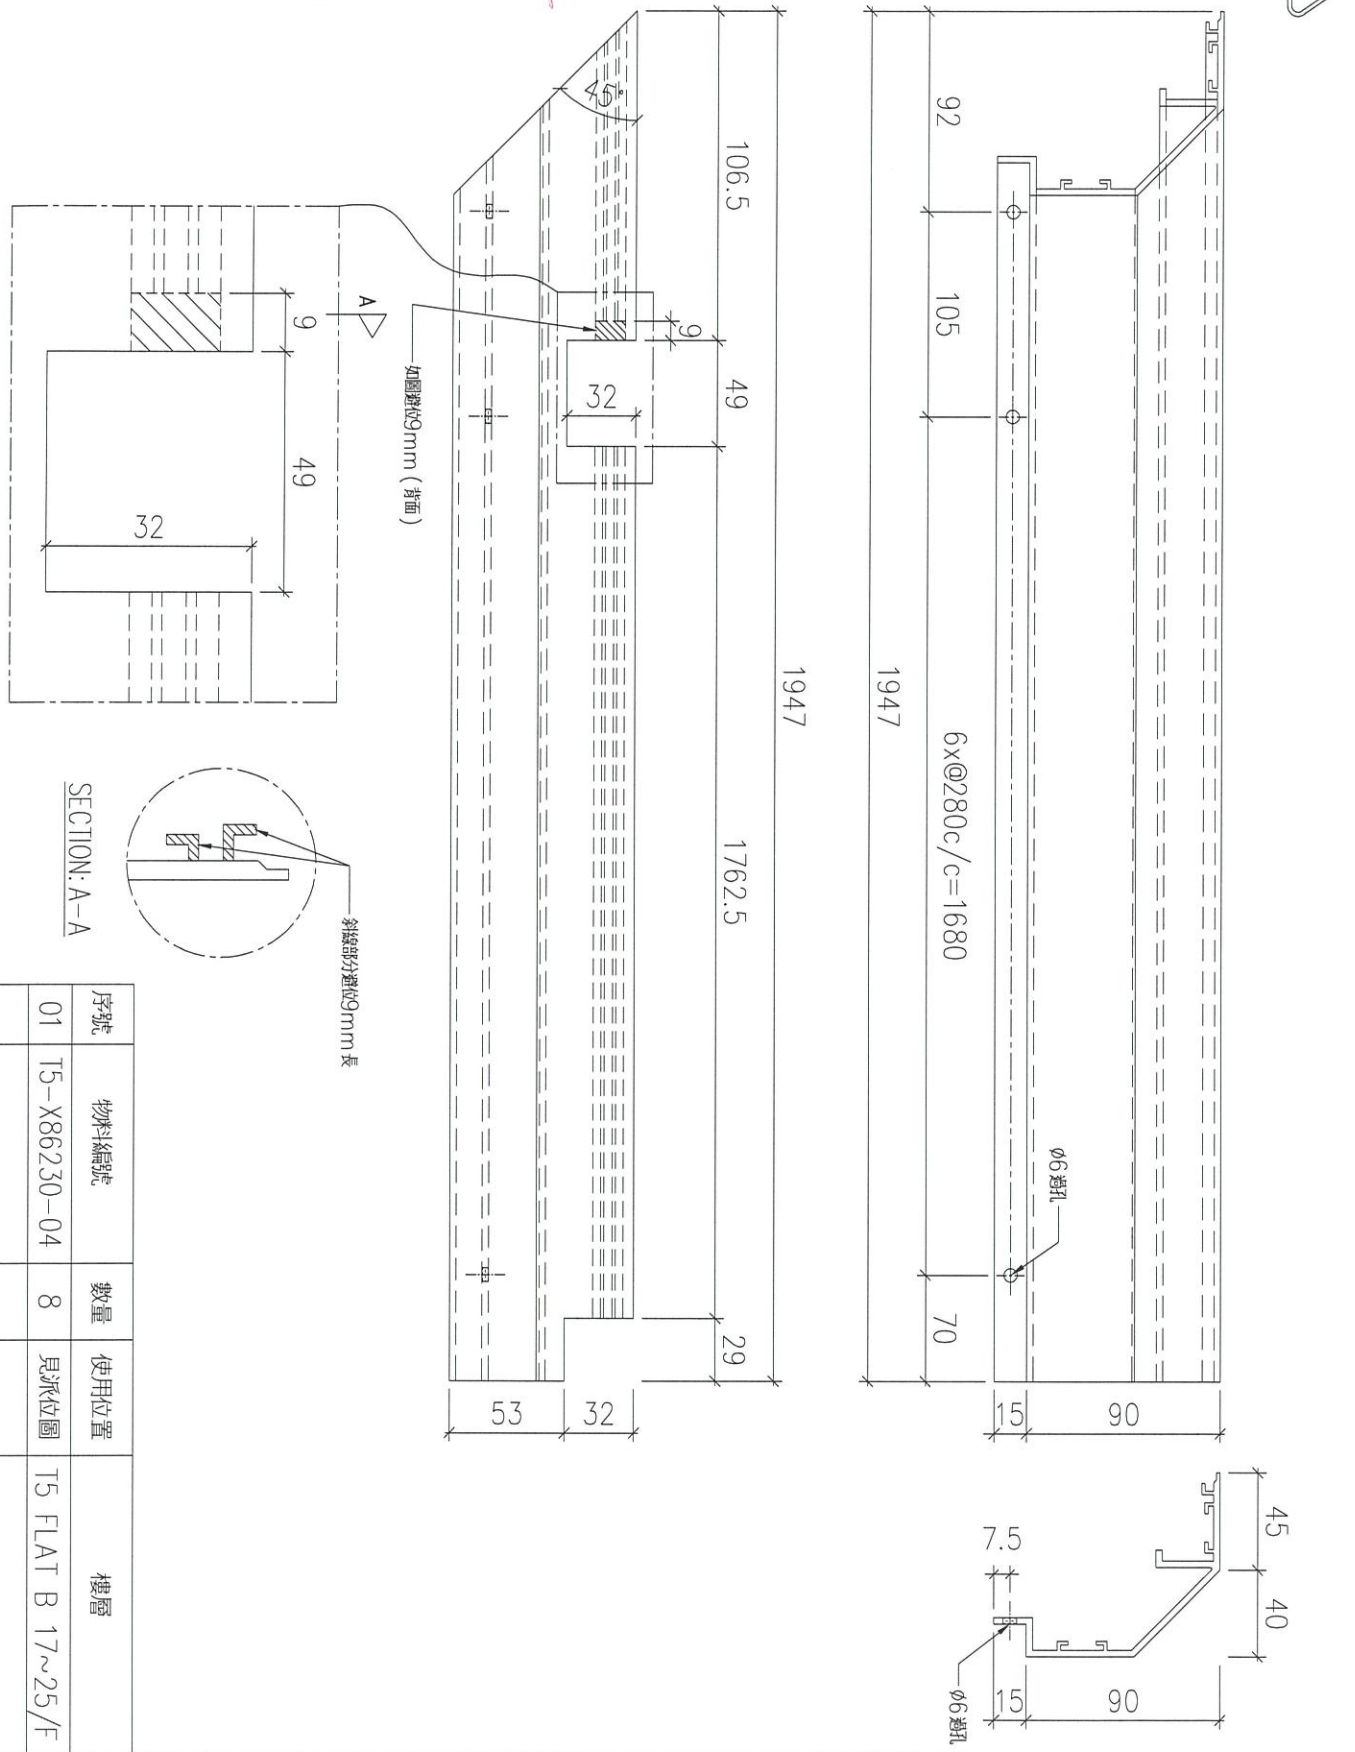

SECTION: A-A

序號	物料編號	數量	使用位置	樓層
01	T5-X86230-04	8	見派位圖	T5 FLAT B 17~25/F


名稱		制圖	LHR	2022,08,30	修改	–		
材料	X86230	復核	–	–	日期	–		
顏色	JMQ213457(3coats)	批準			圖號	J853-GB-FAB2-120		


美特鋁質 有限公司
MIDI Aluminium Fabricator Ltd.


工程號	J853	地盤	~~錦上路~~ Twp


序號	物料編號	數量	使用位置	樓層
01	T5-X86230-05	8	見派位圖	T5 FLAT B 17~25/F

送工地

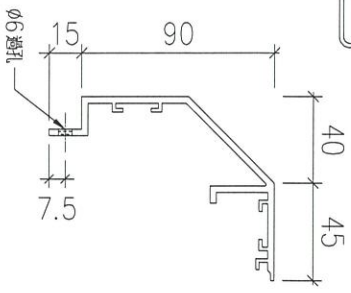


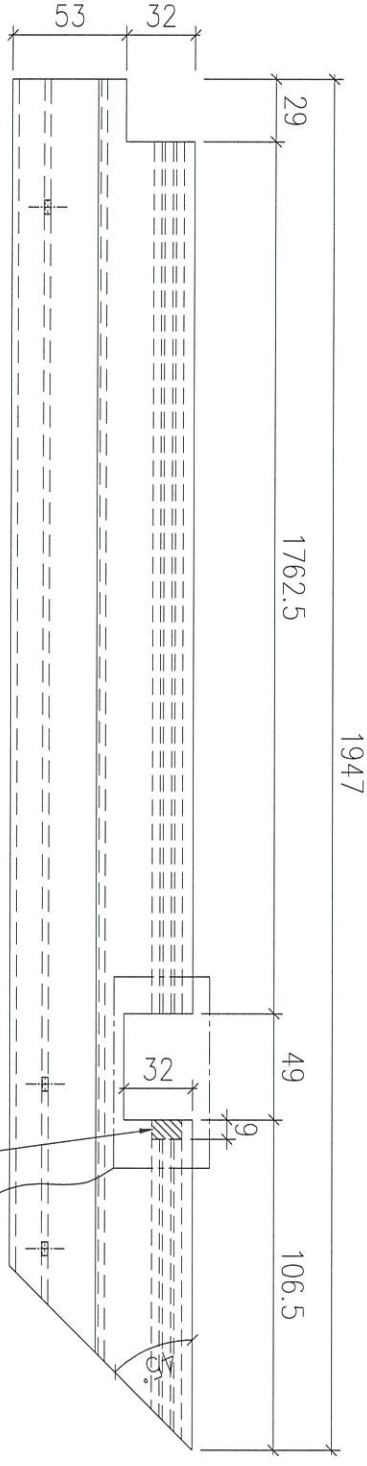

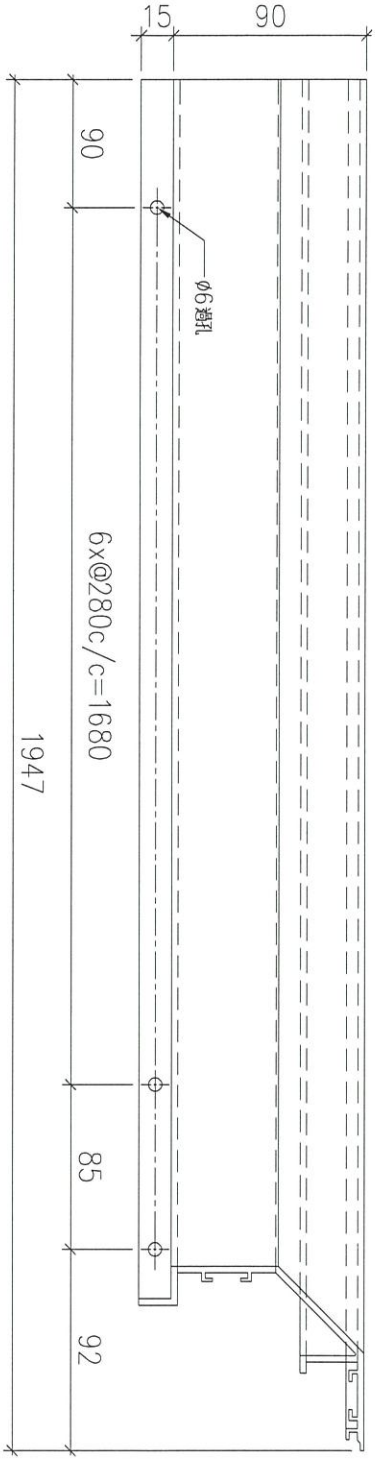

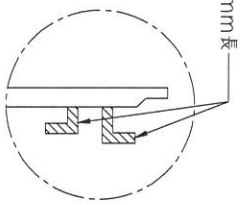

SECTION: A-A

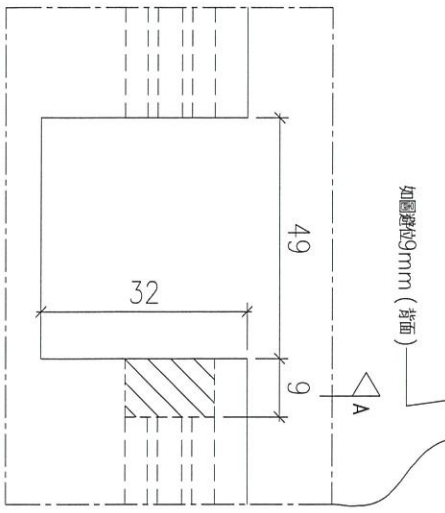


名稱		制圖	LHR	2022,08,30	修改	–		
材料	X86230	復核	–	–	日期	–		
顏色	JMQ213457(3coats)	批準			圖號	J853-GB-FAB2-121		


美特鋁質 有限公司
MIDI Aluminium Fabricator Ltd.


工程號	J853	地盤	錦上路 Twp

送工地

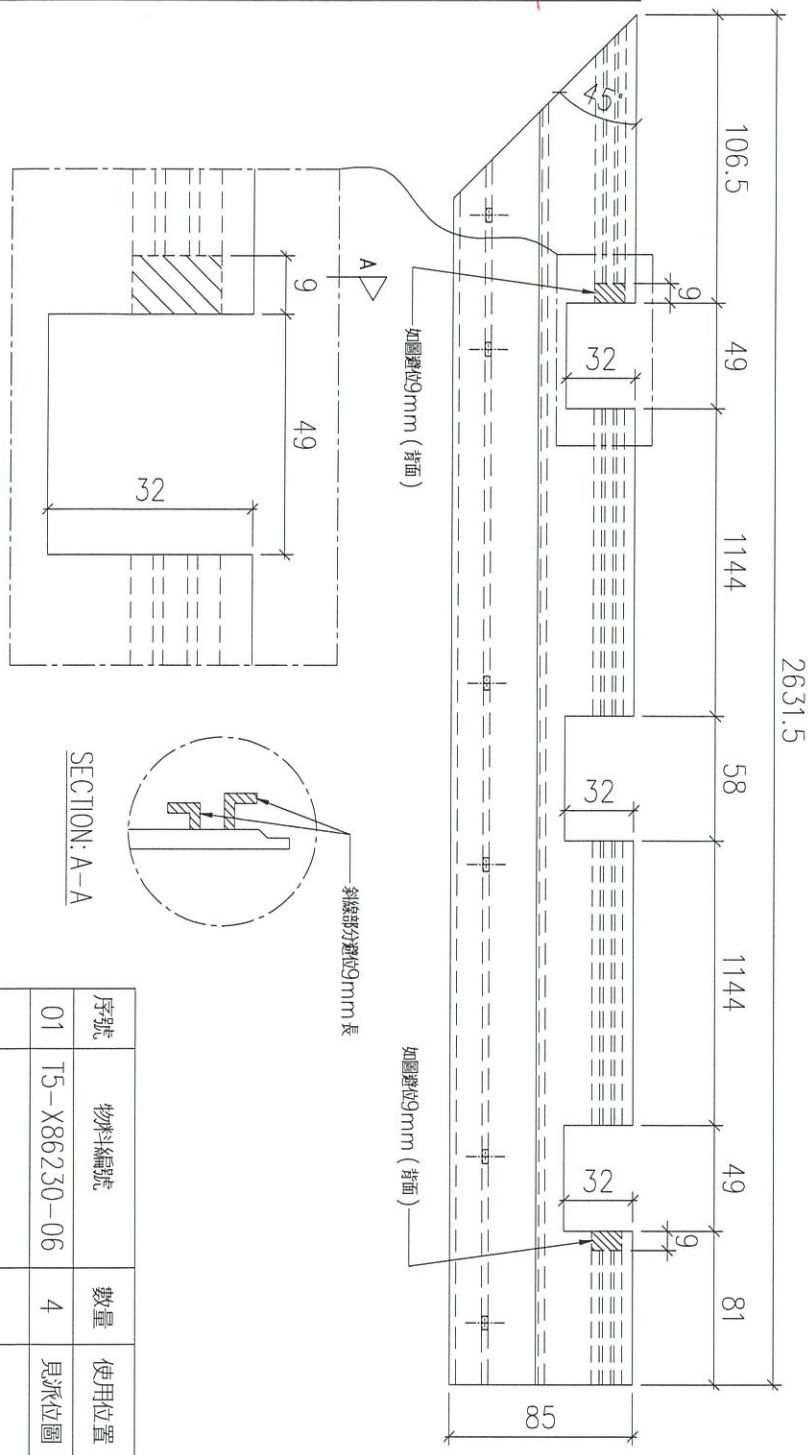

SECTION: A-A

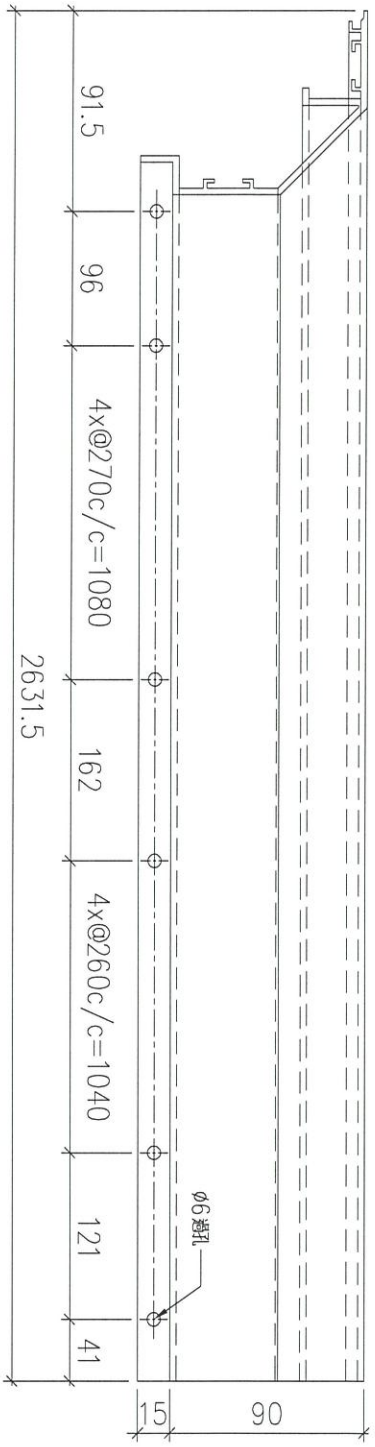

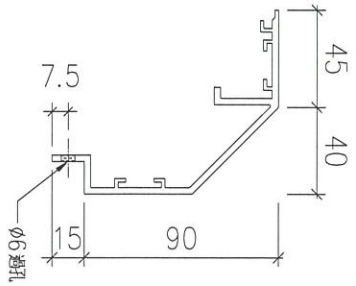


序號	物料編號	數量	使用位置	樓層
01	T5-X86230-06	4	見派位圖	T5 FLAT D 11~16/F


名稱		制圖	LHR	2022,08,30	修改	–		
材料	X86230	復核	–	–	日期	–		
顏色	JMQ213457(3coats)	批準			圖號	J853-GB-FAB2-122		


美特鋁質 有限公司
MIDI Aluminium Fabricator Ltd.

工程號	J853	地盤	錦上路 Tulip

送工地

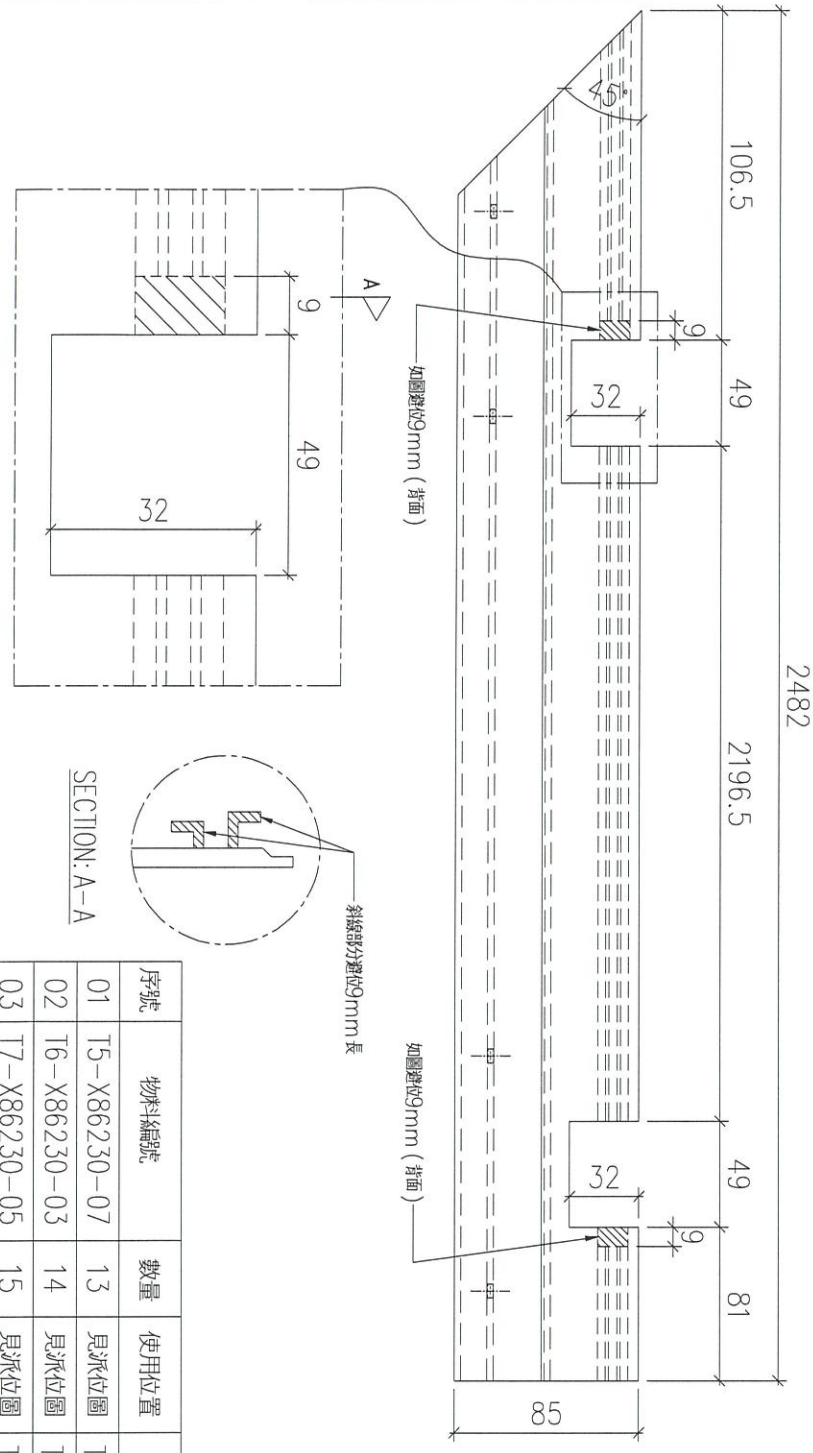

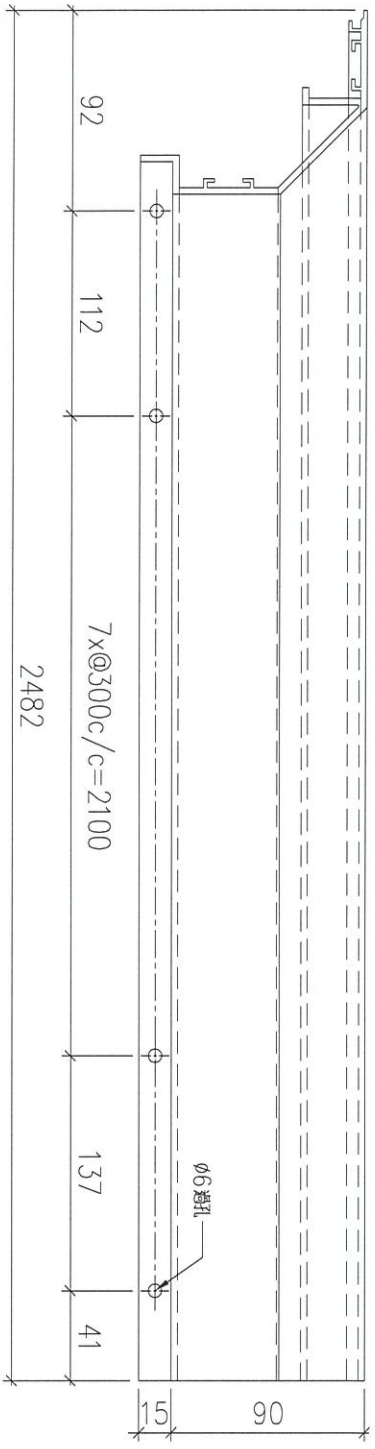

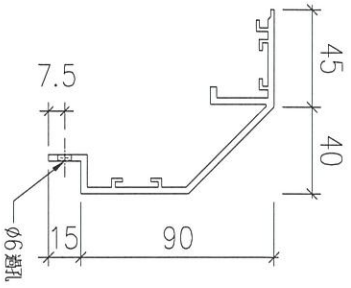

序號	物料編號	數量	使用位置	樓層
01	T5-X86230-07	13	見派位圖	T5 FLAT E/F 11~26/F
02	T6-X86230-03	14	見派位圖	T6 FLAT C/D 10~26/F
03	T7-X86230-05	15	見派位圖	T7 FLAT B 7~23/F


名稱		制圖	LHR	2022,08,30	修改	–		
材料	X86230	復核	–	–	日期	–		
顏色	JMQ213457(3coats)	批準			圖號	J853-GB-FAB2-123		

美特鋁質 有限公司
MIDI Aluminium Fabricator Ltd.

工程號	J853	地盤	錦上路 TWP

序號	物料編號	數量	使用位置	樓層
01	T5-X86230-08	13	見派位圖	T5 FLAT E/F 11~26/F
02	T6-X86230-04	14	見派位圖	T6 FLAT C/D 10~26/F

送工地

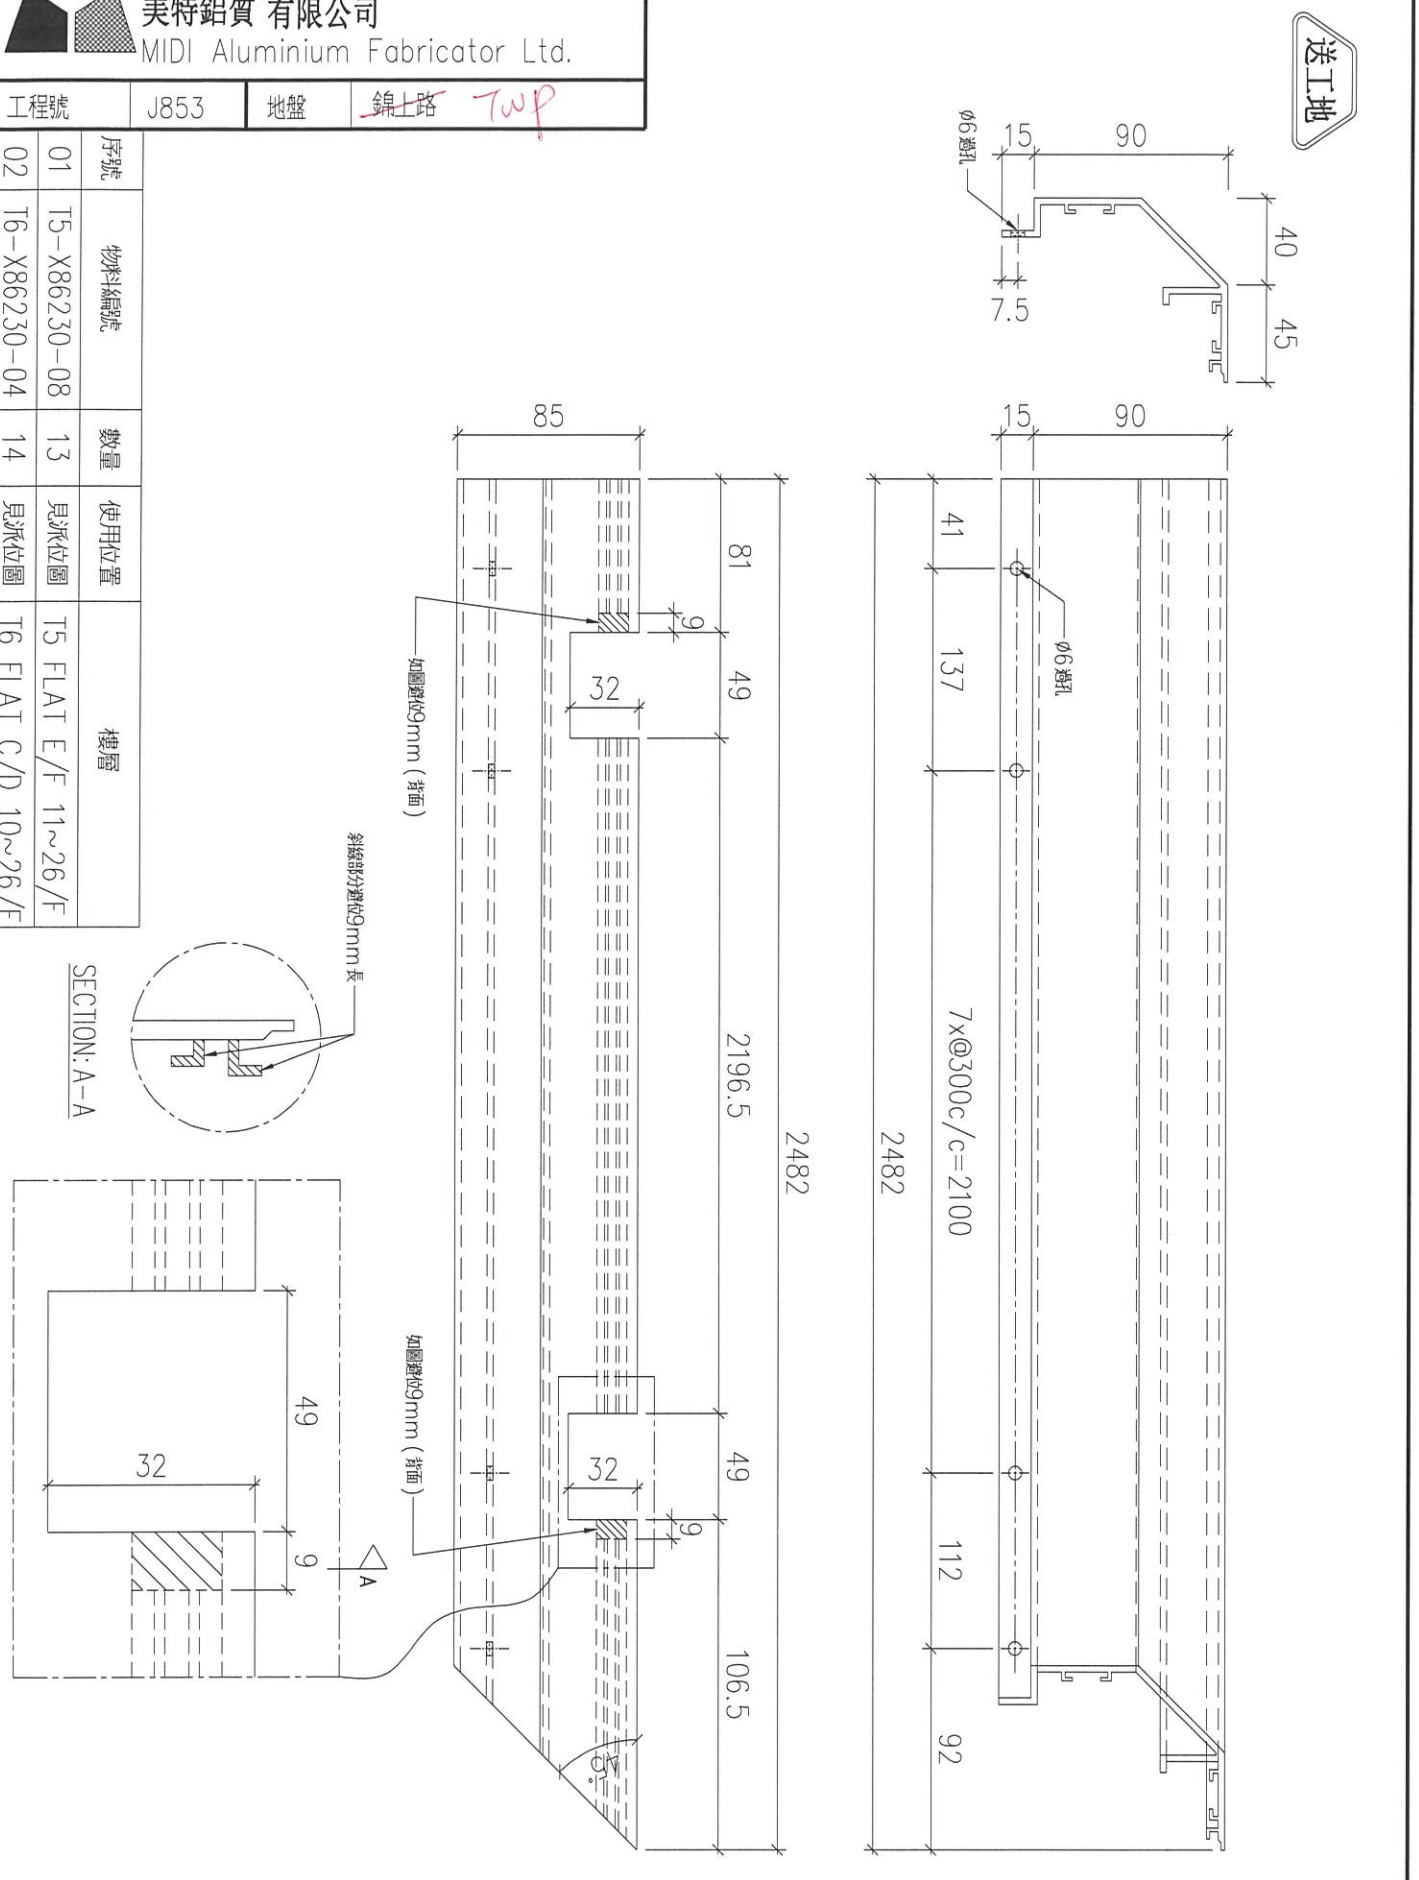


名稱		制圖	LHR	2022,08,30	修改	–		
材料	X86230	復核	–	–	日期	–		
顏色	JMQ213457(3coats)	批準			圖號	J853-GB-FAB2-124		

美特鋁質 有限公司
MIDI Aluminium Fabricator Ltd.

工程號	J853	地盤	~~錦上路~~ TWF

送工地

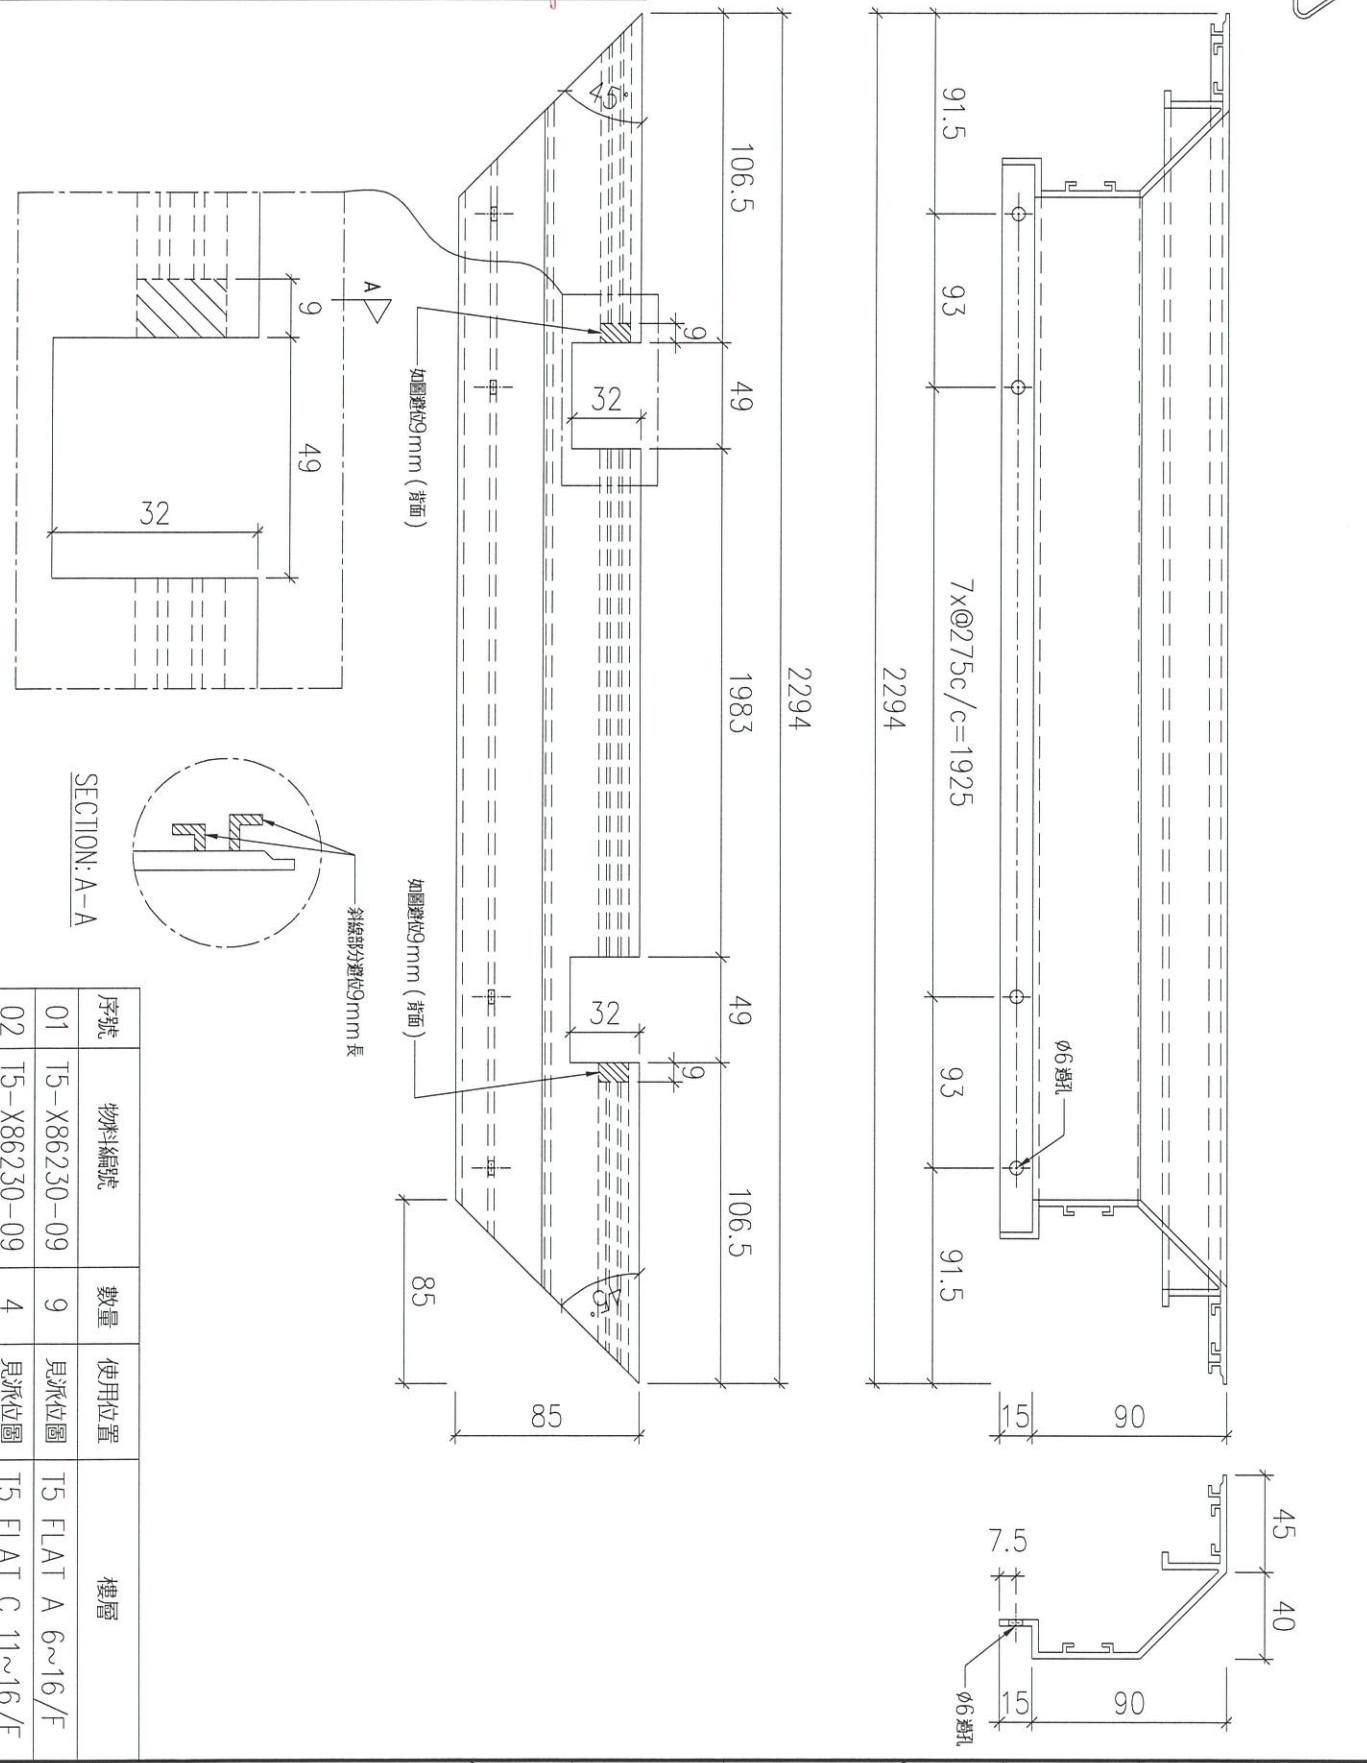


序號	物料編號	數量	使用位置	樓層
01	T5-X86230-09	9	見派位圖	T5 FLAT A 6~16/F
02	T5-X86230-09	4	見派位圖	T5 FLAT C 11~16/F

名稱		制圖	LHR	2022,08,30	修改	–		
材料	X86230	復核	–	–	日期	–		
顏色	JMQ213457(3coats)	批準			圖號	J853-GB-FAB2-125		

美特鋁質 有限公司
MIDI Aluminium Fabricator Ltd.

工程號	J853	地盤	錦上路 ~~TWP~~

送工地

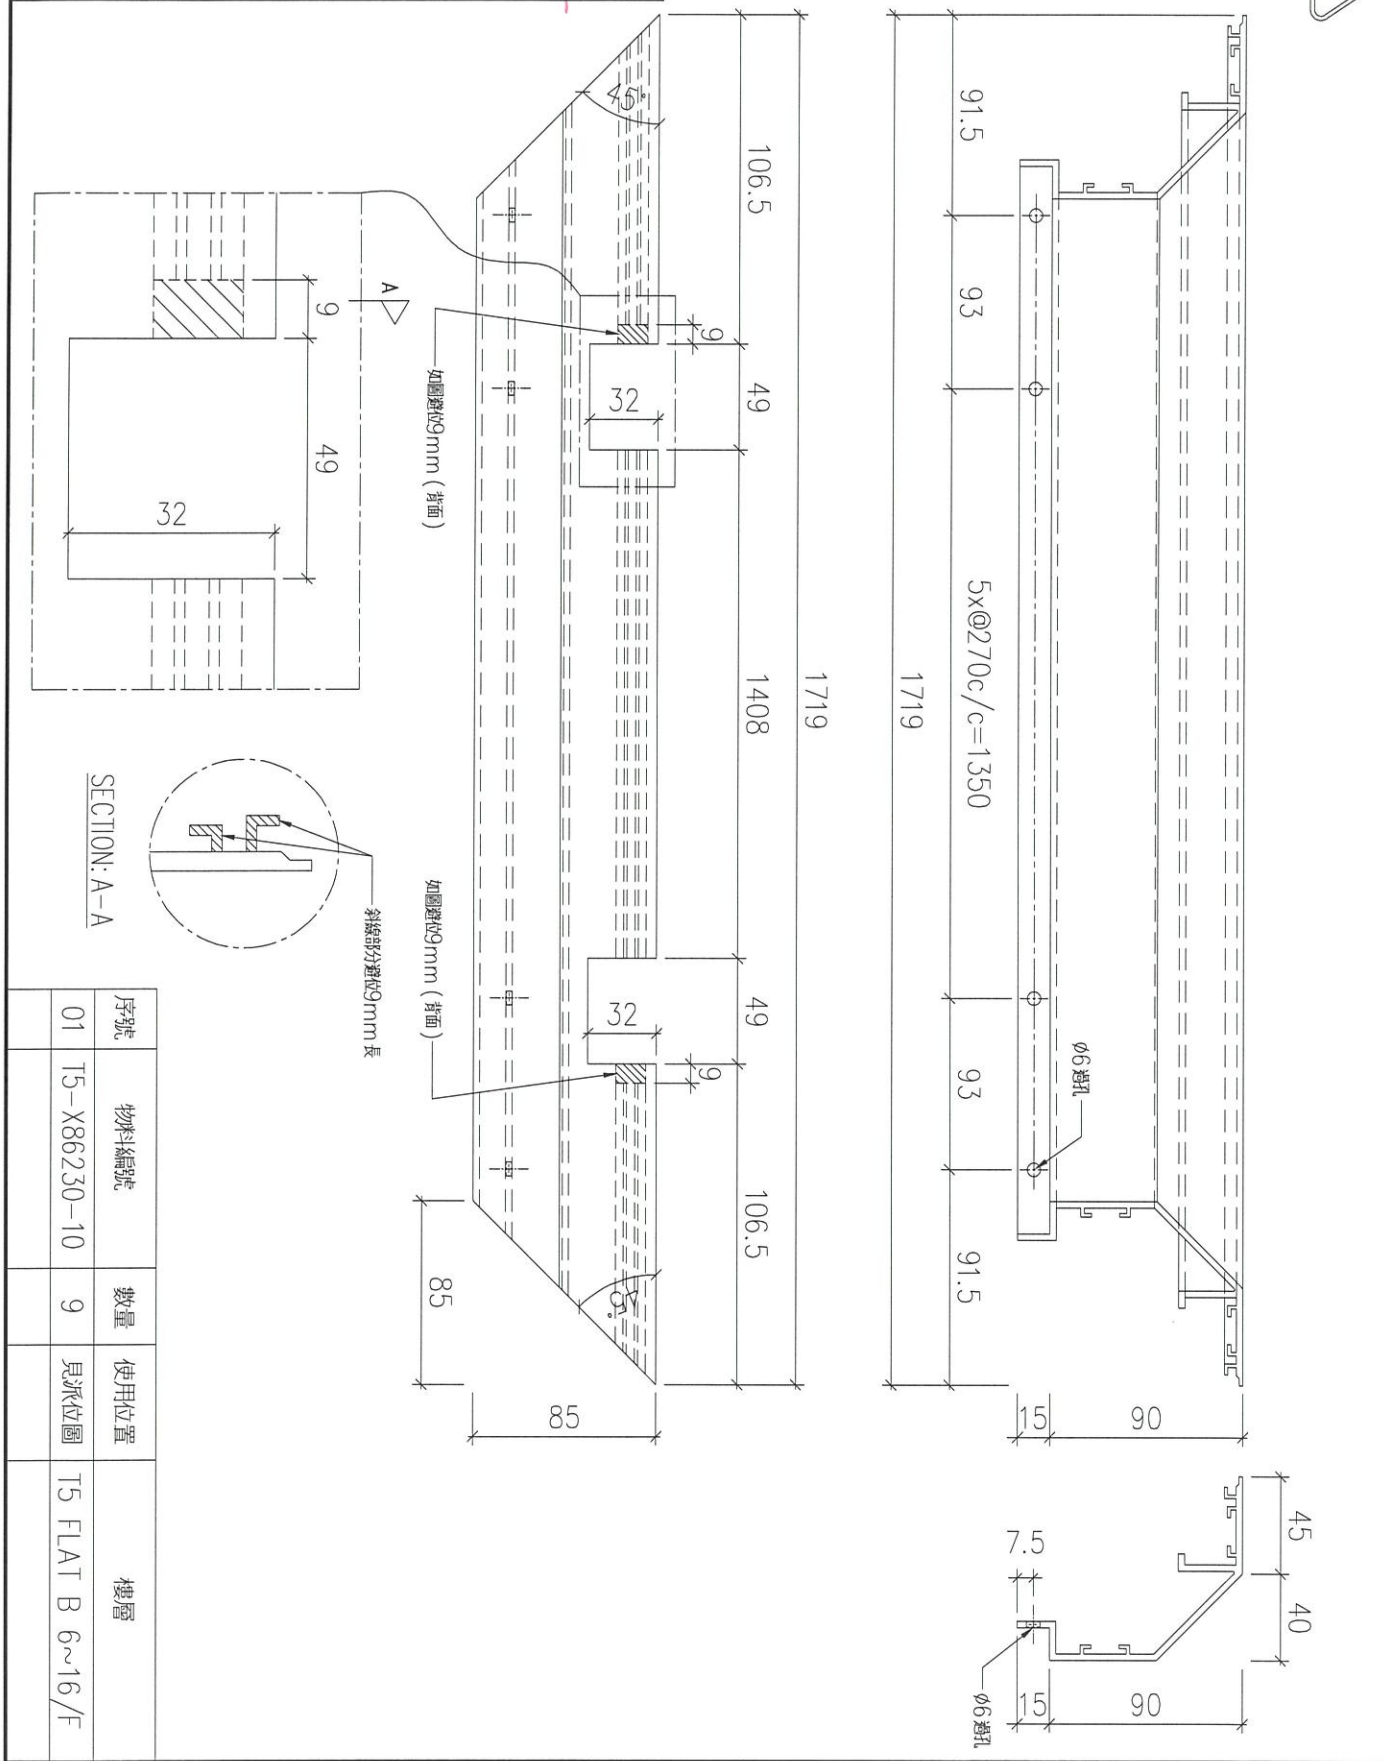


序號	物料編號	數量	使用位置	樓層
01	T5-X86230-10	9	見派位圖	T5 FLAT B 6~16/F

名稱		制圖	LHR	2022,08,30	修改	–		
材料	X86230	復核	–	–	日期	–		
顏色	JMQ213457(3coats)	批準			圖號	J853-GB-FAB2-126		

美特鋁質 有限公司
MIDI Aluminium Fabricator Ltd.

工程號	J853	地盤	錦上路 Twp

送工地

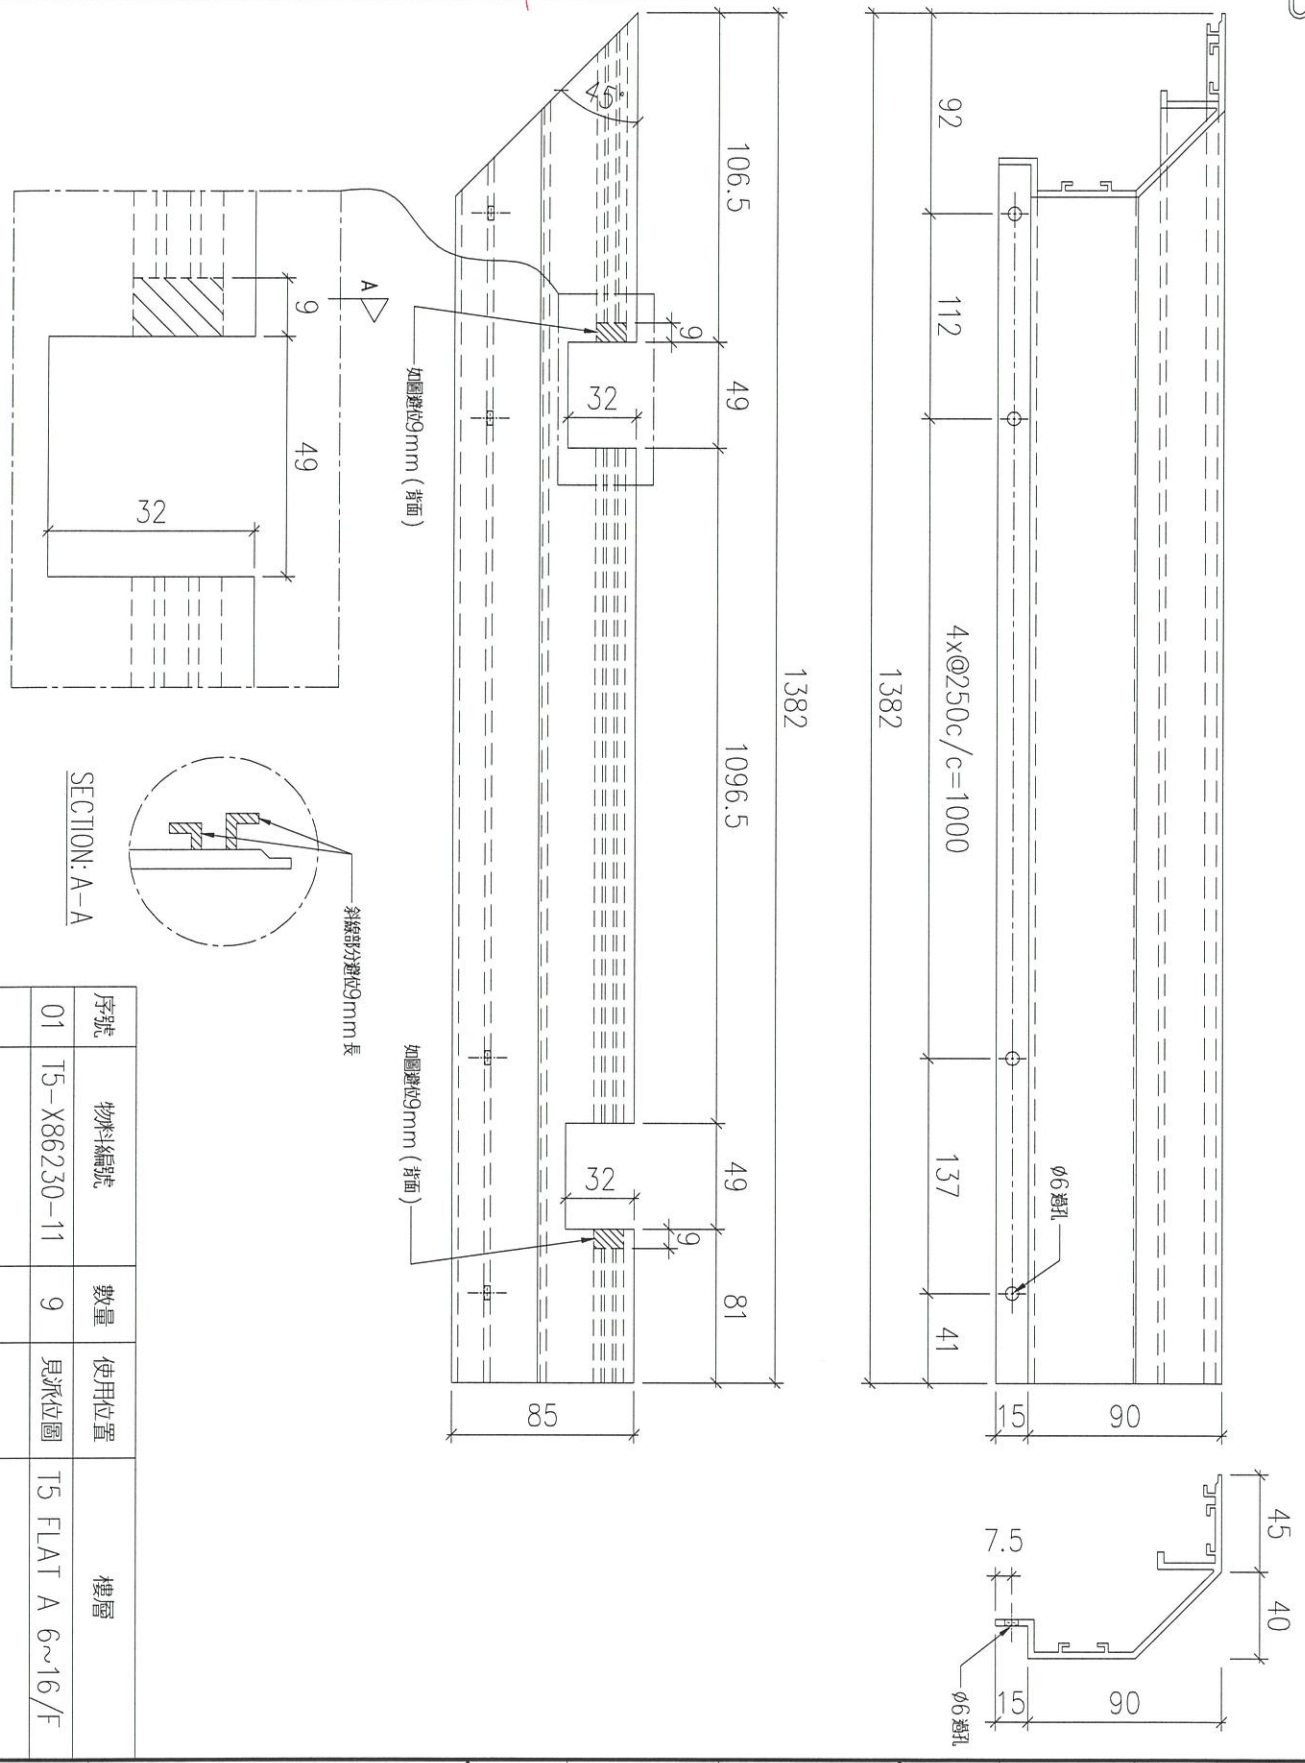

序號	物料編號	數量	使用位置	樓層
01	T5-X86230-11	9	見派位圖	T5 FLAT A 6~16/F


名稱		制圖	LHR	2022,08,30	修改	–		
材料	X86230	復核	–	–	日期	–		
顏色	JMQ213457(3coats)	批準			圖號	J853-GB-FAB2-127		

美特鋁質 有限公司
MIDI Aluminium Fabricator Ltd.

工程號	J853	地點	鎖上路 ~~TWP~~

序號	物料編號	數量	使用位置	樓層
01	T5-X86230-12	9	見派位圖	T5 FLAT B 6~16/F
02	T5-X86230-12	4	見派位圖	T5 FLAT C 11~16/F

送工地

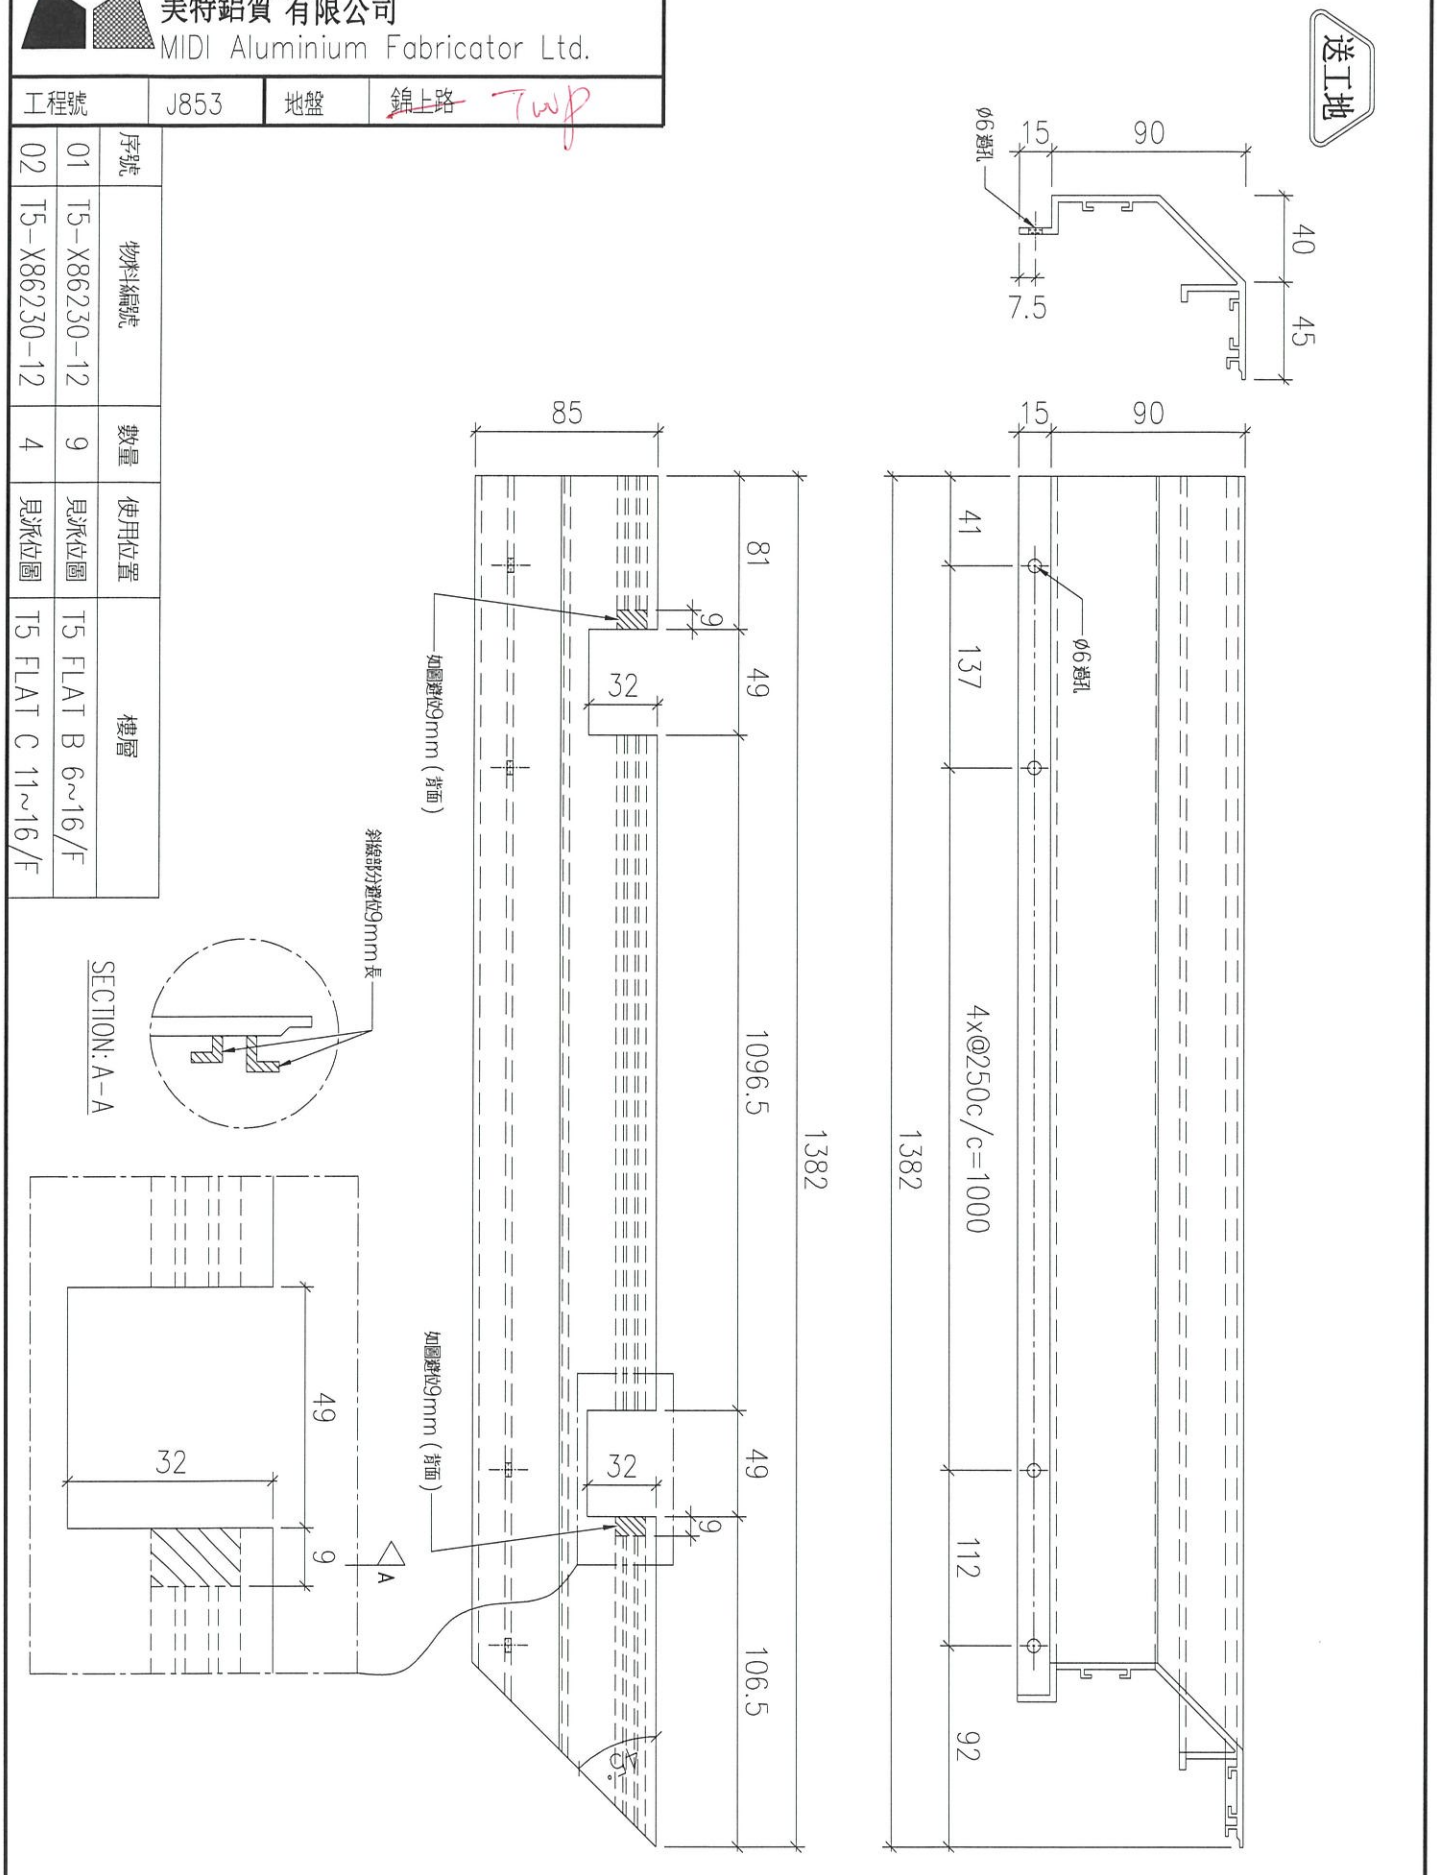


名稱		制圖	LHR	2022,08,30	修改	–		
材料	X86230	復核	–	–	日期	–		
顏色	JMQ213457(3coats)	批準			圖號	J853-GB-FAB2-128		

美特鋁質 有限公司
MIDI Aluminium Fabricator Ltd.

工程號	J853	地盤	錦上路 TWP

送工地

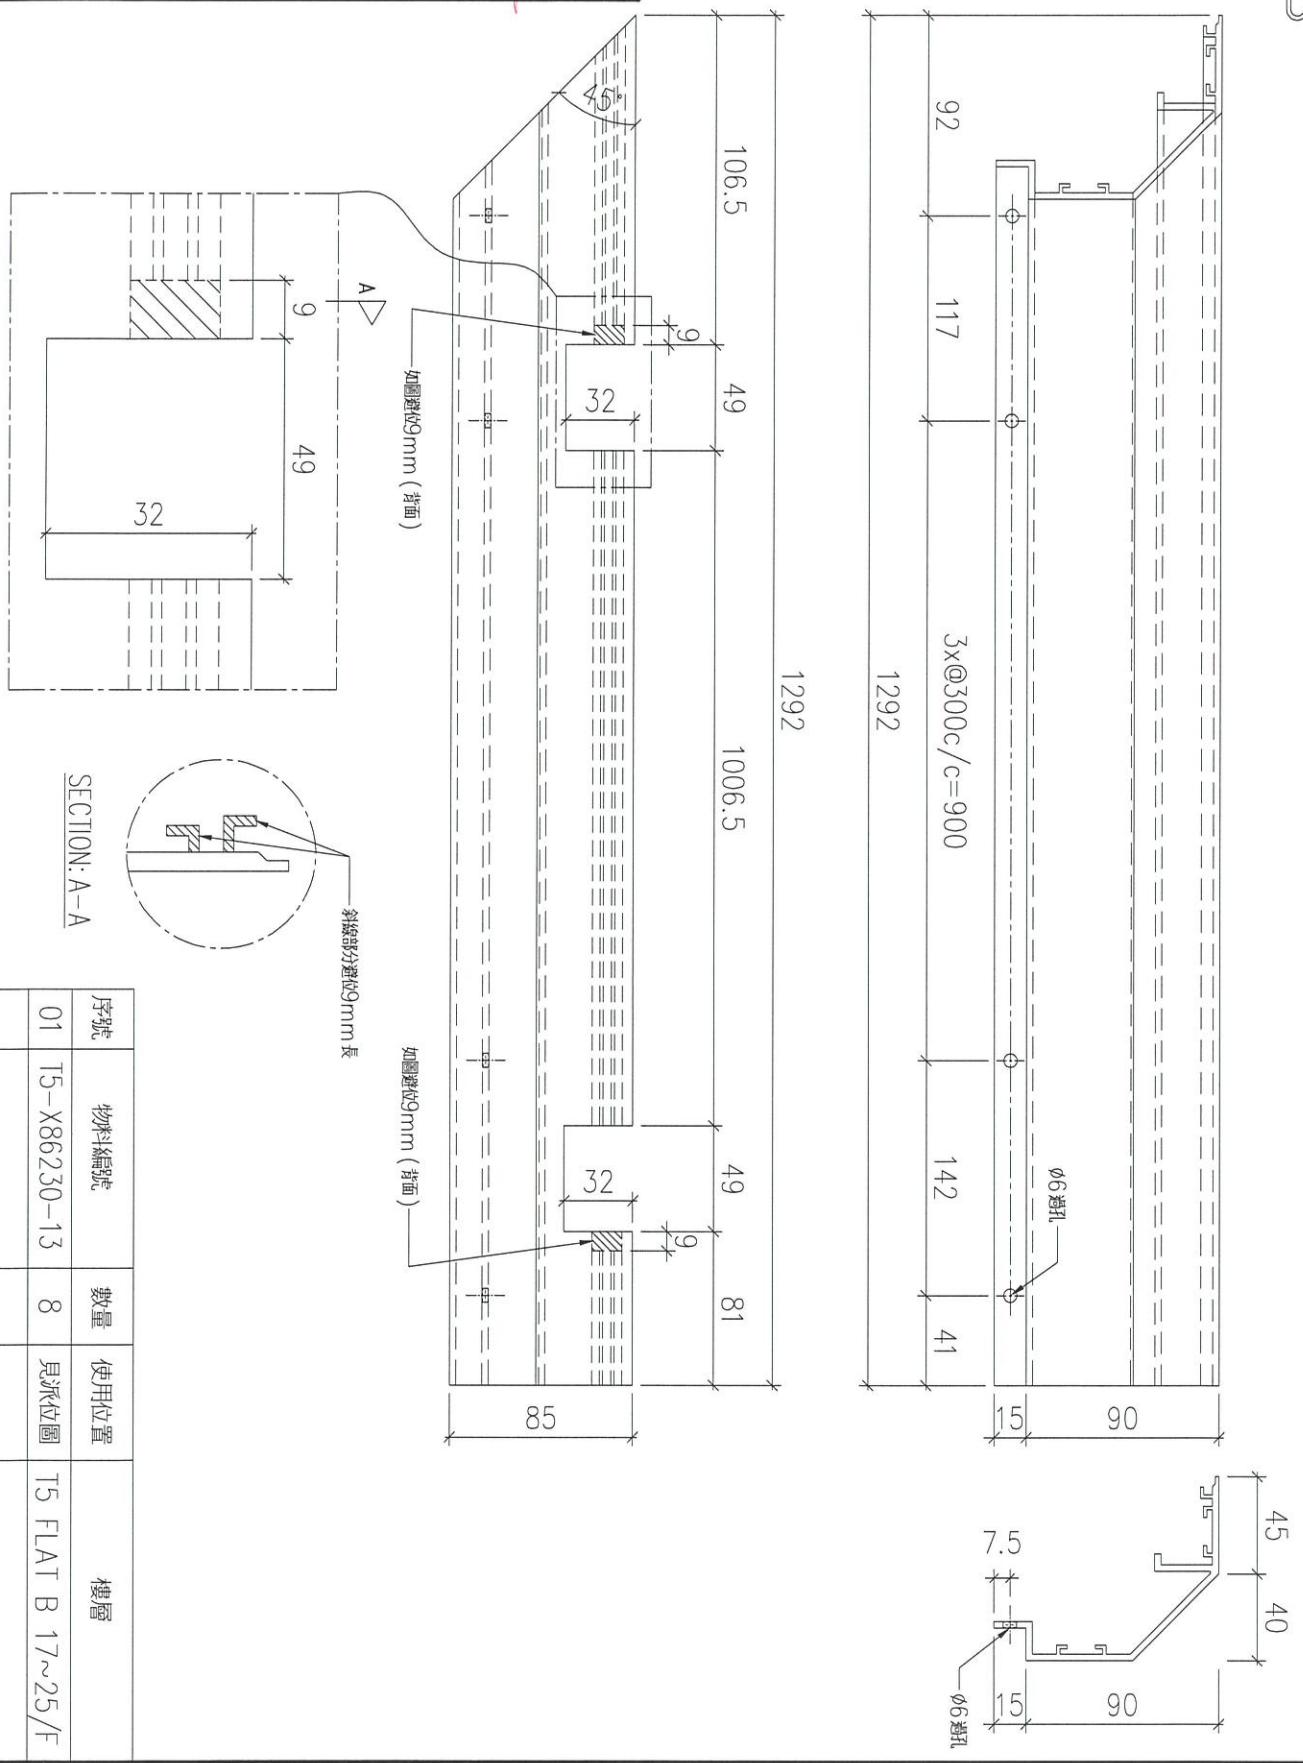

序號	物料編號	數量	使用位置	樓層
01	T5-X86230-13	8	見派位圖	T5 FLAT B 17~25/F


名稱		制圖	LHR	2022,08,30	修改	–		
材料	X86230	復核	–	–	日期	–		
顏色	JMQ213457(3coats)	批準			圖號	J853-GB-FAB2-129		


美特鋁質 有限公司
MIDI Aluminium Fabricator Ltd.


工程號	J853	地盤	~~錦上路~~ TWP


序號	物料編號	數量	使用位置	樓層
02				
01	T5-X86230-14	4	見派位圖	T5 FLAT D 11~16/F

送工地

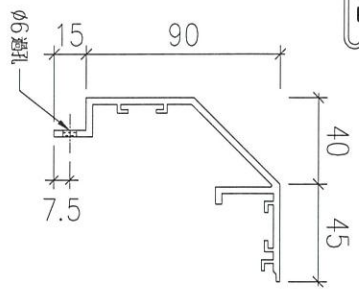


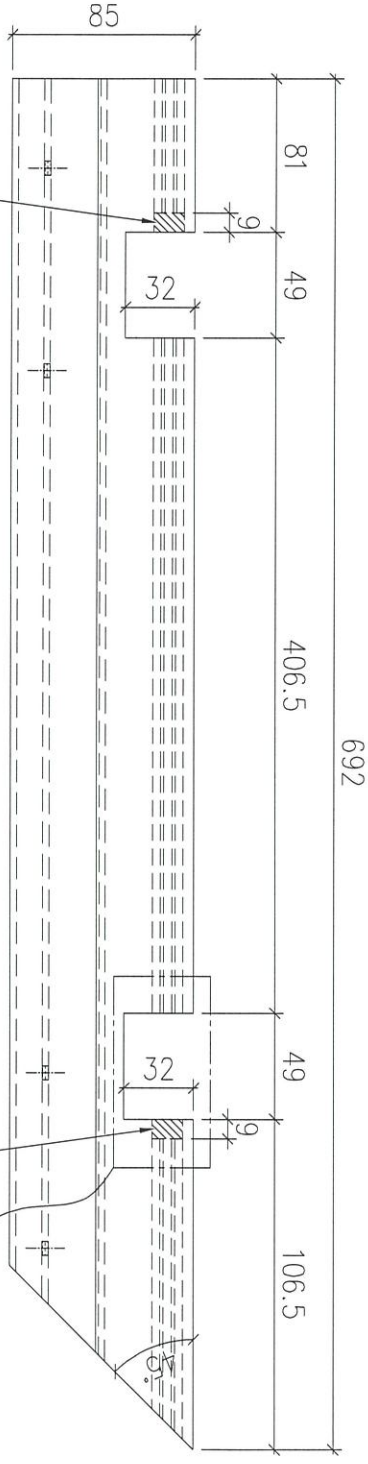

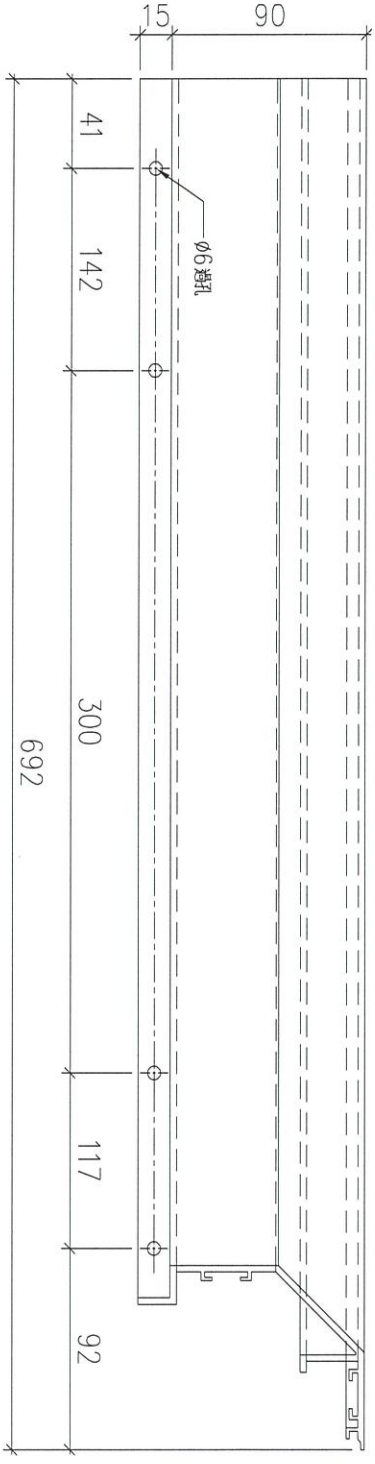

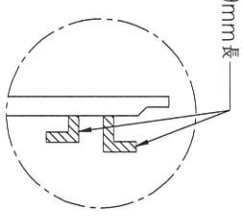

SECTION: A-A

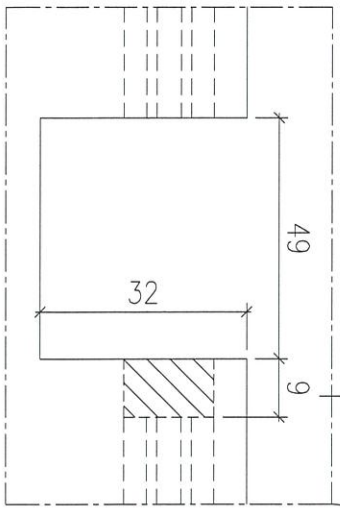


名稱		制圖	LHR	2022,08,30	修改	–		
材料	X86230	復核	–	–	日期	–		
顏色	JMQ213457(3coats)	批準			圖號	J853-GB-FAB2-130		

美特鋁質 有限公司
MIDI Aluminium Fabricator Ltd.

工程號	J853	地盤	錦上路 TWF

送工地

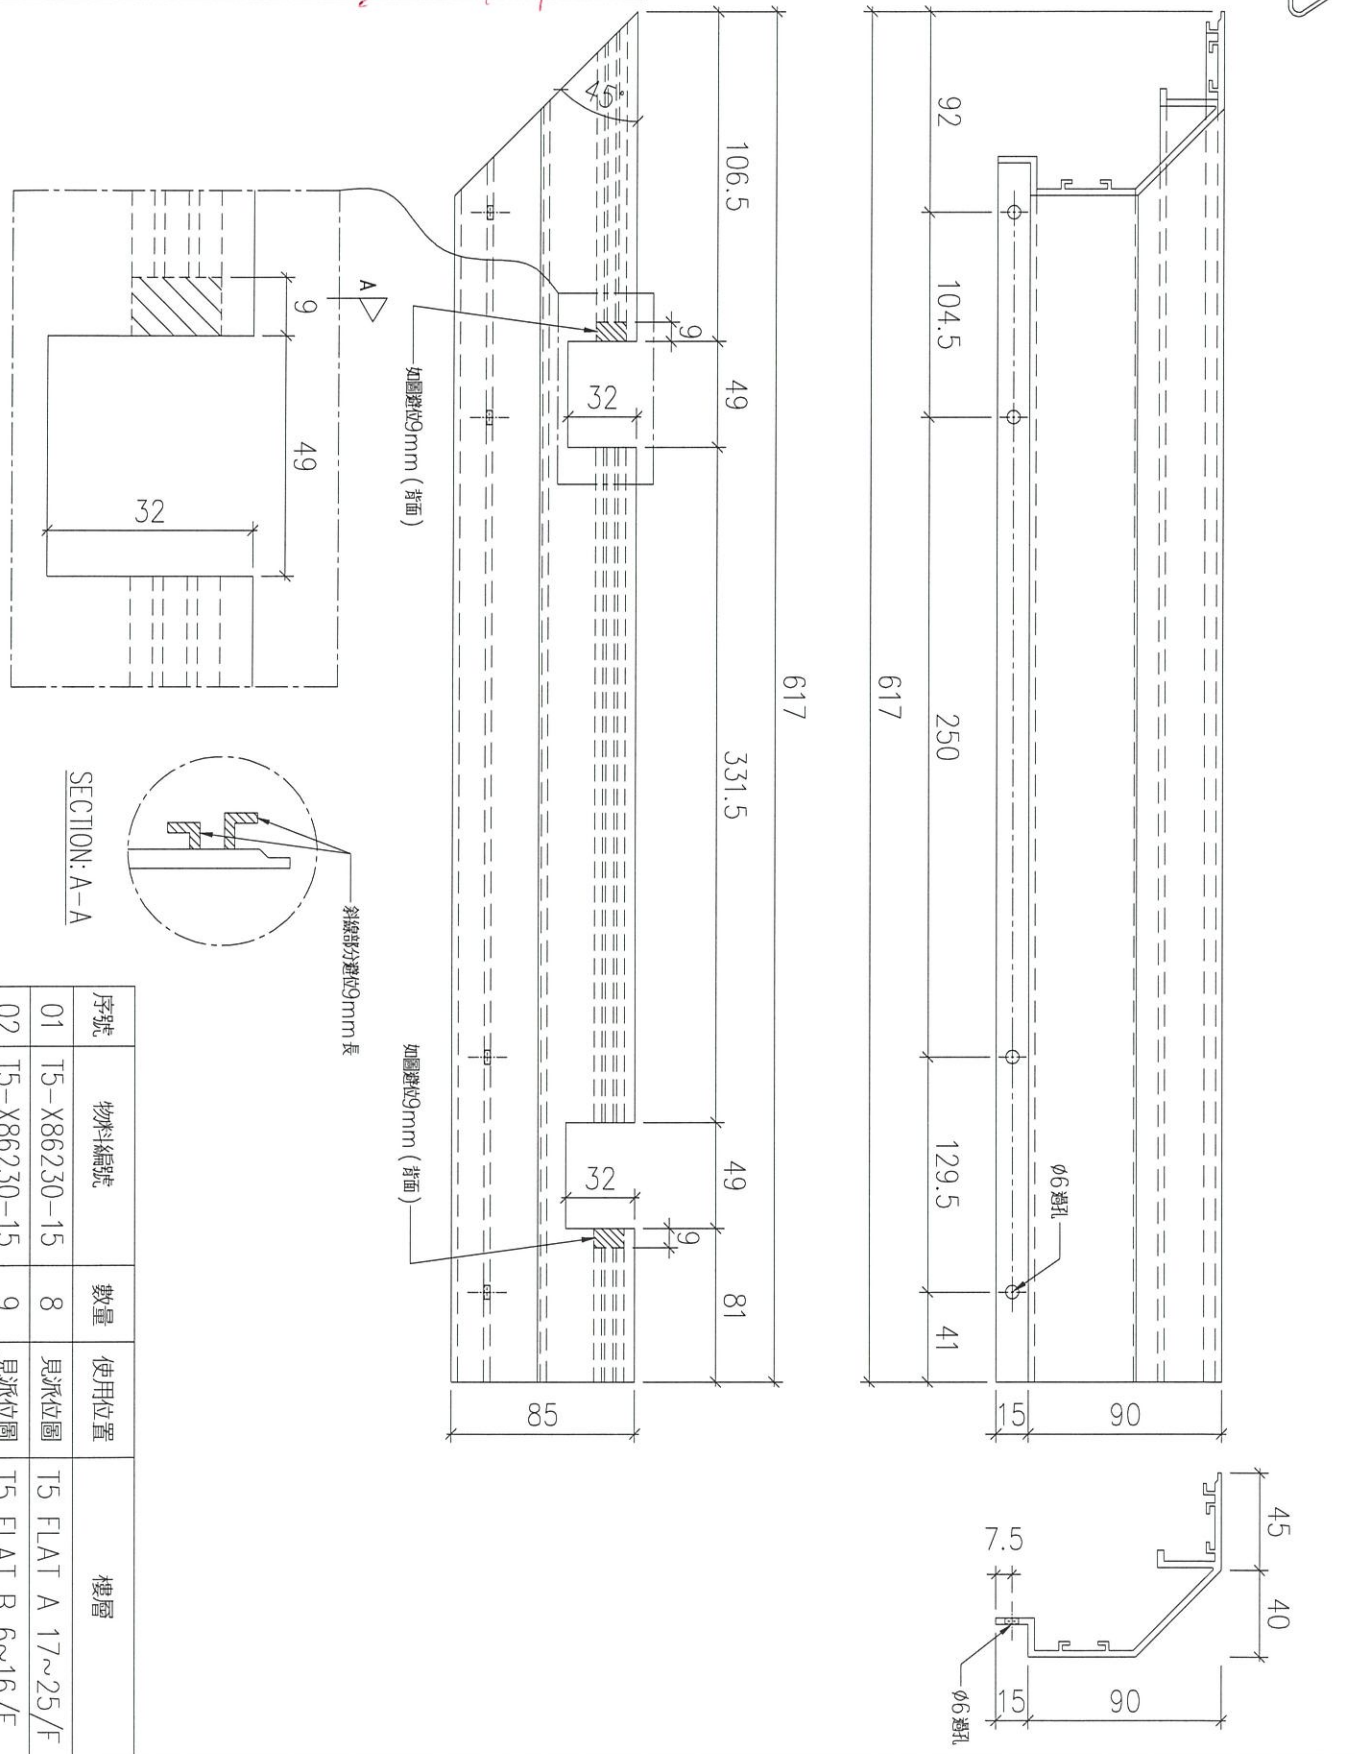

序號	物料編號	數量	使用位置	樓層
01	T5-X86230-15	8	見派位圖	T5 FLAT A 17~25/F
02	T5-X86230-15	9	見派位圖	T5 FLAT B 6~16/F


名稱		制圖	LHR	2022,08,30	修改	–		
材料	X86230	復核	–	–	日期	–		
顏色	JMQ213457(3coats)	批準			圖號	J853-GB-FAB2-131		

美特鋁質 有限公司
MIDI Aluminium Fabricator Ltd.

工程號	J853	地盤	錦上路 ~~TWP~~

送工地

序號	物料編號	數量	使用位置	樓層
01	T5-X86230-16	9	見派位圖	T5 FLAT A 6~16/F
02	T5-X86230-16	8	見派位圖	T5 FLAT A 17~25/F

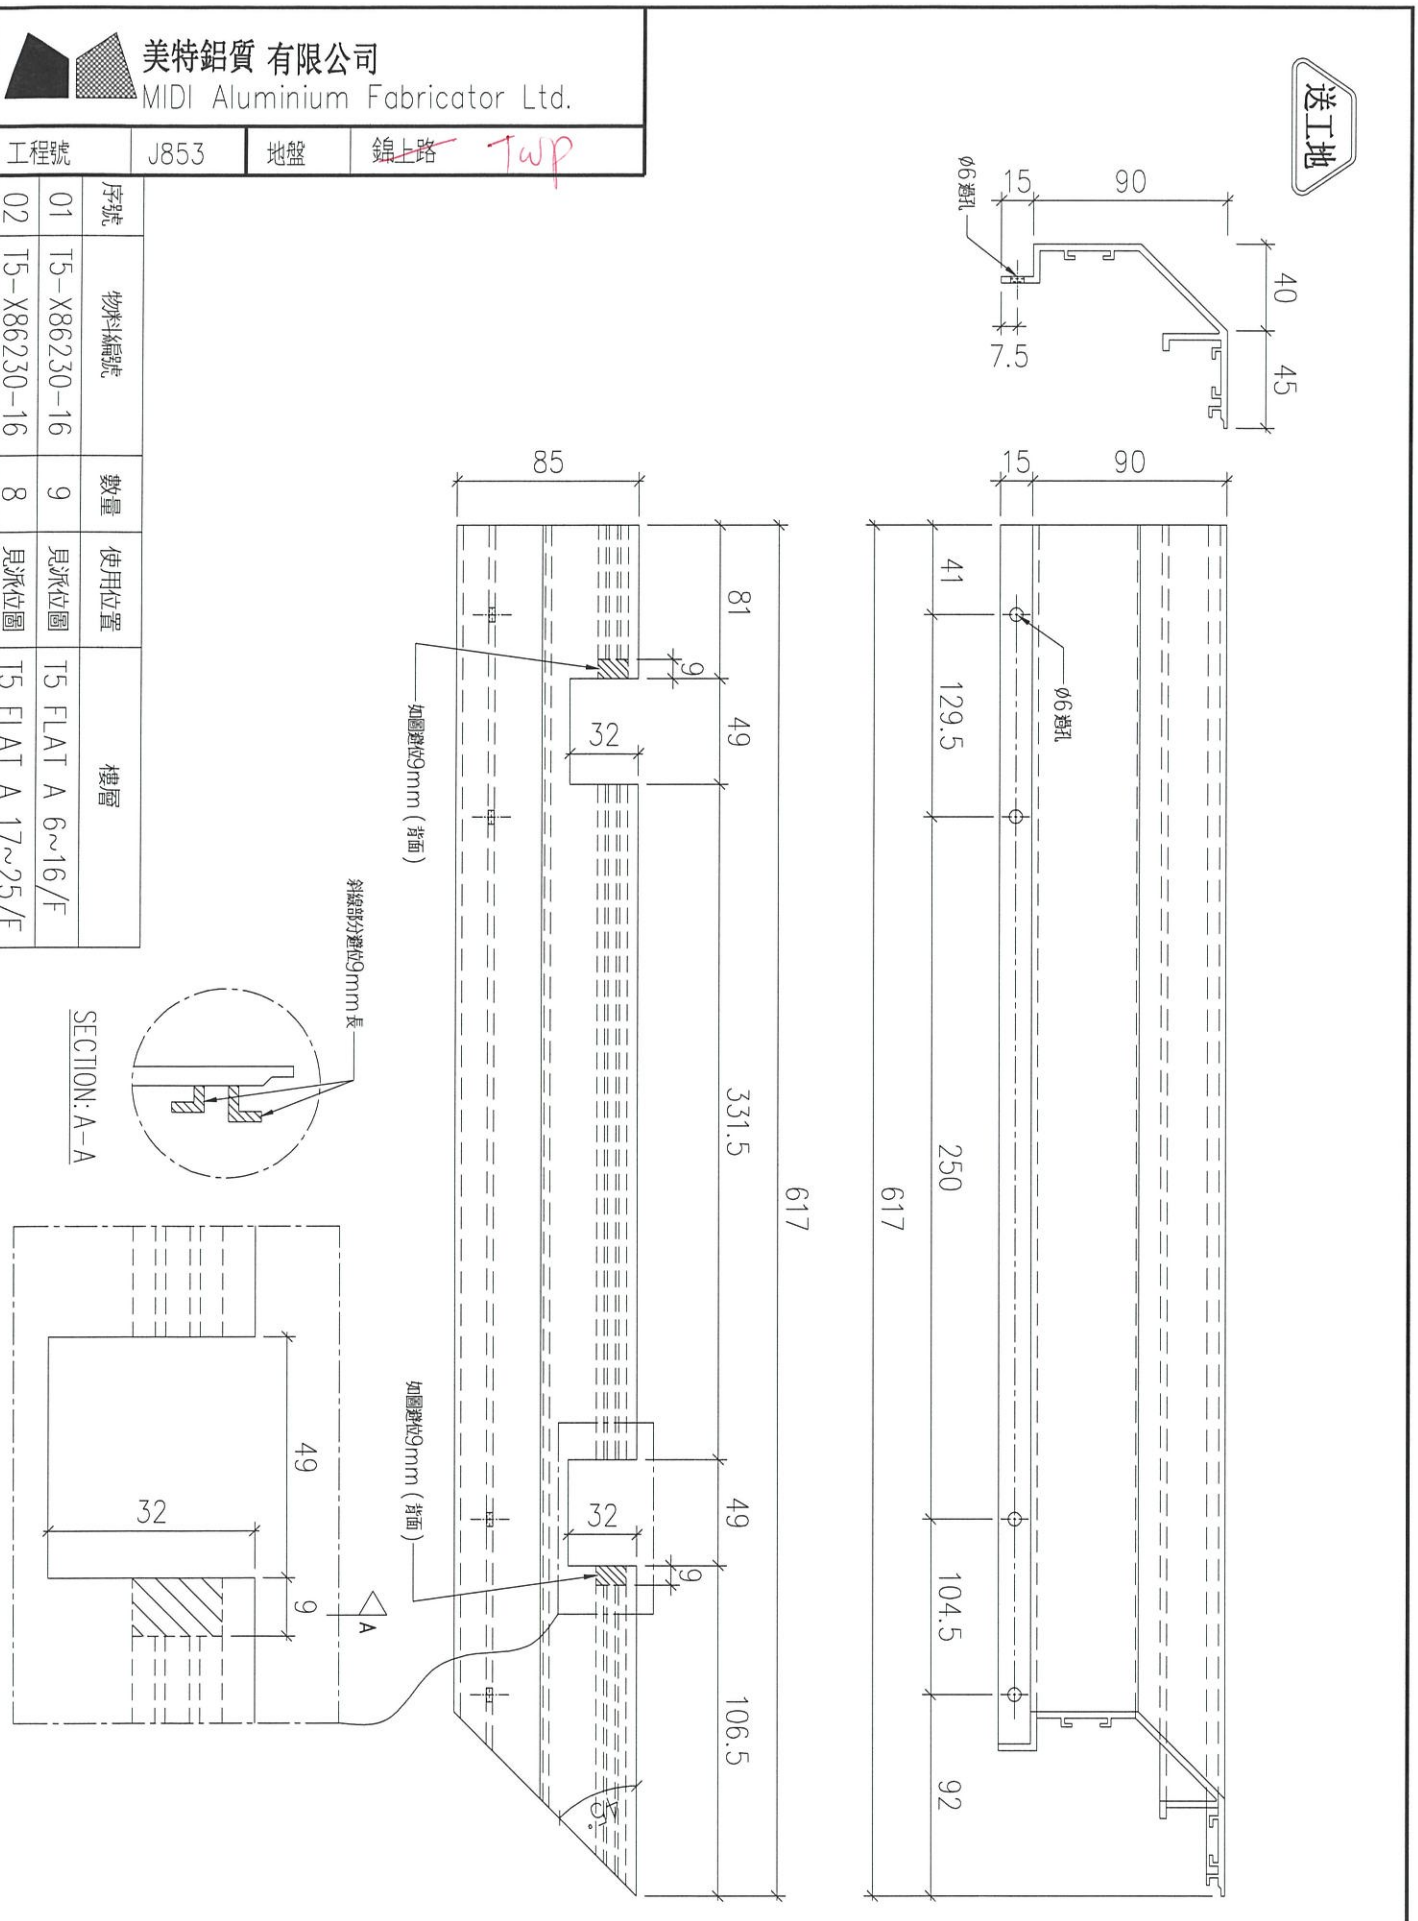



名稱		制圖	LHR	2022,08,30	修改	–		
材料	X86230	復核	–	–	日期	–		
顏色	JMQ213457(3coats)	批準			圖號	J853-GB-FAB2-132		


美特鋁質 有限公司
MIDI Aluminium Fabricator Ltd.

工程號	J853	地盤	~~錦上路~~ TWP


送工地

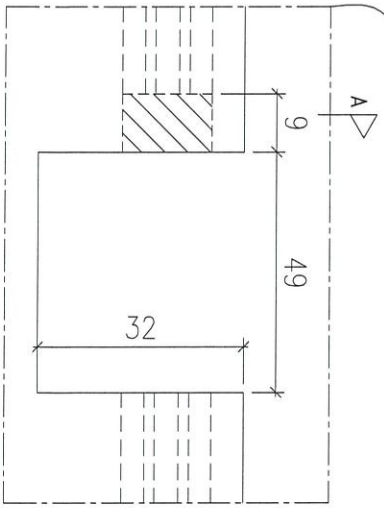


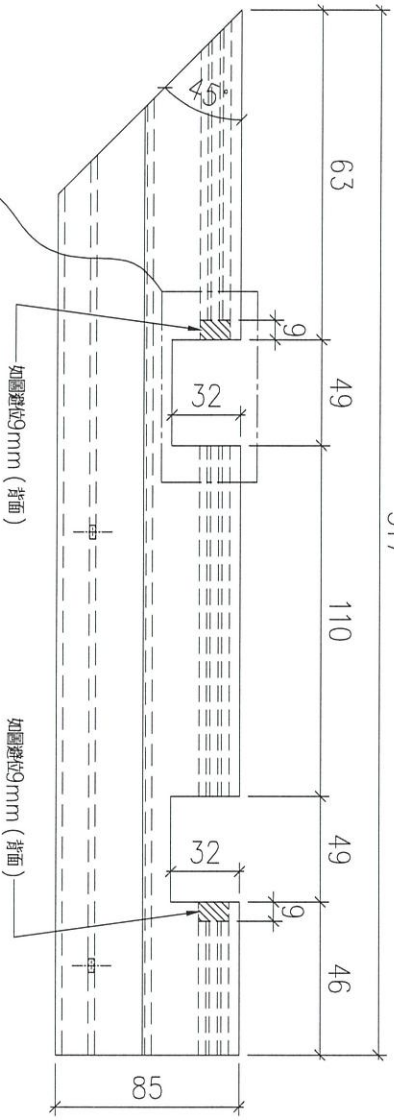

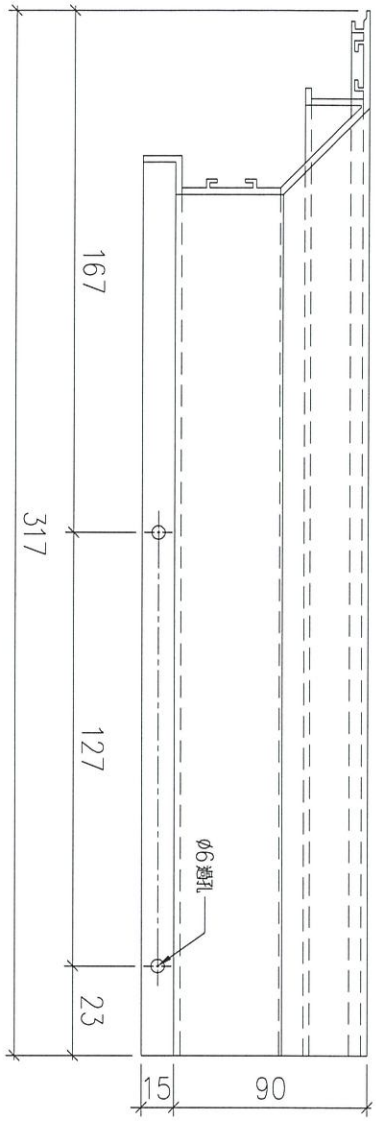

SECTION: A–A

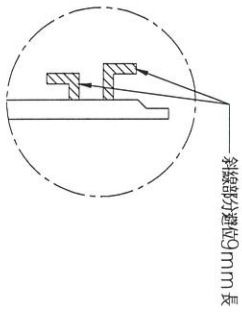

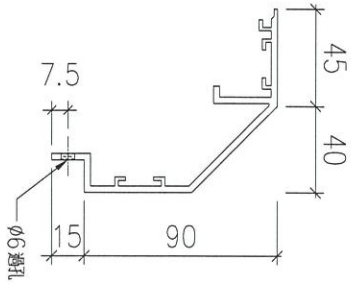

序號	物料編號	數量	使用位置	樓層
01	T5-X86230-17	4	見派位圖	T5 FLAT C 11~16/F


名稱		制圖	LHR	2022,08,30	修改	–		
材料	X86230	復核	–	–	日期	–		
顏色	JMQ213457(3coats)	批準			圖號	J853-GB-FAB2-133		


美特鋁質 有限公司
MIDI Aluminium Fabricator Ltd.


工程號	J853	地盤	~~錦上路~~ Top


序號	物料編號	數量	使用位置	樓層
01	T5-X86230-18	8	見派位圖	T5 FLAT B 17~25/F

送工地

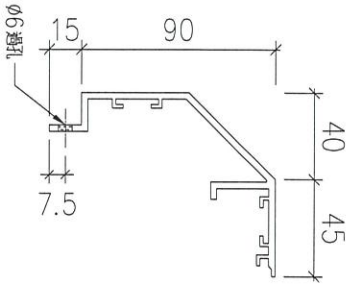


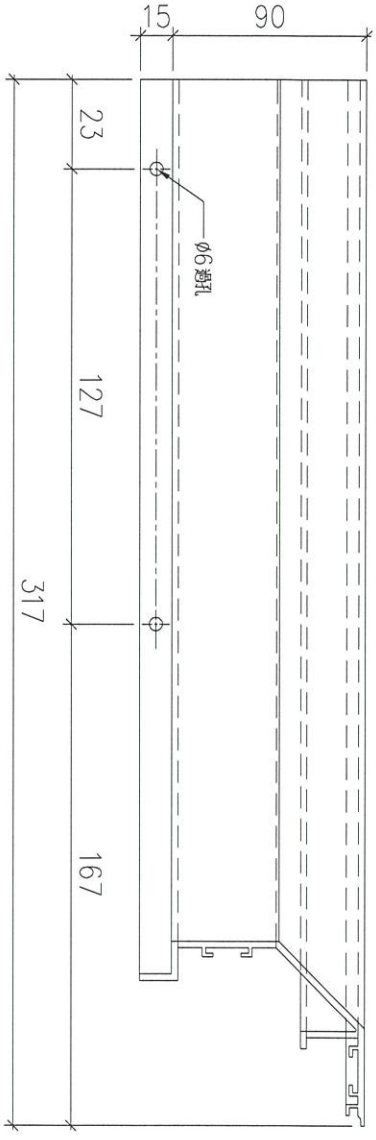

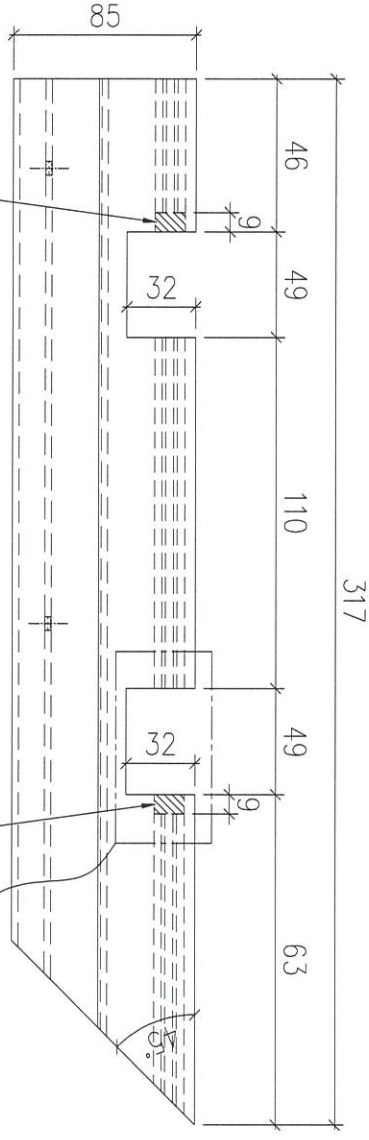

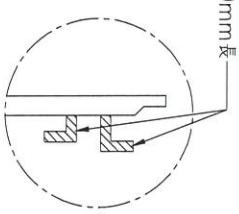

SECTION: A-A

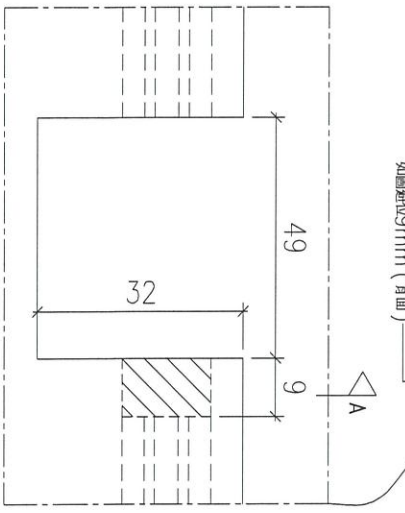


名稱		制圖	LHR	2022,08,30	修改	–		
材料	X86230	復核	–	–	日期	–		
顏色	JMQ213457(3coats)	批準			圖號	J853-GB-FAB2-134		

美特鋁質 有限公司
MIDI Aluminium Fabricator Ltd.

工程號	J853	地盤	錦上路 ~~Tuip~~

送工地

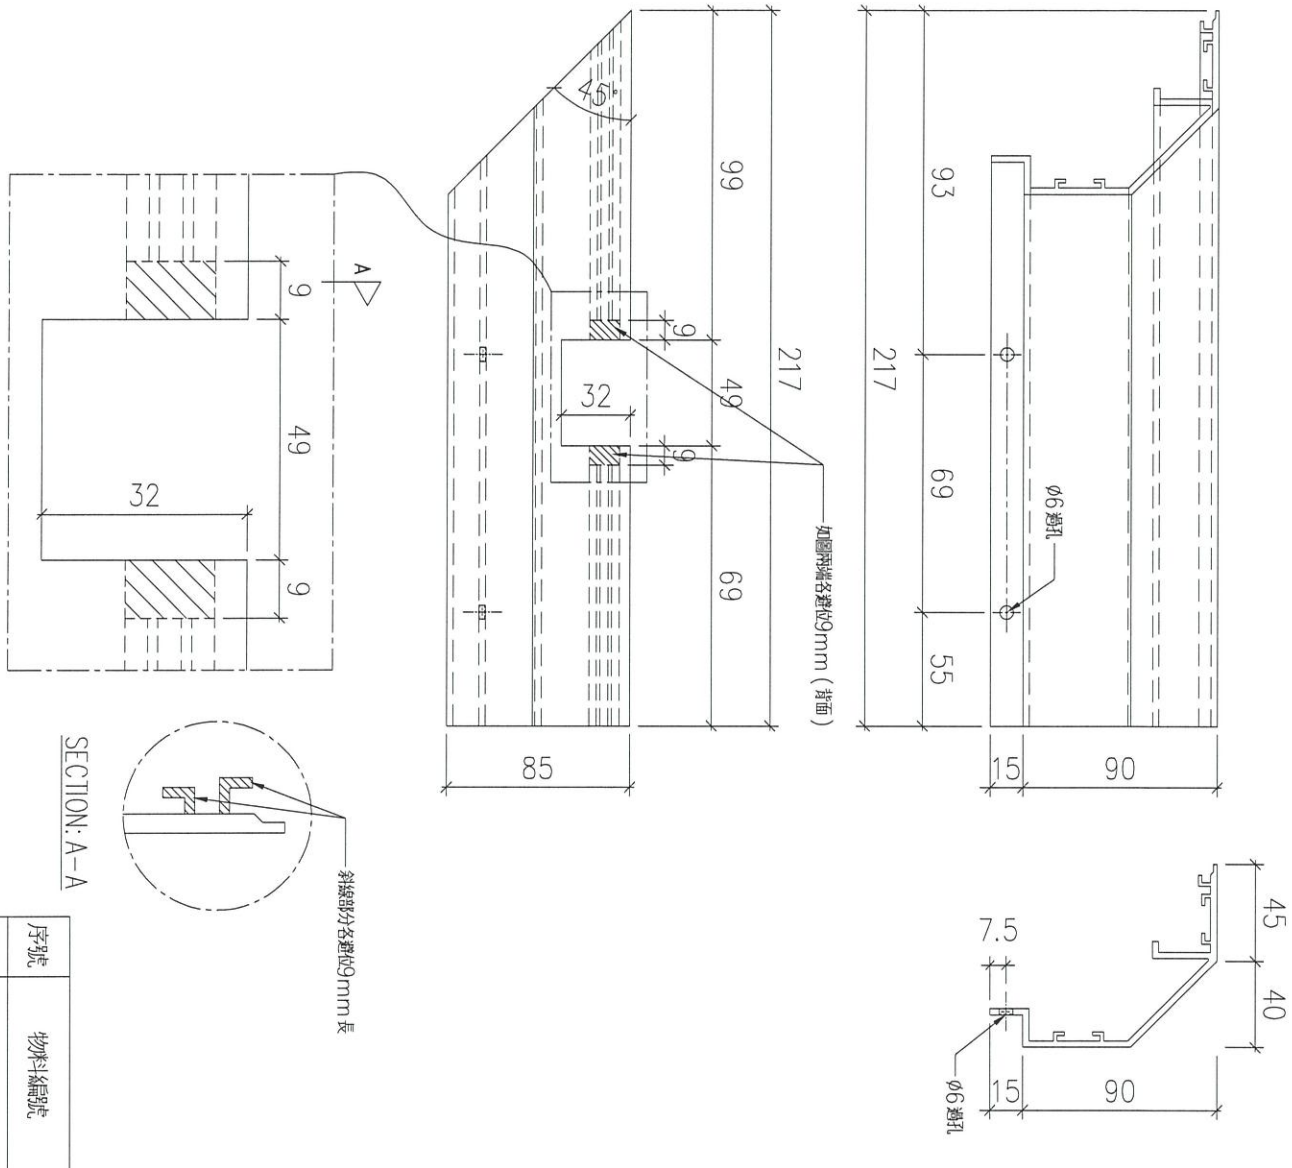

序號	物料編號	數量	使用位置	樓層
01	T5-X86230-19	13	見派位圖	T5 FLAT E/F 11~26/F


名稱		制圖	LHR	2022,08,30	修改	–		
材料	X86230	復核	–	–	日期	–		
顏色	JMQ213457(3coats)	批準			圖號	J853-GB-FAB2-135		


美特鋁質 有限公司
MIDI Aluminium Fabricator Ltd.


工程號	J853	地盤	~~錦上路~~ Twp


送工地


序號	物料編號	數量	使用位置	樓層
01	T5-X86230-20	13	見派位圖	T5 FLAT E/F 11~26/F

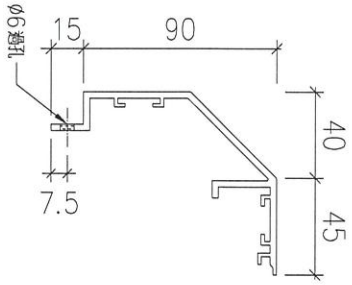

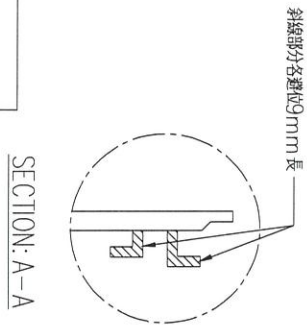

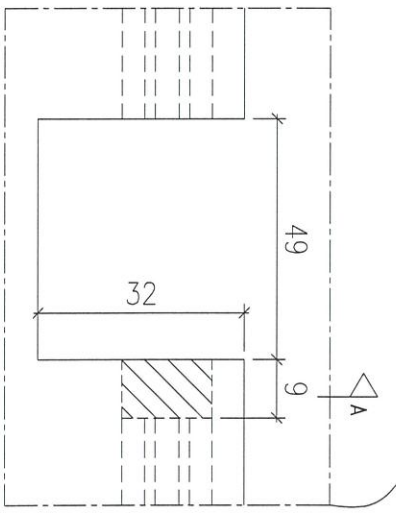

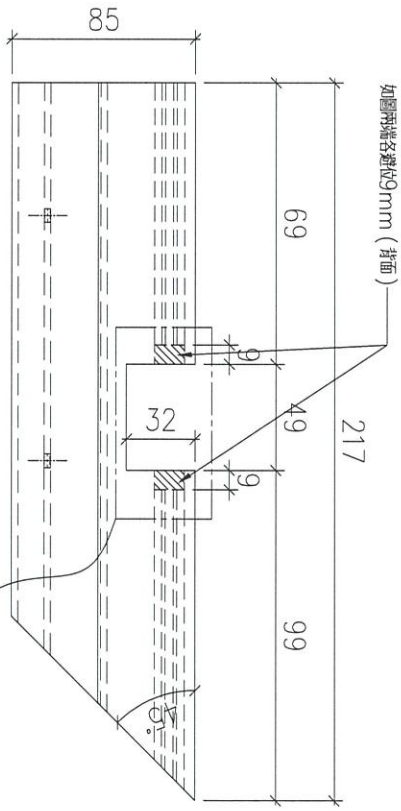

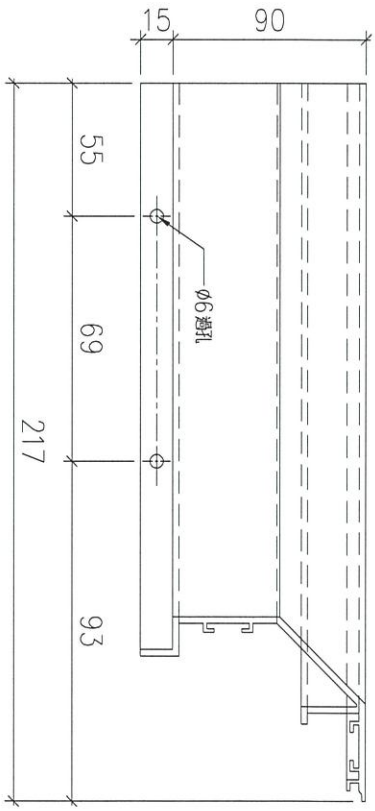


名稱		制圖	LHR	2022,08,30	修改	–		
材料	X86230	復核	–	–	日期	–		
顏色	JMQ213457(3coats)	批準			圖號	J853-GB-FAB2-136		

美特鋁質 有限公司
MIDI Aluminium Fabricator Ltd.

工程號	J853	地盤	錦上路 TWP

送工地

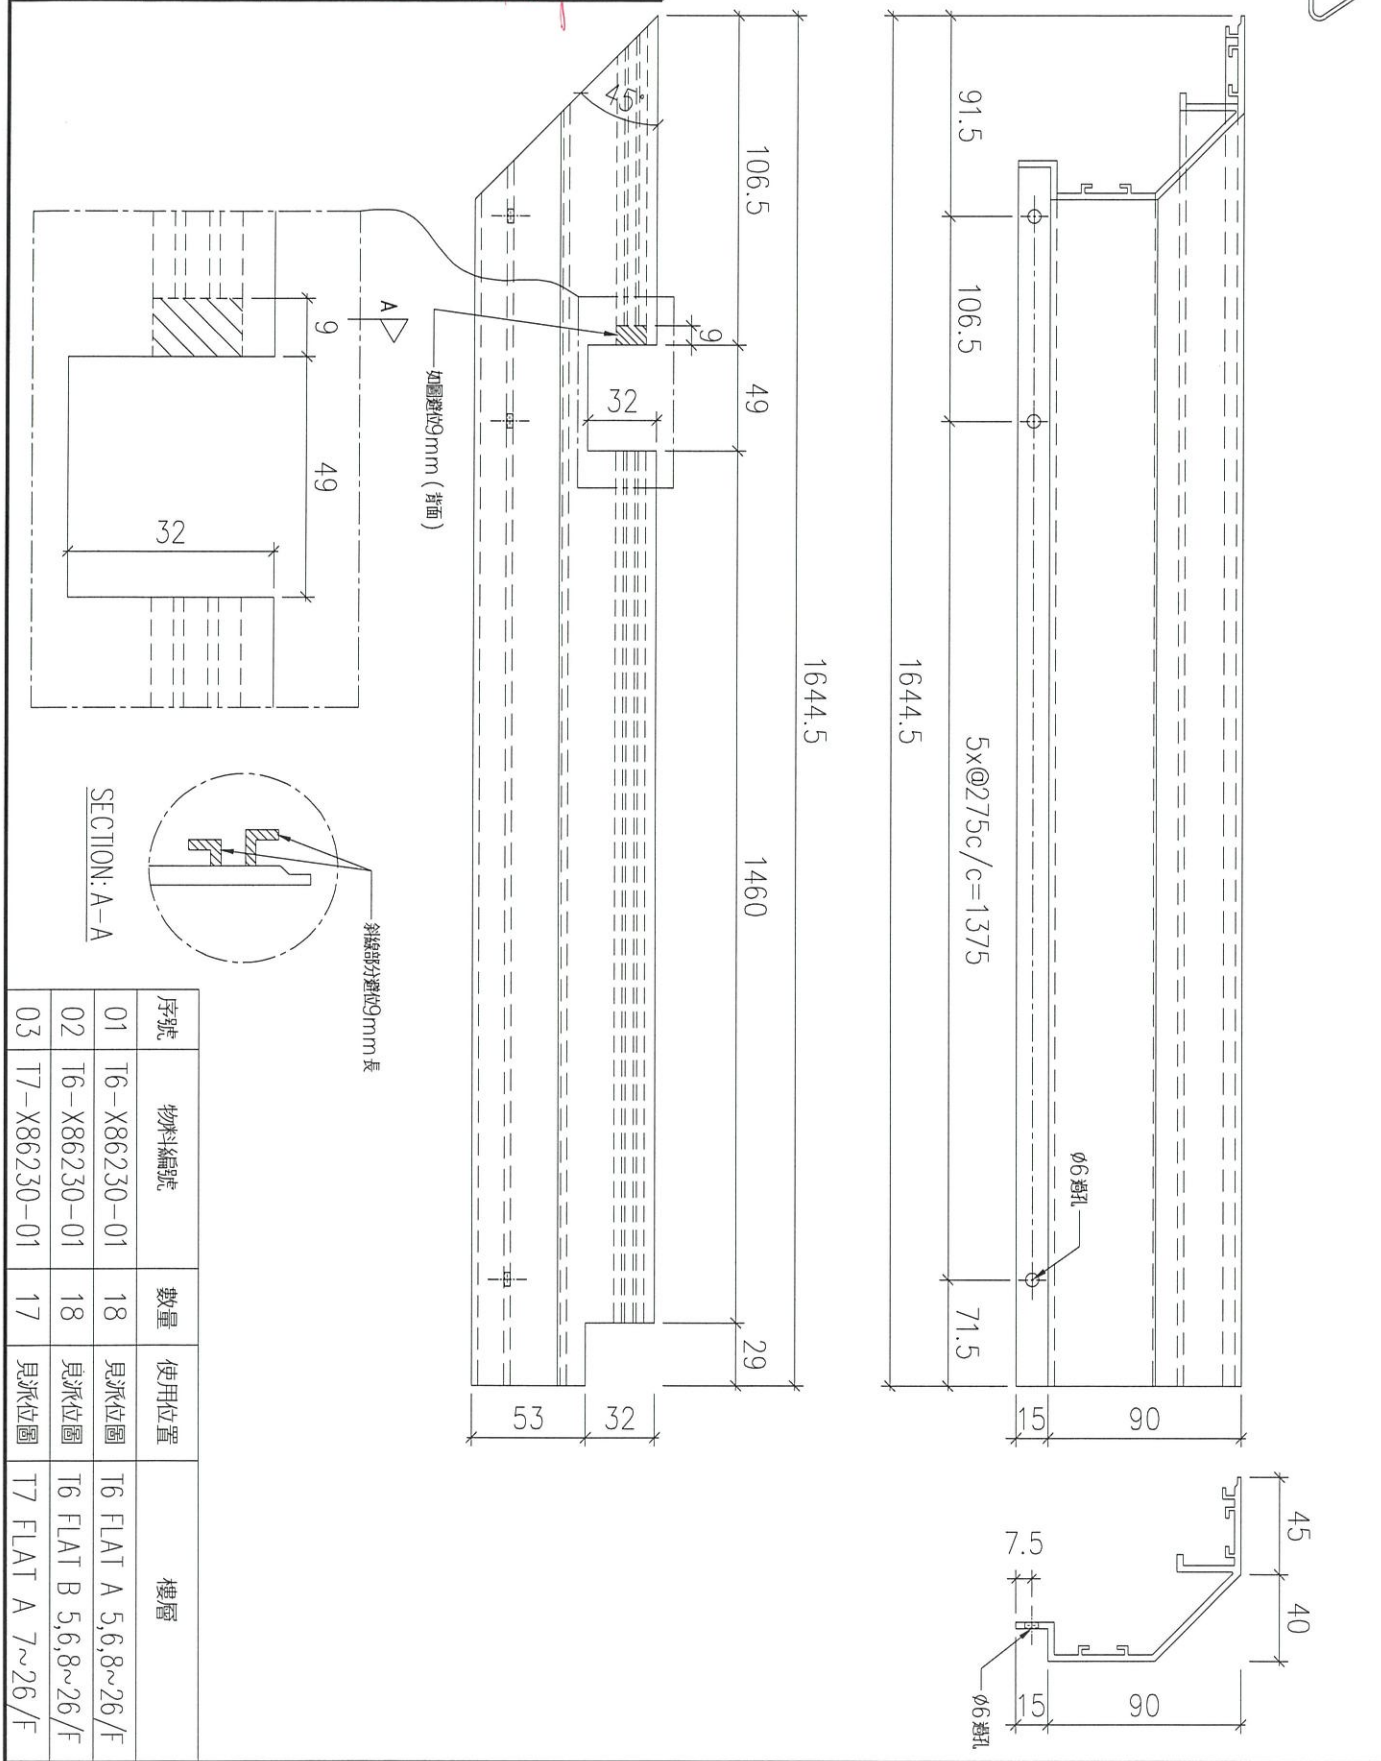

序號	物料編號	數量	使用位置	樓層
01	T6-X86230-01	18	見派位圖	T6 FLAT A 5,6,8~26/F
02	T6-X86230-01	18	見派位圖	T6 FLAT B 5,6,8~26/F
03	T7-X86230-01	17	見派位圖	T7 FLAT A 7~26/F


名稱		制圖	LHR	2022,08,30	修改	–		
材料	X86230	復核	–	–	日期	–		
顏色	JMQ213457(3coats)	批準			圖號	J853-GB-FAB2-137		


美特鋁質 有限公司
MIDI Aluminium Fabricator Ltd.


工程號	J853	地盤	錦上路 Tuf


序號	物料編號	數量	使用位置	樓層
01	T6-X86230-02	18	見派位圖	T6 FLAT A 5,6,8~26/F
02	T6-X86230-02	18	見派位圖	T6 FLAT B 5,6,8~26/F
03	T7-X86230-02	17	見派位圖	T7 FLAT A 7~26/F

送工地

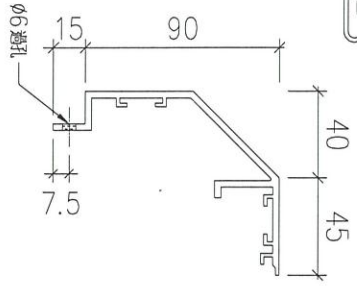


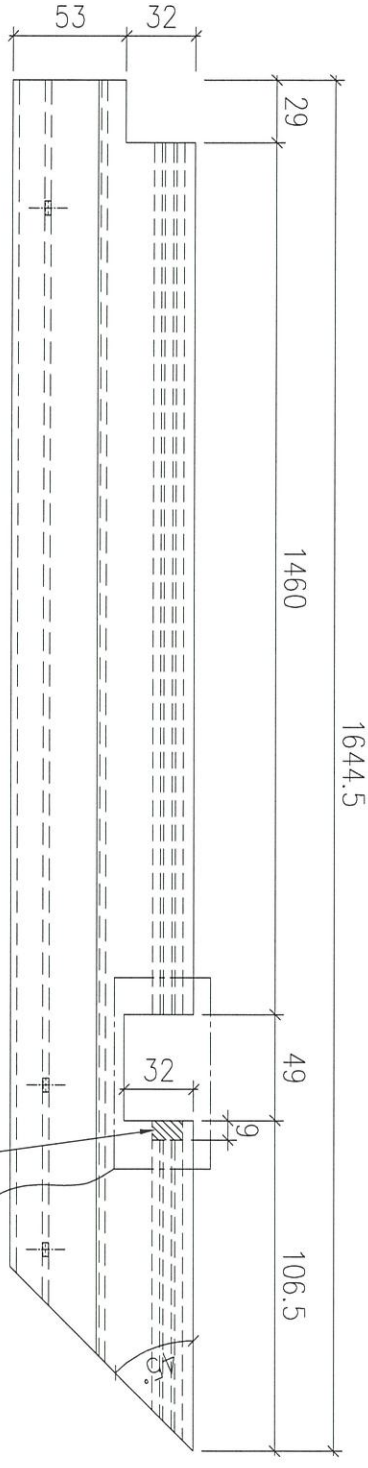

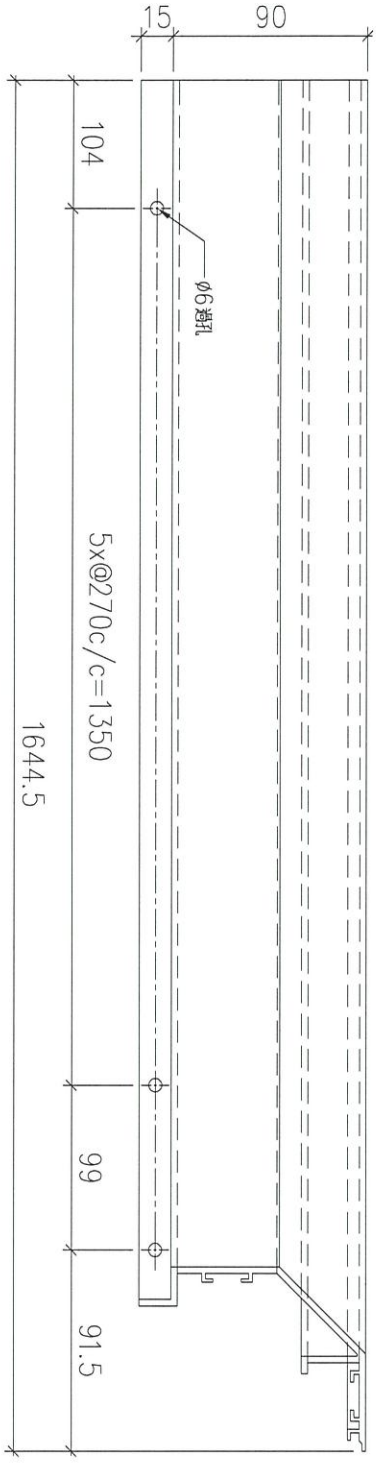

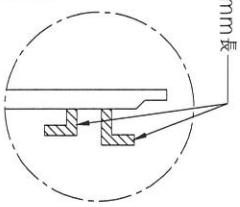

SECTION: A-A

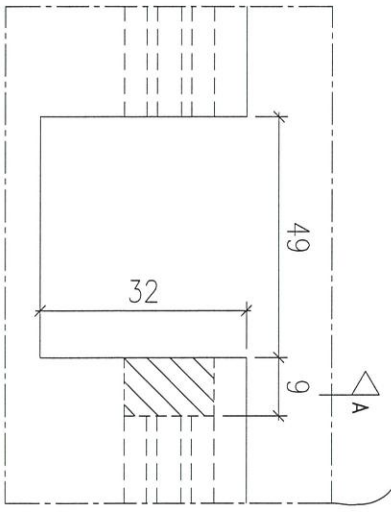



名稱		制圖	LHR	2022,08,30	修改	–		
材料	X86230	復核	–	–	日期	–		
顏色	JMQ213457(3coats)	批準			圖號	J853-GB-FAB2-138		


美特鋁質 有限公司
MIDI Aluminium Fabricator Ltd.

工程號	J853	地盤	錦上路 Twp

送工地

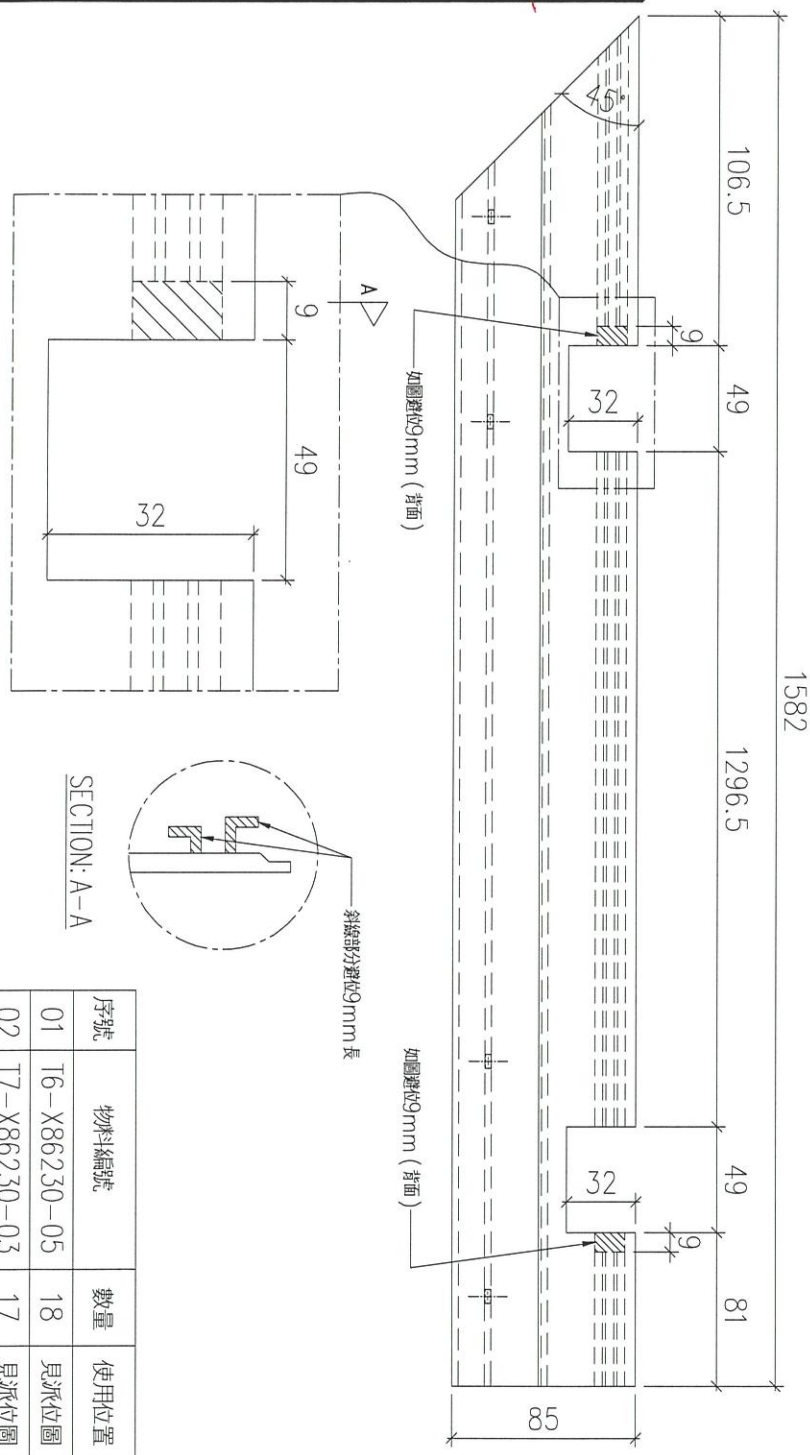

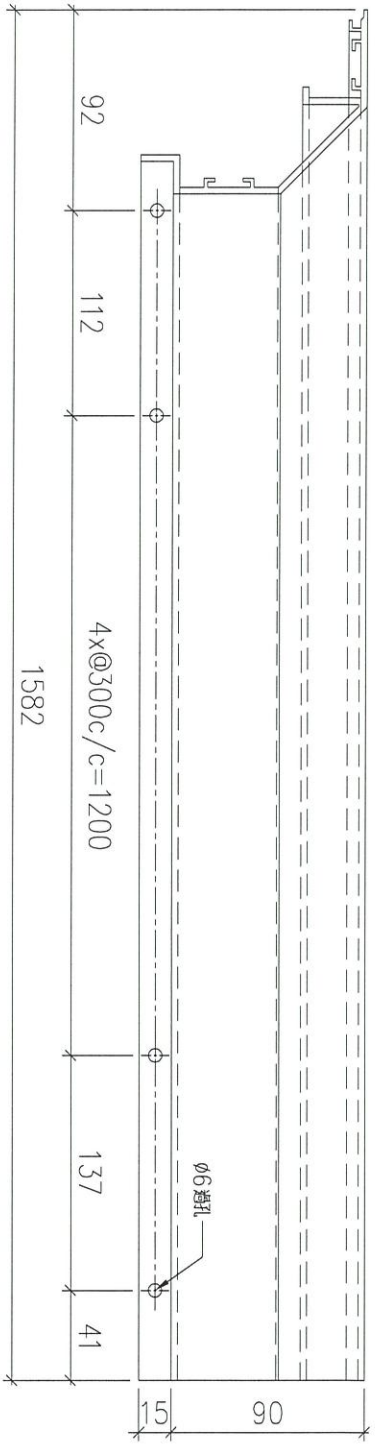

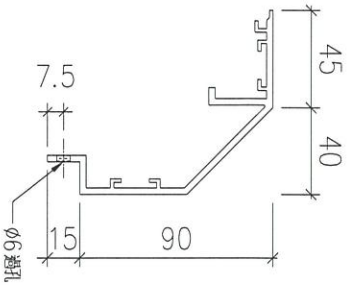

序號	物料編號	數量	使用位置	樓層
01	T6-X86230-05	18	見派位圖	T6 FLAT B 5,6,8~26/F
02	T7-X86230-03	17	見派位圖	T7 FLAT A 7~26/F


名稱		制圖	LHR	2022,08,30	修改	–		
材料	X86230	復核	–	–	日期	–		
顏色	JMQ213457(3coats)	批準			圖號	J853-GB-FAB2-139		

美特鋁質 有限公司
MIDI Aluminium Fabricator Ltd.

工程號	J853	地盤	錦上路 Twp

序號	物料編號	數量	使用位置	樓層
01	T6-X86230-06	18	見派位圖	T6 FLAT A 5,6,8~26/F
02	T7-X86230-04	15	見派位圖	T7 FLAT B 7~23/F

送工地

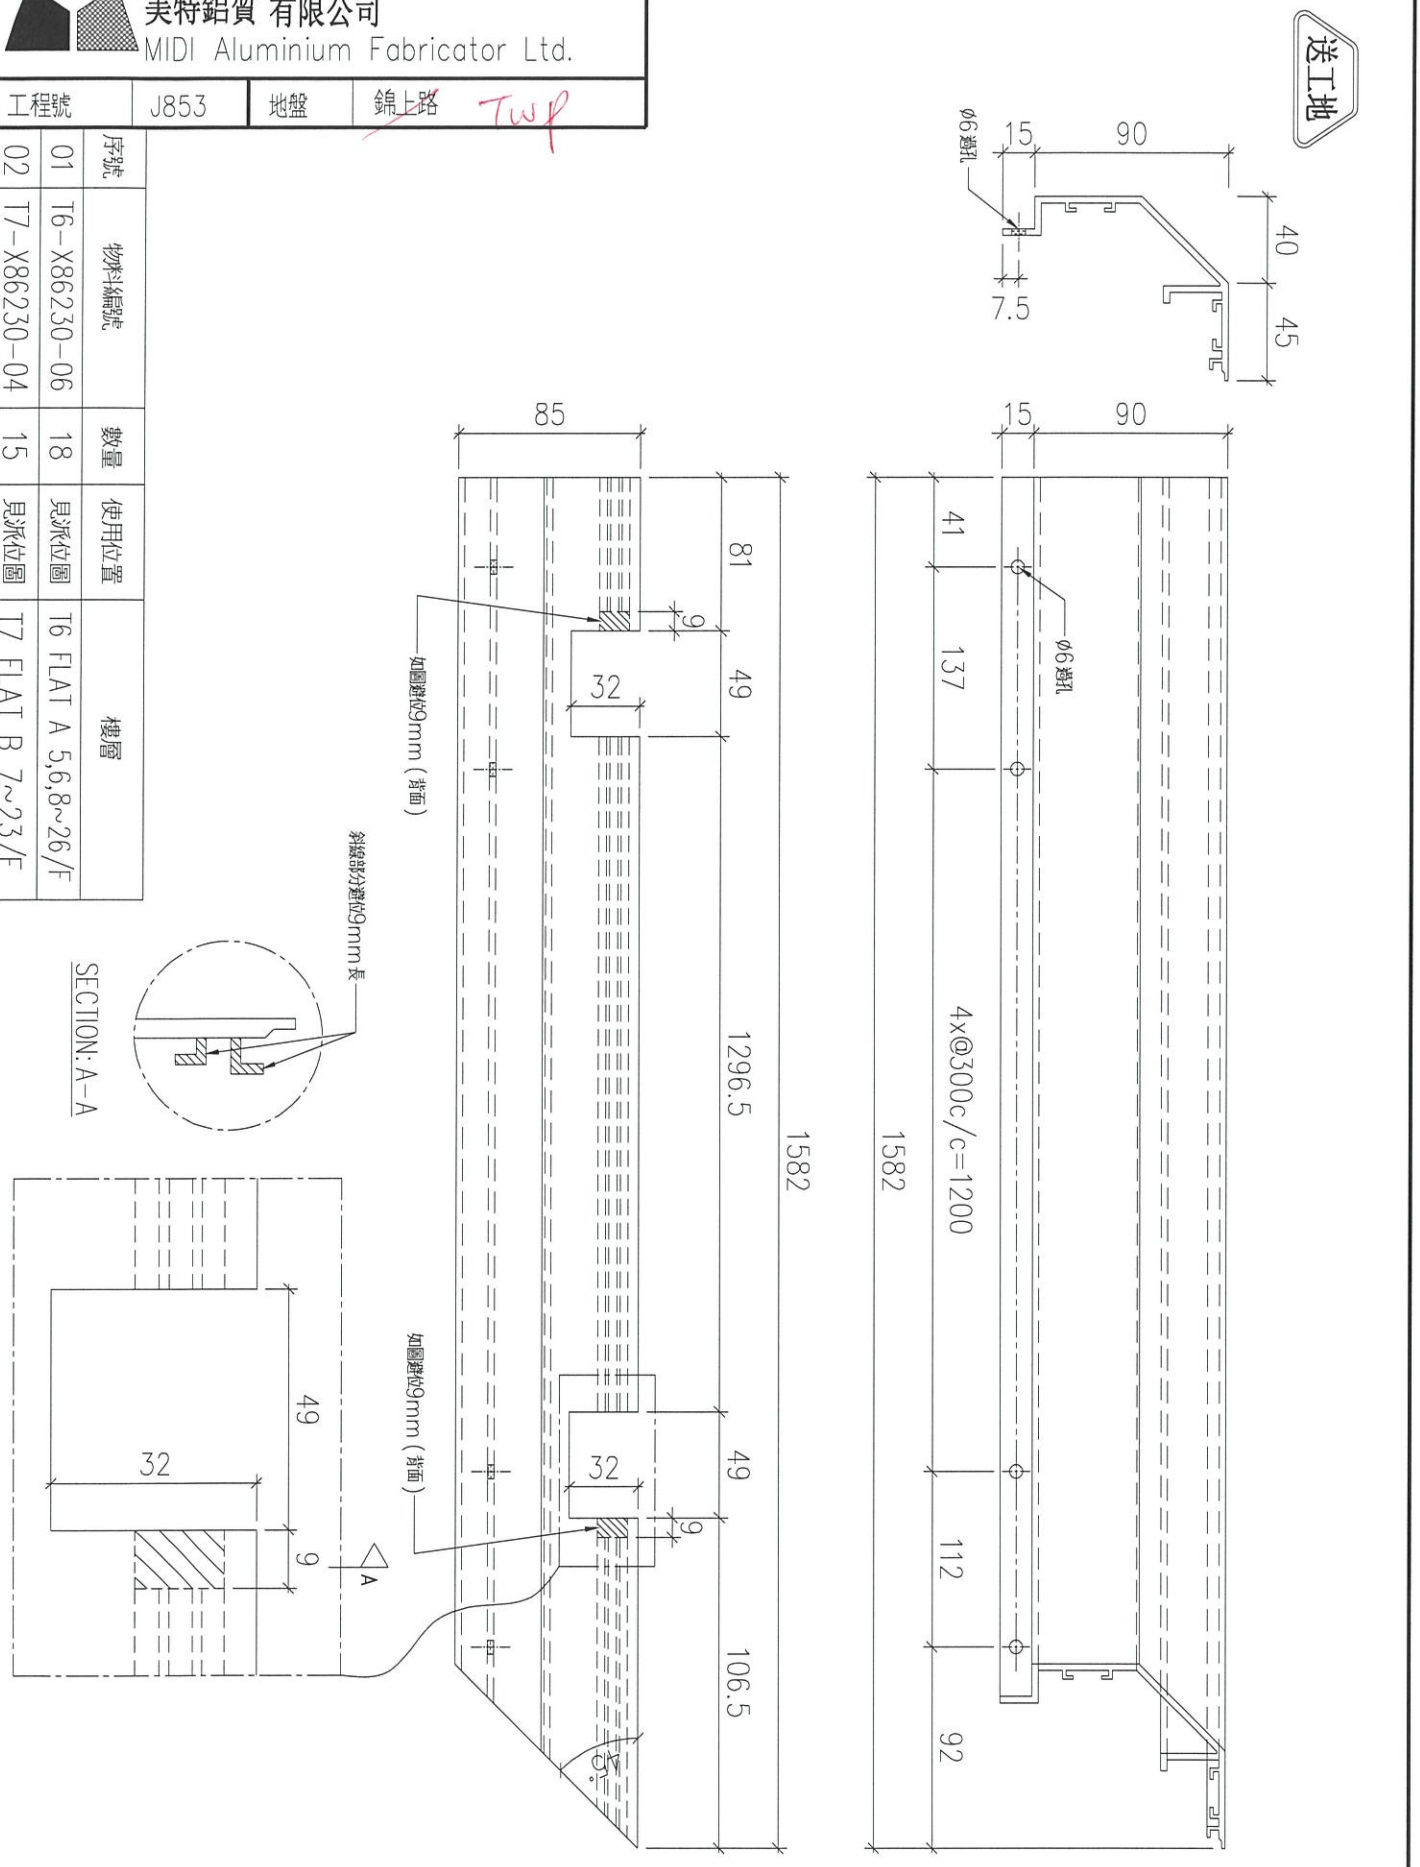


名稱		制圖	LHR	2022,08,30	修改	–		
材料	X86230	復核	–	–	日期	–		
顏色	JMQ213457(3coats)	批準			圖號	J853-GB-FAB2-140		

美特鋁質 有限公司
MIDI Aluminium Fabricator Ltd.

工程號	J853	地盤	錦上路 T12P

送工地

序號	物料編號	數量	使用位置	樓層
01	T7-X86230-06	17	見派位圖	T7 FLAT A 7~26/F

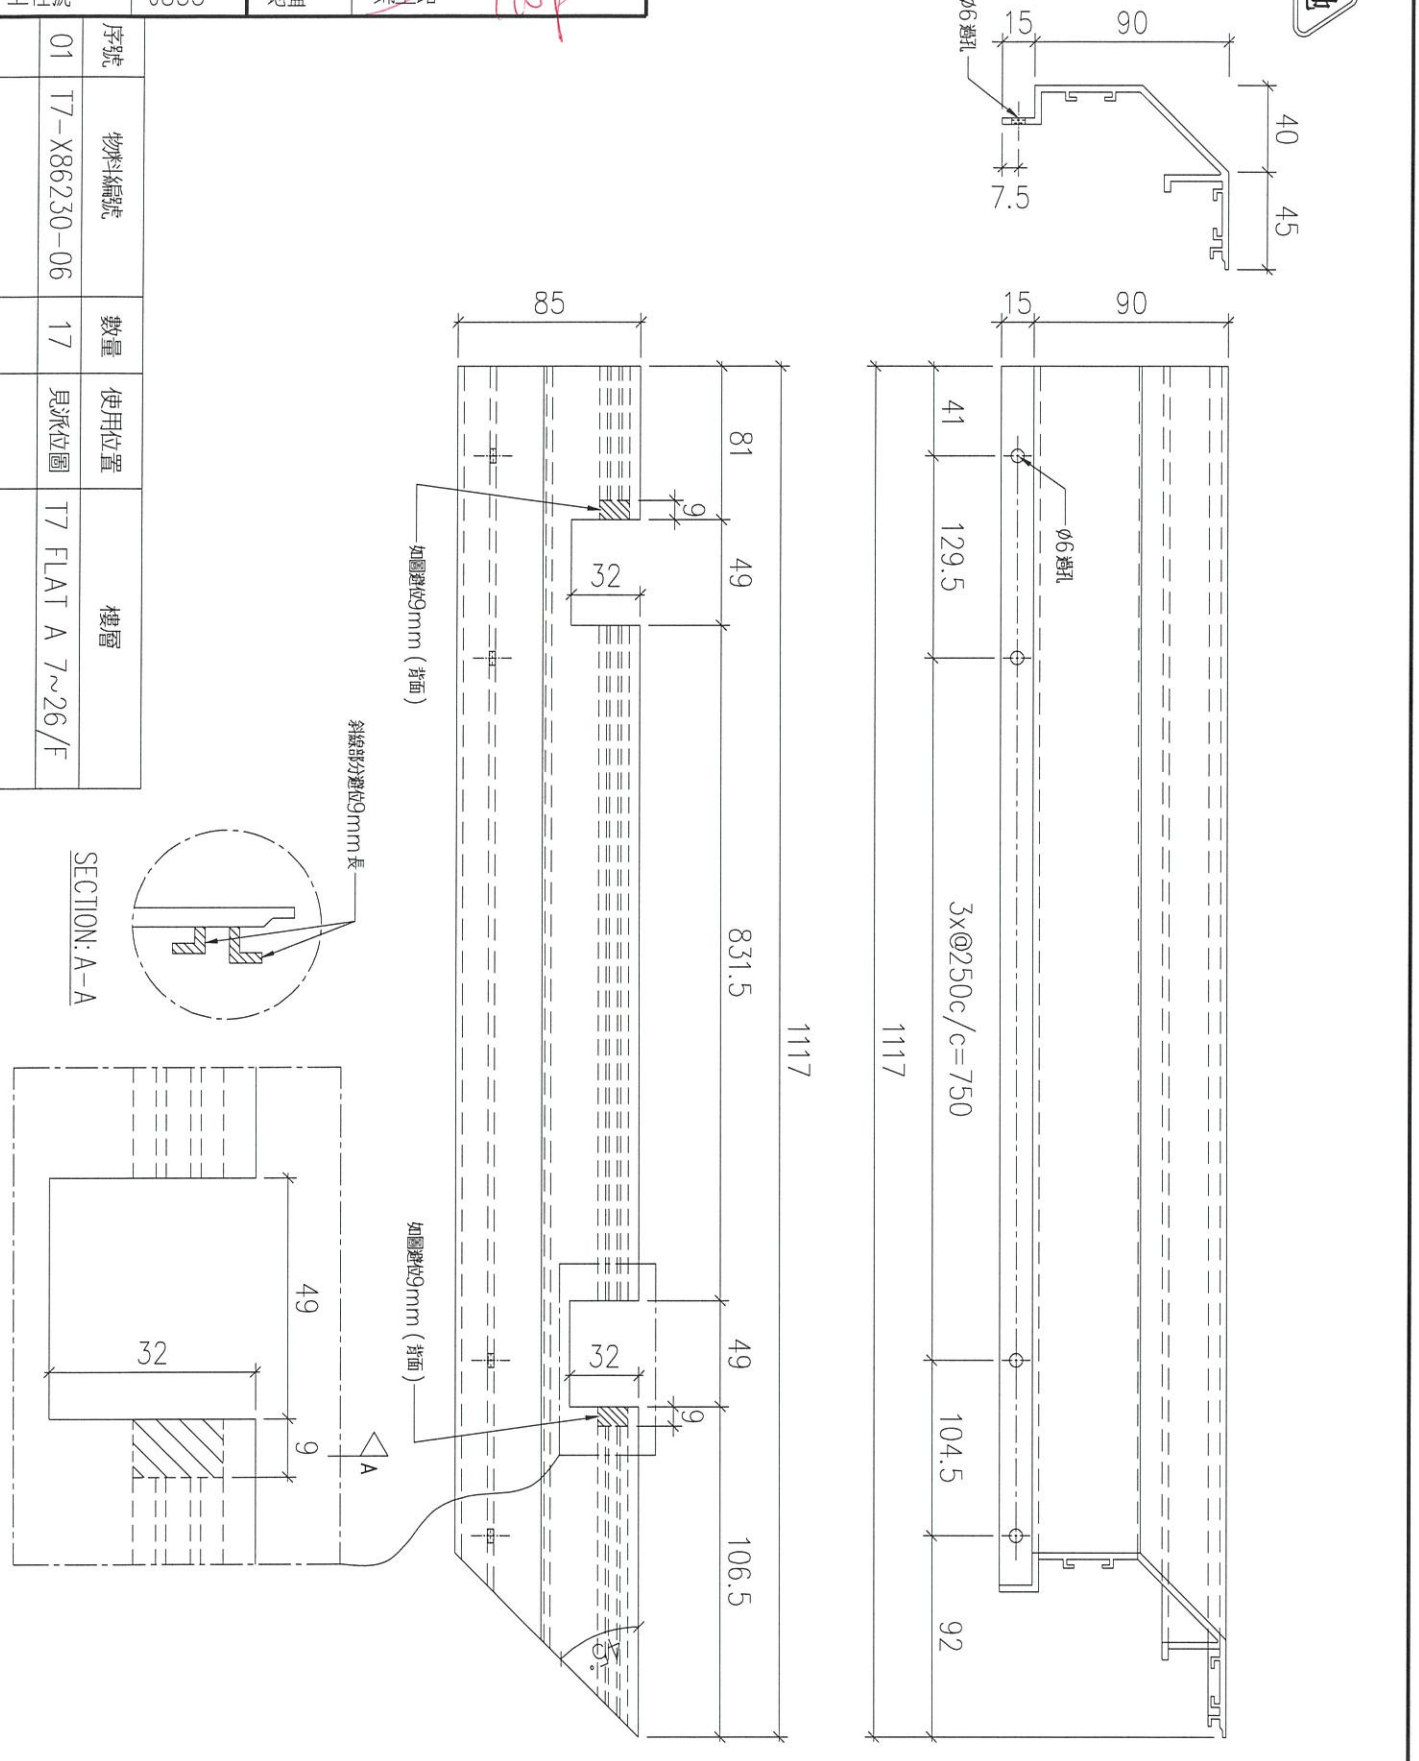



名稱		制圖	LHR	2022,08,30	修改	–		
材料	X86230	復核	–	–	日期	–		
顏色	JMQ213457(3coats)	批準			圖號	J853-GB-FAB2-141		


美特鋁質 有限公司
MIDI Aluminium Fabricator Ltd.


工程號	J853	地盤	錦上路 T3P

送工地

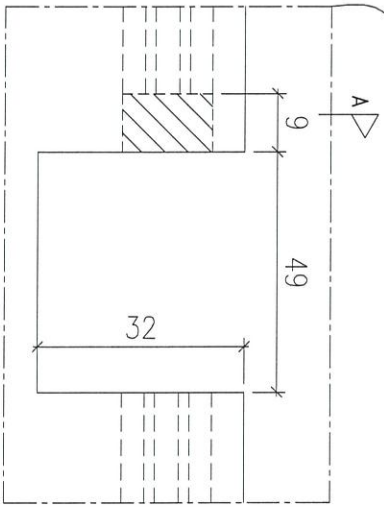


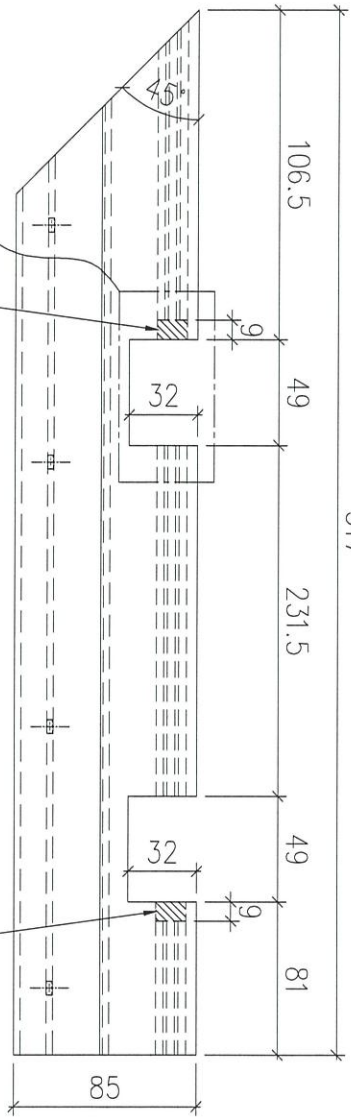

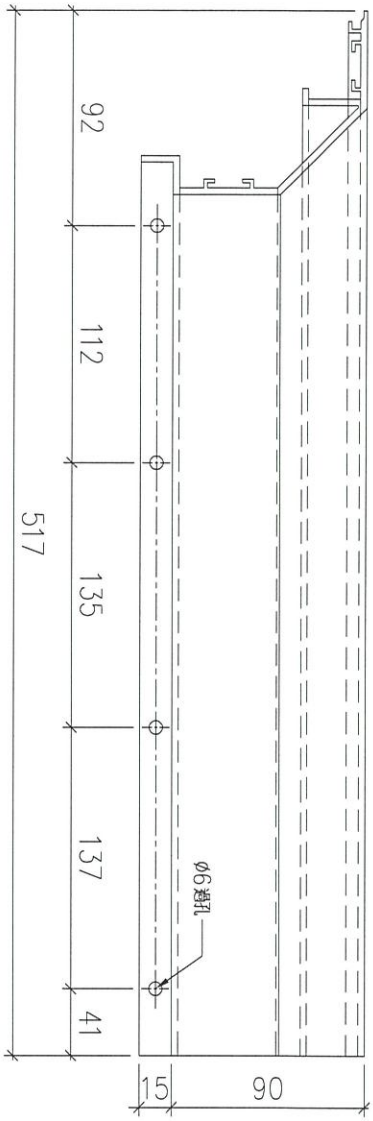

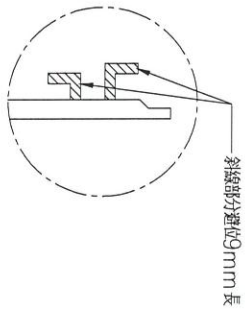

SECTION: A-A

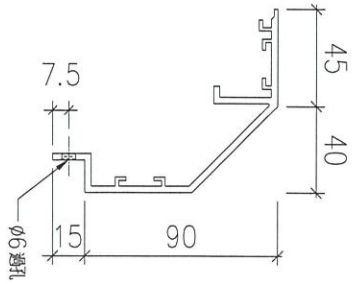

序號	物料編號	數量	使用位置	樓層
01	T6-X86230-07	18	見派位圖	T6 FLAT A 5,6,8~26/F


名稱		制圖	LHR	2022,08,30	修改	–		
材料	X86230	復核	–	–	日期	–		
顏色	JMQ213457(3coats)	批準			圖號	J853-GB-FAB2-142		

美特鋁質 有限公司
MIDI Aluminium Fabricator Ltd.

工程號	J853	地盤	錦上路 Twp

送工地

序號	物料編號	數量	使用位置	樓層
01	T6-X86230-08	18	見派位圖	T6 FLAT B 5,6,8~26/F

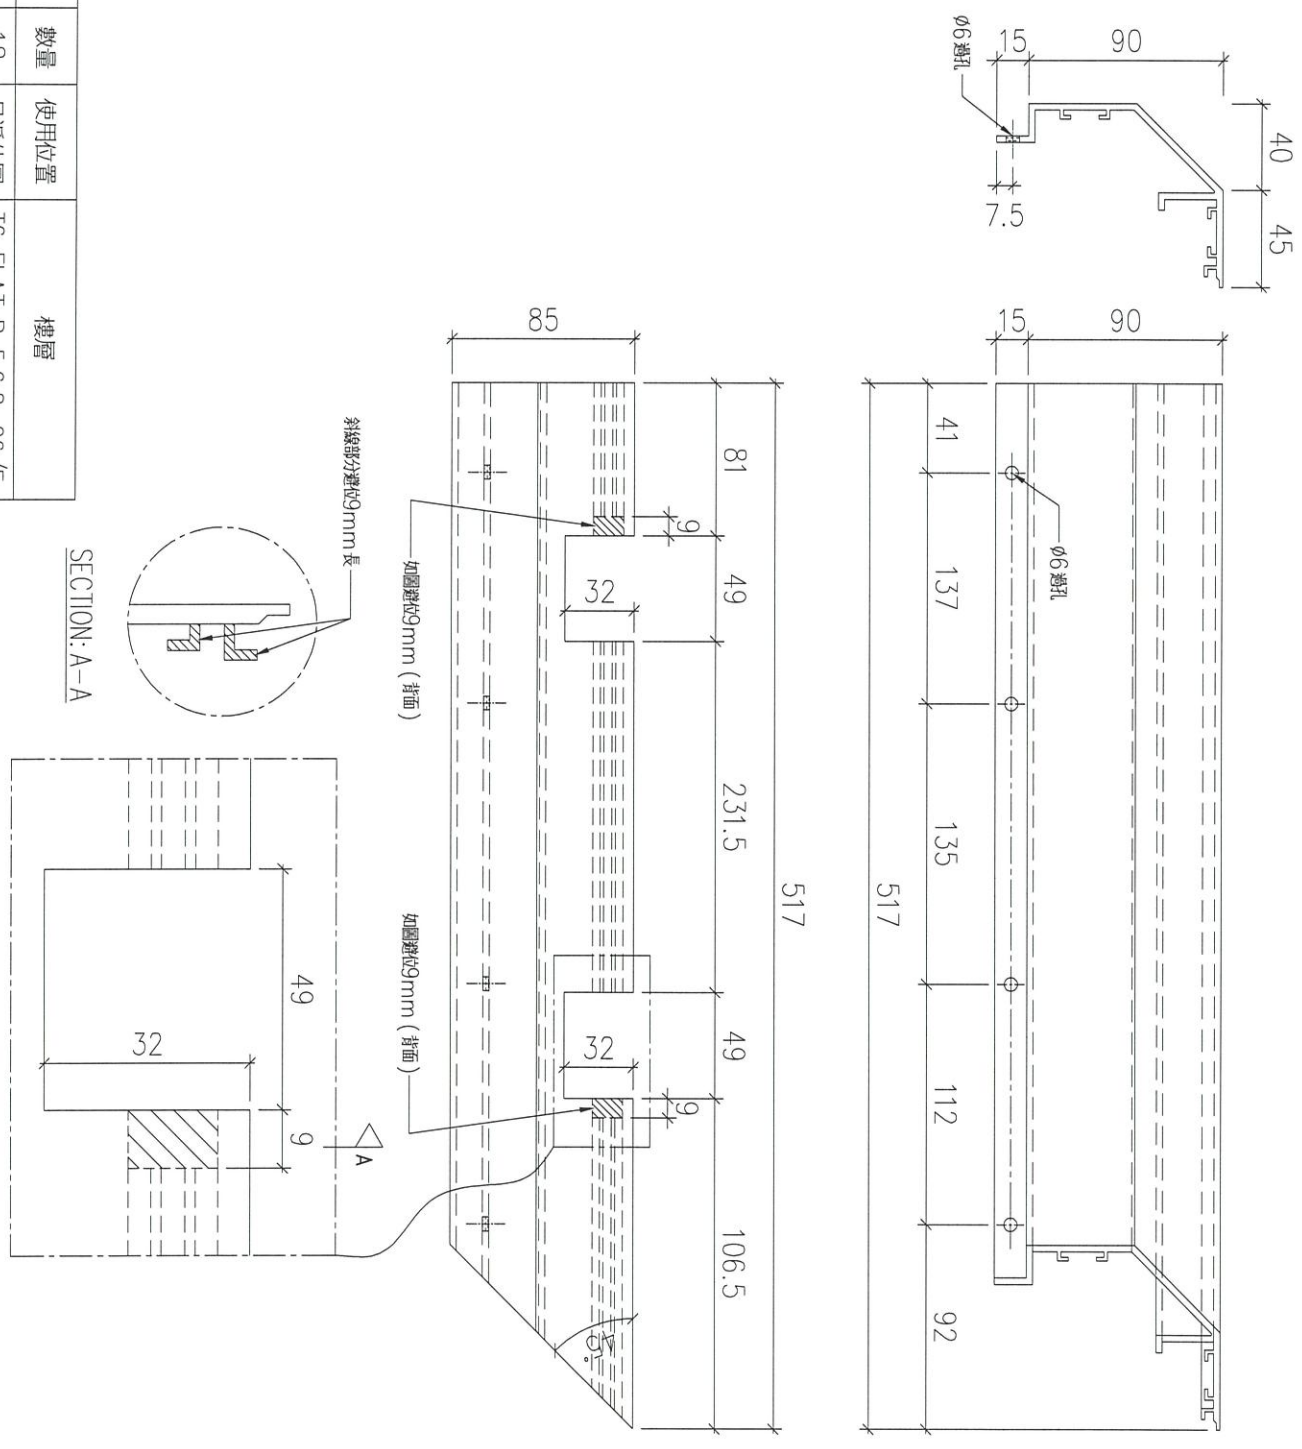



名稱		制圖	LHR	2022,08,30	修改	–		
材料	X86230	復核	–	–	日期	–		
顏色	JMQ213457(3coats)	批準			圖號	J853-GB-FAB2-143		


美特鋁質 有限公司
MIDI Aluminium Fabricator Ltd.


工程號	J853	地盤	錦上路 ~~S~~ TWP

送工地

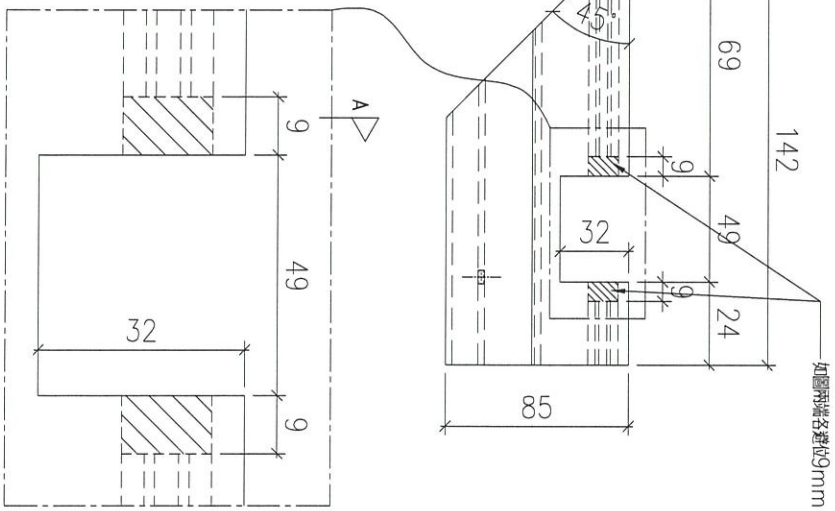

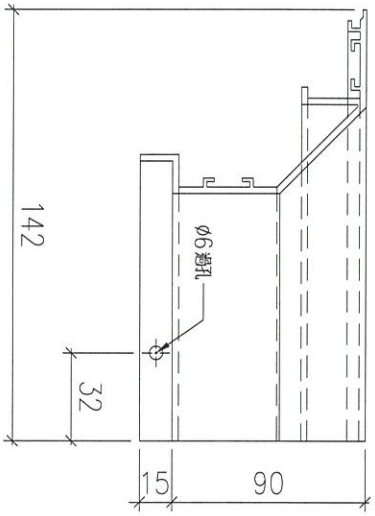

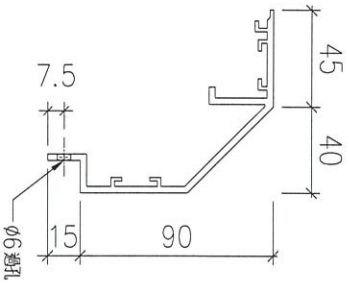

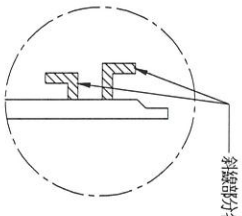

SECTION: A-A

序號	物料編號	數量	使用位置	樓層
01	T6-X86230-09	14	見派位圖	T6 FLAT C/D 10~26/F


名稱		制圖	LHR	2022,08,30	修改	–		
材料	X86230	復核	–	–	日期	–		
顏色	JMQ213457(3coats)	批準			圖號	J853-GB-FAB2-144		

美特鋁質 有限公司
MIDI Aluminium Fabricator Ltd.

工程號	J853	地盤	錦上路 TWP

送工地

序號	物料編號	數量	使用位置	樓層
01	T6-X86230-10	14	見派位圖	T6 FLAT C/D 10~26/F

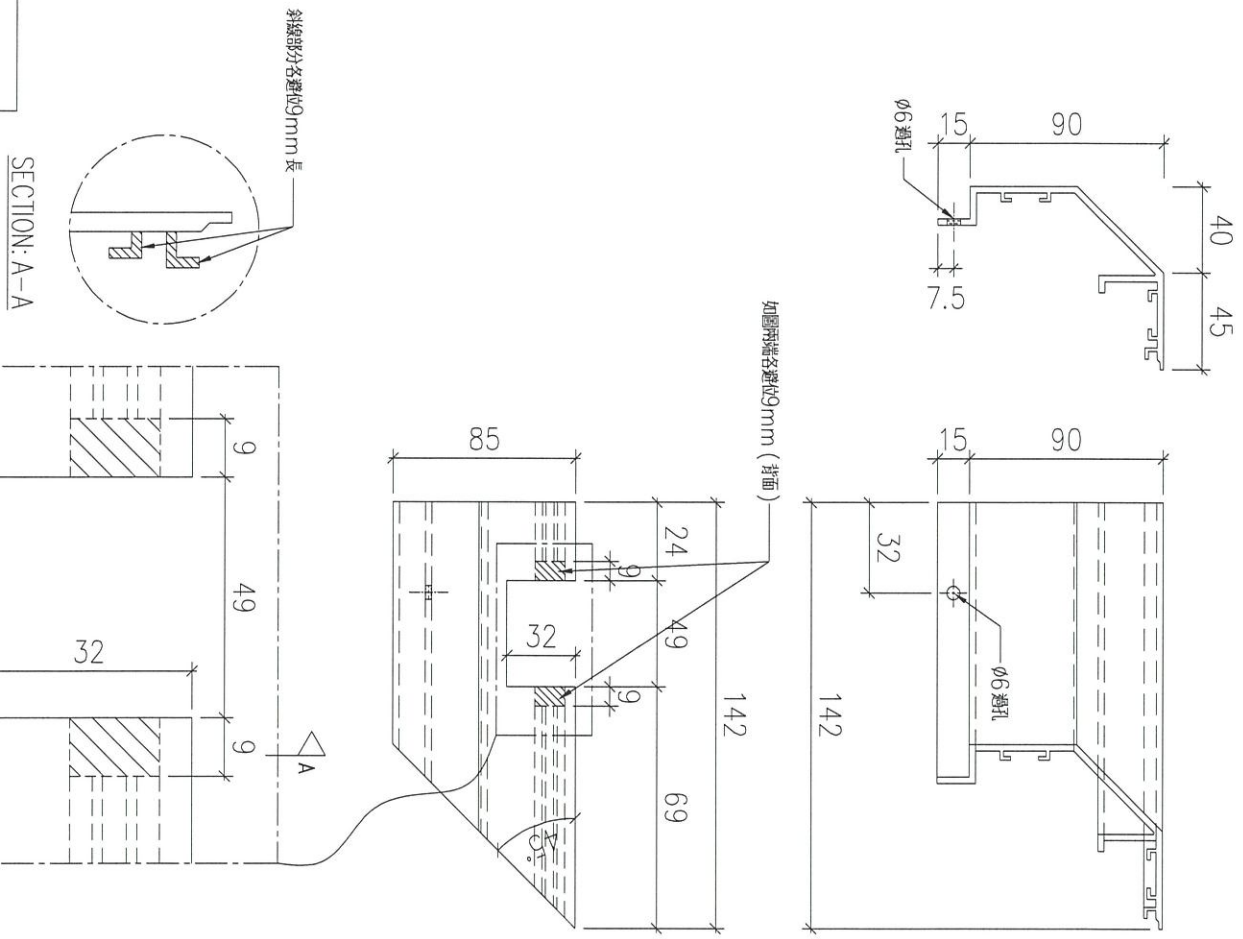

名稱		制圖	LHR	2022,08,30	修改	–		
材料	X86230	復核	–	–	日期	–		
顏色	JMQ213457(3coats)	批準			圖號	J853-GB-FAB2-145		


GB-5501-鋁料派位图

LEGEND :


AL-01 : ALUM. EXTRUSION w/100x40mm THK. GMS FLAT BAR

AL-02 : ALUM. EXTRUSION w/100x40mm THK. GMS FLAT BAR


GL3 : 12mm THK. CLEAR TEMPERED GLASS +1.52mm PVB +
+12mm THK. CLEAR TEMPERED (LAMINATE GLASS)

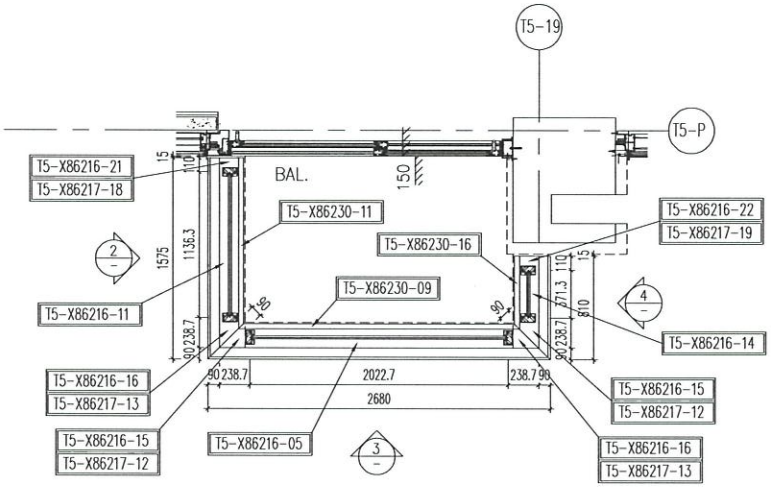


1 PART PLAN For GLASS BALUSTRADE
T5 FLAT A at 6/F~16/F

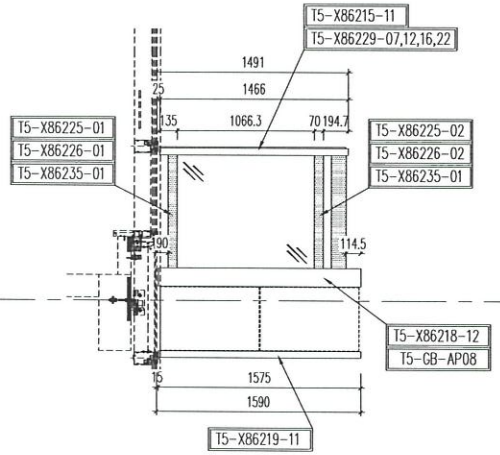

2 PART ELEV For GLASS BALUSTRADE
T5 FLAT A at 6/F~16/F

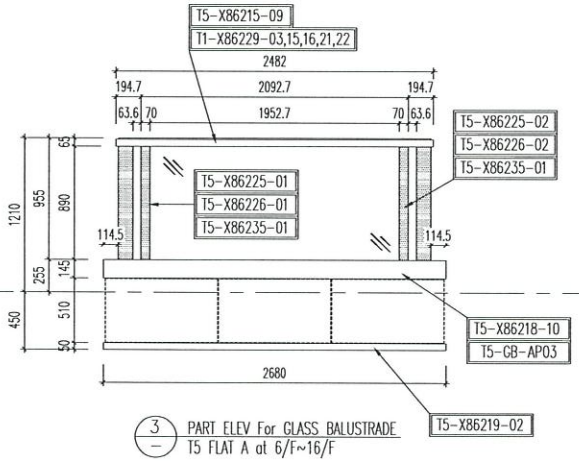

3 PART ELEV For GLASS BALUSTRADE
T5 FLAT A at 6/F~16/F

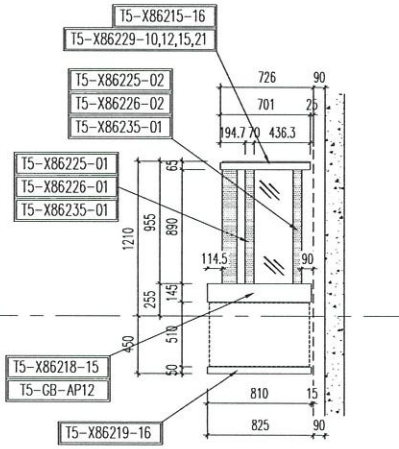

4 PART ELEV For GLASS BALUSTRADE
T5 FLAT A at 6/F~16/F

B.D. REF :

CLIENT :

ARCHITECT : WONG TUNG & PARTNERS LIMITED ARCHITECTS & PLANNERS

MAIN CONTRACTOR :

STRUCTURAL ENGINEER : WONG TUNG & PARTNERS LIMITED ARCHITECTS & PLANNERS

FACADE CONSULTANT: MEINHARDT

NOTE :
1. ALL DIMENSIONS ARE IN mm.
2. ALL ELEVATIONS ARE VIEWED FROM OUTSIDE.
3. ALL DIMENSIONS TO BE VERIFIED ON SITE BEFORE FABRICATION.

LEGEND :
X1 — DETAIL MARK NO.
X001 — REFER SHEET NO.
1. F.F.L. -- FINISHED FLOOR LEVEL
2. S.F.L. -- STRUCTURAL FLOOR LEVEL
3. /R -- REVERSED DETAIL

NO.	DATE	REVISED	BY
D	12/04/2022	REVISION SUBJECT TO ARCH.COMMENT	LHR

JOB NO. : J-853

PROJECT :
PROPOSED RESIDENTIAL
DEVELOPMENT AT N.K.I.L. 6542
YIN PING ROAD
KOWLOON

TITLE :
PART ELEV and PART PLAN
for GLASS BALUSTRADE
AT TOWER 5 FLAT A

DATE : 18-MAY-21 | SCALE : 1:90(A1)

DRAWN BY : Ivan | CHECKED BY :

美特鋁質有限公司
MIDI ALUMINIUM FABRICATOR LTD.
Units 6-8, Sunray Industrial Centre, 1/F
610 Cha Kwo Ling Road, Kowloon
Tel:23489211-4 Fax:(852)27727666

DWG NO. : J853-SD-GB-5501 | REV. : D


GB-5502-鋁料派位图

LEGEND :


AL-01 : ALUM. EXTRUSION w/100x40mm THK. GMS FLAT BAR

AL-02 : ALUM. EXTRUSION w/100x40mm THK. GMS FLAT BAR


GL3 : 12mm THK. CLEAR TEMPERED GLASS +1.52mm PVB +
+12mm THK. CLEAR TEMPERED (LAMINATE GLASS)

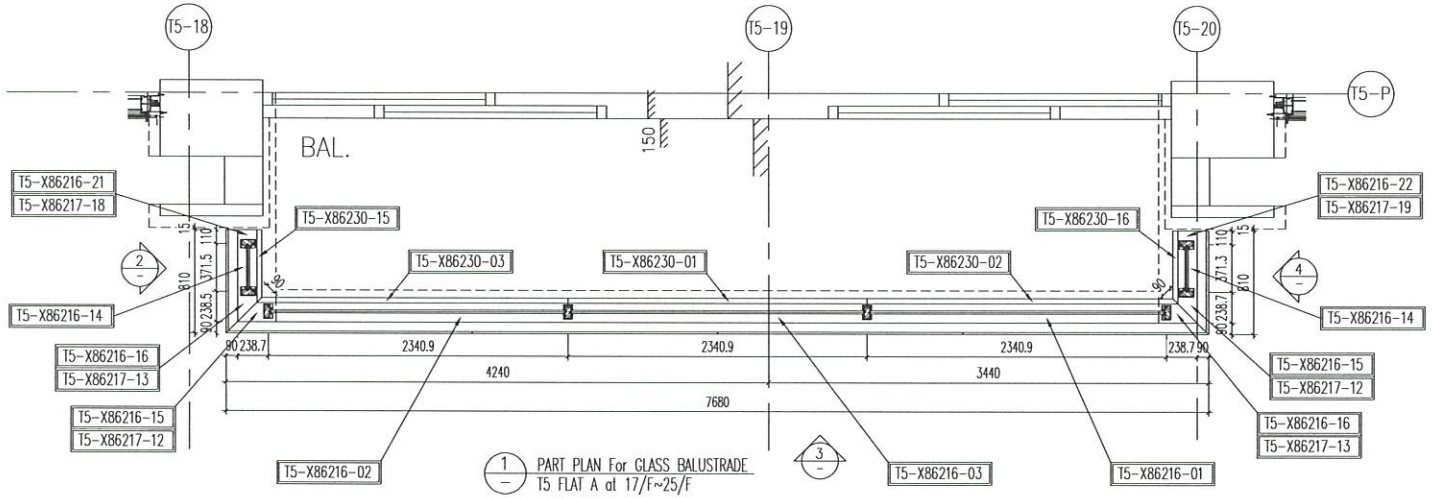


1 — PART PLAN For GLASS BALUSTRADE
T5 FLAT A at 17/F~25/F

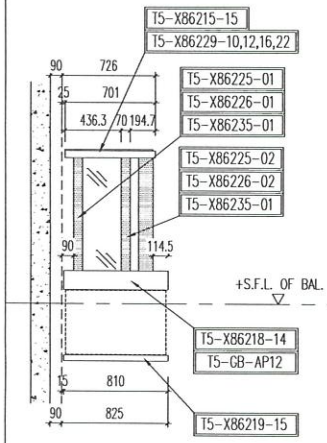

2 — PART ELEV For GLASS BALUSTRADE
T5 FLAT A at 17/F~25/F

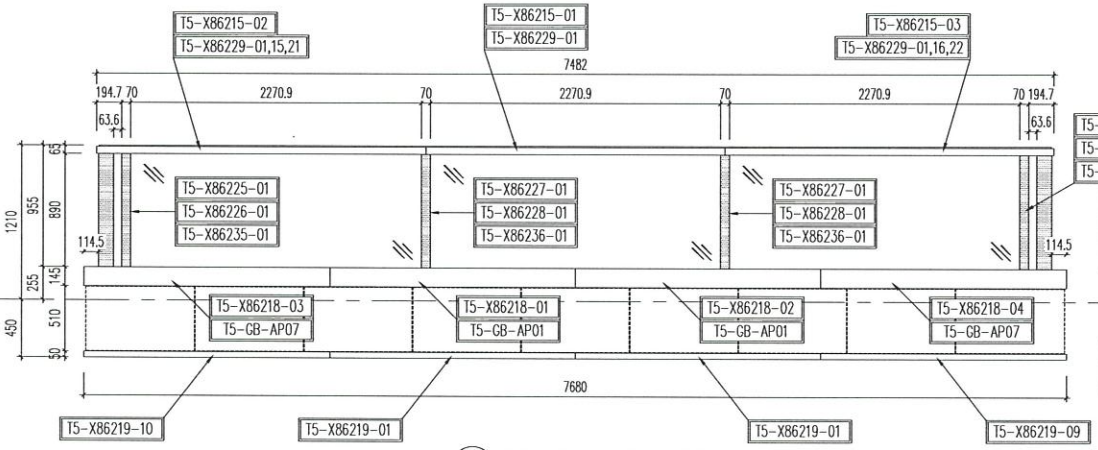

3 — PART ELEV For GLASS BALUSTRADE
T5 FLAT A at 17/F~25/F

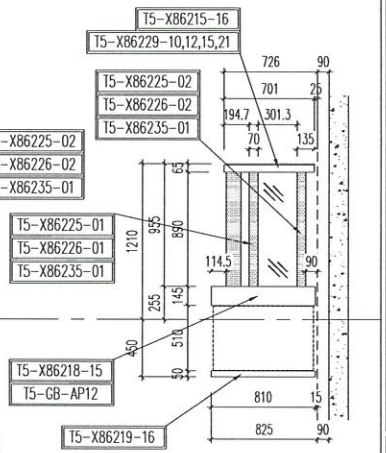

4 — PART ELEV For GLASS BALUSTRADE
T5 FLAT A at 17/F~25/F

B.D. REF :

CLIENT :

ARCHITECT : WONG TUNG & PARTNERS LIMITED ARCHITECTS & PLANNERS

MAIN CONTRACTOR :

STRUCTURAL ENGINEER : WONG TUNG & PARTNERS LIMITED ARCHITECTS & PLANNERS

FACADE CONSULTANT: MEINHARDT

NOTE :
1. ALL DIMENSIONS ARE IN mm.
2. ALL ELEVATIONS ARE VIEWED FROM OUTSIDE.
3. ALL DIMENSIONS TO BE VERIFIED ON SITE BEFORE FABRICATION.

LEGEND :
X1 / X001 — DETAIL MARK NO. / REFER SHEET NO.
1. F.F.L. --FINISHED FLOOR LEVEL
2. S.F.L. --STRUCTURAL FLOOR LEVEL
3. (R) --REVERSED DETAIL

NO.	DATE	REVISED	BY
D	12/04/2022	REVISION SUBJECT TO ARCH.COMMENT	LHK

JOB NO. : J-853

PROJECT :
PROPOSED RESIDENTIAL DEVELOPMENT AT N.K.I.L. 6542 YIN PING ROAD KOWLOON

TITLE :
PART ELEV and PART PLAN for GLASS BALUSTRADE AT TOWER 5 FLAT A

DATE : 18-MAY-21 | SCALE : 1:90(A1)

DRAWN BY : Ivan | CHECKED BY :

美特鋁製有限公司
MIDI ALUMINIUM FABRICATOR LTD.
Units 6-8, Sunray Industrial Centre, 1/F
610 Cha Kwo Ling Road, Kowloon
Tel:23489211-4 Fax:(852)27727666

DWG NO. : J853-SD-GB-5502 | REV. : D


GB-5503-鋁料派位图

LEGEND :


AL-01 : ALUM. EXTRUSION w/100x40mm THK. GMS FLAT BAR

AL-02 : ALUM. EXTRUSION w/100x40mm THK. GMS FLAT BAR


GL3 : 12mm THK. CLEAR TEMPERED GLASS +1.52mm PVB + +12mm THK. CLEAR TEMPERED (LAMINATE GLASS)

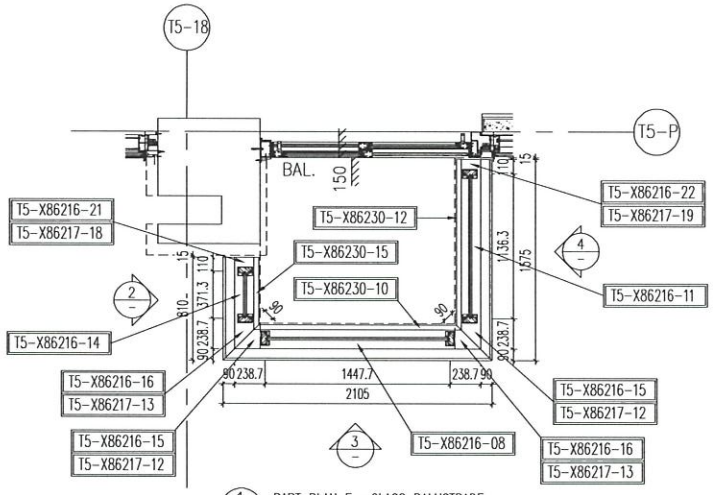


1 — PART PLAN For GLASS BALUSTRADE
T5 FLAT B at 6/F~16/F

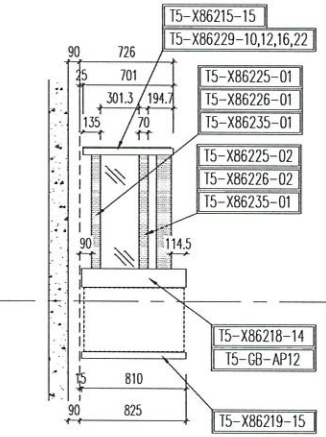

2 — PART ELEV For GLASS BALUSTRADE
T5 FLAT B at 6/F~16/F

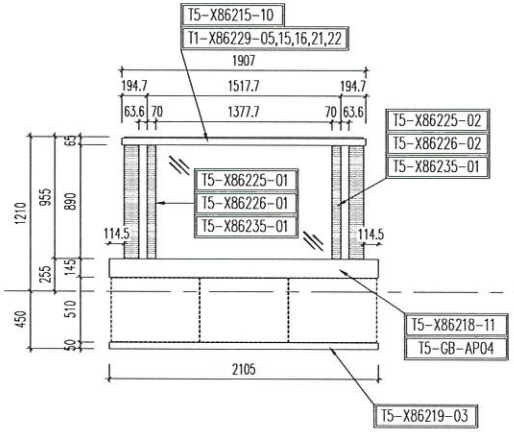

3 — PART ELEV For GLASS BALUSTRADE
T5 FLAT B at 6/F~16/F

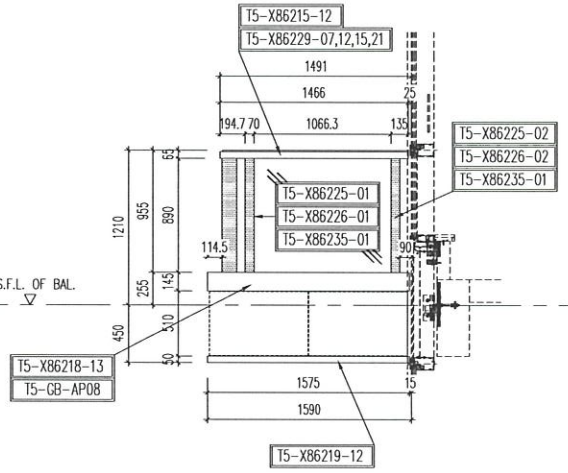

4 — PART ELEV For GLASS BALUSTRADE
T5 FLAT B at 6/F~16/F

B.D. REF :

CLIENT :

ARCHITECT : WONG TUNG & PARTNERS LIMITED ARCHITECTS & PLANNERS

MAIN CONTRACTOR :

STRUCTURAL ENGINEER : WONG TUNG & PARTNERS LIMITED ARCHITECTS & PLANNERS

FACADE CONSULTANT: MEINHARDT

NOTE :
1. ALL DIMENSIONS ARE IN mm.
2. ALL ELEVATIONS ARE VIEWED FROM OUTSIDE.
3. ALL DIMENSIONS TO BE VERIFIED ON SITE BEFORE FABRICATION.

LEGEND :
X1 — DETAIL MARK NO.
X001 — REFER SHEET NO.
1. F.F.L. -- FINISHED FLOOR LEVEL
2. S.F.L. -- STRUCTURAL FLOOR LEVEL
3. /R -- REVERSED DETAIL

NO.	DATE	REVISED	BY
D	12/04/2022	REVISION SUBJECT TO ARCH COMMENT	LHK

JOB NO. : J-853

PROJECT :
PROPOSED RESIDENTIAL DEVELOPMENT AT N.K.I.L. 6542 YIN PING ROAD KOWLOON

TITLE :
PART ELEV and PART PLAN for GLASS BALUSTRADE AT TOWER 5 FLAT B

DATE : 18-MAY-21 | SCALE : 1:90(A1)

DRAWN BY : Ivan | CHECKED BY :

美特鋁製有限公司
MIDI ALUMINIUM FABRICATOR LTD.
Units 6-8, Sunray Industrial Centre, 1/F
610 Cha Kwo Ling Road, Kowloon
Tel:23489211-4 Fax:(852)27727666

DWG NO. : J853-SD-GB-5503 | REV. : D


GB-5504-鋁料派位图

LEGEND :


AL-01 : ALUM. EXTRUSION w/100x40mm THK. GMS FLAT BAR

AL-02 : ALUM. EXTRUSION w/100x40mm THK. GMS FLAT BAR


GL3 : 12mm THK. CLEAR TEMPERED GLASS +1.52mm PVB +
+12mm THK. CLEAR TEMPERED (LAMINATE GLASS)

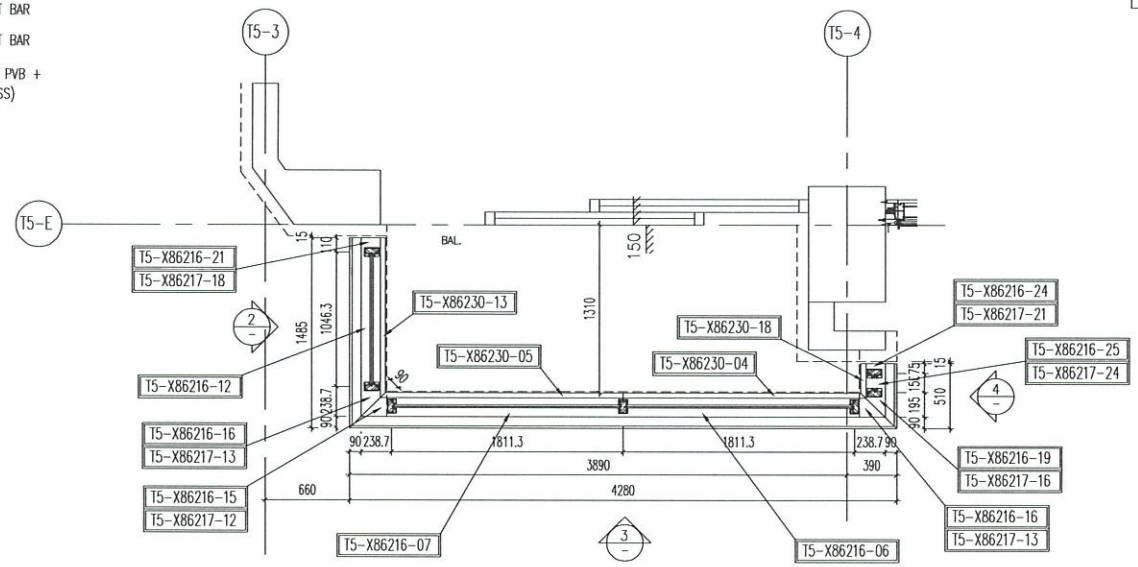


1 / – PART PLAN For GLASS BALUSTRADE
T5 FLAT B at 17/F~25/F

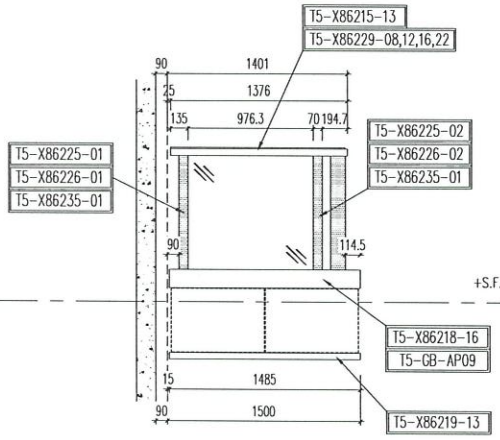

2 / – PART ELEV For GLASS BALUSTRADE
T5 FLAT B at 17/F~25/F

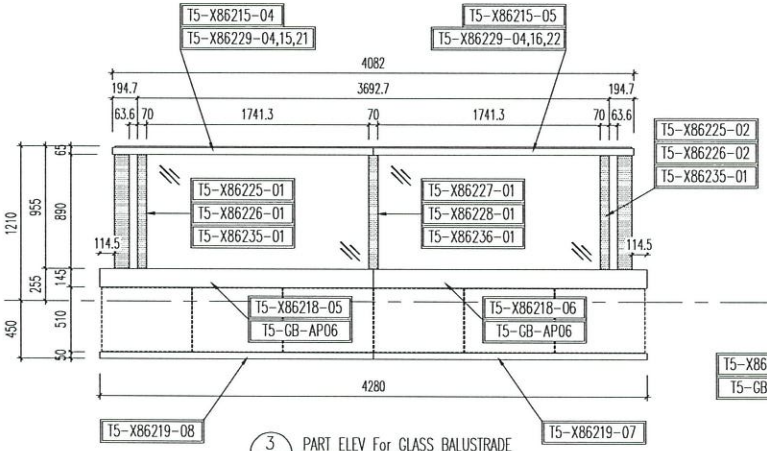

3 / – PART ELEV For GLASS BALUSTRADE
T5 FLAT B at 17/F~25/F

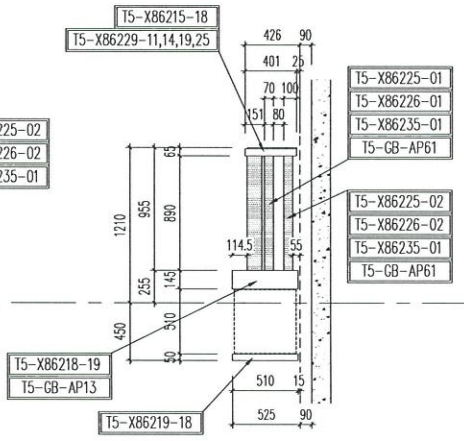

4 / – PART ELEV For GLASS BALUSTRADE
T5 FLAT B at 17/F~25/F

B.D. REF :

CLIENT :

ARCHITECT : WONG TUNG & PARTNERS LIMITED ARCHITECTS & PLANNERS

MAIN CONTRACTOR :

STRUCTURAL ENGINEER : WONG TUNG & PARTNERS LIMITED ARCHITECTS & PLANNERS

FACADE CONSULTANT: MEINHARDT

NOTE :
1. ALL DIMENSIONS ARE IN mm.
2. ALL ELEVATIONS ARE VIEWED FROM OUTSIDE.
3. ALL DIMENSIONS TO BE VERIFIED ON SITE BEFORE FABRICATION.

LEGEND :
X1 / X001 — DETAIL MARK NO. / REFER SHEET NO.
1. F.F.L. -- FINISHED FLOOR LEVEL
2. S.F.L. -- STRUCTURAL FLOOR LEVEL
3. /R -- REVERSED DETAIL

NO.	DATE	REVISED	BY
D	12/04/2022	REVISION SUBJECT TO ARCH.COMMENT	LHK

JOB NO. : J-853

PROJECT :
PROPOSED RESIDENTIAL DEVELOPMENT AT N.K.I.L. 6542 YIN PING ROAD KOWLOON

TITLE :
PART ELEV and PART PLAN for GLASS BALUSTRADE AT TOWER 5 FLAT B (17/F-25/F)

DATE : 18-MAY-21 | SCALE : 1:90(A1)

DRAWN BY : Ivan | CHECKED BY :

美特鋁製有限公司
MIDI ALUMINIUM FABRICATOR LTD.
Units 6-8, Sunray Industrial Centre, 1/F
610 Cha Kwo Ling Road, Kowloon
Tel:23489211-4 Fax:(852)27727666

DWG NO. : J853-SD-GB-5504 | REV. : D


GB-5505-鋁料派位图

LEGEND :


AL-01 : ALUM. EXTRUSION w/100x40mm THK. GMS FLAT BAR

AL-02 : ALUM. EXTRUSION w/100x40mm THK. GMS FLAT BAR


GL3 : 12mm THK. CLEAR TEMPERED GLASS +1.52mm PVB + +12mm THK. CLEAR TEMPERED (LAMINATE GLASS)

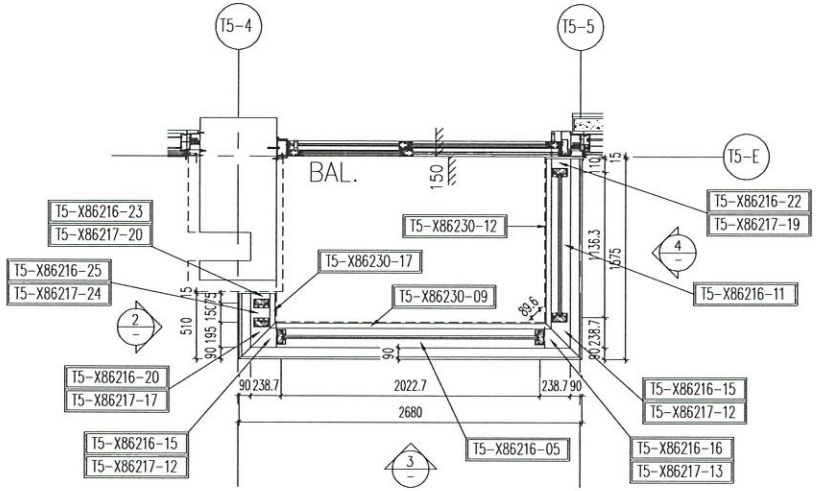


1 PART PLAN For GLASS BALUSTRADE
T5 FLAT C at 11/F~16/F

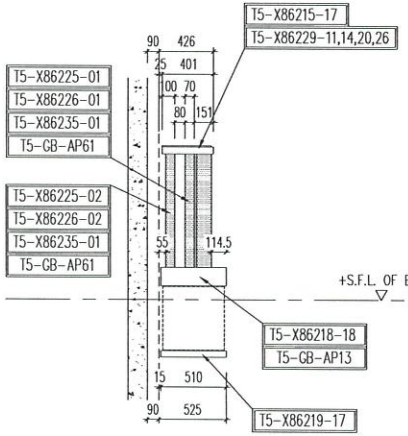

2 PART ELEV For GLASS BALUSTRADE
T5 FLAT C at 11/F~16/F

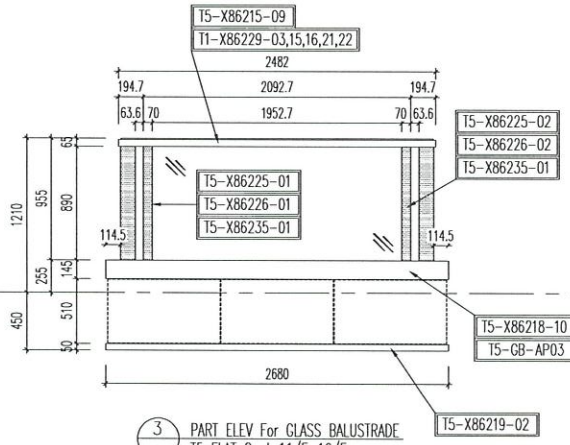

3 PART ELEV For GLASS BALUSTRADE
T5 FLAT C at 11/F~16/F

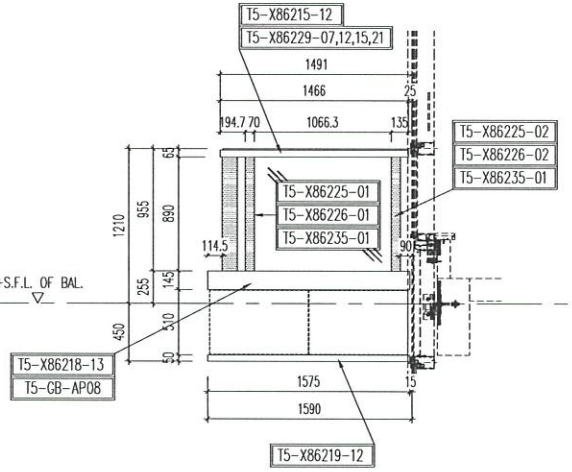

4 PART ELEV For GLASS BALUSTRADE
T5 FLAT C at 11/F~16/F

B.D. REF :

CLIENT :

ARCHITECT : WONG TUNG & PARTNERS LIMITED ARCHITECTS & PLANNERS

MAIN CONTRACTOR :

STRUCTURAL ENGINEER : WONG TUNG & PARTNERS LIMITED ARCHITECTS & PLANNERS

FACADE CONSULTANT: MEINHARDT

NOTE :
1. ALL DIMENSIONS ARE IN mm.
2. ALL ELEVATIONS ARE VIEWED FROM OUTSIDE.
3. ALL DIMENSIONS TO BE VERIFIED ON SITE BEFORE FABRICATION.

LEGEND :
X1 — DETAIL MARK NO.
X001 — REFER SHEET NO.
1. F.F.L. -- FINISHED FLOOR LEVEL
2. S.F.L. -- STRUCTURAL FLOOR LEVEL
3. (R) -- REVERSED DETAIL

NO.	DATE	REVISED	BY
D	12/04/2022	REVISION SUBJECT TO ARCH.COMMENT	LHK

JOB NO. : J-853

PROJECT :
PROPOSED RESIDENTIAL DEVELOPMENT AT N.K.I.L. 6542 YIN PING ROAD KOWLOON

TITLE :
PART ELEV and PART PLAN for GLASS BALUSTRADE AT TOWER 5 FLAT C

DATE : 18-MAY-21 | SCALE : 1:90(A1)

DRAWN BY : Ivan | CHECKED BY :

美特鋁貿有限公司
MIDI ALUMINIUM FABRICATOR LTD.
Units 6-8, Sunray Industrial Centre, 1/F
610 Cha Kwo Ling Road, Kowloon
Tel:23489211-4 Fax:(852)27727666

DWG NO. : J853-SD-GB-5505 | REV. : D


GB-5506-鋁料派位图

LEGEND :


AL-01 : ALUM. EXTRUSION w/100x40mm THK. GMS FLAT BAR

AL-02 : ALUM. EXTRUSION w/100x40mm THK. GMS FLAT BAR

GL3 : 12mm THK. CLEAR TEMPERED GLASS +1.52mm PVB + +12mm THK. CLEAR TEMPERED (LAMINATE GLASS)

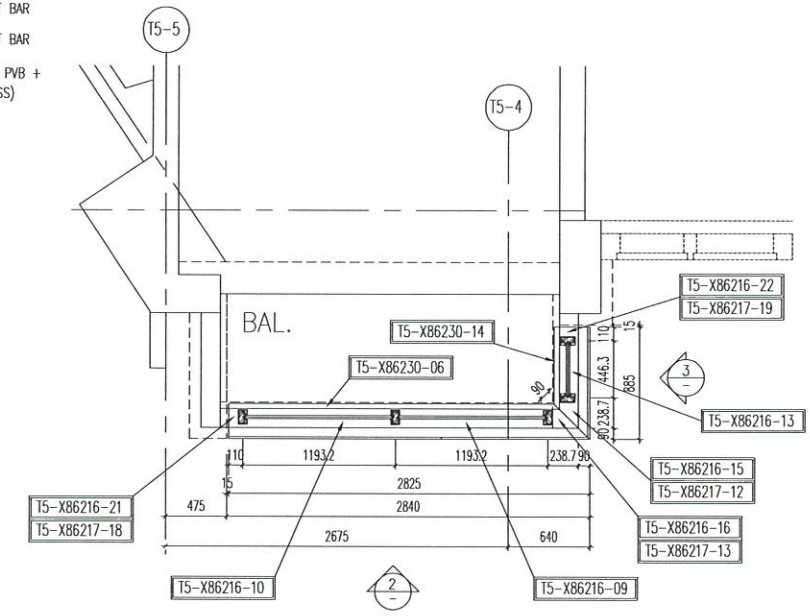


1 PART PLAN For GLASS BALUSTRADE
T5 FLAT D at 11/F~16/F

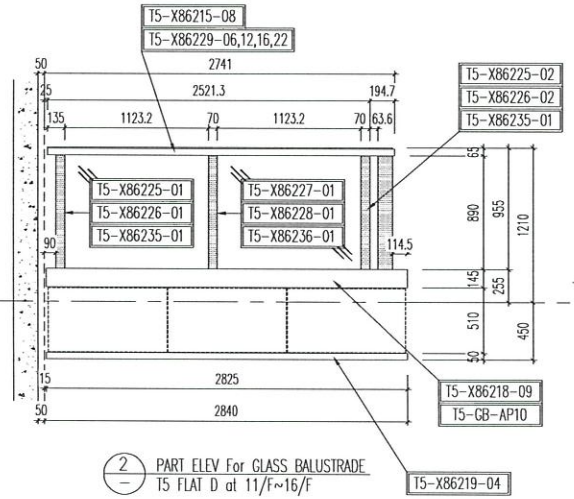

2 PART ELEV For GLASS BALUSTRADE
T5 FLAT D at 11/F~16/F

+S.F.L. OF BAL.

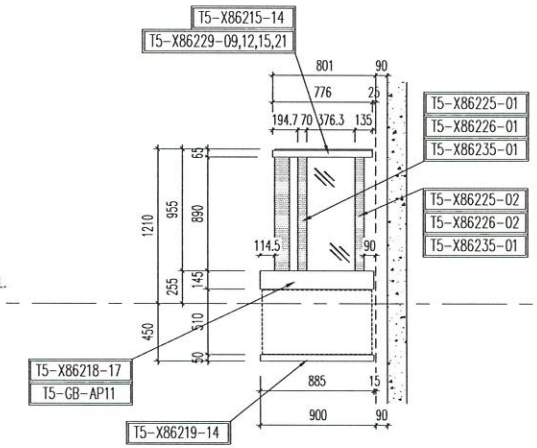

3 PART ELEV For GLASS BALUSTRADE
T5 FLAT D at 11/F~16/F

B.D. REF :

CLIENT :

ARCHITECT : WONG TUNG & PARTNERS LIMITED ARCHITECTS & PLANNERS

MAIN CONTRACTOR :

STRUCTURAL ENGINEER : WONG TUNG & PARTNERS LIMITED ARCHITECTS & PLANNERS

FACADE CONSULTANT: MEINHARDT

NOTE :
1. ALL DIMENSIONS ARE IN mm.
2. ALL ELEVATIONS ARE VIEWED FROM OUTSIDE.
3. ALL DIMENSIONS TO BE VERIFIED ON SITE BEFORE FABRICATION.

LEGEND :
X1 — DETAIL MARK NO.
X001 — REFER SHEET NO.
1. F.F.L. -- FINISHED FLOOR LEVEL
2. S.F.L. -- STRUCTURAL FLOOR LEVEL
3. /R -- REVERSED DETAIL

NO.	DATE	REVISED	BY
D	12/04/2022	REVISION SUBJECT TO ARCH.COMMENT	LHK

JOB NO. : J-853

PROJECT :
PROPOSED RESIDENTIAL DEVELOPMENT AT N.K.I.L. 6542 YIN PING ROAD KOWLOON

TITLE :
PART ELEV and PART PLAN for GLASS BALUSTRADE AT TOWER 5 FLAT D

DATE : 18-MAY-21 | SCALE : 1:90(A1)

DRAWN BY : Ivan | CHECKED BY :

美特鋁質有限公司
MIDI ALUMINIUM FABRICATOR LTD.
Units 6-8, Sunray Industrial Centre, 1/F
610 Cha Kwo Ling Road, Kowloon
Tel:23489211-4 Fax:(852)27727666

DWG NO. : J853-SD-GB-5506 | REV. : D


GB-5507-鋁料派位图

LEGEND :


AL-01 : ALUM. EXTRUSION w/100x40mm THK. GMS FLAT BAR

AL-02 : ALUM. EXTRUSION w/100x40mm THK. GMS FLAT BAR


GL3 : 12mm THK. CLEAR TEMPERED GLASS +1.52mm PVB +
+12mm THK. CLEAR TEMPERED (LAMINATE GLASS)

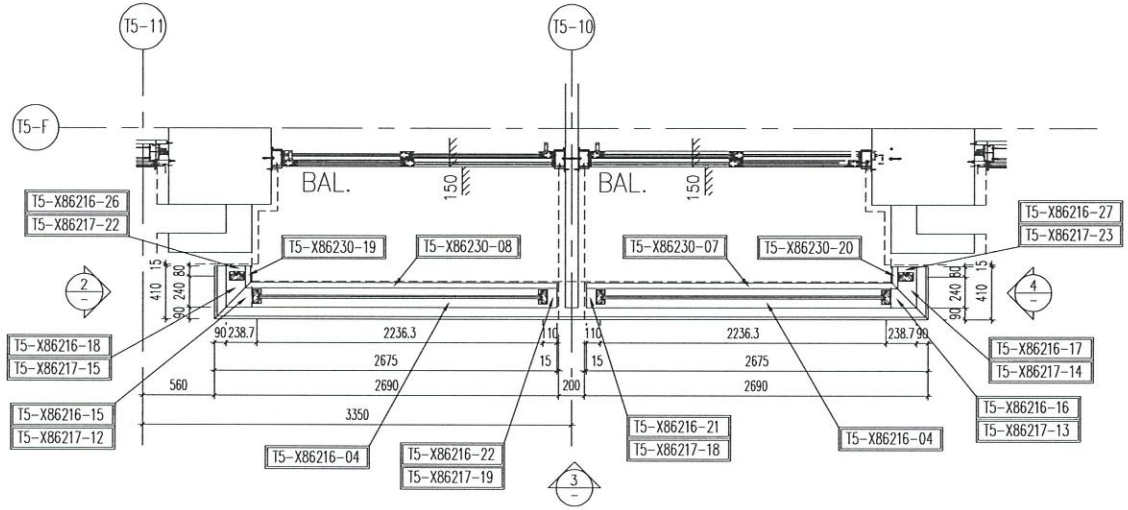


1 / – PART PLAN For GLASS BALUSTRADE
T5 FLAT E/F at 11/F~26/F

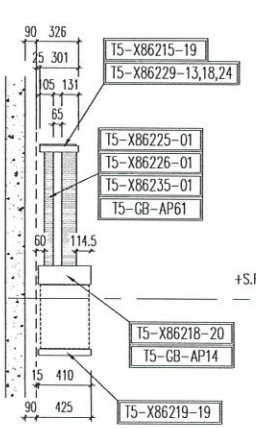

2 / – PART ELEV For GLASS BALUSTRADE
T5 FLAT E/F at 11/F~26/F

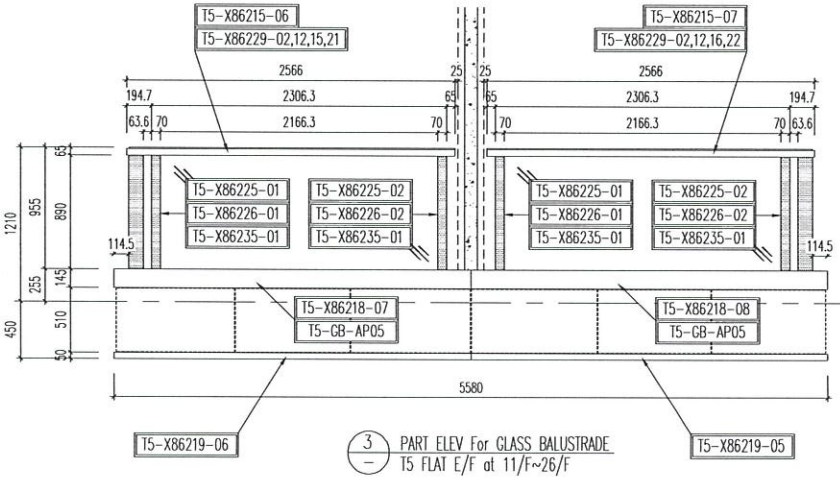

3 / – PART ELEV For GLASS BALUSTRADE
T5 FLAT E/F at 11/F~26/F

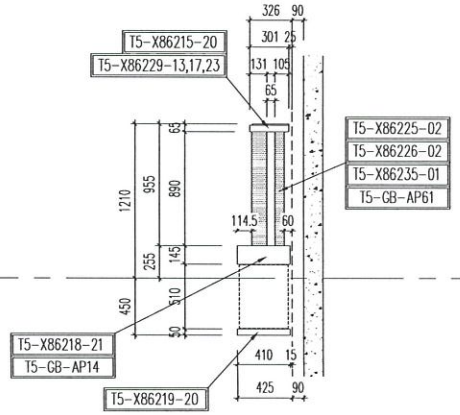

4 / – PART ELEV For GLASS BALUSTRADE
T5 FLAT E/F at 11/F~26/F

B.D. REF :

CLIENT :

ARCHITECT : WONG TUNG & PARTNERS LIMITED ARCHITECTS & PLANNERS

MAIN CONTRACTOR :

STRUCTURAL ENGINEER : WONG TUNG & PARTNERS LIMITED ARCHITECTS & PLANNERS

FACADE CONSULTANT: MEINHARDT

NOTE :
1. ALL DIMENSIONS ARE IN mm.
2. ALL ELEVATIONS ARE VIEWED FROM OUTSIDE.
3. ALL DIMENSIONS TO BE VERIFIED ON SITE BEFORE FABRICATION.

LEGEND :
X1 — DETAIL MARK NO.
X001 — REFER SHEET NO.

1. F.F.L. -- FINISHED FLOOR LEVEL
2. S.F.L. -- STRUCTURAL FLOOR LEVEL
3. (R) -- REVERSED DETAIL

NO.	DATE	REVISED	BY
D	12/04/2022	REVISION SUBJECT TO ARCH.COMMENT	LHK

JOB NO. : J-853

PROJECT :
PROPOSED RESIDENTIAL DEVELOPMENT AT N.K.I.L. 6542 YIN PING ROAD KOWLOON

TITLE :
PART ELEV and PART PLAN for GLASS BALUSTRADE AT TOWER 5 FLAT E/F

DATE : 18-MAY-21 | SCALE : 1:90(A1)

DRAWN BY : Ivan | CHECKED BY :

美特鋁質有限公司
MIDI ALUMINIUM FABRICATOR LTD.
Units 6-8, Sunray Industrial Centre, 1/F
610 Cha Kwo Ling Road, Kowloon
Tel:23489211-4 Fax:(852)27727666

DWG NO. : J853-SD-GB-5507 | REV. : D


GB-5601-鋁料派位图

LEGEND :


AL-01 : ALUM. EXTRUSION w/100x40mm THK. GMS FLAT BAR

AL-02 : ALUM. EXTRUSION w/100x40mm THK. GMS FLAT BAR


GL3 : 12mm THK. CLEAR TEMPERED GLASS +1.52mm PVB +
+12mm THK. CLEAR TEMPERED (LAMINATE GLASS)

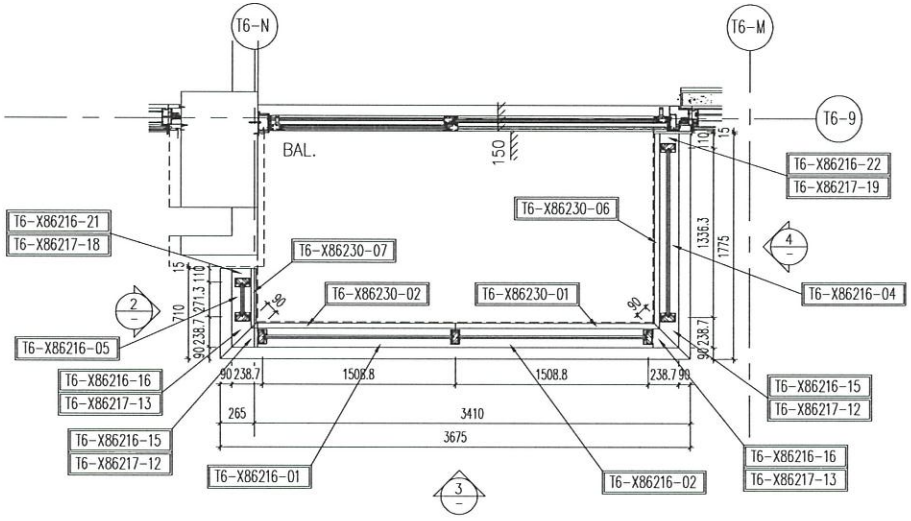


1 PART PLAN For GLASS BALUSTRADE
T6 FLAT A at 5,6,8~26/F

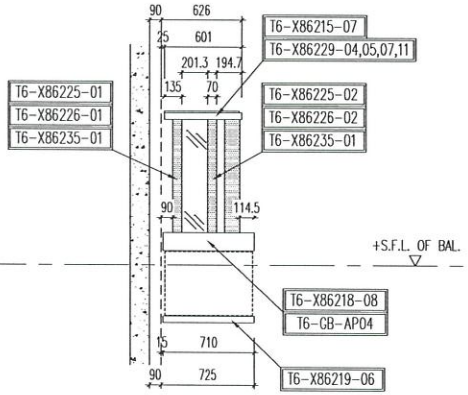

2 PART ELEV For GLASS BALUSTRADE
T6 FLAT A at 5,6,8~26/F

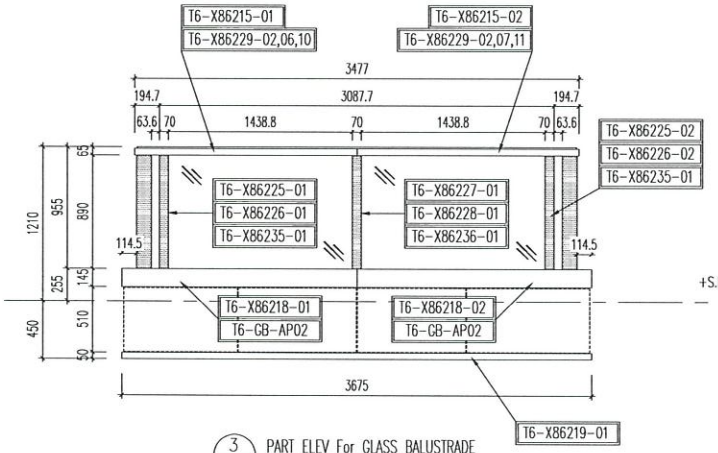

3 PART ELEV For GLASS BALUSTRADE
T6 FLAT A at 5,6,8~26/F

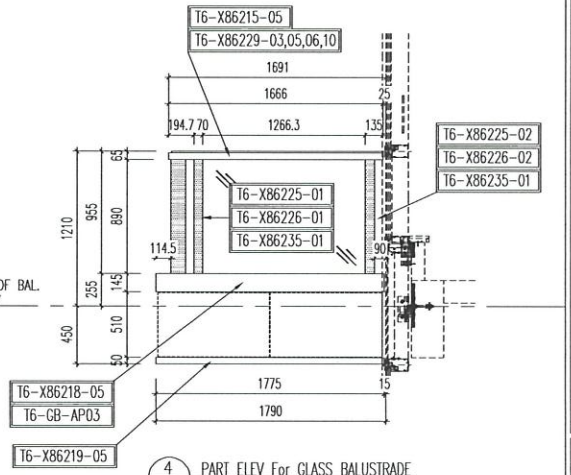

4 PART ELEV For GLASS BALUSTRADE
T6 FLAT A at 5,6,8~26/F

B.D. REF :

CLIENT :

ARCHITECT : WONG TUNG & PARTNERS LIMITED ARCHITECTS & PLANNERS

MAIN CONTRACTOR :

STRUCTURAL ENGINEER : WONG TUNG & PARTNERS LIMITED ARCHITECTS & PLANNERS

FACADE CONSULTANT: MEINHARDT

NOTE :
1. ALL DIMENSIONS ARE IN mm.
2. ALL ELEVATIONS ARE VIEWED FROM OUTSIDE.
3. ALL DIMENSIONS TO BE VERIFIED ON SITE BEFORE FABRICATION.

LEGEND :
X1 / X001 — DETAIL MARK NO. / REFER SHEET NO.
1. F.F.L. -- FINISHED FLOOR LEVEL
2. S.F.L. -- STRUCTURAL FLOOR LEVEL
3. (R) -- REVERSED DETAIL

NO.	DATE	REVISED	BY
D	12/04/2022	REVISION SUBJECT TO ARCH.COMMENT	LHK

JOB NO. : J-853

PROJECT :
PROPOSED RESIDENTIAL DEVELOPMENT AT N.K.I.L. 6542 YIN PING ROAD KOWLOON

TITLE :
PART ELEV and PART PLAN for GLASS BALUSTRADE AT TOWER 6 FLAT A

DATE : 18-MAY-21 | SCALE : 1:90(A1)

DRAWN BY : Ivan | CHECKED BY :

美特鋁製有限公司
MIDI ALUMINIUM FABRICATOR LTD.
Units 6-8, Sunray Industrial Centre, 1/F
610 Cha Kwo Ling Road, Kowloon
Tel:23489211-4 Fax:(852)27727666

DWG NO. : J853-SD-GB-5601 | REV. : D


GB-5602-鋁料派位图

LEGEND :


AL-01 : ALUM. EXTRUSION w/100x40mm THK. GMS FLAT BAR

AL-02 : ALUM. EXTRUSION w/100x40mm THK. GMS FLAT BAR


GL3 : 12mm THK. CLEAR TEMPERED GLASS +1.52mm PVB + +12mm THK. CLEAR TEMPERED (LAMINATE GLASS)

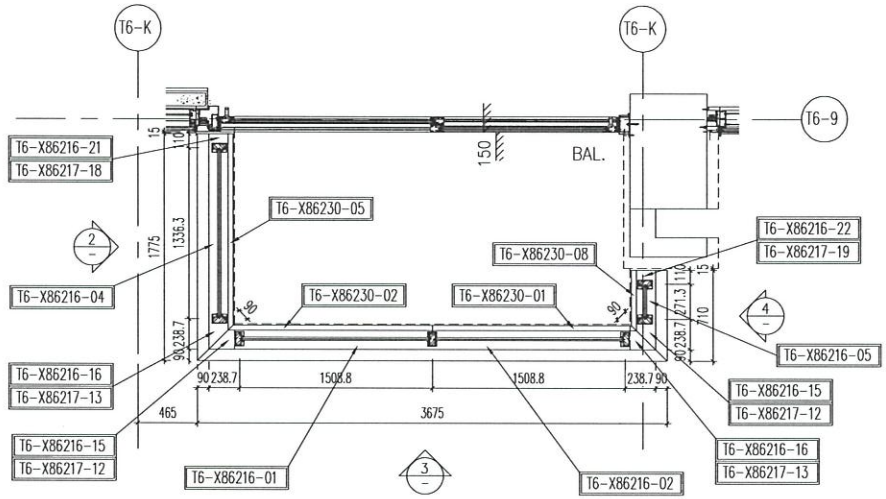


1 — PART PLAN For GLASS BALUSTRADE
T6 FLAT B at 5,6,8~26/F

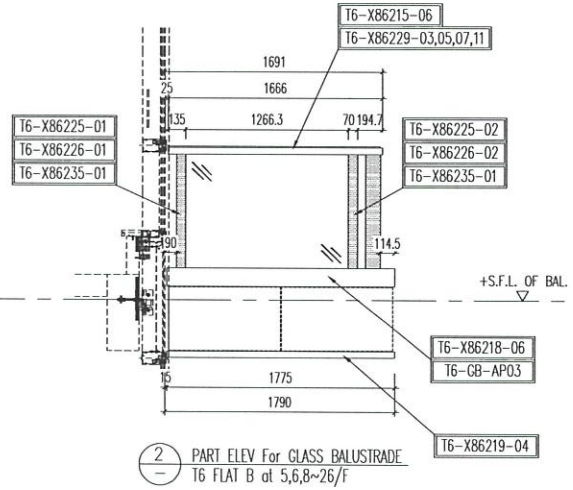

2 — PART ELEV For GLASS BALUSTRADE
T6 FLAT B at 5,6,8~26/F

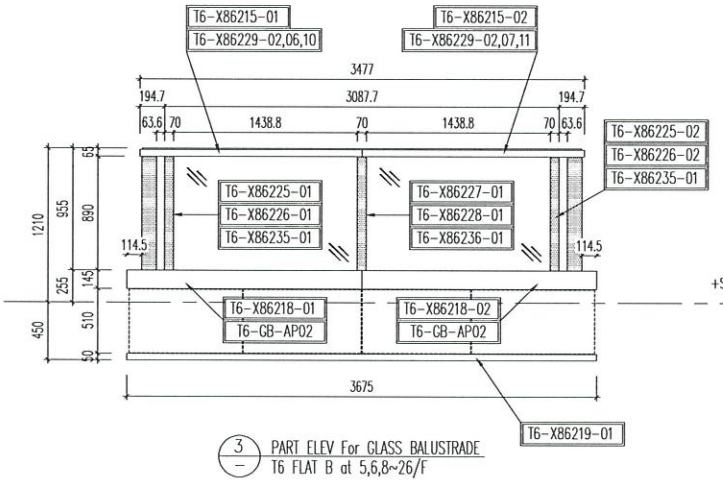

3 — PART ELEV For GLASS BALUSTRADE
T6 FLAT B at 5,6,8~26/F

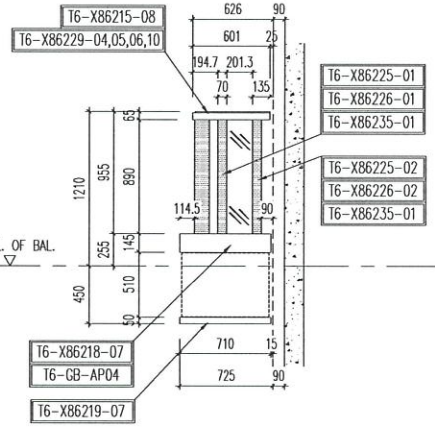

4 — PART ELEV For GLASS BALUSTRADE
T6 FLAT B at 5,6,8~26/F

B.D. REF :

CLIENT :

ARCHITECT : WONG TUNG & PARTNERS LIMITED ARCHITECTS & PLANNERS

MAIN CONTRACTOR :

STRUCTURAL ENGINEER : WONG TUNG & PARTNERS LIMITED ARCHITECTS & PLANNERS

FACADE CONSULTANT: MEINHARDT

NOTE :
1. ALL DIMENSIONS ARE IN mm.
2. ALL ELEVATIONS ARE VIEWED FROM OUTSIDE.
3. ALL DIMENSIONS TO BE VERIFIED ON SITE BEFORE FABRICATION.

LEGEND :
X1 — DETAIL MARK NO.
X001 — REFER SHEET NO.
1. F.F.L. -- FINISHED FLOOR LEVEL
2. S.F.L. -- STRUCTURAL FLOOR LEVEL
3. (R) -- REVERSED DETAIL

NO.	DATE	REVISED	BY
D	12/04/2022	REVISION SUBJECT TO ARCH.COMMENT	LHH

JOB NO. : J-853

PROJECT :
PROPOSED RESIDENTIAL DEVELOPMENT AT N.K.I.L. 6542 YIN PING ROAD KOWLOON

TITLE :
PART ELEV and PART PLAN for GLASS BALUSTRADE AT TOWER 6 FLAT B

DATE : 18-MAY-21 | SCALE : 1:90(A1)

DRAWN BY : Ivan | CHECKED BY :

美特鋁質有限公司
MIDI ALUMINIUM FABRICATOR LTD.
Units 6-8, Sunray Industrial Centre, 1/F
610 Cha Kwo Ling Road, Kowloon
Tel:23489211-4 Fax:(852)27727666

DWG NO. : J853-SD-GB-5602 | REV. : D


GB-5603-鋁料派位图

LEGEND :


AL-01 : ALUM. EXTRUSION w/100x40mm THK. GMS FLAT BAR

AL-02 : ALUM. EXTRUSION w/100x40mm THK. GMS FLAT BAR


GL3 : 12mm THK. CLEAR TEMPERED GLASS +1.52mm PVB +
+12mm THK. CLEAR TEMPERED (LAMINATE GLASS)

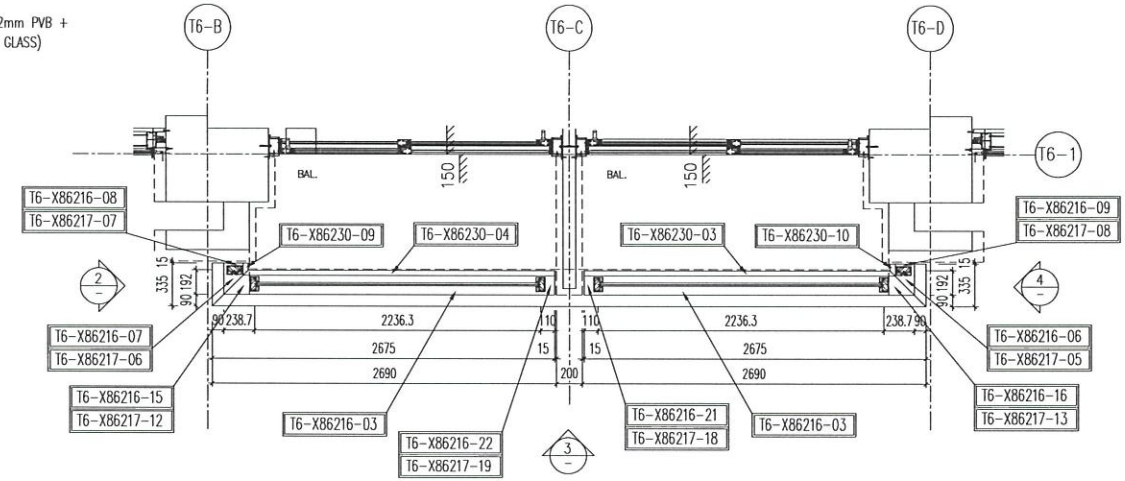


1 / – PART PLAN For GLASS BALUSTRADE
T6 FLAT C/D at 10/F~26/F

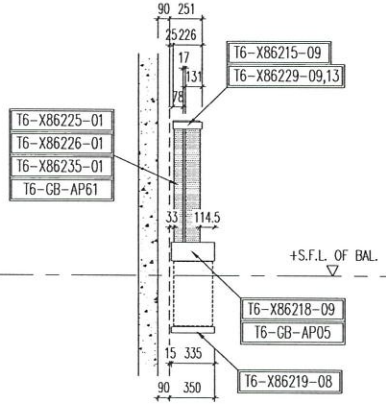

2 / – PART ELEV For GLASS BALUSTRADE
T6 FLAT C/D at 10/F~26/F

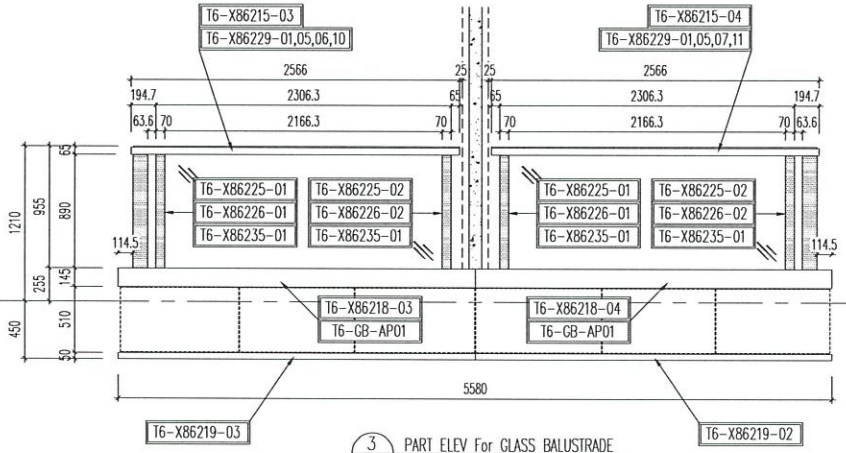

3 / – PART ELEV For GLASS BALUSTRADE
T6 FLAT C/D at 10/F~26/F

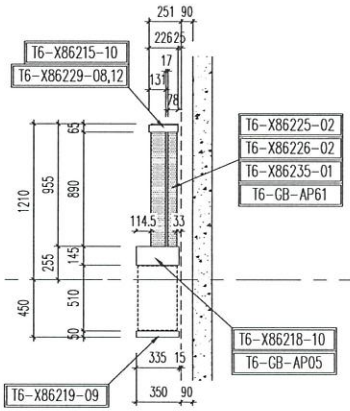

4 / – PART ELEV For GLASS BALUSTRADE
T6 FLAT C/D at 10/F~26/F

B.D. REF :

CLIENT :

ARCHITECT : WONG TUNG & PARTNERS LIMITED ARCHITECTS & PLANNERS

MAIN CONTRACTOR :

STRUCTURAL ENGINEER : WONG TUNG & PARTNERS LIMITED ARCHITECTS & PLANNERS

FACADE CONSULTANT: MEINHARDT

NOTE :
1. ALL DIMENSIONS ARE IN mm.
2. ALL ELEVATIONS ARE VIEWED FROM OUTSIDE.
3. ALL DIMENSIONS TO BE VERIFIED ON SITE BEFORE FABRICATION.

LEGEND :
X1 / X001 — DETAIL MARK NO. / REFER SHEET NO.
1. F.F.L. -- FINISHED FLOOR LEVEL
2. S.F.L. -- STRUCTURAL FLOOR LEVEL
3. /R -- REVERSED DETAIL

NO.	DATE	REVISED	BY
D	12/04/2022	REVISION SUBJECT TO ARCH.COMMENT	LHK

JOB NO. : J-853

PROJECT :
PROPOSED RESIDENTIAL DEVELOPMENT AT N.K.I.L. 6542 YIN PING ROAD KOWLOON

TITLE :
PART ELEV and PART PLAN for GLASS BALUSTRADE AT TOWER 6 FLAT C/D

DATE : 18-MAY-21 | SCALE : 1:90(A1)

DRAWN BY : Ivan | CHECKED BY :

美特鋁質有限公司
MIDI ALUMINIUM FABRICATOR LTD.
Units 6-8, Sunray Industrial Centre, 1/F
610 Cha Kwo Ling Road, Kowloon
Tel:23489211-4 Fax:(852)27727666

DWG NO. : J853-SD-GB-5603 | REV. : D


GB-5701-鋁料派位图

LEGEND :


AL--01 : ALUM. EXTRUSION w/100x40mm THK. GMS FLAT BAR

AL--02 : ALUM. EXTRUSION w/100x40mm THK. GMS FLAT BAR


GL3 : 12mm THK. CLEAR TEMPERED GLASS +1.52mm PVB +
+12mm THK. CLEAR TEMPERED (LAMINATE GLASS)

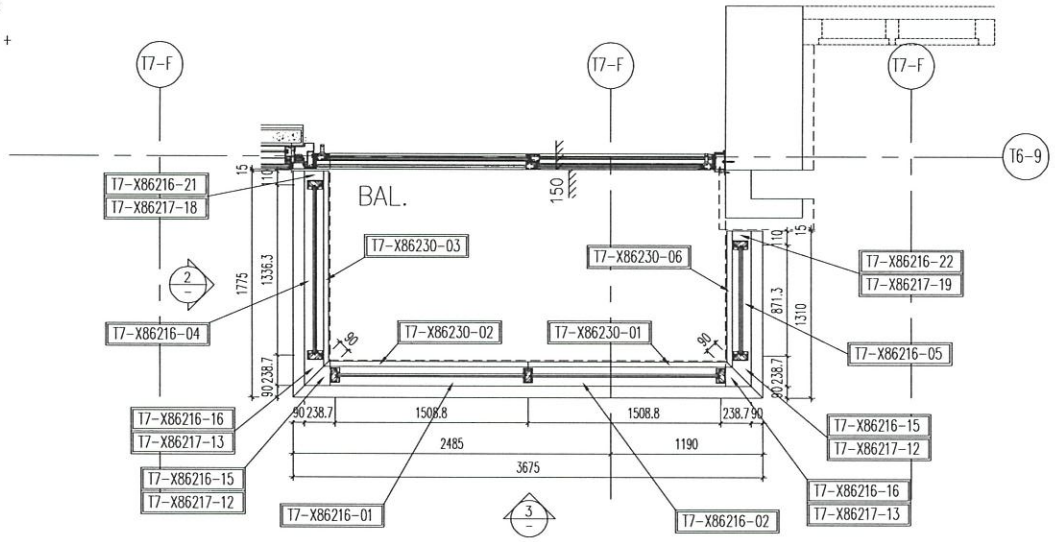


1 — PART PLAN For GLASS BALUSTRADE
T7 FLAT A at 7/F~26/F

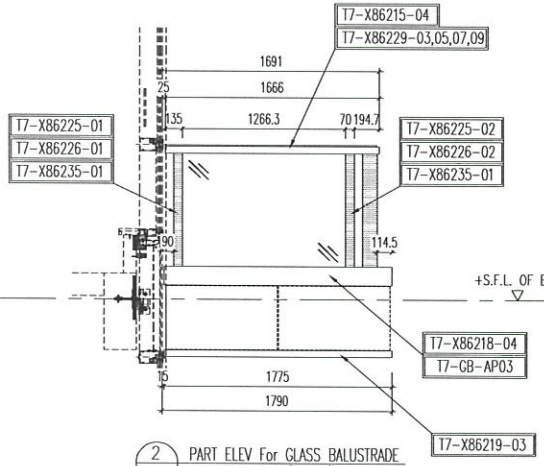

2 — PART ELEV For GLASS BALUSTRADE
T7 FLAT A at 7/F~26/F

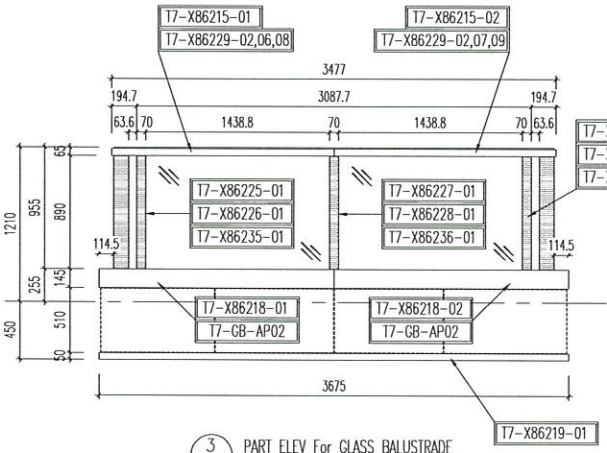

3 — PART ELEV For GLASS BALUSTRADE
T7 FLAT A at 7/F~26/F

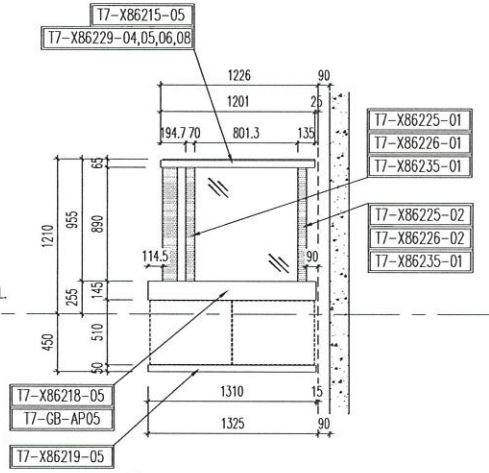

4 — PART ELEV For GLASS BALUSTRADE
T7 FLAT A at 7/F~26/F

NOTE :
1. ALL DIMENSIONS ARE IN mm.
2. ALL ELEVATIONS ARE VIEWED FROM OUTSIDE.
3. ALL DIMENSIONS TO BE VERIFIED ON SITE BEFORE FABRICATION.

LEGEND :

X1 / X001 — DETAIL MARK NO. / REFER SHEET NO.

1. F.F.L. -- FINISHED FLOOR LEVEL
2. S.F.L. -- STRUCTURAL FLOOR LEVEL
3. /R -- REVERSED DETAIL

NO.	DATE	REVISED	BY
D	12/04/2022	REVISION SUBJECT TO ARCHCOMMENT	LHR

B.D. REF :

CLIENT :

ARCHITECT : WONG TUNG & PARTNERS LIMITED ARCHITECTS & PLANNERS

MAIN CONTRACTOR :

STRUCTURAL ENGINEER : WONG TUNG & PARTNERS LIMITED ARCHITECTS & PLANNERS

FACADE CONSULTANT: MEINHARDT

JOB NO. : J-853

PROJECT :
PROPOSED RESIDENTIAL DEVELOPMENT AT N.K.I.L. 6542 YIN PING ROAD KOWLOON

TITLE :
PART ELEV and PART PLAN for GLASS BALUSTRADE AT TOWER 7 FLAT A

DATE : 18-MAY-21 | SCALE : 1:90(A1)

DRAWN BY : Ivan | CHECKED BY :

美特鋁質有限公司
MIDI ALUMINIUM FABRICATOR LTD.
Units 6-8, Sunray Industrial Centre, 1/F
610 Cha Kwo Ling Road, Kowloon
Tel:23489211-4 Fax:(852)27727666

DWG NO. : J853-SD-GB-5701 | REV. : D


GB-5702-鋁料派位图

LEGEND :


AL-01 : ALUM. EXTRUSION w/100x40mm THK. GMS FLAT BAR

AL-02 : ALUM. EXTRUSION w/100x40mm THK. GMS FLAT BAR

GL3 : 12mm THK. CLEAR TEMPERED GLASS +1.52mm PVB + +12mm THK. CLEAR TEMPERED (LAMINATE GLASS)

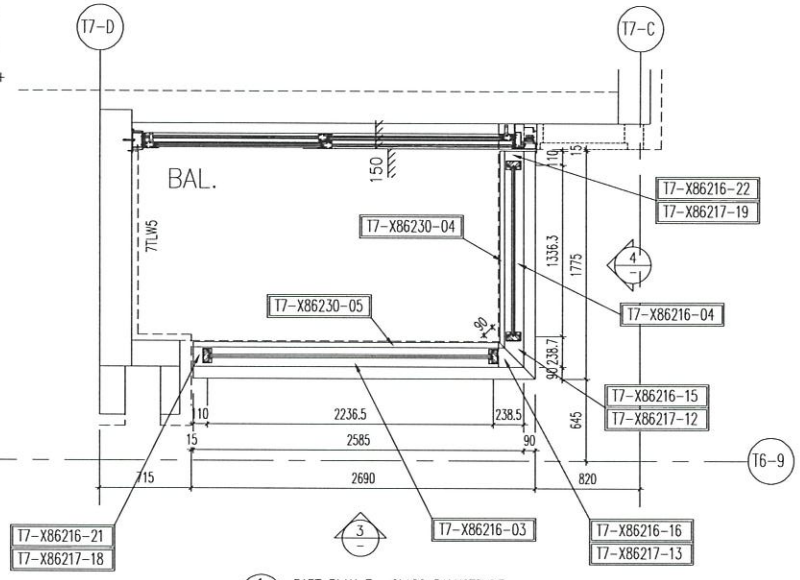


1 PART PLAN For GLASS BALUSTRADE
T7 FLAT B at 7/F~23/F

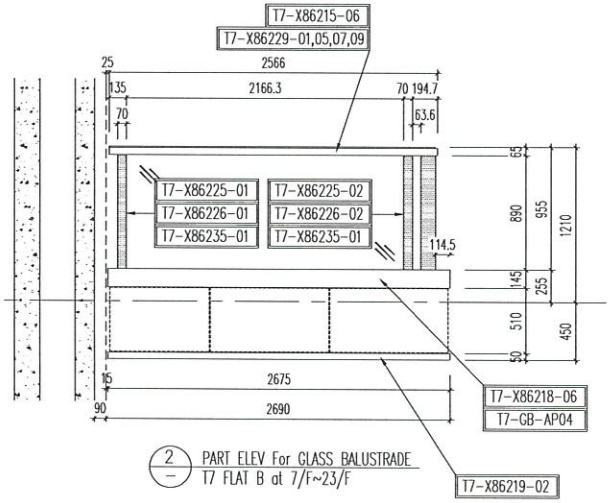

2 PART ELEV For GLASS BALUSTRADE
T7 FLAT B at 7/F~23/F

+S.F.L. OF BAL.

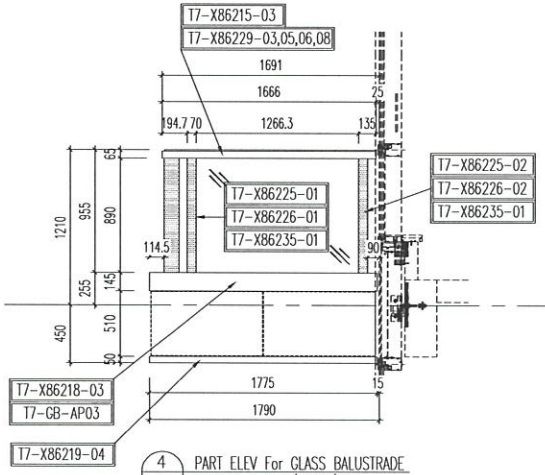

4 PART ELEV For GLASS BALUSTRADE

B.D. REF :

CLIENT :

ARCHITECT : WONG TUNG & PARTNERS LIMITED ARCHITECTS & PLANNERS

MAIN CONTRACTOR :

STRUCTURAL ENGINEER : WONG TUNG & PARTNERS LIMITED ARCHITECTS & PLANNERS

FACADE CONSULTANT: MEINHARDT

NOTE :
1. ALL DIMENSIONS ARE IN mm.
2. ALL ELEVATIONS ARE VIEWED FROM OUTSIDE.
3. ALL DIMENSIONS TO BE VERIFIED ON SITE BEFORE FABRICATION.

LEGEND :
X1 — DETAIL MARK NO.
X001 — REFER SHEET NO.
1. F.F.L. -- FINISHED FLOOR LEVEL
2. S.F.L. -- STRUCTURAL FLOOR LEVEL
3. /R -- REVERSED DETAIL

NO.	DATE	REVISED	BY
D	12/04/2022	REVISION SUBJECT TO ARCHITECT	LHK

JOB NO. : J-853

PROJECT :
PROPOSED RESIDENTIAL DEVELOPMENT AT N.K.I.L. 6542 YIN PING ROAD KOWLOON

TITLE :
PART ELEV and PART PLAN for GLASS BALUSTRADE AT TOWER 7 FLAT B

DATE : 18-MAY-21 | SCALE : 1:90(A1)

DRAWN BY : Ivan | CHECKED BY :

美特鋁製有限公司
MIDI ALUMINIUM FABRICATOR LTD.
Units 6-8, Sunray Industrial Centre, 1/F
610 Cha Kwo Ling Road, Kowloon
Tel:23489211-4 Fax:(852)27727666

DWG NO. : J853-SD-GB-5702 | REV. : D