美特鋁質有限公司
MIDI ALUMINIUM FABRICATOR LTD.

工程指示 / 要求簡箋 ENGINEER INSTRUCTIONS(E.I.)

工程指示編號:	EI- 5675	**修改版本:**	-
	HK- 0143		
工程編號:	J 853	**工程名稱:**	大窩坪（延坪道）
收件人:	生統	**發件人:**	Edwin Ho
工程項目:	地盤用T1-T7單元件橫向頂底防水件	**日期:**	02/02/2023

☐ 原合約工程包	☐ 原合約工程加 / 減賬 QT-	☐ 新工程報價 QT-

信件批核號碼/圖紙參考編號:	**批核模具圖紙編號:**
客戶指示附件:	**管理內部批簽署:**

☐ 初步鋁料 B.M.	☐ 加工拆圖，然後生產	☐ 尺寸表
☐ 正式鋁料 B.M.	☐ 技術上資料／指示	☐ 報價
☑ 配件 B.M.	☐ 樣辦或貨品說明書	☐ 分判合約
☐ 其他:		

內容: 煩請根據附件加工圖生產地盤用T1-T7單元件橫向頂底防水件。

完成上列要求日期: 01/03/2023

國內

☐ 生產技術總監	☐ 連附件	☐ 技術部	☐ 連附件	☐ 生產部	☐ 連附件
☐ 採購部	☐ 連附件	☑ 生產統籌部	☑ 連附件	☐ 報關組	☐ 連附件
☐ 質檢部	☐ 連附件	☐ 會計部	☐ 連附件	☐ 機械設計部	☐ 連附件
☑ 香港辦	☑ 連附件	☐ 其他:			

香港

☐ 行政部	☐ 連附件	☐ 會計部	☐ 連附件	☐ 統籌部	☐ 連附件	☐ 工程部	☐ 連附件
☐ 採購部	☐ 連附件	☐ QS部	☐ 連附件	☑ 地盤管理	☑ 連附件	☐ 維修部	☐ 連附件

*發件人簽署： Edwin Ho	*組別成員批核簽署： 2/2/2023
傳遞編號：	項目經理簽署：

美特鋁質有限公司
MIDI Aluminium Fabricator Ltd.

QF005/8

圖則登記表
DRAWING REGISTER

工程名稱 Project Title:	延坪道住宅 T1-T7橫向頂底防水件拆圖
工程編號 Project No:	J-853

分發予 Distributed To

	接收日期 Receiving Date (適用於客戶圖則)									
年										
月										
日										
年	23									
月	1									
日	11									

圖則編號 Drg. No.	圖則名稱 Drawing Title		修訂編號 Revision No.
PD-AP01	防水鋁板	1	-
PD-AP01-SJ	防水鋁板(數據表)	2	-
FSN-01a	防水鋁板	3	-
FSN-01b	防水鋁板	4	-
FSN-01a-JD	節點示意圖	5	-
FSN-02a	防水鋁板	6	-
FSN-02b	防水鋁板	7	-
FSN-02a-SJ	防水鋁板(數據表)	8	-
FSN-02a-JD	節點示意圖	9	-
FSN-03	防水鋁板	10	-
FSN-03-SJ	防水鋁板(數據表)	11	-
J853-SD-CW-4101	位置圖	12	-
J853-SD-CW-4102	位置圖	13	-
J853-SD-CW-4103	位置圖	14	-
J853-SD-CW-4104	位置圖	15	-
J853-SD-CW-4105	位置圖	16	-
J853-SD-CW-4106	位置圖	17	-
J853-SD-CW-4201	位置圖	18	-
J853-SD-CW-4202	位置圖	19	-
J853-SD-CW-4203	位置圖	20	-
J853-SD-CW-4204	位置圖	21	-
J853-SD-CW-4204A	位置圖	22	-
J853-SD-CW-4205	位置圖	23	-

圖則登記表
DRAWING REGISTER

工程名稱 Project Title:	延坪道住宅 T1-T7橫向頂底防水件拆圖
工程編號 Project No:	J-853

分發予 Distributed To

接收日期 Receiving Date (適用於客戶圖則)										
年										
月										
日										
年	23									
月	1									
日	11									

圖則編號 Drg. No.	圖則名稱 Drawing Title		修訂編號 Revision No.								
J853-SD-CW-4206	位置圖	24	-								
J853-SD-CW-4301	位置圖	25	-								
J853-SD-CW-4302	位置圖	26	-								
J853-SD-CW-4303	位置圖	27	-								
J853-SD-CW-4304	位置圖	28	-								
J853-SD-CW-4304A	位置圖	29	-								
J853-SD-CW-4305	位置圖	30	-								
J853-SD-CW-4306	位置圖	31	-								
J853-SD-CW-4501	位置圖	32	-								
J853-SD-CW-4502	位置圖	33	-								
J853-SD-CW-4503	位置圖	34	-								
J853-SD-CW-4504	位置圖	35	-								
J853-SD-CW-4505	位置圖	36	-								
J853-SD-CW-4506	位置圖	37	-								
J853-SD-CW-4507	位置圖	38	-								
J853-SD-CW-4508	位置圖	39	-								
J853-SD-CW-4509	位置圖	40	-								
J853-SD-CW-4510	位置圖	41	-								
J853-SD-CW-4601	位置圖	42	-								
J853-SD-CW-4602	位置圖	43	-								
J853-SD-CW-4602A	位置圖	44	-								
J853-SD-CW-4606	位置圖	45	-								
J853-SD-CW-4607	位置圖	46	-								

圖則登記表
DRAWING REGISTER

			接收日期 Receiving Date (適用於客戶圖則)									
工程名稱 Project Title:	延坪道住宅 T1-T7橫向頂底防水件拆圖	年										
		月										
工程編號 Project No:	J-853	日										
分發予 Distributed To												
		年	23									
		月	1									
		日	11									

圖則編號 Drg. No.	圖則名稱 Drawing Title		修訂編號 Revision No.									
J853-SD-CW-4603	位置圖	47	-									
J853-SD-CW-4604	位置圖	48	-									
J853-SD-CW-4605	位置圖	49	-									
J853-SD-CW-4608	位置圖	50	-									
J853-SD-CW-4609	位置圖	51	-									

美特鋁質 有限公司 MIDI Aluminium Fabricator Ltd.	工程號: J-853	計算: 方強	日期:	2023.01.07		送呈: 胡哥
	地盤名稱: 九龍延坪道	核對: 謝永林	日期:	2023.01.11		副本:
地盤用鋁板B.M.表	項目類別: T1-T7橫向頂底防水件	批准:	日期:			
	修改版次:	A/C Code:	總V.F.:	0.00	總重量: 1015.39	此BM依據拆圖 資料計算

序號	修改內容	鋁板圖號	鋁板名稱	顏色	實用	後備	總數	總重量	單件展開面積	總展開面積	單件V.F.	總V.F.	備註
									平方米		平方米		
1		PD-AP01	1.5mm厚鋁板	鉻化	77	12	89	566.199	1.565	139.286	0.00	0.00	
2		FSN-01a	1.5mm厚鋁板	鉻化	9	2	11	17.075	0.382	4.200	0.00	0.00	
3		FSN-01b	1.5mm厚鋁板	鉻化	9	2	11	8.674	0.194	2.134	0.00	0.00	
4		FSN-02a	1.5mm厚鋁板	鉻化	87	12	99	203.164	0.505	49.979	0.00	0.00	
5		FSN-02b	1.5mm厚鋁板	鉻化	87	12	99	123.135	0.306	30.292	0.00	0.00	
6		FSN-03	1.5mm厚鋁板	鉻化	16	8	24	97.147	0.996	23.898	0.00	0.00	
						合計：	333	1015.394		249.789			

			T1-T7横向頂底防水件/樓層/數量派位																		
座數	位置	圖號	5F	6F	7F	8F	9F	10F	11F	12F	15F	16F	17F	18F	19F	20F	21F	22F	23F	25F	26F	合計
T1	J853-SD-CW-4101	PD-AP01	6																			6
T1	J853-SD-CW-4102右	PD-AP01	1																			1
T1	J853-SD-CW-4103左	PD-AP01	2																			2
T1	J853-SD-CW-4103右	PD-AP01	1																			1
T1	J853-SD-CW-4104右	PD-AP01	3																			3
T1	J853-SD-CW-4104右	PD-AP01	2																			2
T1	J853-SD-CW-4101	FSN-01a																	3			3
T1	J853-SD-CW-4101	FSN-01a																2				2
T1	J853-SD-CW-4102右	FSN-01a																1				1
T1	J853-SD-CW-4103左	FSN-01a																2				2
T1	J853-SD-CW-4104	FSN-01a																1				1
T1	J853-SD-CW-4101	FSN-01b																	3			3
T1	J853-SD-CW-4101	FSN-01b																2				2
T1	J853-SD-CW-4102右	FSN-01b																1				1
T1	J853-SD-CW-4103左	FSN-01b																2				2
T1	J853-SD-CW-4104	FSN-01b																1				1
T1	J853-SD-CW-4102左	FSN-02a																		3		3
T1	J853-SD-CW-4103右	FSN-02a																		2		2
T1	J853-SD-CW-4104	FSN-02a																		5		5
T1	J853-SD-CW-4105左	FSN-02a																		3		3
T1	J853-SD-CW-4105右	FSN-02a																		3		3
T1	J853-SD-CW-4106	FSN-02a																		3		3
T1	J853-SD-CW-4102左	FSN-02b																		3		3
T1	J853-SD-CW-4103右	FSN-02b																		2		2
T1	J853-SD-CW-4104	FSN-02b																		5		5
T1	J853-SD-CW-4105左	FSN-02b																		3		3
T1	J853-SD-CW-4105右	FSN-02b																		3		3
T1	J853-SD-CW-4106	FSN-02b																		3		3
T2	J853-SD-CW-4201左	PD-AP01	1																			1
T2	J853-SD-CW-4201右	PD-AP01	1																			1
T2	J853-SD-CW-4202左	PD-AP01	2																			2
T2	J853-SD-CW-4203左	PD-AP01	1																			1
T2	J853-SD-CW-4204	PD-AP01	2																			2
T2	J853-SD-CW-4204A	PD-AP01	3																			3
T2	J853-SD-CW-4205	PD-AP01	2																			2
T2	J853-SD-CW-4201左	FSN-02a																			1	1
T2	J853-SD-CW-4202右	FSN-02a																			2	2
T2	J853-SD-CW-4204	FSN-02a																			2	2
T2	J853-SD-CW-4204A	FSN-02a																			3	3


			T1-T7横向顶底防水件/楼層/数量派位																			
座数	位置	圖號	5F	6F	7F	8F	9F	10F	11F	12F	15F	16F	17F	18F	19F	20F	21F	22F	23F	25F	26F	合計
T2	J853-SD-CW-4205	FSN-02a																			2	2
T2	J853-SD-CW-4206左	FSN-02a																			2	2
T2	J853-SD-CW-4206右	FSN-02a																			3	3
T2	J853-SD-CW-4201左	FSN-02b																			1	1
T2	J853-SD-CW-4202右	FSN-02b																			2	2
T2	J853-SD-CW-4204	FSN-02b																			2	2
T2	J853-SD-CW-4204A	FSN-02b																			3	3
T2	J853-SD-CW-4205	FSN-02b																			2	2
T2	J853-SD-CW-4206左	FSN-02b																			2	2
T2	J853-SD-CW-4206右	FSN-02b																			3	3
T2	J853-SD-CW-4201右	FSN-03																	1			1
T2	J853-SD-CW-4203右	FSN-03																	2			2
T3	J853-SD-CW-4301左	PD-AP01	1																			1
T3	J853-SD-CW-4302左	PD-AP01	1																			1
T3	J853-SD-CW-4302右	PD-AP01	1																			1
T3	J853-SD-CW-4303左	PD-AP01	2																			2
T3	J853-SD-CW-4304	PD-AP01	2																			2
T3	J853-SD-CW-4304A	PD-AP01	3																			3
T3	J853-SD-CW-4305	PD-AP01	2																			2
T3	J853-SD-CW-4302左	FSN-02a																			1	1
T3	J853-SD-CW-4303右	FSN-02a																			2	2
T3	J853-SD-CW-4304	FSN-02a																			2	2
T3	J853-SD-CW-4304A	FSN-02a																			3	3
T3	J853-SD-CW-4305	FSN-02a																			2	2
T3	J853-SD-CW-4306左	FSN-02a																			2	2
T3	J853-SD-CW-4306右	FSN-02a																			2	2
T3	J853-SD-CW-4302左	FSN-02b																			1	1
T3	J853-SD-CW-4303右	FSN-02b																			2	2
T3	J853-SD-CW-4304	FSN-02b																			2	2
T3	J853-SD-CW-4304A	FSN-02b																			3	3
T3	J853-SD-CW-4305	FSN-02b																			2	2
T3	J853-SD-CW-4306左	FSN-02b																			2	2
T3	J853-SD-CW-4306右	FSN-02b																			2	2
T3	J853-SD-CW-4301右	FSN-03																	2			2
T3	J853-SD-CW-4302右	FSN-03																	1			1
T5	J853-SD-CW-4501左	PD-AP01	1																			1
T5	J853-SD-CW-4501右	PD-AP01							2													2
T5	J853-SD-CW-4502左	PD-AP01	2																			2
T5	J853-SD-CW-4503右	PD-AP01	1																			1


			T1-T7横向顶底防水件/楼層/数量派位																			
座数	位置	圖號	5F	6F	7F	8F	9F	10F	11F	12F	15F	16F	17F	18F	19F	20F	21F	22F	23F	25F	26F	合計
T5	J853-SD-CW-4504左	PD-AP01							1													1
T5	J853-SD-CW-4504左	PD-AP01	1																			1
T5	J853-SD-CW-4505左	PD-AP01							1													1
T5	J853-SD-CW-4506左	PD-AP01							1													1
T5	J853-SD-CW-4507左	PD-AP01							2													2
T5	J853-SD-CW-4508左中右	PD-AP01							4													4
T5	J853-SD-CW-4503右	FSN-02a																			1	1
T5	J853-SD-CW-4504右	FSN-02a																			1	1
T5	J853-SD-CW-4505右	FSN-02a																			2	2
T5	J853-SD-CW-4506右	FSN-02a																			3	3
T5	J853-SD-CW-4508左中右	FSN-02a																			4	4
T5	J853-SD-CW-4509左	FSN-02a																			3	3
T5	J853-SD-CW-4509右	FSN-02a																			2	2
T5	J853-SD-CW-4510	FSN-02a																			2	2
T5	J853-SD-CW-4503右	FSN-02b																			1	1
T5	J853-SD-CW-4504右	FSN-02b																			1	1
T5	J853-SD-CW-4505右	FSN-02b																			2	2
T5	J853-SD-CW-4506右	FSN-02b																			3	3
T5	J853-SD-CW-4508左中右	FSN-02b																			4	4
T5	J853-SD-CW-4509左	FSN-02b																			3	3
T5	J853-SD-CW-4509右	FSN-02b																			2	2
T5	J853-SD-CW-4510	FSN-02b																			2	2
T5	J853-SD-CW-4501左	FSN-03																	1			1
T5	J853-SD-CW-4502右	FSN-03																	1			1
T5	J853-SD-CW-4506左	FSN-03																	1			1
T5	J853-SD-CW-4507右	FSN-03																	2			2
T6	J853-SD-CW-4601左	PD-AP01	1																			1
T6	J853-SD-CW-4601右	PD-AP01	1																			1
T6	J853-SD-CW-4602	PD-AP01	3																			3
T6	J853-SD-CW-4602A	PD-AP01	2																			2
T6	J853-SD-CW-4606左	PD-AP01						1														1
T6	J853-SD-CW-4606右	PD-AP01						2														2
T6	J853-SD-CW-4607左	PD-AP01						1														1
T6	J853-SD-CW-4607右	PD-AP01						1														1
T6	J853-SD-CW-4601左	FSN-02a																			1	1
T6	J853-SD-CW-4601右	FSN-02a																			1	1
T6	J853-SD-CW-4602	FSN-02a																			3	3
T6	J853-SD-CW-4602A	FSN-02a																			2	2
T6	J853-SD-CW-4606左	FSN-02a																			1	1

			T1-T7横向頂底防水件/樓層/數量派位																			
座數	位置	圖號	5F	6F	7F	8F	9F	10F	11F	12F	15F	16F	17F	18F	19F	20F	21F	22F	23F	25F	26F	合計
T6	J853-SD-CW-4606右	FSN-02a																			2	2
T6	J853-SD-CW-4607左	FSN-02a																			1	1
T6	J853-SD-CW-4607右	FSN-02a																			1	1
T6	J853-SD-CW-4601左	FSN-02b																			1	1
T6	J853-SD-CW-4601右	FSN-02b																			1	1
T6	J853-SD-CW-4602	FSN-02b																			3	3
T6	J853-SD-CW-4602A	FSN-02b																			2	2
T6	J853-SD-CW-4606左	FSN-02b																			1	1
T6	J853-SD-CW-4606右	FSN-02b																			2	2
T6	J853-SD-CW-4607左	FSN-02b																			1	1
T6	J853-SD-CW-4607右	FSN-02b																			1	1
T7	J853-SD-CW-4603左	PD-AP01			2																	2
T7	J853-SD-CW-4603右	PD-AP01			2																	2
T7	J853-SD-CW-4604左	PD-AP01			1																	1
T7	J853-SD-CW-4604右	PD-AP01			2																	2
T7	J853-SD-CW-4605	PD-AP01			2																	2
T7	J853-SD-CW-4608左	PD-AP01			1																	1
T7	J853-SD-CW-4603左	FSN-02a																			2	2
T7	J853-SD-CW-4603右	FSN-02a																			2	2
T7	J853-SD-CW-4608左	FSN-02a																			1	1
T7	J853-SD-CW-4609	FSN-02a																			4	4
T7	J853-SD-CW-4603左	FSN-02b																			2	2
T7	J853-SD-CW-4603右	FSN-02b																			2	2
T7	J853-SD-CW-4608左	FSN-02b																			1	1
T7	J853-SD-CW-4609	FSN-02b																			4	4
T7	J853-SD-CW-4604左	FSN-03																	1			1
T7	J853-SD-CW-4604右	FSN-03																	2			2
T7	J853-SD-CW-4605	FSN-03																	2			2
	-	後備：																			48	48
		合計：	51	0	10	0	0	5	11	0	0	0	0	0	0	0	0	12	22	38	184	333


美特鋁質 有限公司
MIDI Aluminium Fabricator Ltd.

工程號	J-853	地盤	延坪道住宅

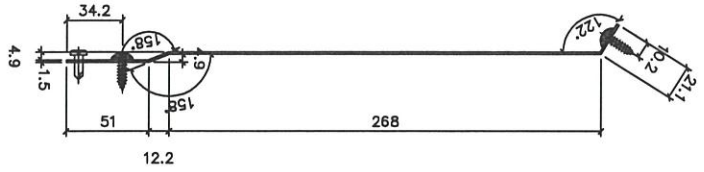

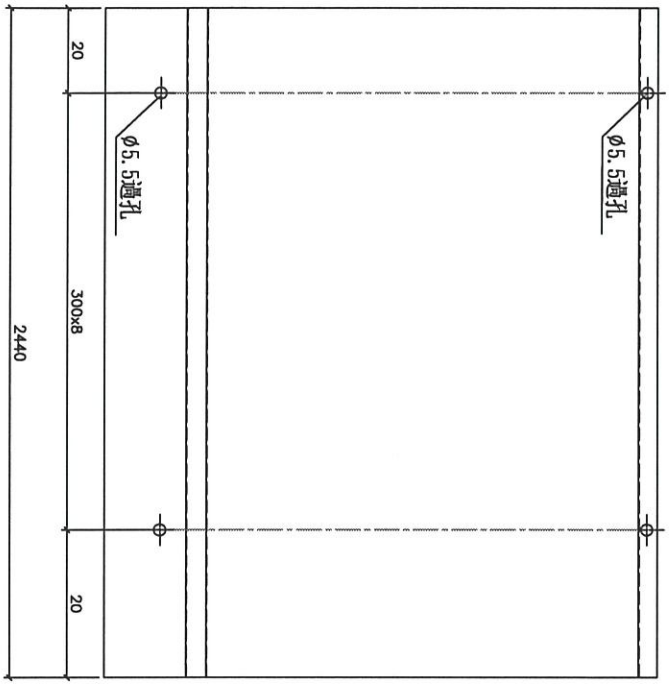

數據表見後頁

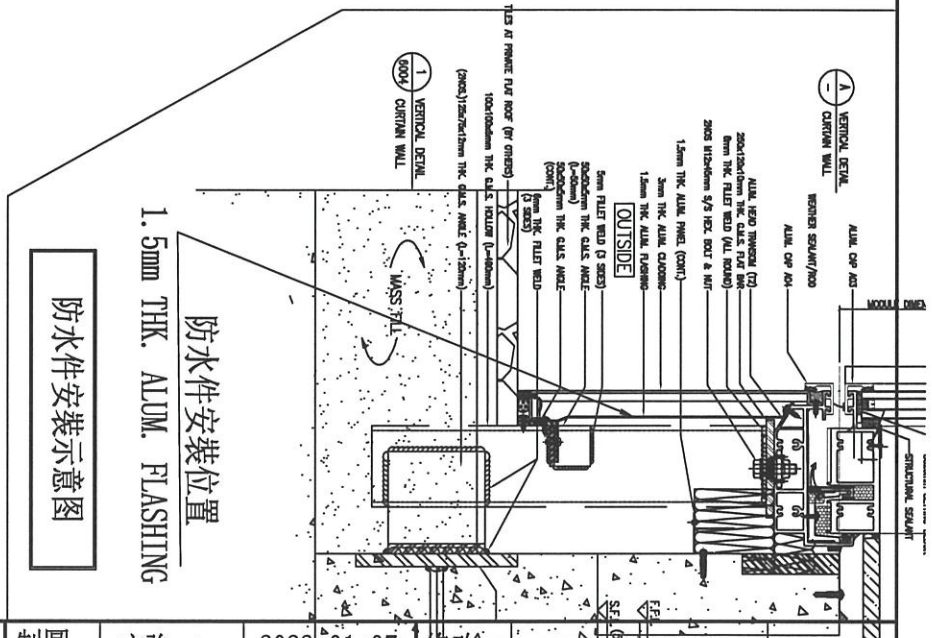

名稱	防水鋁板	制圖	方強	2023.01.07	修改			
材料	1.5㎜鋁板	復核	謝永林	2023.01.11	日期			
顏色	鉻化	批準	Daniel		圖號	PD-AP01		

美特鋁質 有限公司
MIDI Aluminium Fabricator Ltd.

工程號	J-853	地盤	延坪道住宅


數量	樓層數	單層用量	圖號	座數	樓層位置	數量	樓層數	單層用量	圖號	座數	樓層位置
6	1	6	J853-SD-CW-4101	T1	5/F	1	1	1	J853-SD-CW-4501左	T5	5/F
1	1	1	J853-SD-CW-4102右	T1	5/F	2	1	2	J853-SD-CW-4501右	T5	11/F
2	1	2	J853-SD-CW-4103左	T1	5/F	2	1	2	J853-SD-CW-4502左	T5	5/F
1	1	1	J853-SD-CW-4103右	T1	5/F	1	1	1	J853-SD-CW-4503右	T5	5/F
3	1	3	J853-SD-CW-4104右	T1	5/F	1	1	1	J853-SD-CW-4504左	T5	11/F
2	1	2	J853-SD-CW-4104右	T1	5/F	1	1	1	J853-SD-CW-4504左	T5	5/F
2			後備			1	1	1	J853-SD-CW-4505左	T5	11/F
17			合計			1	1	1	J853-SD-CW-4506左	T5	11/F
1	1	1	J853-SD-CW-4201左	T2	5/F	2	1	2	J853-SD-CW-4507左	T5	11/F
1	1	1	J853-SD-CW-4201右	T2	5/F	4	1	4	J853-SD-CW-4508左中右	T5	11/F
2	1	2	J853-SD-CW-4202左	T2	5/F	2			後備		
1	1	1	J853-SD-CW-4203左	T2	5/F	18			合計		
2	1	2	J853-SD-CW-4204	T2	5/F	1	1	1	J853-SD-CW-4601左	T6	5/F
3	1	3	J853-SD-CW-4204A	T2	5/F	1	1	1	J853-SD-CW-4601右	T6	5/F
2	1	2	J853-SD-CW-4205	T2	5/F	3	1	3	J853-SD-CW-4602	T6	5/F
2			後備			2	1	2	J853-SD-CW-4602A	T6	5/F
14			合計			1	1	1	J853-SD-CW-4606左	T6	10/F
1	1	1	J853-SD-CW-4301左	T3	5/F	2	1	2	J853-SD-CW-4606右	T6	10/F
1	1	1	J853-SD-CW-4302左	T3	5/F	1	1	1	J853-SD-CW-4607左	T6	10/F
1	1	1	J853-SD-CW-4302右	T3	5/F	1	1	1	J853-SD-CW-4607右	T6	10/F
2	1	2	J853-SD-CW-4303左	T3	5/F	2			後備		
2	1	2	J853-SD-CW-4304	T3	5/F	14			合計		
3	1	3	J853-SD-CW-4304A	T3	5/F	2	1	2	J853-SD-CW-4603左	T7	7/F
2	1	2	J853-SD-CW-4305	T3	5/F	2	1	2	J853-SD-CW-4603右	T7	7/F
2			後備			1	1	1	J853-SD-CW-4604左	T7	7/F
14			合計			2	1	2	J853-SD-CW-4604右	T7	7/F
						2	1	2	J853-SD-CW-4605	T7	7/F
						1	1	1	J853-SD-CW-4608左	T7	7/F
						2			後備		
						12			合計		
						89			總計		


名稱	防水鋁板(數據表)	制圖	方強	2023.01.07	修改日期			
材料	1.5㎜鋁板	復核	謝永林	2023.01.11				
顏色	鉻化	批準	Daniel		圖號	PD-AP01-SJ		


美特鋁質 有限公司
MIDI Aluminium Fabricator Ltd.

工程號	J-853	地盤	延坪道住宅

數量	樓層數	單層用量	圖號	座數	樓層位置
3	1	3	J853-SD-CW-4101	T1	23/F
2	1	2	J853-SD-CW-4101	T1	22/F
1	1	1	J853-SD-CW-4102右	T1	22/F
2	1	2	J853-SD-CW-4103左	T1	22/F
1	1	1	J853-SD-CW-4104	T1	22/F
2			後備		
11			合計		

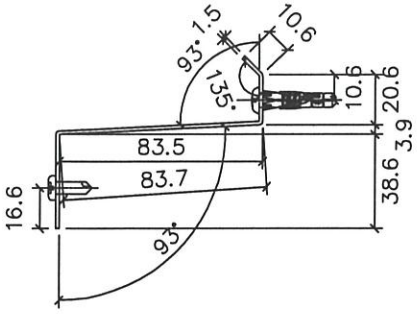

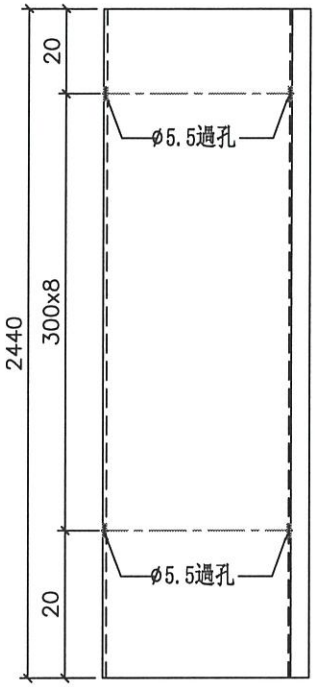

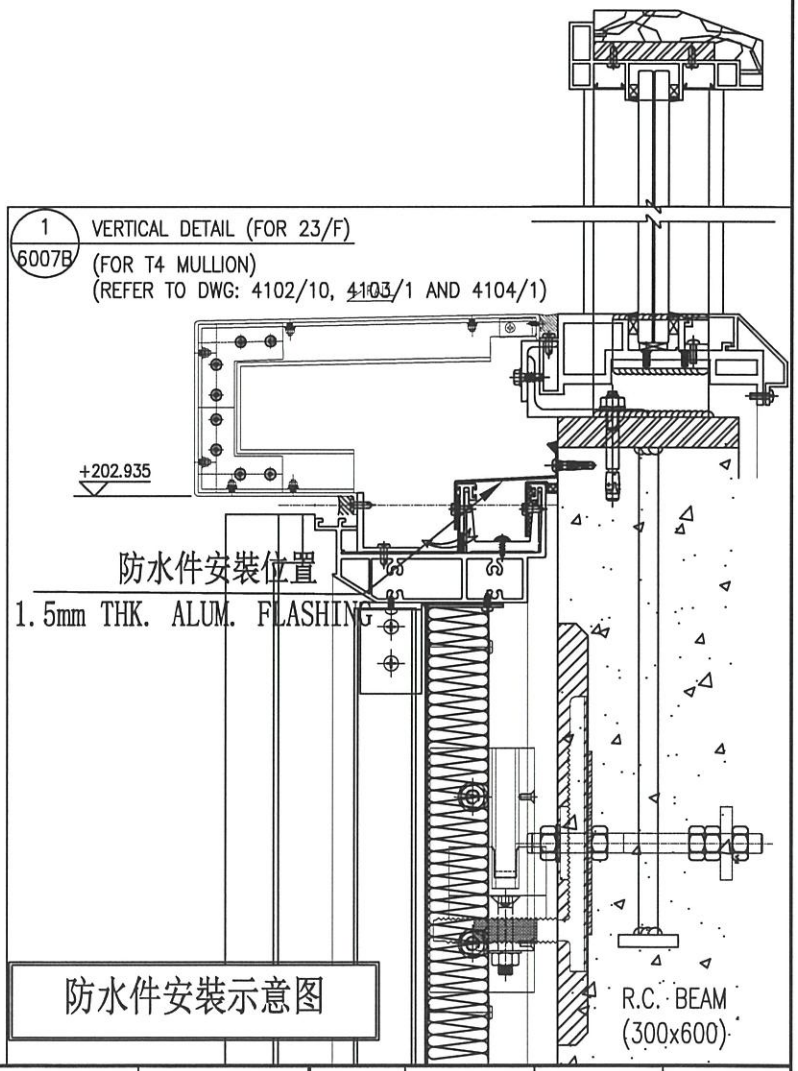


防水件安裝示意图


名稱	防水鋁板	制圖	方強	2023.01.07	修改			
材料	1.5mm鋁板	復核	謝永林	2023.01.11	日期			
顏色	鉻化	批準	Daniel		圖號	FSN-01a		


美特鋁質 有限公司
MIDI Aluminium Fabricator Ltd.

工程號	J-853	地盤	延坪道住宅

數量	樓層數	單層用量	圖號	座數	樓層位置
3	1	3	J853-SD-CW-4101	T1	23/F
2	1	2	J853-SD-CW-4101	T1	22/F
1	1	1	J853-SD-CW-4102右	T1	22/F
2	1	2	J853-SD-CW-4103左	T1	22/F
1	1	1	J853-SD-CW-4104	T1	22/F
2			後備		
11			合計		

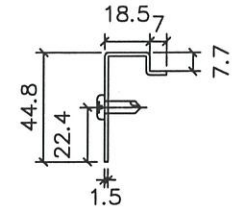

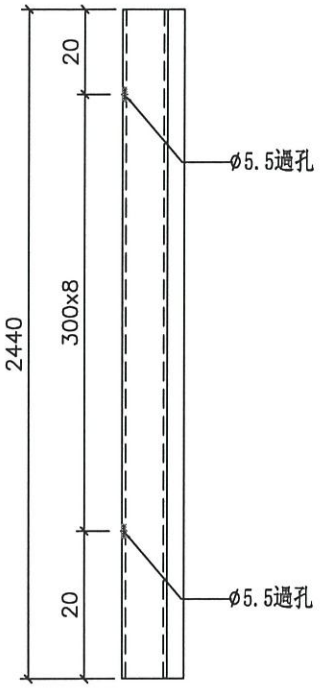

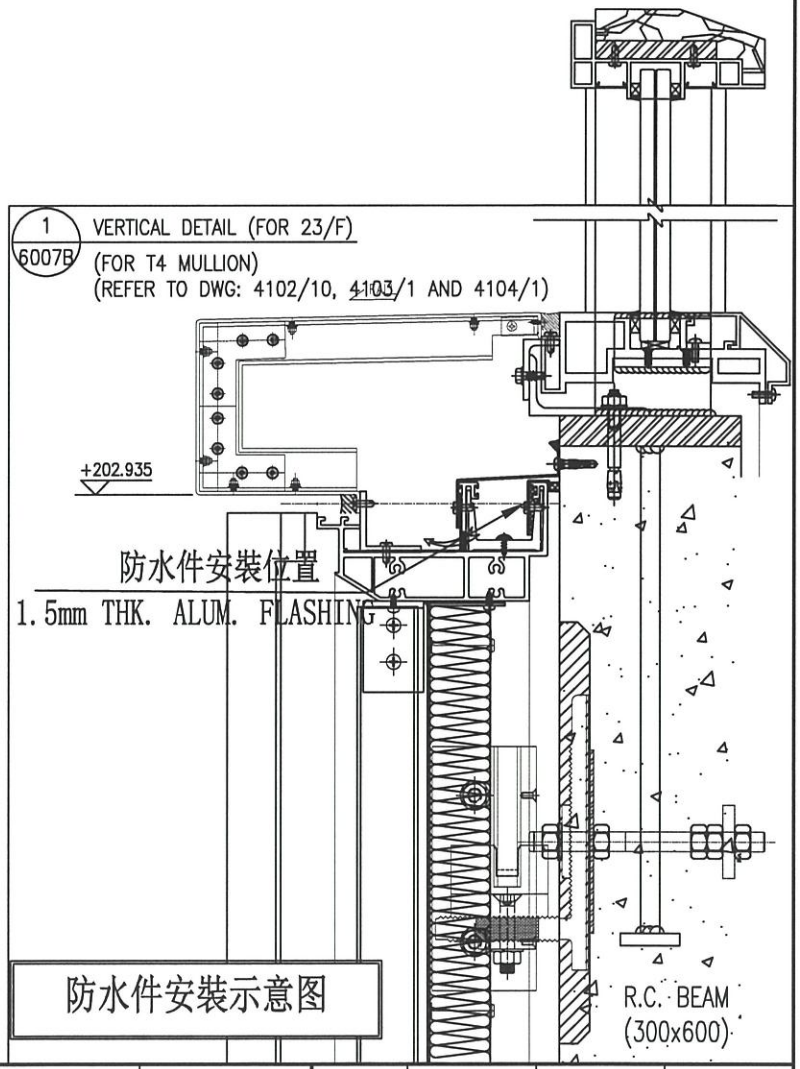


防水件安裝示意图

名稱	防水鋁板	制圖	方強	2023.01.07	修改			
材料	1.5㎜鋁板	復核	謝永林	2023.01.11	日期			
顏色	鉻化	批準	Daniel		圖號	FSN-01b		


美特鋁質 有限公司
MIDI Aluminium Fabricator Ltd.

工程號	J-853	地盤	延坪道住宅

數據表見前兩頁

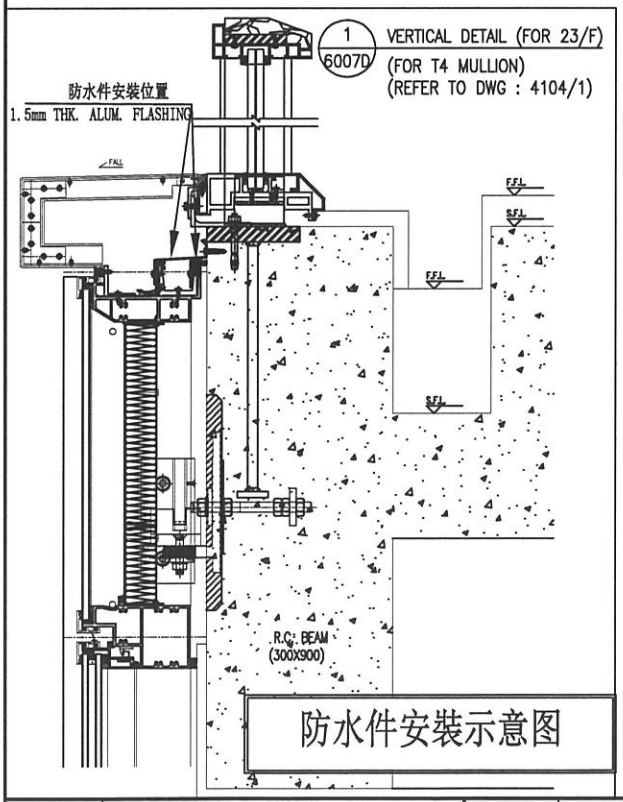

防水件安裝示意图

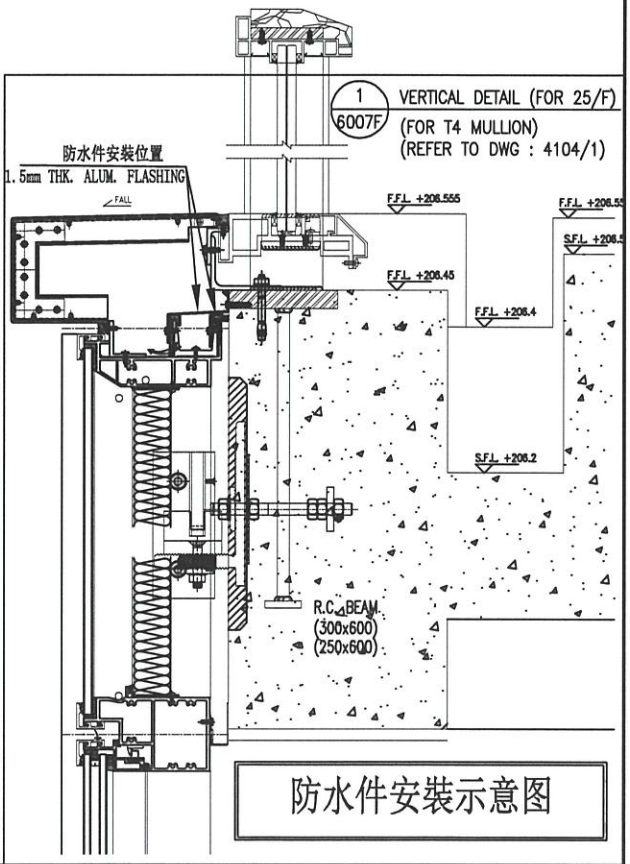



防水件安裝示意图


名稱	節點示意圖	制圖	方強	2023.01.07	修改			
材料	1.5mm鋁板	復核	謝永林	2023.01.11	日期			
顏色	鉻化	批準	Daniel		圖號	FSN-01a-JD		

美特鋁質 有限公司
MIDI Aluminium Fabricator Ltd.

工程號	J-853	地盤	延坪道住宅

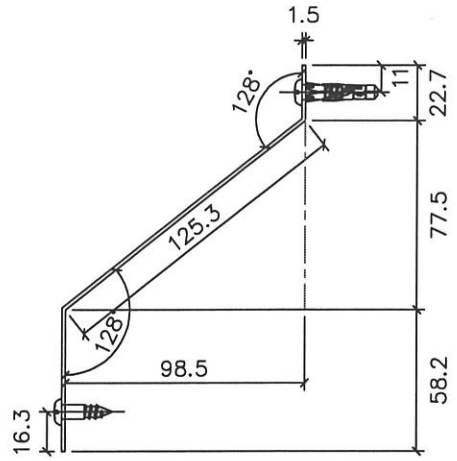

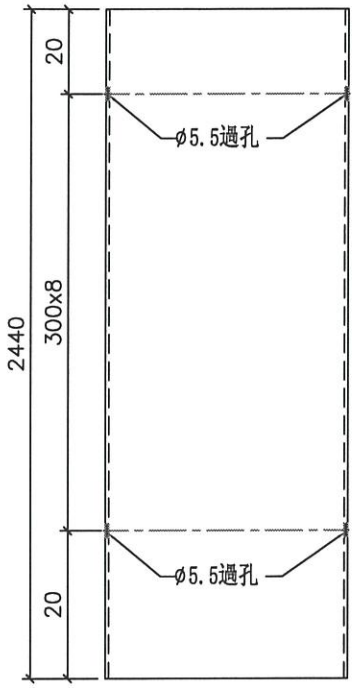

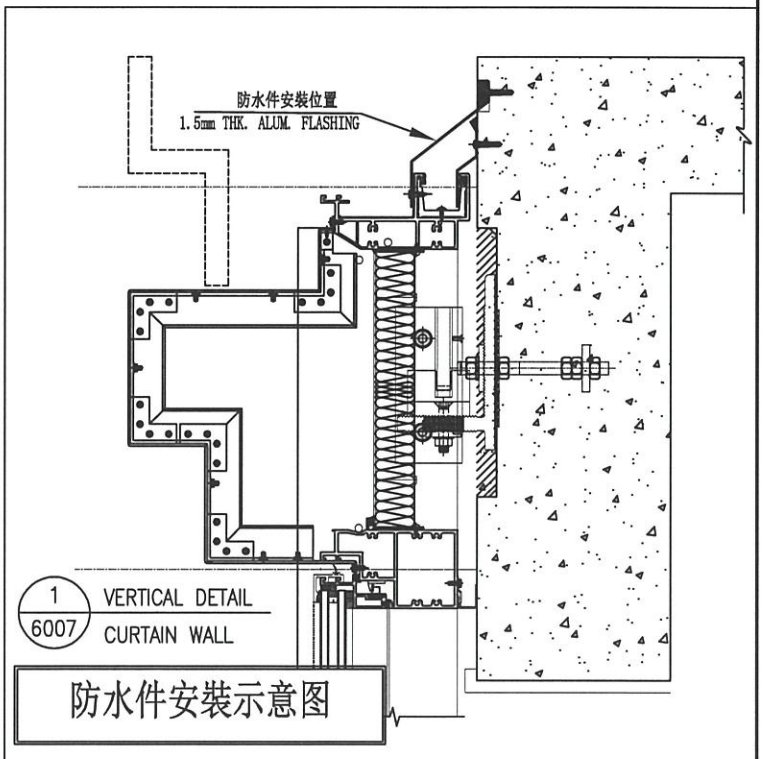



防水件安裝示意图


名稱	防水鋁板	制圖	方強	2023.01.07	修改			
材料	1.5mm鋁板	復核	謝永林	2023.01.11	日期			
顏色	鉻化	批準	Daniel		圖號	FSN-02a		

美特鋁質 有限公司
MIDI Aluminium Fabricator Ltd.

工程號	J-853	地盤	延坪道住宅

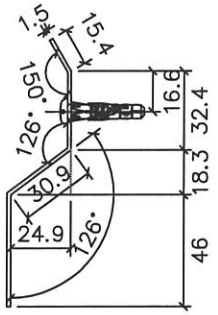

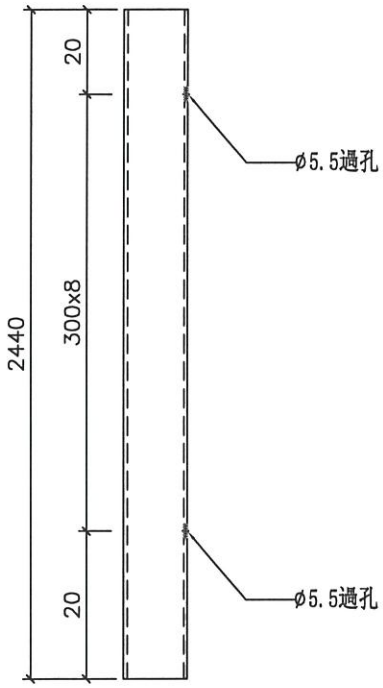

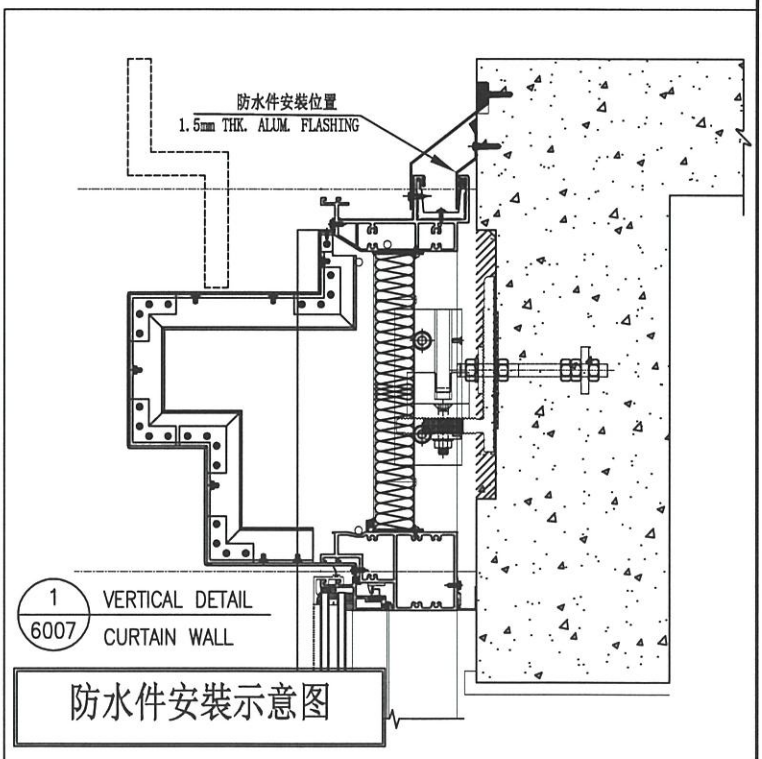

防水件安裝示意图

名稱	防水鋁板	制圖	方強	2023.01.07	修改			
材料	1.5mm鋁板	復核	謝永林	2023.01.11	日期			
顏色	鉻化	批準	Daniel		圖號	FSN-02b		

美特鋁質 有限公司
MIDI Aluminium Fabricator Ltd.

工程號	J-853	地盤	延坪道住宅

數量	樓層數	單層用量	圖號	座數	樓層位置
3	1	3	J853-SD-CW-4102左	T1	25/F
2	1	2	J853-SD-CW-4103右	T1	25/F
5	1	5	J853-SD-CW-4104	T1	25/F
3	1	3	J853-SD-CW-4105左	T1	25/F
3	1	3	J853-SD-CW-4105右	T1	25/F
3	1	3	J853-SD-CW-4106	T1	25/F
2			後備		
21			合計		
1	1	1	J853-SD-CW-4201左	T2	26/F
2	1	2	J853-SD-CW-4202右	T2	26/F
2	1	2	J853-SD-CW-4204	T2	26/F
3	1	3	J853-SD-CW-4204A	T2	26/F
2	1	2	J853-SD-CW-4205	T2	26/F
2	1	2	J853-SD-CW-4206左	T2	26/F
3	1	3	J853-SD-CW-4206右	T2	26/F
2			後備		
17			合計		
1	1	1	J853-SD-CW-4302左	T3	26/F
2	1	2	J853-SD-CW-4303右	T3	26/F
2	1	2	J853-SD-CW-4304	T3	26/F
3	1	3	J853-SD-CW-4304A	T3	26/F
2	1	2	J853-SD-CW-4305	T3	26/F
2	1	2	J853-SD-CW-4306左	T3	26/F
2	1	2	J853-SD-CW-4306右	T3	26/F
2			後備		
16			合計		

數量	樓層數	單層用量	圖號	座數	樓層位置
1	1	1	J853-SD-CW-4503右	T5	26/F
1	1	1	J853-SD-CW-4504右	T5	26/F
2	1	2	J853-SD-CW-4505右	T5	26/F
3	1	3	J853-SD-CW-4506右	T5	26/F
4	1	4	J853-SD-CW-4508左中右	T5	26/F
3	1	3	J853-SD-CW-4509左	T5	26/F
2	1	2	J853-SD-CW-4509右	T5	26/F
2	1	2	J853-SD-CW-4510	T5	26/F
2			後備		
20			合計		
1	1	1	J853-SD-CW-4601左	T6	26/F
1	1	1	J853-SD-CW-4601右	T6	26/F
3	1	3	J853-SD-CW-4602	T6	26/F
2	1	2	J853-SD-CW-4602A	T6	26/F
1	1	1	J853-SD-CW-4606左	T6	26/F
2	1	2	J853-SD-CW-4606右	T6	26/F
1	1	1	J853-SD-CW-4607左	T6	26/F
1	1	1	J853-SD-CW-4607右	T6	26/F
2			後備		
14			合計		
2	1	2	J853-SD-CW-4603左	T7	26/F
2	1	2	J853-SD-CW-4603右	T7	26/F
1	1	1	J853-SD-CW-4608左	T7	26/F
4	1	4	J853-SD-CW-4609	T7	26/F
2			後備		
11			合計		
99			總計		

拆圖見前兩頁


名稱	防水鋁板(數據表)	制圖	方強	2023.01.07	修改			
材料	1.5㎜鋁板	復核	謝永林	2023.01.11	日期			
顏色	鉻化	批準	Daniel		圖號	FSN-02a-SJ		

美特鋁質 有限公司
MIDI Aluminium Fabricator Ltd.

工程號	J-853	地盤	延坪道住宅

數據表見前頁

拆圖見FSN-02a、FSN-02b

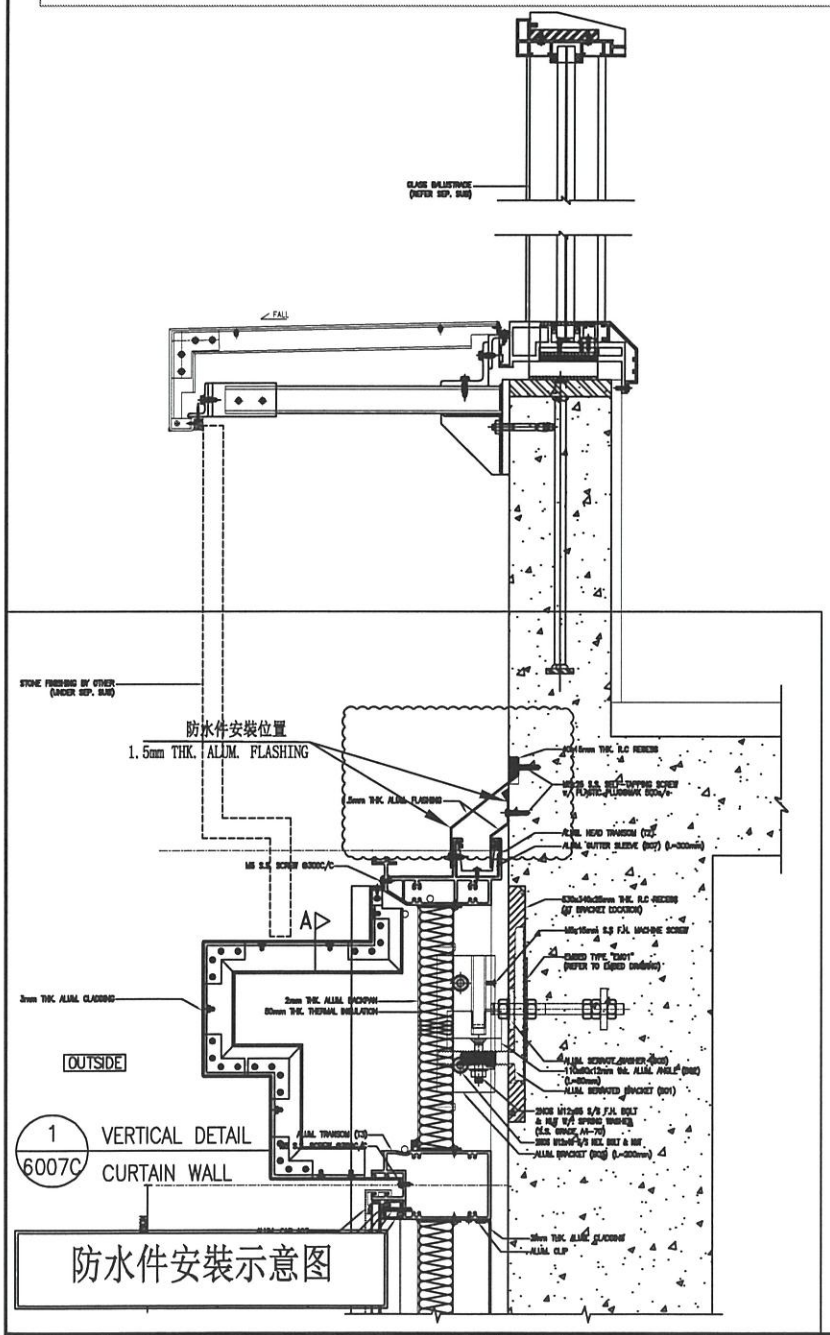



防水件安裝示意图


名稱	節點示意圖	制圖	方強	2023.01.07	修改			
材料	1.5mm铝板	復核	謝永林	2023.01.11	日期			
顏色	鉻化	批準	Daniel		圖號	FSN-02a-JD		

美特鋁質 有限公司
MIDI Aluminium Fabricator Ltd.

工程號	J-853	地盤	延坪道住宅

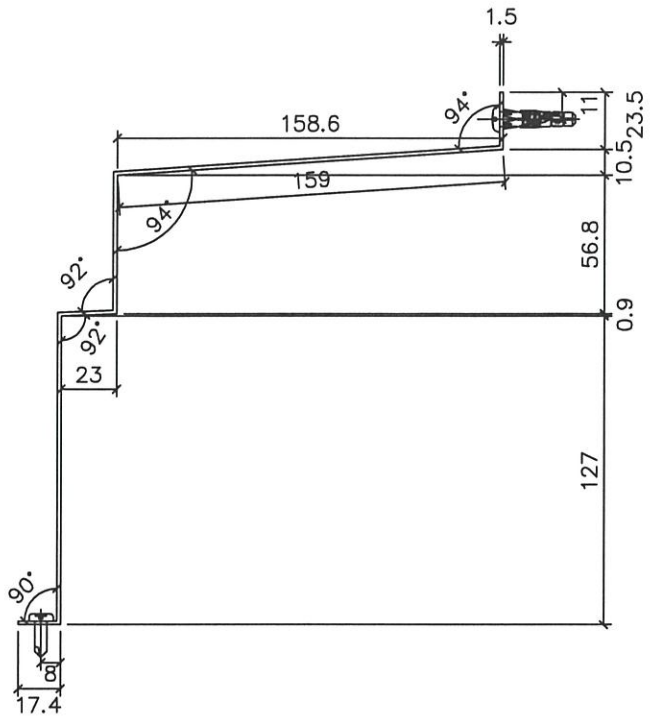

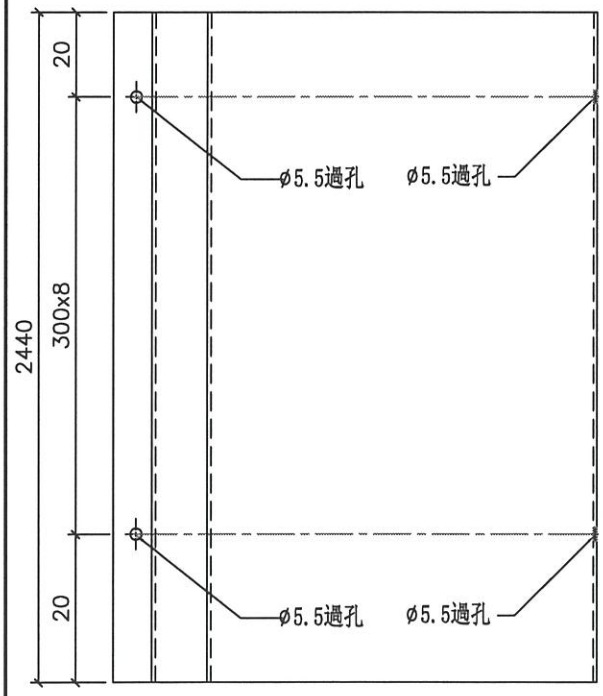

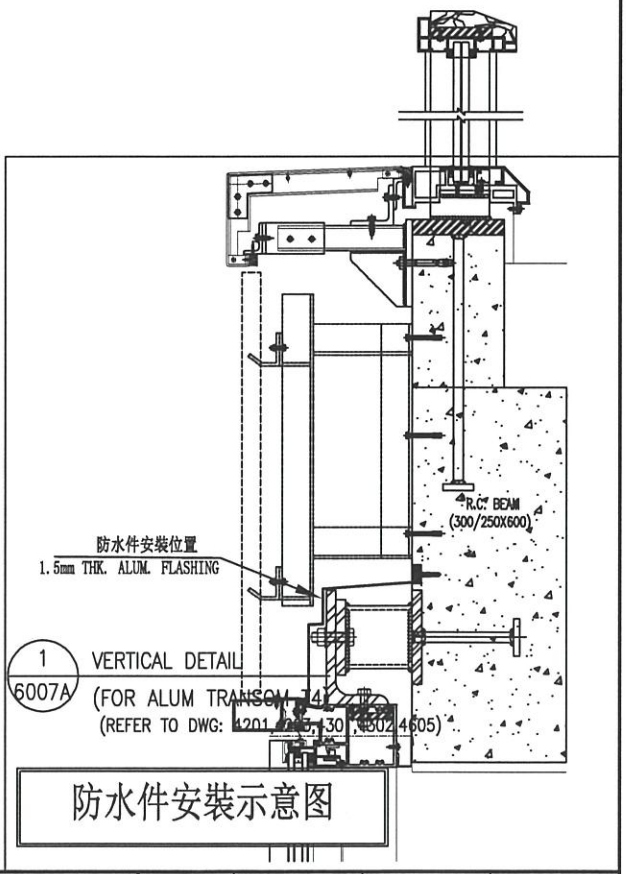

防水件安装示意图

名稱	防水鋁板	制圖	方強	2023.01.07	修改			
材料	1.5mm鋁板	復核	謝永林	2023.01.11	日期			
顏色	銘化	批準	Daniel		圖號	FSN-03		


美特鋁質 有限公司
MIDI Aluminium Fabricator Ltd.

工程號	J-853	地盤	延坪道住宅

數量	樓層數	單層用量	圖號	座數	樓層位置
1	1	1	J853-SD-CW-4201右	T2	23/F
2	1	2	J853-SD-CW-4203右	T2	23/F
2			後備		
5			合計		
2	1	2	J853-SD-CW-4301右	T3	23/F
1	1	1	J853-SD-CW-4302右	T3	23/F
2			後備		
5			合計		


數量	樓層數	單層用量	圖號	座數	樓層位置
1	1	1	J853-SD-CW-4501左	T5	23/F
1	1	1	J853-SD-CW-4502右	T5	23/F
1	1	1	J853-SD-CW-4506左	T5	23/F
2	1	2	J853-SD-CW-4507右	T5	23/F
2			後備		
7			合計		
1	1	1	J853-SD-CW-4604左	T7	23/F
2	1	2	J853-SD-CW-4604右	T7	23/F
2	1	2	J853-SD-CW-4605	T7	25/F
2			後備		
7			合計		
24			總計		

拆圖見前頁

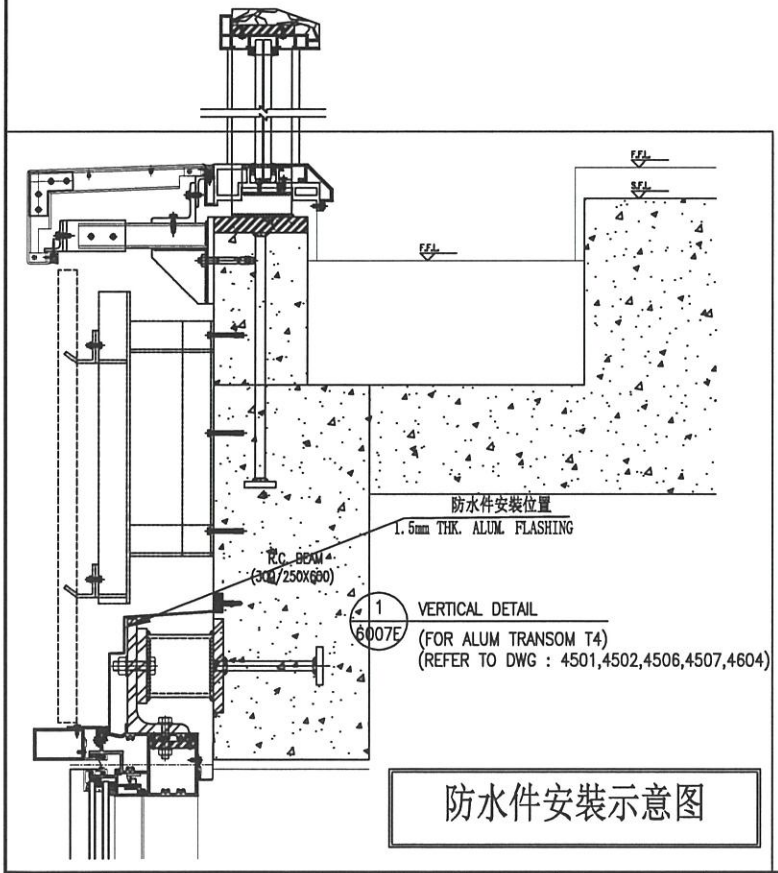


防水件安裝示意图

名稱	防水鋁板(數據表)	制圖	方強	2023.01.07	修改			
材料	1.5㎜鋁板	復核	謝永林	2023.01.11	日期			
顏色	鉻化	批準	Daniel		圖號	FSN-03-SJ		

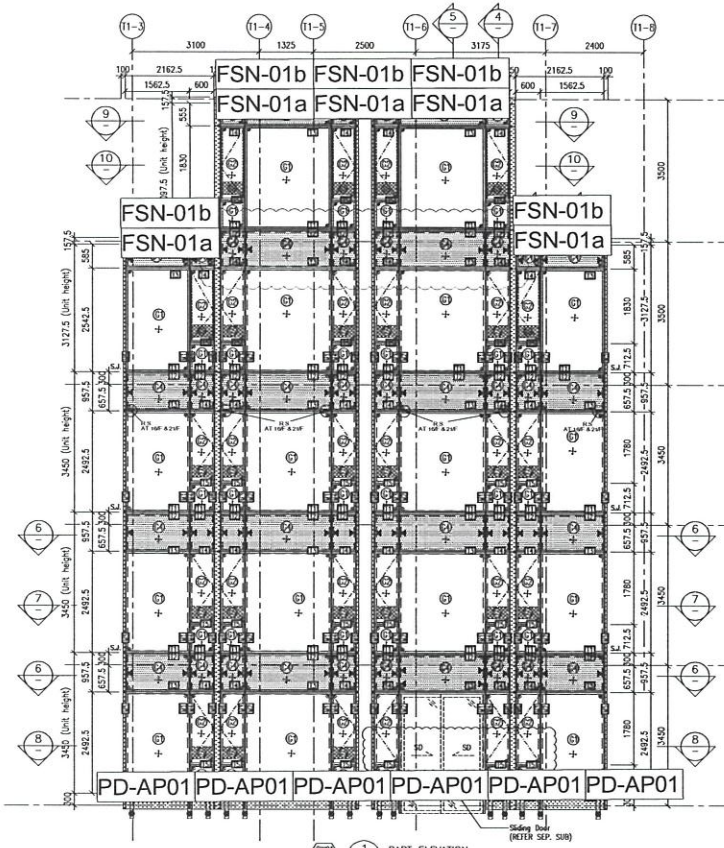


CW01 / T1 — 1 — PART ELEVATION FOR CURTAIN WALL


LEGEND :
R.S. = RESTRAINT SOCKET

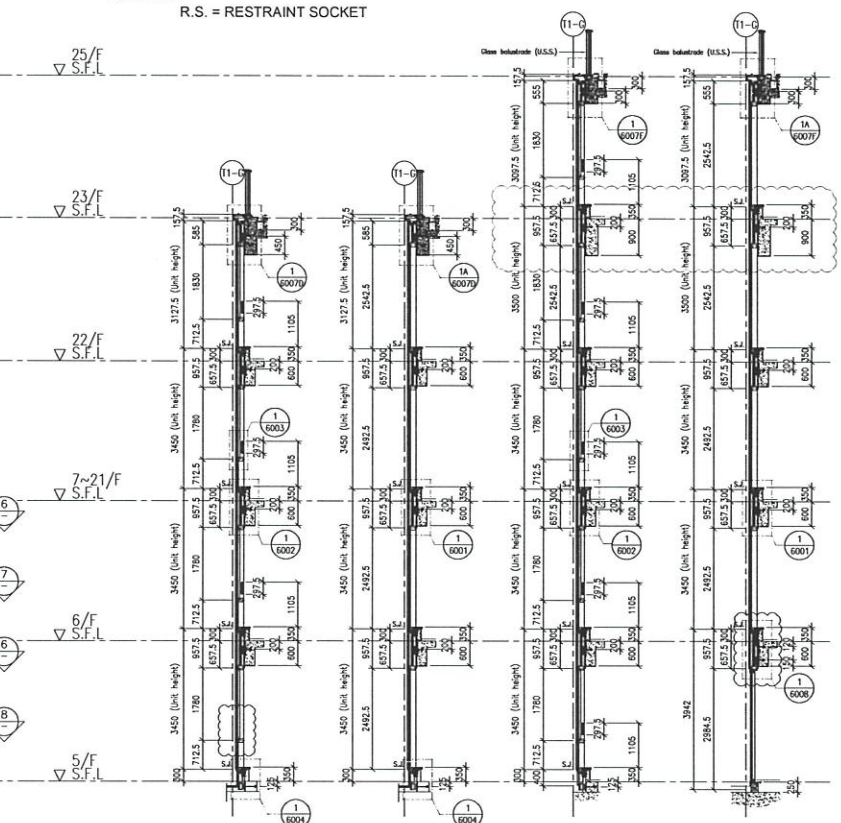


2 — TYPICAL SECTION FOR CURTAIN WALL
3 — TYPICAL SECTION FOR CURTAIN WALL
4 — TYPICAL SECTION FOR CURTAIN WALL
5 — TYPICAL SECTION FOR CURTAIN WALL

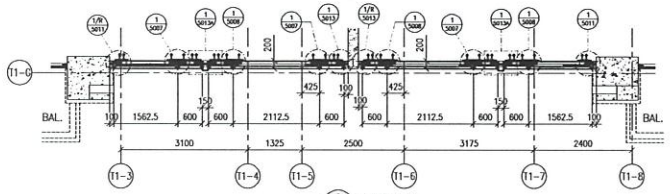


6 — PART PLAN FOR CURTAIN WALL

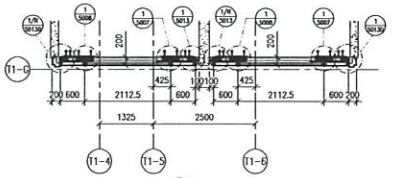


9 — PART PLAN FOR CURTAIN WALL

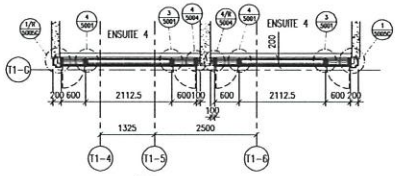

10 — PART PLAN FOR CURTAIN WALL

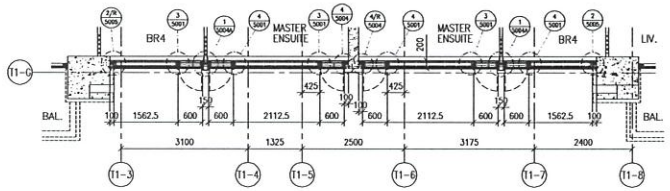

7 — PART PLAN FOR CURTAIN WALL

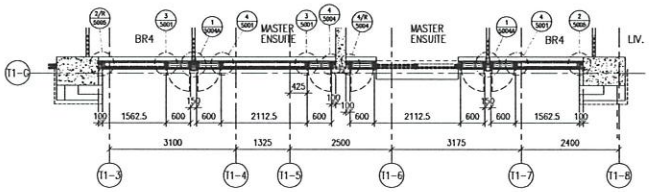

8 — PART PLAN FOR CURTAIN WALL

FLOOR LEVEL (S.F.L.)

FLOOR	LEVEL
R/F	+210.00
25/F	+206.50
23/F	+203.00
22/F	+199.50
21/F	+196.05
20/F	+192.60
19/F	+189.15
18/F	+185.70
17/F	+182.25
16/F	+178.80
15/F	+175.35
12/F	+171.90
11/F	+168.45
10/F	+165.00
9/F	+161.55
8/F	+158.10
7/F	+154.65
6/F	+151.20
5/F	+147.75

- STONE CLADDING (BY OTHERS)

LEGEND:
- 10mm HEAT STRENGTHENED GLASS (OUTER) + 12mm AIR SPACE +12mm THK. TEMPERED CLEAR GLASS (INNER)
- 10mm HEAT STRENGTHENED GLASS (OUTER) + 12mm AIR SPACE +10mm THK. TEMPERED CLEAR GLASS (INNER)
- 12mm THK. HEAT STRENGTHENED GLASS & 2mm THK. ALUM. BACKPAN (SPANDREL GLASS)
- 12mm THK. CLEAR TEMPERED GLASS (INTERNAL PROTECTIVE BARRIER)
- 3mm THK. ALUM. CLADDING
- S.J. — STACK JOINT (WIND LOAD)
- AL01 — ALUM. EXTRUSION DIE NO.
- ▲ — SUPPORT POINT (WIND LOAD + DEAD LOAD)
- ● — SUPPORT POINT (WIND LOAD)

B.D. REF :

CLIENT :
SHIMAO GROUP HOLDINGS LIMITED

ARCHITECT :
WONG TUNG & PARTNERS LIMITED
ARCHITECTS & PLANNERS

MAIN CONTRACTOR :
協興建築有限公司
HIP HING CONSTRUCTION CO LTD

STRUCTURAL ENGINEER :
C M WONG & ASSOCIATES LTD
黃志明建築工程師有限公司

FACADE CONSULTANT:
MEINHARDT

NOTE :
1. ALL DIMENSIONS ARE IN mm.
2. ALL ELEVATIONS ARE VIEWED FROM OUTSIDE.
3. ALL DIMENSIONS TO BE VERIFIED ON SITE BEFORE FABRICATION.

LEGEND :
X1 — DETAIL MARK NO.
X001 — REFER SHEET NO.
1. F.F.L. --FINISHED FLOOR LEVEL
2. S.F.L. --STRUCTURAL FLOOR LEVEL
3. (R) --HANDED DETAIL

NO.	DATE	REVISED	BY
A	02-10-2021	REVISION SUBJECT TO ARCH. COMMENT	

JOB NO. : J-853

PROJECT :
PROPOSED RESIDENTIAL DEVELOPMENT AT N.K.I.L. 6542 YIN PING ROAD KOWLOON


TITLE :
PART ELEVATION OF CURTAIN WALL AT TOWER 1

DATE : 18-MAR-21 | SCALE : 1:60 (A1)

DRAWN BY : LHR | CHECKED BY : --

美特鋁質有限公司
MIDI ALUMINIUM FABRICATOR LTD.
Units 6-8, Sunray Industrial Centre, 1/F
610 Cha Kwo Ling Road, Kowloon
Tel:23489211-4 Fax:(852)27727666

DWG NO. : J853-BD-CW-4101 | REV. : C

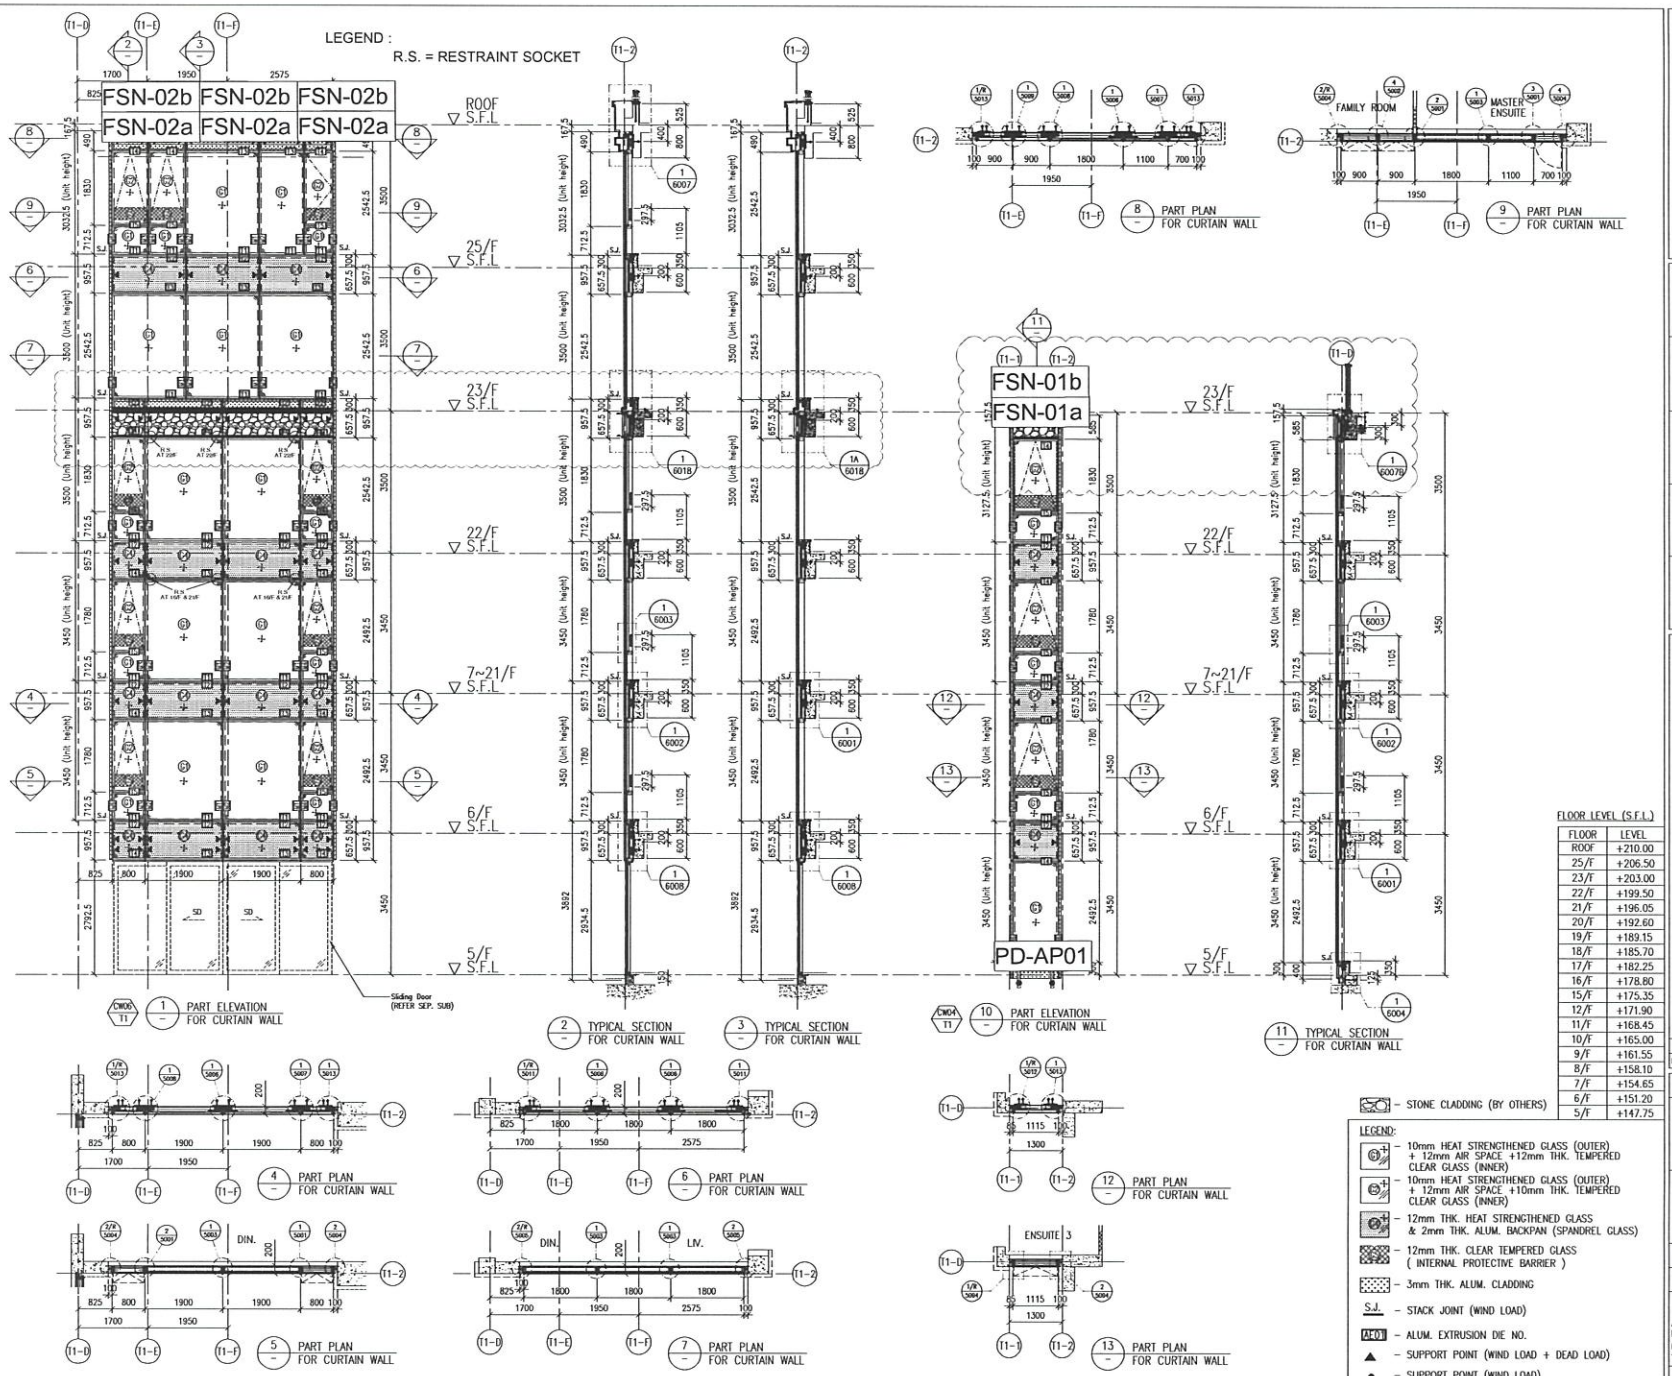

1 PART ELEVATION FOR CURTAIN WALL
2 TYPICAL SECTION FOR CURTAIN WALL
3 TYPICAL SECTION FOR CURTAIN WALL
4 PART PLAN FOR CURTAIN WALL
5 PART PLAN FOR CURTAIN WALL
6 PART PLAN FOR CURTAIN WALL
7 PART PLAN FOR CURTAIN WALL
8 PART PLAN FOR CURTAIN WALL
9 PART PLAN FOR CURTAIN WALL
10 PART ELEVATION FOR CURTAIN WALL
11 TYPICAL SECTION FOR CURTAIN WALL
12 PART PLAN FOR CURTAIN WALL
13 PART PLAN FOR CURTAIN WALL

FLOOR LEVEL (S.F.L.)

FLOOR	LEVEL
ROOF	+210.00
25/F	+206.50
23/F	+203.00
22/F	+199.50
21/F	+196.05
20/F	+192.60
19/F	+189.15
18/F	+185.70
17/F	+182.25
16/F	+178.80
15/F	+175.35
12/F	+171.90
11/F	+168.45
10/F	+165.00
9/F	+161.55
8/F	+158.10
7/F	+154.65
6/F	+151.20
5/F	+147.75

- STONE CLADDING (BY OTHERS)

LEGEND:
- 10mm HEAT STRENGTHENED GLASS (OUTER) + 12mm AIR SPACE +12mm THK. TEMPERED CLEAR GLASS (INNER)
- 10mm HEAT STRENGTHENED GLASS (OUTER) + 12mm AIR SPACE +10mm THK. TEMPERED CLEAR GLASS (INNER)
- 12mm THK. HEAT STRENGTHENED GLASS & 2mm THK. ALUM. BACKPAN (SPANDREL GLASS)
- 12mm THK. CLEAR TEMPERED GLASS (INTERNAL PROTECTIVE BARRIER)
- 3mm THK. ALUM. CLADDING
- S.J. – STACK JOINT (WIND LOAD)
- AE01 – ALUM. EXTRUSION DIE NO.
- ▲ – SUPPORT POINT (WIND LOAD + DEAD LOAD)
- ● – SUPPORT POINT (WIND LOAD)

B.D. REF :

CLIENT :
SHIMAO GROUP HOLDINGS LIMITED

ARCHITECT :
WONG TUNG & PARTNERS LIMITED
ARCHITECTS & PLANNERS

MAIN CONTRACTOR :
協興建築有限公司
HIP HING CONSTRUCTION CO LTD

STRUCTURAL ENGINEER :
C M WONG & ASSOCIATES LTD
黃志明建築工程師有限公司

FACADE CONSULTANT:
MEINHARDT

NOTE :
1. ALL DIMENSIONS ARE IN mm.
2. ALL ELEVATIONS ARE VIEWED FROM OUTSIDE.
3. ALL DIMENSIONS TO BE VERIFIED ON SITE BEFORE FABRICATION.

LEGEND :
X1 — DETAIL MARK NO.
XOO1 — REFER SHEET NO.
1. F.F.L. --FINISHED FLOOR LEVEL
2. S.F.L. --STRUCTURAL FLOOR LEVEL
3. (/R) --REVERSED DETAIL

NO.	DATE	REVISED	BY
A	02-10-2021	REVISION SUBJECT TO ARCH. COMMENT	

JOB NO. : J-853

PROJECT :
PROPOSED RESIDENTIAL DEVELOPMENT AT N.K.I.L. 6542 YIN PING ROAD KOWLOON

TITLE :
PART ELEVATION FOR CURTAIN WALL AT TOWER 1

DATE : 18-MAR-21 | SCALE : 1:60 (A1)


DRAWN BY : LHR | CHECKED BY :

美特鋁質有限公司
MIDI ALUMINIUM FABRICATOR LTD.
Units 6-8, Sunray Industrial Centre, 1/F
610 Cha Kwo Ling Road, Kowloon
Tel:23489211-4 Fax:(852)27727666

DWG NO. : J853-SD-CW-4102 | REV. : B

LEGEND :


R.S. = RESTRAINT SOCKET

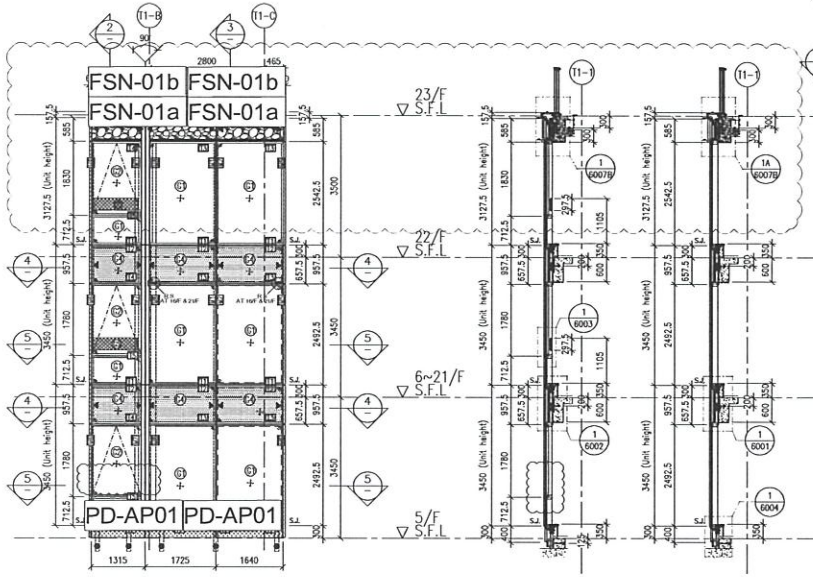


1 PART ELEVATION FOR CURTAIN WALL

2 TYPICAL SECTION FOR CURTAIN WALL


3 TYPICAL SECTION FOR CURTAIN WALL

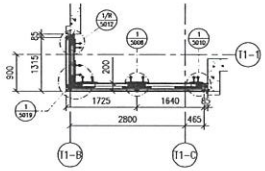


4 PART PLAN FOR CURTAIN WALL

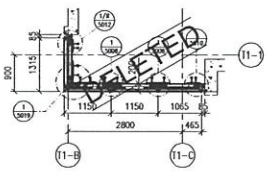


6 PART PLAN FOR CURTAIN WALL

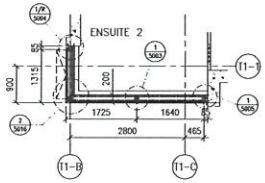


5 PART PLAN FOR CURTAIN WALL

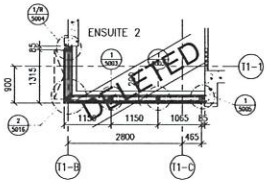

7 PART PLAN FOR CURTAIN WALL

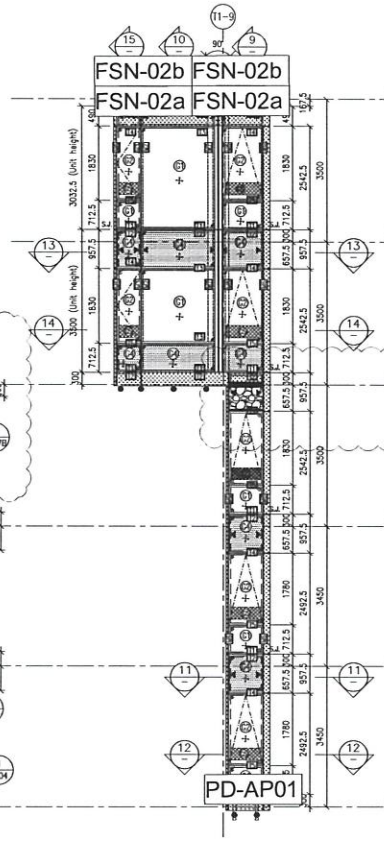


8 PART ELEVATION FOR CURTAIN WALL

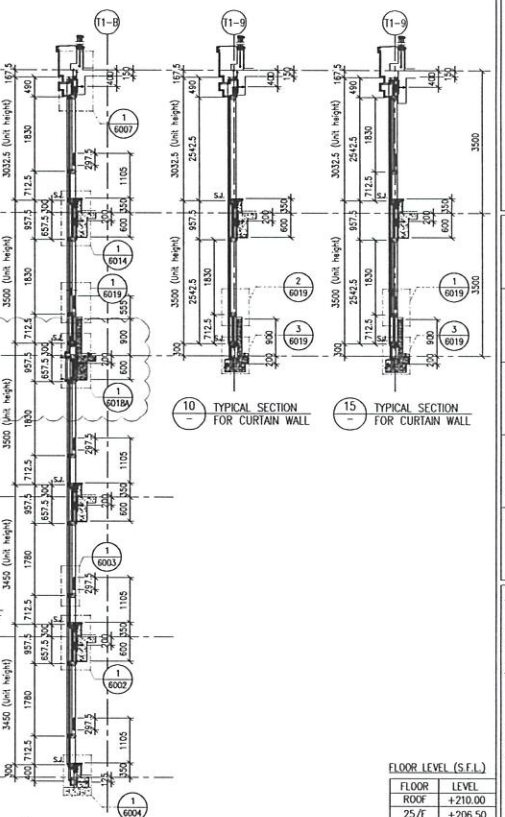


9 TYPICAL SECTION FOR CURTAIN WALL

10 TYPICAL SECTION FOR CURTAIN WALL


15 TYPICAL SECTION FOR CURTAIN WALL

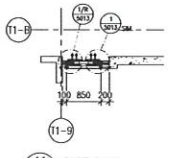


11 PART PLAN FOR CURTAIN WALL

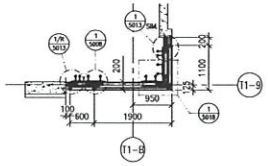

13 PART PLAN FOR CURTAIN WALL

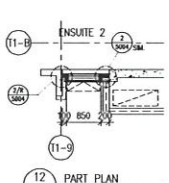

12 PART PLAN FOR CURTAIN WALL

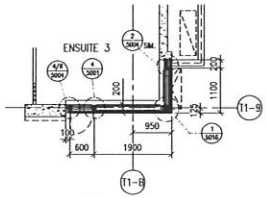

14 PART PLAN FOR CURTAIN WALL

FLOOR LEVEL (S.F.L.)

FLOOR	LEVEL
ROOF	+210.00
25/F	+206.50
23/F	+203.00
22/F	+199.50
21/F	+196.05
20/F	+192.60
19/F	+189.15
18/F	+185.70
17/F	+182.25
16/F	+178.80
15/F	+175.35
12/F	+171.90
11/F	+168.45
10/F	+165.00
9/F	+161.55
8/F	+158.10
7/F	+154.65
6/F	+151.20
5/F	+147.75

– STONE CLADDING (BY OTHERS)

LEGEND:

- – 10mm HEAT STRENGTHENED GLASS (OUTER) + 12mm AIR SPACE +12mm THK. TEMPERED CLEAR GLASS (INNER)
- – 10mm HEAT STRENGTHENED GLASS (OUTER) + 12mm AIR SPACE +10mm THK. TEMPERED CLEAR GLASS (INNER)
- – 12mm THK. HEAT STRENGTHENED GLASS & 2mm THK. ALUM. BACKPAN (SPANDREL GLASS)
- – 12mm THK. CLEAR TEMPERED GLASS (INTERNAL PROTECTIVE BARRIER)
- – 3mm THK. ALUM. CLADDING
- S.J. – STACK JOINT (WIND LOAD)
- AP01 – ALUM. EXTRUSION DIE NO.
- ▲ – SUPPORT POINT (WIND LOAD + DEAD LOAD)
- ● – SUPPORT POINT (WIND LOAD)

B.D. REF :

CLIENT :

SHIMAO GROUP HOLDINGS LIMITED

ARCHITECT :

WONG TUNG & PARTNERS LIMITED
ARCHITECTS & PLANNERS

MAIN CONTRACTOR :

協興建築有限公司
HIP HING CONSTRUCTION CO LTD

STRUCTURAL ENGINEER :

C M WONG & ASSOCIATES LTD
黃志明建築工程師有限公司

FACADE CONSULTANT:

MEINHARDT

NOTE :

1. ALL DIMENSIONS ARE IN mm.
2. ALL ELEVATIONS ARE VIEWED FROM OUTSIDE.
3. ALL DIMENSIONS TO BE VERIFIED ON SITE BEFORE FABRICATION.

LEGEND :

X1 – DETAIL MARK NO.
X001 – REFER SHEET NO.

1. F.F.L. – FINISHED FLOOR LEVEL
2. S.F.L. – STRUCTURAL FLOOR LEVEL
3. (R) – REVERSED DETAIL

NO.	DATE	REVISED	BY
A	02-10-2021	REVISION SUBJECT TO ARCH. COMMENT	

JOB NO. : J-853

PROJECT :

PROPOSED RESIDENTIAL DEVELOPMENT AT N.K.I.L. 6542 YIN PING ROAD KOWLOON

TITLE :


PART ELEVATION FOR CURTAIN WALL AT TOWER 1

DATE : 18-MAR-21 | SCALE : 1:60 (A1)

DRAWN BY : LHR | CHECKED BY :

美特鋁製有限公司
MIDI ALUMINIUM FABRICATOR LTD.
Units 6-8, Sunray Industrial Centre, 1/F
610 Cha Kwo Ling Road, Kowloon
Tel:23489211-4 Fax:(852)27727666

DWG NO. : J853-SD-CW-4103 | REV. : B

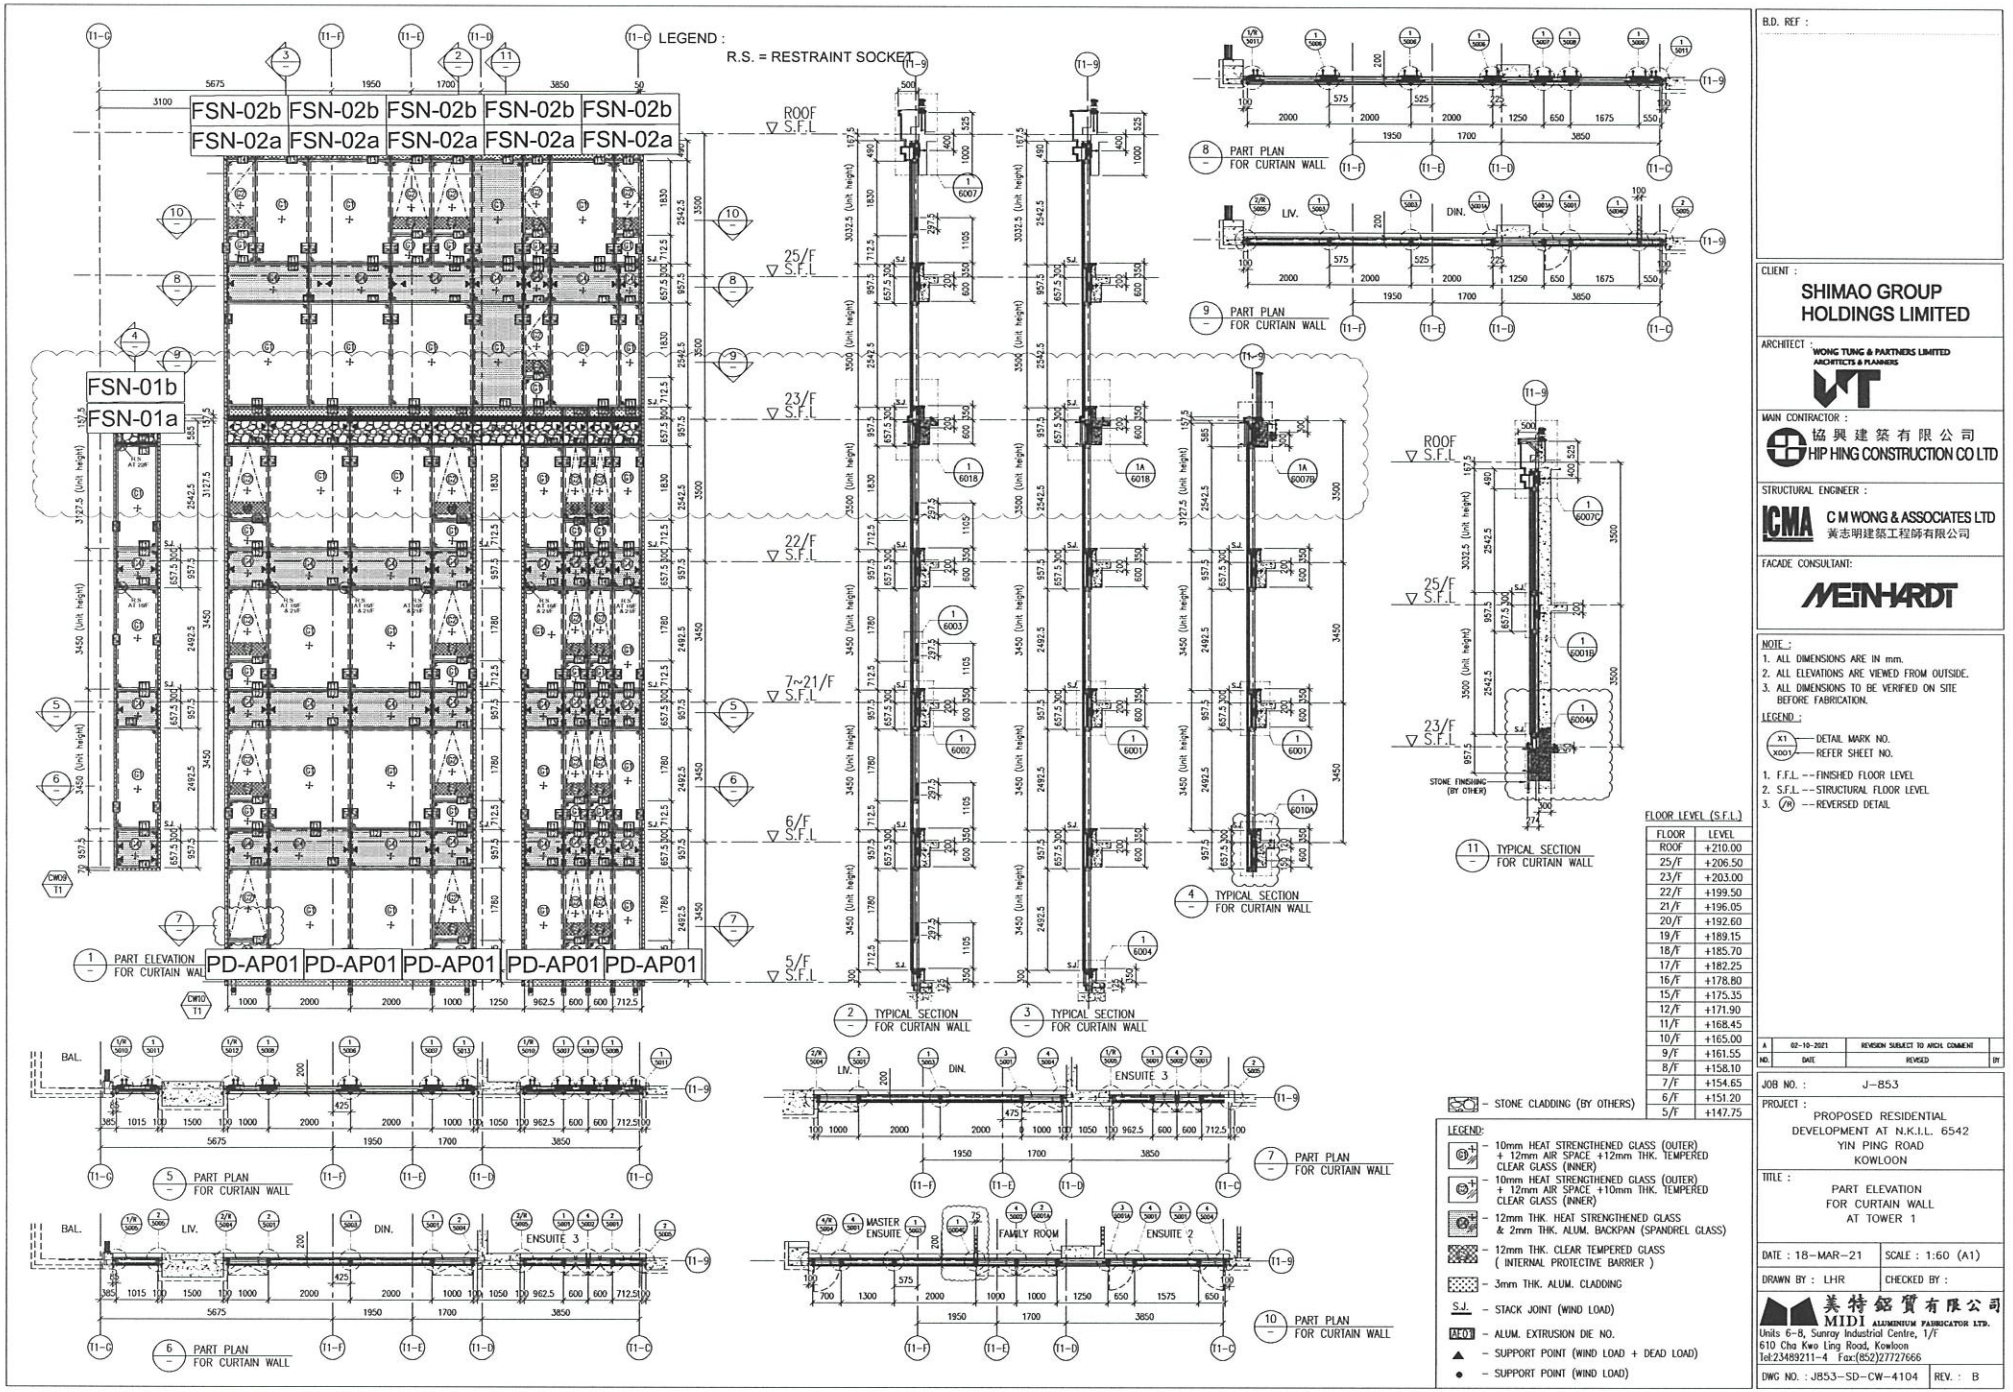

FLOOR LEVEL (S.F.L.)

FLOOR	LEVEL
ROOF	+210.00
25/F	+206.50
23/F	+203.00
22/F	+199.50
21/F	+196.05
20/F	+192.60
19/F	+189.15
18/F	+185.70
17/F	+182.25
16/F	+178.80
15/F	+175.35
12/F	+171.90
11/F	+168.45
10/F	+165.00
9/F	+161.55
8/F	+158.10
7/F	+154.65
6/F	+151.20
5/F	+147.75

LEGEND:

- 10mm HEAT STRENGTHENED GLASS (OUTER) + 12mm AIR SPACE +12mm THK. TEMPERED CLEAR GLASS (INNER)
- 10mm HEAT STRENGTHENED GLASS (OUTER) + 12mm AIR SPACE +10mm THK. TEMPERED CLEAR GLASS (INNER)
- 12mm THK HEAT STRENGTHENED GLASS & 2mm THK. ALUM. BACKPAN (SPANDREL GLASS)
- 12mm THK. CLEAR TEMPERED GLASS (INTERNAL PROTECTIVE BARRIER)
- 3mm THK. ALUM. CLADDING
- S.J. – STACK JOINT (WIND LOAD)
- AE01 – ALUM. EXTRUSION DIE NO.
- ▲ – SUPPORT POINT (WIND LOAD + DEAD LOAD)
- ● – SUPPORT POINT (WIND LOAD)
- STONE CLADDING (BY OTHERS)

B.D. REF :

CLIENT :
SHIMAO GROUP HOLDINGS LIMITED

ARCHITECT :
WONG TUNG & PARTNERS LIMITED
ARCHITECTS & PLANNERS

MAIN CONTRACTOR :
協興建築有限公司
HIP HING CONSTRUCTION CO LTD

STRUCTURAL ENGINEER :
C M WONG & ASSOCIATES LTD
黃志明建築工程師有限公司

FACADE CONSULTANT:
MEINHARDT

NOTE :
1. ALL DIMENSIONS ARE IN mm.
2. ALL ELEVATIONS ARE VIEWED FROM OUTSIDE.
3. ALL DIMENSIONS TO BE VERIFIED ON SITE BEFORE FABRICATION.

LEGEND :
X1 – DETAIL MARK NO.
X001 – REFER SHEET NO.
1. F.F.L. – FINISHED FLOOR LEVEL
2. S.F.L. – STRUCTURAL FLOOR LEVEL
3. /R – REVERSED DETAIL

NO.	DATE	REVISED	BY
A	02-10-2021	REVISION SUBJECT TO ARCH. COMMENT	

JOB NO. : J-853

PROJECT :
PROPOSED RESIDENTIAL DEVELOPMENT AT N.K.I.L. 6542 YIN PING ROAD KOWLOON


TITLE :
PART ELEVATION FOR CURTAIN WALL AT TOWER 1

DATE : 18-MAR-21 | SCALE : 1:60 (A1)

DRAWN BY : LHR | CHECKED BY :

美特鋁質有限公司
MIDI ALUMINIUM FABRICATOR LTD.
Units 6-8, Sunray Industrial Centre, 1/F
610 Cha Kwo Ling Road, Kowloon
Tel:23489211-4 Fax:(852)27727666

DWG NO. : J853-SD-CW-4104 | REV. : B

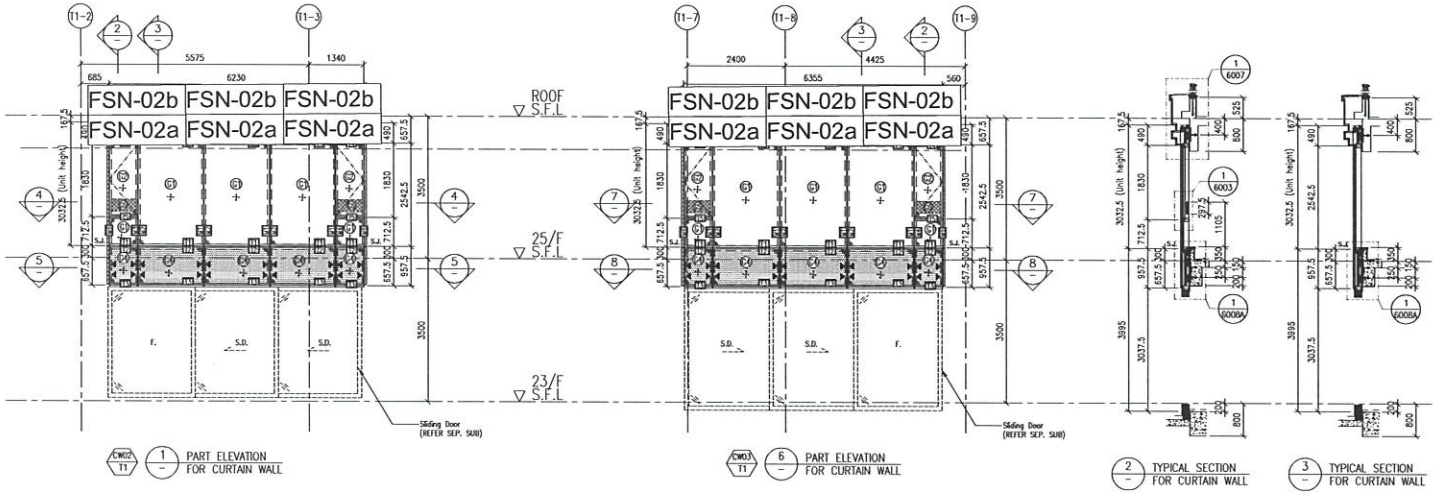


CW02 T1 1 – PART ELEVATION FOR CURTAIN WALL


CW03 T1 6 – PART ELEVATION FOR CURTAIN WALL

2 – TYPICAL SECTION FOR CURTAIN WALL


3 – TYPICAL SECTION FOR CURTAIN WALL

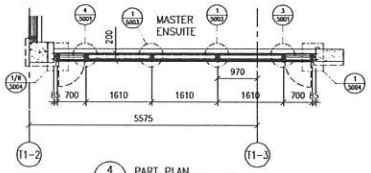


4 – PART PLAN FOR CURTAIN WALL

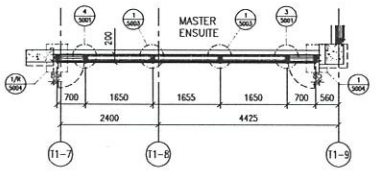

7 – PART PLAN FOR CURTAIN WALL

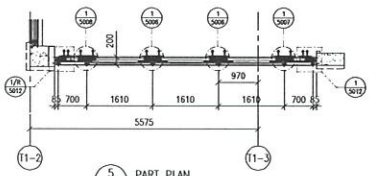

5 – PART PLAN FOR CURTAIN WALL

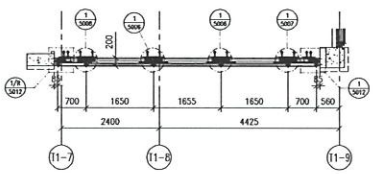

8 – PART PLAN FOR CURTAIN WALL

FLOOR LEVEL (S.F.L.)

FLOOR	LEVEL
ROOF	+210.00
25/F	+206.50
23/F	+203.00

LEGEND:

- 10mm HEAT STRENGTHENED GLASS (OUTER) + 12mm AIR SPACE +12mm THK. TEMPERED CLEAR GLASS (INNER)
- 10mm HEAT STRENGTHENED GLASS (OUTER) + 12mm AIR SPACE +10mm THK. TEMPERED CLEAR GLASS (INNER)
- 12mm THK. HEAT STRENGTHENED GLASS & 2mm THK. ALUM. BACKPAN (SPANDREL GLASS)
- 12mm THK. CLEAR TEMPERED GLASS (INTERNAL PROTECTIVE BARRIER)
- 3mm THK. ALUM. CLADDING
- S.J. – STACK JOINT (WIND LOAD)
- AE01 – ALUM. EXTRUSION DIE NO.
- ▲ – SUPPORT POINT (WIND LOAD + DEAD LOAD)
- ● – SUPPORT POINT (WIND LOAD)

B.D. REF :

CLIENT :
SHIMAO GROUP HOLDINGS LIMITED

ARCHITECT :
WONG TUNG & PARTNERS LIMITED
ARCHITECTS & PLANNERS

MAIN CONTRACTOR :
協興建築有限公司
HIP HING CONSTRUCTION CO LTD

STRUCTURAL ENGINEER :
C M WONG & ASSOCIATES LTD
黃志明建築工程師有限公司

FACADE CONSULTANT:
MEINHARDT

NOTE :
1. ALL DIMENSIONS ARE IN mm.
2. ALL ELEVATIONS ARE VIEWED FROM OUTSIDE.
3. ALL DIMENSIONS TO BE VERIFIED ON SITE BEFORE FABRICATION.

LEGEND :
X1 – DETAIL MARK NO.
X001 – REFER SHEET NO.
1. F.F.L. --FINISHED FLOOR LEVEL
2. S.F.L. --STRUCTURAL FLOOR LEVEL
3. /R --REVERSED DETAIL

NO.	DATE	REVISED	BY

JOB NO. : J-853

PROJECT :
PROPOSED RESIDENTIAL DEVELOPMENT AT N.K.I.L. 6542 YIN PING ROAD KOWLOON


TITLE :
PART ELEVATION FOR CURTAIN WALL AT TOWER 1


DATE : 02-OCT-21 | SCALE : 1:60 (A1)


DRAWN BY : LHR | CHECKED BY :


美特鋁質有限公司
MIDI ALUMINIUM FABRICATOR LTD.
Units 6-8, Sunray Industrial Centre, 1/F
610 Cha Kwo Ling Road, Kowloon
Tel:23489211-4 Fax:(852)27727666


DWG NO. : J853-SD-CW-4105 | REV. : B

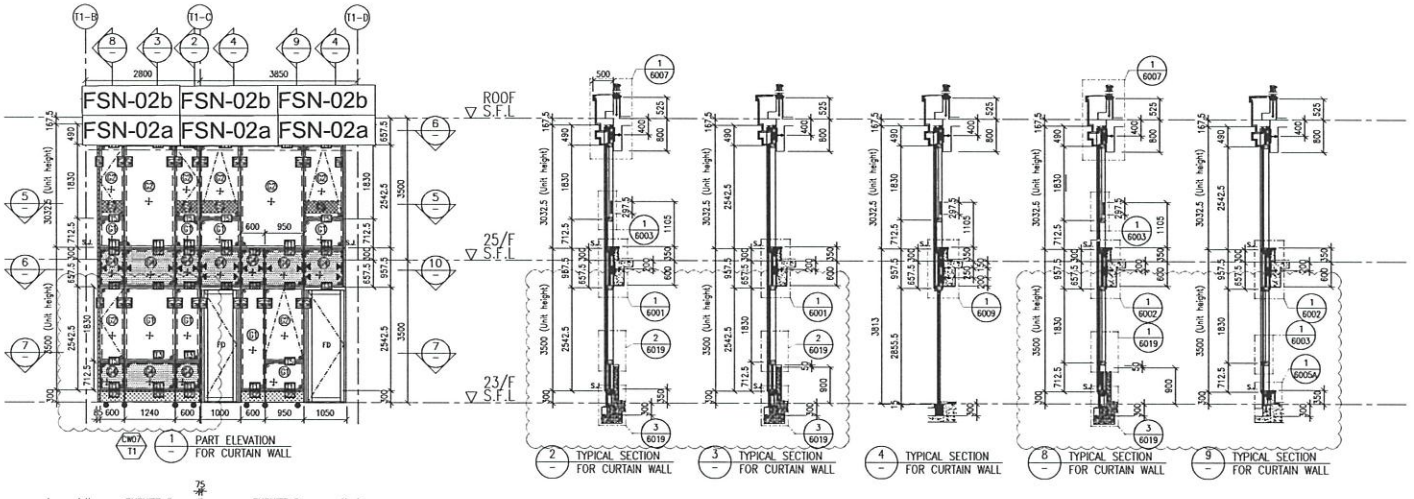

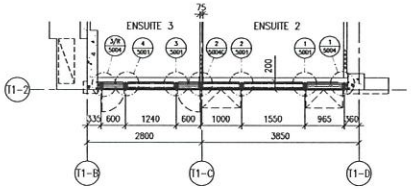

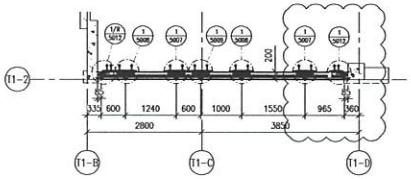

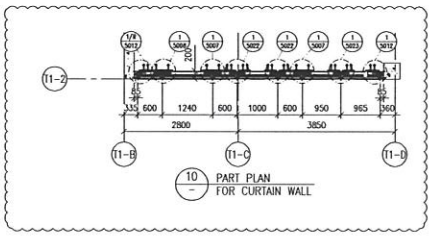

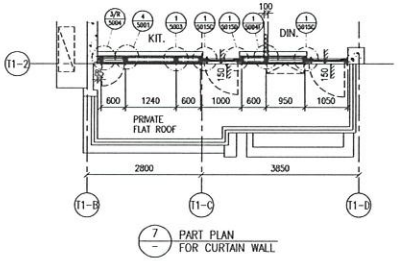

FLOOR LEVEL (S.F.L.)

FLOOR	LEVEL
ROOF	+210.00
25/F	+206.50
23/F	+203.00

LEGEND:

- 10mm HEAT STRENGTHENED GLASS (OUTER) + 12mm AIR SPACE +12mm THK. TEMPERED CLEAR GLASS (INNER)
- 10mm HEAT STRENGTHENED GLASS (OUTER) + 12mm AIR SPACE +10mm THK. TEMPERED CLEAR GLASS (INNER)
- 12mm THK. HEAT STRENGTHENED GLASS & 2mm THK. ALUM. BACKPAN (SPANDREL GLASS)
- 12mm THK. CLEAR TEMPERED GLASS (INTERNAL PROTECTIVE BARRIER)
- 3mm THK. ALUM. CLADDING
- S.J. – STACK JOINT (WIND LOAD)
- AE01 – ALUM. EXTRUSION DIE NO.
- ▲ – SUPPORT POINT (WIND LOAD + DEAD LOAD)
- ● – SUPPORT POINT (WIND LOAD)

B.D. REF :

CLIENT :
SHIMAO GROUP HOLDINGS LIMITED

ARCHITECT :
WONG TUNG & PARTNERS LIMITED
ARCHITECTS & PLANNERS

MAIN CONTRACTOR :
協興建築有限公司
HIP HING CONSTRUCTION CO LTD

STRUCTURAL ENGINEER :
C M WONG & ASSOCIATES LTD
黃志明建築工程師有限公司

FACADE CONSULTANT:
MEINHARDT

NOTE :
1. ALL DIMENSIONS ARE IN mm.
2. ALL ELEVATIONS ARE VIEWED FROM OUTSIDE.
3. ALL DIMENSIONS TO BE VERIFIED ON SITE BEFORE FABRICATION.

LEGEND :
- X1 / X001 — DETAIL MARK NO. / REFER SHEET NO.
1. F.F.L. --FINISHED FLOOR LEVEL
2. S.F.L. --STRUCTURAL FLOOR LEVEL
3. (/R) --REVERSED DETAIL

NO.	DATE	REVISED	BY

JOB NO. : J-853

PROJECT :
PROPOSED RESIDENTIAL DEVELOPMENT AT N.K.I.L. 6542 YIN PING ROAD KOWLOON


TITLE :
PART ELEVATION FOR CURTAIN WALL AT TOWER 1

DATE : 02-OCT-21 | SCALE : 1:60 (A1)

DRAWN BY : LHR | CHECKED BY :

美特鋁質有限公司
MIDI ALUMINIUM FABRICATOR LTD.
Units 6-8, Sunray Industrial Centre, 1/F
610 Cha Kwo Ling Road, Kowloon
Tel:23489211-4 Fax:(852)27727666


DWG NO. : J853-SD-CW-4106 | REV. : B

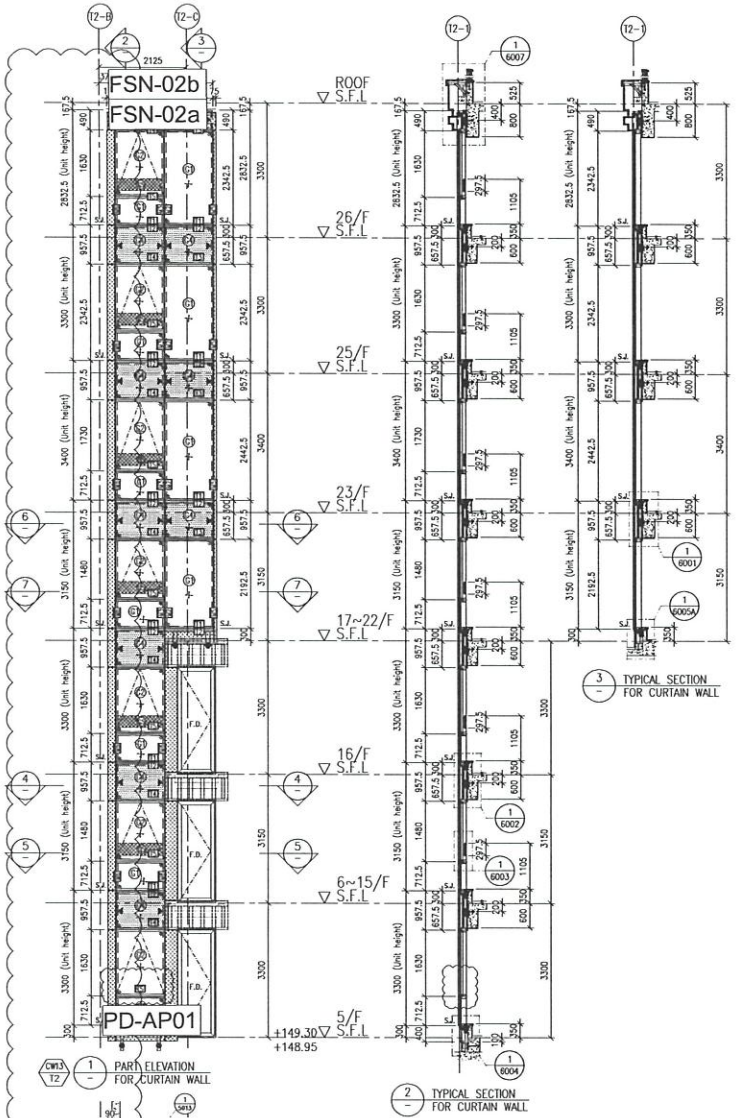


1 PART ELEVATION FOR CURTAIN WALL

2 TYPICAL SECTION FOR CURTAIN WALL


3 TYPICAL SECTION FOR CURTAIN WALL

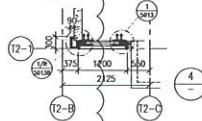


4 PART PLAN FOR CURTAIN WALL

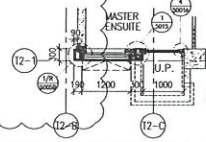


5 PART PLAN FOR CURTAIN WALL

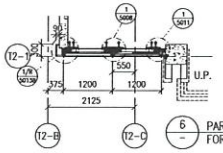

6 PART PLAN FOR CURTAIN WALL

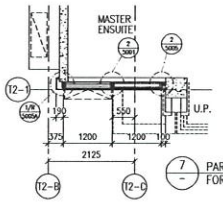


7 PART PLAN FOR CURTAIN WALL

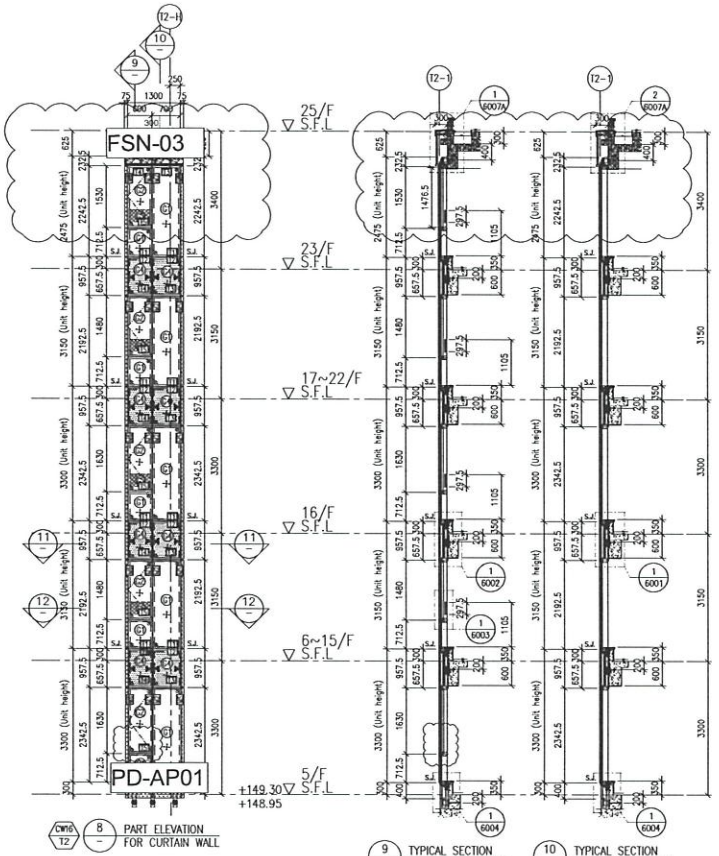


8 PART ELEVATION FOR CURTAIN WALL

9 TYPICAL SECTION FOR CURTAIN WALL

10 TYPICAL SECTION FOR CURTAIN WALL

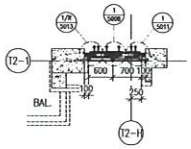

11 PART PLAN FOR CURTAIN WALL

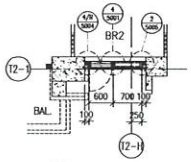

12 PART PLAN FOR CURTAIN WALL

T2 FLOOR LEVEL (S.F.L.)

FLOOR	LEVEL
R/F	+210.00
26/F	+206.70
25/F	+203.40
23/F	+200.00
22/F	+196.85
21/F	+193.70
20/F	+190.55
19/F	+187.40
18/F	+184.25
17/F	+181.10
16/F	+177.80
15/F	+174.65
12/F	+171.50
11/F	+168.35
10/F	+165.20
9/F	+162.05
8/F	+158.90
7/F	+155.75
6/F	+152.60
5/F	+149.30

LEGEND:

- 10mm HEAT STRENGTHENED GLASS (OUTER) + 12mm AIR SPACE +12mm THK. TEMPERED CLEAR GLASS (INNER)
- 10mm HEAT STRENGTHENED GLASS (OUTER) + 12mm AIR SPACE +10mm THK. TEMPERED CLEAR GLASS (INNER)
- 12mm THK. HEAT STRENGTHENED GLASS & 2mm THK. ALUM. BACKPAN (SPANDREL GLASS)
- 12mm THK. CLEAR TEMPERED GLASS (INTERNAL PROTECTIVE BARRIER)
- 3mm THK. ALUM. CLADDING
- S.J. – STACK JOINT (WIND LOAD)
- AF01 – ALUM. EXTRUSION DIE NO.
- ▲ – SUPPORT POINT (WIND LOAD + DEAD LOAD)
- ● – SUPPORT POINT (WIND LOAD)

B.D. REF :

CLIENT :
SHIMAO GROUP HOLDINGS LIMITED

ARCHITECT :
WONG TUNG & PARTNERS LIMITED
ARCHITECTS & PLANNERS

MAIN CONTRACTOR :
協興建築有限公司
HIP HING CONSTRUCTION CO LTD

STRUCTURAL ENGINEER :
C M WONG & ASSOCIATES LTD
黃志明建築工程師有限公司

FACADE CONSULTANT:
MEINHARDT

NOTE :
1. ALL DIMENSIONS ARE IN mm.
2. ALL ELEVATIONS ARE VIEWED FROM OUTSIDE.
3. ALL DIMENSIONS TO BE VERIFIED ON SITE BEFORE FABRICATION.

LEGEND :
X1 – DETAIL MARK NO.
X001 – REFER SHEET NO.
1. F.F.L. --FINISHED FLOOR LEVEL
2. S.F.L. --STRUCTURAL FLOOR LEVEL
3. /R --REVERSED DETAIL

NO.	DATE	REVISED	BY
A	05-10-2021	REVISION SUBJECT TO ARCH. COMMENT	

JOB NO. : J-853

PROJECT :
PROPOSED RESIDENTIAL DEVELOPMENT AT N.K.I.L. 6542 YIN PING ROAD KOWLOON

TITLE :
PART ELEVATION FOR CURTAIN WALL AT TOWER 2


DATE : 26-MAR-21 | SCALE : 1:60 (A1)

DRAWN BY : LHR | CHECKED BY :


美特鋁質有限公司
MIDI ALUMINIUM FABRICATOR LTD.
Units 6-8, Sunray Industrial Centre, 1/F
610 Cha Kwo Ling Road, Kowloon
Tel:23489211-4 Fax:(852)27727666

DWG NO. : J853-SD-CW-4201 | REV. : C


LEGEND :
R.S. = RESTRAINT SOCKET

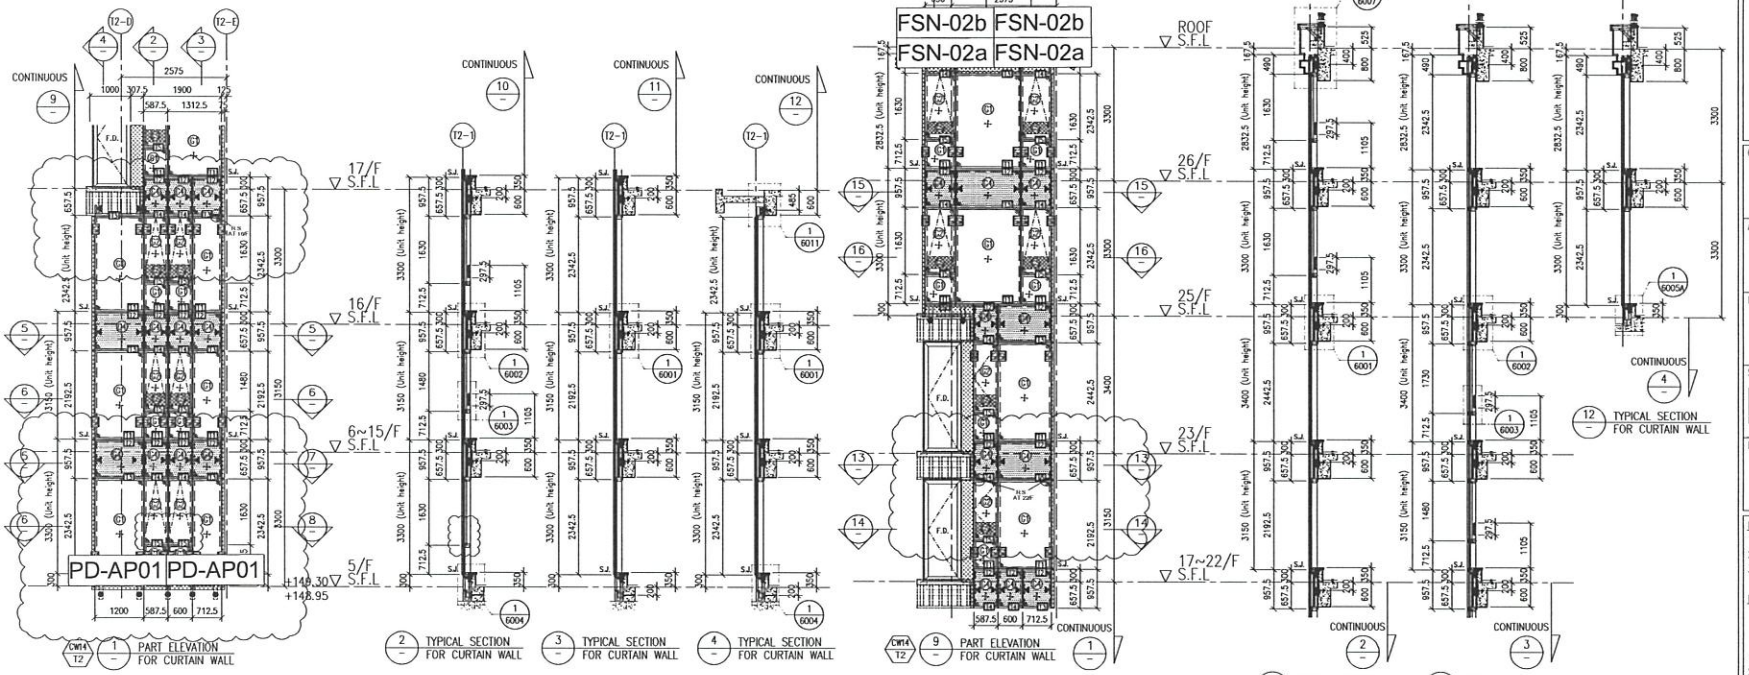


1 PART ELEVATION FOR CURTAIN WALL
2 TYPICAL SECTION FOR CURTAIN WALL
3 TYPICAL SECTION FOR CURTAIN WALL
4 TYPICAL SECTION FOR CURTAIN WALL
9 PART ELEVATION FOR CURTAIN WALL
10 TYPICAL SECTION FOR CURTAIN WALL
11 TYPICAL SECTION FOR CURTAIN WALL
12 TYPICAL SECTION FOR CURTAIN WALL

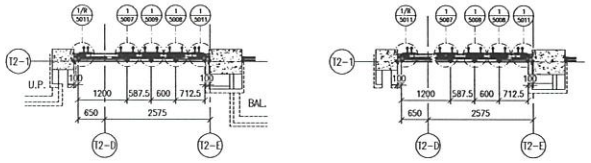


5 PART PLAN FOR CURTAIN WALL
7 PART PLAN FOR CURTAIN WALL

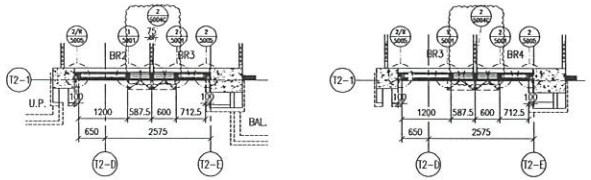

6 PART PLAN FOR CURTAIN WALL
8 PART PLAN FOR CURTAIN WALL

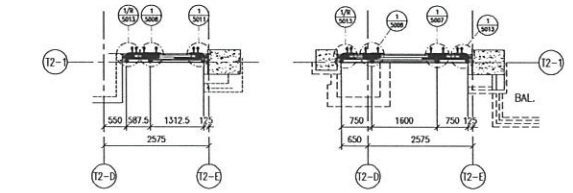

13 PART PLAN FOR CURTAIN WALL
15 PART PLAN FOR CURTAIN WALL

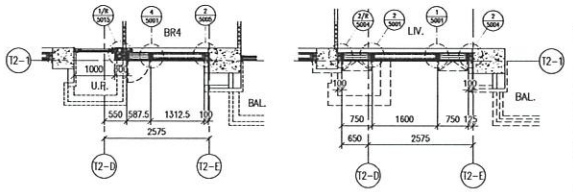

14 PART PLAN FOR CURTAIN WALL
16 PART PLAN FOR CURTAIN WALL

T2 FLOOR LEVEL (S.F.L.)

FLOOR	LEVEL
R/F	+210.00
26/F	+206.70
25/F	+203.40
23/F	+200.00
22/F	+196.85
21/F	+193.70
20/F	+190.55
19/F	+187.40
18/F	+184.25
17/F	+181.10
16/F	+177.80
15/F	+174.65
12/F	+171.50
11/F	+168.35
10/F	+165.20
9/F	+162.05
8/F	+158.90
7/F	+155.75
6/F	+152.60
5/F	+149.30

LEGEND:
- 10mm HEAT STRENGTHENED GLASS (OUTER) + 12mm AIR SPACE +12mm THK. TEMPERED CLEAR GLASS (INNER)
- 10mm HEAT STRENGTHENED GLASS (OUTER) + 12mm AIR SPACE +10mm THK. TEMPERED CLEAR GLASS (INNER)
- 12mm THK. HEAT STRENGTHENED GLASS & 2mm THK. ALUM. BACKPAN (SPANDREL GLASS)
- 12mm THK. CLEAR TEMPERED GLASS (INTERNAL PROTECTIVE BARRIER)
- 3mm THK. ALUM. CLADDING
- S.J. – STACK JOINT (WIND LOAD)
- AE01 – ALUM. EXTRUSION DIE NO.
- ▲ – SUPPORT POINT (WIND LOAD + DEAD LOAD)
- ● – SUPPORT POINT (WIND LOAD)

B.D. REF :

CLIENT :
SHIMAO GROUP HOLDINGS LIMITED

ARCHITECT :
WONG TUNG & PARTNERS LIMITED
ARCHITECTS & PLANNERS

MAIN CONTRACTOR :
協興建築有限公司
HIP HING CONSTRUCTION CO LTD

STRUCTURAL ENGINEER :
C M WONG & ASSOCIATES LTD
黃志明建築工程師有限公司

FACADE CONSULTANT:
MEINHARDT

NOTE :
1. ALL DIMENSIONS ARE IN mm.
2. ALL ELEVATIONS ARE VIEWED FROM OUTSIDE.
3. ALL DIMENSIONS TO BE VERIFIED ON SITE BEFORE FABRICATION.

LEGEND :
- X1 – DETAIL MARK NO.
- X001 – REFER SHEET NO.

1. F.F.L. --FINISHED FLOOR LEVEL
2. S.F.L. --STRUCTURAL FLOOR LEVEL
3. /R --REVERSED DETAIL

NO.	DATE	REVISION	BY
A	05-10-2021	REVISION SUBJECT TO ARCH. COMMENT	

JOB NO. : J-853

PROJECT :
PROPOSED RESIDENTIAL DEVELOPMENT AT N.K.I.L. 6542 YIN PING ROAD KOWLOON


TITLE :
PART ELEVATION FOR CURTAIN WALL AT TOWER 2

DATE : 26-MAR-21 | SCALE : 1:60 (A1)

DRAWN BY : LHR | CHECKED BY :

美特鋁質有限公司
MIDI ALUMINIUM FABRICATOR LTD.
Units 6-8, Sunray Industrial Centre, 1/F
610 Cha Kwo Ling Road, Kowloon
Tel:23489211-4 Fax:(852)27727666

DWG NO. : J853-SD-CW-4202 | REV. : B

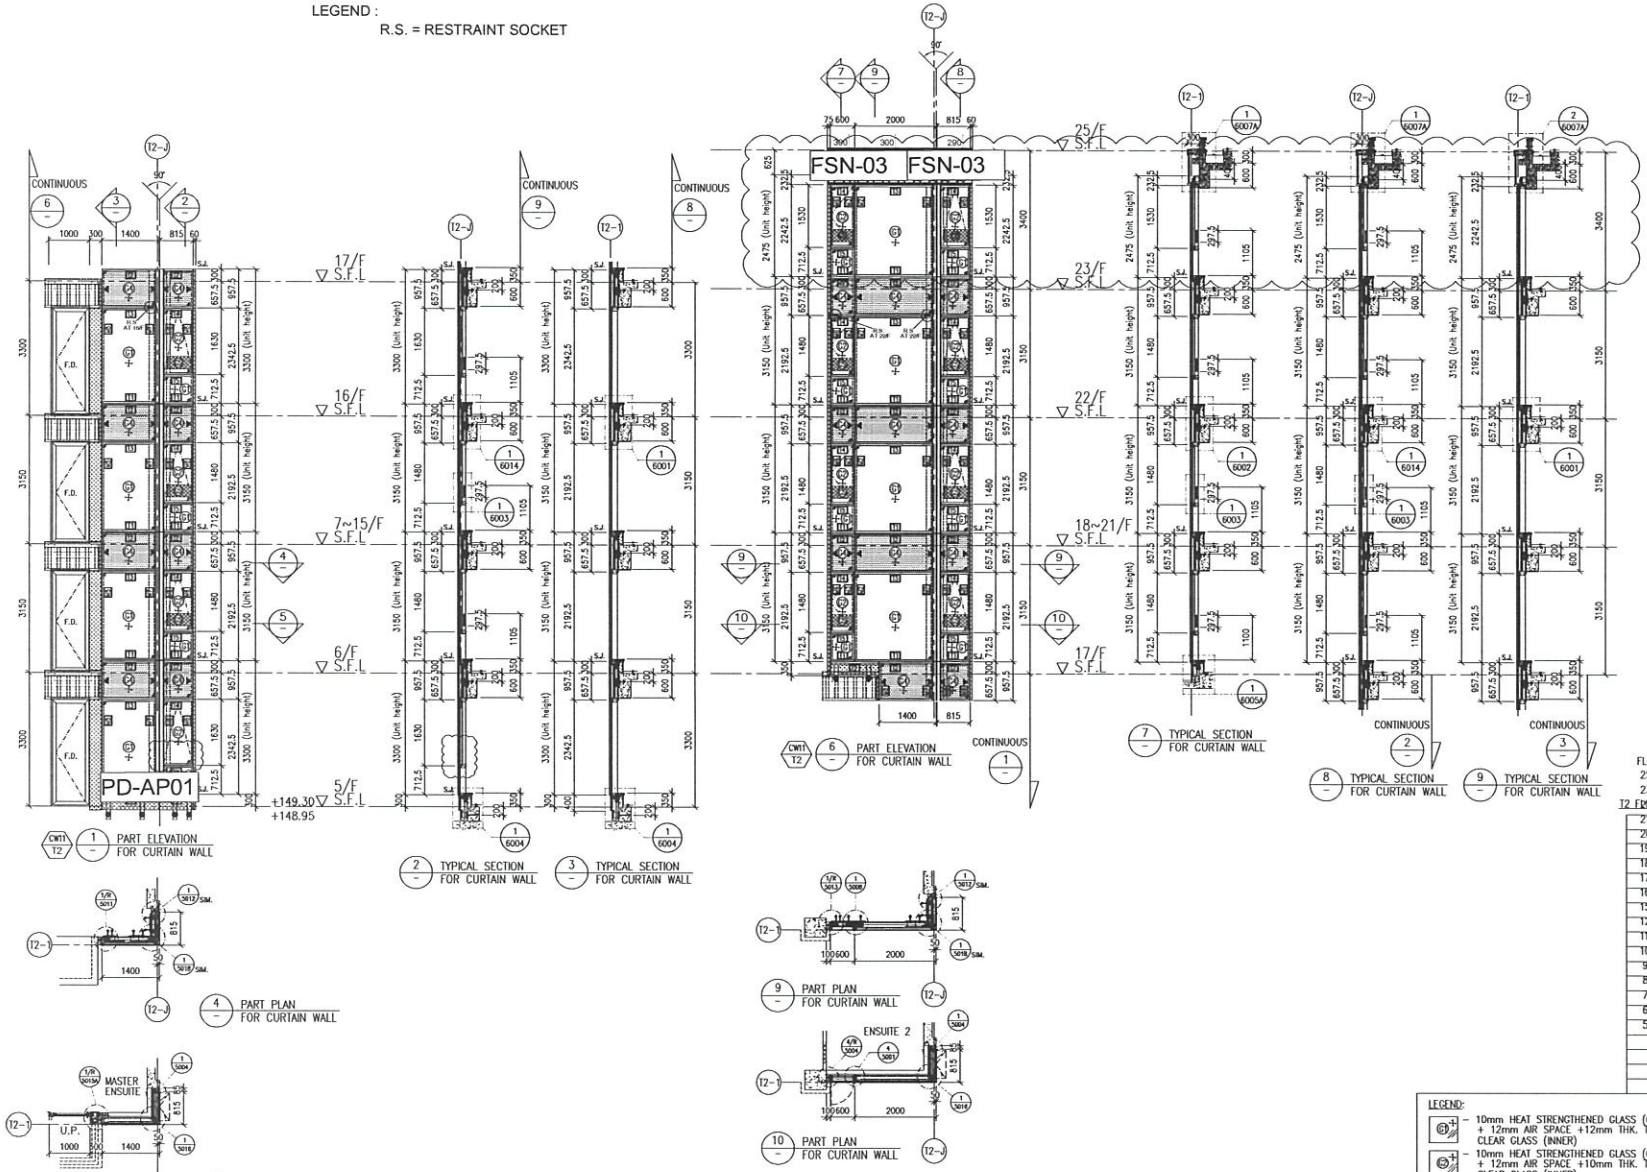

FLOOR	LEVEL
25/F	
23/F	
T2 FLOOR LEVEL (S.F.L.)	

LEGEND:

- 10mm HEAT STRENGTHENED GLASS (OUTER) + 12mm AIR SPACE +12mm THK. TEMPERED CLEAR GLASS (INNER)
- 10mm HEAT STRENGTHENED GLASS (OUTER) + 12mm AIR SPACE +10mm THK. TEMPERED CLEAR GLASS (INNER)
- 12mm THK. HEAT STRENGTHENED GLASS & 2mm THK. ALUM. BACKPAN (SPANDREL GLASS)
- 12mm THK. CLEAR TEMPERED GLASS (INTERNAL PROTECTIVE BARRIER)
- 3mm THK. ALUM. CLADDING
- S.J. – STACK JOINT (WIND LOAD)
- AP01 – ALUM. EXTRUSION DIE NO.
- ▲ – SUPPORT POINT (WIND LOAD + DEAD LOAD)
- ● – SUPPORT POINT (WIND LOAD)

B.D. REF :

CLIENT :
SHIMAO GROUP HOLDINGS LIMITED

ARCHITECT : WONG TUNG & PARTNERS LIMITED ARCHITECTS & PLANNERS

MAIN CONTRACTOR :
協興建築有限公司
HIP HING CONSTRUCTION CO LTD

STRUCTURAL ENGINEER :
C M WONG & ASSOCIATES LTD
黃志明建築工程師有限公司

FACADE CONSULTANT:
MEINHARDT

NOTE :
1. ALL DIMENSIONS ARE IN mm.
2. ALL ELEVATIONS ARE VIEWED FROM OUTSIDE.
3. ALL DIMENSIONS TO BE VERIFIED ON SITE BEFORE FABRICATION.

LEGEND :
X1 – DETAIL MARK NO.
X001 – REFER SHEET NO.

1. F.F.L. --FINISHED FLOOR LEVEL
2. S.F.L. --STRUCTURAL FLOOR LEVEL
3. /H --HANDED DETAIL

NO.	DATE	REVISED	BY
A	05-10-2021	REVISION SUBJECT TO ARCH. COMMENT	

JOB NO. : J-853

PROJECT :
PROPOSED RESIDENTIAL DEVELOPMENT AT N.K.I.L. 6542 YIN PING ROAD KOWLOON

TITLE :
PART ELEVATION OF CURTAIN WALL AT TOWER 2

DATE : 26-MAR-21 | SCALE : 1:60 (A1)


DRAWN BY : LHR | CHECKED BY : –

美特鋁質有限公司
MIDI ALUMINIUM FABRICATOR LTD.
Units 6-8, Sunray Industrial Centre, 1/F
610 Cha Kwo Ling Road, Kowloon
Tel:23489211-4 Fax:(852)27727666

DWG NO. : J853-BD-CW-4203 | REV. : C

LEGEND :


R.S. = RESTRAINT SOCKET

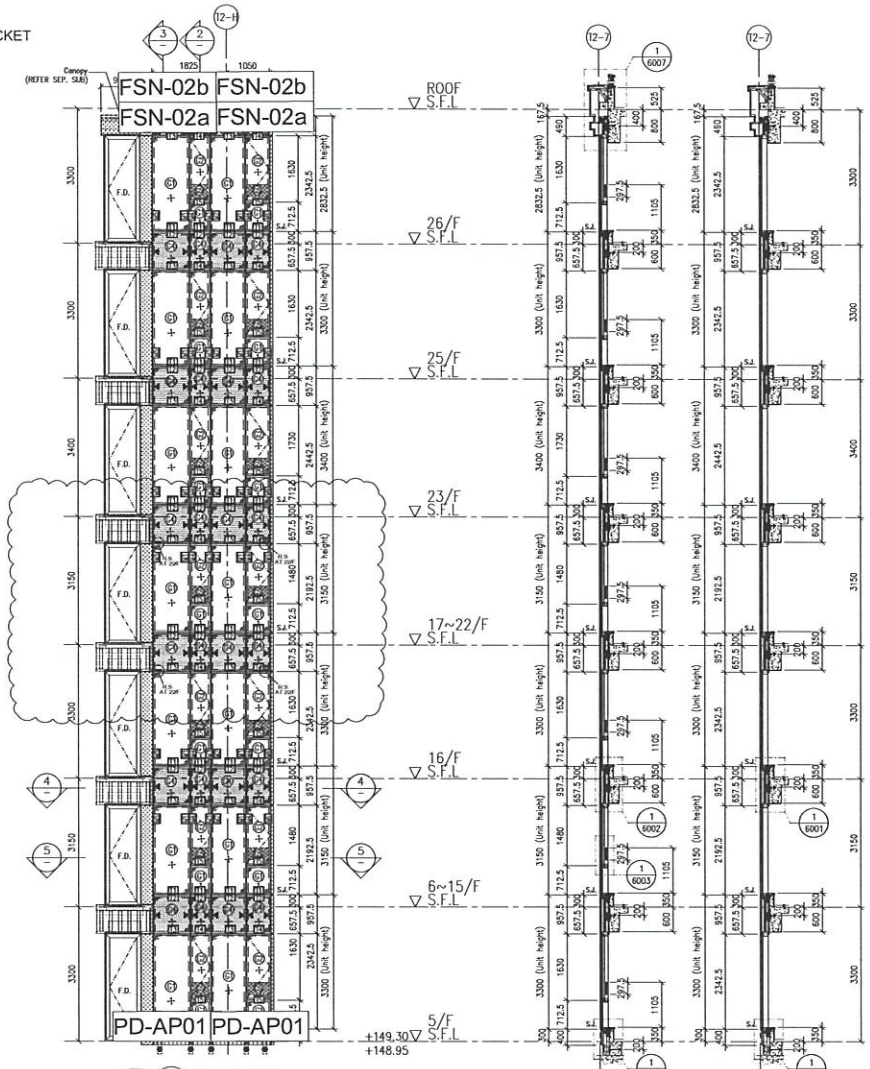


CW18 / T2 — 1 — PART ELEVATION FOR CURTAIN WALL

2 — TYPICAL SECTION FOR CURTAIN WALL

3 — TYPICAL SECTION FOR CURTAIN WALL

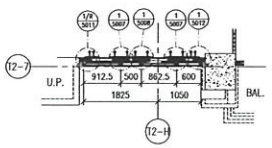

4 — PART PLAN FOR CURTAIN WALL

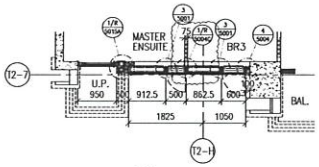

5 — PART PLAN FOR CURTAIN WALL

FLOOR LEVEL (S.F.L.)

FLOOR	LEVEL
ROOF	+210.00
26/F	+206.70
25/F	+203.40
23/F	+200.00
22/F	+196.85
21/F	+193.70
20/F	+190.55
19/F	+187.40
18/F	+184.25
17/F	+181.10
16/F	+177.80
15/F	+174.65
12/F	+171.50
11/F	+168.35
10/F	+165.20
9/F	+162.05
8/F	+158.90
7/F	+155.75
6/F	+152.60
5/F	+149.30

LEGEND:

- 10mm HEAT STRENGTHENED GLASS (OUTER) + 12mm AIR SPACE +12mm THK. TEMPERED CLEAR GLASS (INNER)
- 10mm HEAT STRENGTHENED GLASS (OUTER) + 12mm AIR SPACE +10mm THK. TEMPERED CLEAR GLASS (INNER)
- 12mm THK. HEAT STRENGTHENED GLASS & 2mm THK. ALUM. BACKPAN (SPANDREL GLASS)
- 12mm THK. CLEAR TEMPERED GLASS (INTERNAL PROTECTIVE BARRIER)
- 3mm THK. ALUM. CLADDING
- S.J. – STACK JOINT (WIND LOAD)
- AP01 – ALUM. EXTRUSION DIE NO.
- ▲ – SUPPORT POINT (WIND LOAD + DEAD LOAD)
- ● – SUPPORT POINT (WIND LOAD)

B.D. REF :

CLIENT :
SHIMAO GROUP HOLDINGS LIMITED

ARCHITECT :
WONG TUNG & PARTNERS LIMITED
ARCHITECTS & PLANNERS

MAIN CONTRACTOR :
協興建築有限公司
HIP HING CONSTRUCTION CO LTD

STRUCTURAL ENGINEER :
CMA C M WONG & ASSOCIATES LTD
黃志明建築工程師有限公司

FACADE CONSULTANT:
MEINHARDT

NOTE :
1. ALL DIMENSIONS ARE IN mm.
2. ALL ELEVATIONS ARE VIEWED FROM OUTSIDE.
3. ALL DIMENSIONS TO BE VERIFIED ON SITE BEFORE FABRICATION.

LEGEND :
- X1 / X001 — DETAIL MARK NO. / REFER SHEET NO.
1. F.F.L. --FINISHED FLOOR LEVEL
2. S.F.L. --STRUCTURAL FLOOR LEVEL
3. (R) --REVERSED DETAIL

NO.	DATE	REVISED	BY
A	05-10-2021	REVISION SUBJECT TO ARCH. COMMENT	

JOB NO. : J-853

PROJECT :
PROPOSED RESIDENTIAL DEVELOPMENT AT N.K.I.L. 6542 YIN PING ROAD KOWLOON


TITLE :
PART ELEVATION FOR CURTAIN WALL AT TOWER 2

DATE : 26-MAR-21 | SCALE : 1:60 (A1)

DRAWN BY : LHR | CHECKED BY :

美特鋁質有限公司
MIDI ALUMINIUM FABRICATOR LTD.
Units 6-8, Sunray Industrial Centre, 1/F
610 Cha Kwo Ling Road, Kowloon
Tel:23489211-4 Fax:(852)27727666


DWG NO. : J853-SD-CW-4204 | REV. : B

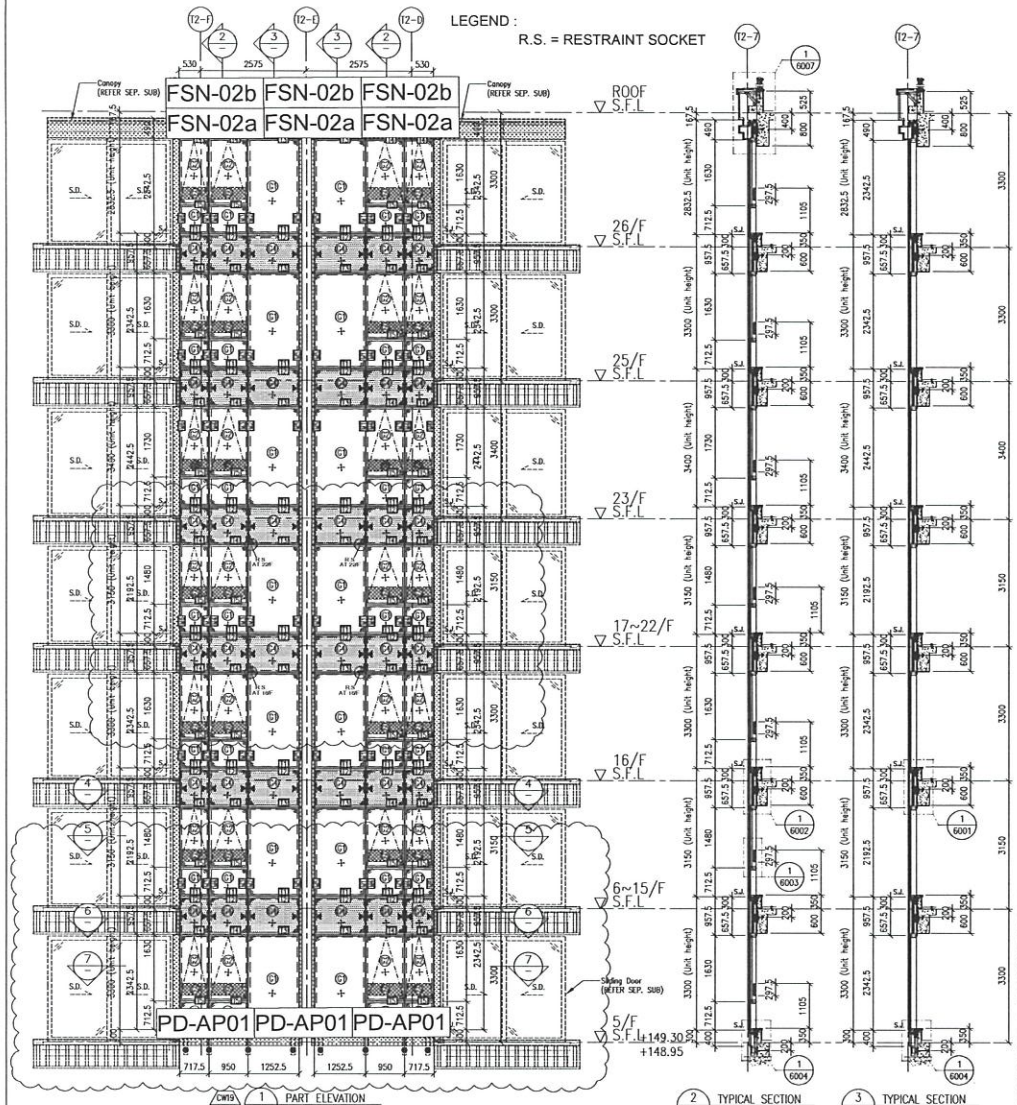


1 PART ELEVATION FOR CURTAIN WALL

2 TYPICAL SECTION FOR CURTAIN WALL


3 TYPICAL SECTION FOR CURTAIN WALL

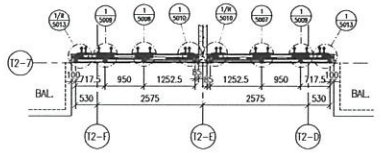


4 PART PLAN FOR CURTAIN WALL

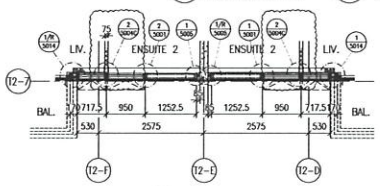

5 PART PLAN FOR CURTAIN WALL

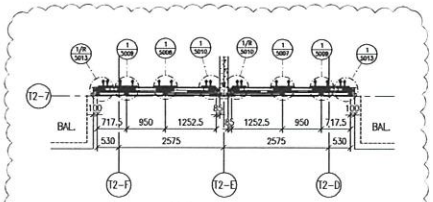

6 PART PLAN FOR CURTAIN WALL

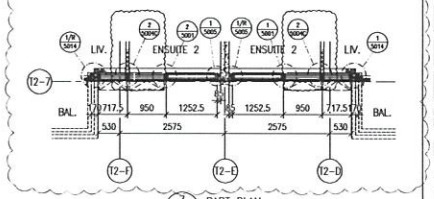

7 PART PLAN FOR CURTAIN WALL

FLOOR LEVEL (S.F.L.)

FLOOR	LEVEL
ROOF	+210.00
26/F	+206.70
25/F	+203.40
23/F	+200.00
22/F	+196.85
21/F	+193.70
20/F	+190.55
19/F	+187.40
18/F	+184.25
17/F	+181.10
16/F	+177.80
15/F	+174.65
12/F	+171.50
11/F	+168.35
10/F	+165.20
9/F	+162.05
8/F	+158.90
7/F	+155.75
6/F	+152.60
5/F	+149.30

LEGEND:

- 10mm HEAT STRENGTHENED GLASS (OUTER) + 12mm AIR SPACE +12mm THK. TEMPERED CLEAR GLASS (INNER)
- 10mm HEAT STRENGTHENED GLASS (OUTER) + 12mm AIR SPACE +10mm THK. TEMPERED CLEAR GLASS (INNER)
- 12mm THK. HEAT STRENGTHENED GLASS & 2mm THK. ALUM. BACKPAN (SPANDREL GLASS)
- 12mm THK. CLEAR TEMPERED GLASS (INTERNAL PROTECTIVE BARRIER)
- 3mm THK. ALUM. CLADDING
- SJ. – STACK JOINT (WIND LOAD)
- AD01 – ALUM. EXTRUSION DIE NO.
- ▲ – SUPPORT POINT (WIND LOAD + DEAD LOAD)
- ● – SUPPORT POINT (WIND LOAD)

B.D. REF :

CLIENT :
SHIMAO GROUP HOLDINGS LIMITED

ARCHITECT :
WONG TUNG & PARTNERS LIMITED
ARCHITECTS & PLANNERS

MAIN CONTRACTOR :
協興建築有限公司
HIP HING CONSTRUCTION CO LTD

STRUCTURAL ENGINEER :
ICMA C M WONG & ASSOCIATES LTD
黃志明建築工程師有限公司

FACADE CONSULTANT:
MEINHARDT

NOTE :
1. ALL DIMENSIONS ARE IN mm.
2. ALL ELEVATIONS ARE VIEWED FROM OUTSIDE.
3. ALL DIMENSIONS TO BE VERIFIED ON SITE BEFORE FABRICATION.

LEGEND :
X1 – DETAIL MARK NO.
X001 – REFER SHEET NO.

1. F.F.L. --FINISHED FLOOR LEVEL
2. S.F.L. --STRUCTURAL FLOOR LEVEL
3. (R) --REVERSED DETAIL

NO.	DATE	REVISED	BY

JOB NO. : J-853

PROJECT :
PROPOSED RESIDENTIAL DEVELOPMENT AT N.K.I.L. 6542 YIN PING ROAD KOWLOON


TITLE :
PART ELEVATION FOR CURTAIN WALL AT TOWER 2


DATE : 22-OCT-21 | SCALE : 1:60 (A1)


DRAWN BY : LHR | CHECKED BY :


美特鋁質有限公司
MTDI ALUMINIUM FABRICATOR LTD.
Units 6-8, Sunray Industrial Centre, 1/F
610 Cha Kwo Ling Road, Kowloon
Tel:23489211-4 Fax:(852)27727666


DWG NO. : J853-SD-CW-4204A | REV. : B

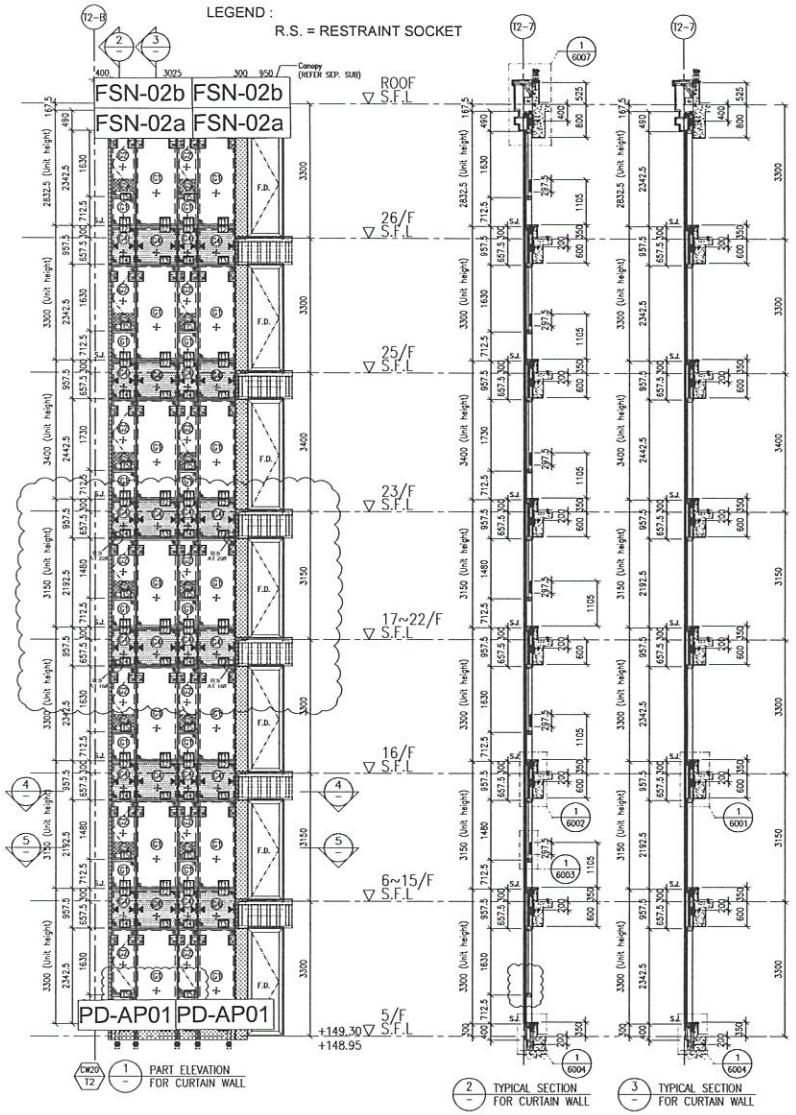


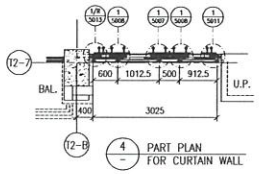

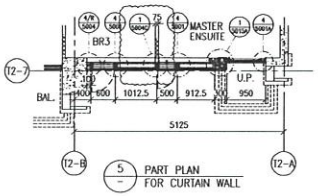

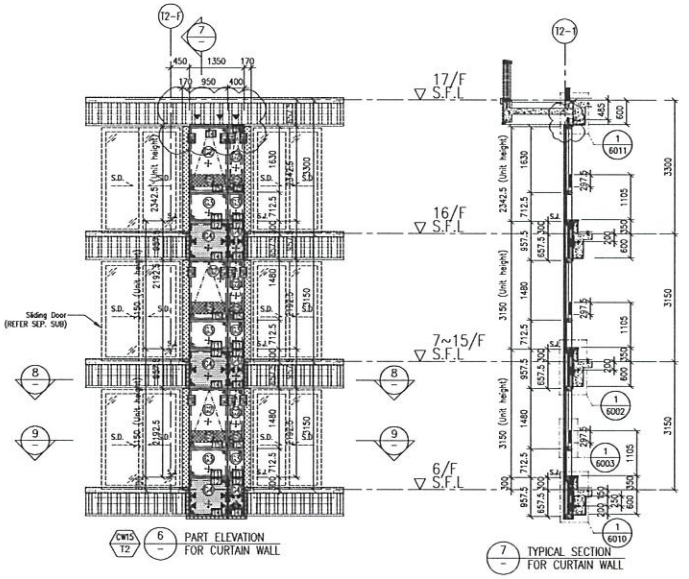

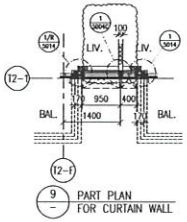

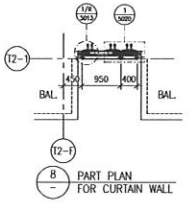

LEGEND:

- 10mm HEAT STRENGTHENED GLASS (OUTER) + 12mm AIR SPACE +12mm THK. TEMPERED CLEAR GLASS (INNER)
- 10mm HEAT STRENGTHENED GLASS (OUTER) + 12mm AIR SPACE +10mm THK. TEMPERED CLEAR GLASS (INNER)
- 12mm THK. HEAT STRENGTHENED GLASS & 2mm THK. ALUM. BACKPAN (SPANDREL GLASS)
- 12mm THK. CLEAR TEMPERED GLASS (INTERNAL PROTECTIVE BARRIER)
- 3mm THK. ALUM. CLADDING
- S.J. – STACK JOINT (WIND LOAD)
- AT01 – ALUM. EXTRUSION DIE NO.
- ▲ – SUPPORT POINT (WIND LOAD + DEAD LOAD)
- ● – SUPPORT POINT (WIND LOAD)

FLOOR LEVEL (S.F.L)

FLOOR	LEVEL
ROOF	+210.00
26/F	+206.70
25/F	+203.40
23/F	+200.00
22/F	+196.85
21/F	+193.70
20/F	+190.55
19/F	+187.40
18/F	+184.25
17/F	+181.10
16/F	+177.80
15/F	+174.65
12/F	+171.50
11/F	+168.35
10/F	+165.20
9/F	+162.05
8/F	+158.90
7/F	+155.75
6/F	+152.60
5/F	+149.30

B.D. REF :

CLIENT :
SHIMAO GROUP HOLDINGS LIMITED

ARCHITECT :
WONG TUNG & PARTNERS LIMITED
ARCHITECTS & PLANNERS

MAIN CONTRACTOR :
協興建築有限公司
HIP HING CONSTRUCTION CO LTD

STRUCTURAL ENGINEER :
C M WONG & ASSOCIATES LTD
黃志明建築工程師有限公司

FACADE CONSULTANT:
MEINHARDT

NOTE :
1. ALL DIMENSIONS ARE IN mm.
2. ALL ELEVATIONS ARE VIEWED FROM OUTSIDE.
3. ALL DIMENSIONS TO BE VERIFIED ON SITE BEFORE FABRICATION.

LEGEND :
- X1 / X001 – DETAIL MARK NO. / REFER SHEET NO.
1. F.F.L. – FINISHED FLOOR LEVEL
2. S.F.L. – STRUCTURAL FLOOR LEVEL
3. (R) – REVERSED DETAIL

NO.	DATE	REVISED	BY
A	05-10-2021	REVISION SUBJECT TO ARCH. COMMENT	

JOB NO. : J-853

PROJECT :
PROPOSED RESIDENTIAL DEVELOPMENT AT N.K.I.L. 6542 YIN PING ROAD KOWLOON


TITLE :
PART ELEVATION FOR CURTAIN WALL AT TOWER 2

DATE : 26-MAR-21 | SCALE : 1:60 (A1)


DRAWN BY : LHR | CHECKED BY :

美特鋁製有限公司
MIDI ALUMINIUM FABRICATOR LTD.
Units 6-8, Sunray Industrial Centre, 1/F
610 Cha Kwo Ling Road, Kowloon
Tel:23489211-4 Fax:(852)27727666

DWG NO. : J853-SD-CW-4205 | REV. : B

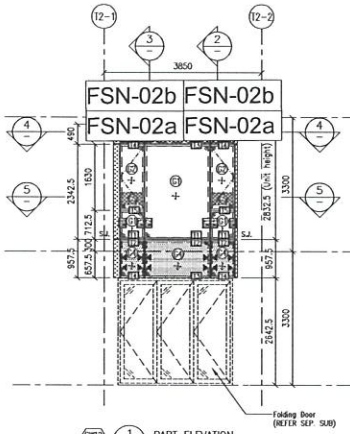


CW12/12 1/– PART ELEVATION FOR CURTAIN WALL

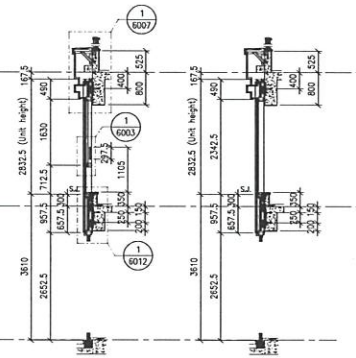


2/– TYPICAL SECTION FOR CURTAIN WALL


3/– TYPICAL SECTION FOR CURTAIN WALL

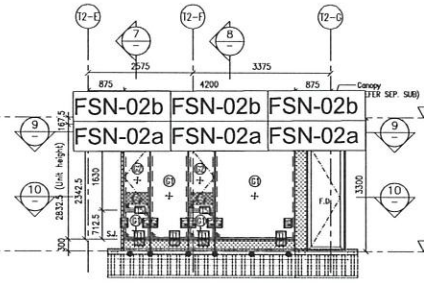


CW17/12 6/– PART ELEVATION FOR CURTAIN WALL

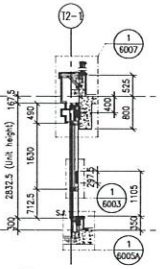


7/– TYPICAL SECTION FOR CURTAIN WALL

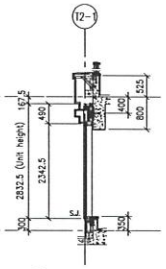


8/– TYPICAL SECTION FOR CURTAIN WALL

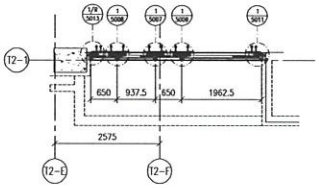


9/– PART PLAN FOR CURTAIN WALL

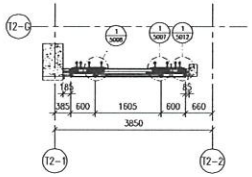

4/– PART PLAN FOR CURTAIN WALL

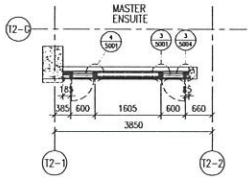

5/– PART PLAN FOR CURTAIN WALL

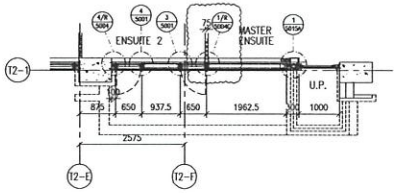

10/– PART PLAN FOR CURTAIN WALL

FLOOR LEVEL (S.F.L.)

FLOOR	LEVEL
ROOF	+210.00
26/F	+206.70
25/F	+203.40

LEGEND:

- 10mm HEAT STRENGTHENED GLASS (OUTER) + 12mm AIR SPACE +12mm THK. TEMPERED CLEAR GLASS (INNER)
- 10mm HEAT STRENGTHENED GLASS (OUTER) + 12mm AIR SPACE +10mm THK. TEMPERED CLEAR GLASS (INNER)
- 12mm THK. HEAT STRENGTHENED GLASS & 2mm THK. ALUM. BACKPAN (SPANDREL GLASS)
- 12mm THK. CLEAR TEMPERED GLASS (INTERNAL PROTECTIVE BARRIER)
- 3mm THK. ALUM. CLADDING
- S.J. – STACK JOINT (WIND LOAD)
- AF01 – ALUM. EXTRUSION DIE NO.
- ▲ – SUPPORT POINT (WIND LOAD + DEAD LOAD)
- ● – SUPPORT POINT (WIND LOAD)

B.D. REF :

CLIENT :
SHIMAO GROUP HOLDINGS LIMITED

ARCHITECT :
WONG TUNG & PARTNERS LIMITED
ARCHITECTS & PLANNERS

MAIN CONTRACTOR :
協興建築有限公司
HIP HING CONSTRUCTION CO LTD

STRUCTURAL ENGINEER :
C M WONG & ASSOCIATES LTD
黃志明建築工程師有限公司

FACADE CONSULTANT:
MEINHARDT

NOTE :
1. ALL DIMENSIONS ARE IN mm.
2. ALL ELEVATIONS ARE VIEWED FROM OUTSIDE.
3. ALL DIMENSIONS TO BE VERIFIED ON SITE BEFORE FABRICATION.

LEGEND :
- X1 / X001 – DETAIL MARK NO. / REFER SHEET NO.
1. F.F.L. – FINISHED FLOOR LEVEL
2. S.F.L. – STRUCTURAL FLOOR LEVEL
3. /R – REVERSED DETAIL

NO.	DATE	REVISED	BY

JOB NO. : J-853

PROJECT :
PROPOSED RESIDENTIAL DEVELOPMENT AT N.K.I.L. 6542 YIN PING ROAD KOWLOON

TITLE :
PART ELEVATION FOR CURTAIN WALL AT TOWER 2


DATE : 05-OCT-21 | SCALE : 1:60 (A1)

DRAWN BY : LHR | CHECKED BY :

美特鋁質有限公司
MIDI ALUMINIUM FABRICATOR LTD.
Units 6-8, Sunray Industrial Centre, 1/F
610 Cha Kwo Ling Road, Kowloon
Tel:23489211-4 Fax:(852)27727666

DWG NO. : J853-SD-CW-4206 | REV. : B

LEGEND :
R.S. = RESTRAINT SOCKET

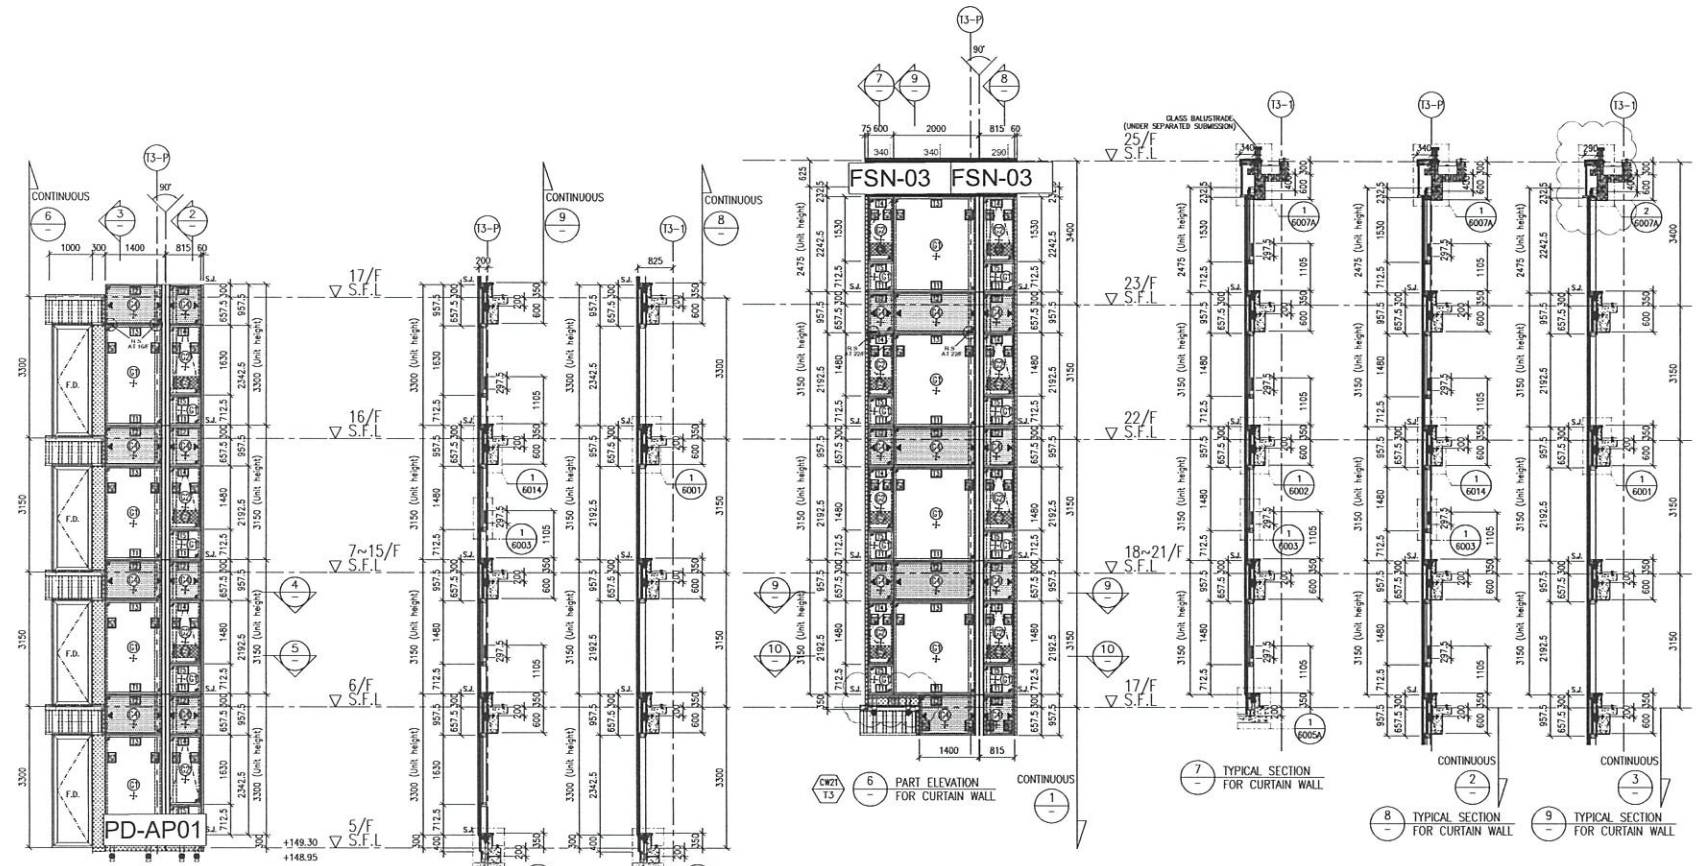

CW21 T3 (1) PART ELEVATION FOR CURTAIN WALL

(2) TYPICAL SECTION FOR CURTAIN WALL


(3) TYPICAL SECTION FOR CURTAIN WALL

CW21 T3 (6) PART ELEVATION FOR CURTAIN WALL


(7) TYPICAL SECTION FOR CURTAIN WALL

(8) TYPICAL SECTION FOR CURTAIN WALL


(9) TYPICAL SECTION FOR CURTAIN WALL

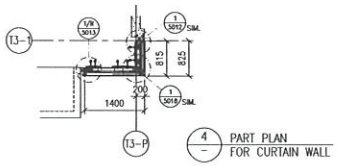


(4) PART PLAN FOR CURTAIN WALL

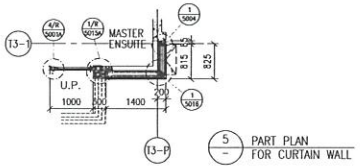

(5) PART PLAN FOR CURTAIN WALL

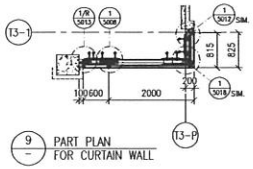

(9) PART PLAN FOR CURTAIN WALL

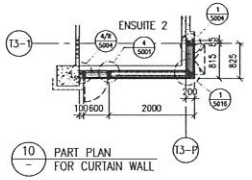

(10) PART PLAN FOR CURTAIN WALL

FLOOR LEVEL (S.F.L.)	
FLOOR	LEVEL
25/F	+203.40
23/F	+200.00
22/F	+196.85
21/F	+193.70
20/F	+190.55
19/F	+187.40
18/F	+184.25
17/F	+181.10
16/F	+177.80
15/F	+174.65
12/F	+171.50
11/F	+168.35
10/F	+165.20
9/F	+162.05
8/F	+158.90
7/F	+155.75
6/F	+152.60
5/F	+149.30

LEGEND:
- 10mm HEAT STRENGTHENED GLASS (OUTER) + 12mm AIR SPACE +12mm THK. TEMPERED CLEAR GLASS (INNER)
- 10mm HEAT STRENGTHENED GLASS (OUTER) + 12mm AIR SPACE +10mm THK. TEMPERED CLEAR GLASS (INNER)
- 12mm THK. HEAT STRENGTHENED GLASS & 2mm THK. ALUM. BACKPAN (SPANDREL GLASS)
- 12mm THK. CLEAR TEMPERED GLASS (INTERNAL PROTECTIVE BARRIER)
- 3mm THK. ALUM. CLADDING
- S.J. – STACK JOINT (WIND LOAD)
- AF01 – ALUM. EXTRUSION DIE NO.
- ▲ – SUPPORT POINT (WIND LOAD + DEAD LOAD)
- ● – SUPPORT POINT (WIND LOAD)

B.D. REF :

CLIENT :
SHIMAO GROUP HOLDINGS LIMITED

ARCHITECT :
WONG TUNG & PARTNERS LIMITED
ARCHITECTS & PLANNERS

MAIN CONTRACTOR :
協興建築有限公司
HIP HING CONSTRUCTION CO LTD

STRUCTURAL ENGINEER :
C M WONG & ASSOCIATES LTD
黃志明建築工程師有限公司

FACADE CONSULTANT:
MEINHARDT

NOTE :
1. ALL DIMENSIONS ARE IN mm.
2. ALL ELEVATIONS ARE VIEWED FROM OUTSIDE.
3. ALL DIMENSIONS TO BE VERIFIED ON SITE BEFORE FABRICATION.

LEGEND :
X1 — DETAIL MARK NO.
X001 — REFER SHEET NO.

1. F.F.L. -- FINISHED FLOOR LEVEL
2. S.F.L. -- STRUCTURAL FLOOR LEVEL
3. /R -- REVERSED DETAIL

NO.	DATE	REVISED	BY
A	05-10-2021	REVISION SUBJECT TO ARCH. COMMENT	

JOB NO. : J-853

PROJECT :
PROPOSED RESIDENTIAL DEVELOPMENT AT N.K.I.L. 6542 YIN PING ROAD KOWLOON


TITLE :
PART ELEVATION FOR CURTAIN WALL AT TOWER 3

DATE : 26-MAR-21 | SCALE : 1:60 (A1)

DRAWN BY : LHR | CHECKED BY :

美特鋁質有限公司
MIDI ALUMINIUM FABRICATOR LTD.
Units 6-8, Sunray Industrial Centre, 1/F
610 Cha Kwo Ling Road, Kowloon
Tel:23489211-4 Fax:(852)27727666

DWG NO. : J853-SD-CW-4301 | REV. : C

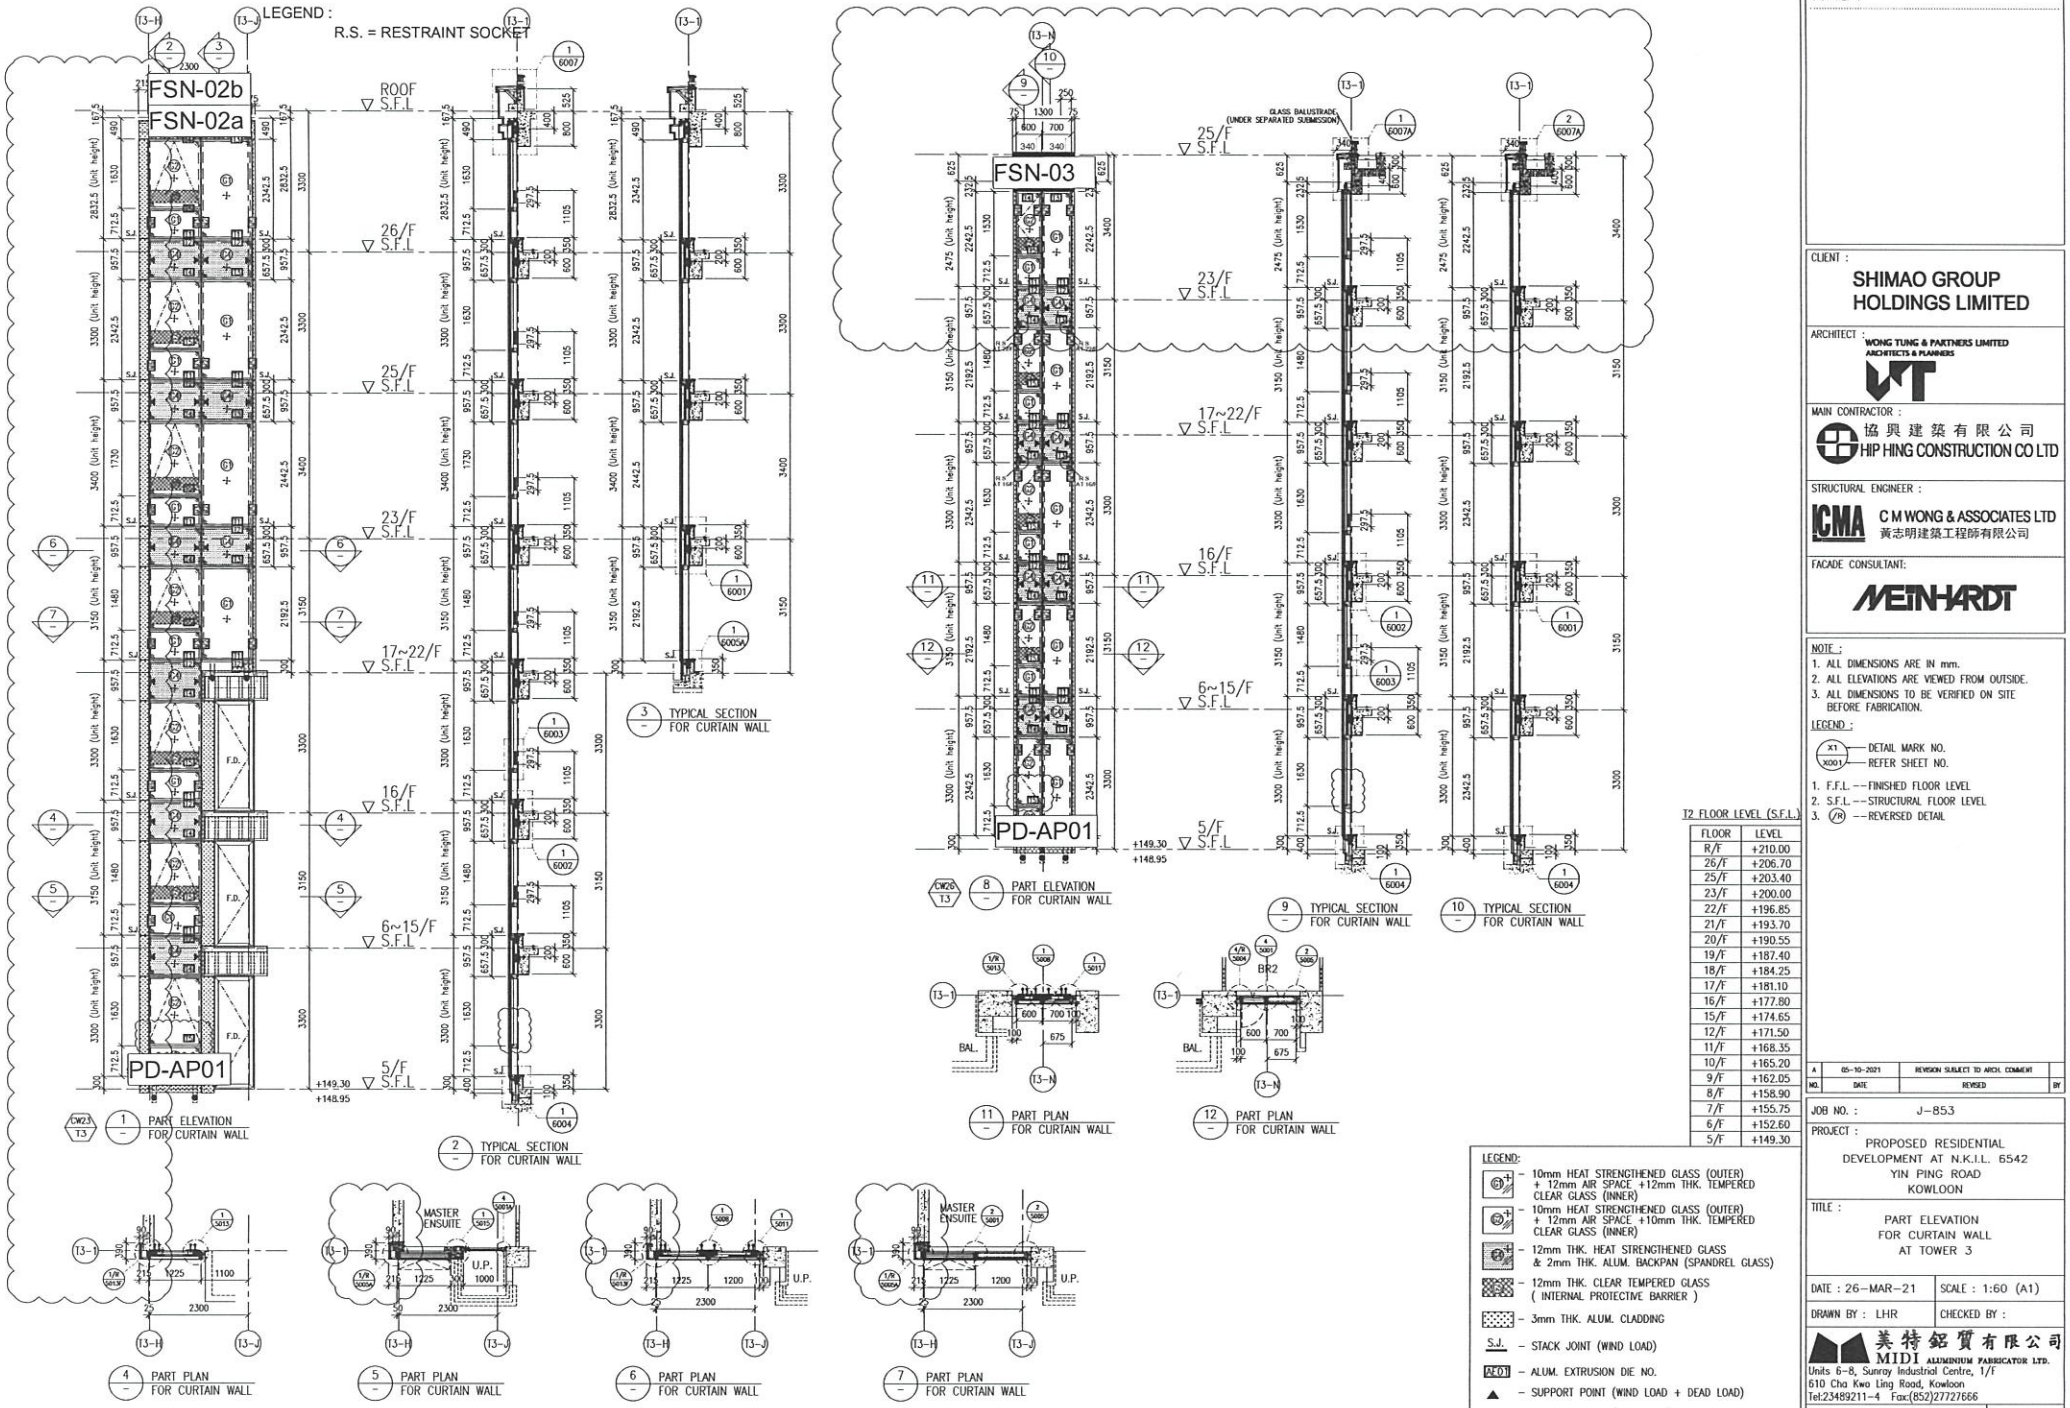

T2 FLOOR LEVEL (S.F.L.)

FLOOR	LEVEL
R/F	+210.00
26/F	+206.70
25/F	+203.40
23/F	+200.00
22/F	+196.85
21/F	+193.70
20/F	+190.55
19/F	+187.40
18/F	+184.25
17/F	+181.10
16/F	+177.80
15/F	+174.65
12/F	+171.50
11/F	+168.35
10/F	+165.20
9/F	+162.05
8/F	+158.90
7/F	+155.75
6/F	+152.60
5/F	+149.30

LEGEND:

- 10mm HEAT STRENGTHENED GLASS (OUTER) + 12mm AIR SPACE +12mm THK. TEMPERED CLEAR GLASS (INNER)
- 10mm HEAT STRENGTHENED GLASS (OUTER) + 12mm AIR SPACE +10mm THK. TEMPERED CLEAR GLASS (INNER)
- 12mm THK. HEAT STRENGTHENED GLASS & 2mm THK. ALUM. BACKPAN (SPANDREL GLASS)
- 12mm THK. CLEAR TEMPERED GLASS (INTERNAL PROTECTIVE BARRIER)
- 3mm THK. ALUM. CLADDING
- S.J. – STACK JOINT (WIND LOAD)
- AP01 – ALUM. EXTRUSION DIE NO.
- ▲ – SUPPORT POINT (WIND LOAD + DEAD LOAD)
- ● – SUPPORT POINT (WIND LOAD)

B.D. REF :

CLIENT :
SHIMAO GROUP HOLDINGS LIMITED

ARCHITECT : WONG TUNG & PARTNERS LIMITED ARCHITECTS & PLANNERS

MAIN CONTRACTOR : 協興建築有限公司 HIP HING CONSTRUCTION CO LTD

STRUCTURAL ENGINEER : C M WONG & ASSOCIATES LTD 黃志明建築工程師有限公司

FACADE CONSULTANT: MEINHARDT

NOTE :
1. ALL DIMENSIONS ARE IN mm.
2. ALL ELEVATIONS ARE VIEWED FROM OUTSIDE.
3. ALL DIMENSIONS TO BE VERIFIED ON SITE BEFORE FABRICATION.

LEGEND :
X1 — DETAIL MARK NO.
X001 — REFER SHEET NO.
1. F.F.L. -- FINISHED FLOOR LEVEL
2. S.F.L. -- STRUCTURAL FLOOR LEVEL
3. /R -- REVERSED DETAIL

NO.	DATE	REVISED	BY
A	05-10-2021	REVISION SUBJECT TO ARCH. COMMENT	

JOB NO. : J-853

PROJECT :
PROPOSED RESIDENTIAL DEVELOPMENT AT N.K.I.L. 6542 YIN PING ROAD KOWLOON

TITLE :
PART ELEVATION FOR CURTAIN WALL AT TOWER 3


DATE : 26-MAR-21 | SCALE : 1:60 (A1)

DRAWN BY : LHR | CHECKED BY :

美特鋁質有限公司 MIDI ALUMINIUM FABRICATOR LTD.
Units 6-8, Sunray Industrial Centre, 1/F
610 Cha Kwo Ling Road, Kowloon
Tel:23489211-4 Fax:(852)27727666

DWG NO. : J853-SD-CW-4302 | REV. : C

LEGEND :
R.S. = RESTRAINT SOCKET

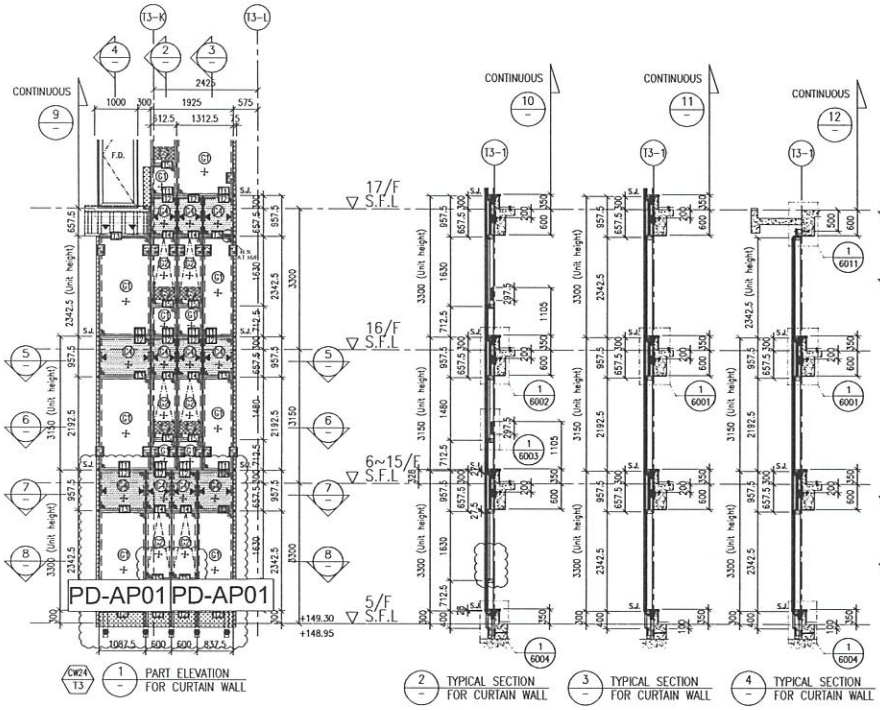


CW24/T3 1 – PART ELEVATION FOR CURTAIN WALL


2 – TYPICAL SECTION FOR CURTAIN WALL

3 – TYPICAL SECTION FOR CURTAIN WALL

4 – TYPICAL SECTION FOR CURTAIN WALL

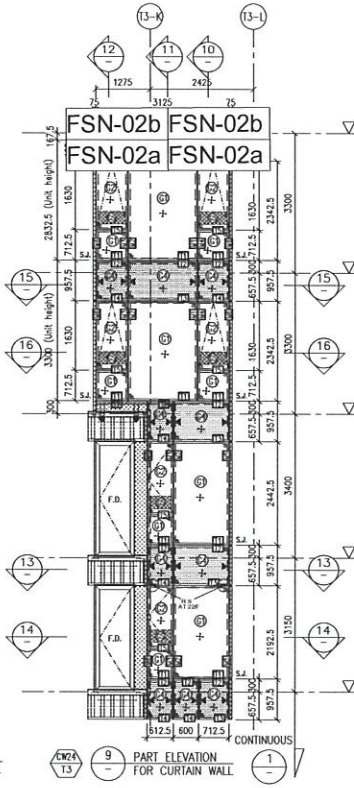


CW24/T3 9 – PART ELEVATION FOR CURTAIN WALL

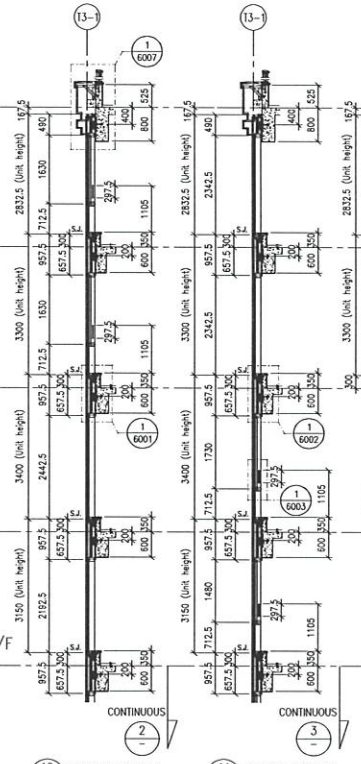


10 – TYPICAL SECTION FOR CURTAIN WALL


11 – TYPICAL SECTION FOR CURTAIN WALL

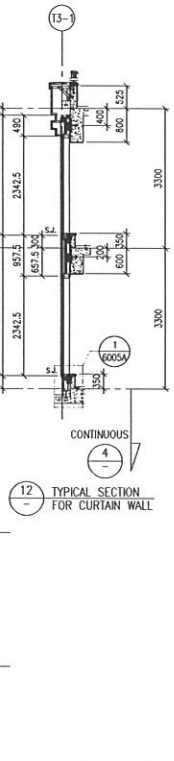


12 – TYPICAL SECTION FOR CURTAIN WALL

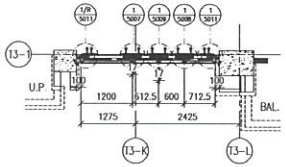


5 – PART PLAN FOR CURTAIN WALL

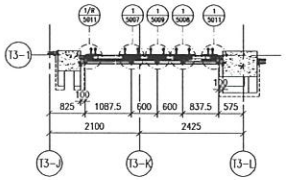


7 – PART PLAN FOR CURTAIN WALL

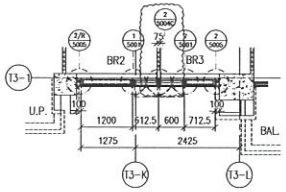


6 – PART PLAN FOR CURTAIN WALL

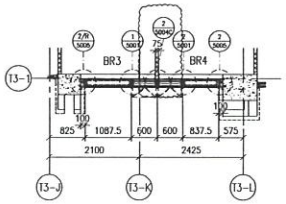


8 – PART PLAN FOR CURTAIN WALL

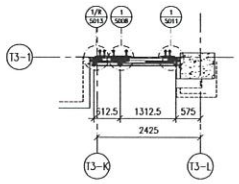


13 – PART PLAN FOR CURTAIN WALL

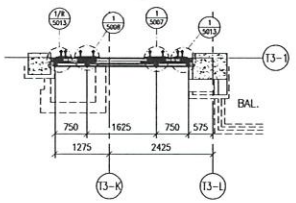

15 – PART PLAN FOR CURTAIN WALL

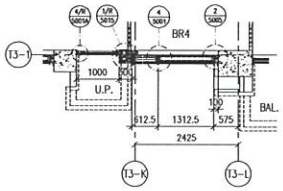

14 – PART PLAN FOR CURTAIN WALL

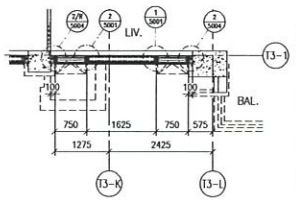

16 – PART PLAN FOR CURTAIN WALL

T2 FLOOR LEVEL (S.F.L.)

FLOOR	LEVEL
R/F	+210.00
26/F	+206.70
25/F	+203.40
23/F	+200.00
22/F	+196.85
21/F	+193.70
20/F	+190.55
19/F	+187.40
18/F	+184.25
17/F	+181.10
16/F	+177.80
15/F	+174.65
12/F	+171.50
11/F	+168.35
10/F	+165.20
9/F	+162.05
8/F	+158.90
7/F	+155.75
6/F	+152.60
5/F	+149.30

LEGEND:
- G1+ – 10mm HEAT STRENGTHENED GLASS (OUTER) + 12mm AIR SPACE +12mm THK. TEMPERED CLEAR GLASS (INNER)
- G2+ – 10mm HEAT STRENGTHENED GLASS (OUTER) + 12mm AIR SPACE +10mm THK. TEMPERED CLEAR GLASS (INNER)
- G3+ – 12mm THK. HEAT STRENGTHENED GLASS & 2mm THK. ALUM. BACKPAN (SPANDREL GLASS)
- 12mm THK. CLEAR TEMPERED GLASS (INTERNAL PROTECTIVE BARRIER)
- 3mm THK. ALUM. CLADDING
- S.J. – STACK JOINT (WIND LOAD)
- AE01 – ALUM. EXTRUSION DIE NO.
- ▲ – SUPPORT POINT (WIND LOAD + DEAD LOAD)
- ● – SUPPORT POINT (WIND LOAD)

B.D. REF :

CLIENT :
SHIMAO GROUP HOLDINGS LIMITED

ARCHITECT :
WONG TUNG & PARTNERS LIMITED
ARCHITECTS & PLANNERS

MAIN CONTRACTOR :
協興建築有限公司
HIP HING CONSTRUCTION CO LTD

STRUCTURAL ENGINEER :
C M WONG & ASSOCIATES LTD
黃志明建築工程師有限公司

FACADE CONSULTANT:
MEINHARDT

NOTE :
1. ALL DIMENSIONS ARE IN mm.
2. ALL ELEVATIONS ARE VIEWED FROM OUTSIDE.
3. ALL DIMENSIONS TO BE VERIFIED ON SITE BEFORE FABRICATION.

LEGEND :
- X1 / X001 – DETAIL MARK NO. / REFER SHEET NO.
1. F.F.L. – FINISHED FLOOR LEVEL
2. S.F.L. – STRUCTURAL FLOOR LEVEL
3. /R – REVERSED DETAIL

NO.	DATE	REVISED	BY
A	05-10-2021	REVISION SUBJECT TO ARCH. COMMENT	

JOB NO. : J-853

PROJECT :
PROPOSED RESIDENTIAL DEVELOPMENT AT N.K.I.L. 6542
YIN PING ROAD
KOWLOON

TITLE :
PART ELEVATION FOR CURTAIN WALL AT TOWER 3


DATE : 26-MAR-21 | SCALE : 1:60 (A1)
DRAWN BY : LHR | CHECKED BY :


美特鋁質有限公司
MIDI ALUMINIUM FABRICATOR LTD.
Units 6-8, Sunray Industrial Centre, 1/F
610 Cha Kwo Ling Rood, Kowloon
Tel:23489211-4 Fax:(852)27727666


DWG NO. : J853-SD-CW-4303 | REV. : B

LEGEND :

R.S. = RESTRAINT SOCKET

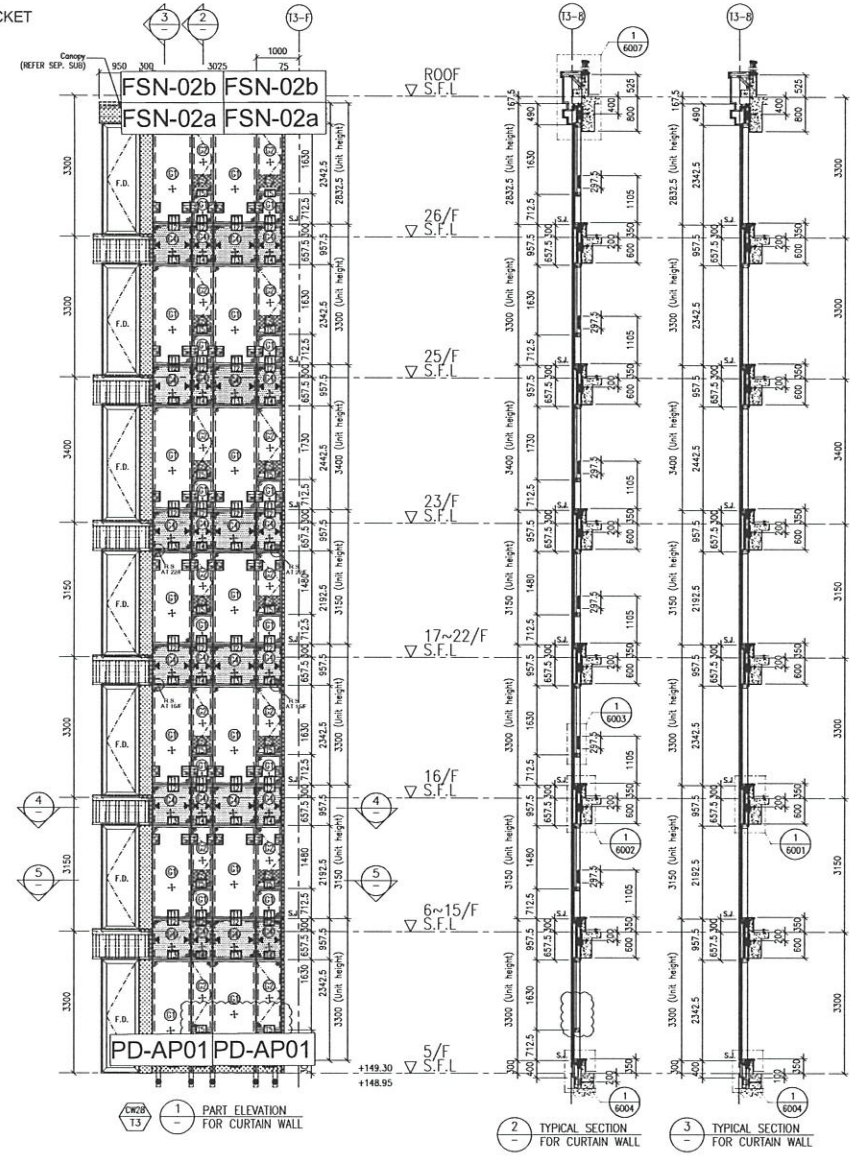

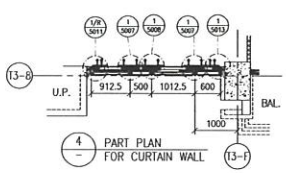

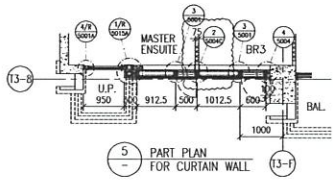

FLOOR LEVEL (S.F.L.)

FLOOR	LEVEL
ROOF	+210.00
26/F	+206.70
25/F	+203.40
23/F	+200.00
22/F	+196.85
21/F	+193.70
20/F	+190.55
19/F	+187.40
18/F	+184.25
17/F	+181.10
16/F	+177.80
15/F	+174.65
12/F	+171.50
11/F	+168.35
10/F	+165.20
9/F	+162.05
8/F	+158.90
7/F	+155.75
6/F	+152.60
5/F	+149.30

LEGEND:

- 10mm HEAT STRENGTHENED GLASS (OUTER) + 12mm AIR SPACE +12mm THK. TEMPERED CLEAR GLASS (INNER)
- 10mm HEAT STRENGTHENED GLASS (OUTER) + 12mm AIR SPACE +10mm THK. TEMPERED CLEAR GLASS (INNER)
- 12mm THK. HEAT STRENGTHENED GLASS & 2mm THK. ALUM. BACKPAN (SPANDREL GLASS)
- 12mm THK. CLEAR TEMPERED GLASS (INTERNAL PROTECTIVE BARRIER)
- 3mm THK. ALUM. CLADDING
- S.J. – STACK JOINT (WIND LOAD)
- AP01 – ALUM. EXTRUSION DIE NO.
- ▲ – SUPPORT POINT (WIND LOAD + DEAD LOAD)
- ● – SUPPORT POINT (WIND LOAD)

B.D. REF :

CLIENT :

SHIMAO GROUP HOLDINGS LIMITED

ARCHITECT :

WONG TUNG & PARTNERS LIMITED
ARCHITECTS & PLANNERS

MAIN CONTRACTOR :

協興建築有限公司
HIP HING CONSTRUCTION CO LTD

STRUCTURAL ENGINEER :

C M WONG & ASSOCIATES LTD
黃志明建築工程師有限公司

FACADE CONSULTANT:

MEINHARDT

NOTE :

1. ALL DIMENSIONS ARE IN mm.
2. ALL ELEVATIONS ARE VIEWED FROM OUTSIDE.
3. ALL DIMENSIONS TO BE VERIFIED ON SITE BEFORE FABRICATION.

LEGEND :

X1 – DETAIL MARK NO.
X001 – REFER SHEET NO.

1. F.F.L. --FINISHED FLOOR LEVEL
2. S.F.L. --STRUCTURAL FLOOR LEVEL
3. /R --REVERSED DETAIL

NO.	DATE	REVISED	BY
A	05-10-2021	REVISION SUBJECT TO ARCH. COMMENT	

JOB NO. : J-853

PROJECT :

PROPOSED RESIDENTIAL DEVELOPMENT AT N.K.I.L. 6542 YIN PING ROAD KOWLOON

TITLE :


PART ELEVATION FOR CURTAIN WALL AT TOWER 3

DATE : 26-MAR-21 | SCALE : 1:60 (A1)

DRAWN BY : LHR | CHECKED BY :

美特鋁質有限公司
MIDI ALUMINIUM FABRICATOR LTD.
Units 6-8, Sunray Industrial Centre, 1/F
610 Cha Kwo Ling Road, Kowloon
Tel:23489211-4 Fax:(852)27727666


DWG NO. : J853-SD-CW-4304 | REV. : B

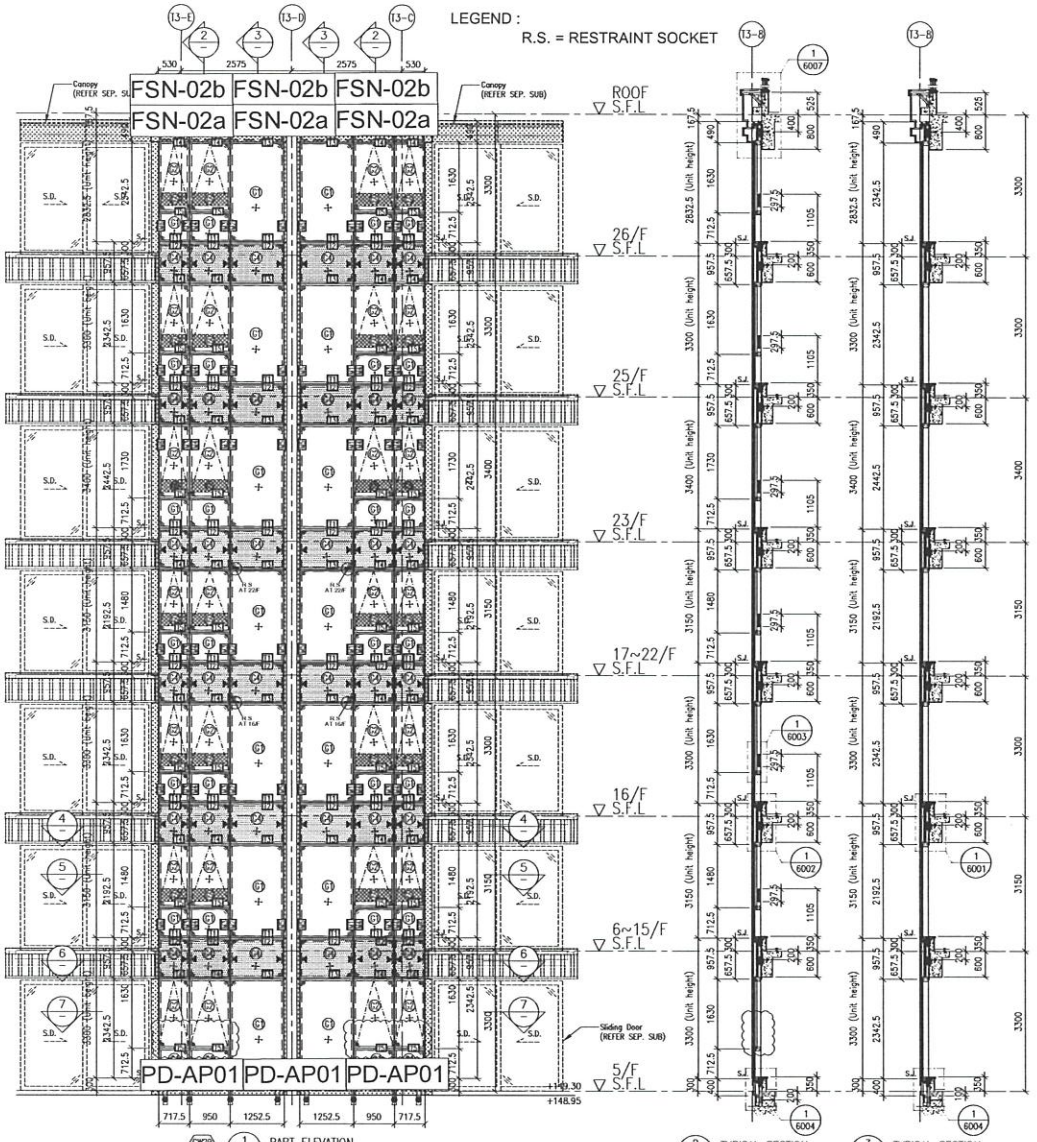


1 PART ELEVATION FOR CURTAIN WALL

2 TYPICAL SECTION FOR CURTAIN WALL


3 TYPICAL SECTION FOR CURTAIN WALL

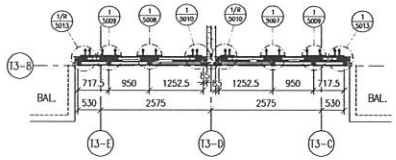


4 PART PLAN FOR CURTAIN WALL

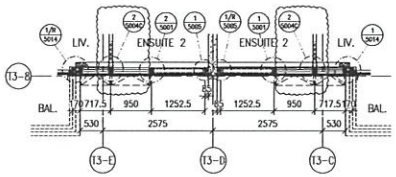

5 PART PLAN FOR CURTAIN WALL

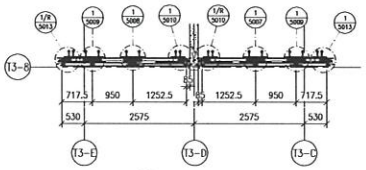

6 PART PLAN FOR CURTAIN WALL

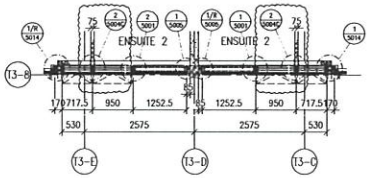

7 PART PLAN FOR CURTAIN WALL

FLOOR LEVEL (S.F.L.)

FLOOR	LEVEL
ROOF	+210.00
26/F	+206.70
25/F	+203.40
23/F	+200.00
22/F	+196.85
21/F	+193.70
20/F	+190.55
19/F	+187.40
18/F	+184.25
17/F	+181.10
16/F	+177.80
15/F	+174.65
12/F	+171.50
11/F	+168.35
10/F	+165.20
9/F	+162.05
8/F	+158.90
7/F	+155.75
6/F	+152.60
5/F	+149.30

LEGEND:

- 10mm HEAT STRENGTHENED GLASS (OUTER) + 12mm AIR SPACE +12mm THK. TEMPERED CLEAR GLASS (INNER)
- 10mm HEAT STRENGTHENED GLASS (OUTER) + 12mm AIR SPACE +10mm THK. TEMPERED CLEAR GLASS (INNER)
- 12mm THK. HEAT STRENGTHENED GLASS & 2mm THK. ALUM. BACKPAN (SPANDREL GLASS)
- 12mm THK. CLEAR TEMPERED GLASS (INTERNAL PROTECTIVE BARRIER)
- 3mm THK. ALUM. CLADDING
- S.J. – STACK JOINT (WIND LOAD)
- AE01 – ALUM. EXTRUSION DIE NO.
- ▲ – SUPPORT POINT (WIND LOAD + DEAD LOAD)
- ● – SUPPORT POINT (WIND LOAD)

B.D. REF :

CLIENT :
SHIMAO GROUP HOLDINGS LIMITED

ARCHITECT :
WONG TUNG & PARTNERS LIMITED
ARCHITECTS & PLANNERS

MAIN CONTRACTOR :
協興建築有限公司
HIP HING CONSTRUCTION CO LTD

STRUCTURAL ENGINEER :
C M WONG & ASSOCIATES LTD
黃志明建築工程師有限公司

FACADE CONSULTANT:
MEINHARDT

NOTE :
1. ALL DIMENSIONS ARE IN mm.
2. ALL ELEVATIONS ARE VIEWED FROM OUTSIDE.
3. ALL DIMENSIONS TO BE VERIFIED ON SITE BEFORE FABRICATION.

LEGEND :
X1 – DETAIL MARK NO.
X001 – REFER SHEET NO.
1. F.F.L. – FINISHED FLOOR LEVEL
2. S.F.L. – STRUCTURAL FLOOR LEVEL
3. (R) – REVERSED DETAIL

NO.	DATE	REVISED	BY
A	05-10-2021	REVISION SUBJECT TO ARCH. COMMENT	

JOB NO. : J-853

PROJECT :
PROPOSED RESIDENTIAL DEVELOPMENT AT N.K.I.L. 6542 YIN PING ROAD KOWLOON

TITLE :
PART ELEVATION FOR CURTAIN WALL AT TOWER 3

DATE : 23-OCT-21 | SCALE : 1:60 (A1)


DRAWN BY : LHR | CHECKED BY :

美特鋁質有限公司
MIDI ALUMINIUM FABRICATOR LTD.
Units 6-8, Sunray Industrial Centre, 1/F
610 Cha Kwo Ling Road, Kowloon
Tel:23489211-4 Fax:(852)27727666

DWG NO. : J853-SD-CW-4304A | REV. : B

LEGEND :


R.S. = RESTRAINT SOCKET

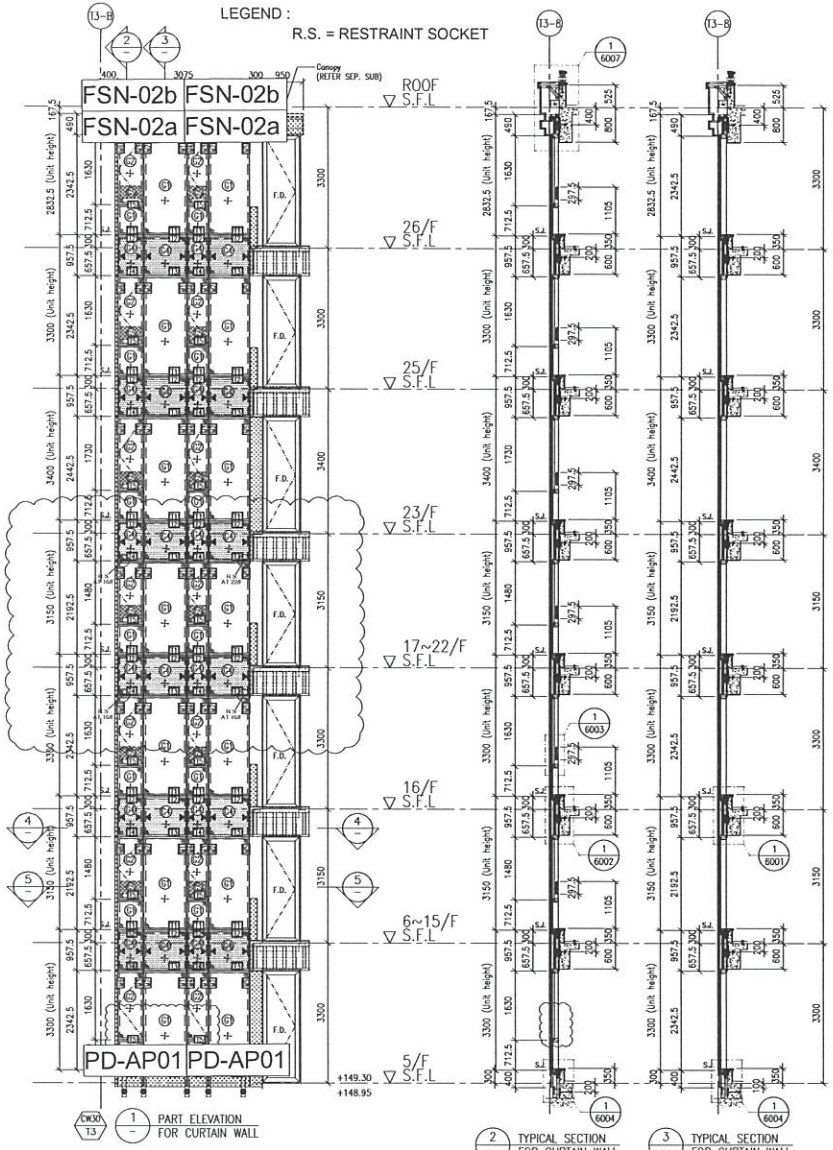


1 PART ELEVATION FOR CURTAIN WALL

2 TYPICAL SECTION FOR CURTAIN WALL


3 TYPICAL SECTION FOR CURTAIN WALL

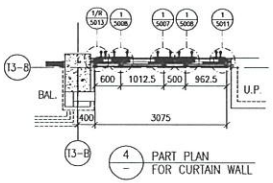


4 PART PLAN FOR CURTAIN WALL

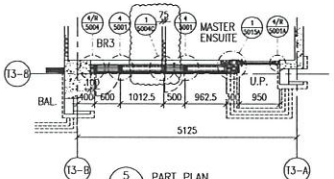


5 PART PLAN FOR CURTAIN WALL

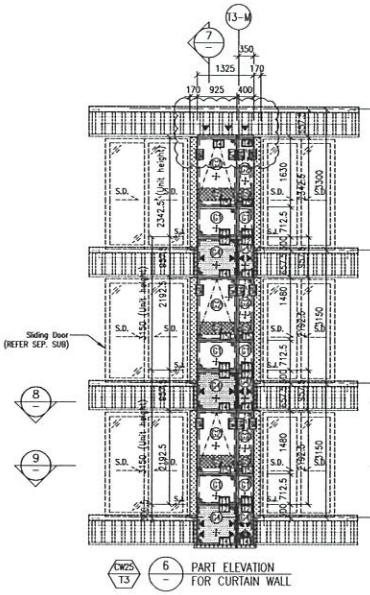


6 PART ELEVATION FOR CURTAIN WALL

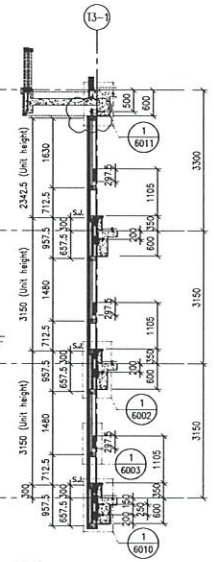

7 TYPICAL SECTION FOR CURTAIN WALL

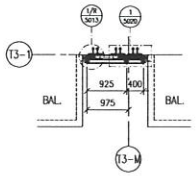

8 PART PLAN FOR CURTAIN WALL

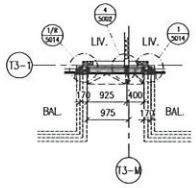

9 PART PLAN FOR CURTAIN WALL

FLOOR LEVEL (S.F.L.)

FLOOR	LEVEL
ROOF	+210.00
26/F	+206.70
25/F	+203.40
23/F	+200.00
22/F	+196.85
21/F	+193.70
20/F	+190.55
19/F	+187.40
18/F	+184.25
17/F	+181.10
16/F	+177.80
15/F	+174.65
12/F	+171.50
11/F	+168.35
10/F	+165.20
9/F	+162.05
8/F	+158.90
7/F	+155.75
6/F	+152.60
5/F	+149.30

LEGEND:

- 10mm HEAT STRENGTHENED GLASS (OUTER) + 12mm AIR SPACE +12mm THK. TEMPERED CLEAR GLASS (INNER)
- 10mm HEAT STRENGTHENED GLASS (OUTER) + 12mm AIR SPACE +10mm THK. TEMPERED CLEAR GLASS (INNER)
- 12mm THK. HEAT STRENGTHENED GLASS & 2mm THK. ALUM. BACKPAN (SPANDREL GLASS)
- 12mm THK. CLEAR TEMPERED GLASS (INTERNAL PROTECTIVE BARRIER)
- 3mm THK. ALUM. CLADDING
- S.J. – STACK JOINT (WIND LOAD)
- AE01 – ALUM. EXTRUSION DIE NO.
- ▲ – SUPPORT POINT (WIND LOAD + DEAD LOAD)
- ● – SUPPORT POINT (WIND LOAD)

B.D. REF :

CLIENT :

SHIMAO GROUP HOLDINGS LIMITED

ARCHITECT : WONG TUNG & PARTNERS LIMITED ARCHITECTS & PLANNERS

MAIN CONTRACTOR : 協興建築有限公司 HIP HING CONSTRUCTION CO LTD

STRUCTURAL ENGINEER : C M WONG & ASSOCIATES LTD 黃志明建築工程師有限公司

FACADE CONSULTANT: MEINHARDT

NOTE :

1. ALL DIMENSIONS ARE IN mm.
2. ALL ELEVATIONS ARE VIEWED FROM OUTSIDE.
3. ALL DIMENSIONS TO BE VERIFIED ON SITE BEFORE FABRICATION.

LEGEND :

X1 – DETAIL MARK NO.
X001 – REFER SHEET NO.

1. F.F.L. – FINISHED FLOOR LEVEL
2. S.F.L. – STRUCTURAL FLOOR LEVEL
3. /R – REVERSED DETAIL

NO.	DATE	REVISED	BY

JOB NO. : J-853

PROJECT :
PROPOSED RESIDENTIAL DEVELOPMENT AT N.K.I.L. 6542 YIN PING ROAD KOWLOON


TITLE :
PART ELEVATION FOR CURTAIN WALL AT TOWER 3

DATE : 05-OCT-21 | SCALE : 1:60 (A1)

DRAWN BY : LHR | CHECKED BY :

美特鋁質有限公司 MIDI ALUMINIUM FABRICATOR LTD.
Units 6-8, Sunray Industrial Centre, 1/F
610 Cha Kwo Ling Road, Kowloon
Tel:23489211-4 Fax:(852)27727666


DWG NO. : J853-SD-CW-4305 | REV. : C

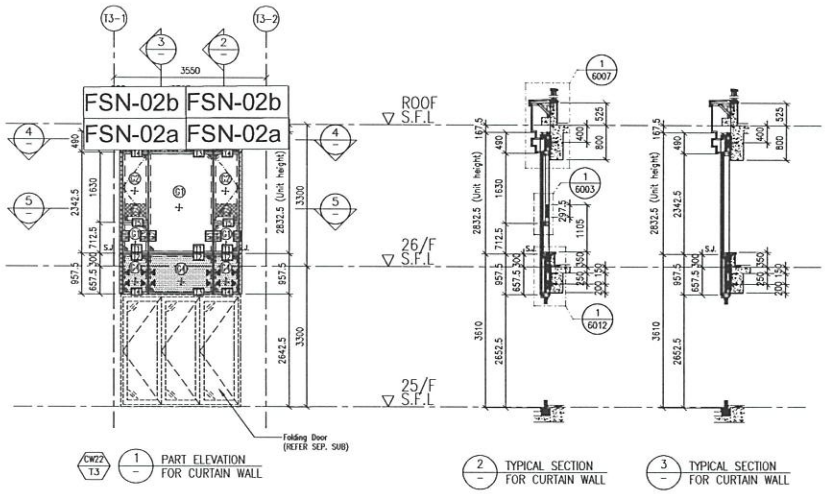


CW22 T3 — 1 — PART ELEVATION FOR CURTAIN WALL

2 — TYPICAL SECTION FOR CURTAIN WALL

3 — TYPICAL SECTION FOR CURTAIN WALL

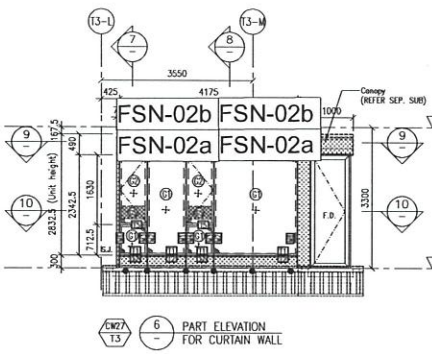


CW27 T3 — 6 — PART ELEVATION FOR CURTAIN WALL

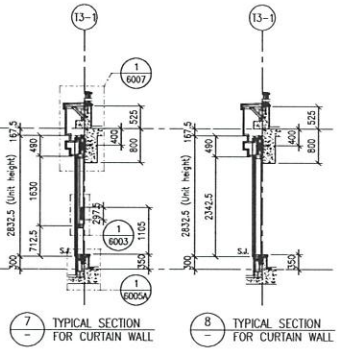


7 — TYPICAL SECTION FOR CURTAIN WALL


8 — TYPICAL SECTION FOR CURTAIN WALL

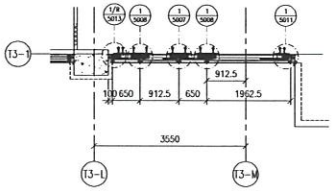


9 — PART PLAN FOR CURTAIN WALL

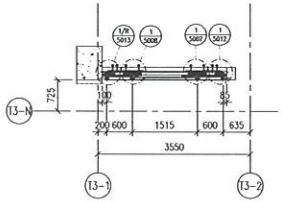

4 — PART PLAN FOR CURTAIN WALL

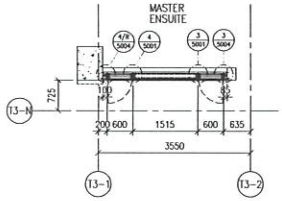

5 — PART PLAN FOR CURTAIN WALL

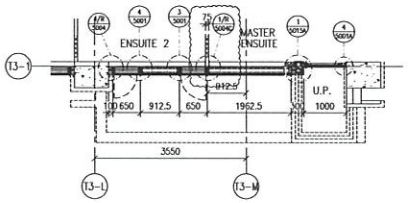

10 — PART PLAN FOR CURTAIN WALL

FLOOR LEVEL (S.F.L.)

FLOOR	LEVEL
ROOF	+210.00
26/F	+206.70
25/F	+203.40

LEGEND:

- 10mm HEAT STRENGTHENED GLASS (OUTER) + 12mm AIR SPACE +12mm THK. TEMPERED CLEAR GLASS (INNER)
- 10mm HEAT STRENGTHENED GLASS (OUTER) + 12mm AIR SPACE +10mm THK. TEMPERED CLEAR GLASS (INNER)
- 12mm THK. HEAT STRENGTHENED GLASS & 2mm THK. ALUM. BACKPAN (SPANDREL GLASS)
- 12mm THK. CLEAR TEMPERED GLASS (INTERNAL PROTECTIVE BARRIER)
- 3mm THK. ALUM. CLADDING
- S.J. – STACK JOINT (WIND LOAD)
- AE01 – ALUM. EXTRUSION DIE NO.
- ▲ – SUPPORT POINT (WIND LOAD + DEAD LOAD)
- ● – SUPPORT POINT (WIND LOAD)

B.D. REF :

CLIENT :
SHIMAO GROUP HOLDINGS LIMITED

ARCHITECT :
WONG TUNG & PARTNERS LIMITED
ARCHITECTS & PLANNERS

MAIN CONTRACTOR :
協興建築有限公司
HIP HING CONSTRUCTION CO LTD

STRUCTURAL ENGINEER :
C M WONG & ASSOCIATES LTD
黃志明建築工程師有限公司

FACADE CONSULTANT:
MEINHARDT

NOTE :
1. ALL DIMENSIONS ARE IN mm.
2. ALL ELEVATIONS ARE VIEWED FROM OUTSIDE.
3. ALL DIMENSIONS TO BE VERIFIED ON SITE BEFORE FABRICATION.

LEGEND :
X1 — DETAIL MARK NO.
X001 — REFER SHEET NO.

1. F.F.L. – – FINISHED FLOOR LEVEL
2. S.F.L. – – STRUCTURAL FLOOR LEVEL
3. /R – – REVERSED DETAIL

NO.	DATE	REVISED	BY

JOB NO. : J-853

PROJECT :
PROPOSED RESIDENTIAL DEVELOPMENT AT N.K.I.L. 6542
YIN PING ROAD
KOWLOON


TITLE :
PART ELEVATION FOR CURTAIN WALL AT TOWER 3

DATE : 05-OCT-21 | SCALE : 1:60 (A1)

DRAWN BY : LHR | CHECKED BY :

美特鋁質有限公司
MIDI ALUMINIUM FABRICATOR LTD.
Units 6-8, Sunray Industrial Centre, 1/F
610 Cha Kwo Ling Road, Kowloon
Tel:23489211-4 Fax:(852)27727666

DWG NO. : J853-SD-CW-4306 | REV. : B

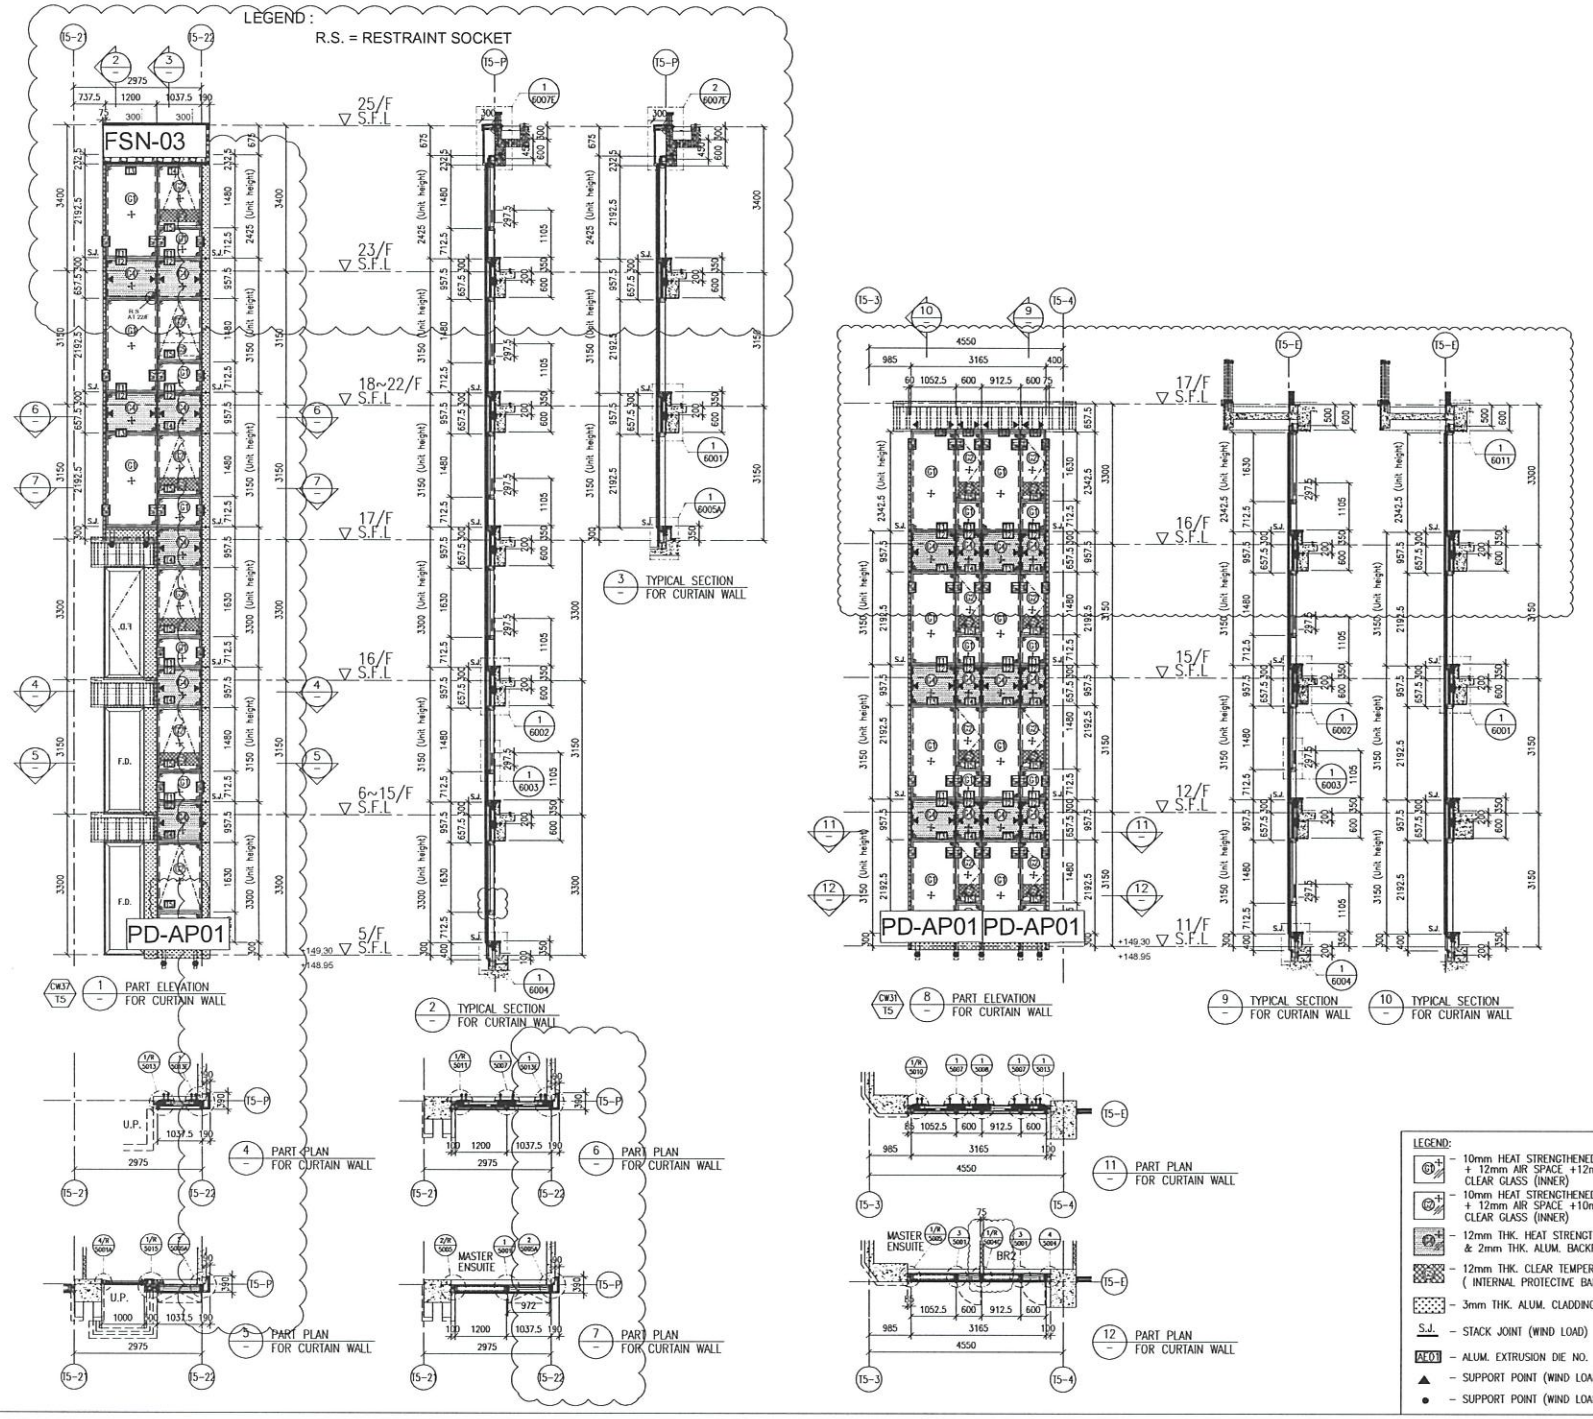

FLOOR LEVEL (S.F.L.)

FLOOR	LEVEL
25/F	+203.40
23/F	+200.00
22/F	+196.85
21/F	+193.70
20/F	+190.55
19/F	+187.40
18/F	+184.25
17/F	+181.10
16/F	+177.80
15/F	+174.65
12/F	+171.50
11/F	+168.35
10/F	+165.20
9/F	+162.05
8/F	+158.90
7/F	+155.75
6/F	+152.60
5/F	+149.30

LEGEND:

- 10mm HEAT STRENGTHENED GLASS (OUTER) + 12mm AIR SPACE +12mm THK. TEMPERED CLEAR GLASS (INNER)
- 10mm HEAT STRENGTHENED GLASS (OUTER) + 12mm AIR SPACE +10mm THK. TEMPERED CLEAR GLASS (INNER)
- 12mm THK. HEAT STRENGTHENED GLASS & 2mm THK. ALUM. BACKPAN (SPANDREL GLASS)
- 12mm THK. CLEAR TEMPERED GLASS (INTERNAL PROTECTIVE BARRIER)
- 3mm THK. ALUM. CLADDING
- S.J. – STACK JOINT (WIND LOAD)
- AE01 – ALUM. EXTRUSION DIE NO.
- ▲ – SUPPORT POINT (WIND LOAD + DEAD LOAD)
- ● – SUPPORT POINT (WIND LOAD)

B.D. REF :

CLIENT :
SHIMAO GROUP HOLDINGS LIMITED

ARCHITECT :
WONG TUNG & PARTNERS LIMITED
ARCHITECTS & PLANNERS

MAIN CONTRACTOR :
協興建築有限公司
HIP HING CONSTRUCTION CO LTD

STRUCTURAL ENGINEER :
C M WONG & ASSOCIATES LTD
黃志明建築工程師有限公司

FACADE CONSULTANT:
MEINHARDT

NOTE :
1. ALL DIMENSIONS ARE IN mm.
2. ALL ELEVATIONS ARE VIEWED FROM OUTSIDE.
3. ALL DIMENSIONS TO BE VERIFIED ON SITE BEFORE FABRICATION.

LEGEND :
- X1 / X001 – DETAIL MARK NO. / REFER SHEET NO.
1. F.F.L. – FINISHED FLOOR LEVEL
2. S.F.L. – STRUCTURAL FLOOR LEVEL
3. /R – REVERSED DETAIL

NO.	DATE	REVISED	BY
A	06-10-2021	REVISION SUBJECT TO ARCH. COMMENT	

JOB NO. : J-853

PROJECT :
PROPOSED RESIDENTIAL DEVELOPMENT AT N.K.I.L. 6542
YIN PING ROAD
KOWLOON


TITLE :
PART ELEVATION FOR CURTAIN WALL AT TOWER 5

DATE : 31-MAR-21 | SCALE : 1:60 (A1)
DRAWN BY : LHR | CHECKED BY :

美特鋁質有限公司
MIDI ALUMINIUM FABRICATOR LTD.
Units 6-8, Sunray Industrial Centre, 1/F
610 Cha Kwo Ling Road, Kowloon
Tel:23489211-4 Fax:(852)27727666

DWG NO. : J853-SD-CW-4501 | REV. : B

LEGEND :
R.S. = RESTRAINT SOCKET

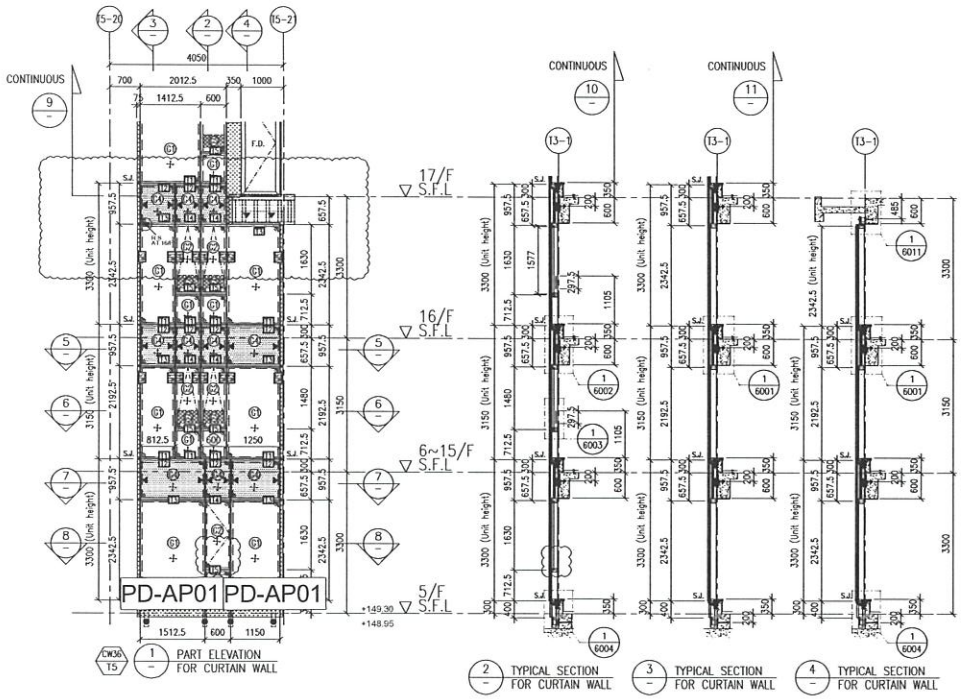


1 PART ELEVATION FOR CURTAIN WALL

2 TYPICAL SECTION FOR CURTAIN WALL

3 TYPICAL SECTION FOR CURTAIN WALL


4 TYPICAL SECTION FOR CURTAIN WALL

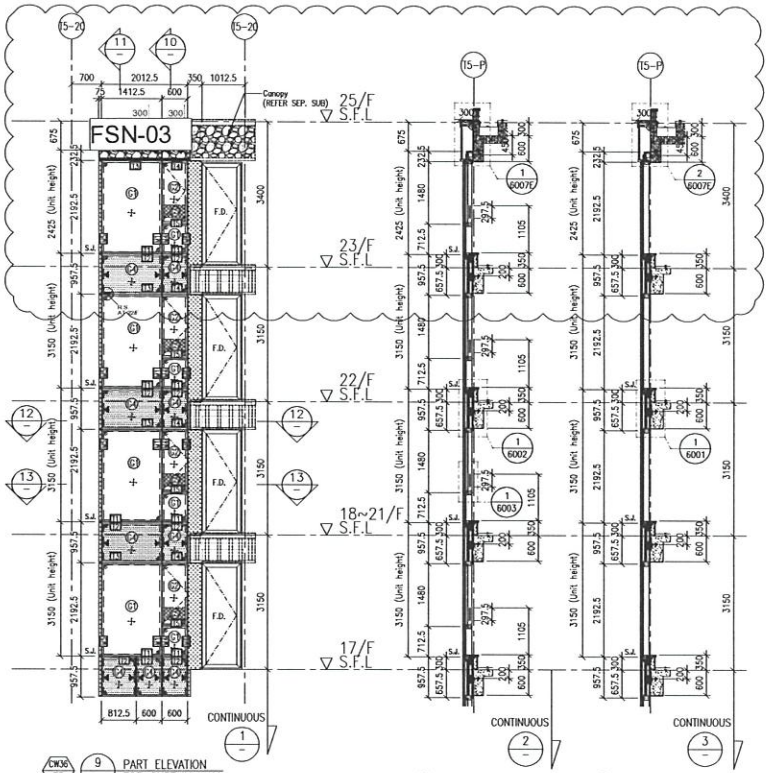


9 PART ELEVATION FOR CURTAIN WALL

10 TYPICAL SECTION FOR CURTAIN WALL


11 TYPICAL SECTION FOR CURTAIN WALL

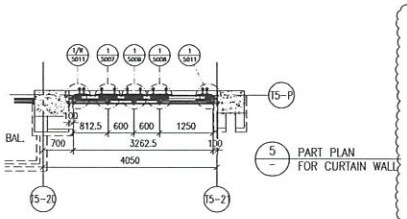


5 PART PLAN FOR CURTAIN WALL

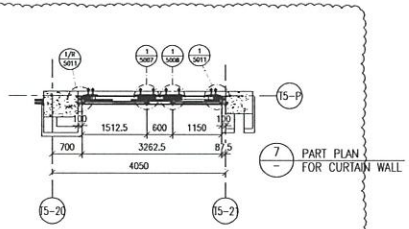


7 PART PLAN FOR CURTAIN WALL

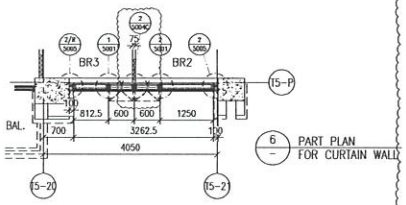


6 PART PLAN FOR CURTAIN WALL

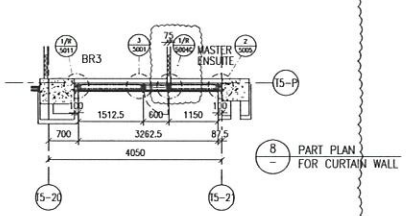

8 PART PLAN FOR CURTAIN WALL

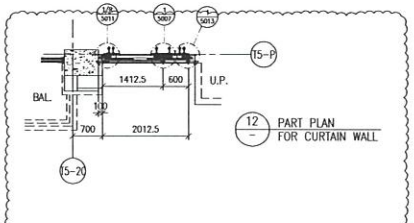

12 PART PLAN FOR CURTAIN WALL

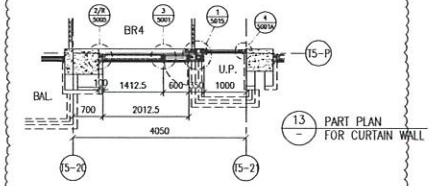

13 PART PLAN FOR CURTAIN WALL

FLOOR LEVEL (S.F.L.)

FLOOR	LEVEL
25/F	+203.40
23/F	+200.00
22/F	+196.85
21/F	+193.70
20/F	+190.55
19/F	+187.40
18/F	+184.25
17/F	+181.10
16/F	+177.80
15/F	+174.65
12/F	+171.50
11/F	+168.35
10/F	+165.20
9/F	+162.05
8/F	+158.90
7/F	+155.75
6/F	+152.60
5/F	+149.30

LEGEND:
- 10mm HEAT STRENGTHENED GLASS (OUTER) + 12mm AIR SPACE +12mm THK. TEMPERED CLEAR GLASS (INNER)
- 10mm HEAT STRENGTHENED GLASS (OUTER) + 12mm AIR SPACE +10mm THK. TEMPERED CLEAR GLASS (INNER)
- 12mm THK. HEAT STRENGTHENED GLASS & 2mm THK. ALUM. BACKPAN (SPANDREL GLASS)
- 12mm THK. CLEAR TEMPERED GLASS (INTERNAL PROTECTIVE BARRIER)
- 3mm THK. ALUM. CLADDING
- S.J. – STACK JOINT (WIND LOAD)
- AP01 – ALUM. EXTRUSION DIE NO.
- ▲ – SUPPORT POINT (WIND LOAD + DEAD LOAD)
- ● – SUPPORT POINT (WIND LOAD)

B.D. REF :

CLIENT :
SHIMAO GROUP HOLDINGS LIMITED

ARCHITECT :
WONG TUNG & PARTNERS LIMITED
ARCHITECTS & PLANNERS

MAIN CONTRACTOR :
協興建築有限公司
HIP HING CONSTRUCTION CO LTD

STRUCTURAL ENGINEER :
C M WONG & ASSOCIATES LTD
黃志明建築工程師有限公司

FACADE CONSULTANT:
MEINHARDT

NOTE :
1. ALL DIMENSIONS ARE IN mm.
2. ALL ELEVATIONS ARE VIEWED FROM OUTSIDE.
3. ALL DIMENSIONS TO BE VERIFIED ON SITE BEFORE FABRICATION.

LEGEND :
- X1 – DETAIL MARK NO.
- X001 – REFER SHEET NO.

1. F.F.L. --FINISHED FLOOR LEVEL
2. S.F.L. --STRUCTURAL FLOOR LEVEL
3. /R --REVERSED DETAIL

NO.	DATE	REVISED	BY
A	06-10-2021	REVISION SUBJECT TO ARCH. COMMENT	

JOB NO. : J-853

PROJECT :
PROPOSED RESIDENTIAL DEVELOPMENT AT N.K.I.L. 6542 YIN PING ROAD KOWLOON

TITLE :
PART ELEVATION FOR CURTAIN WALL AT TOWER 5


DATE : 31-MAR-21 | SCALE : 1:60 (A1)

DRAWN BY : LHR | CHECKED BY :

美特鋁製有限公司
MIDI ALUMINIUM FABRICATOR LTD.
Units 6-8, Sunray Industrial Centre, 1/F
610 Cha Kwo Ling Road, Kowloon
Tel:23489211-4 Fax:(852)27727666


DWG NO. : J853-SD-CW-4502 | REV. : B

LEGEND :
R.S. = RESTRAINT SOCKET

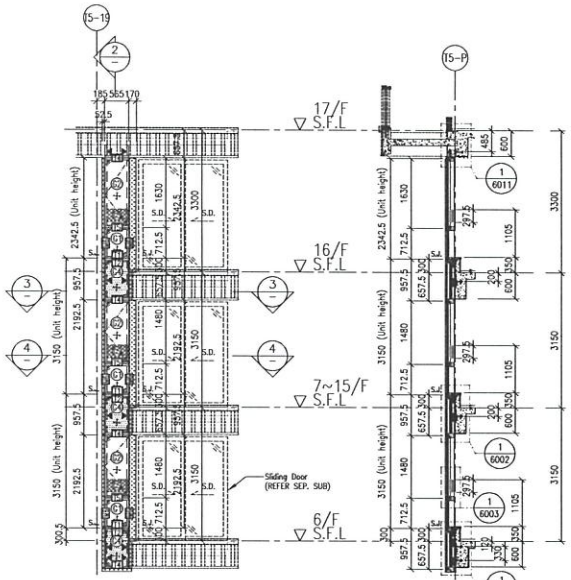


CW35 T5 1 – PART ELEVATION FOR CURTAIN WALL


2 – TYPICAL SECTION FOR CURTAIN WALL

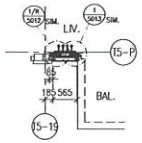

3 – PART PLAN FOR CURTAIN WALL

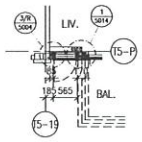


4 – PART PLAN FOR CURTAIN WALL

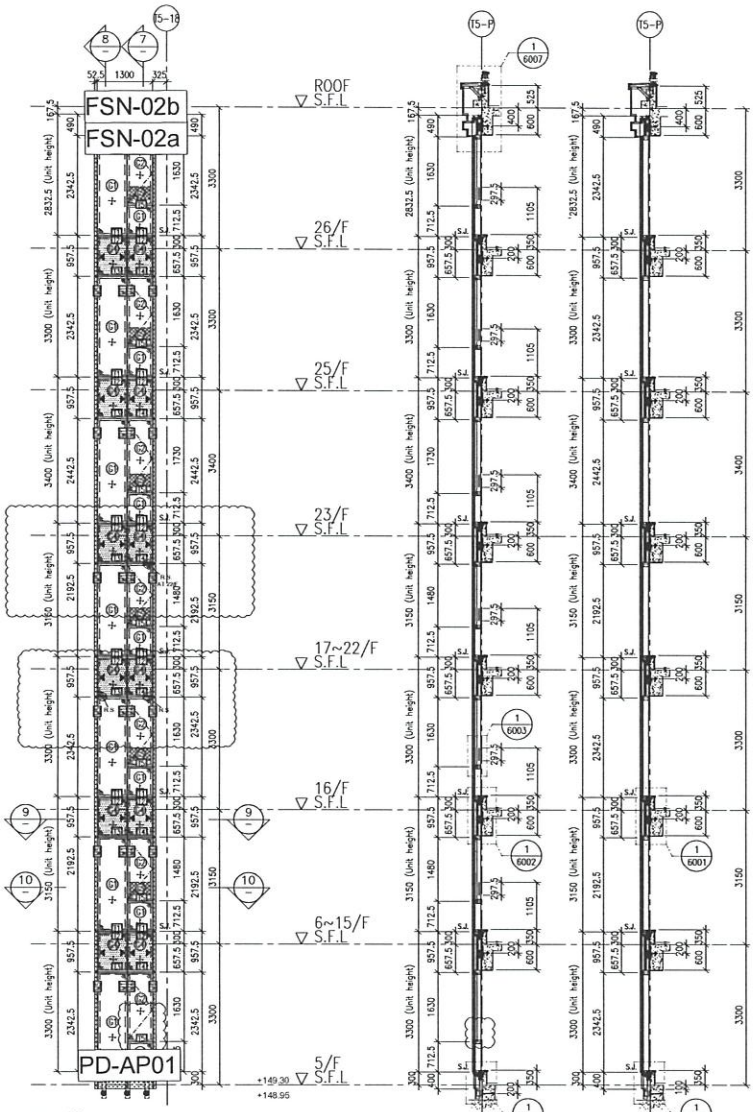


CW34 T5 6 – PART ELEVATION FOR CURTAIN WALL

7 – TYPICAL SECTION FOR CURTAIN WALL

8 – TYPICAL SECTION FOR CURTAIN WALL

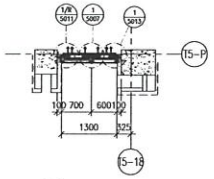

9 – PART PLAN FOR CURTAIN WALL

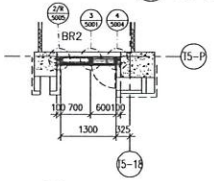

10 – PART PLAN FOR CURTAIN WALL

FLOOR LEVEL (S.F.L.)

FLOOR	LEVEL
ROOF	+210.00
26/F	+206.70
25/F	+203.40
23/F	+200.00
22/F	+196.85
21/F	+193.70
20/F	+190.55
19/F	+187.40
18/F	+184.25
17/F	+181.10
16/F	+177.80
15/F	+174.65
12/F	+171.50
11/F	+168.35
10/F	+165.20
9/F	+162.05
8/F	+158.90
7/F	+155.75
6/F	+152.60
5/F	+149.30

LEGEND:

- 10mm HEAT STRENGTHENED GLASS (OUTER) + 12mm AIR SPACE +12mm THK. TEMPERED CLEAR GLASS (INNER)
- 10mm HEAT STRENGTHENED GLASS (OUTER) + 12mm AIR SPACE +10mm THK. TEMPERED CLEAR GLASS (INNER)
- 12mm THK. HEAT STRENGTHENED GLASS & 2mm THK. ALUM. BACKPAN (SPANDREL GLASS)
- 12mm THK. CLEAR TEMPERED GLASS (INTERNAL PROTECTIVE BARRIER)
- 3mm THK. ALUM. CLADDING
- S.J. – STACK JOINT (WIND LOAD)
- AE01 – ALUM. EXTRUSION DIE NO.
- ▲ – SUPPORT POINT (WIND LOAD + DEAD LOAD)
- ● – SUPPORT POINT (WIND LOAD)

B.D. REF :

CLIENT :
SHIMAO GROUP HOLDINGS LIMITED

ARCHITECT :
WONG TUNG & PARTNERS LIMITED
ARCHITECTS & PLANNERS

MAIN CONTRACTOR :
協興建築有限公司
HIP HING CONSTRUCTION CO LTD

STRUCTURAL ENGINEER :
C M WONG & ASSOCIATES LTD
黃志明建築工程師有限公司

FACADE CONSULTANT:
MEINHARDT

NOTE :
1. ALL DIMENSIONS ARE IN mm.
2. ALL ELEVATIONS ARE VIEWED FROM OUTSIDE.
3. ALL DIMENSIONS TO BE VERIFIED ON SITE BEFORE FABRICATION.

LEGEND :
- X1 / X001 – DETAIL MARK NO. / REFER SHEET NO.
1. F.F.L. --FINISHED FLOOR LEVEL
2. S.F.L. --STRUCTURAL FLOOR LEVEL
3. /R --REVERSED DETAIL

NO.	DATE	REVISED	BY
A	06-10-2021	REVISION SUBJECT TO ARCH. COMMENT	

JOB NO. : J-853

PROJECT :
PROPOSED RESIDENTIAL DEVELOPMENT AT N.K.I.L. 6542 YIN PING ROAD KOWLOON


TITLE :
PART ELEVATION FOR CURTAIN WALL AT TOWER 5

DATE : 31-MAR-21 | SCALE : 1:60 (A1)

DRAWN BY : LHR | CHECKED BY :

美特鋁質有限公司
MIDI ALUMINIUM FABRICATOR LTD.
Units 6-8, Sunray Industrial Centre, 1/F
610 Cha Kwo Ling Road, Kowloon
Tel:23489211-4 Fax:(852)27727666

DWG NO. : J853-SD-CW-4503 | REV. : B

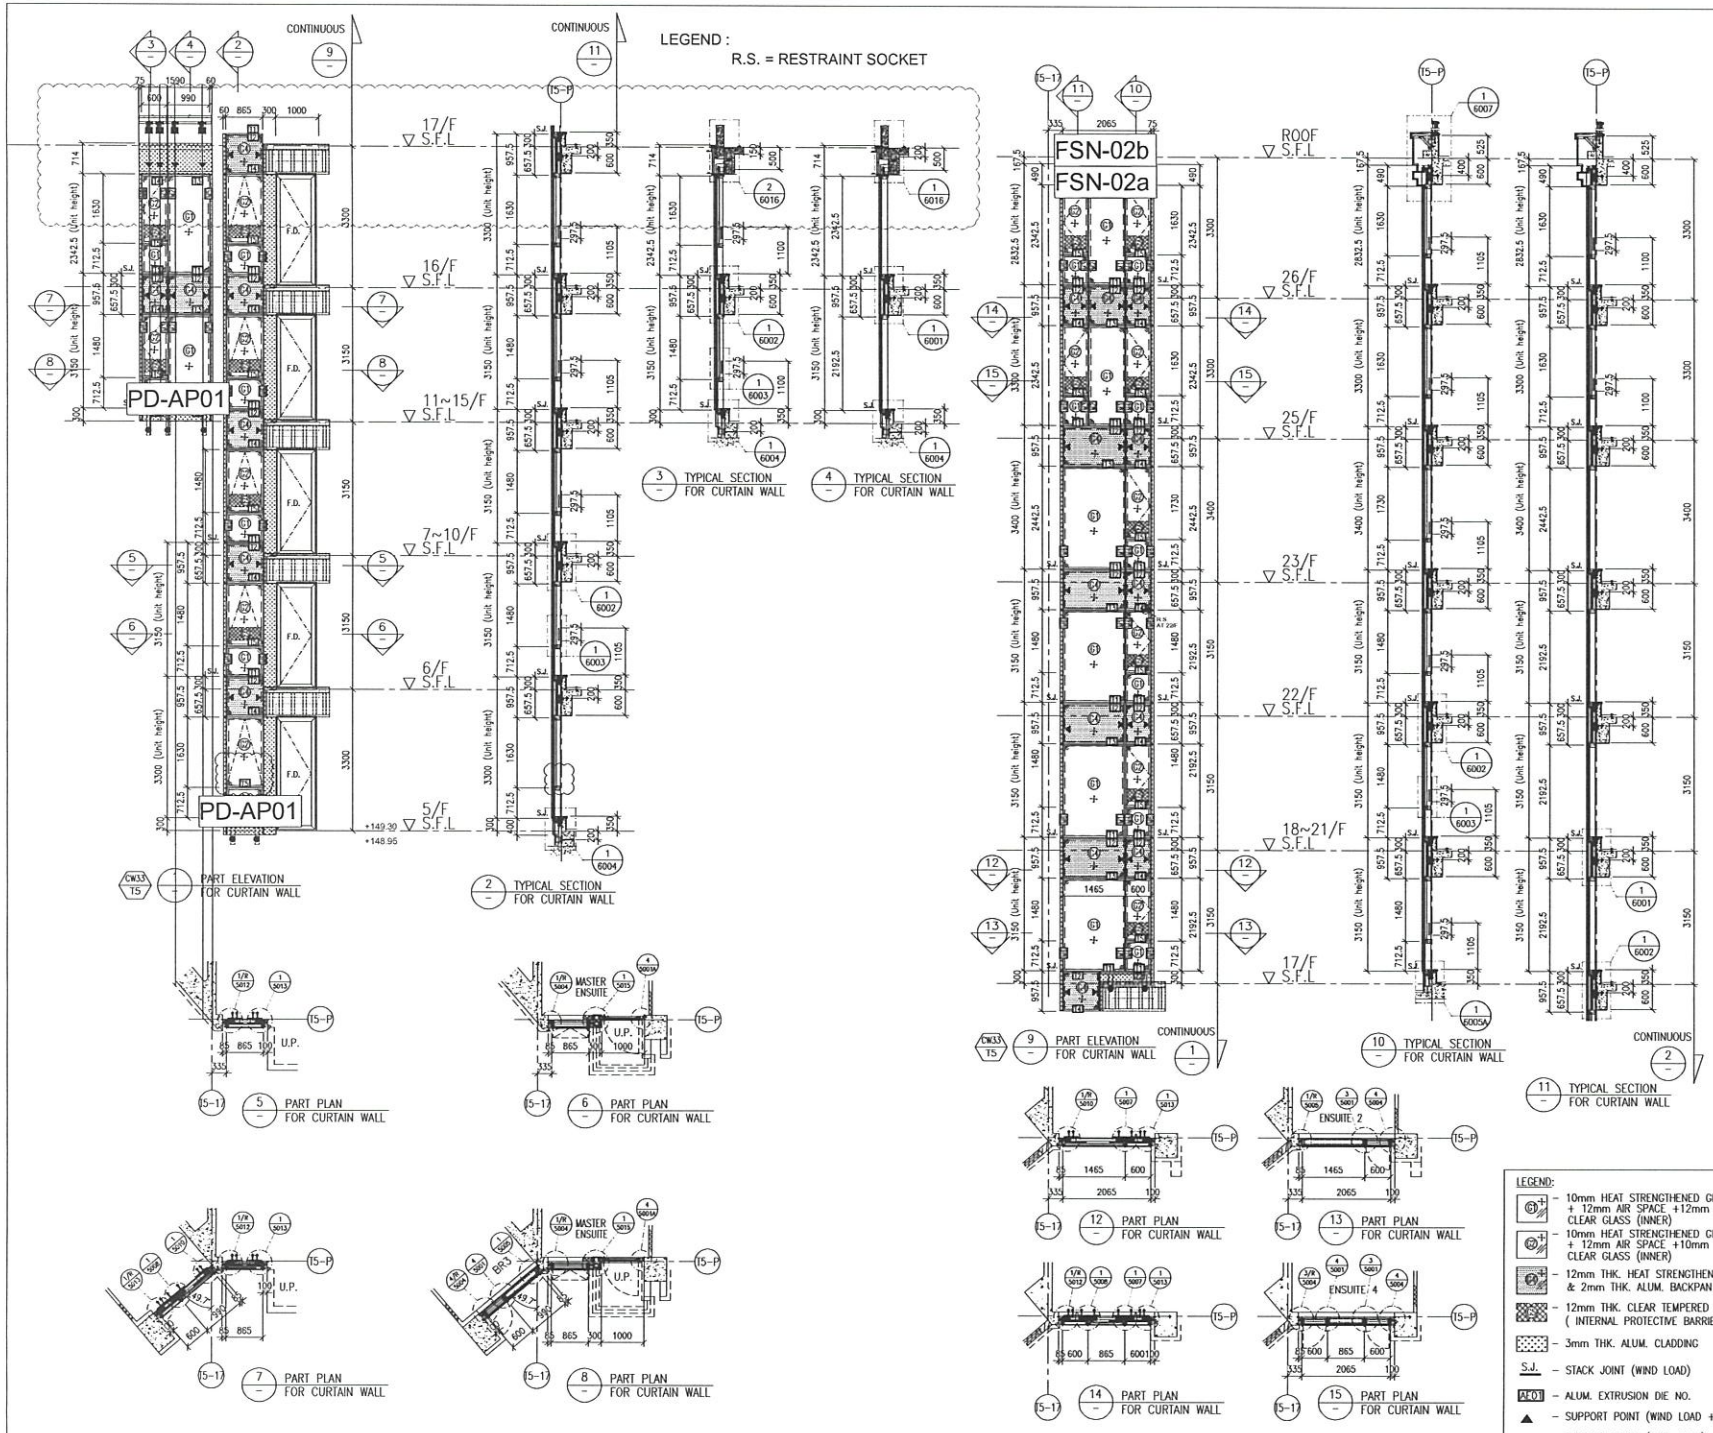

FLOOR LEVEL (S.F.L.)

FLOOR	LEVEL
ROOF	+210.00
26/F	+206.70
25/F	+203.40
23/F	+200.00
22/F	+196.85
21/F	+193.70
20/F	+190.55
19/F	+187.40
18/F	+184.25
17/F	+181.10
16/F	+177.80
15/F	+174.65
12/F	+171.50
11/F	+168.35
10/F	+165.20
9/F	+162.05
8/F	+158.90
7/F	+155.75
6/F	+152.60
5/F	+149.30

LEGEND:
- 10mm HEAT STRENGTHENED GLASS (OUTER) + 12mm AIR SPACE +12mm THK. TEMPERED CLEAR GLASS (INNER)
- 10mm HEAT STRENGTHENED GLASS (OUTER) + 12mm AIR SPACE +10mm THK. TEMPERED CLEAR GLASS (INNER)
- 12mm THK. HEAT STRENGTHENED GLASS & 2mm THK. ALUM. BACKPAN (SPANDREL GLASS)
- 12mm THK. CLEAR TEMPERED GLASS (INTERNAL PROTECTIVE BARRIER)
- 3mm THK. ALUM. CLADDING
- S.J. – STACK JOINT (WIND LOAD)
- AF01 – ALUM. EXTRUSION DIE NO.
- ▲ – SUPPORT POINT (WIND LOAD + DEAD LOAD)
- ● – SUPPORT POINT (WIND LOAD)

B.D. REF :

CLIENT :
SHIMAO GROUP HOLDINGS LIMITED

ARCHITECT :
WONG TUNG & PARTNERS LIMITED
ARCHITECTS & PLANNERS

MAIN CONTRACTOR :
協興建築有限公司
HIP HING CONSTRUCTION CO LTD

STRUCTURAL ENGINEER :
C M WONG & ASSOCIATES LTD
黃志明建築工程師有限公司

FACADE CONSULTANT:
MEINHARDT

NOTE :
1. ALL DIMENSIONS ARE IN mm.
2. ALL ELEVATIONS ARE VIEWED FROM OUTSIDE.
3. ALL DIMENSIONS TO BE VERIFIED ON SITE BEFORE FABRICATION.

LEGEND :
- X1 / X001 – DETAIL MARK NO. / REFER SHEET NO.
1. F.F.L. --FINISHED FLOOR LEVEL
2. S.F.L. --STRUCTURAL FLOOR LEVEL
3. /R --REVERSED DETAIL

NO.	DATE	REVISED	BY
A	06-10-2021	REVISION SUBJECT TO ARCH. COMMENT	

JOB NO. : J-853

PROJECT :
PROPOSED RESIDENTIAL DEVELOPMENT AT N.K.I.L. 6542 YIN PING ROAD KOWLOON


TITLE :
PART ELEVATION FOR CURTAIN WALL AT TOWER 5

DATE : 01-APR-21 | SCALE : 1:60 (A1)

DRAWN BY : LHR | CHECKED BY :


美特鋁質有限公司
MIDI ALUMINIUM FABRICATOR LTD.
Units 6-8, Sunray Industrial Centre, 1/F
610 Cha Kwo Ling Road, Kowloon
Tel:23489211-4 Fax:(852)27727666

DWG NO. : J853-SD-CW-4504 | REV. : C

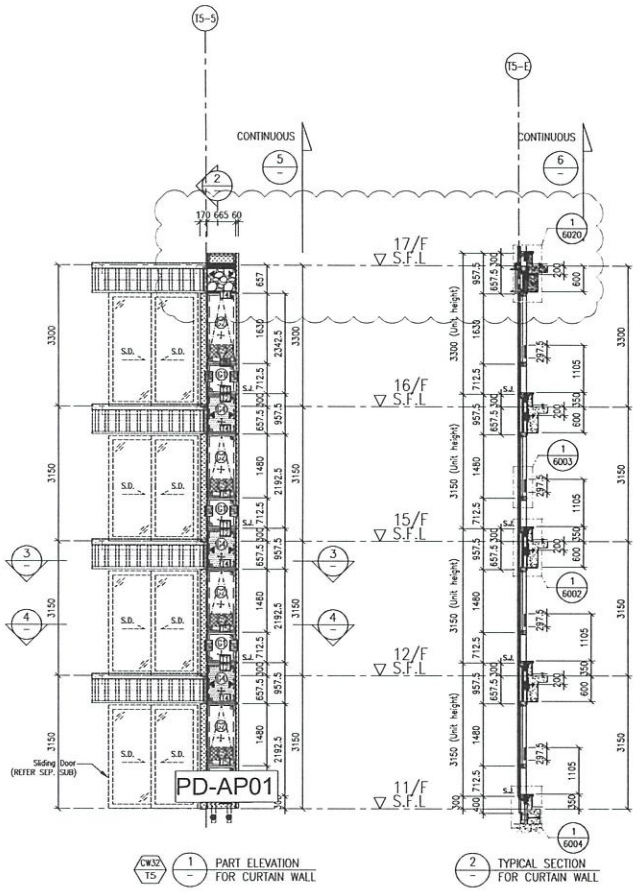


CW32/15 1 — PART ELEVATION FOR CURTAIN WALL

2 — TYPICAL SECTION FOR CURTAIN WALL

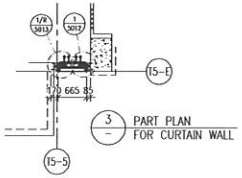


3 — PART PLAN FOR CURTAIN WALL

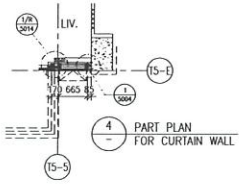


4 — PART PLAN FOR CURTAIN WALL


LEGEND :
R.S. = RESTRAINT SOCKET

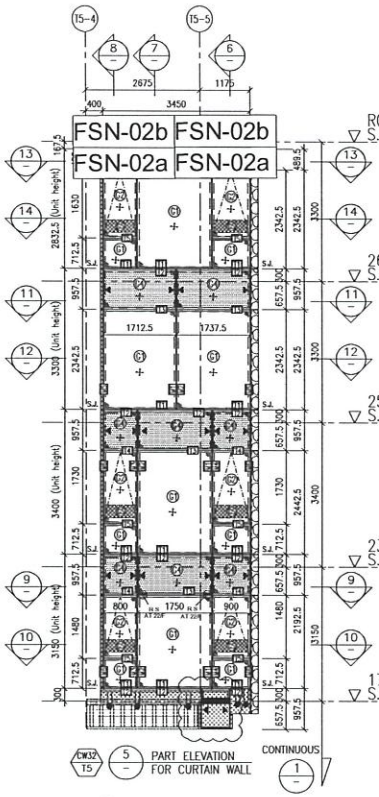

CW32/15 5 — PART ELEVATION FOR CURTAIN WALL

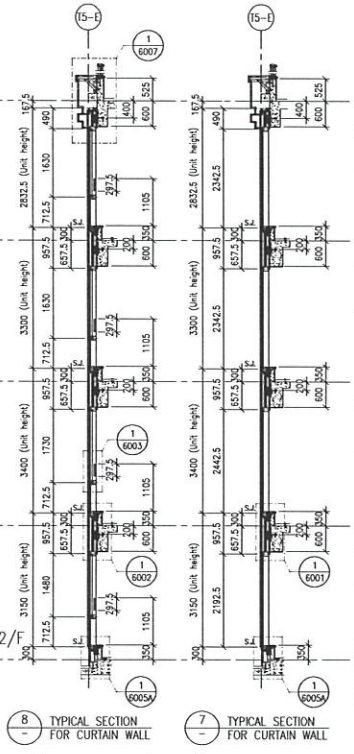


8 — TYPICAL SECTION FOR CURTAIN WALL

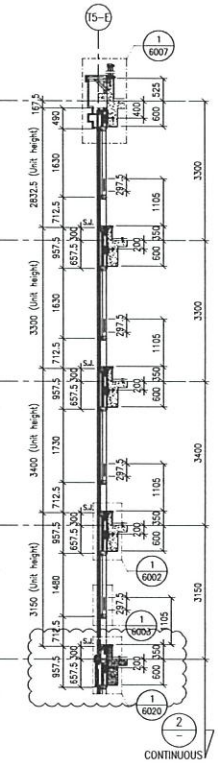




6 — TYPICAL SECTION FOR CURTAIN WALL

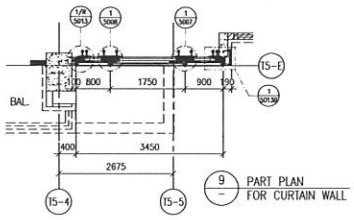


9 — PART PLAN FOR CURTAIN WALL

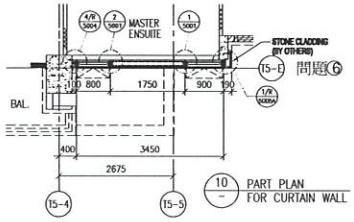


10 — PART PLAN FOR CURTAIN WALL

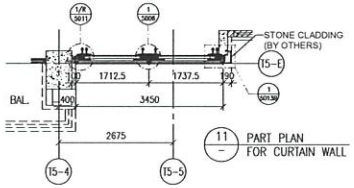


11 — PART PLAN FOR CURTAIN WALL

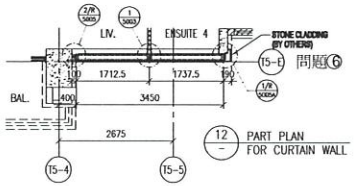

12 — PART PLAN FOR CURTAIN WALL

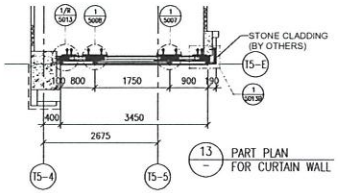

13 — PART PLAN FOR CURTAIN WALL

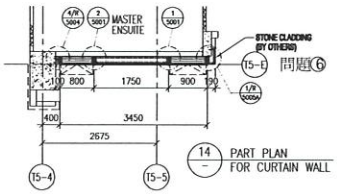

14 — PART PLAN FOR CURTAIN WALL

FLOOR LEVEL (S.F.L.)

FLOOR	LEVEL
ROOF	+210.00
26/F	+206.70
25/F	+203.40
23/F	+200.00
22/F	+196.85
21/F	+193.70
20/F	+190.55
19/F	+187.40
18/F	+184.25
17/F	+181.10
16/F	+177.80
15/F	+174.65
12/F	+171.50
11/F	+168.35

LEGEND:
- 6D+ — 10mm HEAT STRENGTHENED GLASS (OUTER) + 12mm AIR SPACE +12mm THK. TEMPERED CLEAR GLASS (INNER)
- 6D+ — 10mm HEAT STRENGTHENED GLASS (OUTER) + 12mm AIR SPACE +10mm THK. TEMPERED CLEAR GLASS (INNER)
- 6P+ — 12mm THK. HEAT STRENGTHENED GLASS & 2mm THK. ALUM. BACKPAN (SPANDREL GLASS)
- 12mm THK. CLEAR TEMPERED GLASS (INTERNAL PROTECTIVE BARRIER)
- 3mm THK. ALUM. CLADDING
- S.J. — STACK JOINT (WIND LOAD)
- AE01 — ALUM. EXTRUSION DIE NO.
- ▲ — SUPPORT POINT (WIND LOAD + DEAD LOAD)
- ● — SUPPORT POINT (WIND LOAD)

B.D. REF :

CLIENT :
SHIMAO GROUP HOLDINGS LIMITED

ARCHITECT :
WONG TUNG & PARTNERS LIMITED
ARCHITECTS & PLANNERS

MAIN CONTRACTOR :
協興建築有限公司
HIP HING CONSTRUCTION CO LTD

STRUCTURAL ENGINEER :
C M WONG & ASSOCIATES LTD
黃志明建築工程師有限公司

FACADE CONSULTANT:
MEINHARDT

NOTE :
1. ALL DIMENSIONS ARE IN mm.
2. ALL ELEVATIONS ARE VIEWED FROM OUTSIDE.
3. ALL DIMENSIONS TO BE VERIFIED ON SITE BEFORE FABRICATION.

LEGEND :
X1 — DETAIL MARK NO.
X001 — REFER SHEET NO.

1. F.F.L. --FINISHED FLOOR LEVEL
2. S.F.L. --STRUCTURAL FLOOR LEVEL
3. /R --REVERSED DETAIL

NO.	DATE	REVISED	BY
A	06-10-2021	REVISION SUBJECT TO ARCH. COMMENT	

JOB NO. : J-853

PROJECT :
PROPOSED RESIDENTIAL DEVELOPMENT AT N.K.I.L. 6542 YIN PING ROAD KOWLOON


TITLE :
PART ELEVATION FOR CURTAIN WALL AT TOWER 5

DATE : 01-APR-21 | SCALE : 1:60 (A1)

DRAWN BY : LHR | CHECKED BY :

美特鋁質有限公司
MIDI ALUMINIUM FABRICATOR LTD.
Units 6-8, Sunray Industrial Centre, 1/F
610 Cha Kwo Ling Road, Kowloon
Tel:23489211-4 Fax:(852)27727666

DWG NO. : J853-SD-CW-4505 | REV. : C

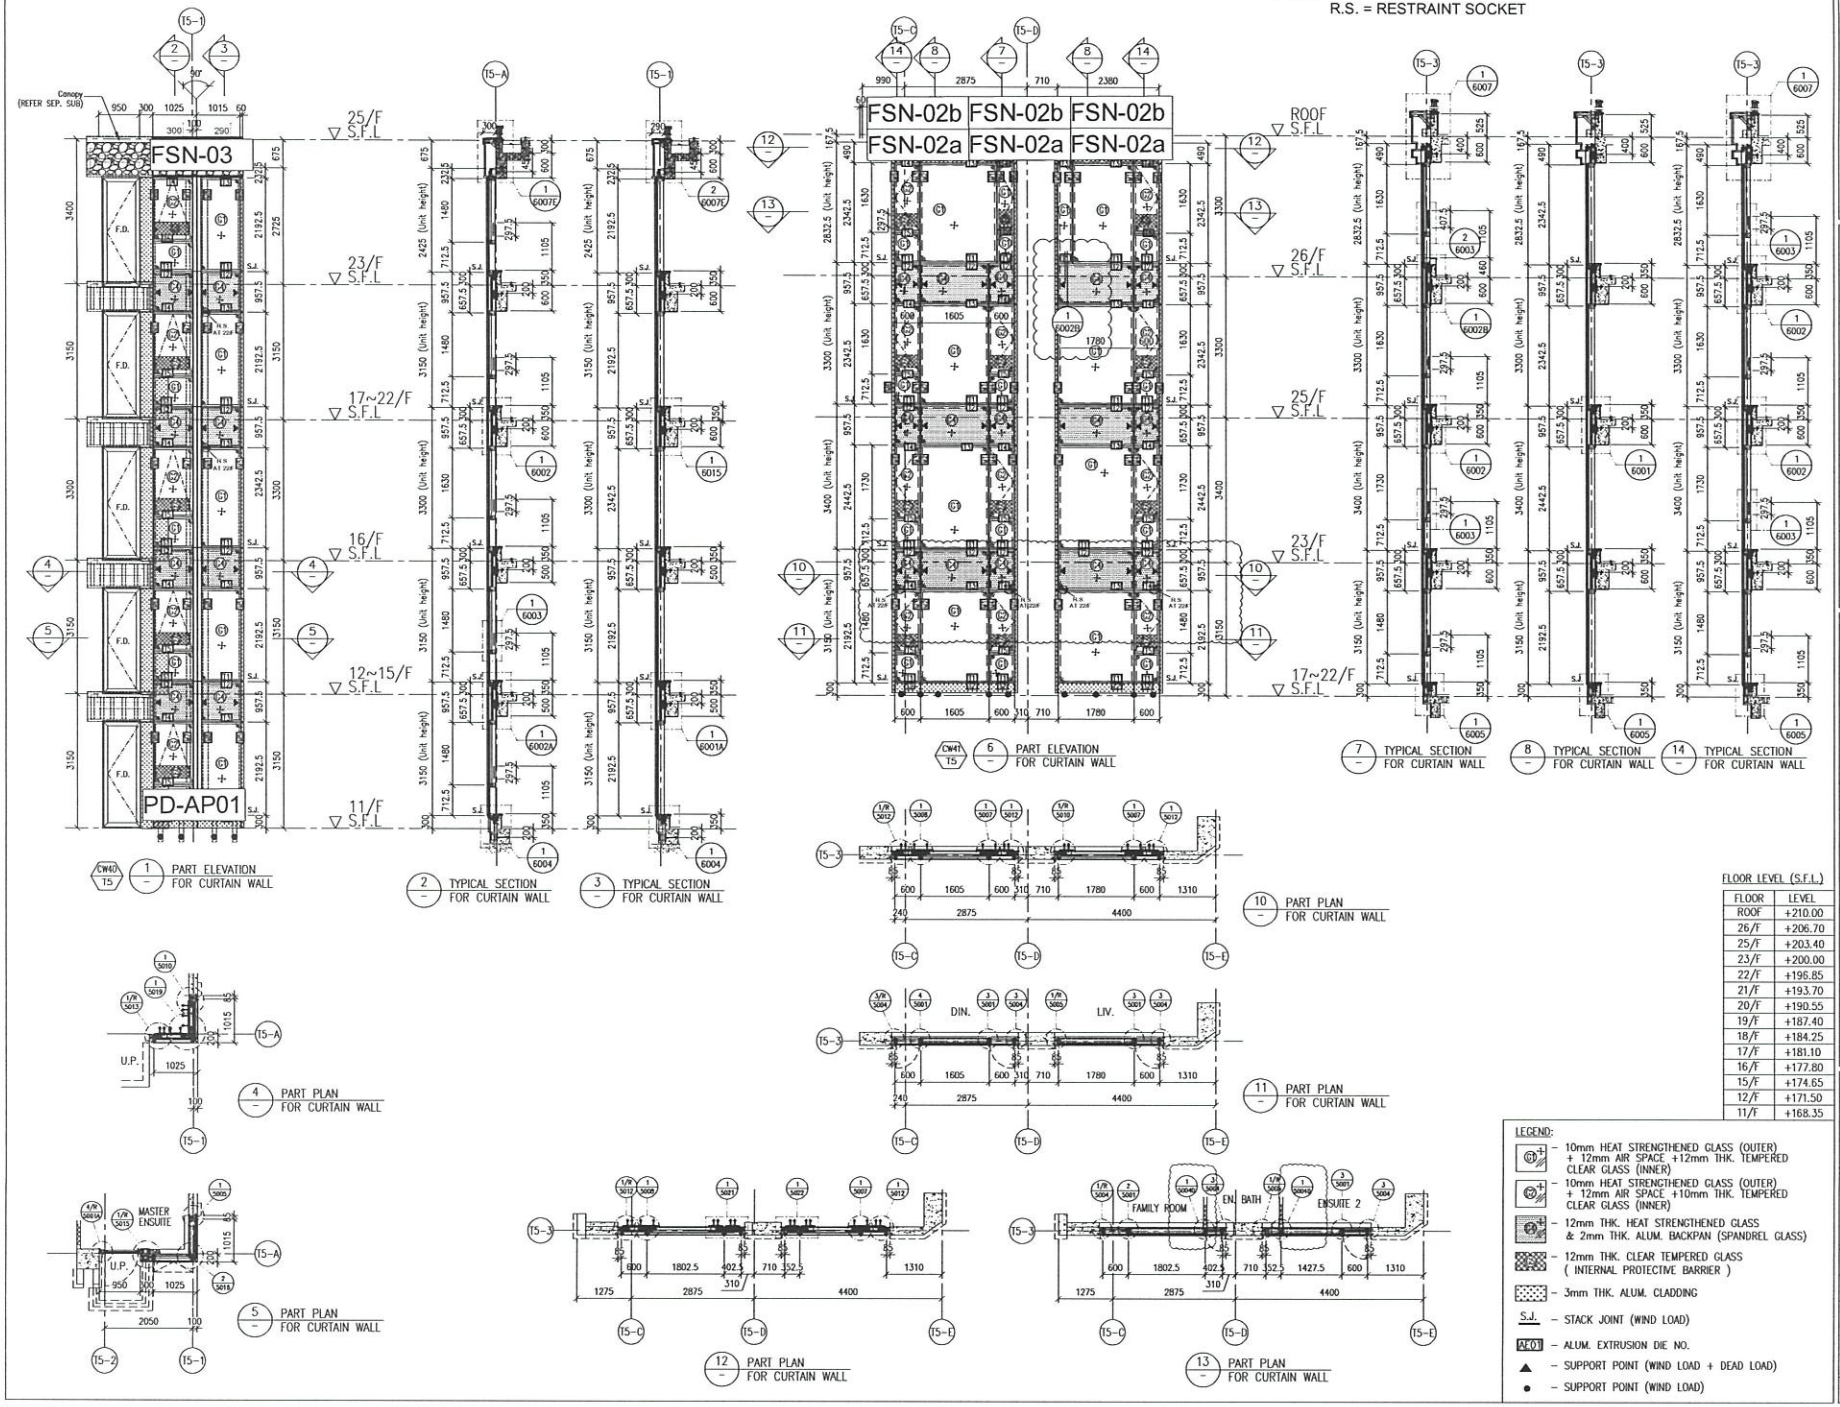

B.D. REF :

CLIENT :

SHIMAO GROUP HOLDINGS LIMITED

ARCHITECT :

WONG TUNG & PARTNERS LIMITED
ARCHITECTS & PLANNERS

MAIN CONTRACTOR :

協興建築有限公司
HIP HING CONSTRUCTION CO LTD

STRUCTURAL ENGINEER :

C M WONG & ASSOCIATES LTD
黃志明建築工程師有限公司

FACADE CONSULTANT:

MEINHARDT

NOTE :

1. ALL DIMENSIONS ARE IN mm.
2. ALL ELEVATIONS ARE VIEWED FROM OUTSIDE.
3. ALL DIMENSIONS TO BE VERIFIED ON SITE BEFORE FABRICATION.

LEGEND :

X1 — DETAIL MARK NO.
X001 — REFER SHEET NO.

1. F.F.L. --FINISHED FLOOR LEVEL
2. S.F.L. --STRUCTURAL FLOOR LEVEL
3. /R --REVERSED DETAIL

FLOOR LEVEL (S.F.L.)

FLOOR	LEVEL
ROOF	+210.00
26/F	+206.70
25/F	+203.40
23/F	+200.00
22/F	+196.85
21/F	+193.70
20/F	+190.55
19/F	+187.40
18/F	+184.25
17/F	+181.10
16/F	+177.80
15/F	+174.65
12/F	+171.50
11/F	+168.35

LEGEND:

- 10mm HEAT STRENGTHENED GLASS (OUTER) + 12mm AIR SPACE +12mm THK. TEMPERED CLEAR GLASS (INNER)
- 10mm HEAT STRENGTHENED GLASS (OUTER) + 12mm AIR SPACE +10mm THK. TEMPERED CLEAR GLASS (INNER)
- 12mm THK. HEAT STRENGTHENED GLASS & 2mm THK. ALUM. BACKPAN (SPANDREL GLASS)
- 12mm THK. CLEAR TEMPERED GLASS (INTERNAL PROTECTIVE BARRIER)
- 3mm THK. ALUM. CLADDING
- S.J. — STACK JOINT (WIND LOAD)
- AF01 — ALUM. EXTRUSION DIE NO.
- ▲ — SUPPORT POINT (WIND LOAD + DEAD LOAD)
- ● — SUPPORT POINT (WIND LOAD)

NO.	DATE	REVISED	BY
A	06-10-2021	REVISION SUBJECT TO ARCH. COMMENT	

JOB NO. : J-853

PROJECT :
PROPOSED RESIDENTIAL DEVELOPMENT AT N.K.I.L. 6542 YIN PING ROAD KOWLOON


TITLE :
PART ELEVATION FOR CURTAIN WALL AT TOWER 5

DATE : 05-APR-21 | SCALE : 1:60 (A1)

DRAWN BY : LHR | CHECKED BY :

美特鋁實有限公司
MIDI ALUMINIUM FABRICATOR LTD.
Units 6-8, Sunray Industrial Centre, 1/F
610 Cha Kwo Ling Road, Kowloon
Tel:23489211-4 Fax:(852)27727666

DWG NO. : J853-SD-CW-4506 | REV. : C

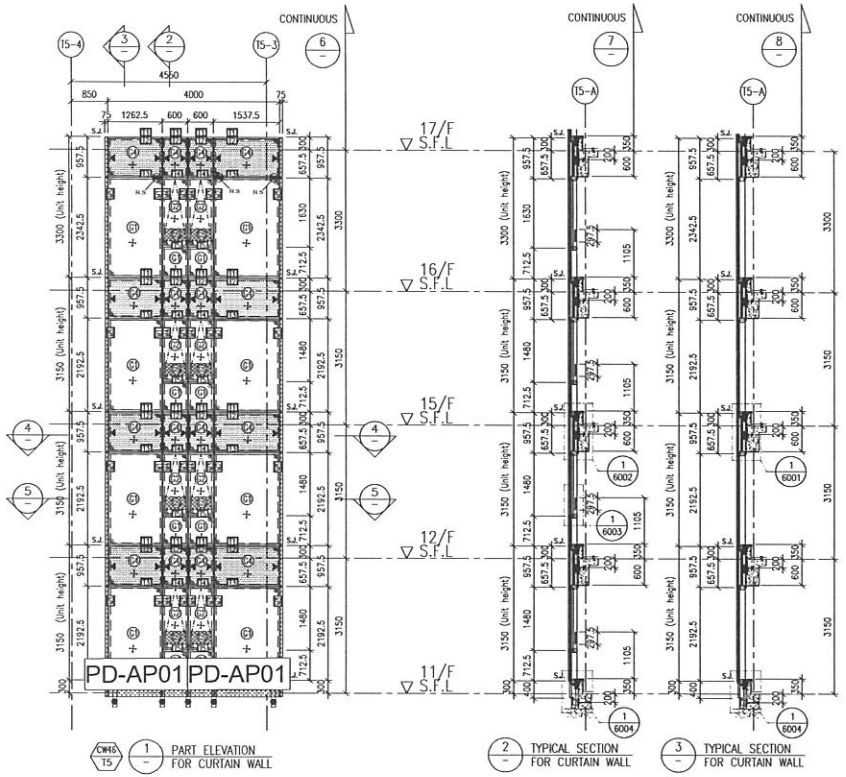


CW46 T5 — 1 — PART ELEVATION FOR CURTAIN WALL

2 — TYPICAL SECTION FOR CURTAIN WALL

3 — TYPICAL SECTION FOR CURTAIN WALL

LEGEND :


R.S. = RESTRAINT SOCKET

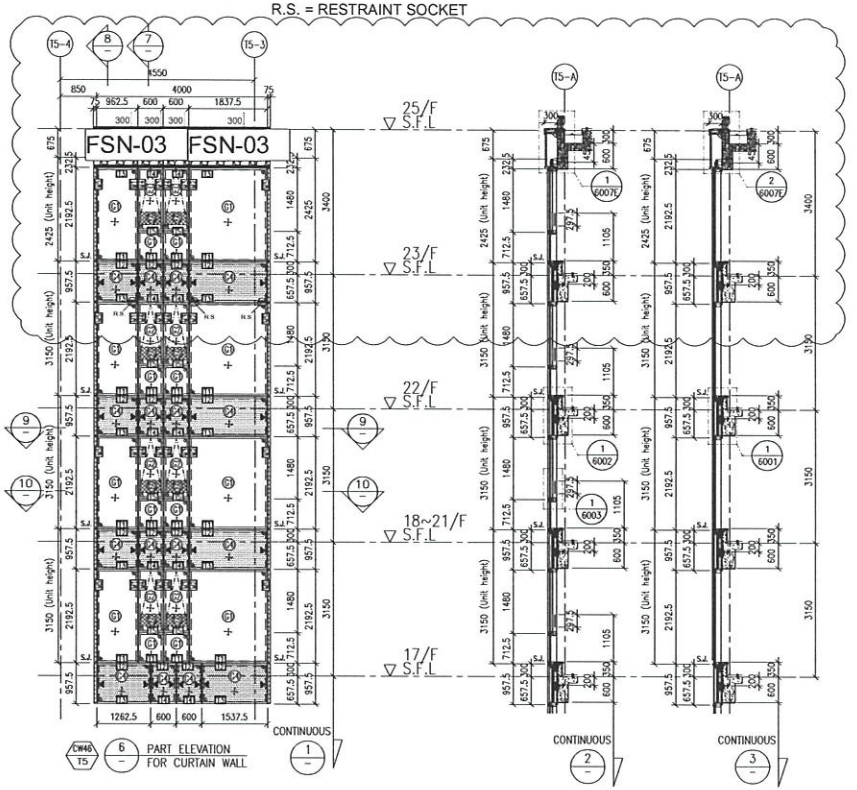


CW46 T5 — 6 — PART ELEVATION FOR CURTAIN WALL

7 — TYPICAL SECTION FOR CURTAIN WALL


8 — TYPICAL SECTION FOR CURTAIN WALL

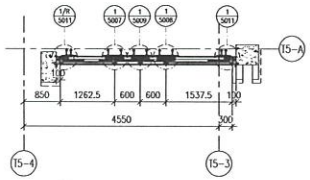


4 — PART PLAN FOR CURTAIN WALL

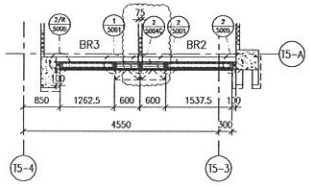

5 — PART PLAN FOR CURTAIN WALL

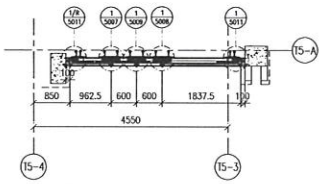

9 — PART PLAN FOR CURTAIN WALL

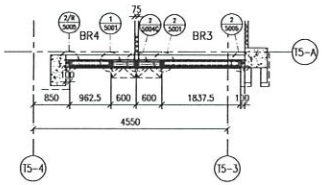

10 — PART PLAN FOR CURTAIN WALL

FLOOR LEVEL (S.F.L)

FLOOR	LEVEL
25/F	+203.40
23/F	+200.00
22/F	+196.85
21/F	+193.70
20/F	+190.55
19/F	+187.40
18/F	+184.25
17/F	+181.10
16/F	+177.80
15/F	+174.65
12/F	+171.50
11/F	+168.35

LEGEND:

- 10mm HEAT STRENGTHENED GLASS (OUTER) + 12mm AIR SPACE +12mm THK. TEMPERED CLEAR GLASS (INNER)
- 10mm HEAT STRENGTHENED GLASS (OUTER) + 12mm AIR SPACE +10mm THK. TEMPERED CLEAR GLASS (INNER)
- 12mm THK. HEAT STRENGTHENED GLASS & 2mm THK. ALUM. BACKPAN (SPANDREL GLASS)
- 12mm THK. CLEAR TEMPERED GLASS (INTERNAL PROTECTIVE BARRIER)
- 3mm THK. ALUM. CLADDING
- S.J. – STACK JOINT (WIND LOAD)
- AK01 – ALUM. EXTRUSION DIE NO.
- ▲ – SUPPORT POINT (WIND LOAD + DEAD LOAD)
- ● – SUPPORT POINT (WIND LOAD)

B.D. REF :

CLIENT :
SHIMAO GROUP HOLDINGS LIMITED

ARCHITECT :
WONG TUNG & PARTNERS LIMITED
ARCHITECTS & PLANNERS

MAIN CONTRACTOR :
協興建築有限公司
HIP HING CONSTRUCTION CO LTD

STRUCTURAL ENGINEER :
C M WONG & ASSOCIATES LTD
黃志明建築工程師有限公司

FACADE CONSULTANT:
MEINHARDT

NOTE :
1. ALL DIMENSIONS ARE IN mm.
2. ALL ELEVATIONS ARE VIEWED FROM OUTSIDE.
3. ALL DIMENSIONS TO BE VERIFIED ON SITE BEFORE FABRICATION.

LEGEND :
X1 / X001 — DETAIL MARK NO. / REFER SHEET NO.
1. F.F.L. -- FINISHED FLOOR LEVEL
2. S.F.L. -- STRUCTURAL FLOOR LEVEL
3. /R -- REVERSED DETAIL

NO.	DATE	REVISED	BY
A	06-10-2021	REVISION SUBJECT TO ARCH. COMMENT	

JOB NO. : J-853

PROJECT :
PROPOSED RESIDENTIAL DEVELOPMENT AT N.K.I.L. 6542 YIN PING ROAD KOWLOON


TITLE :
PART ELEVATION FOR CURTAIN WALL AT TOWER 5

DATE : 05-APR-21 | SCALE : 1:60 (A1)

DRAWN BY : LHR | CHECKED BY :

美特鋁質有限公司
MIDI ALUMINIUM FABRICATOR LTD.
Units 6-8, Sunray Industrial Centre, 1/F
610 Cha Kwo Ling Road, Kowloon
Tel:23489211-4 Fax:(852)27727666

DWG NO. : J853-SD-CW-4507 | REV. : C

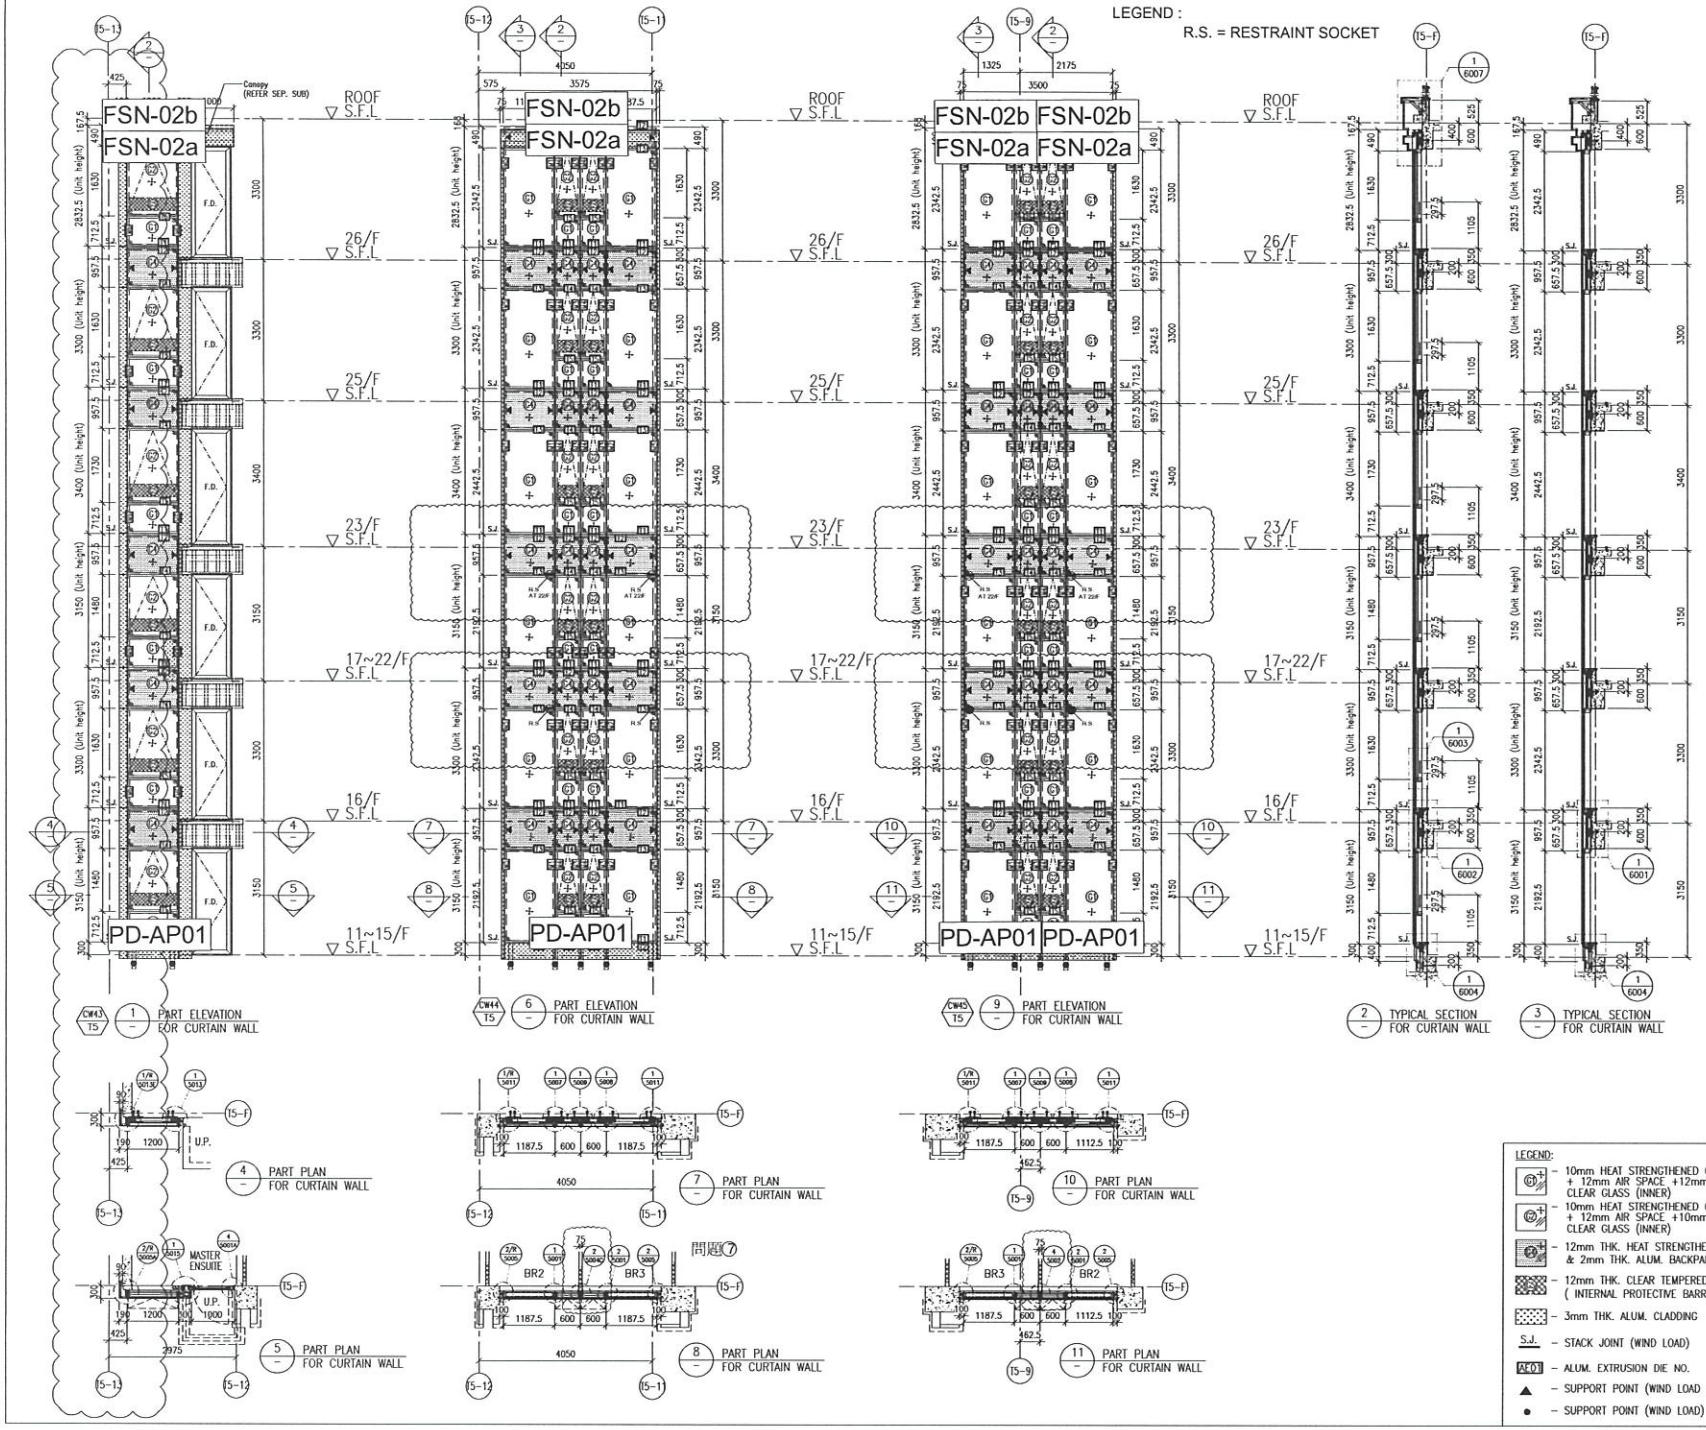

FLOOR LEVEL (S.F.L.)

FLOOR	LEVEL
ROOF	+210.00
26/F	+206.70
25/F	+203.40
23/F	+200.00
22/F	+196.85
21/F	+193.70
20/F	+190.55
19/F	+187.40
18/F	+184.25
17/F	+181.10
16/F	+177.80
15/F	+174.65
12/F	+171.50
11/F	+168.35

LEGEND:

- 10mm HEAT STRENGTHENED GLASS (OUTER) + 12mm AIR SPACE +12mm THK. TEMPERED CLEAR GLASS (INNER)
- 10mm HEAT STRENGTHENED GLASS (OUTER) + 12mm AIR SPACE +10mm THK. TEMPERED CLEAR GLASS (INNER)
- 12mm THK. HEAT STRENGTHENED GLASS & 2mm THK. ALUM. BACKPAN (SPANDREL GLASS)
- 12mm THK. CLEAR TEMPERED GLASS (INTERNAL PROTECTIVE BARRIER)
- 3mm THK. ALUM. CLADDING
- S.J. – STACK JOINT (WIND LOAD)
- AE01 – ALUM. EXTRUSION DIE NO.
- ▲ – SUPPORT POINT (WIND LOAD + DEAD LOAD)
- ● – SUPPORT POINT (WIND LOAD)

B.D. REF :

CLIENT :
SHIMAO GROUP HOLDINGS LIMITED

ARCHITECT :
WONG TUNG & PARTNERS LIMITED
ARCHITECTS & PLANNERS

MAIN CONTRACTOR :
協興建築有限公司
HIP HING CONSTRUCTION CO LTD

STRUCTURAL ENGINEER :
C M WONG & ASSOCIATES LTD
黃志明建築工程師有限公司

FACADE CONSULTANT:
MEINHARDT

NOTE :
1. ALL DIMENSIONS ARE IN mm.
2. ALL ELEVATIONS ARE VIEWED FROM OUTSIDE.
3. ALL DIMENSIONS TO BE VERIFIED ON SITE BEFORE FABRICATION.

LEGEND :
X1 – DETAIL MARK NO.
X001 – REFER SHEET NO.

1. F.F.L. – FINISHED FLOOR LEVEL
2. S.F.L. – STRUCTURAL FLOOR LEVEL
3. (R) – REVERSED DETAIL

NO.	DATE	REVISED	BY
A	06-10-2021	REVISION SUBJECT TO ARCH. COMMENT	

JOB NO. : J-853

PROJECT :
PROPOSED RESIDENTIAL DEVELOPMENT AT N.K.I.L. 6542 YIN PING ROAD KOWLOON


TITLE :
PART ELEVATION FOR CURTAIN WALL AT TOWER 5

DATE : 05-APR-21 | SCALE : 1:60 (A1)

DRAWN BY : LHR | CHECKED BY :

美特鋁質有限公司
MIDI ALUMINIUM FABRICATOR LTD.
Units 6-8, Sunray Industrial Centre, 1/F
610 Cha Kwo Ling Rood, Kowloon
Tel:23489211-4 Fax:(852)27727666


DWG NO. : J853-SD-CW-4508 | REV. : C

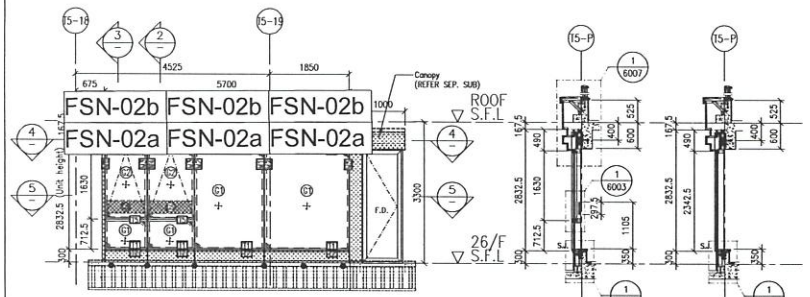


CW39 / 15 — 1 — PART ELEVATION FOR CURTAIN WALL

2 — TYPICAL SECTION FOR CURTAIN WALL


3 — TYPICAL SECTION FOR CURTAIN WALL

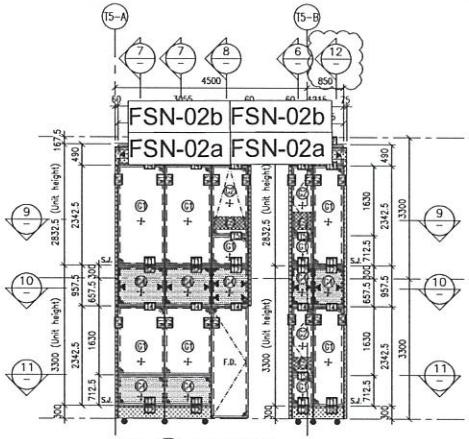


CW47 / 15 — 5 — PART ELEVATION FOR CURTAIN WALL

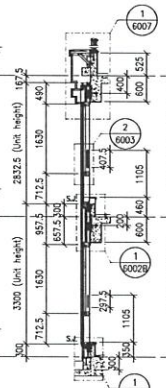


6 — TYPICAL SECTION FOR CURTAIN WALL

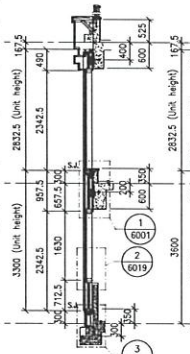


7 — TYPICAL SECTION FOR CURTAIN WALL

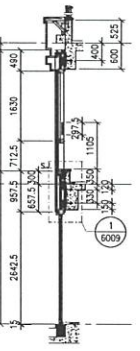


8 — TYPICAL SECTION FOR CURTAIN WALL

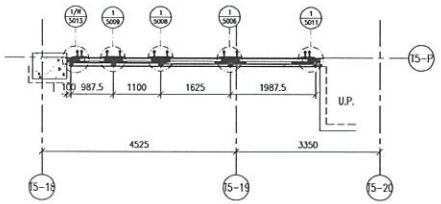


4 — PART PLAN FOR CURTAIN WALL

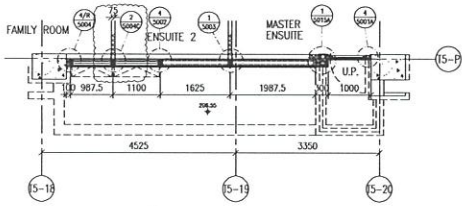


5 — PART PLAN FOR CURTAIN WALL

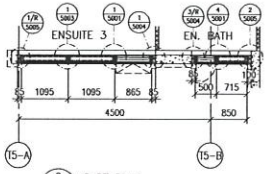


9 — PART PLAN FOR CURTAIN WALL

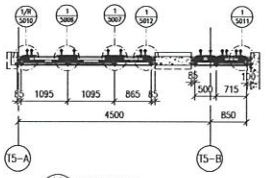

10 — PART PLAN FOR CURTAIN WALL

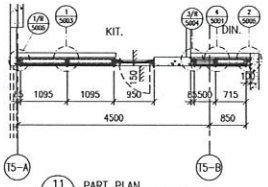

11 — PART PLAN FOR CURTAIN WALL

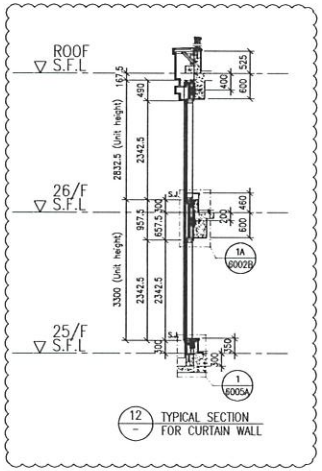

12 — TYPICAL SECTION FOR CURTAIN WALL

FLOOR LEVEL (S.F.L.)

FLOOR	LEVEL
ROOF	+210.00
26/F	+206.70
25/F	+203.40

LEGEND:

- 6+12+6 – 10mm HEAT STRENGTHENED GLASS (OUTER) + 12mm AIR SPACE +12mm THK. TEMPERED CLEAR GLASS (INNER)
- 6+12+10 – 10mm HEAT STRENGTHENED GLASS (OUTER) + 12mm AIR SPACE +10mm THK. TEMPERED CLEAR GLASS (INNER)
- P – 12mm THK. HEAT STRENGTHENED GLASS & 2mm THK. ALUM. BACKPAN (SPANDREL GLASS)
- 12mm THK. CLEAR TEMPERED GLASS (INTERNAL PROTECTIVE BARRIER)
- 3mm THK. ALUM. CLADDING
- S.J. – STACK JOINT (WIND LOAD)
- AF01 – ALUM. EXTRUSION DIE NO.
- ▲ – SUPPORT POINT (WIND LOAD + DEAD LOAD)
- ● – SUPPORT POINT (WIND LOAD)

B.D. REF :

CLIENT :
SHIMAO GROUP HOLDINGS LIMITED

ARCHITECT :
WONG TUNG & PARTNERS LIMITED
ARCHITECTS & PLANNERS

MAIN CONTRACTOR :
協興建築有限公司
HIP HING CONSTRUCTION CO LTD

STRUCTURAL ENGINEER :
C M WONG & ASSOCIATES LTD
黃志明建築工程師有限公司

FACADE CONSULTANT:
MEINHARDT

NOTE :
1. ALL DIMENSIONS ARE IN mm.
2. ALL ELEVATIONS ARE VIEWED FROM OUTSIDE.
3. ALL DIMENSIONS TO BE VERIFIED ON SITE BEFORE FABRICATION.

LEGEND :
X1 — DETAIL MARK NO.
X001 — REFER SHEET NO.

1. F.F.L. -- FINISHED FLOOR LEVEL
2. S.F.L. -- STRUCTURAL FLOOR LEVEL
3. (/R) -- REVERSED DETAIL

NO.	DATE	REVISED	BY

JOB NO. : J-853

PROJECT :
PROPOSED RESIDENTIAL DEVELOPMENT AT N.K.I.L. 6542 YIN PING ROAD KOWLOON


TITLE :
PART ELEVATION FOR CURTAIN WALL AT TOWER 5

DATE : 06-OCT-21 | SCALE : 1:60 (A1)

DRAWN BY : LHR | CHECKED BY :

美特鋁質有限公司
MIDI ALUMINIUM FABRICATOR LTD.
Units 6-8, Sunray Industrial Centre, 1/F
610 Cha Kwa Ling Road, Kowloon
Tel:23489211-4 Fax:(852)27727666


DWG NO. : J853-SD-CW-4509 | REV. : B

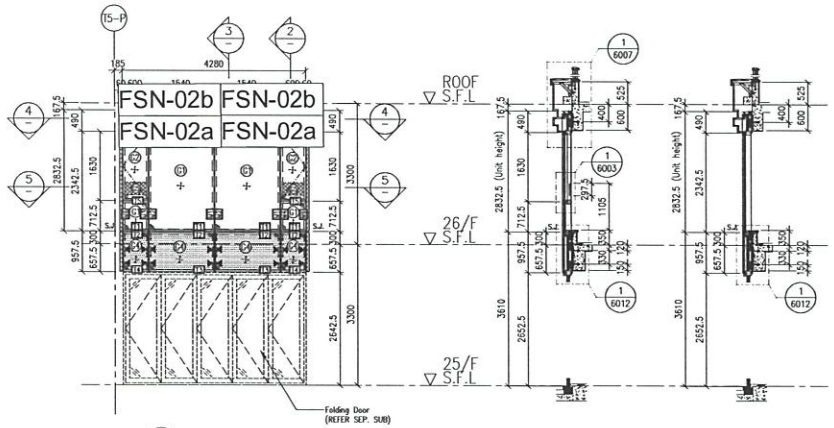


CW47 / T5 — 1 — PART ELEVATION FOR CURTAIN WALL

2 — TYPICAL SECTION FOR CURTAIN WALL

3 — TYPICAL SECTION FOR CURTAIN WALL

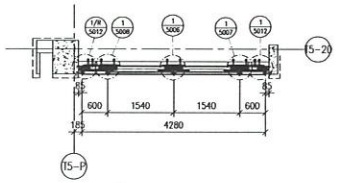

4 — PART PLAN FOR CURTAIN WALL

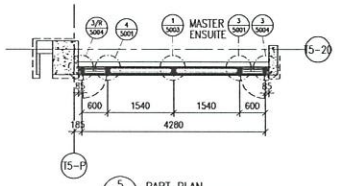

5 — PART PLAN FOR CURTAIN WALL

FLOOR LEVEL (S.F.L)

FLOOR	LEVEL
ROOF	+210.00
26/F	+206.70
25/F	+203.40

LEGEND:

- 10mm HEAT STRENGTHENED GLASS (OUTER) + 12mm AIR SPACE +12mm THK. TEMPERED CLEAR GLASS (INNER)
- 10mm HEAT STRENGTHENED GLASS (OUTER) + 12mm AIR SPACE +10mm THK. TEMPERED CLEAR GLASS (INNER)
- 12mm THK. HEAT STRENGTHENED GLASS & 2mm THK. ALUM. BACKPAN (SPANDREL GLASS)
- 12mm THK. CLEAR TEMPERED GLASS (INTERNAL PROTECTIVE BARRIER)
- 3mm THK. ALUM. CLADDING
- S.J. — STACK JOINT (WIND LOAD)
- AE01 — ALUM. EXTRUSION DIE NO.
- ▲ — SUPPORT POINT (WIND LOAD + DEAD LOAD)
- ● — SUPPORT POINT (WIND LOAD)

B.D. REF :

CLIENT :
SHIMAO GROUP HOLDINGS LIMITED

ARCHITECT :
WONG TUNG & PARTNERS LIMITED
ARCHITECTS & PLANNERS

MAIN CONTRACTOR :
協興建築有限公司
HIP HING CONSTRUCTION CO LTD

STRUCTURAL ENGINEER :
C M WONG & ASSOCIATES LTD
黃志明建築工程師有限公司

FACADE CONSULTANT:
MEINHARDT

NOTE :
1. ALL DIMENSIONS ARE IN mm.
2. ALL ELEVATIONS ARE VIEWED FROM OUTSIDE.
3. ALL DIMENSIONS TO BE VERIFIED ON SITE BEFORE FABRICATION.

LEGEND :
- X1 / X001 — DETAIL MARK NO. / REFER SHEET NO.
1. F.F.L. --FINISHED FLOOR LEVEL
2. S.F.L. --STRUCTURAL FLOOR LEVEL
3. /R --REVERSED DETAIL

NO.	DATE	REVISED	BY

JOB NO. : J-853

PROJECT :
PROPOSED RESIDENTIAL DEVELOPMENT AT N.K.I.L. 6542 YIN PING ROAD KOWLOON


TITLE :
PART ELEVATION FOR CURTAIN WALL AT TOWER 5

DATE : 06-OCT-21 | SCALE : 1:60 (A1)

DRAWN BY : LHR | CHECKED BY :

美特鋁製有限公司
MIDI ALUMINIUM FABRICATOR LTD.
Units 6-8, Sunray Industrial Centre, 1/f
610 Cha Kwo Ling Road, Kowloon
Tel:23489211-4 Fax:(852)27727666

DWG NO. : J853-SD-CW-4510 | REV. : B

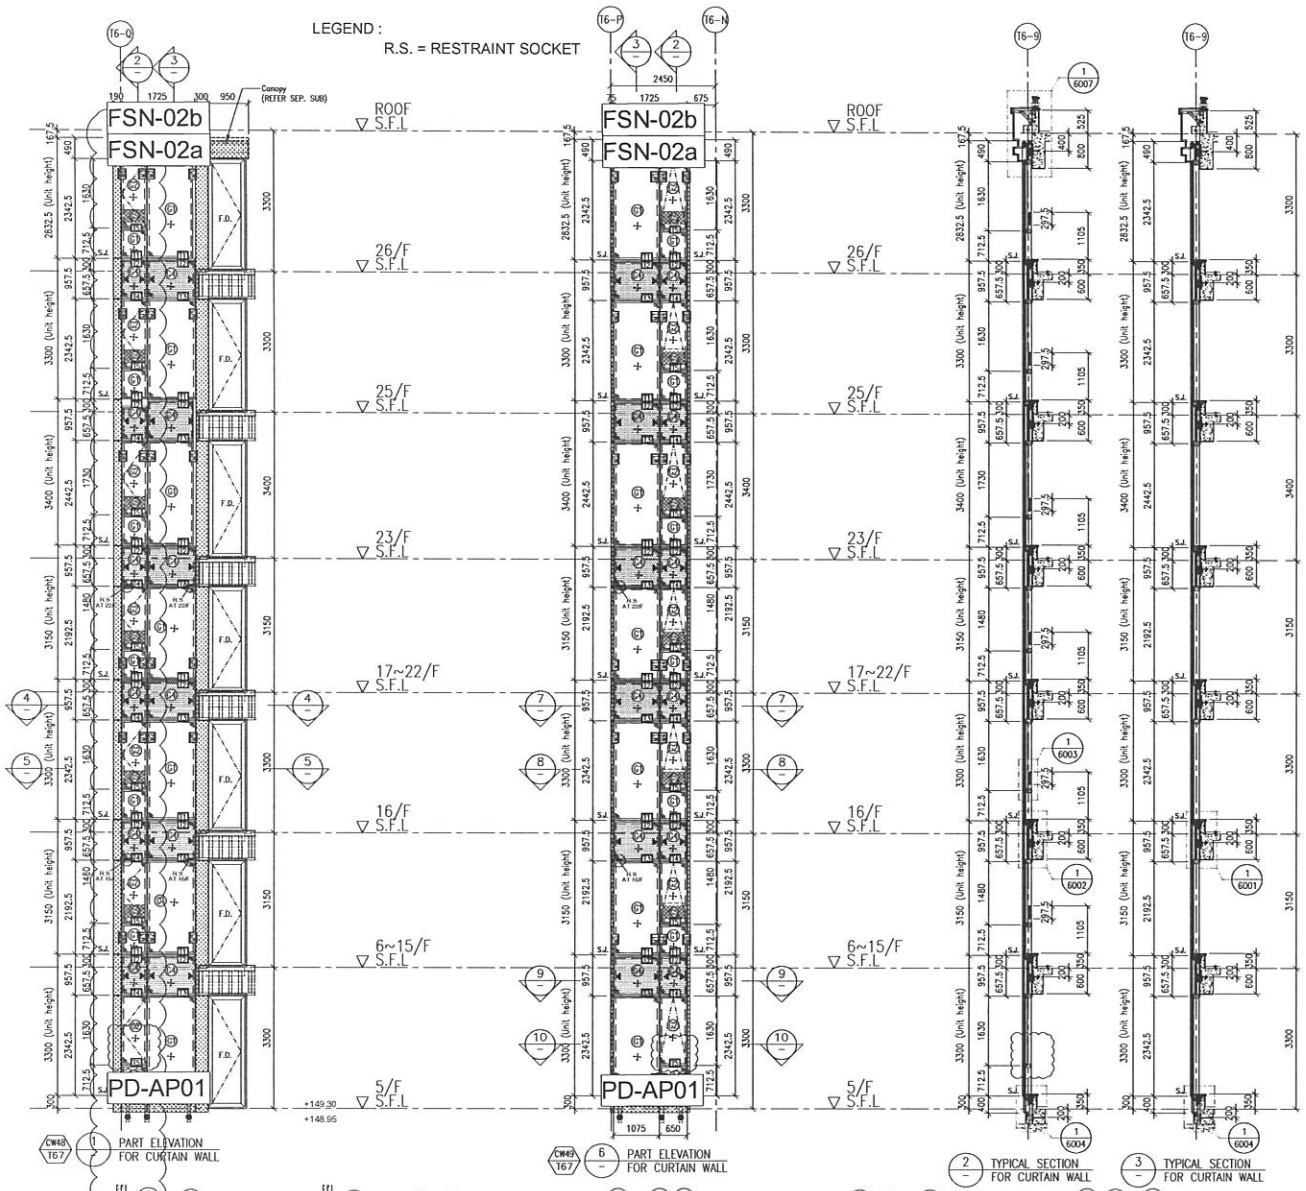

FLOOR LEVEL (S.F.L.)	
FLOOR	LEVEL
ROOF	+210.00
26/F	+206.70
25/F	+203.40
23/F	+200.00
22/F	+196.85
21/F	+193.70
20/F	+190.55
19/F	+187.40
18/F	+184.25
17/F	+181.10
16/F	+177.80
15/F	+174.65
12/F	+171.50
11/F	+168.35
10/F	+165.20
9/F	+162.05
8/F	+158.90
7/F	+155.75
6/F	+152.60
5/F	+149.30

LEGEND:
- 10mm HEAT STRENGTHENED GLASS (OUTER) + 12mm AIR SPACE +12mm THK. TEMPERED CLEAR GLASS (INNER)
- 10mm HEAT STRENGTHENED GLASS (OUTER) + 12mm AIR SPACE +10mm THK. TEMPERED CLEAR GLASS (INNER)
- 12mm THK. HEAT STRENGTHENED GLASS & 2mm THK. ALUM. BACKPAN (SPANDREL GLASS)
- 12mm THK. CLEAR TEMPERED GLASS (INTERNAL PROTECTIVE BARRIER)
- 3mm THK. ALUM. CLADDING
- S.J. – STACK JOINT (WIND LOAD)
- AE01 – ALUM. EXTRUSION DIE NO.
- ▲ – SUPPORT POINT (WIND LOAD + DEAD LOAD)
- ● – SUPPORT POINT (WIND LOAD)

B.D. REF :

CLIENT :
SHIMAO GROUP HOLDINGS LIMITED

ARCHITECT :
WONG TUNG & PARTNERS LIMITED
ARCHITECTS & PLANNERS

MAIN CONTRACTOR :
協興建築有限公司
HIP HING CONSTRUCTION CO LTD

STRUCTURAL ENGINEER :
C M WONG & ASSOCIATES LTD
黃志明建築工程師有限公司

FACADE CONSULTANT:
MEINHARDT

NOTE :
1. ALL DIMENSIONS ARE IN mm.
2. ALL ELEVATIONS ARE VIEWED FROM OUTSIDE.
3. ALL DIMENSIONS TO BE VERIFIED ON SITE BEFORE FABRICATION.

LEGEND :
- X1 / X001 – DETAIL MARK NO. / REFER SHEET NO.
1. F.F.L. – FINISHED FLOOR LEVEL
2. S.F.L. – STRUCTURAL FLOOR LEVEL
3. /R – REVERSED DETAIL

NO.	DATE	REVISED	BY
A	09-10-2021	REVISION SUBJECT TO ARCH. COMMENT	

JOB NO. : J-853

PROJECT :
PROPOSED RESIDENTIAL DEVELOPMENT AT N.K.I.L. 6542 YIN PING ROAD KOWLOON

TITLE :
PART ELEVATION FOR CURTAIN WALL AT TOWER 6 & 7

DATE : 12-APR-21 | SCALE : 1:60 (A1)


DRAWN BY : LHR | CHECKED BY :

美特鋁質有限公司
MIDI ALUMINIUM FABRICATOR LTD.
Units 6-8, Sunray Industrial Centre, 1/F
610 Cha Kwo Ling Road, Kowloon
Tel:23489211-4 Fax:(852)27727666

DWG NO. : J853-SD-CW-4601 | REV. : B

LEGEND :


R.S. = RESTRAINT SOCKET

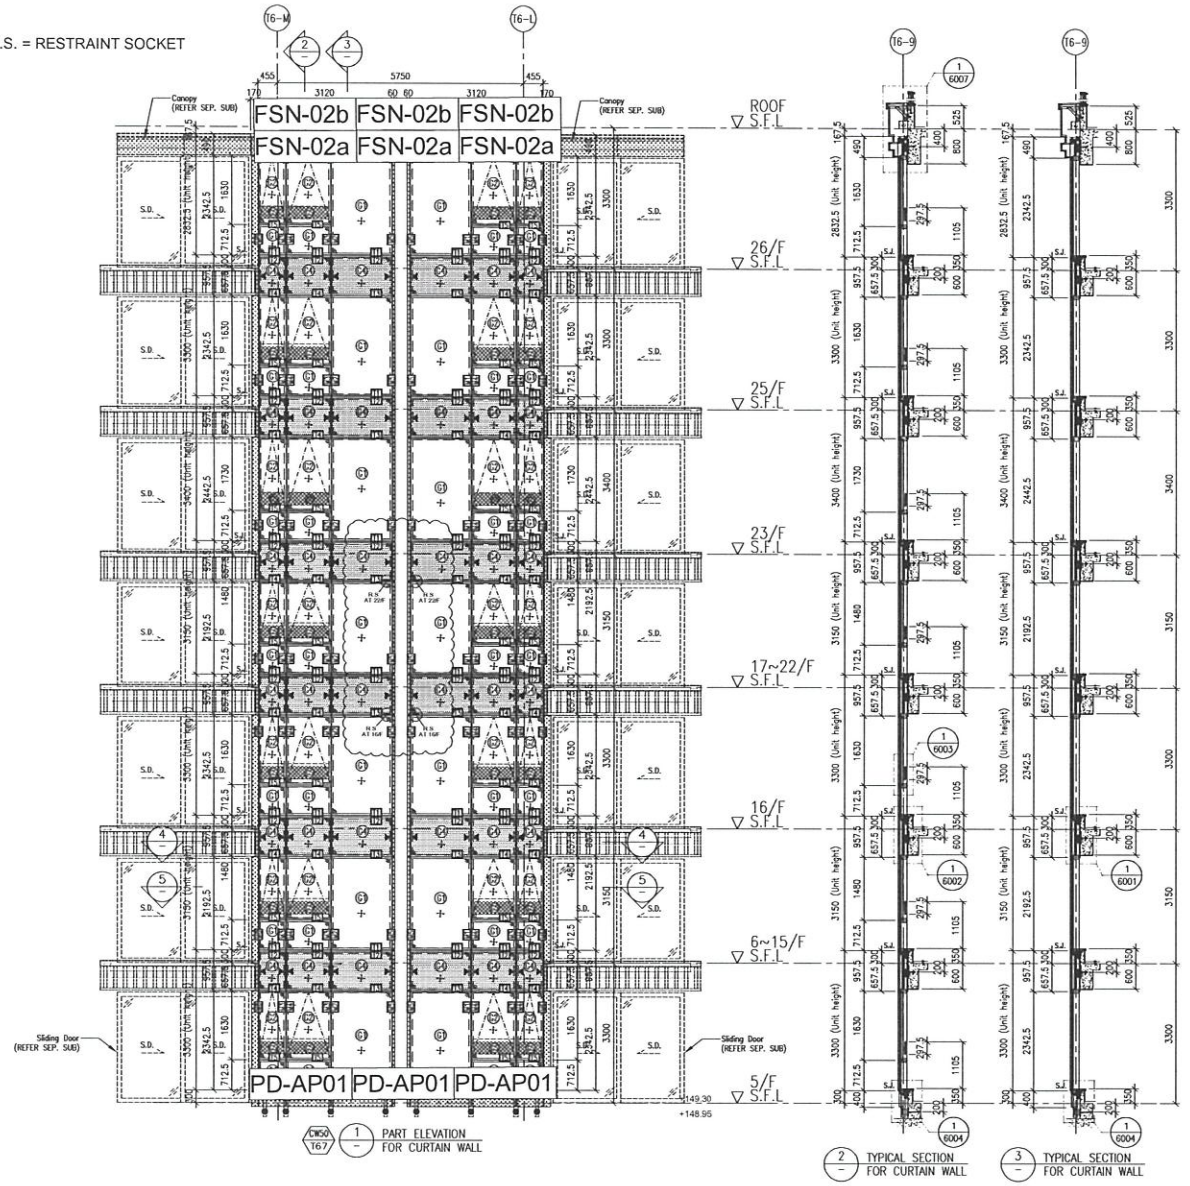


1 PART ELEVATION FOR CURTAIN WALL

2 TYPICAL SECTION FOR CURTAIN WALL

3 TYPICAL SECTION FOR CURTAIN WALL

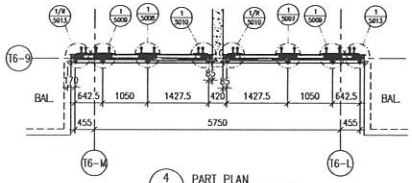

4 PART PLAN FOR CURTAIN WALL

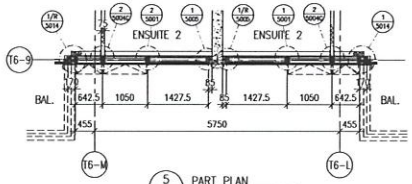

5 PART PLAN FOR CURTAIN WALL

FLOOR LEVEL (S.F.L.)

FLOOR	LEVEL
ROOF	+210.00
26/F	+206.70
25/F	+203.40
23/F	+200.00
22/F	+196.85
21/F	+193.70
20/F	+190.55
19/F	+187.40
18/F	+184.25
17/F	+181.10
16/F	+177.80
15/F	+174.65
12/F	+171.50
11/F	+168.35
10/F	+165.20
9/F	+162.05
8/F	+158.90
7/F	+155.75
6/F	+152.60
5/F	+149.30

LEGEND:

- 10mm HEAT STRENGTHENED GLASS (OUTER) + 12mm AIR SPACE +12mm THK. TEMPERED CLEAR GLASS (INNER)
- 10mm HEAT STRENGTHENED GLASS (OUTER) + 12mm AIR SPACE +10mm THK. TEMPERED CLEAR GLASS (INNER)
- 12mm THK. HEAT STRENGTHENED GLASS & 2mm THK. ALUM. BACKPAN (SPANDREL GLASS)
- 12mm THK. CLEAR TEMPERED GLASS (INTERNAL PROTECTIVE BARRIER)
- 3mm THK. ALUM. CLADDING
- S.J. – STACK JOINT (WIND LOAD)
- AP01 – ALUM. EXTRUSION DIE NO.
- ▲ – SUPPORT POINT (WIND LOAD + DEAD LOAD)
- ● – SUPPORT POINT (WIND LOAD)

B.D. REF :

CLIENT :

SHIMAO GROUP HOLDINGS LIMITED

ARCHITECT :

WONG TUNG & PARTNERS LIMITED
ARCHITECTS & PLANNERS

MAIN CONTRACTOR :

協興建築有限公司
HIP HING CONSTRUCTION CO LTD

STRUCTURAL ENGINEER :

C M WONG & ASSOCIATES LTD
黃志明建築工程師有限公司

FACADE CONSULTANT:

MEINHARDT

NOTE :

1. ALL DIMENSIONS ARE IN mm.
2. ALL ELEVATIONS ARE VIEWED FROM OUTSIDE.
3. ALL DIMENSIONS TO BE VERIFIED ON SITE BEFORE FABRICATION.

LEGEND :

X1 – DETAIL MARK NO.
X001 – REFER SHEET NO.

1. F.F.L. --FINISHED FLOOR LEVEL
2. S.F.L. --STRUCTURAL FLOOR LEVEL
3. /R --REVERSED DETAIL

NO.	DATE	REVISED	BY
A	09-10-2021	REVISION SUBJECT TO ARCH. COMMENT	

JOB NO. : J-853

PROJECT :

PROPOSED RESIDENTIAL DEVELOPMENT AT N.K.I.L. 6542 YIN PING ROAD KOWLOON

TITLE :


PART ELEVATION FOR CURTAIN WALL AT TOWER 6 & 7

DATE : 12-APR-21 | SCALE : 1:60 (A1)

DRAWN BY : LHR | CHECKED BY :

美特鋁質有限公司
MIDI ALUMINIUM FABRICATOR LTD.
Units 6-8, Sunray Industrial Centre, 1/F
610 Cha Kwo Ling Road, Kowloon
Tel:23489211-4 Fax:(852)27727666


DWG NO. : J853-SD-CW-4602 | REV. : B

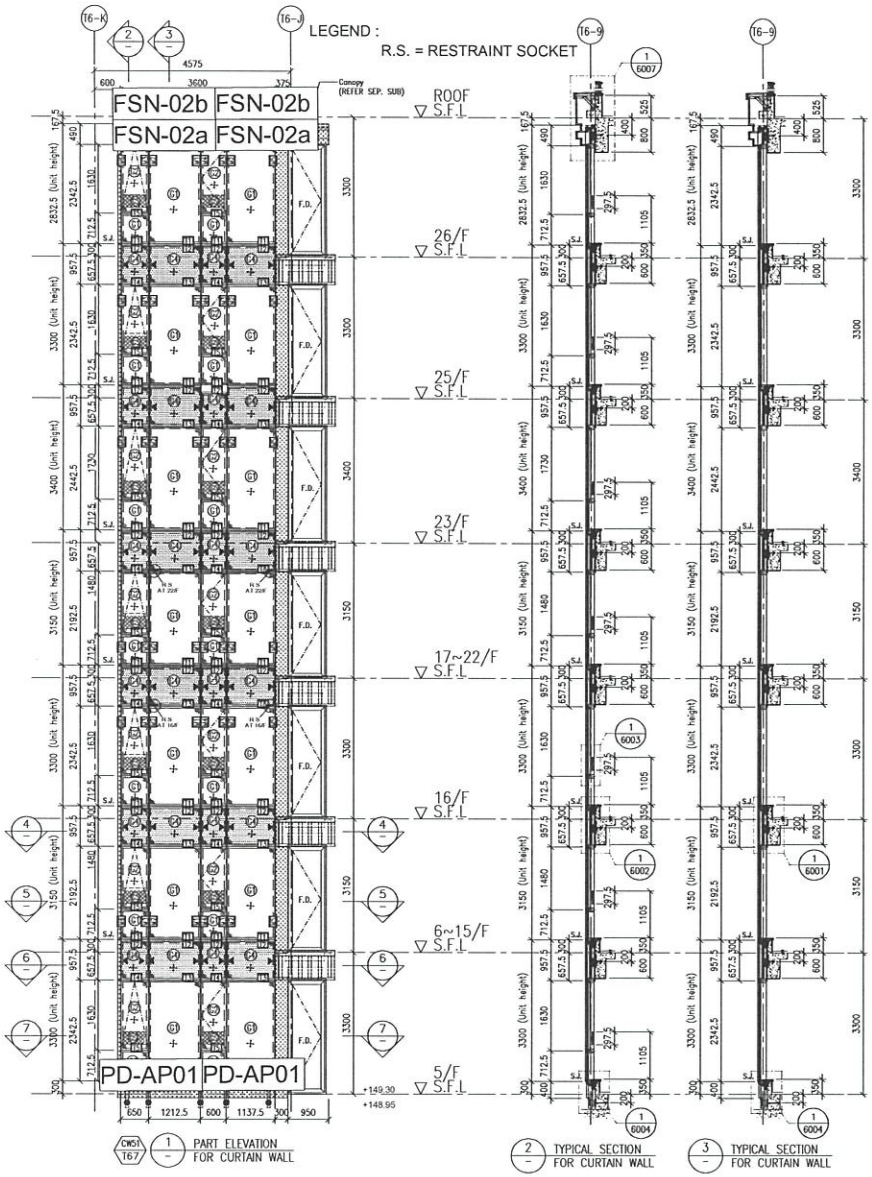


1 PART ELEVATION FOR CURTAIN WALL

2 TYPICAL SECTION FOR CURTAIN WALL


3 TYPICAL SECTION FOR CURTAIN WALL

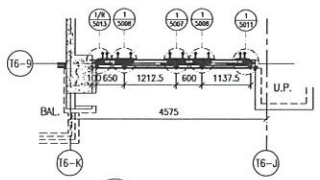


4 PART PLAN FOR CURTAIN WALL

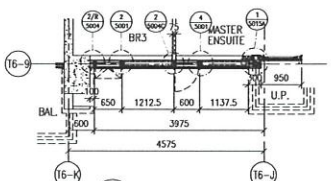

5 PART PLAN FOR CURTAIN WALL

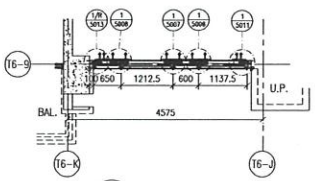

6 PART PLAN FOR CURTAIN WALL

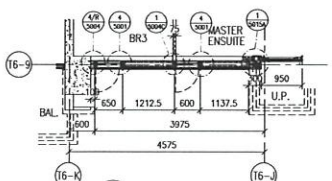

7 PART PLAN FOR CURTAIN WALL

FLOOR LEVEL (S.F.L.)

FLOOR	LEVEL
ROOF	+210.00
26/F	+206.70
25/F	+203.40
23/F	+200.00
22/F	+196.85
21/F	+193.70
20/F	+190.55
19/F	+187.40
18/F	+184.25
17/F	+181.10
16/F	+177.80
15/F	+174.65
12/F	+171.50
11/F	+168.35
10/F	+165.20
9/F	+162.05
8/F	+158.90
7/F	+155.75
6/F	+152.60
5/F	+149.30

LEGEND:

- G1+ – 10mm HEAT STRENGTHENED GLASS (OUTER) + 12mm AIR SPACE +12mm THK. TEMPERED CLEAR GLASS (INNER)
- G2+ – 10mm HEAT STRENGTHENED GLASS (OUTER) + 12mm AIR SPACE +10mm THK. TEMPERED CLEAR GLASS (INNER)
- G3+ – 12mm THK. HEAT STRENGTHENED GLASS & 2mm THK. ALUM. BACKPAN (SPANDREL GLASS)
- 12mm THK. CLEAR TEMPERED GLASS (INTERNAL PROTECTIVE BARRIER)
- 3mm THK. ALUM. CLADDING
- S.J. – STACK JOINT (WIND LOAD)
- AE01 – ALUM. EXTRUSION DIE NO.
- ▲ – SUPPORT POINT (WIND LOAD + DEAD LOAD)
- ● – SUPPORT POINT (WIND LOAD)

B.D. REF :

CLIENT :
SHIMAO GROUP HOLDINGS LIMITED

ARCHITECT :
WONG TUNG & PARTNERS LIMITED
ARCHITECTS & PLANNERS

MAIN CONTRACTOR :
協興建築有限公司
HIP HING CONSTRUCTION CO LTD

STRUCTURAL ENGINEER :
C M WONG & ASSOCIATES LTD
黃志明建築工程師有限公司

FACADE CONSULTANT:
MEINHARDT

NOTE :
1. ALL DIMENSIONS ARE IN mm.
2. ALL ELEVATIONS ARE VIEWED FROM OUTSIDE.
3. ALL DIMENSIONS TO BE VERIFIED ON SITE BEFORE FABRICATION.

LEGEND :
- X1 / X001 – DETAIL MARK NO. / REFER SHEET NO.
1. F.F.L. --FINISHED FLOOR LEVEL
2. S.F.L. --STRUCTURAL FLOOR LEVEL
3. /R --REVERSED DETAIL

NO.	DATE	REVISED	BY

JOB NO. : J-853

PROJECT :
PROPOSED RESIDENTIAL DEVELOPMENT AT N.K.I.L. 6542 YIN PING ROAD KOWLOON


TITLE :
PART ELEVATION FOR CURTAIN WALL AT TOWER 6 & 7

DATE : 24-OCT-21 | SCALE : 1:60 (A1)

DRAWN BY : LHR | CHECKED BY :

美特鋁質有限公司
MIDI ALUMINIUM FABRICATOR LTD.
Units 6-8, Sunray Industrial Centre, 1/F
610 Cha Kwo Ling Road, Kowloon
Tel:23489211-4 Fax:(852)27727666

DWG NO. : J853-SD-CW-4602A | REV. : B

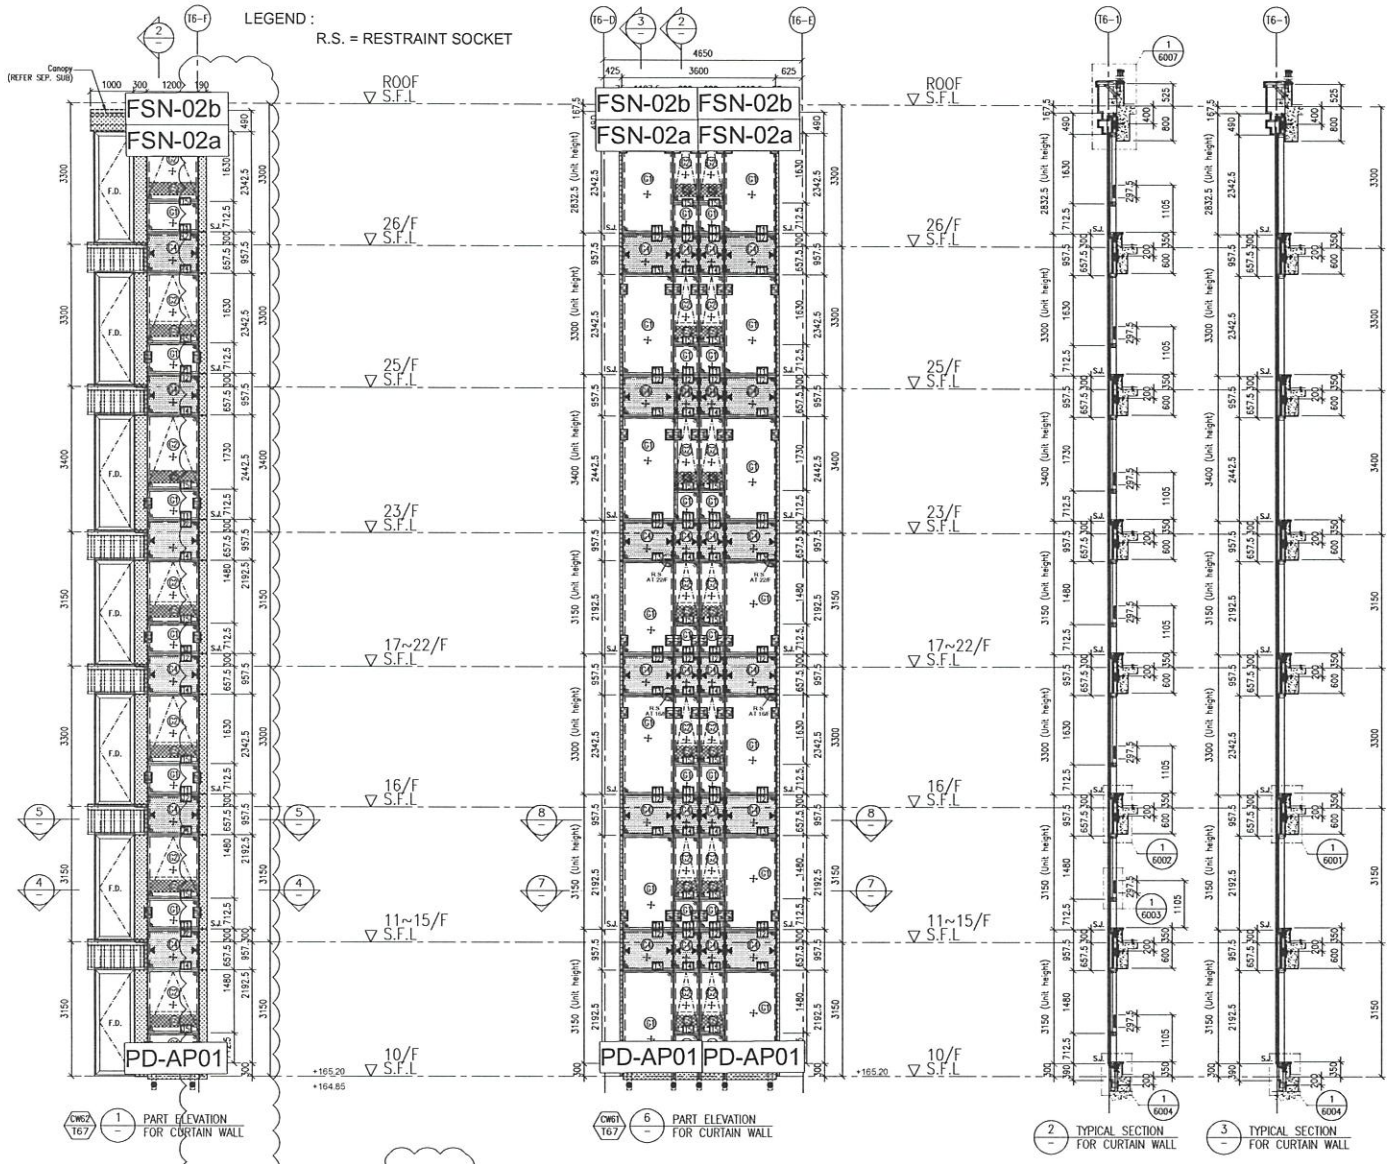

1 PART ELEVATION FOR CURTAIN WALL

6 PART ELEVATION FOR CURTAIN WALL

2 TYPICAL SECTION FOR CURTAIN WALL

3 TYPICAL SECTION FOR CURTAIN WALL

4 PART PLAN FOR CURTAIN WALL

5 PART PLAN FOR CURTAIN WALL

7 PART PLAN FOR CURTAIN WALL

8 PART PLAN FOR CURTAIN WALL

FLOOR LEVEL (S.F.L.)

FLOOR	LEVEL
ROOF	+210.00
26/F	+206.70
25/F	+203.40
23/F	+200.00
22/F	+196.85
21/F	+193.70
20/F	+190.55
19/F	+187.40
18/F	+184.25
17/F	+181.10
16/F	+177.80
15/F	+174.65
12/F	+171.50
11/F	+168.35
10/F	+165.20

LEGEND:

- 10mm HEAT STRENGTHENED GLASS (OUTER) + 12mm AIR SPACE +12mm THK. TEMPERED CLEAR GLASS (INNER)
- 10mm HEAT STRENGTHENED GLASS (OUTER) + 12mm AIR SPACE +10mm THK. TEMPERED CLEAR GLASS (INNER)
- 12mm THK. HEAT STRENGTHENED GLASS & 2mm THK. ALUM. BACKPAN (SPANDREL GLASS)
- 12mm THK. CLEAR TEMPERED GLASS (INTERNAL PROTECTIVE BARRIER)
- 3mm THK. ALUM. CLADDING
- S.J. – STACK JOINT (WIND LOAD)
- AP01 – ALUM. EXTRUSION DIE NO.
- ▲ – SUPPORT POINT (WIND LOAD + DEAD LOAD)
- ● – SUPPORT POINT (WIND LOAD)

B.D. REF :

CLIENT :

SHIMAO GROUP HOLDINGS LIMITED

ARCHITECT : WONG TUNG & PARTNERS LIMITED ARCHITECTS & PLANNERS

MAIN CONTRACTOR : 協興建築有限公司 HIP HING CONSTRUCTION CO LTD

STRUCTURAL ENGINEER : C M WONG & ASSOCIATES LTD 黃志明建築工程師有限公司

FACADE CONSULTANT: MEINHARDT

NOTE :

1. ALL DIMENSIONS ARE IN mm.
2. ALL ELEVATIONS ARE VIEWED FROM OUTSIDE.
3. ALL DIMENSIONS TO BE VERIFIED ON SITE BEFORE FABRICATION.

LEGEND :

X1 – DETAIL MARK NO.
X001 – REFER SHEET NO.

1. F.F.L. – FINISHED FLOOR LEVEL
2. S.F.L. – STRUCTURAL FLOOR LEVEL
3. /R – REVERSED DETAIL

NO.	DATE	REVISED	BY
A	09-10-2021	REVISION SUBJECT TO ARCH. COMMENT	

JOB NO. : J-853

PROJECT :
PROPOSED RESIDENTIAL DEVELOPMENT AT N.K.I.L. 6542 YIN PING ROAD KOWLOON

TITLE :
PART ELEVATION FOR CURTAIN WALL AT TOWER 6 & 7


DATE : 13-APR-21 | SCALE : 1:60 (A1)

DRAWN BY : LHR | CHECKED BY :

美特鋁質有限公司 MIDI ALUMINIUM FABRICATOR LTD.
Units 6-8, Sunray Industrial Centre, 1/F
610 Cha Kwo Ling Road, Kowloon
Tel:23489211-4 Fax:(852)27727666

DWG NO. : J853-SD-CW-4606 | REV. : C

LEGEND :
R.S. = RESTRAINT SOCKET

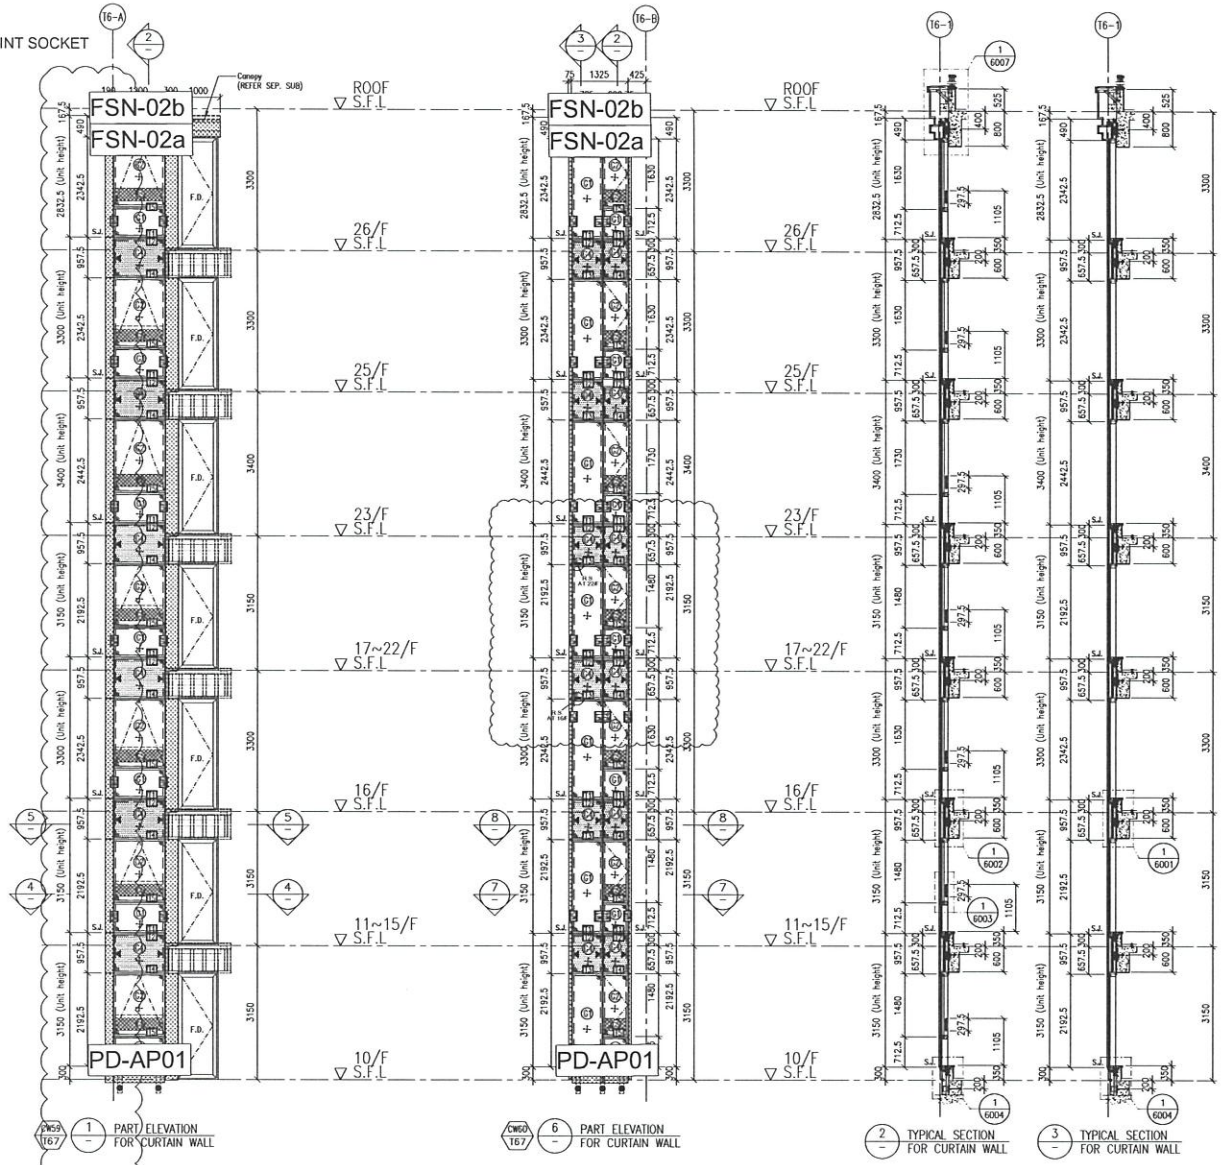


1 PART ELEVATION FOR CURTAIN WALL

6 PART ELEVATION FOR CURTAIN WALL

2 TYPICAL SECTION FOR CURTAIN WALL

3 TYPICAL SECTION FOR CURTAIN WALL

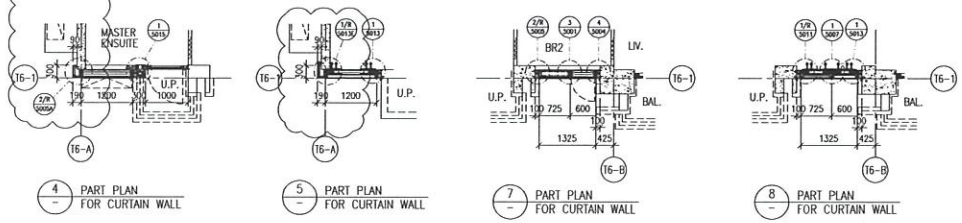

4 PART PLAN FOR CURTAIN WALL

5 PART PLAN FOR CURTAIN WALL

7 PART PLAN FOR CURTAIN WALL

8 PART PLAN FOR CURTAIN WALL

FLOOR LEVEL (S.F.L.)

FLOOR	LEVEL
ROOF	+210.00
26/F	+206.70
25/F	+203.40
23/F	+200.00
22/F	+196.85
21/F	+193.70
20/F	+190.55
19/F	+187.40
18/F	+184.25
17/F	+181.10
16/F	+177.80
15/F	+174.65
12/F	+171.50
11/F	+168.35
10/F	+165.20

LEGEND:
- 10mm HEAT STRENGTHENED GLASS (OUTER) + 12mm AIR SPACE +12mm THK. TEMPERED CLEAR GLASS (INNER)
- 10mm HEAT STRENGTHENED GLASS (OUTER) + 12mm AIR SPACE +10mm THK. TEMPERED CLEAR GLASS (INNER)
- 12mm THK. HEAT STRENGTHENED GLASS & 2mm THK. ALUM. BACKPAN (SPANDREL GLASS)
- 12mm THK. CLEAR TEMPERED GLASS (INTERNAL PROTECTIVE BARRIER)
- 3mm THK. ALUM. CLADDING
- S.J. – STACK JOINT (WIND LOAD)
- AE01 – ALUM. EXTRUSION DIE NO.
- ▲ – SUPPORT POINT (WIND LOAD + DEAD LOAD)
- ● – SUPPORT POINT (WIND LOAD)

B.D. REF :

CLIENT :
SHIMAO GROUP HOLDINGS LIMITED

ARCHITECT :
WONG TUNG & PARTNERS LIMITED
ARCHITECTS & PLANNERS

MAIN CONTRACTOR :
協興建築有限公司
HIP HING CONSTRUCTION CO LTD

STRUCTURAL ENGINEER :
C M WONG & ASSOCIATES LTD
黃志明建築工程師有限公司

FACADE CONSULTANT:
MEINHARDT

NOTE :
1. ALL DIMENSIONS ARE IN mm.
2. ALL ELEVATIONS ARE VIEWED FROM OUTSIDE.
3. ALL DIMENSIONS TO BE VERIFIED ON SITE BEFORE FABRICATION.

LEGEND :
- X1 / XOO1 – DETAIL MARK NO. / REFER SHEET NO.
1. F.F.L. --FINISHED FLOOR LEVEL
2. S.F.L. --STRUCTURAL FLOOR LEVEL
3. /R --REVERSED DETAIL

NO.	DATE	REVISED	BY
A	09-10-2021	REVISION SUBJECT TO ARCH. COMMENT	

JOB NO. : J-853

PROJECT :
PROPOSED RESIDENTIAL DEVELOPMENT AT N.K.I.L. 6542 YIN PING ROAD KOWLOON


TITLE :
PART ELEVATION FOR CURTAIN WALL AT TOWER 6 & 7

DATE : 13-APR-21 | SCALE : 1:60 (A1)

DRAWN BY : LHR | CHECKED BY :

美特鋁質有限公司
MIDI ALUMINIUM FABRICATOR LTD.
Units 6-8, Sunray Industrial Centre, 1/F
610 Cha Kwo Ling Road, Kowloon
Tel:23489211-4 Fax:(852)27727666

DWG NO. : J853-SD-CW-4607 | REV. : C

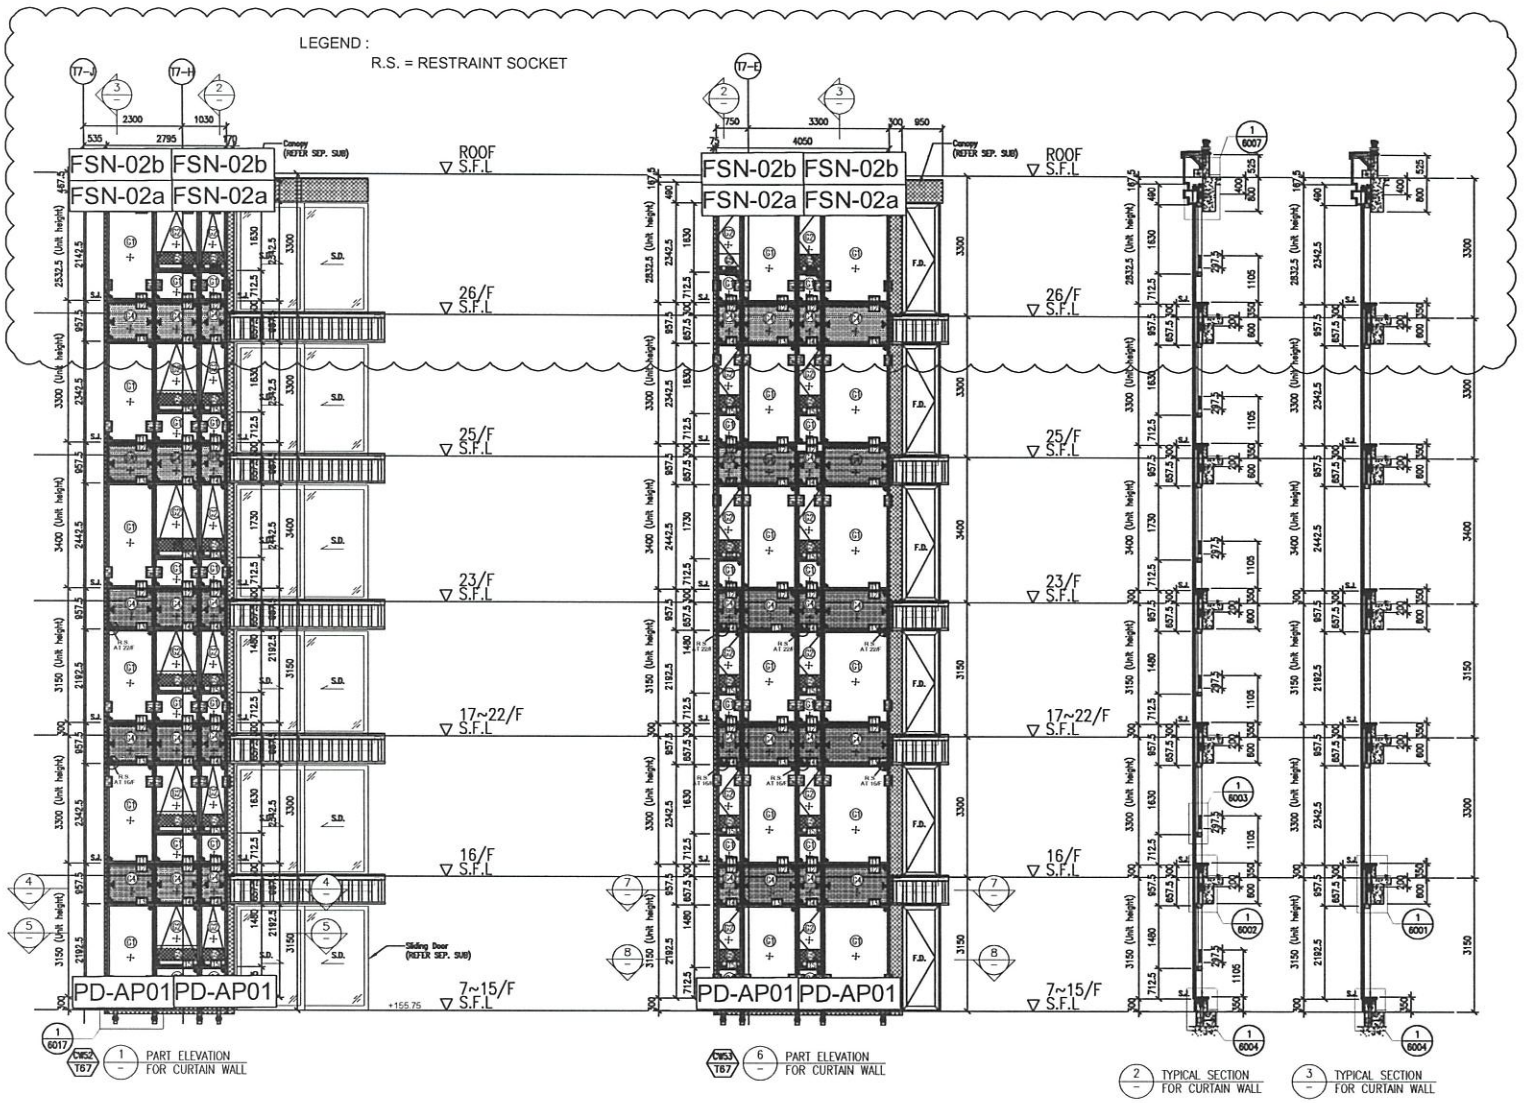


1 PART ELEVATION FOR CURTAIN WALL


6 PART ELEVATION FOR CURTAIN WALL

2 TYPICAL SECTION FOR CURTAIN WALL


3 TYPICAL SECTION FOR CURTAIN WALL

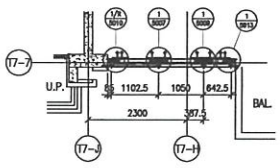


4 PART PLAN FOR CURTAIN WALL

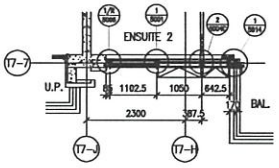

5 PART PLAN FOR CURTAIN WALL

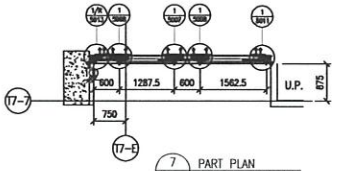

7 PART PLAN FOR CURTAIN WALL

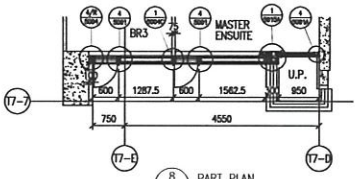

8 PART PLAN FOR CURTAIN WALL

FLOOR LEVEL (S.F.L.)

FLOOR	LEVEL
ROOF	+210.00
26/F	+206.70
25/F	+203.40
23/F	+200.00
22/F	+196.85
21/F	+193.70
20/F	+190.55
19/F	+187.40
18/F	+184.25
17/F	+181.10
16/F	+177.80
15/F	+174.65
12/F	+171.50
11/F	+168.35
10/F	+165.20
9/F	+162.05
8/F	+158.90
7/F	+155.75

LEGEND:

- 10mm HEAT STRENGTHENED GLASS (OUTER) + 12mm AIR SPACE +12mm THK. TEMPERED CLEAR GLASS (INNER)
- 10mm HEAT STRENGTHENED GLASS (OUTER) + 12mm AIR SPACE +10mm THK. TEMPERED CLEAR GLASS (INNER)
- 12mm THK. HEAT STRENGTHENED GLASS & 2mm THK. ALUM. BACKPAN (SPANDREL GLASS)
- 12mm THK. CLEAR TEMPERED GLASS (INTERNAL PROTECTIVE BARRIER)
- 3mm THK. ALUM. CLADDING
- S.J. – STACK JOINT (WIND LOAD)
- AE01 – ALUM. EXTRUSION DIE NO.
- ▲ – SUPPORT POINT (WIND LOAD + DEAD LOAD)
- ● – SUPPORT POINT (WIND LOAD)

B.D. REF :

CLIENT :
SHIMAO GROUP HOLDINGS LIMITED

ARCHITECT :
WONG TUNG & PARTNERS LIMITED
ARCHITECTS & PLANNERS

MAIN CONTRACTOR :
協興建築有限公司
HIP HING CONSTRUCTION CO LTD

STRUCTURAL ENGINEER :
C M WONG & ASSOCIATES LTD
黃志明建築工程師有限公司

FACADE CONSULTANT:
MEINHARDT

NOTE :
1. ALL DIMENSIONS ARE IN mm.
2. ALL ELEVATIONS ARE VIEWED FROM OUTSIDE.
3. ALL DIMENSIONS TO BE VERIFIED ON SITE BEFORE FABRICATION.

LEGEND :
- X1 / X001 — DETAIL MARK NO. / REFER SHEET NO.
1. F.F.L. --FINISHED FLOOR LEVEL
2. S.F.L. --STRUCTURAL FLOOR LEVEL
3. (R) --REVERSED DETAIL

NO.	DATE	REVISED	BY
A	08-10-2021	REVISION SUBJECT TO ARCH. COMMENT	

JOB NO. : J-853

PROJECT :
PROPOSED RESIDENTIAL DEVELOPMENT AT N.K.I.L. 6542 YIN PING ROAD KOWLOON

TITLE :
PART ELEVATION FOR CURTAIN WALL AT TOWER 6 & 7

DATE : 12-APR-21 | SCALE : 1:60 (A1)


DRAWN BY : LHR | CHECKED BY :

美特鋁質有限公司
MIDI ALUMINIUM FABRICATOR LTD.
Units 6-8, Sunray Industrial Centre, 1/F
610 Cha Kwo Ling Road, Kowloon
Tel:23489211-4 Fax:(852)27727668

DWG NO. : J853-SD-CW-4603 | REV. : C

LEGEND :

R.S. = RESTRAINT SOCKET

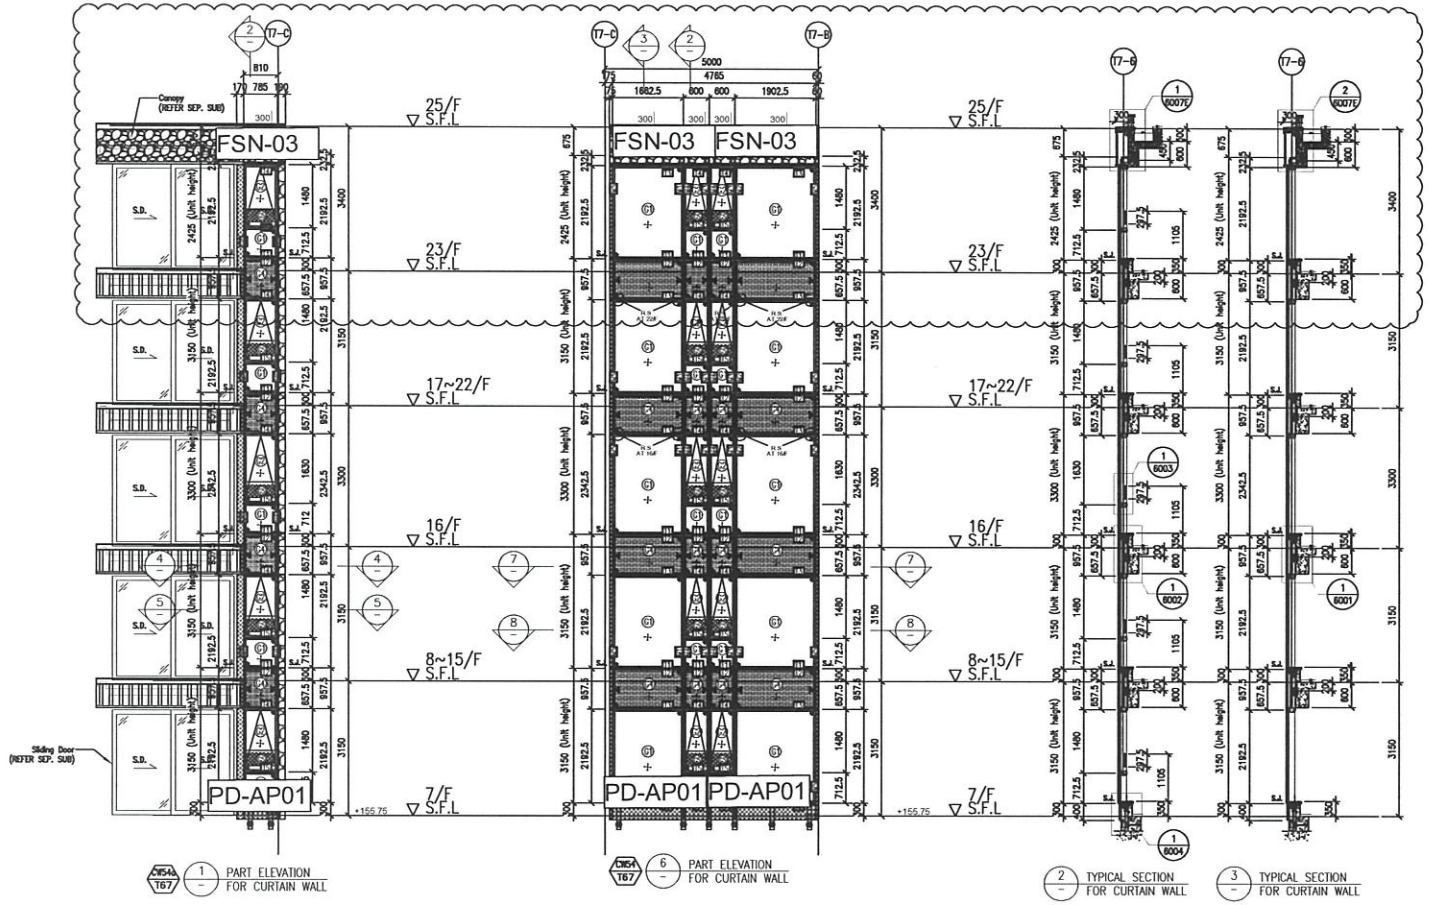


1 PART ELEVATION FOR CURTAIN WALL


6 PART ELEVATION FOR CURTAIN WALL

2 TYPICAL SECTION FOR CURTAIN WALL


3 TYPICAL SECTION FOR CURTAIN WALL

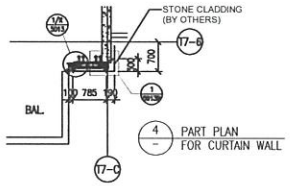


4 PART PLAN FOR CURTAIN WALL

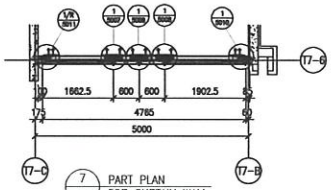

7 PART PLAN FOR CURTAIN WALL

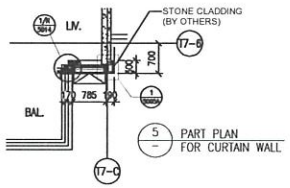

5 PART PLAN FOR CURTAIN WALL

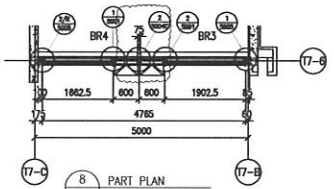

8 PART PLAN FOR CURTAIN WALL

FLOOR LEVEL (S.F.L.)

FLOOR	LEVEL
25/F	+203.40
23/F	+200.00
22/F	+196.85
21/F	+193.70
20/F	+190.55
19/F	+187.40
18/F	+184.25
17/F	+181.10
16/F	+177.80
15/F	+174.65
12/F	+171.50
11/F	+168.35
10/F	+165.20
9/F	+162.05
8/F	+158.90
7/F	+155.75

LEGEND:

- 10mm HEAT STRENGTHENED GLASS (OUTER) + 12mm AIR SPACE +12mm THK. TEMPERED CLEAR GLASS (INNER)
- 10mm HEAT STRENGTHENED GLASS (OUTER) + 12mm AIR SPACE +10mm THK. TEMPERED CLEAR GLASS (INNER)
- 12mm THK. HEAT STRENGTHENED GLASS & 2mm THK. ALUM. BACKPAN (SPANDREL GLASS)
- 12mm THK. CLEAR TEMPERED GLASS (INTERNAL PROTECTIVE BARRIER)
- 3mm THK. ALUM. CLADDING
- S.J. – STACK JOINT (WIND LOAD)
- 6003 – ALUM. EXTRUSION DIE NO.
- ▲ – SUPPORT POINT (WIND LOAD + DEAD LOAD)
- ● – SUPPORT POINT (WIND LOAD)

B.D. REF :

CLIENT :

SHIMAO GROUP HOLDINGS LIMITED

ARCHITECT : WONG TUNG & PARTNERS LIMITED ARCHITECTS & PLANNERS

MAIN CONTRACTOR : 協興建築有限公司 HIP HING CONSTRUCTION CO LTD

STRUCTURAL ENGINEER : C M WONG & ASSOCIATES LTD 黃志明建築工程師有限公司

FACADE CONSULTANT: MEINHARDT

NOTE :

1. ALL DIMENSIONS ARE IN mm.
2. ALL ELEVATIONS ARE VIEWED FROM OUTSIDE.
3. ALL DIMENSIONS TO BE VERIFIED ON SITE BEFORE FABRICATION.

LEGEND :

X1 – DETAIL MARK NO.
H001 – REFER SHEET NO.

1. F.F.L. --- FINISHED FLOOR LEVEL
2. S.F.L. --- STRUCTURAL FLOOR LEVEL
3. /R --- REVERSED DETAIL

NO.	DATE	REVISED	BY
A	08-10-2021	REVISION SUBJECT TO ARCH. COMMENT	

JOB NO. : J-853

PROJECT : PROPOSED RESIDENTIAL DEVELOPMENT AT N.K.I.L. 6542 YIN PING ROAD KOWLOON

TITLE : PART ELEVATION FOR CURTAIN WALL AT TOWER 6 & 7

DATE : 12-APR-21 | SCALE : 1:60 (A1)


DRAWN BY : LHR | CHECKED BY :

美特鋁質有限公司 MIDI ALUMINIUM FABRICATOR LTD.
Units 6-8, Sunray Industrial Centre, 1/F
610 Cha Kwo Ling Road, Kowloon
Tel:23489211-4 Fax:(852)27727666

DWG NO. : J853-SD-CW-4604 | REV. : C

LEGEND :


R.S. = RESTRAINT SOCKET

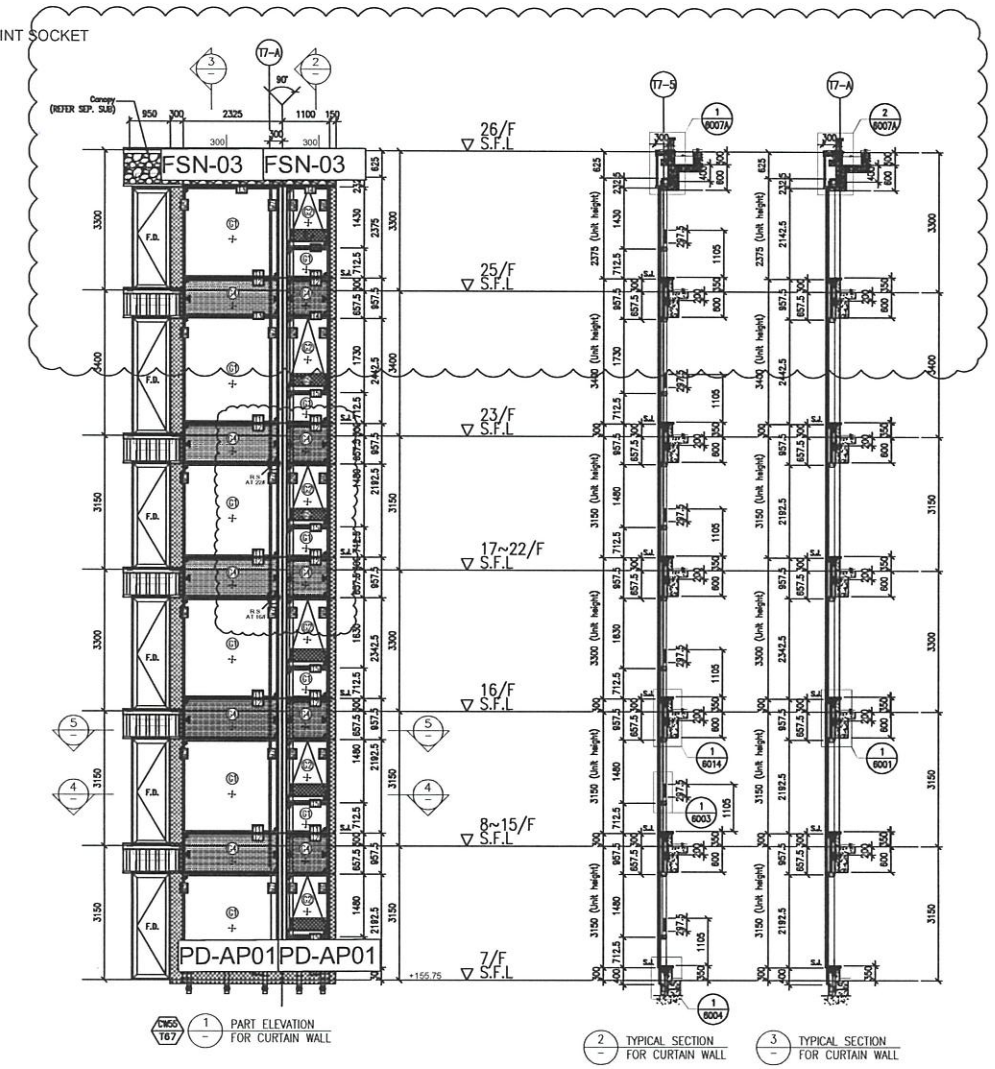


1 PART ELEVATION FOR CURTAIN WALL

2 TYPICAL SECTION FOR CURTAIN WALL

3 TYPICAL SECTION FOR CURTAIN WALL

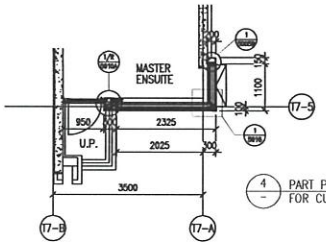

4 PART PLAN FOR CURTAIN WALL

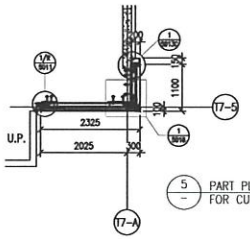

5 PART PLAN FOR CURTAIN WALL

FLOOR LEVEL (S.F.L.)

FLOOR	LEVEL
26/F	+206.70
25/F	+203.40
23/F	+200.00
22/F	+196.85
21/F	+193.70
20/F	+190.55
19/F	+187.40
18/F	+184.25
17/F	+181.10
16/F	+177.80
15/F	+174.65
12/F	+171.50
11/F	+168.35
10/F	+165.20
9/F	+162.05
8/F	+158.90
7/F	+155.75

LEGEND:

- 10mm HEAT STRENGTHENED GLASS (OUTER) + 12mm AIR SPACE +12mm THK. TEMPERED CLEAR GLASS (INNER)
- 10mm HEAT STRENGTHENED GLASS (OUTER) + 12mm AIR SPACE +10mm THK. TEMPERED CLEAR GLASS (INNER)
- 12mm THK. HEAT STRENGTHENED GLASS & 2mm THK. ALUM. BACKPAN (SPANDREL GLASS)
- 12mm THK. CLEAR TEMPERED GLASS (INTERNAL PROTECTIVE BARRIER)
- 3mm THK. ALUM. CLADDING
- S.J. – STACK JOINT (WIND LOAD)
- 8001 – ALUM. EXTRUSION DIE NO.
- ▲ – SUPPORT POINT (WIND LOAD + DEAD LOAD)
- ● – SUPPORT POINT (WIND LOAD)

B.D. REF :

CLIENT :

SHIMAO GROUP HOLDINGS LIMITED

ARCHITECT : WONG TUNG & PARTNERS LIMITED ARCHITECTS & PLANNERS

MAIN CONTRACTOR :

協興建築有限公司
HIP HING CONSTRUCTION CO LTD

STRUCTURAL ENGINEER :

C M WONG & ASSOCIATES LTD
黃志明建築工程師有限公司

FACADE CONSULTANT:

MEINHARDT

NOTE :

1. ALL DIMENSIONS ARE IN mm.
2. ALL ELEVATIONS ARE VIEWED FROM OUTSIDE.
3. ALL DIMENSIONS TO BE VERIFIED ON SITE BEFORE FABRICATION.

LEGEND :

X1 — DETAIL MARK NO.
X001 — REFER SHEET NO.

1. F.F.L. --FINISHED FLOOR LEVEL
2. S.F.L. --STRUCTURAL FLOOR LEVEL
3. /R --REVERSED DETAIL

NO.	DATE	REVISED	BY
A	09-10-2021	REVISION SUBJECT TO ARCH. COMMENT	

JOB NO. : J-853

PROJECT :

PROPOSED RESIDENTIAL DEVELOPMENT AT N.K.I.L. 6542 YIN PING ROAD KOWLOON

TITLE :


PART ELEVATION FOR CURTAIN WALL AT TOWER 6 & 7

DATE : 12-APR-21 | SCALE : 1:60 (A1)

DRAWN BY : LHR | CHECKED BY :

美特鋁質有限公司
MIDI ALUMINIUM FABRICATOR LTD.
Units 6-8, Sunray Industrial Centre, 1/F
610 Cha Kwo Ling Road, Kowloon
Tel:23489211-4 Fax:(852)27727666


DWG NO. : J853-SD-CW-4605 | REV. : C

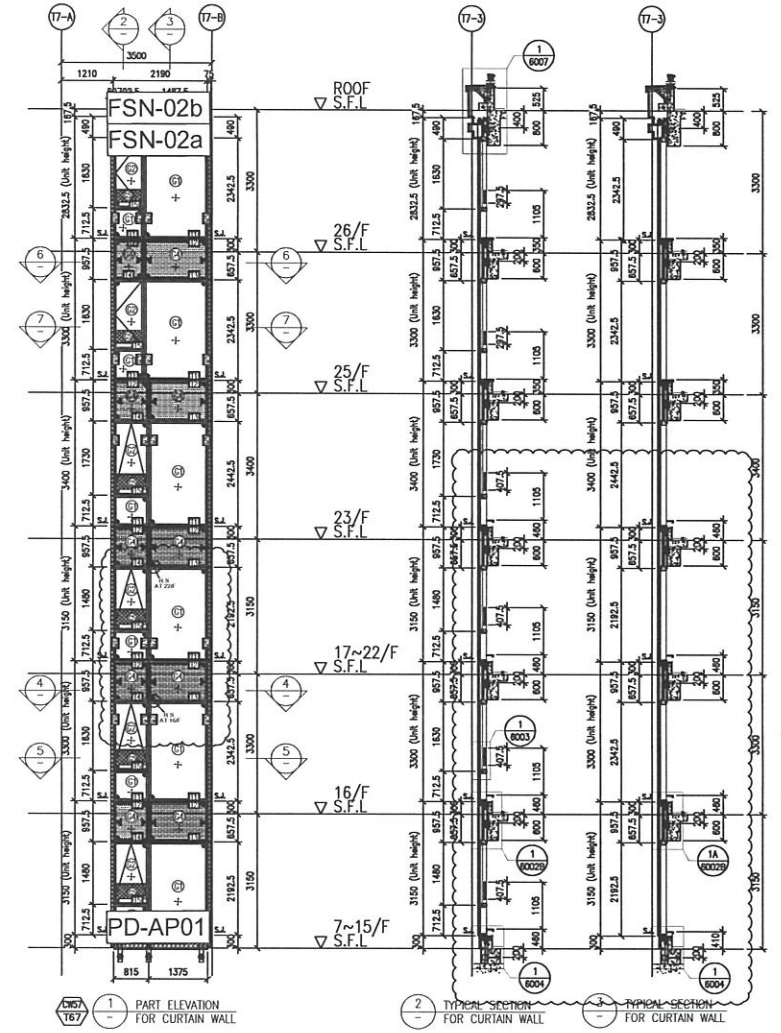


CM57 T67 1 – PART ELEVATION FOR CURTAIN WALL

2 – TYPICAL SECTION FOR CURTAIN WALL


3 – TYPICAL SECTION FOR CURTAIN WALL

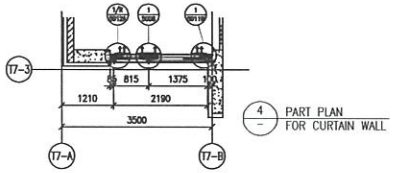


4 – PART PLAN FOR CURTAIN WALL

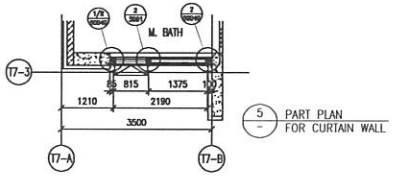

5 – PART PLAN FOR CURTAIN WALL

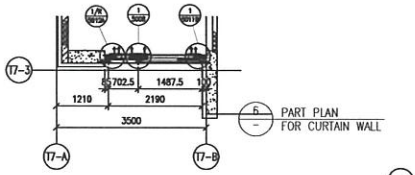

6 – PART PLAN FOR CURTAIN WALL

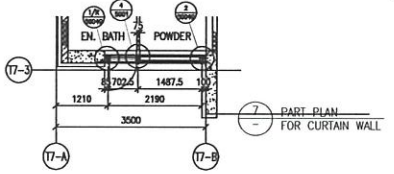


7 – PART PLAN FOR CURTAIN WALL

CM58 T67 8 – PART ELEVATION FOR CURTAIN WALL


9 – TYPICAL SECTION FOR CURTAIN WALL

10 – TYPICAL SECTION FOR CURTAIN WALL


13 – TYPICAL SECTION FOR CURTAIN WALL

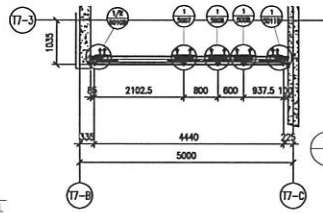

11 – PART PLAN FOR CURTAIN WALL

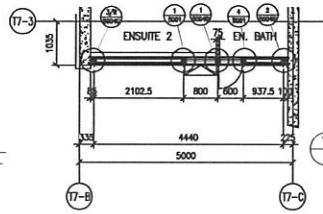

12 – PART PLAN FOR CURTAIN WALL

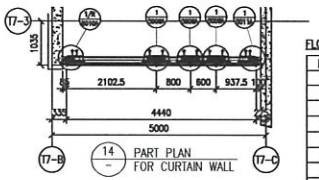

14 – PART PLAN FOR CURTAIN WALL

LEGEND :

R.S. = RESTRAINT SOCKET

FLOOR LEVEL (S.F.L.)

FLOOR	LEVEL	FLOOR	LEVEL
25/F	+203.40	16/F	+177.80
23/F	+200.00	15/F	+174.65
22/F	+196.85	12/F	+171.50
21/F	+193.70	11/F	+168.35
20/F	+190.55	10/F	+165.20
19/F	+187.40	9/F	+162.05
18/F	+184.25	8/F	+158.90
17/F	+181.10	7/F	+155.75

LEGEND:

- 10mm HEAT STRENGTHENED GLASS (OUTER) + 12mm AIR SPACE +12mm THK. TEMPERED CLEAR GLASS (INNER)
- 10mm HEAT STRENGTHENED GLASS (OUTER) + 12mm AIR SPACE +10mm THK. TEMPERED CLEAR GLASS (INNER)
- 12mm THK. HEAT STRENGTHENED GLASS & 2mm THK. ALUM. BACKPAN (SPANDREL GLASS)
- 12mm THK. CLEAR TEMPERED GLASS (INTERNAL PROTECTIVE BARRIER)
- 3mm THK. ALUM. CLADDING
- S.J. – STACK JOINT (WIND LOAD)
- AE01 – ALUM. EXTRUSION DIE NO.
- ▲ – SUPPORT POINT (WIND LOAD + DEAD LOAD)
- ● – SUPPORT POINT (WIND LOAD)

NOTE :

1. ALL DIMENSIONS ARE IN mm.
2. ALL ELEVATIONS ARE VIEWED FROM OUTSIDE.
3. ALL DIMENSIONS TO BE VERIFIED ON SITE BEFORE FABRICATION.

LEGEND :

X1 – DETAIL MARK NO.
XD01 – REFER SHEET NO.

1. F.F.L. --FINISHED FLOOR LEVEL
2. S.F.L. --STRUCTURAL FLOOR LEVEL
3. /R --REVERSED DETAIL

NO.	DATE	REVISED	BY
A	09-10-2021	REVISION SUBJECT TO AMDL COMMENT	

B.D. REF :

CLIENT :
SHIMAO GROUP HOLDINGS LIMITED

ARCHITECT :
WONG TUNG & PARTNERS LIMITED
ARCHITECTS & PLANNERS

MAIN CONTRACTOR :
協興建築有限公司
HIP HING CONSTRUCTION CO LTD

STRUCTURAL ENGINEER :
C M WONG & ASSOCIATES LTD
黃志明建築工程師有限公司

FACADE CONSULTANT:
MEINHARDT

JOB NO. : J-853

PROJECT :
PROPOSED RESIDENTIAL DEVELOPMENT AT N.K.I.L. 6542 YIN PING ROAD KOWLOON


TITLE :
PART ELEVATION FOR CURTAIN WALL AT TOWER 6 & 7

DATE : 13-APR-21 | SCALE : 1:60 (A1)

DRAWN BY : LHR | CHECKED BY :

美特鋁質有限公司
MIDI ALUMINIUM FABRICATOR LTD.
Units 6-8, Sunray Industrial Centre, 1/F
610 Cha Kwo Ling Road, Kowloon
Tel:23489211-4 Fax:(852)27727666


DWG NO. : J853-SD-CW-4608 | REV. : B

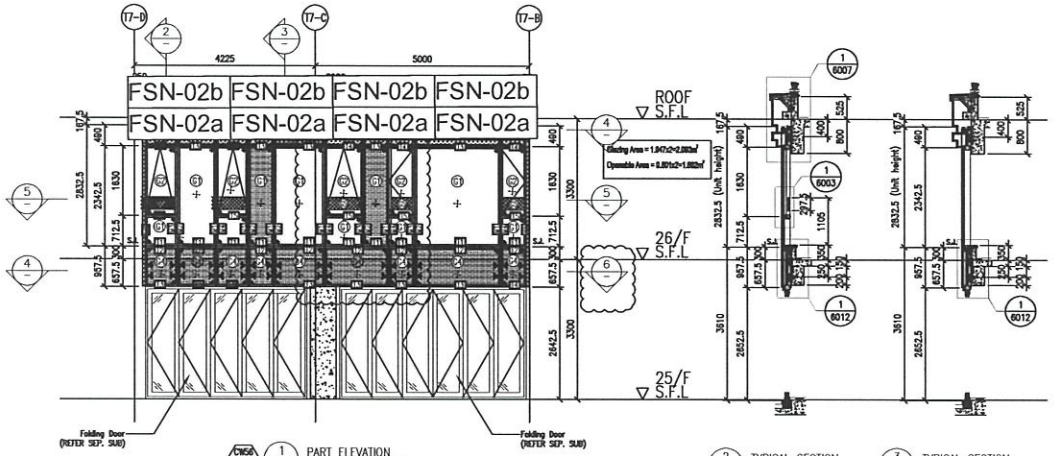


CW64/T67 1 – PART ELEVATION FOR CURTAIN WALL

2 – TYPICAL SECTION FOR CURTAIN WALL


3 – TYPICAL SECTION FOR CURTAIN WALL

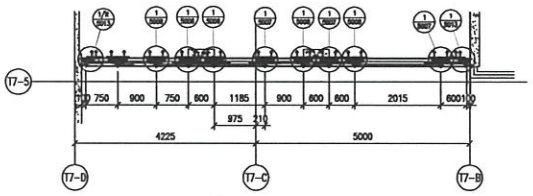

4 – PART PLAN FOR CURTAIN WALL

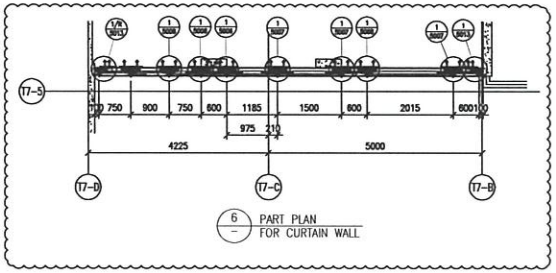

6 – PART PLAN FOR CURTAIN WALL

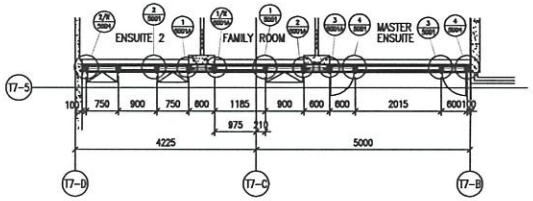

5 – PART PLAN FOR CURTAIN WALL

LEGEND:

- 10mm HEAT STRENGTHENED GLASS (OUTER) + 12mm AIR SPACE +12mm THK. TEMPERED CLEAR GLASS (INNER)
- 10mm HEAT STRENGTHENED GLASS (OUTER) + 12mm AIR SPACE +10mm THK. TEMPERED CLEAR GLASS (INNER)
- 12mm THK. HEAT STRENGTHENED GLASS & 2mm THK. ALUM. BACKPAN (SPANDREL GLASS)
- 12mm THK. CLEAR TEMPERED GLASS (INTERNAL PROTECTIVE BARRIER)
- 3mm THK. ALUM. CLADDING
- S.J. – STACK JOINT (WIND LOAD)
- AE01 – ALUM. EXTRUSION DIE NO.
- ▲ – SUPPORT POINT (WIND LOAD + DEAD LOAD)
- ● – SUPPORT POINT (WIND LOAD)

B.D. REF :

CLIENT :
SHIMAO GROUP HOLDINGS LIMITED

ARCHITECT :
WONG TUNG & PARTNERS LIMITED
ARCHITECTS & PLANNERS

MAIN CONTRACTOR :
協興建築有限公司
HIP HING CONSTRUCTION CO LTD

STRUCTURAL ENGINEER :
C M WONG & ASSOCIATES LTD
黃志明建築工程師有限公司

FACADE CONSULTANT:
MEINHARDT

NOTE :
1. ALL DIMENSIONS ARE IN mm.
2. ALL ELEVATIONS ARE VIEWED FROM OUTSIDE.
3. ALL DIMENSIONS TO BE VERIFIED ON SITE BEFORE FABRICATION.

LEGEND :
- X1 / XD01 – DETAIL MARK NO. / REFER SHEET NO.
1. F.F.L. --FINISHED FLOOR LEVEL
2. S.F.L. --STRUCTURAL FLOOR LEVEL
3. /R --REVERSED DETAIL

NO.	DATE	REVISED	BY

JOB NO. : J-853

PROJECT :
PROPOSED RESIDENTIAL DEVELOPMENT AT N.K.I.L. 6542 YIN PING ROAD KOWLOON

TITLE :
PART ELEVATION FOR CURTAIN WALL AT TOWER 6 & 7

DATE : 09-OCT-21 | SCALE : 1:60 (A1)

DRAWN BY : LHR | CHECKED BY :

美特鋁質有限公司
MIDI ALUMINIUM FABRICATOR LTD.
Units 6-8, Surrey Industrial Centre, 1/F
610 Cha Kwo Ling Road, Kowloon
Tel:23489211-4 Fax:(852)27727666

DWG NO. : J853-SD-CW-4609 | REV. : B