



工程指示 / 要求簡箋 ENGINEER INSTRUCTIONS (E.I.)

工程指示編號:	EI- 6150	修改版本:	A
	HK- 1089		
工程編號:	J 853	工程名稱:	延坪道
收件人:	生統	發件人:	Joe Chan
工程項目:	平台天花頂 鋁板生產 (T3)	日期:	17/05/2023

<input checked="" type="checkbox"/> 原合約工程包	<input type="checkbox"/> 原合約工程加 / 減脹 QT-	<input type="checkbox"/> 新工程報價 QT-
--	--	------------------------------------

信件批核號碼/圖紙參考編號:	批核模具圖紙編號:
客戶指示附件:	管理內部批簽署:

<input type="checkbox"/> 初步鋁料 B.M.	<input type="checkbox"/> 加工拆圖, 然後生產	<input type="checkbox"/> 尺寸表
<input type="checkbox"/> 正式鋁料 B.M.	<input type="checkbox"/> 技術上資料/指示	<input type="checkbox"/> 報價
<input type="checkbox"/> 配件 B.M.	<input type="checkbox"/> 樣辦或貨品說明書	<input type="checkbox"/> 分判合約
<input checked="" type="checkbox"/> 其他: 鋁板		

內容: 請依附件貴, 生產鋁板, 送地盤
修改 A = 新增圖紙 3 張

完成上列要求日期: 30/5/2023 ASAP

國內

<input type="checkbox"/> 生產技術總監	<input type="checkbox"/> 連附件	<input type="checkbox"/> 技術部	<input type="checkbox"/> 連附件	<input type="checkbox"/> 生產部	<input type="checkbox"/> 連附件
<input type="checkbox"/> 採購部	<input type="checkbox"/> 連附件	<input checked="" type="checkbox"/> 生產統籌部	<input checked="" type="checkbox"/> 連附件	<input type="checkbox"/> 報關組	<input type="checkbox"/> 連附件
<input type="checkbox"/> 質檢部	<input type="checkbox"/> 連附件	<input type="checkbox"/> 會計部	<input type="checkbox"/> 連附件	<input type="checkbox"/> 機械設計部	<input type="checkbox"/> 連附件
<input type="checkbox"/> 香港辦	<input type="checkbox"/> 連附件	<input type="checkbox"/> 其他:			

香港

<input type="checkbox"/> 行政部	<input type="checkbox"/> 連附件	<input type="checkbox"/> 會計部	<input type="checkbox"/> 連附件	<input type="checkbox"/> 統籌部	<input type="checkbox"/> 連附件	<input type="checkbox"/> 工程部	<input type="checkbox"/> 連附件
<input type="checkbox"/> 採購部	<input type="checkbox"/> 連附件	<input type="checkbox"/> QS部	<input type="checkbox"/> 連附件	<input checked="" type="checkbox"/> 地盤管理	<input checked="" type="checkbox"/> 連附件	<input type="checkbox"/> 維修部	<input type="checkbox"/> 連附件

*發件人簽署:		*組別成員批核簽署:	
傳遞編號:	HK1089/23	項目經理簽署:	

美特鋁質有限公司 MTDI Aluminium Fabricator Ltd.		工程號: J-853	計算: 李炳安	日期: 2023.05.8	送呈:							
地盤名稱: 廷坪路		核對: 李煥全	日期: 2023.05.8	副本:								
項目類別: T3 P/F		批准:	日期:									
修改版次: A		A/C Code:	總V.F.:	總重量: 1518.55								
序號	修改內容	鋁板圖號	鋁板名稱	顏色	實用	後備	總數	總重量	總展開面積		圖紙編號	
									平方米	平方米		單件展開面積
1		T3-AP01-01	3mm/厚铝板	EC-DG-D334232-ZD1 (AL1)	23	0	23	564.747	3.020	69.465	3.020	69.465
2		T3-AP01-02	3mm/厚铝板	EC-DG-D334232-ZD1 (AL1)	1	0	1	22.853	2.811	2.811	2.811	2.811
3		T3-AP01-03	3mm/厚铝板	EC-DG-D334232-ZD1 (AL1)	1	0	1	22.597	2.780	2.780	2.780	2.780
4		T3-AP01-04	3mm/厚铝板	EC-DG-D334232-ZD1 (AL1)	1	0	1	18.411	2.265	2.265	2.265	2.265
5		T3-AP01-05	3mm/厚铝板	EC-DG-D334232-ZD1 (AL1)	1	0	1	17.195	2.115	2.115	2.115	2.115
6		T3-AP02-01	3mm/厚铝板	EC-DG-D334232-ZD1 (AL1)	1	0	1	22.853	2.811	2.811	2.811	2.811
7		T3-AP02-02	3mm/厚铝板	EC-DG-D334232-ZD1 (AL1)	1	0	1	17.748	2.183	2.183	2.183	2.183
8		T3-AP02-03	3mm/厚铝板	EC-DG-D334232-ZD1 (AL1)	1	0	1	24.554	3.020	3.020	3.020	3.020
9		T3-AP02-04	3mm/厚铝板	EC-DG-D334232-ZD1 (AL1)	1	0	1	24.248	2.983	2.983	2.983	2.983
10		T3-AP02-05	3mm/厚铝板	EC-DG-D334232-ZD1 (AL1)	1	0	1	25.635	3.153	3.153	3.153	3.153
11		T3-AP02-06	3mm/厚铝板	EC-DG-D334232-ZD1 (AL1)	1	0	1	24.512	3.015	3.015	3.015	3.015
12		T3-AP03-01	3mm/厚铝板	EC-DG-D334232-ZD1 (AL1)	1	0	1	24.554	3.020	3.020	3.020	3.020
13		T3-AP03-02	3mm/厚铝板	EC-DG-D334232-ZD1 (AL1)	1	0	1	17.467	2.148	2.148	2.148	2.148
14		T3-AP03-03	3mm/厚铝板	EC-DG-D334232-ZD1 (AL1)	1	0	1	24.554	3.020	3.020	3.020	3.020
15		T3-AP03-04	3mm/厚铝板	EC-DG-D334232-ZD1 (AL1)	1	0	1	24.554	3.020	3.020	3.020	3.020
16		T3-AP03-05	3mm/厚铝板	EC-DG-D334232-ZD1 (AL1)	1	0	1	24.554	3.020	3.020	3.020	3.020
17		T3-AP03-06	3mm/厚铝板	EC-DG-D334232-ZD1 (AL1)	1	0	1	24.554	3.020	3.020	3.020	3.020
18		T3-AP04-01	3mm/厚铝板	EC-DG-D334232-ZD1 (AL1)	1	0	1	26.758	3.291	3.291	3.291	3.291
19		T3-AP05-01	3mm/厚铝板	EC-DG-D334232-ZD1 (AL1)	1	0	1	21.900	2.694	2.694	2.694	2.694
20		T3-AP06-01	3mm/厚铝板	EC-DG-D334232-ZD1 (AL1)	1	0	1	10.193	1.254	1.254	1.254	1.254
21		T3-AP07-01	3mm/厚铝板	EC-DG-D334232-ZD1 (AL1)	1	0	1	26.758	3.291	3.291	3.291	3.291
22		T3-AP11-01	3mm/厚铝板	EC-DG-D334232-ZD1 (AL1)	1	0	1	12.497	1.537	1.537	1.537	1.537


美特鋁質有限公司 MTDI Aluminium Fabricator Ltd.		工程號:	J-853	計算:	李炳安	日期:	2023.05.8		送呈:			
		地盤名稱:	廷坪路	核對:	李煥全	日期:	2023.05.8		副本:			
		項目類別:	T3 P/F	批准:		日期:						
地盤用鋁板B.M.表		修改版次:	A	A/C Code:		總V.F.:	186.783	總重量:	1518.55			
序號	修改內容	鋁板圖號	鋁板名稱	顏色	實用	後備	總數	總重量	總展開面積		圖紙編號	
									單件展開面積	平方米		單件V.F.
23		T3-AP12-01	3mm/厚鋁板	EC-DG-D334232-ZD1 (AL1)	1	0	1	12.142	1.493	1.493	1.493	1.493
24		T3-AP13-01	3mm/厚鋁板	EC-DG-D334232-ZD1 (AL1)	1	0	1	11.887	1.462	1.462	1.462	1.462
25		T3-AP14-01	3mm/厚鋁板	EC-DG-D334232-ZD1 (AL1)	1	0	1	11.962	1.471	1.471	1.471	1.471
26		T3-AP15-01	3mm/厚鋁板	EC-DG-D334232-ZD1 (AL1)	1	0	1	12.428	1.529	1.529	1.529	1.529
27		T3-AP16-01	3mm/厚鋁板	EC-DG-D334232-ZD1 (AL1)	1	0	1	22.100	2.718	2.718	2.718	2.718
28		T3-AP17-01	3mm/厚鋁板	EC-DG-D334232-ZD1 (AL1)	1	0	1	9.659	1.188	1.188	1.188	1.188
29		T3-CE01-01	3mm/厚鋁板	EC-DG-D334232-ZD1 (AL1)	13	0	13	52.921	0.501	6.509	0.501	6.509
30		T3-CE01-03	3mm/厚鋁板	EC-DG-D334232-ZD1 (AL1)	1	0	1	3.746	0.461	0.461	0.461	0.461
31		T3-CE01-04	3mm/厚鋁板	EC-DG-D334232-ZD1 (AL1)	1	0	1	3.052	0.375	0.375	0.375	0.375
32		T3-CE01-06	3mm/厚鋁板	EC-DG-D334232-ZD1 (AL1)	1	0	1	4.071	0.501	0.501	0.501	0.501
33		T3-CE02-01	3mm/厚鋁板	EC-DG-D334232-ZD1 (AL1)	1	0	1	3.728	0.459	0.459	0.459	0.459
34		T3-CE02-02	3mm/厚鋁板	EC-DG-D334232-ZD1 (AL1)	1	0	1	2.831	0.348	0.348	0.348	0.348
35		T3-CE02-04	3mm/厚鋁板	EC-DG-D334232-ZD1 (AL1)	1	0	1	3.873	0.476	0.476	0.476	0.476
36		T3-CE02-06	3mm/厚鋁板	EC-DG-D334232-ZD1 (AL1)	1	0	1	3.978	0.489	0.489	0.489	0.489
37		T3-CE03-03	3mm/厚鋁板	EC-DG-D334232-ZD1 (AL1)	1	0	1	4.000	0.492	0.492	0.492	0.492
38		T3-CE03-04	3mm/厚鋁板	EC-DG-D334232-ZD1 (AL1)	1	0	1	3.924	0.483	0.483	0.483	0.483
39		T3-CE05-01	3mm/厚鋁板	EC-DG-D334232-ZD1 (AL1)	1	0	1	3.706	0.456	0.456	0.456	0.456
40		T3-CE06-01	3mm/厚鋁板	EC-DG-D334232-ZD1 (AL1)	1	0	1	1.659	0.204	0.204	0.204	0.204
41		T3-CE07-01	3mm/厚鋁板	EC-DG-D334232-ZD1 (AL1)	1	0	1	4.651	0.572	0.572	0.572	0.572
42		T3-CE11-01	3mm/厚鋁板	EC-DG-D334232-ZD1 (AL1)	1	0	1	2.954	0.363	0.363	0.363	0.363
43		T3-CE12-01	3mm/厚鋁板	EC-DG-D334232-ZD1 (AL1)	1	0	1	2.828	0.348	0.348	0.348	0.348
44		T3-CE13-01	3mm/厚鋁板	EC-DG-D334232-ZD1 (AL1)	1	0	1	2.728	0.336	0.336	0.336	0.336

美特鋁質有限公司 MIDI Aluminium Fabricator Ltd.		工程號: J-853	計算: 李炳安	日期: 2023.05.8	送呈:										
地盤用鋁板B.M.表		地盤名稱: 廷坪路	核對: 李煥全	日期: 2023.05.8	副本:										
BM編號:		項目類別: T3 P/F	批准:	日期:											
修改版次: A		A/C Code:	後備	總V.F.:	總重量: 1518.55										
序號	修改內容	鋁板名稱	顏色	實用	總重量	單件展開面積	總展開面積	單件V.F.	總V.F.	圖紙編號					
				後備	總重量	平方米		平方米							
45		T3-CE14-01	3mm厚鋁板	EC-DG-D334232-ZD1 (AL1)	1	0	1	2.758	0.339	0.339	0.339	0.339	0.339		
46		T3-CE15-01	3mm厚鋁板	EC-DG-D334232-ZD1 (AL1)	1	0	1	3.020	0.371	0.371	0.371	0.371	0.371		
47		T3-CE16-01	3mm厚鋁板	EC-DG-D334232-ZD1 (AL1)	1	0	1	4.274	0.526	0.526	0.526	0.526	0.526		
48		T3-CE17-01	3mm厚鋁板	EC-DG-D334232-ZD1 (AL1)	1	0	1	1.669	0.205	0.205	0.205	0.205	0.205		
49		T3-CE21-02	3mm厚鋁板	EC-DG-D334232-ZD1 (AL1)	1	0	1	3.789	0.466	0.466	0.466	0.466	0.466		
50		T3-CE21-03	3mm厚鋁板	EC-DG-D334232-ZD1 (AL1)	1	0	1	4.071	0.501	0.501	0.501	0.501	0.501		
51		T3-CE21-04	3mm厚鋁板	EC-DG-D334232-ZD1 (AL1)	1	0	1	4.071	0.501	0.501	0.501	0.501	0.501		
52		T3-CE21-05	3mm厚鋁板	EC-DG-D334232-ZD1 (AL1)	1	0	1	4.071	0.501	0.501	0.501	0.501	0.501		
53		T3-CE21-06	3mm厚鋁板	EC-DG-D334232-ZD1 (AL1)	1	0	1	4.071	0.501	0.501	0.501	0.501	0.501		
54		T3-CE21-07	3mm厚鋁板	EC-DG-D334232-ZD1 (AL1)	1	0	1	4.071	0.501	0.501	0.501	0.501	0.501		
55		T3-CE21-08	3mm厚鋁板	EC-DG-D334232-ZD1 (AL1)	1	0	1	4.071	0.501	0.501	0.501	0.501	0.501		
56		T3-CE21-09	3mm厚鋁板	EC-DG-D334232-ZD1 (AL1)	1	0	1	4.071	0.501	0.501	0.501	0.501	0.501		
57		T3-CE21-10	3mm厚鋁板	EC-DG-D334232-ZD1 (AL1)	1	0	1	4.071	0.501	0.501	0.501	0.501	0.501		
58		T3-CE21-11	3mm厚鋁板	EC-DG-D334232-ZD1 (AL1)	1	0	1	4.071	0.501	0.501	0.501	0.501	0.501		
59		T3-CE22-03	3mm厚鋁板	EC-DG-D334232-ZD1 (AL1)	1	0	1	4.000	0.492	0.492	0.492	0.492	0.492		
60		T3-CE22-05	3mm厚鋁板	EC-DG-D334232-ZD1 (AL1)	1	0	1	4.103	0.505	0.505	0.505	0.505	0.505		
61		T3-CE23-01	3mm厚鋁板	EC-DG-D334232-ZD1 (AL1)	1	0	1	4.010	0.493	0.493	0.493	0.493	0.493		
62		T3-CE23-02	3mm厚鋁板	EC-DG-D334232-ZD1 (AL1)	1	0	1	2.784	0.342	0.342	0.342	0.342	0.342		
63		T3-CE23-05	3mm厚鋁板	EC-DG-D334232-ZD1 (AL1)	1	0	1	3.924	0.483	0.483	0.483	0.483	0.483		
64		T3-CE23-06	3mm厚鋁板	EC-DG-D334232-ZD1 (AL1)	1	0	1	3.985	0.490	0.490	0.490	0.490	0.490		
65		T3-CE24-01	3mm厚鋁板	EC-DG-D334232-ZD1 (AL1)	1	0	1	5.914	0.727	0.727	0.727	0.727	0.727		
66		T3-CE31-01	3mm厚鋁板	EC-DG-D334232-ZD1 (AL1)	12	0	12	60.957	0.625	7.498	0.625	7.498	0.625	7.498	

美特鋁質有限公司 MTDI Aluminium Fabricator Ltd.		工程號: 地盤名稱:	J-853 廷坪路	計算: 核對:	李炳安 李煥全	日期:	2023.05.8 2023.05.8		送呈: 副本:			
地盤用鋁板B.M.表		項目類別:	T3 P/F	批准:		日期:						
BM編號:		修改版次:	A	A/C Code:	顏色	總V.F.:	186.783		總重量: 1518.55			
序號	修改內容	鋁板圖號	鋁板名稱	顏色	實用	後備	總數	總重量	總展開面積		圖紙編號	
									單件展開面積	總展開面積		
										平方米		
67		T3-CE31-02	3mm/厚铝板	EC-DG-D334232-ZD1 (AL1)	2	0	2	7.305	0.449	0.898	0.449	0.898
68		T3-CE31-03	3mm/厚铝板	EC-DG-D334232-ZD1 (AL1)	2	0	2	4.876	0.300	0.600	0.300	0.600
69		T3-CE31-04	3mm/厚铝板	EC-DG-D334232-ZD1 (AL1)	2	0	2	9.118	0.561	1.121	0.561	1.121
70		T3-CE31-05	3mm/厚铝板	EC-DG-D334232-ZD1 (AL1)	1	0	1	3.174	0.390	0.390	0.390	0.390
71		T3-CE31-06	3mm/厚铝板	EC-DG-D334232-ZD1 (AL1)	1	0	1	1.244	0.153	0.153	0.153	0.153
72		T3-CE32-01	3mm/厚铝板	EC-DG-D334232-ZD1 (AL1)	1	0	1	4.582	0.564	0.564	0.564	0.564
73		T3-CE32-02	3mm/厚铝板	EC-DG-D334232-ZD1 (AL1)	1	0	1	4.751	0.584	0.584	0.584	0.584
74		T3-CE32-03	3mm/厚铝板	EC-DG-D334232-ZD1 (AL1)	1	0	1	1.209	0.149	0.149	0.149	0.149
75		T3-CE32-04	3mm/厚铝板	EC-DG-D334232-ZD1 (AL1)	2	0	2	2.302	0.142	0.283	0.142	0.283
76		T3-CE33-01	3mm/厚铝板	EC-DG-D334232-ZD1 (AL1)	2	0	2	1.682	0.103	0.207	0.103	0.207
77		T3-CE34-01	3mm/厚铝板	EC-DG-D334232-ZD1 (AL1)	1	0	1	0.488	0.060	0.060	0.060	0.060
78		T3-CE34-02	3mm/厚铝板	EC-DG-D334232-ZD1 (AL1)	1	0	1	0.756	0.093	0.093	0.093	0.093
79		T3-CE35-01	3mm/厚铝板	EC-DG-D334232-ZD1 (AL1)	1	0	1	4.509	0.555	0.555	0.555	0.555
80		T3-CE36-01	3mm/厚铝板	EC-DG-D334232-ZD1 (AL1)	1	0	1	2.458	0.302	0.302	0.302	0.302
81		T3-CE37-01	3mm/厚铝板	EC-DG-D334232-ZD1 (AL1)	2	0	2	10.019	0.616	1.232	0.616	1.232
82		T3-CE37-02	3mm/厚铝板	EC-DG-D334232-ZD1 (AL1)	1	0	1	1.175	0.145	0.145	0.145	0.145
83		T3-CE38-01	3mm/厚铝板	EC-DG-D334232-ZD1 (AL1)	1	0	1	2.647	0.326	0.326	0.326	0.326
84		T3-CE41-01	3mm/厚铝板	EC-DG-D334232-ZD1 (AL1)	1	0	1	1.156	0.142	0.142	0.142	0.142
85		T3-CE42-01	3mm/厚铝板	EC-DG-D334232-ZD1 (AL1)	1	0	1	2.380	0.293	0.293	0.293	0.293
86		T3-CE43-01	3mm/厚铝板	EC-DG-D334232-ZD1 (AL1)	1	0	1	2.017	0.248	0.248	0.248	0.248
87		T3-CE44-01	3mm/厚铝板	EC-DG-D334232-ZD1 (AL1)	1	0	1	2.841	0.349	0.349	0.349	0.349
88		T3-CE45-01	3mm/厚铝板	EC-DG-D334232-ZD1 (AL1)	1	0	1	0.499	0.061	0.061	0.061	0.061


美特鋁質有限公司 MIDI Aluminium Fabricator Ltd.		工程號:	J-853	計算:	李炳安	日期:	2023.05.8		送呈:				
		地盤名稱:	廷坪路	核對:	李煥全	日期:	2023.05.8		副本:				
		項目類別:	T3 P/F	批准:		日期:							
地盤用鋁板B.M.表		修改版次:	A	A/C Code:		總V.F.:	186.783		總重量:	1518.55			
序號	修改內容	鋁板圖號	鋁板名稱	顏色	實用	後備	總數	總重量	總展開面積		圖紙編號		
									單件展開面積	總展開面積			
平方米													
89		T3-CE46-01	3mm厚鋁板	EC-DG-D334232-ZD1 (AL1)	1	0	1	1.710	0.210	0.210	0.210	0.210	0.210
90		T3-CE47-01	3mm厚鋁板	EC-DG-D334232-ZD1 (AL1)	1	0	1	1.904	0.234	0.234	0.234	0.234	0.234
91		T3-CE48-01	3mm厚鋁板	EC-DG-D334232-ZD1 (AL1)	1	0	1	4.476	0.551	0.551	0.551	0.551	0.551
92		T3-CE51-01	3mm厚鋁板	EC-DG-D334232-ZD1 (AL1)	1	0	1	2.492	0.307	0.307	0.307	0.307	0.307
93		T3-CE52-01	3mm厚鋁板	EC-DG-D334232-ZD1 (AL1)	1	0	1	6.849	0.842	0.842	0.842	0.842	0.842
94		T3-CE53-01	3mm厚鋁板	EC-DG-D334232-ZD1 (AL1)	1	0	1	7.767	0.955	0.955	0.955	0.955	0.955
95		T3-CE54-01	3mm厚鋁板	EC-DG-D334232-ZD1 (AL1)	1	0	1	7.980	0.982	0.982	0.982	0.982	0.982
96		T3-CE55-01	3mm厚鋁板	EC-DG-D334232-ZD1 (AL1)	1	0	1	8.346	1.027	1.027	1.027	1.027	1.027
97		T3-CE56-01	3mm厚鋁板	EC-DG-D334232-ZD1 (AL1)	1	0	1	7.536	0.927	0.927	0.927	0.927	0.927
98		T3-CE57-01	3mm厚鋁板	EC-DG-D334232-ZD1 (AL1)	1	0	1	4.509	0.555	0.555	0.555	0.555	0.555
99		T3-CE58-01	3mm厚鋁板	EC-DG-D334232-ZD1 (AL1)	1	0	1	7.836	0.964	0.964	0.964	0.964	0.964
100		T3-CE59-01	3mm厚鋁板	EC-DG-D334232-ZD1 (AL1)	1	0	1	7.227	0.889	0.889	0.889	0.889	0.889
101		T3-CE60-01	3mm厚鋁板	EC-DG-D334232-ZD1 (AL1)	1	0	1	5.417	0.666	0.666	0.666	0.666	0.666
102		T3-CE61-01	3mm厚鋁板	EC-DG-D334232-ZD1 (AL1)	1	0	1	7.836	0.964	0.964	0.964	0.964	0.964
103		T3-CE62-01	3mm厚鋁板	EC-DG-D334232-ZD1 (AL1)	1	0	1	5.417	0.666	0.666	0.666	0.666	0.666
104		T3-CE63-01	3mm厚鋁板	EC-DG-D334232-ZD1 (AL1)	1	0	1	4.761	0.586	0.586	0.586	0.586	0.586
105	新增	T3-CE18-01	3mm厚鋁板	EC-DG-D334232-ZD1 (AL1)	1	0	1	2.977	0.366	0.366	0.366	0.366	0.366
106	新增	T3-CE39-01	3mm厚鋁板	EC-DG-D334232-ZD1 (AL1)	1	0	1	1.133	0.139	0.139	0.139	0.139	0.139
107	新增	T3-CE40-01	3mm厚鋁板	EC-DG-D334232-ZD1 (AL1)	1	0	1	0.840	0.103	0.103	0.103	0.103	0.103
108													
109													
					總計:		158	0	158	1519	187	187	187

REV.	CHANGED BY	PART NUMBER	Dim. A	Dim. B	Dim. C	Dim. D	Dim. E	Dim. F	Dim. G	QTY	Inv. Code	ASSEMBLE ON PARTS		EXTR. DRAWING	PART DRAWING
-		T3-CE18-01								1					

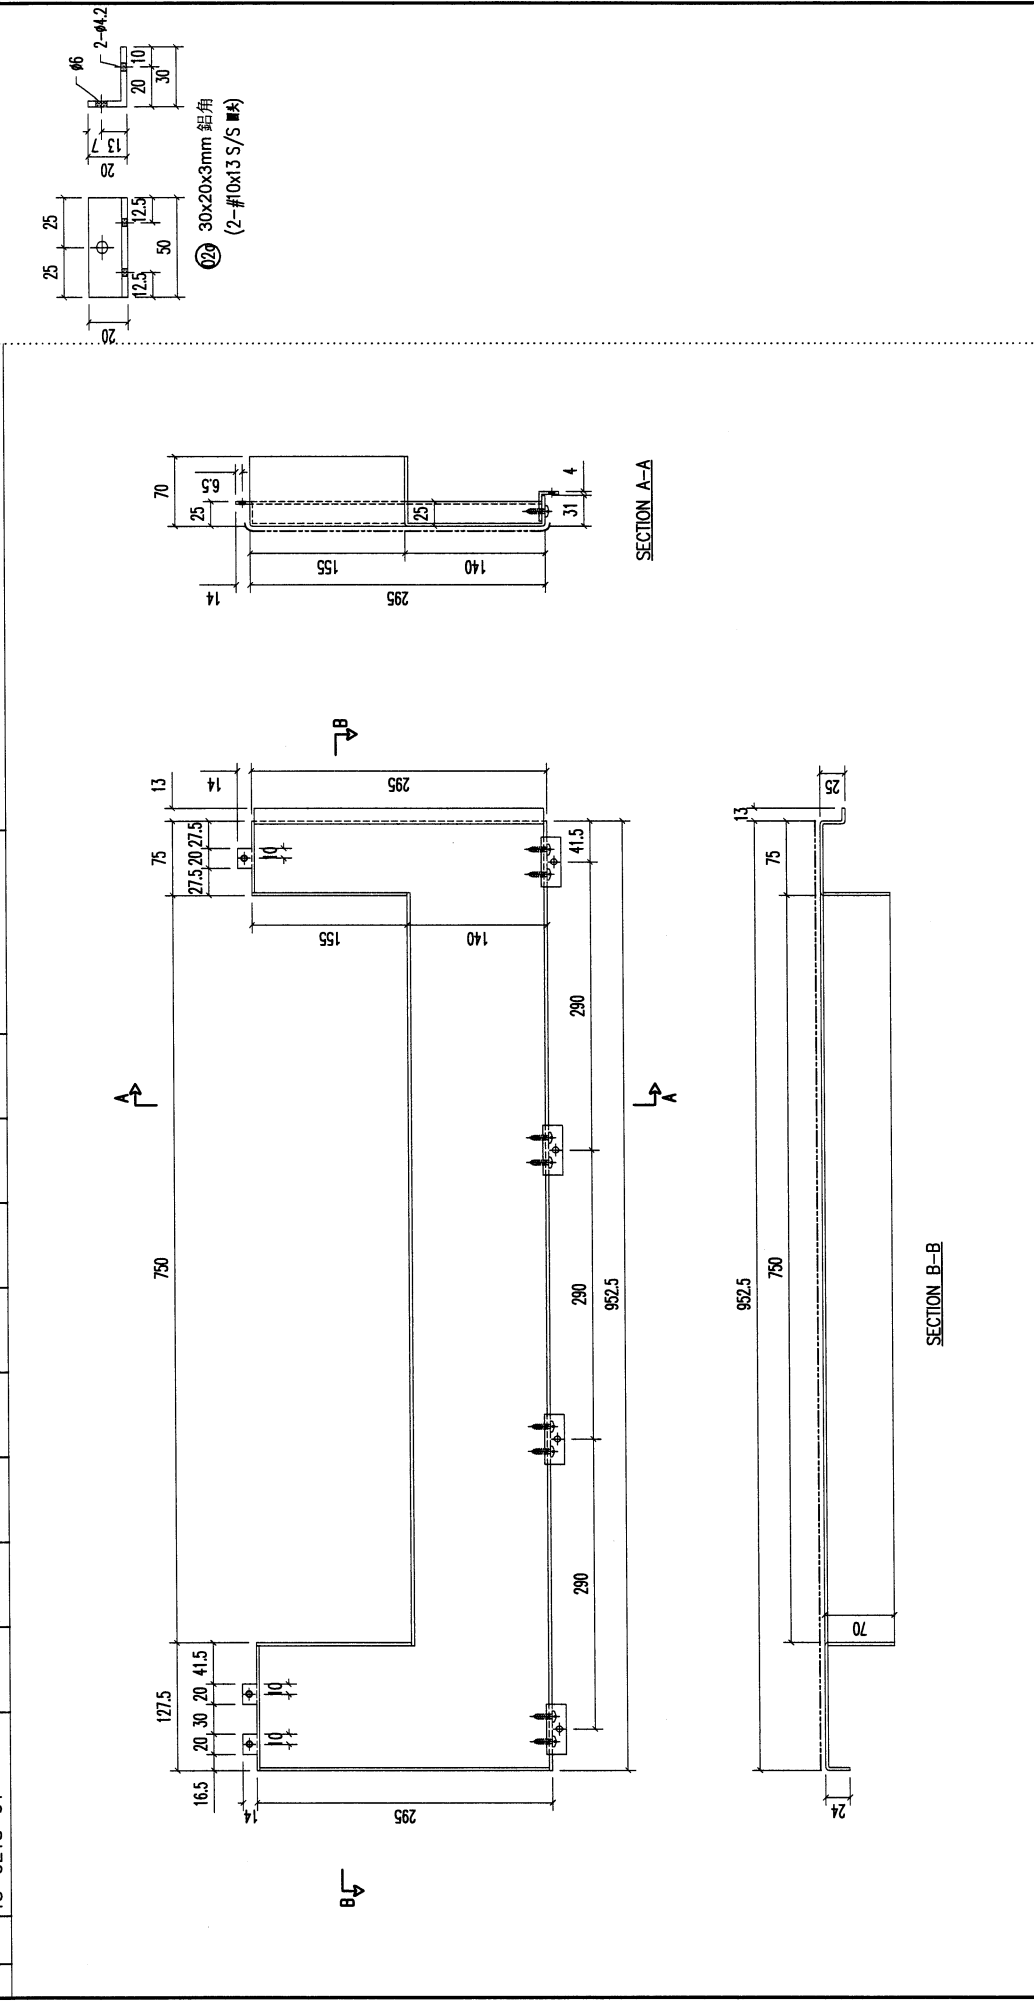

02a	30x20x3mm 鋁角	50	長度	2	開料	2	數量	備註
01	W/CENTRE MAGN/SODA/FAB	EC-DG-034232-ZDI (AL1)	FINISH	EC-DG-034232-ZDI (AL1)	POST PAINT	PRE PAINT	PART	SUB ASSEM.
Standard	X X . = ±1 Tolerances X X . X = ±05	Angle ±1° Squareness ±1°	CUT ENDS	DATE	SCALE	TRACK TYPE	REV.	REV.
				5/11/2023	1:5	S.....	-/-	-
DRAWING TITLE		鋁板天花加工圖		DRAWING NO.		T3-CE18-01		
PROJECT		J853-PODIUM ALUM CEILING & FEATURE CLADDING T3 3/F		JOB NO.		J853		
MIDI ALUMINIUM FABRICATOR LTD.		Units 6-8, Sunray Industrial Centre, 1/F 610 Cha Kwo Ling Road, Kowloon Tel:23489211-4 Fax:(852)27727666		REVISED BY		AMENDMENT		
MIDI 鋁質有限公司				DATE				

B.D. REF : 3/1044/15

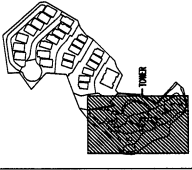


KEY PLAN

CLIENT : **SHIMAO GROUP HOLDINGS LIMITED**
 ARCHITECT : **YONG TUNG & PARTNERS LIMITED**
 MAIN CONTRACTOR : **裕興建築有限公司 / HIP HING CONSTRUCTION CO LTD**
 STRUCTURAL ENGINEER : **CMA C.M WONG & ASSOCIATES LTD / 黃楚明建築工程師有限公司**
 FACADE CONSULTANT : **MENHART**

NOTE:
 1. ALL DIMENSIONS ARE IN MM.
 2. ALL DIMENSIONS ARE VIEWED FROM OUTSIDE.
 3. DIMENSIONS TO BE VIEWED ON SITE.
 4. REFER TO SPECIFICATION FOR MATERIALS.

REVERSE DETAIL MARK NO.
 REFER SHEET NO.
 1. F.F.L. — FINISHED FLOOR LEVEL.
 2. S.F.L. — STRUCTURAL FLOOR LEVEL.
 3. — REVERSED DETAIL.

JOB NO. : J-853
 PROJECT : PROPOSED RESIDENTIAL DEVELOPMENT AT N.C.L.L. 6542 THE HING LAD, KOWLOON
 TITLE : PARTIAL REFLECTED CEILING PLAN AT P/F (13)
 DATE : 29-MAY-212 SCALE : 1:50 (A3)
 DRAWN BY : CJM CHECKED BY :
美特鋸質有限公司
 DWG NO. : J853-CE-0214-38 REV. : A

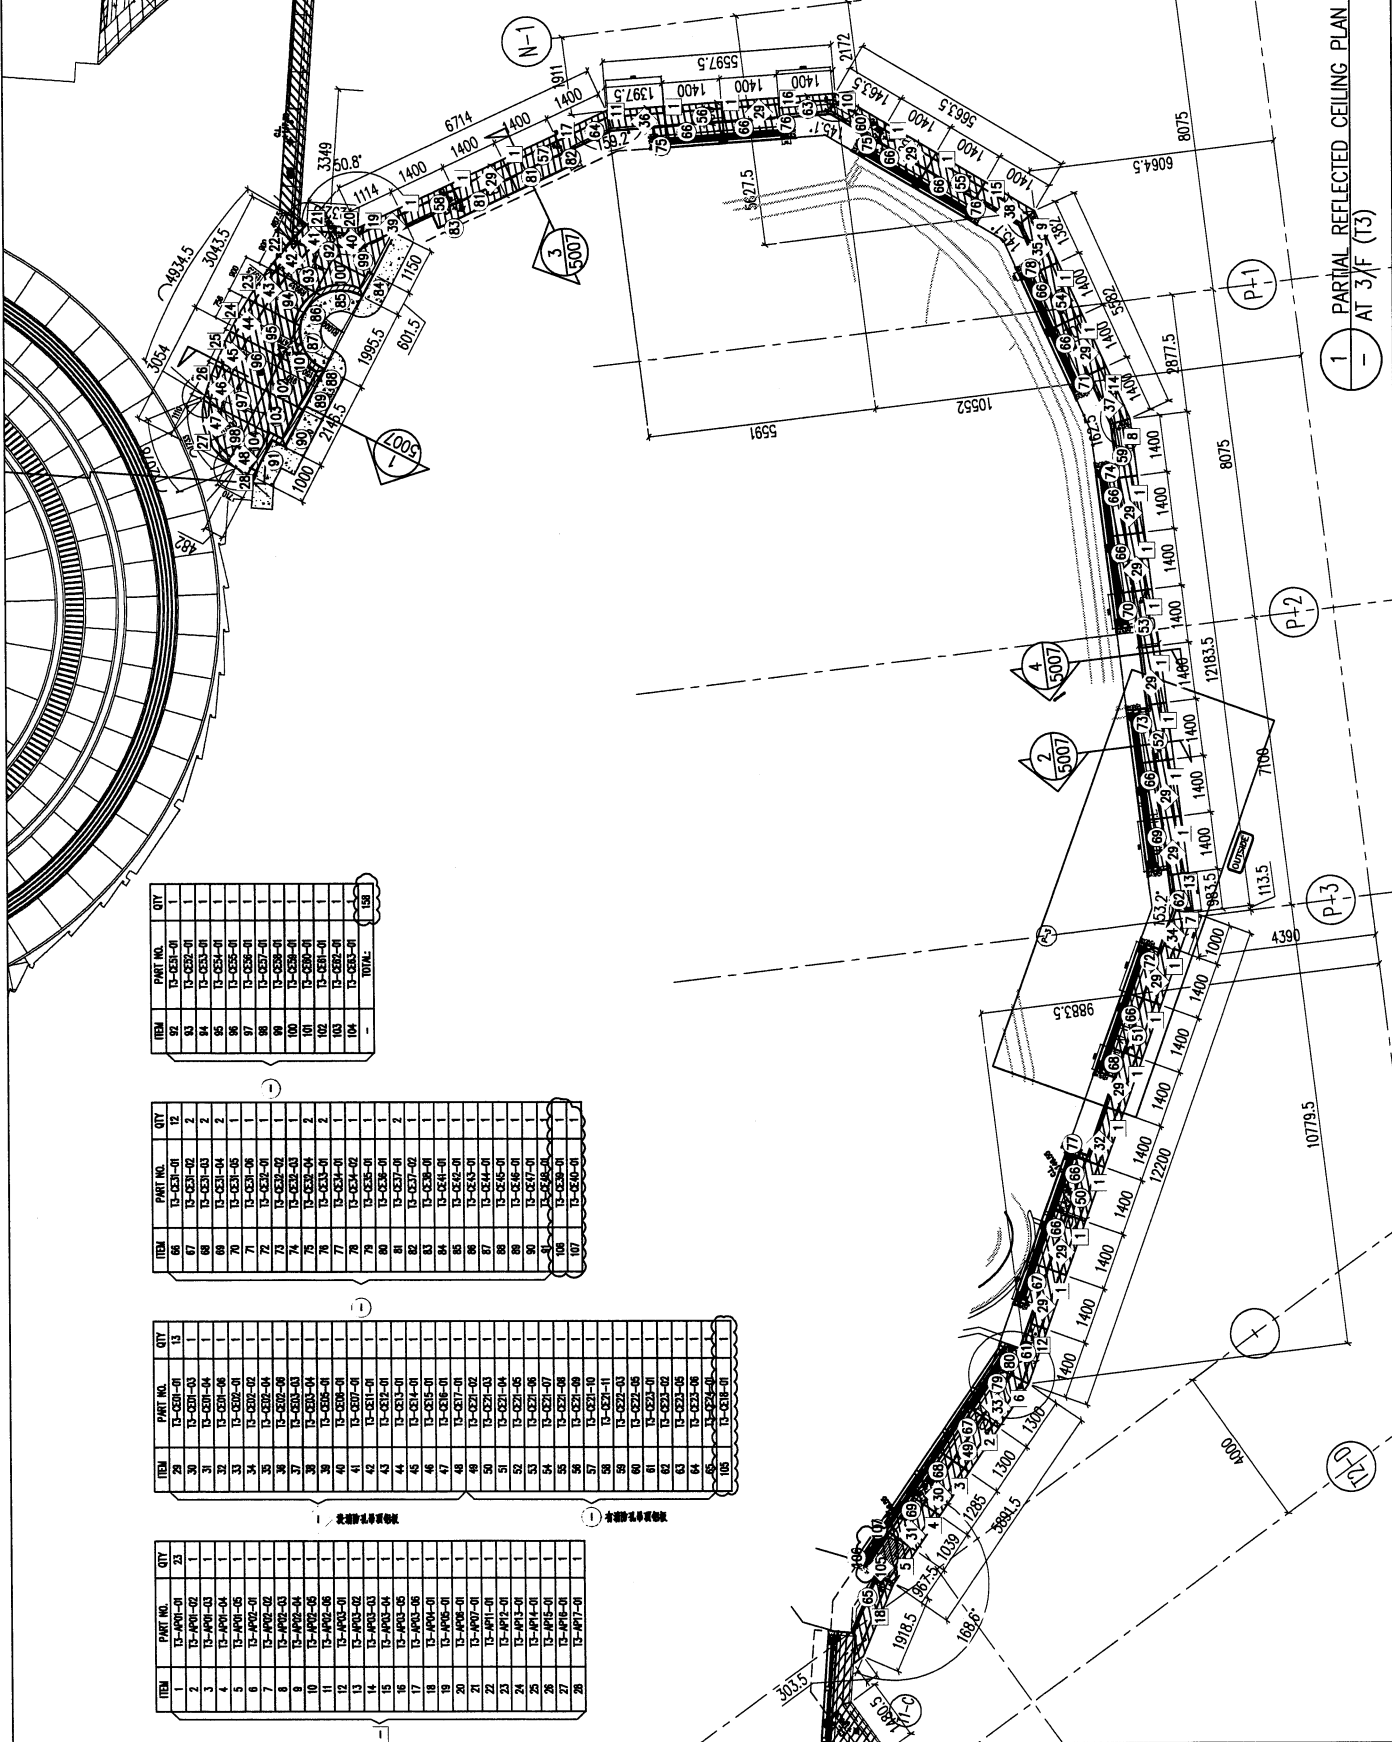

ITEM	PART NO.	QTY
