

工程指示 / 要求簡箋(E.I.)

工程指示編號：EI / 4027 / 21

修改版次：A

工程編號：J - 856

工程名稱：天水圍天榮站

工程項目：佛沙窗 窗用安全欄柵

收件人：青哥/生統/王良/永林

發件人：Eric Liu

日期：30/11/2021

□要求提供 / □確認 事項：

- | | | |
|---------------|----------------|----------|
| () 初步鋁料 B.M. | () 加工拆圖，然後生產 | () 尺寸表 |
| () 正式鋁料 B.M. | () 技術上資料 / 指示 | () 報價 |
| () 配件 B.M. | () 樣辦或貨品說明書 | () 分判合約 |

內容：

A 版：提供窗用安全欄柵大圖，請先按此報價

因應大判要求，所有窗需加上安全欄柵

請見附件安全欄柵做法

趟門,FD 門 有露台位置不需做

佛沙窗出貨到佛沙場，需裝上安全欄柵一同出貨

分 50 窗及 70 窗款，請留意

謝謝

請在 2021.12.02 前完成上列要求。

附：

以上項目為：

☐ 原合約工程包
 ☐ 原合約工程加 / 減賬
 ☐ 新工程報價

原因：-

分發東莞各部門：

() 生產技術總監	☒ 連附件	() 技術部	☒ 連附件	() 生產部	☐ 連附件	() 機械設計部	☐ 連附件
() 採購部	☐ 連附件	() 生產統籌部	☒ 連附件	() 小羅&清	☐ 連附件		
() 質檢部	☒ 連附件	() 會計部	☐ 連附件	() 報關組	☐ 連附件	() 其他	☒ 連附件

分發其他分判：

(v) 水洪 ☐ 連附件

分發香港各部門：

() 行政部	☐ 連附件	() 會計部	☐ 連附件	() 統籌部	☐ 連附件	() 工程部地盤科文	☐ 連附件
() 採購部	☐ 連附件	() QS 部	☐ 連附件	() 維修部	☐ 連附件	() 其他	☐ 連附件

傳遞編號：


HK 2185 / 21

發件人簽署：

項目經理簽署：

PROJECT :

PROPOSED DEVELOPMENT ABOVE
LIGHT RAIL TIN WING STOP, TSWTL
NO.23, AREA 33, TIN SHUI WAI, N.T.

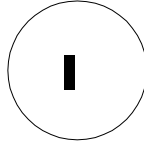

SHOP DRAWING FOR ALUM. PRECAST WINDOW OF TOWER
(SAFETY BARRIER)
DATE: 26-Nov-21



美 特 鋁 質 有 限 公 司
MIDI ALUMINIUM FABRICATOR LTD.

Units 6-8, Sunray Industrial Centre, 1/F
610 Cha Kwo Ling Road, Kowloon
Tel:23489211-4 Fax:(852)2727666

DRAWING SUBMISSION REGISTER

PROJECT: PROPOSED DEVELOPMENT ABOVE LIGHT RAIL, TIN WING STOP, TSWTL NO.23, AREA 33, TIN SHUI WAI, N.T. TITLE: ALUM. WINDOW OF TOWER (safety barrier) SHOPDRAWING SUBMISSION	DATE OF ISSUE										SUBMISSION STATE (FOR B.D / A.S.D)			SUBMISSION STATE (FOR CLIENT / CONSULTANT)			SUBMISSION STATE (FOR ARCHITECT)			FABRICATION / CONSTRUCTION STATE						
	ISSUE		DAY		MONTH		YEAR		AP - APPROVED AC - APPROVED SUB. TO CONDITION NA - NOT APPROVED		AP - APPROVED AC - APPROVED SUB. TO CONDITION NA - NOT APPROVED		AP - APPROVED AC - APPROVED SUB. TO CONDITION NA - NOT APPROVED		ISSUE TO CHINA OFFICE		ISSUE TO SITE		ISSUE TO SUB-CONTRACTOR							
DRAWING TITLE	DWG. NO.	REVISIONS										COMMENT DATE	REV.	STATE	COMMENT DATE	REV.	STATE	COMMENT DATE	REV.	STATE	REV.	DATE	REV.	DATE	REV.	DATE
COVER PAGE	J856-SD-PW-0000	-																								
DRAWING REGISTER	J856-SD-PW-0001	-																								
DRAWING REGISTER	J856-SD-PW-0002	-																								
EXTRUSION LIST FOR ALUM. WINDOW (safety barrier)	J856-SD-PW-1102	A																								
WINDOW SCHEDULE FOR TOWER 1 ALUM. WINDOW (safety barrier)	J856-SD-PW-5101	B																								
WINDOW SCHEDULE FOR TOWER 1 ALUM. WINDOW (safety barrier)	J856-SD-PW-5102	A																								
WINDOW SCHEDULE FOR TOWER 1 ALUM. WINDOW (safety barrier)	J856-SD-PW-5103	A																								
WINDOW SCHEDULE FOR TOWER 1 ALUM. WINDOW (safety barrier)	J856-SD-PW-5104	B																								
WINDOW SCHEDULE FOR TOWER 1 ALUM. WINDOW (safety barrier)	J856-SD-PW-5105	A																								
WINDOW SCHEDULE FOR TOWER 1 ALUM. WINDOW (safety barrier)	J856-SD-PW-5106	B																								
WINDOW SCHEDULE FOR TOWER 1 ALUM. WINDOW (safety barrier)	J856-SD-PW-5107	A																								
WINDOW SCHEDULE FOR TOWER 1 ALUM. WINDOW (safety barrier)	J856-SD-PW-5108	A																								
WINDOW SCHEDULE FOR TOWER 1 ALUM. WINDOW (safety barrier)	J856-SD-PW-5109	B																								
WINDOW SCHEDULE FOR TOWER 1 ALUM. WINDOW (safety barrier)	J856-SD-PW-5110	B																								
WINDOW SCHEDULE FOR TOWER 1 ALUM. WINDOW (safety barrier)	J856-SD-PW-5111	B																								
WINDOW SCHEDULE FOR TOWER 2 ALUM. WINDOW (safety barrier)	J856-SD-PW-5201	B																								
WINDOW SCHEDULE FOR TOWER 2 ALUM. WINDOW (safety barrier)	J856-SD-PW-5202	A																								
WINDOW SCHEDULE FOR TOWER 2 ALUM. WINDOW (safety barrier)	J856-SD-PW-5203	A																								
WINDOW SCHEDULE FOR TOWER 2 ALUM. WINDOW (safety barrier)	J856-SD-PW-5204	B																								
WINDOW SCHEDULE FOR TOWER 2 ALUM. WINDOW (safety barrier)	J856-SD-PW-5205	A																								
WINDOW SCHEDULE FOR TOWER 2 ALUM. WINDOW (safety barrier)	J856-SD-PW-5206	B																								
WINDOW SCHEDULE FOR TOWER 2 ALUM. WINDOW (safety barrier)	J856-SD-PW-5207	A																								
WINDOW SCHEDULE FOR TOWER 2 ALUM. WINDOW (safety barrier)	J856-SD-PW-5208	A																								
WINDOW SCHEDULE FOR TOWER 2 ALUM. WINDOW (safety barrier)	J856-SD-PW-5209	B																								
WINDOW SCHEDULE FOR TOWER 2 ALUM. WINDOW (safety barrier)	J856-SD-PW-5210	B																								
WINDOW SCHEDULE FOR TOWER 2 ALUM. WINDOW (safety barrier)	J856-SD-PW-5211	B																								
WINDOW SCHEDULE FOR TOWER 3 ALUM. WINDOW (safety barrier)	J856-SD-PW-5301	C																								
WINDOW SCHEDULE FOR TOWER 3 ALUM. WINDOW (safety barrier)	J856-SD-PW-5302	D																								
WINDOW SCHEDULE FOR TOWER 3 ALUM. WINDOW (safety barrier)	J856-SD-PW-5303	D																								
WINDOW SCHEDULE FOR TOWER 3 ALUM. WINDOW (safety barrier)	J856-SD-PW-5304	D																								
WINDOW SCHEDULE FOR TOWER 3 ALUM. WINDOW (safety barrier)	J856-SD-PW-5305	D																								
WINDOW SCHEDULE FOR TOWER 3 ALUM. WINDOW (safety barrier)	J856-SD-PW-5306	C																								
WINDOW SCHEDULE FOR TOWER 3 ALUM. WINDOW (safety barrier)	J856-SD-PW-5307	C																								
WINDOW SCHEDULE FOR TOWER 3 ALUM. WINDOW (safety barrier)	J856-SD-PW-5308	D																								
WINDOW SCHEDULE FOR TOWER 3 ALUM. WINDOW (safety barrier)	J856-SD-PW-5309	D																								
TYPICAL DETAILS FOR ALUM. WINDOW (safety barrier)	J856-SD-PW-DT61	B																								
TYPICAL DETAILS FOR ALUM. WINDOW (safety barrier)	J856-SD-PW-DT61a	B																								
TYPICAL DETAILS FOR ALUM. WINDOW (safety barrier)	J856-SD-PW-DT62	C																								
TYPICAL DETAILS FOR ALUM. WINDOW (safety barrier)	J856-SD-PW-DT63	C																								
TYPICAL DETAILS FOR ALUM. WINDOW (safety barrier)	J856-SD-PW-DT64	D																								
TYPICAL DETAILS FOR ALUM. WINDOW (safety barrier)	J856-SD-PW-DT71	B																								

DRAWING SUBMISSION REGISTER

[illegible]

IN-HOUSE DESIGN CHECKER	 美特鋁質有限公司 MMDI ALUMINUM FABRICATOR LTD. Units 6-8, Sunny Industrial Centre, 1/F 610 Che Kwo Ling Road, Kowloon Tel:23469271-4 Fax:852271727666
	DWG NO. : JB56-SD-PW-0002 REV. : —

B.O. REF. :	
CLIENT :	
 SUN HUNG KAI REAL ESTATE AGENCY LTD. 42/F, SUN HUNG KAI CENTRE, WANCHAI, HONGKONG	
ARCHITECT :	
 Iw&k&partners a r c h i t e c t s	
MAIN CONTRACTOR :	
 怡輝建築有限公司 Yee Fai Building Contractors Ltd.	
STRUCTURAL ENGINEER :	
 ARUP	
FACADE CONSULTANT :	
 ALPHA CONSULTING LIMITED Steel Structure & Facade Specialist	
NOTE :	
1. ALL DIMENSIONS ARE IN MM.	
2. ALL ELEVATIONS ARE VIEWED FROM OUTSIDE.	
3. ALL DIMENSIONS TO BE VERIFIED ON SITE BEFORE FABRICATION.	
LEGEND :	
 DETAIL MARK NO. 1001 REFER SHEET NO.	
1. F.F.L. -- FINISHED FLOOR LEVEL	
2. S.F.L. -- STRUCTURAL FLOOR LEVEL	
3.  -- REVERSED DETAIL	
4. GLASS LEEDND	
EG-1 -- 6mmHS+12mm AIR GAP+10mmTP THK. I.G.U.	
EG-2 -- 10mm THK. CLEAR TEMPERED GLASS	
EG-4 -- 10mm THK. TEMPERED ACID ETCHED GLASS	
EG-1A -- 6mmHS+12mm AIR GAP+6mmTP THK. I.G.U.	
A	
02/11/2020	
REVISION SUBJECT TO ARCH/COMMENT	
NO. DATE	
JUN 2020	
REVISED	
BY	
JUN 2020	
J-856	
PROJECT :	
PROPOSED DEVELOPMENT ABOVE	
LIGHT RAIL TIN WING STOP,TSWTL	
NO.23,AREA 33,TIN SHUI WAI, N.T.	
TITLE :	
DIE LIST FOR	
ALUM. WINDOW	
(safety barrier)	
DATE : 02-Aug-21	
SCALE : 1:40	
DRAWN BY : ivan	
CHECKED BY :	
 美特鋁質有限公司 MIDI ALUMINIUM FABRICATOR LTD. Units 6-8, Sunny Industrial Centre, 1/F 610 Shu Kwo Ling Road, Kowloon Tel:23489211-4 Fax:(852)21727666	
DWG NO. : JB56--SD--PW--1102	
REV. : A	

CLIENT :

42/F SUN HUNG KAI CENTRE, WANCHAI, HONGKONG



B.D.	REF
------	-----

CLIENT :

SUN HUNG KAI
REAL ESTATE AGENCY LTD.

42/F SUN HUNG KAI CENTRE, WANCHAI, HONGKONG

ARCHITECT

lwkw&partners
architects

Architect

MAIN CONTRACTOR

怡輝建築有限公司
Yee Fai Building Contractors Ltd.

STRUCTURAL ENGINEER

FACADE CONSULTANT:

ALPHA CONSULTING LIMITEE
Steel Structure & Facade Specialist

NOTE :

1. ALL DIMENSIONS ARE IN mm.
2. ALL ELEVATIONS ARE VIEWED FROM OUTSIDE
3. ALL DIMENSIONS TO BE VERIFIED ON SITE BEFORE FABRICATION.

LEGEND

DETAIL MARK NO. 1
REFER SHEET NO. 01

1. F.F.L. -- FINISHED FLOOR LEVEL
2. S.F.L. -- STRUCTURAL FLOOR LEVEL
3. (R) -- REVERSED DETAIL

4. GLASS LEGEND

ECL-1-8mmHS+12mm AIR GAP+10mmTP THK. I.G.U.
 ECL-2-2-10mm THK. CLEAR TEMPERED GLASS
 ECL-4-4-10mm THK. TEMPERED ACID ETCHED GLASS
 ECL-1A-8mmHS+12mm AIR GAP+8mmTP THK. I.G.U.

NO.	DATE	REVISED	BY
A	03/11/2021	REVISION SUBJECT TO ARCH.COMMENT	[signature]

JOB NO. : J-856

PROJECT :
PROPOSED DEVELOPMENT ABOVE
LIGHT RAIL TIN WING STOP, TSWTL
NO.23, AREA 33, TIN SHUI WAI, N.T.

TITLE :

WINDOW SCHEDULE FOR
TOWER 1 ALUM. WINDOW
(safety barrier)

1 SCALE : 1:40

CHECKED BY :








DRAWN BY : Ivan

 美特鋁質有限公司
MIDI ALUMINIUM FABRICATOR LTD.

610 Cho Kwo Ling Road, Kowloon
Tel:23489211-4 Fax:(852)27727666

DWG NO. : J856-SD-PW-5102

DWG NO. : J856-SD-PW-5102	REV. : A
---------------------------	----------

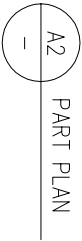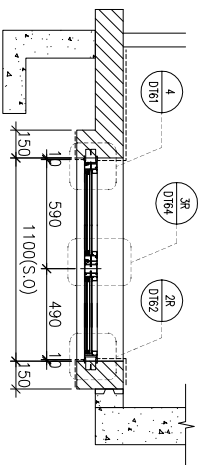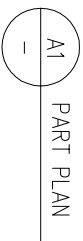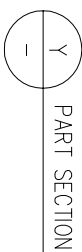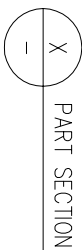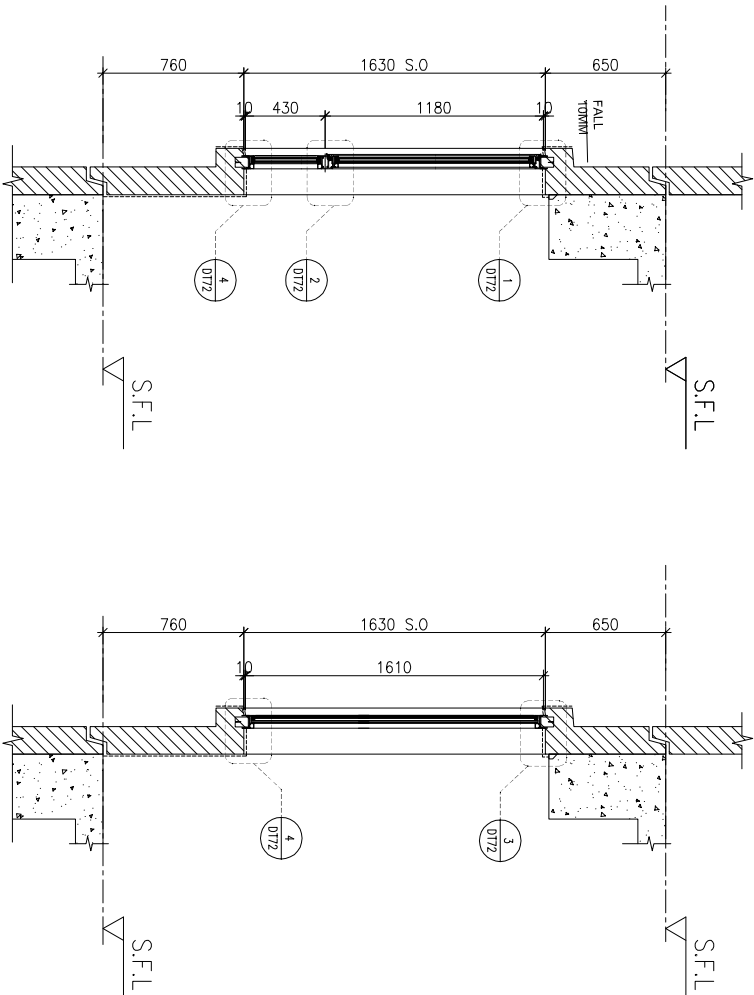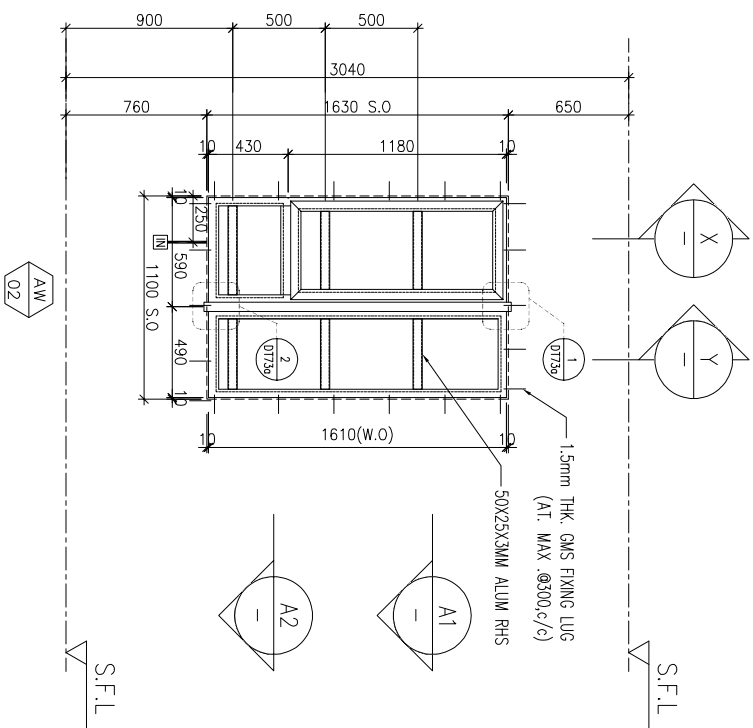

WINDOW MARK		
LOCATION	3/F~42/F(4/F.13/F.14/F.24/F.34/F OMITTED) UNIT A2,A5	3/F~42/F(4/F.13/F.14/F.24/F.34/F OMITTED) UNIT B3
SECTION	70mm ALUM. SECTION	70mm ALUM. SECTION
GLAZING	EGL-1,EGL-1A	EGL-1,EGL-1A
QUANTITY	35 Nos./35 Nos.	35 Nos
REMARKS	FACADE(TYPE T1PF02 FOR 3/F~42/F)	FACADE(TYPE T1PF02R FOR 3/F~42/F)

B.O. REF. :

CLIENT :



SUN HUNG KAI

REAL ESTATE AGENCY LTD.

42/F SUN HUNG KAI CENTRE, WINGHAI, HONGKONG

ARCHITECT :



IWK&partners

a r c h i t e c t s

MAIN CONTRACTOR :



怡輝建築有限公司

Yee Fai Building Contractors Ltd.

STRUCTURAL ENGINEER :



ARUP

FAÇADE CONSULTANT:



ALPHA CONSULTING LIMITED

Steel Structure & Façade Specialist

NOTE.:

1. ALL DIMENSIONS ARE IN mm.
2. ALL ELEVATIONS ARE VIEWED FROM OUTSIDE.
3. ALL DIMENSIONS TO BE VERIFIED ON SITE BEFORE FABRICATION.

LEGEND.:



X1

DETAIL MARK NO.

REFER SHEET NO.

1. F.F.L.--FINISHED FLOOR LEVEL
2. S.F.L.--STRUCTURAL FLOOR LEVEL
3. --REVERSED DETAIL
4. GLASS LEGEND

EGL-1--8mmHS+12mm AIR GAP+10mmTP THK. I.G.U.
EGL-2--10mm THK. CLEAR TEMPERED GLASS
EGL-4--10mm THK. TEMPERED ACID ETCHED GLASS
EGL-1A-8mmHS+12mm AIR GAP+8mmTP THK. I.G.U.

A.		REVISION SUBJECT TO ARCHITECTMENT	
NO.	DATE	REVISION	BY

JOB NO. : J-856

PROJECT :
PROPOSED DEVELOPMENT ABOVE
LIGHT RAIL TIN WING STOP TSWTL
NO.23,AREA 33,TIN SHUI WAI, N.T.

TITLE :
WINDOW SCHEDULE FOR
TOWER 1 ALUM. WINDOW
(safety barrier)

DATE : 02-Aug-21

SCALE : 1:40

DRAWN BY : Ivon

CHECKED BY :



美特鋁寶有限公司

MDI ALUMINIUM FABRICATOR LTD.

Units 6-8, Sunny Industrial Centre, 1/F


610 Ono Kwong Road, Kowloon

Tel:23489211-4 Fax:(852)27277666

DWG NO. : J856-SD-PW-5103

REV. : A

ELEVATION

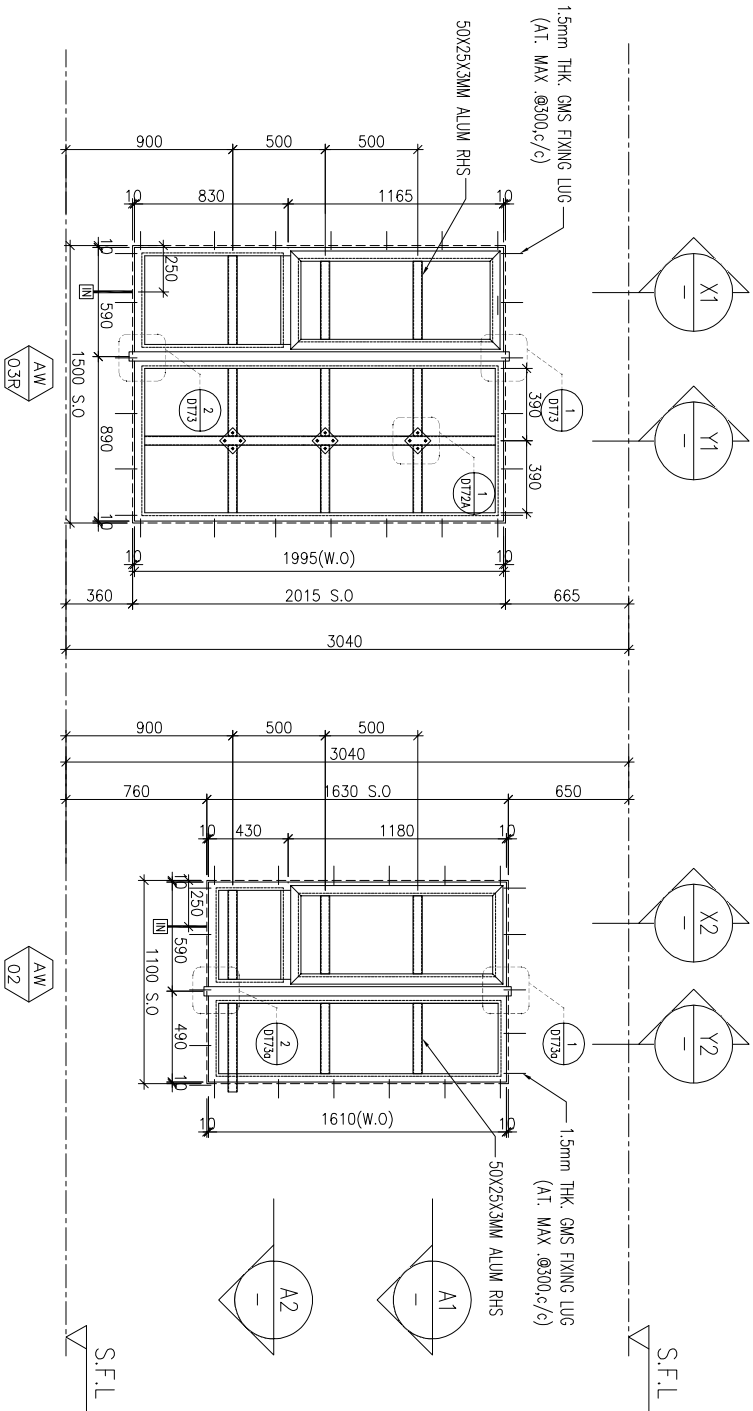

B.O. REF. :

CLIENT :

S

SUN HUNG KAI

REAL ESTATE AGENCY LTD.

42/F SUN HUNG KAI CENTRE, WINGCHAI, HONGKONG

ARCHITECT :

lw&partners

a r c h i t e c t s

MAIN CONTRACTOR :

Y

Yee Fai

怡輝建築有限公司
Building Contractors Ltd.

STRUCTURAL ENGINEER :

ARUP

FAÇADE CONSULTANT:

ALPHA CONSULTING LIMITED

Steel Structure & Façade Specialist

NOTE.:

1. ALL DIMENSIONS ARE IN mm.
2. ALL ELEVATIONS ARE VIEWED FROM OUTSIDE.
3. ALL DIMENSIONS TO BE VERIFIED ON SITE BEFORE FABRICATION.

LEGEND.:

X1

DETAIL MARK NO.

X001

REFER SHEET NO.

1. F.F.L.--FINISHED FLOOR LEVEL
2. S.F.L.--STRUCTURAL FLOOR LEVEL
3.

⌀

--REVERSED DETAIL

4. GLASS LEGEND

EGL-1--8mmH5+12mm AIR GAP+10mmTP THK. I.G.U.

EGL-2--10mm THK. CLEAR TEMPERED GLASS

EGL-4--10mm THK. TEMPERED ACID ETCHED GLASS

EGL-1A-8mmH5+12mm AIR GAP+8mmTP THK. I.G.U.

NO.		DATE	REVISION	BY
B	03/11/2021	REVISION SUBJECT TO ARCHITECTMENT	WON	
A	12/10/2021	REVISION SUBJECT TO ARCHITECTMENT	WON	

JOB NO. : J-856

PROJECT :

PROPOSED DEVELOPMENT ABOVE
LIGHT RAIL TIN WING STOP.TSWTL
NO.23.AREA 33.TIN SHUI WAI, N.T.

TITLE :

WINDOW SCHEDULE FOR
TOWER 1 ALUM. WINDOW
(safety barrier)

DATE : 02-Aug-21	SCALE : 1:40
DRAWN BY : won	CHECKED BY :

MDI






Units 6-8, Sunny Industrial Centre, 1/F
610 Ono Kwo Ling Road, Kowloon
Tel:23489211-4 Fax:(852)27727666

DWG NO. : J856-SD-PW-5104


REV. : B

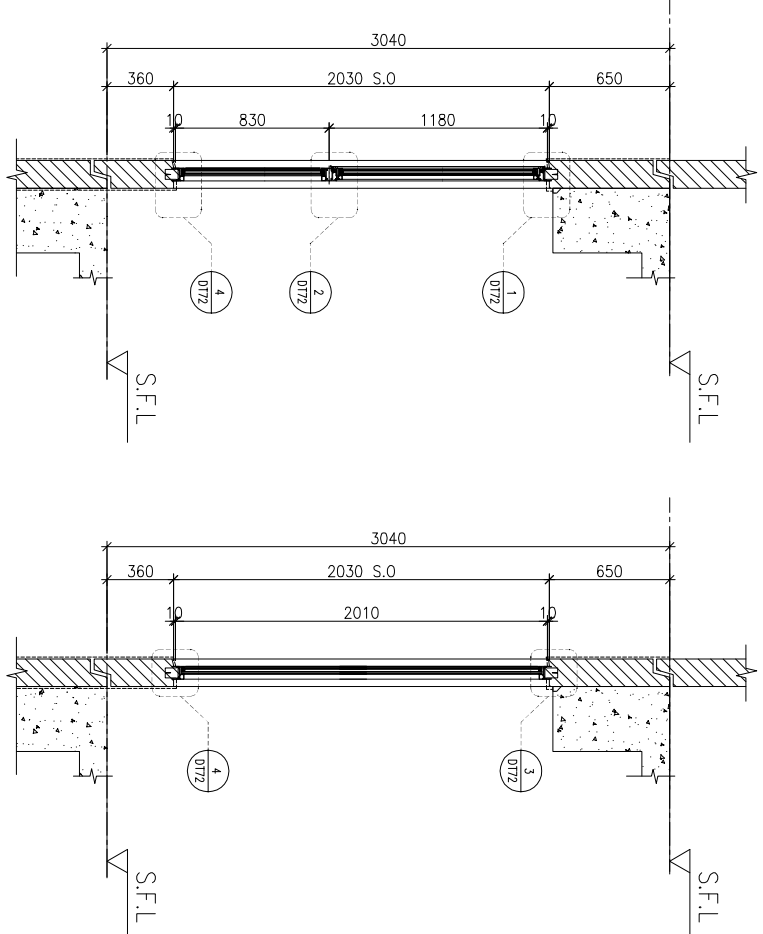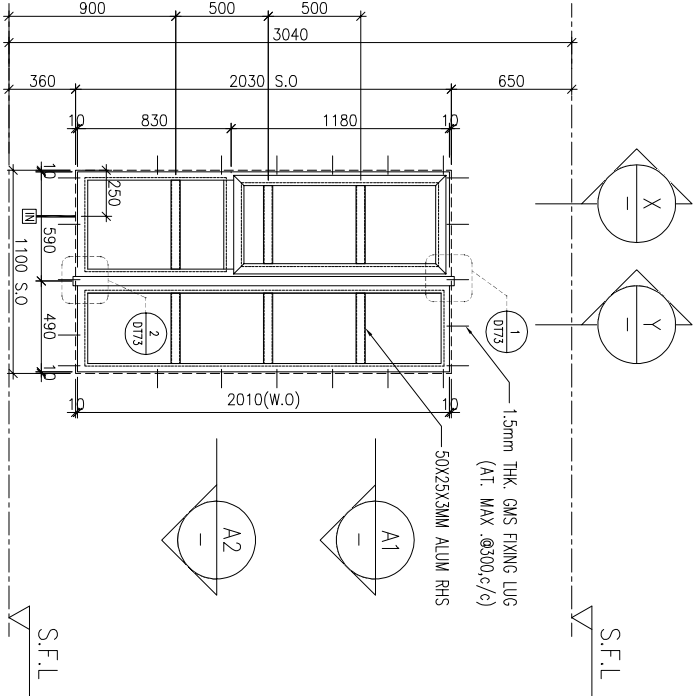

ELEVATION

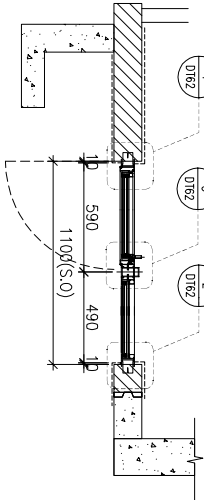

PART PLAN

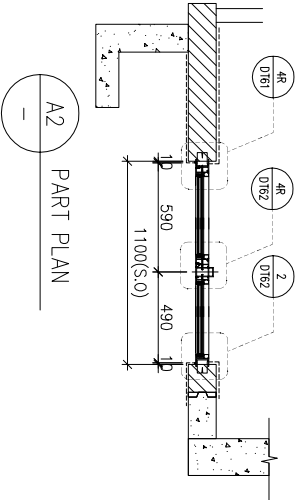

PART PLAN

AW

04R

AW

04

WINDOW MARK

LOCATION 3/F-42/F(4/F,13/F,14/F,24/F,34/F OMITTED) UNIT B2,B6,A3,A7

SECTION 70mm ALUM. SECTION

GLAZING EGL-1,EGL-1A

QUANTITY 35 Nos / 35 Nos / 35 Nos / 35 Nos

REMARKS FACADE(TYPE T1PF04R FOR 3/F~42/F)

SECTION 3/F-42/F(4/F,13/F,14/F,24/F,34/F OMITTED) UNIT B7

SECTION 70mm ALUM. SECTION

GLAZING EGL-1,EGL-1A

QUANTITY 35 Nos

REMARKS FACADE(TYPE T1PF04 FOR 3/F~42/F)

B.O. REF. :

CLIENT :



SUN HUNG KAI
REAL ESTATE AGENCY LTD.

42/F SUN HUNG KAI CENTRE, WINGHAI, HONGKONG

ARCHITECT :



IWK&partners
a r c h i t e c t s

MAIN CONTRACTOR :



怡輝建築有限公司
Yee Fai Building Contractors Ltd.

STRUCTURAL ENGINEER :



ARUP

FAÇADE CONSULTANT:



ALPHA CONSULTING LIMITED
Steel Structure & Façade Specialist

NOTE.:

1. ALL DIMENSIONS ARE IN mm.
2. ALL ELEVATIONS ARE VIEWED FROM OUTSIDE.
3. ALL DIMENSIONS TO BE VERIFIED ON SITE BEFORE FABRICATION.

LEGEND.:



X1—DETAIL MARK NO.





X001—REFER SHEET NO.

1. F.F.L.--FINISHED FLOOR LEVEL
2. S.F.L.--STRUCTURAL FLOOR LEVEL
3. --REVERSED DETAIL

4. GLASS LEGEND

- EGL-1--8mmHS+12mm AIR GAP+10mmTP THK. I.G.U.
- EGL-2--10mm THK. CLEAR TEMPERED GLASS
- EGL-4--10mm THK. TEMPERED ACID ETCHED GLASS
- EGL-1A-8mmHS+12mm AIR GAP+8mmTP THK. I.G.U.

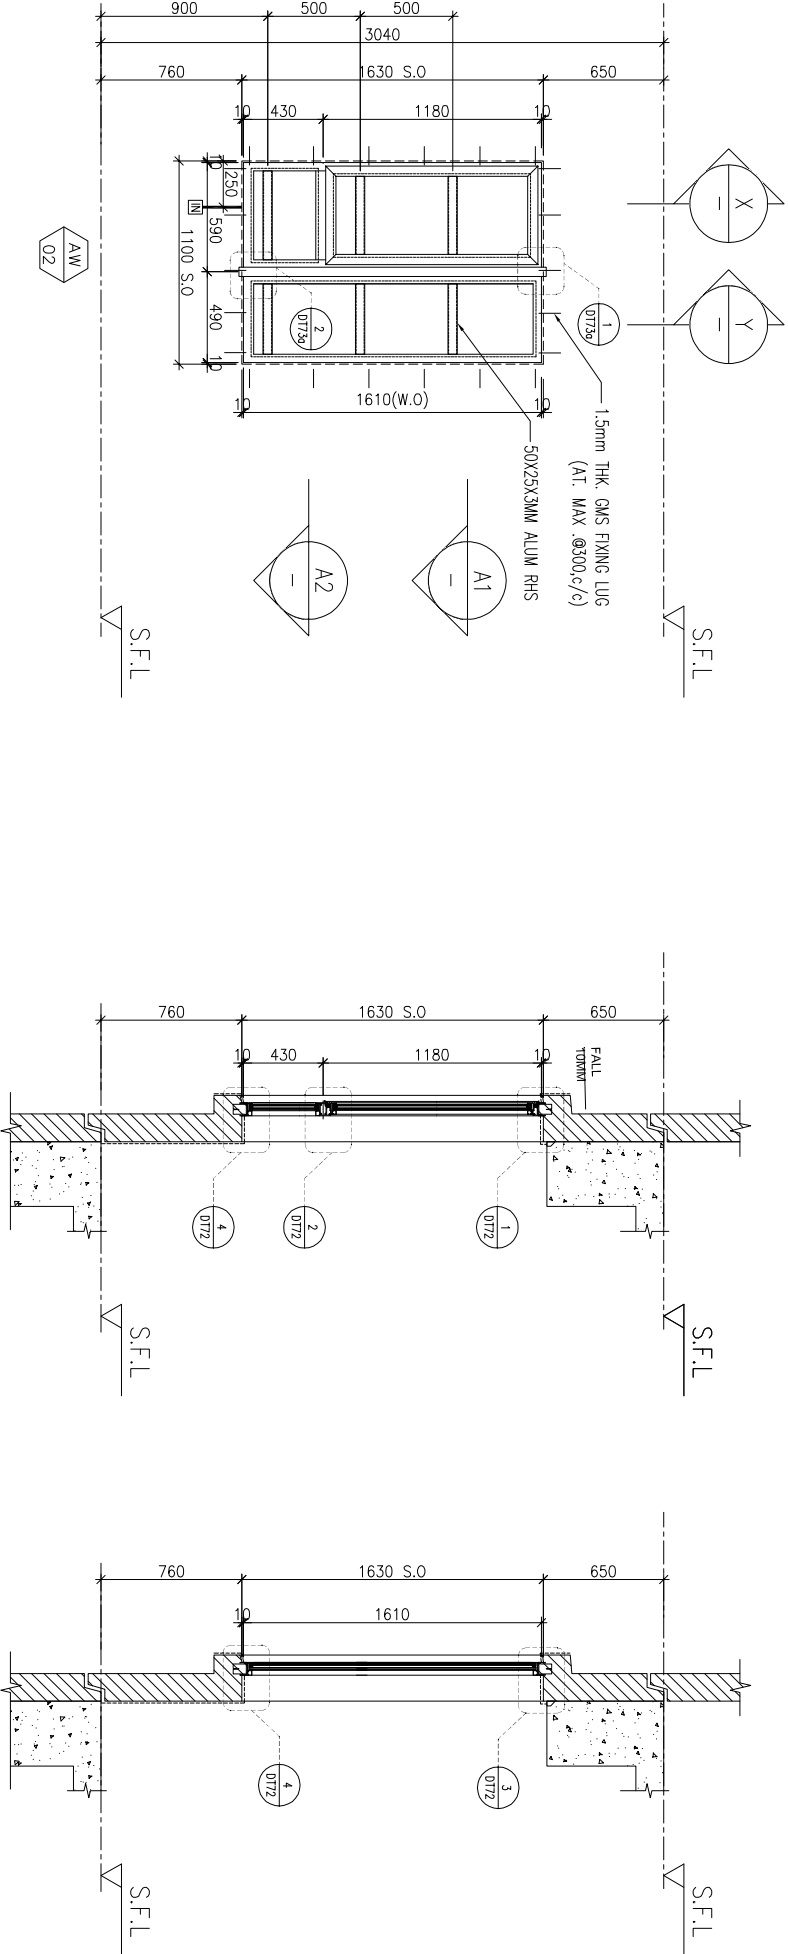ELEVATION			
WINDOW MARK	 AW 02	 AW 02R	
LOCATION	3/F~42/F(4/F,13/F,14/F,24/F,34/F OMITTED) UNIT A7,B2		
SECTION	70mm ALUM. SECTION		
GLAZING	EGL-1,EGL-1A		
QUANTITY	35 Nos / 35 Nos		
REMARKS	FAÇADE(TYPE T1PF05R FOR 3/F~42/F)		

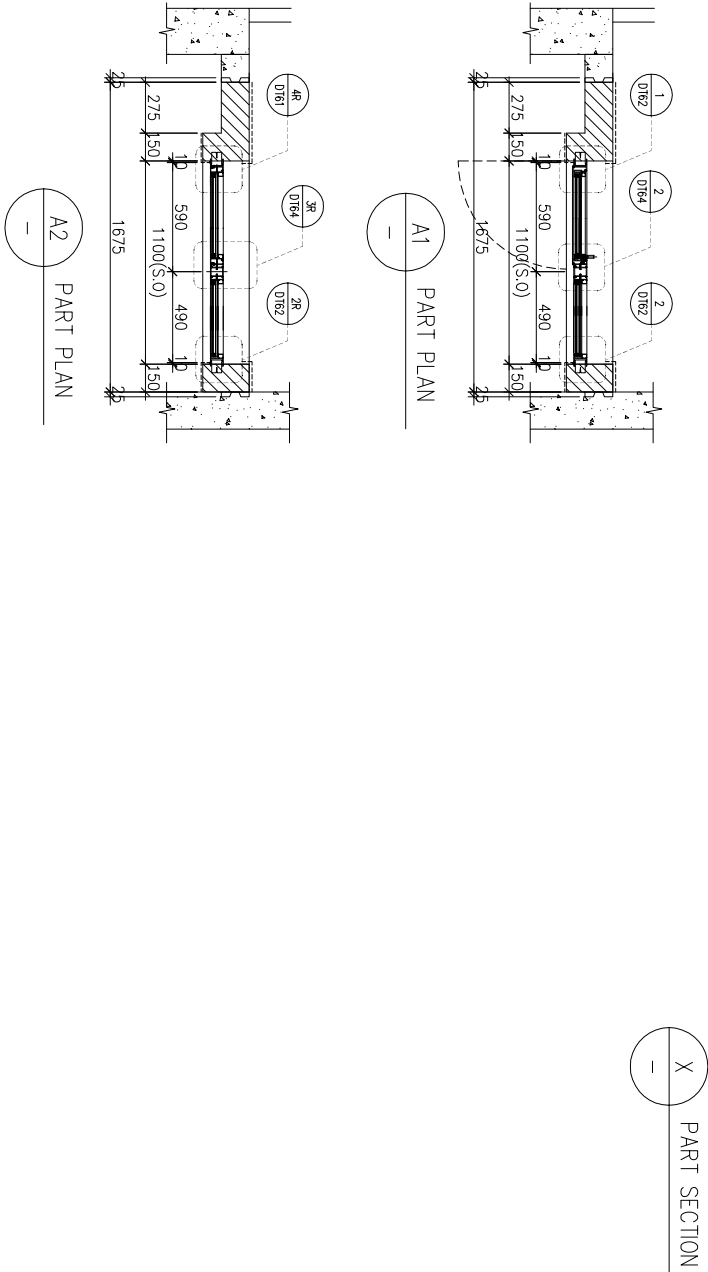

B.O. REF :

CLIENT :

S^K

SUN HUNG KAI

REAL ESTATE AGENCY LTD.

42/F SUNI HUNG KAI CENTRE, WINGCHAI, HONGKONG

ARCHITECT :

lwk&partners

a r c h i t e c t s

MAIN CONTRACTOR :

Y^S

怡輝建築有限公司

Yee Fai Building Contractors Ltd.

STRUCTURAL ENGINEER :

ARUP

FAÇADE CONSULTANT:

ALPHA CONSULTING LIMITED

Steel Structure & Façade Specialist

NOTE :

1. ALL DIMENSIONS ARE IN mm.
2. ALL ELEVATIONS ARE VIEWED FROM OUTSIDE.
3. ALL DIMENSIONS TO BE VERIFIED ON SITE BEFORE FABRICATION.

LEGEND :

X1

DETAIL MARK NO.

X001

REFER SHEET NO.

1. F.F.L.--FINISHED FLOOR LEVEL
2. S.F.L.--STRUCTURAL FLOOR LEVEL
3. --REVERSED DETAIL

4. GLASS LEGEND

- EGL-1--8mmHS+12mm AIR GAP+10mmTP THK. I.G.U.
- EGL-2--10mm THK. CLEAR TEMPERED GLASS
- EGL-4--10mm THK. TEMPERED ACID ETCHED GLASS
- EGL-1A-8mmHS+12mm AIR GAP+8mmTP THK. I.G.U.

NO.		DATE	REVISION	BY
B	03/11/2021	REVISION SUBJECT TO ARCHITECTMENT	WON	
A	12/10/2021	REVISION SUBJECT TO ARCHITECTMENT	WON	

JOB NO. : J-856

PROJECT :

PROPOSED DEVELOPMENT ABOVE
LIGHT RAIL TIN WING STOP.TSWTL
NO.23.AREA 33.TIN SHUI WAI, N.T.

TITLE :

WINDOW SCHEDULE FOR
TOWER 1 ALUM. WINDOW
(safety barrier)

DATE : 02-Aug-21

SCALE : 1:40

DRAWN BY : won

CHECKED BY :



美特鋁寶有限公司

MDI ALUMINIUM FABRICATOR LTD.


Units 6-8, Sunray Industrial Centre, 1/F
610 Ona Kwo Ling Road, Kowloon
Tel:23489211-4 Fax:(852)27727666

DWG NO. : J856-SD-PW-5106

REV. : B

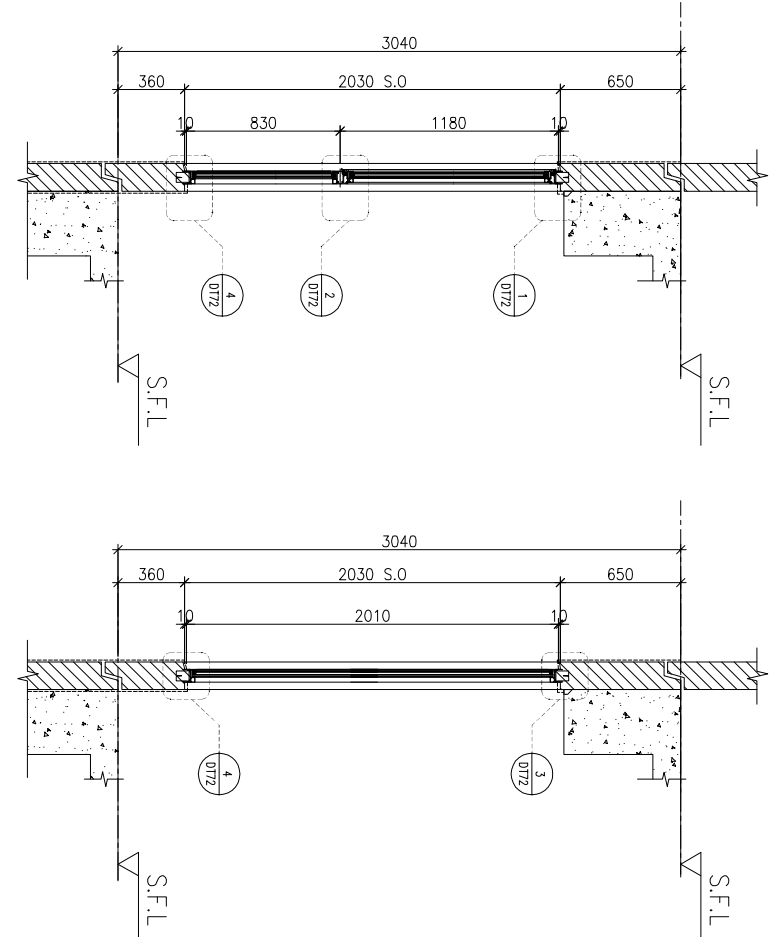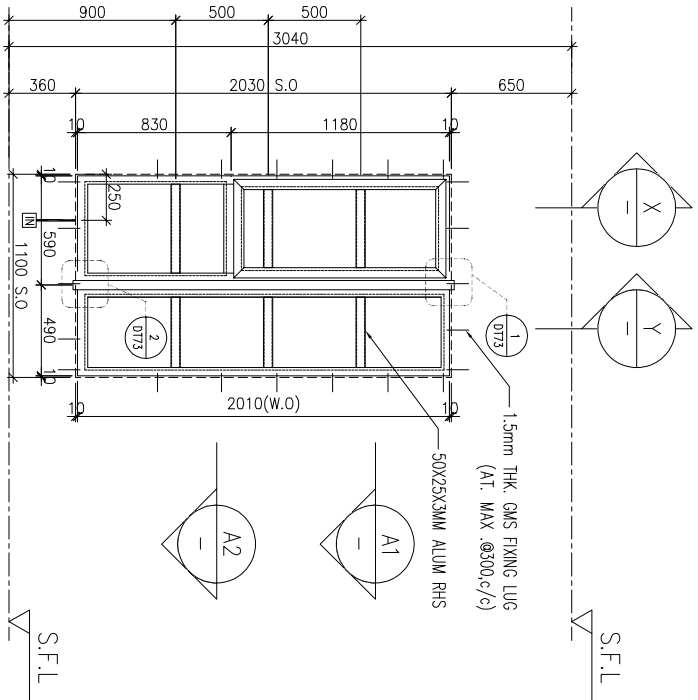

ELEVATION

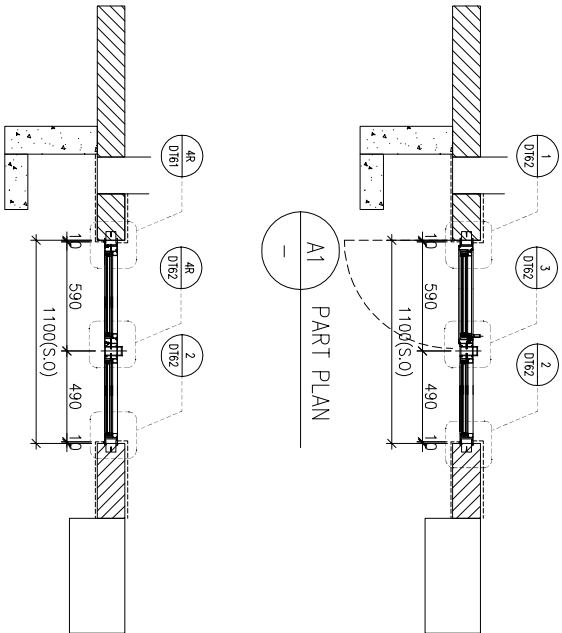

A2 PART PLAN

AW 04R

3/F-42/F(4/F,13/F,14/F,24/F,34/F OMITTED) UNIT A5

70mm ALUM. SECTION

EGL-1,EGL-1A

35 Nos

FAÇADE(TYPE T1PF06R FOR 3/F~42/F)

B.O. REF. :

CLIENT :



SUN HUNG KAI
REAL ESTATE AGENCY LTD.

42/F SUN HUNG KAI CENTRE, WINGHAI, HONGKONG

ARCHITECT :



IWK&partners
a r c h i t e c t s

MAIN CONTRACTOR :



怡輝建築有限公司
Yee Fai Building Contractors Ltd.

STRUCTURAL ENGINEER :



ARUP

FAÇADE CONSULTANT:



ALPHA CONSULTING LIMITED
Steel Structure & Façade Specialist

NOTE.:

1. ALL DIMENSIONS ARE IN mm.
2. ALL ELEVATIONS ARE VIEWED FROM OUTSIDE.
3. ALL DIMENSIONS TO BE VERIFIED ON SITE BEFORE FABRICATION.



LEGEND.:

-  DETAIL MARK NO.
 REFER SHEET NO.



1. F.F.L.--FINISHED FLOOR LEVEL
2. S.F.L.--STRUCTURAL FLOOR LEVEL
3.  --REVERSED DETAIL

4. GLASS LEGEND

- EGL-1--8mmHS+12mm AIR GAP+10mmTP THK. I.G.U.
EGL-2--10mm THK. CLEAR TEMPERED GLASS
EGL-4--10mm THK. TEMPERED ACID ETCHED GLASS
EGL-1A-8mmHS+12mm AIR GAP+8mmTP THK. I.G.U.

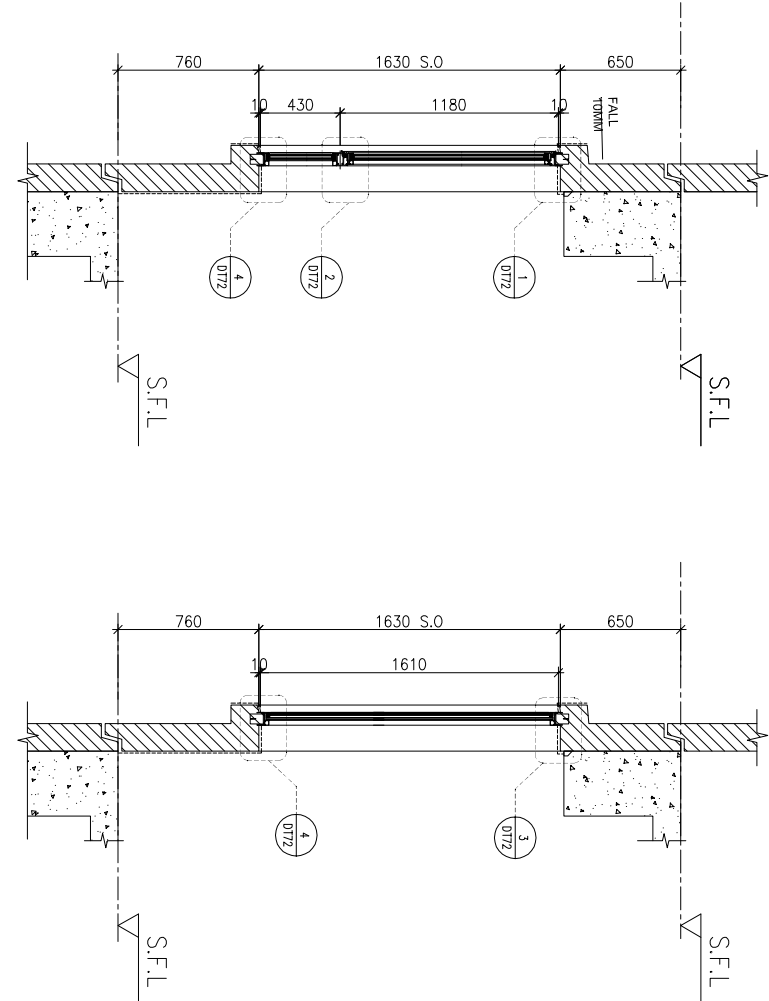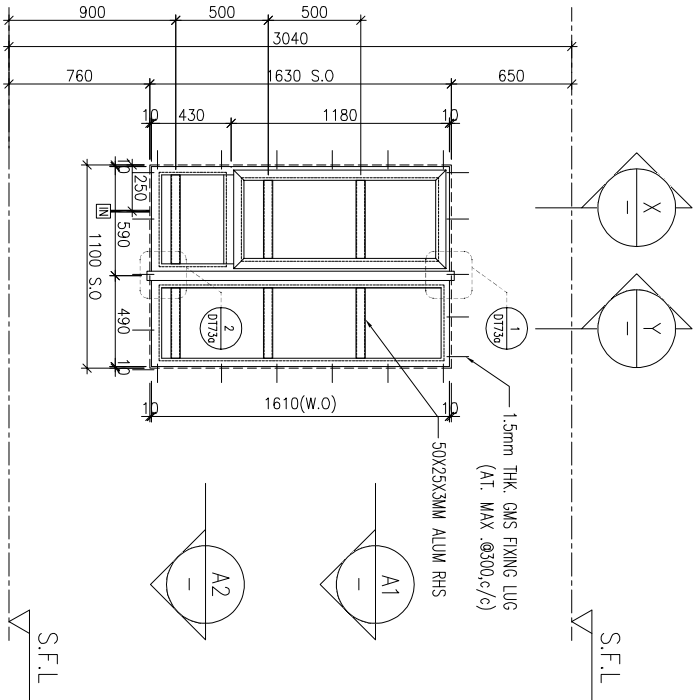

ELEVATION

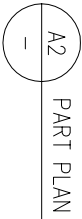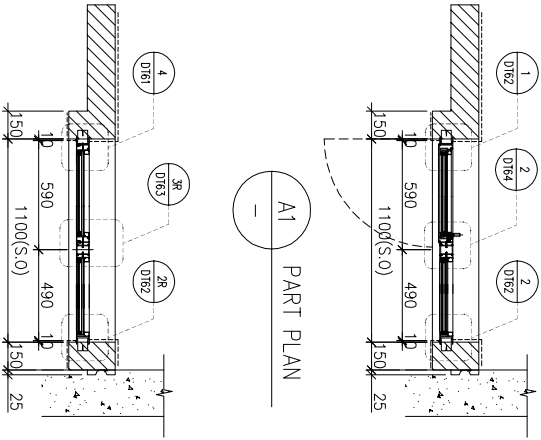

WINDOW MARK		
LOCATION	3/F~42/F(4/F,13/F,14/F,24/F,34/F OMITTED) UNIT B8	
SECTION	70mm ALUM. SECTION	
GLAZING	EGL-1,EGL-1A	
QUANTITY	35 Nos	
REMARKS	FAÇADE(TYPE T1PF08R FOR 3/F~42/F)	

JOB NO. : J-856		PROJECT : PROPOSED DEVELOPMENT ABOVE LIGHT RAIL TIN WING STOP,TSMTL NO.23,AREA 33,TIN SHUI WAI, N.T.	
TITLE : WINDOW SCHEDULE FOR TOWER 1 ALUM. WINDOW (safety barrier)		DATE : 02-Aug-21	
DRAWN BY : Iwon		SCALE : 1:40	
CHECKED BY :		MDI ALUMINUM FABRICATOR LTD. Units 6-8, Sunray Industrial Centre, 1/F 610 Ono Kwo Ling Road, Kowloon Tel:23489211-4 Fax:(852)27727666	
DWG NO. : J856-SD-PW-5107		REV. : A	

B.O. REF. :

CLIENT :



42/F SUN HUNG KAI CENTRE, WINGCHAI, HONGKONG

ARCHITECT :



MAIN CONTRACTOR :



STRUCTURAL ENGINEER :



FAÇADE CONSULTANT:



NOTE :

- 1. ALL DIMENSIONS ARE IN mm.
- 2. ALL ELEVATIONS ARE VIEWED FROM OUTSIDE.
- 3. ALL DIMENSIONS TO BE VERIFIED ON SITE BEFORE FABRICATION.

LEGEND :



- DETAIL MARK NO.
- REFER SHEET NO.

- 1. F.F.L.--FINISHED FLOOR LEVEL
- 2. S.F.L.--STRUCTURAL FLOOR LEVEL
- 3. --REVERSED DETAIL

4. GLASS LEGEND

- EGL-1--8mmHS+12mm AIR GAP+10mmTP THK. I.G.U.
- EGL-2--10mm THK. CLEAR TEMPERED GLASS
- EGL-4--10mm THK. TEMPERED ACID ETCHED GLASS
- EGL-1A-8mmHS+12mm AIR GAP+8mmTP THK. I.G.U.

REVISION SUBJECT TO ARCHITECTMENT			
NO.	DATE	REMOVED	WON BY
A	03/11/2021		Ivon
JOB NO. : J-856			
PROJECT : PROPOSED DEVELOPMENT ABOVE LIGHT RAIL TIN WING STOP.TSWTL NO.23.AREA 33.TIN SHUI WAI, N.T.			
TITLE : WINDOW SCHEDULE FOR TOWER 1 ALUM. WINDOW (safety barrier)			
DATE : 02-Aug-21		SCALE : 1:40	
DRAWN BY : Ivon		CHECKED BY :	
 美特鋁質有限公司 Units 6-8, Sunray Industrial Centre, 1/F 610 Ono Kwo Ling Road, Kowloon Tel:23489211-4 Fax:(852)2727666			
DWG NO. : J856-SD-PW-5108		REV. : A	

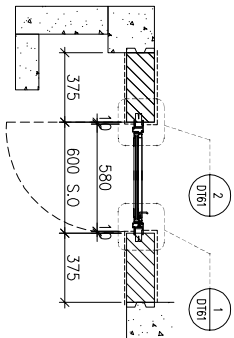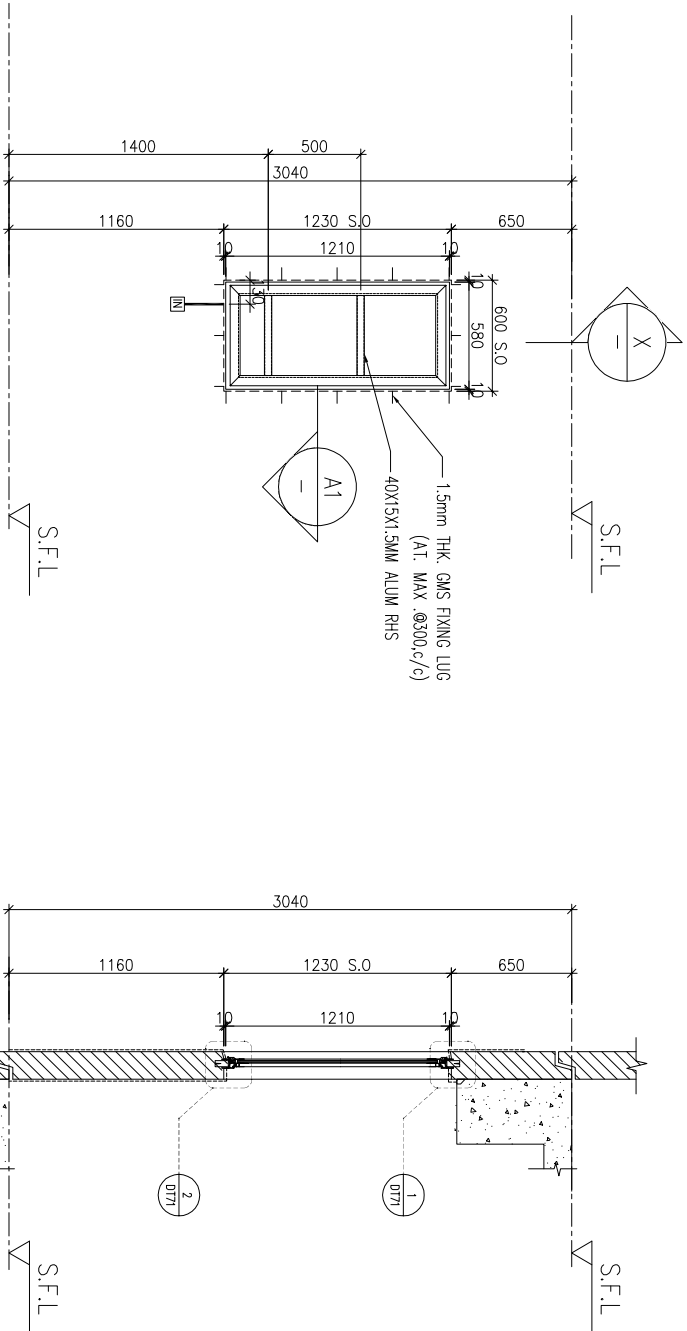

ELEVATION		PART SECTION	
PART PLAN		PART SECTION	
WINDOW MARK		AW 06	
LOCATION		3/F-42/F(4/F,13/F,14/F,24/F,34/F OMITTED) UNIT B3	
SECTION		70mm ALUM. SECTION	
GLAZING		EGL-2	
QUANTITY		35 Nos	
REMARKS		FACADE(TYPE T1PF09 FOR 3/F~42/F)	

B.O. REF. :

CLIENT :

S^K

SUN HUNG KAI

REAL ESTATE AGENCY LTD.

42/F SUN HUNG KAI CENTRE, WINGCHAI, HONGKONG

ARCHITECT :

lwk&partners

a r c h i t e c t s

MAIN CONTRACTOR :

Y^S

怡輝建築有限公司

Yee Fai Building Contractors Ltd.

STRUCTURAL ENGINEER :

ARUP

FAÇADE CONSULTANT:

ALPHA CONSULTING LIMITED

Steel Structure & Façade Specialist

NOTE.:

1. ALL DIMENSIONS ARE IN mm.
2. ALL ELEVATIONS ARE VIEWED FROM OUTSIDE.
3. ALL DIMENSIONS TO BE VERIFIED ON SITE BEFORE FABRICATION.

LEGEND.:

x1

DETAIL MARK NO.

x001

REFER SHEET NO.

1. F.F.L.--FINISHED FLOOR LEVEL
2. S.F.L.--STRUCTURAL FLOOR LEVEL
3. --REVERSED DETAIL
4. GLASS LEGEND

EGL-1--8mmHS+12mm AIR GAP+10mmTP THK. I.G.U.

EGL-2--10mm THK. CLEAR TEMPERED GLASS

EGL-4--10mm THK. TEMPERED ACID ETCHED GLASS

EGL-1A-8mmHS+12mm AIR GAP+8mmTP THK. I.G.U.

NO.	DATE	REVISION	REVISION SUBJECT TO ARCH/COMMENT	
			BY	DATE
B	03/11/2021		WON	
A	12/10/2021		WON	

JOB NO. : J-856

PROJECT :
PROPOSED DEVELOPMENT ABOVE
LIGHT RAIL TIN WING STOP.TSWTL
NO.23.AREA 33.TIN SHUI WAI, N.T.

TITLE :
WINDOW SCHEDULE FOR
TOWER 1 ALUM. WINDOW
(safety barrier)

DATE : 02-Aug-21 SCALE : 1:40



DRAWN BY : won CHECKED BY :

美特鋁質有限公司



MDI ALUMINIUM FABRICATOR LTD.

Units 6-8, Sunny Industrial Centre, 1/F
610 Ona Kwong Road, Kowloon
Tel:23489211-4 Fax:(852)27727666

DWG NO. : J856-SD-PW-5109 REV. : B

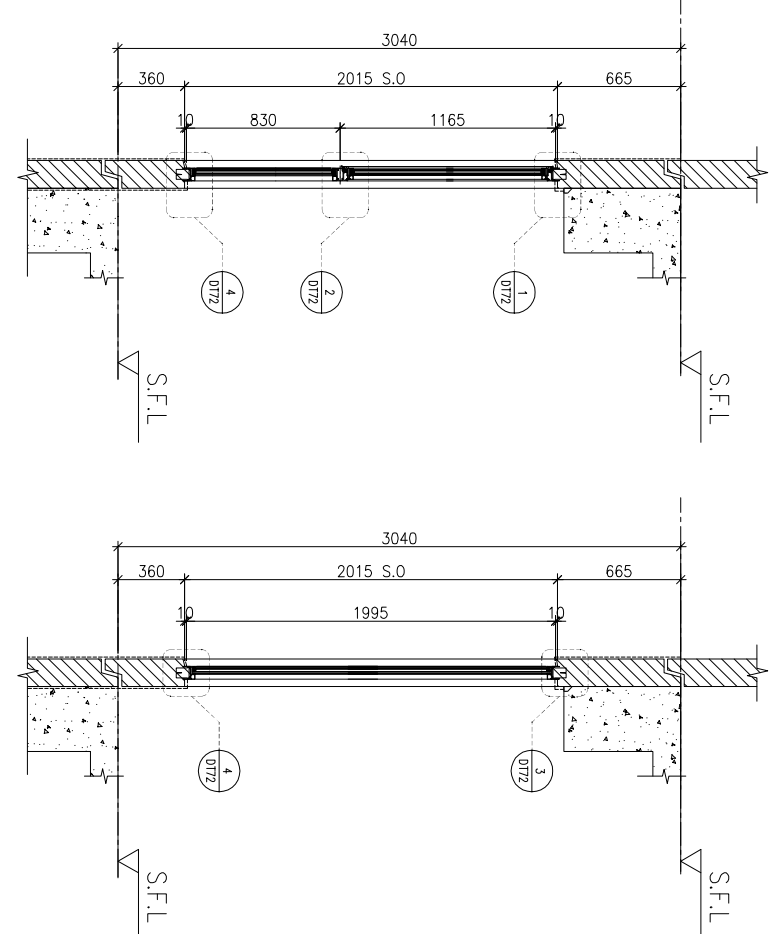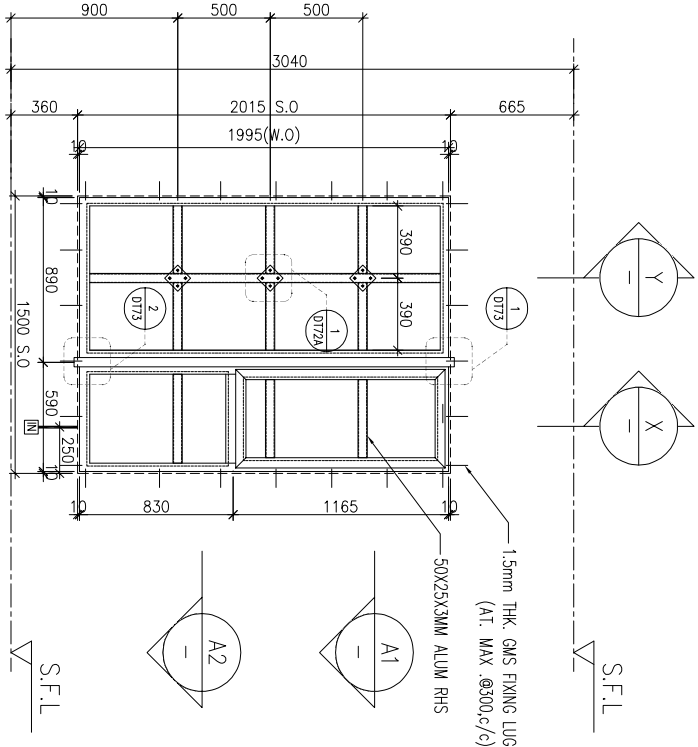

ELEVATION

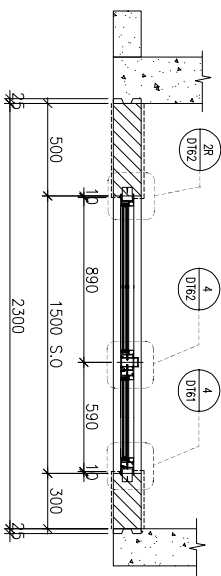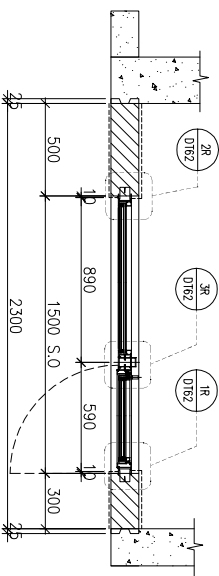

WINDOW MARK

AW

03

LOCATION 3/F-42/F(4/F,13/F,14/F,24/F,34/F OMITTED) UNIT B3

SECTION 70mm ALUM. SECTION

GLAZING EGL-1,EGL-1A

QUANTITY 35 Nos

REMARKS FACADE(TYPE T1P10 FOR 3/F~42/F)

B.D. REF :

CLIENT :

SUN HUNG KAI
REAL ESTATE AGENCY LTD.

42/F SUN HUNG KAI CENTRE, WANCHAI, HONGKONG

ARCHITECT :

lwk&partners
a r c h i t e c t s

MAIN CONTRACTOR :

Yee Fai Building Contractors Ltd.

STRUCTURAL ENGINEER :

FACADE CONSULTANT:

ALPHA CONSULTING LIMITED
Steel Structure & Facade Specialist

NOTE:

1. ALL DIMENSIONS ARE IN mm.
2. ALL ELEVATIONS ARE VIEWED FROM OUTSIDE.
3. ALL DIMENSIONS TO BE VERIFIED ON SITE BEFORE FABRICATION.

LEGEND :



1. F.F.L. --- FINISHED FLOOR LEVEL
2. S.F.L. --- STRUCTURAL FLOOR LEVEL
3. (R) --- REVERSED DETAIL

4. GLASS LEGEND

EGL-1--8mmHS+12mm AIR GAP+10mmTP THK. I.C.U.
 EGL-2--10mm THK. CLEAR TEMPERED GLASS
 EGL-4--10mm THK. TEMPERED ACID ETCHED GLASS
 EGL-1A-8mmHS+12mm AIR GAP+8mmTP THK. I.C.U.

B	03/11/2021	REVISION SUBJECT TO ARCH.COMMENT	[var]
A	12/10/2021	REVISION SUBJECT TO ARCH.COMMENT	[var]
NO.	DATE	REVISED	BY

JOB NO. : J-856

PROJECT : PROPOSED DEVELOPMENT ABOVE
LIGHT RAIL TIN WING STOP, TSWTL
NO.23, AREA 33, TIN SHUI WAI, N.T.

TITLE :

WINDOW SCHEDULE FOR
TOWER 1 ALUM. WINDOW
(safety barrier)

DATE : 02-Aug-21



SCALE : 1:40

DRAWN BY : Ivan



 美特鋁質有限公司
MIDI ALUMINUM FABRICATOR LTD.

Units 8-8, Sunny Industrial Centre, 1/F
610 Cho Kwo Ling Road, Kowloon
Tel: 23489211-4 Fax: (852) 27127666

DWG NO. : J856-SD-PW-5110 REV. : B

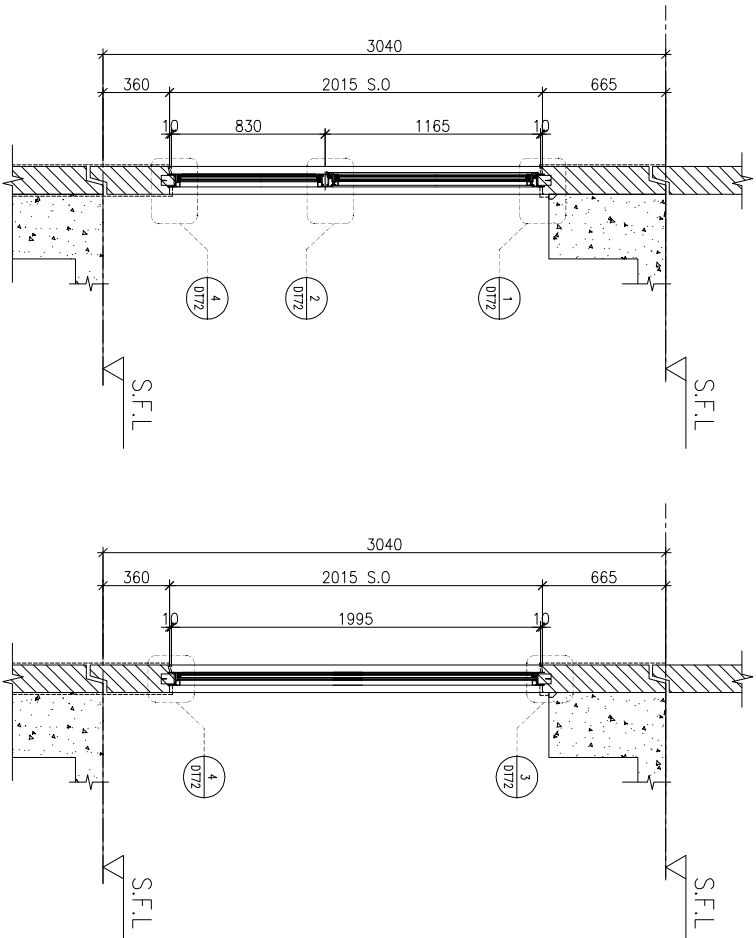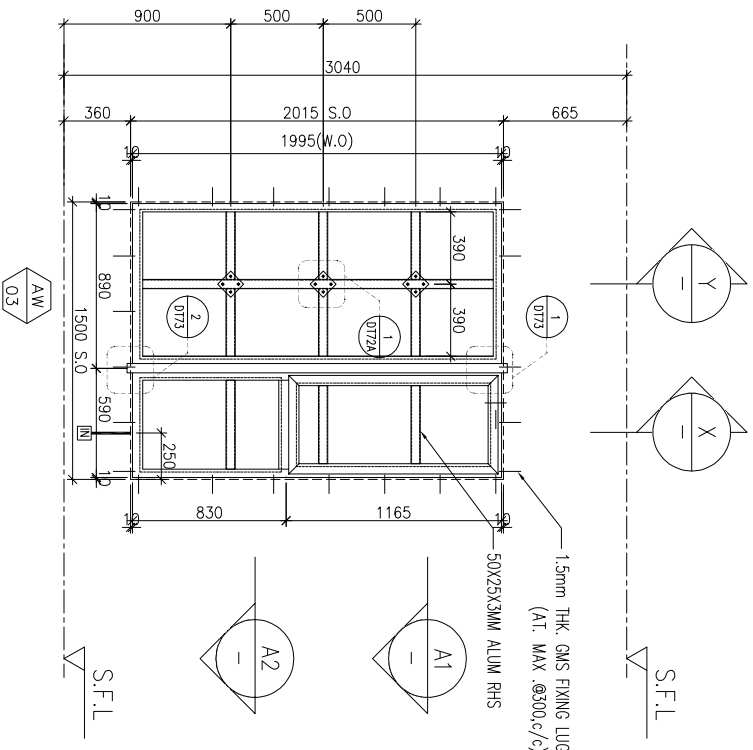

ELEVATION

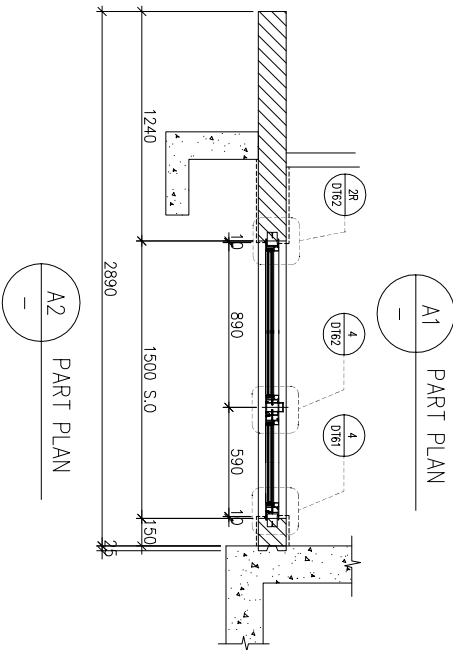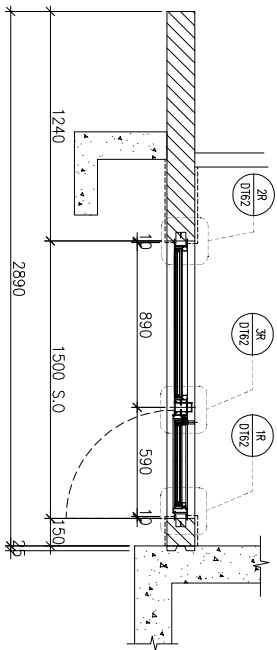

WINDOW MARK	
LOCATION	3/F-42/F(4/F,13/F,14/F,24/F,34/F OMITTED) UNIT B5
SECTION	70mm ALUM. SECTION
GLAZING	EGL-1,EGL-1A
QUANTITY	35 Nos
REMARKS	FACADE(TYPE T1PF11R FOR 3/F~42/F)

B.O. REF :

CLIENT :

S^K

SUN HUNG KAI

REAL ESTATE AGENCY LTD.

42/F SUN HUNG KAI CENTRE, WINGHAI, HONGKONG

ARCHITECT :

lwk&partners

a r c h i t e c t s

MAIN CONTRACTOR :

Y^F

怡輝建築有限公司

Yee Fai Building Contractors Ltd.

STRUCTURAL ENGINEER :

ARUP

FAÇADE CONSULTANT:

α

ALPHA CONSULTING LIMITED

Steel Structure & Façade Specialist

NOTE :

1. ALL DIMENSIONS ARE IN mm.
2. ALL ELEVATIONS ARE VIEWED FROM OUTSIDE.
3. ALL DIMENSIONS TO BE VERIFIED ON SITE BEFORE FABRICATION.

LEGEND :

X1

DETAIL MARK NO.

X001

REFER SHEET NO.

1. F.F.L.--FINISHED FLOOR LEVEL
2. S.F.L.--STRUCTURAL FLOOR LEVEL
3. --REVERSED DETAIL

4. GLASS LEGEND

- EGL-1--8mmHS+12mm AIR GAP+10mmTP THK. I.G.U.
- EGL-2--10mm THK. CLEAR TEMPERED GLASS
- EGL-4--10mm THK. TEMPERED ACID ETCHED GLASS
- EGL-1A-8mmHS+12mm AIR GAP+8mmTP THK. I.G.U.

NO.	DATE	REVISION SUBJECT TO ARCHITECTMENT	
		REVISION	BY
B	03/11/2021	REVISION SUBJECT TO ARCHITECTMENT	
A	12/10/2021	REVISION SUBJECT TO ARCHITECTMENT	

JOB NO. : J-856

PROJECT :

PROPOSED DEVELOPMENT ABOVE
LIGHT RAIL TIN WING STOP.TSWTL
NO.23.AREA 33.TIN SHUI WAI, N.T.

TITLE :

WINDOW SCHEDULE FOR
TOWER 1 ALUM. WINDOW
(safety barrier)

DATE : 02-Aug-21

SCALE : 1:40

DRAWN BY : Ivon

CHECKED BY :

MDI



ALUMINIUM FABRICATOR LTD.

Units 6-8, Sunray Industrial Centre, 1/F
610 Ono Kwo Ling Road, Kowloon
Tel:23489211-4 Fax:(852)2727666

DWG NO. : J856-SD-PW-5111

REV. : B

ELEVATION

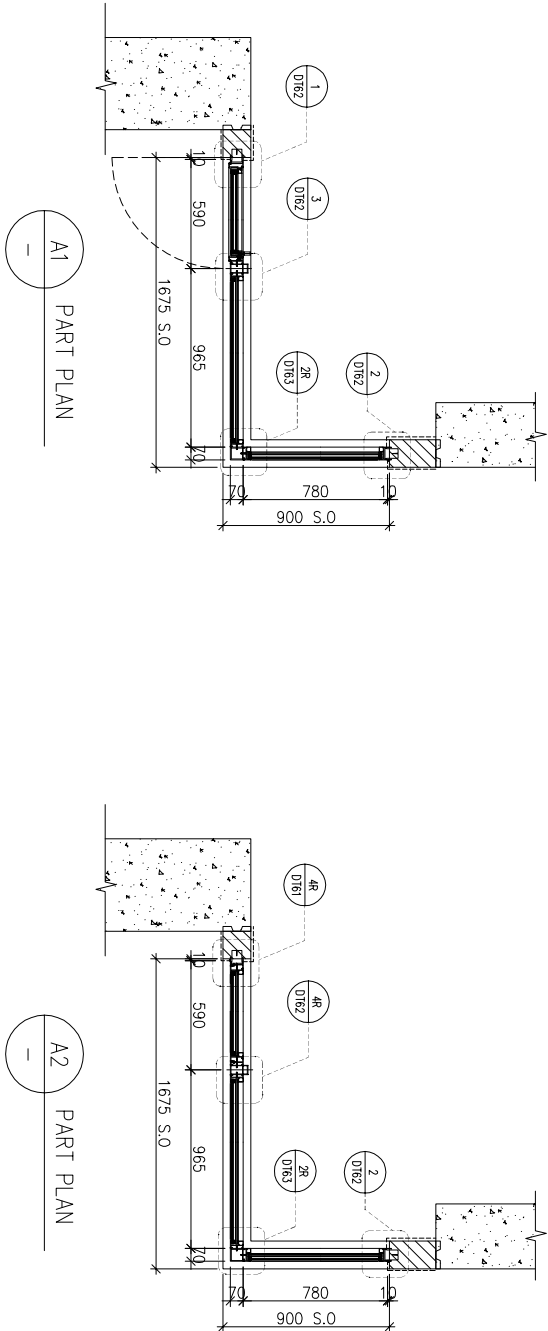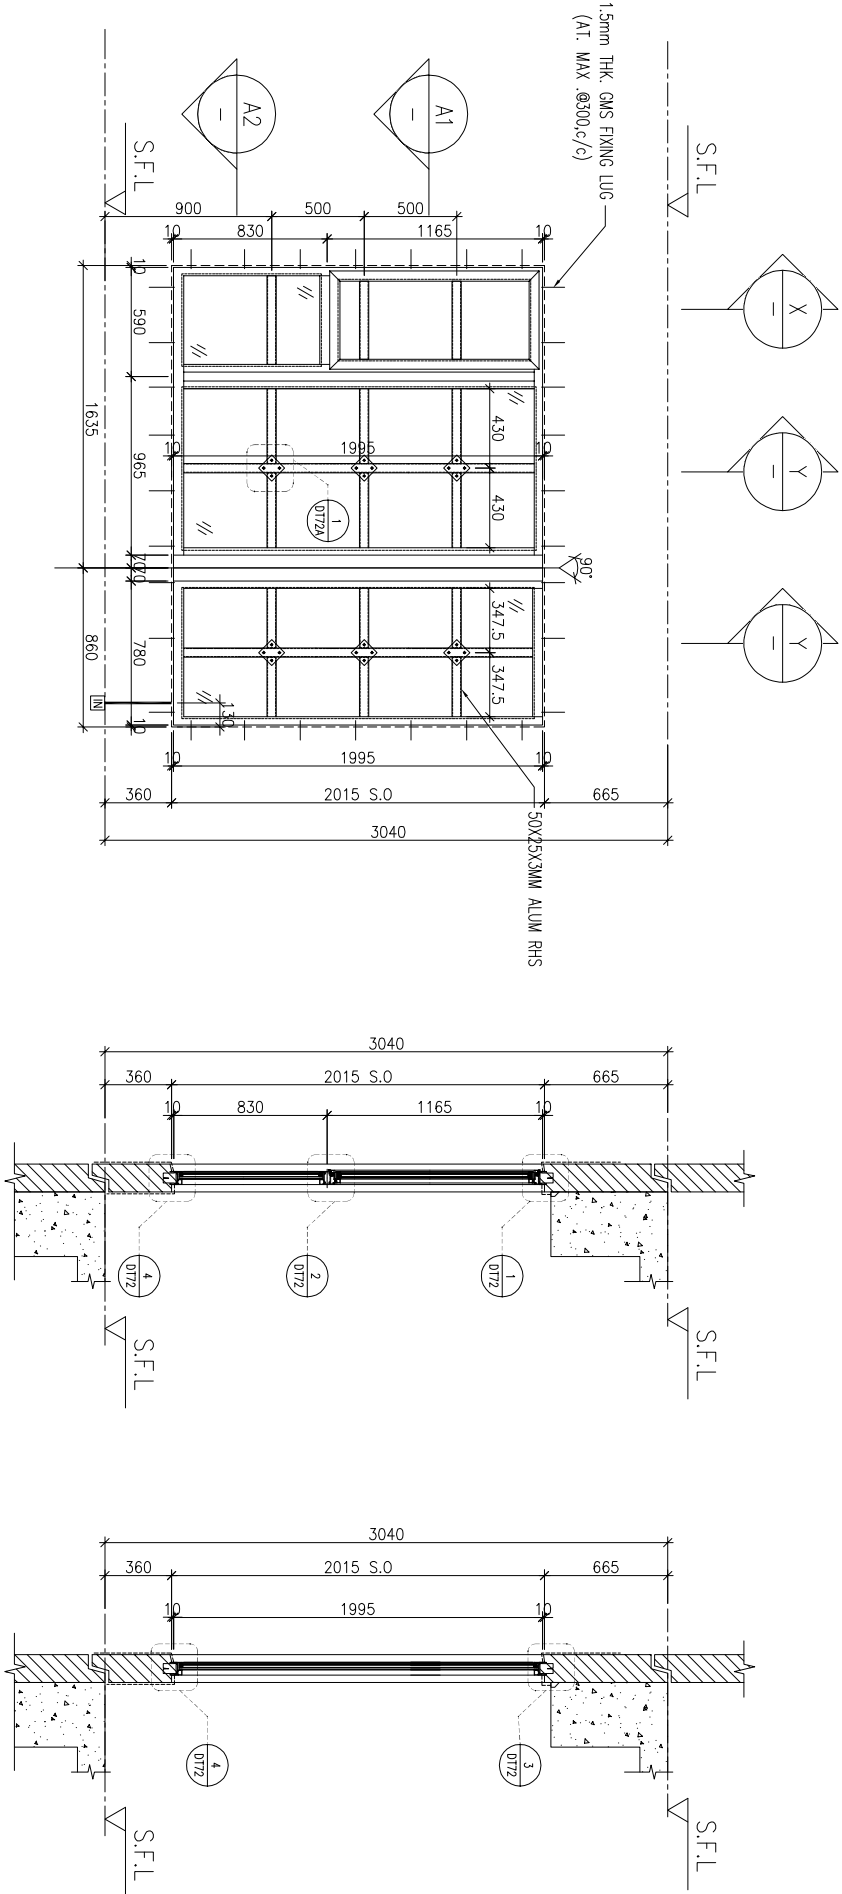

WINDOW MARK	AW 07
LOCATION	3/F-42/F(4/F,13/F,14/F,24/F,34/F OMITTED) UNIT B8
SECTION	70mm ALUM. SECTION
GLAZING	EGL-1,EGL-1A
QUANTITY	35 Nos
REMARKS	FAÇADE(TYPE T1PF12 FOR 3/F~42/F)

B.O. REF. :

CLIENT :



SUN HUNG KAI
REAL ESTATE AGENCY LTD.

42/F SUN HUNG KAI CENTRE, WINGCHAI, HONGKONG

ARCHITECT :



IWK&partners
a r c h i t e c t s

MAIN CONTRACTOR :



怡輝建築有限公司
Yee Fai Building Contractors Ltd.

STRUCTURAL ENGINEER :



ARUP

ALPHA CONSULTING LIMITED
Steel Structure & Facade Specialist

FACADE CONSULTANT:

NOTE.:

1. ALL DIMENSIONS ARE IN mm.
2. ALL ELEVATIONS ARE VIEWED FROM OUTSIDE.
3. ALL DIMENSIONS TO BE VERIFIED ON SITE BEFORE FABRICATION.

LEGEND.:

-  DETAIL MARK NO.
 REFER SHEET NO.

1. F.F.L.--FINISHED FLOOR LEVEL
2. S.F.L.--STRUCTURAL FLOOR LEVEL
3.  --REVERSED DETAIL

4. GLASS LEGEND

- EGL-1--8mmHS+12mm AIR GAP+10mmTP THK. I.G.U.
EGL-2--10mm THK. CLEAR TEMPERED GLASS
EGL-4--10mm THK. TEMPERED ACID ETCHED GLASS
EGL-1A-8mmHS+12mm AIR GAP+8mmTP THK. I.G.U.

JOB NO. :		J-856	
PROJECT :			
PROPOSED DEVELOPMENT ABOVE LIGHT RAIL TIN WING STOP.TSWTL NO.23.AREA 33.TIN SHUI WAI, N.T.			
TITLE :			
WINDOW SCHEDULE FOR TOWER 2 ALUM. WINDOW (safety barrier)			
DATE : 02-Aug-21		SCALE : 1:40	
DRAWN BY : Ivon		CHECKED BY :	
			
Units 6-8, Sunny Industrial Centre, 1/F 610 Ono Kwo Ling Road, Kowloon Tel:23489211-4 Fax:(852)27727666			
DWG NO. : J856-SD-PW-5201		REV. : B	

B.O. REF :

CLIENT :



SUN HUNG KAI

REAL ESTATE AGENCY LTD.

42/F SUN HUNG KAI CENTRE, WINGHAI, HONGKONG

ARCHITECT :



IWK&partners

a r c h i t e c t s

MAIN CONTRACTOR :



怡輝建築有限公司

Yee Fai Building Contractors Ltd.

STRUCTURAL ENGINEER :



ARUP

FACADE CONSULTANT:



ALPHA CONSULTING LIMITED

Steel Structure & Facade Specialist

NOTE :

1. ALL DIMENSIONS ARE IN mm.
2. ALL ELEVATIONS ARE VIEWED FROM OUTSIDE.
3. ALL DIMENSIONS TO BE VERIFIED ON SITE BEFORE FABRICATION.

LEGEND :



X1

DETAIL MARK NO.



X001

REFER SHEET NO.

1. F.F.L.--FINISHED FLOOR LEVEL

2. S.F.L.--STRUCTURAL FLOOR LEVEL

3.  --REVERSED DETAIL

4. GLASS LEGEND

EGL-1--8mmHS+12mm AIR GAP+10mmTP THK. I.G.U.

EGL-2--10mm THK. CLEAR TEMPERED GLASS

EGL-4--10mm THK. TEMPERED ACID ETCHED GLASS

EGL-1A-8mmHS+12mm AIR GAP+8mmTP THK. I.G.U.

TITLE :

WINDOW SCHEDULE FOR
TOWER 2 ALUM. WINDOW
(safety barrier)

DATE : 02-Aug-21 SCALE : 1:40

DRAWN BY : Ivon CHECKED BY :



美特鋁寶有限公司

MIDI ALUMINIUM FABRICATOR LTD.

Units 6-8, Sunray Industrial Centre, 1/F

610 Ono Kwo Ling Road, Kowloon

Tel:23489211-4 Fax:(852)2772666

DWG NO. : J856-SD-PW-5202 REV. : A

900 500 500 3040 650 1180 10 430 10 590 1100 S.O. 1610(W.O.) 1.5mm THK. GMS FIXING LUG (AT. MAX. Ø300c/c) 50X25X3MM ALUM. RHS

AW 02

S.F.L.

A1 A2

760 1630 S.O. 650 1180 10 430 10 590 1100 S.O. 1610

S.F.L.

FALL TOPMM

AW 02R

X Y

ELEVATION

1 Ø182 2 Ø184 2 Ø182 10 590 1100(S.O.) 490 10 150

A1

PART PLAN

4 Ø164 3Ø Ø162 2Ø Ø162 10 590 1100(S.O.) 490 10 150

A2

PART PLAN

WINDOW MARK	AW 02	AW 02R
LOCATION	3/F-42/F(4/F,13/F,14/F,24/F,34/F OMITTED) UNIT B3	
SECTION	70mm ALUM. SECTION	
GLAZING	EGL-1,EGL-1A	
QUANTITY	35 Nos.	
REMARKS	FACADE(TYPE T2PF02 FOR 3/F~42/F)	

B.D. REF :

CLIENT :

SUN HUNG KAI
REAL ESTATE AGENCY LTD.

42/F SUN HUNG KAI CENTRE, WANCHAI, HONGKONG

ARCHITECT :

lwk&partners
a r c h i t e c t s

MAIN CONTRACTOR :

Yee Fai Building Contractors Ltd.

STRUCTURAL ENGINEER :

FACADE CONSULTANT:

ALPHA CONSULTING LIMITED
Steel Structure & Facade Specialist

NOTE:

2. ALL ELEVATIONS ARE VIEWED FROM OUTSIDE.
3. ALL DIMENSIONS TO BE VERIFIED ON SITE BEFORE FABRICATION.

LEGEND :

X1
X001

DETAIL MARK NO.
REFER SHEET NO.

1. F.F.L. -- FINISHED FLOOR LEVEL
2. S.F.L. -- STRUCTURAL FLOOR LEVEL
3. (R) -- REVERSED DETAIL

4. GLASS LEGEND

- EGL-2--10mm THK. CLEAR TEMPERED GLASS
 EGL-4--10mm THK. TEMPERED ACID ETCHED GLASS
 EGL-1A-8mmHS+12mm AIR GAP+8mmTP THK. I.G.U.

A	03/11/2021	REVISION SUBJECT TO ARCH.COMMENT	Var
NO.	DATE	REVISED	BY

JOB NO.: J-856

PROJECT :
PROPOSED DEVELOPMENT ABOVE
LIGHT RAIL TIN WING STOP, TSWTL
NO.23, AREA 33, TIN SHUI WAI, N.T.

TITLE :

WINDOW SCHEDULE FOR
TOWER 2 ALUM. WINDOW
(safety barrier)


DATE : 02-Aug-21

DRAWN BY : Ivan


 美特鋁質有限公司
MIDI ALUMINIUM FABRICATOR LTD.

610 Cha Kwo Ling Road, Kowloon
Tel: 23489211-4 Fax: (852) 27727666

DWG NO. : J856-SD-PW-5203 REV. : A

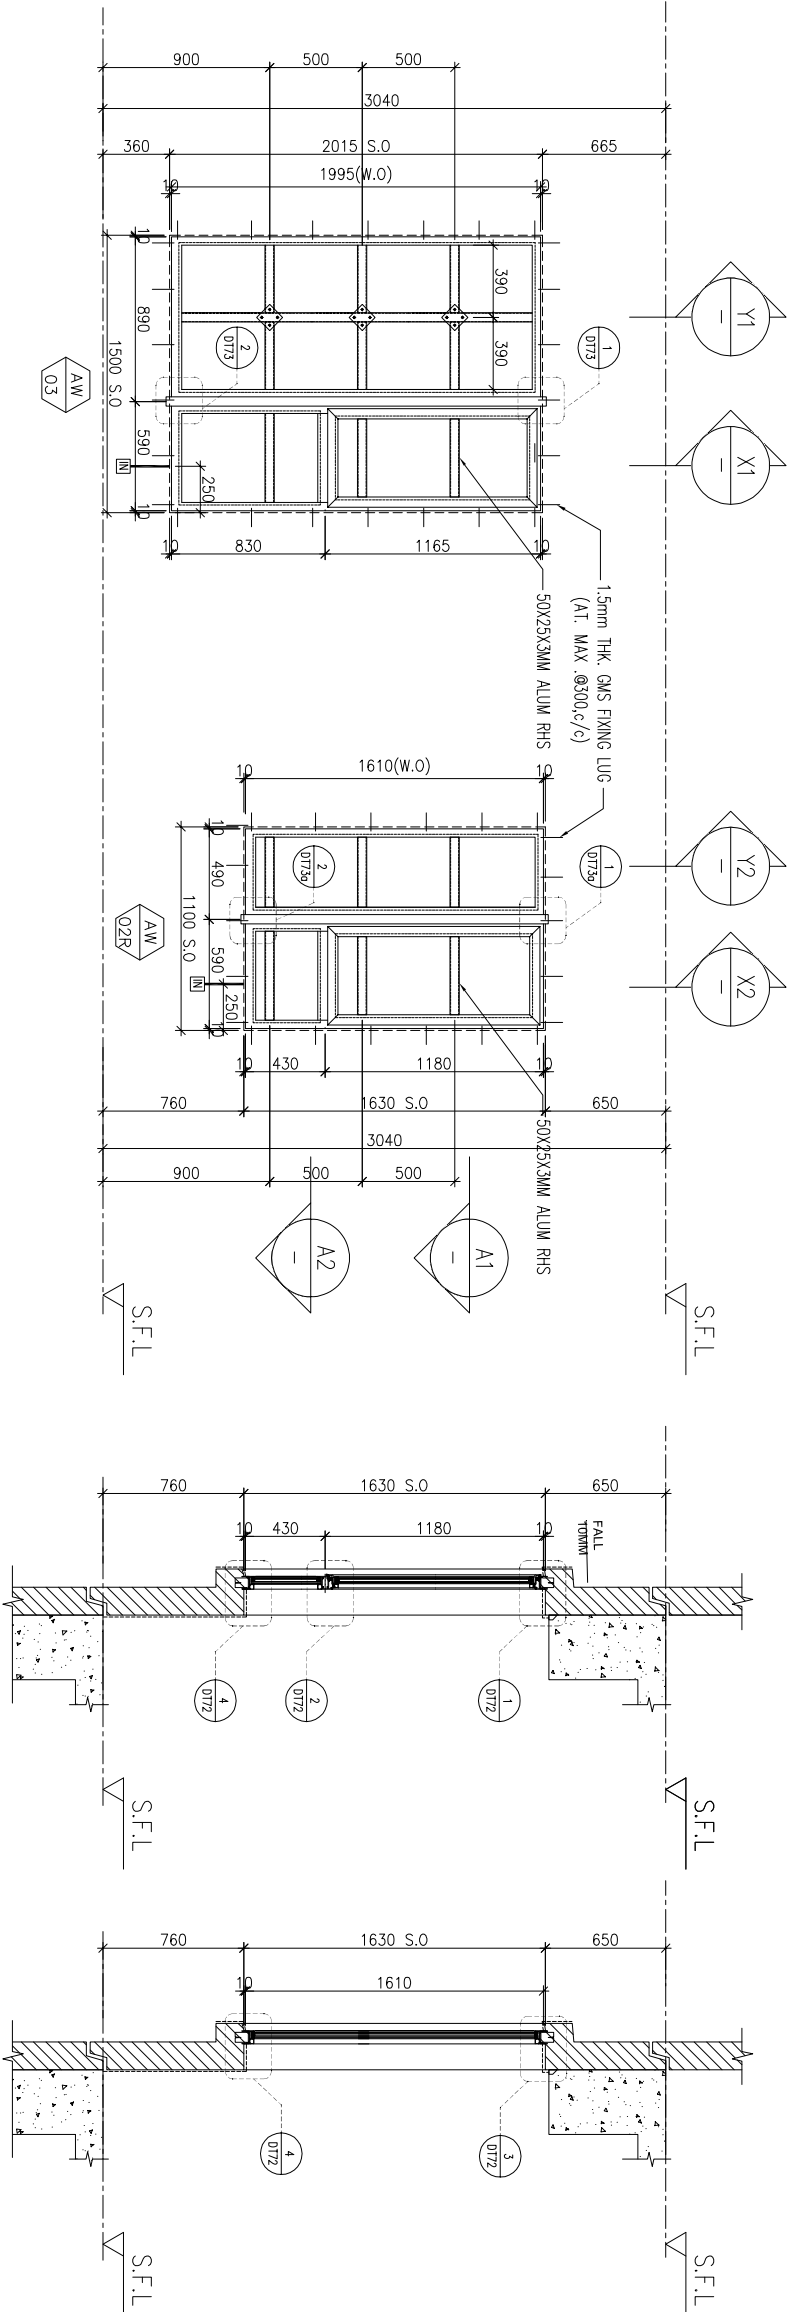

ELEVATION

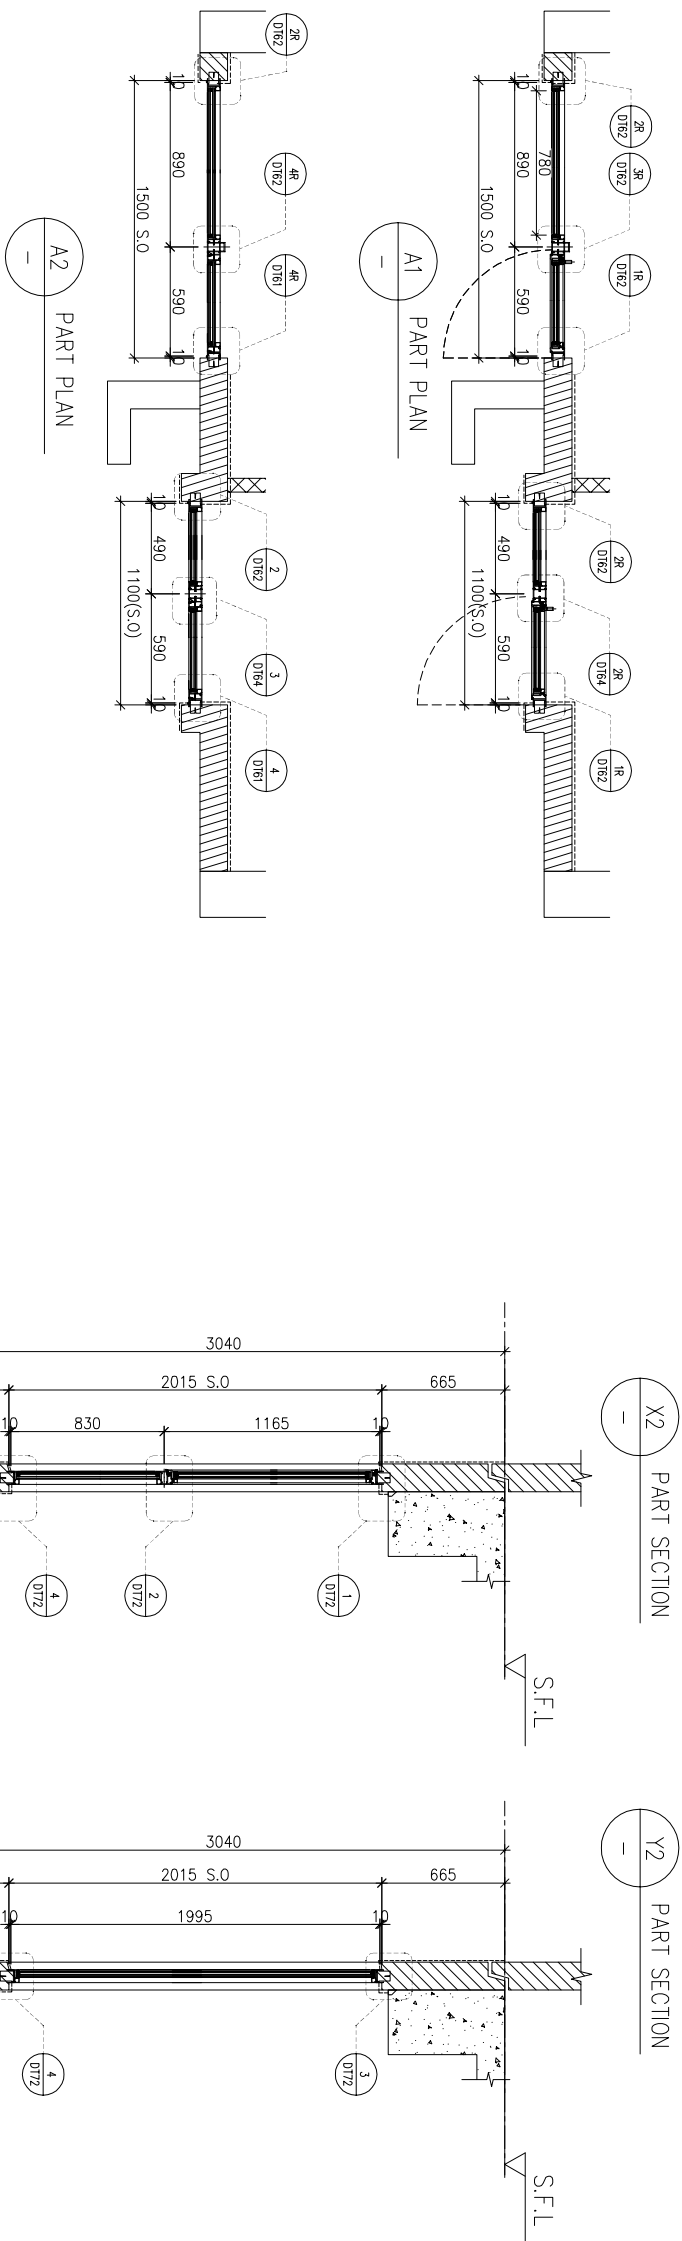

WINDOW MARK

LOCATION	3/F-42/F(4/F,13/F,14/F,24/F,34/F OMITTED)	UNIT A2
----------	---	---------

SECTION	70mm ALUM. SECTION
---------	--------------------

GLAZING	EGL-1,EGL-1A
---------	--------------

QUANTITY	35 Nos./35 Nos.
----------	-----------------

REMARKS	FACADE(TYPE T2PF03 FOR 3/F~42/F)
---------	----------------------------------



42/F SUN HUNG KAI CENTRE, WANCHAI, HONGKONG

lwk&partners



1. ALL DIMENSIONS ARE IN MM.
2. ALL ELEVATIONS ARE VIEWED FROM OUTSIDE.
3. ALL DIMENSIONS TO BE VERIFIED ON SITE BEFORE FABRICATION.



1. F.F.L. -- FINISHED FLOOR LEVEL
2. S.F.L. -- STRUCTURAL FLOOR LEVEL
3. **(/R)** -- REVERSED DETAIL

- EGE-1-8mmHS+12mm AIR GAP+10mmTP THK. I.G.U.
EGE-2-10mm THK. CLEAR TEMPERED GLASS
EGE-4-10mm THK. TEMPERED ACID ETCHED GLASS
EGE-1A-8mmHS+12mm AIR GAP+8mmTP THK. I.G.U.

B	03/11/2021	REVISION SUBJECT TO ARCH.COMMENT	lvor
A	12/10/2021	REVISION SUBJECT TO ARCH.COMMENT	lvor
NO.	DATE	REVISED	BY





PROPOSED DEVELOPMENT ABOVE
LIGHT RAIL TIN WING STOP, TSWL
NO.23, AREA 33, TIN SHUI WAI, N.T.

WINDOW SCHEDULE FOR
TOWER 2 ALUM. WINDOW
(safety barrier)

DATE : 02-Aug-21	SCALE : 1:40
------------------	--------------



Units 6-8, Sunray Industrial Centre, 1/
610 Cha Kwo Ling Road, Kowloon
Tel:23489211-4 Fax:(852)27727666

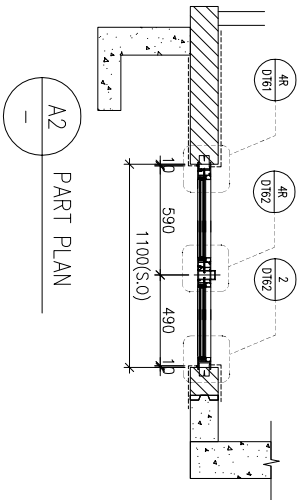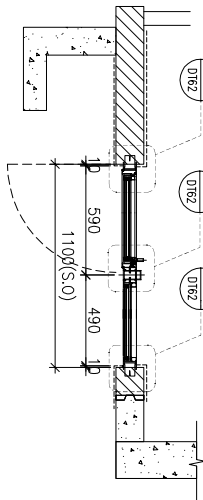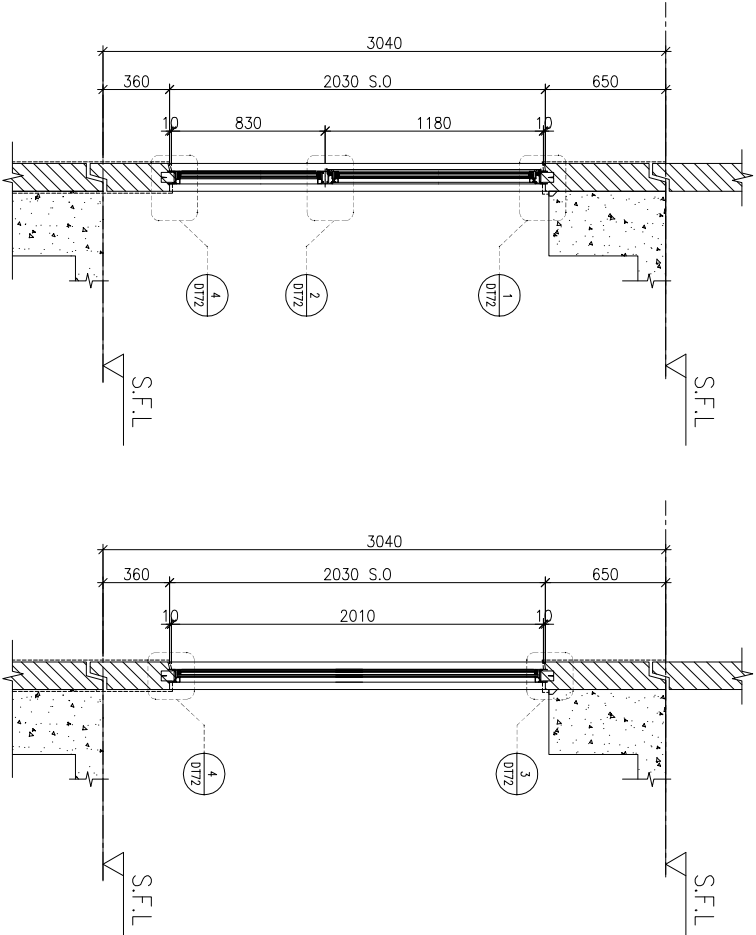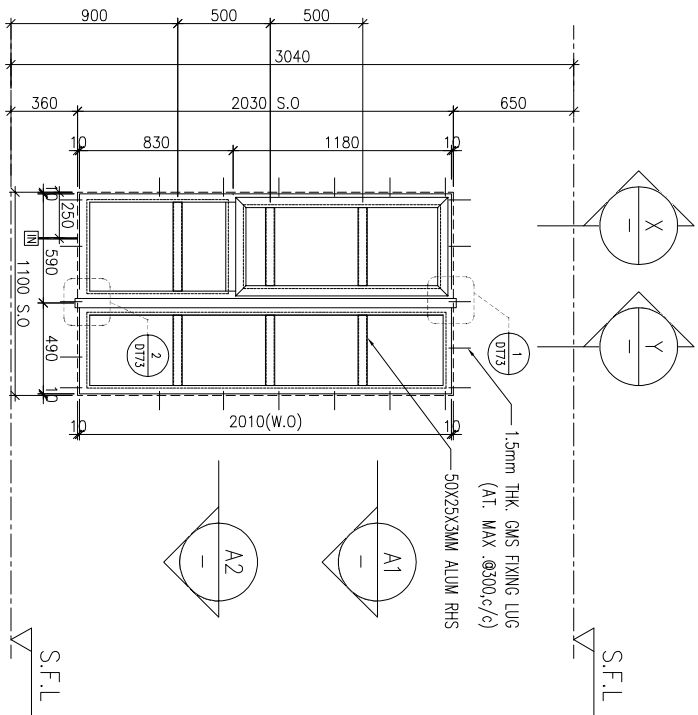

WINDOW MARK	AM 04R	AM 04
LOCATION	3/F~42/F(4/F,13/F,14/F,24/F,34/F OMITTED) UNIT B7	3/F~42/F(4/F,13/F,14/F,24/F,34/F OMITTED) UNIT B2,B6,A3,A7
SECTION	70mm ALUM. SECTION	70mm ALUM. SECTION
GLAZING	EGL-1,EGL-1A	EGL-1,EGL-1A
QUANTITY	35 Nos	35 Nos /35 Nos /35 Nos
REMARKS	FACADE(TYPE T2PF04R FOR 3/F~42/F)	FACADE(TYPE T1PF04 FOR 3/F~42/F)

B.D. REF :

CLIENT :

SUN HUNG KAI
REAL ESTATE AGENCY LTD.

42/F SUN HUNG KAI CENTRE, WANCHAI, HONGKONG

ARCHITECT :

lwk&partners
a r c h i t e c t s

architects

MAIN CONTRACTOR :

怡輝建築有限公司
Yee Fai Building Contractors Ltd.

STRUCTURAL ENGINEER :

FACADE CONSULTANT:

ALPHA CONSULTING LIMITED
Steel Structure & Facade Specialist

NOTE :

1. ALL DIMENSIONS ARE IN mm.
2. ALL ELEVATIONS ARE VIEWED FROM OUTSIDE
3. ALL DIMENSIONS TO BE VERIFIED ON SITE BEFORE FABRICATION.

LEGEND :

DETAIL MARK NO. 101
REFER SHEET NO.

1. F.F.L. -- FINISHED FLOOR LEVEL
2. S.F.L. -- STRUCTURAL FLOOR LEVEL
3. (R) -- REVERSED DETAIL

4. GLASS LEGEND

EGL-1-1-8mmHS+12mm AIR GAP+10mmIP THK. I.G.U.
 EGL-2--10mm THK. CLEAR TEMPERED GLASS
 EGL-4--10mm THK. TEMPERED ACID ETCHED GLASS
 EGL-1A-8mmHS+12mm AIR GAP+8mmIP THK. I.G.U.

A	03/11/2021	REVISION SUBJECT TO ARCH.COMMENT	lvm
NO.	DATE	REVISED	BY

JOB NO. : J-856

PROJECT: PROPOSED DEVELOPMENT ABOVE
LIGHT RAIL TIN WING STOP, TSWTL
NO.23, AREA 33, TIN SHUI WAI, N.T.

TITLE :

WINDOW SCHEDULE FOR
TOWER 2 ALUM. WINDOW
(safety barrier)

DATE : 02-Aug-21	SCALE : 1:40
------------------	--------------

Units 6-8, Sunray Industrial Center, 1/F 610 Che Kwo Ling Road, Kwoklong Tel: 3489211-4 Fax: (852) 27172666	FABRICATOR LTD. 美特鋁有限公司	1/F
DWG NO.: 1856-SD-PW-5205	REV.: A	

B.O. REF. :

CLIENT :



42/F SUN HUNG KAI CENTRE, WINGCHAI, HONGKONG

ARCHITECT :



MAIN CONTRACTOR :



STRUCTURAL ENGINEER :



FAÇADE CONSULTANT:



NOTE :

- 1. ALL DIMENSIONS ARE IN mm.
- 2. ALL ELEVATIONS ARE VIEWED FROM OUTSIDE.
- 3. ALL DIMENSIONS TO BE VERIFIED ON SITE BEFORE FABRICATION.

LEGEND :

- DETAIL MARK NO.
- REFER SHEET NO.

- 1. F.F.L.--FINISHED FLOOR LEVEL
- 2. S.F.L.--STRUCTURAL FLOOR LEVEL
- 3. --REVERSED DETAIL

4. GLASS LEGEND

- EGL-1--8mmHS+12mm AIR GAP+10mmTP THK. I.G.U.
- EGL-2--10mm THK. CLEAR TEMPERED GLASS
- EGL-4--10mm THK. TEMPERED ACID ETCHED GLASS
- EGL-1A-8mmHS+12mm AIR GAP+8mmTP THK. I.G.U.

NO.		DATE	REVISION	BY
B	03/11/2021	REVISION SUBJECT TO ARCHITECTMENT	WON	
A	12/10/2021	REVISION SUBJECT TO ARCHITECTMENT	WON	

JOB NO. : J-856

PROJECT :

PROPOSED DEVELOPMENT ABOVE
LIGHT RAIL TIN WING STOP.TSWTL
NO.23.AREA 33.TIN SHUI WAI, N.T.

TITLE :




































































WINDOW SCHEDULE FOR
TOWER 2 ALUM. WINDOW
(safety barrier)

DATE : 02-Aug-21	SCALE : 1:40
DRAWN BY : won	CHECKED BY :



Units 6-8, Sunray Industrial Centre, 1/F
610 Ona Kwo Ling Road, Kowloon
Tel:23489211-4 Fax:(852)2727666

DWG NO. : J856-SD-PW-5206 REV. : B

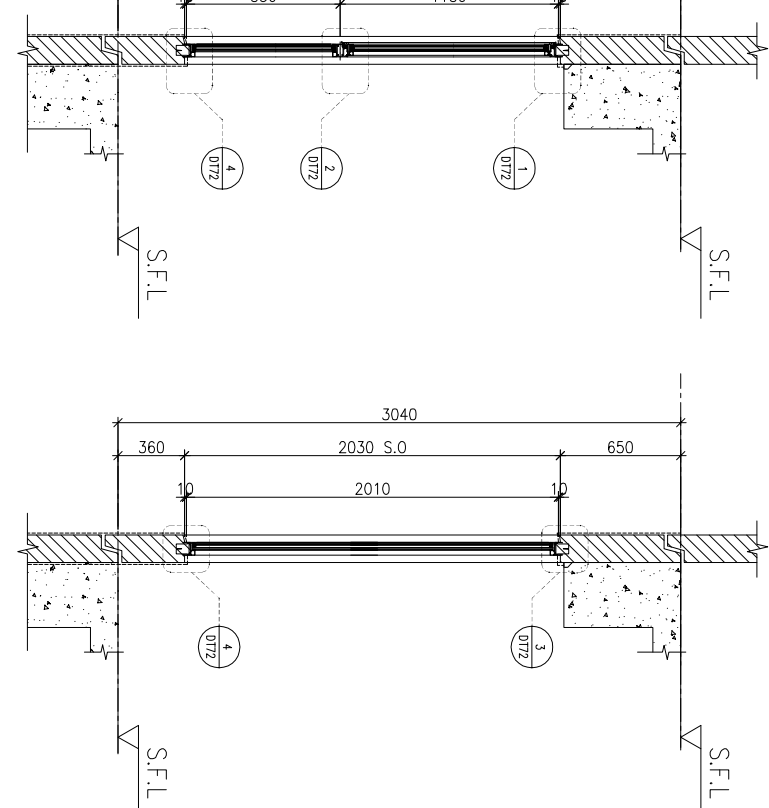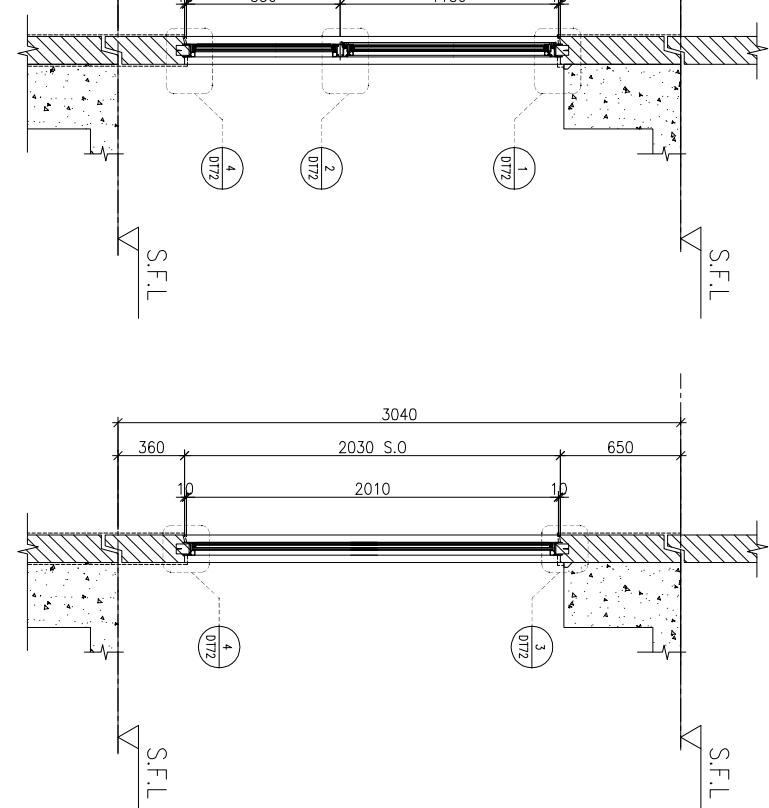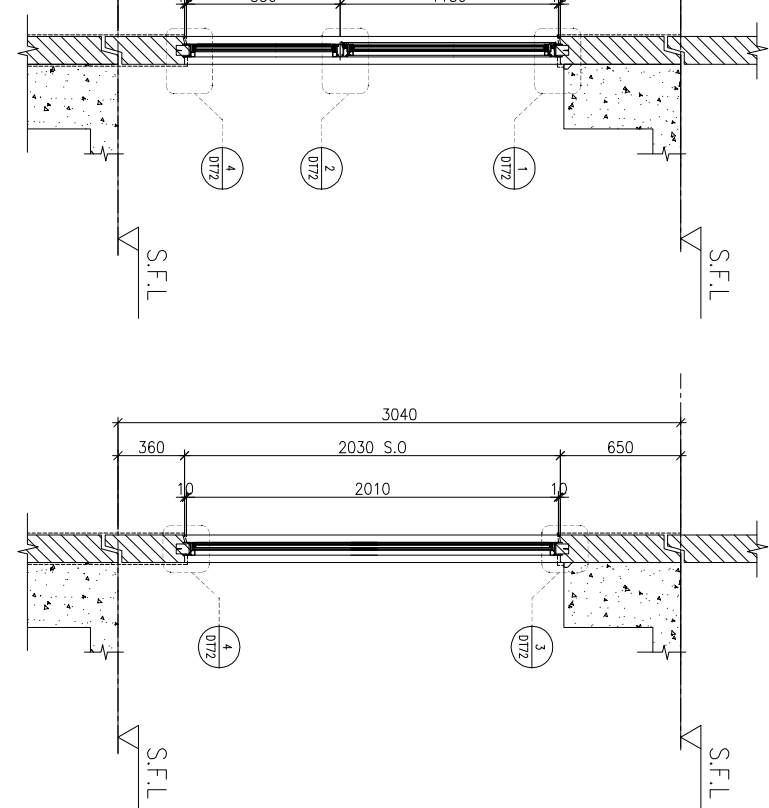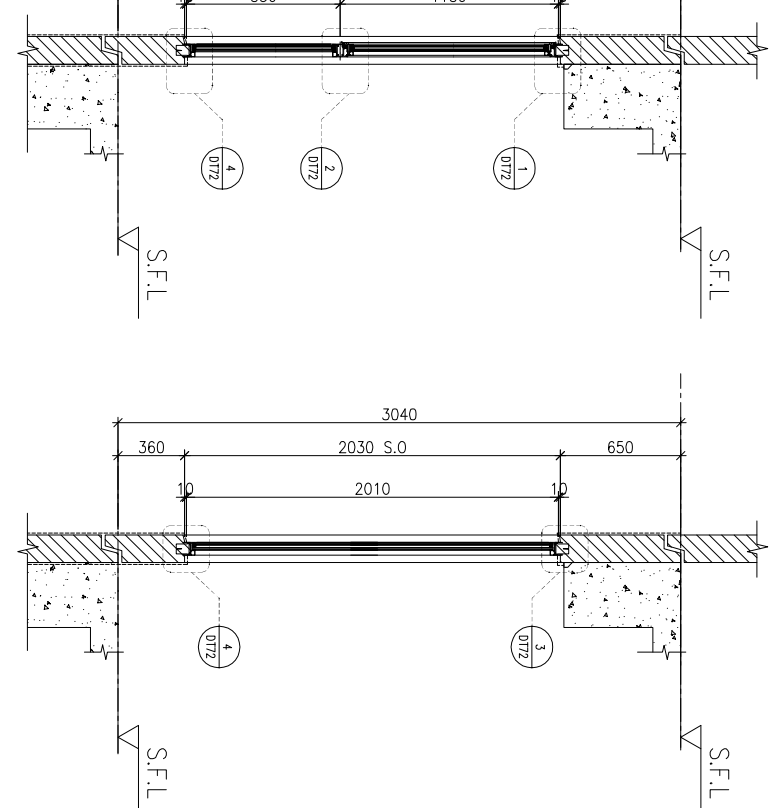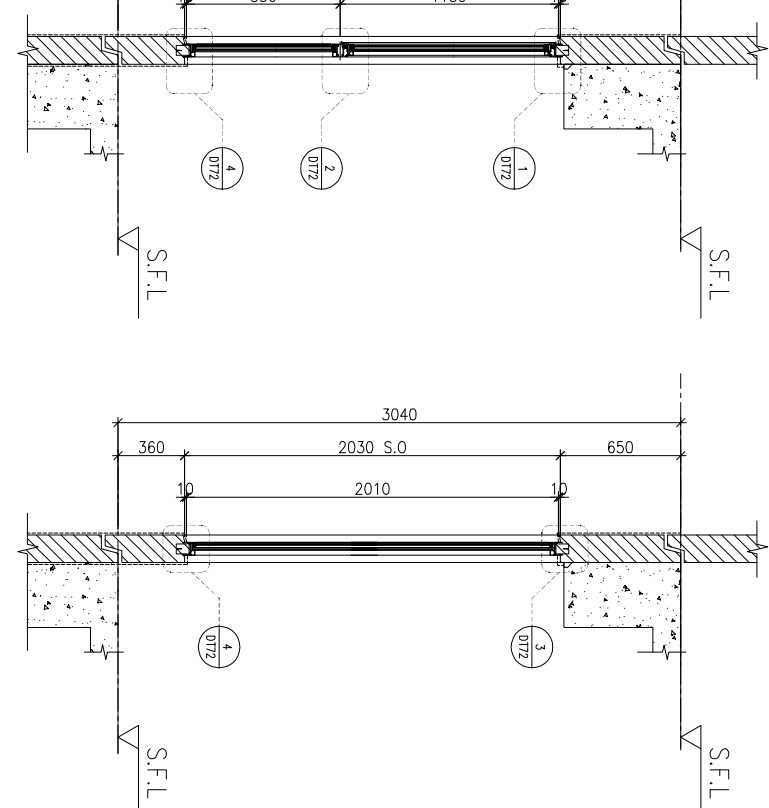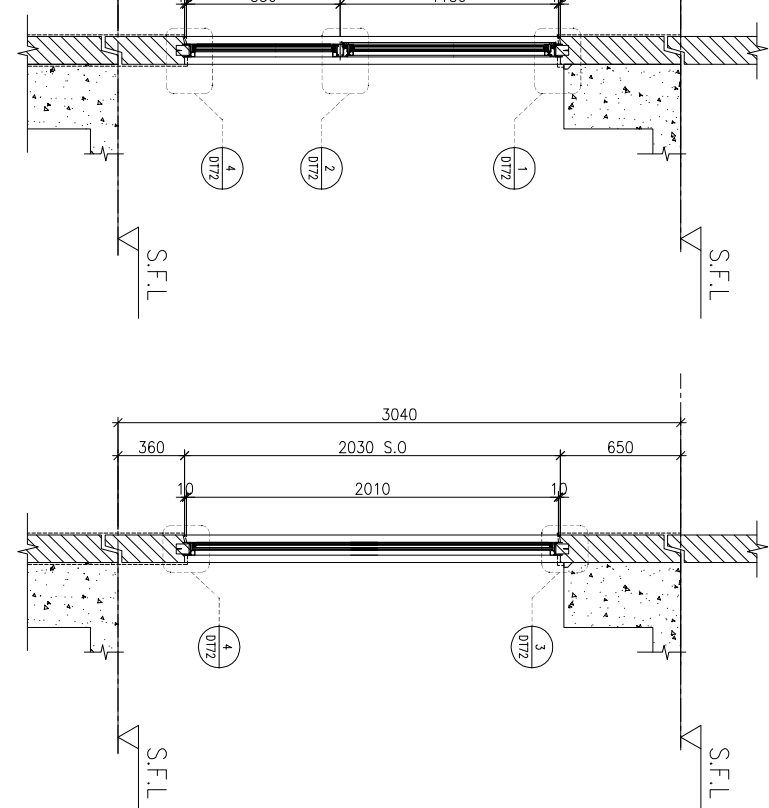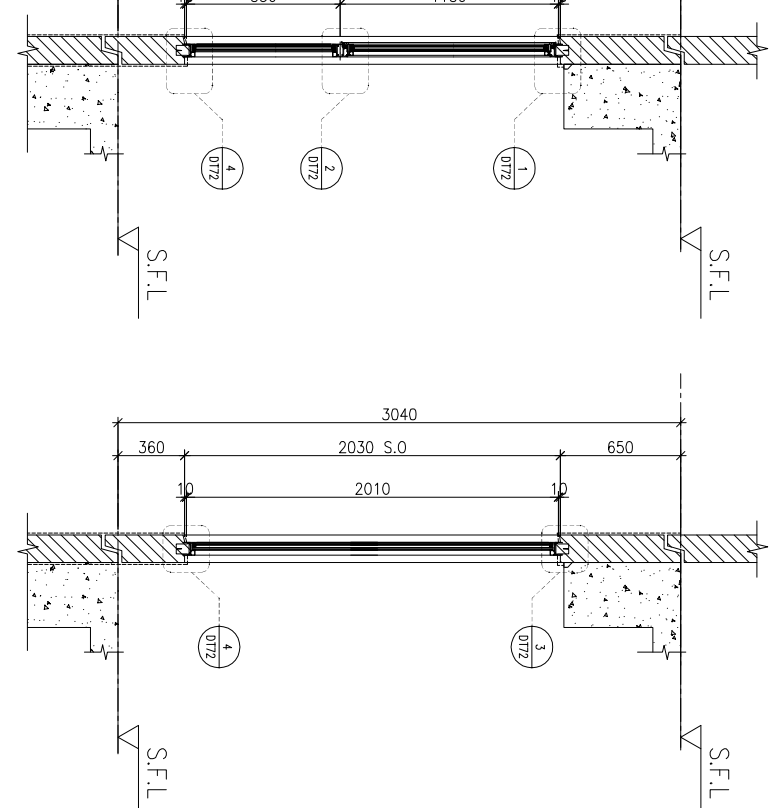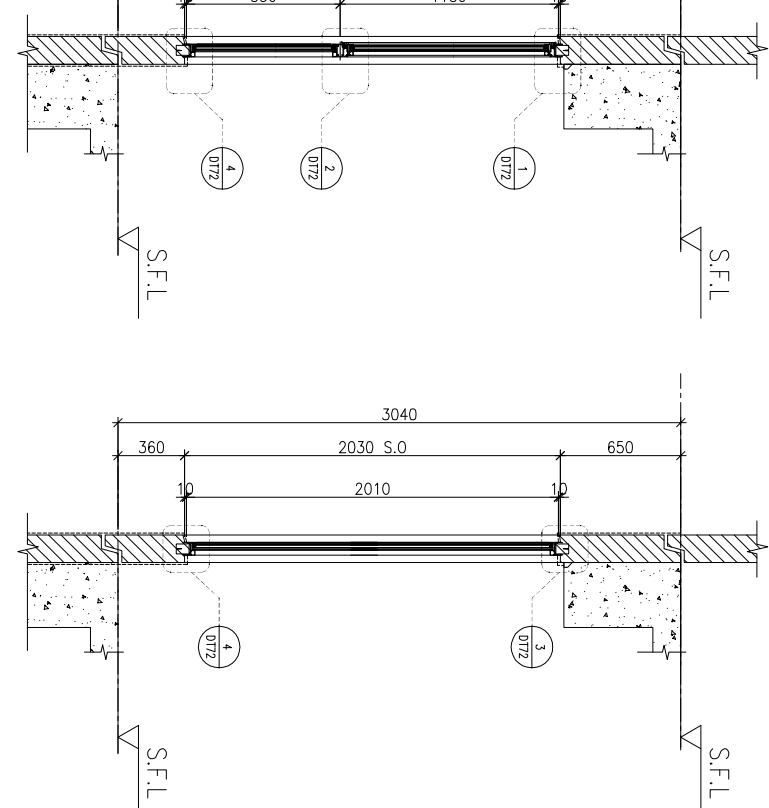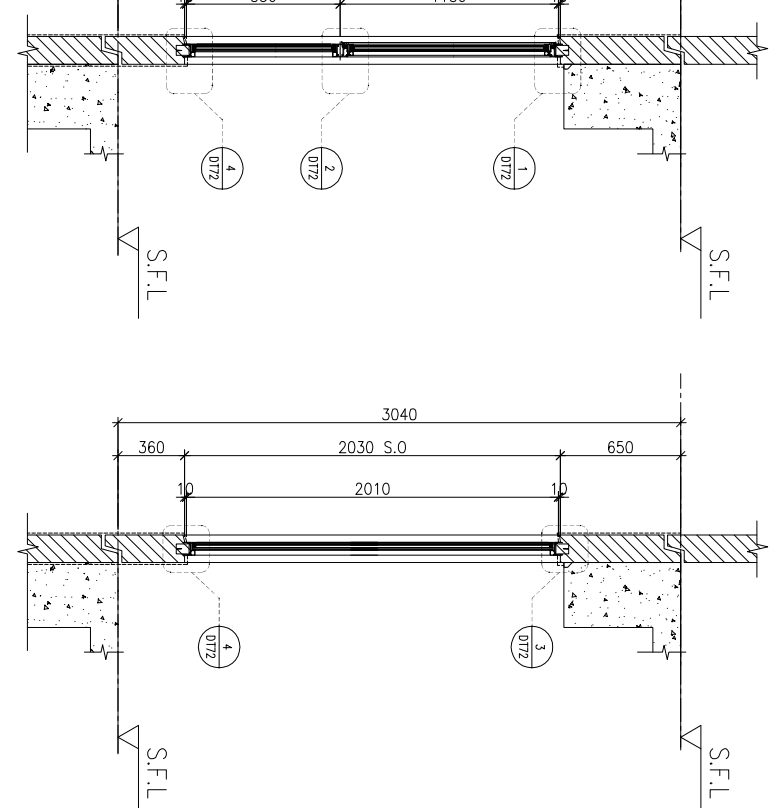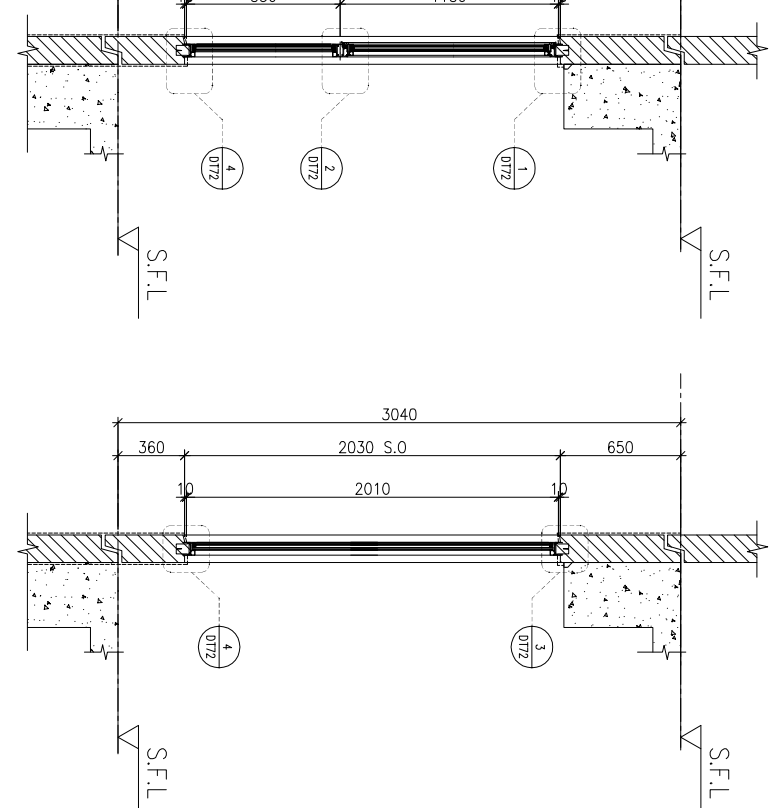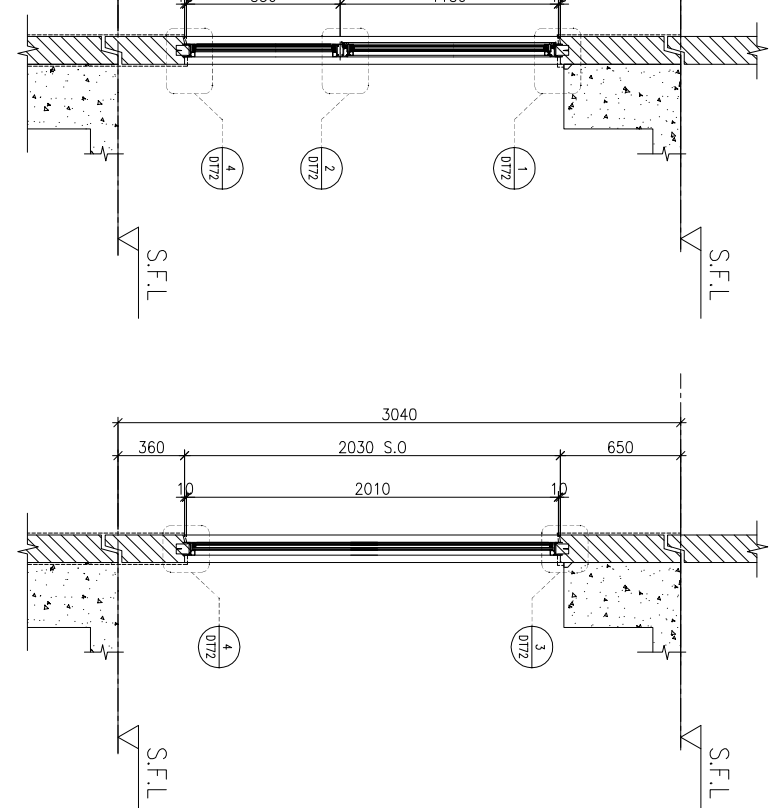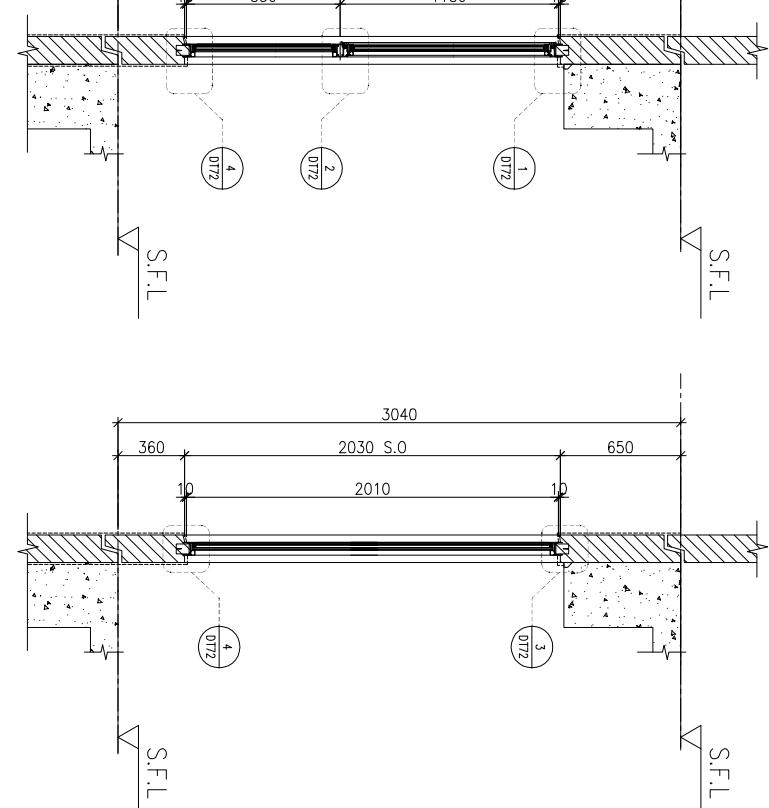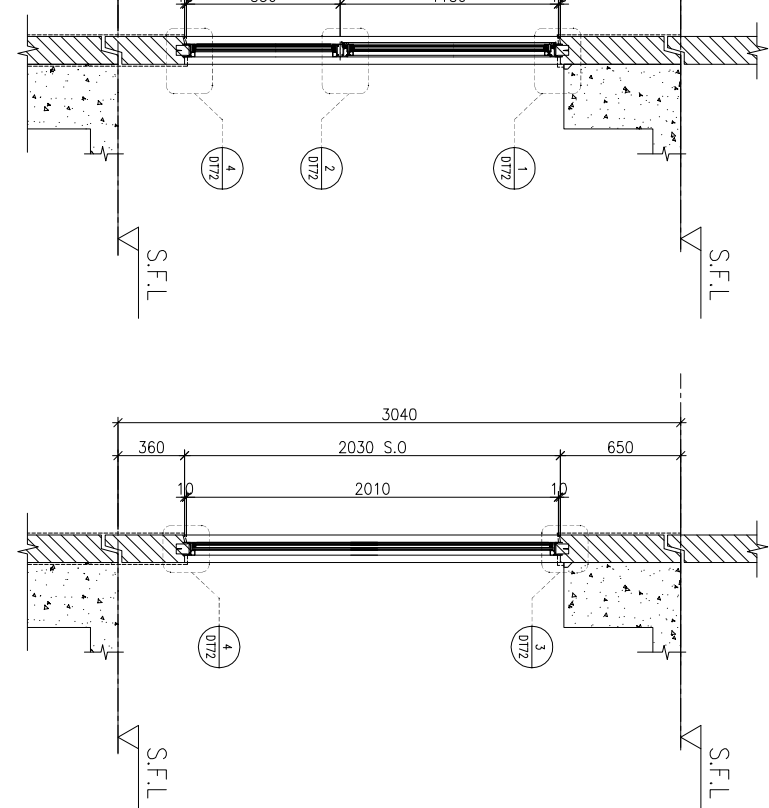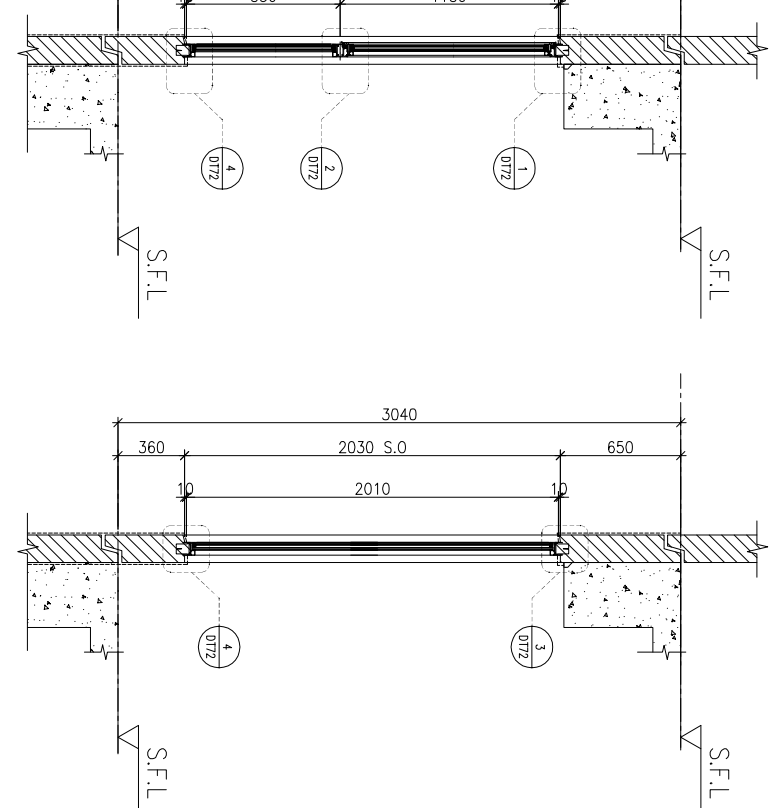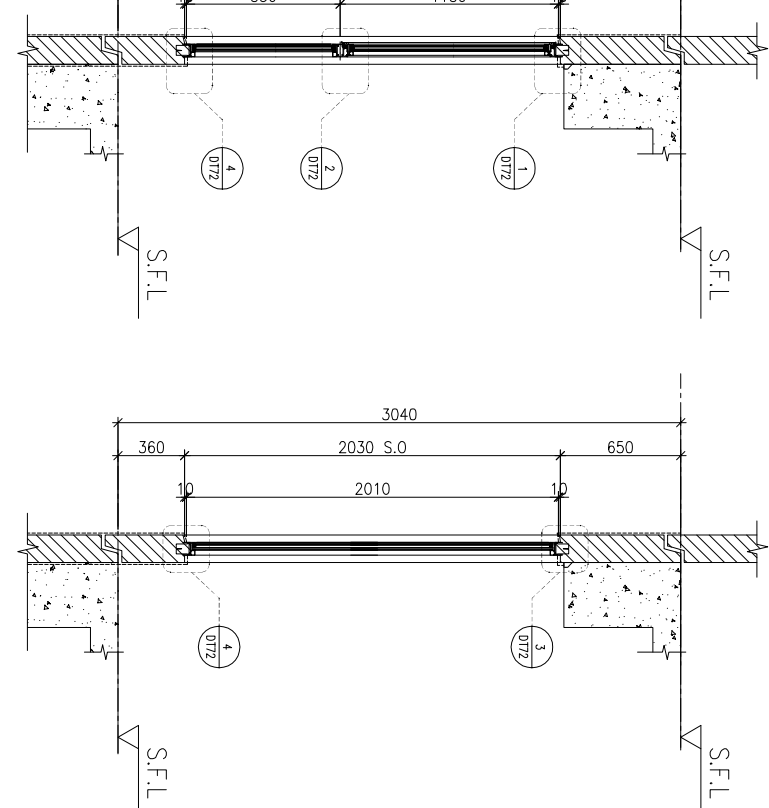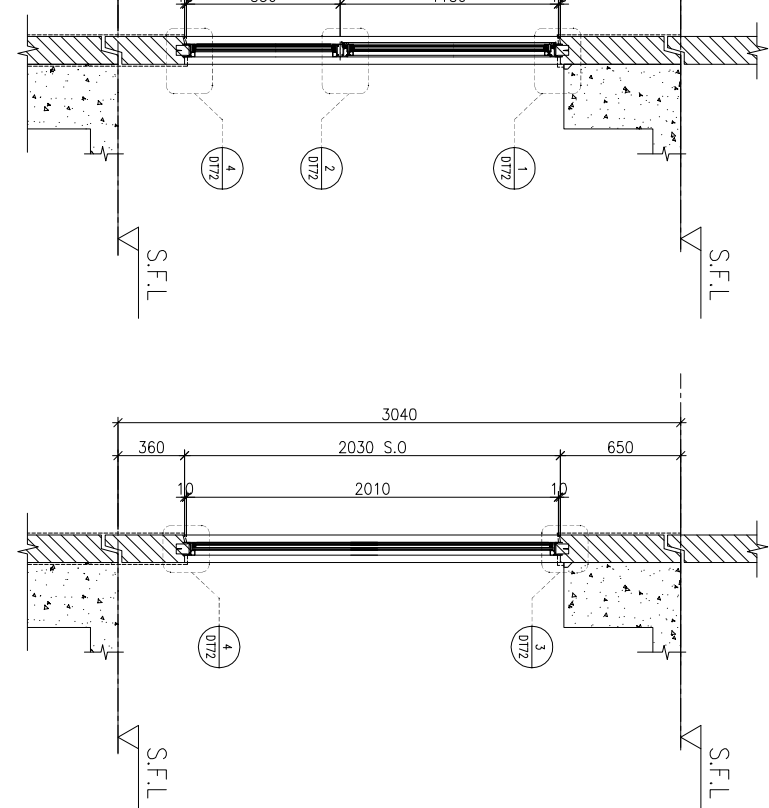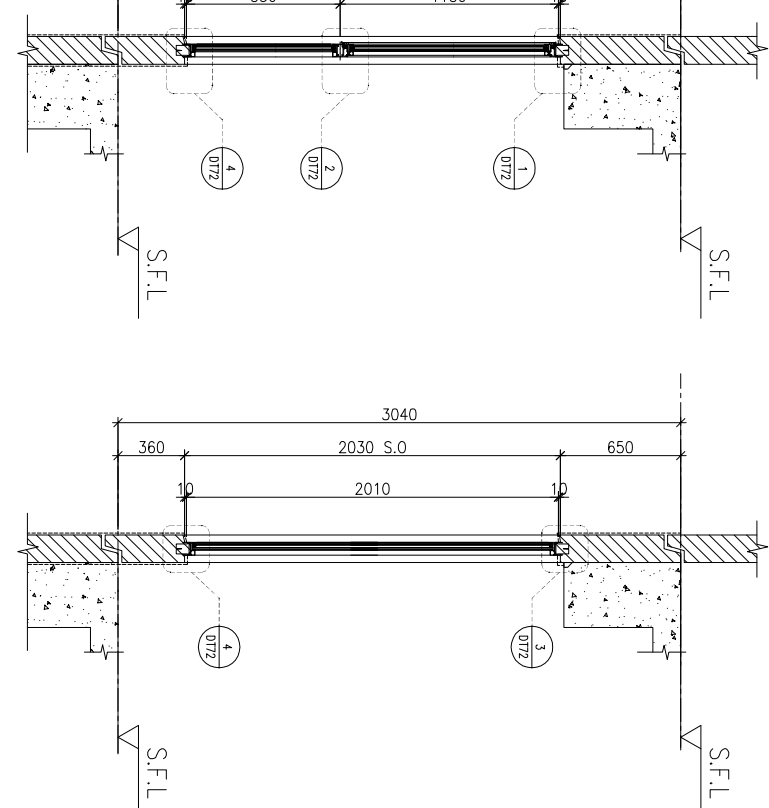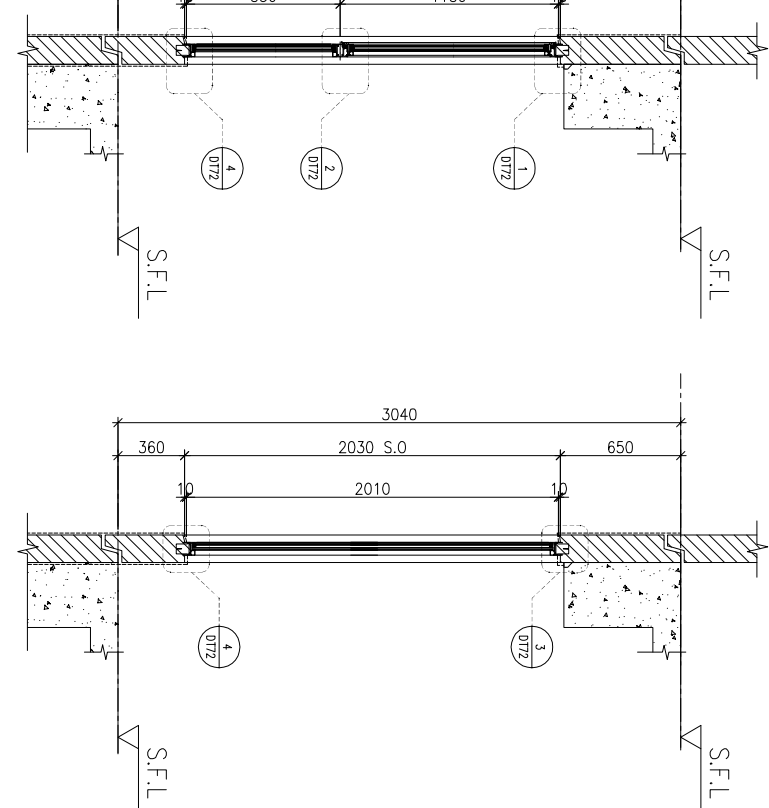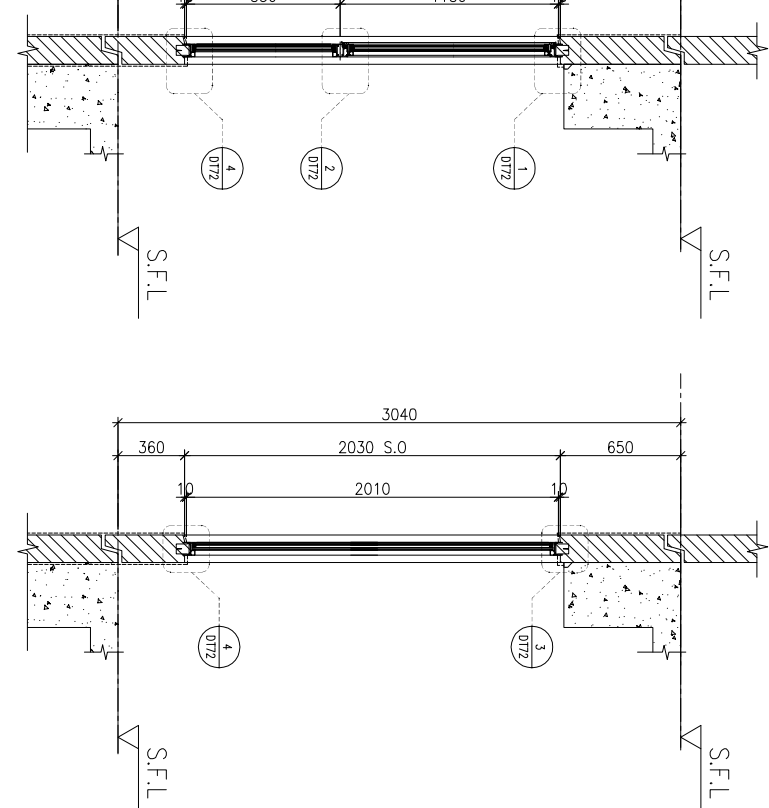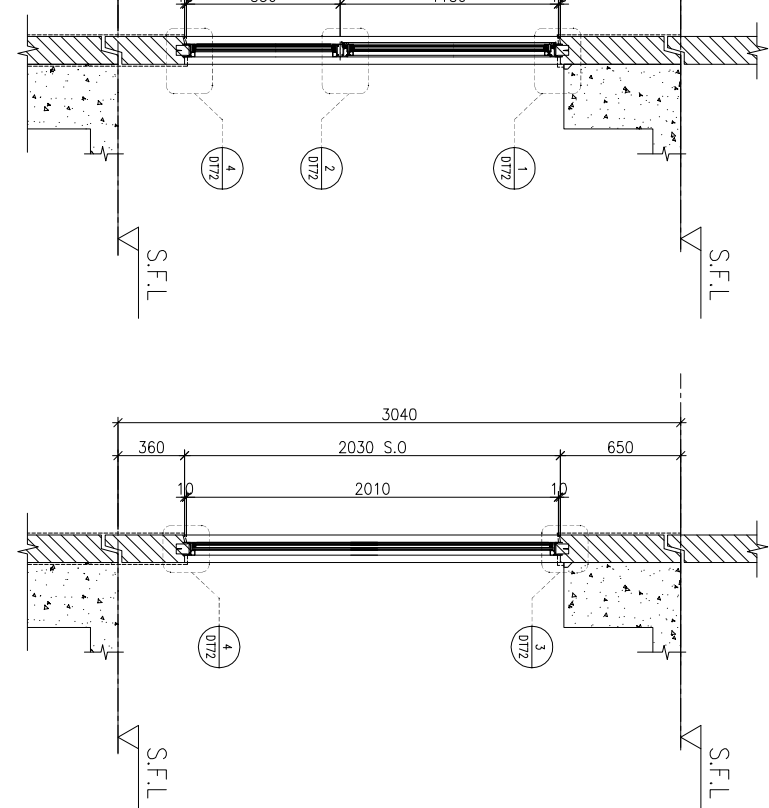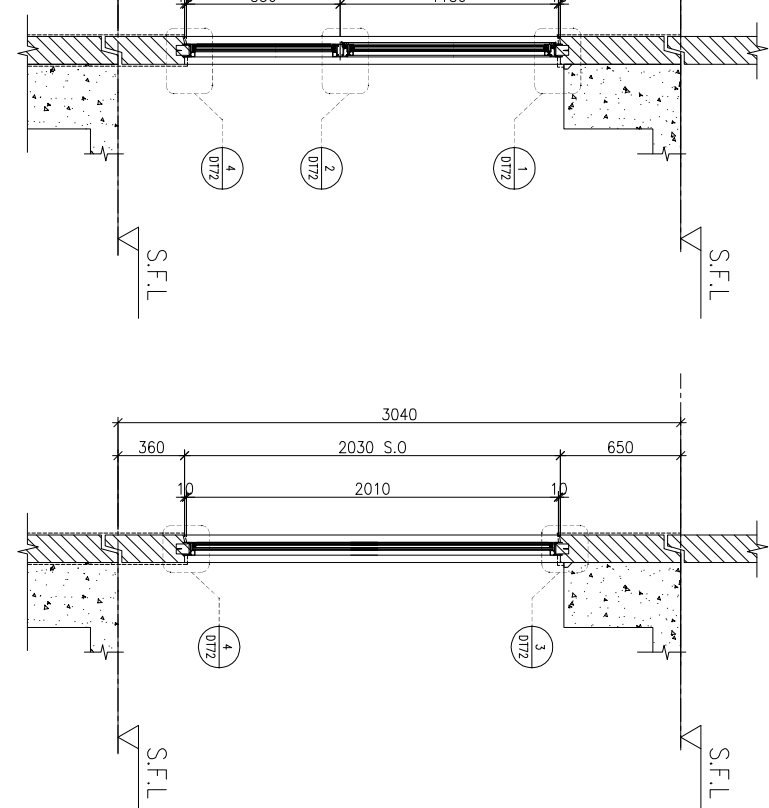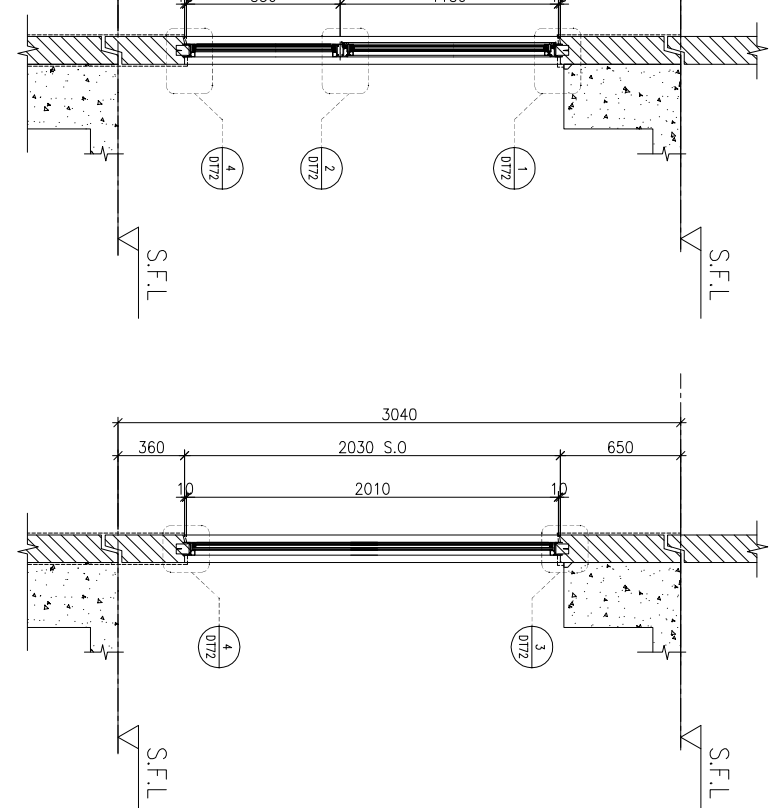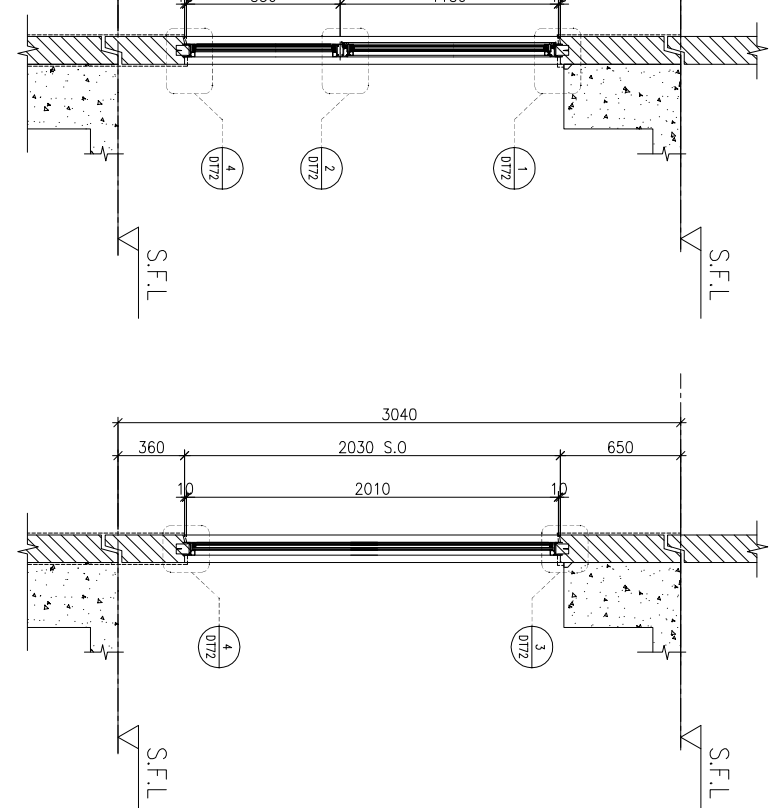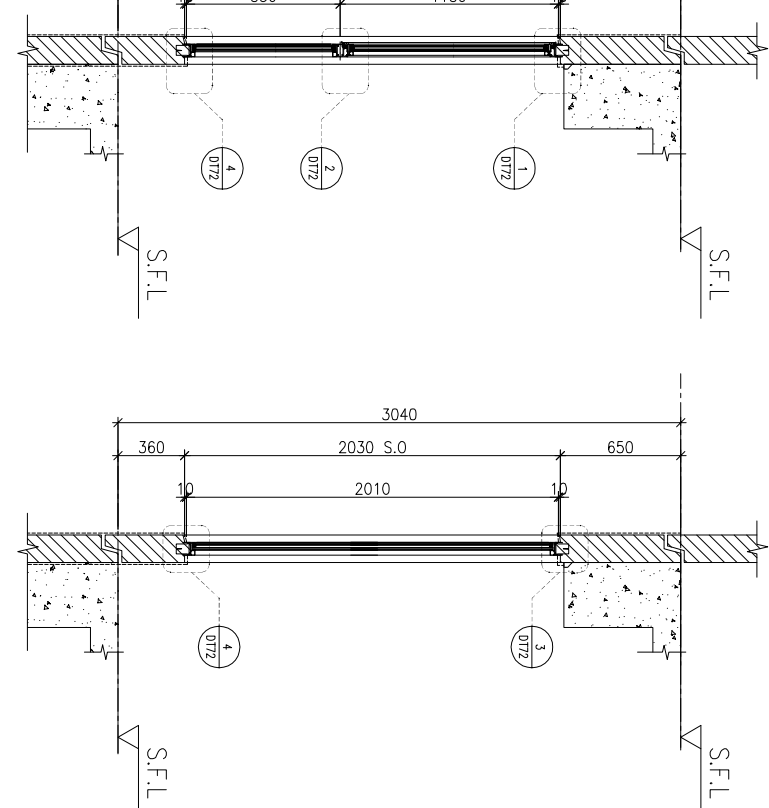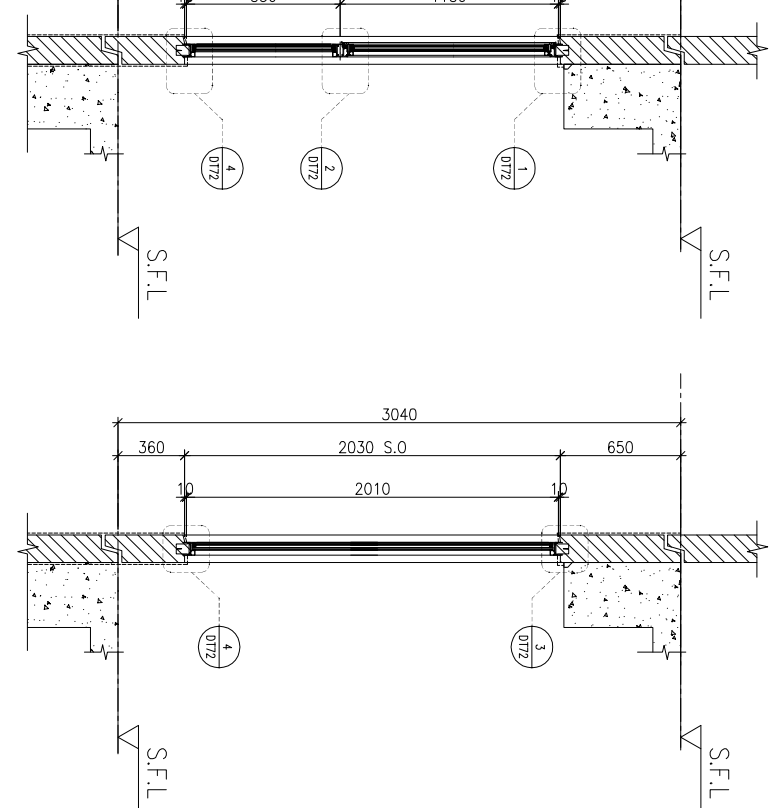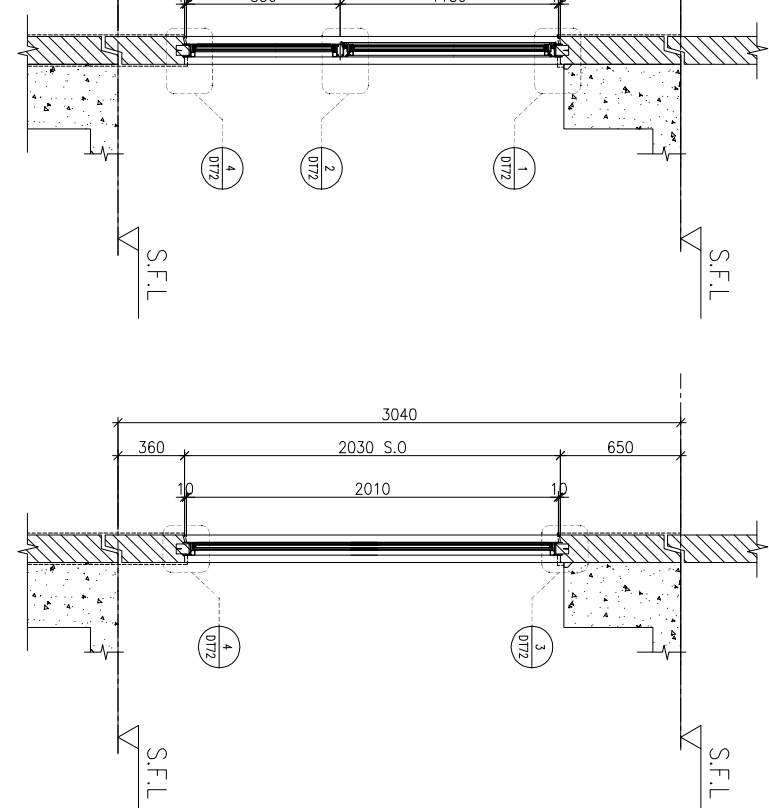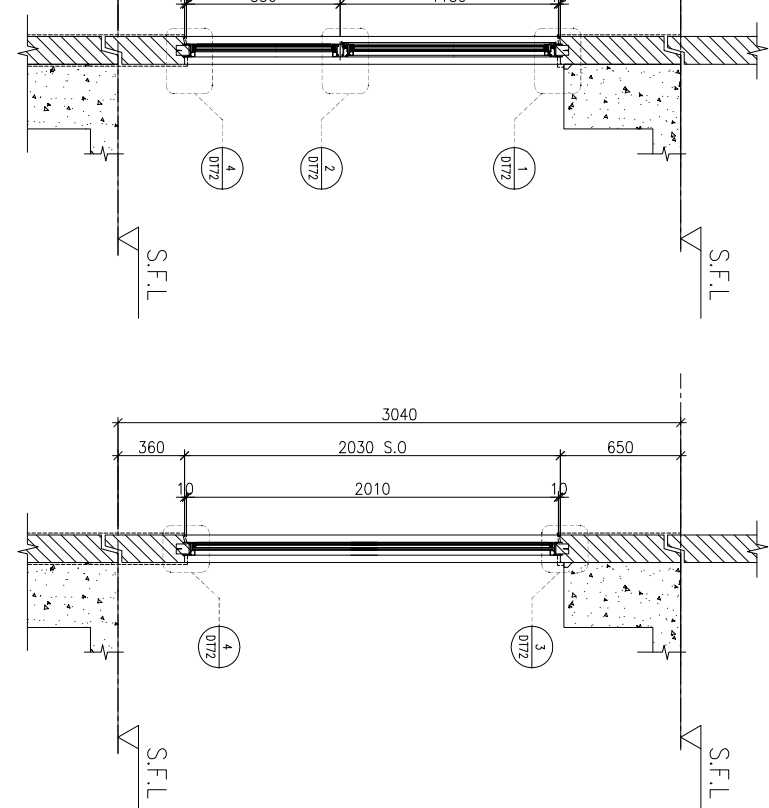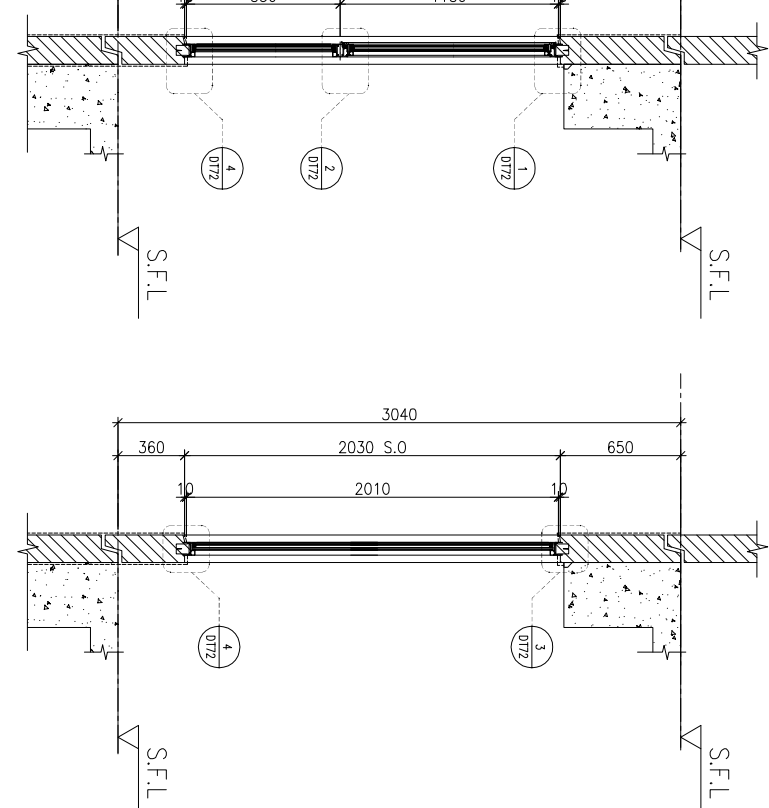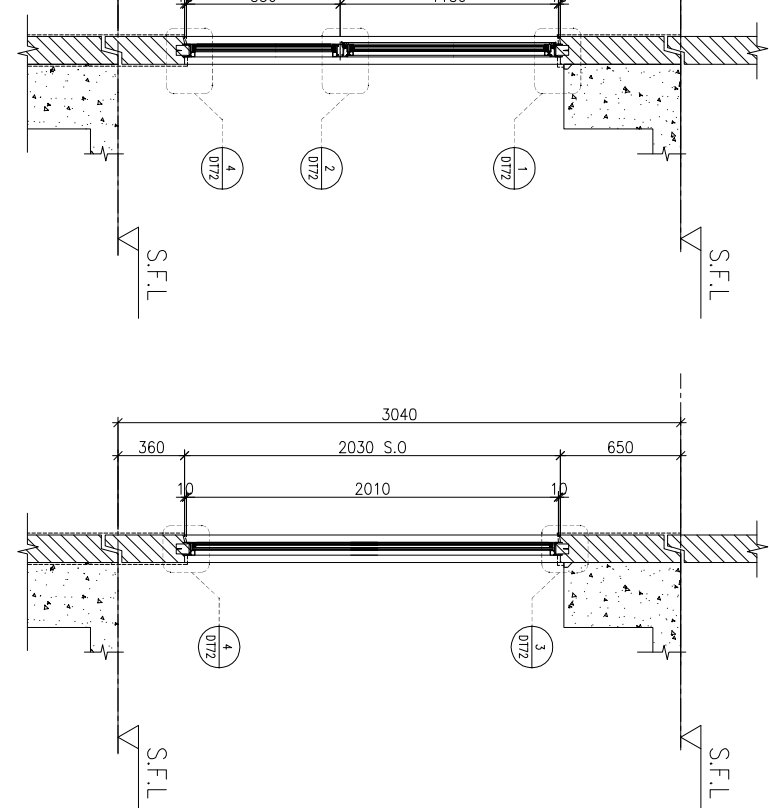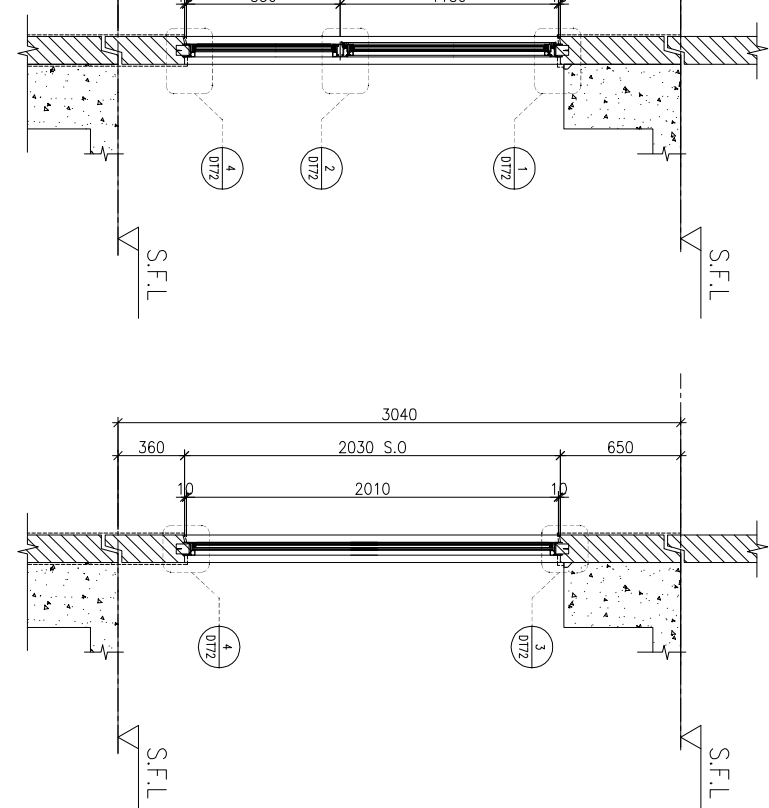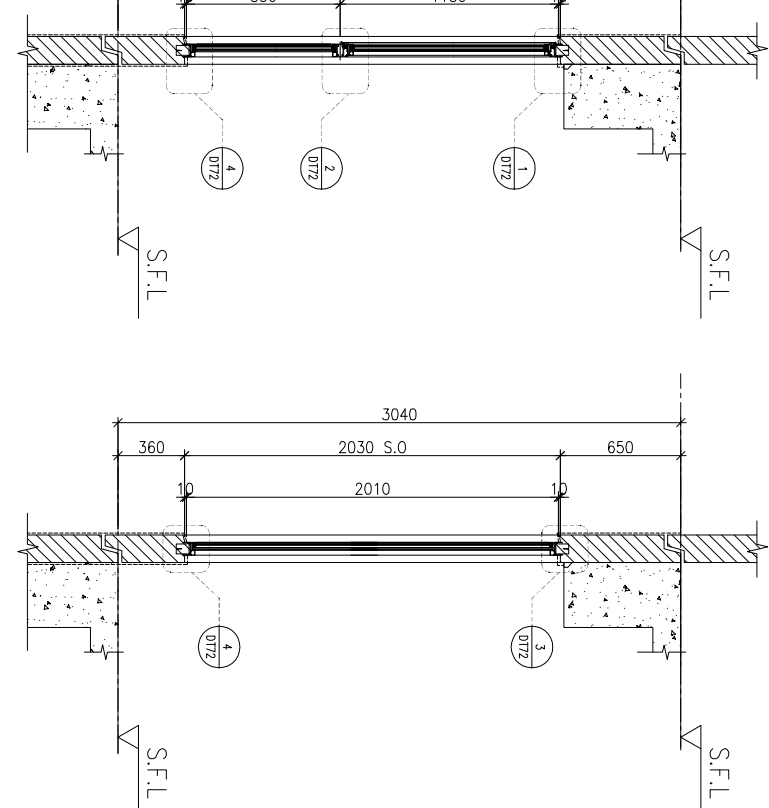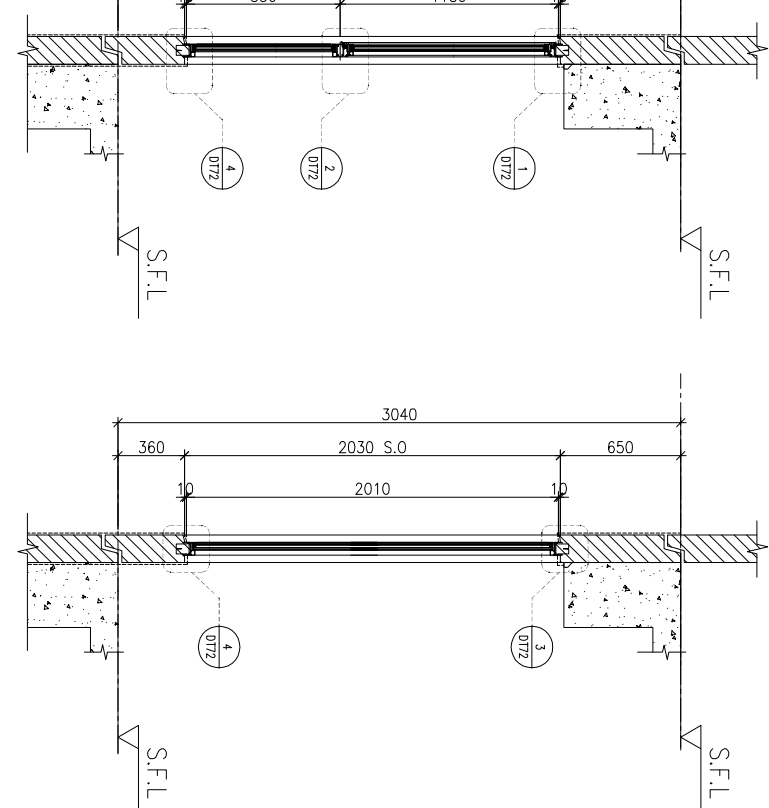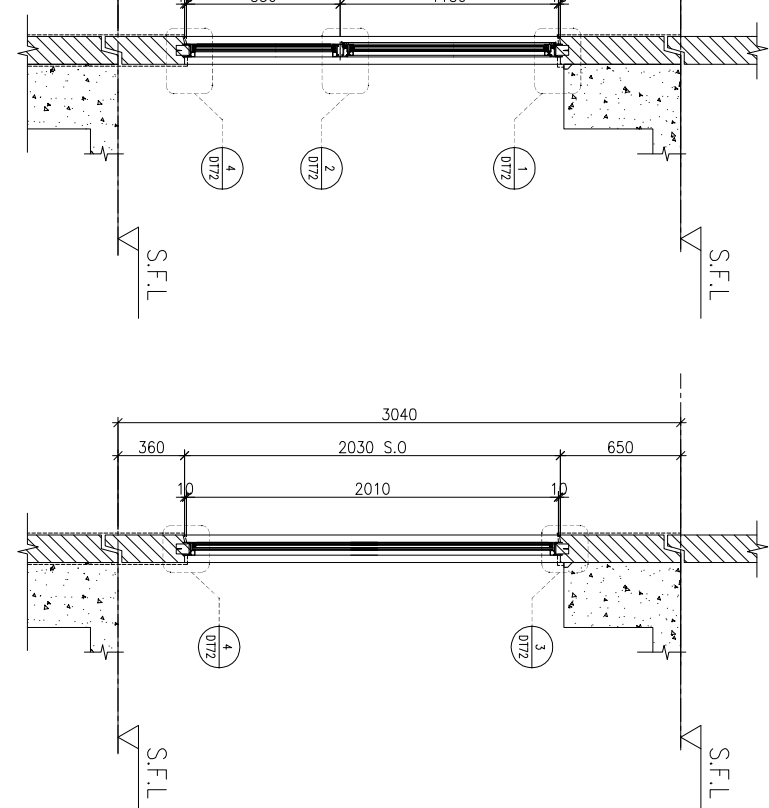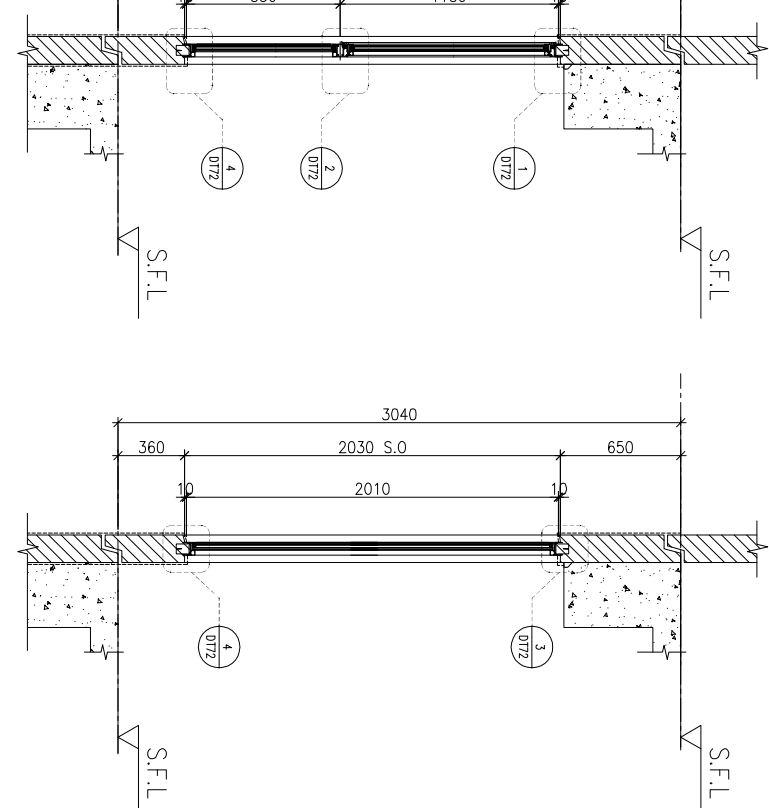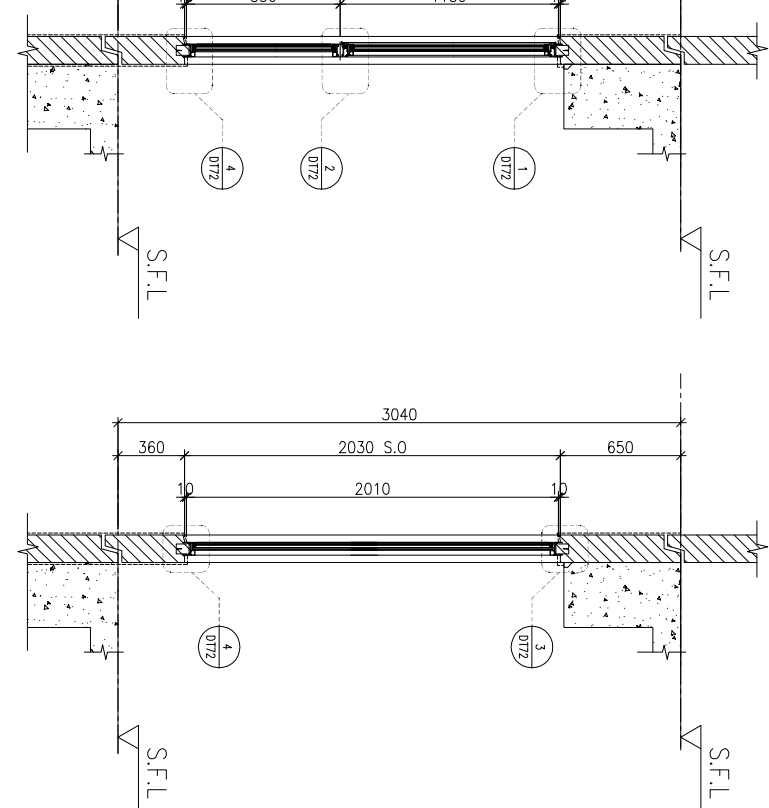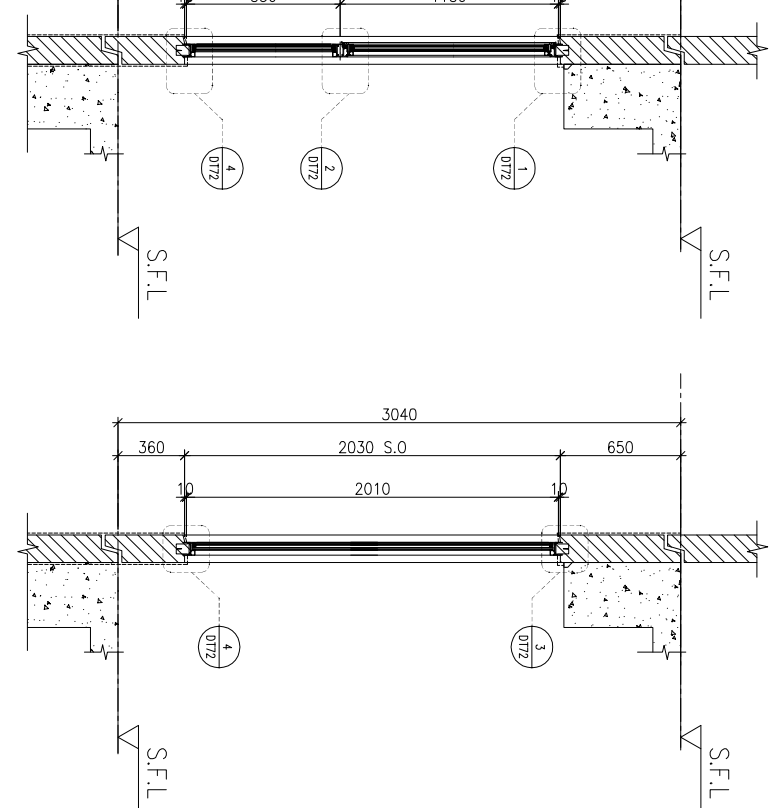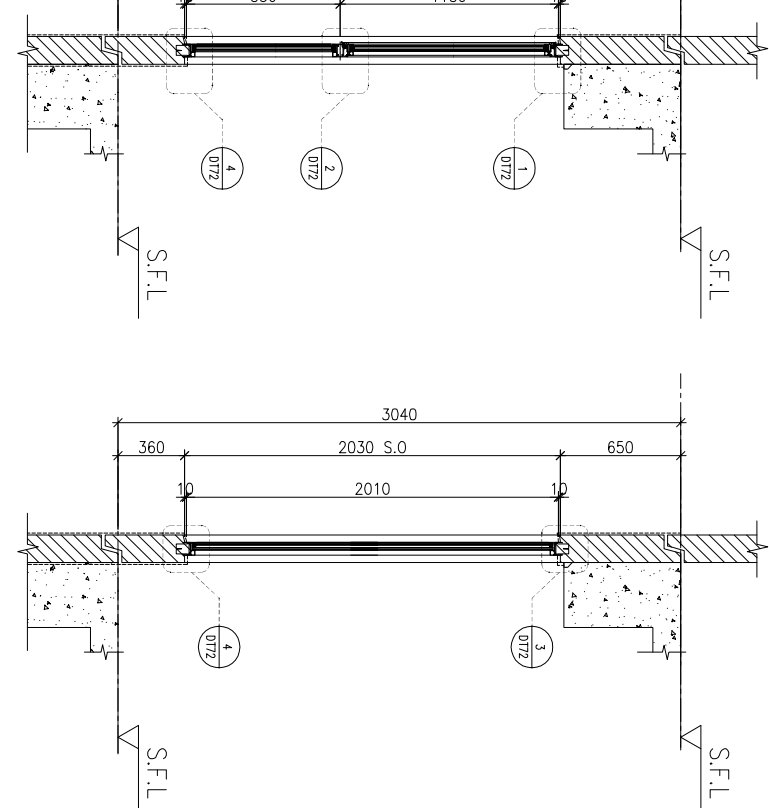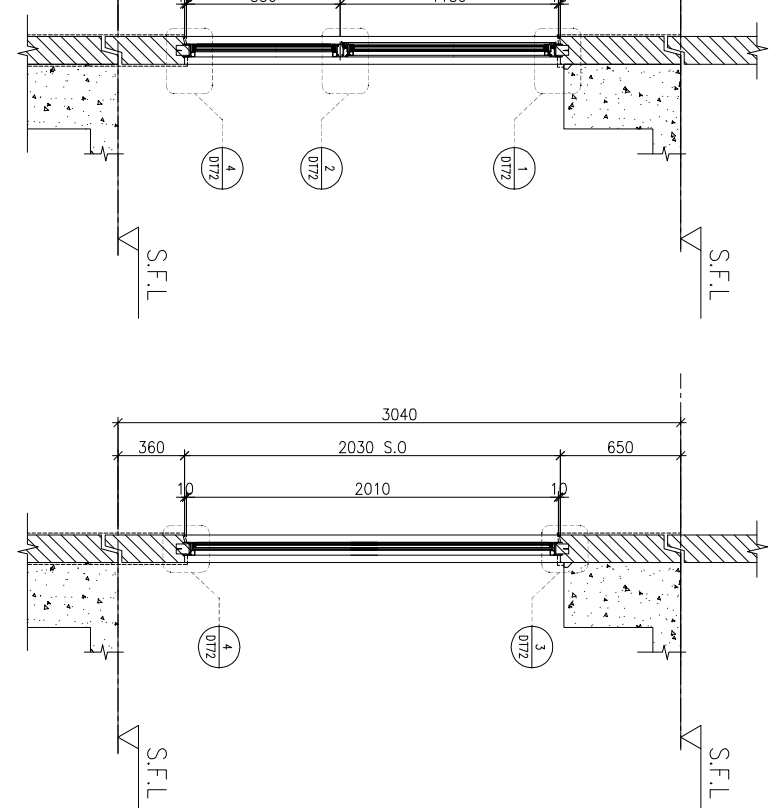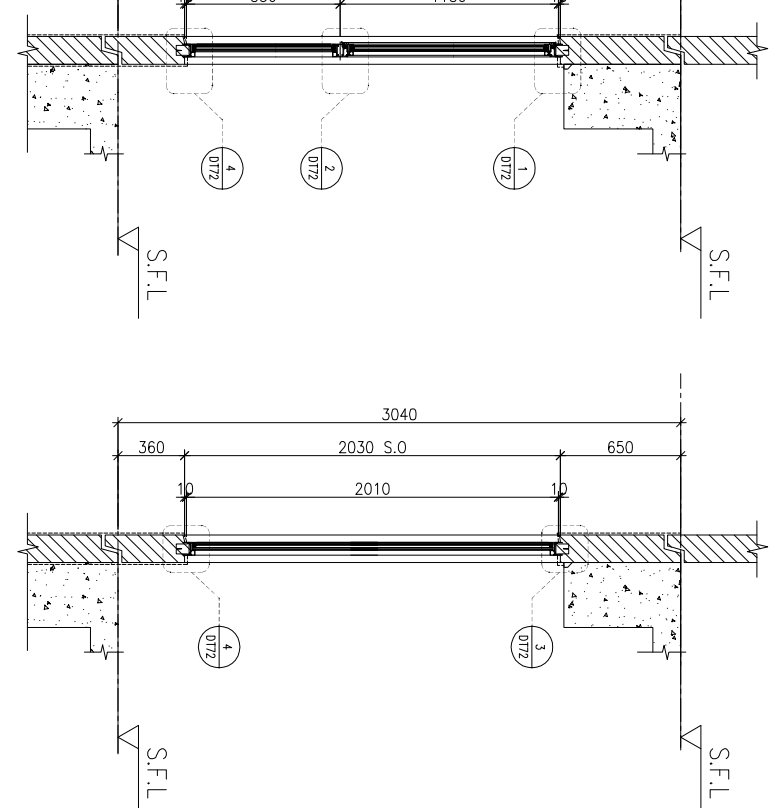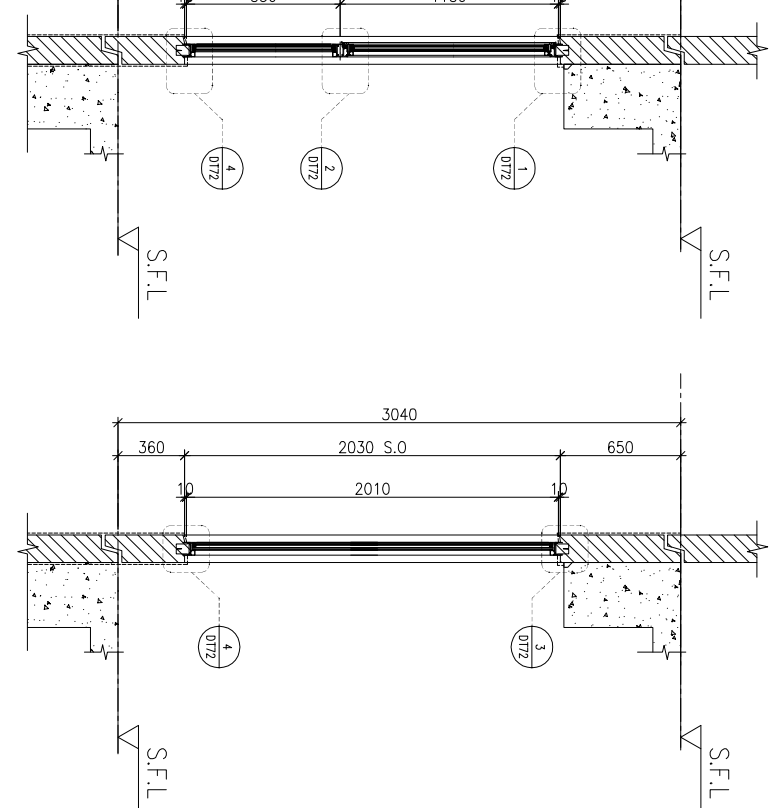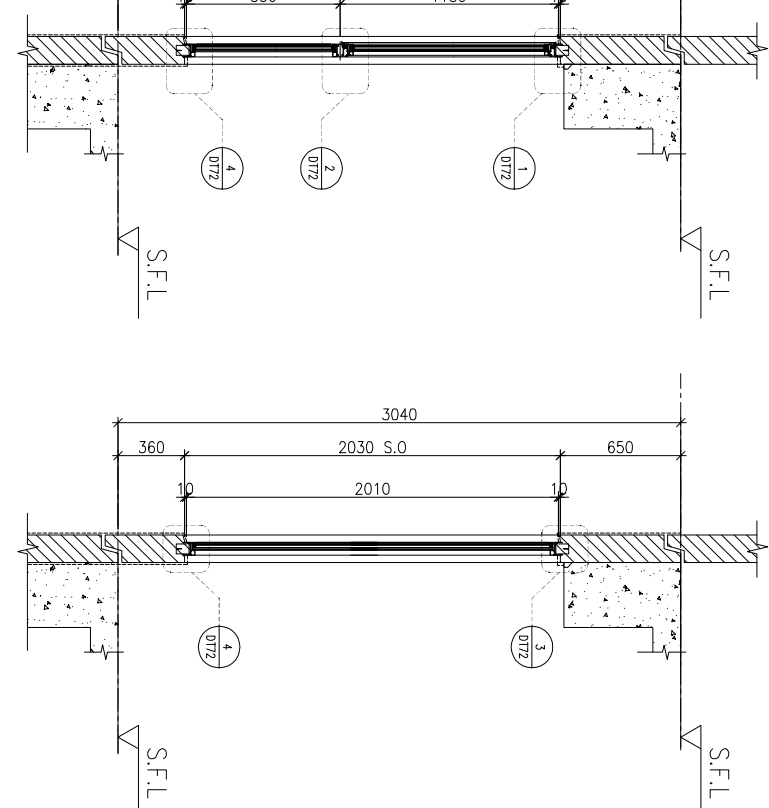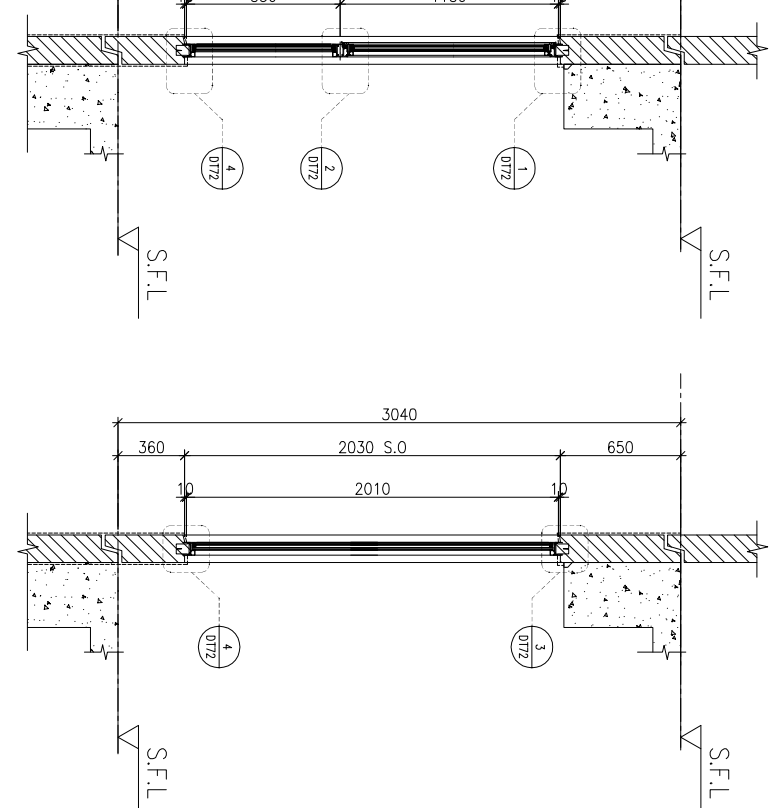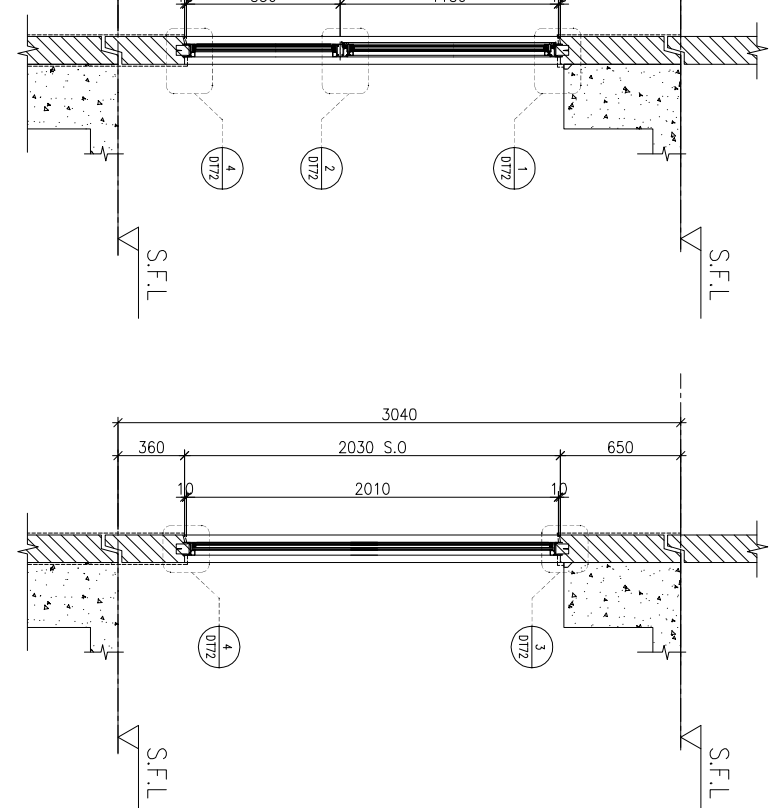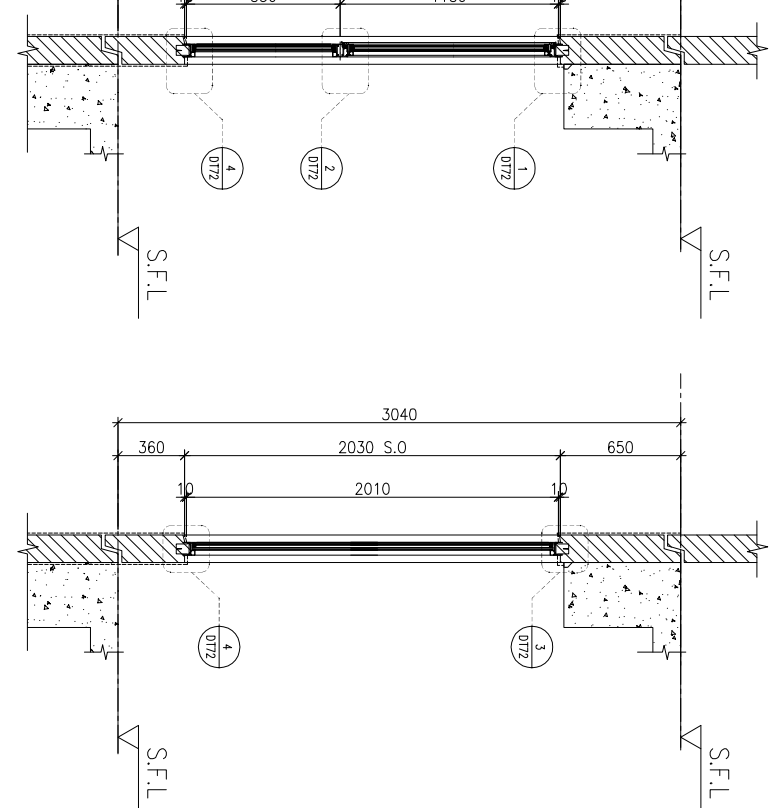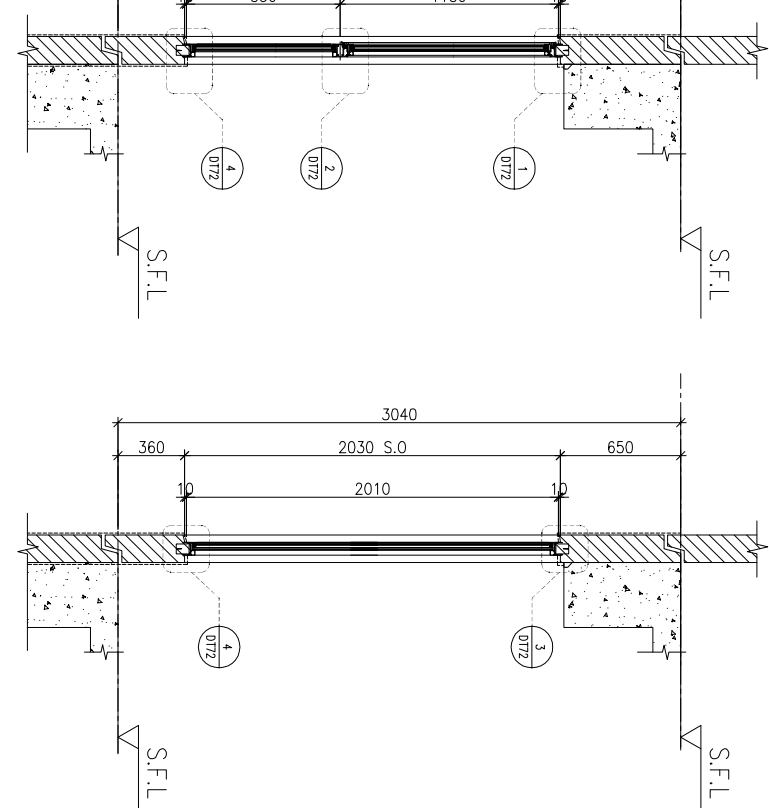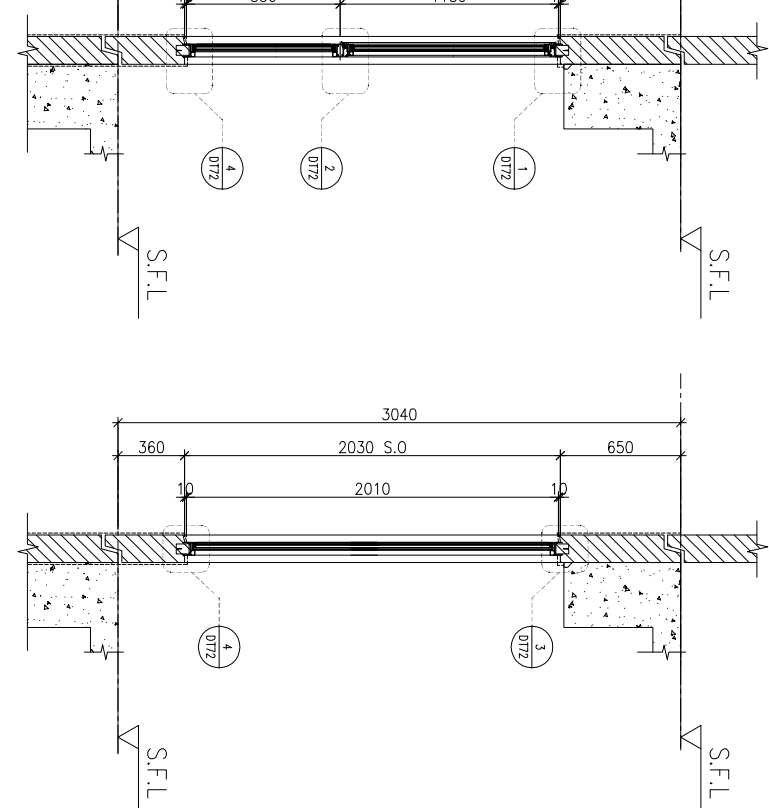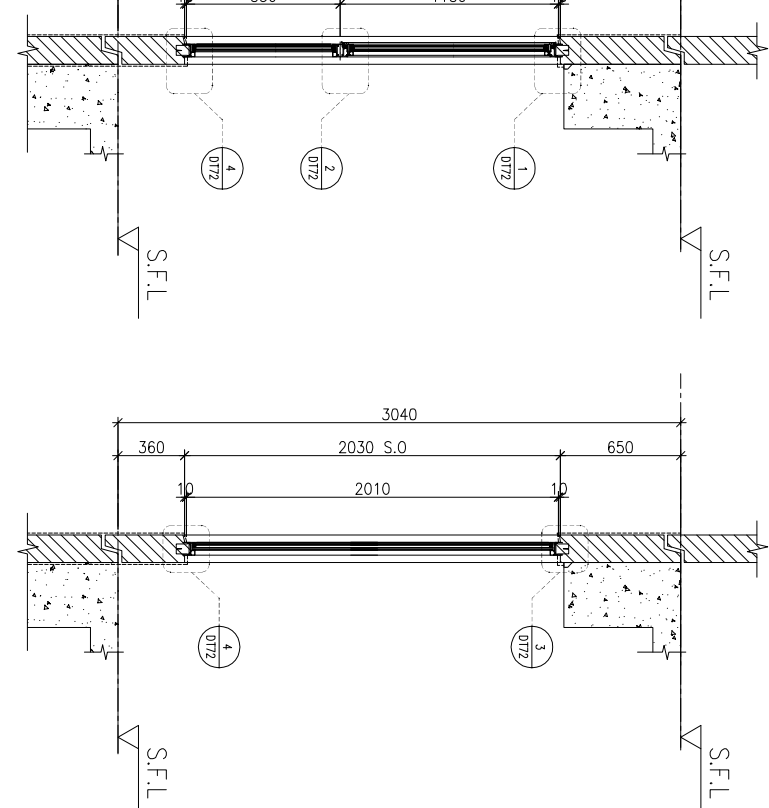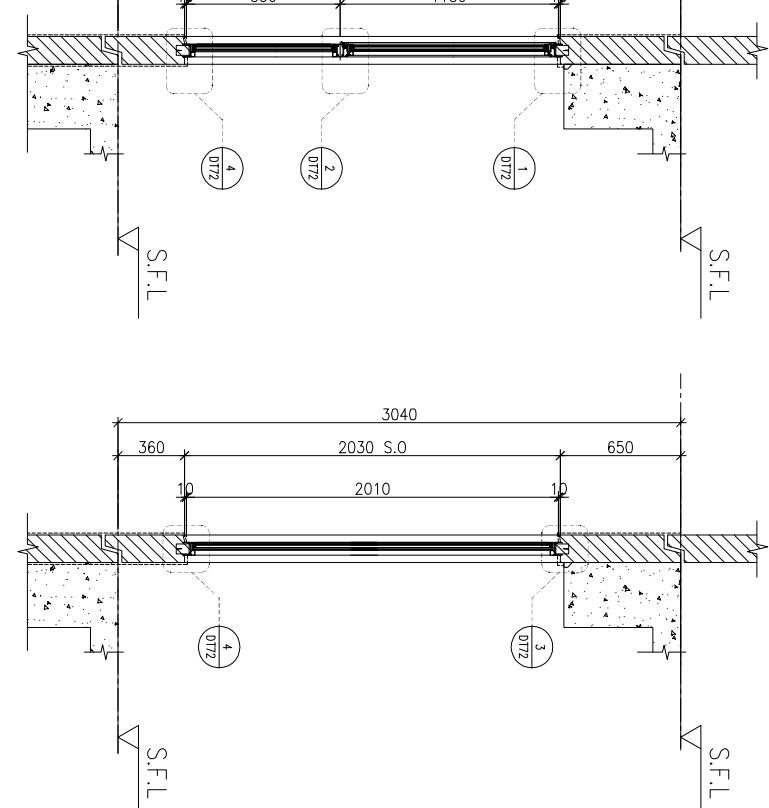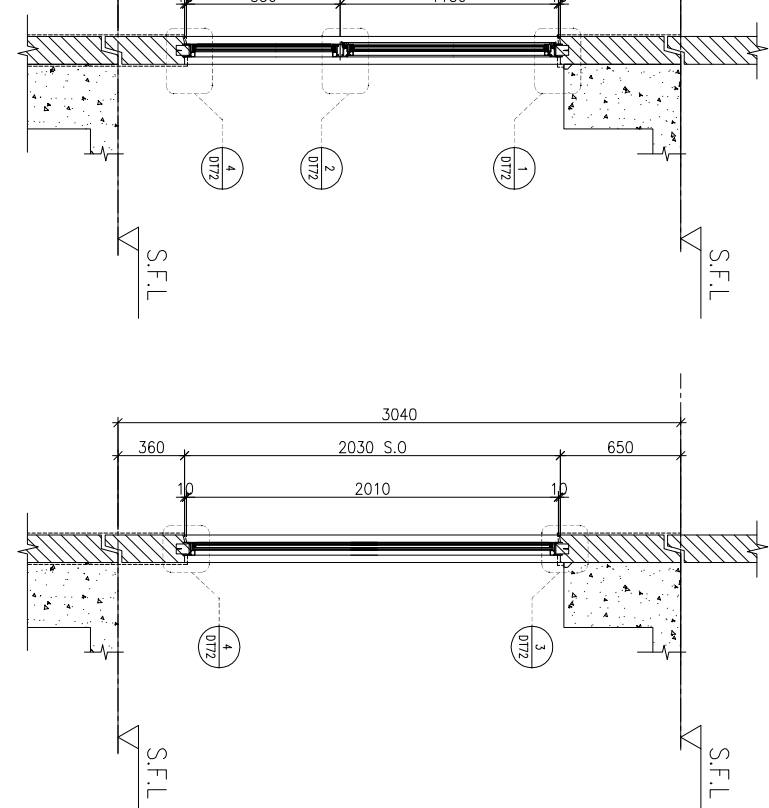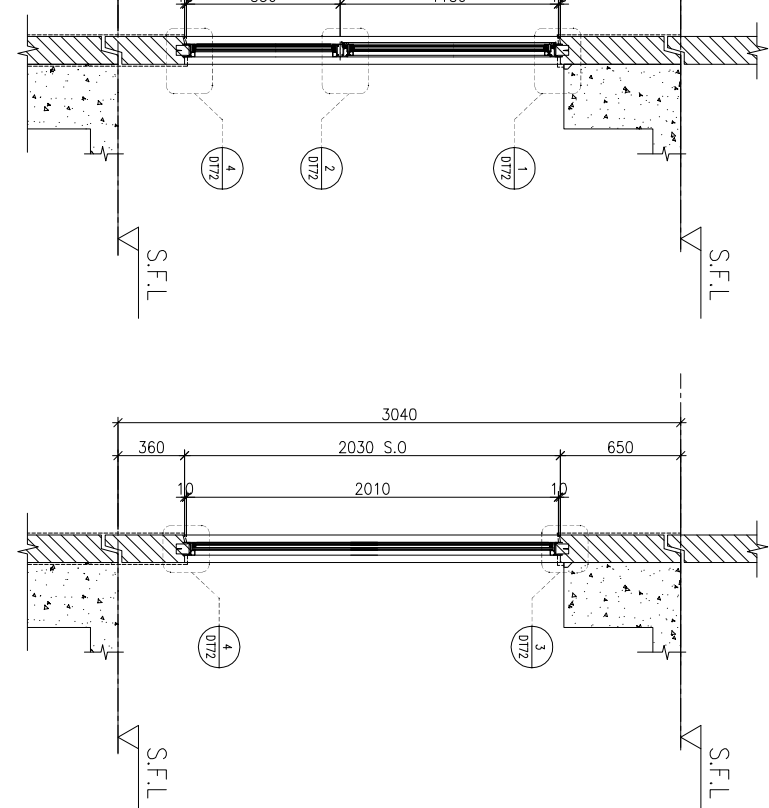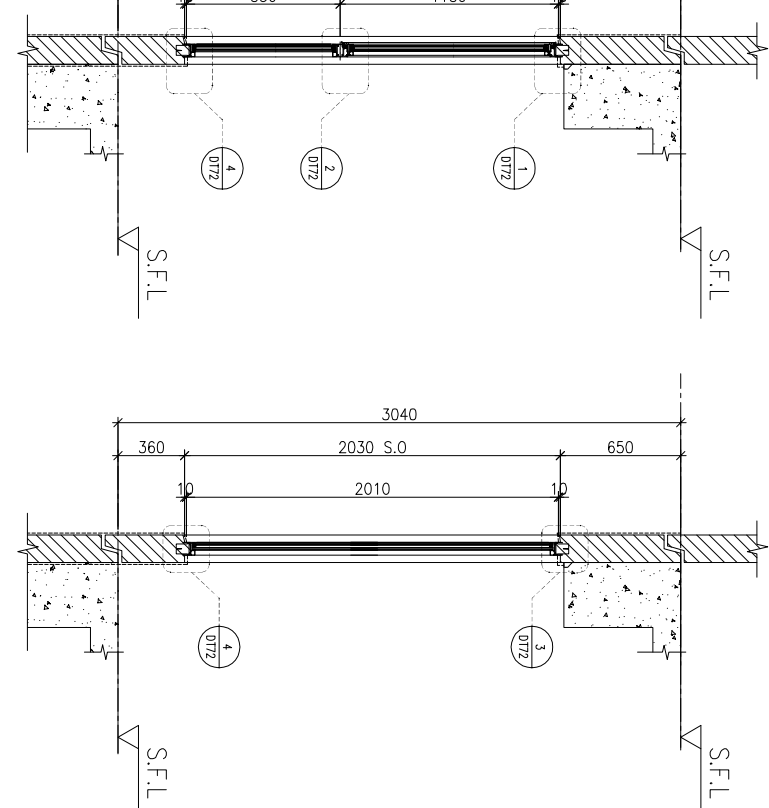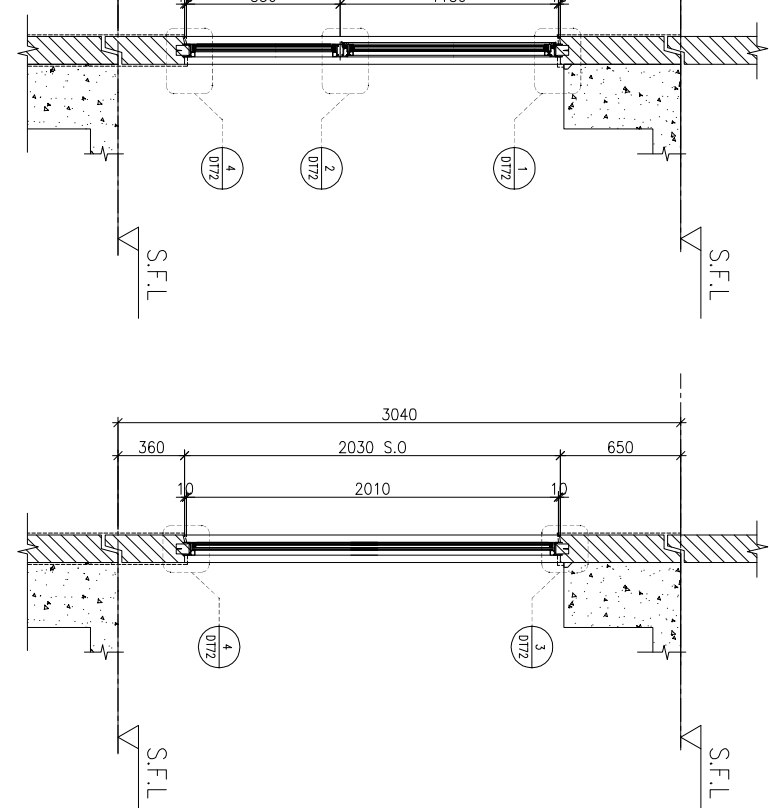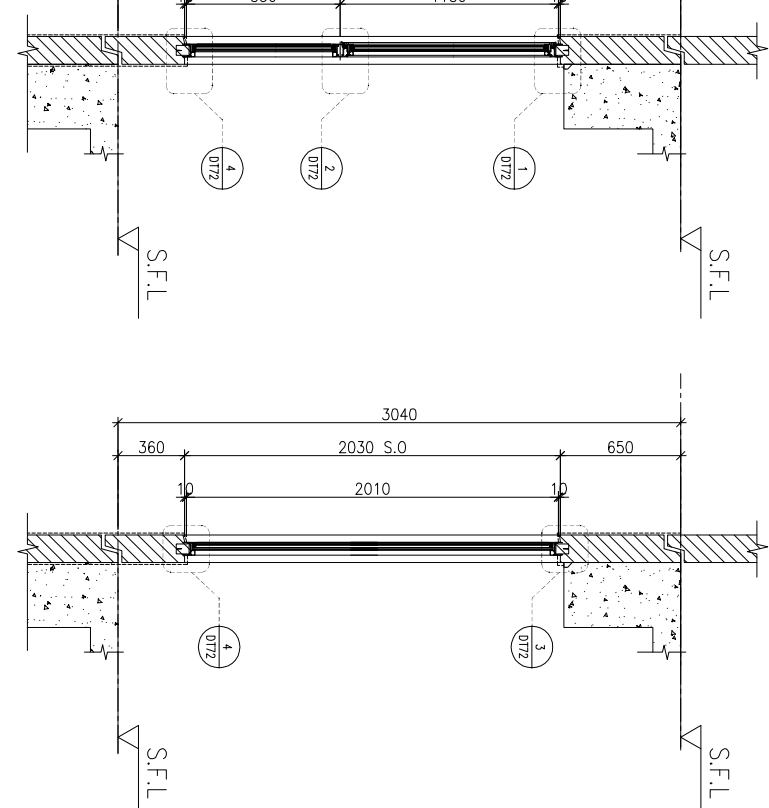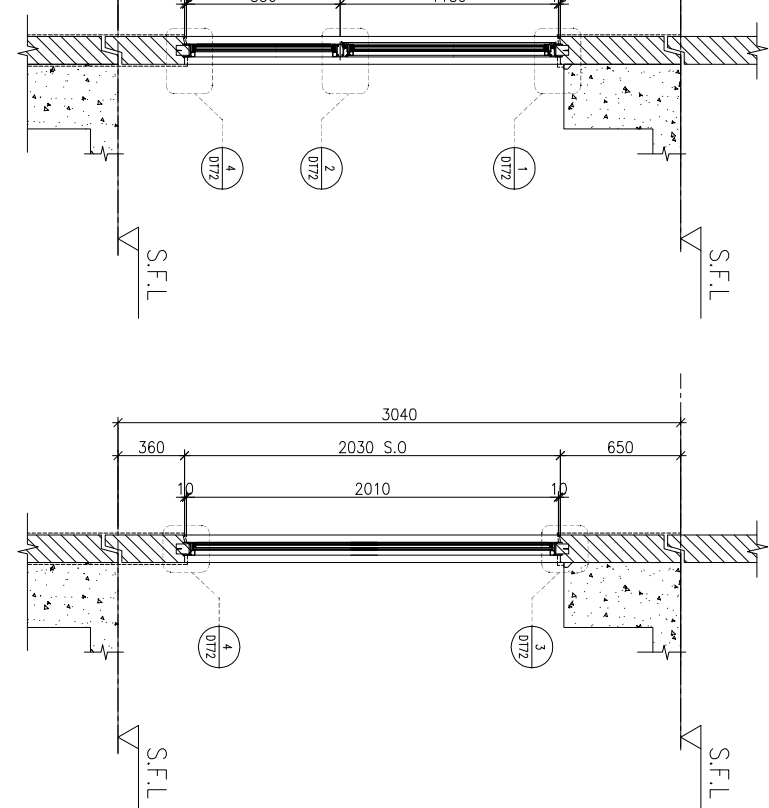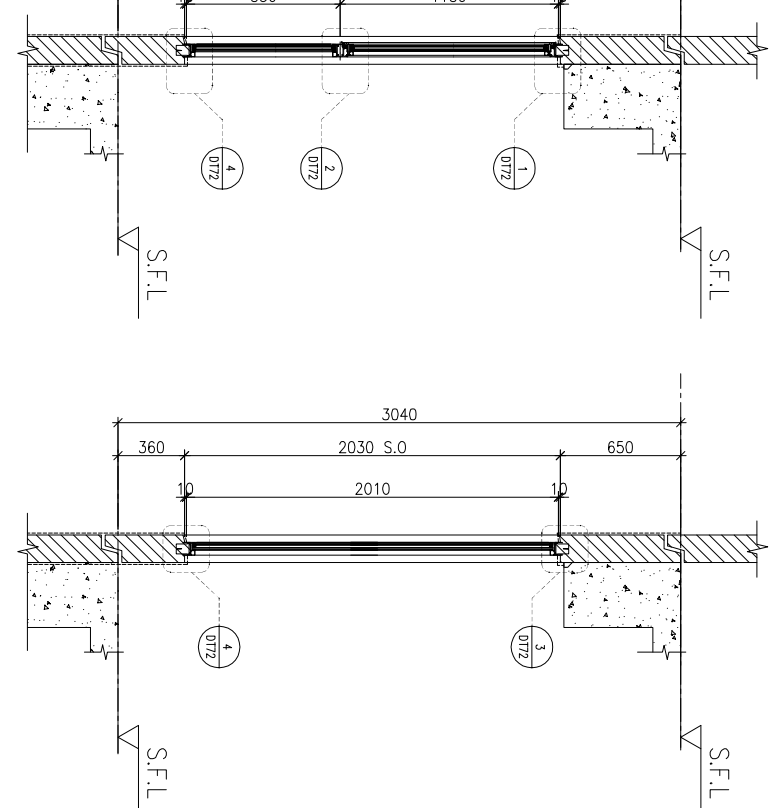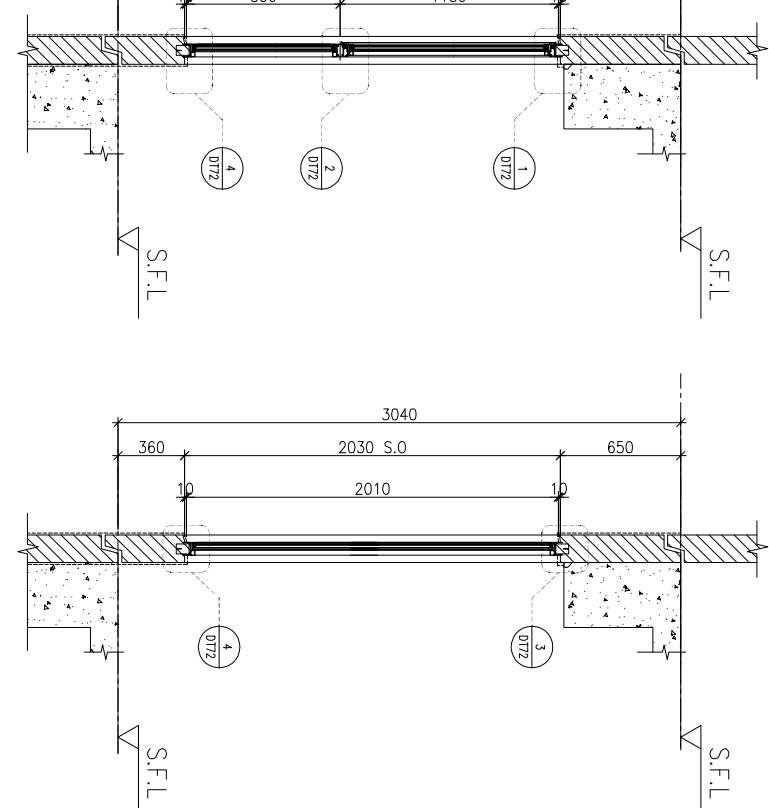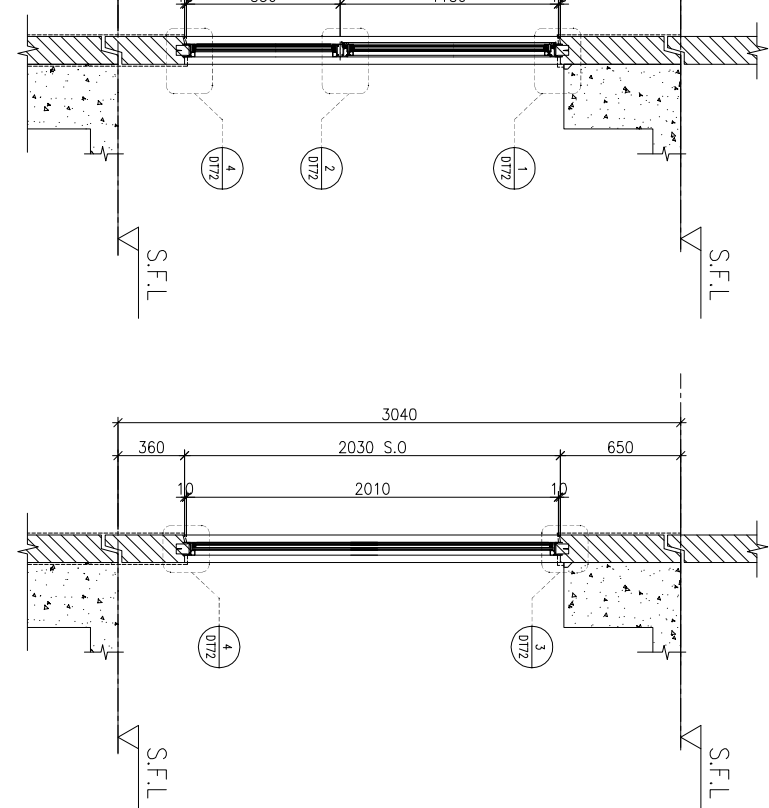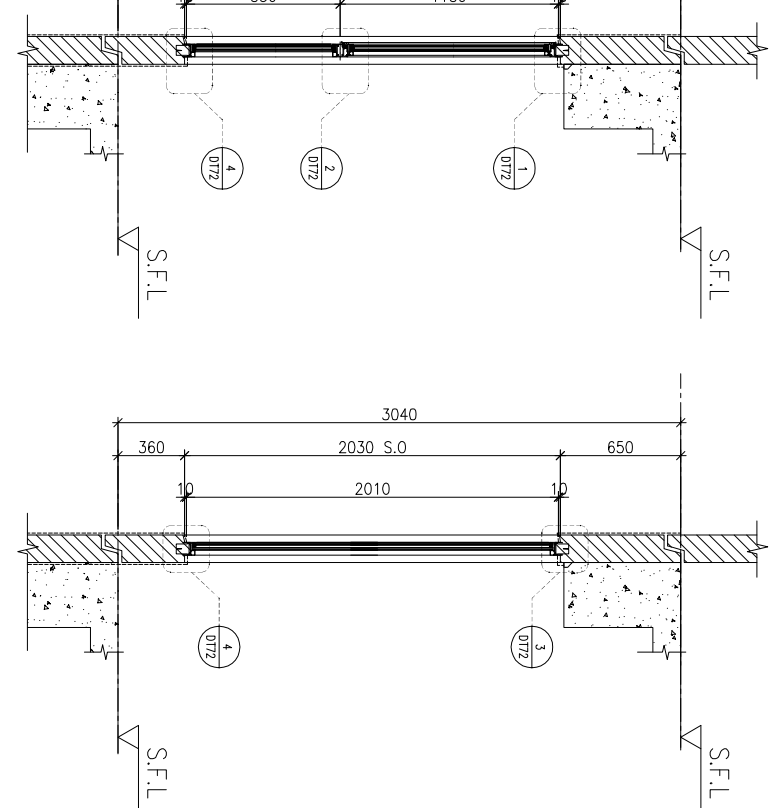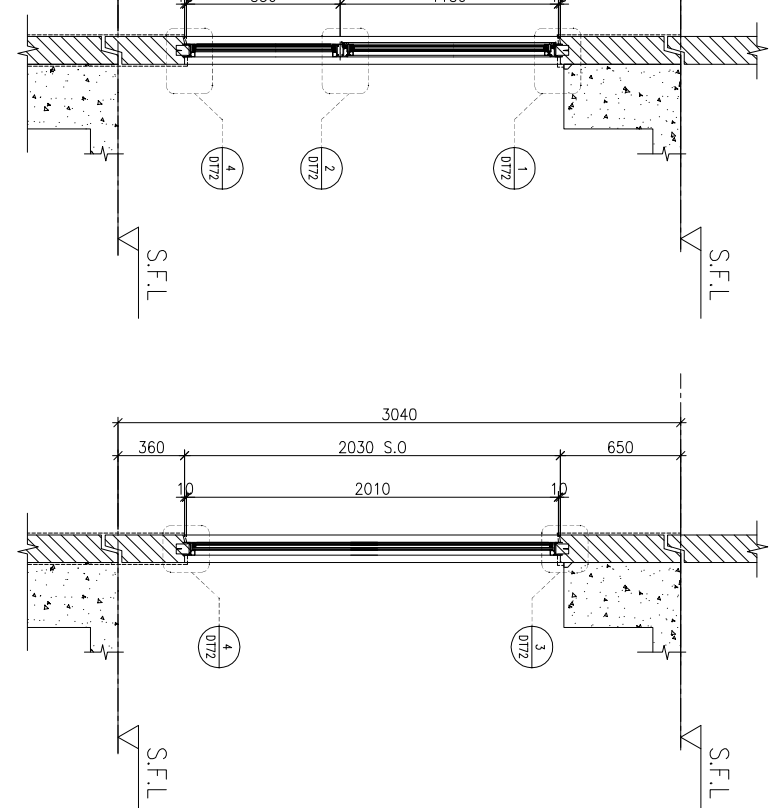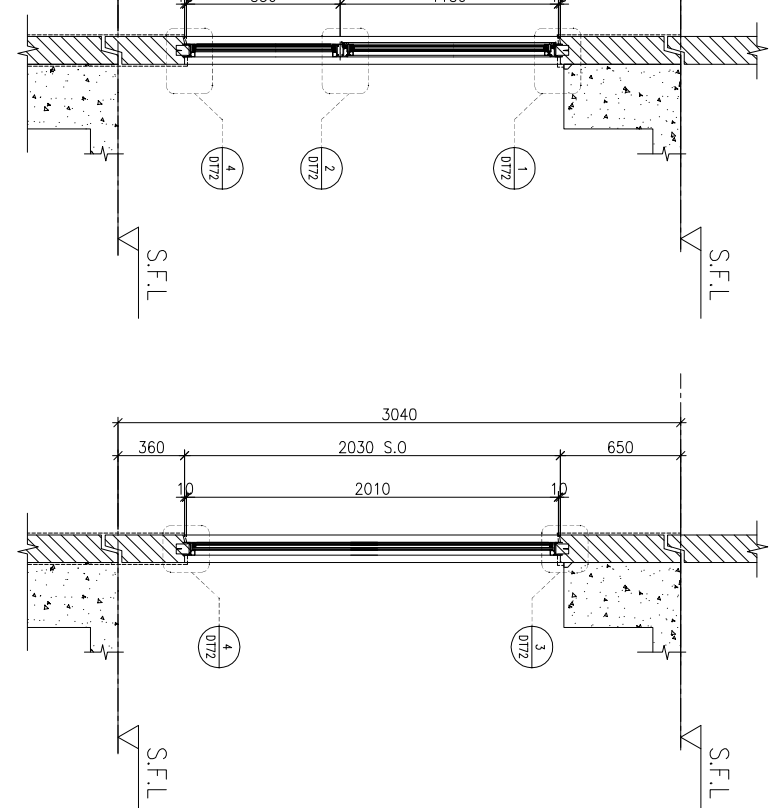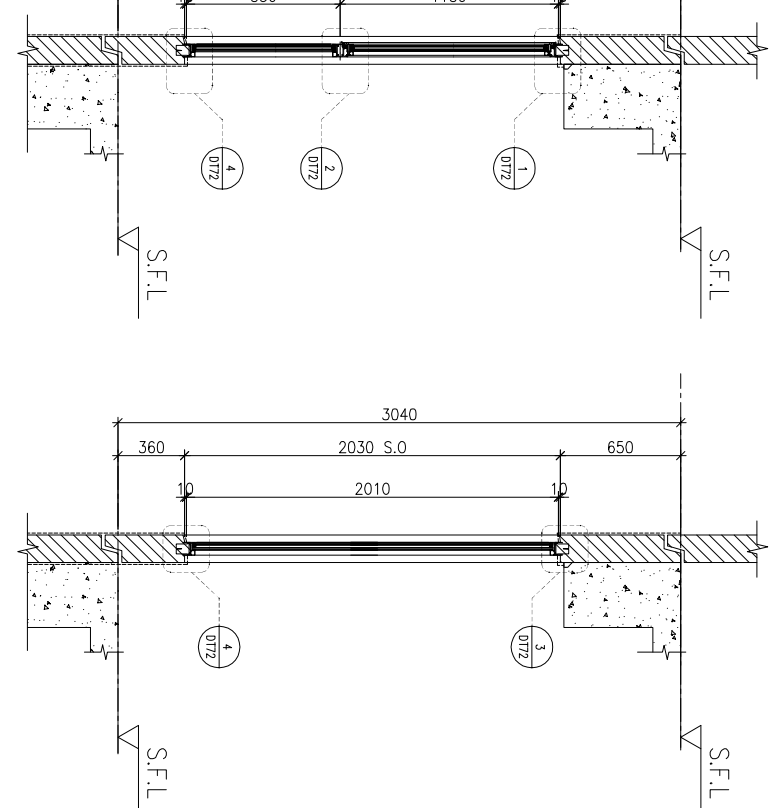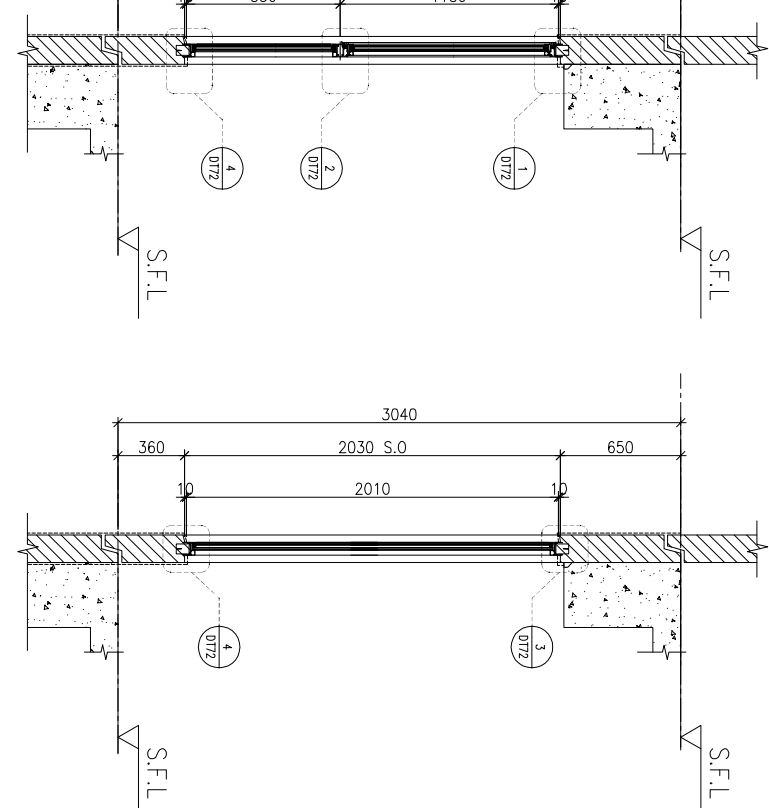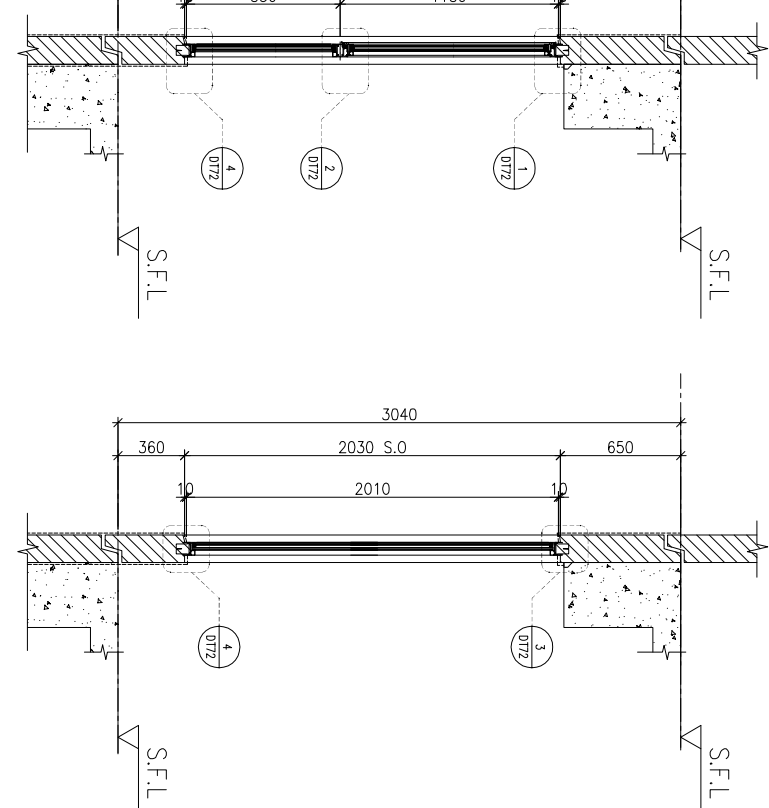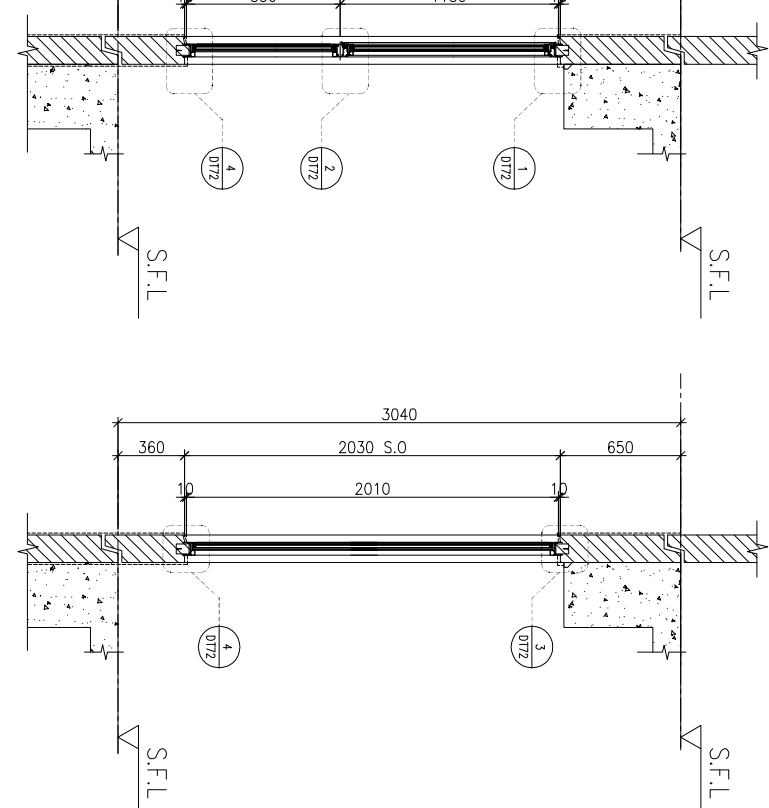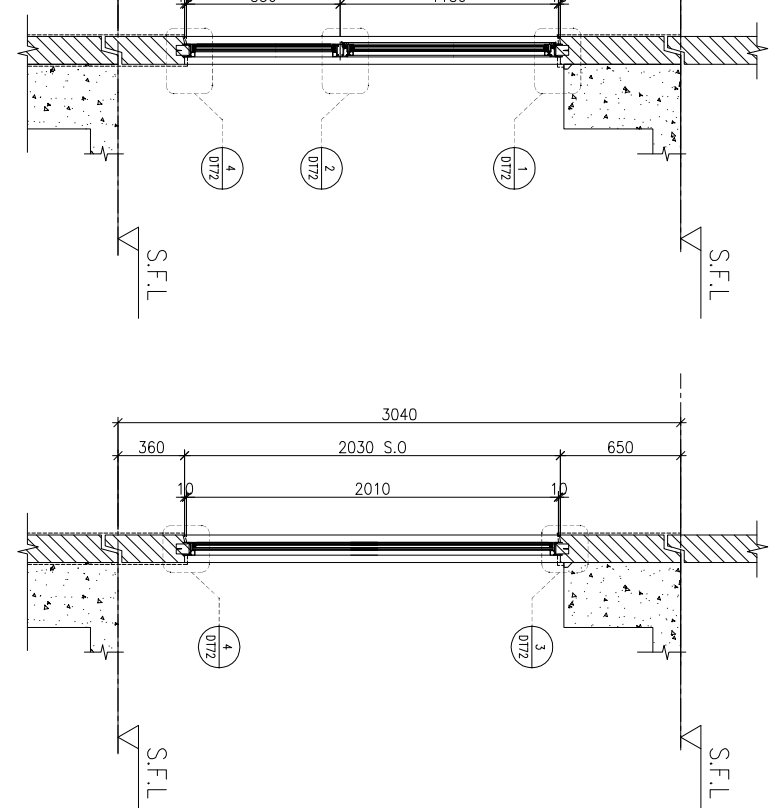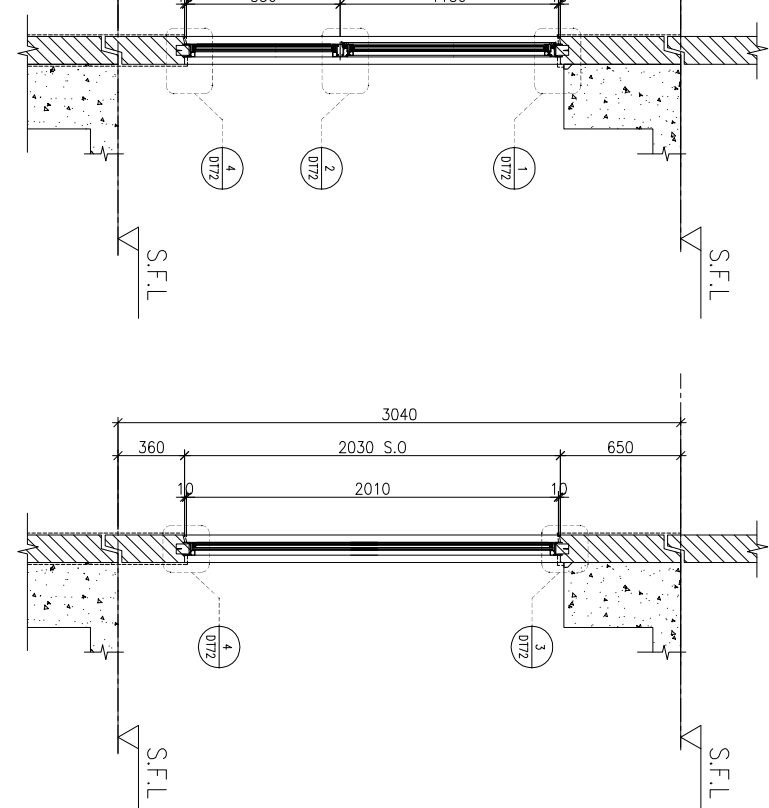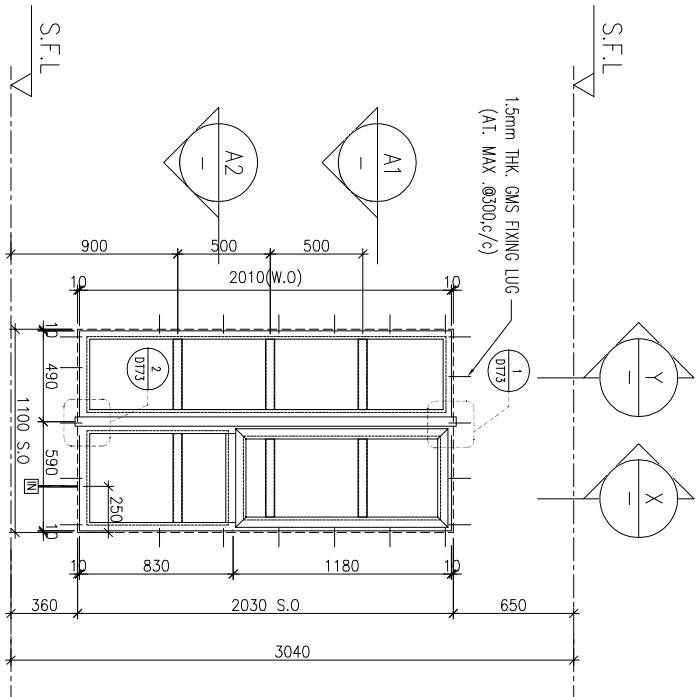

B.O. REF. :

CLIENT :

SUN HUNG KAI
REAL ESTATE AGENCY LTD.
42/F SUN HUNG KAI CENTRE, WINGHAI, HONGKONG

ARCHITECT :

lwk&partners
a r c h i t e c t s

MAIN CONTRACTOR :

Yee Fai 怡輝建築有限公司
Building Contractors Ltd.

STRUCTURAL ENGINEER :

ARUP

FAÇADE CONSULTANT:

ALPHA CONSULTING LIMITED
Steel Structure & Façade Specialist

- NOTE.:
1. ALL DIMENSIONS ARE IN mm.
 2. ALL ELEVATIONS ARE VIEWED FROM OUTSIDE.
 3. ALL DIMENSIONS TO BE VERIFIED ON SITE BEFORE FABRICATION.

LEGEND.:

X1 — DETAIL MARK NO.
X001 — REFER SHEET NO.











1. F.F.L. — FINISHED FLOOR LEVEL
2. S.F.L. — STRUCTURAL FLOOR LEVEL
3. **⊗** — REVERSED DETAIL

4. GLASS LEGEND

EGL-1 — 8mmHS+12mm AIR GAP+10mmTP THK. I.G.U.
EGL-2 — 10mm THK. CLEAR TEMPERED GLASS
EGL-4 — 10mm THK. TEMPERED ACID ETCHED GLASS
EGL-1A — 8mmHS+12mm AIR GAP+8mmTP THK. I.G.U.

REVISION SUBJECT TO ARCHITECTMENT		
NO.	DATE	REVISION
A1	03/11/2021	1. F.F.L. — FINISHED FLOOR LEVEL
J08 NO. : J-856		
PROJECT : PROPOSED DEVELOPMENT ABOVE LIGHT RAIL TIN WING STOP.TSWTL NO.23.AREA 33.TIN SHUI WAI, N.T.		
TITLE : WINDOW SCHEDULE FOR TOWER 2 ALUM. WINDOW (safety barrier)		
DATE : 02-Aug-21		
SCALE : 1:40		
DRAWN BY : Ivon		
CHECKED BY :		
Units 6-8, Sunway Industrial Centre, 1/F		
610 Ono Kwo Ling Road, Kowloon		
Tel:23489211-4 Fax:(852)2727666		
DWG NO. : J856-SD-PW-5207		
REV. : A		

ELEVATION

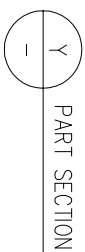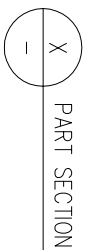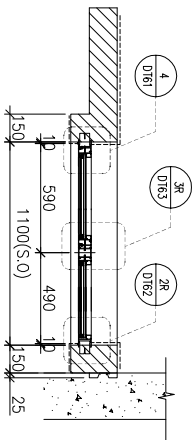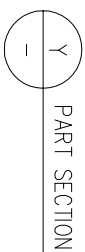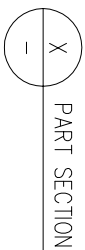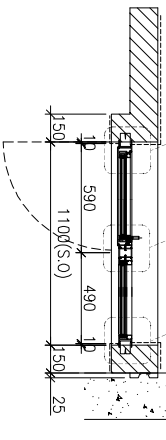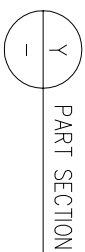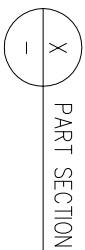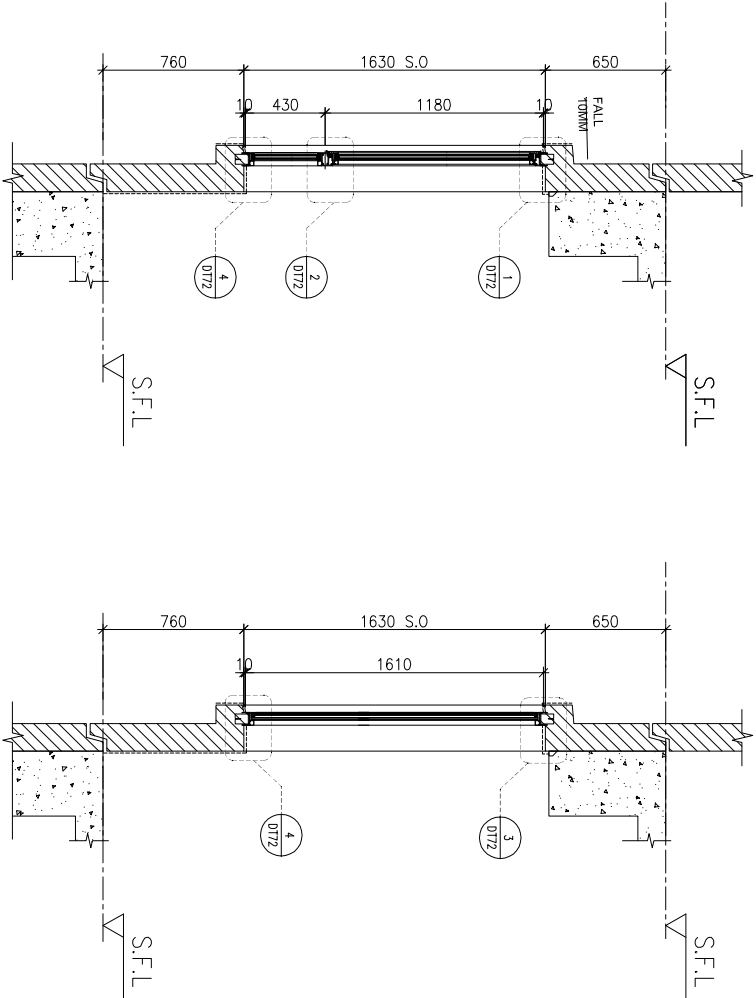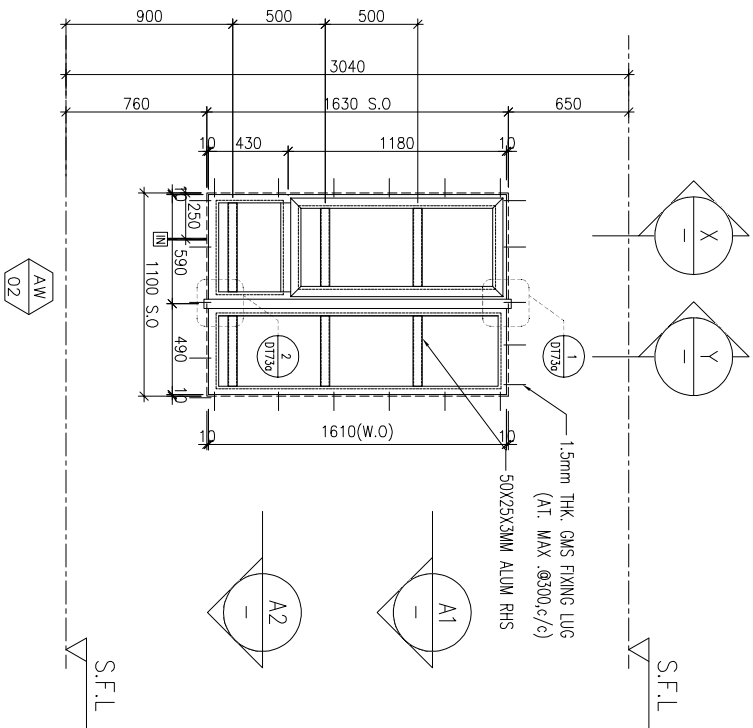

WINDOW MARK	AW 02	AW 02R
LOCATION	3/F-42/F(4/F,13/F,14/F,24/F,34/F OMITTED) UNIT A8,B1	
SECTION	70mm ALUM. SECTION	
GLAZING	EGL-1,EGL-1A	
QUANTITY	35 Nos/35 Nos	
REMARKS	FAÇADE(TYPE T2PF08R FOR 3/F~42/F)	

B.O. REF. :

CLIENT :



42/F SUN HUNG KAI CENTRE, WINGCHAI, HONGKONG

ARCHITECT :



MAIN CONTRACTOR :



STRUCTURAL ENGINEER :



FAÇADE CONSULTANT:



NOTE :

- 1. ALL DIMENSIONS ARE IN mm.
- 2. ALL ELEVATIONS ARE VIEWED FROM OUTSIDE.
- 3. ALL DIMENSIONS TO BE VERIFIED ON SITE BEFORE FABRICATION.

LEGEND :

- DETAIL MARK NO.
- REFER SHEET NO.

- 1. F.F.L.--FINISHED FLOOR LEVEL
- 2. S.F.L.--STRUCTURAL FLOOR LEVEL
- 3. --REVERSED DETAIL

4. GLASS LEGEND

- EGL-1--8mmHS+12mm AIR GAP+10mmTP THK. I.G.U.
- EGL-2--10mm THK. CLEAR TEMPERED GLASS
- EGL-4--10mm THK. TEMPERED ACID ETCHED GLASS
- EGL-1A-8mmHS+12mm AIR GAP+8mmTP THK. I.G.U.

REVISION SUBJECT TO ARCHITECTMENT			
NO.	DATE	REVISION	BY

JOB NO. : J-856

PROJECT :
PROPOSED DEVELOPMENT ABOVE
LIGHT RAIL TIN WING STOP.TSWTL
NO.23.AREA 33.TIN SHUI WAI, N.T.

TITLE :

WINDOW SCHEDULE FOR
TOWER 2 ALUM. WINDOW
(safety barrier)



DATE : 02-Aug-21 SCALE : 1:40

DRAWN BY : Ivon CHECKED BY :




Units 6-8, Sunray Industrial Centre, 1/F
610 Ono Kwo Ling Road, Kowloon
Tel:23489211-4 Fax:(852)27277666

DWG NO. : J856-SD-PW-5208 REV. : A

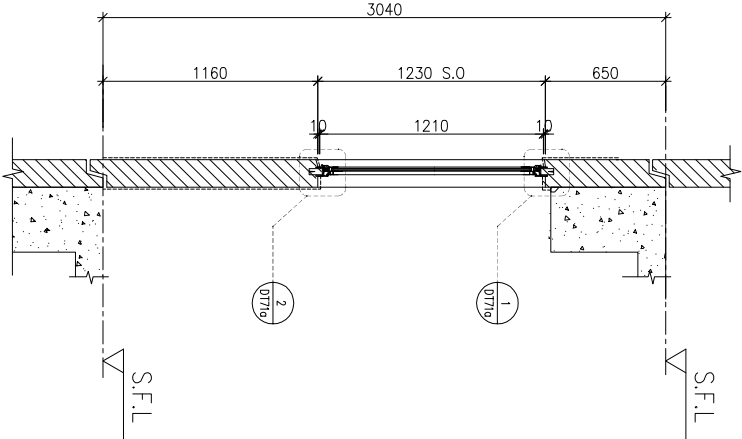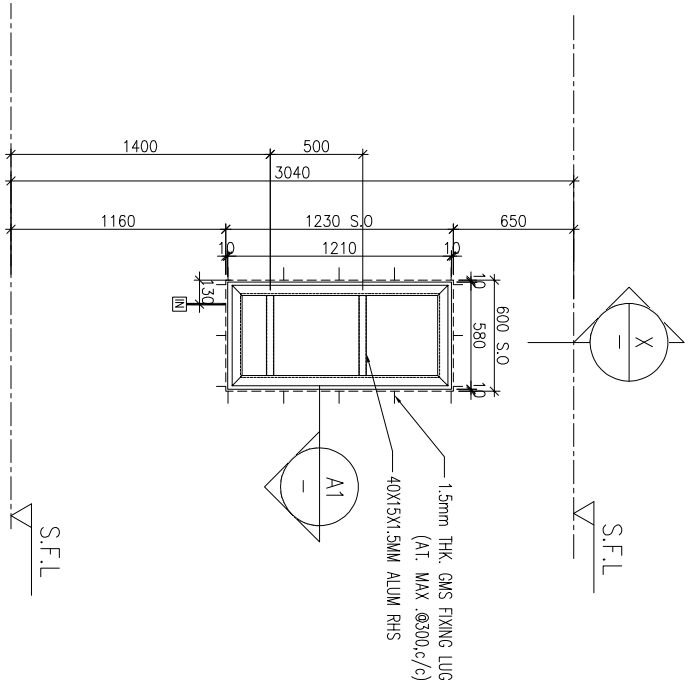

X
-
PART SECTION

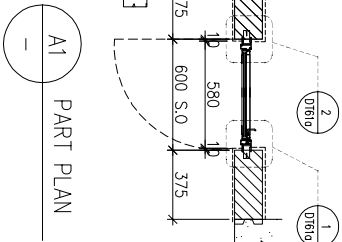

A1
-
PART PLAN

ELEVATION

WINDOW MARK	
LOCATION	3/F-42/F(4/F,13/F,14/F,24/F,34/F OMITTED) UNIT B3
SECTION	70mm ALUM. SECTION
GLAZING	EGL-4
QUANTITY	35 Nos
REMARKS	FAÇADE(TYPE T2PF09 FOR 3/F~42/F)

B.O. REF. :

CLIENT :



42/F SUN HUNG KAI CENTRE, WINGCHAI, HONGKONG

ARCHITECT :



MAIN CONTRACTOR :



STRUCTURAL ENGINEER :



FAÇADE CONSULTANT:



NOTE :

- 1. ALL DIMENSIONS ARE IN mm.
- 2. ALL ELEVATIONS ARE VIEWED FROM OUTSIDE.
- 3. ALL DIMENSIONS TO BE VERIFIED ON SITE BEFORE FABRICATION.

LEGEND :

- DETAIL MARK NO.
- REFER SHEET NO.

- 1. F.F.L.--FINISHED FLOOR LEVEL
- 2. S.F.L.--STRUCTURAL FLOOR LEVEL
- 3. --REVERSED DETAIL

4. GLASS LEGEND

- EGL-1--8mmHS+12mm AIR GAP+10mmTP THK. I.G.U.
- EGL-2--10mm THK. CLEAR TEMPERED GLASS
- EGL-4--10mm THK. TEMPERED ACID ETCHED GLASS
- EGL-1A-8mmHS+12mm AIR GAP+8mmTP THK. I.G.U.

NO.		DATE	REVISION	BY
B	03/11/2021	REVISION SUBJECT TO ARCHITECTMENT	WON	
A	12/10/2021	REVISION SUBJECT TO ARCHITECTMENT	WON	

JOB NO. : J-856

PROJECT :
PROPOSED DEVELOPMENT ABOVE
LIGHT RAIL TIN WING STOP.TSWTL
NO.23,AREA 33,TIN SHUI WAI, N.T.

TITLE :
WINDOW SCHEDULE FOR
TOWER 2 ALUM. WINDOW
(safety barrier)


DATE : 02-Aug-21 SCALE : 1:40

DRAWN BY : won CHECKED BY :




Units 6-8, Sunray Industrial Centre, 1/F
610 Ono Kwo Ling Road, Kowloon
Tel:23489211-4 Fax:(852)27727666


DWG NO. : J856-SD-PW-5209 REV. : B

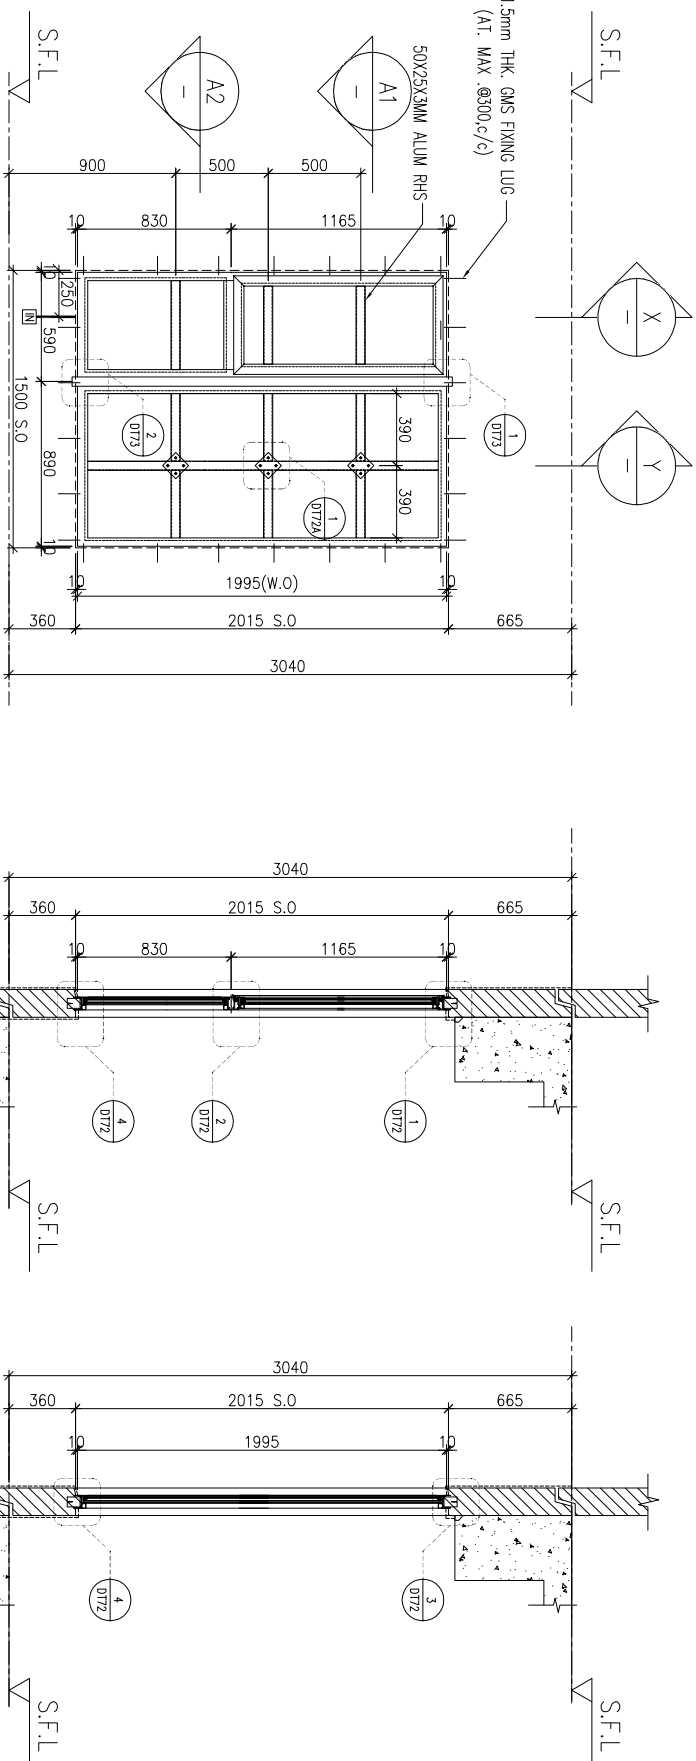

ELEVATION

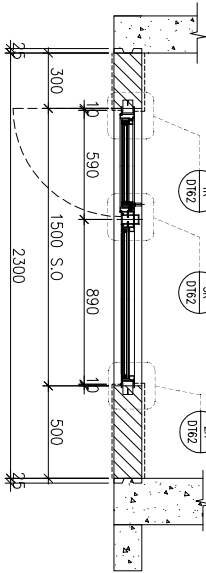

A1 PART PLAN

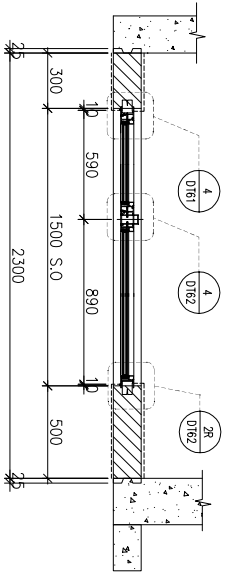

A2 PART PLAN



WINDOW MARK

3/F-42/F(4/F,13/F,14/F,24/F,34/F OMITTED) UNIT B3

70mm ALUM. SECTION

EGL-1,EGL-1A

35 Nos

REMARKS

FAÇADE(TYPE T1PFI0 FOR 3/F~42/F)

B.O. REF. :

CLIENT :



SUN HUNG KAI

REAL ESTATE AGENCY LTD.

42/F SUN HUNG KAI CENTRE, WINGCHAI, HONGKONG

ARCHITECT :



a r c h i t e c t s

MAIN CONTRACTOR :



怡輝建築有限公司

Yee Fai Building Contractors Ltd.

STRUCTURAL ENGINEER :



ALPHA CONSULTING LIMITED

Steel Structure & Facade Specialist

FACADE CONSULTANT:



ALPHA CONSULTING LIMITED

Steel Structure & Facade Specialist

NOTE :

1. ALL DIMENSIONS ARE IN mm.
2. ALL ELEVATIONS ARE VIEWED FROM OUTSIDE.
3. ALL DIMENSIONS TO BE VERIFIED ON SITE BEFORE FABRICATION.

LEGEND :

DETAIL MARK NO.

REFER SHEET NO.

1. F.F.L.--FINISHED FLOOR LEVEL
2. S.F.L.--STRUCTURAL FLOOR LEVEL
3. --REVERSED DETAIL
4. GLASS LEGEND

EGL-1--8mmHS+12mm AIR GAP+10mmTP THK. I.G.U.

EGL-2--10mm THK. CLEAR TEMPERED GLASS

EGL-4--10mm THK. TEMPERED ACID ETCHED GLASS

EGL-1A-8mmHS+12mm AIR GAP+8mmTP THK. I.G.U.

NO.		DATE	REVISION	BY
B	03/11/2021	REVISION SUBJECT TO ARCHITECTMENT	Ivon	Ivon
A	12/10/2021	REVISION SUBJECT TO ARCHITECTMENT	Ivon	Ivon

JOB NO. : J-856

PROJECT :
PROPOSED DEVELOPMENT ABOVE
LIGHT RAIL TIN WING STOP,TSWTL
NO.23,AREA 33,TIN SHUI WAI, N.T.

TITLE :
WINDOW SCHEDULE FOR
TOWER 2 ALUM. WINDOW
(safety barrier)

DATE : 02-Aug-21

SCALE : 1:40

DRAWN BY : Ivon

CHECKED BY :



美特鋁寶有限公司

MDI ALUMINIUM FABRICATOR LTD.


Units 6-8, Sunray Industrial Centre, 1/F

610 Ona Kwong Road, Kowloon


Tel:23489211-4 Fax:(852)27277666

DWG NO. : J856-SD-PW-5210

REV. : B

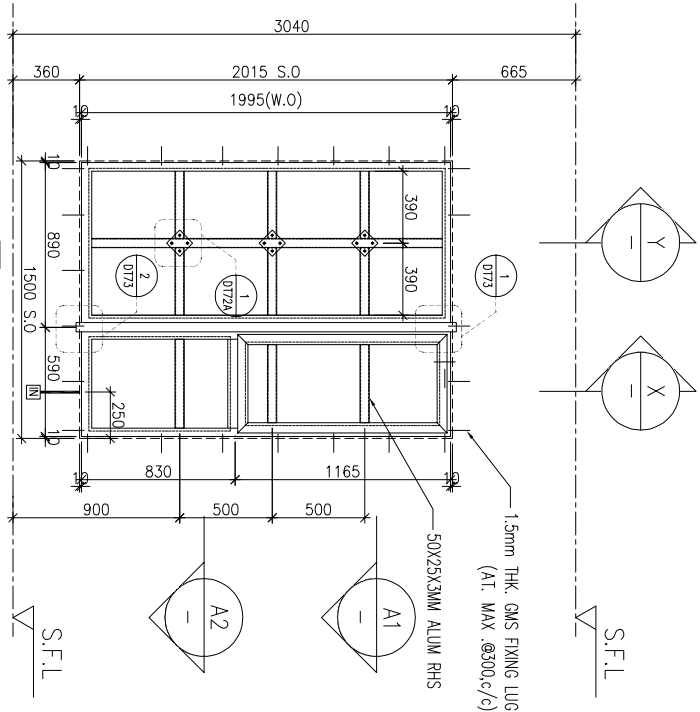


ELEVATION

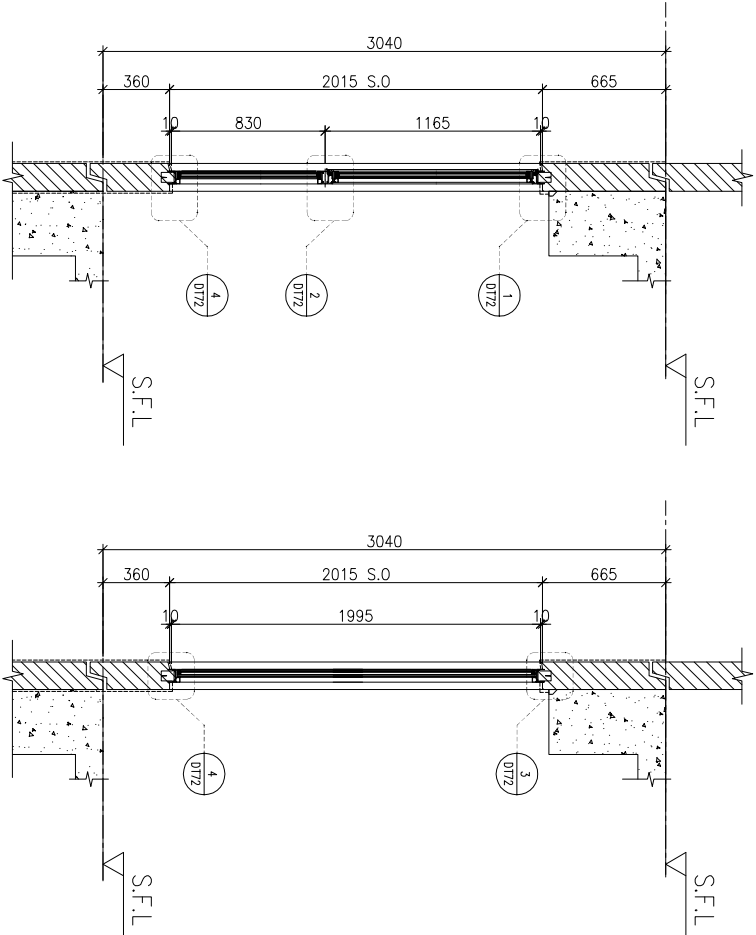


PART SECTION

PART SECTION

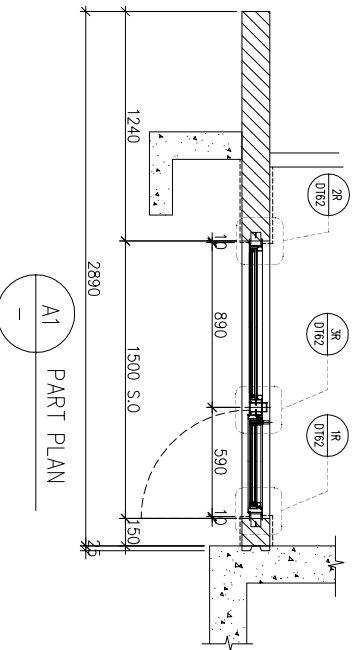

PART PLAN

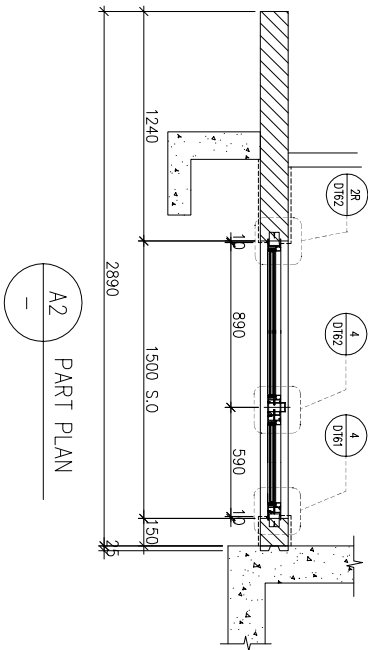

PART PLAN



WINDOW MARK

LOCATION 3/F-42/F(4/F,13/F,14/F,24/F,34/F OMITTED) UNIT B5

SECTION 70mm ALUM. SECTION

GLAZING EGL-1,EGL-1A

QUANTITY 35 Nos

REMARKS FACADE(TYPE T2PF11R FOR 3/F~42/F)

B.O. REF. :

CLIENT :



42/F SUN HUNG KAI CENTRE, WINGHAI, HONGKONG

ARCHITECT :



MAIN CONTRACTOR :



STRUCTURAL ENGINEER :



FAÇADE CONSULTANT:



NOTE.:

1. ALL DIMENSIONS ARE IN mm.
2. ALL ELEVATIONS ARE VIEWED FROM OUTSIDE.
3. ALL DIMENSIONS TO BE VERIFIED ON SITE BEFORE FABRICATION.

LEGEND.:

- DETAIL MARK NO.
- REFER SHEET NO.

1. F.F.L.--FINISHED FLOOR LEVEL
2. S.F.L.--STRUCTURAL FLOOR LEVEL
3. --REVERSED DETAIL

4. GLASS LEGEND

- EGL-1--8mmHS+12mm AIR GAP+10mmTP THK. I.G.U.
- EGL-2--10mm THK. CLEAR TEMPERED GLASS
- EGL-4--10mm THK. TEMPERED ACID ETCHED GLASS
- EGL-1A-8mmHS+12mm AIR GAP+8mmTP THK. I.G.U.

NO.	DATE	REVISION	BY
B	03/11/2021	REVISION SUBJECT TO ARCHITECTMENT	Yvon
A	12/10/2021	REVISION SUBJECT TO ARCHITECTMENT	Yvon

JOB NO. : J-856

PROJECT :

PROPOSED DEVELOPMENT ABOVE
LIGHT RAIL TIN WING STOP,TSMTL
NO.23,AREA 33,TIN SHUI WAI, N.T.

TITLE :

WINDOW SCHEDULE FOR
TOWER 2 ALUM. WINDOW
(safety barrier)

DATE : 02-Aug-21

SCALE : 1:40

DRAWN BY : Yvon

CHECKED BY :





Units 6-8, Sunray Industrial Centre, 1/F
610 Ono Kwo Ling Road, Kowloon
Tel:23489211-4 Fax:(852)2727666

DWG NO. : JB56-SD-PW-5211

REV. : B

ELEVATION

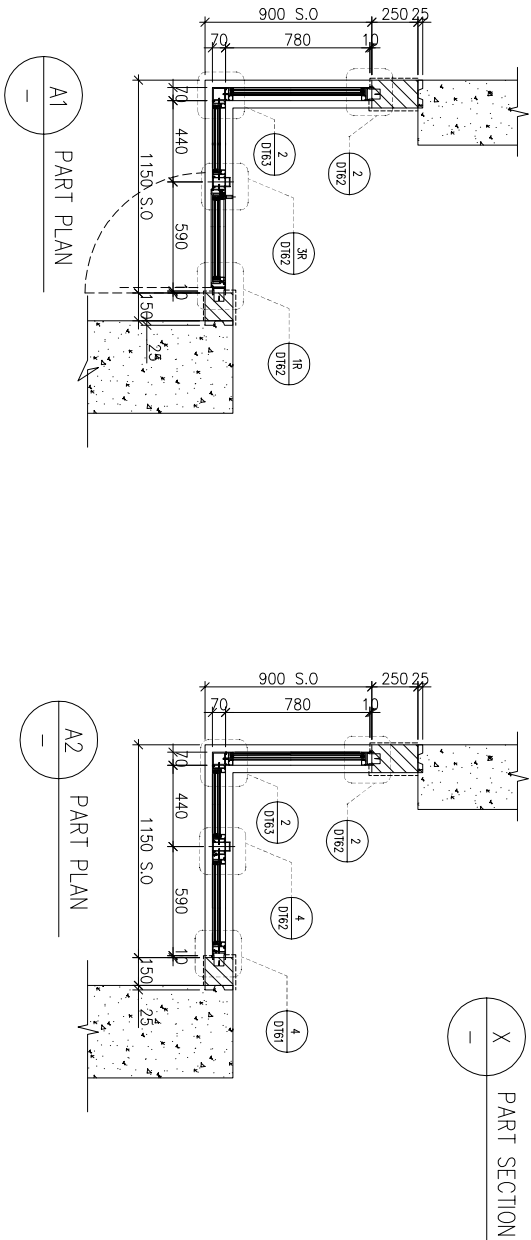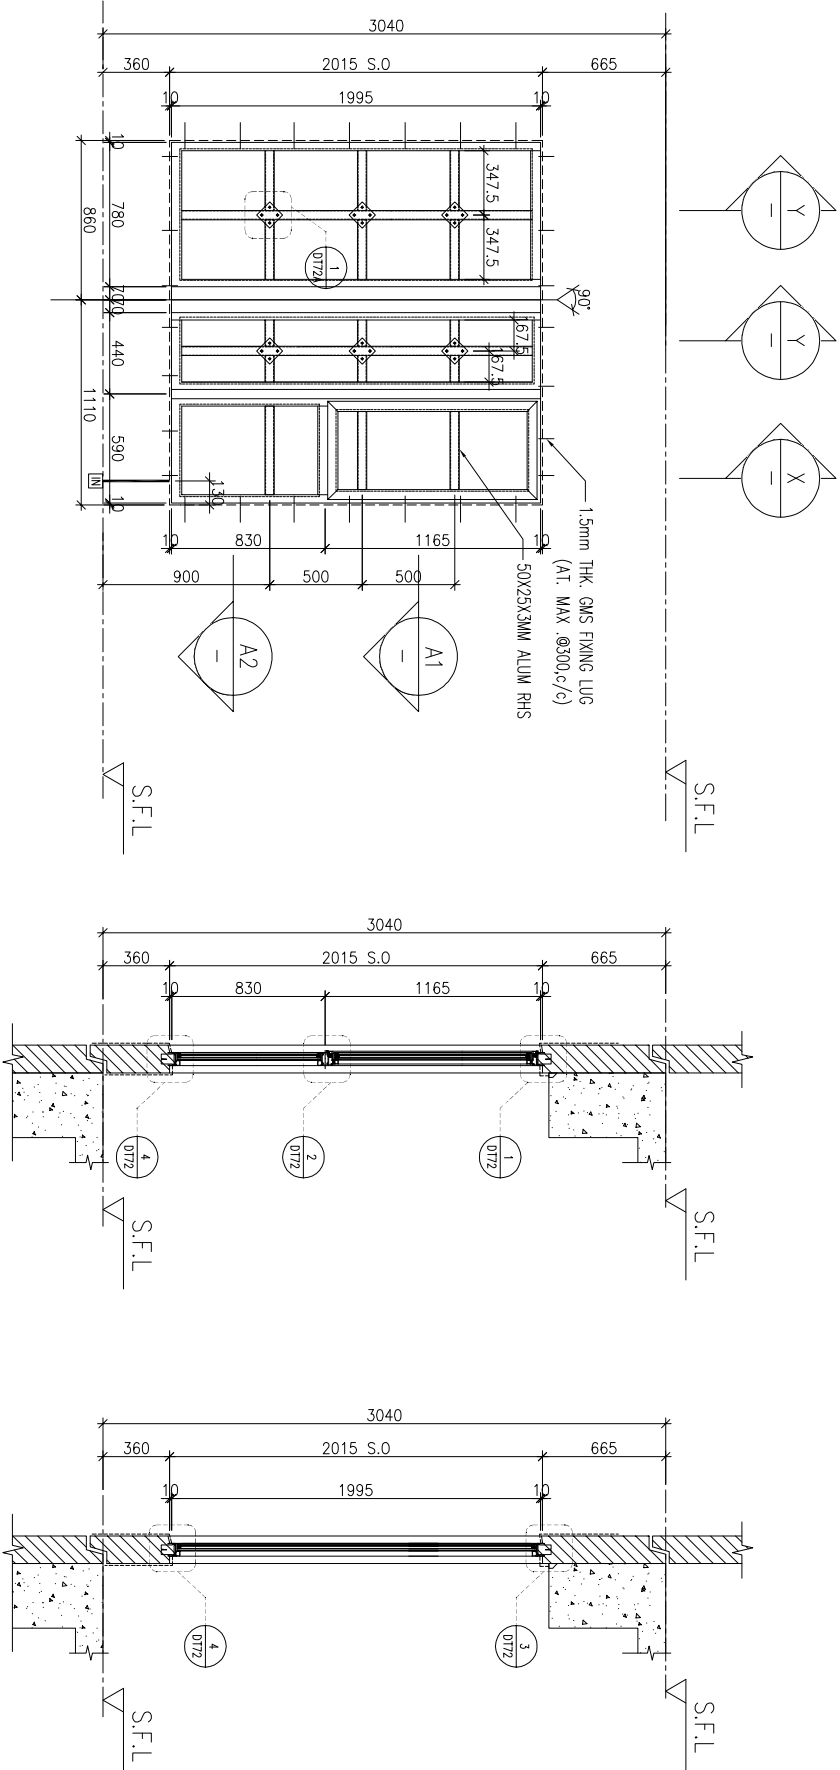

WINDOW MARK	
LOCATION	3/F-42/F(4/F,13/F,14/F,24/F,34/F OMITTED) UNIT B8
SECTION	70mm ALUM. SECTION
GLAZING	EGL-1,EGL-1A
QUANTITY	35 Nos
REMARKS	FAÇADE(TYPE T2P13 FOR 3/F~42/F)

B.O. REF. :

CLIENT :



SUN HUNG KAI

REAL ESTATE AGENCY LTD.

42/F SUN HUNG KAI CENTRE, WINGCHAI, HONGKONG

ARCHITECT :



IWK&partners

a r c h i t e c t s

MAIN CONTRACTOR :



怡輝建築有限公司

Yee Fai Building Contractors Ltd.

STRUCTURAL ENGINEER :



ARUP

FACADE CONSULTANT:



ALPHA CONSULTING LIMITED

Steel Structure & Facade Specialist

NOTE.:

1. ALL DIMENSIONS ARE IN mm.
2. ALL ELEVATIONS ARE VIEWED FROM OUTSIDE.
3. ALL DIMENSIONS TO BE VERIFIED ON SITE BEFORE FABRICATION.

LEGEND.:

X1

DETAIL MARK NO.

X001

REFER SHEET NO.

1. F.F.L.--FINISHED FLOOR LEVEL
2. S.F.L.--STRUCTURAL FLOOR LEVEL
3. --REVERSED DETAIL

4. GLASS LEGEND

- EGL-1--8mmHS+12mm AIR GAP+10mmTP THK. I.G.U.
- EGL-2--10mm THK. CLEAR TEMPERED GLASS
- EGL-4--10mm THK. TEMPERED ACID ETCHED GLASS
- EGL-1A-8mmHS+12mm AIR GAP+8mmTP THK. I.G.U.

TITLE :
WINDOW SCHEDULE FOR
TOWER 3 ALUM. WINDOW
(safety barrier)

DATE : 02-Aug-21 SCALE : 1:40

DRAWN BY : Ivon CHECKED BY :



美特鋁寶有限公司



MIDI ALUMINIUM FABRICATOR LTD.

Units 6-8, Sunray Industrial Centre, 1/F
610 Ono Kwo Ling Road, Kwailoon
Tel:23489211-4 Fax:(852)27727666

DWG NO. : J856-SD-PW-5301

REV. : C


ELEVATION

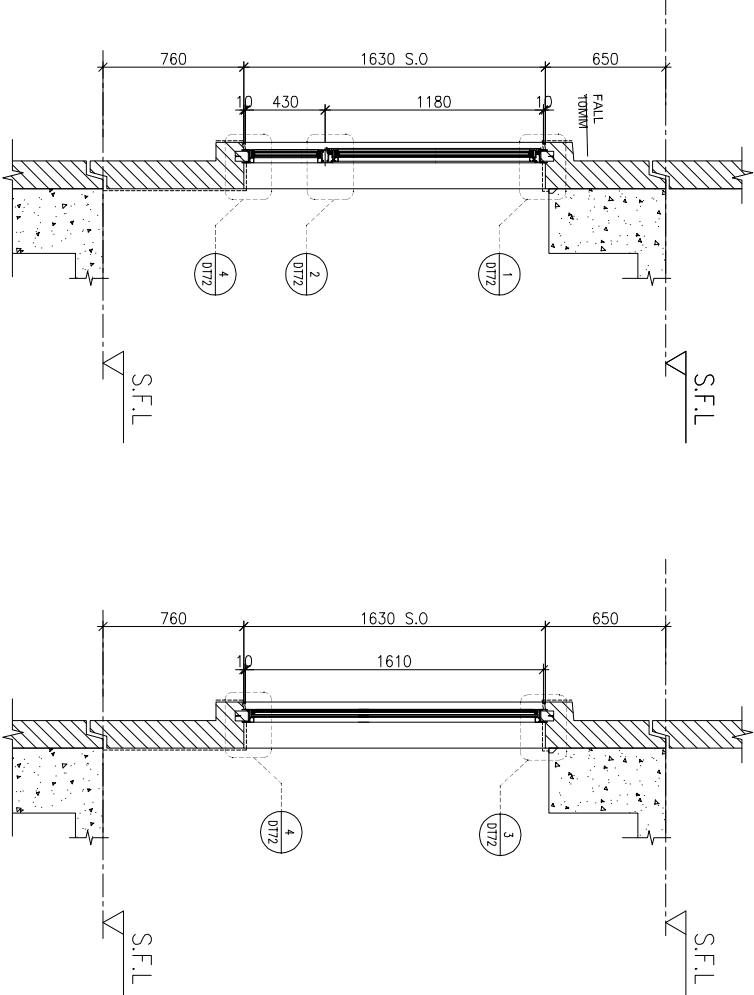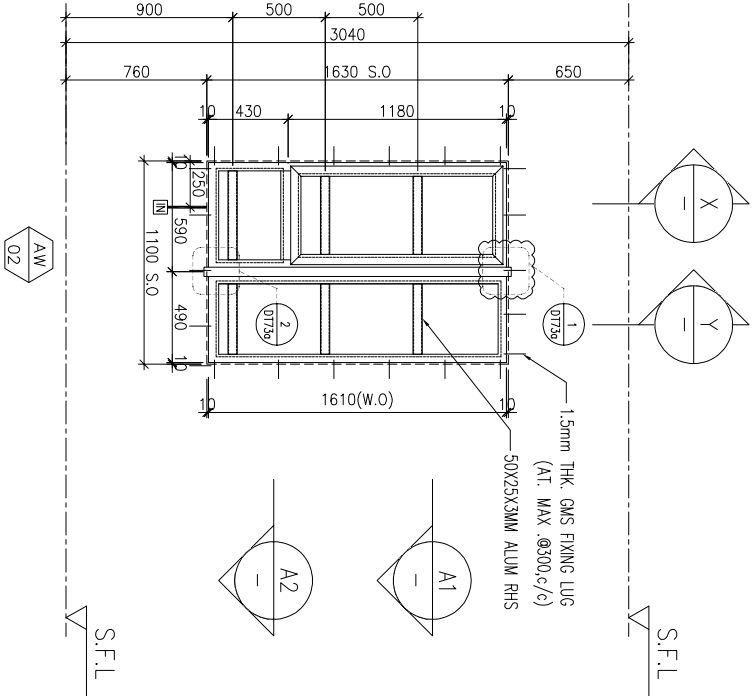


X
-
PART SECTION

Y
-
PART SECTION

A1
-
PART PLAN

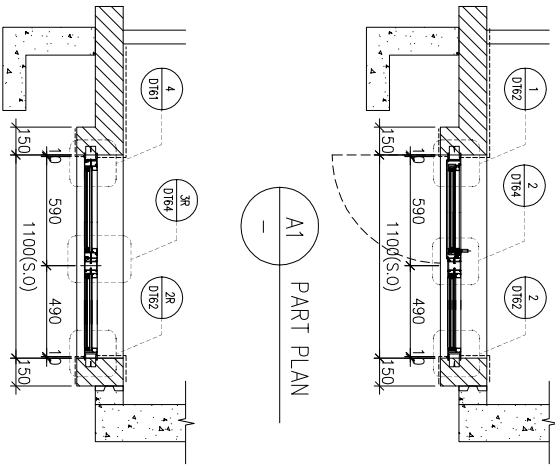

A2
-
PART PLAN

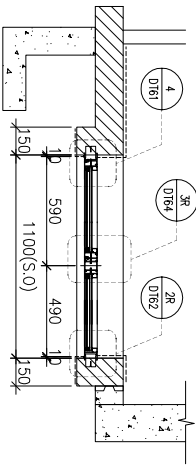

WINDOW MARK		
LOCATION	3/F-42/F(4/F,13/F,14/F,24/F,34/F OMITTED) UNIT B6	
SECTION	70mm ALUM. SECTION	
GLAZING	EGL-1,EGL-1A	
QUANTITY	35 Nos.	
REMARKS	FACADE(TYPE T3PF02 FOR 3/F~42/F)	

C	02/11/2021	REVISION SUBJECT TO ARCHITECTMENT	WON
B	28/10/2021	REVISION SUBJECT TO ARCHITECTMENT	WON
A	18/10/2021	REVISION SUBJECT TO ARCHITECTMENT	WON
NO.	DATE	REVISION	BY
JOB NO. : J-856			
PROJECT : PROPOSED DEVELOPMENT ABOVE LIGHT RAIL TIN WING STOP.TSWTL NO.23.AREA 33.TIN SHUI WAI, N.T.			
TITLE : WINDOW SCHEDULE FOR TOWER 3 ALUM. WINDOW (safety barrier)			
DATE : 02-Aug-21 SCALE : 1:40			
DRAWN BY : Ivon CHECKED BY :			
 美特鋁寶有限公司 MIDI ALUMINIUM FABRICATOR LTD. Units 6-8, Sunray Industrial Centre, 1/F 610 Ono Kwo Ling Road, Kwailoon Tel:23489211-4 Fax:(852)27727666			
DWG NO. : J856-SD-PW-5301		REV. : C	

B.O. REF :

CLIENT :

S^K

SUN HUNG KAI

REAL ESTATE AGENCY LTD.

42/F SUN HUNG KAI CENTRE, WINGCHAI, HONGKONG

ARCHITECT :

lwk&partners

a r c h i t e c t s

MAIN CONTRACTOR :

Y^S

怡輝建築有限公司

Yee Fai Building Contractors Ltd.

STRUCTURAL ENGINEER :

ARUP



FACADE CONSULTANT:

α

ALPHA CONSULTING LIMITED

Steel Structure & Facade Specialist

NOTE :

1. ALL DIMENSIONS ARE IN mm.
2. ALL ELEVATIONS ARE VIEWED FROM OUTSIDE.
3. ALL DIMENSIONS TO BE VERIFIED ON SITE BEFORE FABRICATION.

LEGEND :

x1

—

DETAIL MARK NO.

x001

—

REFER SHEET NO.

1. F.F.L.--FINISHED FLOOR LEVEL
2. S.F.L.--STRUCTURAL FLOOR LEVEL
3. --REVERSED DETAIL
4. GLASS LEGEND

EGL-1--8mmH5+12mm AIR GAP+10mmTP THK. I.G.U.

EGL-2--10mm THK. CLEAR TEMPERED GLASS

EGL-4--10mm THK. TEMPERED ACID ETCHED GLASS

EGL-1A-8mmH5+12mm AIR GAP+8mmTP THK. I.G.U.

D	02/11/2021	REVISION SUBJECT TO ARCHITECTMENT	None
C	28/10/2021	REVISION SUBJECT TO ARCHITECTMENT	None
B	18/10/2021	REVISION SUBJECT TO ARCHITECTMENT	None
A	27/09/2021	REVISION SUBJECT TO ARCHITECTMENT	None
NO.	DATE	REVISION	BY

JOB NO. : J-856

PROJECT :

PROPOSED DEVELOPMENT ABOVE
LIGHT RAIL TIN WING STOP.TSWTL
NO.23.AREA 33.TIN SHUI WAI, N.T.

TITLE :

WINDOW SCHEDULE FOR
TOWER 3 ALUM. WINDOW
(safety barrier)

DATE : 02-Aug-21	SCALE : 1:40
DRAWN BY : Ivon	CHECKED BY :






Units 6-8, Sunray Industrial Centre, 1/F
610 Ono Kwo Ling Road, Kwailoon
Tel:23489211-4 Fax:(852)2727666


DWG NO. : J856-SD-PW-5302 REV. : D

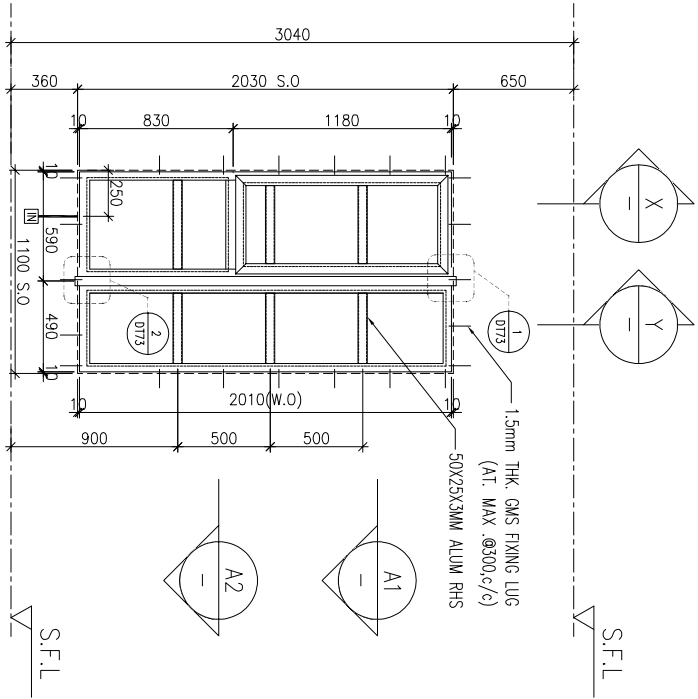


ELEVATION

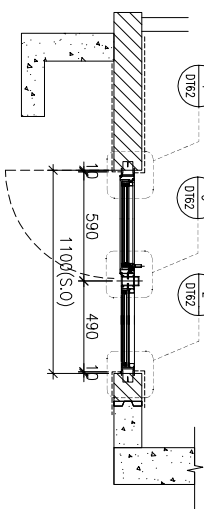


A1
—
PART PLAN

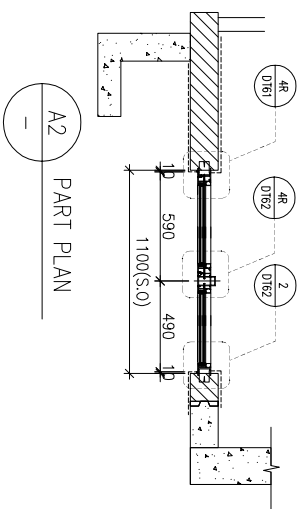

A2
—
PART PLAN

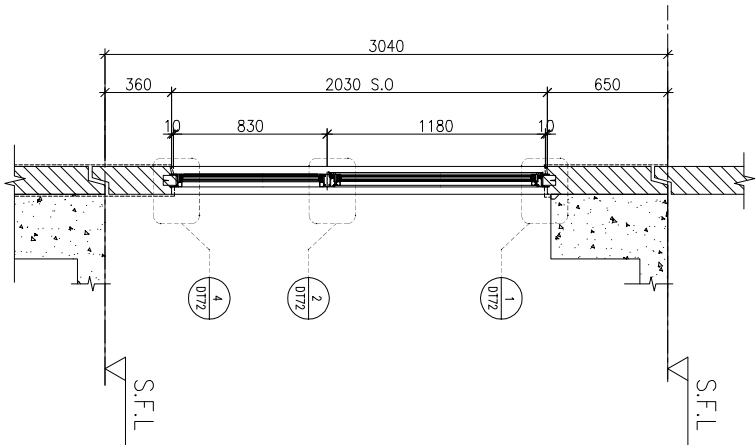

X
—
PART SECTION

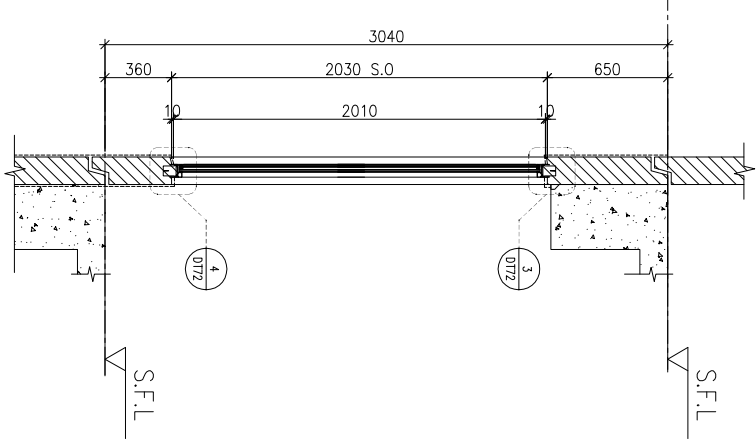

Y
—
PART SECTION

WINDOW MARK	AW 04R		AW 04
LOCATION	3/F-42/F(4/F,13/F,14/F,24/F,34/F OMITTED) UNIT A3,A6,A10,A12,B5,B9		3/F-42/F(4/F,13/F,14/F,24/F,34/F OMITTED) UNIT A11,A13,B11
SECTION	70mm ALUM. SECTION		70mm ALUM. SECTION
GLAZING	EGL-1,EGL-1A		EGL-1,EGL-1A
QUANTITY	35 Nos / 35 Nos / 35 Nos / 35 Nos / 35 Nos		35 Nos / 35 Nos / 35 Nos
REMARKS	FACADE(TYPE T3PF04 FOR 3/F~42/F)		

B.O. REF :

CLIENT :



SUN HUNG KAI

REAL ESTATE AGENCY LTD.

42/F SUN HUNG KAI CENTRE, WINGCHAI, HONGKONG

ARCHITECT :



IWK&partners

architects

MAIN CONTRACTOR :



怡輝建築有限公司

Yee Fai Building Contractors Ltd.

STRUCTURAL ENGINEER :



ARUP

FAÇADE CONSULTANT:



ALPHA CONSULTING LIMITED

Steel Structure & Façade Specialist

NOTE :

1. ALL DIMENSIONS ARE IN mm.
2. ALL ELEVATIONS ARE VIEWED FROM OUTSIDE.
3. ALL DIMENSIONS TO BE VERIFIED ON SITE BEFORE FABRICATION.

LEGEND :



X1

DETAIL MARK NO.



X001

REFER SHEET NO.

1. F.F.L.--FINISHED FLOOR LEVEL
2. S.F.L.--STRUCTURAL FLOOR LEVEL
3. --REVERSED DETAIL
4. GLASS LEGEND

EGL-1--8mmHS+12mm AIR GAP+10mmTP THK. I.G.U.
EGL-2--10mm THK. CLEAR TEMPERED GLASS
EGL-4--10mm THK. TEMPERED ACID ETCHED GLASS
EGL-1A-8mmHS+12mm AIR GAP+8mmTP THK. I.G.U.

D	02/11/2021	REVISION SUBJECT TO ARCHITECTMENT	None
C	28/10/2021	REVISION SUBJECT TO ARCHITECTMENT	None
B	18/10/2021	REVISION SUBJECT TO ARCHITECTMENT	None
A	27/09/2021	REVISION SUBJECT TO ARCHITECTMENT	None
NO.	DATE	REVISION	BY

JOB NO. : J-856

PROJECT :

PROPOSED DEVELOPMENT ABOVE
LIGHT RAIL TIN WING STOP.TSWTL
NO.23.AREA 33.TIN SHUI WAI, N.T.

TITLE :

WINDOW SCHEDULE FOR
TOWER 3 ALUM. WINDOW
(safety barrier)

DATE : 02-Aug-21 SCALE : 1:40

DRAWN BY : Ivon CHECKED BY :





美特鋁寶有限公司

MDI ALUMINIUM FABRICATOR LTD.



Units 6-8, Sunray Industrial Centre, 1/F
610 Ono Kwo Ling Road, Kowloon
Tel:23489211-4 Fax:(852)27727666

DWG NO. : J856-SD-PW-5303 REV. : D

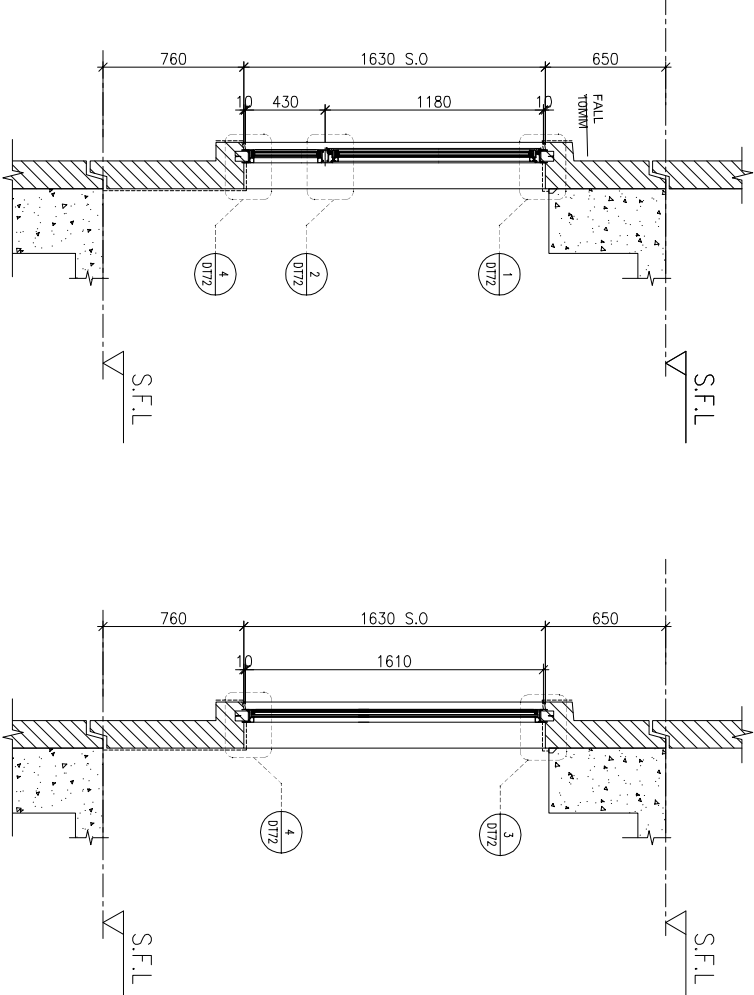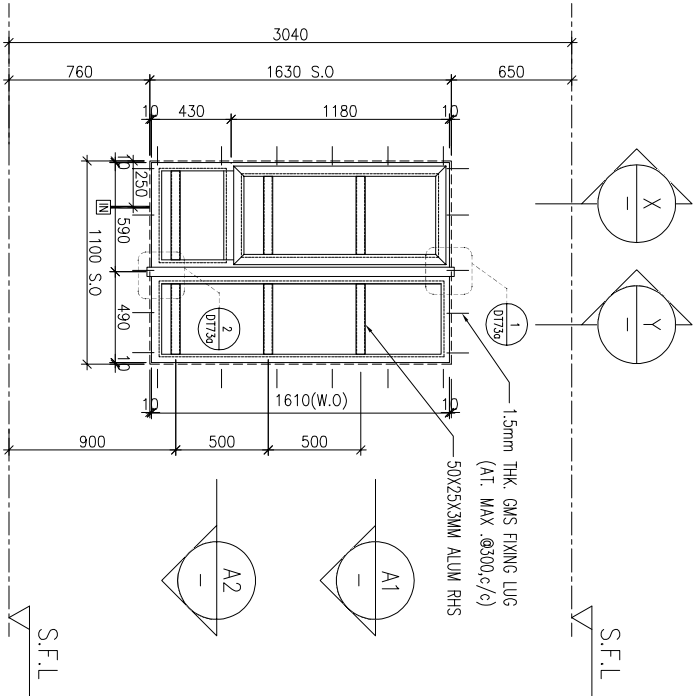

AW
02

ELEVATION

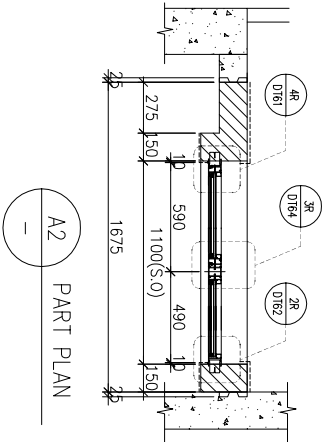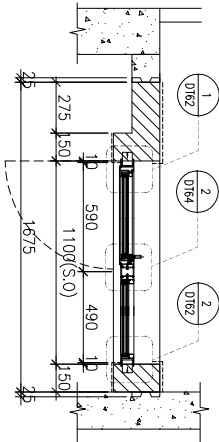

AW
02

WINDOW MARK

3/F~42/F(4/F,13/F,14/F,24/F,34/F OMITTED) UNIT A2,A10,A6,B3,B5,B9

70mm ALUM. SECTION

EGL-1,EGL-1A

35 Nos / 35 Nos / 35 Nos / 35 Nos / 35 Nos / 35 Nos

FAÇADE(TYPE T3PF05R FOR 3/F~42/F)

B.O. REF :

CLIENT :



SUN HUNG KAI

REAL ESTATE AGENCY LTD.

42/F SUN HUNG KAI CENTRE, WINGCHAI, HONGKONG

ARCHITECT :



IWK&partners

a r c h i t e c t s

MAIN CONTRACTOR :



怡輝建築有限公司

Yee Fai Building Contractors Ltd.

STRUCTURAL ENGINEER :



ARUP

FAÇADE CONSULTANT:



ALPHA CONSULTING LIMITED

Steel Structure & Façade Specialist

NOTE :

1. ALL DIMENSIONS ARE IN mm.
2. ALL ELEVATIONS ARE VIEWED FROM OUTSIDE.
3. ALL DIMENSIONS TO BE VERIFIED ON SITE BEFORE FABRICATION.

LEGEND :



X1

DETAIL MARK NO.



X001

REFER SHEET NO.

1. F.F.L.--FINISHED FLOOR LEVEL
2. S.F.L.--STRUCTURAL FLOOR LEVEL
3.  --REVERSED DETAIL

4. GLASS LEGEND

EGL-1--8mmHS+12mm AIR GAP+10mmTP THK. I.G.U.
EGL-2--10mm THK. CLEAR TEMPERED GLASS
EGL-4--10mm THK. TEMPERED ACID ETCHED GLASS
EGL-1A-8mmHS+12mm AIR GAP+8mmTP THK. I.G.U.

D	02/11/2021	REVISION SUBJECT TO ARCHIT.COMMENT	
C	28/10/2021	REVISION SUBJECT TO ARCHIT.COMMENT	
B	18/10/2021	REVISION SUBJECT TO ARCHIT.COMMENT	
A	27/09/2021	REVISION SUBJECT TO ARCHIT.COMMENT	
NO.	DATE	REVISION	BY

JOB NO. : J-856

PROJECT :

PROPOSED DEVELOPMENT ABOVE
LIGHT RAIL TIN WING STOP.TSWTL
NO.23.AREA 33.TIN SHUI WAI, N.T.

TITLE :

WINDOW SCHEDULE FOR
TOWER 3 ALUM. WINDOW
(safety barrier)

DATE : 02-Aug-21 SCALE : 1:40

DRAWN BY : Ivon CHECKED BY :





美特鋁寶有限公司

MDI ALUMINIUM FABRICATOR LTD.


Units 6-8, Sunray Industrial Centre, 1/F
610 Ona Kwo Ling Road, Kowloon
Tel:23489211-4 Fax:(852)27727666

DWG NO. : J856-SD-PW-5304

REV. : D

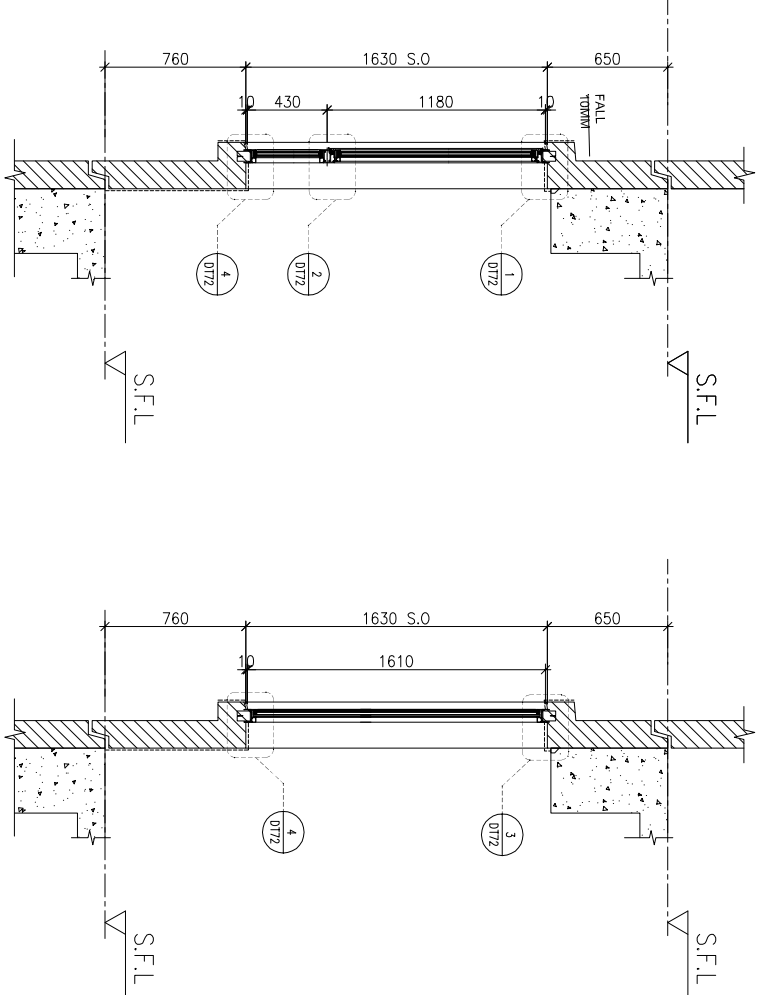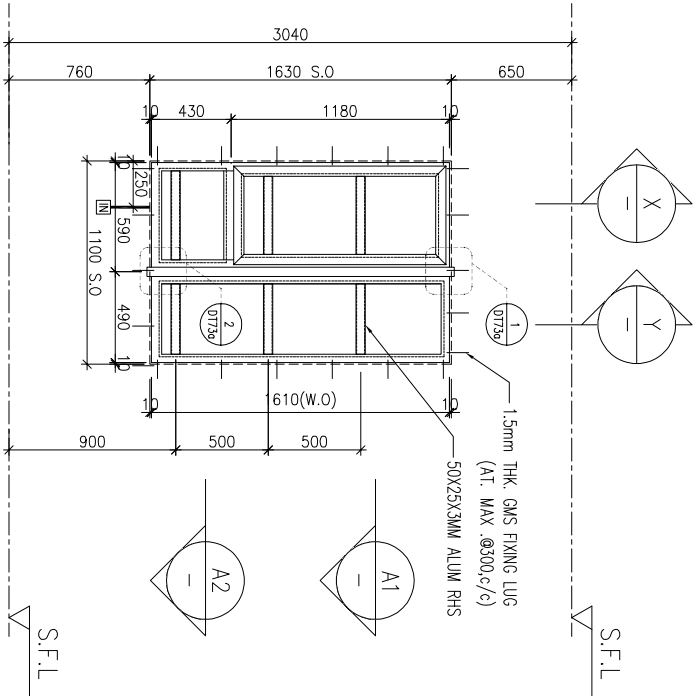


ELEVATION

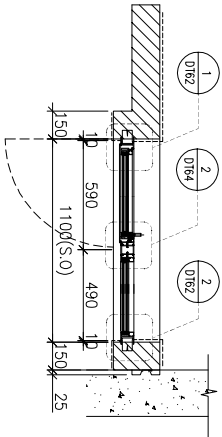

A1
-

PART PLAN

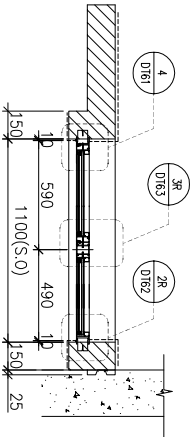

A2
-

PART PLAN

WINDOW MARK

AW 02

LOCATION 3/F-42/F(4/F,13/F,14/F,24/F,34/F OMITTED) UNIT B3

SECTION 70mm ALUM. SECTION

GLAZING EGL-1,EGL-1A

QUANTITY 35 Nos

REMARKS FACADE(TYPE T3PF08R FOR 3/F~42/F)

AW 02R

3/F-42/F(4/F,13/F,14/F,24/F,34/F OMITTED) UNIT A2,A5,B1

70mm ALUM. SECTION

EGL-1,EGL-1A

35 Nos / 35 Nos / 35 Nos

FACADE(TYPE T3PF08 FOR 3/F~42/F)

B.O. REF :

CLIENT :



SUN HUNG KAI

REAL ESTATE AGENCY LTD.

42/F SUN HUNG KAI CENTRE, WINGCHAI, HONGKONG

ARCHITECT :



IWK&partners

a r c h i t e c t s

MAIN CONTRACTOR :



怡輝建築有限公司

Yee Fai Building Contractors Ltd.

STRUCTURAL ENGINEER :



ALPHA CONSULTING LIMITED

Steel Structure & Facade Specialist

FACADE CONSULTANT:



ALPHA CONSULTING LIMITED

Steel Structure & Facade Specialist

NOTE :

1. ALL DIMENSIONS ARE IN mm.
2. ALL ELEVATIONS ARE VIEWED FROM OUTSIDE.
3. ALL DIMENSIONS TO BE VERIFIED ON SITE BEFORE FABRICATION.

LEGEND :



X1

DETAIL MARK NO.



X001

REFER SHEET NO.

1. F.F.L.--FINISHED FLOOR LEVEL

2. S.F.L.--STRUCTURAL FLOOR LEVEL

3.  --REVERSED DETAIL

4. GLASS LEGEND

EGL-1--8mmHS+12mm AIR GAP+10mmTP THK. I.G.U.

EGL-2--10mm THK. CLEAR TEMPERED GLASS

EGL-4--10mm THK. TEMPERED ACID ETCHED GLASS

EGL-1A-8mmHS+12mm AIR GAP+8mmTP THK. I.G.U.

D	02/11/2021	REVISION SUBJECT TO ARCHITECTMENT	WON
C	28/10/2021	REVISION SUBJECT TO ARCHITECTMENT	WON
B	18/10/2021	REVISION SUBJECT TO ARCHITECTMENT	WON
A	27/09/2021	REVISION SUBJECT TO ARCHITECTMENT	WON
NO.	DATE	REVISION	BY

JOB NO. : J-856

PROJECT :

PROPOSED DEVELOPMENT ABOVE
LIGHT RAIL TIN WING STOP.TSWTL
NO.23.AREA 33.TIN SHUI WAI, N.T.

TITLE :

WINDOW SCHEDULE FOR
TOWER 3 ALUM. WINDOW
(safety barrier)

DATE : 02-Aug-21	SCALE : 1:40
DRAWN BY : won	CHECKED BY :



美特鋁寶有限公司

MDI ALUMINIUM FABRICATOR LTD.

Units 6-8, Sunray Industrial Centre, 1/F
610 Ono Kwo Ling Road, Kwailoon
Tel:23489211-4 Fax:8522727666

DWG NO. : J856-SD-PW-5305 REV. : D

3040
360 2015 S.O. 665
1995(W.O)
1 1 1
D773 D773A D773
390 390 390
1.5mm THK. GMS FIXING LUG
(A1. MAX @300c/c)
50X25X3MM ALUM RHS
1165 830 250
900 500 500
1500 S.O. 1500 S.O. 1500 S.O.
S.F.L. S.F.L. S.F.L.

3040
360 2015 S.O. 665
830 1165
10 10
1 2 4
D772 D772 D772
S.F.L. S.F.L. S.F.L.

FACADE CONSULTANT:



ALPHA CONSULTING LIMITED

Steel Structure & Facade Specialist

ELEVATION

28 38 18
D162 D162 D162
500 890 1500 S.O. 590 10 300
2300

A1
-
PART PLAN

28 4 4
D162 D162 D162
500 890 1500 S.O. 590 10 300
2300

A2
-
PART PLAN

WINDOW MARK	AW 03	AW 03R
-------------	-------	--------

LOCATION	3/F-42/F(4/F,13/F,14/F,24/F,34/F OMITTED) UNIT A2,A5,A9,B7	3/F-42/F(4/F,13/F,14/F,24/F,34/F OMITTED) UNIT A8,A15,B6
SECTION	70mm ALUM. SECTION	70mm ALUM. SECTION
GLAZING	EGL-1,EGL-1A	EGL-1,EGL-1A
QUANTITY	35 Nos / 35 Nos / 35 Nos / 35 Nos	35 Nos / 35 Nos / 35 Nos
REMARKS	FACADE(TYPE T3PF10 FOR 3/F~42/F)	FACADE(TYPE T3PF10R FOR 3/F~42/F)

B.O. REF. :

CLIENT :

S^K

SUN HUNG KAI

REAL ESTATE AGENCY LTD.

42/F SUNI HUNG KAI CENTRE, WINGCHAI, HONGKONG

ARCHITECT :

lw&partners

a r c h i t e c t s

MAIN CONTRACTOR :

怡輝建築有限公司

Yee Fai Building Contractors Ltd.

STRUCTURAL ENGINEER :

ALPHA CONSULTING LIMITED

Steel Structure & Facade Specialist

ARUP

ALPHA CONSULTING LIMITED

Steel Structure & Facade Specialist

- NOTE.:
1. ALL DIMENSIONS ARE IN mm.
 2. ALL ELEVATIONS ARE VIEWED FROM OUTSIDE.
 3. ALL DIMENSIONS TO BE VERIFIED ON SITE BEFORE FABRICATION.

LEGEND.:

x1

—

DETAIL MARK NO.

x001

—

REFER SHEET NO.

1. F.F.L.--FINISHED FLOOR LEVEL
2. S.F.L.--STRUCTURAL FLOOR LEVEL
3.  --REVERSED DETAIL

4. GLASS LEGEND
- EGL-1--8mmHS+12mm AIR GAP+10mmTP THK. I.G.U.
- EGL-2--10mm THK. CLEAR TEMPERED GLASS
- EGL-4--10mm THK. TEMPERED ACID ETCHED GLASS
- EGL-1A-8mmHS+12mm AIR GAP+8mmTP THK. I.G.U.

C	02/11/2021	REVISION SUBJECT TO ARCHITECTMENT	WON
B	28/10/2021	REVISION SUBJECT TO ARCHITECTMENT	WON
A	27/09/2021	REVISION SUBJECT TO ARCHITECTMENT	WON
NO.	DATE	REVISION	BY

JOB NO. : J-856

PROJECT :
PROPOSED DEVELOPMENT ABOVE
LIGHT RAIL TIN WING STOP.TSWTL
NO.23.AREA 33.TIN SHUI WAI, N.T.

TITLE :
WINDOW SCHEDULE FOR
TOWER 3 ALUM. WINDOW
(safety barrier)

DATE : 02-Aug-21

SCALE : 1:40

DRAWN BY : Iwon

CHECKED BY :

MDI



美特鋁寶有限公司

ALUMINIUM FABRICATOR LTD.



Units 6-8, Sunny Industrial Centre, 1/F
610 Ona Kwong Road, Kowloon
Tel:23489211-4 Fax:85227277666

DWG NO. : J856-SD-PW-5306

REV. : C

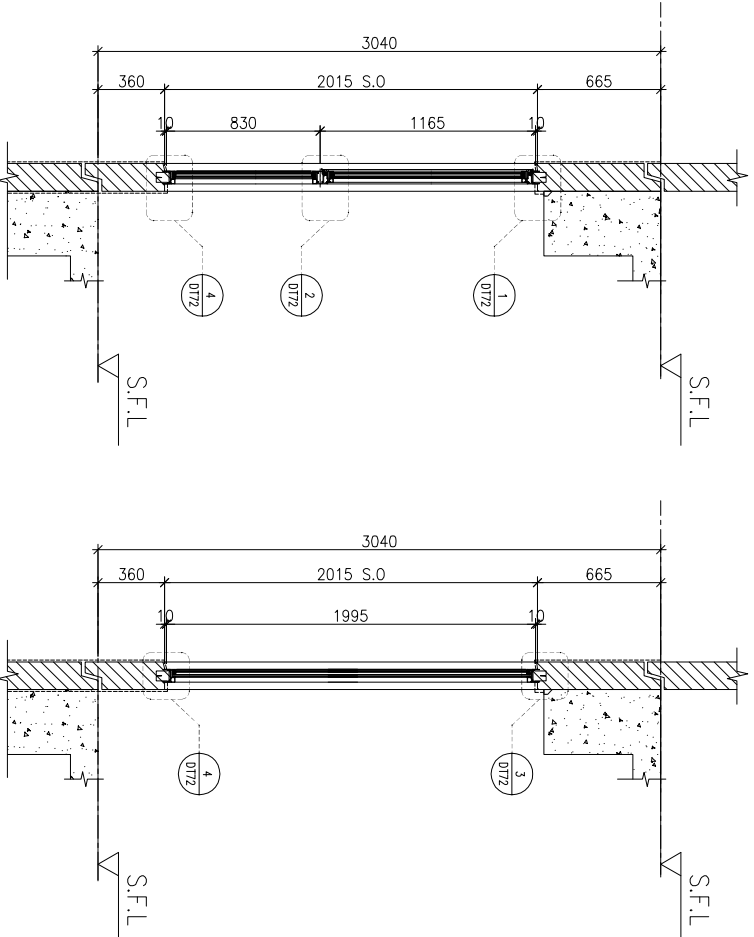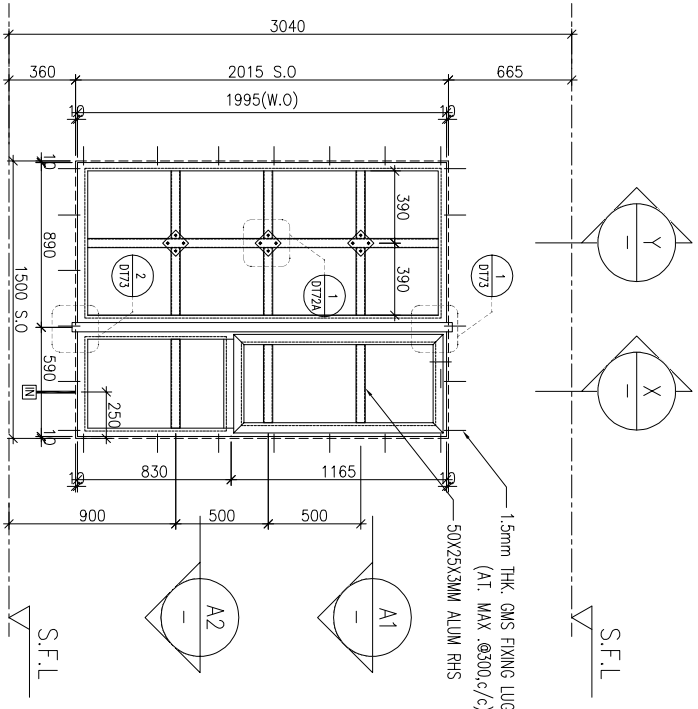

ELEVATION

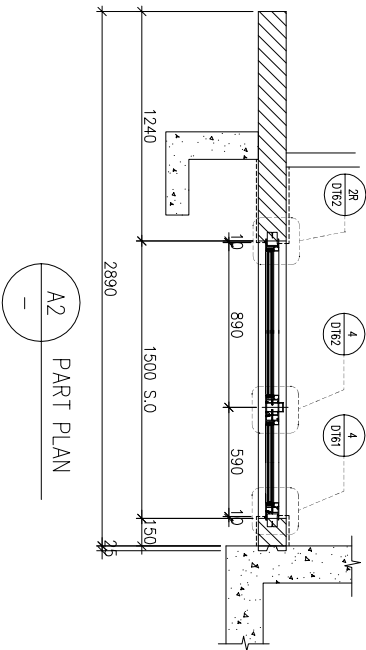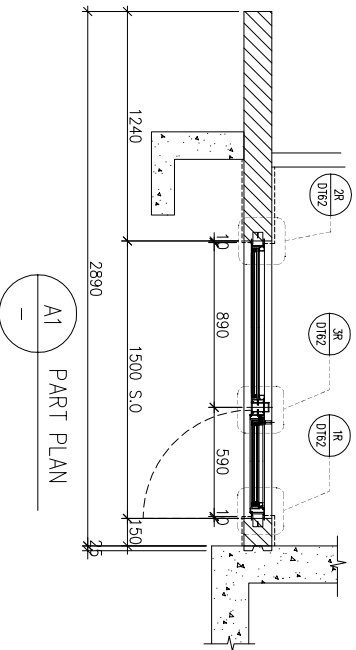

WINDOW MARK	AW 03
-------------	-------

LOCATION 3/F-42/F(4/F,13/F,14/F,24/F,34/F OMITTED) UNIT B10

SECTION 70mm ALUM. SECTION

GLAZING EGL-1,EGL-1A

QUANTITY 35 Nos

REMARKS FACADE(TYPE T3PF11R FOR 3/F~42/F)

B.O. REF. :

CLIENT :



SUN HUNG KAI

REAL ESTATE AGENCY LTD.

42/F SUN HUNG KAI CENTRE, WINGCHAI, HONGKONG

ARCHITECT :



IWK&partners

architects

MAIN CONTRACTOR :



怡輝建築有限公司

Yee Fai Building Contractors Ltd.

STRUCTURAL ENGINEER :



ARUP

FAÇADE CONSULTANT:



ALPHA CONSULTING LIMITED

Steel Structure & Façade Specialist

- NOTE.:
1. ALL DIMENSIONS ARE IN mm.
 2. ALL ELEVATIONS ARE VIEWED FROM OUTSIDE.
 3. ALL DIMENSIONS TO BE VERIFIED ON SITE BEFORE FABRICATION.

LEGEND.:

- Legend:
-  DETAIL MARK NO.
 -  REFER SHEET NO.

1. F.F.L.--FINISHED FLOOR LEVEL
2. S.F.L.--STRUCTURAL FLOOR LEVEL
3.  --REVERSED DETAIL
4. GLASS LEGEND

- Legend:
- EGL-1--8mmHS+12mm AIR GAP+10mmTP THK. I.G.U.
 - EGL-2--10mm THK. CLEAR TEMPERED GLASS
 - EGL-4--10mm THK. TEMPERED ACID ETCHED GLASS
 - EGL-1A--8mmHS+12mm AIR GAP+8mmTP THK. I.G.U.

NO.	DATE	REVISION	BY
C	02/11/2021	REVISION SUBJECT TO ARCHITECTMENT	WON
B	28/10/2021	REVISION SUBJECT TO ARCHITECTMENT	WON
A	27/09/2021	REVISION SUBJECT TO ARCHITECTMENT	WON

JOB NO. : J-856

PROJECT :
PROPOSED DEVELOPMENT ABOVE
LIGHT RAIL TIN WING STOP.TSWTL
NO.23,AREA 33,TIN SHUI WAI, N.T.

TITLE :
WINDOW SCHEDULE FOR
TOWER 3 ALUM. WINDOW
(safety barrier)

DATE : 02-Aug-21 SCALE : 1:40

DRAWN BY : won CHECKED BY :



美特鋁寶有限公司

MDI ALUMINIUM FABRICATOR LTD.


Units 6-8, Sunny Industrial Centre, 1/F

610 Ono Kwo Ling Road, Kowloon



Tel:23489211-4 Fax:(852)27727666

DWG NO. : J856-SD-PW-5307

REV. : C

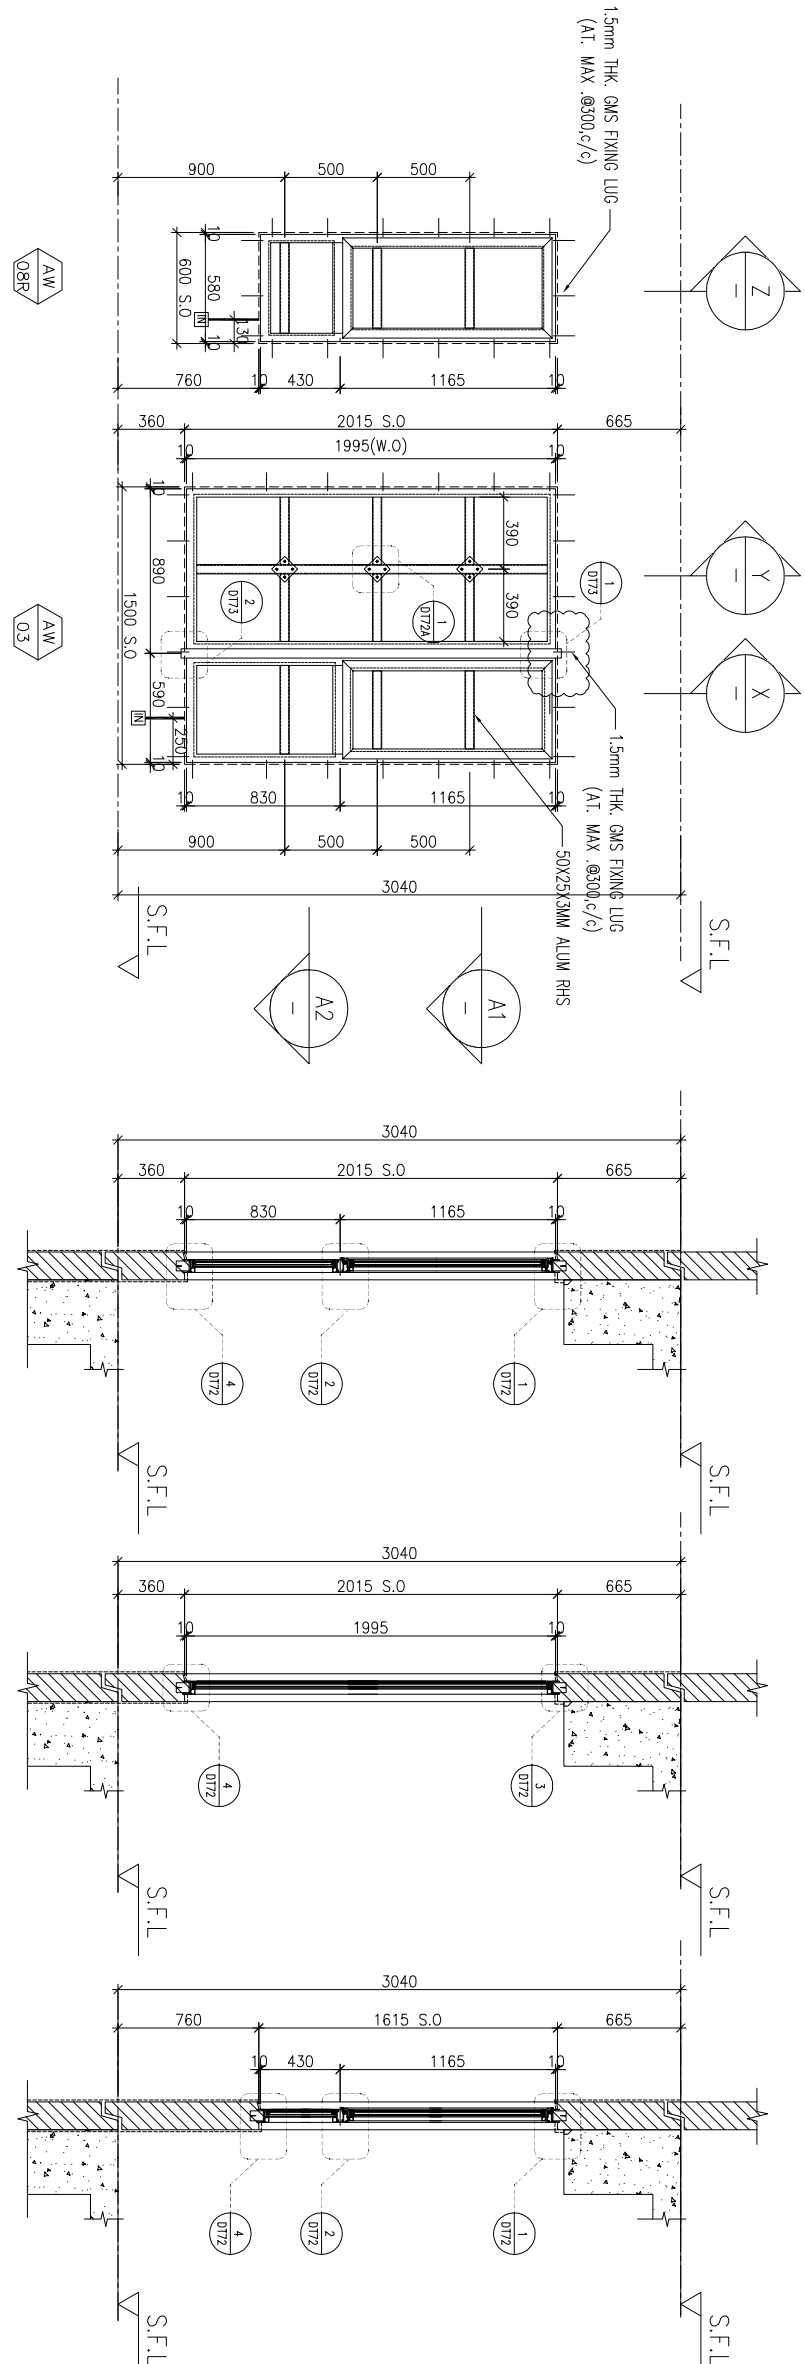

ELEVATION

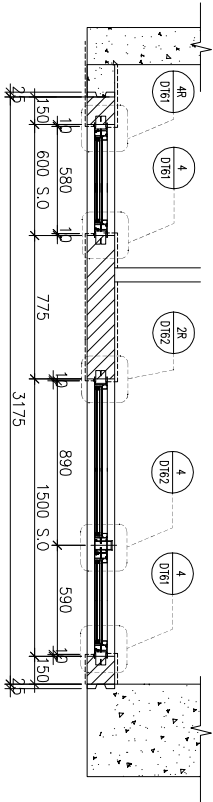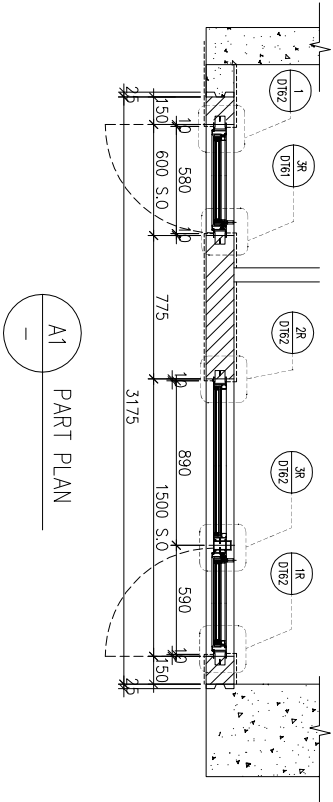

WINDOW MARK	 	
LOCATION	3/F~42/F(4/F,13/F,14/F,24/F,34/F OMITTED) UNIT A1	
SECTION	70mm ALUM. SECTION	
GLAZING	EGL-1,EGL-1A	
QUANTITY	35 Nos	
REMARKS	FAÇADE(TYPE T3PF15 FOR 3/F~42/F)	

 	
3/F~42/F(4/F,13/F,14/F,24/F,34/F OMITTED) UNIT A7	
70mm ALUM. SECTION	
EGL-1,EGL-1A	
35 Nos	
FAÇADE(TYPE T3PF15R FOR 3/F~42/F)	

B.O. REF. :

CLIENT :



42/F SUN HUNG KAI CENTRE, WINGCHAI, HONGKONG

ARCHITECT :



MAIN CONTRACTOR :



STRUCTURAL ENGINEER :



FAÇADE CONSULTANT:



NOTE :

1. ALL DIMENSIONS ARE IN mm.
2. ALL ELEVATIONS ARE VIEWED FROM OUTSIDE.
3. ALL DIMENSIONS TO BE VERIFIED ON SITE BEFORE FABRICATION.

LEGEND :

—DETAIL MARK NO.
—REFER SHEET NO.

1. F.F.L.--FINISHED FLOOR LEVEL
2. S.F.L.--STRUCTURAL FLOOR LEVEL
3. --REVERSED DETAIL

4. GLASS LEGEND

EGL-1--8mmHS+12mm AIR GAP+10mmTP THK. I.G.U.
EGL-2--10mm THK. CLEAR TEMPERED GLASS
EGL-4--10mm THK. TEMPERED ACID ETCHED GLASS
EGL-1A--8mmHS+12mm AIR GAP+8mmTP THK. I.G.U.

D	02/11/2021	REVISION SUBJECT TO ARCHITECTMENT	Yvon
C	28/10/2021	REVISION SUBJECT TO ARCHITECTMENT	Yvon
B	18/10/2021	REVISION SUBJECT TO ARCHITECTMENT	Yvon
A	27/09/2021	REVISION SUBJECT TO ARCHITECTMENT	Yvon
NO.	DATE	REVISION	BY

JOB NO. : J-856

PROJECT :

PROPOSED DEVELOPMENT ABOVE
LIGHT RAIL TIN WING STOP.TSWTL
NO.23.AREA 33.TIN SHUI WAI, N.T.

TITLE :

WINDOW SCHEDULE FOR
TOWER 3 ALUM. WINDOW
(safety barrier)

DATE : 02-Aug-21 SCALE : 1:40

DRAWN BY : Yvon CHECKED BY :







Units 6-8, Sunray Industrial Centre, 1/F
610 Ona Kwo Ling Road, Kowloon
Tel:23489211-4 Fax:(852)27727666

DWG NO. : JB56-SD-PW-5308

REV. : D

ELEVATION

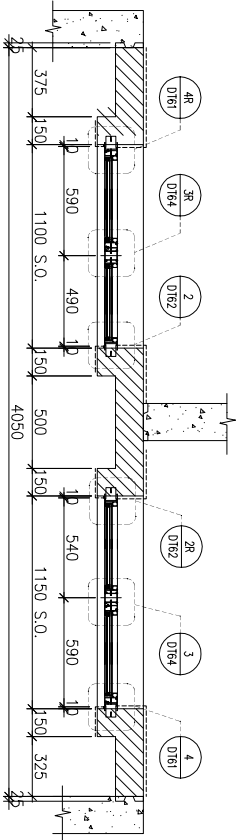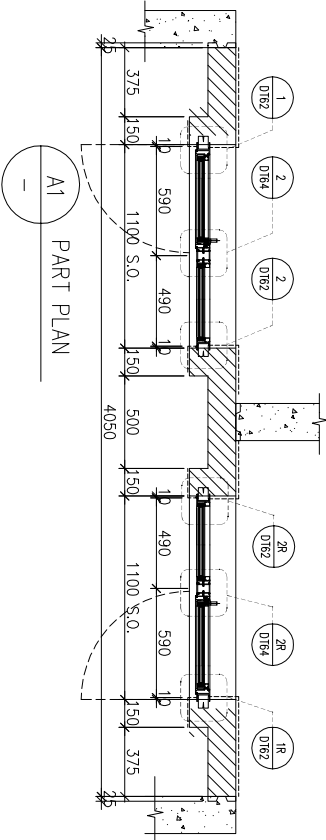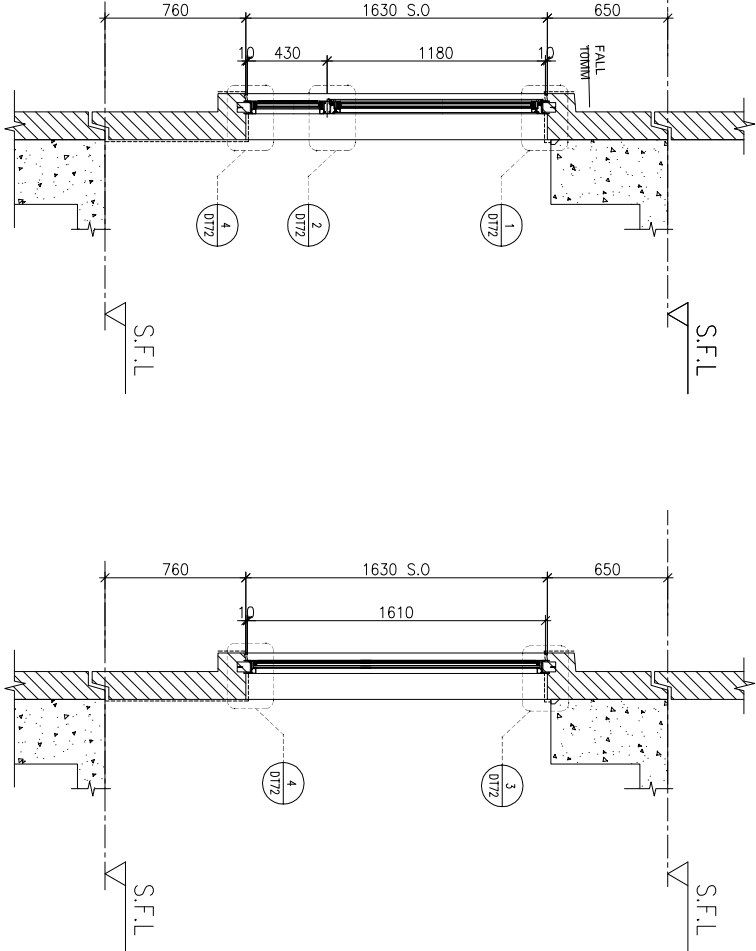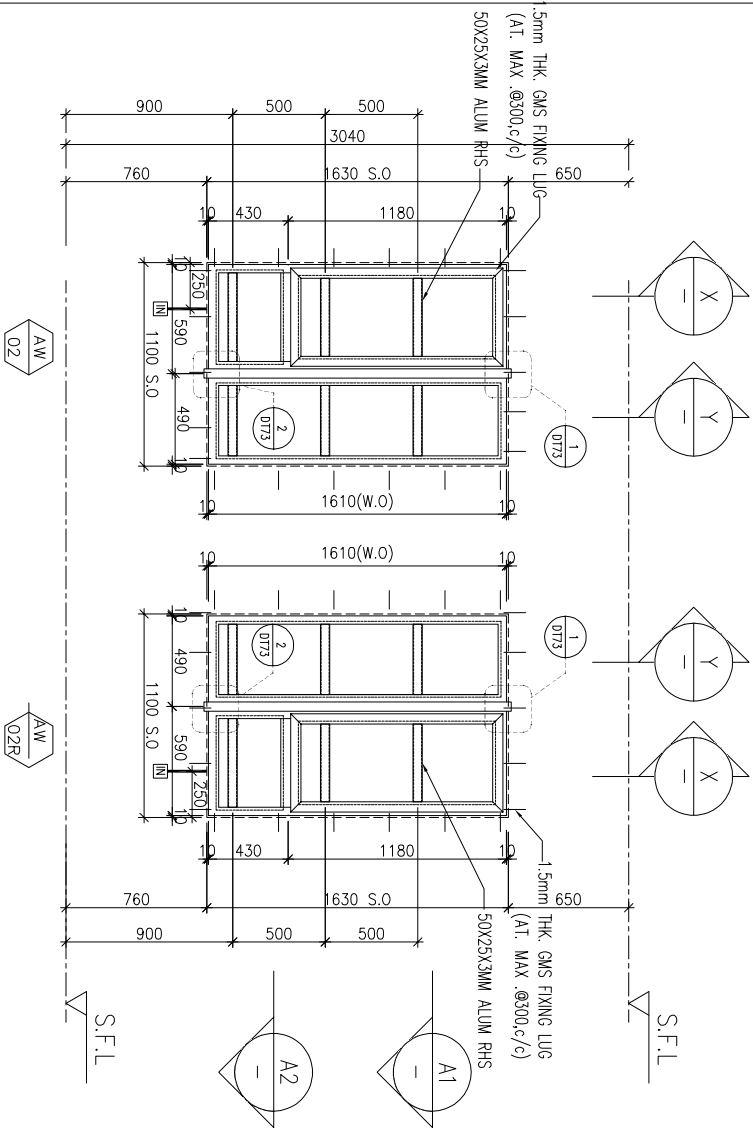

WINDOW MARK		
LOCATION	3/F-42/F(4/F,13/F,14/F,24/F,34/F OMITTED) UNIT A3&A5, A12&A13	
SECTION	70mm ALUM. SECTION	
GLAZING	EGL-1,EGL-1A	
QUANTITY	35 Nos / 35 Nos	
REMARKS	FACADE(TYPE T3PF16 FOR 3/F~42/F)	

B.O. REF :

CLIENT :



SUN HUNG KAI

REAL ESTATE AGENCY LTD.

42/F SUN HUNG KAI CENTRE, WINGCHAI, HONGKONG

ARCHITECT :



architects

MAIN CONTRACTOR :



怡輝建築有限公司

Yee Fai Building Contractors Ltd.

STRUCTURAL ENGINEER :

ARUP

FACADE CONSULTANT:



ALPHA CONSULTING LIMITED

Steel Structure & Facade Specialist

NOTE :

1. ALL DIMENSIONS ARE IN mm.
2. ALL ELEVATIONS ARE VIEWED FROM OUTSIDE.
3. ALL DIMENSIONS TO BE VERIFIED ON SITE BEFORE FABRICATION.

LEGEND :

X1

DETAIL MARK NO.

X001

REFER SHEET NO.

1. F.F.L.--FINISHED FLOOR LEVEL
2. S.F.L.--STRUCTURAL FLOOR LEVEL
3. --REVERSED DETAIL

4. GLASS LEGEND

EGL-1--8mmHS+12mm AIR GAP+10mmTP THK. I.G.U.
EGL-2--10mm THK. CLEAR TEMPERED GLASS
EGL-4--10mm THK. TEMPERED ACID ETCHED GLASS
EGL-1A-8mmHS+12mm AIR GAP+8mmTP THK. I.G.U.

D	02/11/2021	REVISION SUBJECT TO ARCH/COMMITMENT	None
C	28/10/2021	REVISION SUBJECT TO ARCH/COMMITMENT	None
B	18/10/2021	REVISION SUBJECT TO ARCH/COMMITMENT	None
A	27/09/2021	REVISION SUBJECT TO ARCH/COMMITMENT	None
NO.	DATE	REVISED	BY

JOB NO. : J-856

PROJECT :

PROPOSED DEVELOPMENT ABOVE
LIGHT RAIL TIN WING STOP,TSMTL
NO.23,AREA 33,TIN SHUI WAI, N.T.

TITLE :

WINDOW SCHEDULE FOR
TOWER 3 ALUM. WINDOW
(safety barrier)

DATE : 02-Aug-21 SCALE : 1:40

DRAWN BY : Ivon CHECKED BY :




美特鋁寶有限公司


MDI ALUMINIUM FABRICATOR LTD.

Units 6-8, Sunray Industrial Centre, 1/F
610 Ono Kwong Road, Kowloon
Tel:23489211-4 Fax:(852)27727666


DWG NO. : J856-SD-PW-5309 REV. : D

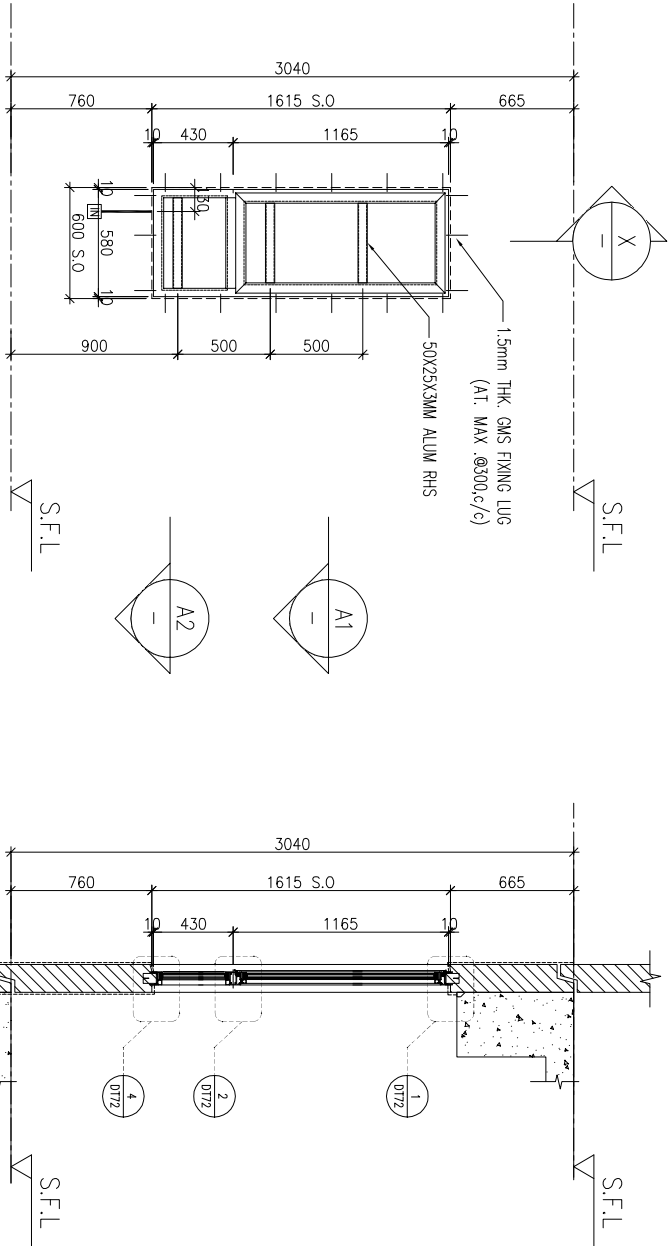

ELEVATION

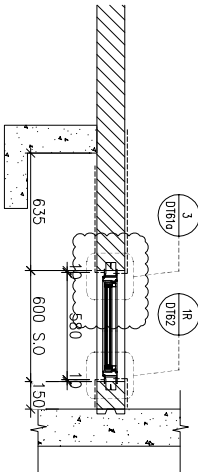

A1
PART PLAN

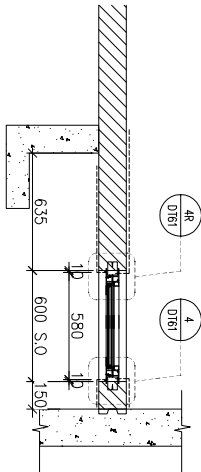

A2
PART PLAN



X
PART SECTION

WINDOW MARK	AW 08
LOCATION	3/F-42/F(4/F,13/F,14/F,24/F,34/F OMITTED) UNIT B2
SECTION	70mm ALUM. SECTION
GLAZING	EGL-1,EGL-1A
QUANTITY	35 Nos
REMARKS	FACADE(TYPE T3PF18 FOR 3/F~42/F)

B.O. REF :

CLIENT :



SUN HUNG KAI
REAL ESTATE AGENCY LTD.

42/F SUN HUNG KAI CENTRE, WINGHAI, HONGKONG

ARCHITECT :



IWK&partners
a r c h i t e c t s

MAIN CONTRACTOR :



怡輝建築有限公司
Yee Fai Building Contractors Ltd.

STRUCTURAL ENGINEER :



ARUP

FAÇADE CONSULTANT:



ALPHA CONSULTING LIMITED
Steel Structure & Façade Specialist

NOTE :
1. ALL DIMENSIONS ARE IN mm.
2. ALL ELEVATIONS ARE VIEWED FROM OUTSIDE.
3. ALL DIMENSIONS TO BE VERIFIED ON SITE BEFORE FABRICATION.

LEGEND :



X1

DETAIL MARK NO.



X001

REFER SHEET NO.

1. F.F.L.--FINISHED FLOOR LEVEL
2. S.F.L.--STRUCTURAL FLOOR LEVEL
3. --REVERSED DETAIL
4. GLASS LEGEND

- EQG-1--8mmHS+12mm AIR GAP+10mmTP THK. IG.U.
- EQG-2--10mm THK. CLEAR TEMPERED GLASS
- EQG-4--10mm THK. TEMPERED ACID ETCHED GLASS
- EQG-1A-8mmHS+12mm AIR GAP+8mmTP THK. IG.U.

NO.		DATE	REVISION	REVISION SUBJECT TO ARCHITECTMENT	BY
A.	02/11/2021	30/10/2021	REVISION SUBJECT TO ARCHITECTMENT	Ivon	
			REVISION SUBJECT TO ARCHITECTMENT	Ivon	

JOB NO. : J-856

PROJECT :
PROPOSED DEVELOPMENT ABOVE
LIGHT RAIL TIN WING STOP,TSWTL
NO.23,AREA 33,TIN SHUI WAI, N.T.

TITLE :
TYPICAL DETAILS FOR
ALUM. WINDOW
(safety barrier)

DATE : 02-Aug-21 SCALE : 1:40


DRAWN BY : Ivon CHECKED BY :




美特鋁質有限公司
MIDI ALUMINIUM FABRICATOR LTD.

Units 6-8, Sunny Industrial Centre, 1/F
610 Ono Kwong Road, Kowloon
Tel:23489211-4 Fax:(852)27727666


DWG NO. : J856-SD-PW-DT61 REV. : B

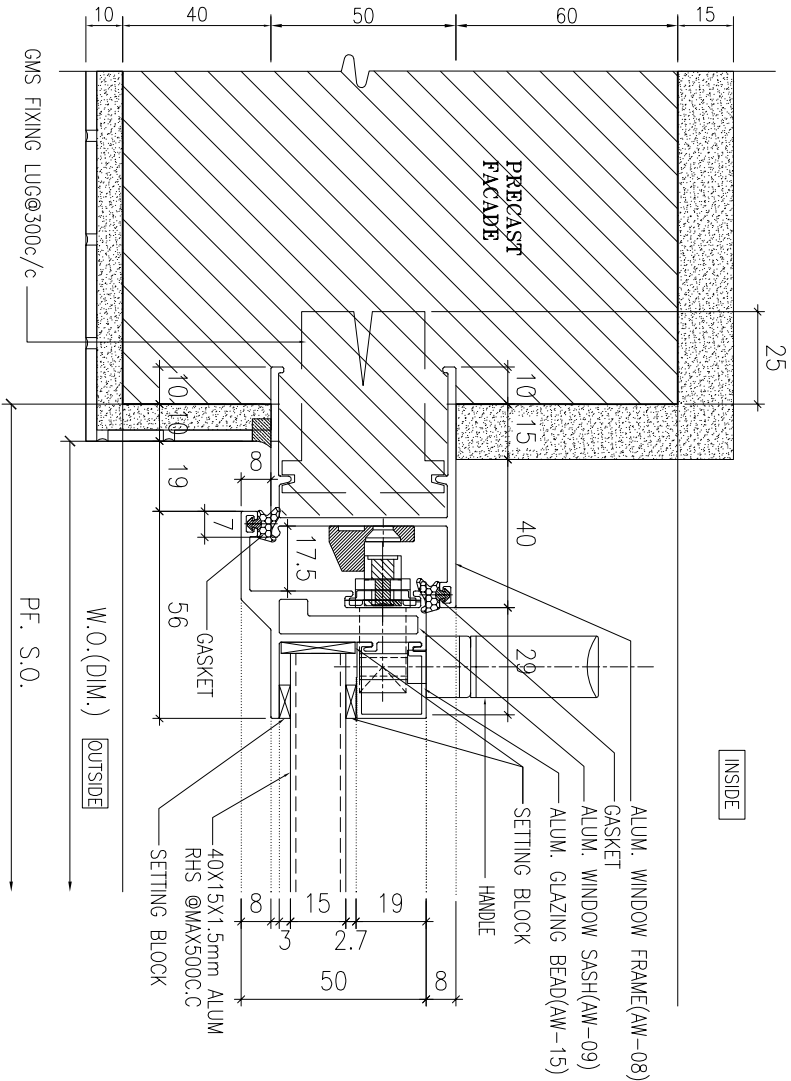


1 HORIZONTAL DETAIL
SCALE 1:2

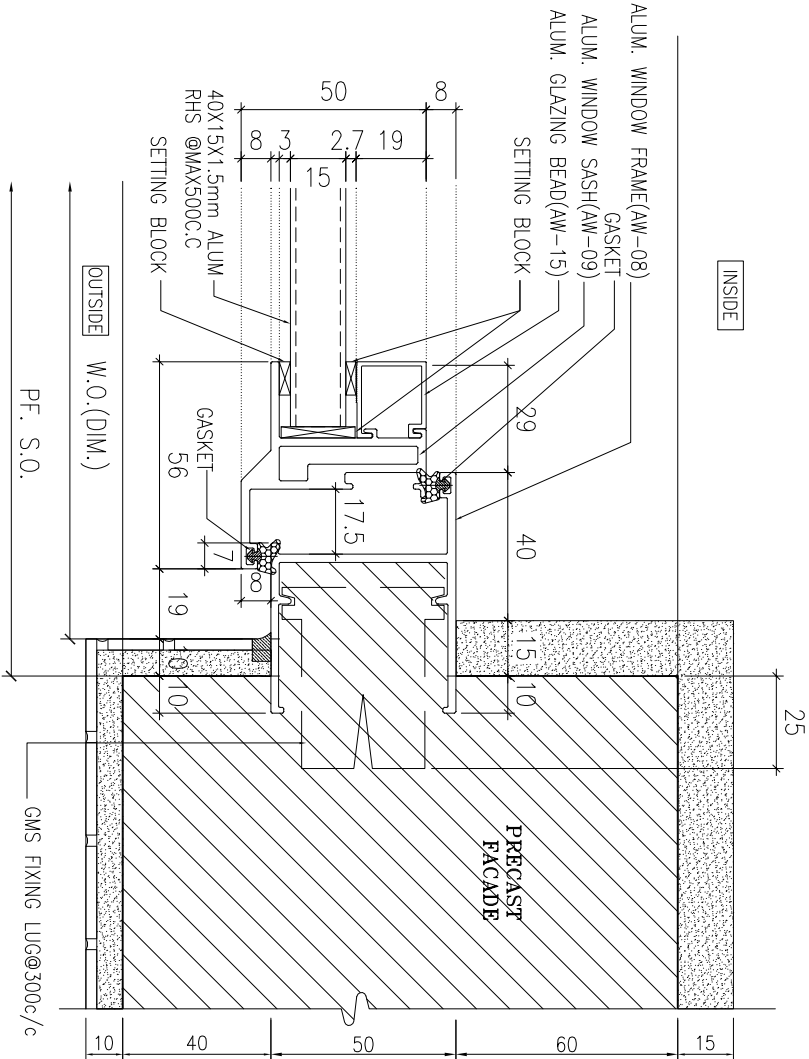

2 HORIZONTAL DETAIL
SCALE 1:2

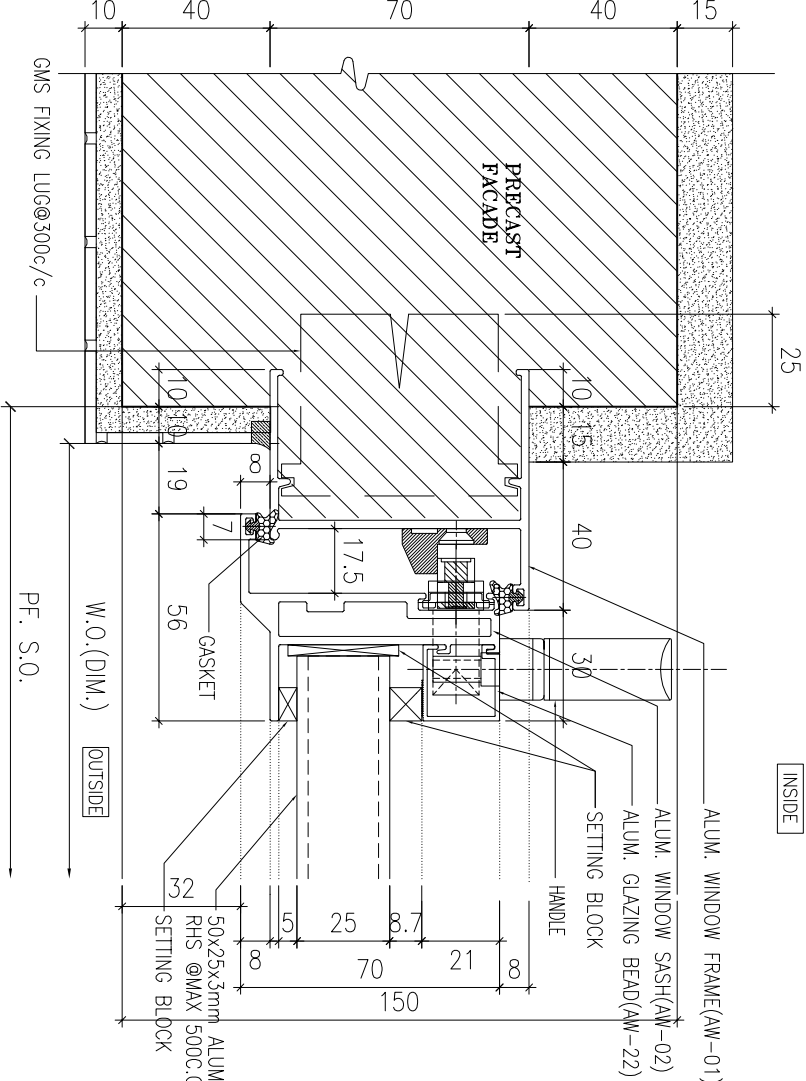

3 HORIZONTAL DETAIL
SCALE 1:2

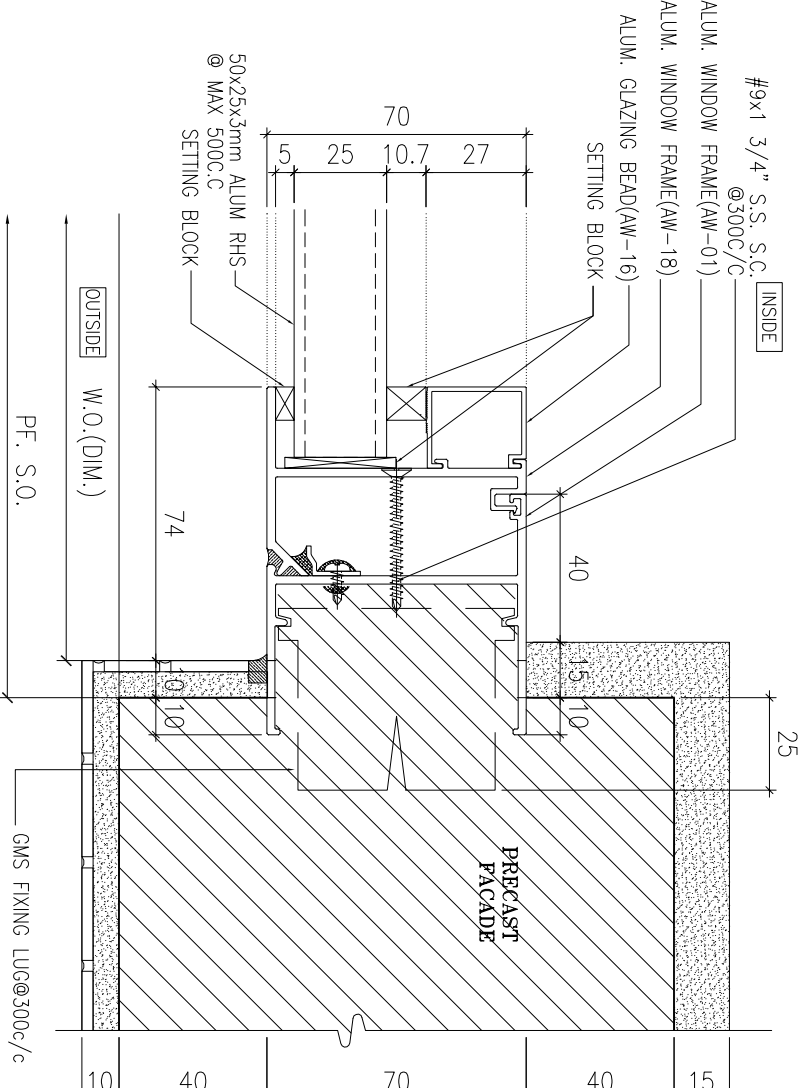

4 HORIZONTAL DETAIL
SCALE 1:2

	1
	2
SUN HUNG KAI
REAL ESTATE AGENCY LTD.

42/F SUN HUNG KAI CENTRE, WANCHAI, HONGKONG

lwk&partners
a r c h i t e c t s

Architect

Yee Fai Building Contractors Ltd

Yee Fai Building Contractors Ltd


ARUP

FAÇADE CONSULTANT:


ALPHA CONSULTING LIMITED
Steel Structure & Facade Specialist

Steel Structure & Facade Specialist

Small

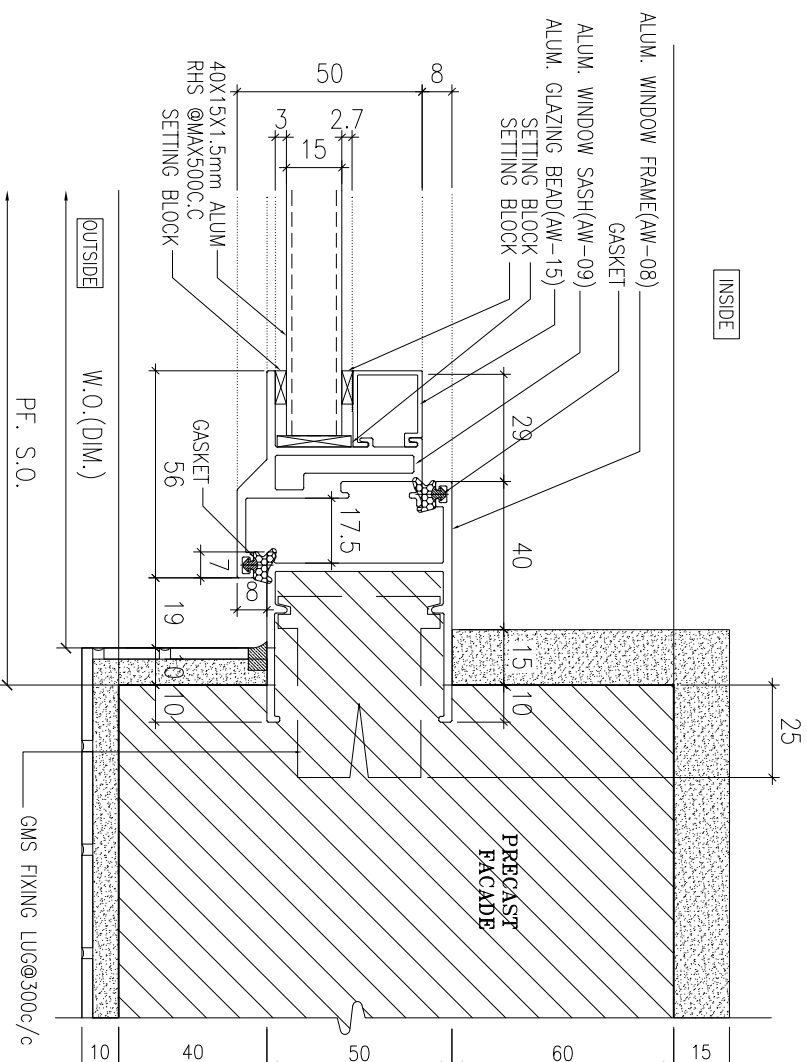

7:17:50

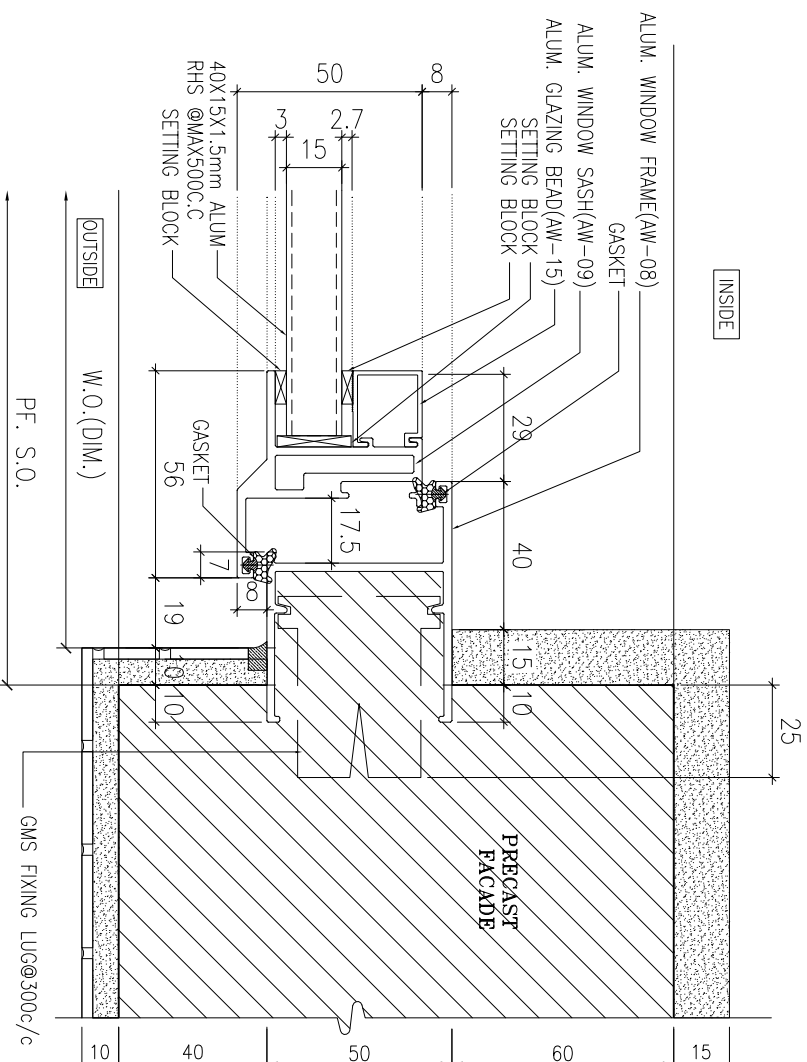

7:17:50

1. ALL DIMENSIONS ARE IN mm.
2. ALL ELEVATIONS ARE VIEWED FROM OUTSIDE.
3. ALL DIMENSIONS TO BE VERIFIED ON SITE BEFORE FABRICATION.

X1
X001

DETAIL MARK NO.
REFER SHEET NO.

X001 — REFERENCE NO.

1. F.F.L. -- FINISHED FLOOR LEVEL

3. (R) -- REVERSED DETAIL

4. GLASS LEGEND

EGL-1--8mmHS+12mm AIR GAP+10mmTP THK. I.G.U.

EGL-2--10mm THK. CLEAR TEMPERED GLASS

EG1-4--10mm THK TEMPERED ACID ETCHED

EGL-1A-8mmHS+12mm AIR GAP+8mmTP THK. I.G.U.

B	02/11/2021	REVISION SUBJECT TO ARCH.COMMENT	Wm
A	30/10/2021	REVISION SUBJECT TO ARCH.COMMENT	Wm
NO.	DATE	REVISED	BY

PROJECT

PROPOSED DEVELOPMENT ABOVE
LIGHT RAIL TIN WING STOP, TSWTL
NO.23, AREA 33, TIN SHUI WAI, N.T.

TYPICAL DETAILS FOR
ALUM. WINDOW
(safety barrier)

--	--	--

DRAWN BY : Ivan	CHECKED BY :
-----------------	--------------




MIDI ALUMINIUM FABRICATOR LTD.

Units 6-8, Sunray Industrial Centre
610 Cho Kwo Ling Road Kowloon

Tel:23489211-4 Fax:(852)27727666

DWG NO. : J856-SD-PW-DT61a REV. : B

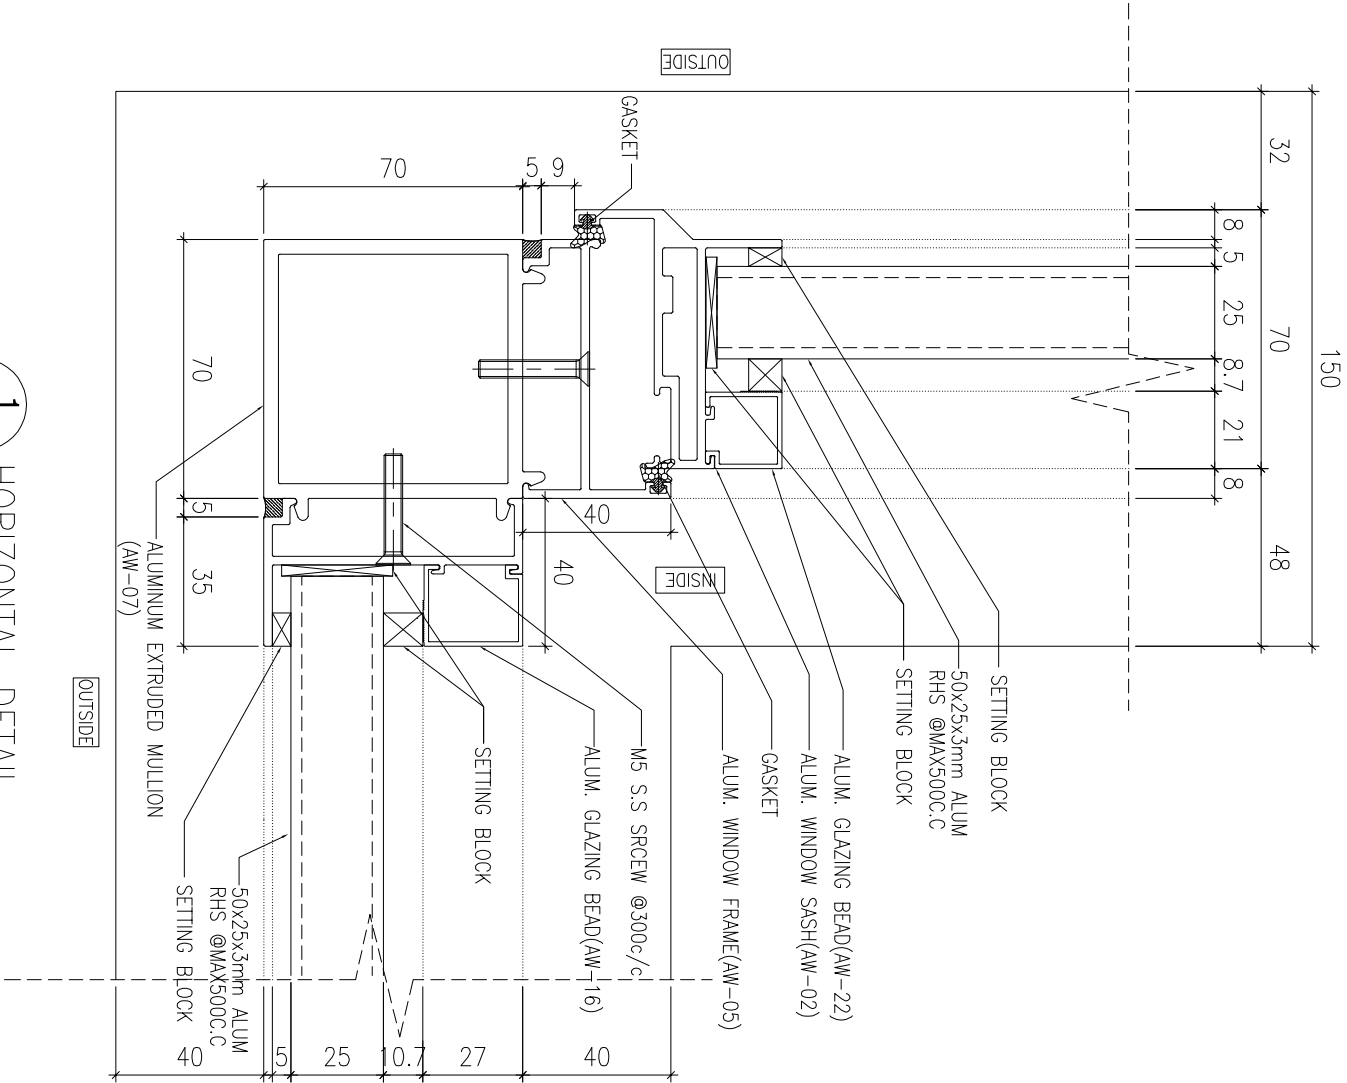

1 HORIZONTAL DETAIL
SCALE 1:2

B.O. REF :

CLIENT :



42/F SUN HUNG KAI CENTRE, WINGCHAI, HONGKONG

ARCHITECT :



MAIN CONTRACTOR :



STRUCTURAL ENGINEER :



FAÇADE CONSULTANT:



NOTE :

1. ALL DIMENSIONS ARE IN mm.
2. ALL ELEVATIONS ARE VIEWED FROM OUTSIDE.
3. ALL DIMENSIONS TO BE VERIFIED ON SITE BEFORE FABRICATION.

LEGEND :

⊗1 DETAIL MARK NO.
X001 REFER SHEET NO.

1. F.F.L.--FINISHED FLOOR LEVEL
2. S.F.L.--STRUCTURAL FLOOR LEVEL
3. Ⓡ --REVERSED DETAIL

4. GLASS LEGEND

- EGL-1--8mmHS+12mm AIR GAP+10mmTP THK. IG.U.
- EGL-2--10mm THK. CLEAR TEMPERED GLASS
- EGL-4--10mm THK. TEMPERED ACID ETCHED GLASS
- EGL-1A-8mmHS+12mm AIR GAP+8mmTP THK. IG.U.

C	02/11/2021	REVISION SUBJECT TO ARCH/COMMITMENT	Yvon
B	30/10/2021	REVISION SUBJECT TO ARCH/COMMITMENT	Yvon
A	30/09/2021	REVISION SUBJECT TO ARCH/COMMITMENT	Yvon
NO.	DATE	REVISION	BY

JOB NO. : J-856

PROJECT :
PROPOSED DEVELOPMENT ABOVE
LIGHT RAIL TIN WING STOP.TSWTL
NO.23,AREA 33,TIN SHUI WAI, N.T.

TITLE :
TYPICAL DETAILS FOR
ALUM. WINDOW
(safety barrier)




DATE : 02-Aug-21 SCALE : 1:40

DRAWN BY : Yvon CHECKED BY :



Units 6-8, Sunny Industrial Centre, 1/F
610 Ono Ling Road, Kowloon
Tel:23489211-4 Fax:(852)27727666

DWG NO. : J856-SD-PW-DT63 REV. : C

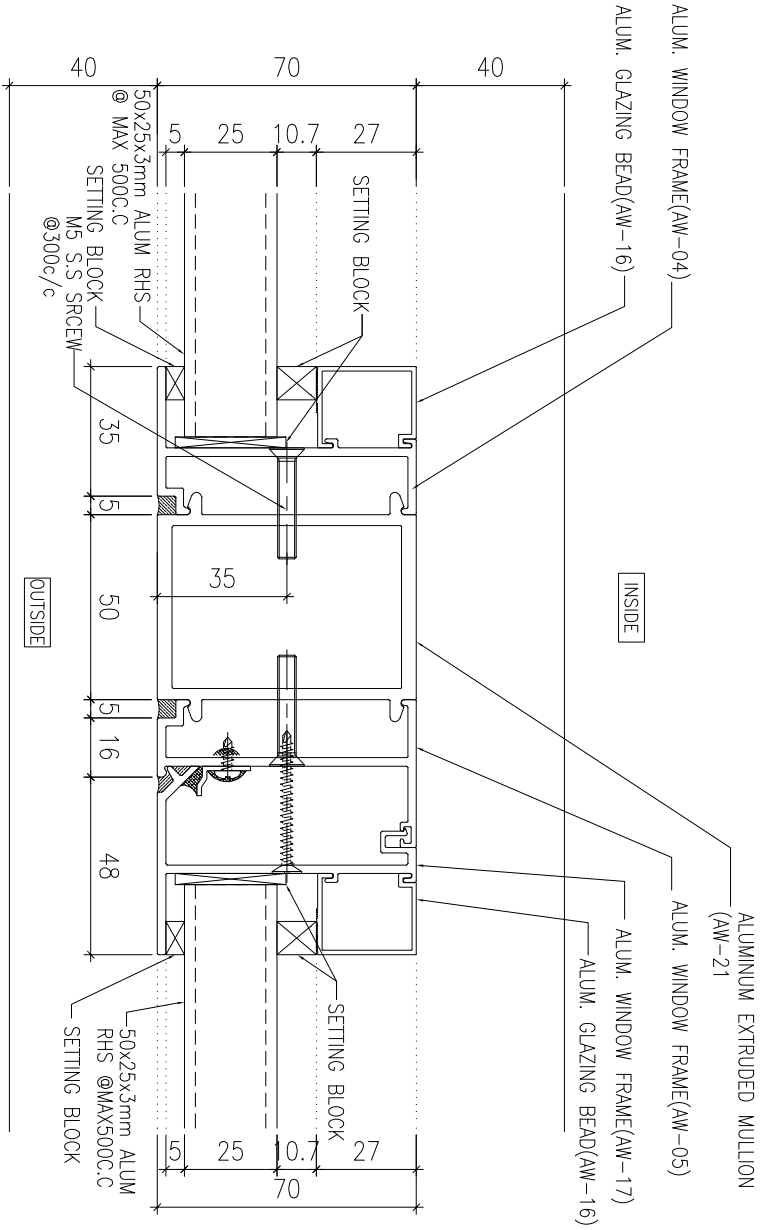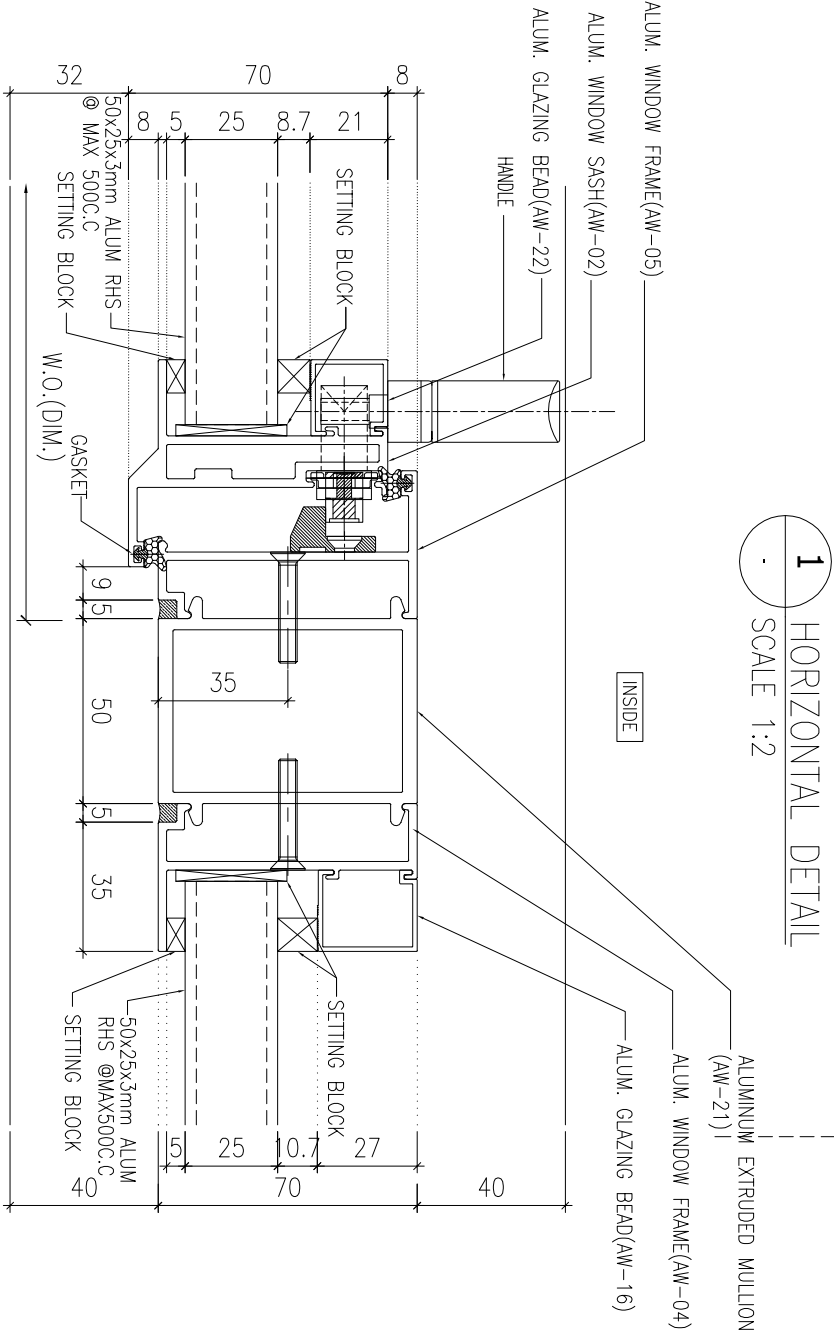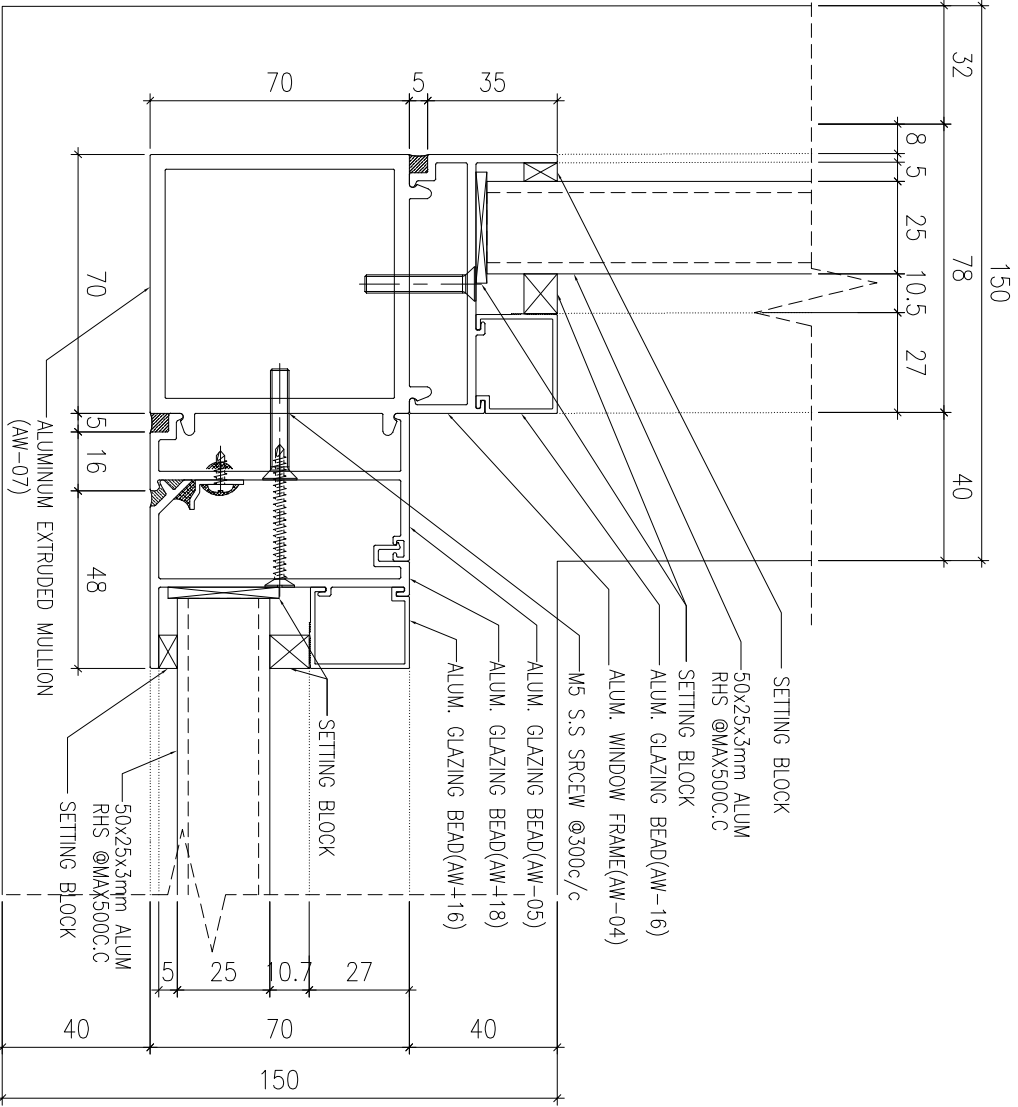

B.O. REF :

CLIENT :



42/F SUN HUNG KAI CENTRE, WINGHAI, HONGKONG

ARCHITECT :



MAIN CONTRACTOR :



STRUCTURAL ENGINEER :

FAÇADE CONSULTANT:



NOTE :

1. ALL DIMENSIONS ARE IN mm.
2. ALL ELEVATIONS ARE VIEWED FROM OUTSIDE.
3. ALL DIMENSIONS TO BE VERIFIED ON SITE BEFORE FABRICATION.

LEGEND :



1. F.F.L.--FINISHED FLOOR LEVEL
2. S.F.L.--STRUCTURAL FLOOR LEVEL
3. (R) --REVERSED DETAIL

4. GLASS LEGEND

- EG-1--8mmH+12mm AIR GAP+10mmTP THK. I.G.U.
EG-2--10mm THK. CLEAR TEMPERED GLASS
EG-4--10mm THK. TEMPERED ACID ETCHED GLASS
EG-1A-8mmH+12mm AIR GAP+8mmTP THK. I.G.U.

D	02/11/2021	REVISION SUBJECT TO ARCHITECTMENT	Rev
C	30/10/2021	REVISION SUBJECT TO ARCHITECTMENT	Rev
B	18/10/2021	REVISION SUBJECT TO ARCHITECTMENT	Rev
A	30/09/2021	REVISION SUBJECT TO ARCHITECTMENT	Rev
NO.	DATE	REVISION	BY


JOB NO. : J-856

PROJECT :
PROPOSED DEVELOPMENT ABOVE
LIGHT RAIL TIN WING STOP,TSMTL
NO.23,AREA 33,TIN SHUI WAI, N.T.

TITLE :
TYPICAL DETAILS FOR
ALUM. WINDOW
(safety barrier)

DATE : 02-Aug-21 SCALE : 1:40

DRAWN BY : Ivon CHECKED BY :

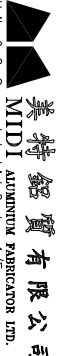

Units 6-8, Sunray Industrial Centre, 1/F
610 Ono Ling Road, Kowloon
Tel:23489211-4 Fax:(852)27277666

DWG NO. : J856-SD-PW-DT64 REV. : D

2 HORIZONTAL DETAIL
SCALE 1:2

3 HORIZONTAL DETAIL
SCALE 1:2

[illegible]

42/F SUN HUNG KAI CENTRE, WANCHAI, HONGKONG

42/F SUN HUNG KAI CENTRE, WANCHAI, HONGKONG

lwk&partners
a r c h i t e c t s

α

Yee Fai Building Contractors Ltd.

Index

α ALPHA CONSULTING LIMITED
Steel Structure & Facade Specialist

--

- BEFORE FABRICATION.

BEFORE FABRICATION.

DETAIL MARK NO. X1
REFER SHEET NO. X001

3. (R) -- REVERSED DETAIL

3. (R) -- REVERSED DETAIL

- EGL-1A-8mmHS+12mm AIR GAP+8mmTP THK. I.G.U.

B	02/11/2021	REVISION SUBJECT TO ARCH.COMMENT	not
A	30/10/2021	REVISION SUBJECT TO ARCH.COMMENT	not
NA	DATE	REVISION	BY

[illegible]

NO.23, AREA 33, TIN SHUI WAI, N.T.

ALUM. WINDOW
(safety barrier)



--	--

DATE : 02 Aug 21	CALL : 1.70
------------------	-------------

 美特鋁貿有限公司
MIDI ALUMINIUM FABRICATOR LTD.

Units 6-8, Sunray Industrial Centre, 1/t
610 Cha Kwo Ling Road, Kowloon
Tel:23489211-4 Fax:(852)27727666

le:23489211-4	fox:(852)21121666
---------------	-------------------

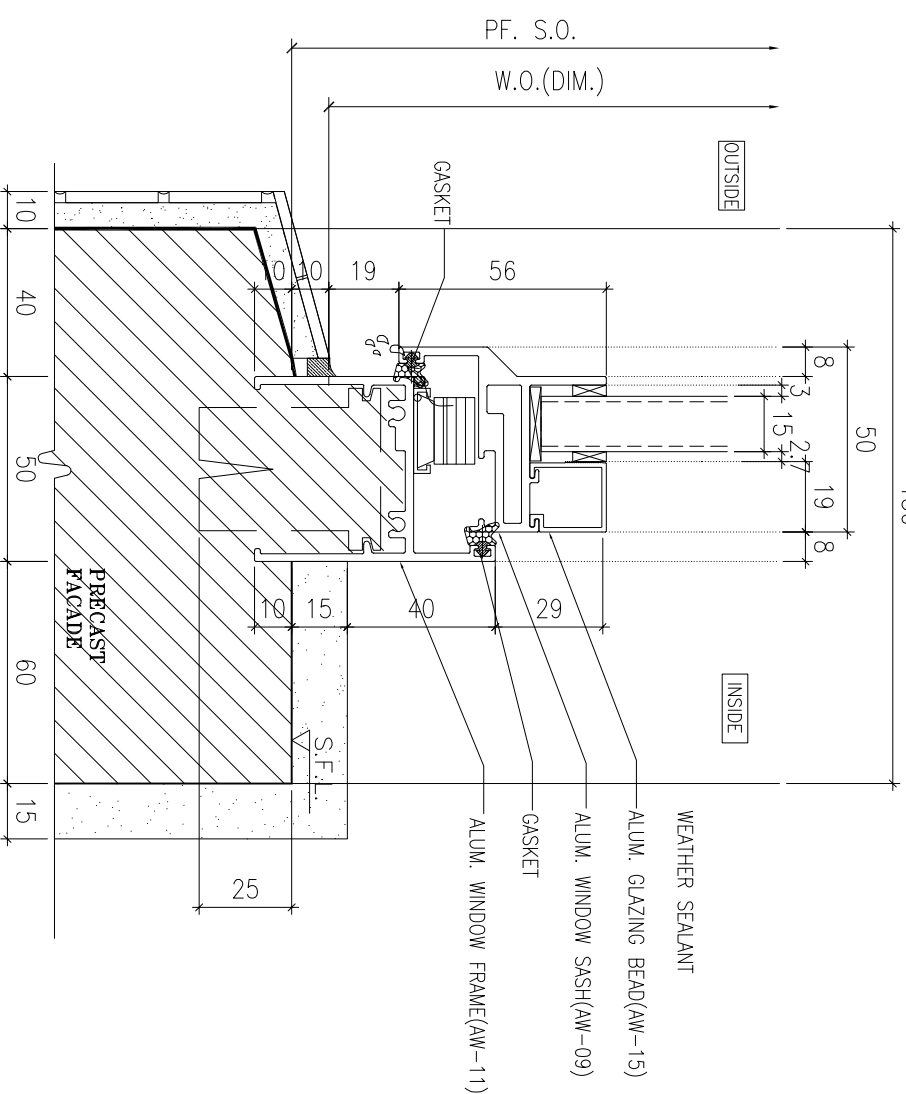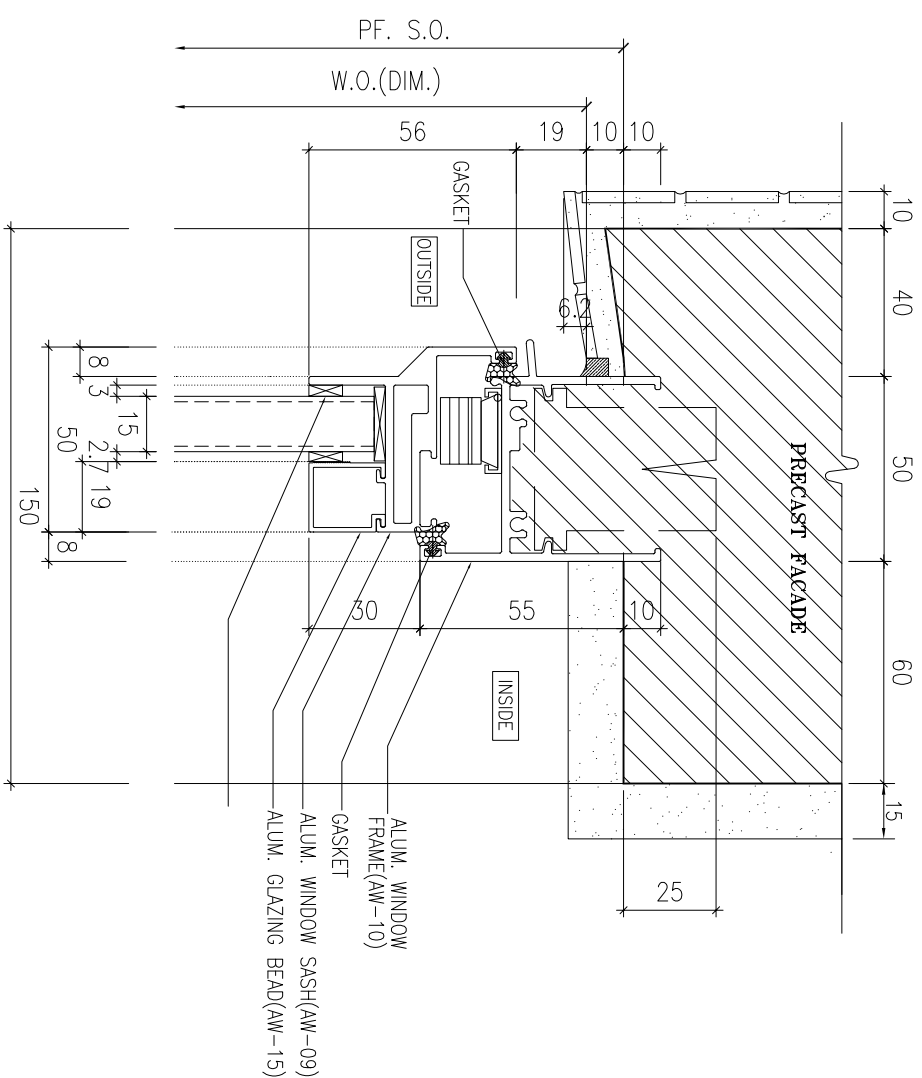

2 HORIZONTAL DETAIL
SCALE 1:2

B.O. REF :

CLIENT :



42/F, SUN HUNG KAI CENTRE, WINGCHAI, HONGKONG

ARCHITECT :



MAIN CONTRACTOR :



STRUCTURAL ENGINEER :



FAÇADE CONSULTANT:



NOTE :

1. ALL DIMENSIONS ARE IN mm.
2. ALL ELEVATIONS ARE VIEWED FROM OUTSIDE.
3. ALL DIMENSIONS TO BE VERIFIED ON SITE BEFORE FABRICATION.

LEGEND :

ⓧ1 DETAIL MARK NO.
X001 REFER SHEET NO.

1. F.F.L.--FINISHED FLOOR LEVEL
2. S.F.L.--STRUCTURAL FLOOR LEVEL
3. Ⓣ9 --REVERSED DETAIL
4. GLASS LEGEND

EQ1-1--8mmHS+12mm AIR GAP+10mmTP THK. IG.U.
EQ1-2--10mm THK. CLEAR TEMPERED GLASS
EQ1-4--10mm THK. TEMPERED ACID ETCHED GLASS
EQ1-1A-8mmHS+12mm AIR GAP+8mmTP THK. IG.U.

NO.	DATE	REVISION	REVISION SUBJECT TO ARCH/COMMENT	
			BY	DATE
B	02/11/2021			
A	30/10/2021			

JOB NO. : J-856

PROJECT :
PROPOSED DEVELOPMENT ABOVE
LIGHT RAIL TIN WING STOP,TSWTL
NO.23,AREA 33,TIN SHUI WAI, N.T.

TITLE :

TYPICAL DETAILS FOR
ALUM. WINDOW
(safety barrier)




DATE : 02-Aug-21 SCALE : 1:40

DRAWN BY : IYON CHECKED BY :



Units 6-8, Sunray Industrial Centre, 1/F
610 Ono Kwo Ling Road, Kowloon
Tel:23489211-4 Fax:(852)27727666

DWG NO. : J856-SD-PW-D172A REV. : -

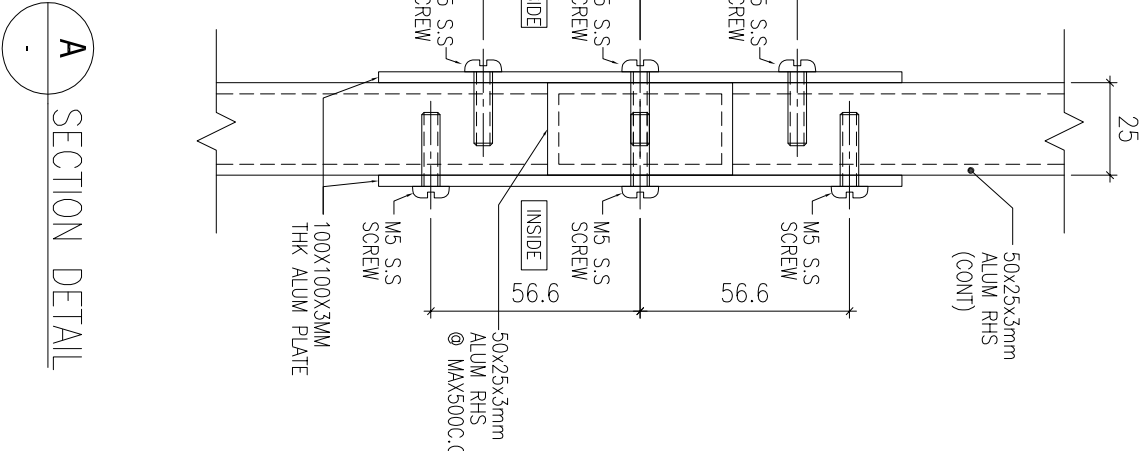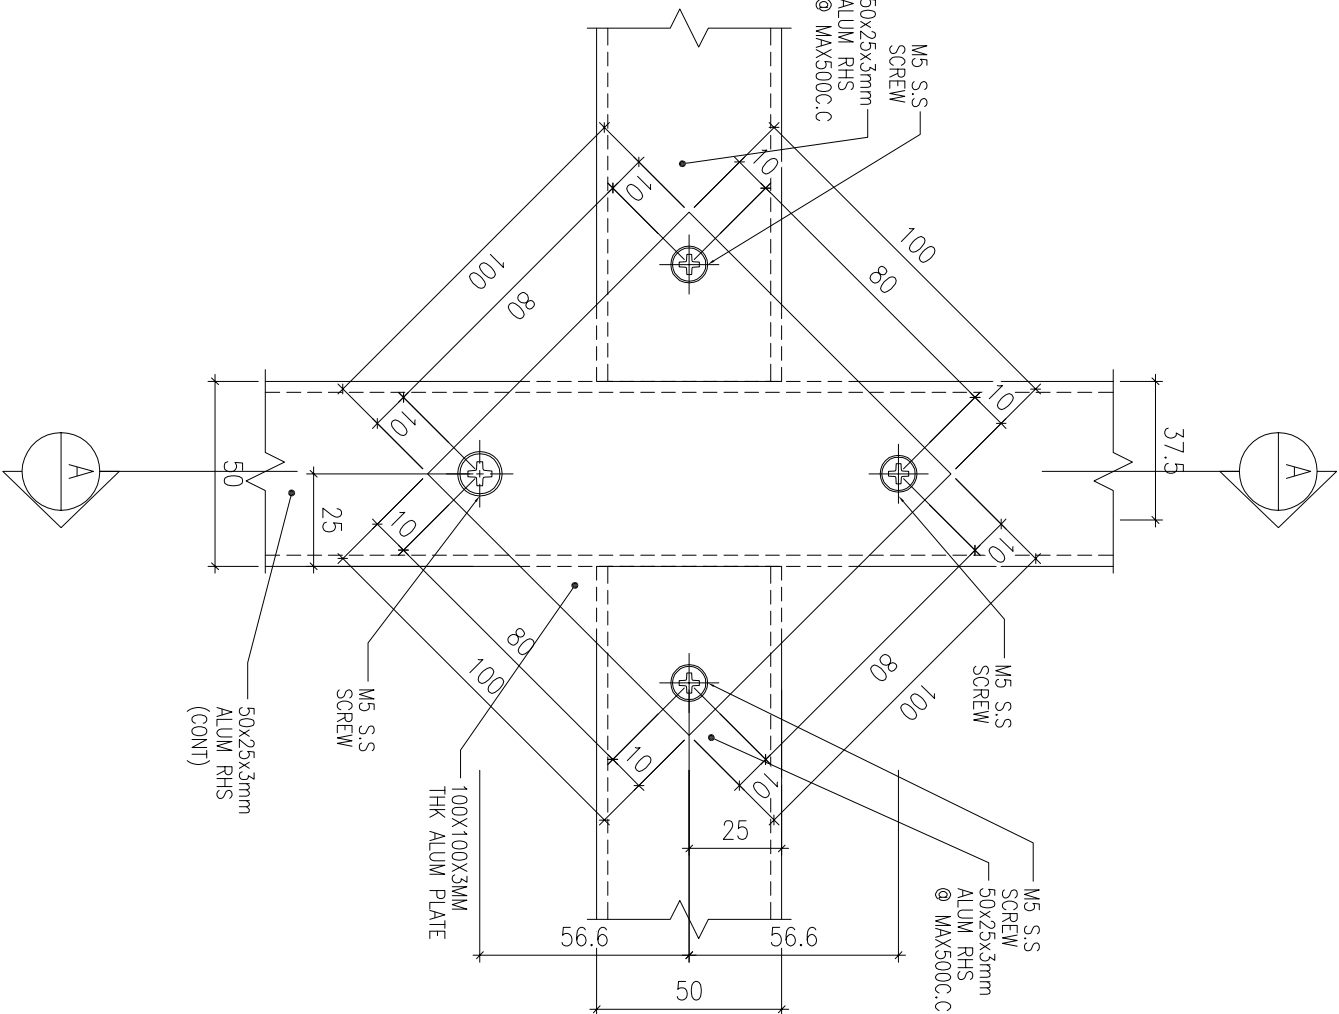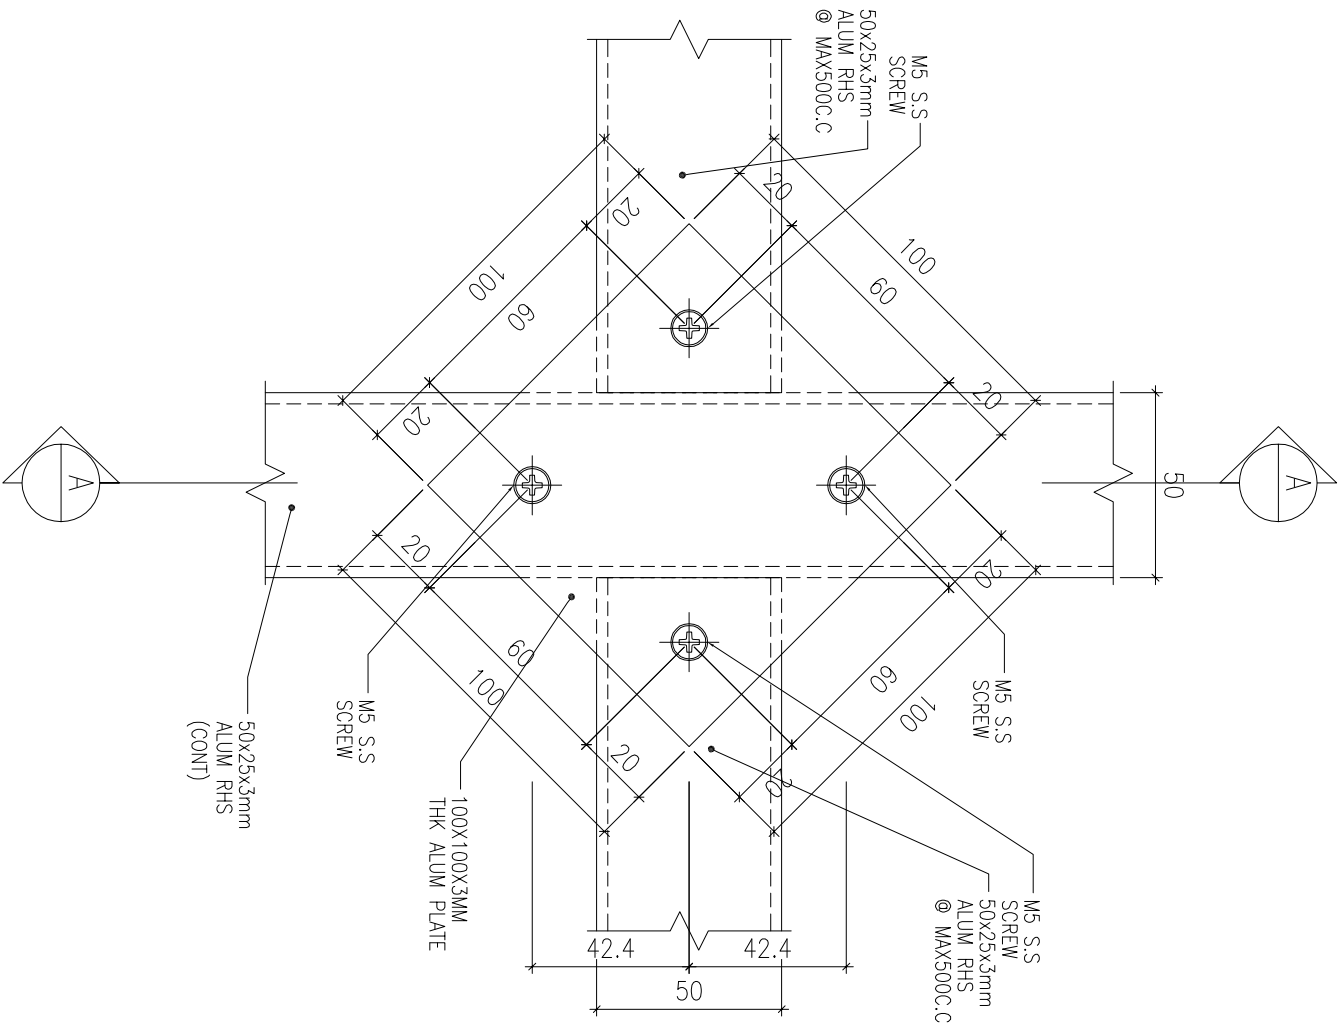

1 HORIZONTAL DETAIL(CONNECTION)

-

2 HORIZONTAL DETAIL(CONNECTION)

-

A SECTION DETAIL

-