

工程指示 / 要求簡箋 ENGINEER INSTRUCTIONS(E.I.)

工程指示編號:	EI- 5699	修改版本:	-
工程編號:	J 856	工程名稱:	天榮站
收件人:	Maggie Lor	發件人:	Lai Sik Hung
工程項目:	後裝窗 夾通頂底鐵碼 生產 大貨	日期:	20/02/2023

<input type="checkbox"/> 原合約工程包	<input type="checkbox"/> 原合約工程加 / 減賬 QT-	<input type="checkbox"/> 新工程報價 QT-
---------------------------------	--	------------------------------------

信件批核號碼/圖紙參考編號:	批核模具圖紙編號:
客戶指示附件:	管理內部批簽署:

<input type="checkbox"/> 初步鋁料 B.M.	<input type="checkbox"/> 加工拆圖, 然後生產	<input type="checkbox"/> 尺寸表
<input type="checkbox"/> 正式鋁料 B.M.	<input type="checkbox"/> 技術上資料 / 指示	<input type="checkbox"/> 報價
<input type="checkbox"/> 配件 B.M.	<input type="checkbox"/> 樣辦或貨品說明書	<input type="checkbox"/> 分判合約
<input type="checkbox"/> 其他:		

內容: 後裝窗 夾通頂底鐵碼 生產 大貨 需驗焊, 100%目視, 20%磁粉, 驗焊報告名稱: Insitu Window 需分座包裝	鐵角及鐵板需符合BS EN 10025 Grade S275J0或以上及CS2:2005或(最新版); 方通及扁通需符合BS EN 10210 Grade S275J0或以上及CS2:2005或(最新版); 若是6mm厚度或以上者, 需有沖擊測試數據(Impact Test Data); 若要求熱浸者, 需符合BS EN ISO 1461:1999或(最新版)(=85 Micro);
---	--

完成上列要求日期: 01/03/2023

國內

<input type="checkbox"/> 生產技術總監	<input type="checkbox"/> 連附件	<input type="checkbox"/> 技術部	<input type="checkbox"/> 連附件	<input type="checkbox"/> 生產部	<input type="checkbox"/> 連附件
<input type="checkbox"/> 採購部	<input type="checkbox"/> 連附件	<input type="checkbox"/> 生產統籌部	<input type="checkbox"/> 連附件	<input type="checkbox"/> 報關組	<input type="checkbox"/> 連附件
<input type="checkbox"/> 質檢部	<input type="checkbox"/> 連附件	<input type="checkbox"/> 會計部	<input type="checkbox"/> 連附件	<input type="checkbox"/> 機械設計部	<input type="checkbox"/> 連附件
<input type="checkbox"/> 香港辦	<input type="checkbox"/> 連附件	<input type="checkbox"/> 其他:			

<input type="checkbox"/> 行政部	<input type="checkbox"/> 連附件	<input type="checkbox"/> 會計部	<input type="checkbox"/> 連附件	<input type="checkbox"/> 統籌部	<input type="checkbox"/> 連附件	<input type="checkbox"/> 工程部	<input type="checkbox"/> 連附件
<input checked="" type="checkbox"/> 採購部	<input checked="" type="checkbox"/> 連附件	<input type="checkbox"/> QS部	<input type="checkbox"/> 連附件	<input type="checkbox"/> 地盤管理	<input type="checkbox"/> 連附件	<input type="checkbox"/> 維修部	<input type="checkbox"/> 連附件


*發件人簽署:		*組別成員批核簽署:	
傳遞編號:		項目經理簽署:	


圖則登記表



DRAWING REGISTER

接收日期 Receiving Date (適用於客戶圖則)


工程名稱 Project Title: 天水圍天榮站		年								
後裝窗地盤用鐵件			月							
工程編號 Project No: J-856				日						
分發予 Distributed To		年	23							
			月	2						
				日	13					
圖則編號 Drg. No.	圖則名稱 Drawing Title		修訂編號 Revision No.							
J856-IW-BT1	鐵件拆圖	1	-							
J856-IW-BB1	鐵件拆圖	2	-							
J856-IW-BT3	鐵件拆圖	3	-							
J856-IW-BB3	鐵件拆圖	4	-							
J856-SD-IW-5114	鐵件位置圖	5	-							
J856-SD-IW-5116	鐵件位置圖	6	-							
J856-SD-IW-5216	鐵件位置圖	7	-							
J856-SD-IW-5318	鐵件位置圖	8	-							
J856-SD-IW-5320	鐵件位置圖	9	-							
J856-SD-IW-5321	鐵件位置圖	10	-							
J856-SD-IW-5351	鐵件位置圖	11	-							
J856-SD-IW-5353	鐵件位置圖	12	-							

 美特鋁質有限公司 MIDI Aluminium Fabricator Ltd.		工程號: J-856	計算: 謝永林	日期: 2023.02.06	送呈: 胡哥							
		地盤名稱: 天榮站	核對: 謝永林	日期: 2023.02.13	副本:							
地盤用鐵件B.M.表		項目類別: 后裝窗	批准: 胡哥	日期:	總重量: 1240.392 KG							
		A/C Code:		此BM依據EI/S219B資料計算								
序號	修改標示	鐵件圖號	物料編號	配件名稱	顏色	實用	後備	總數	單位 件	重量		備注
										單件重量	總重量	
										KG		
1		J856-IW-BT1		中企固定鐵件	熱浸鋅/涂瀝青油	224	0	224	件	2.509	561.908	地盤用
2		J856-IW-BB1		中企固定鐵件	熱浸鋅/涂瀝青油	224	0	224	件	2.509	561.908	地盤用
3		J856-IW-BT3		中企固定鐵件	熱浸鋅/涂瀝青油	24	0	24	件	2.429	58.288	地盤用
4		J856-IW-BB3		中企固定鐵件	熱浸鋅/涂瀝青油	24	0	24	件	2.429	58.288	地盤用
5								總計	496	件	1240.392	

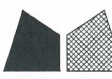 美特鋁質有限公司 MIDI Aluminium Fabricator			序號	數量	座數	單位	樓層位置	窗號	施工圖圖號
工程號 J-856 地盤 天榮站			1	37	T1	B5	3/F-45/F	AW04ai	J856-SD-IW-5114
焊接示意件出地盤			2	36	T2	B5	5/F-45/F	AW03i	J856-SD-IW-5216
地盤用			3	1	T3	B5	3/F	AW03iR	J856-SD-IW-5216
			4	37	T3	A2	3/F-45/F	AW03i	J856-SD-IW-5318
			5	37	T3	B3	3/F-45/F	AW03i	J856-SD-IW-5318
			6	37	T3	A9	3/F-45/F	AW04i	J856-SD-IW-5320
			7	37	T3	A9	3/F-45/F	AW04i	J856-SD-IW-5320
			8	1	T3	SIMPLEX 2B	46/F	AW301	J856-SD-IW-5351
			9	1	T3	SIMPLEX 2A	46/F	AW303	J856-SD-IW-5353
			合計	224.0					

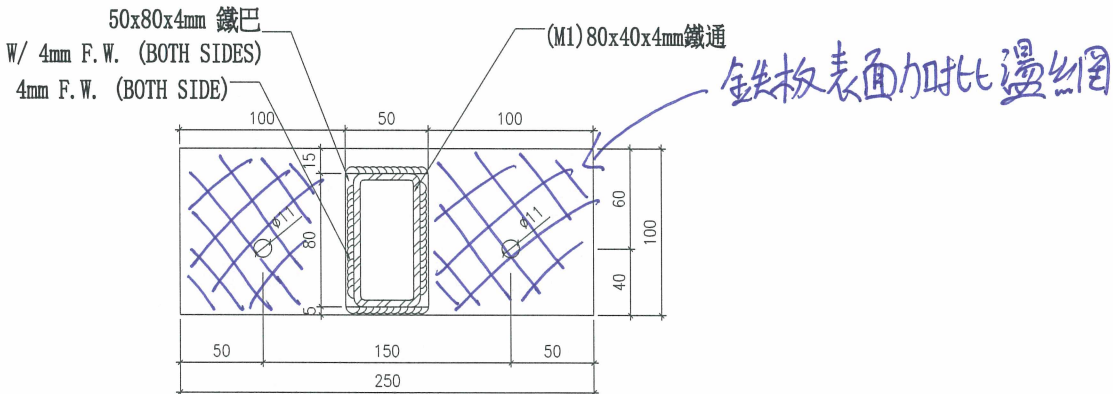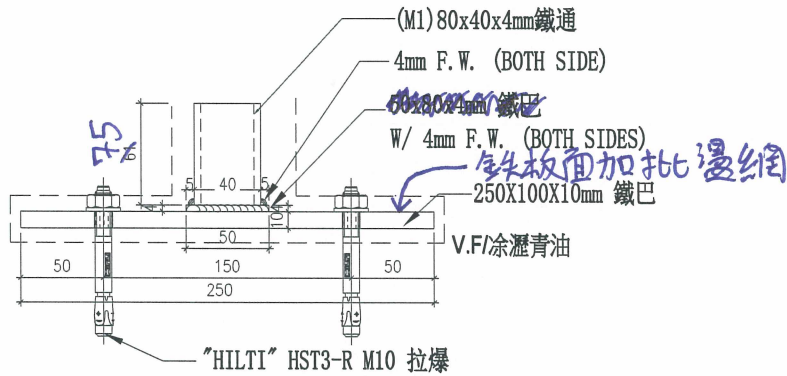

OUTSIDE
TOP PLAN

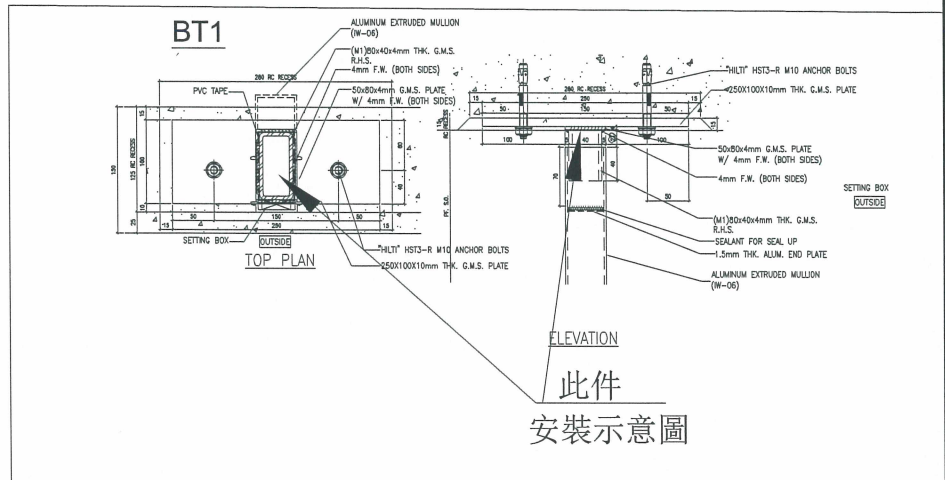

名稱	中企固定鐵件	制圖	謝永林	2023.02.06	修改		
材料	80x40x4mm鐵通/(4mm/10mm)鐵巴	復核	謝永林	2023.02.08	日期		
顏色	熱浸鋅/涂瀝青油	批准	胡哥		圖號	J856-IW-BT1	





美特鋁質有限公司
MIDI Aluminium Fabricator

序號	數量	座數	單位	樓層位置	窗號	施工圖圖號
1	37	T1	B5	3/F-45/F	AW04ai	J856-SD-IW-5114
2	36	T2	B5	5/F-45/F	AW03i	J856-SD-IW-5216
3	1	T3	B5	3/F	AW03iR	J856-SD-IW-5216
4	37	T3	A2	3/F-45/F	AW03i	J856-SD-IW-5318
5	37	T3	B3	3/F-45/F	AW03i	J856-SD-IW-5318
6	37	T3	A9	3/F-45/F	AW04i	J856-SD-IW-5320
7	37	T3	A9	3/F-45/F	AW04i	J856-SD-IW-5320
8	1	T3	SIMPLEX 2B	46/F	AW301	J856-SD-IW-5351
9	1	T3	SIMPLEX 2A	46/F	AW303	J856-SD-IW-5353
合計	224.0					


工程號 J-856 地盤 天榮站

焊接示意件出地盤

地盤用

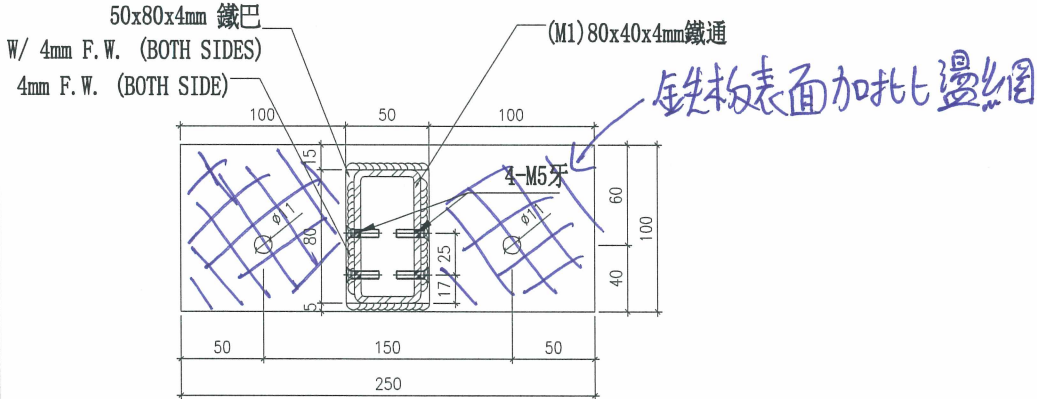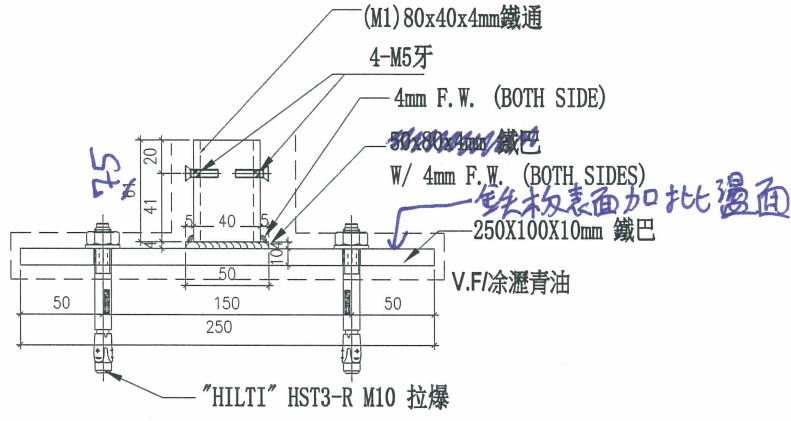

OUTSIDE
BOTTOM PLAN


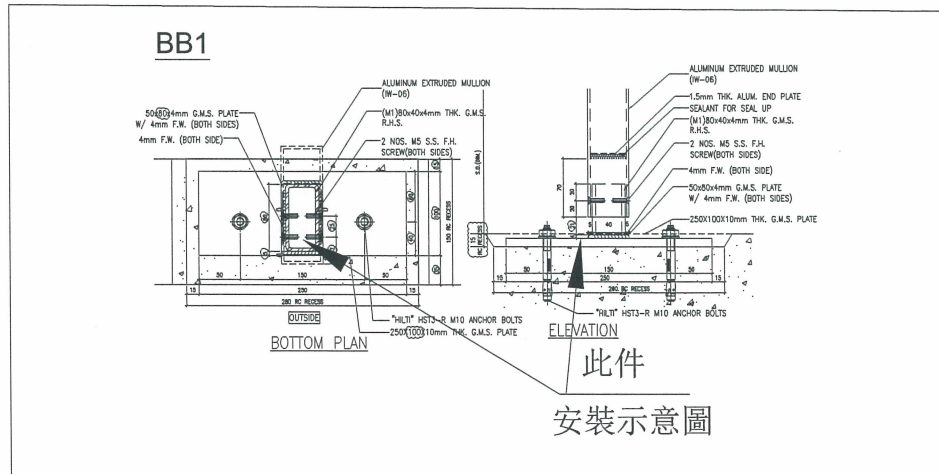


名稱	中企固定鐵件	制圖	謝永林	2023.02.06	修改	
材料	80x40x4mm鐵通/(4mm/10mm)鐵巴	復核	謝永林	2023.02.08	日期	
顏色	熱浸鋅/涂瀝青油	批准	胡哥		圖號	J856-IW-BB1

 美特鋁質有限公司 MIDI Aluminium Fabricator				序號	數量	座數	單位	樓層位置	窗號	施工圖圖號
工程號	J-856	地盤	天榮站	1	8	T1	B3	10/F,16/F,20/F,25/F,29/F,33/F,38/F,42/F	W02iR	J856-SD-W-5116
				2	8	T1	B2	10/F,16/F,20/F,25/F,29/F,33/F,38/F,42/F	W02i	J856-SD-W-5116
				3	8	T3	A3	10/F,16/F,20/F,25/F,29/F,33/F,38/F,42/F	W02iR	J856-SD-W-5321
合計 24.0										

焊接示意件出地盤

地盤用

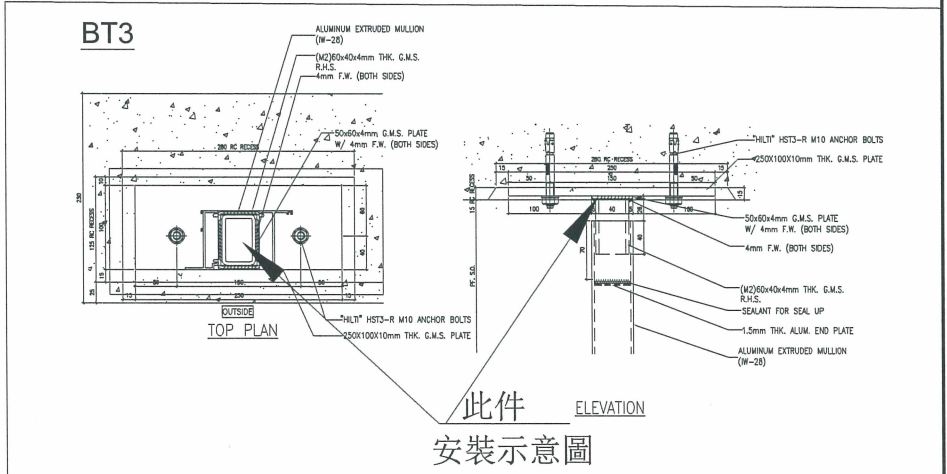
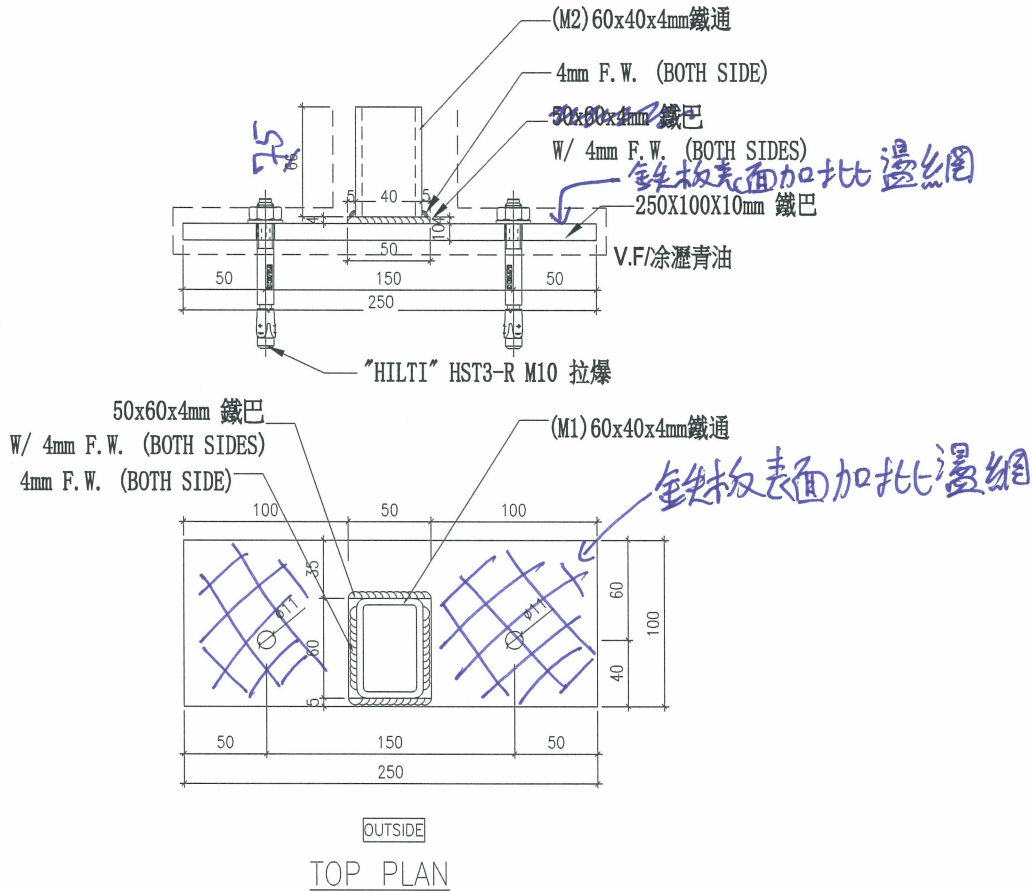


名稱	中企固定鐵件	制圖	謝永林	2023.02.06	修改		
材料	60x40x4mm鐵通/(4mm/10mm)鐵巴	復核	謝永林	2023.02.08	日期		
顏色	熱浸鋅/涂瀝青油	批准	胡哥		圖號	J856-IW-BT3	


 美特鋁質有限公司 MIDI Aluminium Fabricator	序號	數量	座數	單位	樓層位置	窗號	施工圖圖號			
	1	8	T1	B3	10/F,16/F,20/F,25/F,29/F,33/F,38/F,42/F	W02iR	J856-SD-IW-5116			
	2	8	T1	B2	10/F,16/F,20/F,25/F,29/F,33/F,38/F,42/F	W02i	J856-SD-IW-5116			
工程號	J-856	地盤	天榮站	3	8	T3	A3	10/F,16/F,20/F,25/F,29/F,33/F,38/F,42/F	W02iR	J856-SD-IW-5321

焊接示意件出地盤	合計	24.0
----------	----	------

地盤用



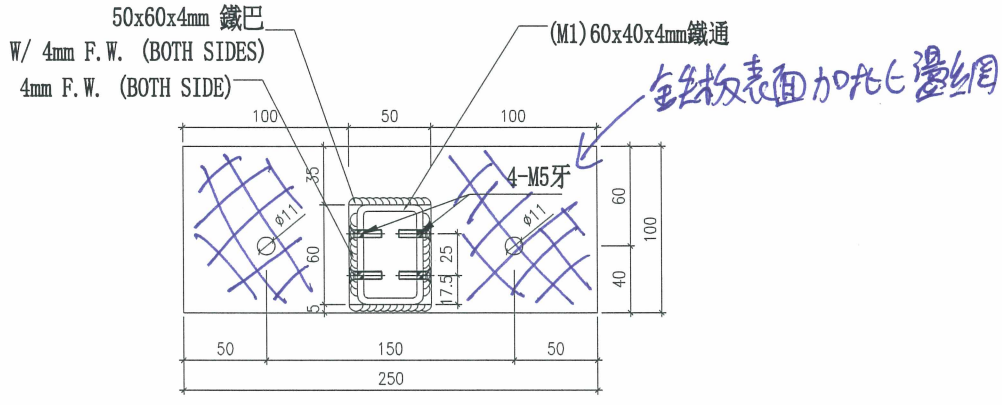
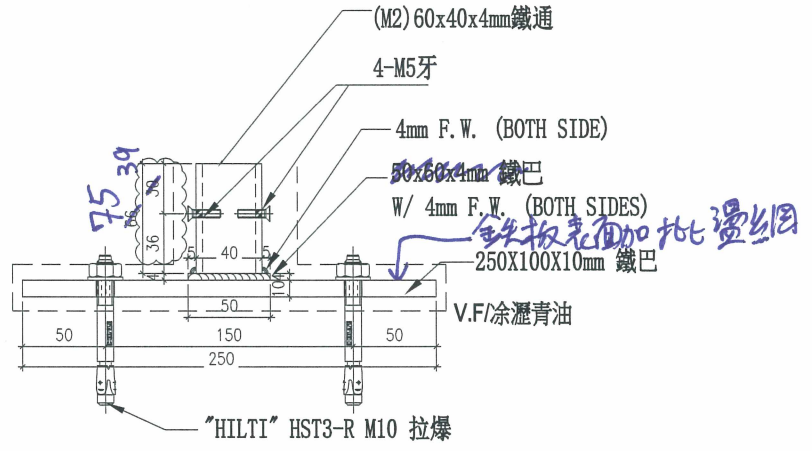


OUTSIDE
BOTTOM PLAN

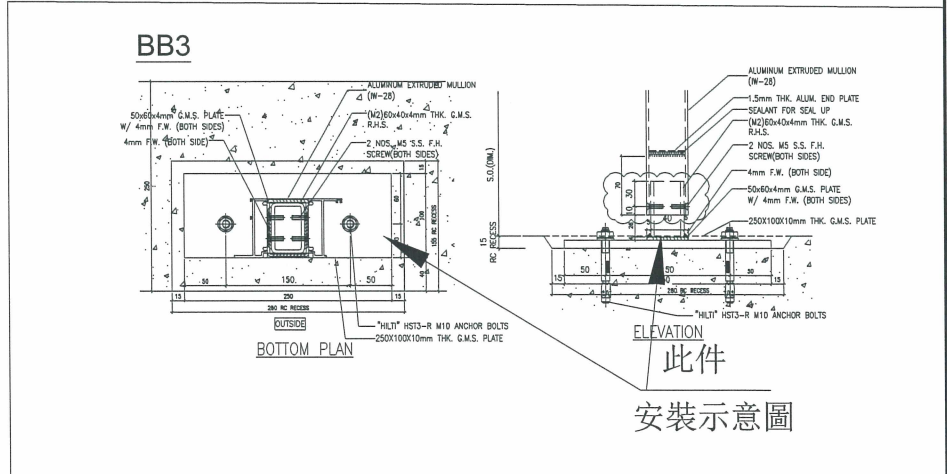

名稱	中企固定鐵件	制圖	謝永林	2023.02.06	修改		
材料	60x40x4mm鐵通/(4mm/10mm)鐵巴	復核	謝永林	2023.02.08	日期		
顏色	熱浸鋅/涂瀝青油	批准	胡哥		圖號	J856-IW-BB3	

LOCATION	REQUIRED	PROVIDED
B2-BR2	0.263	0.420
B3-BR2	0.263	0.420

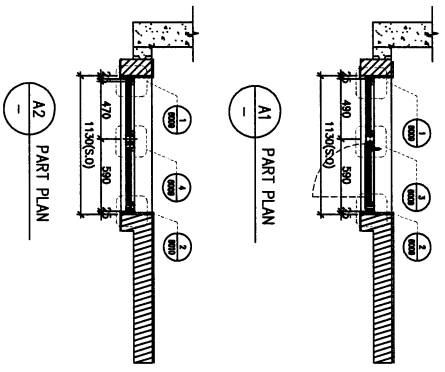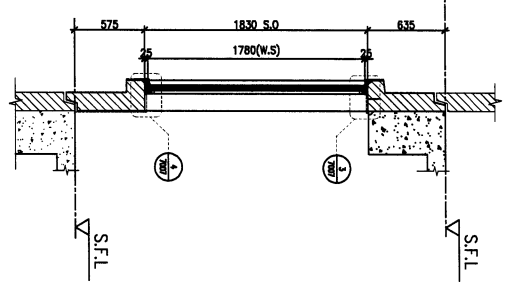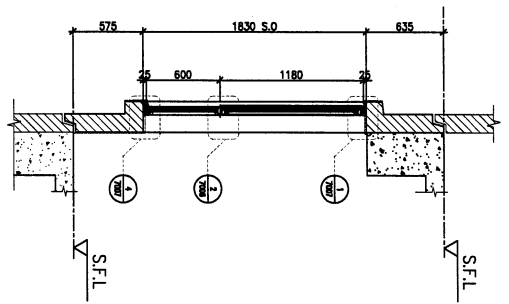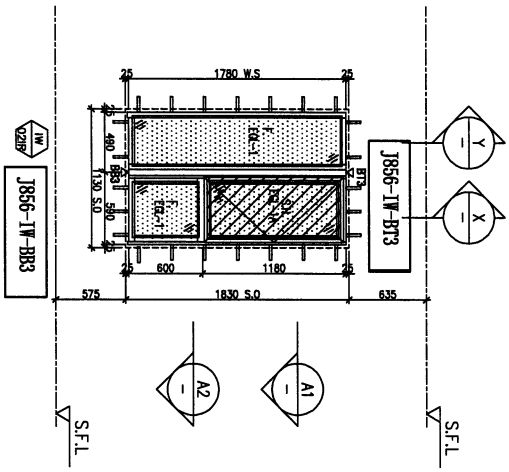

ELEVATION

WINDOW MARK	DESCRIPTION	DESCRIPTION
J856	PRECAST WINDOW CHANGE TO IN-SITU WINDOW	PRECAST WINDOW CHANGE TO IN-SITU WINDOW
LOCATION	10/F, 16/F, 20/F, 25/F, 29/F, 33/F, 38/F, 42/F UNIT B3	10/F, 16/F, 20/F, 25/F, 29/F, 33/F, 38/F, 42/F UNIT B2
GLAZING	70mm ALUM. SECTION	70mm ALUM. SECTION
QUANTITY	EGL-1, EGL-1A	EGL-1, EGL-1A
REMARKS	8 Nos	8 Nos
	70mm ALUM. WINDOW SECTION, 4 BAR HINGE-LIP HING (HHMS-N16)	70mm ALUM. WINDOW SECTION, 4 BAR HINGE-LIP HING (HHMS-N16)

LD. REF :

CLIENT :
SUN HUNG KAI
 REAL ESTATE DEVELOPMENT LTD.




MAIN CONTRACTOR :
怡和建築有限公司
 Yee Ho Fall Building Contractors Ltd.

STRUCTURAL ENGINEER :
ARUP

FRAME CONSULTANT:
ALPHA CONSULTING LIMITED
 Steel Structure & Special Specialist

NOTE:
 1. ALL DIMENSIONS ARE IN MM.
 2. ALL DIMENSIONS ARE VERIFIED FROM COURSE.
 3. BEFORE FABRICATION.
 4. BEFORE ERECTION.

LEGEND:
 Z1 --- DETAIL MARK NO.
 Z2 --- REFER SHEET NO.
 1. F.F.L. --- FINISHED FLOOR LEVEL.
 2. S.F.L. --- STRUCTURAL FLOOR LEVEL.
 3. --- REVERSED DETAIL.
 4. GLASS LEGEND

EA-1 --- 10mmHS+12mm AR 60+10mmTP THK LGLL
 EA-2 --- 10mm THK CRISTAL SUN TINTED GLASS
 EA-4 --- 10mm THK CRISTAL TINTED AND ETCHED GLASS
 EA-14 --- 10mmHS+12mm AR 60+10mmTP THK LGLL
 801/881 --- FRAME DETAIL (DWG. NO. F001)
 882-2 --- FRAME DETAIL (DWG. NO. F002)

GLAZING AREA
 OPENABLE AREA

NO.	DATE	REVISION
1	02-AUG-21	SCALE: 1:40





PROJECT : PROPOSED DEVELOPMENT ABOVE
 TOWER 1 IN-SITU WINDOW

TITLE : WINDOW SCHEDULE FOR
 TOWER 1 IN-SITU WINDOW

DWG. NO. : J-856
 CHECKED BY :
 DRAWN BY : JKH

怡和建築有限公司


LOCATION	OPENABLE AREA	GLAZING AREA	OPENABLE AREA	GLAZING AREA
A3-BH1	0.263	0.420	0.292	1.284

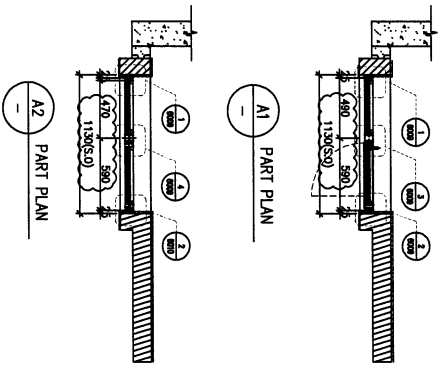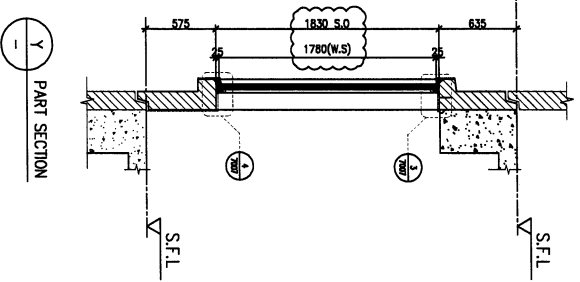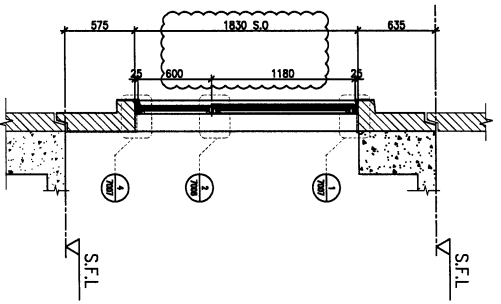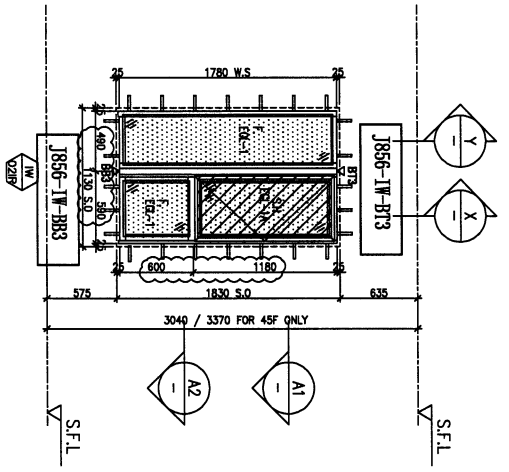

FACADE CODE	
LWK	鴻運 UNIT
PF-02IR	T3PF-05 A3

WINDOW MARK	PRECAST WINDOW CHANGE TO IN-SITU WINDOW
LOCATION	10/F, 16/F, 20/F, 25/F, 29/F, 33/F, 38/F, 42/F UNIT A3
SECTION	70mm ALUM. SECTION
GLAZING	EGL-1, EGL-1A
QUANTITY	8 Nos
REMARKS	FACADE TYPE T3PF02IR FOR 3/F~45/F 4 BAR HINGE-LIP HING (HHMS-N16)

BD. NO. :

CLIENT :

SUN HUNG KAI
REAL ESTATE DEVELOPMENT LTD.
477 King's Road, 47th Floor, The Center, Hong Kong, Hong Kong

ARCHITECT :
hw&partners
HONG KONG

MAIN CONTRACTOR :
怡和建築有限公司
Yee Hee Building Construction Ltd.

STRUCTURAL ENGINEER :
ARUP

FAÇADE CONSULTANT :
ALPHA CONSULTING LIMITED
Steel Structures & Façade Specialist

NOTE :
1. ALL DIMENSIONS ARE IN mm.
2. ALL DIMENSIONS ARE GIVEN FROM OUTSIDE.
3. ALL DIMENSIONS TO BE CHECKED ON SITE BEFORE FABRICATION.

LEGEND :
①1 --- DETAIL MARK NO.
① --- REFER SHEET NO.

1. FF.L. --- FINISHED FLOOR LEVEL
2. S.F.L. --- STRUCTURAL FLOOR LEVEL
3. Ⓞ --- REVERSED DETAIL
4. GLASS LEAD
E24-1 --- 6mmx12mm AIR GAP+10mmTP THK. LGAL.
E24-2 --- 10mm THK. CRYSTAL GRAY TEMPERED GLASS
E24-4 --- 10mm THK. CRYSTAL GRAY TEMPERED AND ETCHED GLASS
E24-1A --- 6mmx12mm AIR GAP+10mmTP THK. LGAL.
E24-1B --- 10mm THK. CRYSTAL GRAY TEMPERED THK. LGAL.
E24-1C --- 10mm THK. CRYSTAL GRAY TEMPERED THK. LGAL.
PROJECT :
TOP-UP DEVELOPMENT ABOVE
1/F OF SAH TUN WING STOP TSMU,
NO.23, AREA 33, TIN SHUI WAI, N.T.


DATE : 02-Aug-21 SCALE : 1:40
DRAWN BY : Ivan CHECKED BY :
JOB NO. : J-0566






WINDOW MARK	AR 307
LOCATION	46/F UNIT SIMPLEX 2B LV/DIN. AT TOWER 3
SECTION	70mm ALUM. SECTION
GLAZING	EGL-1A
QUANTITY	1 NO.
REMARKS	-

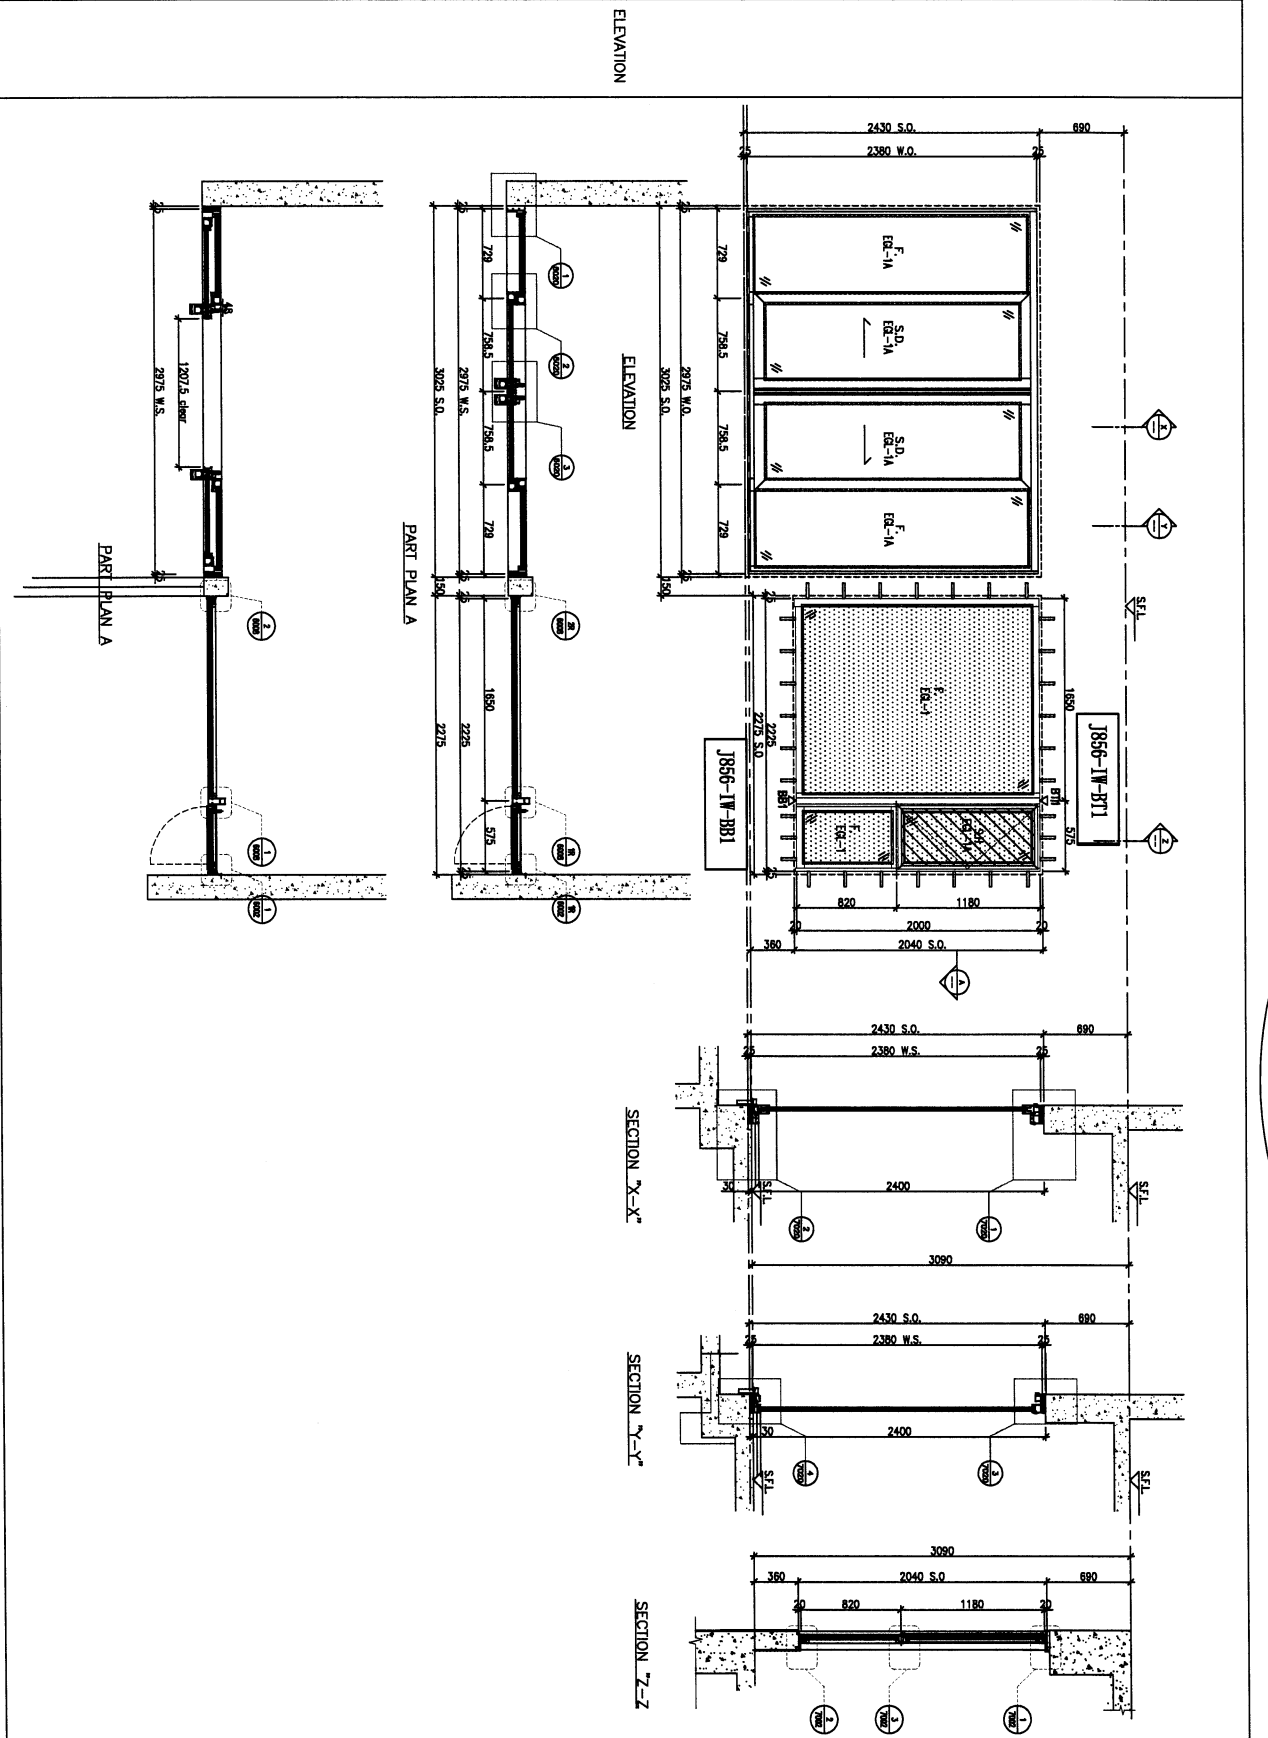

<p>CLIENT : SUN HUNG KAI REAL ESTATE DEVELOPMENT LTD. 42/F, 43/F, 44/F, 100/F</p>	<p>ARCHITECT : IWK&partners INCORPORATED 10/F, 11/F, 12/F, 100/F</p>	<p>MAIN CONTRACTOR : Yee Kee Construction Ltd. 怡和建築有限公司</p>	<p>STRUCTURAL ENGINEER : ARUP ALPHA CONSULTING LIMITED Steel Structure & Special Structures</p>	<p>DATE : 02-Aug-21 SCALE : 1:40 DRAWN BY : Ivan CHECKED BY :</p>	<p>PROJECT : PROPOSED DEVELOPMENT ABOVE LOT 1007 BAY TUN WING STOP TSMU, NO.23, AREA 33, TIN SHUI WAI, N.T. TITLE : WINDOW SCHEDULE FOR TOWER 3 IN-STTU WINDOW</p>	<p>JOB NO. : J-856 DATE : 02-Aug-21 SCALE : 1:40 DRAWN BY : Ivan CHECKED BY :</p>	<p>REVISIONS :</p> <table border="1"> <tr> <th>NO.</th> <th>DATE</th> <th>DESCRIPTION</th> </tr> <tr> <td>1</td> <td></td> <td></td> </tr> </table>	NO.	DATE	DESCRIPTION	1		
NO.	DATE	DESCRIPTION											
1													

NOTE: 1. ALL DIMENSIONS ARE IN MM. 2. ALL DIMENSIONS ARE VERIFIED FROM OUTSIDE. 3. BEFORE FABRICATION. 4. GLASS LEAD. 5. EGL-1A-12mm-12mm AR 04P+10mm TPK LGU. 6. EGL-2-10mm TPK CRISTAL ONLY TEMPERED GLASS. 

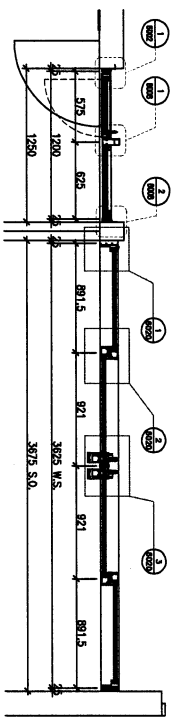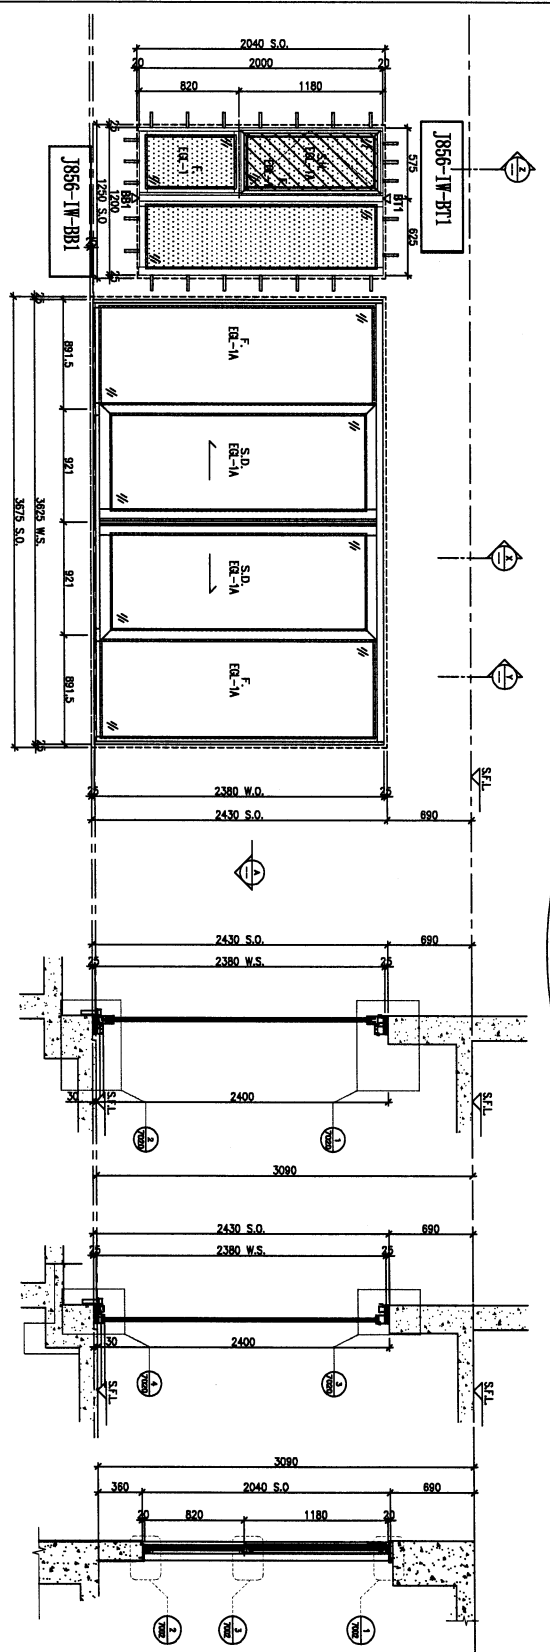

PART PLAN A

ELEVATION

ELEVATION

SECTION 'X-X'

SECTION 'Y-Y'

SECTION 'Z-Z'

WINDOW MARK	J856
LOCATION	48/F UNIT SIMPLEX 2A LV/DIN. AT TOWER 3
SECTION	70mm ALUM. SECTION
GLAZING	EGL-1A
QUANTITY	1 NO.
REMARKS	-

1. ALL DIMENSIONS ARE IN MM.
2. ALL DIMENSIONS ARE VERIFIED FROM OUTSIDE BEFORE FABRICATION.
3. REVERSED DETAIL.

NOTE:
1. ALL DIMENSIONS ARE IN MM.
2. ALL DIMENSIONS ARE VERIFIED FROM OUTSIDE BEFORE FABRICATION.
3. REVERSED DETAIL.

LEGEND:
1. DETAIL MARK NO.
2. REFER SHEET NO.
3. FINISHED FLOOR LEVEL
4. STRUCTURAL FLOOR LEVEL
5. REVERSED DETAIL
6. GLASS LEGEND
EGL-1--6mmx12mm AIR GAP+10mmTP THK LGLL
EGL-2--10mm THK CRISTAL SUN TEmPERED GLASS
EGL-4--10mm THK CRISTAL TEmPERED AND EXED GLASS
EGL-1A--6mmx12mm AIR GAP+10mmTP THK LGLL
EGL-1B--10mm THK CRISTAL TEmPERED THK LGLL
EGL-2A--10mm THK CRISTAL TEmPERED THK LGLL
EGL-2B--10mm THK CRISTAL TEmPERED THK LGLL
EGL-4A--10mm THK CRISTAL TEmPERED AND EXED GLASS
EGL-4B--10mm THK CRISTAL TEmPERED AND EXED GLASS
PROJECT: PROPOSED DEVELOPMENT ABOVE
NO.23, AREA 33, TIN SHUI WAN, N.T.
DATE: 02-AUG-21 SCALE: 1:40
DRAWN BY: FIONA CHECKED BY:
SUN HUNG KAI
HEAD ESTIMATE/FABRICATION
ARCHITECT: IWK&PARTNERS
IWK&PARTNERS
MAIN CONTRACTOR: 怡和建築有限公司
YEE FOI BUILDING CONTRACTORS LTD.
STRUCTURAL ENGINEER: ARUP
ARUP
ALPHA CONSULTING LIMITED
Steel Structure & Head Specification


