美特鋁質有限公司
MIDI ALUMINIUM FABRICATOR LTD.

工程指示 / 要求簡箋 ENGINEER INSTRUCTIONS(E.I.)

工程指示編號:	EI- 6909 A	**修改版本:**	A
	HK- 2710		
工程編號:	J 856	**工程名稱:**	天榮站
收件人:	生統/林仁安	**發件人:**	Iris
工程項目:	Curtain Wall 9th Shop Drawing拆圖用 (修改A)	**日期:**	23/11/2023

☑ 原合約工程包	☐ 原合約工程加 / 減賬 QT-	☐ 新工程報價 QT-

信件批核號碼/圖紙參考編號:	**批核模具圖紙編號:**
客戶指示附件:	**管理內部批簽署:**

☐ 初步鋁料 B.M.	☐ 加工拆圖，然後生產	☐ 尺寸表
☐ 正式鋁料 B.M.	☐ 技術上資料／指示	☐ 報價
☐ 配件 B.M.	☐ 樣辦或貨品說明書	☐ 分判合約
☐ 其他:		

內容:
Curtain Wall 9th Shop Drawing拆圖用 (修改A)
請按附件的Shop Drawing更改加工圖以及拆圖

完成上列要求日期: 28/11/2023


國內

☐ 生產技術總監	☐ 連附件	☑ 技術部	☑ 連附件	☐ 生產部	☐ 連附件
☐ 採購部	☐ 連附件	☑ 生產統籌部	☑ 連附件	☐ 報關組	☐ 連附件
☐ 質檢部	☐ 連附件	☐ 會計部	☐ 連附件	☐ 機械設計部	☐ 連附件
☐ 香港辦	☐ 連附件	☐ 其他:			

香港

☐ 行政部	☐ 連附件	☐ 會計部	☐ 連附件	☐ 統籌部	☐ 連附件	☐ 工程部	☐ 連附件
☐ 採購部	☐ 連附件	☐ QS部	☐ 連附件	☑ 地盤管理	☑ 連附件	☐ 維修部	☐ 連附件

*發件人簽署： Iris	*組別成員批核簽署：
傳遞編號：	項目經理簽署：

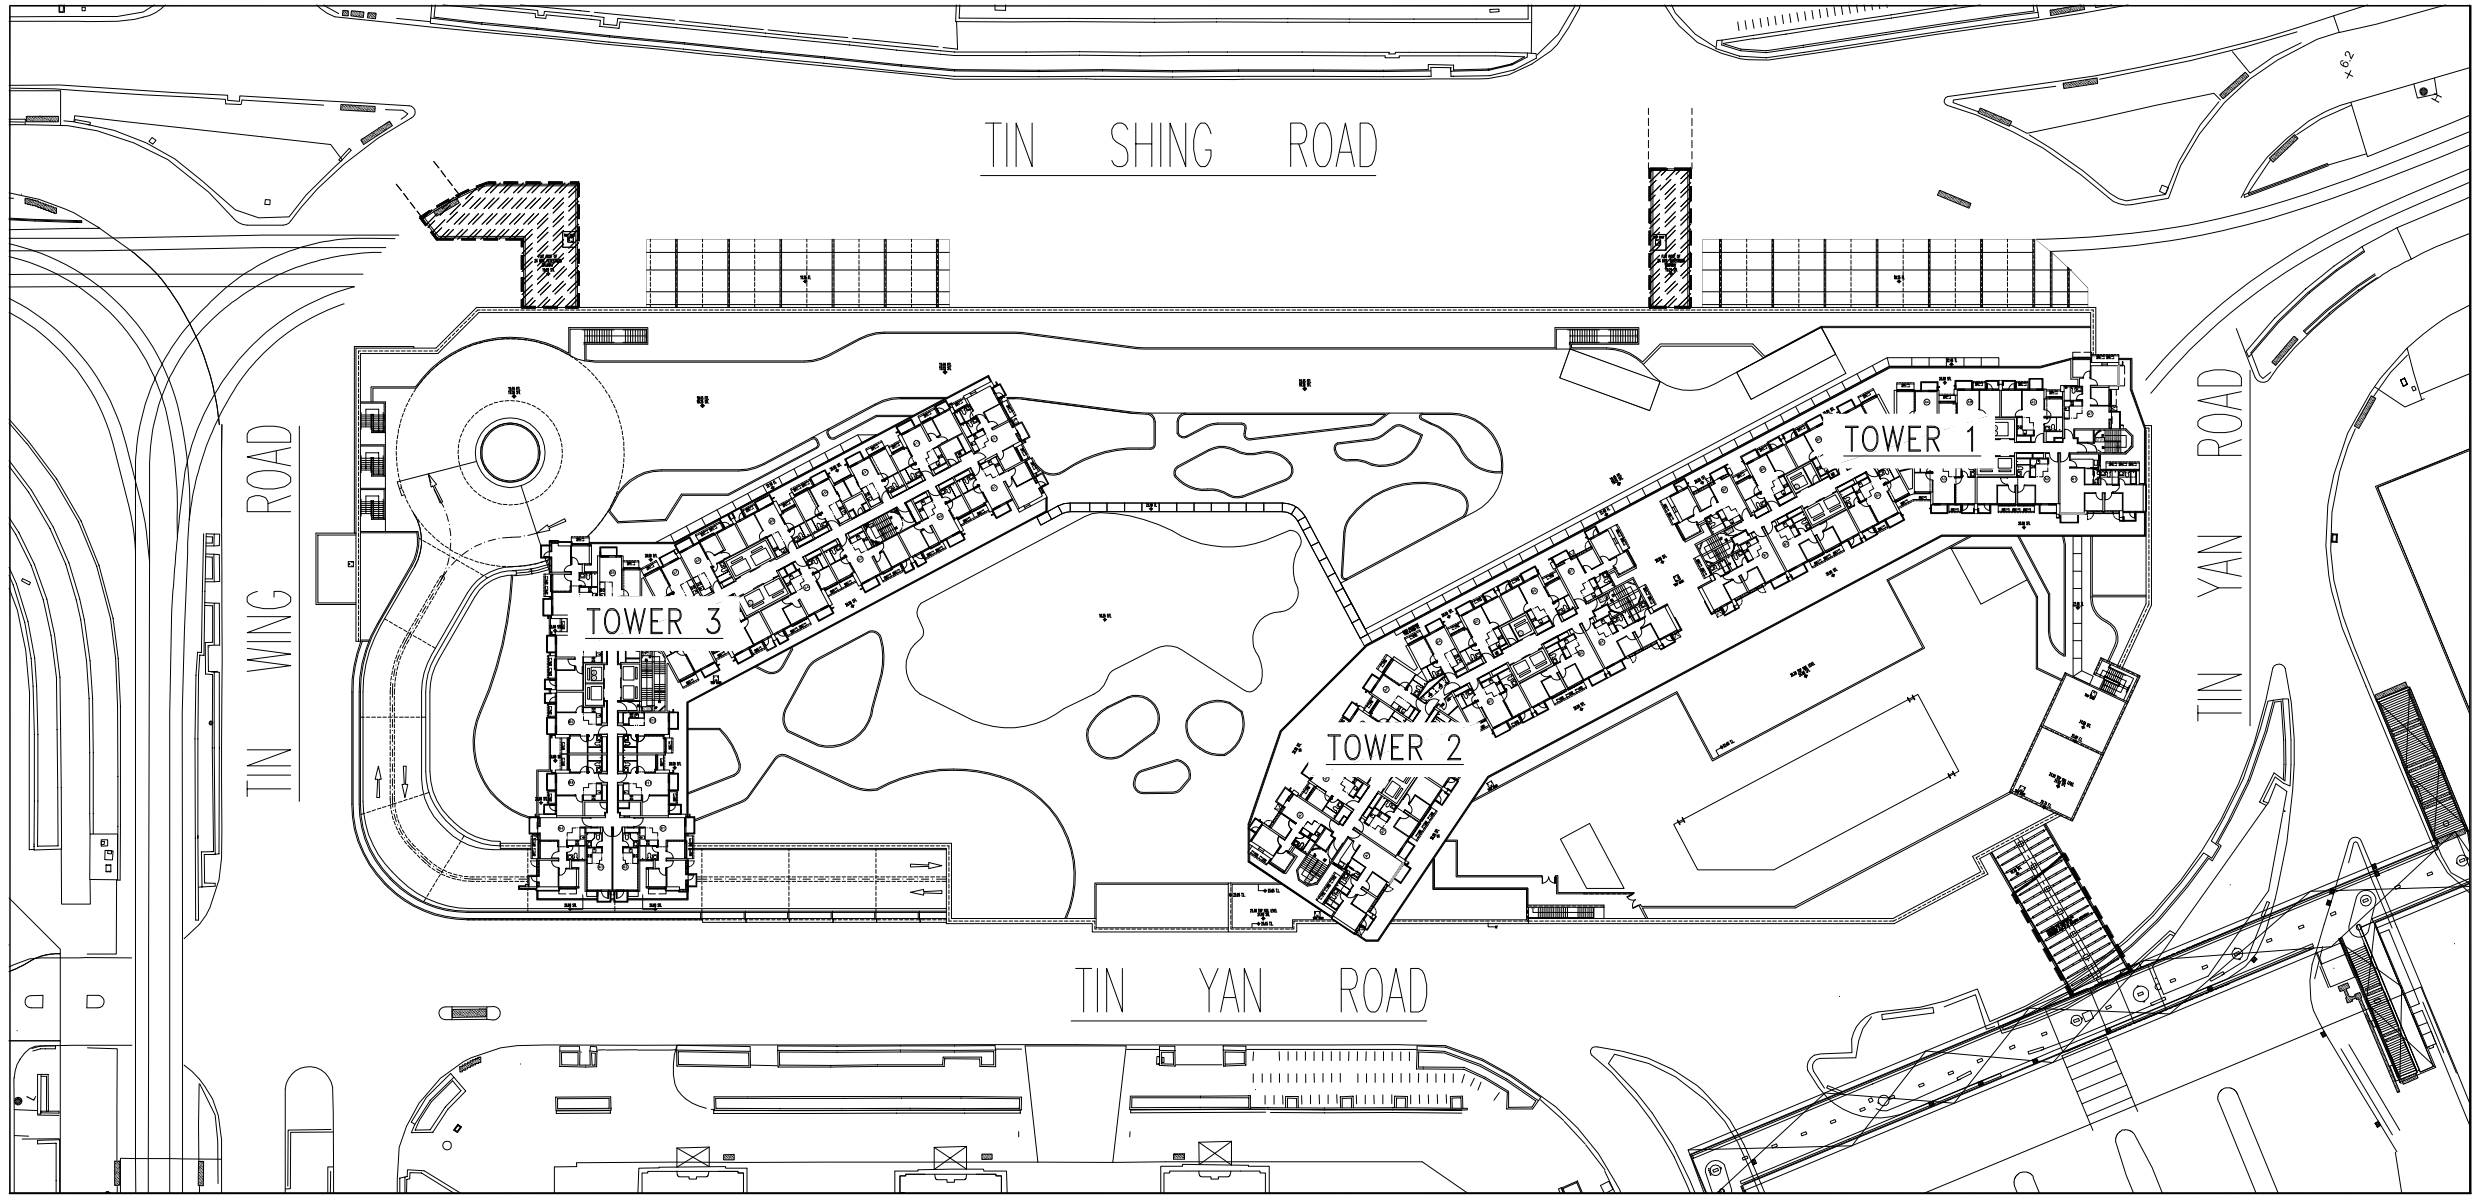

PROJECT : PROPOSED DEVELOPMENT ABOVE LIGHT RAIL TIN WING STOP,TSWTL
NO.23,AREA 33,TIN SHUI WAI, N.T.

9

TITLE : CURTAIN WALL
9TH SD DRAWING

DATE: 23-NOV-2023

美特鋁質有限公司
MIDI ALUMINIUM FABRICATOR LTD.
Units 6-8, Sunray Industrial Centre, 1/F
610 Cha Kwo Ling Road, Kowloon
Tel:23489211-4 Fax:(852)27727666

DWG NO. : J856-SD-CW-0000 | REV. : 1

DRAWING SUBMISSION REGISTER

PROJECT:
PROPOSED DEVELOPMENT ABOVE LIGHT RAIL TIN WING STOP,TSWTL NO.23,AREA 33,TIN SHUI WAI, N.T.

TITLE:
9TH SHOPDRAWING FOR CURTAIN WALL

DATE OF ISSUE										
ISSUE	01	2r1	03	04	4r 2	05	06	07	8r1	09
DAY	23	30	13	10	03	10	31	22	04	23
MONTH	11	12	01	03	04	05	05	08	10	11
YEAR	22	22	23	23	23	23	23	23	23	23

SUBMISSION STATE (FOR B.D / A.S.D)
AP - APPROVED
AC - APPROVED SUB. TO CONDITION
NA - NOT APPROVED

SUBMISSION STATE (FOR CLIENT / CONSULTANT)
AP - APPROVED
AC - APPROVED SUB. TO CONDITION
NA - NOT APPROVED

SUBMISSION STATE (FOR ARCHITECT)
AP - APPROVED
AC - APPROVED SUB. TO CONDITION
NA - NOT APPROVED

FABRICATION / CONSTRUCTION STATE: ISSUE TO CHINA OFFICE; ISSUE TO SITE; ISSUE TO SUB-CONTRACTOR

DRAWING TITLE	DWG. NO.	REVISIONS										B.D / A.S.D			CLIENT / CONSULTANT			ARCHITECT			CHINA OFFICE		SITE		SUB-CONTRACTOR	
												COMMENT DATE	REV.	STATE	COMMENT DATE	REV.	STATE	COMMENT DATE	REV.	STATE	REV.	DATE	REV.	DATE	REV.	DATE
COVER PAGE	J856-SD-CW-0000	-	A	B	C	D	E	F	G	H	I															
DRAWING REGISTER	J856-SD-CW-0001	-	A	B	C	C	D	E	F	G	H															
DRAWING REGISTER	J856-SD-CW-0002	-	A	B	C	C	D	E	F	G	H															
DRAWING REGISTER	J856-SD-CW-0003				C	C	D	E	F	G	H															
DRAWING REGISTER	J856-SD-CW-0004								-	A	H															
GENERAL NOTE FOR CURTAIN WALL	J856-SD-CW-1001	-	A	A	B	B	C	D	E	F	G															
SECTION PROPERTIES	J856-SD-CW-1101		-	-	-	-	-	-	C	C	C															
SECTION PROPERTIES	J856-SD-CW-1102		-	-	-	-	-	-	C	C	C															
SECTION PROPERTIES	J856-SD-CW-1103	-	A	A	A	A	A	A	C	C	C															
SECTION PROPERTIES	J856-SD-CW-1104	-	A	A	B	B	B	B	C	C	D															
SECTION PROPERTIES	J856-SD-CW-1105		-	-	A	A	A	A	C	C	D															
PART LIST	J856-SD-CW-1106					-	-	-	A	B	B															
CAST-IN EMBED DETAIL FOR CURTAIN WALL	J856-SD-CW-2001	-	A	B	B	B	B	B	B	B	B															
LAYOUT PLAN FOR CURTAIN WALL @ TOWER 1 (3/F)	J856-SD-CW-3001	-	A	A	B	B	B	B	B	B	B															
LAYOUT PLAN FOR CURTAIN WALL @ TOWER 2 (3/F)	J856-SD-CW-3002	-	-	-	-	-	-	-	-	B	B															
LAYOUT PLAN FOR CURTAIN WALL @ TOWER 3 (3/F)	J856-SD-CW-3003	-	A	B	B	B	B	B	B	C	C															
LAYOUT PLAN FOR CURTAIN WALL @ TOWER 1 (TYP)	J856-SD-CW-3004	-	A	A	B	B	B	B	B	C	C															
LAYOUT PLAN FOR CURTAIN WALL @ TOWER 2 (TYP)	J856-SD-CW-3005		-	-	-	-	-	-	-	A	A															
LAYOUT PLAN FOR CURTAIN WALL @ TOWER 3 (TYP)	J856-SD-CW-3006	-	A	B	B	B	B	B	B	C	C															
LAYOUT PLAN FOR CURTAIN WALL @ TOWER 1 (46/F)	J856-SD-CW-3007		-	A	B	B	B	B	C	C	C															
LAYOUT PLAN FOR CURTAIN WALL @ TOWER 2 (46/F)	J856-SD-CW-3008		-	A	B	B	B	B	C	C	C															
LAYOUT PLAN FOR CURTAIN WALL @ TOWER 3 (46/F)	J856-SD-CW-3009	-	A	B	B	B	B	B	C	C	C															
LAYOUT PLAN FOR ALUM FEATURE @ TOWER 1 (46/F)	J856-SD-CW-3010								-	-	A															
LAYOUT PLAN FOR ALUM FEATURE @ TOWER 2 (46/F)	J856-SD-CW-3011								-	-	A															
LAYOUT PLAN FOR ALUM FEATURE @ TOWER 3 (46/F)	J856-SD-CW-3012								-	A	B															
LAYOUT PLAN FOR GLASS CLADDING @ TOWER 1 (ROOF/F)	J856-SD-CW-3013								-	-	-															
LAYOUT PLAN FOR GLASS CLADDING @ TOWER 2 (ROOF/F)	J856-SD-CW-3014								-	-	-															
LAYOUT PLAN FOR GLASS CLADDING @ TOWER 3 (ROOF/F)	J856-SD-CW-3015								-	-	-															
LAYOUT PLAN FOR ALUM FEATURE @ TOWER 1 (ROOF/F)	J856-SD-CW-3016								-	A	B															
LAYOUT PLAN FOR ALUM FEATURE @ TOWER 2 (ROOF/F)	J856-SD-CW-3017								-	A	B															
LAYOUT PLAN FOR ALUM FEATURE @ TOWER 3 (ROOF/F)	J856-SD-CW-3018								-	A	B															
PART ELEV & PLAN & SECTION FOR CURTAIN WALL @ TOWER 1 (TYPICAL)	J856-SD-CW-4001	-	A	B	C	C	D	D	E	E	E															
PART ELEV & PLAN & SECTION FOR CURTAIN WALL @ TOWER 1 (TYPICAL)	J856-SD-CW-4002	-	A	B	C	C	D	D	E	E	E															
PART ELEV & PLAN & SECTION FOR CURTAIN WALL @ TOWER 1 (TYPICAL)	J856-SD-CW-4002A		-	-	A	A	B	B	C	C	C															
PART ELEV & PLAN & SECTION FOR CURTAIN WALL @ TOWER 2 (TYPICAL)	J856-SD-CW-4003	-	A	B	C	C	D	D	E	F	F															
PART ELEV & PLAN & SECTION FOR CURTAIN WALL @ TOWER 2 (TYPICAL)	J856-SD-CW-4004	-	A	B	C	C	D	D	E	F	F															
PART ELEV & PLAN & SECTION FOR CURTAIN WALL @ TOWER 3 (TYPICAL)	J856-SD-CW-4005	-	A	B	C	C	D	D	E	F	F															
PART ELEV & PLAN & SECTION FOR CURTAIN WALL @ TOWER 3 (TYPICAL)	J856-SD-CW-4006	-	A	B	C	C	D	D	E	F	F															
PART ELEV & PLAN & SECTION FOR CURTAIN WALL @ TOWER 1 SU (46/F)	J856-SD-CW-4007	-	A	A	B	B	B	B	C	C	D															
PART ELEV & PLAN & SECTION FOR CURTAIN WALL @ TOWER 1 SU (46/F)	J856-SD-CW-4008	-	A	A	B	B	B	B	C	C	D															
PART ELEV & PLAN & SECTION FOR CURTAIN WALL @ TOWER 2 SU (46/F)	J856-SD-CW-4009	-	A	A	B	B	B	B	C	C	D															
PART ELEV & PLAN & SECTION FOR CURTAIN WALL @ TOWER 2 SU (46/F)	J856-SD-CW-4010	-	A	A	B	B	B	B	C	C	D															
PART ELEV & PLAN & SECTION FOR CURTAIN WALL @ TOWER 3 SU (46/F)	J856-SD-CW-4011	-	A	A	B	B	B	B	C	C	D															
PART PLAN FOR CURTAIN WALL @ TOWER 1 (TYPICAL)	J856-SD-CW-5001	-	A	B	C	C	D	D	E	E	E															

IN-HOUSE DESIGN CHECKER

美特鋁質有限公司
MIDI ALUMINIUM FABRICATOR LTD.
Units 6-8, Sunray Industrial Centre, 1/F
610 Cha Kwo Ling Road, Kowloon
Tel:23489211-4 Fax:(852)27727666

J856-SD-CW-0001 | REV. : H

DRAWING SUBMISSION REGISTER

PROJECT:
PROPOSED DEVELOPMENT ABOVE LIGHT RAIL TIN WING STOP,TSWTL NO.23,AREA 33,TIN SHUI WAI, N.T.
TITLE:
9TH SHOPDRAWING FOR CURTAIN WALL

DATE OF ISSUE										
ISSUE	01	2r1	03	04	4r2	05	06	07	8r1	09
DAY	23	30	13	10	03	10	31	22	04	23
MONTH	11	12	01	03	04	05	05	08	10	11
YEAR	22	22	23	23	23	23	23	23	23	23

SUBMISSION STATE (FOR B.D / A.S.D)

AP - APPROVED
AC - APPROVED SUB. TO CONDITION
NA - NOT APPROVED

SUBMISSION STATE (FOR CLIENT / CONSULTANT)

AP - APPROVED
AC - APPROVED SUB. TO CONDITION
NA - NOT APPROVED

SUBMISSION STATE (FOR ARCHITECT)

AP - APPROVED
AC - APPROVED SUB. TO CONDITION
NA - NOT APPROVED

FABRICATION / CONSTRUCTION STATE

ISSUE TO CHINA OFFICE
ISSUE TO SITE
ISSUE TO SUB-CONTRACTOR

DRAWING TITLE	DWG. NO.	REVISIONS										B.D / A.S.D			CLIENT / CONSULTANT			ARCHITECT			CHINA OFFICE		SITE		SUB-CONTRACTOR	
												COMMENT DATE	REV.	STATE	COMMENT DATE	REV.	STATE	COMMENT DATE	REV.	STATE	REV.	DATE	REV.	DATE	REV.	DATE
PART PLAN FOR CURTAIN WALL @ TOWER 2 (TYPICAL)	J856-SD-CW-5002	-	A	B	C	C	D	D	E	E	E															
PART PLAN FOR CURTAIN WALL @ TOWER 3 (TYPICAL)	J856-SD-CW-5003	-	A	B	C	C	D	D	E	E	E															
PART PLAN FOR CURTAIN WALL @ TOWER 1 SU (46/F)	J856-SD-CW-5004				-	-	-	-	A	A	A															
PART PLAN FOR CURTAIN WALL @ TOWER 1 SU (46/F)	J856-SD-CW-5005				-	-	A	A	B	B	B															
PART PLAN FOR CURTAIN WALL @ TOWER 2 SU (46/F)	J856-SD-CW-5006				-	-	-	-	A	A	A															
PART PLAN FOR CURTAIN WALL @ TOWER 2 SU (46/F)	J856-SD-CW-5007				-	-	-	-	A	A	A															
PART PLAN FOR CURTAIN WALL @ TOWER 3 SU (46/F)	J856-SD-CW-5008				-	-	-	-	A	A	A															
TYPICAL DETAIL FOR CURTAIN WALL	J856-SD-CW-8001		-	-	A	A	A	A	A	A	A															
TYPICAL DETAIL FOR CURTAIN WALL	J856-SD-CW-8002	-	A	A	B	B	C	D	D	D	D															
TYPICAL DETAIL FOR CURTAIN WALL	J856-SD-CW-8002A			-	-	-	-	-	-	-	-															
TYPICAL DETAIL FOR CURTAIN WALL	J856-SD-CW-8003		-	-	A	A	A	A	A	A	A															
TYPICAL DETAIL FOR CURTAIN WALL	J856-SD-CW-8004	-	A	B	C	C	D	E	E	E	E															
TYPICAL DETAIL FOR CURTAIN WALL	J856-SD-CW-8005	-	-	A	B	B	B	B	B	B	B															
TYPICAL DETAIL FOR CURTAIN WALL	J856-SD-CW-8006	-	A	B	C	C	D	E	E	E	E															
TYPICAL DETAIL FOR CURTAIN WALL	J856-SD-CW-8007	-	A	A	B	B	C	C	C	C	C															
TYPICAL DETAIL FOR CURTAIN WALL	J856-SD-CW-8008	-	A	A	B	B	C	D	D	D	D															
TYPICAL DETAIL FOR CURTAIN WALL	J856-SD-CW-8008A			-	A	A	B	B	B	B	C															
TYPICAL DETAIL FOR CURTAIN WALL	J856-SD-CW-8009	-	A	A	B	B	C	C	C	C	D															
TYPICAL DETAIL FOR CURTAIN WALL	J856-SD-CW-8010	-	A	A	B	B	C	D	D	D	D															
TYPICAL DETAIL FOR CURTAIN WALL	J856-SD-CW-8011	-	A	A	B	B	C	C	C	C	C															
TYPICAL DETAIL FOR CURTAIN WALL	J856-SD-CW-8012		-	-	A	A	A	A	A	A	A															
TYPICAL DETAIL FOR CURTAIN WALL	J856-SD-CW-8013	-	A	A	B	B	B	B	B	B	B															
TYPICAL DETAIL FOR CURTAIN WALL	J856-SD-CW-8014	-	A	A	B	B	B	B	B	B	B															
TYPICAL DETAIL FOR CURTAIN WALL	J856-SD-CW-8015	-	A	A	B	B	B	B	B	B	B															
TYPICAL DETAIL FOR CURTAIN WALL	J856-SD-CW-8016	-	A	DEL																						
TYPICAL DETAIL FOR CURTAIN WALL	J856-SD-CW-8017	-	A	DEL																						
TYPICAL DETAIL FOR CURTAIN WALL	J856-SD-CW-8018	-	A	A	B	B	B	B	C	DEL																
TYPICAL DETAIL FOR CURTAIN WALL	J856-SD-CW-8018A				-	-	-	-	A	DEL																
TYPICAL DETAIL FOR CURTAIN WALL	J856-SD-CW-8019	-	A	A	B	B	B	B	C	DEL																
TYPICAL DETAIL FOR CURTAIN WALL	J856-SD-CW-8019A				-	-	-	-	A	DEL																
TYPICAL DETAIL FOR CURTAIN WALL	J856-SD-CW-8020	-	A	B	C	C	C	C	C	C	C															
TYPICAL DETAIL FOR CURTAIN WALL	J856-SD-CW-8020A			-	A	A	A	A	A	A	A															
TYPICAL DETAIL FOR CURTAIN WALL	J856-SD-CW-8020B			-	-	-	-	-	-	-	-															
TYPICAL DETAIL FOR CURTAIN WALL	J856-SD-CW-8021			-	A	A	A	B	B	B	B															
TYPICAL DETAIL FOR CURTAIN WALL	J856-SD-CW-8022				-	-	A	B	B	B	B															
TYPICAL DETAIL FOR CURTAIN WALL	J856-SD-CW-8023				-	-	A	A	A	A	A															
TYPICAL DETAIL FOR CURTAIN WALL	J856-SD-CW-8024				-	-	A	B	B	B	B															
TYPICAL DETAIL FOR CURTAIN WALL	J856-SD-CW-8025				-	-	A	A	A	A	A															
TYPICAL DETAIL FOR CURTAIN WALL	J856-SD-CW-8026				-	-	-	-	-	-	-															
TYPICAL DETAIL FOR CURTAIN WALL	J856-SD-CW-8027				-	-	A	A	A	A	A															
TYPICAL DETAIL FOR CURTAIN WALL	J856-SD-CW-8028				-	-	A	B	B	B	B															
TYPICAL DETAIL FOR CURTAIN WALL	J856-SD-CW-8029				-	-	A	A	A	A	A															
TYPICAL DETAIL FOR CURTAIN WALL	J856-SD-CW-8030				-	-	A	B	C	C	C															
TYPICAL DETAIL FOR CURTAIN WALL	J856-SD-CW-8031				-	-	A	A	A	A	A															

IN-HOUSE DESIGN CHECKER

美特鋁質有限公司
MIDI ALUMINIUM FABRICATOR LTD.
Units 6-8, Sunray Industrial Centre, 1/F
610 Cha Kwo Ling Road, Kowloon
Tel:23489211-4 Fax:(852)27727666

DWG NO. : J856-SD-CW-0002 | REV. : H

DRAWING SUBMISSION REGISTER

PROJECT:
PROPOSED DEVELOPMENT ABOVE LIGHT RAIL TIN WING STOP,TSWTL NO.23,AREA 33,TIN SHUI WAI, N.T.
TITLE:
9TH SHOPDRAWING FOR CURTAIN WALL

DATE OF ISSUE										
ISSUE	01	2r1	03	04	4r 2	05	06	07	8r1	09
DAY	23	30	13	10	03	10	31	22	04	23
MONTH	11	12	01	03	04	05	05	08	10	11
YEAR	22	22	23	23	23	23	23	23	23	23

SUBMISSION STATE (FOR B.D / A.S.D)
AP - APPROVED
AC - APPROVED SUB. TO CONDITION
NA - NOT APPROVED

SUBMISSION STATE (FOR CLIENT / CONSULTANT)
AP - APPROVED
AC - APPROVED SUB. TO CONDITION
NA - NOT APPROVED

SUBMISSION STATE (FOR ARCHITECT)
AP - APPROVED
AC - APPROVED SUB. TO CONDITION
NA - NOT APPROVED

FABRICATION / CONSTRUCTION STATE

DRAWING TITLE	DWG. NO.	REVISIONS										SUBMISSION STATE (FOR B.D / A.S.D)			SUBMISSION STATE (FOR CLIENT / CONSULTANT)			SUBMISSION STATE (FOR ARCHITECT)			FABRICATION / CONSTRUCTION STATE: ISSUE TO CHINA OFFICE		ISSUE TO SITE		ISSUE TO SUB-CONTRACTOR	
												COMMENT DATE	REV.	STATE	COMMENT DATE	REV.	STATE	COMMENT DATE	REV.	STATE	REV.	DATE	REV.	DATE	REV.	DATE
TYPICAL DETAIL FOR CURTAIN WALL	J856-SD-CW-8032				-	-	A	A	A	A	A															
TYPICAL DETAIL FOR CURTAIN WALL	J856-SD-CW-8033				-	-	A	A	A	A	A															
TYPICAL DETAIL FOR CURTAIN WALL	J856-SD-CW-8034				-	-	A	A	A	A	A															
TYPICAL DETAIL FOR CURTAIN WALL	J856-SD-CW-8035				-	-	A	B	B	B	D															
TYPICAL DETAIL FOR CURTAIN WALL	J856-SD-CW-8036				-	-	A	A	A	A	A															
TYPICAL DETAIL FOR CURTAIN WALL	J856-SD-CW-8037				-	-	A	A	A	A	A															
TYPICAL DETAIL FOR CURTAIN WALL	J856-SD-CW-8038				-	-	-	-	-	-	-															
TYPICAL DETAIL FOR CURTAIN WALL	J856-SD-CW-8039				-	-	-	-	-	-	-															
TYPICAL DETAIL FOR CURTAIN WALL (GLASS CLADDING)	J856-SD-CW-8040								-	-	A															
TYPICAL DETAIL FOR CURTAIN WALL (GLASS CLADDING)	J856-SD-CW-8041								-	-	A															
TYPICAL DETAIL FOR CURTAIN WALL (GLASS CLADDING)	J856-SD-CW-8042								-	-	A															
TYPICAL DETAIL FOR CURTAIN WALL (GLASS CLADDING)	J856-SD-CW-8043								-	-	A															
TYPICAL DETAIL FOR CURTAIN WALL	J856-SD-CW-8501	-	A	A	B	B	C	D	E	E	E															
TYPICAL DETAIL FOR CURTAIN WALL	J856-SD-CW-8501A	-	A	A	B	B	C	D	D	D	D															
TYPICAL DETAIL FOR CURTAIN WALL	J856-SD-CW-8501B				-	-	A	B	B	B	B															
TYPICAL DETAIL FOR CURTAIN WALL	J856-SD-CW-8502	-	A	DEL																						
TYPICAL DETAIL FOR CURTAIN WALL	J856-SD-CW-8503	-	A	A	B	B	C	C	D	D	E															
TYPICAL DETAIL FOR CURTAIN WALL	J856-SD-CW-8503A				-	-	A	A	B	B	B															
TYPICAL DETAIL FOR CURTAIN WALL	J856-SD-CW-8503A				-	-	A	A	B	B	B															
TYPICAL DETAIL FOR CURTAIN WALL	J856-SD-CW-8504	-	A	A	B	B	C	C	D	D	E															
TYPICAL DETAIL FOR CURTAIN WALL	J856-SD-CW-8504A				-	-	A	A	B	B	B															
TYPICAL DETAIL FOR CURTAIN WALL	J856-SD-CW-8505	-	A	A	B	B	C	C	D	E	G															
TYPICAL DETAIL FOR CURTAIN WALL	J856-SD-CW-8505A	-	A	A	B	B	C	C	D	E	F															
TYPICAL DETAIL FOR CURTAIN WALL	J856-SD-CW-8506	-	A	A	B	B	C	C	D	F	G															
TYPICAL DETAIL FOR CURTAIN WALL	J856-SD-CW-8507	-	A	B	C	C	D	D	D	D	D															
TYPICAL DETAIL FOR CURTAIN WALL	J856-SD-CW-8508	-	A	B	C	C	D	E	E	E	E															
TYPICAL DETAIL FOR CURTAIN WALL	J856-SD-CW-8508A			-	A	A	B	C	C	C	D															
CURTAIN WALL REMEIDAL CASE FOR STARTER EMBED	J856-SD-CW-8508B				-	-	A	B	B	B	B															
CURTAIN WALL REMEIDAL CASE FOR TYPICAL EMBED	J856-SD-CW-8508C								-	-	-															
CURTAIN WALL REMEIDAL CASE	J856-SD-CW-8508D									-	-															
CURTAIN WALL REMEIDAL CASE	J856-SD-CW-8508E									-	-															
CURTAIN WALL REMEIDAL CASE	J856-SD-CW-8508F									-	A															
TYPICAL DETAIL FOR CURTAIN WALL	J856-SD-CW-8509	-	A	A	B	B	C	D	D	D	D															
TYPICAL DETAIL FOR CURTAIN WALL	J856-SD-CW-8510	-	A	A	B	B	C	D	D	D	E															
TYPICAL DETAIL FOR CURTAIN WALL	J856-SD-CW-8510A	-	A	A	B	B	C	D	D	D	D															
TYPICAL DETAIL FOR CURTAIN WALL	J856-SD-CW-8510B							-	-	-	-															
TYPICAL DETAIL FOR CURTAIN WALL	J856-SD-CW-8510C							-	-	-	-															
TYPICAL DETAIL FOR CURTAIN WALL	J856-SD-CW-8511	-	A	A	B	B	C	D	D	D	E															
TYPICAL DETAIL FOR CURTAIN WALL	J856-SD-CW-8512		-	-	-	A	B	C	D	E	F															
TYPICAL DETAIL FOR CURTAIN WALL	J856-SD-CW-8513		-	-	-	-	A	A	B	C	D															
TYPICAL DETAIL FOR CURTAIN WALL	J856-SD-CW-8513A									-	A															
TYPICAL DETAIL FOR CURTAIN WALL	J856-SD-CW-8514				-	-	A	A	B	B	C															

IN-HOUSE DESIGN CHECKER

美特鋁質有限公司
MIDI ALUMINIUM FABRICATOR LTD.
Units 6-8, Sunray Industrial Centre, 1/F
610 Cha Kwo Ling Road, Kowloon
Tel:23489211-4 Fax:(852)27727666

DWG NO. : J856-SD-CW-0003 | REV. : H

DRAWING SUBMISSION REGISTER

PROJECT:
PROPOSED DEVELOPMENT ABOVE LIGHT RAIL TIN WING STOP,TSWTL NO.23,AREA 33,TIN SHUI WAI, N.T.
TITLE:
9TH SHOPDRAWING FOR CURTAIN WALL

DATE OF ISSUE										
ISSUE	01	2r1	03	04	4r 2	05	06	07	8r1	09
DAY	23	30	13	10	03	10	31	22	04	23
MONTH	11	12	01	03	04	05	05	08	10	11
YEAR	22	22	23	23	23	23	23	23	23	23

SUBMISSION STATE (FOR B.D / A.S.D)

AP - APPROVED
AC - APPROVED SUB. TO CONDITION
NA - NOT APPROVED

SUBMISSION STATE (FOR CLIENT / CONSULTANT)

AP - APPROVED
AC - APPROVED SUB. TO CONDITION
NA - NOT APPROVED

SUBMISSION STATE (FOR ARCHITECT)

AP - APPROVED
AC - APPROVED SUB. TO CONDITION
NA - NOT APPROVED

FABRICATION / CONSTRUCTION STATE

ISSUE TO CHINA OFFICE
ISSUE TO SITE
ISSUE TO SUB-CONTRACTOR

DRAWING TITLE	DWG. NO.	REVISIONS										COMMENT DATE	REV.	STATE	COMMENT DATE	REV.	STATE	COMMENT DATE	REV.	STATE	REV.	DATE	REV.	DATE	REV.	DATE
TYPICAL DETAIL FOR CURTAIN WALL	J856-SD-CW-8515					-	-	A	A	A	A															
TYPICAL DETAIL FOR CURTAIN WALL	J856-SD-CW-8516					-	-	A	A	A	A															
TYPICAL DETAIL FOR CURTAIN WALL	J856-SD-CW-8517								-	A	B															
TYPICAL DETAIL FOR CURTAIN WALL	J856-SD-CW-8518								-	A	B															
TYPICAL DETAIL FOR CURTAIN WALL	J856-SD-CW-8519								-	A	A															
TYPICAL DETAIL FOR CURTAIN WALL	J856-SD-CW-8520								-	A	A															
TYPICAL DETAIL FOR CURTAIN WALL	J856-SD-CW-8521								-	A	A															
TYPICAL DETAIL FOR CURTAIN WALL	J856-SD-CW-8522								-	A	B															
TYPICAL EMBED SECTION SETTING OUT	J856-SD-CW-9001	-	A	A	B	B	B	B	B	B	B															

IN-HOUSE DESIGN CHECKER

美特鋁質有限公司
MIDI ALUMINIUM FABRICATOR LTD.
Units 6-8, Sunray Industrial Centre, 1/F
610 Cha Kwo Ling Road, Kowloon
Tel:23489211-4 Fax:(852)27727666

DWG NO. : J856-SD-CW-0004 | REV. : H

GENERAL NOTES FOR TOWER CURTAIN WALL (TOWER 1,2,3) (3/F-R/F; OMIT: 4/F,13/F,14/F,24/F,34/F,44/F)

1. DESIGN CODES :
   a) BUILDING (CONSTRUCTION) REGULATIONS, HONG KONG.
   b) CODE OF PRACTICE FOR THE STRUCTURAL USE OF STEEL 2011, HONG KONG.
   c) CODE OF PRACTICE FOR THE STRUCTURAL USE OF CONCRETE 2013, HONG KONG.
   d) CODE OF PRACTICE ON WIND EFFECTS IN HONG KONG 2004.
   e) CODE OF PRACTICE FOR DEAD AND IMPOSED LOADS 2011.
   f) BS 8118 - THE STRUCTURAL USE OF ALUMINIUM, PART I - 1991. (WIND LOAD FACTOR COMPLY TO PNAP APP-53)
   g) CODE OF PRACTICE FOR STRUCTURAL USE OF GLASS 2018.
   h) STRUCTURAL DESIGN FOR OF STAINLESS STEEL, THE STEEL CONSTRUCTION INSTITUTE PUBLICATION P291 (PUBLISHED 2002).

2. DESIGN LOADS :
   a) WIND LOAD (TOPOGRAPHIC FACTOR Sa = 1) :
      HEIGHT ABOVE GROUND LEVEL = 151.8 - 5.91 = 145.89m
      BASIC WIND LOAD: 3.05 KPa (BELOW 150m) FOR TOWER
      DESIGN WIND LOAD (Cp = +1.0/-1.4): 3.05 x (Cp = +1.0/-1.4) = +3.05/-4.27 KPa (FOR CURTAIN WALL)
      DESIGN WIND LOAD (Cp = -2.2): 3.05 x (Cp = -2.2) = -6.71 KPa (FOR ALUM FEATURE)
   b) IMPOSED LOAD : (FOR PROTECTIVE BARRIER)
      HORIZONTAL IMPOSED LOAD SHALL BE COMPLIED WITH CODE OF PRACTICE FOR DEAD & IMPOSED LOADS 2011.
      FOR AREAS (WHERE CONGREGATION OF PEOPLE IS NOT EXPECTED) :-
      i) LIVE LOAD TO BE APPLIED AT A HEIGHT OF 1.1m ABOVE F.F.L. = 0.75 kN/m
      ii) UNIFORMLY DISTRIBUTED LOAD TO BE APPLIED ON THE INFILL BETWEEN FLOOR AND TOP RAIL = 1.0 kPa
      iii) CONCENTRATED LOAD TO BE APPLIED ON ANY PART OF THE INFILL BETWEEN FLOOR AND TOP RAIL = 0.5 kN
   c) DEAD LOAD :
      GLASS WEIGHT: 26 kN/m³
      STEEL WEIGHT: 77 kN/m³
      ALUMINIUM WEIGHT: 27.2 kN/m³

3. ALUMINIUM ALLOY :
   a) ALUMINIUM SHEET : ALL ALUMINIUM SHEET TO BE ALLOY 3003-H14 TO ALUMINUM AND ALUMINUM ALLOYS - SHEET, STRIP AND PLATE, BS EN 485-2:2008 & ALUMINUM AND ALUMINUM ALLOYS CHEMICAL COMPOSITION AND FORM OF WROUGHT PRODUCTS, BS EN 573-3:2009.

0.2% PROOF (YIELD) STRENGTH	= 125 MPa	DENSITY	= 27.2kN/m
MINIMUM ULTIMATE TENSILE STRESS	= 145 MPa	LIMITING BENDING STRENGTH	= 125 MPa
MODULUS OF ELASTICITY (E)	= 70000 MPa	LIMITING TENSILE STRENGTH	= 135 MPa
LIMITING SHEAR STRENGTH	= 75 MPa	DEFLECTION LIMIT = SPAN/180 OR 20mm	

   b) ALUMINIUM EXTRUSION : IN ACCORDANCE WITH DESIGN CODE BS 8118-1:1991, COMPLY TO ALUMINUM AND ALUMINUM ALLOYS, EXTRUDED ROD/BAR, TUBE AND PROFILES, BS EN 755-2:2008 & ALUMINUM AND ALUMINUM ALLOYS CHEMICAL COMPOSITION AND FORM OF WROUGHT PRODUCTS, BS EN 573-3:2009.
      MODULUS OF ELASTICITY = 70000 MPa

ALLOY NAME:	6063-T5	6063-T6	6061-T6
MINIMUM 0.2% PROOF STRENGTH:	f_{o2} = 110 N/mm²	f_{o2} = 160 N/mm²	f_{o2} = 240 N/mm²
LIMITING STRESS FOR BENDING AND OVERALL YIELDING:	P_o = 110 N/mm²	P_o = 160 N/mm²	P_o = 240 N/mm²
LIMITING STRESS FOR LOCAL CAPACITY OF THE SECTION IN TENSION OR COMPRESSION:	P_a = 130 N/mm²	P_a = 175 N/mm²	P_a = 260 N/mm²
LIMITING STRESS IN SHEAR:	P_v = 65 N/mm²	P_v = 95 N/mm²	P_v = 145 N/mm²
LIMITING STRESS IN BEARING:	P_{bs} = 130 N/mm²	P_{bs} = 175 N/mm²	P_{bs} = 260 N/mm²

4. STRUCTURAL MILD STEEL AND FINISH :
   a) ALL MILD STEEL SHALL BE GRADE S275 (CLASS 1) TO CODE OF PRACTICE FOR THE STRUCTURAL USE OF STEEL 2011 AND COMPLY TO BS EN 10025:2004 (FOR JO) & BS EN 10210-1:2006 (FOR J0H).
   b) SURFACE TREATMENT SHALL BE HOT-DIP GALVANIZED COMPLIED WITH BS EN ISO 1461:2009.

   FOR THICKNESS "T" : T≤16mm (GRADE S275)

YOUNG'S MODULUS	205,000 N/mm²
DENSITY	77 kN/m³
YIELD STRENGTH	275 N/mm²
TENSILE STRENGTH	275 N/mm²
BENDING STRENGTH	275 N/mm²
SHEAR STRENGTH	158.8 N/mm²

BS EN ISO 1461:2009 (TABLE 3) COATING THICKNESS (MIN):	
STEEL THICKNESS (T)	AVERAGE COATING THICKNESS
T > 6mm	85 um
3mm< T <= 6mm	70 um
1.5mm< T <= 3mm	55 um
T < 1.5mm	45 um

5. GLASS :
   a) GLASS USED TO BE :
      (G) IGU GLASS (8mm THICK HEAT STRENGTHENED GLASS + 12mm THICK AIR + 10mm THICK TEMPERED GLASS)
      (G) IGU GLASS (8mm THICK HEAT STRENGTHENED GLASS + 12mm THICK AIR + 12mm THICK TEMPERED GLASS)
      (G) 10mm THICK HEAT STRENGTHENED GLASS
      (G) 12mm THICK HEAT STRENGTHENED GLASS
      (G) 12mm THICK TEMPERED GLASS
   b) DESIGN OF GLASS SHALL COMPLY TO BS 6262:2005.
      -ALLOWABLE BENDING STRENGTH (TEMPERED) =80 N/mm² (FOR CLEAR GLASS)
      -ALLOWABLE BENDING STRENGTH (HEAT STRENGTHENED) =40 N/mm² (FOR CLEAR GLASS)
      -YOUNG'S MODULUS =70,000 N/mm²
   c) GLASS MATERIALS SHALL COMPLY TO BS 952:1995.
   d) RESIDUAL SURFACE COMPRESSION FOR TEMPERED GLASS TO BE NOT LESS THAN 69 MPa. RESIDUAL SURFACE COMPRESSIVE FOR HEAT STRENGTHENED GLASS TO BETWEEN 24 AND 52 mpa.
   e) FULLY TEMPERED GLASS TO BE 100% HEAT SOAK TESTED IN ACCORDANCE WITH BS EN 14179-1:2016 & COMPLIED WITH PNAP APP-37.

6. WELDING FOR STRUCTURAL STEEL:
   a) ALL WELDING SHALL BE COMPLIED WITH BS EN 1011-1:2009.
   b) ALL SITE WELDS SHALL BE RECEIVED 2 COATS OF ZINE CHROMATE PRIMER TO BS 4652:2003.
   c) ALL WELDING SHALL BE CARRIED OUT BY QUALIFIED WELDER, WELDER SHALL BE TESTED TO BS EN ISO 9606-1:2013.
   d) ELECTRODES USED IN WELD SHALL BE COMPLIED WITH BS EN ISO 2560:2009 OR BS EN ISO 17632:2008
   e) UNLESS OTHERWISE INDICATED, ALL WELDS SHALL BE 5mm THICK FILLET WELD ALL AROUND.
   f) DESIGN WELD STRENGHT: pw = 220 MPa.

7. SILICONE SEALANT, GASKET & SETTING BLOCK :
   a) "DOW CORNING(R) - DC791" SILICON SEALANT TO BE USED AS WEATHER GLAZING SEALANT.
   b) "DOW CORNING(R) STRUCTURAL SILICONE SEALANT TYPE 983" TO BE USED AS STRUCTURAL GLAZING SEALANT. (BD. REF. no.: BD-SS001) ALLOWABLE DESIGN STRENGTH = 138kPa FOR WIND LOAD CHECKING ONLY.
   c) ALL GASKET USED SHALL BE DENSE EXTRUDED SILICONE WITH A SHORE HARDNESS OF 65°±5°.
   d) SETTING BLOCKS SHALL BE DENSE EXTRUDED SILICONE WITH A SHORE HARDNESS OF 85°±5° DUROMETER SHORE A, A MIN. LENGTH OF 100 mm & A MIN. WIDTH CORRESPONDING TO THE GLASS THICKNESS & LOCATED AT GLASS QUARTER POINTS.

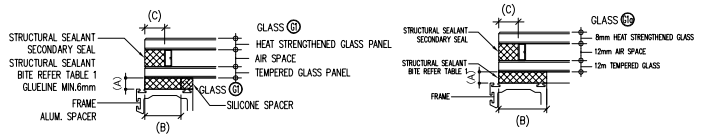


TABLE 1 (FOR VISION GLASS (G1) & (G2))

GLASS TYPE	SHORT SIDE, S	SEALANT THICKNESS (A)	SEALANT BITE (B)	SEALANT BITE (C)
(G1) (OPENABLE WINDOW)	S <= 1200mm	6mm	21mm (MIN)	15mm
(G1) (FIX WINDOW)	S <= 1200mm	10mm	21mm (MIN)	15mm
(G1) (FIX WINDOW)	S <= 1970mm	10mm	33mm (MIN)	15mm
(G2) (FIX WINDOW)	S <= 2065mm	8mm	37mm (MIN: 33)	15mm

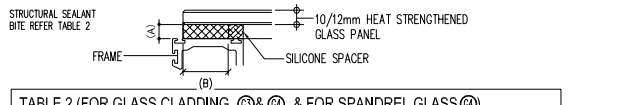


TABLE 2 (FOR GLASS CLADDING (G3)& (G4) & FOR SPANDREL GLASS (G4))

GLASS TYPE	SHORT SIDE, S	SEALANT THICKNESS (A)	SEALANT BITE (B)
(G3) (GLASS CLADDING)	S <= 675mm	8mm	16mm (MIN)
(G4) (SPANDREL GLASS) TYPICAL CASE	S <= 1005mm	8mm	21mm (MIN)
(G4) (SPANDREL GLASS) CORNER CASE	S <= 1005mm	6mm	21mm (MIN)
(G4) (GLASS CLADDING @ 46/F)	S <= 1020mm	8mm	24mm (MIN)

8. FASTENERS
   ALL FASTENERS, SCREWS, BOLTS & NUTS SHALL BE STAINLESS STEEL GRADE A4-70 COMPLYING WITH BS EN ISO 3506:2009.

MINIMUM YIELD STRENGTH, Ysb	=	450 MPa
ULTIMATE TENSILE STRENGTH, Usb	=	700 MPa
SHEAR STRENGTH, Psb	=	311 MPa
TENSILE STRENGTH, Ptb	=	450 MPa
BEARING STRENGTH, Pbb	=	828 MPa

   UNLESS OTHER SPECIFIED, ALL SCREWS SHALL BE M5 AT 300 C/C GRADE A4-70 STAINLESS STEEL COMPLIED WITH BS EN ISO 3506:2009.

9. FIRE STOP AND THERMAL INSULATION:
   9.1) THERMAL INSULATION: "CSR" 110Kg/mm ROCKWOOL FIBERTES-820 (KNOWN AS "ROCKWOOL CURTAINROCK 80 PLUS 110kg/m³)
   9.2) FIRE STOP: "CSR" FIRE SEAL FS60 (KNOWN AS ROCKWOOL ROCKSAFE 60kg/m³) SHALL BE 135mm THK., DENSITY=60kg/m³) (BD REF. : BD-FS-011) FOR FIRE RATING OF 2HRS
   9.3) SMOKE SEAL: "MIDI ALUMINIUM FABRICATOR LTD" SMOKE SEAL, SHALL BE COMPLY WITH FIRE CODE CLAUSE C10.2

10. ANCHOR BOLT (FOR ALUM. CAPPING & GLASS CLADDING ONLY)
    a) ALL DRILL-IN ANCHOR BOLTS SHALL BE HILTI HST3-R AS SHOWN IN THE DRAWINGS. AND SHALL BE DESIGNED
    b) THE INSTALLATION OF DRILL-IN ANCHOR BOLTS SHALL BE STRICTLY IN ACCORDANCE WITH MANUFACTURER'S SPECIFICATION & RECOMMENDATION.
    c) COVER-METER SHOULD BE APPLIED TO PREVENT ANCHOR BOLTS HIT THE EXISTING REINFORCEMENT BARS.


FOR CRACKED CONCRETE TABLE:

ANCHOR TYPE	MINIMUM SPACING (mm)	MINIMUM EDGE DISTANCE (mm)	EFFECTIVE ANCHORAGE LENGTH (mm) TO SOUND CONCRETE	RECOMMENDED LOAD (kN) FOR CRACKED CONCRETE INFLUENCING FACTOR FOR GRADE 600 CONCRETE = 1.55		TENSION TEST LOAD (kN)	BD REF. NO.	MINIMUM BASE MATERIAL THICKNESS (mm)	
				TENSION	SHEAR				
HILTI HST3-R M8	35 (50)	40 (50)	47	2.8x1.55 = 4.34	5.2x1.55 = 8.06	6.57	BD-AF151	100	(FOR GLASS CLADDING ONLY)
HILTI HST3-R M10	40 (55)	45 (80)	60	5x1.55 = 7.75	8.4x1.55 = 13.02	11.63	BD-AF149	120	(FOR ALUM. CLADDING ONLY)
HILTI HST3-R M16	65	65	85	9.4x1.55 = 14.57	21.2x1.55 = 32.86	21.86	BD-AF148	140	(FOR REMEDIAL CASE)

INFLUENCING FACTOR FOR GRADE 600 CONCRETE = 1.55, TEST LOAD SHOULD BE 1.5xRECOMMENDED TENSION LOAD.

11. ALUMINIUM STUD BY DRAWN ARC STUD WELD
    ALUMINIUM STUD SHALL BE M6 GRADE 5754 AND DESIGNED TO BS 8118-1:1991.
    DESIGN AND QUALITY ASSURANCE OF DRAWN ARC STUD WELD SHALL COMPLY WITH BS EN ISO 14555:2017.
    ALUMINIUM STUD TYPE SHALL BE THREADED STUD (PT) AND COMPLY WITH BS EN ISO 13918:2018.
    MINIMUM 0.2% PROOF STRENGTH: f_{o2} = 60 N/mm²

12. CAST-IN CHANNEL (BD Ref. : BD-AF132 & BD-AF134)
    a) ALL CAST-IN CHANNEL UESD TO BE "HILTI" HAC-50, HAC-60 & HAC-70 CHANNEL TO CRACKED CONCRETE
    b) THE INSTALLATION OF CHANNEL FIXING SHALL STRICTLY IN ACCORDANCE WITH MANUFACTURER'S RECOMMENDATION AND LIMITATION INCLUDING CONCRETE GRADE EDGE DISTANCE ANCHOR SPACING ETC.
    c) USED TO BE HBC-C 8.8-M16x80mm LONG WHICH COMPLY WITH BS 3692. 1967 (FOR TYPICAL)
       USED TO BE HBC-C-N 8.8-M16x80mm LONG WHICH COMPLY WITH BS 3692. 1967 (FOR END BAY)
    d) 2 NOS. OF M16 GRADE 8.8 F.T. BOLT SPACING REFER TO EMBED DETAIL (DWG. NO. BD-TCW-ED01)
    e) BOTH 350mm, 450mm LENGTH OF HILTI CAST-IN CHANNEL WILL BE TESTED OF THE TEST LOAD.
    f) METHOD STATEMENT OF TEST WILL BE SUBMITTED ONE WEEK BEFORE THE COMMER CEMENT OF THE CAST-IN CHANNEL.

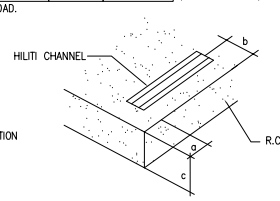

CHANNEL TYPE	MIN. EDGE DIM. (a)	MIN. EDGE DIM. (b)	MIN. DEPTH DIM. (c)	RECOMMENDED LOAD FOR CHANNEL (kN)		TEST LOAD (kN) = RECOMMENDED LOAD x 1.5	BD REF. NO.
HAC-60 W/. 2 NOS. M16 G.M.S. HBC-C T-BOLT (GR. 8.8)	75mm	150mm	148mm	TENSION : 32.7	SHEAR : 17.4	TENSION : 49.05	BD-AF132
HAC-70 W/. 2 NOS. M16 G.M.S. HBC-C T-BOLT (GR. 8.8)	75mm	150mm	175mm	TENSION : 41.7	SHEAR : 22.8	TENSION : 62.55	BD-AF134

13. G.M.S. CAST-IN EMBED:
    a) CAST-IN EMBED BAR SHALL BE GRADE 500B TO COMPLIED WITH CS2-2012. SPECIFIED CHARACTERISTIC STRENGTH = 500 N/mm² (EMBED TYPE: EM03)
    b) ALL CAST-IN PLATE SHALL BE GRADE S275 (CLASS 1) TO CODE OF PRACTICE FOR STRUCTURE USE OF STEEL 2011 AND COMPLY TO BS EN 10025:2004 (FOR JO) & BS EN 10210-1:2006 (FOR J0H). YIELD STRENGTH = 275 N/mm²
    c) SURFACE TREATMENT SHALL BE HOT-DIP GALVANIZED COMPLIED WITH BS EN ISO 1461:2009. (MIN. THICKNESS = 85 MICRONS)
    d) CAST-IN EMBED STEEL ROD (FOR EM09) SHALL BE GRADE S275 J0 TO BE COMPLIED WITH BS EN 10025 2004.

14. ISOLATION FOR METALS
    APPLIED A LAYER OF BITUMINOUS PAINT (COMPLY WITH BS 3416:1991) FOR PROTECTION AGAINST BI-METALLIC CORROSION FOR BARE ALUMINIUM/STEEL CONTACTED SURFACE & STEEL/CONCRETE INTERFACE.
    PLASTIC ISOLATION TYPE (COMPLY WITH BS PD 6484: 1979) TO BE PROVIDED BETWEEN CONTACT SURFACE OF ALUMINIUM AND STEEL TO PREVENT DIRECT CONTACT BETWEEN DISSIMILAR METALS

15. OPENABLE WINDOW
    ALL OPENABLE WINDOW OF CURTAIN WALL ARE FOR INFORMATION ONLY AND SHOULD BE APPROVED UNDER CLOSED AND LOCKED CONDITION.

15a. CONCRETE GRADE (FOR INFORMATION ONLY)
    ALL R.C. STRUCTURE SHOWN IN THE SUBMISSION SHALL BE GRADE C45 COMPLY WITH CODE OF PRACTICE FOR THE STRUCTURAL USE OF CONCRETE, 2013 HONG KONG.

16. GBP APPROVAL DATE: 19/06/2023
    SUPERSTRUCTURE APPROVAL DATE: 11/07/2018

17. TOLERANCE OF FIXING BRACKET OF CURTAIN WALL SHALL BE ± 15mm [HORIZONTAL DIRECTION : (PARALLEL / PERPENDICULAR TO CURTAIN WALL & VERTICAL DIRECTION)]


18. STAINLESS STEEL :
    ALL STAINLESS STEEL TO BE GRADE 304 (1.4301) AND GRADE 316 (1.4401) TO BS EN 10088-1


YOUNG'S MODULUS	200,000 N/mm²
DENSITY	79 KN/m³
MIN. 0.2% PROOF STRENGTH	210 N/mm² (FOR GRADE 304) 220 N/mm² (FOR GRADE 316)
ULTIMATE TENSILE STRENGTH	520 N/mm²


19. HOLDING DOWN BOLT (FOR EMBED ONLY) :
    ALL HOLDING DOWN BOLT SHOULD BE GRADE 8.8 BOLT COMPPLY WITH BS 4190:2011 AND DESIGN TO CODE OF PRACTICE FOR THE STRUCTURAL USE OF STEEL 2011

    GRADE 8.8


SHEAR STRENGTH	375 N/mm²
TENSILE STRENGTH	560 N/mm²
BEARING STRENGTH	1000 N/mm²

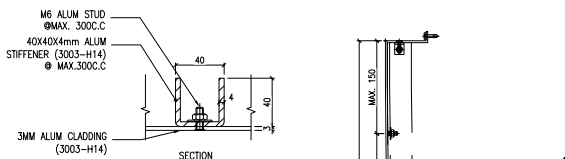


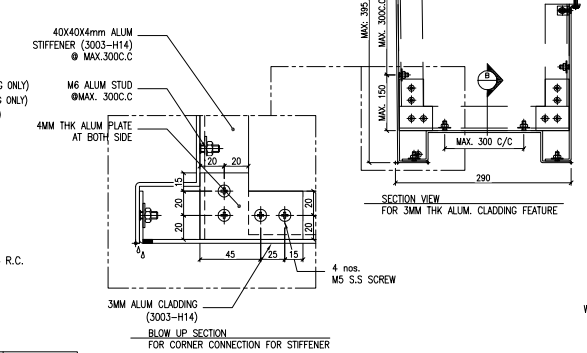


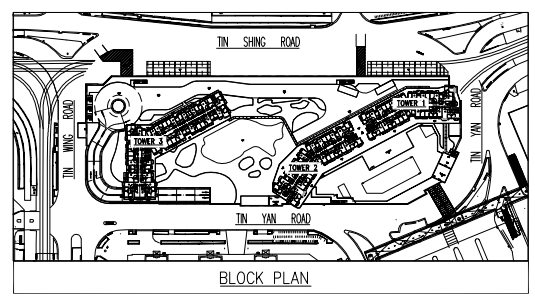


BLOCK PLAN

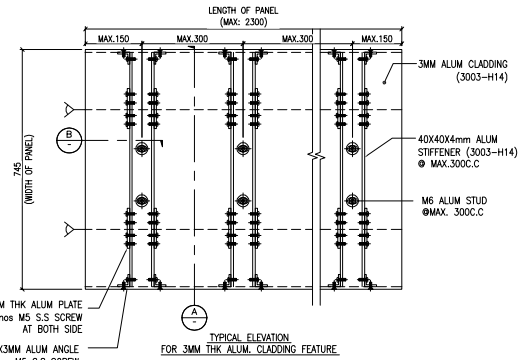

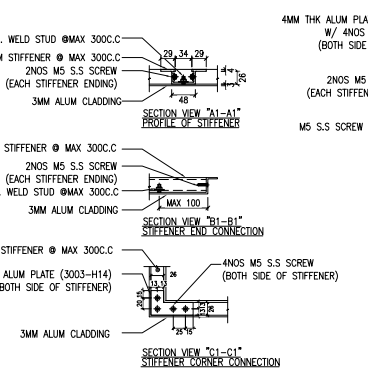


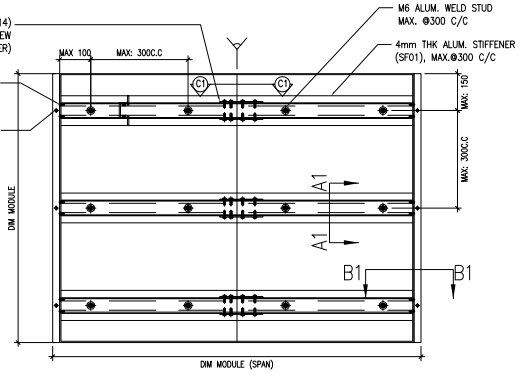


REMARK: 3mm ALUM. CLADDING SPAN EXCEED 300MM, WITH 4mm STIFFENER @ MAX.300C.C FOR & : 3mm ALUM CLADDING WITH 4MM STIFFENER @ MAX.200C.C

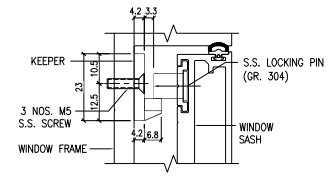


BLOW UP DETAIL "1A"

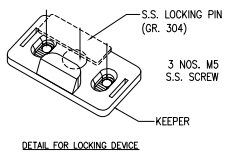


DETAIL FOR LOCKING DEVICE

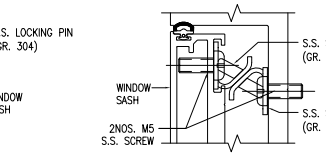


BLOW UP DETAIL "B"

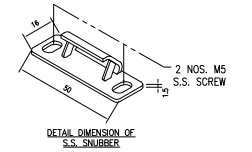


REMARK:
MODEL#: STAINLESS STEEL WEDGE "SBS"

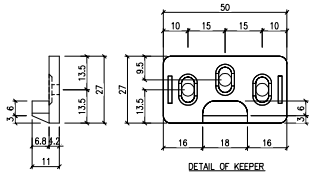


REMARK:
MODEL#: "KPB"

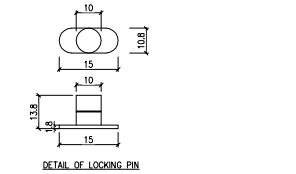


REMARK:
MODEL#: ROLLER (ASRP-13.8)

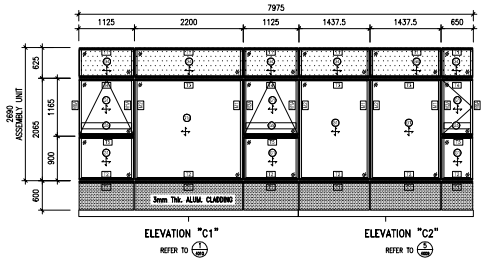


CURTAIN WALL SAFETY TEST ELEVATION

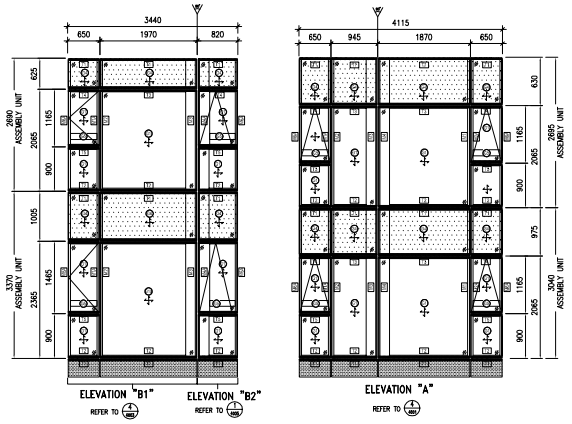


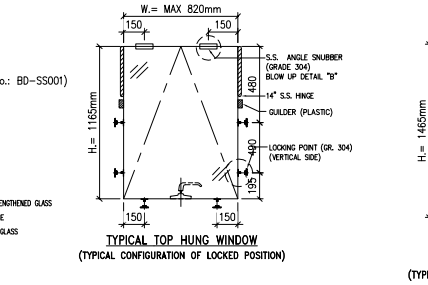


TYPICAL TOP HUNG WINDOW
(TYPICAL CONFIGURATION OF LOCKED POSITION)

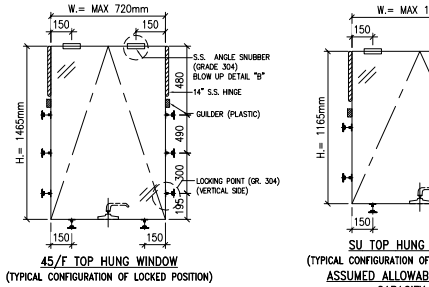


45/F TOP HUNG WINDOW
(TYPICAL CONFIGURATION OF LOCKED POSITION)

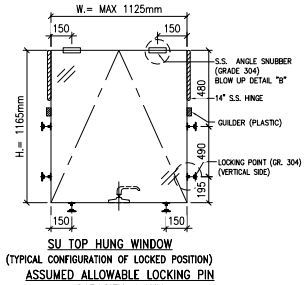


SU TOP HUNG WINDOW
(TYPICAL CONFIGURATION OF LOCKED POSITION)
ASSUMED ALLOWABLE LOCKING PIN CAPACITY=1.1KN
(F.O.S.=2.52 , PROOF LOAD TEST SHALL COMPLY WITH PNAP APP-37)

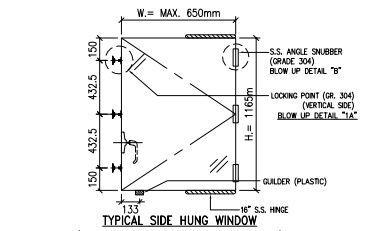

TYPICAL SIDE HUNG WINDOW
(TYPICAL CONFIGURATION OF LOCKED POSITION)
ASSUMED ALLOWABLE LOCKING PIN CAPACITY=1.1KN
(F.O.S.=2.52 , PROOF LOAD TEST SHALL COMPLY WITH PNAP APP-37)

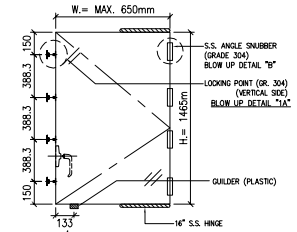

45/F SIDE HUNG WINDOW
(TYPICAL CONFIGURATION OF LOCKED POSITION)

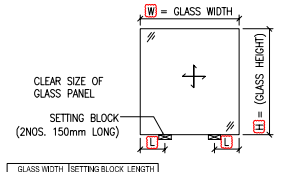

GLASS WIDTH	SETTING BLOCK LENGTH
W<=1000	100mm
1000<W<=1500	125mm
1500<W<=2200	150mm

W<1800, L =1/4 FOR SPAN
W>1800, L =1/8 FOR SPAN

OPENABLE WINDOW HINGE(FOR INFORMATION)

L (mm)	H (mm)	WEIGHT(MAX) (kg)	GLASS TYPE	SH/TH	HINGE MODEL	MAX LOAD (kg)	80% LOAD (kg)
650	1165	43.48521	8HS+12air+10T	SH	HYLS16 (PAIR)	83	65
650	1465	53.81541	8HS+12air+10T	SH	HYLS16 (PAIR)	83	65
820/720	1165	53.27874	8HS+12air+10T	TH	HYLP14-L + HYLP-14R (PAIR)	92	74
720	1465	58.79304	8HS+12air+10T	TH		92	74
1125	1165	70.84836	8HS+12air+10T	TH		92	74
815	1165	52.99070	8HS+12air+10T	TH		92	74
900	1165	57.88746	8HS+12air+10T	TH		92	74

B.D. REF :

CLIENT :
SUN HUNG KAI REAL ESTATE AGENCY LTD.
42/F SUN HUNG KAI CENTRE, WANCHAI, HONGKONG

ARCHITECT :
lwk&partners architects

MAIN CONTRACTOR :
怡輝建築有限公司
Yee Fai Building Contractors Ltd.

STRUCTURAL ENGINEER :
ARUP

FACADE CONSULTANT:
ALPHA CONSULTING LIMITED
Steel Structure & Facade Specialist

NOTE :
1. ALL DIMENSIONS ARE IN mm.
2. ALL ELEVATIONS ARE VIEWED FROM OUTSIDE.
3. ALL DIMENSIONS TO BE VERIFIED ON SITE BEFORE FABRICATION.

LEGEND :
X1 — DETAIL MARK NO.
X001 — REFER SHEET NO.
1. F.F.L. --FINISHED FLOOR LEVEL
2. S.F.L. --STRUCTURAL FLOOR LEVEL
3. (R) --REVERSED DETAIL

NO.	DATE	REVISED	BY
G	29-OCT-2023	9TH SUBMISSION	CF
F	29-SEP-2023	8TH SUBMISSION	CF
E	22-AUG-2023	7TH SUBMISSION	CF
D	30-MAY-2023	6TH SUBMISSION	CF
C	27-APR-2023	5TH SUBMISSION	CF

JOB NO. : J-856

PROJECT :
PROPOSED DEVELOPMENT ABOVE LIGHT RAIL TIN WING STOP,TSWTL NO.23,AREA 33,TIN SHUI WAI, N.T.
















TITLE :
GENERAL NOTE FOR CURTAIN WALL

DATE : 31-OCT-21 | SCALE : NTS

DRAWN BY : C.F | CHECKED BY :

美特鋁質有限公司
MIDI ALUMINIUM FABRICATOR LTD.
Units 6-8, Sunray Industrial Centre, 1/F
610 Cha Kwo Ling Road, Kowloon
Tel:23489211-4 Fax:(852)27727666

DWG NO. : J856-SD-CW-1001 | REV. : G

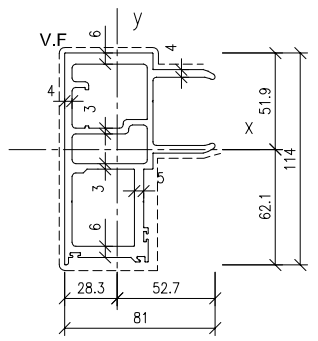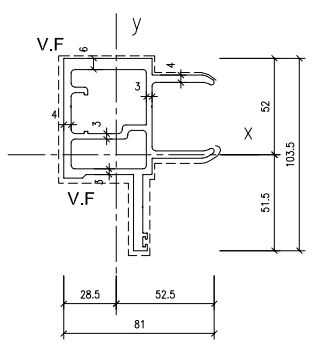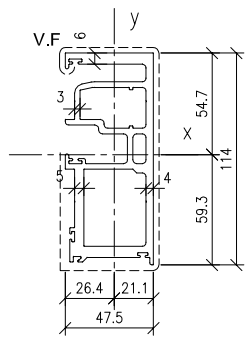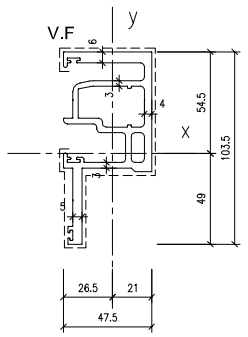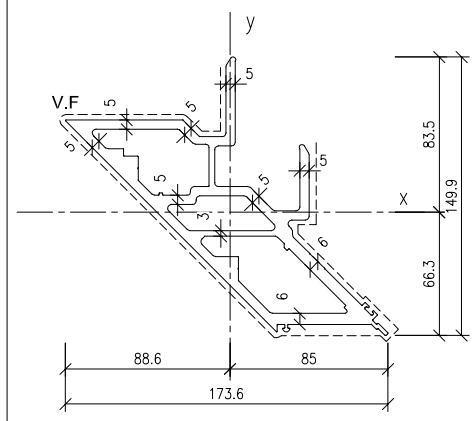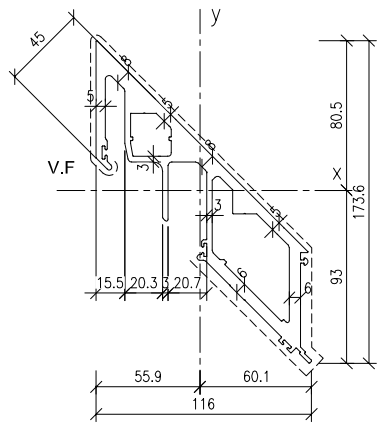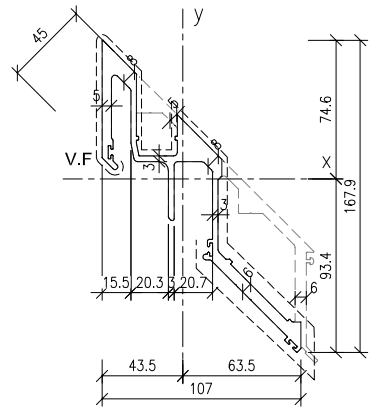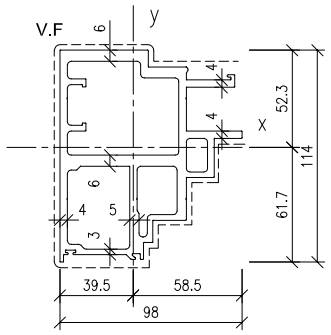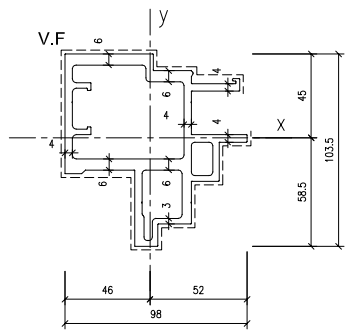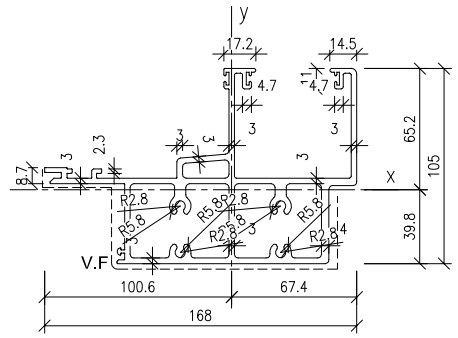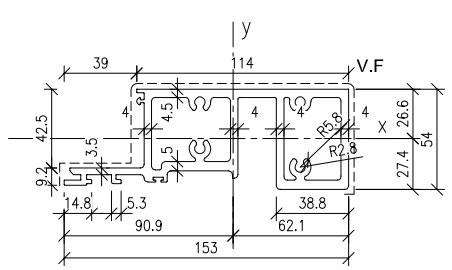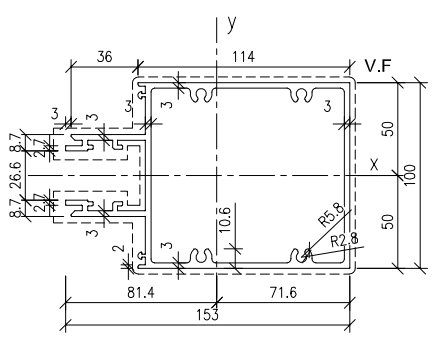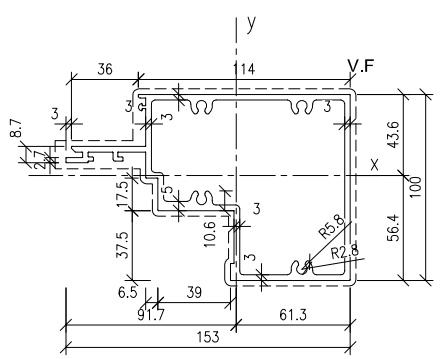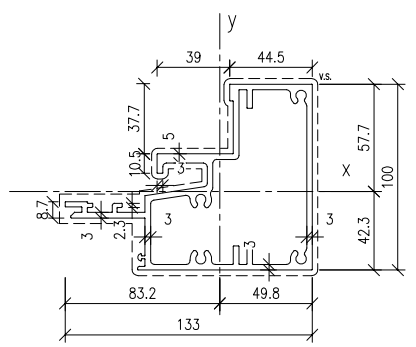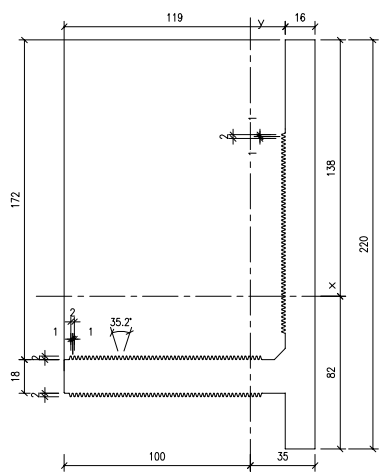SECTION		 (KNOWN AS "X86364")		 (KNOWN AS "X86365")	
MEMBER MARK	AM01	AM01A	AM02	AM02A	AM03
AREA (mm^2)	1917.31	1477.42	1693.56	1253.67	3256.80
Ixx (mm^4)	2501812.00	1166887.75	2285209.18	1049677.05	4486881.58
Iyy (mm^4)	883943.98	695880.38	425304.85	310610.02	5426661.15
Zxx (mm^3)	40291.17	17794.39	38532.42	16323.00	53711.56
Zyy (mm^3)	16765.98	14211.50	16102.43	12673.60	61249.83
MATERIAL	ALLOY 6063-T6	ALLOY 6063-T6	ALLOY 6063-T6	ALLOY 6063-T6	ALLOY 6063-T6
SECTION		 (KNOWN AS "AM04")		 (KNOWN AS "X86367")	
MEMBER MARK	AM04	AM04A (NOTCH FROM AM04)	AM06	AM06A	AT01
AREA (mm^2)	2689.67	1708.43	2442.99	2082.53	2226.59
Ixx (mm^4)	5292002.00	3421880.38	2680562.40	1747579.57	1836603.44
Iyy (mm^4)	3453878.23	1695730.43	1887501.90	1524869.32	4191067.58
Zxx (mm^3)	56875.89	36643.67	43447.88	29616.14	28178.20
Zyy (mm^3)	57506.48	26691.87	32238.84	28176.63	41647.28
MATERIAL	ALLOY 6063-T6	ALLOY 6063-T6	ALLOY 6063-T6	ALLOY 6063-T6	ALLOY 6063-T6
SECTION					
MEMBER MARK	AT02	AT03	AT04	AT05	AB01(NEW)
AREA (mm^2)	2086.75	1830.66	1676.56	1720.99	5995.963
Ixx (mm^4)	735247.52	2564163.20	2019225.97	1799076.38	21628099.831
Iyy (mm^4)	3503765.41	4354414.77	3274776.17	2219338.32	9340917.314
Zxx (mm^3)	26826.25	51283.26	35798.58	31154.61	156841
Zyy (mm^3)	38528.12	53502.69	35719.67	26667.76	93238
MATERIAL	ALLOY 6063-T6	ALLOY 6063-T6	ALLOY 6063-T6	ALLOY 6063-T6	ALLOY 6061-T6

B.D. REF :

CLIENT :

SUN HUNG KAI REAL ESTATE AGENCY LTD.
42/F SUN HUNG KAI CENTRE, WANCHAI, HONGKONG

ARCHITECT :

lwk&partners
a r c h i t e c t s

MAIN CONTRACTOR :

怡輝建築有限公司
Yee Fai Building Contractors Ltd.

STRUCTURAL ENGINEER :

ARUP

FACADE CONSULTANT:

ALPHA CONSULTING LIMITED
Steel Structure & Facade Specialist

NOTE :
1. ALL DIMENSIONS ARE IN mm.
2. ALL ELEVATIONS ARE VIEWED FROM OUTSIDE.
3. ALL DIMENSIONS TO BE VERIFIED ON SITE BEFORE FABRICATION.

LEGEND :

X1 — DETAIL MARK NO.
X001 — REFER SHEET NO.

1. F.F.L. --FINISHED FLOOR LEVEL
2. S.F.L. --STRUCTURAL FLOOR LEVEL
3. (/R) --REVERSED DETAIL

NO.	DATE	REVISED	BY
C	22-AUG-2023	7TH SUBMISSION	

JOB NO. : J-856

PROJECT :
PROPOSED DEVELOPMENT ABOVE LIGHT RAIL TIN WING STOP,TSWTL NO.23,AREA 33,TIN SHUI WAI, N.T.
















TITLE :
SECTION PROPERTIES

DATE : 31-OCT-21 | SCALE : NTS

DRAWN BY : C.F | CHECKED BY :

美特鋁質有限公司
MIDI ALUMINIUM FABRICATOR LTD.
Units 6-8, Sunray Industrial Centre, 1/F
610 Cho Kwo Ling Road, Kowloon
Tel:23489211-4 Fax:(852)27727666

DWG NO. : J856-SD-CW-1101 | REV. : C

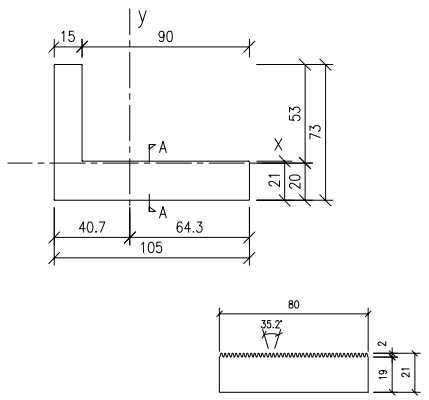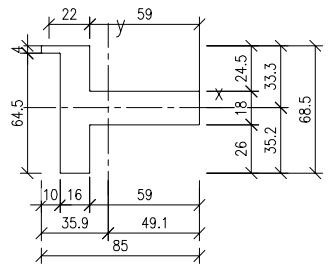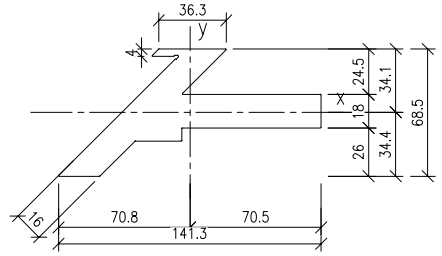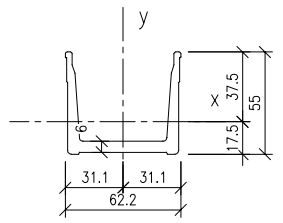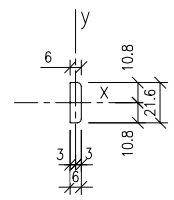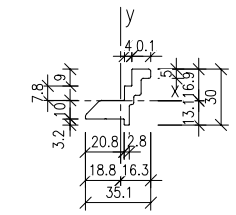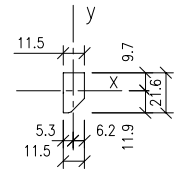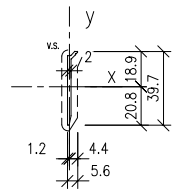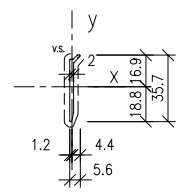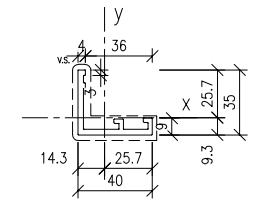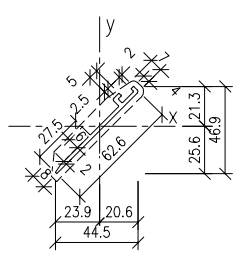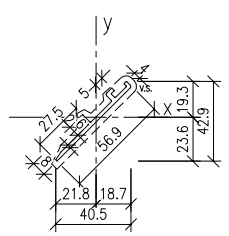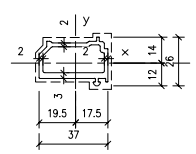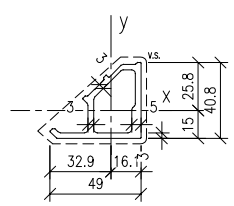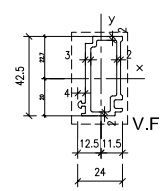SECTION	 SECTION A	 (KNOWN AS "X86372")	 (KNOWN AS "X86373")		
MEMBER MARK	AB02	AB03	AB04	GS01	MS01
AREA (mm^2)	2984.92	2197.9229	3269.0104	837.94	127.70
Ixx (mm^4)	1024287.28	497415.1697	725812.4725	209007.75	4850.13
Iyy (mm^4)	3207011.87	1128979.7412	3866320.1755	470263.80	375.75
Zxx (mm^3)	19339.77	14131	21078	5570.30	449.09
Zyy (mm^3)	49907.51	22985	54593	15121.02	124.00
MATERIAL	ALLOY 6061–T6	ALLOY 6061–T6	ALLOY 6061–T6	ALLOY 6061–T6	ALLOY 6061–T6
SECTION					 (KNOWN AS "X86412")
MEMBER MARK	MS02	MS03	AC01	AC02	AC03
AREA (mm^2)	348.66	217.69	78.52	70.52	260.43
Ixx (mm^4)	22437.21	7205.55	9979.70	7213.19	27661.95
Iyy (mm^4)	25609.38	2284.89	63.39	60.47	48777.55
Zxx (mm^3)	1327.87	603.02	480.19	384.28	1077.53
Zyy (mm^3)	1360.10	369.41	14.44	13.84	1900.53
MATERIAL	ALLOY 6061–T6	ALLOY 6061–T6	ALLOY 6063–T5	ALLOY 6063–T5	ALLOY 6063–T6
SECTION		 (KNOWN AS "X86369")	 (KNOWN AS "X86371")	 (KNOWN AS "X86391")	 (KNOWN AS "X86374")
MEMBER MARK	AC04	AC05	AD01	AD02	AD03
AREA (mm^2)	152.69	141.37	257.490	442.43	293.6887
Ixx (mm^4)	25181.97	18988.27	15153.153	76291.37	59294.3218
Iyy (mm^4)	22896.97	16930.31	39468.534	81383.11	59294.3218
Zxx (mm^3)	982.91	803.32	1084	2954.70	2613
Zyy (mm^3)	958.14	775.42	2011	2473.77	1318
MATERIAL	ALLOY 6063–T5	ALLOY 6063–T5	ALLOY 6063–T6	ALLOY 6063–T6	ALLOY 6063–T6

B.D. REF :

CLIENT :

SUN HUNG KAI REAL ESTATE AGENCY LTD.
42/F SUN HUNG KAI CENTRE, WANCHAI, HONGKONG

ARCHITECT :

lwk&partners
a r c h i t e c t s

MAIN CONTRACTOR :

怡輝建築有限公司
Yee Fai Building Contractors Ltd.

STRUCTURAL ENGINEER :

ARUP

FACADE CONSULTANT:

ALPHA CONSULTING LIMITED
Steel Structure & Facade Specialist

NOTE :
1. ALL DIMENSIONS ARE IN mm.
2. ALL ELEVATIONS ARE VIEWED FROM OUTSIDE.
3. ALL DIMENSIONS TO BE VERIFIED ON SITE BEFORE FABRICATION.

LEGEND :

X1 — DETAIL MARK NO.
X001 — REFER SHEET NO.

1. F.F.L. --FINISHED FLOOR LEVEL
2. S.F.L. --STRUCTURAL FLOOR LEVEL
3. /R --REVERSED DETAIL

NO.	DATE	REVISED	BY
C	22–AUG–2023	7TH SUBMISSION	

JOB NO. : J–856

PROJECT :
PROPOSED DEVELOPMENT ABOVE LIGHT RAIL TIN WING STOP,TSWTL NO.23,AREA 33,TIN SHUI WAI, N.T.
















TITLE :
SECTION PROPERTIES

DATE : 31–OCT–21 | SCALE : NTS

DRAWN BY : C.F | CHECKED BY :

美特鋁質有限公司
MIDI ALUMINIUM FABRICATOR LTD.
Units 6–8, Sunray Industrial Centre, 1/F
610 Cha Kwo Ling Road, Kowloon
Tel:23489211–4 Fax:(852)27727666

DWG NO. : J856–SD–CW–1102 | REV. : C

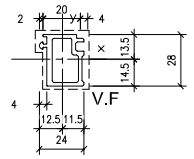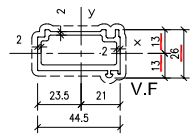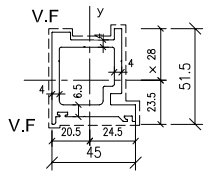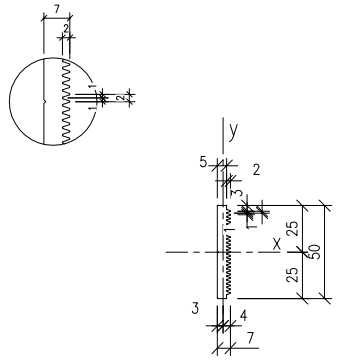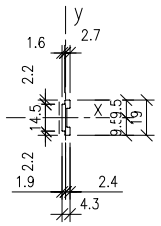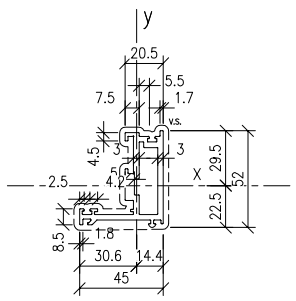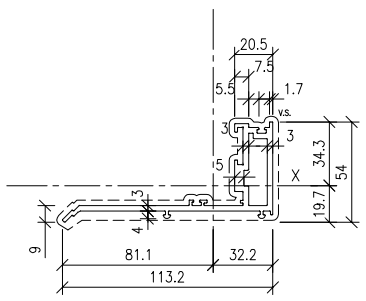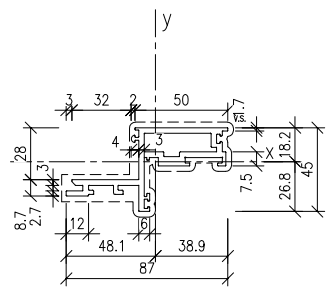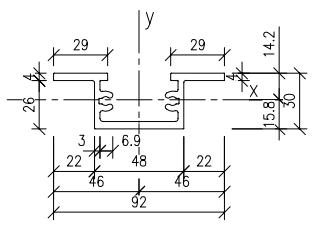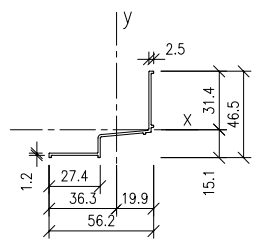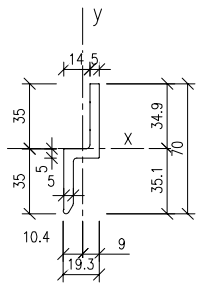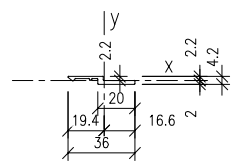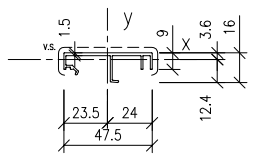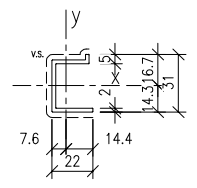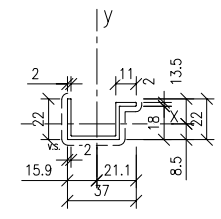SECTION					
	(KNOWN AS "X86375")	(KNOWN AS "X86376")	(KNOWN AS "X86366")		(KNOWN AS "X86370")
MEMBER MARK	AD04	AD05	AD06	AW01	AW02
AREA (mm^2)	222.691	313.934	786.590	295.75	56.06
Ixx (mm^4)	19909.683	21938.365	203207.388	60169.14	1783.72
Iyy (mm^4)	12007.134	71608.627	158412.546	949.18	73.94
Zxx (mm^3)	1372	3058	7296	2406.30	187.76
Zyy (mm^3)	966	1662	6439	237.00	30.97
MATERIAL	ALLOY 6063-T6	ALLOY 6063-T6	ALLOY 6063-T6	ALLOY 6061-T6	ALLOY 6063-T6
SECTION					
				(KNOWN AS "X86396")	
MEMBER MARK	WS01	WS02	WS03	SF02	AS01
AREA (mm^2)	535.50	736.92	698.05	639.53	122.57
Ixx (mm^4)	136349.77	181260.93	108546.26	78374.95	21149.87
Iyy (mm^4)	74323.15	759910.70	355649.73	376825.86	38516.02
Zxx (mm^3)	4622.95	5291.46	4052.40	4958.84	674.44
Zyy (mm^3)	2426.72	9371.79	7393.90	8191.87	1061.06
MATERIAL	ALLOY 6063-T6	ALLOY 6063-T6	ALLOY 6063-T6	ALLOY 6063-T6	ALLOY 6063-T5
SECTION					
MEMBER MARK	AJ01	AJ04	AC06	AC07	AC08
AREA (mm^2)	413.99	68.43	122.16	137.92	149.92
Ixx (mm^4)	135148.05	115.86	2103.80	17943.25	8166.26
Iyy (mm^4)	19156.31	6484.87	27987.64	6720.70	22256.75
Zxx (mm^3)	3845.33	52.43	169.56	1074.22	604.34
Zyy (mm^3)	1848.41	334.80	1166.17	465.83	1053.42
MATERIAL	ALLOY 6061-T6	ALLOY 6063-T5	ALLOY 6063-T5	ALLOY 6063-T5	ALLOY 6063-T5

B.D. REF :

CLIENT :

SUN HUNG KAI REAL ESTATE AGENCY LTD.
42/F SUN HUNG KAI CENTRE, WANCHAI, HONGKONG

ARCHITECT :

lwk&partners
a r c h i t e c t s

MAIN CONTRACTOR :

怡輝建築有限公司
Yee Fai Building Contractors Ltd.

STRUCTURAL ENGINEER :

ARUP

FACADE CONSULTANT:

ALPHA CONSULTING LIMITED
Steel Structure & Facade Specialist

NOTE :
1. ALL DIMENSIONS ARE IN mm.
2. ALL ELEVATIONS ARE VIEWED FROM OUTSIDE.
3. ALL DIMENSIONS TO BE VERIFIED ON SITE BEFORE FABRICATION.

LEGEND :

X1 — DETAIL MARK NO.
X001 — REFER SHEET NO.

1. F.F.L. --FINISHED FLOOR LEVEL
2. S.F.L. --STRUCTURAL FLOOR LEVEL
3. (R) --REVERSED DETAIL

NO.	DATE	REVISED	BY
C	22-AUG-2023	7TH SUBMISSION	

JOB NO. : J-856

PROJECT :
PROPOSED DEVELOPMENT ABOVE LIGHT RAIL TIN WING STOP,TSWTL NO.23,AREA 33,TIN SHUI WAI, N.T.












TITLE :
SECTION PROPERTIES

DATE : 31-OCT-21 | SCALE : NTS

DRAWN BY : C.F | CHECKED BY :

美特鋁製有限公司
MIDI ALUMINIUM FABRICATOR LTD.
Units 6-8, Sunray Industrial Centre, 1/F
610 Cha Kwo Ling Road, Kowloon
Tel:23489211-4 Fax:(852)27727666

DWG NO. : J856-SD-CW-1103 | REV. : C

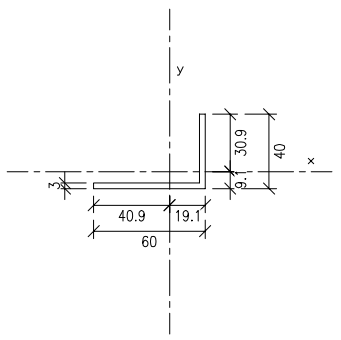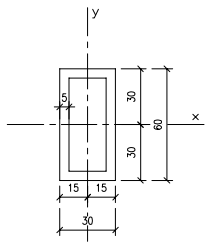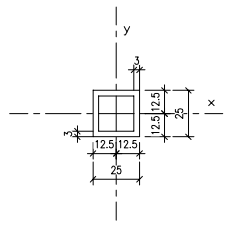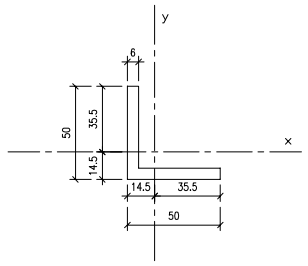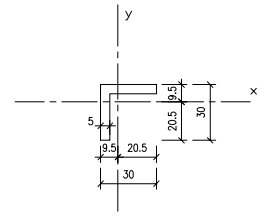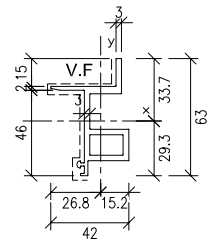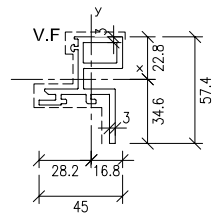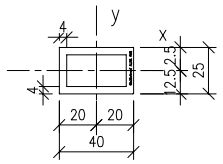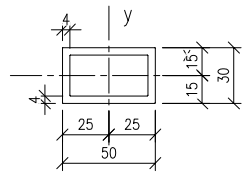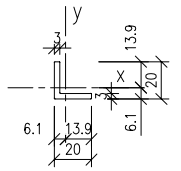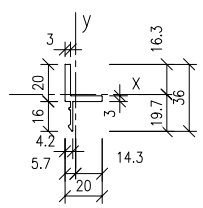SECTION					
MEMBER MARK	60x40x3mm ALUM ANGLE	60x30x5mm THK. ALUM. HOLLOW	25x25x3mm THK. ALUM. HOLLOW	50x50x6mm THK. ALUM. ANGLE	30x30x5mm THK. ALUM. ANGLE
AREA (mm^2)	291.0000	800.000	264.000	564.000	275.000
Ixx (mm^4)	40262.1675	331666.667	21692.000	131257.958	22163.826
Iyy (mm^4)	109852.1675	101666.667	21692.000	131257.958	22163.826
Zxx (mm^3)	1304	11056	1735	3719	1072
Zyy (mm^3)	2688	6778	1735	3719	1072
MATERIAL	ALLOY 6063-T6	ALLOY 6063-T6	ALLOY 6063-T6	6063-T6	6063-T6
SECTION	 (KNOWN AS "X86377")	 (KNOWN AS "X86378")			
MEMBER MARK	GC01	GC02	40x25x4mm THK ALUM. R.H.S.	50x30x4mm THK ALUM. R.H.S.	20x20x3mm THK ALUM. ANGLE
AREA (mm^2)	453.4319	512.2927	455.9	576	110.92
Ixx (mm^4)	127624.0761	110006.2200	38970.1	75224	4021.19
Iyy (mm^4)	39818.9402	69077.1601	86881.3	176657.8	4021.19
Zxx (mm^3)	3793	3180	3117.6	5014.9	289.13
Zyy (mm^3)	1488	2452	4344.1	7066.3	289.13
MATERIAL	ALLOY 6063-T6	ALLOY 6063-T6	ALLOY 6063-T6	ALLOY 6063-T6	ALLOY 6063-T6
SECTION					
MEMBER MARK	AJ03				
AREA (mm^2)	132.83				
Ixx (mm^4)	8200.79				
Iyy (mm^4)	4152.83				
Zxx (mm^3)	415.38				
Zyy (mm^3)	289.57				
MATERIAL	ALLOY 6063-T5				

B.D. REF :

CLIENT :

SUN HUNG KAI REAL ESTATE AGENCY LTD.
42/F SUN HUNG KAI CENTRE, WANCHAI, HONGKONG

ARCHITECT :

lwk&partners
a r c h i t e c t s

MAIN CONTRACTOR :

怡輝建築有限公司
Yee Fai Building Contractors Ltd.

STRUCTURAL ENGINEER :

ARUP

FACADE CONSULTANT:

ALPHA CONSULTING LIMITED
Steel Structure & Facade Specialist

NOTE :
1. ALL DIMENSIONS ARE IN mm.
2. ALL ELEVATIONS ARE VIEWED FROM OUTSIDE.
3. ALL DIMENSIONS TO BE VERIFIED ON SITE BEFORE FABRICATION.

LEGEND :

X1 — DETAIL MARK NO.
X001 — REFER SHEET NO.

1. F.F.L. --FINISHED FLOOR LEVEL
2. S.F.L. --STRUCTURAL FLOOR LEVEL
3. /R --REVERSED DETAIL

NO.	DATE	REVISED	BY
D	30-OCT-2023	9TH SUBMISSION	
C	22-AUG-2023	7TH SUBMISSION	

JOB NO. : J-856

PROJECT :
PROPOSED DEVELOPMENT ABOVE LIGHT RAIL TIN WING STOP,TSWTL NO.23,AREA 33,TIN SHUI WAI, N.T.










TITLE :
SECTION PROPERTIES

DATE : 31-OCT-21 | SCALE : NTS

DRAWN BY : C.F | CHECKED BY :

美特鋁製有限公司
MIDI ALUMINIUM FABRICATOR LTD.
Units 6-8, Sunray Industrial Centre, 1/F
610 Cha Kwo Ling Road, Kowloon
Tel:23489211-4 Fax:(852)27727666

DWG NO. : J856-SD-CW-1104 | REV. : D

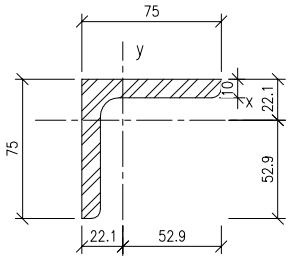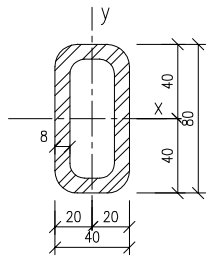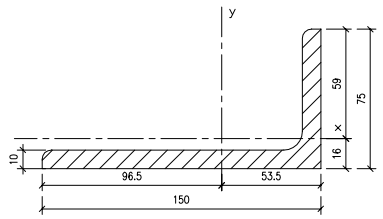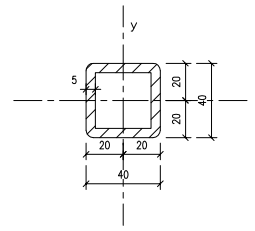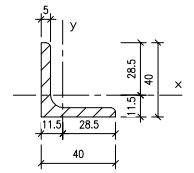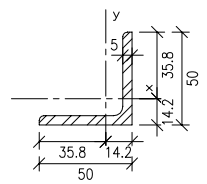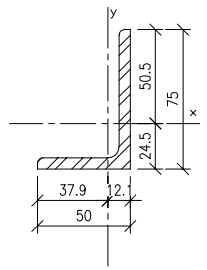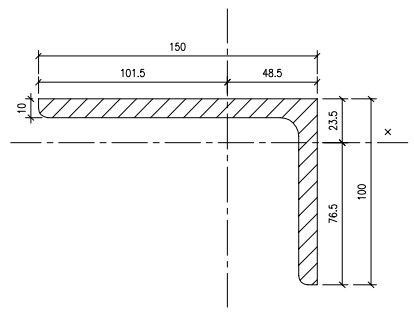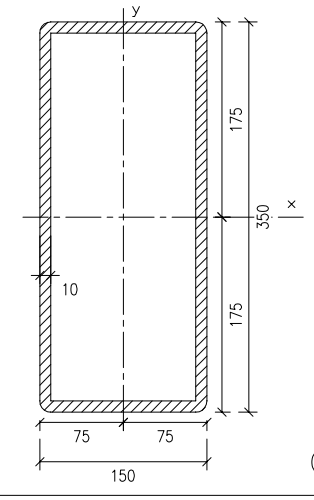SECTION			 (CUT TO 75X110X10 GMS ANGLE)		
MEMBER MARK	75X75X10MM THK GMS ANGLE	R.H.S. 01: 80X40X8MM THK GMS RHS	150X75X10MM THK GMS ANGLE	40X40X5MM GMS SHS	40X40X5MM THK GMS ANGLE
AREA (mm^2)	1410.73	1595.33	2160.730	686.265	382.833
Ixx (mm^4)	711746.98	1059866.60	861376.003	140811.692	54810.723
Iyy (mm^4)	711746.98	321087.62	5017286.542	140811.692	54810.723
Zxx (mm^3)	13457.52	26496.66	14642	7041	1931
Zyy (mm^3)	13457.52	16054.38	51885	7041	1931
MATERIAL	S275 J0H	S275J2H	S355 J0H	S275 J0H	S275 J0H
SECTION				 NTS (CUT TO 195X150X10 GMS U-CHANNEL)	
MEMBER MARK	50x50x5mm GMS ANGLE	75X50X6MM GMS ANGLE	150X100X10MM THK GMS ANGLE	350X150X10MM THK GMS RHS	
AREA (mm^2)	477.6825	717.8628	2410.730	9514.159	
Ixx (mm^4)	111073.2578	406590.9784	1997555.756	144057506.648	
Iyy (mm^4)	111073.2578	145366.2634	5542103.159	37565176.879	
Zxx (mm^3)	3101	8047	26116	823186	
Zyy (mm^3)	3101	3837	54490	500869	
MATERIAL	S275J0H	S275 J0H	S275 J0H	S275 J0H	
SECTION					
MEMBER MARK					
AREA (mm^2)					
Ixx (mm^4)					
Iyy (mm^4)					
Zxx (mm^3)					
Zyy (mm^3)					
MATERIAL					

B.D. REF :

CLIENT :

SUN HUNG KAI REAL ESTATE AGENCY LTD.
22/F SUN HUNG KAI CENTRE, WANCHAI, HONGKONG
(KNOWN AS "X863/4")

ARCHITECT :

lwk&partners
a r c h i t e c t s

MAIN CONTRACTOR :

怡輝建築有限公司
Yee Fai Building Contractors Ltd.

STRUCTURAL ENGINEER :

ARUP

FACADE CONSULTANT:

ALPHA CONSULTING LIMITED
Steel Structure & Facade Specialist

NOTE :
1. ALL DIMENSIONS ARE IN mm.
2. ALL ELEVATIONS ARE VIEWED FROM OUTSIDE.
3. ALL DIMENSIONS TO BE VERIFIED ON SITE BEFORE FABRICATION.

LEGEND :

X1 — DETAIL MARK NO.
X001 — REFER SHEET NO.

1. F.F.L. --FINISHED FLOOR LEVEL
2. S.F.L. --STRUCTURAL FLOOR LEVEL
3. (/R) --REVERSED DETAIL

NO.	DATE	REVISED	BY
D	20-NOV-2023	9TH SUBMISSION	
C	22-AUG-2023	7TH SUBMISSION	

JOB NO. : J-856

PROJECT :
PROPOSED DEVELOPMENT ABOVE LIGHT RAIL TIN WING STOP,TSWTL NO.23,AREA 33,TIN SHUI WAI, N.T.







TITLE :
SECTION PROPERTIES

DATE : 31-OCT-21 | SCALE : NTS

DRAWN BY : C.F | CHECKED BY :

美特鋁質有限公司
MIDI ALUMINIUM FABRICATOR LTD.
Units 6-8, Sunray Industrial Centre, 1/F
610 Cha Kwo Ling Road, Kowloon
Tel:23489211-4 Fax:(852)27727666

DWG NO. : J856-SD-CW-1105 | REV. : D

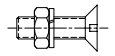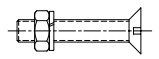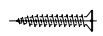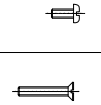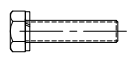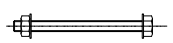F01		M12X45mm FLAT HEAD MACHINE SCREW STAINLESS STEEL Gr. A4-70 NUT : GR. A4-80 SPRING WASHER : GR. A4	F35		M8X32mm FLAT HEAD MACHINE SCREW STAINLESS STEEL Gr. A4-70	S01		"DOW CORNING(R) - DC791" SILICON SEALANT (WEATHER SEALANT)
F02		M12X70 FLAT HEAD MACHINE SCREW STAINLESS STEEL Gr. A4-70 NUT : GR. A4-80 SPRING WASHER : GR. A4	F36		M10x80mm HEX HEAD BOLT STAINLESS STEEL GR. A4-70 NUT : GR. A4-80 SPRING WASHER : GR. A4	S02		"DOW CORNING(R) STRUCTURAL SILICONE SEALANT TYPE 983" (STRUCTURAL SILICONE SEALANT)
F03		M5X12mm FLAT HEAD MACHINE SCREW MACHINE SCREW STAINLESS STEEL Gr. A4-70	F38		M6X20mm PAN HEAD SELF DRILLING SCREW STAINLESS STEEL Gr. A4-70	B01		SETTING BLOCK (L=150) @ 1/4 MODULE WIDTH GLASS PANEL MATERIAL : SILICON SHORE HARDNESS 85°±5°
F04		M6.3X38mm PAN HEAD SELF TAPPING SCREW STAINLESS STEEL Gr. A4-70	F39		M6.3x25mm FLAT HEAD MACHINE SCREW MACHINE SCREW STAINLESS STEEL Gr. A4-70	B02		ø10mm CLOSED CELL FOAM BACKER ROD
F05		M5X10mm FLAT HEAD MACHINE SCREW STAINLESS STEEL Gr. A4-70	F04		M6X30mm PAN HEAD MACHINE SCREW STAINLESS STEEL Gr. A4-70	B03		CLOSED CELL FOAM BACKER ROD (FOR COMMON USE)
F06		M5X15mm PAN HEAD MACHINE SCREW STAINLESS STEEL Gr. A4-70	F41		M5X25mm PAN HEAD SELF DRILLING SCREW STAINLESS STEEL Gr. A4-70	B04		CLOSED CELL FOAM BACKER ROD
F07		M5X10mm PAN HEAD MACHINE SCREW STAINLESS STEEL Gr. A4-70	F42		M16 "HILTI HST3-R ANCHOR BOLT STAINLESS STEEL GR. A4	G01		GASKET MATERIAL : SILICON SHORE HARDNESS 65°±5°
F08		M5X35mm FLAT HEAD MACHINE SCREW STAINLESS STEEL Gr. A4-70				G02		GASKET MATERIAL : SILICON SHORE HARDNESS 65°±5°
F09		M5X12mm FLAT HEAD MACHINE SCREW STAINLESS STEEL Gr. A4-70				G03		GASKET MATERIAL : SILICON SHORE HARDNESS 65°±5°
F10		M4.2X16mm PAN HEAD SELF TAPPING SCREW STAINLESS STEEL Gr. A4-70				G04		GASKET MATERIAL : SILICON SHORE HARDNESS 65°±5°
F11		M6.3X38mm FLAT HEAD SELF TAPPING SCREW STAINLESS STEEL Gr. A4-70				G05		GASKET MATERIAL : SILICON SHORE HARDNESS 65°±5°
F13		M4.2X12mm FLAT HEAD SELF TAPPING SCREW STAINLESS STEEL Gr. A4-70				G06		GASKET MATERIAL : SILICON SHORE HARDNESS 65°±5°
F14		M5X12mm PAN HEAD MACHINE SCREW STAINLESS STEEL Gr. A4-70				G07		GASKET MATERIAL : SILICON SHORE HARDNESS 65°±5°
F23		M5X28mm FLAT HEAD MACHINE SCREW STAINLESS STEEL Gr. A4-70				G08		GASKET MATERIAL : SILICON SHORE HARDNESS 65°±5°
F24		M5X20mm FLAT HEAD MACHINE SCREW STAINLESS STEEL Gr. A4-70				G09		GASKET MATERIAL : SILICON SHORE HARDNESS 65°±5°
F25		M5X8mm PAN HEAD MACHINE SCREW STAINLESS STEEL Gr. A4-70				G10		GASKET MATERIAL : SILICON SHORE HARDNESS 65°±5°
F26		M6 ALUM. STUD BOLT : AW-5754[Al Mg3] NUT : GR. A4-80 1-SPRING WASHER : GR. A4				G11		GASKET MATERIAL : SILICON SHORE HARDNESS 65°±5°
F27		M5X20mm PAN HEAD SELF DRILLING SCREW STAINLESS STEEL Gr. A4-70				G12		GASKET MATERIAL : SILICON SHORE HARDNESS 65°±5°
F28		M5X20mm FLAT HEAD SELF DRILLING SCREW STAINLESS STEEL Gr. A4-70				G13		GASKET MATERIAL : SILICON SHORE HARDNESS 65°±5°
F29		#10X38mm PLAN HEAD SELF TAPPING SCREW WITH PLASTIC PLUG				G14		GASKET MATERIAL : SILICON SHORE HARDNESS 65°±5°
F30		M10x90mm "HILTI HST3-R ANCHOR BOLT STAINLESS STEEL GR. A4				G15		GASKET MATERIAL : SILICON SHORE HARDNESS 65°±5°
F31		M8x70mm "HILTI HST3-R ANCHOR BOLT STAINLESS STEEL GR. A4				G16		GASKET MATERIAL : SILICON SHORE HARDNESS 65°±5°
F32		M12x50/45mm HEX HEAD BOLT STAINLESS STEEL GR. A4-70						
F33		M6x60mm HEX HEAD BOLT STAINLESS STEEL GR. A4-70 NUT : GR. A4-80 SPRING WASHER : GR. A4						
F34		M6x70mm HEX HEAD BOLT STAINLESS STEEL GR. A4-70 NUT : GR. A4-80 SPRING WASHER : GR. A4						
F35		M6.3X20mm FLAT HEAD SELF TAPPING SCREW STAINLESS STEEL Gr. A4-70						

B.D. REF :

CLIENT :

SUN HUNG KAI REAL ESTATE AGENCY LTD.
42/F SUN HUNG KAI CENTRE, WANCHAI, HONGKONG

ARCHITECT :

lwk&partners
a r c h i t e c t s

MAIN CONTRACTOR :

怡輝建築有限公司
Yee Fai Building Contractors Ltd.

STRUCTURAL ENGINEER :

ARUP

FACADE CONSULTANT:

ALPHA CONSULTING LIMITED
Steel Structure & Facade Specialist

NOTE :
1. ALL DIMENSIONS ARE IN mm.
2. ALL ELEVATIONS ARE VIEWED FROM OUTSIDE.
3. ALL DIMENSIONS TO BE VERIFIED ON SITE BEFORE FABRICATION.

LEGEND :

X1 — DETAIL MARK NO.
X001 — REFER SHEET NO.

1. F.F.L. --FINISHED FLOOR LEVEL
2. S.F.L. --STRUCTURAL FLOOR LEVEL
3. (R) --REVERSED DETAIL

NO.	DATE	REVISED	BY
B	30-OCT-2023	9TH SUBMISSION	CF
A	22-AUG-2023	7TH SUBMISSION	CF

JOB NO. : J-856

PROJECT :
PROPOSED DEVELOPMENT ABOVE LIGHT RAIL TIN WING STOP,TSWTL NO.23,AREA 33,TIN SHUI WAI, N.T.


TITLE :
PART LIST
FOR CURTAIN WALL

DATE : 10-MAR-23 | SCALE : 1:4


DRAWN BY : C.F | CHECKED BY :

美特鋁質有限公司
MIDI ALUMINIUM FABRICATOR LTD.
Units 6-8, Sunray Industrial Centre, 1/F
610 Cha Kwo Ling Road, Kowloon
Tel:23489211-4 Fax:(852)27727666


DWG NO. : J856-SD-CW-1106 | REV. : B

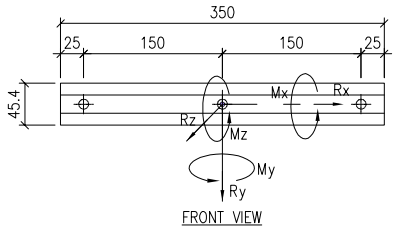

FRONT VIEW

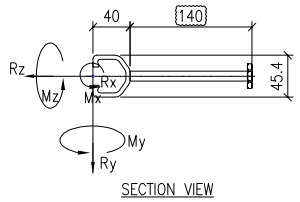

SECTION VIEW

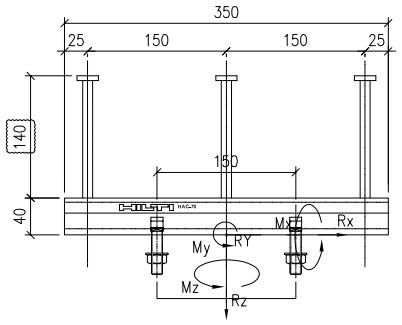

PLAN VIEW

(HILTI HAC-70, L=350mm)

(FOR TYPICAL)

EM01 MAX. UN-FACTORED LOAD			
	DL	WL	LL
Rx (kN)	0	0	0
Ry (kN)	3.314	0	2.207
Rz (kN)	0	±18.602	0
Mx (kNm)	0.396	±0.632	0.075
My (kNm)	0	0	0
Mz (kNm)	0	0	0


(END-BAY SIDE MOUNT ; FIXED WINDOW)

EM01 MAX. UN-FACTORED LOAD			
	DL	WL	LL
Rx (kN)	0	±3.195	0
Ry (kN)	2.818	0	1.877
Rz (kN)	0	±15.815	0
Mx (kNm)	0.337	±0.538	0.064
My (kNm)	0	±2.596	0
Mz (kNm)	0.394	±0.109	0


(END-BAY: SIDE MOUNT ;OPEN WINDOW)

EM01 MAX. UN-FACTORED LOAD			
	DL	WL	LL
Rx (kN)	0	±2.059	0
Ry (kN)	1.543	0	1.028
Rz (kN)	0	±8.662	0
Mx (kNm)	0.184	±0.295	0.035
My (kNm)	0	±1.459	0
Mz (kNm)	0.216	±0.07	0


CAST-IN EMBED : EM01

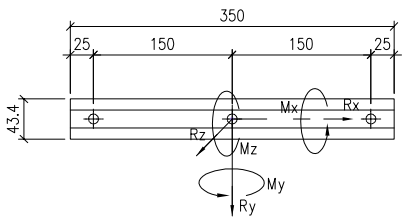

FRONT VIEW

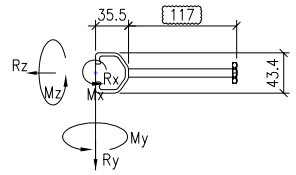

SECTION VIEW

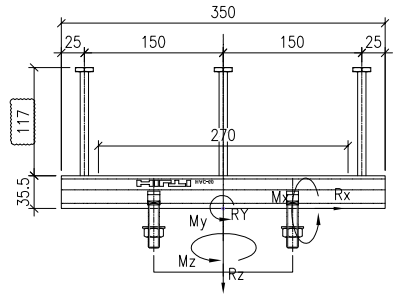

PLAN VIEW

(HILTI HAC-60, L=350mm)

FOR TYPICAL CASE

MAX. UNFACTORED LOAD:


TYPE A	DL	WL	LL
Fx (kN)	0	0	0
Fy (kN)	2.018	0	1.344
Fz (kN)	0	±11.325	0
Mx (kNm)	0.241	±0.385	0.046
My (kNm)	0	0	0
Mz (kNm)	0	0	0

FOR END BAY CASE


MAX. UNFACTORED LOAD:

TYPE A	DL	WL	LL
Fx (kN)	0	0	0
Fy (kN)	1.025	0	0.682
Fz (kN)	0	±5.751	0
Mx (kNm)	0.122	±0.196	0.023
My (kNm)	0	0	0
Mz (kNm)	0	0	0

CAST-IN EMBED : EM02

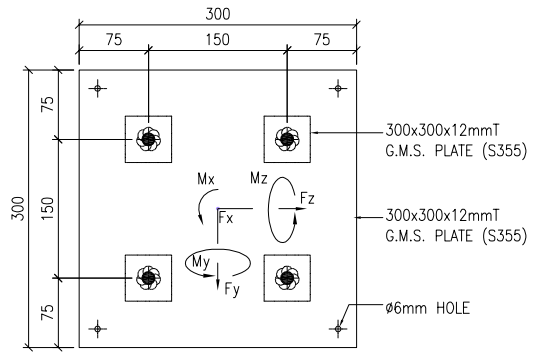

FRONT VIEW

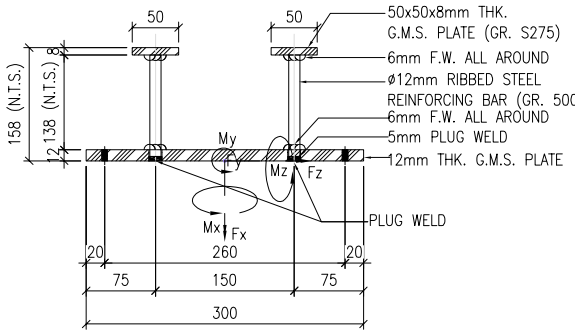

PLAN VIEW


(FOR 3/F TYPICAL)


EM03 MAX. UN-FACTORED LOAD			
	DL	WL	LL
Fx (kN)	0	±7	±1.5
Fy (kN)	−1	0	0
Fz (kN)	0	0	0
Mx (kNm)	±0.1	0	0
My (kNm)	0	0	0
Mz (kNm)	0	±3.5	0.75

(FOR 3/F END BAY)

EM03 MAX. UN-FACTORED LOAD			
	DL	WL	LL
Fx (kN)	0	±4	0.6
Fy (kN)	−1	0	0
Fz (kN)	0	±0.5	0
Mx (kNm)	±0.15	±0.15	0
My (kNm)	0	±0.1	±0.2
Mz (kNm)	±0.1	±2	+0.45

CAST-IN EMBED : EM03

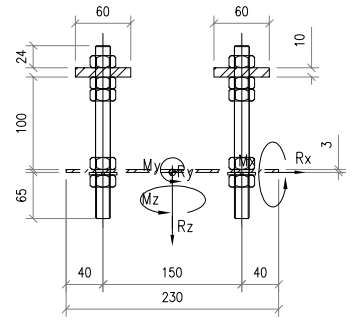


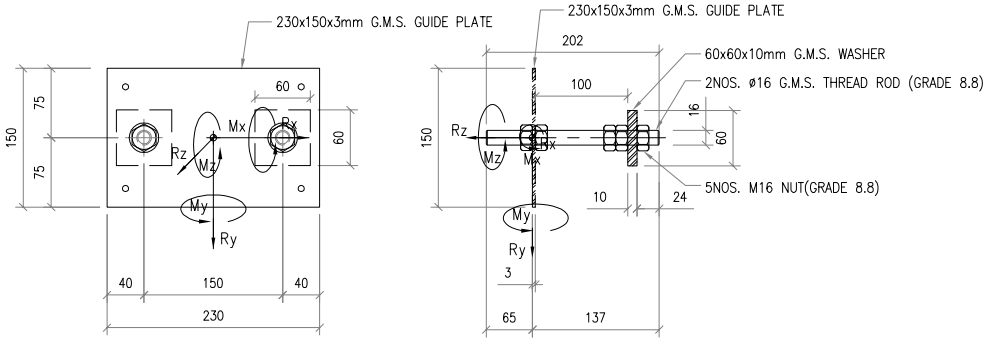



(FOR TYPICAL)

EM08 UN-FACTORED LOAD			
	DL	WL	LL
Rx (kN)	0	0	0
Ry (kN)	2.5	0	1.645
Rz (kN)	0	±14	0
Mx (kNm)	0.30	±0.48	0.056
My (kNm)	0	±2.7	0
Mz (kNm)	0.48	0	0

CAST-IN EMBED : EM08

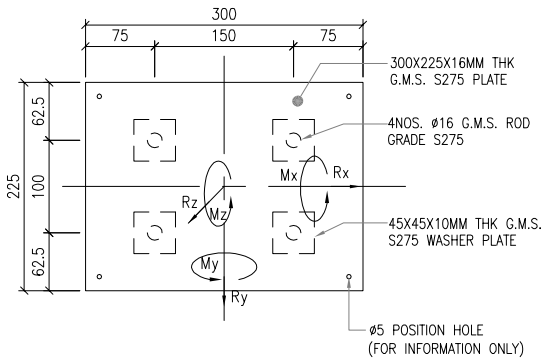

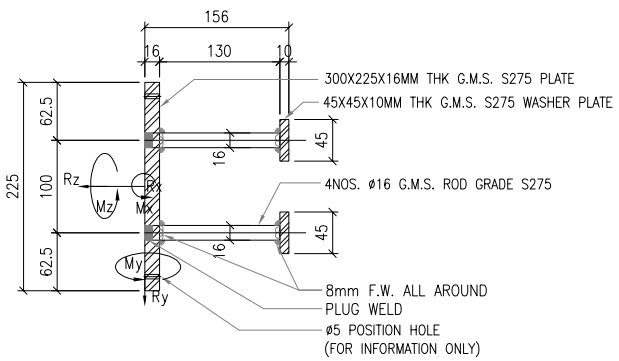

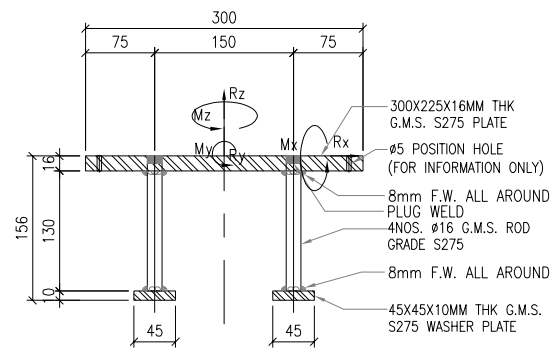

(FOR 46/F SU)

EM09 MAX. UN-FACTORED LOAD			
	DL	WL	LL
Rx (kN)	0	0	0
Ry (kN)	0.7	±1.06	0
Rz (kN)	0	±10.209	2.594
Mx (kNm)	0.064	±4.675	1.200
My (kNm)	0	0	0
Mz (kNm)	0	0	0

CAST-IN EMBED : EM09

B.D. REF :

CLIENT :

SUN HUNG KAI REAL ESTATE AGENCY LTD.
42/F SUN HUNG KAI CENTRE, WANCHAI, HONGKONG

ARCHITECT :

lwk&partners
a r c h i t e c t s

MAIN CONTRACTOR :

怡輝建築有限公司
Yee Fai Building Contractors Ltd.

STRUCTURAL ENGINEER :

ARUP

FACADE CONSULTANT:

ALPHA CONSULTING LIMITED
Steel Structure & Facade Specialist

NOTE :

1. ALL DIMENSIONS ARE IN mm.
2. ALL ELEVATIONS ARE VIEWED FROM OUTSIDE.
3. ALL DIMENSIONS TO BE VERIFIED ON SITE BEFORE FABRICATION.

LEGEND :

X1 — DETAIL MARK NO.
X001 — REFER SHEET NO.

1. F.F.L. --FINISHED FLOOR LEVEL
2. S.F.L. --STRUCTURAL FLOOR LEVEL
3. /R --REVERSED DETAIL

NO.	DATE	REVISED	BY
B	27-APR-2023	3RD SUBMISSION	CF
A	22-DEC-2022	2ND SUBMISSION	CF

JOB NO. : J-856

PROJECT :
PROPOSED DEVELOPMENT ABOVE LIGHT RAIL TIN WING STOP,TSWTL NO.23,AREA 33,TIN SHUI WAI, N.T.


TITLE :
CAST-IN EMBED DETAIL FOR CURTAIN WALL

DATE : 31-OCT-21 | SCALE : 1:8

DRAWN BY : C.F | CHECKED BY :

美特鋁質有限公司
MIDI ALUMINIUM FABRICATOR LTD.
Units 6-8, Sunray Industrial Centre, 1/F
610 Cha Kwo Ling Road, Kowloon
Tel:23489211-4 Fax:(852)27727666

DWG NO. : J856-SD-CW-2001 | REV. : B

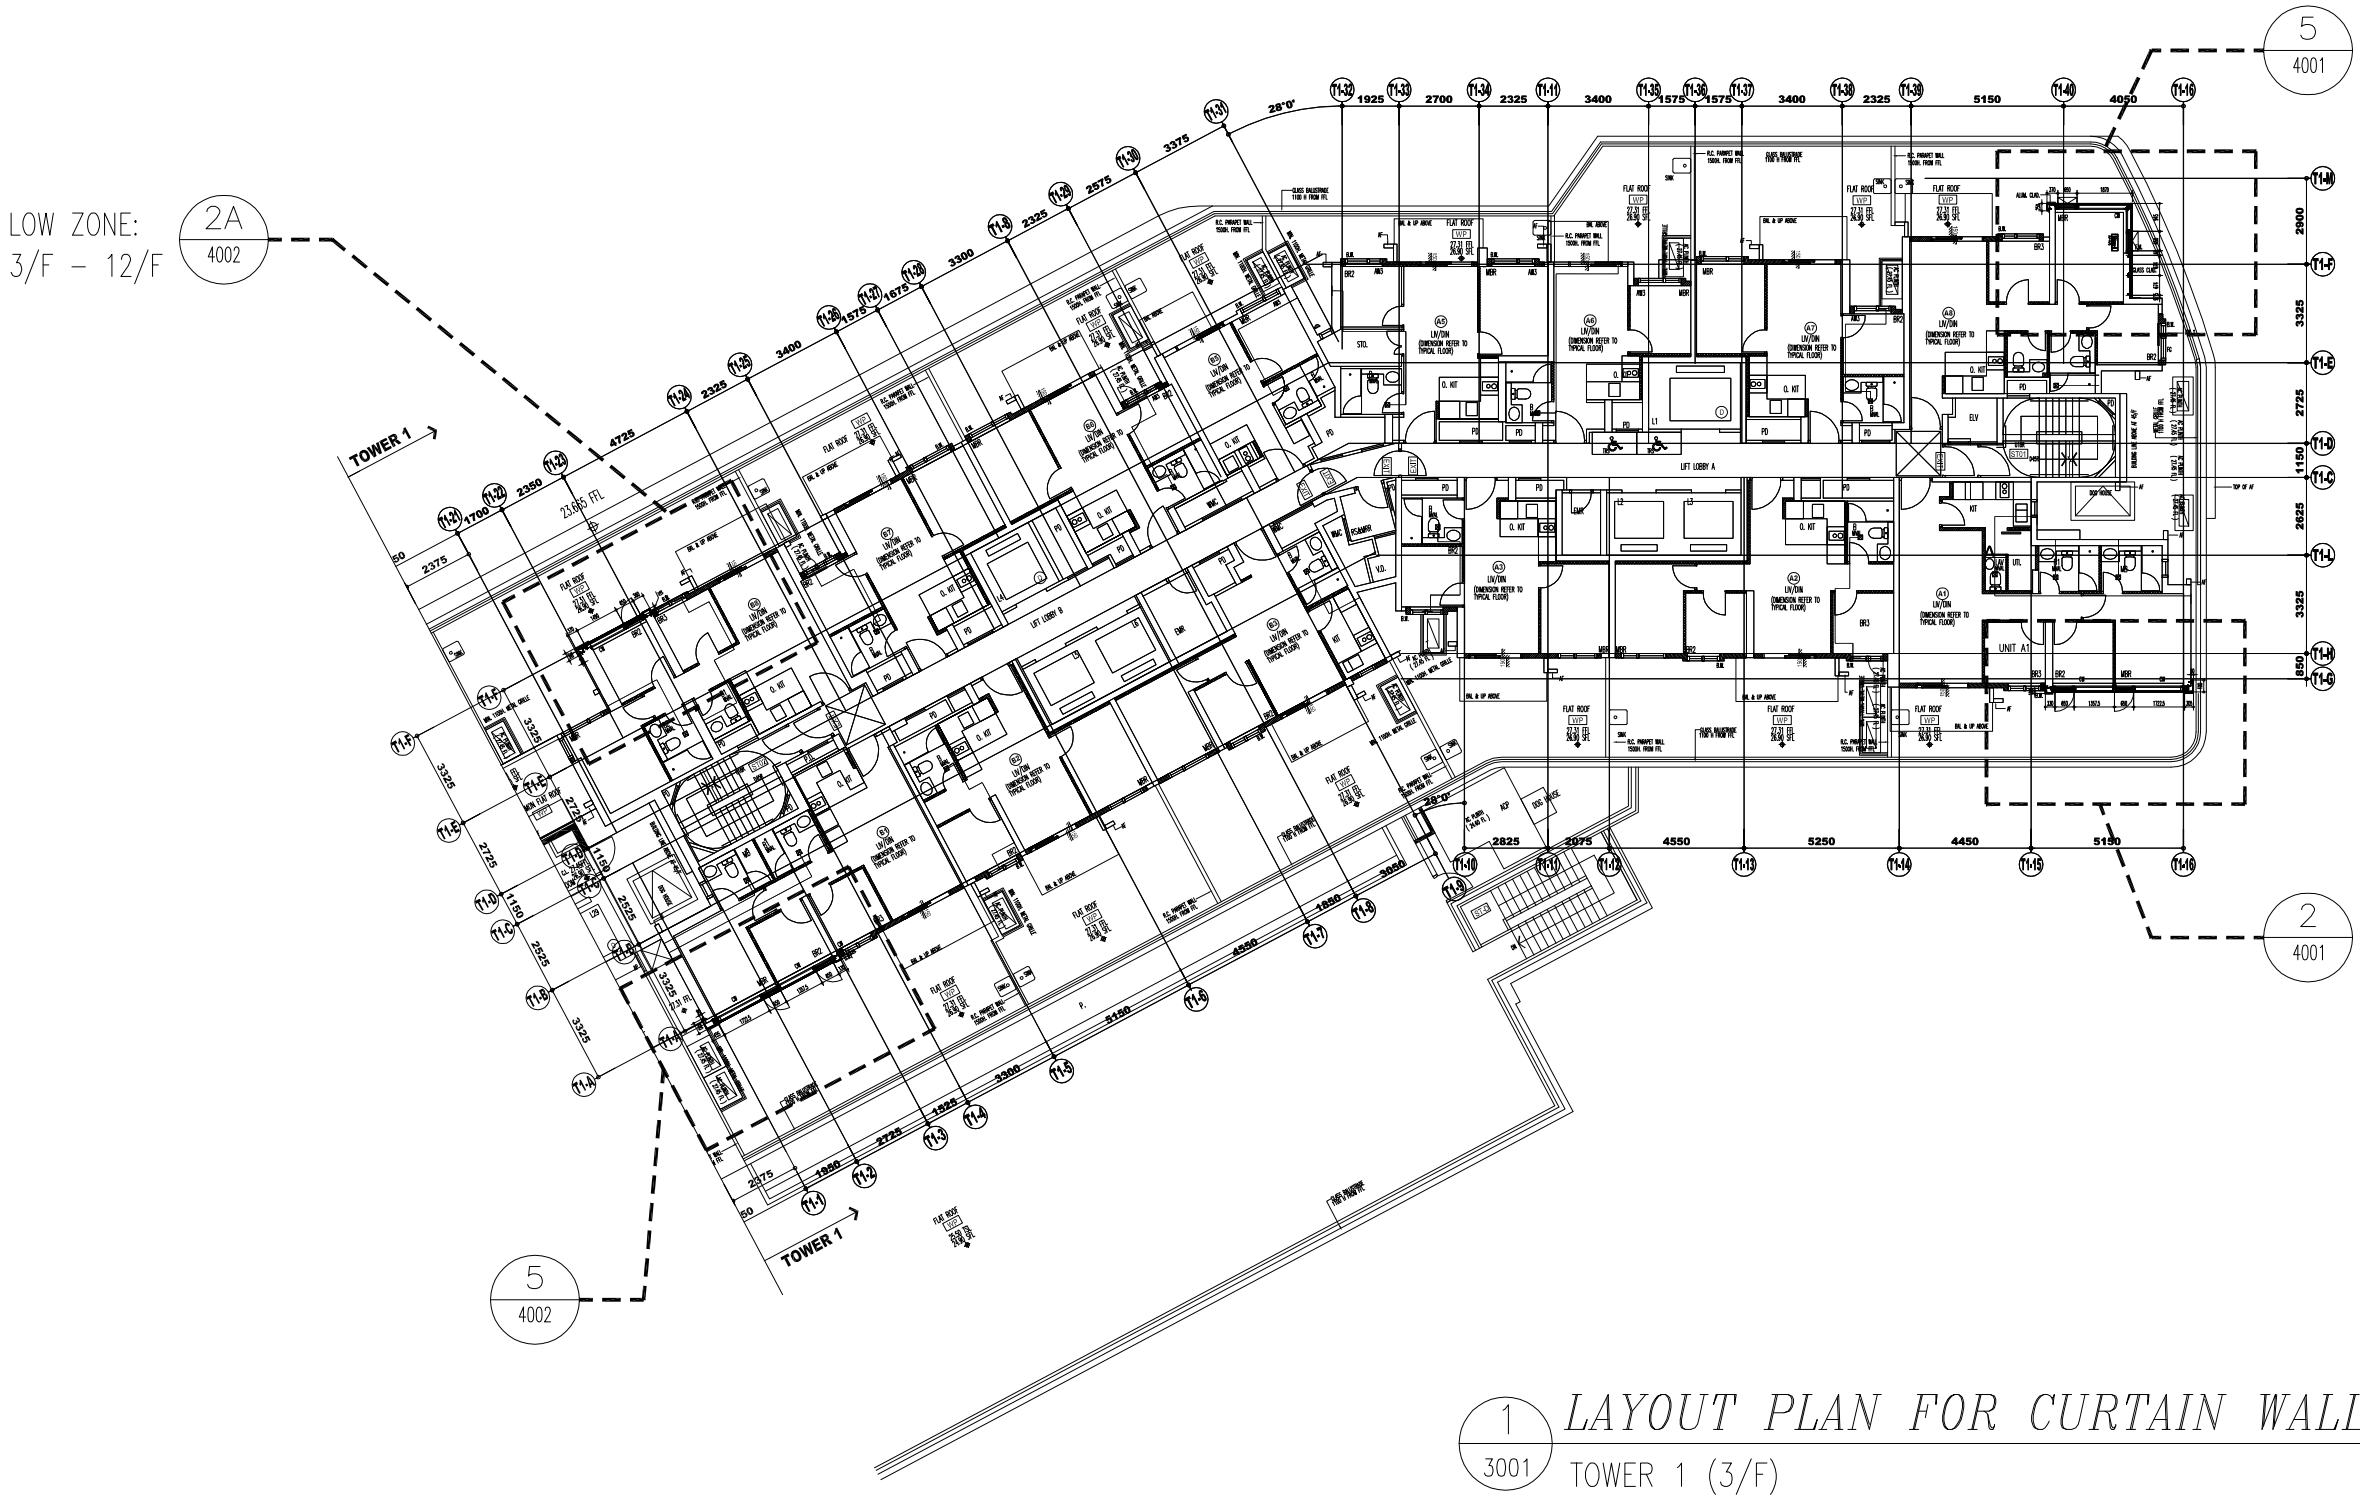

1 3001 LAYOUT PLAN FOR CURTAIN WALL

TOWER 1 (3/F)

B.D. REF :

CLIENT :
SUN HUNG KAI REAL ESTATE AGENCY LTD.
42/F SUN HUNG KAI CENTRE, WANCHAI, HONGKONG

ARCHITECT :
lwk&partners architects

MAIN CONTRACTOR :
怡輝建築有限公司
Yee Fai Building Contractors Ltd.

STRUCTURAL ENGINEER :
ARUP

FACADE CONSULTANT:
ALPHA CONSULTING LIMITED
Steel Structure & Facade Specialist

NOTE :
1. ALL DIMENSIONS ARE IN mm.
2. ALL ELEVATIONS ARE VIEWED FROM OUTSIDE.
3. ALL DIMENSIONS TO BE VERIFIED ON SITE BEFORE FABRICATION.

LEGEND :
X1 — DETAIL MARK NO.
X001 — REFER SHEET NO.
1. F.F.L. --FINISHED FLOOR LEVEL
2. S.F.L. --STRUCTURAL FLOOR LEVEL
3. (R) --REVERSED DETAIL

NO.	DATE	REVISED	BY
B	29-SEP-2023	8TH SUBMISSION	CF
A	16-DEC-2022	2ND SUBMISSION	CF

JOB NO. : J-856

PROJECT :
PROPOSED DEVELOPMENT ABOVE LIGHT RAIL TIN WING STOP,TSWTL NO.23,AREA 33,TIN SHUI WAI, N.T.


TITLE :
LAYOUT PLAN FOR CURTAIN WALL @ TOWER 1 (3/F)

DATE : 31-OCT-21 | SCALE : 1:250

DRAWN BY : C.F | CHECKED BY :

美特鋁質有限公司
MIDI ALUMINIUM FABRICATOR LTD.
Units 6-8, Sunray Industrial Centre, 1/F
610 Cha Kwo Ling Road, Kowloon
Tel:23489211-4 Fax:(852)27727666

DWG NO. : J856-SD-CW-3001 | REV. : B

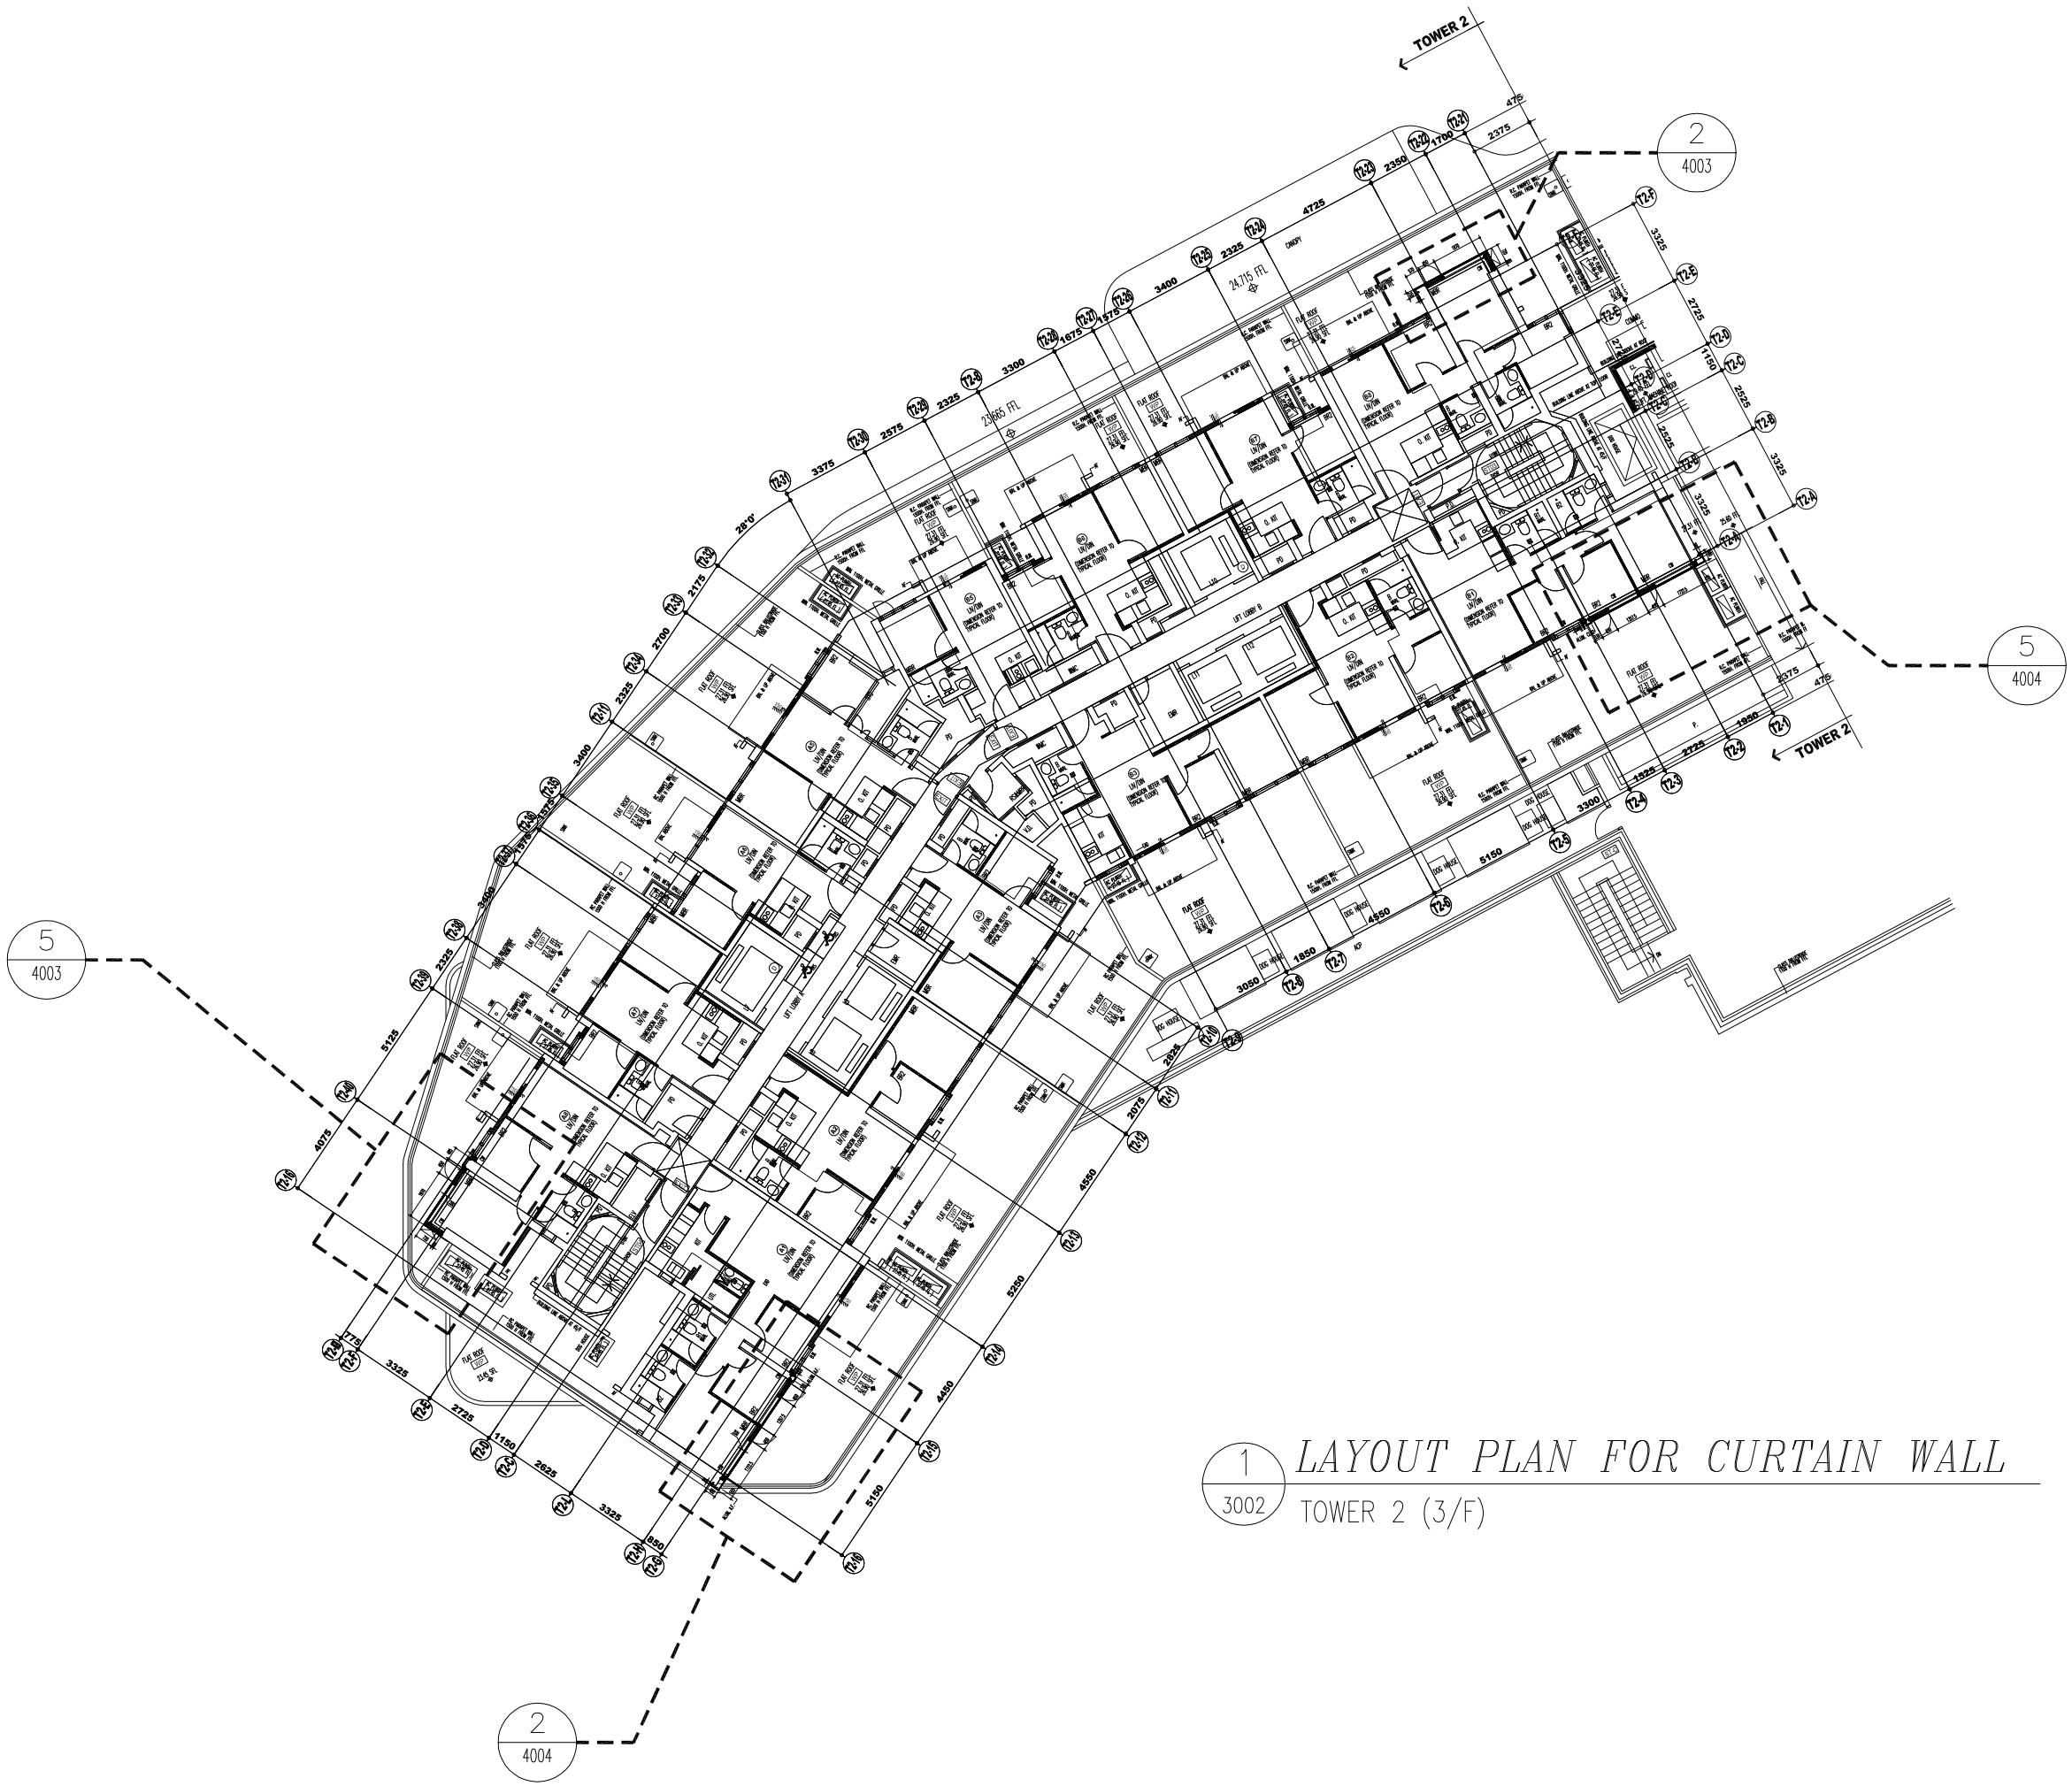

1 / 3002 *LAYOUT PLAN FOR CURTAIN WALL*

TOWER 2 (3/F)

B.D. REF :

CLIENT :

SUN HUNG KAI REAL ESTATE AGENCY LTD.
42/F SUN HUNG KAI CENTRE, WANCHAI, HONGKONG

ARCHITECT :

lwk&partners
a r c h i t e c t s

MAIN CONTRACTOR :

怡輝建築有限公司
Yee Fai Building Contractors Ltd.

STRUCTURAL ENGINEER :

ARUP

FACADE CONSULTANT:

ALPHA CONSULTING LIMITED
Steel Structure & Facade Specialist

NOTE :
1. ALL DIMENSIONS ARE IN mm.
2. ALL ELEVATIONS ARE VIEWED FROM OUTSIDE.
3. ALL DIMENSIONS TO BE VERIFIED ON SITE BEFORE FABRICATION.

LEGEND :

X1 / X001 — DETAIL MARK NO. / REFER SHEET NO.

1. F.F.L. --FINISHED FLOOR LEVEL
2. S.F.L. --STRUCTURAL FLOOR LEVEL
3. /R --REVERSED DETAIL

NO.	DATE	REVISED	BY
B	29-SEP-2023	8TH SUBMISSION	CF

JOB NO. : J-856

PROJECT :
PROPOSED DEVELOPMENT ABOVE LIGHT RAIL TIN WING STOP,TSWTL NO.23,AREA 33,TIN SHUI WAI, N.T.


TITLE :
LAYOUT PLAN FOR CURTAIN WALL @ TOWER 2 (3/F)

DATE : 02-Aug-21 | SCALE : 1:250

DRAWN BY : C.F | CHECKED BY :

美特鋁質有限公司
MIDI ALUMINIUM FABRICATOR LTD.
Units 6-8, Sunray Industrial Centre, 1/F
610 Cha Kwo Ling Road, Kowloon
Tel:23489211-4 Fax:(852)27727666

DWG NO. : J856-SD-CW-3002 | REV. : B

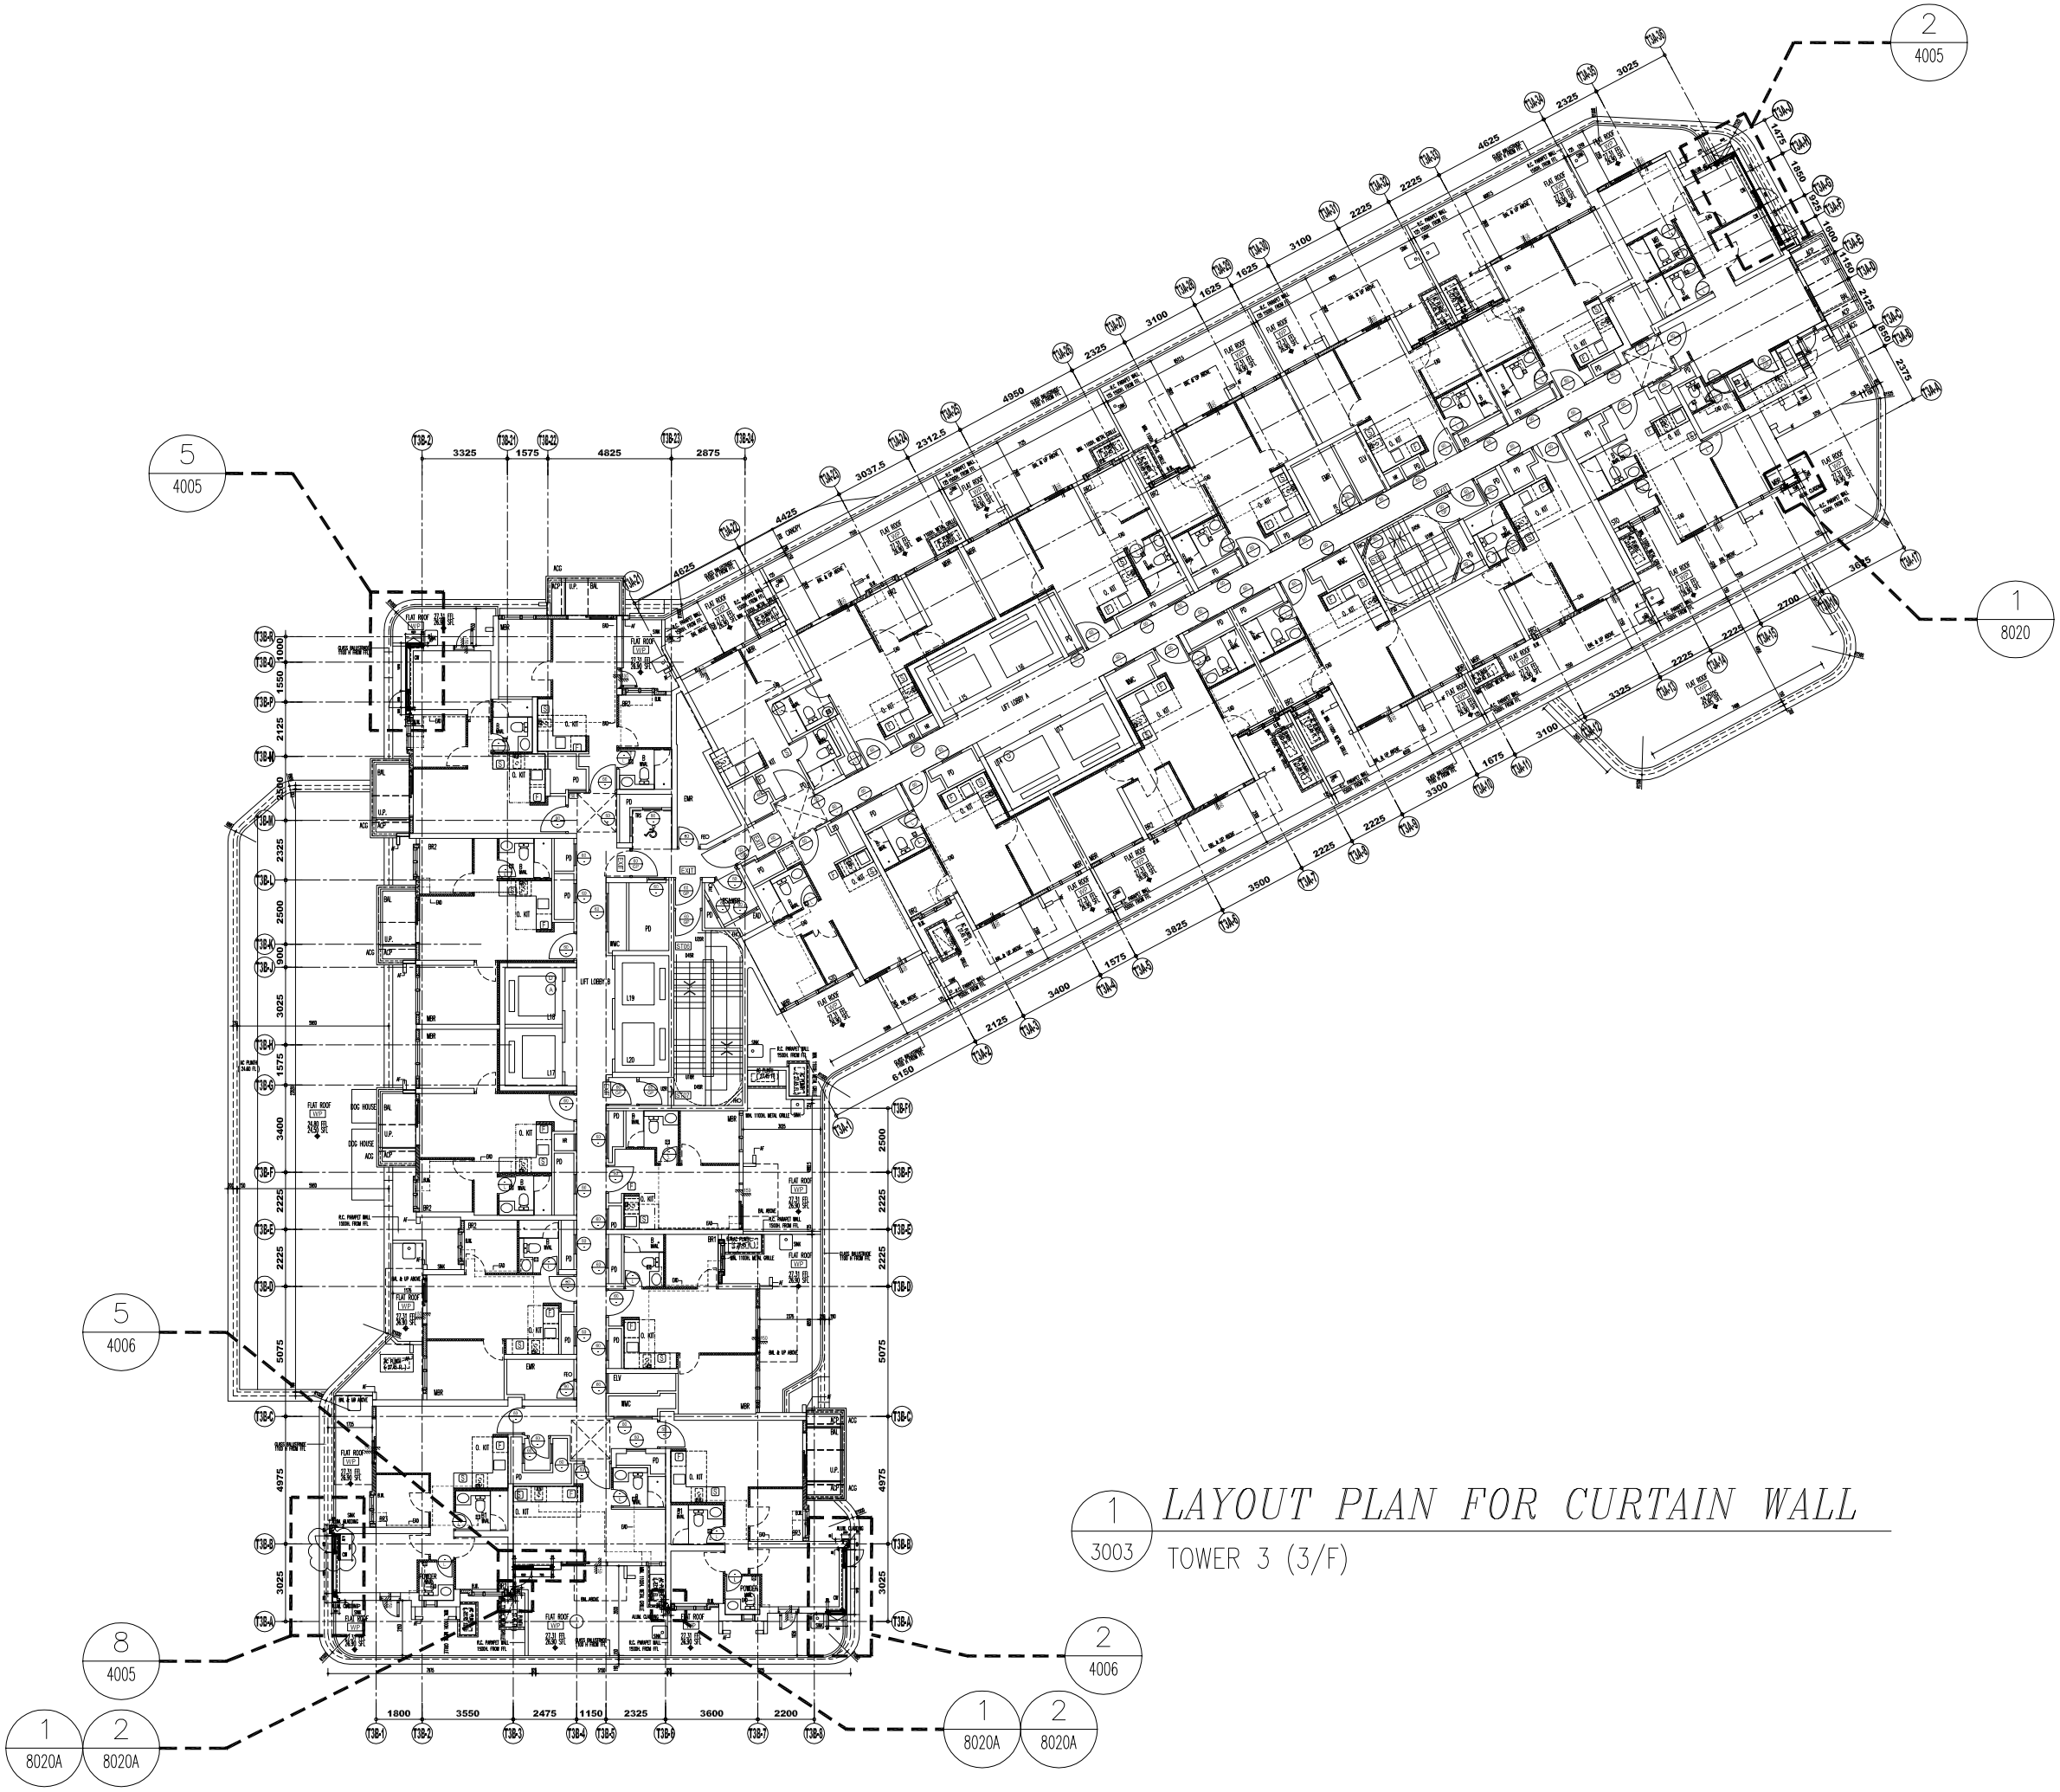

1 / 3003 *LAYOUT PLAN FOR CURTAIN WALL*

TOWER 3 (3/F)

B.D. REF :

CLIENT :

SUN HUNG KAI REAL ESTATE AGENCY LTD.
42/F SUN HUNG KAI CENTRE, WANCHAI, HONGKONG

ARCHITECT :

lwk&partners
a r c h i t e c t s

MAIN CONTRACTOR :

怡輝建築有限公司
Yee Fai Building Contractors Ltd.

STRUCTURAL ENGINEER :

ARUP

FACADE CONSULTANT:

ALPHA CONSULTING LIMITED
Steel Structure & Facade Specialist

NOTE :
1. ALL DIMENSIONS ARE IN mm.
2. ALL ELEVATIONS ARE VIEWED FROM OUTSIDE.
3. ALL DIMENSIONS TO BE VERIFIED ON SITE BEFORE FABRICATION.

LEGEND :

X1 — DETAIL MARK NO.
X001 — REFER SHEET NO.

1. F.F.L. --FINISHED FLOOR LEVEL
2. S.F.L. --STRUCTURAL FLOOR LEVEL
3. /R --REVERSED DETAIL

NO.	DATE	REVISED	BY
C	29-SEP-2023	8TH SUBMISSION	CF
B	13-JAN-2023	2ND SUBMISSION	CF
A	16-DEC-2022	2ND SUBMISSION	CF

JOB NO. : J-856

PROJECT :
PROPOSED DEVELOPMENT ABOVE LIGHT RAIL TIN WING STOP,TSWTL NO.23,AREA 33,TIN SHUI WAI, N.T.

TITLE :
LAYOUT PLAN FOR CURTAIN WALL @ TOWER 3 (3/F)

DATE : 02-Aug-21 | SCALE : 1:250


DRAWN BY : C.F | CHECKED BY :

美特鋁質有限公司
MIDI ALUMINIUM FABRICATOR LTD.
Units 6-8, Sunray Industrial Centre, 1/F
610 Cha Kwo Ling Road, Kowloon
Tel:23489211-4 Fax:(852)27727666

DWG NO. : J856-SD-CW-3003 | REV. : C

LOW ZONE:
3/F – 12/F
2A / 4002

HIGH ZONE:
15/F – 45/F
2 / 4002

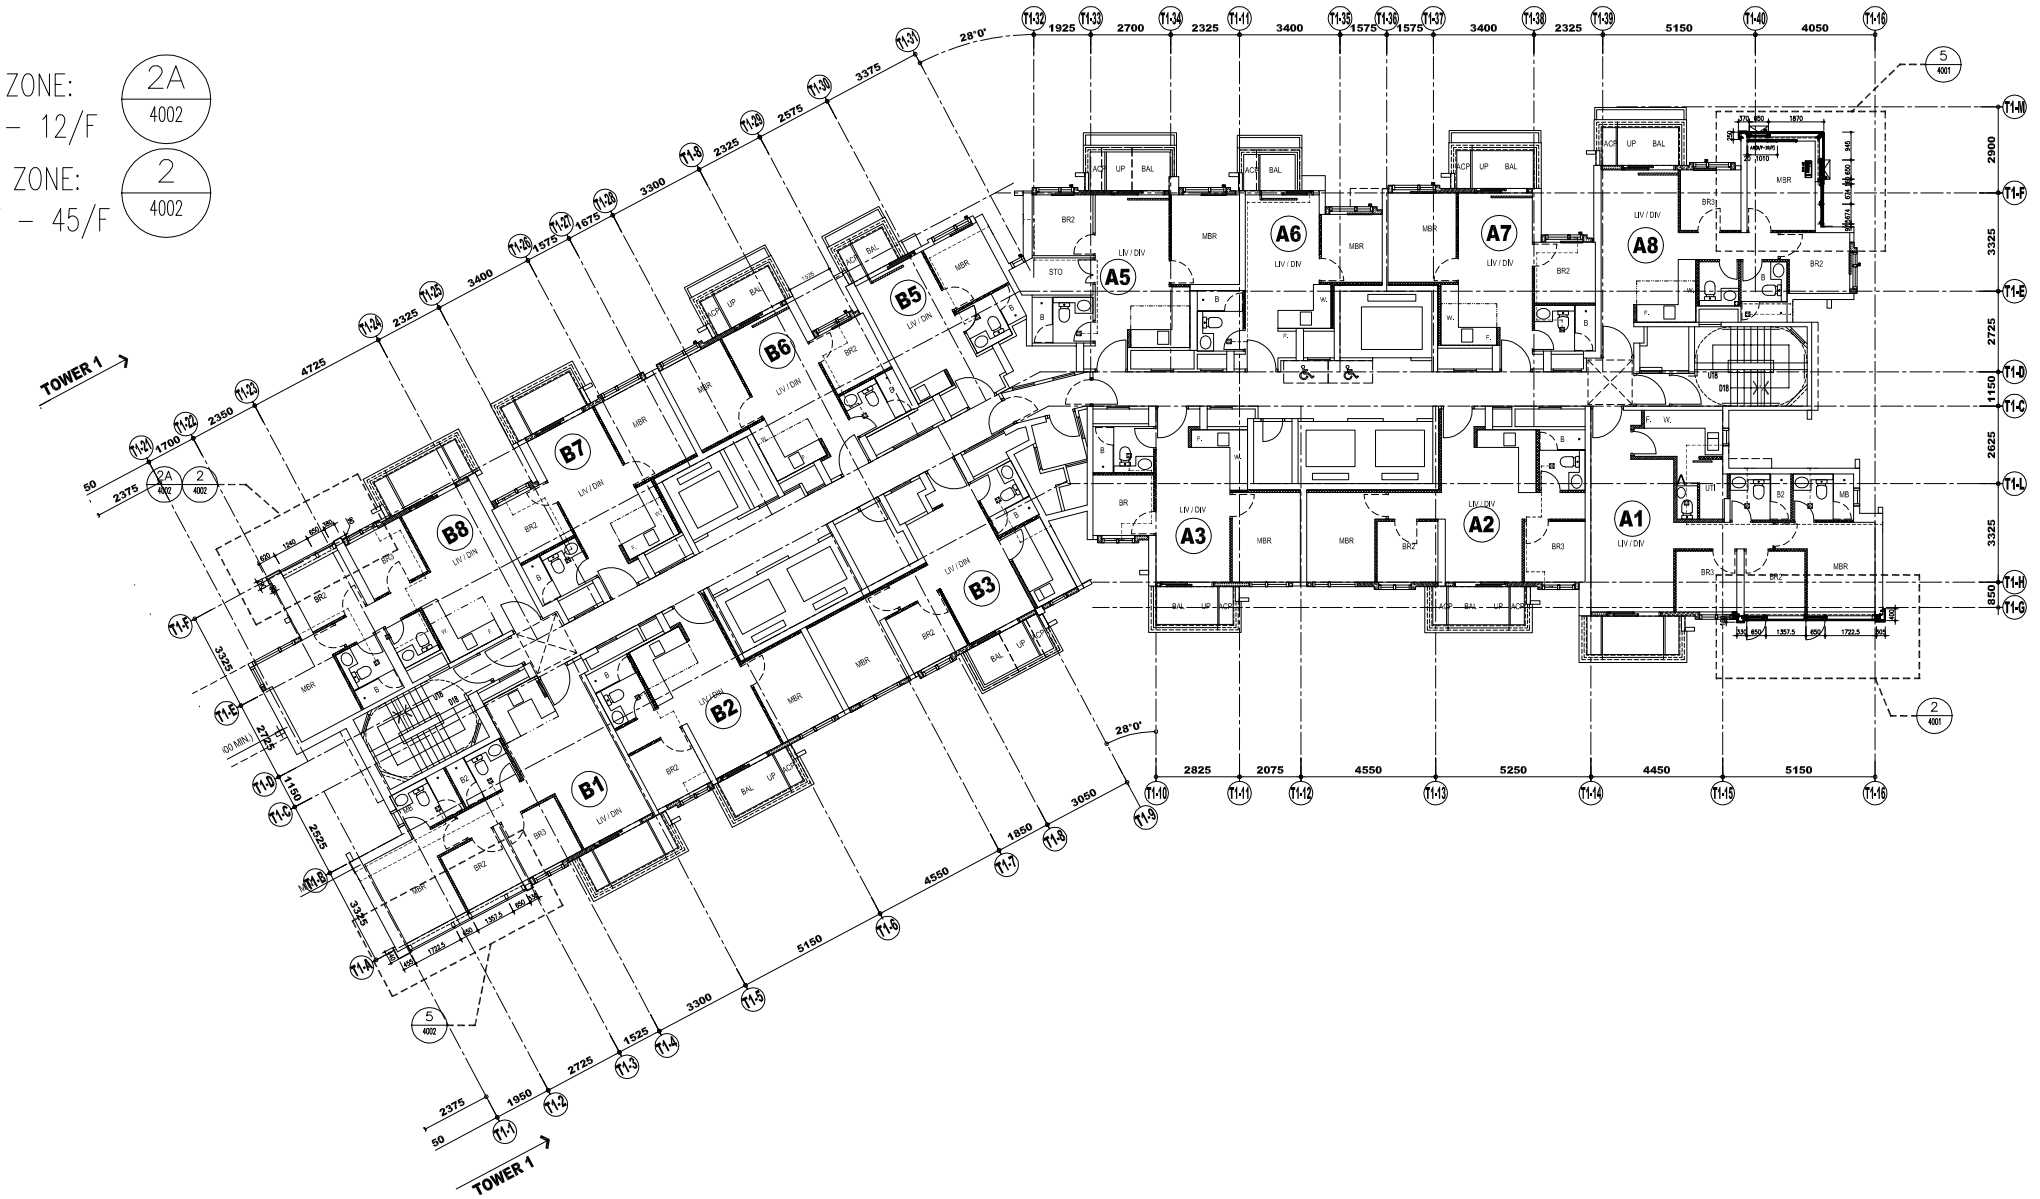

1 / 3004 *LAYOUT PLAN FOR CURTAIN WALL*

TOWER 1 (TYPICAL FLOOR: 5/F TO 45/F)

B.D. REF :

CLIENT :
SUN HUNG KAI REAL ESTATE AGENCY LTD.
42/F SUN HUNG KAI CENTRE, WANCHAI, HONGKONG

ARCHITECT :
lwk&partners architects

MAIN CONTRACTOR :
怡輝建築有限公司
Yee Fai Building Contractors Ltd.

STRUCTURAL ENGINEER :
ARUP

FACADE CONSULTANT:
ALPHA CONSULTING LIMITED
Steel Structure & Facade Specialist

NOTE :
1. ALL DIMENSIONS ARE IN mm.
2. ALL ELEVATIONS ARE VIEWED FROM OUTSIDE.
3. ALL DIMENSIONS TO BE VERIFIED ON SITE BEFORE FABRICATION.

LEGEND :
X1 / X001 — DETAIL MARK NO. / REFER SHEET NO.
1. F.F.L. -- FINISHED FLOOR LEVEL
2. S.F.L. -- STRUCTURAL FLOOR LEVEL
3. /R -- REVERSED DETAIL

NO.	DATE	REVISED	BY
C	29-SEP-2023	8TH SUBMISSION	CF
B	27-FEB-2023	4TH SUBMISSION	CF
A	16-DEC-2022	2ND SUBMISSION	CF

JOB NO. : J-856

PROJECT :
PROPOSED DEVELOPMENT ABOVE LIGHT RAIL TIN WING STOP,TSWTL NO.23,AREA 33,TIN SHUI WAI, N.T.


TITLE :
LAYOUT PLAN FOR CURTAIN WALL @ TOWER 1 (TYP)

DATE : 31-OCT-22 | SCALE : 1:250

DRAWN BY : C.F | CHECKED BY :

美特鋁質有限公司
MIDI ALUMINIUM FABRICATOR LTD.
Units 6-8, Sunray Industrial Centre, 1/F
610 Cha Kwo Ling Road, Kowloon
Tel:23489211-4 Fax:(852)27727666

DWG NO. : J856-SD-CW-3004 | REV. : C

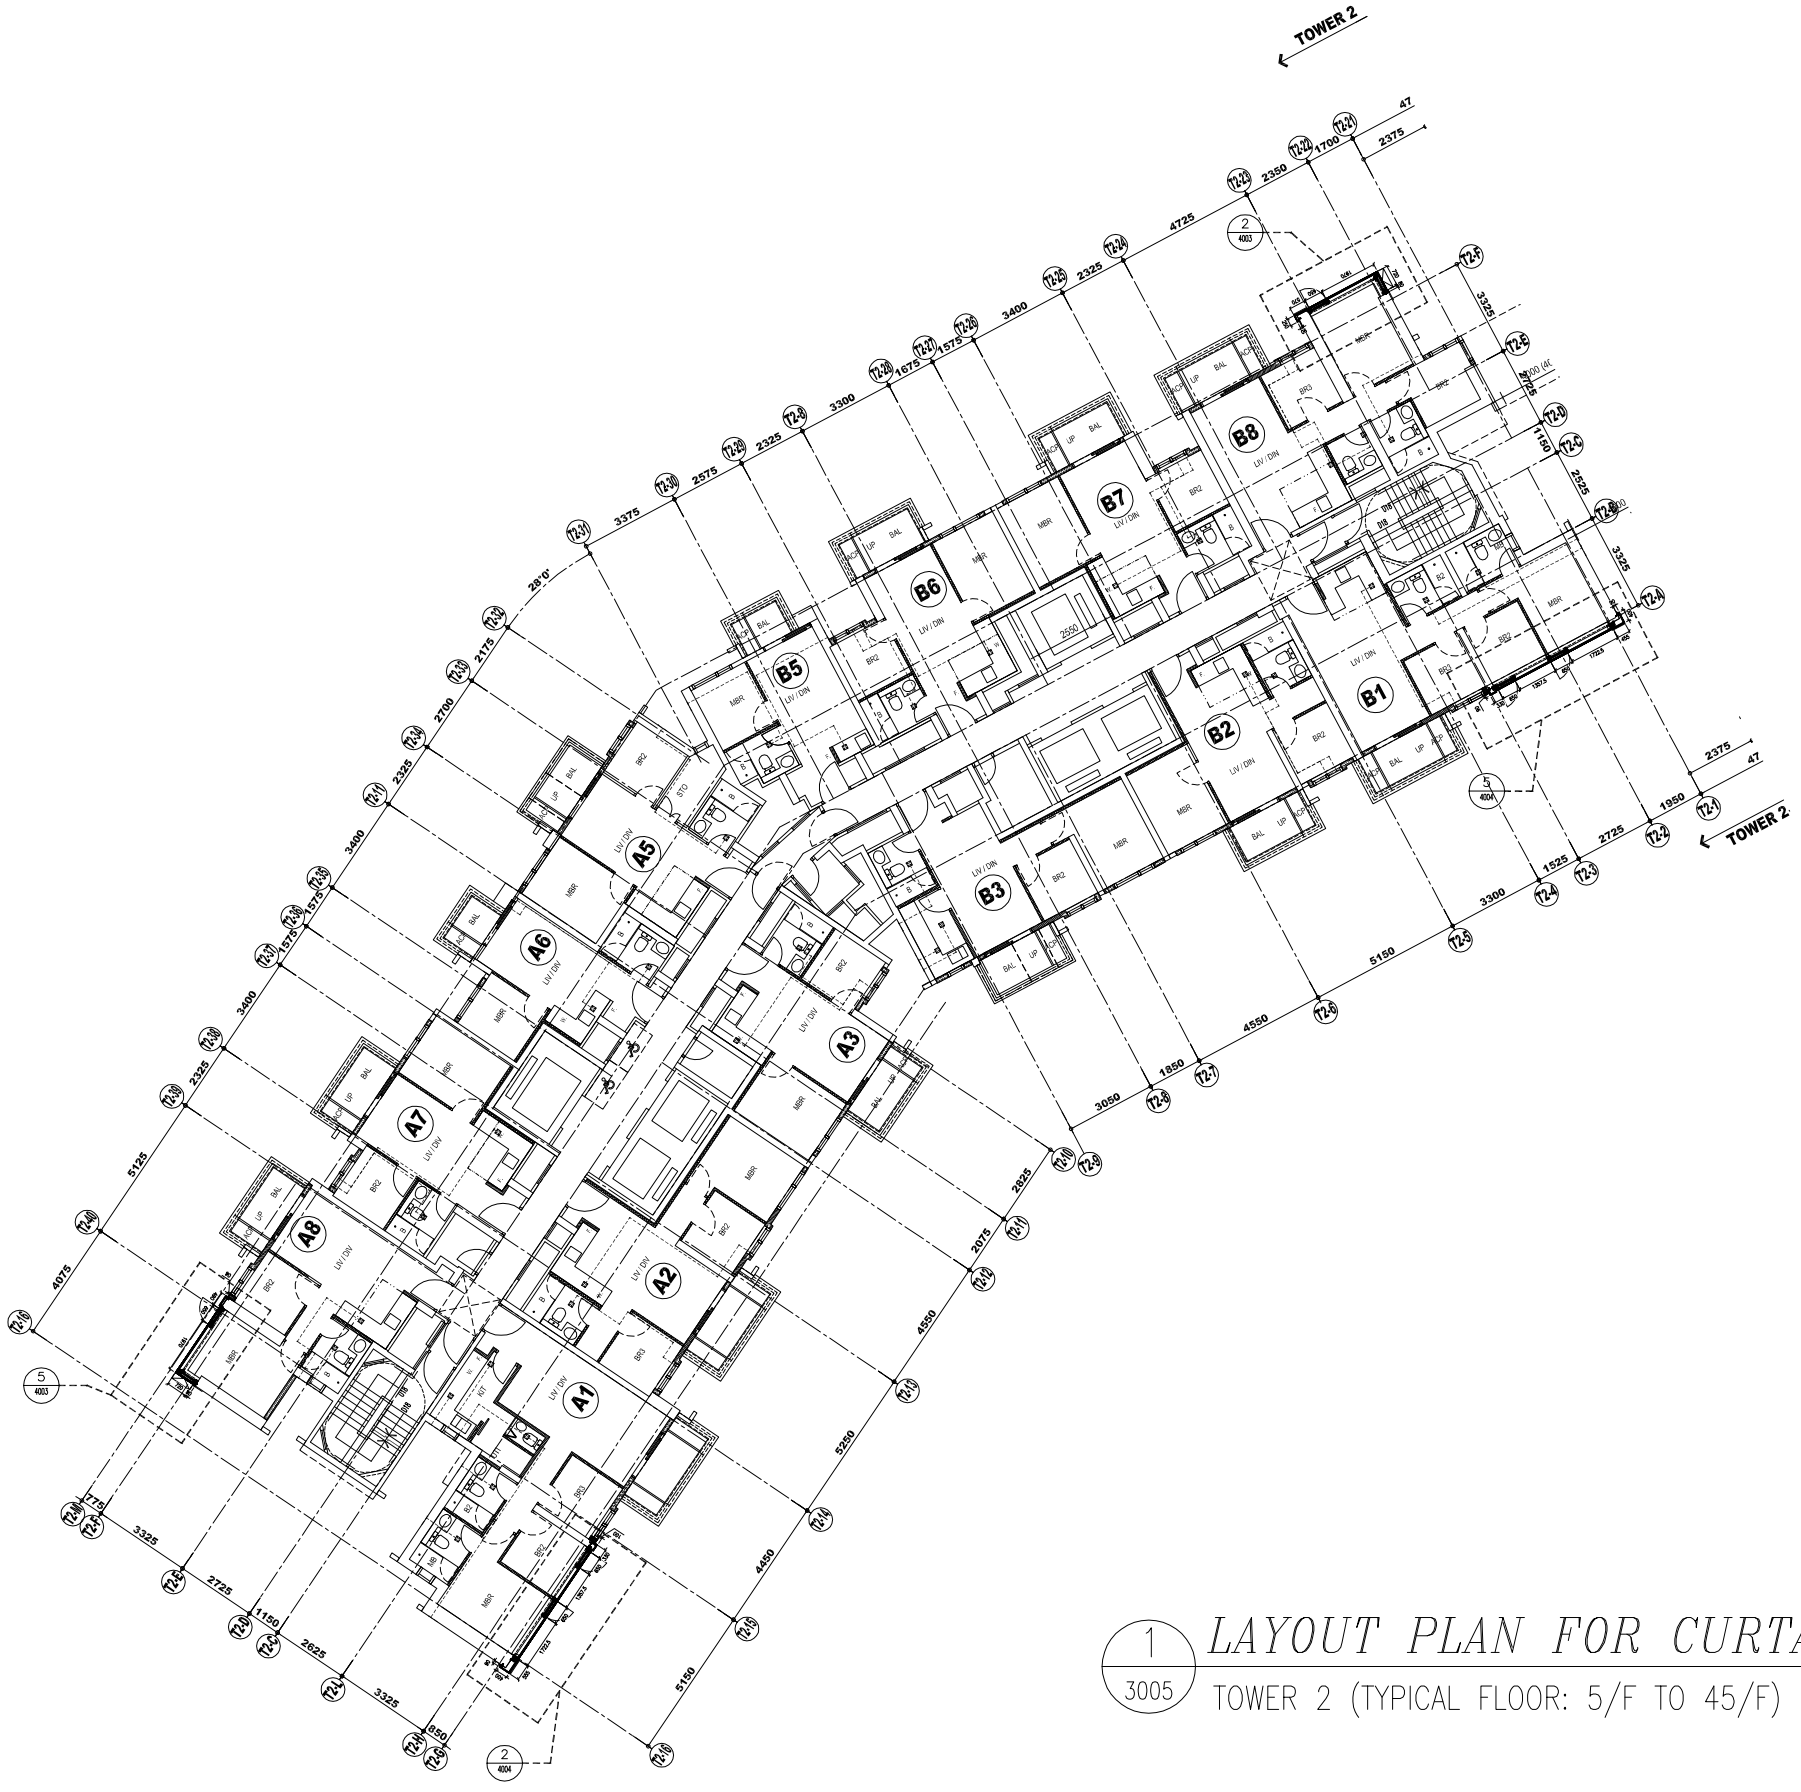

1 / 3005 *LAYOUT PLAN FOR CURTAIN WALL*

TOWER 2 (TYPICAL FLOOR: 5/F TO 45/F)

B.D. REF :

CLIENT :

SUN HUNG KAI REAL ESTATE AGENCY LTD.
42/F SUN HUNG KAI CENTRE, WANCHAI, HONGKONG

ARCHITECT :

lwk&partners
a r c h i t e c t s

MAIN CONTRACTOR :

怡輝建築有限公司
Yee Fai Building Contractors Ltd.

STRUCTURAL ENGINEER :

ARUP

FACADE CONSULTANT:

ALPHA CONSULTING LIMITED
Steel Structure & Facade Specialist

NOTE :
1. ALL DIMENSIONS ARE IN mm.
2. ALL ELEVATIONS ARE VIEWED FROM OUTSIDE.
3. ALL DIMENSIONS TO BE VERIFIED ON SITE BEFORE FABRICATION.

LEGEND :

X1 / X001 — DETAIL MARK NO. / REFER SHEET NO.

1. F.F.L. --FINISHED FLOOR LEVEL
2. S.F.L. --STRUCTURAL FLOOR LEVEL
3. (/R) --REVERSED DETAIL

NO.	DATE	REVISED	BY
A	29-SEP-2023	8TH SUBMISSION	CF

JOB NO. : J-856

PROJECT :
PROPOSED DEVELOPMENT ABOVE LIGHT RAIL TIN WING STOP,TSWTL NO.23,AREA 33,TIN SHUI WAI, N.T.


TITLE :
LAYOUT PLAN FOR CURTAIN WALL @ TOWER 2 (TYP)

DATE : 31-OCT-22 | SCALE : 1:250

DRAWN BY : C.F | CHECKED BY :

美特鋁質有限公司
MIDI ALUMINIUM FABRICATOR LTD.
Units 6-8, Sunray Industrial Centre, 1/F
610 Cha Kwo Ling Road, Kowloon
Tel:23489211-4 Fax:(852)27727666

DWG NO. : J856-SD-CW-3005 | REV. : A

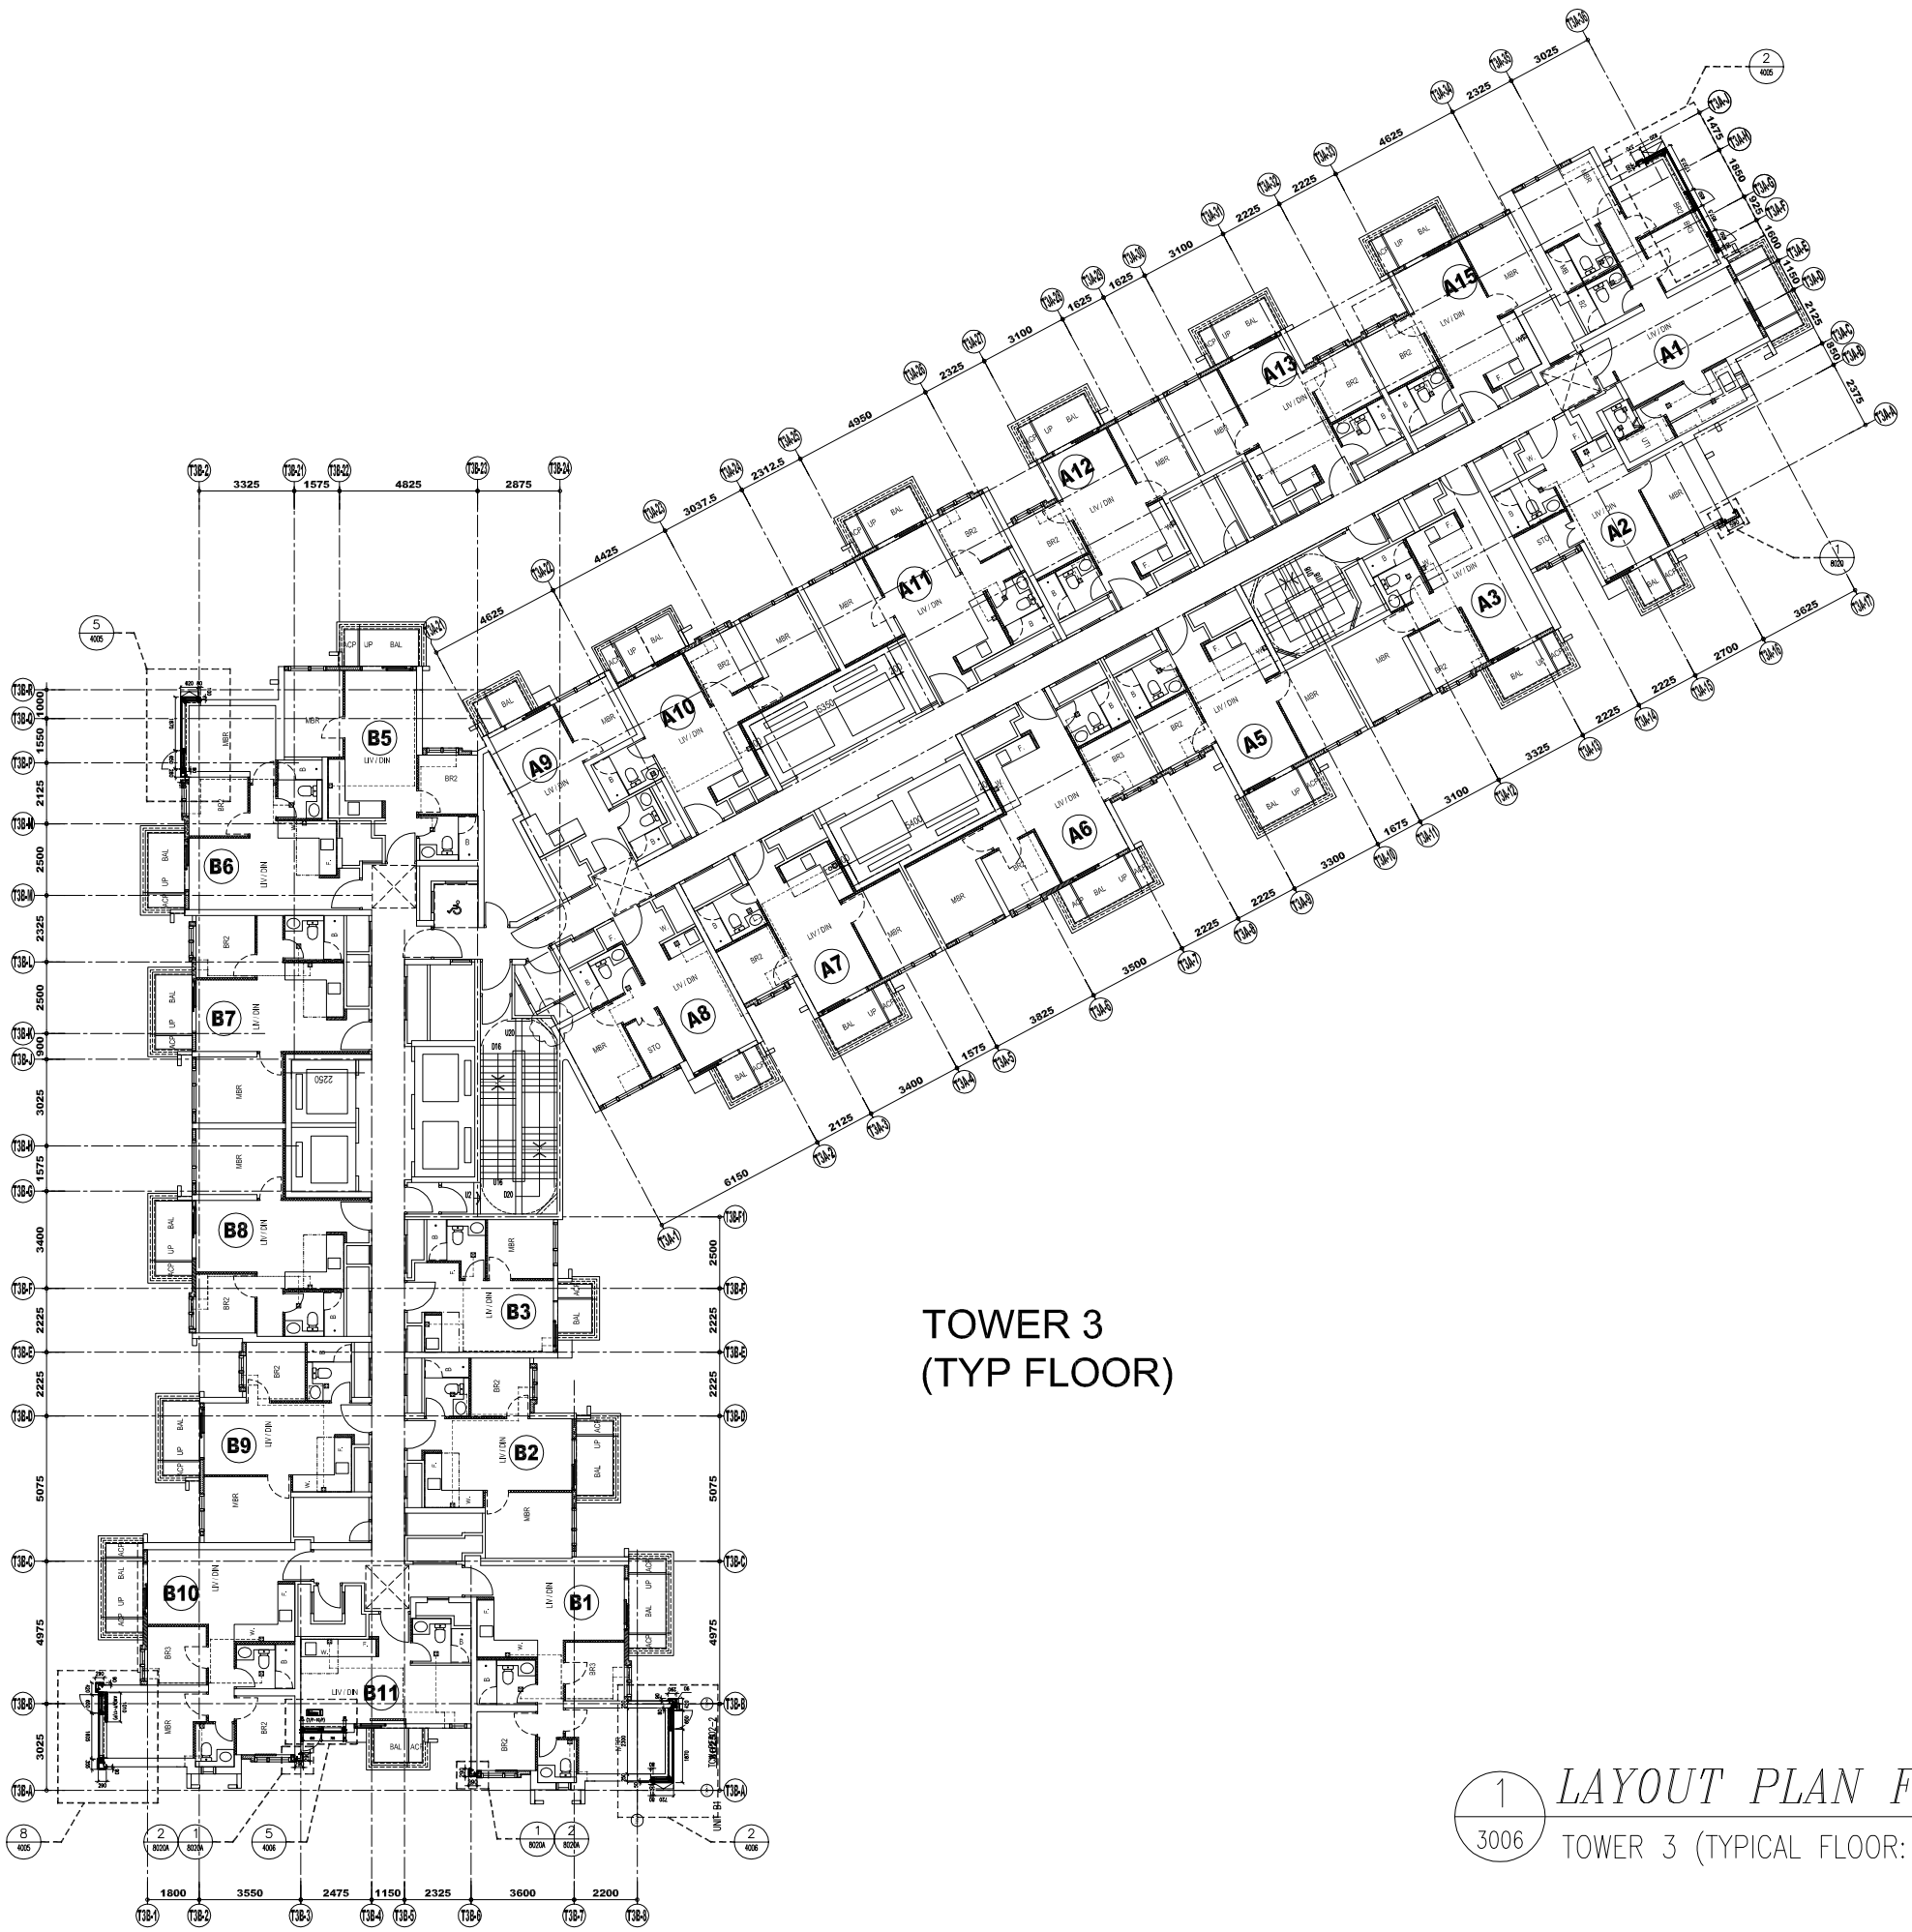

TOWER 3
(TYP FLOOR)

1 / 3006 *LAYOUT PLAN FOR CURTAIN WALL*

TOWER 3 (TYPICAL FLOOR: 5/F TO 45/F)

B.D. REF :

CLIENT :

SUN HUNG KAI REAL ESTATE AGENCY LTD.
42/F SUN HUNG KAI CENTRE, WANCHAI, HONGKONG

ARCHITECT :

lwk&partners
a r c h i t e c t s

MAIN CONTRACTOR :

怡輝建築有限公司
Yee Fai Building Contractors Ltd.

STRUCTURAL ENGINEER :

ARUP

FACADE CONSULTANT:

ALPHA CONSULTING LIMITED
Steel Structure & Facade Specialist

NOTE :
1. ALL DIMENSIONS ARE IN mm.
2. ALL ELEVATIONS ARE VIEWED FROM OUTSIDE.
3. ALL DIMENSIONS TO BE VERIFIED ON SITE BEFORE FABRICATION.

LEGEND :

X1 / X001 — DETAIL MARK NO. / REFER SHEET NO.

1. F.F.L. --FINISHED FLOOR LEVEL
2. S.F.L. --STRUCTURAL FLOOR LEVEL
3. (/R) --REVERSED DETAIL

NO.	DATE	REVISED	BY
C	29-SEP-2023	8TH SUBMISSION	CF
B	13-JAN-2023	3RD SUBMISSION	CF
A	16-DEC-2022	2ND SUBMISSION	CF

JOB NO. : J-856

PROJECT :
PROPOSED DEVELOPMENT ABOVE LIGHT RAIL TIN WING STOP,TSWTL NO.23,AREA 33,TIN SHUI WAI, N.T.


TITLE :
LAYOUT PLAN FOR CURTAIN WALL @ TOWER 3 (TYP)

DATE : 31-OCT-22 | SCALE : 1:250

DRAWN BY : C.F | CHECKED BY :

美特鋁質有限公司
MIDI ALUMINIUM FABRICATOR LTD.
Units 6-8, Sunray Industrial Centre, 1/F
610 Cha Kwo Ling Road, Kowloon
Tel:23489211-4 Fax:(852)27727666

DWG NO. : J856-SD-CW-3006 | REV. : C

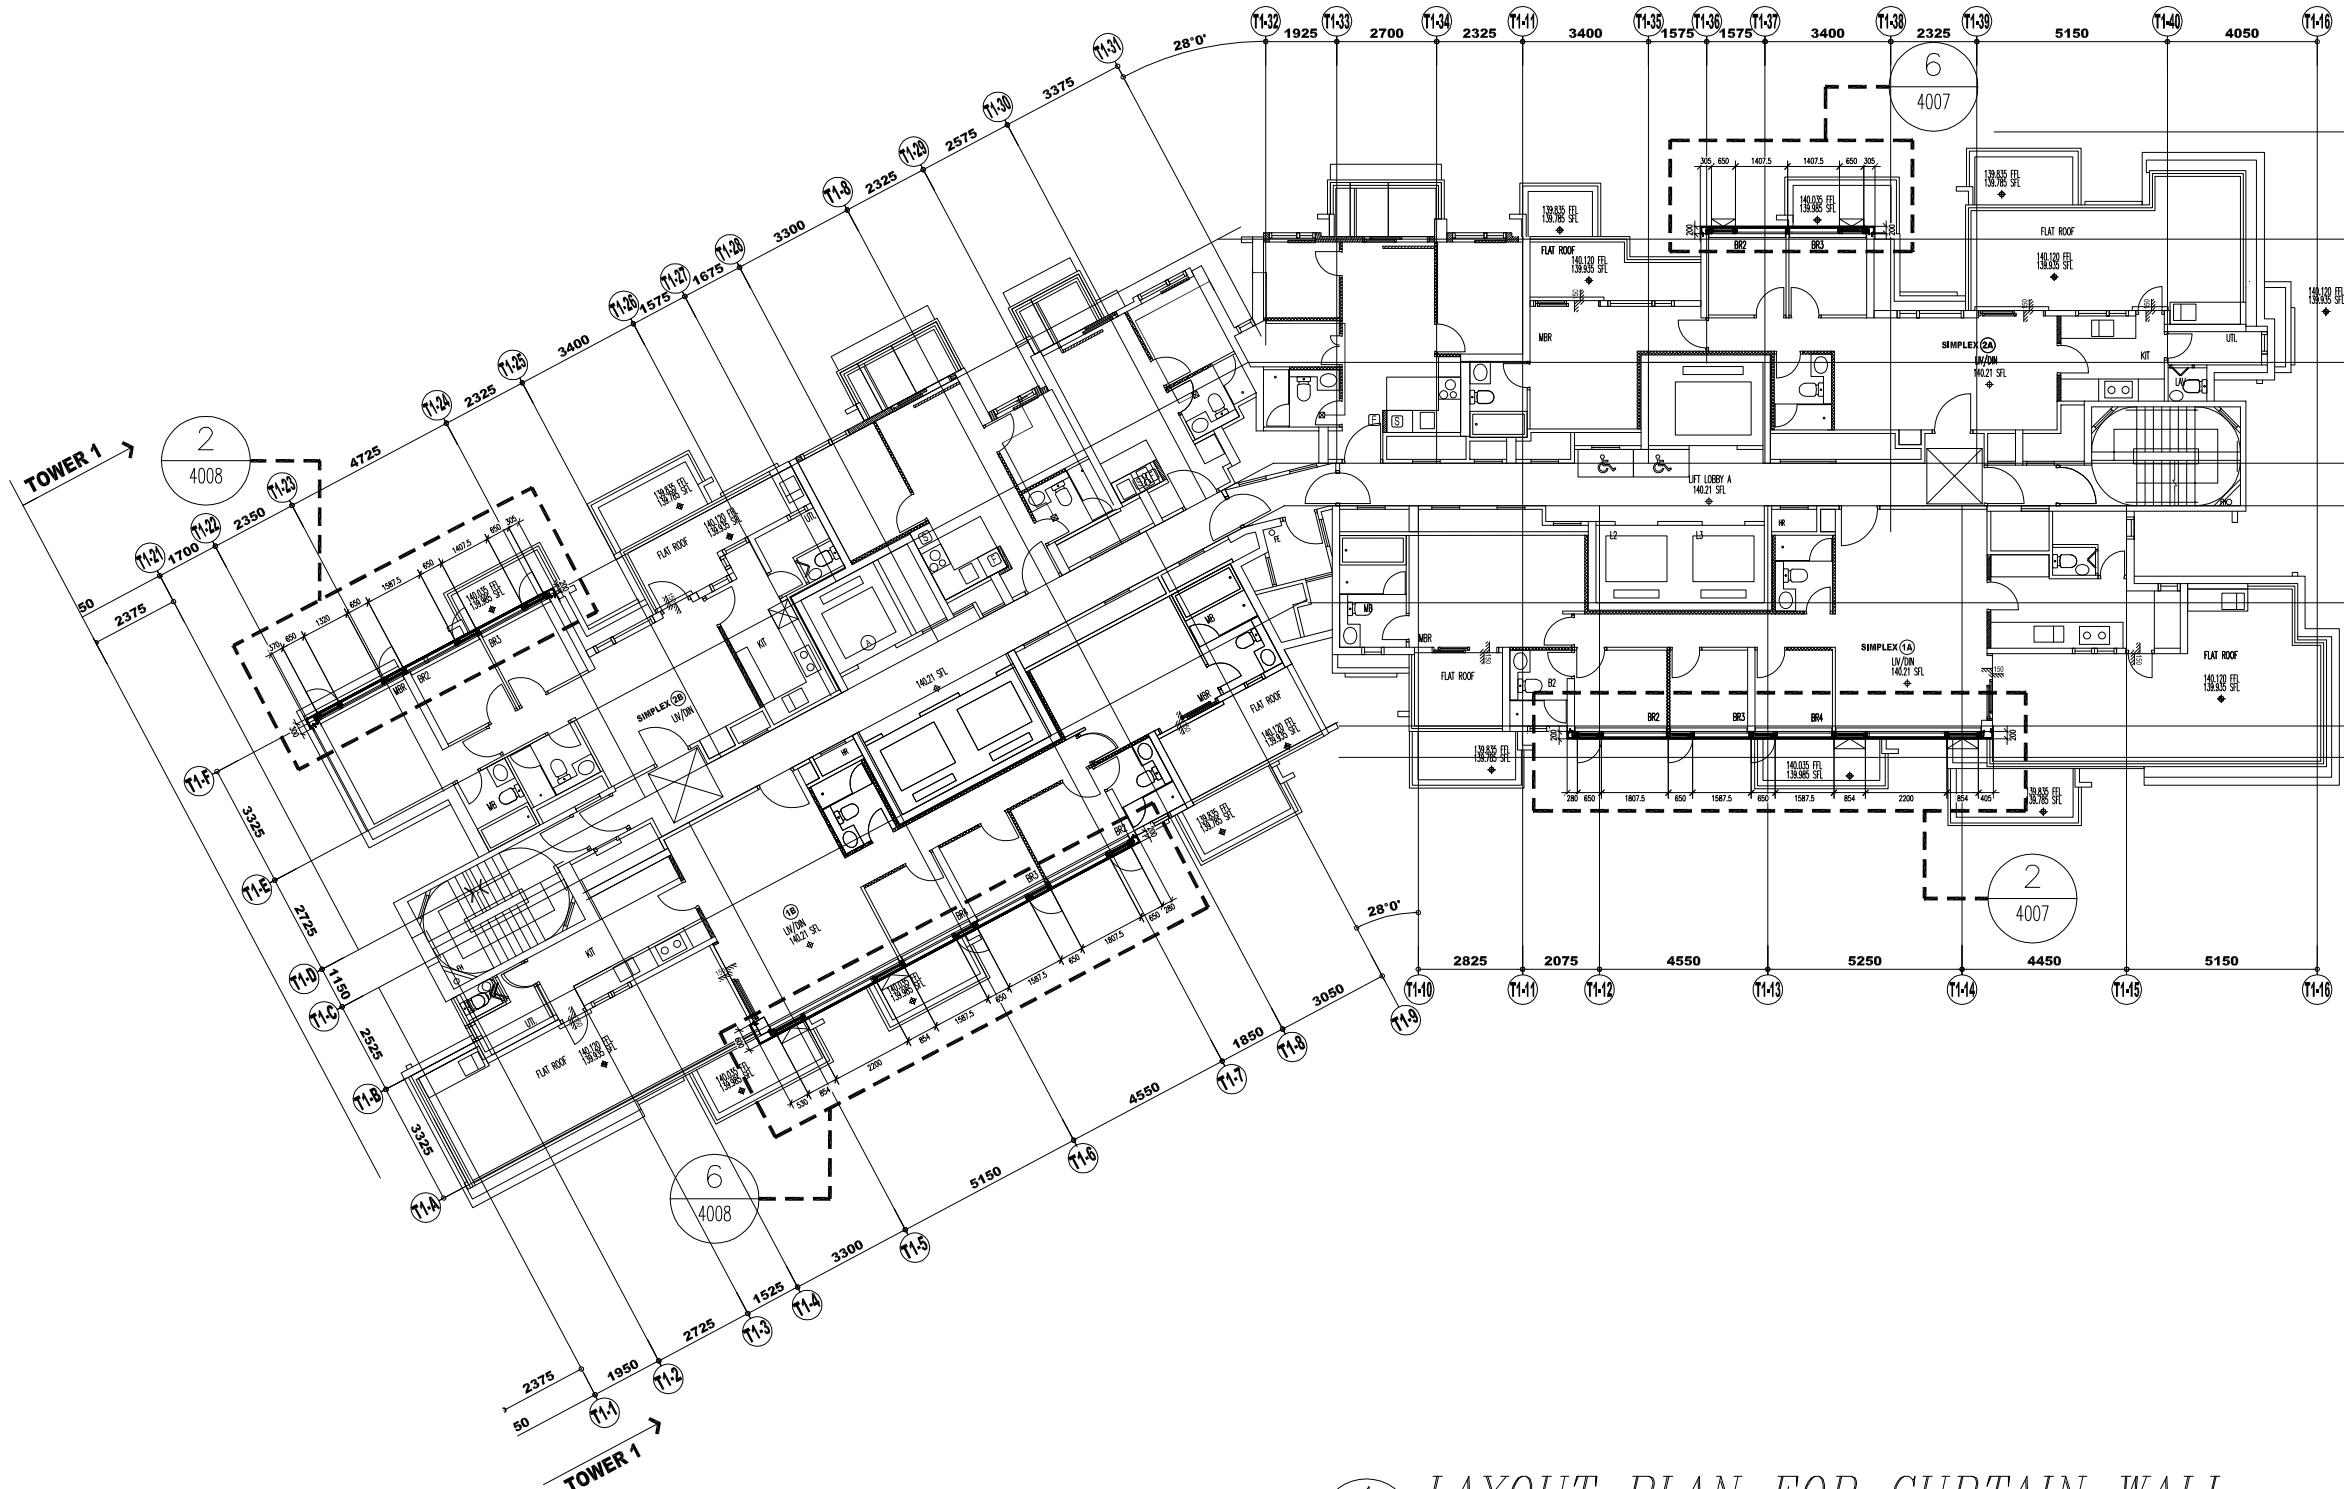

1 / 3007 *LAYOUT PLAN FOR CURTAIN WALL*

TOWER 1 (46/F)

B.D. REF :

CLIENT :

SUN HUNG KAI REAL ESTATE AGENCY LTD.
42/F SUN HUNG KAI CENTRE, WANCHAI, HONGKONG

ARCHITECT :

lwk&partners
a r c h i t e c t s

MAIN CONTRACTOR :

怡輝建築有限公司
Yee Fai Building Contractors Ltd.

STRUCTURAL ENGINEER :

ARUP

FACADE CONSULTANT:

ALPHA CONSULTING LIMITED
Steel Structure & Facade Specialist

NOTE :
1. ALL DIMENSIONS ARE IN mm.
2. ALL ELEVATIONS ARE VIEWED FROM OUTSIDE.
3. ALL DIMENSIONS TO BE VERIFIED ON SITE BEFORE FABRICATION.

LEGEND :

X1 / X001 — DETAIL MARK NO. / REFER SHEET NO.

1. F.F.L. --FINISHED FLOOR LEVEL
2. S.F.L. --STRUCTURAL FLOOR LEVEL
3. (R) --REVERSED DETAIL

NO.	DATE	REVISED	BY
C	11-AUG-2023	7TH SUBMISSION	CF
B	13-JAN-2023	3RD SUBMISSION	CF
A	28-DEC-2022	2ND SUBMISSION	CF

JOB NO. : J-856

PROJECT :
PROPOSED DEVELOPMENT ABOVE LIGHT RAIL TIN WING STOP,TSWTL NO.23,AREA 33,TIN SHUI WAI, N.T.


TITLE :
LAYOUT PLAN FOR CURTAIN WALL @ TOWER 1 (46/F)

DATE : 31-OCT-22 | SCALE : 1:200

DRAWN BY : C.F | CHECKED BY :

美特鋁質有限公司
MIDI ALUMINIUM FABRICATOR LTD.
Units 6-8, Sunray Industrial Centre, 1/F
610 Cha Kwo Ling Road, Kowloon
Tel:23489211-4 Fax:(852)27727666

DWG NO. : J856-SD-CW-3007 | REV. : C

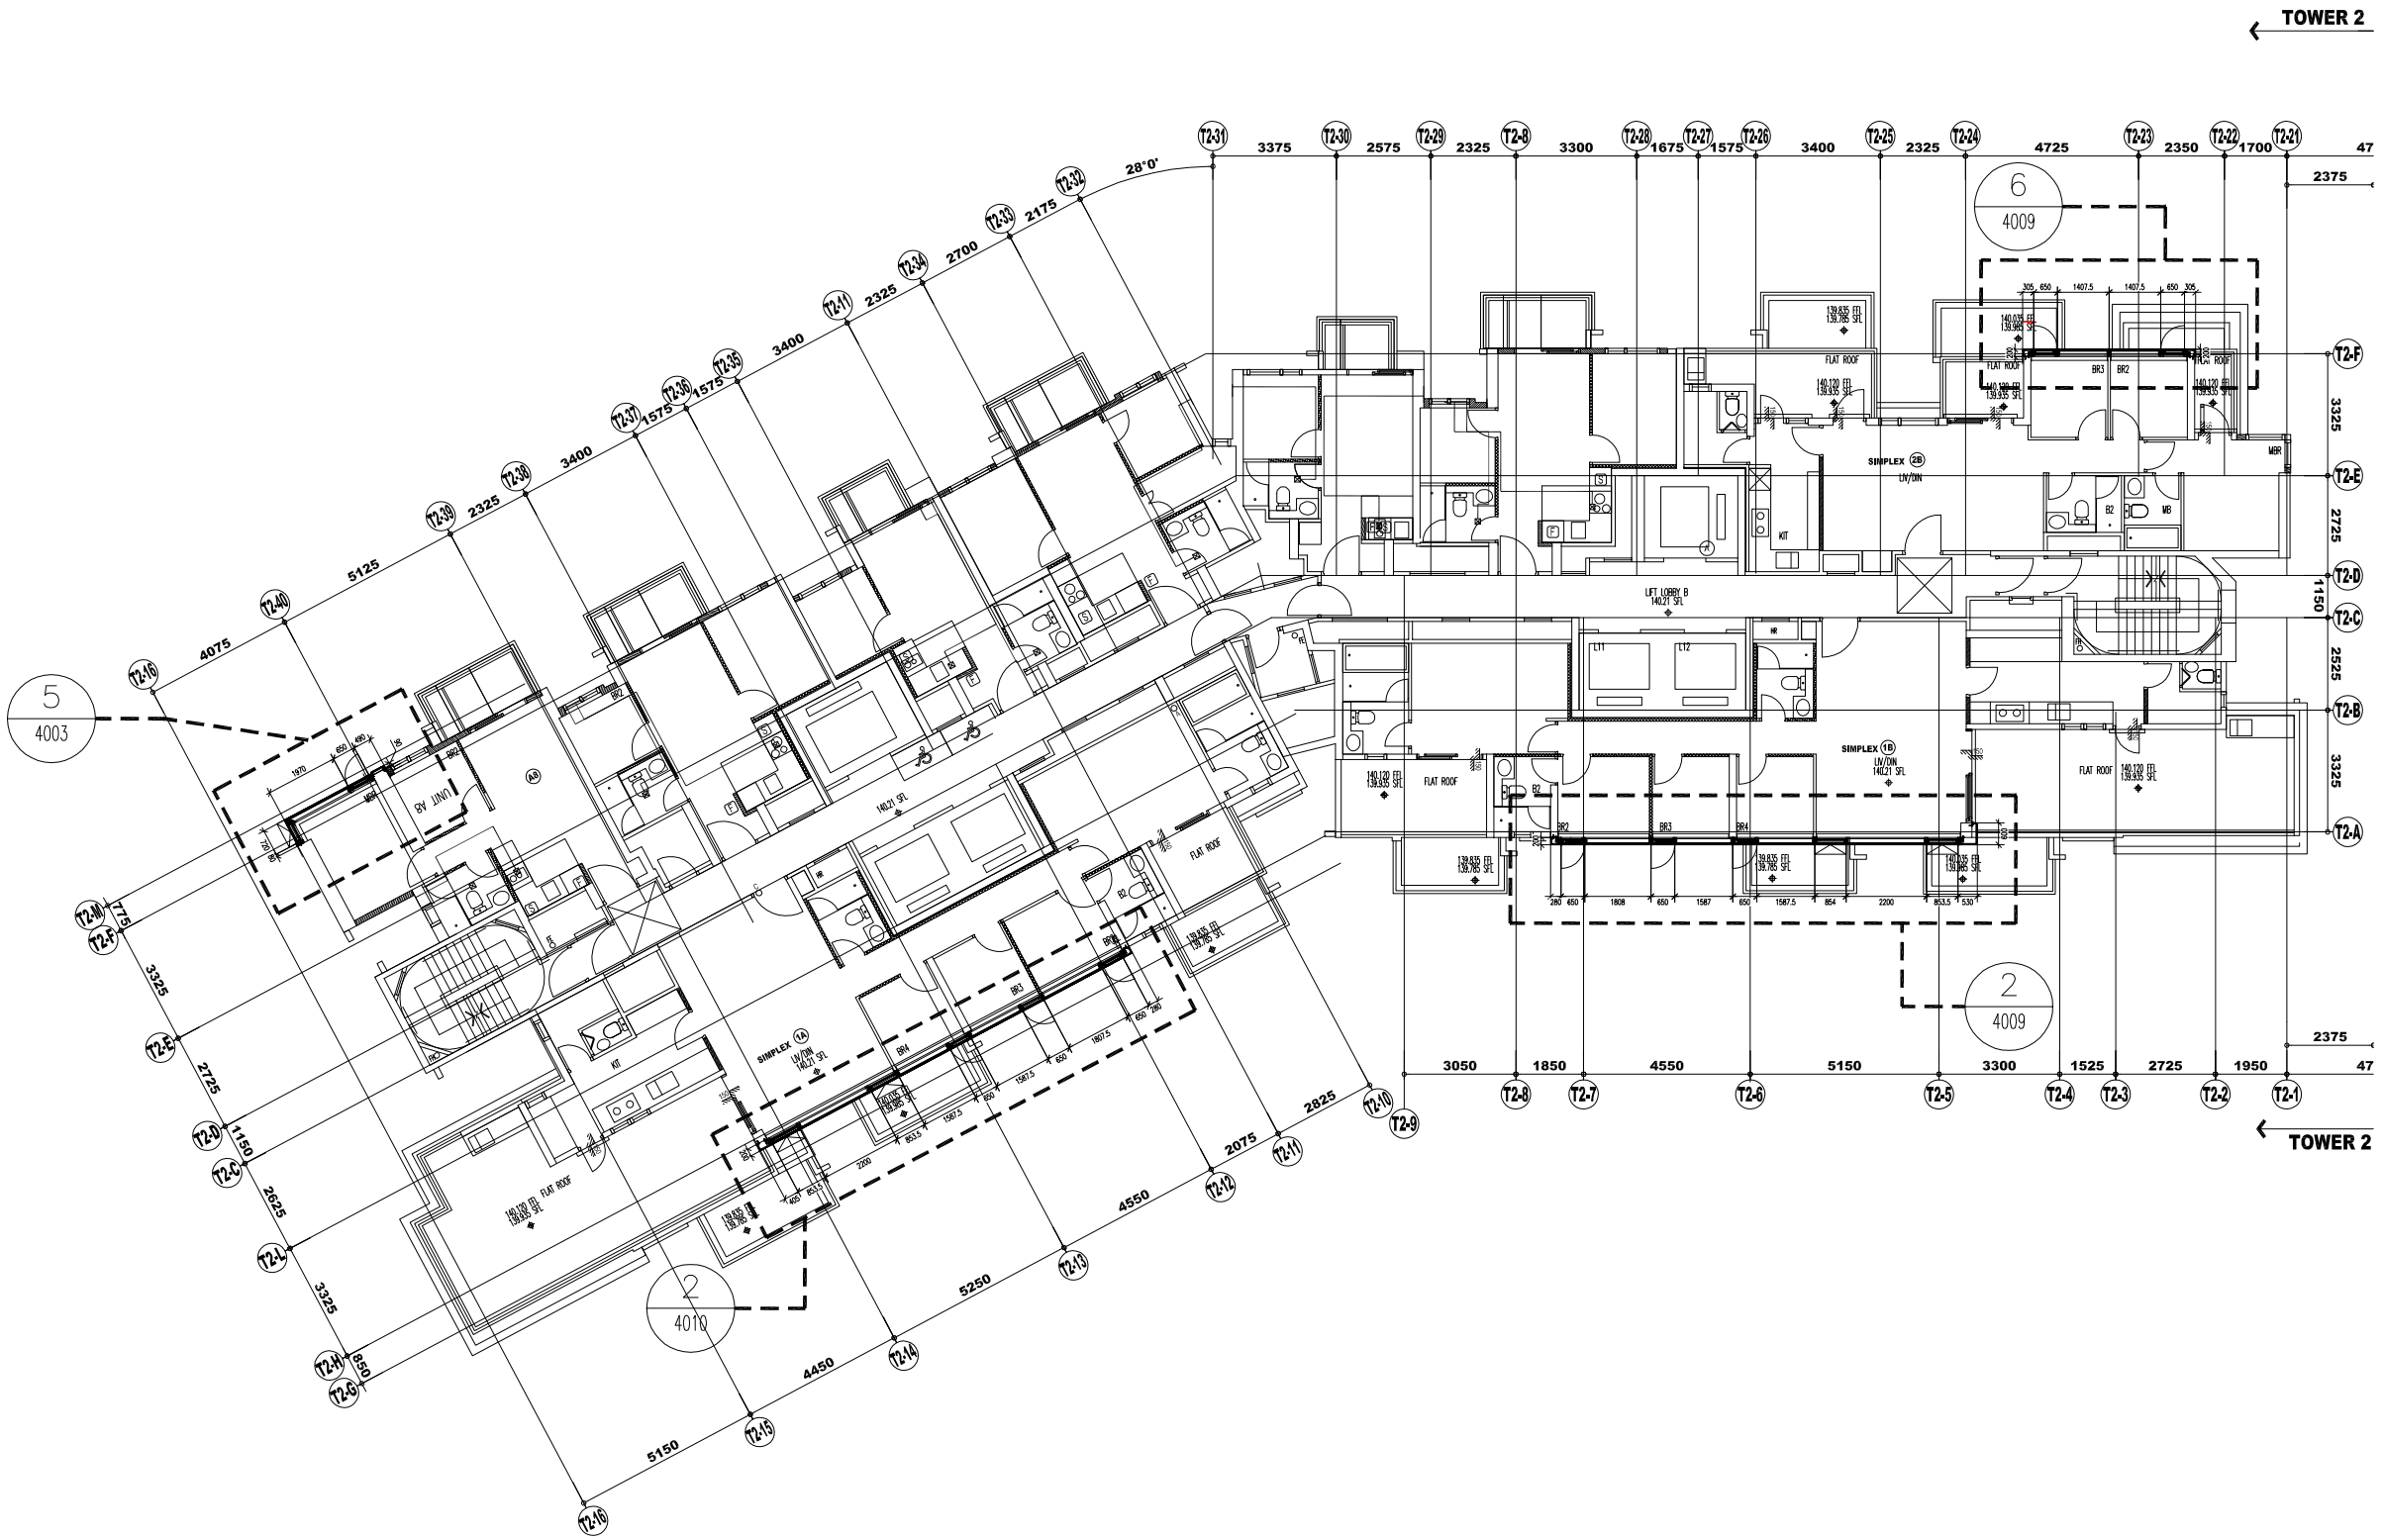

1 / 3008 *LAYOUT PLAN FOR CURTAIN WALL*

TOWER 2 (46/F)

B.D. REF :

CLIENT :

SUN HUNG KAI REAL ESTATE AGENCY LTD.
42/F SUN HUNG KAI CENTRE, WANCHAI, HONGKONG

ARCHITECT :

lwk&partners architects

MAIN CONTRACTOR :

怡輝建築有限公司 Yee Fai Building Contractors Ltd.

STRUCTURAL ENGINEER :

ARUP

FACADE CONSULTANT:

ALPHA CONSULTING LIMITED
Steel Structure & Facade Specialist

NOTE :
1. ALL DIMENSIONS ARE IN mm.
2. ALL ELEVATIONS ARE VIEWED FROM OUTSIDE.
3. ALL DIMENSIONS TO BE VERIFIED ON SITE BEFORE FABRICATION.

LEGEND :

X1 / X001 — DETAIL MARK NO. / REFER SHEET NO.

1. F.F.L. -- FINISHED FLOOR LEVEL
2. S.F.L. -- STRUCTURAL FLOOR LEVEL
3. (R) -- REVERSED DETAIL

NO.	DATE	REVISED	BY
C	11-AUG-2023	7TH SUBMISSION	CF
B	13-JAN-2023	3RD SUBMISSION	CF
A	28-DEC-2022	2ND SUBMISSION	CF

JOB NO. : J-856

PROJECT :
PROPOSED DEVELOPMENT ABOVE LIGHT RAIL TIN WING STOP,TSWTL NO.23,AREA 33,TIN SHUI WAI, N.T.

TITLE :
LAYOUT PLAN FOR CURTAIN WALL @ TOWER 2 (46/F)

DATE : 31-OCT-22 | SCALE : 1:200

DRAWN BY : C.F | CHECKED BY :

美特鋁質有限公司
MIDI ALUMINIUM FABRICATOR LTD.
Units 6-8, Sunray Industrial Centre, 1/F
610 Cha Kwo Ling Road, Kowloon
Tel:23489211-4 Fax:(852)27727666

DWG NO. : J856-SD-CW-3008 | REV. : C



LAYOUT PLAN FOR CURTAIN WALL

1 / 3009 TOWER 3 (46/F)

B.D. REF :

CLIENT :
SUN HUNG KAI REAL ESTATE AGENCY LTD.
42/F SUN HUNG KAI CENTRE, WANCHAI, HONGKONG

ARCHITECT :
lwk&partners architects

MAIN CONTRACTOR :
怡輝建築有限公司 Yee Fai Building Contractors Ltd.

STRUCTURAL ENGINEER :
ARUP

FACADE CONSULTANT:
ALPHA CONSULTING LIMITED
Steel Structure & Facade Specialist

NOTE :
1. ALL DIMENSIONS ARE IN mm.
2. ALL ELEVATIONS ARE VIEWED FROM OUTSIDE.
3. ALL DIMENSIONS TO BE VERIFIED ON SITE BEFORE FABRICATION.

LEGEND :
X1 — DETAIL MARK NO.
X001 — REFER SHEET NO.

1. F.F.L. --FINISHED FLOOR LEVEL
2. S.F.L. --STRUCTURAL FLOOR LEVEL
3. (/R) --REVERSED DETAIL

NO.	DATE	REVISED	BY
C	11-AUG-2023	7TH SUBMISSION	CF
B	13-JAN-2023	3RD SUBMISSION	CF
A	28-DEC-2022	2ND SUBMISSION	CF

JOB NO. : J-856

PROJECT :
PROPOSED DEVELOPMENT ABOVE LIGHT RAIL TIN WING STOP,TSWTL NO.23,AREA 33,TIN SHUI WAI, N.T.


TITLE :
LAYOUT PLAN FOR CURTAIN WALL @ TOWER 3 (46/F)

DATE : 31-OCT-22 | SCALE : 1:250

DRAWN BY : C.F | CHECKED BY :

美特鋁質有限公司
MIDI ALUMINIUM FABRICATOR LTD.
Units 6-8, Sunray Industrial Centre, 1/F
610 Cha Kwo Ling Road, Kowloon
Tel:23489211-4 Fax:(852)27727666

DWG NO. : J856-SD-CW-3009 | REV. : C

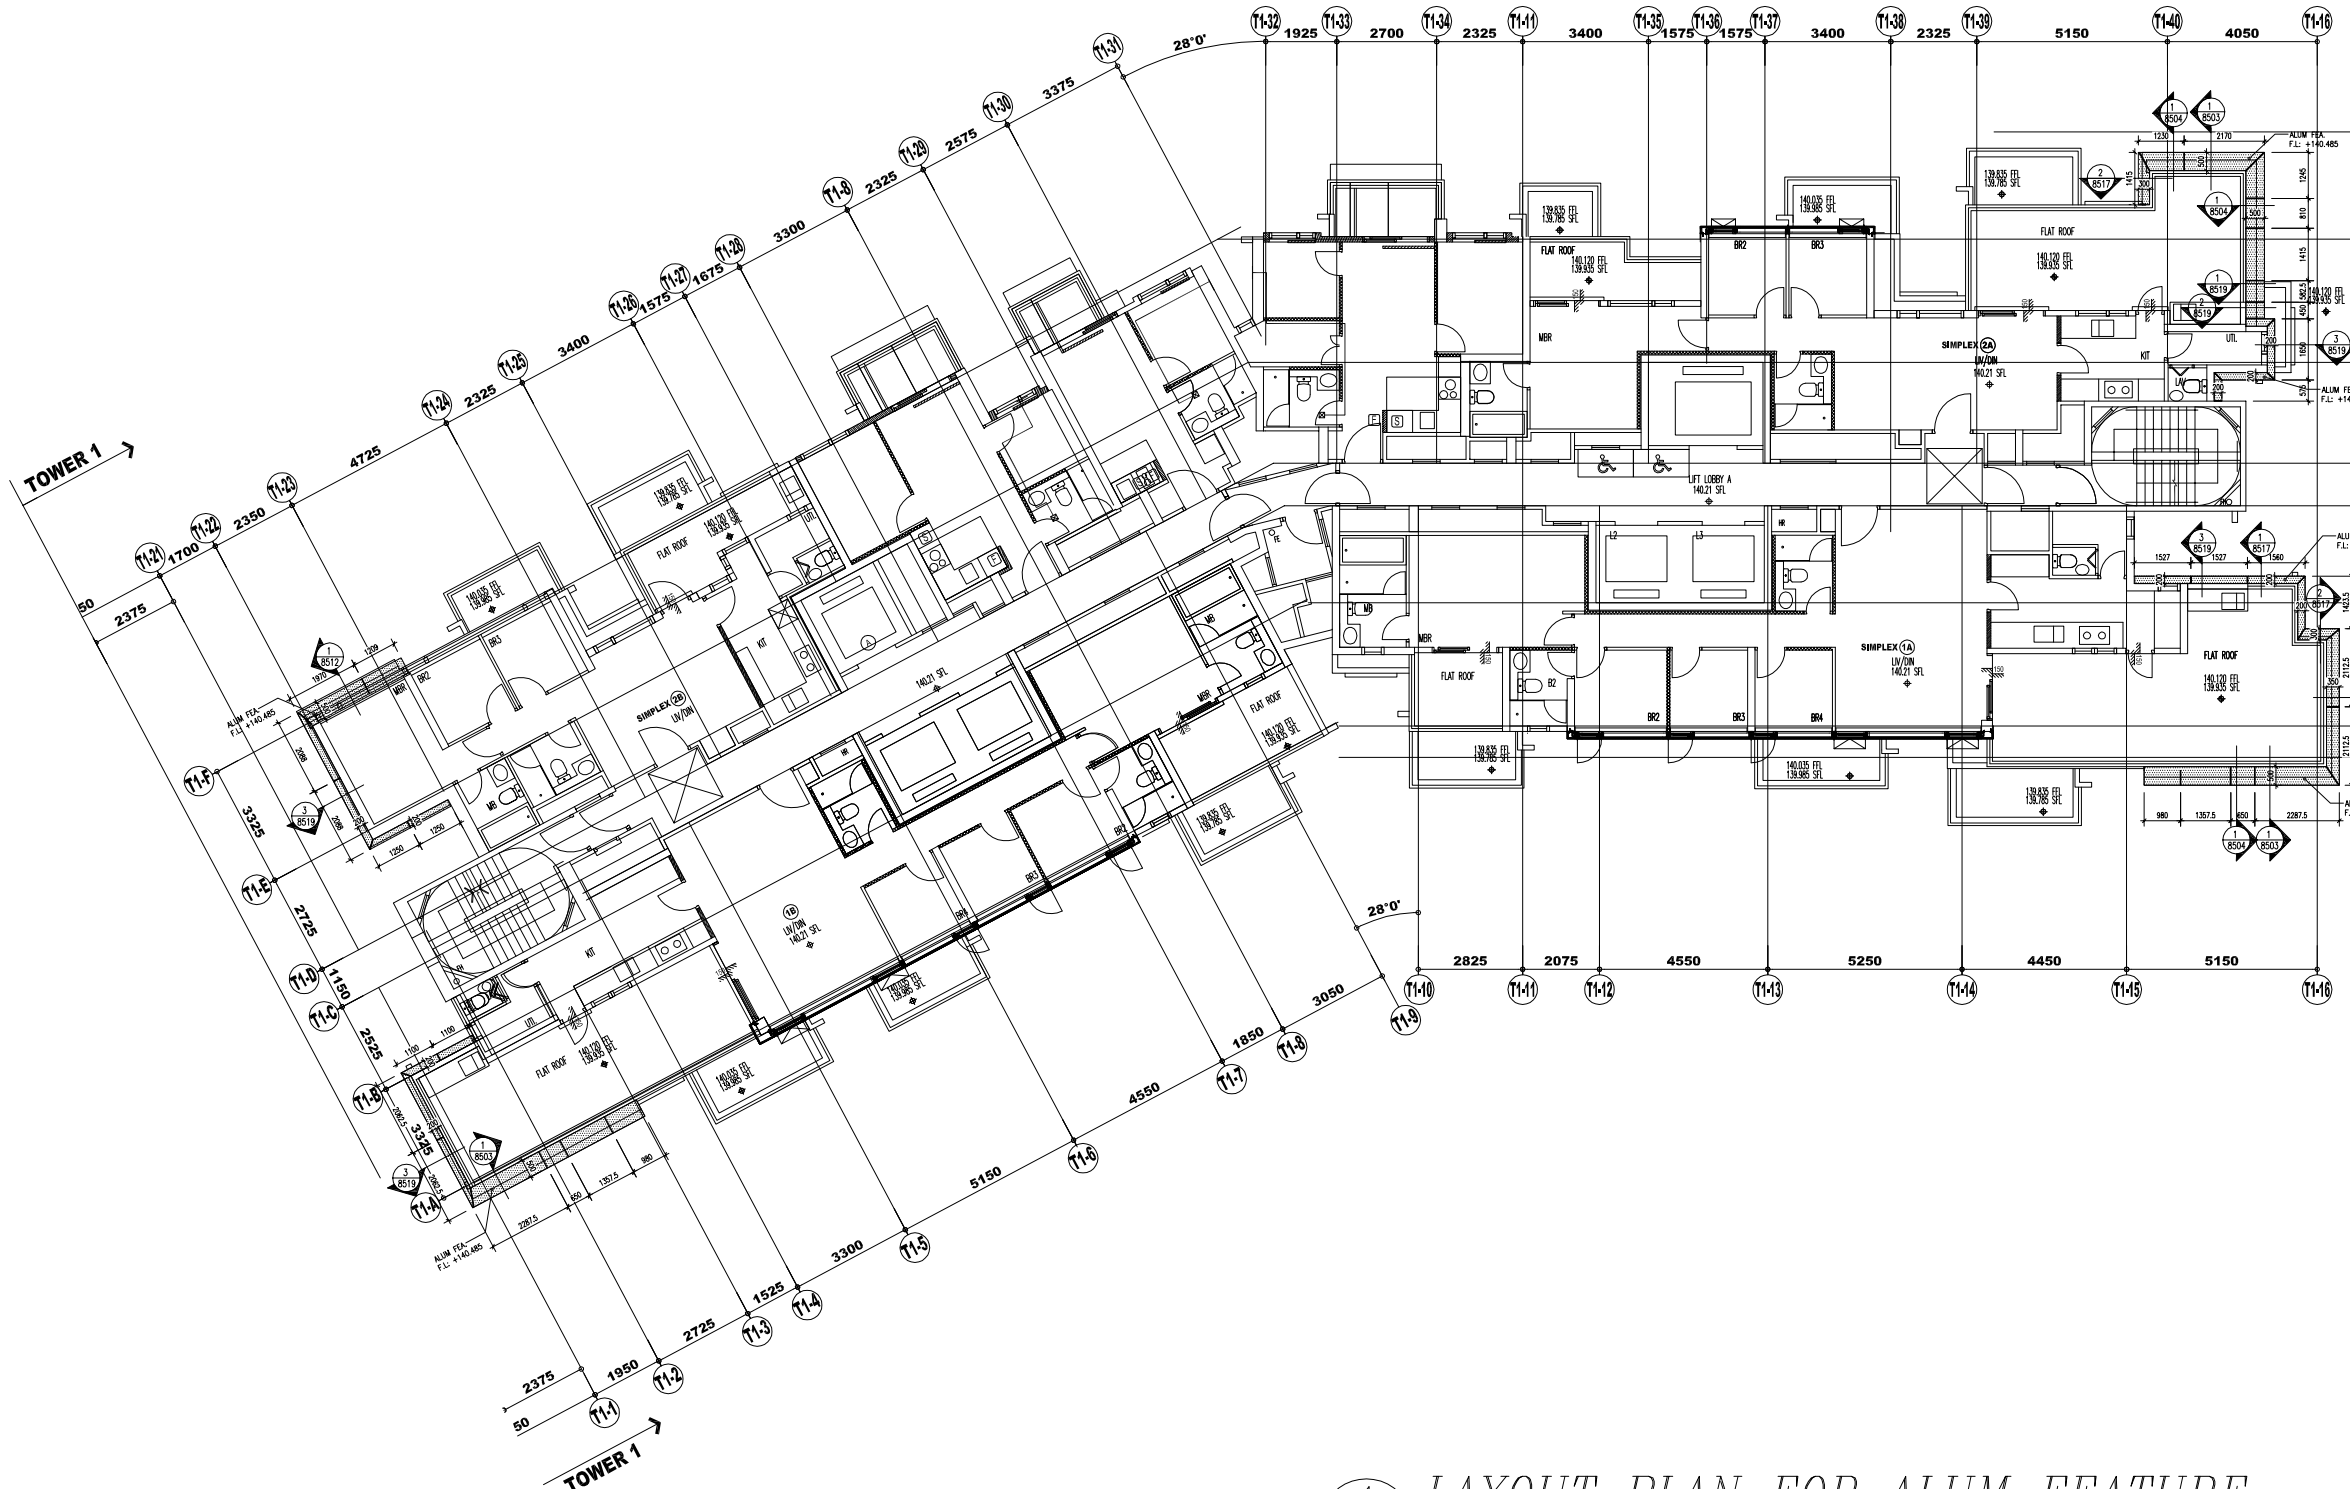

1 / 3010 *LAYOUT PLAN FOR ALUM FEATURE*

TOWER 1 (46/F)

B.D. REF :

CLIENT :

SUN HUNG KAI REAL ESTATE AGENCY LTD.
42/F SUN HUNG KAI CENTRE, WANCHAI, HONGKONG

ARCHITECT :

lwk&partners architects

MAIN CONTRACTOR :

怡輝建築有限公司 Yee Fai Building Contractors Ltd.

STRUCTURAL ENGINEER :

ARUP

FACADE CONSULTANT:

ALPHA CONSULTING LIMITED
Steel Structure & Facade Specialist

NOTE :
1. ALL DIMENSIONS ARE IN mm.
2. ALL ELEVATIONS ARE VIEWED FROM OUTSIDE.
3. ALL DIMENSIONS TO BE VERIFIED ON SITE BEFORE FABRICATION.

LEGEND :

X1 — DETAIL MARK NO.
X001 — REFER SHEET NO.

1. F.F.L. --FINISHED FLOOR LEVEL
2. S.F.L. --STRUCTURAL FLOOR LEVEL
3. (R) --REVERSED DETAIL

3mm ALUM. CLADDING FEATURE COLOR COLOR: UCT309119XLB-3
3mm ALUM. CLADDING FEATURE COLOR COLOR: UCT542919XL-3

NO.	DATE	REVISED	BY
A	12-OCT-2023	9TH SUBMISSION	CF
–	11-AUG-2023	(NEW DRAWING) 7TH SUBMISSION	CF

JOB NO. : J-856

PROJECT :
PROPOSED DEVELOPMENT ABOVE LIGHT RAIL TIN WING STOP,TSWTL NO.23,AREA 33,TIN SHUI WAI, N.T.


TITLE :
LAYOUT PLAN FOR ALUM FEATURE @ TOWER 1 (46/F)

DATE : 31-OCT-22 | SCALE : 1:200

DRAWN BY : C.F | CHECKED BY :

美特鋁質有限公司
MIDI ALUMINIUM FABRICATOR LTD.
Units 6-8, Sunray Industrial Centre, 1/F
610 Cha Kwo Ling Road, Kowloon
Tel:23489211-4 Fax:(852)27727666

DWG NO. : J856-SD-CW-3010 | REV. : A

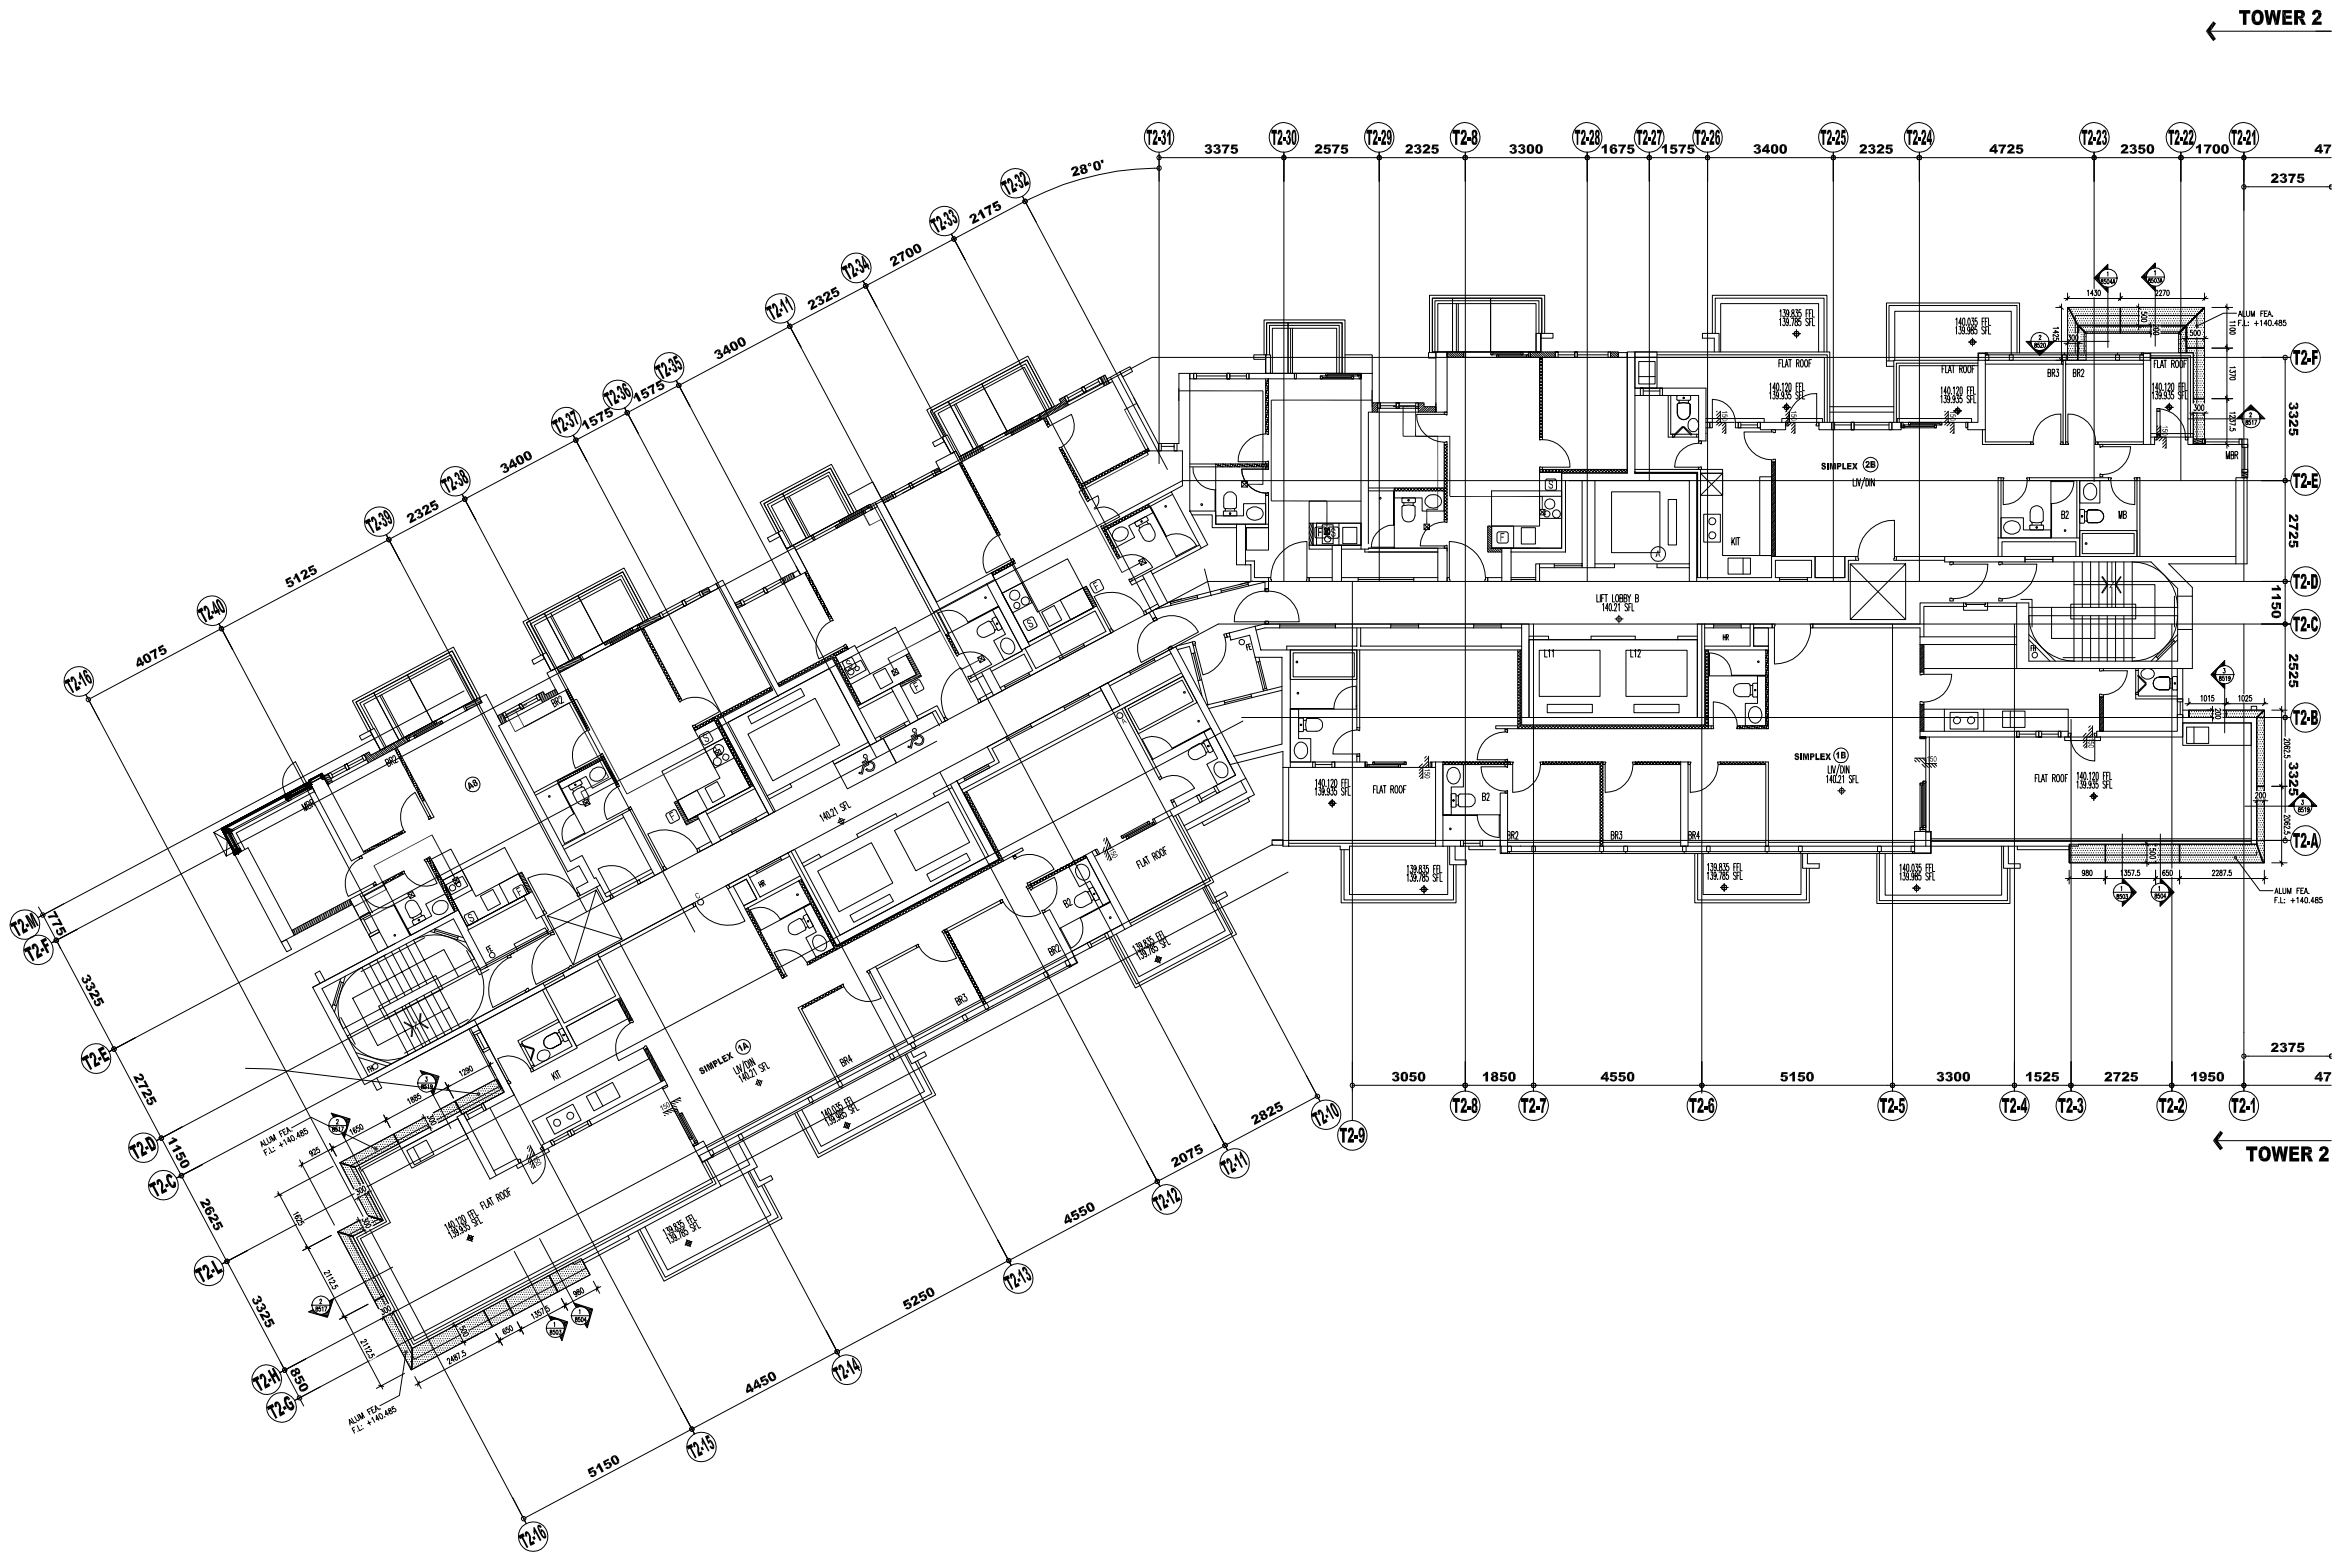

1 / 3008A *LAYOUT PLAN FOR ALUM FEATURE*

TOWER 2 (46/F)

B.D. REF :

CLIENT :

SUN HUNG KAI REAL ESTATE AGENCY LTD.
42/F SUN HUNG KAI CENTRE, WANCHAI, HONGKONG

ARCHITECT :

lwk&partners
a r c h i t e c t s

MAIN CONTRACTOR :

怡輝建築有限公司
Yee Fai Building Contractors Ltd.

STRUCTURAL ENGINEER :

ARUP

FACADE CONSULTANT:

ALPHA CONSULTING LIMITED
Steel Structure & Facade Specialist

NOTE :
1. ALL DIMENSIONS ARE IN mm.
2. ALL ELEVATIONS ARE VIEWED FROM OUTSIDE.
3. ALL DIMENSIONS TO BE VERIFIED ON SITE BEFORE FABRICATION.

LEGEND :

X1 / X001 — DETAIL MARK NO. / REFER SHEET NO.

1. F.F.L. --FINISHED FLOOR LEVEL
2. S.F.L. --STRUCTURAL FLOOR LEVEL
3. (/R) --REVERSED DETAIL

3mm ALUM. CLADDING FEATURE COLOR COLOR: UCT3091191JL-3

3mm ALUM. CLADDING FEATURE COLOR COLOR: UCT5429191JL-3

NO.	DATE	REVISED	BY
A	12-OCT-2023	9TH SUBMISSION	CF
–	11-AUG-2023	7TH SUBMISSION (NEW DRAWING)	CF

JOB NO. : J-856

PROJECT :
PROPOSED DEVELOPMENT ABOVE LIGHT RAIL TIN WING STOP,TSWTL NO.23,AREA 33,TIN SHUI WAI, N.T.


TITLE :
LAYOUT PLAN FOR ALUM FEATURE @ TOWER 2 (46/F)


DATE : 31-OCT-22 | SCALE : 1:200

DRAWN BY : C.F | CHECKED BY :

美特鋁質有限公司
MIDI ALUMINIUM FABRICATOR LTD.
Units 6-8, Sunray Industrial Centre, 1/F
610 Cha Kwo Ling Road, Kowloon
Tel:23489211-4 Fax:(852)27727666

DWG NO. : J856-SD-CW-3011 | REV. : A

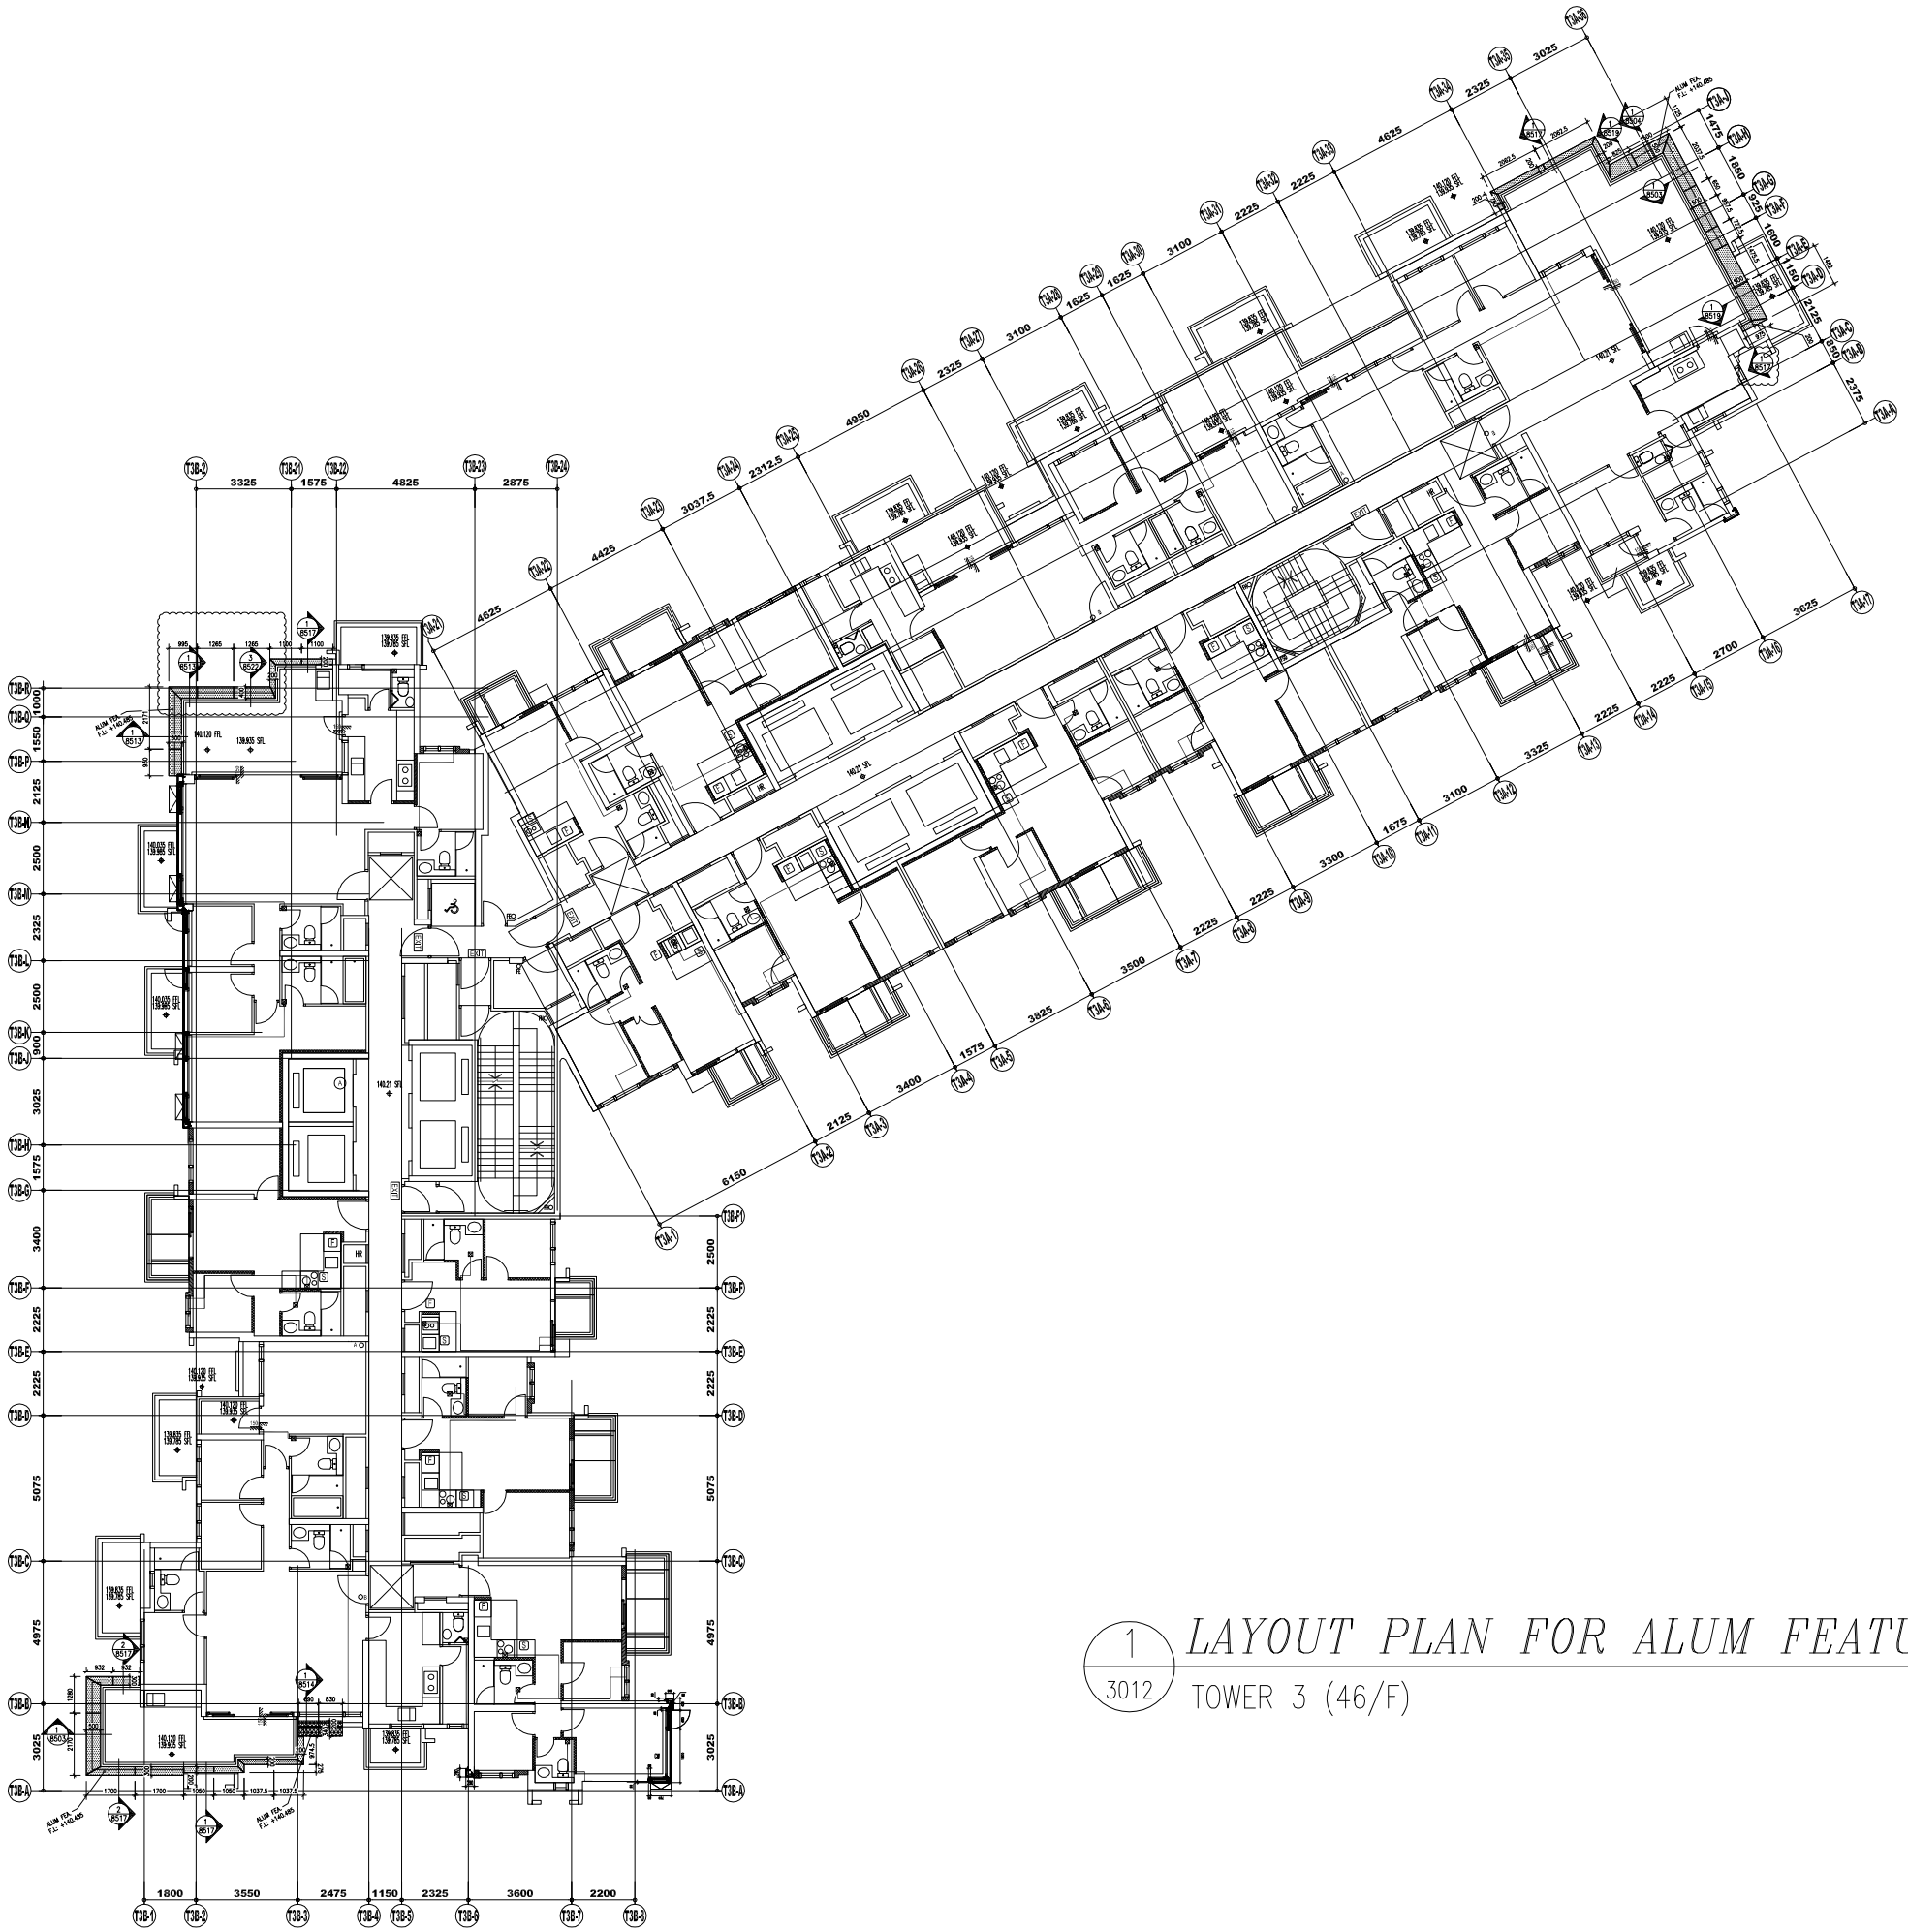
T38-1
T38-2
T38-3
T38-4
T38-5
T38-6
T38-7
T38-8
T38-A
T38-B
T38-C
T38-D
T38-E
T38-F
T38-G
T38-H
T38-J
T38-K
T38-L
T38-M
T38-N
T38-P
T38-Q
T38-R
T38-AWD
T38-AWE
T38-AWF
T38-AWG
T38-AWH
T38-AWJ
T38-AWK
T38-AWL
T38-AWM
T38-AWN
T38-AWP
T38-AWQ
T38-AWR
T38-AWS
T38-AWT
T38-AWU
T38-AWV
T38-AWW
T38-AWX
T38-AWY
T38-AWZ
T38-AXA
T38-AXB
T38-AXC
T38-AXD
T38-AXE
T38-AXF
T38-AXG
T38-AXH
T38-AXJ
T38-AXK
T38-AXL
T38-AXM
T38-AXN
T38-AXP
T38-AXQ
T38-AXR
T38-AXS
T38-AXT
T38-AXU
T38-AXV
T38-AXW
T38-AXX
T38-AXY
T38-AXZ
T38-AYA
T38-AYB
T38-AYC
T38-AYD
T38-AYE
T38-AYF
T38-AYG
T38-AYH
T38-AYJ
T38-AYK
T38-AYL
T38-AYM
T38-AYN
T38-AYP
T38-AYQ
T38-AYR
T38-AYS
T38-AYT
T38-AYU
T38-AYV
T38-AYW
T38-AYX
T38-AYY
T38-AYZ
T38-AZA
T38-AZB
T38-AZC
T38-AZD
T38-AZE
T38-AZF
T38-AZG
T38-AZH
T38-AZJ
T38-AZK
T38-AZL
T38-AZM
T38-AZN
T38-AZP
T38-AZQ
T38-AZR
T38-AZS
T38-AZT
T38-AZU
T38-AZV
T38-AZW
T38-AZX
T38-AZY
T38-AZZ
T38-BAA
T38-BAB
T38-BAC
T38-BAD
T38-BAE
T38-BAF
T38-BAG
T38-BAH
T38-BAJ
T38-BAK
T38-BAL
T38-BAM
T38-BAN
T38-BAP
T38-BAQ
T38-BAR
T38-BAS
T38-BAT
T38-BAU
T38-BAV
T38-BAW
T38-BAX
T38-BAY
T38-BAZ
T38-BBA
T38-BBB
T38-BBC
T38-BBD
T38-BBE
T38-BBF
T38-BBG
T38-BBH
T38-BBJ
T38-BBK
T38-BBL
T38-BBM
T38-BBN
T38-BBP
T38-BBQ
T38-BBR
T38-BBS
T38-BBT
T38-BBU
T38-BBV
T38-BBW
T38-BBX
T38-BBY
T38-BBZ
T38-BCA
T38-BCB
T38-BCC
T38-BCD
T38-BCE
T38-BCF
T38-BCG
T38-BCH
T38-BCJ
T38-BCK
T38-BCL
T38-BCM
T38-BCN
T38-BCP
T38-BCQ
T38-BCR
T38-BCS
T38-BCT
T38-BCU
T38-BCV
T38-BCW
T38-BCX
T38-BCY
T38-BCZ
T38-BDA
T38-BDB
T38-BDC
T38-BDD
T38-BDE
T38-BDF
T38-BDG
T38-BDH
T38-BDJ
T38-BDK
T38-BDL
T38-BDM
T38-BDN
T38-BDP
T38-BDQ
T38-BDR
T38-BDS
T38-BDT
T38-BDU
T38-BDV
T38-BDW
T38-BDX
T38-BDY
T38-BDZ
T38-BEA
T38-BEB
T38-BEC
T38-BED
T38-BEE
T38-BEF
T38-BEG
T38-BEH
T38-BEJ
T38-BEK
T38-BEL
T38-BEM
T38-BEN
T38-BEP
T38-BEQ
T38-BER
T38-BES
T38-BET
T38-BEU
T38-BEV
T38-BEW
T38-BEX
T38-BEY
T38-BEZ
T38-BFA
T38-BFB
T38-BFC
T38-BFD
T38-BFE
T38-BFF
T38-BFG
T38-BFH
T38-BFJ
T38-BFK
T38-BFL
T38-BFM
T38-BFN
T38-BFP
T38-BFQ
T38-BFR
T38-BFS
T38-BFT
T38-BFU
T38-BFV
T38-BFW
T38-BFX
T38-BFY
T38-BFZ
T38-BGA
T38-BGB
T38-BGC
T38-BGD
T38-BGE
T38-BGF
T38-BGG
T38-BGH
T38-BGJ
T38-BGK
T38-BGL
T38-BGM
T38-BGN
T38-BGP
T38-BGQ
T38-BGR
T38-BGS
T38-BGT
T38-BGU
T38-BGV
T38-BGW
T38-BGX
T38-BGY
T38-BGZ
T38-BHA
T38-BHB
T38-BHC
T38-BHD
T38-BHE
T38-BHF
T38-BHG
T38-BHH
T38-BHJ
T38-BHK
T38-BHL
T38-BHM
T38-BHN
T38-BHP
T38-BHQ
T38-BHR
T38-BHS
T38-BHT
T38-BHU
T38-BHV
T38-BHW
T38-BHX
T38-BHY
T38-BHZ
T38-BJA
T38-BJB
T38-BJC
T38-BJD
T38-BJE
T38-BJF
T38-BJG
T38-BJH
T38-BJJ
T38-BJK
T38-BJL
T38-BJM
T38-BJN
T38-BJP
T38-BJQ
T38-BJR
T38-BJS
T38-BJT
T38-BJU
T38-BJV
T38-BJW
T38-BJX
T38-BJY
T38-BJZ
T38-BKA
T38-BKB
T38-BKC
T38-BKD
T38-BKE
T38-BKF
T38-BKG
T38-BKH
T38-BKJ
T38-BKK
T38-BKL
T38-BKM
T38-BKN
T38-BKP
T38-BKQ
T38-BKR
T38-BKS
T38-BKT
T38-BKU
T38-BKV
T38-BKW
T38-BKX
T38-BKY
T38-BKZ
T38-BLA
T38-BLB
T38-BLC
T38-BLD
T38-BLE
T38-BLF
T38-BLG
T38-BLH
T38-BLJ
T38-BLK
T38-BLL
T38-BLM
T38-BLN
T38-BLP
T38-BLQ
T38-BLR
T38-BLS
T38-BLT
T38-BLU
T38-BLV
T38-BLW
T38-BLX
T38-BLY
T38-BLZ
T38-BMA
T38-BMB
T38-BMC
T38-BMD
T38-BME
T38-BMF
T38-BMG
T38-BMH
T38-BMJ
T38-BMK
T38-BML
T38-BMM
T38-BMN
T38-BMP
T38-BMQ
T38-BMR
T38-BMS
T38-BMT
T38-BMU
T38-BMV
T38-BMW
T38-BMX
T38-BMY
T38-BMZ
T38-BNA
T38-BNB
T38-BNC
T38-BND
T38-BNE
T38-BNF
T38-BNG
T38-BNH
T38-BNJ
T38-BNK
T38-BNL
T38-BNM
T38-BNN
T38-BNP
T38-BNQ
T38-BNR
T38-BNS
T38-BNT
T38-BNU
T38-BNV
T38-BNW
T38-BNX
T38-BNY
T38-BNZ
T38-BPA
T38-BPB
T38-BPC
T38-BPD
T38-BPE
T38-BPF
T38-BPG
T38-BPH
T38-BPJ
T38-BPK
T38-BPL
T38-BPM
T38-BPN
T38-BPP
T38-BPQ
T38-BPR
T38-BPS
T38-BPT
T38-BPU
T38-BPV
T38-BPW
T38-BPX
T38-BPY
T38-BPZ
T38-BQA
T38-BQB
T38-BQC
T38-BQD
T38-BQE
T38-BQF
T38-BQG
T38-BQH
T38-BQJ
T38-BQK
T38-BQL
T38-BQM
T38-BQN
T38-BQP
T38-BQQ
T38-BQR
T38-BQS
T38-BQT
T38-BQU
T38-BQV
T38-BQW
T38-BQX
T38-BQY
T38-BQZ
T38-BRA
T38-BRB
T38-BRC
T38-BRD
T38-BRE
T38-BRF
T38-BRG
T38-BRH
T38-BRJ
T38-BRK
T38-BRL
T38-BRM
T38-BRN
T38-BRP
T38-BRQ
T38-BRR
T38-BRS
T38-BRT
T38-BRU
T38-BRV
T38-BRW
T38-BRX
T38-BRY
T38-BRZ
T38-BSA
T38-BSB
T38-BSC
T38-BSD
T38-BSE
T38-BSF
T38-BSG
T38-BSH
T38-BSJ
T38-BSK
T38-BSL
T38-BSM
T38-BSN
T38-BSP
T38-BSQ
T38-BSR
T38-BSS
T38-BST
T38-BSU
T38-BSV
T38-BSW
T38-BSX
T38-BSY
T38-BSZ
T38-BTA
T38-BTB
T38-BTC
T38-BTD
T38-BTE
T38-BTF
T38-BTG
T38-BTH
T38-BTJ
T38-BTK
T38-BTL
T38-BTM
T38-BTN
T38-BTP
T38-BTQ
T38-BTR
T38-BTS
T38-BTT
T38-BTU
T38-BTV
T38-BTW
T38-BTX
T38-BTY
T38-BTZ
T38-BUA
T38-BUB
T38-BUC
T38-BUD
T38-BUE
T38-BUF
T38-BUG
T38-BUH
T38-BUJ
T38-BUK
T38-BUL
T38-BUM
T38-BUN
T38-BUP
T38-BUQ
T38-BUR
T38-BUS
T38-BUT
T38-BUU
T38-BUV
T38-BUW
T38-BUX
T38-BUY
T38-BUZ
T38-BVA
T38-BVB
T38-BVC
T38-BVD
T38-BVE
T38-BVF
T38-BVG
T38-BVH
T38-BVJ
T38-BVK
T38-BVL
T38-BVM
T38-BVN
T38-BVP
T38-BVQ
T38-BVR
T38-BVS
T38-BVT
T38-BVU
T38-BVV
T38-BVW
T38-BVX
T38-BVY
T38-BVZ
T38-BWA
T38-BWB
T38-BWC
T38-BWD
T38-BWE
T38-BWF
T38-BWG
T38-BWH
T38-BWJ
T38-BWK
T38-BWL
T38-BWM
T38-BWN
T38-BWP
T38-BWQ
T38-BWR
T38-BWS
T38-BWT
T38-BWU
T38-BWV
T38-BWW
T38-BWX
T38-BWY
T38-BWZ
T38-BXA
T38-BXB
T38-BXC
T38-BXD
T38-BXE
T38-BXF
T38-BXG
T38-BXH
T38-BXJ
T38-BXK
T38-BXL
T38-BXM
T38-BXN
T38-BXP
T38-BXQ
T38-BXR
T38-BXS
T38-BXT
T38-BXU
T38-BXV
T38-BXW
T38-BXX
T38-BXY
T38-BXZ
T38-BYA
T38-BYB
T38-BYC
T38-BYD
T38-BYE
T38-BYF
T38-BYG
T38-BYH
T38-BYJ
T38-BYK
T38-BYL
T38-BYM
T38-BYN
T38-BYP
T38-BYQ
T38-BYR
T38-BYS
T38-BYT
T38-BYU
T38-BYV
T38-BYW
T38-BYX
T38-BYY
T38-BYZ
T38-BZA
T38-BZB
T38-BZC
T38-BZD
T38-BZE
T38-BZF
T38-BZG
T38-BZH
T38-BZJ
T38-BZK
T38-BZL
T38-BZM
T38-BZN
T38-BZP
T38-BZQ
T38-BZR
T38-BZS
T38-BZT
T38-BZU
T38-BZV
T38-BZW
T38-BZX
T38-BZY
T38-BZZ
T38-CAA
T38-CAB
T38-CAC
T38-CAD
T38-CAE
T38-CAF
T38-CAG
T38-CAH
T38-CAJ
T38-CAK
T38-CAL
T38-CAM
T38-CAN
T38-CAP
T38-CAQ
T38-CAR
T38-CAS
T38-CAT
T38-CAU
T38-CAV
T38-CAW
T38-CAX
T38-CAY
T38-CAZ
T38-CBA
T38-CBB
T38-CBC
T38-CBD
T38-CBE
T38-CBF
T38-CBG
T38-CBH
T38-CBJ
T38-CBK
T38-CBL
T38-CBM
T38-CBN
T38-CBP
T38-CBQ
T38-CBR
T38-CBS
T38-CBT
T38-CBU
T38-CBV
T38-CBW
T38-CBX
T38-CBY
T38-CBZ
T38-CCA
T38-CCB
T38-CCC
T38-CCD
T38-CCE
T38-CCF
T38-CCG
T38-CCH
T38-CCJ
T38-CCK
T38-CCL
T38-CCM
T38-CCN
T38-CCP
T38-CCQ
T38-CCR
T38-CCS
T38-CCT
T38-CCU
T38-CCV
T38-CCW
T38-CCX
T38-CCY
T38-CCZ
T38-CDA
T38-CDB
T38-CDC
T38-CDD
T38-CDE
T38-CDF
T38-CDG
T38-CDH
T38-CDJ
T38-CDK
T38-CDL
T38-CDM
T38-CDN
T38-CDP
T38-CDQ
T38-CDR
T38-CDS
T38-CDT
T38-CDU
T38-CDV
T38-CDW
T38-CDX
T38-CDY
T38-CDZ
T38-CEA
T38-CEB
T38-CEC
T38-CED
T38-CEE
T38-CEF
T38-CEG
T38-CEH
T38-CEJ
T38-CEK
T38-CEL
T38-CEM
T38-CEN
T38-CEP
T38-CEQ
T38-CER
T38-CES
T38-CET
T38-CEU
T38-CEV
T38-CEW
T38-CEX
T38-CEY
T38-CEZ
T38-CFA
T38-CFB
T38-CFC
T38-CFD
T38-CFE
T38-CFF
T38-CFG
T38-CFH
T38-CFJ
T38-CFK
T38-CFL
T38-CFM
T38-CFN
T38-CFP
T38-CFQ
T38-CFR
T38-CFS
T38-CFT
T38-CFU
T38-CFV
T38-CFW
T38-CFX
T38-CFY
T38-CFZ
T38-CGA
T38-CGB
T38-CGC
T38-CGD
T38-CGE
T38-CGF
T38-CGG
T38-CGH
T38-CGJ
T38-CGK
T38-CGL
T38-CGM
T38-CGN
T38-CGP
T38-CGQ
T38-CGR
T38-CGS
T38-CGT
T38-CGU
T38-CGV
T38-CGW
T38-CGX
T38-CGY
T38-CGZ
T38-CHA
T38-CHB
T38-CHC
T38-CHD
T38-CHE
T38-CHF
T38-CHG
T38-CHH
T38-CHJ
T38-CHK
T38-CHL
T38-CHM
T38-CHN
T38-CHP
T38-CHQ
T38-CHR
T38-CHS
T38-CHT
T38-CHU
T38-CHV
T38-CHW
T38-CHX
T38-CHY
T38-CHZ
T38-CJA
T38-CJB
T38-CJC
T38-CJD
T38-CJE
T38-CJF
T38-CJG
T38-CJH
T38-CJJ
T38-CJK
T38-CJL
T38-CJM
T38-CJN
T38-CJP
T38-CJQ
T38-CJR
T38-CJS
T38-CJT
T38-CJU
T38-CJV
T38-CJW
T38-CJX
T38-CJY
T38-CJZ
T38-CKA
T38-CKB
T38-CKC
T38-CKD
T38-CKE
T38-CKF
T38-CKG
T38-CKH
T38-CKJ
T38-CKK
T38-CKL
T38-CKM
T38-CKN
T38-CKP
T38-CKQ
T38-CKR

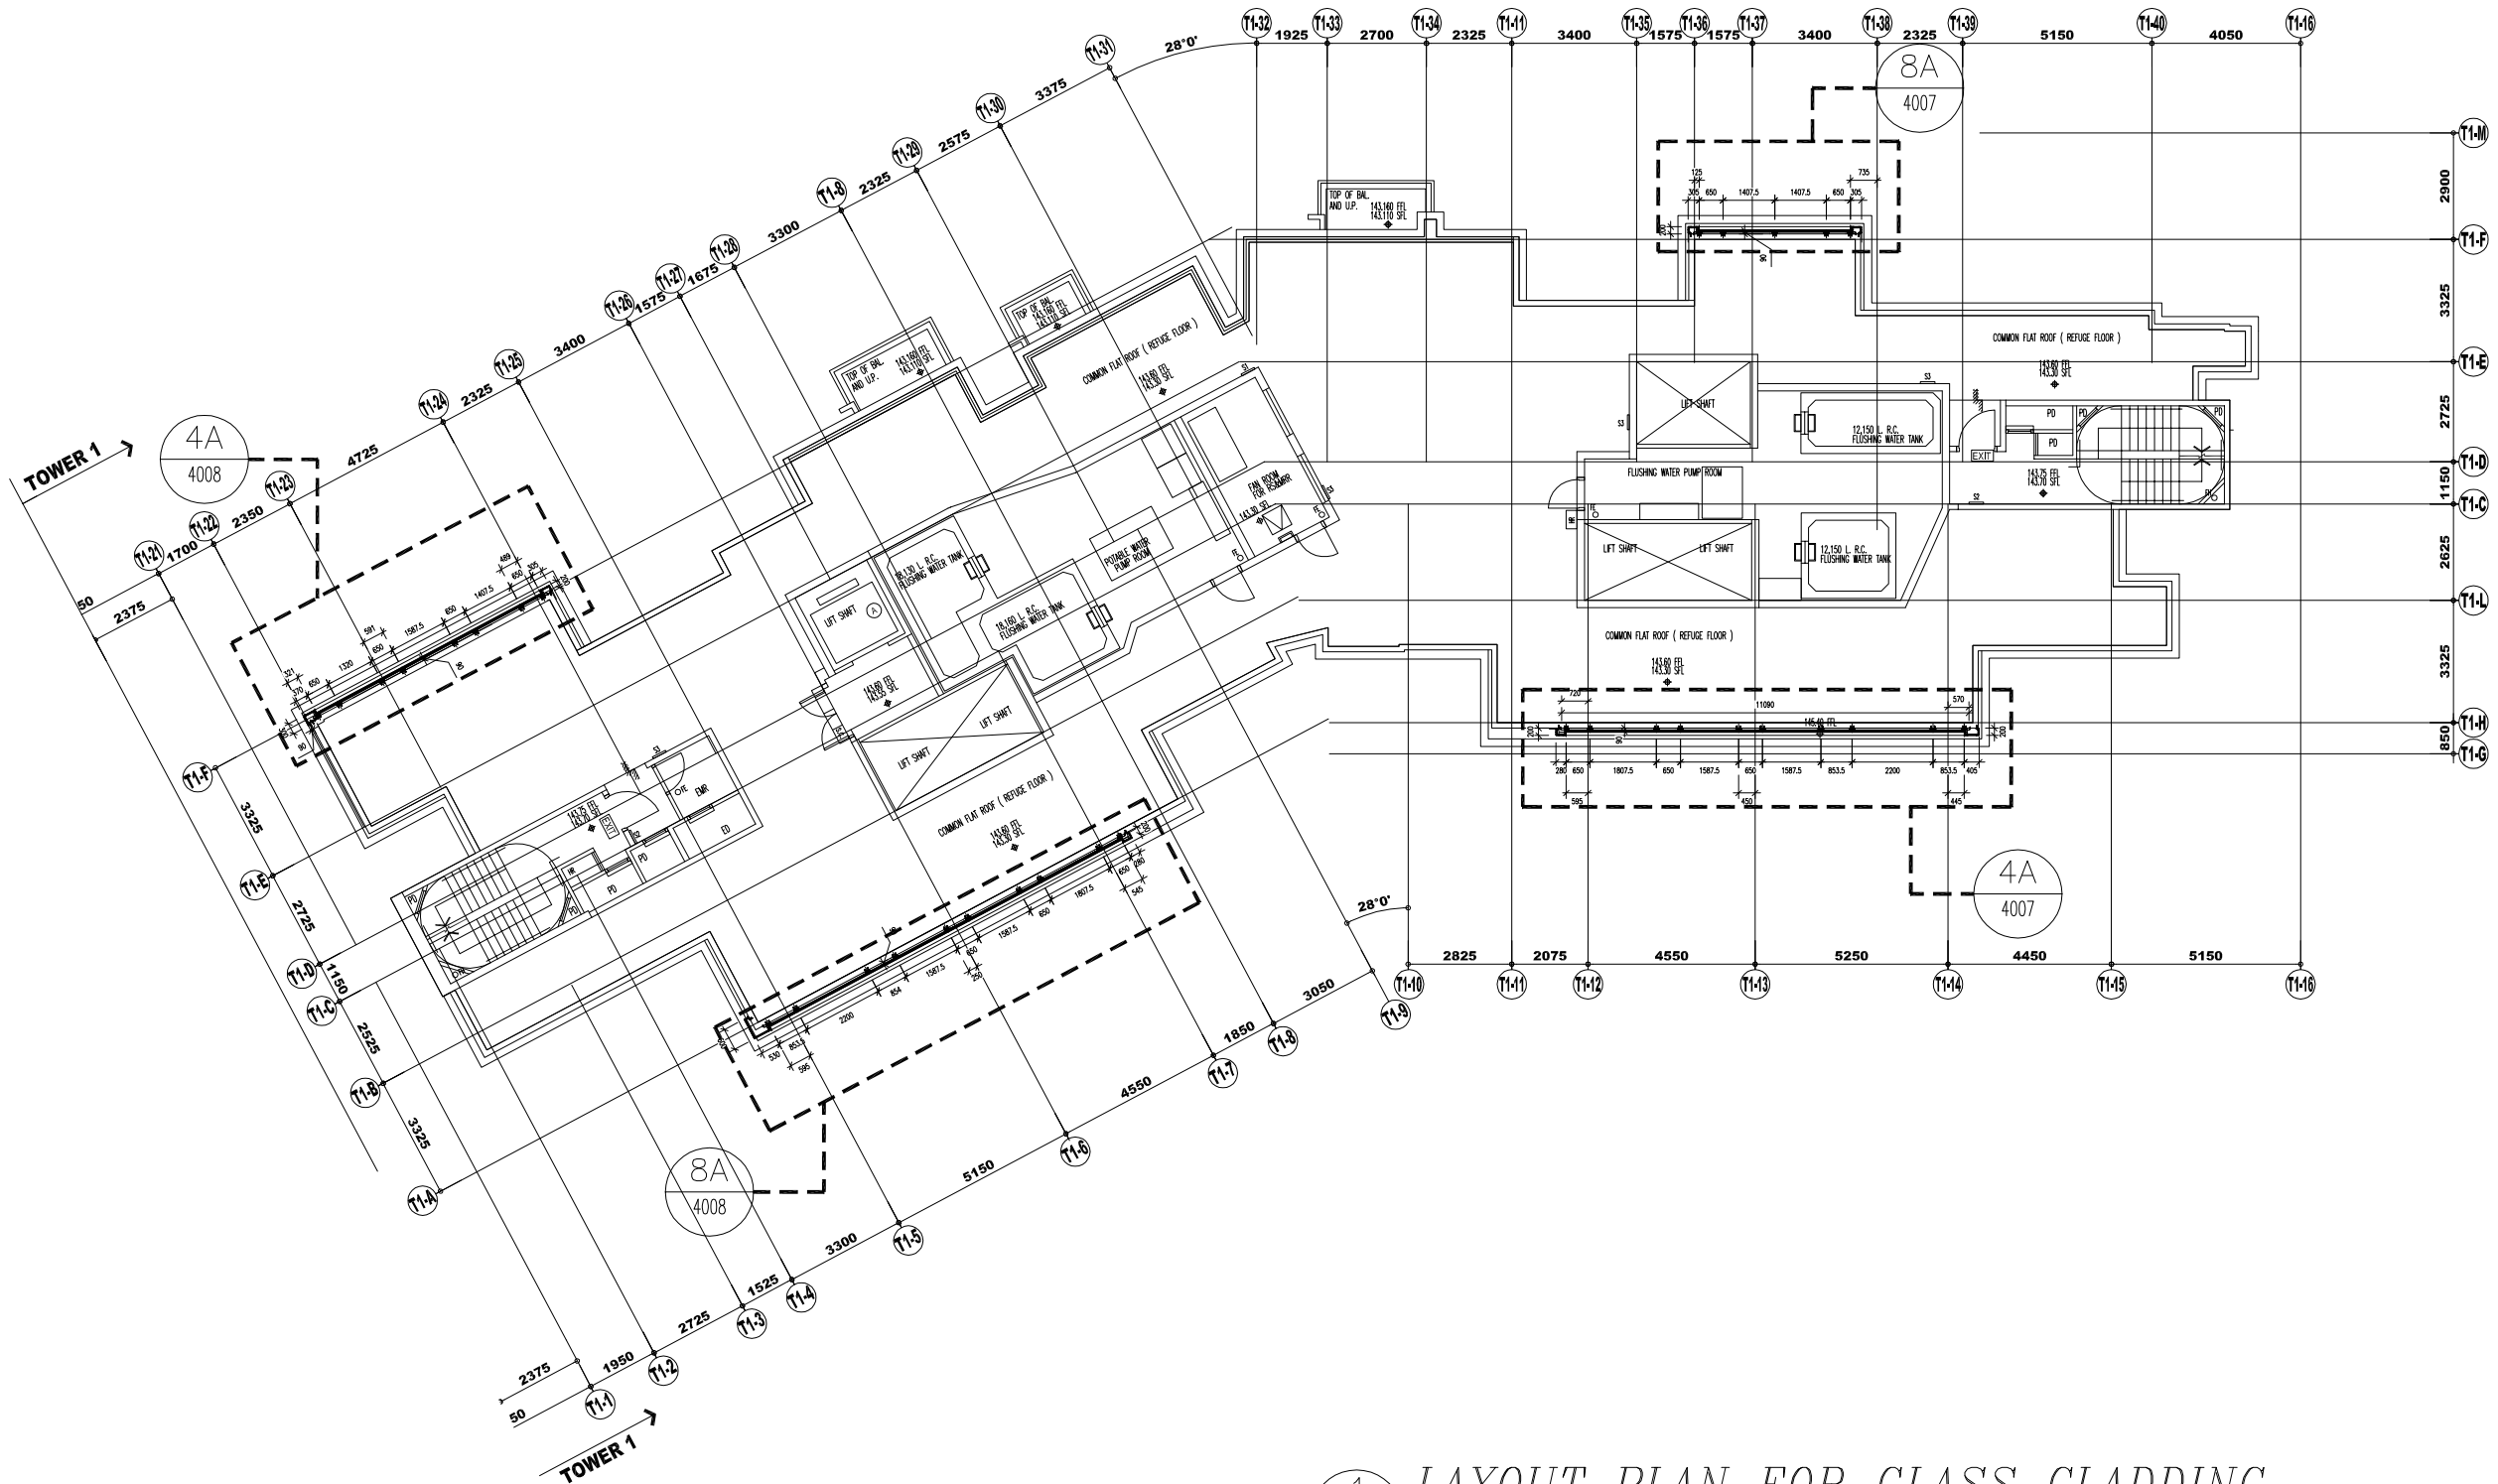

1 / 3013 *LAYOUT PLAN FOR GLASS CLADDING*

TOWER 1 (ROOF/F)

B.D. REF :

CLIENT :

SUN HUNG KAI REAL ESTATE AGENCY LTD.
42/F SUN HUNG KAI CENTRE, WANCHAI, HONGKONG

ARCHITECT :

lwk&partners
a r c h i t e c t s

MAIN CONTRACTOR :

怡輝建築有限公司
Yee Fai Building Contractors Ltd.

STRUCTURAL ENGINEER :

ARUP

FACADE CONSULTANT:

ALPHA CONSULTING LIMITED
Steel Structure & Facade Specialist

NOTE :
1. ALL DIMENSIONS ARE IN mm.
2. ALL ELEVATIONS ARE VIEWED FROM OUTSIDE.
3. ALL DIMENSIONS TO BE VERIFIED ON SITE BEFORE FABRICATION.

LEGEND :

X1 — DETAIL MARK NO.
X001 — REFER SHEET NO.

1. F.F.L. --FINISHED FLOOR LEVEL
2. S.F.L. --STRUCTURAL FLOOR LEVEL
3. /R --REVERSED DETAIL

NO.	DATE	REVISED	BY
–	11-AUG-2023	(NEW DRAWING) 7TH SUBMISSION	CF

JOB NO. : J-856

PROJECT :
PROPOSED DEVELOPMENT ABOVE LIGHT RAIL TIN WING STOP,TSWTL NO.23,AREA 33,TIN SHUI WAI, N.T.


TITLE :
LAYOUT PLAN FOR GLASS CLADDING @ TOWER 1 (ROOF/F)


DATE : 31-OCT-22 | SCALE : 1:200

DRAWN BY : C.F | CHECKED BY :

美特鋁質有限公司
MIDI ALUMINIUM FABRICATOR LTD.
Units 6-8, Sunray Industrial Centre, 1/F
610 Cha Kwo Ling Road, Kowloon
Tel:23489211-4 Fax:(852)27727666

DWG NO. : J856-SD-CW-3013 | REV. : –

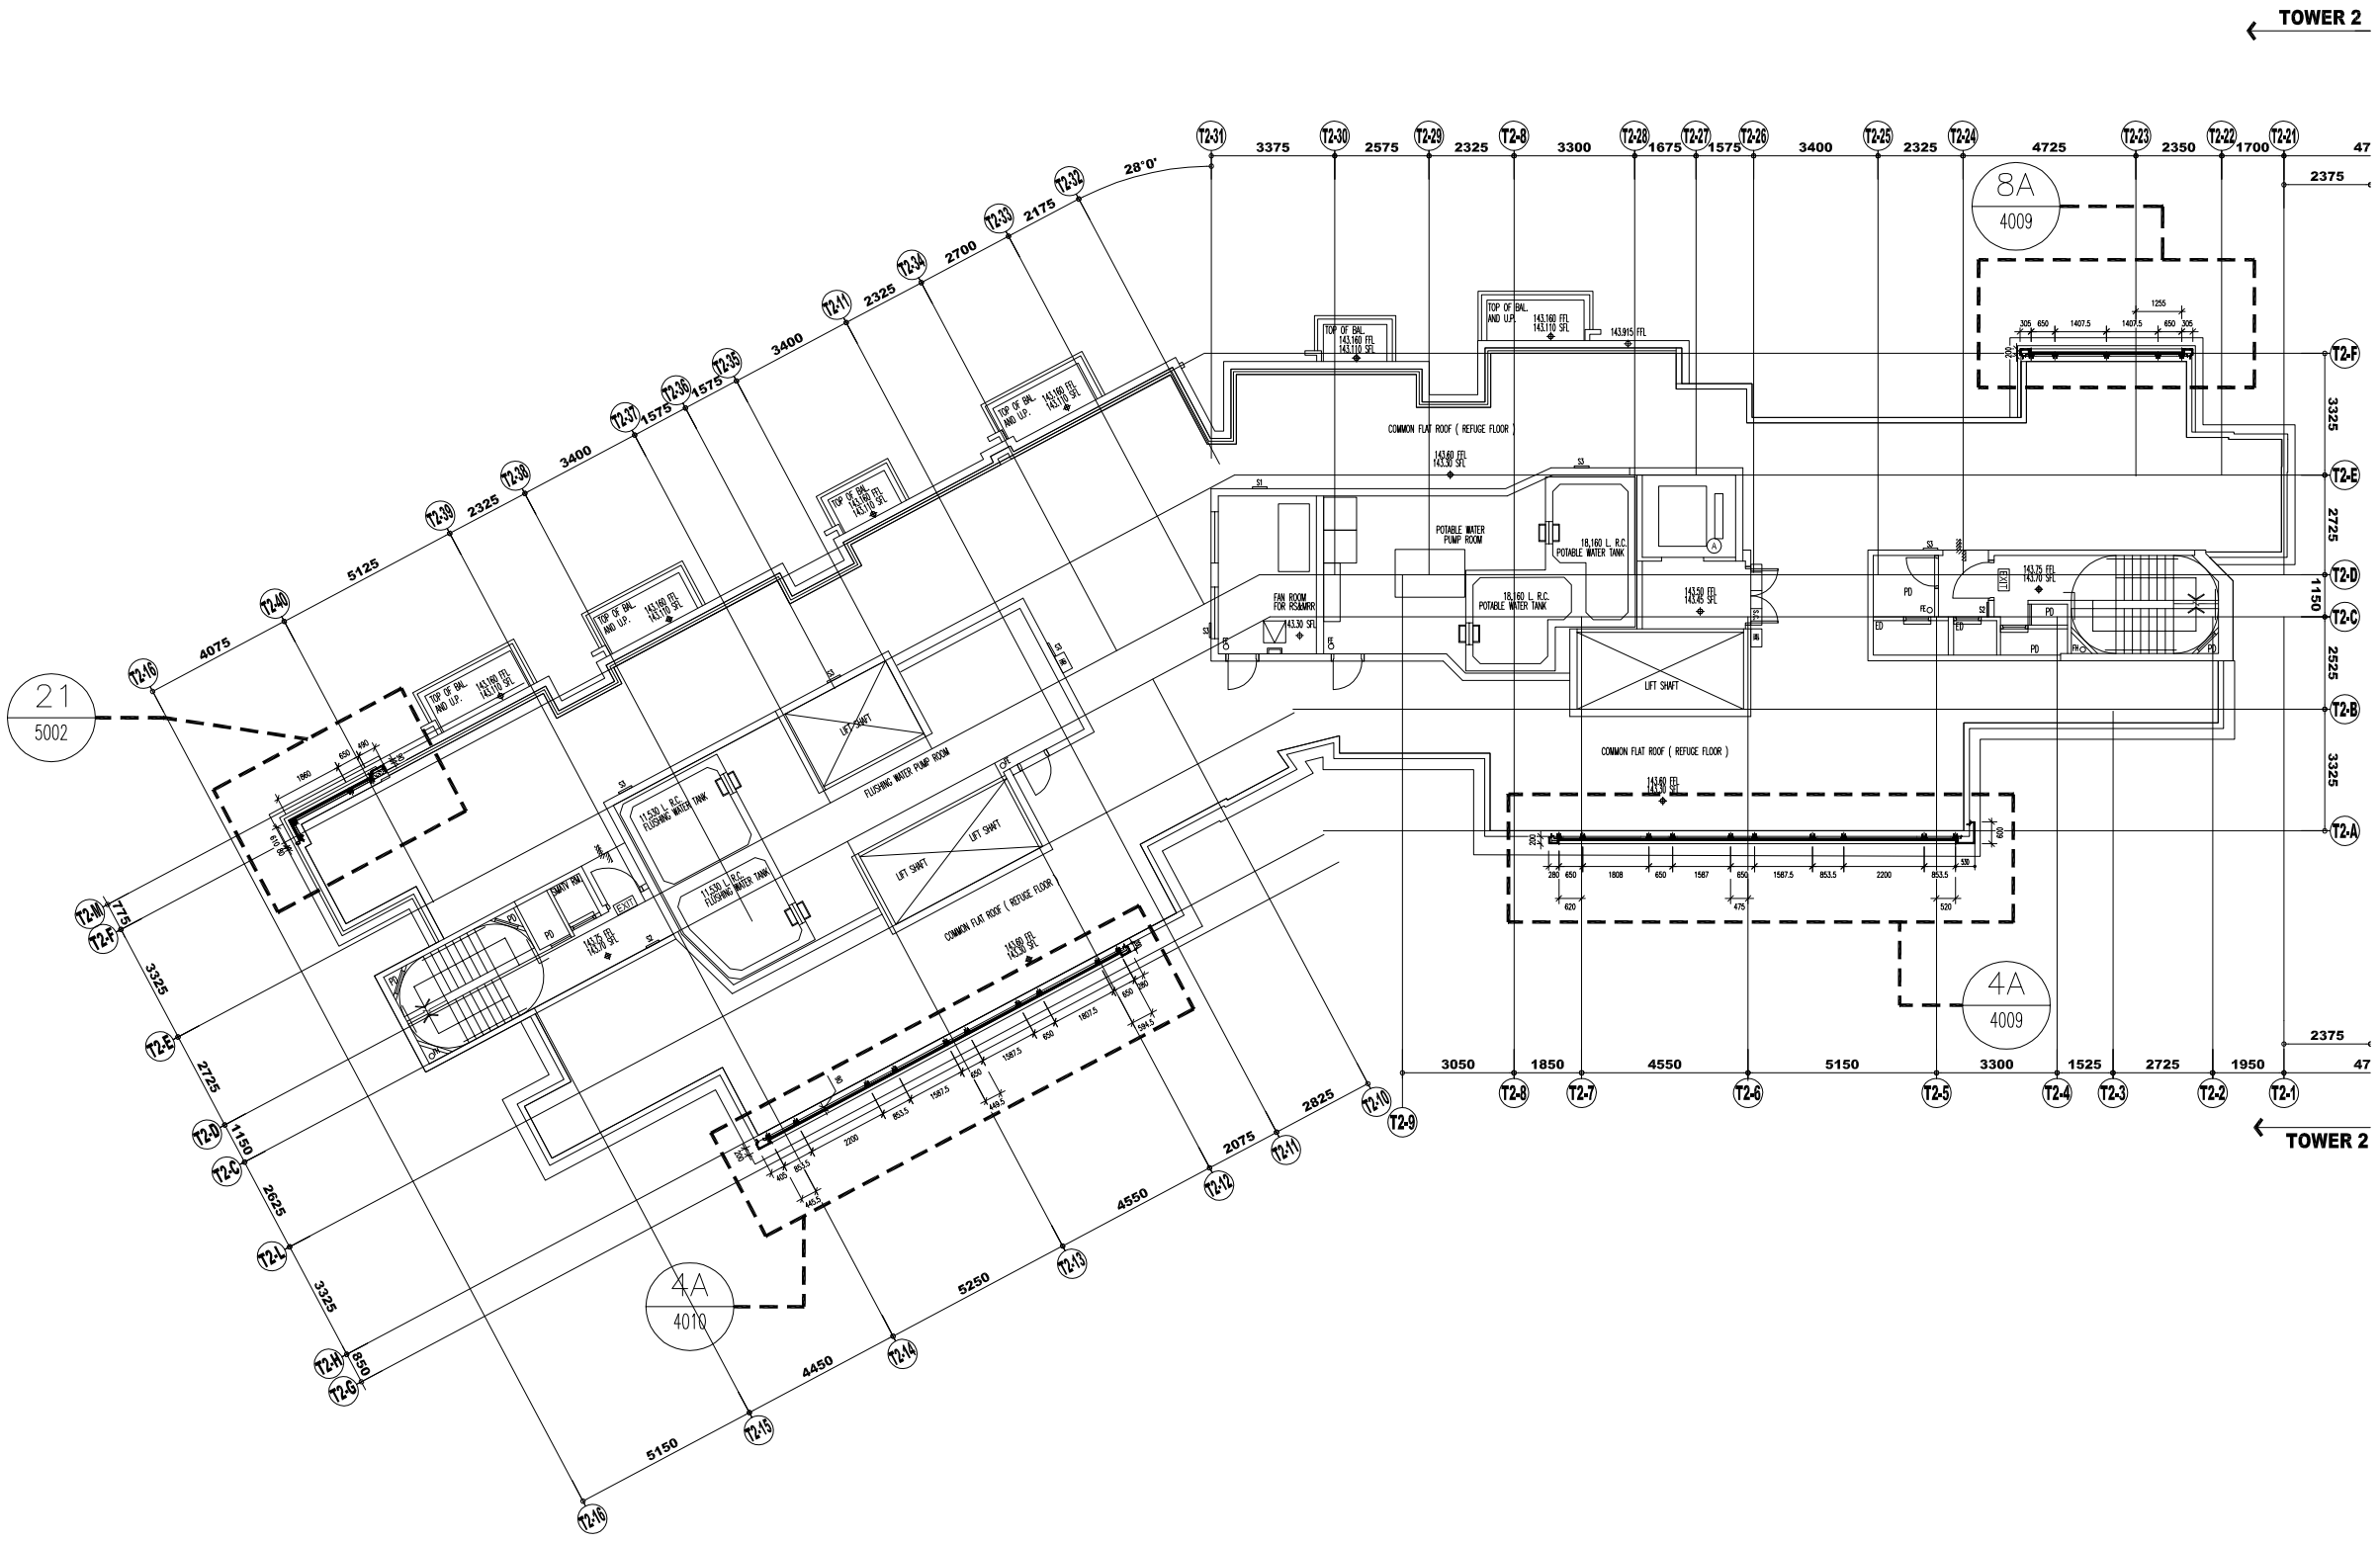
TOWER 2
T2-31
T2-30
T2-29
T2-8
T2-28
T2-27
T2-26
T2-25
T2-24
T2-23
T2-22
T2-21
3375
2575
2325
3300
1675
1575
3400
2325
4725
2350
1700
2375
8A
4009
T2-F
T2-E
T2-D
T2-C
T2-B
T2-A
3325
2725
1150
2525
3325
TOP OF BAL. AND U.P. 143.160 FFL 143.110 SFL
143.915 FFL
COMMON FLAT ROOF (REFUGE FLOOR)
143.60 FFL 143.30 SFL
POTABLE WATER PUMP ROOM
18.180 L.R.C. POTABLE WATER TANK
FAN ROOM FOR RGAMRR
143.30 SFL
LIFT SHAFT
143.50 FFL 143.20 SFL
143.76 FFL 143.46 SFL
PD
FHC
E/S
1255
305
650
1407.5
T2-20
T2-39
T2-38
T2-37
T2-36
T2-35
T2-34
T2-33
T2-32
28°0'
3400
1575
2325
2700
2175
T2-40
T2-16
4075
5125
21
5002
T2-18
T2-5
T2-19
T2-6
T2-17
T2-7
T2-4
T2-3
T2-2
T2-1
T2-L
T2-K
T2-J
T2-H
T2-G
T2-I
T2-E
T2-D
T2-C
T2-B
T2-A
3325
2725
1150
2625
3325
850
1775
FLUSHING WATER PUMP ROOM
11.530 L.R.C. FLUSHING WATER TANK
LIFT SHAFT
LIFT SHAFT
LIFT SHAFT
COMMON FLAT ROOF (REFUGE FLOOR)
143.60 FFL 143.30 SFL
143.60 FFL 143.30 SFL

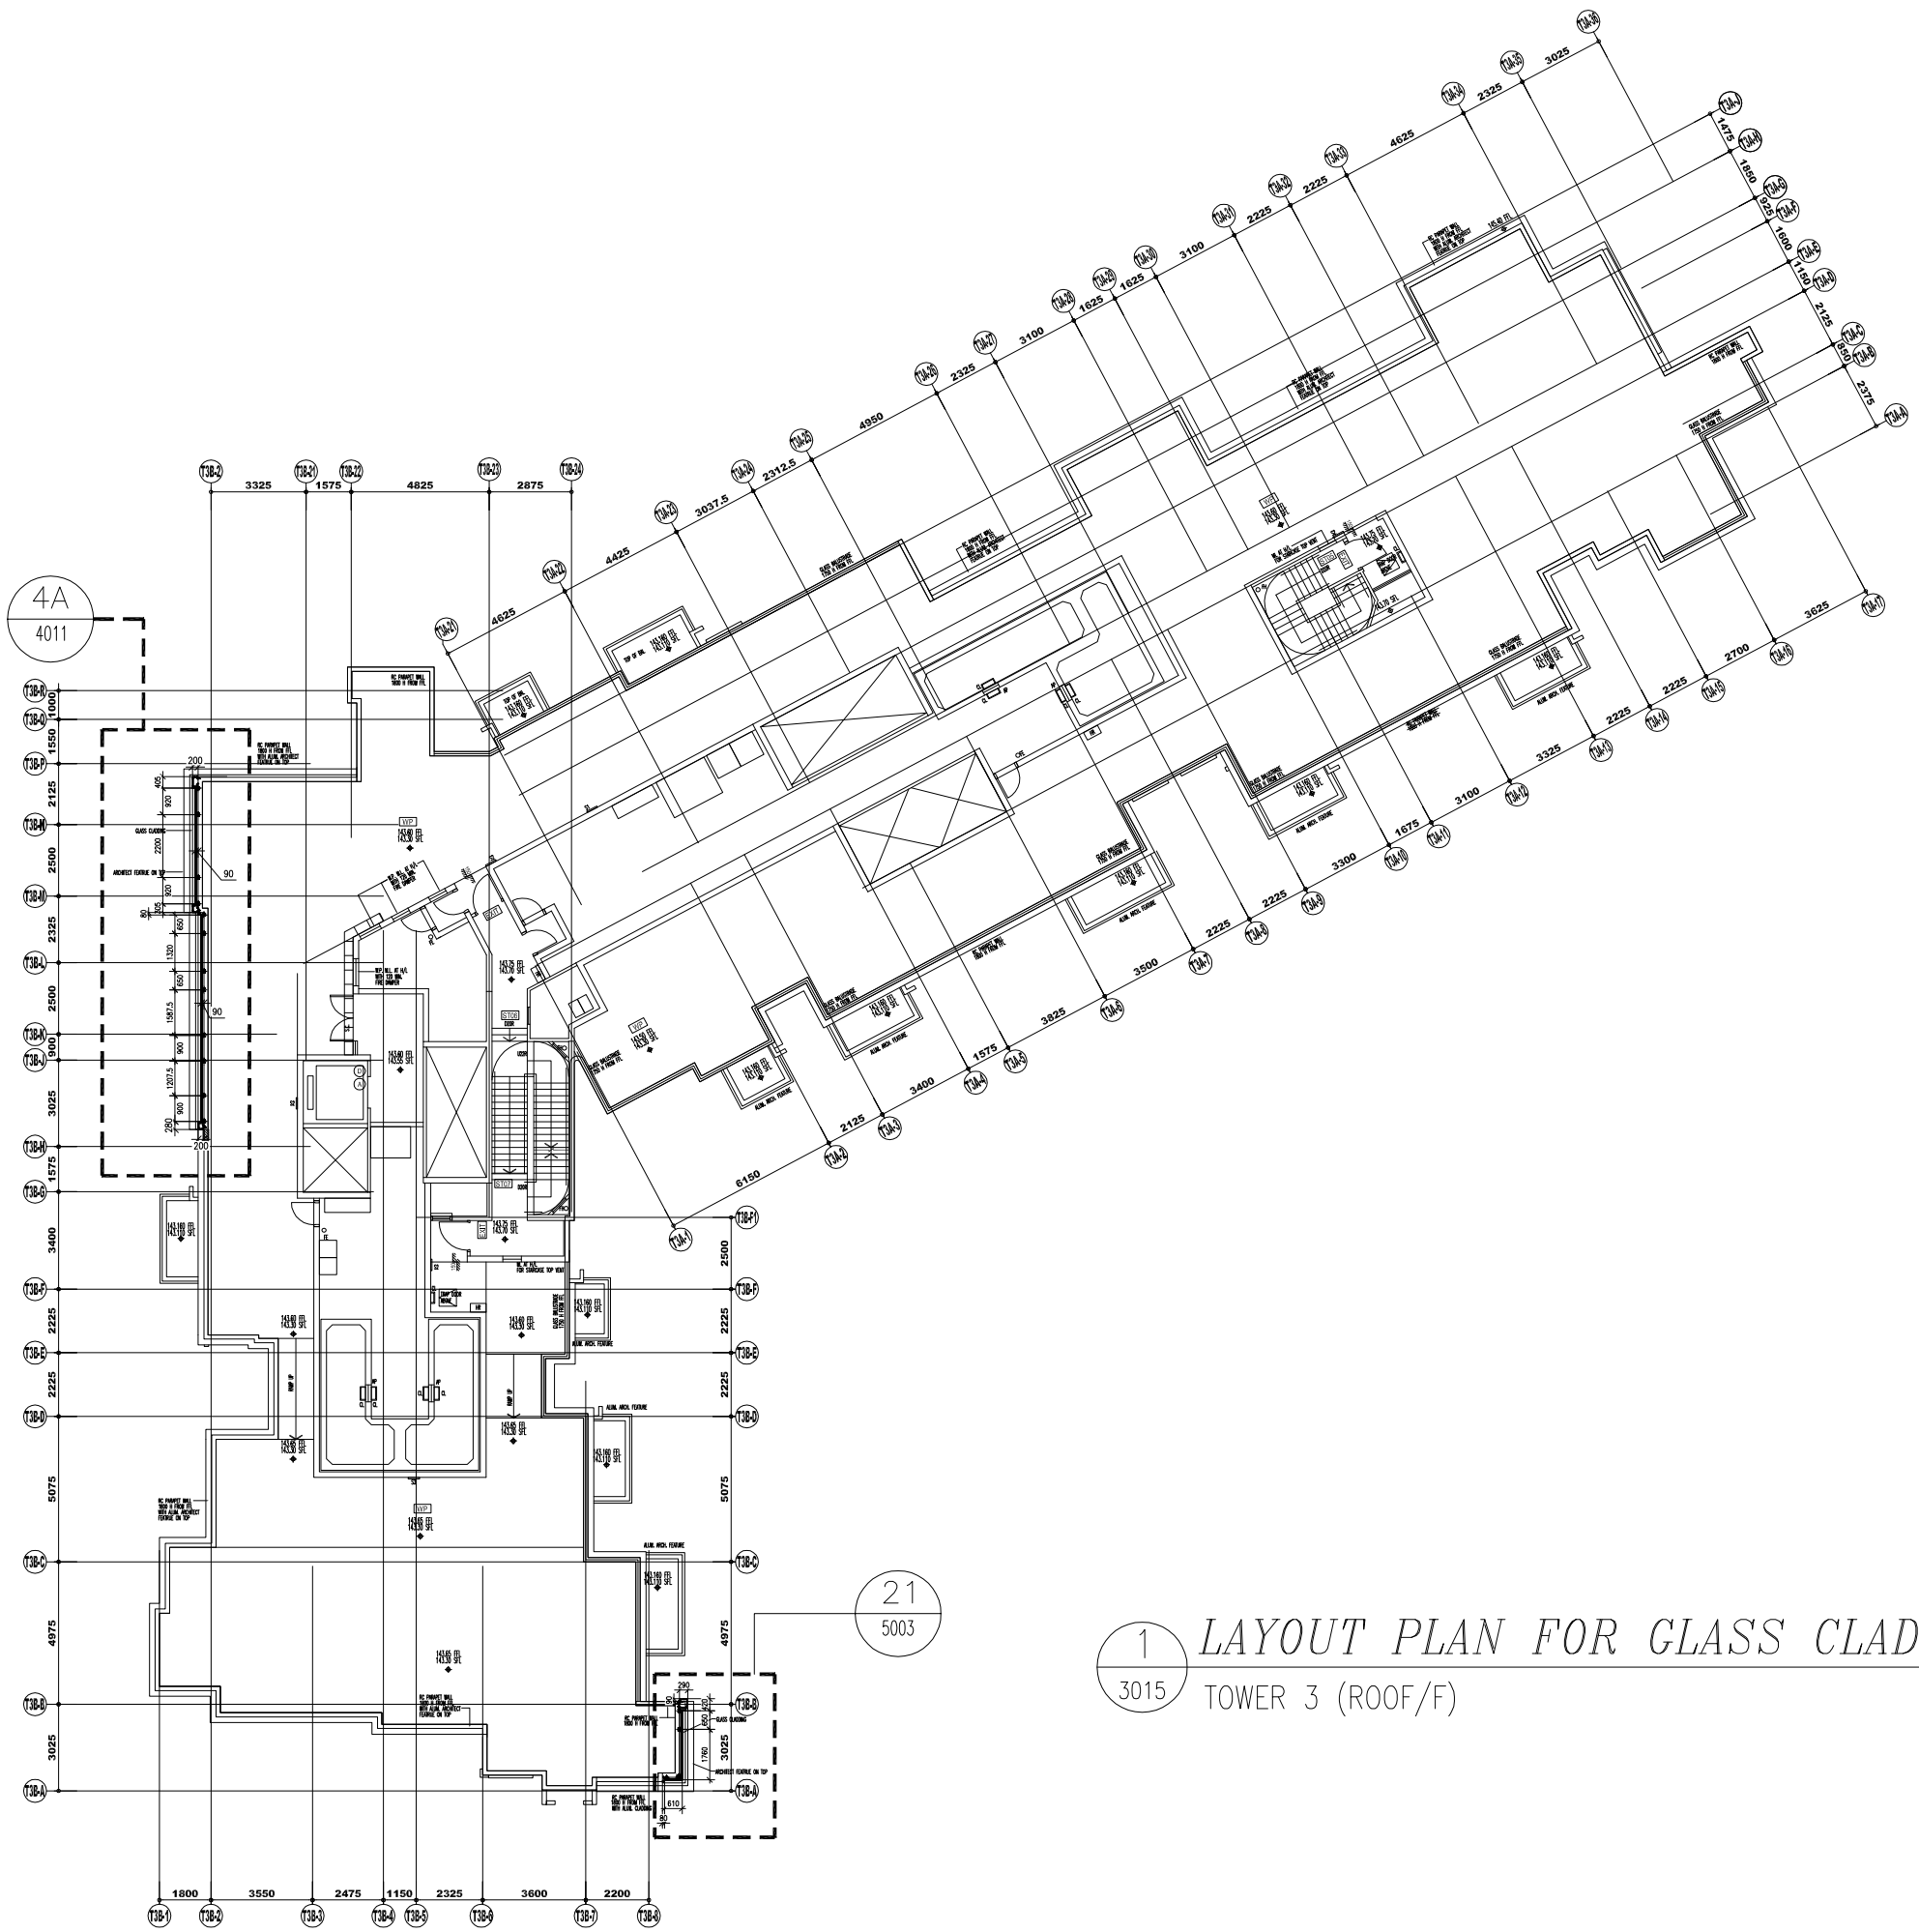

1 / 3015 LAYOUT PLAN FOR GLASS CLADDING

TOWER 3 (ROOF/F)

B.D. REF :

CLIENT :

SUN HUNG KAI REAL ESTATE AGENCY LTD.
42/F SUN HUNG KAI CENTRE, WANCHAI, HONGKONG

ARCHITECT :

lwk&partners
a r c h i t e c t s

MAIN CONTRACTOR :

怡輝建築有限公司
Yee Fai Building Contractors Ltd.

STRUCTURAL ENGINEER :

ARUP

FACADE CONSULTANT:

ALPHA CONSULTING LIMITED
Steel Structure & Facade Specialist

NOTE :
1. ALL DIMENSIONS ARE IN mm.
2. ALL ELEVATIONS ARE VIEWED FROM OUTSIDE.
3. ALL DIMENSIONS TO BE VERIFIED ON SITE BEFORE FABRICATION.

LEGEND :

X1 — DETAIL MARK NO.
X001 — REFER SHEET NO.

1. F.F.L. -- FINISHED FLOOR LEVEL
2. S.F.L. -- STRUCTURAL FLOOR LEVEL
3. /R -- REVERSED DETAIL

NO.	DATE	REVISED	BY
–	11–AUG–2023	7TH SUBMISSION (NEW DRAWING)	CF

JOB NO. : J–856


PROJECT :
PROPOSED DEVELOPMENT ABOVE LIGHT RAIL TIN WING STOP,TSWTL NO.23,AREA 33,TIN SHUI WAI, N.T.

TITLE :
LAYOUT PLAN FOR GLASS CLADDING @ TOWER 3 (ROOF/F)

DATE : 31–OCT–22	SCALE : 1:250
DRAWN BY : C.F	CHECKED BY :

美特鋁質有限公司
MIDI ALUMINIUM FABRICATOR LTD.
Units 6–8, Sunray Industrial Centre, 1/F
610 Cha Kwo Ling Road, Kowloon
Tel:23489211–4 Fax:(852)27727666

DWG NO. : J856–SD–CW–3015 | REV. : –

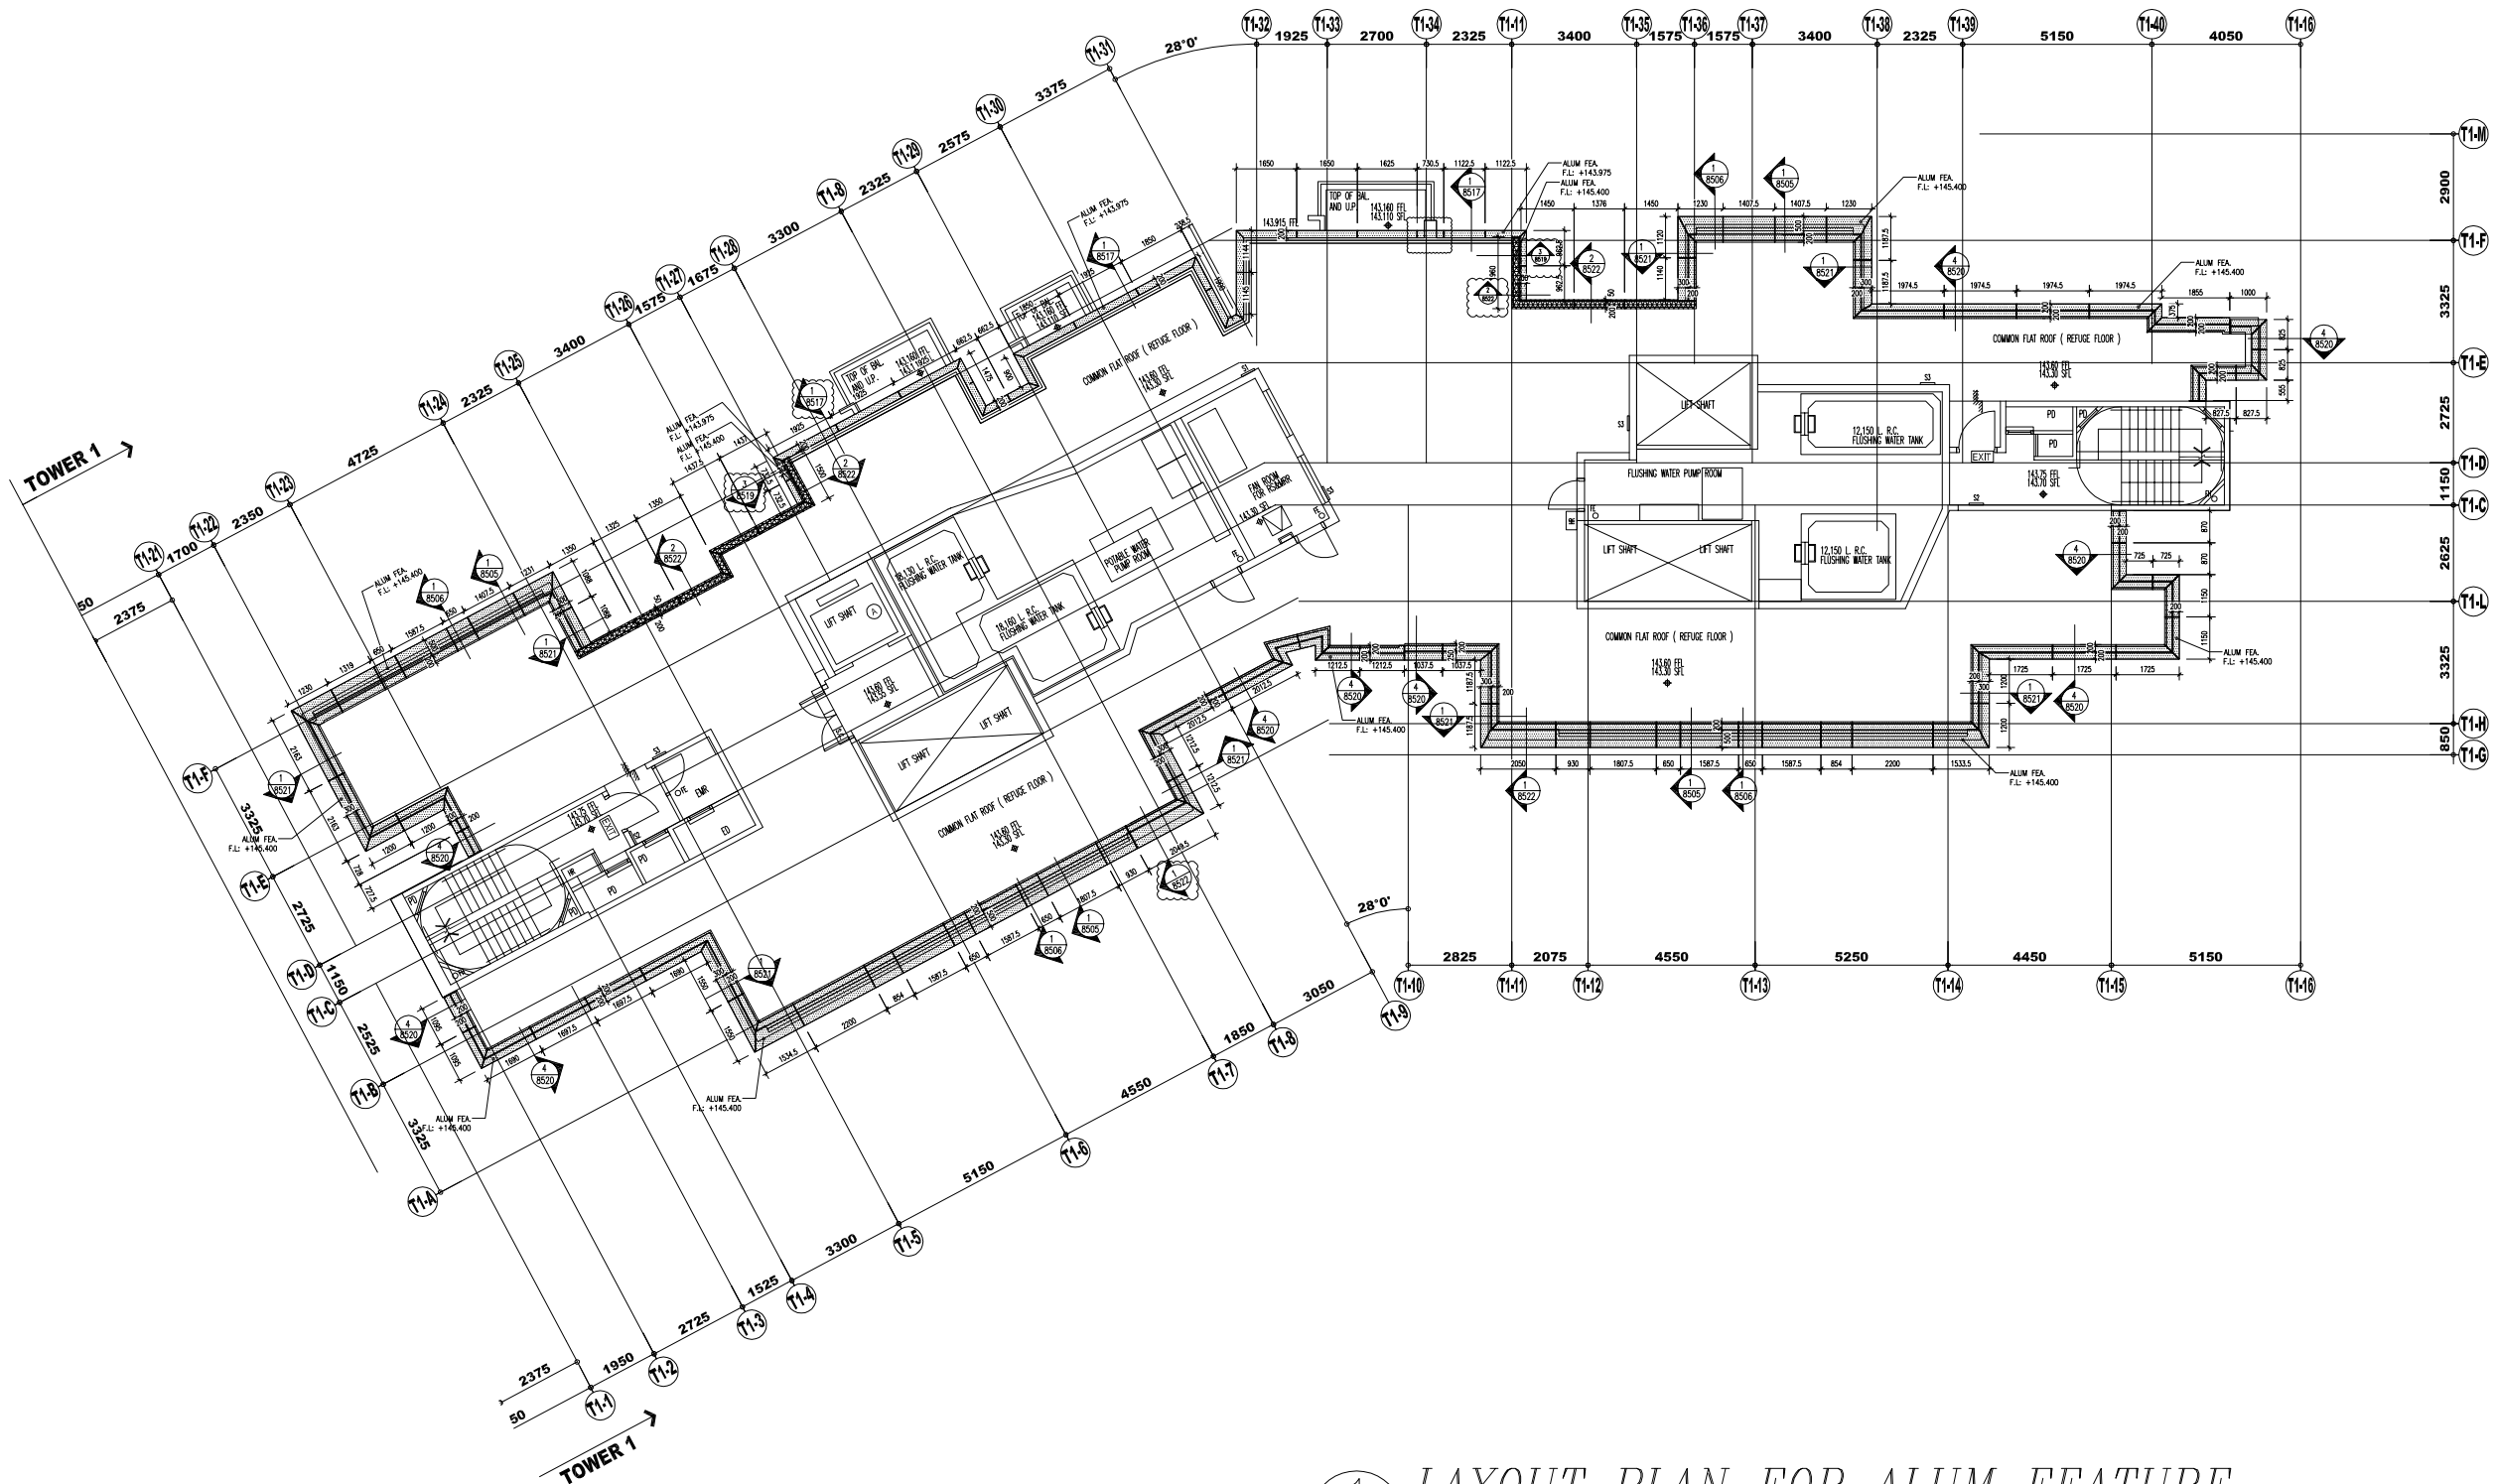

1 / 3016 *LAYOUT PLAN FOR ALUM FEATURE*

TOWER 1 (ROOF/F)

B.D. REF :

CLIENT :
SUN HUNG KAI REAL ESTATE AGENCY LTD.
42/F SUN HUNG KAI CENTRE, WANCHAI, HONGKONG

ARCHITECT :
lwk&partners architects

MAIN CONTRACTOR :
怡輝建築有限公司
Yee Fai Building Contractors Ltd.

STRUCTURAL ENGINEER :
ARUP

FACADE CONSULTANT:
ALPHA CONSULTING LIMITED
Steel Structure & Facade Specialist

NOTE :
1. ALL DIMENSIONS ARE IN mm.
2. ALL ELEVATIONS ARE VIEWED FROM OUTSIDE.
3. ALL DIMENSIONS TO BE VERIFIED ON SITE BEFORE FABRICATION.

LEGEND :
X1 — DETAIL MARK NO.
X001 — REFER SHEET NO.

1. F.F.L. --FINISHED FLOOR LEVEL
2. S.F.L. --STRUCTURAL FLOOR LEVEL
3. (/R) --REVERSED DETAIL

3mm ALUM. CLADDING FEATURE COLOR COLOR: UCT309119XLB-3
3mm ALUM. CLADDING FEATURE COLOR COLOR: UCT54291BXL-3

NO.	DATE	REVISED	BY
B	12-OCT-2023	9TH SUBMISSION	CF
A	29-SEP-2023	8TH SUBMISSION	CF
–	11-AUG-2023	(NEW DRAWING) 7TH SUBMISSION	CF

JOB NO. : J-856

PROJECT :
PROPOSED DEVELOPMENT ABOVE LIGHT RAIL TIN WING STOP,TSWTL NO.23,AREA 33,TIN SHUI WAI, N.T.


TITLE :
LAYOUT PLAN FOR ALUM FEATURE @ TOWER 1 (ROOF/F)

DATE : 31-OCT-22 | SCALE : 1:200

DRAWN BY : C.F | CHECKED BY :

美特鋁質有限公司
MIDI ALUMINIUM FABRICATOR LTD.
Units 6-8, Sunray Industrial Centre, 1/F
610 Cha Kwo Ling Road, Kowloon
Tel:23489211-4 Fax:(852)27727666

DWG NO. : J856-SD-CW-3016 | REV. : B

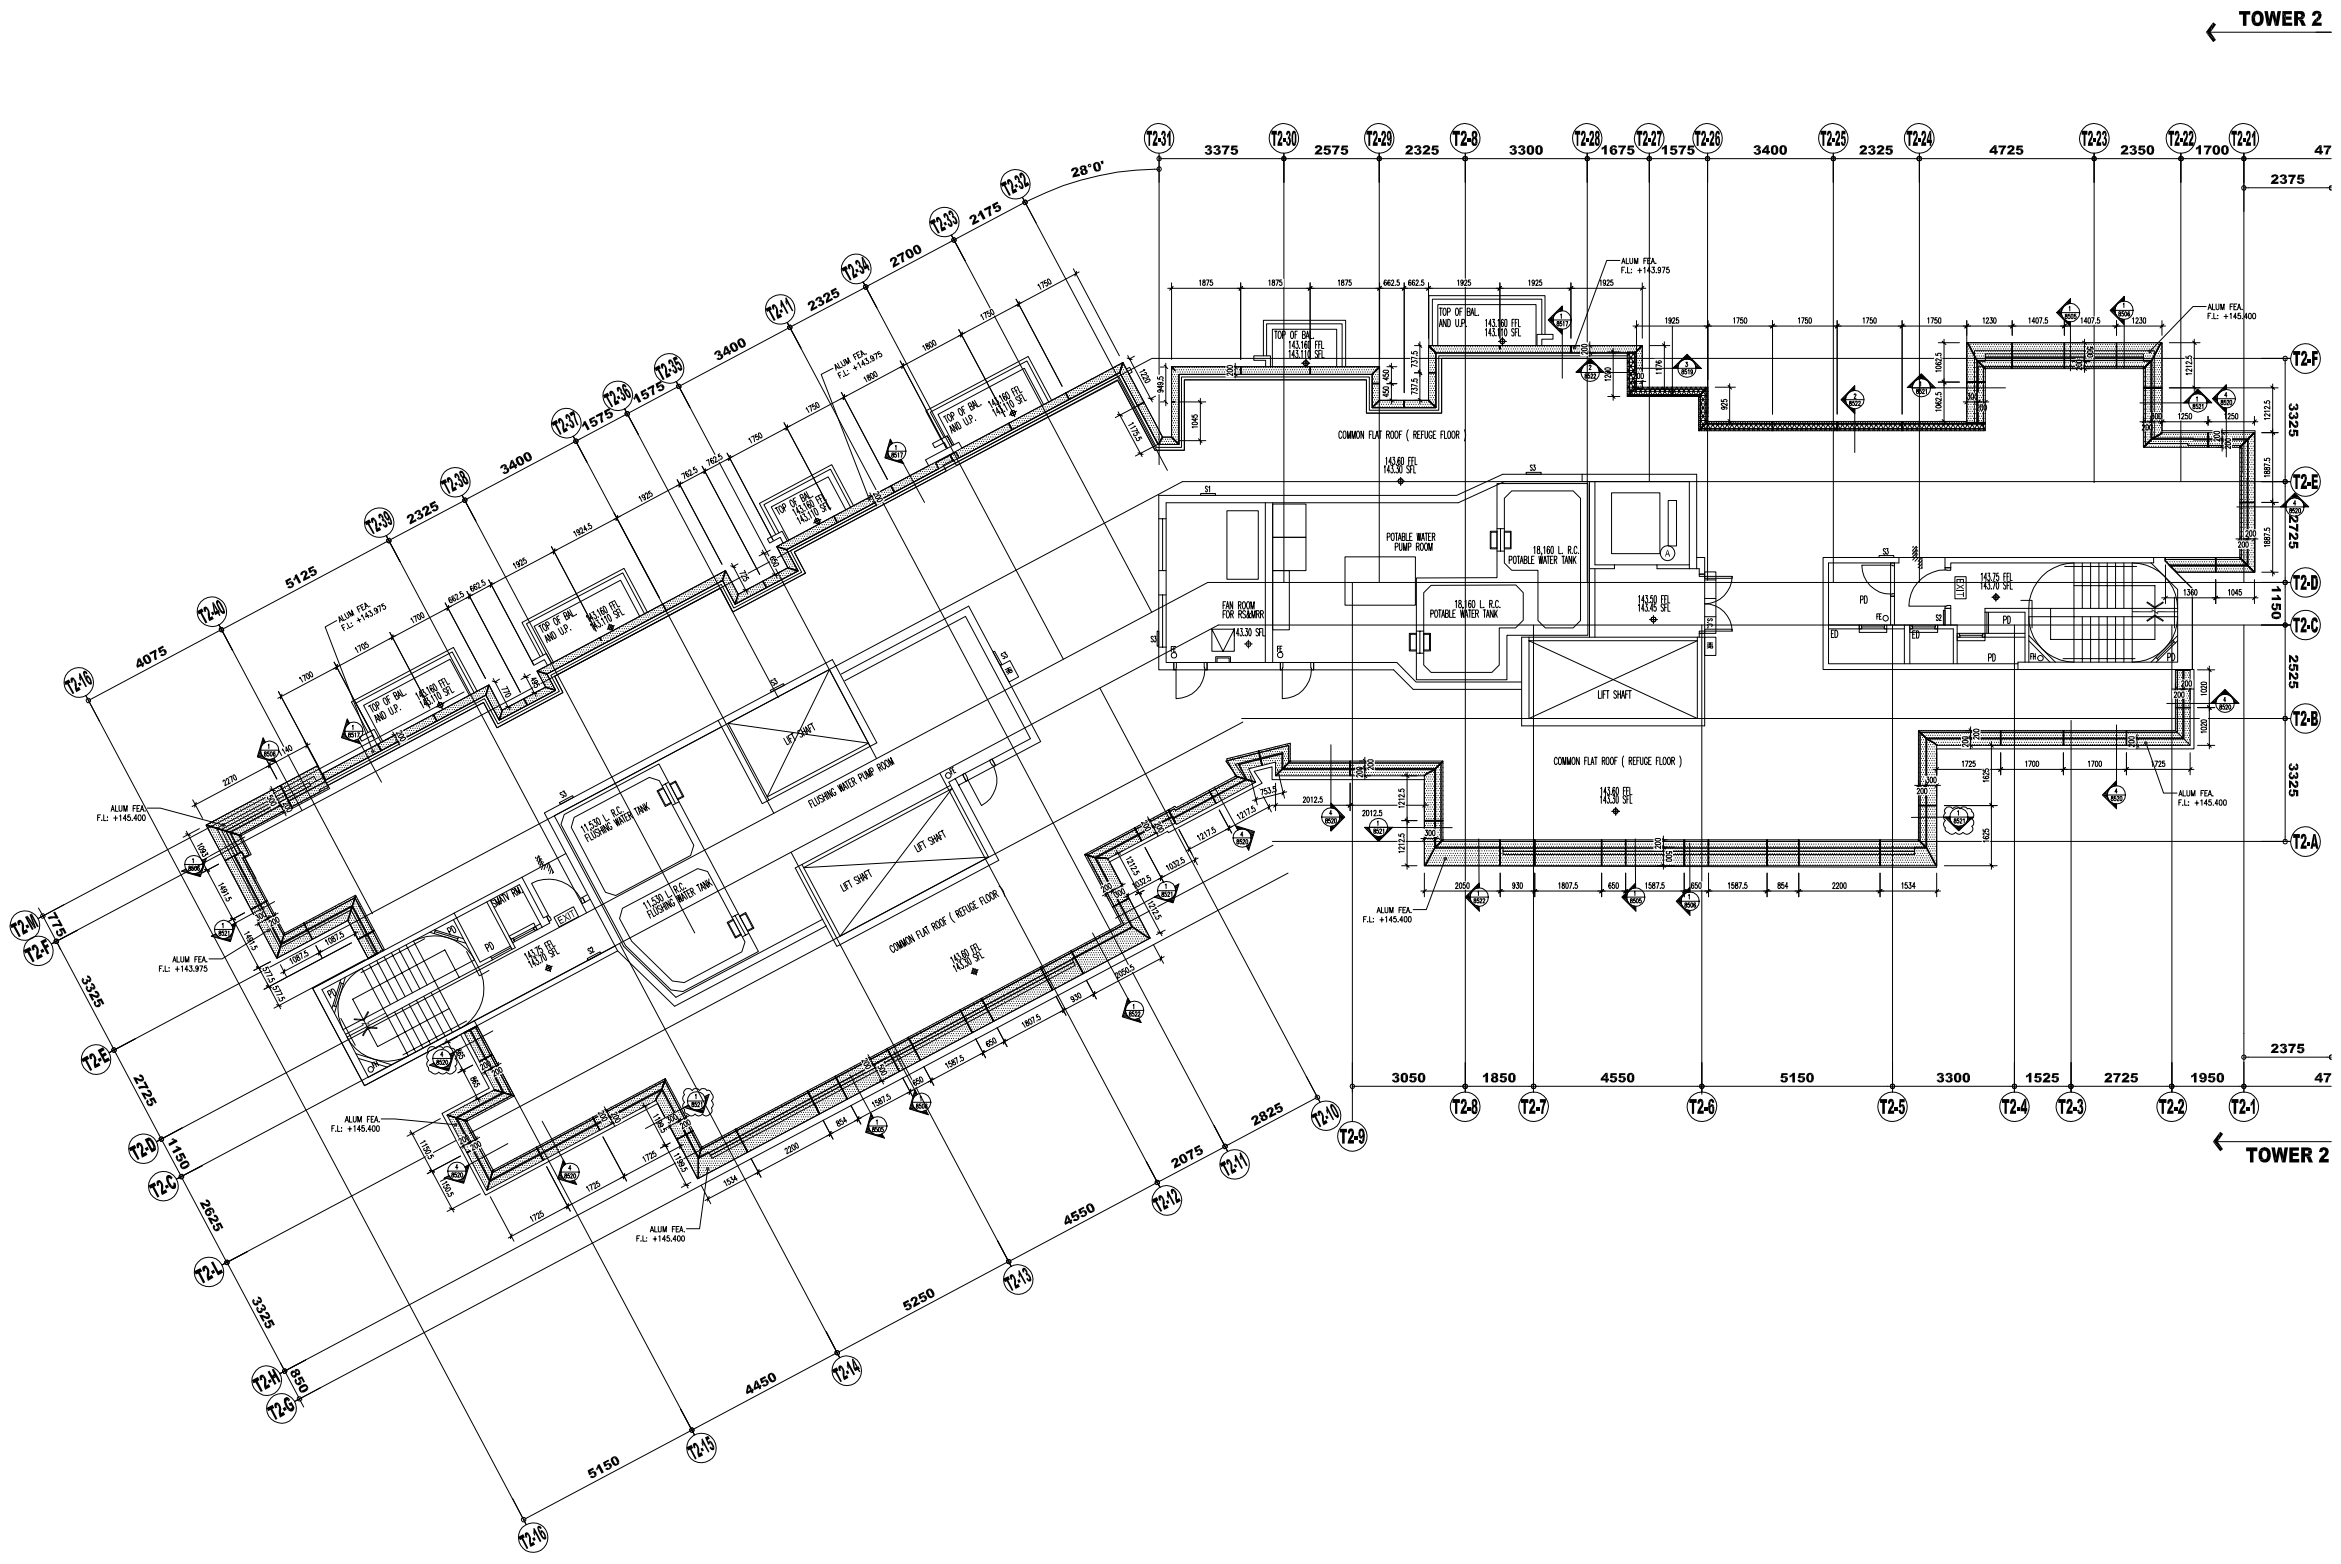

1 / 3017

LAYOUT PLAN FOR ALUM FEATURE

TOWER 2 (ROOF/F)

B.D. REF :

CLIENT :

SUN HUNG KAI REAL ESTATE AGENCY LTD.
42/F SUN HUNG KAI CENTRE, WANCHAI, HONGKONG

ARCHITECT :

lwk&partners
a r c h i t e c t s

MAIN CONTRACTOR :

怡輝建築有限公司
Yee Fai Building Contractors Ltd.

STRUCTURAL ENGINEER :

ARUP

FACADE CONSULTANT:

ALPHA CONSULTING LIMITED
Steel Structure & Facade Specialist

NOTE :

1. ALL DIMENSIONS ARE IN mm.
2. ALL ELEVATIONS ARE VIEWED FROM OUTSIDE.
3. ALL DIMENSIONS TO BE VERIFIED ON SITE BEFORE FABRICATION.

LEGEND :

X1 — DETAIL MARK NO.
X001 — REFER SHEET NO.

1. F.F.L. --FINISHED FLOOR LEVEL
2. S.F.L. --STRUCTURAL FLOOR LEVEL
3. (/R) --REVERSED DETAIL

3mm ALUM. CLADDING FEATURE COLOR COLOR: UC1309119XLB-3
3mm ALUM. CLADDING FEATURE COLOR COLOR: UC1542919XL-3

NO.	DATE	REVISED	BY
B	12-OCT-2023	9TH SUBMISSION	CF
A	29-SEP-2023	8TH SUBMISSION	CF
–	11-AUG-2023	7TH SUBMISSION (NEW DRAWING)	CF

JOB NO. : J-856

PROJECT :
PROPOSED DEVELOPMENT ABOVE LIGHT RAIL TIN WING STOP,TSWTL NO.23,AREA 33,TIN SHUI WAI, N.T.


TITLE :
LAYOUT PLAN FOR ALUM FEATURE @ TOWER 2 (ROOF/F)

DATE : 31-OCT-22 | SCALE : 1:200

DRAWN BY : C.F | CHECKED BY :

美特鋁質有限公司
MIDI ALUMINIUM FABRICATOR LTD.
Units 6-8, Sunray Industrial Centre, 1/F
610 Cha Kwo Ling Road, Kowloon
Tel:23489211-4 Fax:(852)27727666

DWG NO. : J856-SD-CW-3017 | REV. : B

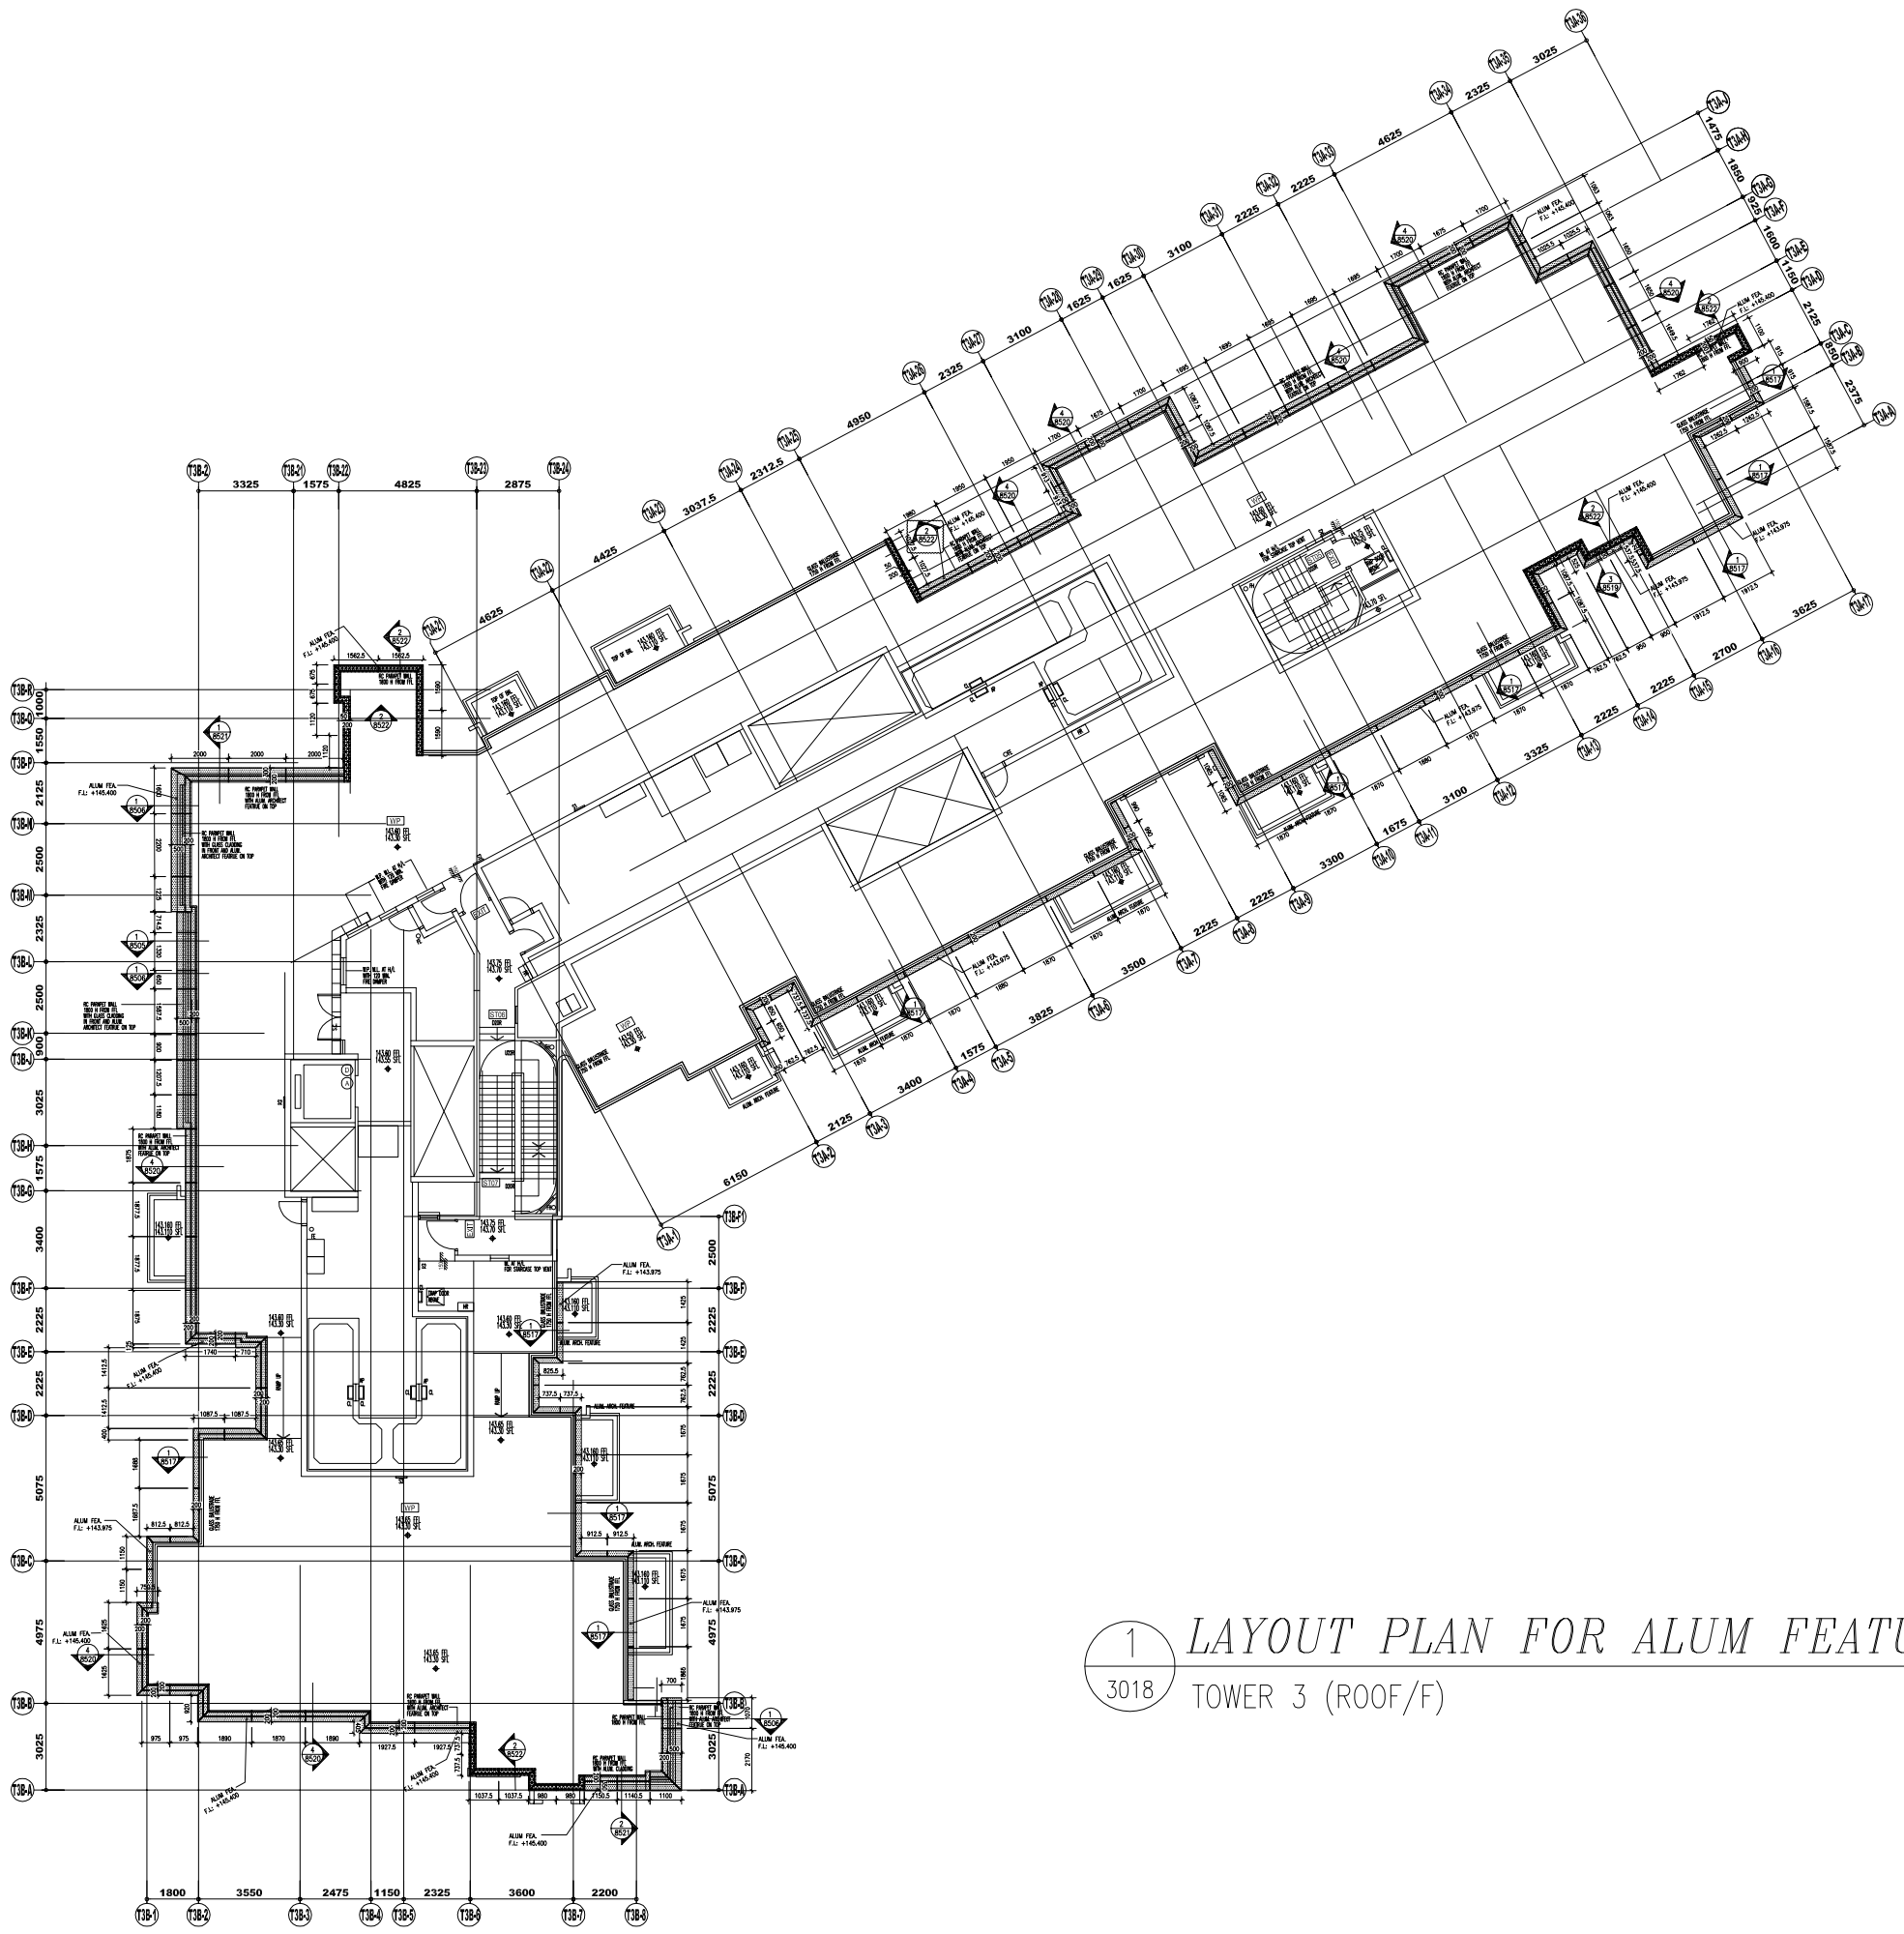

1 / 3018 LAYOUT PLAN FOR ALUM FEATURE

TOWER 3 (ROOF/F)

B.D. REF :

CLIENT :

SUN HUNG KAI REAL ESTATE AGENCY LTD.
42/F SUN HUNG KAI CENTRE, WANCHAI, HONGKONG

ARCHITECT :

lwk&partners
a r c h i t e c t s

MAIN CONTRACTOR :

怡輝建築有限公司
Yee Fai Building Contractors Ltd.

STRUCTURAL ENGINEER :

ARUP

FACADE CONSULTANT:

ALPHA CONSULTING LIMITED
Steel Structure & Facade Specialist

NOTE :
1. ALL DIMENSIONS ARE IN mm.
2. ALL ELEVATIONS ARE VIEWED FROM OUTSIDE.
3. ALL DIMENSIONS TO BE VERIFIED ON SITE BEFORE FABRICATION.

LEGEND :

X1 / X001 — DETAIL MARK NO. / REFER SHEET NO.

1. F.F.L. -- FINISHED FLOOR LEVEL
2. S.F.L. -- STRUCTURAL FLOOR LEVEL
3. (R) -- REVERSED DETAIL

3mm ALUM. CLADDING FEATURE COLOR COLOR: UCT309119XL8-3
3mm ALUM. CLADDING FEATURE COLOR COLOR: UCT542919XL-3

NO.	DATE	REVISED	BY
B	12-OCT-2023	9TH SUBMISSION	CF
A	29-SEP-2023	8TH SUBMISSION	CF
-	11-AUG-2023	7TH SUBMISSION (NEW DRAWING)	CF

JOB NO. : J-856

PROJECT :
PROPOSED DEVELOPMENT ABOVE LIGHT RAIL TIN WING STOP,TSWTL NO.23,AREA 33,TIN SHUI WAI, N.T.


TITLE :
LAYOUT PLAN FOR ALUM FEATURE @ TOWER 3 (ROOF/F)

DATE : 31-OCT-22 | SCALE : 1:250

DRAWN BY : C.F | CHECKED BY :


美特鋁質有限公司
MIDI ALUMINIUM FABRICATOR LTD.
Units 6-8, Sunray Industrial Centre, 1/F
610 Cha Kwo Ling Road, Kowloon
Tel:23489211-4 Fax:(852)27727666

DWG NO. : J856-SD-CW-3018 | REV. : B

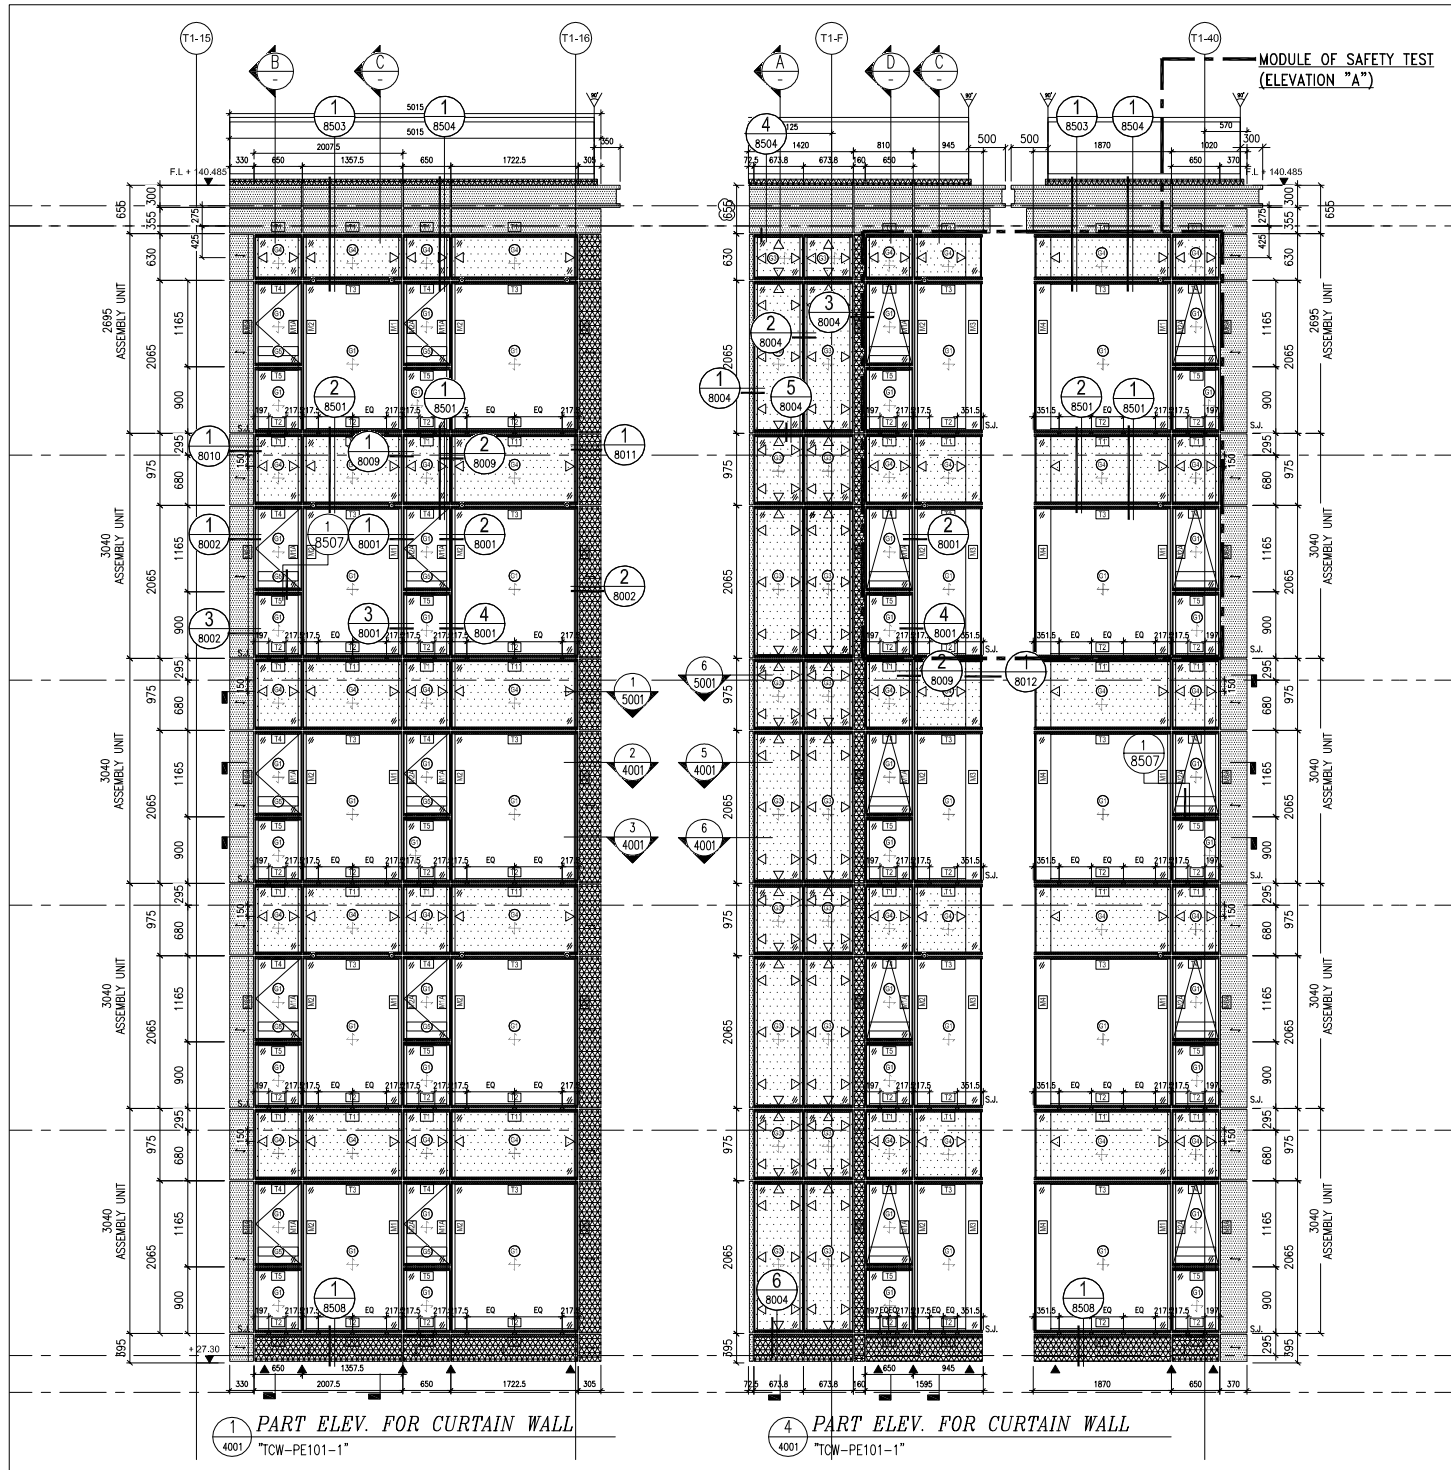

1 4001 "TCW-PE101-1"
PART ELEV. FOR CURTAIN WALL

4 4001 "TCW-PE101-1"
PART ELEV. FOR CURTAIN WALL

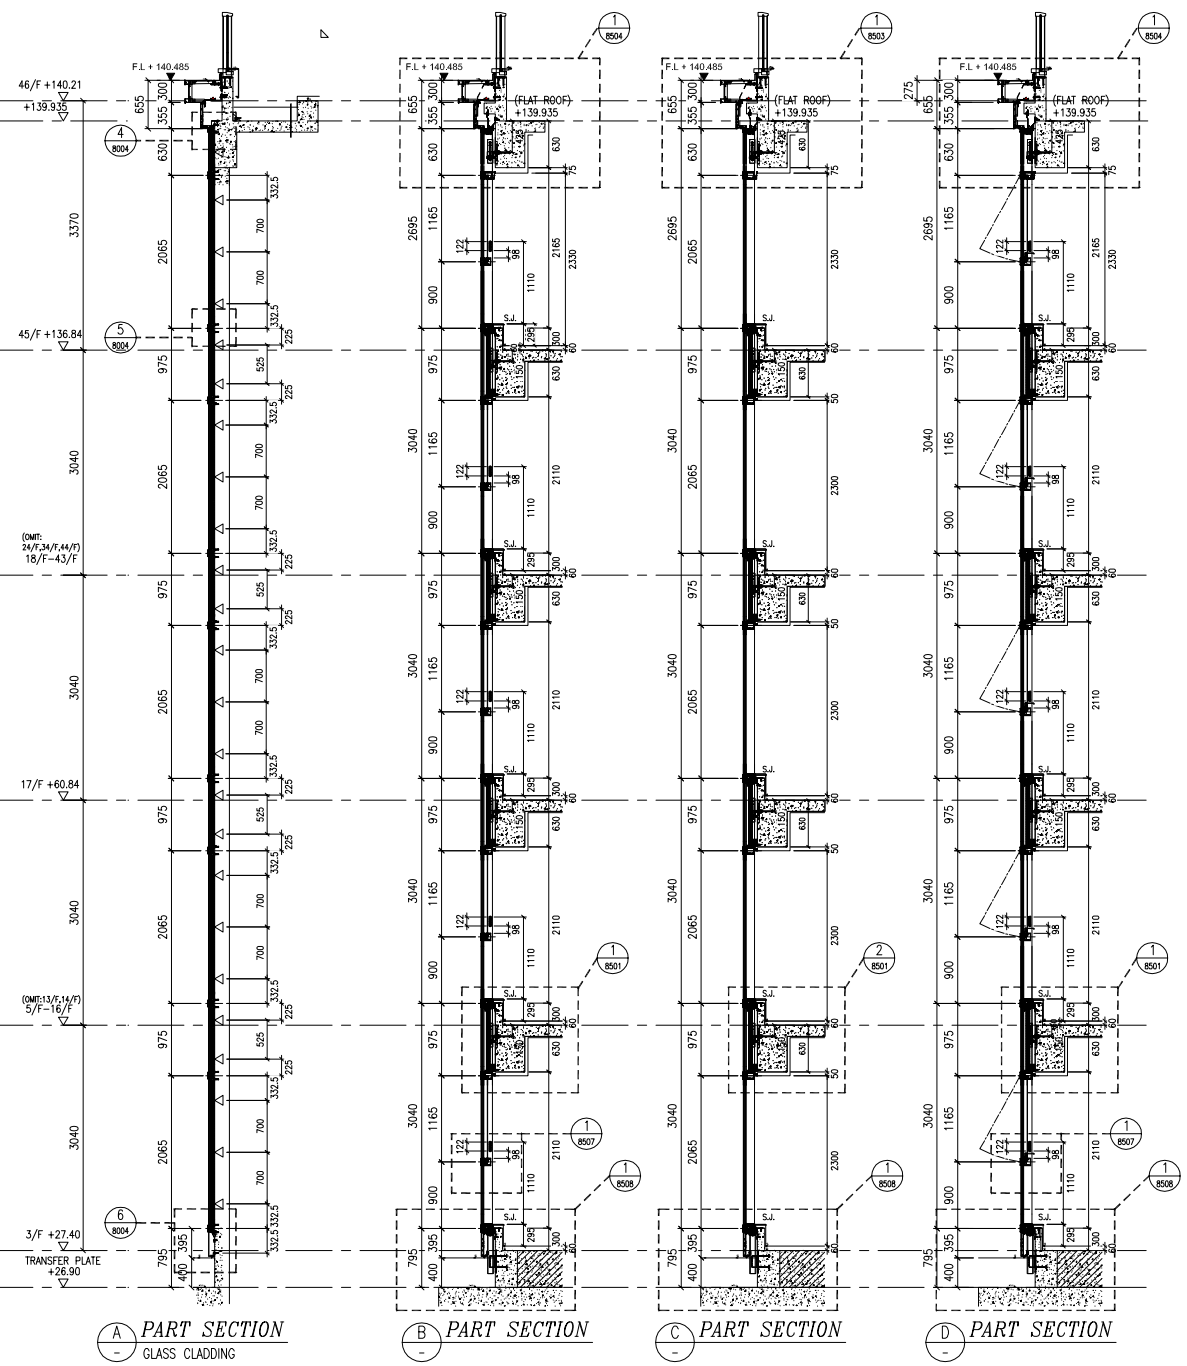


A – *PART SECTION*
GLASS CLADDING


B – *PART SECTION*

C – *PART SECTION*


D – *PART SECTION*

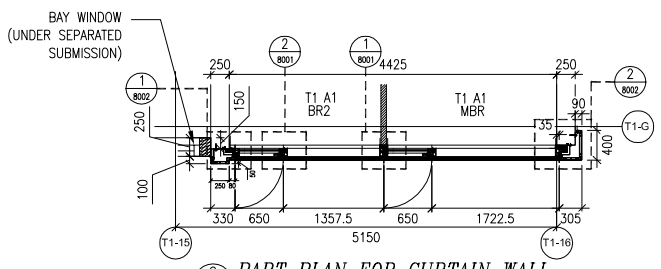


2 4001 "TCW-PE101-1" (HI-VISION)
PART PLAN FOR CURTAIN WALL

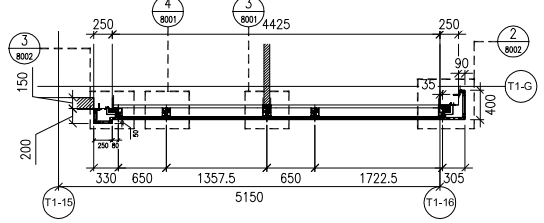

3 4001 "TCW-PE101-1" (LO-VISION)
PART PLAN FOR CURTAIN WALL

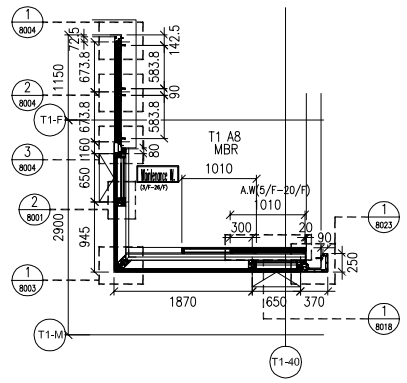


5 4001 "TCW-PE101-2" (HI-VISION)
ACOUSTIC SCREEN FOR (5/F-20/F) ONLY
MAINTENANCE WINDOW FOR (3/F-26/F) ONLY
PART PLAN FOR CURTAIN WALL

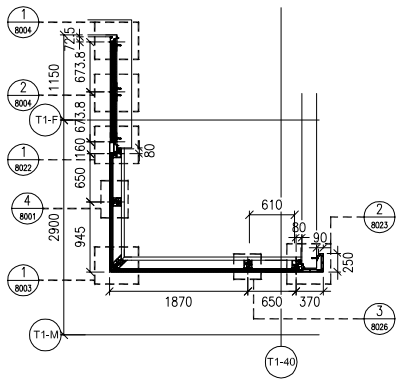

6 4001 "TCW-PE101-2" (LO-VISION)
PART PLAN FOR CURTAIN WALL

LIGHTING AND OPENABLE AREA								
TOWER	FLAT	ROOM	LIGHTING		OPENABLE		REFER CW
			REQUIRED	PROVIDED	REQUIRED	PROVIDED	
T1	A1	MBR	0.793 M²	4.143 M²	0.496 M²	0.509 M²	TCW-PE101-1
T1	A1	BR2	0.420 M²	3.432 M²	0.263 M²	0.509 M²	TCW-PE101-1
T1	A8	MBR	0.696 M²	6.186 M²	0.435 M²	0.509 M²	TCW-PE101-2

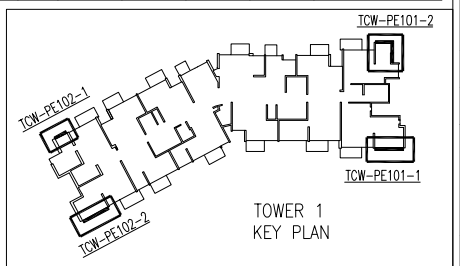

TOWER 1
KEY PLAN

B.D. REF :

CLIENT :
SUN HUNG KAI REAL ESTATE AGENCY LTD.
42/F SUN HUNG KAI CENTRE, WANCHAI, HONGKONG

ARCHITECT :
lwk&partners
a r c h i t e c t s

MAIN CONTRACTOR :
怡輝建築有限公司
Yee Fai Building Contractors Ltd.

STRUCTURAL ENGINEER :
ARUP

FACADE CONSULTANT:
ALPHA CONSULTING LIMITED
Steel Structure & Facade Specialist

NOTE :
1. ALL DIMENSIONS ARE IN mm.
2. ALL ELEVATIONS ARE VIEWED FROM OUTSIDE.
3. ALL DIMENSIONS TO BE VERIFIED ON SITE BEFORE FABRICATION.

LEGEND :
X1 — DETAIL MARK NO.
X001 — REFER SHEET NO.
1. F.F.L. --FINISHED FLOOR LEVEL
2. S.F.L. --STRUCTURAL FLOOR LEVEL
3. (R) --REVERSED DETAIL

LEGEND:
- IGU GLASS: 8mm HEAT STRENGTHENED +12mm AIR +10mm TEMPERED (VISION)
- IGU GLASS: 8mm HEAT STRENGTHENED +12mm AIR +12mm TEMPERED (VISION)
- 12mm HEAT STRENDTHENED GLASS (SPANDREL) /W ALUM BACK PANEL
- 12mm TEMPERED GLASS (PROTECTIVE BARRIER)
- 10mm HEAT STRENDTHENED GLASS (CLASS CLADDING) /W ALUM BACK PANEL
- 3mm ALUM. CLADDING COLOR: UCT5209119XL8~3
- 3mm ALUM. CLADDING COLOR: UCT5429119XL~3
- 22MM WEEP HOLE (HIGH)
- ▲ : WIND LOAD (STARTER CAST-IN EMBED)
- S.J.: WIND LOAD (STACK JOINT)
- WIND LOAD + DEAD LOAD BRACKET
- RESTRAINT SOCKET ONLY APPLY AT: 7/F, 15/F, 21/F, 28/F, 35/F AND 41/F ONLY

NO.	DATE	REVISED	BY
E	25-AUG-2023	7TH SUBMISSION	CF
D	20-APR-2023	5TH SUBMISSION	CF
C	21-FEB-2023	4TH SUBMISSION	CF
B	13-JAN-2023	3TH SUBMISSION	CF
A	28-DEC-2022	2ND SUBMISSION	CF

JOB NO. : J-856

PROJECT :
PROPOSED DEVELOPMENT ABOVE LIGHT RAIL TIN WING STOP,TSWTL NO.23,AREA 33,TIN SHUI WAI, N.T.


TITLE :
PART ELEV & PLAN & SECTION FOR CURTAIN WALL @ TOWER 1 (TYPICAL)


DATE : 31-OCT-22 | SCALE : 1:100


DRAWN BY : C.F | CHECKED BY :


美特鋁質有限公司
MIDI ALUMINIUM FABRICATOR LTD.
Units 6-8, Sunray Industrial Centre, 1/F
610 Cha Kwo Ling Road, Kowloon
Tel:23489211-4 Fax:(852)27727666


DWG NO. : J856-SD-CW-4001 | REV. : E

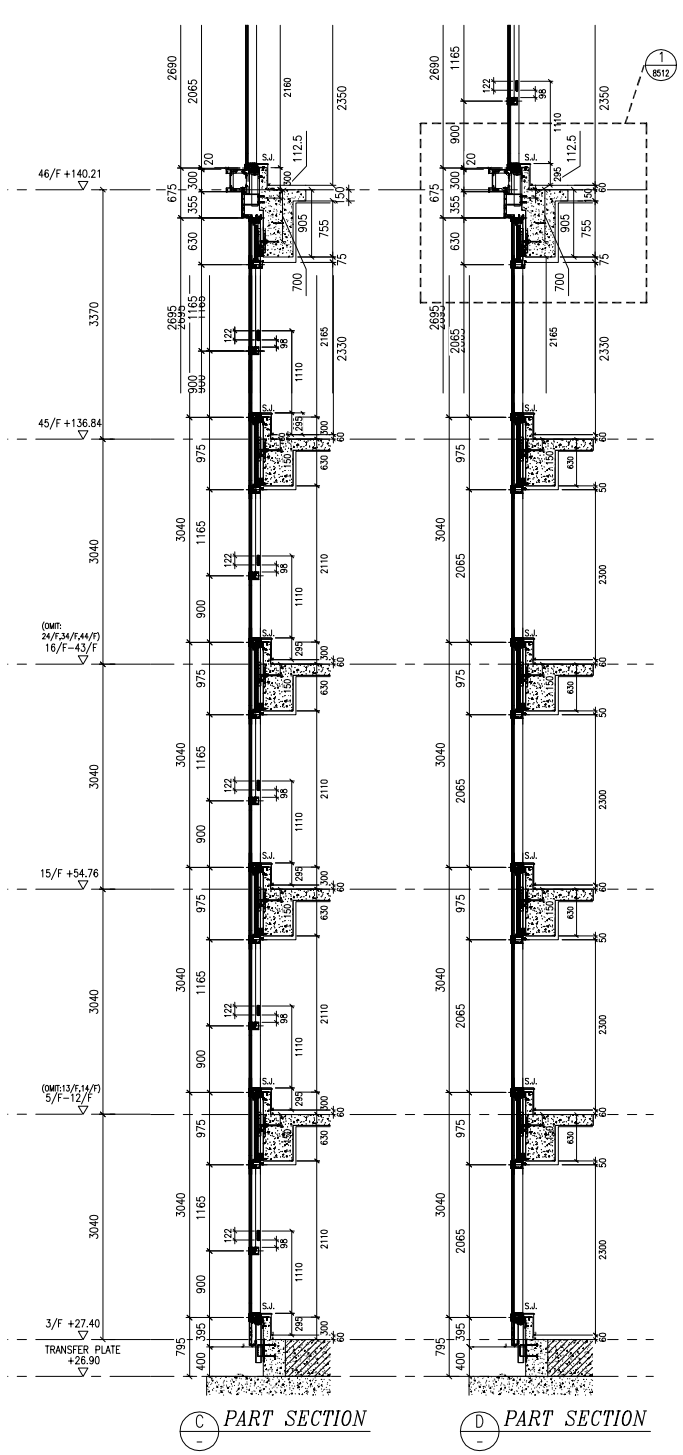


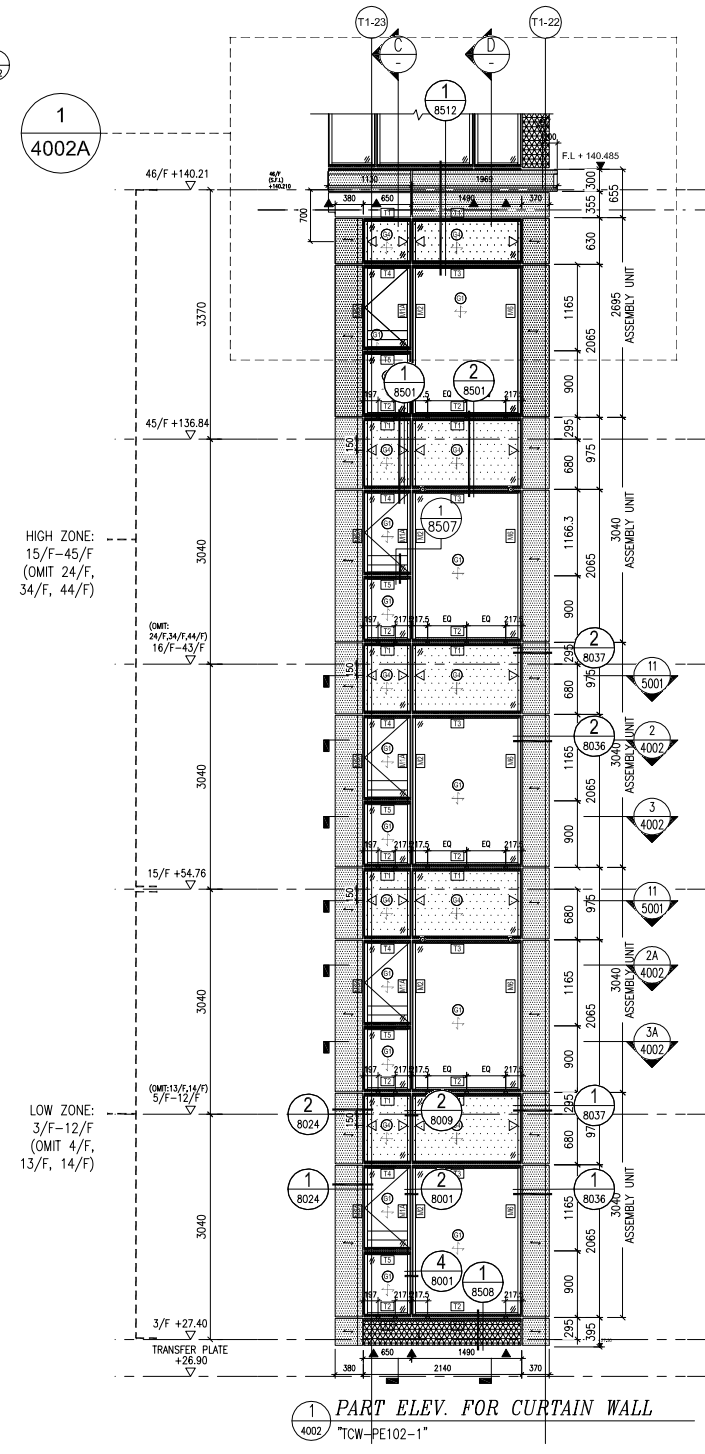


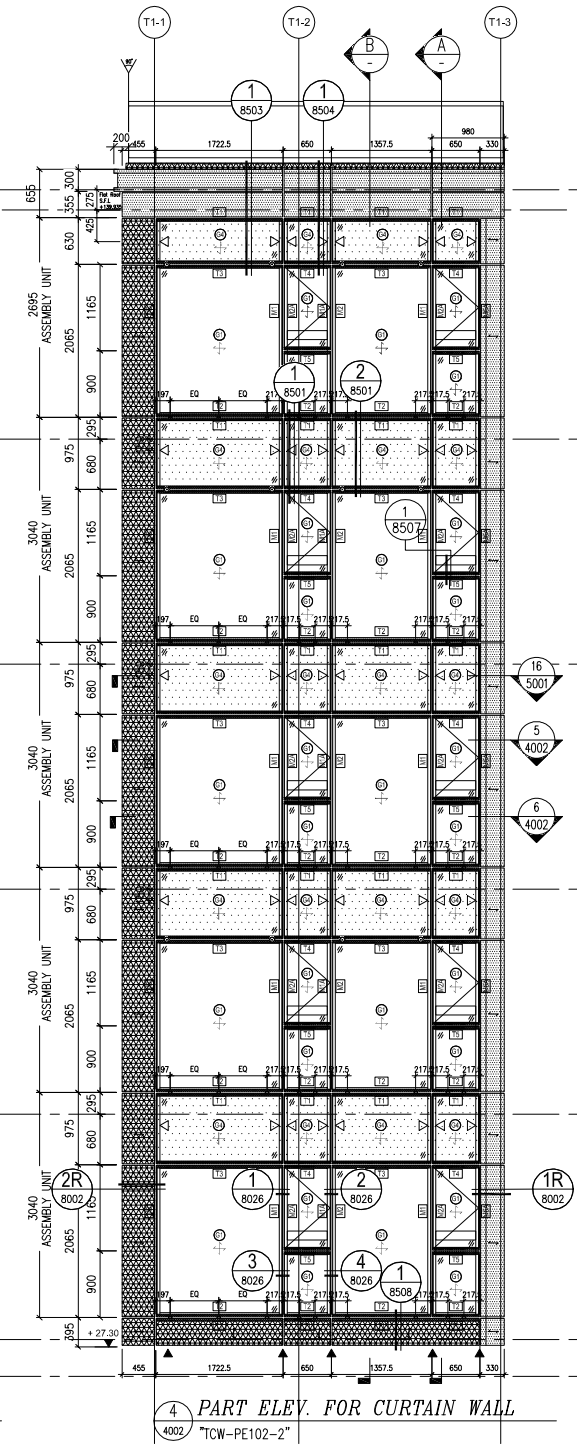


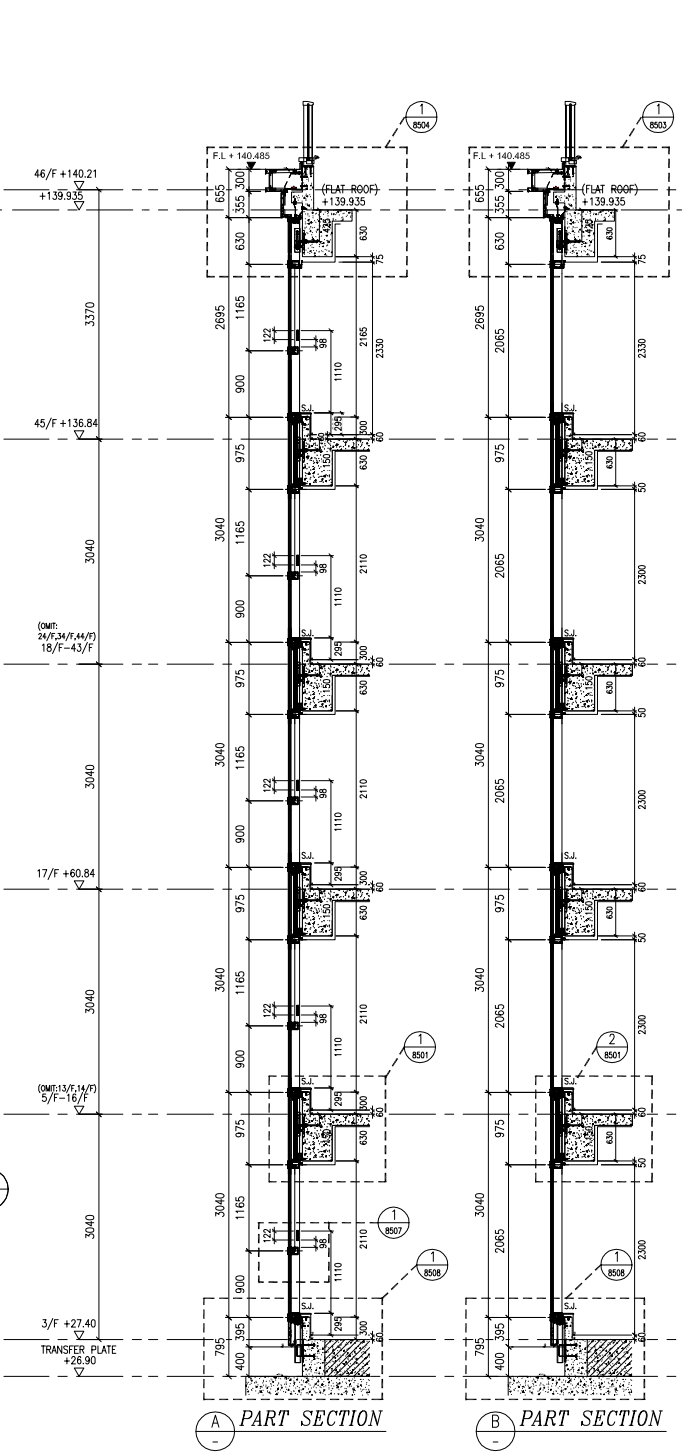


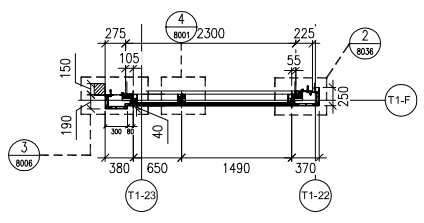


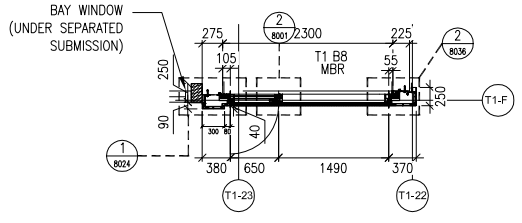

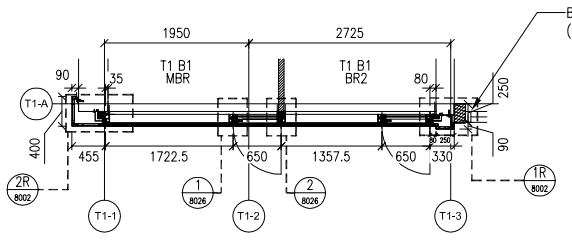


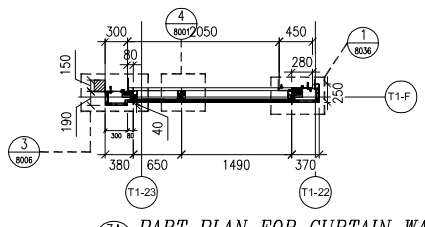

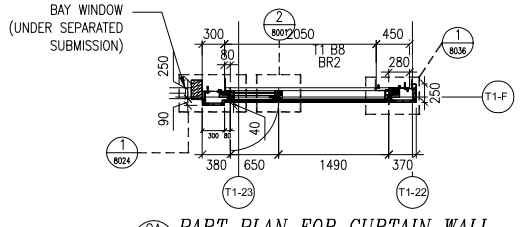

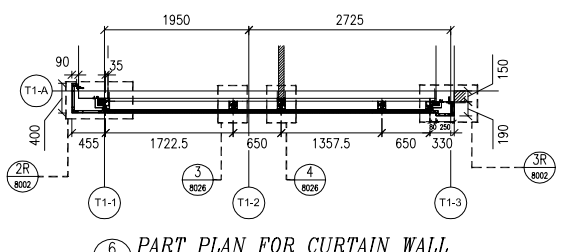

LIGHTING AND OPENABLE AREA							
TOWER	FLAT	ROOM	LIGHTING		OPENABLE		REFER CW
			REQUIRED	PROVIDED	REQUIRED	PROVIDED	
T1	B8	MBR (LOW Z)	0.759 M²	3.690 M²	0.474 M²	0.509 M²	TCW–PE102–1
T1	B8	MBR (HIGH Z)	0.716 M²	3.690 M²	0.448 M²	0.509 M²	TCW–PE102–1
T1	B1	BR2	0.420 M²	3.433 M²	0.263 M²	0.509 M²	TCW–PE102–2
T1	B1	MBR	0.798 M²	4.144 M²	0.498 M²	0.509 M²	TCW–PE102–2

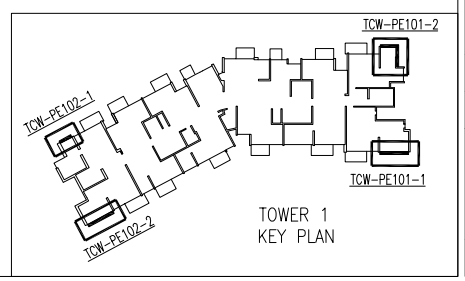

B.D. REF :

CLIENT :
SUN HUNG KAI REAL ESTATE AGENCY LTD.
42/F SUN HUNG KAI CENTRE, WANCHAI, HONGKONG

ARCHITECT :
lwk&partners architects

MAIN CONTRACTOR :
怡輝建築有限公司
Yee Fai Building Contractors Ltd.

STRUCTURAL ENGINEER :
ARUP

FACADE CONSULTANT:
ALPHA CONSULTING LIMITED
Steel Structure & Facade Specialist

NOTE :
1. ALL DIMENSIONS ARE IN mm.
2. ALL ELEVATIONS ARE VIEWED FROM OUTSIDE.
3. ALL DIMENSIONS TO BE VERIFIED ON SITE BEFORE FABRICATION.

LEGEND :
X1 — DETAIL MARK NO.
X001 — REFER SHEET NO.
1. F.F.L. --FINISHED FLOOR LEVEL
2. S.F.L. --STRUCTURAL FLOOR LEVEL
3. /R --REVERSED DETAIL

LEGEND:
- IGU GLASS: 8mm HEAT STRENGTHENED +12mm AIR +10mm TEMPERED (VISION)
- IGU GLASS: 8mm HEAT STRENGTHENED +12mm AIR +12mm TEMPERED (VISION)
- 12mm HEAT STRENGTHENED GLASS (SPANDREL) /W ALUM BACK PANEL
- 12mm TEMPERED GLASS (PROTECTIVE BARRIER)
- 10mm HEAT STRENGTHENED GLASS (CLADDING) /W ALUM BACK PANEL
- 3mm ALUM. CLADDING COLOR: UCT309119XLB–3
- 3mm ALUM. CLADDING COLOR: UCT9429190–3
- 22MM WEEP HOLE (HIGH)
- ▲ : WIND LOAD (STARTER CAST–IN EMBED)
- S.J.: WIND LOAD (STACK JOINT)
- WIND LOAD + DEAD LOAD BRACKET
- RESTRAINT SOCKET ONLY APPLY AT: 7/F, 15/F, 21/F, 28/F, 35/F AND 41/F ONLY

NO.	DATE	REVISED	BY
E	25–AUG–2023	7TH SUBMISSION	CF
D	20–APR–2023	5TH SUBMISSION	CF
C	21–FEB–2023	4TH SUBMISSION	CF
B	13–JAN–2023	3TH SUBMISSION	CF
A	22–DEC–2022	2ND SUBMISSION	CF

JOB NO. : J–856

PROJECT :
PROPOSED DEVELOPMENT ABOVE LIGHT RAIL TIN WING STOP,TSWTL NO.23,AREA 33,TIN SHUI WAI, N.T.


TITLE :
PART ELEV & PLAN & SECTION FOR CURTAIN WALL @ TOWER 1 (TYPICAL)

DATE : 31–OCT–22 | SCALE : 1:100

DRAWN BY : C.F | CHECKED BY :

美特鋁質有限公司
MIDI ALUMINIUM FABRICATOR LTD.
Units 6–8, Sunray Industrial Centre, 1/F
610 Cha Kwo Ling Road, Kowloon
Tel:23489211–4 Fax:(852)27727666

DWG NO. : J856–SD–CW–4002 | REV. : E

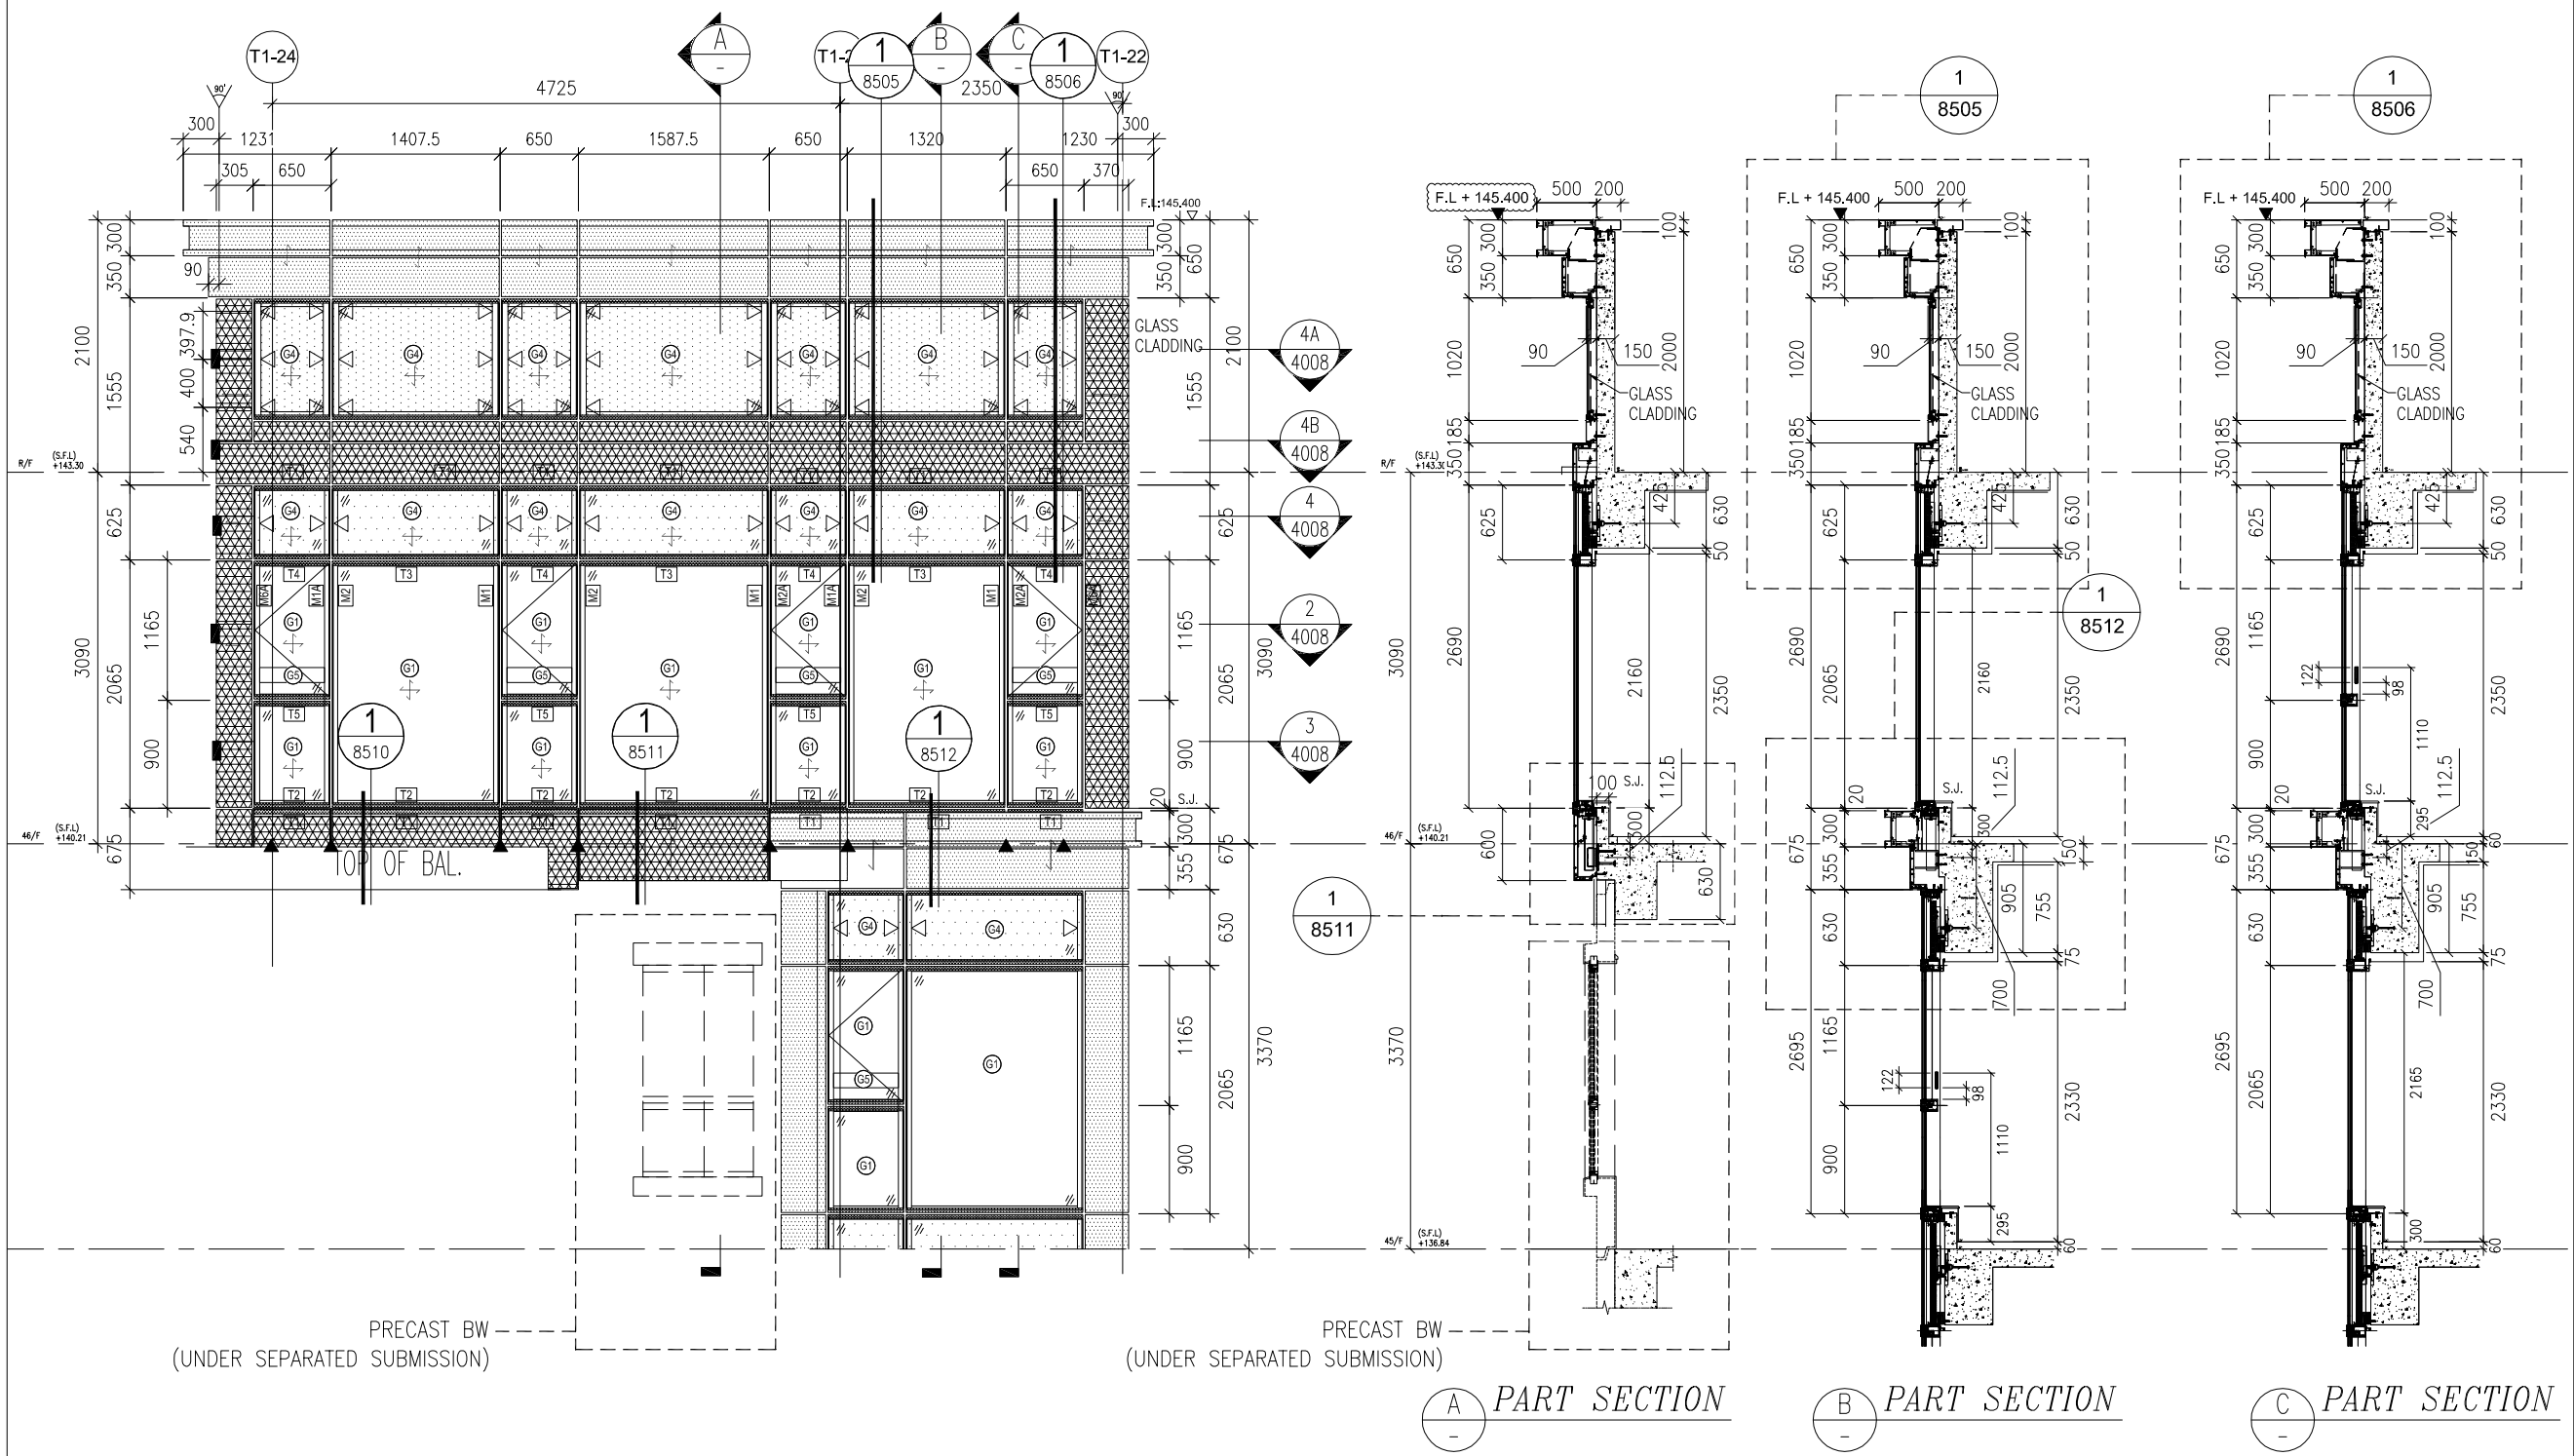

A – PART SECTION

B – PART SECTION

C – PART SECTION

1 / 4002A PART ELEV. FOR CURTAIN WALL

"TCW-PE102-1" INTERFACING WITH "T1-SU-CW3"

B.D. REF :

CLIENT :

SUN HUNG KAI REAL ESTATE AGENCY LTD.
42/F SUN HUNG KAI CENTRE, WANCHAI, HONGKONG

ARCHITECT :

lwk&partners
a r c h i t e c t s

MAIN CONTRACTOR :

怡輝建築有限公司
Yee Fai Building Contractors Ltd.

STRUCTURAL ENGINEER :

ARUP

FACADE CONSULTANT:

ALPHA CONSULTING LIMITED
Steel Structure & Facade Specialist

NOTE :
1. ALL DIMENSIONS ARE IN mm.
2. ALL ELEVATIONS ARE VIEWED FROM OUTSIDE.
3. ALL DIMENSIONS TO BE VERIFIED ON SITE BEFORE FABRICATION.

LEGEND :

X1 / X001 — DETAIL MARK NO. / REFER SHEET NO.

1. F.F.L. -- FINISHED FLOOR LEVEL
2. S.F.L. -- STRUCTURAL FLOOR LEVEL
3. /R -- REVERSED DETAIL

LEGEND:

- IGU GLASS: 8mm HEAT STRENGTHENED +12mm AIR +10mm TEMPERED (VISION)
- IGU GLASS: 8mm HEAT STRENGTHENED +12mm AIR +12mm TEMPERED (VISION)
- 12mm HEAT STREND/THENED GLASS (SPANDREL) /W ALUM BACK PANEL
- 12mm TEMPERED GLASS (PROTECTIVE BARRIER)
- 10mm HEAT STREND/THENED GLASS (CLASS CLADDING) /W ALUM BACK PANEL
- 3mm ALUM. CLADDING COLOR: UCT309119XLB-3
- 3mm ALUM. CLADDING COLOR: UCT429191XL-3
- 22MM WEEP HOLE (HIGH)
- ▲ : WIND LOAD (STARTER CAST-IN EMBED)
- S.J.: WIND LOAD (STACK JOINT)
- WIND LOAD + DEAD LOAD BRACKET
- EMBED EM09 (FOR GLASS CLADDING)

NO.	DATE	REVISED	BY
C	25-AUG-2023	7TH SUBMISSION	CF
B	08-MAY-2023	5TH SUBMISSION	CF
A	27-FEB-2022	4TH SUBMISSION	CF
–	16-DEC-2022	NEW DRAWING	CF

JOB NO. : J-856

PROJECT :
PROPOSED DEVELOPMENT ABOVE LIGHT RAIL TIN WING STOP,TSWTL NO.23,AREA 33,TIN SHUI WAI, N.T.


TITLE :
PART ELEV & PLAN & SECTION FOR CURTAIN WALL @ TOWER 1 (TYPICAL)

DATE : 31-OCT-22 | SCALE : 1:60

DRAWN BY : C.F | CHECKED BY :

美特鋁製有限公司
MIDI ALUMINIUM FABRICATOR LTD.
Units 6-8, Sunray Industrial Centre, 1/F
610 Cha Kwo Ling Road, Kowloon
Tel:23489211-4 Fax:(852)27727666

DWG NO. : J856-SD-CW-4002A | REV. : C

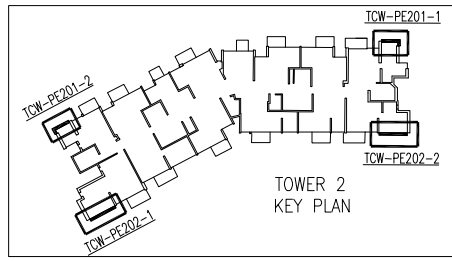

TOWER 2
KEY PLAN

LIGHTING AND OPENABLE AREA							
TOWER	FLAT	ROOM	LIGHTING		OPENABLE		REFER CW
			REQUIRED	PROVIDED	REQUIRED	PROVIDED	
T2	B8	MBR	0.701 M²	5.061 M²	0.438 M²	0.912 M²	TCW-PE201-1
T2	A8	MBR	0.721 M²	5.061 M²	0.451 M²	0.912 M²	TCW-PE201-2

MODULE OF SAFETY TEST
(ELEVATION "B1")

REMEDIAL CASE:
@46/F
REFER TO: 2 8508E

REMEDIAL CASE:
@46/F
REFER TO: 1 8508E

REMEDIAL CASE:
@46/F
REFER TO: 3R 8508E

R/F +143.30
46/F +140.21
45/F +136.84
17/F +60.84
3/F +27.40
TRANSFER PLATE +26.90

A - PART SECTION

B - PART SECTION

1 4003 PART ELEV. FOR CURTAIN WALL
"TCW-PE201-1"

4 4003 PART ELEV. FOR CURTAIN WALL
"TCW-PE201-2"

C - PART SECTION

D - PART SECTION

3 4003 PART PLAN FOR CURTAIN WALL
"TCW-PE201-1" (LO-VISION)

2 4003 PART PLAN FOR CURTAIN WALL
"TCW-PE201-1" (HI-VISION)

5 4003 PART PLAN FOR CURTAIN WALL
"TCW-PE201-2" (HI-VISION)

6 4003 PART PLAN FOR CURTAIN WALL
"TCW-PE201-2" (LO-VISION)

B.D. REF :

CLIENT :
SUN HUNG KAI REAL ESTATE AGENCY LTD.
42/F SUN HUNG KAI CENTRE, WANCHAI, HONGKONG

ARCHITECT :
lwk&partners architects

MAIN CONTRACTOR :
怡輝建築有限公司
Yee Fai Building Contractors Ltd.

STRUCTURAL ENGINEER :
ARUP

FACADE CONSULTANT:
ALPHA CONSULTING LIMITED
Steel Structure & Facade Specialist

NOTE :
1. ALL DIMENSIONS ARE IN mm.
2. ALL ELEVATIONS ARE VIEWED FROM OUTSIDE.
3. ALL DIMENSIONS TO BE VERIFIED ON SITE BEFORE FABRICATION.

LEGEND :
X1 — DETAIL MARK NO.
X001 — REFER SHEET NO.

1. F.F.L. --FINISHED FLOOR LEVEL
2. S.F.L. --STRUCTURAL FLOOR LEVEL
3. /R --REVERSED DETAIL

LEGEND:
- IGU GLASS: 8mm HEAT STRENGTHENED +12mm AIR +10mm TEMPERED (VISION)
- IGU GLASS: 8mm HEAT STRENGTHENED +12mm AIR +12mm TEMPERED (VISION)
- 12mm HEAT STRENDTHENED GLASS (SPANDREL) /W ALUM BACK PANEL
- 12mm TEMPERED GLASS (PROTECTIVE BARRIER)
- 10mm HEAT STRENDTHENED GLASS (CLASS CLADDING) /W ALUM BACK PANEL
- 3mm ALUM. CLADDING COLOR: UCT5091190L8-3 — ▲: WIND LOAD (STARTER CAST-IN EMBED)
- 3mm ALUM. CLADDING COLOR: UCT5429190L-3 — S.J.: WIND LOAD (STACK JOINT)
- WIND LOAD + DEAD LOAD BRACKET
- RESTRAINT SOCKET ONLY APPLY AT: 7/F, 15/F, 21/F, 28/F, 35/F AND 41/F ONLY

NO.	DATE	REVISED	BY
F	29-SEP-2023	8TH SUBMISSION	CF
E	25-AUG-2023	7TH SUBMISSION	CF
D	03-MAY-2023	5TH SUBMISSION	CF
C	21-FEB-2023	4TH SUBMISSION	CF
B	13-JAN-2023	3TH SUBMISSION	CF

JOB NO. : J-856

PROJECT :
PROPOSED DEVELOPMENT ABOVE LIGHT RAIL TIN WING STOP,TSWTL NO.23,AREA 33,TIN SHUI WAI, N.T.


TITLE :
PART ELEV & PLAN & SECTION FOR CURTAIN WALL @ TOWER 2 (TYPICAL)

DATE : 31-OCT-22 | SCALE : 1:100

DRAWN BY : C.F | CHECKED BY :

美特鋁質有限公司
MIDI ALUMINIUM FABRICATOR LTD.
Units 6-8, Sunray Industrial Centre, 1/F
610 Cha Kwo Ling Road, Kowloon
Tel:23489211-4 Fax:(852)27727666

DWG NO. : J856-SD-CW-4003 | REV. : F

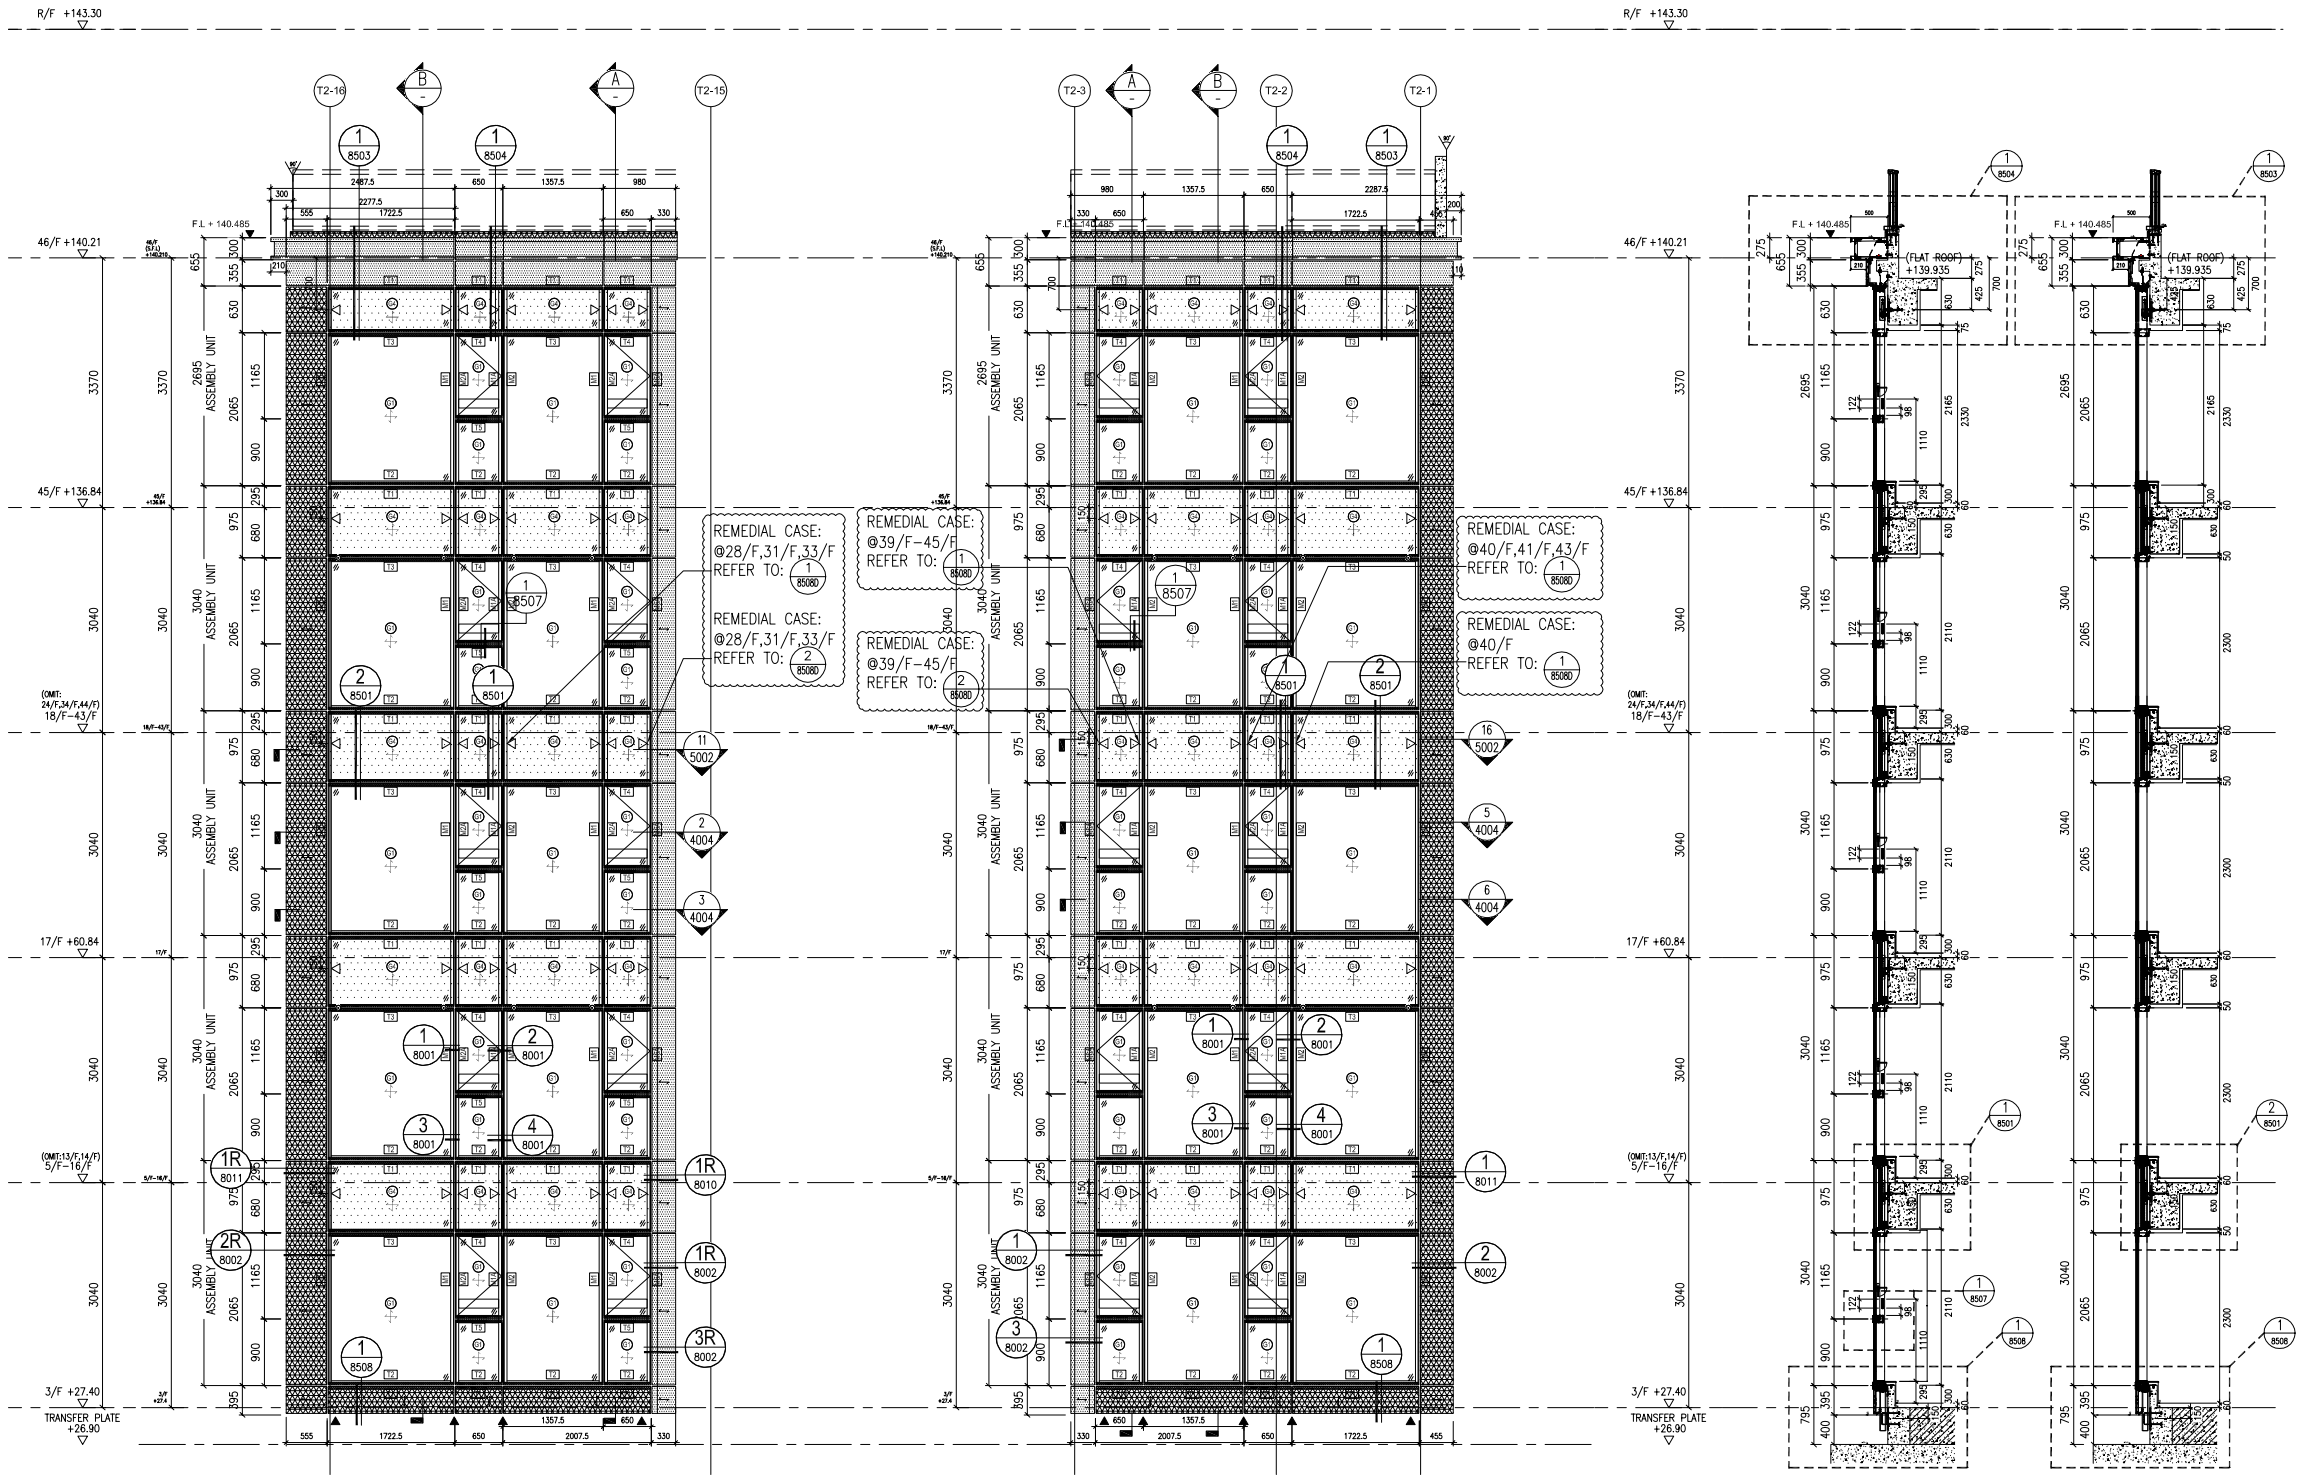


1 4004 *PART ELEV. FOR CURTAIN WALL* "TCW-PE202-1"


4 4004 *PART ELEV. FOR CURTAIN WALL* "TCW-PE202-2"

A *PART SECTION*


B *PART SECTION*

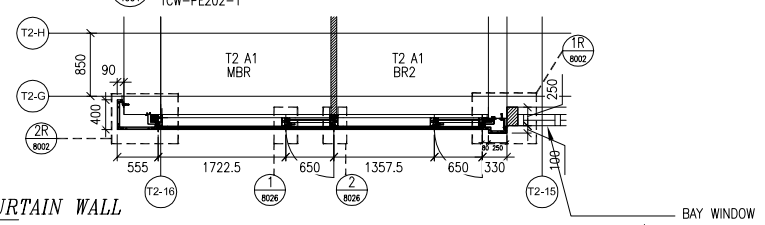


2 4004 *PART PLAN FOR CURTAIN WALL* "TCW-PE202-1" (HI-VISION)

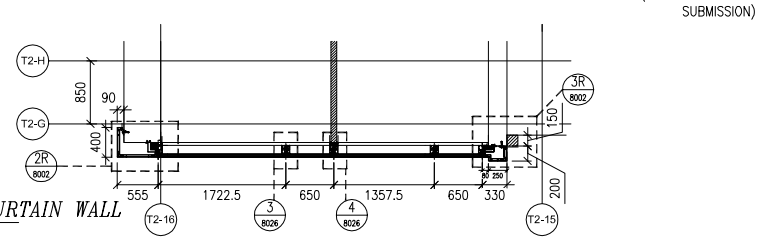

3 4004 *PART PLAN FOR CURTAIN WALL* "TCW-PE202-1" (LO-VISION)

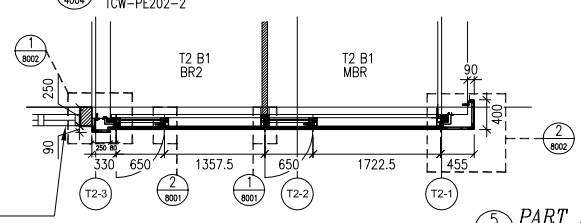


5 4004 *PART PLAN FOR CURTAIN WALL* "TCW-PE202-2" (HI-VISION)

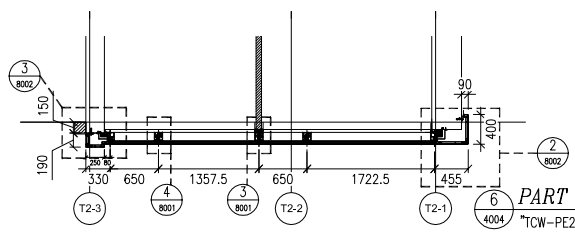

6 4004 *PART PLAN FOR CURTAIN WALL* "TCW-PE202-2" (LO-VISION)

LIGHTING AND OPENABLE AREA								
TOWER	FLAT	ROOM	LIGHTING		OPENABLE		REFER CW
			REQUIRED	PROVIDED	REQUIRED	PROVIDED	
T2	A1	MBR	0.793 M²	4.143 M²	0.496 M²	0.509 M²	TCW-PE202-1
T2	A1	BR2	0.420 M²	3.432 M²	0.263 M²	0.509 M²	TCW-PE202-1
T2	B1	MBR	0.798 M²	4.143 M²	0.498 M²	0.509 M²	TCW-PE202-2
T2	B1	BR2	0.420 M²	3.432 M²	0.263 M²	0.509 M²	TCW-PE202-2

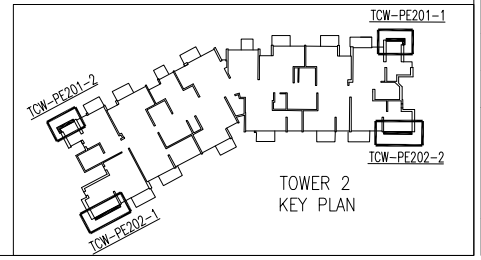

B.D. REF :

CLIENT :
SUN HUNG KAI REAL ESTATE AGENCY LTD.
42/F SUN HUNG KAI CENTRE, WANCHAI, HONGKONG

ARCHITECT :
lwk&partners architects

MAIN CONTRACTOR :
怡輝建築有限公司
Yee Fai Building Contractors Ltd.

STRUCTURAL ENGINEER :
ARUP

FACADE CONSULTANT:
ALPHA CONSULTING LIMITED
Steel Structure & Facade Specialist

NOTE :
1. ALL DIMENSIONS ARE IN mm.
2. ALL ELEVATIONS ARE VIEWED FROM OUTSIDE.
3. ALL DIMENSIONS TO BE VERIFIED ON SITE BEFORE FABRICATION.

LEGEND :
X1 — DETAIL MARK NO.
X001 — REFER SHEET NO.

1. F.F.L. --FINISHED FLOOR LEVEL
2. S.F.L. --STRUCTURAL FLOOR LEVEL
3. (R) --REVERSED DETAIL

LEGEND:
- IGU GLASS: 8mm HEAT STRENGTHENED +12mm AIR +10mm TEMPERED (VISION)
- IGU GLASS: 8mm HEAT STRENGTHENED +12mm AIR +12mm TEMPERED (VISION)
- 12mm HEAT STRENDTHENED CLASS (SPANDREL) /W ALUM BACK PANEL
- 12mm TEMPERED GLASS (PROTECTIVE BARRIER)
- 10mm HEAT STRENDTHENED GLASS (CLASS CLADDING) /W ALUM BACK PANEL
- 3mm ALUM. CLADDING COLOR: UCT5091910L-3 — ▲: WIND LOAD (STARTER CAST-IN EMBED)
- 3mm ALUM. CLADDING COLOR: UCT5429190L-3 — S.J.: WIND LOAD (STACK JOINT)
- WIND LOAD + DEAD LOAD BRACKET
- RESTRAINT SOCKET ONLY APPLY AT: 7/F, 15/F, 21/F, 28/F, 35/F AND 41/F ONLY

NO.	DATE	REVISED	BY
F	29-SEP-2023	8TH SUBMISSION	CF
E	25-AUG-2023	7TH SUBMISSION	CF
D	03-MAY-2023	5TH SUBMISSION	CF
C	21-FEB-2023	4TH SUBMISSION	CF
B	13-JAN-2023	3TH SUBMISSION	CF

JOB NO. : J-856

PROJECT :
PROPOSED DEVELOPMENT ABOVE LIGHT RAIL TIN WING STOP,TSWTL NO.23,AREA 33,TIN SHUI WAI, N.T.


TITLE :
PART ELEV & PLAN & SECTION FOR CURTAIN WALL @ TOWER 2 (TYPICAL)

DATE : 31-OCT-22 | SCALE : 1:10

DRAWN BY : C.F | CHECKED BY :

美特鋁質有限公司
MIDI ALUMINIUM FABRICATOR LTD.
Units 6-8, Sunray Industrial Centre, 1/F
610 Cha Kwo Ling Road, Kowloon
Tel:23489211-4 Fax:(852)27727666

DWG NO. : J856-SD-CW-4004 | REV. : F

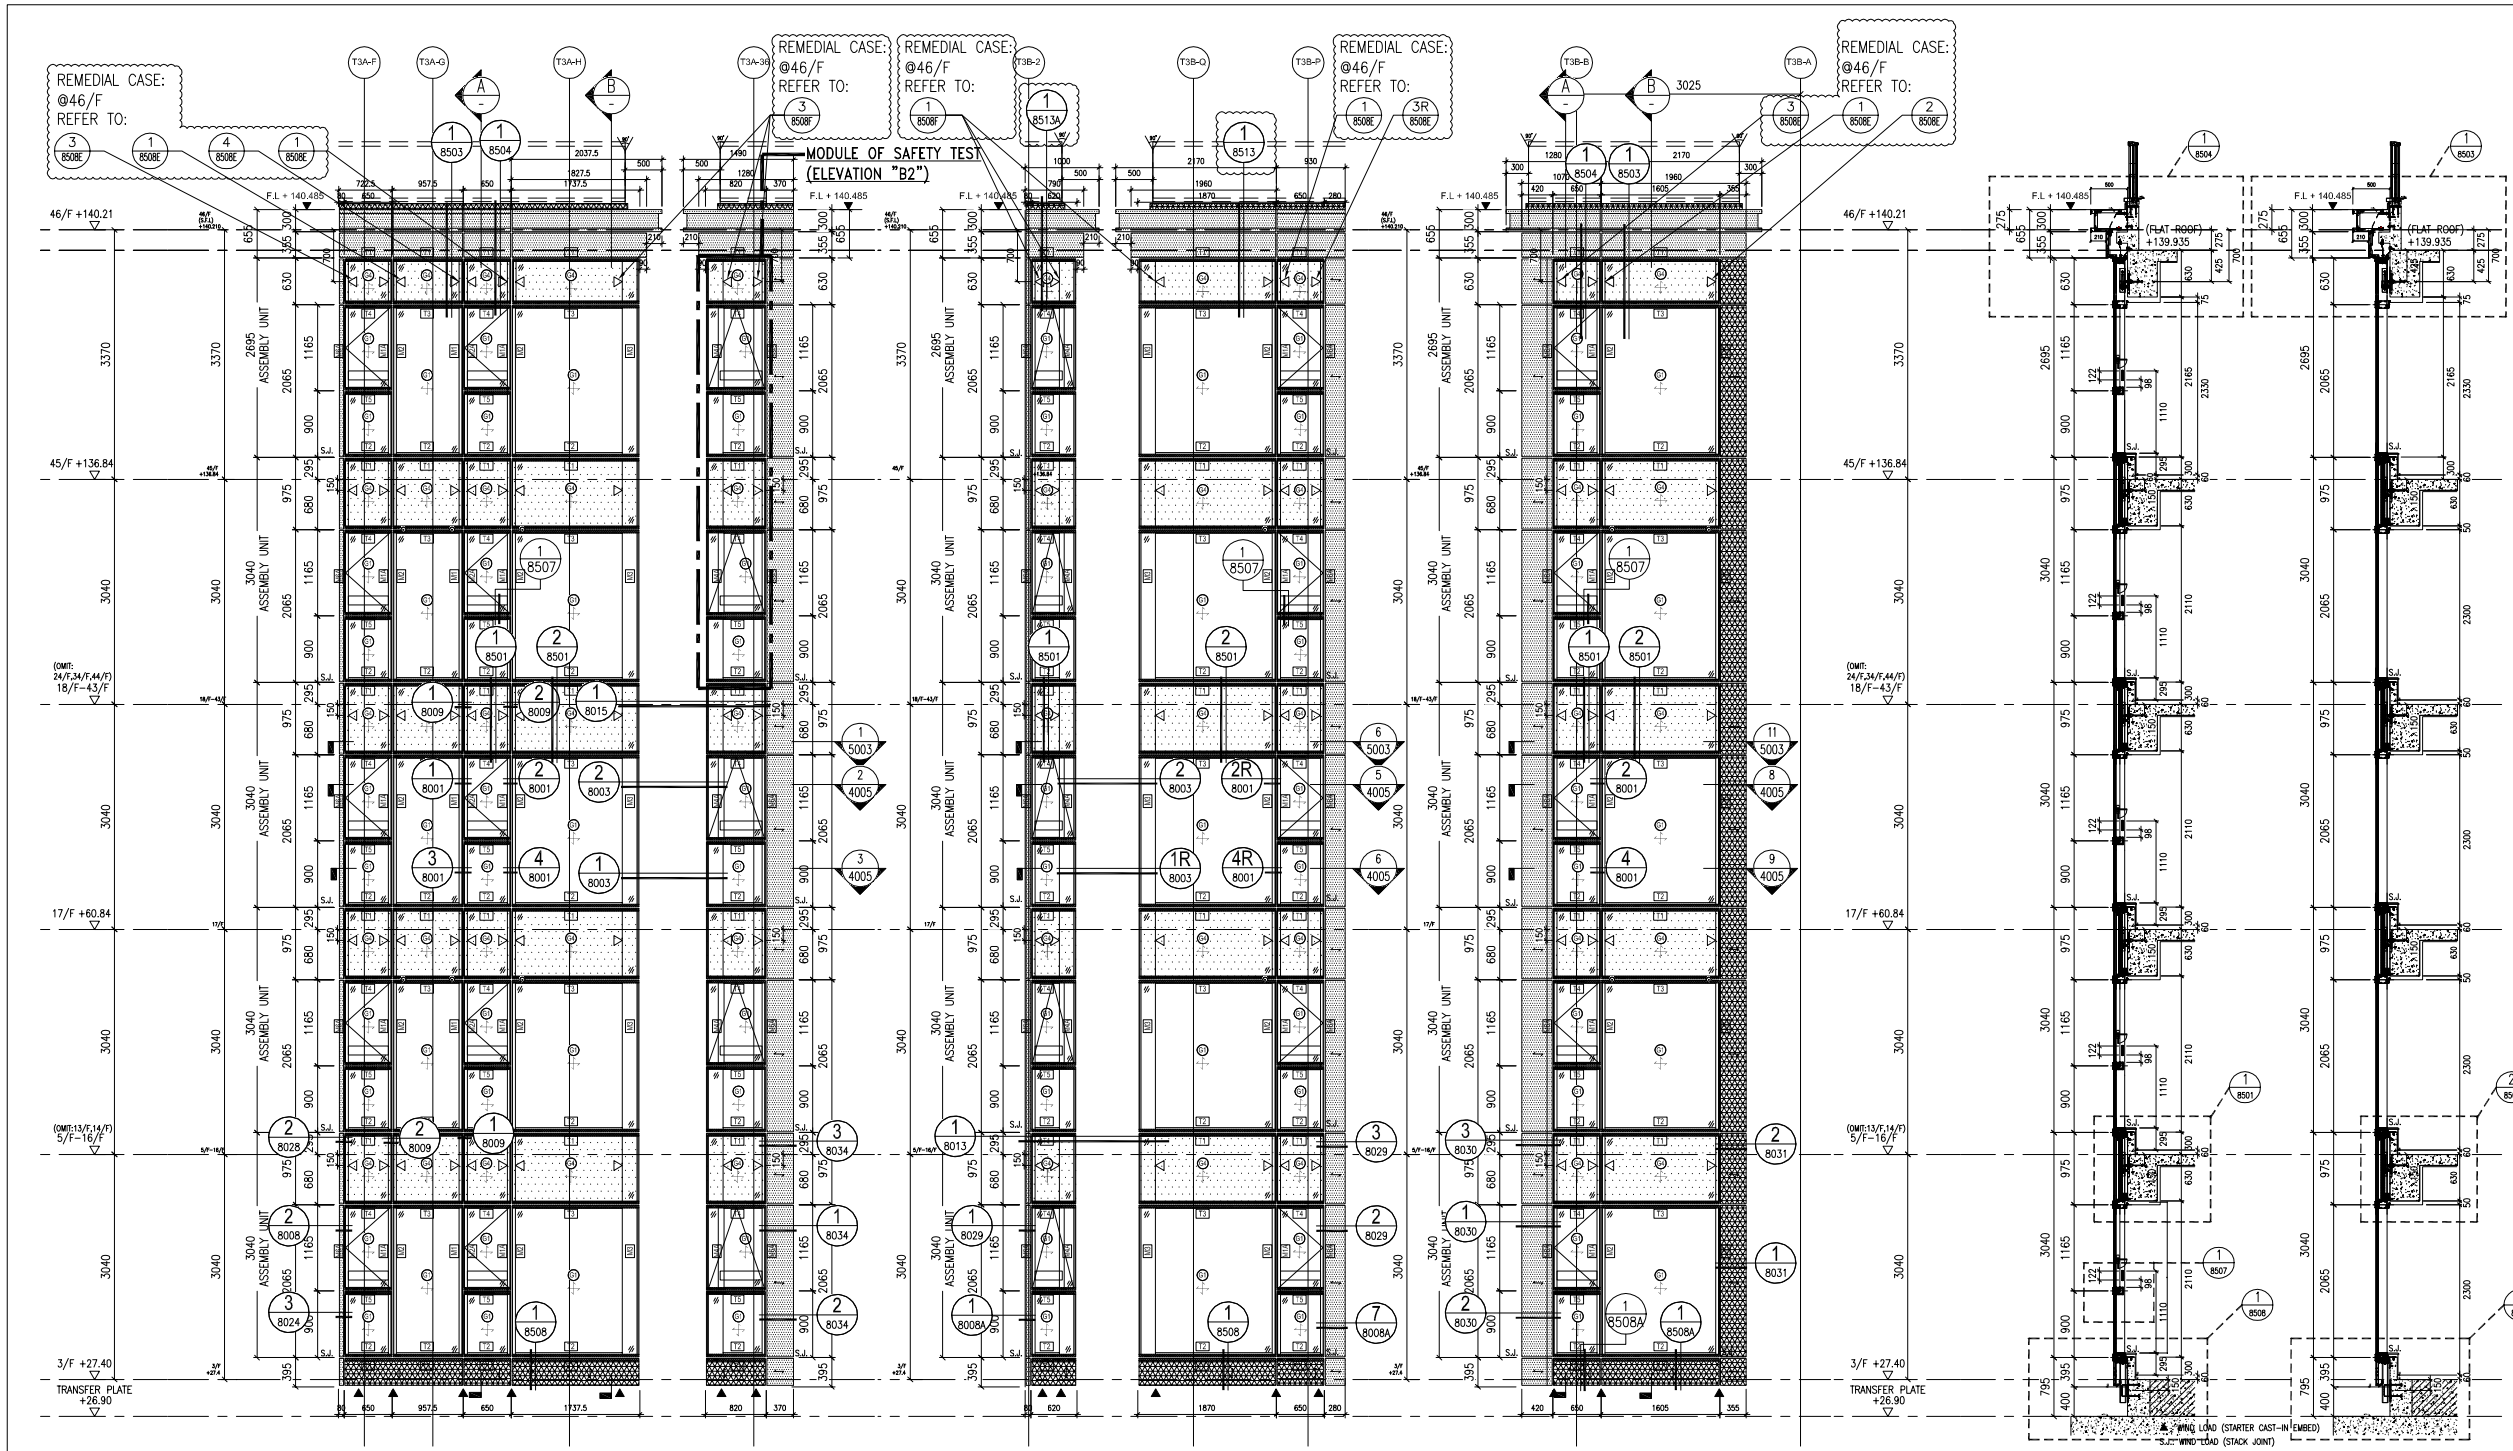


1 4005 *PART ELEV. FOR CURTAIN WALL*
"TCW-PE301-1"

4 4005 *PART ELEV. FOR CURTAIN WALL*
"TCW-PE301-2"


7 4005 *PART ELEV. FOR CURTAIN WALL*
"TCW-PE302-1"

A – *PART SECTION*


B – *PART SECTION*

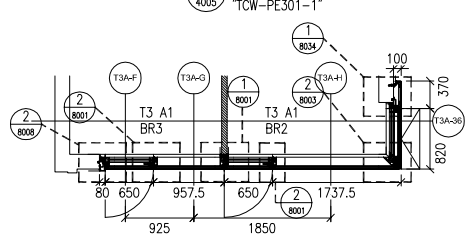


2 4005 *PART PLAN FOR CURTAIN WALL*
"TCW-PE301-1" (HI-VISION)

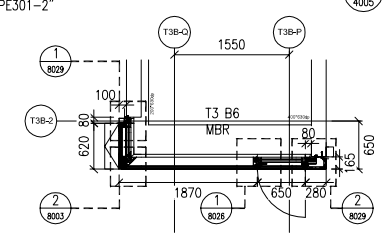


5 4005 *PART PLAN FOR CURTAIN WALL*
"TCW-PE301-2" (HI-VISION)

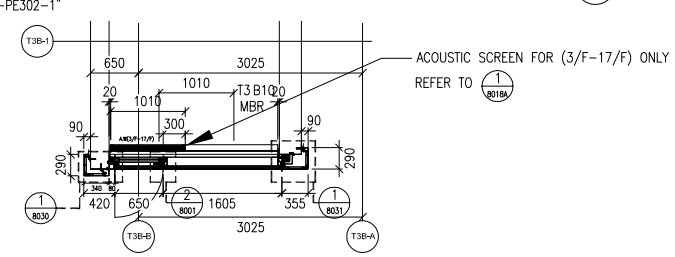


8 4005 *PART PLAN FOR CURTAIN WALL*
"TCW-PE302-1" (HI-VISION) ACOUSTIC SCREEN FOR (3/F-17/F) ONLY

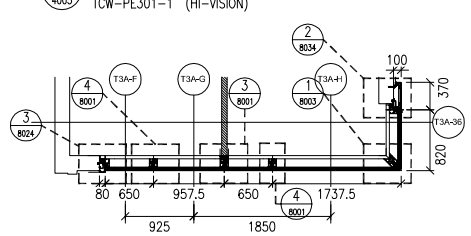

3 4005 *PART PLAN FOR CURTAIN WALL*
"TCW-PE301-1" (LO-VISION)

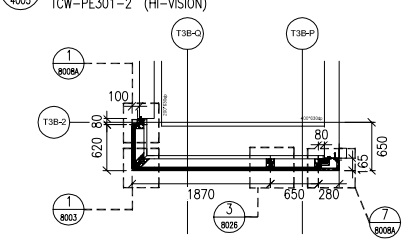


6 4005 *PART PLAN FOR CURTAIN WALL*
"TCW-PE301-2" (LO-VISION)

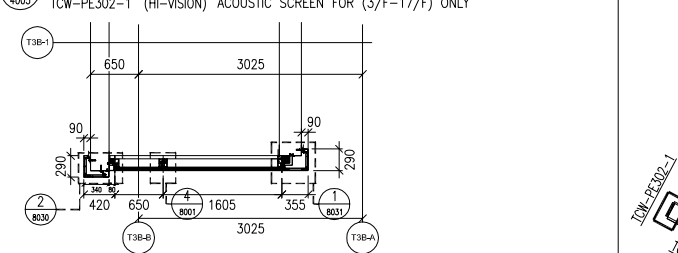

9 4005 *PART PLAN FOR CURTAIN WALL*
"TCW-PE302-1" (LO-VISION)

LIGHTING AND OPENABLE AREA							
TOWER	FLAT	ROOM	LIGHTING		OPENABLE		REFER CW
			REQUIRED	PROVIDED	REQUIRED	PROVIDED	
T3	A1	BR2	0.420 M²	4.793 M²	0.263 M²	1.137 M²	TCW-PE301-1
T3	A1	BR3	0.420 M²	2.652 M²	0.263 M²	0.509 M²	TCW-PE301-1
T3	B6	MBR	0.732 M²	4.681 M²	0.457 M²	0.818 M²	TCW-PE301-2
T3	B10	MBR	0.742 M²	3.914 M²	0.464 M²	0.509 M²	TCW-PE302-1

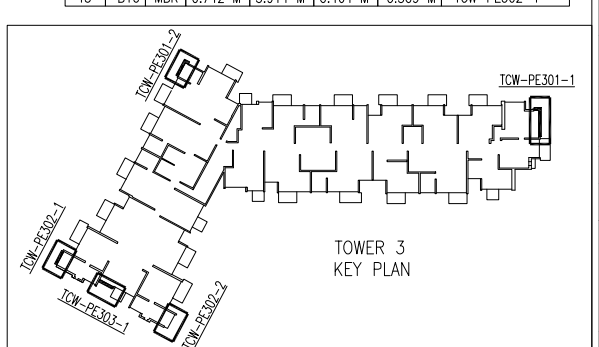

B.D. REF :

CLIENT :
SUN HUNG KAI REAL ESTATE AGENCY LTD.
42/F SUN HUNG KAI CENTRE, WANCHAI, HONGKONG

ARCHITECT :
lwk&partners
a r c h i t e c t s

MAIN CONTRACTOR :
怡輝建築有限公司
Yee Fai Building Contractors Ltd.

STRUCTURAL ENGINEER :
ARUP

FACADE CONSULTANT:
ALPHA CONSULTING LIMITED
Steel Structure & Facade Specialist

NOTE :
1. ALL DIMENSIONS ARE IN mm.
2. ALL ELEVATIONS ARE VIEWED FROM OUTSIDE.
3. ALL DIMENSIONS TO BE VERIFIED ON SITE BEFORE FABRICATION.

LEGEND :
X1 — DETAIL MARK NO.
X001 — REFER SHEET NO.
1. F.F.L. --FINISHED FLOOR LEVEL
2. S.F.L. --STRUCTURAL FLOOR LEVEL
3. (/R) --REVERSED DETAIL

LEGEND:
- IGU GLASS: 8mm HEAT STRENGTHENED +12mm AIR +10mm TEMPERED (VISION)
- IGU GLASS: 8mm HEAT STRENGTHENED +12mm AIR +12mm TEMPERED (VISION)
- 12mm HEAT STRENGTHENED GLASS (SPANDREL) /W ALUM BACK PANEL
- 12mm TEMPERED GLASS (PROTECTIVE BARRIER)
- 10mm HEAT STRENGTHENED GLASS (CLASS CLADDING) /W ALUM BACK PANEL
- 3mm ALUM. CLADDING COLOR: UCTS09119XL8-3 — ▲ : WIND LOAD (STARTER CAST-IN EMBED)
- 3mm ALUM. CLADDING COLOR: UCTS42191XL-3 — S.J.: WIND LOAD (STACK JOINT)
- ▲ WIND LOAD (STARTER CAST-IN EMBED) S.J. WIND LOAD (STACK JOINT)
- WIND LOAD + DEAD LOAD BRACKET
- RESTRAINT SOCKET ONLY APPLY AT: 7/F, 15/F, 21/F, 28/F, 35/F AND 41/F ONLY

NO.	DATE	REVISED	BY
F	29-SEP-2023	8TH SUBMISSION	CF
E	25-AUG-2023	7TH SUBMISSION	CF
D	03-MAY-2023	5TH SUBMISSION	CF
C	21-FEB-2023	4TH SUBMISSION	CF
B	13-JAN-2023	3ND SUBMISSION	CF

JOB NO. : J-856

PROJECT :
PROPOSED DEVELOPMENT ABOVE LIGHT RAIL TIN WING STOP,TSWTL NO.23,AREA 33,TIN SHUI WAI, N.T.


TITLE :
PART ELEV & PLAN & SECTION FOR CURTAIN WALL @ TOWER 3 (TYPICAL)


DATE : 31-OCT-22 | SCALE : 1:100

DRAWN BY : C.F | CHECKED BY :

美特鋁質有限公司
MIDI ALUMINIUM FABRICATOR LTD.
Units 6-8, Sunray Industrial Centre, 1/F
610 Cha Kwo Ling Road, Kowloon
Tel:23489211-4 Fax:(852)27727666

DWG NO. : J856-SD-CW-4005 | REV. : F

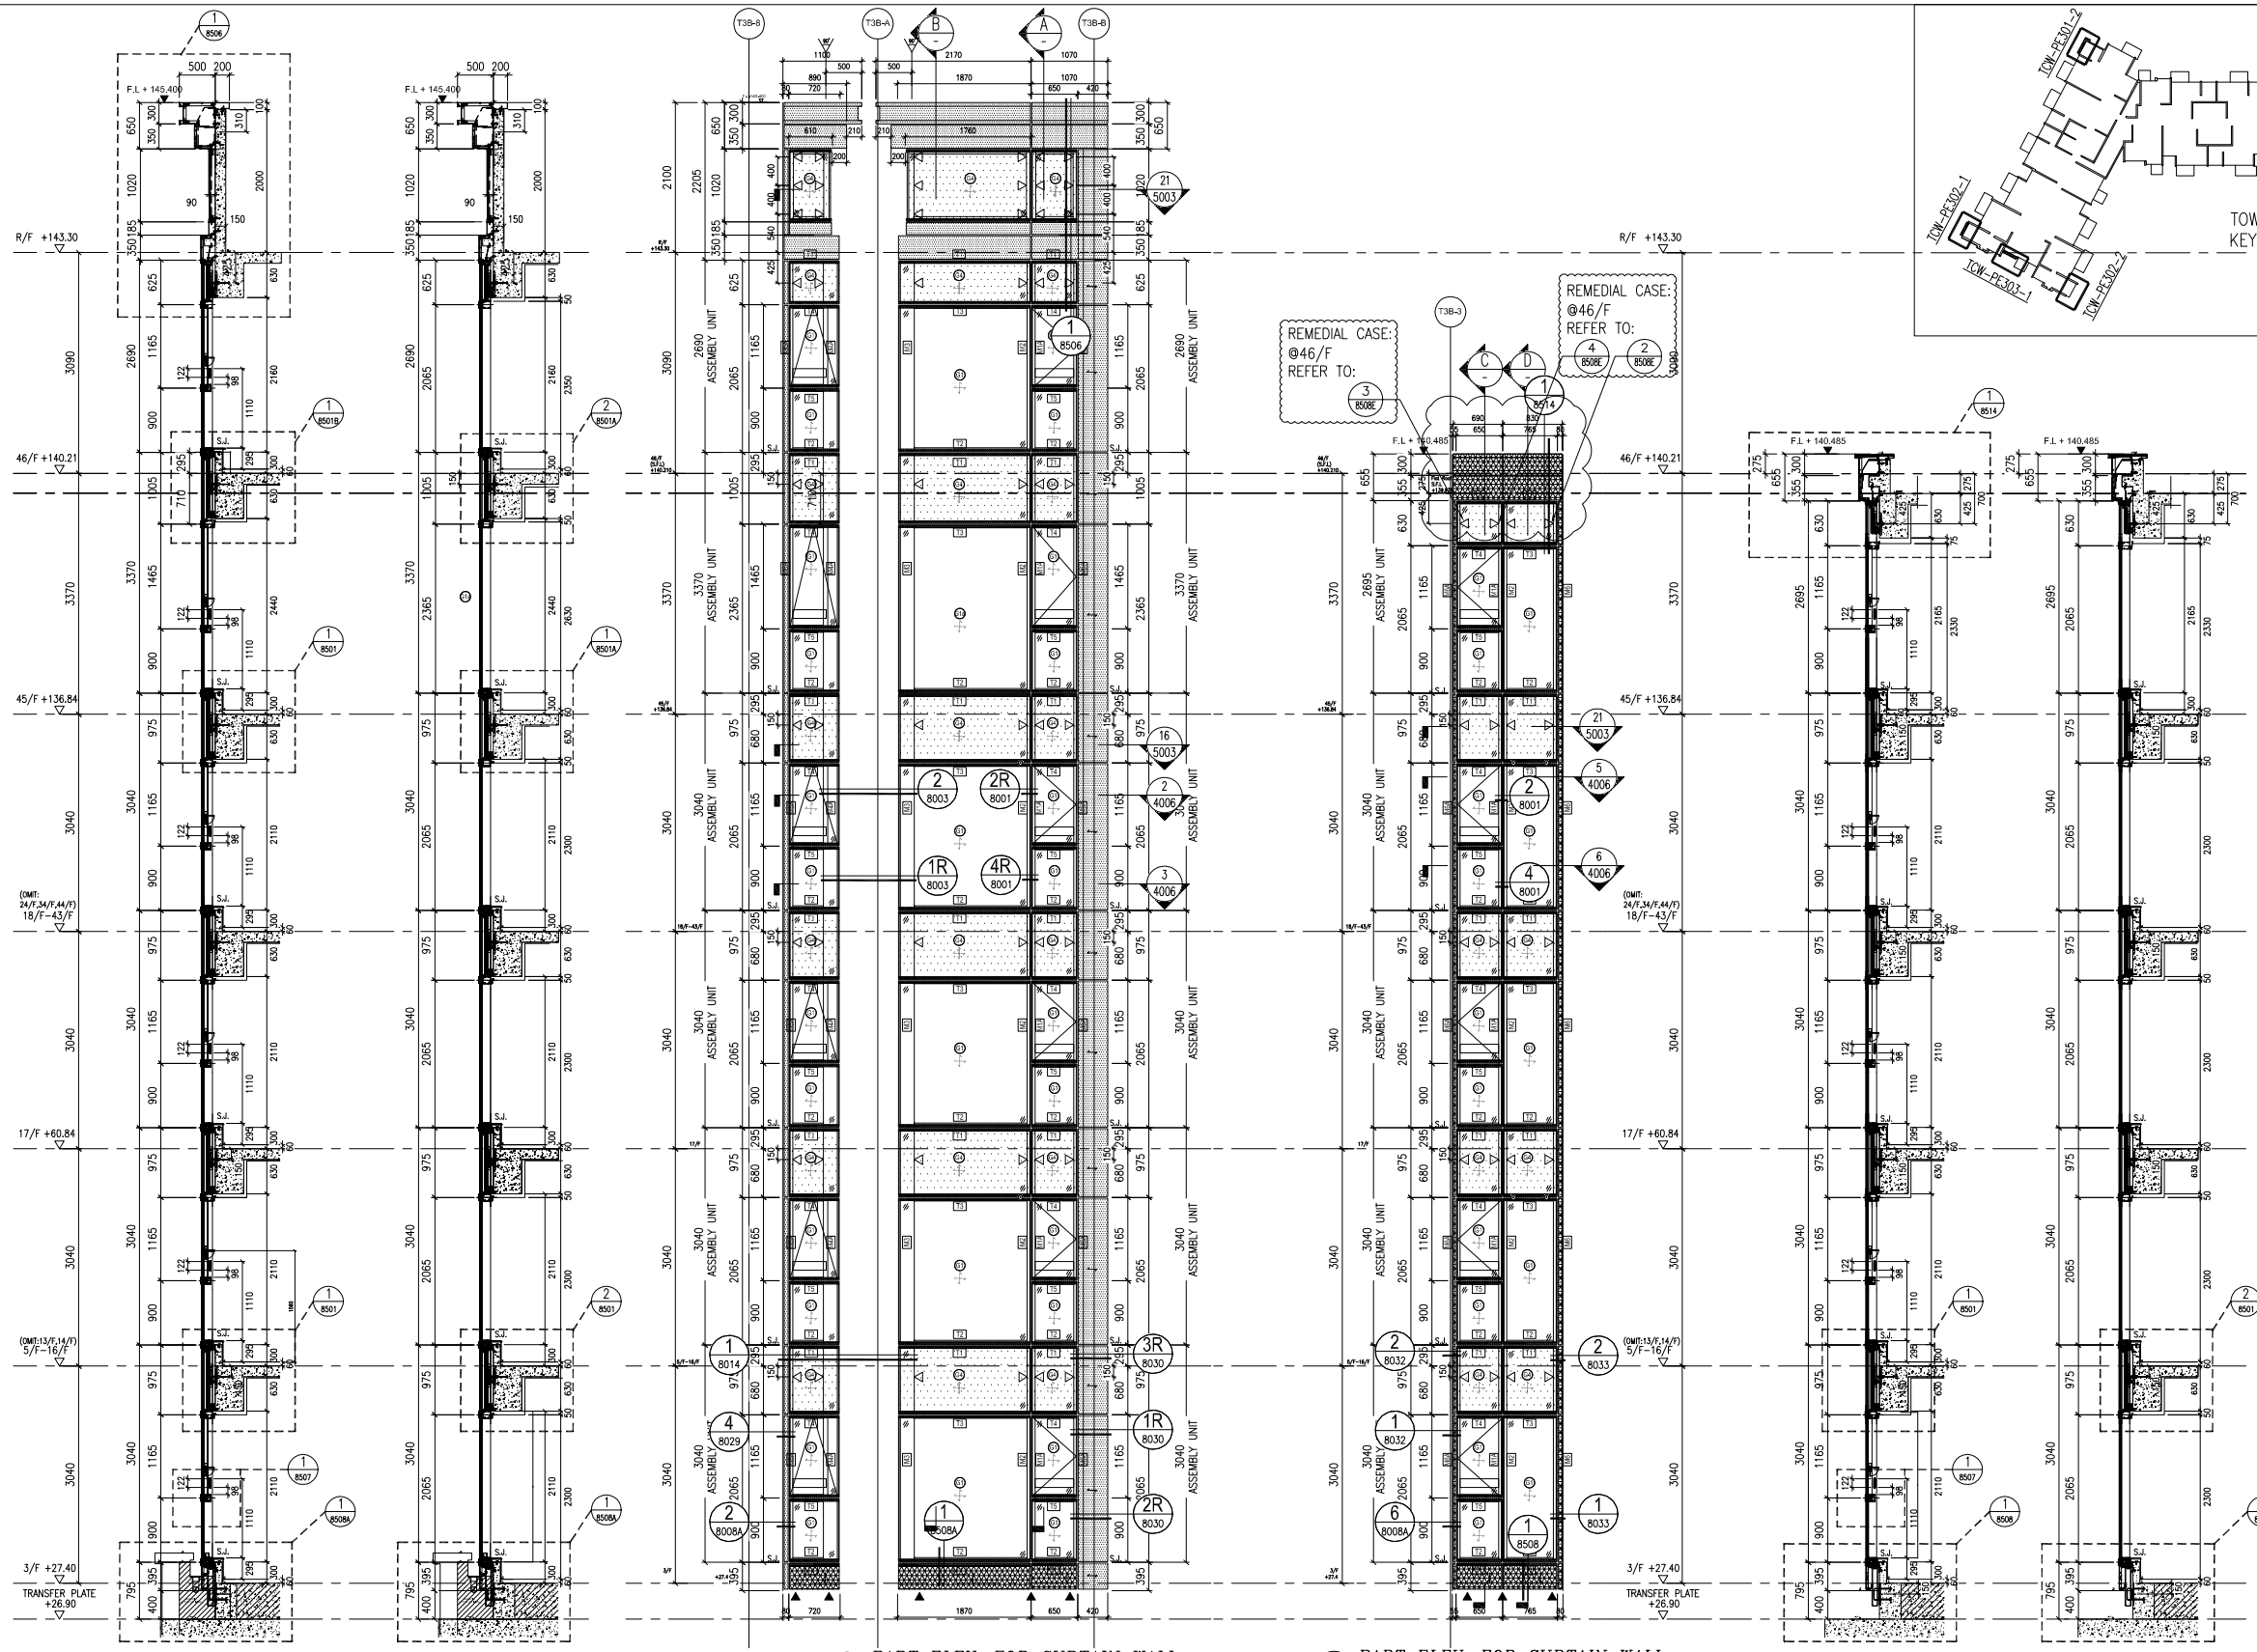

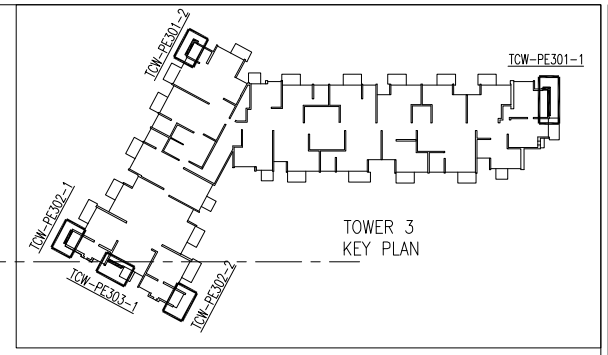

A PART SECTION


B PART SECTION

1 4006 PART ELEV. FOR CURTAIN WALL "TCW-PE302-2"


4 4006 PART ELEV. FOR CURTAIN WALL "TCW-PE303-1"

C PART SECTION


D PART SECTION

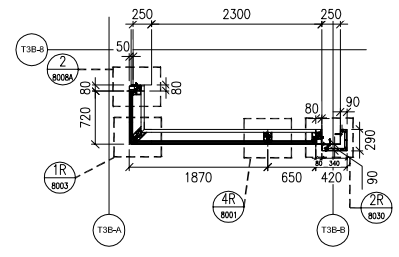


3 4006 PART PLAN FOR CURTAIN WALL "TCW-PE302-2" (LO-VISION)

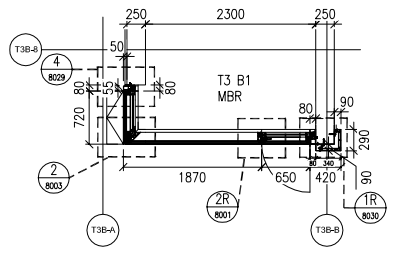

2 4006 PART PLAN FOR CURTAIN WALL "TCW-PE302-2" (HI-VISION)

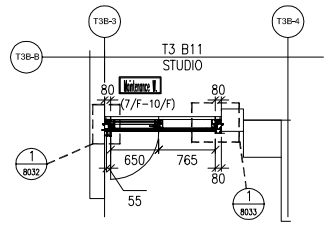

5 4006 PART PLAN FOR CURTAIN WALL "TCW-PE303-1" (HI-VISION)
MAINTENANCE WINDOW FOR (7/F-10/F) ONLY

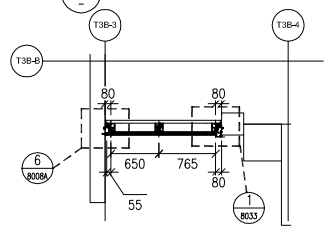

6 4006 PART PLAN FOR CURTAIN WALL "TCW-PE303-1" (LO-VISION)

LIGHTING AND OPENABLE AREA

TOWER	FLAT	ROOM	LIGHTING		OPENABLE		REFER CW
			REQUIRED	PROVIDED	REQUIRED	PROVIDED	
T3	B1	MBR	0.742 M²	4.866 M²	0.464 M²	0.912 M²	TCW-PE302-2
T3	B11	STO	1.552 M²	2.276 M²	1.288 M²	0.509+1.657=2.166 M²	TCW-PE302-3

B.D. REF :

CLIENT :
SUN HUNG KAI REAL ESTATE AGENCY LTD.
42/F SUN HUNG KAI CENTRE, WANCHAI, HONGKONG

ARCHITECT :
lwk&partners architects

MAIN CONTRACTOR :
怡輝建築有限公司 Yee Fai Building Contractors Ltd.

STRUCTURAL ENGINEER :
ARUP

FACADE CONSULTANT:
ALPHA CONSULTING LIMITED
Steel Structure & Facade Specialist

NOTE :
1. ALL DIMENSIONS ARE IN mm.
2. ALL ELEVATIONS ARE VIEWED FROM OUTSIDE.
3. ALL DIMENSIONS TO BE VERIFIED ON SITE BEFORE FABRICATION.

LEGEND :
X1 — DETAIL MARK NO.
X001 — REFER SHEET NO.

1. F.F.L. --FINISHED FLOOR LEVEL
2. S.F.L. --STRUCTURAL FLOOR LEVEL
3. /R --REVERSED DETAIL

LEGEND:
- 6(12)6 — IGU GLASS: 8mm HEAT STRENGTHENED +12mm AIR +10mm TEMPERED (VISION)
- 6(12)6 — IGU GLASS: 8mm HEAT STRENGTHENED +12mm AIR +12mm TEMPERED (VISION)
- 6 — 12mm HEAT STRENGTHENED GLASS (SPANDREL) /W ALUM BACK PANEL
- 12 — 12mm TEMPERED GLASS (PROTECTIVE BARRIER)
- 10 — 10mm HEAT STRENGTHENED GLASS (GLASS CLADDING) /W ALUM BACK PANEL
- 3mm ALUM. CLADDING COLOR: UCT-509193XLB-3
- 3mm ALUM. CLADDING COLOR: UCT-529199XC-3
- ▲ : WIND LOAD (STARTER CAST-IN EMBED)
- S.J.: WIND LOAD (STACK JOINT)
- WIND LOAD + DEAD LOAD BRACKET
- RESTRAINT SOCKET ONLY APPLY AT: 7/F, 15/F, 21/F, 28/F, 35/F AND 41/F ONLY

NO.	DATE	REVISED	BY
F	29-SEP-2023	8TH SUBMISSION	CF
E	25-AUG-2023	7TH SUBMISSION	CF
D	03-MAY-2023	5TH SUBMISSION	CF
C	21-FEB-2023	4TH SUBMISSION	CF
B	13-JAN-2023	3ND SUBMISSION	CF

JOB NO. : J-856

PROJECT :
PROPOSED DEVELOPMENT ABOVE LIGHT RAIL TIN WING STOP,TSWTL NO.23,AREA 33,TIN SHUI WAI, N.T.


TITLE :
PART ELEV & PLAN & SECTION FOR CURTAIN WALL @ TOWER 3 (TYPICAL)

DATE : 31-OCT-22 | SCALE : 1:100


DRAWN BY : C.F | CHECKED BY :

美特鋁製有限公司 MIDI ALUMINIUM FABRICATOR LTD.
Units 6-8, Sunray Industrial Centre, 1/F
610 Cha Kwo Ling Road, Kowloon
Tel:23489211-4 Fax:(852)27727666


DWG NO. : J856-SD-CW-4006 | REV. : F

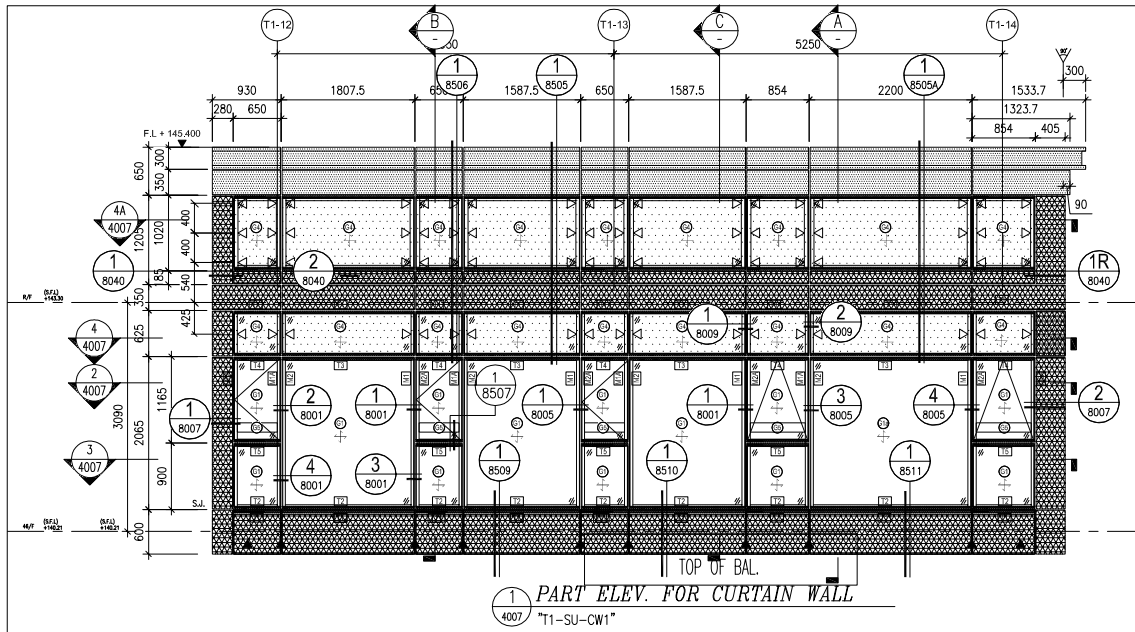

1 4007 *PART ELEV. FOR CURTAIN WALL*
"T1-SU-CW1"

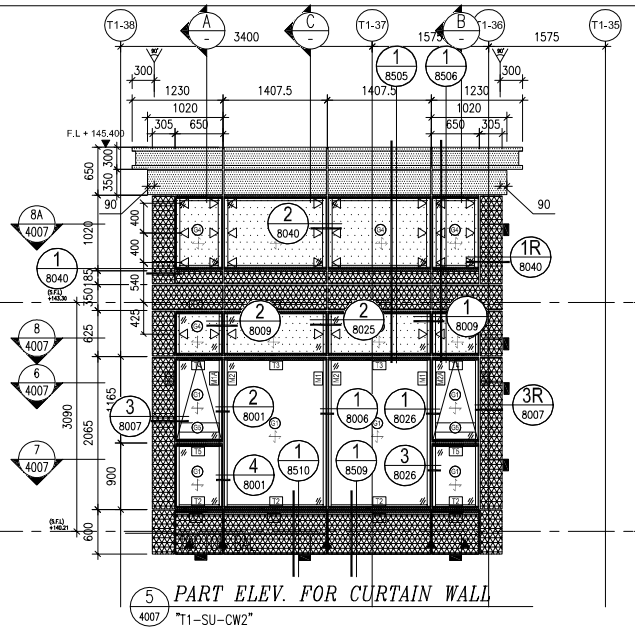


5 4007 *PART ELEV. FOR CURTAIN WALL*
"T1-SU-CW2"

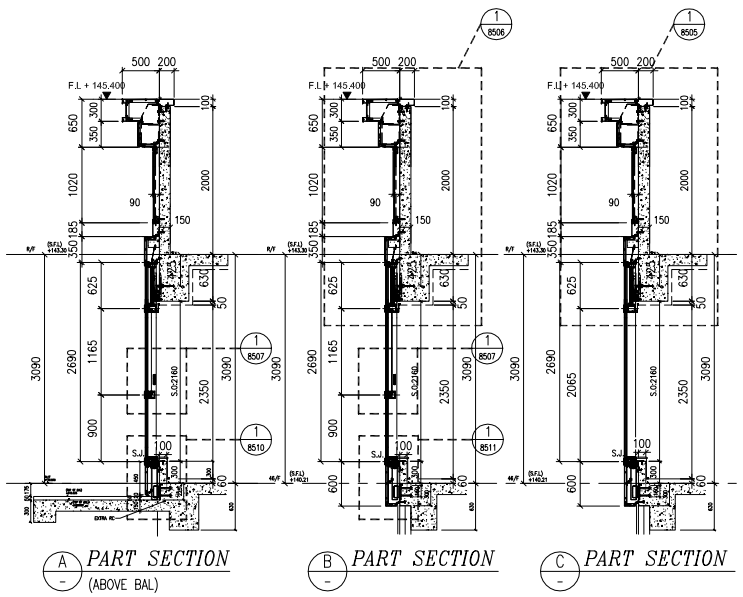


A - *PART SECTION*
(ABOVE BAL)

B - *PART SECTION*


C - *PART SECTION*

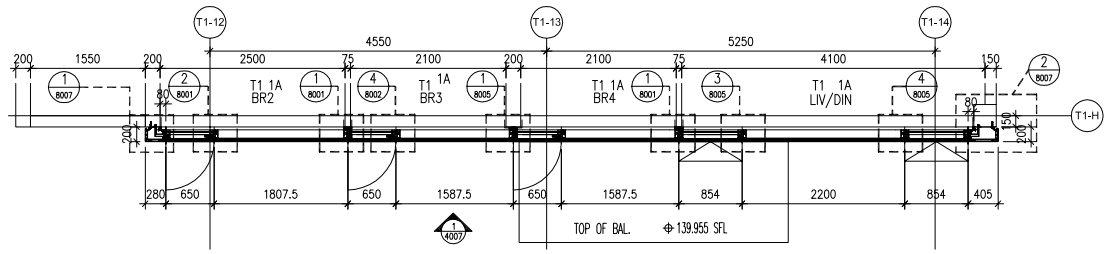


2 4007 *PART PLAN FOR CURTAIN WALL*
"T1-SU-CW1" (HI-VISION)

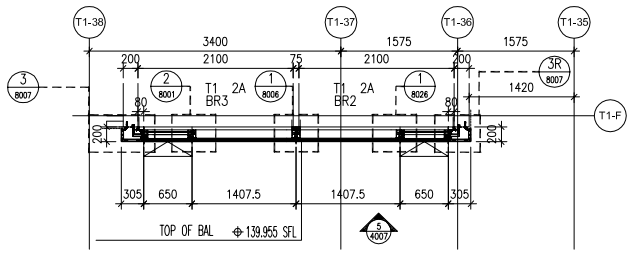


6 4007 *PART PLAN FOR CURTAIN WALL*
"T1-SU-CW2" (HI-VISION)

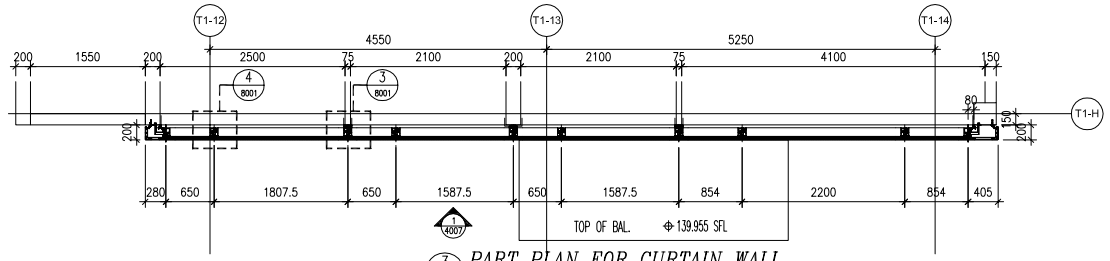


3 4007 *PART PLAN FOR CURTAIN WALL*
"T1-SU-CW1" (LO-VISION)

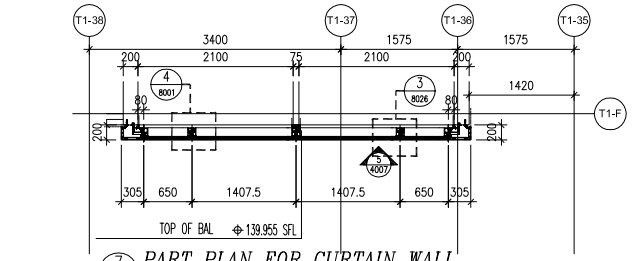


7 4007 *PART PLAN FOR CURTAIN WALL*
"T1-SU-CW2" (LO-VISION)

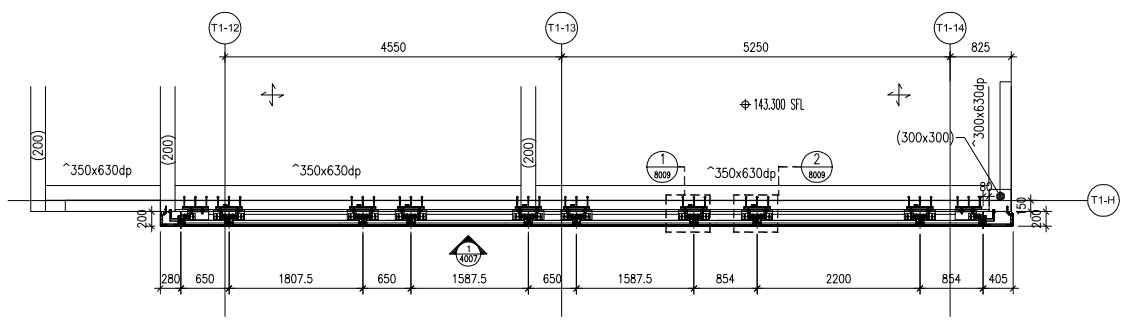


4 4007 *PART PLAN FOR CURTAIN WALL*
"T1-SU-CW1" (SPANDREL)

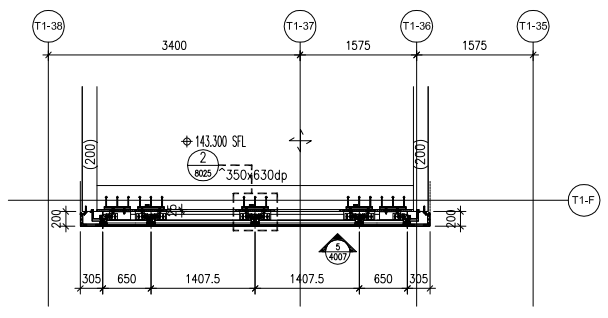

8 4007 *PART PLAN FOR CURTAIN WALL*
"T1-SU-CW2" (SPANDREL)

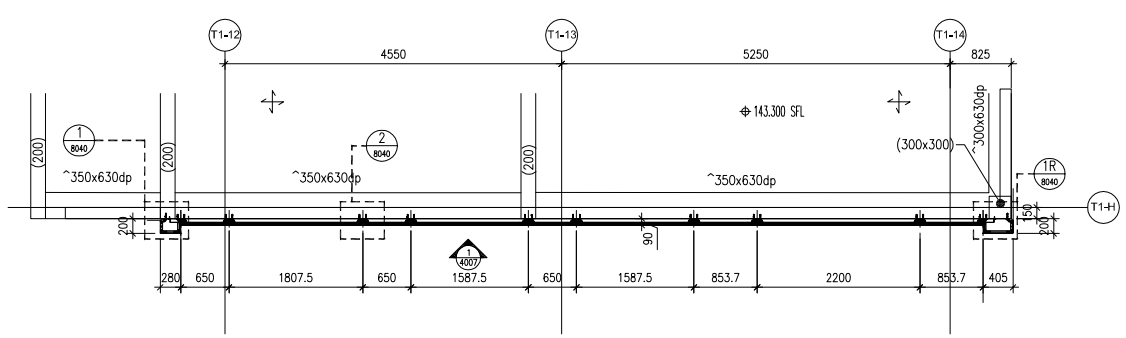


4A 4007 *PART PLAN FOR CURTAIN WALL*
"T1-SU-CW1" (GLASS CLADDING)

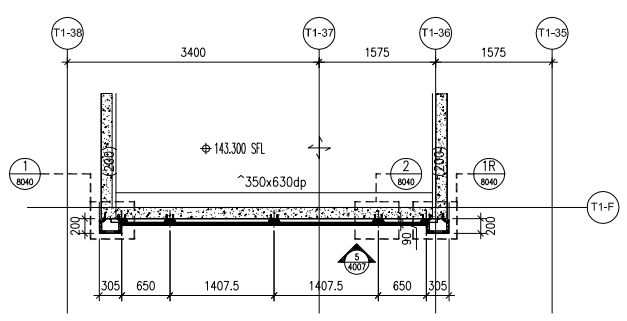

8A 4007 *PART PLAN FOR CURTAIN WALL*
"T1-SU-CW2" (GLASS CLADDING)

LIGHTING AND OPENABLE AREA							
TOWER	FLAT	ROOM	LIGHTING		OPENABLE		REFER CW
			REQUIRED	PROVIDED	REQUIRED	PROVIDED	
T1(SU)	1A	LIV/DIN	3.079 M²	6.827 M²	2.242 M²	1.403(CW)+3.996(SD)= 5.399 M²	T1-SU-CW1
T1(SU)	1A	BR2	0.525 M²	4.310 M²	0.328 M²	0.509 M²	T1-SU-CW1
T1(SU)	1A	BR3	0.441 M²	3.880 M²	0.276 M²	0.509 M²	T1-SU-CW1
T1(SU)	1A	BR4	0.441 M²	3.880 M²	0.276 M²	0.509 M²	T1-SU-CW1
T1(SU)	2A	BR2	0.441 M²	3.529 M²	0.276 M²	0.509 M²	T1-SU-CW2
T1(SU)	2A	BR3	0.441 M²	3.529 M²	0.276 M²	0.509 M²	T1-SU-CW2

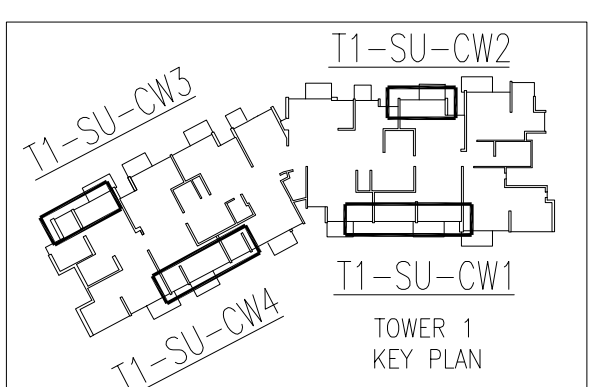

B.D. REF :

CLIENT :
SUN HUNG KAI REAL ESTATE AGENCY LTD.
42/F SUN HUNG KAI CENTRE, WANCHAI, HONGKONG

ARCHITECT :
lwk&partners
a r c h i t e c t s

MAIN CONTRACTOR :
怡輝建築有限公司
Yee Fai Building Contractors Ltd.

STRUCTURAL ENGINEER :
ARUP

FACADE CONSULTANT:
ALPHA CONSULTING LIMITED
Steel Structure & Facade Specialist

NOTE :
1. ALL DIMENSIONS ARE IN mm.
2. ALL ELEVATIONS ARE VIEWED FROM OUTSIDE.
3. ALL DIMENSIONS TO BE VERIFIED ON SITE BEFORE FABRICATION.

LEGEND :
X1 — DETAIL MARK NO.
X001 — REFER SHEET NO.

1. F.F.L. --FINISHED FLOOR LEVEL
2. S.F.L. --STRUCTURAL FLOOR LEVEL
3. /R --REVERSED DETAIL

LEGEND:
G1 IGU GLASS: 8mm HEAT STRENGTHENED +12mm AIR +10mm TEMPERED (VISION)
G1 IGU GLASS: 8mm HEAT STRENGTHENED +12mm AIR +12mm TEMPERED (VISION)
G2A 12mm HEAT STRENDTHENED GLASS (SPANDREL) /W 2MM BACK PANEL
G2 12mm TEMPERED GLASS (PROTECTIVE BARRIER)
3mm ALUM. CLADDING COLOR: UCT309119XLB-3
3mm ALUM. CLADDING COLOR: UCT542919XL-3
WIND LOAD + DEAD LOAD BRACKET
▲ : WIND LOAD (STARTER CAST-IN EMBED)
S.J.: WIND LOAD (STACK JOINT)

NO.	DATE	REVISED	BY
D	12-OCT-2023	9TH SUBMISSION	CF
C	22-AUG-2023	7TH SUBMISSION	CF
B	21-FEB-2023	4TH SUBMISSION	CF
A	22-DEC-2022	2ND SUBMISSION	CF

JOB NO. : J-856

PROJECT :
PROPOSED DEVELOPMENT ABOVE LIGHT RAIL TIN WING STOP,TSWTL NO.23,AREA 33,TIN SHUI WAI, N.T.


TITLE :
PART ELEV & PLAN & SECTION FOR CURTAIN WALL @ TOWER 1 SU (46/F)

DATE : 31-OCT-22 | SCALE : 1:100


DRAWN BY : C.F | CHECKED BY :

美特鋁質有限公司
MIDI ALUMINIUM FABRICATOR LTD.
Units 6-8, Sunray Industrial Centre, 1/F
610 Cha Kwo Ling Road, Kowloon
Tel:23489211-4 Fax:(852)27727666


DWG NO. : J856-SD-CW-4007 | REV. : D

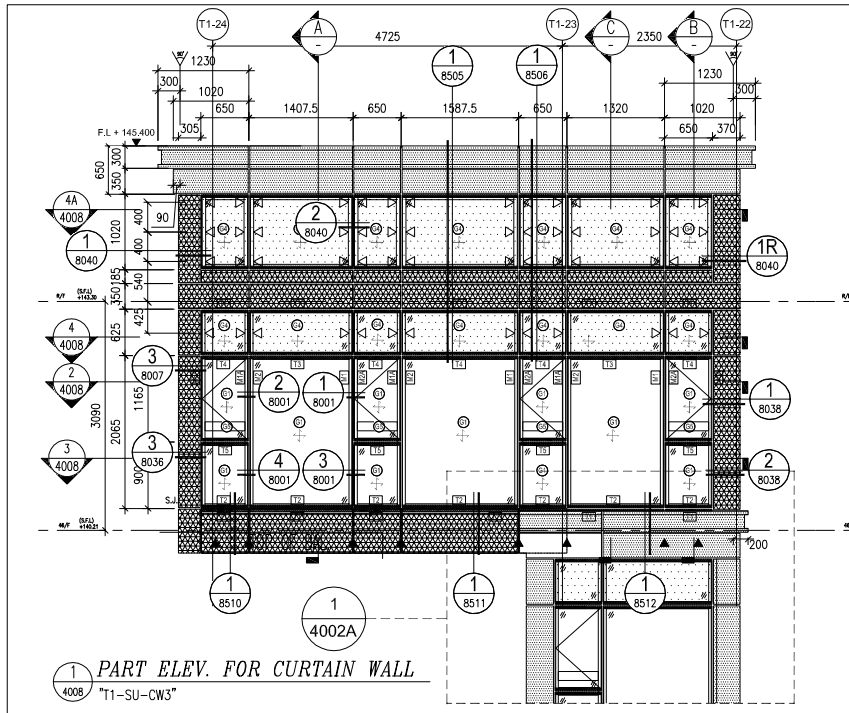

1 4008 *PART ELEV. FOR CURTAIN WALL*
"T1-SU-CW3"

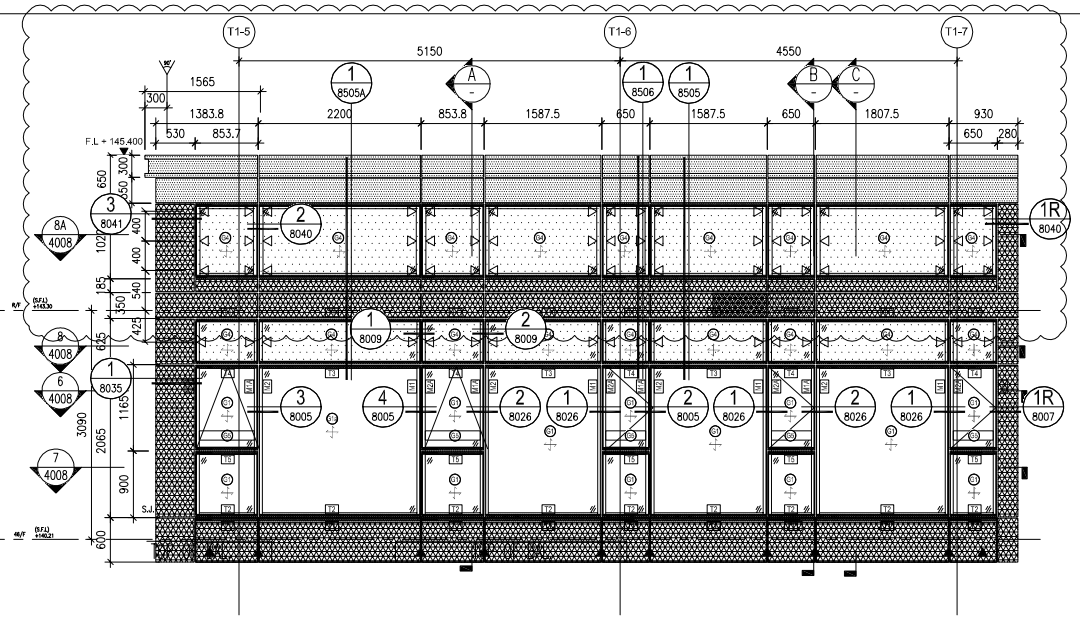


5 4008 *PART ELEV. FOR CURTAIN WALL*
"T1-SU-CW4"

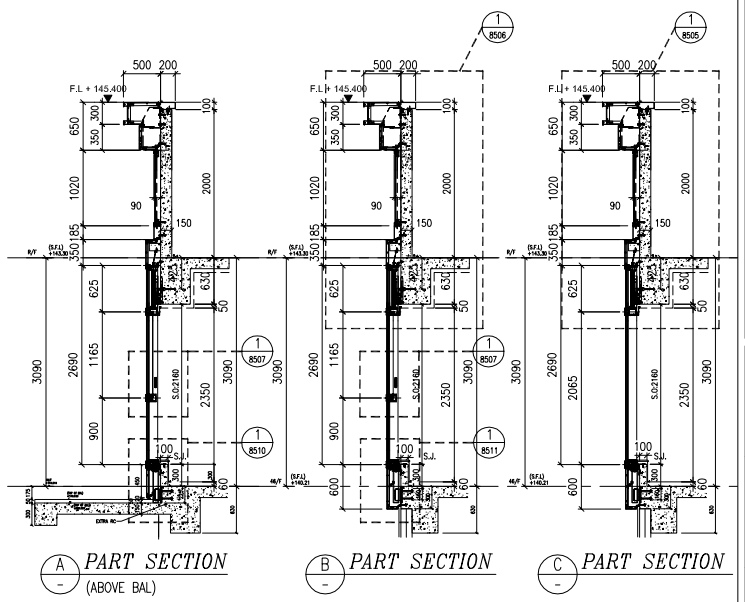


A - *PART SECTION*
(ABOVE BAL)

B - *PART SECTION*


C - *PART SECTION*

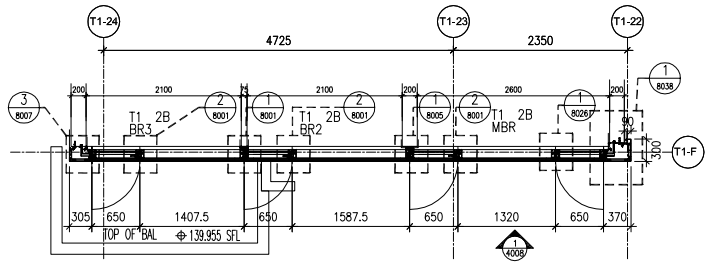


2 4008 *PART PLAN FOR CURTAIN WALL*
"T1-SU-CW3" (HI-VISION)

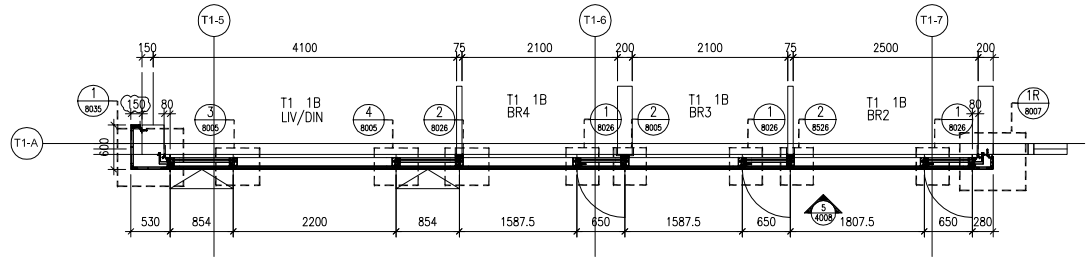


6 4008 *PART PLAN FOR CURTAIN WALL*
"T1-SU-CW4" (HI-VISION)

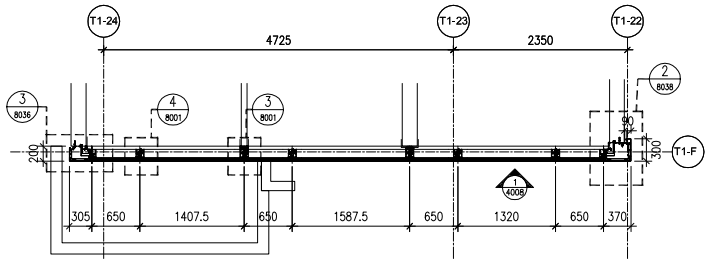


3 4008 *PART PLAN FOR CURTAIN WALL*
"T1-SU-CW3" (LO-VISION)

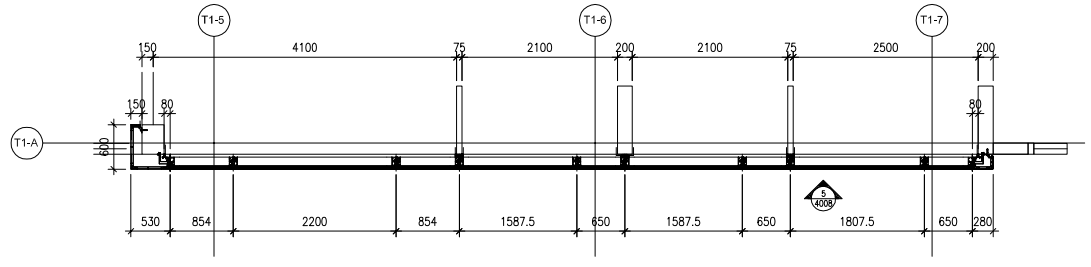


7 4008 *PART PLAN FOR CURTAIN WALL*
"T1-SU-CW4" (LO-VISION)

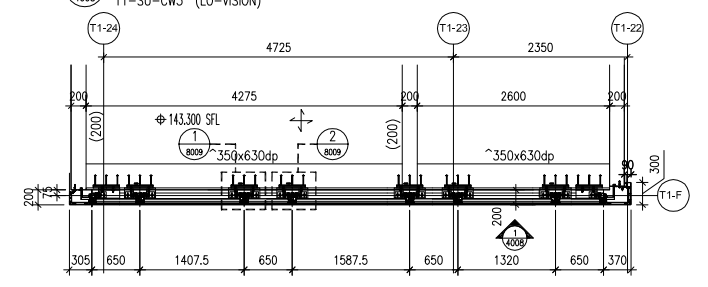


4 4008 *PART PLAN FOR CURTAIN WALL*
"T1-SU-CW3" (SPANDREL)

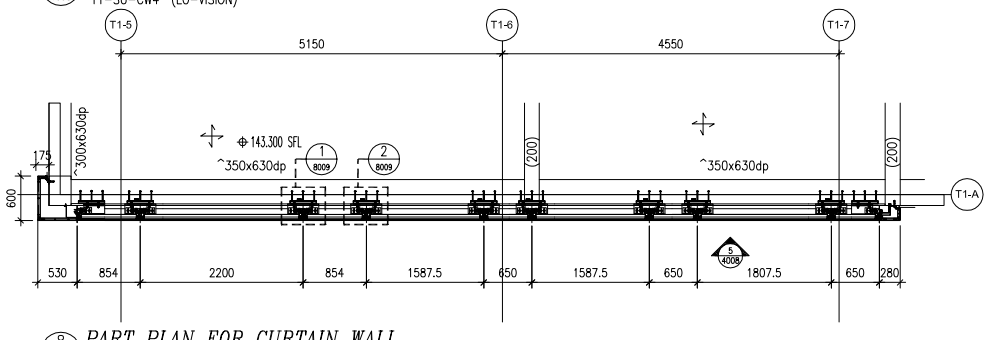

8 4008 *PART PLAN FOR CURTAIN WALL*
"T1-SU-CW4" (SPANDREL)

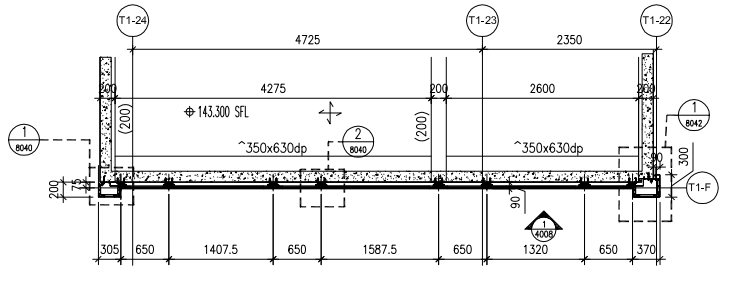


4A 4008 *PART PLAN FOR CURTAIN WALL*
"T1-SU-CW3" (GLASS CLADDING)

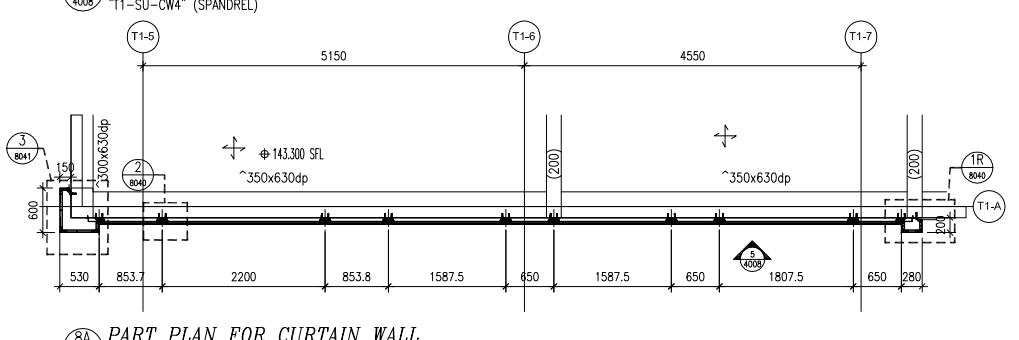

8A 4008 *PART PLAN FOR CURTAIN WALL*
"T1-SU-CW4" (GLASS CLADDING)

LIGHTING AND OPENABLE AREA								
TOWER	FLAT	ROOM	LIGHTING		OPENABLE		REFER CW
			REQUIRED	PROVIDED	REQUIRED	PROVIDED	
T1(SU)	2B	BR2	0.441 M²	3.881 M²	0.276 M²	0.509 M²	T1-SU-CW3
T1(SU)	2B	BR3	0.441 M²	3.530 M²	0.276 M²	0.509 M²	T1-SU-CW3
T1(SU)	2B	MBR	0.919 M²	4.358 M²	0.892 M²	1.018 M²	T1-SU-CW3
T1(SU)	1B	LIV/DIN	2.534 M²	6.828 M²	2.213 M²	1.403(CW)+2.236(SD) =3.639M²	T1-SU-CW4
T1(SU)	1B	BR2	0.525 M²	4.309 M²	0.328 M²	0.509 M²	T1-SU-CW4
T1(SU)	1B	BR3	0.441 M²	3.880 M²	0.276 M²	0.509 M²	T1-SU-CW4
T1(SU)	1B	BR4	0.441 M²	3.880 M²	0.276 M²	0.509 M²	T1-SU-CW4

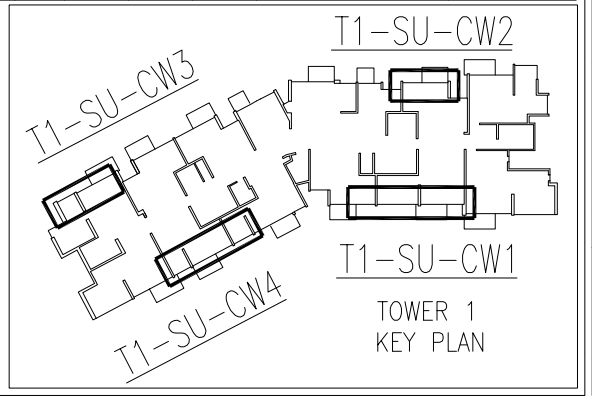

B.D. REF :

CLIENT :
SUN HUNG KAI REAL ESTATE AGENCY LTD.
42/F SUN HUNG KAI CENTRE, WANCHAI, HONGKONG

ARCHITECT :
lwk&partners
a r c h i t e c t s

MAIN CONTRACTOR :
怡輝建築有限公司
Yee Fai Building Contractors Ltd.

STRUCTURAL ENGINEER :
ARUP

FACADE CONSULTANT:
ALPHA CONSULTING LIMITED
Steel Structure & Facade Specialist

NOTE :
1. ALL DIMENSIONS ARE IN mm.
2. ALL ELEVATIONS ARE VIEWED FROM OUTSIDE.
3. ALL DIMENSIONS TO BE VERIFIED ON SITE BEFORE FABRICATION.

LEGEND :
X1 — DETAIL MARK NO.
X001 — REFER SHEET NO.
1. F.F.L. -- FINISHED FLOOR LEVEL
2. S.F.L. -- STRUCTURAL FLOOR LEVEL
3. (R) -- REVERSED DETAIL

LEGEND:
G1 — IGU GLASS: 8mm HEAT STRENGTHENED +12mm AIR +10mm TEMPERED (VISION)
G19 — IGU GLASS: 8mm HEAT STRENGTHENED +12mm AIR +12mm TEMPERED (VISION)
G34 — 12mm HEAT STRENDTHENED GLASS (SPANDREL) /W 2MM BACK PANEL
G35 — 12mm TEMPERED GLASS (PROTECTIVE BARRIER)
3mm ALUM. CLADDING COLOR: UCT309119XLB-3
3mm ALUM. CLADDING COLOR: UCT542919XL-3
WIND LOAD + DEAD LOAD BRACKET
▲ : WIND LOAD (STARTER CAST-IN EMBED)
S.J.: WIND LOAD (STACK JOINT)

NO.	DATE	REVISED	BY
D	12-OCT-2023	9TH SUBMISSION	CF
C	22-AUG-2023	7TH SUBMISSION	CF
B	21-FEB-2023	4TH SUBMISSION	CF
A	22-DEC-2022	2ND SUBMISSION	CF

JOB NO. : J-856

PROJECT :
PROPOSED DEVELOPMENT ABOVE LIGHT RAIL TIN WING STOP,TSWTL NO.23,AREA 33,TIN SHUI WAI, N.T.


TITLE :
PART ELEV & PLAN & SECTION FOR CURTAIN WALL @ TOWER 1 SU (46/F)

DATE : 31-OCT-22 | SCALE : 1:100


DRAWN BY : C.F | CHECKED BY :

美特鋁質有限公司
MIDI ALUMINIUM FABRICATOR LTD.
Units 6-8, Sunray Industrial Centre, 1/F
610 Cha Kwo Ling Road, Kowloon
Tel:23489211-4 Fax:(852)27727666


DWG NO. : J856-SD-CW-4008 | REV. : D

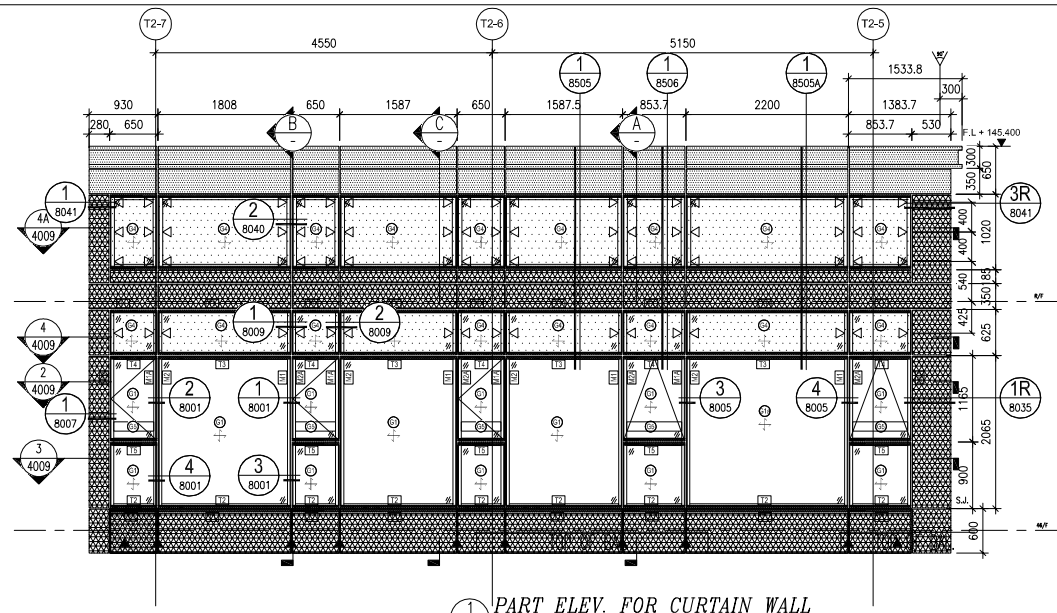

1 4009 *PART ELEV. FOR CURTAIN WALL*
"T2-SU-CW1"

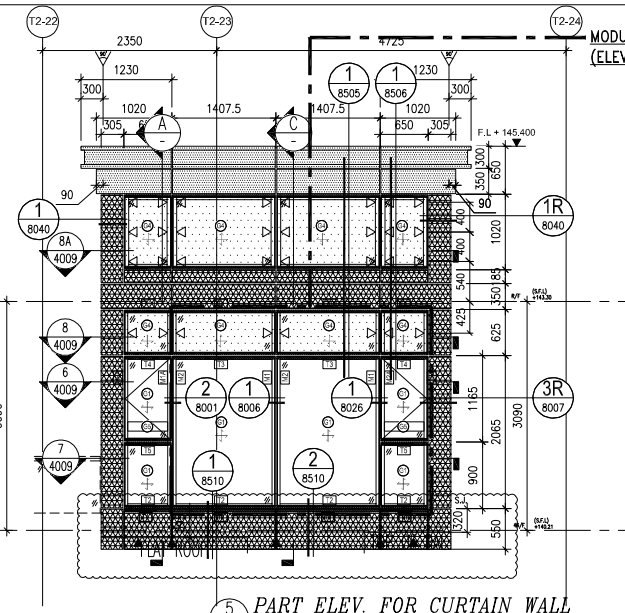


5 4009 *PART ELEV. FOR CURTAIN WALL*
"T2-SU-CW2"

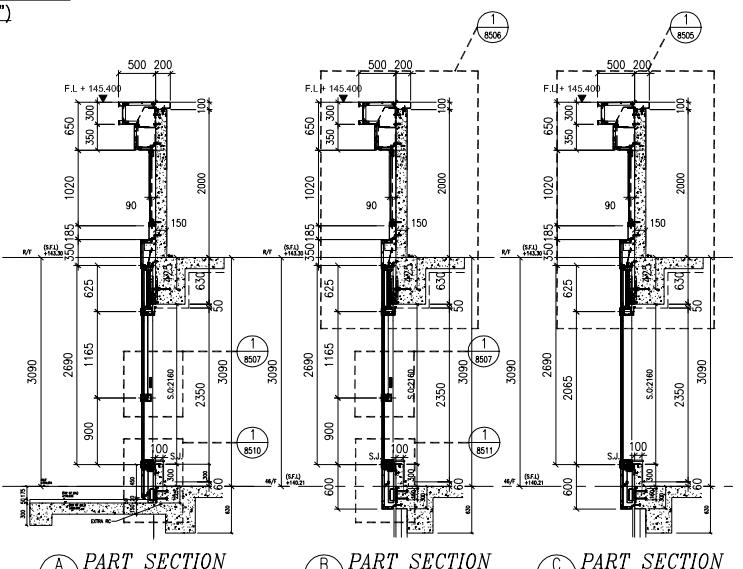


A – *PART SECTION*
(ABOVE BAL)

B – *PART SECTION*


C – *PART SECTION*

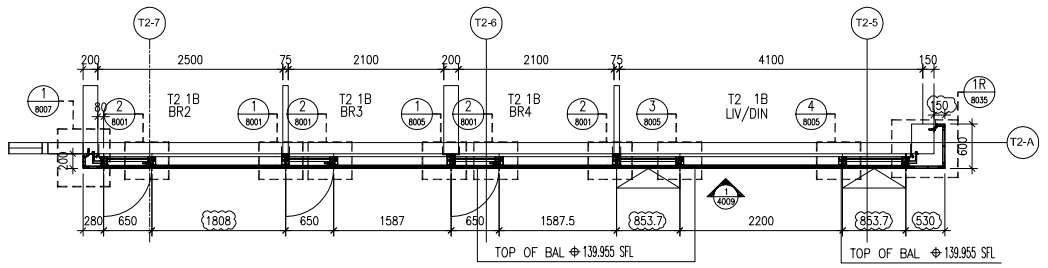


2 4009 *PART PLAN FOR CURTAIN WALL*
"T2-SU-CW1" (HI-VISION)

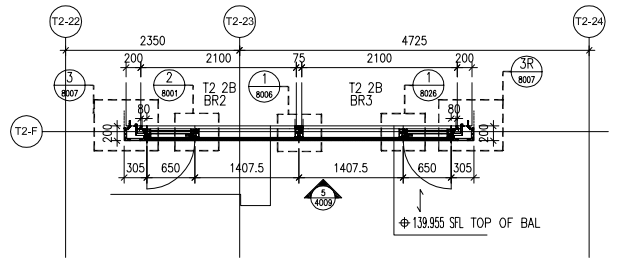


6 4009 *PART PLAN FOR CURTAIN WALL*
"T2-SU-CW2" (HI-VISION)

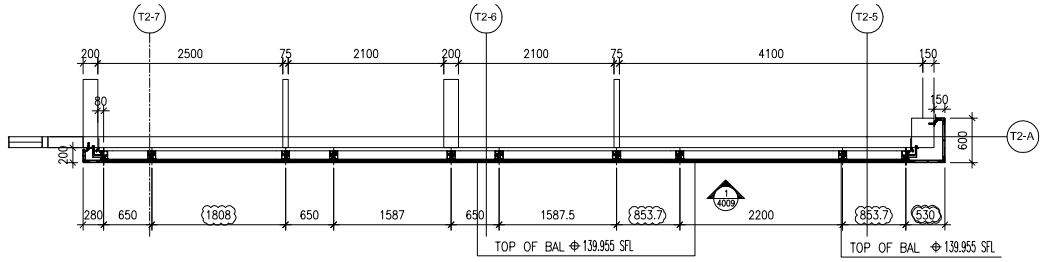


3 4009 *PART PLAN FOR CURTAIN WALL*
"T2-SU-CW1" (LO-VISION)

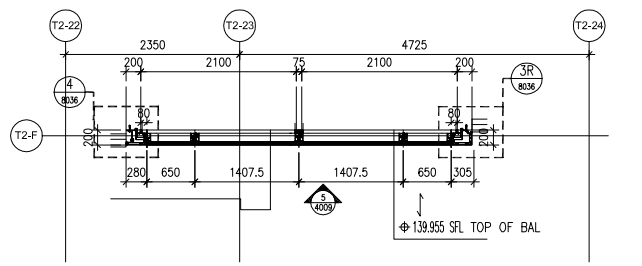


7 4009 *PART PLAN FOR CURTAIN WALL*
"T2-SU-CW2" (LO-VISION)

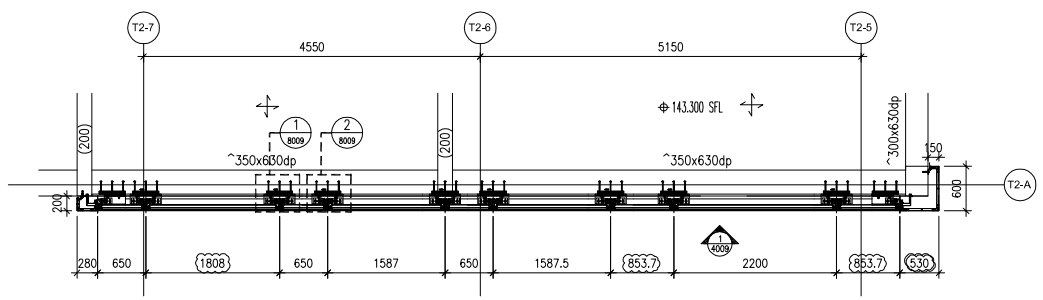


4 4009 *PART PLAN FOR CURTAIN WALL*
"T2-SU-CW1" (SPANDREL)

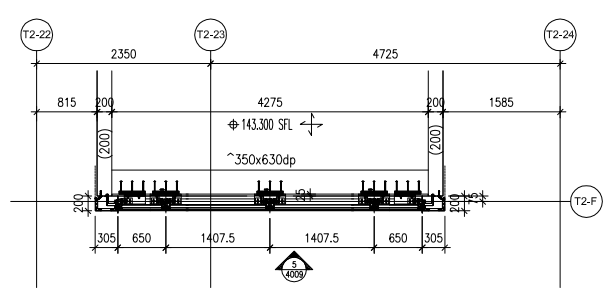

8 4009 *PART PLAN FOR CURTAIN WALL*
"T2-SU-CW2" (SPANDREL)

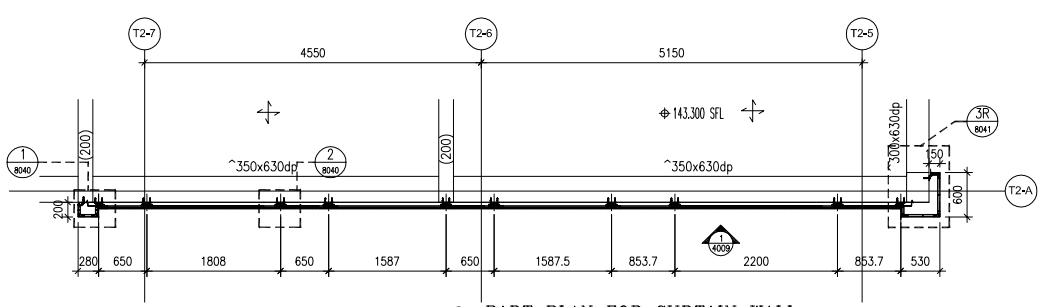


4A 4009 *PART PLAN FOR CURTAIN WALL*
"T2-SU-CW1" (GLASS CLADDING)

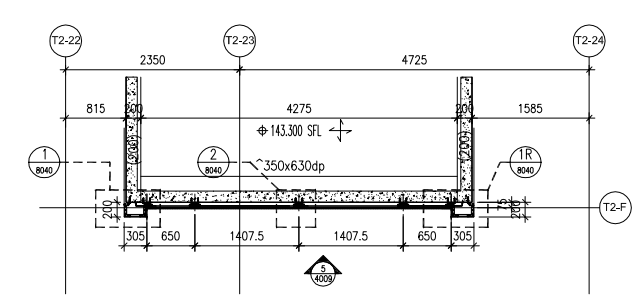

8A 4009 *PART PLAN FOR CURTAIN WALL*
"T2-SU-CW2" (GLASS CLADDING)

0.441 M²

LIGHTING AND OPENABLE AREA							
TOWER	FLAT	ROOM	LIGHTING		OPENABLE		REFER CW
			REQUIRED	PROVIDED	REQUIRED	PROVIDED	
T2(SU)	1B	LIV/DIN	3.033 M²	6.828 M²	2.213 M²	1.403(CW)+2.405(SD)=3.808M²	T2-SU-CW1
T2(SU)	1B	BR2	0.525 M²	4.310 M²	0.328 M²	0.509 M²	T2-SU-CW1
T2(SU)	1B	BR3	0.441 M²	3.880 M²	0.276 M²	0.509 M²	T2-SU-CW1
T2(SU)	1B	BR4	0.441 M²	3.880 M²	0.276 M²	0.509 M²	T2-SU-CW1
T2(SU)	2B	BR2	0.441 M²	3.529 M²	0.276 M²	0.509 M²	T2-SU-CW2
T2(SU)	2B	BR3	0.441 M²	3.529 M²	0.276 M²	0.509 M²	T2-SU-CW2

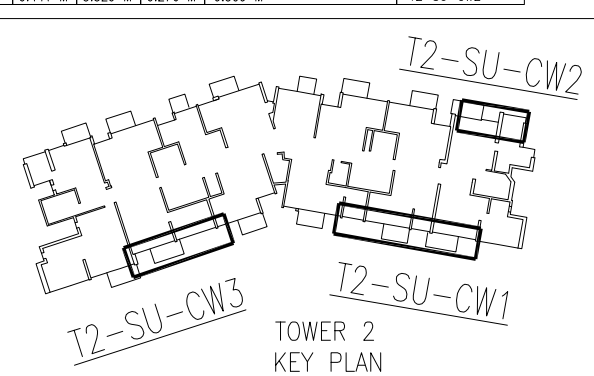

B.D. REF :

CLIENT :
SUN HUNG KAI REAL ESTATE AGENCY LTD.
42/F SUN HUNG KAI CENTRE, WANCHAI, HONGKONG

ARCHITECT :
lwk&partners
a r c h i t e c t s

MAIN CONTRACTOR :
怡輝建築有限公司
Yee Fai Building Contractors Ltd.

STRUCTURAL ENGINEER :
ARUP

FACADE CONSULTANT:
ALPHA CONSULTING LIMITED
Steel Structure & Facade Specialist

NOTE :
1. ALL DIMENSIONS ARE IN mm.
2. ALL ELEVATIONS ARE VIEWED FROM OUTSIDE.
3. ALL DIMENSIONS TO BE VERIFIED ON SITE BEFORE FABRICATION.

LEGEND :
X1 — DETAIL MARK NO.
X001 — REFER SHEET NO.
1. F.F.L. -- FINISHED FLOOR LEVEL
2. S.F.L. -- STRUCTURAL FLOOR LEVEL
3. (R) -- REVERSED DETAIL

LEGEND:
G1 IGU GLASS: 8mm HEAT STRENGTHENED +12mm AIR +10mm TEMPERED (VISION)
G1a IGU GLASS: 8mm HEAT STRENGTHENED +12mm AIR +12mm TEMPERED (VISION)
G4 12mm HEAT STRENDTHENED GLASS (SPANDREL) /W 2MM BACK PANEL
G5 12mm TEMPERED GLASS (PROTECTIVE BARRIER)
3mm ALUM. CLADDING COLOR: UCT309119XLB-3
3mm ALUM. CLADDING COLOR: UCT542919XL-3
WIND LOAD + DEAD LOAD BRACKET
▲ : WIND LOAD (STARTER CAST-IN EMBED)
S.J.: WIND LOAD (STACK JOINT)

NO.	DATE	REVISED	BY
D	12-OCT-2023	9TH SUBMISSION	CF
C	22-AUG-2023	7TH SUBMISSION	CF
B	21-FEB-2023	4TH SUBMISSION	CF
A	22-DEC-2022	2ND SUBMISSION	CF

JOB NO. : J-856

PROJECT :
PROPOSED DEVELOPMENT ABOVE LIGHT RAIL TIN WING STOP,TSWTL NO.23,AREA 33,TIN SHUI WAI, N.T.

TITLE :
PART ELEV & PLAN & SECTION FOR CURTAIN WALL @ TOWER 2 SU (46/F)


DATE : 31-OCT-22 | SCALE : 1:100

DRAWN BY : C.F | CHECKED BY :


美特鋁製有限公司
MIDI ALUMINIUM FABRICATOR LTD.
Units 6-8, Sunray Industrial Centre, 1/F
610 Cha Kwo Ling Road, Kowloon
Tel:23489211-4 Fax:(852)27727666

DWG NO. : J856-SD-CW-4009 | REV. : D

MODULE OF SAFETY TEST
(ELEVATION C1")

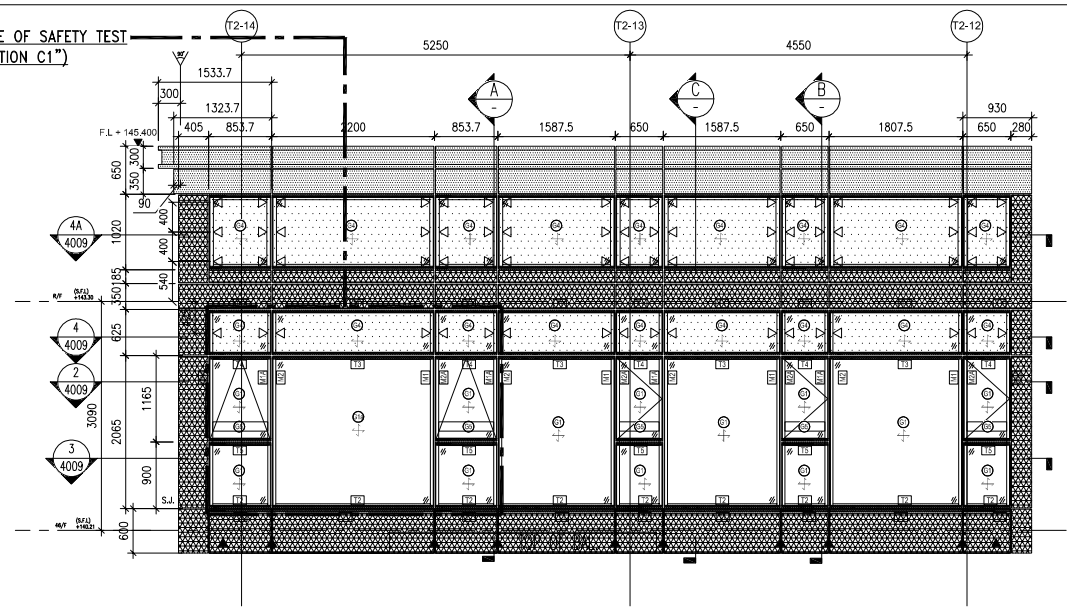


1 4010 *PART ELEV. FOR CURTAIN WALL*
"T2-SU-CW3"

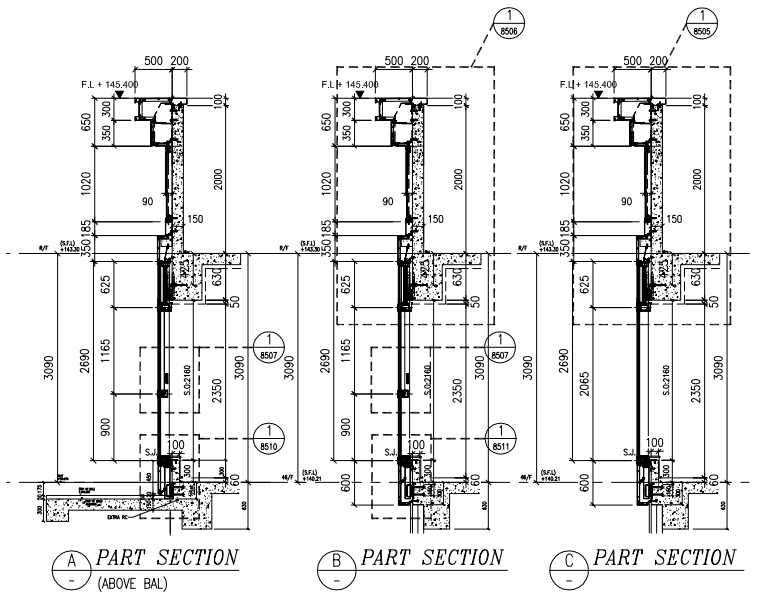


A – *PART SECTION* (ABOVE BAL)

B – *PART SECTION*


C – *PART SECTION*

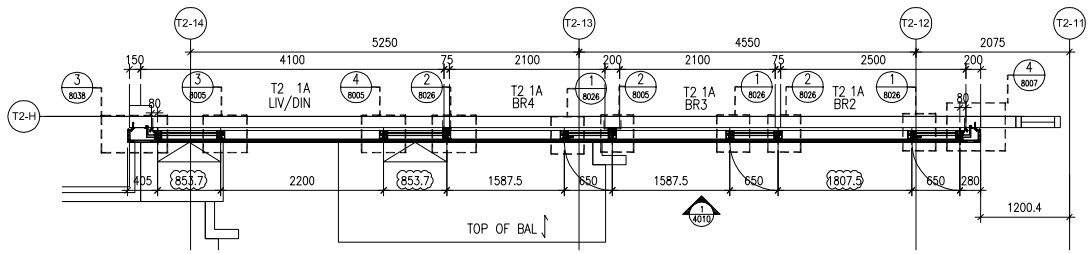


2 4010 *PART PLAN FOR CURTAIN WALL*
"T2-SU-CW3" (HI-VISION)

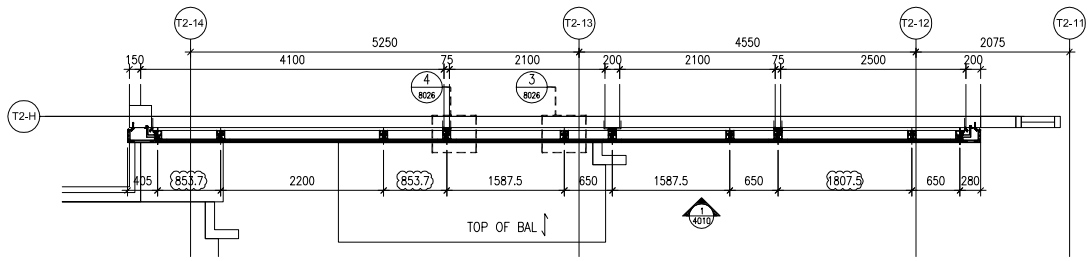

3 4010 *PART PLAN FOR CURTAIN WALL*
"T2-SU-CW3" (LO-VISION)

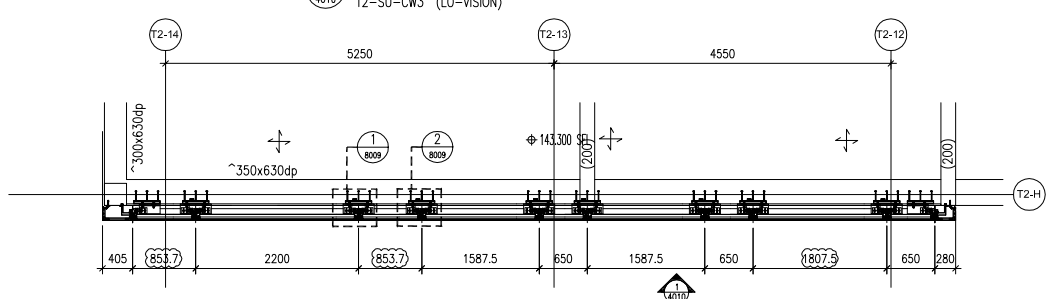


4 4010 *PART PLAN FOR CURTAIN WALL*
"T2-SU-CW3" (SPANDREL)

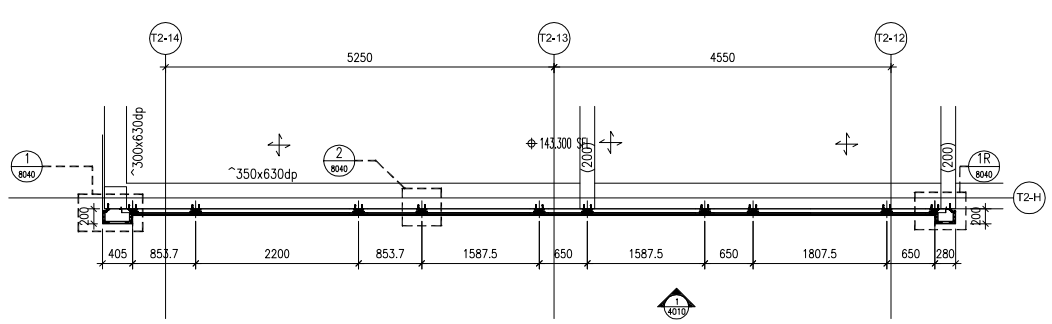

4A 4010 *PART PLAN FOR CURTAIN WALL*
"T2-SU-CW3" (GLASS CLADDING)

LIGHTING AND OPENABLE AREA							
TOWER	FLAT	ROOM	LIGHTING		OPENABLE		REFER CW
			REQUIRED	PROVIDED	REQUIRED	PROVIDED	
T2(SU)	1A	LIV/DIN	3.079 M²	6.828 M²	2.242 M²	1.403(CW)+1.924(SD)=3.327M²	T2-SU-CW3
T2(SU)	1A	BR2	0.525 M²	4.309 M²	0.328 M²	0.509 M²	T2-SU-CW3
T2(SU)	1A	BR3	0.441 M²	3.880 M²	0.276 M²	0.509 M²	T2-SU-CW3
T2(SU)	1A	BR4	0.441 M²	3.880 M²	0.276 M²	0.509 M²	T2-SU-CW3

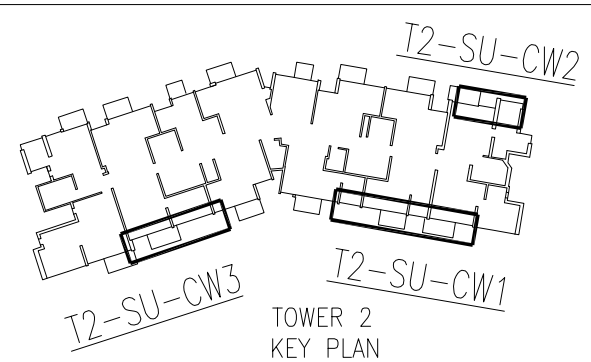

TOWER 2
KEY PLAN

B.D. REF :

CLIENT :
SUN HUNG KAI REAL ESTATE AGENCY LTD.
42/F SUN HUNG KAI CENTRE, WANCHAI, HONGKONG

ARCHITECT :
lwk&partners
a r c h i t e c t s

MAIN CONTRACTOR :
怡輝建築有限公司
Yee Fai Building Contractors Ltd.

STRUCTURAL ENGINEER :
ARUP

FACADE CONSULTANT:
ALPHA CONSULTING LIMITED
Steel Structure & Facade Specialist

NOTE :
1. ALL DIMENSIONS ARE IN mm.
2. ALL ELEVATIONS ARE VIEWED FROM OUTSIDE.
3. ALL DIMENSIONS TO BE VERIFIED ON SITE BEFORE FABRICATION.

LEGEND :
X1 — DETAIL MARK NO.
X001 — REFER SHEET NO.

1. F.F.L. -- FINISHED FLOOR LEVEL
2. S.F.L. -- STRUCTURAL FLOOR LEVEL
3. /R -- REVERSED DETAIL

LEGEND:
G1 IGU GLASS: 8mm HEAT STRENGTHENED +12mm AIR +10mm TEMPERED (VISION)
G13 IGU GLASS: 8mm HEAT STRENGTHENED +12mm AIR +12mm TEMPERED (VISION)
G14 12mm HEAT STRENDTHENED GLASS (SPANDREL) /W 2MM BACK PANEL
G15 12mm TEMPERED GLASS (PROTECTIVE BARRIER)
3mm ALUM. CLADDING COLOR: UCT309119XLB-3
3mm ALUM. CLADDING COLOR: UCT542919XL-3
WIND LOAD + DEAD LOAD BRACKET
▲ : WIND LOAD (STARTER CAST-IN EMBED)
S.J.: WIND LOAD (STACK JOINT)

NO.	DATE	REVISED	BY
D	12-OCT-2023	9TH SUBMISSION	CF
C	22-AUG-2023	7TH SUBMISSION	CF
B	21-FEB-2023	4TH SUBMISSION	CF
A	22-DEC-2022	2ND SUBMISSION	CF

JOB NO. : J-856

PROJECT :
PROPOSED DEVELOPMENT ABOVE LIGHT RAIL TIN WING STOP,TSWTL NO.23,AREA 33,TIN SHUI WAI, N.T.


TITLE :
PART ELEV & PLAN & SECTION FOR CURTAIN WALL @ TOWER 2 SU (46/F)

DATE : 31-OCT-22 | SCALE : 1:100


DRAWN BY : C.F | CHECKED BY :

美特鋁質有限公司
MIDI ALUMINIUM FABRICATOR LTD.
Units 6-8, Sunray Industrial Centre, 1/F
610 Cha Kwo Ling Road, Kowloon
Tel:23489211-4 Fax:(852)27727666

DWG NO. : J856-SD-CW-4010 | REV. : D

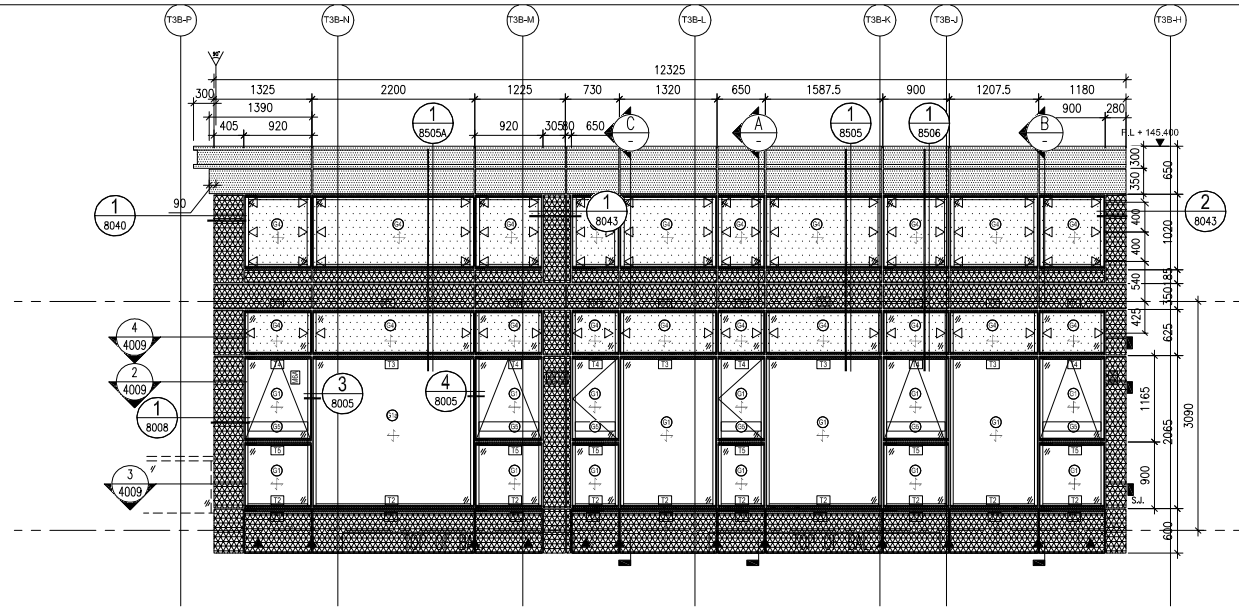


1 4011 *PART ELEV. FOR CURTAIN WALL*
"T3-SU-CW1"

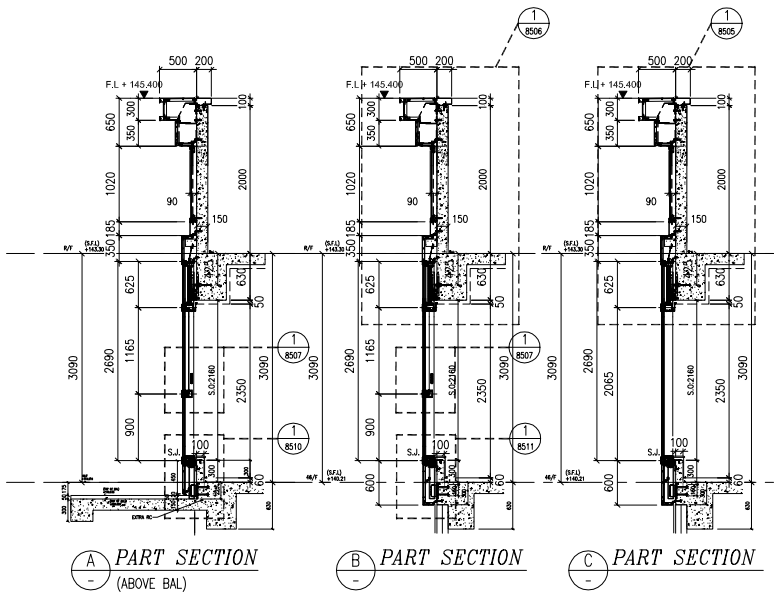

A – *PART SECTION* (ABOVE BAL)


B – *PART SECTION*

C – *PART SECTION*

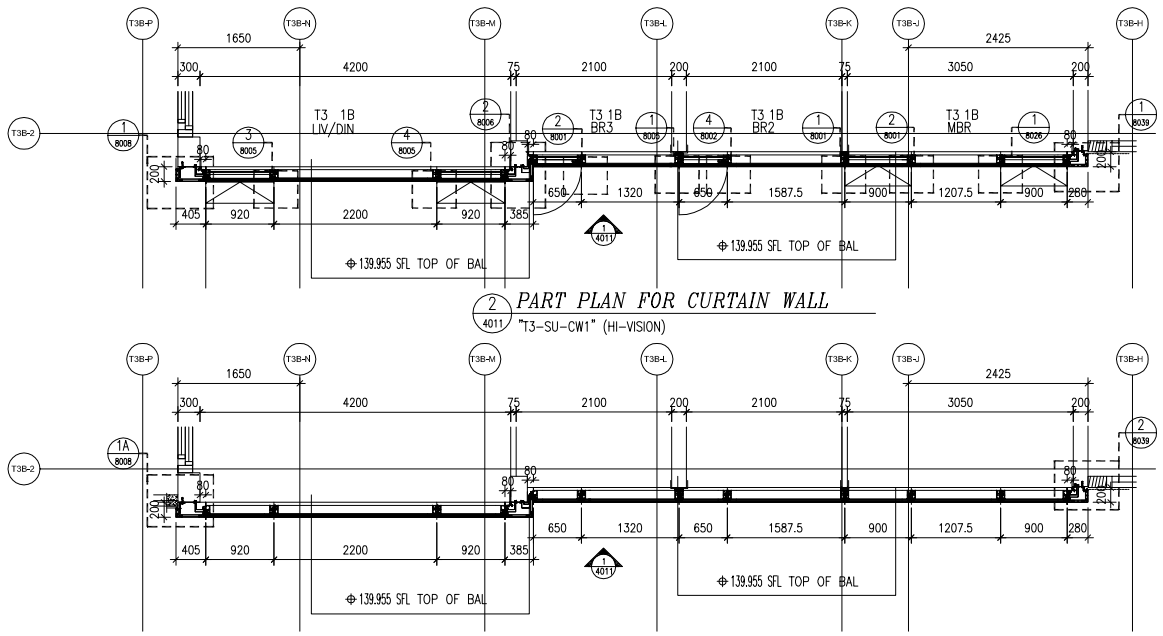


2 4011 *PART PLAN FOR CURTAIN WALL*
"T3-SU-CW1" (HI-VISION)

3 4011 *PART PLAN FOR CURTAIN WALL*
"T3-SU-CW1" (LO-VISION)

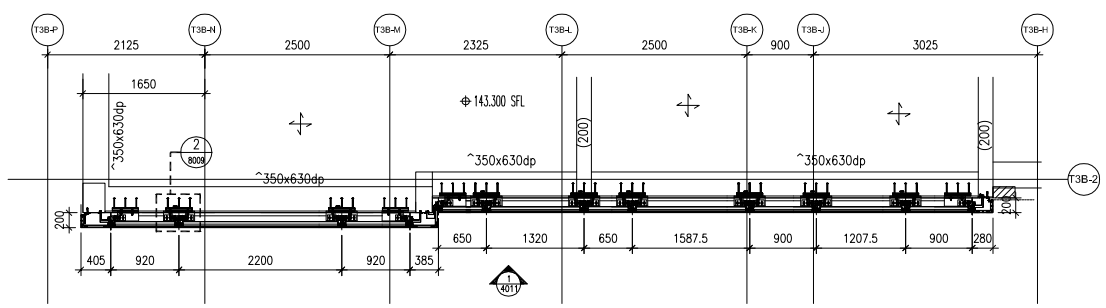


4 4011 *PART PLAN FOR CURTAIN WALL*
"T3-SU-CW1" (SPANDREL)

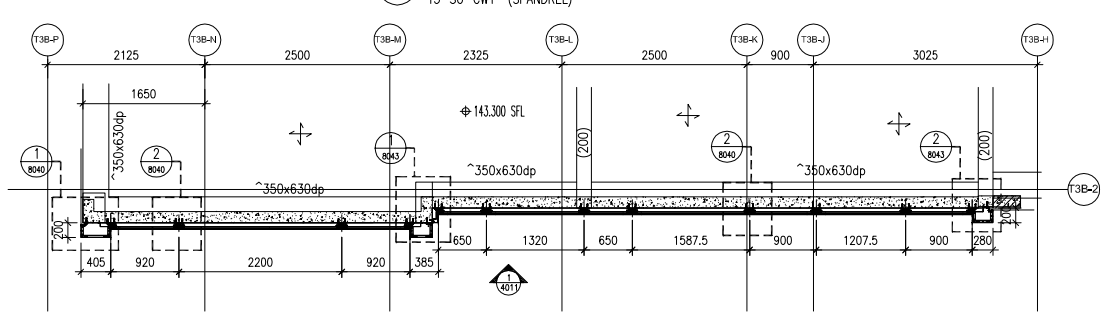

4A 4011 *PART PLAN FOR CURTAIN WALL*
"T3-SU-CW1" (GLASS CLADDING)

LIGHTING AND OPENABLE AREA							
TOWER	FLAT	ROOM	LIGHTING		OPENABLE		REFER CW
			REQUIRED	PROVIDED	REQUIRED	PROVIDED	
T3(SU)	1B	LIV/DIN	3.106 M²	7.073 M²	2.259 M²	1.528(CW)+4.934(SD)=6.462M²	T3-SU-CW1
T3(SU)	1B	BR2	0.441 M²	3.880 M²	0.276 M²	0.509 M²	T3-SU-CW1
T3(SU)	1B	BR3	0.440 M²	3.880 M²	0.275 M²	0.509 M²	T3-SU-CW1
T3(SU)	1B	MBR	1.505 M²	5.063 M²	1.442 M²	1.490 M²	T3-SU-CW1

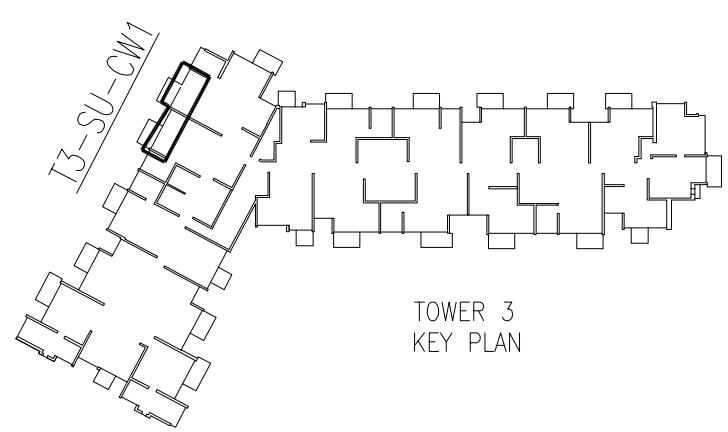

B.D. REF :

CLIENT :
SUN HUNG KAI REAL ESTATE AGENCY LTD.
42/F SUN HUNG KAI CENTRE, WANCHAI, HONGKONG

ARCHITECT :
lwk&partners
a r c h i t e c t s

MAIN CONTRACTOR :
怡輝建築有限公司
Yee Fai Building Contractors Ltd.

STRUCTURAL ENGINEER :
ARUP

FACADE CONSULTANT:
ALPHA CONSULTING LIMITED
Steel Structure & Facade Specialist

NOTE :
1. ALL DIMENSIONS ARE IN mm.
2. ALL ELEVATIONS ARE VIEWED FROM OUTSIDE.
3. ALL DIMENSIONS TO BE VERIFIED ON SITE BEFORE FABRICATION.

LEGEND :
X1 / X001 — DETAIL MARK NO. / REFER SHEET NO.
1. F.F.L. -- FINISHED FLOOR LEVEL
2. S.F.L. -- STRUCTURAL FLOOR LEVEL
3. /R -- REVERSED DETAIL

LEGEND:
G1 IGU GLASS: 8mm HEAT STRENGTHENED +12mm AIR +10mm TEMPERED (VISION)
G1a IGU GLASS: 8mm HEAT STRENGTHENED +12mm AIR +12mm TEMPERED (VISION)
G4 12mm HEAT STRENDTHENED GLASS (SPANDREL) /W 2MM BACK PANEL
G5 12mm TEMPERED GLASS (PROTECTIVE BARRIER)
3mm ALUM. CLADDING COLOR: UCT309119XLB-3
3mm ALUM. CLADDING COLOR: UCT542919XL-3
WIND LOAD + DEAD LOAD BRACKET
▲ : WIND LOAD (STARTER CAST-IN EMBED)
S.J.: WIND LOAD (STACK JOINT)

NO.	DATE	REVISED	BY
D	12-OCT-2023	9TH SUBMISSION	CF
C	22-AUG-2023	7TH SUBMISSION	CF
B	21-FEB-2023	4TH SUBMISSION	CF
A	22-DEC-2022	2ND SUBMISSION	CF

JOB NO. : J-856

PROJECT :
PROPOSED DEVELOPMENT ABOVE LIGHT RAIL TIN WING STOP,TSWTL NO.23,AREA 33,TIN SHUI WAI, N.T.


TITLE :
PART ELEV & PLAN & SECTION FOR CURTAIN WALL @ TOWER 3 SU (46/F)

DATE : 31-OCT-22 | SCALE : 1:100


DRAWN BY : C.F | CHECKED BY :

美特鋁質有限公司
MIDI ALUMINIUM FABRICATOR LTD.
Units 6-8, Sunray Industrial Centre, 1/F
610 Cha Kwo Ling Road, Kowloon
Tel:23489211-4 Fax:(852)27727666


DWG NO. : J856-SD-CW-4011 | REV. : D

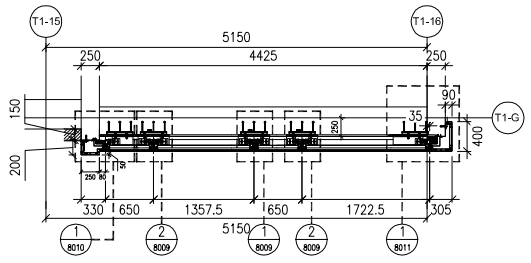


1 5001 *PART PLAN FOR CURTAIN WALL*
"TCW-PE101-1" (GLASS SPANDREL)

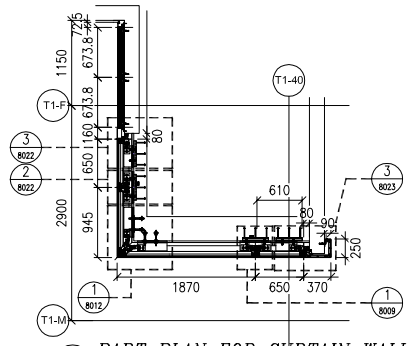


6 5001 *PART PLAN FOR CURTAIN WALL*
"TCW-PE101-2" (GLASS SPANDREL)

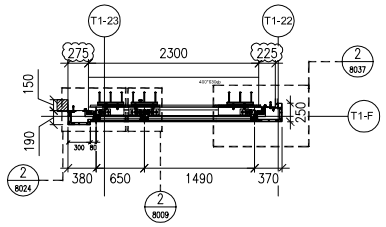


11 5001 *PART PLAN FOR CURTAIN WALL*
"TCW-PE102-1" (GLASS SPANDREL) HIGH 15/F - 45/F

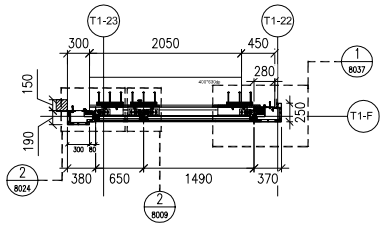


11A 5001 *PART PLAN FOR CURTAIN WALL*
"TCW-PE102-1" (GLASS SPANDREL) LO 5/F -12/F

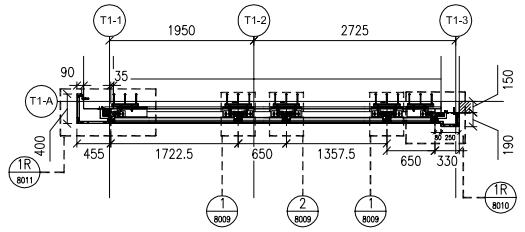


16 5001 *PART PLAN FOR CURTAIN WALL*
"TCW-PE102-2" (GLASS SPANDREL)

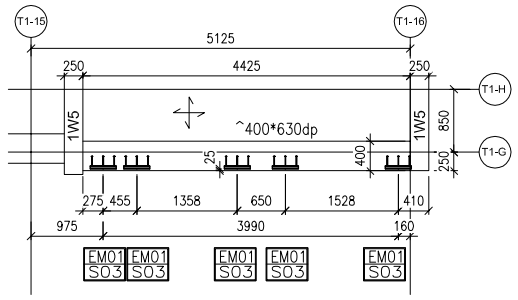


3 5001 *CAST-IN EMBED LAYOUT PLAN*
"TCW-PE101-1" (TOP FIXING)

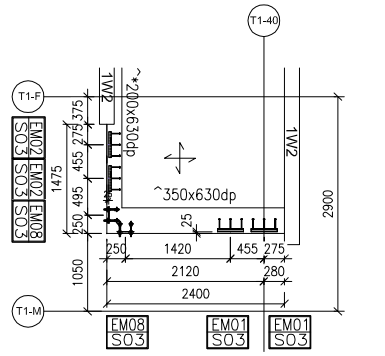


8 5001 *CAST-IN EMBED LAYOUT PLAN*
"TCW-PE101-2" (TOP FIXING)

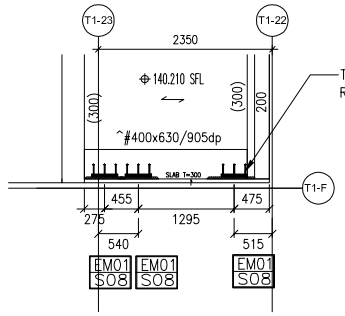


13 5001 *CAST-IN EMBED LAYOUT PLAN*
"TCW-PE102-1" (TOP FIXING)

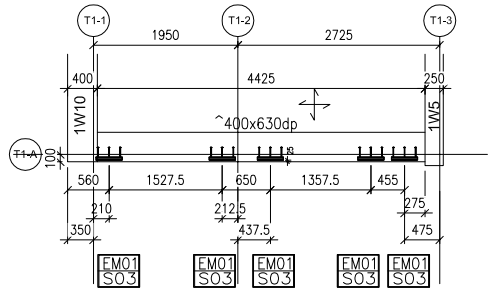


18 5001 *CAST-IN EMBED LAYOUT PLAN*
"TCW-PE102-2" (TOP FIXING)

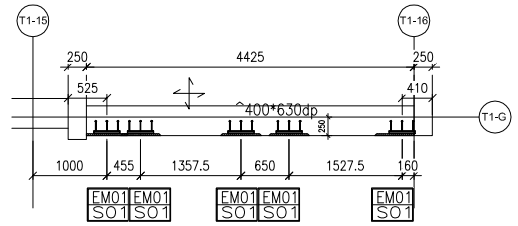


4 5001 *CAST-IN EMBED LAYOUT PLAN*
"TCW-PE101-1" (TYPICAL FIXING)

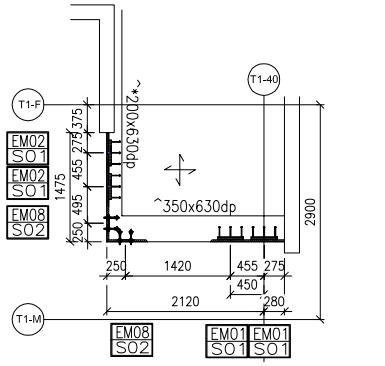


9 5001 *CAST-IN EMBED LAYOUT PLAN*
"TCW-PE101-2" (TYPICAL FIXING)

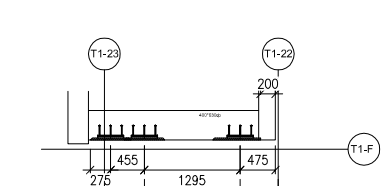


14 5001 *CAST-IN EMBED LAYOUT PLAN*
"TCW-PE102-1" (TYPICAL FIXING)

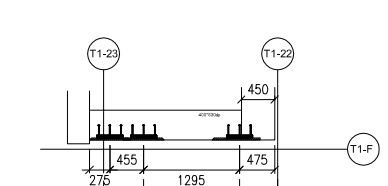


14A 5001 *CAST-IN EMBED LAYOUT PLAN*
"TCW-PE102-1" (TYPICAL FIXING)

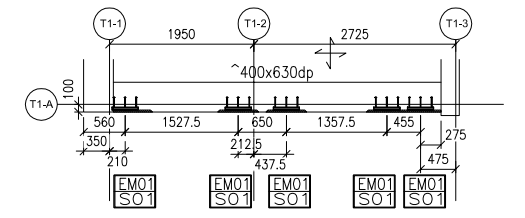


19 5001 *CAST-IN EMBED LAYOUT PLAN*
"TCW-PE102-2" (TYPICAL FIXING)

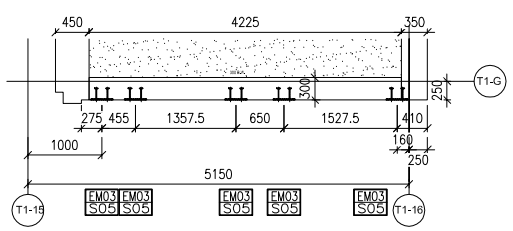


5 5001 *CAST-IN EMBED LAYOUT PLAN*
"TCW-PE101-1" (STARTER)

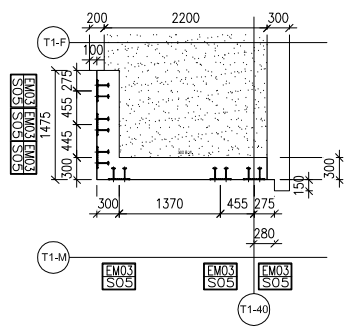


10 5001 *CAST-IN EMBED LAYOUT PLAN*
"TCW-PE101-2" (STARTER)

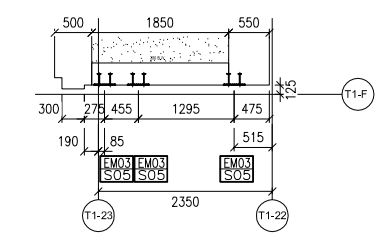

15 5001 *CAST-IN EMBED LAYOUT PLAN*
"TCW-PE102-1" (STARTER)

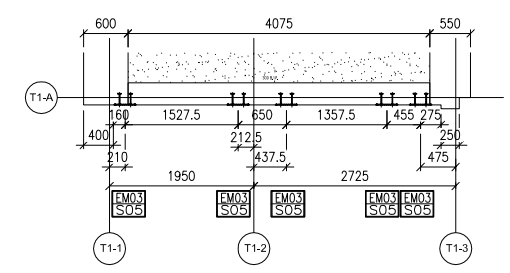

20 5001 *CAST-IN EMBED LAYOUT PLAN*
"TCW-PE102-2" (STARTER)

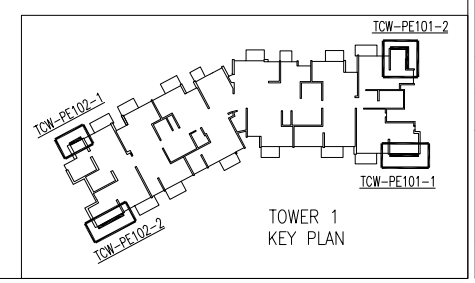

TOWER 1
KEY PLAN

B.D. REF :

CLIENT :
SUN HUNG KAI REAL ESTATE AGENCY LTD.
42/F SUN HUNG KAI CENTRE, WANCHAI, HONGKONG

ARCHITECT :
lwk&partners
a r c h i t e c t s

MAIN CONTRACTOR :
怡輝建築有限公司
Yee Fai Building Contractors Ltd.

STRUCTURAL ENGINEER :
ARUP

FACADE CONSULTANT:
ALPHA CONSULTING LIMITED
Steel Structure & Facade Specialist

NOTE :
1. ALL DIMENSIONS ARE IN mm.
2. ALL ELEVATIONS ARE VIEWED FROM OUTSIDE.
3. ALL DIMENSIONS TO BE VERIFIED ON SITE BEFORE FABRICATION.

LEGEND :
X1 — DETAIL MARK NO.
X001 — REFER SHEET NO.

1. F.F.L. --FINISHED FLOOR LEVEL
2. S.F.L. --STRUCTURAL FLOOR LEVEL
3. /R --REVERSED DETAIL

NO.	DATE	REVISED	BY
E	25-AUG-2023	7TH SUBMISSION	CF
D	20-APR-2023	5TH SUBMISSION	CF
C	21-FEB-2023	4TH SUBMISSION	CF
B	13-JAN-2023	3TH SUBMISSION	CF
A	22-DEC-2022	2ND SUBMISSION	CF

JOB NO. : J-856

PROJECT :
PROPOSED DEVELOPMENT ABOVE LIGHT RAIL TIN WING STOP,TSWTL NO.23,AREA 33,TIN SHUI WAI, N.T.


TITLE :
PART PLAN
FOR CURTAIN WALL
@ TOWER 1 (TYPICAL)

DATE : 31-OCT-22 | SCALE : 1:100


DRAWN BY : C.F | CHECKED BY :

美特鋁質有限公司
MIDI ALUMINIUM FABRICATOR LTD.
Units 6-8, Sunray Industrial Centre, 1/F
610 Cha Kwo Ling Road, Kowloon
Tel:23489211-4 Fax:(852)27727666


DWG NO. : J856-SD-CW-5001 | REV. : E

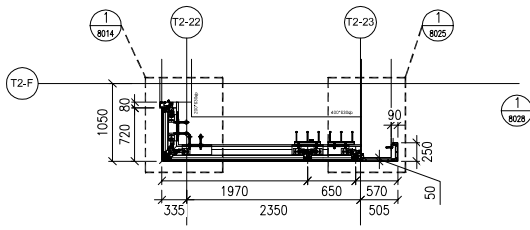


1 5002 *PART PLAN FOR CURTAIN WALL*
"TCW-PE201-1" (GLASS SPANDREL)

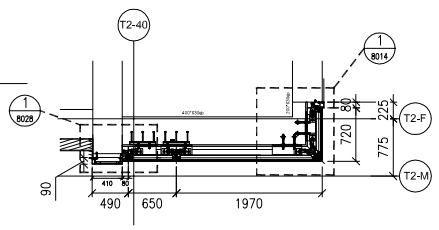


6 5002 *PART PLAN FOR CURTAIN WALL*
"TCW-PE201-2" (GLASS SPANDREL)

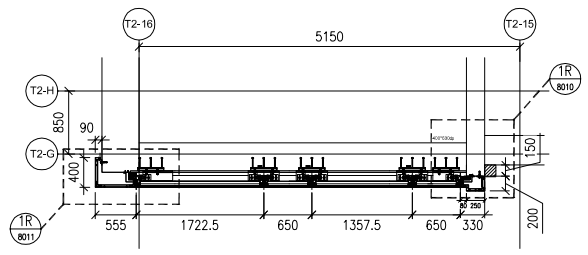


11 5002 *PART PLAN FOR CURTAIN WALL*
"TCW-PE202-1" (GLASS SPANDREL)

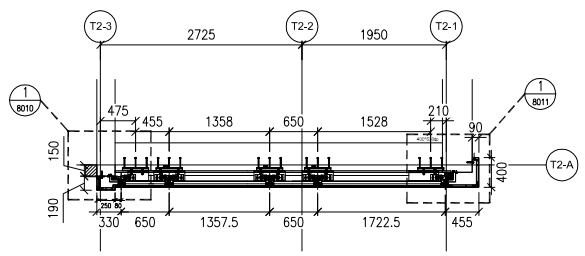


16 5002 *PART PLAN FOR CURTAIN WALL*
"TCW-PE202-2" (GLASS SPANDREL)

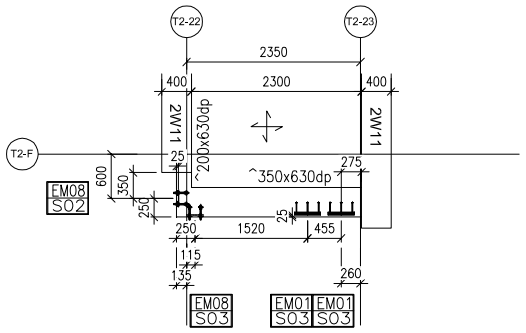


3 5002 *CAST-IN EMBED LAYOUT PLAN*
"TCW-PE201-1" (TOP FIXING)

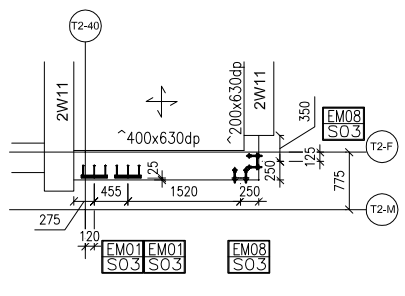


8 5002 *CAST-IN EMBED LAYOUT PLAN*
"TCW-PE201-2" (TOP FIXING)

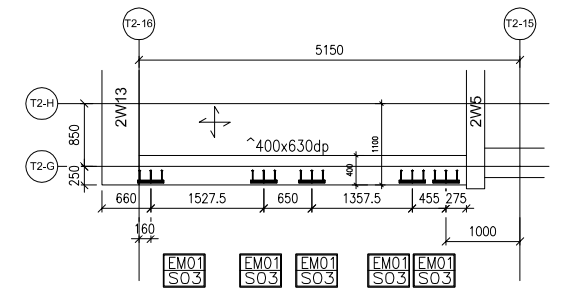


13 5002 *CAST-IN EMBED LAYOUT PLAN*
"TCW-PE202-1" (TOP FIXING)

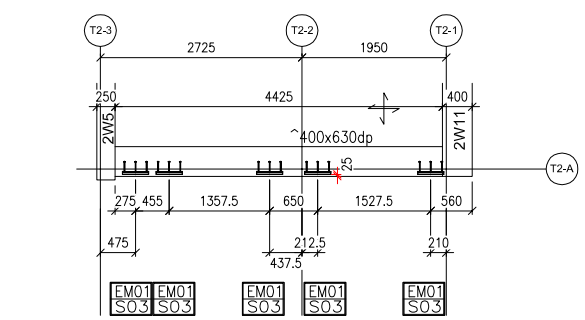


18 5002 *CAST-IN EMBED LAYOUT PLAN*
"TCW-PE202-2" (TOP FIXING)

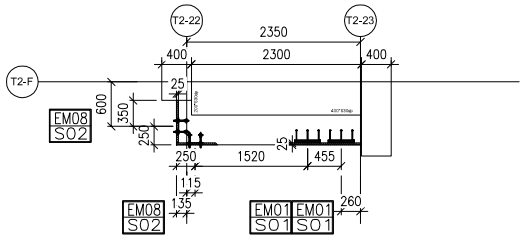


4 5002 *CAST-IN EMBED LAYOUT PLAN*
"TCW-PE201-1" (TYPICAL FIXING)

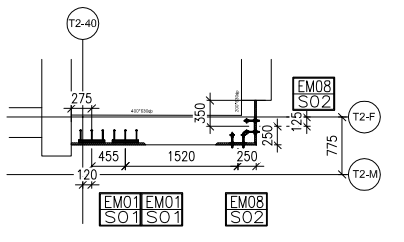


9 5002 *CAST-IN EMBED LAYOUT PLAN*
"TCW-PE201-2" (TYPICAL FIXING)

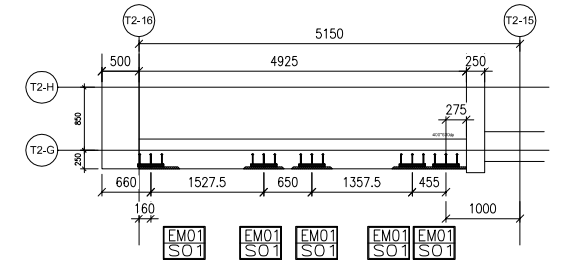


14 5002 *CAST-IN EMBED LAYOUT PLAN*
"TCW-PE202-1" (TYPICAL FIXING)

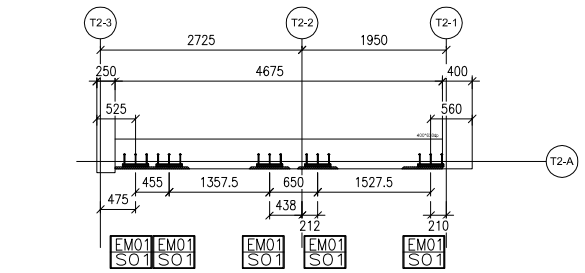


19 5002 *CAST-IN EMBED LAYOUT PLAN*
"TCW-PE202-2" (TYPICAL FIXING)

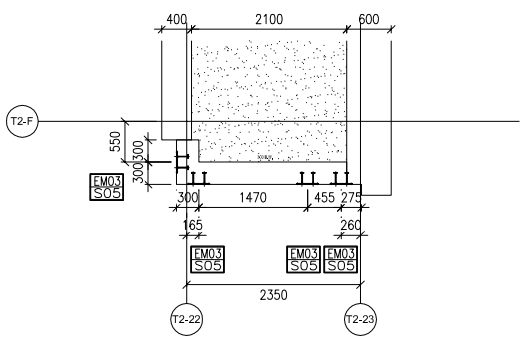


5 5002 *CAST-IN EMBED LAYOUT PLAN*
"TCW-PE201-1" (STARTER)

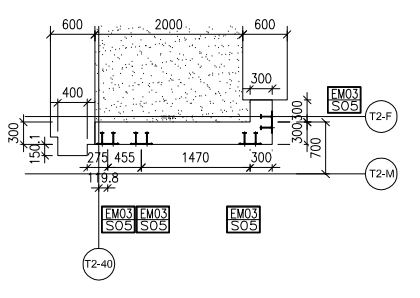


10 5002 *CAST-IN EMBED LAYOUT PLAN*
"TCW-PE201-2" (STARTER)

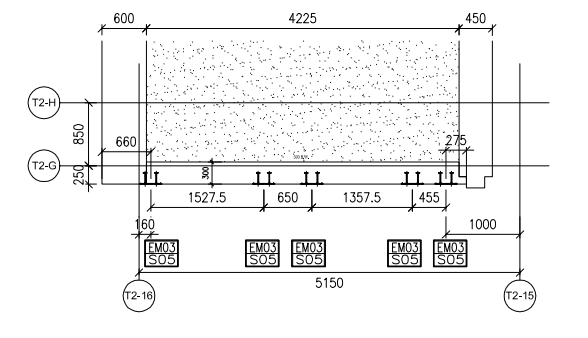


15 5002 *CAST-IN EMBED LAYOUT PLAN*
"TCW-PE202-1" (STARTER)

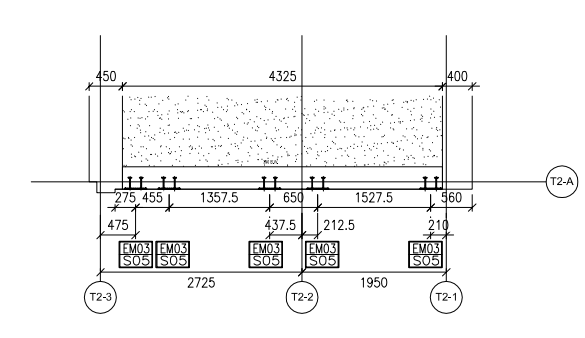

20 5002 *CAST-IN EMBED LAYOUT PLAN*
"TCW-PE202-2" (STARTER)

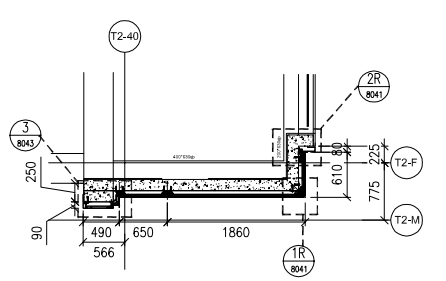

21 5002 *PART PLAN FOR GLASS CLADDING*
"TCW-PE201-2" (GLASS CLADDING @46/F))

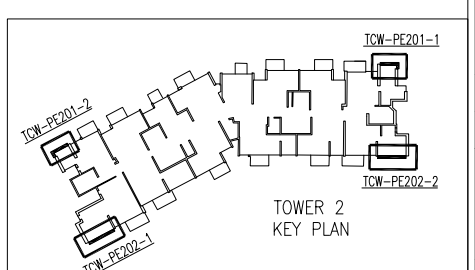

B.D. REF :

CLIENT :

SUN HUNG KAI REAL ESTATE AGENCY LTD.
42/F SUN HUNG KAI CENTRE, WANCHAI, HONGKONG

ARCHITECT :

lwk&partners
a r c h i t e c t s

MAIN CONTRACTOR :

怡輝建築有限公司
Yee Fai Building Contractors Ltd.

STRUCTURAL ENGINEER :

ARUP

FACADE CONSULTANT:

ALPHA CONSULTING LIMITED
Steel Structure & Facade Specialist

NOTE :
1. ALL DIMENSIONS ARE IN mm.
2. ALL ELEVATIONS ARE VIEWED FROM OUTSIDE.
3. ALL DIMENSIONS TO BE VERIFIED ON SITE BEFORE FABRICATION.

LEGEND :

X1 — DETAIL MARK NO.
X001 — REFER SHEET NO.

1. F.F.L. --FINISHED FLOOR LEVEL
2. S.F.L. --STRUCTURAL FLOOR LEVEL
3. (R) --REVERSED DETAIL

NO.	DATE	REVISED	BY
E	25-AUG-2023	7TH SUBMISSION	CF
D	03-MAY-2023	5TH SUBMISSION	CF
C	21-FEB-2023	4TH SUBMISSION	CF
B	13-JAN-2023	3TH SUBMISSION	CF
A	22-DEC-2022	2ND SUBMISSION	CF

JOB NO. : J-856

PROJECT :
PROPOSED DEVELOPMENT ABOVE LIGHT RAIL TIN WING STOP,TSWTL NO.23,AREA 33,TIN SHUI WAI, N.T.


TITLE :
PART PLAN
FOR CURTAIN WALL
@ TOWER 2 (TYPICAL)

DATE : 31-OCT-22 | SCALE : 1:10


DRAWN BY : C.F | CHECKED BY :

美特鋁質有限公司
MIDI ALUMINIUM FABRICATOR LTD.
Units 6-8, Sunray Industrial Centre, 1/F
610 Cha Kwo Ling Road, Kowloon
Tel:23489211-4 Fax:(852)27727666


DWG NO. : J856-SD-CW-5002 | REV. : E

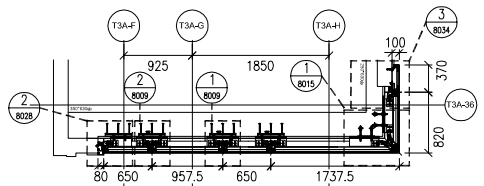


1 5003 *PART PLAN FOR CURTAIN WALL*
"TCW-PE301-1" (GLASS SPANDREL)

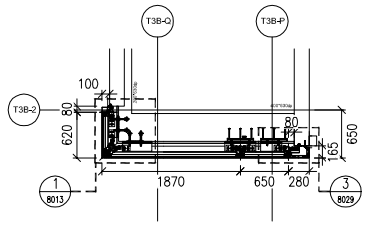


6 5003 *PART PLAN FOR CURTAIN WALL*
"TCW-PE301-2" (GLASS SPANDREL)

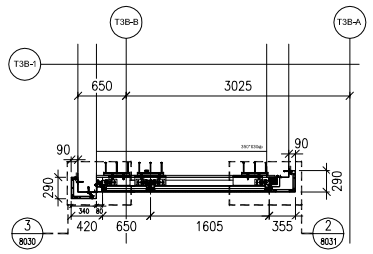


11 5003 *PART PLAN FOR CURTAIN WALL*
"TCW-PE302-1" (GLASS SPANDREL)

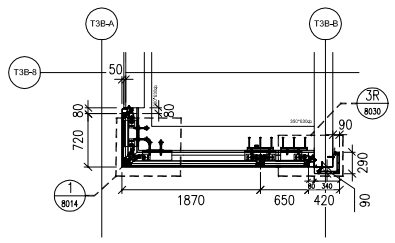


16 5003 *PART PLAN FOR CURTAIN WALL*
"TCW-PE302-2" (GLASS SPANDREL)

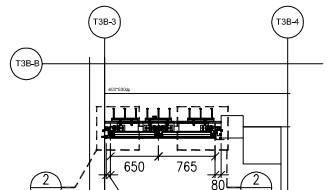


21 5003 *PART PLAN FOR CURTAIN WALL*
"TCW-PE303-1" (GLASS SPANDREL)

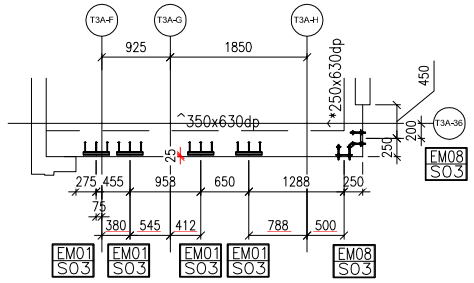


3 5003 *CAST-IN EMBED LAYOUT PLAN*
"TCW-PE301-1" (TOP FIXING)

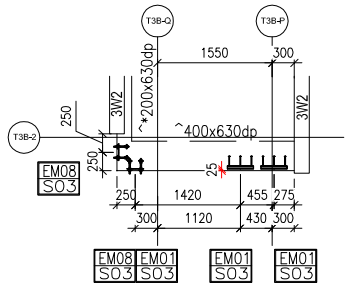


8 5003 *CAST-IN EMBED LAYOUT PLAN*
"TCW-PE301-2" (TOP FIXING)

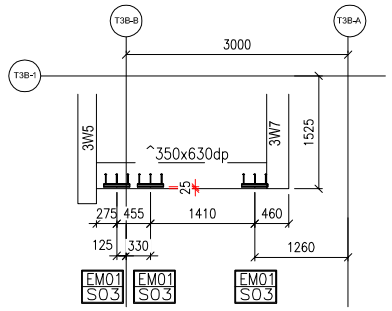


13 5003 *CAST-IN EMBED LAYOUT PLAN*
"TCW-PE302-1" (TOP FIXING)

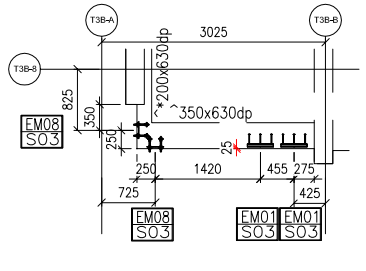


18 5003 *CAST-IN EMBED LAYOUT PLAN*
"TCW-PE302-2" (TOP FIXING)

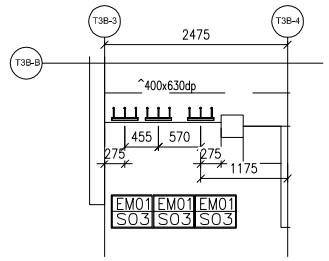


23 5003 *CAST-IN EMBED LAYOUT PLAN*
"TCW-PE303-1" (TOP FIXING)

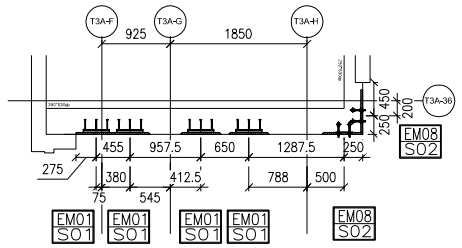


4 5003 *CAST-IN EMBED LAYOUT PLAN*
"TCW-PE301-1" (TYPICAL FIXING)

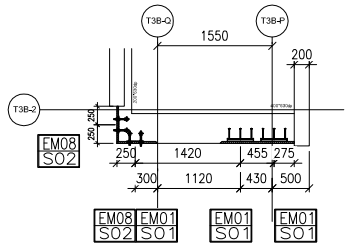


9 5003 *CAST-IN EMBED LAYOUT PLAN*
"TCW-PE301-2" (TYPICAL FIXING)

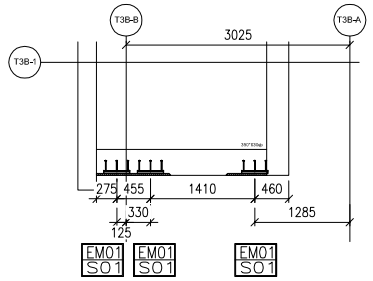


14 5003 *CAST-IN EMBED LAYOUT PLAN*
"TCW-PE302-1" (TYPICAL FIXING)

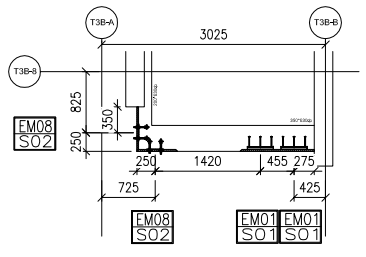


19 5003 *CAST-IN EMBED LAYOUT PLAN*
"TCW-PE302-2" (TYPICAL FIXING)

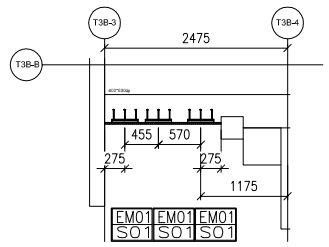


24 5003 *CAST-IN EMBED LAYOUT PLAN*
"TCW-PE303-1" (TYPICAL FIXING)

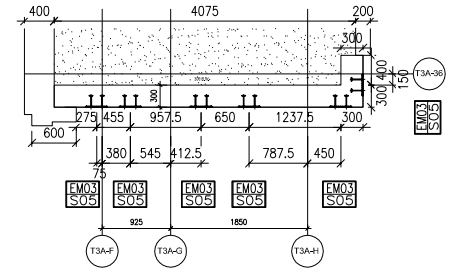


5 5003 *CAST-IN EMBED LAYOUT PLAN*
"TCW-PE301-1" (STARTER)

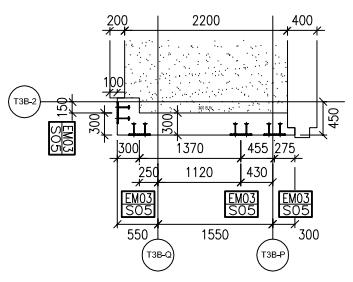


10 5003 *CAST-IN EMBED LAYOUT PLAN*
"TCW-PE301-2" (STARTER)

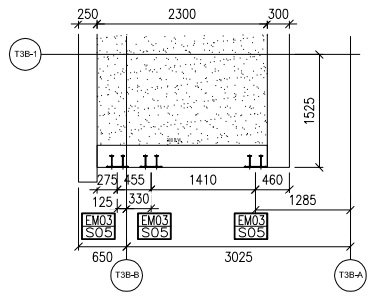


15 5003 *CAST-IN EMBED LAYOUT PLAN*
"TCW-PE302-1" (STARTER)

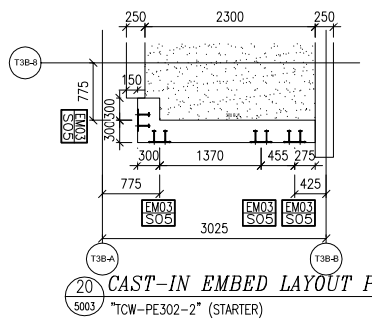


20 5003 *CAST-IN EMBED LAYOUT PLAN*
"TCW-PE302-2" (STARTER)

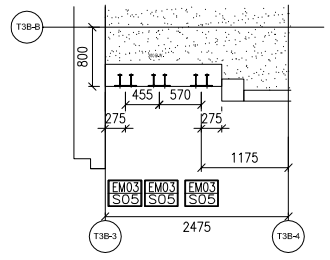

25 5003 *CAST-IN EMBED LAYOUT PLAN*
"TCW-PE303-1" (STARTER)

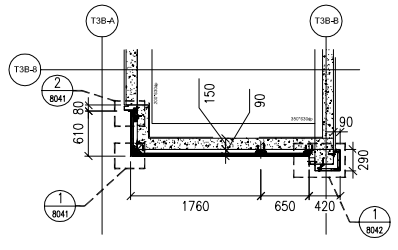

21 5003 *PART PLAN FOR CLASS CLADDING*
"TCW-PE302-2" (GLASS CLADDING @46/F))

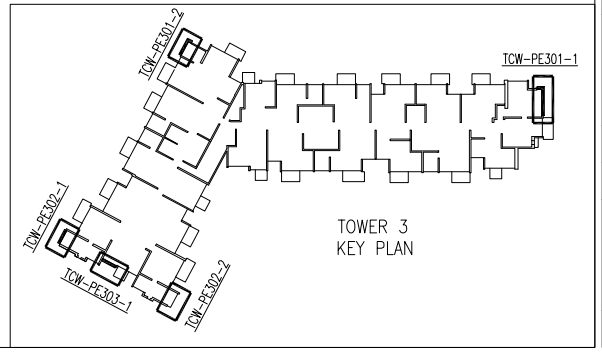

B.D. REF :

CLIENT :
SUN HUNG KAI REAL ESTATE AGENCY LTD.
42/F SUN HUNG KAI CENTRE, WANCHAI, HONGKONG

ARCHITECT :
lwk&partners
a r c h i t e c t s

MAIN CONTRACTOR :
怡輝建築有限公司
Yee Fai Building Contractors Ltd.

STRUCTURAL ENGINEER :
ARUP

FACADE CONSULTANT:
ALPHA CONSULTING LIMITED
Steel Structure & Facade Specialist

NOTE :
1. ALL DIMENSIONS ARE IN mm.
2. ALL ELEVATIONS ARE VIEWED FROM OUTSIDE.
3. ALL DIMENSIONS TO BE VERIFIED ON SITE BEFORE FABRICATION.

LEGEND :
X1 — DETAIL MARK NO.
X001 — REFER SHEET NO.
1. F.F.L. --FINISHED FLOOR LEVEL
2. S.F.L. --STRUCTURAL FLOOR LEVEL
3. /R --REVERSED DETAIL

NO.	DATE	REVISED	BY
E	25-AUG-2023	7TH SUBMISSION	CF
D	03-MAY-2023	5TH SUBMISSION	CF
C	21-FEB-2023	4TH SUBMISSION	CF
B	13-JAN-2023	3ND SUBMISSION	CF
A	22-DEC-2022	2ND SUBMISSION	CF

JOB NO. : J-856

PROJECT :
PROPOSED DEVELOPMENT ABOVE LIGHT RAIL TIN WING STOP,TSWTL NO.23,AREA 33,TIN SHUI WAI, N.T.


TITLE :
PART PLAN
FOR CURTAIN WALL
@ TOWER 3 (TYPICAL)

DATE : 31-OCT-22 | SCALE : 1:100


DRAWN BY : C.F | CHECKED BY :

美特鋁製有限公司
MIDI ALUMINIUM FABRICATOR LTD.
Units 6-8, Sunray Industrial Centre, 1/F
610 Cha Kwo Ling Road, Kowloon
Tel:23489211-4 Fax:(852)27727666


DWG NO. : J856-SD-CW-5003 | REV. : E

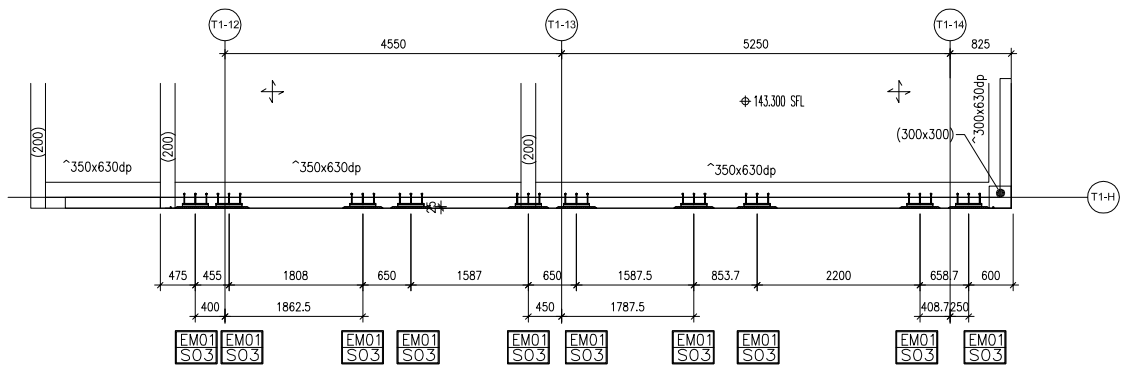


1 5004 *CAST-IN EMBED LAYOUT PLAN*
"T1-SU-CW1" (TOP FIXING) (EM01 @ +142.875)

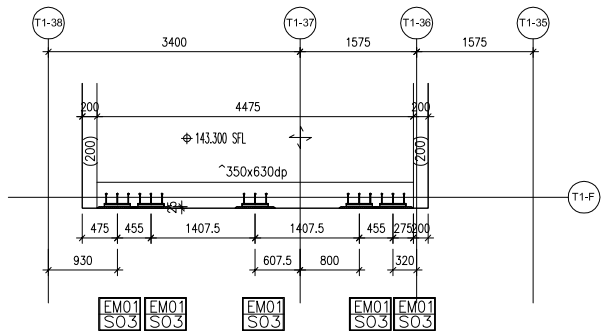


4 5004 *CAST-IN EMBED LAYOUT PLAN*
"T1-SU-CW2" (TOP FIXING) (EM01 @ +142.875)

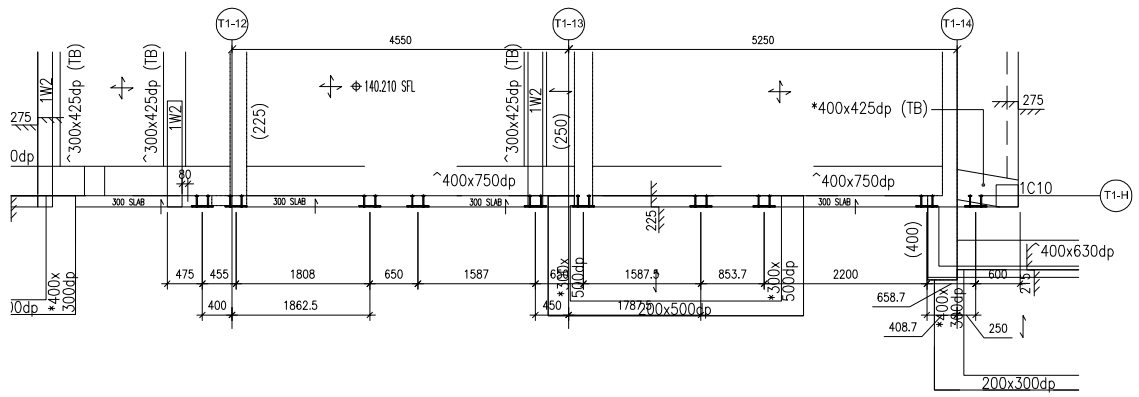


2 5004 *CAST-IN EMBED LAYOUT PLAN*
"T1-SU-CW1" (STARTER) (EM09 @ +140.0975)

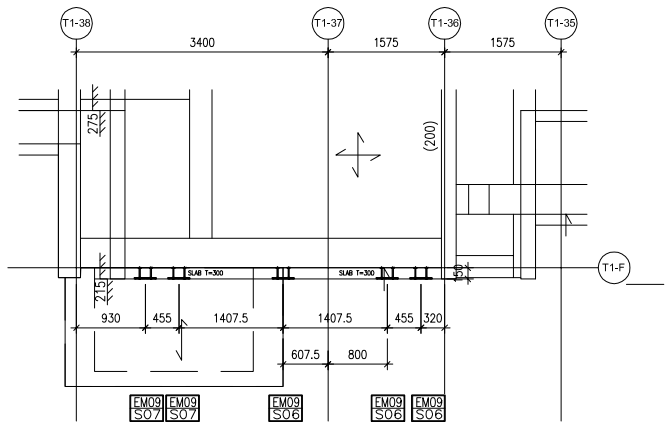


5 5004 *CAST-IN EMBED LAYOUT PLAN*
"T1-SU-CW2" (STARTER) (EM09 @ +140.0975)

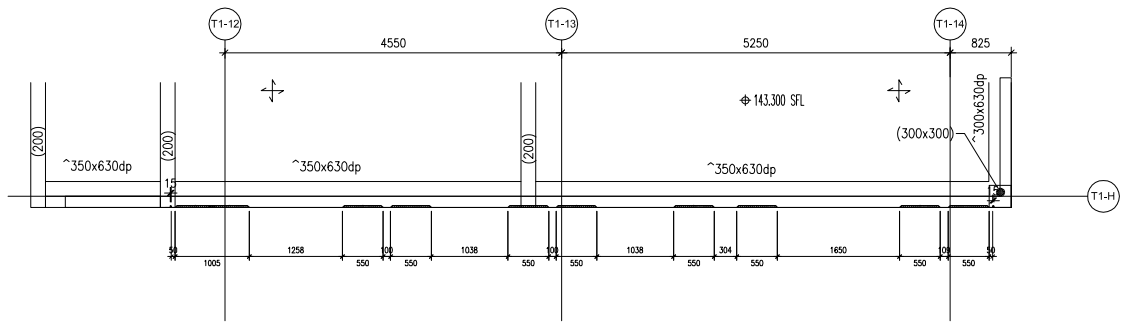

3 5004 *RC RECESS LAYOUT PLAN*
"T1-SU-CW1"

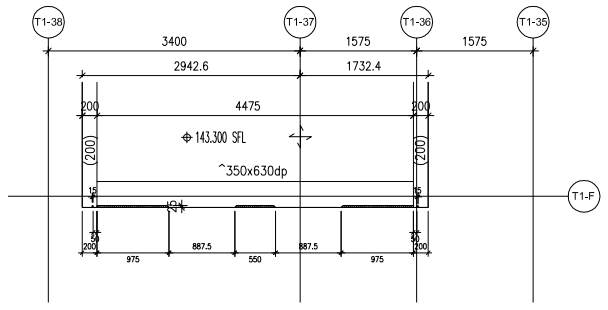

6 5004 *RC RECESS LAYOUT PLAN*
"T1-SU-CW2"

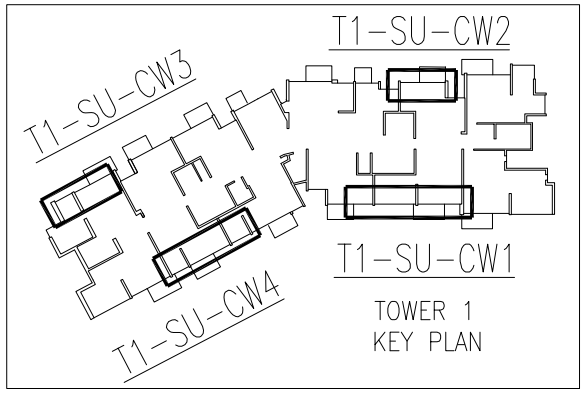

B.D. REF :

CLIENT :
SUN HUNG KAI REAL ESTATE AGENCY LTD.
42/F SUN HUNG KAI CENTRE, WANCHAI, HONGKONG

ARCHITECT :
lwk&partners
a r c h i t e c t s

MAIN CONTRACTOR :
怡輝建築有限公司
Yee Fai Building Contractors Ltd.

STRUCTURAL ENGINEER :
ARUP

FACADE CONSULTANT:
ALPHA CONSULTING LIMITED
Steel Structure & Facade Specialist

NOTE :
1. ALL DIMENSIONS ARE IN mm.
2. ALL ELEVATIONS ARE VIEWED FROM OUTSIDE.
3. ALL DIMENSIONS TO BE VERIFIED ON SITE BEFORE FABRICATION.

LEGEND :
X1 / X001 — DETAIL MARK NO. / REFER SHEET NO.

1. F.F.L. --FINISHED FLOOR LEVEL
2. S.F.L. --STRUCTURAL FLOOR LEVEL
3. /R --REVERSED DETAIL

NO.	DATE	REVISED	BY
A	22-AUG-2023	7TH SUBMISSION	CF
–	21-FEB-2023	4TH SUBMISSION	CF

JOB NO. : J-856

PROJECT :
PROPOSED DEVELOPMENT ABOVE LIGHT RAIL TIN WING STOP,TSWTL NO.23,AREA 33,TIN SHUI WAI, N.T.


TITLE :
EMBED LAYOUT PLAN FOR CURTAIN WALL @ TOWER 1 SU (46/F)

DATE : 28-FEB-23 | SCALE : 1:100


DRAWN BY : C.F | CHECKED BY :

美特鋁質有限公司
MIDI ALUMINIUM FABRICATOR LTD.
Units 6-8, Sunray Industrial Centre, 1/F
610 Cha Kwo Ling Road, Kowloon
Tel:23489211-4 Fax:(852)27727666


DWG NO. : J856-SD-CW-5004 | REV. : A

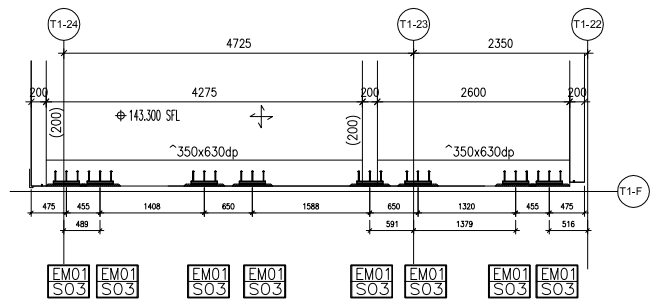


1 5005 *CAST-IN EMBED LAYOUT PLAN*
"T1-SU-CW3" (TOP FIXING) (EM01 @ +142.875)

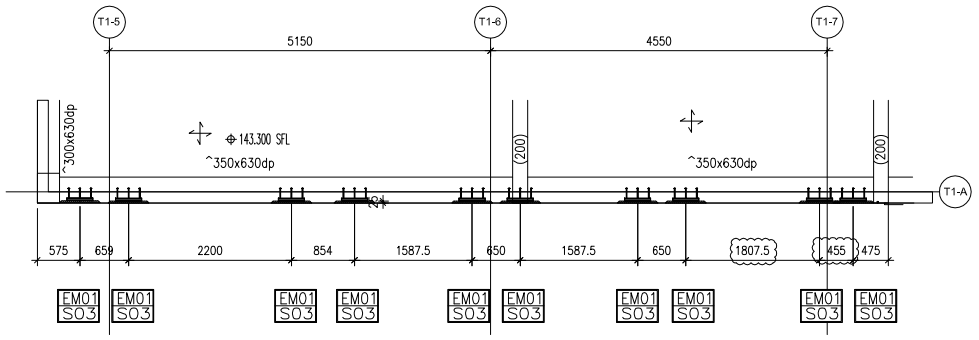


4 5005 *CAST-IN EMBED LAYOUT PLAN*
"T1-SU-CW4" (TOP FIXING) (EM01 @ +142.875)

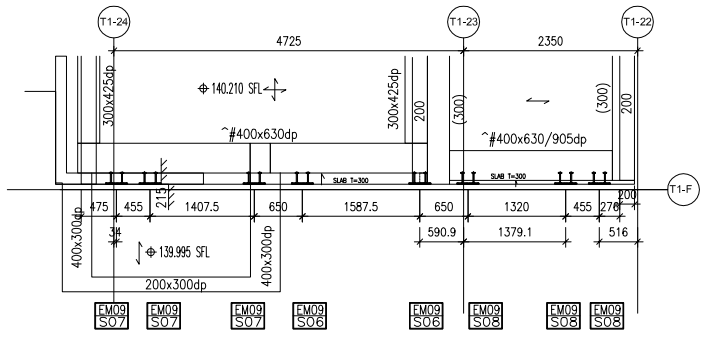


2 5005 *CAST-IN EMBED LAYOUT PLAN*
"T1-SU-CW3" (STARTER) (EM09 @ +140.0975)

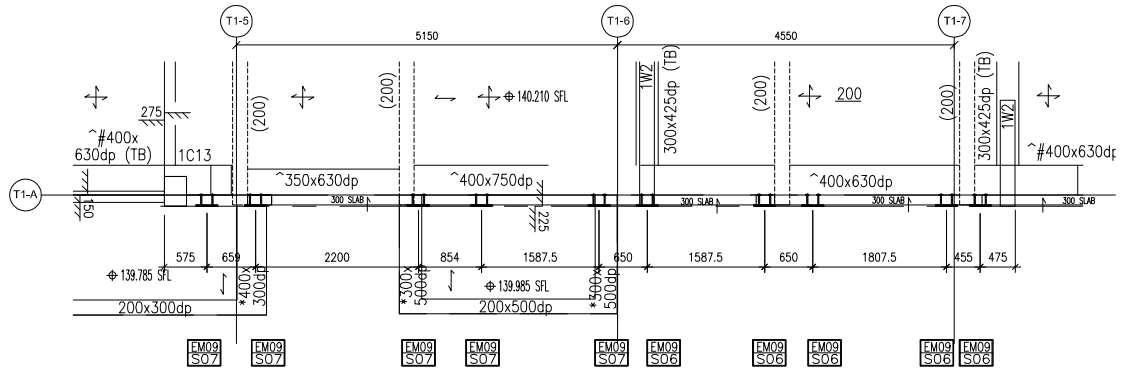


5 5005 *CAST-IN EMBED LAYOUT PLAN*
"T1-SU-CW4" (STARTER) (EM09 @ +140.0975)

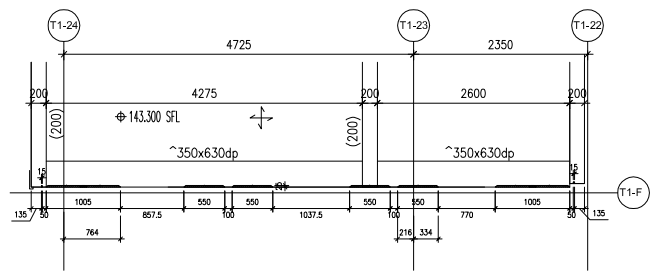

3 5005 *RC RECESS LAYOUT PLAN*
"T1-SU-CW3"

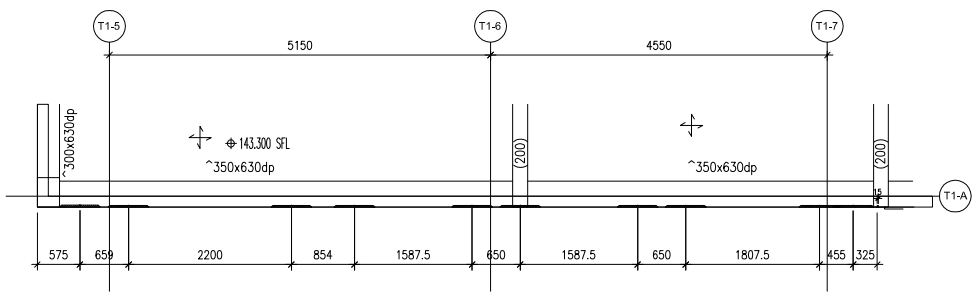

6 5005 *RC RECESS LAYOUT PLAN*
"T1-SU-CW4"

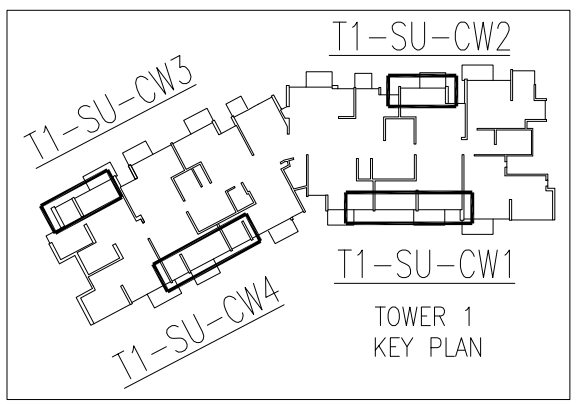

B.D. REF :

CLIENT :
SUN HUNG KAI REAL ESTATE AGENCY LTD.
42/F SUN HUNG KAI CENTRE, WANCHAI, HONGKONG

ARCHITECT :
lwk&partners
a r c h i t e c t s

MAIN CONTRACTOR :
怡輝建築有限公司
Yee Fai Building Contractors Ltd.

STRUCTURAL ENGINEER :
ARUP

FACADE CONSULTANT:
ALPHA CONSULTING LIMITED
Steel Structure & Facade Specialist

NOTE :
1. ALL DIMENSIONS ARE IN mm.
2. ALL ELEVATIONS ARE VIEWED FROM OUTSIDE.
3. ALL DIMENSIONS TO BE VERIFIED ON SITE BEFORE FABRICATION.

LEGEND :
X1 / X001 — DETAIL MARK NO. / REFER SHEET NO.
1. F.F.L. -- FINISHED FLOOR LEVEL
2. S.F.L. -- STRUCTURAL FLOOR LEVEL
3. /R -- REVERSED DETAIL

NO.	DATE	REVISED	BY
B	22-AUG-2023	7TH SUBMISSION	CF
A	10-MAY-2023	5TH SUBMISSION	CF
–	21-FEB-2023	4TH SUBMISSION	CF

JOB NO. : J-856

PROJECT :
PROPOSED DEVELOPMENT ABOVE LIGHT RAIL TIN WING STOP,TSWTL NO.23,AREA 33,TIN SHUI WAI, N.T.


TITLE :
EMBED LAYOUT PLAN
FOR CURTAIN WALL
@ TOWER 1 SU (46/F)

DATE : 28-FEB-23 | SCALE : 1:100


DRAWN BY : C.F | CHECKED BY :

美特鋁質有限公司
MIDI ALUMINIUM FABRICATOR LTD.
Units 6-8, Sunray Industrial Centre, 1/F
610 Cha Kwo Ling Road, Kowloon
Tel:23489211-4 Fax:(852)27727666


DWG NO. : J856-SD-CW-5005 | REV. : B

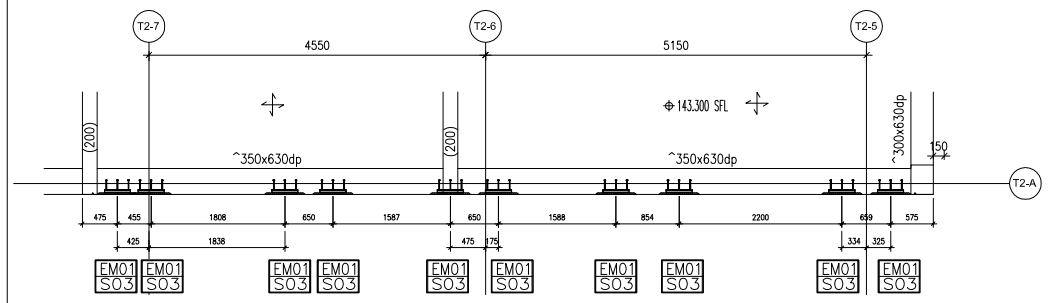


1 5006 *CAST-IN EMBED LAYOUT PLAN*
"T2-SU-CW1" (TOP FIXING) (EM01 @ +142.875)

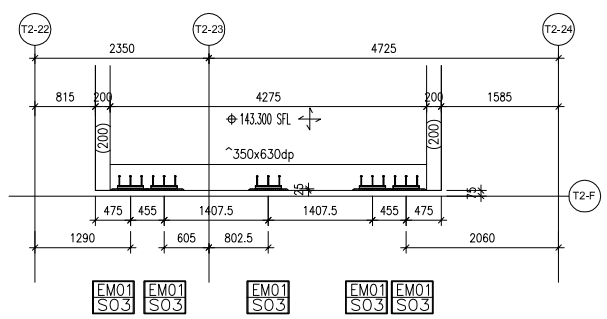


4 5006 *CAST-IN EMBED LAYOUT PLAN*
"T2-SU-CW2" (TOP FIXING) (EM01 @ +142.875)

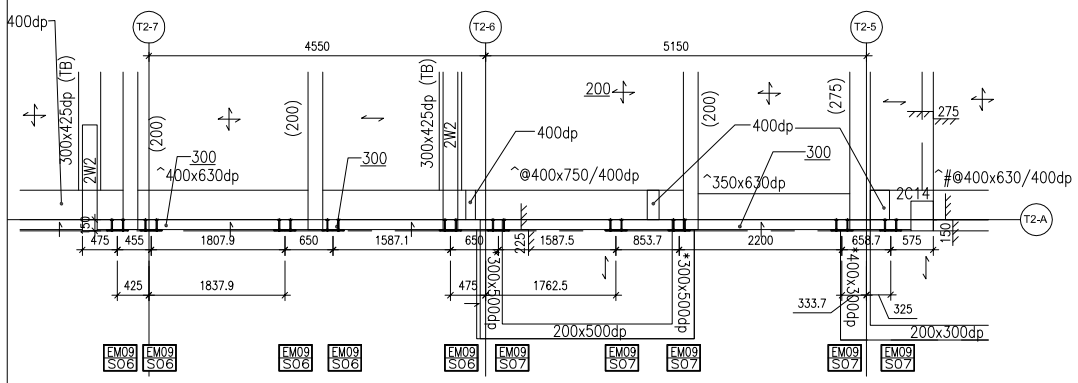


2 5006 *CAST-IN EMBED LAYOUT PLAN*
"T2-SU-CW1" (STARTER) (EM09 @ +140.0975)

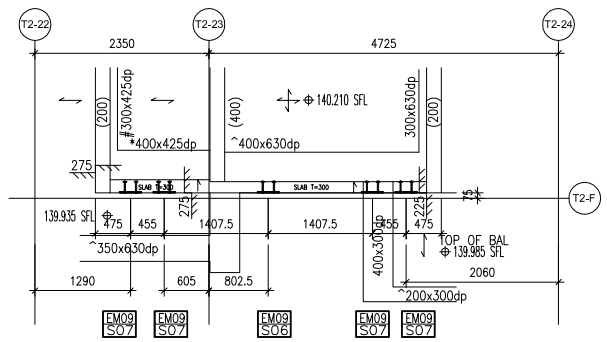


5 5006 *CAST-IN EMBED LAYOUT PLAN*
"T2-SU-CW2" (STARTER) (EM09 @ +140.0975)

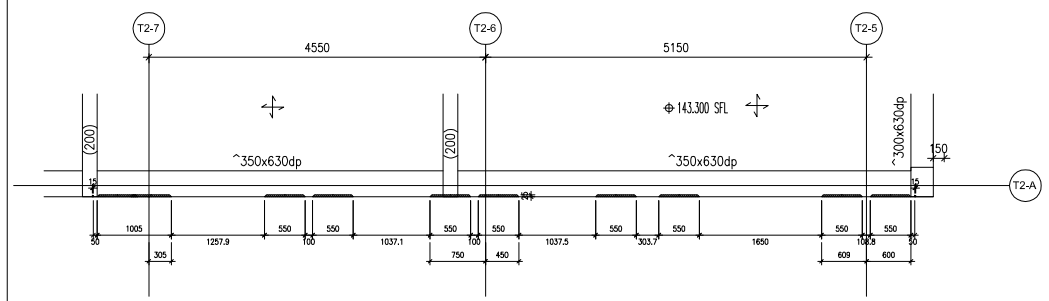

3 5006 *RC RECESS LAYOUT PLAN*
"T2-SU-CW1"

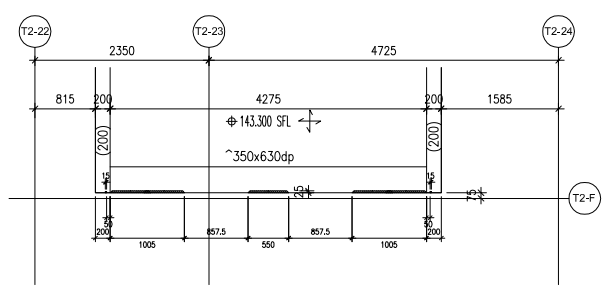

6 5006 *RC RECESS LAYOUT PLAN*
"T2-SU-CW2"

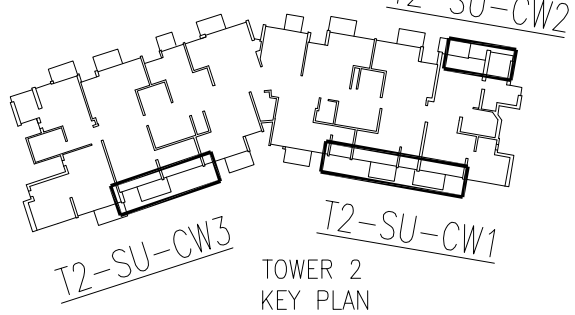

TOWER 2
KEY PLAN

B.D. REF :

CLIENT :
SUN HUNG KAI REAL ESTATE AGENCY LTD.
42/F SUN HUNG KAI CENTRE, WANCHAI, HONGKONG

ARCHITECT :
lwk&partners
a r c h i t e c t s

MAIN CONTRACTOR :
怡輝建築有限公司
Yee Fai Building Contractors Ltd.

STRUCTURAL ENGINEER :
ARUP

FACADE CONSULTANT:
ALPHA CONSULTING LIMITED
Steel Structure & Facade Specialist

NOTE :
1. ALL DIMENSIONS ARE IN mm.
2. ALL ELEVATIONS ARE VIEWED FROM OUTSIDE.
3. ALL DIMENSIONS TO BE VERIFIED ON SITE BEFORE FABRICATION.

LEGEND :
X1 — DETAIL MARK NO.
X001 — REFER SHEET NO.
1. F.F.L. --FINISHED FLOOR LEVEL
2. S.F.L. --STRUCTURAL FLOOR LEVEL
3. /R --REVERSED DETAIL

NO.	DATE	REVISED	BY
A	22-AUG-2023	7TH SUBMISSION	CF
–	21-FEB-2023	4TH SUBMISSION	CF

JOB NO. : J-856

PROJECT :
PROPOSED DEVELOPMENT ABOVE LIGHT RAIL TIN WING STOP,TSWTL NO.23,AREA 33,TIN SHUI WAI, N.T.


TITLE :
EMBED LAYOUT PLAN
FOR CURTAIN WALL
@ TOWER 2 SU (46/F)

DATE : 28-FEB-23 | SCALE : 1:100


DRAWN BY : C.F | CHECKED BY :

美特鋁質有限公司
MIDI ALUMINIUM FABRICATOR LTD.
Units 6-8, Sunray Industrial Centre, 1/F
610 Cha Kwo Ling Road, Kowloon
Tel:23489211-4 Fax:(852)27727666


DWG NO. : J856-SD-CW-5006 | REV. : A

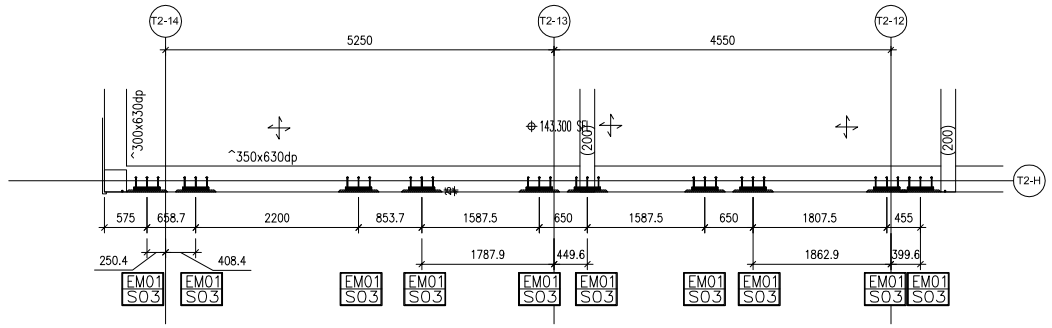


1 5007 *CAST-IN EMBED LAYOUT PLAN*
"T2-SU-CW3" (TOP FIXING) (EM01 @ +142.875)

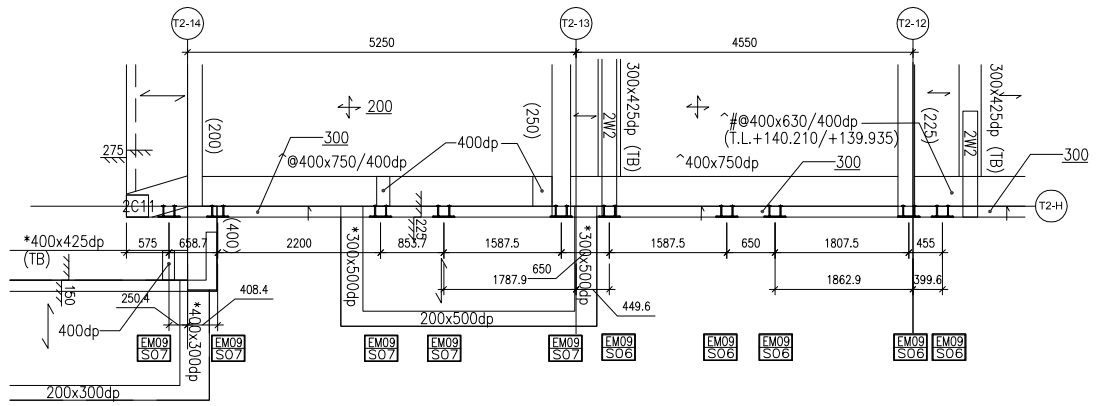

2 5007 *CAST-IN EMBED LAYOUT PLAN*
"T2-SU-CW3" (STARTER) (EM09 @ +140.0975)

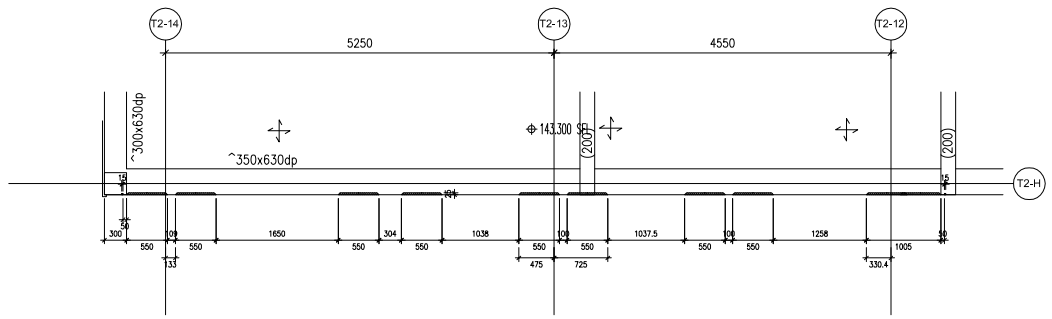

3 5007 *RC RECESS LAYOUT PLAN*
"T2-SU-CW3"

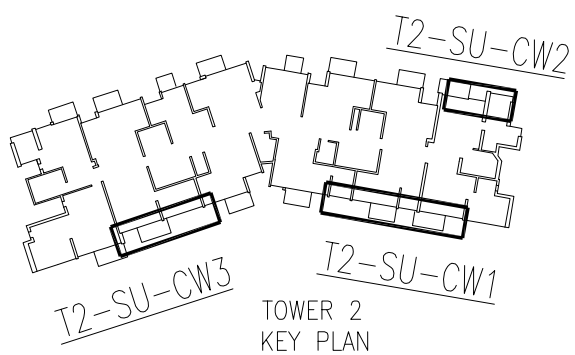

B.D. REF :

CLIENT :
SUN HUNG KAI REAL ESTATE AGENCY LTD.
42/F SUN HUNG KAI CENTRE, WANCHAI, HONGKONG

ARCHITECT :
lwk&partners
a r c h i t e c t s

MAIN CONTRACTOR :
怡輝建築有限公司
Yee Fai Building Contractors Ltd.

STRUCTURAL ENGINEER :
ARUP

FACADE CONSULTANT:
ALPHA CONSULTING LIMITED
Steel Structure & Facade Specialist

NOTE :
1. ALL DIMENSIONS ARE IN mm.
2. ALL ELEVATIONS ARE VIEWED FROM OUTSIDE.
3. ALL DIMENSIONS TO BE VERIFIED ON SITE BEFORE FABRICATION.

LEGEND :
X1 — DETAIL MARK NO.
X001 — REFER SHEET NO.
1. F.F.L. --FINISHED FLOOR LEVEL
2. S.F.L. --STRUCTURAL FLOOR LEVEL
3. (/R) --REVERSED DETAIL

NO.	DATE	REVISED	BY
A	22-AUG-2023	7TH SUBMISSION	CF
–	21-FEB-2023	4TH SUBMISSION	CF

JOB NO. : J-856

PROJECT :
PROPOSED DEVELOPMENT ABOVE LIGHT RAIL TIN WING STOP,TSWTL NO.23,AREA 33,TIN SHUI WAI, N.T.


TITLE :
EMBED LAYOUT PLAN
FOR CURTAIN WALL
@ TOWER 2 SU (46/F)

DATE : 28-FEB-23 | SCALE : 1:100

DRAWN BY : C.F | CHECKED BY :


美特鋁質有限公司
MIDI ALUMINIUM FABRICATOR LTD.
Units 6-8, Sunray Industrial Centre, 1/F
610 Cha Kwo Ling Road, Kowloon
Tel:23489211-4 Fax:(852)27727666

DWG NO. : J856-SD-CW-5007 | REV. : A

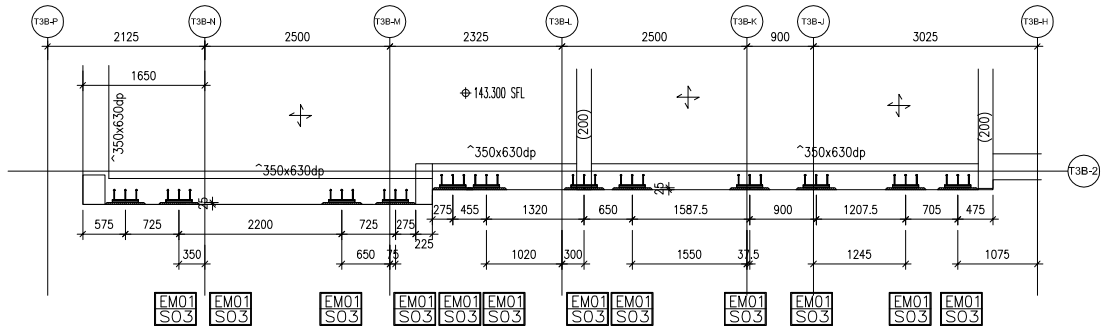


1 5008 *CAST-IN EMBED LAYOUT PLAN*

"T3-SU-CW1" (TOP FIXING) (EM01 @ +142.875)

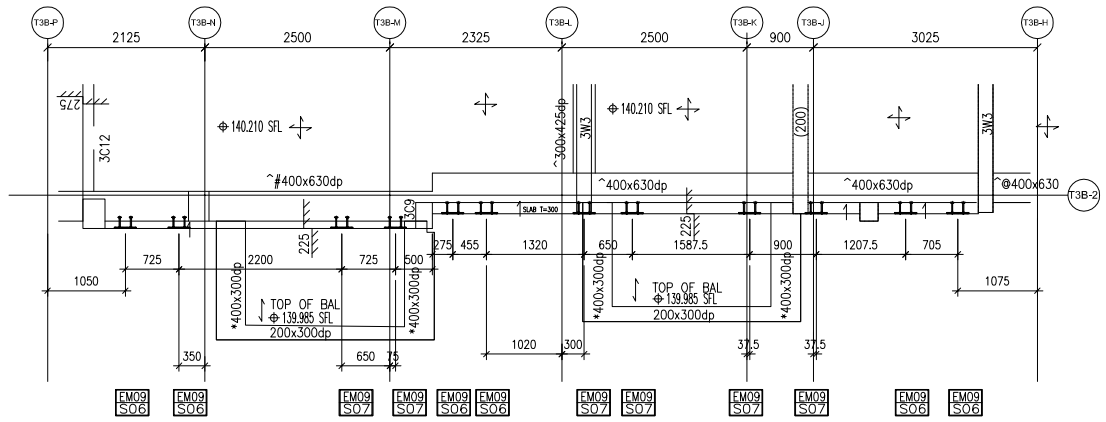


2 5008 *CAST-IN EMBED LAYOUT PLAN*

"T3-SU-CW1" (STARTER) (EM09 @ +140.0975)

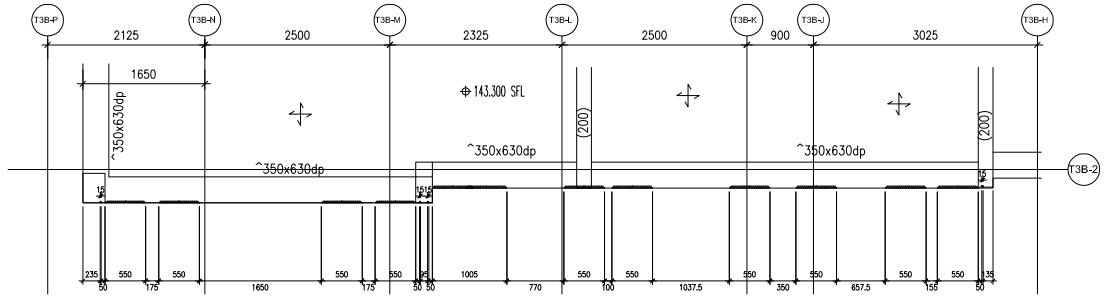

3 5008 *RC RECESS LAYOUT PLAN*

"T3-SU-CW1"

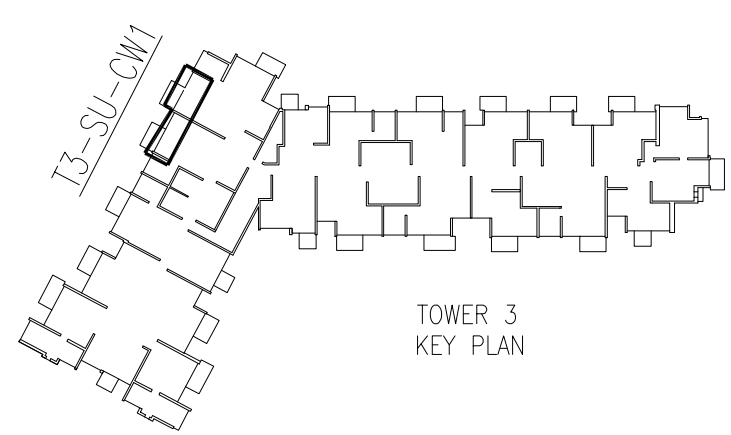

B.D. REF :

CLIENT :

SUN HUNG KAI REAL ESTATE AGENCY LTD.
42/F SUN HUNG KAI CENTRE, WANCHAI, HONGKONG

ARCHITECT :

lwk&partners
a r c h i t e c t s

MAIN CONTRACTOR :

怡輝建築有限公司
Yee Fai Building Contractors Ltd.

STRUCTURAL ENGINEER :

ARUP

FACADE CONSULTANT:

ALPHA CONSULTING LIMITED
Steel Structure & Facade Specialist

NOTE :

1. ALL DIMENSIONS ARE IN mm.
2. ALL ELEVATIONS ARE VIEWED FROM OUTSIDE.
3. ALL DIMENSIONS TO BE VERIFIED ON SITE BEFORE FABRICATION.

LEGEND :

X1 — DETAIL MARK NO.
X001 — REFER SHEET NO.

1. F.F.L. --FINISHED FLOOR LEVEL
2. S.F.L. --STRUCTURAL FLOOR LEVEL
3. /R --REVERSED DETAIL

NO.	DATE	REVISED	BY
A	22-AUG-2023	7TH SUBMISSION	CF
–	21-FEB-2023	4TH SUBMISSION	CF

JOB NO. : J-856

PROJECT :
PROPOSED DEVELOPMENT ABOVE LIGHT RAIL TIN WING STOP,TSWTL NO.23,AREA 33,TIN SHUI WAI, N.T.


TITLE :
EMBED LAYOUT PLAN FOR CURTAIN WALL @ TOWER 3 SU (46/F)

DATE : 28-FEB-23 | SCALE : 1:100


DRAWN BY : C.F | CHECKED BY :

美特鋁質有限公司
MIDI ALUMINIUM FABRICATOR LTD.
Units 6-8, Sunray Industrial Centre, 1/F
610 Cha Kwo Ling Road, Kowloon
Tel:23489211-4 Fax:(852)27727666


DWG NO. : J856-SD-CW-5008 | REV. : A

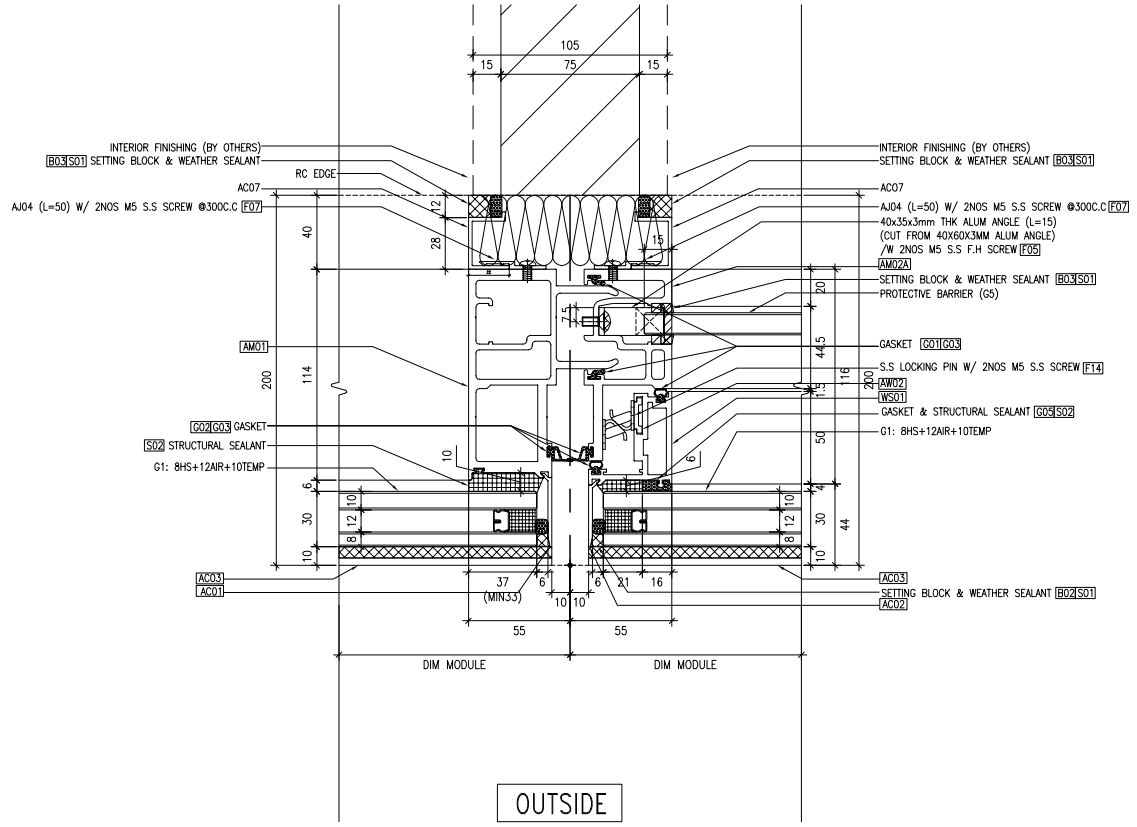


1 8001 *TYPICAL DETAIL OF CURTAIN WALL*

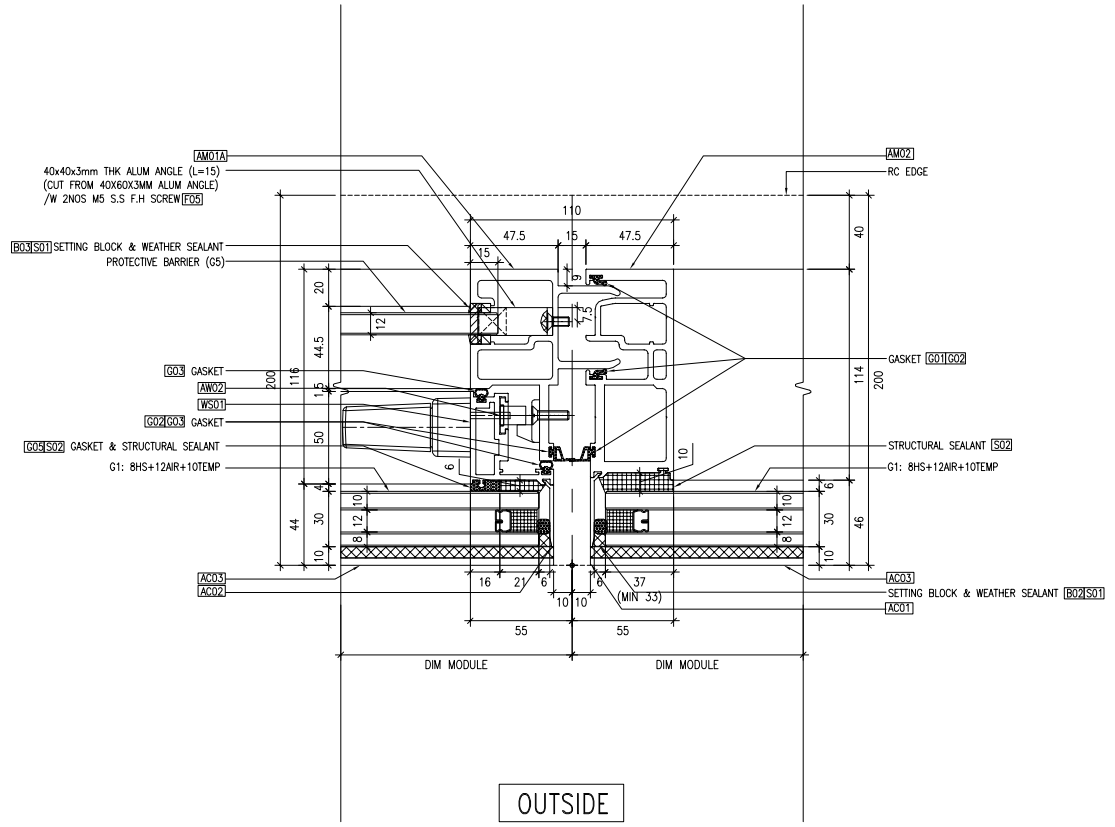

2 8001 *TYPICAL DETAIL OF CURTAIN WALL*

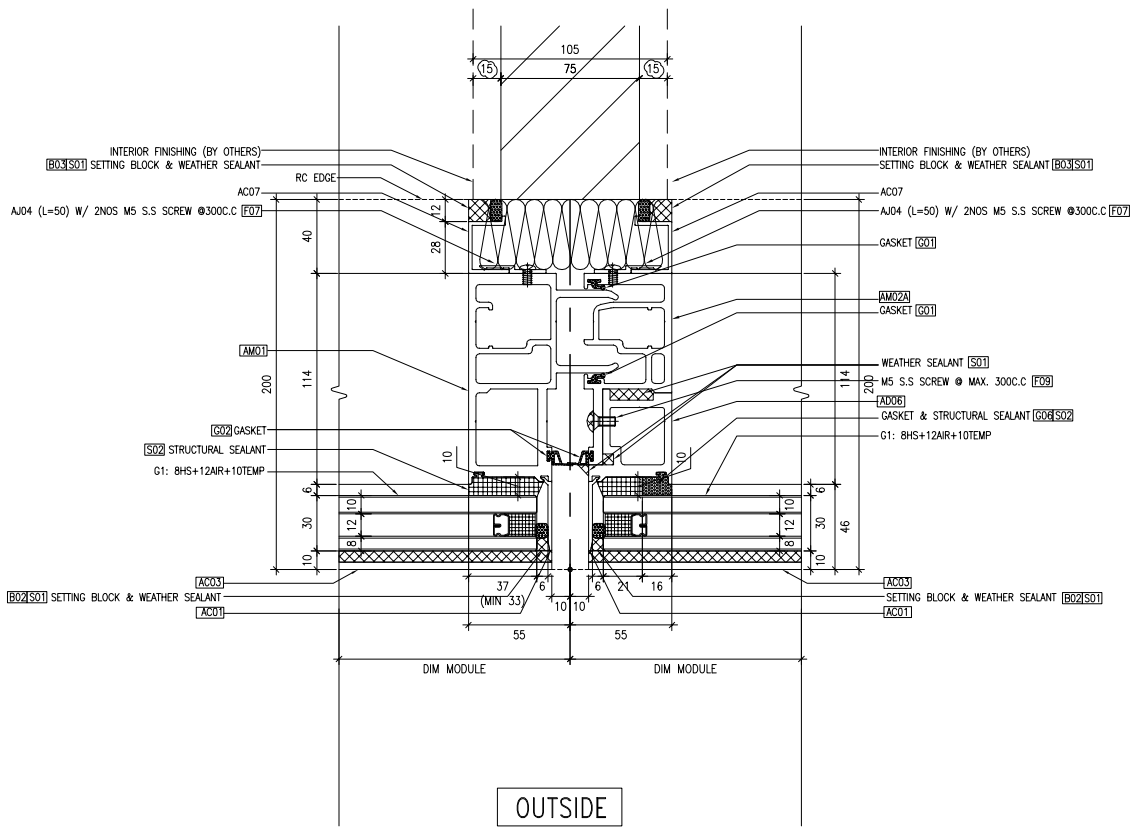

3 8001 *TYPICAL DETAIL OF CURTAIN WALL*

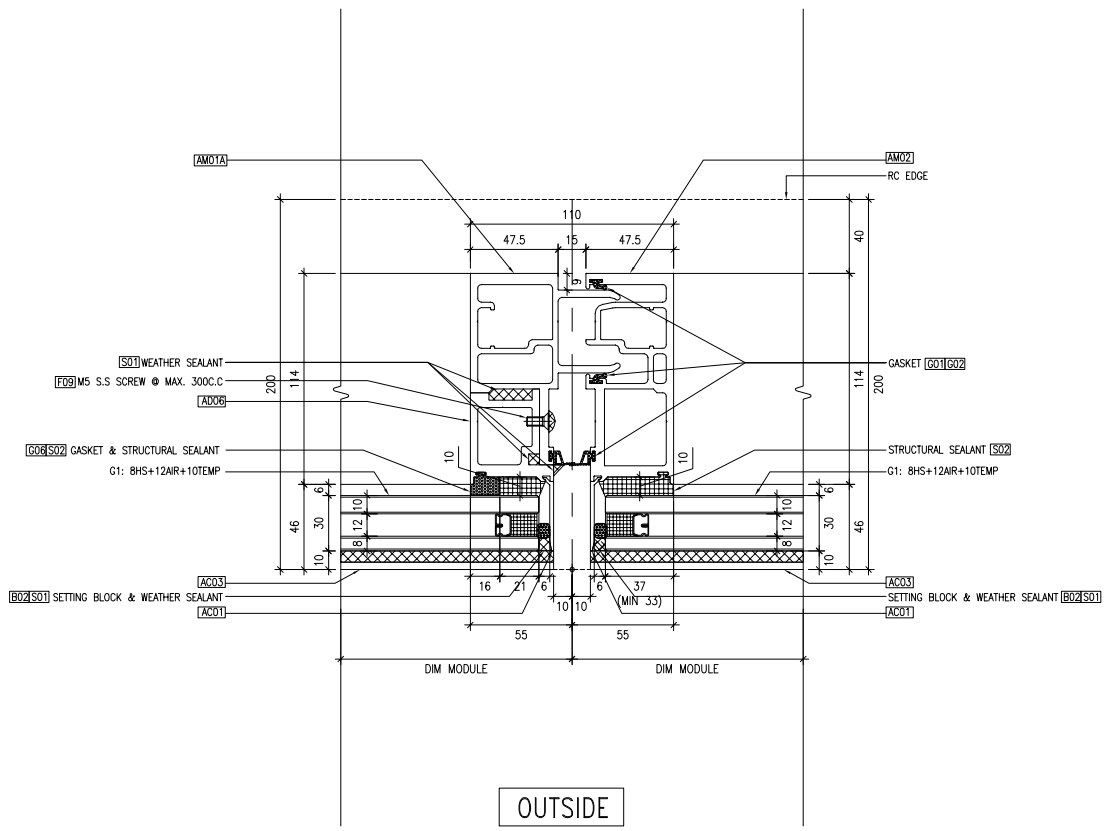

4 8001 *TYPICAL DETAIL OF CURTAIN WALL*

B.D. REF :

CLIENT :

SUN HUNG KAI REAL ESTATE AGENCY LTD.
42/F SUN HUNG KAI CENTRE, WANCHAI, HONGKONG

ARCHITECT :

lwk&partners
a r c h i t e c t s

MAIN CONTRACTOR :

怡輝建築有限公司
Yee Fai Building Contractors Ltd.

STRUCTURAL ENGINEER :

ARUP

FACADE CONSULTANT:

ALPHA CONSULTING LIMITED
Steel Structure & Facade Specialist

NOTE :
1. ALL DIMENSIONS ARE IN mm.
2. ALL ELEVATIONS ARE VIEWED FROM OUTSIDE.
3. ALL DIMENSIONS TO BE VERIFIED ON SITE BEFORE FABRICATION.

LEGEND :

X1 — DETAIL MARK NO.
X001 — REFER SHEET NO.

1. F.F.L. --FINISHED FLOOR LEVEL
2. S.F.L. --STRUCTURAL FLOOR LEVEL
3. /R --REVERSED DETAIL

NO.	DATE	REVISED	BY
A	21-FEB-2023	4TH SUBMISSION	CF
–	23-NOV-2022	1ST SUBMISSION	CF

JOB NO. : J-856

PROJECT :
PROPOSED DEVELOPMENT ABOVE LIGHT RAIL TIN WING STOP,TSWTL NO.23,AREA 33,TIN SHUI WAI, N.T.


TITLE :
TYPICAL DETAIL FOR CURTAIN WALL

DATE : 31-OCT-22 | SCALE : 1:4


DRAWN BY : C.F | CHECKED BY :

美特鋁質有限公司
MIDI ALUMINIUM FABRICATOR LTD.
Units 6-8, Sunray Industrial Centre, 1/F
610 Cha Kwo Ling Road, Kowloon
Tel:23489211-4 Fax:(852)27727666


DWG NO. : J856-SD-CW-8001 | REV. : A

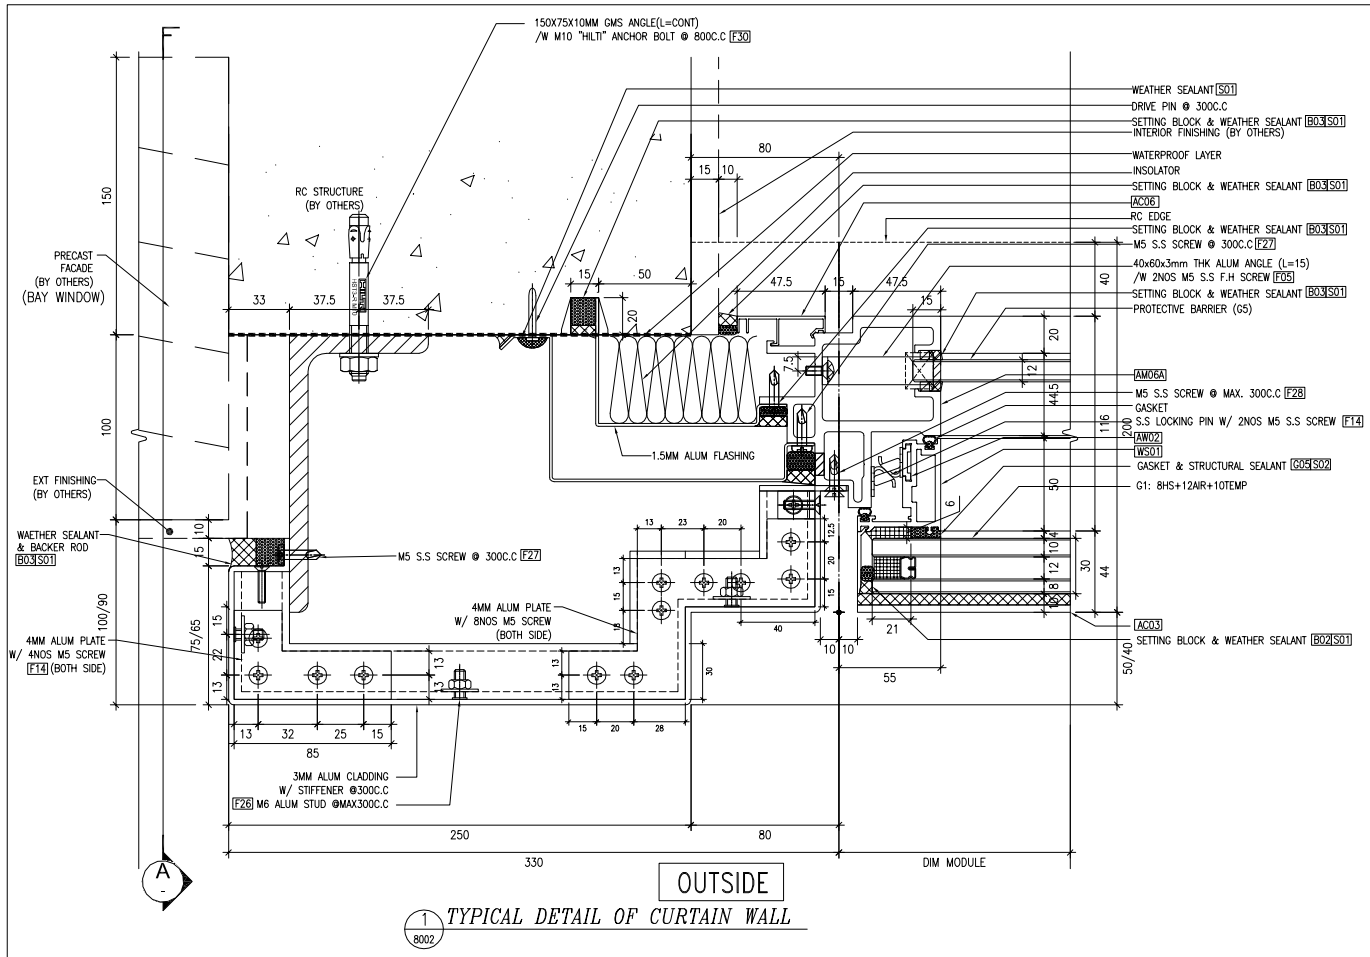


1 / 8002 *TYPICAL DETAIL OF CURTAIN WALL*

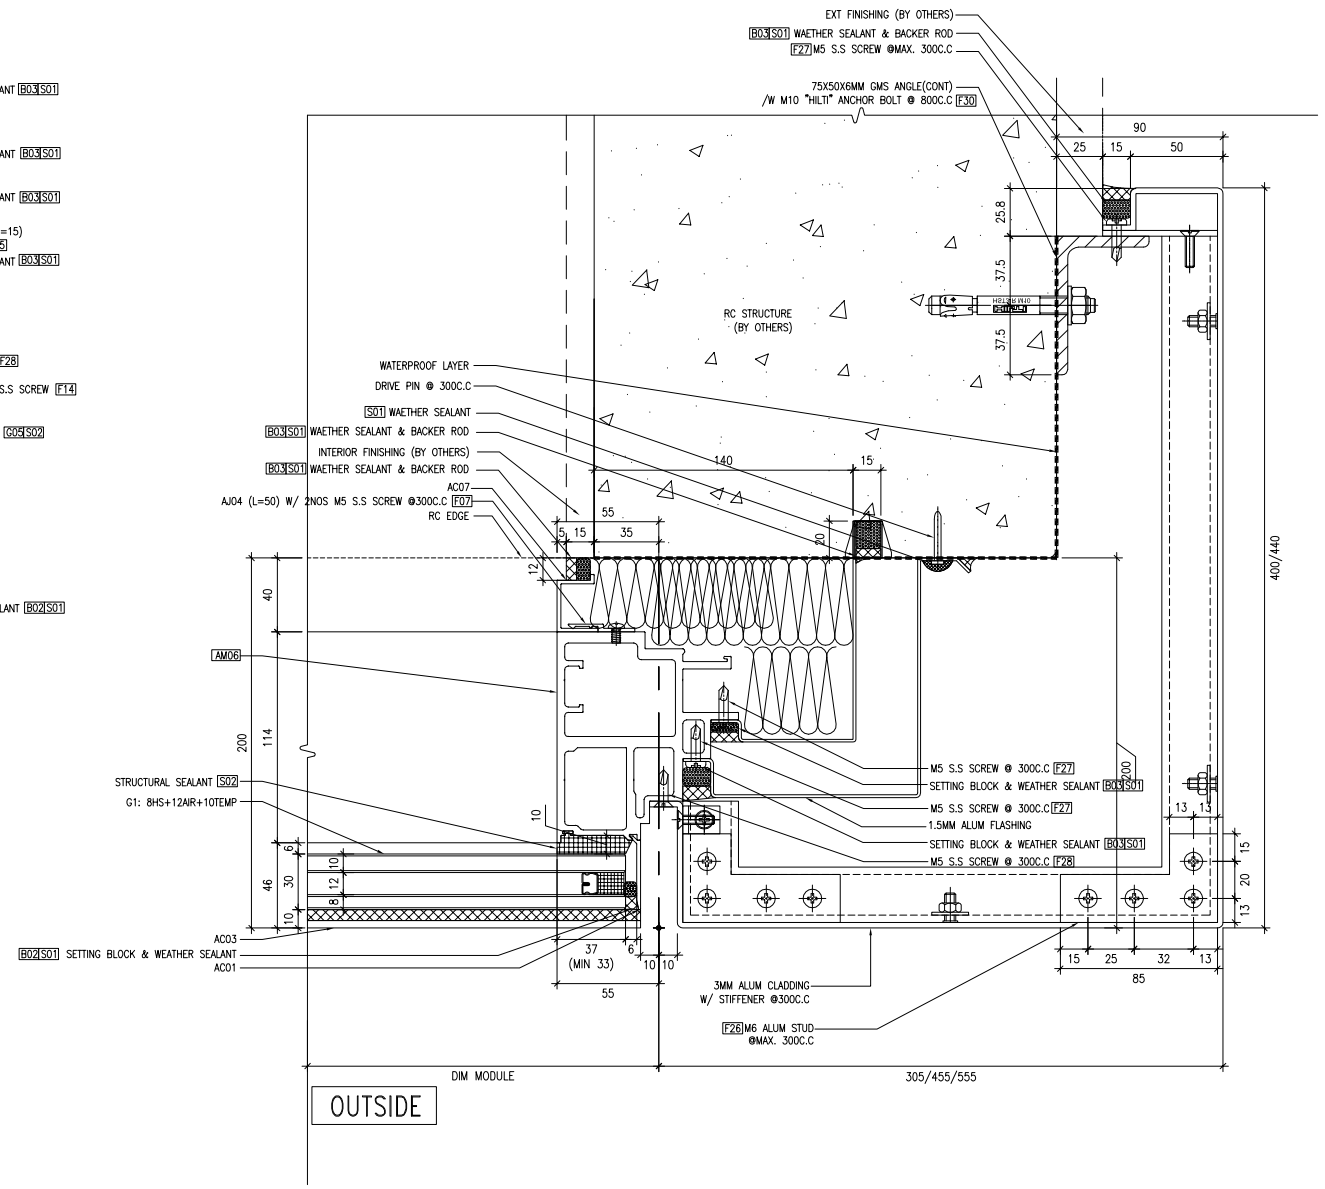

2 / 8002 *TYPICAL DETAIL OF CURTAIN WALL*

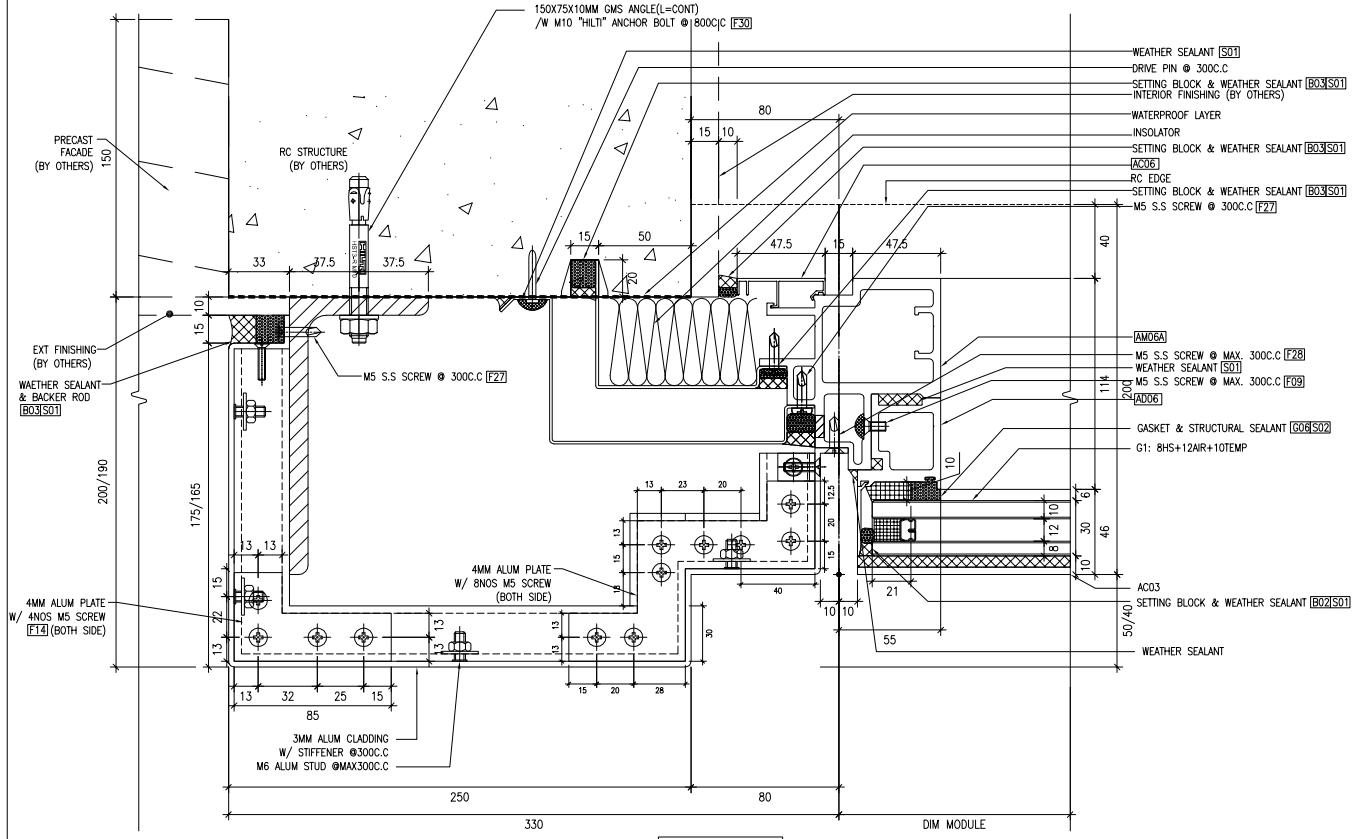

3 / 8002 *TYPICAL DETAIL OF CURTAIN WALL*

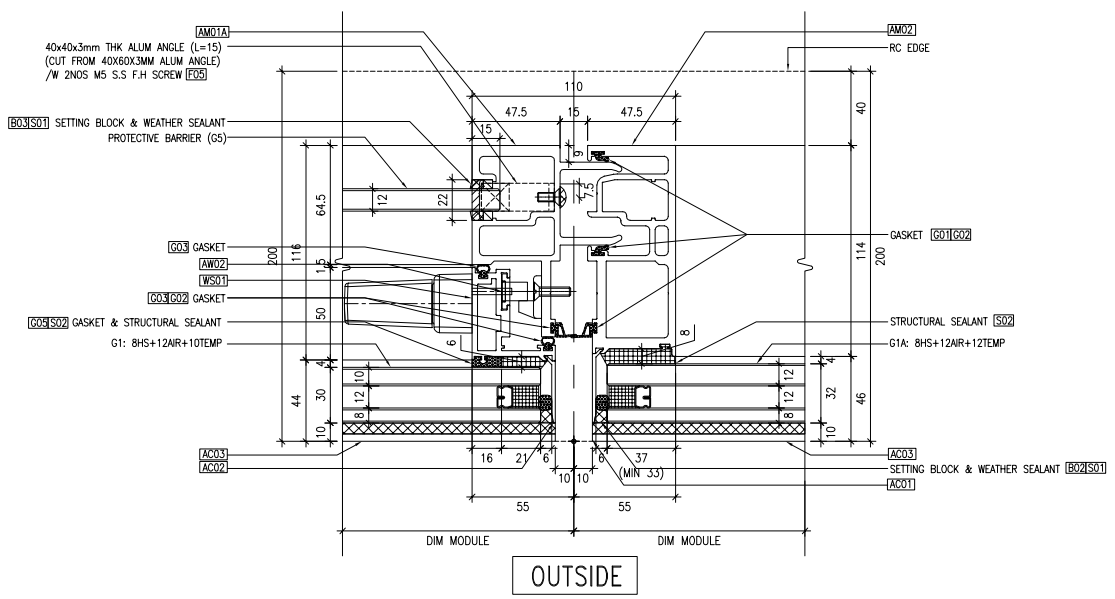

4 / 8002 *TYPICAL DETAIL OF CURTAIN WALL*
FOR G1A: 8HS+12AIR+12TEMP

B.D. REF :

CLIENT :
SUN HUNG KAI REAL ESTATE AGENCY LTD.
42/F SUN HUNG KAI CENTRE, WANCHAI, HONGKONG

ARCHITECT :
lwk&partners
a r c h i t e c t s

MAIN CONTRACTOR :
怡輝建築有限公司
Yee Fai Building Contractors Ltd.

STRUCTURAL ENGINEER :
ARUP

FACADE CONSULTANT:
ALPHA CONSULTING LIMITED
Steel Structure & Facade Specialist

NOTE :
1. ALL DIMENSIONS ARE IN mm.
2. ALL ELEVATIONS ARE VIEWED FROM OUTSIDE.
3. ALL DIMENSIONS TO BE VERIFIED ON SITE BEFORE FABRICATION.

LEGEND :
X1 / X001 — DETAIL MARK NO. / REFER SHEET NO.
1. F.F.L. -- FINISHED FLOOR LEVEL
2. S.F.L. -- STRUCTURAL FLOOR LEVEL
3. /R -- REVERSED DETAIL

#1: ALUM FLASHING OVERLAPPING
REFER TO DWG: 3 / 8008A

NO.	DATE	REVISED	BY
D	30-MAY-2023	6TH SUBMISSION	CF
C	02-MAY-2023	5TH SUBMISSION	CF
B	21-FEB-2023	4TH SUBMISSION	CF
A	30-DEC-2023	2ND SUBMISSION	CF
-	23-NOV-2022	1ST SUBMISSION	CF

JOB NO. : J-856

PROJECT :
PROPOSED DEVELOPMENT ABOVE LIGHT RAIL TIN WING STOP,TSWTL NO.23,AREA 33,TIN SHUI WAI, N.T.


TITLE :
TYPICAL DETAIL FOR CURTAIN WALL

DATE : 31-OCT-22 | SCALE : 1:4

DRAWN BY : C.F | CHECKED BY :

美特鋁製有限公司
MIDI ALUMINIUM FABRICATOR LTD.
Units 6-8, Sunray Industrial Centre, 1/F
610 Cha Kwo Ling Road, Kowloon
Tel:23489211-4 Fax:(852)27727666

DWG NO. : J856-SD-CW-8002 | REV. : D

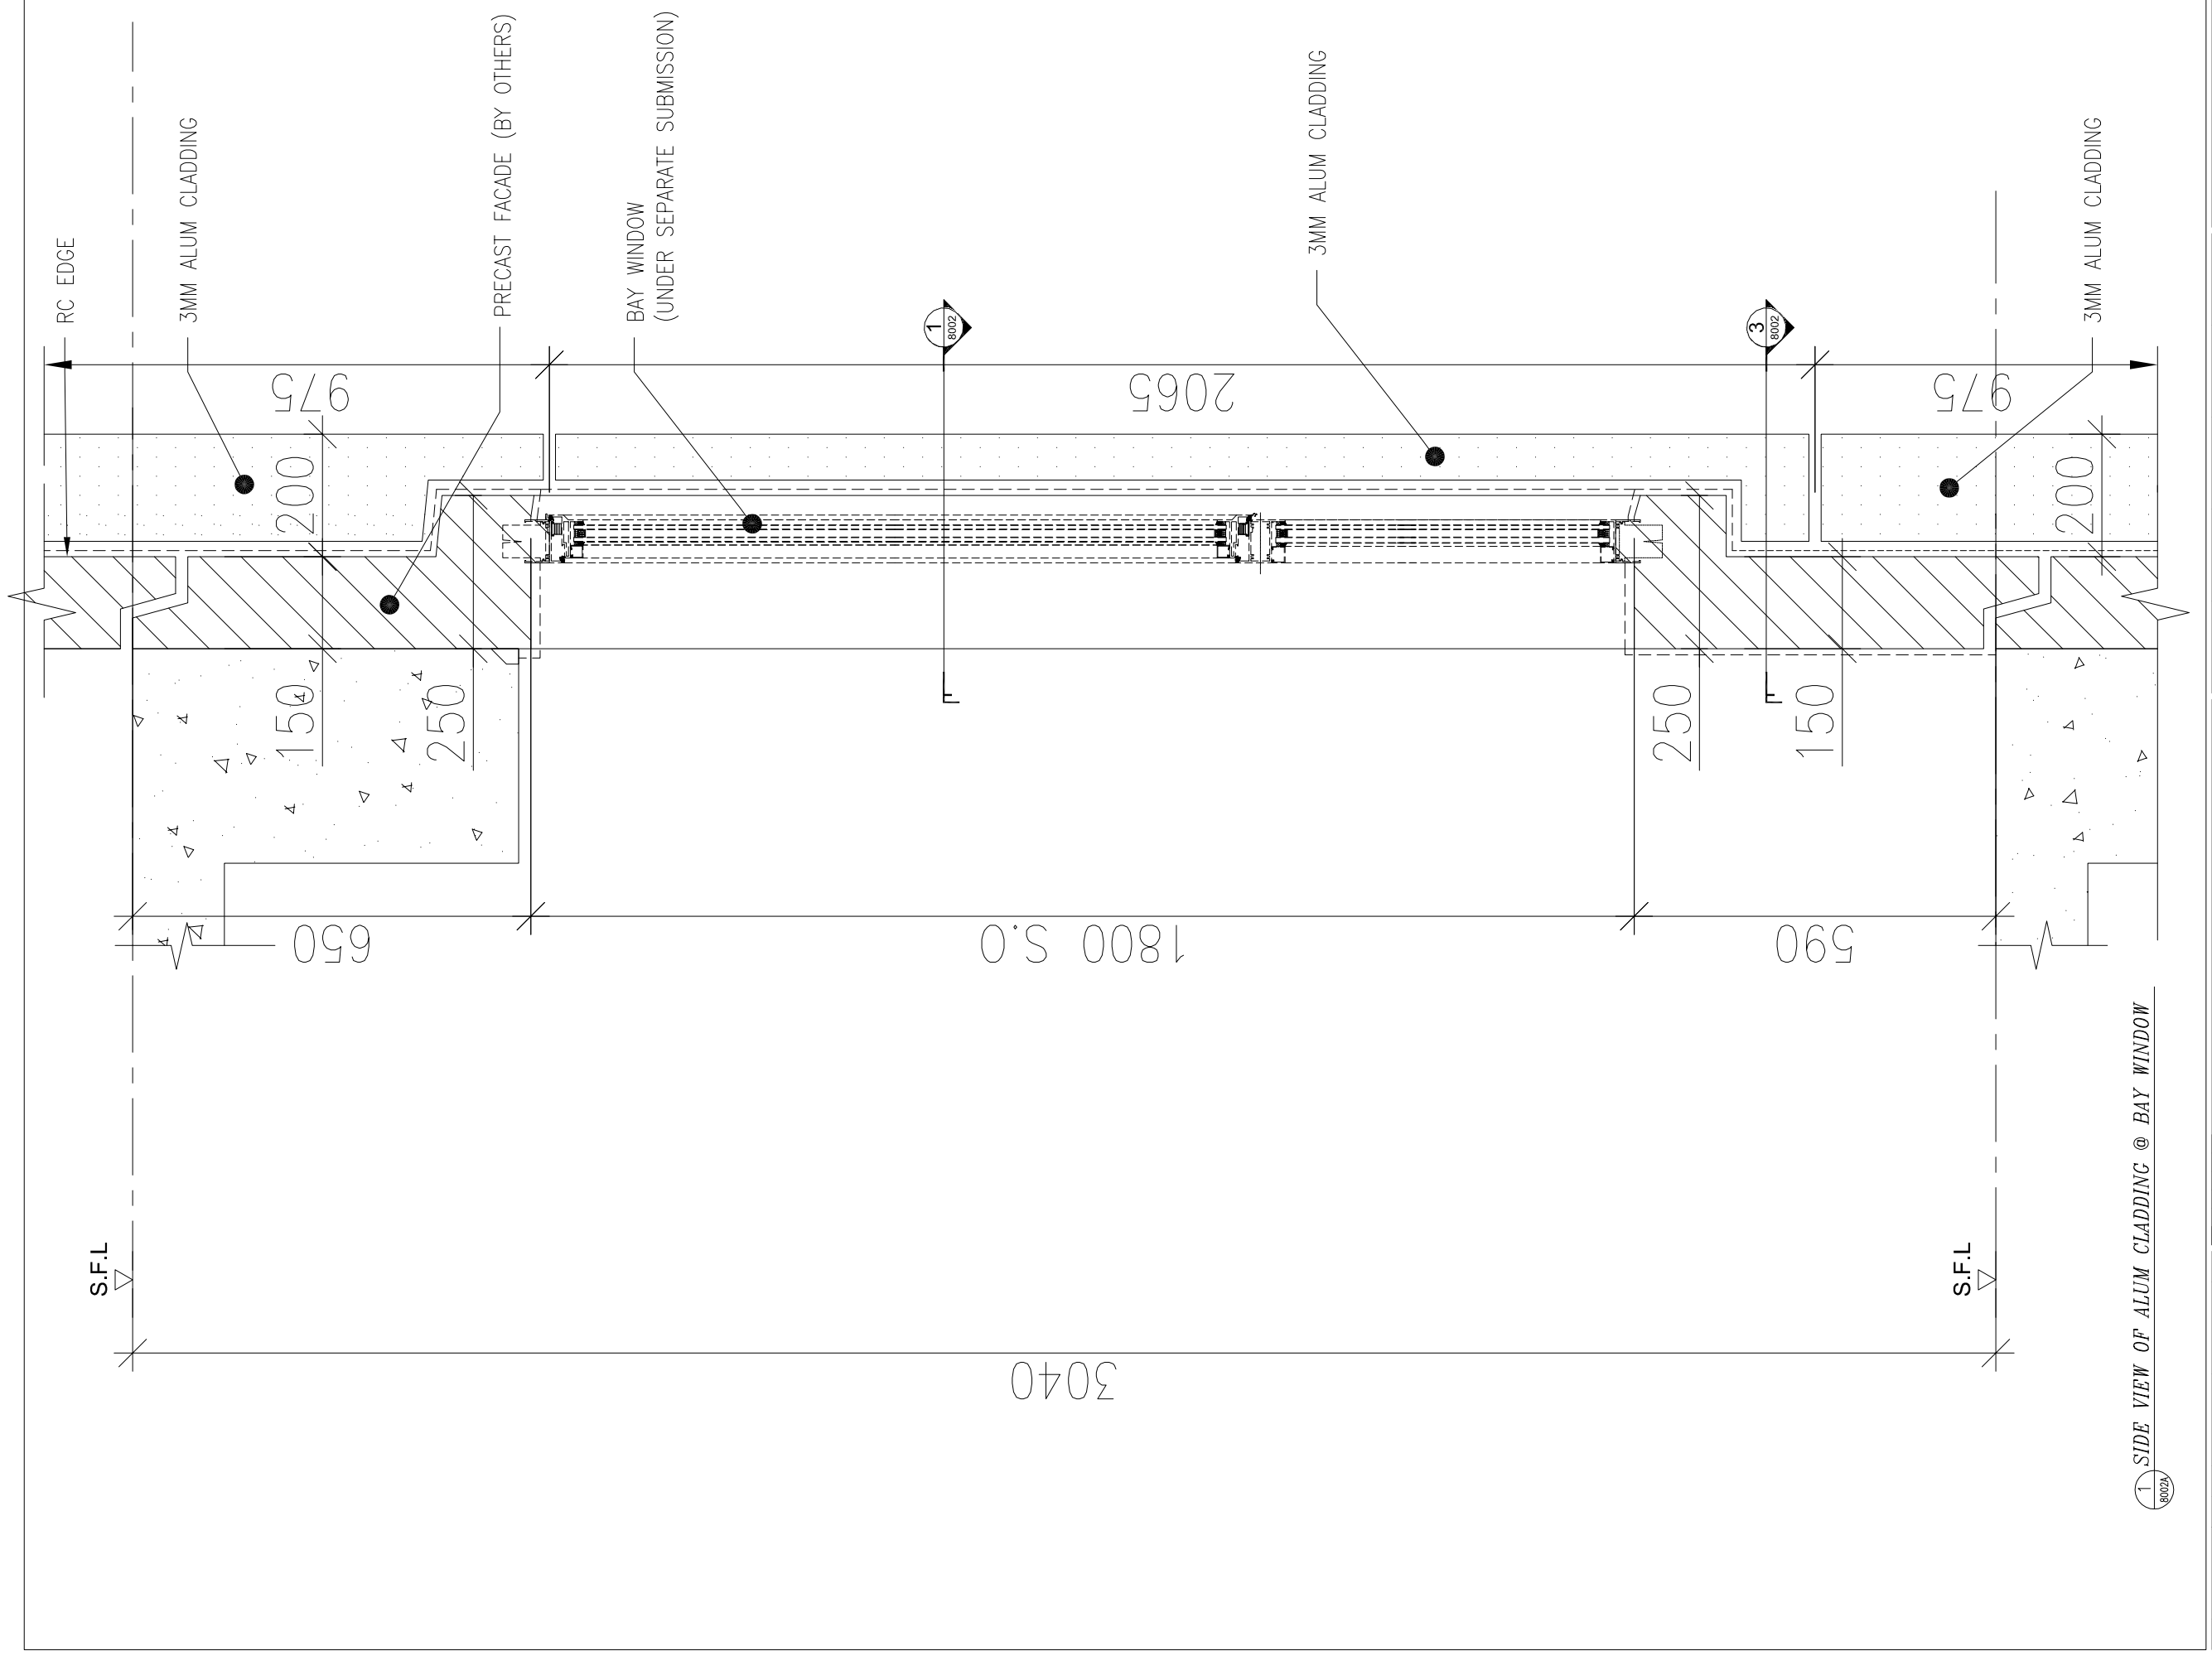

B.D. REF :

CLIENT :

SUN HUNG KAI REAL ESTATE AGENCY LTD.
42/F SUN HUNG KAI CENTRE, WANCHAI, HONGKONG

ARCHITECT :

lwk&partners
a r c h i t e c t s

MAIN CONTRACTOR :

怡輝建築有限公司
Yee Fai Building Contractors Ltd.

STRUCTURAL ENGINEER :

ARUP

FACADE CONSULTANT:

ALPHA CONSULTING LIMITED
Steel Structure & Facade Specialist

NOTE :
1. ALL DIMENSIONS ARE IN mm.
2. ALL ELEVATIONS ARE VIEWED FROM OUTSIDE.
3. ALL DIMENSIONS TO BE VERIFIED ON SITE BEFORE FABRICATION.

LEGEND :

X1 — DETAIL MARK NO.
X001 — REFER SHEET NO.

1. F.F.L. --FINISHED FLOOR LEVEL
2. S.F.L. --STRUCTURAL FLOOR LEVEL
3. (R) --REVERSED DETAIL

NO.	DATE	REVISED	BY
		NO CHANGE	
–	13-JAN-2023	NEW DRAWING (3RD SUBMISSION)	CF

JOB NO. : J-856

PROJECT :
PROPOSED DEVELOPMENT ABOVE LIGHT RAIL TIN WING STOP,TSWTL NO.23,AREA 33,TIN SHUI WAI, N.T.


TITLE :
TYPICAL DETAIL FOR CURTAIN WALL

DATE : 11-JAN-23 | SCALE : 1:10


DRAWN BY : C.F | CHECKED BY :

美特鋁質有限公司
MIDI ALUMINIUM FABRICATOR LTD.
Units 6-8, Sunray Industrial Centre, 1/F
610 Cha Kwo Ling Road, Kowloon
Tel:23489211-4 Fax:(852)27727666


DWG NO. : J856-SD-CW-8002A | REV. : –

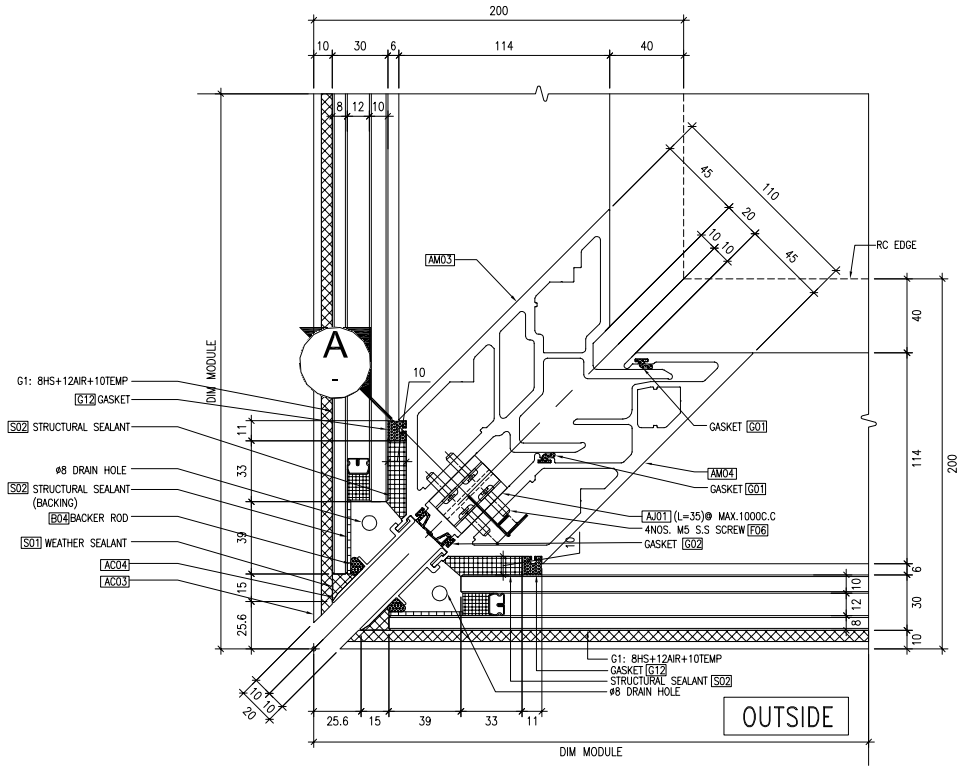


1 8003 *TYPICAL DETAIL OF CURTAIN WALL*

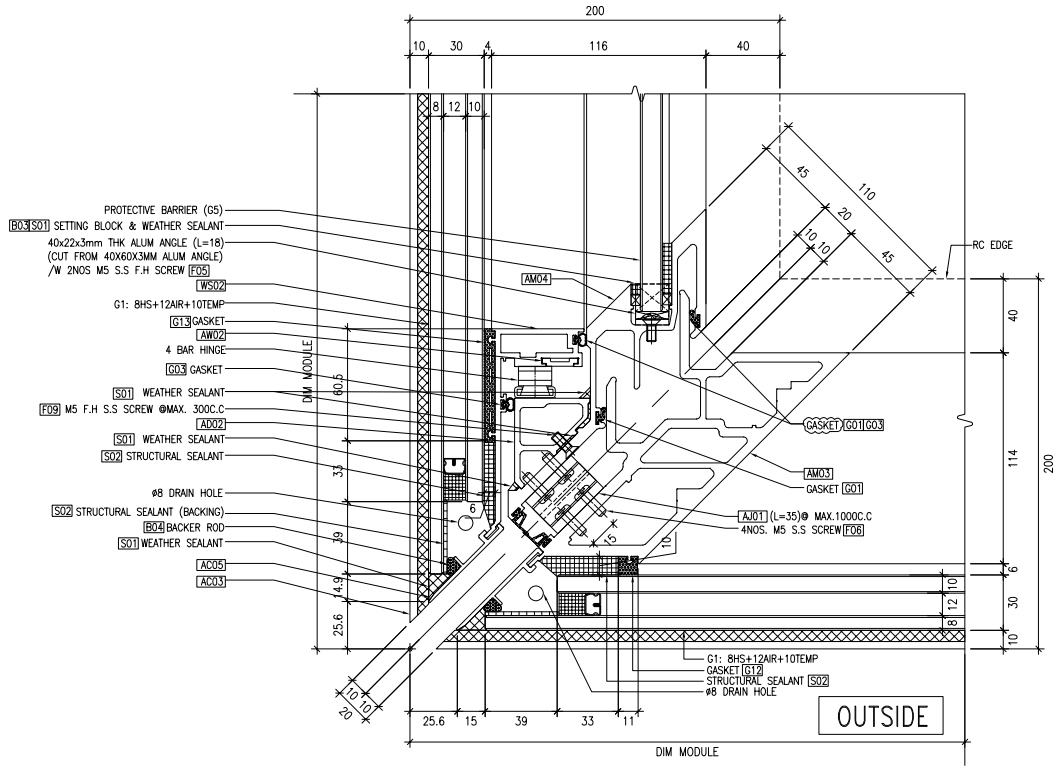

2 8003 *TYPICAL DETAIL OF CURTAIN WALL*

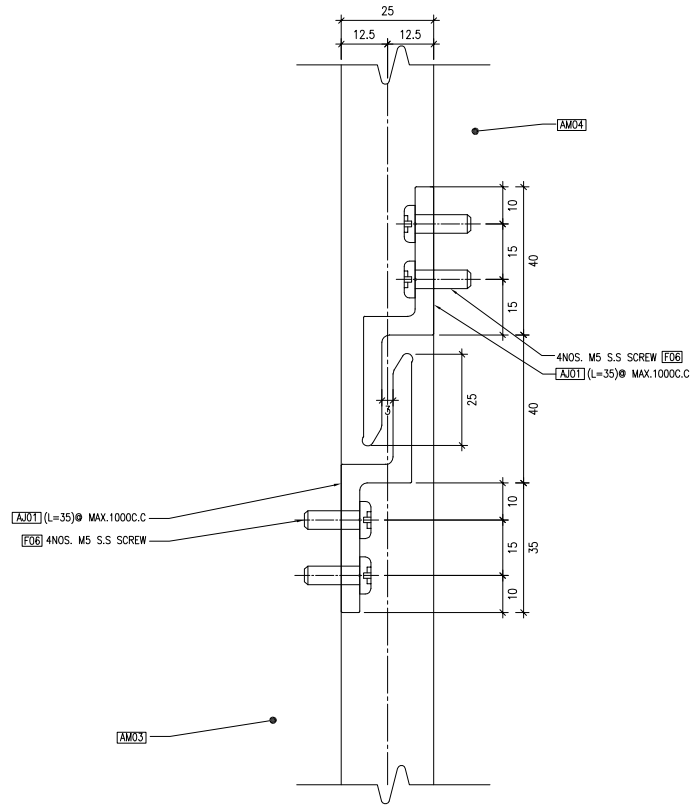

A 8003 *SECTION DETAIL FOR CONNERCTOR*
NTS

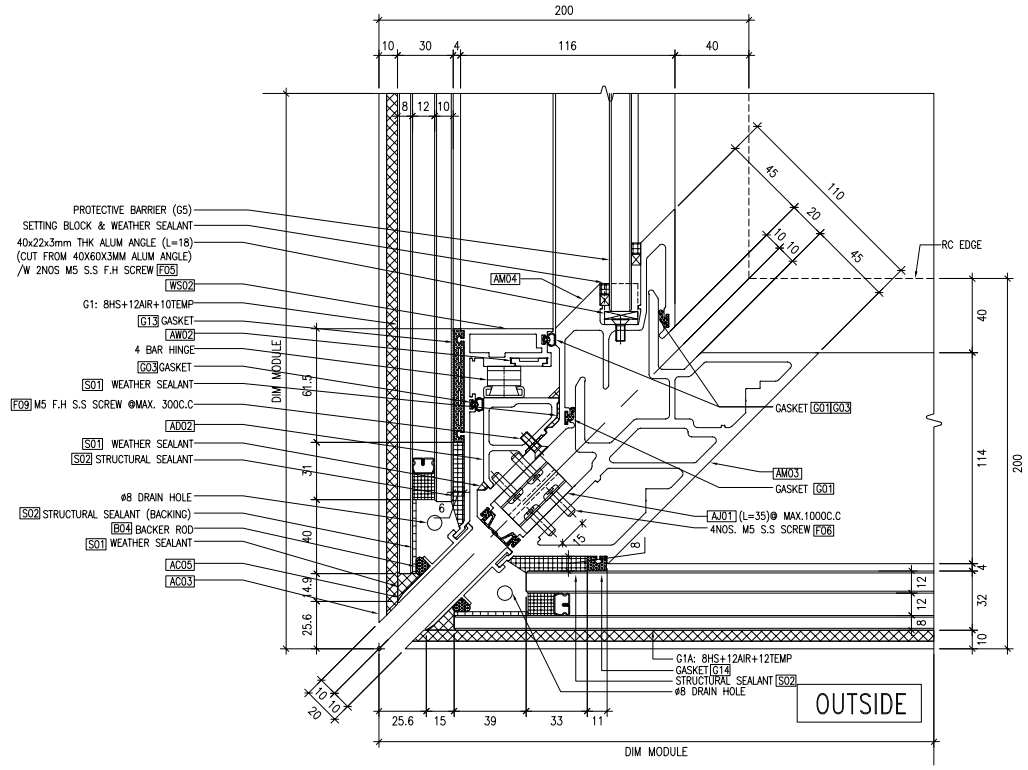

3 8003 *TYPICAL DETAIL OF CURTAIN WALL*
FOR G1A:8HS+12AIR+12TEMP

B.D. REF :

CLIENT :
SUN HUNG KAI REAL ESTATE AGENCY LTD.
42/F SUN HUNG KAI CENTRE, WANCHAI, HONGKONG

ARCHITECT :
lwk&partners
a r c h i t e c t s

MAIN CONTRACTOR :
怡輝建築有限公司
Yee Fai Building Contractors Ltd.

STRUCTURAL ENGINEER :
ARUP

FACADE CONSULTANT:
ALPHA CONSULTING LIMITED
Steel Structure & Facade Specialist

NOTE :
1. ALL DIMENSIONS ARE IN mm.
2. ALL ELEVATIONS ARE VIEWED FROM OUTSIDE.
3. ALL DIMENSIONS TO BE VERIFIED ON SITE BEFORE FABRICATION.

LEGEND :
X1 / X001 — DETAIL MARK NO. / REFER SHEET NO.
1. F.F.L. --FINISHED FLOOR LEVEL
2. S.F.L. --STRUCTURAL FLOOR LEVEL
3. /R --REVERSED DETAIL

NO.	DATE	REVISED	BY
A	21-FEB-2023	4TH SUBMISSION	
–	30-DEC-2022	2ND SUBMISSION	CF

JOB NO. : J-856

PROJECT :
PROPOSED DEVELOPMENT ABOVE LIGHT RAIL TIN WING STOP,TSWTL NO.23,AREA 33,TIN SHUI WAI, N.T.


TITLE :
TYPICAL DETAIL FOR CURTAIN WALL

DATE : 31-OCT-22 | SCALE : 1:4

DRAWN BY : C.F | CHECKED BY :

美特鋁質有限公司
MIDI ALUMINIUM FABRICATOR LTD.
Units 6-8, Sunray Industrial Centre, 1/F
610 Cha Kwo Ling Road, Kowloon
Tel:23489211-4 Fax:(852)27727666


DWG NO. : J856-SD-CW-8003 | REV. : A

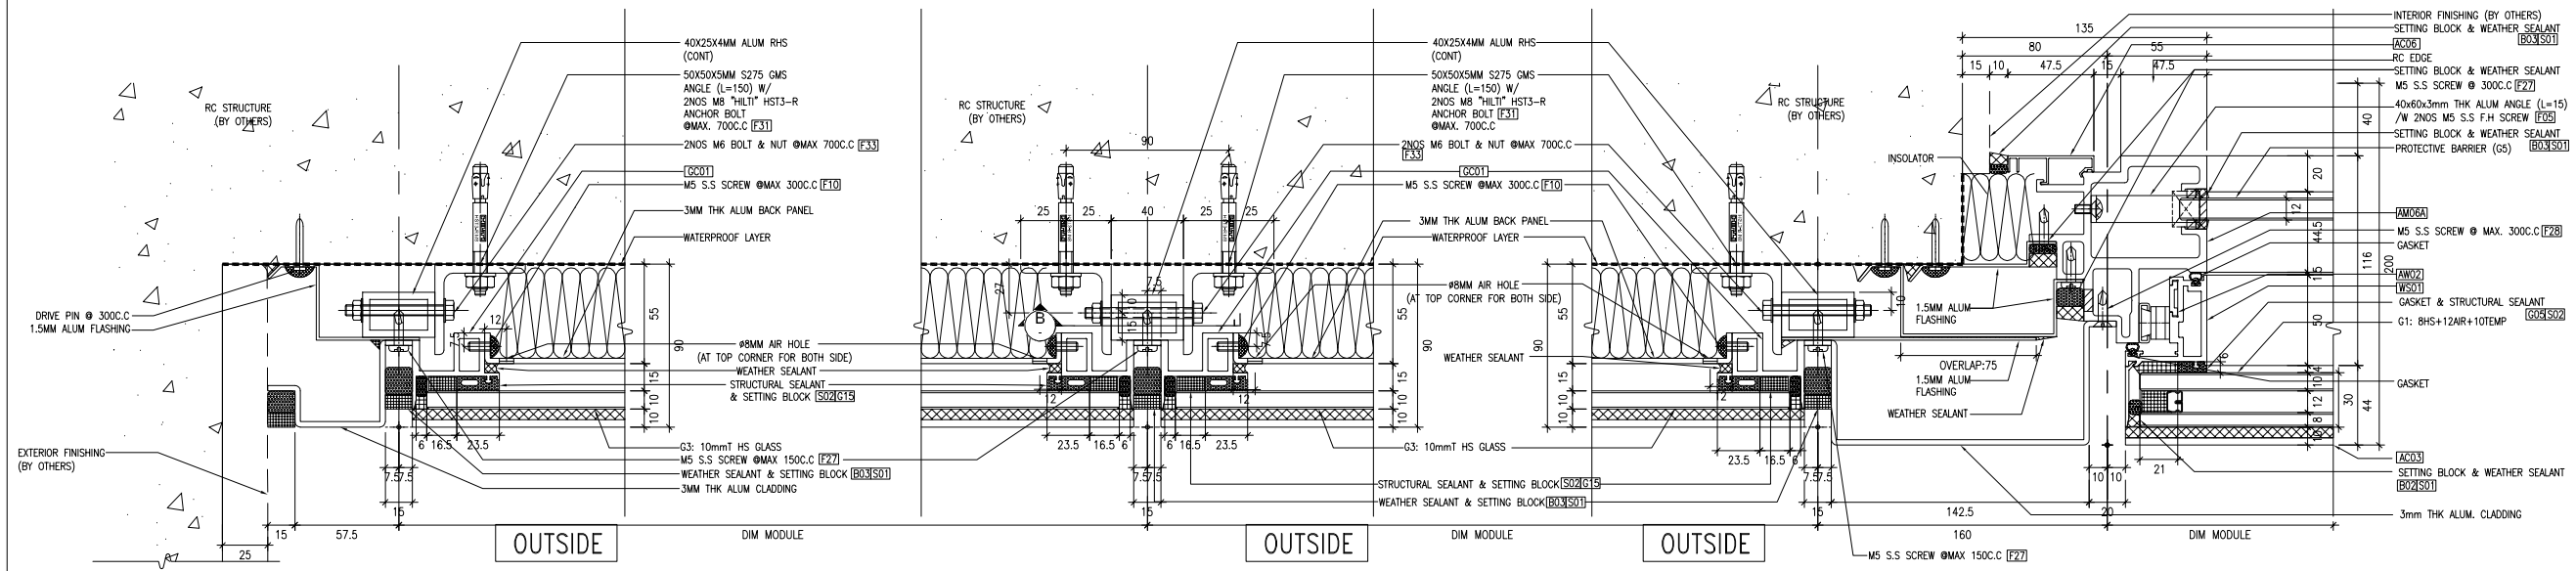


1 8004 *TYPICAL DETAIL* GLASS CLADDING (SIDE)

2 8004 *TYPICAL DETAIL* GLASS CLADDING


3 8004 *TYPICAL DETAIL* GLASS CLADDING

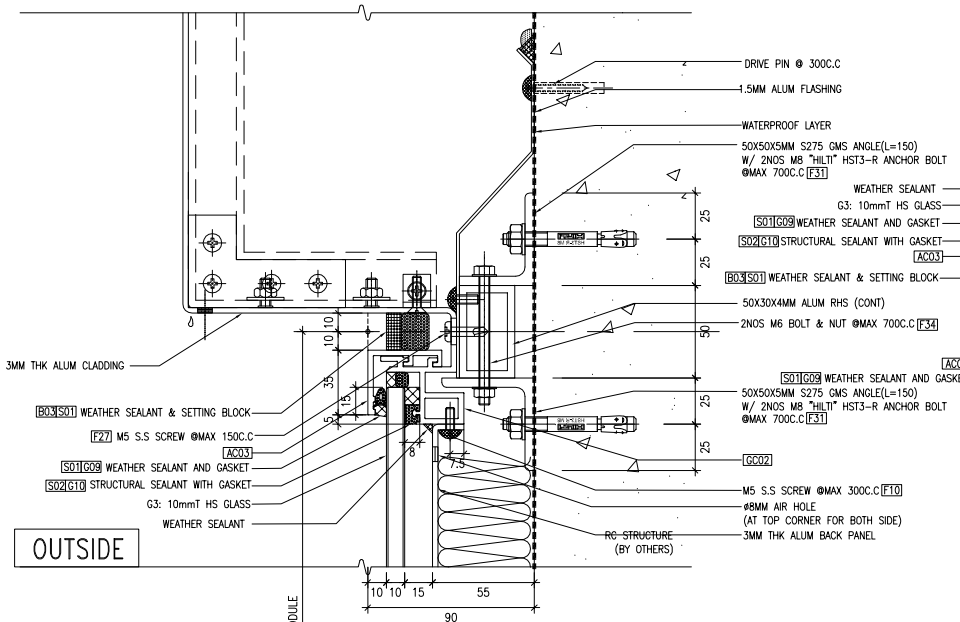


4 8004 *TYPICAL DETAIL (SECTION)* GLASS CLADDING (TOP-END)

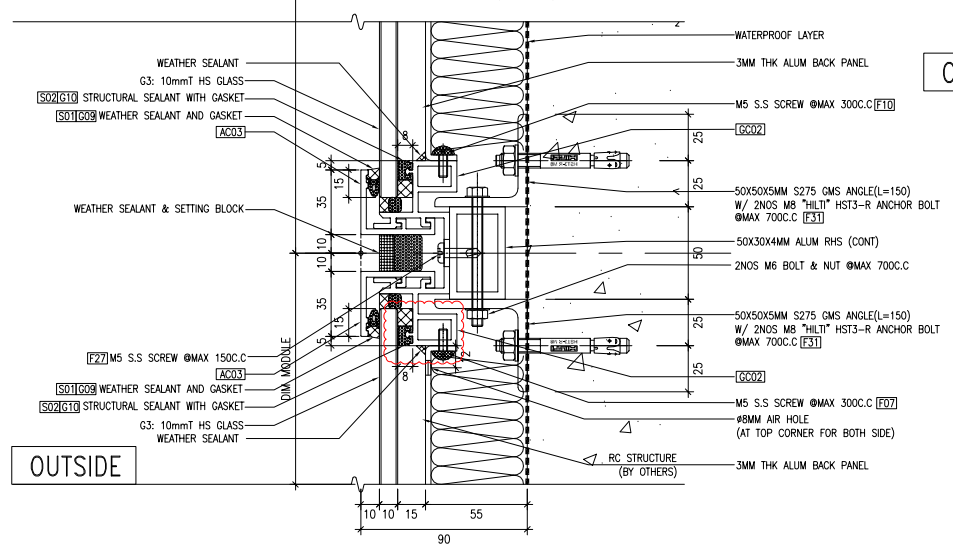


5 8004 *TYPICAL DETAIL (SECTION)* GLASS CLADDING

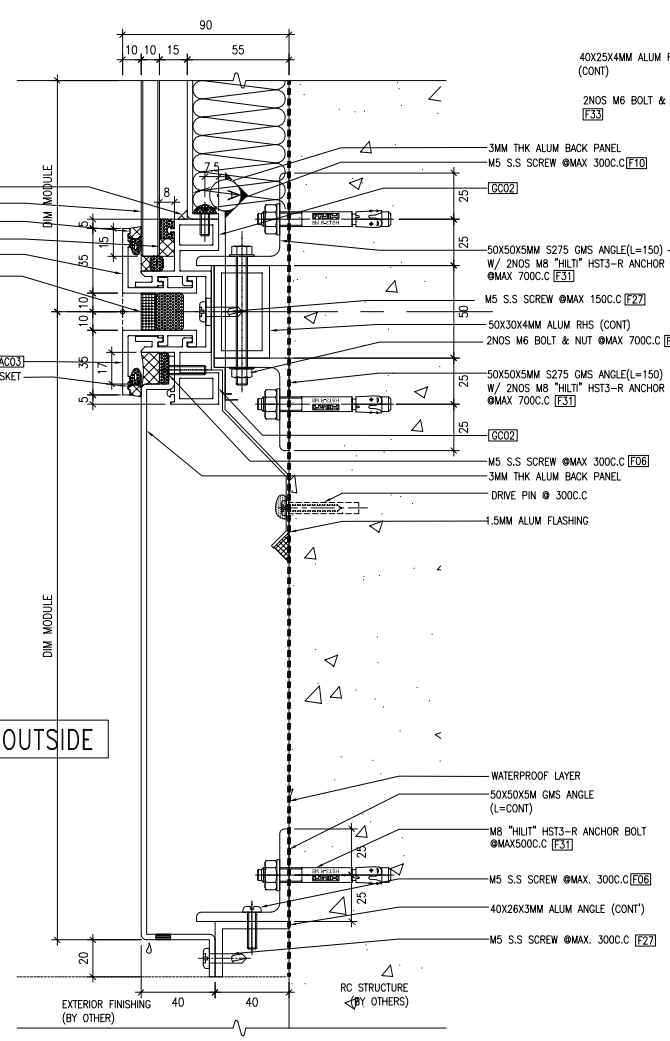


6 8004 *TYPICAL DETAIL (SECTION)* GLASS CLADDING (BOTTOM-END)

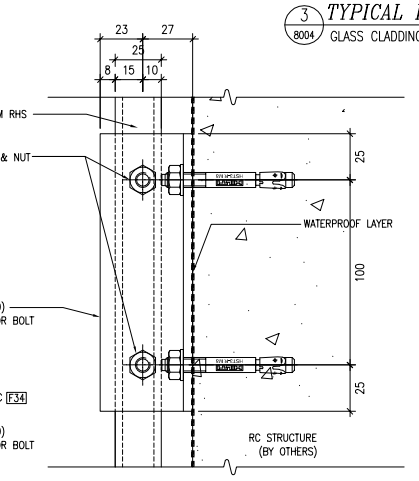

A 8004 *SECTION*

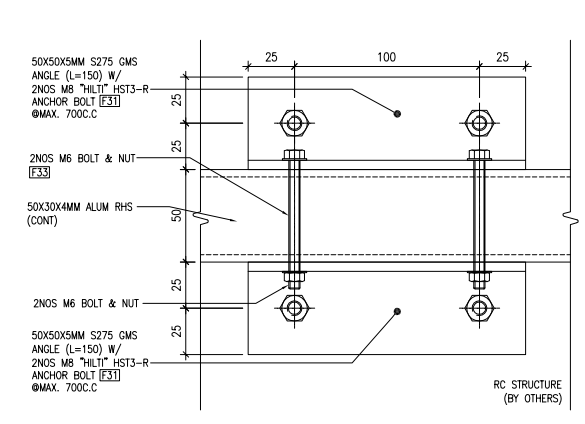

B 8004 *SECTION*

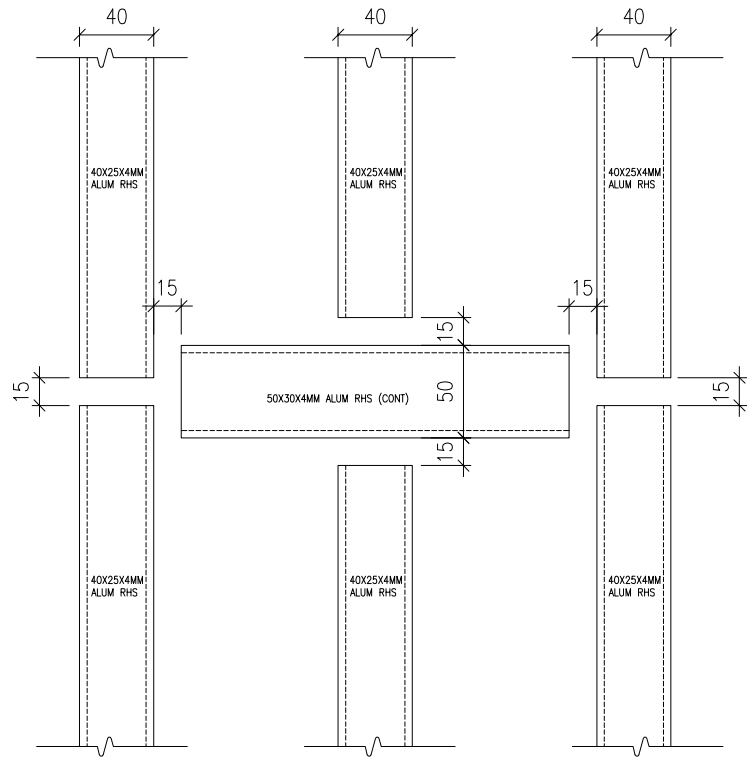

7 8004 *HOLLOW ALLOCATION* GLASS CLADDING

B.D. REF :

CLIENT :
SUN HUNG KAI REAL ESTATE AGENCY LTD.
42/F SUN HUNG KAI CENTRE, WANCHAI, HONGKONG

ARCHITECT :
lwk&partners architects

MAIN CONTRACTOR :
怡輝建築有限公司
Yee Fai Building Contractors Ltd.

STRUCTURAL ENGINEER :
ARUP

FACADE CONSULTANT:
ALPHA CONSULTING LIMITED
Steel Structure & Facade Specialist

NOTE :
1. ALL DIMENSIONS ARE IN mm.
2. ALL ELEVATIONS ARE VIEWED FROM OUTSIDE.
3. ALL DIMENSIONS TO BE VERIFIED ON SITE BEFORE FABRICATION.

LEGEND :
X1 — DETAIL MARK NO.
X001 — REFER SHEET NO.

1. F.F.L. --FINISHED FLOOR LEVEL
2. S.F.L. --STRUCTURAL FLOOR LEVEL
3. (R) --REVERSED DETAIL

NO.	DATE	REVISED	BY
E	30-MAY-2023	6TH SUBMISSION	CF
D	02-MAY-2023	5TH SUBMISSION	CF
C	21-FEB-2023	4TH SUBMISSION	CF
B	13-JAN-2023	3RD SUBMISSION	CF
A	30-DEC-2022	2ND SUBMISSION	CF

JOB NO. : J-856

PROJECT :
PROPOSED DEVELOPMENT ABOVE LIGHT RAIL TIN WING STOP,TSWTL NO.23,AREA 33,TIN SHUI WAI, N.T.


TITLE :
TYPICAL DETAIL FOR CURTAIN WALL

DATE : 31-OCT-22 | SCALE : 1:4

DRAWN BY : C.F | CHECKED BY :


美特鋁製有限公司
MIDI ALUMINIUM FABRICATOR LTD.
Units 6-8, Sunray Industrial Centre, 1/F
610 Cha Kwo Ling Road, Kowloon
Tel:23489211-4 Fax:(852)27727666

DWG NO. : J856-SD-CW-8004 | REV. : E

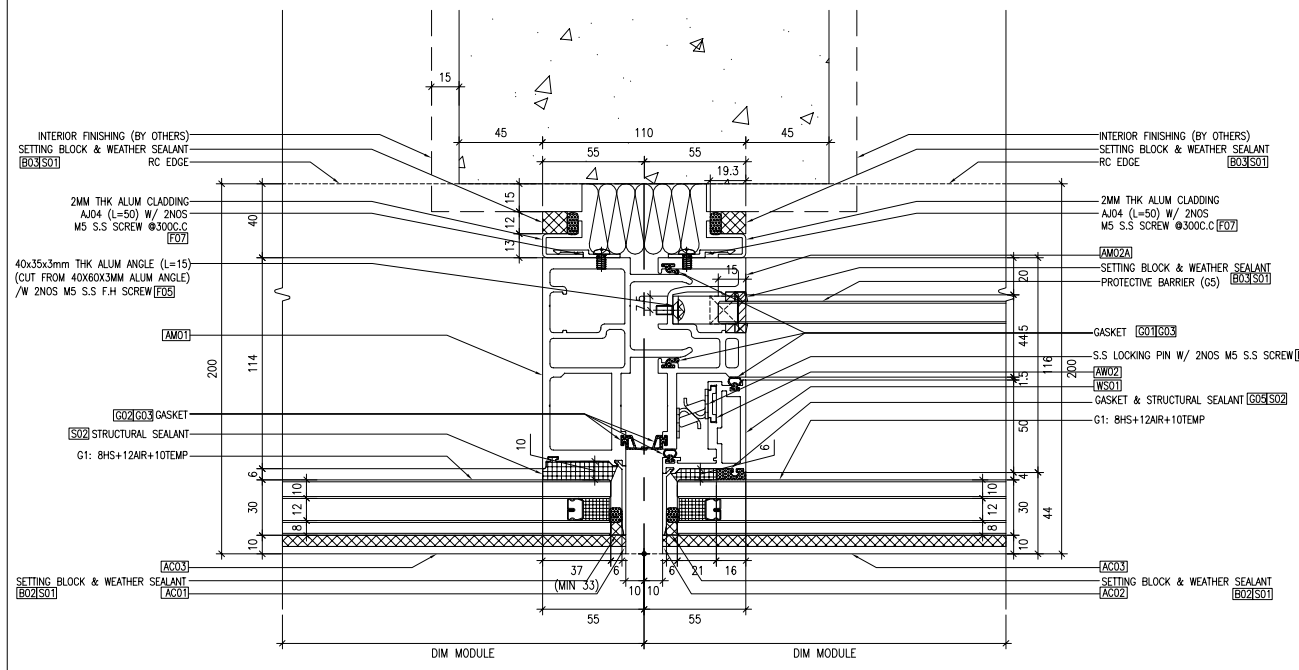


OUTSIDE

1 8005 *TYPICAL DETAIL OF CURTAIN WALL*

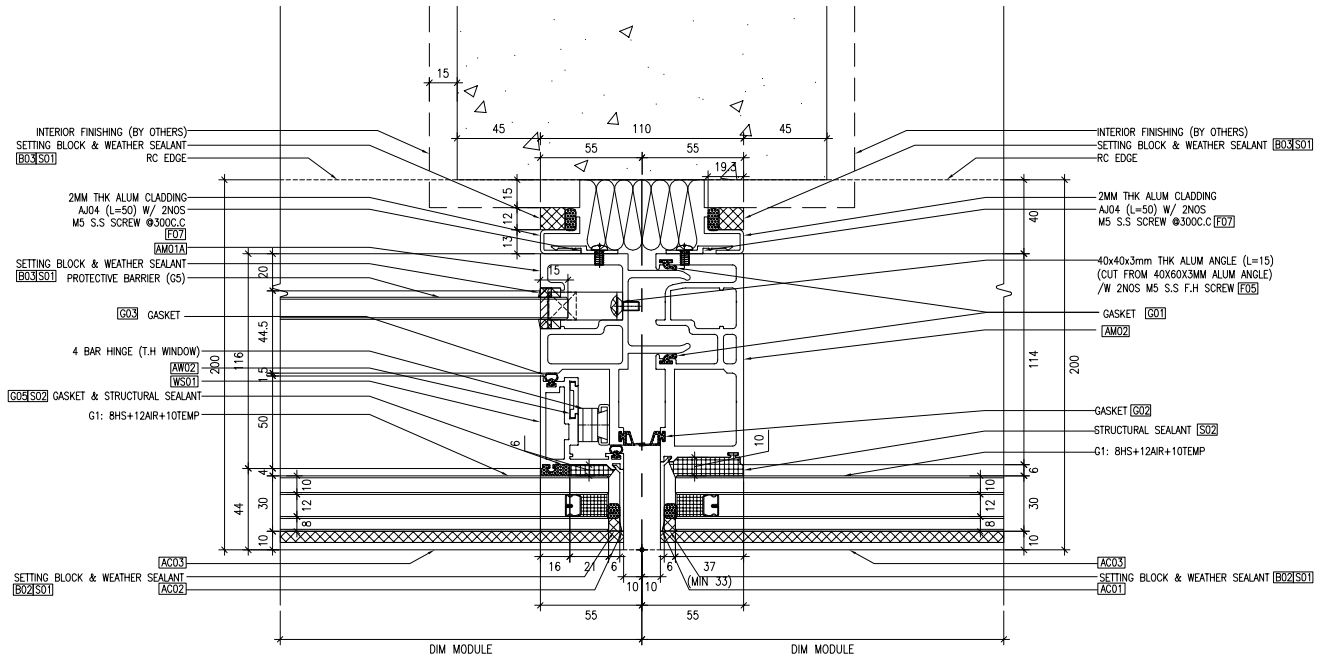


OUTSIDE

2 8005 *TYPICAL DETAIL OF CURTAIN WALL*

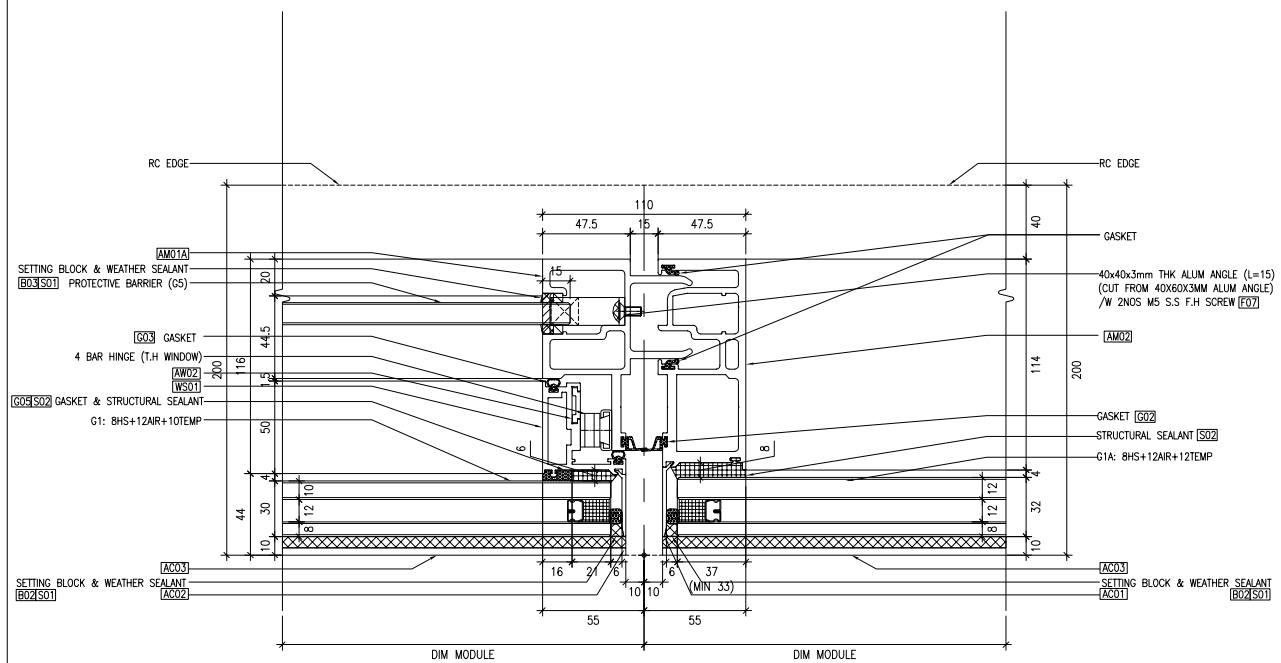

OUTSIDE

3 8005 *TYPICAL DETAIL OF CURTAIN WALL*
FOR (G1A)

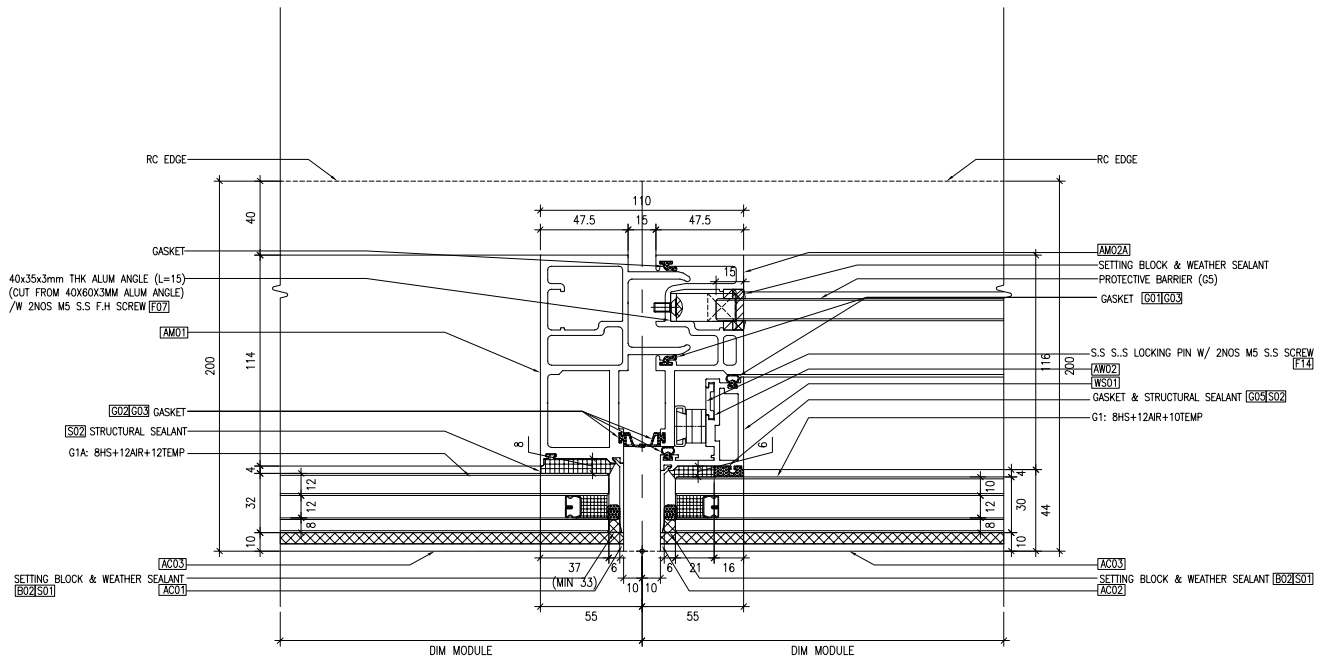

OUTSIDE

4 8005 *TYPICAL DETAIL OF CURTAIN WALL*
FOR (G1A)

B.D. REF :

NO CHANGE

CLIENT :

SUN HUNG KAI REAL ESTATE AGENCY LTD.
42/F SUN HUNG KAI CENTRE, WANCHAI, HONGKONG

ARCHITECT :

lwk&partners
a r c h i t e c t s

MAIN CONTRACTOR :

怡輝建築有限公司
Yee Fai Building Contractors Ltd.

STRUCTURAL ENGINEER :

ARUP

FACADE CONSULTANT:

ALPHA CONSULTING LIMITED
Steel Structure & Facade Specialist

NOTE :
1. ALL DIMENSIONS ARE IN mm.
2. ALL ELEVATIONS ARE VIEWED FROM OUTSIDE.
3. ALL DIMENSIONS TO BE VERIFIED ON SITE BEFORE FABRICATION.

LEGEND :

X1 — DETAIL MARK NO.
X001 — REFER SHEET NO.

1. F.F.L. --FINISHED FLOOR LEVEL
2. S.F.L. --STRUCTURAL FLOOR LEVEL
3. (/R) --REVERSED DETAIL

NO.	DATE	REVISED	BY
B	21-FEB-2023	4TH SUBMISSION	CF
A	13-JAN-2023	3RD SUBMISSION	CF
–	23-NOV-2022	1ST SUBMISSION	

JOB NO. : J-856

PROJECT :
PROPOSED DEVELOPMENT ABOVE LIGHT RAIL TIN WING STOP,TSWTL NO.23,AREA 33,TIN SHUI WAI, N.T.


TITLE :
TYPICAL DETAIL FOR CURTAIN WALL

DATE : 31-OCT-22 | SCALE : 1:4

DRAWN BY : C.F | CHECKED BY :


美特鋁質有限公司
MIDI ALUMINIUM FABRICATOR LTD.
Units 6-8, Sunray Industrial Centre, 1/F
610 Cha Kwo Ling Road, Kowloon
Tel:23489211-4 Fax:(852)27727666

DWG NO. : J856-SD-CW-8005 | REV. : B

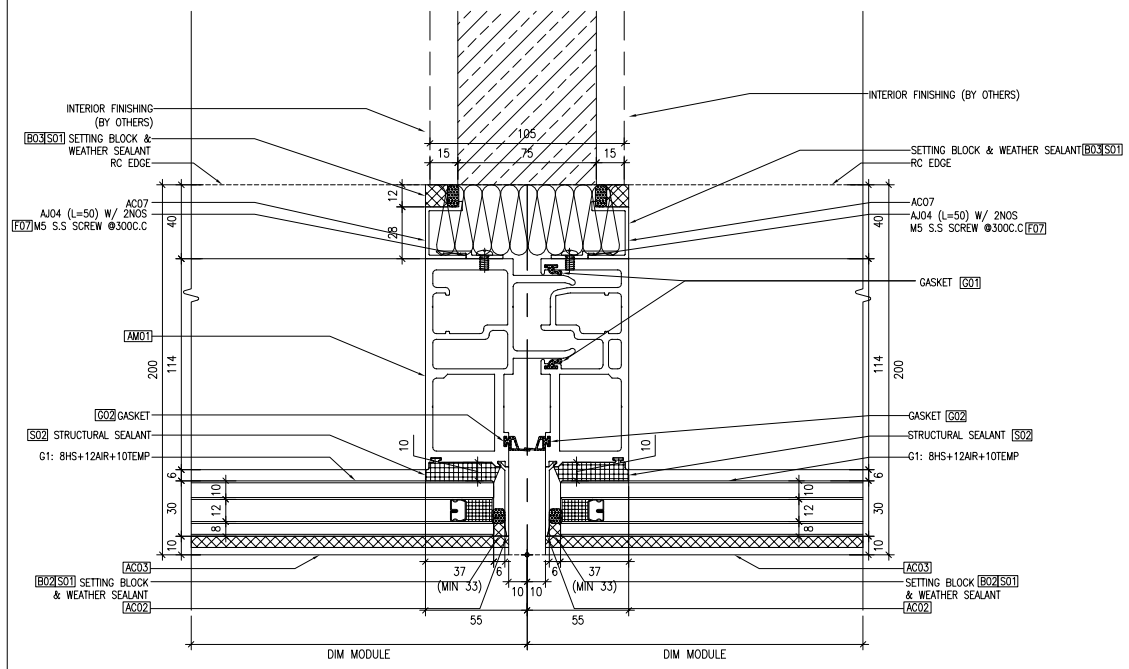


OUTSIDE

1 8006 *TYPICAL DETAIL OF CURTAIN WALL*

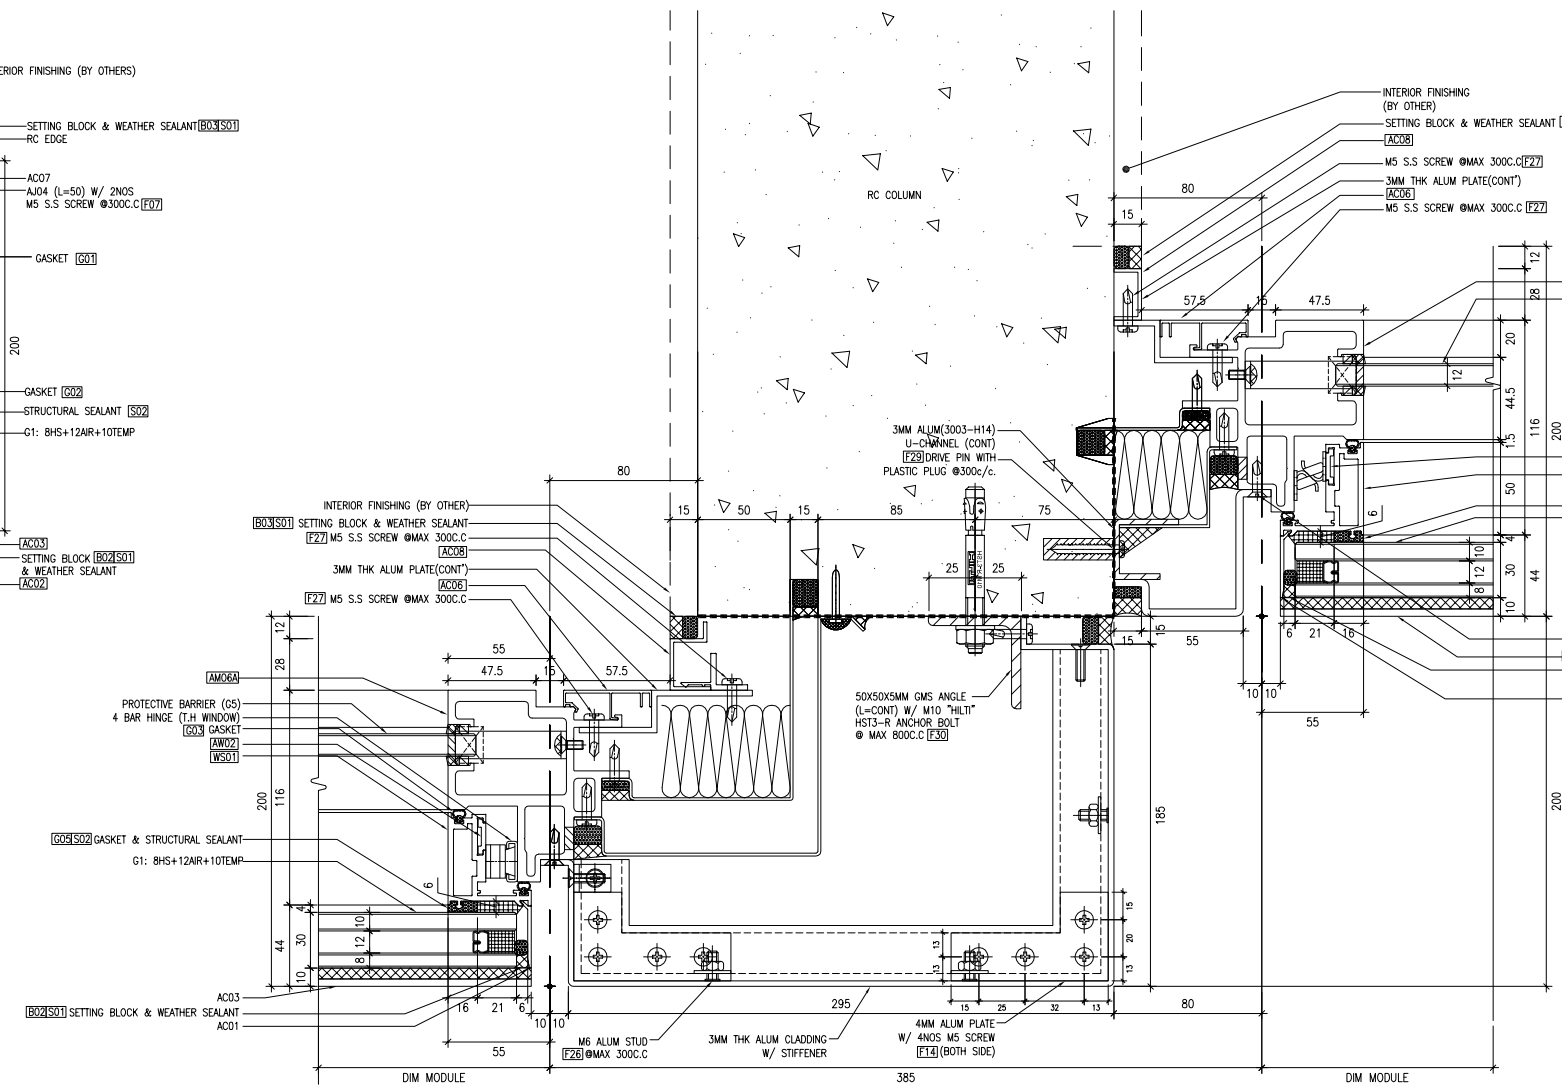

OUTSIDE

2 8006 *TYPICAL DETAIL OF CURTAIN WALL*

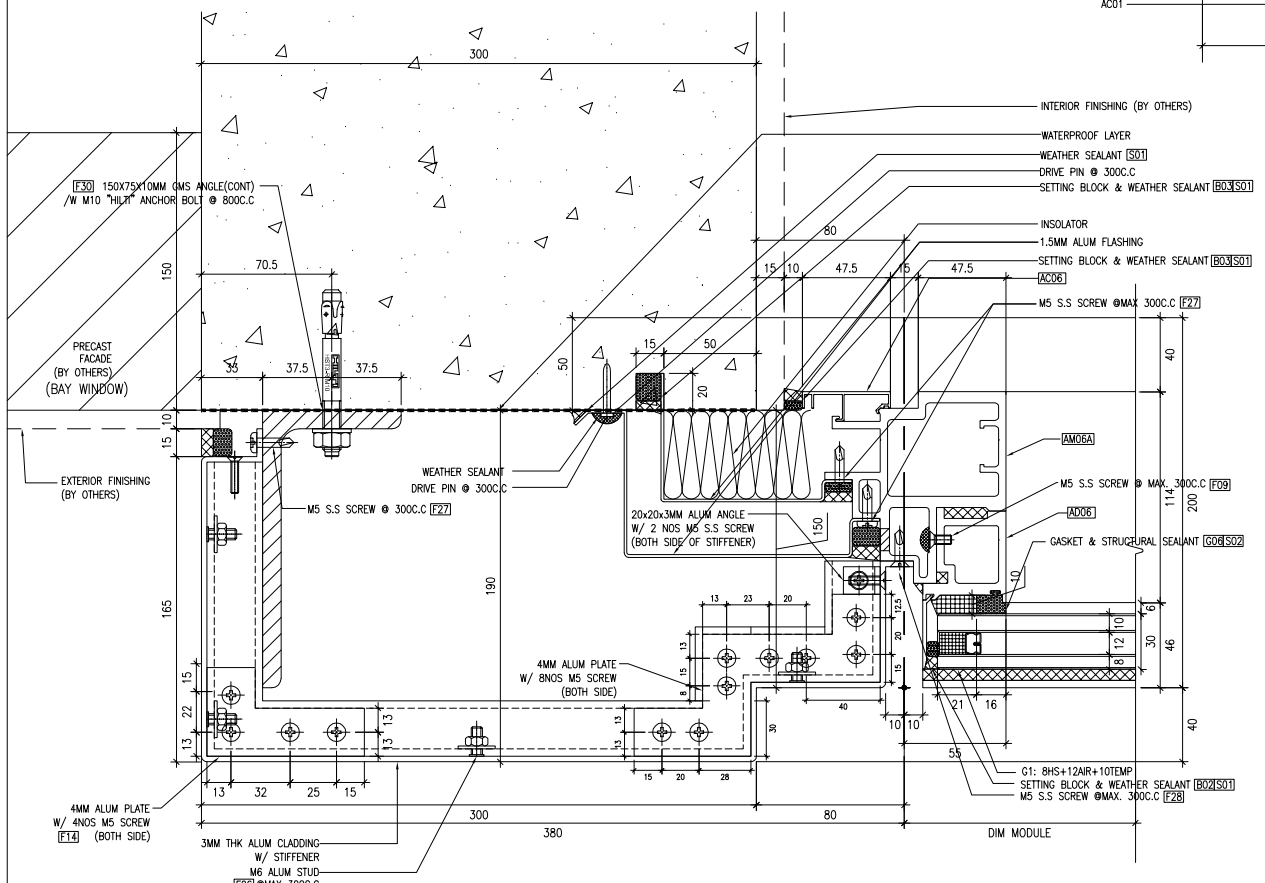

3 8006 *TYPICAL DETAIL OF CURTAIN WALL*

B.D. REF :

CLIENT :

SUN HUNG KAI REAL ESTATE AGENCY LTD.
42/F SUN HUNG KAI CENTRE, WANCHAI, HONGKONG

ARCHITECT :

lwk&partners
a r c h i t e c t s

MAIN CONTRACTOR :

怡輝建築有限公司
Yee Fai Building Contractors Ltd.

STRUCTURAL ENGINEER :

ARUP

FACADE CONSULTANT:

ALPHA CONSULTING LIMITED
Steel Structure & Facade Specialist

NOTE :
1. ALL DIMENSIONS ARE IN mm.
2. ALL ELEVATIONS ARE VIEWED FROM OUTSIDE.
3. ALL DIMENSIONS TO BE VERIFIED ON SITE BEFORE FABRICATION.

LEGEND :

X1 — DETAIL MARK NO.
X001 — REFER SHEET NO.

1. F.F.L. --FINISHED FLOOR LEVEL
2. S.F.L. --STRUCTURAL FLOOR LEVEL
3. /R --REVERSED DETAIL

#1: ALUM FLASHING OVERLAPPING REFER TO DWG: 5 8006A

NO.	DATE	REVISED	BY
E	30-MAY-2023	6TH SUBMISSION	CF
D	02-MAY-2023	5TH SUBMISSION	CF
C	21-FEB-2023	4TH SUBMISSION	CF
B	13-JAN-2023	3RD SUBMISSION	CF
A	30-DEC-2022	2ND SUBMISSION	CF

JOB NO. : J-856

PROJECT :
PROPOSED DEVELOPMENT ABOVE LIGHT RAIL TIN WING STOP,TSWTL NO.23,AREA 33,TIN SHUI WAI, N.T.


TITLE :
TYPICAL DETAIL FOR CURTAIN WALL

DATE : 31-OCT-22 | SCALE : 1:4


DRAWN BY : C.F | CHECKED BY :

美特鋁質有限公司
MIDI ALUMINIUM FABRICATOR LTD.
Units 6-8, Sunray Industrial Centre, 1/F
610 Cha Kwo Ling Road, Kowloon
Tel:23489211-4 Fax:(852)27727666


DWG NO. : J856-SD-CW-8006 | REV. : E

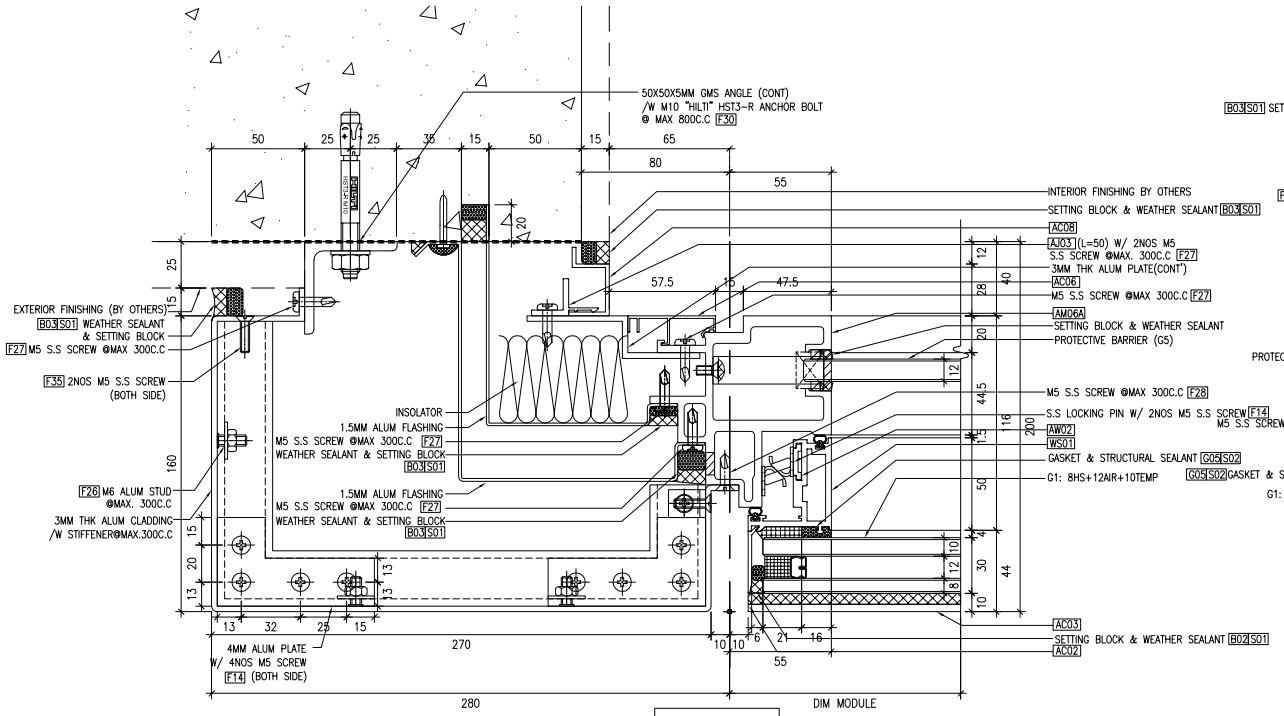


1 8007 *TYPICAL DETAIL OF CURTAIN WALL*

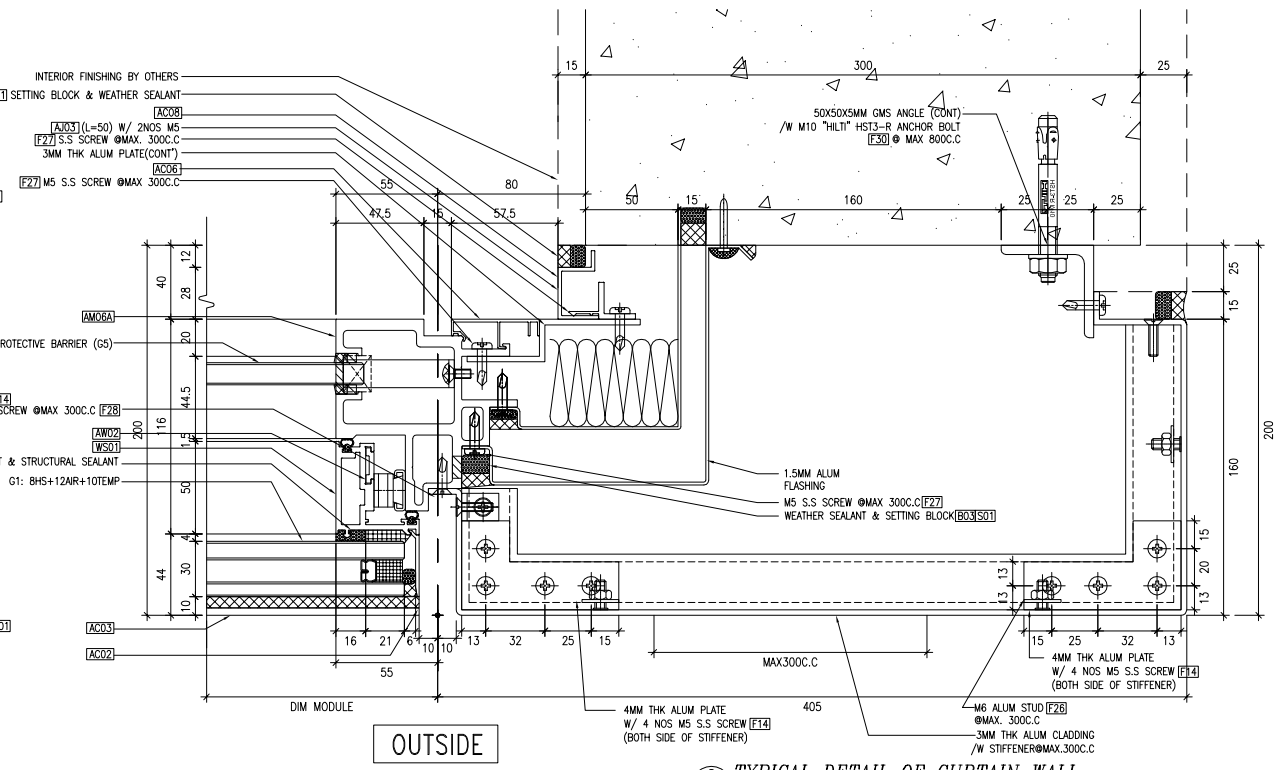

2 8007 *TYPICAL DETAIL OF CURTAIN WALL*

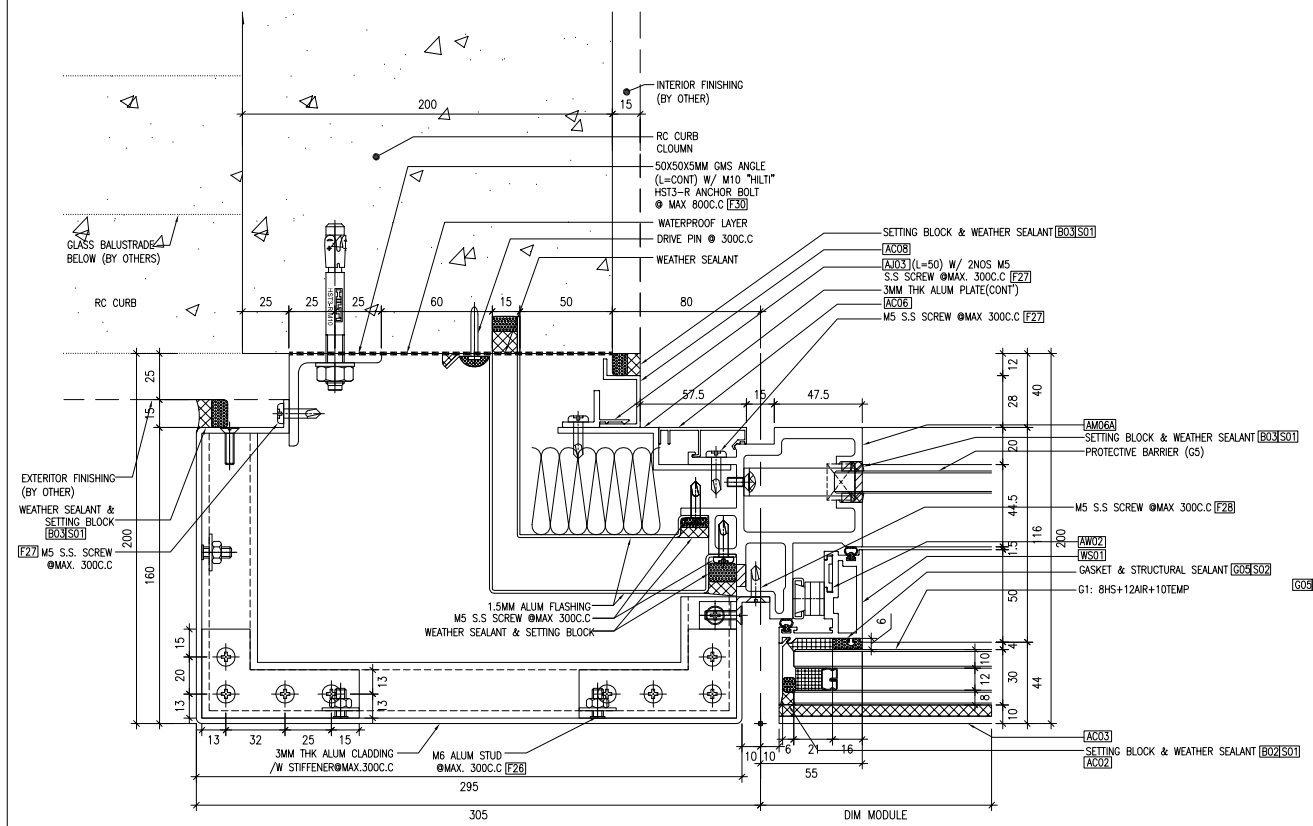

3 8007 *TYPICAL DETAIL OF CURTAIN WALL*

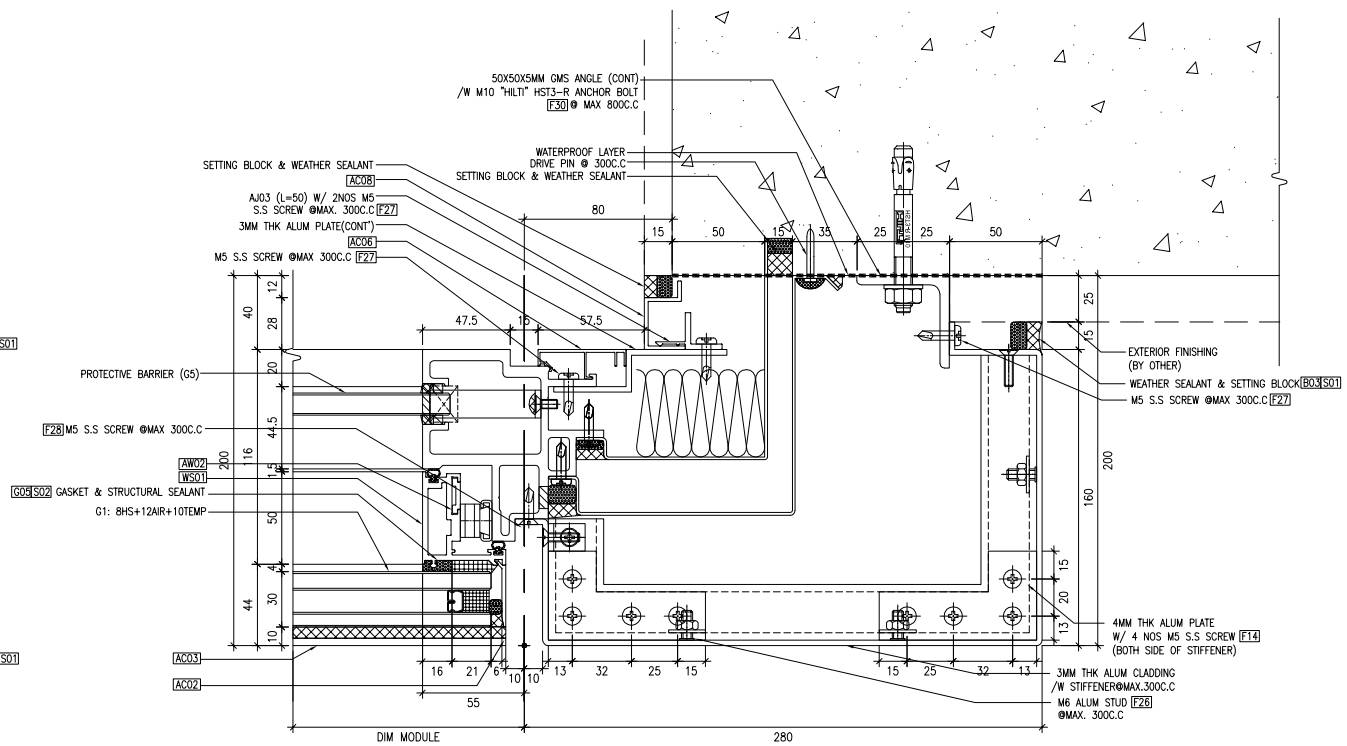

4 8007 *TYPICAL DETAIL OF CURTAIN WALL*

B.D. REF :

CLIENT :

SUN HUNG KAI REAL ESTATE AGENCY LTD.
42/F SUN HUNG KAI CENTRE, WANCHAI, HONGKONG

ARCHITECT :

lwk&partners
a r c h i t e c t s

MAIN CONTRACTOR :

怡輝建築有限公司
Yee Fai Building Contractors Ltd.

STRUCTURAL ENGINEER :

ARUP

FACADE CONSULTANT:

ALPHA CONSULTING LIMITED
Steel Structure & Facade Specialist

NOTE :
1. ALL DIMENSIONS ARE IN mm.
2. ALL ELEVATIONS ARE VIEWED FROM OUTSIDE.
3. ALL DIMENSIONS TO BE VERIFIED ON SITE BEFORE FABRICATION.

LEGEND :

X1 / X001 — DETAIL MARK NO. / REFER SHEET NO.

1. F.F.L. --FINISHED FLOOR LEVEL
2. S.F.L. --STRUCTURAL FLOOR LEVEL
3. (R) --REVERSED DETAIL

#1: ALUM FLASHING OVERLAPPING
REFER TO DWG: 3 / 8008A

NO.	DATE	REVISED	BY
C	02-MAY-2023	5TH SUBMISSION	CF
B	21-FEB-2023	4TH SUBMISSION	CF
A	30-DEC-2022	2ND SUBMISSION	CF
–	21-NOV-2022		CF

JOB NO. : J-856

PROJECT :
PROPOSED DEVELOPMENT ABOVE LIGHT RAIL TIN WING STOP,TSWTL NO.23,AREA 33,TIN SHUI WAI, N.T.


TITLE :
TYPICAL DETAIL FOR CURTAIN WALL

DATE : 31-OCT-22 | SCALE : 1:4


DRAWN BY : C.F | CHECKED BY :

美特鋁質有限公司
MIDI ALUMINIUM FABRICATOR LTD.
Units 6-8, Sunray Industrial Centre, 1/F
610 Cha Kwo Ling Road, Kowloon
Tel:23489211-4 Fax:(852)27727666


DWG NO. : J856-SD-CW-8007 | REV. : C

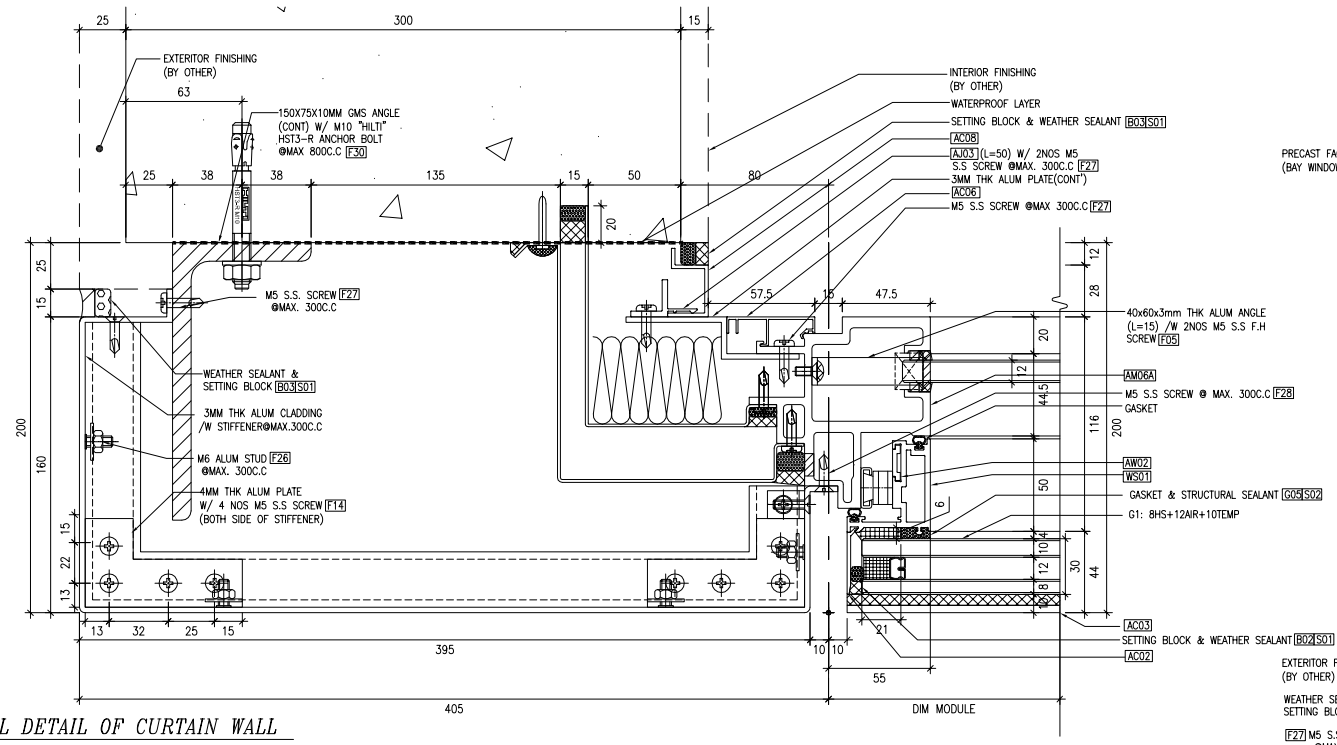


1 8008 *TYPICAL DETAIL OF CURTAIN WALL*

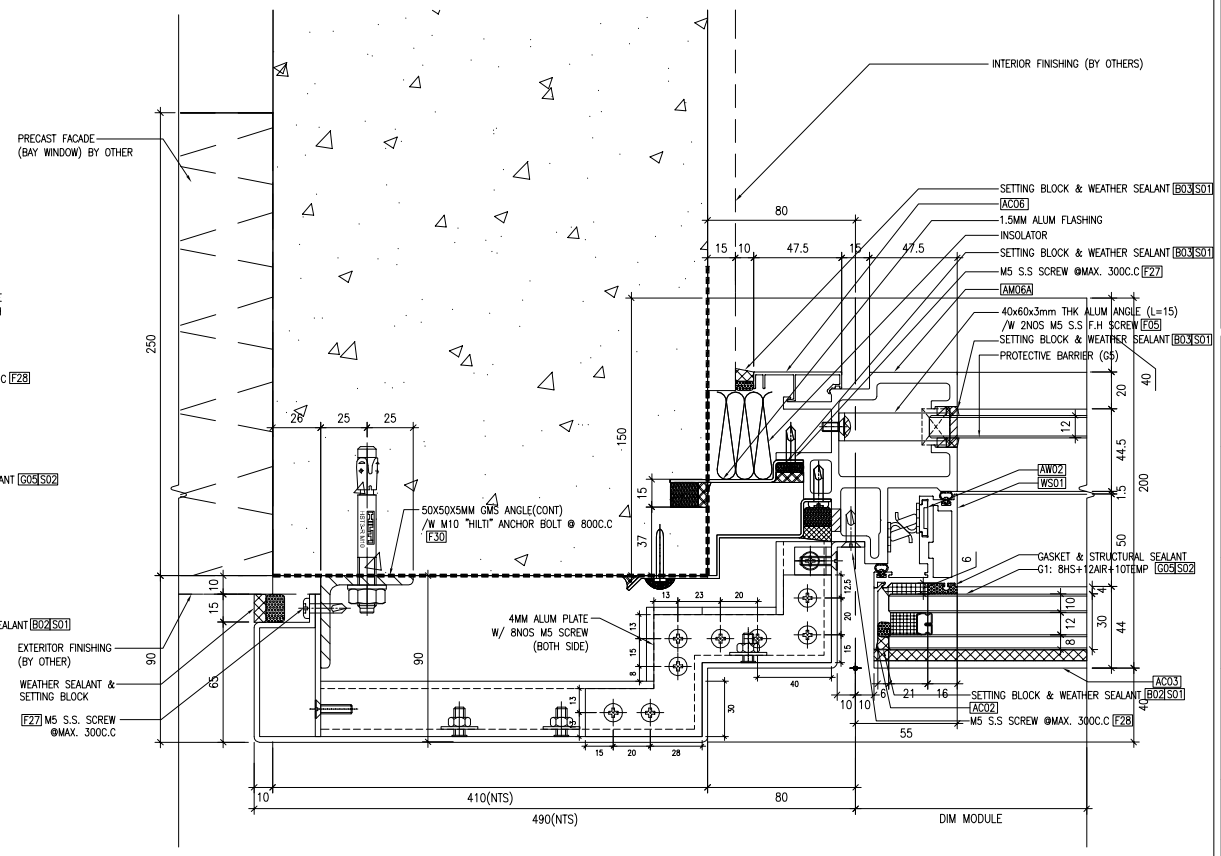


3 8008 *TYPICAL DETAIL OF CURTAIN WALL*

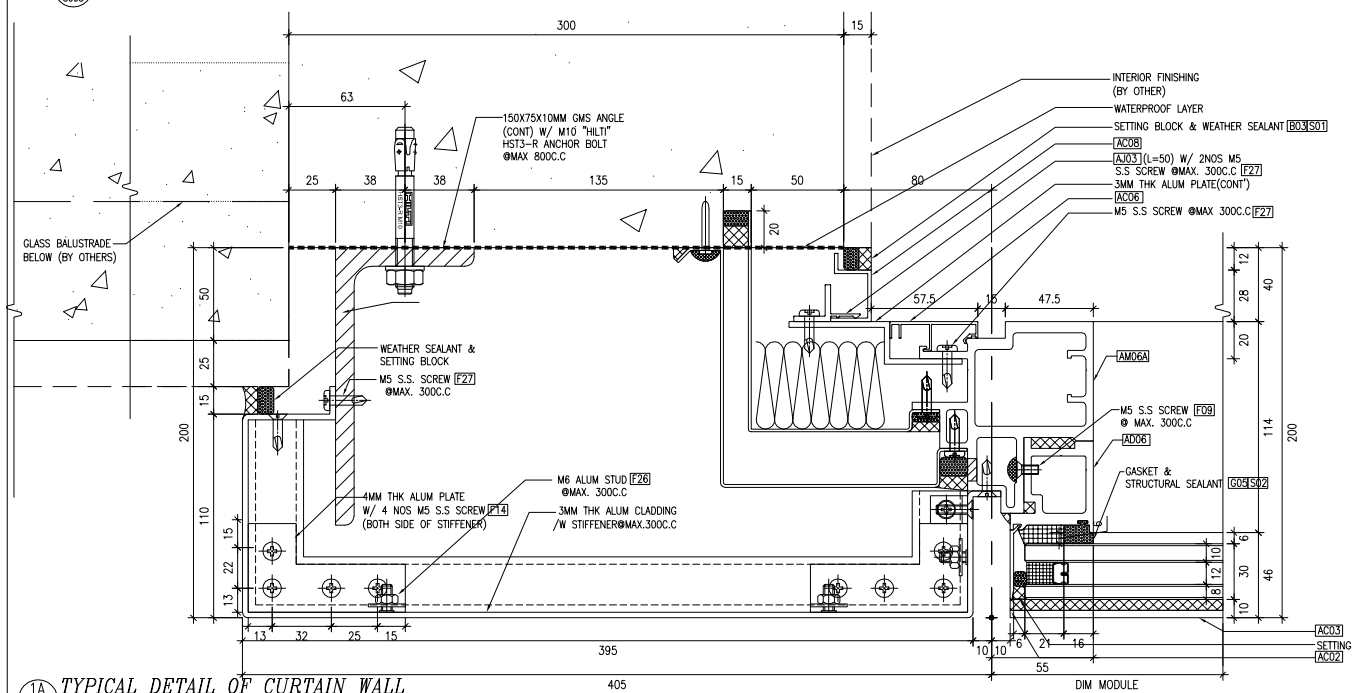

1A 8008 *TYPICAL DETAIL OF CURTAIN WALL*

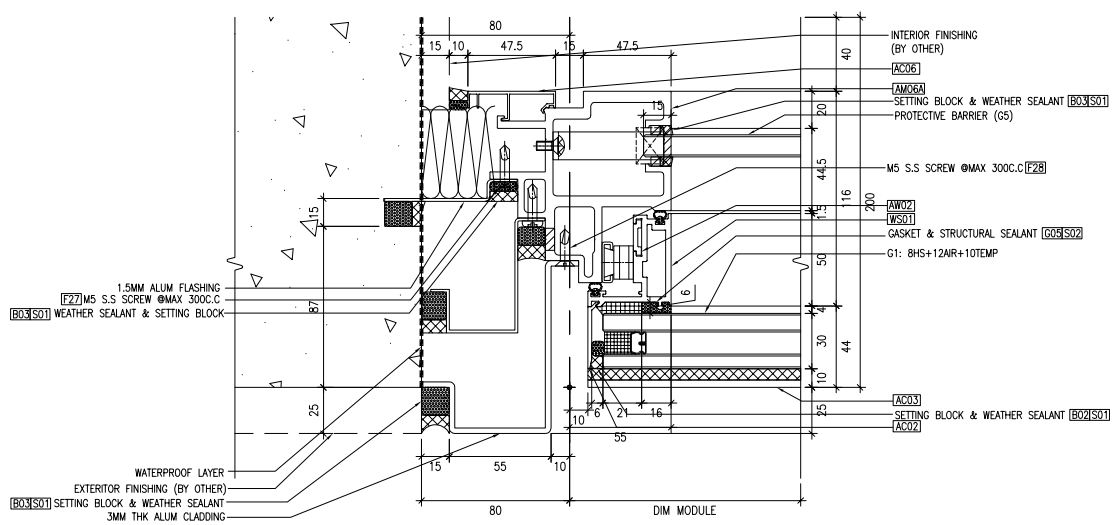

2 8008 *TYPICAL DETAIL OF CURTAIN WALL*

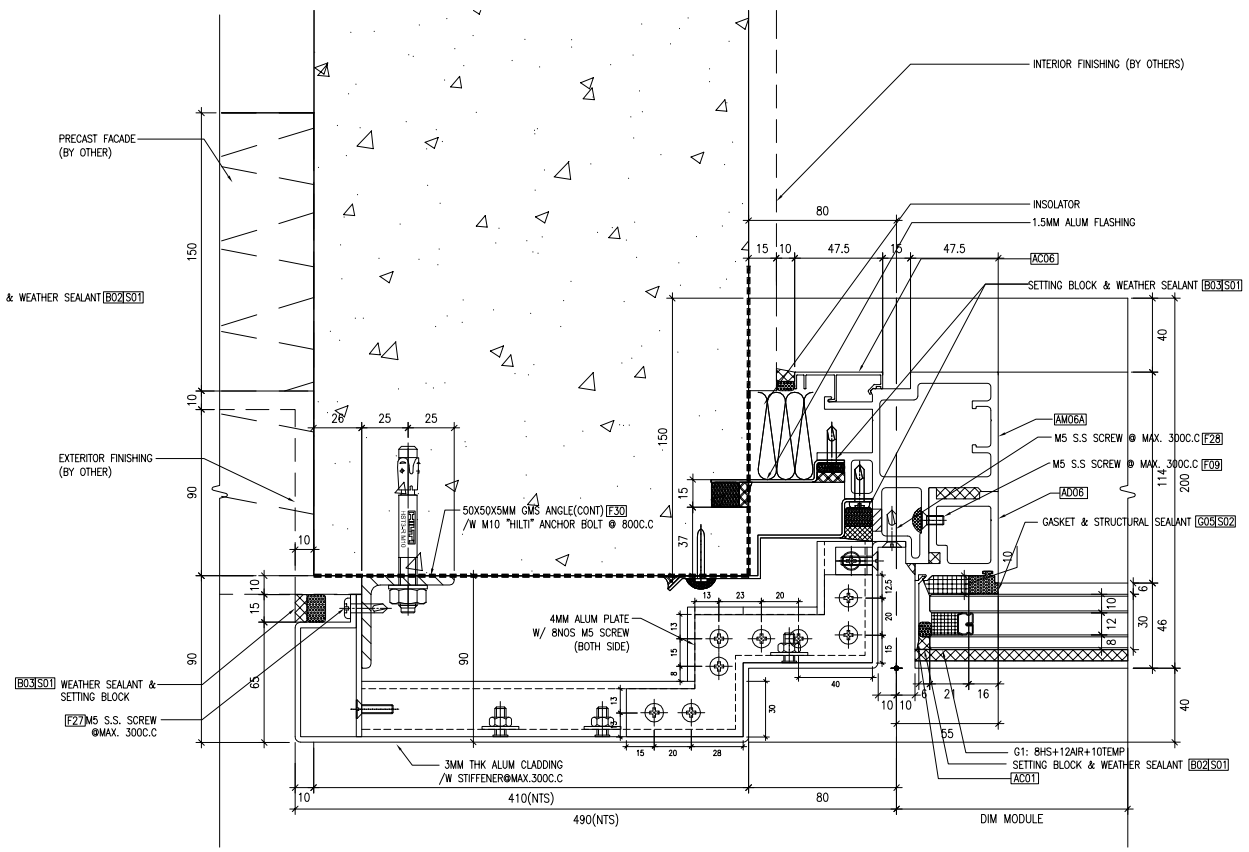

3A 8008 *TYPICAL DETAIL OF CURTAIN WALL*

B.D. REF :

CLIENT :

SUN HUNG KAI REAL ESTATE AGENCY LTD.
42/F SUN HUNG KAI CENTRE, WANCHAI, HONGKONG

ARCHITECT :

lwk&partners
a r c h i t e c t s

MAIN CONTRACTOR :

怡輝建築有限公司
Yee Fai Building Contractors Ltd.

STRUCTURAL ENGINEER :

ARUP

FACADE CONSULTANT:

ALPHA CONSULTING LIMITED
Steel Structure & Facade Specialist

NOTE :
1. ALL DIMENSIONS ARE IN mm.
2. ALL ELEVATIONS ARE VIEWED FROM OUTSIDE.
3. ALL DIMENSIONS TO BE VERIFIED ON SITE BEFORE FABRICATION.

LEGEND :

X1 / X001 — DETAIL MARK NO. / REFER SHEET NO.

1. F.F.L. --FINISHED FLOOR LEVEL
2. S.F.L. --STRUCTURAL FLOOR LEVEL
3. (/R) --REVERSED DETAIL

#1: ALUM FLASHING OVERLAPPING REFER TO DWG: 3 / 8008A

NO.	DATE	REVISED	BY
D	30-MAY-2023	6TH SUBMISSION	CF
C	02-MAY-2023	5TH SUBMISSION	CF
B	21-FEB-2023	4TH SUBMISSION	CF
A	30-DEC-2022	2ND SUBMISSION	CF
-	21-NOV-2022		CF

JOB NO. : J-856

PROJECT :
PROPOSED DEVELOPMENT ABOVE LIGHT RAIL TIN WING STOP,TSWTL NO.23,AREA 33,TIN SHUI WAI, N.T.


TITLE :
TYPICAL DETAIL FOR CURTAIN WALL

DATE : 31-OCT-22 | SCALE : 1:4


DRAWN BY : C.F | CHECKED BY :

美特鋁製有限公司
MIDI ALUMINIUM FABRICATOR LTD.
Units 6-8, Sunray Industrial Centre, 1/F
610 Cha Kwo Ling Road, Kowloon
Tel:23489211-4 Fax:(852)27727666


DWG NO. : J856-SD-CW-8008 | REV. : D

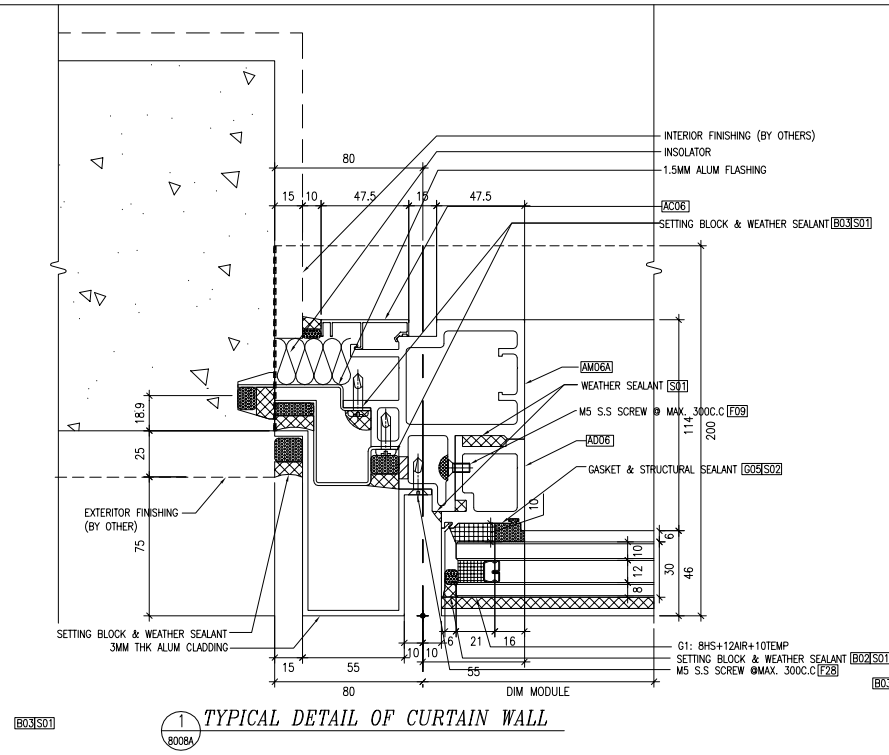


1 / 8008A *TYPICAL DETAIL OF CURTAIN WALL*

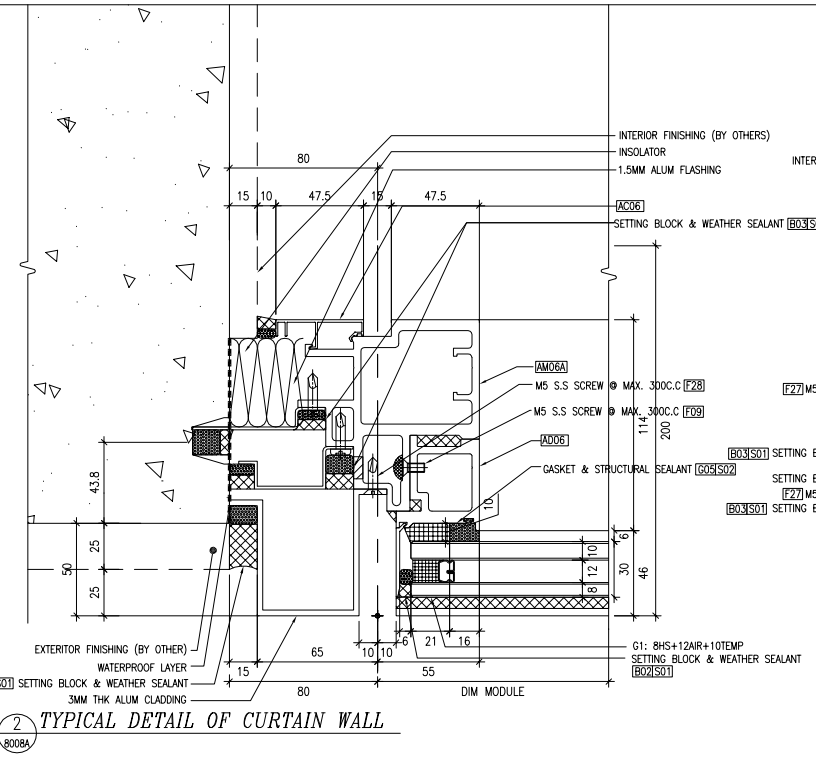


2 / 8008A *TYPICAL DETAIL OF CURTAIN WALL*

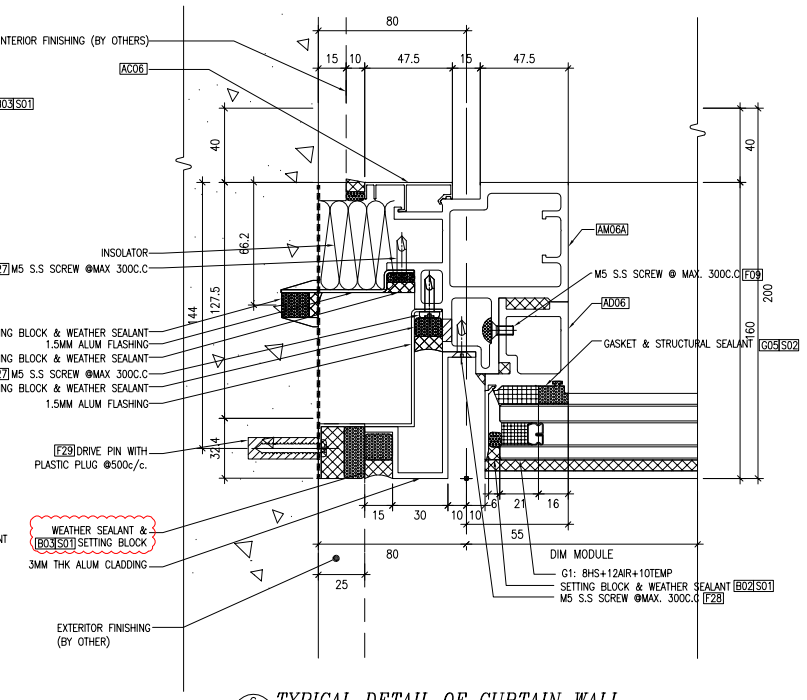


6 / 8008A *TYPICAL DETAIL OF CURTAIN WALL*

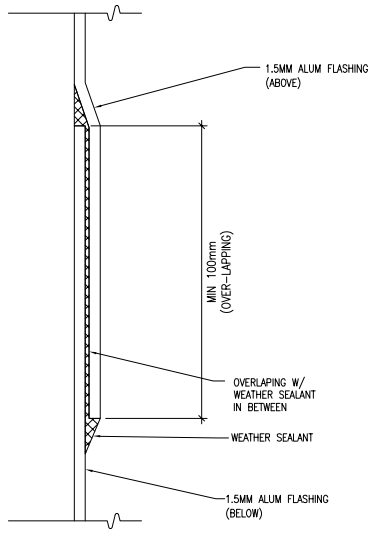

3 / 8008A *SECTION DETAIL*
1.5MM FLASHING (VERT.)

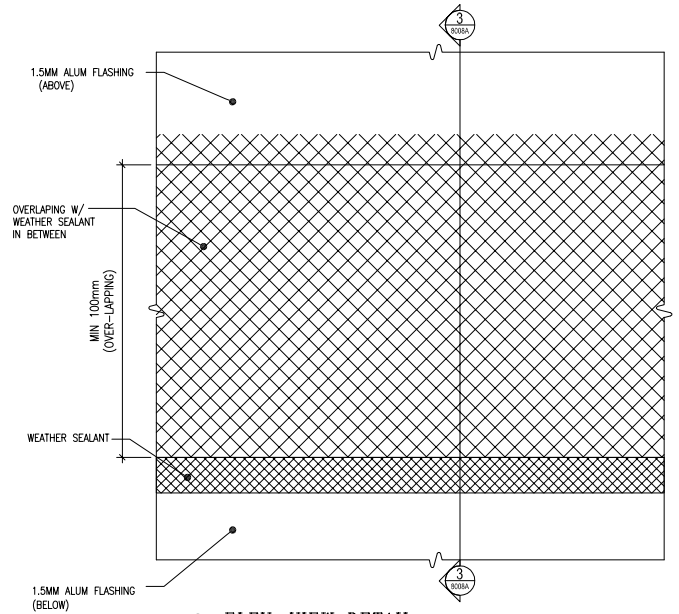

3A / 8008A *ELEV. VIEW DETAIL*
1.5MM FLASHING (VERT)

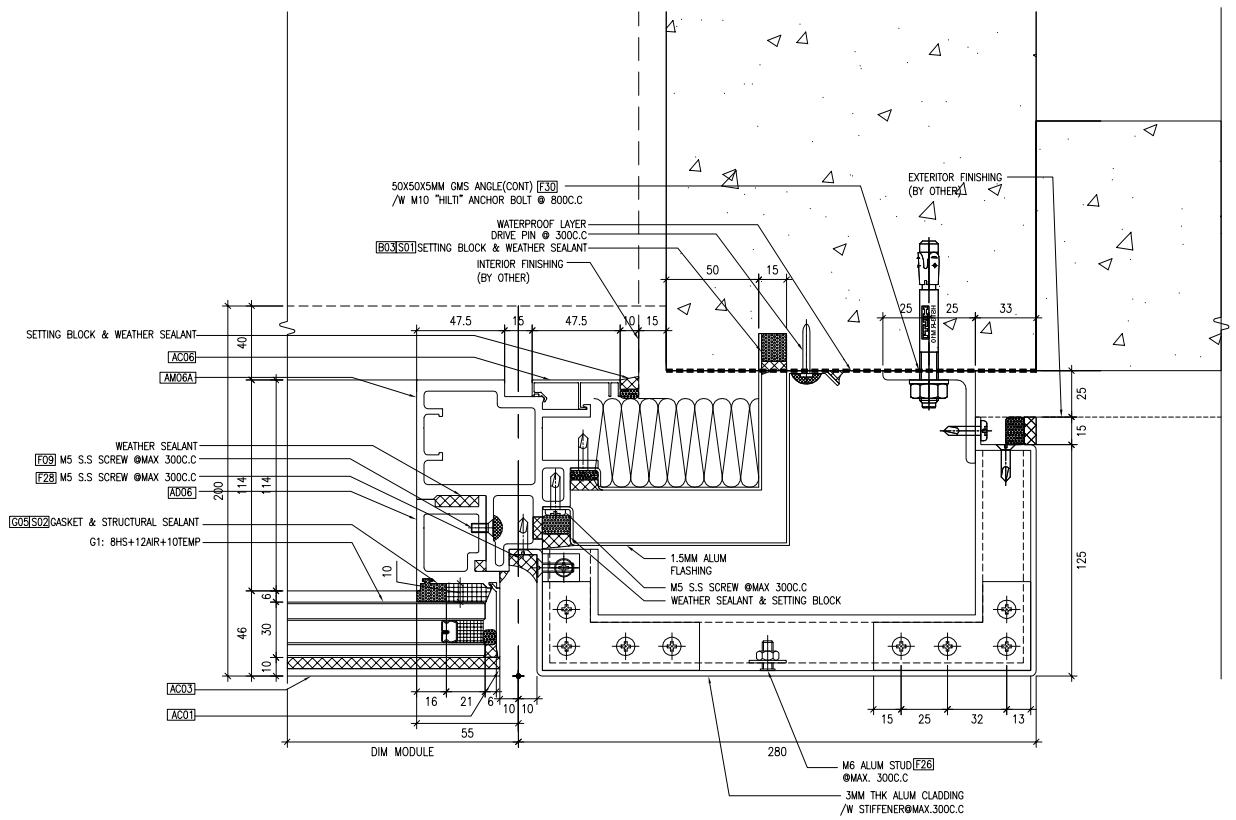

7 / 8008A *TYPICAL DETAIL OF CURTAIN WALL*

B.D. REF :

CLIENT :
SUN HUNG KAI REAL ESTATE AGENCY LTD.
42/F SUN HUNG KAI CENTRE, WANCHAI, HONGKONG

ARCHITECT :
lwk&partners architects

MAIN CONTRACTOR :
怡輝建築有限公司
Yee Fai Building Contractors Ltd.

STRUCTURAL ENGINEER :
ARUP

FACADE CONSULTANT:
ALPHA CONSULTING LIMITED
Steel Structure & Facade Specialist

NOTE :
1. ALL DIMENSIONS ARE IN mm.
2. ALL ELEVATIONS ARE VIEWED FROM OUTSIDE.
3. ALL DIMENSIONS TO BE VERIFIED ON SITE BEFORE FABRICATION.

LEGEND :
X1 / X001 — DETAIL MARK NO. / REFER SHEET NO.
1. F.F.L. --FINISHED FLOOR LEVEL
2. S.F.L. --STRUCTURAL FLOOR LEVEL
3. (/R) --REVERSED DETAIL

NO.	DATE	REVISED	BY
C	30-OCT-2023	9TH SUBMISSION	CF
B	02-MAY-2023	5TH SUBMISSION	CF
A	21-FEB-2023	4TH SUBMISSION	CF
–	13-JAN-2023	NEW DRAWING (3RD SUBMISSION)	CF

JOB NO. : J-856

PROJECT :
PROPOSED DEVELOPMENT ABOVE LIGHT RAIL TIN WING STOP,TSWTL NO.23,AREA 33,TIN SHUI WAI, N.T.


TITLE :
TYPICAL DETAIL FOR CURTAIN WALL

DATE : 31-OCT-22 | SCALE : 1:4

DRAWN BY : C.F | CHECKED BY :


美特鋁質有限公司
MIDI ALUMINIUM FABRICATOR LTD.
Units 6-8, Sunray Industrial Centre, 1/F
610 Cha Kwo Ling Road, Kowloon
Tel:23489211-4 Fax:(852)27727666

DWG NO. : J856-SD-CW-8008A | REV. : C

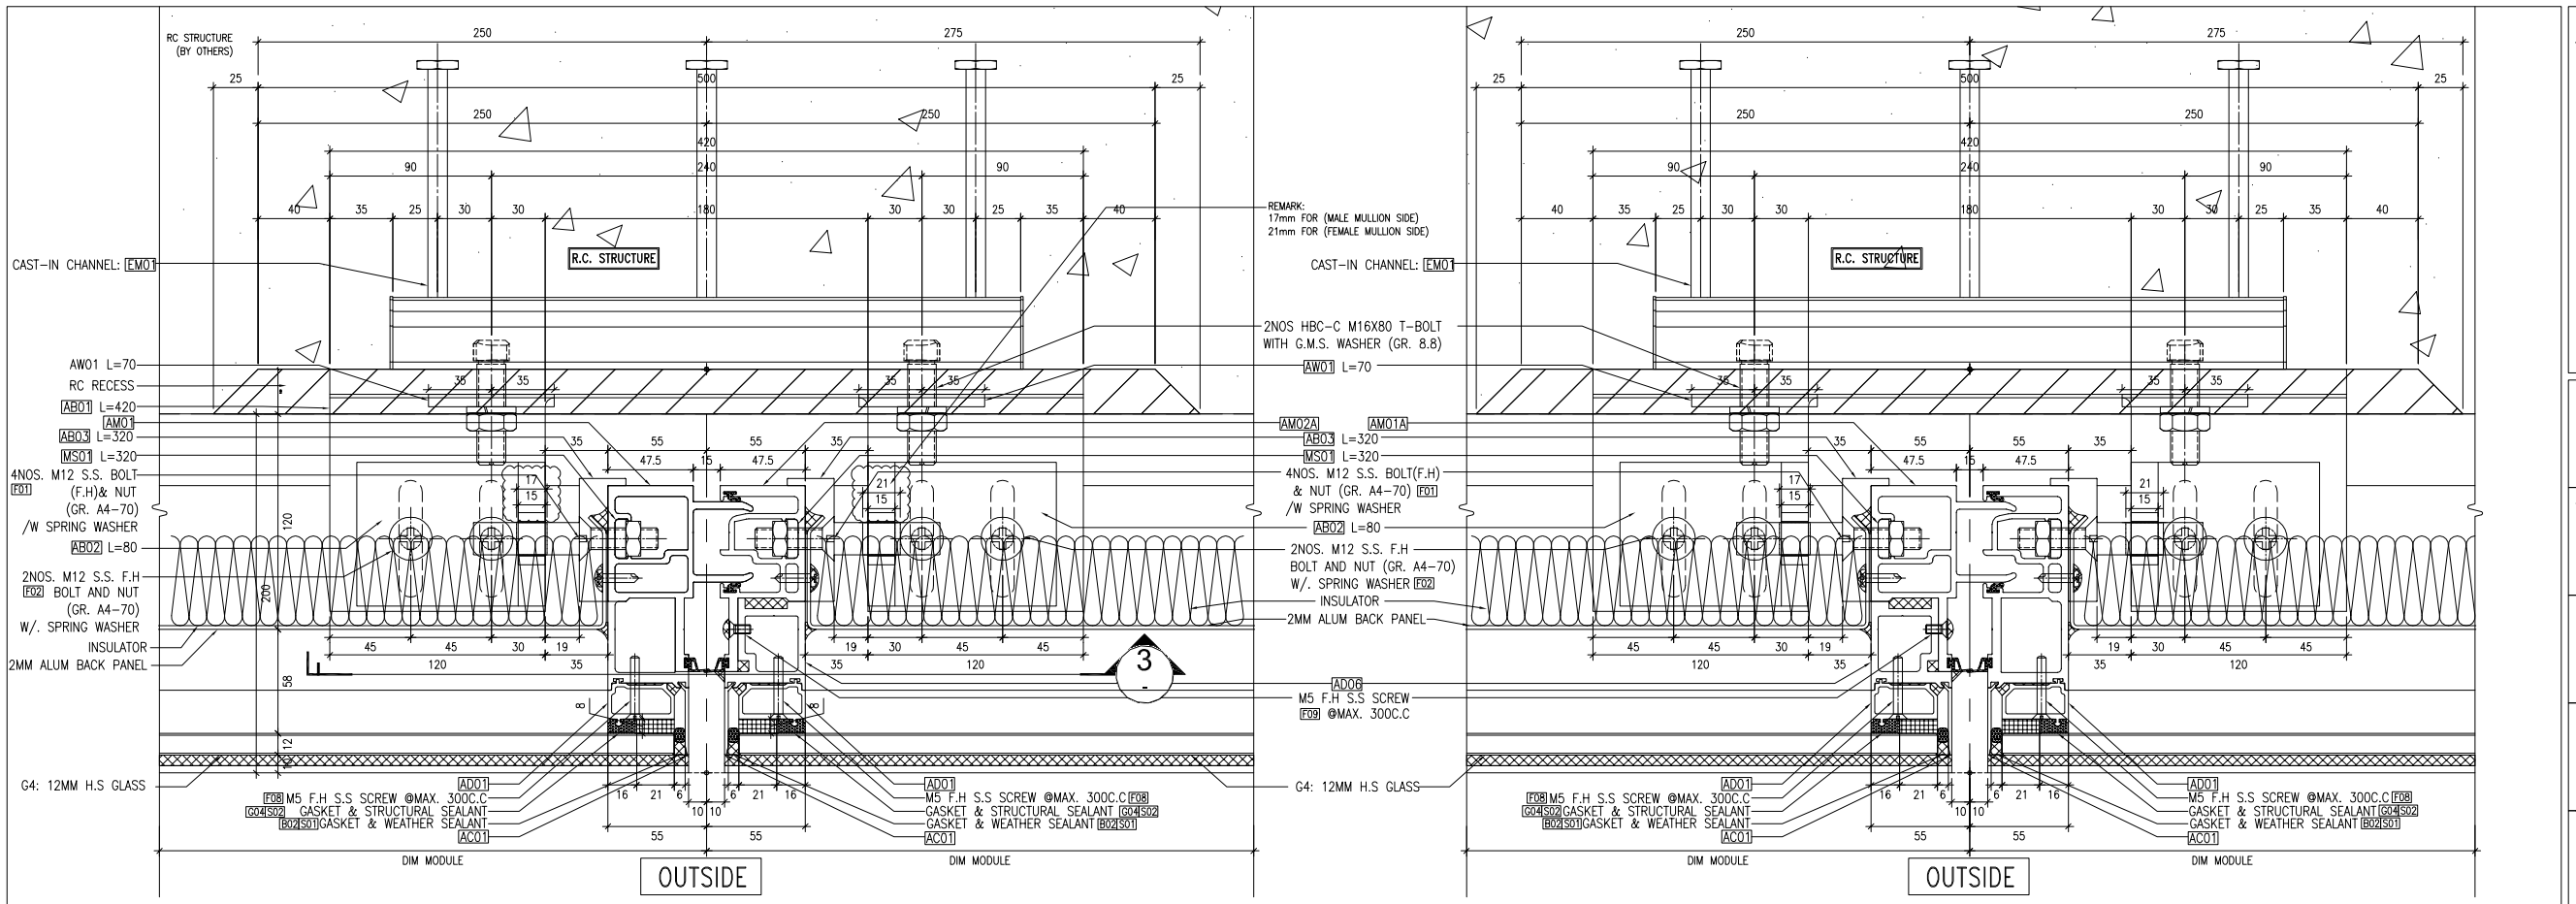


1 8009 *TYPICAL DETAIL OF CURTAIN WALL*


2 8009 *TYPICAL DETAIL OF CURTAIN WALL*

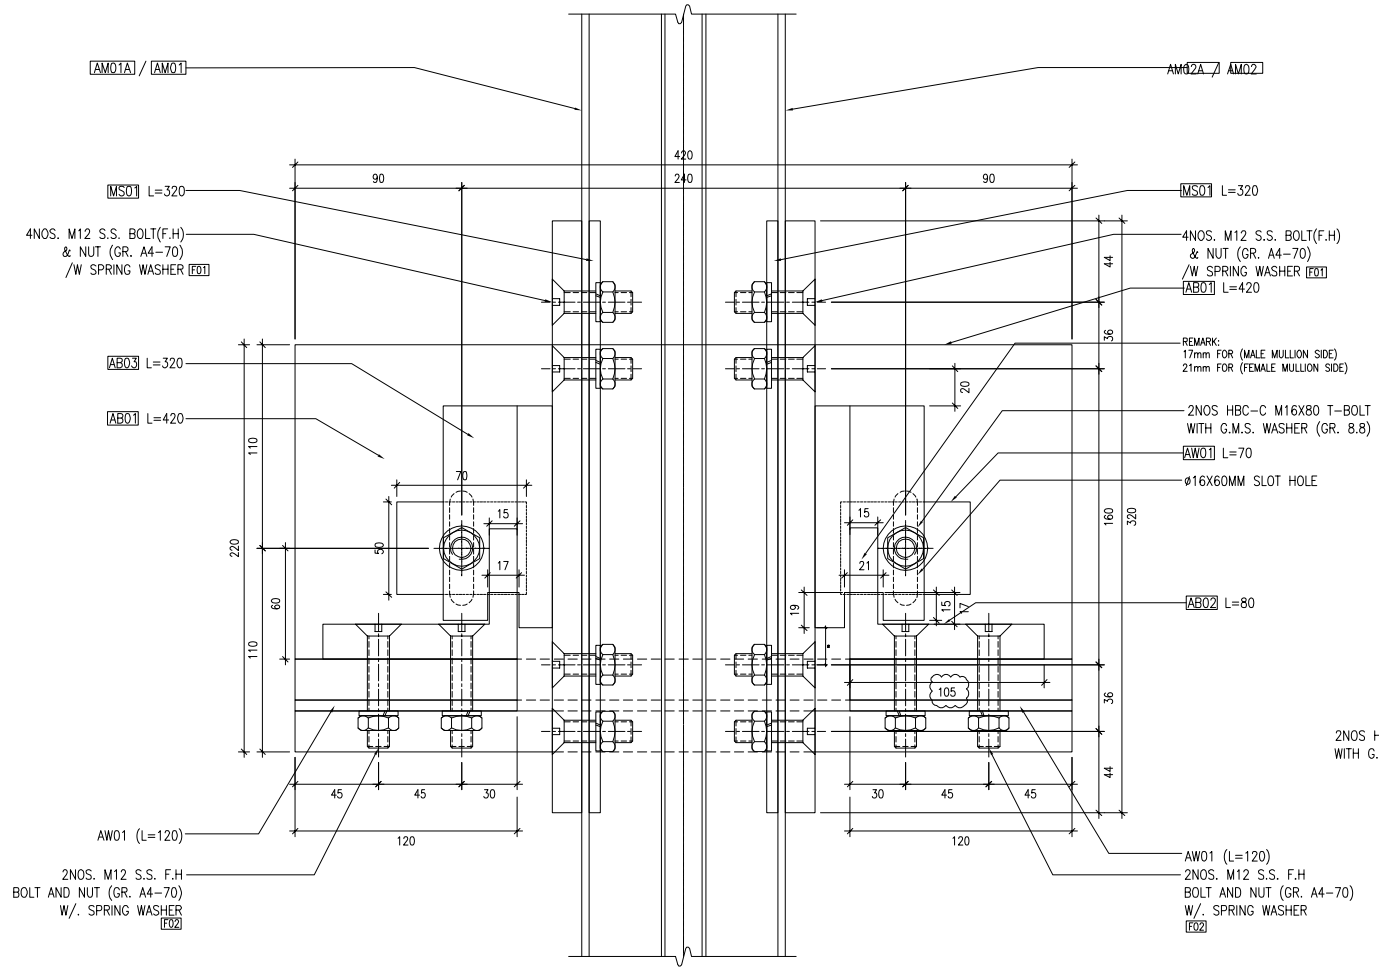

3 8009 *SECTION VIEW (FIXING)*

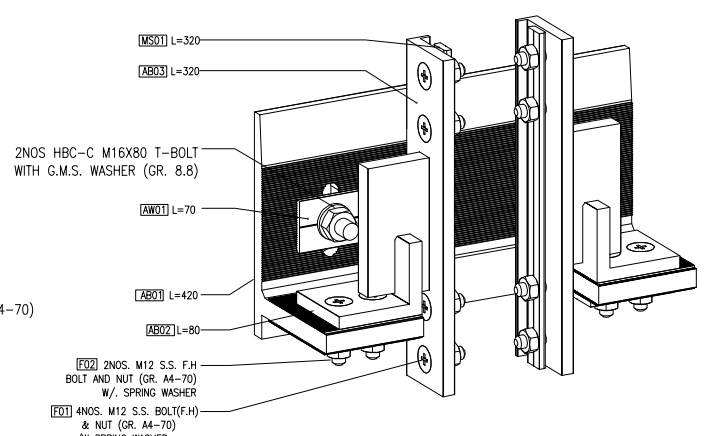

4 8009 *ISOMETRIC VIEW (FIXING)*

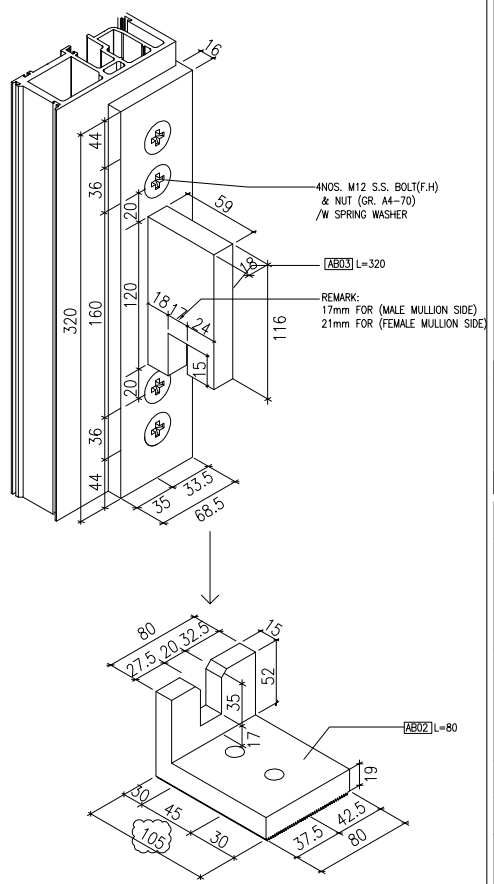

5 8009 *ISOMETRIC VIEW (FIXING)*

B.D. REF :

CLIENT :
SUN HUNG KAI REAL ESTATE AGENCY LTD.
42/F SUN HUNG KAI CENTRE, WANCHAI, HONGKONG

ARCHITECT :
lwk&partners architects

MAIN CONTRACTOR :
怡輝建築有限公司 Yee Fai Building Contractors Ltd.

STRUCTURAL ENGINEER :
ARUP

FACADE CONSULTANT:
ALPHA CONSULTING LIMITED
Steel Structure & Facade Specialist

NOTE :
1. ALL DIMENSIONS ARE IN mm.
2. ALL ELEVATIONS ARE VIEWED FROM OUTSIDE.
3. ALL DIMENSIONS TO BE VERIFIED ON SITE BEFORE FABRICATION.

LEGEND :
X1 — DETAIL MARK NO.
X001 — REFER SHEET NO.

1. F.F.L. -- FINISHED FLOOR LEVEL
2. S.F.L. -- STRUCTURAL FLOOR LEVEL
3. (R) -- REVERSED DETAIL

NO.	DATE	REVISED	BY
D	30-OCT-2023	9TH SUBMISSION	CF
C	02-MAY-2023	5TH SUBMISSION	CF
B	21-FEB-2023	4TH SUBMISSION	CF
A	30-DEC-2022	2ND SUBMISSION	CF
–	21-NOV-2022		CF

JOB NO. : J-856

PROJECT :
PROPOSED DEVELOPMENT ABOVE LIGHT RAIL TIN WING STOP,TSWTL NO.23,AREA 33,TIN SHUI WAI, N.T.


TITLE :
TYPICAL DETAIL FOR CURTAIN WALL

DATE : 31-OCT-22 | SCALE : 1:4


DRAWN BY : C.F | CHECKED BY :

美特鋁質有限公司 MIDI ALUMINIUM FABRICATOR LTD.
Units 6-8, Sunray Industrial Centre, 1/F
610 Cha Kwo Ling Road, Kowloon
Tel:23489211-4 Fax:(852)27727666

DWG NO. : J856-SD-CW-8009 | REV. : D

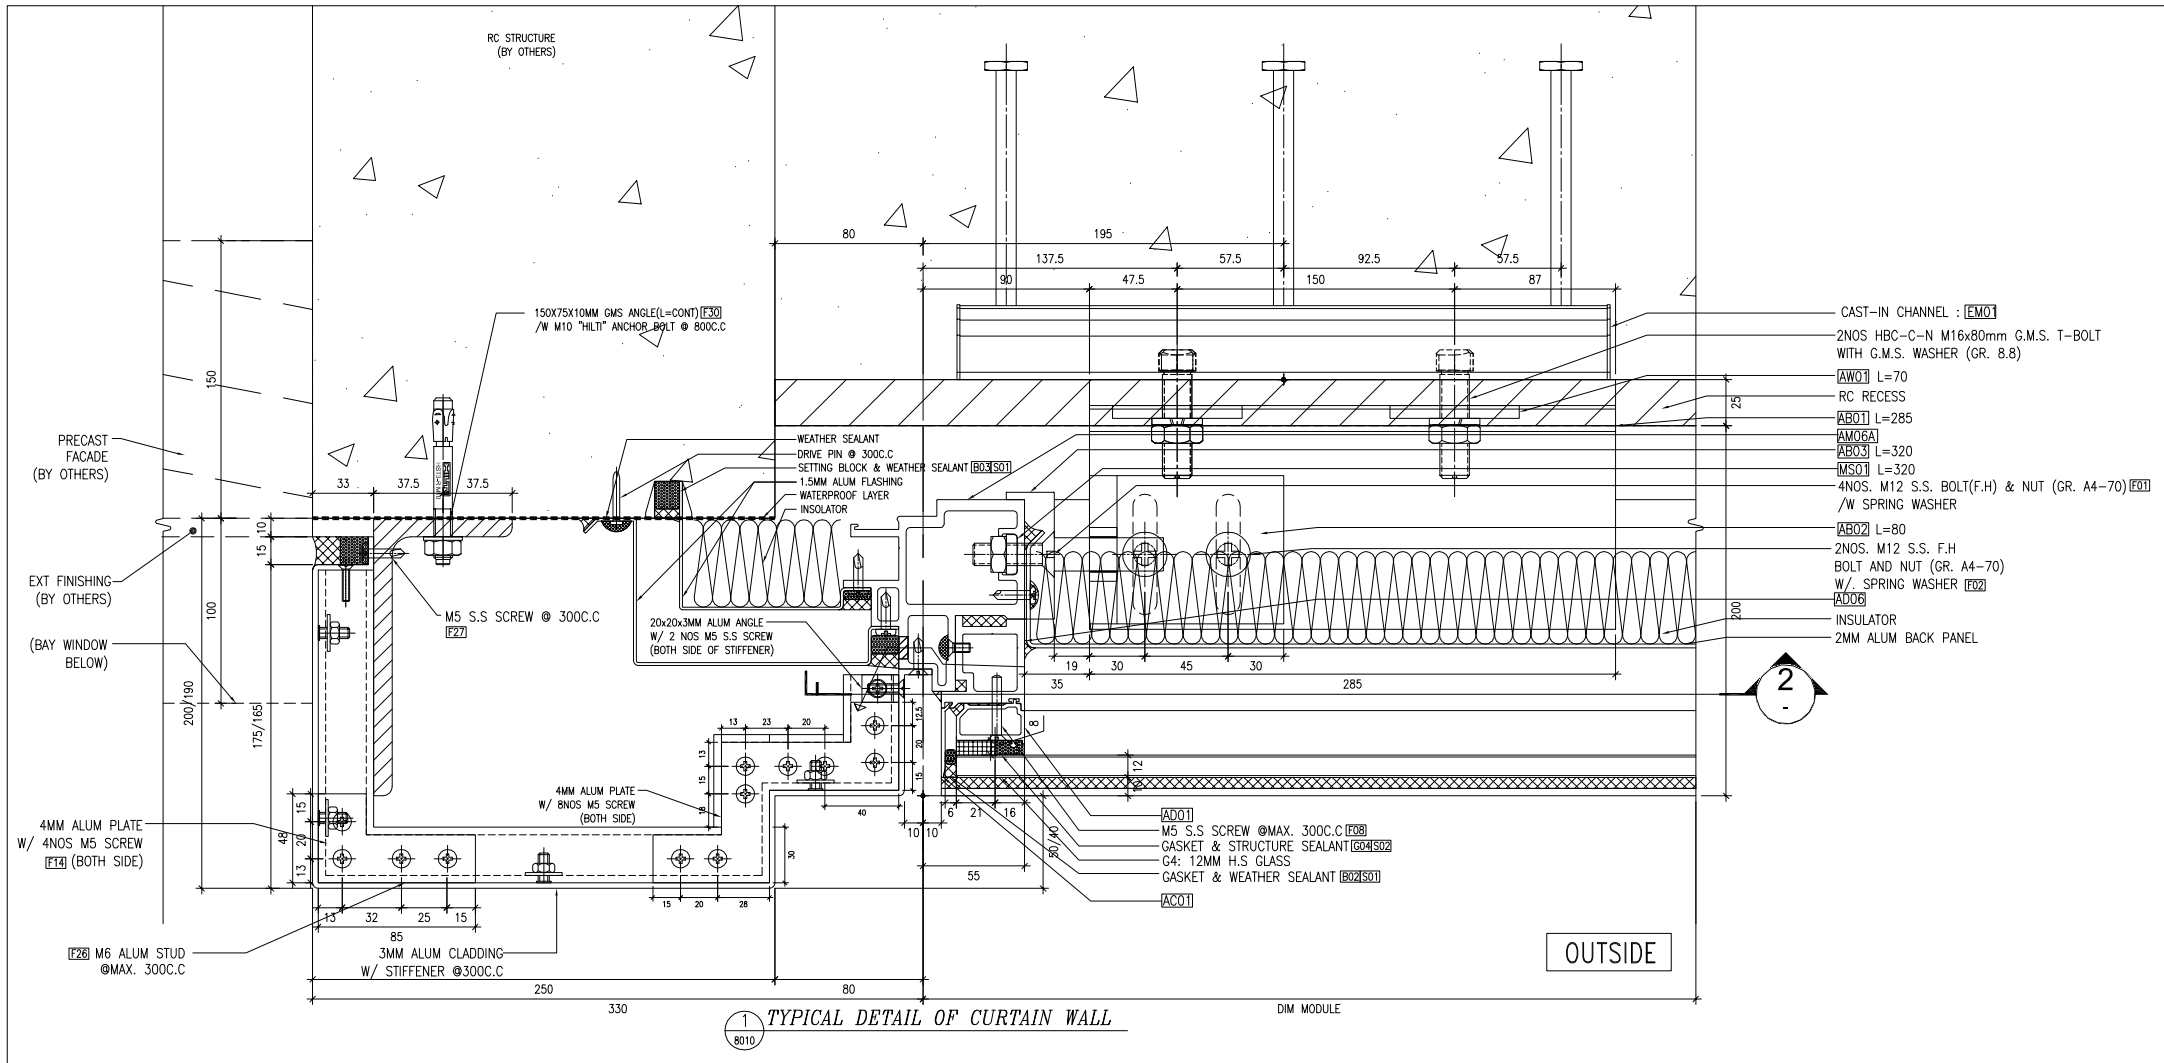

1 / 8010 *TYPICAL DETAIL OF CURTAIN WALL*

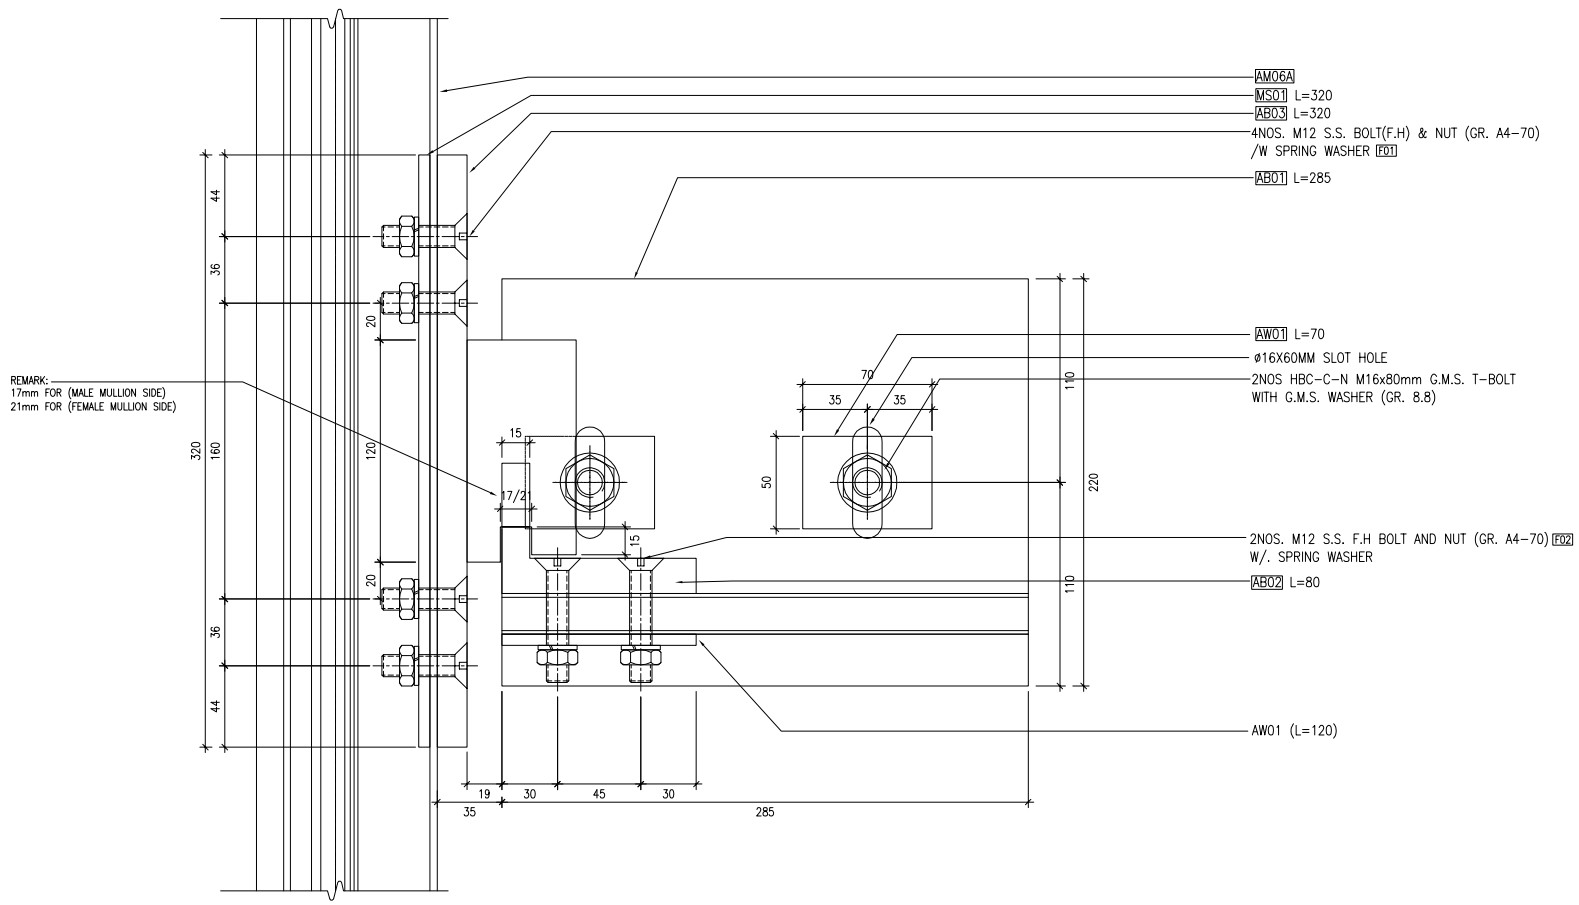

2 / 8010 *SECTION VIEW (FIXING)*

B.D. REF :

CLIENT :
SUN HUNG KAI REAL ESTATE AGENCY LTD.
42/F SUN HUNG KAI CENTRE, WANCHAI, HONGKONG

ARCHITECT :
lwk&partners
a r c h i t e c t s

MAIN CONTRACTOR :
怡輝建築有限公司
Yee Fai Building Contractors Ltd.

STRUCTURAL ENGINEER :
ARUP

FACADE CONSULTANT:
ALPHA CONSULTING LIMITED
Steel Structure & Facade Specialist

NOTE :
1. ALL DIMENSIONS ARE IN mm.
2. ALL ELEVATIONS ARE VIEWED FROM OUTSIDE.
3. ALL DIMENSIONS TO BE VERIFIED ON SITE BEFORE FABRICATION.

LEGEND :
X1 / X001 — DETAIL MARK NO. / REFER SHEET NO.
1. F.F.L. --FINISHED FLOOR LEVEL
2. S.F.L. --STRUCTURAL FLOOR LEVEL
3. /R --REVERSED DETAIL

#1: ALUM FLASHING OVERLAPPING
REFER TO DWG: 3 / 8008A

NO.	DATE	REVISED	BY
D	30-MAY-2023	6TH SUBMISSION	CF
C	02-MAY-2023	5TH SUBMISSION	CF
B	21-FEB-2023	4TH SUBMISSION	CF
A	30-DEC-2022	2ND SUBMISSION	CF
–	21-NOV-2022		CF

JOB NO. : J-856

PROJECT :
PROPOSED DEVELOPMENT ABOVE LIGHT RAIL TIN WING STOP,TSWTL NO.23,AREA 33,TIN SHUI WAI, N.T.


TITLE :
TYPICAL DETAIL FOR CURTAIN WALL

DATE : 31-OCT-22 | SCALE : 1:4


DRAWN BY : C.F | CHECKED BY :

美特鋁質有限公司
MIDI ALUMINIUM FABRICATOR LTD.
Units 6-8, Sunray Industrial Centre, 1/F
610 Cha Kwo Ling Road, Kowloon
Tel:23489211-4 Fax:(852)27727666

DWG NO. : J856-SD-CW-8010 | REV. : D

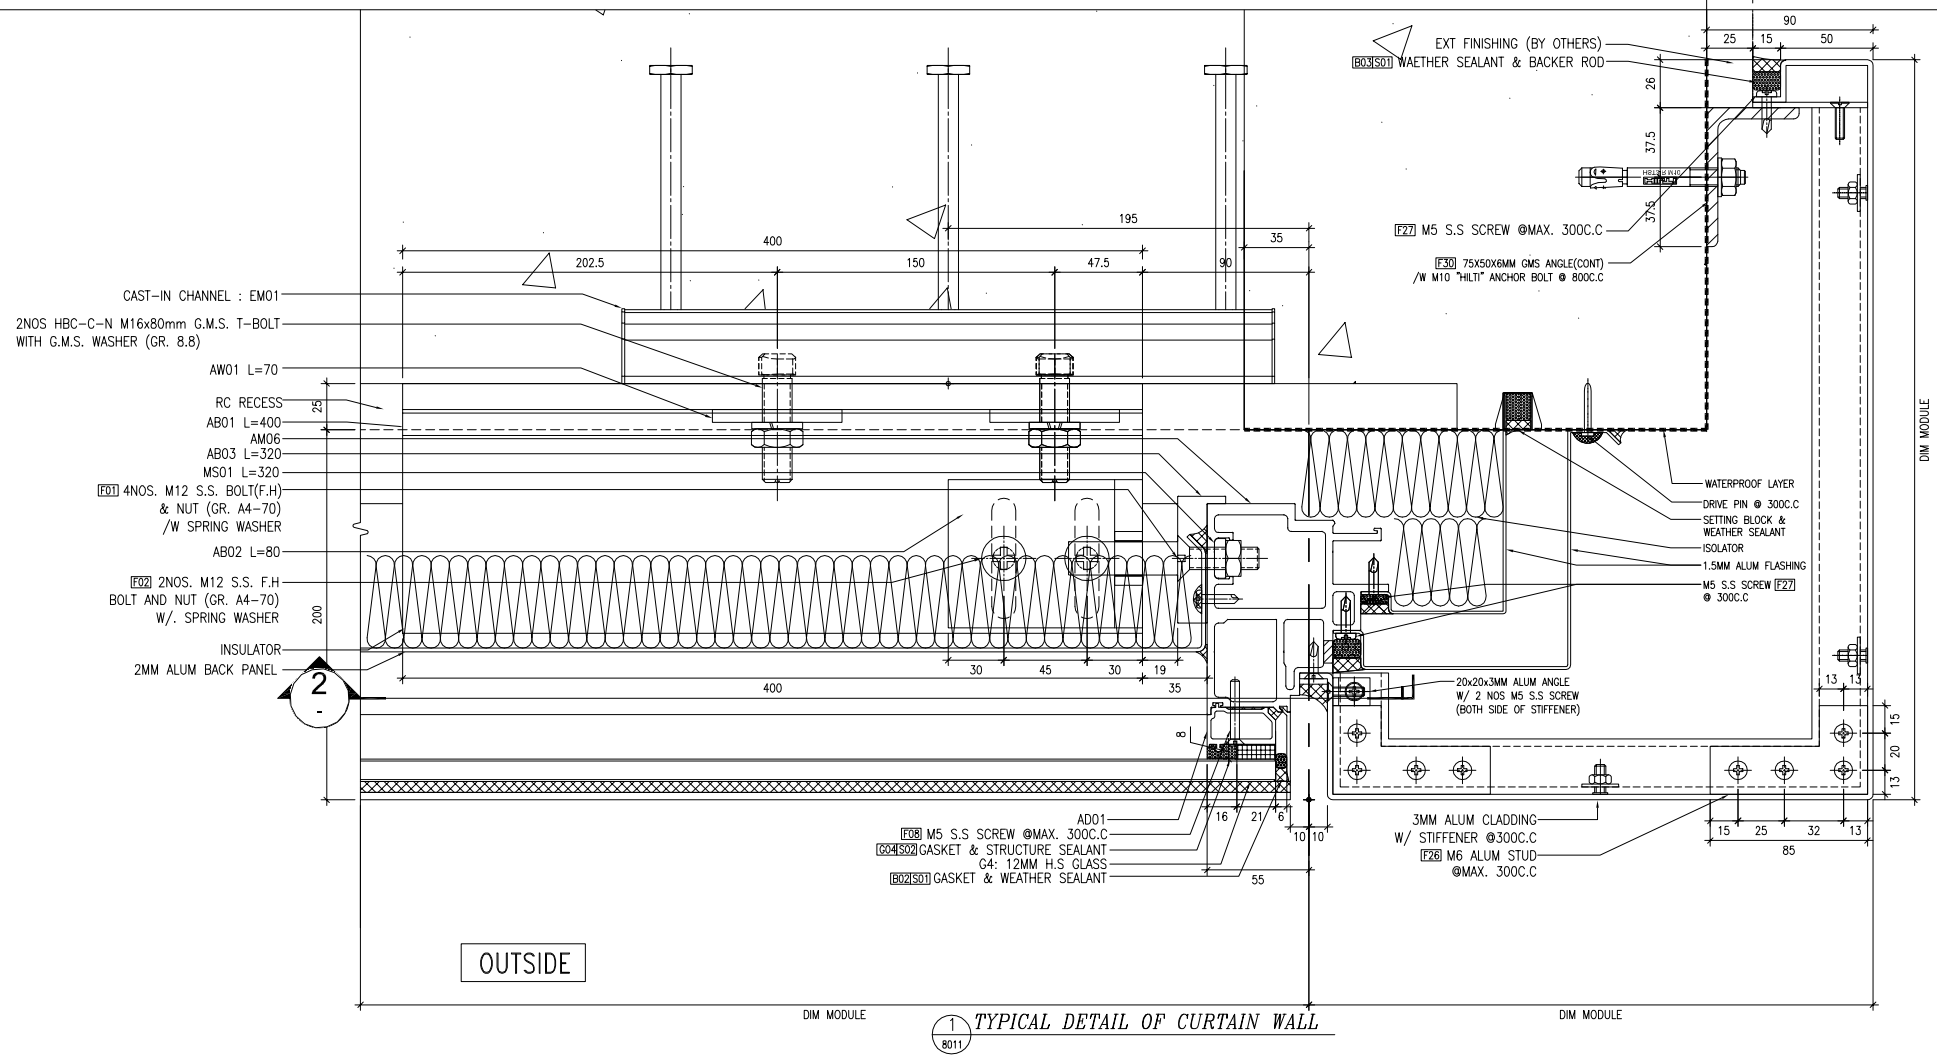

1 / 8011 *TYPICAL DETAIL OF CURTAIN WALL*

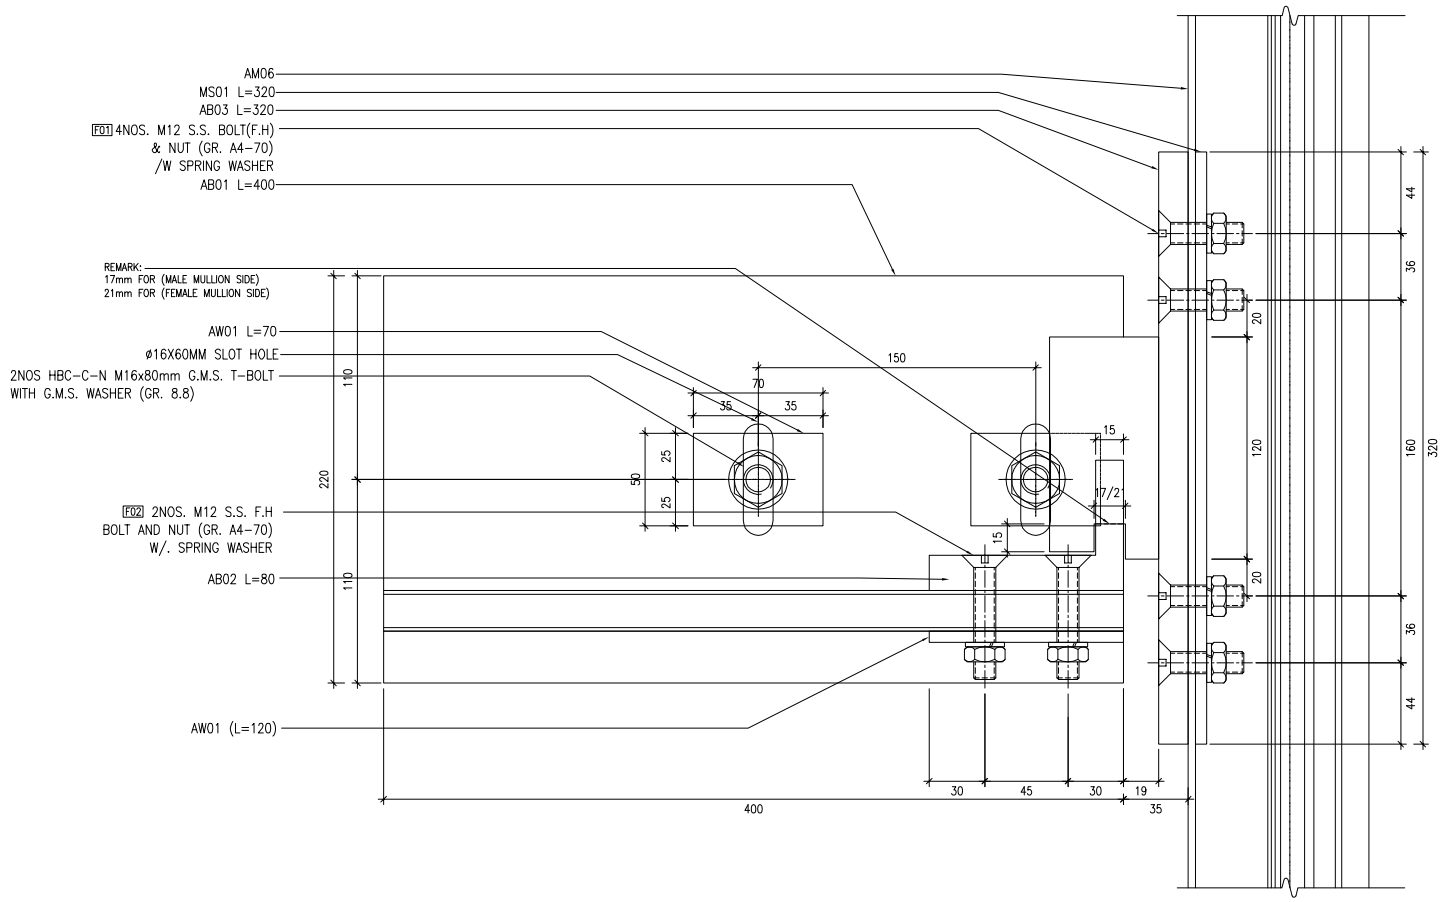

2 / 8011 *SECTION VIEW (FIXING)*

B.D. REF :

CLIENT :

SUN HUNG KAI REAL ESTATE AGENCY LTD.
42/F SUN HUNG KAI CENTRE, WANCHAI, HONGKONG

ARCHITECT :

lwk&partners
a r c h i t e c t s

MAIN CONTRACTOR :

怡輝建築有限公司
Yee Fai Building Contractors Ltd.

STRUCTURAL ENGINEER :

ARUP

FACADE CONSULTANT:

ALPHA CONSULTING LIMITED
Steel Structure & Facade Specialist

NOTE :
1. ALL DIMENSIONS ARE IN mm.
2. ALL ELEVATIONS ARE VIEWED FROM OUTSIDE.
3. ALL DIMENSIONS TO BE VERIFIED ON SITE BEFORE FABRICATION.

LEGEND :

X1 / X001 — DETAIL MARK NO. / REFER SHEET NO.

1. F.F.L. --FINISHED FLOOR LEVEL
2. S.F.L. --STRUCTURAL FLOOR LEVEL
3. (R) --REVERSED DETAIL

NO.	DATE	REVISED	BY
C	02-MAY-2023	5TH SUBMISSION	CF
B	21-FEB-2023	4TH SUBMISSION	CF
A	30-DEC-2022	2ND SUBMISSION	CF
–	21-NOV-2022		CF

JOB NO. : J-856

PROJECT :
PROPOSED DEVELOPMENT ABOVE LIGHT RAIL TIN WING STOP,TSWTL NO.23,AREA 33,TIN SHUI WAI, N.T.


TITLE :
TYPICAL DETAIL FOR CURTAIN WALL

DATE : 31-OCT-22 | SCALE : 1:4

DRAWN BY : C.F | CHECKED BY :

美特鋁質有限公司
MIDI ALUMINIUM FABRICATOR LTD.
Units 6-8, Sunray Industrial Centre, 1/F
610 Cha Kwo Ling Road, Kowloon
Tel:23489211-4 Fax:(852)27727666

DWG NO. : J856-SD-CW-8011 | REV. : C

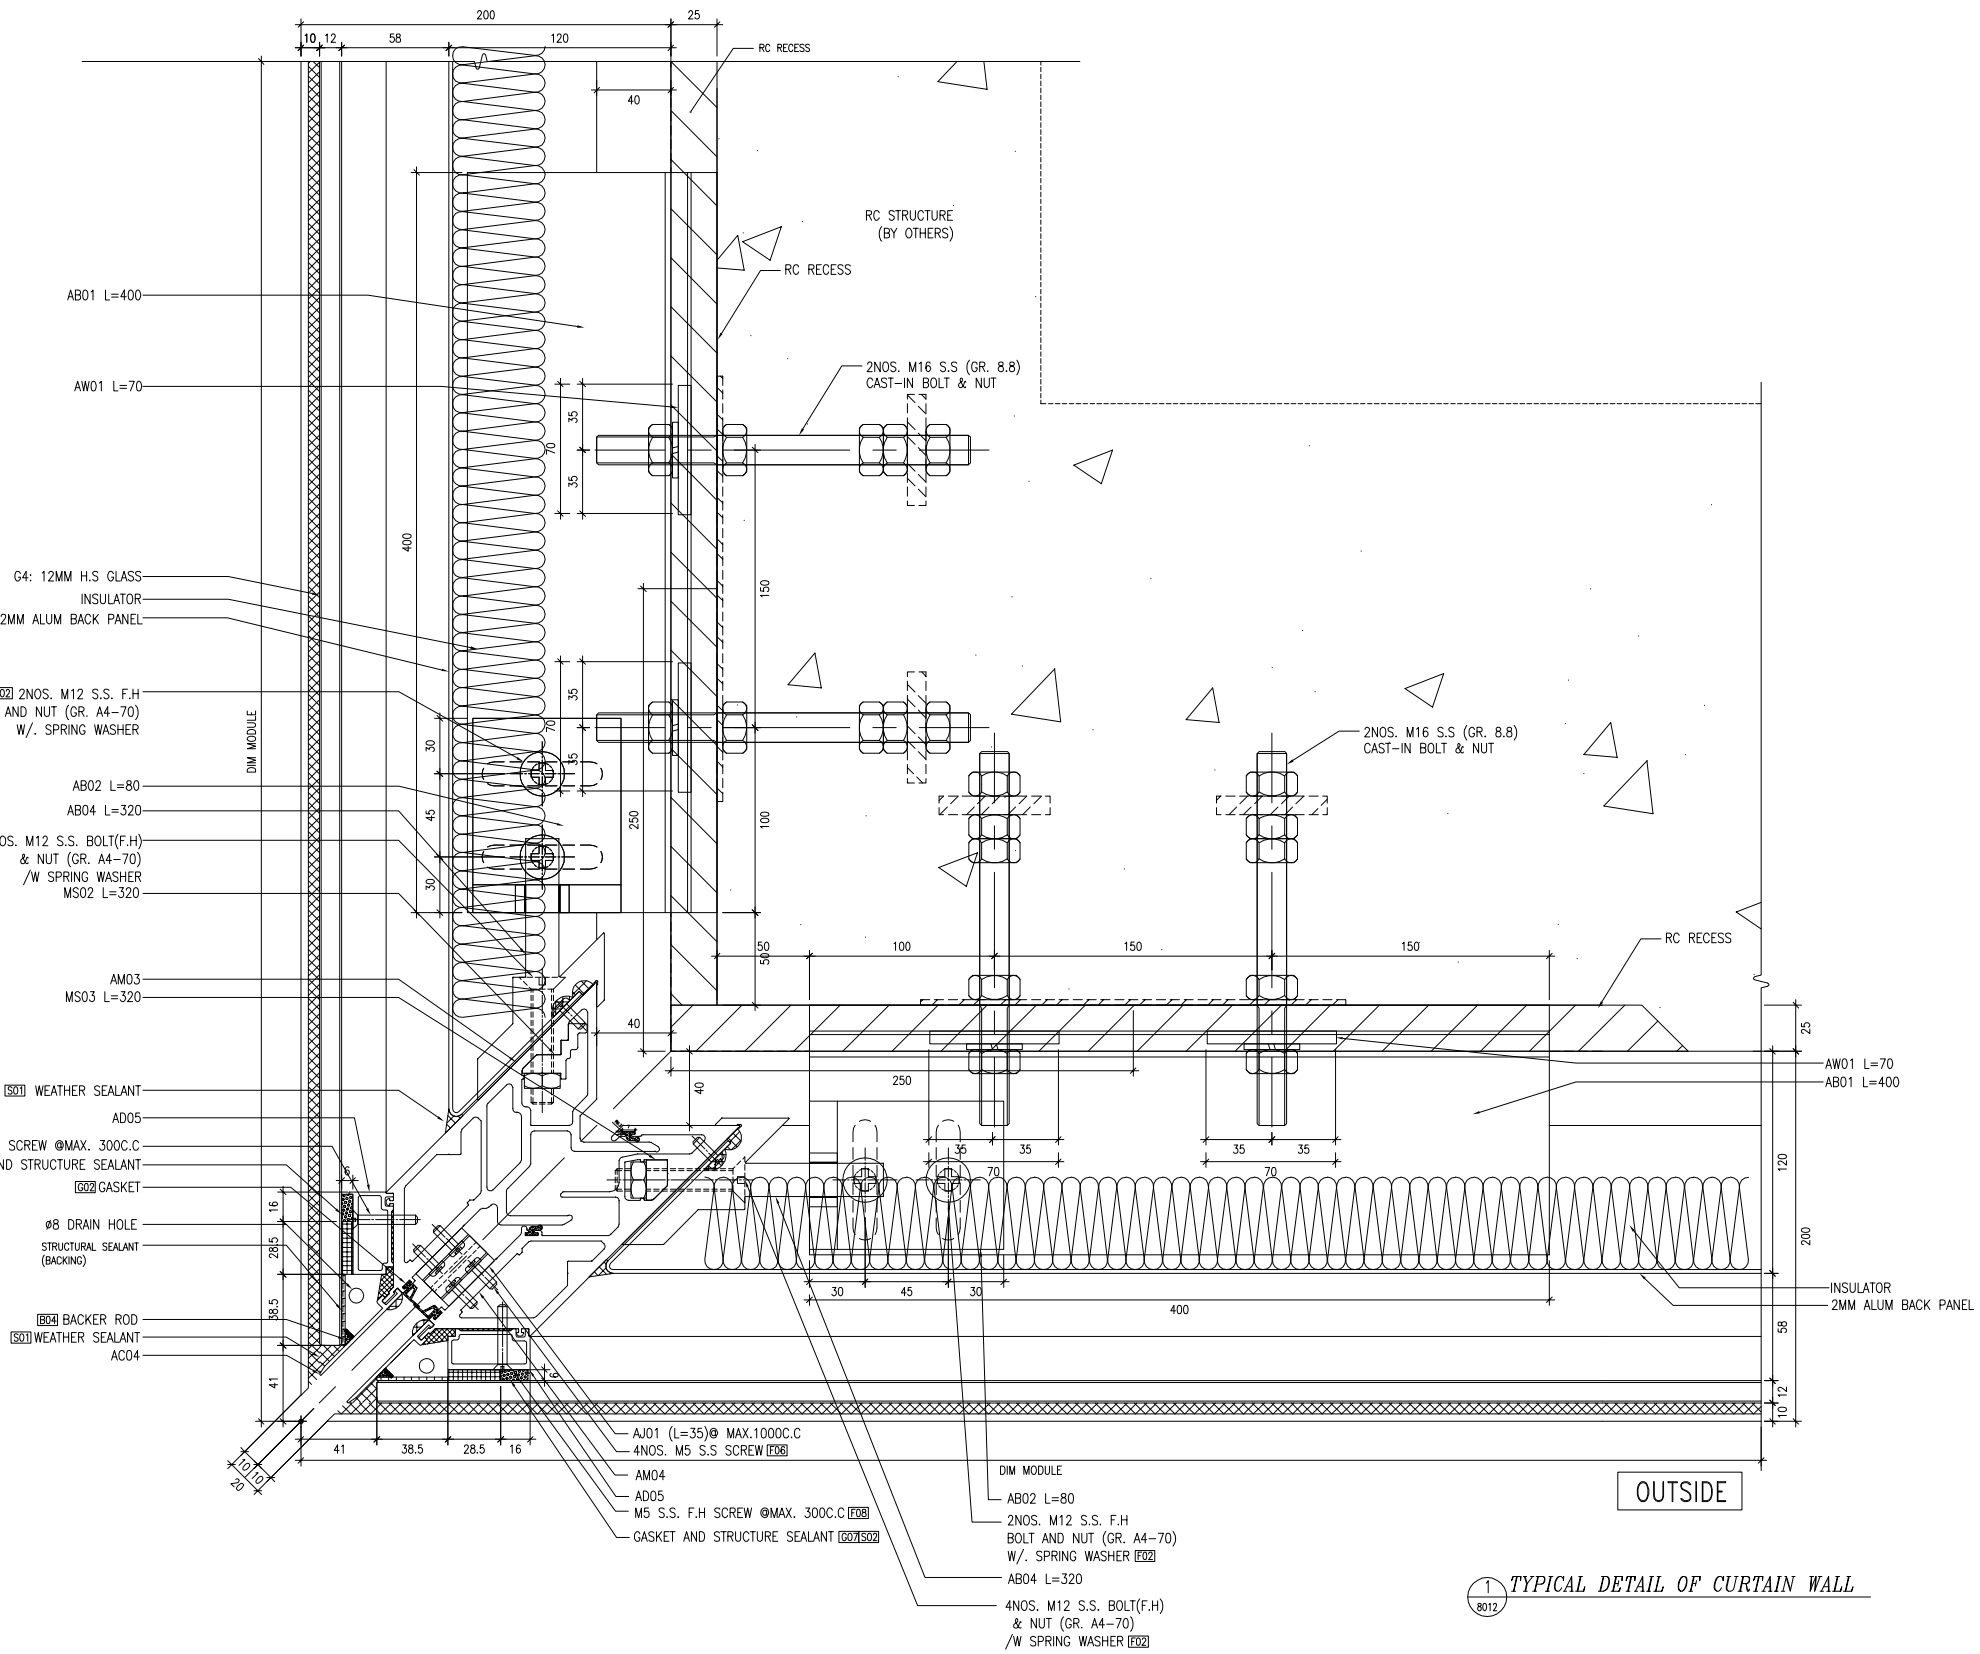

1 / 8012 *TYPICAL DETAIL OF CURTAIN WALL*

B.D. REF :

CLIENT :

SUN HUNG KAI
REAL ESTATE AGENCY LTD.
42/F SUN HUNG KAI CENTRE, WANCHAI, HONGKONG

ARCHITECT :

lwk&partners
a r c h i t e c t s

MAIN CONTRACTOR :

怡輝建築有限公司
Yee Fai Building Contractors Ltd.

STRUCTURAL ENGINEER :

ARUP

FACADE CONSULTANT:

ALPHA CONSULTING LIMITED
Steel Structure & Facade Specialist

NOTE :
1. ALL DIMENSIONS ARE IN mm.
2. ALL ELEVATIONS ARE VIEWED FROM OUTSIDE.
3. ALL DIMENSIONS TO BE VERIFIED ON SITE BEFORE FABRICATION.

LEGEND :

X1 / X001 — DETAIL MARK NO. / REFER SHEET NO.

1. F.F.L. --FINISHED FLOOR LEVEL
2. S.F.L. --STRUCTURAL FLOOR LEVEL
3. /R --REVERSED DETAIL

NO.	DATE	REVISED	BY
A	21-FEB-2023	4TH SUBMISSION	CF
–	30-DEC-2022	2ND SUBMISSION	CF

JOB NO. : J-856

PROJECT :
PROPOSED DEVELOPMENT ABOVE
LIGHT RAIL TIN WING STOP,TSWTL
NO.23,AREA 33,TIN SHUI WAI, N.T.


TITLE :
TYPICAL DETAIL
FOR CURTAIN WALL

DATE : 31-OCT-22 | SCALE : 1:4

DRAWN BY : C.F | CHECKED BY :

美特鋁質有限公司
MIDI ALUMINIUM FABRICATOR LTD.
Units 6-8, Sunray Industrial Centre, 1/F
610 Cha Kwo Ling Road, Kowloon
Tel:23489211-4 Fax:(852)27727666

DWG NO. : J856-SD-CW-8012 | REV. : A

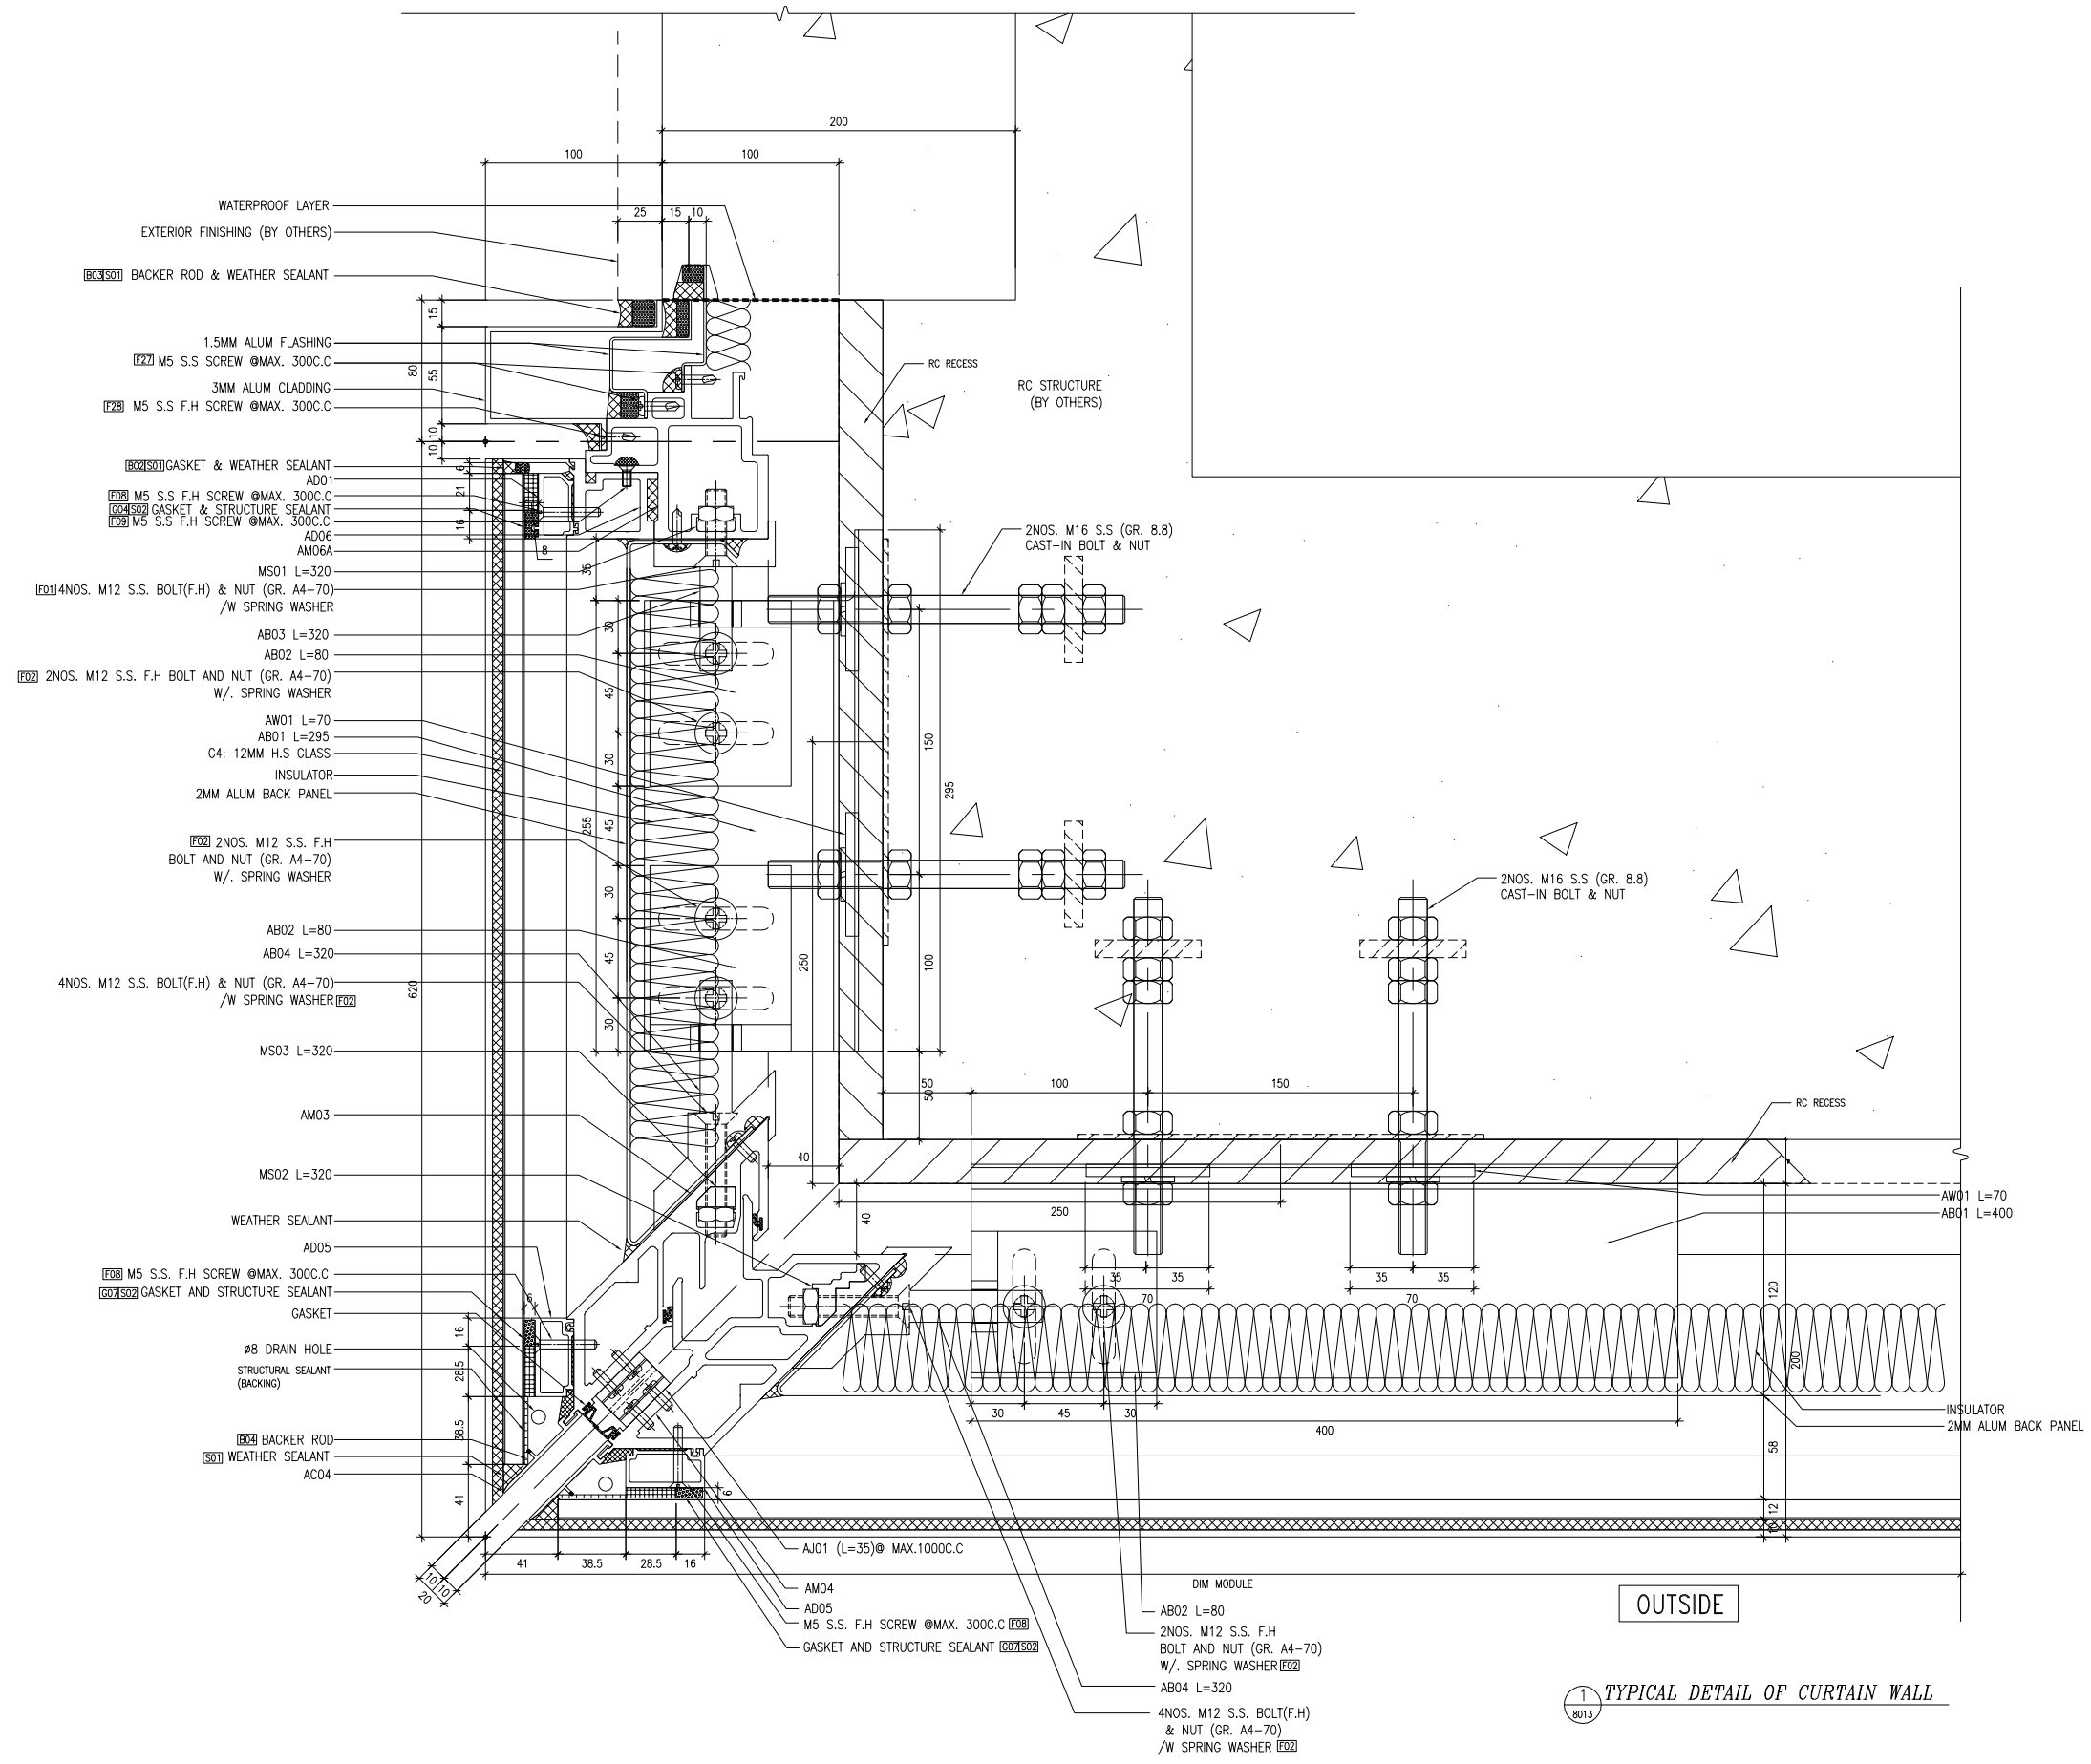

1/8013 *TYPICAL DETAIL OF CURTAIN WALL*

B.D. REF :

CLIENT :

SUN HUNG KAI REAL ESTATE AGENCY LTD.
42/F SUN HUNG KAI CENTRE, WANCHAI, HONGKONG

ARCHITECT :

lwk&partners
a r c h i t e c t s

MAIN CONTRACTOR :

怡輝建築有限公司
Yee Fai Building Contractors Ltd.

STRUCTURAL ENGINEER :

ARUP

FACADE CONSULTANT:

ALPHA CONSULTING LIMITED
Steel Structure & Facade Specialist

NOTE :
1. ALL DIMENSIONS ARE IN mm.
2. ALL ELEVATIONS ARE VIEWED FROM OUTSIDE.
3. ALL DIMENSIONS TO BE VERIFIED ON SITE BEFORE FABRICATION.

LEGEND :

X1 — DETAIL MARK NO.
X001 — REFER SHEET NO.

1. F.F.L. --FINISHED FLOOR LEVEL
2. S.F.L. --STRUCTURAL FLOOR LEVEL
3. /R --REVERSED DETAIL

#1: ALUM FLASHING OVERLAPPING
REFER TO DWG: 3/8008A

NO.	DATE	REVISED	BY
D	02-MAY-2023	5TH SUBMISSION	CF
B	21-FEB-2023	4TH SUBMISSION	CF
A	30-DEC-2022	2ND SUBMISSION	CF
–	21-NOV-2022		CF

JOB NO. : J-856

PROJECT :
PROPOSED DEVELOPMENT ABOVE LIGHT RAIL TIN WING STOP,TSWTL NO.23,AREA 33,TIN SHUI WAI, N.T.


TITLE :
TYPICAL DETAIL FOR CURTAIN WALL

DATE : 31-OCT-22 | SCALE : 1:4

DRAWN BY : C.F | CHECKED BY :

美特鋁製有限公司
MIDI ALUMINIUM FABRICATOR LTD.
Units 6-8, Sunray Industrial Centre, 1/F
610 Cha Kwo Ling Road, Kowloon
Tel:23489211-4 Fax:(852)27727666

DWG NO. : J856-SD-CW-8013 | REV. : B

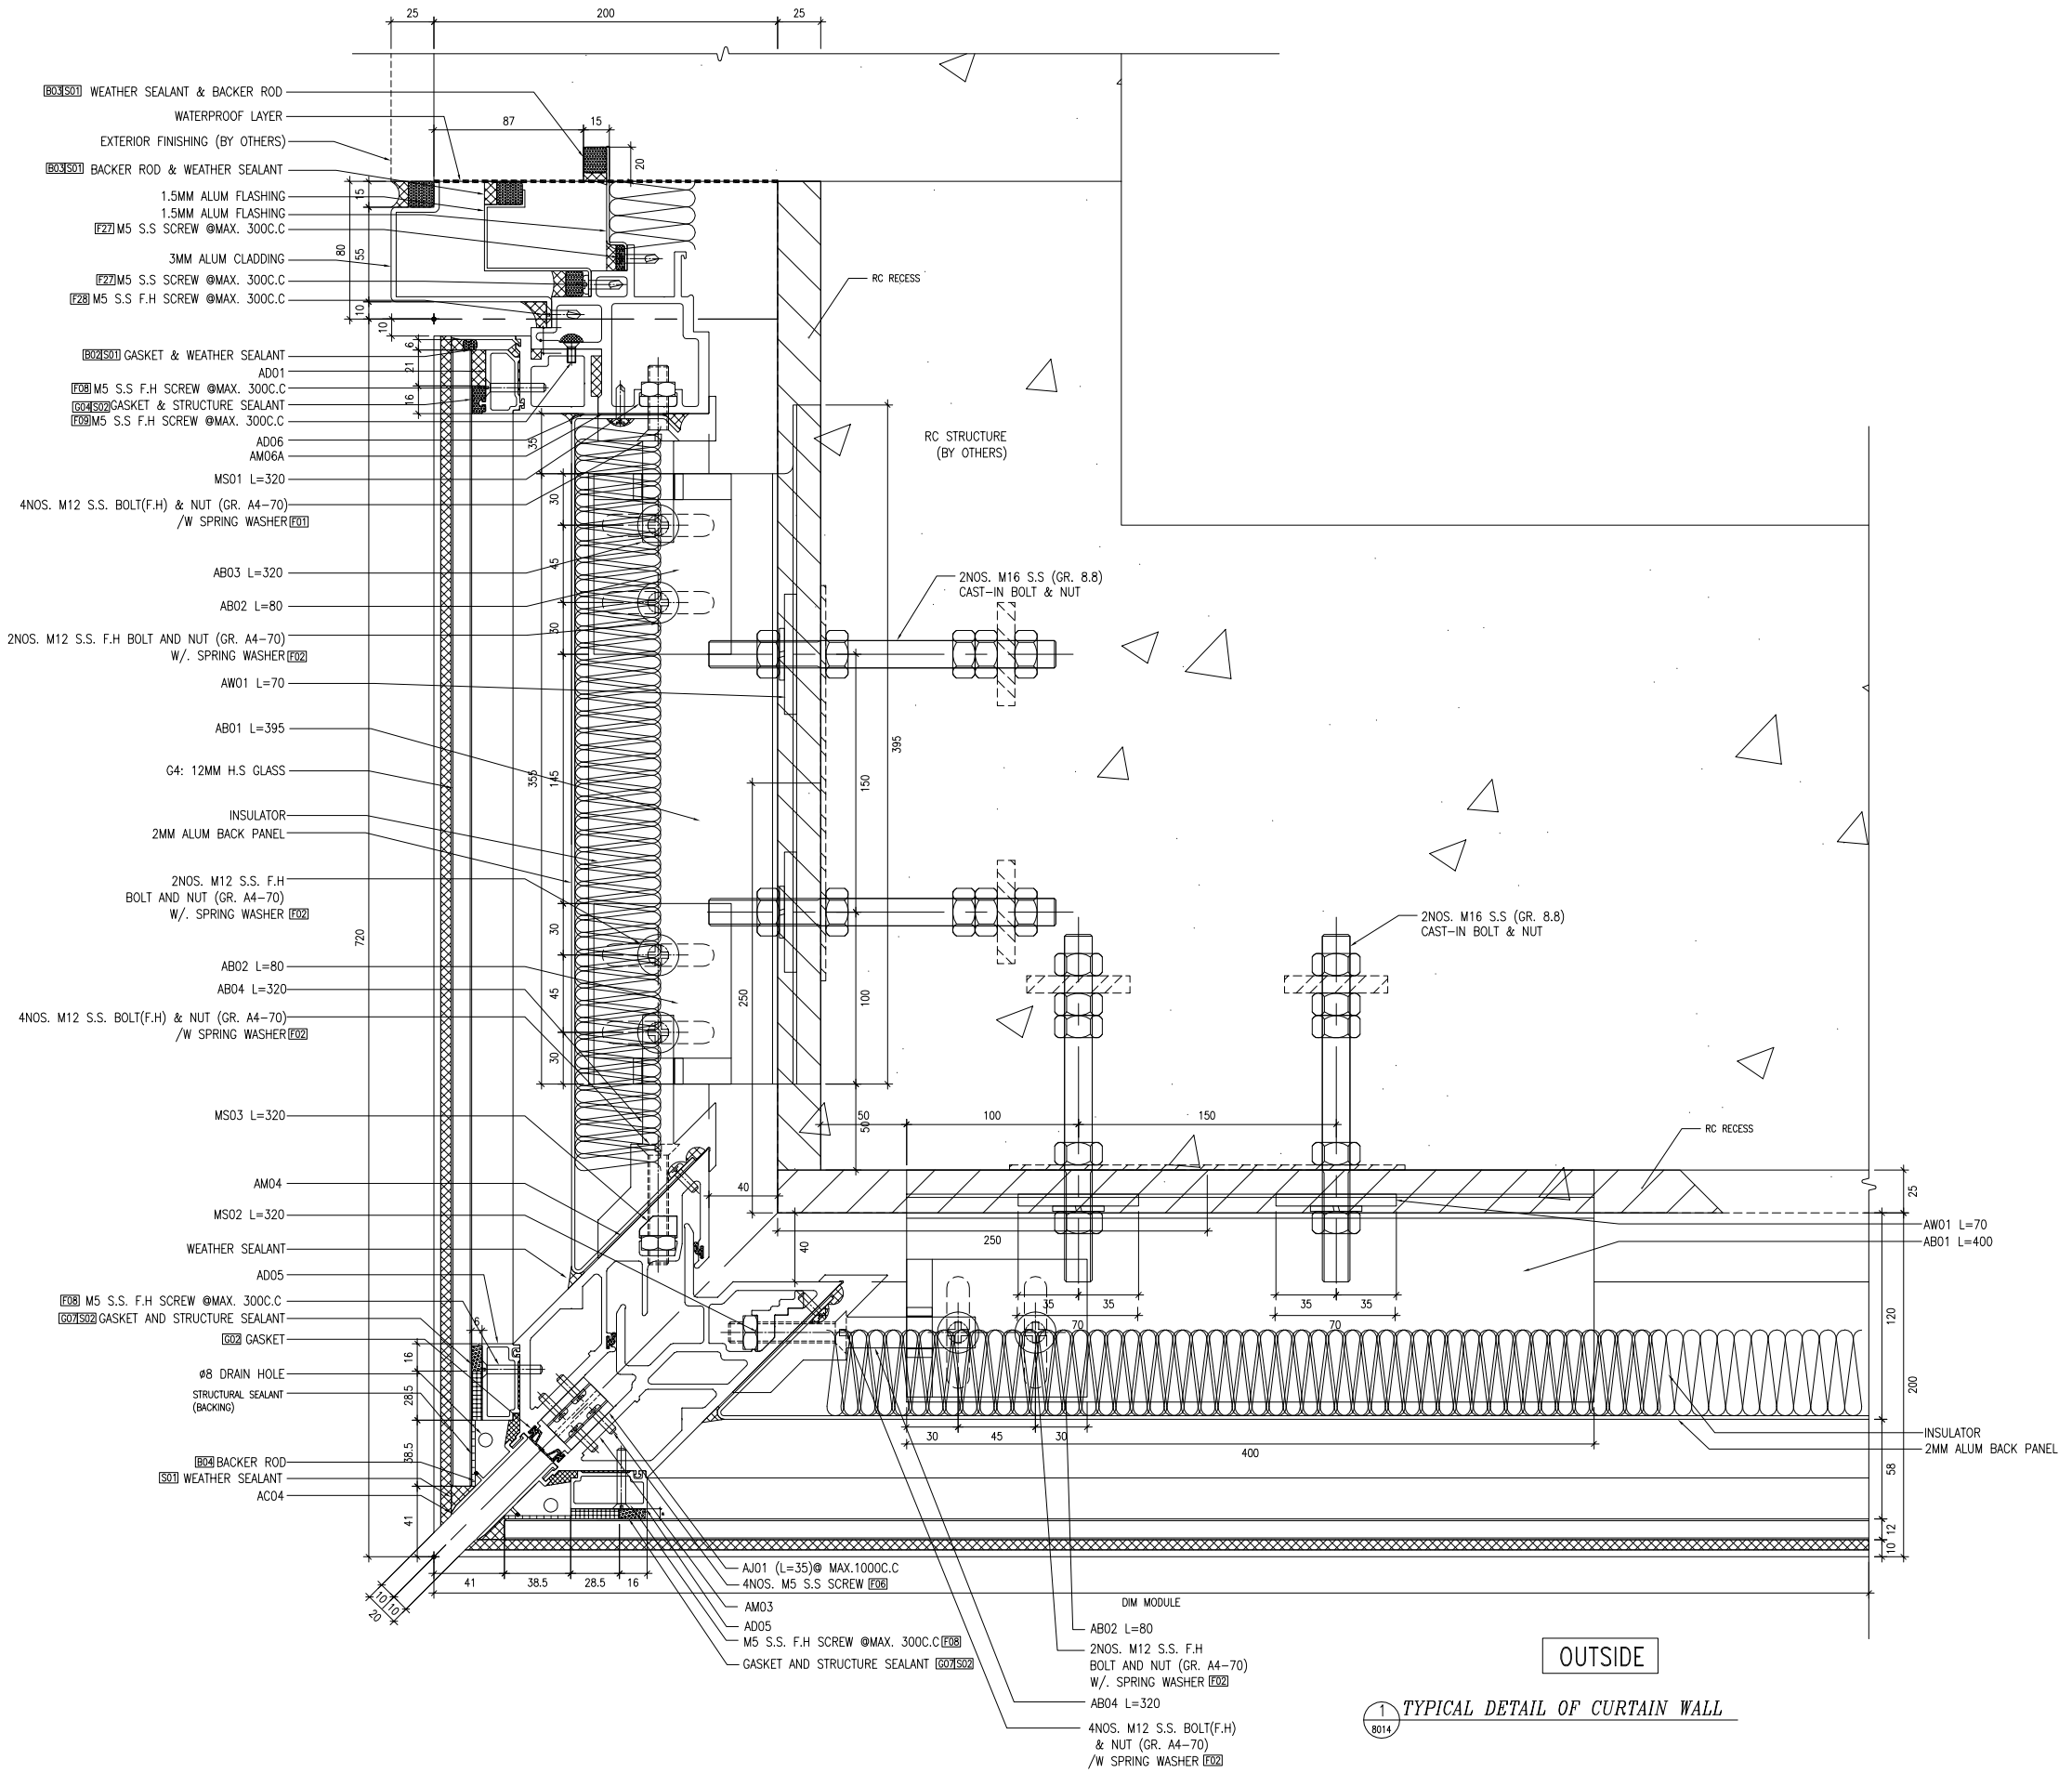

1 8014 *TYPICAL DETAIL OF CURTAIN WALL*

B.D. REF :

CLIENT :

SUN HUNG KAI REAL ESTATE AGENCY LTD.
42/F SUN HUNG KAI CENTRE, WANCHAI, HONGKONG

ARCHITECT :

lwk&partners
a r c h i t e c t s

MAIN CONTRACTOR :

怡輝建築有限公司
Yee Fai Building Contractors Ltd.

STRUCTURAL ENGINEER :

ARUP

FACADE CONSULTANT:

ALPHA CONSULTING LIMITED
Steel Structure & Facade Specialist

NOTE :
1. ALL DIMENSIONS ARE IN mm.
2. ALL ELEVATIONS ARE VIEWED FROM OUTSIDE.
3. ALL DIMENSIONS TO BE VERIFIED ON SITE BEFORE FABRICATION.

LEGEND :

X1 — DETAIL MARK NO.
X001 — REFER SHEET NO.

1. F.F.L. --FINISHED FLOOR LEVEL
2. S.F.L. --STRUCTURAL FLOOR LEVEL
3. /R --REVERSED DETAIL

#1: ALUM FLASHING OVERLAPPING
REFER TO DWG: 3 8008A

NO.	DATE	REVISED	BY
B	21-FEB-2023	4TH SUBMISSION	CF
A	30-DEC-2022	2ND SUBMISSION	CF
–	21-NOV-2022		CF

JOB NO. : J-856

PROJECT :
PROPOSED DEVELOPMENT ABOVE LIGHT RAIL TIN WING STOP,TSWTL NO.23,AREA 33,TIN SHUI WAI, N.T.


TITLE :
TYPICAL DETAIL FOR CURTAIN WALL

DATE : 31-OCT-22 | SCALE : 1:4

DRAWN BY : C.F | CHECKED BY :

美特鋁質有限公司
MIDI ALUMINIUM FABRICATOR LTD.
Units 6-8, Sunray Industrial Centre, 1/F
610 Cha Kwo Ling Road, Kowloon
Tel:23489211-4 Fax:(852)27727666

DWG NO. : J856-SD-CW-8014 | REV. : B

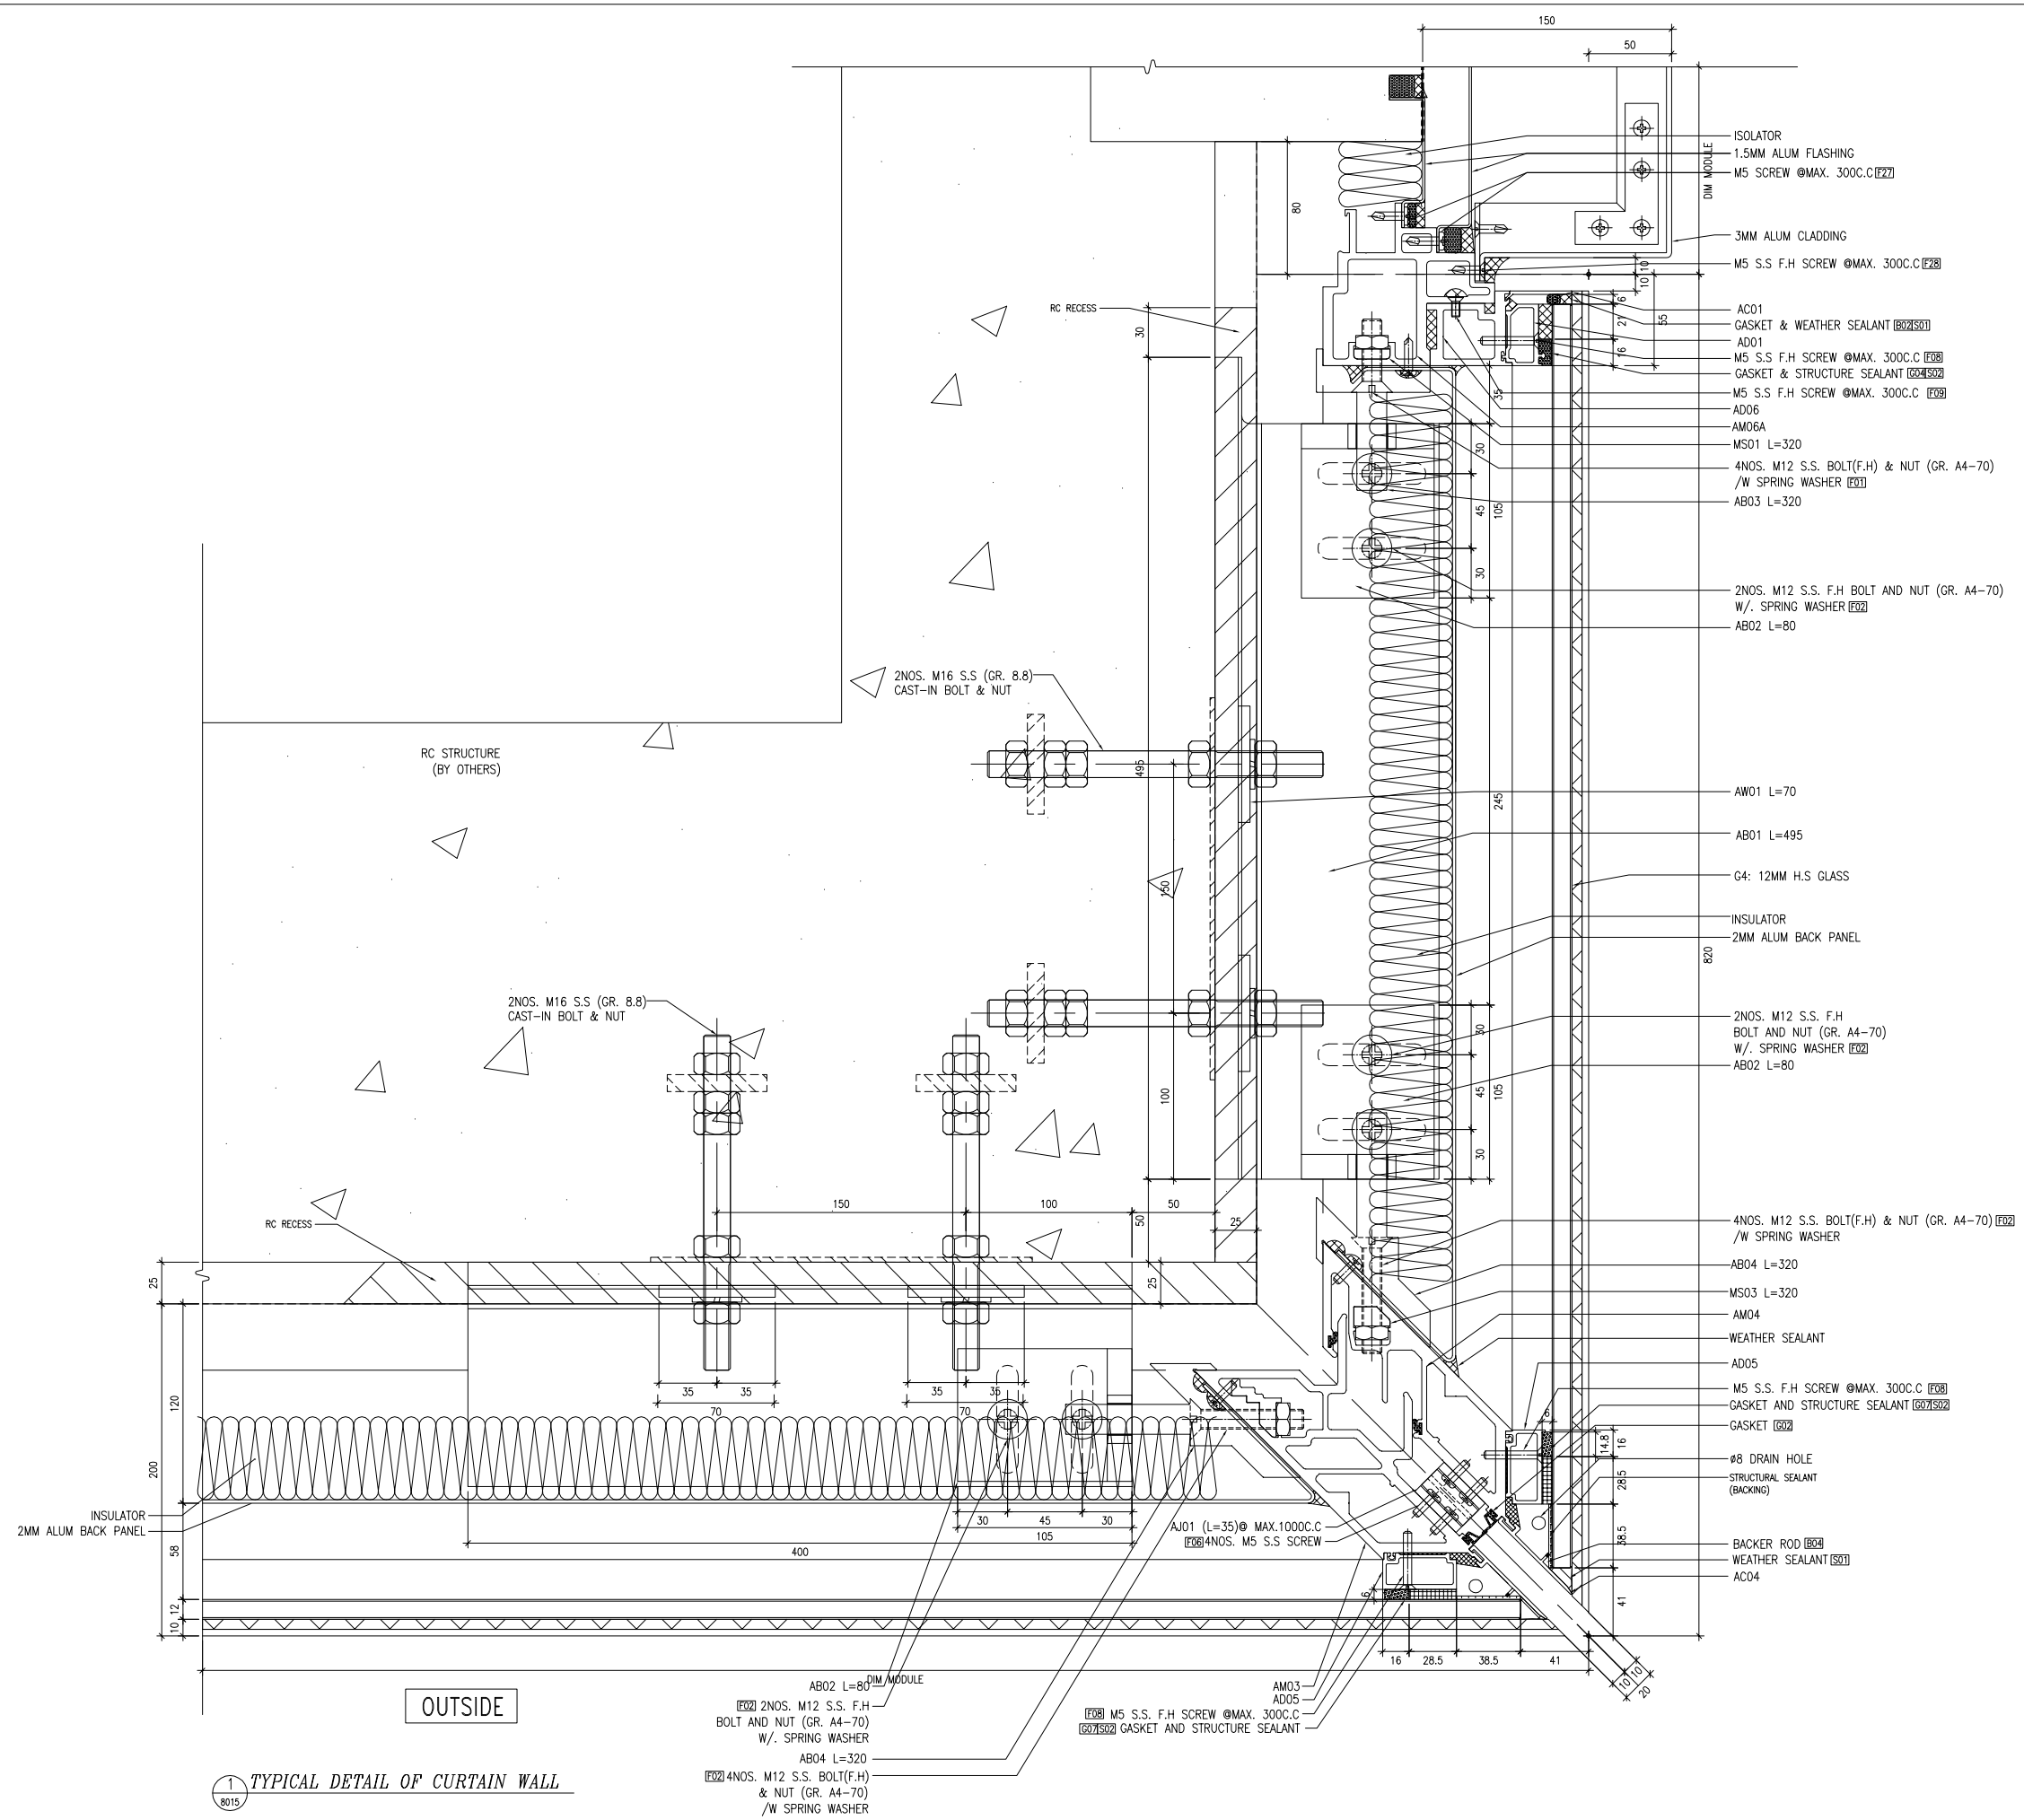

1 / 8015 *TYPICAL DETAIL OF CURTAIN WALL*

B.D. REF :

CLIENT :

SUN HUNG KAI REAL ESTATE AGENCY LTD.
42/F SUN HUNG KAI CENTRE, WANCHAI, HONGKONG

ARCHITECT :

lwk&partners
a r c h i t e c t s

MAIN CONTRACTOR :

怡輝建築有限公司
Yee Fai Building Contractors Ltd.

STRUCTURAL ENGINEER :

ARUP

FACADE CONSULTANT:

ALPHA CONSULTING LIMITED
Steel Structure & Facade Specialist

NOTE :
1. ALL DIMENSIONS ARE IN mm.
2. ALL ELEVATIONS ARE VIEWED FROM OUTSIDE.
3. ALL DIMENSIONS TO BE VERIFIED ON SITE BEFORE FABRICATION.

LEGEND :

X1 — DETAIL MARK NO.
X001 — REFER SHEET NO.

1. F.F.L. --FINISHED FLOOR LEVEL
2. S.F.L. --STRUCTURAL FLOOR LEVEL
3. /R --REVERSED DETAIL

NO.	DATE	REVISED	BY
B	21-FEB-2023	4TH SUBMISSION	CF
A	30-DEC-2022	2ND SUBMISSION	CF
–	21-NOV-2022		CF

JOB NO. : J-856

PROJECT :
PROPOSED DEVELOPMENT ABOVE LIGHT RAIL TIN WING STOP,TSWTL NO.23,AREA 33,TIN SHUI WAI, N.T.


TITLE :
TYPICAL DETAIL FOR CURTAIN WALL

DATE : 31-OCT-22 | SCALE : 1:4


DRAWN BY : C.F | CHECKED BY :

美特鋁製有限公司
MIDI ALUMINIUM FABRICATOR LTD.
Units 6-8, Sunray Industrial Centre, 1/F
610 Cha Kwo Ling Road, Kowloon
Tel:23489211-4 Fax:(852)27727666

DWG NO. : J856-SD-CW-8015 | REV. : B

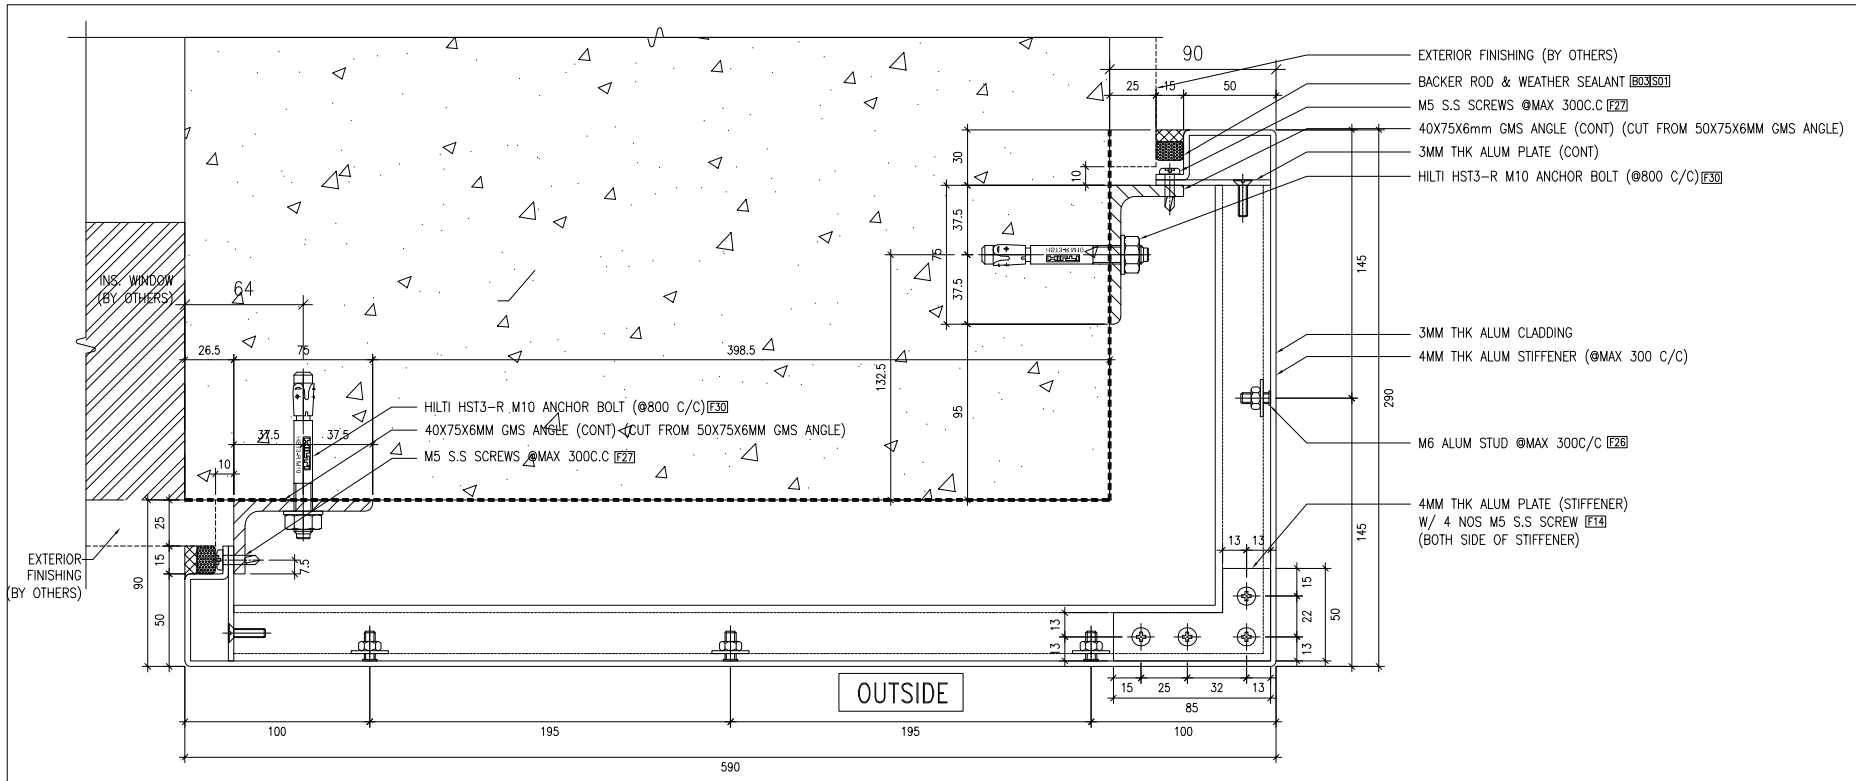

1 8020 *PLAN DETAIL*
ALUM. CLADDING

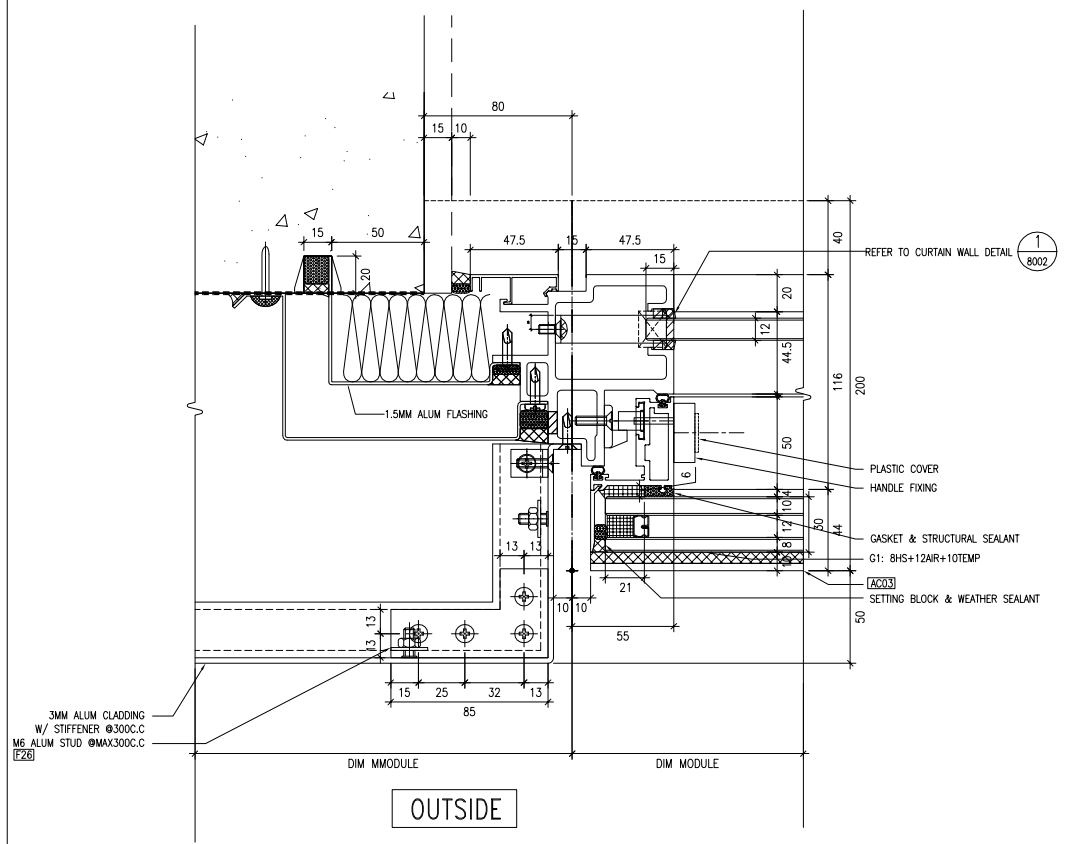

2 8020 *PLAN DETAIL*
MAINTENANCE WINDOW

MAINTENANCE WINDOW FOR:
T1 FLAT A8 3/F TO 26/F ONLY
T3 FLAT B11 7/F TO 10/F ONLY

B.D. REF :

CLIENT :
SUN HUNG KAI REAL ESTATE AGENCY LTD.
42/F SUN HUNG KAI CENTRE, WANCHAI, HONGKONG

ARCHITECT :
lwk&partners
a r c h i t e c t s

MAIN CONTRACTOR :
怡輝建築有限公司
Yee Fai Building Contractors Ltd.

STRUCTURAL ENGINEER :
ARUP

FACADE CONSULTANT:
ALPHA CONSULTING LIMITED
Steel Structure & Facade Specialist

NOTE :
1. ALL DIMENSIONS ARE IN mm.
2. ALL ELEVATIONS ARE VIEWED FROM OUTSIDE.
3. ALL DIMENSIONS TO BE VERIFIED ON SITE BEFORE FABRICATION.

LEGEND :
X1 / X001 — DETAIL MARK NO. / REFER SHEET NO.
1. F.F.L. -- FINISHED FLOOR LEVEL
2. S.F.L. -- STRUCTURAL FLOOR LEVEL
3. /R -- REVERSED DETAIL

NO.	DATE	REVISED	BY
C	21-FEB-2023	4TH SUBMISSION	CF
B	13-JAN-2023	3RD SUBMISSION	CF
A	30-DEC-2022	2ND SUBMISSION	CF
–	21-NOV-2022		CF

JOB NO. : J-856

PROJECT :
PROPOSED DEVELOPMENT ABOVE LIGHT RAIL TIN WING STOP,TSWTL NO.23,AREA 33,TIN SHUI WAI, N.T.


TITLE :
TYPICAL DETAIL FOR CURTAIN WALL

DATE : 31-OCT-22 | SCALE : 1:4


DRAWN BY : C.F | CHECKED BY :

美特鋁質有限公司
MIDI ALUMINIUM FABRICATOR LTD.
Units 6-8, Sunray Industrial Centre, 1/F
610 Cha Kwo Ling Road, Kowloon
Tel:23489211-4 Fax:(852)27727666


DWG NO. : J856-SD-CW-8020 | REV. : C

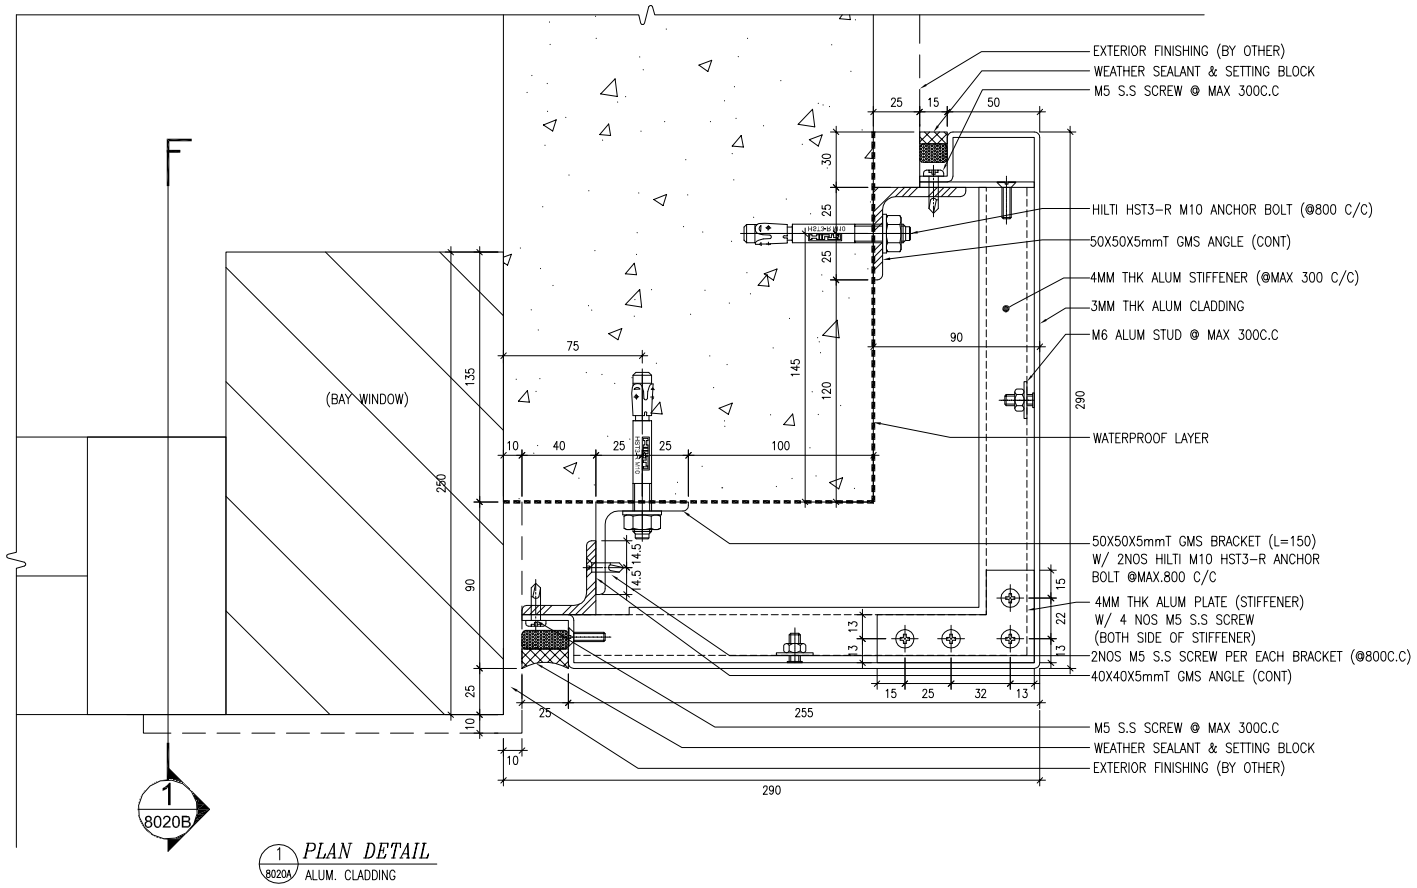

1 8020A *PLAN DETAIL*
ALUM. CLADDING

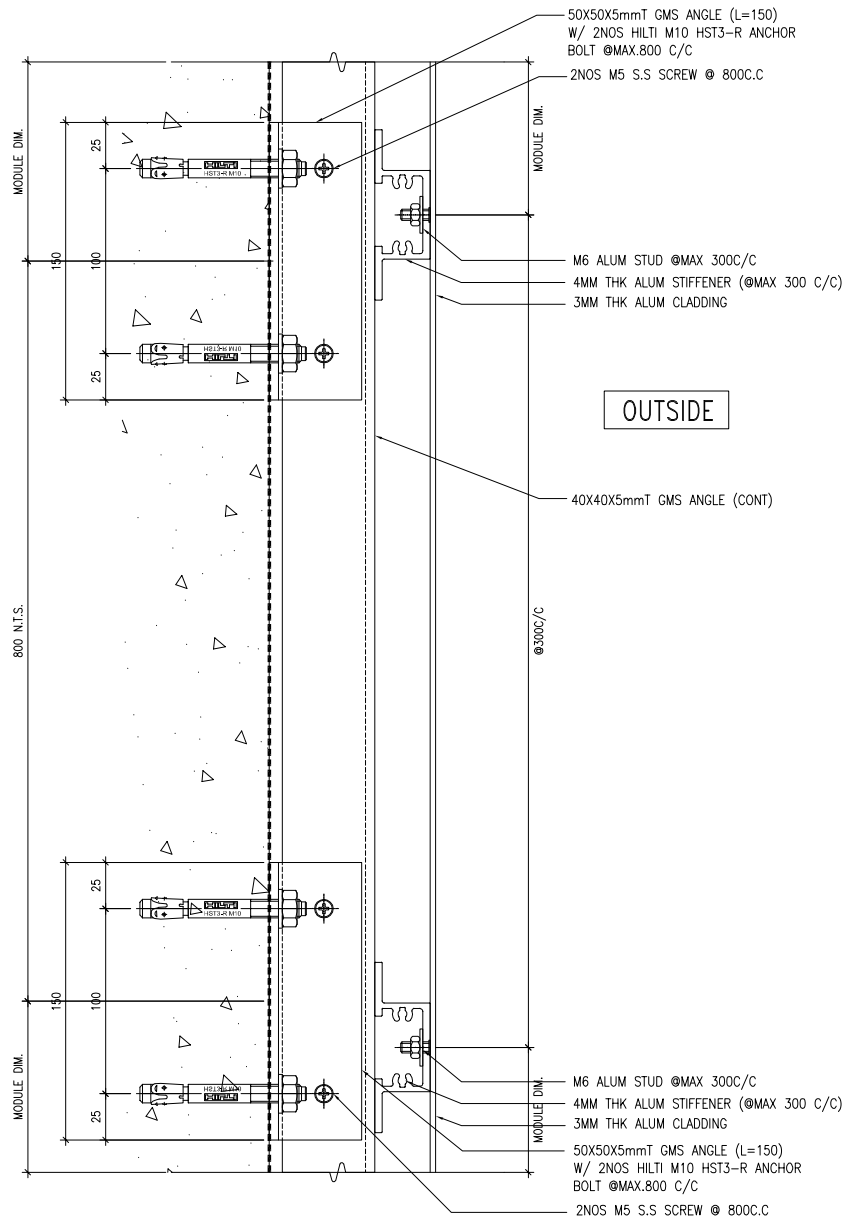

3 8020A *SECTION DETAIL*
ALUM. CLADDING

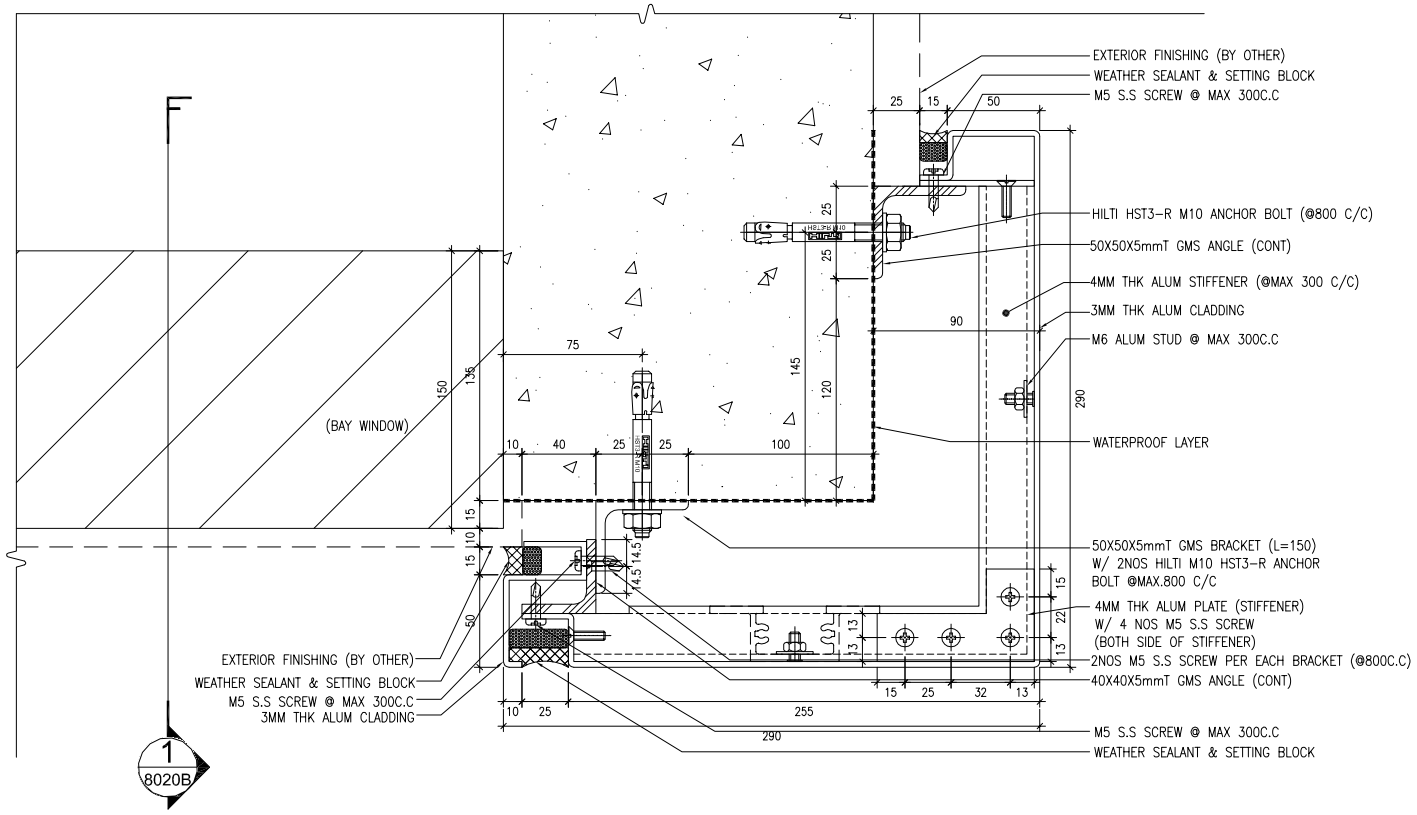

2 8020A *PLAN DETAIL*
ALUM. CLADDING

B.D. REF :

CLIENT :
SUN HUNG KAI REAL ESTATE AGENCY LTD.
42/F SUN HUNG KAI CENTRE, WANCHAI, HONGKONG

ARCHITECT :
lwk&partners
a r c h i t e c t s

MAIN CONTRACTOR :
怡輝建築有限公司
Yee Fai Building Contractors Ltd.

STRUCTURAL ENGINEER :
ARUP

FACADE CONSULTANT:
ALPHA CONSULTING LIMITED
Steel Structure & Facade Specialist

NOTE :
1. ALL DIMENSIONS ARE IN mm.
2. ALL ELEVATIONS ARE VIEWED FROM OUTSIDE.
3. ALL DIMENSIONS TO BE VERIFIED ON SITE BEFORE FABRICATION.

LEGEND :
X1 — DETAIL MARK NO.
X001 — REFER SHEET NO.

1. F.F.L. -- FINISHED FLOOR LEVEL
2. S.F.L. -- STRUCTURAL FLOOR LEVEL
3. /R -- REVERSED DETAIL

NO.	DATE	REVISED	BY
A	21-FEB-2023	4TH SUBMISSION	
–	13-JAN-2023	NEW DRAWING (3RD SUBMISSION)	CF

JOB NO. : J-856

PROJECT :
PROPOSED DEVELOPMENT ABOVE LIGHT RAIL TIN WING STOP,TSWTL NO.23,AREA 33,TIN SHUI WAI, N.T.


TITLE :
TYPICAL DETAIL FOR CURTAIN WALL

DATE : 31-OCT-22 | SCALE : 1:4

DRAWN BY : C.F | CHECKED BY :

美特鋁質有限公司
MIDI ALUMINIUM FABRICATOR LTD.
Units 6-8, Sunray Industrial Centre, 1/F
610 Cha Kwo Ling Road, Kowloon
Tel:23489211-4 Fax:(852)27727666

DWG NO. : J856-SD-CW-8020A | REV. : A

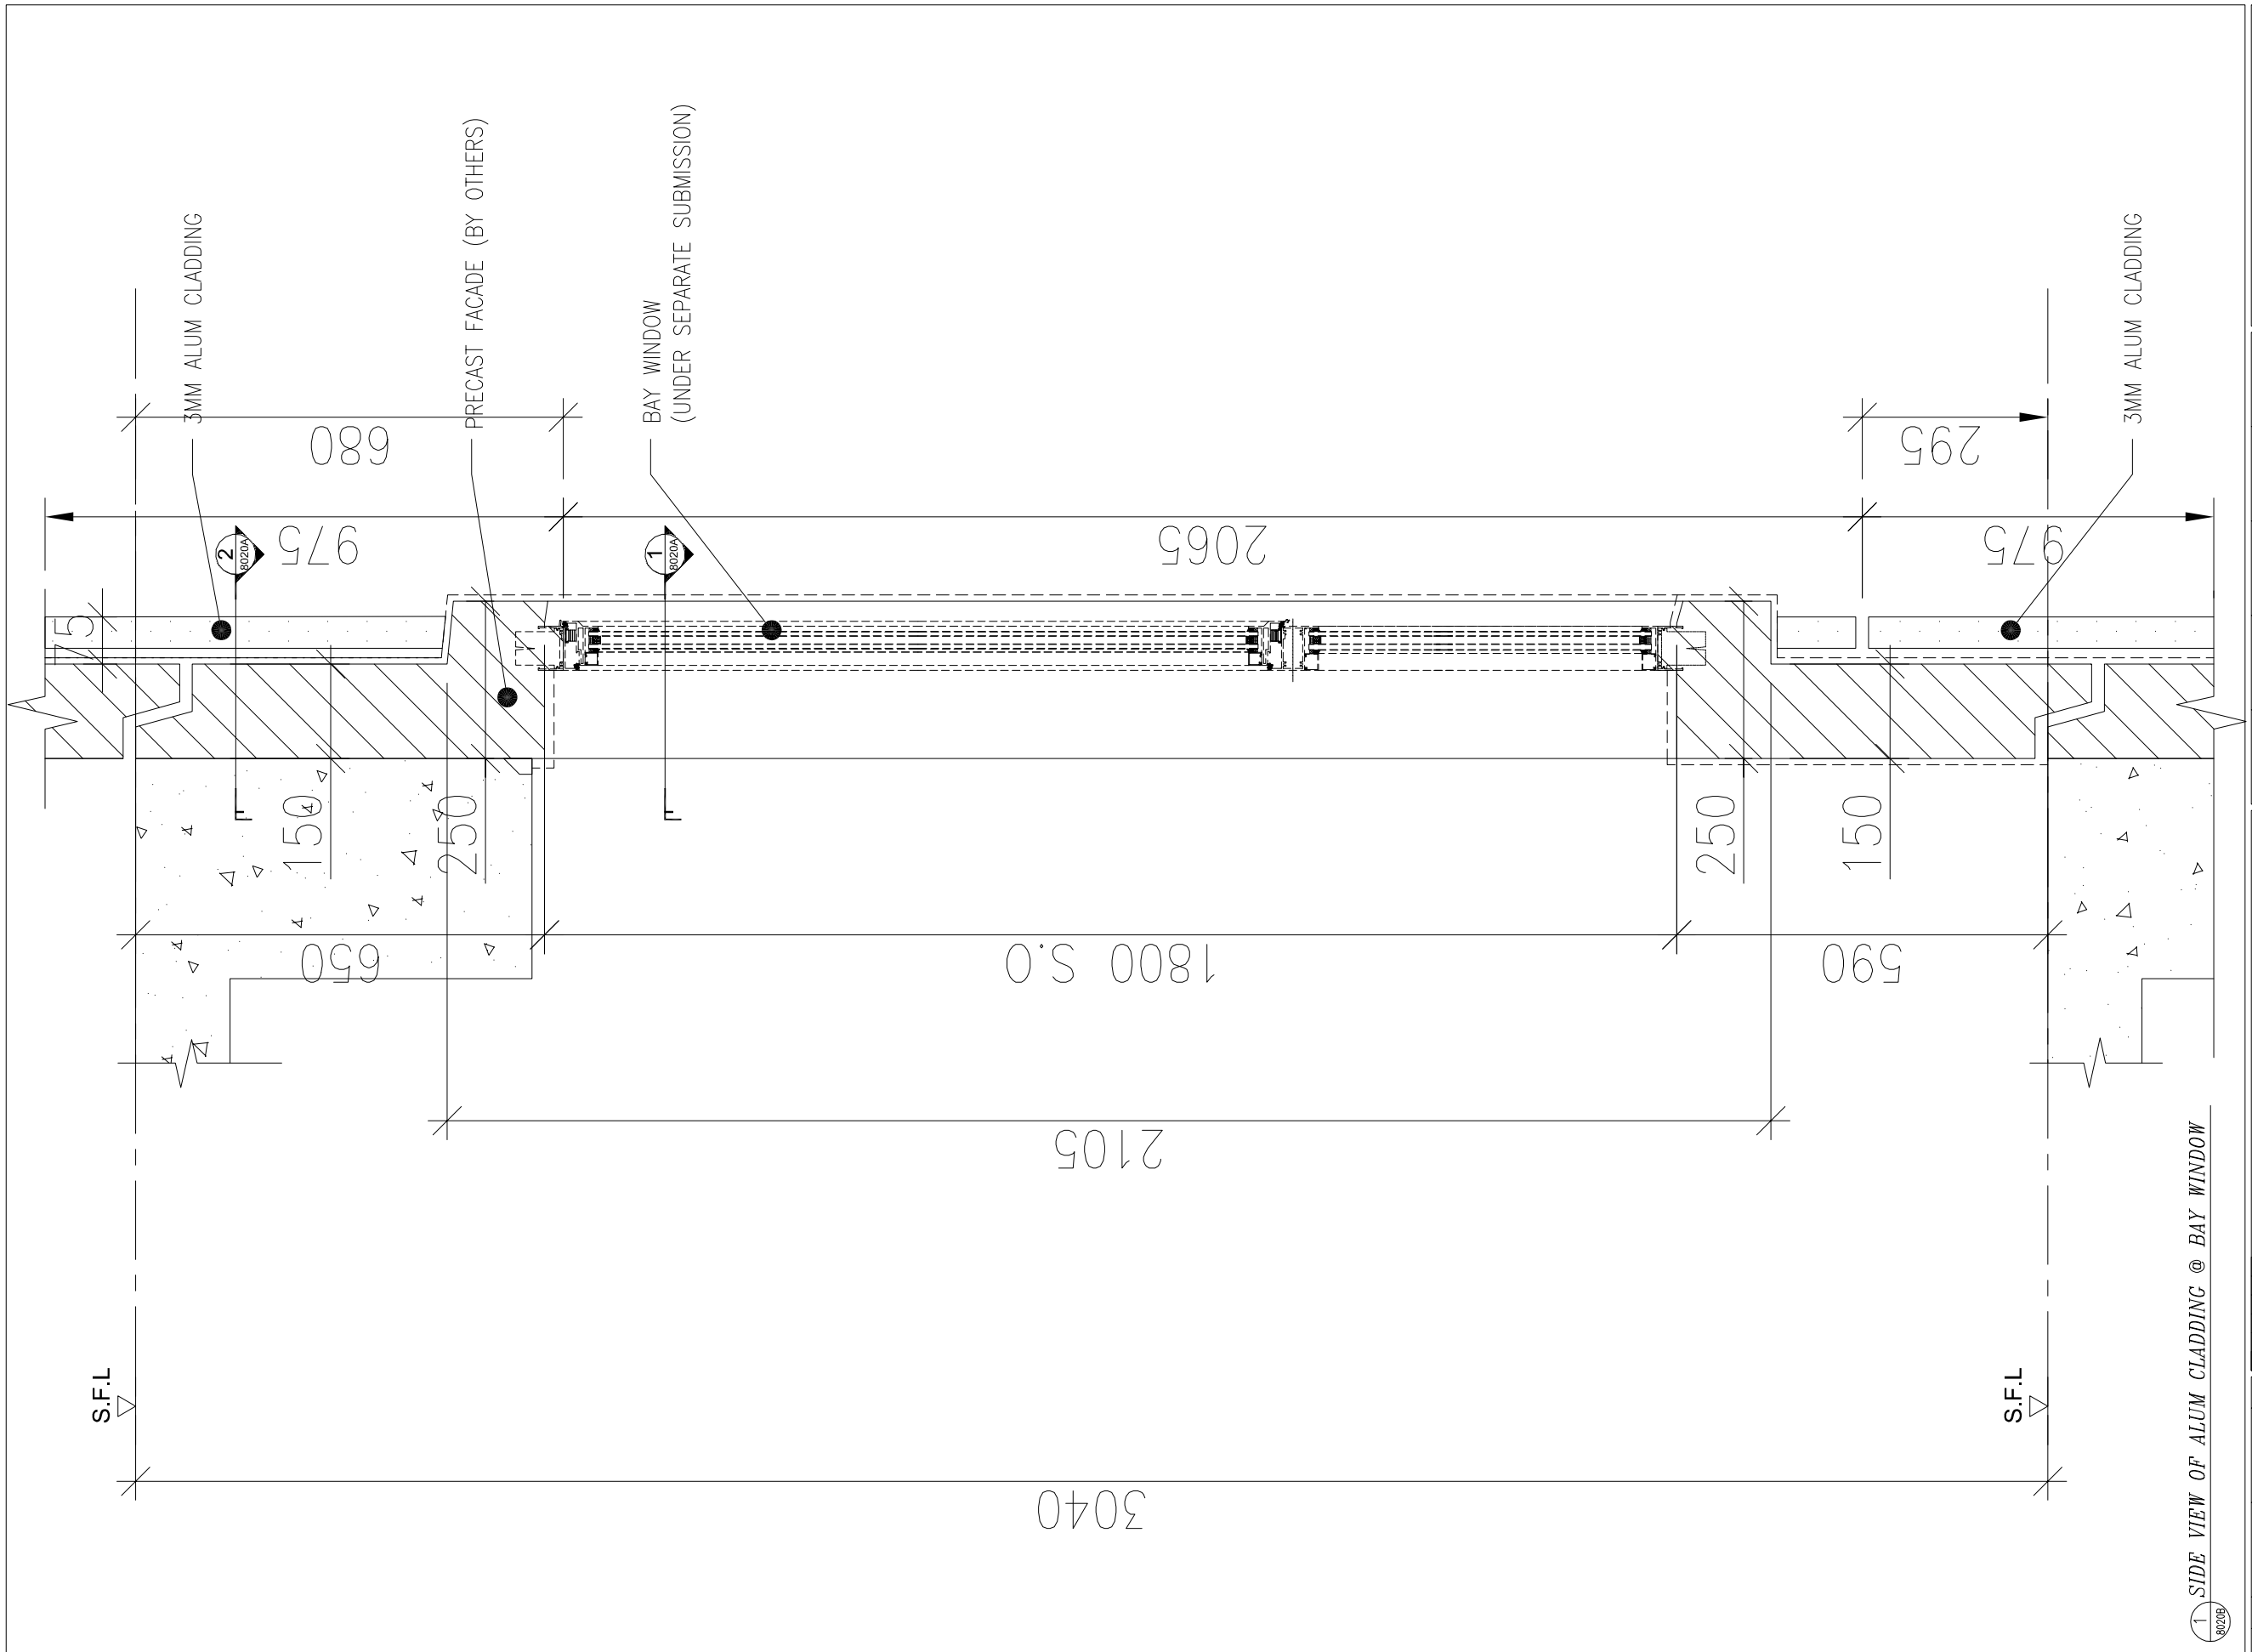

1 SIDE VIEW OF ALUM CLADDING @ BAY WINDOW 8020B

B.D. REF :

CLIENT :

SUN HUNG KAI REAL ESTATE AGENCY LTD.
42/F SUN HUNG KAI CENTRE, WANCHAI, HONGKONG

ARCHITECT :

lwk&partners
a r c h i t e c t s

MAIN CONTRACTOR :

怡輝建築有限公司
Yee Fai Building Contractors Ltd.

STRUCTURAL ENGINEER :

ARUP

FACADE CONSULTANT:

ALPHA CONSULTING LIMITED
Steel Structure & Facade Specialist

NOTE :

1. ALL DIMENSIONS ARE IN mm.
2. ALL ELEVATIONS ARE VIEWED FROM OUTSIDE.
3. ALL DIMENSIONS TO BE VERIFIED ON SITE BEFORE FABRICATION.

LEGEND :

X1 / X001 — DETAIL MARK NO. / REFER SHEET NO.

1. F.F.L. --FINISHED FLOOR LEVEL
2. S.F.L. --STRUCTURAL FLOOR LEVEL
3. /R --REVERSED DETAIL

NO.	DATE	REVISED	BY
–	13-JAN-2023	NEW DRAWING (3RD SUBMISSION)	CF

JOB NO. : J-856

PROJECT :
PROPOSED DEVELOPMENT ABOVE LIGHT RAIL TIN WING STOP,TSWTL NO.23,AREA 33,TIN SHUI WAI, N.T.


TITLE :
TYPICAL DETAIL FOR CURTAIN WALL

DATE : 11-JAN-23 | SCALE : 1:10

DRAWN BY : C.F | CHECKED BY :

美特鋁質有限公司
MIDI ALUMINIUM FABRICATOR LTD.
Units 6-8, Sunray Industrial Centre, 1/F
610 Cha Kwo Ling Road, Kowloon
Tel:23489211-4 Fax:(852)27727666


DWG NO. : J856-SD-CW-8020B | REV. : –

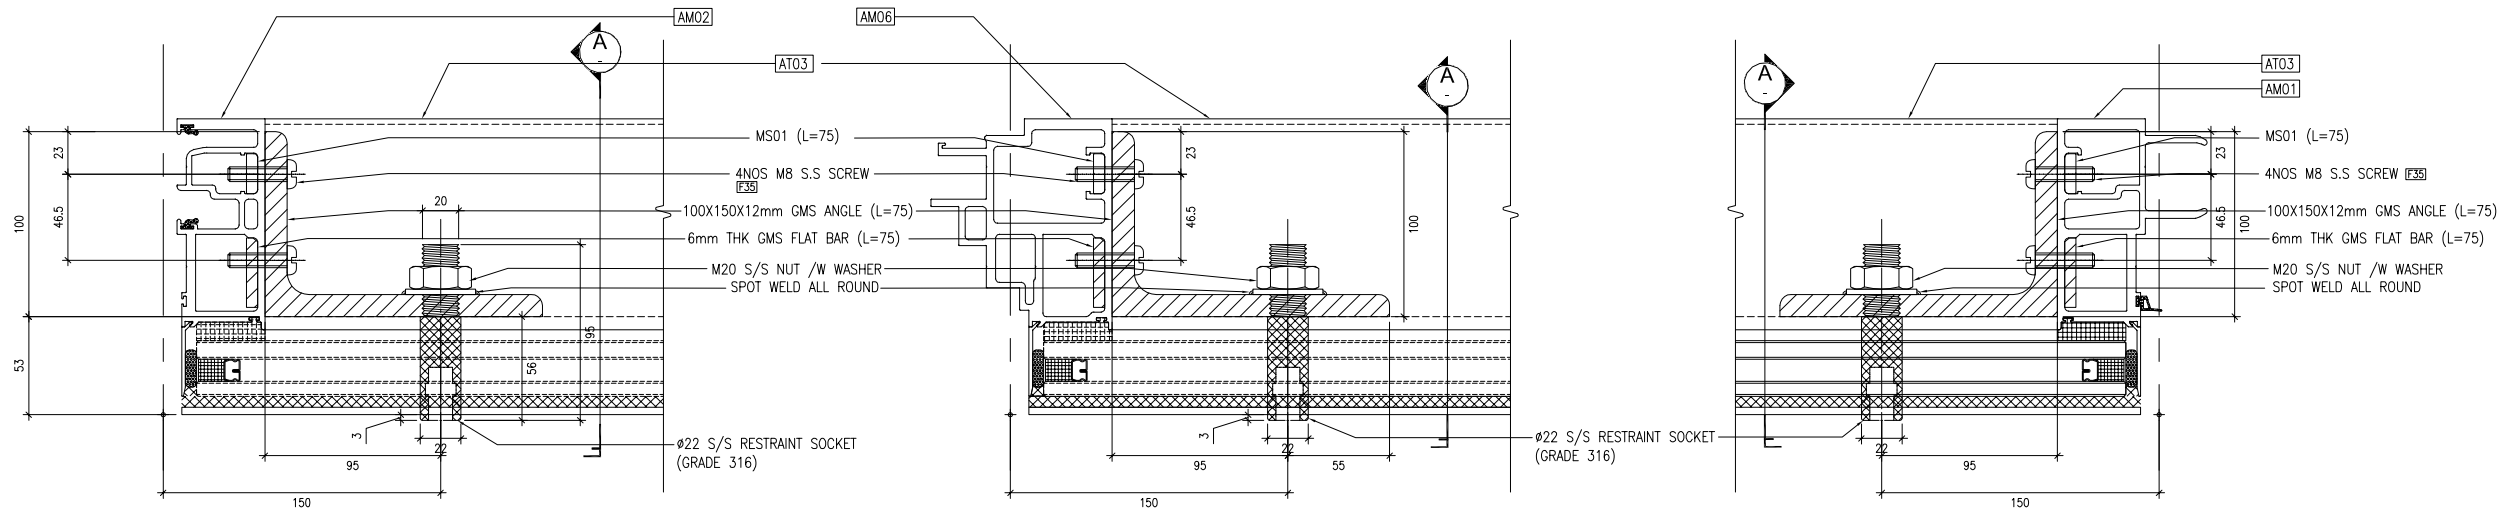


1 8021 *TYPICAL DETAIL OF CURTAIN WALL*
RESTRAINT SOCKET @ FIX WINDOW (APPLY ON AM02)

2 8021 *TYPICAL DETAIL OF CURTAIN WALL*
RESTRAINT SOCKET @ FIX WINDOW (APPLY ON AM06)

3 8021 *TYPICAL DETAIL OF CURTAIN WALL*
RESTRAINT SOCKET @ FIX WINDOW (APPLY ON AM01)

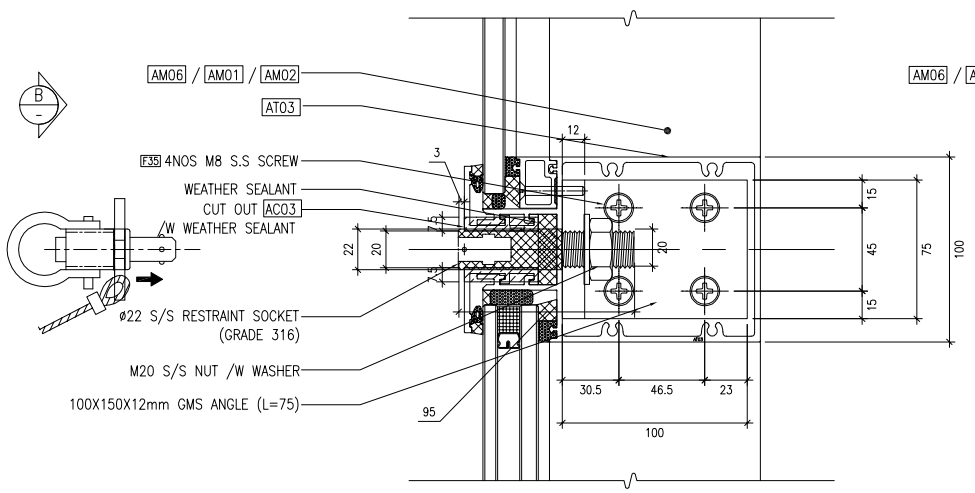

A *TYPICAL DETAIL OF CURTAIN WALL*
RESTRAINT SOCKET @ FIX WINDOW (SECTION VIEW)

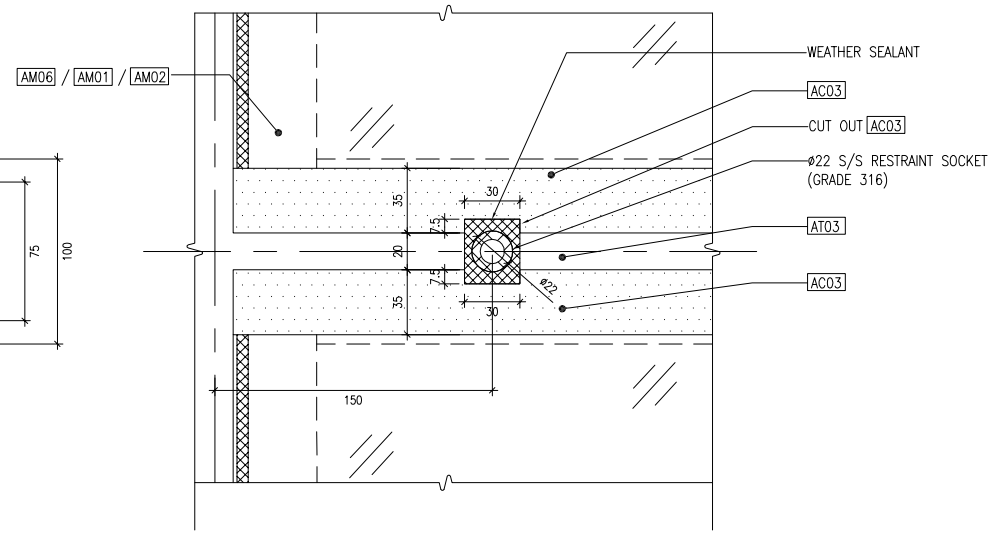

B *TYPICAL DETAIL OF CURTAIN WALL*
RESTRAINT SOCKET @ FIX WINDOW (ELEV VIEW)

B.D. REF :

CLIENT :
SUN HUNG KAI REAL ESTATE AGENCY LTD.
42/F SUN HUNG KAI CENTRE, WANCHAI, HONGKONG

ARCHITECT :
lwk&partners
a r c h i t e c t s

MAIN CONTRACTOR :
怡輝建築有限公司
Yee Fai Building Contractors Ltd.

STRUCTURAL ENGINEER :
ARUP

FACADE CONSULTANT:
ALPHA CONSULTING LIMITED
Steel Structure & Facade Specialist

NOTE :
1. ALL DIMENSIONS ARE IN mm.
2. ALL ELEVATIONS ARE VIEWED FROM OUTSIDE.
3. ALL DIMENSIONS TO BE VERIFIED ON SITE BEFORE FABRICATION.

LEGEND :
X1 / X001 — DETAIL MARK NO. / REFER SHEET NO.

1. F.F.L. -- FINISHED FLOOR LEVEL
2. S.F.L. -- STRUCTURAL FLOOR LEVEL
3. /R -- REVERSED DETAIL

NO.	DATE	REVISED	BY
B	30-MAY-2023	6TH SUBMISSION	CF
A	21-FEB-2023	4TH SUBMISSION	CF
–	13-JAN-2023	NEW DRAWING (3RD SUBMISSION)	CF

JOB NO. : J-856

PROJECT :
PROPOSED DEVELOPMENT ABOVE LIGHT RAIL TIN WING STOP,TSWTL NO.23,AREA 33,TIN SHUI WAI, N.T.


TITLE :
TYPICAL DETAIL FOR CURTAIN WALL

DATE : 31-OCT-22 | SCALE : 1:4


DRAWN BY : C.F | CHECKED BY :

美特鋁質有限公司
MIDI ALUMINIUM FABRICATOR LTD.
Units 6-8, Sunray Industrial Centre, 1/F
610 Cha Kwo Ling Road, Kowloon
Tel:23489211-4 Fax:(852)27727666


DWG NO. : J856-SD-CW-8021 | REV. : B

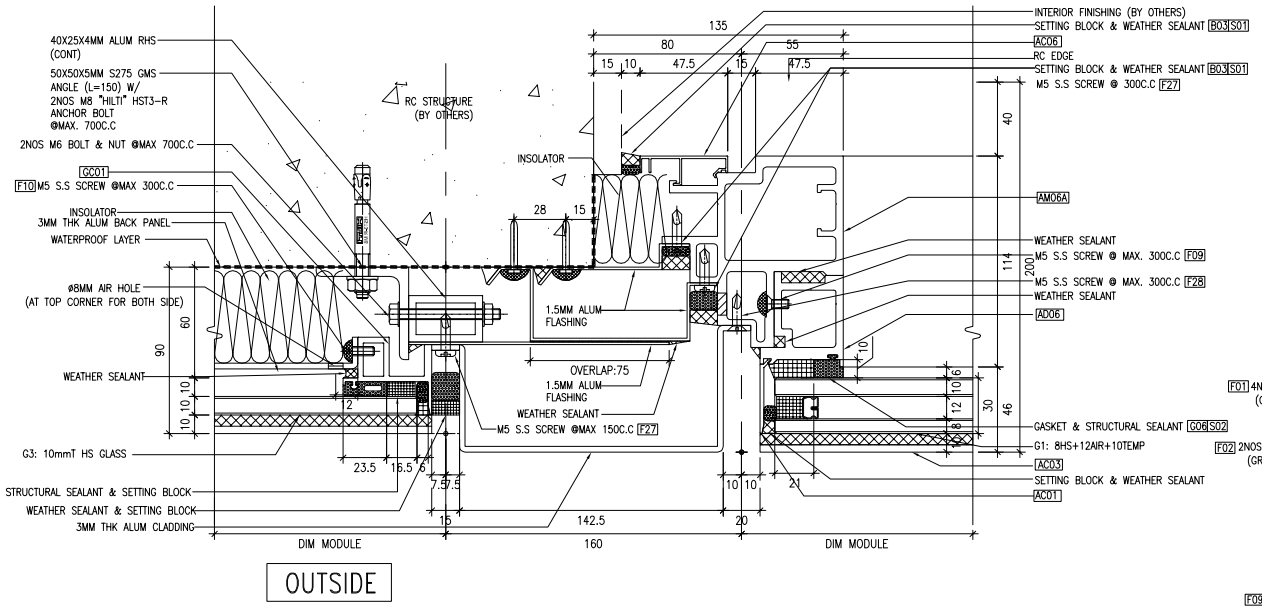

1 8022 *TYPICAL DETAIL OF CURTAIN WALL*

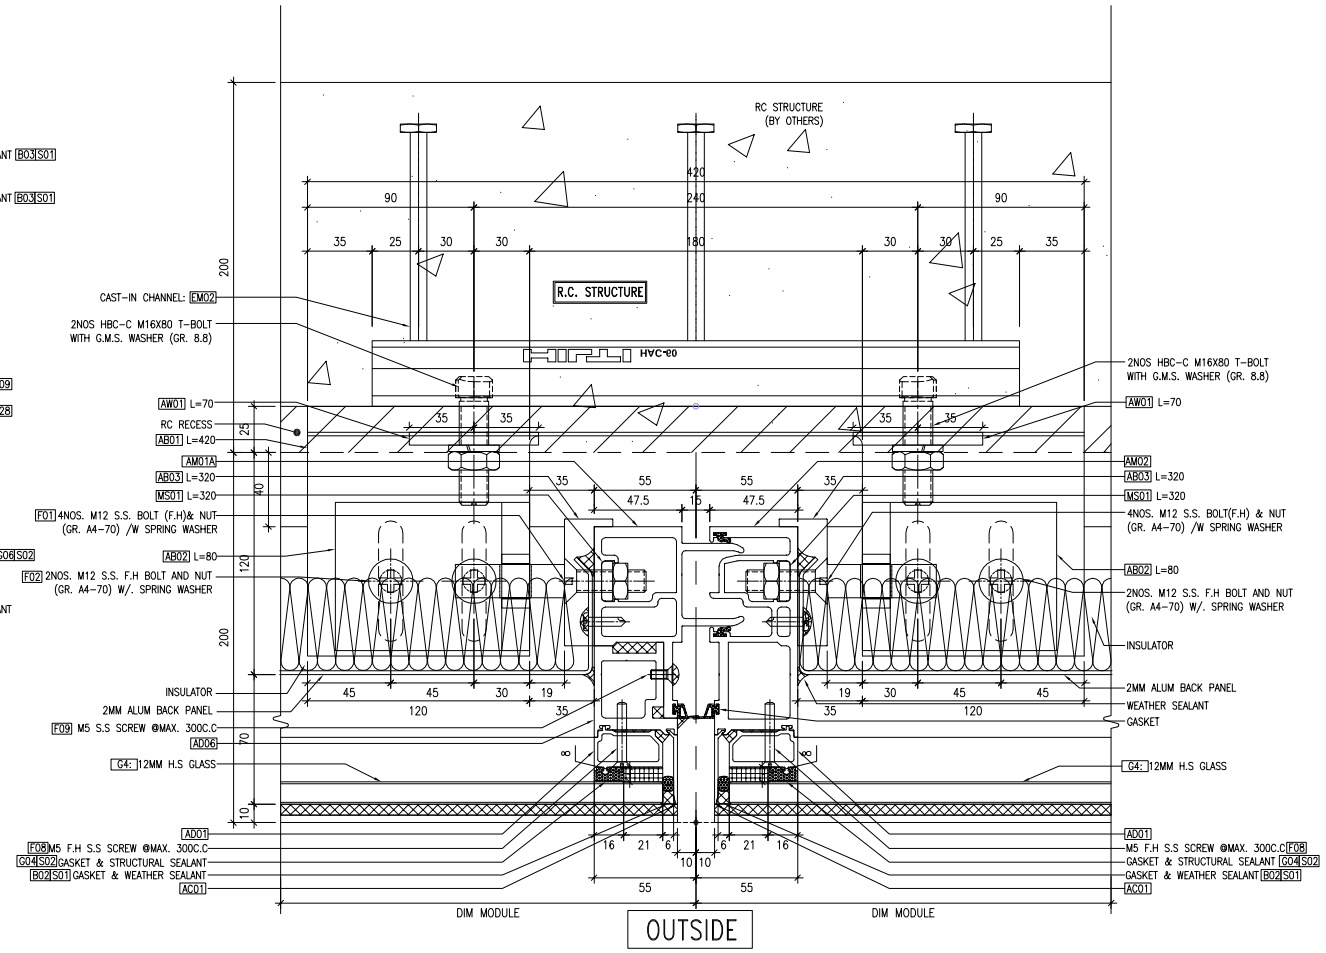

2 8022 *TYPICAL DETAIL OF CURTAIN WALL*

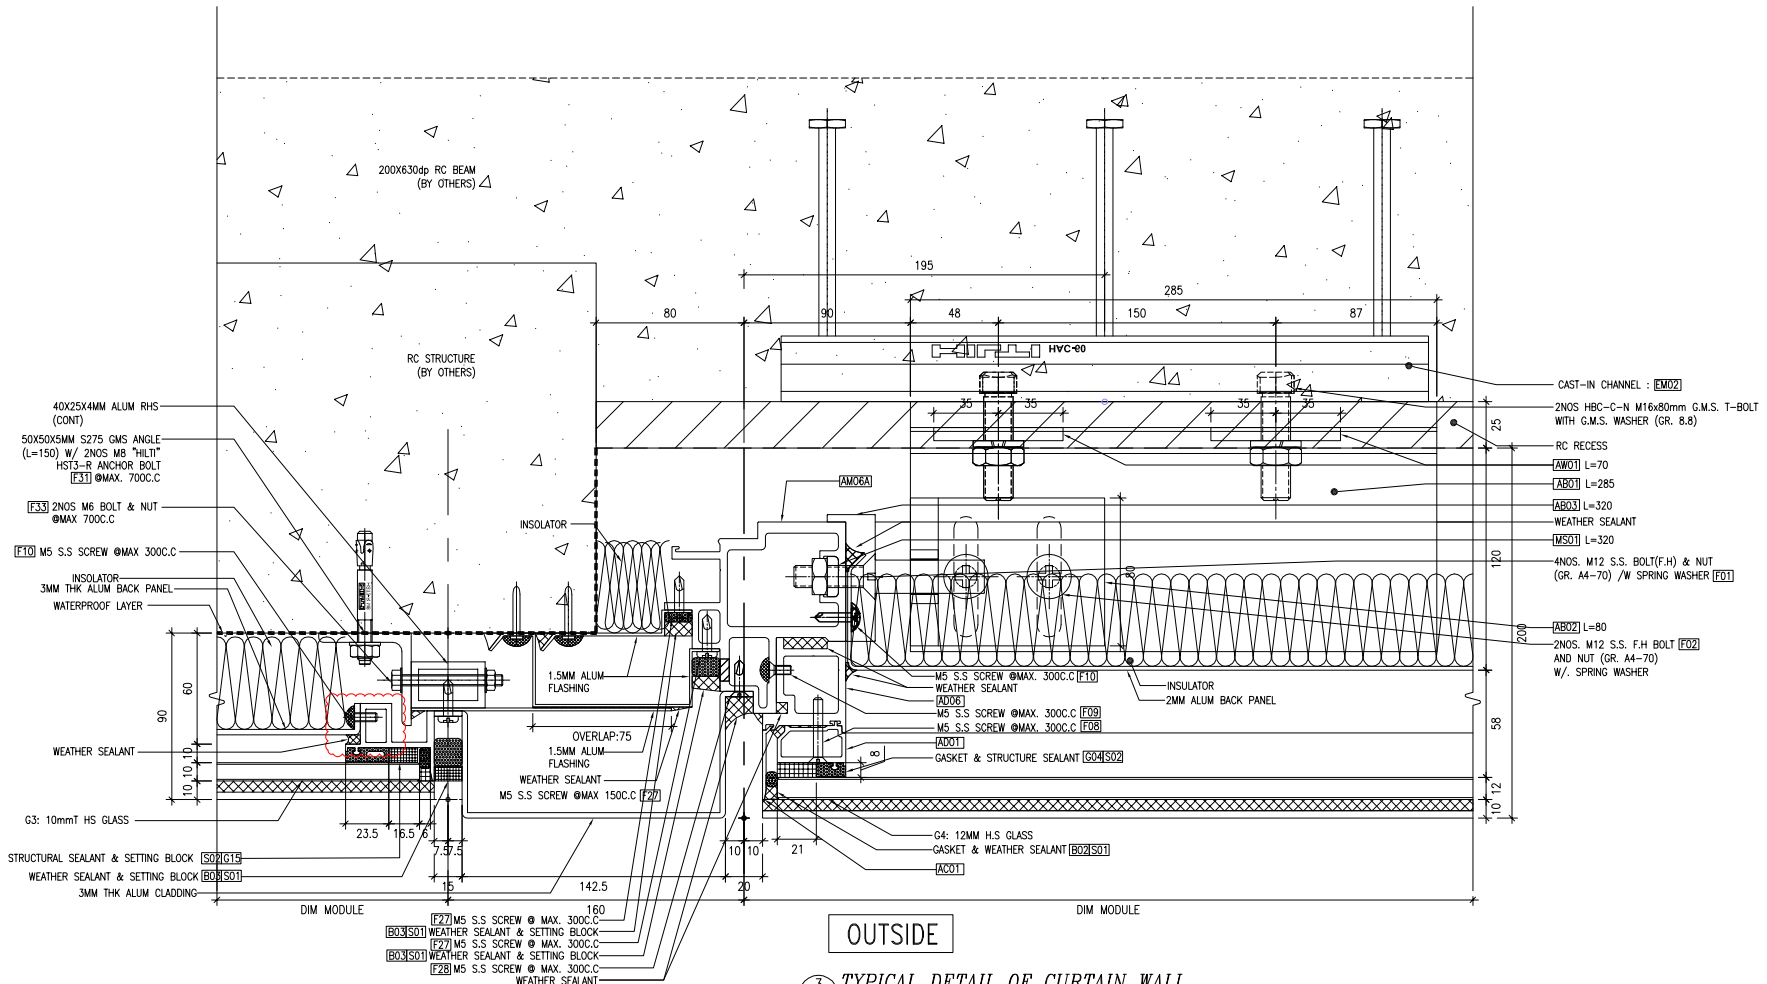

3 8022 *TYPICAL DETAIL OF CURTAIN WALL*

B.D. REF :

CLIENT :

SUN HUNG KAI REAL ESTATE AGENCY LTD.
42/F SUN HUNG KAI CENTRE, WANCHAI, HONGKONG

ARCHITECT :

lwk&partners
a r c h i t e c t s

MAIN CONTRACTOR :

怡輝建築有限公司
Yee Fai Building Contractors Ltd.

STRUCTURAL ENGINEER :

ARUP

FACADE CONSULTANT:

ALPHA CONSULTING LIMITED
Steel Structure & Facade Specialist

NOTE :
1. ALL DIMENSIONS ARE IN mm.
2. ALL ELEVATIONS ARE VIEWED FROM OUTSIDE.
3. ALL DIMENSIONS TO BE VERIFIED ON SITE BEFORE FABRICATION.

LEGEND :

X1 — DETAIL MARK NO.
X001 — REFER SHEET NO.

1. F.F.L. --FINISHED FLOOR LEVEL
2. S.F.L. --STRUCTURAL FLOOR LEVEL
3. /R --REVERSED DETAIL

NO.	DATE	REVISED	BY
B	30-MAY-2023	6TH SUBMISSION	CF
A	02-MAY-2023	5TH SUBMISSION	CF
-	21-FEB-2023	NEW DRAWING (4TH SUBMISSION)	CF

JOB NO. : J-856

PROJECT :
PROPOSED DEVELOPMENT ABOVE LIGHT RAIL TIN WING STOP,TSWTL NO.23,AREA 33,TIN SHUI WAI, N.T.


TITLE :
TYPICAL DETAIL FOR CURTAIN WALL

DATE : 23-JAN-23 | SCALE : 1:4


DRAWN BY : C.F | CHECKED BY :

美特鋁質有限公司
MIDI ALUMINIUM FABRICATOR LTD.
Units 6-8, Sunray Industrial Centre, 1/F
610 Cha Kwo Ling Road, Kowloon
Tel:23489211-4 Fax:(852)27727666


DWG NO. : J856-SD-CW-8022 | REV. : B

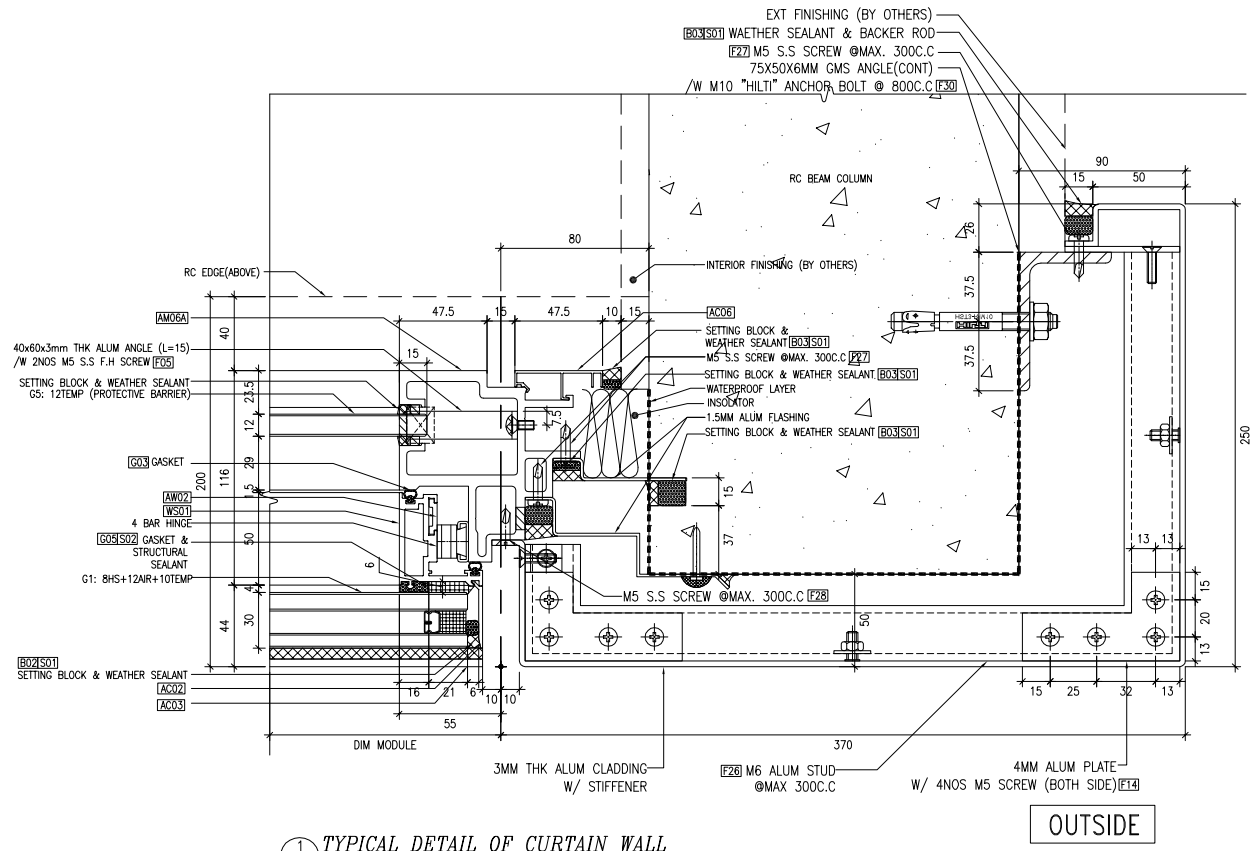

1 8023 *TYPICAL DETAIL OF CURTAIN WALL*

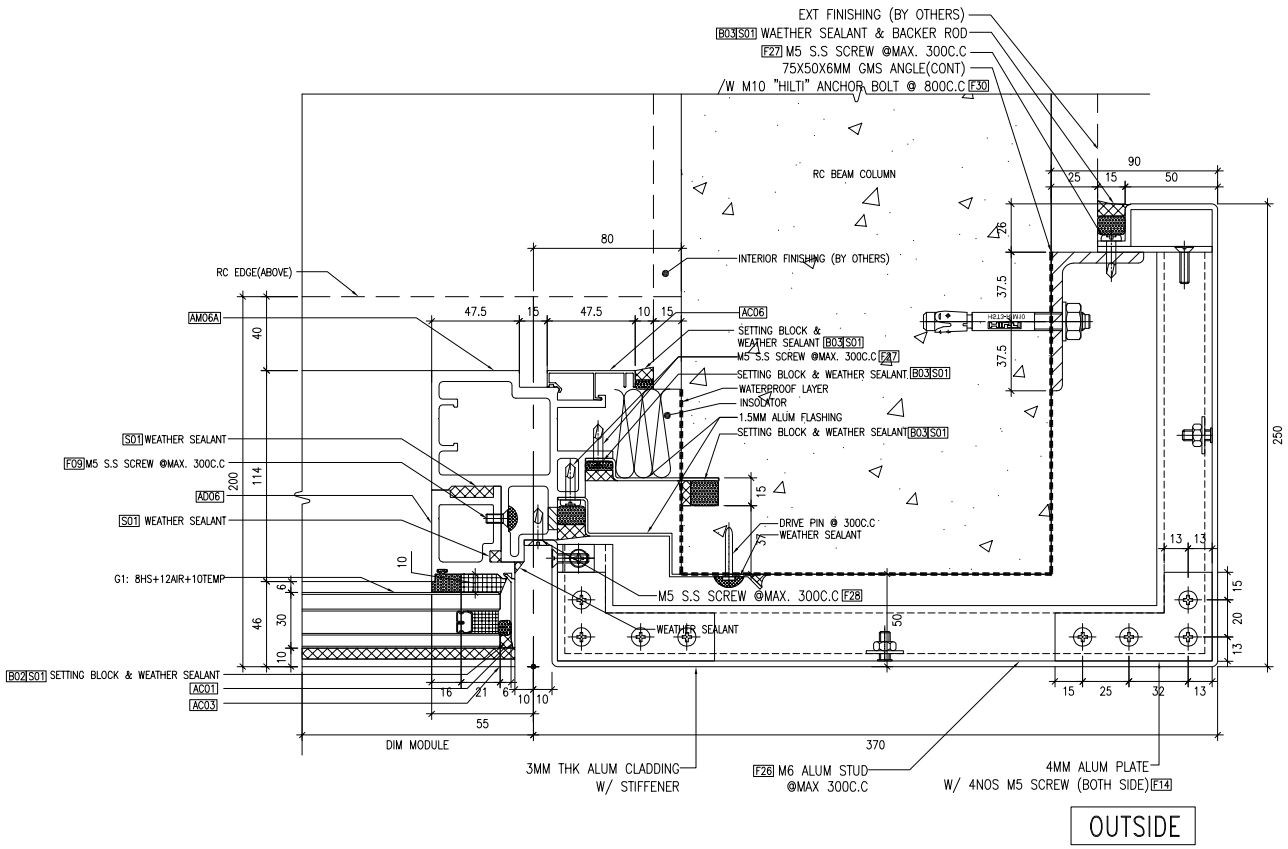

2 8023 *TYPICAL DETAIL OF CURTAIN WALL*

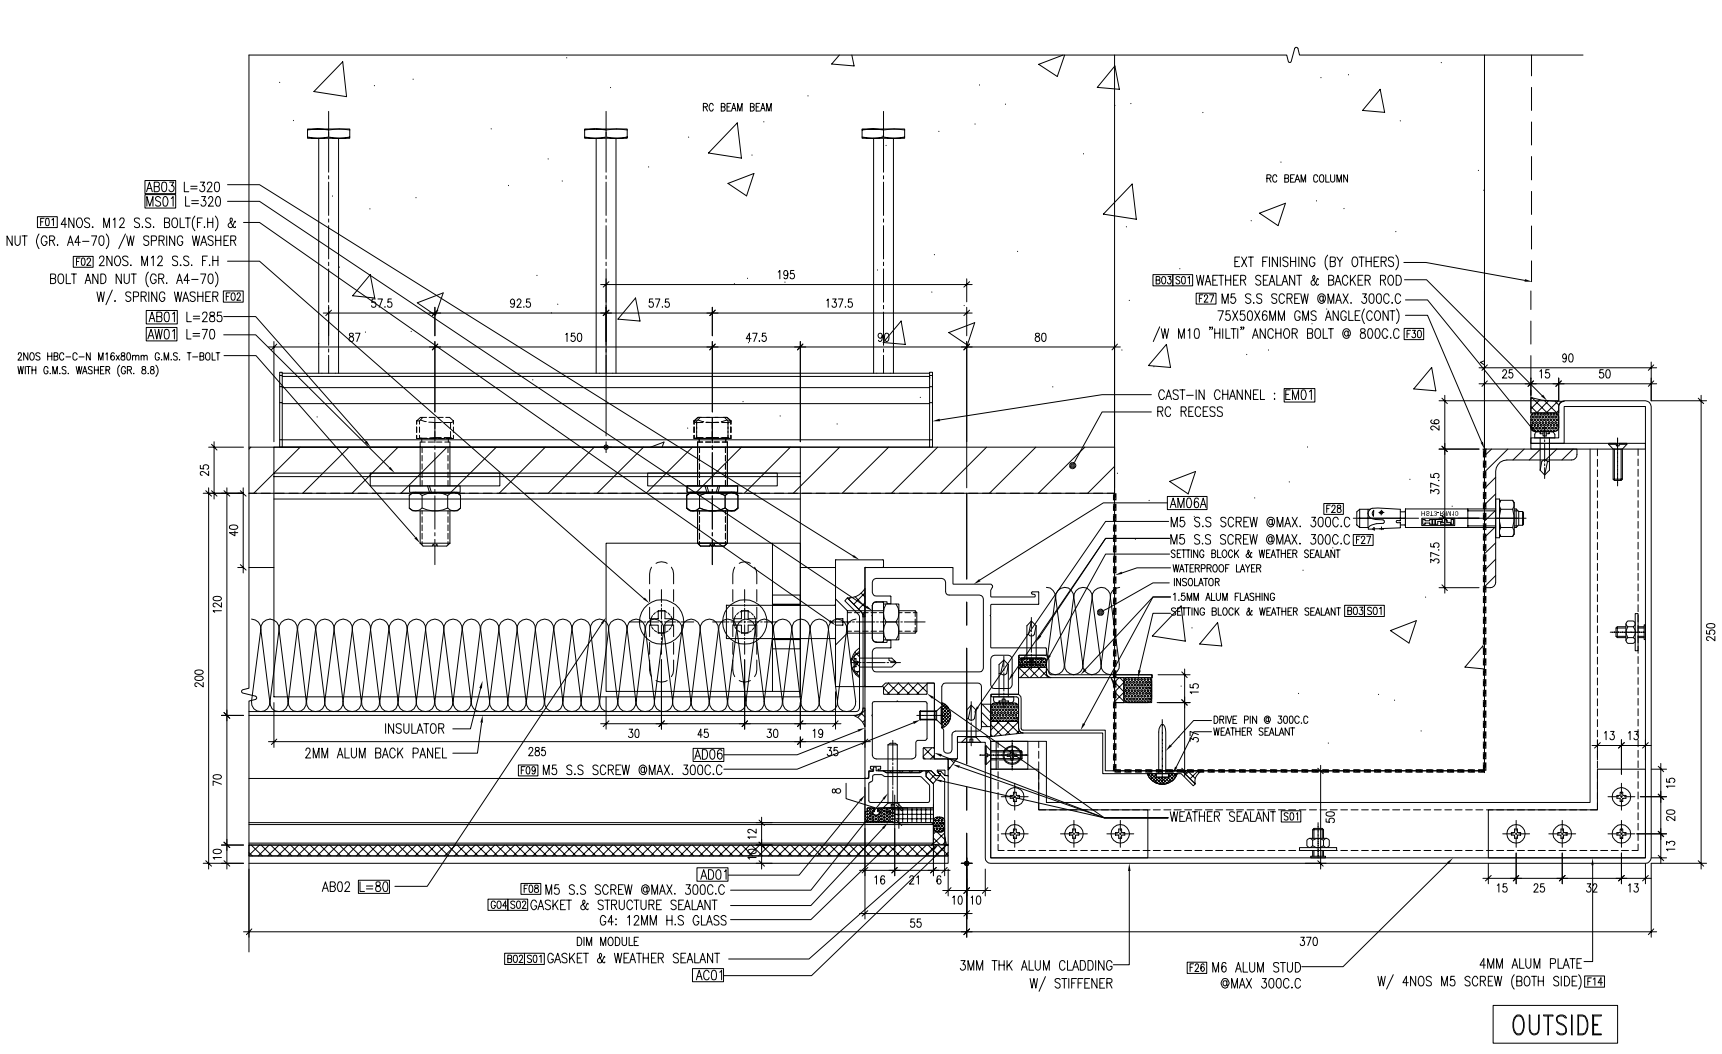

3 8023 *TYPICAL DETAIL OF CURTAIN WALL*

B.D. REF :

CLIENT :

SUN HUNG KAI REAL ESTATE AGENCY LTD.
42/F SUN HUNG KAI CENTRE, WANCHAI, HONGKONG

ARCHITECT :

lwk&partners
a r c h i t e c t s

MAIN CONTRACTOR :

怡輝建築有限公司
Yee Fai Building Contractors Ltd.

STRUCTURAL ENGINEER :

ARUP

FACADE CONSULTANT:

ALPHA CONSULTING LIMITED
Steel Structure & Facade Specialist

NOTE :
1. ALL DIMENSIONS ARE IN mm.
2. ALL ELEVATIONS ARE VIEWED FROM OUTSIDE.
3. ALL DIMENSIONS TO BE VERIFIED ON SITE BEFORE FABRICATION.

LEGEND :

X1 — DETAIL MARK NO.
X001 — REFER SHEET NO.

1. F.F.L. --FINISHED FLOOR LEVEL
2. S.F.L. --STRUCTURAL FLOOR LEVEL
3. (/R) --REVERSED DETAIL

NO.	DATE	REVISED	BY
A	02-MAY-2023	5TH SUBMISSION	CF
-	21-FEB-2023	NEW DRAWING (4TH SUBMISSION)	CF

JOB NO. : J-856

PROJECT :
PROPOSED DEVELOPMENT ABOVE LIGHT RAIL TIN WING STOP,TSWTL NO.23,AREA 33,TIN SHUI WAI, N.T.


TITLE :
TYPICAL DETAIL FOR CURTAIN WALL

DATE : 23-JAN-23 | SCALE : 1:4


DRAWN BY : C.F | CHECKED BY :

美特鋁質有限公司
MIDI ALUMINIUM FABRICATOR LTD.
Units 6-8, Sunray Industrial Centre, 1/F
610 Cha Kwo Ling Road, Kowloon
Tel:23489211-4 Fax:(852)27727666


DWG NO. : J856-SD-CW-8023 | REV. : A

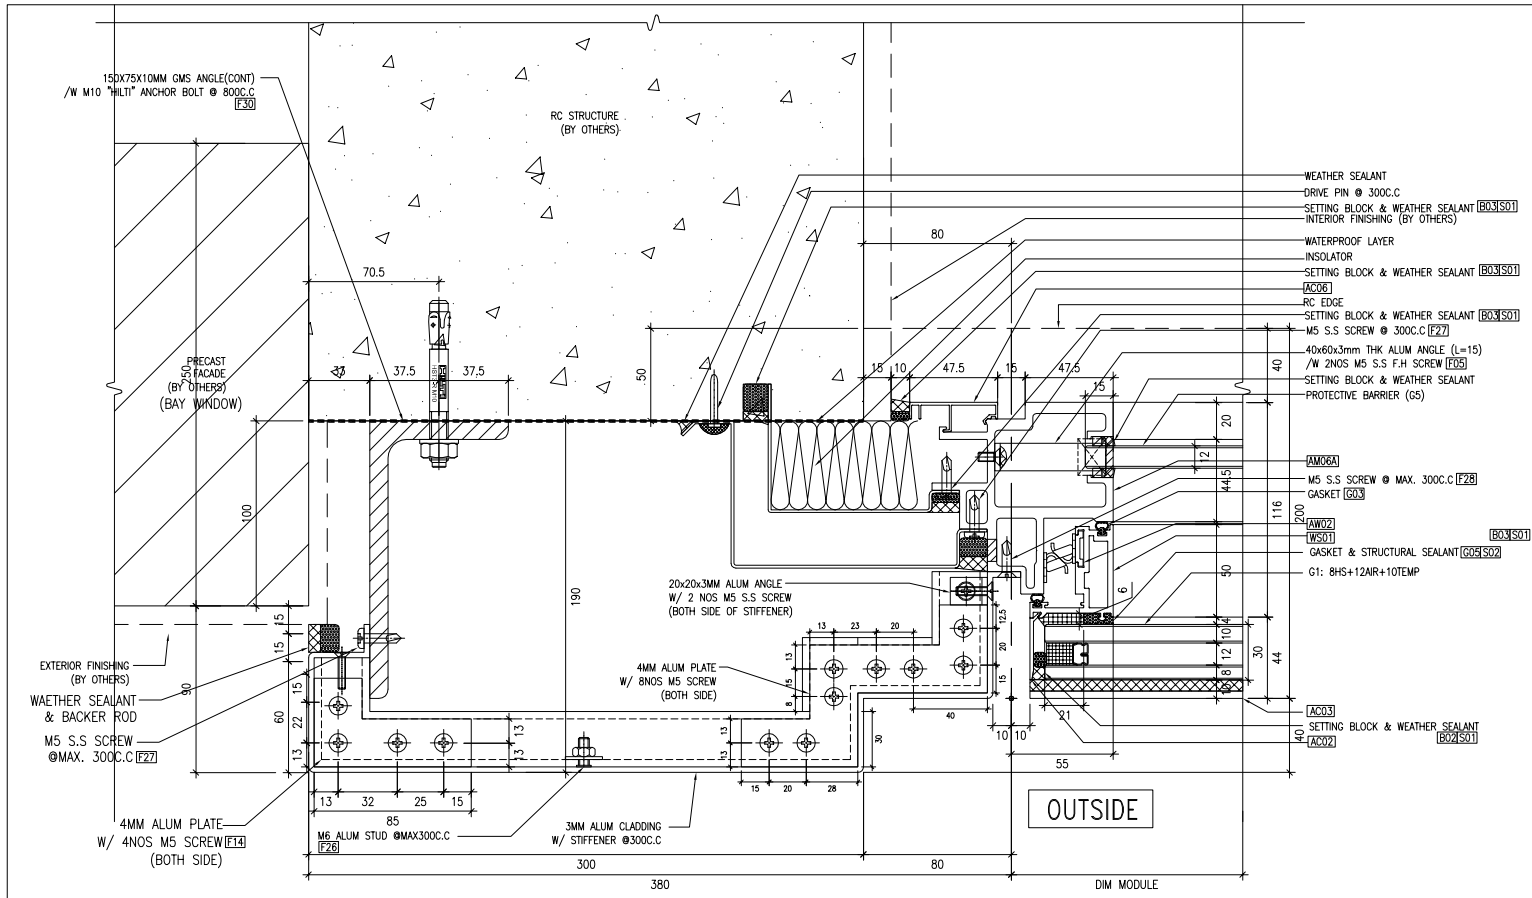

1 8024 *TYPICAL DETAIL OF CURTAIN WALL*

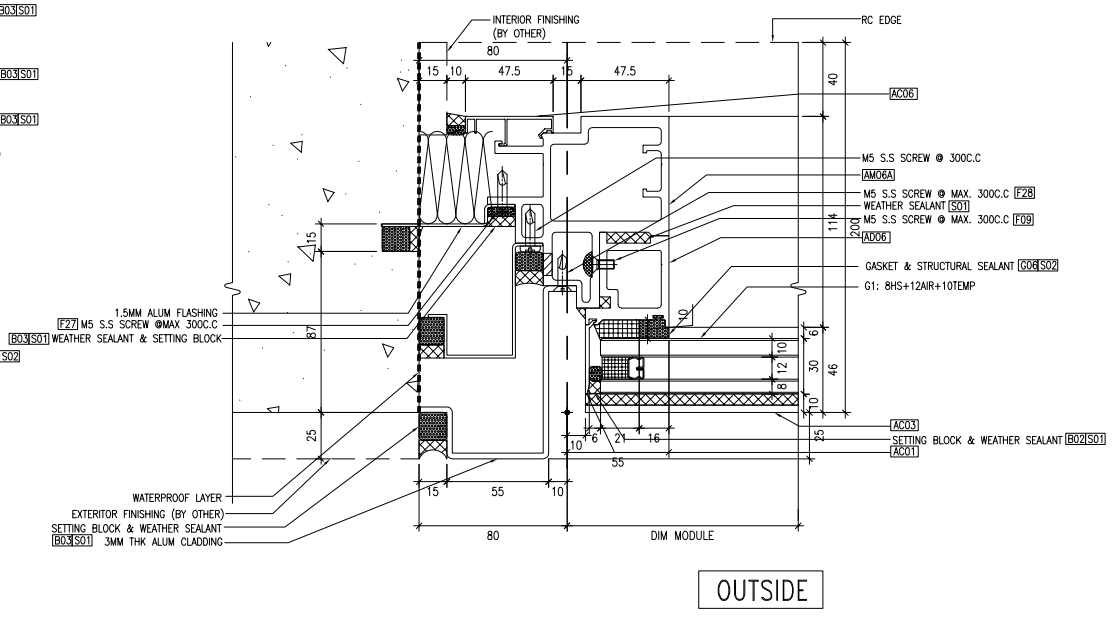

3 8024 *TYPICAL DETAIL OF CURTAIN WALL*

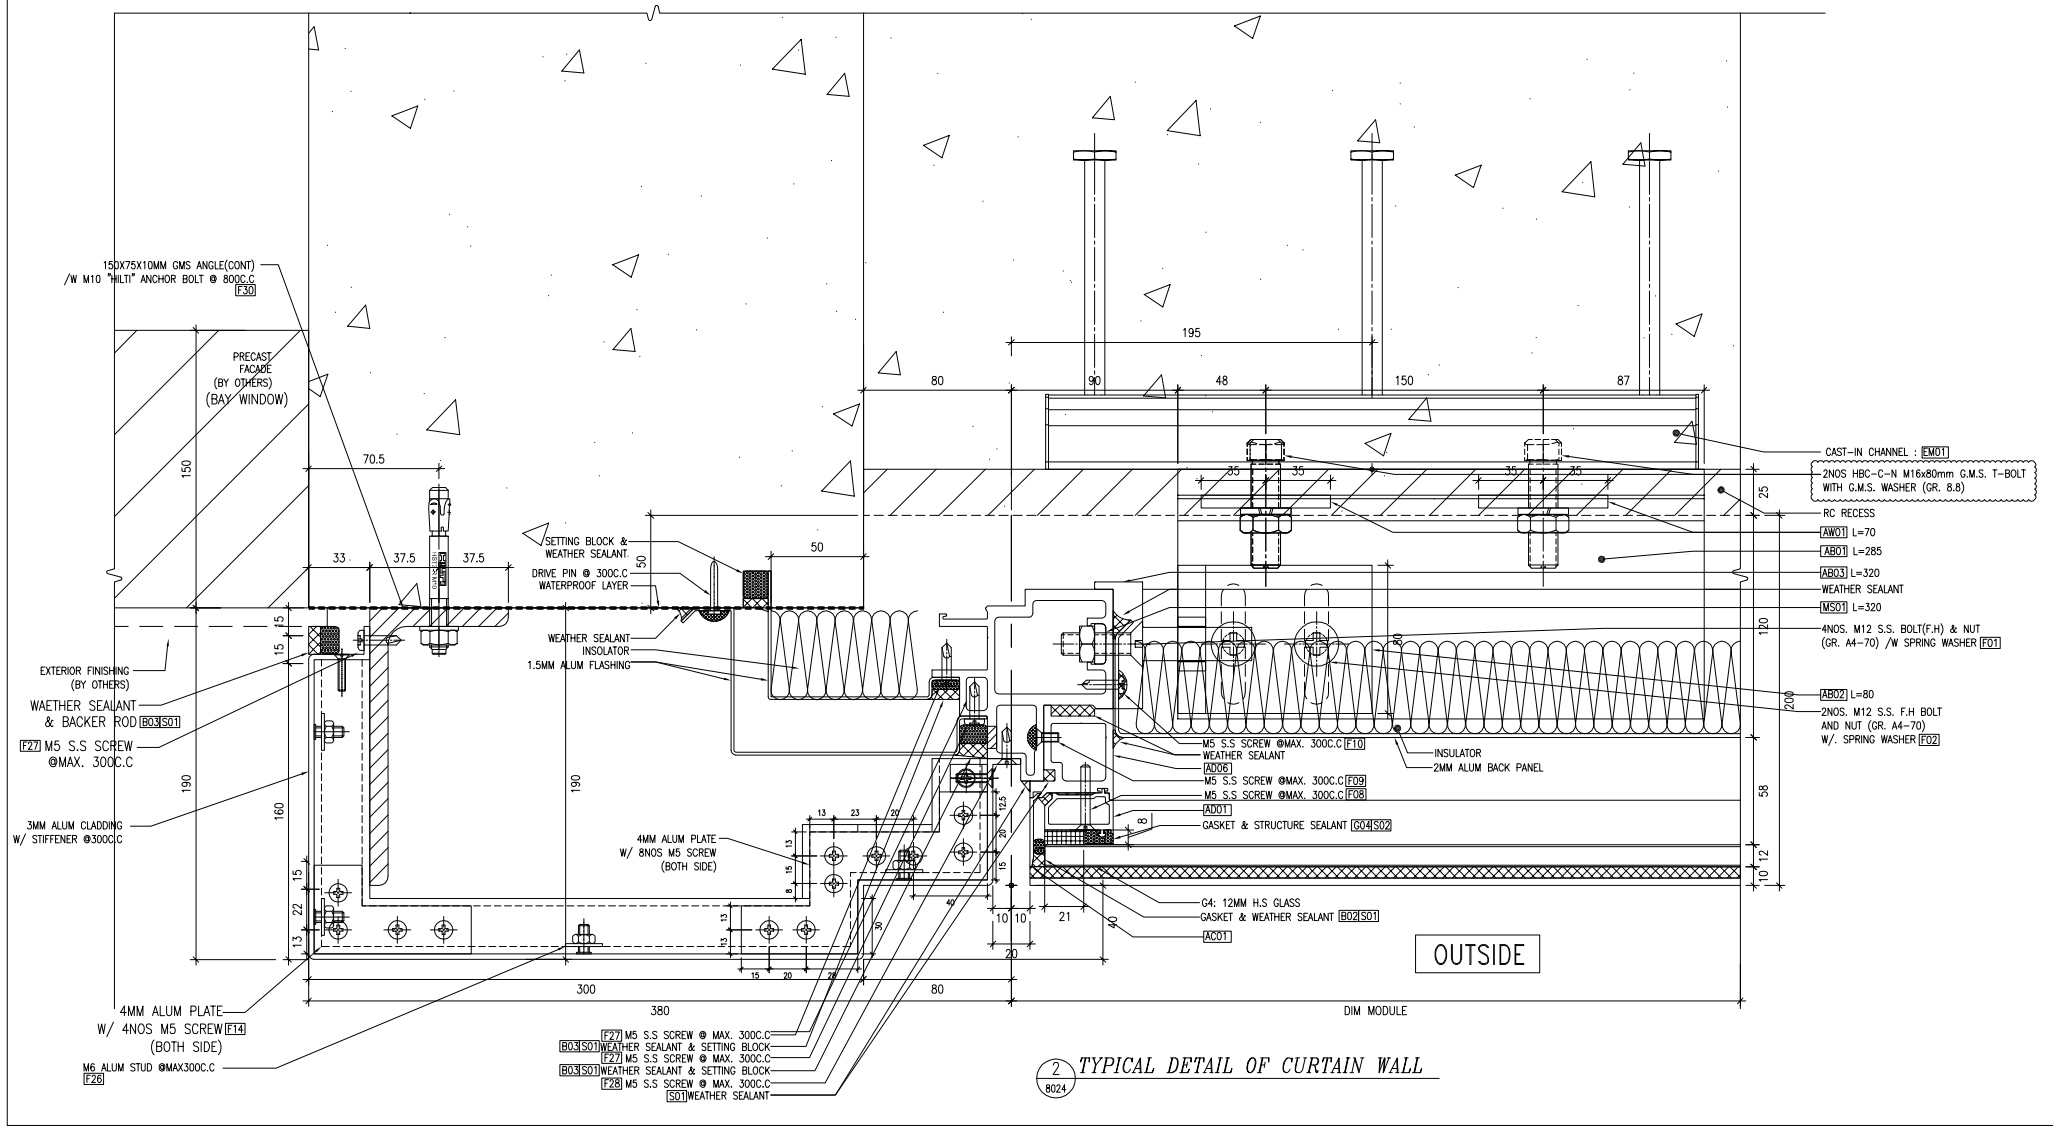

2 8024 *TYPICAL DETAIL OF CURTAIN WALL*

B.D. REF :

CLIENT :

SUN HUNG KAI REAL ESTATE AGENCY LTD.
42/F SUN HUNG KAI CENTRE, WANCHAI, HONGKONG

ARCHITECT :

lwk&partners
a r c h i t e c t s

MAIN CONTRACTOR :

怡輝建築有限公司
Yee Fai Building Contractors Ltd.

STRUCTURAL ENGINEER :

ARUP

FACADE CONSULTANT:

ALPHA CONSULTING LIMITED
Steel Structure & Facade Specialist

NOTE :
1. ALL DIMENSIONS ARE IN mm.
2. ALL ELEVATIONS ARE VIEWED FROM OUTSIDE.
3. ALL DIMENSIONS TO BE VERIFIED ON SITE BEFORE FABRICATION.

LEGEND :

X1 — DETAIL MARK NO.
X001 — REFER SHEET NO.

1. F.F.L. --FINISHED FLOOR LEVEL
2. S.F.L. --STRUCTURAL FLOOR LEVEL
3. (R) --REVERSED DETAIL

NO.	DATE	REVISED	BY
B	31-MAY-2023	6TH SUBMISSION	CF
A	02-MAY-2023	5TH SUBMISSION	CF
-	21-FEB-2023	NEW DRAWING (4TH SUBMISSION)	CF

JOB NO. : J-856

PROJECT :
PROPOSED DEVELOPMENT ABOVE LIGHT RAIL TIN WING STOP,TSWTL NO.23,AREA 33,TIN SHUI WAI, N.T.


TITLE :
TYPICAL DETAIL FOR CURTAIN WALL

DATE : 23-JAN-23 | SCALE : 1:4


DRAWN BY : C.F | CHECKED BY :

美特鋁製有限公司
MIDI ALUMINIUM FABRICATOR LTD.
Units 6-8, Sunray Industrial Centre, 1/F
610 Cha Kwo Ling Road, Kowloon
Tel:23489211-4 Fax:(852)27727666

DWG NO. : J856-SD-CW-8024 | REV. : B

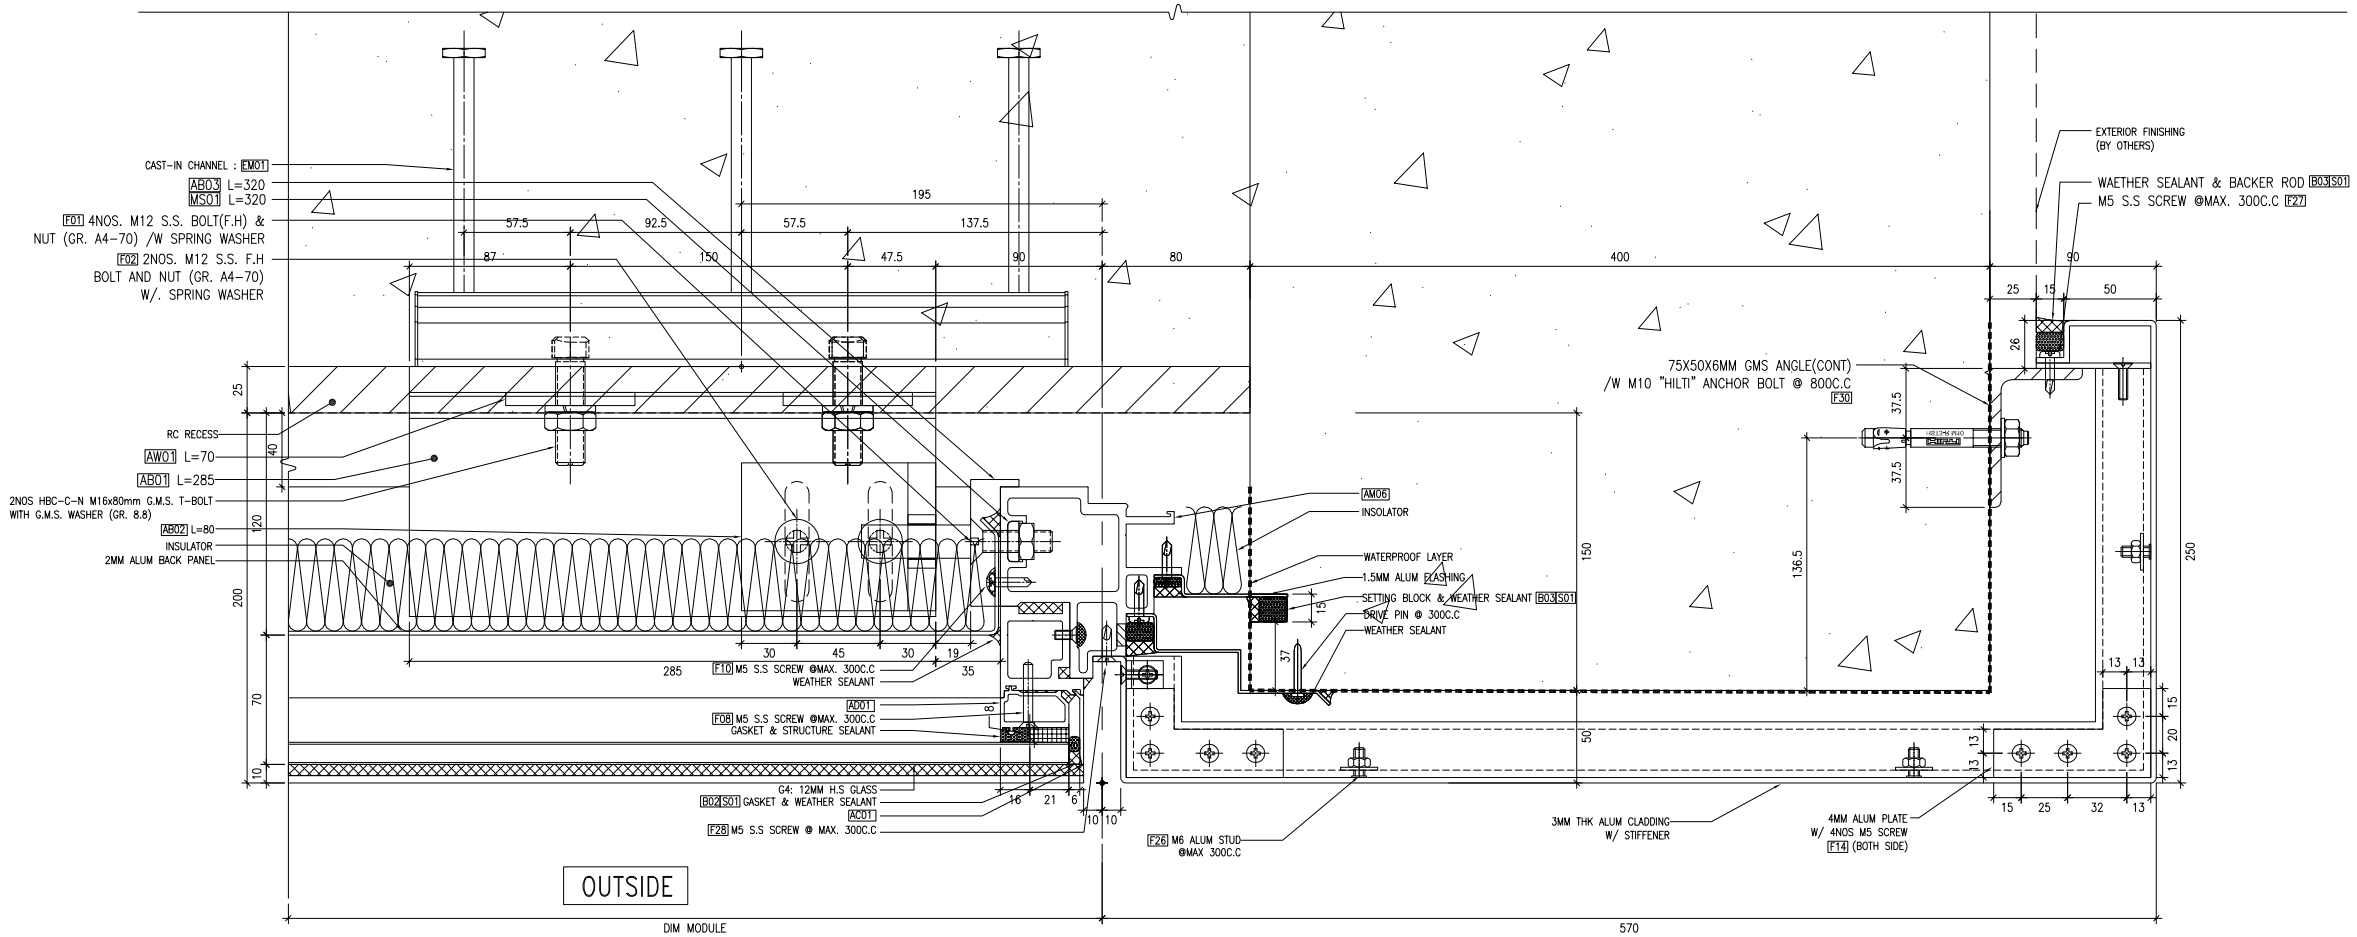

1 / 8025 *TYPICAL DETAIL OF CURTAIN WALL*

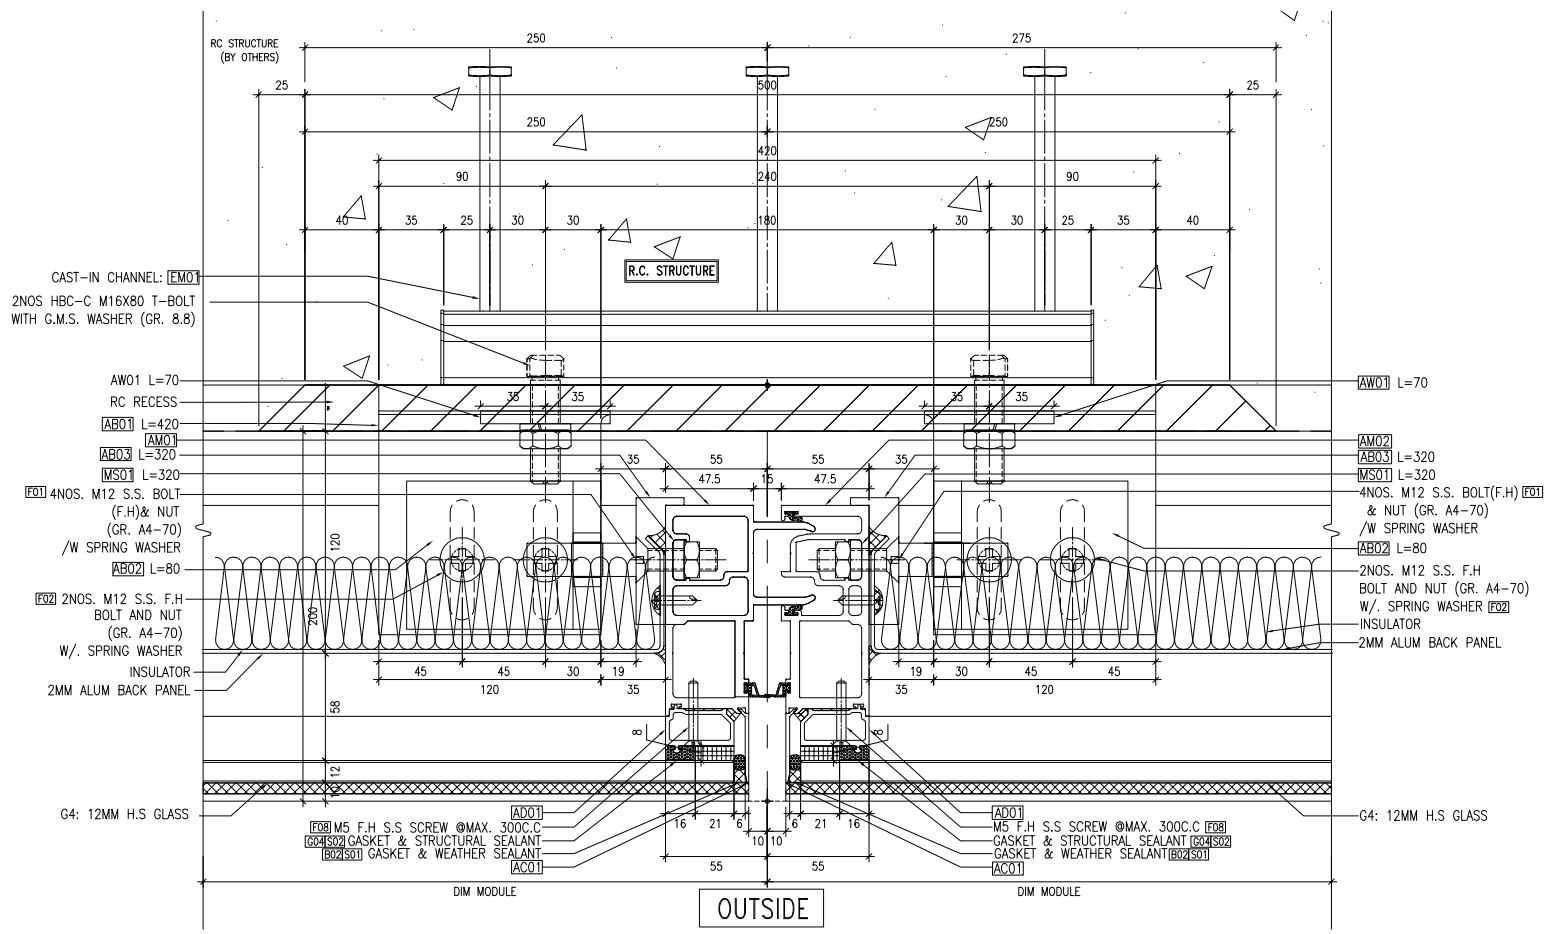

2 / 8025 *TYPICAL DETAIL OF CURTAIN WALL*

B.D. REF :

CLIENT :

SUN HUNG KAI REAL ESTATE AGENCY LTD.
42/F SUN HUNG KAI CENTRE, WANCHAI, HONGKONG

ARCHITECT :

lwk&partners
a r c h i t e c t s

MAIN CONTRACTOR :

怡輝建築有限公司
Yee Fai Building Contractors Ltd.

STRUCTURAL ENGINEER :

ARUP

FACADE CONSULTANT:

ALPHA CONSULTING LIMITED
Steel Structure & Facade Specialist

NOTE :
1. ALL DIMENSIONS ARE IN mm.
2. ALL ELEVATIONS ARE VIEWED FROM OUTSIDE.
3. ALL DIMENSIONS TO BE VERIFIED ON SITE BEFORE FABRICATION.

LEGEND :

X1 / X001 — DETAIL MARK NO. / REFER SHEET NO.

1. F.F.L. --FINISHED FLOOR LEVEL
2. S.F.L. --STRUCTURAL FLOOR LEVEL
3. /R --REVERSED DETAIL

NO.	DATE	REVISED	BY
A	02-MAY-2023	5TH SUBMISSION	
-	21-FEB-2023	NEW DRAWING (4TH SUBMISSION)	CF

JOB NO. : J-856

PROJECT :
PROPOSED DEVELOPMENT ABOVE LIGHT RAIL TIN WING STOP,TSWTL NO.23,AREA 33,TIN SHUI WAI, N.T.


TITLE :
TYPICAL DETAIL FOR CURTAIN WALL

DATE : 23-JAN-23 | SCALE : 1:4


DRAWN BY : C.F | CHECKED BY :

美特鋁質有限公司
MIDI ALUMINIUM FABRICATOR LTD.
Units 6-8, Sunray Industrial Centre, 1/F
610 Cha Kwo Ling Road, Kowloon
Tel:23489211-4 Fax:(852)27727666


DWG NO. : J856-SD-CW-8025 | REV. : A

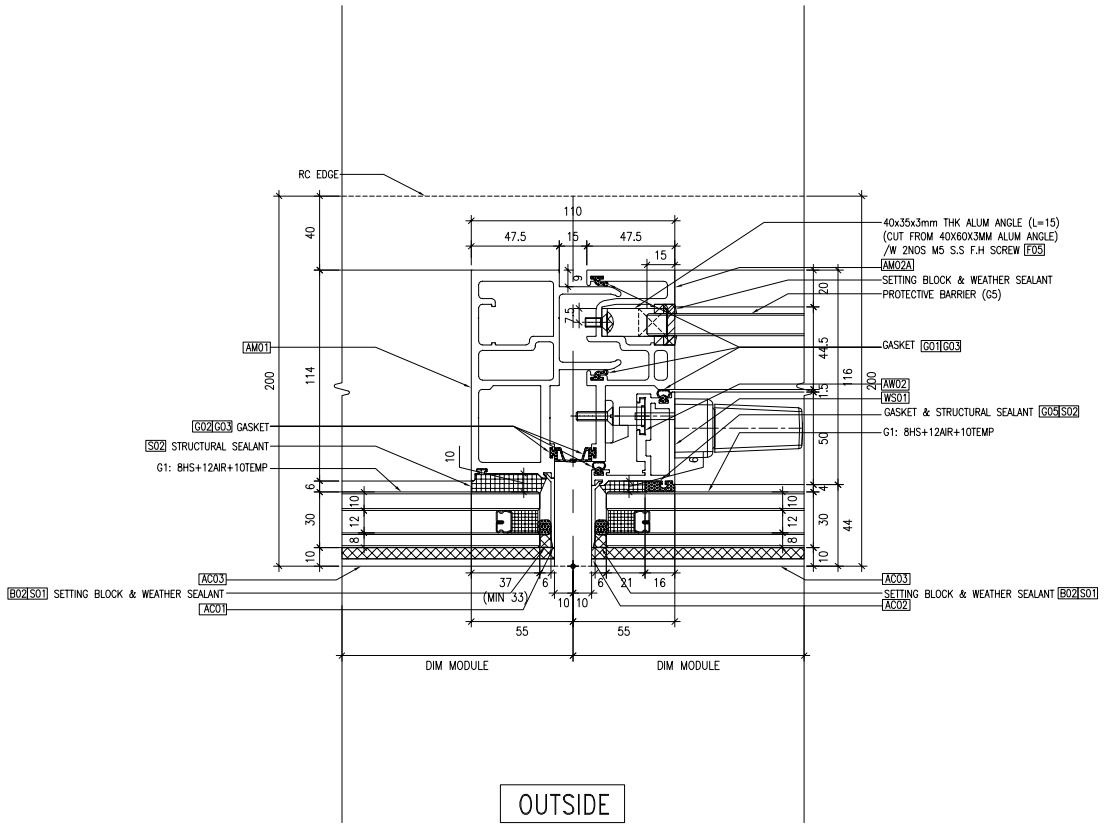


1/8026 *TYPICAL DETAIL OF CURTAIN WALL*

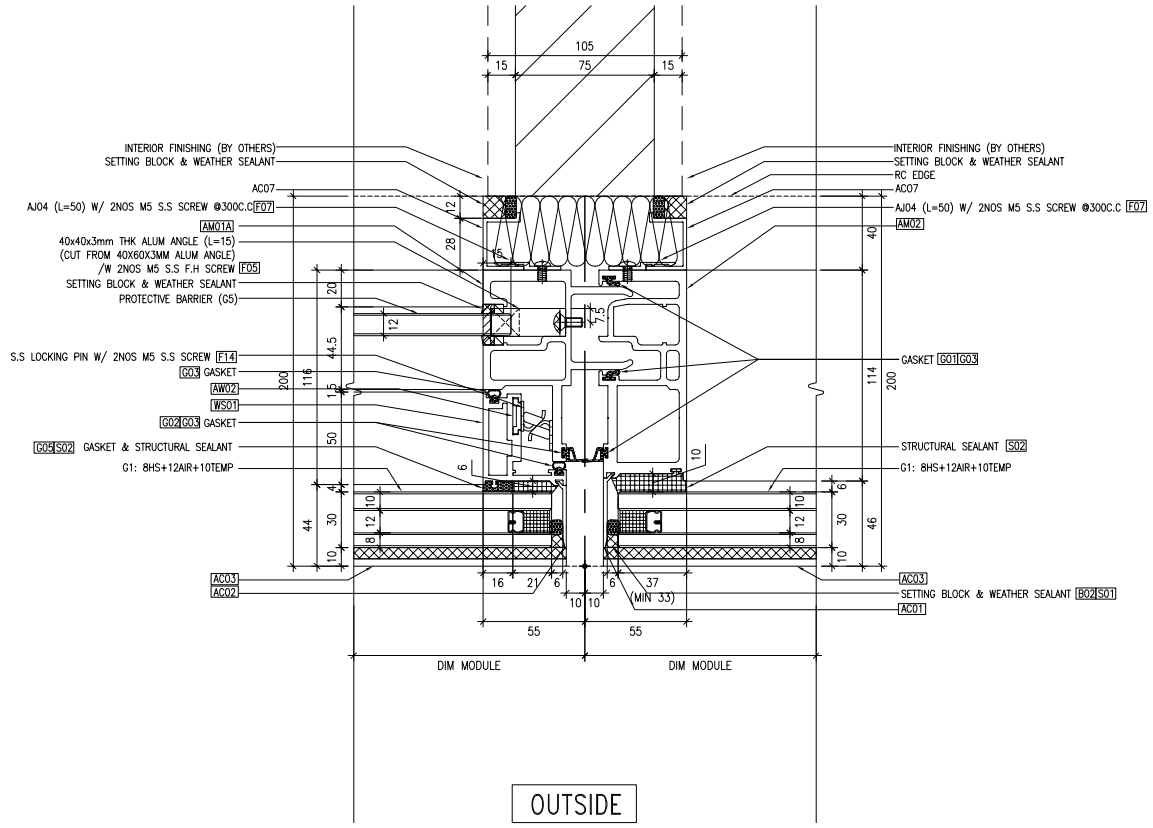

2/8026 *TYPICAL DETAIL OF CURTAIN WALL*

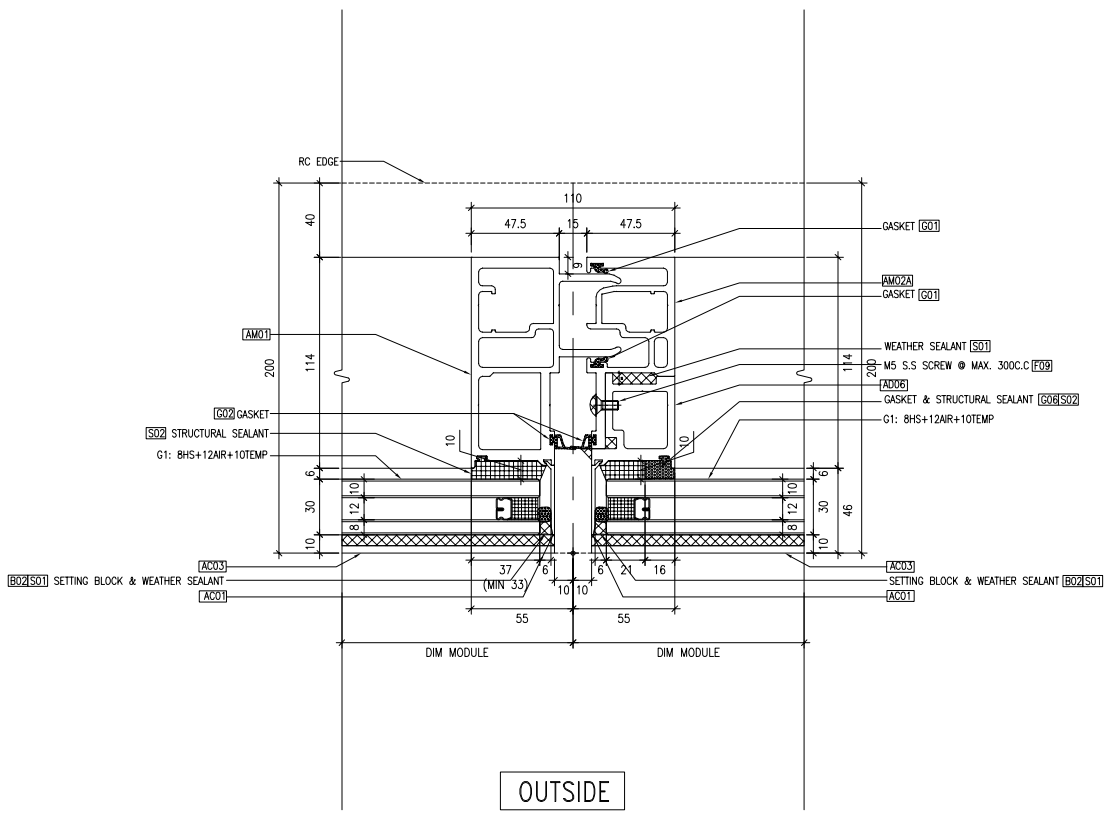

3/8026 *TYPICAL DETAIL OF CURTAIN WALL*

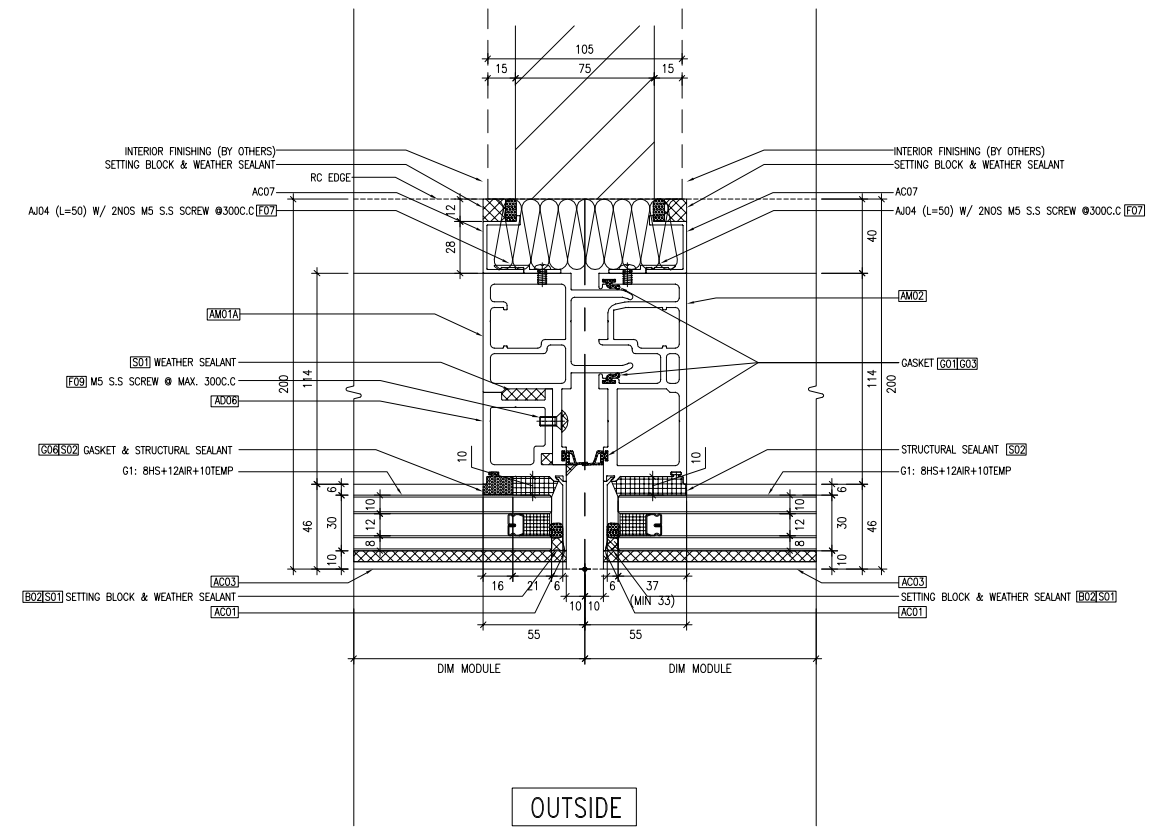

4/8026 *TYPICAL DETAIL OF CURTAIN WALL*

B.D. REF :

CLIENT :

SUN HUNG KAI REAL ESTATE AGENCY LTD.
42/F SUN HUNG KAI CENTRE, WANCHAI, HONGKONG

ARCHITECT :

lwk&partners
a r c h i t e c t s

MAIN CONTRACTOR :

怡輝建築有限公司
Yee Fai Building Contractors Ltd.

STRUCTURAL ENGINEER :

ARUP

FACADE CONSULTANT:

ALPHA CONSULTING LIMITED
Steel Structure & Facade Specialist

NOTE :
1. ALL DIMENSIONS ARE IN mm.
2. ALL ELEVATIONS ARE VIEWED FROM OUTSIDE.
3. ALL DIMENSIONS TO BE VERIFIED ON SITE BEFORE FABRICATION.

LEGEND :

X1 / X001 — DETAIL MARK NO. / REFER SHEET NO.

1. F.F.L. --FINISHED FLOOR LEVEL
2. S.F.L. --STRUCTURAL FLOOR LEVEL
3. (R) --REVERSED DETAIL

NO.	DATE	REVISED	BY
–	21-FEB-2023	NEW DRAWING (4TH SUBMISSION)	CF

JOB NO. : J-856

PROJECT :
PROPOSED DEVELOPMENT ABOVE LIGHT RAIL TIN WING STOP,TSWTL NO.23,AREA 33,TIN SHUI WAI, N.T.


TITLE :
TYPICAL DETAIL FOR CURTAIN WALL

DATE : 23-JAN-23 | SCALE : 1:4


DRAWN BY : C.F | CHECKED BY :

美特鋁質有限公司
MIDI ALUMINIUM FABRICATOR LTD.
Units 6-8, Sunray Industrial Centre, 1/F
610 Cha Kwo Ling Road, Kowloon
Tel:23489211-4 Fax:(852)27727666

DWG NO. : J856-SD-CW-8026 | REV. : –

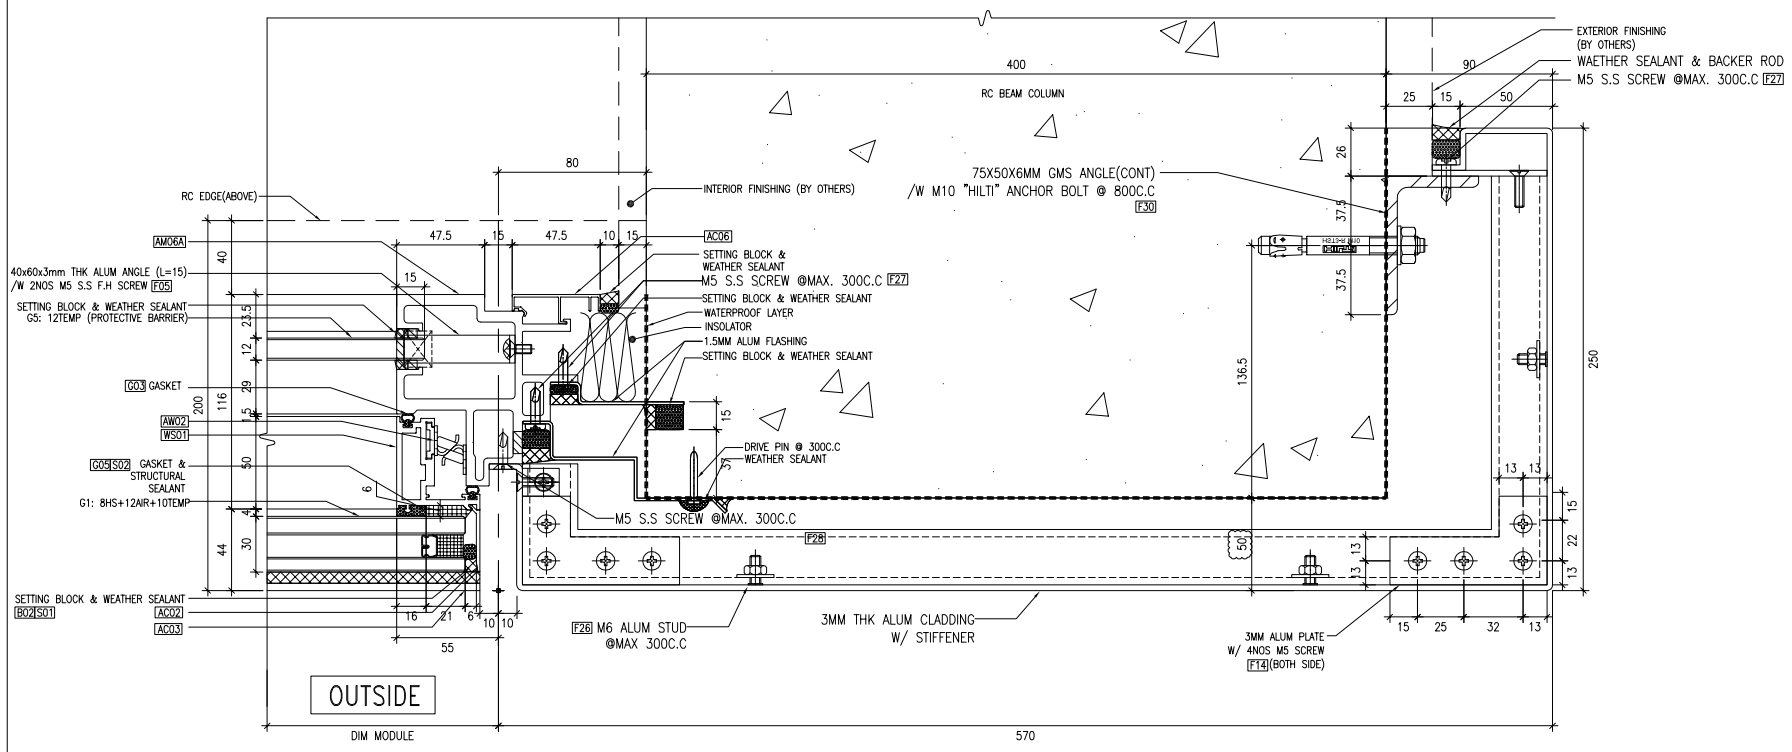

1 / 8027 *TYPICAL DETAIL OF CURTAIN WALL*

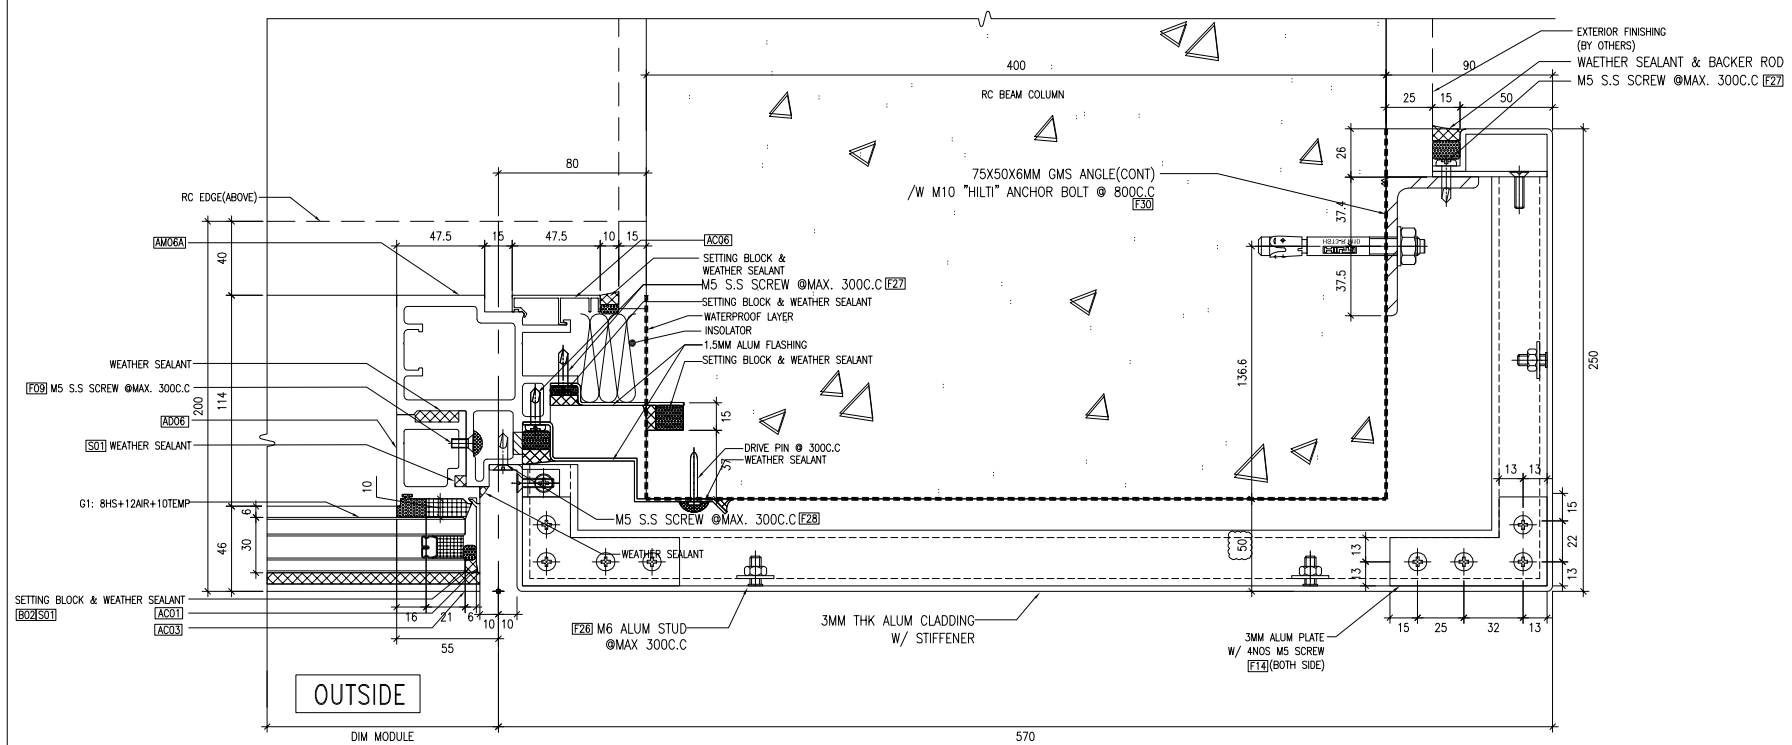

2 / 8027 *TYPICAL DETAIL OF CURTAIN WALL*

B.D. REF :

CLIENT :
SUN HUNG KAI REAL ESTATE AGENCY LTD.
42/F SUN HUNG KAI CENTRE, WANCHAI, HONGKONG

ARCHITECT :
lwk&partners
a r c h i t e c t s

MAIN CONTRACTOR :
怡輝建築有限公司
Yee Fai Building Contractors Ltd.

STRUCTURAL ENGINEER :
ARUP

FACADE CONSULTANT:
ALPHA CONSULTING LIMITED
Steel Structure & Facade Specialist

NOTE :
1. ALL DIMENSIONS ARE IN mm.
2. ALL ELEVATIONS ARE VIEWED FROM OUTSIDE.
3. ALL DIMENSIONS TO BE VERIFIED ON SITE BEFORE FABRICATION.

LEGEND :
X1 / X001 — DETAIL MARK NO. / REFER SHEET NO.
1. F.F.L. --FINISHED FLOOR LEVEL
2. S.F.L. --STRUCTURAL FLOOR LEVEL
3. (/R) --REVERSED DETAIL

NO.	DATE	REVISED	BY
A	02-MAY-2023	5TH SUBMISSION	CF
–	21-FEB-2023	NEW DRAWING (4TH SUBMISSION)	CF

JOB NO. : J-856

PROJECT :
PROPOSED DEVELOPMENT ABOVE LIGHT RAIL TIN WING STOP,TSWTL NO.23,AREA 33,TIN SHUI WAI, N.T.


TITLE :
TYPICAL DETAIL FOR CURTAIN WALL

DATE : 23-JAN-23 | SCALE : 1:4


DRAWN BY : C.F | CHECKED BY :

美特鋁質有限公司
MIDI ALUMINIUM FABRICATOR LTD.
Units 6-8, Sunray Industrial Centre, 1/F
610 Cha Kwo Ling Road, Kowloon
Tel:23489211-4 Fax:(852)27727666

DWG NO. : J856-SD-CW-8027 | REV. : A

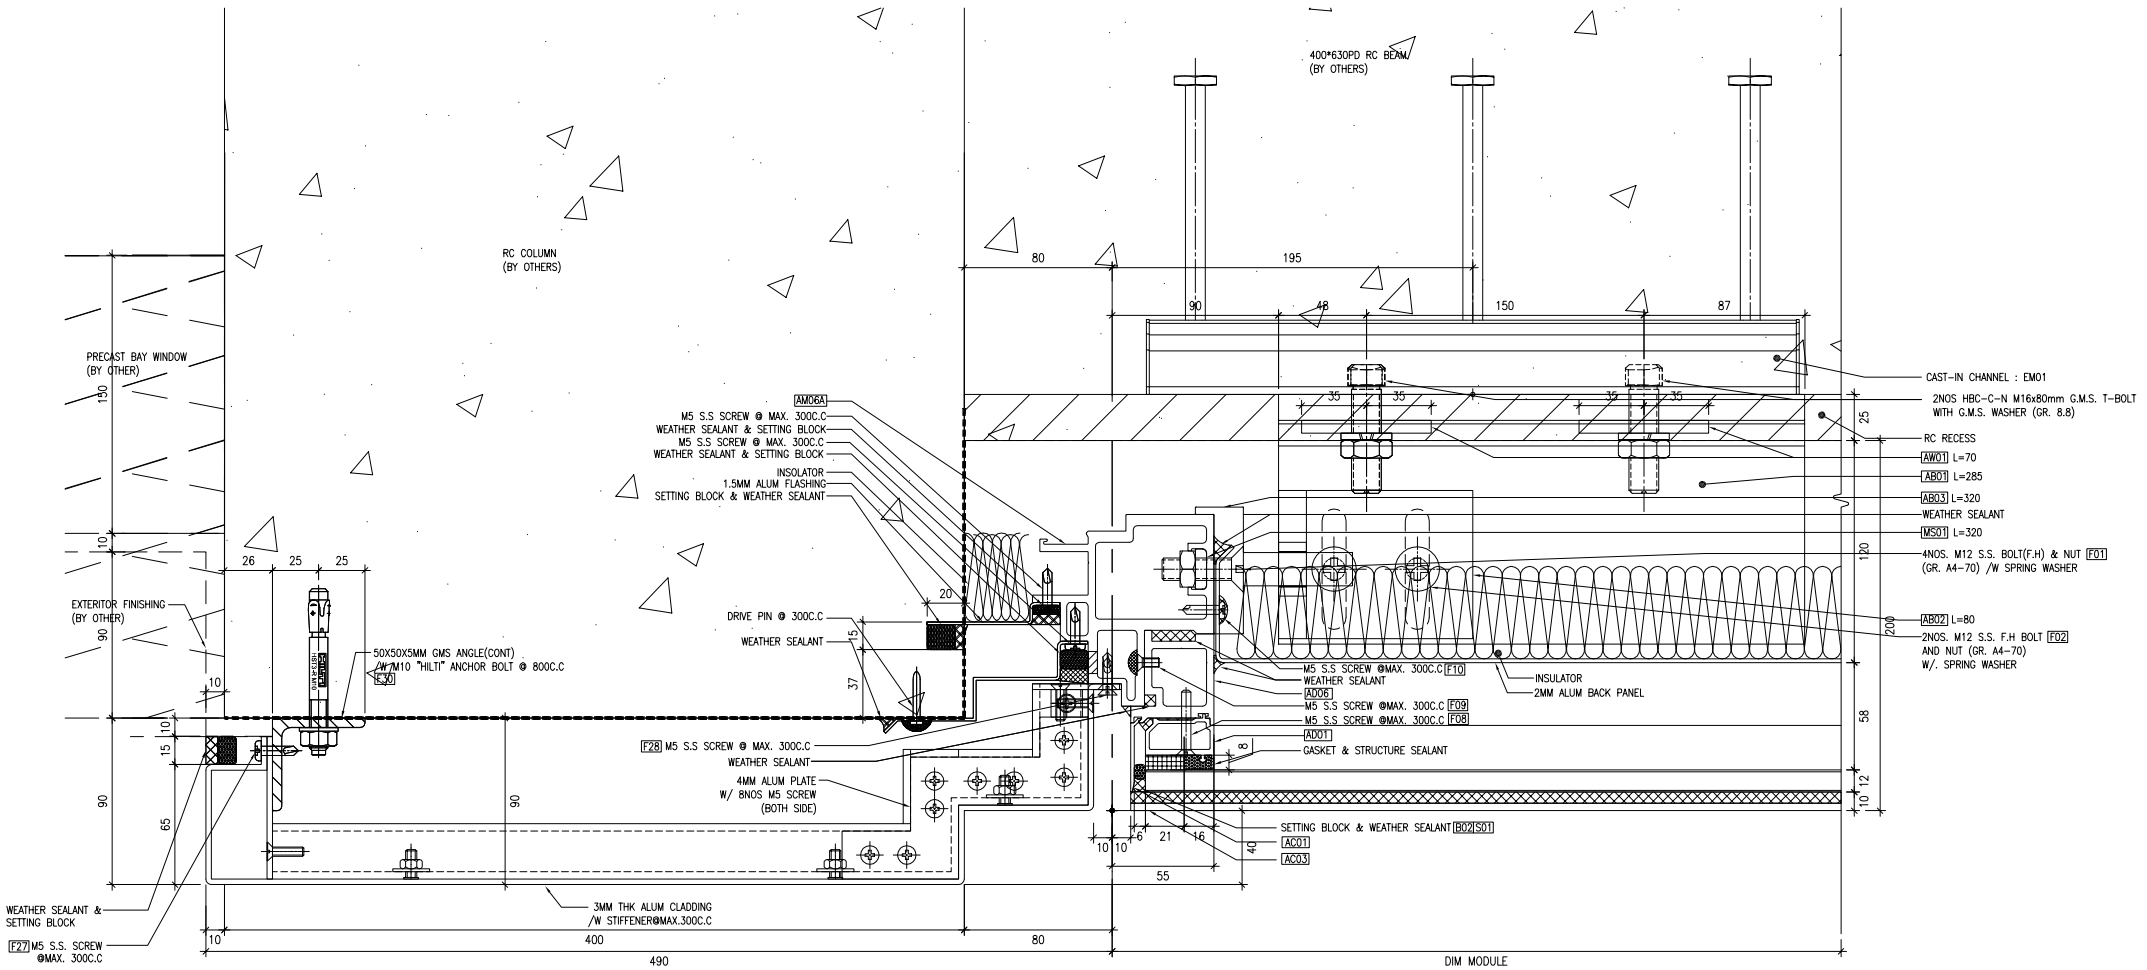

1 / 8028 *TYPICAL DETAIL OF CURTAIN WALL*

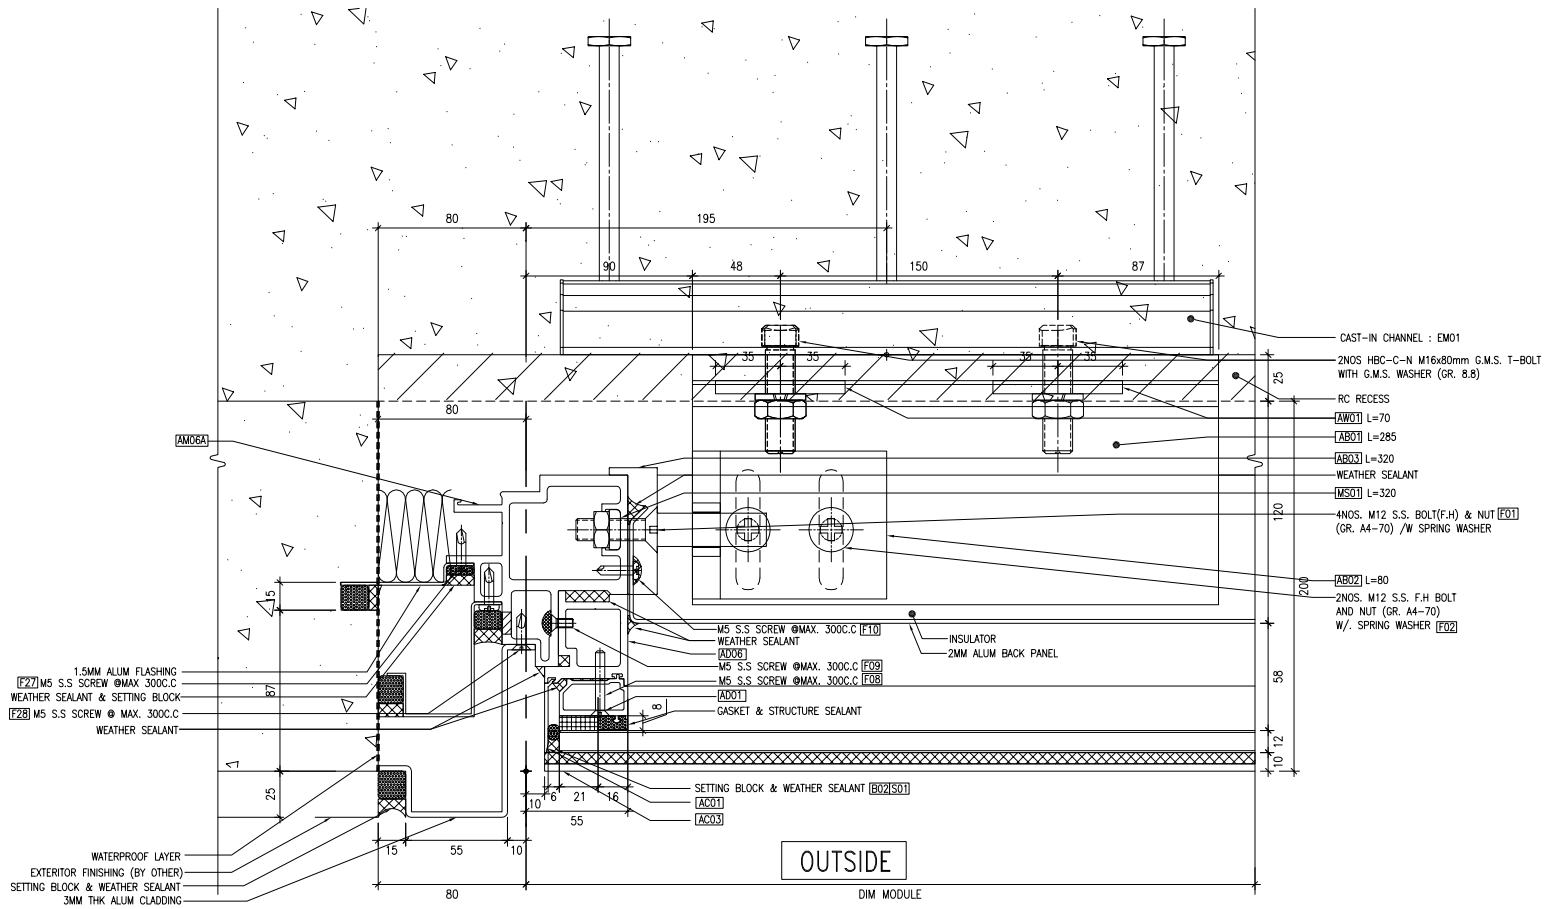

2 / 8028 *TYPICAL DETAIL OF CURTAIN WALL*

B.D. REF :

CLIENT :

SUN HUNG KAI REAL ESTATE AGENCY LTD.
42/F SUN HUNG KAI CENTRE, WANCHAI, HONGKONG

ARCHITECT :

lwk&partners
a r c h i t e c t s

MAIN CONTRACTOR :

怡輝建築有限公司
Yee Fai Building Contractors Ltd.

STRUCTURAL ENGINEER :

ARUP

FACADE CONSULTANT:

ALPHA CONSULTING LIMITED
Steel Structure & Facade Specialist

NOTE :
1. ALL DIMENSIONS ARE IN mm.
2. ALL ELEVATIONS ARE VIEWED FROM OUTSIDE.
3. ALL DIMENSIONS TO BE VERIFIED ON SITE BEFORE FABRICATION.

LEGEND :

X1 — DETAIL MARK NO.
X001 — REFER SHEET NO.

1. F.F.L. --FINISHED FLOOR LEVEL
2. S.F.L. --STRUCTURAL FLOOR LEVEL
3. /R --REVERSED DETAIL

NO.	DATE	REVISED	BY
B	30-MAY-2023	6TH SUBMISSION	CF
A	02-MAY-2023	5TH SUBMISSION	CF
–	21-FEB-2023	NEW DRAWING (4TH SUBMISSION)	CF

JOB NO. : J-856

PROJECT :
PROPOSED DEVELOPMENT ABOVE LIGHT RAIL TIN WING STOP,TSWTL NO.23,AREA 33,TIN SHUI WAI, N.T.


TITLE :
TYPICAL DETAIL FOR CURTAIN WALL

DATE : 23-JAN-23 | SCALE : 1:4


DRAWN BY : C.F | CHECKED BY :

美特鋁質有限公司
MIDI ALUMINIUM FABRICATOR LTD.
Units 6-8, Sunray Industrial Centre, 1/F
610 Cha Kwo Ling Road, Kowloon
Tel:23489211-4 Fax:(852)27727666


DWG NO. : J856-SD-CW-8028 | REV. : B

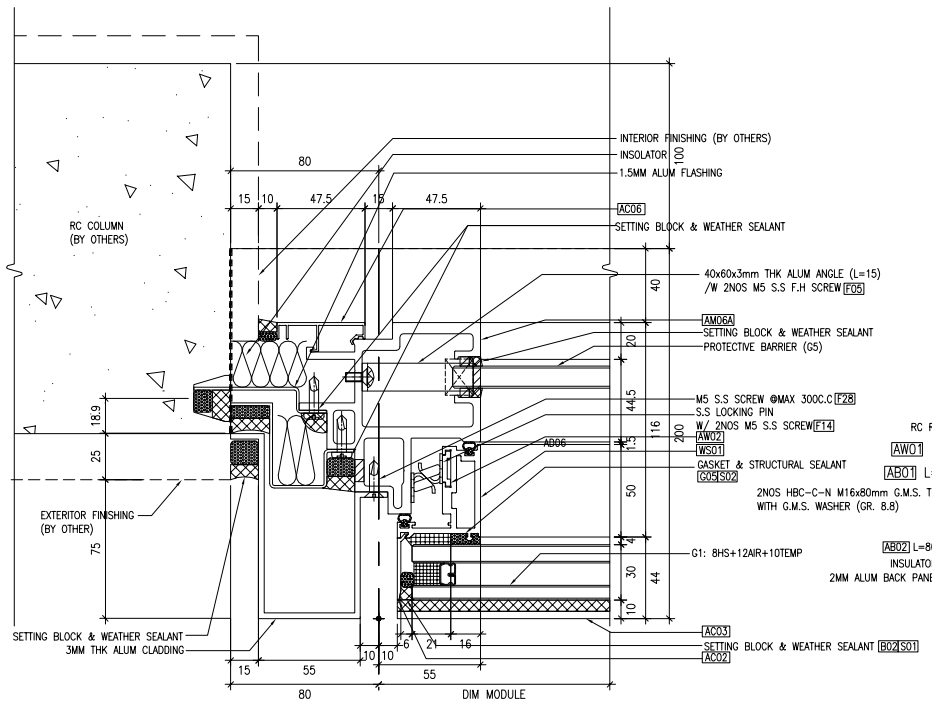


1 8029 *TYPICAL DETAIL OF CURTAIN WALL*

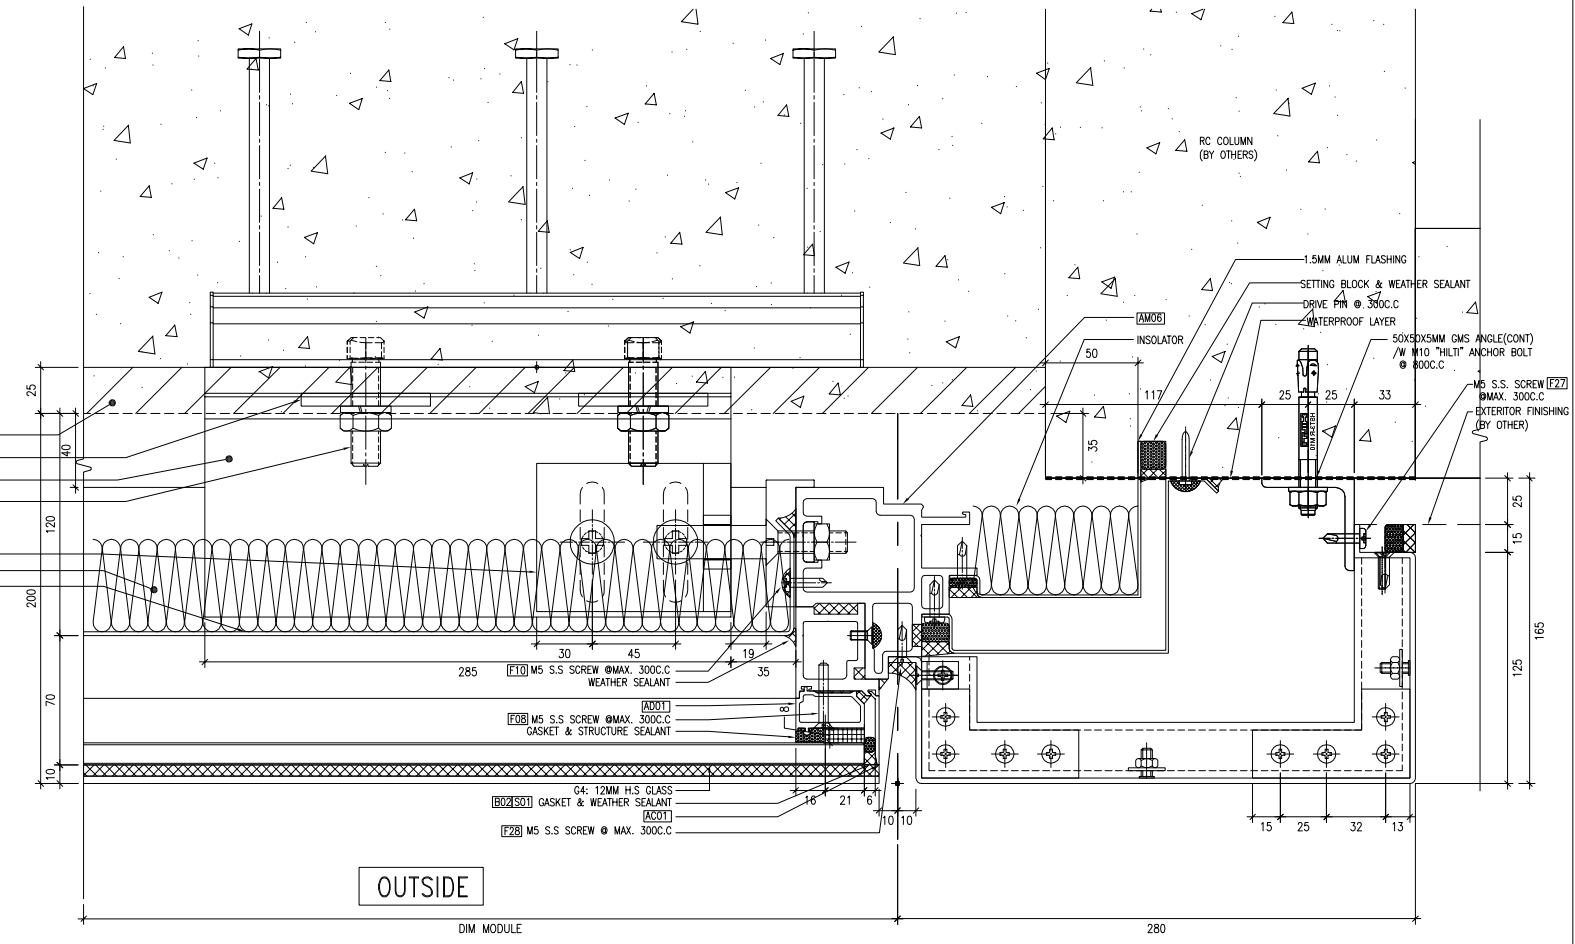

3 8029 *TYPICAL DETAIL OF CURTAIN WALL*

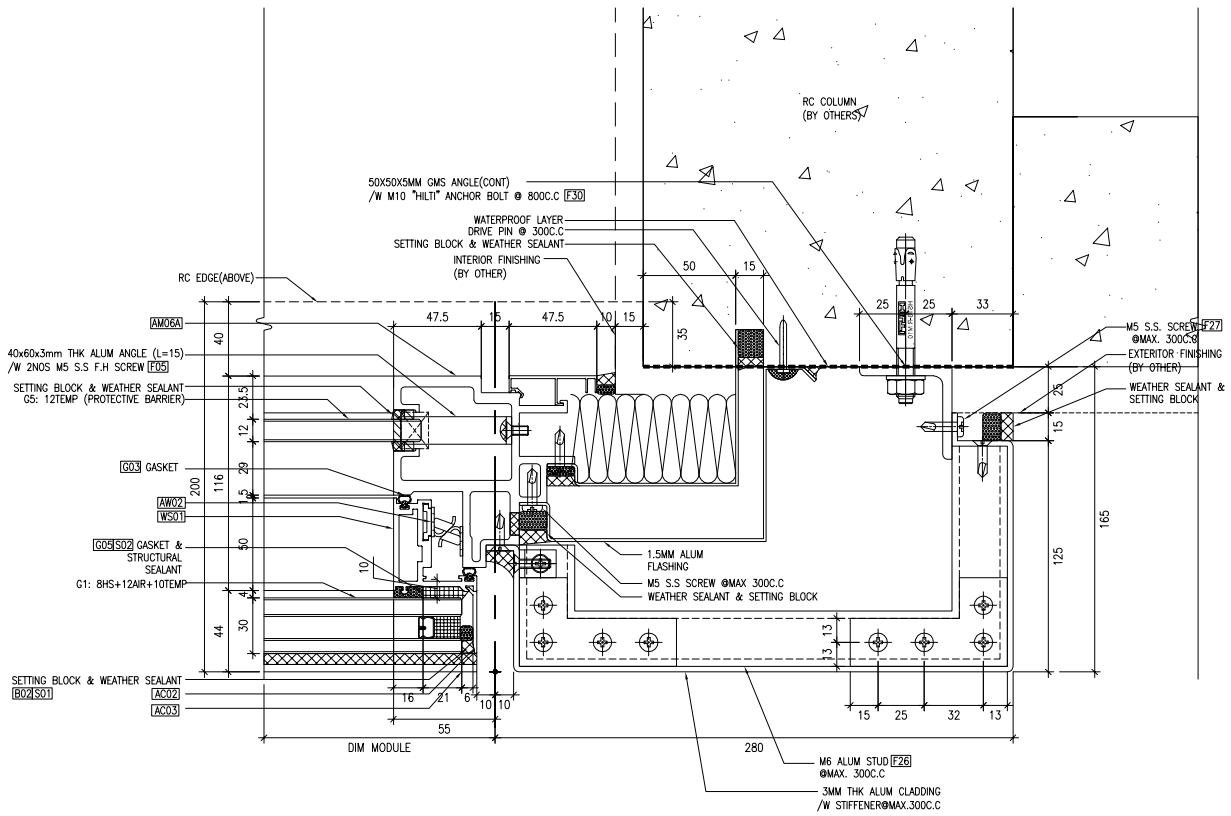

2 8029 *TYPICAL DETAIL OF CURTAIN WALL*

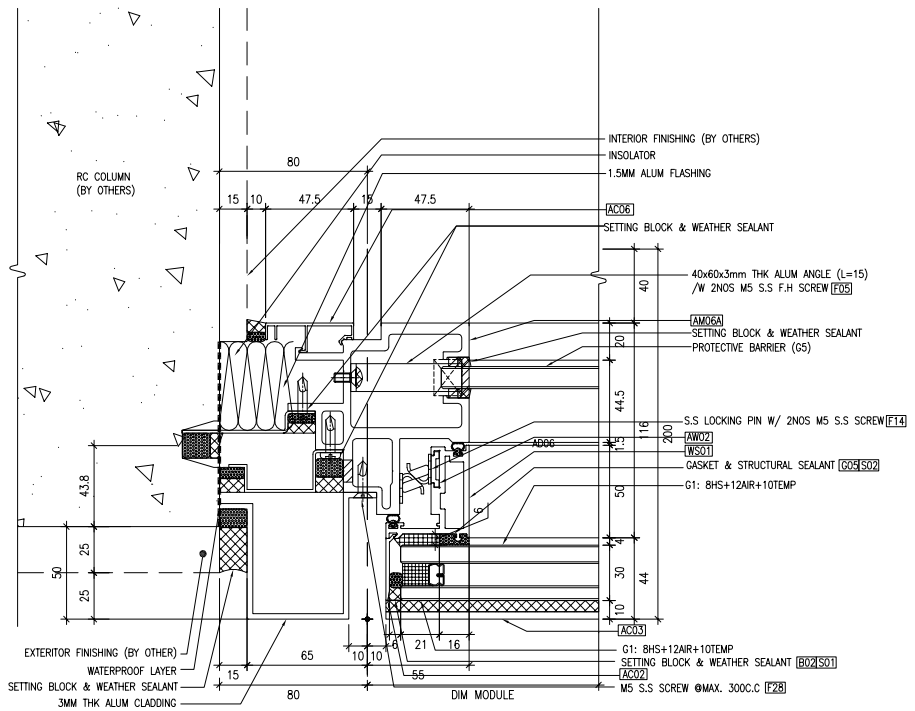

4 8029 *TYPICAL DETAIL OF CURTAIN WALL*

B.D. REF :

CLIENT :
SUN HUNG KAI REAL ESTATE AGENCY LTD.
42/F SUN HUNG KAI CENTRE, WANCHAI, HONGKONG

ARCHITECT :
lwk&partners
a r c h i t e c t s

MAIN CONTRACTOR :
怡輝建築有限公司
Yee Fai Building Contractors Ltd.

STRUCTURAL ENGINEER :
ARUP

FACADE CONSULTANT:
ALPHA CONSULTING LIMITED
Steel Structure & Facade Specialist

NOTE :
1. ALL DIMENSIONS ARE IN mm.
2. ALL ELEVATIONS ARE VIEWED FROM OUTSIDE.
3. ALL DIMENSIONS TO BE VERIFIED ON SITE BEFORE FABRICATION.

LEGEND :
X1 — DETAIL MARK NO.
X001 — REFER SHEET NO.

1. F.F.L. --FINISHED FLOOR LEVEL
2. S.F.L. --STRUCTURAL FLOOR LEVEL
3. /R --REVERSED DETAIL

NO.	DATE	REVISED	BY
A	02-MAY-2023	5TH SUBMISSION	
–	21-FEB-2023	NEW DRAWING (4TH SUBMISSION)	CF

JOB NO. : J-856

PROJECT :
PROPOSED DEVELOPMENT ABOVE LIGHT RAIL TIN WING STOP,TSWTL NO.23,AREA 33,TIN SHUI WAI, N.T.


TITLE :
TYPICAL DETAIL FOR CURTAIN WALL

DATE : 23-JAN-23 | SCALE : 1:4


DRAWN BY : C.F | CHECKED BY :

美特鋁製有限公司
MIDI ALUMINIUM FABRICATOR LTD.
Units 6-8, Sunray Industrial Centre, 1/F
610 Cha Kwo Ling Road, Kowloon
Tel:23489211-4 Fax:(852)27727666


DWG NO. : J856-SD-CW-8029 | REV. : A

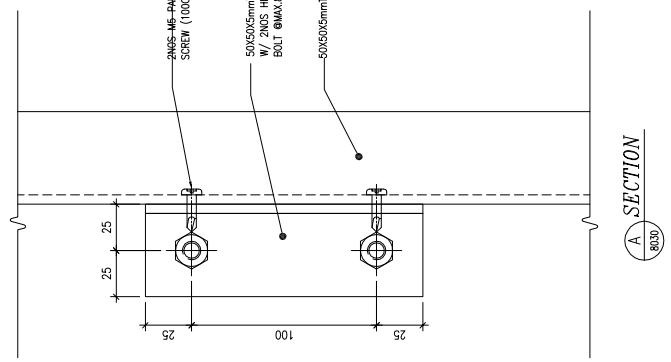


A SECTION 8030

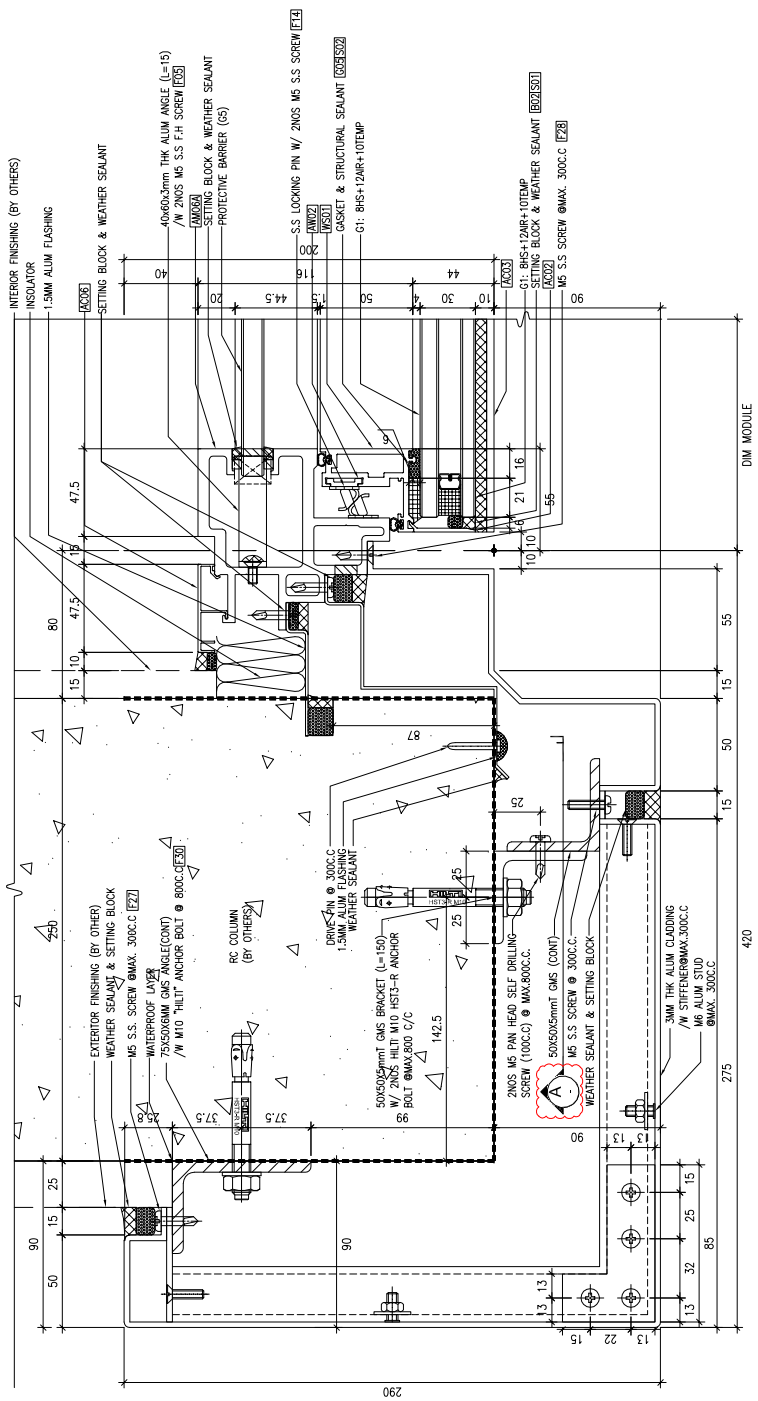

1 TYPICAL DETAIL OF CURTAIN WALL 8030

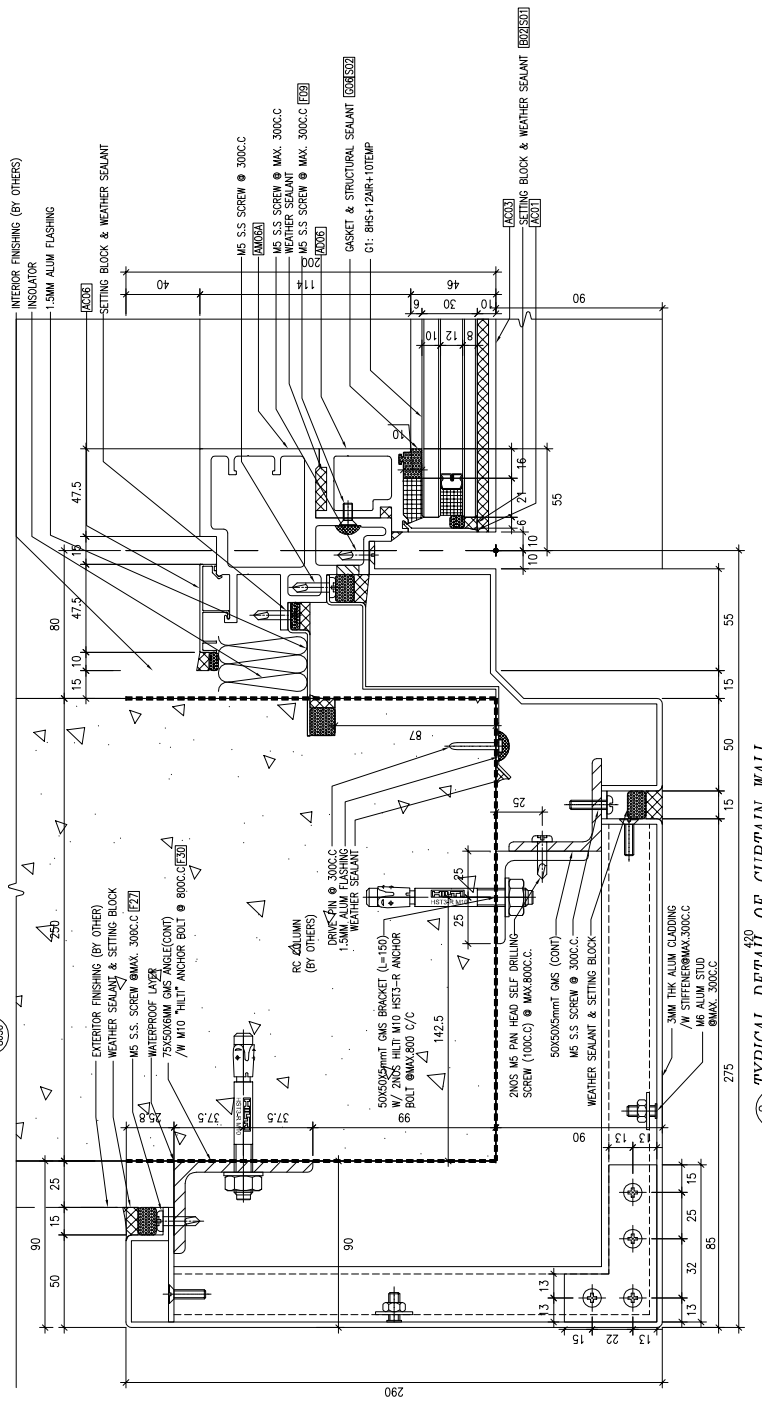

2 TYPICAL DETAIL OF CURTAIN WALL 8030

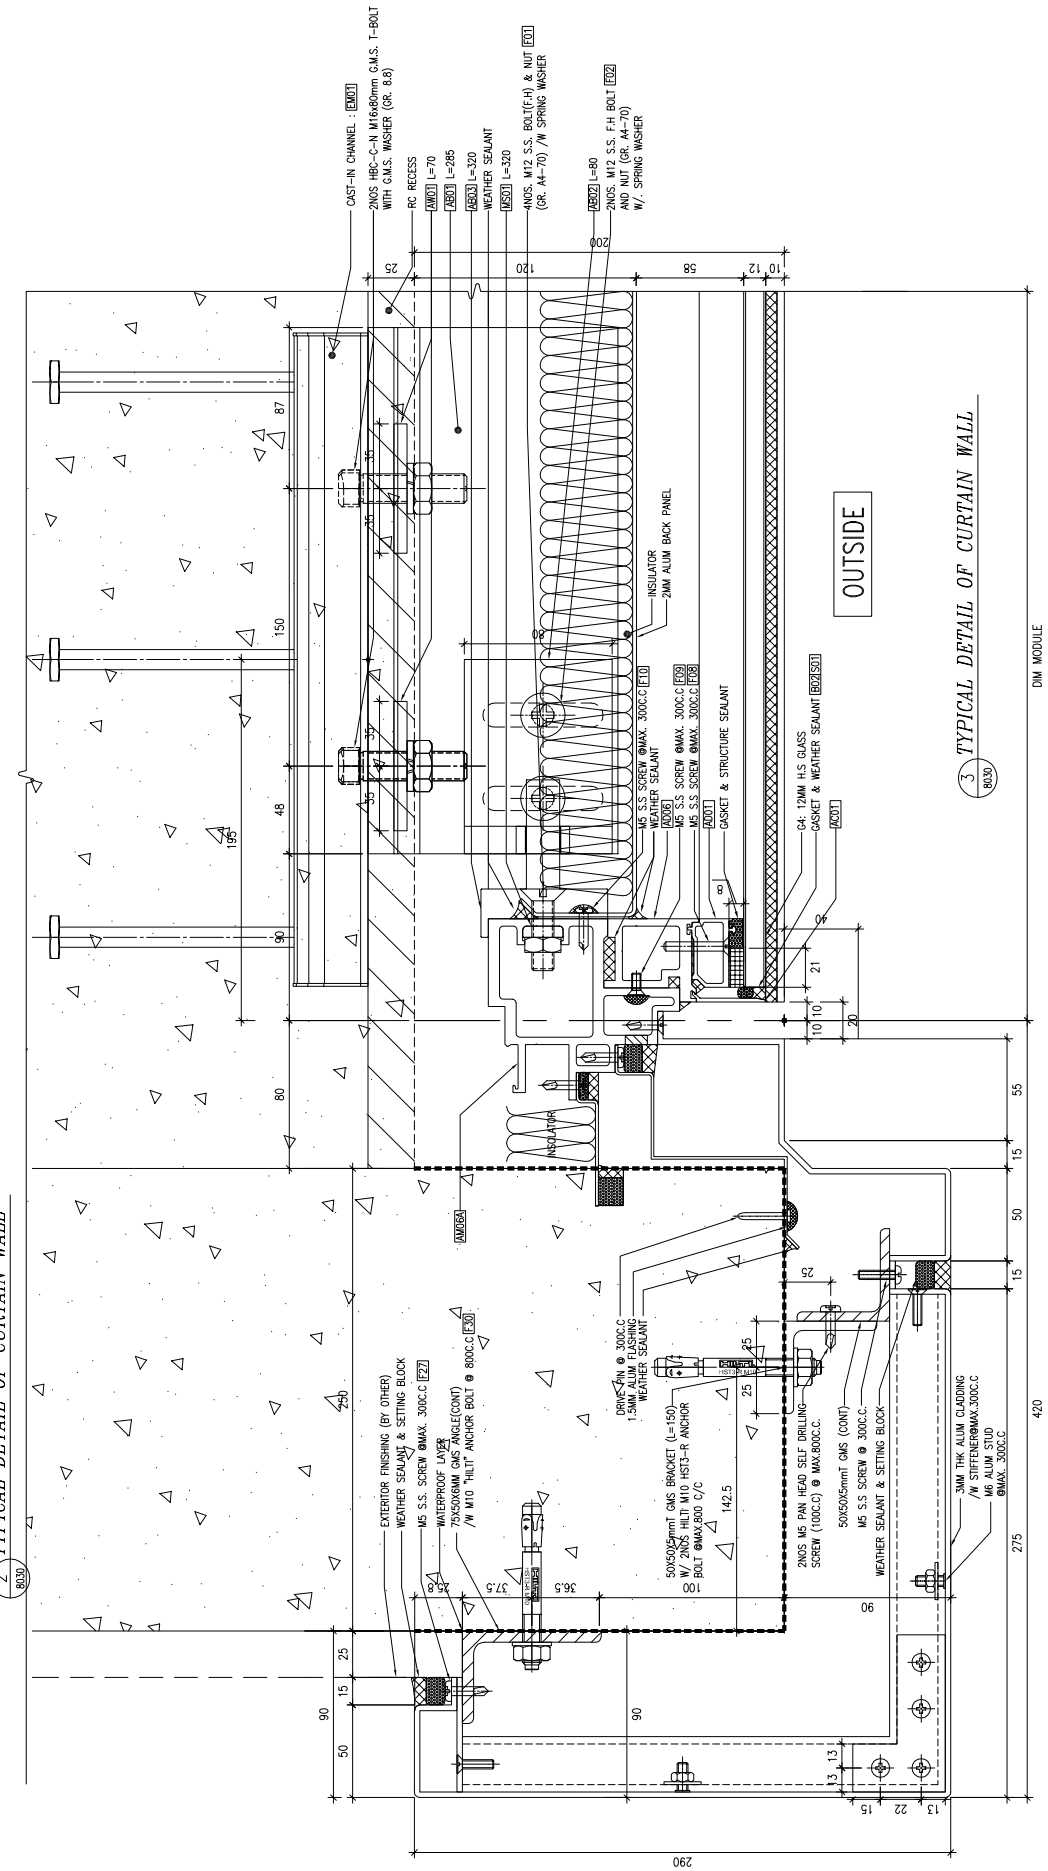

3 TYPICAL DETAIL OF CURTAIN WALL 8030

B.D. REF :

CLIENT :

SUN HUNG KAI REAL ESTATE AGENCY LTD.
42/F SUN HUNG KAI CENTRE, WANCHAI, HONGKONG

ARCHITECT :

lwk&partners
a r c h i t e c t s

MAIN CONTRACTOR :

怡輝建築有限公司
Yee Fai Building Contractors Ltd.

STRUCTURAL ENGINEER :

ARUP

FACADE CONSULTANT:

ALPHA CONSULTING LIMITED
Steel Structure & Facade Specialist

NOTE :

1. ALL DIMENSIONS ARE IN mm.
2. ALL ELEVATIONS ARE VIEWED FROM OUTSIDE.
3. ALL DIMENSIONS TO BE VERIFIED ON SITE BEFORE FABRICATION.

LEGEND :

X1 / X001 — DETAIL MARK NO. / REFER SHEET NO.

1. F.F.L. --FINISHED FLOOR LEVEL
2. S.F.L. --STRUCTURAL FLOOR LEVEL
3. /R --REVERSED DETAIL

NO.	DATE	REVISED	BY
C	22-AUG-2023	7TH SUBMISSION	
B	30-MAY-2023	6TH SUBMISSION	
A	02-MAY-2023	5TH SUBMISSION	CF
–	21-FEB-2023	NEW DRAWING (4TH SUBMISSION)	CF

JOB NO. : J-856

PROJECT :
PROPOSED DEVELOPMENT ABOVE LIGHT RAIL TIN WING STOP,TSWTL NO.23,AREA 33,TIN SHUI WAI, N.T.


TITLE :
TYPICAL DETAIL FOR CURTAIN WALL

DATE : 23-JAN-23 | SCALE : 1:4


DRAWN BY : C.F | CHECKED BY :

美特鋁製有限公司
MIDI ALUMINIUM FABRICATOR LTD.
Units 6-8, Sunray Industrial Centre, 1/F
610 Cha Kwo Ling Road, Kowloon
Tel:23489211-4 Fax:(852)27727666

DWG NO. : J856-SD-CW-8030 | REV. : C

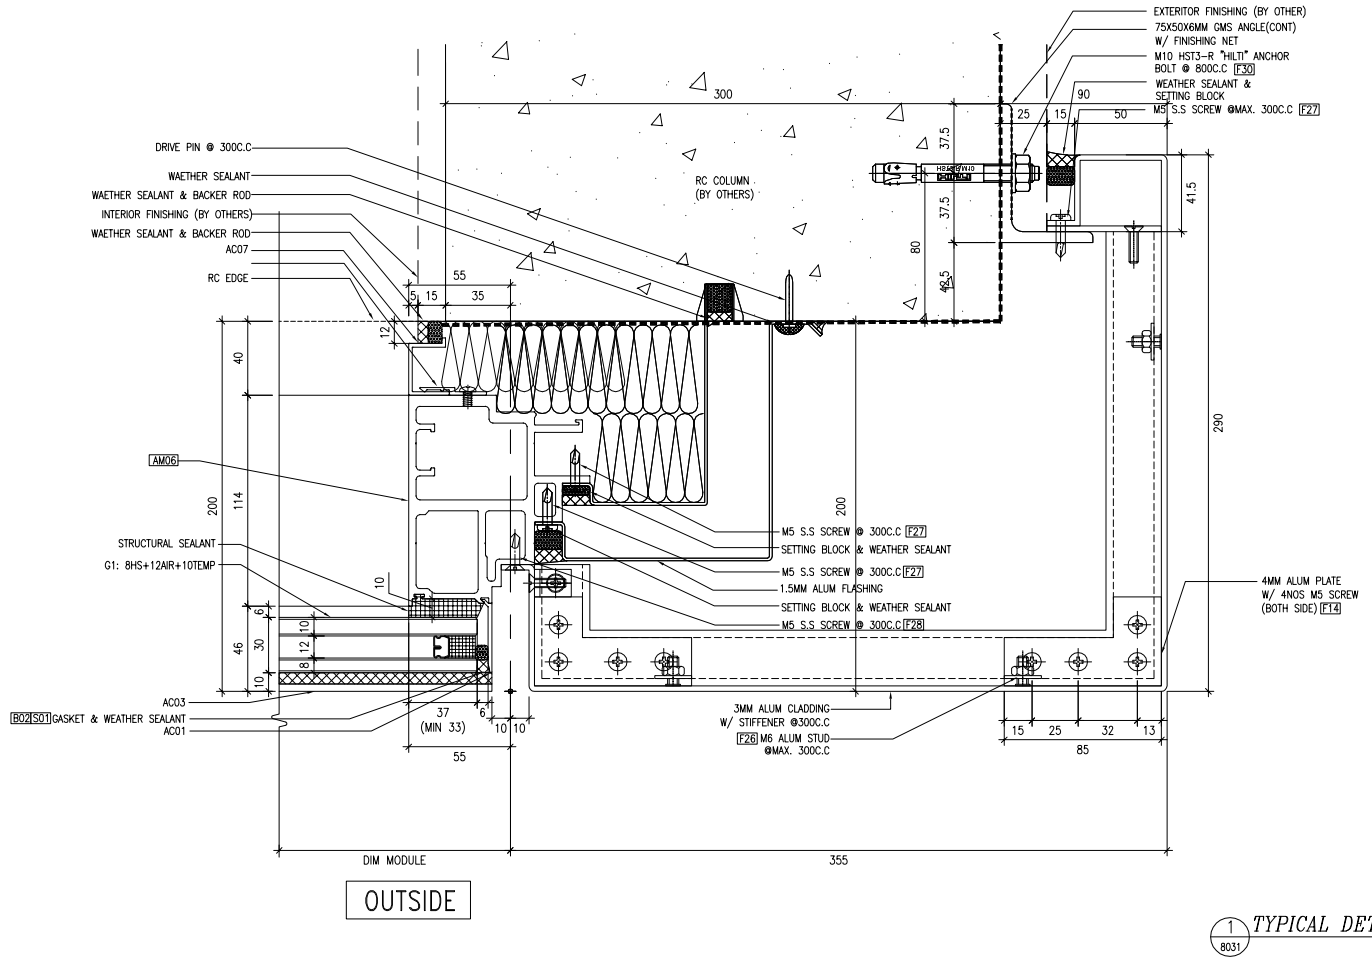

1 / 8031 *TYPICAL DETAIL OF CURTAIN WALL*

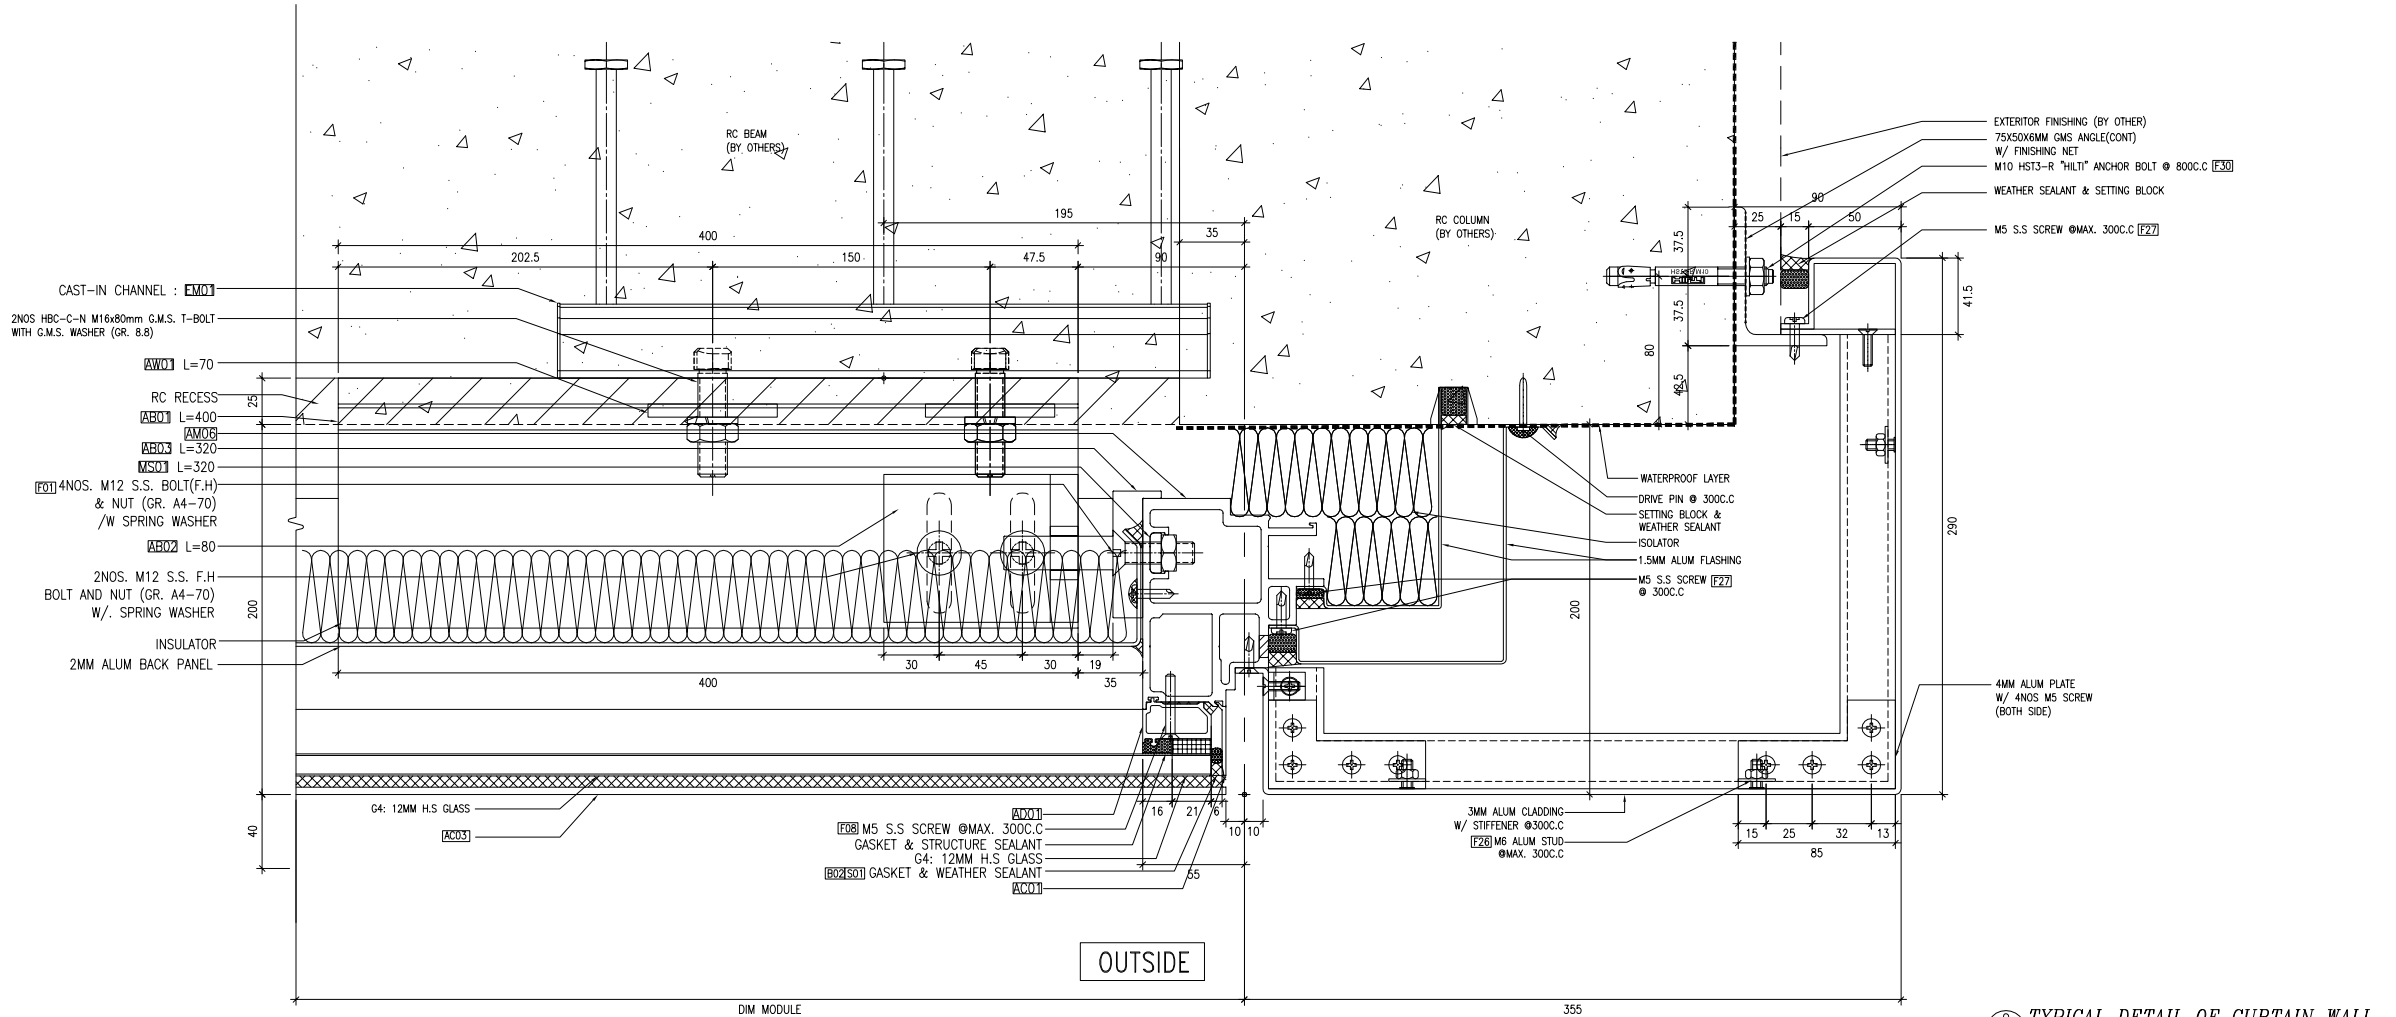

2 / 8031 *TYPICAL DETAIL OF CURTAIN WALL*

B.D. REF :

CLIENT :

SUN HUNG KAI REAL ESTATE AGENCY LTD.
42/F SUN HUNG KAI CENTRE, WANCHAI, HONGKONG

ARCHITECT :

lwk&partners
a r c h i t e c t s

MAIN CONTRACTOR :

怡輝建築有限公司
Yee Fai Building Contractors Ltd.

STRUCTURAL ENGINEER :

ARUP

FACADE CONSULTANT:

ALPHA CONSULTING LIMITED
Steel Structure & Facade Specialist

NOTE :
1. ALL DIMENSIONS ARE IN mm.
2. ALL ELEVATIONS ARE VIEWED FROM OUTSIDE.
3. ALL DIMENSIONS TO BE VERIFIED ON SITE BEFORE FABRICATION.

LEGEND :

X1 / X001 — DETAIL MARK NO. / REFER SHEET NO.

1. F.F.L. --FINISHED FLOOR LEVEL
2. S.F.L. --STRUCTURAL FLOOR LEVEL
3. (R) --REVERSED DETAIL

NO.	DATE	REVISED	BY
A	02-MAY-2023	5TH SUBMISSION	CF
–	21-FEB-2023	NEW DRAWING (4TH SUBMISSION)	CF

JOB NO. : J-856

PROJECT :
PROPOSED DEVELOPMENT ABOVE LIGHT RAIL TIN WING STOP,TSWTL NO.23,AREA 33,TIN SHUI WAI, N.T.


TITLE :
TYPICAL DETAIL FOR CURTAIN WALL

DATE : 23-JAN-23 | SCALE : 1:4


DRAWN BY : C.F | CHECKED BY :

美特鋁質有限公司
MIDI ALUMINIUM FABRICATOR LTD.
Units 6-8, Sunray Industrial Centre, 1/F
610 Cha Kwo Ling Road, Kowloon
Tel:23489211-4 Fax:(852)27727666

DWG NO. : J856-SD-CW-8031 | REV. : A

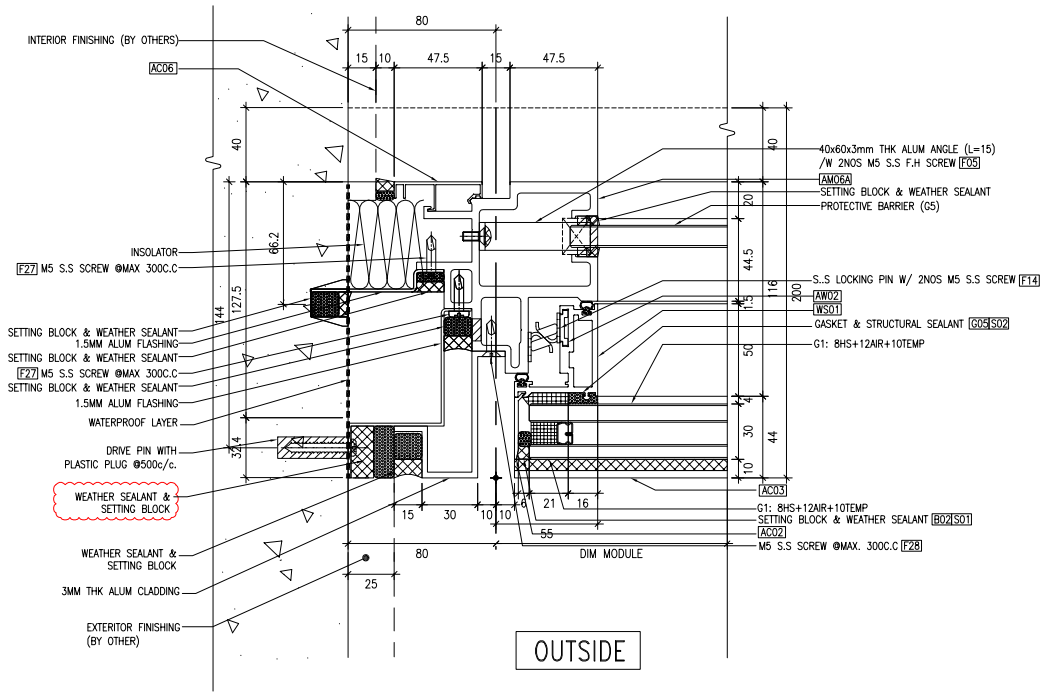

1/8032 *TYPICAL DETAIL OF CURTAIN WALL*

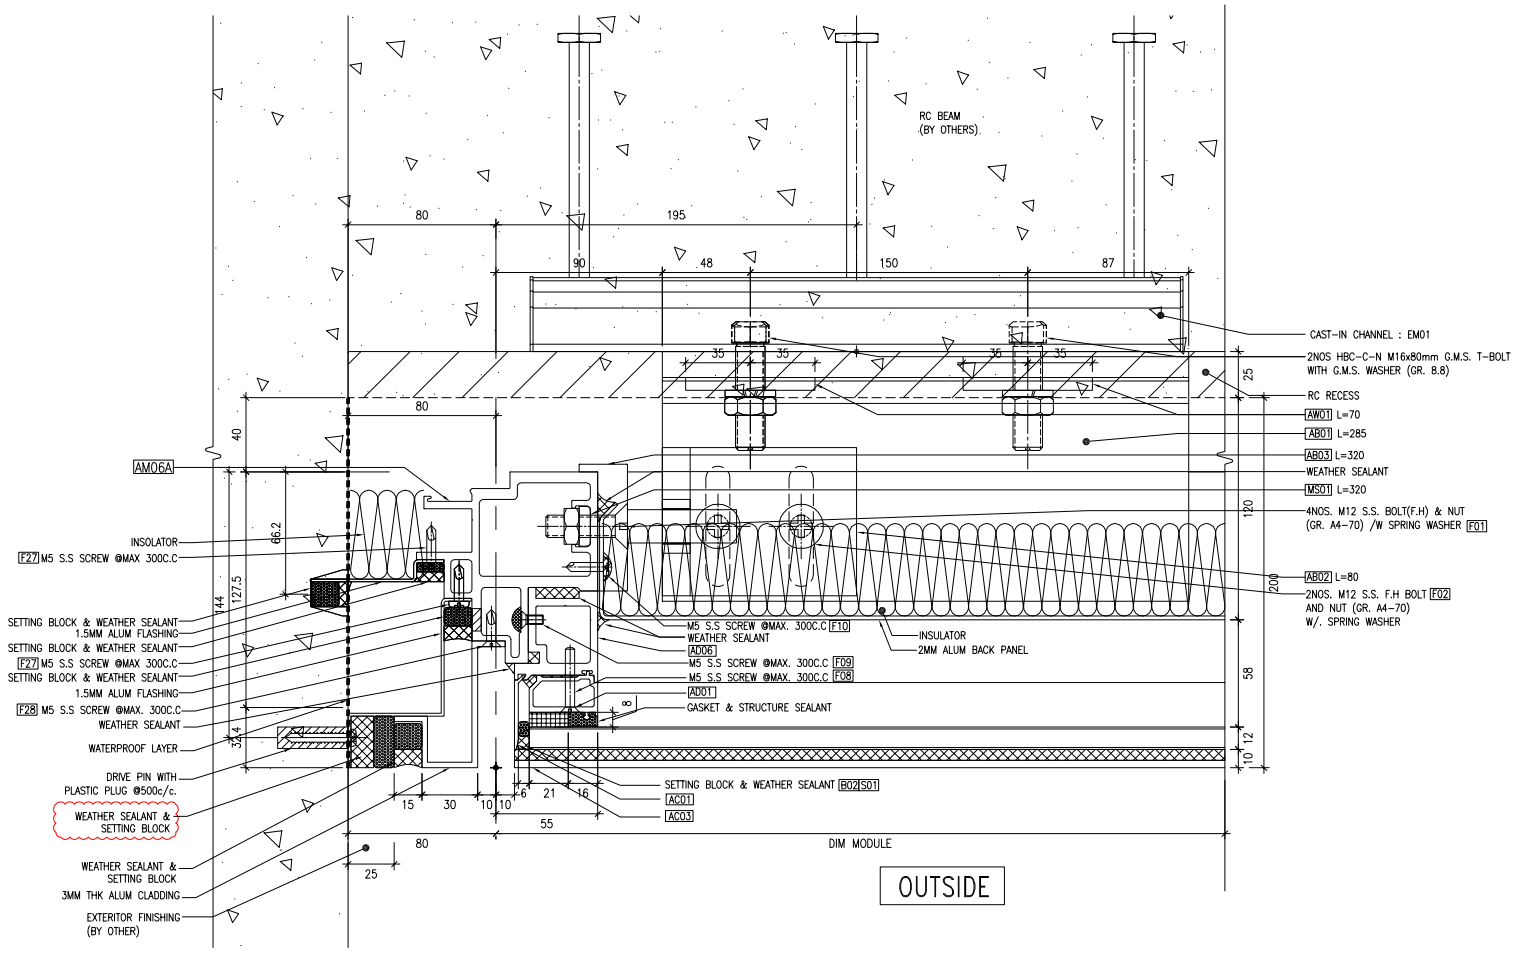

2/8032 *TYPICAL DETAIL OF CURTAIN WALL*

B.D. REF :

CLIENT :

SUN HUNG KAI
REAL ESTATE AGENCY LTD.
42/F SUN HUNG KAI CENTRE, WANCHAI, HONGKONG

ARCHITECT :

lwk&partners
a r c h i t e c t s

MAIN CONTRACTOR :

怡輝建築有限公司
Yee Fai Building Contractors Ltd.

STRUCTURAL ENGINEER :

ARUP

FACADE CONSULTANT:

ALPHA CONSULTING LIMITED
Steel Structure & Facade Specialist

NOTE :
1. ALL DIMENSIONS ARE IN mm.
2. ALL ELEVATIONS ARE VIEWED FROM OUTSIDE.
3. ALL DIMENSIONS TO BE VERIFIED ON SITE BEFORE FABRICATION.

LEGEND :

X1 / X001 — DETAIL MARK NO. / REFER SHEET NO.

1. F.F.L. --FINISHED FLOOR LEVEL
2. S.F.L. --STRUCTURAL FLOOR LEVEL
3. /R --REVERSED DETAIL

NO.	DATE	REVISED	BY
A	02-MAY-2023	5TH SUBMISSION	CF
–	21-FEB-2023	NEW DRAWING (4TH SUBMISSION)	CF

JOB NO. : J-856

PROJECT :
PROPOSED DEVELOPMENT ABOVE LIGHT RAIL TIN WING STOP,TSWTL NO.23,AREA 33,TIN SHUI WAI, N.T.


TITLE :
TYPICAL DETAIL FOR CURTAIN WALL

DATE : 23-JAN-23 | SCALE : 1:4


DRAWN BY : C.F | CHECKED BY :

美特鋁製有限公司
MIDI ALUMINIUM FABRICATOR LTD.
Units 6-8, Sunray Industrial Centre, 1/F
610 Cha Kwo Ling Road, Kowloon
Tel:23489211-4 Fax:(852)27727666

DWG NO. : J856-SD-CW-8032 | REV. : A

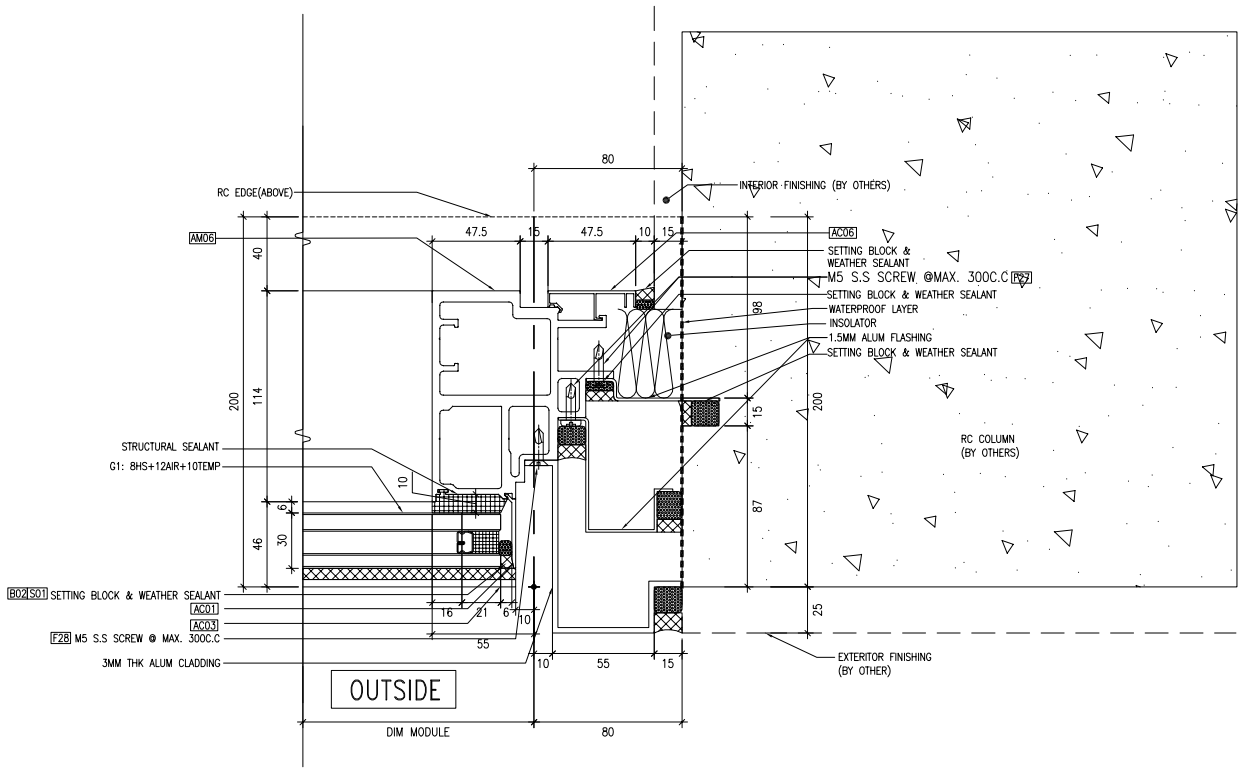

1 / 8033 *TYPICAL DETAIL OF CURTAIN WALL*

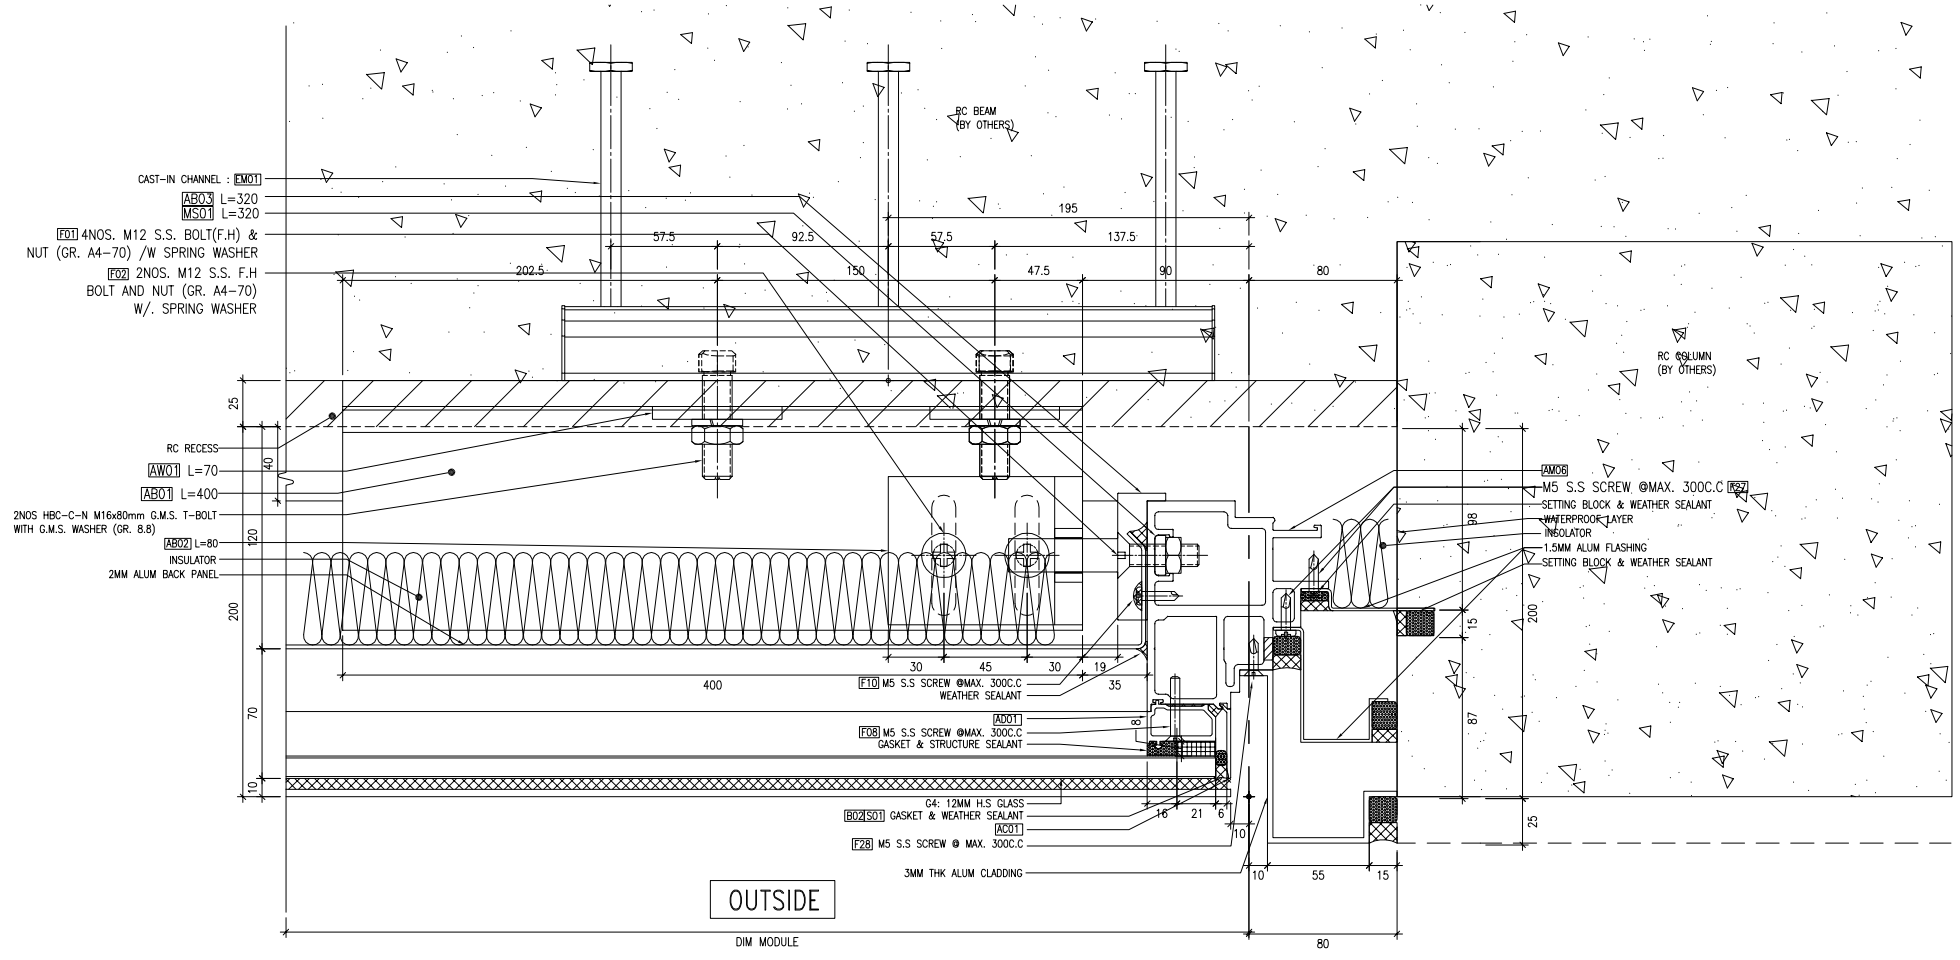

2 / 8033 *TYPICAL DETAIL OF CURTAIN WALL*

B.D. REF :

CLIENT :

SUN HUNG KAI REAL ESTATE AGENCY LTD.
42/F SUN HUNG KAI CENTRE, WANCHAI, HONGKONG

ARCHITECT :

lwk&partners
a r c h i t e c t s

MAIN CONTRACTOR :

怡輝建築有限公司
Yee Fai Building Contractors Ltd.

STRUCTURAL ENGINEER :

ARUP

FACADE CONSULTANT:

ALPHA CONSULTING LIMITED
Steel Structure & Facade Specialist

NOTE :
1. ALL DIMENSIONS ARE IN mm.
2. ALL ELEVATIONS ARE VIEWED FROM OUTSIDE.
3. ALL DIMENSIONS TO BE VERIFIED ON SITE BEFORE FABRICATION.

LEGEND :

X1 — DETAIL MARK NO.
X001 — REFER SHEET NO.

1. F.F.L. --FINISHED FLOOR LEVEL
2. S.F.L. --STRUCTURAL FLOOR LEVEL
3. (R) --REVERSED DETAIL

NO.	DATE	REVISED	BY
A	02-MAY-2023	5TH SUBMISSION	CF
-	21-FEB-2023	NEW DRAWING (4TH SUBMISSION)	CF

JOB NO. : J-856

PROJECT :
PROPOSED DEVELOPMENT ABOVE LIGHT RAIL TIN WING STOP,TSWTL NO.23,AREA 33,TIN SHUI WAI, N.T.


TITLE :
TYPICAL DETAIL FOR CURTAIN WALL

DATE : 23-JAN-23 | SCALE : 1:4


DRAWN BY : C.F | CHECKED BY :

美特鋁質有限公司
MIDI ALUMINIUM FABRICATOR LTD.
Units 6-8, Sunray Industrial Centre, 1/F
610 Cha Kwo Ling Road, Kowloon
Tel:23489211-4 Fax:(852)27727666


DWG NO. : J856-SD-CW-8033 | REV. : A

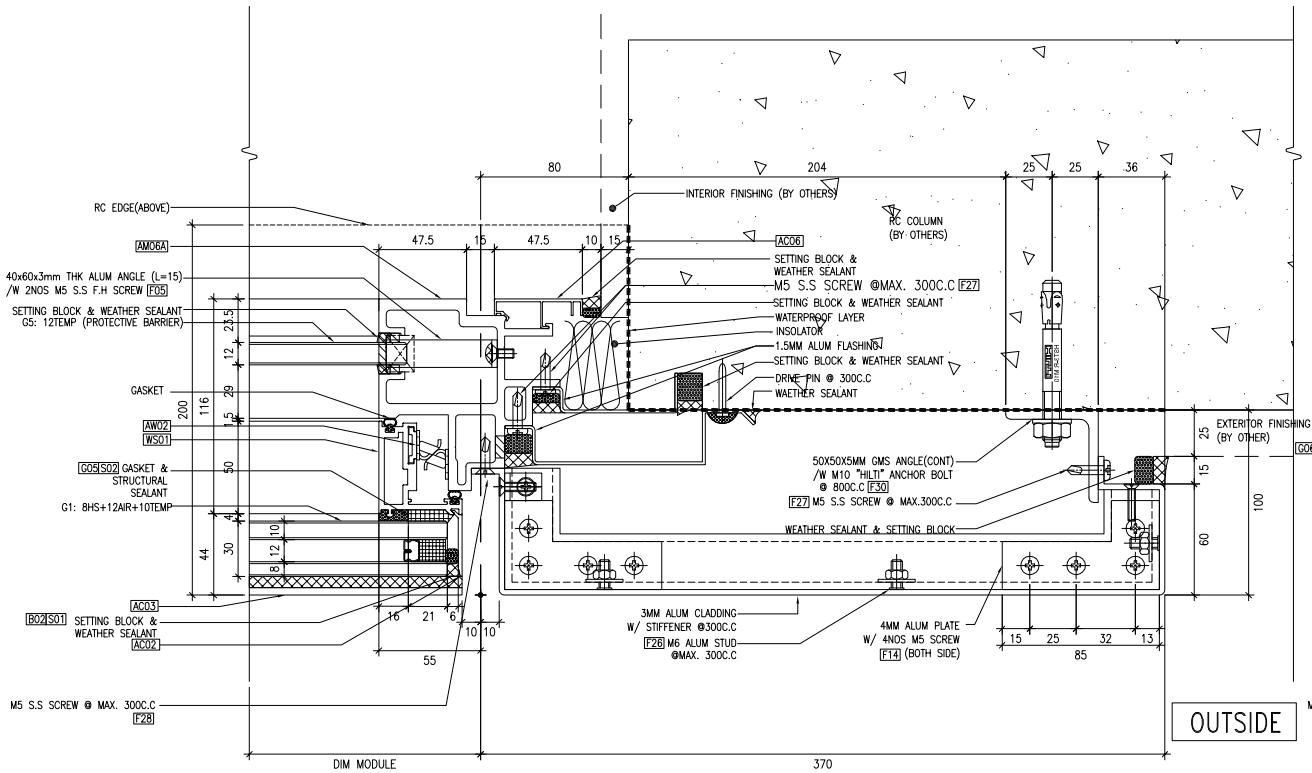

1 8034 *TYPICAL DETAIL OF CURTAIN WALL*

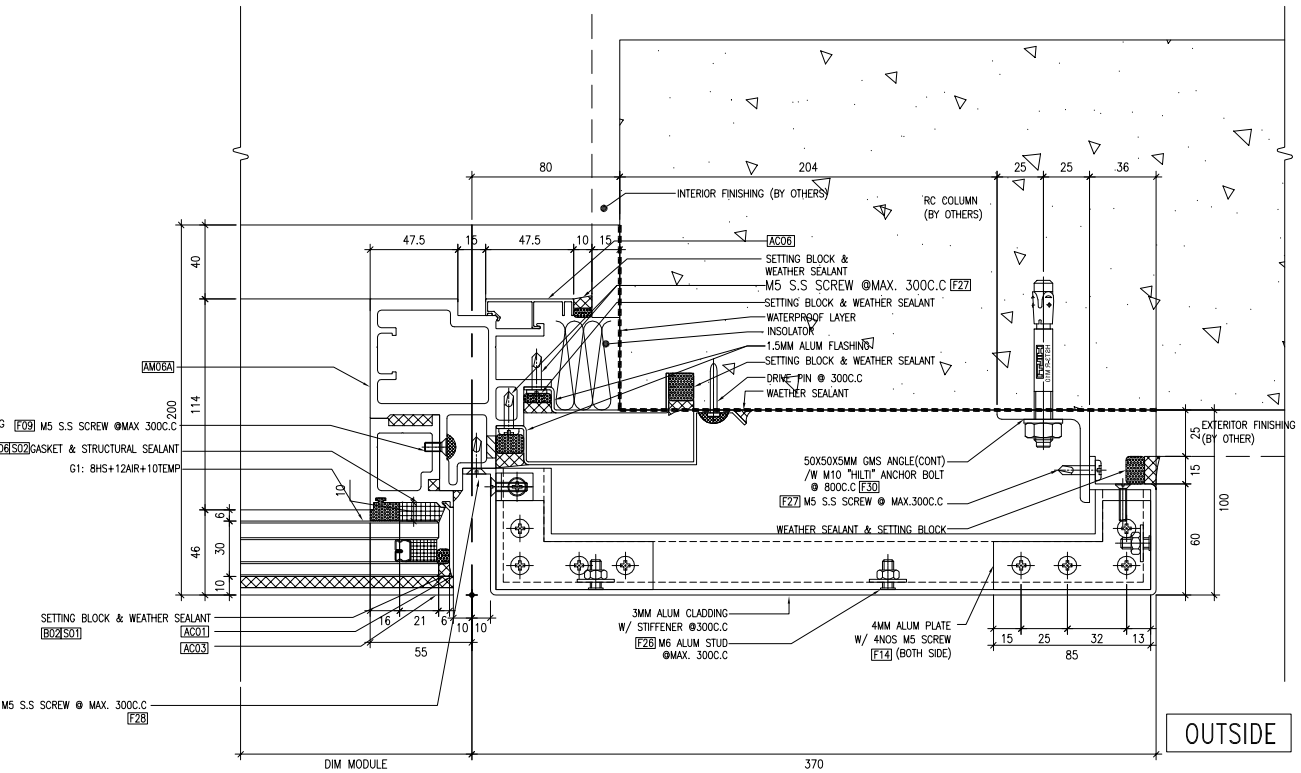

2 8034 *TYPICAL DETAIL OF CURTAIN WALL*

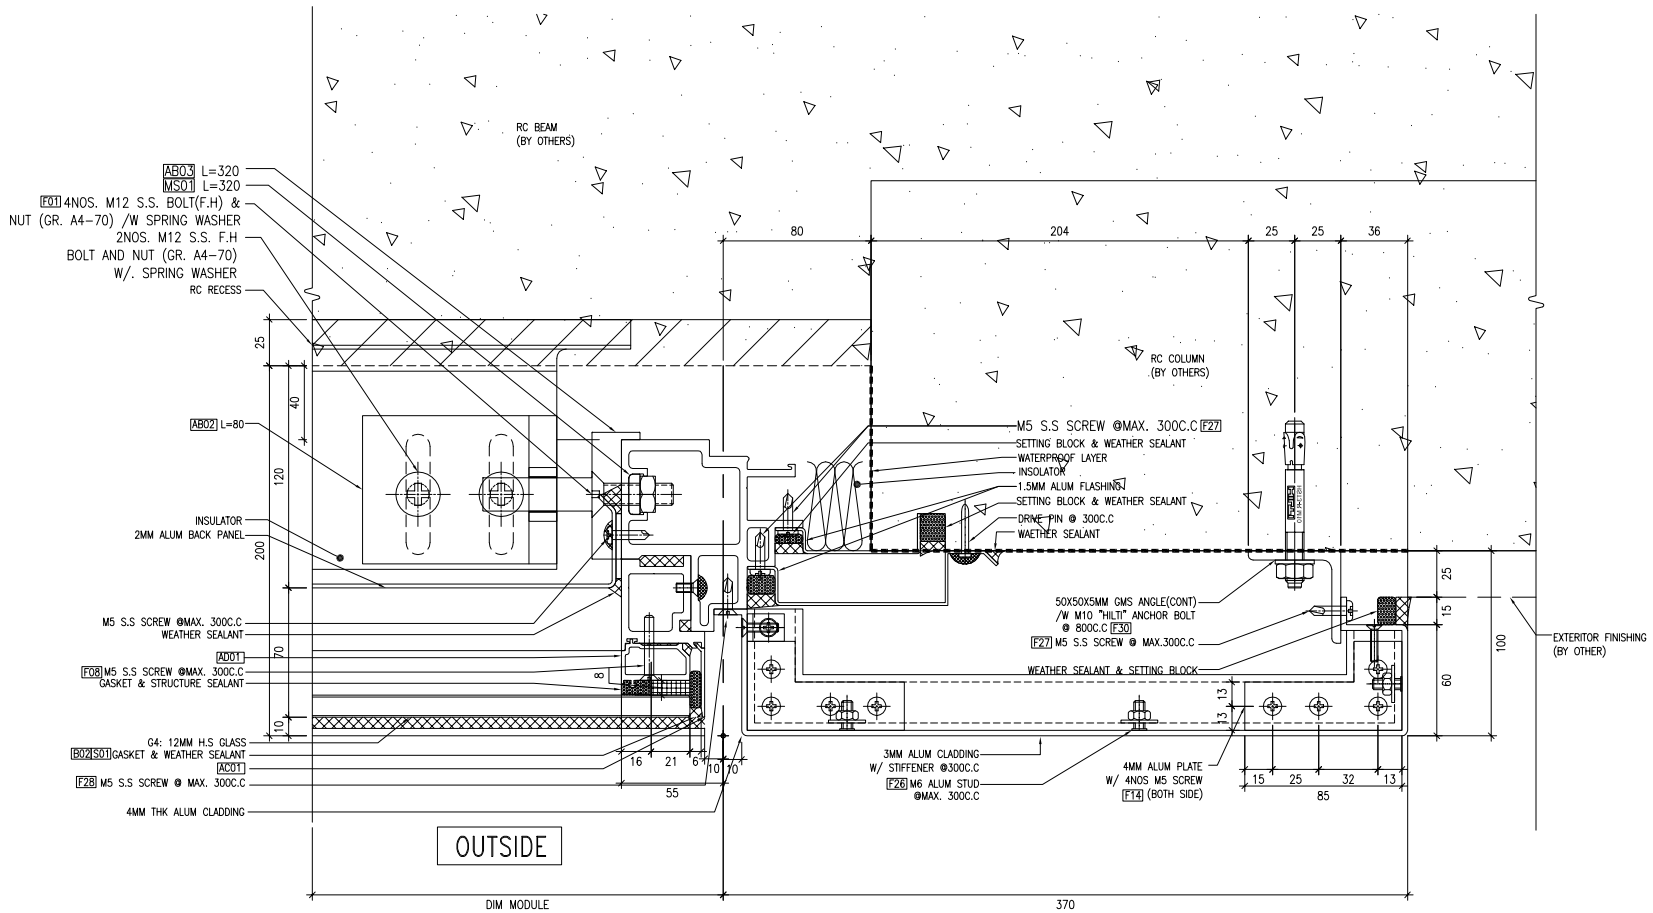

3 8034 *TYPICAL DETAIL OF CURTAIN WALL*

B.D. REF :

CLIENT :

SUN HUNG KAI REAL ESTATE AGENCY LTD.
42/F SUN HUNG KAI CENTRE, WANCHAI, HONGKONG

ARCHITECT :

lwk&partners
a r c h i t e c t s

MAIN CONTRACTOR :

怡輝建築有限公司
Yee Fai Building Contractors Ltd.

STRUCTURAL ENGINEER :

ARUP

FACADE CONSULTANT:

ALPHA CONSULTING LIMITED
Steel Structure & Facade Specialist

NOTE :
1. ALL DIMENSIONS ARE IN mm.
2. ALL ELEVATIONS ARE VIEWED FROM OUTSIDE.
3. ALL DIMENSIONS TO BE VERIFIED ON SITE BEFORE FABRICATION.

LEGEND :

X1 — DETAIL MARK NO.
X001 — REFER SHEET NO.

1. F.F.L. --FINISHED FLOOR LEVEL
2. S.F.L. --STRUCTURAL FLOOR LEVEL
3. (R) --REVERSED DETAIL

NO.	DATE	REVISED	BY
A	02-MAY-2023	5TH SUBMISSION	CF
–	21-FEB-2023	NEW DRAWING (4TH SUBMISSION)	CF

JOB NO. : J-856

PROJECT :
PROPOSED DEVELOPMENT ABOVE LIGHT RAIL TIN WING STOP,TSWTL NO.23,AREA 33,TIN SHUI WAI, N.T.


TITLE :
TYPICAL DETAIL FOR CURTAIN WALL

DATE : 23-JAN-23 | SCALE : 1:4

DRAWN BY : C.F | CHECKED BY :

美特鋁質有限公司
MIDI ALUMINIUM FABRICATOR LTD.
Units 6-8, Sunray Industrial Centre, 1/F
610 Cha Kwo Ling Road, Kowloon
Tel:23489211-4 Fax:(852)27727666

DWG NO. : J856-SD-CW-8034 | REV. : A

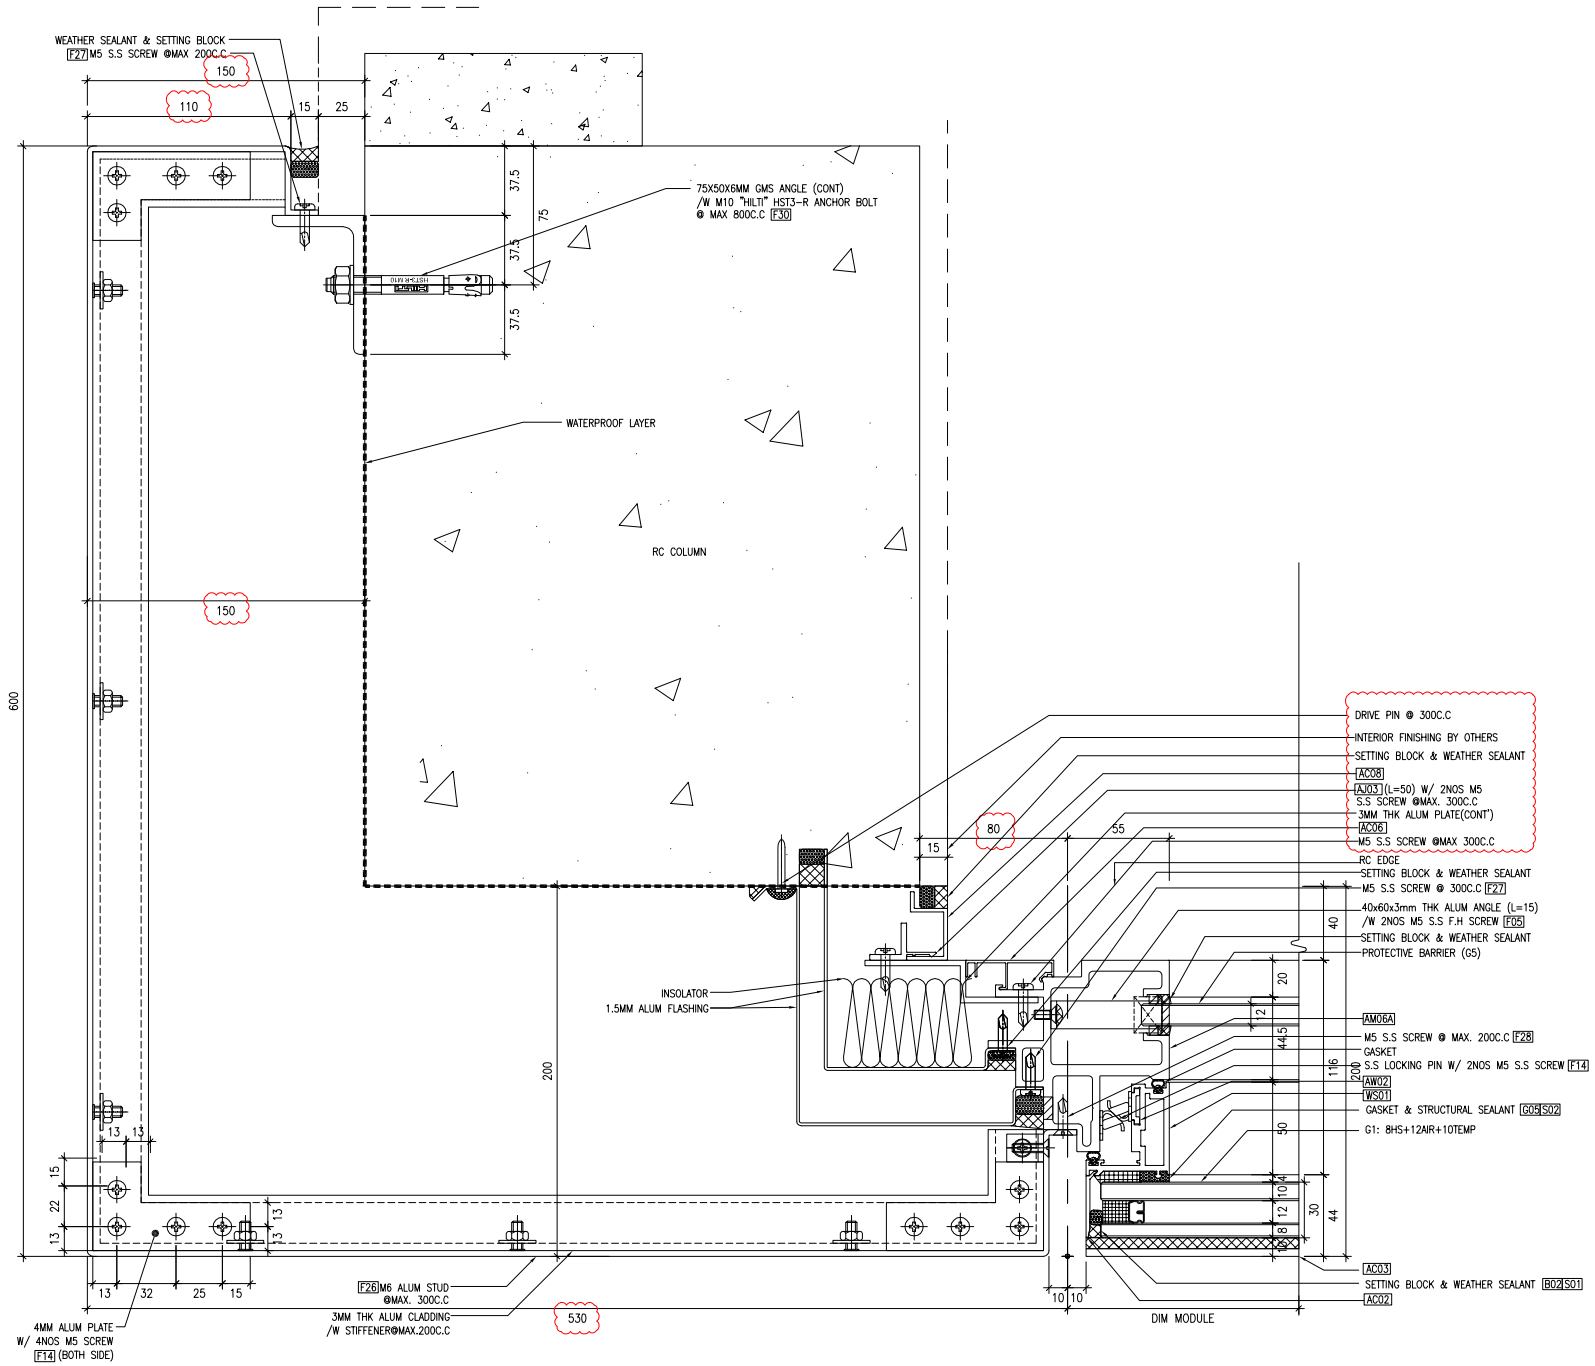

1 / 8035 *TYPICAL DETAIL OF CURTAIN WALL*

REMARK: REFER TO STRUCTURE CALCULATION,
FOR THIS DETAIL 1/8035:
3mm ALUM CLADDING W/ 4MM STIFFENER @ MAX 200C.C

B.D. REF :

CLIENT :
SUN HUNG KAI
REAL ESTATE AGENCY LTD.
42/F SUN HUNG KAI CENTRE, WANCHAI, HONGKONG

ARCHITECT :
lwk&partners
a r c h i t e c t s

MAIN CONTRACTOR :
怡輝建築有限公司
Yee Fai Building Contractors Ltd.

STRUCTURAL ENGINEER :
ARUP

FACADE CONSULTANT:
ALPHA CONSULTING LIMITED
Steel Structure & Facade Specialist

NOTE :
1. ALL DIMENSIONS ARE IN mm.
2. ALL ELEVATIONS ARE VIEWED FROM OUTSIDE.
3. ALL DIMENSIONS TO BE VERIFIED ON SITE BEFORE FABRICATION.

LEGEND :
X1 / X001 — DETAIL MARK NO. / REFER SHEET NO.
1. F.F.L. -- FINISHED FLOOR LEVEL
2. S.F.L. -- STRUCTURAL FLOOR LEVEL
3. /R -- REVERSED DETAIL

NO.	DATE	REVISED	BY
D	30-OCT-2023	9TH SUBMISSION	CF
C	28-SEP-2023	6TH SUBMISSION	CF
B	30-MAY-2023	6TH SUBMISSION	CF
A	02-MAY-2023	5TH SUBMISSION	CF
-	21-FEB-2023	NEW DRAWING (4TH SUBMISSION)	CF

JOB NO. : J-856

PROJECT :
PROPOSED DEVELOPMENT ABOVE
LIGHT RAIL TIN WING STOP,TSWTL
NO.23,AREA 33,TIN SHUI WAI, N.T.


TITLE :
TYPICAL DETAIL
FOR CURTAIN WALL

DATE : 23-JAN-23 | SCALE : 1:4

DRAWN BY : C.F | CHECKED BY :


美特鋁質有限公司
MIDI ALUMINIUM FABRICATOR LTD.
Units 6-8, Sunray Industrial Centre, 1/F
610 Cha Kwo Ling Road, Kowloon
Tel:23489211-4 Fax:(852)27727666

DWG NO. : J856-SD-CW-8035 | REV. : D

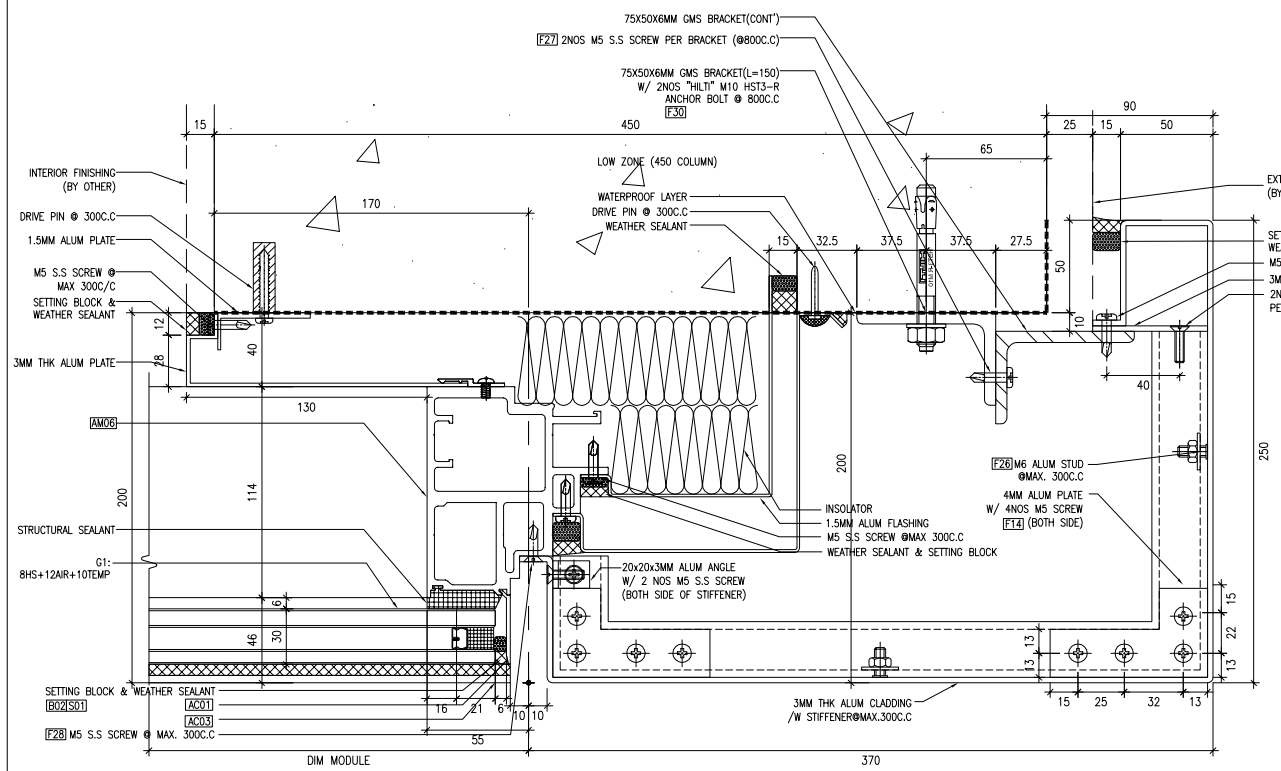


1 8036 *TYPICAL DETAIL OF CURTAIN WALL*

TCW-PE102-1(LOW ZONE 3-12/F)

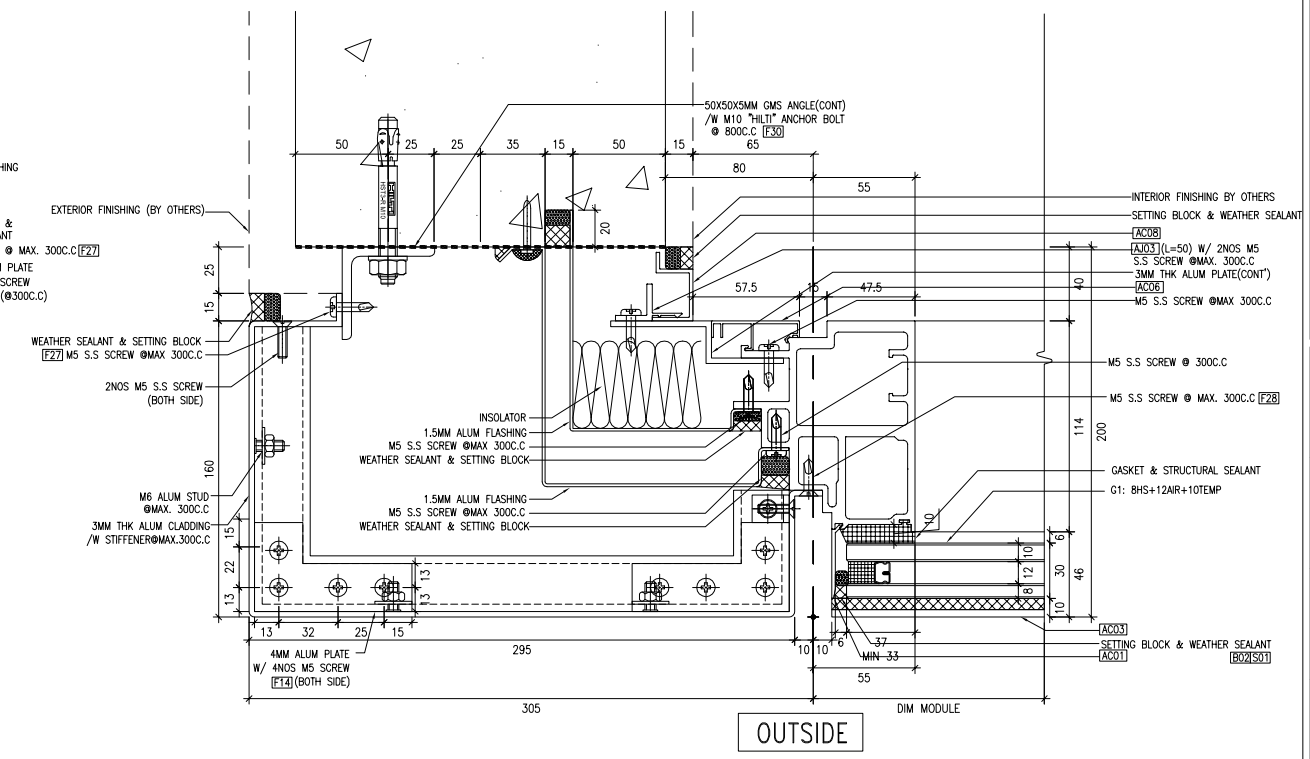


3 8036 *TYPICAL DETAIL OF CURTAIN WALL*

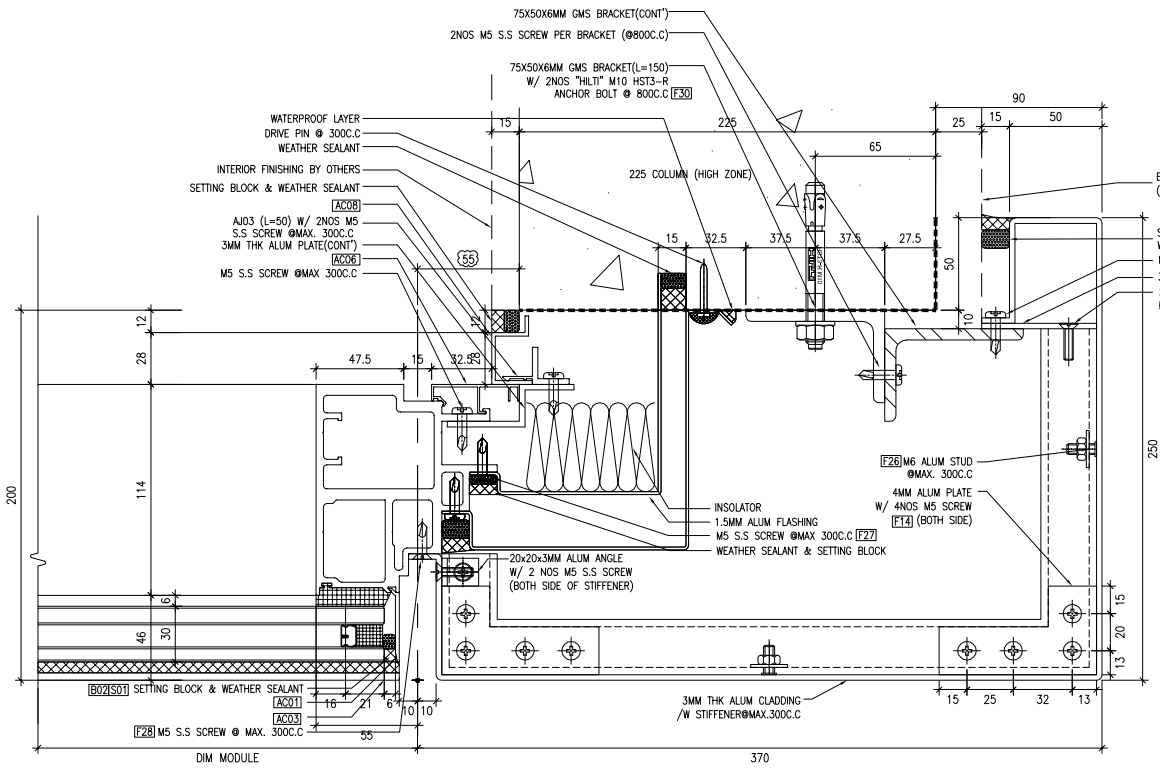

2 8036 *TYPICAL DETAIL OF CURTAIN WALL*

TCW-PE102-1(HIGH ZONE 15-45/F)

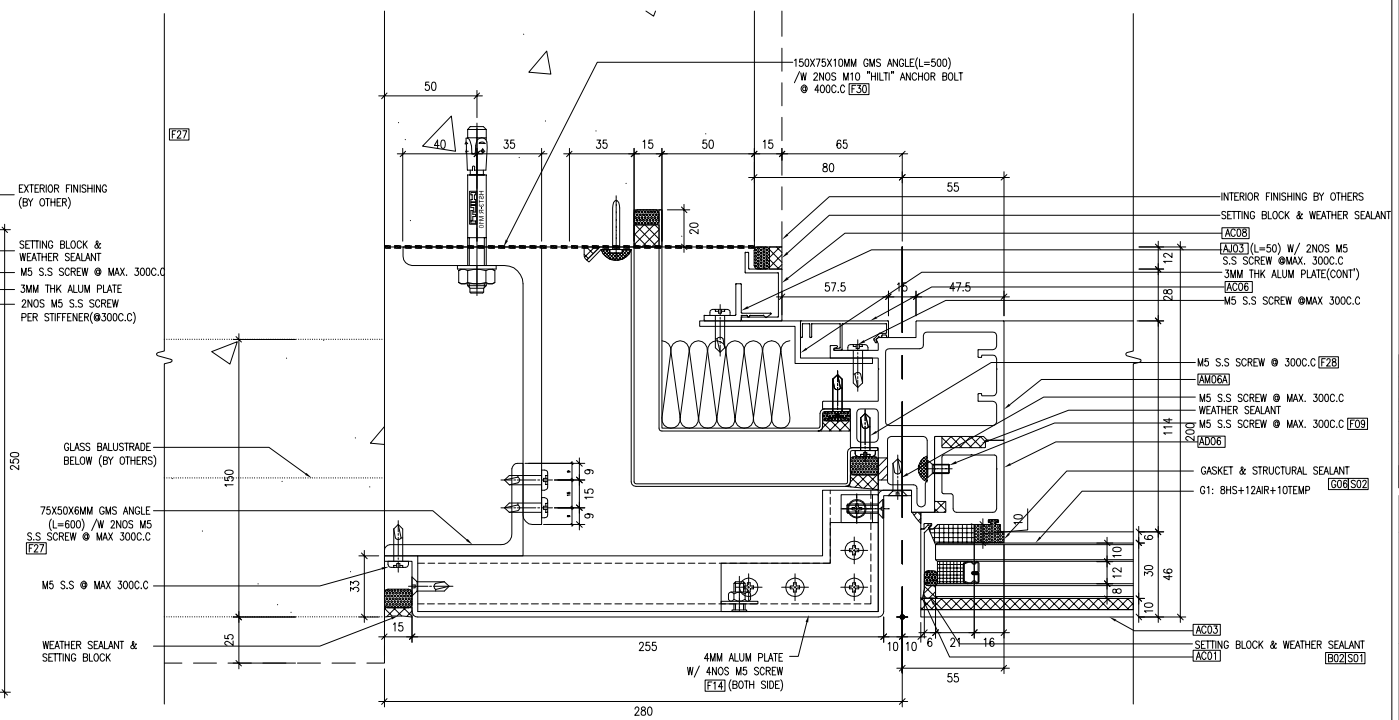

4 8036 *TYPICAL DETAIL OF CURTAIN WALL*

B.D. REF :

CLIENT :

SUN HUNG KAI REAL ESTATE AGENCY LTD.
42/F SUN HUNG KAI CENTRE, WANCHAI, HONGKONG

ARCHITECT :

lwk&partners
a r c h i t e c t s

MAIN CONTRACTOR :

怡輝建築有限公司
Yee Fai Building Contractors Ltd.

STRUCTURAL ENGINEER :

ARUP

FACADE CONSULTANT:

ALPHA CONSULTING LIMITED
Steel Structure & Facade Specialist

NOTE :

1. ALL DIMENSIONS ARE IN mm.
2. ALL ELEVATIONS ARE VIEWED FROM OUTSIDE.
3. ALL DIMENSIONS TO BE VERIFIED ON SITE BEFORE FABRICATION.

LEGEND :

X1 / X001 — DETAIL MARK NO. / REFER SHEET NO.

1. F.F.L. --FINISHED FLOOR LEVEL
2. S.F.L. --STRUCTURAL FLOOR LEVEL
3. /R --REVERSED DETAIL

NO.	DATE	REVISED	BY
A	02-MAY-2023	5TH SUBMISSION	CF
–	21-FEB-2023	NEW DRAWING (4TH SUBMISSION)	CF

JOB NO. : J-856

PROJECT :
PROPOSED DEVELOPMENT ABOVE LIGHT RAIL TIN WING STOP,TSWTL NO.23,AREA 33,TIN SHUI WAI, N.T.


TITLE :
TYPICAL DETAIL FOR CURTAIN WALL

DATE : 23-JAN-23 | SCALE : 1:4


DRAWN BY : C.F | CHECKED BY :

美特鋁質有限公司
MIDI ALUMINIUM FABRICATOR LTD.
Units 6-8, Sunray Industrial Centre, 1/F
610 Cha Kwo Ling Road, Kowloon
Tel:23489211-4 Fax:(852)27727666

DWG NO. : J856-SD-CW-8036 | REV. : A

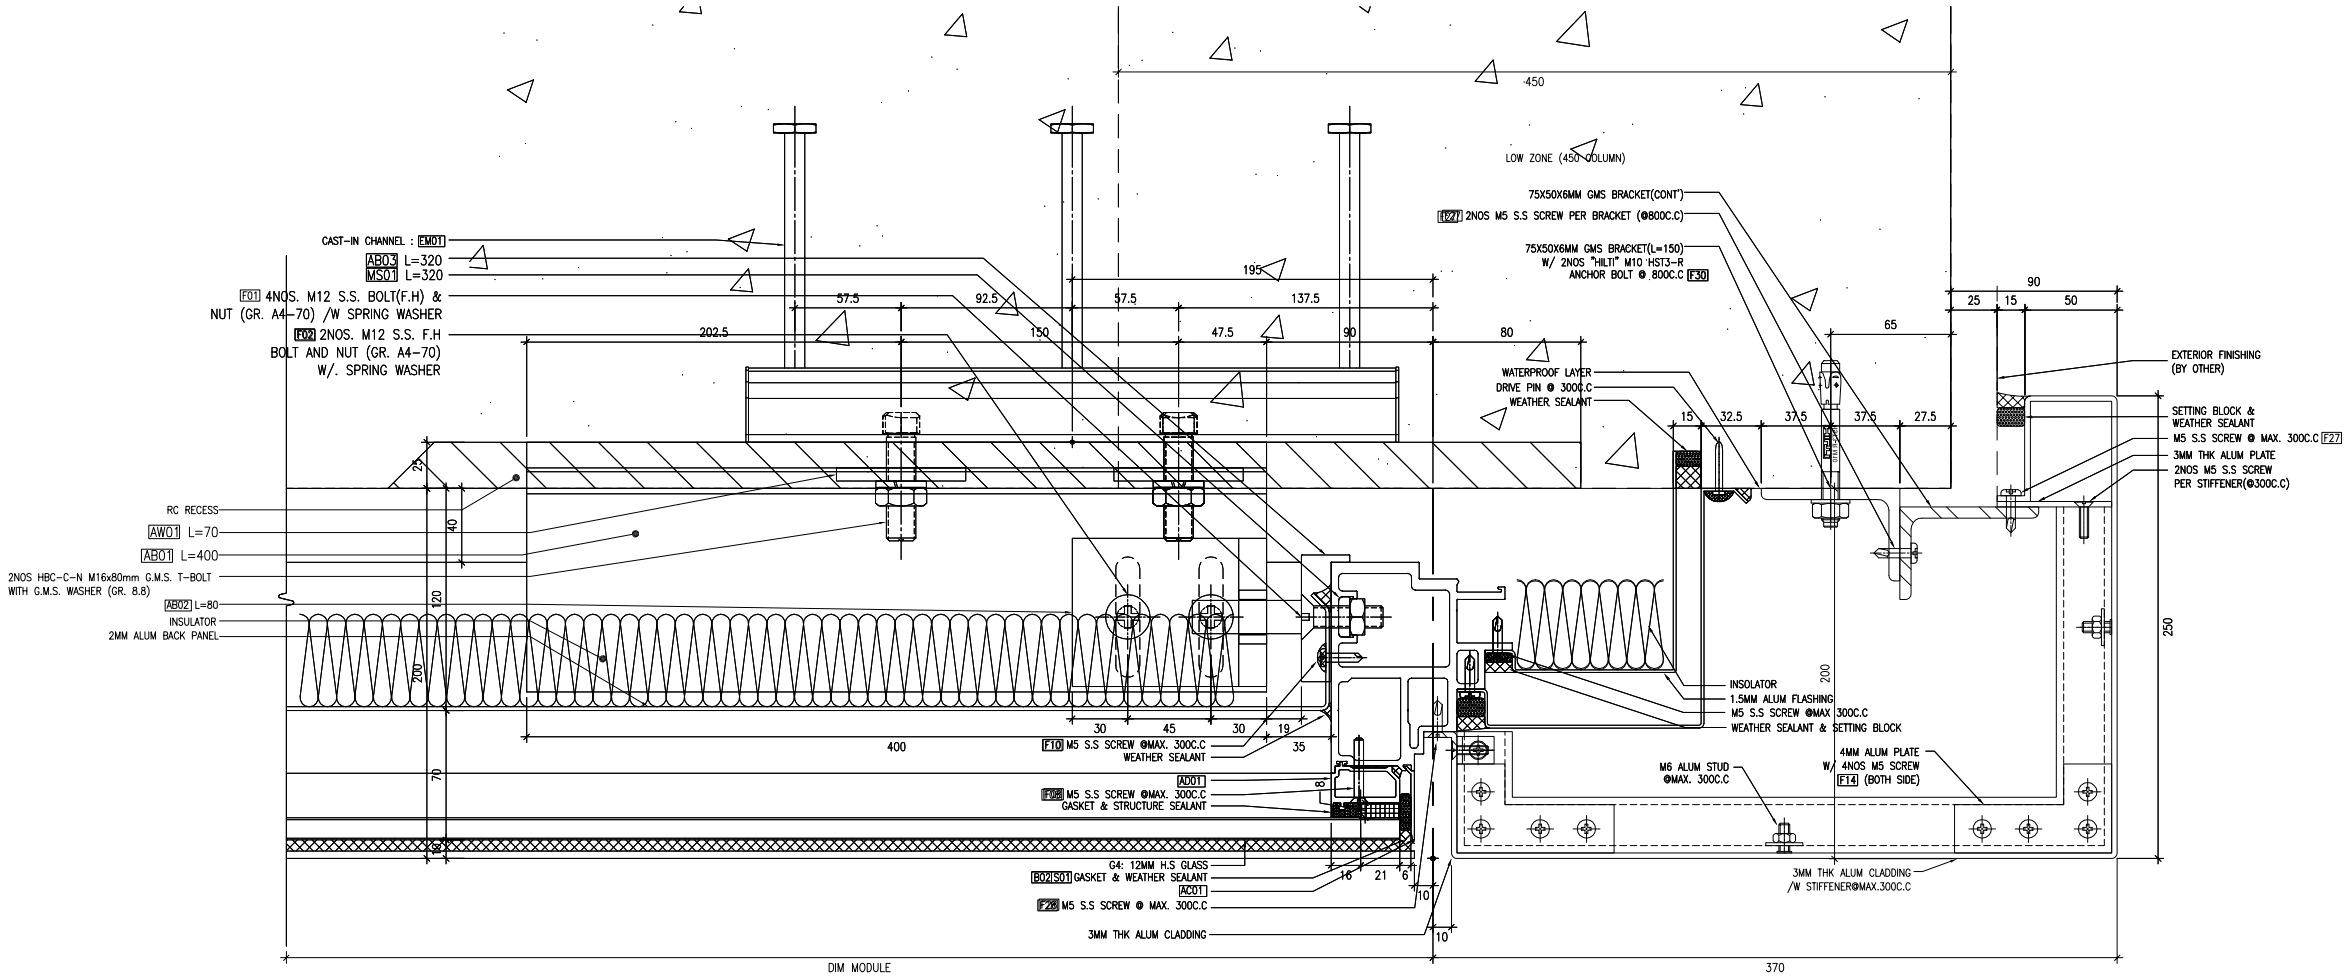

1 / 8037 *TYPICAL DETAIL OF CURTAIN WALL*

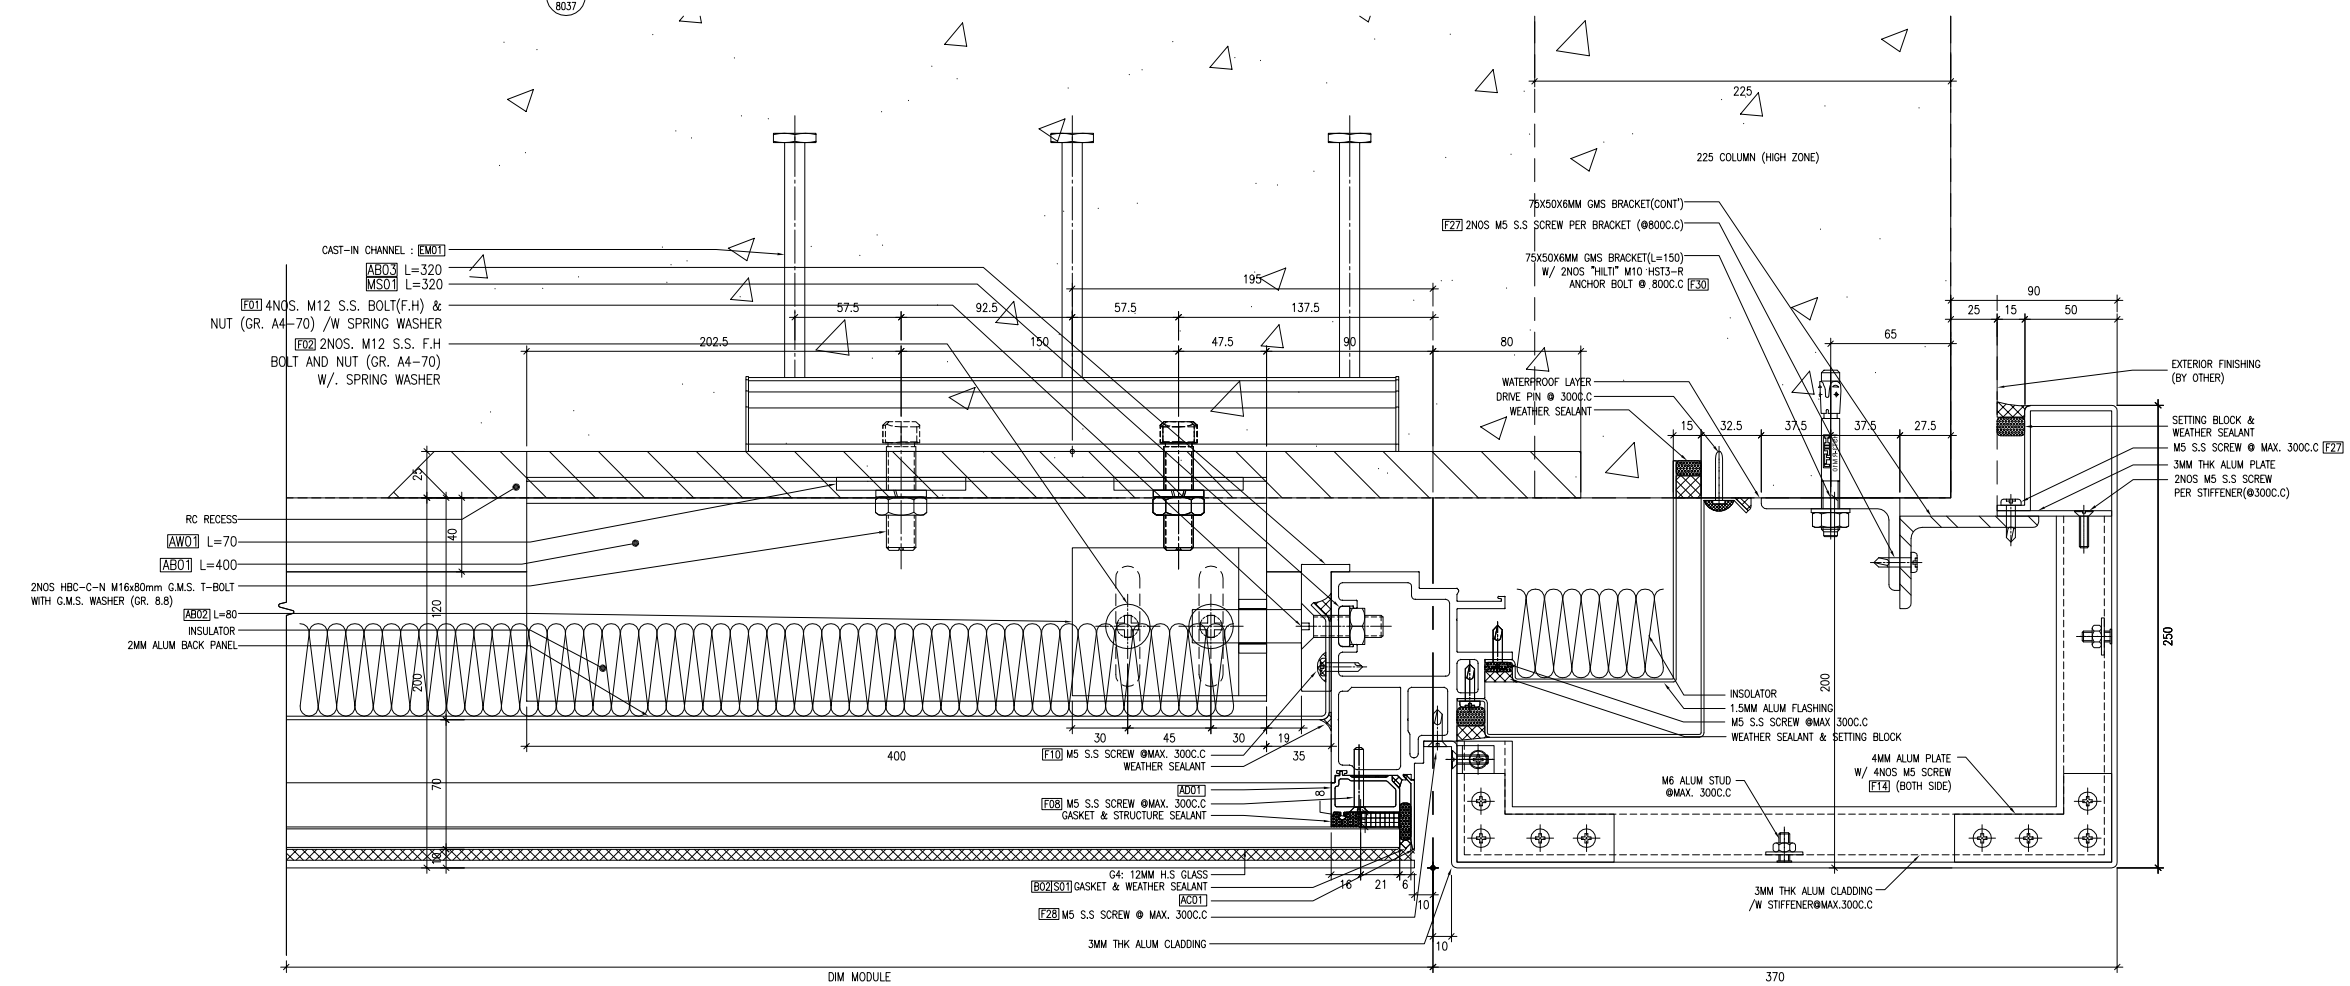

2 / 8037 *TYPICAL DETAIL OF CURTAIN WALL*

B.D. REF :

CLIENT :

SUN HUNG KAI REAL ESTATE AGENCY LTD.
42/F SUN HUNG KAI CENTRE, WANCHAI, HONGKONG

ARCHITECT :

lwk&partners
a r c h i t e c t s

MAIN CONTRACTOR :

怡輝建築有限公司
Yee Fai Building Contractors Ltd.

STRUCTURAL ENGINEER :

ARUP

FACADE CONSULTANT:

ALPHA CONSULTING LIMITED
Steel Structure & Facade Specialist

NOTE :
1. ALL DIMENSIONS ARE IN mm.
2. ALL ELEVATIONS ARE VIEWED FROM OUTSIDE.
3. ALL DIMENSIONS TO BE VERIFIED ON SITE BEFORE FABRICATION.

LEGEND :

X1 / X001 — DETAIL MARK NO. / REFER SHEET NO.

1. F.F.L. --FINISHED FLOOR LEVEL
2. S.F.L. --STRUCTURAL FLOOR LEVEL
3. /R --REVERSED DETAIL

NO.	DATE	REVISED	BY
A	02-MAY-2023	5TH SUBMISSION	CF

JOB NO. : J-856

PROJECT :
PROPOSED DEVELOPMENT ABOVE LIGHT RAIL TIN WING STOP,TSWTL NO.23,AREA 33,TIN SHUI WAI, N.T.


TITLE :
TYPICAL DETAIL FOR CURTAIN WALL

DATE : 23-JAN-23 | SCALE : 1:4


DRAWN BY : C.F | CHECKED BY :

美特鋁質有限公司
MIDI ALUMINIUM FABRICATOR LTD.
Units 6-8, Sunray Industrial Centre, 1/F
610 Cha Kwo Ling Road, Kowloon
Tel:23489211-4 Fax:(852)27727666


DWG NO. : J856-SD-CW-8037 | REV. : A

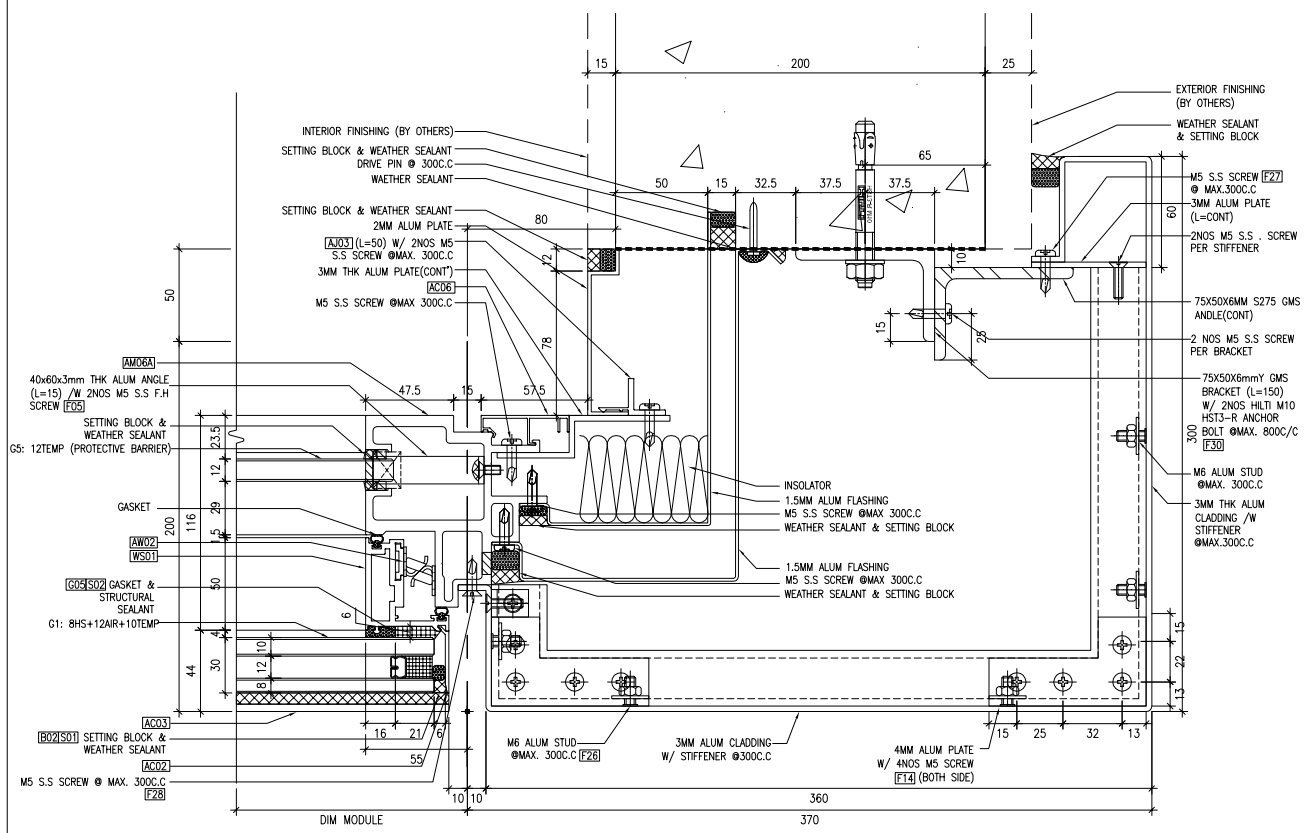


1 8038 *TYPICAL DETAIL OF CURTAIN WALL*

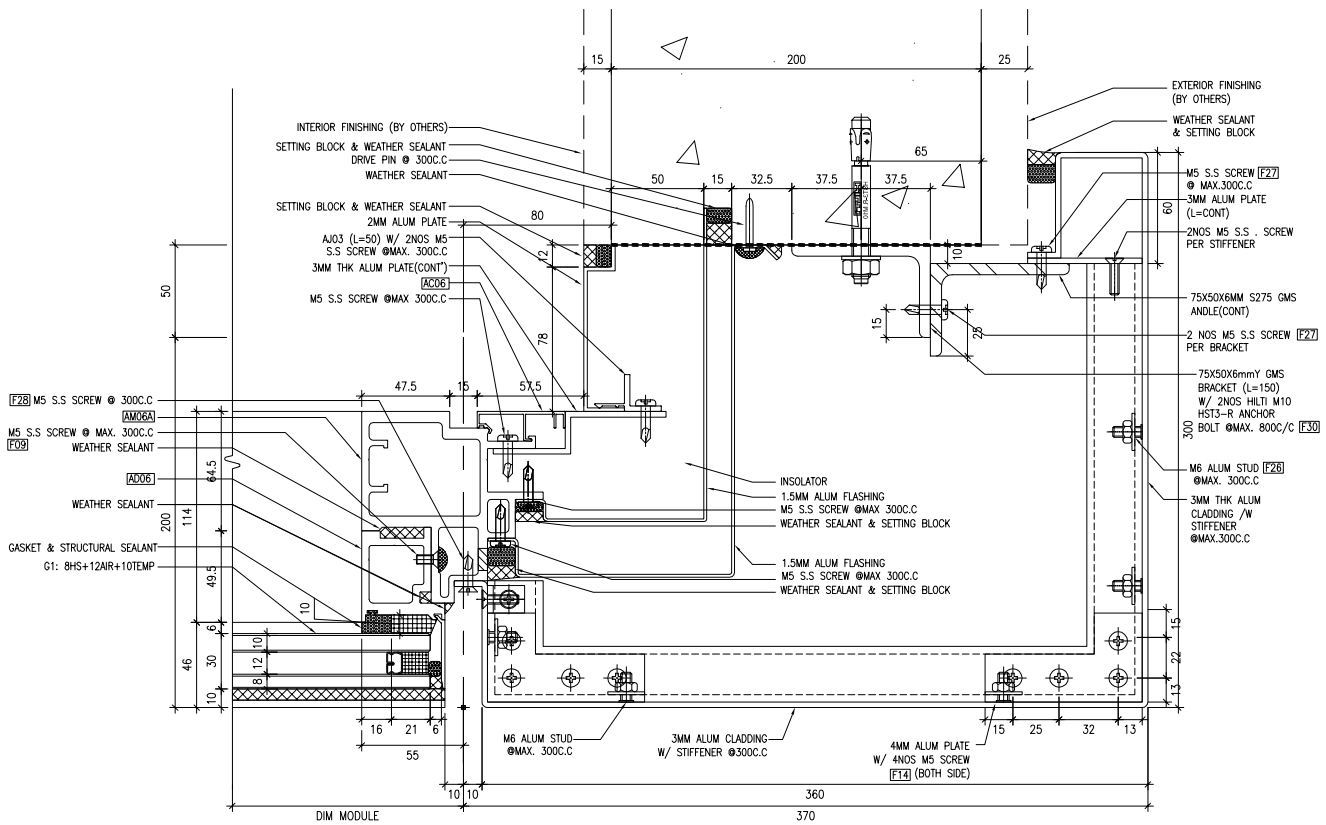

2 8038 *TYPICAL DETAIL OF CURTAIN WALL*

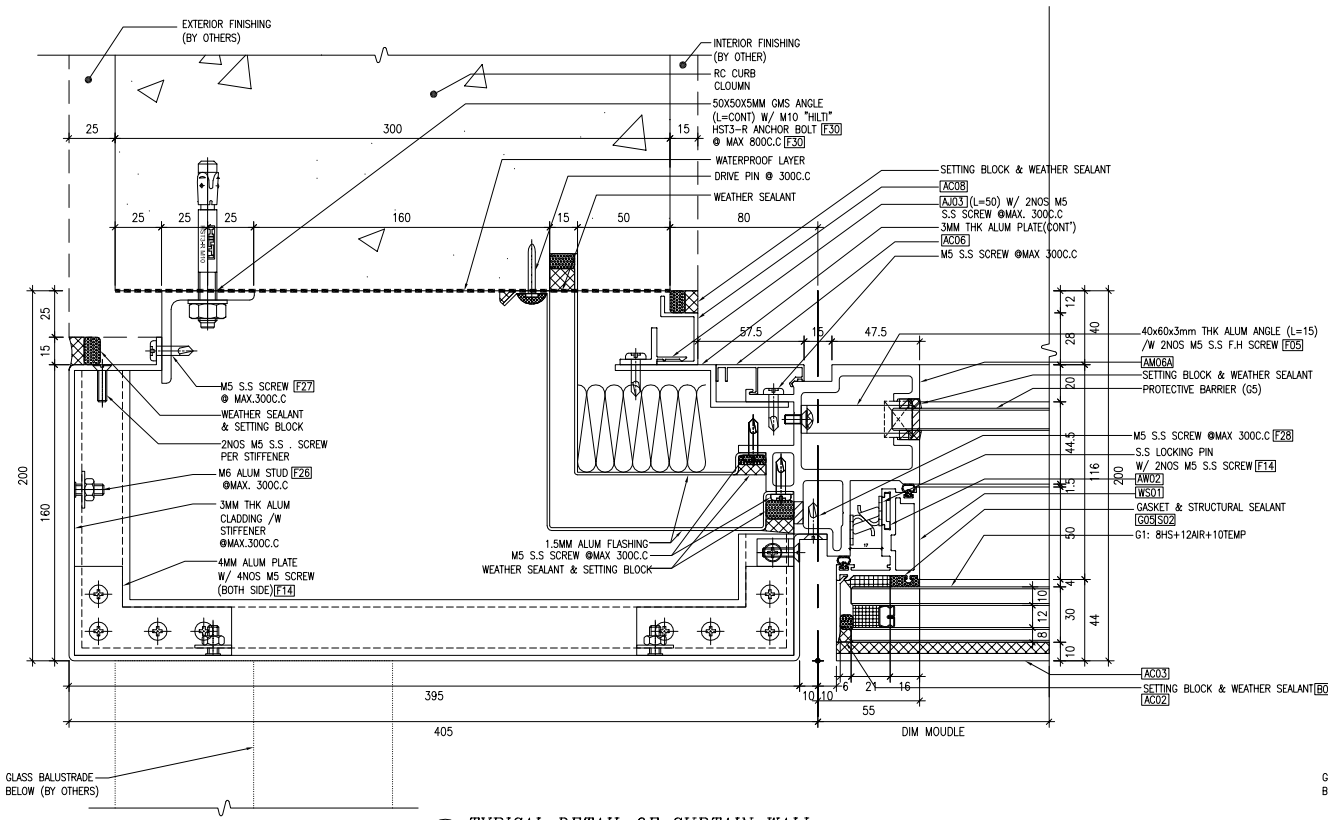

3 8038 *TYPICAL DETAIL OF CURTAIN WALL*

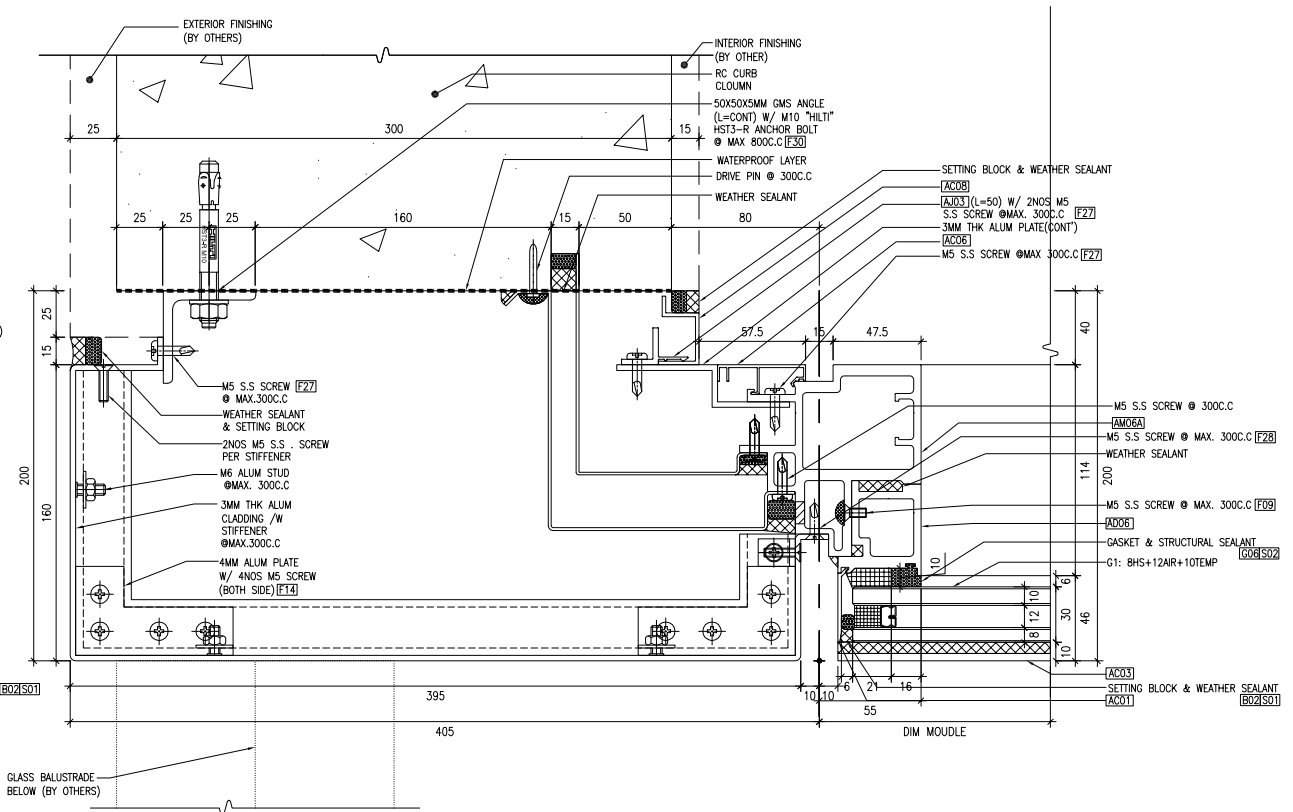

4 8038 *TYPICAL DETAIL OF CURTAIN WALL*

B.D. REF :

CLIENT :

SUN HUNG KAI REAL ESTATE AGENCY LTD.
42/F SUN HUNG KAI CENTRE, WANCHAI, HONGKONG

ARCHITECT :

lwk&partners
a r c h i t e c t s

MAIN CONTRACTOR :

怡輝建築有限公司
Yee Fai Building Contractors Ltd.

STRUCTURAL ENGINEER :

ARUP

FACADE CONSULTANT:

ALPHA CONSULTING LIMITED
Steel Structure & Facade Specialist

NOTE :

1. ALL DIMENSIONS ARE IN mm.
2. ALL ELEVATIONS ARE VIEWED FROM OUTSIDE.
3. ALL DIMENSIONS TO BE VERIFIED ON SITE BEFORE FABRICATION.

LEGEND :

X1 — DETAIL MARK NO.
X001 — REFER SHEET NO.

1. F.F.L. --FINISHED FLOOR LEVEL
2. S.F.L. --STRUCTURAL FLOOR LEVEL
3. (R) --REVERSED DETAIL

NO.	DATE	REVISED	BY

JOB NO. : J-856

PROJECT :
PROPOSED DEVELOPMENT ABOVE LIGHT RAIL TIN WING STOP,TSWTL NO.23,AREA 33,TIN SHUI WAI, N.T.


TITLE :
TYPICAL DETAIL FOR CURTAIN WALL

DATE : 23-JAN-23 | SCALE : 1:4


DRAWN BY : C.F | CHECKED BY :

美特鋁質有限公司
MIDI ALUMINIUM FABRICATOR LTD.
Units 6-8, Sunray Industrial Centre, 1/F
610 Cha Kwo Ling Road, Kowloon
Tel:23489211-4 Fax:(852)27727666

DWG NO. : J856-SD-CW-8038 | REV. : -

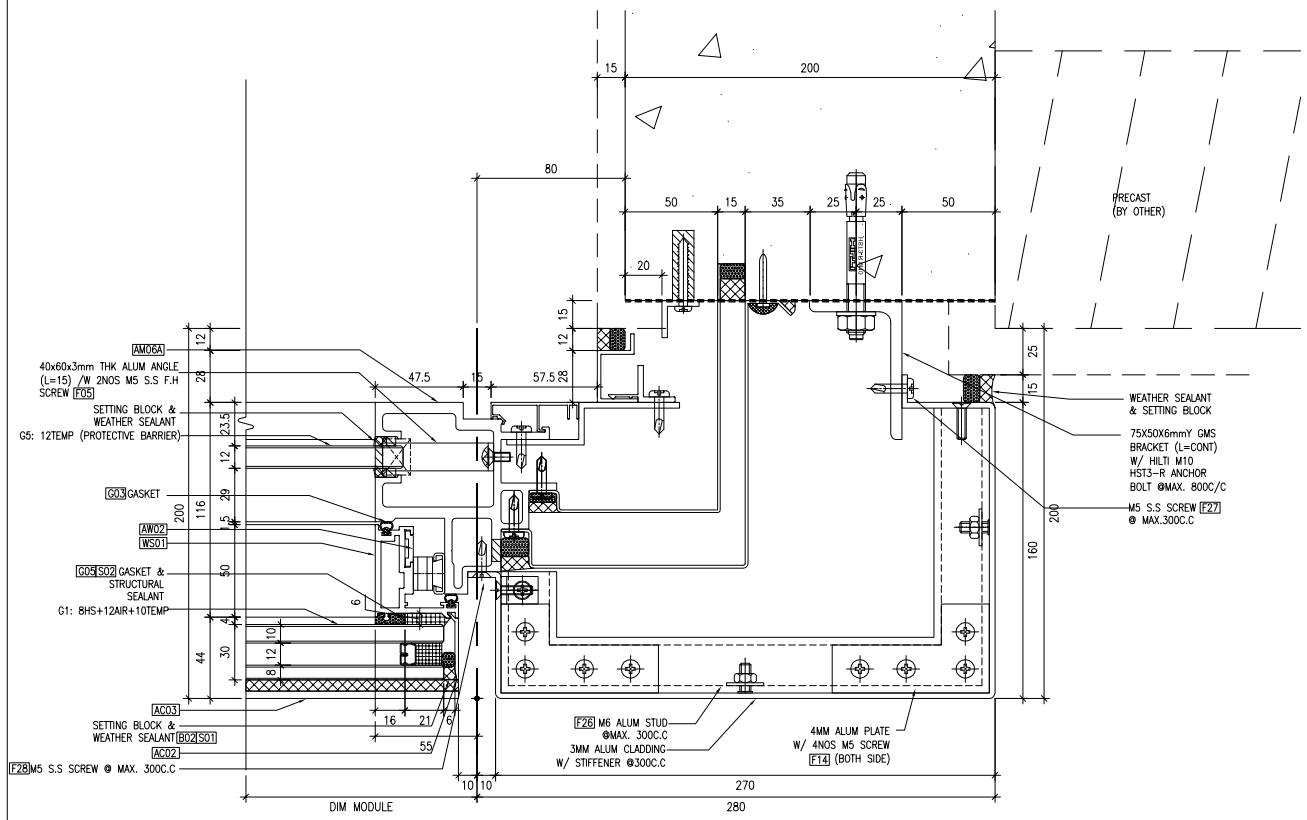

1 / 8039 *TYPICAL DETAIL OF CURTAIN WALL*

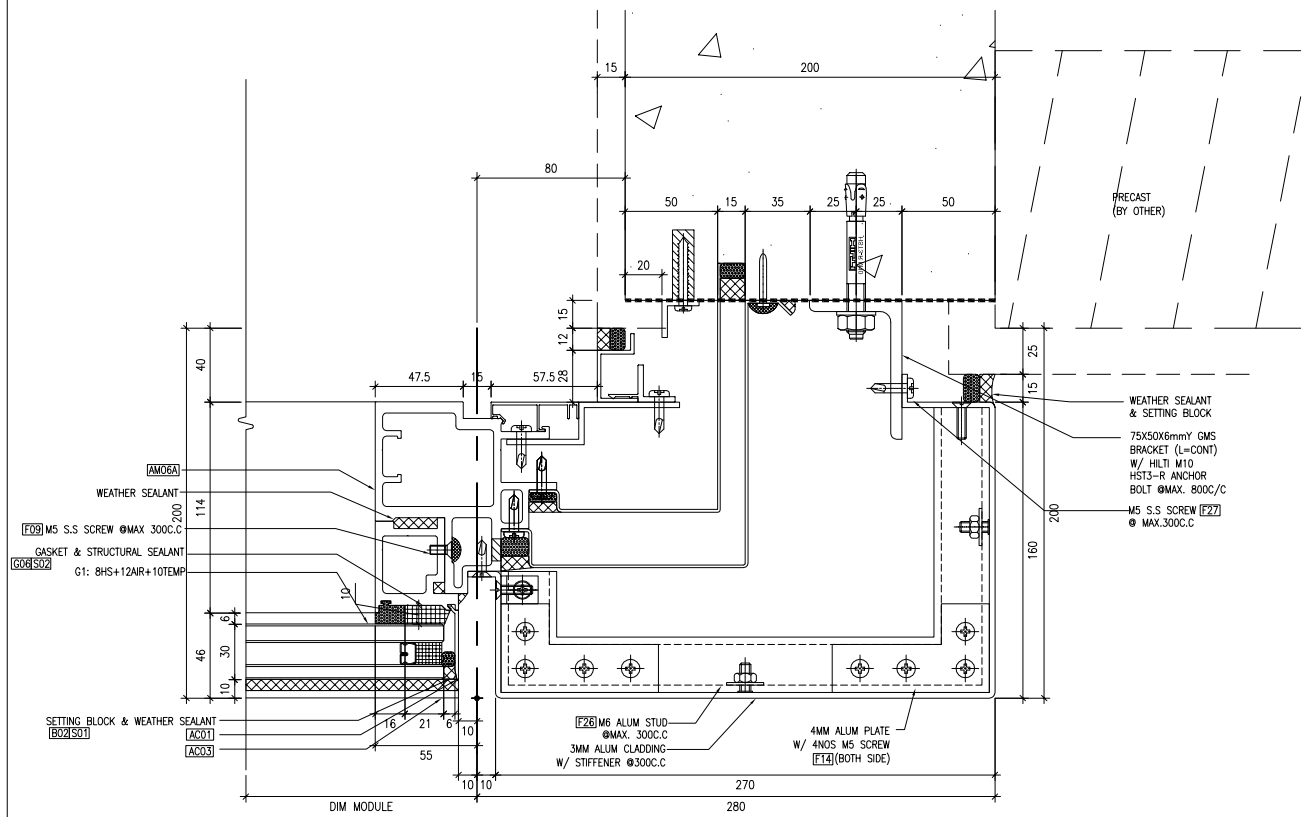

2 / 8039 *TYPICAL DETAIL OF CURTAIN WALL*

B.D. REF :

NO CHANGE

CLIENT :

SUN HUNG KAI REAL ESTATE AGENCY LTD.
42/F SUN HUNG KAI CENTRE, WANCHAI, HONGKONG

ARCHITECT :

lwk&partners
a r c h i t e c t s

MAIN CONTRACTOR :

怡輝建築有限公司
Yee Fai Building Contractors Ltd.

STRUCTURAL ENGINEER :

ARUP

FACADE CONSULTANT:

ALPHA CONSULTING LIMITED
Steel Structure & Facade Specialist

NOTE :

1. ALL DIMENSIONS ARE IN mm.
2. ALL ELEVATIONS ARE VIEWED FROM OUTSIDE.
3. ALL DIMENSIONS TO BE VERIFIED ON SITE BEFORE FABRICATION.

LEGEND :

X1 / X001 — DETAIL MARK NO. / REFER SHEET NO.

1. F.F.L. --FINISHED FLOOR LEVEL
2. S.F.L. --STRUCTURAL FLOOR LEVEL
3. /R --REVERSED DETAIL

NO.	DATE	REVISED	BY

JOB NO. : J-856

PROJECT :
PROPOSED DEVELOPMENT ABOVE LIGHT RAIL TIN WING STOP,TSWTL NO.23,AREA 33,TIN SHUI WAI, N.T.


TITLE :
TYPICAL DETAIL FOR CURTAIN WALL

DATE : 23-JAN-23 | SCALE : 1:4


DRAWN BY : C.F | CHECKED BY :

美特鋁質有限公司
MIDI ALUMINIUM FABRICATOR LTD.
Units 6-8, Sunray Industrial Centre, 1/F
610 Cha Kwo Ling Road, Kowloon
Tel:23489211-4 Fax:(852)27727666


DWG NO. : J856-SD-CW-8039 | REV. : -

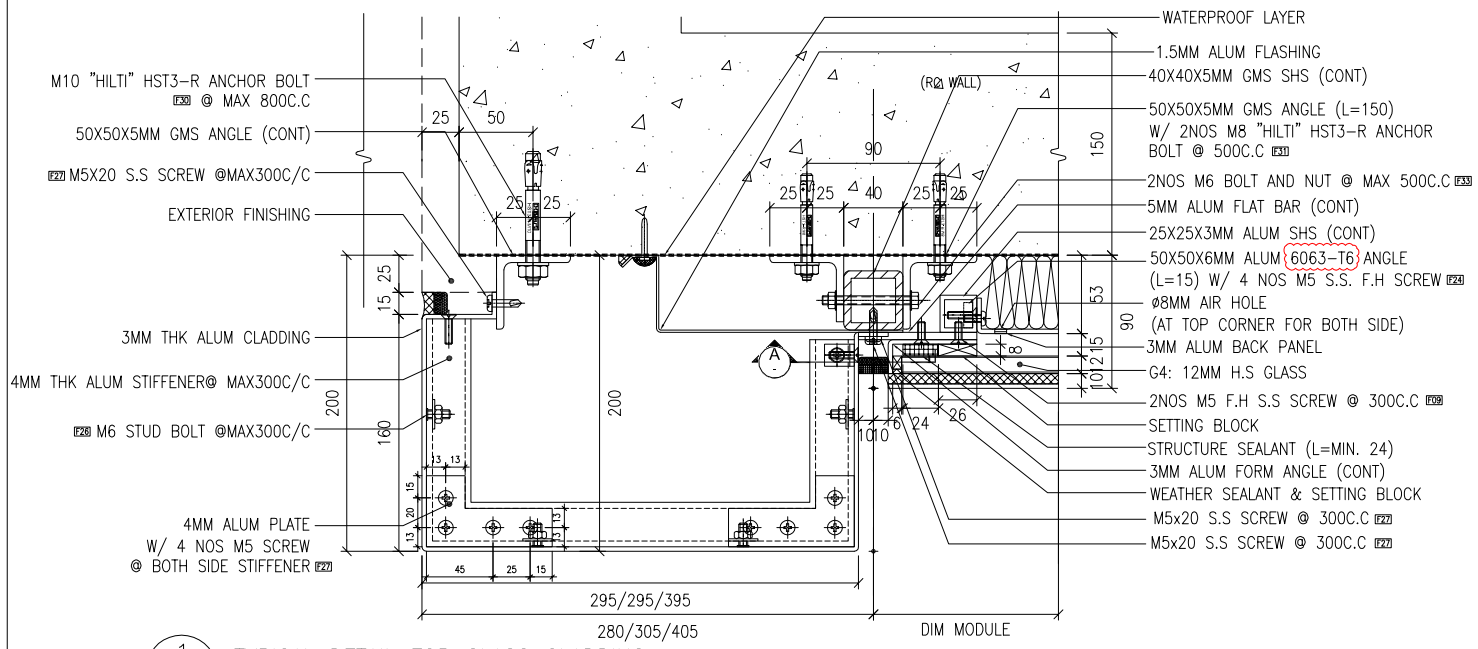


1 / 8040 TYPICAL DETAIL FOR GLASS CLADDING

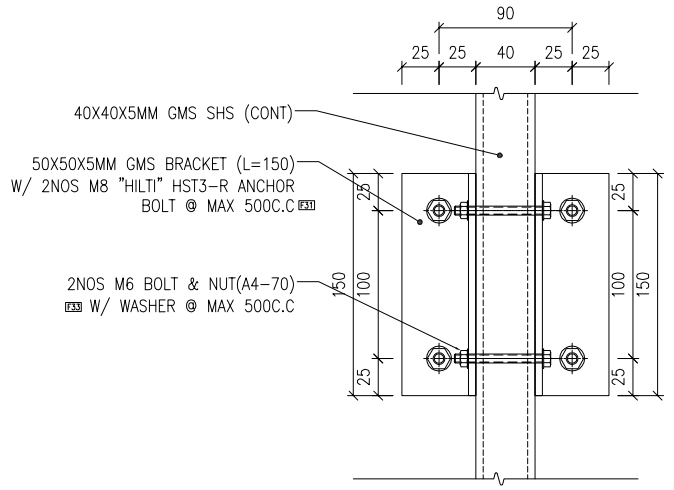


A / 8040 SECTION DETAIL FOR GLASS CLADDING (TYPICAL FIXING)

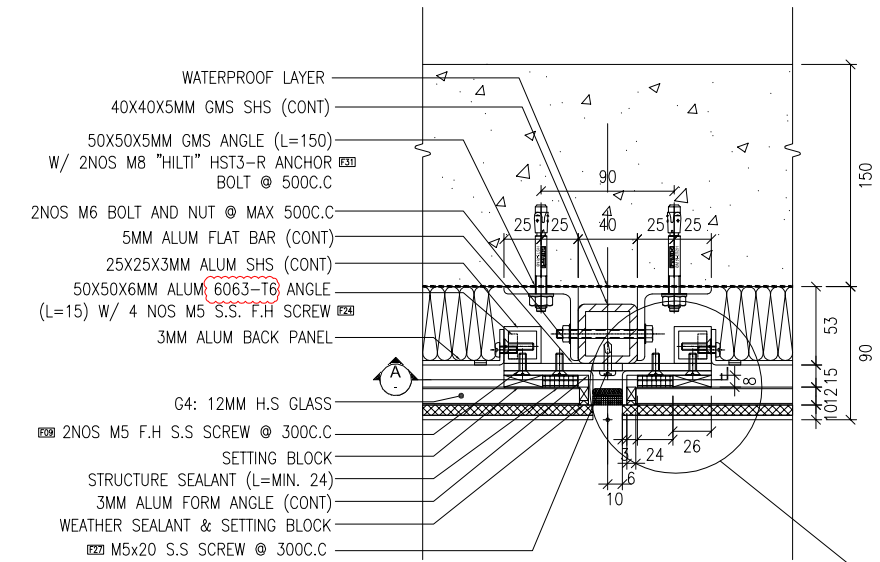


2 / 8040 TYPICAL DETAIL FOR GLASS CLADDING (TYPICAL MIDDLE)

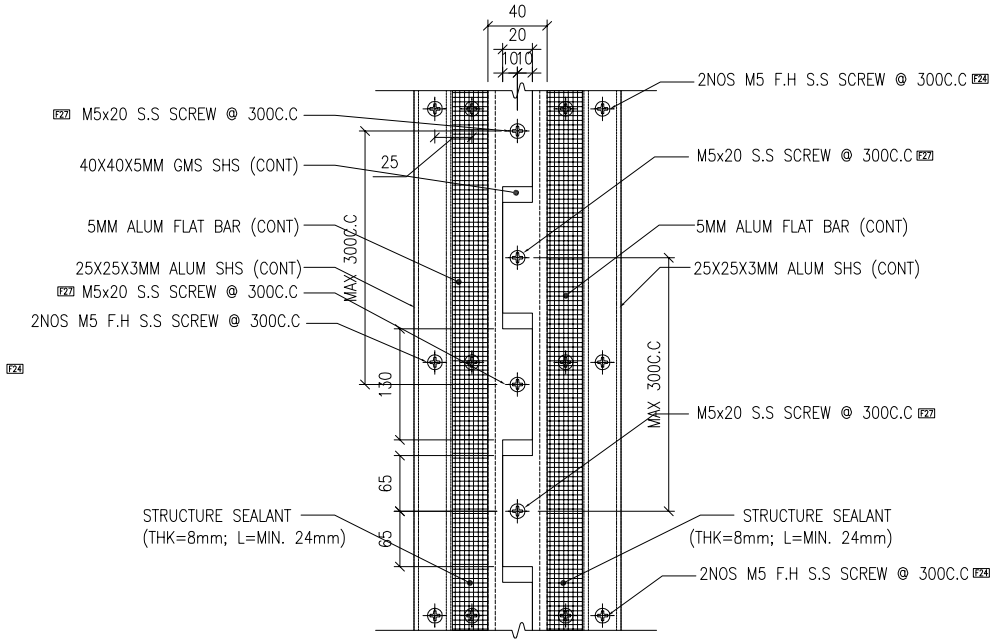

2A / 8040 JOINT LOCATION DETAIL

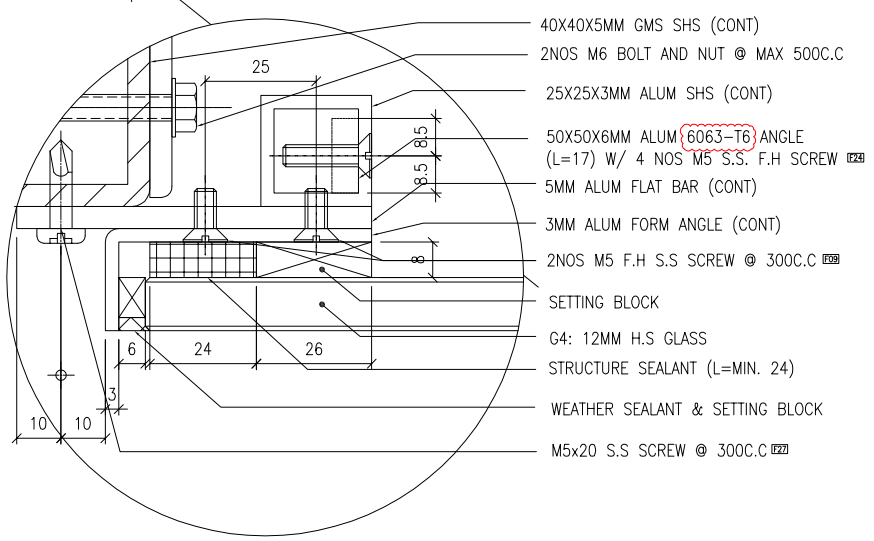

C / 8040 BLOW UP DETAIL

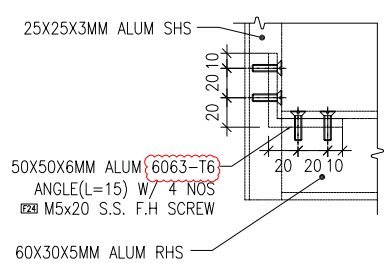

3 / 8040 TYPICAL DETAIL FOR GLASS CLADDING (INNER CONNECTION FOR MULLION & TRANSOM) FOR INSTALLATION ONLY

B.D. REF :

NEW DRAWING

CLIENT :

SUN HUNG KAI REAL ESTATE AGENCY LTD.
42/F SUN HUNG KAI CENTRE, WANCHAI, HONGKONG

ARCHITECT :

lwk&partners architects

MAIN CONTRACTOR :

怡輝建築有限公司 Yee Fai Building Contractors Ltd.

STRUCTURAL ENGINEER :

ARUP

FACADE CONSULTANT:

ALPHA CONSULTING LIMITED
Steel Structure & Facade Specialist

NOTE :
1. ALL DIMENSIONS ARE IN mm.
2. ALL ELEVATIONS ARE VIEWED FROM OUTSIDE.
3. ALL DIMENSIONS TO BE VERIFIED ON SITE BEFORE FABRICATION.

LEGEND :
- X1 / X001 — DETAIL MARK NO. / REFER SHEET NO.
1. F.F.L. --FINISHED FLOOR LEVEL
2. S.F.L. --STRUCTURAL FLOOR LEVEL
3. /R --REVERSED DETAIL

NO.	DATE	REVISED	BY
A	30-OCT-2023	9TH SUBMISSION	CF
–	31-JUL-2023	NEW DRAWING (7TH SUBMISSION)	CF

JOB NO. : J-856

PROJECT :
PROPOSED DEVELOPMENT ABOVE LIGHT RAIL TIN WING STOP,TSWTL NO.23,AREA 33,TIN SHUI WAI, N.T.


TITLE :
TYPICAL DETAIL FOR CURTAIN WALL (GLASS CLADDING)

DATE : 23-MAY-23 | SCALE : 1:5


DRAWN BY : C.F | CHECKED BY :

美特鋁質有限公司 MIDI ALUMINIUM FABRICATOR LTD.
Units 6-8, Sunray Industrial Centre, 1/F
610 Cha Kwo Ling Road, Kowloon
Tel:23489211-4 Fax:(852)27727666


DWG NO. : J856-SD-CW-8040 | REV. : A

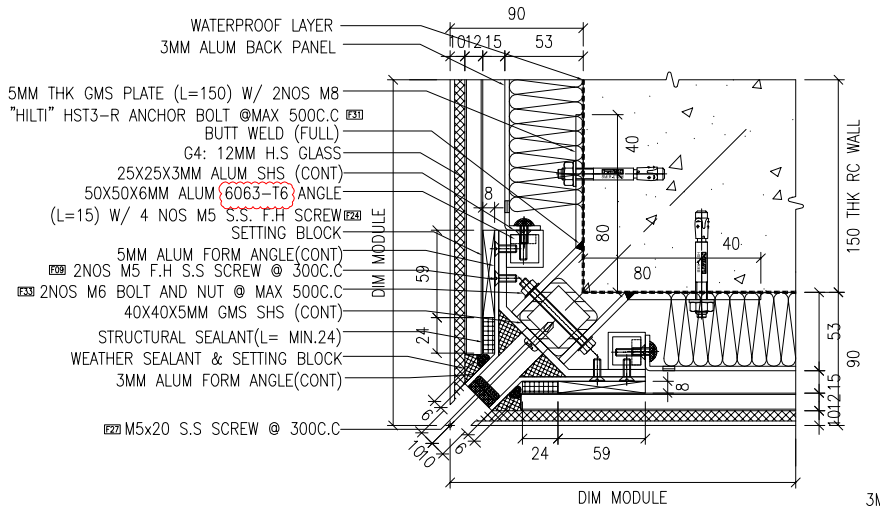


1 / 8041 TYPICAL DETAIL FOR GLASS CLADDING (CORNER)

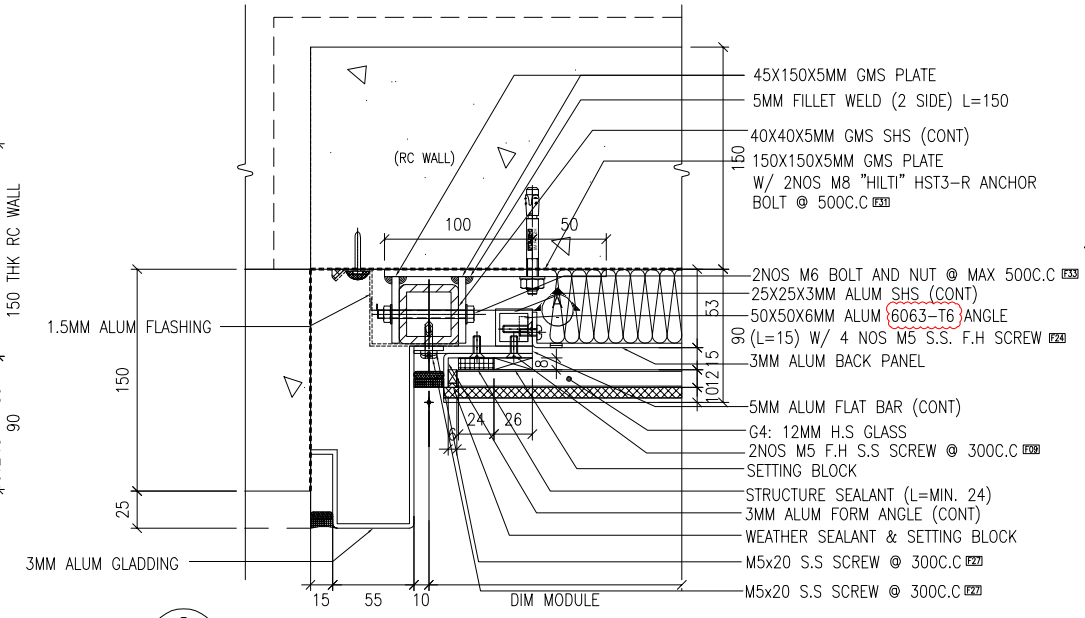

2 / 8041 TYPICAL DETAIL FOR GLASS CLADDING (END BAY)

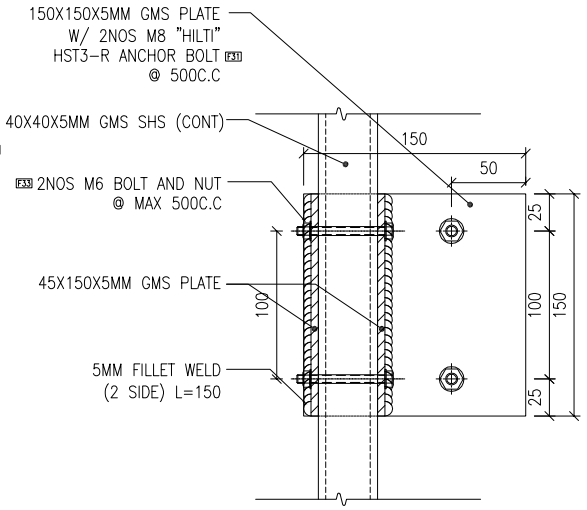

A / 8041 SECTION DETAIL FOR GLASS CLADDING (TYPICAL FIXING)

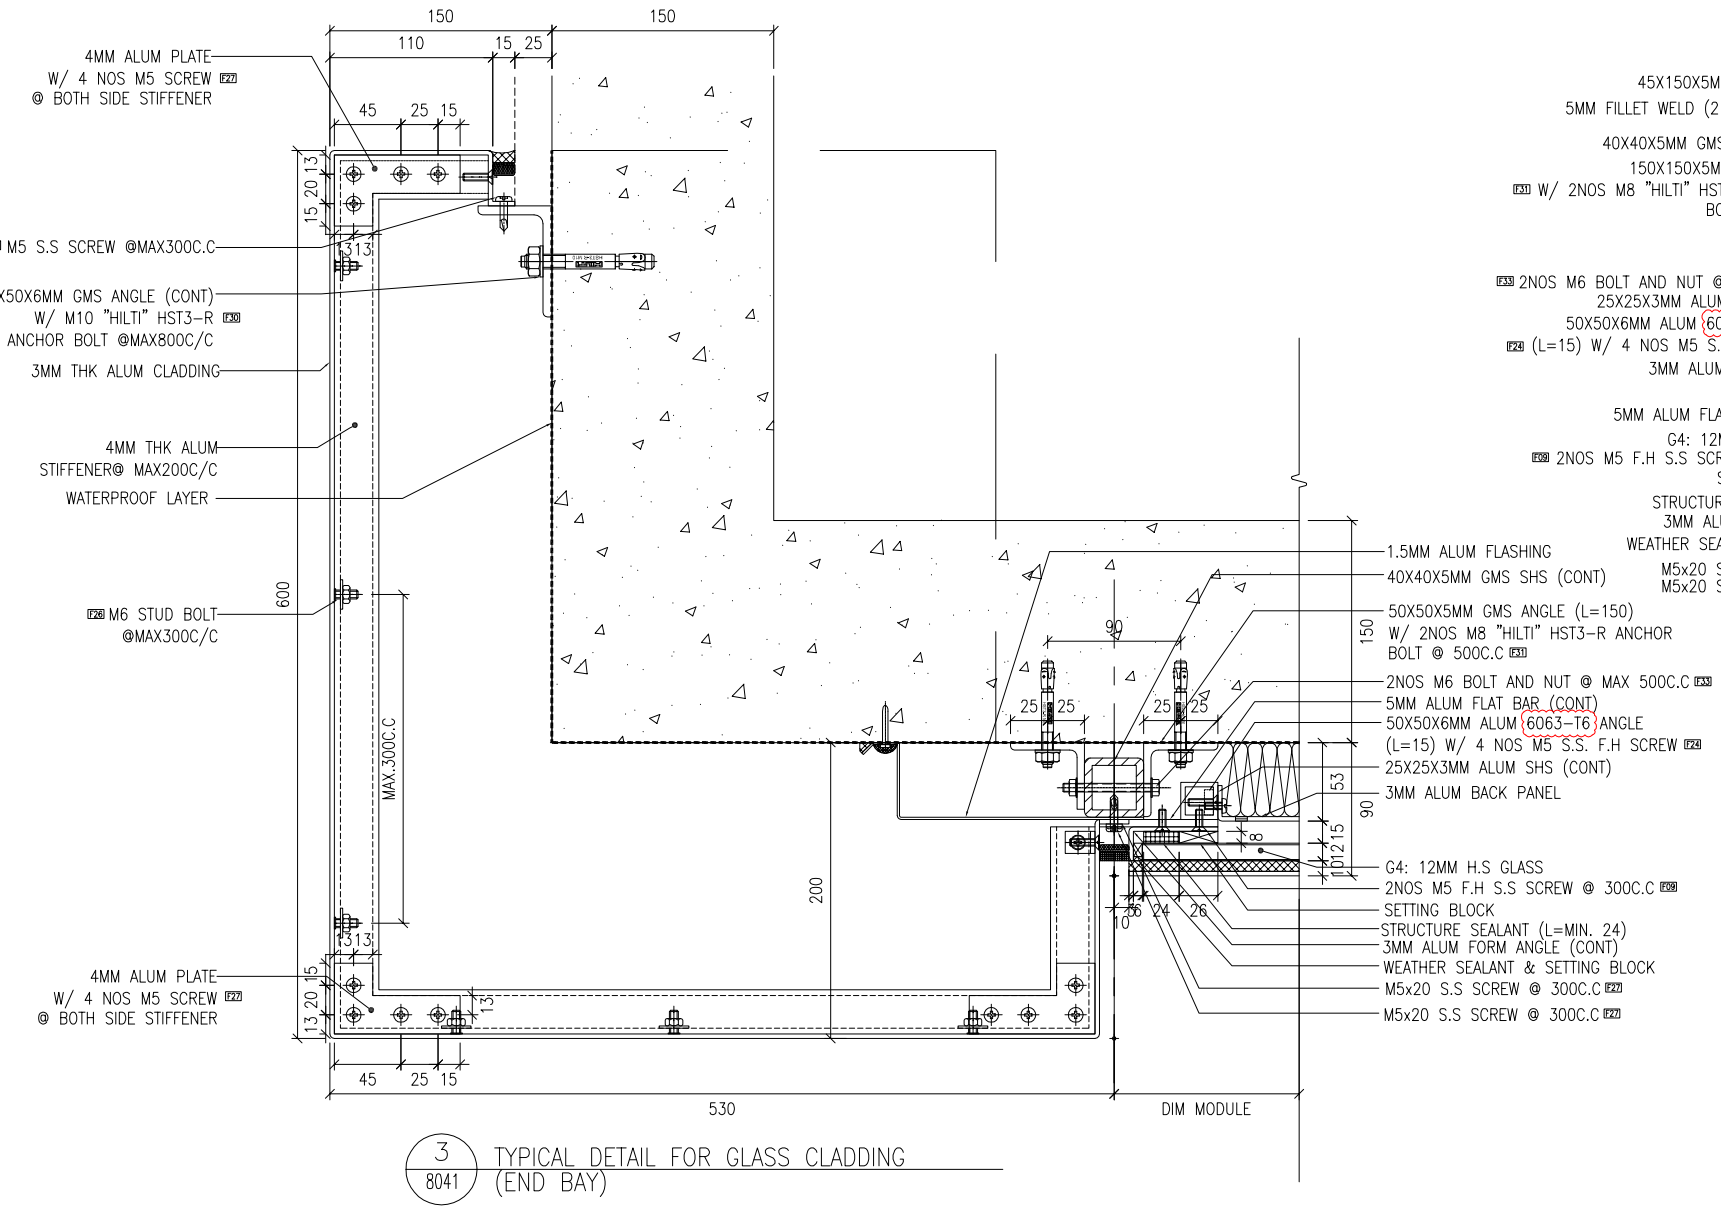

3 / 8041 TYPICAL DETAIL FOR GLASS CLADDING (END BAY)

4 / 8041 TYPICAL DETAIL FOR GLASS CLADDING (END BAY)

B.D. REF :

NEW DRAWING

CLIENT :

SUN HUNG KAI REAL ESTATE AGENCY LTD.
42/F SUN HUNG KAI CENTRE, WANCHAI, HONGKONG

ARCHITECT :

lwk&partners
a r c h i t e c t s

MAIN CONTRACTOR :

怡輝建築有限公司
Yee Fai Building Contractors Ltd.

STRUCTURAL ENGINEER :

ARUP

FACADE CONSULTANT:

ALPHA CONSULTING LIMITED
Steel Structure & Facade Specialist

NOTE :
1. ALL DIMENSIONS ARE IN mm.
2. ALL ELEVATIONS ARE VIEWED FROM OUTSIDE.
3. ALL DIMENSIONS TO BE VERIFIED ON SITE BEFORE FABRICATION.

LEGEND :

X1 / X001 — DETAIL MARK NO. / REFER SHEET NO.

1. F.F.L. --FINISHED FLOOR LEVEL
2. S.F.L. --STRUCTURAL FLOOR LEVEL
3. (R) --REVERSED DETAIL

NO.	DATE	REVISED	BY
A	30-OCT-2023	9TH SUBMISSION	CF
-	31-JUL-2023	NEW DRAWING (7TH SUBMISSION)	CF

JOB NO. : J-856

PROJECT :
PROPOSED DEVELOPMENT ABOVE LIGHT RAIL TIN WING STOP,TSWTL NO.23,AREA 33,TIN SHUI WAI, N.T.


TITLE :
TYPICAL DETAIL FOR CURTAIN WALL (GLASS CLADDING)

DATE : 23-MAY-23 | SCALE : 1:5


DRAWN BY : C.F | CHECKED BY :

美特鋁質有限公司
MIDI ALUMINIUM FABRICATOR LTD.
Units 6-8, Sunray Industrial Centre, 1/F
610 Cha Kwo Ling Road, Kowloon
Tel:23489211-4 Fax:(852)27727666


DWG NO. : J856-SD-CW-8041 | REV. : A

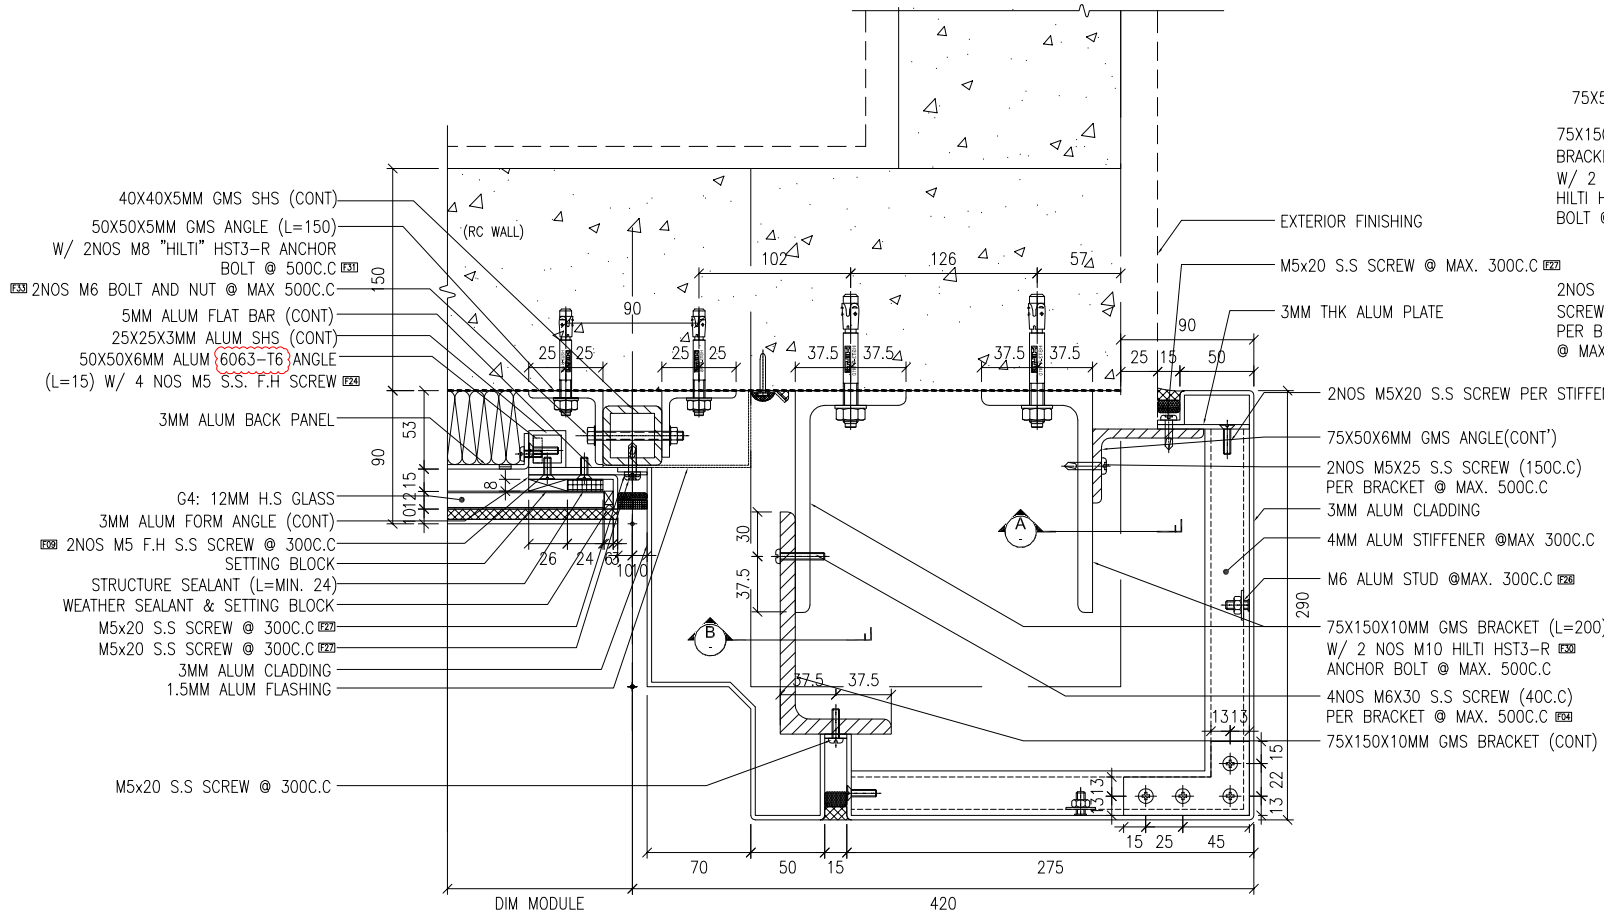


1 / 8042 TYPICAL DETAIL FOR GLASS CLADDING (END BAY)

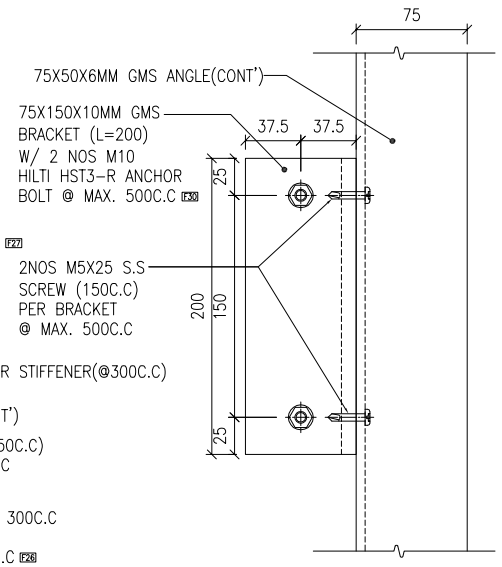


A / 8042 SECTION DETAIL

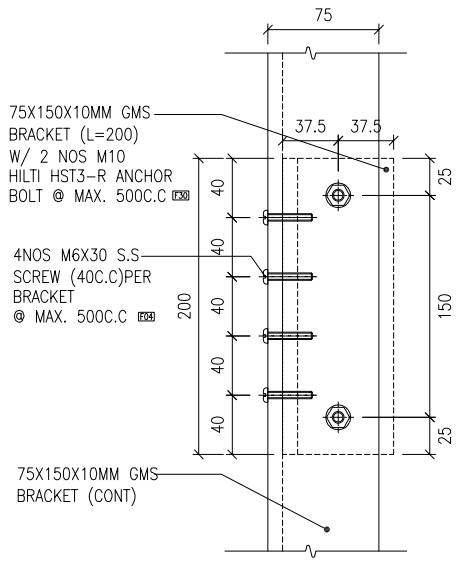

B / 8042 SECTION DETAIL

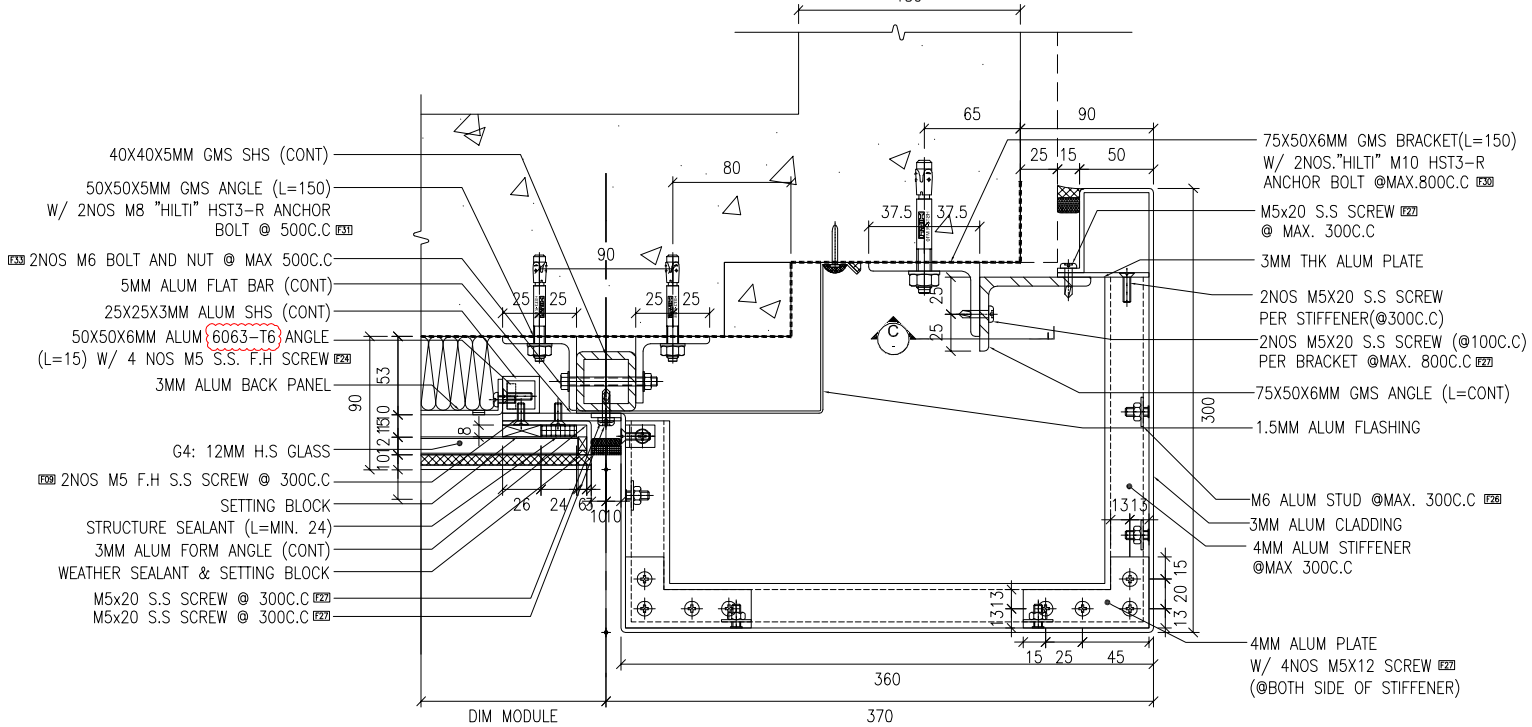

2 / 8042 TYPICAL DETAIL FOR GLASS CLADDING (END BAY)

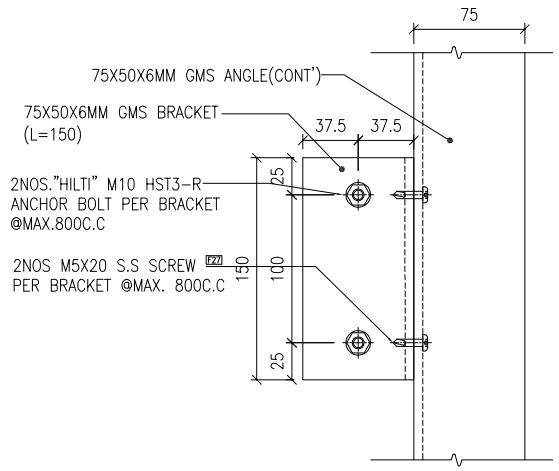

C / 8042 SECTION DETAIL

B.D. REF :

NEW DRAWING

CLIENT :

SUN HUNG KAI REAL ESTATE AGENCY LTD.
42/F SUN HUNG KAI CENTRE, WANCHAI, HONGKONG

ARCHITECT :

lwk&partners architects

MAIN CONTRACTOR :

怡輝建築有限公司 Yee Fai Building Contractors Ltd.

STRUCTURAL ENGINEER :

ARUP

FACADE CONSULTANT:

ALPHA CONSULTING LIMITED
Steel Structure & Facade Specialist

NOTE :

1. ALL DIMENSIONS ARE IN mm.
2. ALL ELEVATIONS ARE VIEWED FROM OUTSIDE.
3. ALL DIMENSIONS TO BE VERIFIED ON SITE BEFORE FABRICATION.

LEGEND :

X1 / X001 — DETAIL MARK NO. / REFER SHEET NO.

1. F.F.L. --FINISHED FLOOR LEVEL
2. S.F.L. --STRUCTURAL FLOOR LEVEL
3. (R) --REVERSED DETAIL

NO.	DATE	REVISED	BY
A	30-OCT-2023	9TH SUBMISSION	CF
–	31-JUL-2023	NEW DRAWING (7TH SUBMISSION)	CF

JOB NO. : J-856

PROJECT :
PROPOSED DEVELOPMENT ABOVE LIGHT RAIL TIN WING STOP,TSWTL NO.23,AREA 33,TIN SHUI WAI, N.T.


TITLE :
TYPICAL DETAIL FOR CURTAIN WALL (GLASS CLADDING)

DATE : 23-MAY-23 | SCALE : 1:5


DRAWN BY : C.F | CHECKED BY :

美特鋁質有限公司 MIDI ALUMINIUM FABRICATOR LTD.
Units 6-8, Sunray Industrial Centre, 1/F
610 Cha Kwo Ling Road, Kowloon
Tel:23489211-4 Fax:(852)27727666


DWG NO. : J856-SD-CW-8042 | REV. : A

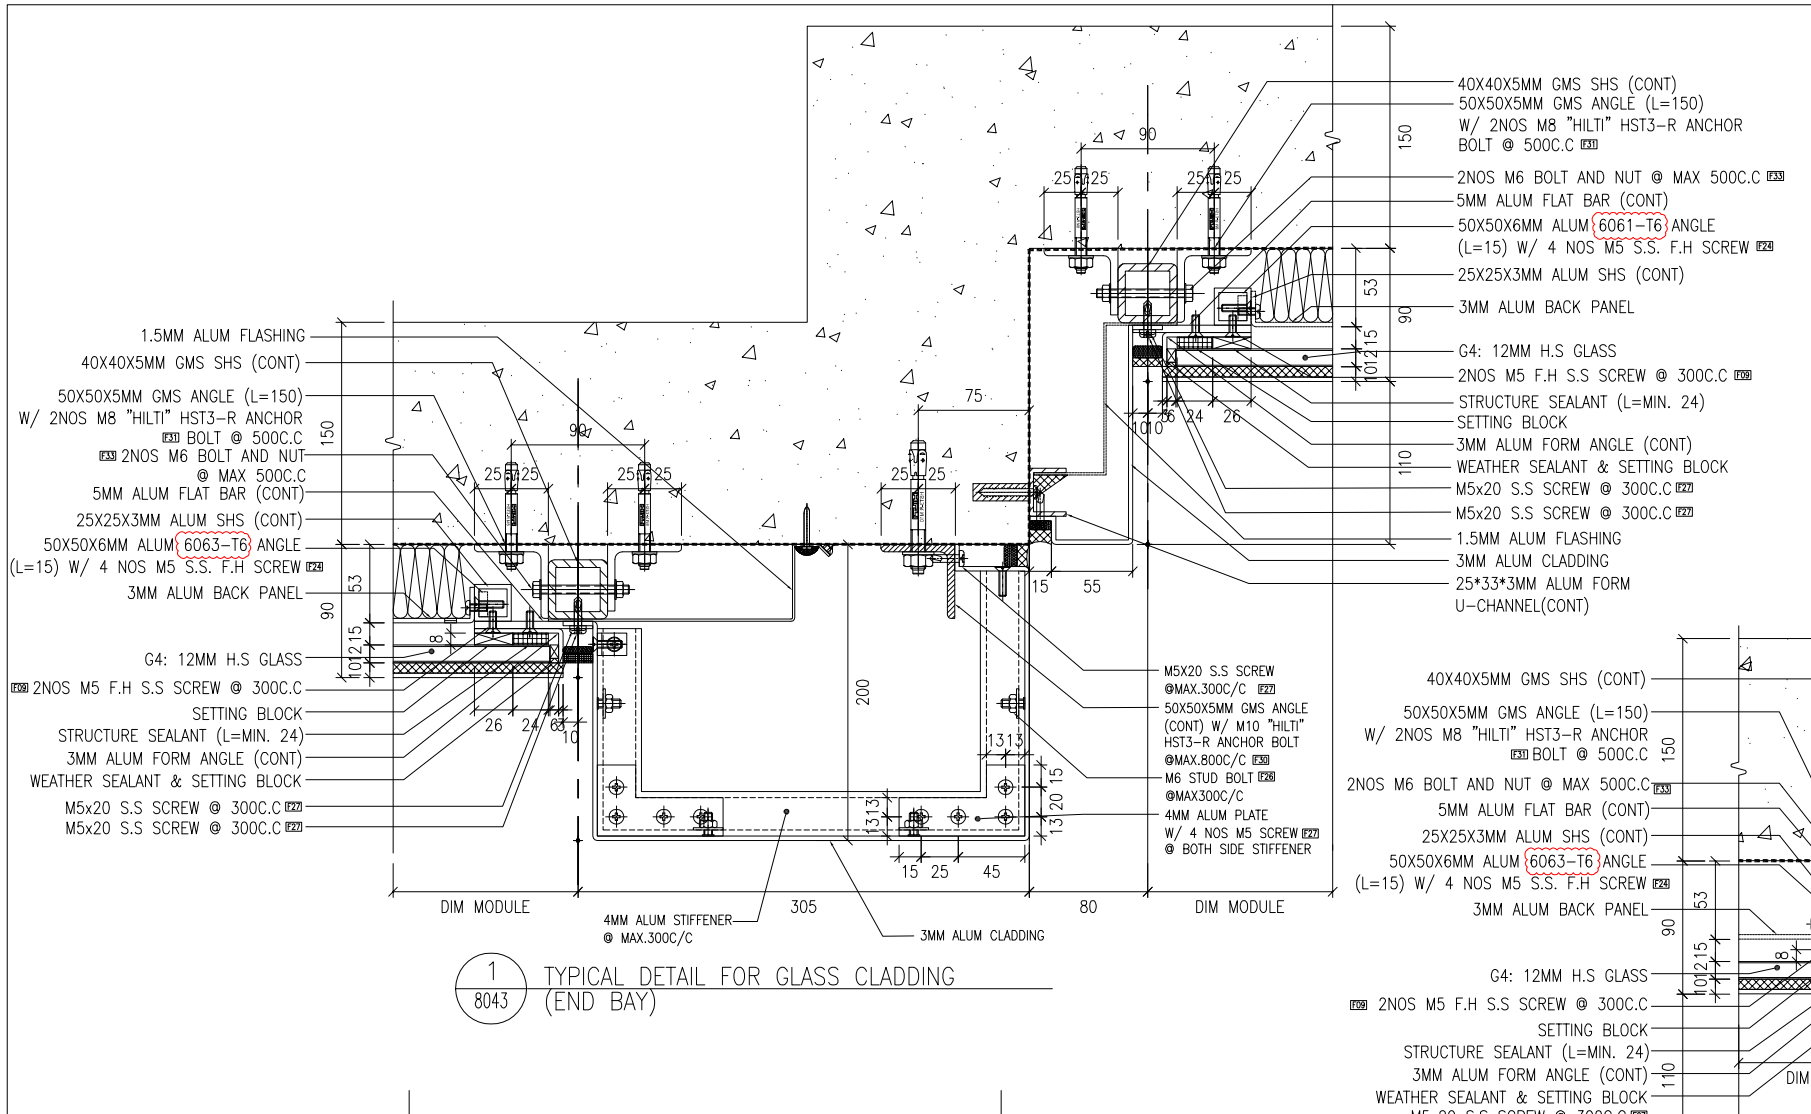

1 / 8043 TYPICAL DETAIL FOR GLASS CLADDING (END BAY)

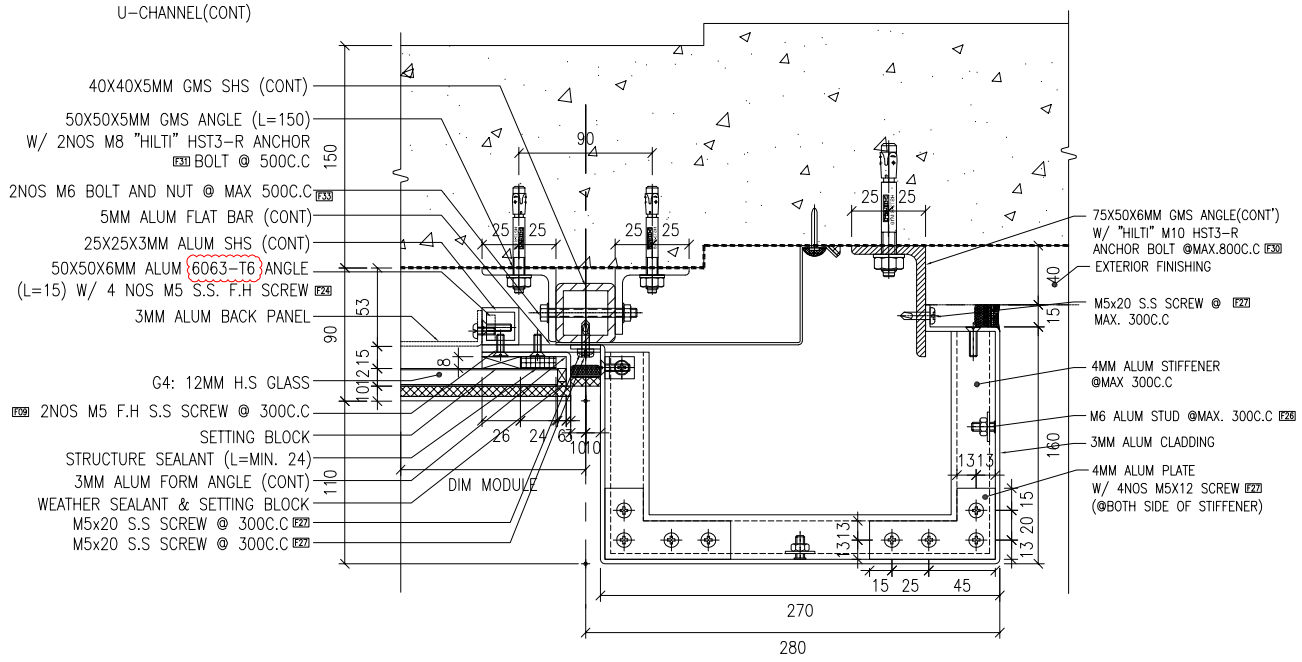

2 / 8043 TYPICAL DETAIL FOR GLASS CLADDING (END BAY)

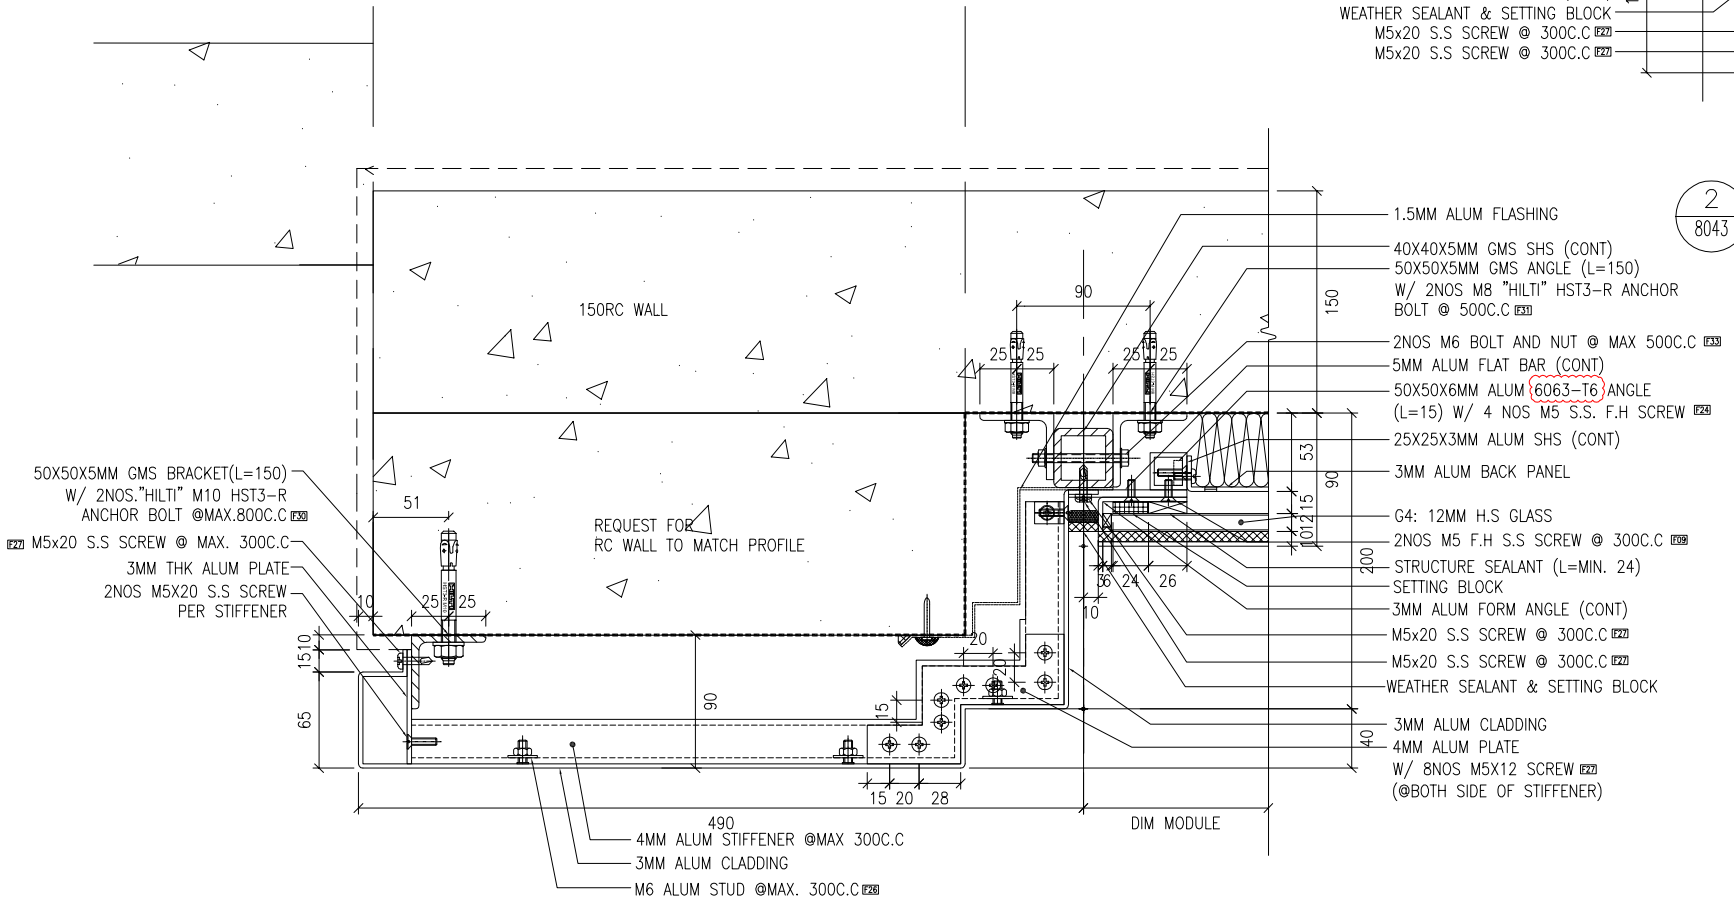

3 / 8043 TYPICAL DETAIL FOR GLASS CLADDING (END BAY)

B.D. REF :

NEW DRAWING

CLIENT :

SUN HUNG KAI REAL ESTATE AGENCY LTD.
42/F SUN HUNG KAI CENTRE, WANCHAI, HONGKONG

ARCHITECT :

lwk&partners
a r c h i t e c t s

MAIN CONTRACTOR :

怡輝建築有限公司
Yee Fai Building Contractors Ltd.

STRUCTURAL ENGINEER :

ARUP

FACADE CONSULTANT:

ALPHA CONSULTING LIMITED
Steel Structure & Facade Specialist

NOTE :
1. ALL DIMENSIONS ARE IN mm.
2. ALL ELEVATIONS ARE VIEWED FROM OUTSIDE.
3. ALL DIMENSIONS TO BE VERIFIED ON SITE BEFORE FABRICATION.

LEGEND :

X1 / X001 — DETAIL MARK NO. / REFER SHEET NO.

1. F.F.L. --FINISHED FLOOR LEVEL
2. S.F.L. --STRUCTURAL FLOOR LEVEL
3. (R) --REVERSED DETAIL

NO.	DATE	REVISED	BY
A	30-OCT-2023	9TH SUBMISSION	CF
–	31-JUL-2023	NEW DRAWING (7TH SUBMISSION)	CF

JOB NO. : J-856

PROJECT :
PROPOSED DEVELOPMENT ABOVE LIGHT RAIL TIN WING STOP,TSWTL NO.23,AREA 33,TIN SHUI WAI, N.T.


TITLE :
TYPICAL DETAIL FOR CURTAIN WALL (GLASS CLADDING)

DATE : 23-MAY-23 | SCALE : 1:5

DRAWN BY : C.F | CHECKED BY :


美特鋁質有限公司
MIDI ALUMINIUM FABRICATOR LTD.
Units 6-8, Sunray Industrial Centre, 1/F
610 Cha Kwo Ling Road, Kowloon
Tel:23489211-4 Fax:(852)27727666

DWG NO. : J856-SD-CW-8043 | REV. : A

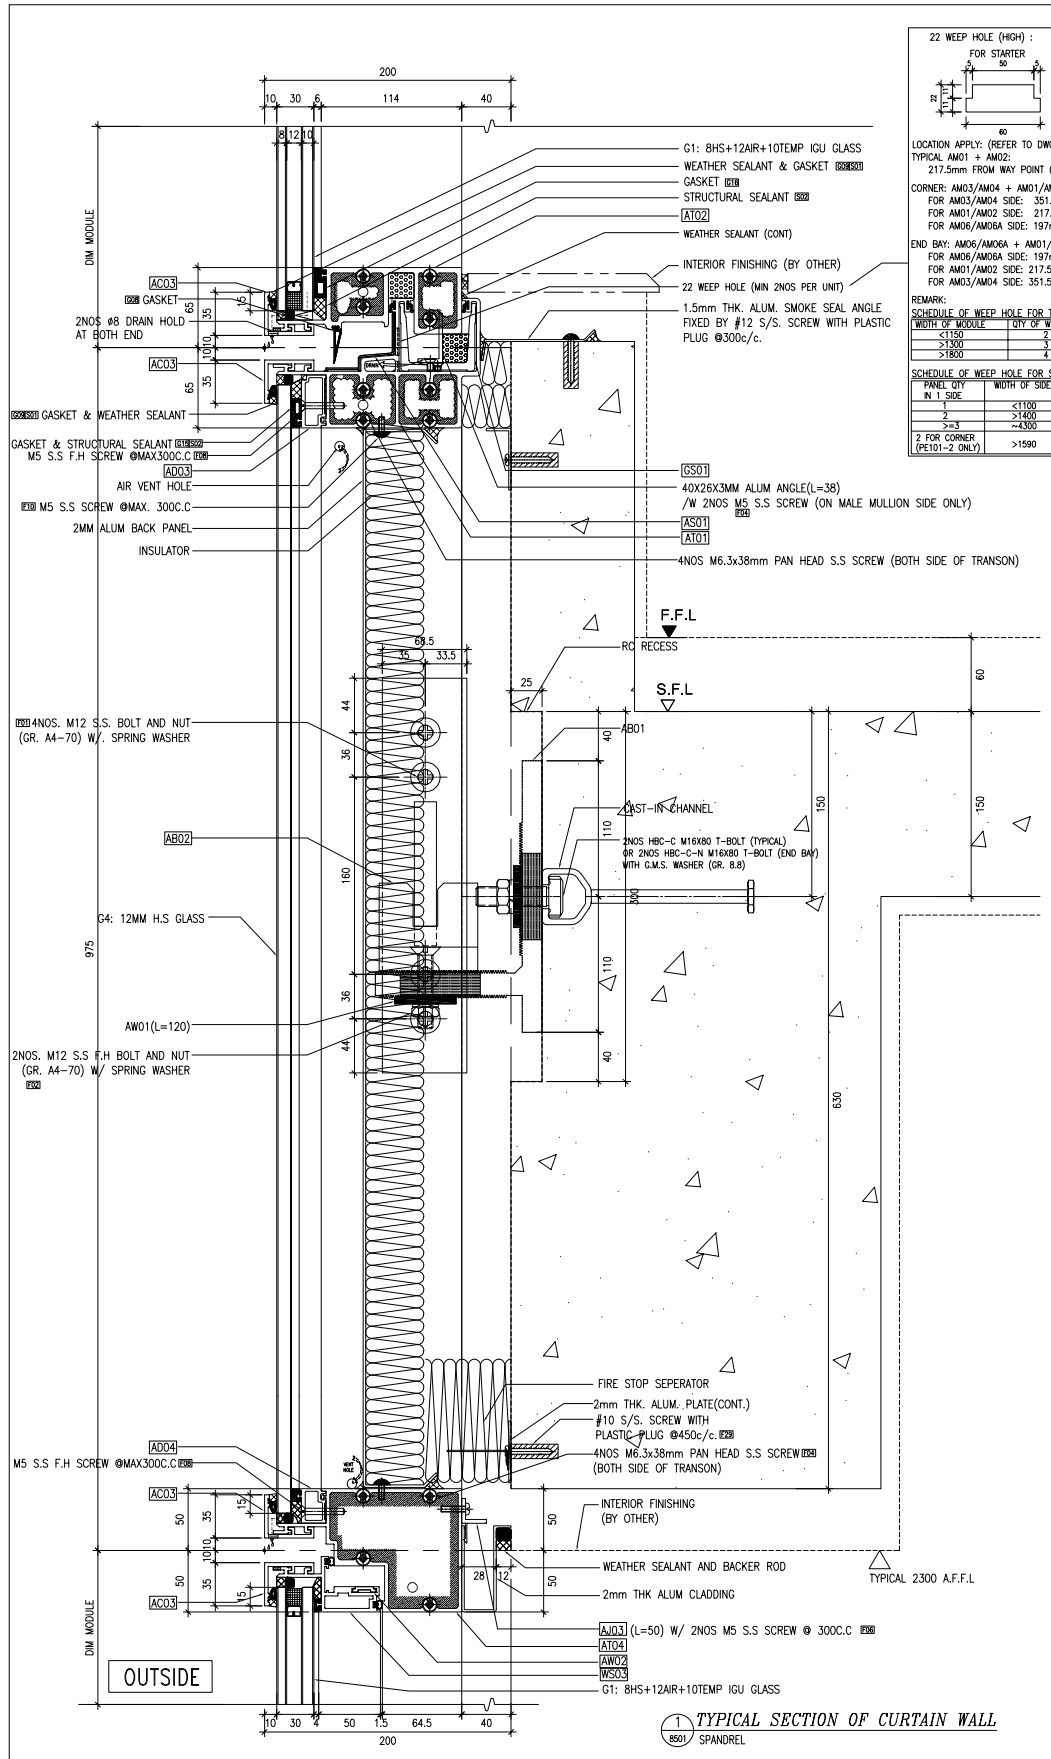

1 8501 *TYPICAL SECTION OF CURTAIN WALL*
SPANDREL

22 WEEP HOLE (HIGH) :

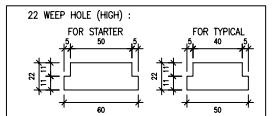

LOCATION APPLY: (REFER TO DWG: D32/8510A)
TYPICAL AM01 + AM02:
217.5mm FROM WAY POINT (BOTH SIDE)

CORNER: AM03/AM04 + AM01/AM02 OR AM06/AM06A:
FOR AM03/AM04 SIDE: 351.5mm FROM WAY POINT
FOR AM01/AM02 SIDE: 217.5mm FROM WAY POINT
FOR AM06/AM06A SIDE: 197mm FROM WAY POINT

END BAY: AM06/AM06A + AM01/AM02 OR AM03/AM04:
FOR AM06/AM06A SIDE: 197mm FROM WAY POINT
FOR AM01/AM02 SIDE: 217.5mm FROM WAY POINT
FOR AM03/AM04 SIDE: 351.5mm FROM WAY POINT


REMARK:

SCHEDULE OF WEEP HOLE FOR TYPICAL (AT01)


WIDTH OF MODULE	QTY OF WEEP HOLE/MODULE
<1150	2 NOS.
>1300	3 NOS. (@ ⅓ EQ DISTANCE)
>1800	4 NOS. (@ ¼ EQ DISTANCE)

SCHEDULE OF WEEP HOLE FOR STARTER (AT01)

PANEL QTY IN 1 SIDE	WIDTH OF SIDE	QTY OF WEEP HOLE
1	<1100	2 NOS.
2	>1400	4 NOS.
>=3	<4300	REFER TO TYP QTY
2 FOR CORNER (PE101~2 ONLY)	>1590	6NOS

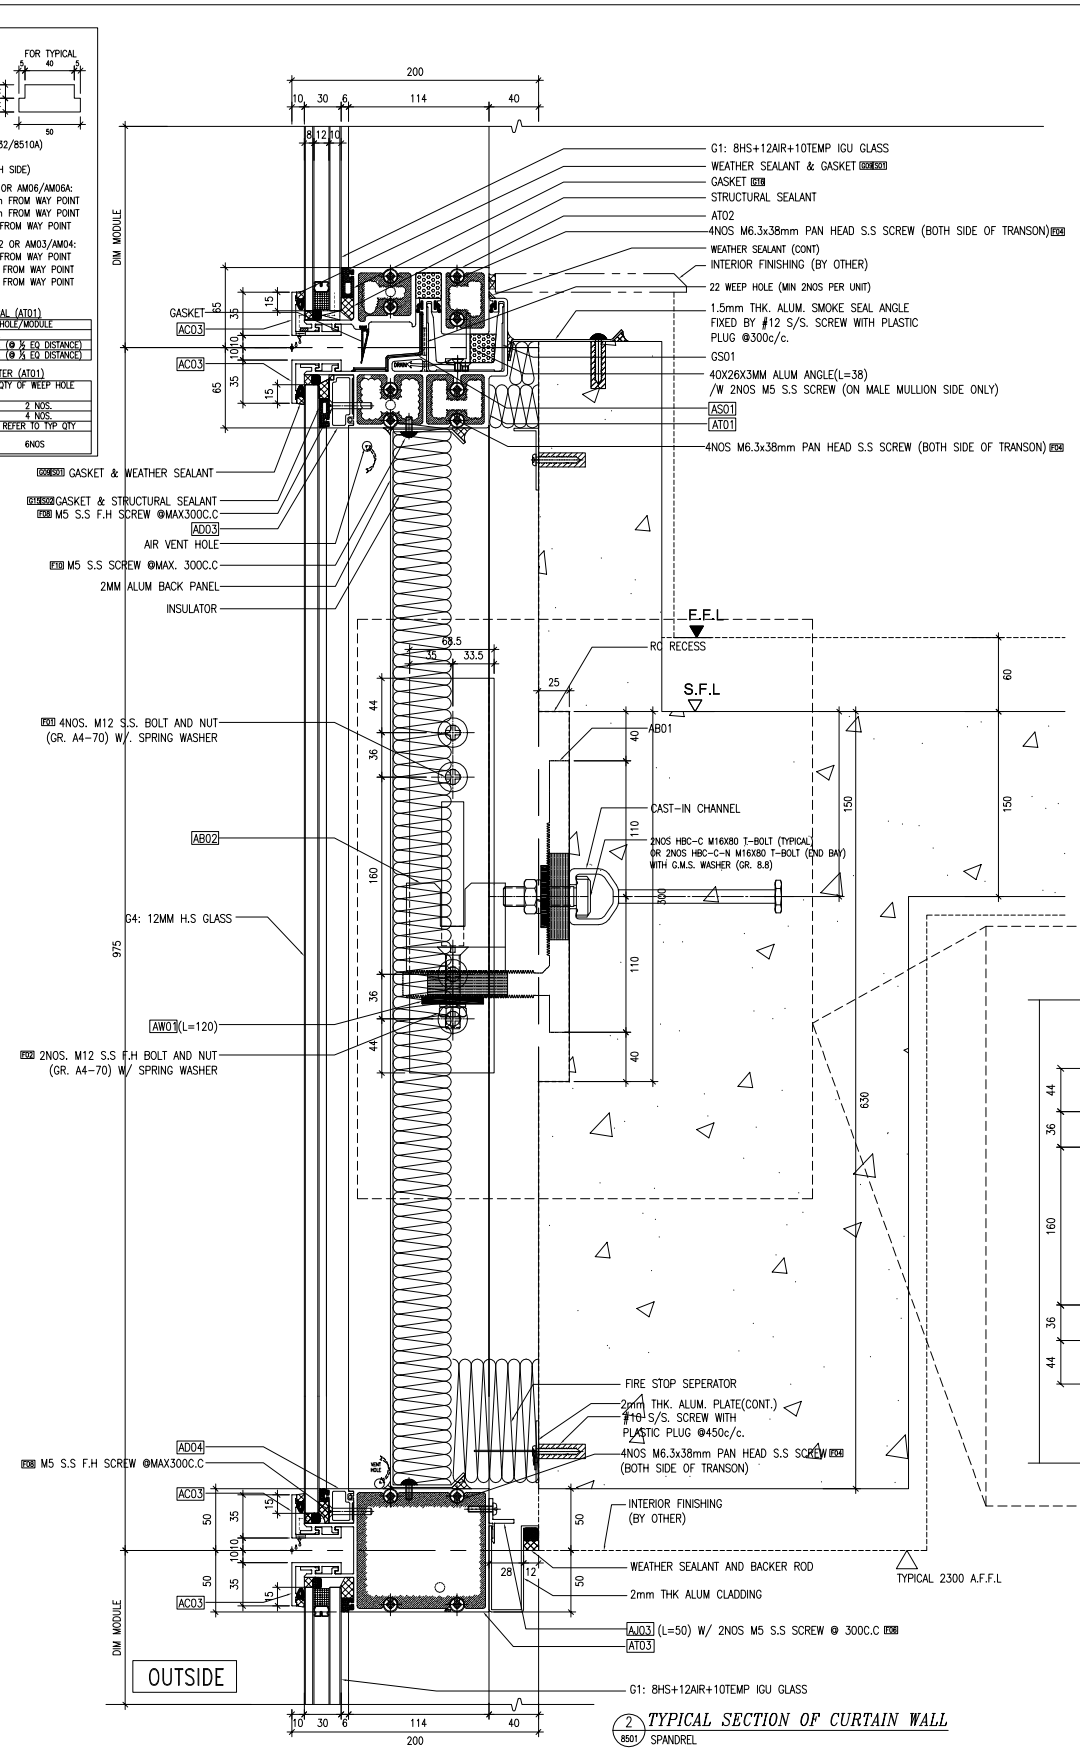

2 8501 *TYPICAL SECTION OF CURTAIN WALL*
SPANDREL

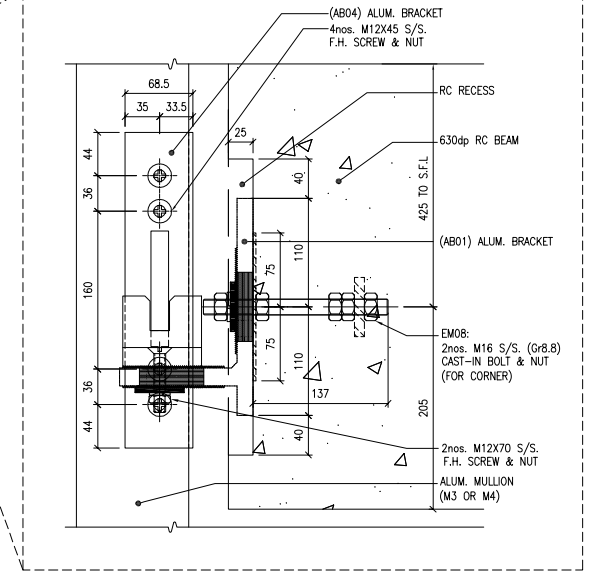

2A 8501 *SECTION DETAIL OF CURTAIN WALL*
FIXING FOR CORNER

B.D. REF :

CLIENT :
SUN HUNG KAI REAL ESTATE AGENCY LTD.
42/F SUN HUNG KAI CENTRE, WANCHAI, HONGKONG

ARCHITECT :
lwk&partners
a r c h i t e c t s

MAIN CONTRACTOR :
怡輝建築有限公司
Yee Fai Building Contractors Ltd.

STRUCTURAL ENGINEER :
ARUP

FACADE CONSULTANT:
ALPHA CONSULTING LIMITED
Steel Structure & Facade Specialist

NOTE :
1. ALL DIMENSIONS ARE IN mm.
2. ALL ELEVATIONS ARE VIEWED FROM OUTSIDE.
3. ALL DIMENSIONS TO BE VERIFIED ON SITE BEFORE FABRICATION.

LEGEND :
X1 / X001 — DETAIL MARK NO. / REFER SHEET NO.
1. F.F.L. --FINISHED FLOOR LEVEL
2. S.F.L. --STRUCTURAL FLOOR LEVEL
3. (R) --REVERSED DETAIL

NO.	DATE	REVISED	BY
E	22-AUG-2023	7TH SUBMISSION	CF
D	30-MAY-2023	6TH SUBMISSION	CF
C	10-MAY-2023	5TH SUBMISSION	CF
B	21-FEB-2023	4TH SUBMISSION	CF
A	30-DEC-2022	2ND SUBMISSION	CF

JOB NO. : J-856

PROJECT :
PROPOSED DEVELOPMENT ABOVE LIGHT RAIL TIN WING STOP,TSWTL NO.23,AREA 33,TIN SHUI WAI, N.T.


TITLE :
TYPICAL DETAIL FOR CURTAIN WALL

DATE : 31-OCT-22 | SCALE : 1:6


DRAWN BY : C.F | CHECKED BY :

美特鋁質有限公司
MIDI ALUMINIUM FABRICATOR LTD.
Units 6-8, Sunray Industrial Centre, 1/F
610 Cha Kwo Ling Road, Kowloon
Tel:23489211-4 Fax:(852)27727666

DWG NO. : J856-SD-CW-8501 | REV. : E

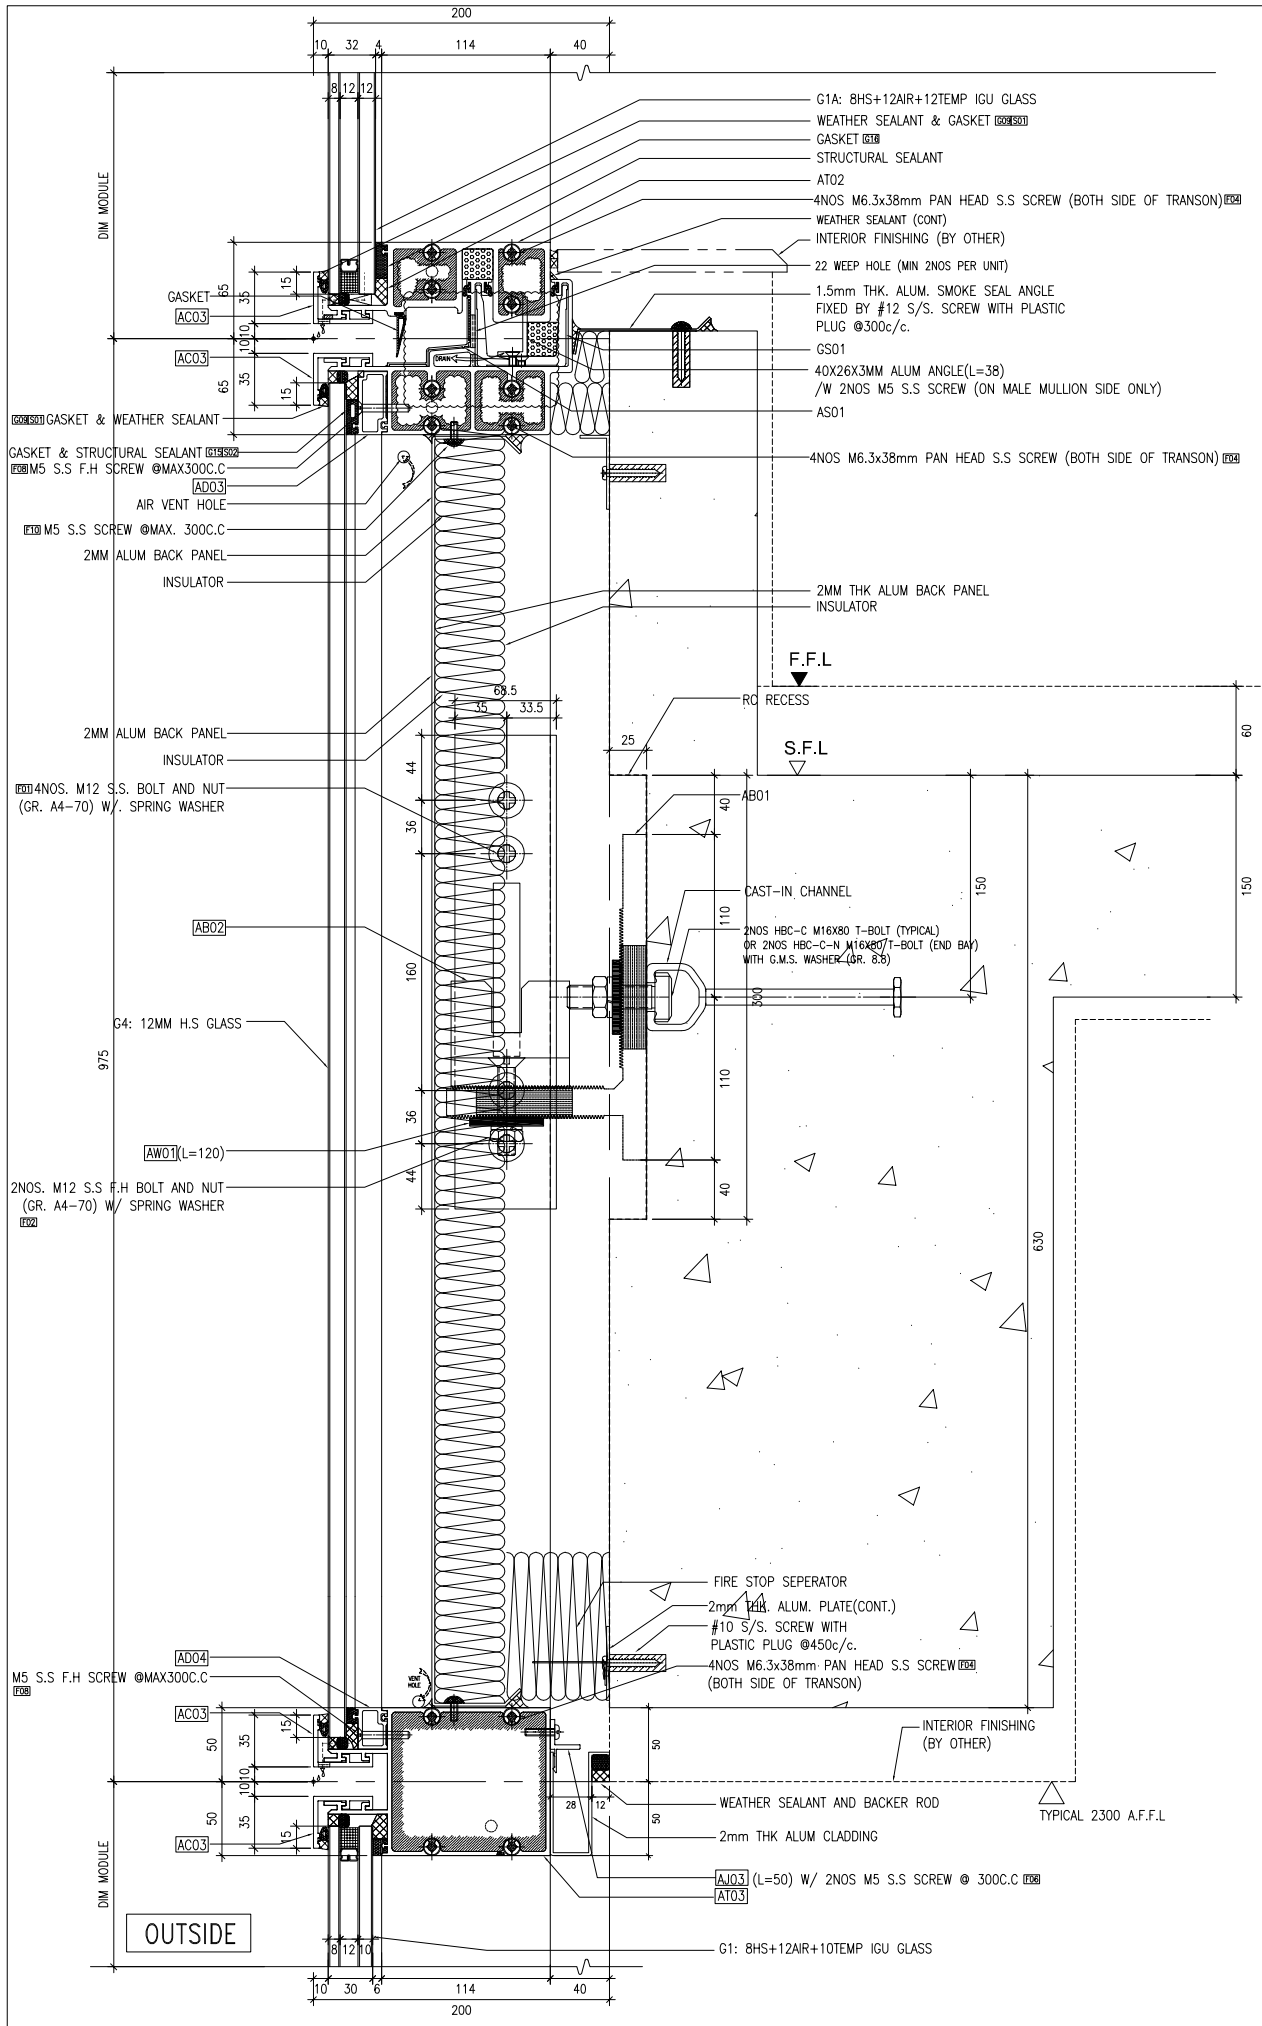

1 8501A *TYPICAL SECTION OF CURTAIN WALL*
SPANDREL

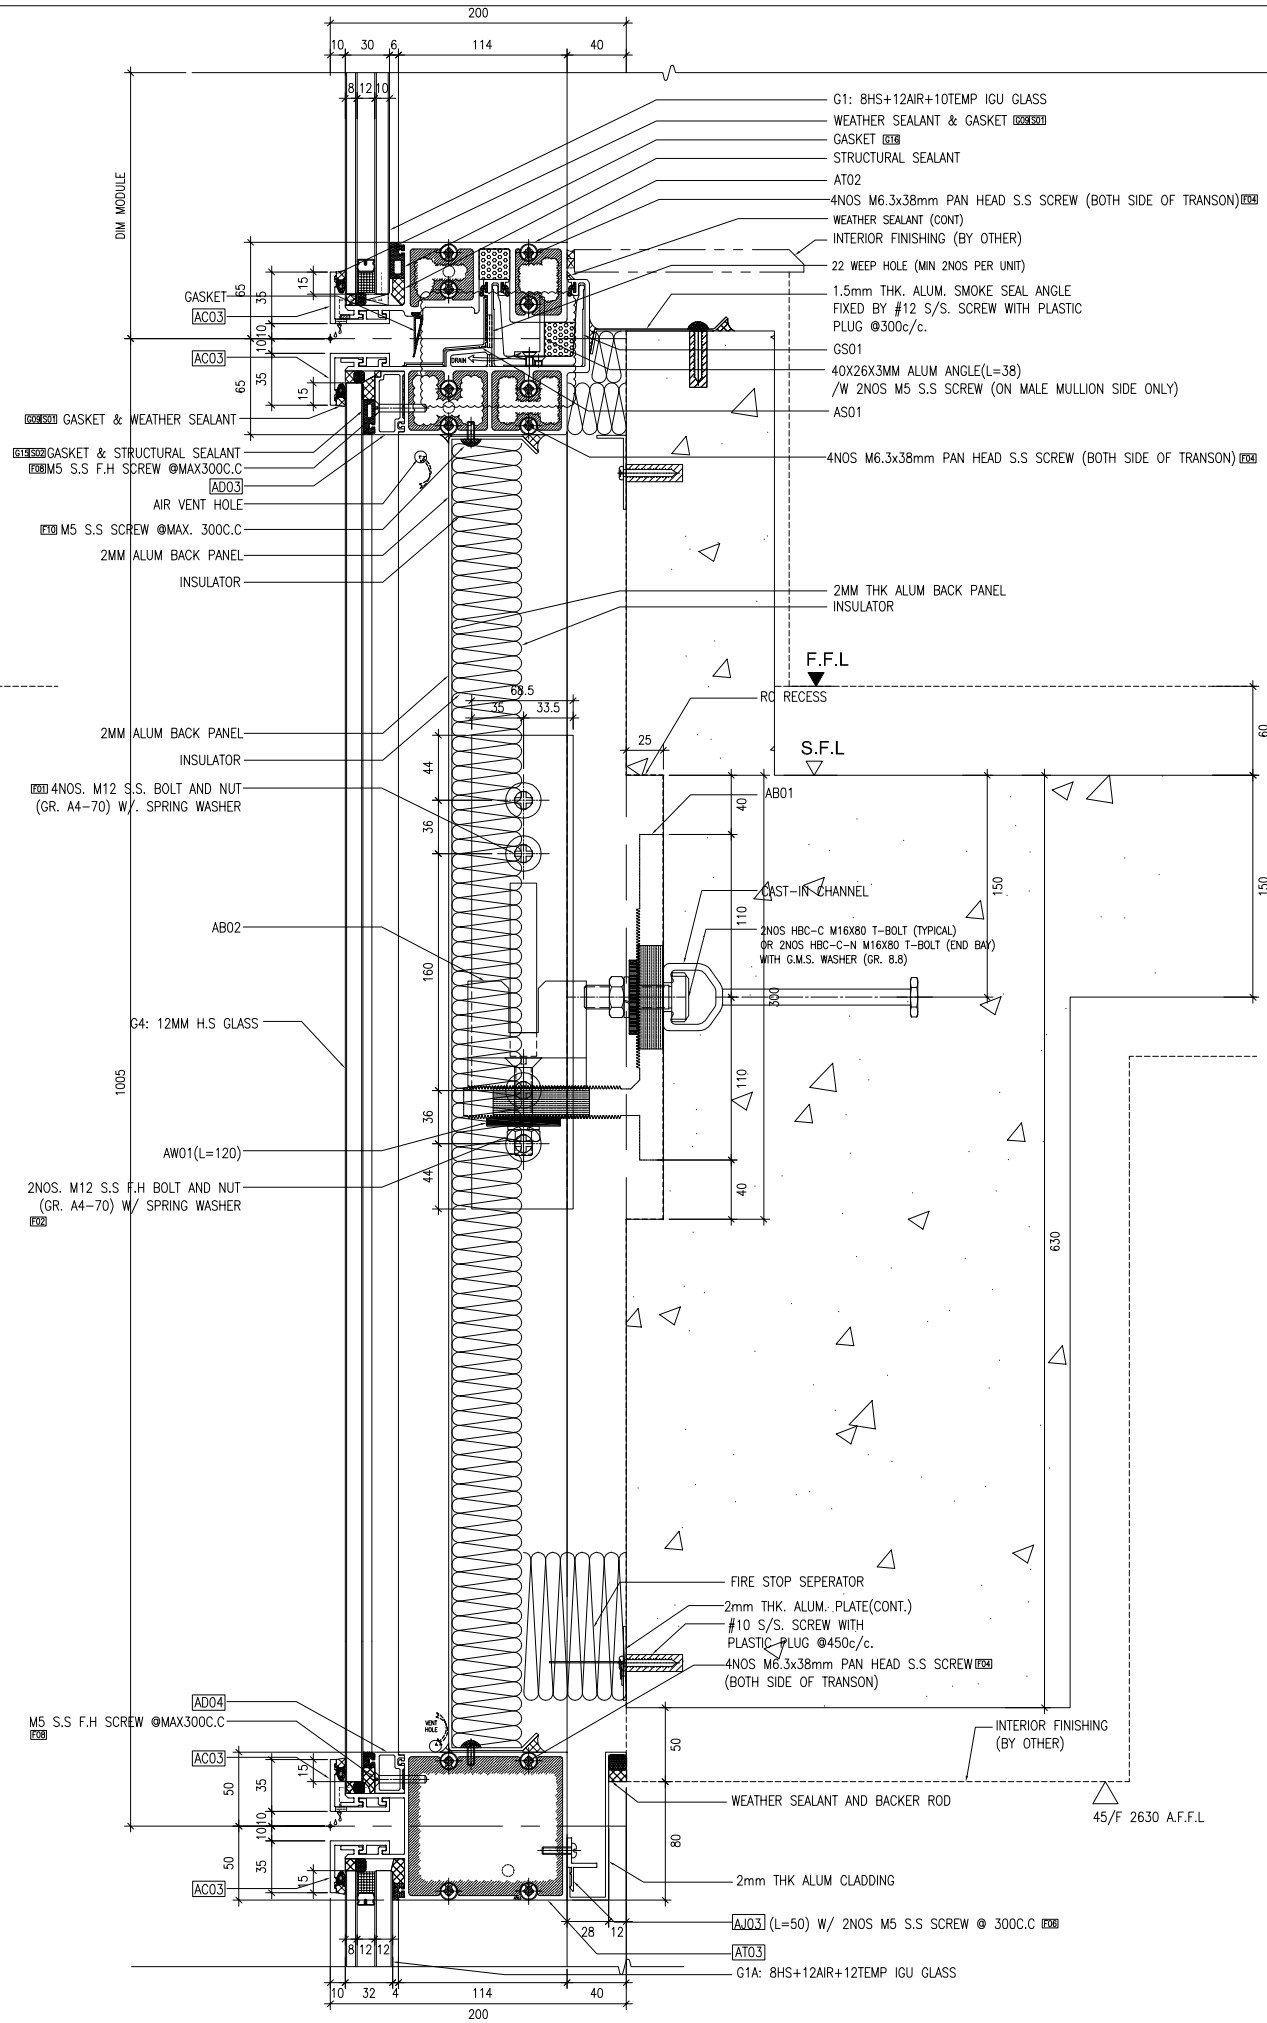

2 8501A *TYPICAL SECTION OF CURTAIN WALL*
SPANDREL

B.D. REF :

CLIENT :
SUN HUNG KAI REAL ESTATE AGENCY LTD.
42/F SUN HUNG KAI CENTRE, WANCHAI, HONGKONG

ARCHITECT :
lwk&partners
a r c h i t e c t s

MAIN CONTRACTOR :
怡輝建築有限公司
Yee Fai Building Contractors Ltd.

STRUCTURAL ENGINEER :
ARUP

FACADE CONSULTANT:
ALPHA CONSULTING LIMITED
Steel Structure & Facade Specialist

NOTE :
1. ALL DIMENSIONS ARE IN mm.
2. ALL ELEVATIONS ARE VIEWED FROM OUTSIDE.
3. ALL DIMENSIONS TO BE VERIFIED ON SITE BEFORE FABRICATION.

LEGEND :
X1 / X001 — DETAIL MARK NO. / REFER SHEET NO.
1. F.F.L. --FINISHED FLOOR LEVEL
2. S.F.L. --STRUCTURAL FLOOR LEVEL
3. /R --REVERSED DETAIL

NO.	DATE	REVISED	BY
D	30-MAY-2023	6TH SUBMISSION	CF
C	10-MAY-2023	5TH SUBMISSION	CF
B	21-FEB-2023	4TH SUBMISSION	CF
A	30-DEC-2022	2ND SUBMISSION	CF
-	21-NOV-2022		CF

JOB NO. : J-856

PROJECT :
PROPOSED DEVELOPMENT ABOVE LIGHT RAIL TIN WING STOP,TSWTL NO.23,AREA 33,TIN SHUI WAI, N.T.


TITLE :
TYPICAL DETAIL FOR CURTAIN WALL

DATE : 31-OCT-22 | SCALE : 1:5

DRAWN BY : C.F | CHECKED BY :

美特鋁製有限公司
MIDI ALUMINIUM FABRICATOR LTD.
Units 6-8, Sunray Industrial Centre, 1/F
610 Cha Kwo Ling Road, Kowloon
Tel:23489211-4 Fax:(852)27727666

DWG NO. : J856-SD-CW-8501A | REV. : D

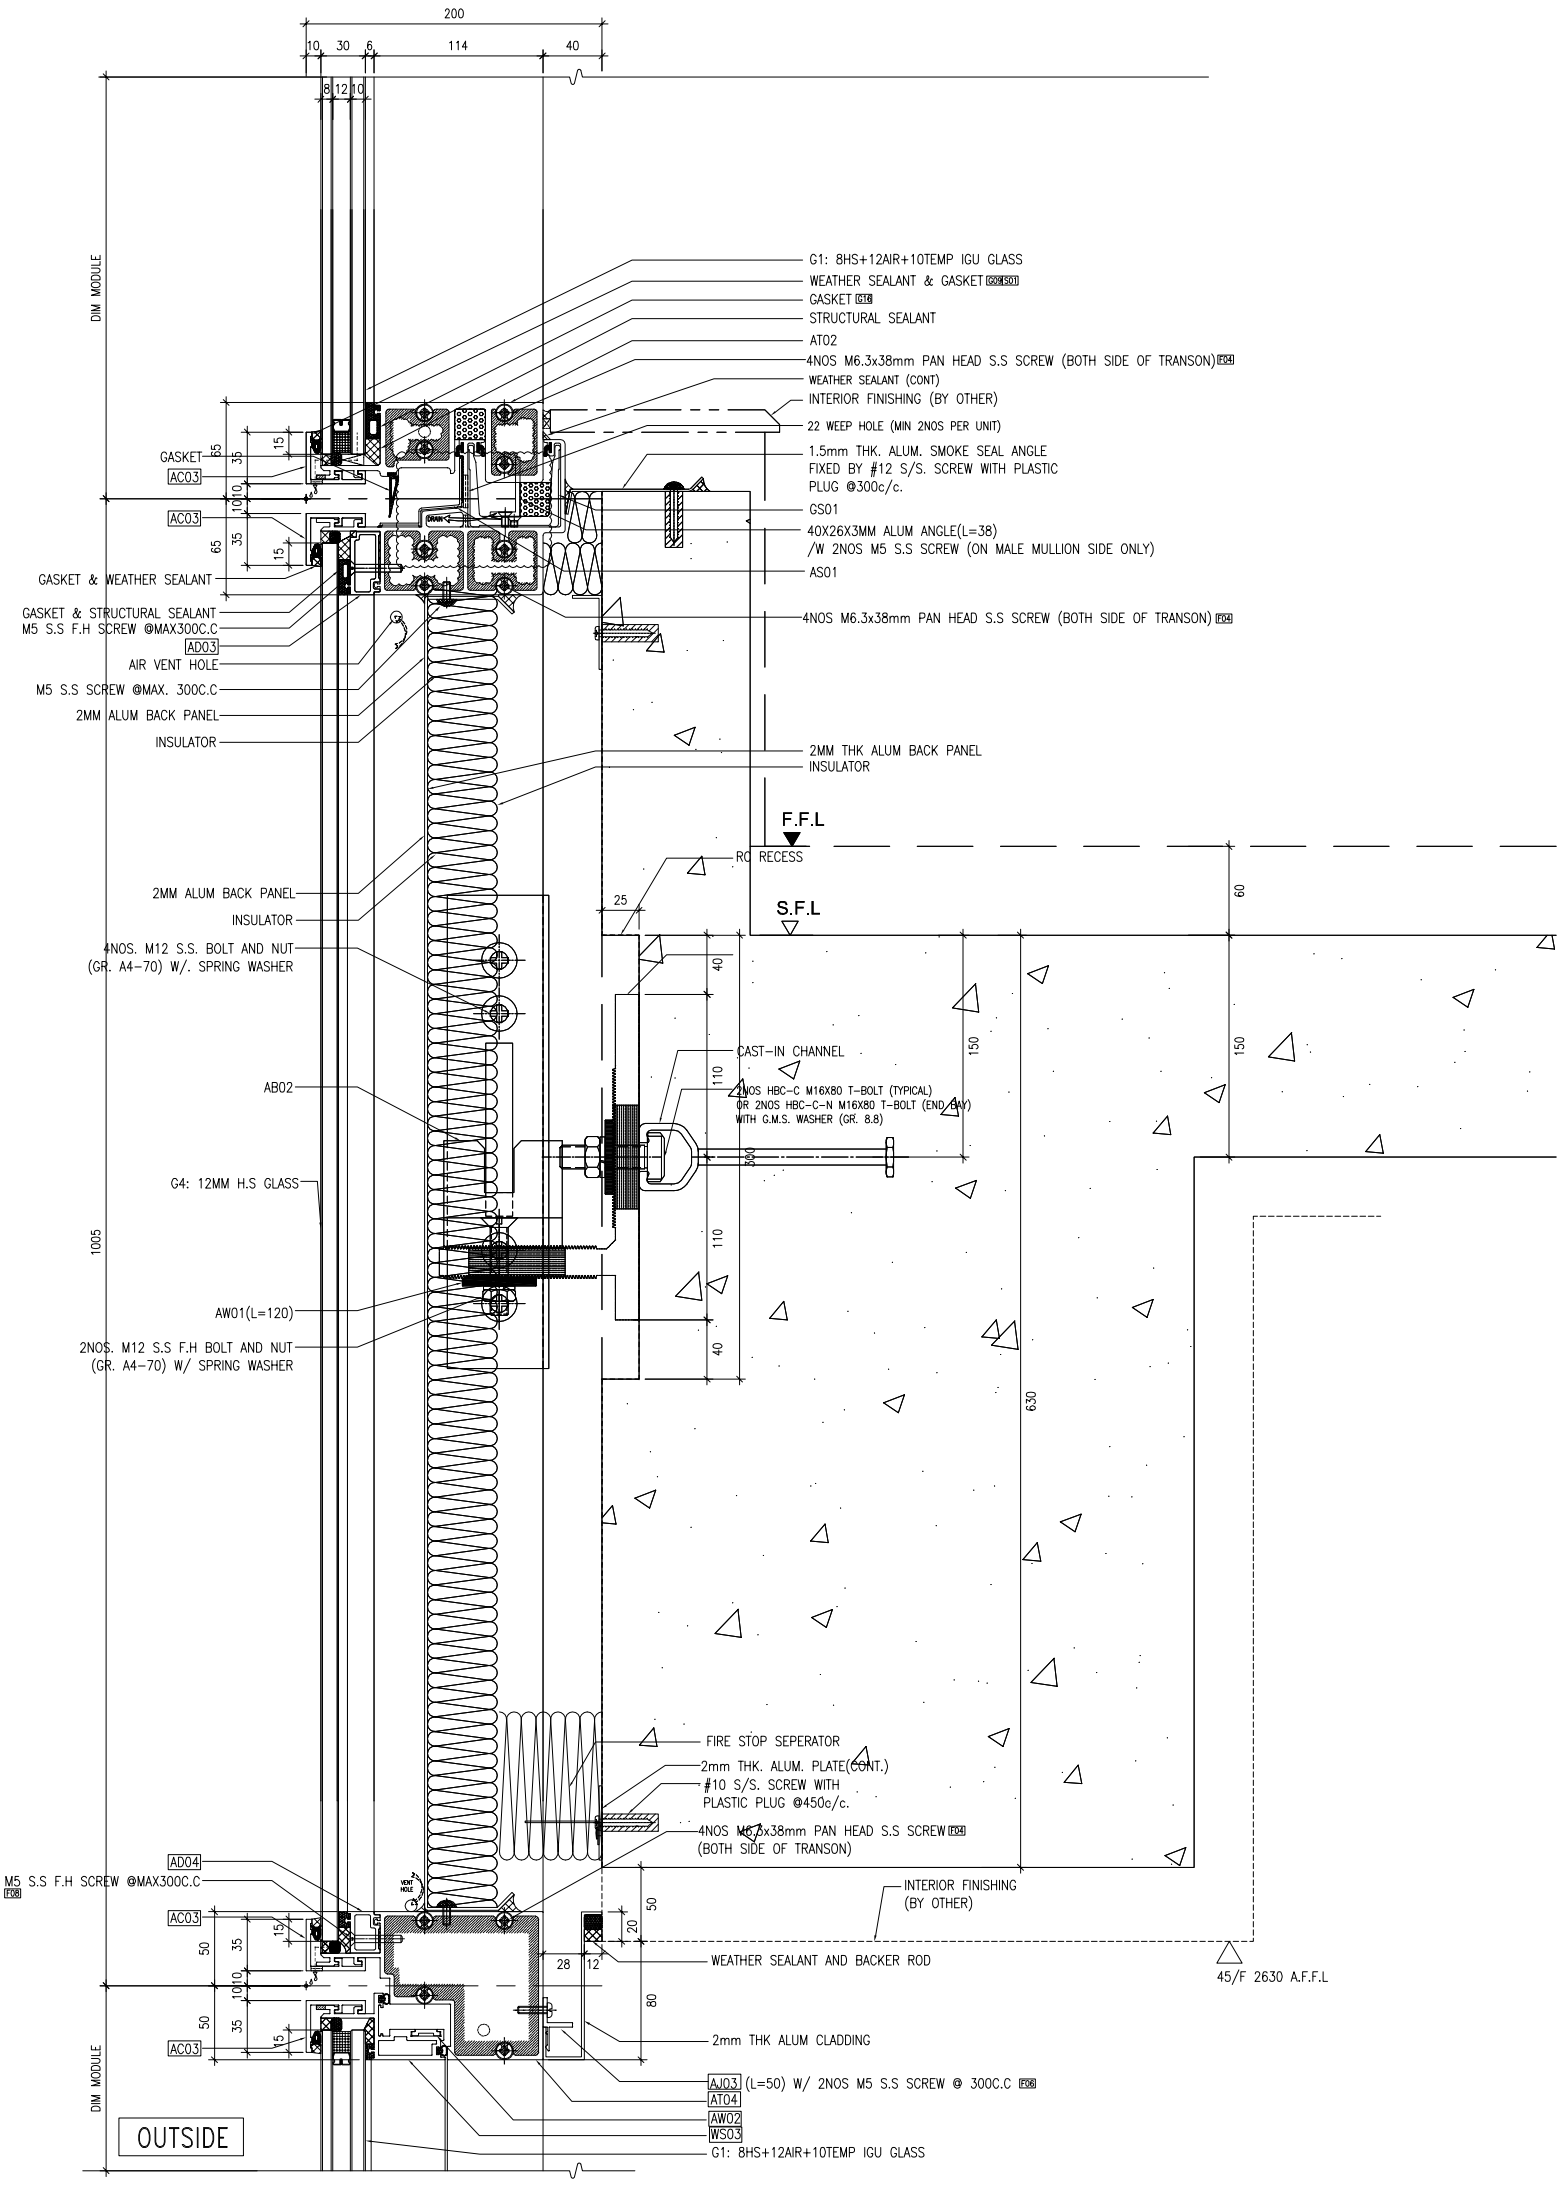

2 / 8501B *TYPICAL SECTION OF CURTAIN WALL*
SPANDREL (45/F TO 46/F)

NOTE :
1. ALL DIMENSIONS ARE IN mm.
2. ALL ELEVATIONS ARE VIEWED FROM OUTSIDE.
3. ALL DIMENSIONS TO BE VERIFIED ON SITE BEFORE FABRICATION.

LEGEND :
X1 / X001 — DETAIL MARK NO. / REFER SHEET NO.

1. F.F.L. -- FINISHED FLOOR LEVEL
2. S.F.L. -- STRUCTURAL FLOOR LEVEL
3. /R -- REVERSED DETAIL

NO.	DATE	REMRD	BY
B	30-MAY-2023	6TH SUBMISSION	CF
A	10-MAY-2023	5TH SUBMISSION	CF
-	21-FEB-2023	NEW DRAWING (4TH SUBMISSION)	CF

JOB NO. : J-856

PROJECT :
PROPOSED DEVELOPMENT ABOVE
LIGHT RAIL TIN WING STOP,TSWTL
NO.23,AREA 33,TIN SHUI WAI, N.T.

TITLE :
TYPICAL DETAIL
FOR CURTAIN WALL

DATE : 31-OCT-22 | SCALE : 1:5

DRAWN BY : C.F | CHECKED BY :

美特鋁質有限公司
MIDI ALUMINUM FABRICATOR LTD.
Units 6-8, Sunray Industrial Centre, 1/F
610 Cha Kwo Ling Road, Kowloon
Tel:23489211-4 Fax:(852)27727666

DWG NO. : J856-SD-CW-8501B | REV. : B

CLIENT :
SUN HUNG KAI REAL ESTATE AGENCY LTD.
42/F SUN HUNG KAI CENTRE, WANCHAI, HONGKONG


ARCHITECT :
lwk&partners architects

MAIN CONTRACTOR :
怡輝建築有限公司
Yee Fai Building Contractors Ltd.

STRUCTURAL ENGINEER :
ARUP

FACADE CONSULTANT :
ALPHA CONSULTING LIMITED
Steel Structure & Facade Specialist

B.D. REF :

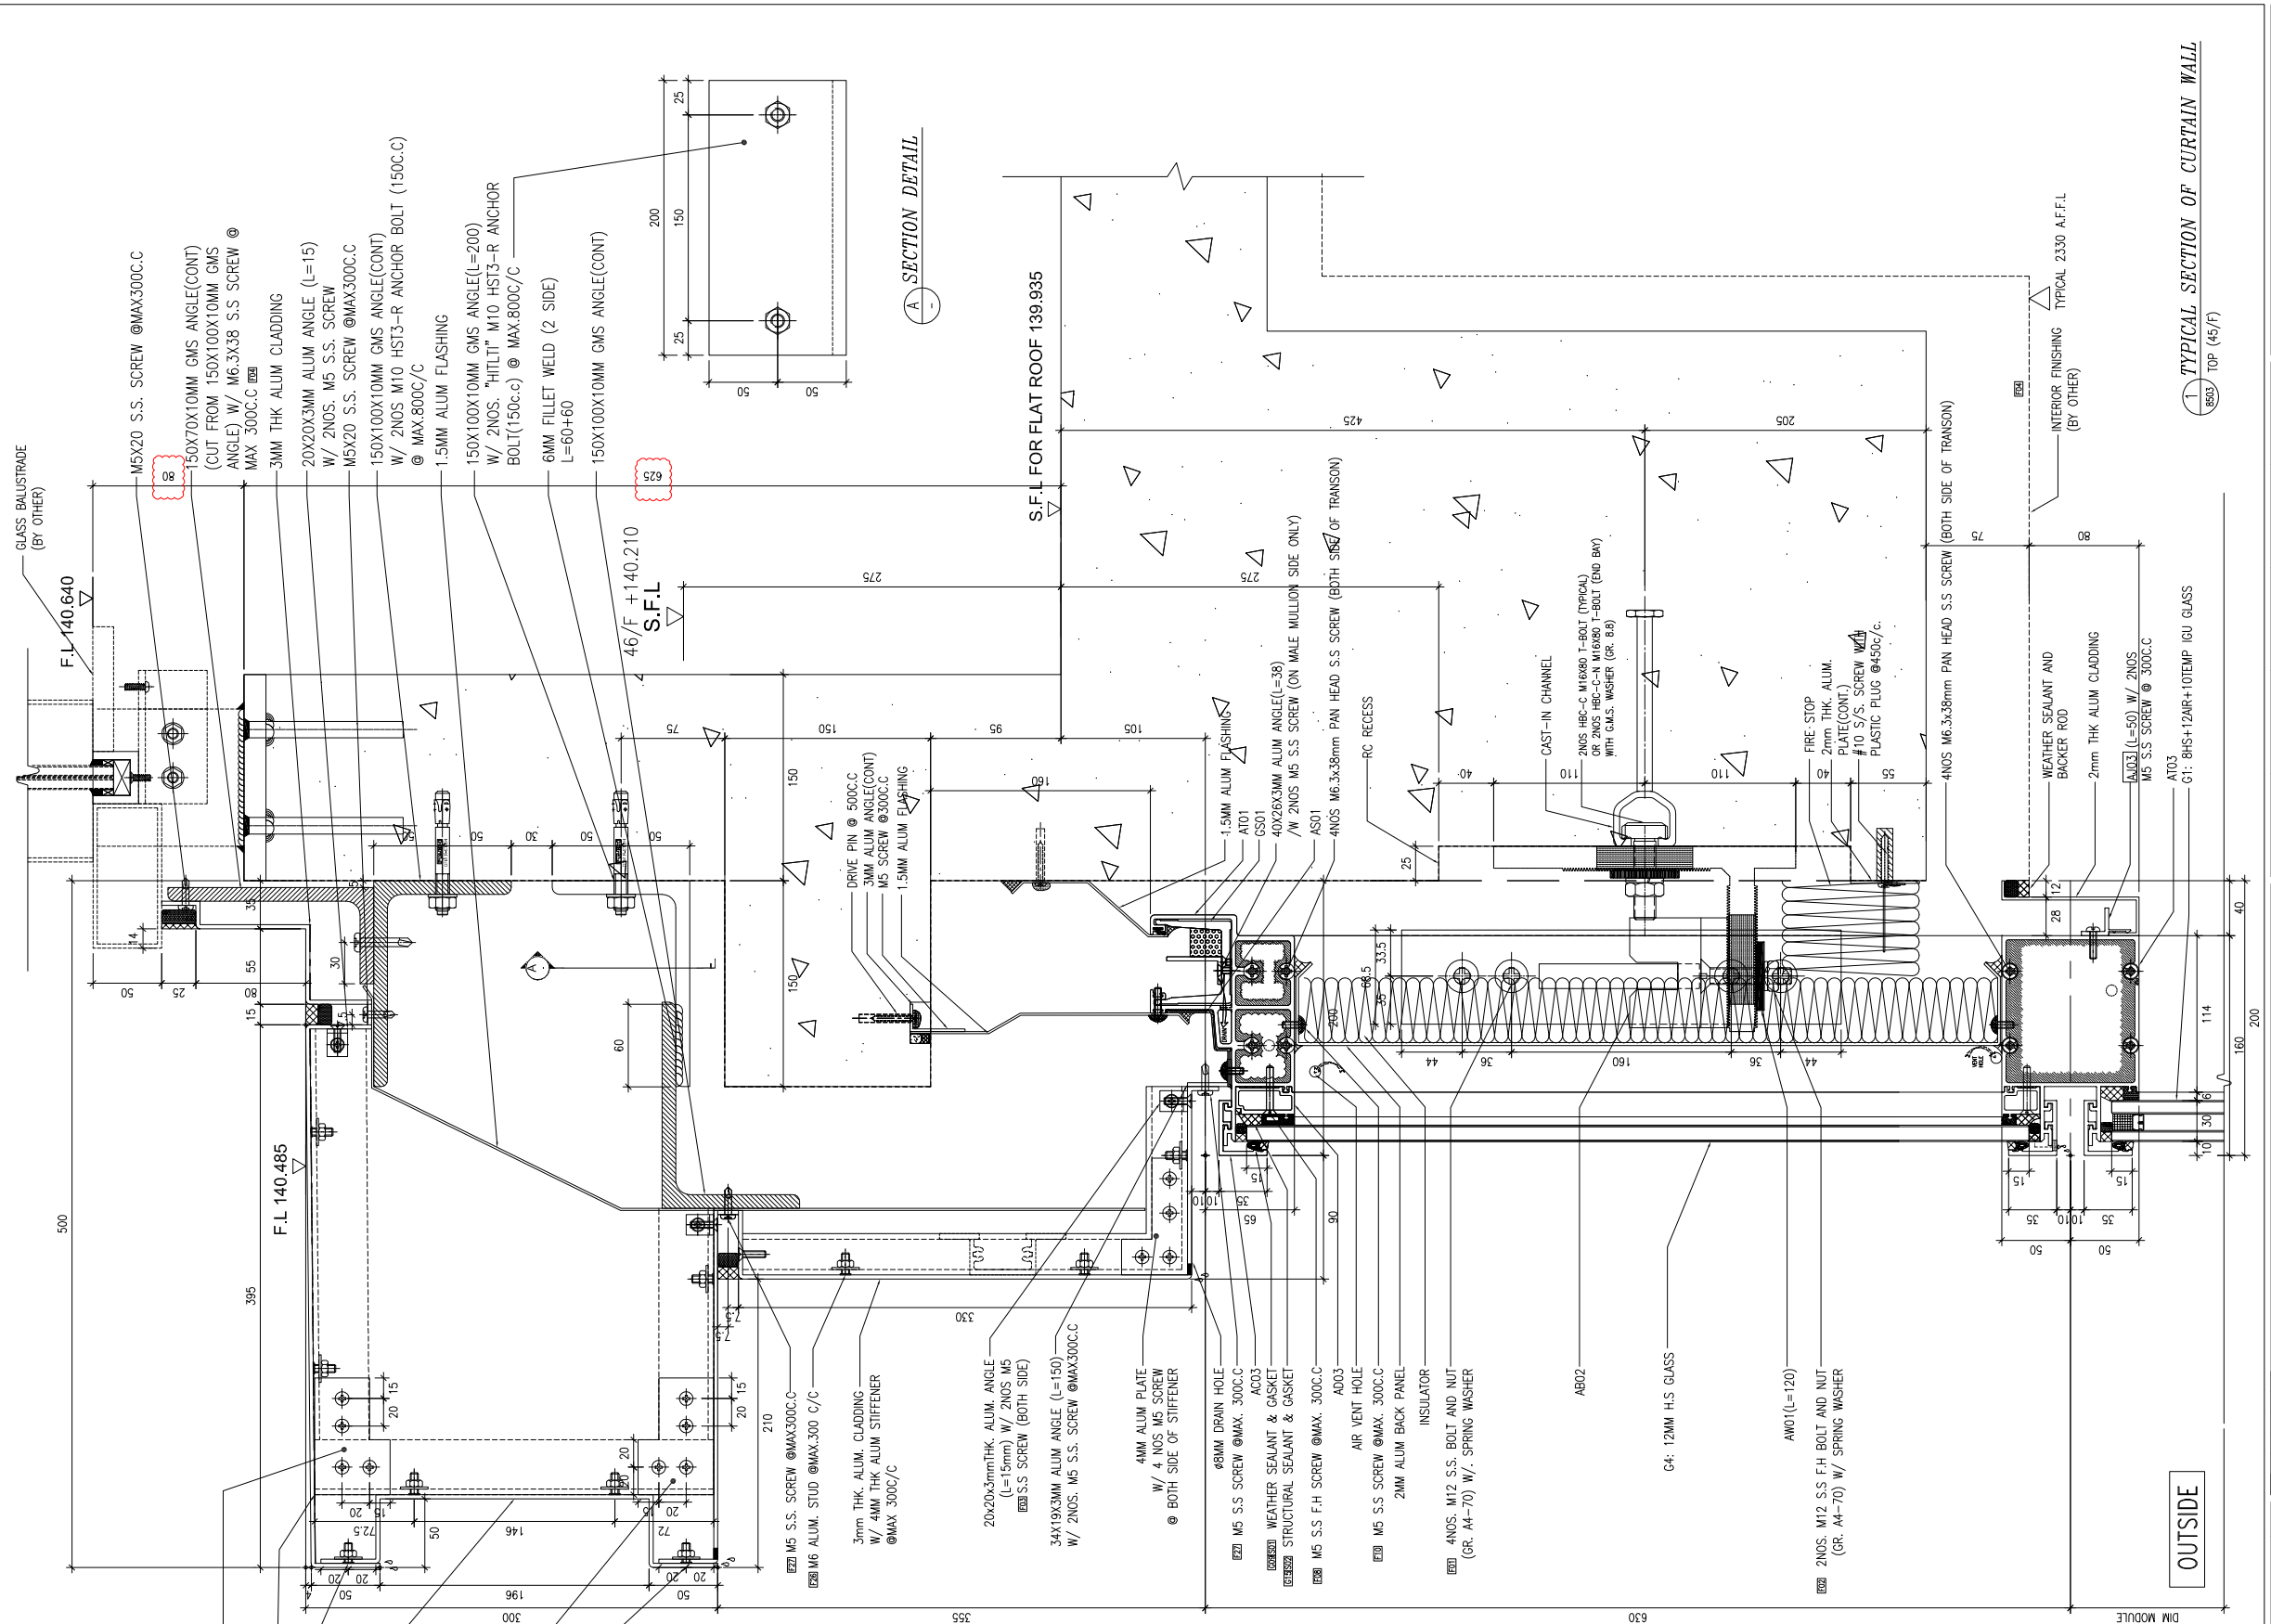

B.D. REF :

CLIENT :

SUN HUNG KAI REAL ESTATE AGENCY LTD.
42/F SUN HUNG KAI CENTRE, WANCHAI, HONGKONG

ARCHITECT :

lwk&partners
a r c h i t e c t s

MAIN CONTRACTOR :

怡輝建築有限公司
Yee Fai Building Contractors Ltd.

STRUCTURAL ENGINEER :

ARUP

FACADE CONSULTANT:

ALPHA CONSULTING LIMITED
Steel Structure & Facade Specialist

NOTE :
1. ALL DIMENSIONS ARE IN mm.
2. ALL ELEVATIONS ARE VIEWED FROM OUTSIDE.
3. ALL DIMENSIONS TO BE VERIFIED ON SITE BEFORE FABRICATION.

LEGEND :

X1 — DETAIL MARK NO.
X001 — REFER SHEET NO.

1. F.F.L. --FINISHED FLOOR LEVEL
2. S.F.L. --STRUCTURAL FLOOR LEVEL
3. (R) --REVERSED DETAIL

NO.	DATE	REVISED	BY
E	30-OCT-2023	9TH SUBMISSION	CF
D	22-AUG-2023	7TH SUBMISSION	CF
C	10-MAY-2023	5TH SUBMISSION	CF
B	21-FEB-2023	4TH SUBMISSION	CF
A	30-DEC-2022	2ND SUBMISSION	CF

JOB NO. : J-856

PROJECT :
PROPOSED DEVELOPMENT ABOVE LIGHT RAIL TIN WING STOP,TSWTL NO.23,AREA 33,TIN SHUI WAI, N.T.


TITLE :
TYPICAL DETAIL FOR CURTAIN WALL

DATE : 31-OCT-22 | SCALE : 1:5

DRAWN BY : C.F | CHECKED BY :

美特鋁質有限公司
MIDI ALUMINIUM FABRICATOR LTD.
Units 6-8, Sunray Industrial Centre, 1/F
610 Cha Kwo Ling Road, Kowloon
Tel:23489211-4 Fax:(852)27727666

DWG NO. : J856-SD-CW-8503 | REV. : E

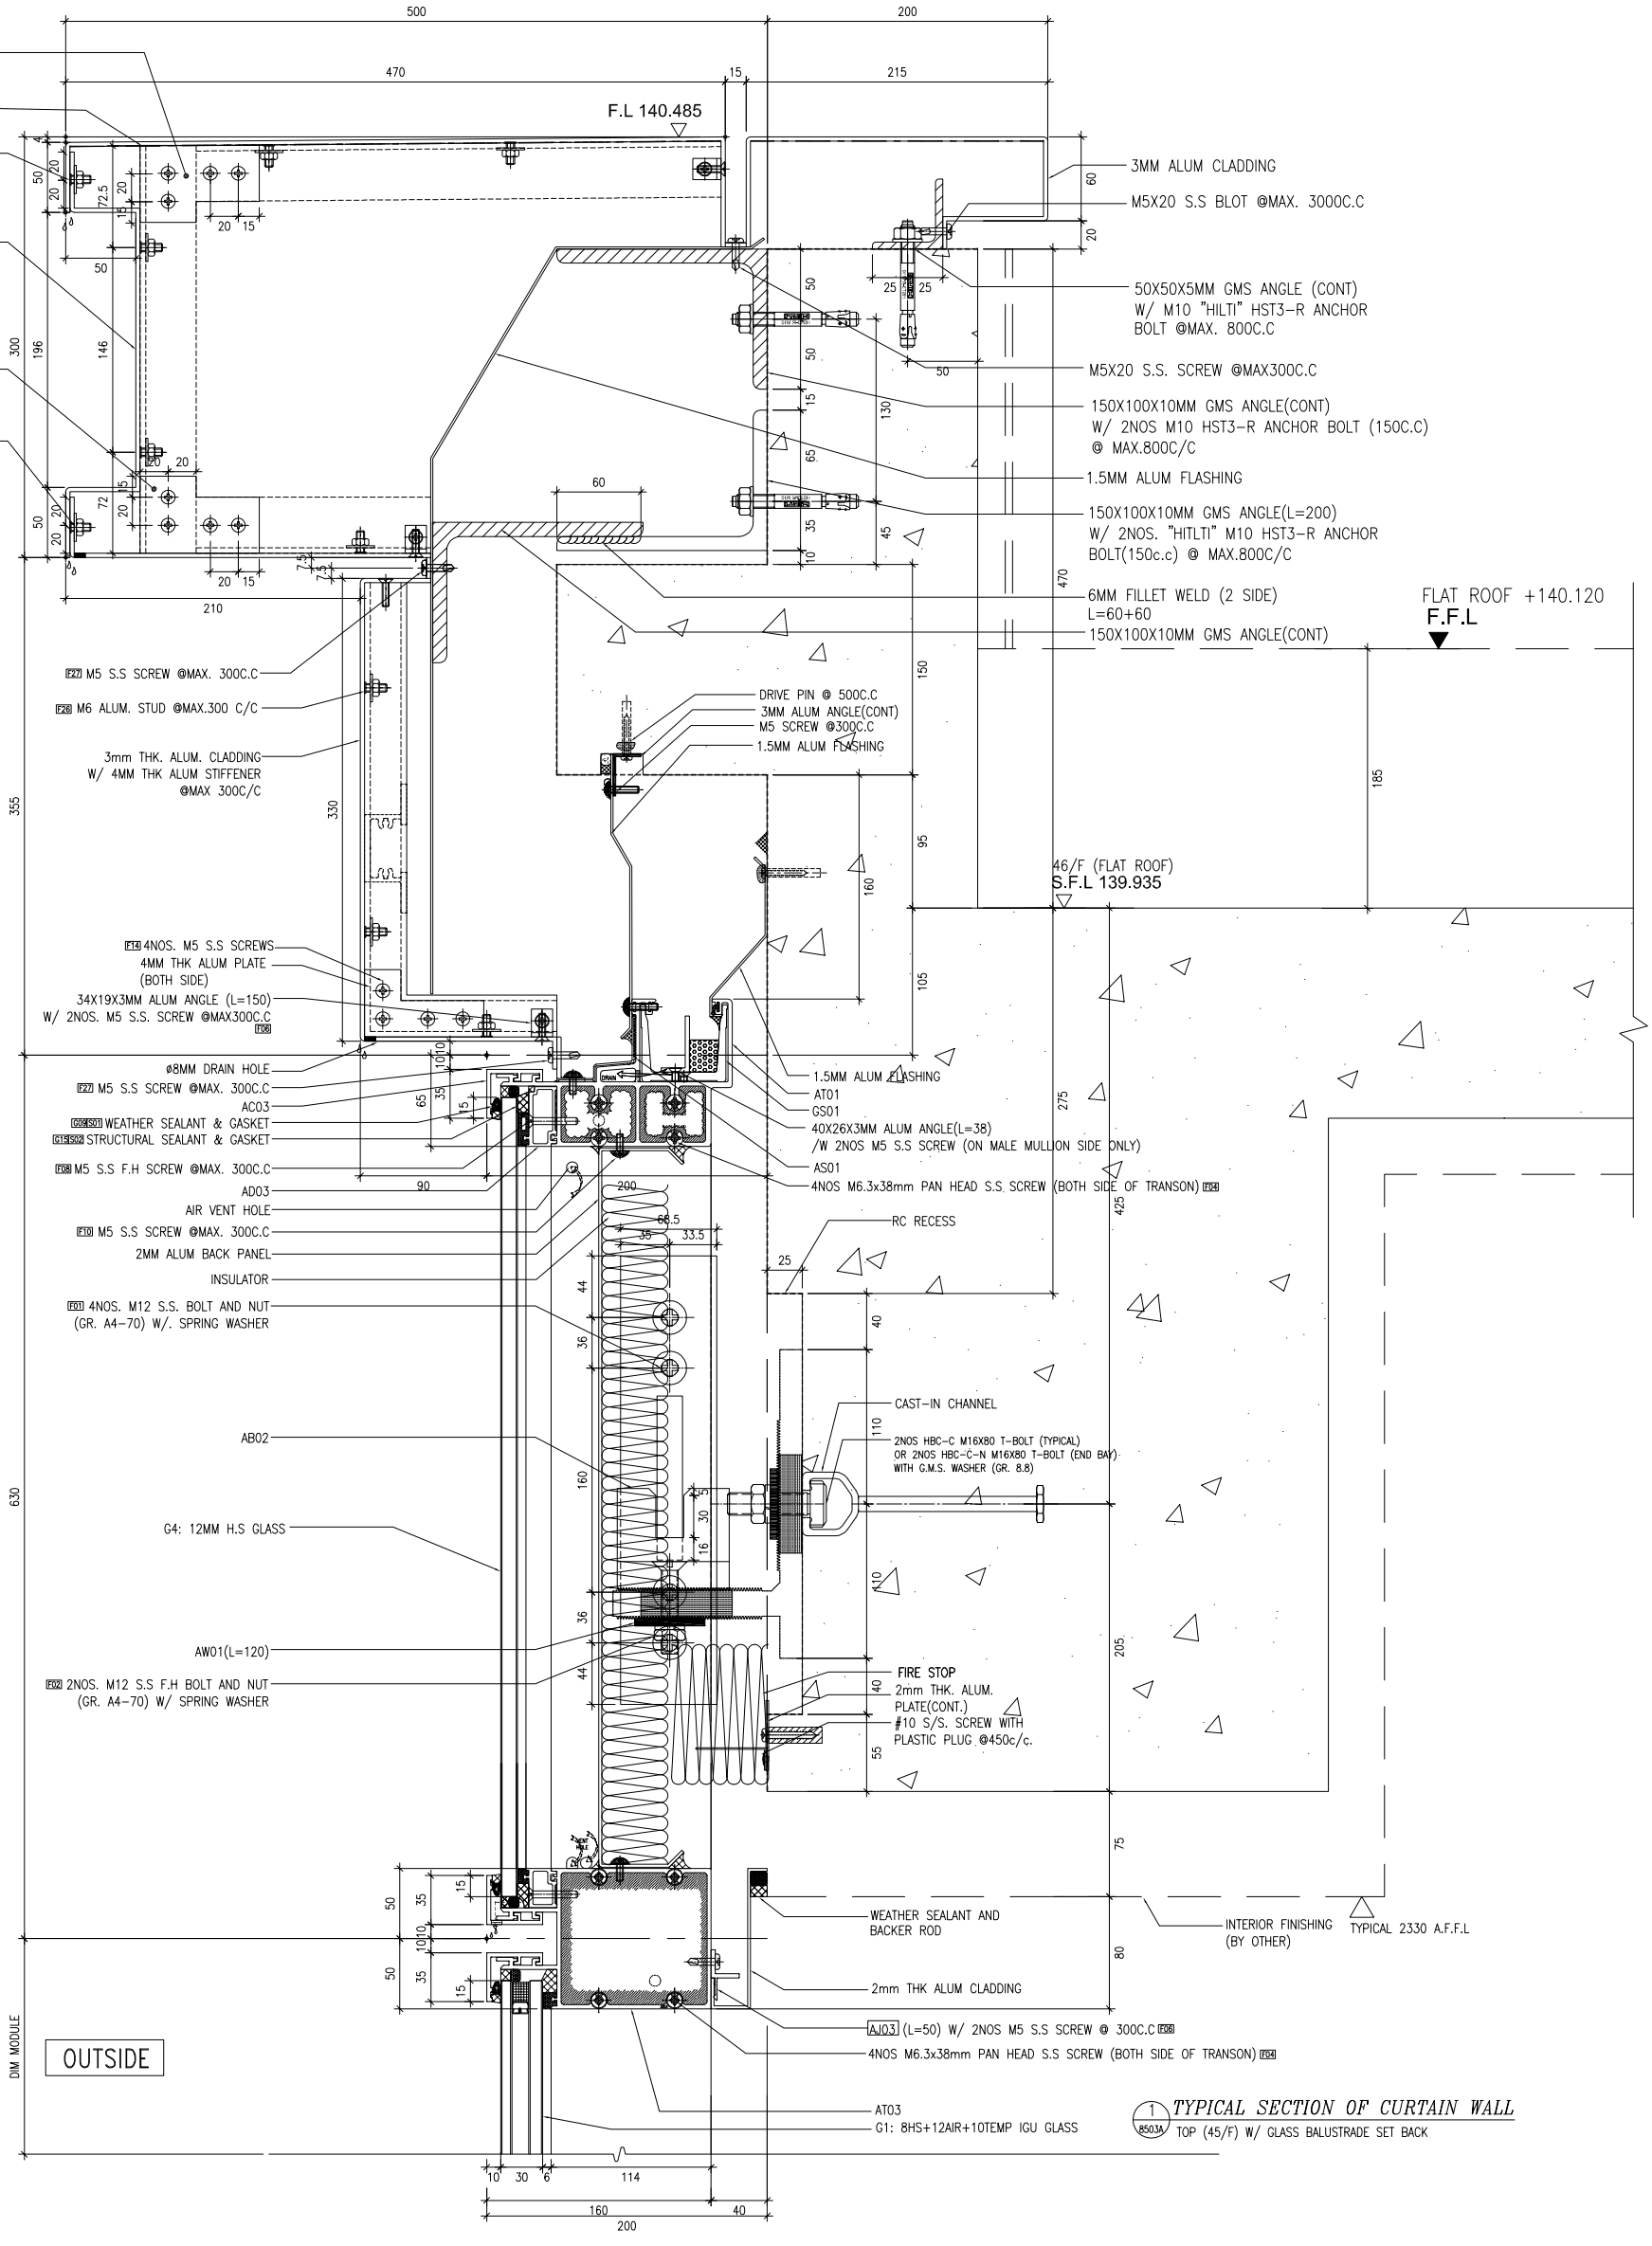

1 / 8503A TYPICAL SECTION OF CURTAIN WALL
TOP (45/F) W/ GLASS BALUSTRADE SET BACK

NOTE :
1. ALL DIMENSIONS ARE IN mm.
2. ALL ELEVATIONS ARE VIEWED FROM OUTSIDE.
3. ALL DIMENSIONS TO BE VERIFIED ON SITE BEFORE FABRICATION.

LEGEND :
X1 / X001 — DETAIL MARK NO. / REFER SHEET NO.
1. F.F.L. -- FINISHED FLOOR LEVEL
2. S.F.L. -- STRUCTURAL FLOOR LEVEL
3. /R -- REVERSED DETAIL

NO.	DATE	
B	22-AUG-2023	7TH SUBMISSION
A	10-MAY-2023	5TH SUBMISSION
-	21-FEB-2023	NEW DRAWING (4TH SUBMISSION)
	DATE	REVISED

JOB NO. : J-856

PROJECT :
PROPOSED DEVELOPMENT ABOVE LIGHT RAIL TIN WING STOP,TSWTL NO.23,AREA 33,TIN SHUI WAI, N.T.

TITLE :
TYPICAL DETAIL FOR CURTAIN WALL

DATE : 31-OCT-22 | SCALE : 1:5
DRAWN BY : C.F | CHECKED BY :

美特鋁廠有限公司
MIDI ALUMINUM FABRICATOR LTD.
Units 6-8, Sunray Industrial Centre, 1/F
610 Cha Kwo Ling Road, Kowloon
Tel:23489211-4 Fax:(852)27727666

DWG NO. : J856-SD-CW-8503A | REV. : B

CLIENT :
SUN HUNG KAI REAL ESTATE AGENCY LTD.
42/F SUN HUNG KAI CENTRE, WANCHAI, HONGKONG


ARCHITECT :
lwk&partners architects

MAIN CONTRACTOR :
怡輝建築有限公司
Yee Fai Building Contractors Ltd.

STRUCTURAL ENGINEER :
ARUP

FACADE CONSULTANT :
ALPHA CONSULTING LIMITED
Steel Structure & Facade Specialist

B.D. REF :

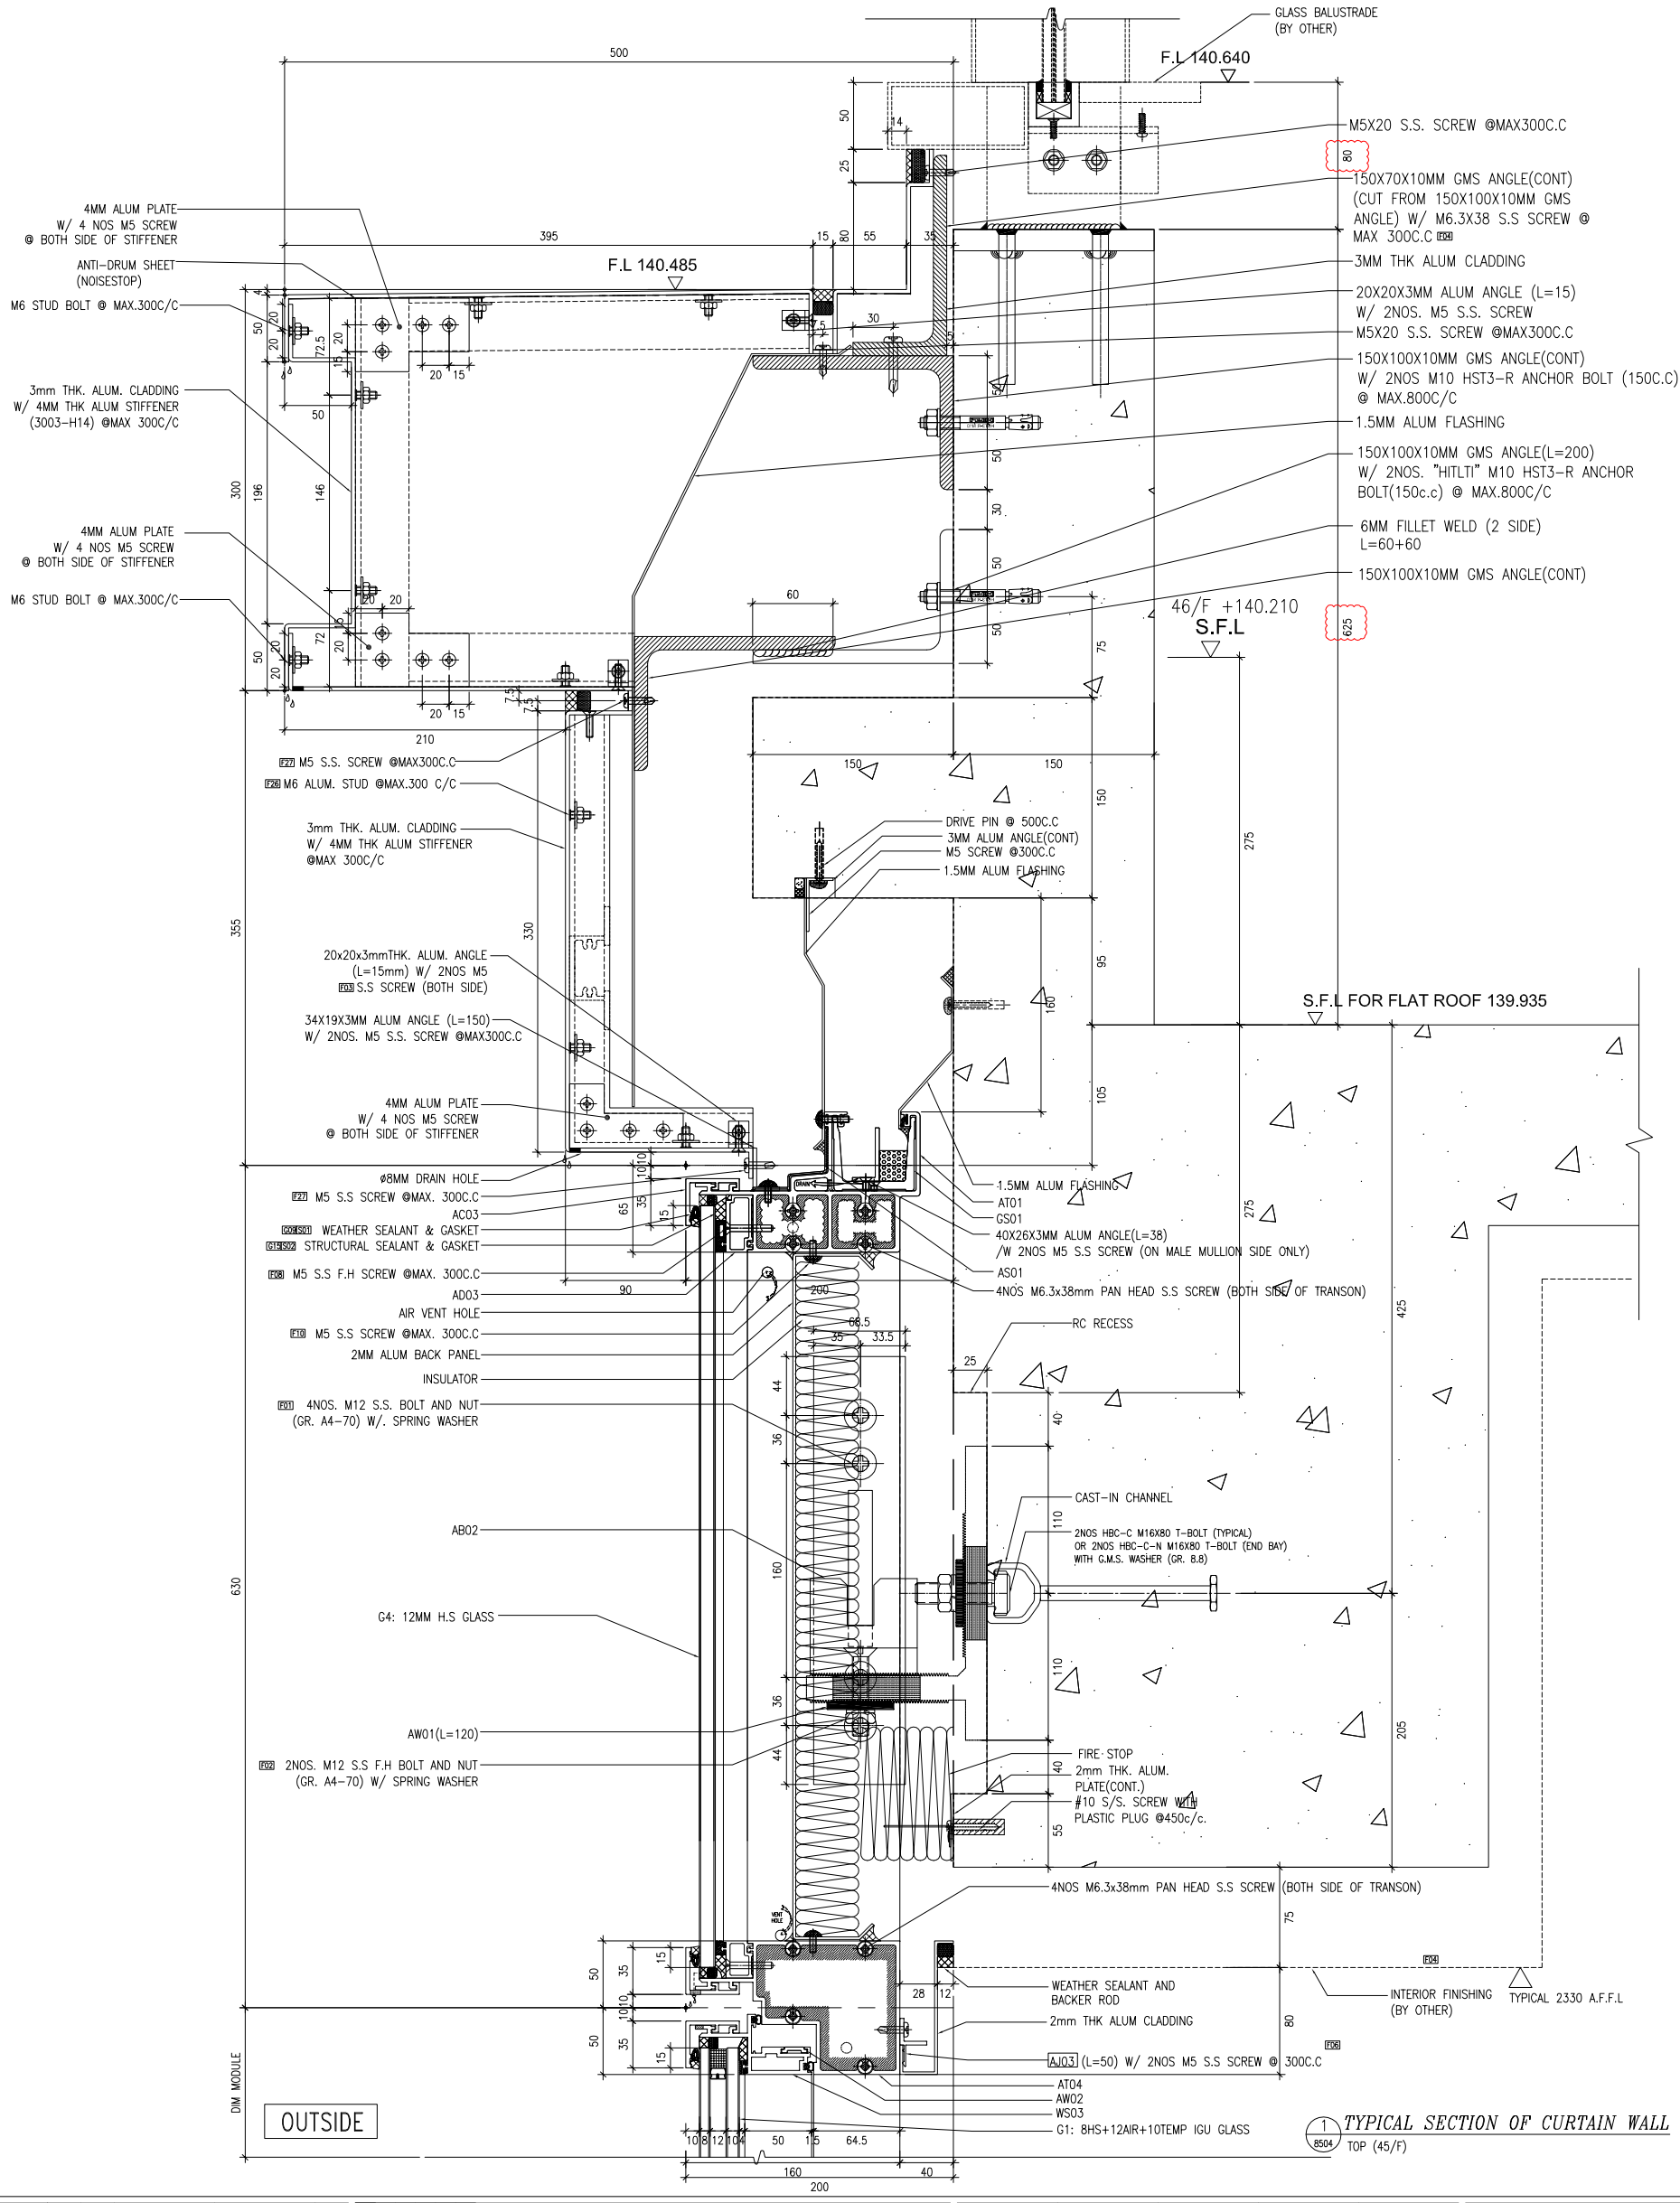

NOTE :
1. ALL DIMENSIONS ARE IN mm.
2. ALL ELEVATIONS ARE VIEWED FROM OUTSIDE.
3. ALL DIMENSIONS TO BE VERIFIED ON SITE BEFORE FABRICATION.

LEGEND :
X1 / X001 — DETAIL MARK NO. / REFER SHEET NO.
1. F.F.L. -- FINISHED FLOOR LEVEL
2. S.F.L. -- STRUCTURAL FLOOR LEVEL
3. (R) -- REVERSED DETAIL

NO.	DATE	REMARK	BY
E	30-OCT-2023	9TH SUBMISSION	CF
D	22-AUG-2023	7TH SUBMISSION	CF
C	10-MAY-2023	5TH SUBMISSION	CF
B	21-FEB-2023	4TH SUBMISSION	CF
A	30-DEC-2022	2ND SUBMISSION	CF

JOB NO. : J-856

PROJECT :
PROPOSED DEVELOPMENT ABOVE
LIGHT RAIL TIN WING STOP,TSWTL
NO.23,AREA 33,TIN SHUI WAI, N.T.

TITLE :
TYPICAL DETAIL
FOR CURTAIN WALL

DATE : 31-OCT-22 | SCALE : 1:5

DRAWN BY : C.F | CHECKED BY :

DWG NO. : J856-SD-CW-8504 | REV. : E

特銘鋁廠有限公司
MIDI ALUMINIUM FABRICATOR LTD.
Units 6-8, Sunray Industrial Centre, 1/F
610 Cho Kwo Ling Road, Kowloon
Tel:23489211-4 Fax:(852)27727666

CLIENT :
SUN HUNG KAI REAL ESTATE AGENCY LTD.
42/F SUN HUNG KAI CENTRE, WANCHAI, HONGKONG


ARCHITECT :
lwk&partners architects

MAIN CONTRACTOR :
怡輝建築有限公司
Yee Fai Building Contractors Ltd.

STRUCTURAL ENGINEER :
ARUP

FACADE CONSULTANT :
ALPHA CONSULTING LIMITED
Steel Structure & Facade Specialist

B.D. REF :

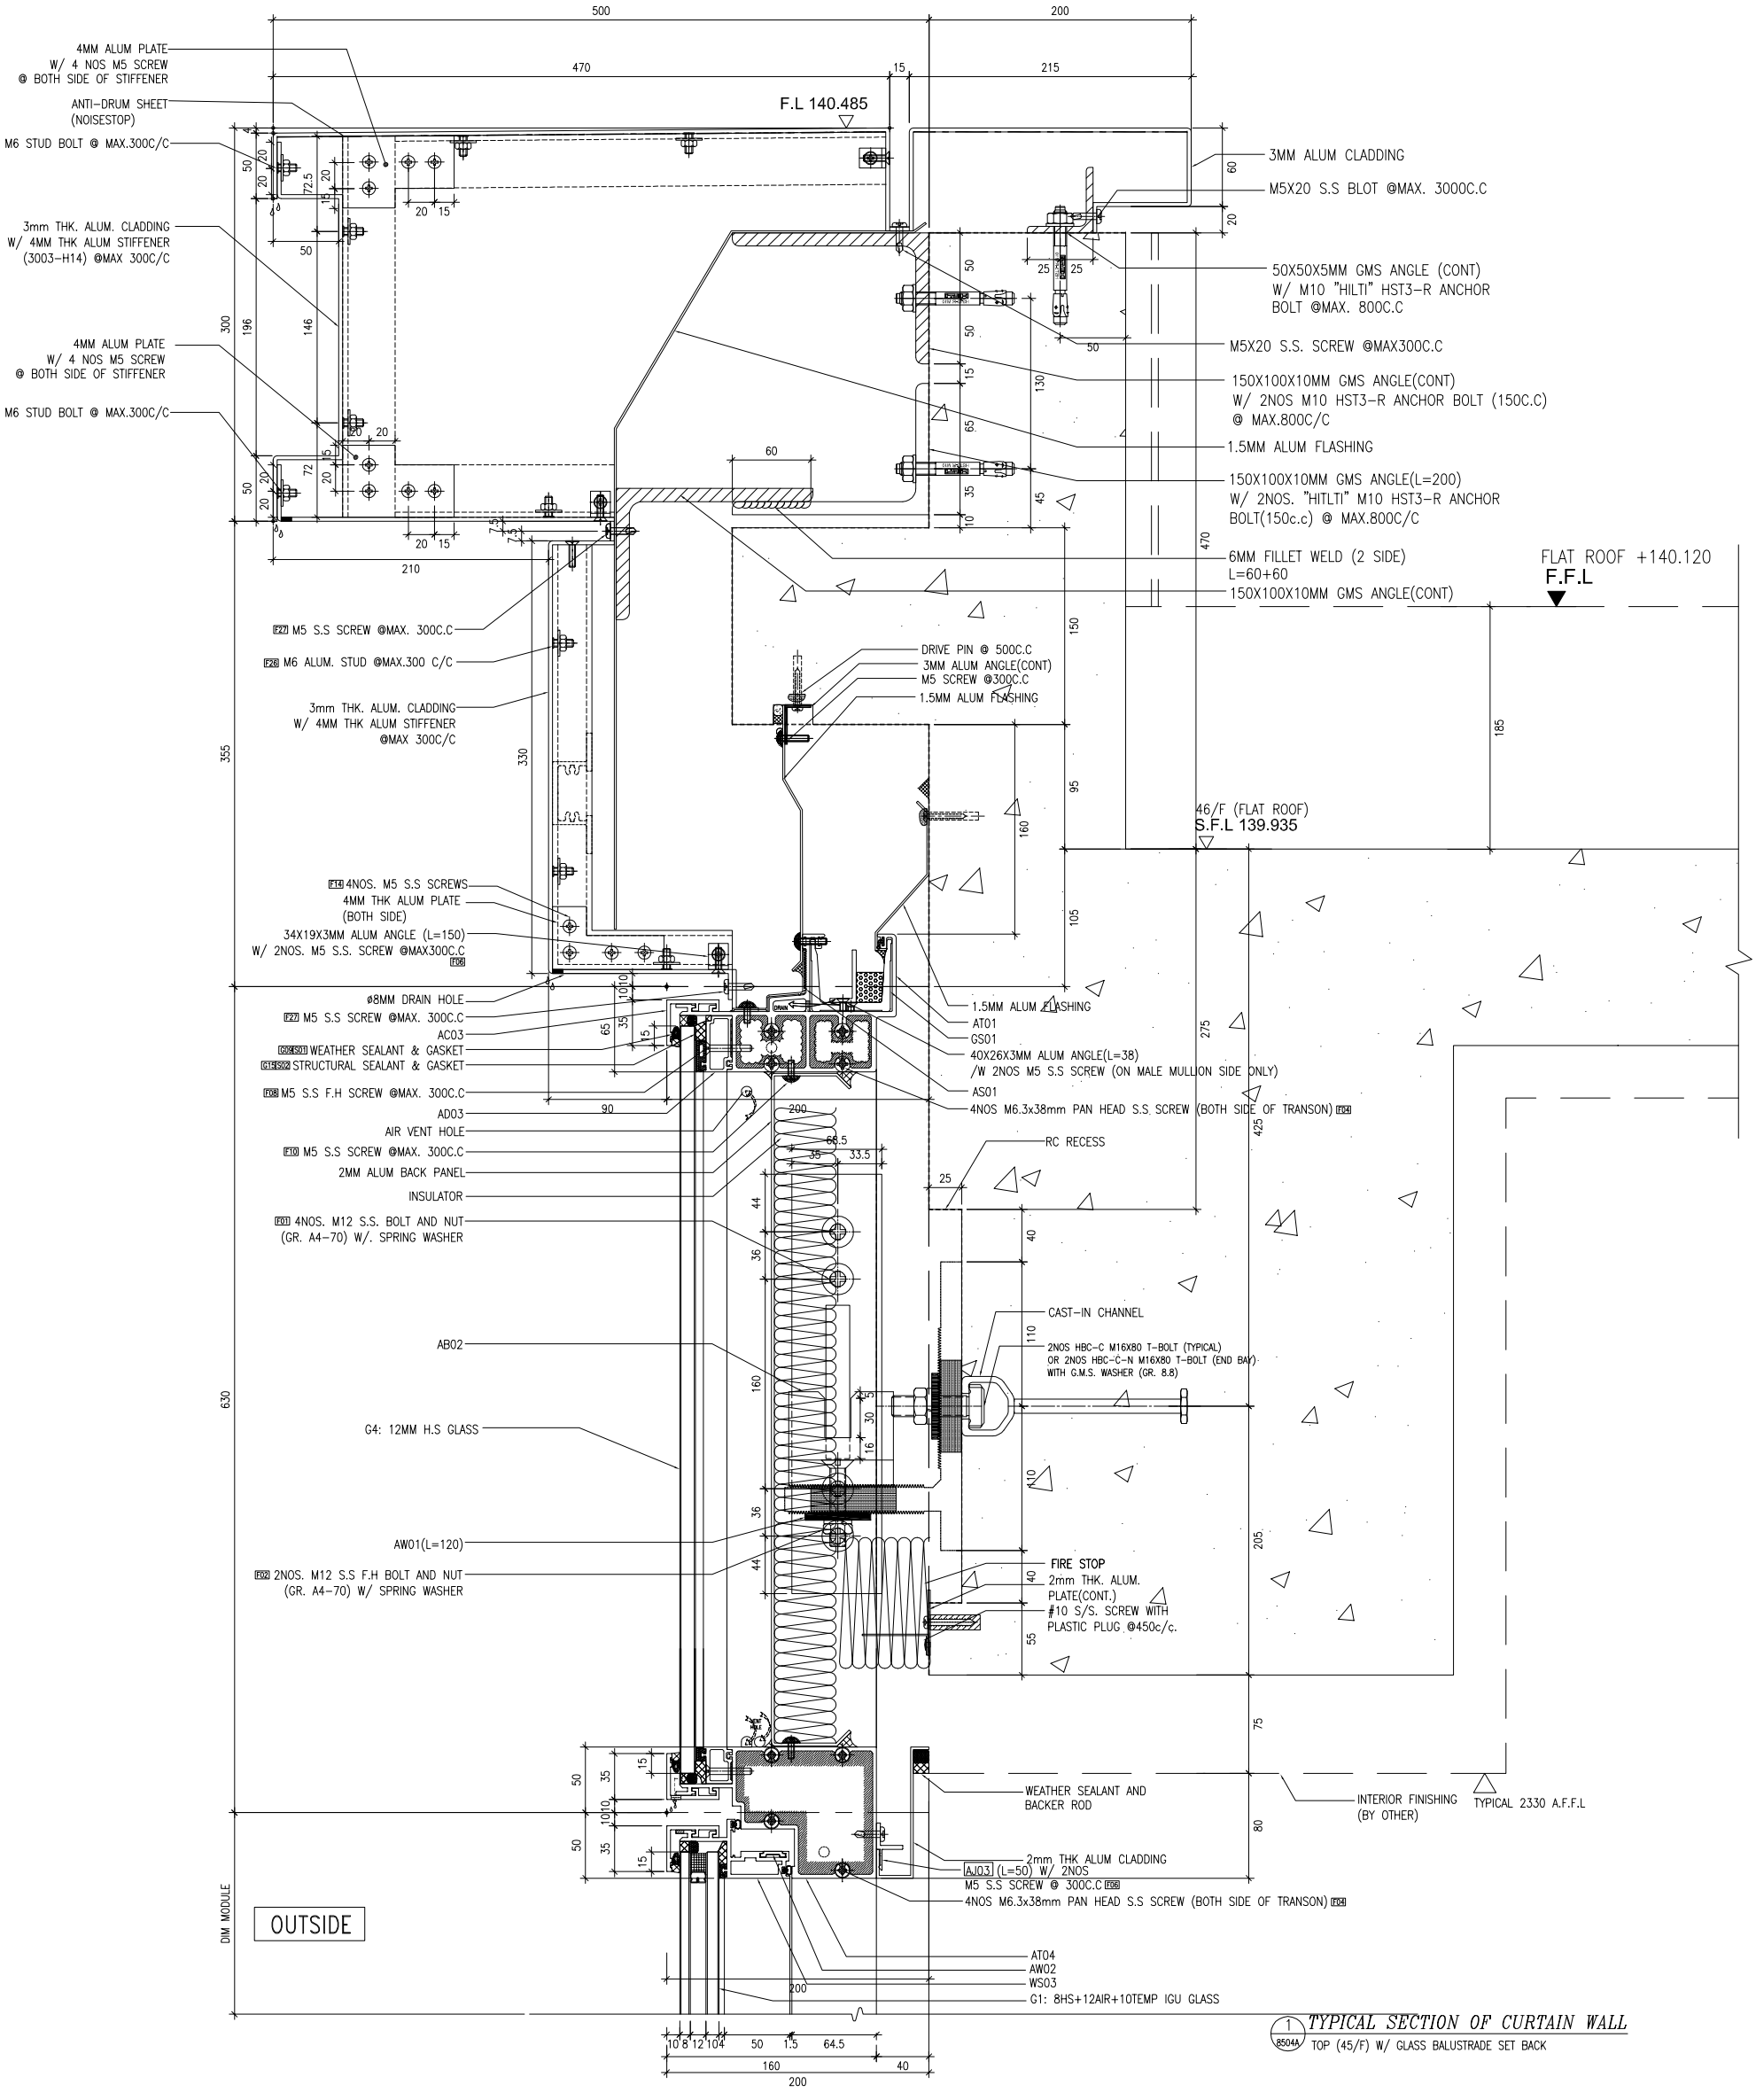

1 / 8504A TYPICAL SECTION OF CURTAIN WALL
TOP (45/F) W/ GLASS BALUSTRADE SET BACK

NOTE :
1. ALL DIMENSIONS ARE IN mm.
2. ALL ELEVATIONS ARE VIEWED FROM OUTSIDE.
3. ALL DIMENSIONS TO BE VERIFIED ON SITE BEFORE FABRICATION.

LEGEND :
X1 / X001 — DETAIL MARK NO. / REFER SHEET NO.
1. F.F.L. -- FINISHED FLOOR LEVEL
2. S.F.L. -- STRUCTURAL FLOOR LEVEL
3. /R -- REVERSED DETAIL

NO.	DATE	
B	22-AUG-2023	7TH SUBMISSION
A	10-MAY-2023	5TH SUBMISSION
-	21-FEB-2023	NEW DRAWING (4TH SUBMISSION)

JOB NO. : J-856

PROJECT :
PROPOSED DEVELOPMENT ABOVE LIGHT RAIL TIN WING STOP, TSWTL NO.23, AREA 33, TIN SHUI WAI, N.T.

TITLE :
TYPICAL DETAIL FOR CURTAIN WALL

DATE : 31-OCT-22 | SCALE : 1:5
DRAWN BY : C.F | CHECKED BY :

美特鋁質有限公司
MIDI ALUMINUM FABRICATOR LTD.
Units 6-8, Sunray Industrial Centre, 1/F
610 Cha Kwo Ling Road, Kowloon
Tel:23489211-4 Fax:(852)27727666

DWG NO. : J856-SD-CW-8504A | REV. : B

CLIENT :
SUN HUNG KAI REAL ESTATE AGENCY LTD.
42/F SUN HUNG KAI CENTRE, WANCHAI, HONGKONG


ARCHITECT :
lwk&partners architects

MAIN CONTRACTOR :
怡輝建築有限公司
Yee Fai Building Contractors Ltd.

STRUCTURAL ENGINEER :
ARUP

FACADE CONSULTANT :
ALPHA CONSULTING LIMITED
Steel Structure & Facade Specialist

B.D. REF :

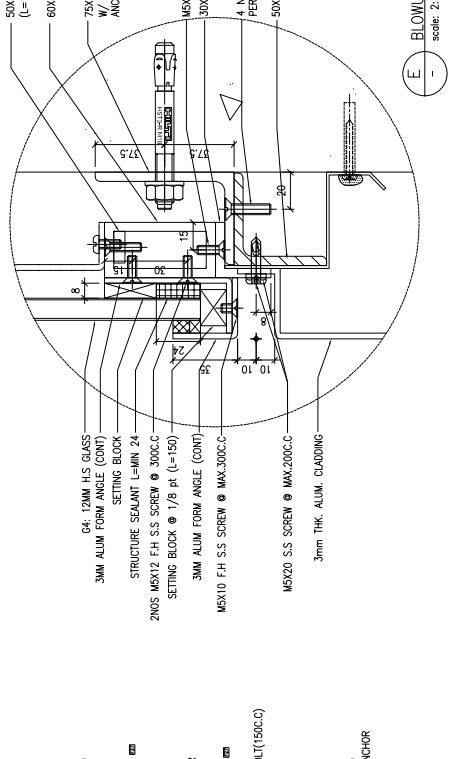

B.D. REF :

CLIENT :

SUN HUNG KAI REAL ESTATE AGENCY LTD.
42/F SUN HUNG KAI CENTRE, WANCHAI, HONGKONG

ARCHITECT :

lwk&partners
a r c h i t e c t s

MAIN CONTRACTOR :

怡輝建築有限公司
Yee Fai Building Contractors Ltd.

STRUCTURAL ENGINEER :

ARUP

FACADE CONSULTANT:

ALPHA CONSULTING LIMITED
Steel Structure & Facade Specialist

NOTE :
1. ALL DIMENSIONS ARE IN mm.
2. ALL ELEVATIONS ARE VIEWED FROM OUTSIDE.
3. ALL DIMENSIONS TO BE VERIFIED ON SITE BEFORE FABRICATION.

LEGEND :

X1 — DETAIL MARK NO.
X001 — REFER SHEET NO.

1. F.F.L. --FINISHED FLOOR LEVEL
2. S.F.L. --STRUCTURAL FLOOR LEVEL
3. /R --REVERSED DETAIL

NO.	DATE	REVISED	BY
G	30-OCT-2023	9TH SUBMISSION	CF
F	03-OCT-2023	8TH SUBMISSION (R1)	CF
E	28-SEP-2023	8TH SUBMISSION	CF
D	18-AUG-2023	7TH SUBMISSION	CF
C	10-MAY-2023	5TH SUBMISSION	CF

JOB NO. : J-856

PROJECT :
PROPOSED DEVELOPMENT ABOVE LIGHT RAIL TIN WING STOP,TSWTL NO.23,AREA 33,TIN SHUI WAI, N.T.


TITLE :
TYPICAL DETAIL FOR CURTAIN WALL

DATE : 31-OCT-22 | SCALE : 1:7

DRAWN BY : C.F | CHECKED BY :

美特鋁製有限公司
MIDI ALUMINIUM FABRICATOR LTD.
Units 6-8, Sunray Industrial Centre, 1/F
610 Cha Kwo Ling Road, Kowloon
Tel:23489211-4 Fax:(852)27727666

DWG NO. : J856-SD-CW-8505 | REV. : G

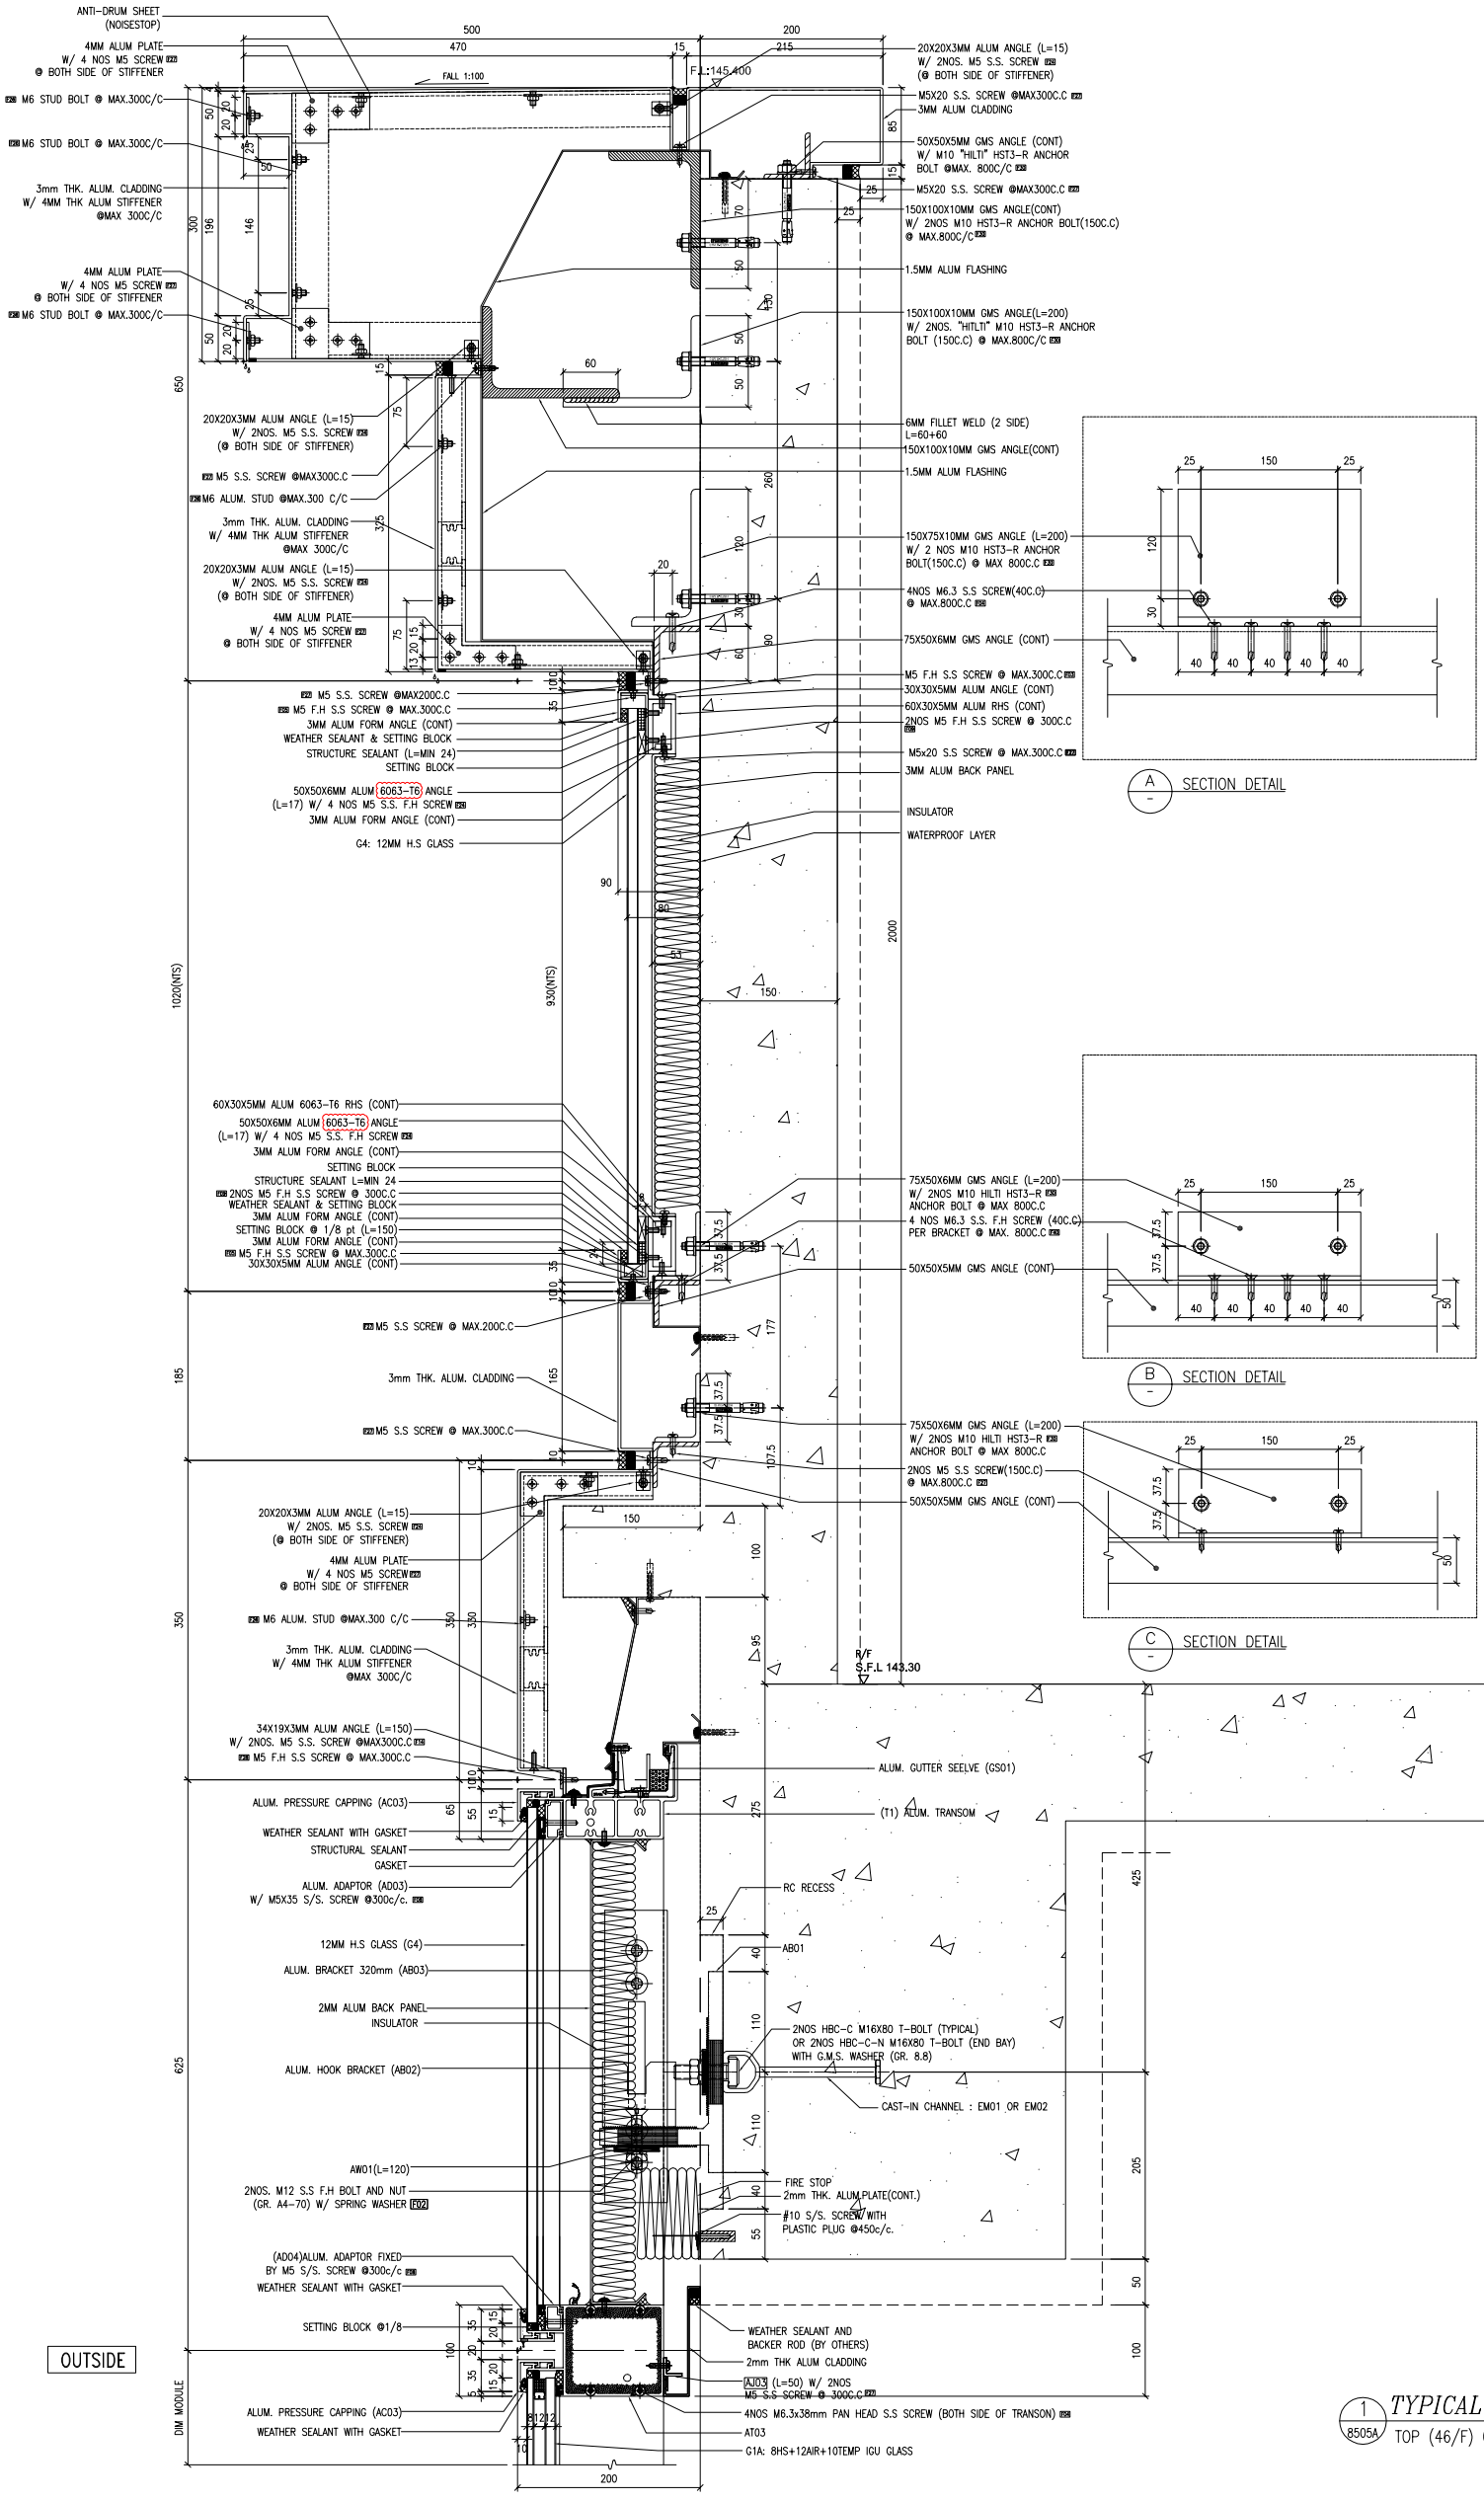

1 / 8505A TYPICAL SECTION OF CURTAIN WALL
TOP (46/F) GLASS CLADDING

NOTE :
1. ALL DIMENSIONS ARE IN mm.
2. ALL ELEVATIONS ARE VIEWED FROM OUTSIDE.
3. ALL DIMENSIONS TO BE VERIFIED ON SITE BEFORE FABRICATION.

LEGEND :
X1 / X001 — DETAIL MARK NO. / REFER SHEET NO.
1. F.F.L. --FINISHED FLOOR LEVEL
2. S.F.L. --STRUCTURAL FLOOR LEVEL
3. /R — --REVERSED DETAIL

NO.	DATE	REVISED	BY
F	30-OCT-2023	9TH SUBMISSION	CF
E	03-OCT-2023	8TH SUBMISSION (R1)	CF
D	26-SEP-2023	8TH SUBMISSION	CF
C	18-AUG-2023	7TH SUBMISSION	CF
B	10-MAY-2023	5TH SUBMISSION	CF

JOB NO. : J-856
PROJECT : PROPOSED DEVELOPMENT ABOVE LIGHT RAIL TIN WING STOP,TSWTL NO.23,AREA 33,TIN SHUI WAI, N.T.
TITLE : TYPICAL DETAIL FOR CURTAIN WALL


DATE : 31-OCT-22 | SCALE : 1:7
DRAWN BY : C.F | CHECKED BY :

特鋁建築有限公司 MIDI ALUMINIUM FABRICATOR LTD.
Units 6-8, Sunray Industrial Centre, 1/F
610 Cho Kwo Ling Road, Kowloon
Tel:23489211-4 Fax:(852)27727666

DWG NO. : J856-SD-CW-8505A | REV. : F

CLIENT : SUN HUNG KAI REAL ESTATE AGENCY LTD. 42/F SUN HUNG KAI CENTRE, WANCHAI, HONGKONG
ARCHITECT : lwk&partners architects
MAIN CONTRACTOR : 怡輝建築有限公司 Yee Fai Building Contractors Ltd.
STRUCTURAL ENGINEER : ARUP
FACADE CONSULTANT: ALPHA CONSULTING LIMITED — Steel Structure & Facade Specialist

B.D. REF :

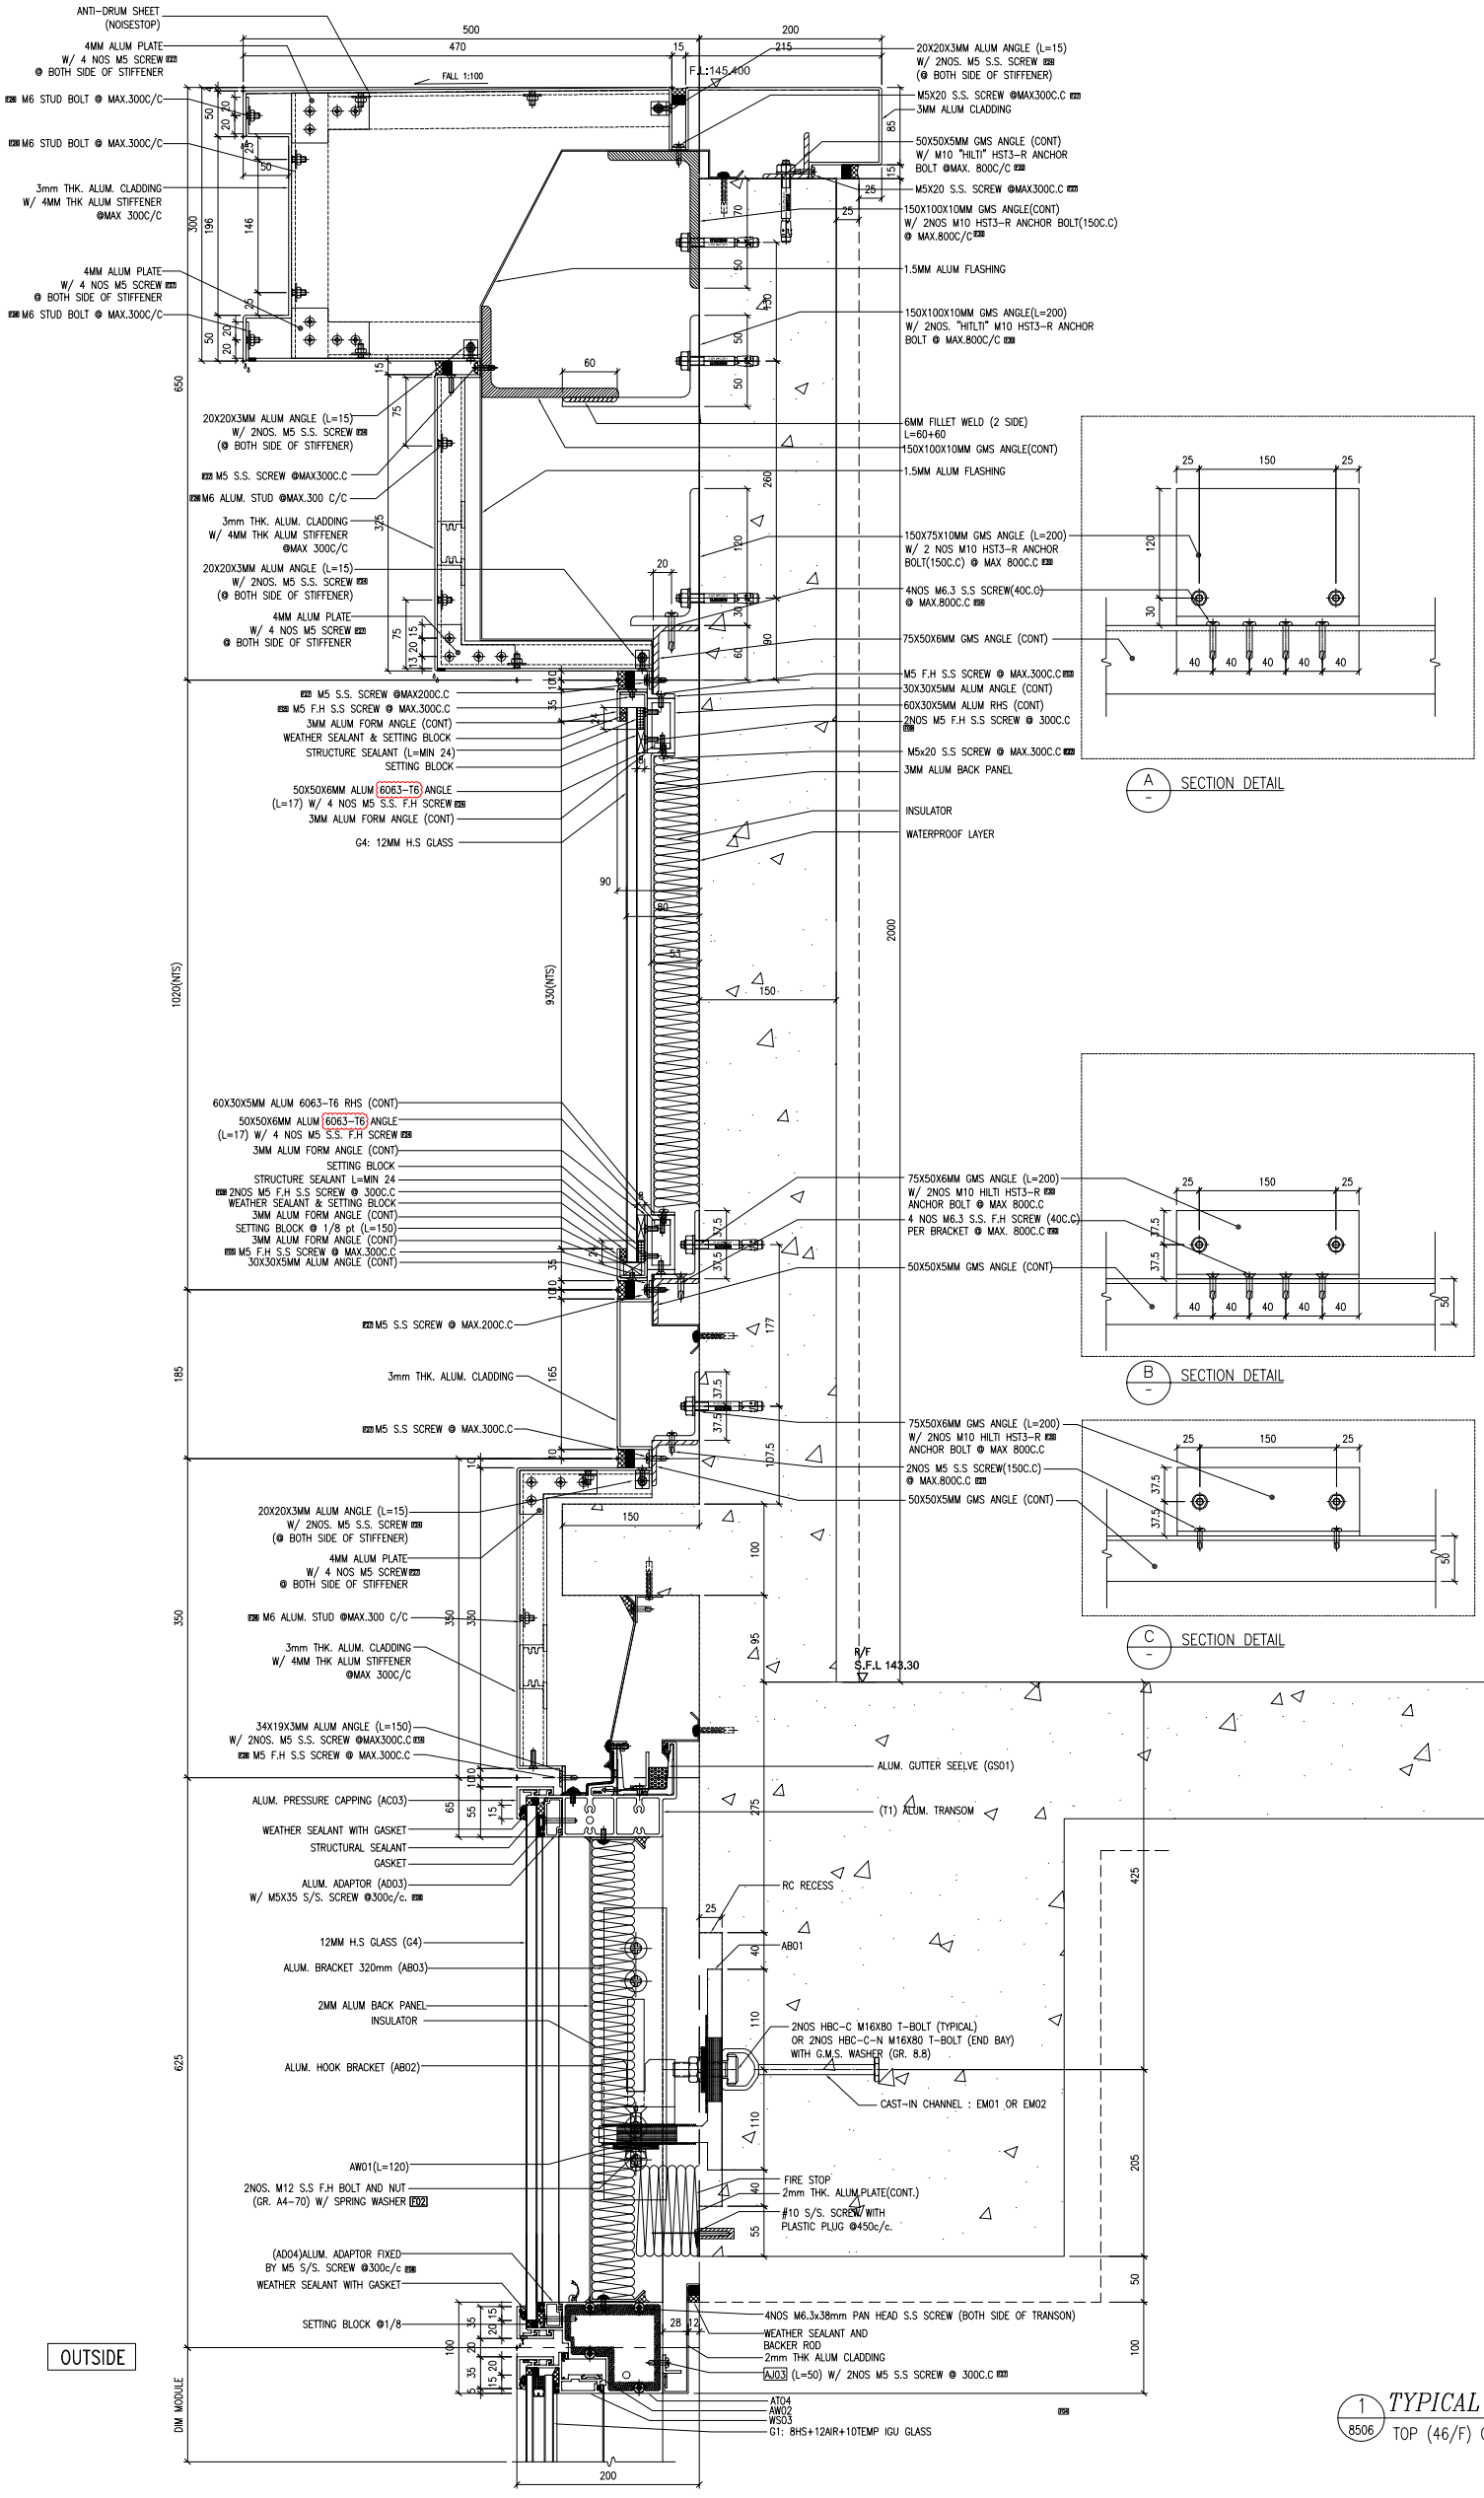

1 / 8506 *TYPICAL SECTION OF CURTAIN WALL*
TOP (46/F) GLASS CLADDING

B.D. REF :

CLIENT :
SUN HUNG KAI REAL ESTATE AGENCY LTD.
42/F SUN HUNG KAI CENTRE, WANCHAI, HONGKONG

ARCHITECT :
lwk&partners architects

MAIN CONTRACTOR :
怡輝建築有限公司 Yee Fai Building Contractors Ltd.

STRUCTURAL ENGINEER :
ARUP

FACADE CONSULTANT:
ALPHA CONSULTING LIMITED
Steel Structure & Facade Specialist

NOTE :
1. ALL DIMENSIONS ARE IN mm.
2. ALL ELEVATIONS ARE VIEWED FROM OUTSIDE.
3. ALL DIMENSIONS TO BE VERIFIED ON SITE BEFORE FABRICATION.

LEGEND :
X1 / X001 — DETAIL MARK NO. / REFER SHEET NO.
1. F.F.L. --FINISHED FLOOR LEVEL
2. S.F.L. --STRUCTURAL FLOOR LEVEL
3. (R) --REVERSED DETAIL


NO.	DATE	REVISED	BY
G	30-OCT-2023	9TH SUBMISSION	CF
F	03-OCT-2023	8TH SUBMISSION (R1)	CF
E	26-SEP-2023	8TH SUBMISSION	CF
D	18-AUG-2023	7TH SUBMISSION	CF
C	10-MAY-2023	5TH SUBMISSION	CF

JOB NO. : J-856
PROJECT : PROPOSED DEVELOPMENT ABOVE LIGHT RAIL TIN WING STOP,TSWTL NO.23,AREA 33,TIN SHUI WAI, N.T.
TITLE : TYPICAL DETAIL FOR CURTAIN WALL


DATE : 31-OCT-22 | SCALE : 1:7
DRAWN BY : C.F | CHECKED BY :

特輝鋁廠有限公司 MIDI ALUMINIUM FABRICATOR LTD.
Units 6-8, Sunray Industrial Centre, 1/F
610 Cho Kwo Ling Road, Kowloon
Tel:23489211-4 Fax:(852)27727666


DWG NO. : J856-SD-CW-8506 | REV. : G

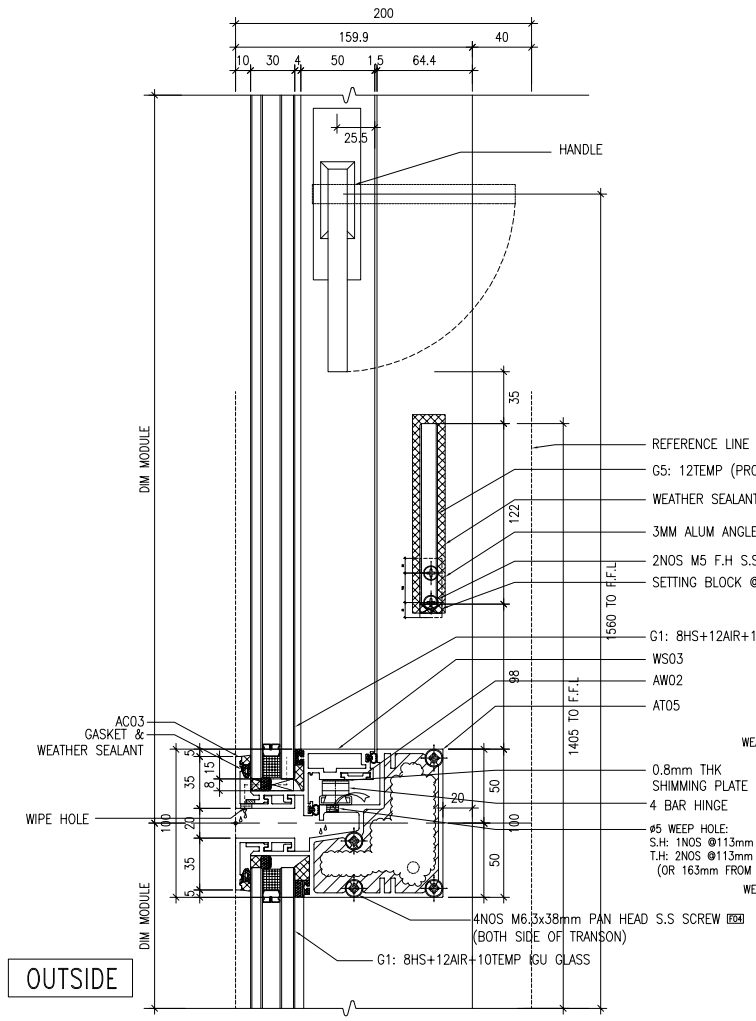

1 8507 *TYPICAL SECTION OF CURTAIN WALL*
PROTECTIVE BARRIER (S.H)

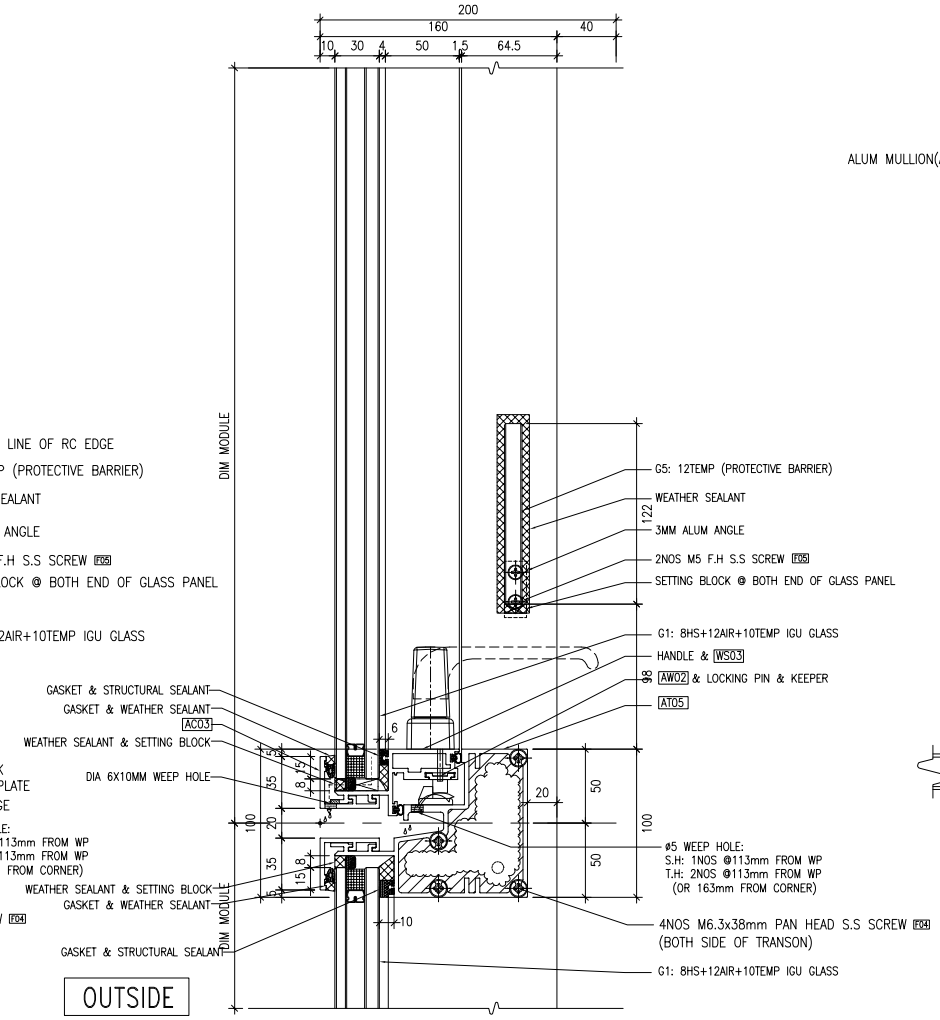


1A 8507 *TYPICAL SECTION OF CURTAIN WALL*
PROTECTIVE BARRIER (T.H)

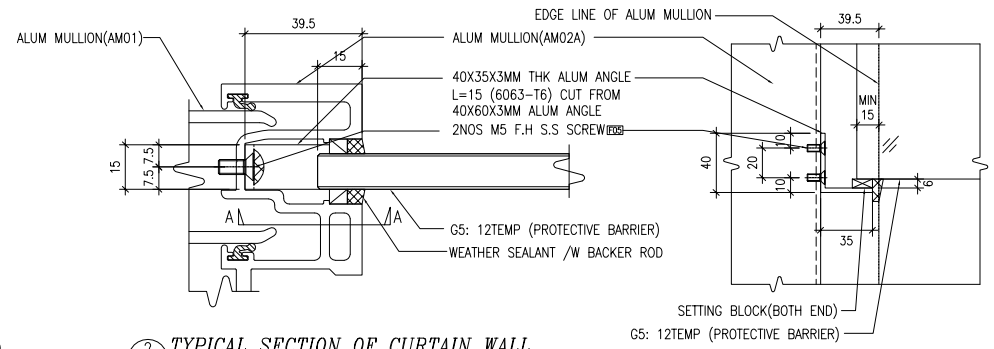


2 8507 *TYPICAL SECTION OF CURTAIN WALL*
PROTECTIVE BARRIER

VIEW A-A

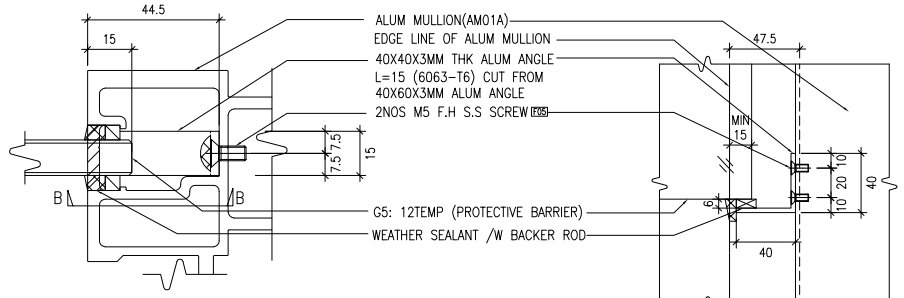


3 8507 *TYPICAL SECTION OF CURTAIN WALL*
PROTECTIVE BARRIER

VIEW B-B

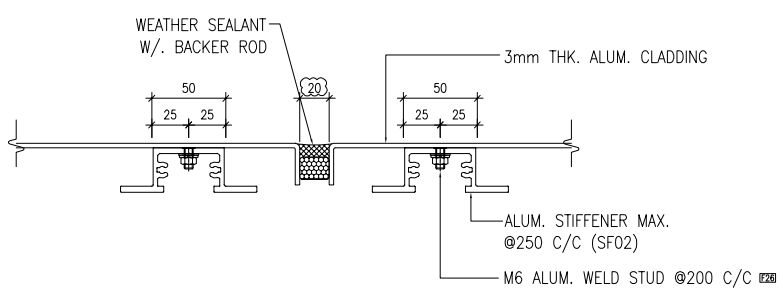

3 8507 *TYPICAL SECTION OF CLADDING JOINT*

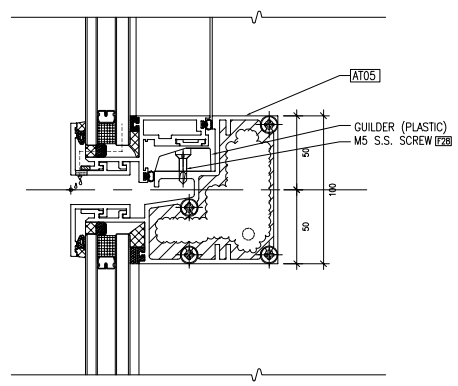

1B 8507 *TYPICAL SECTION OF CURTAIN WALL*
GUILDER for S.H

B.D. REF :

CLIENT :
SUN HUNG KAI REAL ESTATE AGENCY LTD.
42/F SUN HUNG KAI CENTRE, WANCHAI, HONGKONG

ARCHITECT :
lwk&partners architects

MAIN CONTRACTOR :
怡輝建築有限公司
Yee Fai Building Contractors Ltd.

STRUCTURAL ENGINEER :
ARUP

FACADE CONSULTANT:
ALPHA CONSULTING LIMITED
Steel Structure & Facade Specialist

NOTE :
1. ALL DIMENSIONS ARE IN mm.
2. ALL ELEVATIONS ARE VIEWED FROM OUTSIDE.
3. ALL DIMENSIONS TO BE VERIFIED ON SITE BEFORE FABRICATION.

LEGEND :
X1 — DETAIL MARK NO.
X001 — REFER SHEET NO.

1. F.F.L. --FINISHED FLOOR LEVEL
2. S.F.L. --STRUCTURAL FLOOR LEVEL
3. /R --REVERSED DETAIL

NO.	DATE	REVISED	BY
D	20-APR-2023	5TH SUBMISSION	CF
C	21-FEB-2023	4TH SUBMISSION	CF
B	13-JAN-2023	3RD SUBMISSION	CF
A	30-DEC-2022	2ND SUBMISSION	CF
-	21-NOV-2022		CF

JOB NO. : J-856

PROJECT :
PROPOSED DEVELOPMENT ABOVE LIGHT RAIL TIN WING STOP,TSWTL NO.23,AREA 33,TIN SHUI WAI, N.T.


TITLE :
TYPICAL DETAIL FOR CURTAIN WALL

DATE : 31-OCT-22 | SCALE : 1:5

DRAWN BY : C.F | CHECKED BY :

美特鋁質有限公司
MIDI ALUMINIUM FABRICATOR LTD.
Units 6-8, Sunray Industrial Centre, 1/F
610 Cha Kwo Ling Road, Kowloon
Tel:23489211-4 Fax:(852)27727666

DWG NO. : J856-SD-CW-8507 | REV. : D

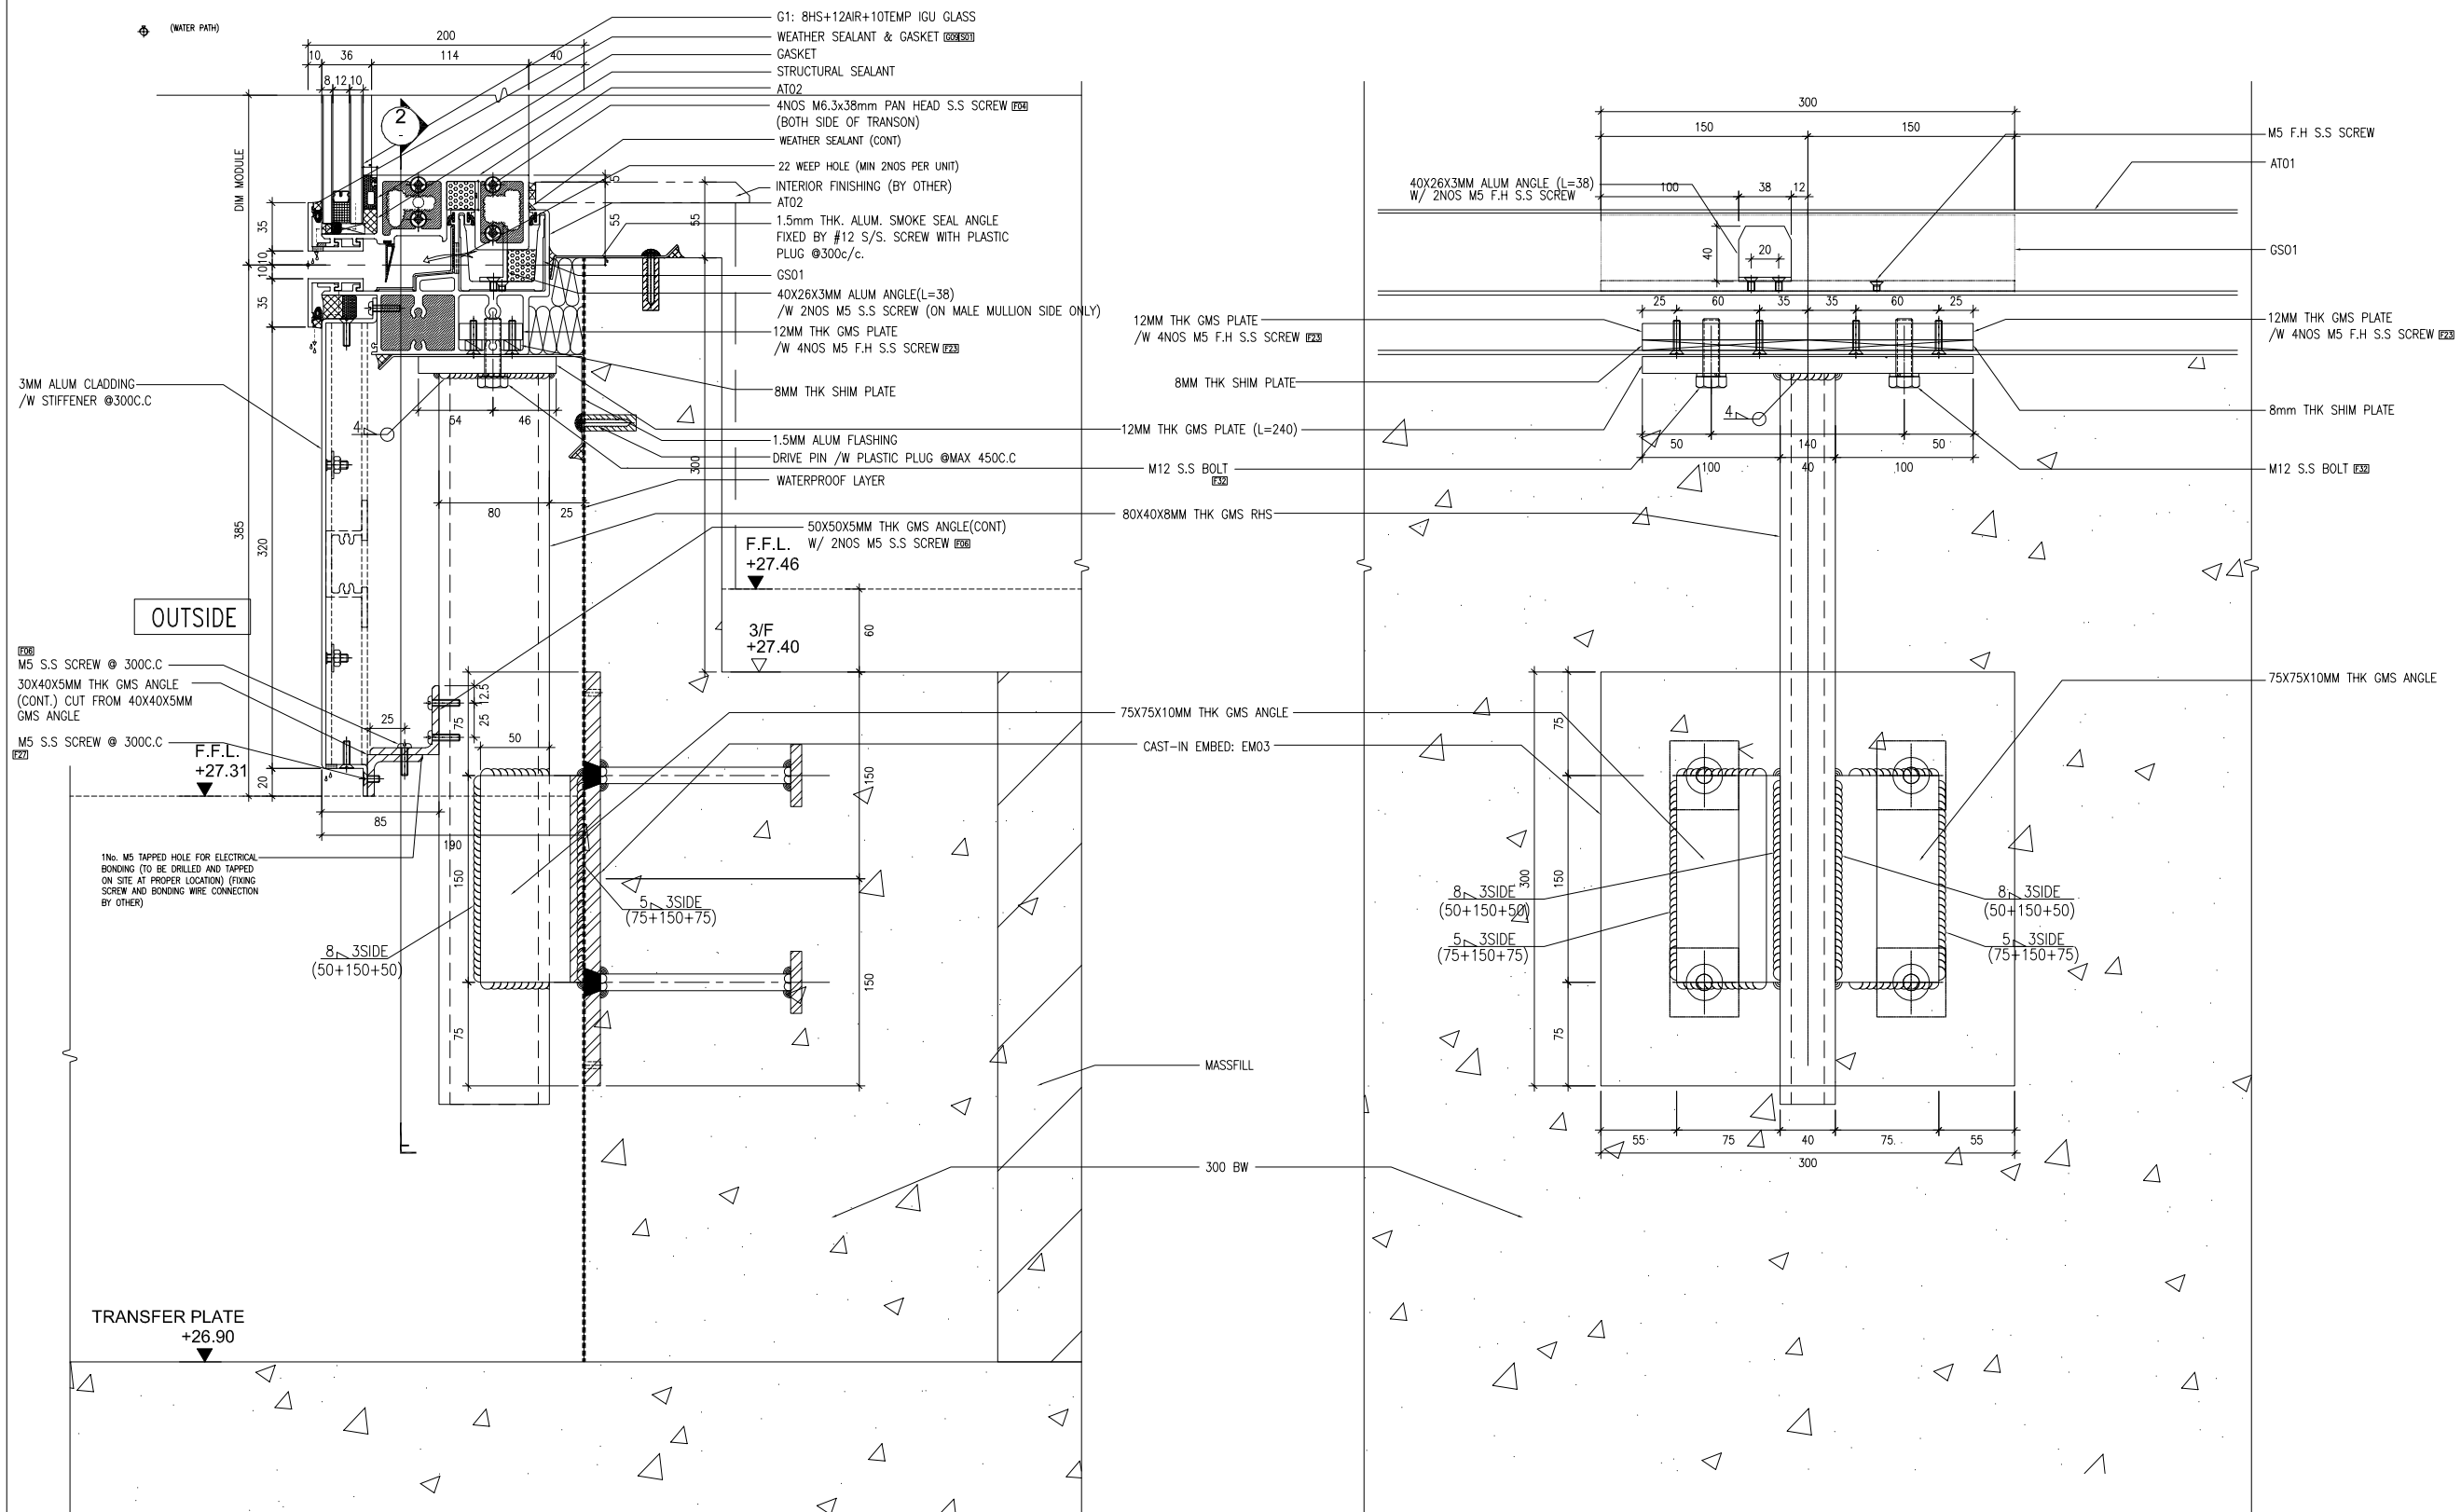

1 8508 *TYPICAL SECTION OF CURTAIN WALL*
STARTER

2 8508 *SECTION VIEW*
STARTER

B.D. REF :

CLIENT :
SUN HUNG KAI REAL ESTATE AGENCY LTD.
42/F SUN HUNG KAI CENTRE, WANCHAI, HONGKONG

ARCHITECT :
lwk&partners
a r c h i t e c t s

MAIN CONTRACTOR :
怡輝建築有限公司
Yee Fai Building Contractors Ltd.

STRUCTURAL ENGINEER :
ARUP

FACADE CONSULTANT:
ALPHA CONSULTING LIMITED
Steel Structure & Facade Specialist

NOTE :
1. ALL DIMENSIONS ARE IN mm.
2. ALL ELEVATIONS ARE VIEWED FROM OUTSIDE.
3. ALL DIMENSIONS TO BE VERIFIED ON SITE BEFORE FABRICATION.

LEGEND :
X1 — DETAIL MARK NO.
X001 — REFER SHEET NO.
1. F.F.L. -- FINISHED FLOOR LEVEL
2. S.F.L. -- STRUCTURAL FLOOR LEVEL
3. /R -- REVERSED DETAIL

NO.	DATE	REVISED	BY
E	30-MAY-2023	6TH SUBMISSION	CF
D	10-MAY-2023	5TH SUBMISSION	CF
C	21-FEB-2023	4TH SUBMISSION	CF
B	13-JAN-2023	3RD SUBMISSION	CF
A	30-DEC-2022	2ND SUBMISSION	CF

JOB NO. : J-856

PROJECT :
PROPOSED DEVELOPMENT ABOVE LIGHT RAIL TIN WING STOP,TSWTL NO.23,AREA 33,TIN SHUI WAI, N.T.


TITLE :
TYPICAL DETAIL FOR CURTAIN WALL

DATE : 31-OCT-22 | SCALE : 1:5

DRAWN BY : C.F | CHECKED BY :

美特鋁製有限公司
MIDI ALUMINIUM FABRICATOR LTD.
Units 6-8, Sunray Industrial Centre, 1/F
610 Cha Kwo Ling Road, Kowloon
Tel:23489211-4 Fax:(852)27727666

DWG NO. : J856-SD-CW-8508 | REV. : E

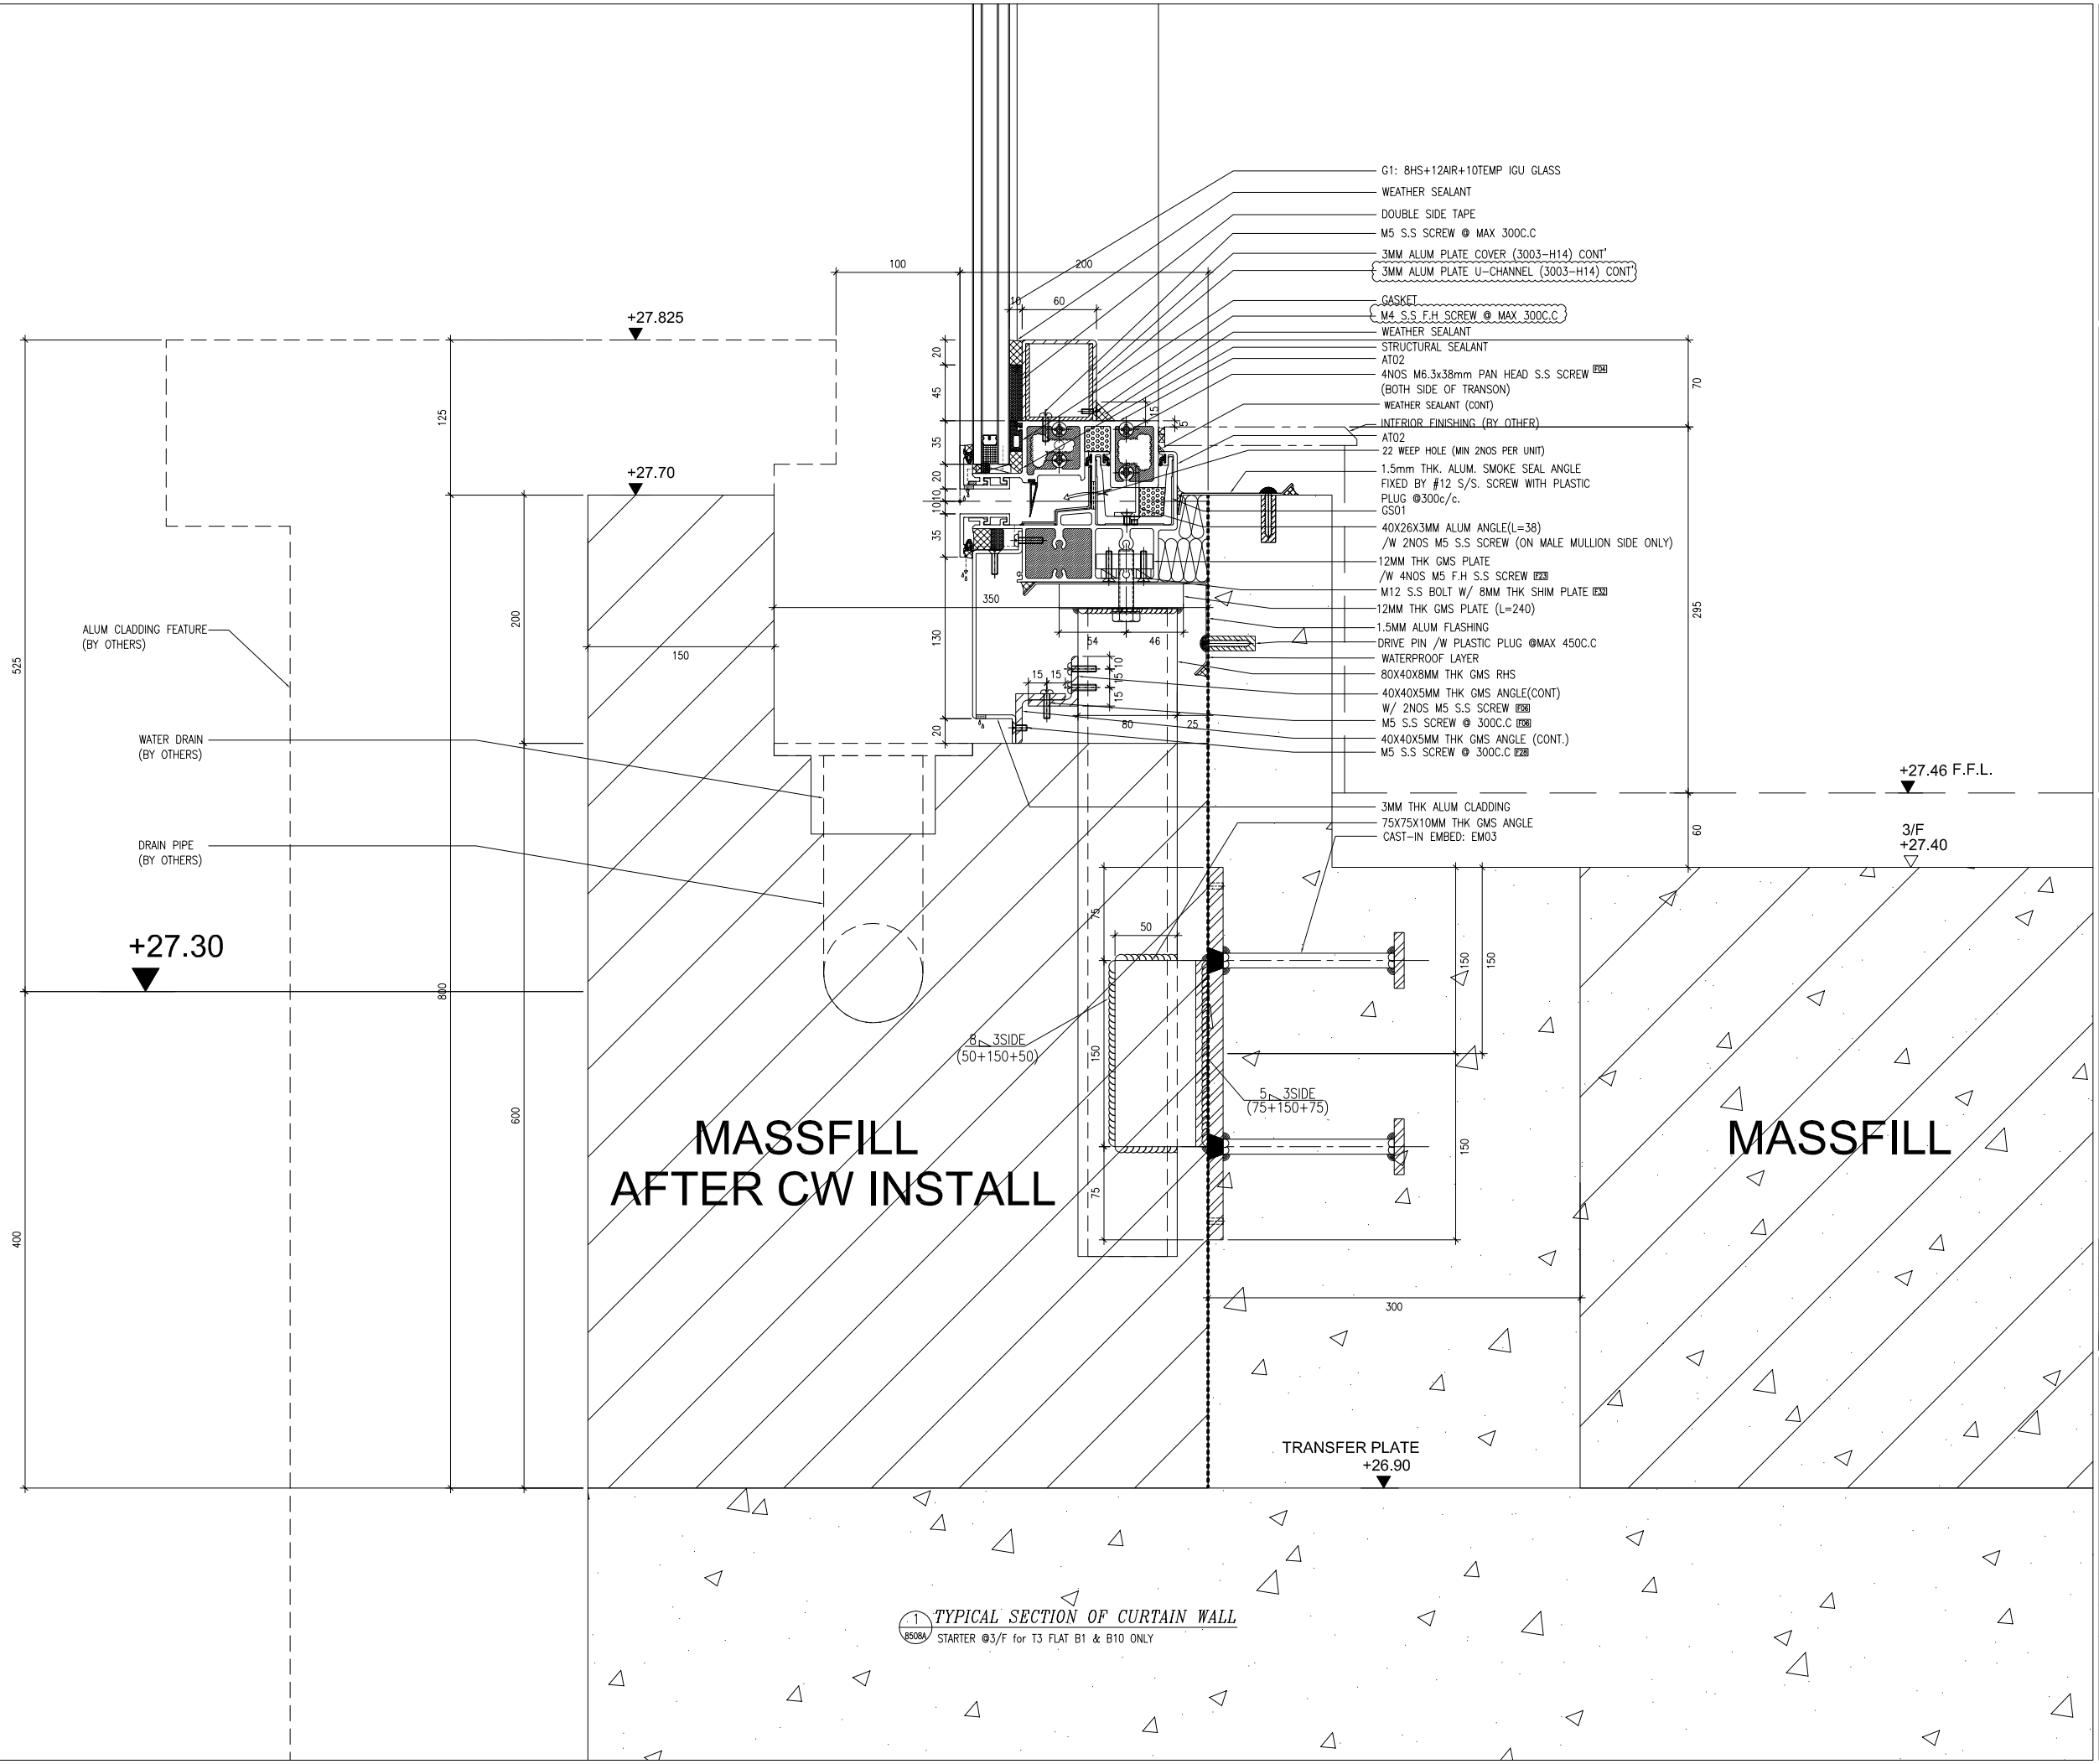

1 8508A *TYPICAL SECTION OF CURTAIN WALL*
STARTER @3/F for T3 FLAT B1 & B10 ONLY

B.D. REF :

CLIENT :
SUN HUNG KAI REAL ESTATE AGENCY LTD.
42/F SUN HUNG KAI CENTRE, WANCHAI, HONGKONG

ARCHITECT :
lwk&partners
a r c h i t e c t s

MAIN CONTRACTOR :
怡輝建築有限公司
Yee Fai Building Contractors Ltd.

STRUCTURAL ENGINEER :
ARUP

FACADE CONSULTANT:
ALPHA CONSULTING LIMITED
Steel Structure & Facade Specialist

NOTE :
1. ALL DIMENSIONS ARE IN mm.
2. ALL ELEVATIONS ARE VIEWED FROM OUTSIDE.
3. ALL DIMENSIONS TO BE VERIFIED ON SITE BEFORE FABRICATION.

LEGEND :
X1 / X001 — DETAIL MARK NO. / REFER SHEET NO.
1. F.F.L. --FINISHED FLOOR LEVEL
2. S.F.L. --STRUCTURAL FLOOR LEVEL
3. /R --REVERSED DETAIL

NO.	DATE	REVISED	BY
D	18-NOV-2023	9TH SUBMISSION	CF
C	30-MAY-2023	6TH SUBMISSION	CF
B	10-MAY-2023	5TH SUBMISSION	CF
A	21-FEB-2023	4TH SUBMISSION	CF
-	12-JAN-2023	NEW DRAWING (3ND SUBMISSION)	CF

JOB NO. : J-856

PROJECT :
PROPOSED DEVELOPMENT ABOVE LIGHT RAIL TIN WING STOP,TSWTL NO.23,AREA 33,TIN SHUI WAI, N.T.


TITLE :
TYPICAL DETAIL FOR CURTAIN WALL

DATE : 12-JAN-23 | SCALE : 1:5


DRAWN BY : C.F | CHECKED BY :

美特鋁質有限公司
MIDI ALUMINIUM FABRICATOR LTD.
Units 6-8, Sunray Industrial Centre, 1/F
610 Cha Kwo Ling Road, Kowloon
Tel:23489211-4 Fax:(852)27727666

DWG NO. : J856-SD-CW-8508A | REV. : D

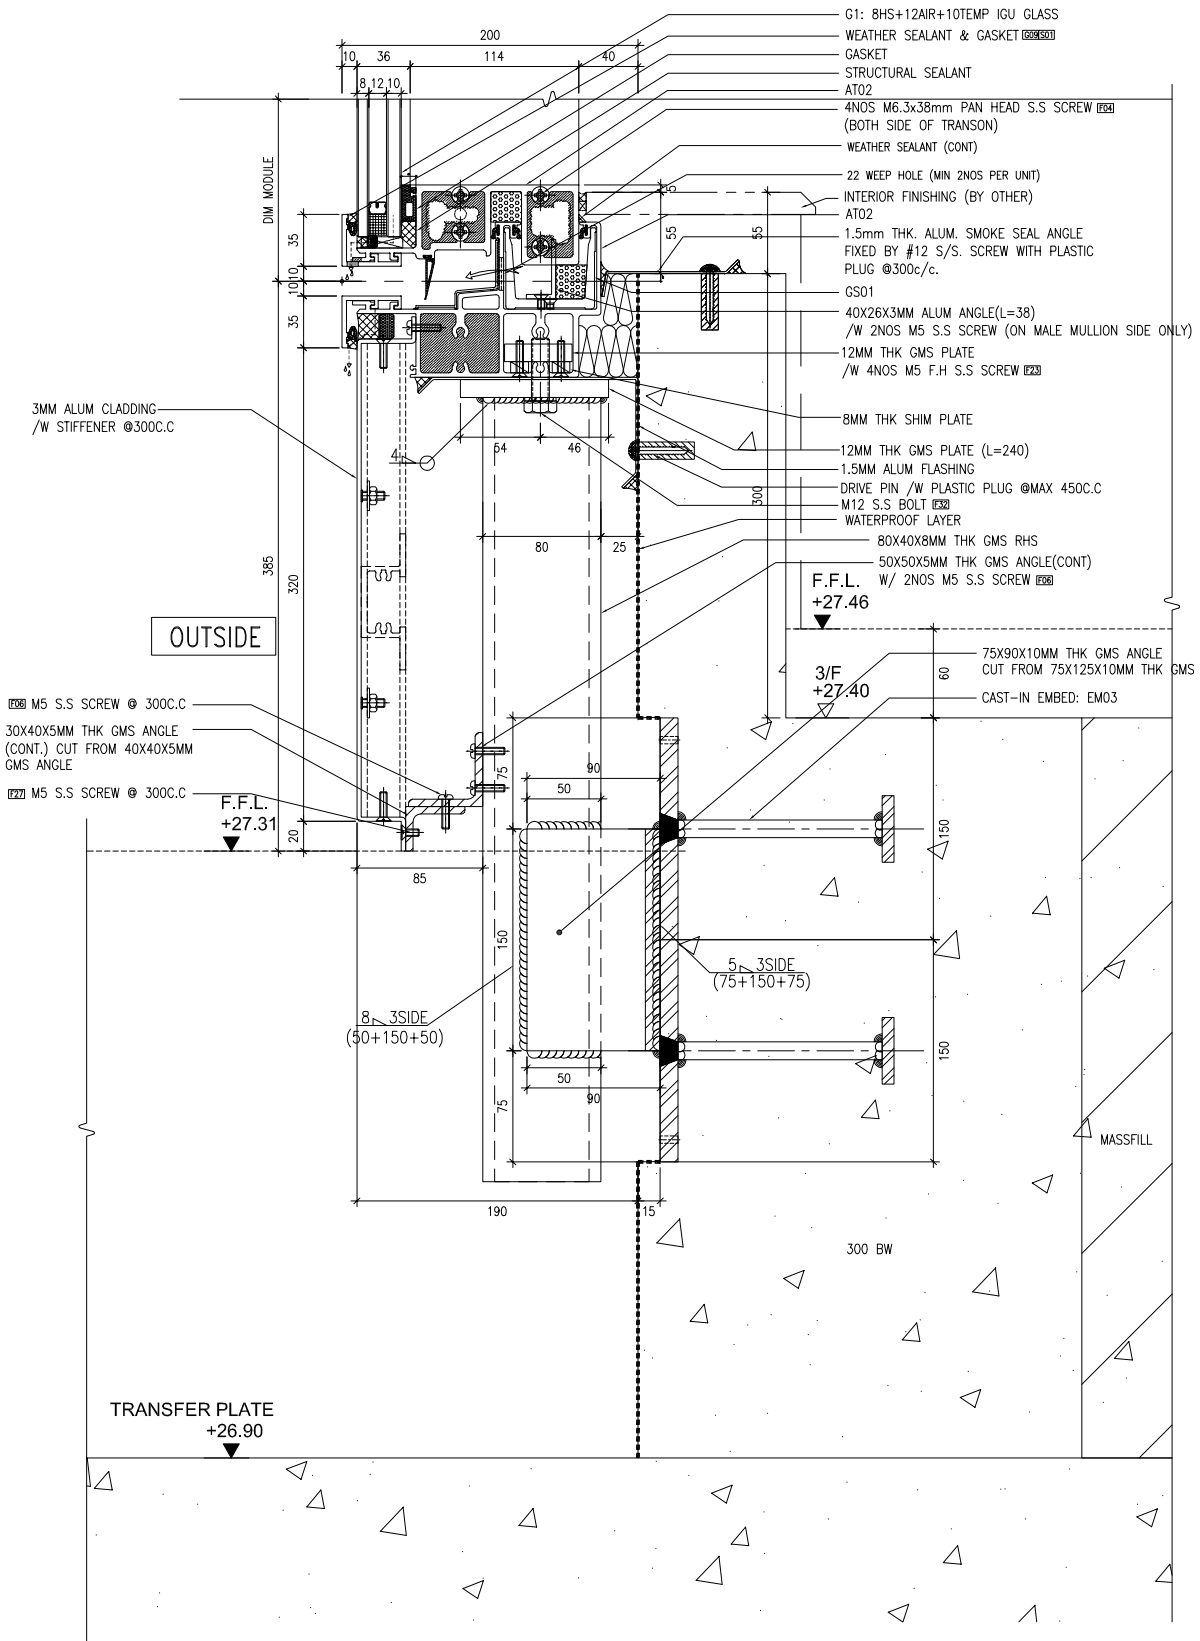

2 8508B *TYPICAL SECTION OF CURTAIN WALL*
STARTER (remedial case)

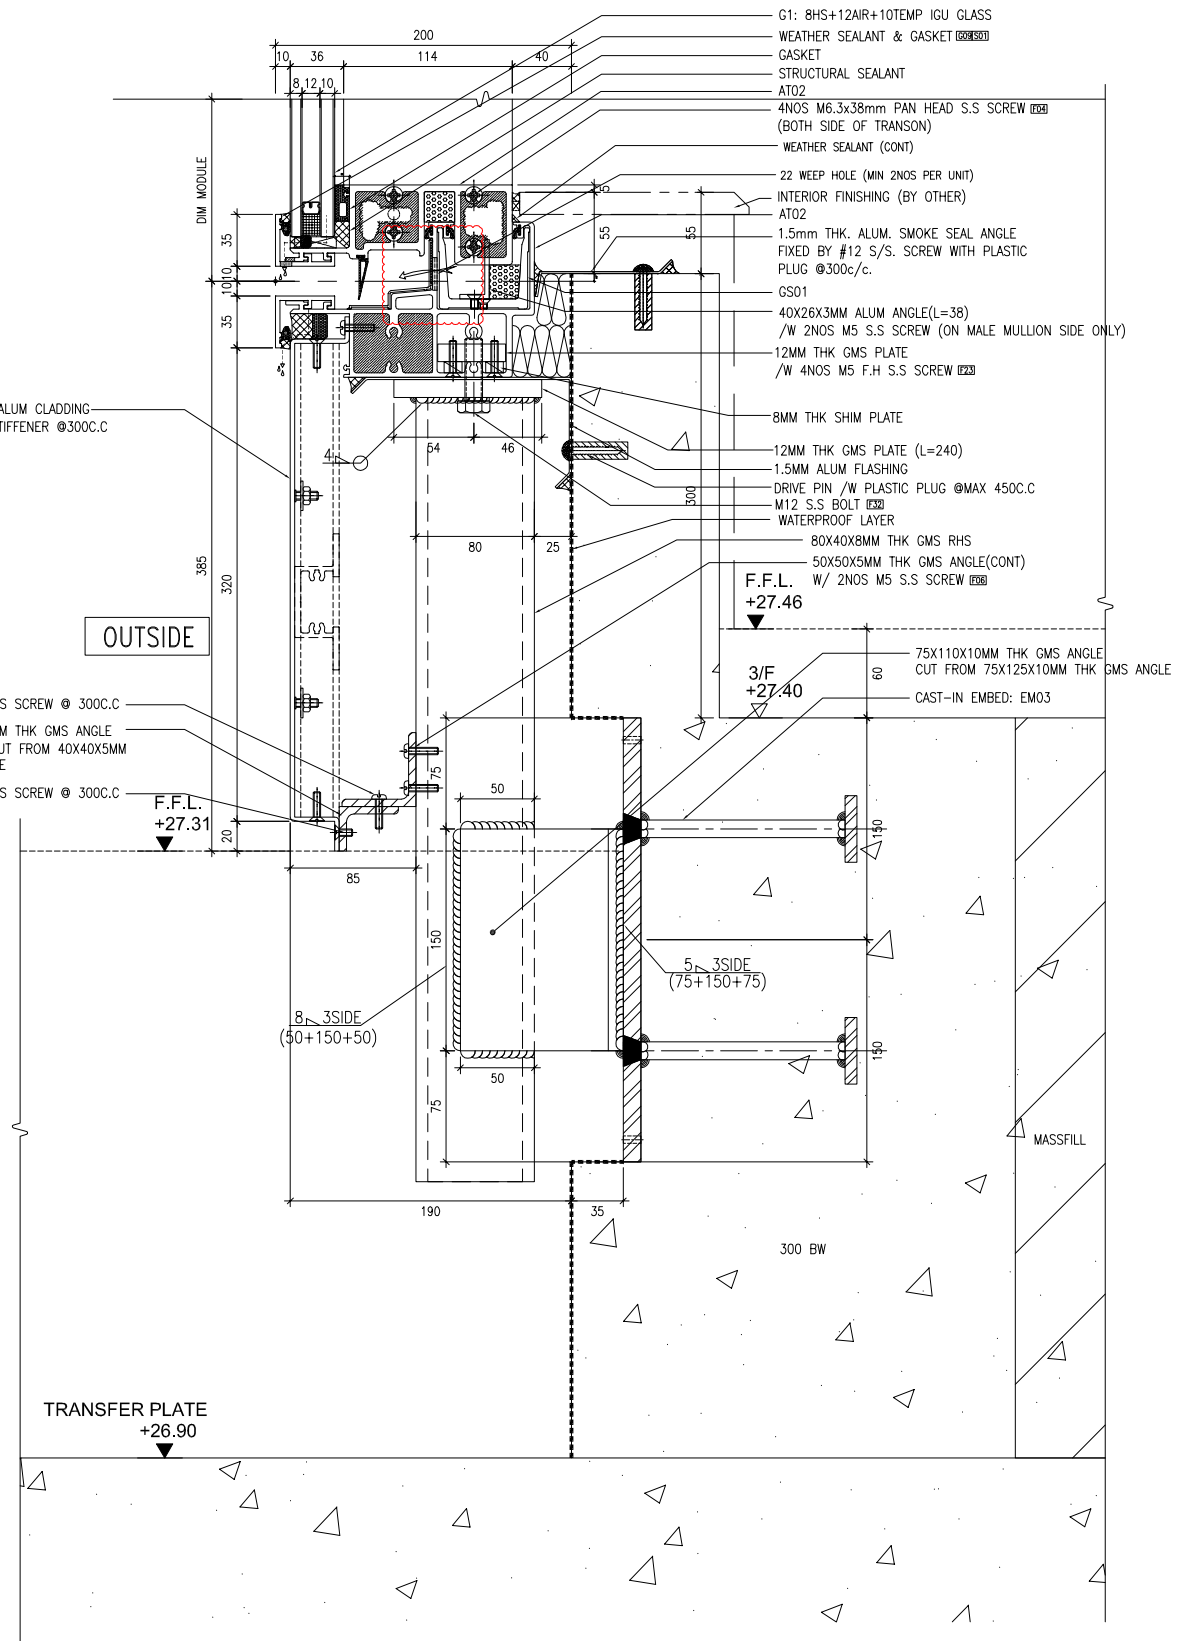

2 8508B *TYPICAL SECTION OF CURTAIN WALL*
STARTER (remedial case: embed offset 35MM)

B.D. REF :

CLIENT :
SUN HUNG KAI REAL ESTATE AGENCY LTD.
42/F SUN HUNG KAI CENTRE, WANCHAI, HONGKONG

ARCHITECT :
lwk&partners architects

MAIN CONTRACTOR :
怡輝建築有限公司
Yee Fai Building Contractors Ltd.

STRUCTURAL ENGINEER :
ARUP

FACADE CONSULTANT:
ALPHA CONSULTING LIMITED
Steel Structure & Facade Specialist

NOTE :
1. ALL DIMENSIONS ARE IN mm.
2. ALL ELEVATIONS ARE VIEWED FROM OUTSIDE.
3. ALL DIMENSIONS TO BE VERIFIED ON SITE BEFORE FABRICATION.

LEGEND :
X1 / X001 — DETAIL MARK NO. / REFER SHEET NO.
1. F.F.L. --FINISHED FLOOR LEVEL
2. S.F.L. --STRUCTURAL FLOOR LEVEL
3. (R) --REVERSED DETAIL

NO.	DATE	REVISED	BY
B	30-MAY-2023	6TH SUBMISSION	CF
A	10-MAY-2023	5TH SUBMISSION	CF

JOB NO. : J-856

PROJECT :
PROPOSED DEVELOPMENT ABOVE LIGHT RAIL TIN WING STOP,TSWTL NO.23,AREA 33,TIN SHUI WAI, N.T.


TITLE :
CURTAIN WALL
REMEIDAL CASE FOR STARTER EMBED

DATE : 31-OCT-22 | SCALE : 1:5

DRAWN BY : C.F | CHECKED BY :


美特鋁質有限公司
MIDI ALUMINIUM FABRICATOR LTD.
Units 6-8, Sunray Industrial Centre, 1/F
610 Cha Kwo Ling Road, Kowloon
Tel:23489211-4 Fax:(852)27727666

DWG NO. : J856-SD-CW-8508B | REV. : B

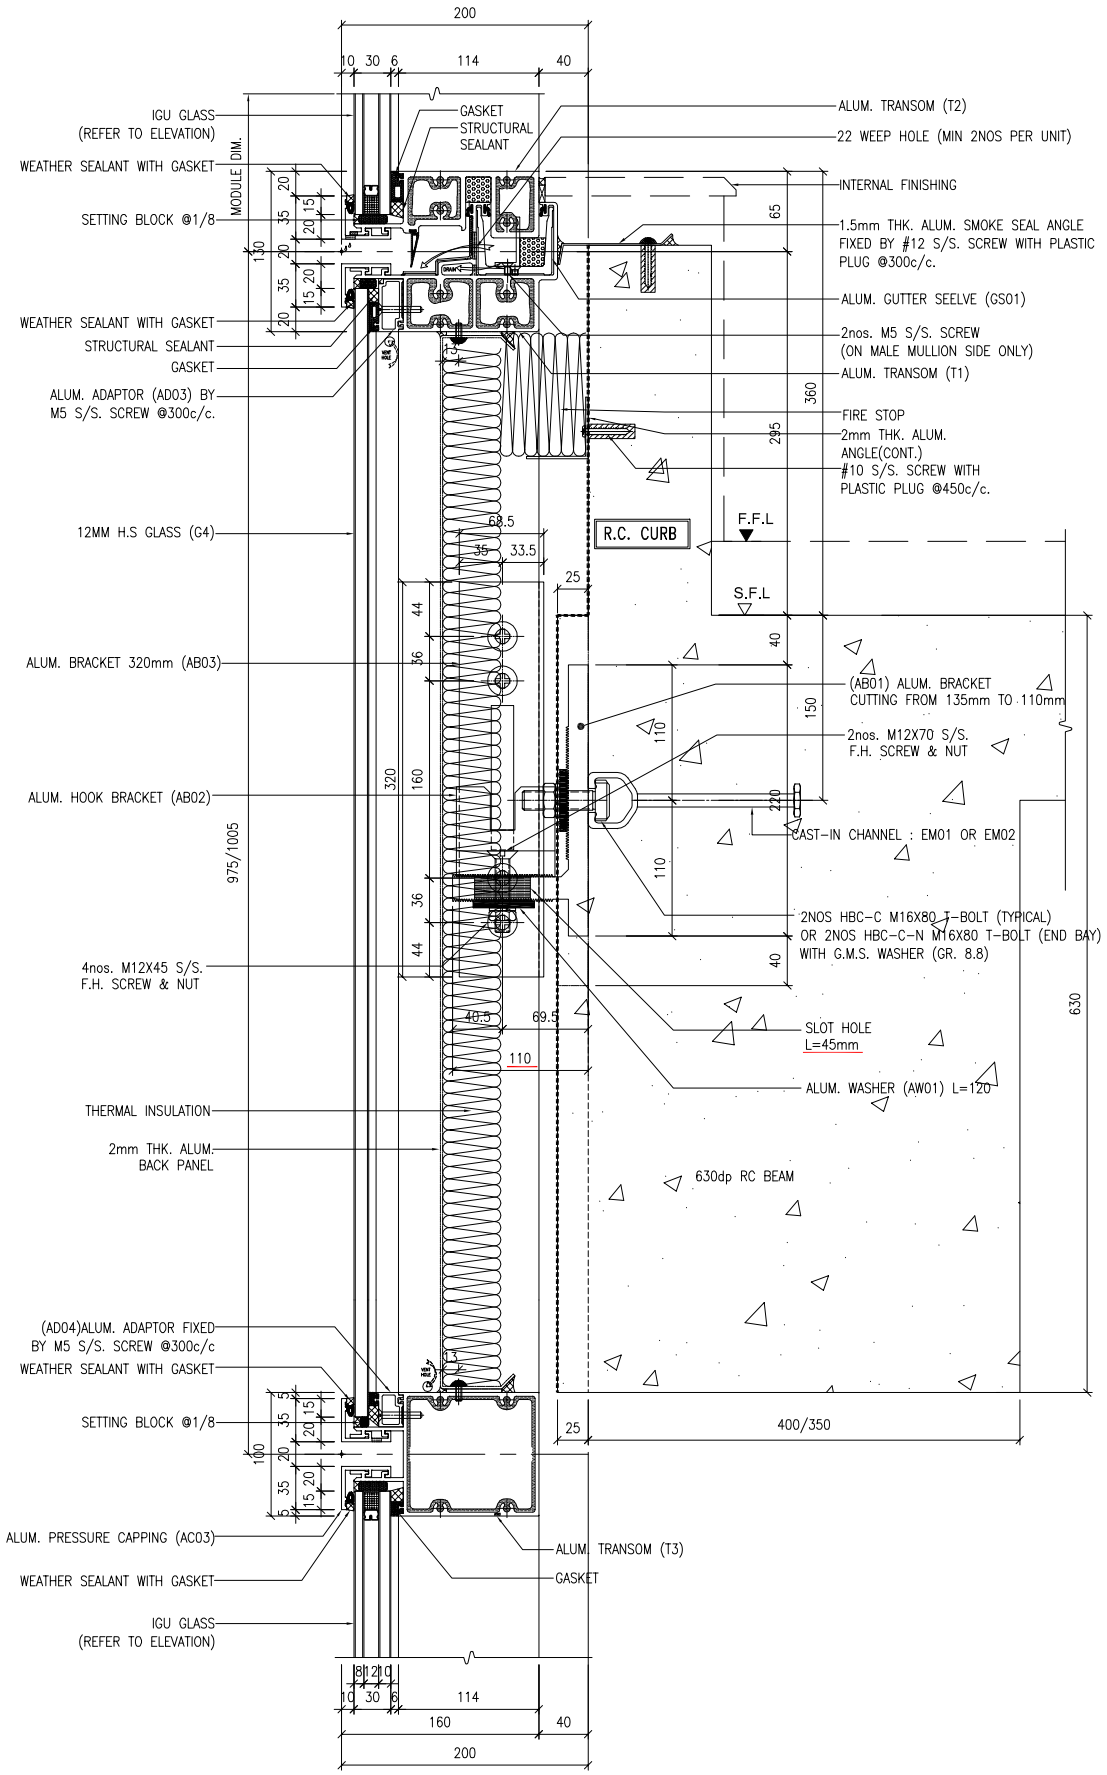

1 8508C SECTION DETAIL FOR REMEDIAL CURTAIN WALL FIXING

REMEDIAL CASE : RC BEAM OUTLINE OFFSET (OUTWARD) 25MM

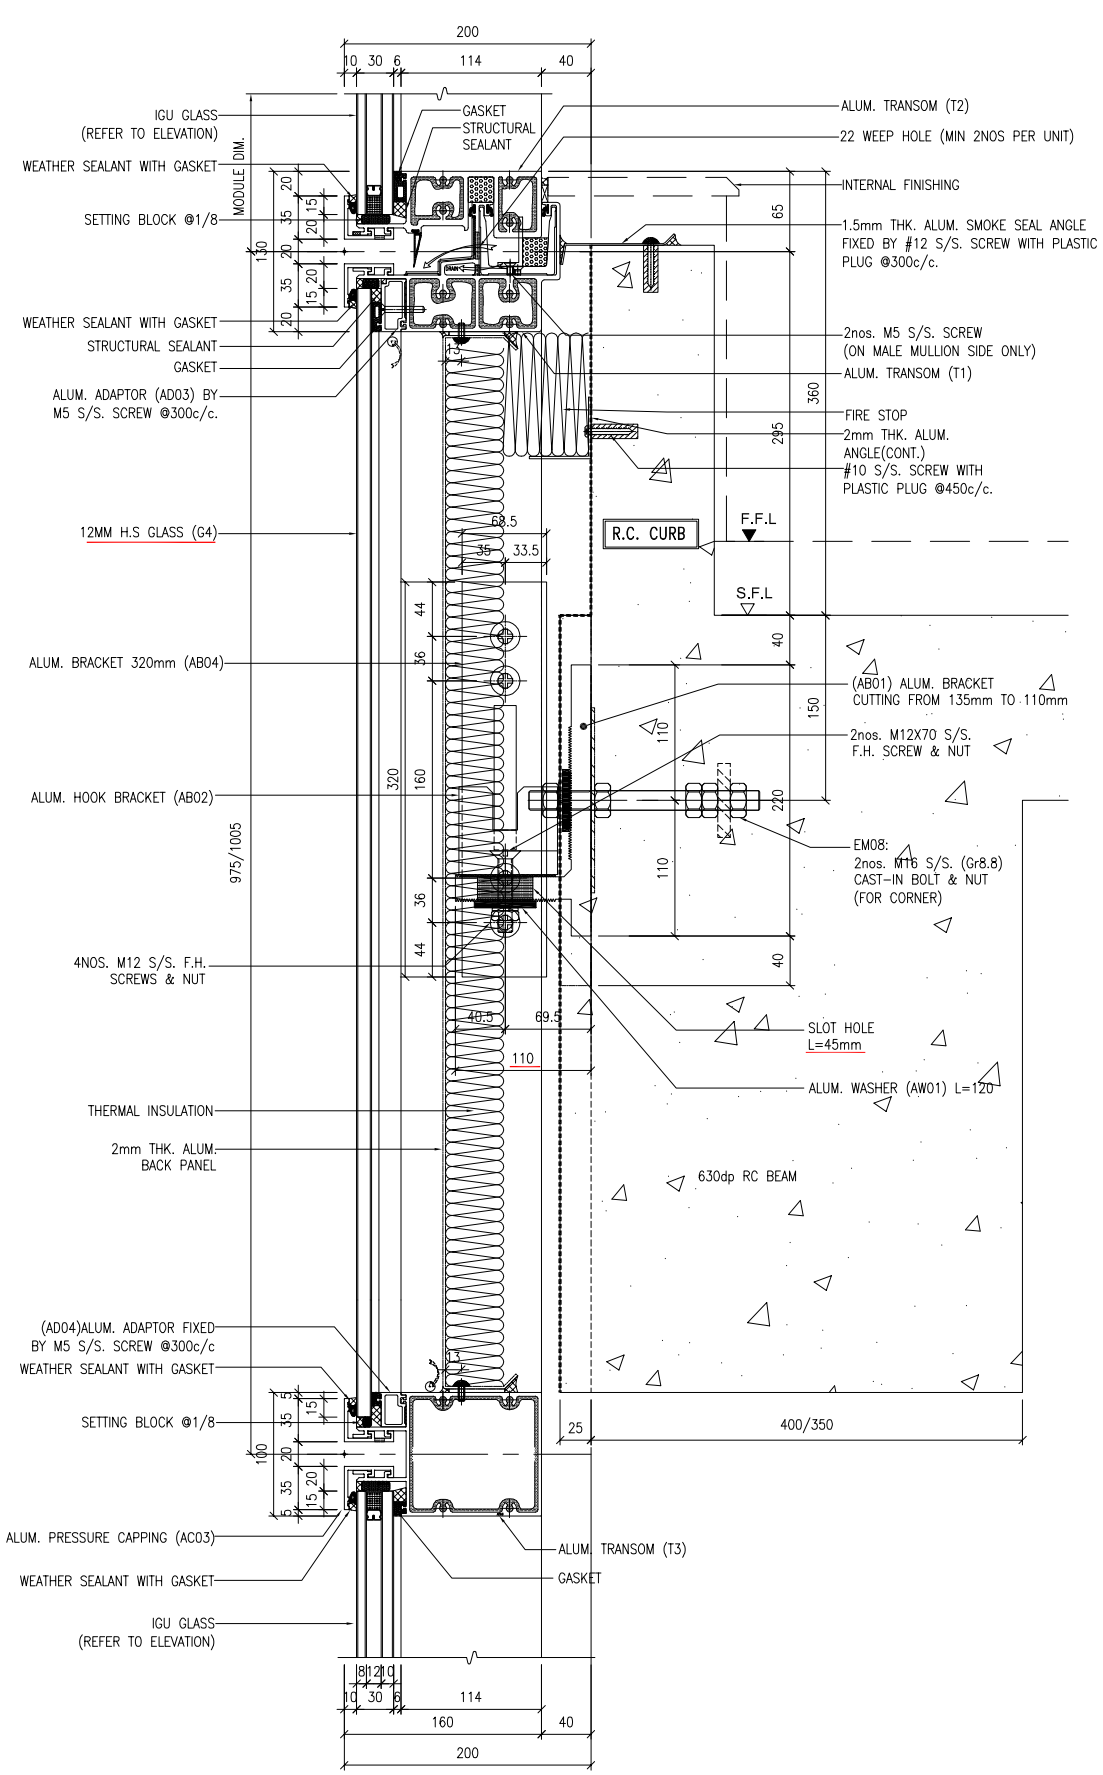

2 8508C SECTION DETAIL FOR REMEDIAL CURTAIN WALL FIXING

REMEDIAL CASE : RC BEAM OUTLINE OFFSET (OUTWARD) 25MM

B.D. REF :

NEW DRAWING FOR REMEDIAL

CLIENT :

SUN HUNG KAI REAL ESTATE AGENCY LTD.
42/F SUN HUNG KAI CENTRE, WANCHAI, HONGKONG

ARCHITECT :

lwk&partners
a r c h i t e c t s

MAIN CONTRACTOR :

怡輝建築有限公司
Yee Fai Building Contractors Ltd.

STRUCTURAL ENGINEER :

ARUP

FACADE CONSULTANT:

ALPHA CONSULTING LIMITED
Steel Structure & Facade Specialist

NOTE :
1. ALL DIMENSIONS ARE IN mm.
2. ALL ELEVATIONS ARE VIEWED FROM OUTSIDE.
3. ALL DIMENSIONS TO BE VERIFIED ON SITE BEFORE FABRICATION.

LEGEND :

X1 / X001 — DETAIL MARK NO. / REFER SHEET NO.

1. F.F.L. --FINISHED FLOOR LEVEL
2. S.F.L. --STRUCTURAL FLOOR LEVEL
3. (R) --REVERSED DETAIL

NO.	DATE	REVISED	BY
–	22-AUG-2023	(NEW DRAWING) 7TH SUBMISSION	CF

JOB NO. : J-856

PROJECT :
PROPOSED DEVELOPMENT ABOVE LIGHT RAIL TIN WING STOP,TSWTL NO.23,AREA 33,TIN SHUI WAI, N.T.


TITLE :
CURTAIN WALL
REMEIDAL CASE FOR TYPICAL EMBED

DATE : 31-OCT-22 | SCALE : 1:6

DRAWN BY : C.F | CHECKED BY :

美特鋁質有限公司
MIDI ALUMINIUM FABRICATOR LTD.
Units 6-8, Sunray Industrial Centre, 1/F
610 Cha Kwo Ling Road, Kowloon
Tel:23489211-4 Fax:(852)27727666

DWG NO. : J856-SD-CW-8508C | REV. : –

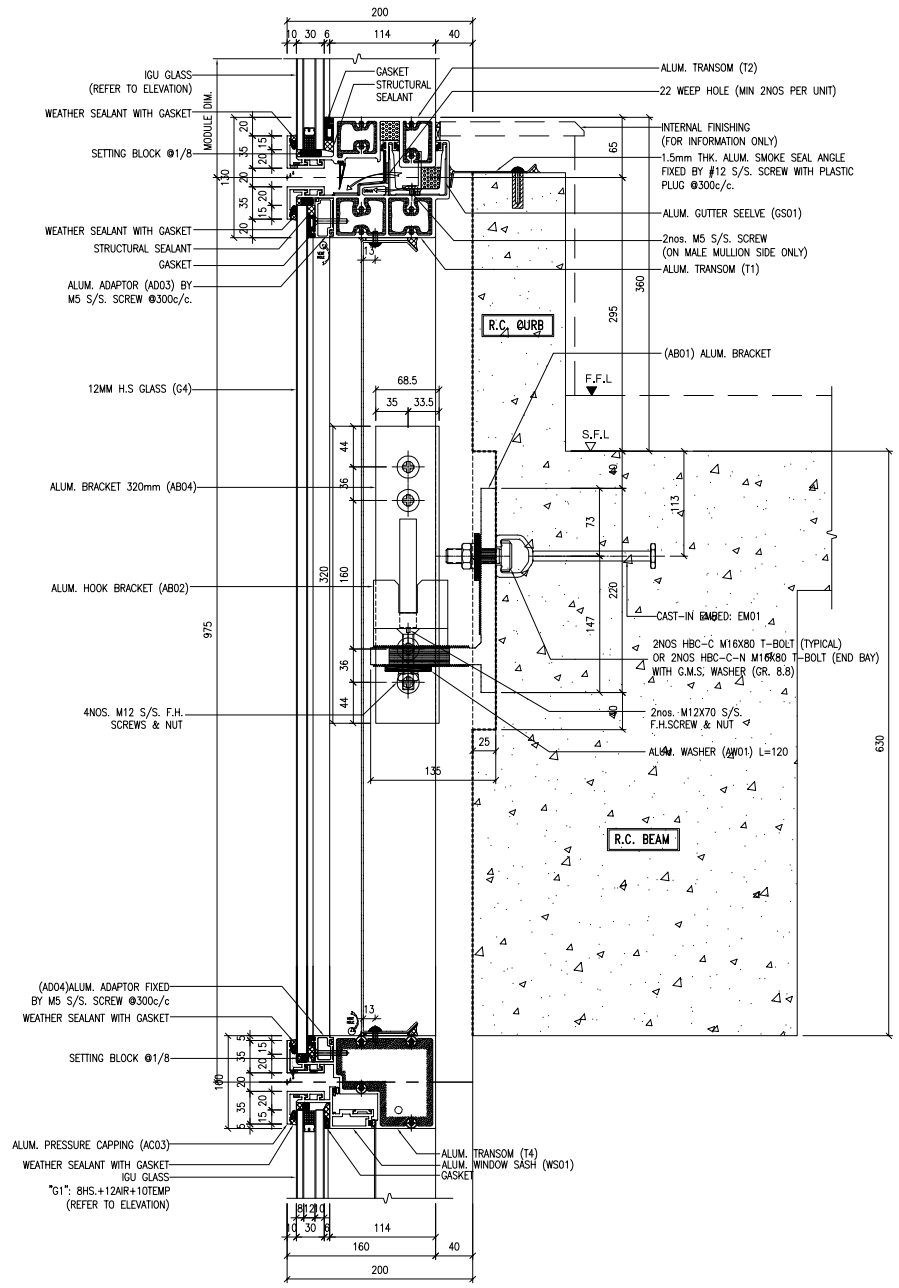


1 / 8508D SECTION DETAIL FOR REMEDIAL CURTAIN WALL FIXING

REMEDIAL CASE : CAST-IN EMBED EM01 SHIFT UPWARD 25~37MM(MAX) FOR MIDDLE CASE

LOCATION AT:

T2: 28/F, 31/F, 33/F REFER DRAWING 1 / 4004

T2: 39/F-45/F REFER DRAWING 4 / 4004

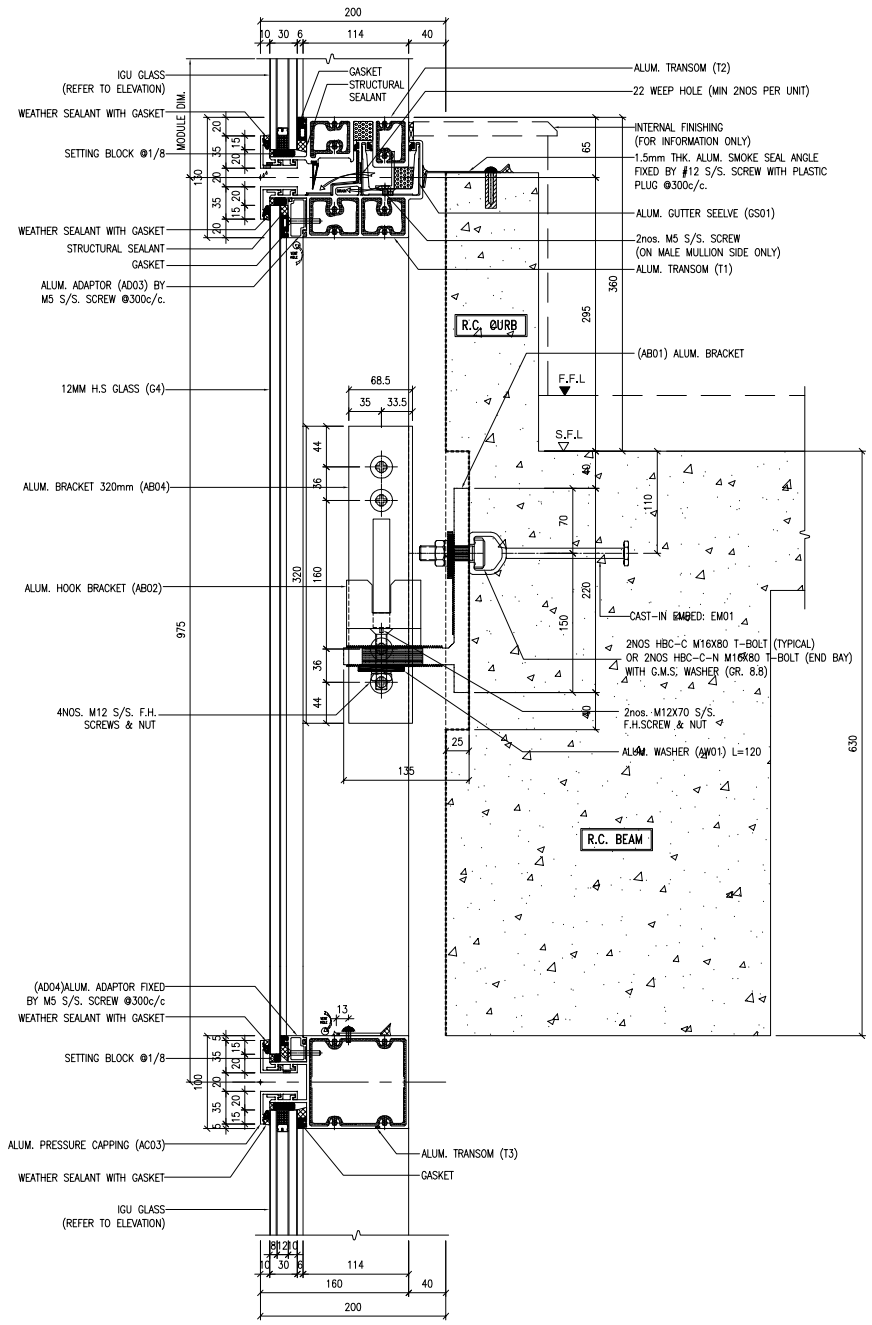

2 / 8508D SECTION DETAIL FOR REMEDIAL CURTAIN WALL FIXING

REMEDIAL CASE : CAST-IN EMBED EM01 SHIFT UPWARD 25~40MM(MAX) FOR EDGE CASE

LOCATION AT:

T2: 28/F, 31/F-33/F REFER DRAWING 1 / 4004

T2: 39/F-45/F REFER DRAWING 4 / 4004

B.D. REF :

CLIENT :

SUN HUNG KAI REAL ESTATE AGENCY LTD.
42/F SUN HUNG KAI CENTRE, WANCHAI, HONGKONG

ARCHITECT :

lwk&partners
a r c h i t e c t s

MAIN CONTRACTOR :

怡輝建築有限公司
Yee Fai Building Contractors Ltd.

STRUCTURAL ENGINEER :

ARUP

FACADE CONSULTANT:

ALPHA CONSULTING LIMITED
Steel Structure & Facade Specialist

NOTE :

1. ALL DIMENSIONS ARE IN mm.
2. ALL ELEVATIONS ARE VIEWED FROM OUTSIDE.
3. ALL DIMENSIONS TO BE VERIFIED ON SITE BEFORE FABRICATION.

LEGEND :

X1 / X001 — DETAIL MARK NO. / REFER SHEET NO.

1. F.F.L. --FINISHED FLOOR LEVEL
2. S.F.L. --STRUCTURAL FLOOR LEVEL
3. /R --REVERSED DETAIL

NO.	DATE	REVISED	BY
-	29-SEP-2023	(NEW DRAWING) 8TH SUBMISSION	CF

JOB NO. : J-856

PROJECT :
PROPOSED DEVELOPMENT ABOVE LIGHT RAIL TIN WING STOP,TSWTL NO.23,AREA 33,TIN SHUI WAI, N.T.


TITLE :
CURTAIN WALL
REMEIDAL CASE

DATE : 31-OCT-22 | SCALE : 1:6

DRAWN BY : C.F | CHECKED BY :

美特鋁質有限公司
MIDI ALUMINIUM FABRICATOR LTD.
Units 6-8, Sunray Industrial Centre, 1/F
610 Cha Kwo Ling Road, Kowloon
Tel:23489211-4 Fax:(852)27727666

DWG NO. : J856-SD-CW-8508D | REV. : -

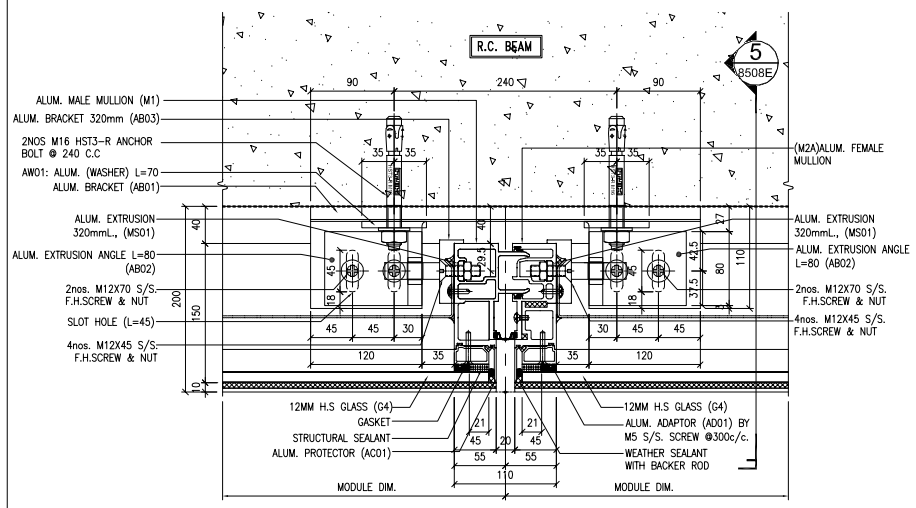


1 / 8508E HORIZONTAL DETAIL FOR REMEDIAL FIXING MIDDLE CASE

REMEDIAL CASE : CAST-IN EMBED EM01/EM02/EM08
EITHER EMBED MISSING OR OFFSET OUTWARD >25~50mm


LOCATION AT:
T2: 46/F REFER DRAWING 1/4003

T3: 46/F REFER DRAWING 1/4005 · 4/4005 · 7/4005

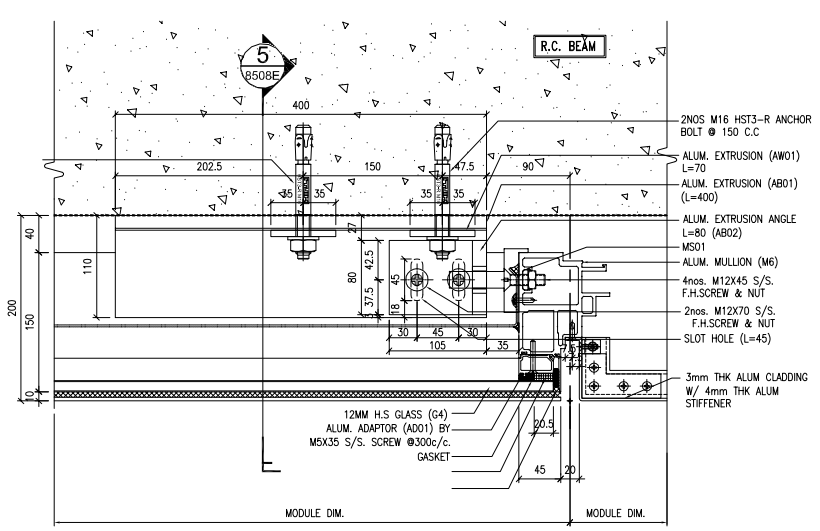

2 / 8508E HORIZONTAL DETAIL FOR REMEDIAL FIXING END BAY


REMEDIAL CASE : CAST-IN EMBED EM01/EM02/EM08
EITHER EMBED MISSING OR OFFSET OUTWARD >25~50mm
LOCATION AT:
T3: 46/F REFER DRAWING 7/4005 · 4/4006

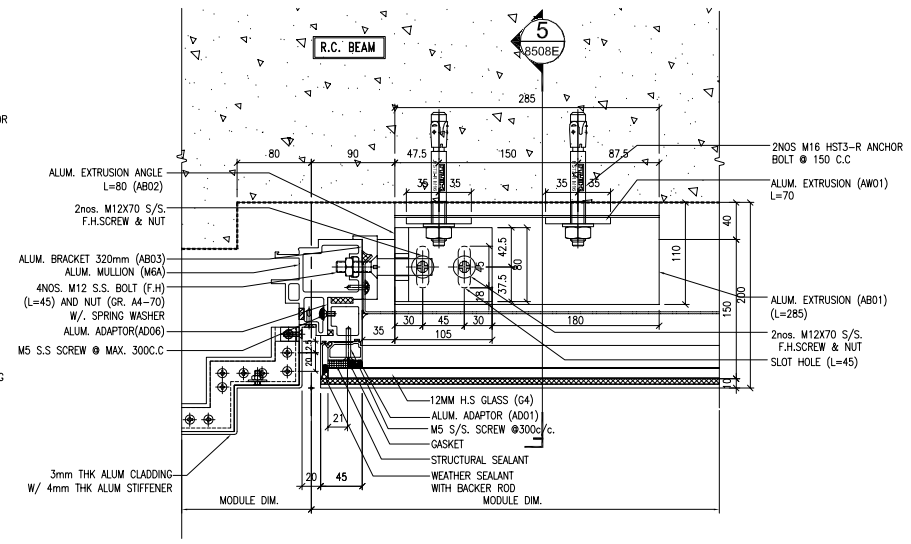

3 / 8508E HORIZONTAL DETAIL FOR REMEDIAL FIXING END BAY


REMEDIAL CASE : CAST-IN EMBED EM01/EM02/EM08
EITHER EMBED MISSING OR OFFSET OUTWARD >25~50mm
LOCATION AT:
T2: 46/F REFER DRAWING 1/4003

T3: 46/F REFER DRAWING 1/4005 · 4/4005 · 7/4005 · 4/4006

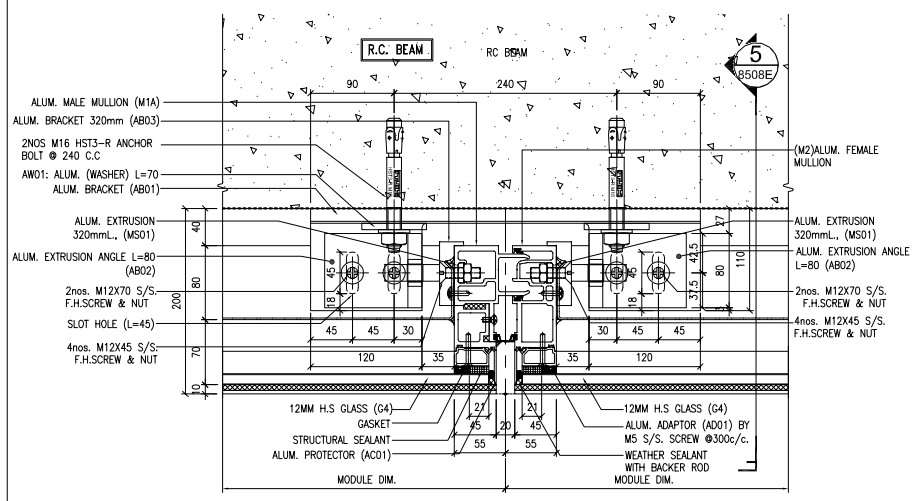

4 / 8508E HORIZONTAL DETAIL FOR REMEDIAL FIXING MIDDLE CASE

REMEDIAL CASE : CAST-IN EMBED EM01/EM02/EM08
EITHER EMBED MISSING OR OFFSET OUTWARD >25~50mm
LOCATION AT:
T3: 46/F REFER DRAWING 1/4005 · 4/4006

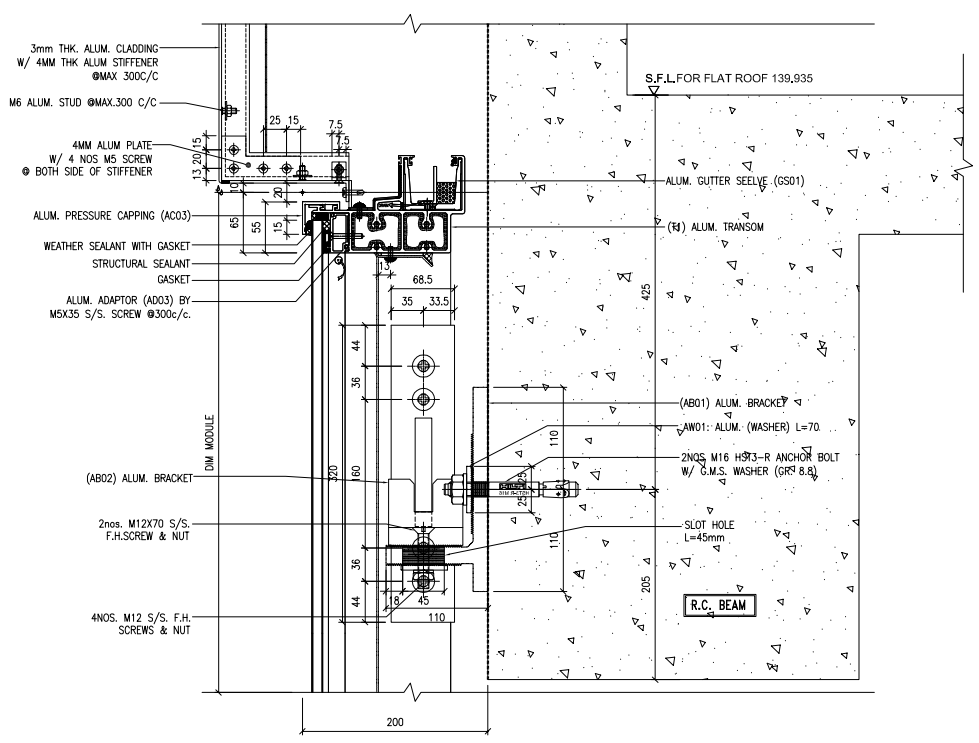

5 / 8508E SECTION DETAIL FOR REMEDIAL CURTAIN WALL FIXING VERT. VIEW

B.D. REF :

CLIENT :
SUN HUNG KAI REAL ESTATE AGENCY LTD.
42/F SUN HUNG KAI CENTRE, WANCHAI, HONGKONG

ARCHITECT :
lwk&partners
a r c h i t e c t s

MAIN CONTRACTOR :
怡輝建築有限公司
Yee Fai Building Contractors Ltd.

STRUCTURAL ENGINEER :
ARUP

FACADE CONSULTANT:
ALPHA CONSULTING LIMITED
Steel Structure & Facade Specialist

NOTE :
1. ALL DIMENSIONS ARE IN mm.
2. ALL ELEVATIONS ARE VIEWED FROM OUTSIDE.
3. ALL DIMENSIONS TO BE VERIFIED ON SITE BEFORE FABRICATION.

LEGEND :
X1 — DETAIL MARK NO.
X001 — REFER SHEET NO.

1. F.F.L. --FINISHED FLOOR LEVEL
2. S.F.L. --STRUCTURAL FLOOR LEVEL
3. (R) --REVERSED DETAIL

NO.	DATE	REVISED	BY
–	29-SEP-2023	(NEW DRAWING) 8TH SUBMISSION	CF

JOB NO. : J-856

PROJECT :
PROPOSED DEVELOPMENT ABOVE LIGHT RAIL TIN WING STOP,TSWTL NO.23,AREA 33,TIN SHUI WAI, N.T.


TITLE :
CURTAIN WALL
REMEIDAL CASE

DATE : 31-OCT-22 | SCALE : 1:6


DRAWN BY : C.F | CHECKED BY :

美特鋁質有限公司
MIDI ALUMINIUM FABRICATOR LTD.
Units 6-8, Sunray Industrial Centre, 1/F
610 Cha Kwo Ling Road, Kowloon
Tel:23489211-4 Fax:(852)27727666


DWG NO. : J856-SD-CW-8508E | REV. : –

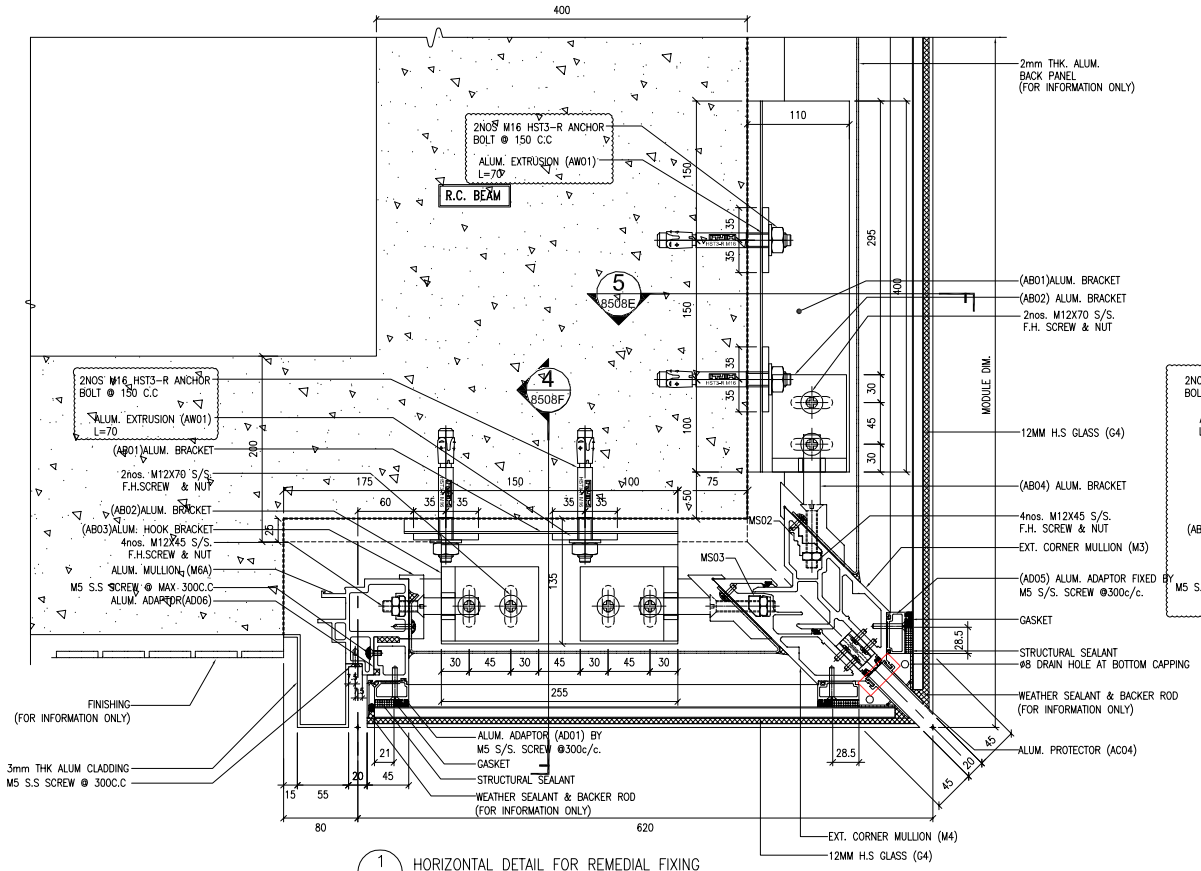


1 8508F HORIZONTAL DETAIL FOR REMEDIAL FIXING CORNER END BAY (620 SPAN)
REMEDIAL CASE : CAST-IN EMBED EM01/EM02/EM08
EITHER EMBED MISSING OR OFFSET OUTWARD >25~50mm
LOCATION AT:
T3: 46/F REFER DRAWING 4/405

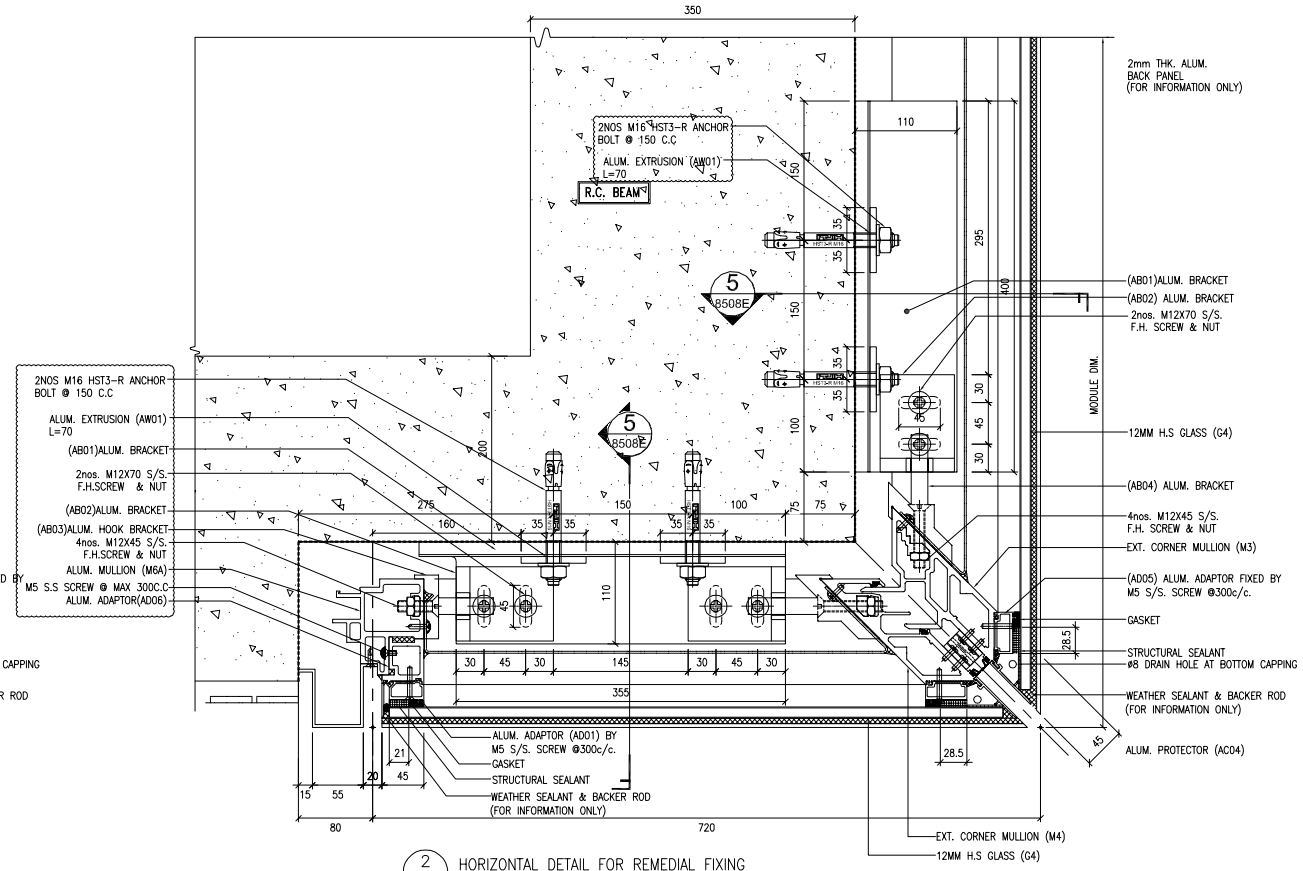

2 8508F HORIZONTAL DETAIL FOR REMEDIAL FIXING CORNER END BAY (720 SPAN)
REMEDIAL CASE : CAST-IN EMBED EM01/EM02/EM08
EITHER EMBED MISSING OR OFFSET OUTWARD >25~50mm
LOCATION AT:
T2: 46/F REFER DRAWING 1/403

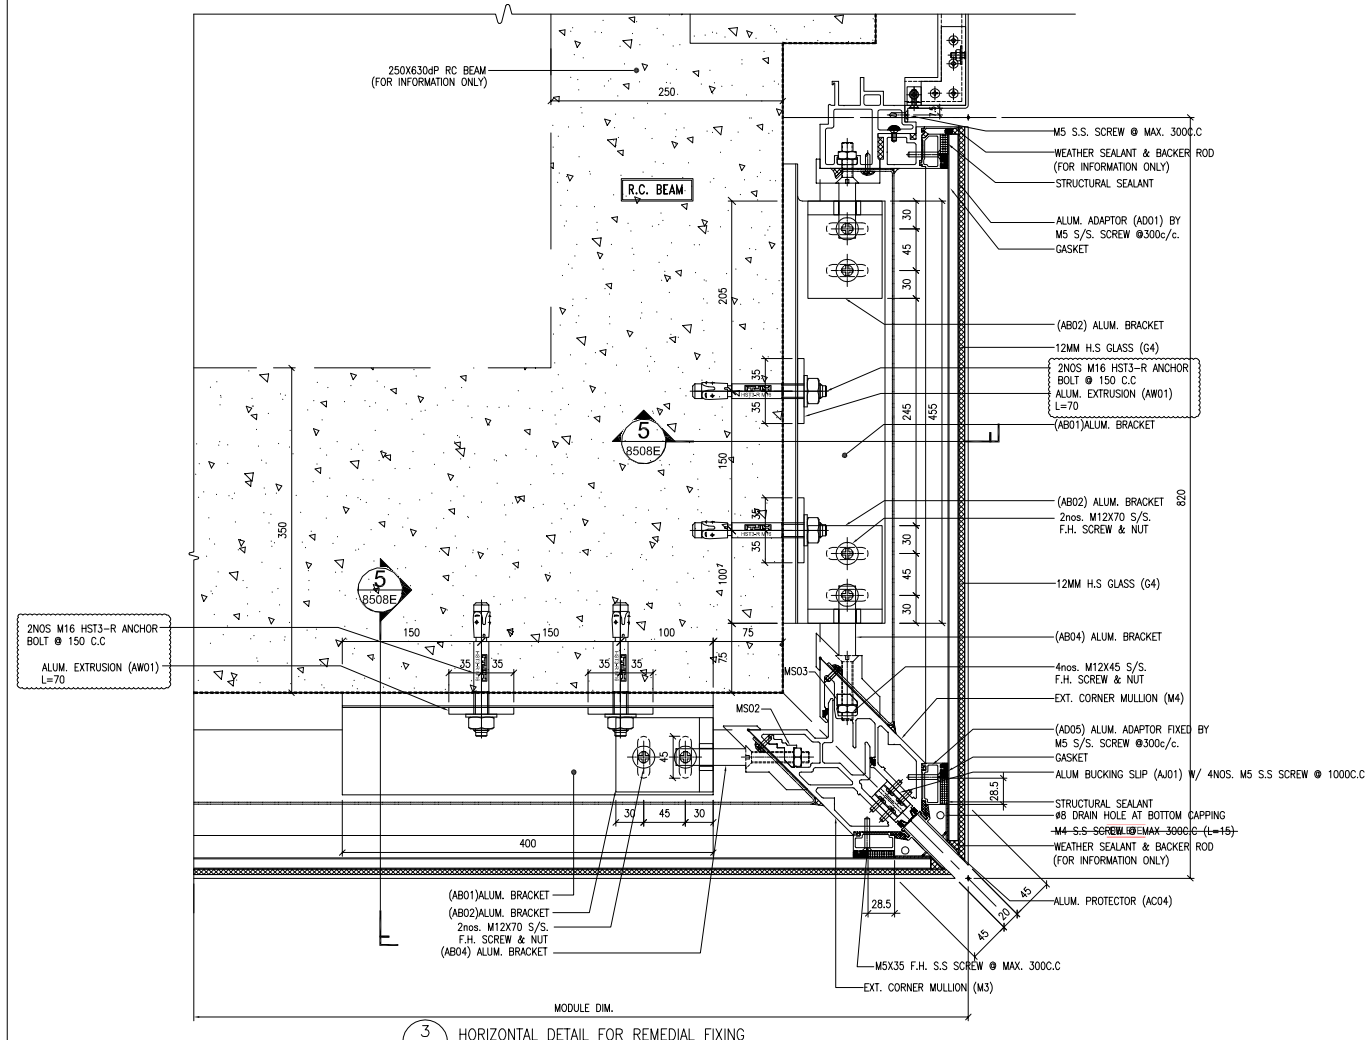

3 8508F HORIZONTAL DETAIL FOR REMEDIAL FIXING CORNER END BAY (820 SPAN)
REMEDIAL CASE : CAST-IN EMBED EM01/EM02/EM08
EITHER EMBED MISSING OR OFFSET OUTWARD >25~50mm
LOCATION AT:
T3: 46/F REFER DRAWING 1/405

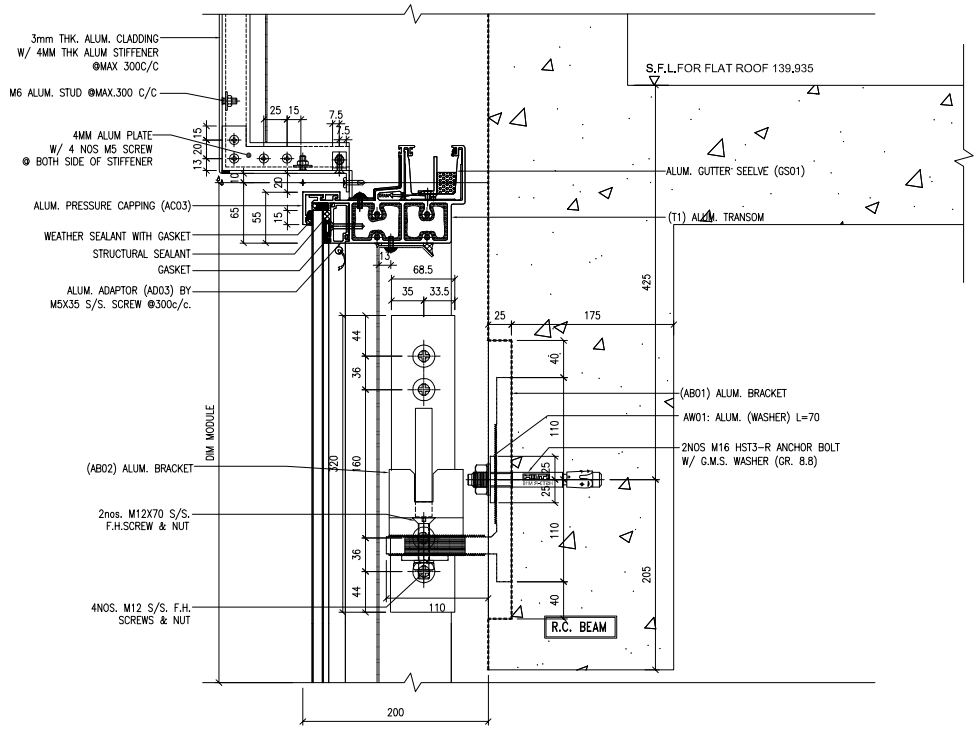

4 8508F REMEDIAL SECTION DETAIL (MISSING EMBED) VERT. VIEW

B.D. REF :

CLIENT :
SUN HUNG KAI REAL ESTATE AGENCY LTD.
42/F SUN HUNG KAI CENTRE, WANCHAI, HONGKONG

ARCHITECT :
lwk&partners a r c h i t e c t s

MAIN CONTRACTOR :
怡輝建築有限公司 Yee Fai Building Contractors Ltd.

STRUCTURAL ENGINEER :
ARUP

FACADE CONSULTANT:
ALPHA CONSULTING LIMITED
Steel Structure & Facade Specialist

NOTE :
1. ALL DIMENSIONS ARE IN mm.
2. ALL ELEVATIONS ARE VIEWED FROM OUTSIDE.
3. ALL DIMENSIONS TO BE VERIFIED ON SITE BEFORE FABRICATION.

LEGEND :
X1 / X001 — DETAIL MARK NO. / REFER SHEET NO.
1. F.F.L. -- FINISHED FLOOR LEVEL
2. S.F.L. -- STRUCTURAL FLOOR LEVEL
3. (R) -- REVERSED DETAIL

NO.	DATE	REVISED	BY
A	30-OCT-2023	9TH SUBMISSION	CF
–	29-SEP-2023	(NEW DRAWING) 8TH SUBMISSION	CF

JOB NO. : J-856

PROJECT :
PROPOSED DEVELOPMENT ABOVE LIGHT RAIL TIN WING STOP,TSWTL NO.23,AREA 33,TIN SHUI WAI, N.T.


TITLE :
CURTAIN WALL REMEIDAL CASE

DATE : 31-OCT-22 | SCALE : 1:6


DRAWN BY : C.F | CHECKED BY :

美特鋁製有限公司 MIDI ALUMINIUM FABRICATOR LTD.
Units 6-8, Sunray Industrial Centre, 1/F
610 Cha Kwo Ling Road, Kowloon
Tel:23489211-4 Fax:(852)27727666

DWG NO. : J856-SD-CW-8508F | REV. : A

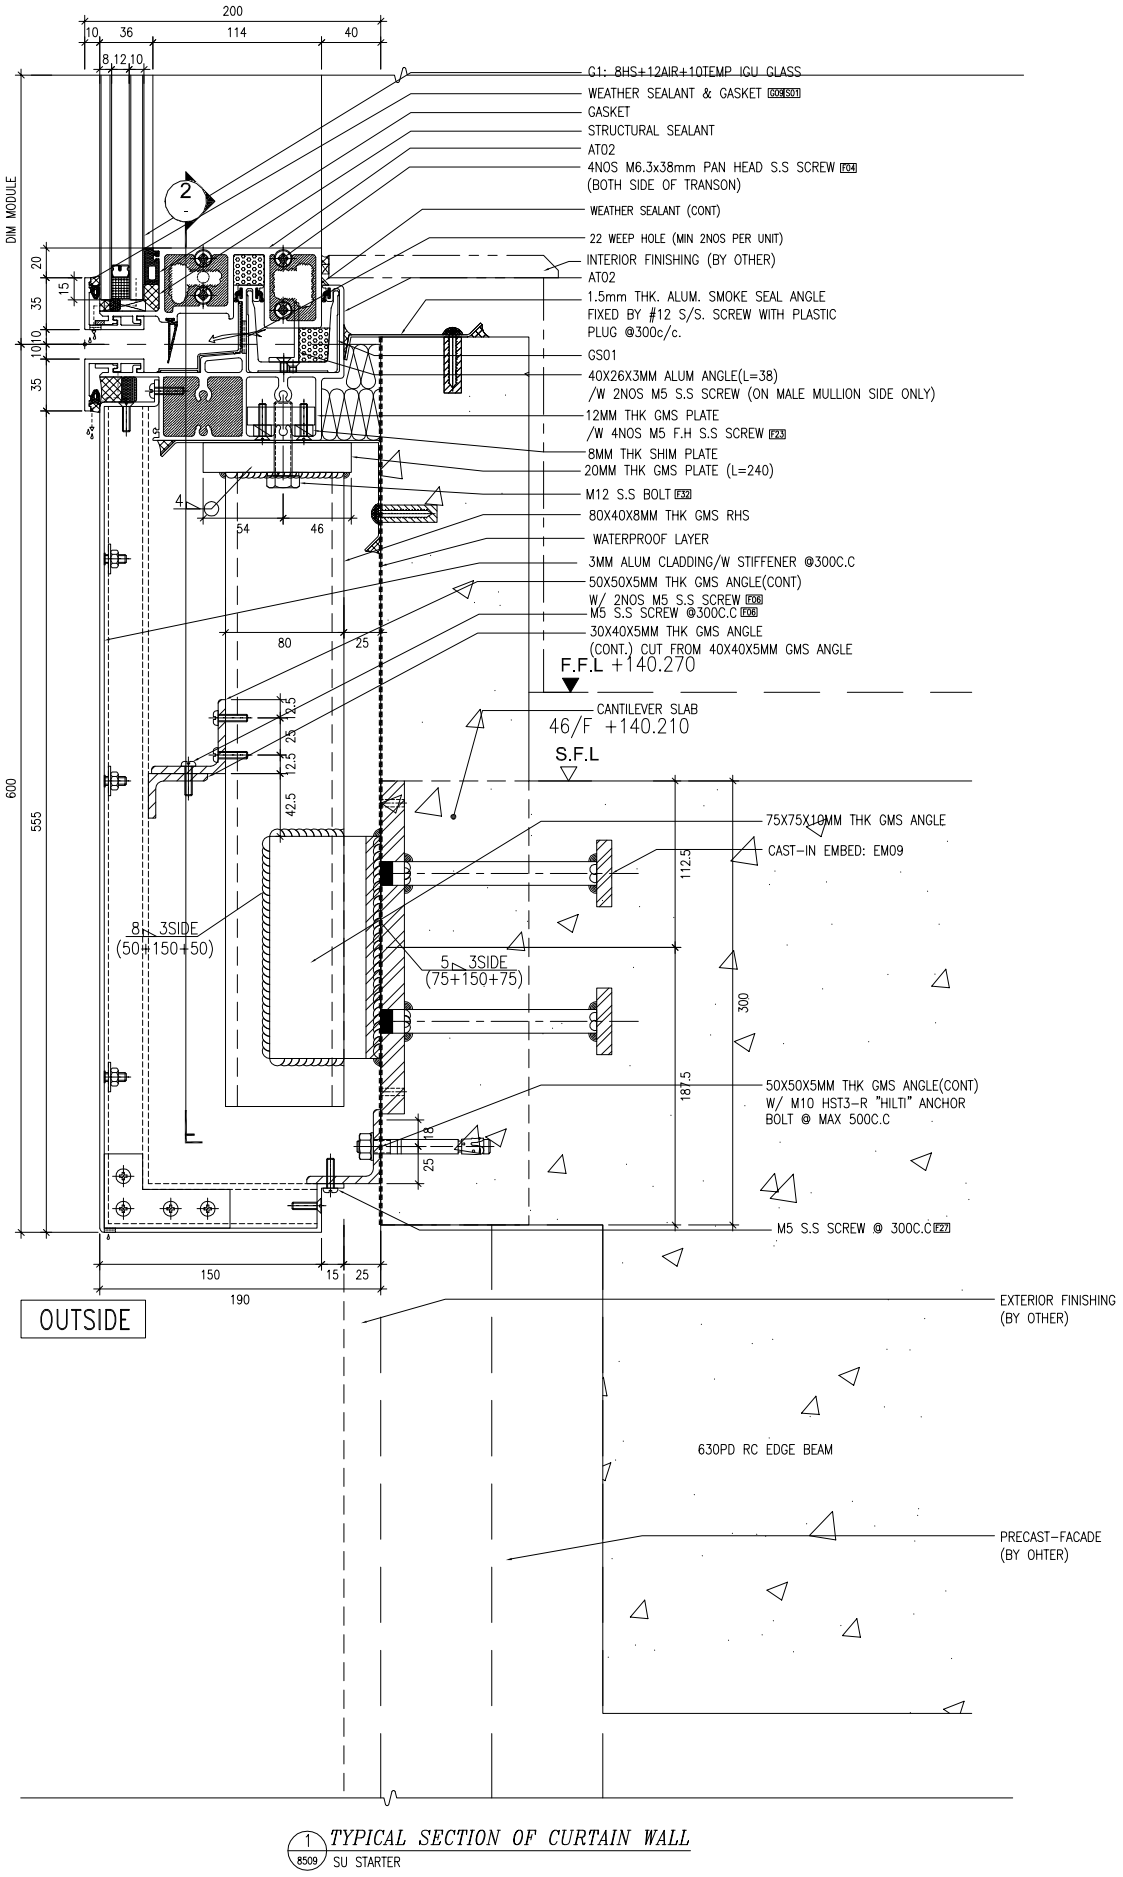

1 8509 *TYPICAL SECTION OF CURTAIN WALL*
SU STARTER

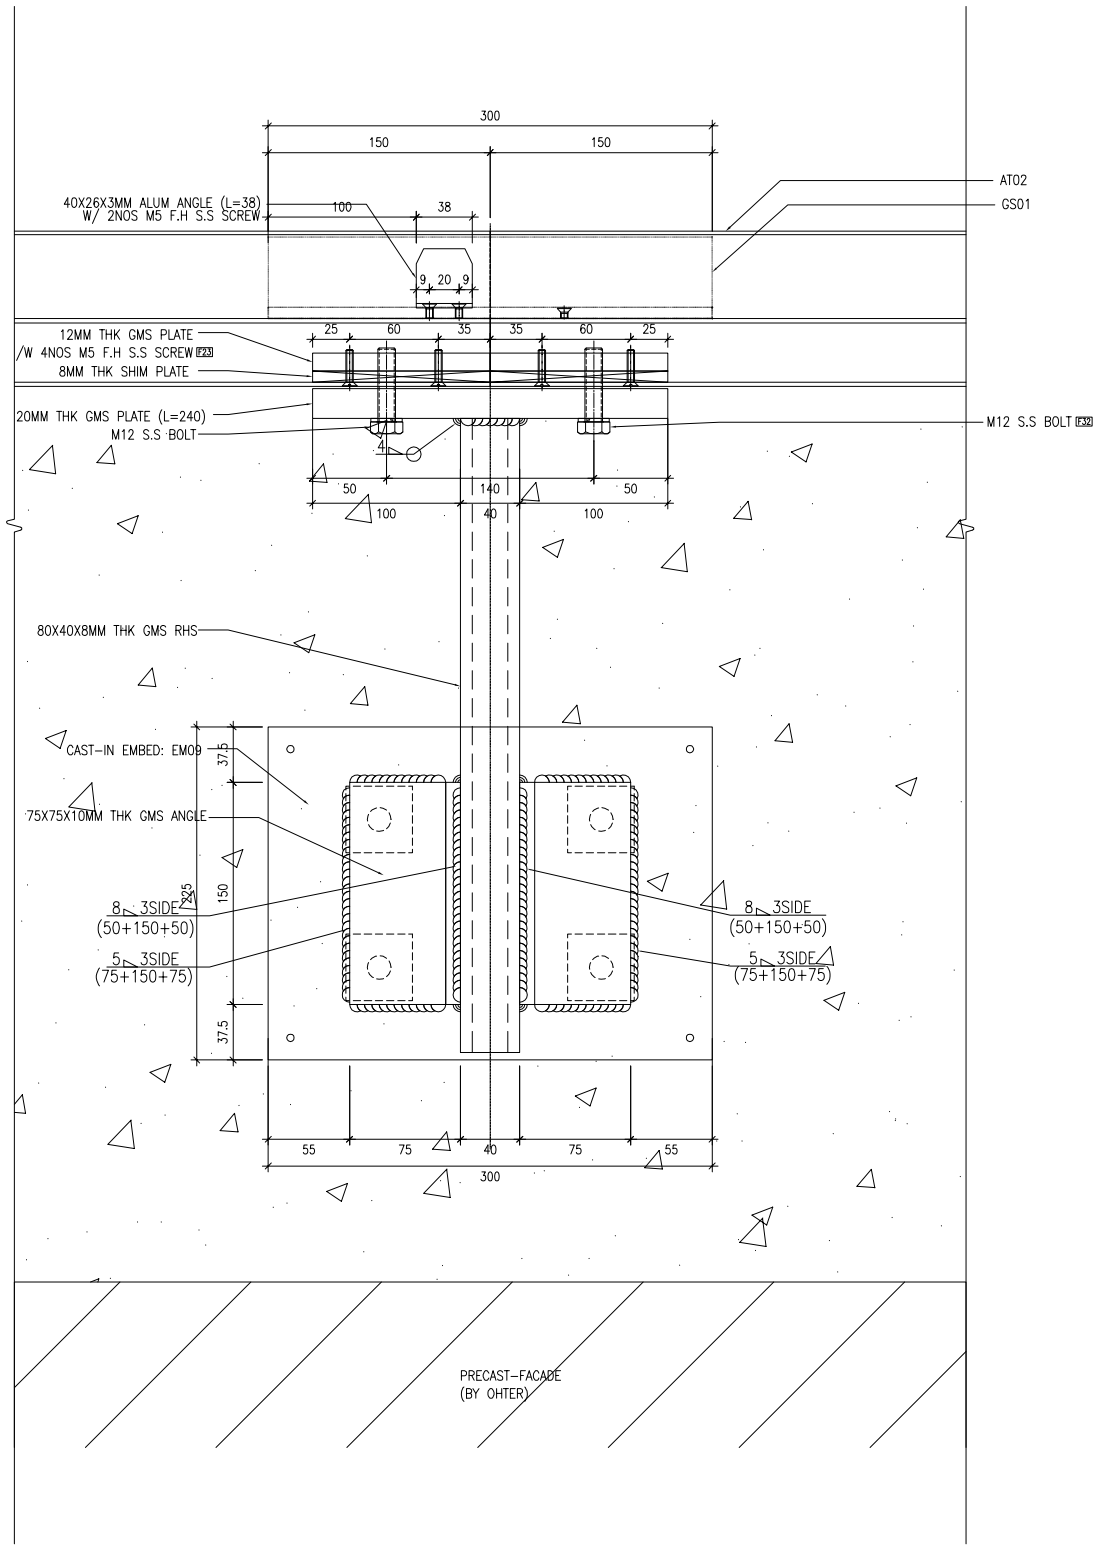

2 8509 *SECTION VIEW*
STARTER

B.D. REF :

CLIENT :
SUN HUNG KAI
REAL ESTATE AGENCY LTD.
42/F SUN HUNG KAI CENTRE, WANCHAI, HONGKONG

ARCHITECT :
lwk&partners
a r c h i t e c t s

MAIN CONTRACTOR :
怡輝建築有限公司
Yee Fai Building Contractors Ltd.

STRUCTURAL ENGINEER :
ARUP

FACADE CONSULTANT:
ALPHA CONSULTING LIMITED
Steel Structure & Facade Specialist

NOTE :
1. ALL DIMENSIONS ARE IN mm.
2. ALL ELEVATIONS ARE VIEWED FROM OUTSIDE.
3. ALL DIMENSIONS TO BE VERIFIED ON SITE BEFORE FABRICATION.

LEGEND :
X1 / X001 — DETAIL MARK NO. / REFER SHEET NO.
1. F.F.L. --FINISHED FLOOR LEVEL
2. S.F.L. --STRUCTURAL FLOOR LEVEL
3. /R --REVERSED DETAIL

NO.	DATE	REVISED	BY
D	30-MAY-2023	6TH SUBMISSION	CF
C	10-MAY-2023	5TH SUBMISSION	CF
B	21-FEB-2023	4TH SUBMISSION	CF
A	30-DEC-2022	2ND SUBMISSION	CF
-	21-NOV-2022		CF

JOB NO. : J-856


PROJECT :
PROPOSED DEVELOPMENT ABOVE
LIGHT RAIL TIN WING STOP,TSWTL
NO.23,AREA 33,TIN SHUI WAI, N.T.

TITLE :
TYPICAL DETAIL
FOR CURTAIN WALL


DATE : 31-OCT-22 | SCALE : 1:5
DRAWN BY : C.F | CHECKED BY :

美特鋁製有限公司
MIDI ALUMINIUM FABRICATOR LTD.
Units 6-8, Sunray Industrial Centre, 1/F
610 Cha Kwo Ling Road, Kowloon
Tel:23489211-4 Fax:(852)27727666

DWG NO. : J856-SD-CW-8509 | REV. : D

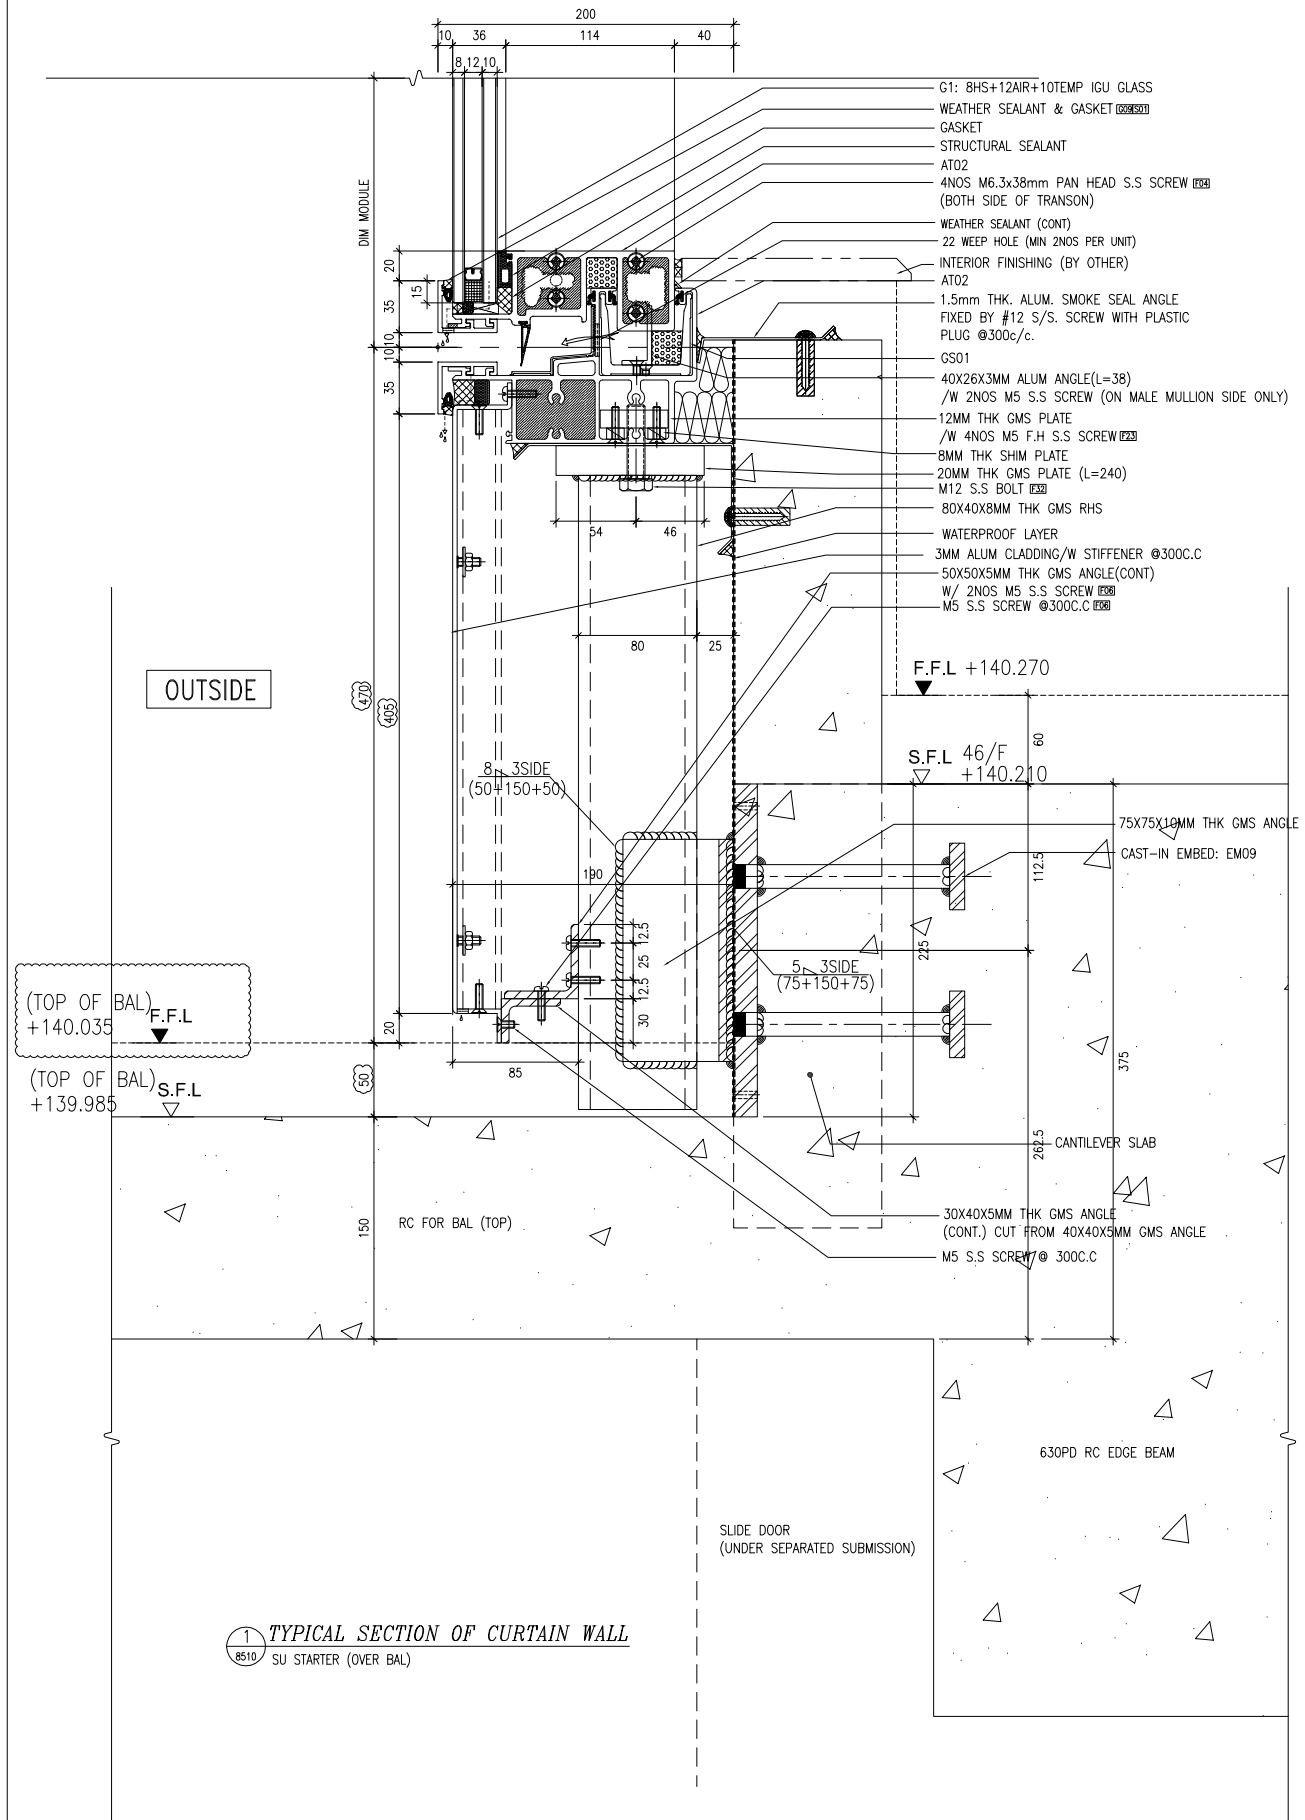

1 8510 *TYPICAL SECTION OF CURTAIN WALL*
SU STARTER (OVER BAL)

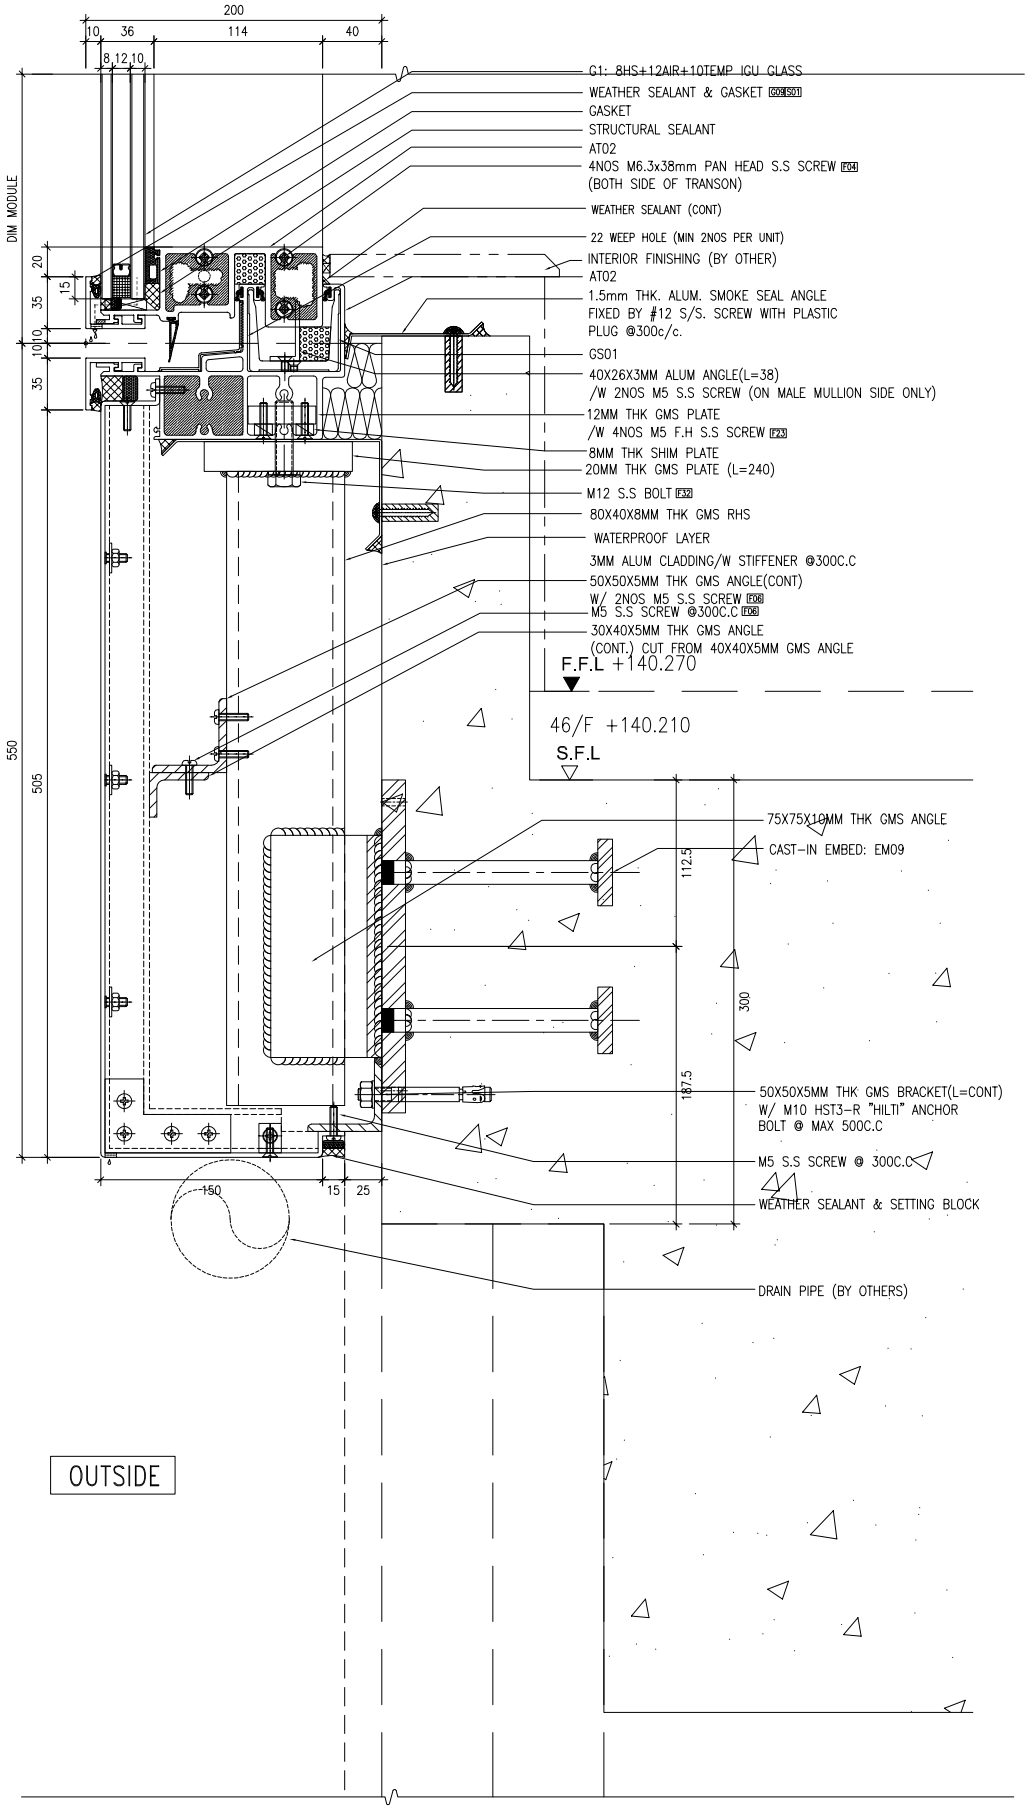

2 8510 *TYPICAL SECTION OF CURTAIN WALL*
SU STARTER FOR T2-SU-CW2 ONLY

B.D. REF :

CLIENT :
SUN HUNG KAI REAL ESTATE AGENCY LTD.
42/F SUN HUNG KAI CENTRE, WANCHAI, HONGKONG

ARCHITECT :
lwk&partners
a r c h i t e c t s

MAIN CONTRACTOR :
怡輝建築有限公司
Yee Fai Building Contractors Ltd.

STRUCTURAL ENGINEER :
ARUP

FACADE CONSULTANT:
ALPHA CONSULTING LIMITED
Steel Structure & Facade Specialist

NOTE :
1. ALL DIMENSIONS ARE IN mm.
2. ALL ELEVATIONS ARE VIEWED FROM OUTSIDE.
3. ALL DIMENSIONS TO BE VERIFIED ON SITE BEFORE FABRICATION.

LEGEND :
X1 / X001 — DETAIL MARK NO. / REFER SHEET NO.
1. F.F.L. --FINISHED FLOOR LEVEL
2. S.F.L. --STRUCTURAL FLOOR LEVEL
3. /R --REVERSED DETAIL

NO.	DATE	REVISED	BY
E	30-OCT-2023	9TH SUBMISSION	CF
D	30-MAY-2023	6TH SUBMISSION	CF
C	10-MAY-2023	5TH SUBMISSION	CF
B	21-FEB-2023	4TH SUBMISSION	CF
A	30-DEC-2022	2ND SUBMISSION	CF

JOB NO. : J-856

PROJECT :
PROPOSED DEVELOPMENT ABOVE LIGHT RAIL TIN WING STOP,TSWTL NO.23,AREA 33,TIN SHUI WAI, N.T.


TITLE :
TYPICAL DETAIL FOR CURTAIN WALL

DATE : 31-OCT-22 | SCALE : 1:5

DRAWN BY : C.F | CHECKED BY :


美特鋁質有限公司
MIDI ALUMINIUM FABRICATOR LTD.
Units 6-8, Sunray Industrial Centre, 1/F
610 Cha Kwo Ling Road, Kowloon
Tel:23489211-4 Fax:(852)27727666

DWG NO. : J856-SD-CW-8510 | REV. : E

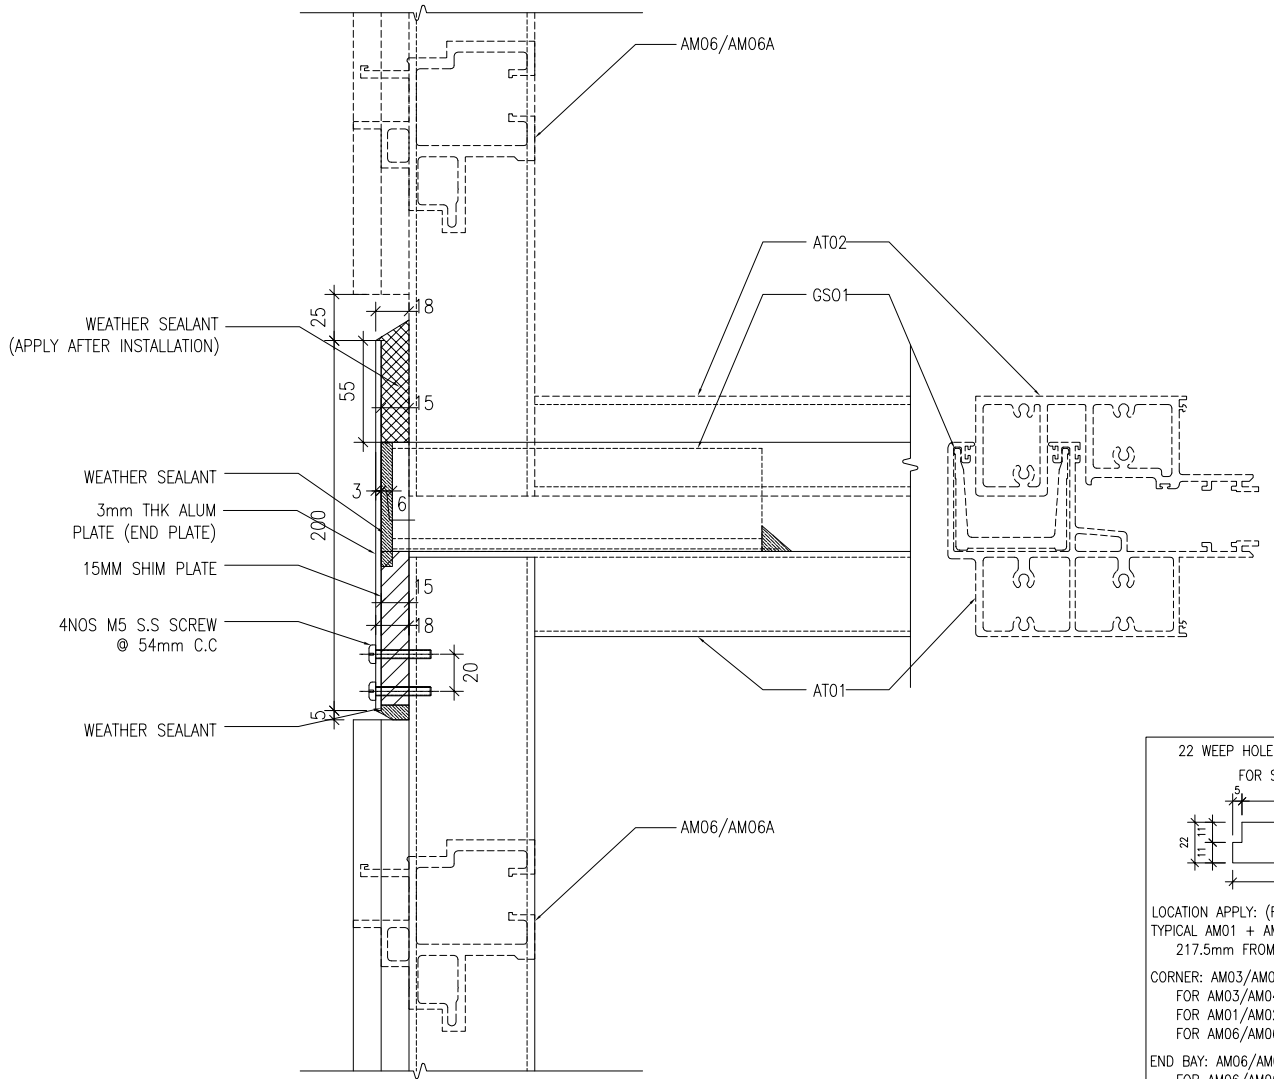

A *END PLATE SECTION DETAIL*

22 WEEP HOLE (HIGH) :

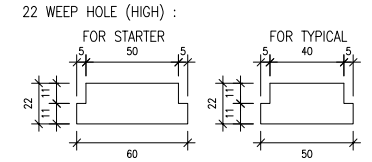

LOCATION APPLY: (REFER TO DWG: D32/8510A)
TYPICAL AM01 + AM02:
217.5mm FROM WAY POINT (BOTH SIDE)

CORNER: AM03/AM04 + AM01/AM02 OR AM06/AM06A:
FOR AM03/AM04 SIDE: 351.5mm FROM WAY POINT
FOR AM01/AM02 SIDE: 217.5mm FROM WAY POINT
FOR AM06/AM06A SIDE: 197mm FROM WAY POINT

END BAY: AM06/AM06A + AM01/AM02 OR AM03/AM04:
FOR AM06/AM06A SIDE: 197mm FROM WAY POINT
FOR AM01/AM02 SIDE: 217.5mm FROM WAY POINT
FOR AM03/AM04 SIDE: 351.5mm FROM WAY POINT


REMARK:


SCHEDULE OF WEEP HOLE FOR TYPICAL (AT01)

WIDTH OF MODULE	QTY OF WEEP HOLE/MODULE
<1150	2 NOS.
>1300	3 NOS. (@ ½ EQ DISTANCE)
>1800	4 NOS. (@ ½ EQ DISTANCE)

SCHEDULE OF WEEP HOLE FOR STARTER (AT01)

PANEL QTY IN 1 SIDE	WIDTH OF SIDE	QTY OF WEEP HOLE
1	<1100	2 NOS.
2	>1400	4 NOS.
>=3	~4300	REFER TO TYP QTY
2 FOR CORNER (PE101-2 ONLY)	>1590	6NOS

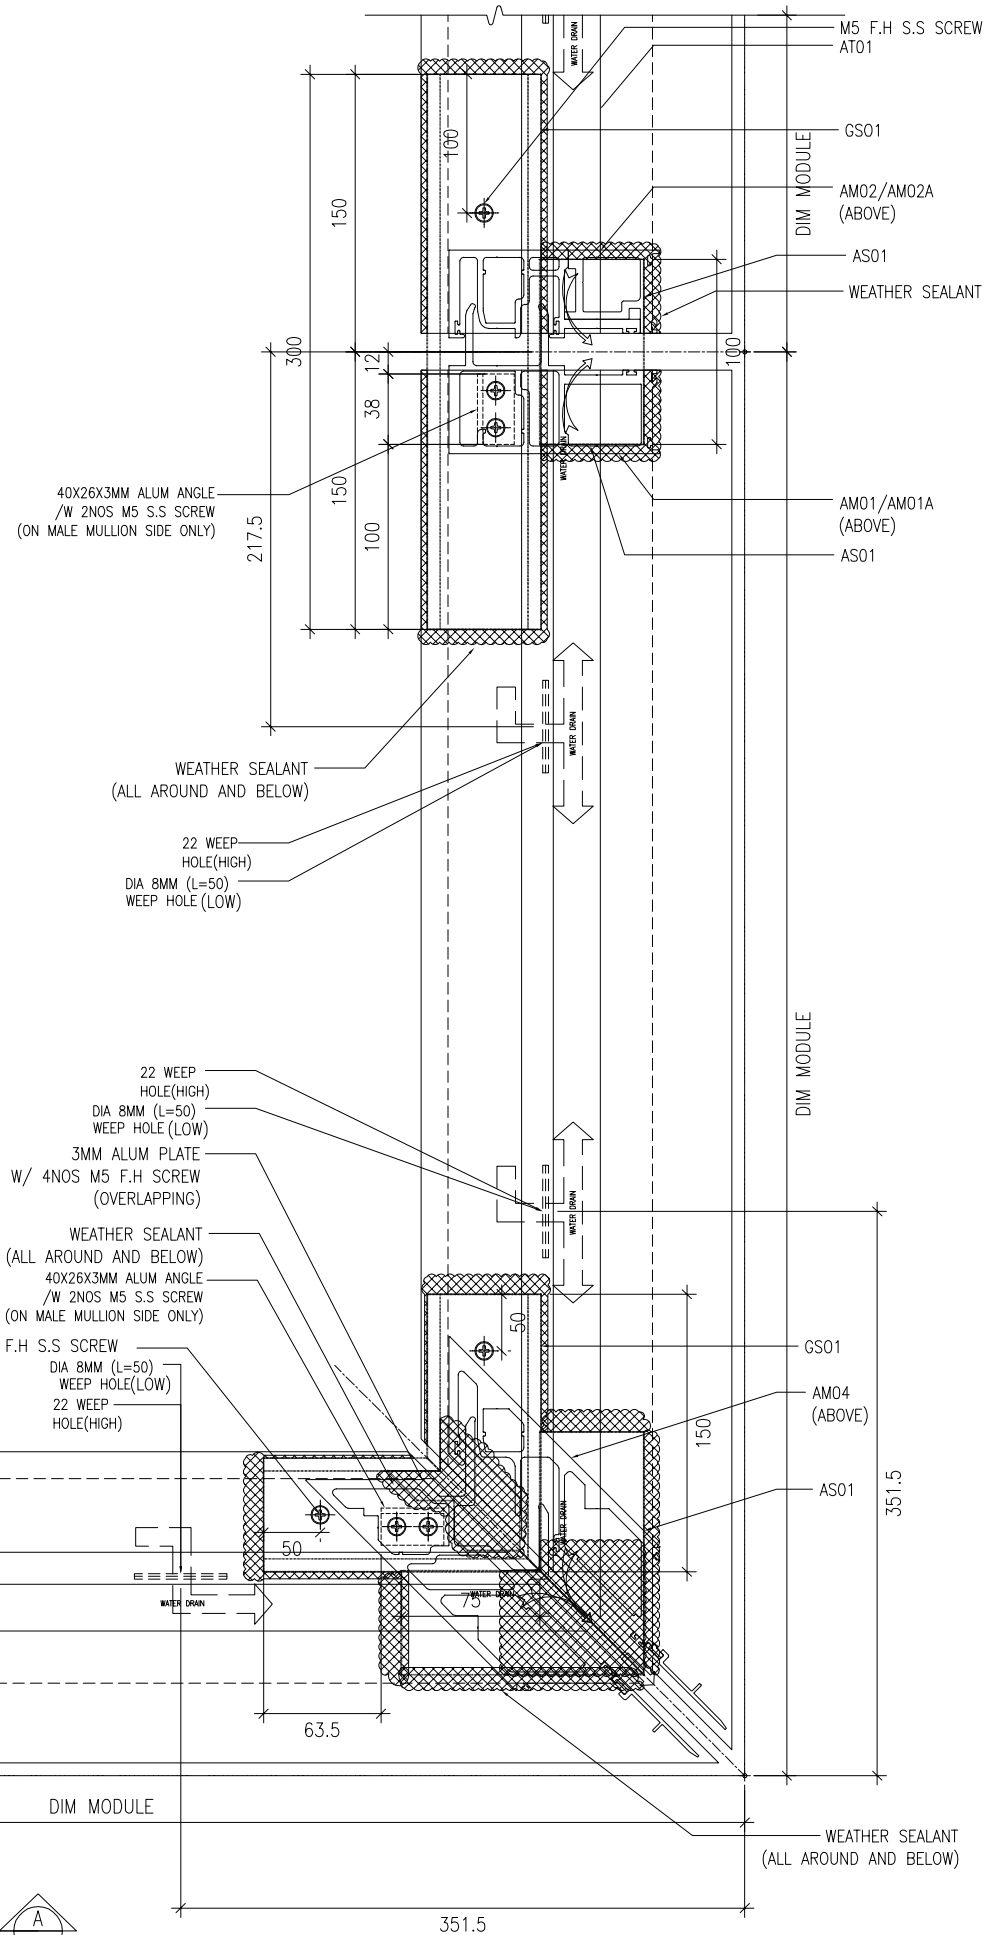

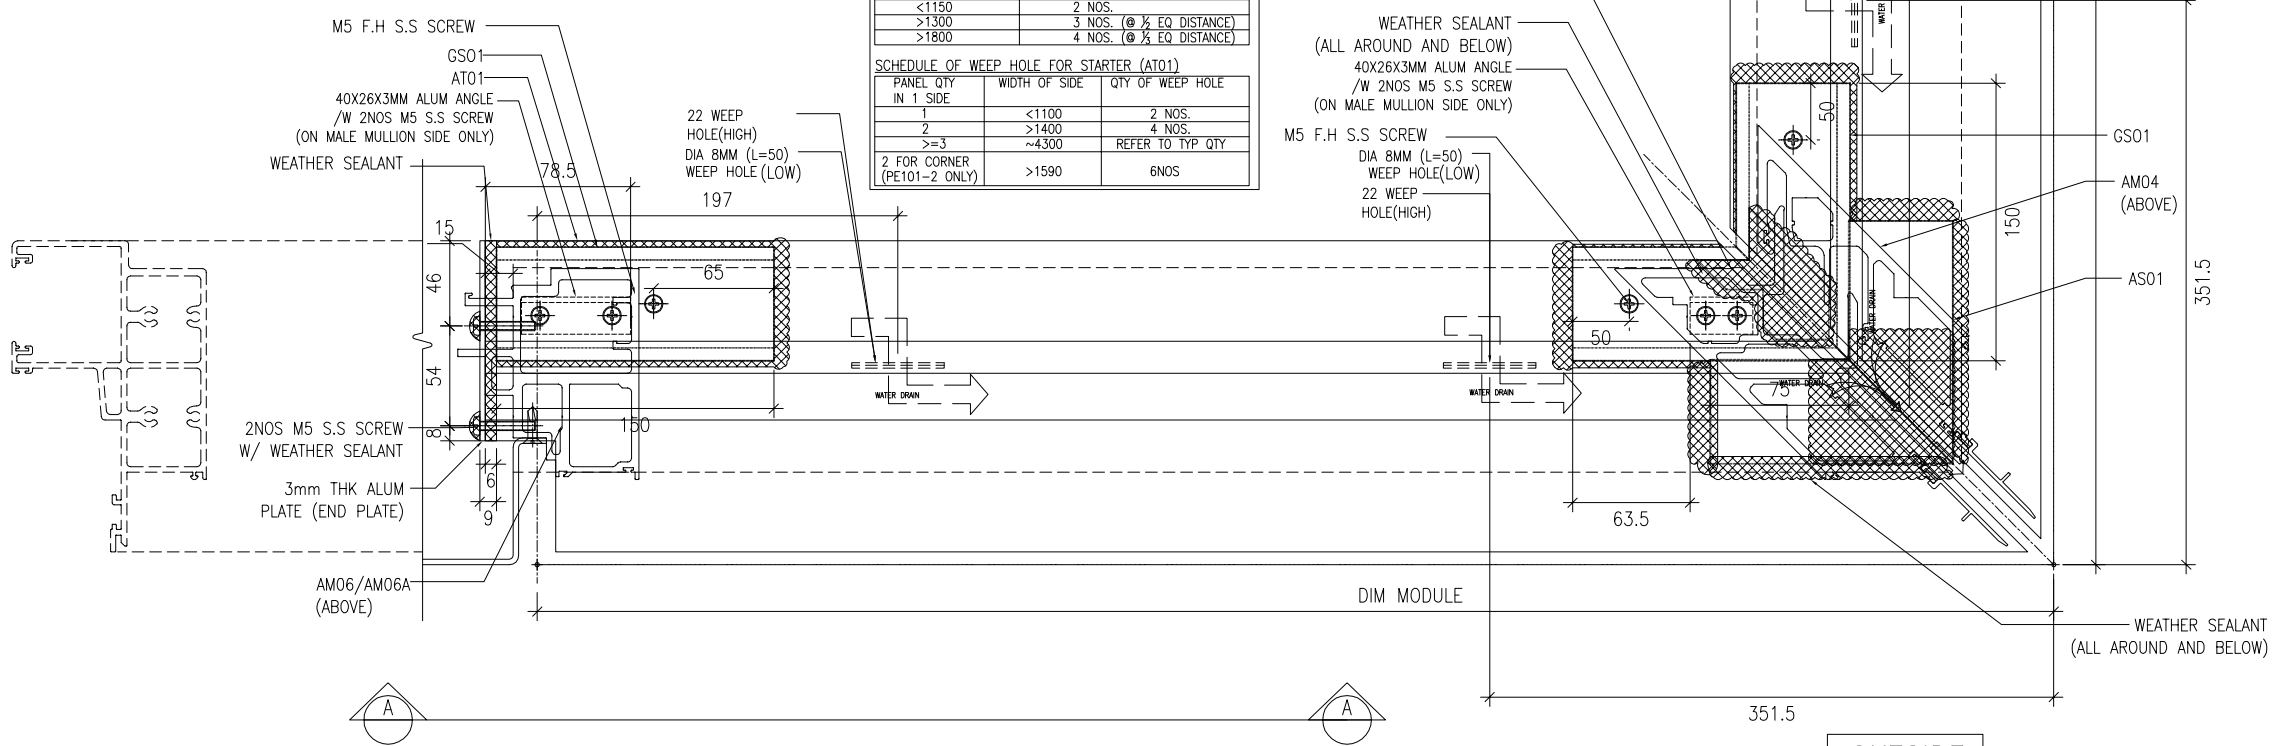

D32 *SLEEVE ALLOCATION*

B.D. REF :

CLIENT :
SUN HUNG KAI REAL ESTATE AGENCY LTD.
42/F SUN HUNG KAI CENTRE, WANCHAI, HONGKONG

ARCHITECT :
lwk&partners architects

MAIN CONTRACTOR :
怡輝建築有限公司
Yee Fai Building Contractors Ltd.

STRUCTURAL ENGINEER :
ARUP

FACADE CONSULTANT:
ALPHA CONSULTING LIMITED
Steel Structure & Facade Specialist

NOTE :
1. ALL DIMENSIONS ARE IN mm.
2. ALL ELEVATIONS ARE VIEWED FROM OUTSIDE.
3. ALL DIMENSIONS TO BE VERIFIED ON SITE BEFORE FABRICATION.

LEGEND :
X1 / X001 — DETAIL MARK NO. / REFER SHEET NO.
1. F.F.L. --FINISHED FLOOR LEVEL
2. S.F.L. --STRUCTURAL FLOOR LEVEL
3. /R --REVERSED DETAIL

NO.	DATE	REVISED	BY
D	30 MAY 2023	6TH SUBMISSION	
C	10 MAY 2023	5TH SUBMISSION	
B	10 MAR 2023	4TH SUBMISSION	
A	30 DEC 2022	2ND SUBMISSION	

JOB NO. : J-856

PROJECT :
PROPOSED DEVELOPMENT ABOVE LIGHT RAIL TIN WING STOP,TSWTL NO.23,AREA 33,TIN SHUI WAI, N.T.


TITLE :
TYPICAL DETAIL FOR CURTAIN WALL

DATE : 20-FEB-23 | SCALE : 1:4


DRAWN BY : C.F | CHECKED BY :

美特鋁質有限公司
MIDI ALUMINIUM FABRICATOR LTD.
Units 6-8, Sunray Industrial Centre, 1/F
610 Cha Kwo Ling Road, Kowloon
Tel:23489211-4 Fax:(852)27727666


DWG NO. : J856-SD-CW-8510A | REV. : D

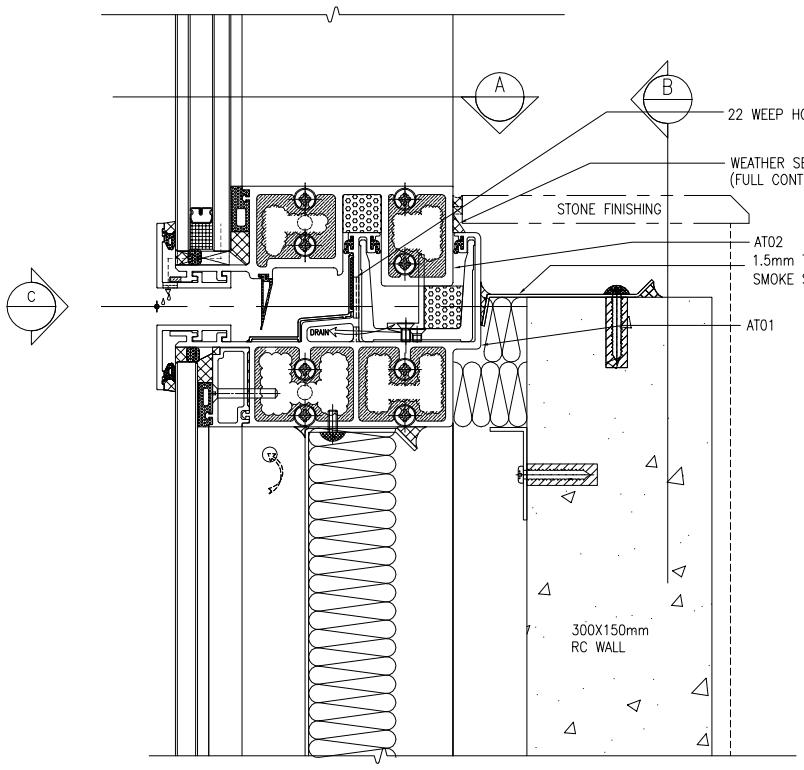

1 8510B *SECTION DETAIL OF CURTAIN WALL*
SEALANT JOINT BETWEEN 2 MODULE

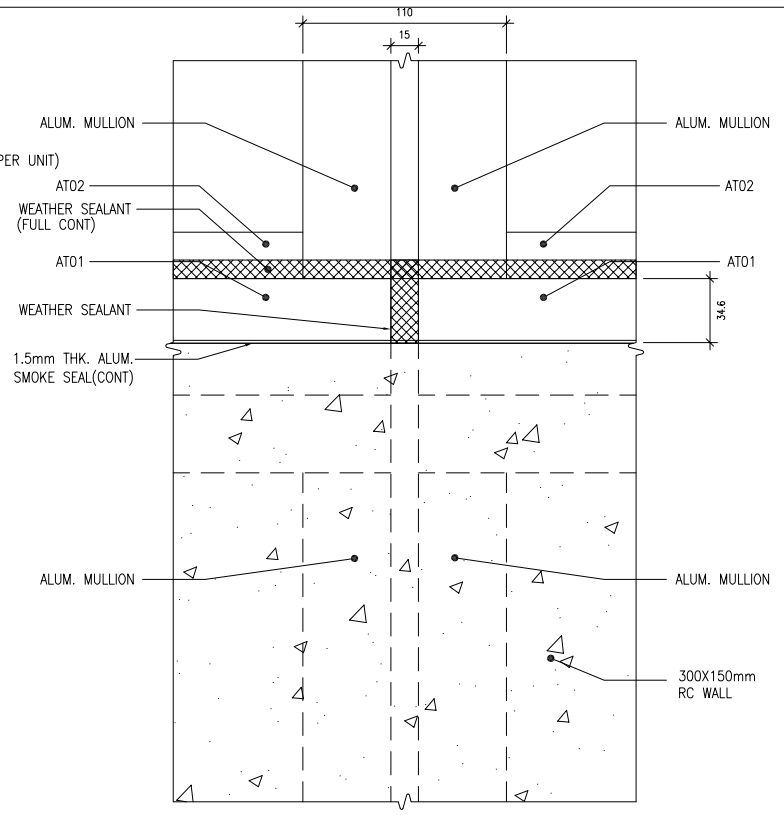


B - *SECTION DETAIL OF CURTAIN WALL*
SEALANT JOINT (BACK VIEW)

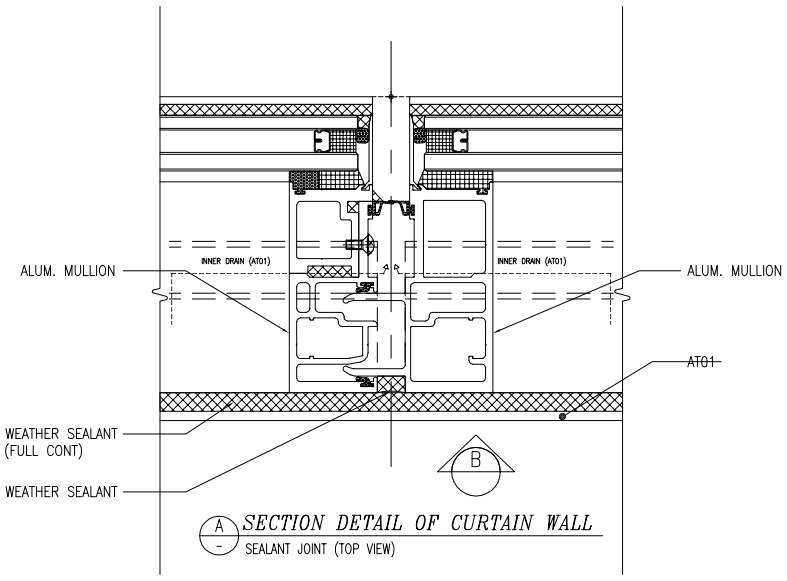

A - *SECTION DETAIL OF CURTAIN WALL*
SEALANT JOINT (TOP VIEW)

22 WEEP HOLE (HIGH) :

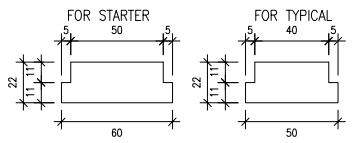

LOCATION APPLY: (REFER TO DWG: D32/8510A)
TYPICAL AM01 + AM02:
217.5mm FROM WAY POINT (BOTH SIDE)

CORNER: AM03/AM04 + AM01/AM02 OR AM06/AM06A:
FOR AM03/AM04 SIDE: 351.5mm FROM WAY POINT
FOR AM01/AM02 SIDE: 217.5mm FROM WAY POINT
FOR AM06/AM06A SIDE: 197mm FROM WAY POINT

END BAY: AM06/AM06A + AM01/AM02 OR AM03/AM04:
FOR AM06/AM06A SIDE: 197mm FROM WAY POINT
FOR AM01/AM02 SIDE: 217.5mm FROM WAY POINT
FOR AM03/AM04 SIDE: 351.5mm FROM WAY POINT


REMARK:

SCHEDULE OF WEEP HOLE FOR TYPICAL (AT01)

WIDTH OF MODULE	QTY OF WEEP HOLE/MODULE
<1150	2 NOS.
>1300	3 NOS. (@ ½ EQ DISTANCE)
>1800	4 NOS. (@ ⅓ EQ DISTANCE)

SCHEDULE OF WEEP HOLE FOR STARTER (AT01)

PANEL QTY IN 1 SIDE	WIDTH OF SIDE	QTY OF WEEP HOLE
1	<1100	2 NOS.
2	>1400	4 NOS.
>=3	~4300	REFER TO TYP QTY
2 FOR CORNER (PE101-2 ONLY)	>1590	6NOS

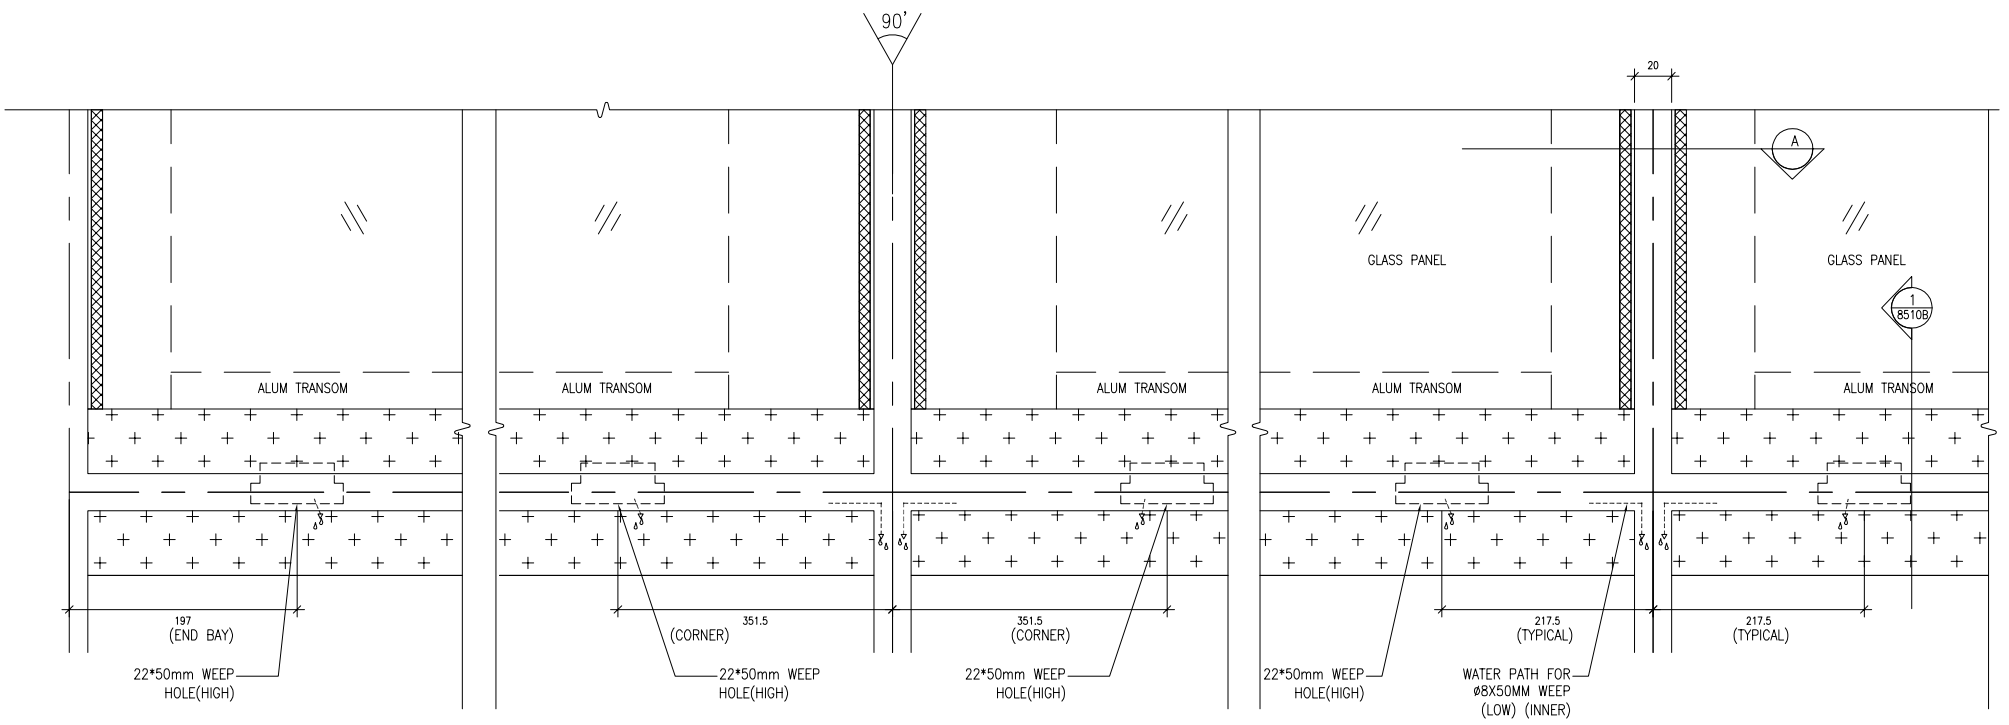

C - *ELEV VIEW FOR CURTAIN WALL*
(NTS)

B.D. REF :

CLIENT :
SUN HUNG KAI REAL ESTATE AGENCY LTD.
42/F SUN HUNG KAI CENTRE, WANCHAI, HONGKONG

ARCHITECT :
lwk&partners
architects

MAIN CONTRACTOR :
怡輝建築有限公司
Yee Fai Building Contractors Ltd.

STRUCTURAL ENGINEER :
ARUP

FACADE CONSULTANT:
ALPHA CONSULTING LIMITED
Steel Structure & Facade Specialist

NOTE :
1. ALL DIMENSIONS ARE IN mm.
2. ALL ELEVATIONS ARE VIEWED FROM OUTSIDE.
3. ALL DIMENSIONS TO BE VERIFIED ON SITE BEFORE FABRICATION.

LEGEND :
X1 / X001 — DETAIL MARK NO. / REFER SHEET NO.
1. F.F.L. --FINISHED FLOOR LEVEL
2. S.F.L. --STRUCTURAL FLOOR LEVEL
3. (R) --REVERSED DETAIL

NO.	DATE	REVISED	BY
-	22-MAY-2023	NEW DRAWING (6TH SUBMISSION)	CF

JOB NO. : J-856


PROJECT :
PROPOSED DEVELOPMENT ABOVE LIGHT RAIL TIN WING STOP,TSWTL NO.23,AREA 33,TIN SHUI WAI, N.T.


TITLE :
TYPICAL DETAIL FOR CURTAIN WALL


DATE : 22-FEB-23 | SCALE : 1:4
DRAWN BY : C.F | CHECKED BY :

美特鋁廠有限公司 MIDI ALUMINIUM FABRICATOR LTD.
Units 6-8, Sunray Industrial Centre, 1/F
610 Cho Kwo Ling Road, Kowloon
Tel:23489211-4 Fax:(852)27727666


DWG NO. : J856-SD-CW-8510B | REV. : -

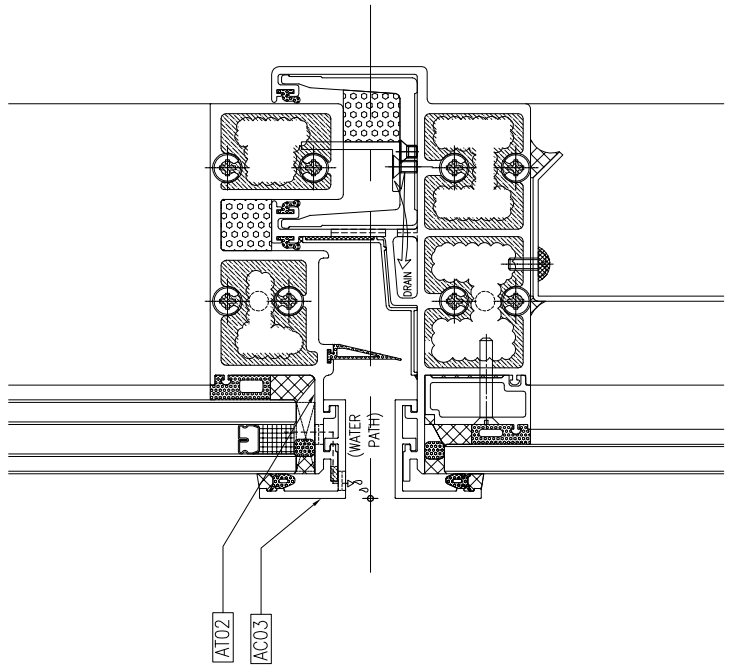


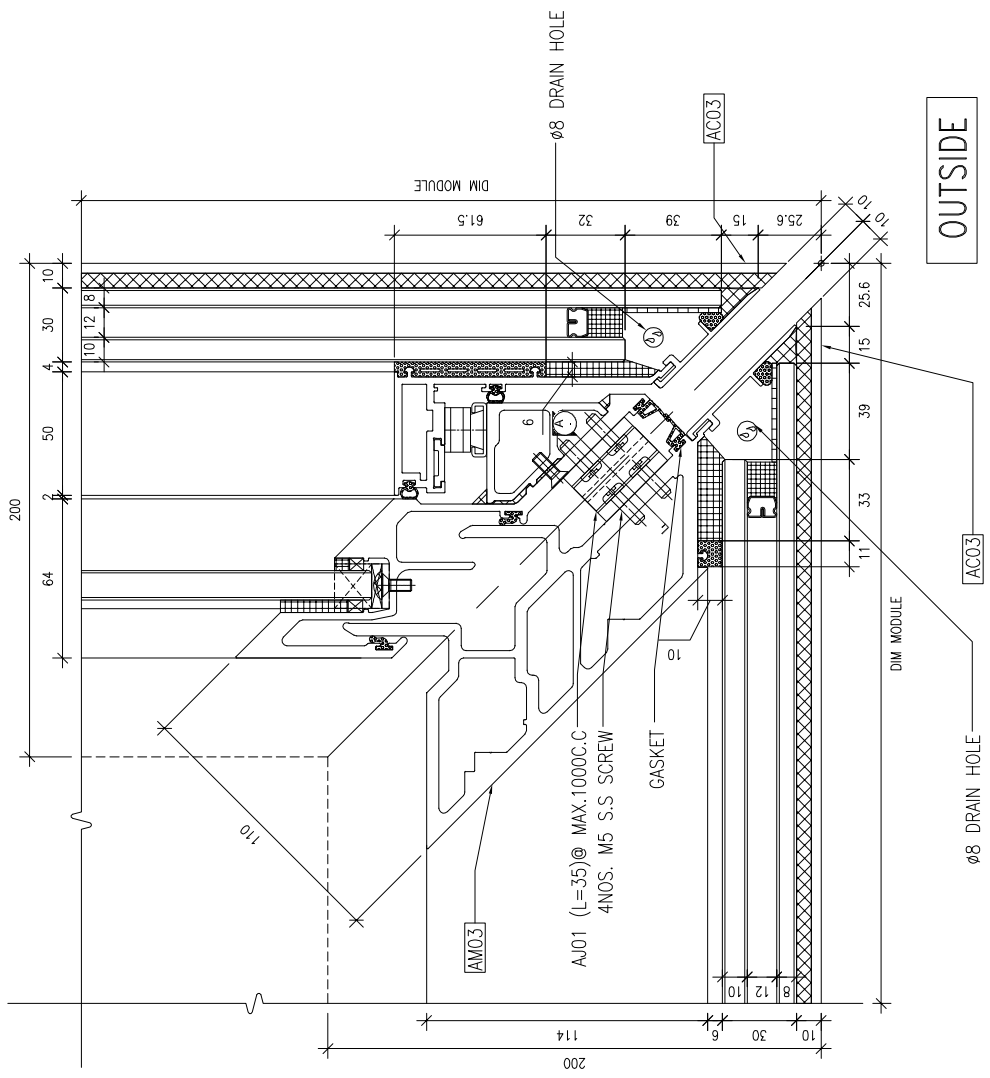

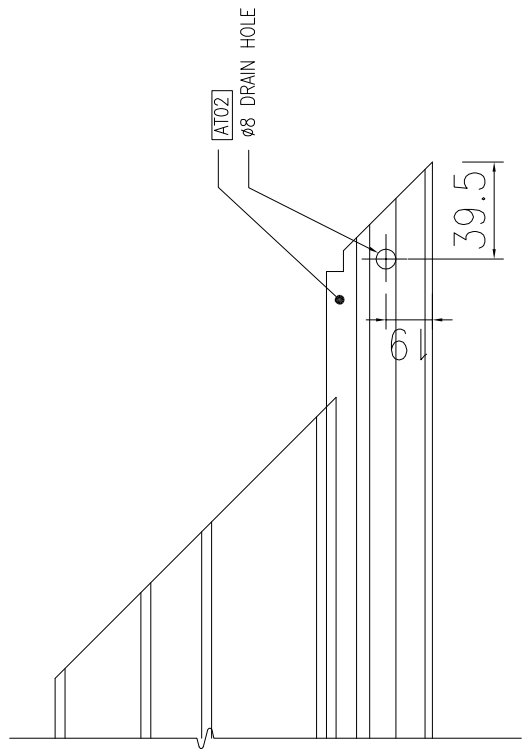

1 WATER PATH OF CURTAIN WALL (CORNER)
8510C

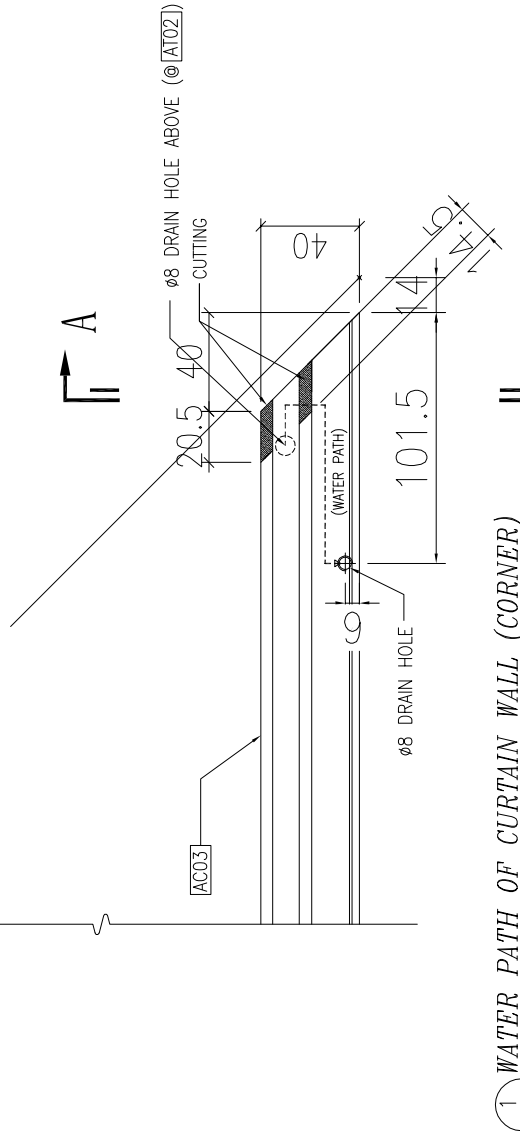

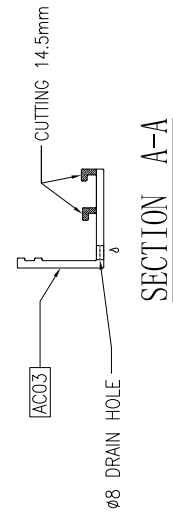

SECTION A-A

B.D. REF :

CLIENT :
SUN HUNG KAI
REAL ESTATE AGENCY LTD.
42/F SUN HUNG KAI CENTRE, WANCHAI, HONGKONG

ARCHITECT :
lwk&partners
a r c h i t e c t s

MAIN CONTRACTOR :
怡輝建築有限公司
Yee Fai Building Contractors Ltd.

STRUCTURAL ENGINEER :
ARUP

FACADE CONSULTANT:
ALPHA CONSULTING LIMITED
Steel Structure & Facade Specialist

NOTE :
1. ALL DIMENSIONS ARE IN mm.
2. ALL ELEVATIONS ARE VIEWED FROM OUTSIDE.
3. ALL DIMENSIONS TO BE VERIFIED ON SITE BEFORE FABRICATION.

LEGEND :
X1 — DETAIL MARK NO.
X001 — REFER SHEET NO.

1. F.F.L. --FINISHED FLOOR LEVEL
2. S.F.L. --STRUCTURAL FLOOR LEVEL
3. /R --REVERSED DETAIL

NO.	DATE	REVISED	BY
–	22–MAY–2023	NEW DRAWING (6TH SUBMISSION)	CF

JOB NO. : J–856

PROJECT :
PROPOSED DEVELOPMENT ABOVE LIGHT RAIL TIN WING STOP,TSWTL NO.23,AREA 33,TIN SHUI WAI, N.T.


TITLE :
TYPICAL DETAIL FOR CURTAIN WALL

DATE : 22–FEB–23 | SCALE : 1:3


DRAWN BY : C.F | CHECKED BY :

美特鋁質有限公司
MIDI ALUMINIUM FABRICATOR LTD.
Units 6–8, Sunray Industrial Centre, 1/F
610 Cha Kwo Ling Road, Kowloon
Tel:23489211–4 Fax:(852)27727666

DWG NO. : J856–SD–CW–8510C | REV. : –

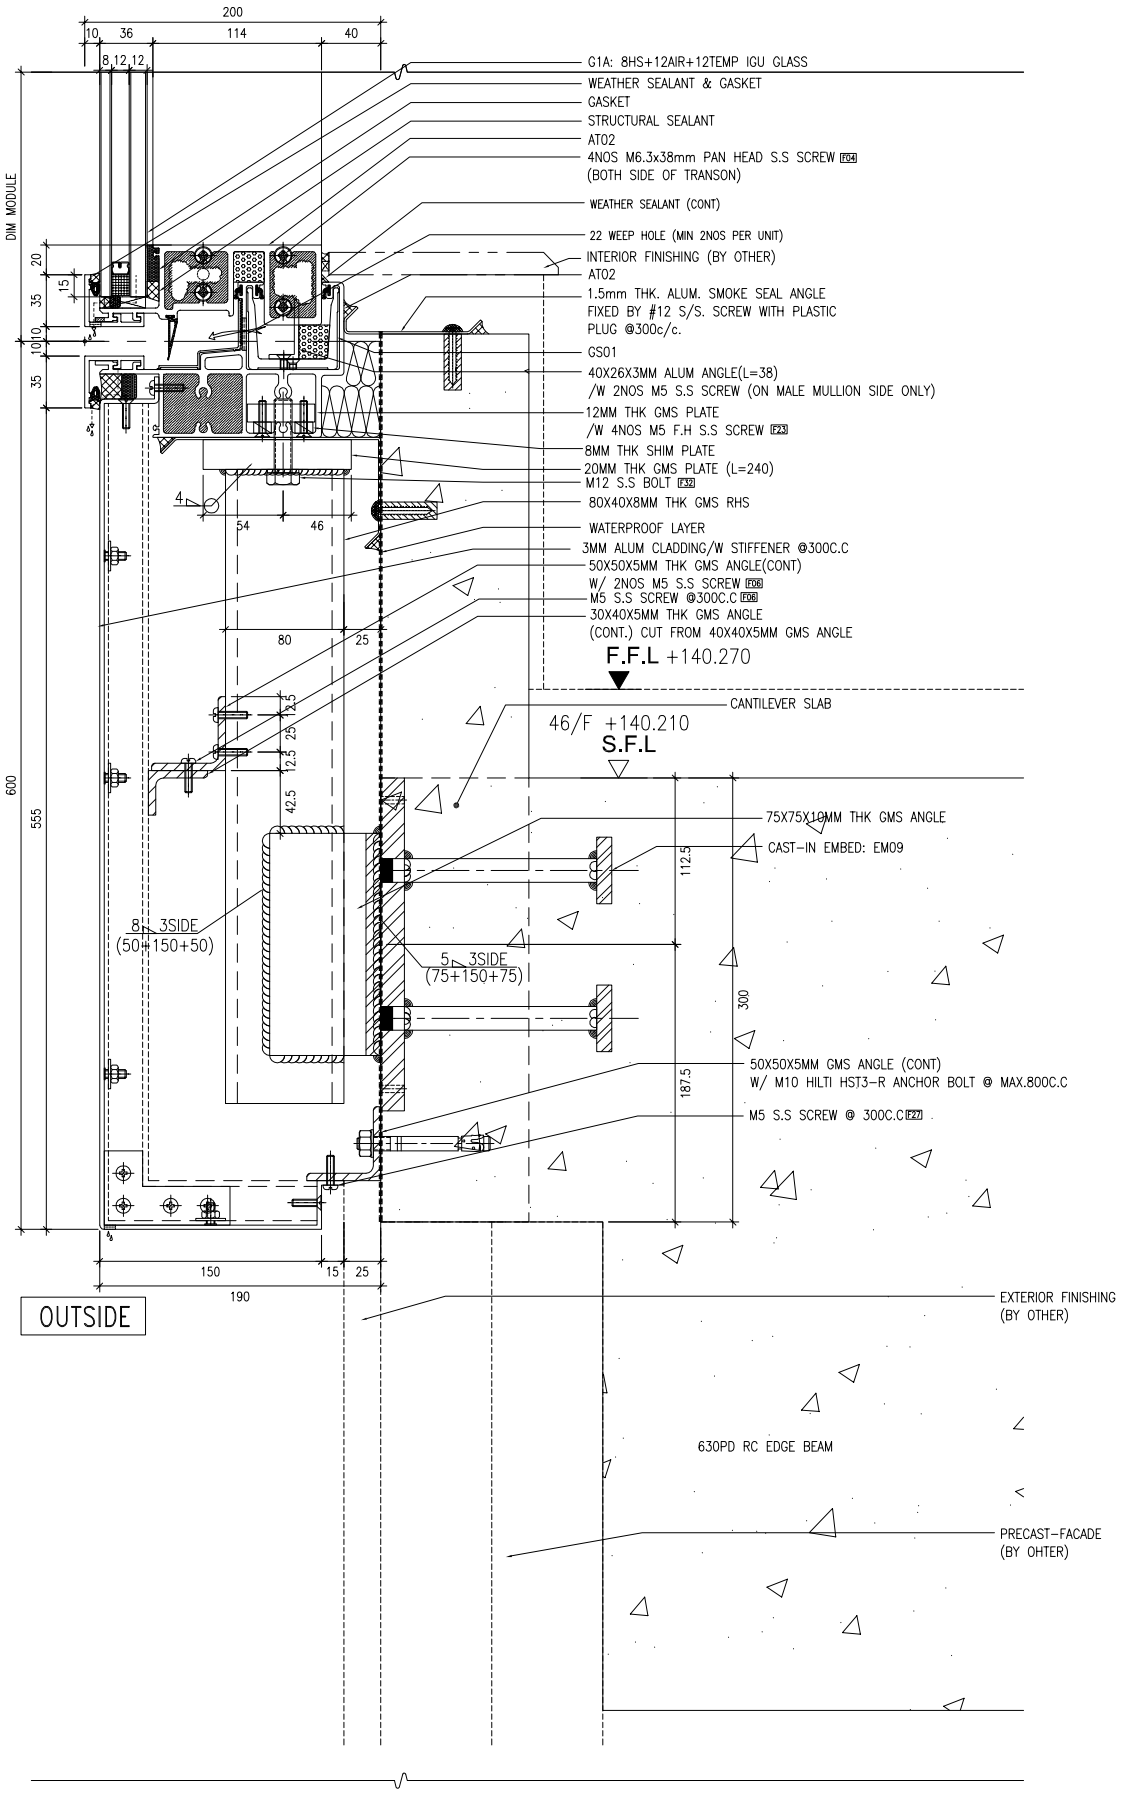

1 8511 *TYPICAL SECTION OF CURTAIN WALL*
SU STARTER

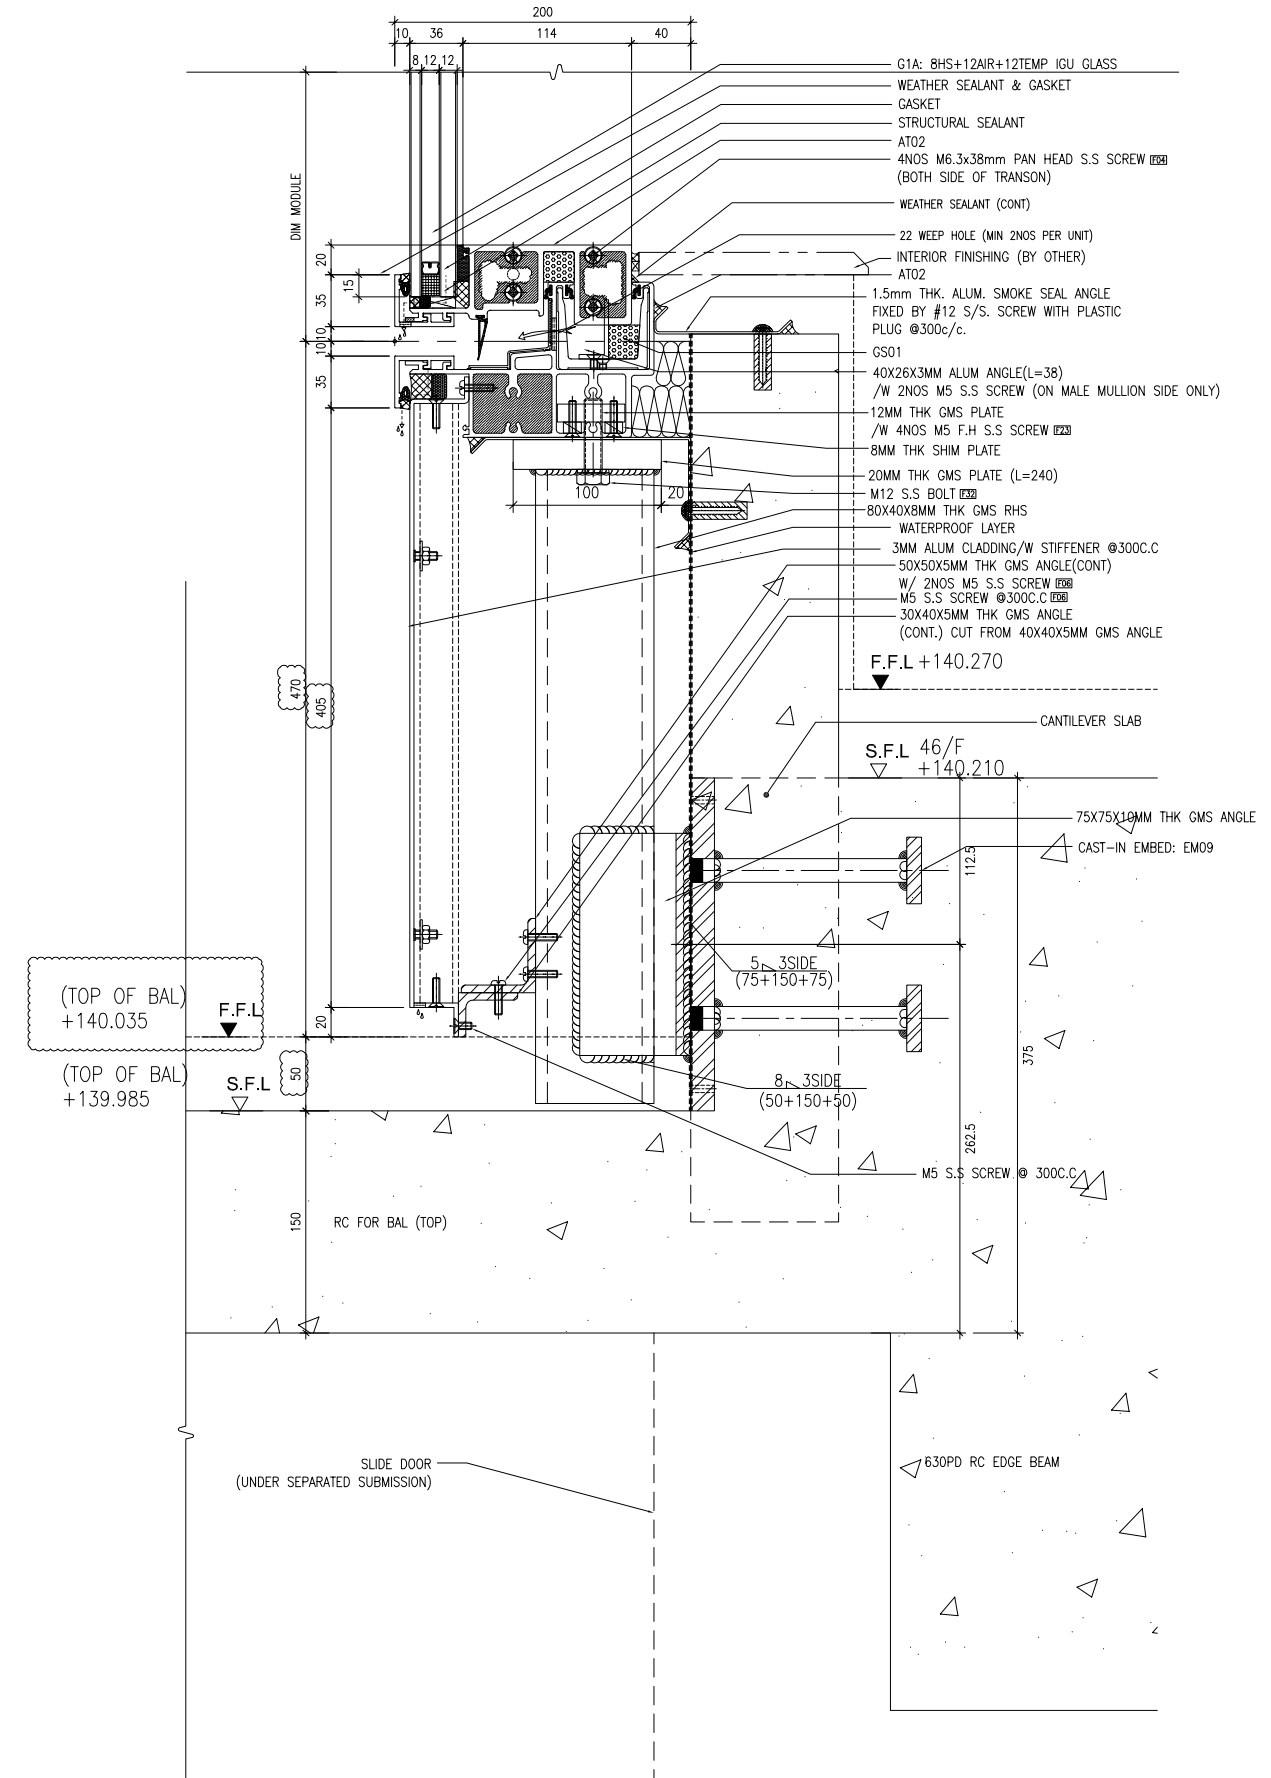

2 8511 *TYPICAL SECTION OF CURTAIN WALL*
SU STARTER

B.D. REF :

CLIENT :
SUN HUNG KAI REAL ESTATE AGENCY LTD.
42/F SUN HUNG KAI CENTRE, WANCHAI, HONGKONG

ARCHITECT :
lwk&partners
a r c h i t e c t s

MAIN CONTRACTOR :
怡輝建築有限公司
Yee Fai Building Contractors Ltd.

STRUCTURAL ENGINEER :
ARUP

FACADE CONSULTANT:
ALPHA CONSULTING LIMITED
Steel Structure & Facade Specialist

NOTE :
1. ALL DIMENSIONS ARE IN mm.
2. ALL ELEVATIONS ARE VIEWED FROM OUTSIDE.
3. ALL DIMENSIONS TO BE VERIFIED ON SITE BEFORE FABRICATION.

LEGEND :
X1 / X001 — DETAIL MARK NO. / REFER SHEET NO.
1. F.F.L. --FINISHED FLOOR LEVEL
2. S.F.L. --STRUCTURAL FLOOR LEVEL
3. /R --REVERSED DETAIL

NO.	DATE	REVISED	BY
E	30-OCT-2023	9TH SUBMISSION	CF
D	30-MAY-2023	6TH SUBMISSION	CF
C	10-MAY-2023	5TH SUBMISSION	CF
B	21-FEB-2023	4TH SUBMISSION	CF
A	30-DEC-2022	2ND SUBMISSION	CF

JOB NO. : J-856

PROJECT :
PROPOSED DEVELOPMENT ABOVE LIGHT RAIL TIN WING STOP,TSWTL NO.23,AREA 33,TIN SHUI WAI, N.T.


TITLE :
TYPICAL DETAIL FOR CURTAIN WALL

DATE : 31-OCT-22 | SCALE : 1:5

DRAWN BY : C.F | CHECKED BY :

美特鋁質有限公司
MIDI ALUMINIUM FABRICATOR LTD.
Units 6-8, Sunray Industrial Centre, 1/F
610 Cha Kwo Ling Road, Kowloon
Tel:23489211-4 Fax:(852)27727666

DWG NO. : J856-SD-CW-8511 | REV. : E

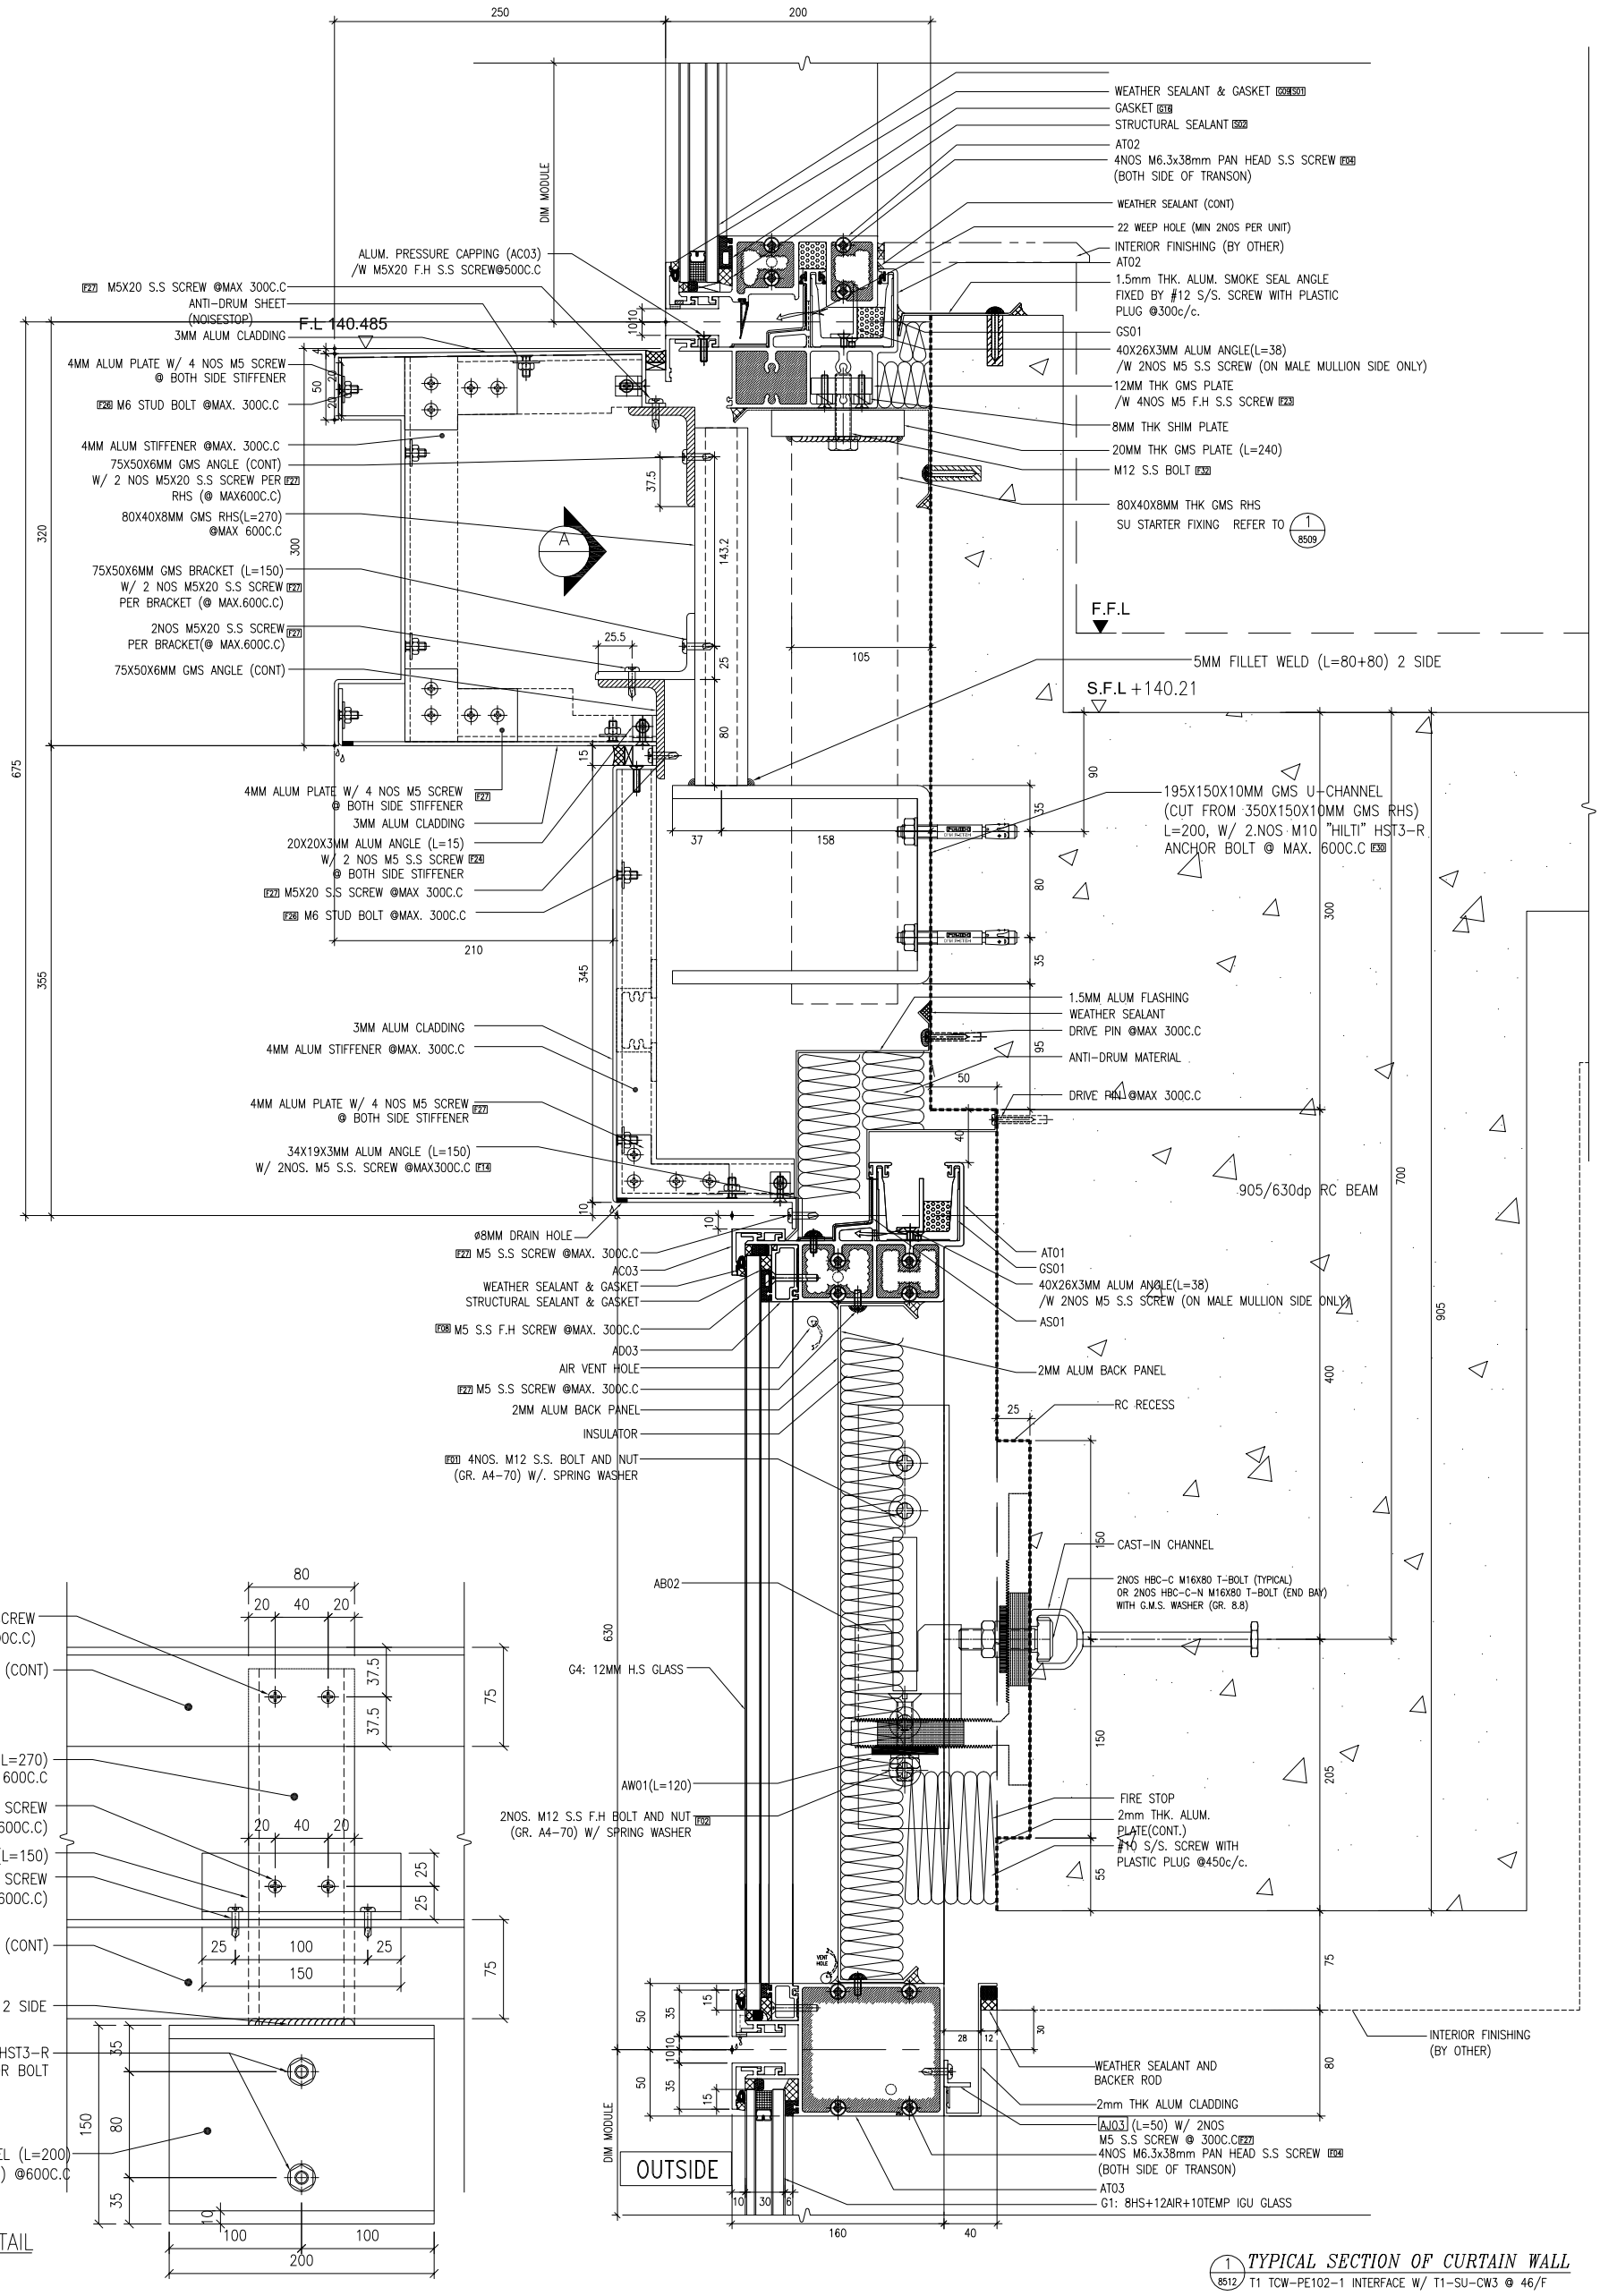

NOTE :
1. ALL DIMENSIONS ARE IN mm.
2. ALL ELEVATIONS ARE VIEWED FROM OUTSIDE.
3. ALL DIMENSIONS TO BE VERIFIED ON SITE BEFORE FABRICATION.

LEGEND :
X1 / X001 — DETAIL MARK NO. / REFER SHEET NO.
1. F.F.L. -- FINISHED FLOOR LEVEL
2. S.F.L. -- STRUCTURAL FLOOR LEVEL
3. (R) -- REVERSED DETAIL

NO.	DATE	REVISED	BY
F	03-OCT-2023	8TH SUBMISSION(R1)	CF
E	29-SEP-2023	8TH SUBMISSION	CF
D	22-AUG-2023	7TH SUBMISSION	CF
C	30-MAY-2023	6TH SUBMISSION	CF
B	10-MAY-2023	5TH SUBMISSION	CF

JOB NO. : J-856

PROJECT :
PROPOSED DEVELOPMENT ABOVE
LIGHT RAIL TIN WING STOP,TSWTL
NO.23,AREA 33,TIN SHUI WAI, N.T.

TITLE :
TYPICAL DETAIL
FOR CURTAIN WALL

DATE : 31-OCT-22 | SCALE : 1:5
DRAWN BY : C.F | CHECKED BY :

DWG NO. : J856-SD-CW-8512 | REV. : F

美特鋁廠有限公司 MIDI ALUMINIUM FABRICATOR LTD.
Units 6-8, Sunray Industrial Centre, 1/F
610 Cha Kwo Ling Road, Kowloon
Tel:23489211-4 Fax:(852)27727666

CLIENT :
SUN HUNG KAI REAL ESTATE AGENCY LTD.
42/F SUN HUNG KAI CENTRE, WANCHAI, HONGKONG


ARCHITECT :
lwk&partners architects

MAIN CONTRACTOR :
怡輝建築有限公司 Yee Fai Building Contractors Ltd.

STRUCTURAL ENGINEER :
ARUP

FACADE CONSULTANT :
ALPHA CONSULTING LIMITED
Steel Structure & Facade Specialist

B.D. REF :

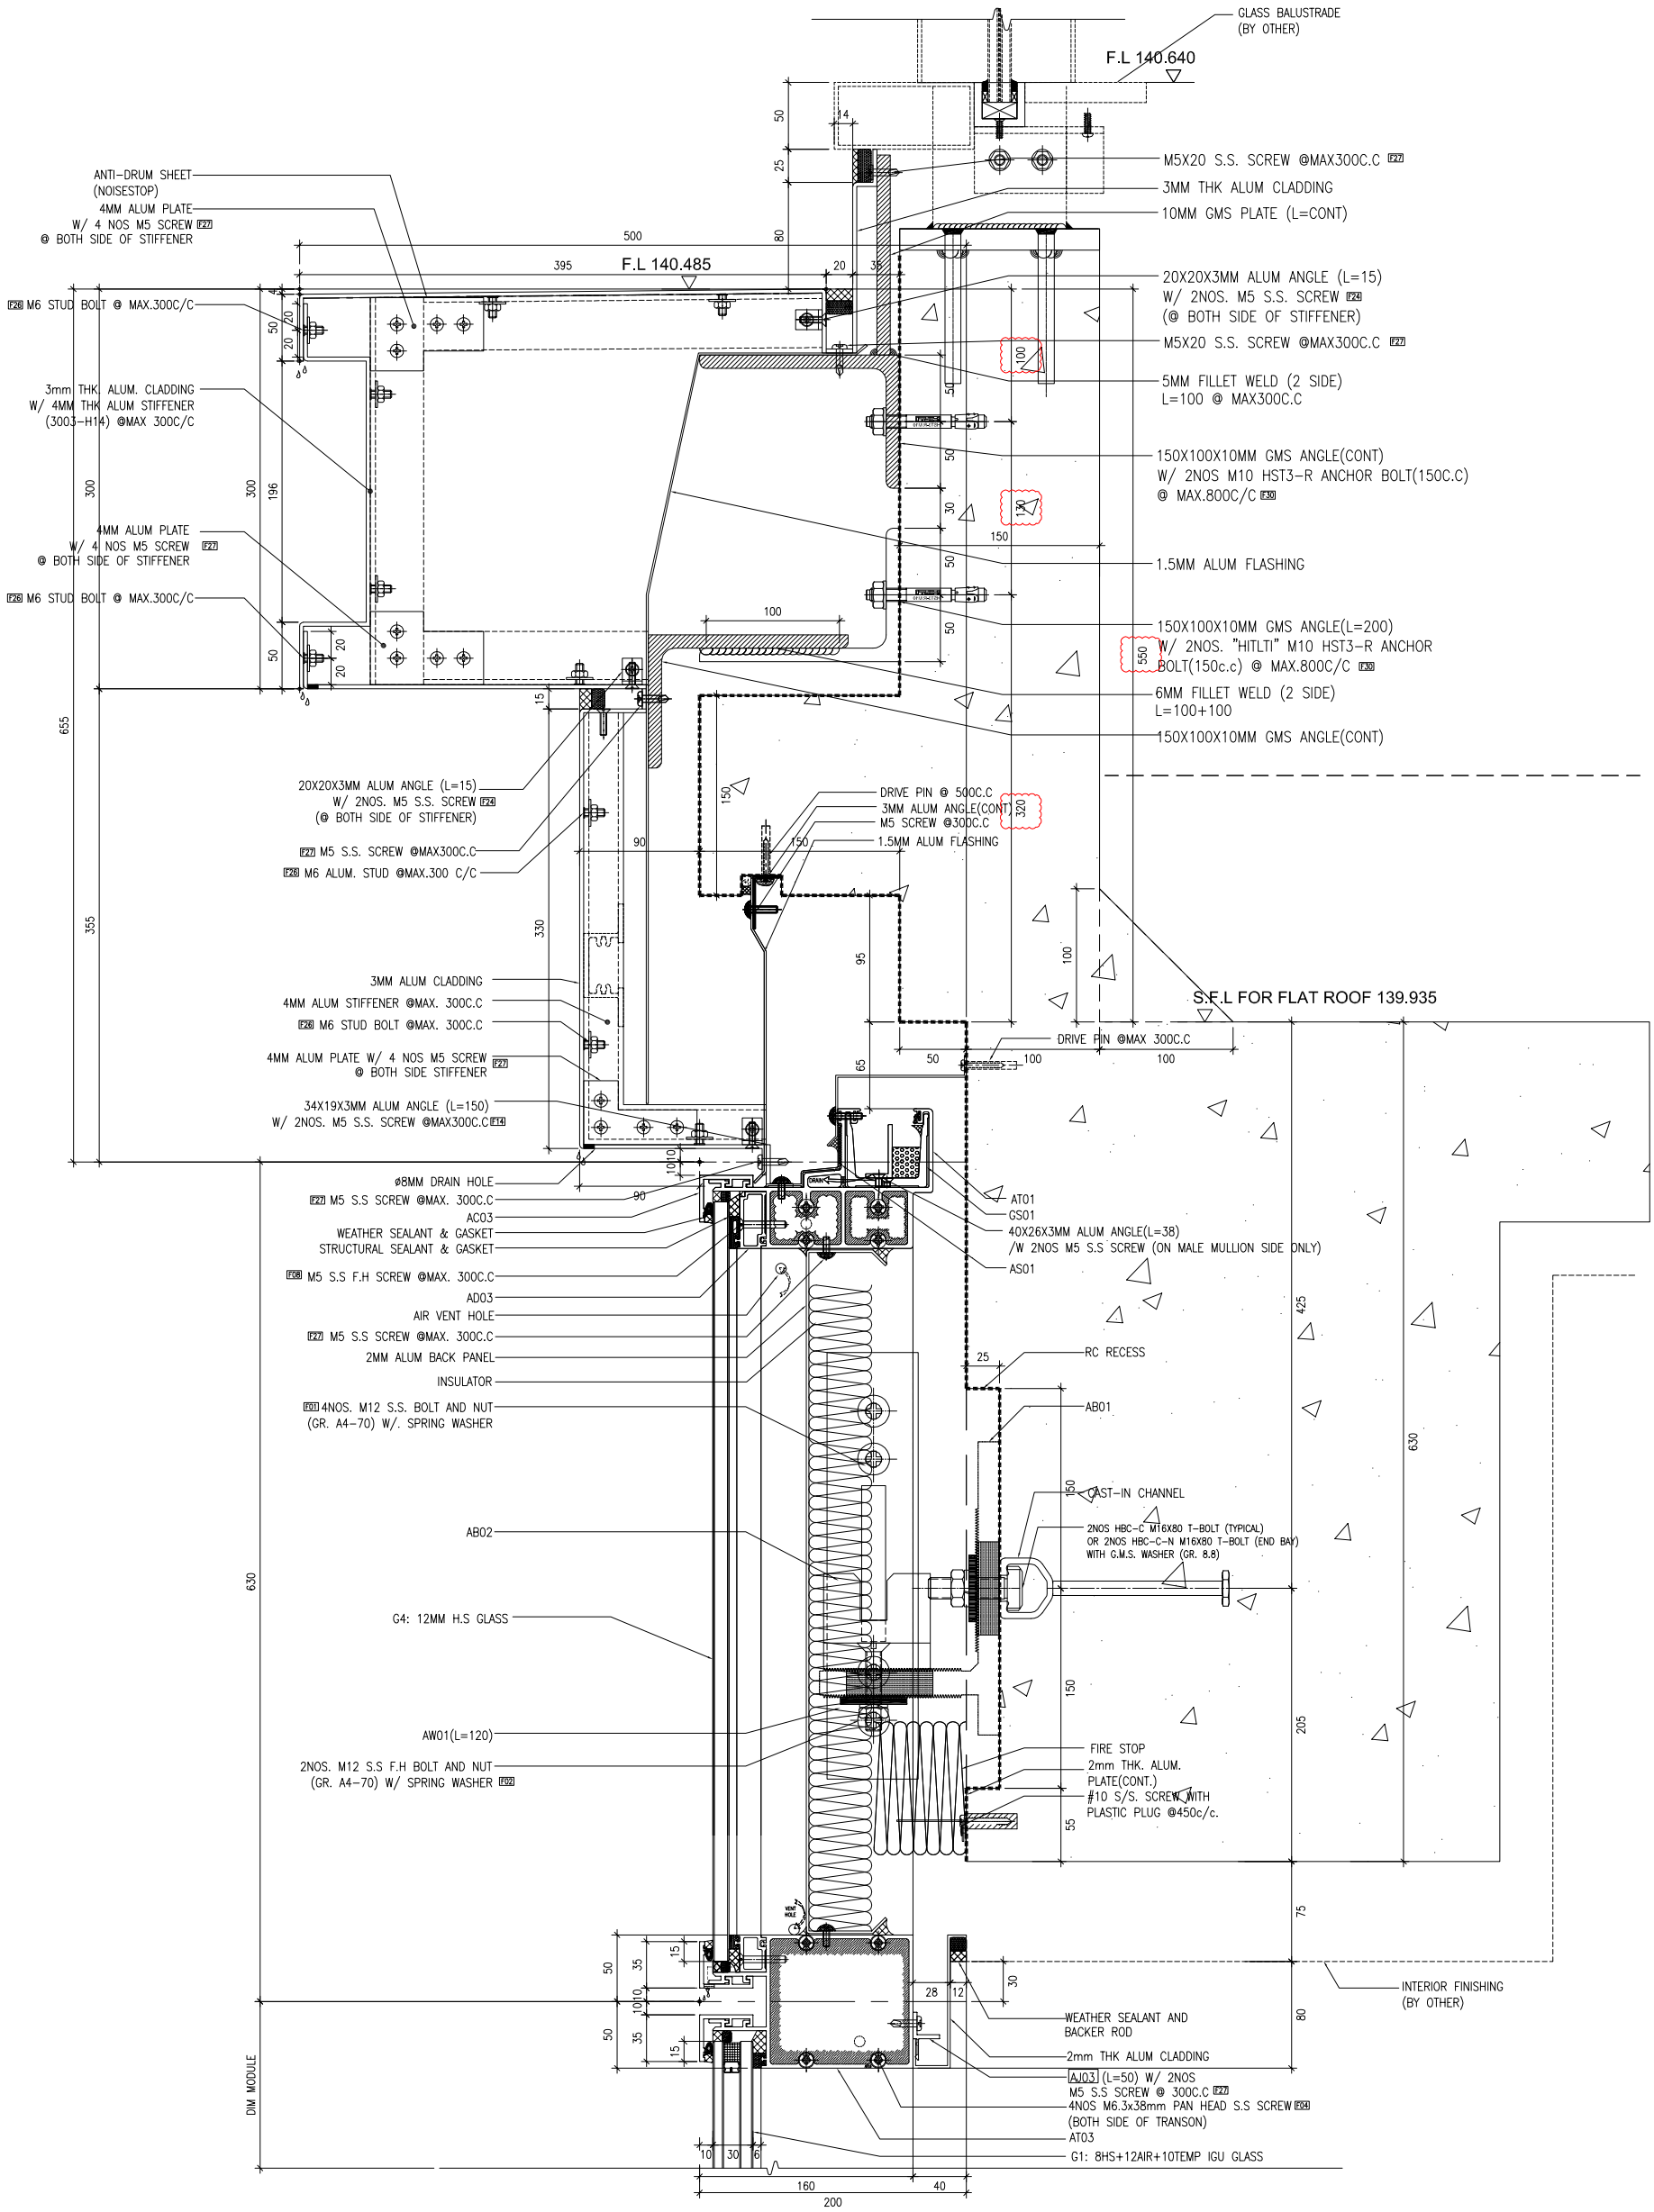

1 / 8513 *TYPICAL SECTION OF CURTAIN WALL*
T3 TCW-PE301-2

NOTE :
1. ALL DIMENSIONS ARE IN mm.
2. ALL ELEVATIONS ARE VIEWED FROM OUTSIDE.
3. ALL DIMENSIONS TO BE VERIFIED ON SITE BEFORE FABRICATION.

LEGEND :
X1 / X001 — DETAIL MARK NO. / REFER SHEET NO.
1. F.F.L. -- FINISHED FLOOR LEVEL
2. S.F.L. -- STRUCTURAL FLOOR LEVEL
3. /R -- REVERSED DETAIL

NO.	DATE	REVISED	BY
D	30-OCT-2023	9TH SUBMISSION	CF
C	03-OCT-2023	8TH SUBMISSION(R1)	CF
B	22-AUG-2023	7TH SUBMISSION	CF
A	10-MAY-2022	5TH SUBMISSION	CF
-	16-DEC-2022	NEW DRAWING	CF

JOB NO. : J-856

PROJECT :
PROPOSED DEVELOPMENT ABOVE
LIGHT RAIL TIN WING STOP,TSWTL
NO.23,AREA 33,TIN SHUI WAI, N.T.

TITLE :
TYPICAL DETAIL
FOR CURTAIN WALL

DATE : 31-OCT-22 | SCALE : 1:5
DRAWN BY : C.F | CHECKED BY :

DWG NO. : J856-SD-CW-8513 | REV. : D

美特鋁廠有限公司
MIDI ALUMINUM FABRICATOR LTD.
Units 6-8, Sunray Industrial Centre, 1/F
610 Cha Kwo Ling Road, Kowloon
Tel:23489211-4 Fax:(852)27727666

CLIENT :
SUN HUNG KAI REAL ESTATE AGENCY LTD.
42/F SUN HUNG KAI CENTRE, WANCHAI, HONGKONG


ARCHITECT :
lwk&partners architects

MAIN CONTRACTOR :
怡輝建築有限公司
Yee Fai Building Contractors Ltd.

STRUCTURAL ENGINEER :
ARUP

FACADE CONSULTANT:
ALPHA CONSULTING LIMITED
Steel Structure & Facade Specialist

B.D. REF :

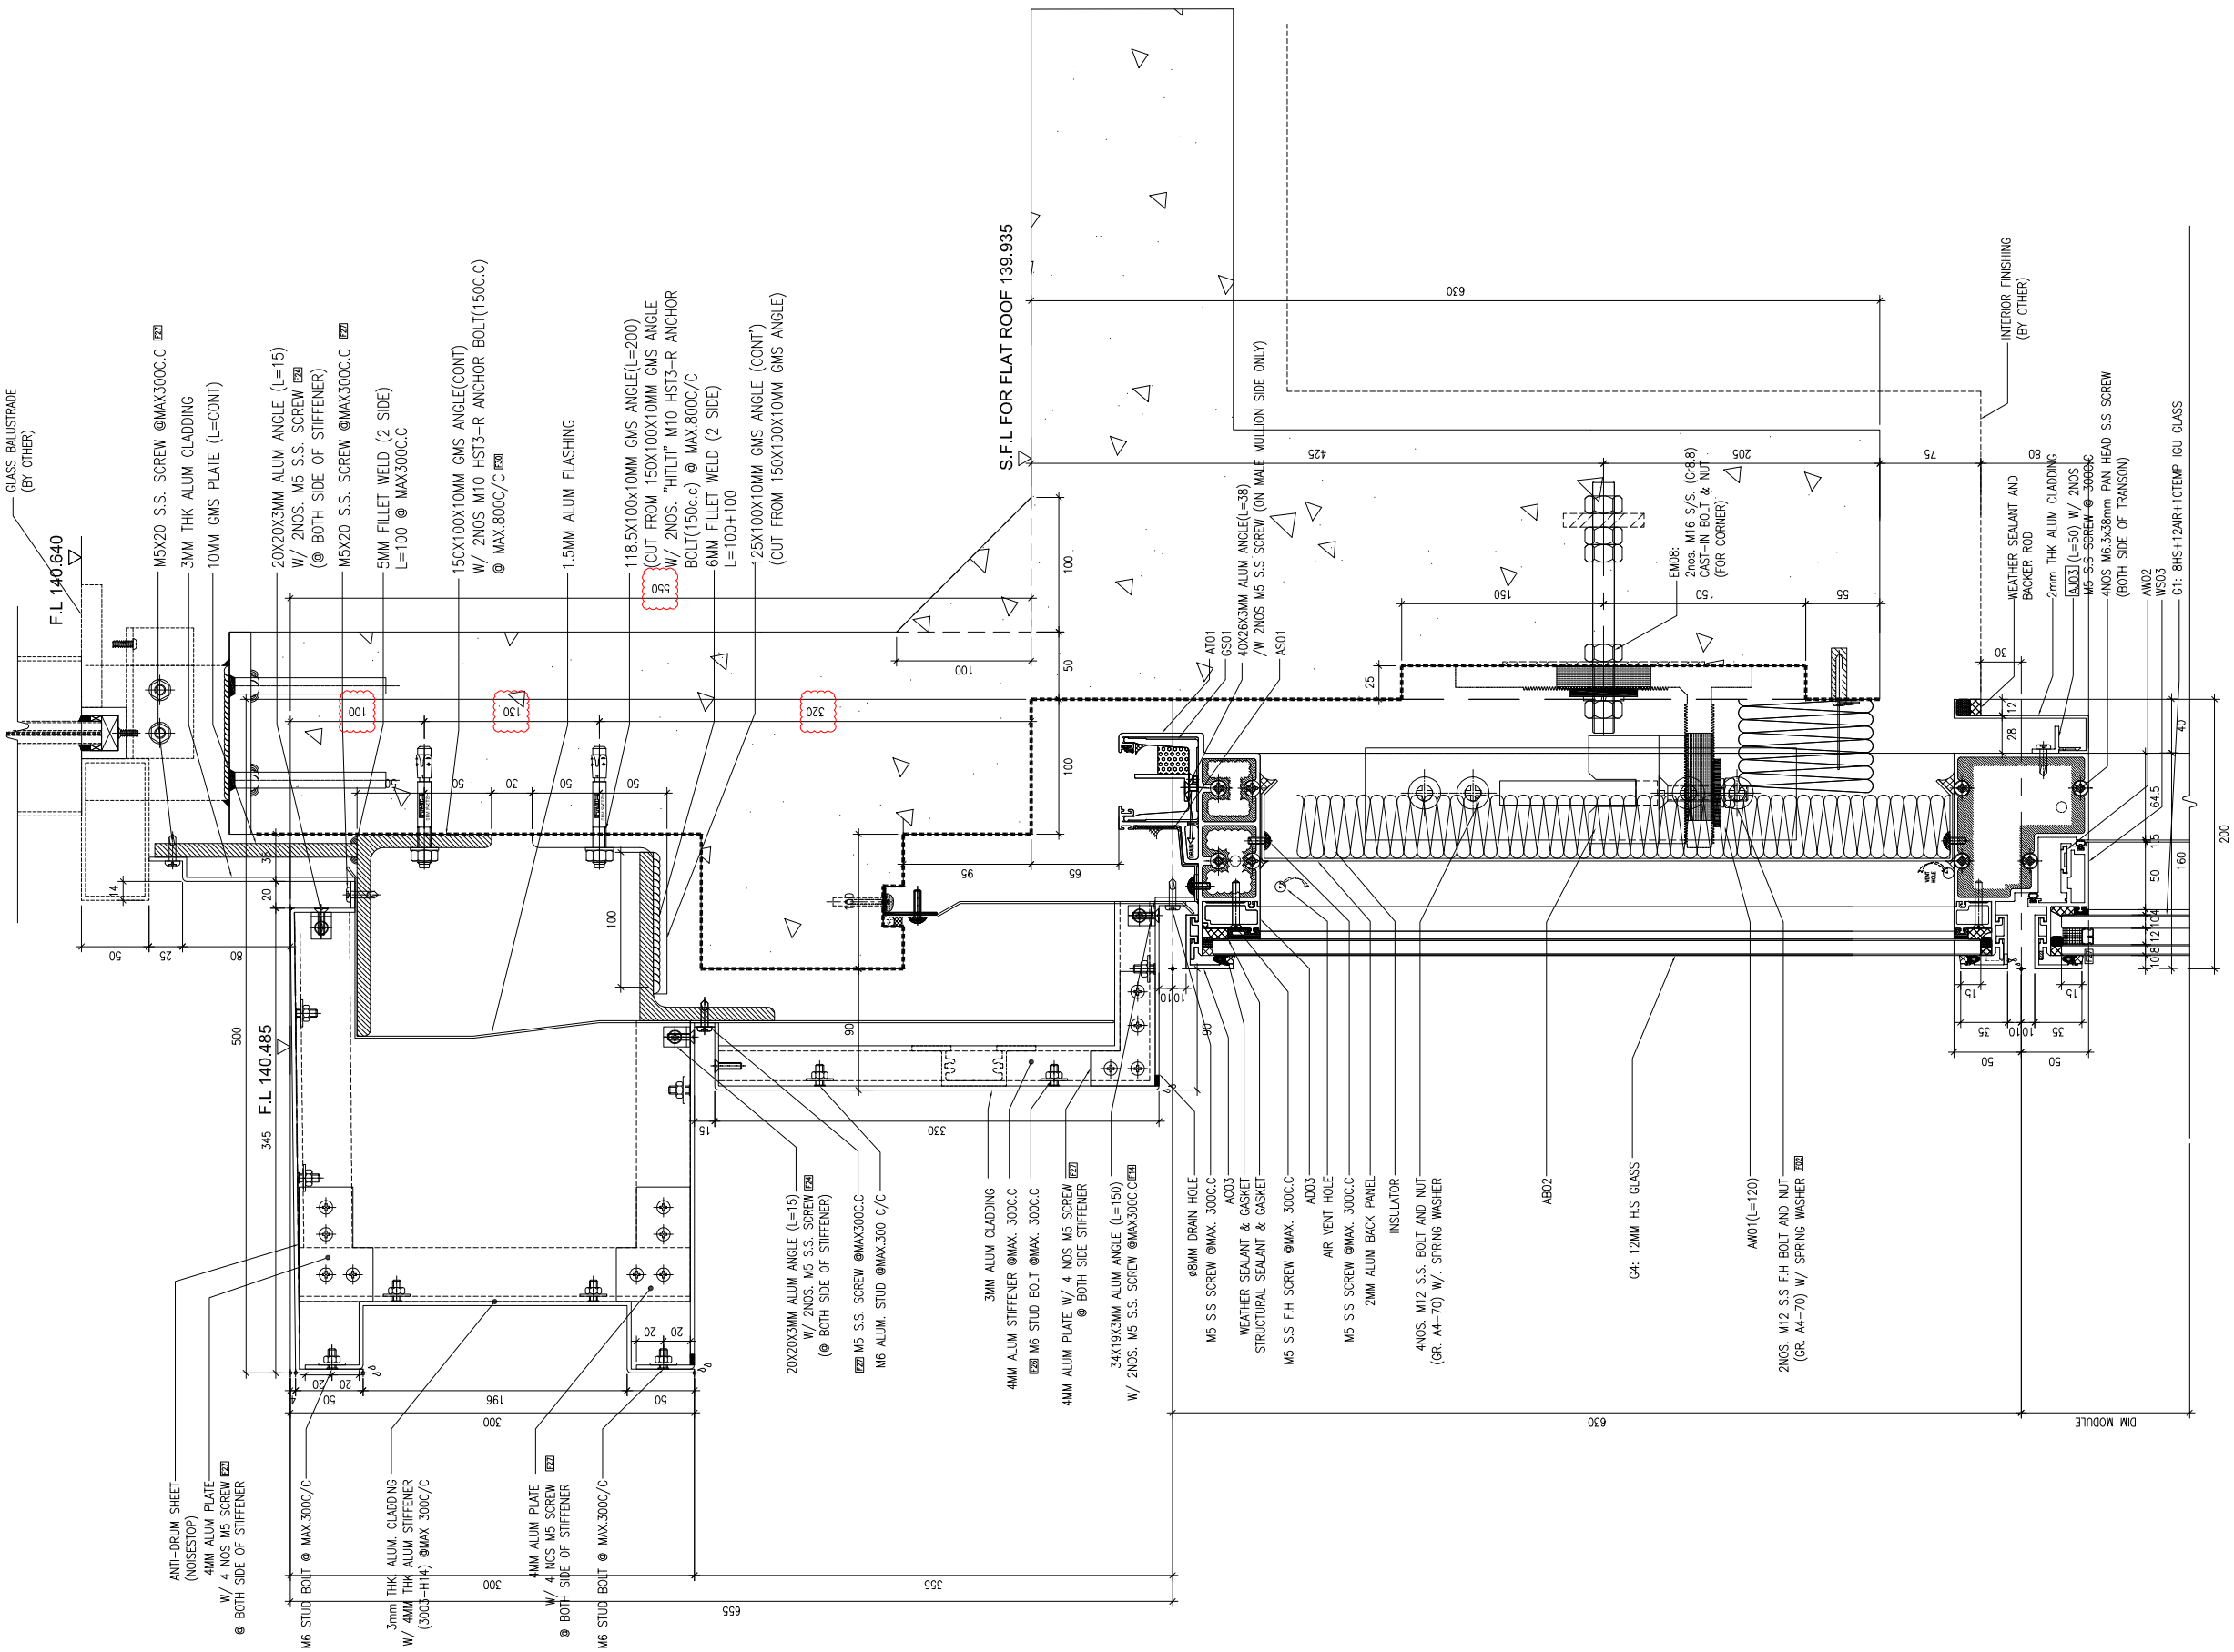

1 TYPICAL SECTION OF CURTAIN WALL
SCALE 1:5 T3 TCW-PE301-2

B.D. REF :

REDESIGN ALUM FEATURE
PER UPDATED GBP

CLIENT :

SUN HUNG KAI REAL ESTATE AGENCY LTD.
42/F SUN HUNG KAI CENTRE, WANCHAI, HONGKONG

ARCHITECT :

lwk&partners
a r c h i t e c t s

MAIN CONTRACTOR :

怡輝建築有限公司
Yee Fai Building Contractors Ltd.

STRUCTURAL ENGINEER :

ARUP

FACADE CONSULTANT:

ALPHA CONSULTING LIMITED
Steel Structure & Facade Specialist

NOTE :
1. ALL DIMENSIONS ARE IN mm.
2. ALL ELEVATIONS ARE VIEWED FROM OUTSIDE.
3. ALL DIMENSIONS TO BE VERIFIED ON SITE BEFORE FABRICATION.

LEGEND :

X1 / X001 — DETAIL MARK NO. / REFER SHEET NO.

1. F.F.L. --FINISHED FLOOR LEVEL
2. S.F.L. --STRUCTURAL FLOOR LEVEL
3. (R) --REVERSED DETAIL

NO.	DATE	REVISED	BY
A	30-OCT-2023	9TH SUBMISSION	CF
–	29-SEP-2023	8TH SUBMISSION(NEW DRAWING)	CF

JOB NO. : J-856

PROJECT :
PROPOSED DEVELOPMENT ABOVE LIGHT RAIL TIN WING STOP,TSWTL NO.23,AREA 33,TIN SHUI WAI, N.T.


TITLE :
TYPICAL DETAIL FOR CURTAIN WALL

DATE : 31-OCT-22 | SCALE : 1:5

DRAWN BY : C.F | CHECKED BY :

美特鋁質有限公司
MIDI ALUMINIUM FABRICATOR LTD.
Units 6-8, Sunray Industrial Centre, 1/F
610 Cho Kwo Ling Road, Kowloon
Tel:23489211-4 Fax:(852)27727666

DWG NO. : J856-SD-CW-8513A | REV. : A

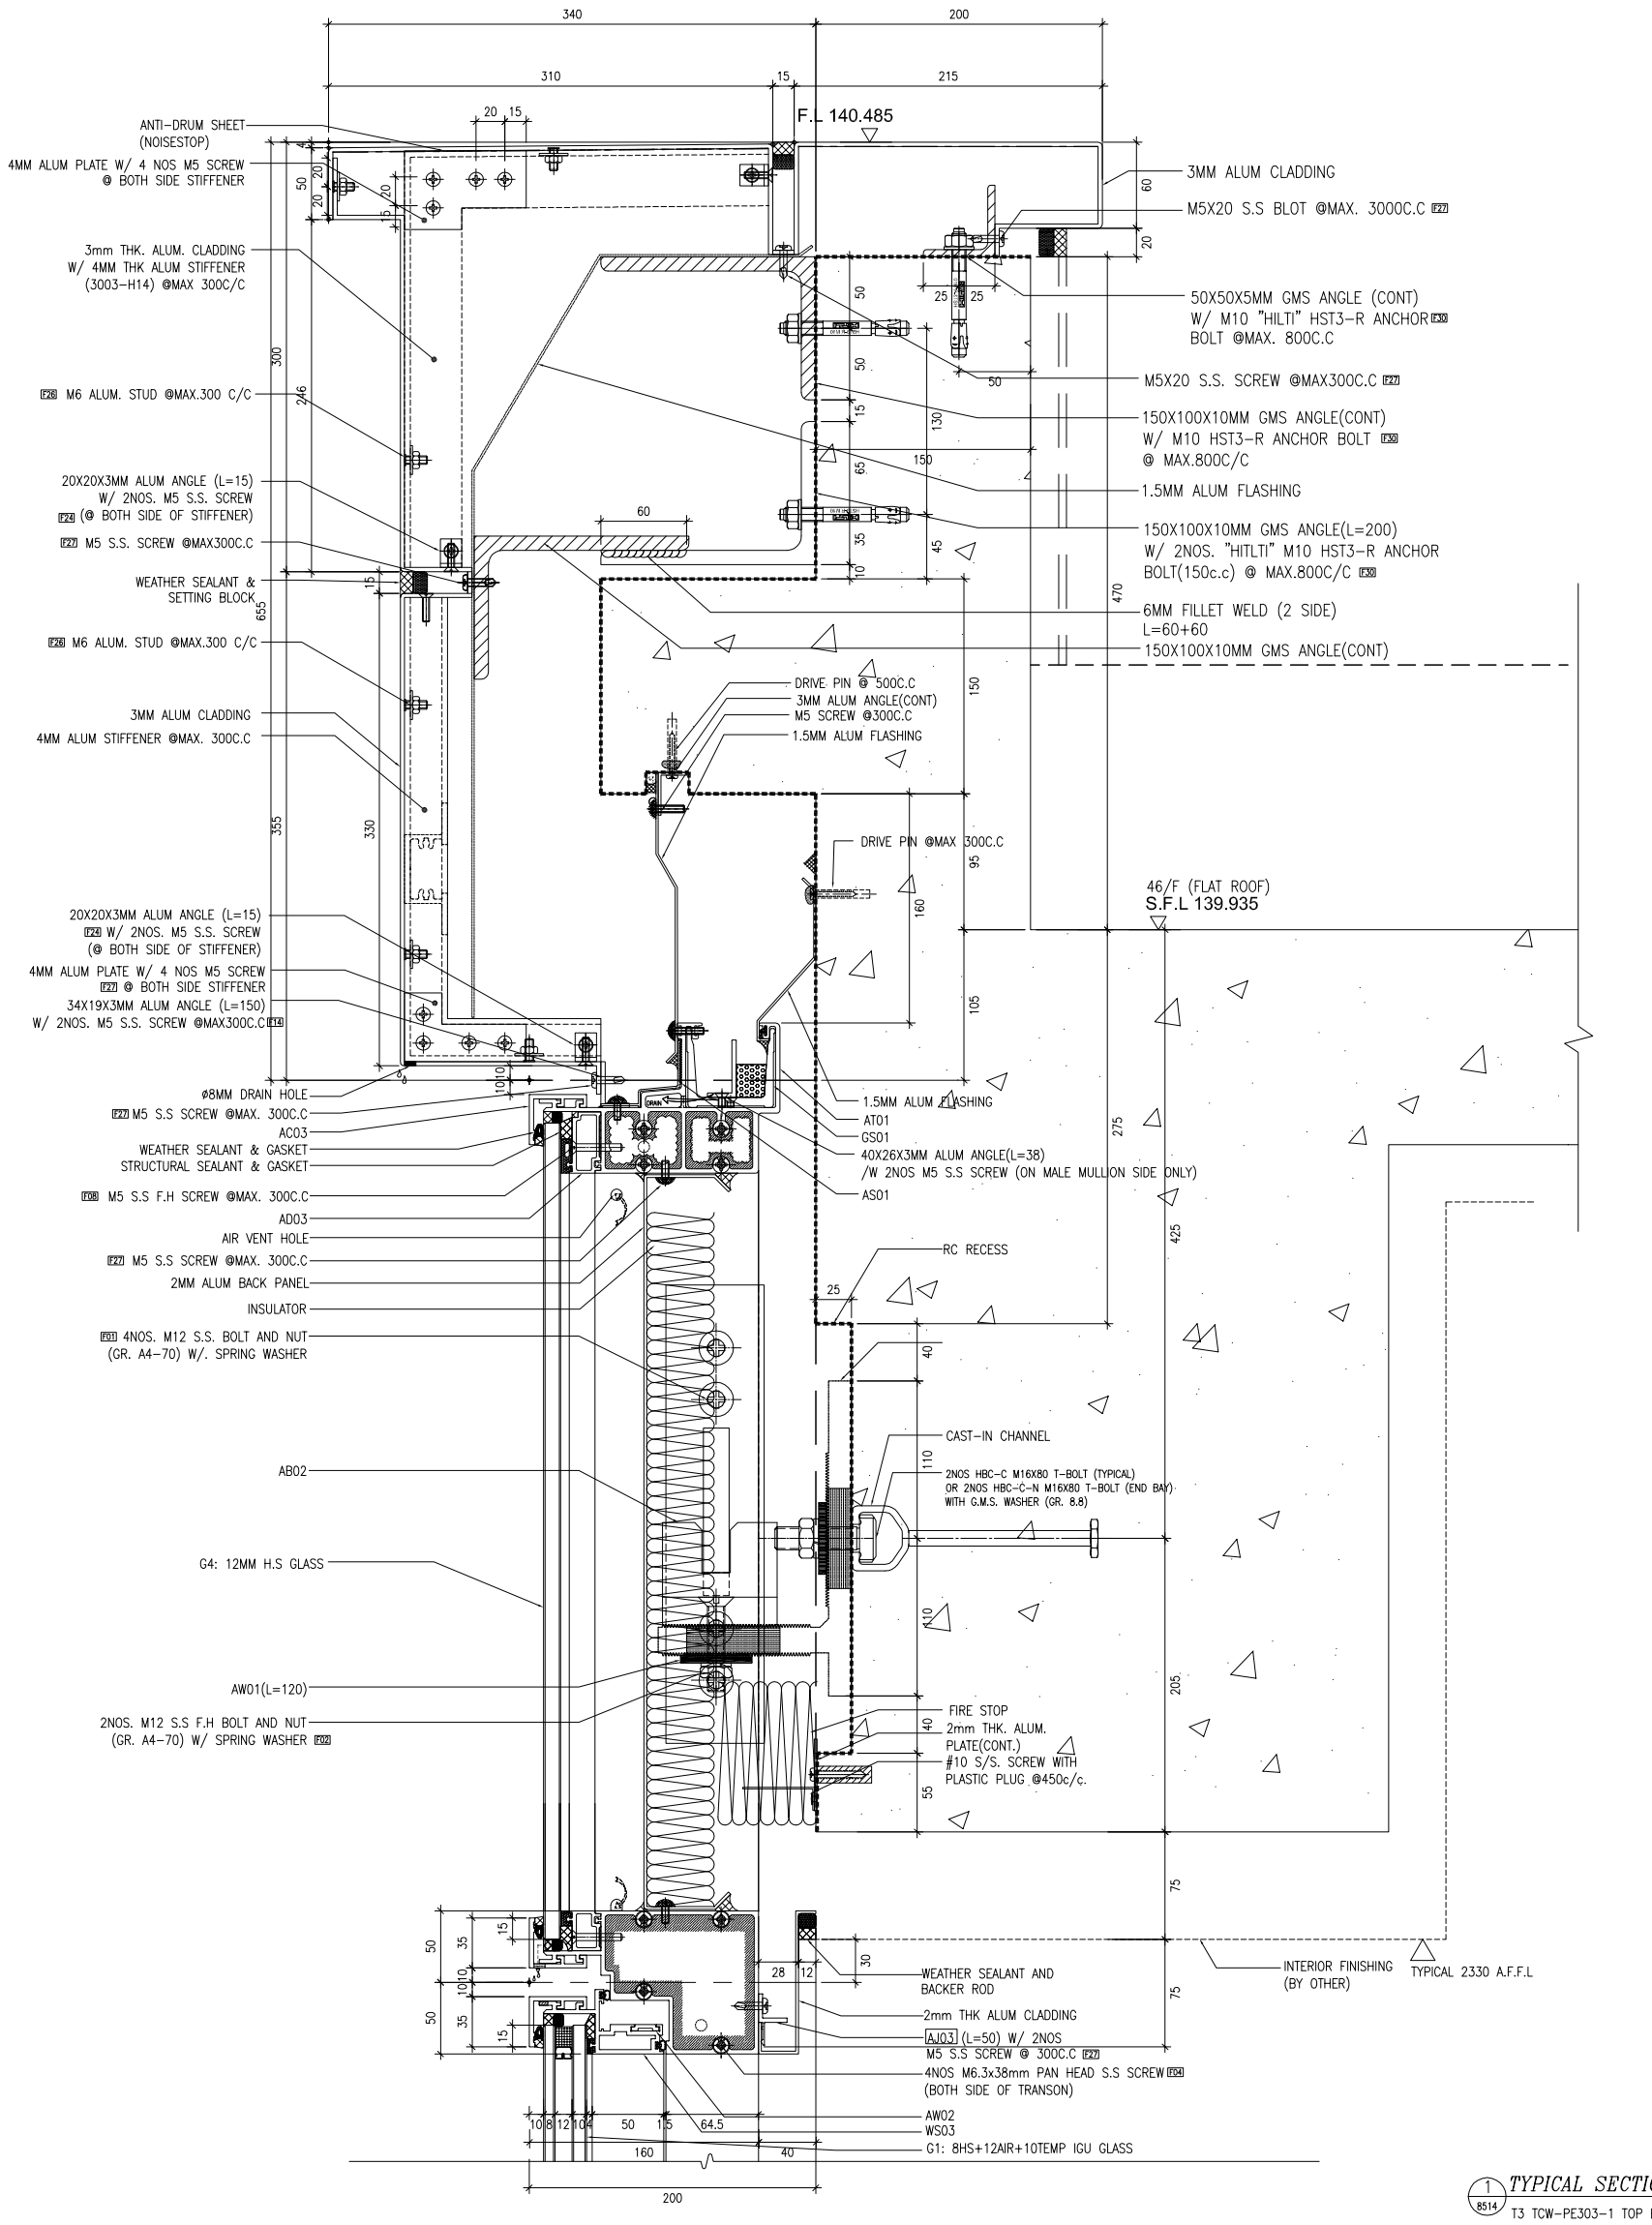

1 / 8514 *TYPICAL SECTION OF CURTAIN WALL*

T3 TCW-PE303-1 TOP END

B.D. REF :

CLIENT :

SUN HUNG KAI REAL ESTATE AGENCY LTD.
42/F SUN HUNG KAI CENTRE, WANCHAI, HONGKONG

ARCHITECT :

iwk&partners architects

MAIN CONTRACTOR :

怡輝建築有限公司 Yee Fai Building Contractors Ltd.

STRUCTURAL ENGINEER :

ARUP

FACADE CONSULTANT:

ALPHA CONSULTING LIMITED
Steel Structure & Facade Specialist

NOTE :
1. ALL DIMENSIONS ARE IN mm.
2. ALL ELEVATIONS ARE VIEWED FROM OUTSIDE.
3. ALL DIMENSIONS TO BE VERIFIED ON SITE BEFORE FABRICATION.

LEGEND :
X1 / X001 — DETAIL MARK NO. / REFER SHEET NO.
1. F.F.L. -- FINISHED FLOOR LEVEL
2. S.F.L. -- STRUCTURAL FLOOR LEVEL
3. /R -- REVERSED DETAIL

NO.	DATE	REMARKS	BY
C	03-OCT-2023	8TH SUBMISSION(R1)	CF
B	22-AUG-2023	7TH SUBMISSION	CF
A	10-MAY-2022	5TH SUBMISSION	CF
-	14-FEB-2022	NEW DRAWING (4TH SUBMISSION)	CF

JOB NO. : J-856

PROJECT :
PROPOSED DEVELOPMENT ABOVE LIGHT RAIL TIN WING STOP,TSWTL NO.23,AREA 33,TIN SHUI WAI, N.T.


TITLE :
TYPICAL DETAIL FOR CURTAIN WALL


DATE : 31-OCT-22 | SCALE : 1:5

DRAWN BY : C.F | CHECKED BY :


MIDI ALUMINUM FABRICATOR LTD. 美特鋁廠有限公司
Units 6-8, Sunray Industrial Centre, 1/F
610 Cha Kwo Ling Road, Kowloon
Tel:23489211-4 Fax:(852)27727666


DWG NO. : J856-SD-CW-8514 | REV. : C

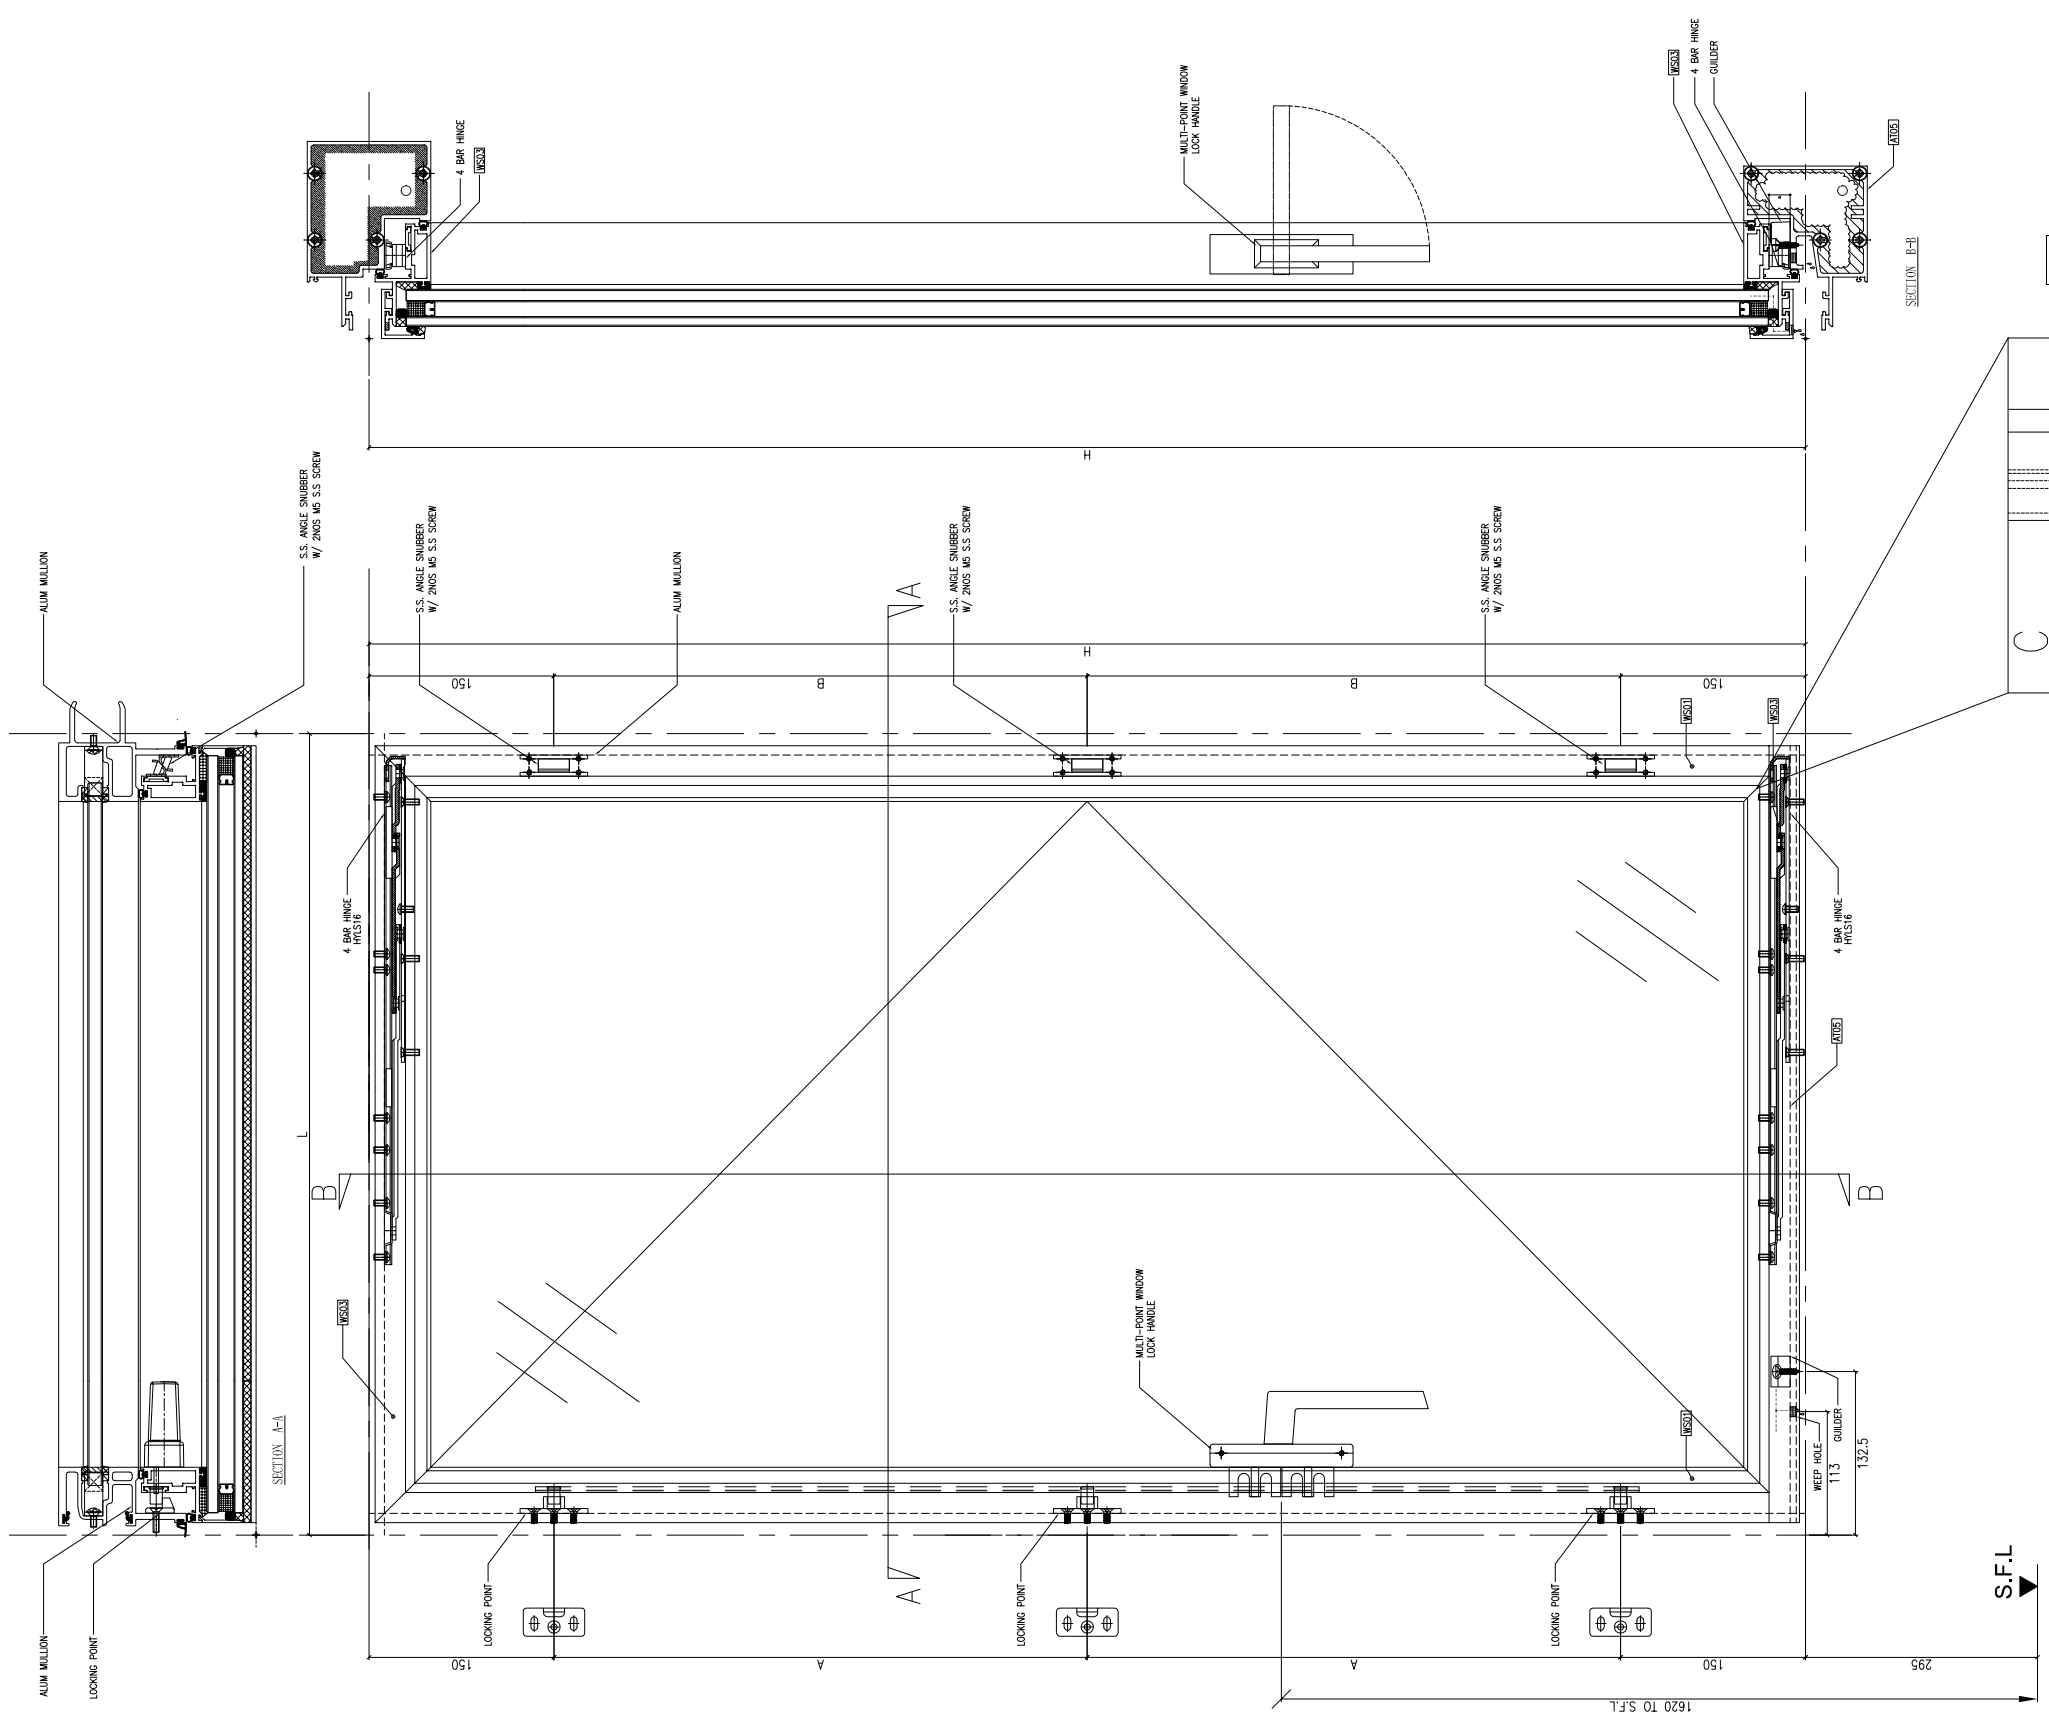

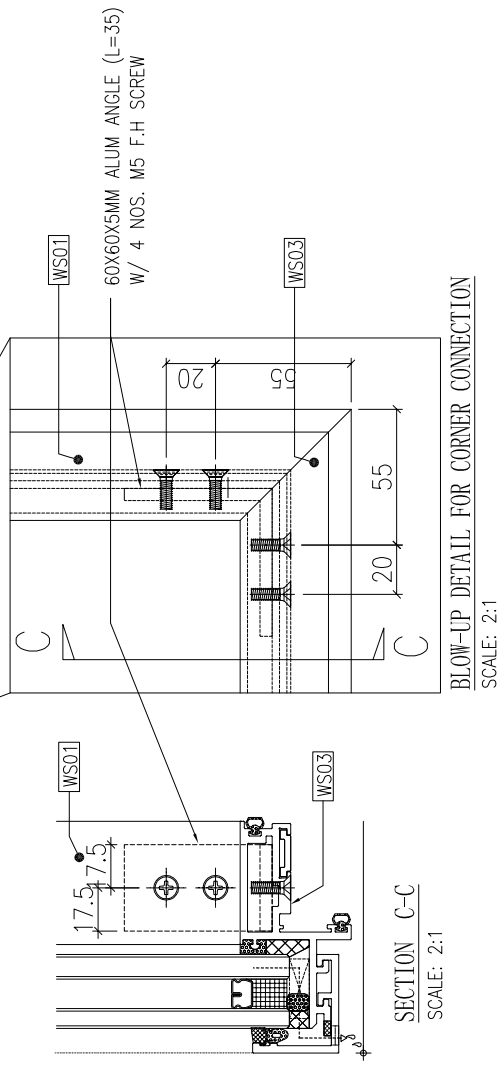

S.H. WINDOW					
L(mm)	H(mm)	LOCK PT	A (mm)	SNUBBER	B (mm)
650	1165	3 NOs	432.5	3 NOs	432.5
650	1465	4 NOs	388.3	4 NOs	388.3

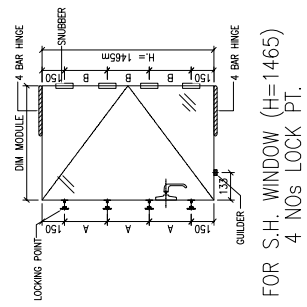

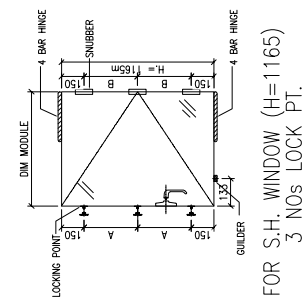

B.D. REF :

CLIENT :

SUN HUNG KAI REAL ESTATE AGENCY LTD.
42/F SUN HUNG KAI CENTRE, WANCHAI, HONGKONG

ARCHITECT :

lwk&partners
a r c h i t e c t s

MAIN CONTRACTOR :

怡輝建築有限公司
Yee Fai Building Contractors Ltd.

STRUCTURAL ENGINEER :

ARUP

FACADE CONSULTANT:

ALPHA CONSULTING LIMITED
Steel Structure & Facade Specialist

NOTE :
1. ALL DIMENSIONS ARE IN mm.
2. ALL ELEVATIONS ARE VIEWED FROM OUTSIDE.
3. ALL DIMENSIONS TO BE VERIFIED ON SITE BEFORE FABRICATION.

LEGEND :

X1 — DETAIL MARK NO.
X001 — REFER SHEET NO.

1. F.F.L. --FINISHED FLOOR LEVEL
2. S.F.L. --STRUCTURAL FLOOR LEVEL
3. (/R) --REVERSED DETAIL

NO.	DATE	REVISED	BY
A	30-MAY-2023	6TH SUBMISSION	CF

JOB NO. : J-856

PROJECT :
PROPOSED DEVELOPMENT ABOVE LIGHT RAIL TIN WING STOP,TSWTL NO.23,AREA 33,TIN SHUI WAI, N.T.


TITLE :
TYPICAL DETAIL FOR CURTAIN WALL (PMU)


DATE : 31-MAR-23 | SCALE : 1:6


DRAWN BY : C.F | CHECKED BY :

美特鋁質有限公司
MIDI ALUMINIUM FABRICATOR LTD.
Units 6-8, Sunray Industrial Centre, 1/F
610 Cha Kwo Ling Road, Kowloon
Tel:23489211-4 Fax:(852)27727666


DWG NO. : J856-SD-CW-8515 | REV. : A

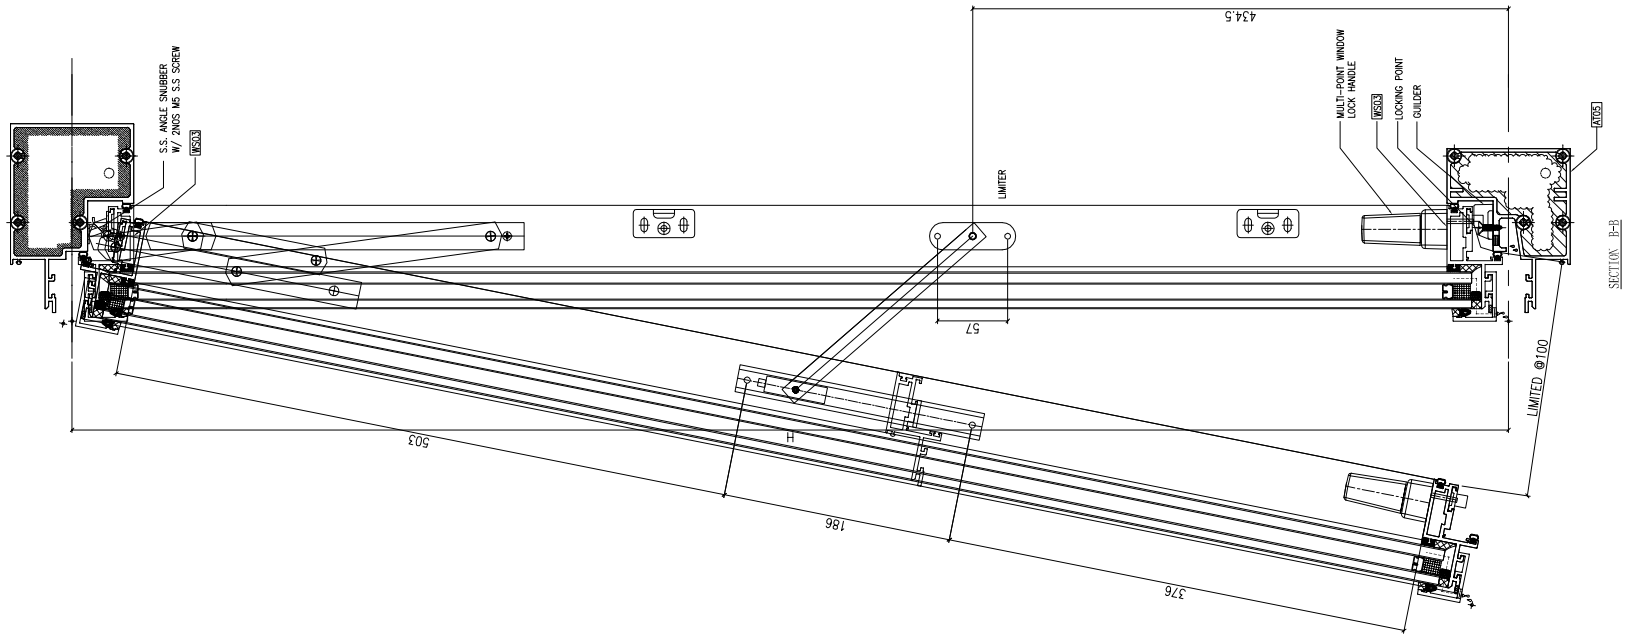

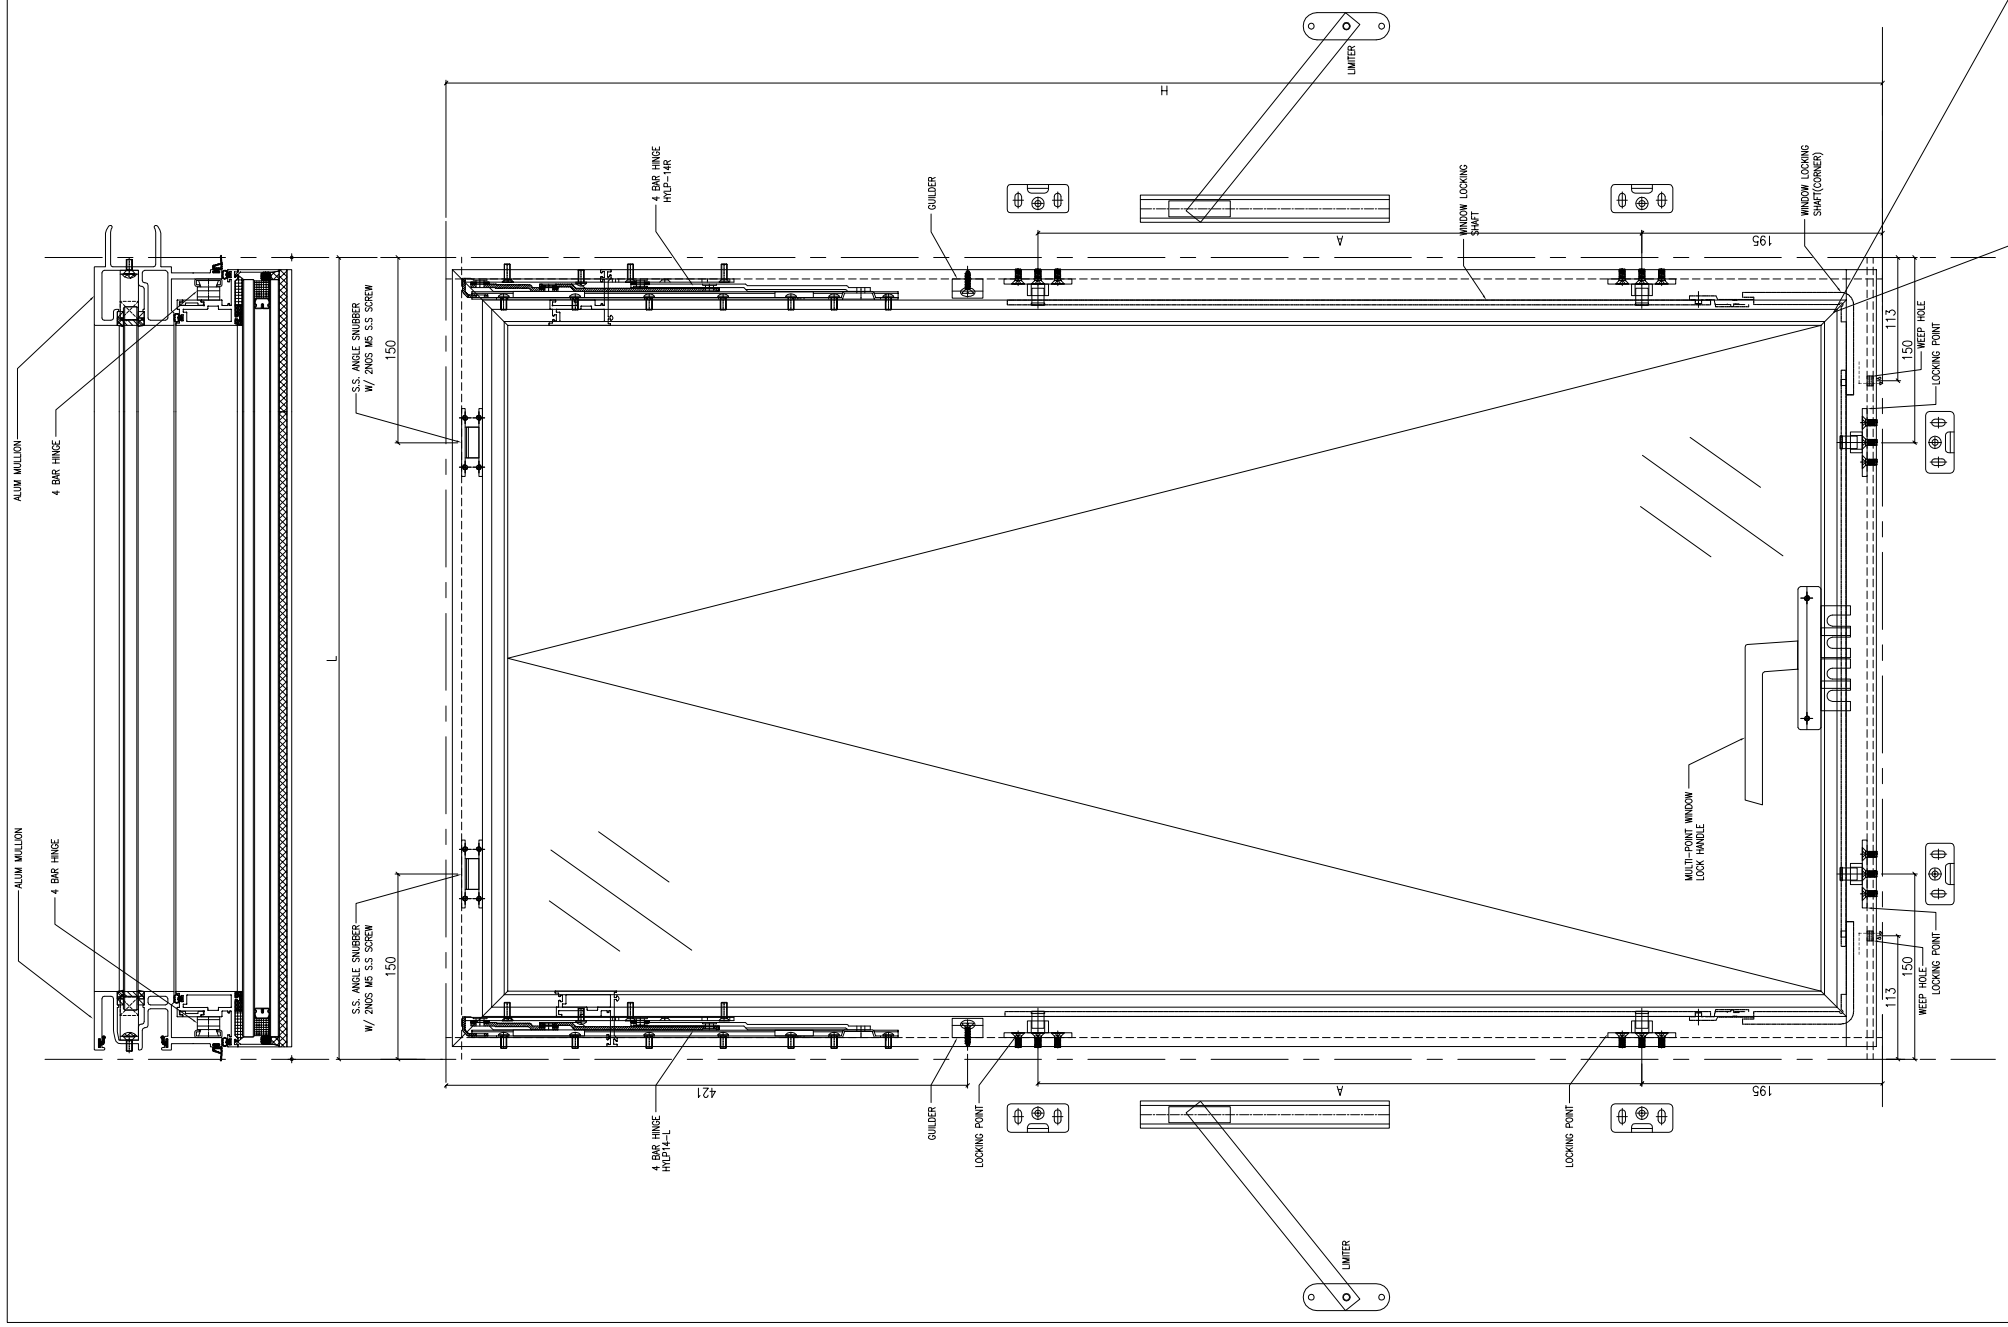

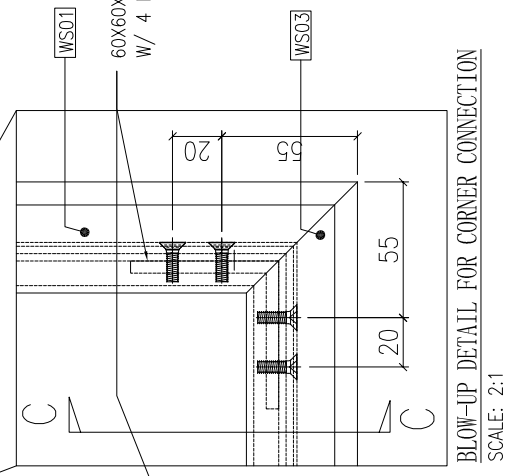


BLOW-UP DETAIL FOR CORNER CONNECTION
SCALE: 2:1

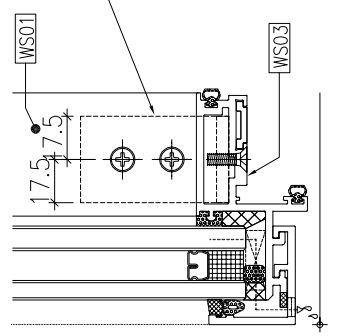


SECTION C-C
SCALE: 2:1

T.H. WINDOW				
L(mm)	H(mm)	LOCK PT	A (mm)	B (mm)	SNUBBER
<=820	1165	6 NOs	490	490	2 NOs
<=820	1465	8 NOs	330		2 NOs
<=1125	1165	6 NOs	490		2 NOs

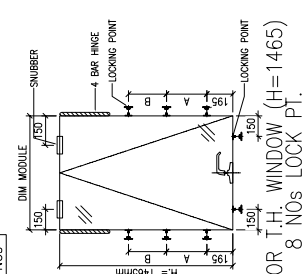

FOR T.H. WINDOW (H=1465)
8 NOs LOCK PT.

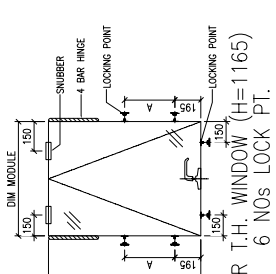

FOR T.H. WINDOW (H=1165)
6 NOs LOCK PT.

B.D. REF :

CLIENT :
SUN HUNG KAI REAL ESTATE AGENCY LTD.
42/F SUN HUNG KAI CENTRE, WANCHAI, HONGKONG

ARCHITECT :
lwk&partners architects

MAIN CONTRACTOR :
怡輝建築有限公司
Yee Fai Building Contractors Ltd.

STRUCTURAL ENGINEER :
ARUP

FACADE CONSULTANT:
ALPHA CONSULTING LIMITED
Steel Structure & Facade Specialist

NOTE :
1. ALL DIMENSIONS ARE IN mm.
2. ALL ELEVATIONS ARE VIEWED FROM OUTSIDE.
3. ALL DIMENSIONS TO BE VERIFIED ON SITE BEFORE FABRICATION.

LEGEND :
X1 — DETAIL MARK NO.
X001 — REFER SHEET NO.

1. F.F.L. --FINISHED FLOOR LEVEL
2. S.F.L. --STRUCTURAL FLOOR LEVEL
3. (R) --REVERSED DETAIL

NO.	DATE	REVISED	BY
A	30-MAY-2023	6TH SUBMISSION	CF

JOB NO. : J-856

PROJECT :
PROPOSED DEVELOPMENT ABOVE LIGHT RAIL TIN WING STOP,TSWTL NO.23,AREA 33,TIN SHUI WAI, N.T.


TITLE :
TYPICAL DETAIL FOR CURTAIN WALL (PMU)

DATE : 31-MAR-23 | SCALE : 1:4


DRAWN BY : C.F | CHECKED BY :

美特鋁質有限公司
MIDI ALUMINIUM FABRICATOR LTD.
Units 6-8, Sunray Industrial Centre, 1/F
610 Cha Kwo Ling Road, Kowloon
Tel:23489211-4 Fax:(852)27727666


DWG NO. : J856-SD-CW-8516 | REV. : A

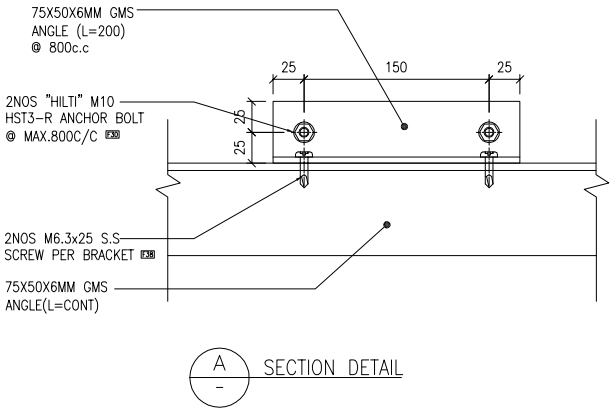

A – SECTION DETAIL

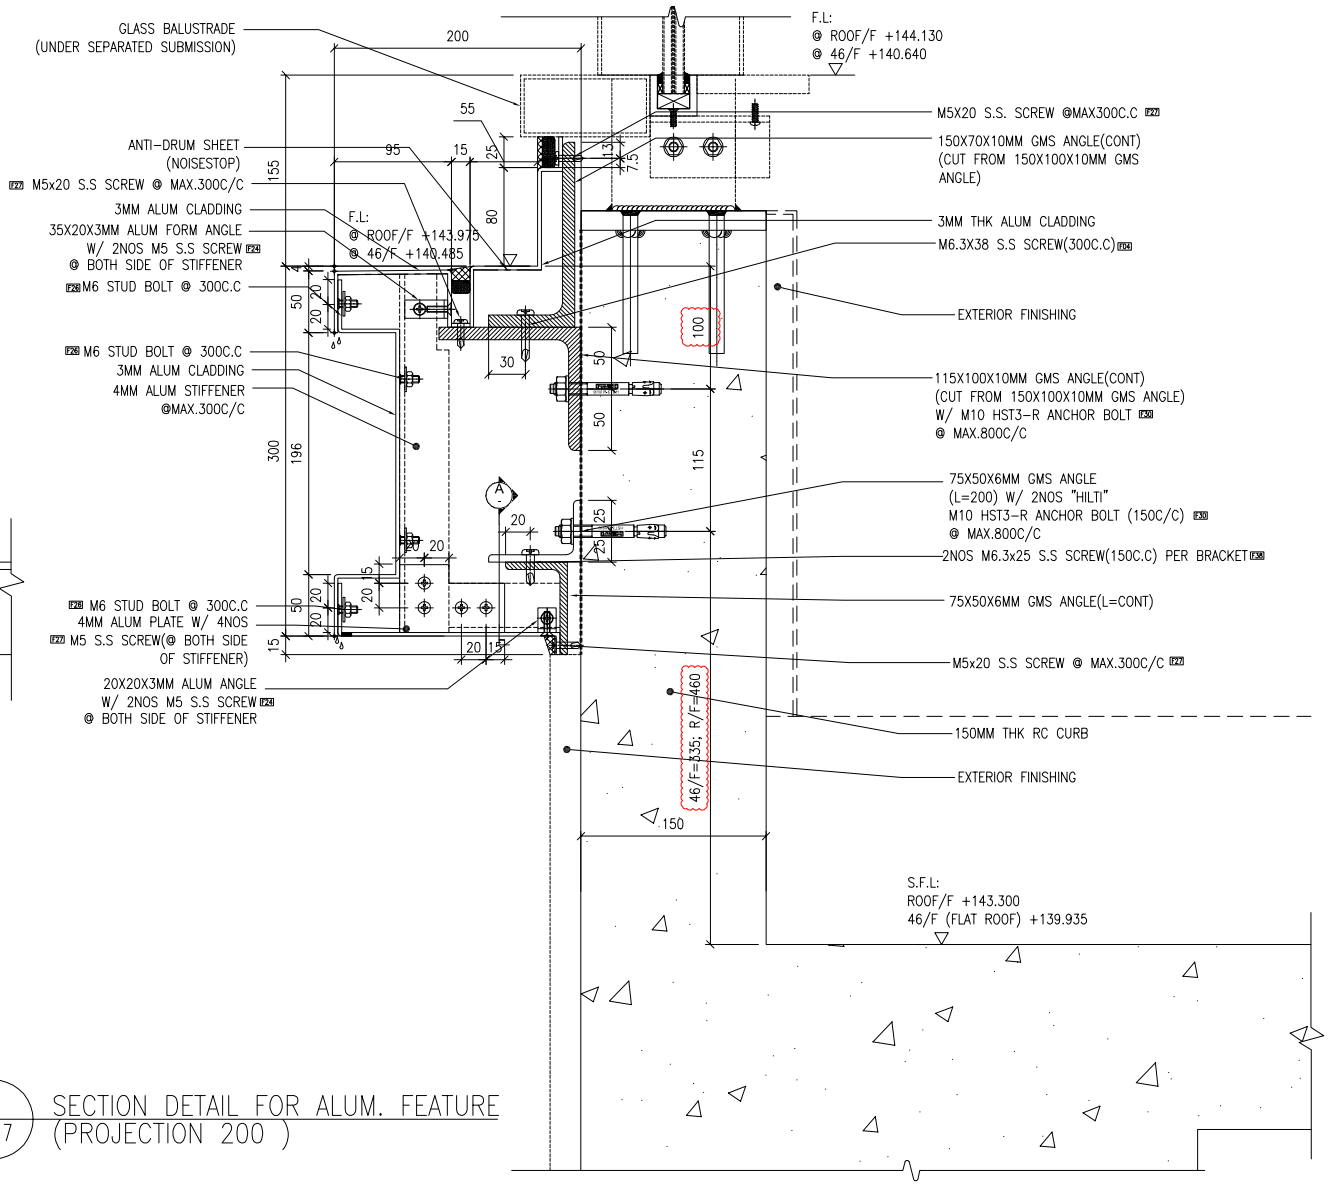

1/8517 SECTION DETAIL FOR ALUM. FEATURE (PROJECTION 200)

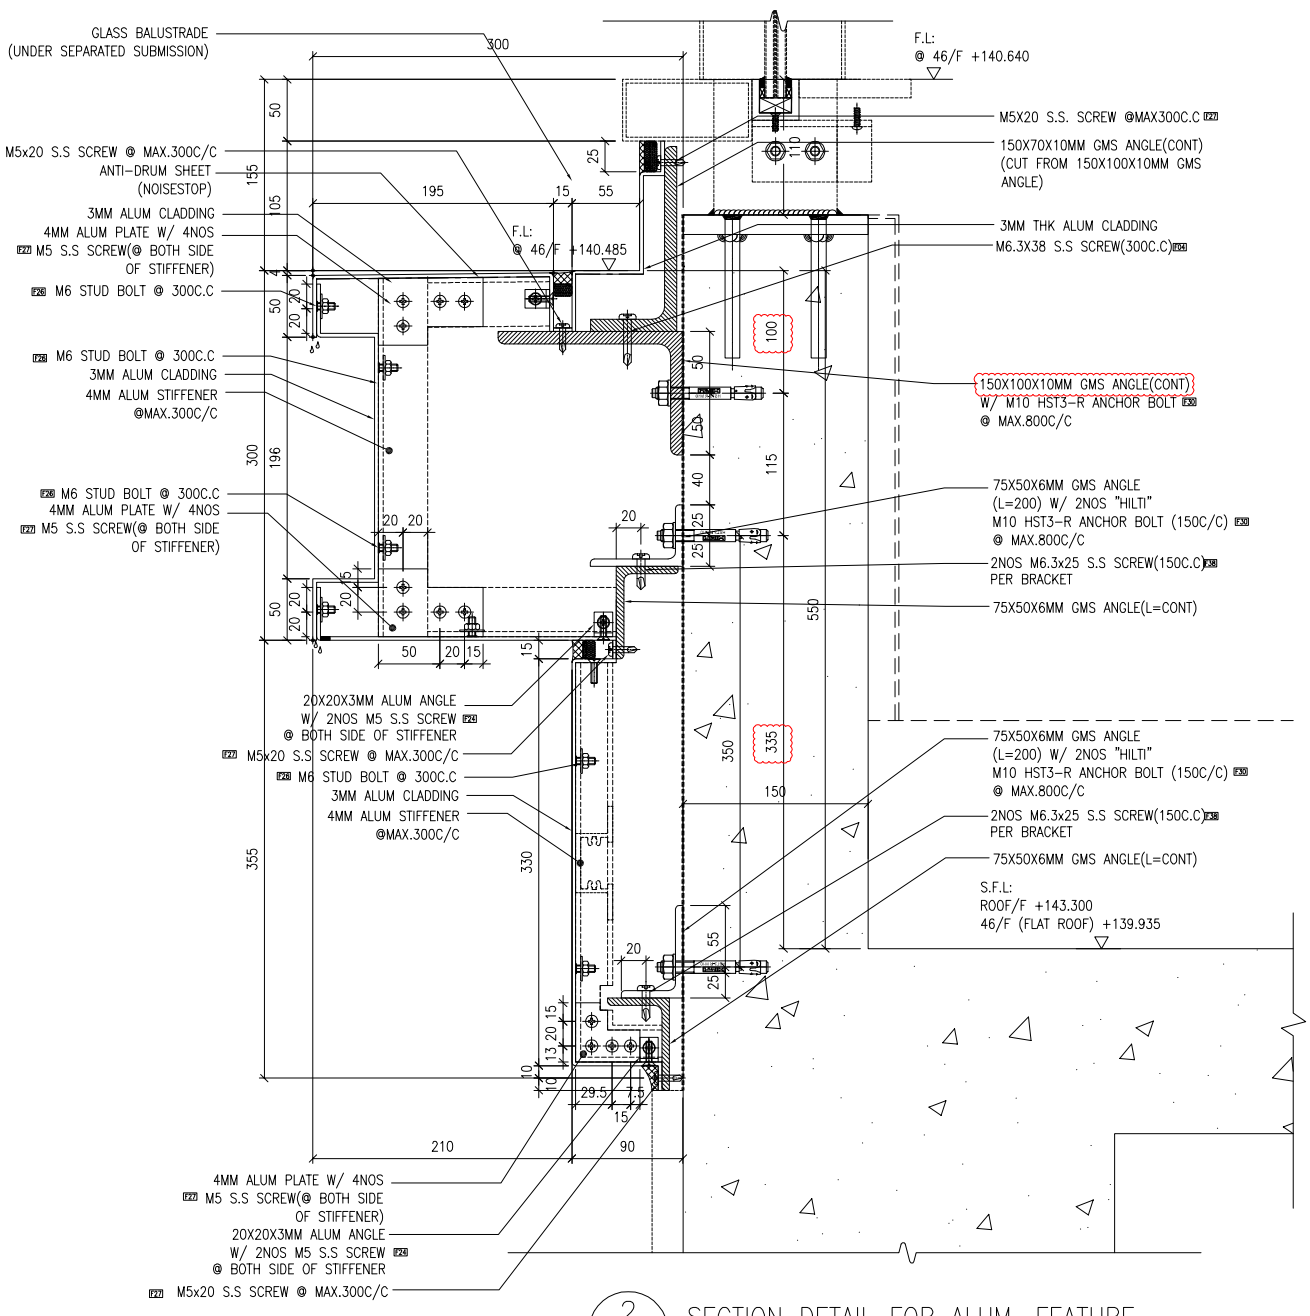

2/8517 SECTION DETAIL FOR ALUM. FEATURE (PROJECTION 300)

NOTE :
1. ALL DIMENSIONS ARE IN mm.
2. ALL ELEVATIONS ARE VIEWED FROM OUTSIDE.
3. ALL DIMENSIONS TO BE VERIFIED ON SITE BEFORE FABRICATION.

LEGEND :
X1 / X001 — DETAIL MARK NO. / REFER SHEET NO.
1. F.F.L. --FINISHED FLOOR LEVEL
2. S.F.L. --STRUCTURAL FLOOR LEVEL
3. /R --REVERSED DETAIL

NO.	DATE	REMARKS	BY
B	30-OCT-2023	9TH SUBMISSION	CF
A	29-SEP-2023	8TH SUBMISSION	CF
–	22-AUG-2023	7TH SUBMISSION (NEW DRAWING)	CF

JOB NO. : J-856

PROJECT :
PROPOSED DEVELOPMENT ABOVE LIGHT RAIL TIN WING STOP,TSWTL NO.23,AREA 33,TIN SHUI WAI, N.T.

TITLE :
TYPICAL DETAIL FOR CURTAIN WALL

DATE : 31-OCT-22 | SCALE : 1:7

DRAWN BY : C.F | CHECKED BY :

美特鋁廠有限公司
MIDI ALUMINIUM FABRICATOR LTD.
Units 6-8, Sunray Industrial Centre, 1/F
610 Cha Kwo Ling Road, Kowloon
Tel:23489211-4 Fax:(852)27727666

DWG NO. : J856-SD-CW-8517 | REV. : B

CLIENT :
SUN HUNG KAI REAL ESTATE AGENCY LTD.
42/F SUN HUNG KAI CENTRE, WANCHAI, HONGKONG


ARCHITECT :
lw&partners architects

MAIN CONTRACTOR :
怡輝建築有限公司
Yee Fai Building Contractors Ltd.


STRUCTURAL ENGINEER :
ARUP

FACADE CONSULTANT:
ALPHA CONSULTING LIMITED
Steel Structure & Facade Specialist


B.D. REF :

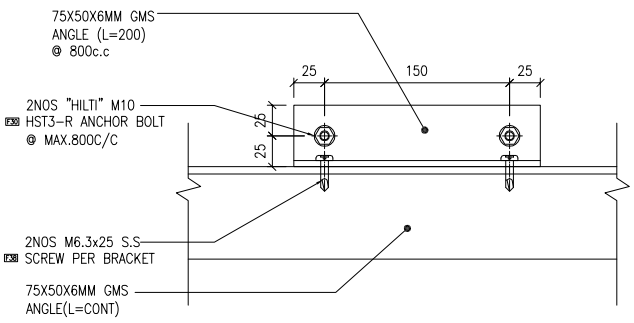


A / - SECTION DETAIL

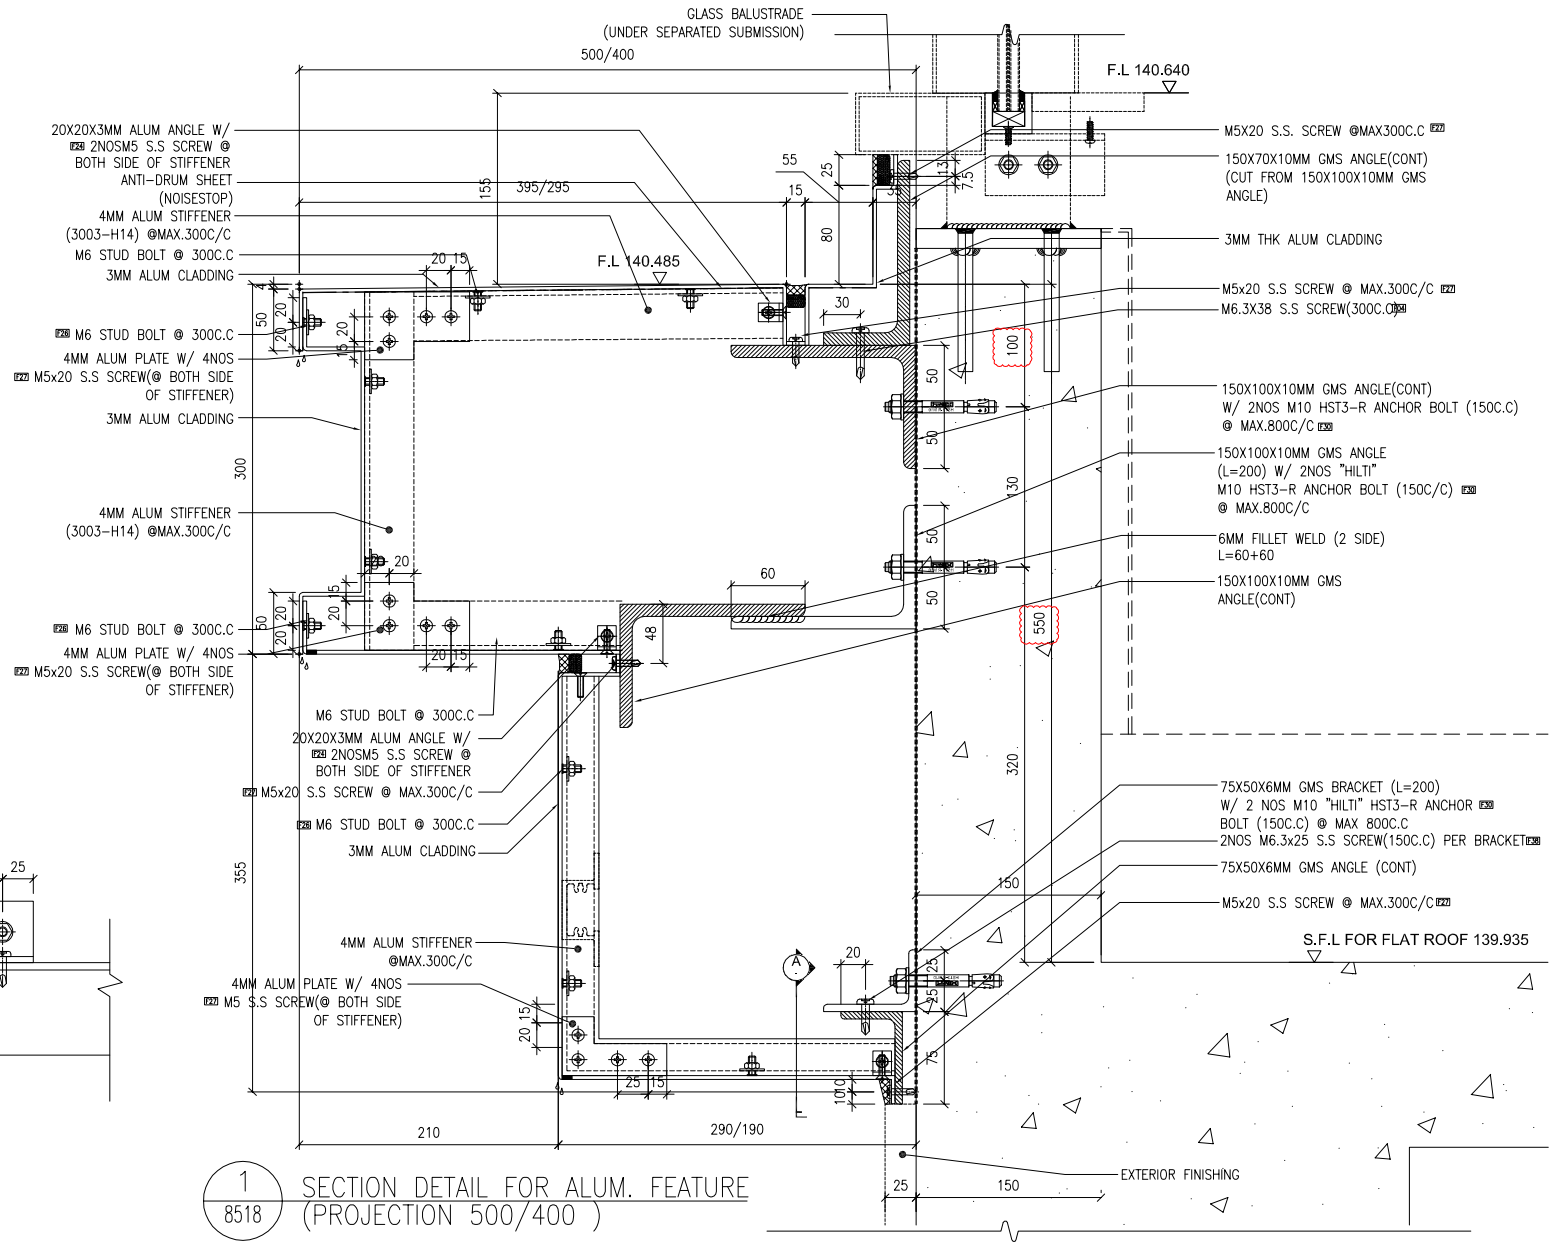

1 / 8518 SECTION DETAIL FOR ALUM. FEATURE (PROJECTION 500/400)

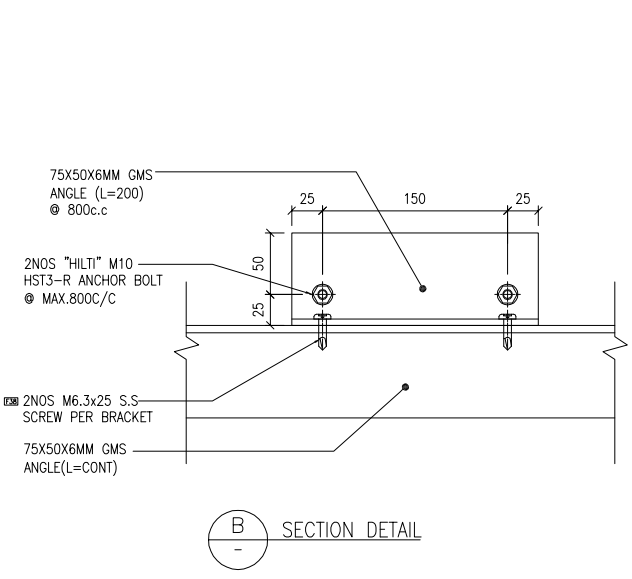

B / - SECTION DETAIL

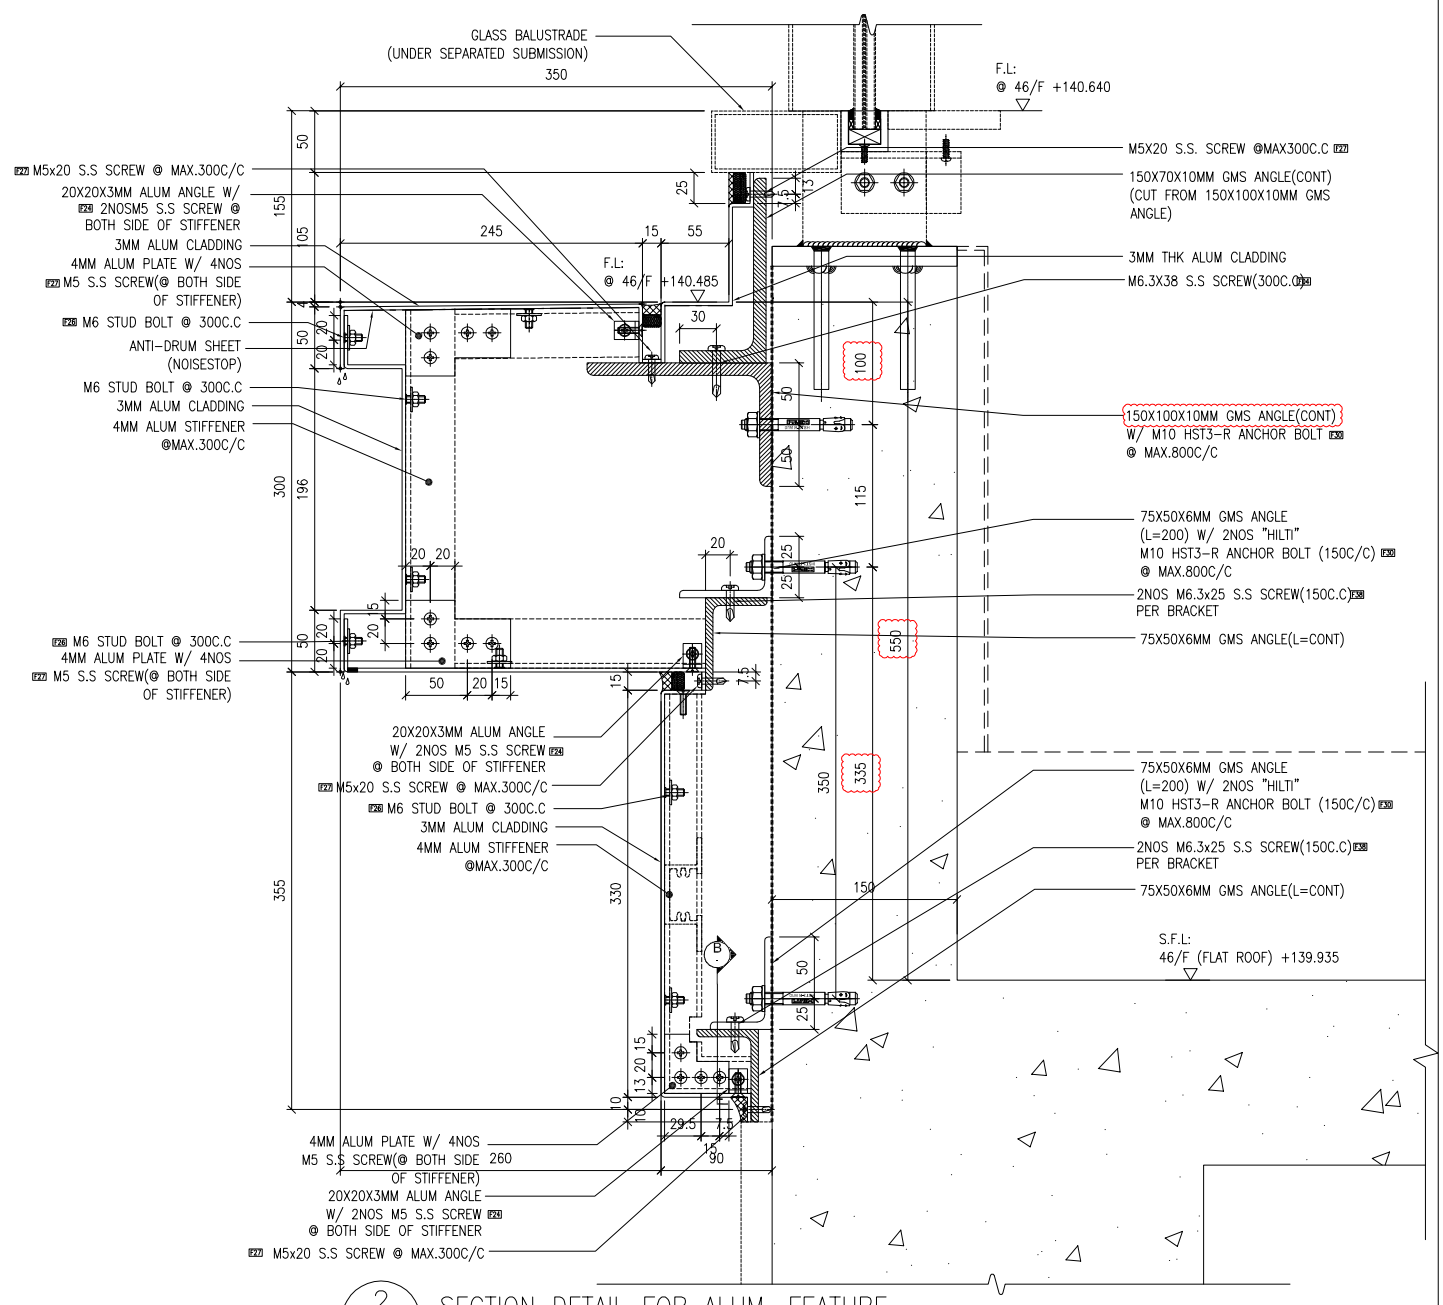

2 / 8518 SECTION DETAIL FOR ALUM. FEATURE (PROJECTION 350)

NOTE :
1. ALL DIMENSIONS ARE IN mm.
2. ALL ELEVATIONS ARE VIEWED FROM OUTSIDE.
3. ALL DIMENSIONS TO BE VERIFIED ON SITE BEFORE FABRICATION.

LEGEND :
X1 / X001 — DETAIL MARK NO. / REFER SHEET NO.
1. F.F.L. --FINISHED FLOOR LEVEL
2. S.F.L. --STRUCTURAL FLOOR LEVEL
3. (R) --REVERSED DETAIL

NO.	DATE	
B	30-OCT-2023	9TH SUBMISSION
A	29-SEP-2023	8TH SUBMISSION
-	22-AUG-2023	7TH SUBMISSION (NEW DRAWING)

JOB NO. : J-856

PROJECT : PROPOSED DEVELOPMENT ABOVE LIGHT RAIL TIN WING STOP,TSWTL NO.23,AREA 33,TIN SHUI WAI, N.T.

TITLE : TYPICAL DETAIL FOR CURTAIN WALL

DATE : 31-OCT-22 | SCALE : 1:7

DRAWN BY : C.F | CHECKED BY :

DWG NO. : J856-SD-CW-8518 | REV. : B

特銘鑫有限公司 MIDI ALUMINIUM FABRICATOR LTD.
Units 6-8, Sunray Industrial Centre, 1/F
610 Cho Kwo Ling Road, Kowloon
Tel:23489211-4 Fax:(852)27727666

CLIENT : SUN HUNG KAI REAL ESTATE AGENCY LTD.
42/F SUN HUNG KAI CENTRE, WANCHAI, HONGKONG


ARCHITECT : lwk&partners architects

MAIN CONTRACTOR : 怡輝建築有限公司 Yee Fai Building Contractors Ltd.


STRUCTURAL ENGINEER : ARUP

FACADE CONSULTANT : ALPHA CONSULTING LIMITED
Steel Structure & Facade Specialist


B.D. REF :

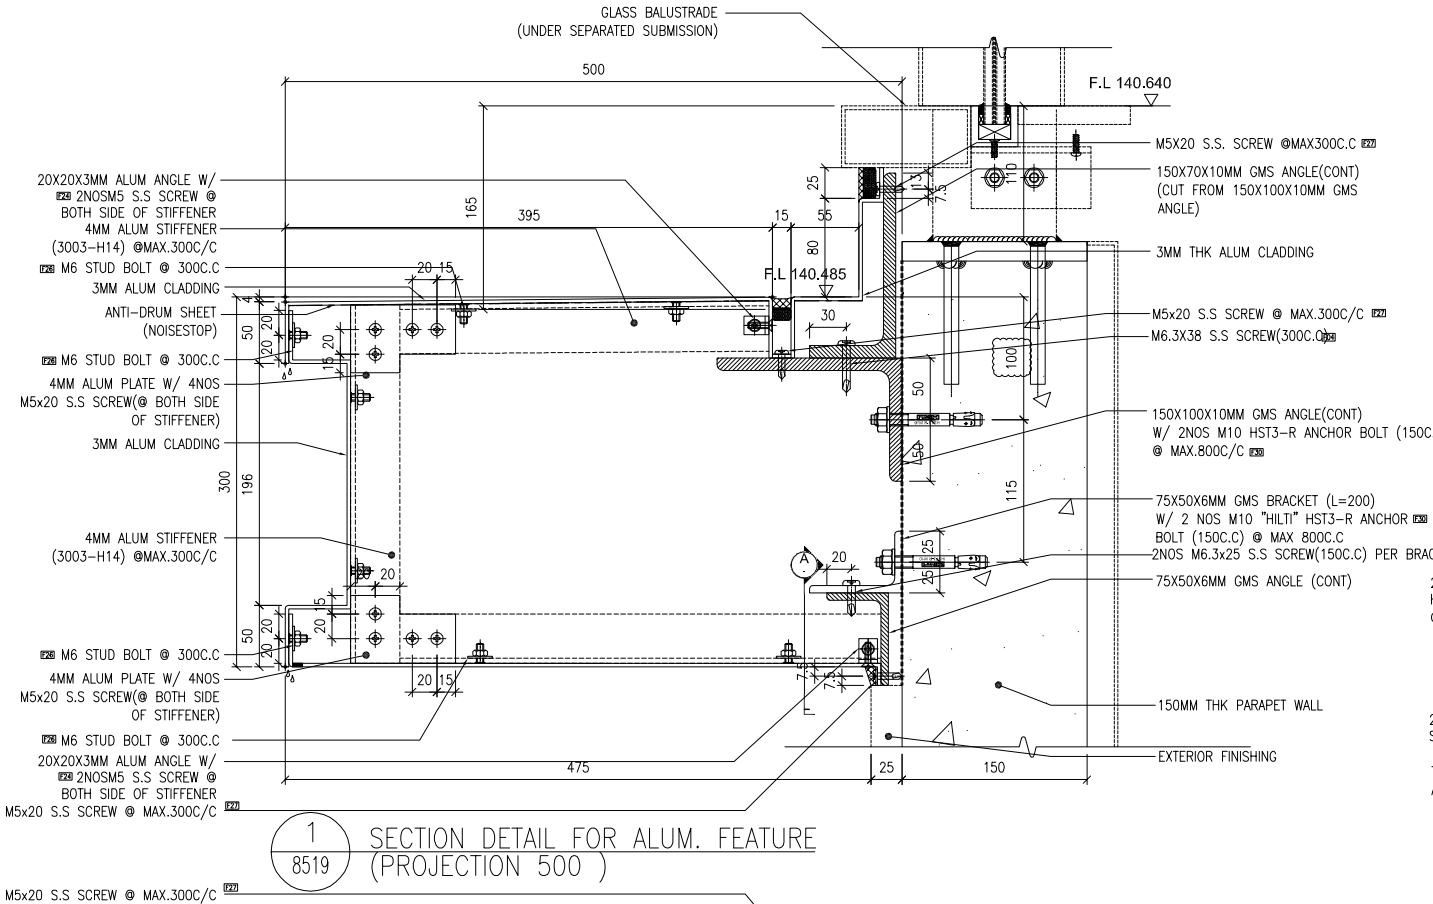


1 / 8519 SECTION DETAIL FOR ALUM. FEATURE (PROJECTION 500)

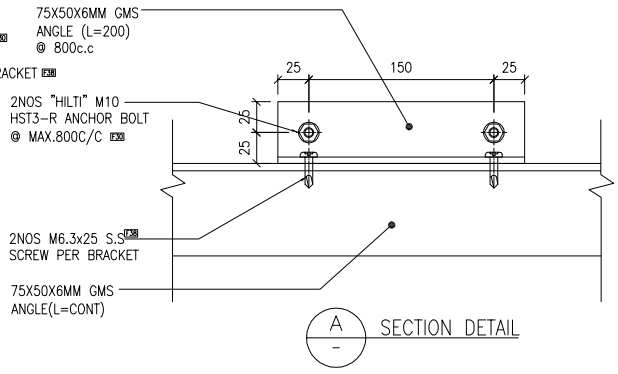


A / - SECTION DETAIL

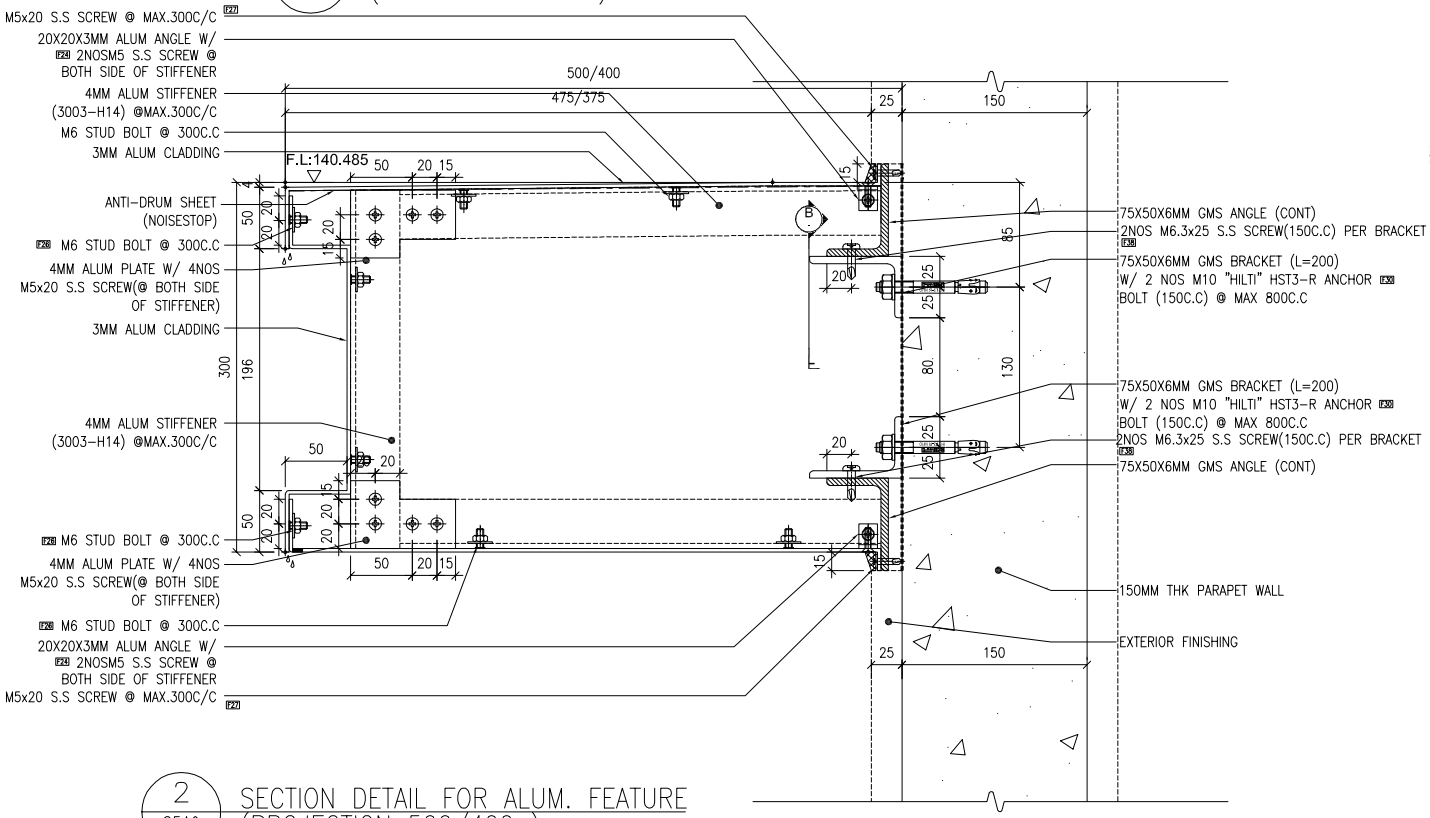

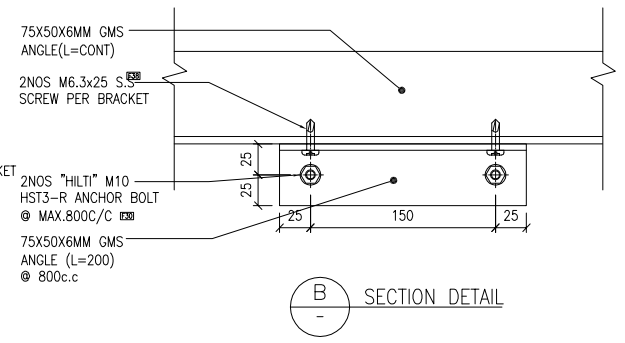

B / - SECTION DETAIL

2 / 8519 SECTION DETAIL FOR ALUM. FEATURE (PROJECTION 500/400)

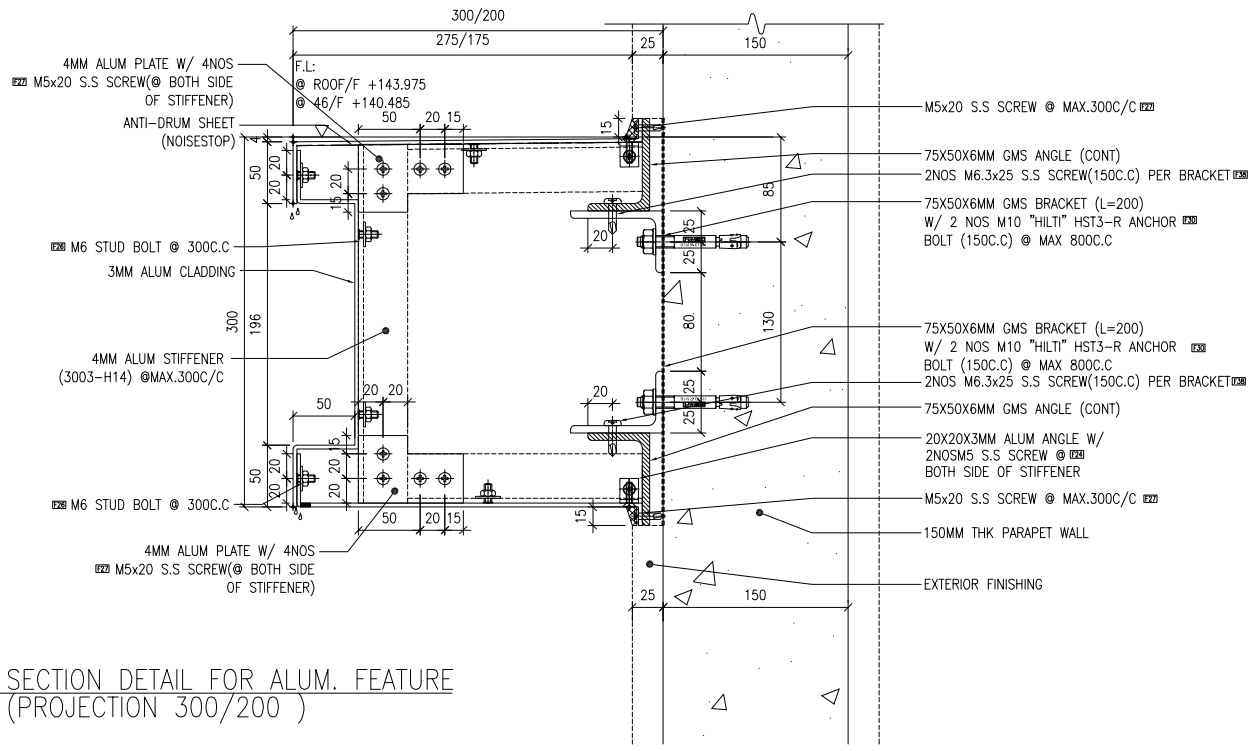

3 / 8519 SECTION DETAIL FOR ALUM. FEATURE (PROJECTION 300/200)

NOTE :
1. ALL DIMENSIONS ARE IN mm.
2. ALL ELEVATIONS ARE VIEWED FROM OUTSIDE.
3. ALL DIMENSIONS TO BE VERIFIED ON SITE BEFORE FABRICATION.

LEGEND :
X1 / X001 — DETAIL MARK NO. / REFER SHEET NO.
1. F.F.L. -- FINISHED FLOOR LEVEL
2. S.F.L. -- STRUCTURAL FLOOR LEVEL
3. (R) -- REVERSED DETAIL

NO.	DATE	REVISED	BY
B	30-OCT-2023	9TH SUBMISSION	CF
A	29-SEP-2023	8TH SUBMISSION	CF
-	22-AUG-2023	7TH SUBMISSION (NEW DRAWING)	CF

JOB NO. : J-856

PROJECT :
PROPOSED DEVELOPMENT ABOVE LIGHT RAIL TIN WING STOP,TSWTL NO.23,AREA 33,TIN SHUI WAI, N.T.

TITLE :
TYPICAL DETAIL FOR CURTAIN WALL

DATE : 31-OCT-22 | SCALE : 1:7

DRAWN BY : C.F | CHECKED BY :

DWG NO. : J856-SD-CW-8519 | REV. : A

美特鋁質有限公司 MIDI ALUMINIUM FABRICATOR LTD.
Units 6-8, Sunray Industrial Centre, 1/F
610 Cha Kwo Ling Road, Kowloon
Tel:23489211-4 Fax:(852)27727666

FACADE CONSULTANT:
ALPHA CONSULTING LIMITED
Steel Structure & Facade Specialist


STRUCTURAL ENGINEER :
ARUP

MAIN CONTRACTOR :
怡輝建築有限公司
Yee Fai Building Contractors Ltd.


ARCHITECT :
lwk&partners
architects

CLIENT :
SUN HUNG KAI REAL ESTATE AGENCY LTD.
42/F SUN HUNG KAI CENTRE, WANCHAI, HONGKONG


B.D. REF :

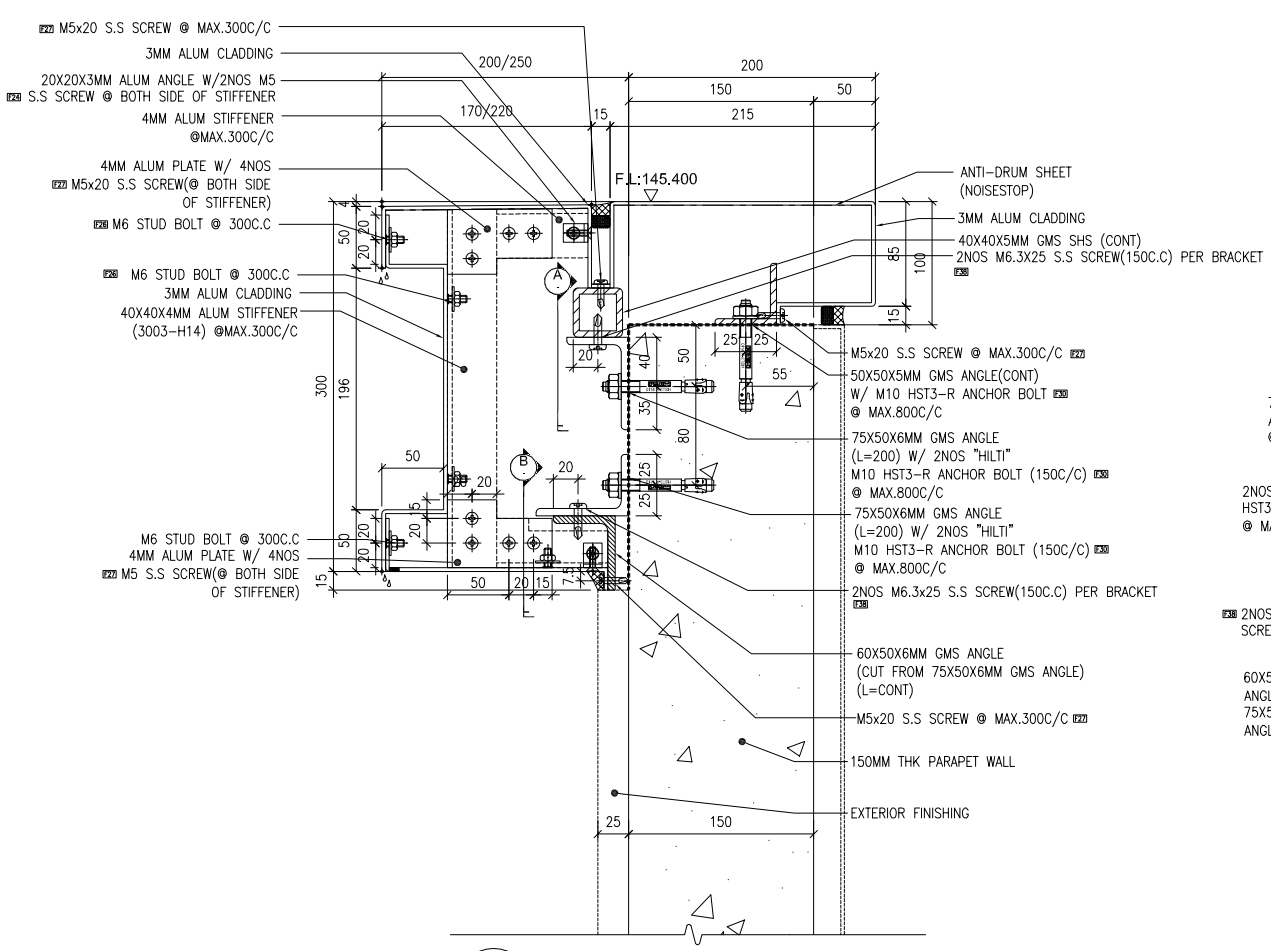


4 / 8520 SECTION DETAIL FOR ALUM. FEATURE (PROJECTION 200/250)

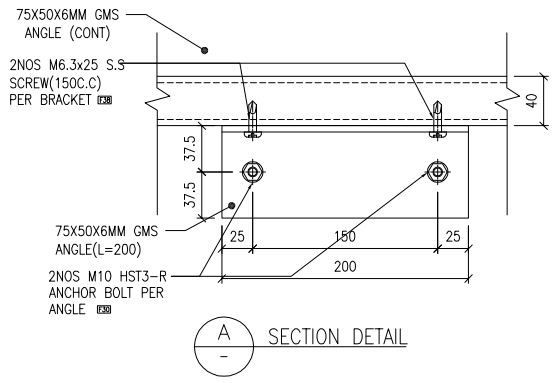


A / - SECTION DETAIL

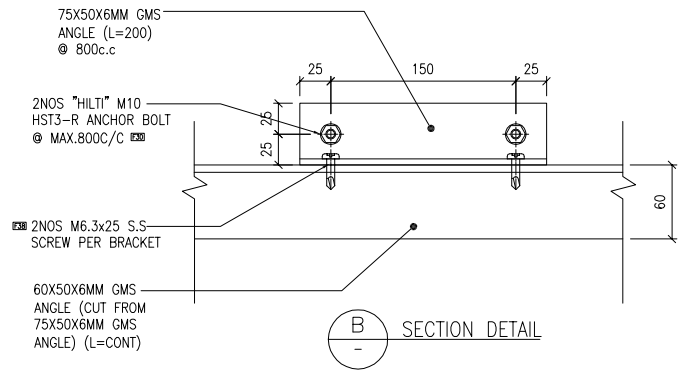


B / - SECTION DETAIL

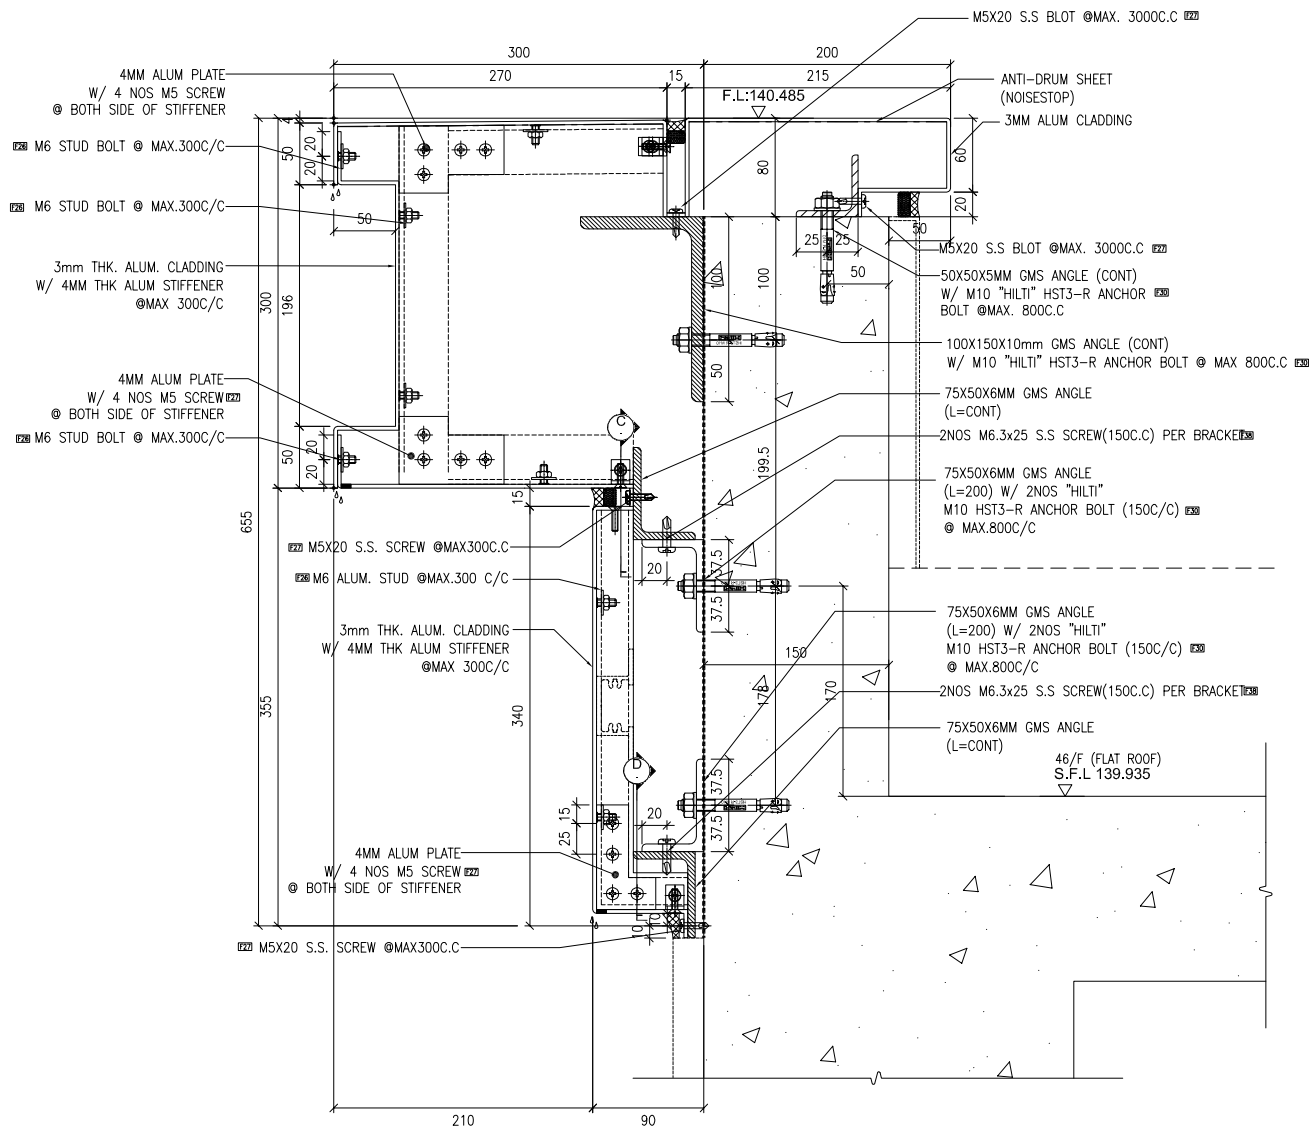

2 / 8520 SECTION DETAIL FOR TOP CLADDING (PROJECTION 300)
FOR TOP OF 45/F

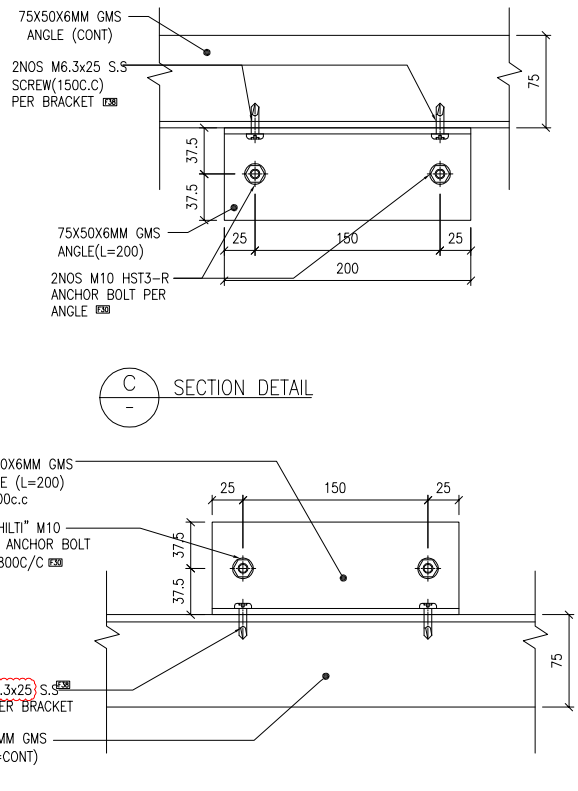

C / - SECTION DETAIL

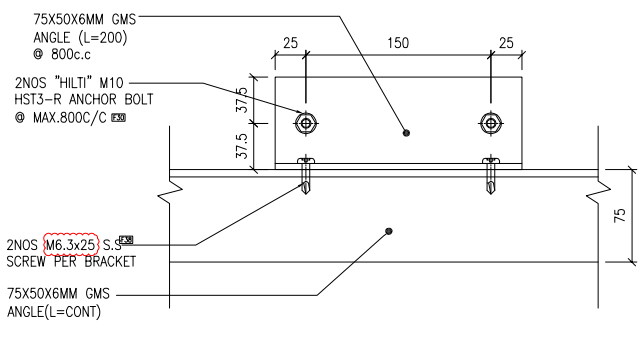

D / - SECTION DETAIL

NOTE :
1. ALL DIMENSIONS ARE IN mm.
2. ALL ELEVATIONS ARE VIEWED FROM OUTSIDE.
3. ALL DIMENSIONS TO BE VERIFIED ON SITE BEFORE FABRICATION.

LEGEND :
X1 / X001 — DETAIL MARK NO. / REFER SHEET NO.
1. F.F.L. --FINISHED FLOOR LEVEL
2. S.F.L. --STRUCTURAL FLOOR LEVEL
3. (R) --REVERSED DETAIL

NO.	DATE		BY
A	29-SEP-2023	8TH SUBMISSION	
-	22-AUG-2023	7TH SUBMISSION (NEW DRAWING)	CF

JOB NO. : J-856

PROJECT : PROPOSED DEVELOPMENT ABOVE LIGHT RAIL TIN WING STOP,TSWTL NO.23,AREA 33,TIN SHUI WAI, N.T.

TITLE : TYPICAL DETAIL FOR CURTAIN WALL

DATE : 31-OCT-22 | SCALE : 1:7

DRAWN BY : C.F | CHECKED BY :

美特鋁廠有限公司 MIDI ALUMINIUM FABRICATOR LTD.
Units 6-8, Sunray Industrial Centre, 1/F
610 Cha Kwo Ling Road, Kowloon
Tel:23489211-4 Fax:(852)27727666

DWG NO. : J856-SD-CW-8520 | REV. : A

CLIENT : SUN HUNG KAI REAL ESTATE AGENCY LTD. 42/F SUN HUNG KAI CENTRE, WANCHAI, HONGKONG


ARCHITECT : lwk&partners architects

MAIN CONTRACTOR : 怡輝建築有限公司 Yee Fai Building Contractors Ltd.


STRUCTURAL ENGINEER : ARUP

FACADE CONSULTANT: ALPHA CONSULTING LIMITED Steel Structure & Facade Specialist


B.D. REF :

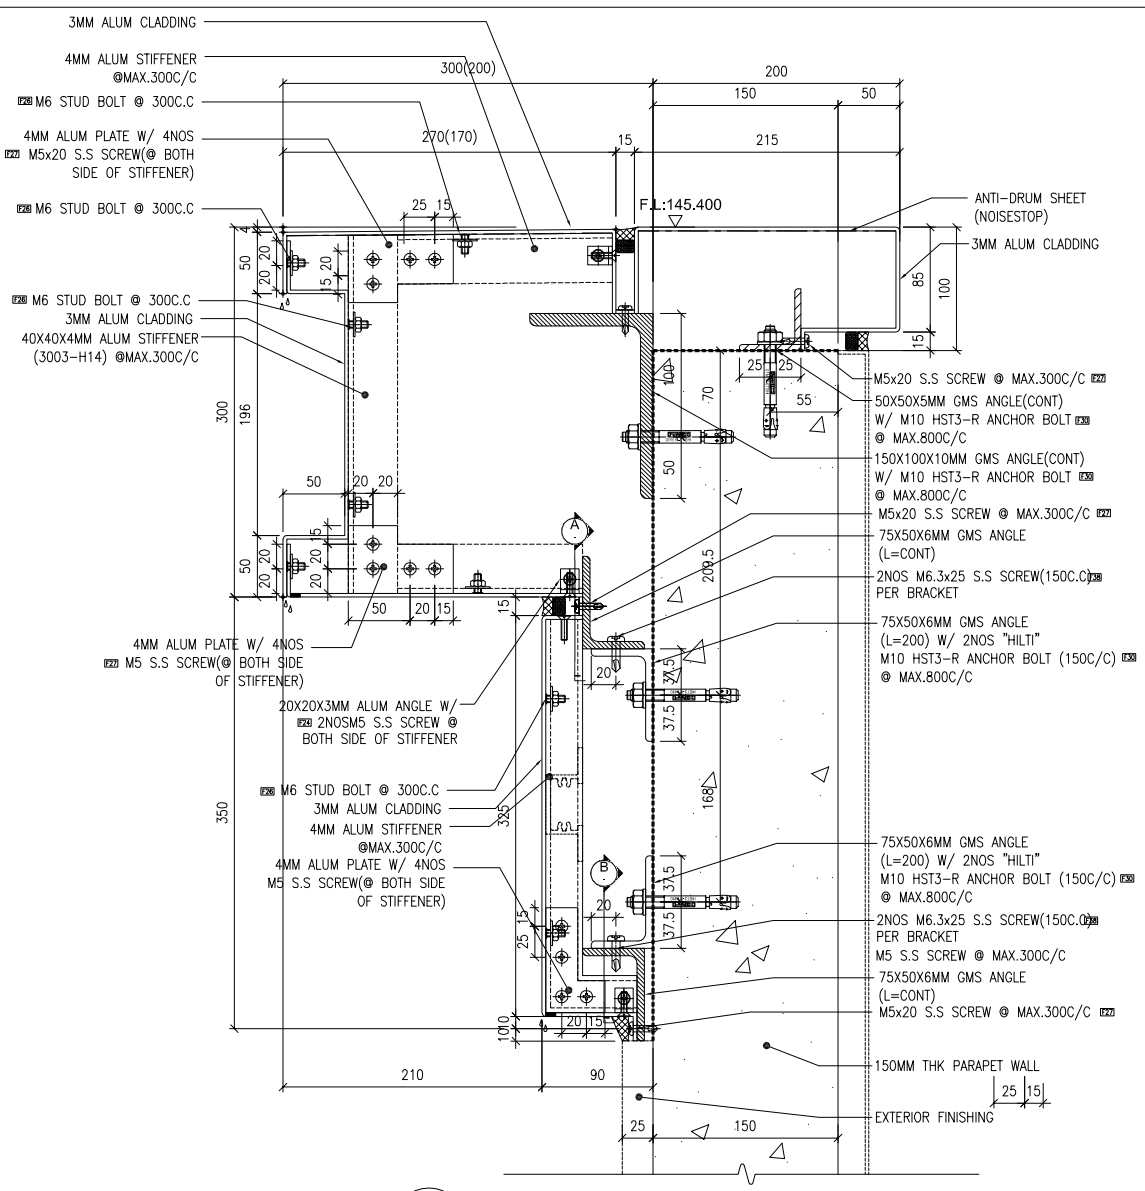


1 / 8521 SECTION DETAIL FOR ALUM. FEATURE (PROJECTION 300/200)

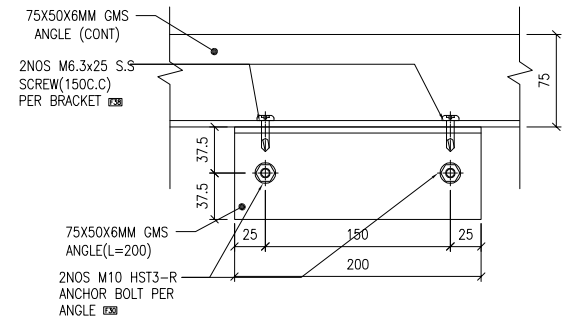

A / - SECTION DETAIL

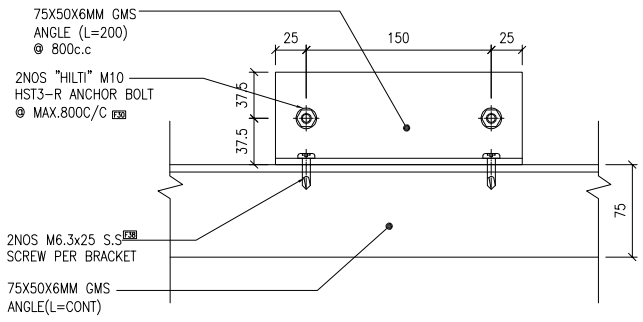

B / - SECTION DETAIL

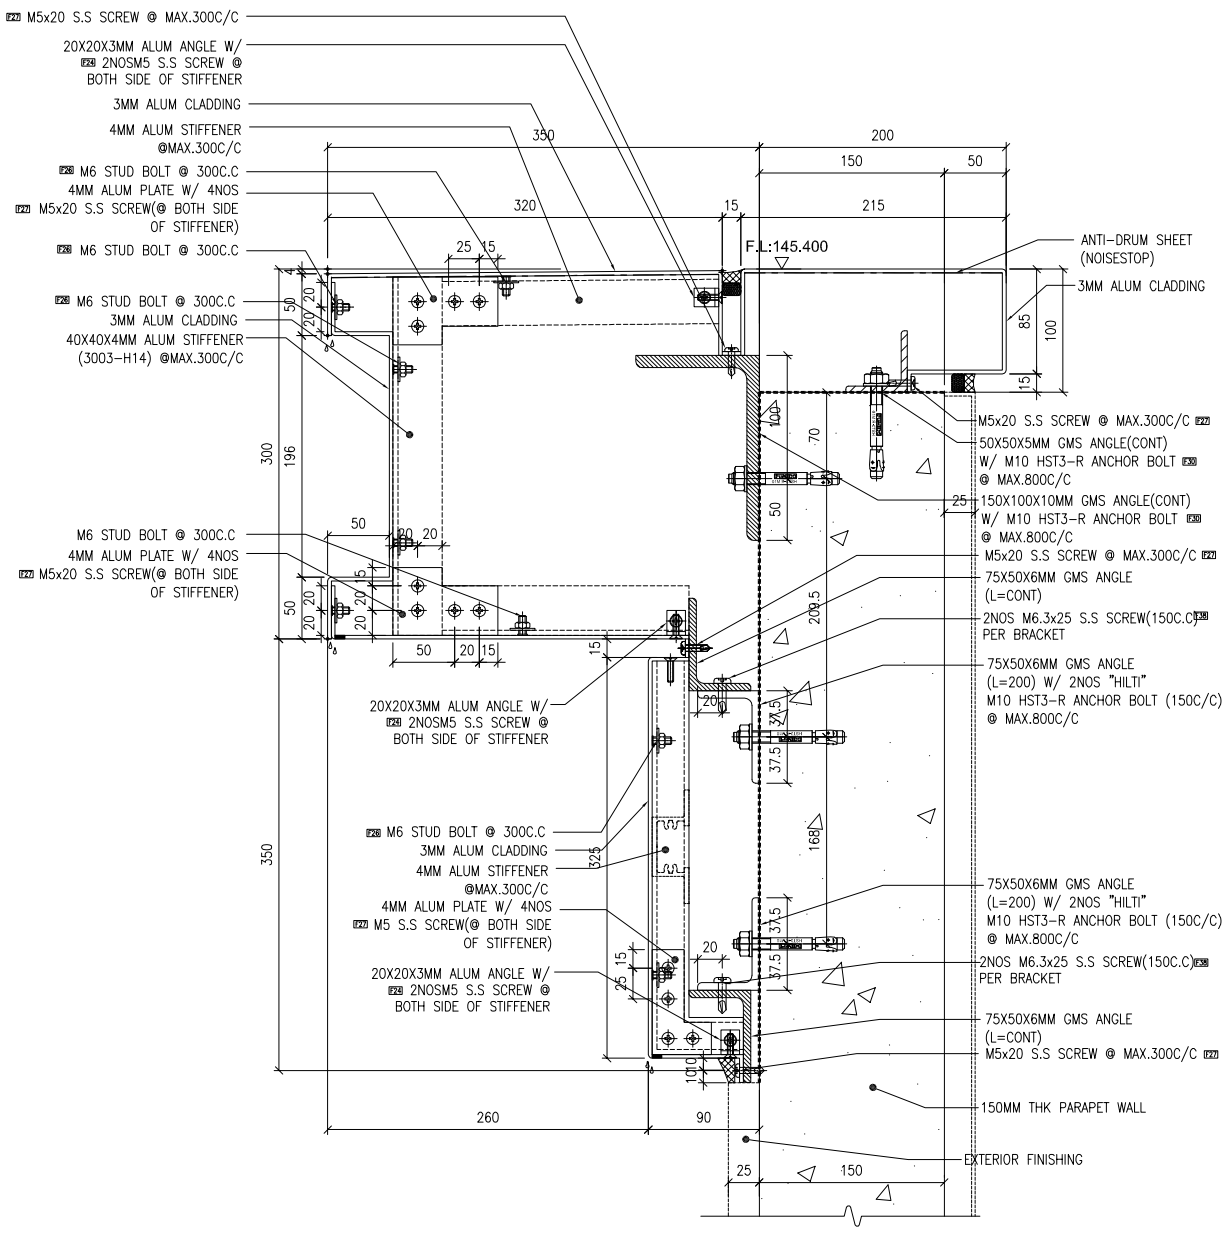

2 / 8521 SECTION DETAIL FOR ALUM. FEATURE (PROJECTION 350)

B.D. REF :

CLIENT :
SUN HUNG KAI REAL ESTATE AGENCY LTD.
42/F SUN HUNG KAI CENTRE, WANCHAI, HONGKONG

ARCHITECT :
lwk&partners architects

MAIN CONTRACTOR :
怡輝建築有限公司 Yee Fai Building Contractors Ltd.

STRUCTURAL ENGINEER :
ARUP

FACADE CONSULTANT:
ALPHA CONSULTING LIMITED
Steel Structure & Facade Specialist

NOTE :
1. ALL DIMENSIONS ARE IN mm.
2. ALL ELEVATIONS ARE VIEWED FROM OUTSIDE.
3. ALL DIMENSIONS TO BE VERIFIED ON SITE BEFORE FABRICATION.

LEGEND :
X1 / X001 — DETAIL MARK NO. / REFER SHEET NO.
1. F.F.L. --FINISHED FLOOR LEVEL
2. S.F.L. --STRUCTURAL FLOOR LEVEL
3. (R) --REVERSED DETAIL

NO.	DATE	REVISED	BY
A	29-SEP-2023	8TH SUBMISSION	CF
-	22-AUG-2023	7TH SUBMISSION (NEW DRAWING)	CF

JOB NO. : J-856

PROJECT :
PROPOSED DEVELOPMENT ABOVE LIGHT RAIL TIN WING STOP,TSWTL NO.23,AREA 33,TIN SHUI WAI, N.T.


TITLE :
TYPICAL DETAIL FOR CURTAIN WALL

DATE : 31-OCT-22 | SCALE : 1:7


DRAWN BY : C.F | CHECKED BY :

特銘鋁業有限公司 MIDI ALUMINIUM FABRICATOR LTD.
Units 6-8, Sunray Industrial Centre, 1/F
610 Cho Kwo Ling Road, Kowloon
Tel:23489211-4 Fax:(852)27727666


DWG NO. : J856-SD-GW-8521 | REV. : A

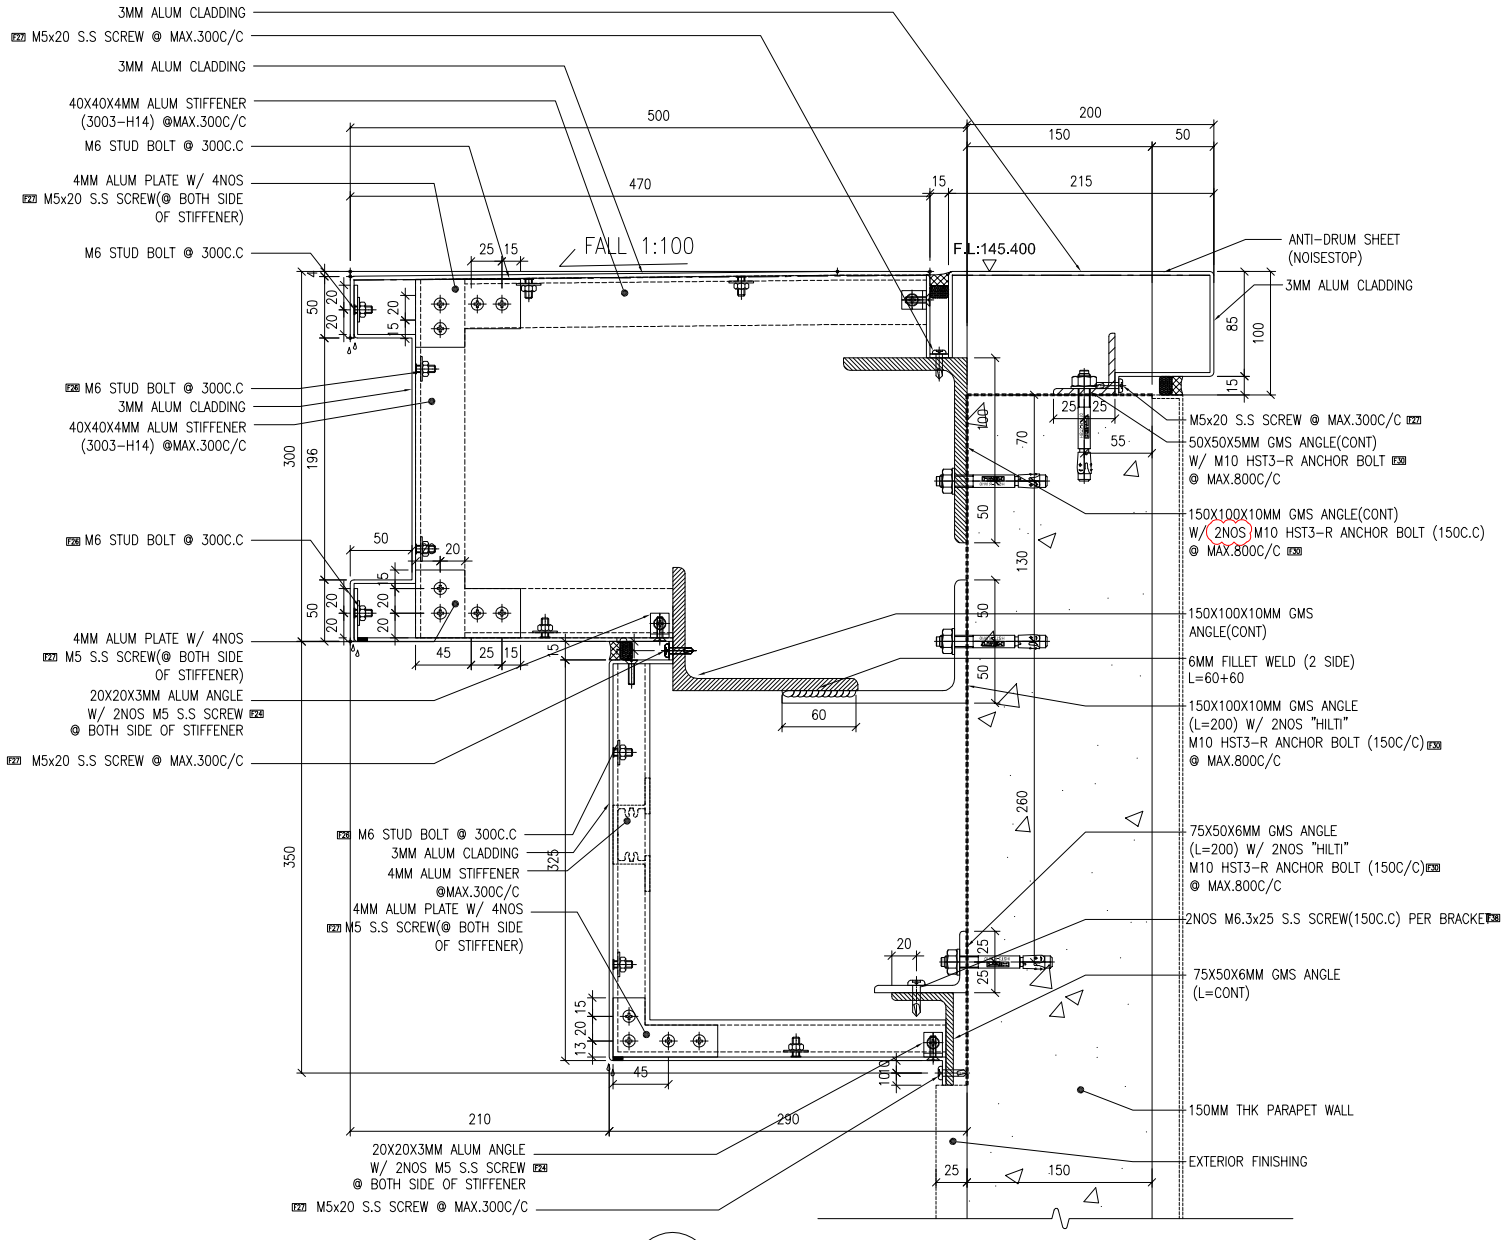

1 / 8522 SECTION DETAIL FOR ALUM. FEATURE (PROJECTION 500)

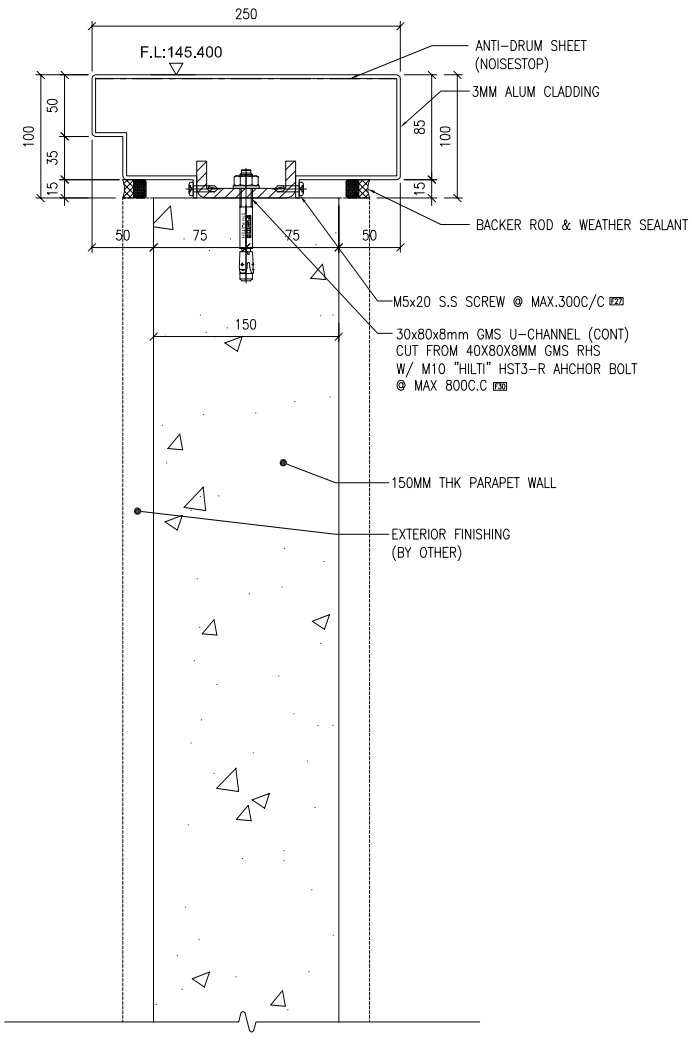

2 / 8522 SECTION DETAIL FOR ALUM. FEATURE (PROJECTION 50)

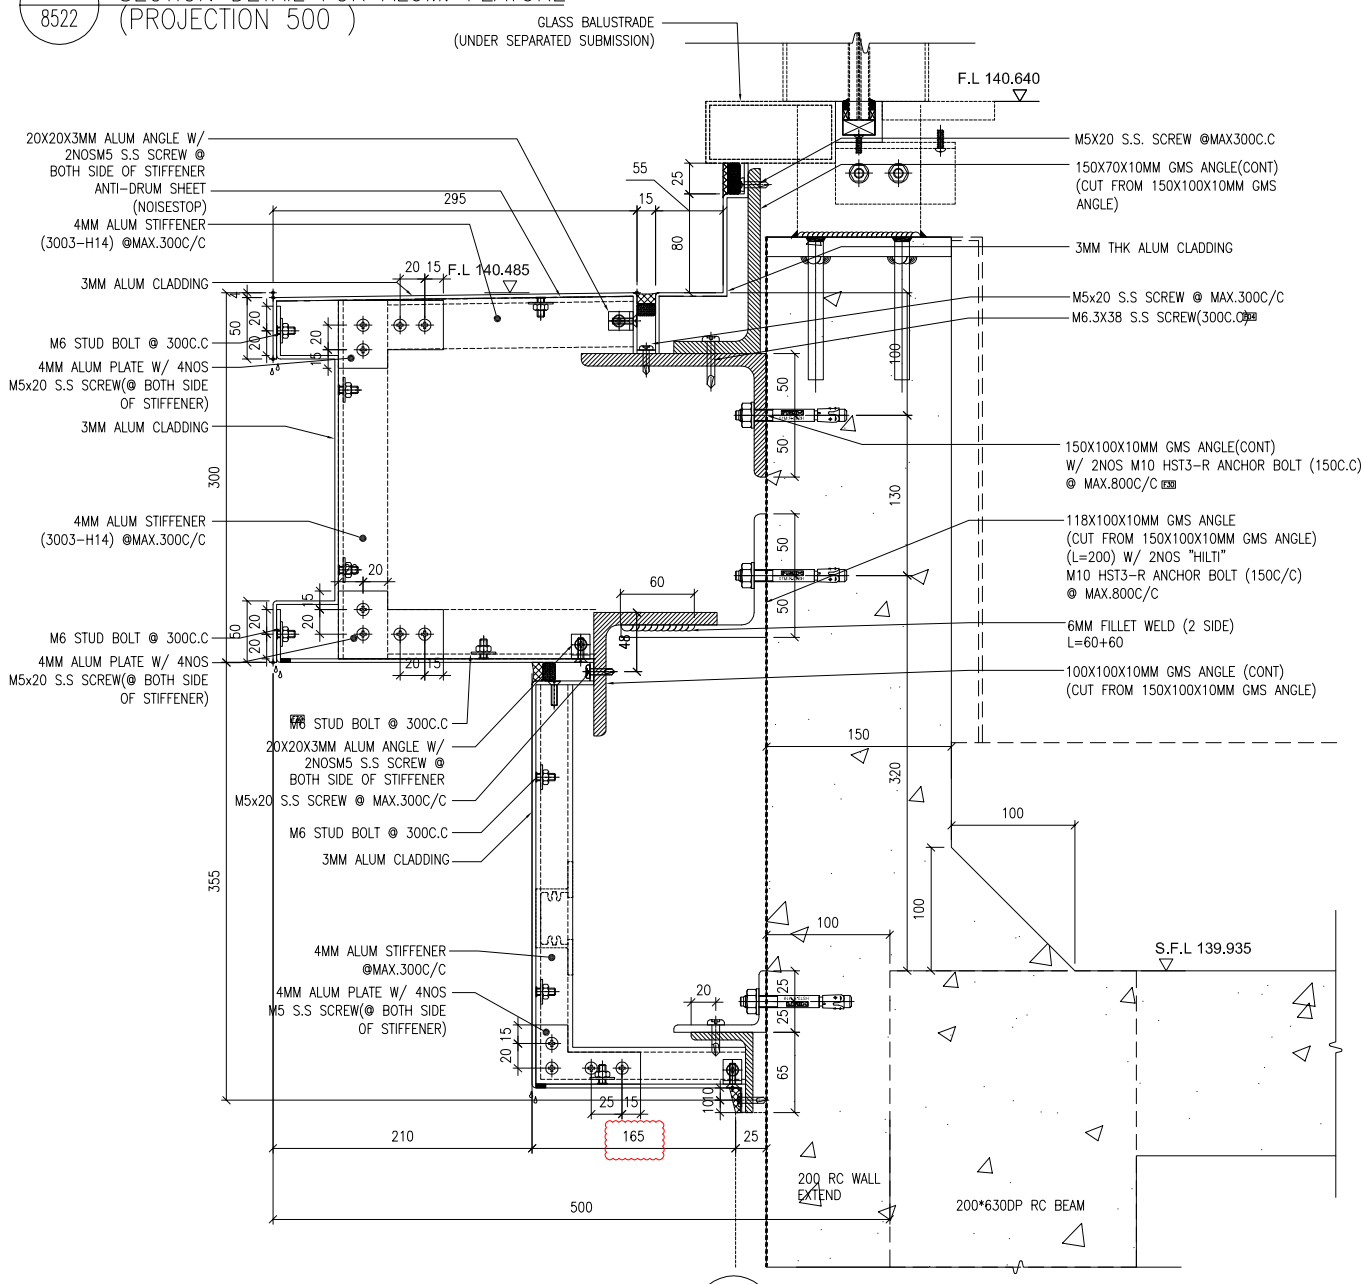

3 / 8522 SECTION DETAIL FOR ALUM. FEATURE (PROJECTION 500)

NOTE :
1. ALL DIMENSIONS ARE IN mm.
2. ALL ELEVATIONS ARE VIEWED FROM OUTSIDE.
3. ALL DIMENSIONS TO BE VERIFIED ON SITE BEFORE FABRICATION.

LEGEND :
X1 / X001 — DETAIL MARK NO. / REFER SHEET NO.
1. F.F.L. -- FINISHED FLOOR LEVEL
2. S.F.L. -- STRUCTURAL FLOOR LEVEL
3. (R) -- REVERSED DETAIL

NO.	DATE	REMARKS	BY
B	30-OCT-2023	9TH SUBMISSION	CF
A	29-SEP-2023	8TH SUBMISSION	CF
-	29-SEP-2023	8TH SUBMISSION (NEW DRAWING)	CF

JOB NO. : J-856

PROJECT : PROPOSED DEVELOPMENT ABOVE LIGHT RAIL TIN WING STOP,TSWTL NO.23,AREA 33,TIN SHUI WAI, N.T.

TITLE : TYPICAL DETAIL FOR CURTAIN WALL

DATE : 31-OCT-22 | SCALE : 1:7

DRAWN BY : C.F | CHECKED BY :

美特鋁廠有限公司 MIDI ALUMINUM FABRICATOR LTD.
Units 6-8, Sunray Industrial Centre, 1/F
610 Cha Kwo Ling Road, Kowloon
Tel:23489211-4 Fax:(852)27727666

DWG NO. : J856-SD-CW-8522 | REV. : B

B.D. REF :


CLIENT : SUN HUNG KAI REAL ESTATE AGENCY LTD. 42/F SUN HUNG KAI CENTRE, WANCHAI, HONGKONG

ARCHITECT : lwk&partners architects


MAIN CONTRACTOR : 怡輝建築有限公司 Yee Fai Building Contractors Ltd.

STRUCTURAL ENGINEER : ARUP


FACADE CONSULTANT : ALPHA CONSULTING LIMITED Steel Structure & Facade Specialist

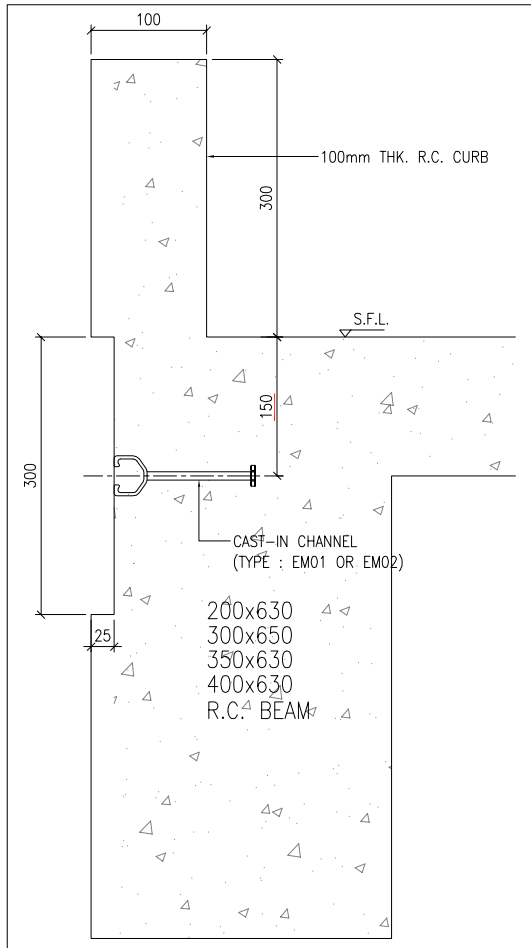


S01 EMBED INSTALLATION DETAIL

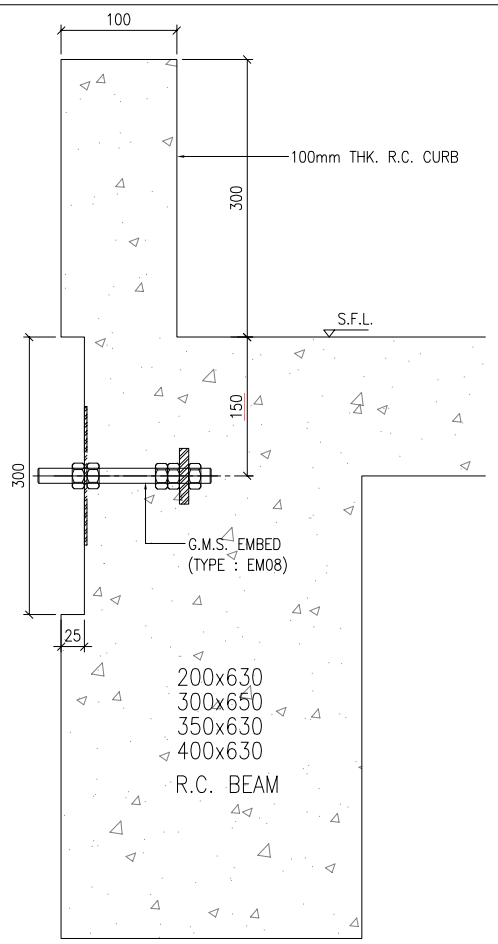


S02 EMBED INSTALLATION DETAIL

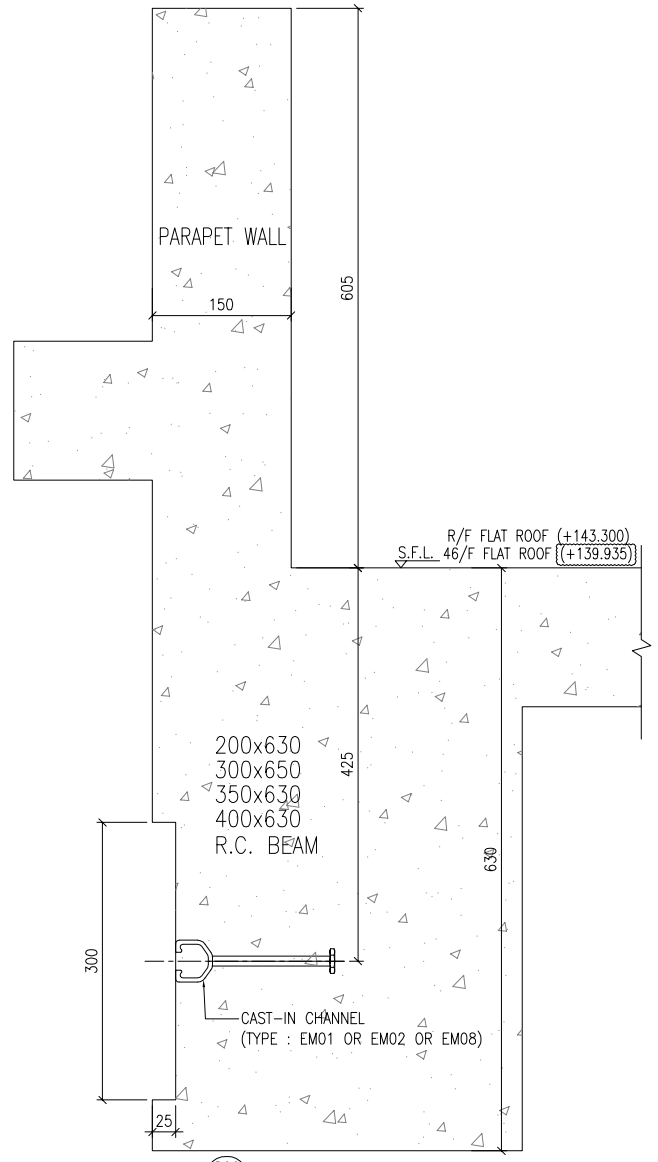


S03 EMBED INSTALLATION DETAIL

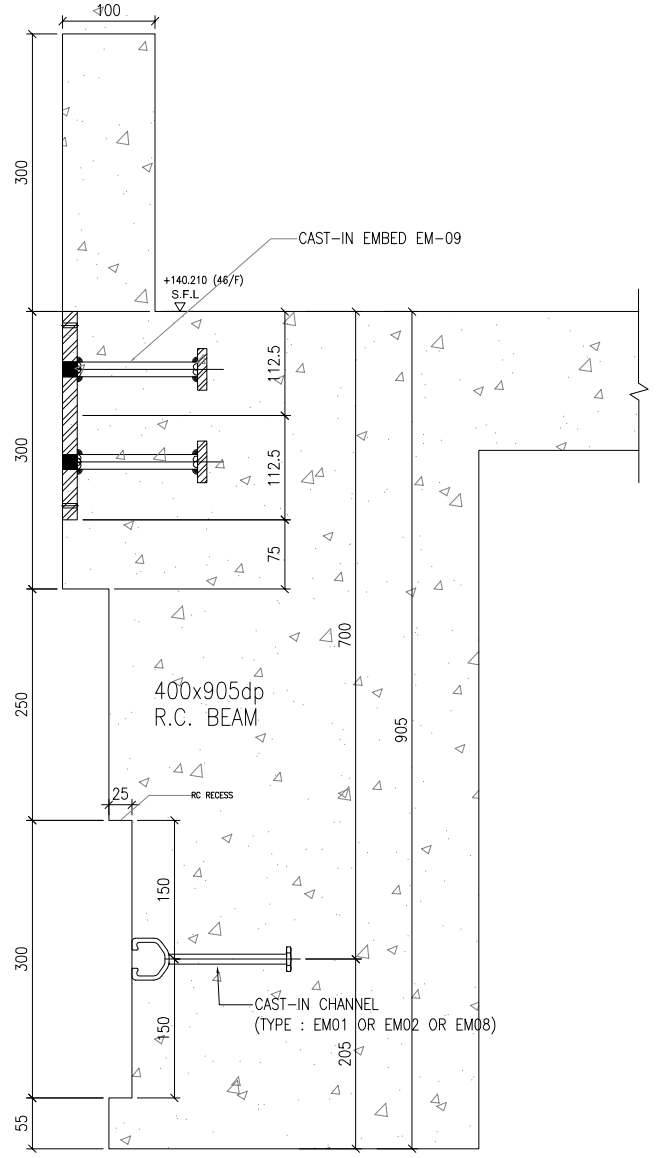


S08 EMBED INSTALLATION DETAIL
FOR LAST TYPICAL TOP & 46/F SU STARTER

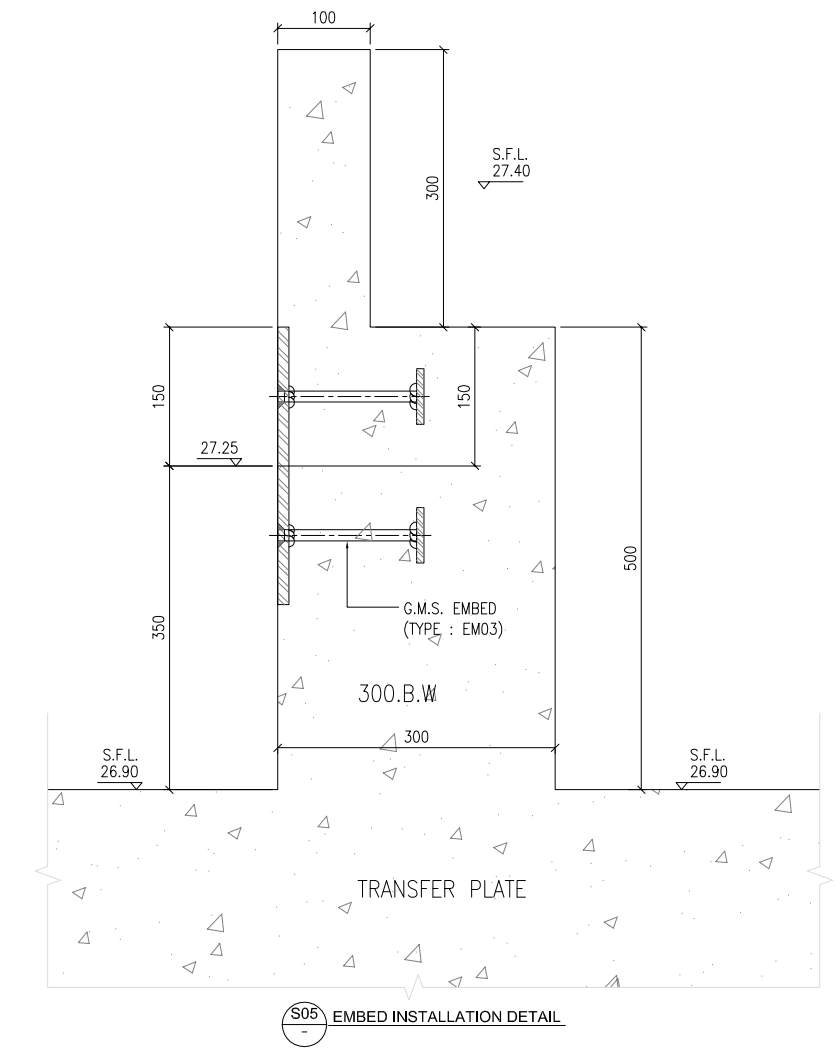

S05 EMBED INSTALLATION DETAIL

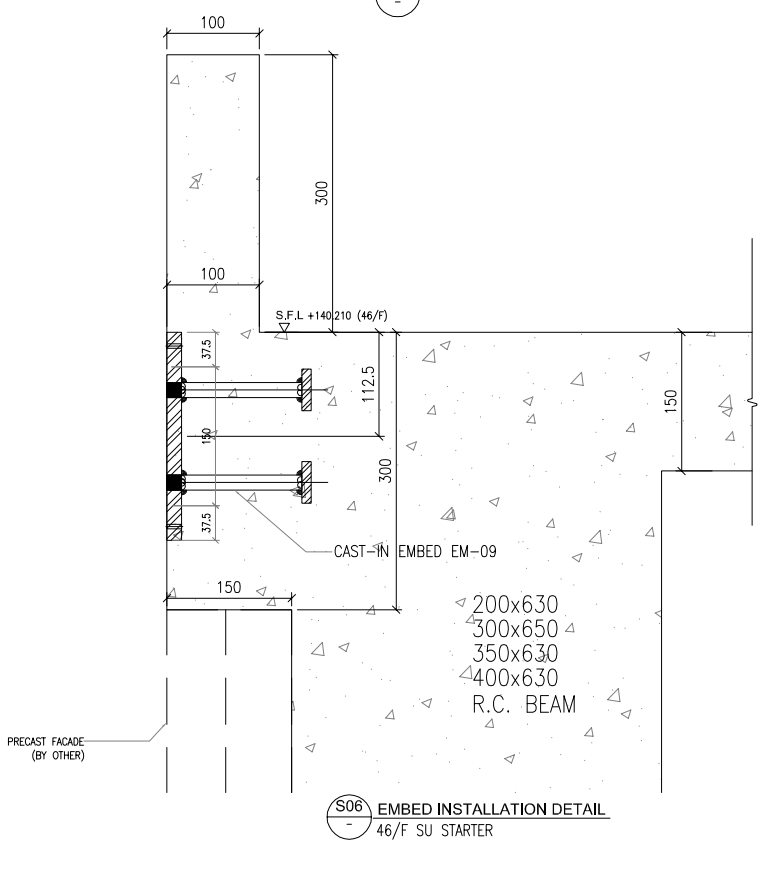

S06 EMBED INSTALLATION DETAIL
46/F SU STARTER

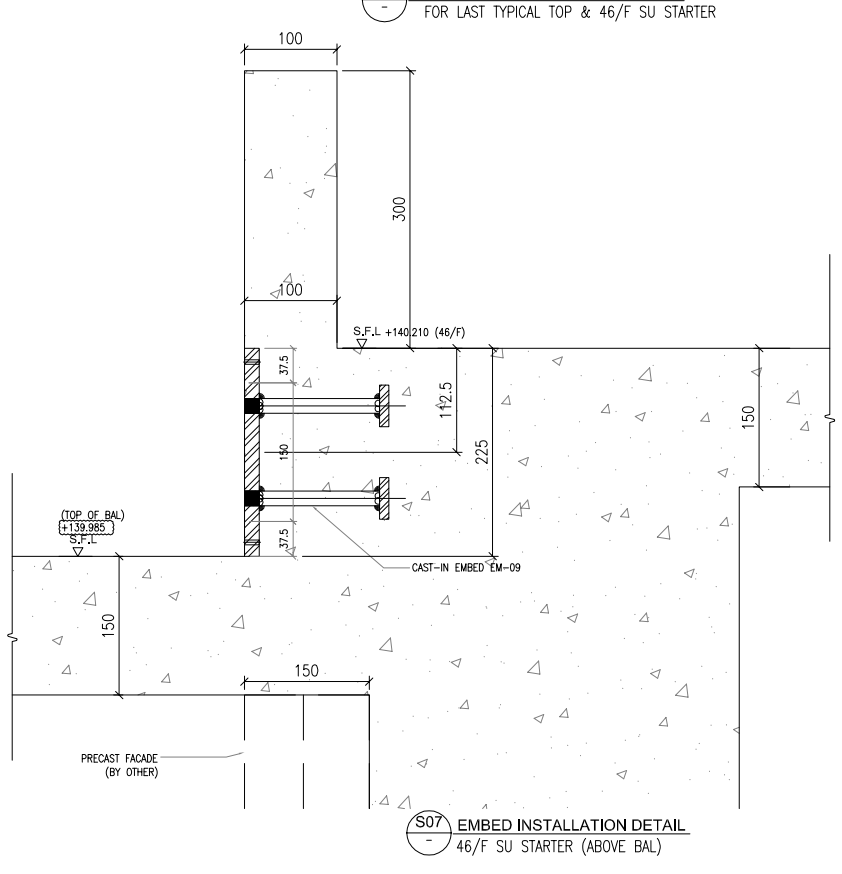

S07 EMBED INSTALLATION DETAIL
46/F SU STARTER (ABOVE BAL)

B.D. REF :

CLIENT :
SUN HUNG KAI REAL ESTATE AGENCY LTD.
42/F SUN HUNG KAI CENTRE, WANCHAI, HONGKONG

ARCHITECT :
lwk&partners architects

MAIN CONTRACTOR :
怡輝建築有限公司 Yee Fai Building Contractors Ltd.

STRUCTURAL ENGINEER :
ARUP

FACADE CONSULTANT:
ALPHA CONSULTING LIMITED
Steel Structure & Facade Specialist

NOTE :
1. ALL DIMENSIONS ARE IN mm.
2. ALL ELEVATIONS ARE VIEWED FROM OUTSIDE.
3. ALL DIMENSIONS TO BE VERIFIED ON SITE BEFORE FABRICATION.

LEGEND :
X1 / X001 — DETAIL MARK NO. / REFER SHEET NO.
1. F.F.L. -- FINISHED FLOOR LEVEL
2. S.F.L. -- STRUCTURAL FLOOR LEVEL
3. /R -- REVERSED DETAIL

NO.	DATE	REVISED	BY
B	21-FEB-2023	4TH SUBMISSION	CF
A	30-DEC-2022	2ND SUBMISSION	CF

JOB NO. : J-856

PROJECT :
PROPOSED DEVELOPMENT ABOVE LIGHT RAIL TIN WING STOP,TSWTL NO.23,AREA 33,TIN SHUI WAI, N.T.

TITLE :
TYPICAL EMBED SECTION SETTING OUT

DATE : 31-OCT-22 | SCALE : 1:10

DRAWN BY : C.F | CHECKED BY :

美特鋁質有限公司
MIDI ALUMINIUM FABRICATOR LTD.
Units 6-8, Sunray Industrial Centre, 1/F
610 Cha Kwo Ling Road, Kowloon
Tel:23489211-4 Fax:(852)27727666

DWG NO. : J856-SD-CW-9001 | REV. : B