

工程指示 / 要求簡箋(E.I.)

工程指示編號：EI / 4285 / 22 修改版次：F

工程編號：J857 工程名稱：啟德 6552

工程項目：幕牆單元件 - 廠用鋁背板 BM

收件人：生統 發件人：Nero HO 日期：08/03/2022

要求提供 / 確認 事項：

- () 初步鋁料 B.M. () 加工拆圖，然後生產 () 尺寸表
- () 正式鋁料 B.M. () 技術上資料 / 指示 () 報價
- () 配件 B.M. () 樣辦或貨品說明書 () 分判合約
- () 其他：_____

內容：

按附 BM 表及加工圖修改加工
 第二及第三批背板變更
 第一批加工圖修改

請在 22/3/2022 (MO1) & 30/03/2022 (MO2) & 30/04/2022 (MO3) 前完成上列要求。

附：

1+ 99 頁

以上項目為：

- 原合約工程包 原合約工程加 / 減賬 新工程報價

原因：-

分發東莞各部門：

- () 生產技術總監 連附件 () 技術部 連附件 () 生產部 連附件 () 機械設計部 連附件
- () 採購部 連附件 (/) 生產統籌部 連附件
- () 質檢部 連附件 () 會計部 連附件 () 報關組 連附件 () 其他 _____ 連附件

分發香港各部門：


- () 行政部 連附件 () 會計部 連附件 () 統籌部 連附件 () 工程部地盤科文 連附件
- () 採購部 連附件 () QS 部 連附件 () 維修部 連附件 () 其他 _____ 連附件


傳遞編號：


發件人簽署：


H150356/22

項目經理簽署：

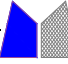
 美特鋁質 有限公司 MIDI Aluminium Fabricator Ltd.		工程號:	J-857	計算:	刘灿		日期:	2022.01.06		送呈:	施哥		
		地盤名稱:	啟德6552	核對:	徐祥坤		日期:	2022.01.07		副本:	细佬		
廠用鋁板B.M表		項目類別:	第一批	批准:	林仁安		日期:	2022.01.12					
BM編號:		修改版次:	C	A/C Code:	2022.03.05		總V.F.:	814.021		總重量:	5713.87		
序號	修改內容	鋁板圖號	鋁板名稱	顏色	實用	後備	總數	總重量	單件展開面積	總展開面積	單件V.F.	總V.F.	圖紙編號
									平方米		平方米		
1		BST-BY001	3mm厚鋁板	ECK3M96295S-ZD1	1	0	1	3.546	0.654	0.654	0.483	0.483	BST-B01
2		BST-BY011	3mm厚鋁板	ECK3M96295S-ZD1	1	0	1	5.275	0.973	0.973	0.759	0.759	BST-B01
3		BST-BY013	3mm厚鋁板	ECK3M96295S-ZD1	1	0	1	4.162	0.768	0.768	0.581	0.581	BST-B01
4		BST-BY015	3mm厚鋁板	ECK3M96295S-ZD1	1	0	1	2.103	0.388	0.388	0.254	0.254	BST-B03
5		BST-BY018	3mm厚鋁板	ECK3M96295S-ZD1	1	0	1	2.909	0.537	0.537	0.382	0.382	BST-B01
6		BST-BY020	3mm厚鋁板	ECK3M96295S-ZD1	1	0	1	3.566	0.658	0.658	0.487	0.487	BST-B01
7		BST-BZ001	3mm厚鋁板	ECK3M96295S-ZD1	1	0	1	7.083	1.307	1.307	1.046	1.046	BST-B02
8		BST-BZ005	3mm厚鋁板	ECK3M96295S-ZD1	1	0	1	2.206	0.407	0.407	0.274	0.274	BST-B07
9		BST-BZ010	3mm厚鋁板	ECK3M96295S-ZD1	1	0	1	6.877	1.269	1.269	1.014	1.014	BST-B02
10		BST-BZ012	3mm厚鋁板	ECK3M96295S-ZD1	1	0	1	2.905	0.536	0.536	0.381	0.381	BST-B02
11		BST-BZ016	3mm厚鋁板	ECK3M96295S-ZD1	1	0	1	5.674	1.047	1.047	0.822	0.822	BST-B04
12		BST-BZ017	3mm厚鋁板	ECK3M96295S-ZD1	1	0	1	8.200	1.513	1.513	1.224	1.224	BST-B02
13		BST-BZ019	3mm厚鋁板	ECK3M96295S-ZD1	1	0	1	3.566	0.658	0.658	0.487	0.487	BST-B02
14		BST-CY001	3mm厚鋁板	ECK3M96295S-ZD1	6	0	6	21.049	0.647	3.884	0.477	2.864	BST-C01
15		BST-CY003	3mm厚鋁板	ECK3M96295S-ZD1	4	0	4	36.552	1.686	6.744	1.372	5.488	BST-C01
16		BST-CY007	3mm厚鋁板	ECK3M96295S-ZD1	23	0	23	180.819	1.451	33.362	1.169	26.893	BST-C01
17		BST-CY008	3mm厚鋁板	ECK3M96295S-ZD1	23	0	23	108.735	0.872	20.062	0.671	15.437	BST-C01
18		BST-CY011	3mm厚鋁板	ECK3M96295S-ZD1	8	0	8	41.756	0.963	7.704	0.749	5.995	BST-C01
19		BST-CY013	3mm厚鋁板	ECK3M96295S-ZD1	8	0	8	32.943	0.760	6.078	0.574	4.594	BST-C01
20		BST-CY014	3mm厚鋁板	ECK3M96295S-ZD1	4	0	4	23.317	1.076	4.302	0.846	3.385	BST-C01
21		BST-CY015	3mm厚鋁板	ECK3M96295S-ZD1	8	0	8	16.650	0.384	3.072	0.251	2.005	BST-C03
22		BST-CY018	3mm厚鋁板	ECK3M96295S-ZD1	1	0	1	2.878	0.531	0.531	0.377	0.377	BST-C01
23		BST-CY020	3mm厚鋁板	ECK3M96295S-ZD1	1	0	1	3.528	0.651	0.651	0.481	0.481	BST-C01

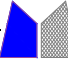 美特鋁質 有限公司 MIDI Aluminium Fabricator Ltd.		工程號:	J-857	計算:	刘灿		日期:	2022.01.06		送呈:	施哥		
		地盤名稱:	啟德6552	核對:	徐祥坤		日期:	2022.01.07		副本:	细佬		
廠用鋁板B.M表		項目類別:	第一批	批准:	林仁安		日期:	2022.01.12					
BM編號:		修改版次:	C	A/C Code:	2022.03.05		總V.F.:	814.021		總重量:	5713.87		
序號	修改內容	鋁板圖號	鋁板名稱	顏色	實用	後備	總數	總重量	單件展開面積	總展開面積	單件V.F.	總V.F.	圖紙編號
									平方米		平方米		
24		BST-CZ001	3mm厚鋁板	ECK3M96295S-ZD1	6	0	6	42.048	1.293	7.758	1.034	6.202	BST-C02
25		BST-CZ004	3mm厚鋁板	ECK3M96295S-ZD1	4	0	4	25.577	1.180	4.719	0.936	3.744	BST-C02
26		BST-CZ005	3mm厚鋁板	ECK3M96295S-ZD1	4	0	4	9.967	0.460	1.839	0.316	1.264	BST-C02
27		BST-CZ006	3mm厚鋁板	ECK3M96295S-ZD1	23	0	23	180.819	1.451	33.362	1.169	26.893	BST-C02
28		BST-CZ009	3mm厚鋁板	ECK3M96295S-ZD1	23	0	23	108.735	0.872	20.062	0.671	15.437	BST-C02
29		BST-CZ010	3mm厚鋁板	ECK3M96295S-ZD1	8	0	8	54.438	1.256	10.044	1.001	8.010	BST-C02
30		BST-CZ012	3mm厚鋁板	ECK3M96295S-ZD1	8	0	8	22.992	0.530	4.242	0.377	3.013	BST-C02
31		BST-CZ016	3mm厚鋁板	ECK3M96295S-ZD1	8	0	8	44.910	1.036	8.286	0.812	6.496	BST-C04
32		BST-CZ017	3mm厚鋁板	ECK3M96295S-ZD1	1	0	1	8.114	1.497	1.497	1.209	1.209	BST-C02
33		BST-CZ019	3mm厚鋁板	ECK3M96295S-ZD1	1	0	1	3.528	0.651	0.651	0.481	0.481	BST-C02
34		BST-D001	3mm厚鋁板	ECK3M96295S-ZD1	1	0	1	2.844	0.525	0.525	0.384	0.384	BST-D01
35		BST-D002	3mm厚鋁板	ECK3M96295S-ZD1	1	0	1	7.566	1.396	1.396	1.117	1.117	BST-D01
36		BST-D003	3mm厚鋁板	ECK3M96295S-ZD1	1	0	1	1.952	0.360	0.360	0.246	0.246	BST-D01
37		BST-D004	3mm厚鋁板	ECK3M96295S-ZD1	1	0	1	4.302	0.794	0.794	0.611	0.611	BST-D01
38		BST-D005	3mm厚鋁板	ECK3M96295S-ZD1	5	0	5	14.222	0.525	2.624	0.384	1.921	BST-D01
39		BST-D006	3mm厚鋁板	ECK3M96295S-ZD1	1	0	1	3.858	0.712	0.712	0.542	0.542	BST-D01
40		BST-D007	3mm厚鋁板	ECK3M96295S-ZD1	4	0	4	11.363	0.524	2.097	0.384	1.535	BST-D01
41		BST-D008	3mm厚鋁板	ECK3M96295S-ZD1	2	0	2	9.877	0.911	1.822	0.709	1.419	BST-D01
42		BST-D009	3mm厚鋁板	ECK3M96295S-ZD1	3	0	3	8.320	0.512	1.535	0.373	1.119	BST-D01
43		BST-D010	3mm厚鋁板	ECK3M96295S-ZD1	1	0	1	3.769	0.695	0.695	0.528	0.528	BST-D01
44		BST-D011	3mm厚鋁板	ECK3M96295S-ZD1	2	0	2	7.651	0.706	1.412	0.537	1.073	BST-D01
45		BST-D012	3mm厚鋁板	ECK3M96295S-ZD1	4	0	4	7.822	0.361	1.443	0.246	0.985	BST-D01
46		BST-D013	3mm厚鋁板	ECK3M96295S-ZD1	4	0	4	22.898	1.056	4.225	0.831	3.325	BST-D01

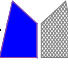 美特鋁質 有限公司 MIDI Aluminium Fabricator Ltd.		工程號:	J-857	計算:	刘灿			日期:	2022.01.06		送呈:	施哥	
		地盤名稱:	啟德6552	核對:	徐祥坤			日期:	2022.01.07		副本:	细佬	
廠用鋁板B.M表		項目類別:	第一批	批准:	林仁安			日期:	2022.01.12				
BM編號:		修改版次:	C	A/C Code:	2022.03.05			總V.F.:	814.021		總重量:	5713.87	
序號	修改內容	鋁板圖號	鋁板名稱	顏色	實用	後備	總數	總重量	單件展開面積	總展開面積	單件V.F.	總V.F.	圖紙編號
									平方米		平方米		
47		BST-D014	3mm厚鋁板	ECK3M96295S-ZD1	2	0	2	8.135	0.750	1.501	0.574	1.148	BST-D01
48		BST-D016	3mm厚鋁板	ECK3M96295S-ZD1	2	0	2	11.683	1.078	2.156	0.850	1.699	BST-D01
49		BST-D017	3mm厚鋁板	ECK3M96295S-ZD1	2	0	2	14.919	1.376	2.753	1.101	2.201	BST-D01
50		BST-D018	3mm厚鋁板	ECK3M96295S-ZD1	4	0	4	12.089	0.558	2.230	0.412	1.647	BST-D01
51		BST-D019	3mm厚鋁板	ECK3M96295S-ZD1	2	0	2	9.379	0.865	1.731	0.671	1.341	BST-D01
52		BST-D080	3mm厚鋁板	ECK3M96295S-ZD1	4	0	4	11.463	0.529	2.115	0.388	1.550	BST-D01
53		BST-D081	3mm厚鋁板	ECK3M96295S-ZD1	2	0	2	7.694	0.710	1.420	0.540	1.080	BST-D01
54		BST-EY001	3mm厚鋁板	ECK3M96295S-ZD1	1	0	1	3.068	0.566	0.566	0.408	0.408	BST-E01
55		BST-EZ001	3mm厚鋁板	ECK3M96295S-ZD1	1	0	1	6.130	1.131	1.131	0.883	0.883	BST-E02
56		BST-F001	3mm厚鋁板	ECK3M96295S-ZD1	41	0	41	431.596	1.942	79.630	1.613	66.130	BST-F01
57		BST-G001	3mm厚鋁板	ECK3M96295S-ZD1	2	0	2	5.559	0.513	1.026	0.374	0.748	BST-G01
58		BST-G002	3mm厚鋁板	ECK3M96295S-ZD1	2	0	2	14.786	1.364	2.728	1.087	2.174	BST-G01
59		BST-G003	3mm厚鋁板	ECK3M96295S-ZD1	2	0	2	3.815	0.352	0.704	0.239	0.478	BST-G01
60		BST-G004	3mm厚鋁板	ECK3M96295S-ZD1	2	0	2	8.408	0.776	1.551	0.594	1.188	BST-G01
61		BST-G005	3mm厚鋁板	ECK3M96295S-ZD1	11	0	11	30.573	0.513	5.641	0.374	4.111	BST-G01
62		BST-G006	3mm厚鋁板	ECK3M96295S-ZD1	2	0	2	7.539	0.695	1.391	0.527	1.054	BST-G01
63		BST-G007	3mm厚鋁板	ECK3M96295S-ZD1	12	0	12	33.311	0.512	6.146	0.373	4.479	BST-G01
64		BST-G008	3mm厚鋁板	ECK3M96295S-ZD1	6	0	6	28.954	0.890	5.342	0.690	4.140	BST-G01
65		BST-G009	3mm厚鋁板	ECK3M96295S-ZD1	7	0	7	18.969	0.500	3.500	0.363	2.541	BST-G01
66		BST-G010	3mm厚鋁板	ECK3M96295S-ZD1	4	0	4	14.731	0.679	2.718	0.513	2.053	BST-G01
67		BST-G011	3mm厚鋁板	ECK3M96295S-ZD1	3	0	3	11.215	0.690	2.069	0.522	1.566	BST-G01
68		BST-G012	3mm厚鋁板	ECK3M96295S-ZD1	7	0	7	13.376	0.353	2.468	0.240	1.677	BST-G01
69		BST-G013	3mm厚鋁板	ECK3M96295S-ZD1	7	0	7	39.154	1.032	7.224	0.809	5.661	BST-G01


 美特鋁質 有限公司 MIDI Aluminium Fabricator Ltd.		工程號:	J-857	計算:	刘灿		日期:	2022.01.06		送呈:		施哥	
		地盤名稱:	啟德6552	核對:	徐祥坤		日期:	2022.01.07		副本:		细佬	
廠用鋁板B.M表		項目類別:	第一批	批准:	林仁安		日期:	2022.01.12					
BM編號:		修改版次:	C	A/C Code:	2022.03.05		總V.F.:	814.021		總重量:	5713.87		
序號	修改內容	鋁板圖號	鋁板名稱	顏色	實用	後備	總數	總重量	單件展開面積	總展開面積	單件V.F.	總V.F.	圖紙編號
									平方米		平方米		
70		BST-G014	3mm厚鋁板	ECK3M96295S-ZD1	4	0	4	15.898	0.733	2.933	0.558	2.234	BST-G01
71		BST-G016	3mm厚鋁板	ECK3M96295S-ZD1	4	0	4	22.833	1.053	4.213	0.826	3.306	BST-G01
72		BST-G017	3mm厚鋁板	ECK3M96295S-ZD1	4	0	4	29.156	1.345	5.379	1.071	4.283	BST-G01
73		BST-G018	3mm厚鋁板	ECK3M96295S-ZD1	8	0	8	23.625	0.545	4.359	0.401	3.205	BST-G01
74		BST-G019	3mm厚鋁板	ECK3M96295S-ZD1	4	0	4	18.330	0.845	3.382	0.652	2.610	BST-G01
75		BST-G021	3mm厚鋁板	ECK3M96295S-ZD1	1	0	1	2.891	0.533	0.533	0.391	0.391	BST-G01
76		BST-G022	3mm厚鋁板	ECK3M96295S-ZD1	2	0	2	4.384	0.404	0.809	0.283	0.566	BST-G01
77		BST-G023	3mm厚鋁板	ECK3M96295S-ZD1	1	0	1	1.702	0.314	0.314	0.207	0.207	BST-G01
78		BST-G062	3mm厚鋁板	ECK3M96295S-ZD1	1	0	1	2.224	0.410	0.410	0.288	0.288	BST-G01
79		BST-G080	3mm厚鋁板	ECK3M96295S-ZD1	8	0	8	22.402	0.517	4.133	0.377	3.016	BST-G01
80		BST-G081	3mm厚鋁板	ECK3M96295S-ZD1	4	0	4	15.036	0.694	2.774	0.525	2.101	BST-G01
81		BST-G084	3mm厚鋁板	ECK3M96295S-ZD1	1	0	1	5.698	1.051	1.051	0.825	0.825	BST-G01
82		BST-HY001	3mm厚鋁板	ECK3M96295S-ZD1	2	0	2	5.997	0.553	1.106	0.397	0.794	BST-H01
83		BST-HY003	3mm厚鋁板	ECK3M96295S-ZD1	1	0	1	7.810	1.441	1.441	1.141	1.141	BST-H01
84		BST-HY014	3mm厚鋁板	ECK3M96295S-ZD1	1	0	1	4.982	0.919	0.919	0.703	0.703	BST-H01
85		BST-HZ001	3mm厚鋁板	ECK3M96295S-ZD1	2	0	2	11.979	1.105	2.210	0.859	1.718	BST-H02
86		BST-HZ004	3mm厚鋁板	ECK3M96295S-ZD1	1	0	1	5.465	1.008	1.008	0.778	0.778	BST-H02
87		BST-HZ005	3mm厚鋁板	ECK3M96295S-ZD1	1	0	1	2.130	0.393	0.393	0.263	0.263	BST-H02
88		BST-J051	3mm厚鋁板	ECK3M96295S-ZD1	1	0	1	3.326	0.614	0.614	0.438	0.438	BST-J01
89		BST-J052	3mm厚鋁板	ECK3M96295S-ZD1	2	0	2	3.555	0.328	0.656	0.217	0.433	BST-J01
90		BST-J053	3mm厚鋁板	ECK3M96295S-ZD1	1	0	1	2.986	0.551	0.551	0.389	0.389	BST-J01
91		BST-J054	3mm厚鋁板	ECK3M96295S-ZD1	1	0	1	3.637	0.671	0.671	0.482	0.482	BST-J01
92		BST-J055	3mm厚鋁板	ECK3M96295S-ZD1	1	0	1	2.117	0.391	0.391	0.265	0.265	BST-J01

 美特鋁質 有限公司 MIDI Aluminium Fabricator Ltd.		工程號:	J-857	計算:	刘灿		日期:	2022.01.06		送呈:	施哥		
		地盤名稱:	啟德6552	核對:	徐祥坤		日期:	2022.01.07		副本:	细佬		
廠用鋁板B.M表		項目類別:	第一批	批准:	林仁安		日期:	2022.01.12					
BM編號:		修改版次:	C	A/C Code:	2022.03.05		總V.F.:	814.021		總重量:	5713.87		
序號	修改內容	鋁板圖號	鋁板名稱	顏色	實用	後備	總數	總重量	單件展開面積	總展開面積	單件V.F.	總V.F.	圖紙編號
									平方米		平方米		
93		BST-J056	3mm厚鋁板	ECK3M96295S-ZD1	1	0	1	1.807	0.333	0.333	0.221	0.221	BST-J01
94		BST-J057	3mm厚鋁板	ECK3M96295S-ZD1	1	0	1	3.172	0.585	0.585	0.416	0.416	BST-J01
95		BST-J058	3mm厚鋁板	ECK3M96295S-ZD1	1	0	1	3.761	0.694	0.694	0.499	0.499	BST-J01
96		BST-J059	3mm厚鋁板	ECK3M96295S-ZD1	1	0	1	1.638	0.302	0.302	0.197	0.197	BST-J01
97		BST-J060	3mm厚鋁板	ECK3M96295S-ZD1	2	0	2	2.904	0.268	0.536	0.170	0.341	BST-J01
98		BST-J061	3mm厚鋁板	ECK3M96295S-ZD1	1	0	1	3.793	0.700	0.700	0.504	0.504	BST-J01
99		BST-J085	3mm厚鋁板	ECK3M96295S-ZD1	8	0	8	15.689	0.362	2.895	0.243	1.943	BST-J01
100		BST-L005	3mm厚鋁板	ECK3M96295S-ZD1	5	0	5	16.433	0.606	3.032	0.455	2.276	BST-L01
101		BST-L006	3mm厚鋁板	ECK3M96295S-ZD1	1	0	1	4.458	0.822	0.822	0.642	0.642	BST-L01
102		BST-L007	3mm厚鋁板	ECK3M96295S-ZD1	4	0	4	13.130	0.606	2.423	0.455	1.818	BST-L01
103		BST-L008	3mm厚鋁板	ECK3M96295S-ZD1	2	0	2	11.413	1.053	2.106	0.840	1.681	BST-L01
104		BST-L009	3mm厚鋁板	ECK3M96295S-ZD1	3	0	3	9.614	0.591	1.774	0.442	1.326	BST-L01
105		BST-L010	3mm厚鋁板	ECK3M96295S-ZD1	1	0	1	4.355	0.803	0.803	0.625	0.625	BST-L01
106		BST-L011	3mm厚鋁板	ECK3M96295S-ZD1	1	0	1	4.421	0.816	0.816	0.636	0.636	BST-L01
107		BST-L012	3mm厚鋁板	ECK3M96295S-ZD1	3	0	3	6.779	0.417	1.251	0.292	0.875	BST-L01
108		BST-L013	3mm厚鋁板	ECK3M96295S-ZD1	3	0	3	19.843	1.220	3.661	0.985	2.955	BST-L01
109		BST-L014	3mm厚鋁板	ECK3M96295S-ZD1	2	0	2	9.400	0.867	1.734	0.680	1.360	BST-L01
110		BST-L016	3mm厚鋁板	ECK3M96295S-ZD1	2	0	2	13.500	1.245	2.491	1.007	2.013	BST-L01
111		BST-L017	3mm厚鋁板	ECK3M96295S-ZD1	2	0	2	17.239	1.590	3.181	1.304	2.608	BST-L01
112		BST-L018	3mm厚鋁板	ECK3M96295S-ZD1	4	0	4	13.968	0.644	2.577	0.488	1.952	BST-L01
113		BST-L019	3mm厚鋁板	ECK3M96295S-ZD1	2	0	2	10.838	1.000	2.000	0.795	1.589	BST-L01
114		BST-L023	3mm厚鋁板	ECK3M96295S-ZD1	2	0	2	4.026	0.371	0.743	0.252	0.505	BST-L01
115		BST-L049	3mm厚鋁板	ECK3M96295S-ZD1	1	0	1	6.388	1.179	1.179	0.949	0.949	BST-L01

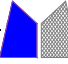 美特鋁質 有限公司 MIDI Aluminium Fabricator Ltd.		工程號:	J-857	計算:	刘灿		日期:	2022.01.06		送呈:	施哥		
		地盤名稱:	啟德6552	核對:	徐祥坤		日期:	2022.01.07		副本:	细佬		
廠用鋁板B.M表		項目類別:	第一批	批准:	林仁安		日期:	2022.01.12					
BM編號:		修改版次:	C	A/C Code:	2022.03.05		總V.F.:	814.021		總重量:	5713.87		
序號	修改內容	鋁板圖號	鋁板名稱	顏色	實用	後備	總數	總重量	單件展開面積	總展開面積	單件V.F.	總V.F.	圖紙編號
									平方米		平方米		
116		BST-L051	3mm厚鋁板	ECK3M96295S-ZD1	1	0	1	5.505	1.016	1.016	0.808	0.808	BST-L01
117		BST-L052	3mm厚鋁板	ECK3M96295S-ZD1	2	0	2	5.883	0.543	1.085	0.400	0.800	BST-L01
118		BST-L053	3mm厚鋁板	ECK3M96295S-ZD1	1	0	1	4.942	0.912	0.912	0.719	0.719	BST-L01
119		BST-L054	3mm厚鋁板	ECK3M96295S-ZD1	1	0	1	6.019	1.110	1.110	0.890	0.890	BST-L01
120		BST-L055	3mm厚鋁板	ECK3M96295S-ZD1	1	0	1	3.504	0.647	0.647	0.490	0.490	BST-L01
121		BST-L056	3mm厚鋁板	ECK3M96295S-ZD1	1	0	1	2.991	0.552	0.552	0.408	0.408	BST-L01
122		BST-L057	3mm厚鋁板	ECK3M96295S-ZD1	1	0	1	5.250	0.969	0.969	0.768	0.768	BST-L01
123		BST-L058	3mm厚鋁板	ECK3M96295S-ZD1	1	0	1	6.224	1.148	1.148	0.923	0.923	BST-L01
124		BST-L059	3mm厚鋁板	ECK3M96295S-ZD1	1	0	1	2.712	0.500	0.500	0.364	0.364	BST-L01
125		BST-L060	3mm厚鋁板	ECK3M96295S-ZD1	2	0	2	4.807	0.443	0.887	0.315	0.629	BST-L01
126		BST-L061	3mm厚鋁板	ECK3M96295S-ZD1	1	0	1	6.278	1.158	1.158	0.931	0.931	BST-L01
127		BST-L062	3mm厚鋁板	ECK3M96295S-ZD1	3	0	3	7.888	0.485	1.455	0.351	1.052	BST-L01
128		BST-L080	3mm厚鋁板	ECK3M96295S-ZD1	3	0	3	9.934	0.611	1.833	0.459	1.377	BST-L01
129		BST-L081	3mm厚鋁板	ECK3M96295S-ZD1	2	0	2	8.890	0.820	1.640	0.640	1.279	BST-L01
130		BST-L085	3mm厚鋁板	ECK3M96295S-ZD1	8	0	8	25.965	0.599	4.791	0.449	3.589	BST-L01
131		BST-L086	3mm厚鋁板	ECK3M96295S-ZD1	1	0	1	3.872	0.714	0.714	0.544	0.544	BST-L03
132		BST-L087	3mm厚鋁板	ECK3M96295S-ZD1	1	0	1	1.979	0.365	0.365	0.250	0.250	BST-L03
133		BST-L088	3mm厚鋁板	ECK3M96295S-ZD1	1	0	1	2.901	0.535	0.535	0.393	0.393	BST-L03
134		BST-L089	3mm厚鋁板	ECK3M96295S-ZD1	1	0	1	5.794	1.069	1.069	0.843	0.843	BST-L03
135		BST-L090	3mm厚鋁板	ECK3M96295S-ZD1	2	0	2	7.630	0.704	1.408	0.535	1.071	BST-L03
136		BST-L091	3mm厚鋁板	ECK3M96295S-ZD1	4	0	4	11.502	0.531	2.122	0.389	1.557	BST-L03
137		BST-L092	3mm厚鋁板	ECK3M96295S-ZD1	2	0	2	9.998	0.922	1.845	0.720	1.439	BST-L03
138		BST-L093	3mm厚鋁板	ECK3M96295S-ZD1	1	0	1	2.807	0.518	0.518	0.379	0.379	BST-L03


 美特鋁質 有限公司 MIDI Aluminium Fabricator Ltd.		工程號:	J-857	計算:	刘灿			日期:	2022.01.06		送呈:	施哥	
		地盤名稱:	啟德6552	核對:	徐祥坤			日期:	2022.01.07		副本:	细佬	
廠用鋁板B.M表		項目類別:	第一批	批准:	林仁安			日期:	2022.01.12				
BM編號:		修改版次:	C	A/C Code:	2022.03.05			總V.F.:	814.021		總重量:	5713.87	
序號	修改內容	鋁板圖號	鋁板名稱	顏色	實用	後備	總數	總重量	單件展開面積	總展開面積	單件V.F.	總V.F.	圖紙編號
									平方米		平方米		
139		BST-L094	3mm厚鋁板	ECK3M96295S-ZD1	1	0	1	2.994	0.552	0.552	0.408	0.408	BST-L03
140		BST-L095	3mm厚鋁板	ECK3M96295S-ZD1	1	0	1	2.879	0.531	0.531	0.390	0.390	BST-L03
141		BST-L096	3mm厚鋁板	ECK3M96295S-ZD1	1	0	1	2.901	0.535	0.535	0.393	0.393	BST-L03
142		BST-L097	3mm厚鋁板	ECK3M96295S-ZD1	2	0	2	4.542	0.419	0.838	0.295	0.590	BST-L03
143		BST-L098	3mm厚鋁板	ECK3M96295S-ZD1	1	0	1	5.902	1.089	1.089	0.860	0.860	BST-L03
144		BST-L099	3mm厚鋁板	ECK3M96295S-ZD1	1	0	1	2.303	0.425	0.425	0.300	0.300	BST-L03
145		BST-L100	3mm厚鋁板	ECK3M96295S-ZD1	1	0	1	1.763	0.325	0.325	0.216	0.216	BST-L03
146		BST-LY003	3mm厚鋁板	ECK3M96295S-ZD1	1	0	1	8.090	1.493	1.493	1.189	1.189	BST-B05
147		BST-LY014	3mm厚鋁板	ECK3M96295S-ZD1	1	0	1	5.161	0.952	0.952	0.734	0.734	BST-B05
148		BST-LZ004	3mm厚鋁板	ECK3M96295S-ZD1	1	0	1	5.661	1.044	1.044	0.811	0.811	BST-B06
149		BST-M001	3mm厚鋁板	ECK3M96295S-ZD1	6	0	6	19.512	0.600	3.600	0.450	2.698	BST-M01
150		BST-M002	3mm厚鋁板	ECK3M96295S-ZD1	6	0	6	51.902	1.596	9.576	1.308	7.845	BST-M01
151		BST-M003	3mm厚鋁板	ECK3M96295S-ZD1	6	0	6	13.390	0.412	2.471	0.287	1.725	BST-M01
152		BST-M004	3mm厚鋁板	ECK3M96295S-ZD1	6	0	6	29.512	0.908	5.445	0.714	4.287	BST-M01
153		BST-M005	3mm厚鋁板	ECK3M96295S-ZD1	43	0	43	139.836	0.600	25.800	0.450	19.333	BST-M01
154		BST-M006	3mm厚鋁板	ECK3M96295S-ZD1	6	0	6	26.463	0.814	4.883	0.634	3.802	BST-M01
155		BST-M007	3mm厚鋁板	ECK3M96295S-ZD1	40	0	40	129.917	0.599	23.970	0.449	17.959	BST-M01
156		BST-M008	3mm厚鋁板	ECK3M96295S-ZD1	20	0	20	112.926	1.042	20.835	0.830	16.602	BST-M01
157		BST-M009	3mm厚鋁板	ECK3M96295S-ZD1	40	0	40	126.828	0.585	23.400	0.437	17.468	BST-M01
158		BST-M010	3mm厚鋁板	ECK3M96295S-ZD1	14	0	14	60.325	0.795	11.130	0.618	8.646	BST-M01
159		BST-M011	3mm厚鋁板	ECK3M96295S-ZD1	10	0	10	43.739	0.807	8.070	0.628	6.279	BST-M01
160		BST-M012	3mm厚鋁板	ECK3M96295S-ZD1	122	0	122	272.762	0.413	50.325	0.288	35.150	BST-M01
161		BST-M013	3mm厚鋁板	ECK3M96295S-ZD1	22	0	22	143.982	1.208	26.565	0.973	21.403	BST-M01

 美特鋁質 有限公司 MIDI Aluminium Fabricator Ltd.		工程號:	J-857	計算:	刘灿		日期:	2022.01.06		送呈:	施哥		
		地盤名稱:	啟德6552	核對:	徐祥坤		日期:	2022.01.07		副本:	細佬		
廠用鋁板B.M表		項目類別:	第一批	批准:	林仁安		日期:	2022.01.12					
BM編號:		修改版次:	C	A/C Code:	2022.03.05		總V.F.:	814.021		總重量:	5713.87		
序號	修改內容	鋁板圖號	鋁板名稱	顏色	實用	後備	總數	總重量	單件展開面積	總展開面積	單件V.F.	總V.F.	圖紙編號
									平方米		平方米		
162		BST-M014	3mm厚鋁板	ECK3M96295S-ZD1	12	0	12	55.804	0.858	10.296	0.672	8.062	BST-M01
163		BST-M016	3mm厚鋁板	ECK3M96295S-ZD1	12	0	12	80.146	1.232	14.787	0.994	11.930	BST-M01
164		BST-M017	3mm厚鋁板	ECK3M96295S-ZD1	12	0	12	102.340	1.574	18.882	1.288	15.457	BST-M01
165		BST-M018	3mm厚鋁板	ECK3M96295S-ZD1	24	0	24	82.926	0.638	15.300	0.482	11.566	BST-M01
166		BST-M019	3mm厚鋁板	ECK3M96295S-ZD1	12	0	12	64.341	0.989	11.871	0.785	9.419	BST-M01
167		BST-M021	3mm厚鋁板	ECK3M96295S-ZD1	4	0	4	13.528	0.624	2.496	0.470	1.881	BST-M01
168		BST-M022	3mm厚鋁板	ECK3M96295S-ZD1	8	0	8	20.520	0.473	3.786	0.340	2.724	BST-M01
169		BST-M023	3mm厚鋁板	ECK3M96295S-ZD1	80	0	80	159.348	0.368	29.400	0.249	19.948	BST-M01
170		BST-M026	3mm厚鋁板	ECK3M96295S-ZD1	5	0	5	22.093	0.815	4.076	0.635	3.175	BST-M01



 美特鋁質 有限公司 MIDI Aluminium Fabricator Ltd.		工程號:	J-857	計算:	刘灿		日期:	2022.01.06		送呈:		施哥	
		地盤名稱:	啟德6552	核對:	徐祥坤		日期:	2022.01.07		副本:		细佬	
廠用鋁板B.M表		項目類別:	第一批	批准:	林仁安		日期:	2022.01.12					
BM編號:		修改版次:	C	A/C Code:	2022.03.05		總V.F.:	814.021		總重量:	5713.87		
序號	修改內容	鋁板圖號	鋁板名稱	顏色	實用	後備	總數	總重量	單件展開面積	總展開面積	單件V.F.	總V.F.	圖紙編號
									平方米		平方米		
171		BST-M028	3mm厚鋁板	ECK3M96295S-ZD1	5	0	5	31.971	1.180	5.899	0.949	4.745	BST-M01
172		BST-M029	3mm厚鋁板	ECK3M96295S-ZD1	5	0	5	14.024	0.518	2.588	0.379	1.893	BST-M01
173		BST-M031	3mm厚鋁板	ECK3M96295S-ZD1	14	0	14	80.698	1.064	14.889	0.849	11.884	BST-M01
174		BST-M032	3mm厚鋁板	ECK3M96295S-ZD1	14	0	14	30.048	0.396	5.544	0.274	3.835	BST-M01
175		BST-M035	3mm厚鋁板	ECK3M96295S-ZD1	18	0	18	68.780	0.705	12.690	0.540	9.721	BST-M01
176		BST-M037	3mm厚鋁板	ECK3M96295S-ZD1	18	0	18	101.121	1.037	18.657	0.826	14.861	BST-M01
177		BST-M038	3mm厚鋁板	ECK3M96295S-ZD1	18	0	18	132.584	1.359	24.462	1.103	19.861	BST-M01
178		BST-M039	3mm厚鋁板	ECK3M96295S-ZD1	18	0	18	92.341	0.947	17.037	0.748	13.465	BST-M01
179		BST-M042	3mm厚鋁板	ECK3M96295S-ZD1	9	0	9	62.634	1.284	11.556	1.039	9.349	BST-M01
180		BST-M043	3mm厚鋁板	ECK3M96295S-ZD1	9	0	9	41.304	0.847	7.621	0.662	5.959	BST-M01
181		BST-M046	3mm厚鋁板	ECK3M96295S-ZD1	9	0	9	55.902	1.146	10.314	0.920	8.279	BST-M01
182		BST-M048	3mm厚鋁板	ECK3M96295S-ZD1	9	0	9	58.536	1.200	10.800	0.966	8.698	BST-M01
183		BST-M049	3mm厚鋁板	ECK3M96295S-ZD1	8	0	8	50.569	1.166	9.330	0.937	7.499	BST-M01
184		BST-M051	3mm厚鋁板	ECK3M96295S-ZD1	1	0	1	5.447	1.005	1.005	0.798	0.798	BST-M01
185		BST-M052	3mm厚鋁板	ECK3M96295S-ZD1	2	0	2	5.821	0.537	1.074	0.395	0.791	BST-M01
186		BST-M053	3mm厚鋁板	ECK3M96295S-ZD1	1	0	1	4.890	0.902	0.902	0.710	0.710	BST-M01
187		BST-M054	3mm厚鋁板	ECK3M96295S-ZD1	1	0	1	5.955	1.099	1.099	0.879	0.879	BST-M01
188		BST-M055	3mm厚鋁板	ECK3M96295S-ZD1	1	0	1	3.467	0.640	0.640	0.484	0.484	BST-M01
189		BST-M056	3mm厚鋁板	ECK3M96295S-ZD1	1	0	1	2.959	0.546	0.546	0.403	0.403	BST-M01
190		BST-M057	3mm厚鋁板	ECK3M96295S-ZD1	1	0	1	5.195	0.959	0.959	0.758	0.758	BST-M01
191		BST-M058	3mm厚鋁板	ECK3M96295S-ZD1	1	0	1	6.158	1.136	1.136	0.912	0.912	BST-M01
192		BST-M059	3mm厚鋁板	ECK3M96295S-ZD1	1	0	1	2.683	0.495	0.495	0.359	0.359	BST-M01
193		BST-M060	3mm厚鋁板	ECK3M96295S-ZD1	2	0	2	4.756	0.439	0.878	0.311	0.621	BST-M01

 美特鋁質 有限公司 MIDI Aluminium Fabricator Ltd.		工程號:	J-857	計算:	刘灿		日期:	2022.01.06		送呈:		施哥	
		地盤名稱:	啟德6552	核對:	徐祥坤		日期:	2022.01.07		副本:		细佬	
廠用鋁板B.M表		項目類別:	第一批	批准:	林仁安		日期:	2022.01.12					
BM編號:		修改版次:	C	A/C Code:	2022.03.05		總V.F.:	814.021		總重量:	5713.87		
序號	修改內容	鋁板圖號	鋁板名稱	顏色	實用	後備	總數	總重量	單件展開面積	總展開面積	單件V.F.	總V.F.	圖紙編號
									平方米		平方米		
194		BST-M061	3mm厚鋁板	ECK3M96295S-ZD1	1	0	1	6.211	1.146	1.146	0.920	0.920	BST-M01
195		BST-M062	3mm厚鋁板	ECK3M96295S-ZD1	83	0	83	215.933	0.480	39.840	0.346	28.739	BST-M01
196		BST-M080	3mm厚鋁板	ECK3M96295S-ZD1	26	0	26	85.186	0.605	15.717	0.453	11.791	BST-M01
197		BST-M081	3mm厚鋁板	ECK3M96295S-ZD1	12	0	12	52.780	0.812	9.738	0.632	7.581	BST-M01
198		BST-M082	3mm厚鋁板	ECK3M96295S-ZD1	15	0	15	70.792	0.871	13.061	0.683	10.242	BST-M01
199		BST-M083	3mm厚鋁板	ECK3M96295S-ZD1	9	0	9	41.231	0.845	7.607	0.661	5.948	BST-M01
200		BST-M084	3mm厚鋁板	ECK3M96295S-ZD1	4	0	4	26.666	1.230	4.920	0.992	3.969	BST-M01
201		BST-M085	3mm厚鋁板	ECK3M96295S-ZD1	8	0	8	25.691	0.593	4.740	0.443	3.545	BST-M01
202		BST-NY018	3mm厚鋁板	ECK3M96295S-ZD1	1	0	1	1.758	0.324	0.324	0.207	0.207	BST-N01
203		BST-NY020	3mm厚鋁板	ECK3M96295S-ZD1	1	0	1	2.155	0.398	0.398	0.263	0.263	BST-N01
204		BST-NZ017	3mm厚鋁板	ECK3M96295S-ZD1	1	0	1	4.955	0.914	0.914	0.663	0.663	BST-N02
205		BST-NZ019	3mm厚鋁板	ECK3M96295S-ZD1	1	0	1	2.155	0.398	0.398	0.263	0.263	BST-N02
206		BST-P051	3mm厚鋁板	ECK3M96295S-ZD1	1	0	1	7.118	1.313	1.313	1.083	1.083	BST-P01
207		BST-P052	3mm厚鋁板	ECK3M96295S-ZD1	1	0	1	3.803	0.702	0.702	0.536	0.536	BST-P01
208		BST-P060	3mm厚鋁板	ECK3M96295S-ZD1	1	0	1	3.107	0.573	0.573	0.421	0.421	BST-P01
209		BST-P061	3mm厚鋁板	ECK3M96295S-ZD1	1	0	1	8.116	1.497	1.497	1.247	1.247	BST-P01
210		BST-P085	3mm厚鋁板	ECK3M96295S-ZD1	2	0	2	8.392	0.774	1.548	0.601	1.202	BST-P01
211		BST-QY020	3mm厚鋁板	ECK3M96295S-ZD1	1	0	1	4.610	0.851	0.851	0.652	0.652	BST-Q01
212		BST-QZ017	3mm厚鋁板	ECK3M96295S-ZD1	1	0	1	10.602	1.956	1.956	1.640	1.640	BST-Q02
					總計:		1351	5713.87	169.976	1054.22	131.09	814.021	

 美特鋁質有限公司 MIDI Aluminium Fabricator Ltd.				工程號 J857 地盘 啟德6552	類別 制圖 刘灿	物料號 - 2021-12-14	圖號 BST-L01
修改 A - - 採用工廠 ✓ 地盘	图纸名称 铝板加工图			復核 徐詳坤	2021-12-15	數量 -	
日期 2022.03.02 - - 材料颜色 BCK3M96295S-ZD1	材料 (3mm) THK. 铝板			批准 林仁安	2021-12-16	單件重量 - (KG)	

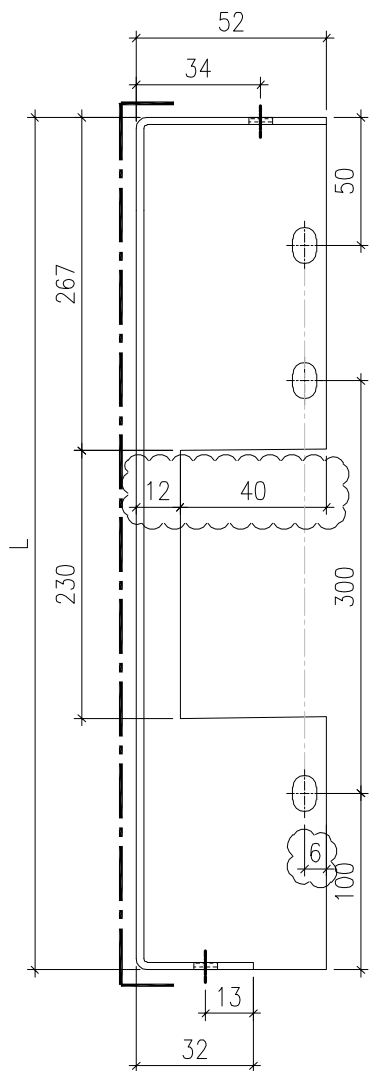

SECTION A-A

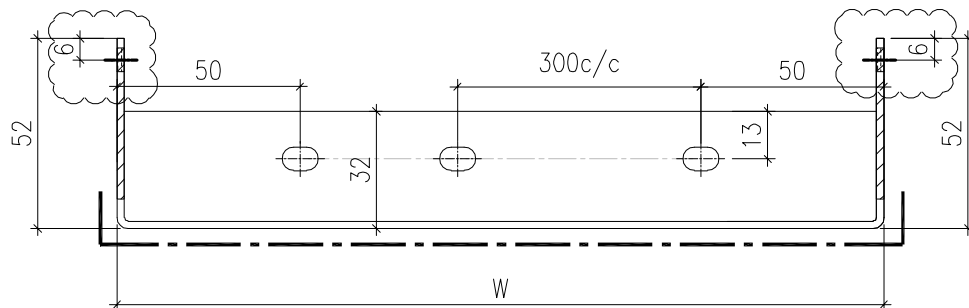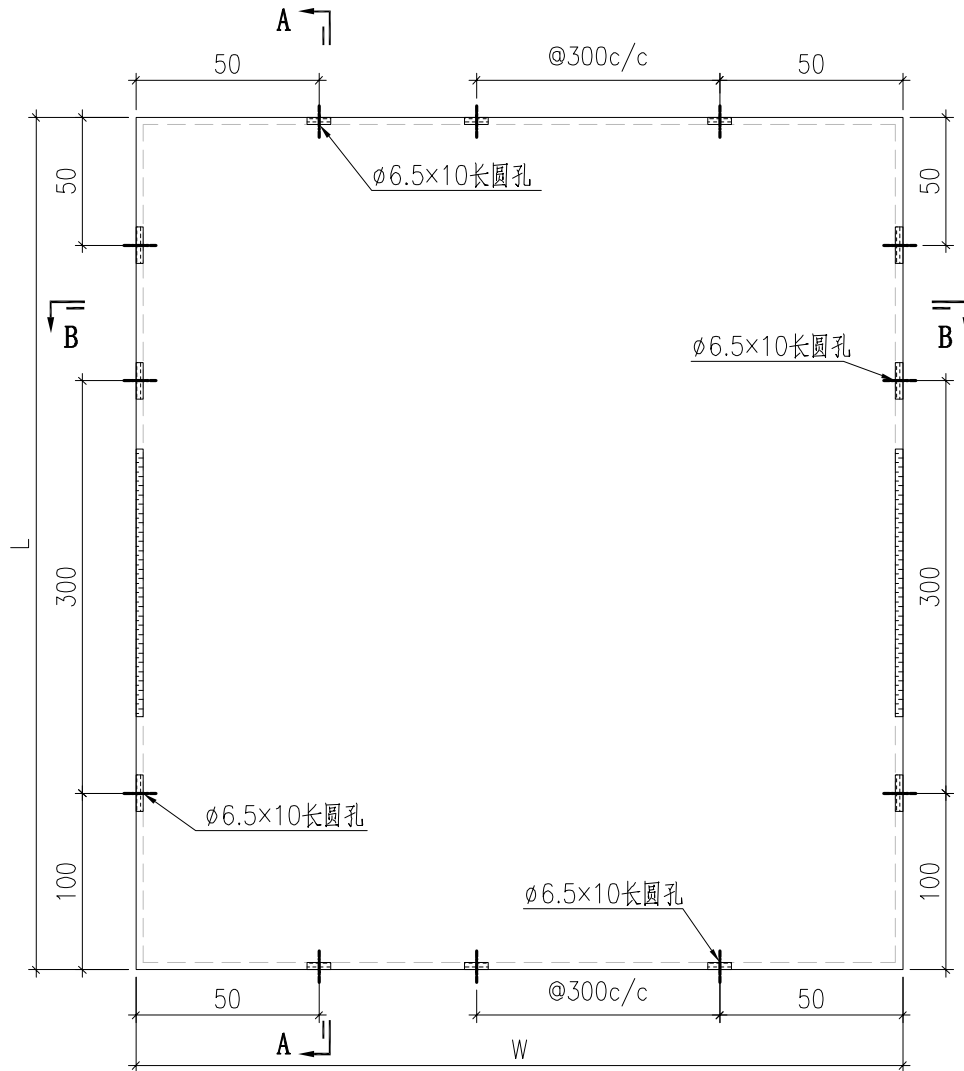


SECTION B-B

背板长宽数据見BST-L02



 美特鋁質有限公司 MIDI Aluminium Fabricator Ltd.				工程號	J857	類別		物料號	-					
				地盤	啟德6552	制圖	刘灿	2021-12-14	圖號	BST-L02				
修改	A	-	-	採用工廠	✓	地盤		圖紙名稱	铝板加工圖	復核	徐詳坤	2021-12-15	數量	-
日期	2022.03.02	-	-	材料顏色	ECK3M96295S-ZD1		材料	3mm THK. 铝板	批准	林仁安	2021-12-16	單件重量	-	(KG)

序號	鋁板編號	寬度 (W)	高度 (H)	數量
1	BST-L005	696	654	5
2	BST-L006	981	654	1
3	BST-L007	695	654	4
4	BST-L008	1285	654	2
5	BST-L009	676	654	3
6	BST-L010	956	654	1
7	BST-L011	972	654	1
8	BST-L012	446	654	3
9	BST-L013	1506	654	3
10	BST-L014	1040	654	2
11	BST-L016	1539	654	2
12	BST-L017	1994	654	2
13	BST-L018	746	654	4
14	BST-L019	1215	654	2
15	BST-L023	386	654	2
16	BST-L049	1451	654	1
17	BST-L051	1236	654	1
18	BST-L052	612	654	2
19	BST-L053	1099	654	1
20	BST-L054	1361	654	1
21	BST-L055	749	654	1
22	BST-L056	624	654	1
23	BST-L057	1174	654	1
24	BST-L058	1411	654	1
25	BST-L059	556	654	1
26	BST-L060	481	654	2
27	BST-L061	1424	654	1
28	BST-L062	536	654	3
29	BST-L080	702	654	3
30	BST-L081	978	654	2
31	BST-L085	686	654	8

 美特鋁質有限公司 MIDI Aluminium Fabricator Ltd.				工程號 J857 地盘 啟德6552	類別 制圖 刘灿	物料號 - 2021-12-14	圖號 BST-L03
修改 A 日期 2022.03.02	-	-	採用工廠 ✓ 材料颜色 BCK3M96295S-ZD1	图纸名称 铝板加工图 材料 3mm THK. 铝板	復核 徐詳坤 批准 林仁安	2021-12-15 2021-12-16	數量 - 單件重量 - (KG)

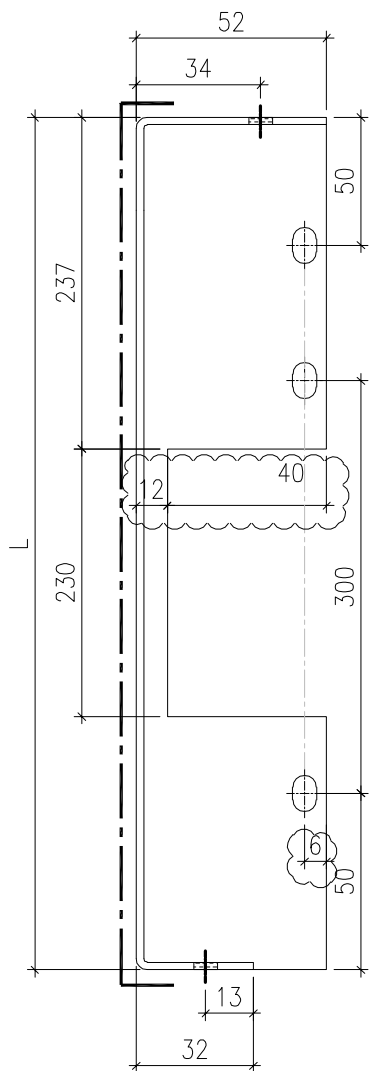

SECTION A-A

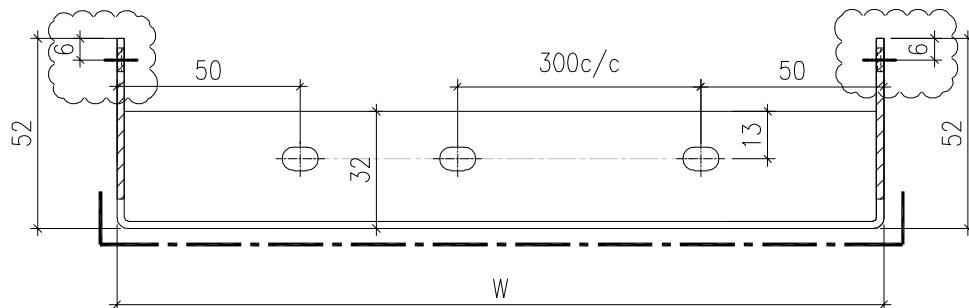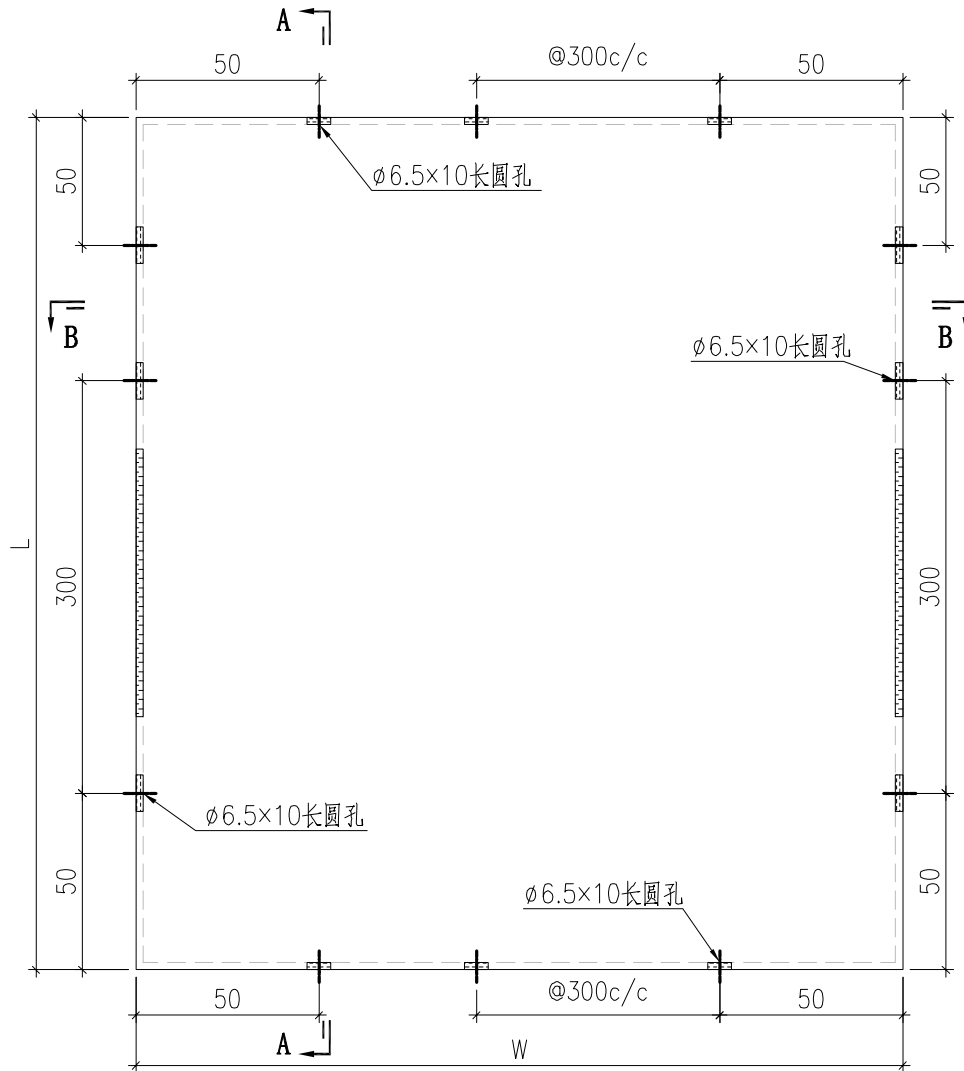


SECTION B-B

背板长宽数据見BST-L04

 美特鋁質有限公司 MIDI Aluminium Fabricator Ltd.				工程號	J857	類別		物料號	-					
				地盘	啟德6552	制圖	刘灿	2021-12-14	圖號	BST-L04				
修改	A	-	-	採用工廠	✓	地盤		图纸名称	铝板加工图	復核	徐詳坤	2021-12-15	數量	-
日期	2022.03.02	-	-	材料颜色	ECK3M96295S-ZD1		材料	3mm THK. 铝板	批准	林仁安	2021-12-16	單件重量	-	(KG)


序號	鋁板編號	寬度 (W)	高度 (H)	數量
1	BST-L086	972	560	1
2	BST-L087	446	560	1
3	BST-L088	702	560	1
4	BST-L089	1506	560	1
5	BST-L090	956	560	2
6	BST-L091	695	560	4
7	BST-L092	1285	560	2
8	BST-L093	676	560	1
9	BST-L094	728	560	1
10	BST-L095	696	560	1
11	BST-L096	702	560	1
12	BST-L097	527	560	2
13	BST-L098	1536	560	1
14	BST-L099	536	560	1
15	BST-L100	386	560	1

 美特鋁質有限公司 MIDI Aluminium Fabricator Ltd.				工程號 J857	類別	物料號 -		
				地盤 啟德6552	制圖 刘灿	2021-12-14	圖號 BST-B01	
修改 A	-	-	採用工廠 <input checked="" type="checkbox"/> 地盤	图纸名称 铝板加工图	復核 徐詳坤	2021-12-15	數量 -	
日期 2022.03.02	-	-	材料颜色 ECK3M96295S-ZD1	材料 (3mm) THK. 铝板	批准 林仁安	2021-12-16	單件重量 -	(KG)

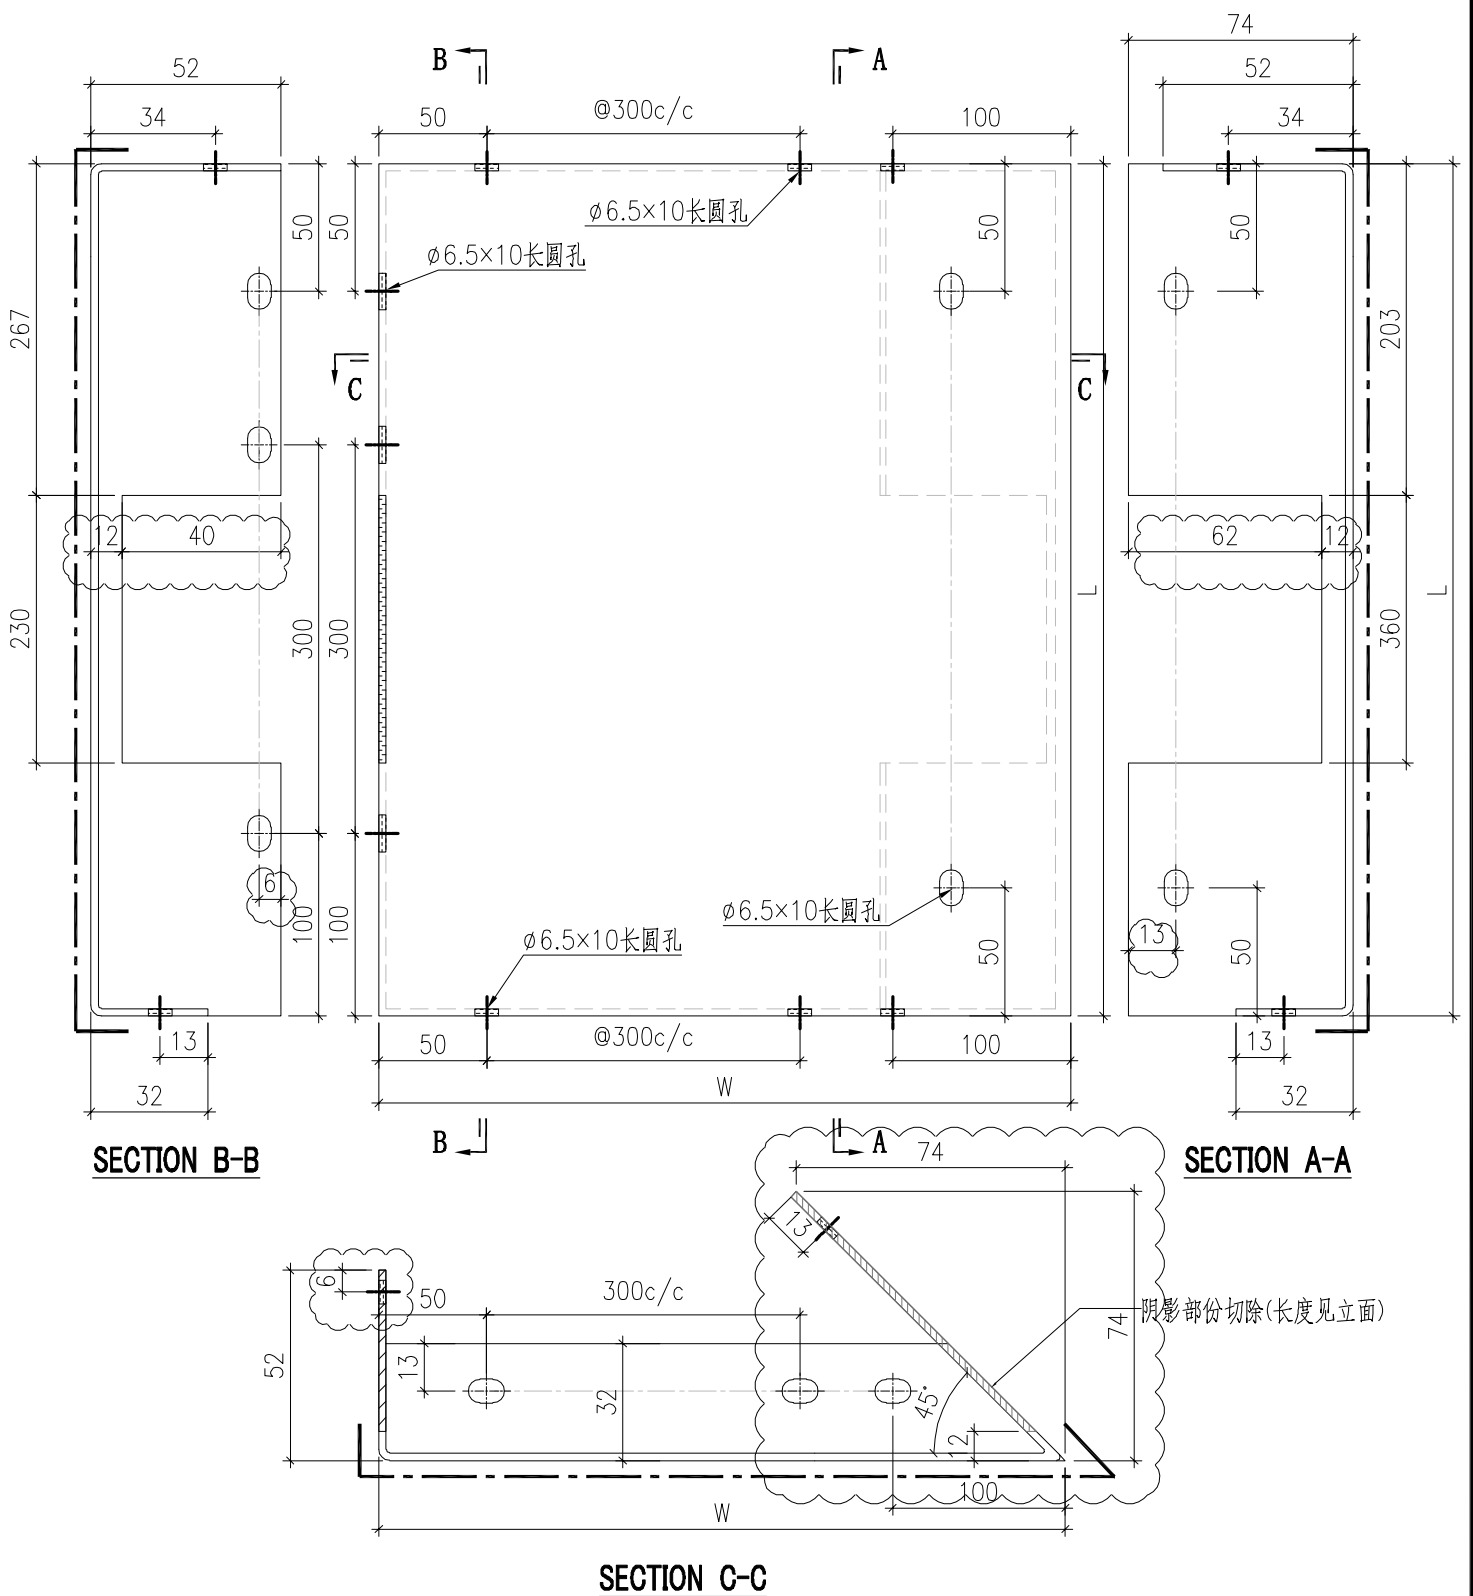

序號	鋁板編號	寬度 (W)	高度 (H)	數量
1	BST-BY001	740	654	1
2	BST-BY011	1161	654	1
3	BST-BY013	890	654	1
4	BST-BY018	585	654	1
5	BST-BY020	745	654	1

 美特鋁質有限公司 MIDI Aluminium Fabricator Ltd.				工程號 J857 地盘 啟德6552	類別 制圖 刘灿	物料號 - 2021-12-14	圖號 BST-B02
修改 A - - 採用工廠 ✓ 地盘	图纸名称 铝板加工图			復核 徐詳坤	2021-12-15	數量 -	
日期 2022.03.02 - - 材料颜色 ECK3M96295S-ZD1	材料 3mm THK. 铝板			批准 林仁安	2021-12-16	單件重量 - (KG)	

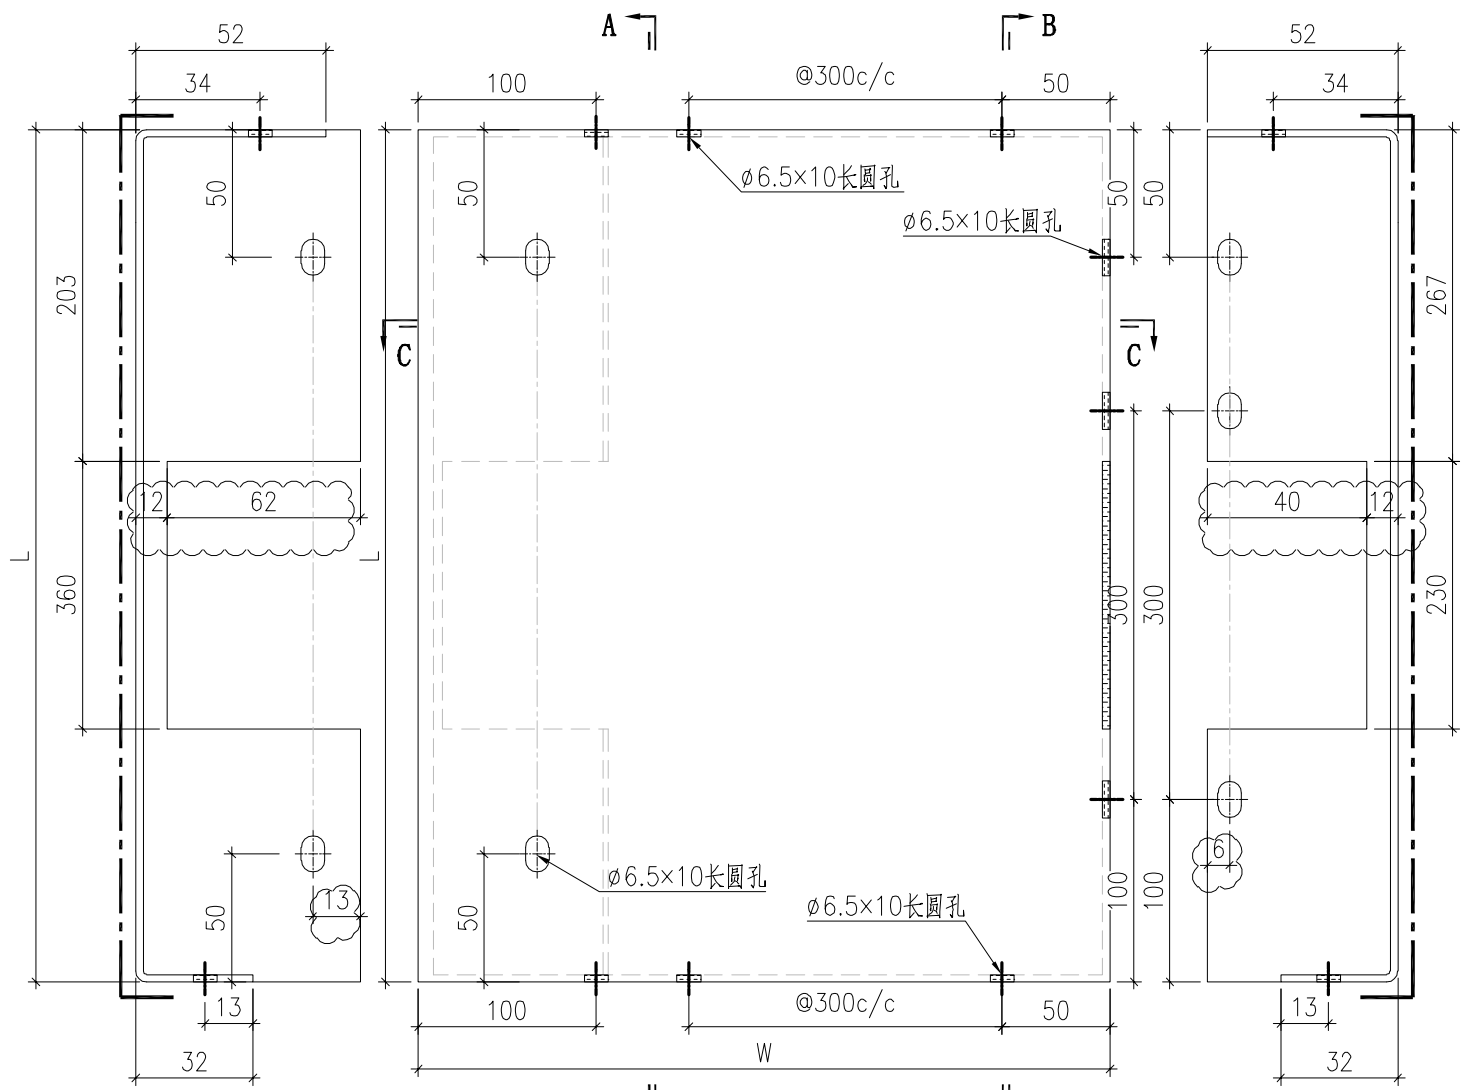


SECTION A-A

SECTION B-B

SECTION C-C

序號	鋁板編號	寬度 (W)	高度 (H)	數量
1	BST-BZ001	1601	654	1
2	BST-BZ010	1551	654	1
3	BST-BZ012	584	654	1
4	BST-BZ017	1873	654	1
5	BST-BZ019	745	654	1



 美特鋁質有限公司 MIDI Aluminium Fabricator Ltd.				工程號 J857 地盘 啟德6552	類別 制圖 刘灿	物料號 - 2021-12-14	圖號 BST-B03
修改 A 日期 2022.03.02	採用工廠 材料颜色 ECK3M96295S-ZD1	图纸名称 铝板加工图 材料 3mm THK. 铝板	復核 徐詳坤 批准 林仁安	2021-12-15 2021-12-16	數量 - 單件重量 - (KG)		

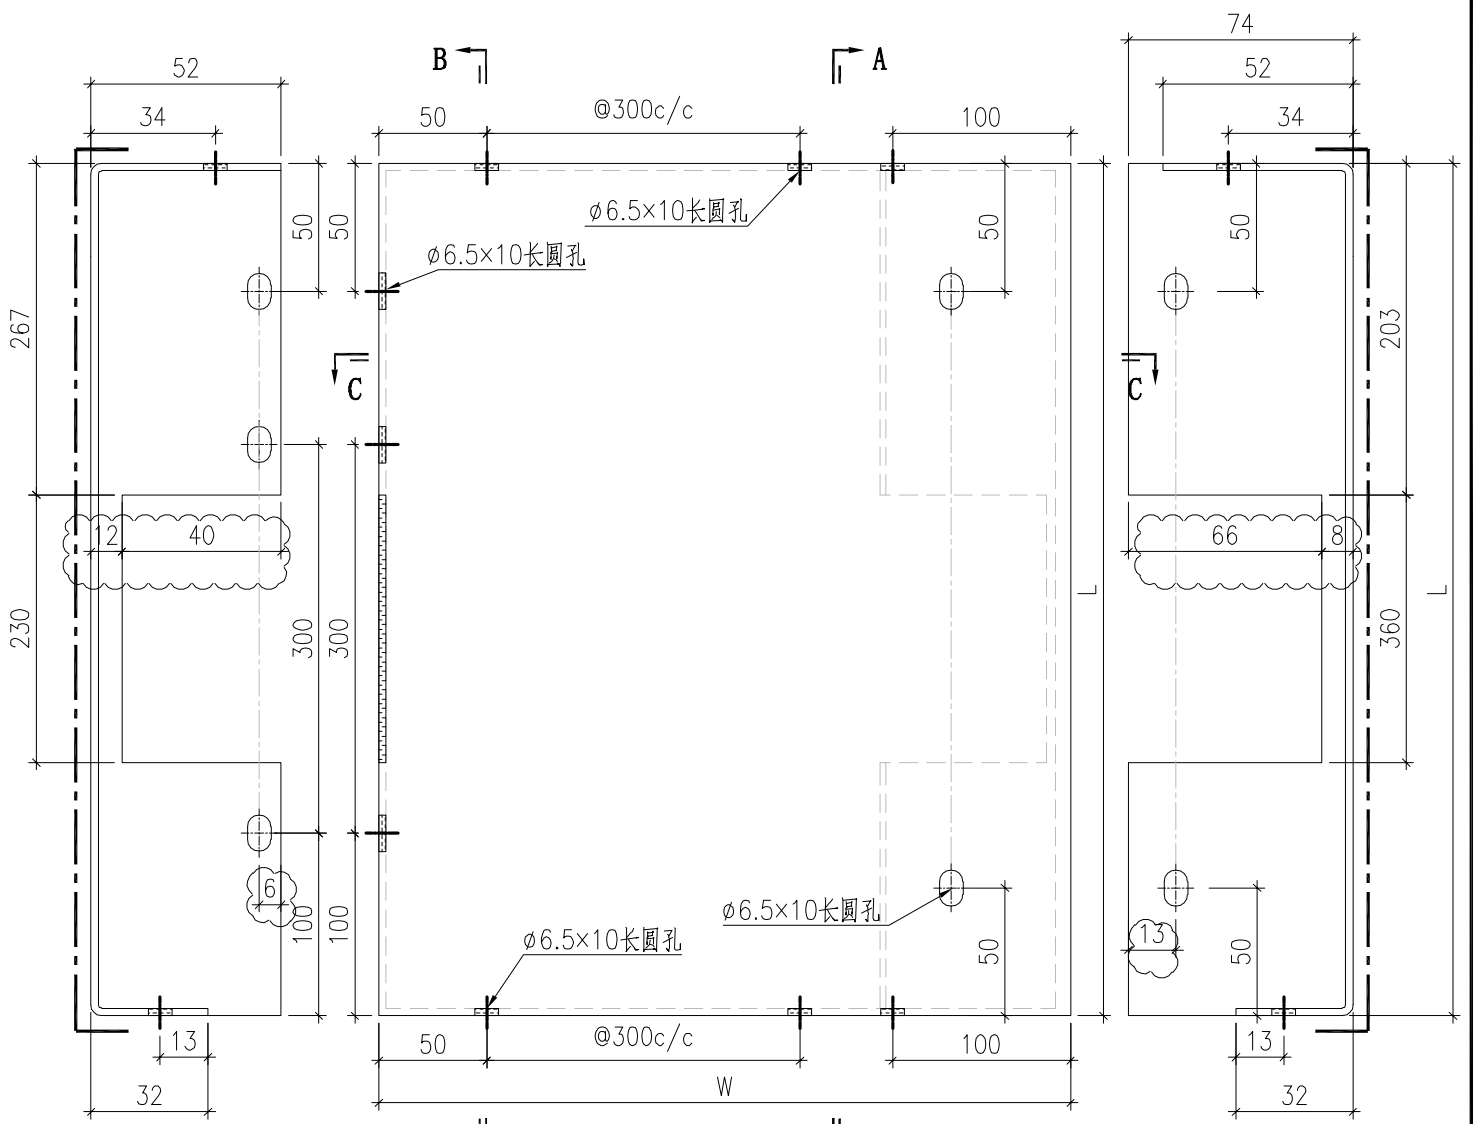

阴影部份切除(长度见立面)


序號	鋁板編號	寬度 (W)	高度 (H)	數量
1	BST-BY015	388	654	1

 美特鋁質有限公司 MIDI Aluminium Fabricator Ltd.				工程號 J857 地盘 啟德6552	類別 制圖 刘灿	物料號 - 2021-12-14	圖號 BST-B04
修改 A - - 採用工廠 ✓ 地盘	图纸名称 铝板加工图		復核 徐詳坤	2021-12-15	數量 -		
日期 2022.03.02 - - 材料颜色 BCK3M96295S-ZD1	材料 3mm THK. 铝板		批准 林仁安	2021-12-16	單件重量 - (KG)		

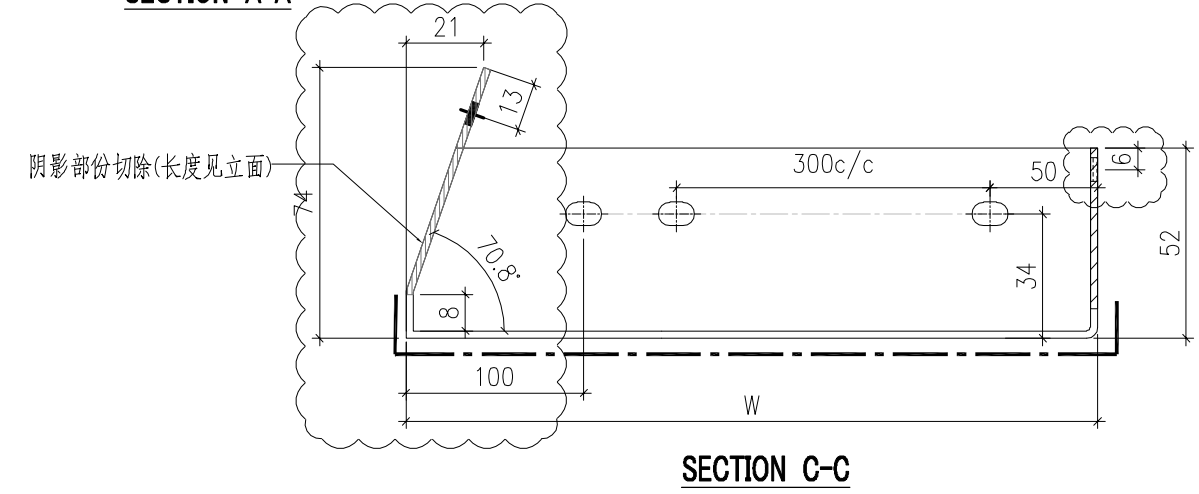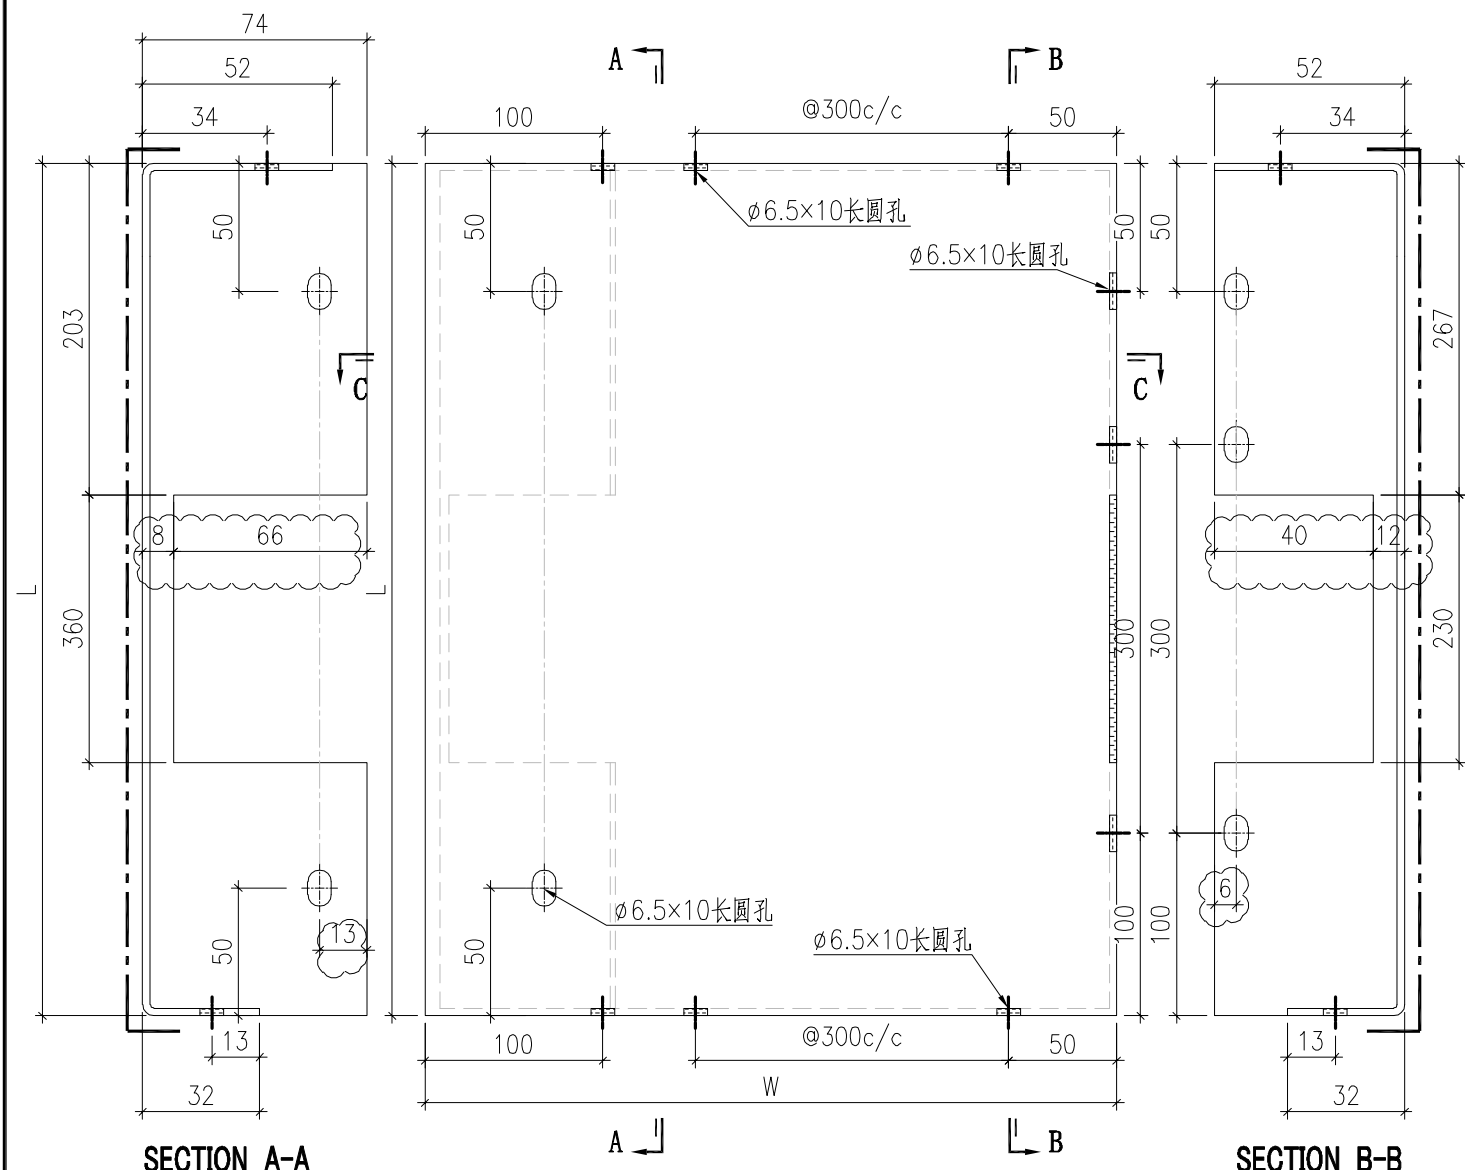


序號	鋁板編號	寬度 (W)	高度 (H)	數量
1	BST-BZ016	1257	654	1

 美特鋁質有限公司 MIDI Aluminium Fabricator Ltd.				工程號 J857 地盤 啟德6552	類別 制圖 刘灿	物料號 - 2021-12-14	圖號 BST-B05
修改 A - - 採用工廠 ✓ 地盤	图纸名称 铝板加工图			復核 徐詳坤	2021-12-15	數量 -	
日期 2022.03.02 - - 材料颜色 ECK3M96295S-ZD1	材料 3mm THK. 铝板			批准 林仁安	2021-12-16	單件重量 - (KG)	

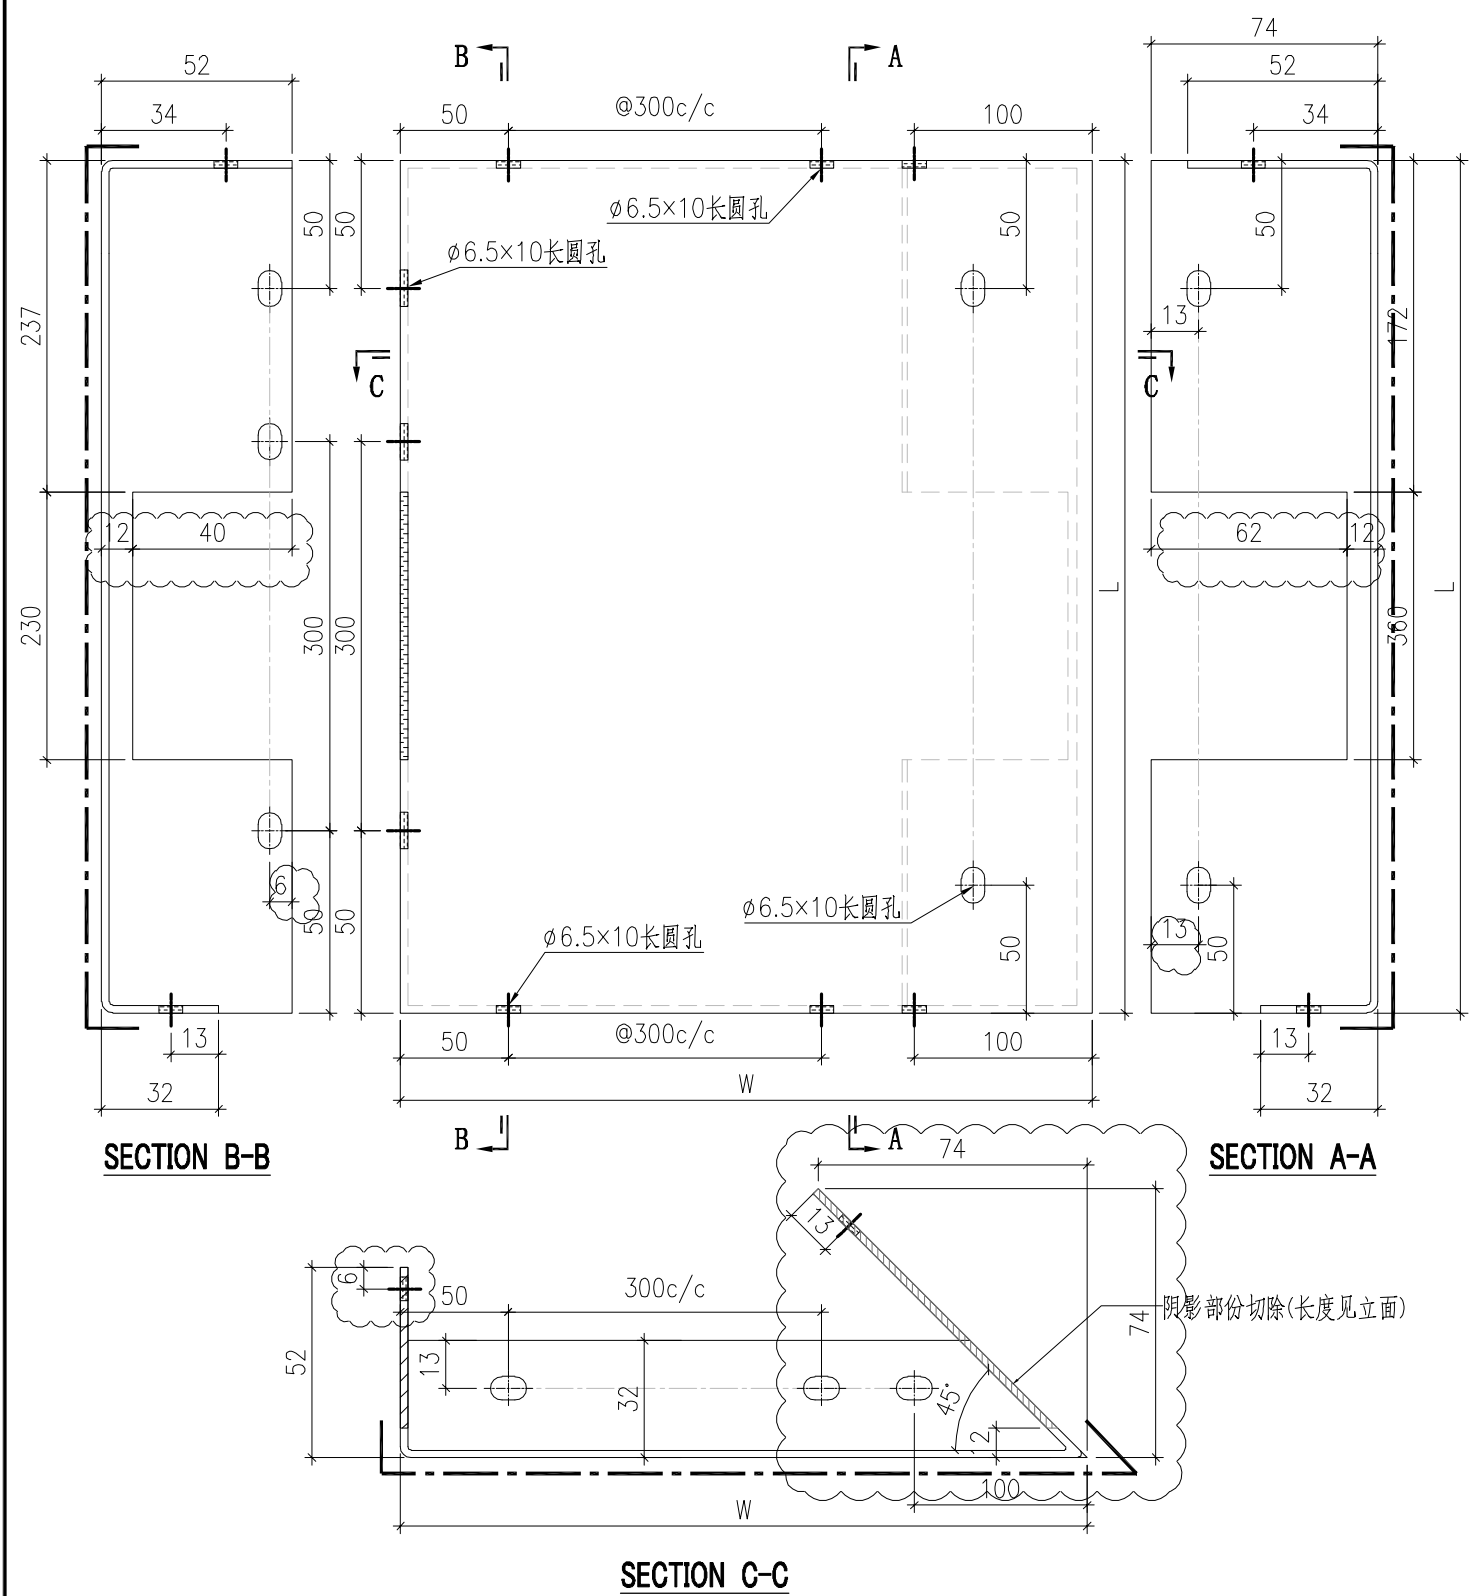


序號	鋁板編號	寬度 (W)	高度 (H)	數量
1	BST-LY003	2125	560	1
2	BST-LY014	1311	560	1

 美特鋁質有限公司 MIDI Aluminium Fabricator Ltd.				工程號 J857	類別	物料號 -		
				地盤 啟德6552	制圖 刘灿	2021-12-14	圖號 BST-M01	
修改 A	-	-	採用工廠 ✓ 地盤	图纸名称 铝板加工图	復核 徐詳坤	2021-12-15	數量 -	
日期 2022.03.02	-	-	材料颜色 ECK3M96295S-ZD1	材料 3mm THK. 铝板	批准 林仁安	2021-12-16	單件重量 -	(KG)

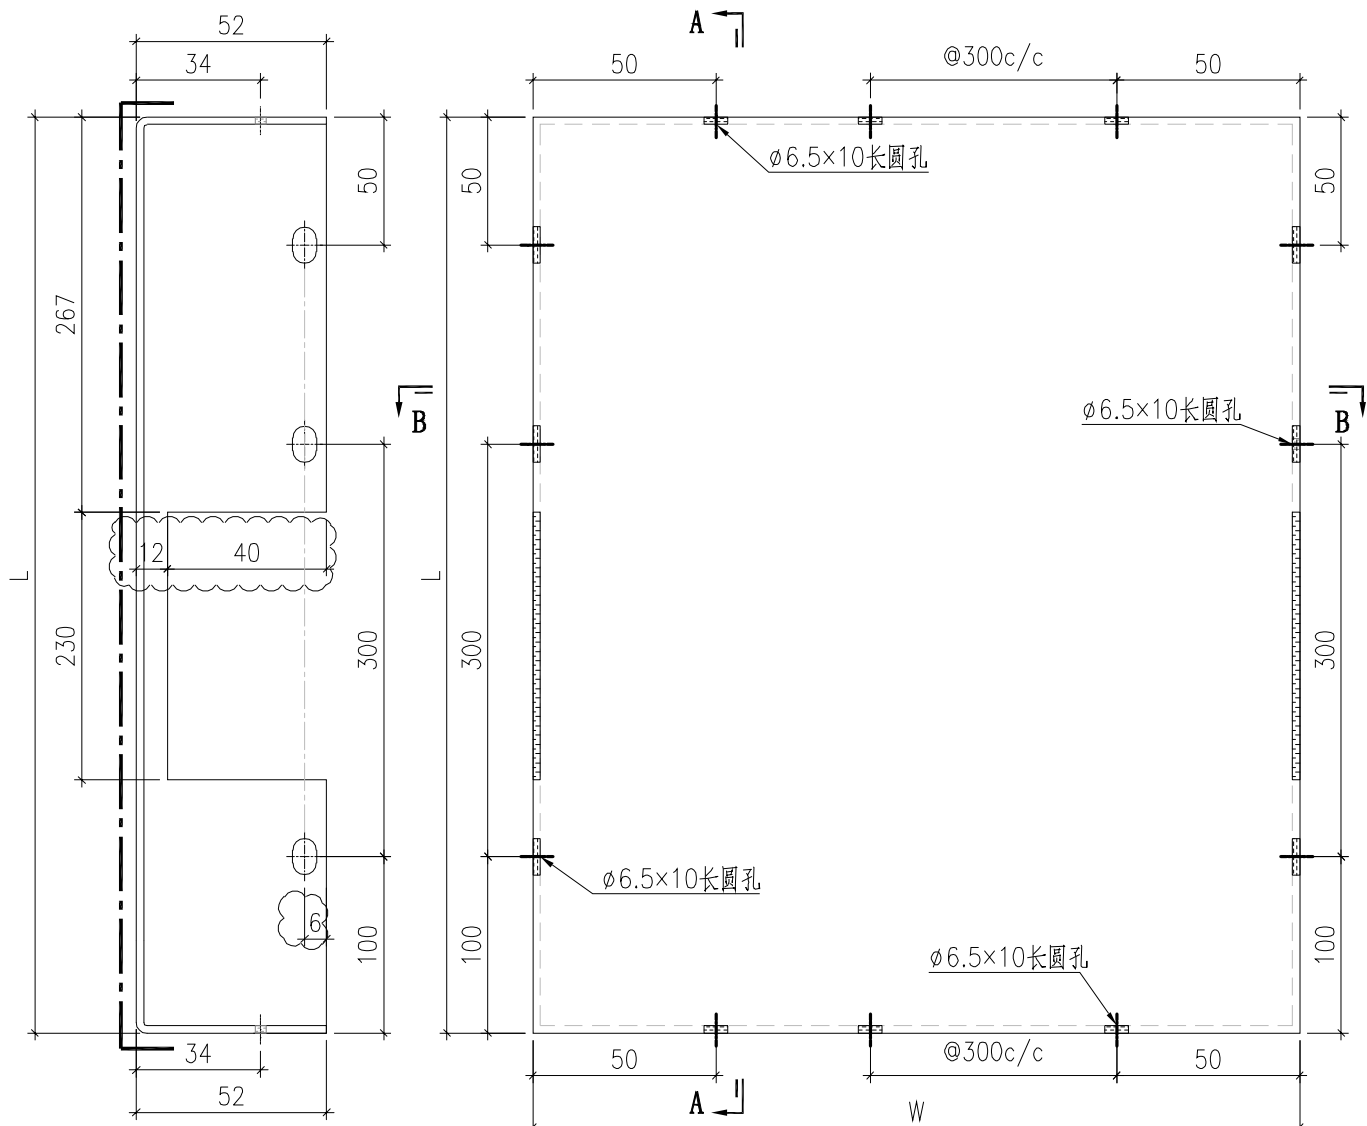

SECTION A-A

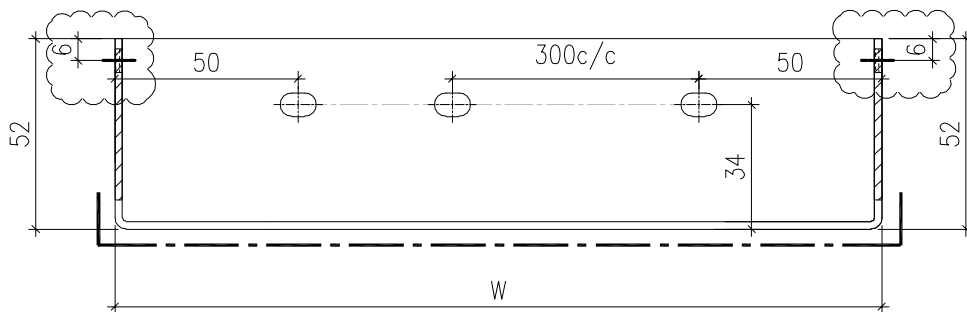

SECTION B-B


背板长宽数据見BST-M02

 美特鋁質有限公司 MIDI Aluminium Fabricator Ltd.				工程號	J857	類別		物料號	-					
				地盘	啟德6552	制圖	刘灿	2021-12-14	圖號	BST-M02				
修改	A	-	-	採用工廠	✓	地盘		图纸名称	铝板加工图	復核	徐詳坤	2021-12-15	數量	-
日期	2022.03.02	-	-	材料颜色	ECK3M96295S-ZD1		材料	3mm THK. 铝板	批准	林仁安	2021-12-16	單件重量	-	(KG)

序號	鋁板編號	寬度 (W)	高度 (H)	數量
1	BST-M001	696	646	6
2	BST-M002	2024	646	6
3	BST-M003	445	646	6
4	BST-M004	1106	646	6
5	BST-M005	696	646	43
6	BST-M006	981	646	6
7	BST-M007	695	646	40
8	BST-M008	1285	646	20
9	BST-M009	676	646	40
10	BST-M010	956	646	14
11	BST-M011	972	646	10
12	BST-M012	446	646	122
13	BST-M013	1506	646	22
14	BST-M014	1040	646	12
15	BST-M016	1539	646	12
16	BST-M017	1994	646	12
17	BST-M018	746	646	24
18	BST-M019	1215	646	12
19	BST-M021	728	646	4
20	BST-M022	527	646	8
21	BST-M023	386	646	80
22	BST-M026	983	646	5
23	BST-M028	1469	646	5
24	BST-M029	586	646	5
25	BST-M031	1314	646	14
26	BST-M032	424	646	14


序號	鋁板編號	寬度 (W)	高度 (H)	數量
27	BST-M035	836	646	18
28	BST-M037	1278	646	18
29	BST-M038	1708	646	18
30	BST-M039	1158	646	18
31	BST-M042	1608	646	9
32	BST-M043	1025	646	9
33	BST-M046	1424	646	9
34	BST-M048	1496	646	9
35	BST-M049	1451	646	8
36	BST-M051	1236	646	1
37	BST-M052	612	646	2
38	BST-M053	1099	646	1
39	BST-M054	1361	646	1
40	BST-M055	749	646	1
41	BST-M056	624	646	1
42	BST-M057	1174	646	1
43	BST-M058	1411	646	1
44	BST-M059	556	646	1
45	BST-M060	481	646	2
46	BST-M061	1424	646	1
47	BST-M062	536	646	83
48	BST-M080	702	646	26
49	BST-M081	978	646	12
50	BST-M082	1057	646	15
51	BST-M083	1023	646	9
52	BST-M084	1536	646	4
53	BST-M085	686	646	8

 美特鋁質有限公司 MIDI Aluminium Fabricator Ltd.				工程號 J857	類別	物料號 -		
				地盤 啟德6552	制圖 刘灿	2021-12-14	圖號 BST-C02	
修改 A - -	採用工廠 ✓	地盤	图纸名称 铝板加工图	復核 徐詳坤	2021-12-15	數量 -		
日期 2022.03.02	材料颜色 ECK3M96295S-ZD1	材料 3mm THK. 铝板		批准 林仁安	2021-12-16	單件重量 -	(KG)	

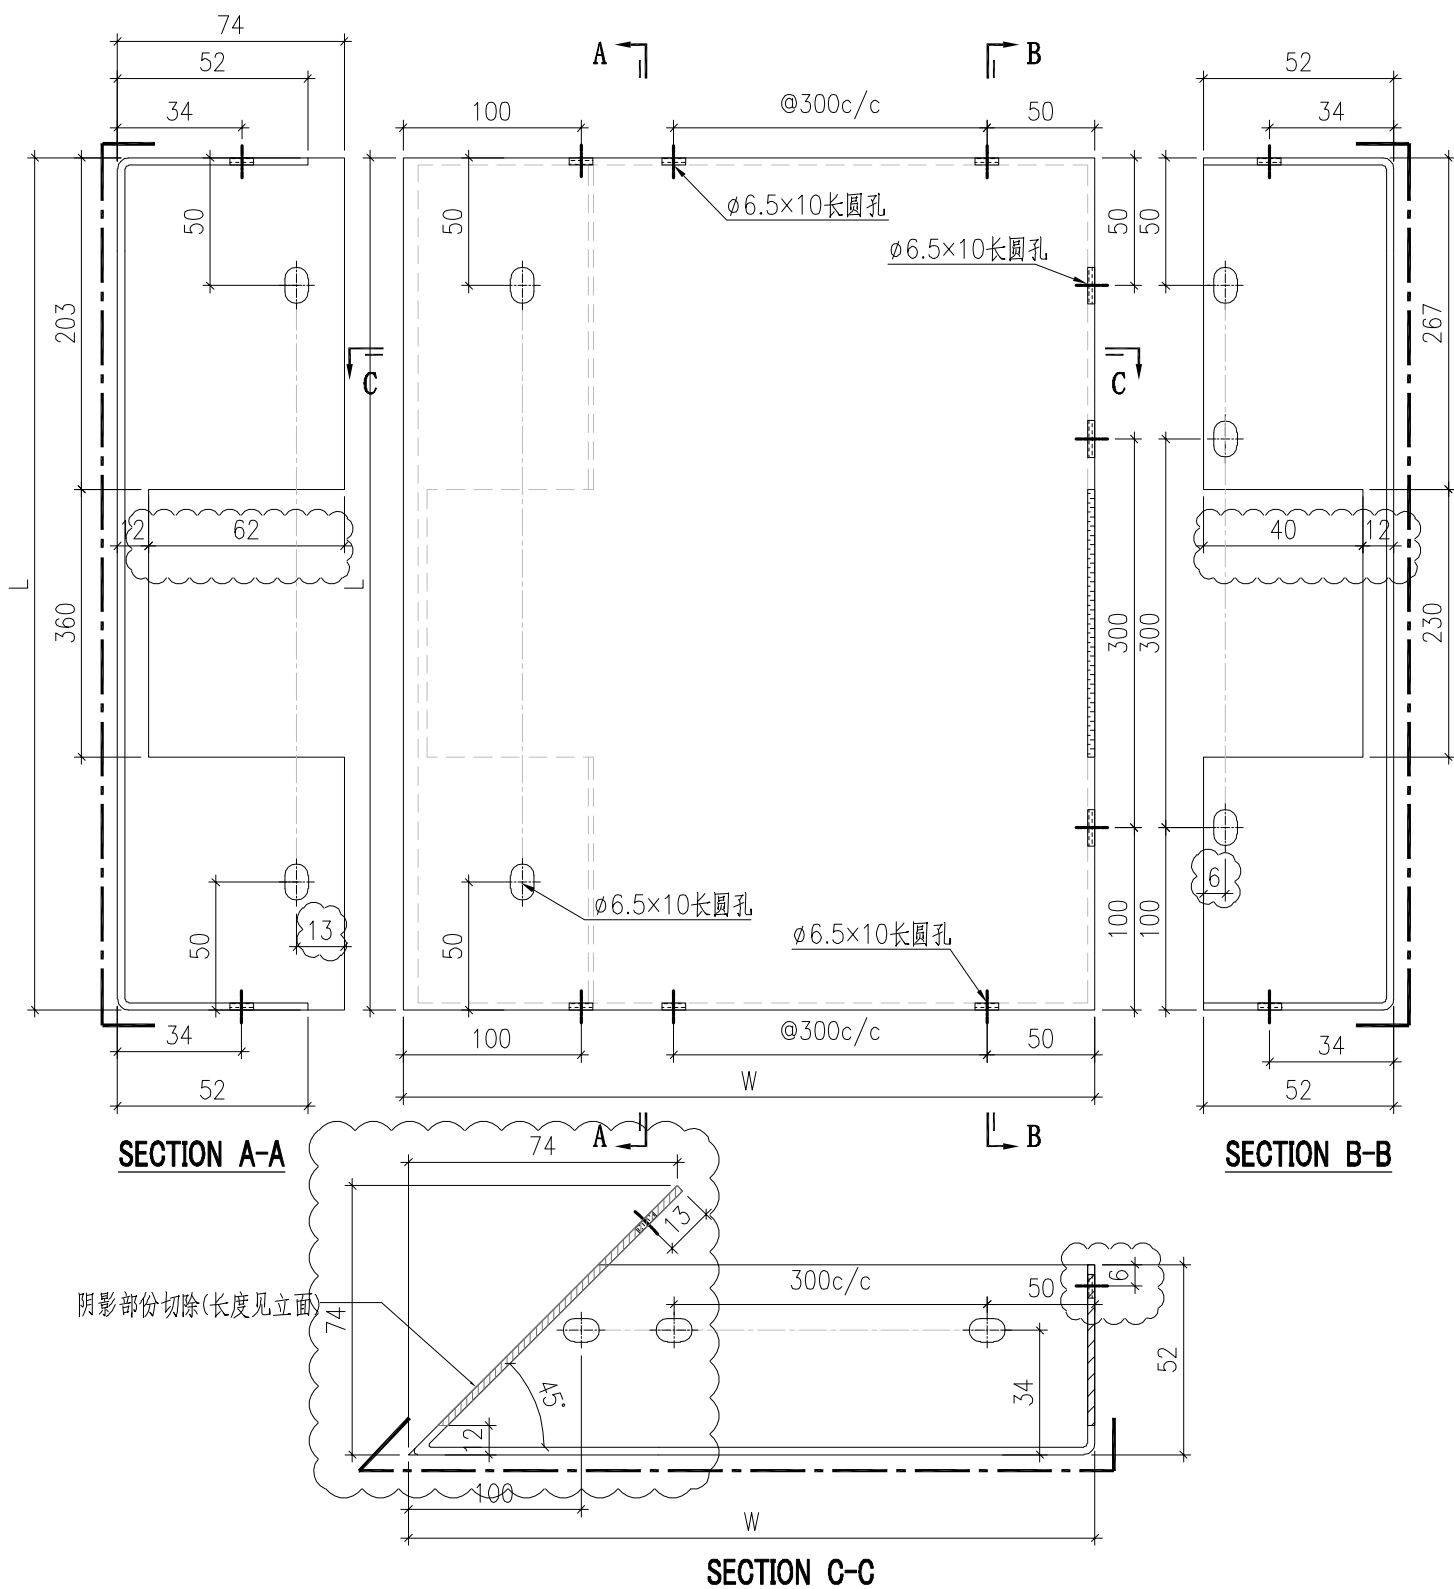

序號	鋁板編號	寬度 (W)	高度 (H)	數量
1	BST-CZ001	1601	646	6
2	BST-CZ004	1450	646	4
3	BST-CZ005	490	646	4
4	BST-CZ006	1811	646	23
5	BST-CZ009	1040	646	23
6	BST-CZ010	1551	646	8
7	BST-CZ012	584	646	8
8	BST-CZ017	1873	646	1
9	BST-CZ019	745	646	1

 美特鋁質有限公司 MIDI Aluminium Fabricator Ltd.				工程號 J857	類別	物料號 -		
				地盤 啟德6552	制圖 刘灿	2021-12-14	圖號 BST-C03	
修改 A	-	-	採用工廠 ✓ 地盤	图纸名称 铝板加工图	復核 徐詳坤	2021-12-15	數量 -	
日期 2022.03.02	-	-	材料颜色 ECK3M96295S-ZD1	材料 3mm THK. 铝板	批准 林仁安	2021-12-16	單件重量 -	(KG)

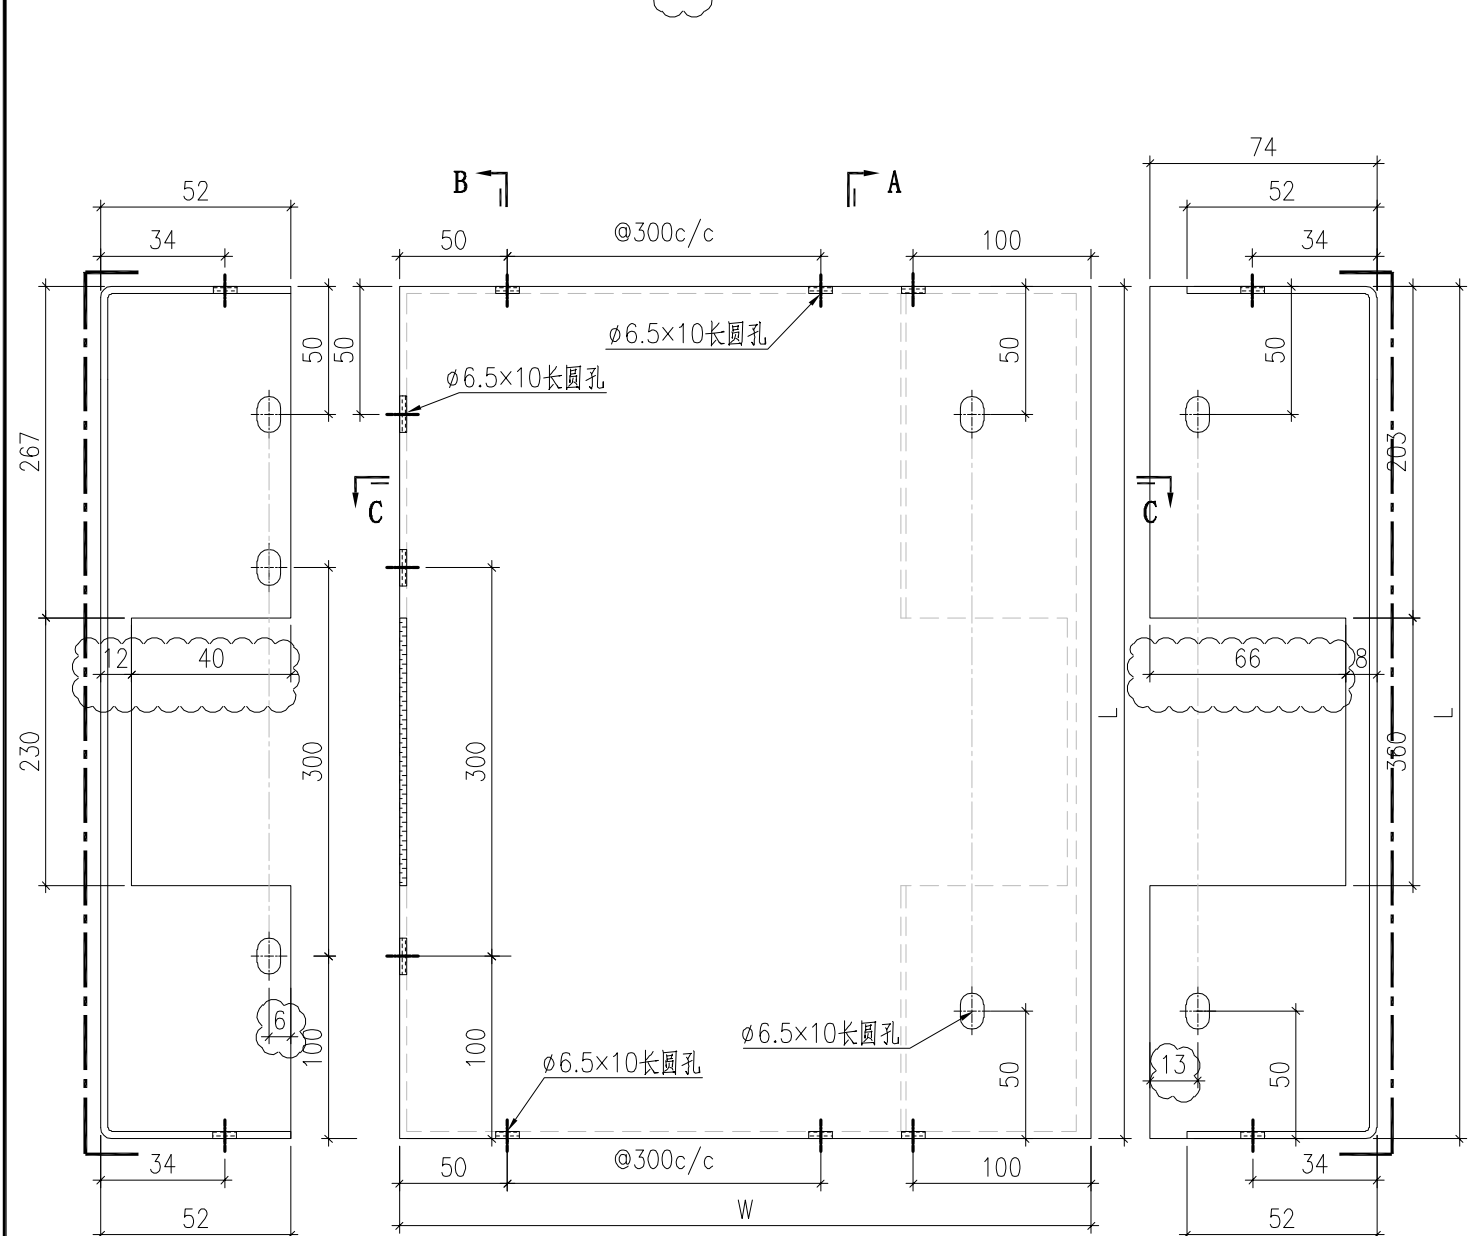

SECTION B-B



SECTION A-A

SECTION C-C

阴影部份切除(长度见立面)


序號	鋁板編號	寬度 (W)	高度 (H)	數量
1	BST-CY015	388	646	8

 美特鋁質有限公司 MIDI Aluminium Fabricator Ltd.				工程號 J857 地盤 啟德6552	類別 制圖 刘灿	物料號 - 2021-12-14	圖號 BST-C04
修改 A - - 採用工廠 ✓ 地盤	图纸名称 铝板加工图			復核 徐詳坤	2021-12-15	數量 -	
日期 2022.03.02 - - 材料颜色 ECK3M96295S-ZD1	材料 3mm THK. 铝板			批准 林仁安	2021-12-16	單件重量 - (KG)	

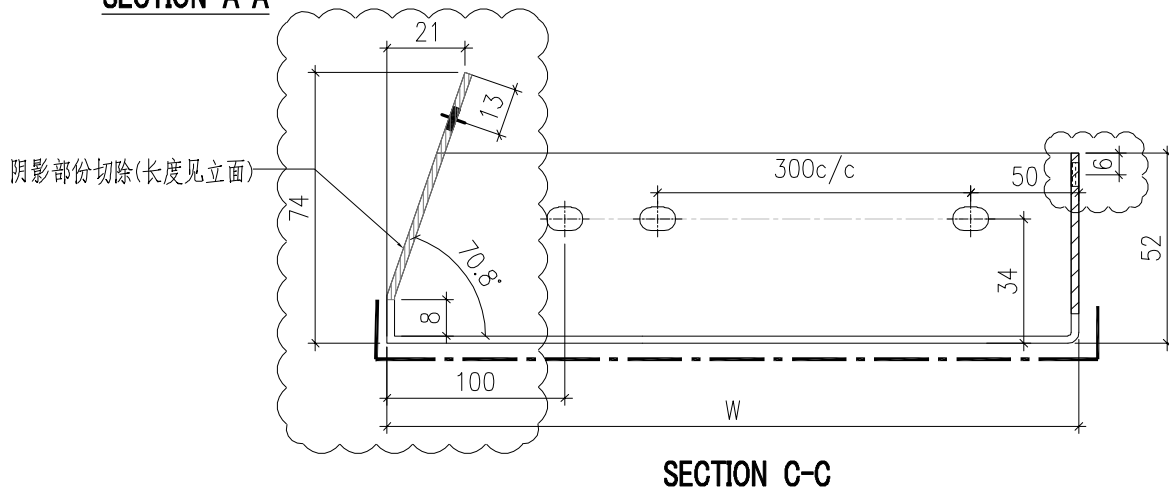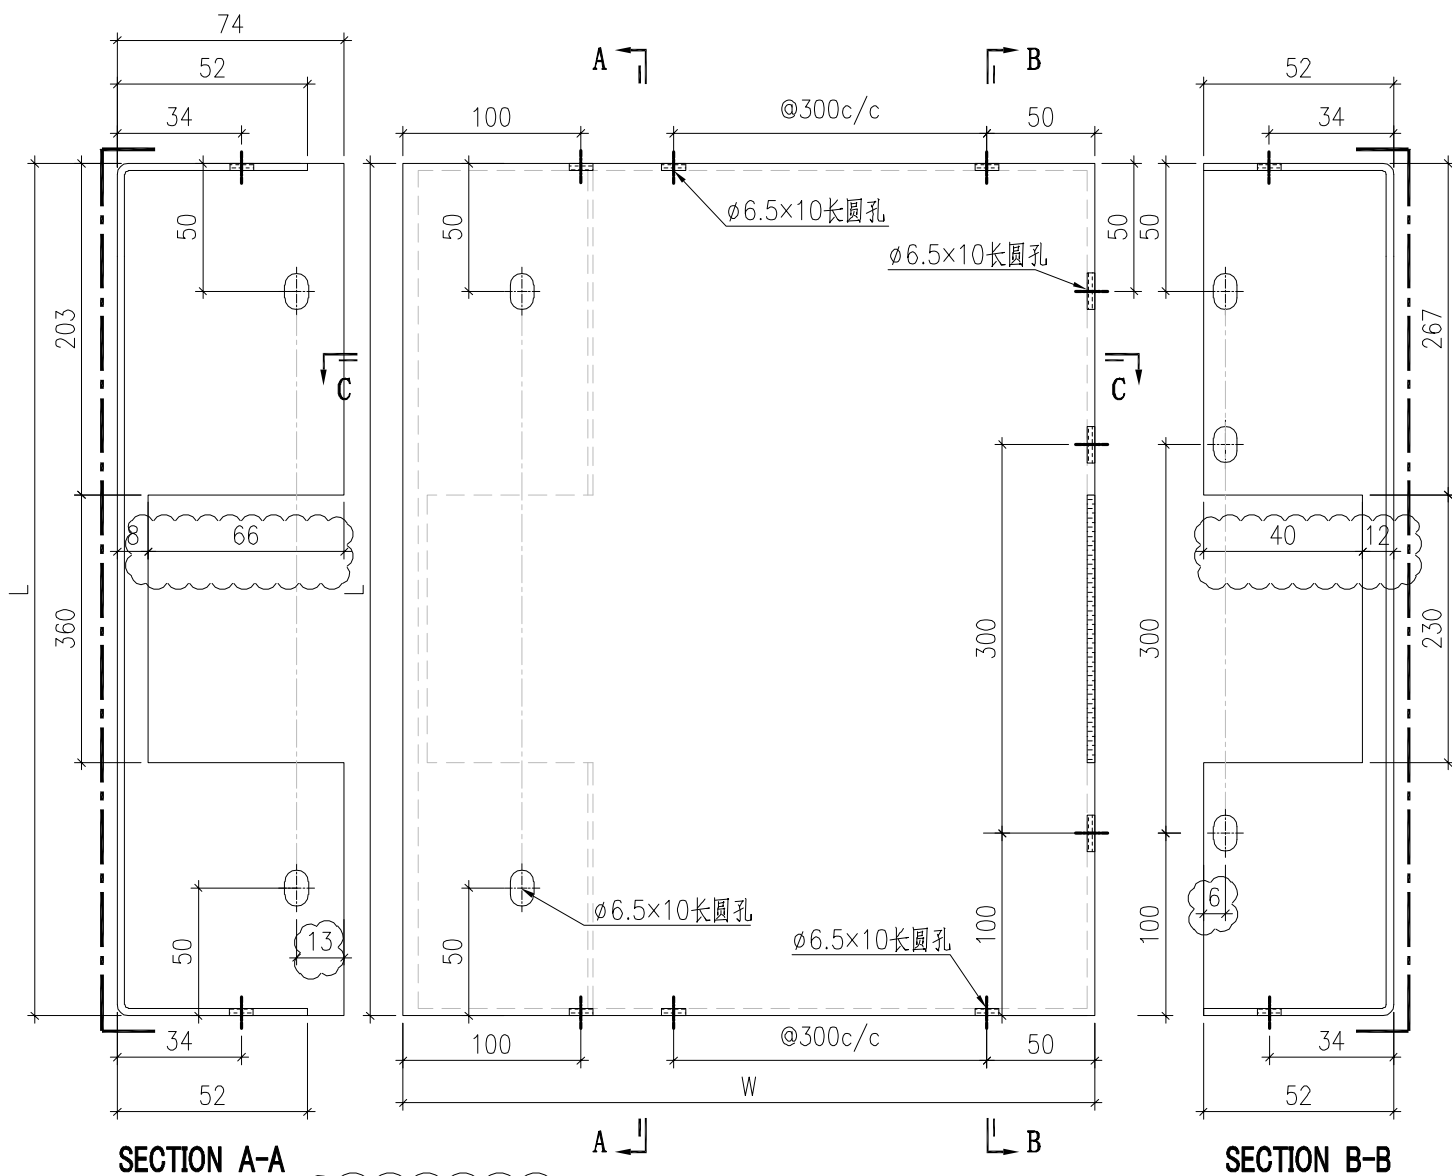

序號	鋁板編號	寬度 (W)	高度 (H)	數量
1	BST-CZ016	1257	646	8

 美特鋁質有限公司 MIDI Aluminium Fabricator Ltd.				工程號 J857 地盘 啟德6552	類別 制圖 刘灿	物料號 - 2021-12-14	圖號 BST-F01
修改 A 日期 2022.03.02	-	-	採用工廠 ✓ 材料颜色 BCK3M96295S-ZD1	图纸名称 铝板加工图 材料 3mm THK. 铝板	復核 徐詳坤 批准 林仁安	2021-12-15 2021-12-16	數量 - 單件重量 - (KG)

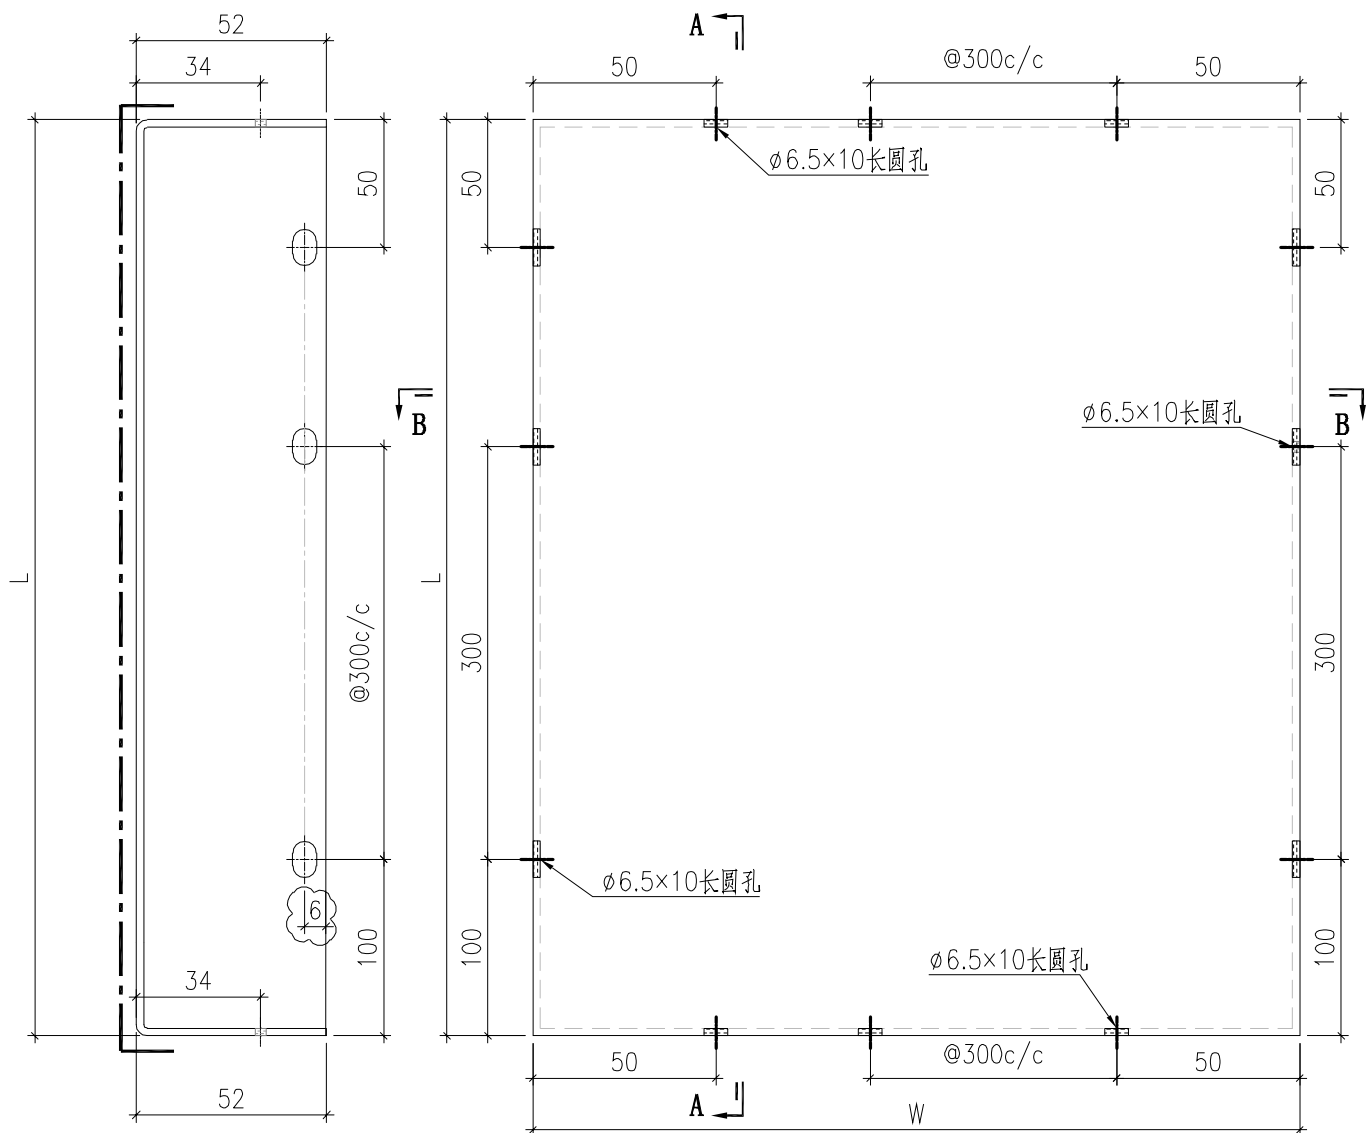


SECTION A-A


SECTION B-B

序號	鋁板編號	寬度 (W)	高度 (H)	數量
1	BST-F001	676	2386	41

 美特鋁質有限公司 MIDI Aluminium Fabricator Ltd.				工程號 J857 地盘 啟德6552	類別 制圖 刘灿	物料號 - 2021-12-14	圖號 BST-D01
修改 A 日期 2022.03.02	-	-	採用工廠 ✓ 材料颜色 BCK3M96295S-ZD1	图纸名称 铝板加工图 材料 3mm THK. 铝板	復核 徐詳坤 批准 林仁安	2021-12-15 2021-12-16	數量 - 單件重量 - (KG)

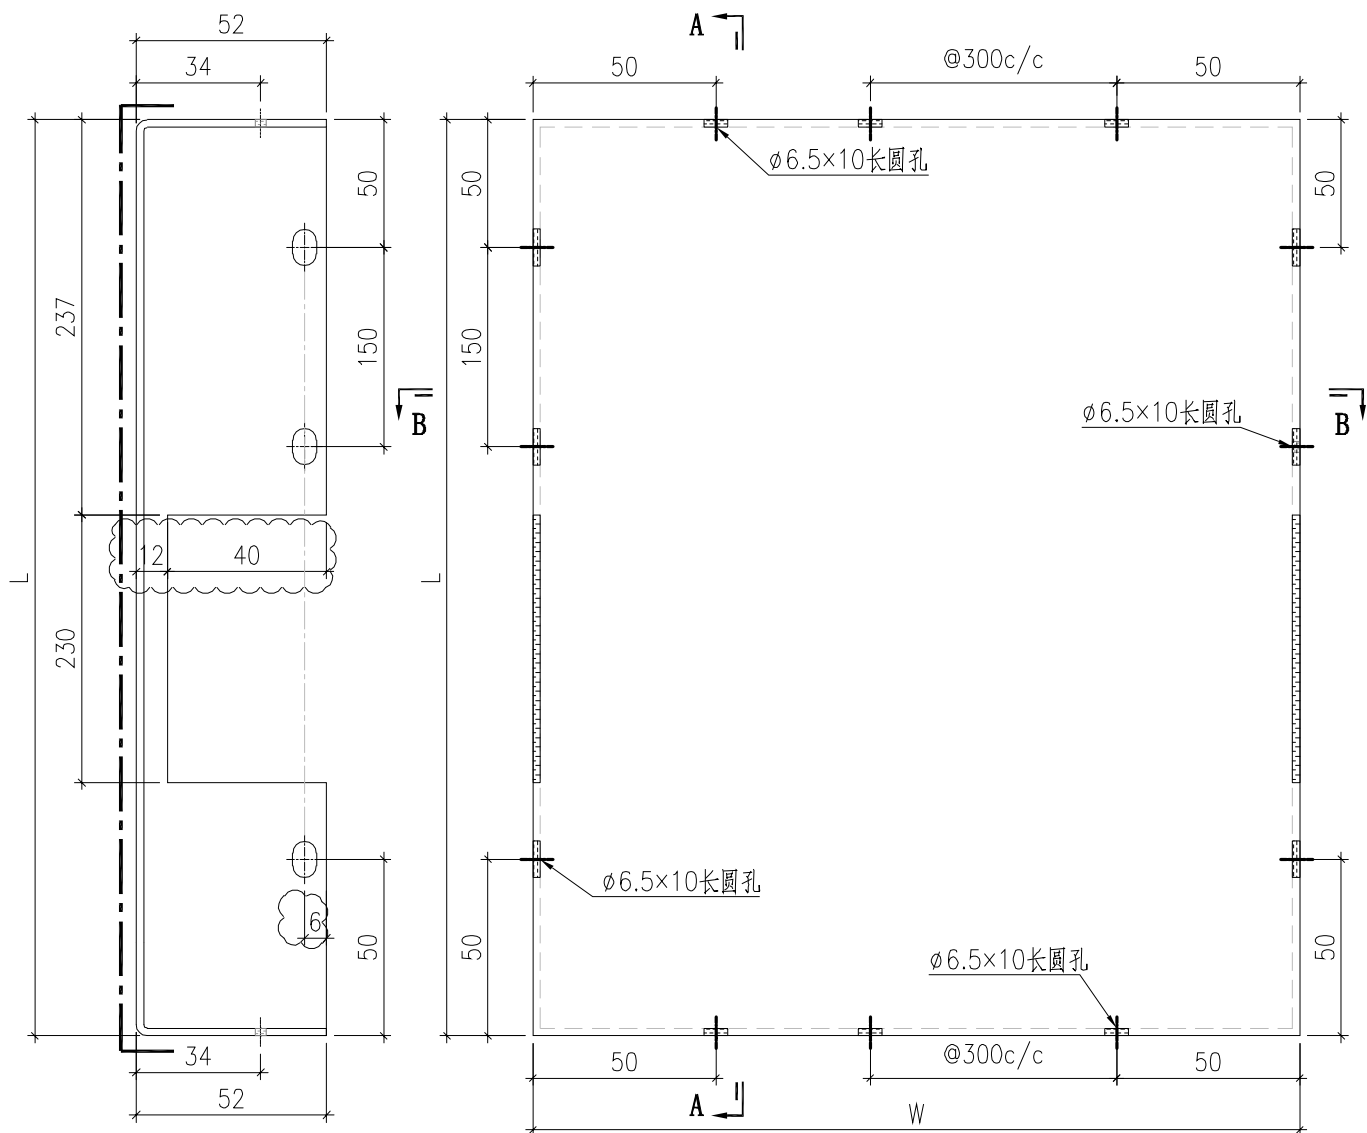

SECTION A-A

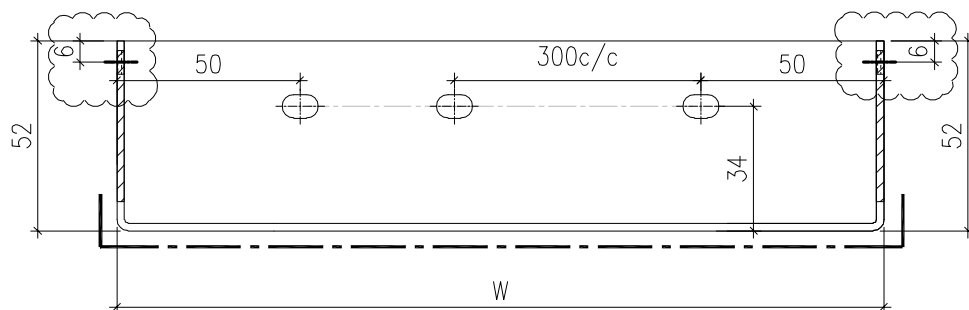


SECTION B-B

背板长宽数据見BST-D02

 美特鋁質有限公司 MIDI Aluminium Fabricator Ltd.				工程號	J857	類別		物料號	-		
				地盘	啟德6552	制圖	刘灿	2021-12-14	圖號	BST-D02	
修改	A	-	-	採用工廠	✓	地盘					
日期	2022.03.02	-	-	材料颜色	ECK3M96295S-ZD1		图纸名称	铝板加工图	復核	徐詳坤	
				材料	3mm THK. 铝板		批准	林仁安	2021-12-16	數量	-
									單件重量	- (KG)	


序號	鋁板編號	寬度 (W)	高度 (H)	數量
1	BST-D001	696	552	1
2	BST-D002	2024	552	1
3	BST-D003	445	552	1
4	BST-D004	1106	552	1
5	BST-D005	696	552	5
6	BST-D006	981	552	1
7	BST-D007	695	552	4
8	BST-D008	1285	552	2
9	BST-D009	676	552	3
10	BST-D010	956	552	1
11	BST-D011	972	552	2
12	BST-D012	446	552	4
13	BST-D013	1506	552	4
14	BST-D014	1040	552	2
15	BST-D016	1539	552	2
16	BST-D017	1994	552	2
17	BST-D018	746	552	4
18	BST-D019	1215	552	2
19	BST-D080	702	552	4
20	BST-D081	978	552	2

 美特鋁質有限公司 MIDI Aluminium Fabricator Ltd.				工程號 J857 地盘 啟德6552	類別 制圖 刘灿	物料號 - 2021-12-14	圖號 BST-E01
修改 A 日期 2022.03.02	-	-	採用工廠 <input checked="" type="checkbox"/> 地盘 材料颜色 ECK3M96295S-ZD1	图纸名称 铝板加工图 材料 3mm THK. 铝板	復核 徐詳坤 批准 林仁安	2021-12-15 2021-12-16	數量 - 單件重量 - (KG)

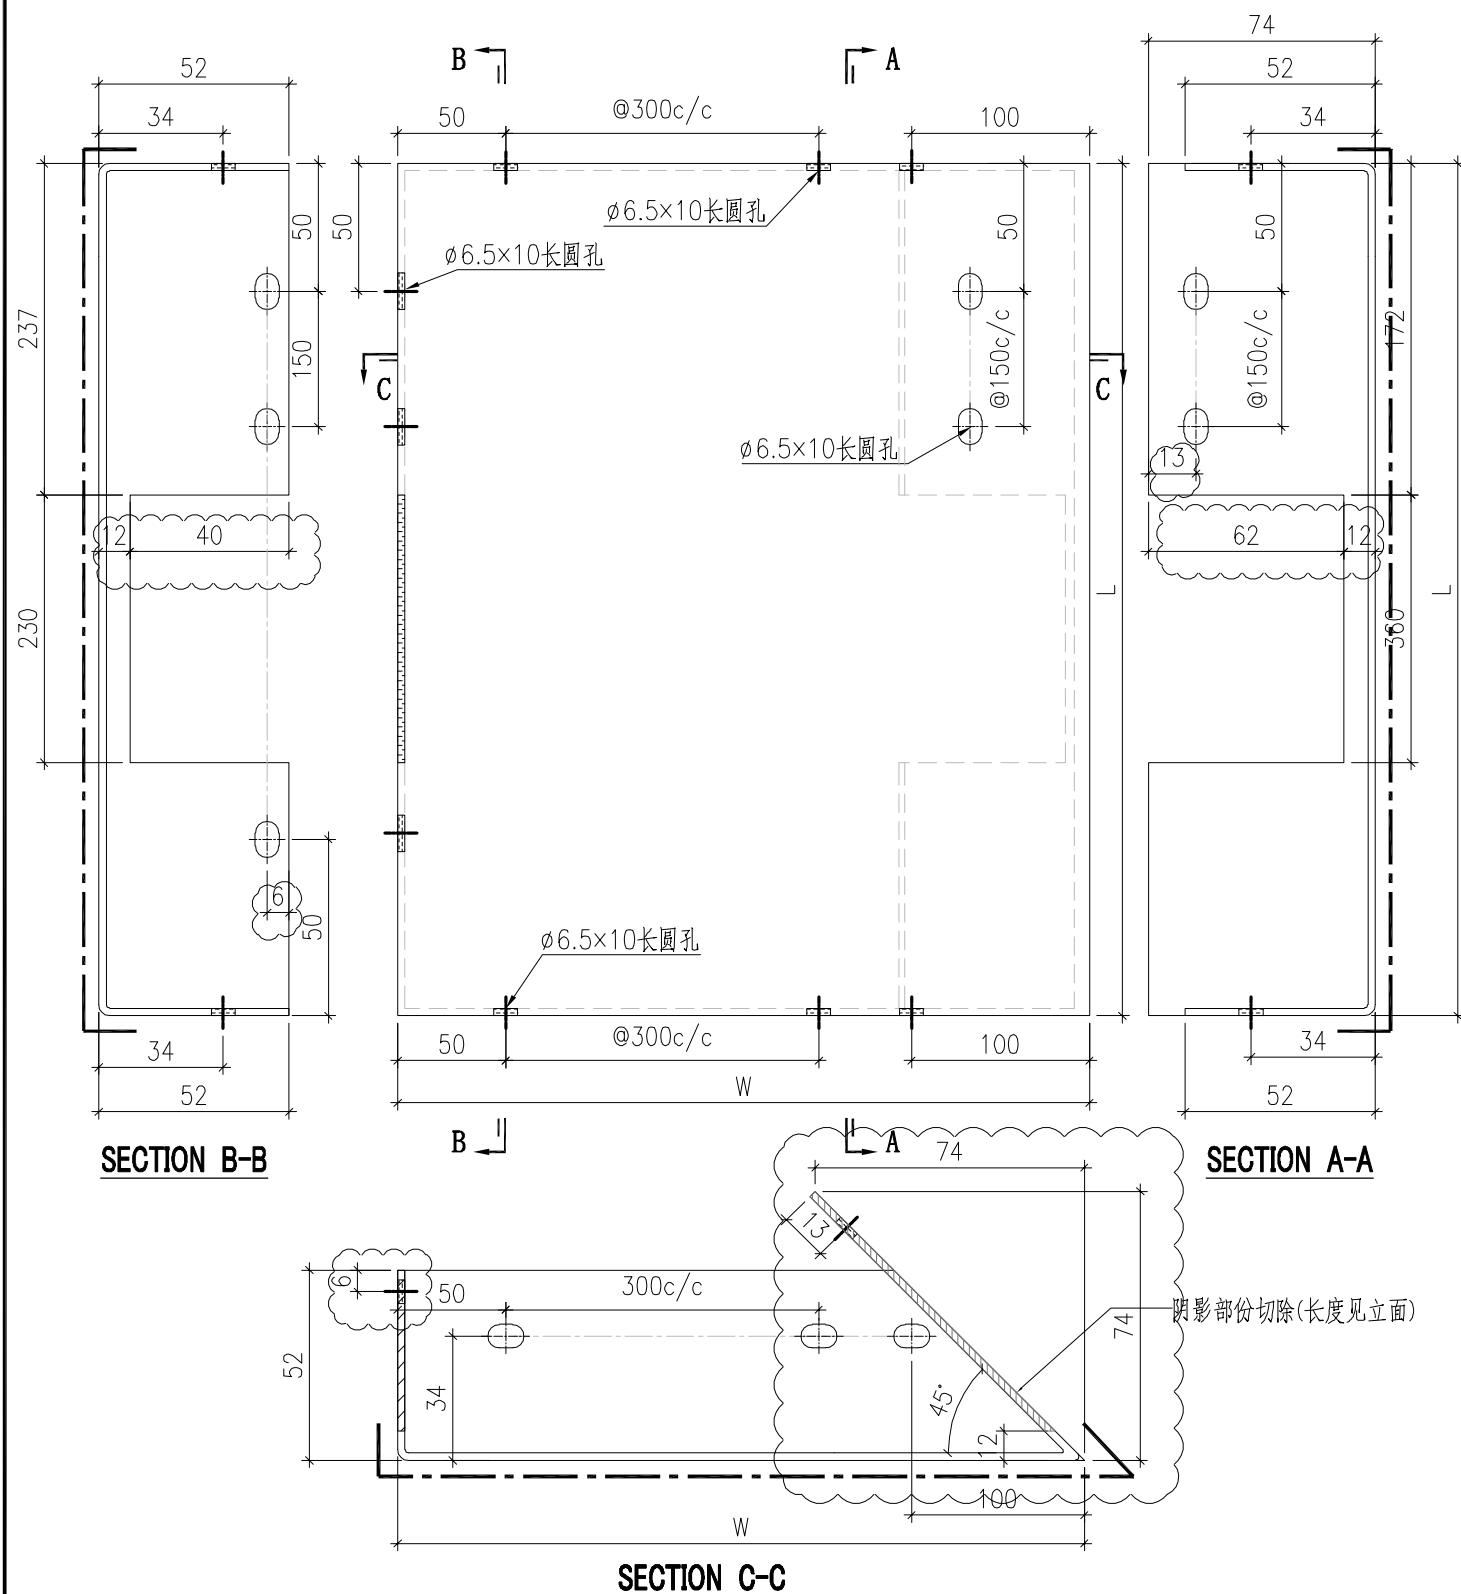


序號	鋁板編號	寬度 (W)	高度 (H)	數量
1	BST-EY001	740	552	1

 美特鋁質有限公司 MIDI Aluminium Fabricator Ltd.				工程號 J857	類別	物料號 -		
				地盘 啟德6552	制圖 刘灿	2021-12-14	圖號 BST-E02	
修改 A	-	-	採用工廠 ✓ 地盘	图纸名称 铝板加工图	復核 徐詳坤	2021-12-15	數量 -	
日期 2022.03.02	-	-	材料颜色 ECK3M96295S-ZD1	材料 3mm THK. 铝板	批准 林仁安	2021-12-16	單件重量 -	(KG)


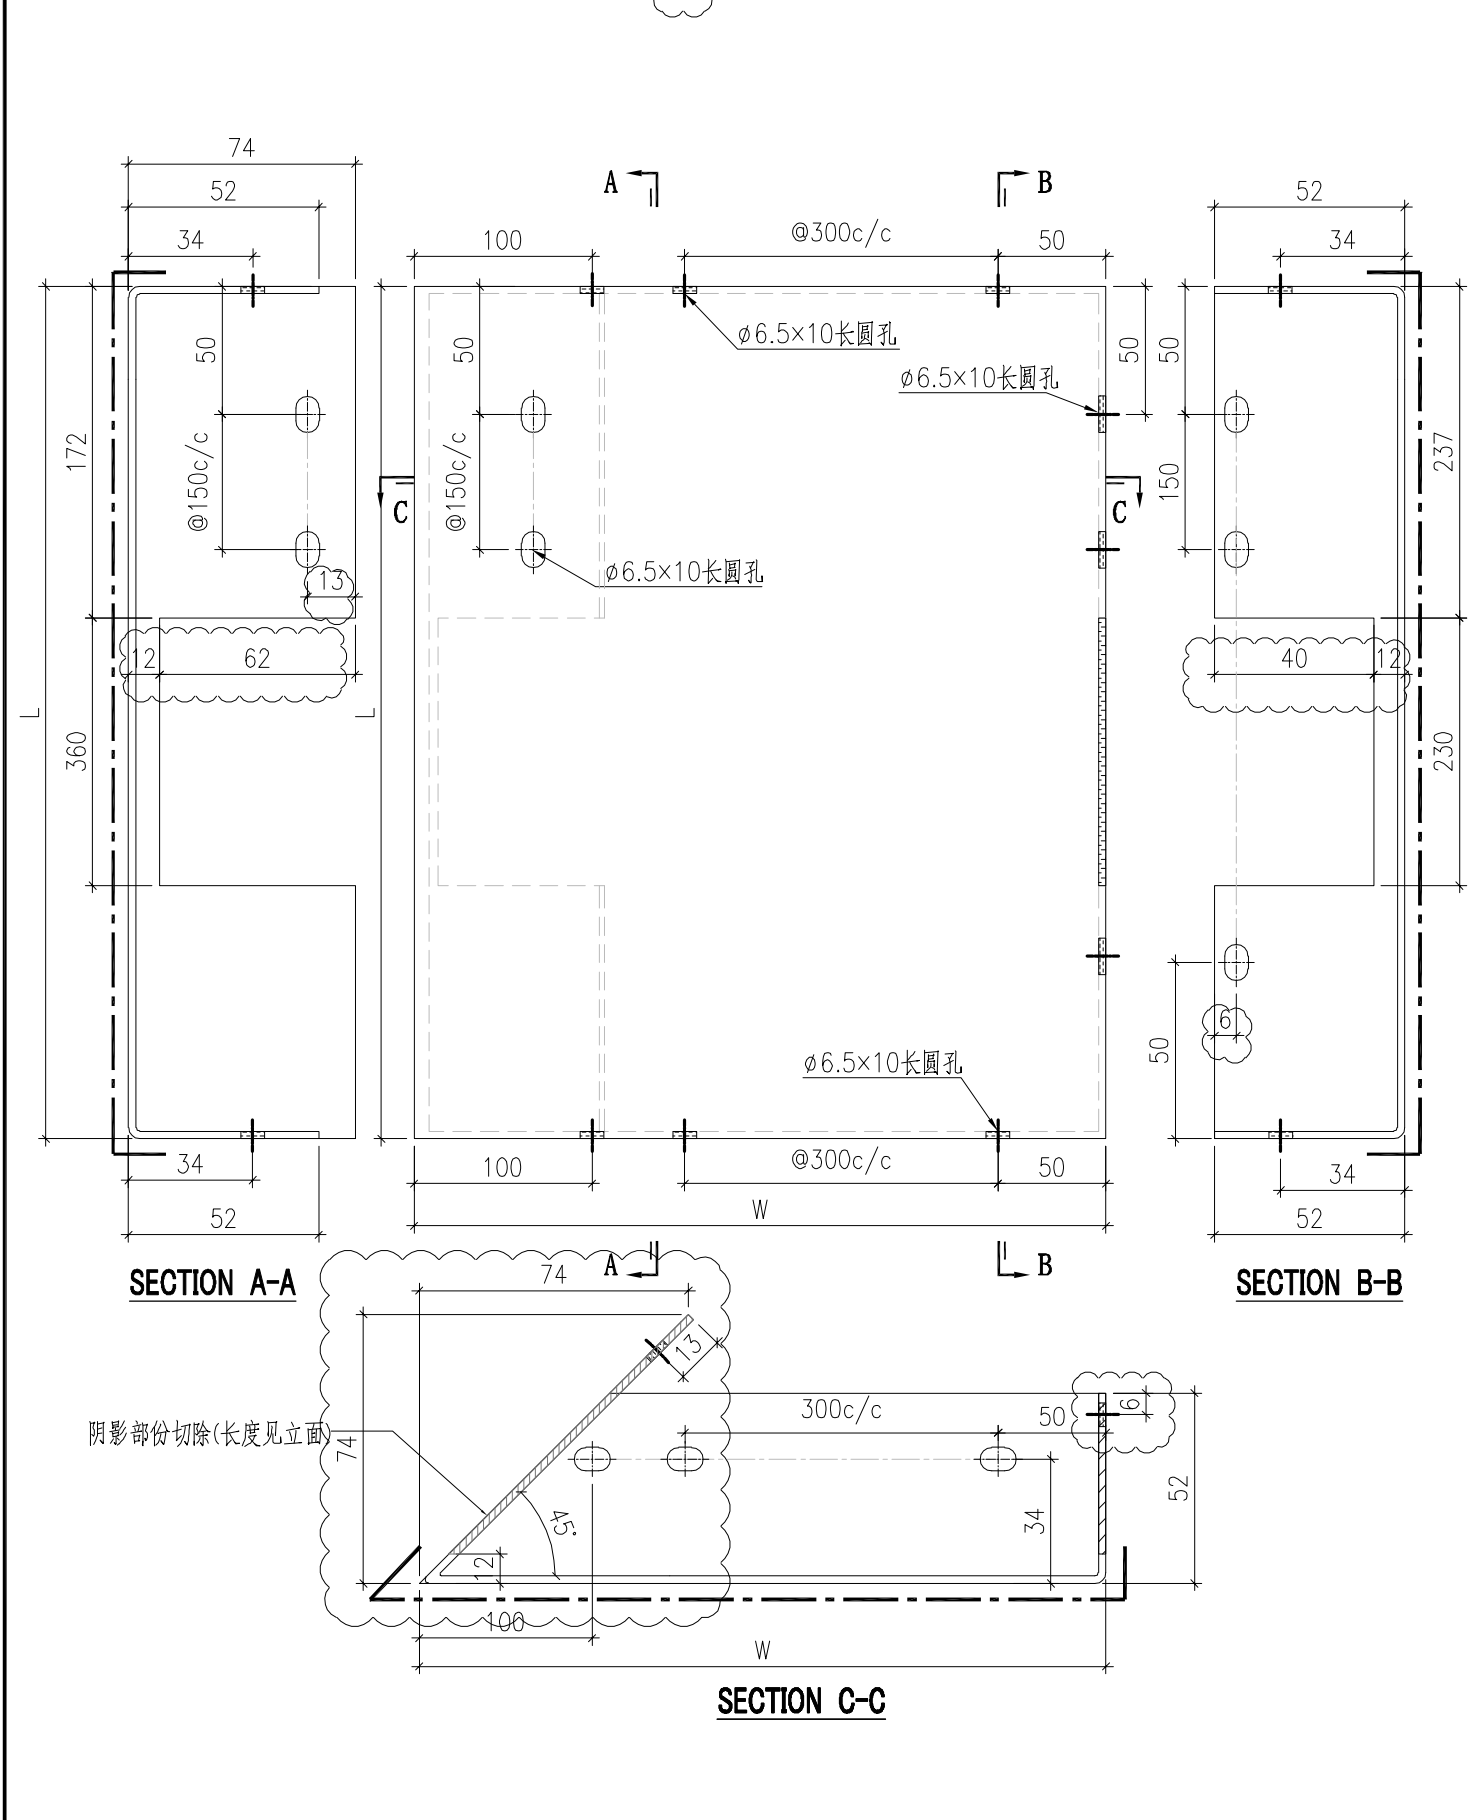


序號	鋁板編號	寬度 (W)	高度 (H)	數量
1	BST-EZ001	1601	552	1

 美特鋁質有限公司 MIDI Aluminium Fabricator Ltd.				工程號 J857 地盘 啟德6552	類別 制圖 刘灿	物料號 - 2021-12-14	圖號 BST-G01
修改 A 日期 2022.03.02	-	-	採用工廠 ✓ 材料颜色 BCK3M96295S-ZD1	图纸名称 铝板加工图 材料 3mm THK. 铝板	復核 徐詳坤 批准 林仁安	2021-12-15 2021-12-16	數量 - 單件重量 - (KG)

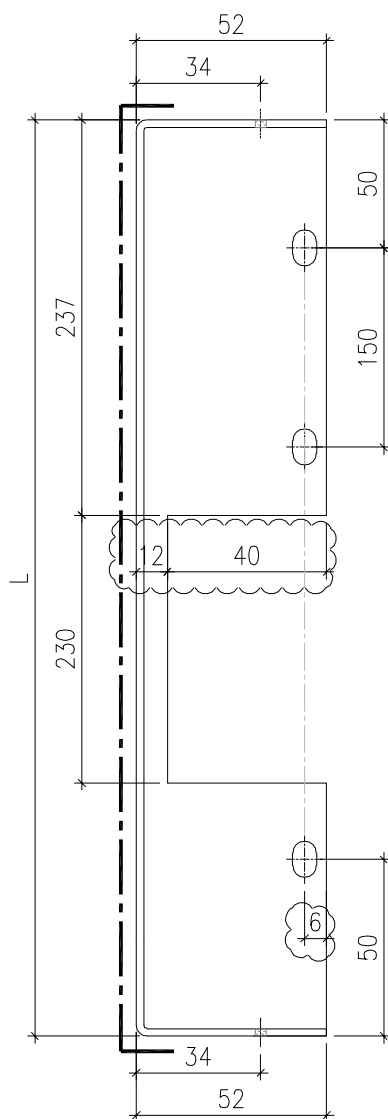

SECTION A-A

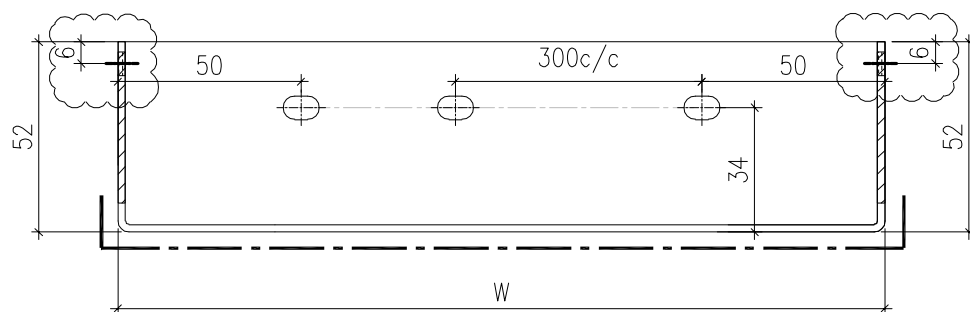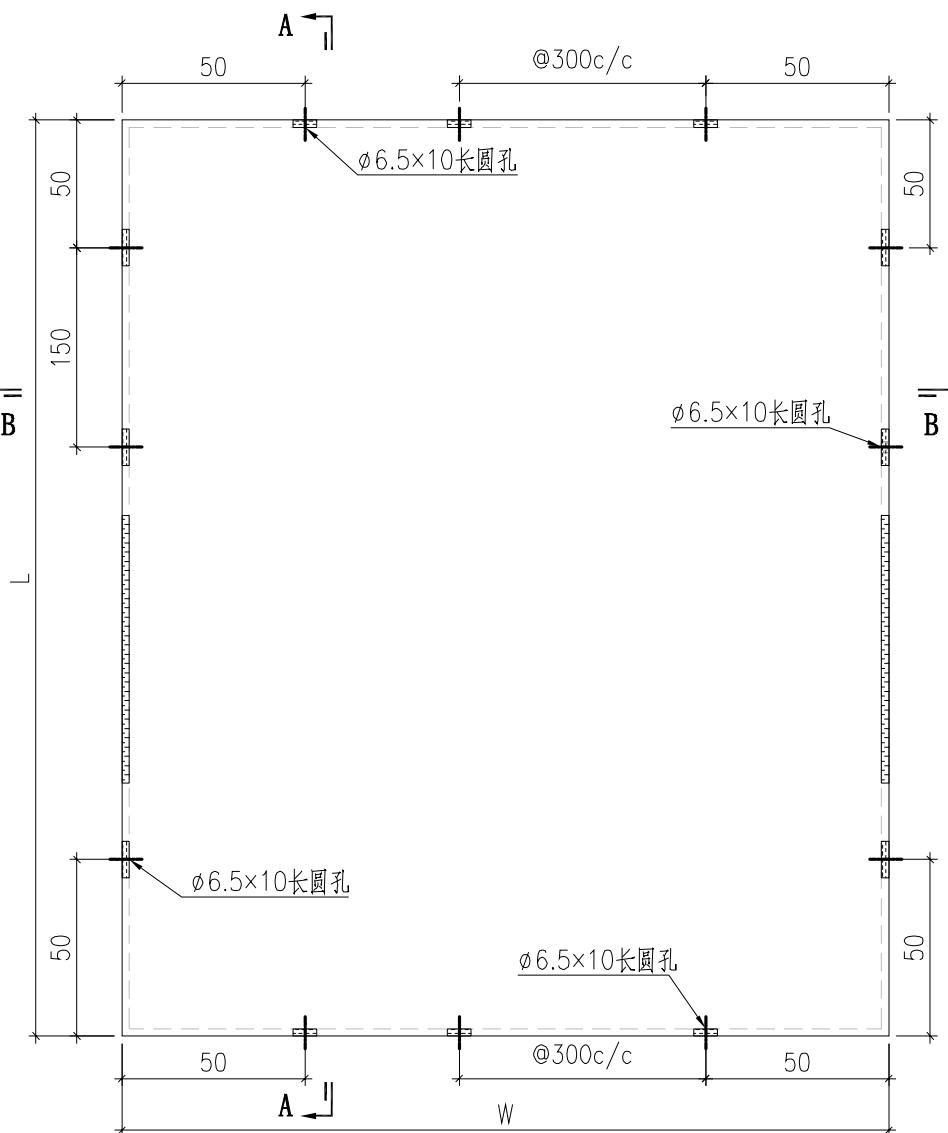


SECTION B-B

 美特鋁質有限公司 MIDI Aluminium Fabricator Ltd.				工程號	J857	類別		物料號	-					
				地盤	啟德6552	制圖	刘灿	2021-12-14	圖號	BST-G02				
修改	A	-	-	採用工廠	✓	地盤		圖紙名稱	铝板加工圖	復核	徐詳坤	2021-12-15	數量	-
日期	2022.03.02	-	-	材料顏色	ECK3M96295S-ZD1		材料	3mm THK. 铝板	批准	林仁安	2021-12-16	單件重量	-	(KG)

序號	鋁板編號	寬度 (W)	高度 (H)	數量
1	BST-G001	696	537	2
2	BST-G002	2024	537	2
3	BST-G003	445	537	2
4	BST-G004	1106	537	2
5	BST-G005	696	537	11
6	BST-G006	981	537	2
7	BST-G007	695	537	12
8	BST-G008	1285	537	6
9	BST-G009	676	537	7
10	BST-G010	956	537	4
11	BST-G011	972	537	3
12	BST-G012	446	537	7
13	BST-G013	1506	537	7
14	BST-G014	1040	537	4
15	BST-G016	1539	537	4
16	BST-G017	1994	537	4
17	BST-G018	746	537	8
18	BST-G019	1215	537	4
19	BST-G021	728	537	1
20	BST-G022	527	537	2
21	BST-G023	386	537	1
22	BST-G062	536	537	1
23	BST-G080	702	537	8
24	BST-G081	978	537	4
25	BST-G084	1536	537	1


 美特鋁質有限公司 MIDI Aluminium Fabricator Ltd.				工程號 J857	類別	物料號 -		
				地盤 啟德6552	制圖 刘灿	2021-12-14	圖號 BST-H01	
修改 A	-	-	採用工廠 ✓	地盤	图纸名称 铝板加工图	復核 徐詳坤	2021-12-15	數量 -
日期 2022.03.02	-	-	材料颜色 ECK3M96295S-ZD1		材料 3mm THK. 铝板	批准 林仁安	2021-12-16	單件重量 - (KG)

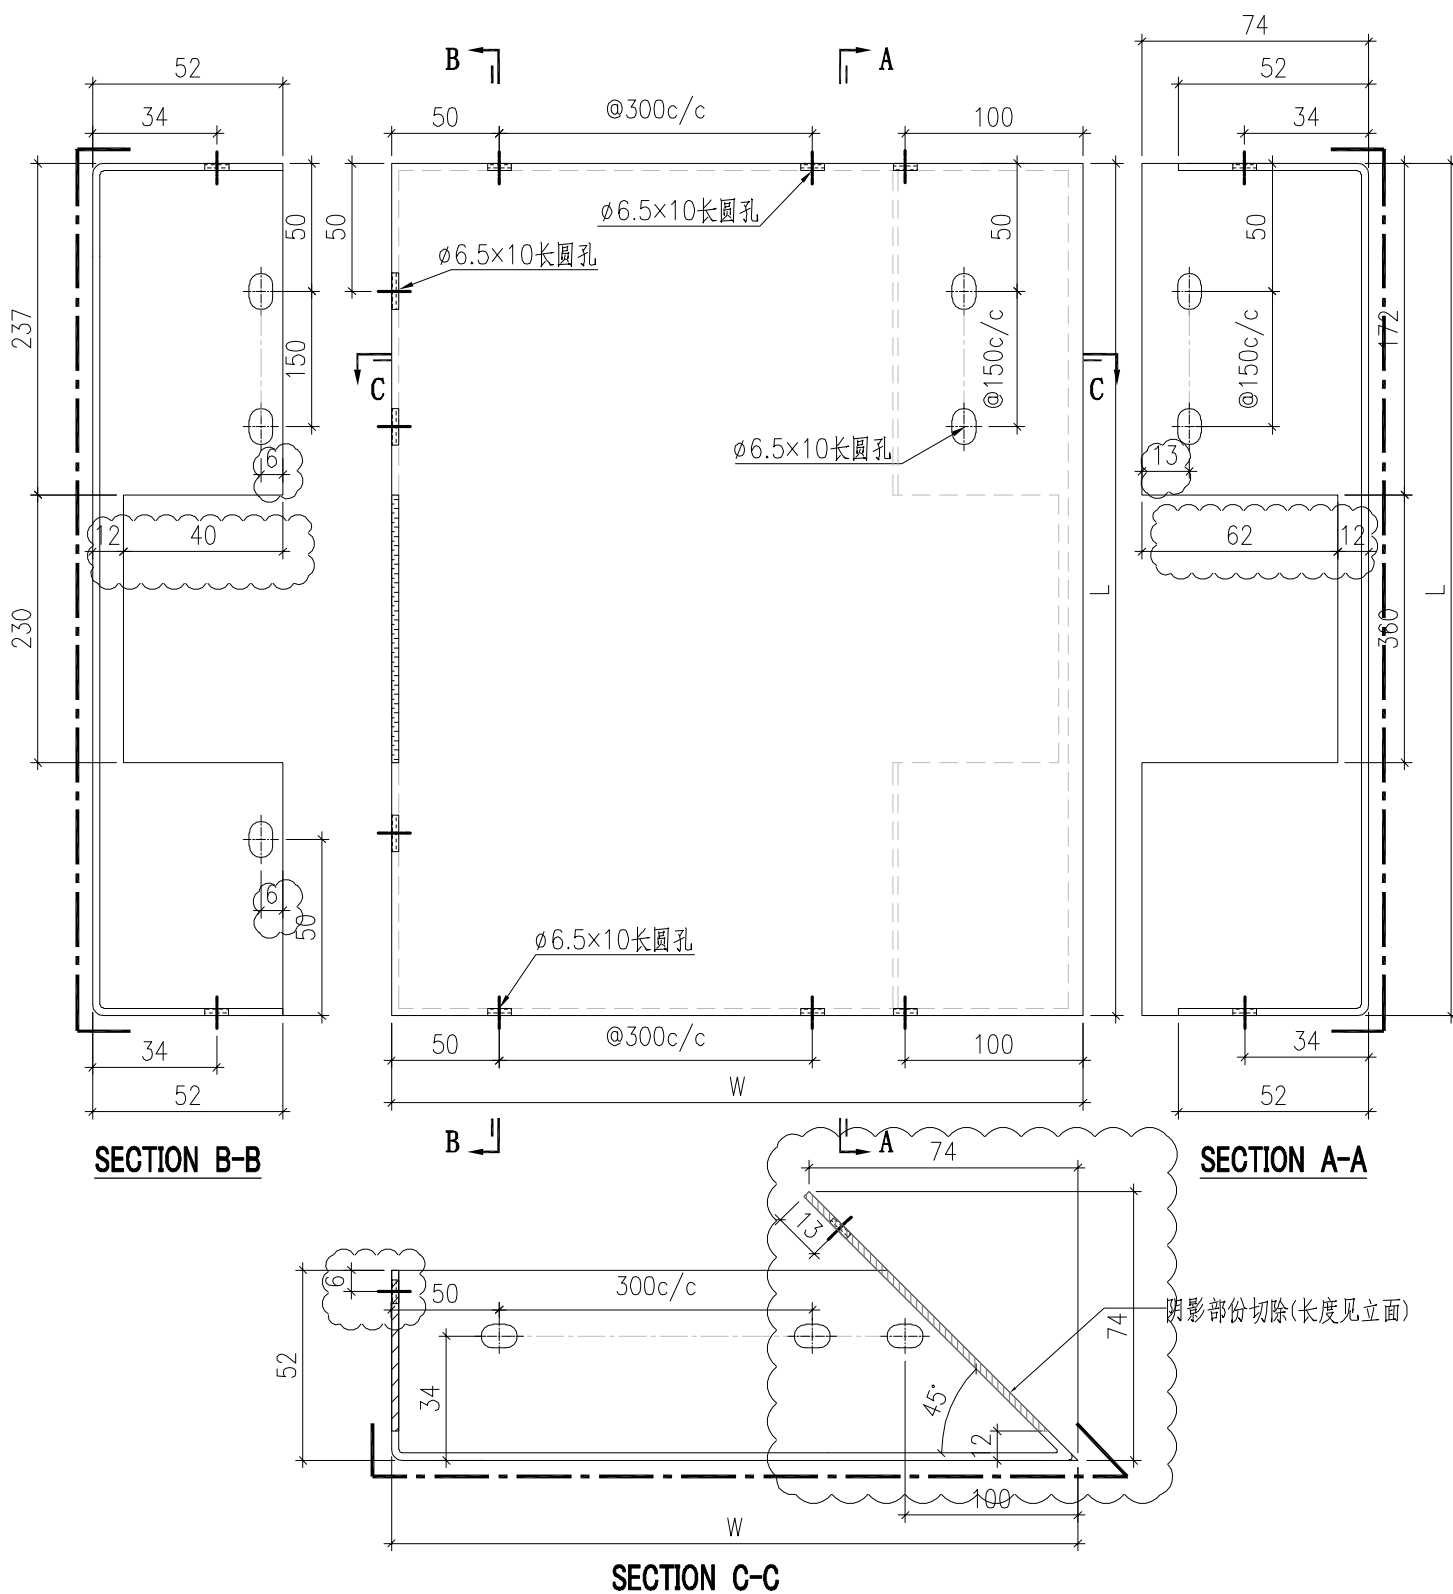

阴影部份切除(长度见立面)


序號	鋁板編號	寬度 (W)	高度 (H)	數量
1	BST-HY001	740	537	2
2	BST-HY003	2125	537	1
3	BST-HY014	1311	537	1

 美特鋁質有限公司 MIDI Aluminium Fabricator Ltd.				工程號 J857 地盘 啟德6552	類別 制圖 刘灿	物料號 - 2021-12-14	圖號 BST-H02
修改 A - - 採用工廠 ✓ 地盘	图纸名称 铝板加工图			復核 徐詳坤	2021-12-15	數量 -	
日期 2022.03.02 - - 材料颜色 BCK3M96295S-ZD1	材料 3mm THK. 铝板			批准 林仁安	2021-12-16	單件重量 - (KG)	

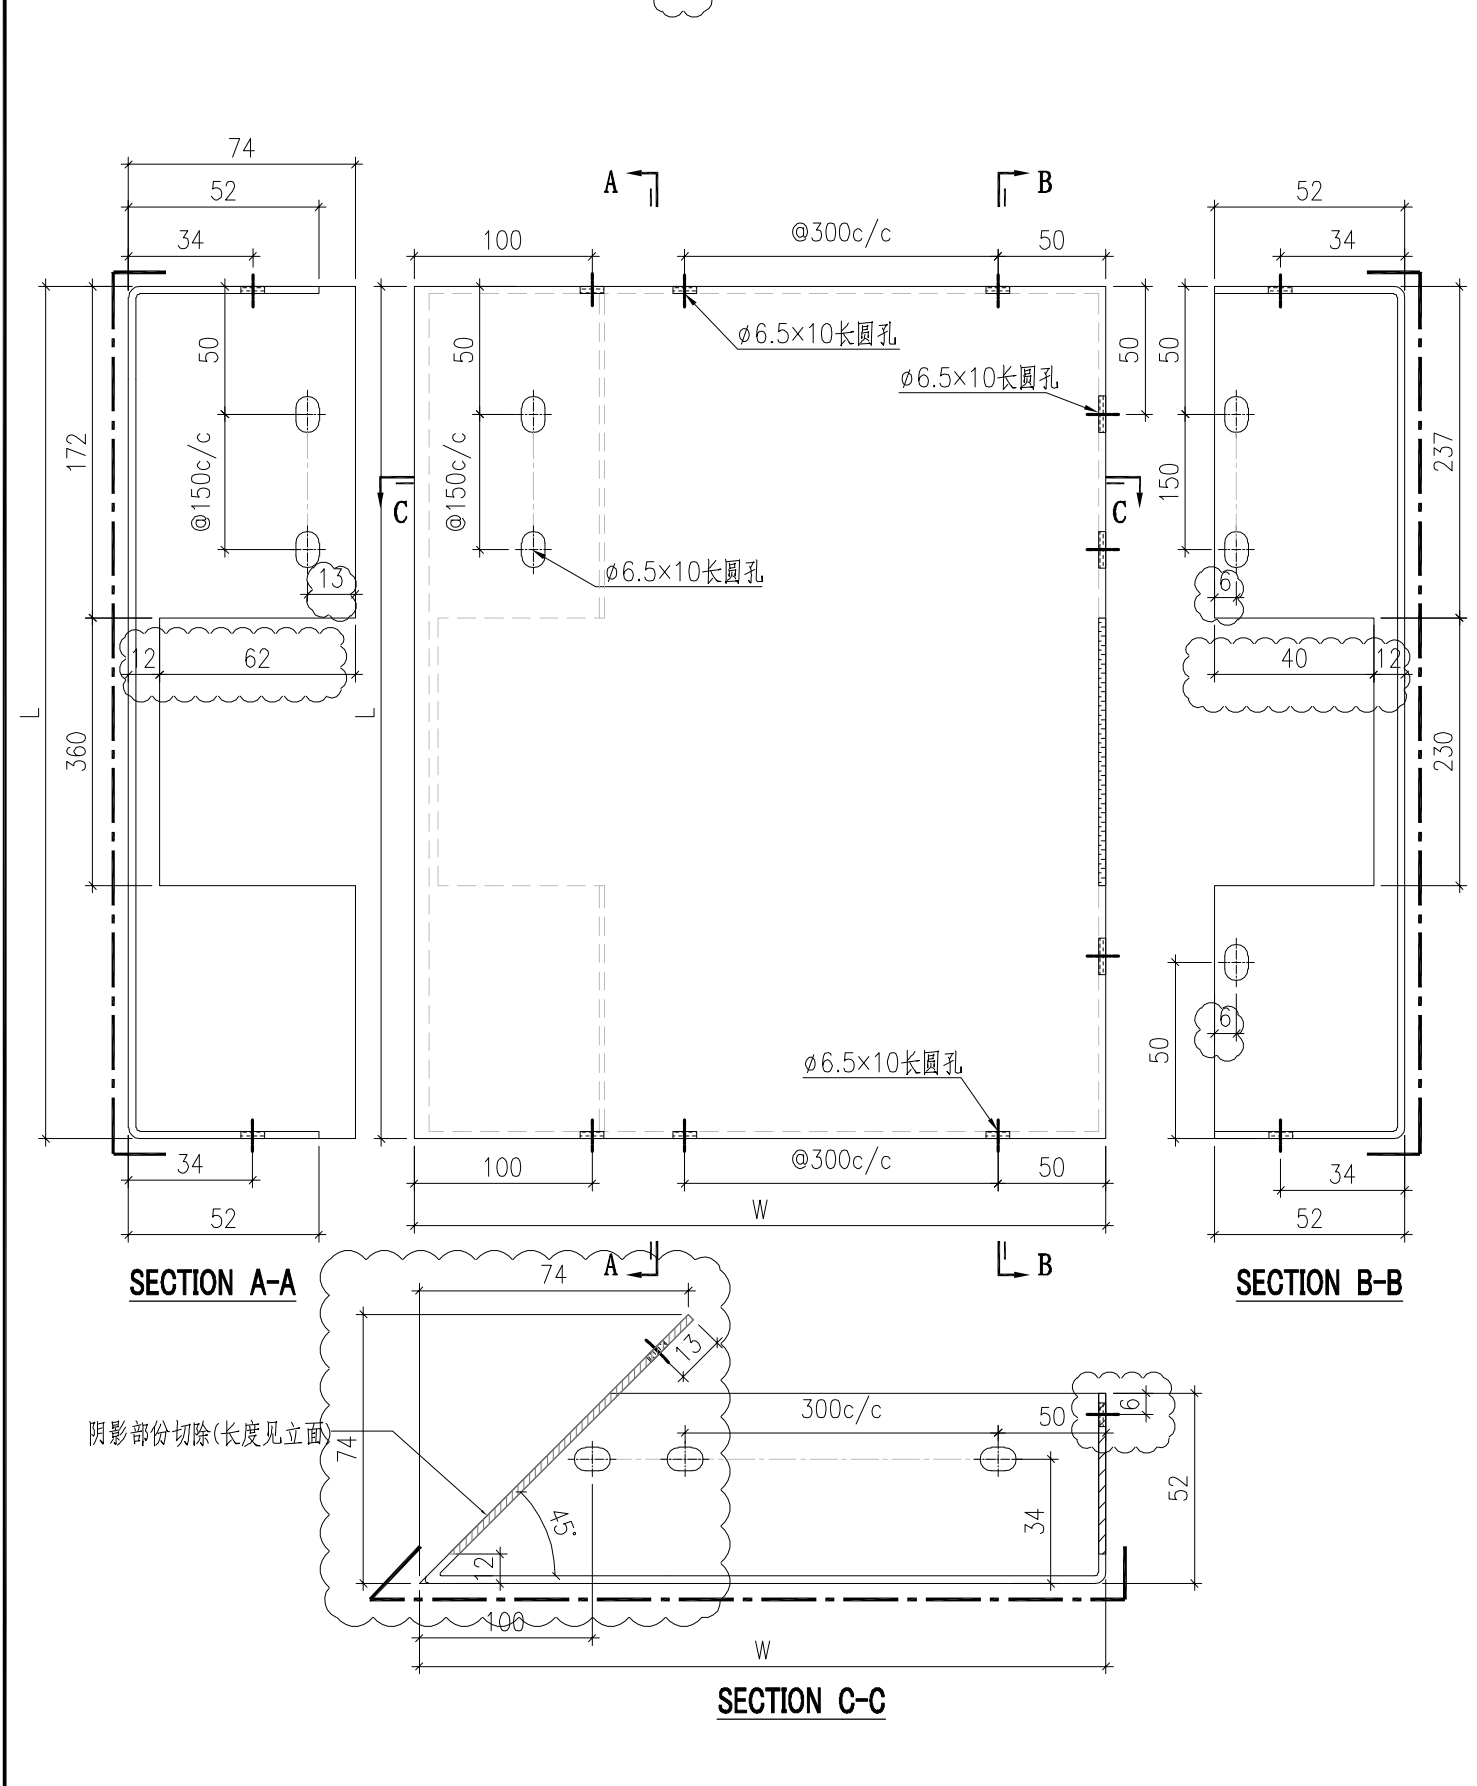


序號	鋁板編號	寬度 (W)	高度 (H)	數量
1	BST-HZ001	1601	537	2
2	BST-HZ004	1450	537	1
3	BST-HZ005	490	537	1

 美特鋁質有限公司 MIDI Aluminium Fabricator Ltd.				工程號 J857	類別	物料號 -		
				地盤 啟德6552	制圖 刘灿	2021-12-14	圖號 BST-J01	
修改 A - -	採用工廠 ✓	地盤	图纸名称 铝板加工图	復核 徐詳坤	2021-12-15	數量 -		
日期 2022.03.02	材料颜色 ECK3M96295S-ZD1		材料 3mm THK. 铝板	批准 林仁安	2021-12-16	單件重量 -	(KG)	

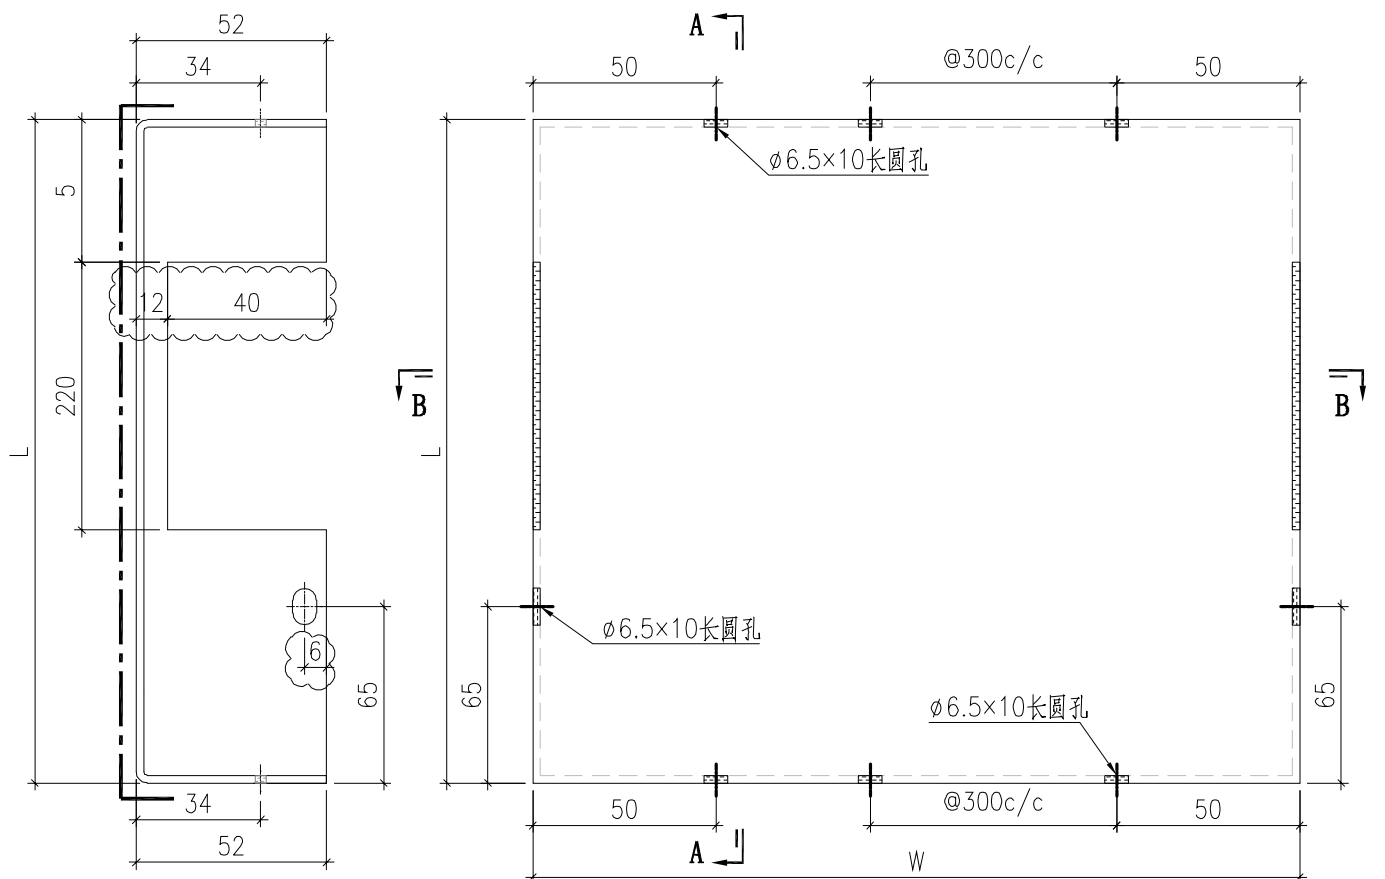


SECTION A-A

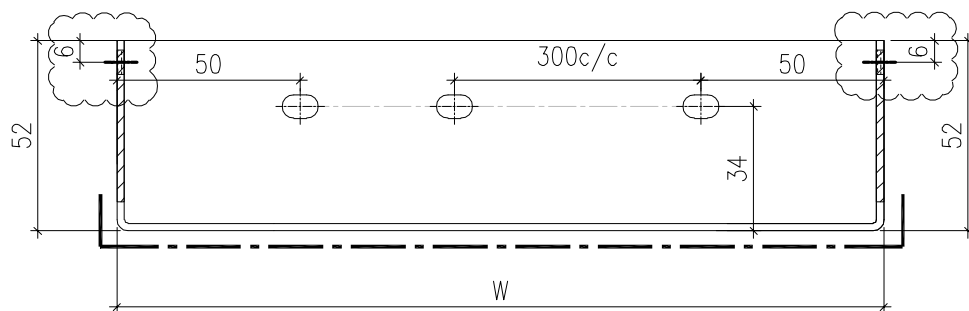

SECTION B-B



序號	鋁板編號	寬度 (W)	高度 (H)	數量
1	BST-J051	1236	354	1
2	BST-J052	612	354	2
3	BST-J053	1099	354	1
4	BST-J054	1361	354	1
5	BST-J055	749	354	1
6	BST-J056	624	354	1
7	BST-J057	1174	354	1
8	BST-J058	1411	354	1
9	BST-J059	556	354	1
10	BST-J060	481	354	2
11	BST-J061	1424	354	1
12	BST-J085	686	354	8

 美特鋁質有限公司 MIDI Aluminium Fabricator Ltd.				工程號 J857 地盤 啟德6552	類別 制圖 刘灿	物料號 - 2021-12-14	圖號 BST-N01
修改 A - - 日期 2022.03.02 - -	採用工廠 ✓ 材料颜色 ECK3M96295S-ZD1	地盤 材料 3mm THK. 铝板	图纸名称 铝板加工图	復核 徐詳坤 批准 林仁安	2021-12-15 2021-12-16	數量 - 單件重量 - (KG)	

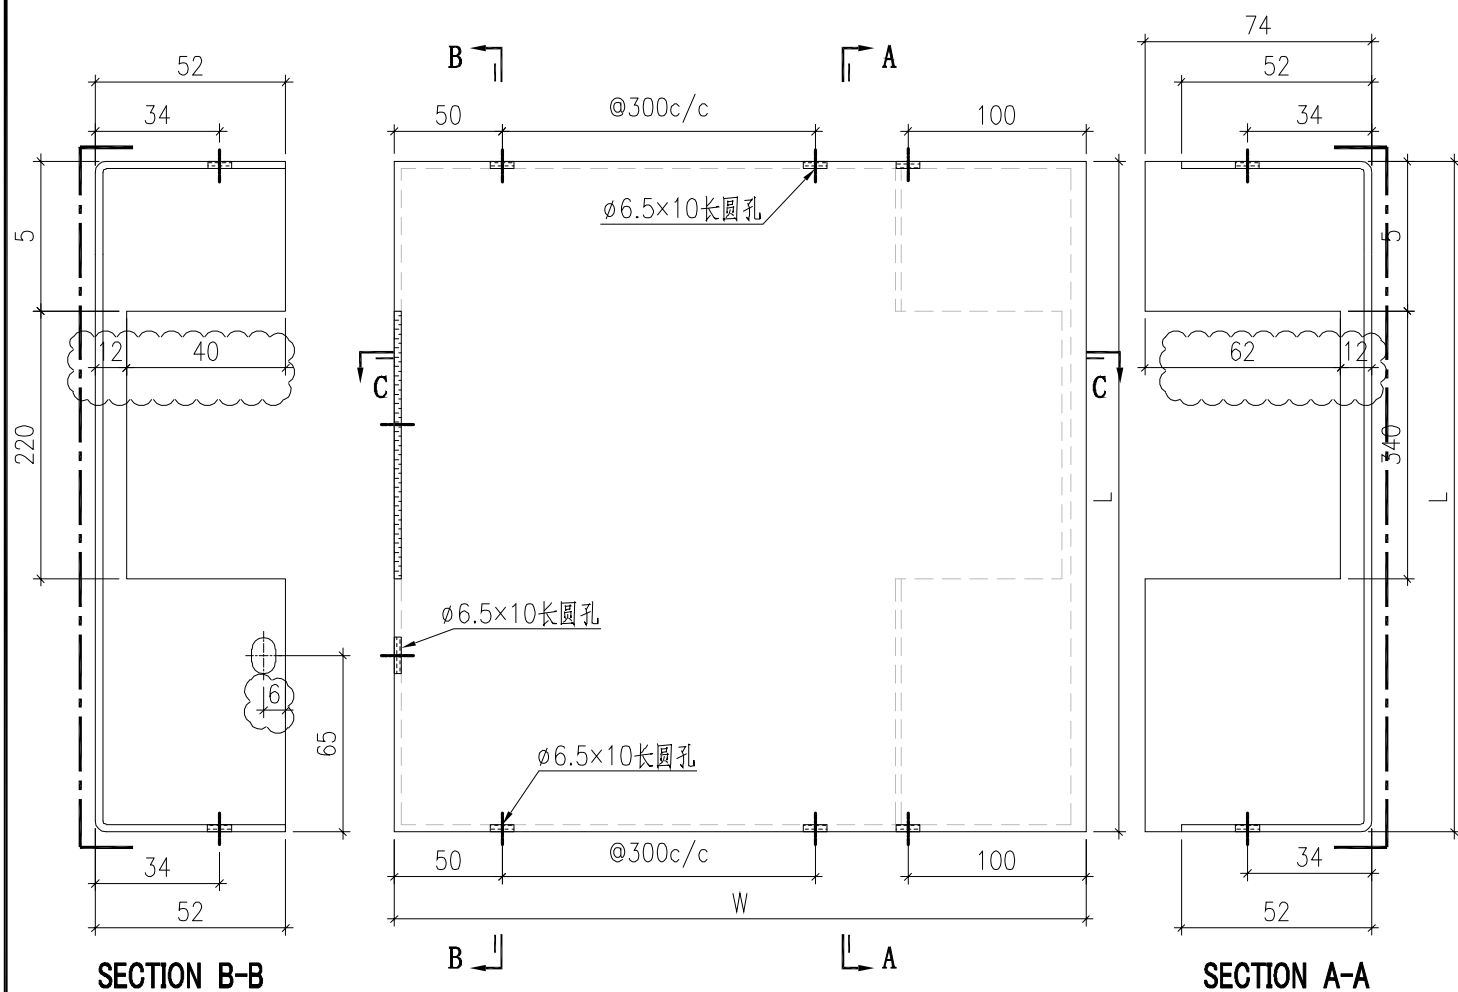


序號	鋁板編號	寬度 (W)	高度 (H)	數量
1	BST-NY018	585	354	1
2	BST-NY020	745	354	1

 美特鋁質有限公司 MIDI Aluminium Fabricator Ltd.				工程號 J857	類別	物料號 -		
				地盤 啟德6552	制圖 刘灿	2021-12-14	圖號 BST-N02	
修改 A	-	-	採用工廠 ✓ 地盤	图纸名称 铝板加工图	復核 徐詳坤	2021-12-15	數量 -	
日期 2022.03.02	-	-	材料颜色 ECK3M96295S-ZD1	材料 3mm THK. 铝板	批准 林仁安	2021-12-16	單件重量 -	(KG)

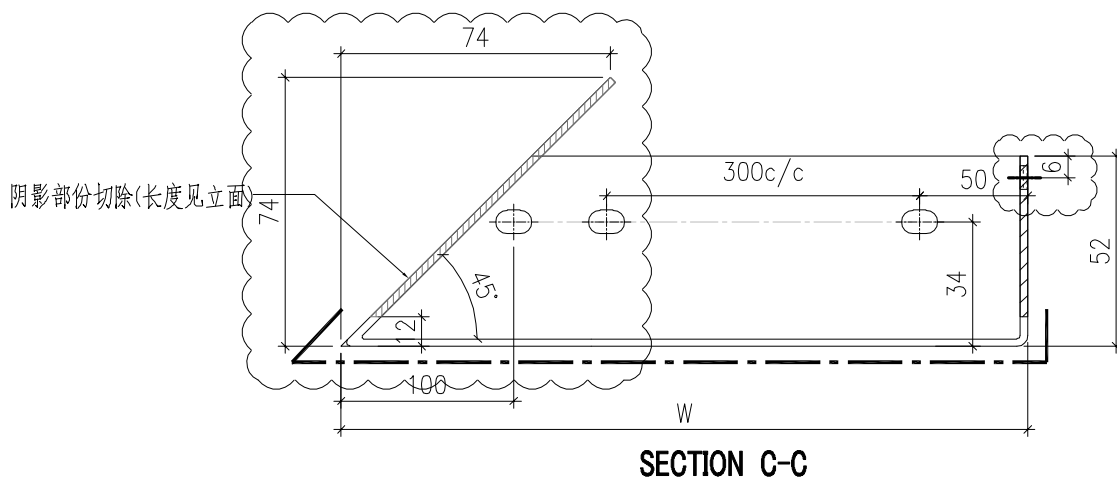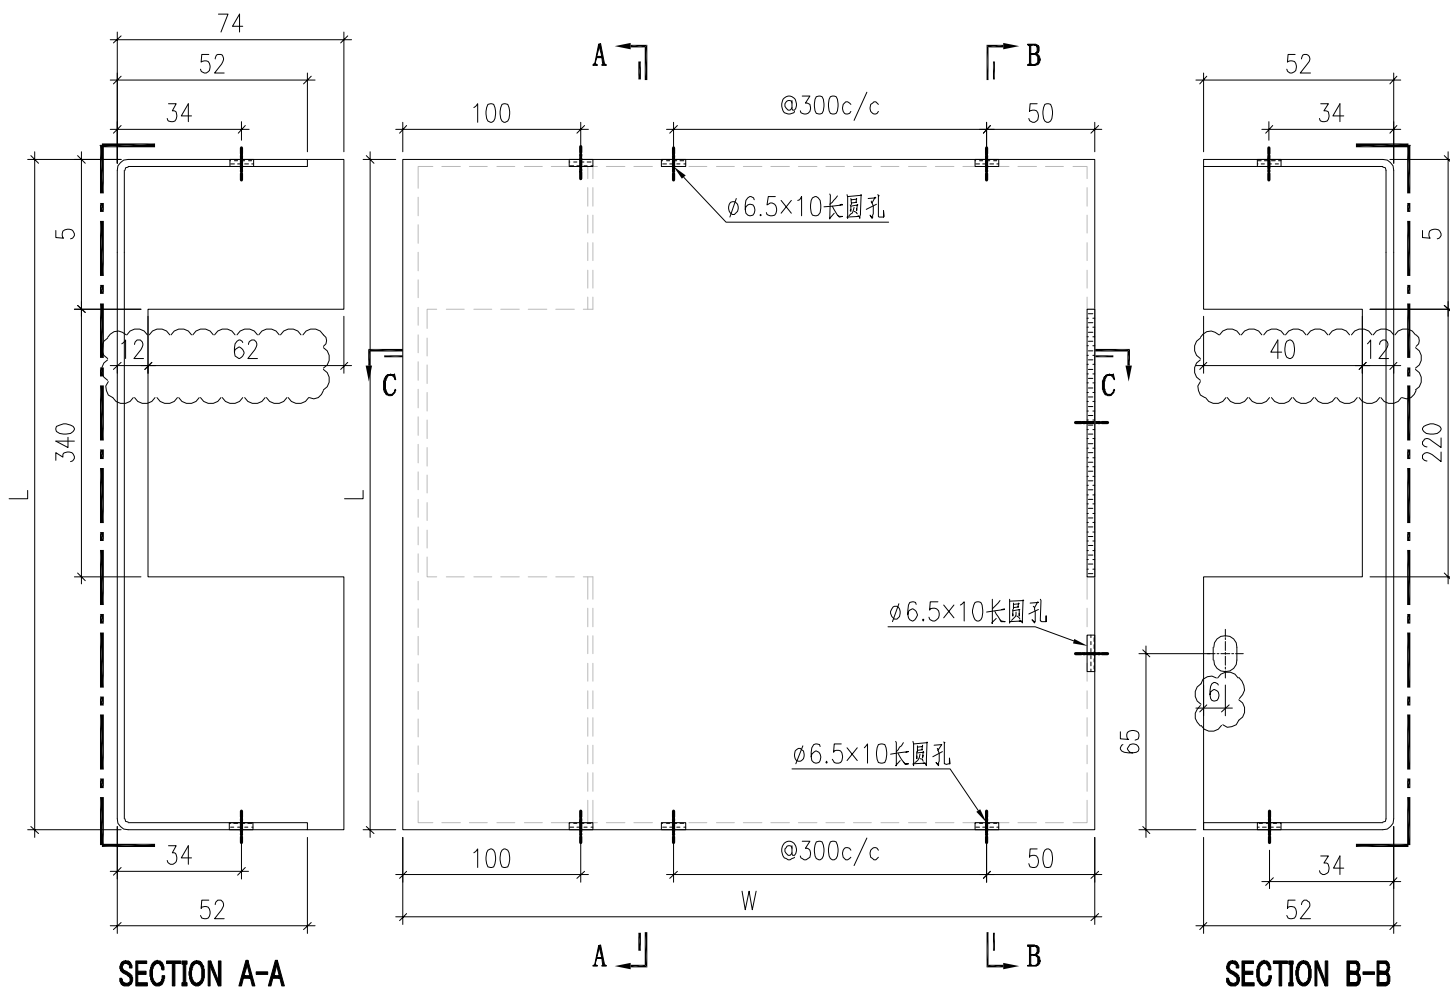

序號	鋁板編號	寬度 (W)	高度 (H)	數量
1	BST-NZ017	1873	354	1
2	BST-NZ019	745	354	1

 美特鋁質有限公司 MIDI Aluminium Fabricator Ltd.				工程號	J857	類別		物料號	-			
				地盘	啟德6552	制圖	刘灿	2021-12-14	圖號	BST-P01		
修改	A	-	-	採用工廠	✓ 地盘	图纸名称	铝板加工图	復核	徐詳坤	2021-12-15	數量	-
日期	2022.03.02	-	-	材料颜色	ECK3M96295S-ZD1	材料	3mm THK. 铝板	批准	林仁安	2021-12-16	單件重量	- (KG)

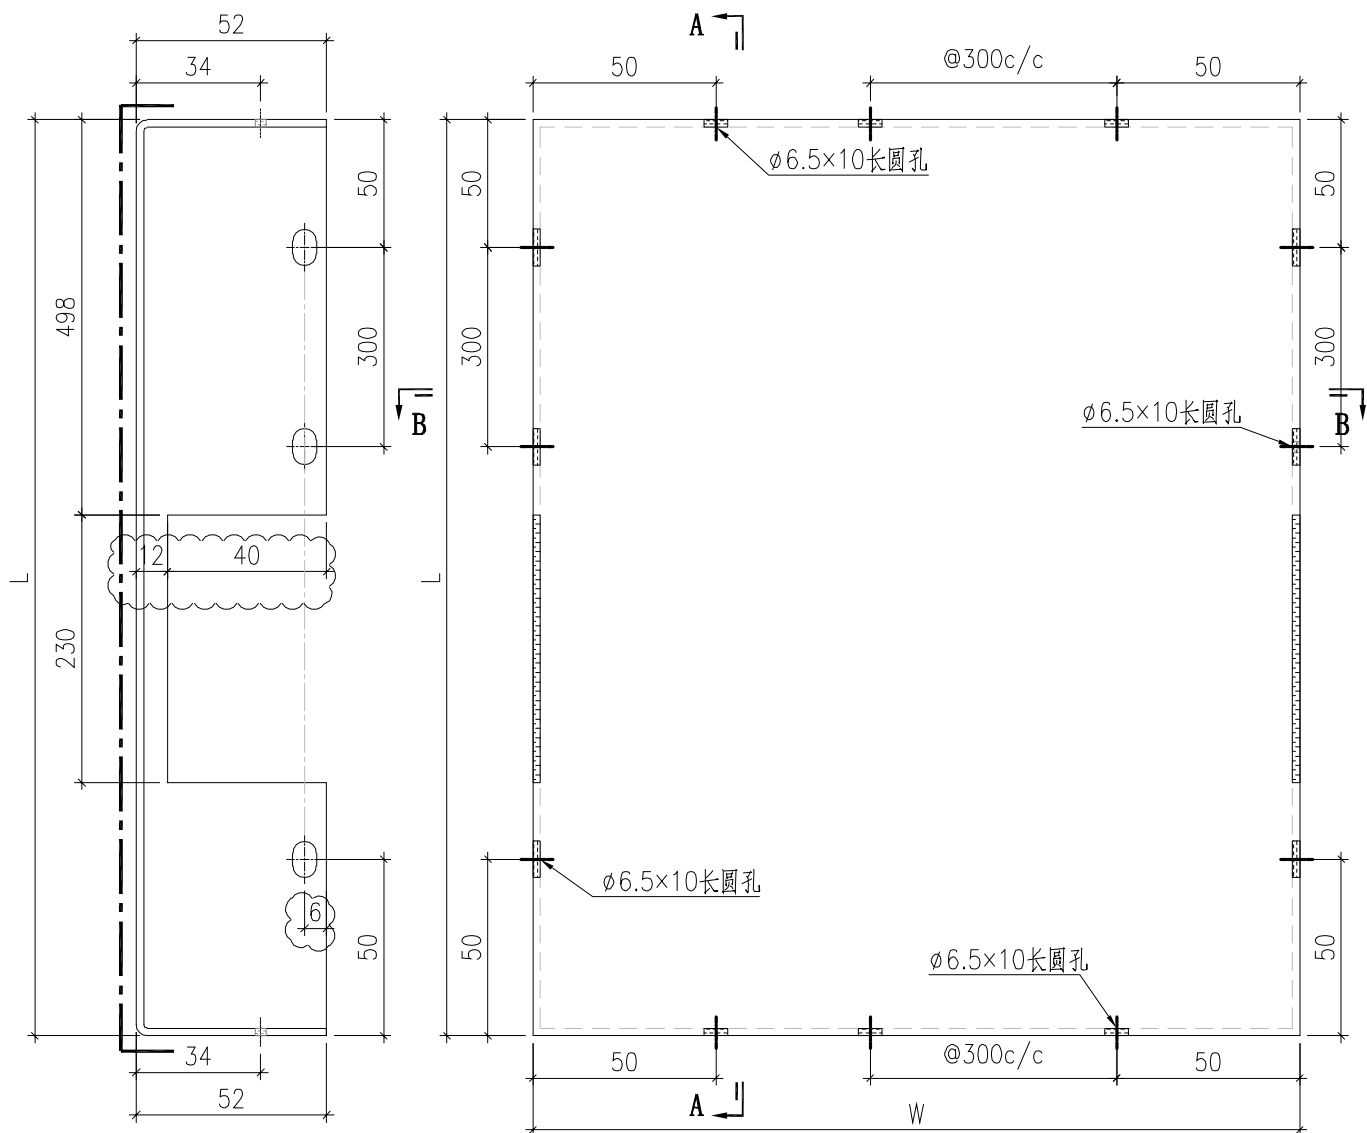


SECTION A-A

SECTION B-B

序號	鋁板編號	寬度 (W)	高度 (H)	數量
1	BST-P051	1236	876	1
2	BST-P052	612	876	1
3	BST-P060	481	876	1
4	BST-P061	1424	876	1
5	BST-P085	686	876	2

 美特鋁質有限公司 MIDI Aluminium Fabricator Ltd.				工程號 J857	類別	物料號 -		
				地盤 啟德6552	制圖 刘灿	2021-12-14	圖號 BST-Q01	
修改 A	-	-	採用工廠 ✓ 地盤	图纸名称 铝板加工图	復核 徐詳坤	2021-12-15	數量 -	
日期 2022.03.02	-	-	材料颜色 ECK3M96295S-ZD1	材料 3mm THK. 铝板	批准 林仁安	2021-12-16	單件重量 -	(KG)

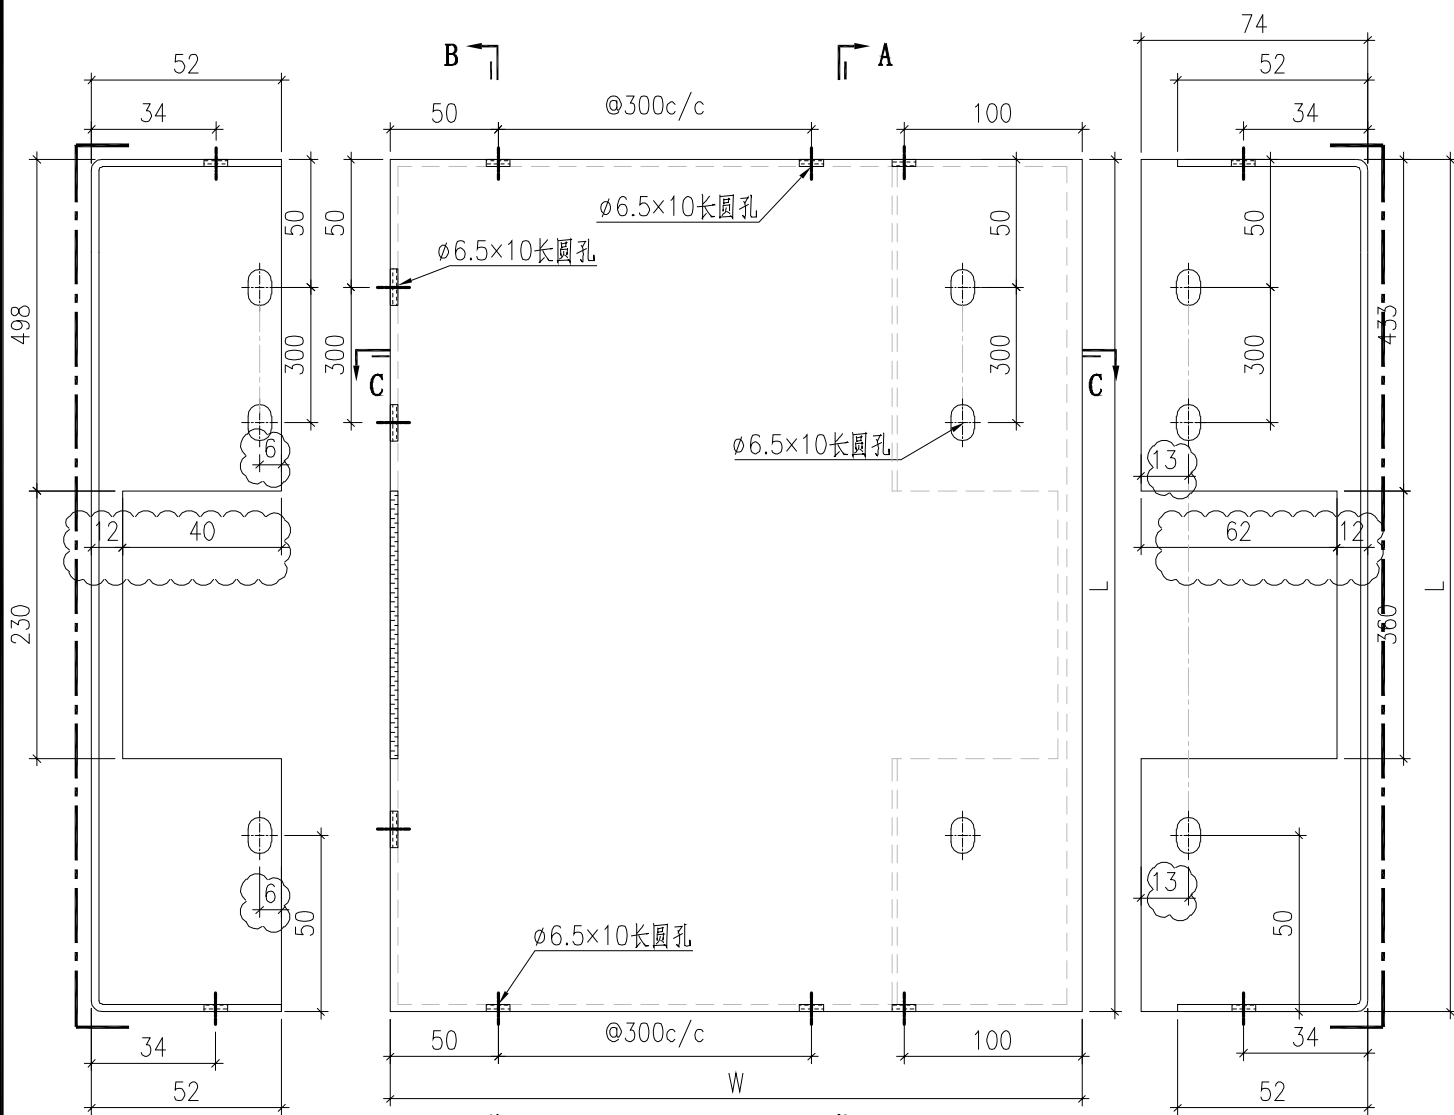


SECTION B-B

SECTION A-A

SECTION C-C

序號	鋁板編號	寬度 (W)	高度 (H)	數量
1	BST-QY020	745	876	1


 美特鋁質有限公司 MIDI Aluminium Fabricator Ltd.				工程號 J857	類別	物料號 -		
				地盤 啟德6552	制圖 刘灿	2021-12-14	圖號 BST-Q02	
修改 A	-	-	採用工廠 ✓ 地盤	图纸名称 铝板加工图	復核 徐詳坤	2021-12-15	數量 -	
日期 2022.03.02	-	-	材料颜色 ECK3M96295S-ZD1	材料 3mm THK. 铝板	批准 林仁安	2021-12-16	單件重量 -	(KG)

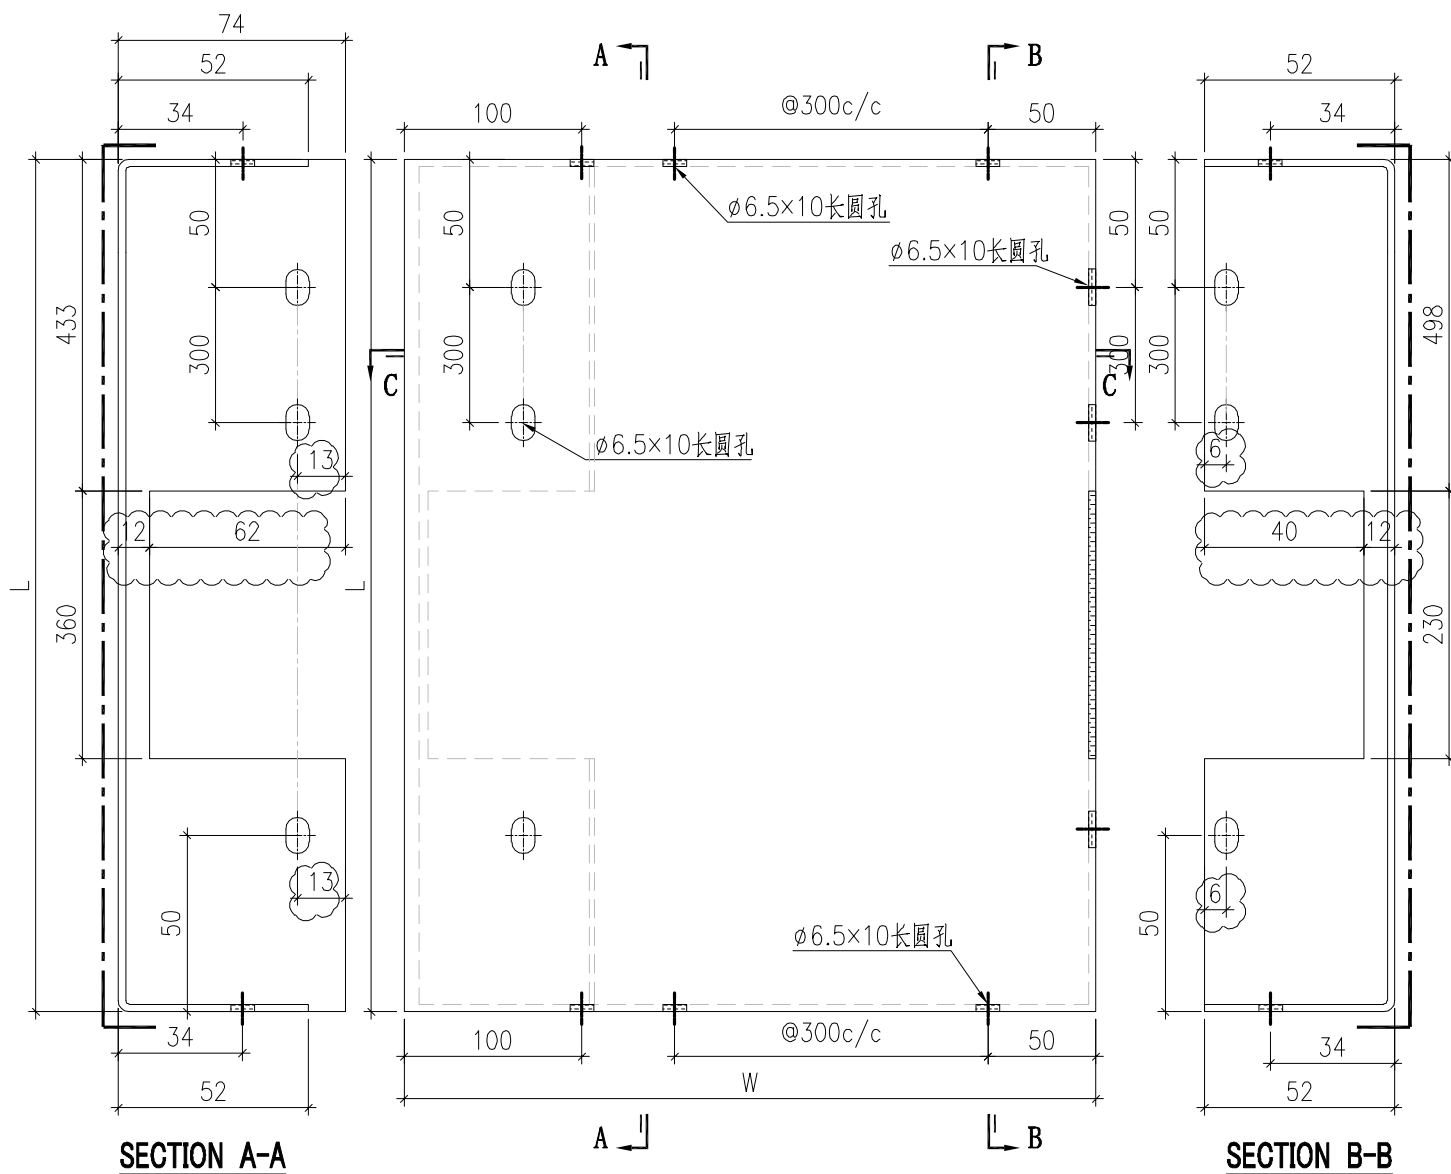

阴影部份切除(长度见立面)


序號	鋁板編號	寬度 (W)	高度 (H)	數量
2	BST-QZ017	1873	876	1

 美特鋁質 有限公司 MIDI Aluminium Fabricator Ltd.		工程號: J-857	計算: 刘灿	日期: 2022.01.06	送呈: 施哥								
		地盤名稱: 啟德6552	核對: 徐祥坤	日期: 2022.01.07	副本: 细佬								
廠用鋁板B.M表		項目類別: 第二批	批准: 林仁安	日期: 2022.01.12									
BM編號:	修改版次: C	A/C Code: 2022.03.05	總V.F.: 924.686	總重量: 6486.22									
序號	修改內容	鋁板圖號	鋁板名稱	顏色	實用	後備	總數	總重量	單件展開面積	總展開面積	單件V.F.	總V.F.	圖紙編號
									平方米				
1		BST-CY001	3mm厚鋁板	ECK3M96295S-ZD1	7	0	7	24.557	0.647	4.531	0.477	3.342	BST-C01
2		BST-CY003	3mm厚鋁板	ECK3M96295S-ZD1	7	0	7	63.967	1.686	11.802	1.372	9.605	BST-C01
3		BST-CY007	3mm厚鋁板	ECK3M96295S-ZD1	30	0	30	235.851	1.451	43.515	1.169	35.078	BST-C01
4		BST-CY008	3mm厚鋁板	ECK3M96295S-ZD1	30	0	30	141.828	0.872	26.168	0.671	20.136	BST-C01
5		BST-CY011	3mm厚鋁板	ECK3M96295S-ZD1	10	0	10	52.195	0.963	9.630	0.749	7.494	BST-C01
6		BST-CY013	3mm厚鋁板	ECK3M96295S-ZD1	10	0	10	41.178	0.760	7.598	0.574	5.743	BST-C01
7		BST-CY014	3mm厚鋁板	ECK3M96295S-ZD1	7	0	7	40.804	1.076	7.529	0.846	5.924	BST-C01
8		BST-CY015	3mm厚鋁板	ECK3M96295S-ZD1	11	0	11	22.894	0.384	4.224	0.251	2.757	BST-C03
9		BST-CZ001	3mm厚鋁板	ECK3M96295S-ZD1	7	0	7	49.056	1.293	9.051	1.034	7.235	BST-C02
10	C修改	BST-CZ004	3mm厚鋁板	ECK3M96295S-ZD1	0	0	0	0.000	1.180	0.000	0.936	0.000	BST-C02
11		BST-CZ005	3mm厚鋁板	ECK3M96295S-ZD1	7	0	7	17.443	0.460	3.218	0.316	2.211	BST-C02
12		BST-CZ006	3mm厚鋁板	ECK3M96295S-ZD1	30	0	30	235.851	1.451	43.515	1.169	35.078	BST-C02
13		BST-CZ009	3mm厚鋁板	ECK3M96295S-ZD1	30	0	30	141.828	0.872	26.168	0.671	20.136	BST-C02
14		BST-CZ010	3mm厚鋁板	ECK3M96295S-ZD1	10	0	10	68.048	1.256	12.555	1.001	10.013	BST-C02
15		BST-CZ012	3mm厚鋁板	ECK3M96295S-ZD1	11	0	11	31.614	0.530	5.833	0.377	4.143	BST-C02
16		BST-CZ016	3mm厚鋁板	ECK3M96295S-ZD1	11	0	11	61.751	1.036	11.393	0.812	8.932	BST-C04
17	C新增	BST-CZ030	3mm厚鋁板	ECK3M96295S-ZD1	7	0	7	44.902	1.184	8.285	0.939	6.575	BST-C05
18		BST-D001	3mm厚鋁板	ECK3M96295S-ZD1	2	0	2	5.689	0.525	1.050	0.384	0.768	BST-D01
19		BST-D002	3mm厚鋁板	ECK3M96295S-ZD1	2	0	2	15.132	1.396	2.792	1.117	2.234	BST-D01
20		BST-D003	3mm厚鋁板	ECK3M96295S-ZD1	2	0	2	3.904	0.360	0.720	0.246	0.491	BST-D01
21		BST-D004	3mm厚鋁板	ECK3M96295S-ZD1	2	0	2	8.604	0.794	1.588	0.611	1.221	BST-D01
22		BST-D005	3mm厚鋁板	ECK3M96295S-ZD1	12	0	12	34.133	0.525	6.298	0.384	4.610	BST-D01
23		BST-D006	3mm厚鋁板	ECK3M96295S-ZD1	2	0	2	7.715	0.712	1.424	0.542	1.083	BST-D01

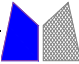 美特鋁質 有限公司 MIDI Aluminium Fabricator Ltd.		工程號: J-857	計算: 刘灿	日期: 2022.01.06	送呈: 施哥								
		地盤名稱: 啟德6552	核對: 徐祥坤	日期: 2022.01.07	副本: 细佬								
廠用鋁板B.M表		項目類別: 第二批	批准: 林仁安	日期: 2022.01.12									
BM編號:	修改版次: C	A/C Code: 2022.03.05	總V.F.: 924.686	總重量: 6486.22									
序號	修改內容	鋁板圖號	鋁板名稱	顏色	實用	後備	總數	總重量	單件展開面積	總展開面積	單件V.F.	總V.F.	圖紙編號
									平方米				
24		BST-D007	3mm厚鋁板	ECK3M96295S-ZD1	16	0	16	45.454	0.524	8.386	0.384	6.138	BST-D01
25		BST-D008	3mm厚鋁板	ECK3M96295S-ZD1	8	0	8	39.509	0.911	7.289	0.709	5.675	BST-D01
26		BST-D009	3mm厚鋁板	ECK3M96295S-ZD1	8	0	8	22.186	0.512	4.093	0.373	2.985	BST-D01
27		BST-D010	3mm厚鋁板	ECK3M96295S-ZD1	6	0	6	22.613	0.695	4.172	0.528	3.166	BST-D01
28		BST-D011	3mm厚鋁板	ECK3M96295S-ZD1	4	0	4	15.303	0.706	2.823	0.537	2.146	BST-D01
29		BST-D012	3mm厚鋁板	ECK3M96295S-ZD1	8	0	8	15.644	0.361	2.886	0.246	1.970	BST-D01
30		BST-D013	3mm厚鋁板	ECK3M96295S-ZD1	8	0	8	45.795	1.056	8.449	0.831	6.650	BST-D01
31		BST-D014	3mm厚鋁板	ECK3M96295S-ZD1	4	0	4	16.270	0.750	3.002	0.574	2.296	BST-D01
32		BST-D016	3mm厚鋁板	ECK3M96295S-ZD1	4	0	4	23.367	1.078	4.311	0.850	3.398	BST-D01
33		BST-D017	3mm厚鋁板	ECK3M96295S-ZD1	4	0	4	29.838	1.376	5.505	1.101	4.403	BST-D01
34		BST-D018	3mm厚鋁板	ECK3M96295S-ZD1	8	0	8	24.178	0.558	4.461	0.412	3.294	BST-D01
35		BST-D019	3mm厚鋁板	ECK3M96295S-ZD1	4	0	4	18.759	0.865	3.461	0.671	2.683	BST-D01
36		BST-D021	3mm厚鋁板	ECK3M96295S-ZD1	2	0	2	5.916	0.546	1.092	0.402	0.804	BST-D01
37	C修改	BST-D022	3mm厚鋁板	ECK3M96295S-ZD1	0	0	0	0.000	0.414	0.000	0.291	0.000	BST-D01
38		BST-D023	3mm厚鋁板	ECK3M96295S-ZD1	2	0	2	3.484	0.321	0.643	0.213	0.426	BST-D01
39		BST-D062	3mm厚鋁板	ECK3M96295S-ZD1	2	0	2	4.551	0.420	0.840	0.296	0.592	BST-D01
40		BST-D080	3mm厚鋁板	ECK3M96295S-ZD1	10	0	10	28.657	0.529	5.287	0.388	3.875	BST-D01
41		BST-D081	3mm厚鋁板	ECK3M96295S-ZD1	4	0	4	15.388	0.710	2.839	0.540	2.159	BST-D01
42		BST-D084	3mm厚鋁板	ECK3M96295S-ZD1	2	0	2	11.662	1.076	2.152	0.848	1.696	BST-D01
43	C新增	BST-D090	3mm厚鋁板	ECK3M96295S-ZD1	4	0	4	9.102	0.420	1.679	0.296	1.183	BST-D03
44		BST-EY001	3mm厚鋁板	ECK3M96295S-ZD1	2	0	2	6.137	0.566	1.132	0.408	0.816	BST-E01
45		BST-EY003	3mm厚鋁板	ECK3M96295S-ZD1	2	0	2	15.986	1.475	2.949	1.172	2.345	BST-E01
46		BST-EY014	3mm厚鋁板	ECK3M96295S-ZD1	2	0	2	10.197	0.941	1.881	0.723	1.446	BST-E01


 美特鋁質 有限公司 MIDI Aluminium Fabricator Ltd.		工程號: J-857	計算: 刘灿	日期: 2022.01.06	送呈: 施哥								
		地盤名稱: 啟德6552	核對: 徐祥坤	日期: 2022.01.07	副本: 细佬								
廠用鋁板B.M表		項目類別: 第二批	批准: 林仁安	日期: 2022.01.12									
BM編號:	修改版次: C	A/C Code: 2022.03.05	總V.F.: 924.686	總重量: 6486.22									
序號	修改內容	鋁板圖號	鋁板名稱	顏色	實用	後備	總數	總重量	單件展開面積	總展開面積	單件V.F.	總V.F.	圖紙編號
									平方米				
47		BST-EZ001	3mm厚鋁板	ECK3M96295S-ZD1	2	0	2	12.259	1.131	2.262	0.883	1.766	BST-E02
48	C修改	BST-EZ004	3mm厚鋁板	ECK3M96295S-ZD1	0	0	0	0.000	1.032	0.000	0.800	0.000	BST-E02
49		BST-EZ005	3mm厚鋁板	ECK3M96295S-ZD1	2	0	2	4.359	0.402	0.804	0.270	0.540	BST-E02
50	C新增	BST-EZ030	3mm厚鋁板	ECK3M96295S-ZD1	2	0	2	11.221	1.035	2.070	0.803	1.605	BST-E03
51		BST-F001	3mm厚鋁板	ECK3M96295S-ZD1	49	0	49	515.809	1.942	95.168	1.613	79.034	BST-F01
52		BST-G001	3mm厚鋁板	ECK3M96295S-ZD1	1	0	1	2.779	0.513	0.513	0.374	0.374	BST-G01
53		BST-G002	3mm厚鋁板	ECK3M96295S-ZD1	1	0	1	7.393	1.364	1.364	1.087	1.087	BST-G01
54		BST-G003	3mm厚鋁板	ECK3M96295S-ZD1	1	0	1	1.907	0.352	0.352	0.239	0.239	BST-G01
55		BST-G004	3mm厚鋁板	ECK3M96295S-ZD1	1	0	1	4.204	0.776	0.776	0.594	0.594	BST-G01
56		BST-G005	3mm厚鋁板	ECK3M96295S-ZD1	6	0	6	16.676	0.513	3.077	0.374	2.243	BST-G01
57		BST-G006	3mm厚鋁板	ECK3M96295S-ZD1	1	0	1	3.770	0.695	0.695	0.527	0.527	BST-G01
58		BST-G007	3mm厚鋁板	ECK3M96295S-ZD1	8	0	8	22.207	0.512	4.097	0.373	2.986	BST-G01
59		BST-G008	3mm厚鋁板	ECK3M96295S-ZD1	4	0	4	19.303	0.890	3.561	0.690	2.760	BST-G01
60		BST-G009	3mm厚鋁板	ECK3M96295S-ZD1	4	0	4	10.840	0.500	2.000	0.363	1.452	BST-G01
61		BST-G010	3mm厚鋁板	ECK3M96295S-ZD1	3	0	3	11.048	0.679	2.038	0.513	1.540	BST-G01
62		BST-G011	3mm厚鋁板	ECK3M96295S-ZD1	2	0	2	7.477	0.690	1.379	0.522	1.044	BST-G01
63		BST-G012	3mm厚鋁板	ECK3M96295S-ZD1	4	0	4	7.643	0.353	1.410	0.240	0.958	BST-G01
64		BST-G013	3mm厚鋁板	ECK3M96295S-ZD1	4	0	4	22.374	1.032	4.128	0.809	3.235	BST-G01
65		BST-G014	3mm厚鋁板	ECK3M96295S-ZD1	2	0	2	7.949	0.733	1.467	0.558	1.117	BST-G01
66		BST-G016	3mm厚鋁板	ECK3M96295S-ZD1	2	0	2	11.416	1.053	2.106	0.826	1.653	BST-G01
67		BST-G017	3mm厚鋁板	ECK3M96295S-ZD1	2	0	2	14.578	1.345	2.690	1.071	2.142	BST-G01
68		BST-G018	3mm厚鋁板	ECK3M96295S-ZD1	4	0	4	11.812	0.545	2.179	0.401	1.602	BST-G01
69		BST-G019	3mm厚鋁板	ECK3M96295S-ZD1	2	0	2	9.165	0.845	1.691	0.652	1.305	BST-G01

 美特鋁質 有限公司 MIDI Aluminium Fabricator Ltd.		工程號: J-857	計算: 刘灿	日期: 2022.01.06	送呈: 施哥								
		地盤名稱: 啟德6552	核對: 徐祥坤	日期: 2022.01.07	副本: 细佬								
廠用鋁板B.M表		項目類別: 第二批	批准: 林仁安	日期: 2022.01.12									
BM編號:	修改版次: C	A/C Code: 2022.03.05	總V.F.: 924.686	總重量: 6486.22									
序號	修改內容	鋁板圖號	鋁板名稱	顏色	實用	後備	總數	總重量	單件展開面積	總展開面積	單件V.F.	總V.F.	圖紙編號
									平方米				
70		BST-G021	3mm厚鋁板	ECK3M96295S-ZD1	1	0	1	2.891	0.533	0.533	0.391	0.391	BST-G01
71	C修改	BST-G022	3mm厚鋁板	ECK3M96295S-ZD1	0	0	0	0.000	0.404	0.000	0.283	0.000	BST-G01
72		BST-G023	3mm厚鋁板	ECK3M96295S-ZD1	1	0	1	1.702	0.314	0.314	0.207	0.207	BST-G01
73		BST-G062	3mm厚鋁板	ECK3M96295S-ZD1	1	0	1	2.224	0.410	0.410	0.288	0.288	BST-G01
74		BST-G080	3mm厚鋁板	ECK3M96295S-ZD1	5	0	5	14.001	0.517	2.583	0.377	1.885	BST-G01
75		BST-G081	3mm厚鋁板	ECK3M96295S-ZD1	2	0	2	7.518	0.694	1.387	0.525	1.050	BST-G01
76		BST-G084	3mm厚鋁板	ECK3M96295S-ZD1	1	0	1	5.698	1.051	1.051	0.825	0.825	BST-G01
77	C新增	BST-G090	3mm厚鋁板	ECK3M96295S-ZD1	2	0	2	4.447	0.410	0.820	0.288	0.576	BST-G03
78		BST-HY001	3mm厚鋁板	ECK3M96295S-ZD1	1	0	1	2.998	0.553	0.553	0.397	0.397	BST-H01
79		BST-HY003	3mm厚鋁板	ECK3M96295S-ZD1	1	0	1	7.810	1.441	1.441	1.141	1.141	BST-H01
80		BST-HY014	3mm厚鋁板	ECK3M96295S-ZD1	1	0	1	4.982	0.919	0.919	0.703	0.703	BST-H01
81		BST-HZ001	3mm厚鋁板	ECK3M96295S-ZD1	1	0	1	5.990	1.105	1.105	0.859	0.859	BST-H02
82	C修改	BST-HZ004	3mm厚鋁板	ECK3M96295S-ZD1	0	0	0	0.000	1.008	0.000	0.778	0.000	BST-H02
83		BST-HZ005	3mm厚鋁板	ECK3M96295S-ZD1	1	0	1	2.130	0.393	0.393	0.263	0.263	BST-H02
84	C新增	BST-HZ030	3mm厚鋁板	ECK3M96295S-ZD1	1	0	1	5.413	0.999	0.999	0.781	0.781	BST-H03
85		BST-M001	3mm厚鋁板	ECK3M96295S-ZD1	7	0	7	22.764	0.600	4.200	0.450	3.147	BST-M01
86		BST-M002	3mm厚鋁板	ECK3M96295S-ZD1	7	0	7	60.552	1.596	11.172	1.308	9.153	BST-M01
87		BST-M003	3mm厚鋁板	ECK3M96295S-ZD1	7	0	7	15.622	0.412	2.882	0.287	2.012	BST-M01
88		BST-M004	3mm厚鋁板	ECK3M96295S-ZD1	7	0	7	34.431	0.908	6.353	0.714	5.001	BST-M01
89		BST-M005	3mm厚鋁板	ECK3M96295S-ZD1	52	0	52	169.104	0.600	31.200	0.450	23.380	BST-M01
90		BST-M006	3mm厚鋁板	ECK3M96295S-ZD1	7	0	7	30.874	0.814	5.696	0.634	4.436	BST-M01
91		BST-M007	3mm厚鋁板	ECK3M96295S-ZD1	56	0	56	181.884	0.599	33.558	0.449	25.142	BST-M01
92		BST-M008	3mm厚鋁板	ECK3M96295S-ZD1	28	0	28	158.096	1.042	29.169	0.830	23.243	BST-M01

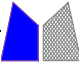 美特鋁質 有限公司 MIDI Aluminium Fabricator Ltd.		工程號: J-857	計算: 刘灿	日期: 2022.01.06	送呈: 施哥								
		地盤名稱: 啟德6552	核對: 徐祥坤	日期: 2022.01.07	副本: 细佬								
廠用鋁板B.M表		項目類別: 第二批	批准: 林仁安	日期: 2022.01.12									
BM編號:		修改版次: C	A/C Code: 2022.03.05	總V.F.: 924.686	總重量: 6486.22								
序號	修改內容	鋁板圖號	鋁板名稱	顏色	實用	後備	總數	總重量	單件展開面積	總展開面積	單件V.F.	總V.F.	圖紙編號
									平方米				
93		BST-M009	3mm厚鋁板	ECK3M96295S-ZD1	48	0	48	152.194	0.585	28.080	0.437	20.961	BST-M01
94		BST-M010	3mm厚鋁板	ECK3M96295S-ZD1	21	0	21	90.487	0.795	16.695	0.618	12.969	BST-M01
95		BST-M011	3mm厚鋁板	ECK3M96295S-ZD1	14	0	14	61.235	0.807	11.298	0.628	8.791	BST-M01
96		BST-M012	3mm厚鋁板	ECK3M96295S-ZD1	148	0	148	330.891	0.413	61.050	0.288	42.641	BST-M01
97		BST-M013	3mm厚鋁板	ECK3M96295S-ZD1	28	0	28	183.250	1.208	33.810	0.973	27.241	BST-M01
98		BST-M014	3mm厚鋁板	ECK3M96295S-ZD1	14	0	14	65.105	0.858	12.012	0.672	9.406	BST-M01
99		BST-M016	3mm厚鋁板	ECK3M96295S-ZD1	14	0	14	93.503	1.232	17.252	0.994	13.919	BST-M01
100		BST-M017	3mm厚鋁板	ECK3M96295S-ZD1	14	0	14	119.397	1.574	22.029	1.288	18.034	BST-M01
101		BST-M018	3mm厚鋁板	ECK3M96295S-ZD1	28	0	28	96.747	0.638	17.850	0.482	13.494	BST-M01
102		BST-M019	3mm厚鋁板	ECK3M96295S-ZD1	14	0	14	75.064	0.989	13.850	0.785	10.988	BST-M01
103		BST-M021	3mm厚鋁板	ECK3M96295S-ZD1	7	0	7	23.675	0.624	4.368	0.470	3.292	BST-M01
104	C修改	BST-M022	3mm厚鋁板	ECK3M96295S-ZD1	0	0	0	0.000	0.473	0.000	0.340	0.000	BST-M01
105		BST-M023	3mm厚鋁板	ECK3M96295S-ZD1	108	0	108	215.120	0.368	39.690	0.249	26.930	BST-M01
106		BST-M026	3mm厚鋁板	ECK3M96295S-ZD1	10	0	10	44.187	0.815	8.153	0.635	6.350	BST-M01
107		BST-M028	3mm厚鋁板	ECK3M96295S-ZD1	10	0	10	63.942	1.180	11.798	0.949	9.490	BST-M01
108		BST-M029	3mm厚鋁板	ECK3M96295S-ZD1	10	0	10	28.049	0.518	5.175	0.379	3.786	BST-M01
109		BST-M031	3mm厚鋁板	ECK3M96295S-ZD1	20	0	20	115.283	1.064	21.270	0.849	16.977	BST-M01
110		BST-M032	3mm厚鋁板	ECK3M96295S-ZD1	20	0	20	42.926	0.396	7.920	0.274	5.478	BST-M01
111		BST-M035	3mm厚鋁板	ECK3M96295S-ZD1	20	0	20	76.422	0.705	14.100	0.540	10.801	BST-M01
112		BST-M037	3mm厚鋁板	ECK3M96295S-ZD1	20	0	20	112.357	1.037	20.730	0.826	16.512	BST-M01
113		BST-M038	3mm厚鋁板	ECK3M96295S-ZD1	20	0	20	147.316	1.359	27.180	1.103	22.067	BST-M01
114		BST-M039	3mm厚鋁板	ECK3M96295S-ZD1	20	0	20	102.601	0.947	18.930	0.748	14.961	BST-M01
115		BST-M042	3mm厚鋁板	ECK3M96295S-ZD1	10	0	10	69.593	1.284	12.840	1.039	10.388	BST-M01

 美特鋁質 有限公司 MIDI Aluminium Fabricator Ltd.		工程號: J-857	計算: 刘灿	日期: 2022.01.06	送呈: 施哥								
		地盤名稱: 啟德6552	核對: 徐祥坤	日期: 2022.01.07	副本: 细佬								
廠用鋁板B.M表		項目類別: 第二批	批准: 林仁安	日期: 2022.01.12									
BM編號:		修改版次: C	A/C Code: 2022.03.05	總V.F.: 924.686	總重量: 6486.22								
序號	修改內容	鋁板圖號	鋁板名稱	顏色	實用	後備	總數	總重量	單件展開面積	總展開面積	單件V.F.	總V.F.	圖紙編號
									平方米				
116	C修改	BST-M043	3mm厚鋁板	ECK3M96295S-ZD1	0	0	0	0.000	0.847	0.000	0.662	0.000	BST-M01
117		BST-M046	3mm厚鋁板	ECK3M96295S-ZD1	10	0	10	62.113	1.146	11.460	0.920	9.199	BST-M01
118		BST-M048	3mm厚鋁板	ECK3M96295S-ZD1	10	0	10	65.040	1.200	12.000	0.966	9.664	BST-M01
119		BST-M049	3mm厚鋁板	ECK3M96295S-ZD1	11	0	11	69.532	1.166	12.829	0.937	10.311	BST-M01
120		BST-M062	3mm厚鋁板	ECK3M96295S-ZD1	108	0	108	280.973	0.480	51.840	0.346	37.396	BST-M01
121		BST-M080	3mm厚鋁板	ECK3M96295S-ZD1	35	0	35	114.674	0.605	21.158	0.453	15.872	BST-M01
122		BST-M081	3mm厚鋁板	ECK3M96295S-ZD1	14	0	14	61.577	0.812	11.361	0.632	8.845	BST-M01
123		BST-M082	3mm厚鋁板	ECK3M96295S-ZD1	20	0	20	94.389	0.871	17.415	0.683	13.656	BST-M01
124		BST-M083	3mm厚鋁板	ECK3M96295S-ZD1	10	0	10	45.813	0.845	8.453	0.661	6.609	BST-M01
125		BST-M084	3mm厚鋁板	ECK3M96295S-ZD1	7	0	7	46.666	1.230	8.610	0.992	6.946	BST-M01
126	C新增	BST-M090	3mm厚鋁板	ECK3M96295S-ZD1	10	0	10	43.414	0.801	8.010	0.623	6.227	BST-M03
127	C新增	BST-M091	3mm厚鋁板	ECK3M96295S-ZD1	14	0	14	36.422	0.480	6.720	0.346	4.848	BST-M03
總計:					1525		1525	6486.22	104.821	1196.72	81.04	924.686	

 美特鋁質有限公司 MIDI Aluminium Fabricator Ltd.				工程號 J857 地盘 啟德6552	類別 制圖 刘灿	物料號 - 2021-12-14	圖號 BST-M01
修改 A - - 採用工廠 ✓ 地盘	图纸名称 铝板加工图			復核 徐詳坤	2021-12-15	數量 -	
日期 2022.03.02 - - 材料颜色 ECK3M96295S-ZD1	材料 3mm THK. 铝板			批准 林仁安	2021-12-16	單件重量 - (KG)	

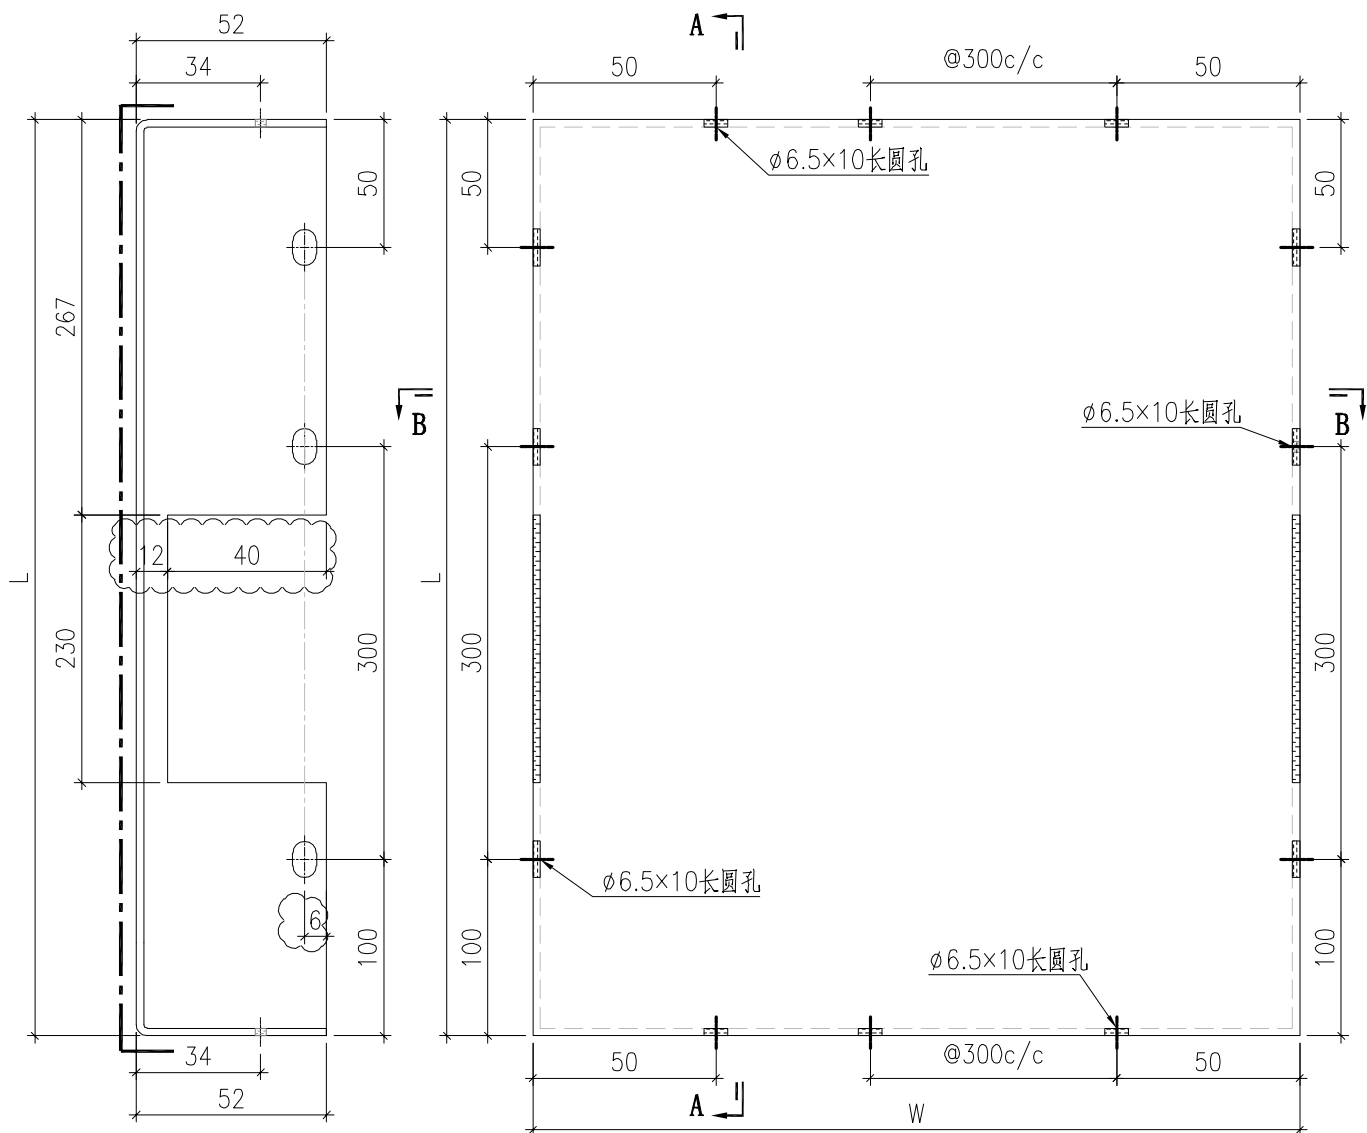


背板长宽数据見BST-M02

 美特鋁質有限公司 MIDI Aluminium Fabricator Ltd.				工程號	J857	類別		物料號	-					
				地盤	啟德6552	制圖	刘灿	2021-12-14	圖號	BST-M02				
修改	A	-	-	採用工廠	✓	地盤		圖紙名稱	铝板加工图	復核	徐詳坤	2021-12-15	數量	-
日期	2022.03.02	-	-	材料顏色	ECK3M96295S-ZD1		材料	3mm THK. 铝板	批准	林仁安	2021-12-16	單件重量	-	(KG)

序號	鋁板編號	寬度 (W)	高度 (H)	數量
1	BST-M001	696	646	7
2	BST-M002	2024	646	7
3	BST-M003	445	646	7
4	BST-M004	1106	646	7
5	BST-M005	696	646	52
6	BST-M006	981	646	7
7	BST-M007	695	646	56
8	BST-M008	1285	646	28
9	BST-M009	676	646	48
10	BST-M010	956	646	21
11	BST-M011	972	646	14
12	BST-M012	446	646	148
13	BST-M013	1506	646	28
14	BST-M014	1040	646	14
15	BST-M016	1539	646	14
16	BST-M017	1994	646	14
17	BST-M018	746	646	28
18	BST-M019	1215	646	14
19	BST-M021	728	646	7
20	BST-M022	527	646	14


序號	鋁板編號	寬度 (W)	高度 (H)	數量
21	BST-M023	386	646	108
22	BST-M026	983	646	10
23	BST-M028	1469	646	10
24	BST-M029	586	646	10
25	BST-M031	1314	646	20
26	BST-M032	424	646	20
27	BST-M035	836	646	20
28	BST-M037	1278	646	20
29	BST-M038	1708	646	20
30	BST-M039	1158	646	20
31	BST-M042	1608	646	10
32	BST-M043	1025	646	10
33	BST-M046	1424	646	10
34	BST-M048	1496	646	10
35	BST-M049	1451	646	11
36	BST-M062	536	646	108
37	BST-M080	702	646	35
38	BST-M081	978	646	14
39	BST-M082	1057	646	20
40	BST-M083	1023	646	10
41	BST-M084	1536	646	7

 美特鋁質有限公司 MIDI Aluminium Fabricator Ltd.				工程號 J857 地盘 啟德6552	類別 制圖 刘灿	物料號 - 2021-12-14	圖號 BST-C01
修改 A - - 採用工廠 <input checked="" type="checkbox"/> 地盘	图纸名称 铝板加工图			復核 徐詳坤	2021-12-15	數量 -	
日期 2022.03.02 - - 材料颜色 ECK3M96295S-ZD1	材料 3mm THK. 铝板			批准 林仁安	2021-12-16	單件重量 - (KG)	

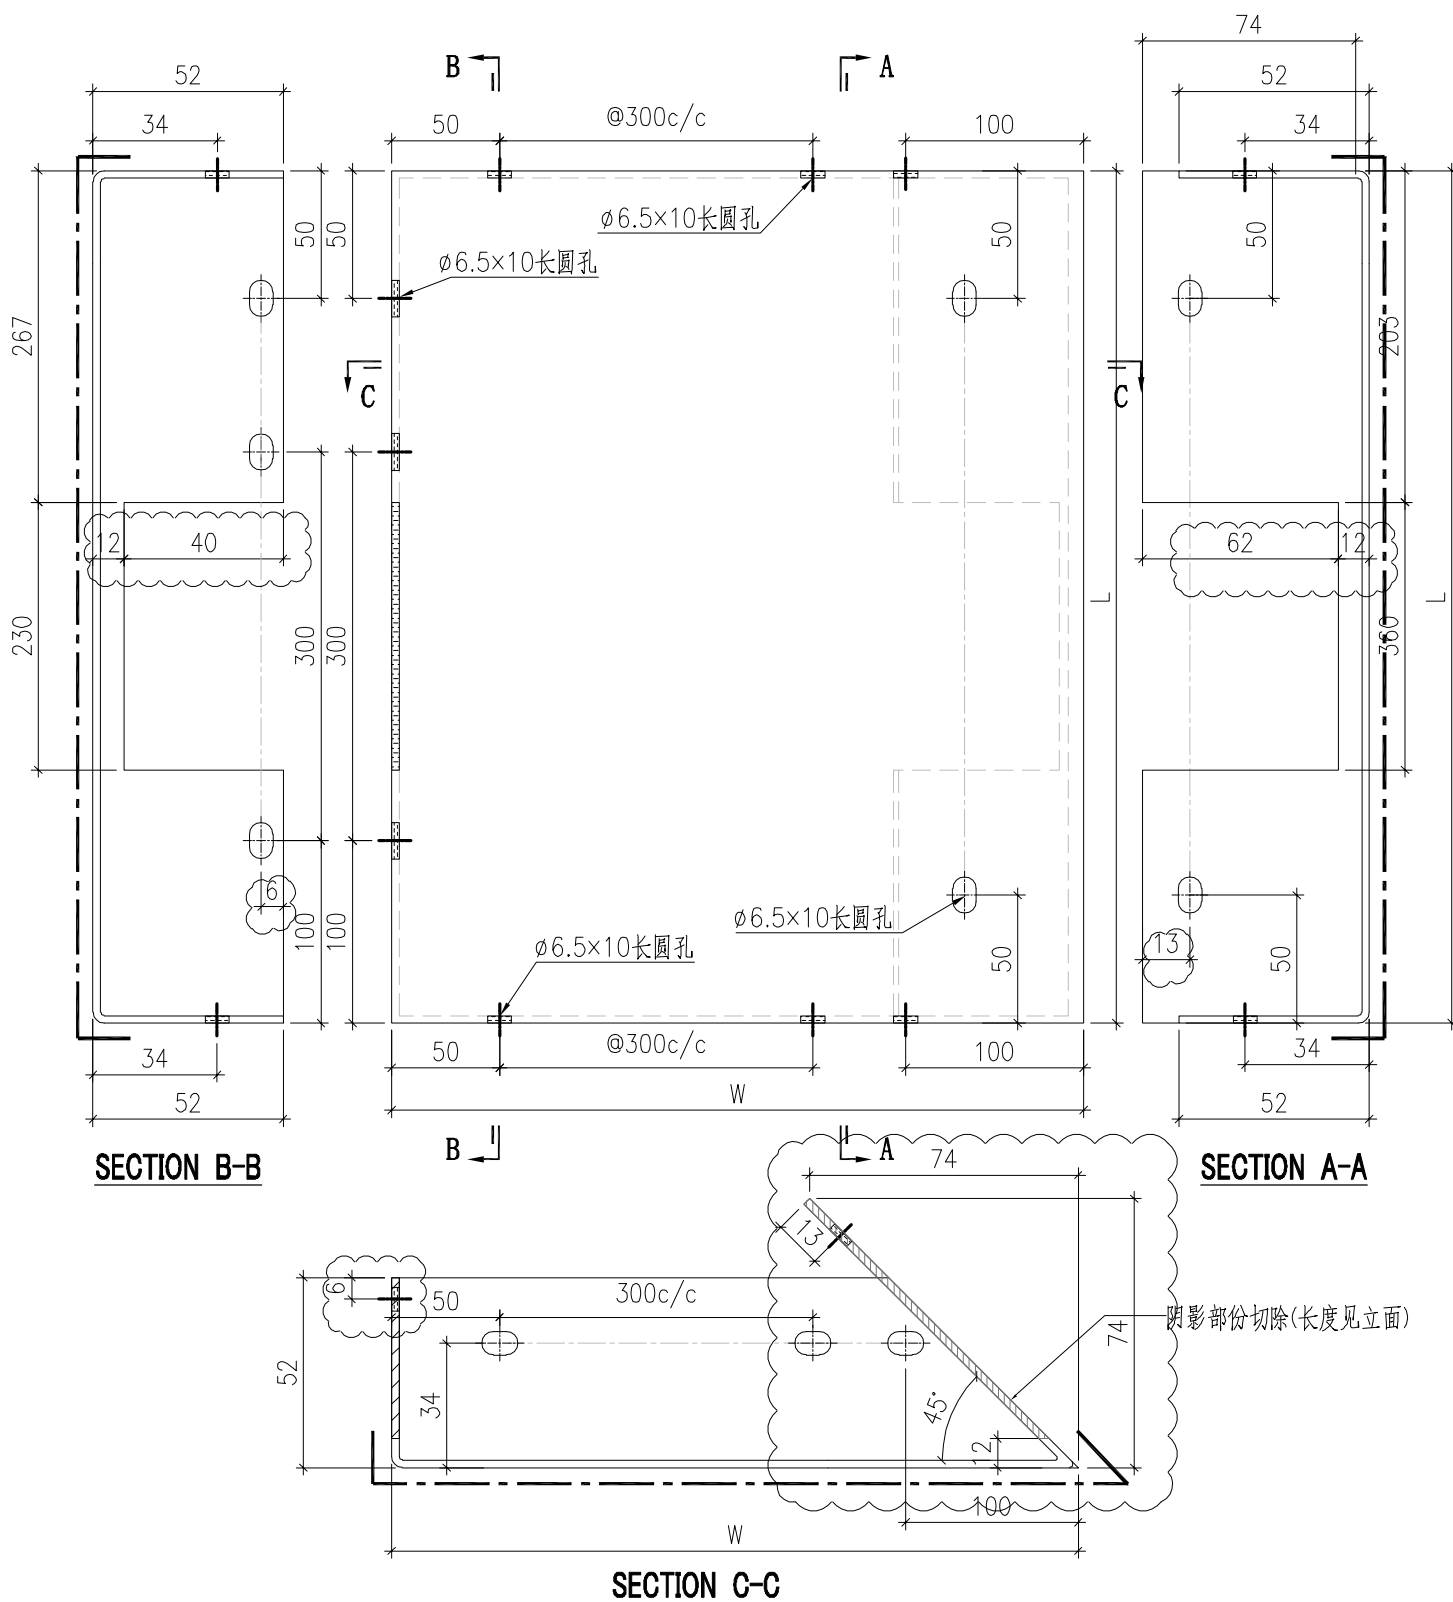

序號	鋁板編號	寬度 (W)	高度 (H)	數量
1	BST-CY001	740	646	7
2	BST-CY003	2125	646	7
3	BST-CY007	1811	646	30
4	BST-CY008	1040	646	30
5	BST-CY011	1161	646	10
6	BST-CY013	890	646	10
7	BST-CY014	1311	646	7

 美特鋁質有限公司 MIDI Aluminium Fabricator Ltd.				工程號	J857	類別		物料號	-			
				地盘	啟德6552	制圖	刘灿	2021-12-14	圖號	BST-C02		
修改	A	-	-	採用工廠	✓ 地盘	图纸名称	铝板加工图	復核	徐詳坤	2021-12-15	數量	-
日期	2022.03.02	-	-	材料颜色	ECK3M96295S-ZD1	材料	3mm THK. 铝板	批准	林仁安	2021-12-16	單件重量	- (KG)

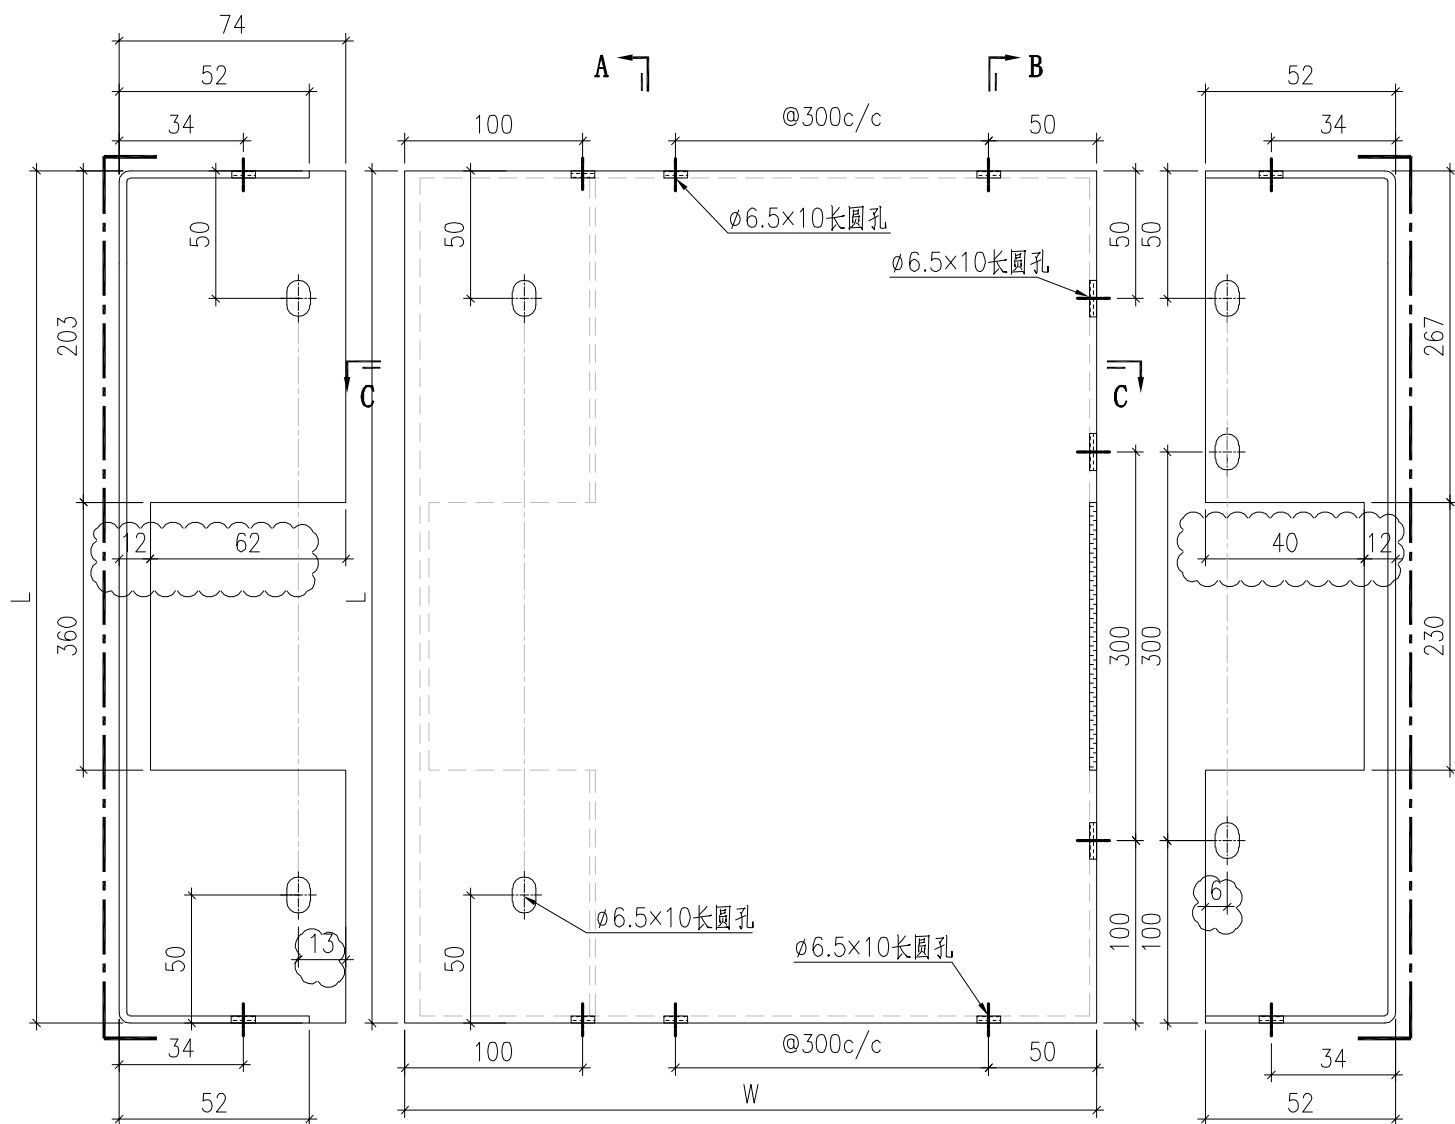

SECTION A-A


SECTION B-B

SECTION C-C

阴影部份切除(长度见立面)

序号	铝板编号	宽度 (W)	高度 (H)	数量
1	BST-CZ001	1601	646	7
2	BST-CZ004	1450	646	7
3	BST-CZ005	490	646	7
4	BST-CZ006	1811	646	30
5	BST-CZ009	1040	646	30
6	BST-CZ010	1551	646	10
7	BST-CZ012	584	646	11

 美特鋁質有限公司 MIDI Aluminium Fabricator Ltd.				工程號	J857	類別		物料號	-	
				地盤	啟德6552	制圖	刘灿	2021-12-14	圖號	BST-C04
修改		採用工廠	✓ 地盤	图纸名称	铝板加工图	復核	徐詳坤	2021-12-15	數量	-
日期		材料颜色	ECK3M96295S-ZD1	材料	3mm THK. 铝板	批准	林仁安	2021-12-16	單件重量	- (KG)

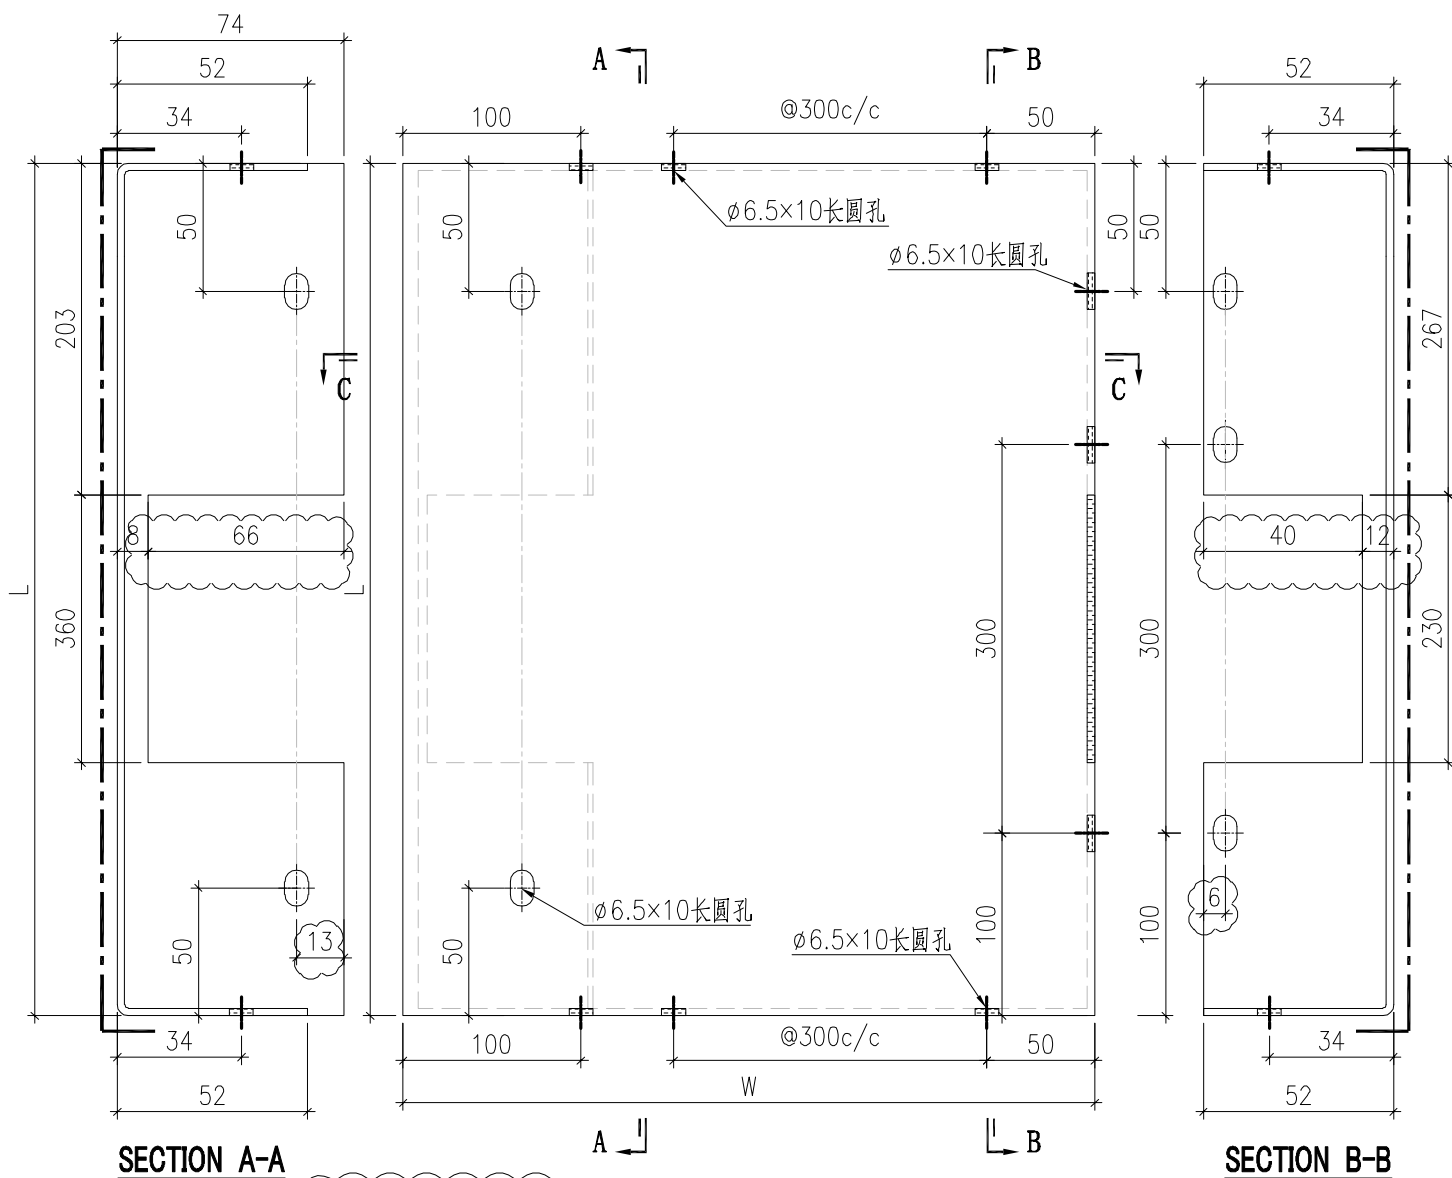


阴影部份切除(长度见立面)

SECTION C-C

序號	鋁板編號	寬度 (W)	高度 (H)	數量
1	BST-CZ016	1257	646	11

 美特鋁質有限公司 MIDI Aluminium Fabricator Ltd.				工程號 J857 地盤 啟德6552	類別 制圖 刘灿	物料號 - 2021-12-14	圖號 BST-F01
修改 A 日期 2022.03.02	-	-	採用工廠 ✓ 材料颜色 BCK3M96295S-ZD1	图纸名称 铝板加工图 材料 3mm THK. 铝板	復核 徐詳坤 批准 林仁安	2021-12-15 2021-12-16	數量 - 單件重量 - (KG)

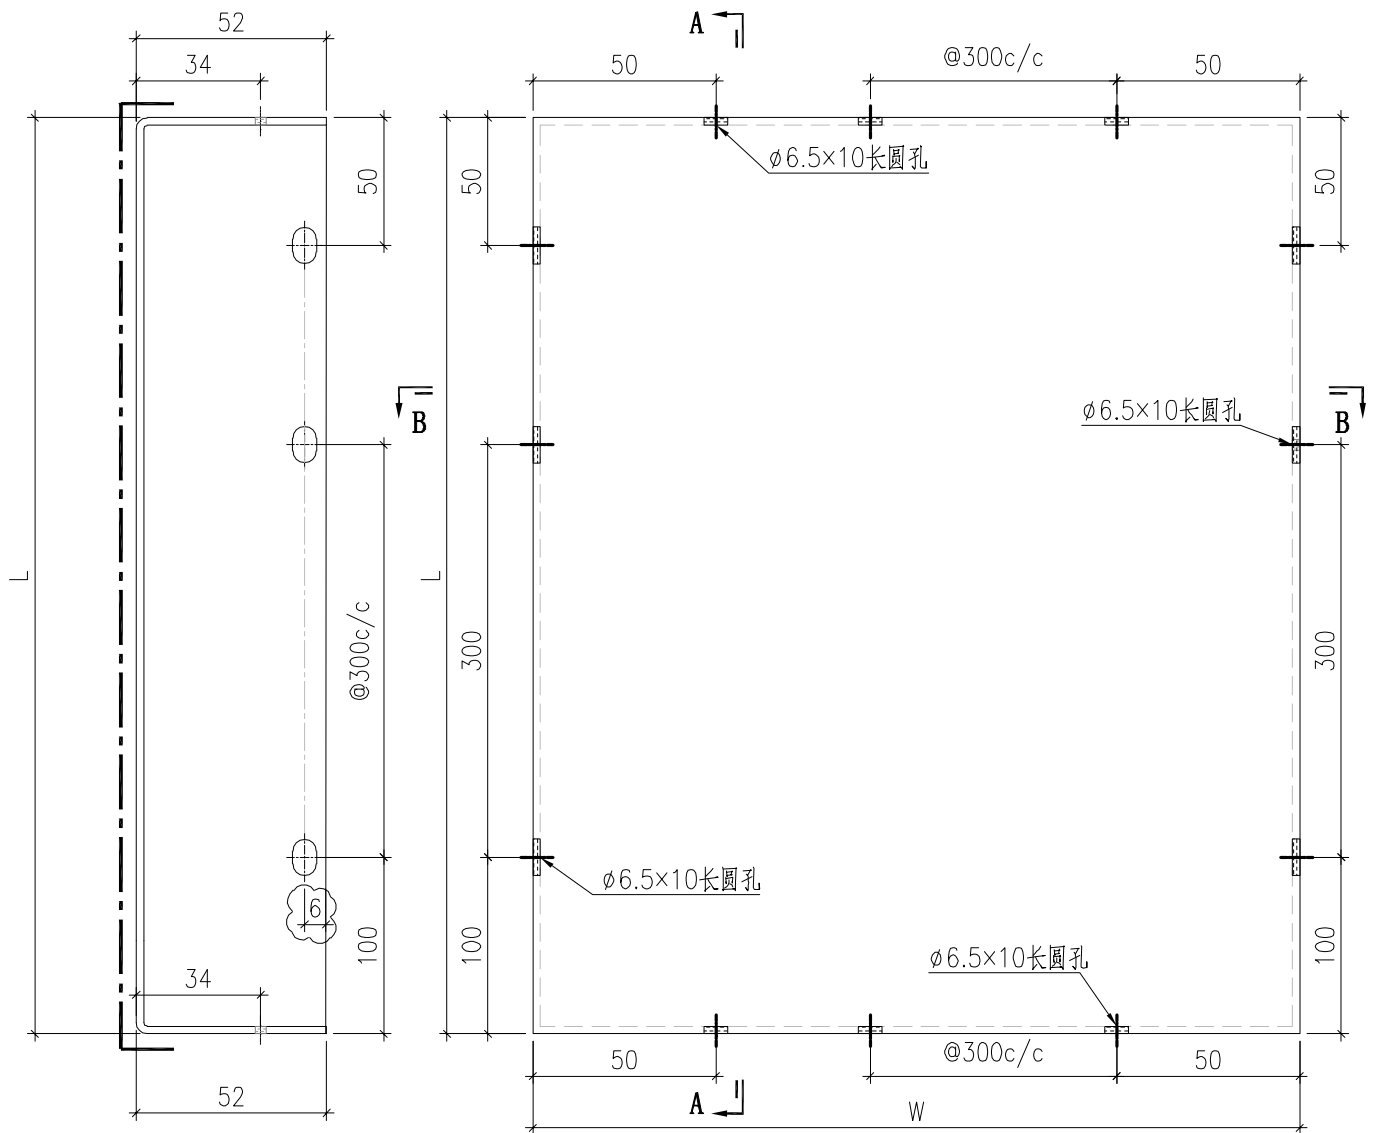


SECTION A-A


SECTION B-B

序號	鋁板編號	寬度 (W)	高度 (H)	數量
1	BST-F001	676	2386	49

 美特鋁質有限公司 MIDI Aluminium Fabricator Ltd.				工程號 J857 地盘 啟德6552	類別 制圖 刘灿	物料號 - 2021-12-14	圖號 BST-D01
修改 A 日期 2022.03.02	-	-	採用工廠 ✓ 材料颜色 BCK3M96295S-ZD1	图纸名称 铝板加工图 材料 3mm THK. 铝板	復核 徐詳坤 批准 林仁安	2021-12-15 2021-12-16	數量 - 單件重量 - (KG)

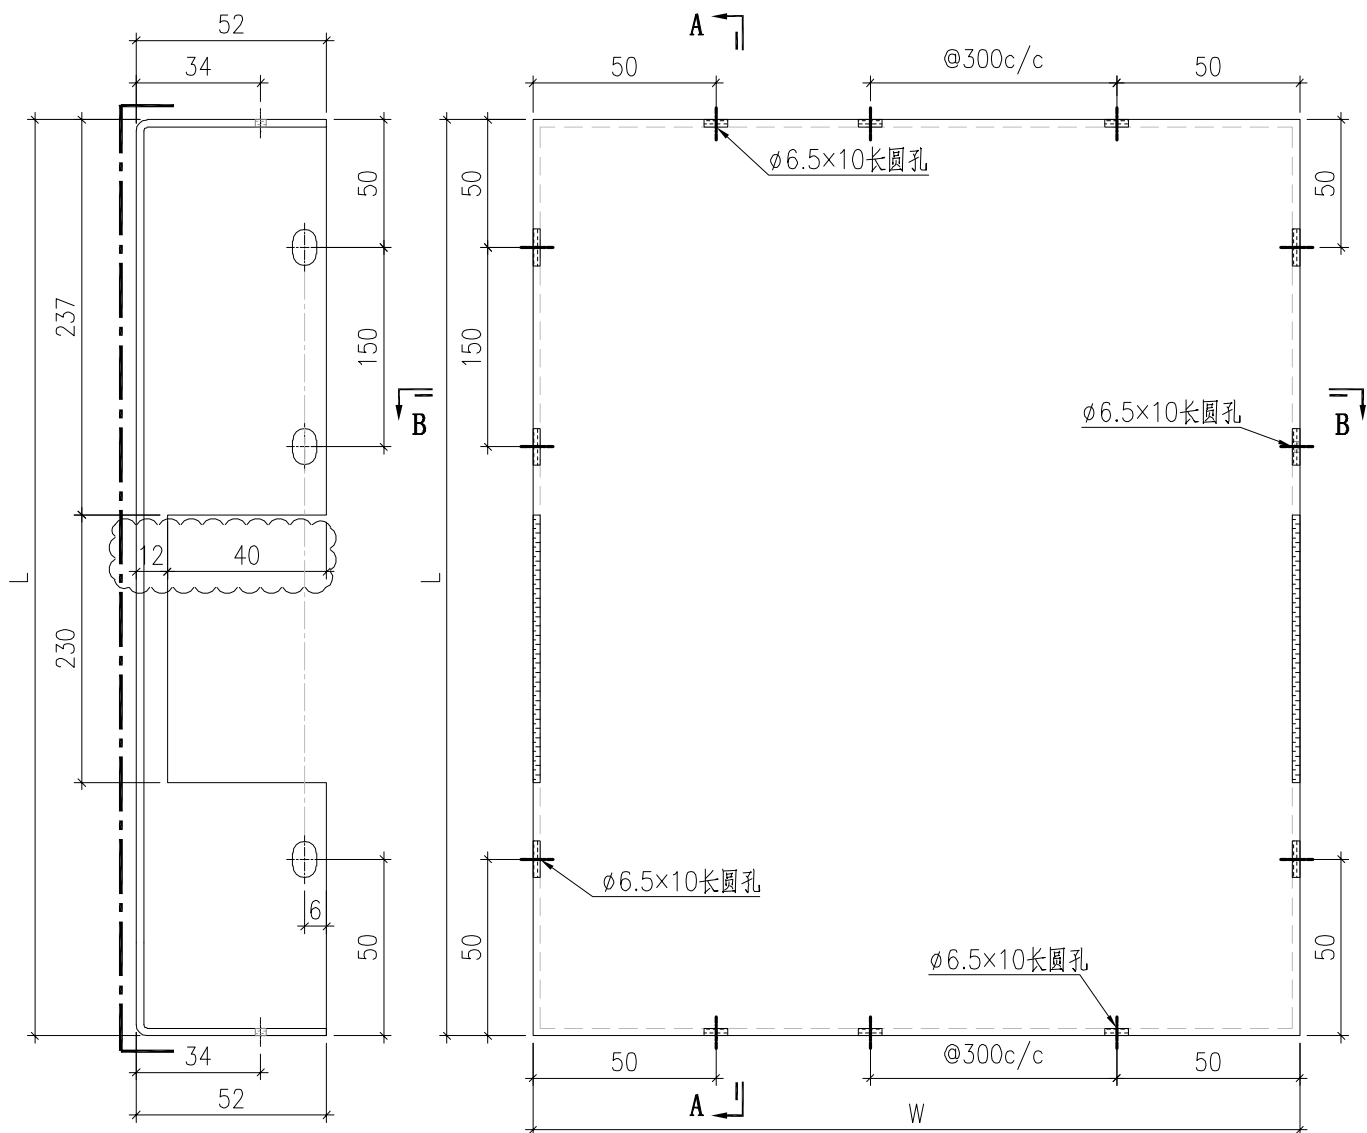

SECTION A-A

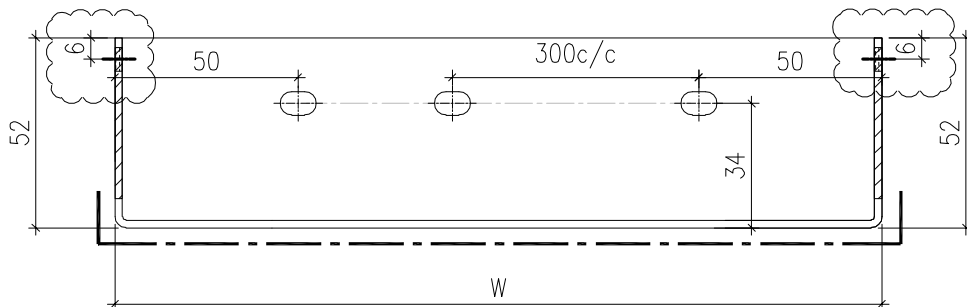


SECTION B-B

背板长宽数据見BST-D02

 美特鋁質有限公司 MIDI Aluminium Fabricator Ltd.				工程號	J857	類別		物料號	-					
				地盤	啟德6552	制圖	刘灿	2021-12-14	圖號	BST-D02				
修改	A	-	-	採用工廠	✓	地盤		圖紙名稱	铝板加工图	復核	徐詳坤	2021-12-15	數量	-
日期	2022.03.02	-	-	材料顏色	ECK3M96295S-ZD1		材料	3mm THK. 铝板	批准	林仁安	2021-12-16	單件重量	-	(KG)


序號	鋁板編號	寬度 (W)	高度 (H)	數量
1	BST-D001	696	552	2
2	BST-D002	2024	552	2
3	BST-D003	445	552	2
4	BST-D004	1106	552	2
5	BST-D005	696	552	12
6	BST-D006	981	552	2
7	BST-D007	695	552	16
8	BST-D008	1285	552	8
9	BST-D009	676	552	8
10	BST-D010	956	552	6
11	BST-D011	972	552	4
12	BST-D012	446	552	8
13	BST-D013	1506	552	8
14	BST-D014	1040	552	4
15	BST-D016	1539	552	4
16	BST-D017	1994	552	4
17	BST-D018	746	552	8
18	BST-D019	1215	552	4
19	BST-D021	728	552	2
20	BST-D022	527	552	4
21	BST-D023	386	552	2
22	BST-D062	536	552	2
23	BST-D080	702	552	10
24	BST-D081	978	552	4
25	BST-D084	1536	552	2

 美特鋁質有限公司 MIDI Aluminium Fabricator Ltd.				工程號	J857	類別		物料號	-					
				地盘	啟德6552	制圖	刘灿	2021-12-14	圖號	BST-E01				
修改	A	-	-	採用工廠	✓	地盘		图纸名称	铝板加工图	復核	徐詳坤	2021-12-15	數量	-
日期	2022.03.02	-	-	材料颜色	ECX3M96295S-ZD1	材料	3mm THK. 铝板	批准	林仁安	2021-12-16	單件重量	-	(KG)	

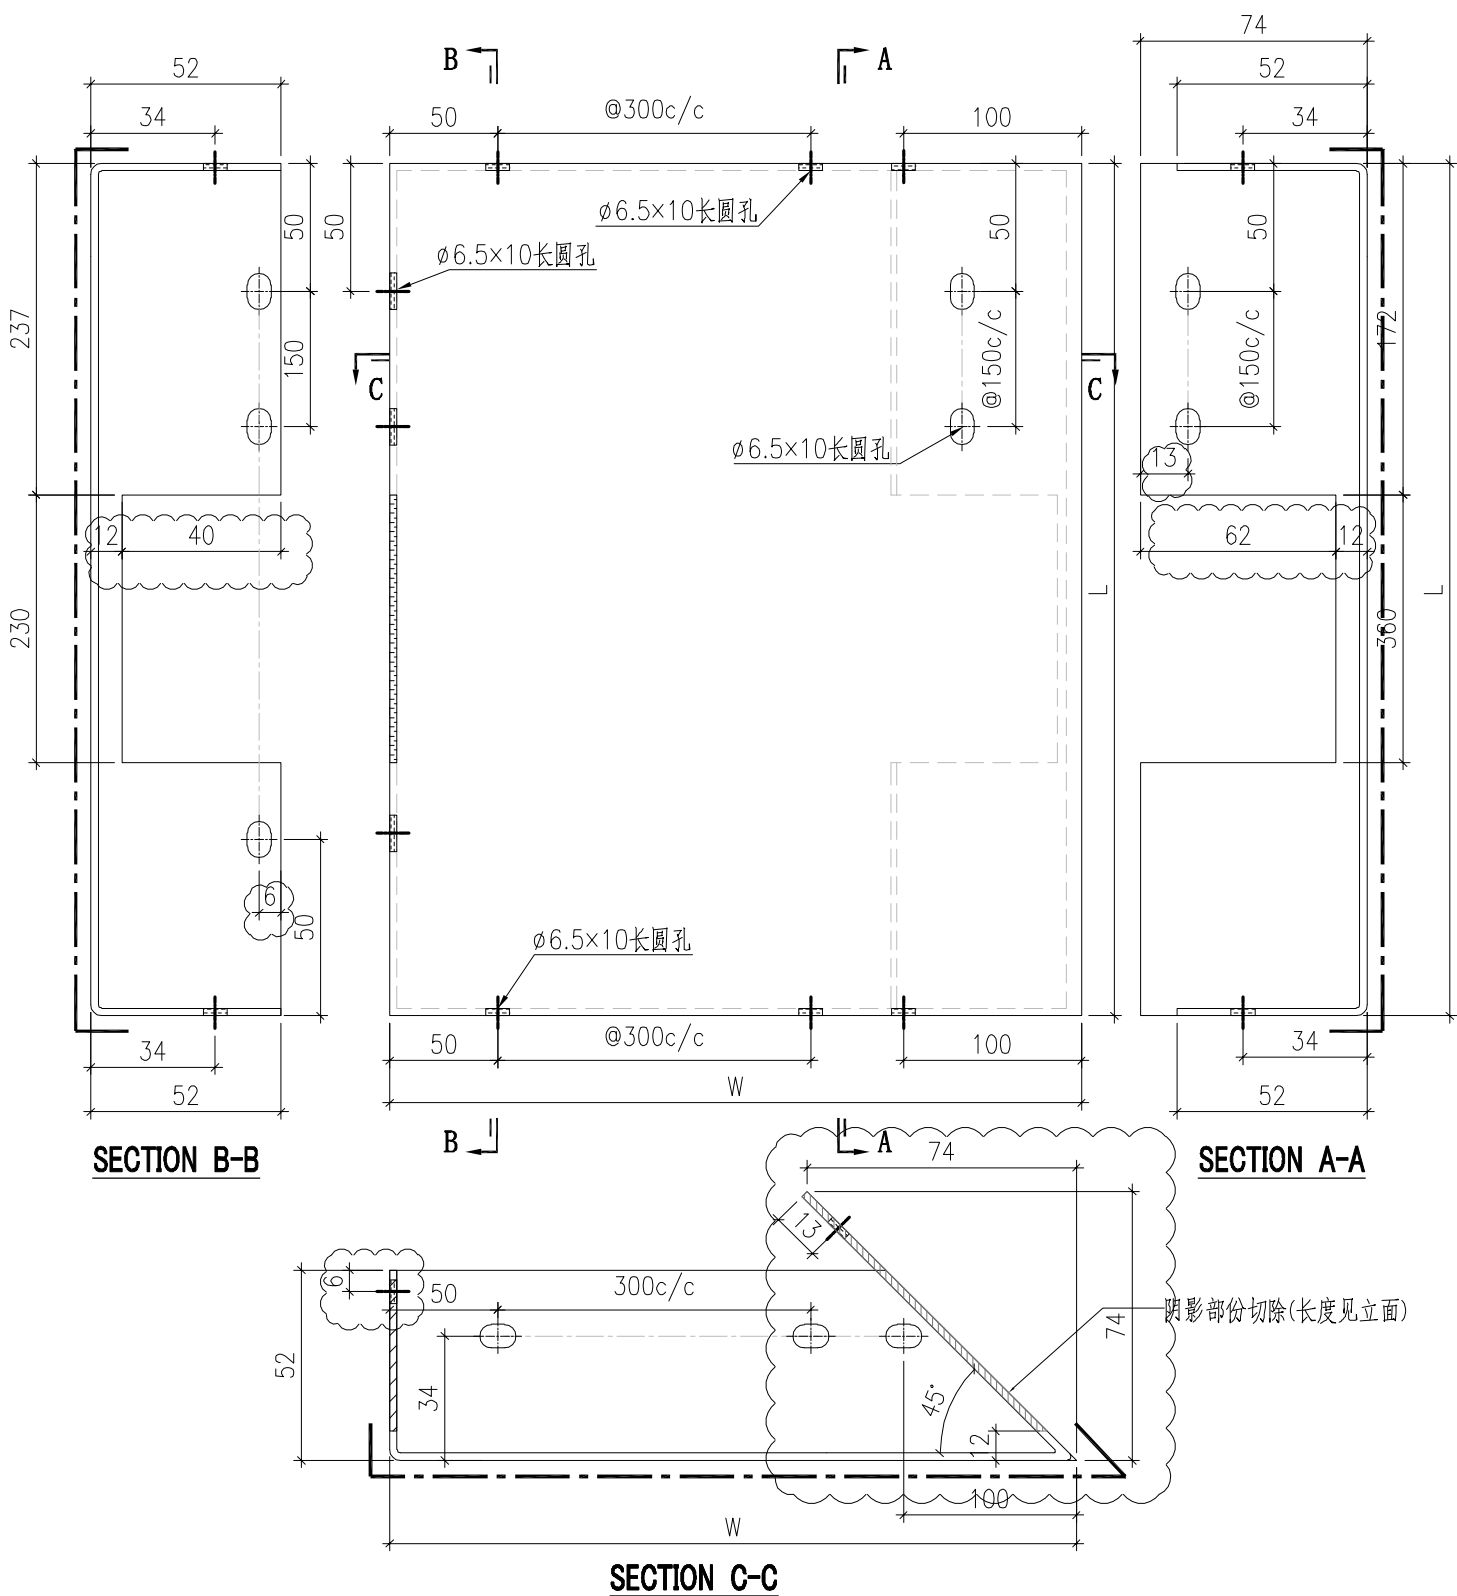


序號	鋁板編號	寬度 (W)	高度 (H)	數量
1	BST-EY001	740	552	2
2	BST-EY003	2125	552	2
3	BST-EY014	1311	552	2

 美特鋁質有限公司 MIDI Aluminium Fabricator Ltd.				工程號 J857	類別	物料號 -		
				地盤 啟德6552	制圖 刘灿	2021-12-14	圖號 BST-E02	
修改 A - -	採用工廠 ✓	地盤	图纸名称 铝板加工图	復核 徐詳坤	2021-12-15	數量 -		
日期 2022.03.02	材料颜色 ECK3M96295S-ZD1		材料 3mm THK. 铝板	批准 林仁安	2021-12-16	單件重量 -	(KG)	


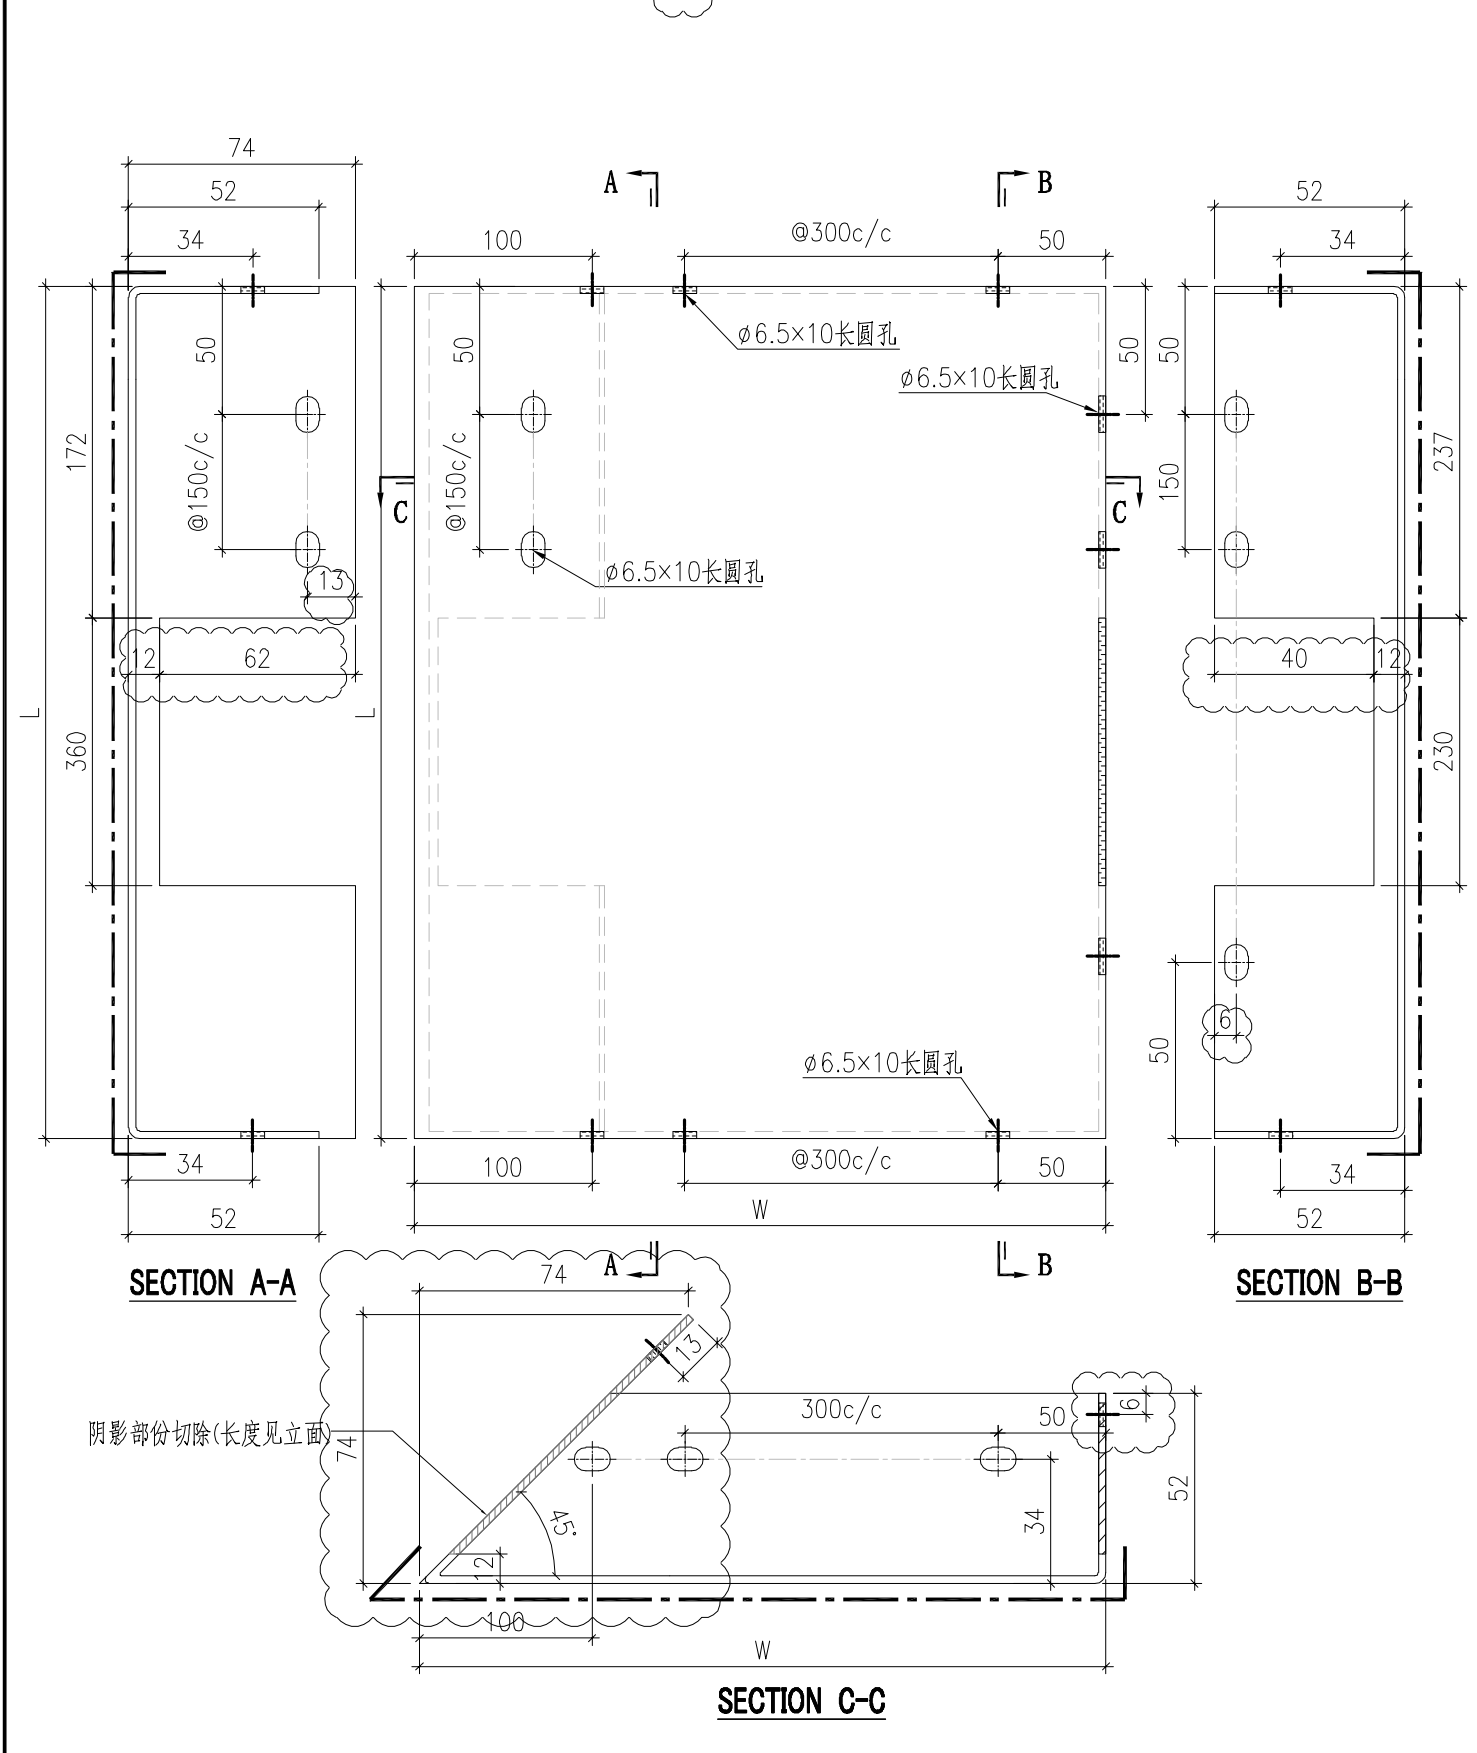


序號	鋁板編號	寬度 (W)	高度 (H)	數量
1	BST-EZ001	1601	552	2
2	BST-EZ004	1450	552	2
3	BST-EZ005	490	552	2

 美特鋁質有限公司 MIDI Aluminium Fabricator Ltd.				工程號 J857 地盘 啟德6552	類別 制圖 刘灿	物料號 - 2021-12-14	圖號 BST-G01
修改 A 日期 2022.03.02	-	-	採用工廠 ✓ 材料颜色 BCK3M96295S-ZD1	图纸名称 铝板加工图 材料 3mm THK. 铝板	復核 徐詳坤 批准 林仁安	2021-12-15 2021-12-16	數量 - 單件重量 - (KG)

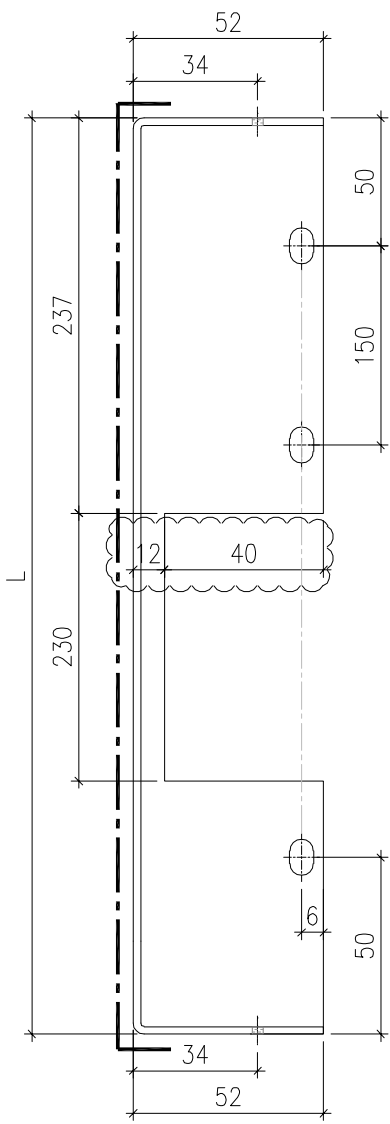

SECTION A-A

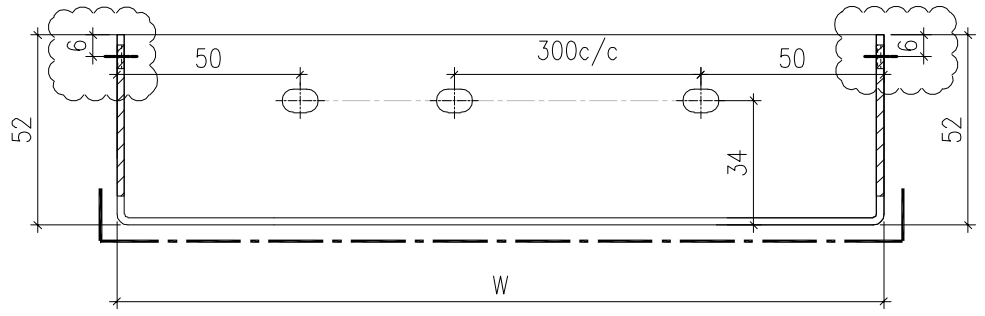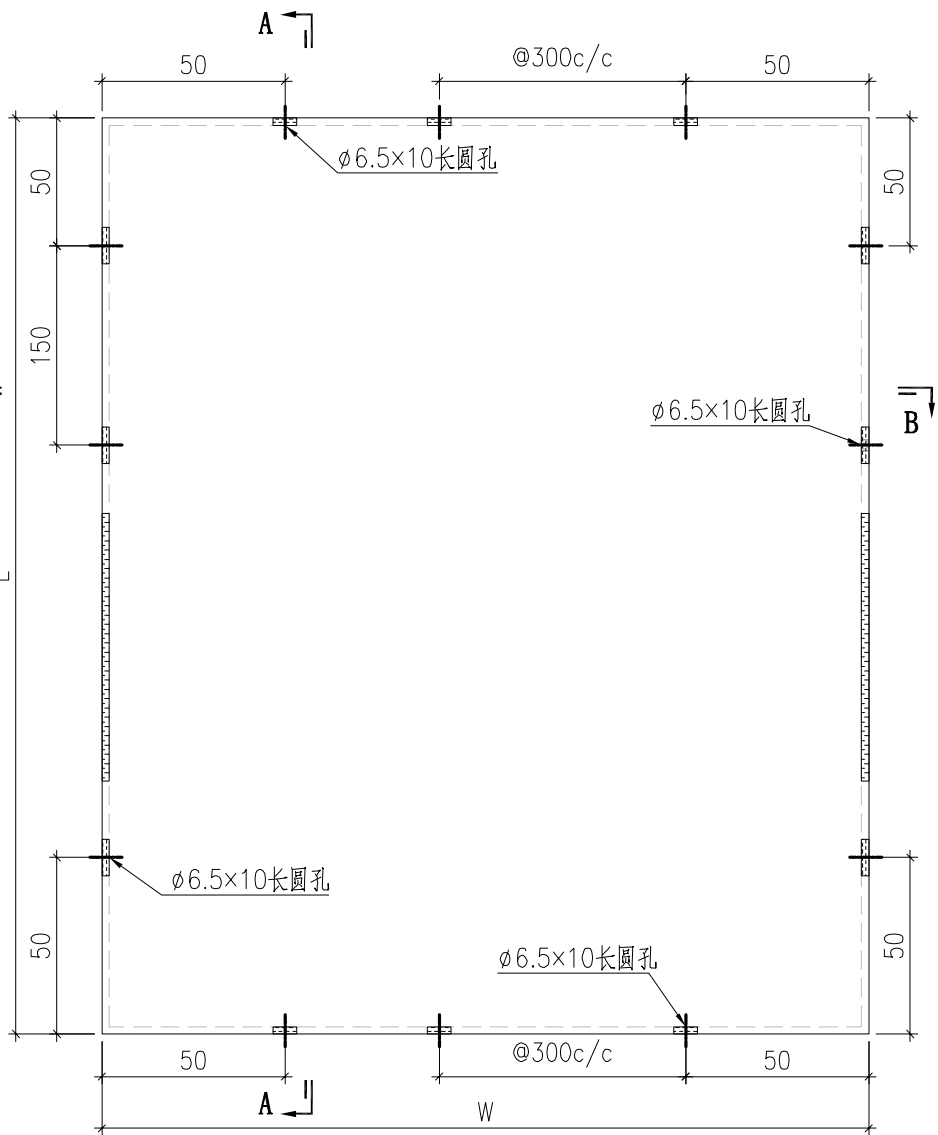


SECTION B-B

 美特鋁質有限公司 MIDI Aluminium Fabricator Ltd.				工程號	J857	類別		物料號	-					
				地盤	啟德6552	制圖	刘灿	2021-12-14	圖號	BST-G02				
修改	A	-	-	採用工廠	✓	地盤		圖紙名稱	铝板加工图	復核	徐詳坤	2021-12-15	數量	-
日期	2022.03.02	-	-	材料颜色	ECK3M96295S-ZD1		材料	3mm THK. 铝板	批准	林仁安	2021-12-16	單件重量	-	(KG)

序號	鋁板編號	寬度 (W)	高度 (H)	數量
1	BST-G001	696	537	1
2	BST-G002	2024	537	1
3	BST-G003	445	537	1
4	BST-G004	1106	537	1
5	BST-G005	696	537	6
6	BST-G006	981	537	1
7	BST-G007	695	537	8
8	BST-G008	1285	537	4
9	BST-G009	676	537	4
10	BST-G010	956	537	3
11	BST-G011	972	537	2
12	BST-G012	446	537	4
13	BST-G013	1506	537	4
14	BST-G014	1040	537	2
15	BST-G016	1539	537	2
16	BST-G017	1994	537	2
17	BST-G018	746	537	4
18	BST-G019	1215	537	2
19	BST-G021	728	537	1
20	BST-G022	527	537	2
21	BST-G023	386	537	1
22	BST-G062	536	537	1
23	BST-G080	702	537	5
24	BST-G081	978	537	2
25	BST-G084	1536	537	1


 美特鋁質有限公司 MIDI Aluminium Fabricator Ltd.				工程號 J857	類別	物料號 -		
				地盤 啟德6552	制圖 刘灿	2021-12-14	圖號 BST-H01	
修改 A	-	-	採用工廠 ✓	地盤	图纸名称 铝板加工图	復核 徐詳坤	2021-12-15	數量 -
日期 2022.03.02	-	-	材料颜色 ECK3M96295S-ZD1		材料 3mm THK. 铝板	批准 林仁安	2021-12-16	單件重量 - (KG)

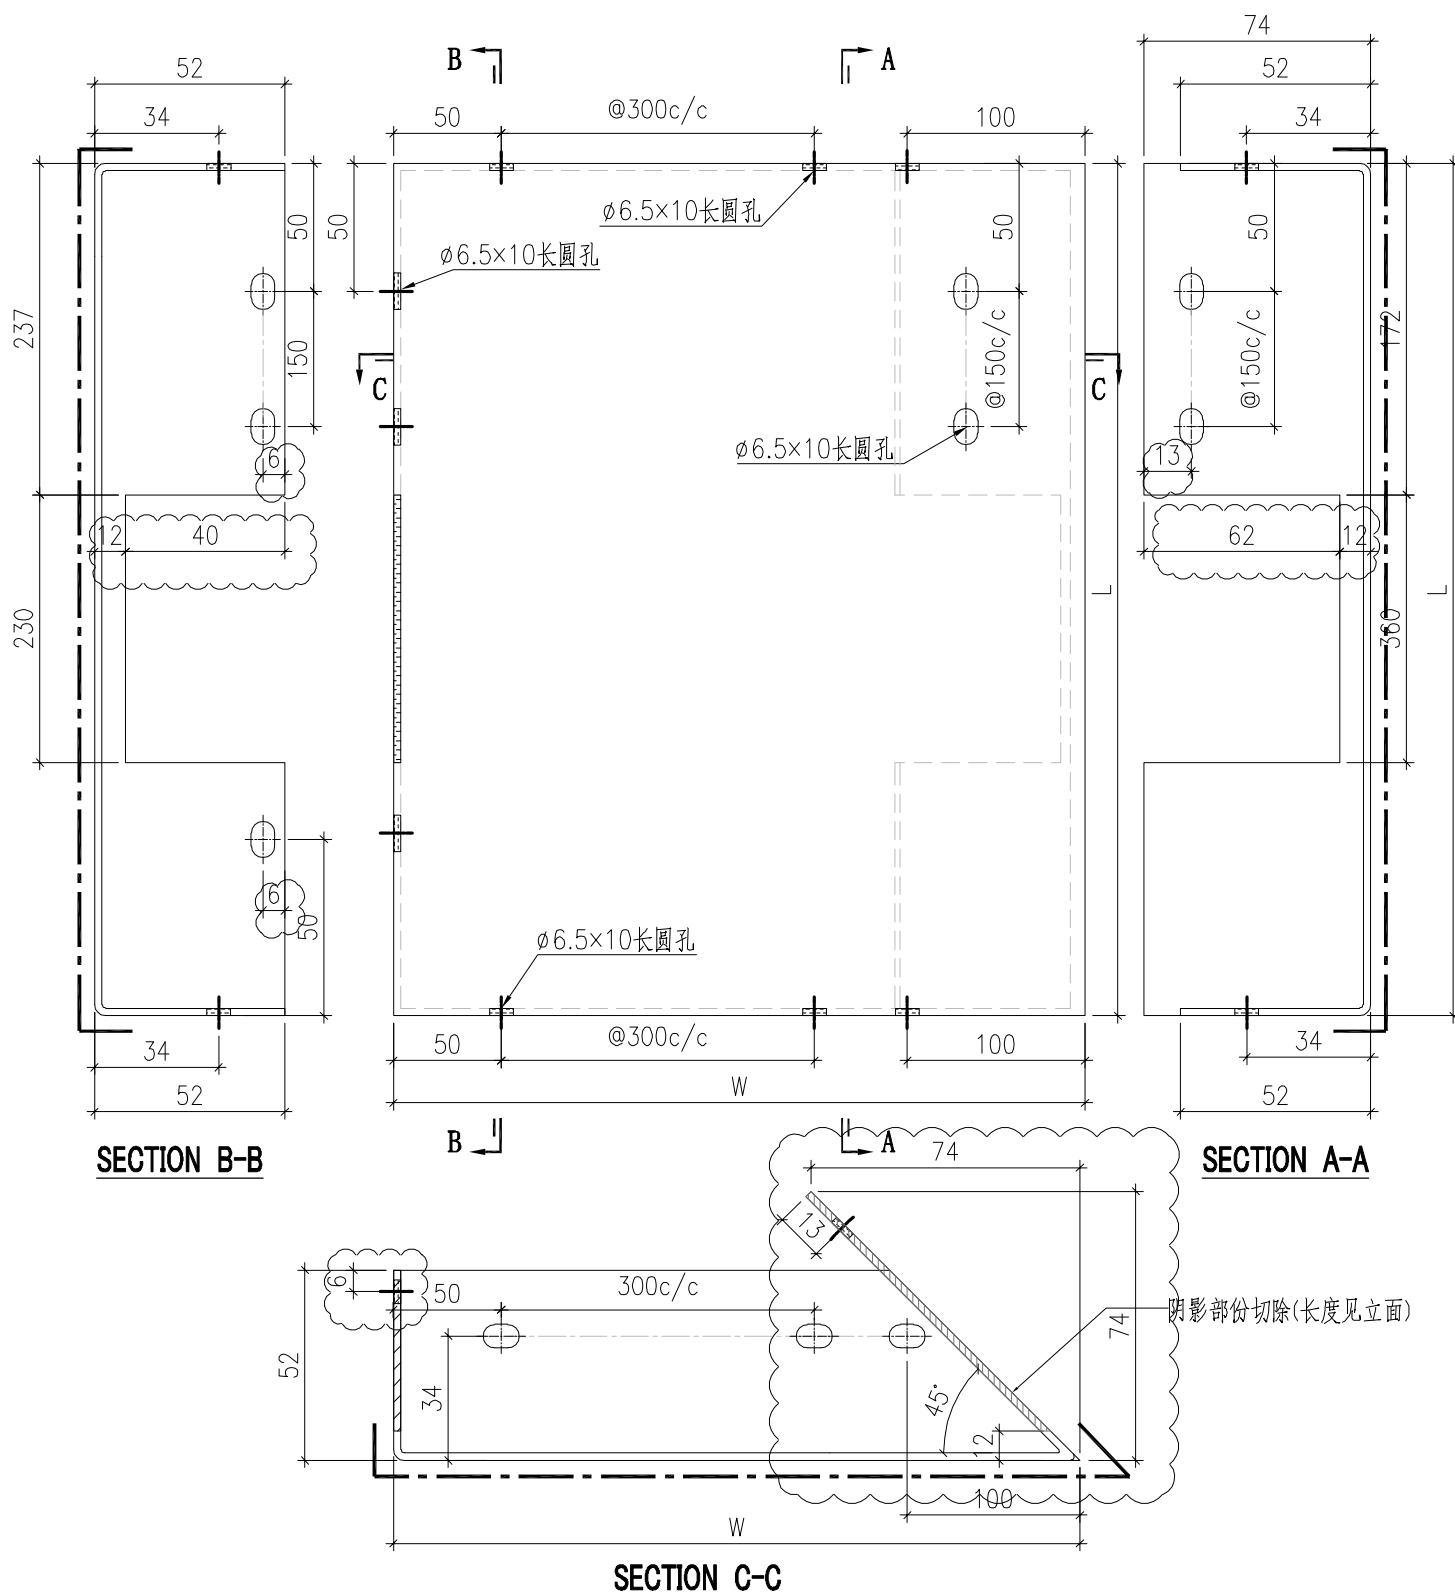

阴影部份切除(长度见立面)


序號	鋁板編號	寬度 (W)	高度 (H)	數量
1	BST-HY001	740	537	1
2	BST-HY003	2125	537	1
3	BST-HY014	1311	537	1

 美特鋁質有限公司 MIDI Aluminium Fabricator Ltd.				工程號 J857	類別	物料號 -		
				地盤 啟德6552	制圖 刘灿	2021-12-14	圖號 BST-H02	
修改 A - -	採用工廠 ✓	地盤	图纸名称 铝板加工图	復核 徐詳坤	2021-12-15	數量 -		
日期 2022.03.02	材料颜色 ECK3M96295S-ZD1		材料 3mm THK. 铝板	批准 林仁安	2021-12-16	單件重量 -	(KG)	

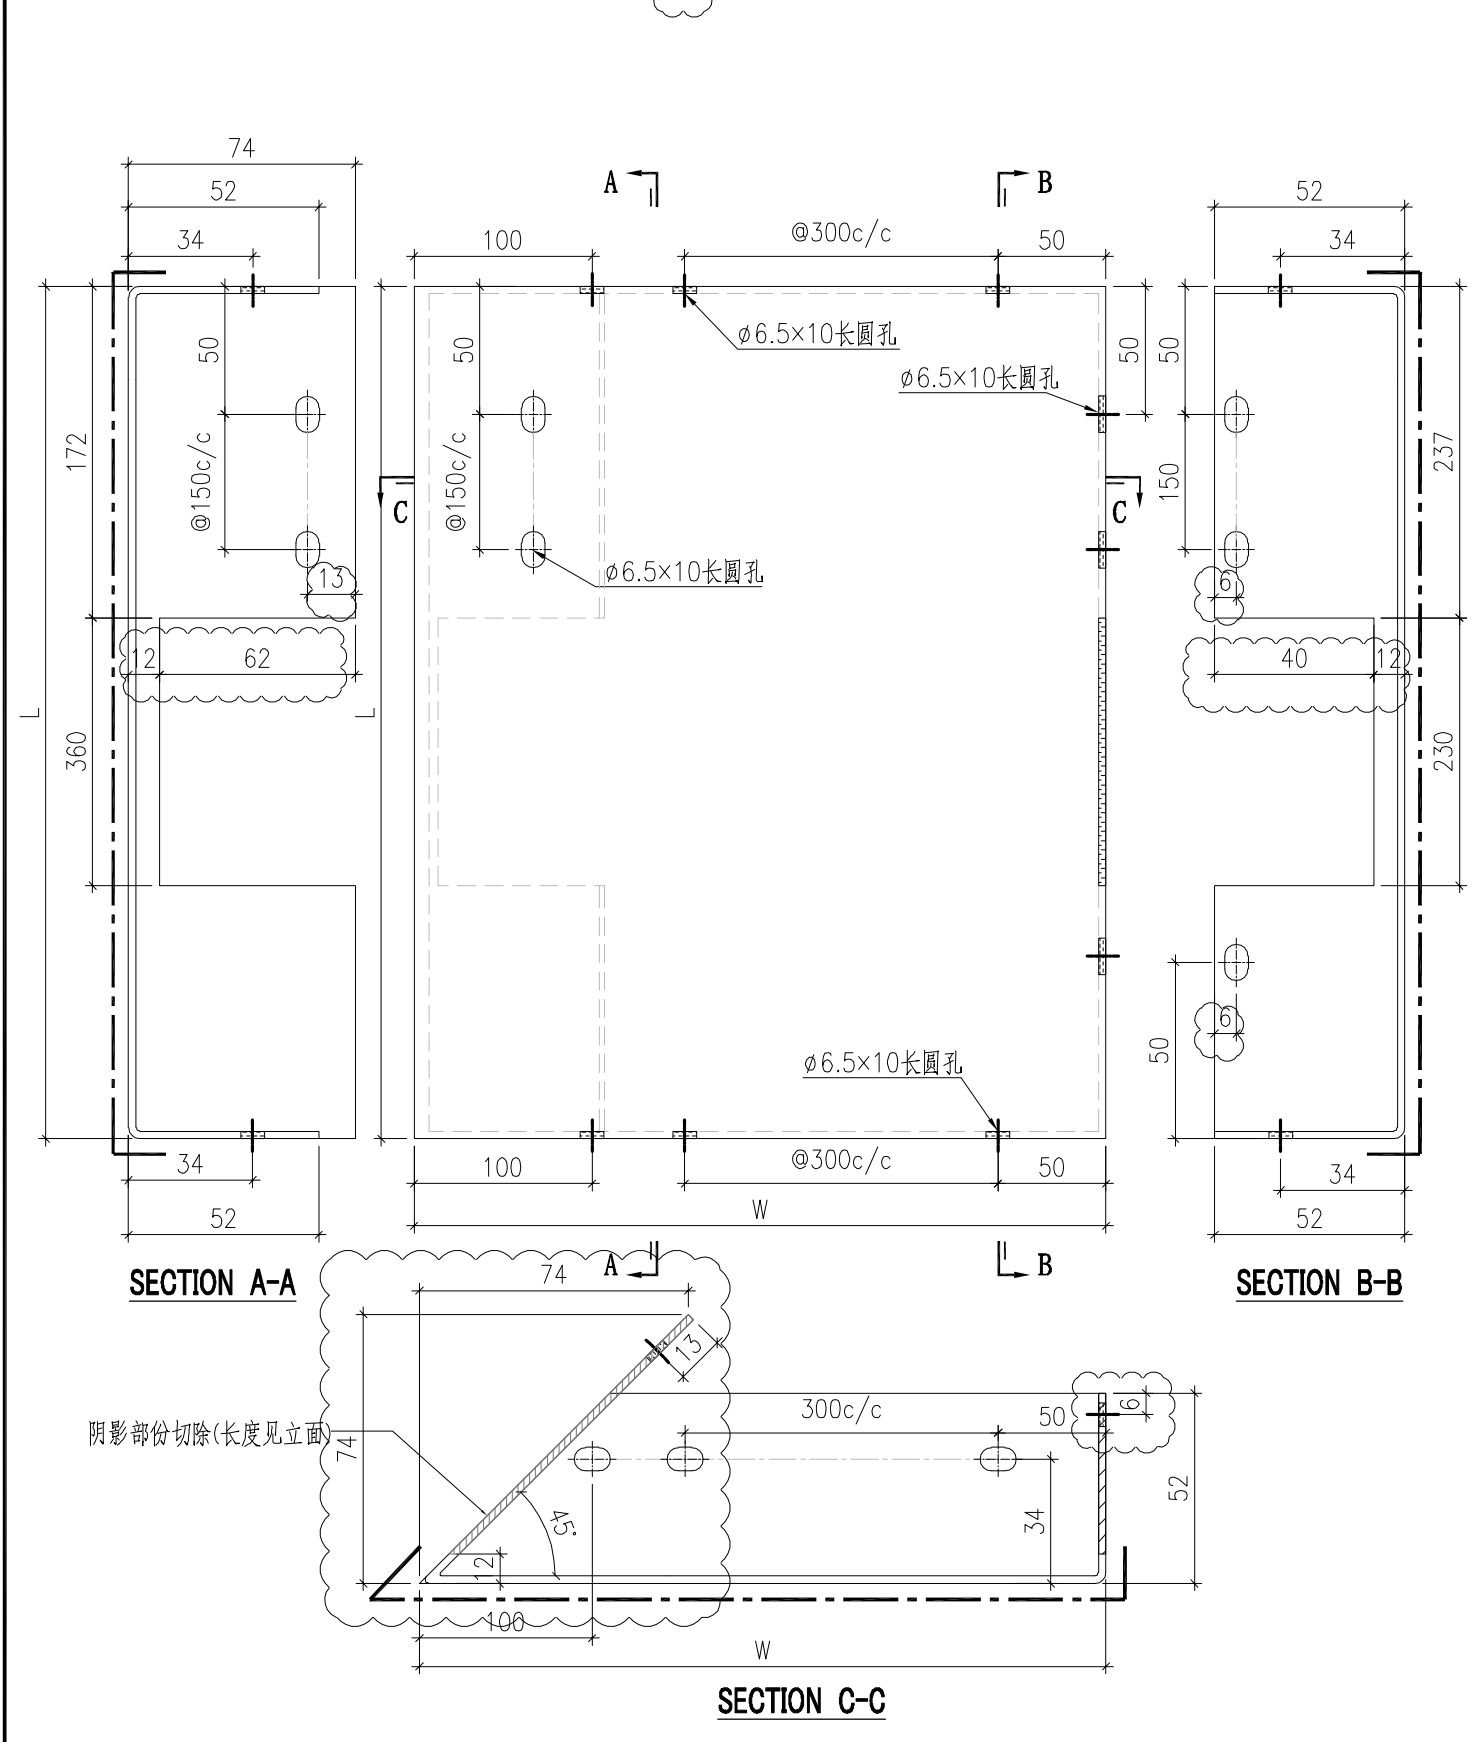

序號	鋁板編號	寬度 (W)	高度 (H)	數量
1	BST-HZ001	1601	537	1
2	BST-HZ004	1450	537	1
3	BST-HZ005	490	537	1

 美特鋁質有限公司 MIDI Aluminium Fabricator Ltd.				工程號 J857 地盤 啟德6552	類別 制圖 刘灿	物料號 - 2021-12-14	圖號 BST-D03
修改 - 日期 -	採用工廠 ✓ 材料颜色 ECK3M96295S-ZD1	地盤 材料 3mm THK. 铝板	图纸名称 铝板加工图	復核 徐詳坤 批准 林仁安	2021-12-15 2021-12-16	數量 - 單件重量 - (KG)	

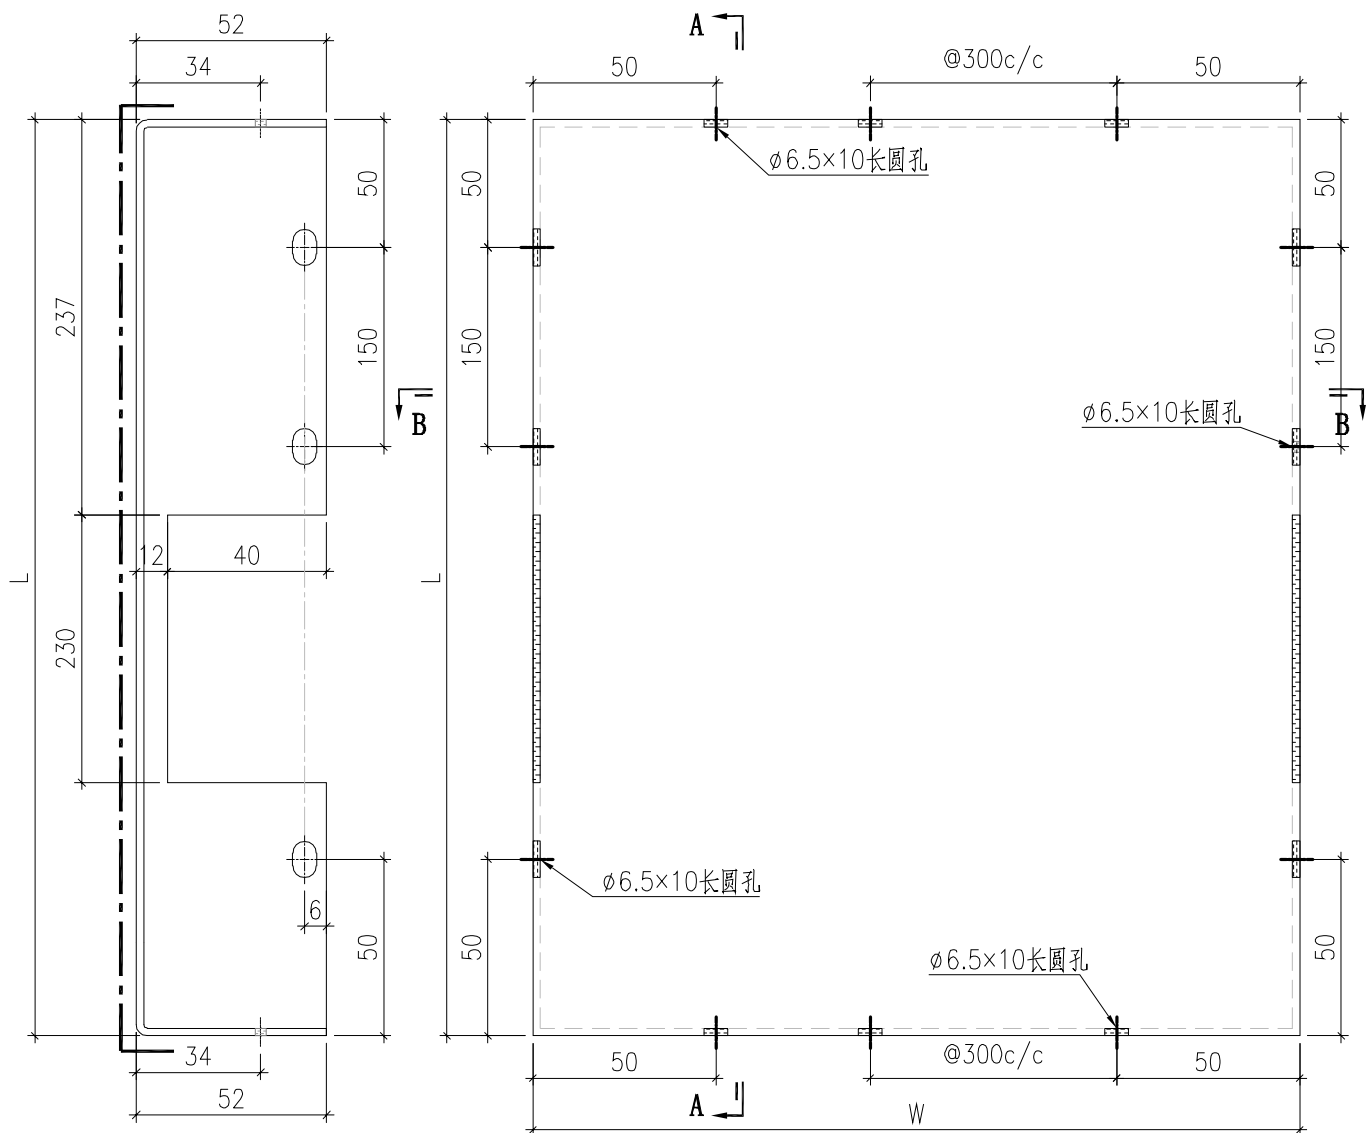


SECTION A-A

SECTION B-B


序號	鋁板編號	寬度 (W)	高度 (H)	數量
1	BST-D090	536	552	4

 美特鋁質有限公司 MIDI Aluminium Fabricator Ltd.				工程號 J857	類別	物料號 -		
				地盤 啟德6552	制圖 刘灿	2021-12-14	圖號 BST-E03	
修改 -			採用工廠 ✓	地盤	图纸名称 铝板加工图	復核 徐詳坤	2021-12-15	數量 -
日期 -			材料颜色 BCK3M96295S-ZD1		材料 3mm THK. 铝板	批准 林仁安	2021-12-16	單件重量 - (KG)

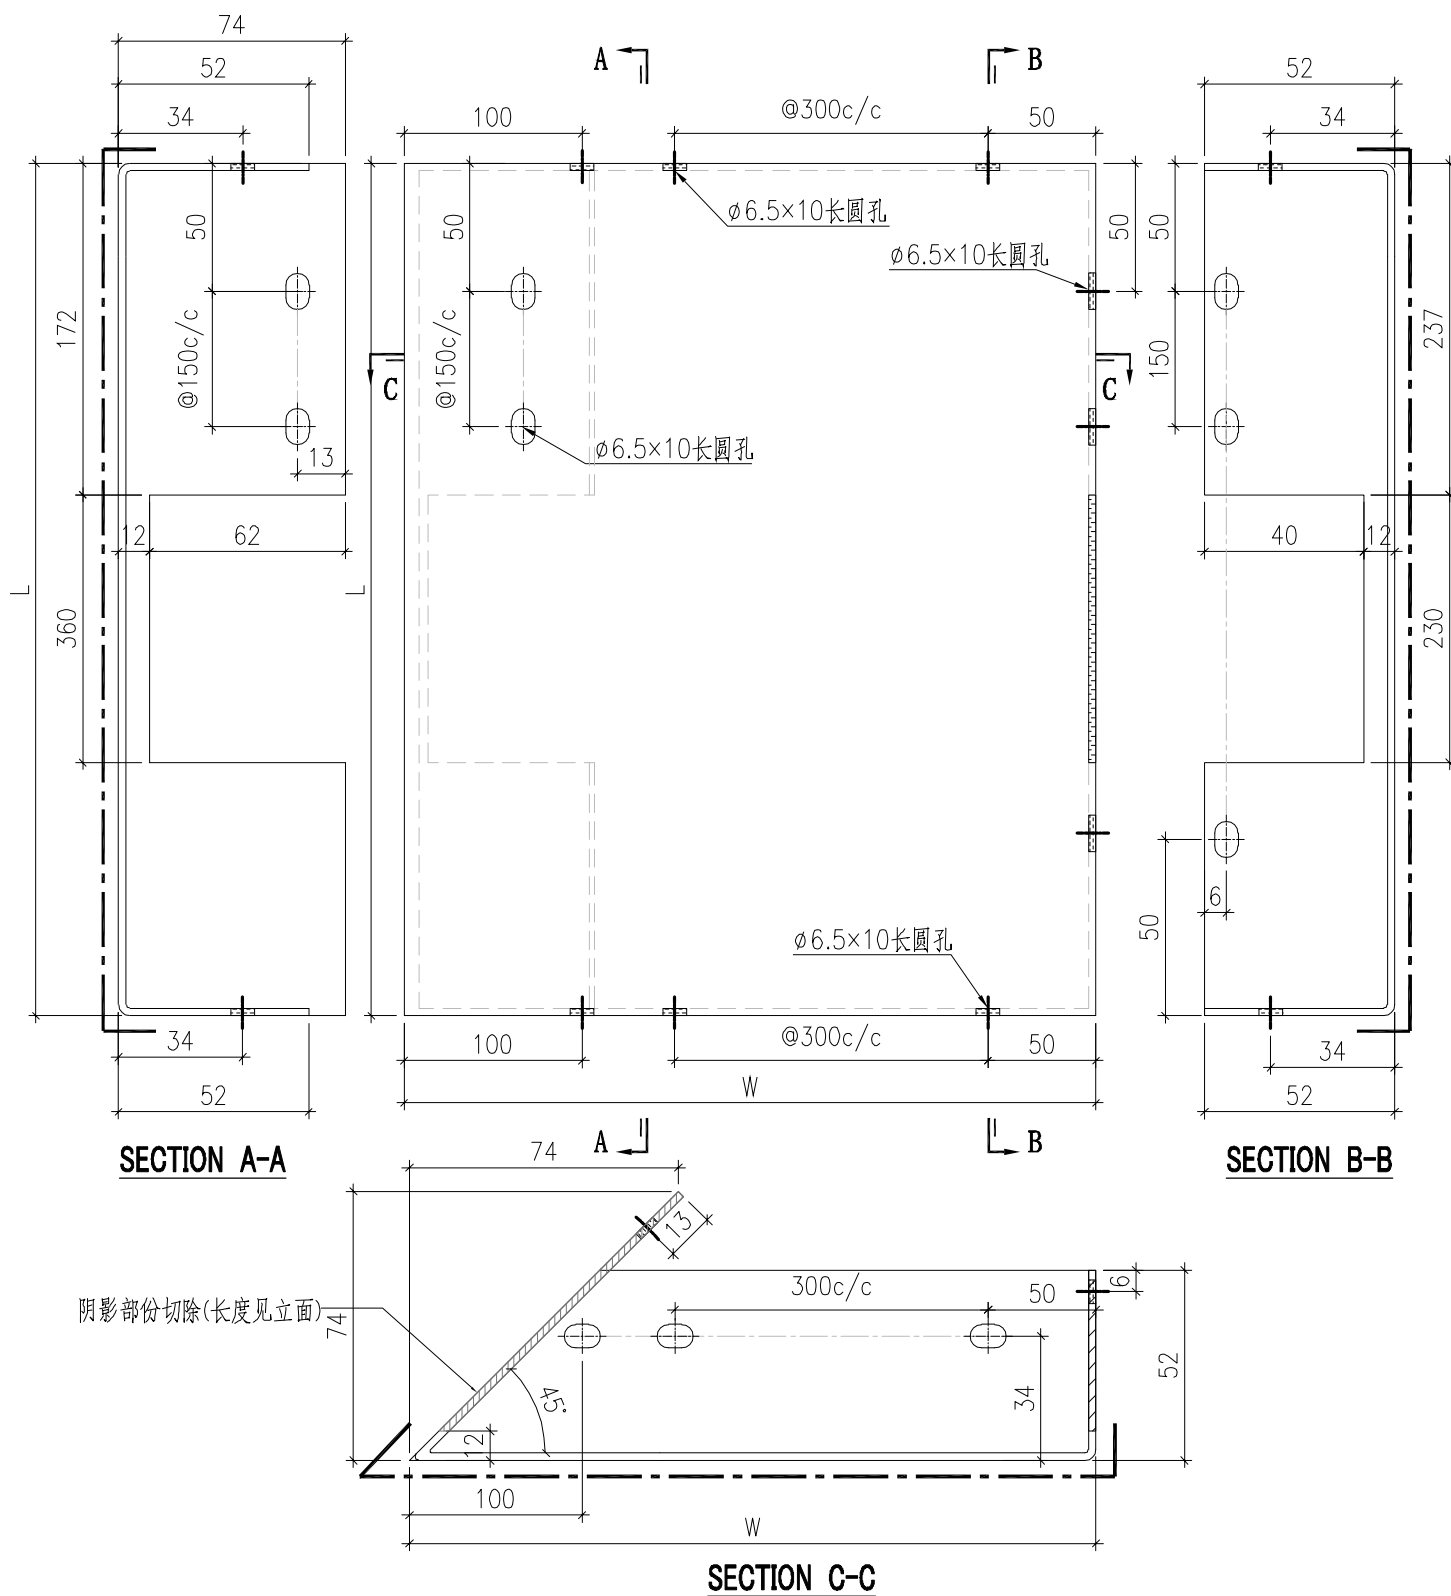


序號	鋁板編號	寬度 (W)	高度 (H)	數量
1	BST-EZ030	1454	552	2

 美特鋁質有限公司 MIDI Aluminium Fabricator Ltd.				工程號 J857 地盤 啟德6552	類別 制圖 刘灿	物料號 - 2021-12-14	圖號 BST-G03
修改 - 日期 -	採用工廠 ✓ 材料颜色 BCK3M96295S-ZD1	地盤 材料 3mm THK. 铝板	图纸名称 铝板加工图 材料	復核 徐詳坤 批准 林仁安	2021-12-15 2021-12-16	數量 - 單件重量 - (KG)	

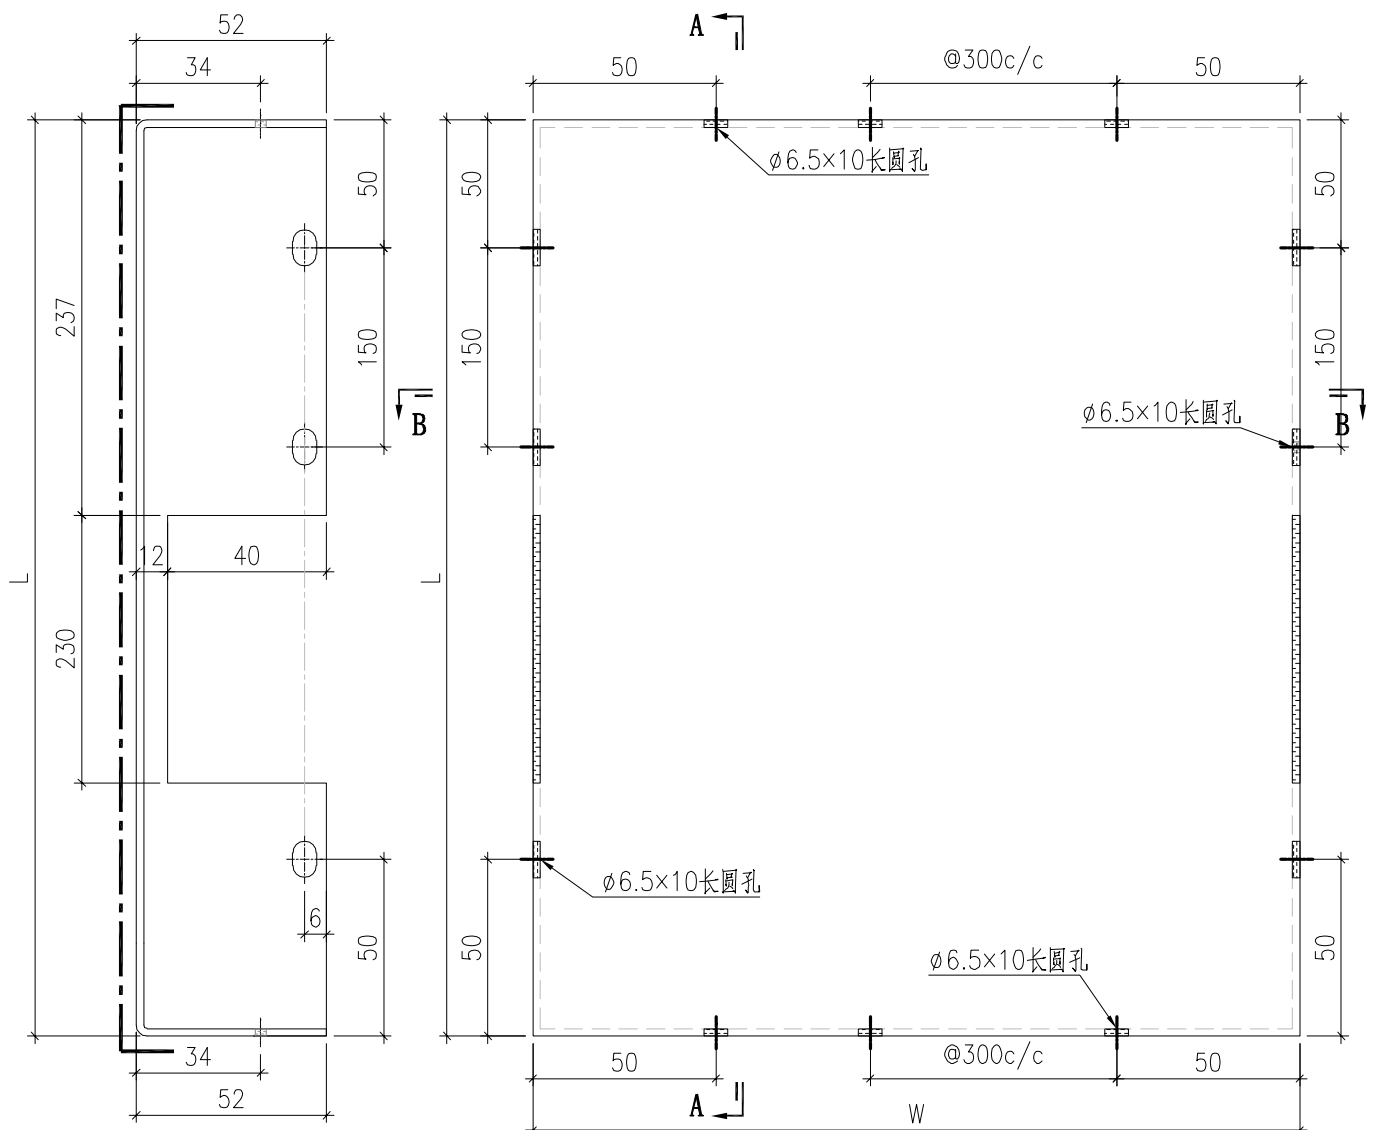


SECTION A-A

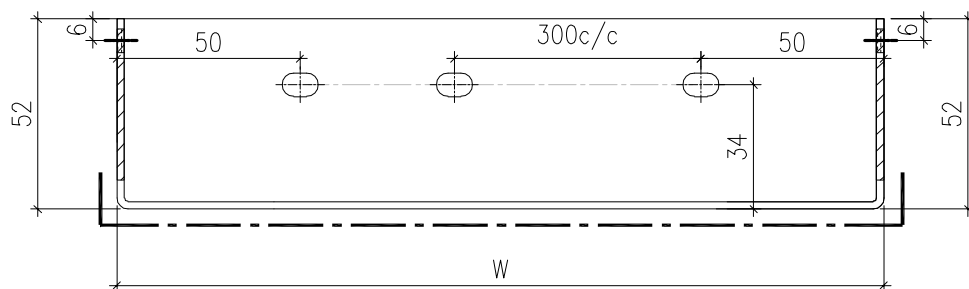

SECTION B-B


序號	鋁板編號	寬度 (W)	高度 (H)	數量
1	BST-G090	536	537	2

 美特鋁質有限公司 MIDI Aluminium Fabricator Ltd.				工程號 J857	類別	物料號 -		
				地盤 啟德6552	制圖 刘灿	2021-12-14	圖號 BST-H03	
修改 -	-	-	採用工廠 ✓	地盤	图纸名称 铝板加工图	復核 徐詳坤	2021-12-15	數量 -
日期 -	-	-	材料颜色 ECK3M96295S-ZD1		材料 3mm THK. 铝板	批准 林仁安	2021-12-16	單件重量 - (KG)

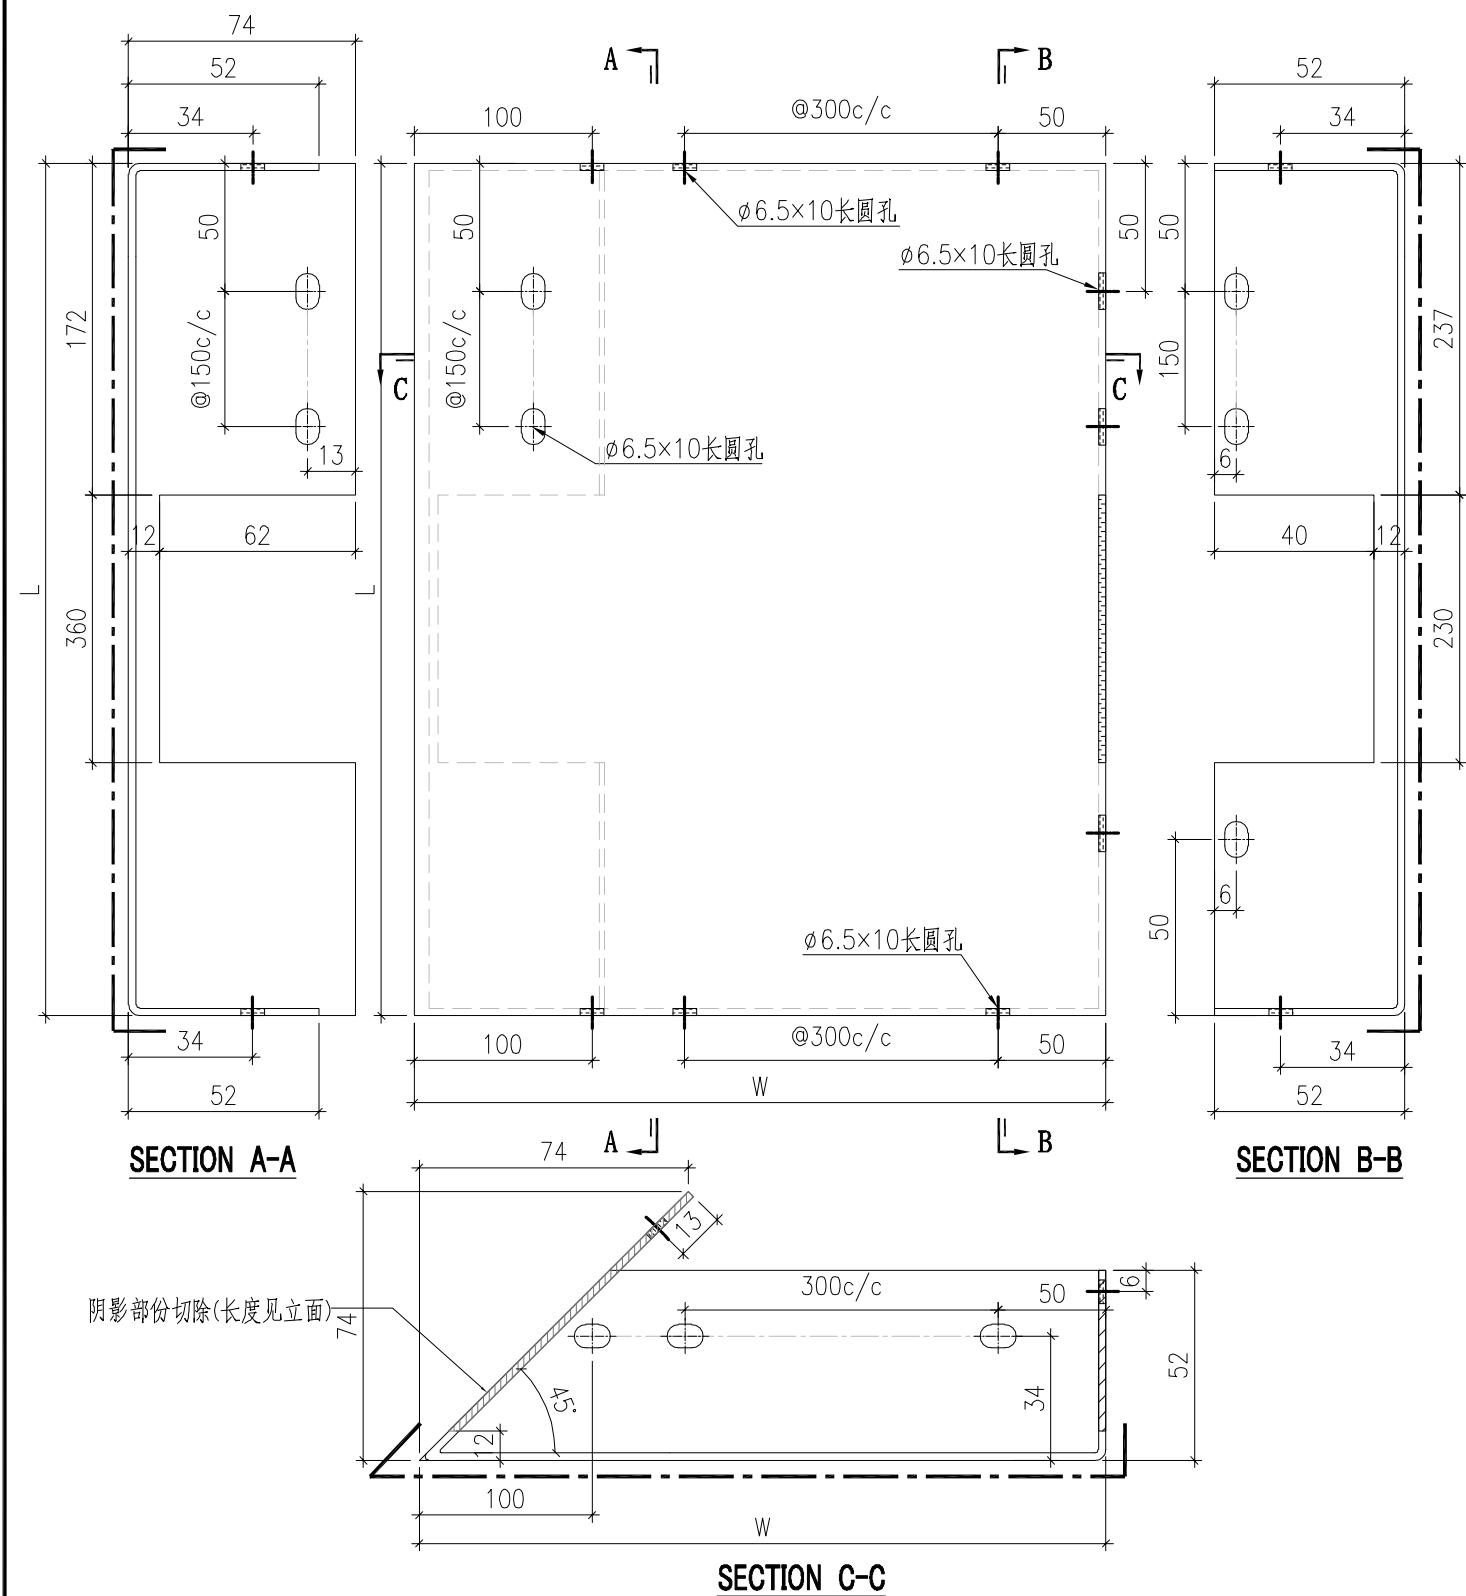



序號	鋁板編號	寬度 (W)	高度 (H)	數量
1	BST-HZ030	1454	537	1


 美特鋁質有限公司 MIDI Aluminium Fabricator Ltd.					工程號 J857	類別	物料號 -		
					地盤 啟德6552	制圖 刘灿	2021-12-14	圖號 BST-M03	
修改 -	-	-	採用工廠 ✓	地盤	图纸名称 铝板加工图	復核 徐詳坤	2021-12-15	數量 -	
日期 -	-	-	材料颜色 ECK3M96295S-ZD1		材料 3mm THK. 铝板	批准 林仁安	2021-12-16	單件重量 -	(KG)

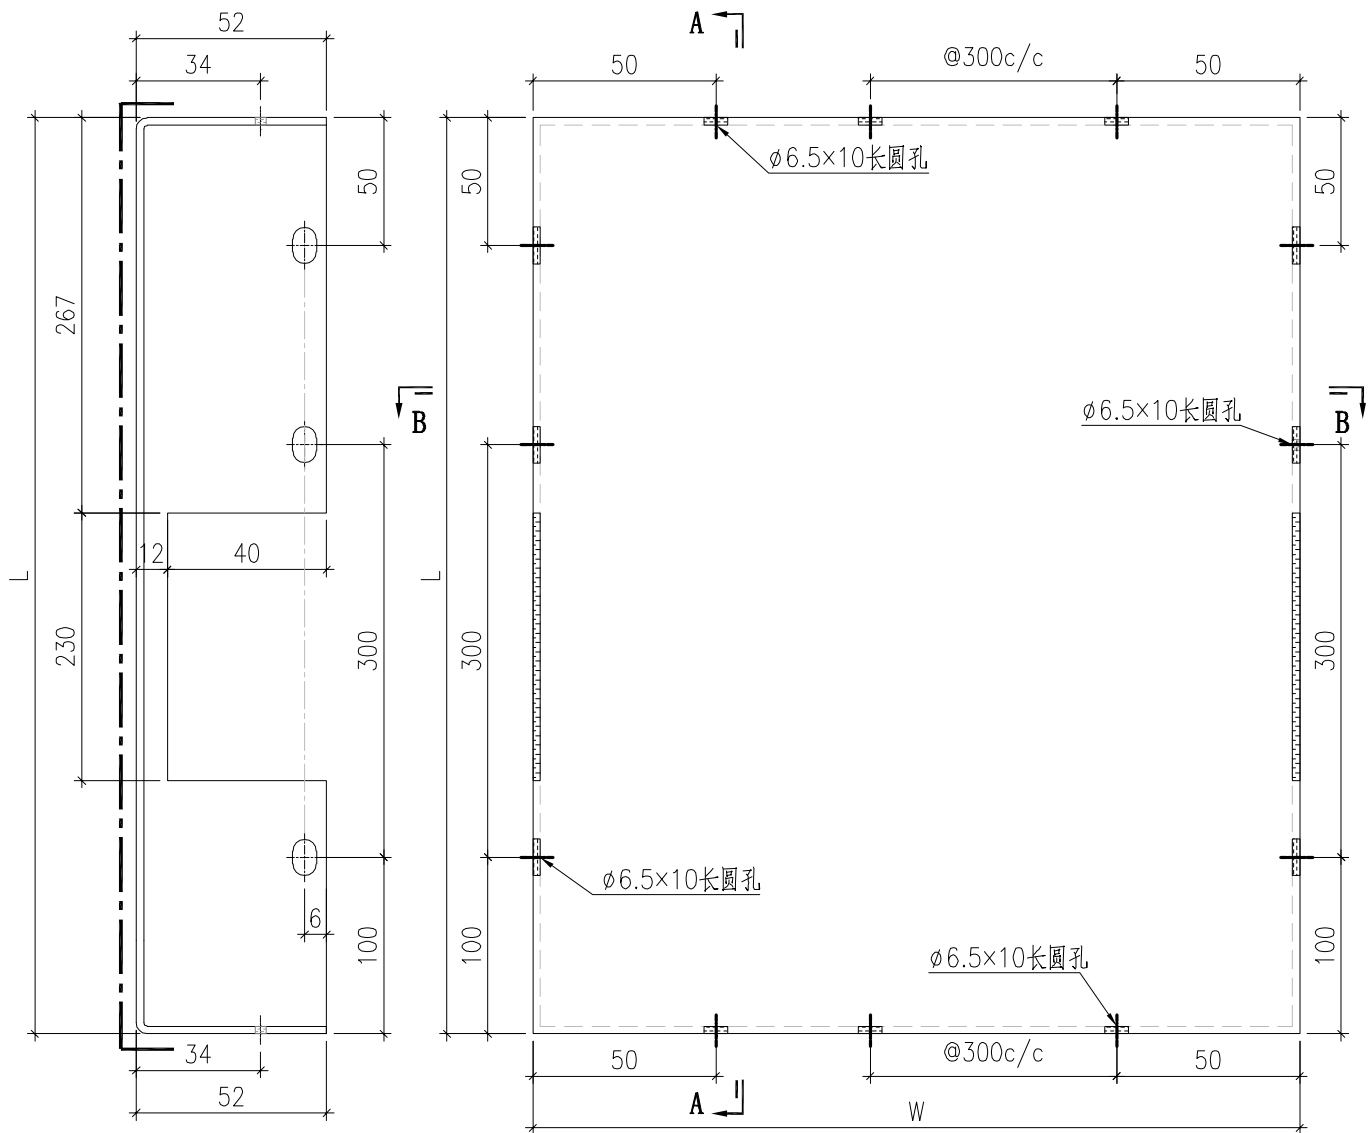


序號	鋁板編號	寬度 (W)	高度 (H)	數量
1	BST-M090	964	646	10
2	BST-M091	536	646	14

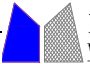 美特鋁質 有限公司 MIDI Aluminium Fabricator Ltd.		工程號: J-857	計算: 刘灿	日期: 2022.01.06	送呈: 施哥									
		地盤名稱: 啟德6552	核對: 徐祥坤	日期: 2022.01.07	副本: 细佬									
廠用鋁板B.M表		項目類別: 第三批	批准: 林仁安	日期: 2022.01.12										
BM編號:		修改版次: C	A/C Code: 2022.03.05	總V.F.: 646.660	總重量: 4534.65									
序號	修改內容	鋁板圖號	鋁板名稱	顏色	實用	後備	總數	總重量	展開面積		單件V.F.		圖紙編號	
									單件展開面積	總展開面積	單件V.F.	總V.F.		
									平方米		平方米			
1		BST-CY001	3mm厚鋁板	ECK3M96295S-ZD1	5	0	5	17.540	0.647	3.236	0.477	2.387	BST-C01	
2		BST-CY003	3mm厚鋁板	ECK3M96295S-ZD1	5	0	5	45.691	1.686	8.430	1.372	6.861	BST-C01	
3		BST-CY007	3mm厚鋁板	ECK3M96295S-ZD1	21	0	21	165.096	1.451	30.461	1.169	24.554	BST-C01	
4		BST-CY008	3mm厚鋁板	ECK3M96295S-ZD1	21	0	21	99.279	0.872	18.317	0.671	14.095	BST-C01	
5		BST-CY011	3mm厚鋁板	ECK3M96295S-ZD1	7	0	7	36.536	0.963	6.741	0.749	5.246	BST-C01	
6		BST-CY013	3mm厚鋁板	ECK3M96295S-ZD1	7	0	7	28.825	0.760	5.318	0.574	4.020	BST-C01	
7		BST-CY014	3mm厚鋁板	ECK3M96295S-ZD1	5	0	5	29.146	1.076	5.378	0.846	4.231	BST-C01	
8		BST-CY015	3mm厚鋁板	ECK3M96295S-ZD1	7	0	7	14.569	0.384	2.688	0.251	1.755	BST-C03	
9		BST-CZ001	3mm厚鋁板	ECK3M96295S-ZD1	5	0	5	35.040	1.293	6.465	1.034	5.168	BST-C02	
10	C修改	BST-CZ004	3mm厚鋁板	ECK3M96295S-ZD1	0	0	0	0.000	1.180	0.000	0.936	0.000	BST-C02	
11		BST-CZ005	3mm厚鋁板	ECK3M96295S-ZD1	5	0	5	12.459	0.460	2.299	0.316	1.579	BST-C02	
12		BST-CZ006	3mm厚鋁板	ECK3M96295S-ZD1	21	0	21	165.096	1.451	30.461	1.169	24.554	BST-C02	
13		BST-CZ009	3mm厚鋁板	ECK3M96295S-ZD1	21	0	21	99.279	0.872	18.317	0.671	14.095	BST-C02	
14		BST-CZ010	3mm厚鋁板	ECK3M96295S-ZD1	7	0	7	47.634	1.256	8.789	1.001	7.009	BST-C02	
15		BST-CZ012	3mm厚鋁板	ECK3M96295S-ZD1	7	0	7	20.118	0.530	3.712	0.377	2.636	BST-C02	
16		BST-CZ016	3mm厚鋁板	ECK3M96295S-ZD1	7	0	7	39.296	1.036	7.250	0.812	5.684	BST-C04	
17	C新增	BST-CZ030	3mm厚鋁板	ECK3M96295S-ZD1	5	0	5	32.073	1.184	5.918	0.939	4.696	BST-C05	
18		BST-D001	3mm厚鋁板	ECK3M96295S-ZD1	1	0	1	2.844	0.525	0.525	0.384	0.384	BST-D01	
19		BST-D002	3mm厚鋁板	ECK3M96295S-ZD1	1	0	1	7.566	1.396	1.396	1.117	1.117	BST-D01	
20		BST-D003	3mm厚鋁板	ECK3M96295S-ZD1	1	0	1	1.952	0.360	0.360	0.246	0.246	BST-D01	
21		BST-D004	3mm厚鋁板	ECK3M96295S-ZD1	1	0	1	4.302	0.794	0.794	0.611	0.611	BST-D01	
22		BST-D005	3mm厚鋁板	ECK3M96295S-ZD1	6	0	6	17.066	0.525	3.149	0.384	2.305	BST-D01	

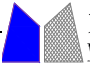 美特鋁質 有限公司 MIDI Aluminium Fabricator Ltd.		工程號:	J-857	計算:	刘灿		日期:	2022.01.06		送呈:	施哥		
		地盤名稱:	啟德6552	核對:	徐祥坤		日期:	2022.01.07		副本:	细佬		
廠用鋁板B.M表		項目類別:	第三批	批准:	林仁安		日期:	2022.01.12					
BM編號:		修改版次:	C	A/C Code:	2022.03.05		總V.F.:	646.660		總重量:	4534.65		
序號	修改內容	鋁板圖號	鋁板名稱	顏色	實用	後備	總數	總重量	單件展開面積	總展開面積	單件V.F.	總V.F.	圖紙編號
									平方米		平方米		
23		BST-D006	3mm厚鋁板	ECK3M96295S-ZD1	1	0	1	3.858	0.712	0.712	0.542	0.542	BST-D01
24		BST-D007	3mm厚鋁板	ECK3M96295S-ZD1	8	0	8	22.727	0.524	4.193	0.384	3.069	BST-D01
25		BST-D008	3mm厚鋁板	ECK3M96295S-ZD1	4	0	4	19.754	0.911	3.645	0.709	2.837	BST-D01
26		BST-D009	3mm厚鋁板	ECK3M96295S-ZD1	4	0	4	11.093	0.512	2.047	0.373	1.493	BST-D01
27		BST-D010	3mm厚鋁板	ECK3M96295S-ZD1	3	0	3	11.307	0.695	2.086	0.528	1.583	BST-D01
28		BST-D011	3mm厚鋁板	ECK3M96295S-ZD1	2	0	2	7.651	0.706	1.412	0.537	1.073	BST-D01
29		BST-D012	3mm厚鋁板	ECK3M96295S-ZD1	4	0	4	7.822	0.361	1.443	0.246	0.985	BST-D01
30		BST-D013	3mm厚鋁板	ECK3M96295S-ZD1	4	0	4	22.898	1.056	4.225	0.831	3.325	BST-D01
31		BST-D014	3mm厚鋁板	ECK3M96295S-ZD1	2	0	2	8.135	0.750	1.501	0.574	1.148	BST-D01
32		BST-D016	3mm厚鋁板	ECK3M96295S-ZD1	2	0	2	11.683	1.078	2.156	0.850	1.699	BST-D01
33		BST-D017	3mm厚鋁板	ECK3M96295S-ZD1	2	0	2	14.919	1.376	2.753	1.101	2.201	BST-D01
34		BST-D018	3mm厚鋁板	ECK3M96295S-ZD1	4	0	4	12.089	0.558	2.230	0.412	1.647	BST-D01
35		BST-D019	3mm厚鋁板	ECK3M96295S-ZD1	2	0	2	9.379	0.865	1.731	0.671	1.341	BST-D01
36		BST-D021	3mm厚鋁板	ECK3M96295S-ZD1	1	0	1	2.958	0.546	0.546	0.402	0.402	BST-D01
37	C修改	BST-D022	3mm厚鋁板	ECK3M96295S-ZD1	0	0	0	0.000	0.414	0.000	0.291	0.000	BST-D01
38		BST-D023	3mm厚鋁板	ECK3M96295S-ZD1	1	0	1	1.742	0.321	0.321	0.213	0.213	BST-D01
39		BST-D062	3mm厚鋁板	ECK3M96295S-ZD1	1	0	1	2.276	0.420	0.420	0.296	0.296	BST-D01
40		BST-D080	3mm厚鋁板	ECK3M96295S-ZD1	5	0	5	14.329	0.529	2.644	0.388	1.938	BST-D01
41		BST-D081	3mm厚鋁板	ECK3M96295S-ZD1	2	0	2	7.694	0.710	1.420	0.540	1.080	BST-D01
42		BST-D084	3mm厚鋁板	ECK3M96295S-ZD1	1	0	1	5.831	1.076	1.076	0.848	0.848	BST-D01
43	C新增	BST-D090	3mm厚鋁板	ECK3M96295S-ZD1	2	0	2	4.551	0.420	0.840	0.296	0.592	BST-D03
44		BST-EY001	3mm厚鋁板	ECK3M96295S-ZD1	1	0	1	3.068	0.566	0.566	0.408	0.408	BST-E01

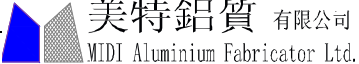
 美特鋁質 有限公司 MIDI Aluminium Fabricator Ltd.		工程號:	J-857	計算:	刘灿		日期:	2022.01.06		送呈:	施哥			
		地盤名稱:	啟德6552	核對:	徐祥坤		日期:	2022.01.07		副本:	细佬			
廠用鋁板B.M表		項目類別:	第三批	批准:	林仁安		日期:	2022.01.12						
BM編號:		修改版次:	C	A/C Code:	2022.03.05		總V.F.:	646.660		總重量:	4534.65			
序號	修改內容	鋁板圖號	鋁板名稱	顏色	實用	後備	總數	總重量	展開面積		單件V.F.		圖紙編號	
									單件展開面積	總展開面積	單件V.F.	總V.F.		
									平方米		平方米			
45		BST-EY003	3mm厚鋁板	ECK3M96295S-ZD1	1	0	1	7.993	1.475	1.475	1.172	1.172	BST-E01	
46		BST-EY014	3mm厚鋁板	ECK3M96295S-ZD1	1	0	1	5.099	0.941	0.941	0.723	0.723	BST-E01	
47		BST-EZ001	3mm厚鋁板	ECK3M96295S-ZD1	1	0	1	6.130	1.131	1.131	0.883	0.883	BST-E02	
48	C修改	BST-EZ004	3mm厚鋁板	ECK3M96295S-ZD1	0	0	0	0.000	1.032	0.000	0.800	0.000	BST-E02	
49		BST-EZ005	3mm厚鋁板	ECK3M96295S-ZD1	1	0	1	2.180	0.402	0.402	0.270	0.270	BST-E02	
50	C新增	BST-EZ030	3mm厚鋁板	ECK3M96295S-ZD1	1	0	1	5.611	1.035	1.035	0.803	0.803	BST-E03	
51		BST-F001	3mm厚鋁板	ECK3M96295S-ZD1	35	0	35	368.435	1.942	67.977	1.613	56.453	BST-F01	
52		BST-G001	3mm厚鋁板	ECK3M96295S-ZD1	1	0	1	2.779	0.513	0.513	0.374	0.374	BST-G01	
53		BST-G002	3mm厚鋁板	ECK3M96295S-ZD1	1	0	1	7.393	1.364	1.364	1.087	1.087	BST-G01	
54		BST-G003	3mm厚鋁板	ECK3M96295S-ZD1	1	0	1	1.907	0.352	0.352	0.239	0.239	BST-G01	
55		BST-G004	3mm厚鋁板	ECK3M96295S-ZD1	1	0	1	4.204	0.776	0.776	0.594	0.594	BST-G01	
56		BST-G005	3mm厚鋁板	ECK3M96295S-ZD1	6	0	6	16.676	0.513	3.077	0.374	2.243	BST-G01	
57		BST-G006	3mm厚鋁板	ECK3M96295S-ZD1	1	0	1	3.770	0.695	0.695	0.527	0.527	BST-G01	
58		BST-G007	3mm厚鋁板	ECK3M96295S-ZD1	8	0	8	22.207	0.512	4.097	0.373	2.986	BST-G01	
59		BST-G008	3mm厚鋁板	ECK3M96295S-ZD1	4	0	4	19.303	0.890	3.561	0.690	2.760	BST-G01	
60		BST-G009	3mm厚鋁板	ECK3M96295S-ZD1	4	0	4	10.840	0.500	2.000	0.363	1.452	BST-G01	
61		BST-G010	3mm厚鋁板	ECK3M96295S-ZD1	3	0	3	11.048	0.679	2.038	0.513	1.540	BST-G01	
62		BST-G011	3mm厚鋁板	ECK3M96295S-ZD1	2	0	2	7.477	0.690	1.379	0.522	1.044	BST-G01	
63		BST-G012	3mm厚鋁板	ECK3M96295S-ZD1	4	0	4	7.643	0.353	1.410	0.240	0.958	BST-G01	
64		BST-G013	3mm厚鋁板	ECK3M96295S-ZD1	4	0	4	22.374	1.032	4.128	0.809	3.235	BST-G01	
65		BST-G014	3mm厚鋁板	ECK3M96295S-ZD1	2	0	2	7.949	0.733	1.467	0.558	1.117	BST-G01	
66		BST-G016	3mm厚鋁板	ECK3M96295S-ZD1	2	0	2	11.416	1.053	2.106	0.826	1.653	BST-G01	

 美特鋁質 有限公司 MIDI Aluminium Fabricator Ltd.		工程號:	J-857	計算:	刘灿		日期:	2022.01.06		送呈:	施哥		
		地盤名稱:	啟德6552	核對:	徐祥坤		日期:	2022.01.07		副本:	细佬		
廠用鋁板B.M表		項目類別:	第三批	批准:	林仁安		日期:	2022.01.12					
BM編號:		修改版次:	C	A/C Code:	2022.03.05		總V.F.:	646.660		總重量:	4534.65		
序號	修改內容	鋁板圖號	鋁板名稱	顏色	實用	後備	總數	總重量	單件展開面積	總展開面積	單件V.F.	總V.F.	圖紙編號
									平方米		平方米		
67		BST-G017	3mm厚鋁板	ECK3M96295S-ZD1	2	0	2	14.578	1.345	2.690	1.071	2.142	BST-G01
68		BST-G018	3mm厚鋁板	ECK3M96295S-ZD1	4	0	4	11.812	0.545	2.179	0.401	1.602	BST-G01
69		BST-G019	3mm厚鋁板	ECK3M96295S-ZD1	2	0	2	9.165	0.845	1.691	0.652	1.305	BST-G01
70		BST-G021	3mm厚鋁板	ECK3M96295S-ZD1	1	0	1	2.891	0.533	0.533	0.391	0.391	BST-G01
71	C修改	BST-G022	3mm厚鋁板	ECK3M96295S-ZD1	0	0	0	0.000	0.404	0.000	0.283	0.000	BST-G01
72		BST-G023	3mm厚鋁板	ECK3M96295S-ZD1	1	0	1	1.702	0.314	0.314	0.207	0.207	BST-G01
73		BST-G062	3mm厚鋁板	ECK3M96295S-ZD1	1	0	1	2.224	0.410	0.410	0.288	0.288	BST-G01
74		BST-G080	3mm厚鋁板	ECK3M96295S-ZD1	5	0	5	14.001	0.517	2.583	0.377	1.885	BST-G01
75		BST-G081	3mm厚鋁板	ECK3M96295S-ZD1	2	0	2	7.518	0.694	1.387	0.525	1.050	BST-G01
76		BST-G084	3mm厚鋁板	ECK3M96295S-ZD1	1	0	1	5.698	1.051	1.051	0.825	0.825	BST-G01
77	C新增	BST-G090	3mm厚鋁板	ECK3M96295S-ZD1	2	0	2	4.447	0.410	0.820	0.288	0.576	BST-G03
78		BST-HY001	3mm厚鋁板	ECK3M96295S-ZD1	1	0	1	2.998	0.553	0.553	0.397	0.397	BST-H01
79		BST-HY003	3mm厚鋁板	ECK3M96295S-ZD1	1	0	1	7.810	1.441	1.441	1.141	1.141	BST-H01
80		BST-HY014	3mm厚鋁板	ECK3M96295S-ZD1	1	0	1	4.982	0.919	0.919	0.703	0.703	BST-H01
81		BST-HZ001	3mm厚鋁板	ECK3M96295S-ZD1	1	0	1	5.990	1.105	1.105	0.859	0.859	BST-H02
82	C修改	BST-HZ004	3mm厚鋁板	ECK3M96295S-ZD1	0	0	0	0.000	1.008	0.000	0.778	0.000	BST-H02
83		BST-HZ005	3mm厚鋁板	ECK3M96295S-ZD1	1	0	1	2.130	0.393	0.393	0.263	0.263	BST-H02
84	C新增	BST-HZ030	3mm厚鋁板	ECK3M96295S-ZD1	1	0	1	5.413	0.999	0.999	0.781	0.781	BST-H03
85		BST-M001	3mm厚鋁板	ECK3M96295S-ZD1	5	0	5	16.260	0.600	3.000	0.450	2.248	BST-M01
86		BST-M002	3mm厚鋁板	ECK3M96295S-ZD1	5	0	5	43.252	1.596	7.980	1.308	6.538	BST-M01
87		BST-M003	3mm厚鋁板	ECK3M96295S-ZD1	5	0	5	11.158	0.412	2.059	0.287	1.437	BST-M01
88		BST-M004	3mm厚鋁板	ECK3M96295S-ZD1	5	0	5	24.593	0.908	4.538	0.714	3.572	BST-M01

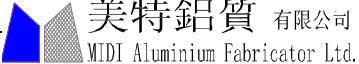 美特鋁質 有限公司 MIDI Aluminium Fabricator Ltd.		工程號:	J-857	計算:	刘灿		日期:	2022.01.06		送呈:	施哥		
		地盤名稱:	啟德6552	核對:	徐祥坤		日期:	2022.01.07		副本:	细佬		
廠用鋁板B.M表		項目類別:	第三批	批准:	林仁安		日期:	2022.01.12					
BM編號:		修改版次:	C	A/C Code:	2022.03.05		總V.F.:	646.660		總重量:	4534.65		
序號	修改內容	鋁板圖號	鋁板名稱	顏色	實用	後備	總數	總重量	單件展開面積	總展開面積	單件V.F.	總V.F.	圖紙編號
									平方米		平方米		
89		BST-M005	3mm厚鋁板	ECK3M96295S-ZD1	37	0	37	120.324	0.600	22.200	0.450	16.636	BST-M01
90		BST-M006	3mm厚鋁板	ECK3M96295S-ZD1	5	0	5	22.053	0.814	4.069	0.634	3.169	BST-M01
91		BST-M007	3mm厚鋁板	ECK3M96295S-ZD1	40	0	40	129.917	0.599	23.970	0.449	17.959	BST-M01
92		BST-M008	3mm厚鋁板	ECK3M96295S-ZD1	20	0	20	112.926	1.042	20.835	0.830	16.602	BST-M01
93		BST-M009	3mm厚鋁板	ECK3M96295S-ZD1	34	0	34	107.804	0.585	19.890	0.437	14.848	BST-M01
94		BST-M010	3mm厚鋁板	ECK3M96295S-ZD1	15	0	15	64.634	0.795	11.925	0.618	9.264	BST-M01
95		BST-M011	3mm厚鋁板	ECK3M96295S-ZD1	10	0	10	43.739	0.807	8.070	0.628	6.279	BST-M01
96		BST-M012	3mm厚鋁板	ECK3M96295S-ZD1	104	0	104	232.518	0.413	42.900	0.288	29.964	BST-M01
97		BST-M013	3mm厚鋁板	ECK3M96295S-ZD1	20	0	20	130.893	1.208	24.150	0.973	19.458	BST-M01
98		BST-M014	3mm厚鋁板	ECK3M96295S-ZD1	10	0	10	46.504	0.858	8.580	0.672	6.718	BST-M01
99		BST-M016	3mm厚鋁板	ECK3M96295S-ZD1	10	0	10	66.788	1.232	12.323	0.994	9.942	BST-M01
100		BST-M017	3mm厚鋁板	ECK3M96295S-ZD1	10	0	10	85.284	1.574	15.735	1.288	12.881	BST-M01
101		BST-M018	3mm厚鋁板	ECK3M96295S-ZD1	20	0	20	69.105	0.638	12.750	0.482	9.638	BST-M01
102		BST-M019	3mm厚鋁板	ECK3M96295S-ZD1	10	0	10	53.617	0.989	9.893	0.785	7.849	BST-M01
103		BST-M021	3mm厚鋁板	ECK3M96295S-ZD1	5	0	5	16.910	0.624	3.120	0.470	2.351	BST-M01
104	C修改	BST-M022	3mm厚鋁板	ECK3M96295S-ZD1	0	0	0	0.000	0.473	0.000	0.340	0.000	BST-M01
105		BST-M023	3mm厚鋁板	ECK3M96295S-ZD1	75	0	75	149.389	0.368	27.563	0.249	18.702	BST-M01
106		BST-M026	3mm厚鋁板	ECK3M96295S-ZD1	7	0	7	30.931	0.815	5.707	0.635	4.445	BST-M01
107		BST-M028	3mm厚鋁板	ECK3M96295S-ZD1	7	0	7	44.760	1.180	8.258	0.949	6.643	BST-M01
108		BST-M029	3mm厚鋁板	ECK3M96295S-ZD1	7	0	7	19.634	0.518	3.623	0.379	2.650	BST-M01
109		BST-M031	3mm厚鋁板	ECK3M96295S-ZD1	14	0	14	80.698	1.064	14.889	0.849	11.884	BST-M01
110		BST-M032	3mm厚鋁板	ECK3M96295S-ZD1	14	0	14	30.048	0.396	5.544	0.274	3.835	BST-M01

 美特鋁質 有限公司 MIDI Aluminium Fabricator Ltd.		工程號:	J-857	計算:	刘灿		日期:	2022.01.06		送呈:	施哥		
		地盤名稱:	啟德6552	核對:	徐祥坤		日期:	2022.01.07		副本:	细佬		
廠用鋁板B.M表		項目類別:	第三批	批准:	林仁安		日期:	2022.01.12					
BM編號:		修改版次:	C	A/C Code:	2022.03.05		總V.F.:	646.660		總重量:	4534.65		
序號	修改內容	鋁板圖號	鋁板名稱	顏色	實用	後備	總數	總重量	單件展開面積	總展開面積	單件V.F.	總V.F.	圖紙編號
									平方米		平方米		
111		BST-M035	3mm厚鋁板	ECK3M96295S-ZD1	14	0	14	53.495	0.705	9.870	0.540	7.561	BST-M01
112		BST-M037	3mm厚鋁板	ECK3M96295S-ZD1	14	0	14	78.650	1.037	14.511	0.826	11.558	BST-M01
113		BST-M038	3mm厚鋁板	ECK3M96295S-ZD1	14	0	14	103.121	1.359	19.026	1.103	15.447	BST-M01
114		BST-M039	3mm厚鋁板	ECK3M96295S-ZD1	14	0	14	71.820	0.947	13.251	0.748	10.473	BST-M01
115		BST-M042	3mm厚鋁板	ECK3M96295S-ZD1	7	0	7	48.715	1.284	8.988	1.039	7.271	BST-M01
116	C修改	BST-M043	3mm厚鋁板	ECK3M96295S-ZD1	0	0	0	0.000	0.847	0.000	0.662	0.000	BST-M01
117		BST-M046	3mm厚鋁板	ECK3M96295S-ZD1	7	0	7	43.479	1.146	8.022	0.920	6.439	BST-M01
118		BST-M048	3mm厚鋁板	ECK3M96295S-ZD1	7	0	7	45.528	1.200	8.400	0.966	6.765	BST-M01
119		BST-M049	3mm厚鋁板	ECK3M96295S-ZD1	7	0	7	44.248	1.166	8.164	0.937	6.561	BST-M01
120		BST-M062	3mm厚鋁板	ECK3M96295S-ZD1	75	0	75	195.120	0.480	36.000	0.346	25.969	BST-M01
121		BST-M080	3mm厚鋁板	ECK3M96295S-ZD1	25	0	25	81.910	0.605	15.113	0.453	11.337	BST-M01
122		BST-M081	3mm厚鋁板	ECK3M96295S-ZD1	10	0	10	43.983	0.812	8.115	0.632	6.318	BST-M01
123		BST-M082	3mm厚鋁板	ECK3M96295S-ZD1	14	0	14	66.073	0.871	12.191	0.683	9.560	BST-M01
124		BST-M083	3mm厚鋁板	ECK3M96295S-ZD1	7	0	7	32.069	0.845	5.917	0.661	4.626	BST-M01
125		BST-M084	3mm厚鋁板	ECK3M96295S-ZD1	5	0	5	33.333	1.230	6.150	0.992	4.961	BST-M01
126	C新增	BST-M090	3mm厚鋁板	ECK3M96295S-ZD1	7	0	7	30.390	0.801	5.607	0.623	4.359	BST-M03
127	C新增	BST-M091	3mm厚鋁板	ECK3M96295S-ZD1	10	0	10	26.016	0.480	4.800	0.346	3.463	BST-M03
總計:					1064		1064	4534.65	104.821	836.65	81.04	646.660	

 美特鋁質有限公司 MIDI Aluminium Fabricator Ltd.				工程號 J857 地盘 啟德6552	類別 制圖 刘灿	物料號 - 2021-12-14	圖號 BST-M01
修改 A 日期 2022.03.02	-	-	採用工廠 ✓ 材料颜色 ECK3M96295S-ZD1	图纸名称 铝板加工图 材料 3mm THK. 铝板	復核 徐詳坤 批准 林仁安	2021-12-15 2021-12-16	數量 - 單件重量 - (KG)

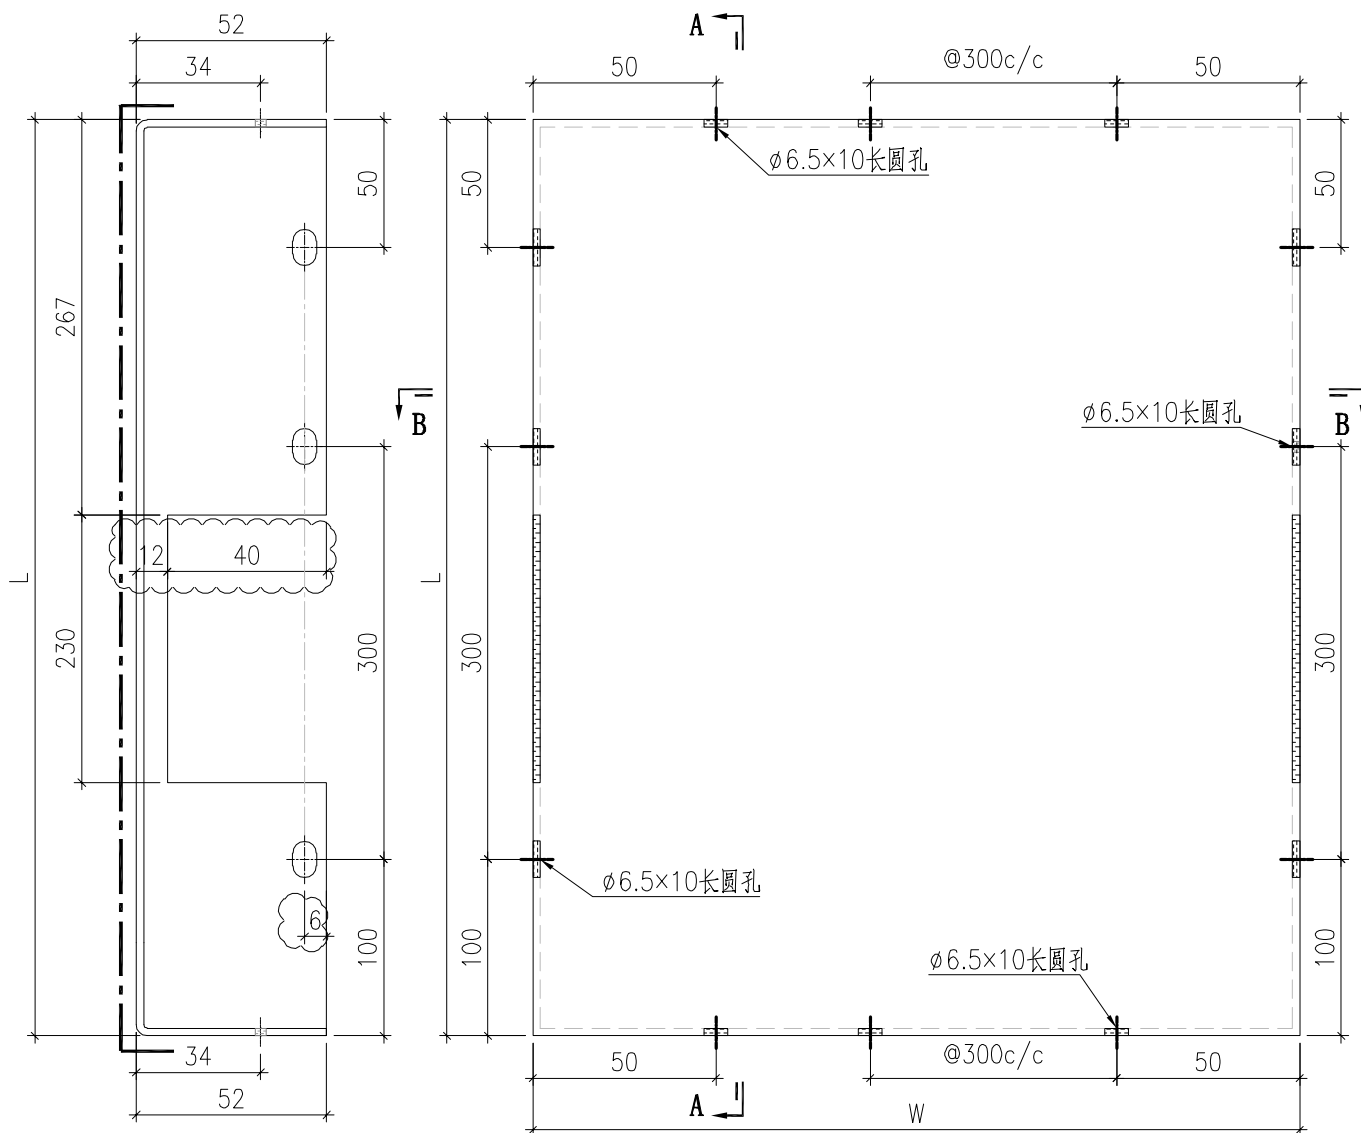


背板长宽数据見BST-M02

 美特鋁質有限公司 MIDI Aluminium Fabricator Ltd.				工程號	J857	類別		物料號	-					
				地盘	啟德6552	制圖	刘灿	2021-12-14	圖號	BST-M02				
修改	A	-	-	採用工廠	✓	地盤		图纸名称	铝板加工图	復核	徐詳坤	2021-12-15	數量	-
日期	2022.03.02	-	-	材料颜色	ECK3M96295S-ZD1		材料	3mm THK. 铝板	批准	林仁安	2021-12-16	單件重量	-	(KG)

序號	鋁板編號	寬度 (W)	高度 (H)	數量
1	BST-M001	696	646	5
2	BST-M002	2024	646	5
3	BST-M003	445	646	5
4	BST-M004	1106	646	5
5	BST-M005	696	646	37
6	BST-M006	981	646	5
7	BST-M007	695	646	40
8	BST-M008	1285	646	20
9	BST-M009	676	646	34
10	BST-M010	956	646	15
11	BST-M011	972	646	10
12	BST-M012	446	646	104
13	BST-M013	1506	646	20
14	BST-M014	1040	646	10
15	BST-M016	1539	646	10
16	BST-M017	1994	646	10
17	BST-M018	746	646	20
18	BST-M019	1215	646	10
19	BST-M021	728	646	5
20	BST-M022	527	646	10


序號	鋁板編號	寬度 (W)	高度 (H)	數量
21	BST-M023	386	646	75
22	BST-M026	983	646	7
23	BST-M028	1469	646	7
24	BST-M029	586	646	7
25	BST-M031	1314	646	14
26	BST-M032	424	646	14
27	BST-M035	836	646	14
28	BST-M037	1278	646	14
29	BST-M038	1708	646	14
30	BST-M039	1158	646	14
31	BST-M042	1608	646	7
32	BST-M043	1025	646	7
33	BST-M046	1424	646	7
34	BST-M048	1496	646	7
35	BST-M049	1451	646	7
36	BST-M062	536	646	75
37	BST-M080	702	646	25
38	BST-M081	978	646	10
39	BST-M082	1057	646	14
40	BST-M083	1023	646	7
41	BST-M084	1536	646	5

 美特鋁質有限公司 MIDI Aluminium Fabricator Ltd.				工程號 J857 地盤 啟德6552	類別 制圖 刘灿	物料號 - 2021-12-14	圖號 BST-C01
修改 A 日期 2022.03.02	採用工廠 材料颜色 BCK3M96295S-ZD1	地盤 材料 3mm THK. 铝板	图纸名称 铝板加工图	復核 徐詳坤 批准 林仁安	2021-12-15 2021-12-16	數量 - 單件重量 - (KG)	

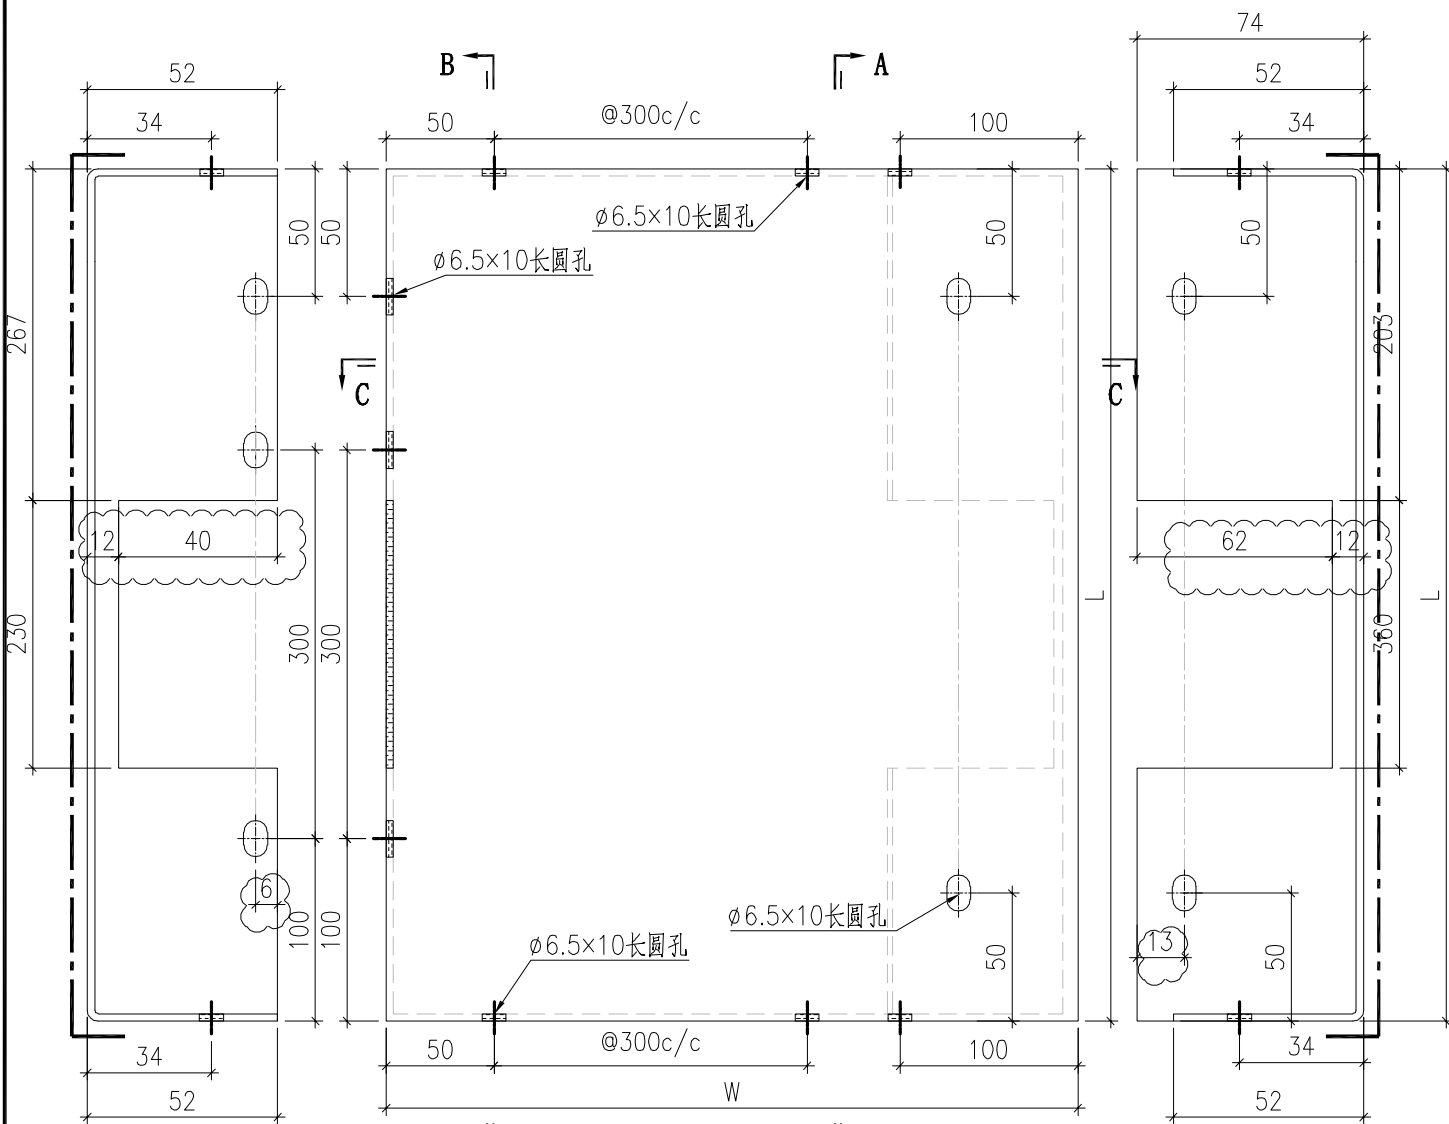

SECTION B-B

SECTION A-A

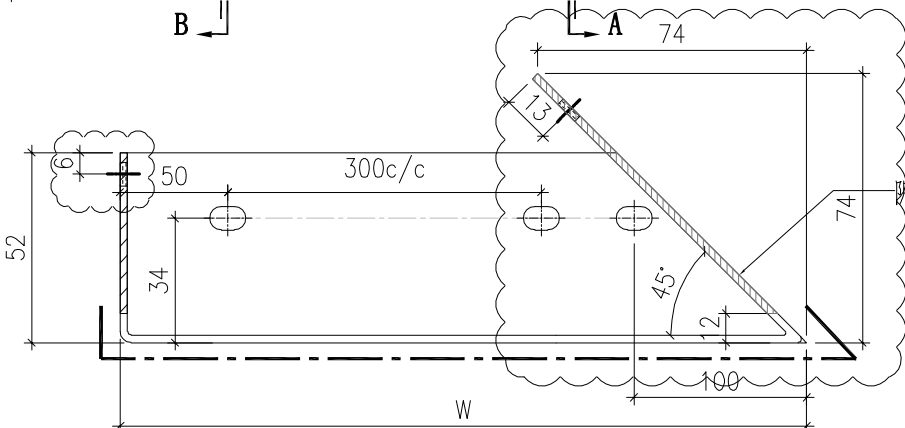


SECTION C-C

阴影部份切除(长度见立面)

序號	鋁板編號	寬度 (W)	高度 (H)	數量
1	BST-CY001	740	646	5
2	BST-CY003	2125	646	5
3	BST-CY007	1811	646	21
4	BST-CY008	1040	646	21
5	BST-CY011	1161	646	7
6	BST-CY013	890	646	7
7	BST-CY014	1311	646	5

 美特鋁質有限公司 MIDI Aluminium Fabricator Ltd.				工程號 J857 地盘 啟德6552	類別 制圖 刘灿	物料號 - 2021-12-14	圖號 BST-C02
修改 A - - 採用工廠 ✓ 地盘	图纸名称 铝板加工图			復核 徐詳坤	2021-12-15	數量 -	
日期 2022.03.02 - - 材料颜色 ECK3M96295S-ZD1	材料 3mm THK. 铝板			批准 林仁安	2021-12-16	單件重量 - (KG)	

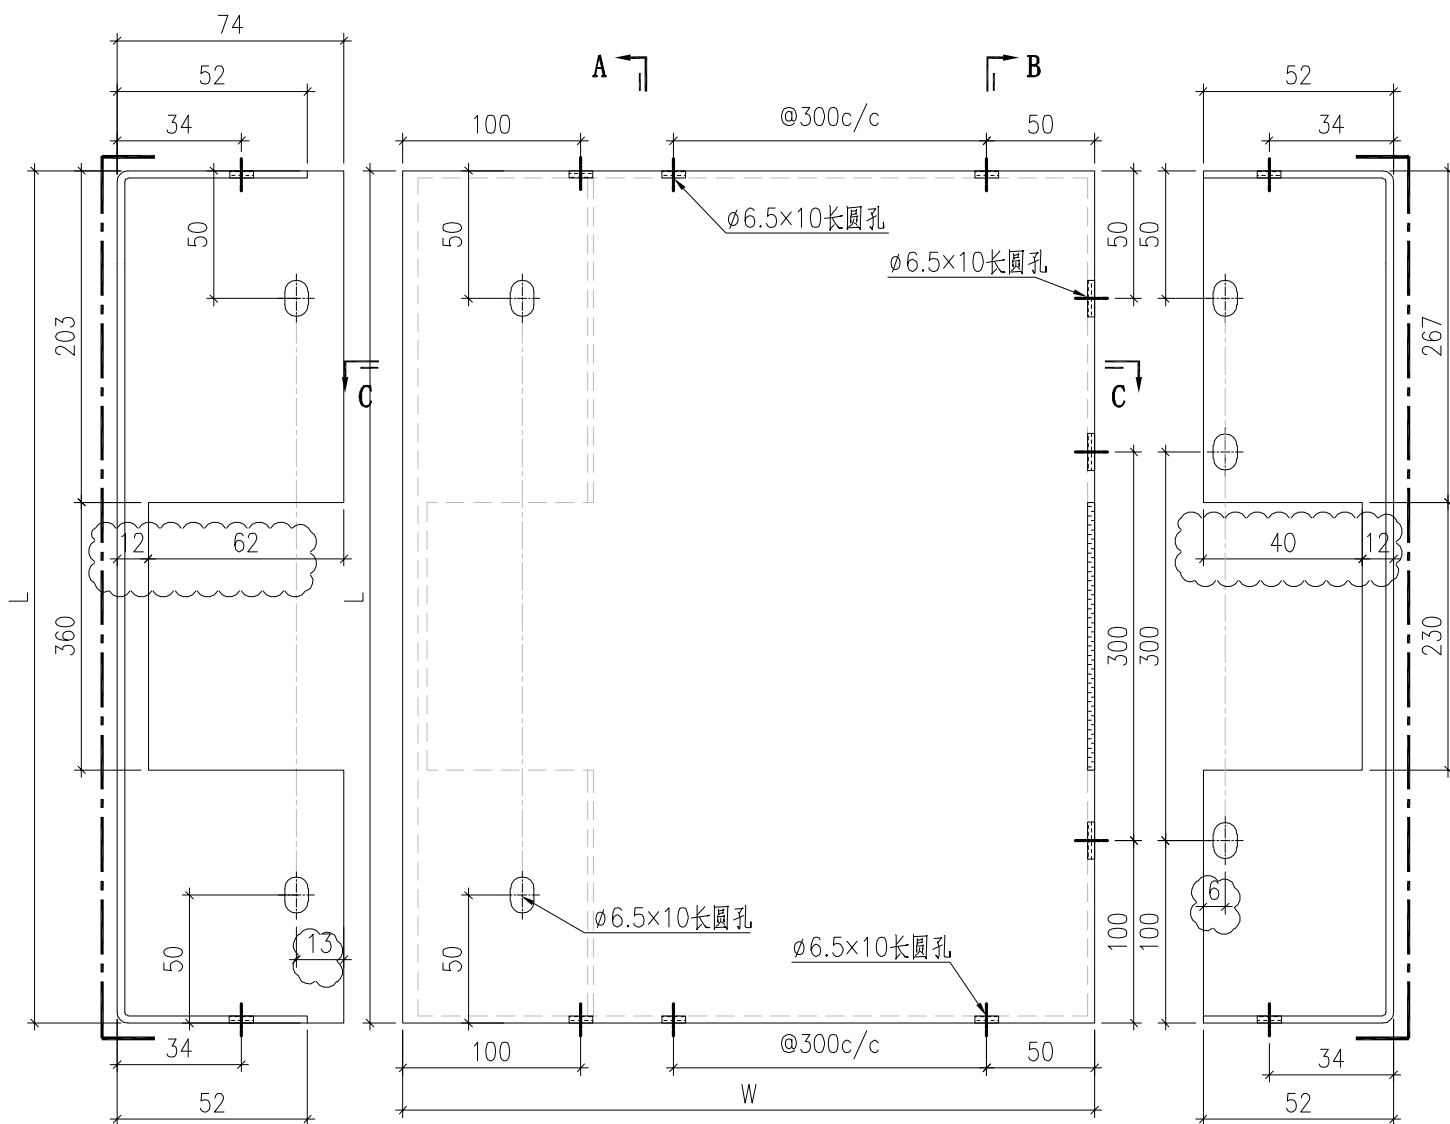

SECTION A-A


SECTION B-B

SECTION C-C

阴影部份切除(长度见立面)

序號	鋁板編號	寬度 (W)	高度 (H)	數量
1	BST-CZ001	1601	646	5
2	BST-CZ004	1450	646	5
3	BST-CZ005	490	646	5
4	BST-CZ006	1811	646	21
5	BST-CZ009	1040	646	21
6	BST-CZ010	1551	646	7
7	BST-CZ012	584	646	7

 美特鋁質有限公司 MIDI Aluminium Fabricator Ltd.				工程號 J857 地盘 啟德6552	類別 制圖 刘灿	物料號 - 2021-12-14	圖號 BST-C03
修改 A - - 採用工廠 ✓ 地盘	图纸名称 铝板加工图			復核 徐詳坤	2021-12-15	數量 -	
日期 2022.03.02 - - 材料颜色 ECK3M96295S-ZD1	材料 3mm THK. 铝板			批准 林仁安	2021-12-16	單件重量 - (KG)	

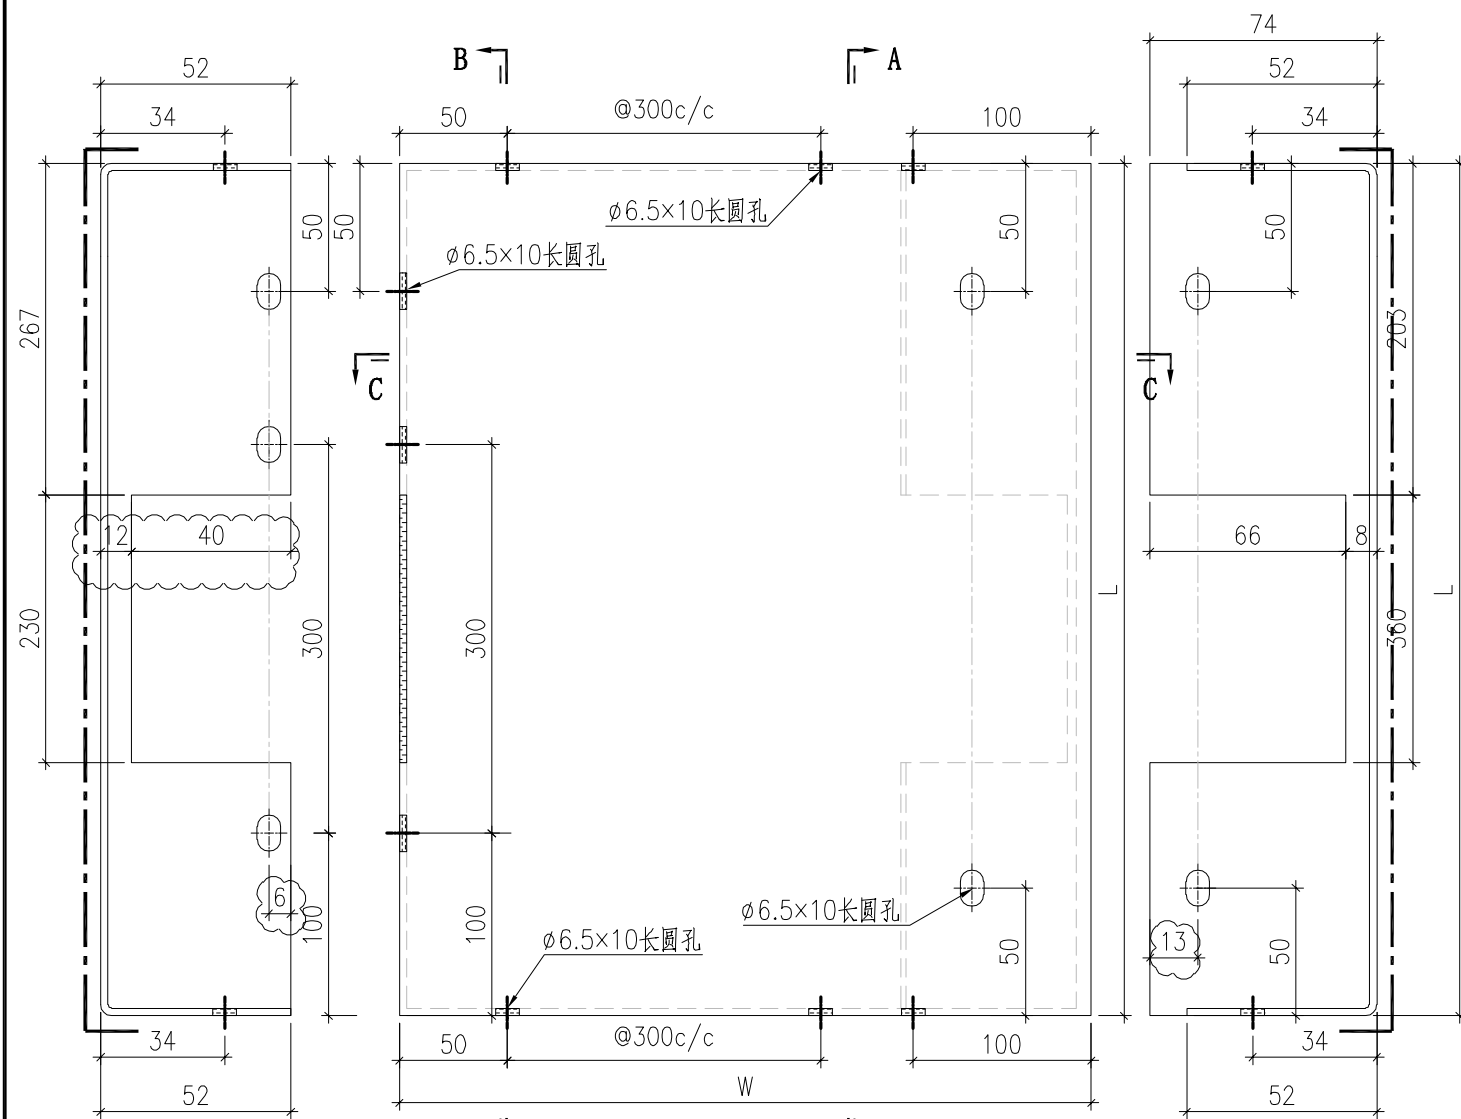

SECTION B-B



SECTION A-A

SECTION C-C

阴影部份切除(长度见立面)


序號	鋁板編號	寬度 (W)	高度 (H)	數量
1	BST-CY015	388	646	7

 美特鋁質有限公司 MIDI Aluminium Fabricator Ltd.				工程號 J857	類別	物料號 -		
				地盤 啟德6552	制圖 刘灿	2021-12-14	圖號 BST-C04	
修改 A	-	-	採用工廠 ✓ 地盤	图纸名称 铝板加工图	復核 徐詳坤	2021-12-15	數量 -	
日期 2022.03.02	-	-	材料颜色 ECK3M96295S-ZD1	材料 3mm THK. 铝板	批准 林仁安	2021-12-16	單件重量 -	(KG)

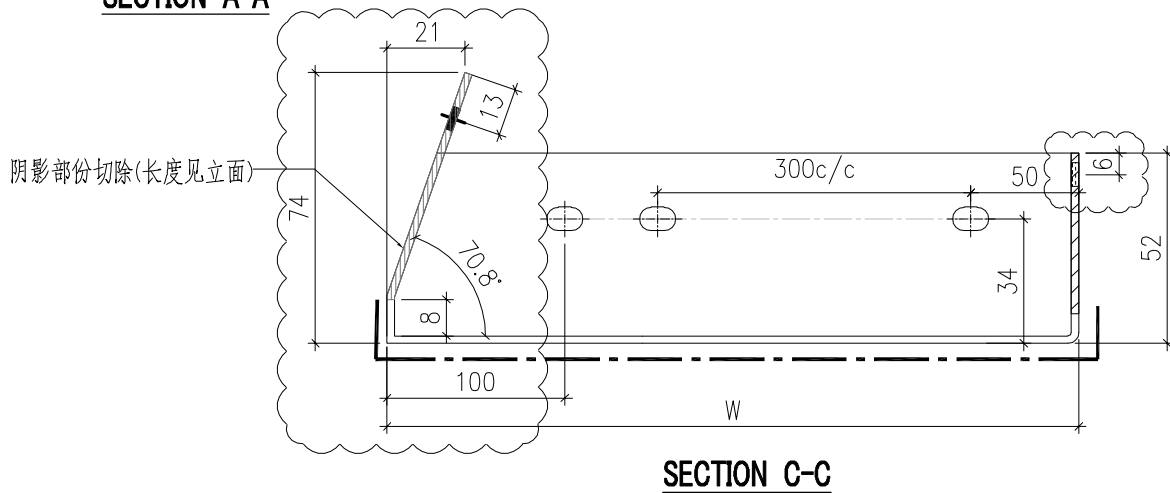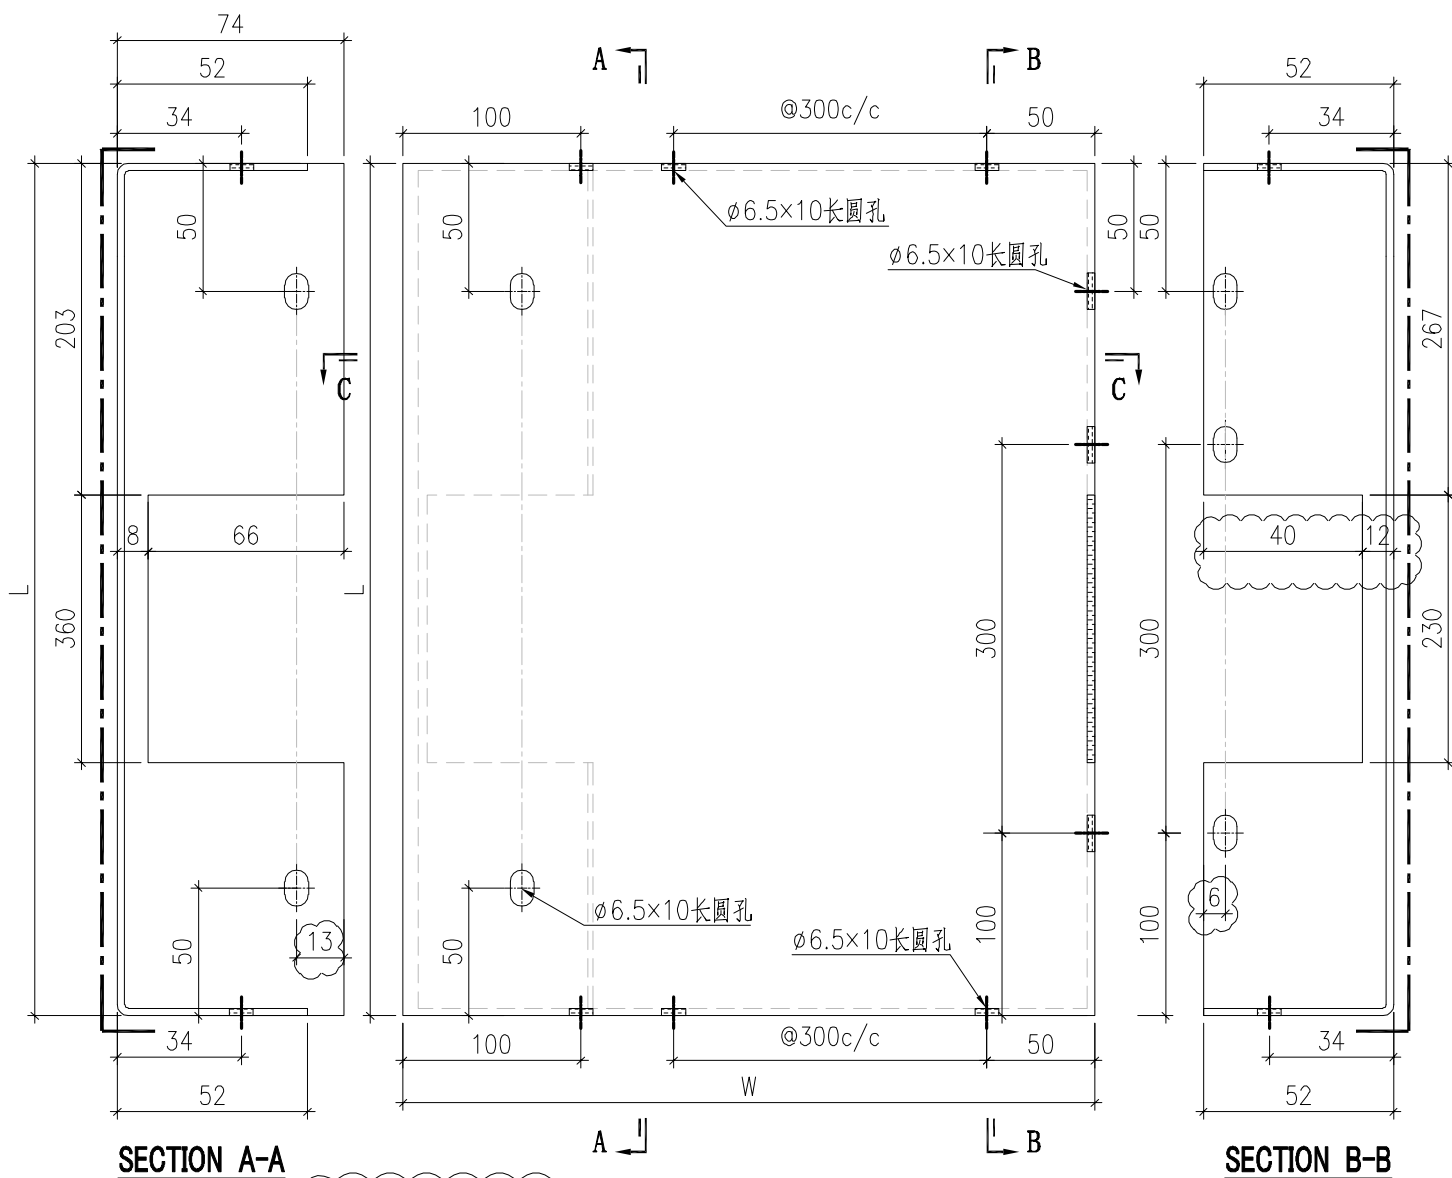

序號	鋁板編號	寬度 (W)	高度 (H)	數量
1	BST-CZ016	1257	646	7

 美特鋁質有限公司 MIDI Aluminium Fabricator Ltd.				工程號 J857 地盤 啟德6552	類別 制圖 刘灿	物料號 - 2021-12-14	圖號 BST-F01
修改 A 日期 2022.03.02	-	-	採用工廠 ✓ 材料颜色 ECK3M96295S-ZD1	图纸名称 铝板加工图 材料 3mm THK. 铝板	復核 徐詳坤 批准 林仁安	2021-12-15 2021-12-16	數量 - 單件重量 - (KG)

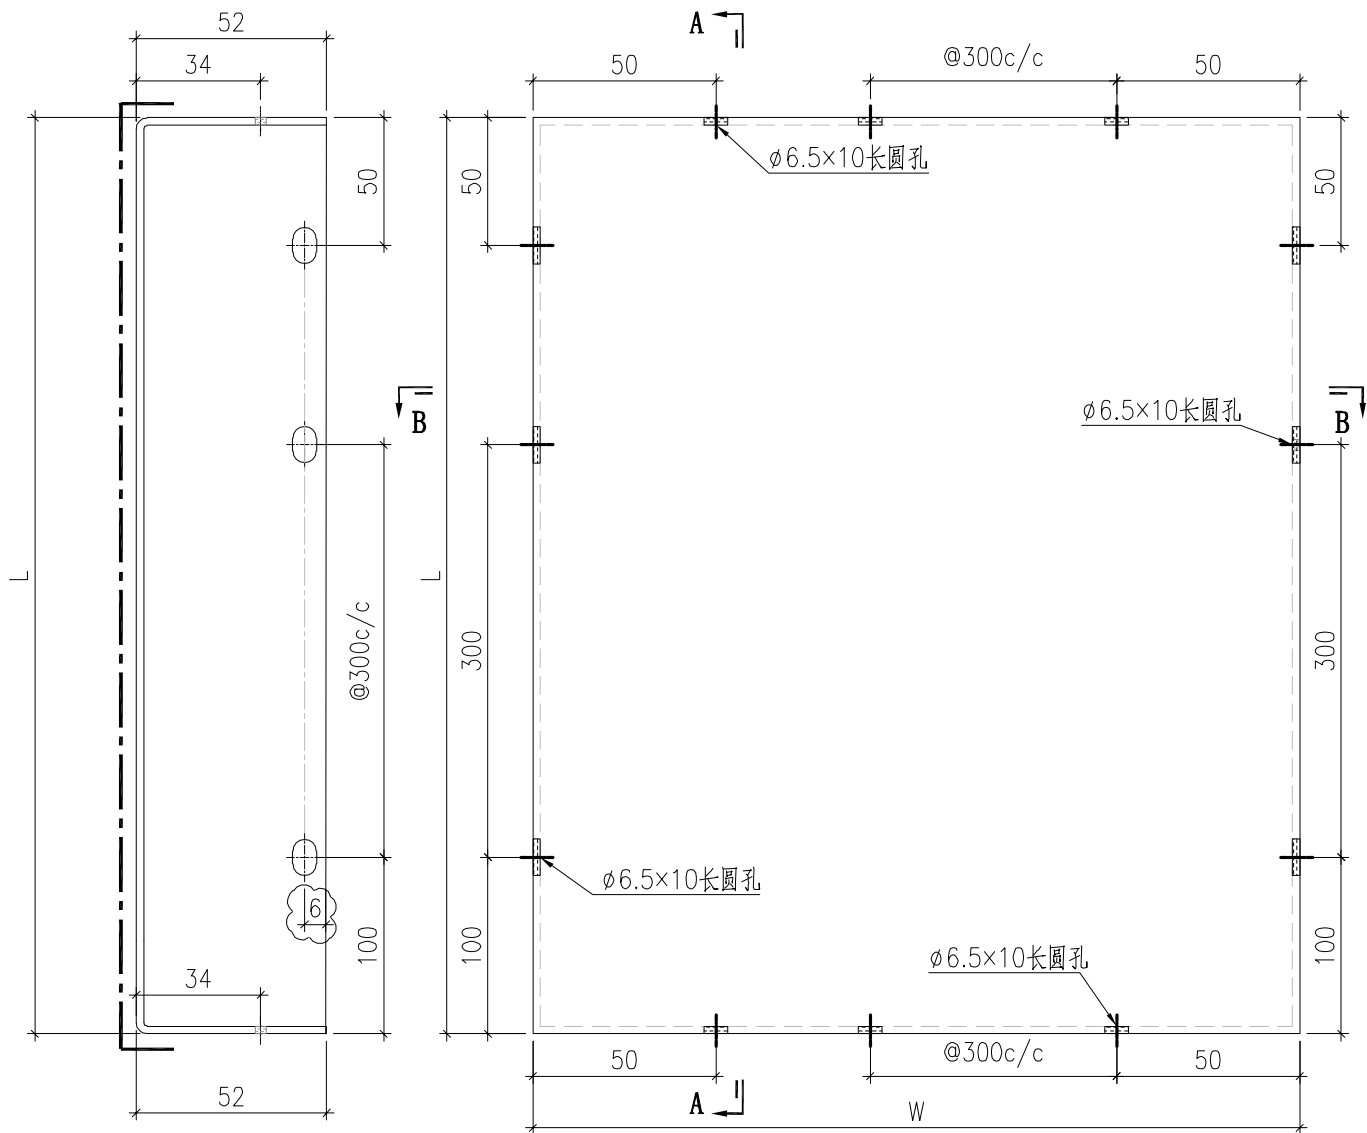


SECTION A-A


SECTION B-B

序號	鋁板編號	寬度 (W)	高度 (H)	數量
1	BST-F001	676	2386	35

 美特鋁質有限公司 MIDI Aluminium Fabricator Ltd.				工程號 J857 地盘 啟德6552	類別 制圖 刘灿	物料號 - 2021-12-14	圖號 BST-D01
修改 A 日期 2022.03.02	-	-	採用工廠 ✓ 材料颜色 BCK3M96295S-ZD1	图纸名称 铝板加工图 材料 3mm THK. 铝板	復核 徐詳坤 批准 林仁安	2021-12-15 2021-12-16	數量 - 單件重量 - (KG)

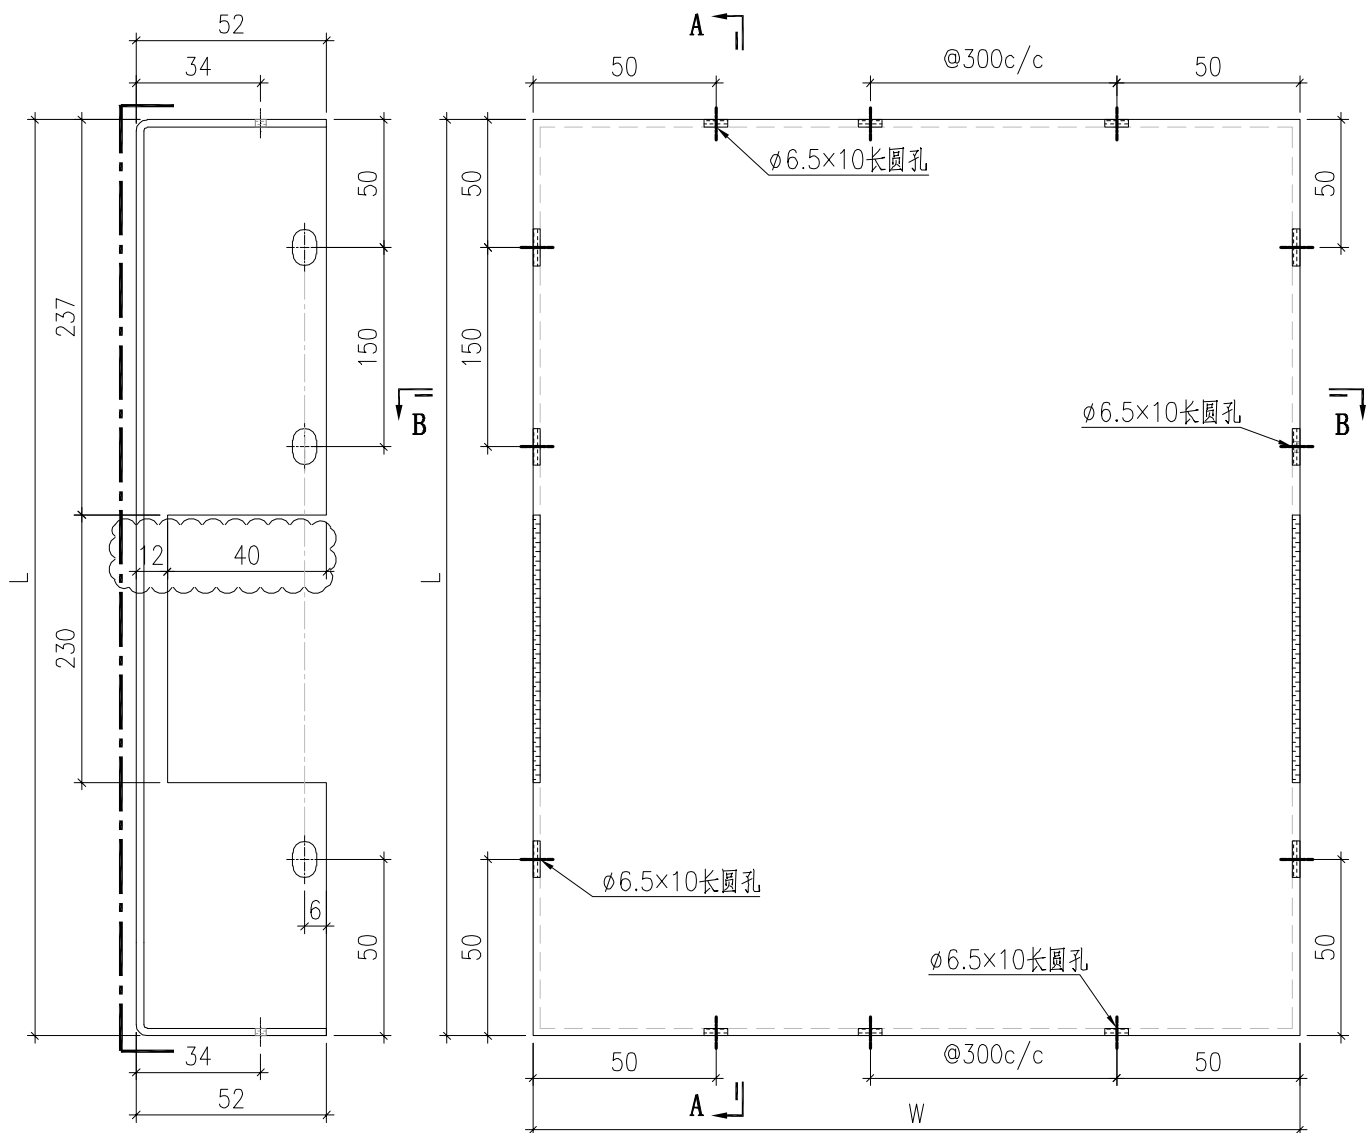

SECTION A-A

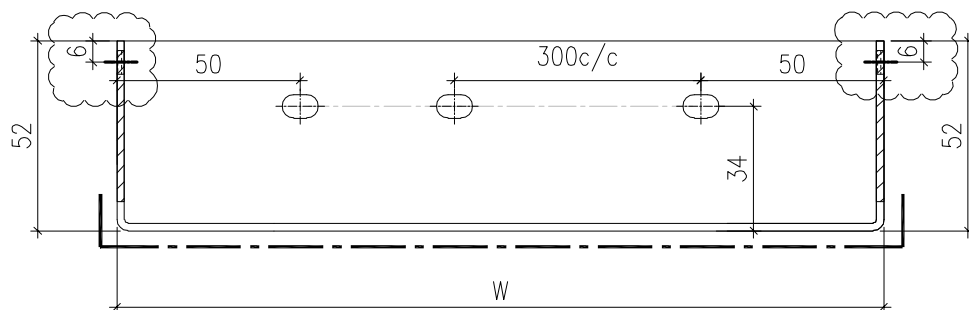


SECTION B-B

背板长宽数据見BST-D02

 美特鋁質有限公司 MIDI Aluminium Fabricator Ltd.				工程號	J857	類別		物料號	-					
				地盤	啟德6552	制圖	刘灿	2021-12-14	圖號	BST-D02				
修改	A	-	-	採用工廠	✓	地盤		圖紙名稱	铝板加工图	復核	徐詳坤	2021-12-15	數量	-
日期	2022.03.02	-	-	材料颜色	ECK3M96295S-ZD1		材料	3mm THK. 铝板	批准	林仁安	2021-12-16	單件重量	-	(KG)

序號	鋁板編號	寬度 (W)	高度 (H)	數量
1	BST-D001	696	552	1
2	BST-D002	2024	552	1
3	BST-D003	445	552	1
4	BST-D004	1106	552	1
5	BST-D005	696	552	6
6	BST-D006	981	552	1
7	BST-D007	695	552	8
8	BST-D008	1285	552	4
9	BST-D009	676	552	4
10	BST-D010	956	552	3
11	BST-D011	972	552	2
12	BST-D012	446	552	4
13	BST-D013	1506	552	4
14	BST-D014	1040	552	2
15	BST-D016	1539	552	2
16	BST-D017	1994	552	2
17	BST-D018	746	552	4
18	BST-D019	1215	552	2
19	BST-D021	728	552	1
20	BST-D022	527	552	2
21	BST-D023	386	552	1
22	BST-D062	536	552	1
23	BST-D080	702	552	5
24	BST-D081	978	552	2
25	BST-D084	1536	552	1


 美特鋁質有限公司 MIDI Aluminium Fabricator Ltd.				工程號	J857	類別		物料號	-					
				地盘	啟德6552	制圖	刘灿	2021-12-14	圖號	BST-E01				
修改	A	-	-	採用工廠	✓	地盤		图纸名称	铝板加工图	復核	徐詳坤	2021-12-15	數量	-
日期	2022.03.02	-	-	材料颜色	ECK3M96295S-ZD1	材料	3mm THK. 铝板	批准	林仁安	2021-12-16	單件重量	-	(KG)	

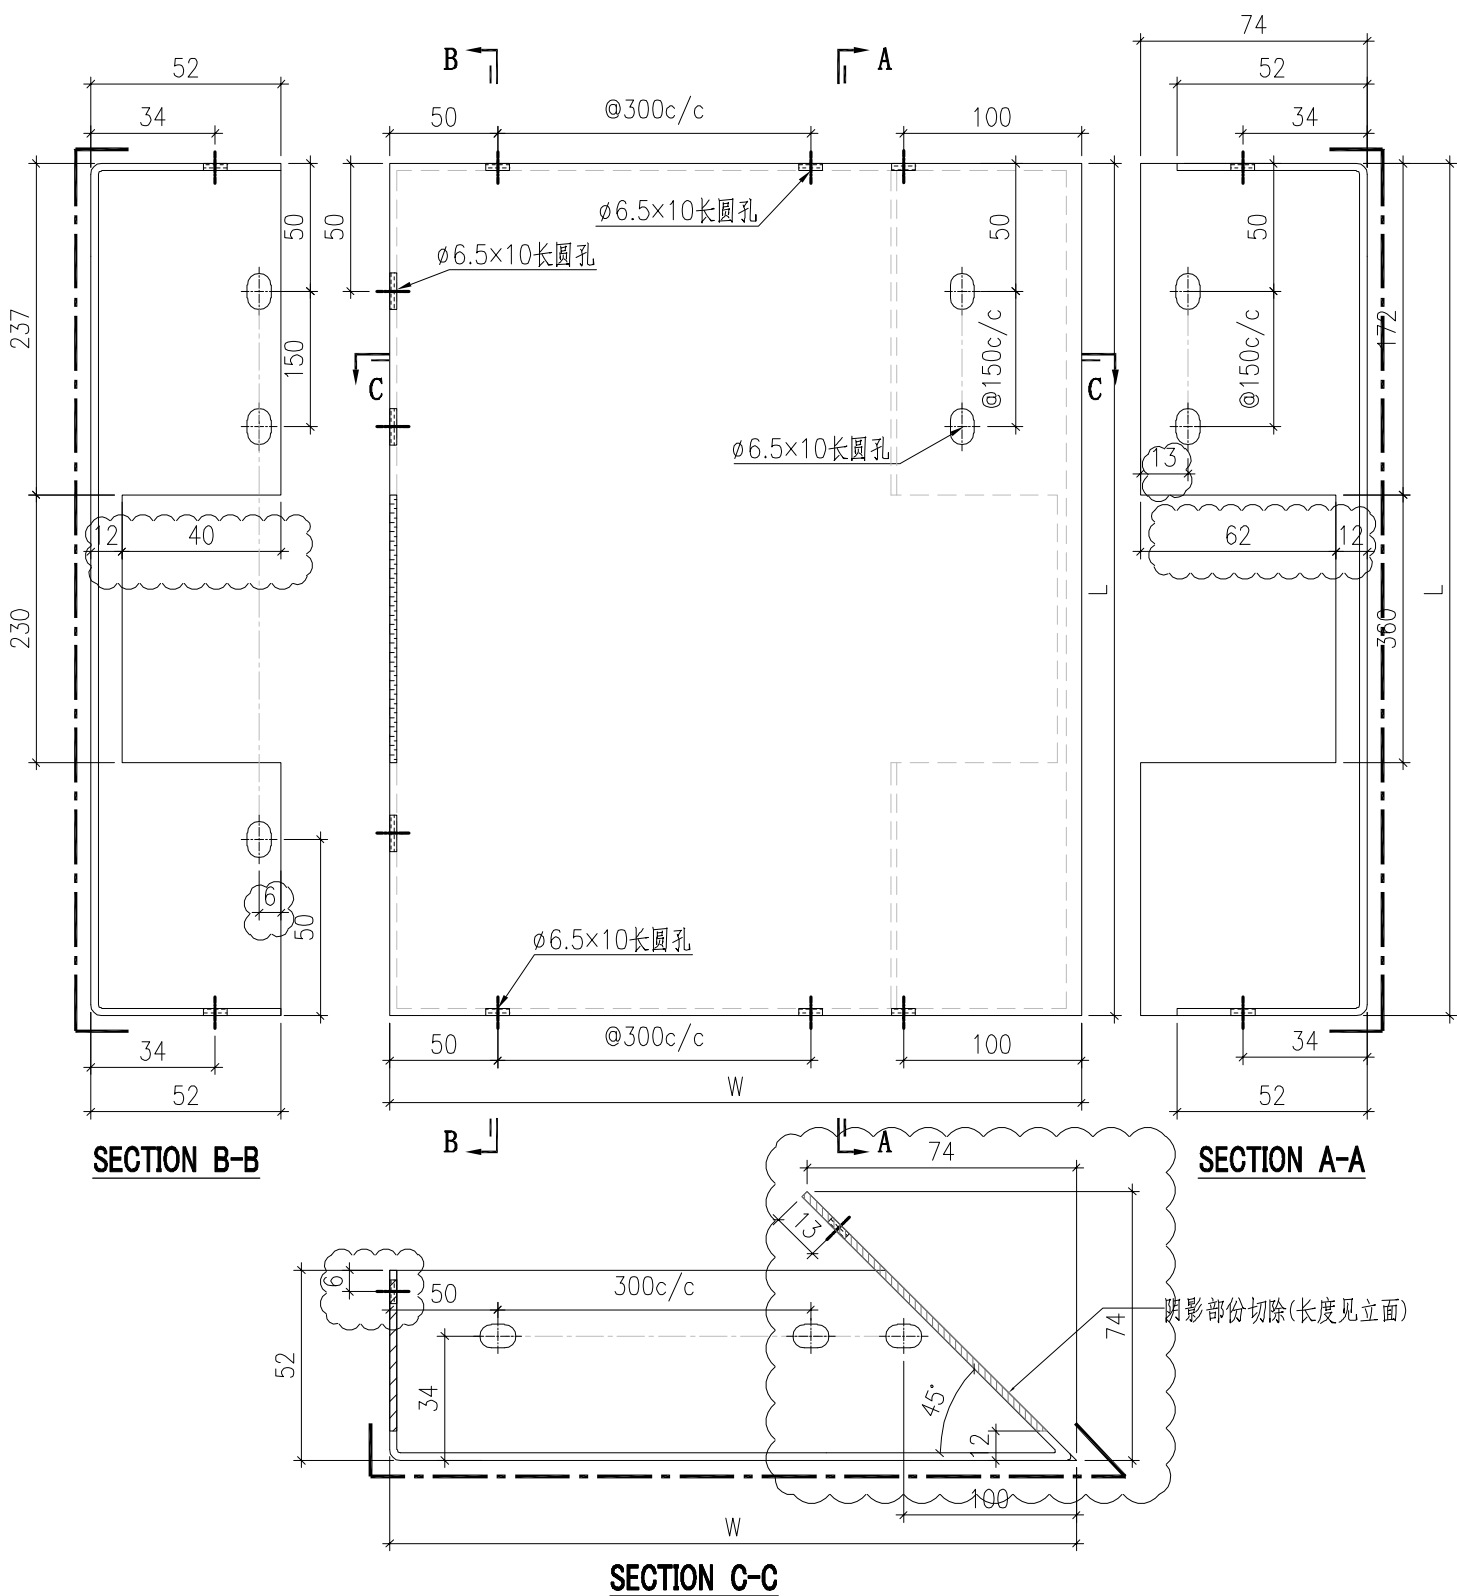

阴影部份切除(长度见立面)


序號	鋁板編號	寬度 (W)	高度 (H)	數量
1	BST-EY001	740	552	1
2	BST-EY003	2125	552	1
3	BST-EY014	1311	552	1

 美特鋁質有限公司 MIDI Aluminium Fabricator Ltd.				工程號	J857	類別		物料號	-			
				地盘	啟德6552	制圖	刘灿	2021-12-14	圖號	BST-E02		
修改	A	-	-	採用工廠	✓ 地盘	图纸名称	铝板加工图	復核	徐詳坤	2021-12-15	數量	-
日期	2022.03.02	-	-	材料颜色	ECK3M96295S-ZD1	材料	3mm THK. 铝板	批准	林仁安	2021-12-16	單件重量	- (KG)

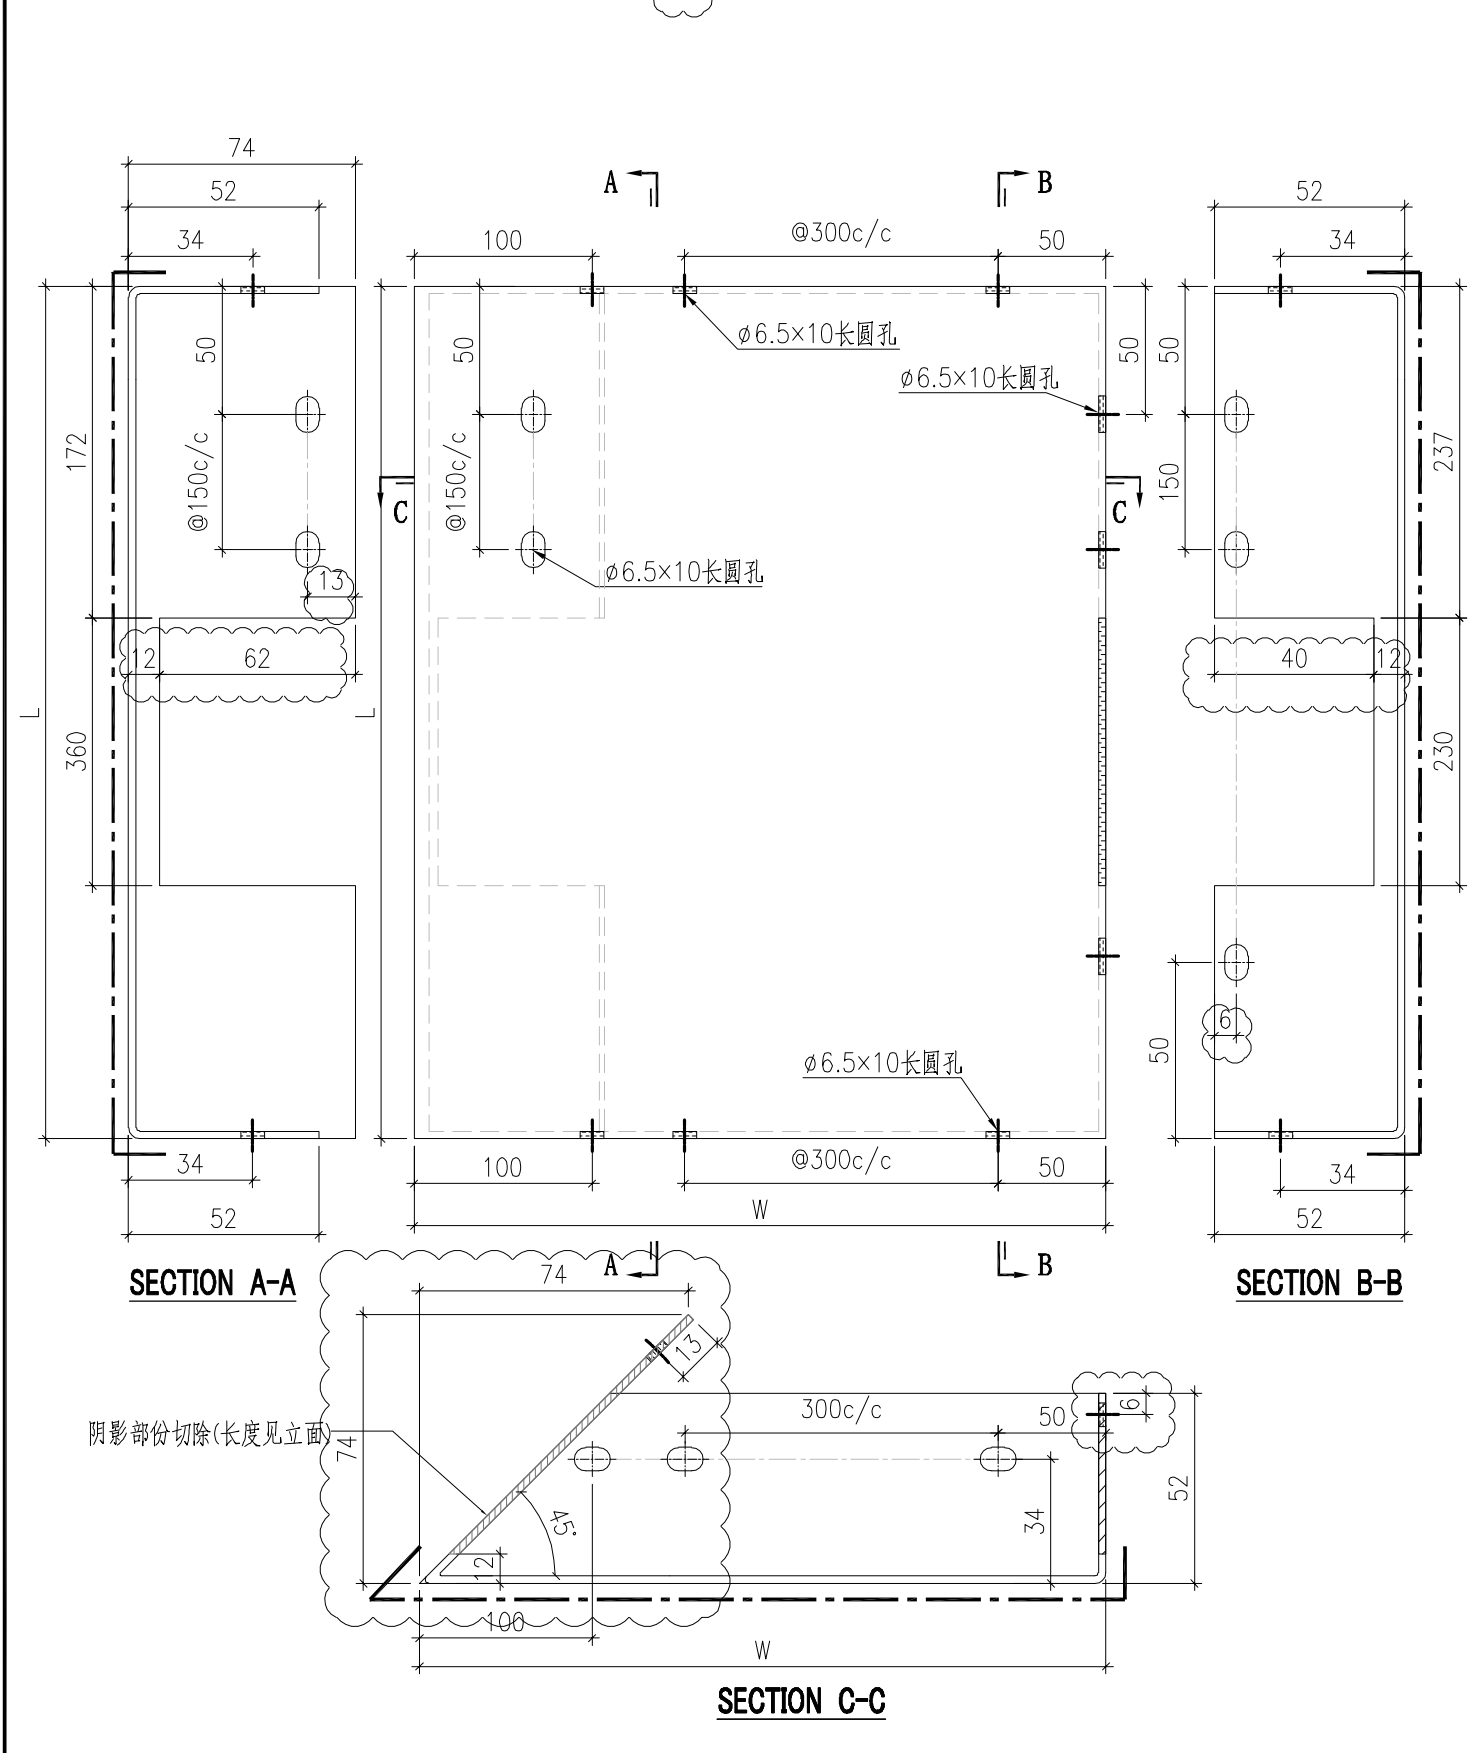


序號	鋁板編號	寬度 (W)	高度 (H)	數量
1	BST-EZ001	1601	552	1
2	BST-EZ004	1450	552	1
3	BST-EZ005	490	552	1

 美特鋁質有限公司 MIDI Aluminium Fabricator Ltd.				工程號 J857 地盘 啟德6552	類別 制圖 刘灿	物料號 - 2021-12-14	圖號 BST-G01
修改 A 日期 2022.03.02	-	-	採用工廠 ✓ 材料颜色 BCK3M96295S-ZD1	图纸名称 铝板加工图 材料 3mm THK. 铝板	復核 徐詳坤 批准 林仁安	2021-12-15 2021-12-16	數量 - 單件重量 - (KG)

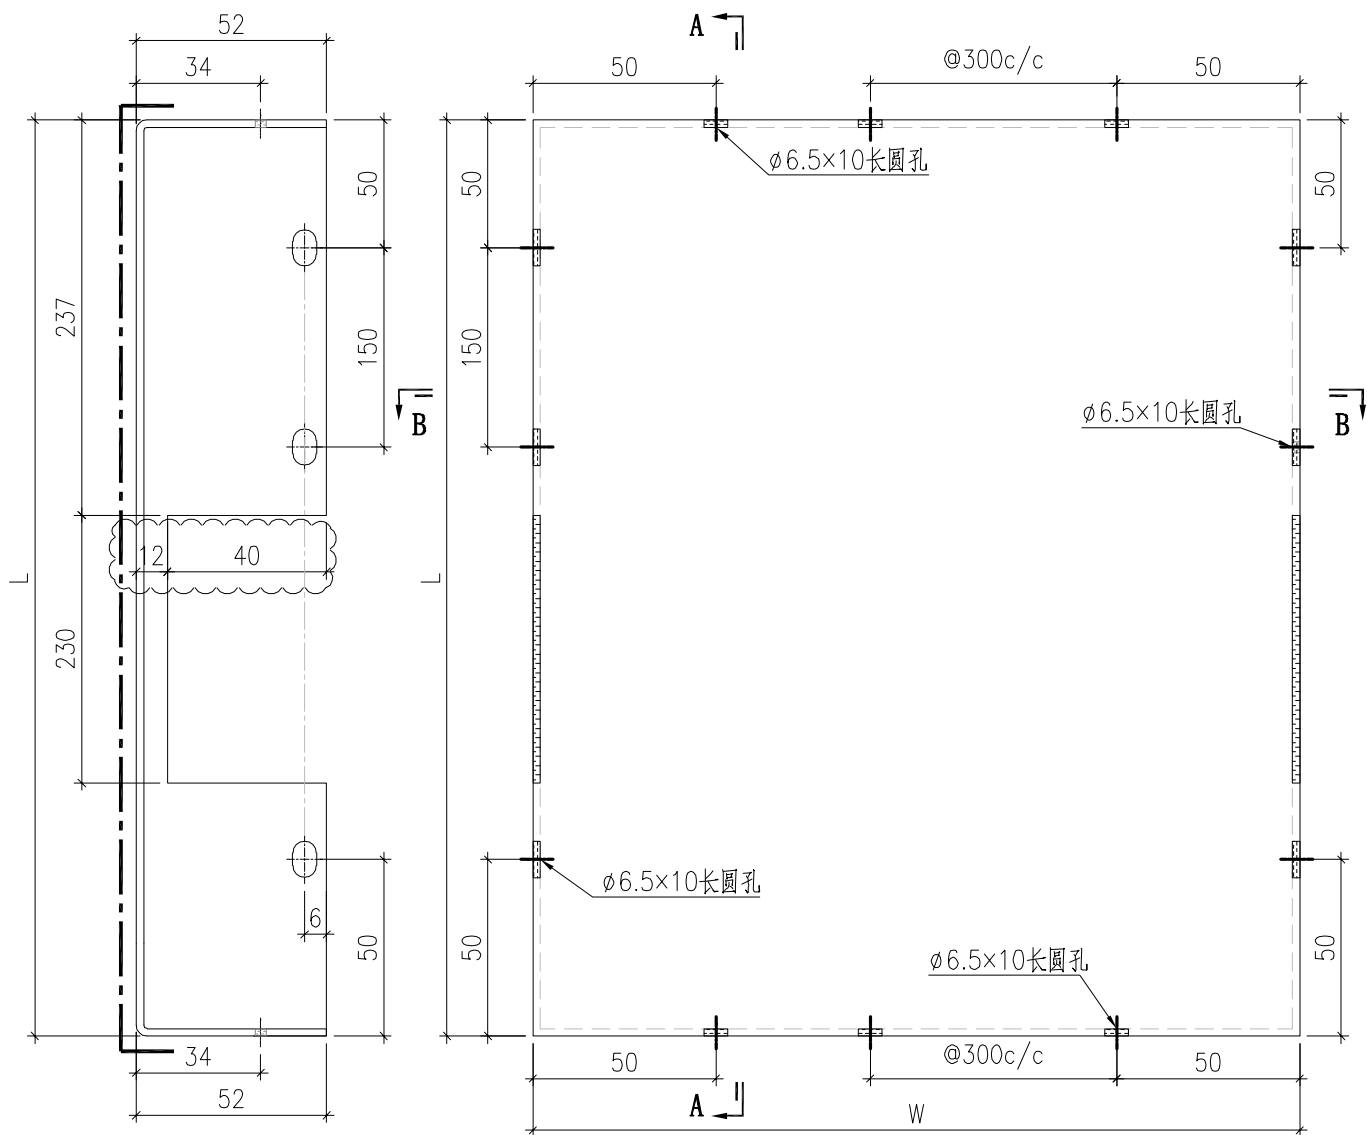

SECTION A-A

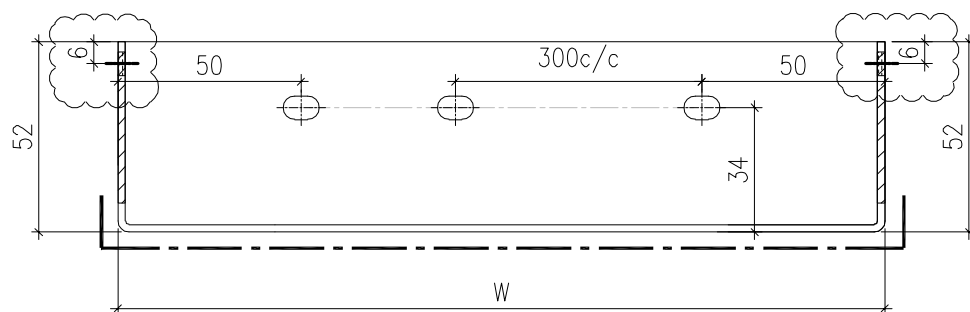


SECTION B-B

 美特鋁質有限公司 MIDI Aluminium Fabricator Ltd.				工程號	J857	類別		物料號	-					
				地盤	啟德6552	制圖	刘灿	2021-12-14	圖號	BST-G02				
修改	A	-	-	採用工廠	✓	地盤		圖紙名稱	铝板加工图	復核	徐詳坤	2021-12-15	數量	-
日期	2022.03.02	-	-	材料顏色	ECK3M96295S-ZD1		材料	3mm THK. 铝板	批准	林仁安	2021-12-16	單件重量	-	(KG)

序號	鋁板編號	寬度 (W)	高度 (H)	數量
1	BST-G001	696	537	1
2	BST-G002	2024	537	1
3	BST-G003	445	537	1
4	BST-G004	1106	537	1
5	BST-G005	696	537	6
6	BST-G006	981	537	1
7	BST-G007	695	537	8
8	BST-G008	1285	537	4
9	BST-G009	676	537	4
10	BST-G010	956	537	3
11	BST-G011	972	537	2
12	BST-G012	446	537	4
13	BST-G013	1506	537	4
14	BST-G014	1040	537	2
15	BST-G016	1539	537	2
16	BST-G017	1994	537	2
17	BST-G018	746	537	4
18	BST-G019	1215	537	2
19	BST-G021	728	537	1
20	BST-G022	527	537	2
21	BST-G023	386	537	1
22	BST-G062	536	537	1
23	BST-G080	702	537	5
24	BST-G081	978	537	2
25	BST-G084	1536	537	1

 美特鋁質有限公司 MIDI Aluminium Fabricator Ltd.				工程號 J857	類別	物料號 -		
				地盤 啟德6552	制圖 刘灿	2021-12-14	圖號 BST-H01	
修改 A	-	-	採用工廠 ✓	地盤	图纸名称 铝板加工图	復核 徐詳坤	2021-12-15	數量 -
日期 2022.03.02	-	-	材料颜色 ECK3M96295S-ZD1	材料 3mm THK. 铝板	批准 林仁安	2021-12-16	單件重量 -	(KG)

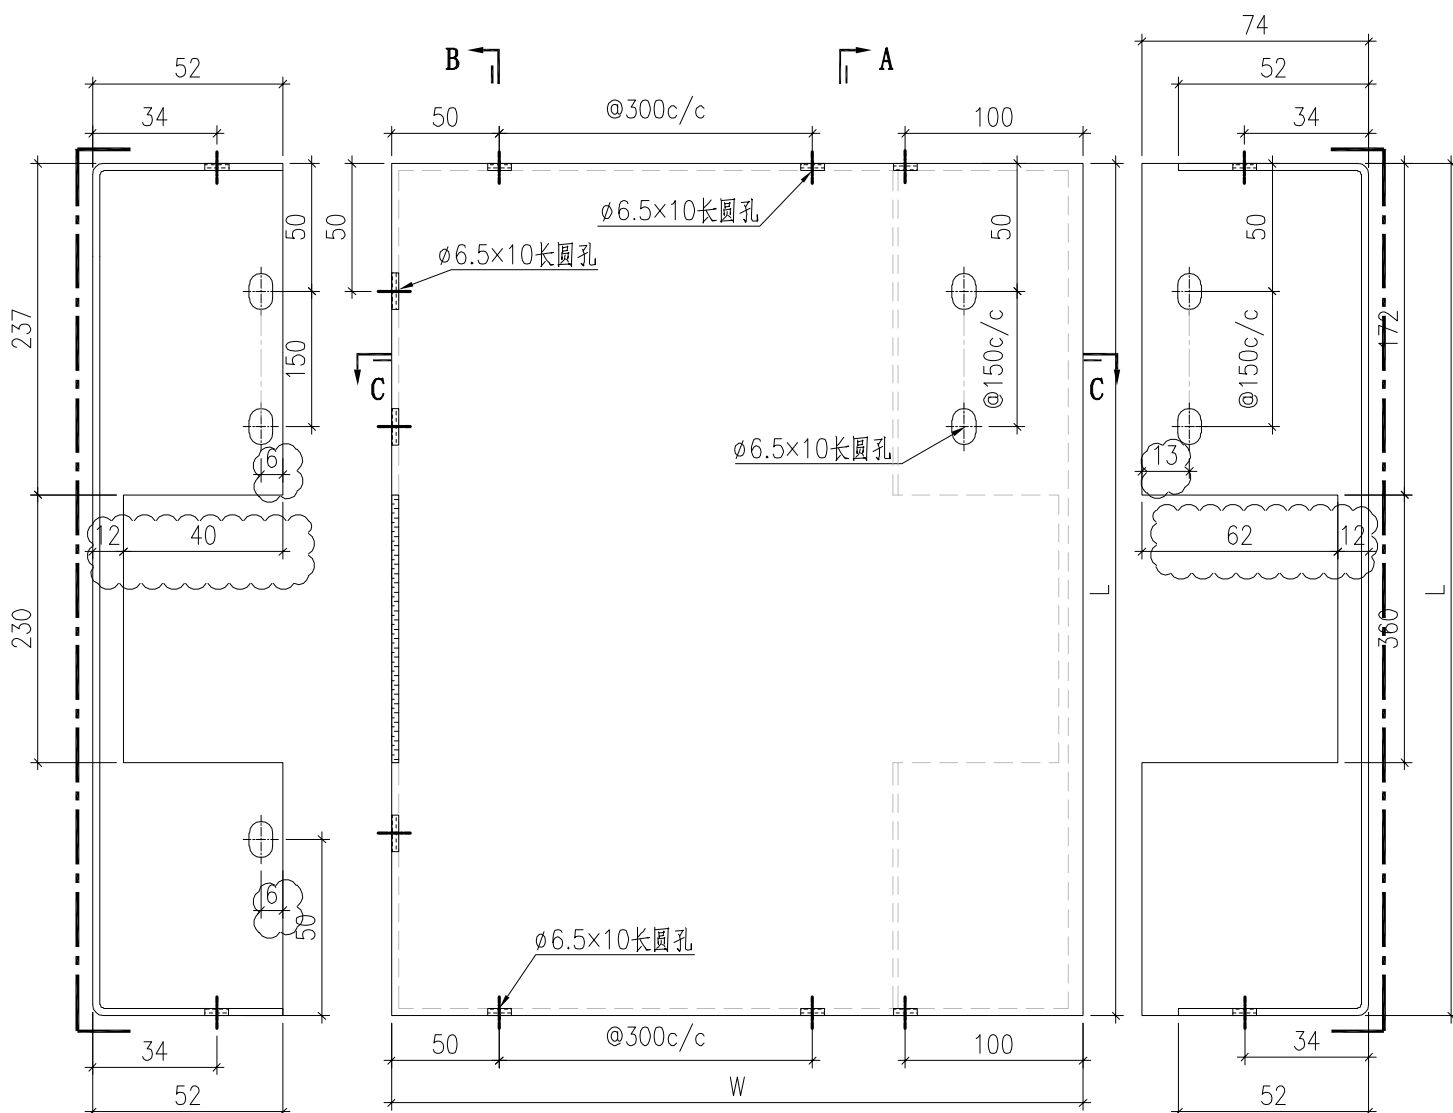


阴影部份切除(长度见立面)

SECTION C-C


序號	鋁板編號	寬度 (W)	高度 (H)	數量
1	BST-HY001	740	537	1
2	BST-HY003	2125	537	1
3	BST-HY014	1311	537	1

 美特鋁質有限公司 MIDI Aluminium Fabricator Ltd.				工程號 J857 地盘 啟德6552	類別 制圖 刘灿	物料號 - 2021-12-14	圖號 BST-H02
修改 A - - 採用工廠 ✓ 地盘	图纸名称 铝板加工图			復核 徐詳坤	2021-12-15	數量 -	
日期 2022.03.02 - - 材料颜色 BCK3M96295S-ZD1	材料 3mm THK. 铝板			批准 林仁安	2021-12-16	單件重量 - (KG)	

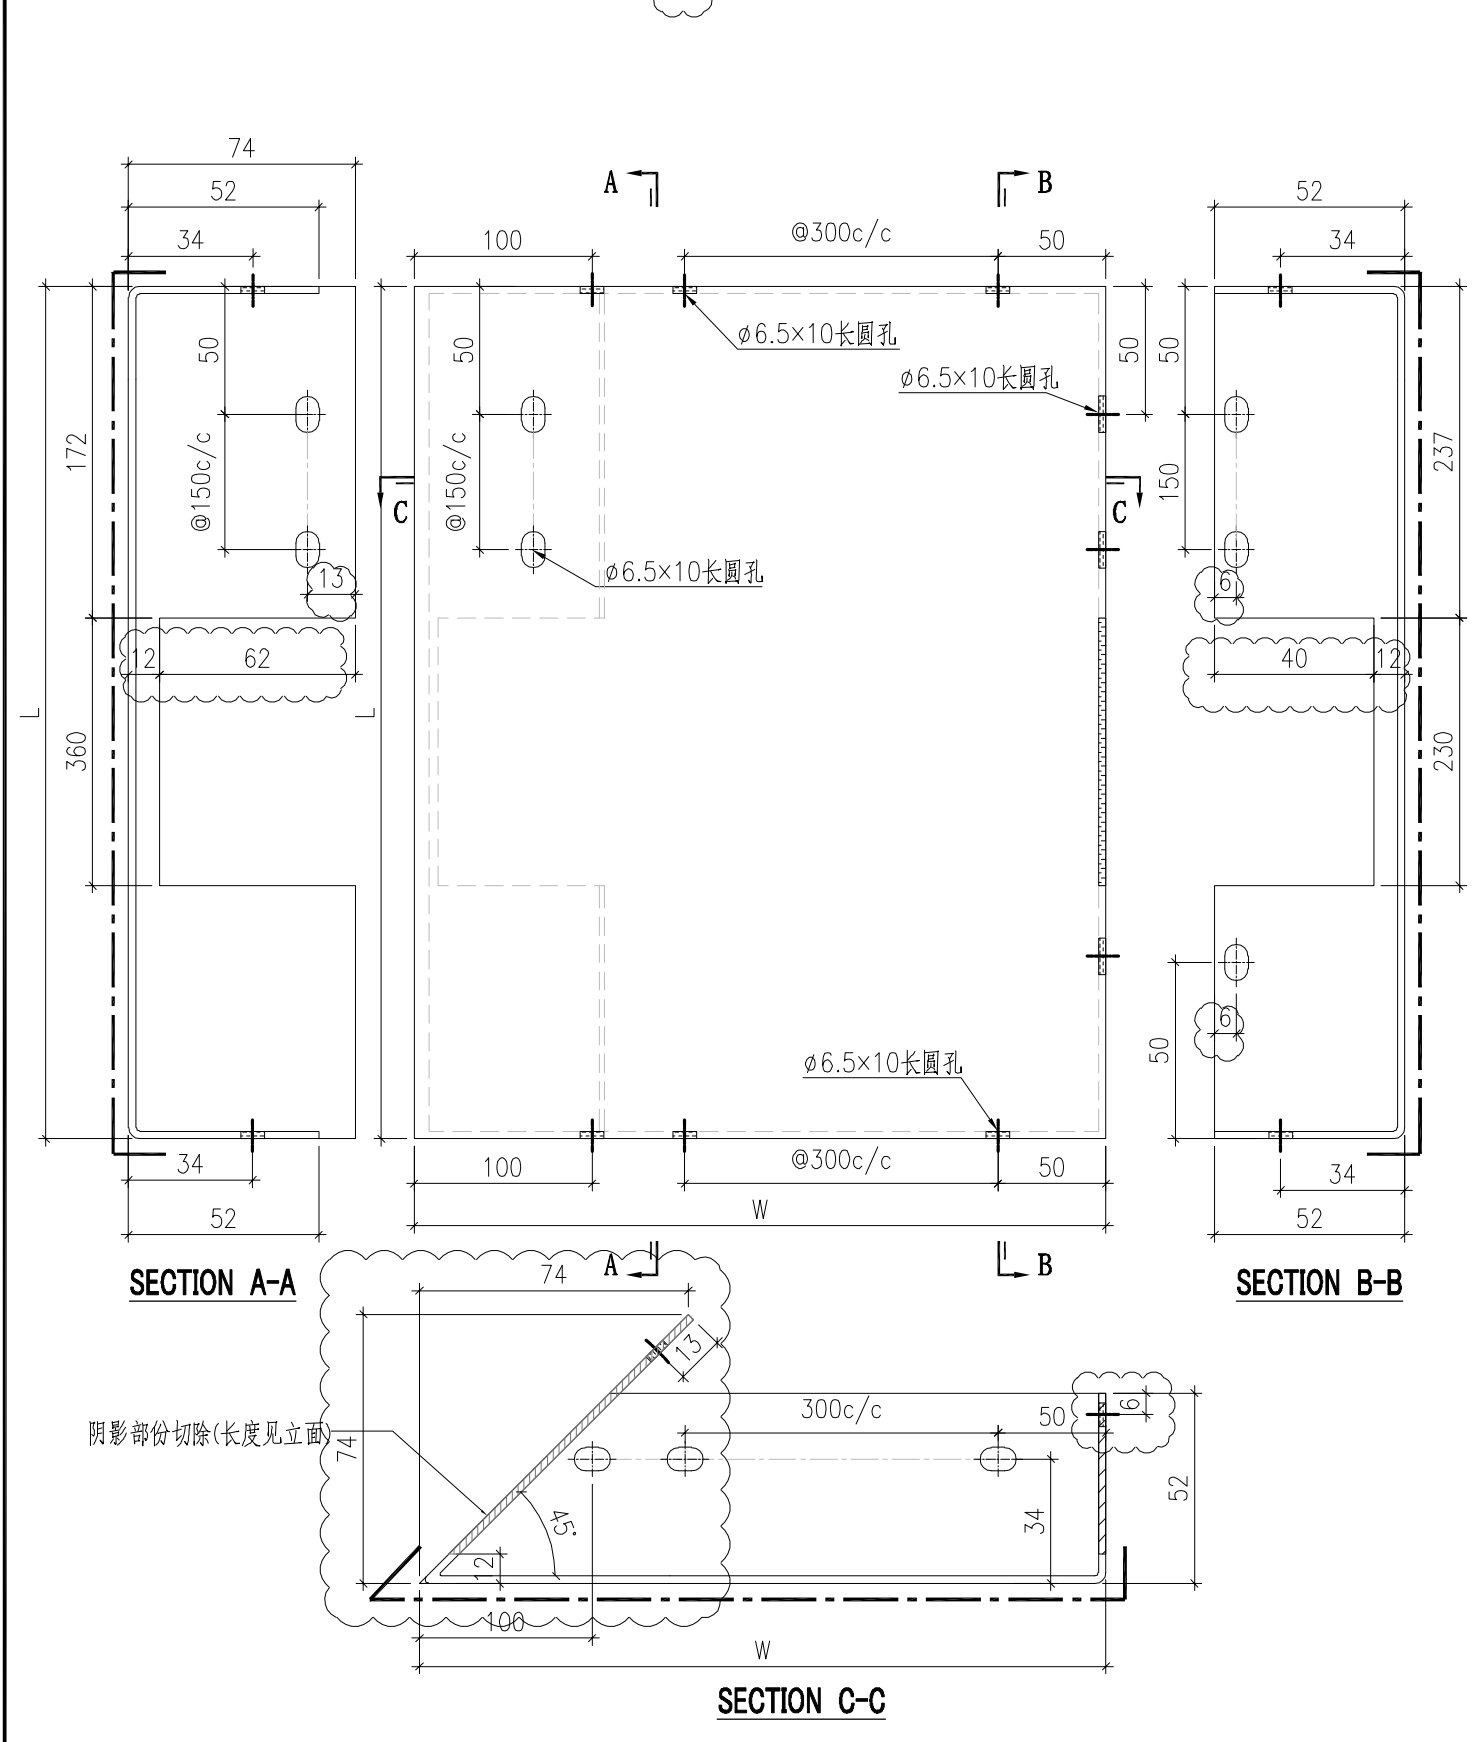


序號	鋁板編號	寬度 (W)	高度 (H)	數量
1	BST-HZ001	1601	537	1
2	BST-HZ004	1450	537	1
3	BST-HZ005	490	537	1

 美特鋁質有限公司 MIDI Aluminium Fabricator Ltd.				工程號 J857	類別	物料號 -		
				地盤 啟德6552	制圖 刘灿	2021-12-14	圖號 BST-C05	
修改 -	-	-	採用工廠 ✓	地盤	图纸名称 铝板加工图	復核 徐詳坤	2021-12-15	數量 -
日期 -	-	-	材料颜色 ECK3M96295S-ZD1		材料 3mm THK. 铝板	批准 林仁安	2021-12-16	單件重量 - (KG)

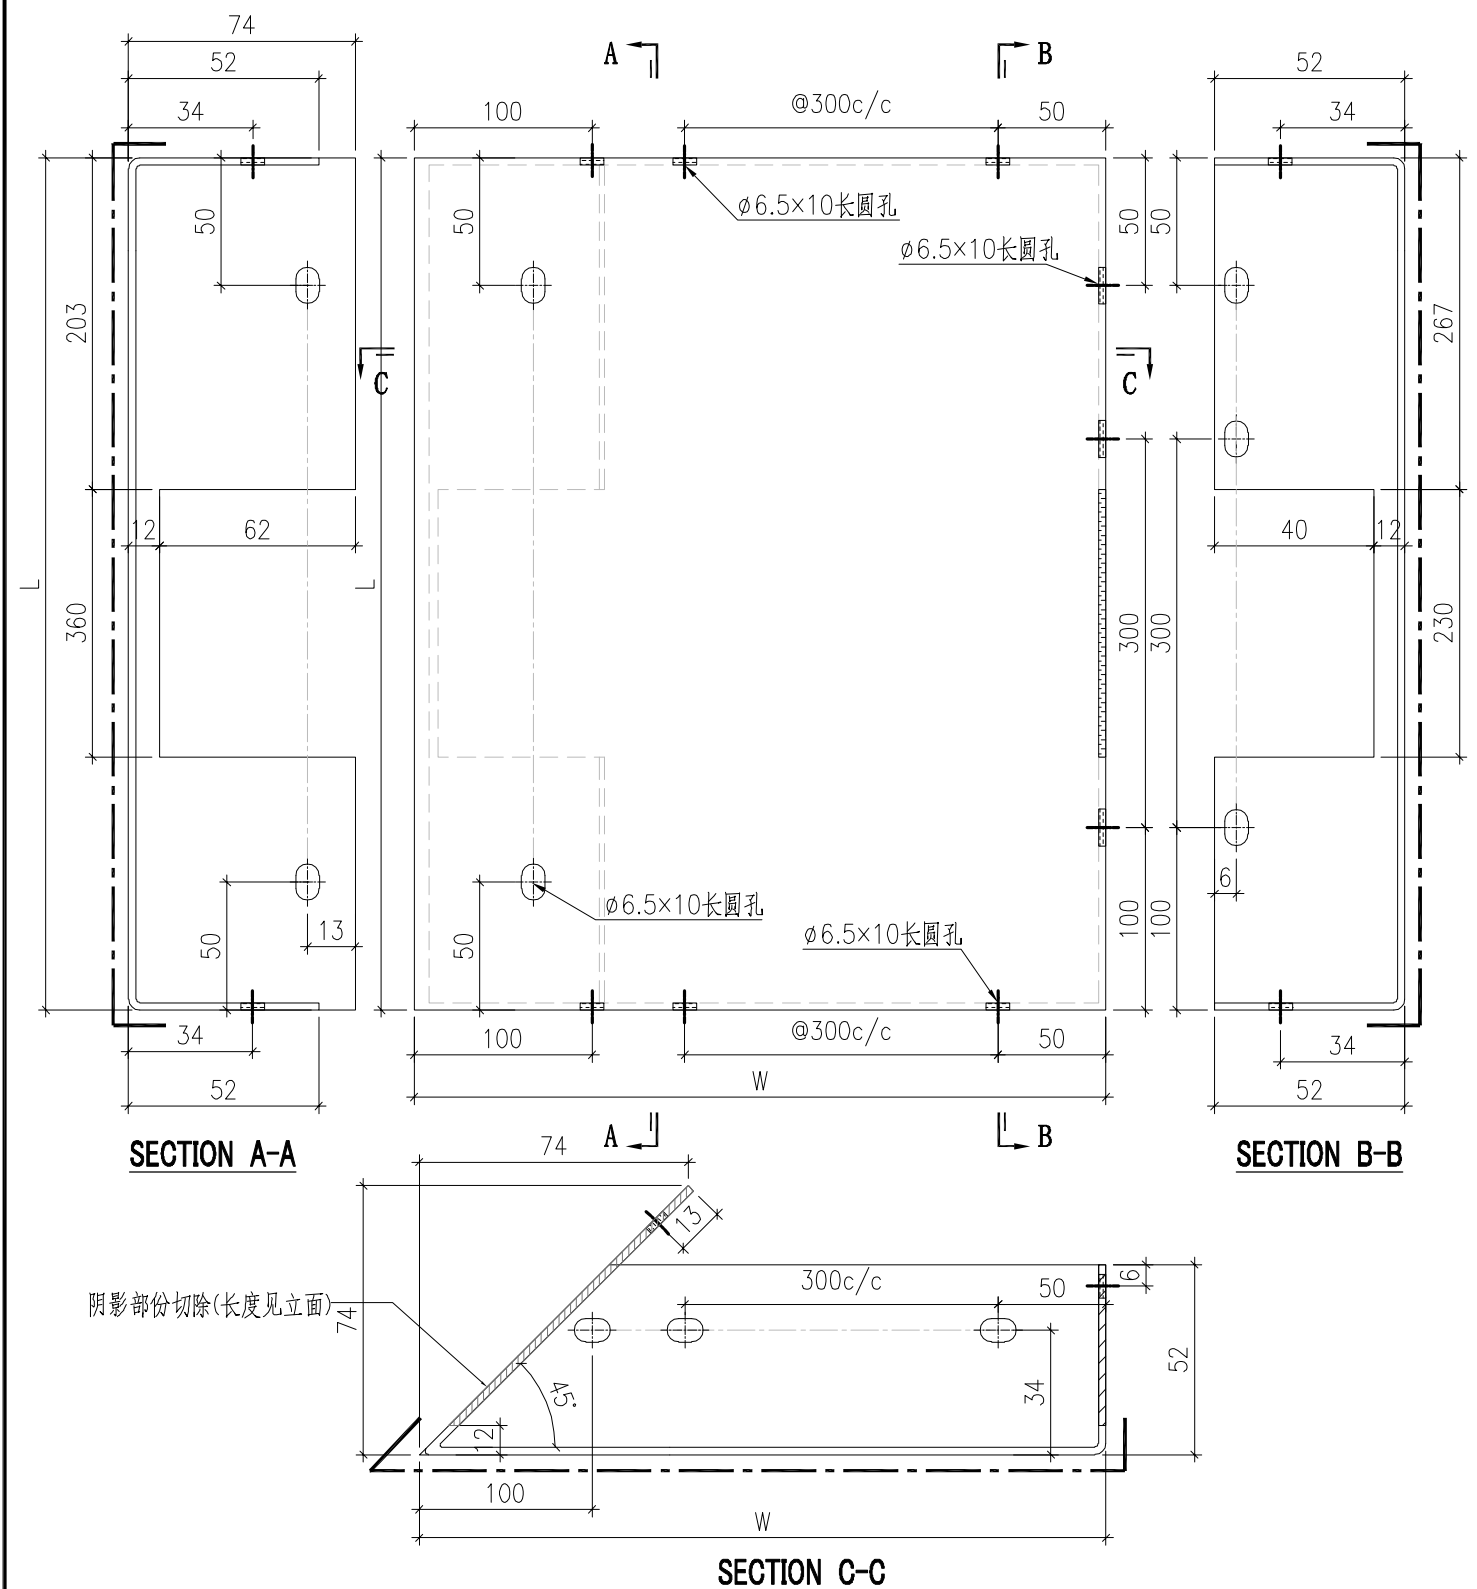

序號	鋁板編號	寬度 (W)	高度 (H)	數量
1	BST-CZ030	1454	646	5

 美特鋁質有限公司 MIDI Aluminium Fabricator Ltd.				工程號 J857	類別 制圖	物料號 -		
				地盤 啟德6552	劉燦	2021-12-14	圖號 BST-D03	
修改 -	-	-	採用工廠 ✓	地盤 ✓	圖紙名稱 鋁板加工圖	復核 徐詳坤	2021-12-15	數量 -
日期 -	-	-	材料顏色 ECK3M96295S-ZD1		材料 3mm THK. 鋁板	批准 林仁安	2021-12-16	單件重量 - (KG)

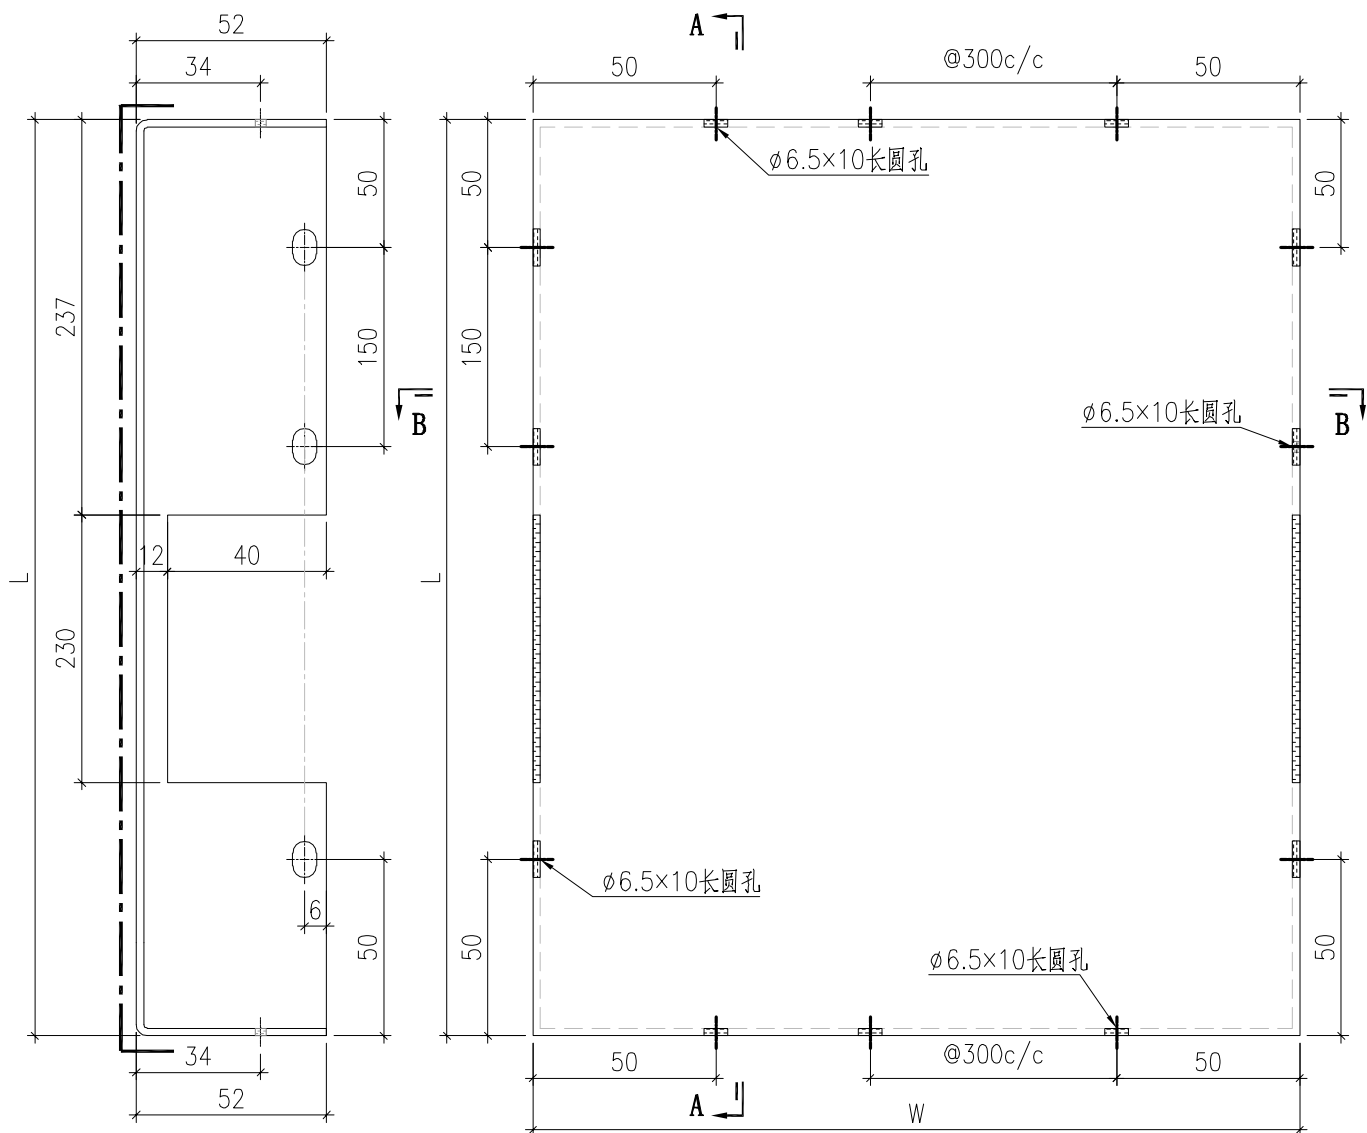


SECTION A-A


SECTION B-B


序號	鋁板編號	寬度 (W)	高度 (H)	數量
1	BST-D090	536	552	2

 美特鋁質有限公司 MIDI Aluminium Fabricator Ltd.				工程號	J857	類別		物料號	-			
				地盘	啟德6552	制圖	刘灿	2021-12-14	圖號	BST-E03		
修改	-	-	採用工廠	✓	地盘	图纸名称	铝板加工图	復核	徐詳坤	2021-12-15	數量	-
日期	-	-	材料颜色	ECK3M96295S-ZD1		材料	3mm THK. 铝板	批准	林仁安	2021-12-16	單件重量	- (KG)

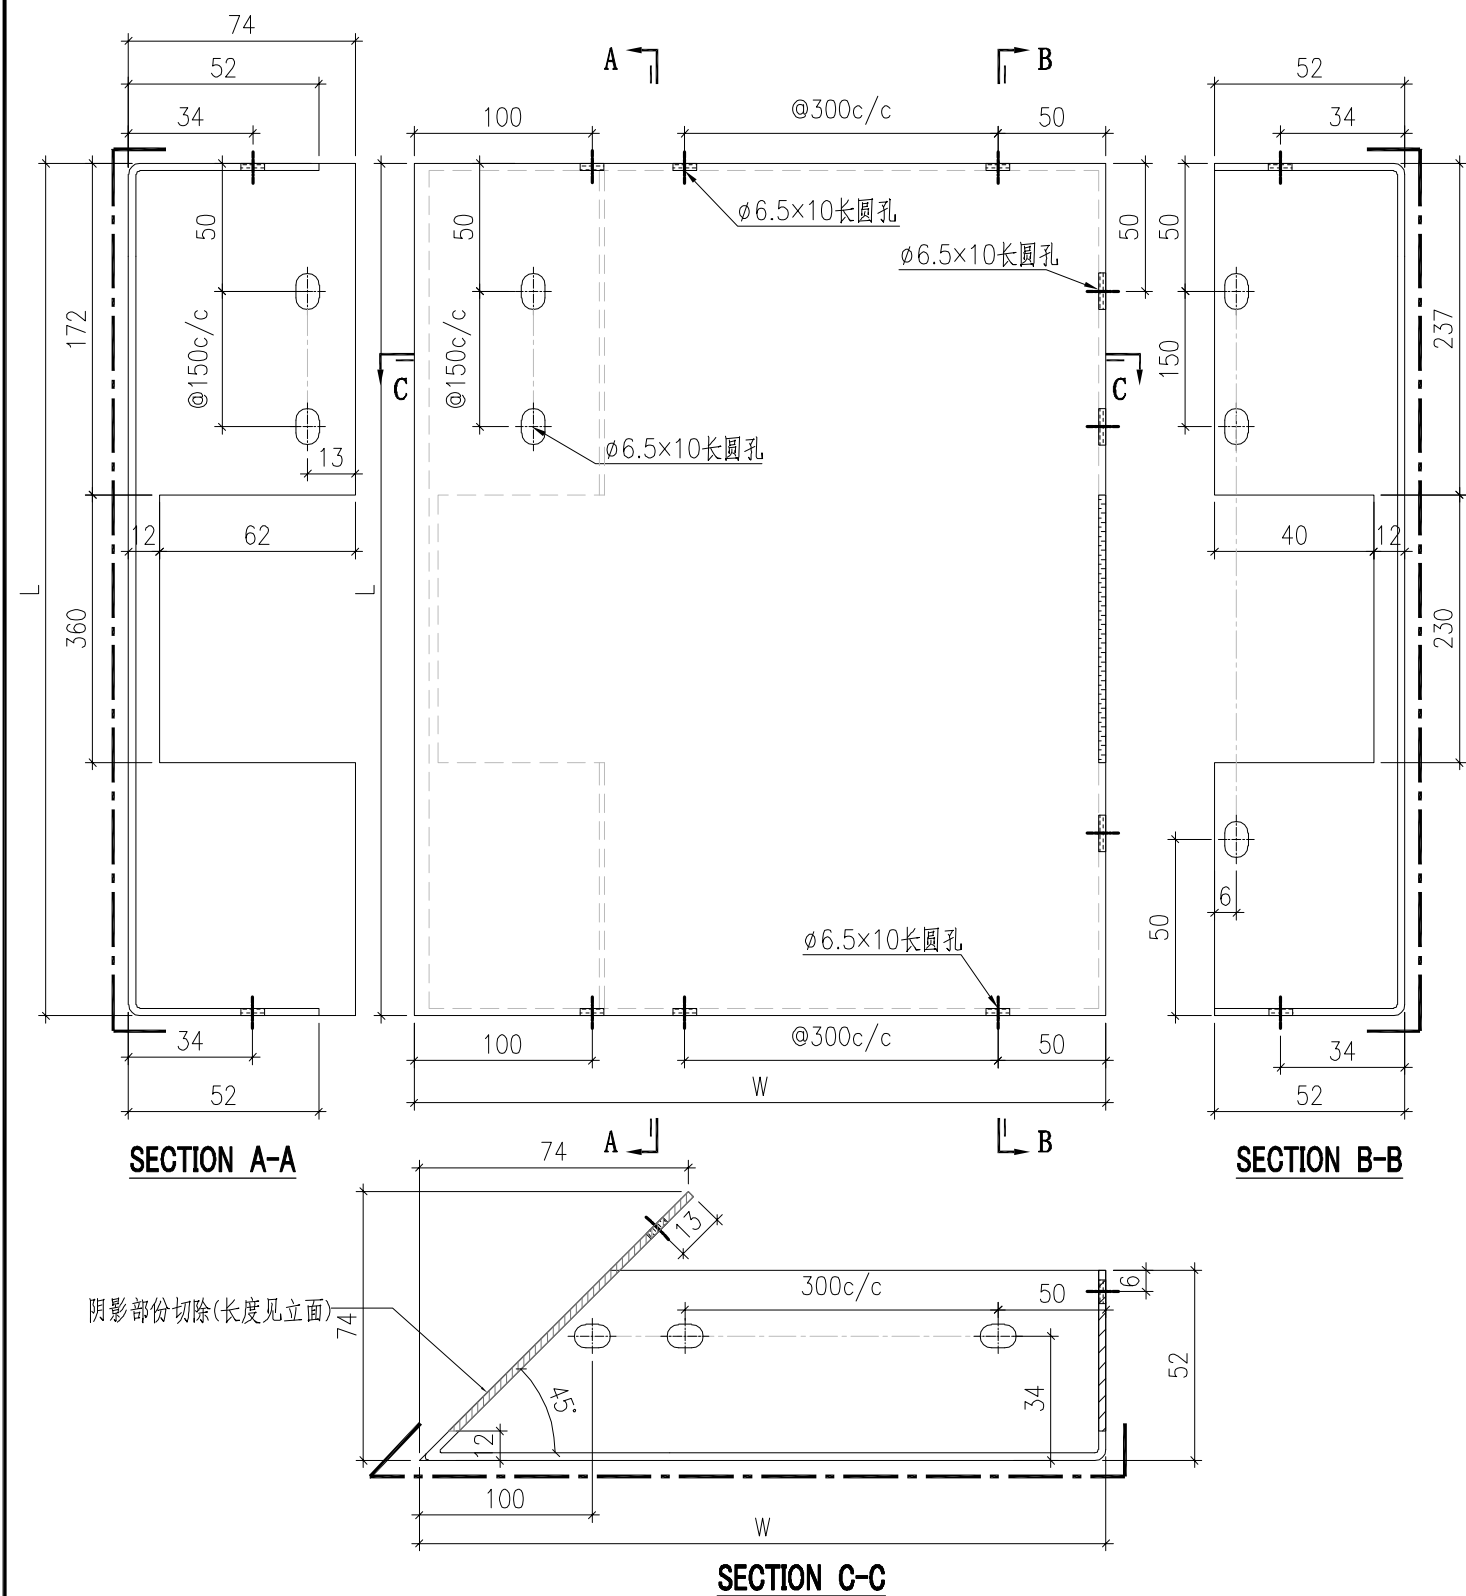

序號	鋁板編號	寬度 (W)	高度 (H)	數量
1	BST-EZ030	1454	552	1

 美特鋁質有限公司 MIDI Aluminium Fabricator Ltd.				工程號 J857 地盤 啟德6552	類別 制圖 刘灿	物料號 - 2021-12-14	圖號 BST-G03
修改 - 日期 -	採用工廠 ✓ 材料颜色 ECK3M96295S-ZD1	地盤 材料 3mm THK. 铝板	图纸名称 铝板加工图 材料	復核 徐詳坤 批准 林仁安	2021-12-15 2021-12-16	數量 - 單件重量 - (KG)	

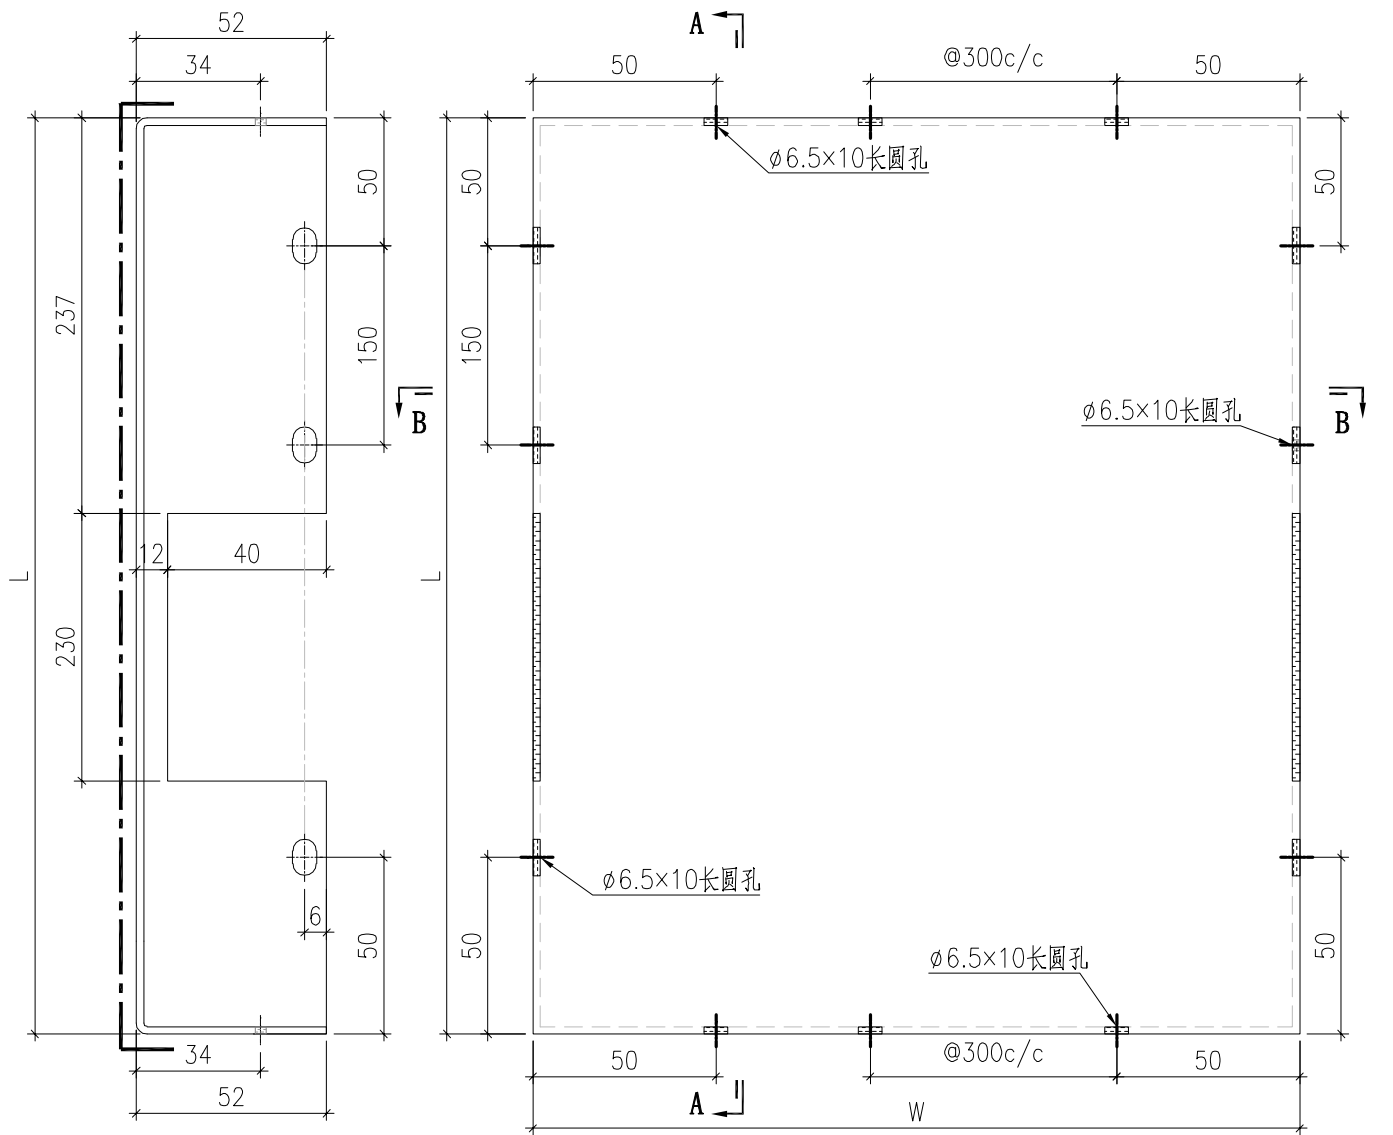


SECTION A-A

SECTION B-B


序號	鋁板編號	寬度 (W)	高度 (H)	數量
1	BST-G090	536	537	2

 美特鋁質有限公司 MIDI Aluminium Fabricator Ltd.				工程號	J857	類別		物料號	-			
				地盘	啟德6552	制圖	刘灿	2021-12-14	圖號	BST-H03		
修改	-	-	採用工廠	✓	地盘	图纸名称	铝板加工图	復核	徐詳坤	2021-12-15	數量	-
日期	-	-	材料颜色	ECK3M96295S-ZD1		材料	3mm THK. 铝板	批准	林仁安	2021-12-16	單件重量	- (KG)

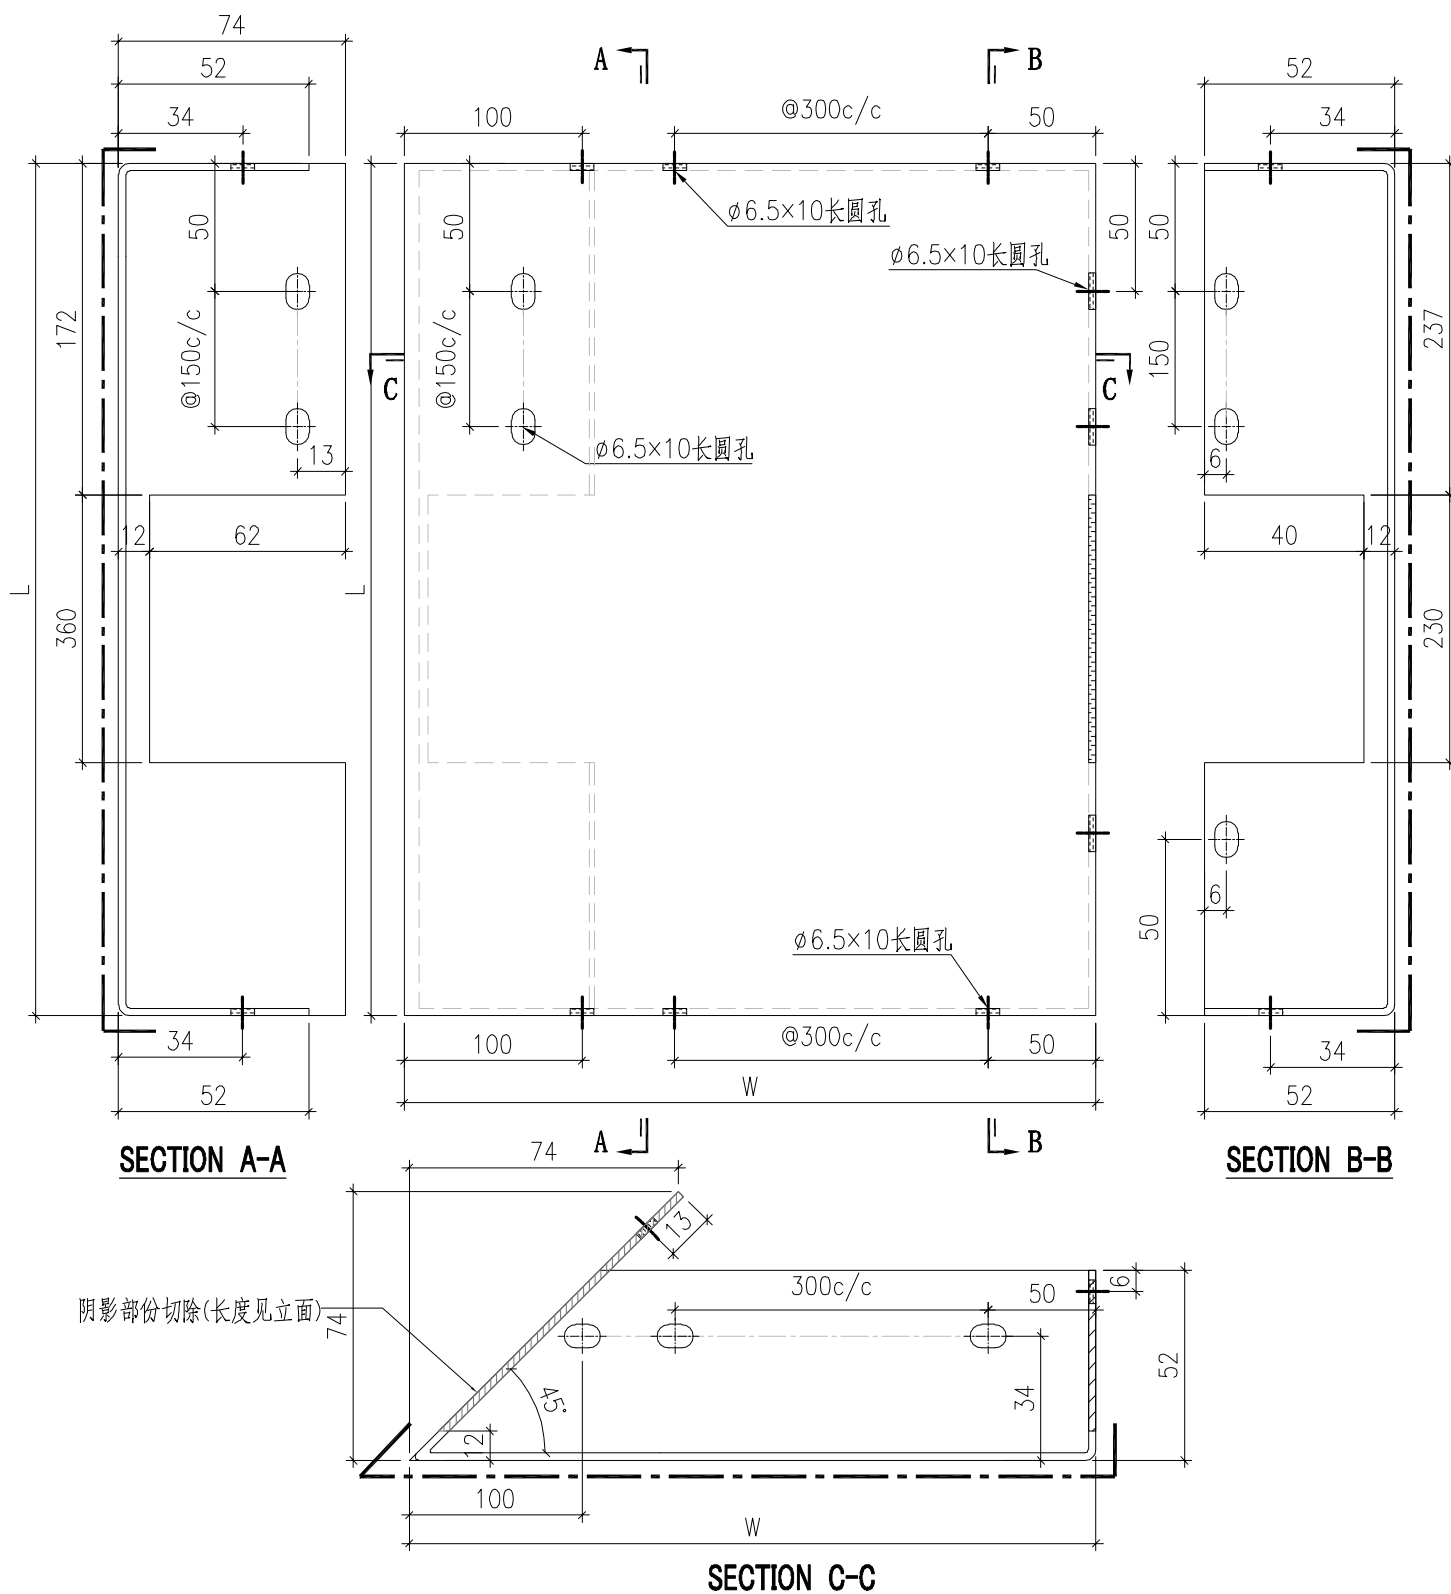

序號	鋁板編號	寬度 (W)	高度 (H)	數量
1	BST-HZ030	1454	537	1


 美特鋁質有限公司 MIDI Aluminium Fabricator Ltd.				工程號 J857	類別 制圖	物料號 -		
				地盤 啟德6552	劉燦	2021-12-14	圖號 BST-M03	
修改 -	-	-	採用工廠 ✓	地盤 ✓	圖紙名稱 鋁板加工圖	復核 徐詳坤	2021-12-15	數量 -
日期 -	-	-	材料顏色 ECK3M96295S-ZD1		材料 3mm THK. 鋁板	批准 林仁安	2021-12-16	單件重量 - (KG)

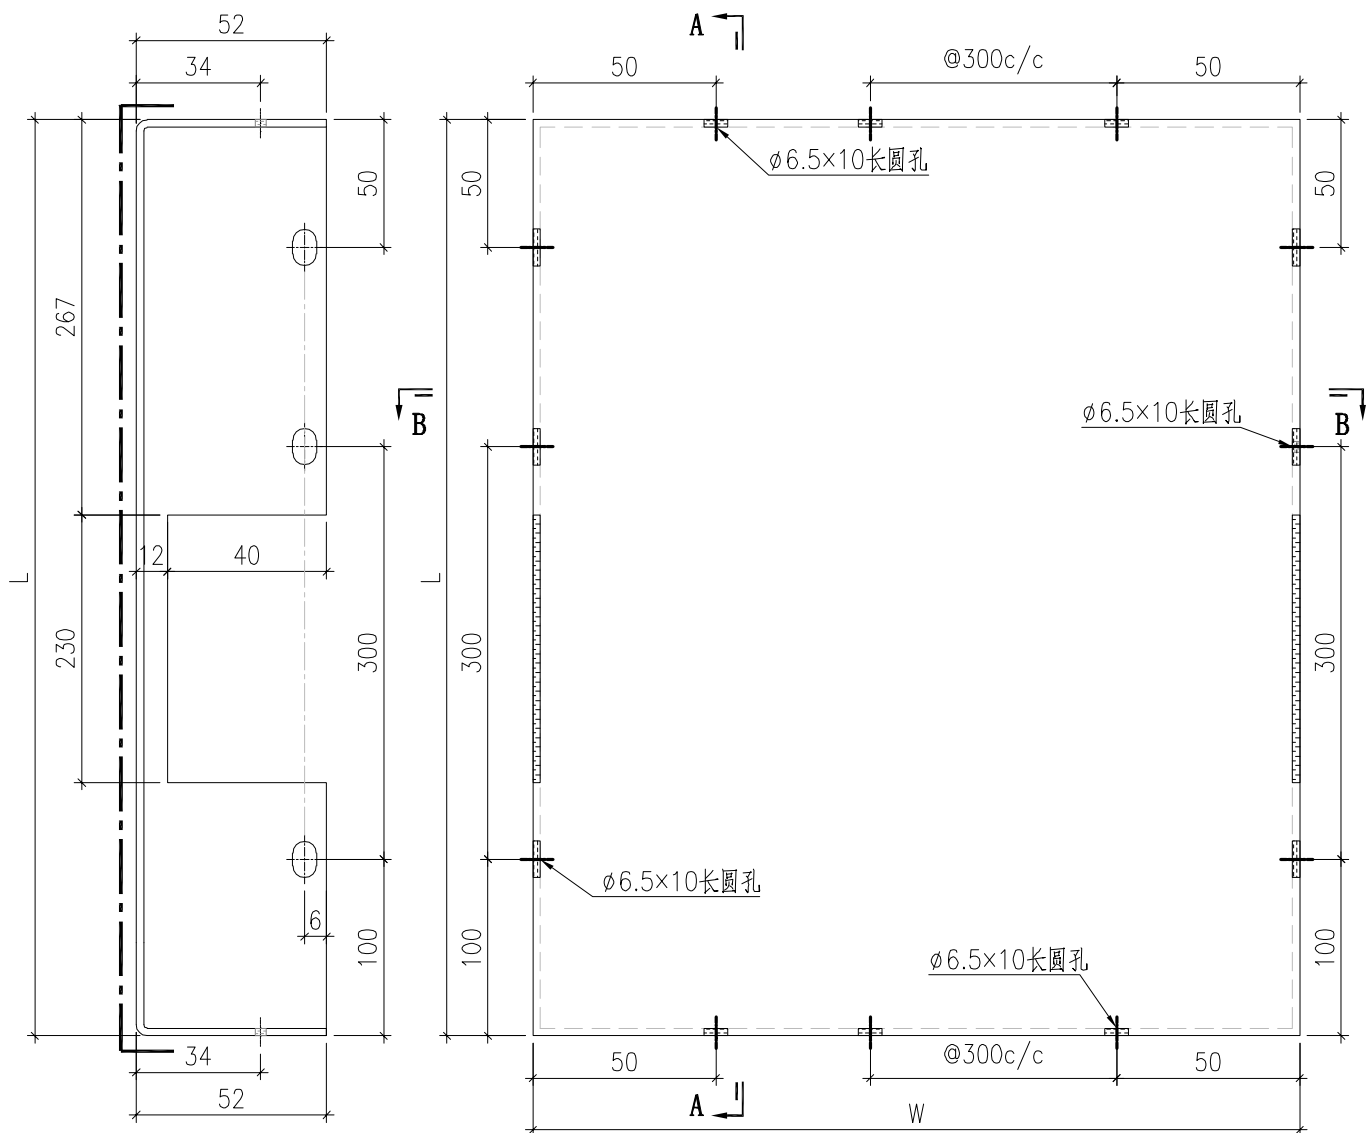

SECTION A-A

SECTION B-B

序號	鋁板編號	寬度 (W)	高度 (H)	數量
1	BST-M090	964	646	7
2	BST-M091	536	646	10

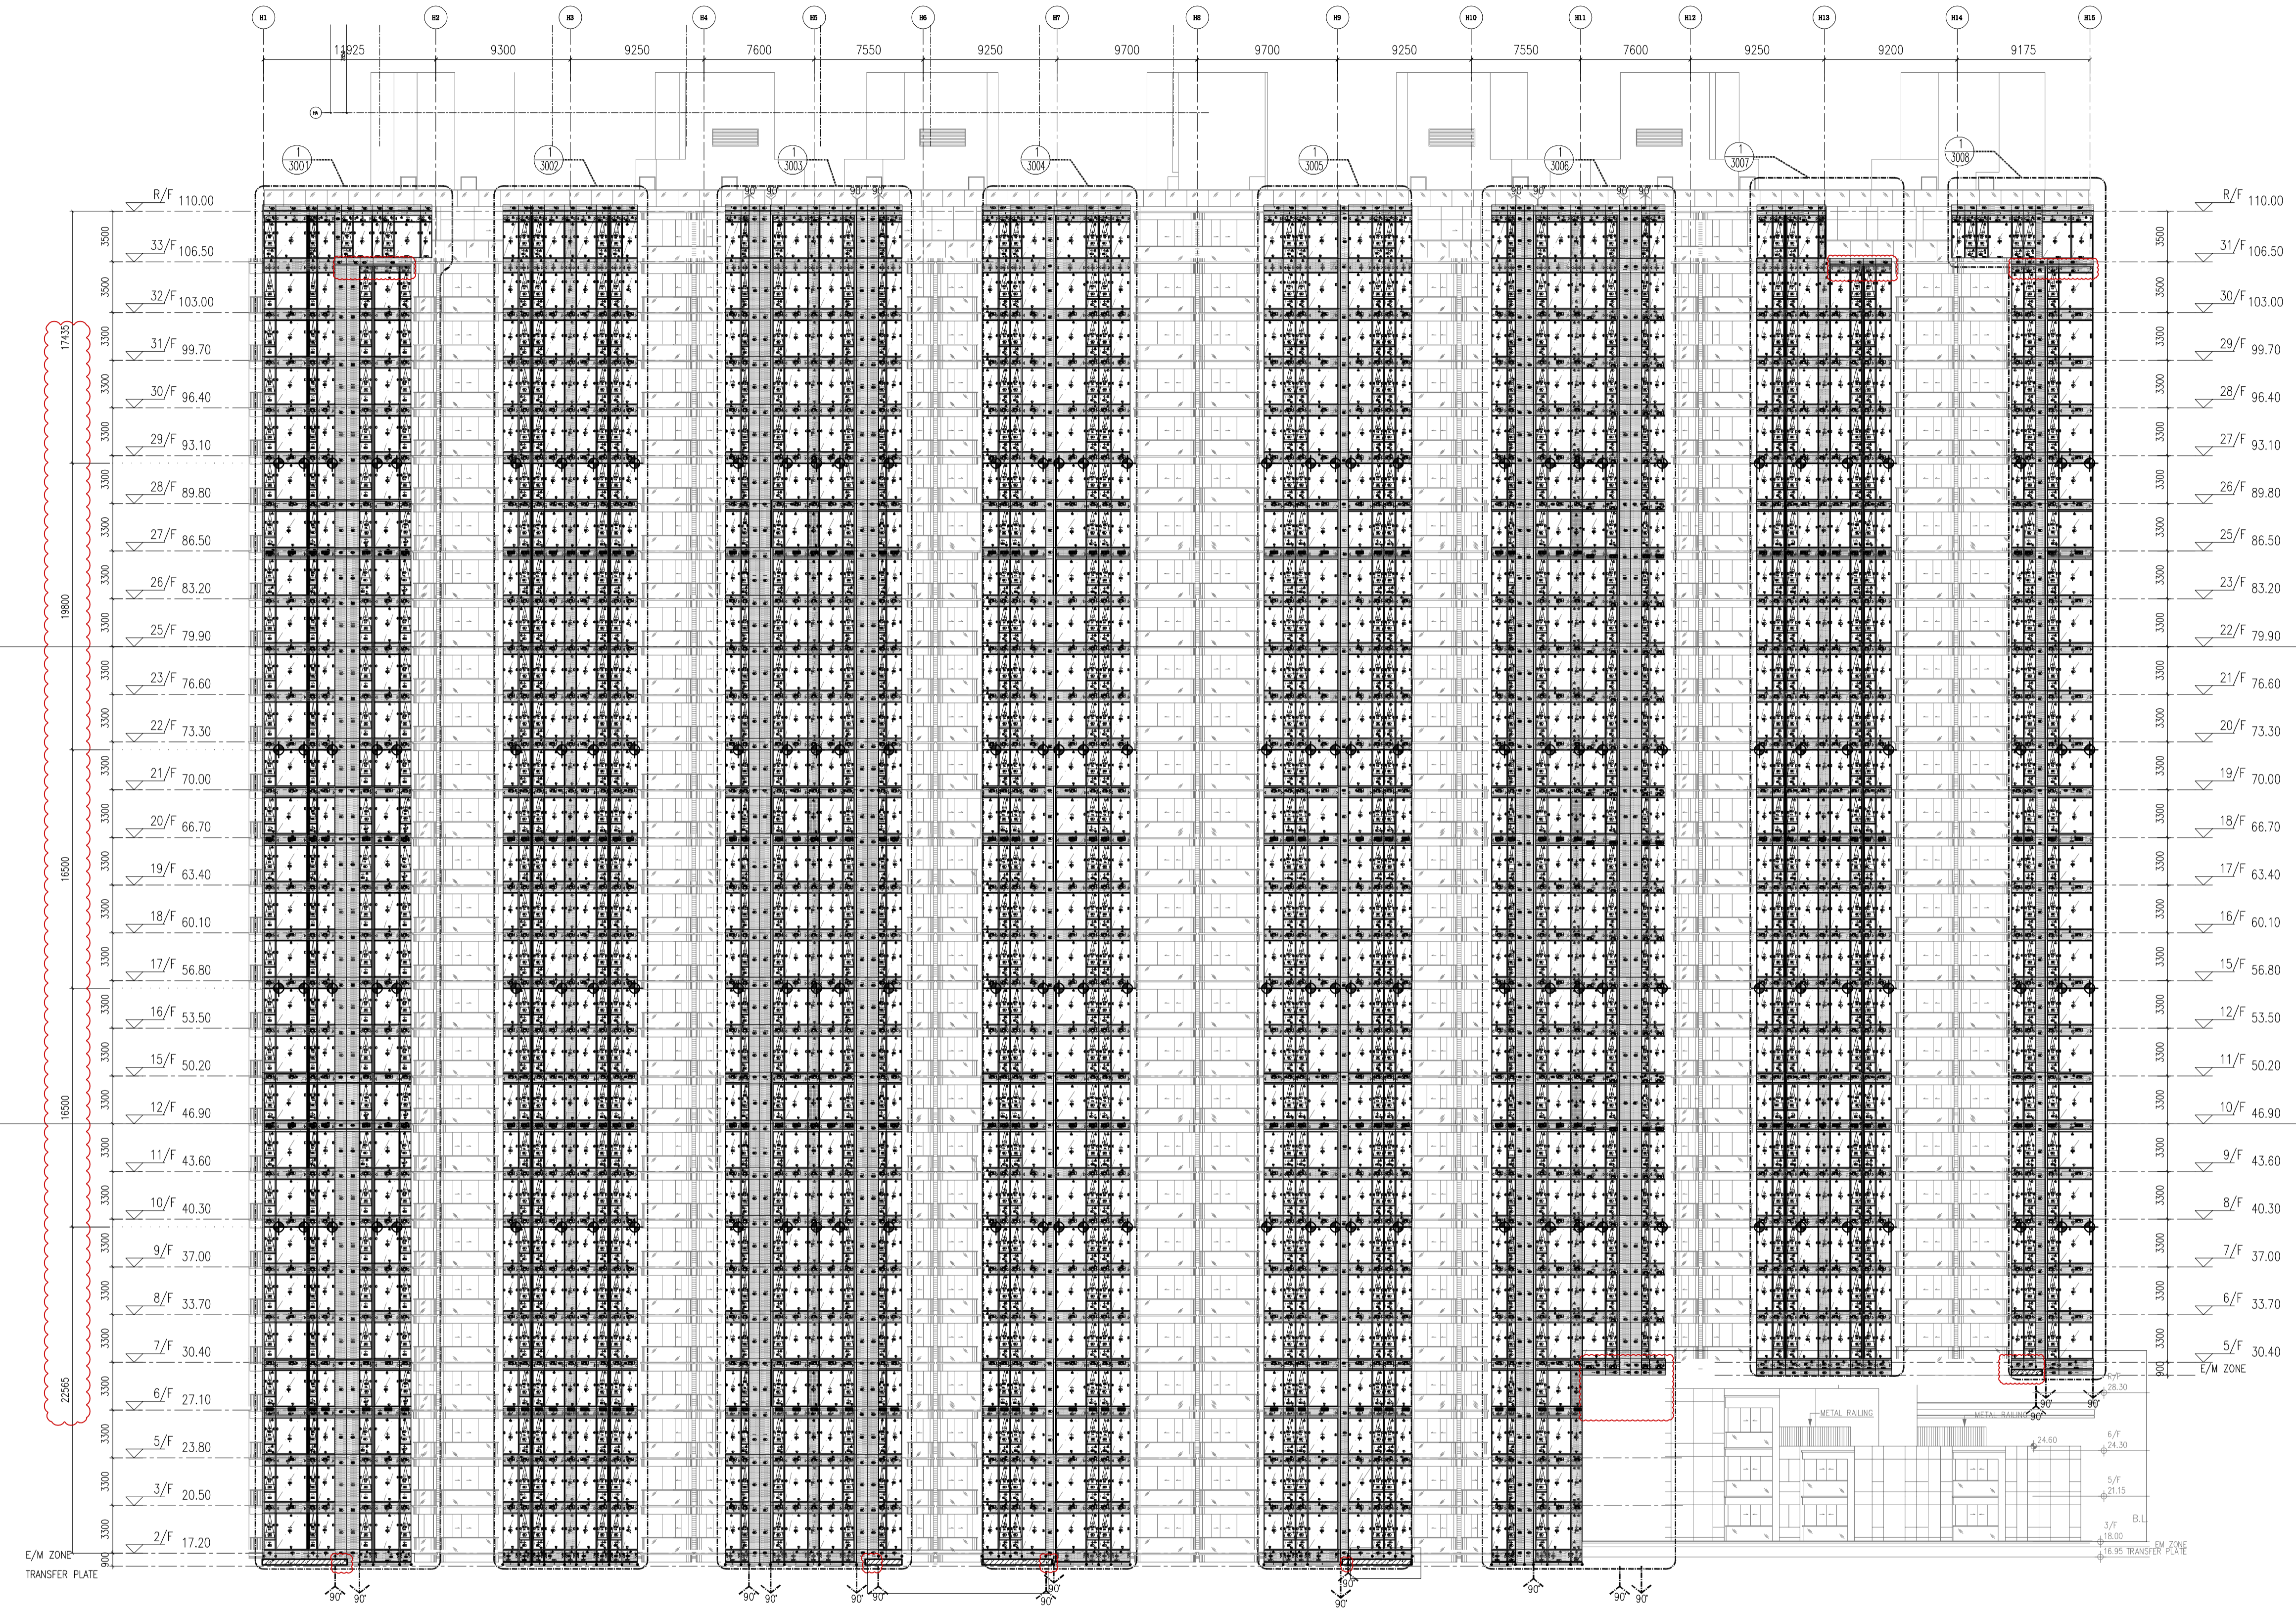

B.D. REF :
 F.S.D. REF :
 Note :
 1. All dimensions are in mm.
 2. All elevations are viewed from outside.
 3. All dimensions to be verified on site before fabrication.

GENERAL NOTES
 Legend :
 1. F.F.L.-- Finished Floor Level
 2. S.F.L.-- Structural Floor Level
 3. (R) -- Reversed Detail

X1 -- DETAIL MARK NO.
 X001 -- REFERS SHEET NO.

REV.	DATE	DESCRIPTION	BY
D	04.FEB.2022	GENERAL REVISION	
C	04.JAN.2022	GENERAL REVISION	
B	22.NOV.2021	GENERAL REVISION	
A	10.NOV.2021	GENERAL REVISION	

CLIENT :
MARBLE EDGE INVESTMENT LTD.

ARCHITECT :
RONALD LU & PARTNERS
 ARCHITECTS | PLANNERS | INTERIOR DESIGNERS

STRUCTURAL ENGINEER :
CMA C M WONG & ASSOCIATES LTD
 TEL: (852) 2822 1088
 E-mail: cma@cma.com

MAIN CONTRACTOR :
裕民建築有限公司

美特鋁質有限公司
 MIDI ALUMINIUM FABRICATOR LTD.
 Units 6-8, Sunray Industrial Centre, 1/F
 610 Cho Kwo Ling Road, Kowloon
 Tel: 23489211-4 Fax: (852) 27727666

PROJECT :
PROPOSED RESIDENTIAL DEVELOPMENT AT NEW KOWLOON INLAND LOT. NO.6552

TITLE :
TOWER ELEVATION "1" FOR TOWER 1-8


JOB NO. : J-857


DRAWN BY : AN DATE : 18.Oct.2021

CHKD BY : SCALE A1:250.000000 A3:
 DWG. NO. : SD-EL-2001 REV. : A

- LEGEND :
- S.F.L. = STRUCTURAL FLOOR LEVEL
 - C.W. = UNITIZED CURTAIN WALL (FOR BD APPROVAL)
 - ◁EM1= WIND LOAD +DEAD LOAD FIXING LOCATION
 - ◁EM2= WIND LOAD +DEAD LOAD FIXING LOCATION
 - ◀EM3= WIND LOAD FIXING LOCATION
 - GL1 = 8mm HEAT STRENGTHEN LOW IRON GLASS + 1.52 PVB INTERLAYER
 - GL2 = 8mm HEAT STRENGTHEN LOW IRON GLASS + 12mm AIR SPACE +12mm LOW IRON FULLY TEMPERED IGU LAMINATED CLEAR GLASS
 - GL3 = 8mm HEAT STRENGTHEN LOW IRON GLASS + 1.52 PVB INTERLAYER+ 8mm HEAT STRENGTHEN LOW IRON GLASS + 9mm AIR SPACE +8mm LOW IRON FULLY TEMPERED IGU LAMINATED CLEAR GLASS
 - GL4 = 8mm FULLY TEMPERED GLASS + 1.52 PVB INTERLAYER+ 8mm FULLY TEMPERED LAMINATED GLASS
 - GB = 10mm FULLY TEMPERED MONOLITHIC CLEAR GLASS (BARRIER)
 - S.J. = STACK JOINT
 - M1 = EXTRUDED ALUM. MALE MULLION (AL03)
 - M2 = EXTRUDED ALUM. MALE MULLION (AL03A)
 - M3 = EXTRUDED ALUM. FEMALE MULLION (AL04)
 - M4 = EXTRUDED ALUM. FEMALE MULLION (AL04A)
 - M7 = EXTRUDED ALUM. OUTER CORNER MALE MULLION (AL07)
 - M8 = EXTRUDED ALUM. OUTER CORNER FEMALE MULLION (AL08)
 - M9 = EXTRUDED ALUM. OUTER CORNER MALE MULLION (AL86)
 - M10 = EXTRUDED ALUM. OUTER CORNER FEMALE MULLION (AL85)
 - M13 = EXTRUDED ALUM. INTERMEDIATE MULLION (AL65)
 - M14 = EXTRUDED ALUM. INTERMEDIATE MULLION (AL66)
 - M15 = EXTRUDED ALUM. MALE MULLION (AL67)
 - M16 = EXTRUDED ALUM. FEMALE MULLION (AL68)
 - T1 = EXTRUDED ALUM. SILL STACK JOINT (AL11)
 - T2 = EXTRUDED ALUM. GUTTER STACK JOINT (AL12)
 - T3 = EXTRUDED ALUM. INTERMEDIATE TRANSOM (AL13)
 - T4 = EXTRUDED ALUM. INTERMEDIATE TRANSOM (AL15)
 - T5 = EXTRUDED ALUM. INTERMEDIATE TRANSOM (AL14)
 - T7 = EXTRUDED ALUM. TRANSOM (AL71)
 - T8 = EXTRUDED ALUM. TRANSOM (AL72)
 - T9 = EXTRUDED ALUM. TRANSOM (AL69)
 - T10 = EXTRUDED ALUM. TRANSOM (AL70)
 - T11 = EXTRUDED ALUM. INTERMEDIATE TRANSOM(AL106)
 - T12 = EXTRUDED ALUM. INTERMEDIATE TRANSOM(AL107)
 - T13 = EXTRUDED ALUM. GUTTER STACK JOINT (AL105)

⊕ = BMU SOCKET(GLASS UNIT)

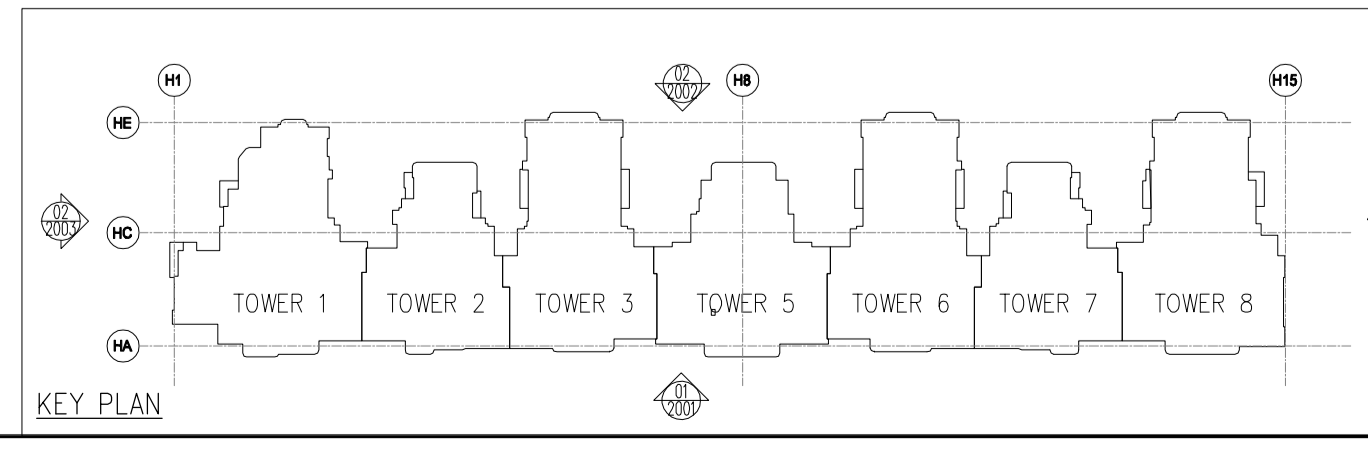

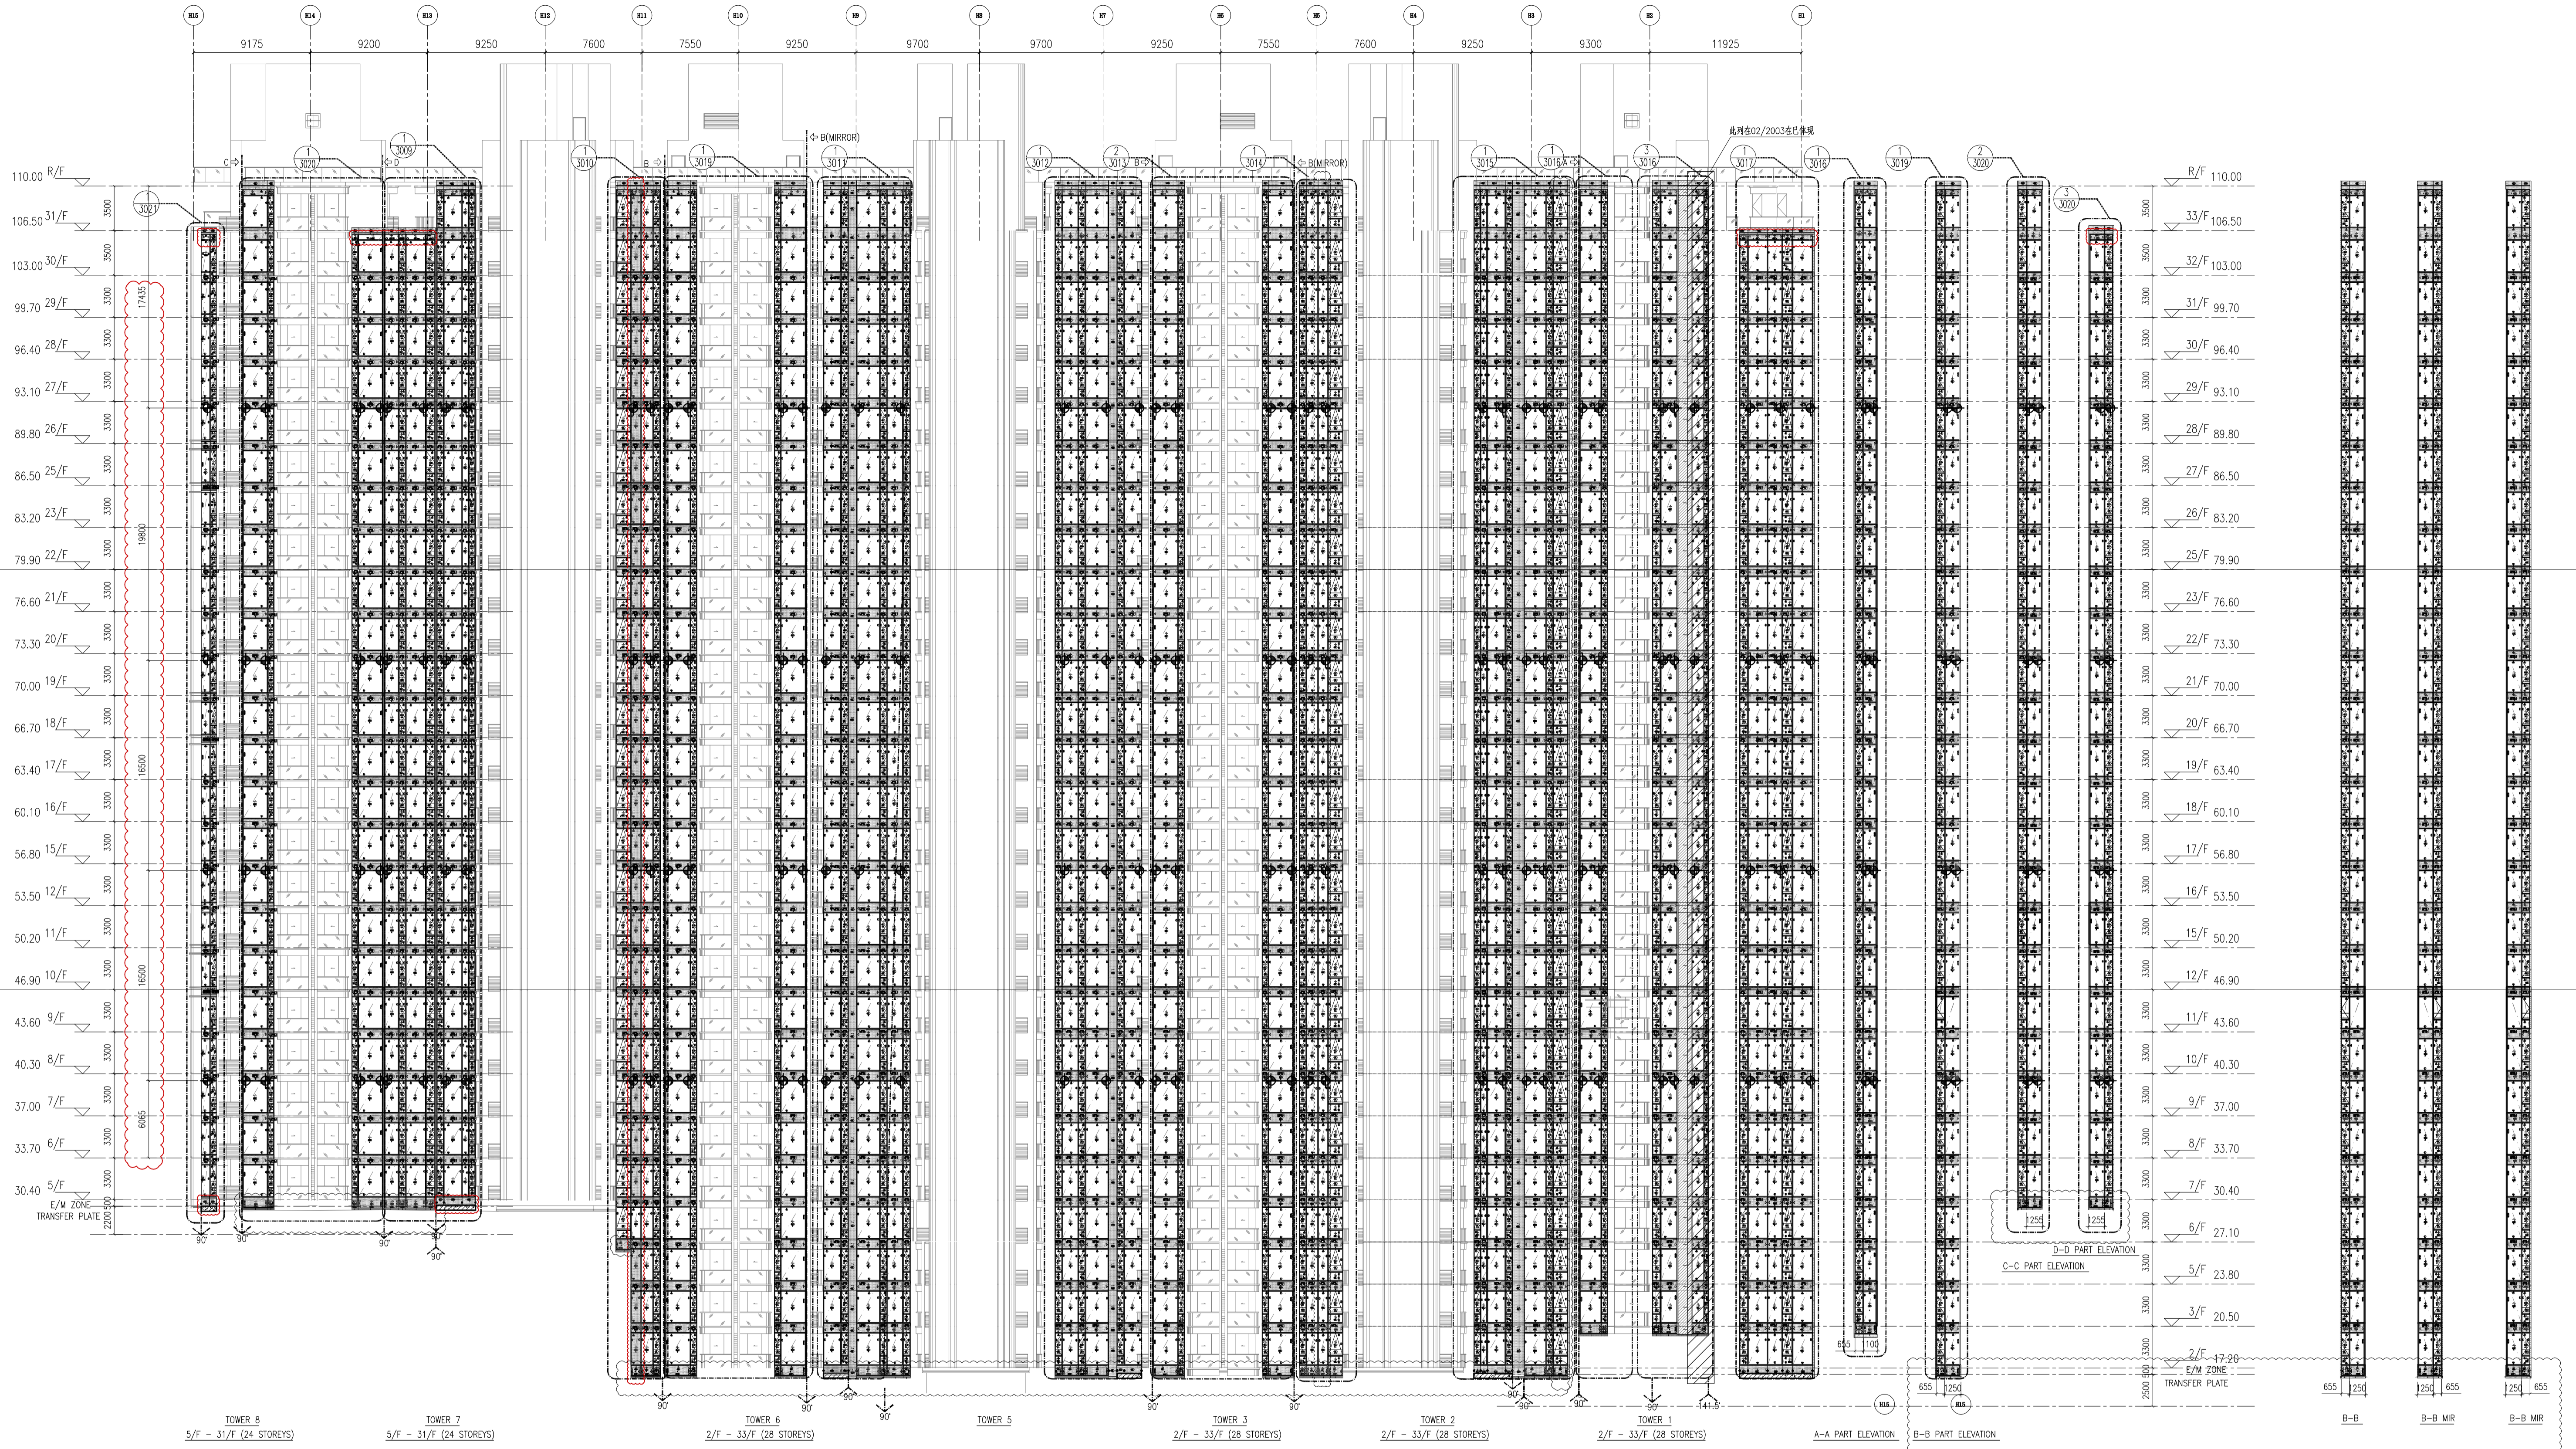






- LEGEND :**
- S.F.L. = STRUCTURAL FLOOR LEVEL
 - C.W. = UNITIZED CURTAIN WALL (FOR BD APPROVAL)
 - ◁EM1= WIND LOAD +DEAD LOAD FIXING LOCATION
 - ◁EM2= WIND LOAD +DEAD LOAD FIXING LOCATION
 - ◀EM3= WIND LOAD FIXING LOCATION
 - GL1 = 8mm HEAT STRENGTHEN LOW IRON GLASS + 1.52 PVB INTERLAYER
 - GL2 = 8mm HEAT STRENGTHEN LOW IRON GLASS + 12mm AIR SPACE +12mm LOW IRON FULLY TEMPERED IGU LAMINATED CLEAR GLASS
 - GL3 = 8mm HEAT STRENGTHEN LOW IRON GLASS + 1.52 PVB INTERLAYER+ 8mm HEAT STRENGTHEN LOW IRON GLASS + 9mm AIR SPACE +8mm LOW IRON FULLY TEMPERED IGU LAMINATED CLEAR GLASS
 - GL4 = 8mm FULLY TEMPERED GLASS + 1.52 PVB INTERLAYER+ 8mm FULLY TEMPERED LAMINATED GLASS
 - GB = 10mm FULLY TEMPERED MONOLITHIC CLEAR GLASS (BARRIER)

- M1 = EXTRUDED ALUM. MALE MULLION (AL03)
- M2 = EXTRUDED ALUM. MALE MULLION (AL03A)
- M3 = EXTRUDED ALUM. FEMALE MULLION (AL04)
- M4 = EXTRUDED ALUM. FEMALE MULLION (AL04A)
- M7 = EXTRUDED ALUM. OUTER CORNER MALE MULLION (AL07)
- M8 = EXTRUDED ALUM. OUTER CORNER FEMALE MULLION (AL08)
- M9 = EXTRUDED ALUM. OUTER CORNER MALE MULLION (AL86)
- M10 = EXTRUDED ALUM. OUTER CORNER FEMALE MULLION (AL85)
- M13 = EXTRUDED ALUM. INTERMEDIATE MULLION (AL65)
- M14 = EXTRUDED ALUM. INTERMEDIATE MULLION (AL66)
- M15 = EXTRUDED ALUM. MALE MULLION (AL67)
- M16 = EXTRUDED ALUM. FEMALE MULLION (AL68)

- S.J. = STACK JOINT
- T1 = EXTRUDED ALUM. SILL STACK JOINT (AL11)
- T2 = EXTRUDED ALUM. GUTTER STACK JOINT (AL12)
- T3 = EXTRUDED ALUM. INTERMEDIATE TRANSOM (AL13)
- T4 = EXTRUDED ALUM. INTERMEDIATE TRANSOM (AL15)
- T5 = EXTRUDED ALUM. INTERMEDIATE TRANSOM (AL14)
- T7 = EXTRUDED ALUM. TRANSOM (AL71)
- T8 = EXTRUDED ALUM. TRANSOM (AL72)
- T9 = EXTRUDED ALUM. TRANSOM (AL69)
- T10 = EXTRUDED ALUM. TRANSOM (AL70)
- T11 = EXTRUDED ALUM. INTERMEDIATE TRANSOM(AL106)
- T12 = EXTRUDED ALUM. INTERMEDIATE TRANSOM(AL107)
- T13 = EXTRUDED ALUM. GUTTER STACK JOINT (AL105)

- 01 TOWER 1-8-ELEVATION**
 1:250.000000
- ☉ = BMU SOCKET(GLASS UNIT)

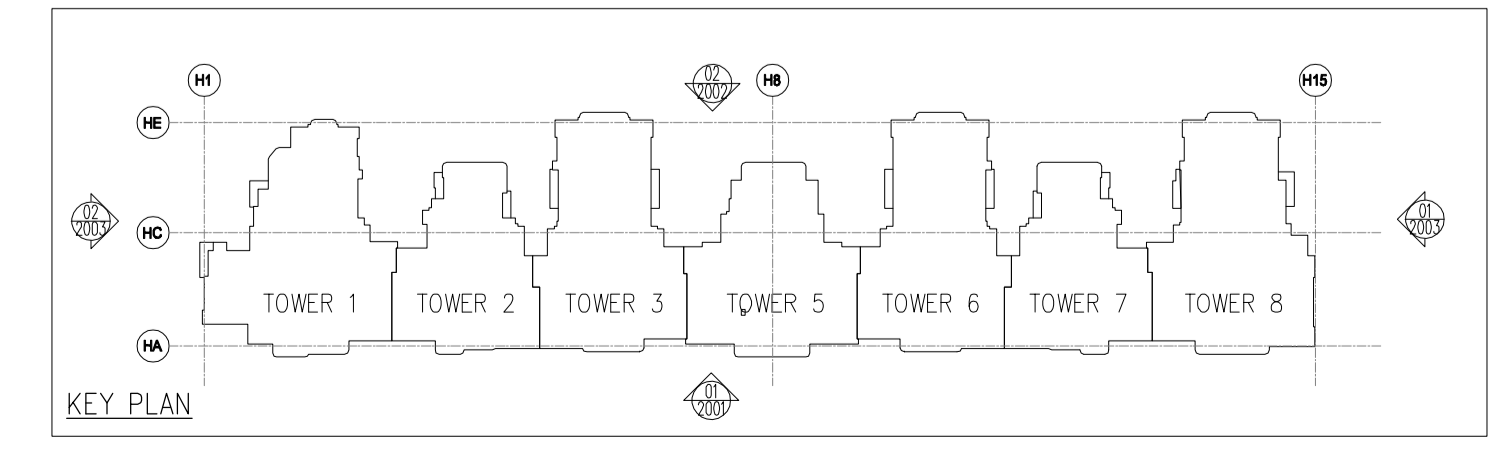

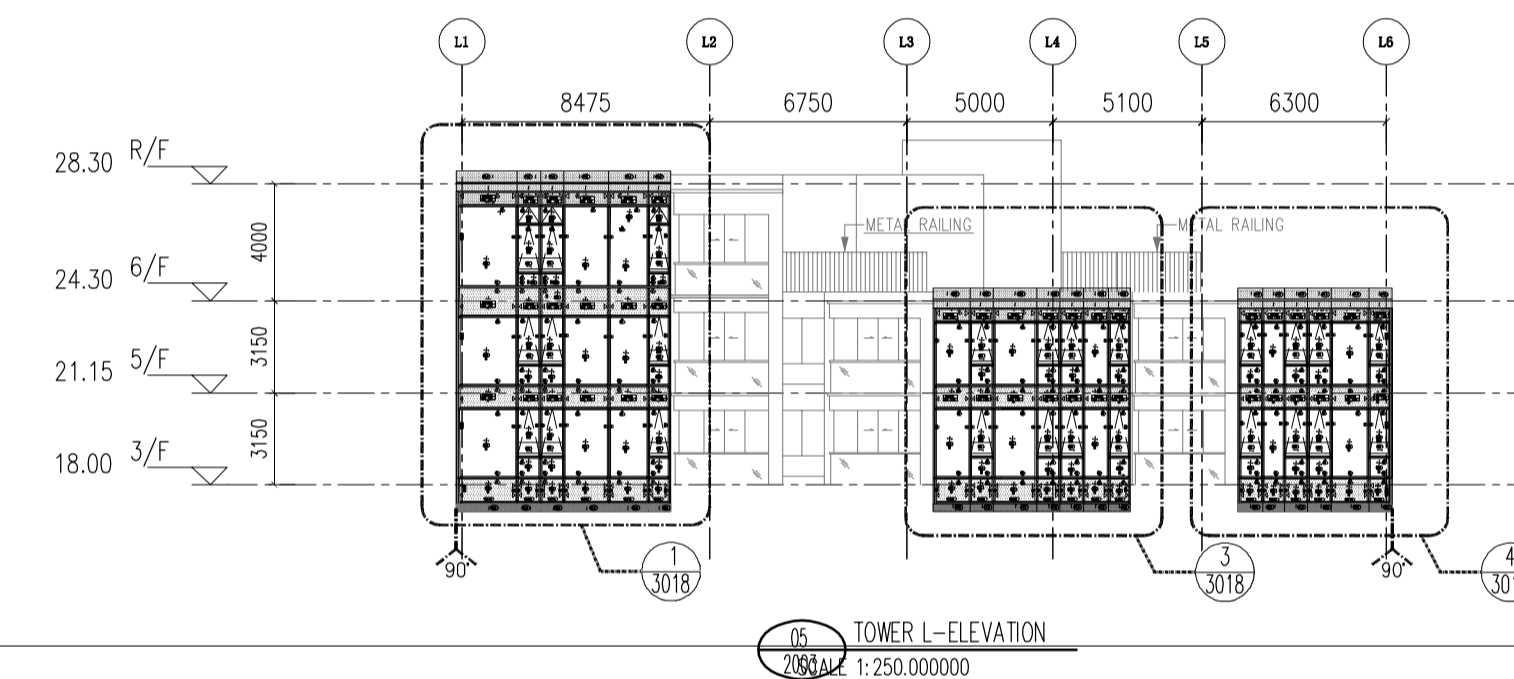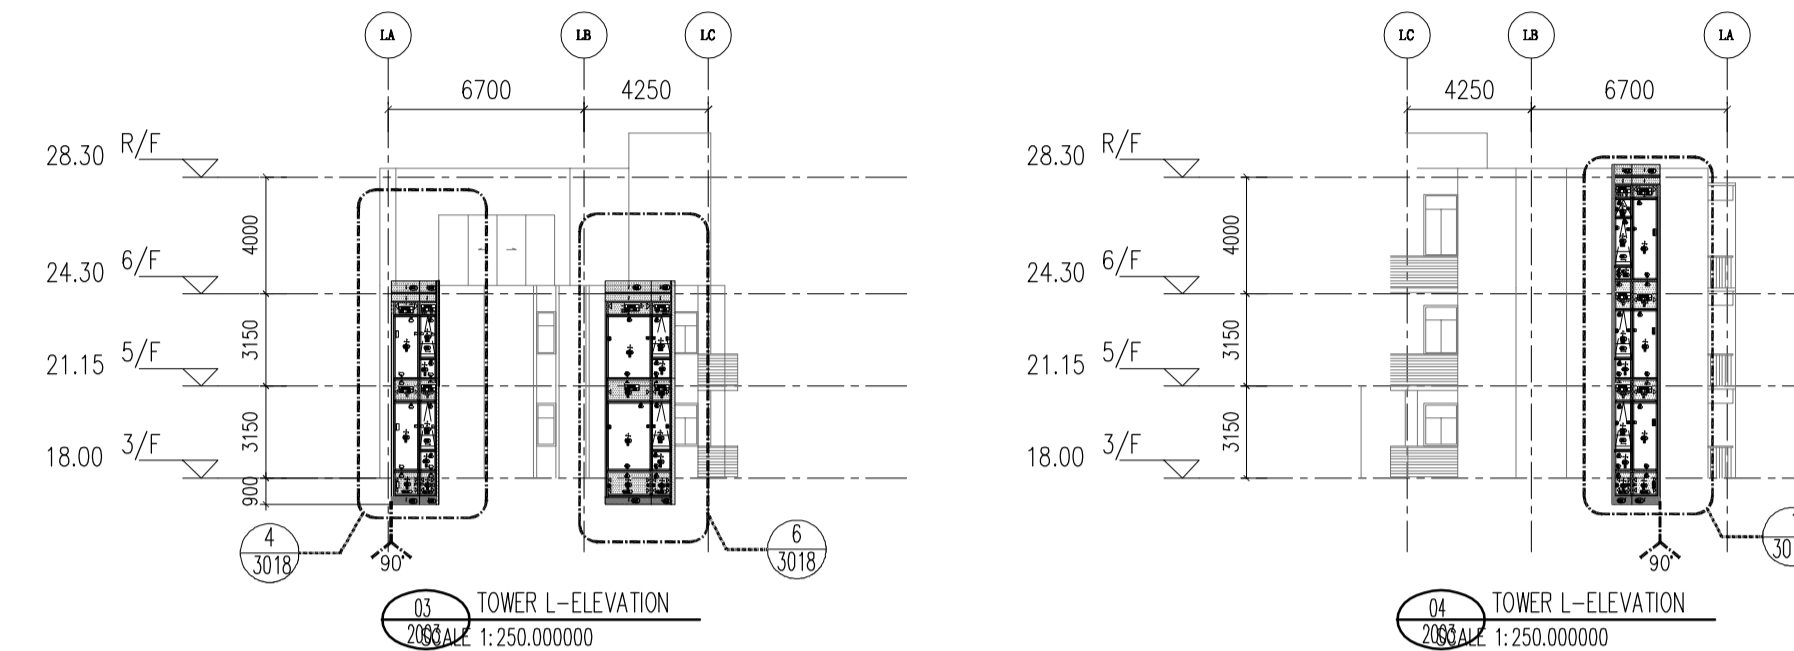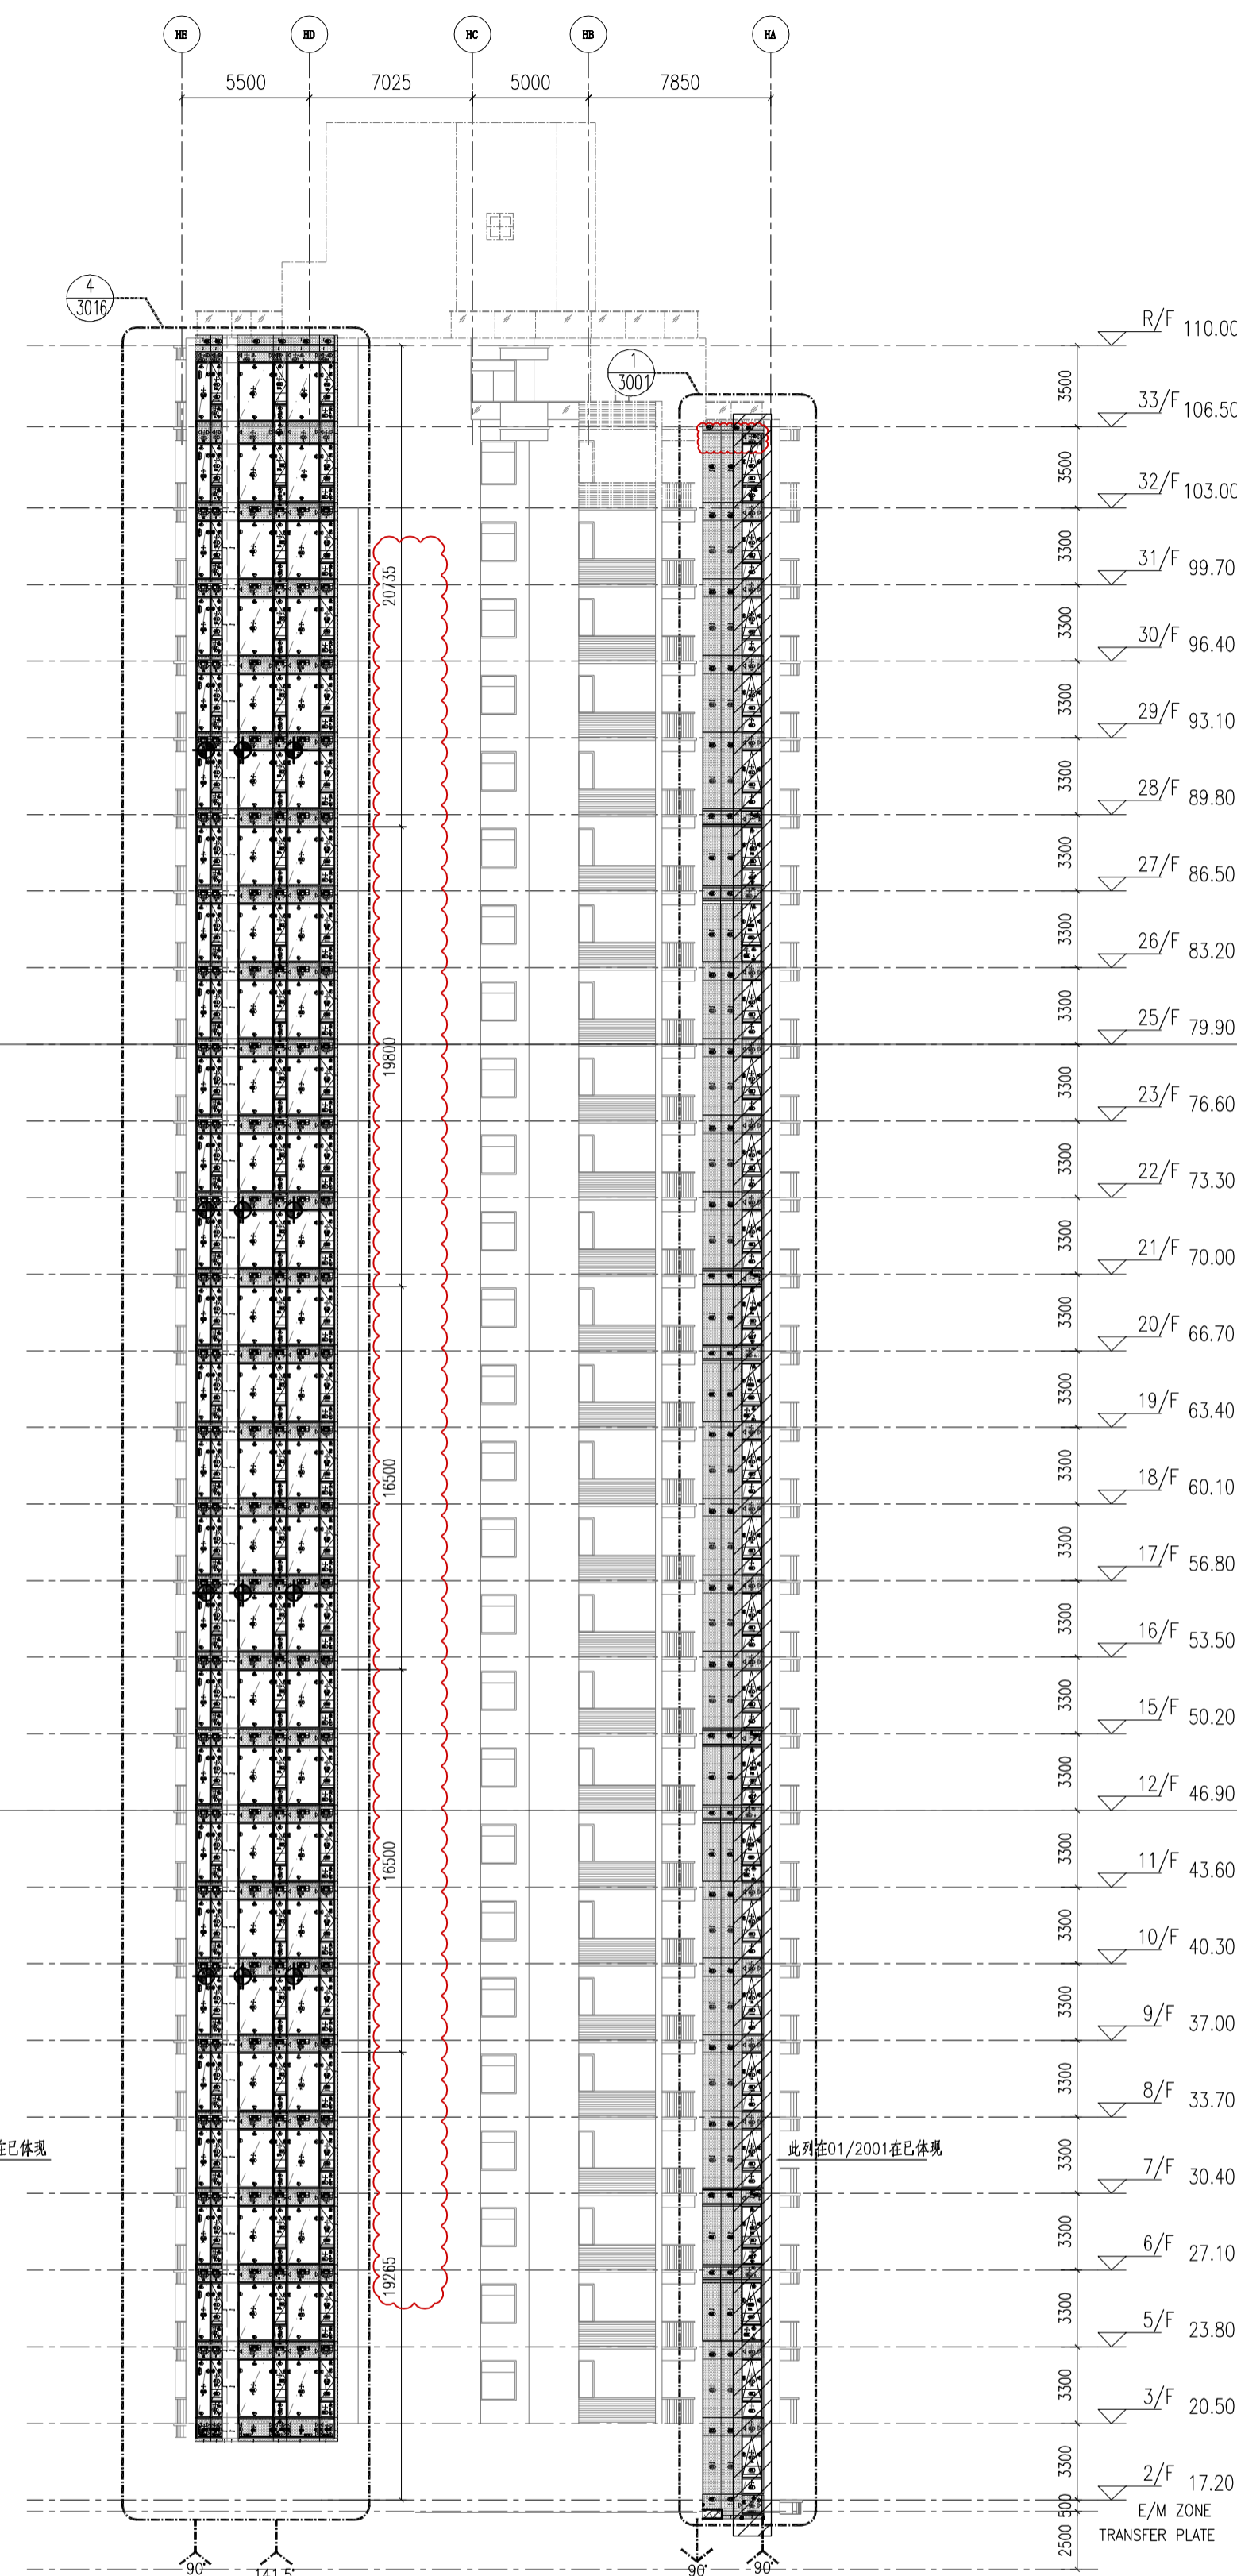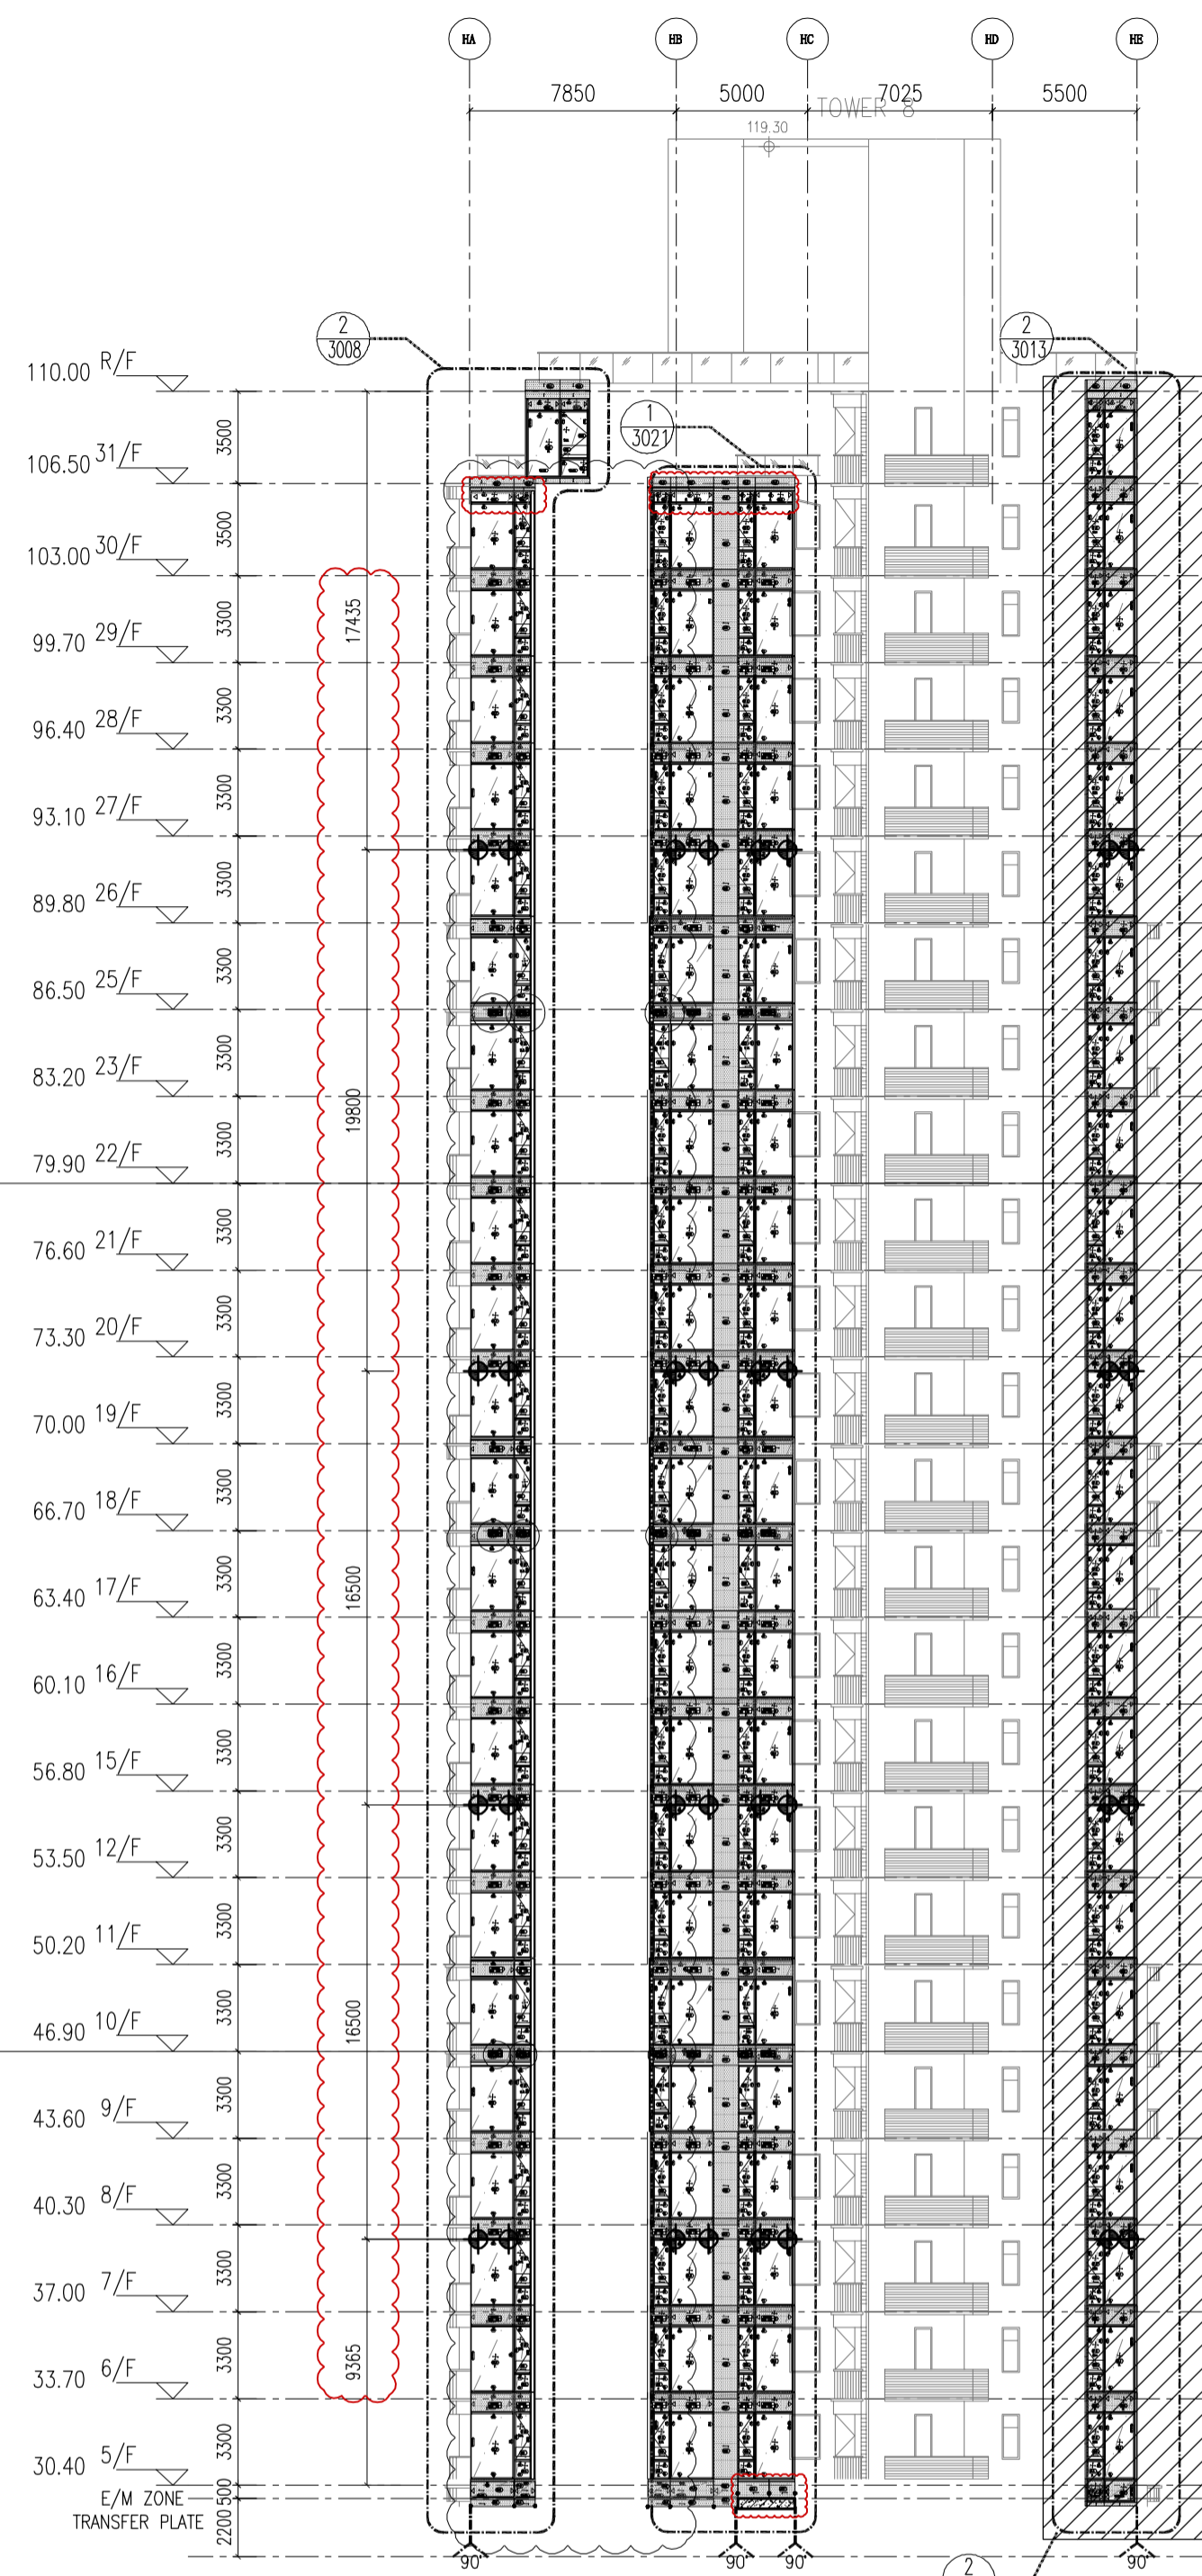

01 TOWER 8-ELEVATION
1:250.000000

02 TOWER 8-ELEVATION
1:250.000000

03 TOWER L-ELEVATION
1:250.000000

04 TOWER L-ELEVATION
1:250.000000

LEGEND :

S.F.L. = STRUCTURAL FLOOR LEVEL

C.W. = UNITIZED CURTAIN WALL (FOR BD APPROVAL)

◁EM1= WIND LOAD +DEAD LOAD FIXING LOCATION

◁EM2= WIND LOAD +DEAD LOAD FIXING LOCATION

◀EM3= WIND LOAD FIXING LOCATION

GL1 = 8mm HEAT STRENGTHEN LOW IRON GLASS + 1.52 PVB INTERLAYER

GL2 = 8mm HEAT STRENGTHEN LOW IRON GLASS + 12mm AIR SPACE +12mm LOW IRON FULLY TEMPERED IGU LAMINATED CLEAR GLASS

GL3 = 8mm HEAT STRENGTHEN LOW IRON GLASS + 1.52 PVB INTERLAYER+ 8mm HEAT STRENGTHEN LOW IRON GLASS + 12mm AIR SPACE +10mm LOW IRON FULLY TEMPERED IGU LAMINATED CLEAR GLASS

GL4 = 8mm FULLY TEMPERED GLASS + 1.52 PVB INTERLAYER+ 8mm FULLY TEMPERED LAMINATED GLASS

GL2 = 8mm HEAT STRENGTHEN LOW IRON GLASS + 1.52 PVB INTERLAYER+ 8mm HEAT STRENGTHEN LOW IRON GLASS + 12mm AIR SPACE +12mm LOW IRON FULLY TEMPERED IGU LAMINATED CLEAR GLASS

GL3 = 8mm HEAT STRENGTHEN LOW IRON GLASS + 1.52 PVB INTERLAYER+ 8mm HEAT STRENGTHEN LOW IRON GLASS + 9mm AIR SPACE +8mm LOW IRON FULLY TEMPERED IGU LAMINATED CLEAR GLASS

GL4 = 8mm FULLY TEMPERED GLASS + 1.52 PVB INTERLAYER+ 8mm FULLY TEMPERED LAMINATED GLASS

GB = 10mm FULLY TEMPERED MONOLITHIC CLEAR GLASS (BARRIER)

S.J. = STACK JOINT
M1 = EXTRUDED ALUM. MALE MULLION (AL03)
M2 = EXTRUDED ALUM. MALE MULLION (AL03A)
M3 = EXTRUDED ALUM. FEMALE MULLION (AL04)
M4 = EXTRUDED ALUM. FEMALE MULLION (AL04A)
M7 = EXTRUDED ALUM. OUTER CORNER MALE MULLION (AL07)
M8 = EXTRUDED ALUM. OUTER CORNER FEMALE MULLION (AL08)
M9 = EXTRUDED ALUM. OUTER CORNER MALE MULLION (AL86)
M10 = EXTRUDED ALUM. OUTER CORNER FEMALE MULLION (AL85)
M13 = EXTRUDED ALUM. INTERMEDIATE MULLION (AL65)
M14 = EXTRUDED ALUM. INTERMEDIATE MULLION (AL66)
M15 = EXTRUDED ALUM. MALE MULLION (AL67)
M16 = EXTRUDED ALUM. FEMALE MULLION (AL68)

T1 = EXTRUDED ALUM. SILL STACK JOINT (AL11)
T2 = EXTRUDED ALUM. GUTTER STACK JOINT (AL12)
T3 = EXTRUDED ALUM. INTERMEDIATE TRANSOM (AL13)
T4 = EXTRUDED ALUM. INTERMEDIATE TRANSOM (AL15)
T5 = EXTRUDED ALUM. INTERMEDIATE TRANSOM (AL14)
T7 = EXTRUDED ALUM. TRANSOM (AL71)
T8 = EXTRUDED ALUM. TRANSOM (AL72)
T9 = EXTRUDED ALUM. TRANSOM (AL69)
T10 = EXTRUDED ALUM. TRANSOM (AL70)
T11 = EXTRUDED ALUM. INTERMEDIATE TRANSOM(AL106)
T12 = EXTRUDED ALUM. INTERMEDIATE TRANSOM(AL107)
T13 = EXTRUDED ALUM. GUTTER STACK JOINT (AL105)

⊕ = BMU SOCKET(GLASS UNIT)

B.D. REF :

F.S.D. REF :

Note :

- 1.All dimensions are in mm.
- 2.All elevations are viewed from outside.
- 3.All dimensions to be verified on site before fabrication.

GENERAL NOTES

Legend :

1. F.F.L.-- Finished Floor Level
2. S.F.L.-- Structural Floor Level
3. (R) -- Reversed Detail

X1 -- DETAIL MARK NO.
X001 -- REFERS SHEET NO.

REV.	DATE	DESCRIPTION	BY
D	04.FEB.2022	GENERAL REVISION	
C	04.JAN.2022	GENERAL REVISION	
B	22.Nov.2021	GENERAL REVISION	
A	10.Nov.2021	GENERAL REVISION	

CLIENT :

MARBLE EDGE INVESTMENT LTD.

ARCHITECT :

RONALD LU & PARTNERS
ARCHITECTS | PLANNERS | INTERIOR DESIGNERS

STRUCTURAL ENGINEER :

CMA C M WONG & ASSOCIATES LTD
TEL: (852) 3823 1088
E-mail: cma@cma.com

MAIN CONTRACTOR :

裕民建築有限公司

美特鋁質有限公司
MIDI ALUMINIUM FABRICATOR LTD.

Units 6-8, Sunray Industrial Centre, 1/F
610 Cho Kwo Ling Road, Kowloon
Tel:23489211-4 Fax:(852)27727666

PROJECT :

PROPOSED RESIDENTIAL DEVELOPMENT AT NEW KOWLOON INLAND LOT. NO.6552

TITLE :

TOWER ELEVATION "3"
FOR TOWER 1-8&L

JOB NO. : J-857

DRAWN BY : AN DATE : 18.Oct.2021

CHKD BY : SCALE A:1:250.000000 A3:

DWG. NO. : SD-EL-2003

REV. : A

