

工程指示 / 要求簡箋 ENGINEER INSTRUCTIONS(E.I.)

工程指示編號:	EI- 5428	修改版本:	B
	HK- 0328/23		
工程編號:	J 857	工程名稱:	啟德6552
收件人:	生統	發件人:	Nero HO
工程項目:	屋頂欄河 - 地盤用鋁板(T1~T8)	日期:	27/02/2023

<input type="checkbox"/> 原合約工程包	<input type="checkbox"/> 原合約工程加 / 減脹 QT-	<input type="checkbox"/> 新工程報價 QT-
---------------------------------	--	------------------------------------

信件批核號碼/圖紙參考編號:	批核模具圖紙編號:
客戶指示附件:	管理內部批簽署:

<input type="checkbox"/> 初步鋁料 B.M.	<input type="checkbox"/> 加工拆圖, 然後生產	<input type="checkbox"/> 尺寸表
<input type="checkbox"/> 正式鋁料 B.M.	<input type="checkbox"/> 技術上資料/指示	<input type="checkbox"/> 報價
<input type="checkbox"/> 配件 B.M.	<input type="checkbox"/> 樣辦或貨品說明書	<input type="checkbox"/> 分判合約
<input type="checkbox"/> 其他:		

內容:
按附件修改加工圖加工,
另外放行EI5428無修改版本定的"標示了「此長度需複核後再加工」的鋁板"先備料不用加工指示
亦可以按附件資料生產加工。
完成上列要求日期: 10/03/2023

國內

<input type="checkbox"/> 生產技術總監	<input type="checkbox"/> 連附件	<input type="checkbox"/> 技術部	<input type="checkbox"/> 連附件	<input type="checkbox"/> 生產部	<input type="checkbox"/> 連附件
<input type="checkbox"/> 採購部	<input type="checkbox"/> 連附件	<input checked="" type="checkbox"/> 生產統籌部	<input checked="" type="checkbox"/> 連附件	<input type="checkbox"/> 報關組	<input type="checkbox"/> 連附件
<input type="checkbox"/> 質檢部	<input type="checkbox"/> 連附件	<input type="checkbox"/> 會計部	<input type="checkbox"/> 連附件	<input type="checkbox"/> 機械設計部	<input type="checkbox"/> 連附件
<input type="checkbox"/> 香港辦	<input type="checkbox"/> 連附件	<input type="checkbox"/> 其他:			

<input type="checkbox"/> 行政部	<input type="checkbox"/> 連附件	<input type="checkbox"/> 會計部	<input type="checkbox"/> 連附件	<input type="checkbox"/> 統籌部	<input type="checkbox"/> 連附件	<input type="checkbox"/> 工程部	<input type="checkbox"/> 連附件
<input type="checkbox"/> 採購部	<input type="checkbox"/> 連附件	<input type="checkbox"/> QS部	<input type="checkbox"/> 連附件	<input checked="" type="checkbox"/> 地盤管理	<input checked="" type="checkbox"/> 連附件	<input type="checkbox"/> 維修部	<input type="checkbox"/> 連附件

*發件人簽署:	*組別成員批核簽署:
傳遞編號: H/K 0328/23	項目經理簽署:



工程號

J857

地盤

啓德6552

編號
857-GB3-AP36

數量
1

N




A

裝飾條編號
857-GB3-ZS36

M




B

新增

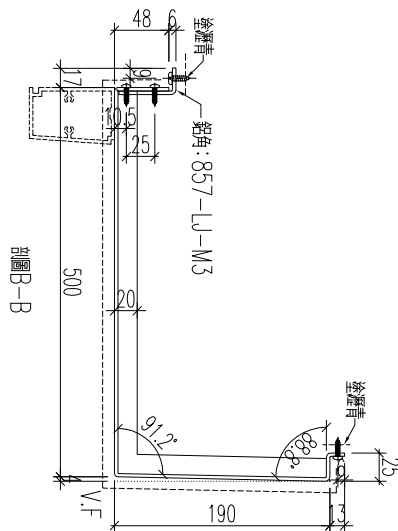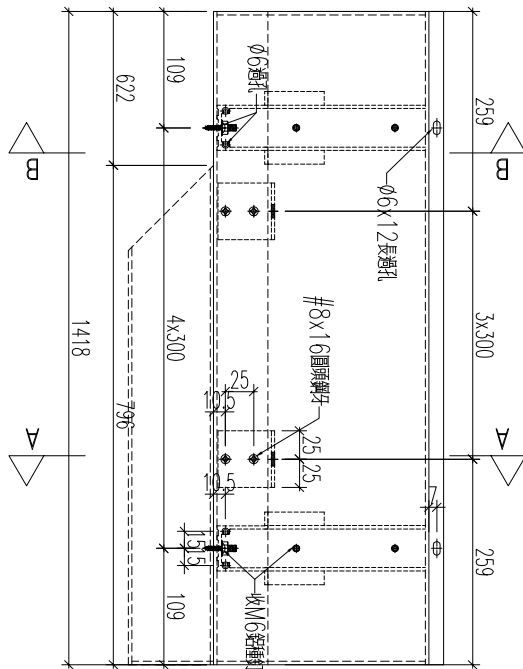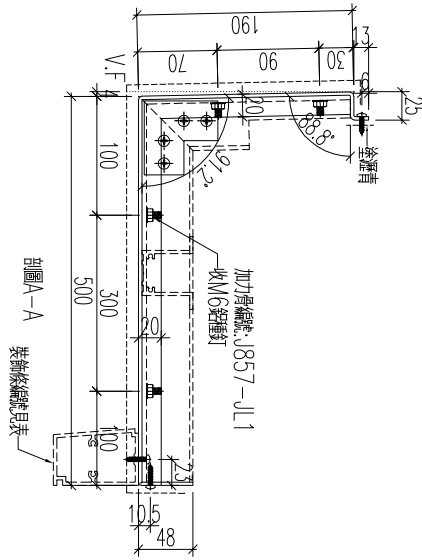

名稱	鋁板加工圖	制圖	黃漢卿	2022.12.2	修改		
材料	3mm厚板	復核	王禮秋	2022.12.2	日期		
顏色	銅色(AL1)	批准			圖號	857-GB3-AP36	

新增

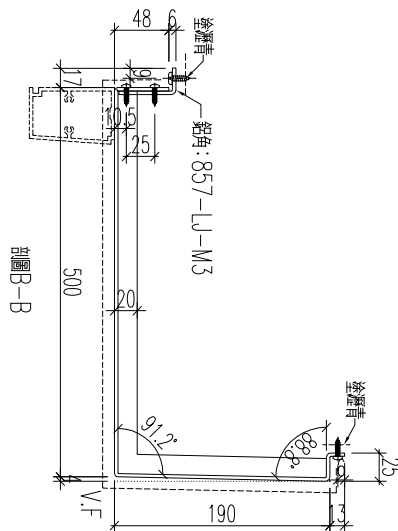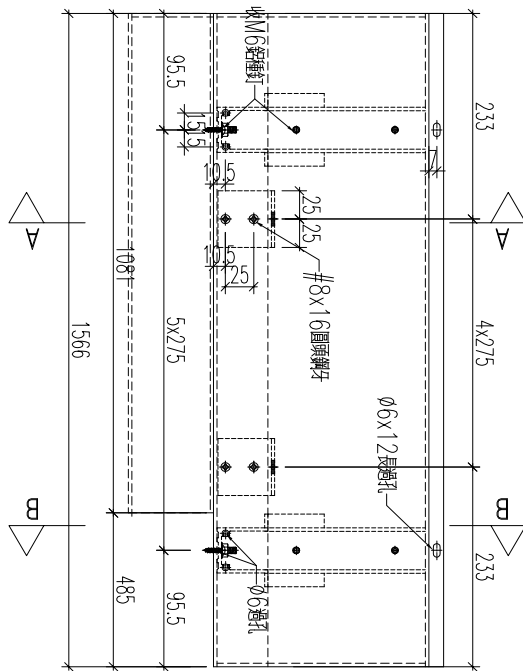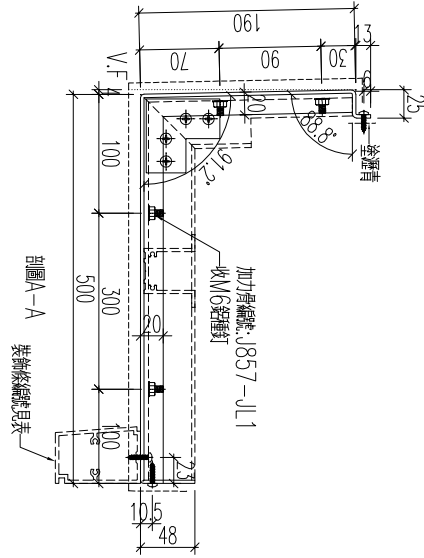

編號	數量	N	A	裝納條線燈罩	M	B
857-GB2-AP35	1			857-GB2-ZS35		

名稱	鋁板加工圖	制圖	黃漢卿	2022.12.2	修改		
材料	3mm厚板	復核	王禮秋	2022.12.2	日期		
顏色	銅色(AL1)	批准			圖號	857-GB2-AP35	



工程號

J857

地盤

啓德6552

線號
857-GB3-AP7

數量
1

N




A

裝卸線號
857-GB3-ZS7

M

B

新增

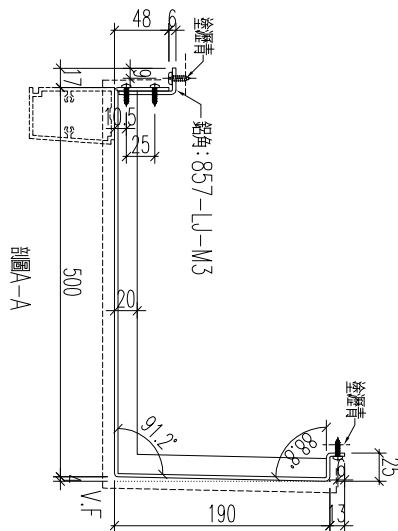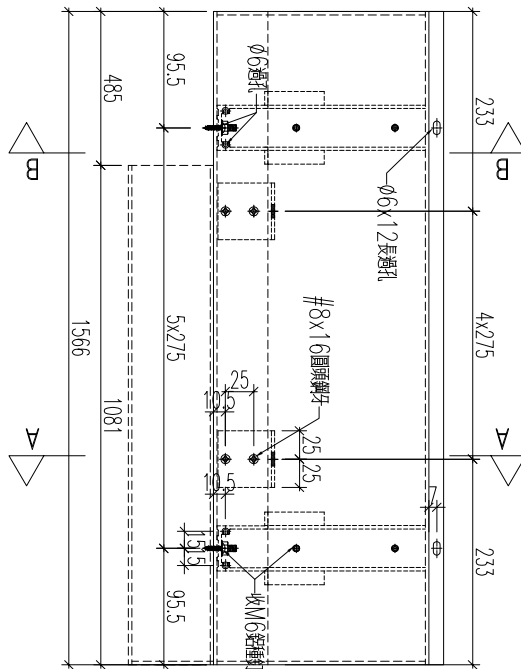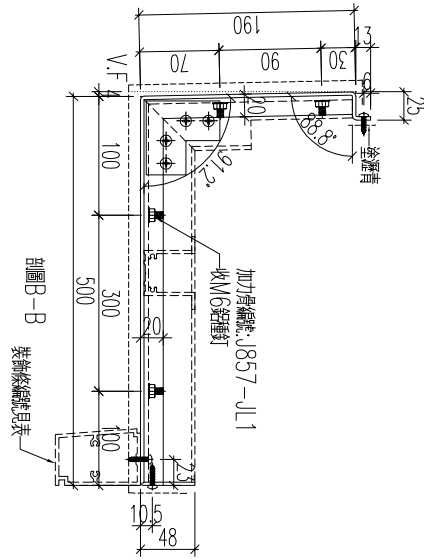

名稱	鋁板加工圖	制圖	黃漢卿	2022.12.2	修改		
材料	3mm磨板	復核	王禮秋	2022.12.2	日期		
顏色	銅色(AL1)	批准			圖號	857-GB3-AP7	



工程號

J857

地盤

啓德6552

線號
857-GB2-AP3

數量
1

N




A

裝飾線編號
857-GB2-ZS3


M

B

新增

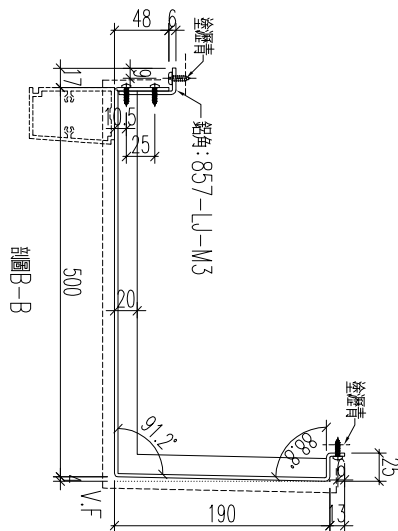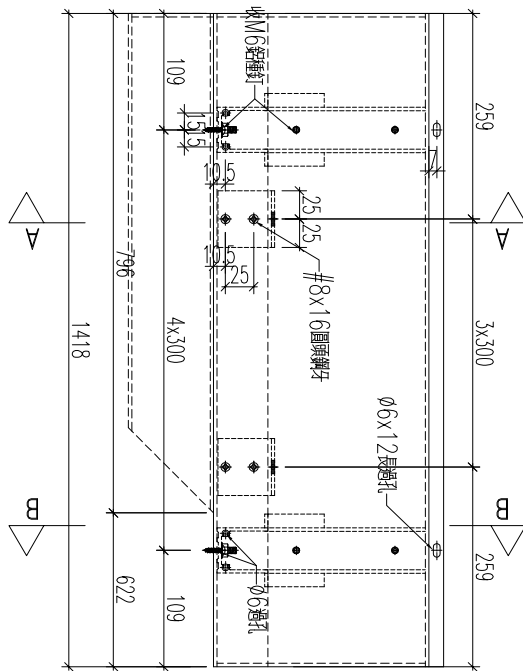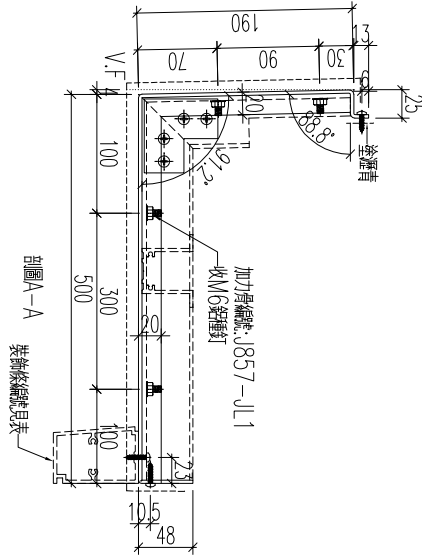

名稱	鋁板加工圖	制圖	黃漢卿	2022.12.2	修改		
材料	3mm厚板	復核	王禮秋	2022.12.2	日期		
顏色	銅色(AL1)	批准			圖號	857-GB2-AP3	

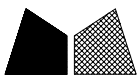




美特鋁質 有限公司
MIDI Aluminium Fabricator Ltd.

工程號: J857 地盤: 啓德6552


編號	數量	長度	N	A	裝飾條編號	M	B
857-GB1-AP19	1	1103	3x300	101.5	857-GB1-ZS19	2x300	251.5
857-GB2-AP1	1	1319	4x300	59.5	857-GB2-ZS1	3x300	209.5
857-GB2-AP15	1	1103	3x300	101.5	857-GB2-ZS15	2x300	251.5
857-GB3-AP7	1	1497	5x275	61	857-GB3-ZS7	4x275	198.5
857-GB3-AP1	1	1313	4x275	106.5	857-GB3-ZS11	3x275	244
857-GB3-AP29	1	1103	3x300	101.5	857-GB3-ZS29	2x300	101.5
857-GB3-AP36	1	1334	4x300	67	857-GB3-ZS36	3x300	217
857-GB4-AP4	1	1297	4x300	48.5	857-GB4-ZS4	3x300	198.5
857-GB4-AP27	1	853	2x300	126.5	857-GB4-ZS27	1x300	276.5
857-GB6-AP10	1	820	2x300	110	857-GB6-ZS10	1x300	260
857-GB7-AP14	1	1053	3x300	76.5	857-GB7-ZS14	2x300	226.5
857-GB8-AP12	1	820	2x300	110	857-GB8-ZS12	1x300	260
857-GB9-AP7	1	1515	5x275	70	857-GB9-ZS7	4x275	207.5

取消

取消

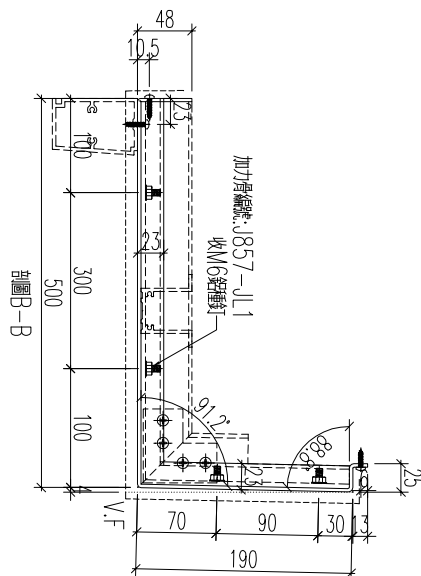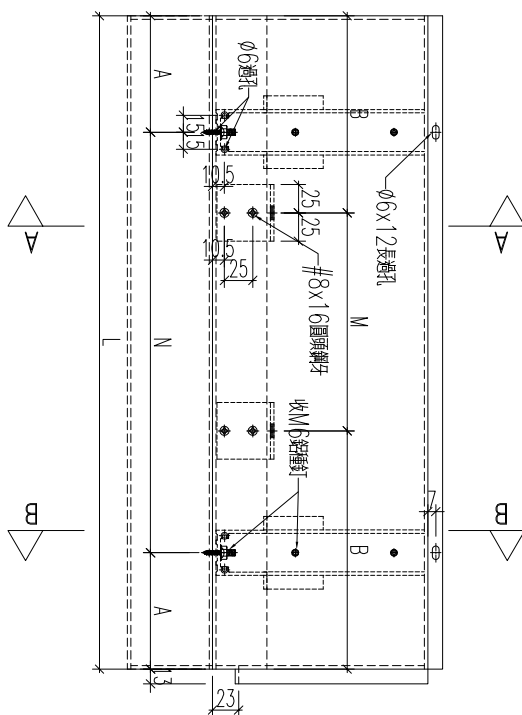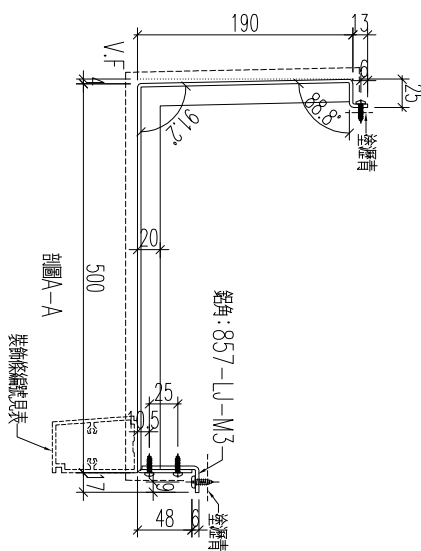




名稱	鋁板加工圖	制圖	黃漢卿	2022.12.2	修改	A
材料	3mm磨板	復核	王禮秋	2022.12.2	日期	2.23
顏色	銅色(AL1)	批准			圖號	857-GB1-AP19

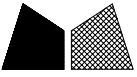


工程號 J857 地盤 啓德6552

編號	數量	長度	N	A	裝銲條編號	M	B
857-GB1-AP13	1	1103	3x300	101.5	857-GB1-ZS13	2x300	251.5
857-GB1-AP35	1	1297	4x300	48.5	857-GB1-ZS35	3x300	198.5
857-GB2-AP3	1	1334	4x300	67	857-GB2-ZS3	3x300	217
857-GB2-AP10	1	1103	3x300	101.5	857-GB2-ZS10	2x300	251.5
857-GB2-AP31	1	1313	4x275	106.5	857-GB2-ZS31	3x275	244
857-GB2-AP35	1	1496	5x275	60.5	857-GB2-ZS34	3x300	298
857-GB3-AP23	1	1103	3x300	101.5	857-GB3-ZS23	2x300	251.5
857-GB3-AP38	1	1319	4x300	59.5	857-GB3-ZS38	3x300	209.5
857-GB4-AP21	1	973	3x300	36.5	857-GB4-ZS21	2x300	186.5
857-GB6-AP1	1	1515	5x275	70	857-GB6-ZS1	4x275	207.5
857-GB6-AP102	1	820	2x300	110	857-GB6-ZS102	1x300	260
857-GB7-AP8	1	1053	3x300	76.5	857-GB7-ZS8	2x300	226.5
857-GB8-AP122	1	820	2x300	110	857-GB8-ZS122	1x300	260




取消

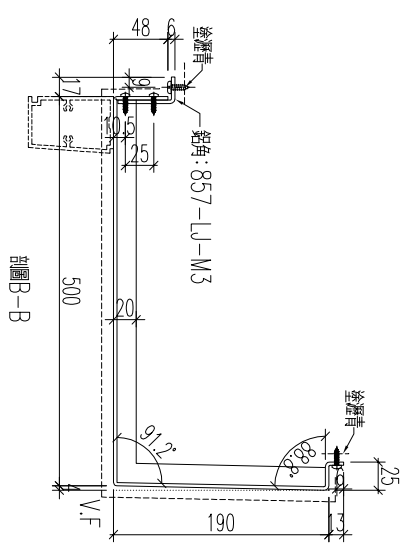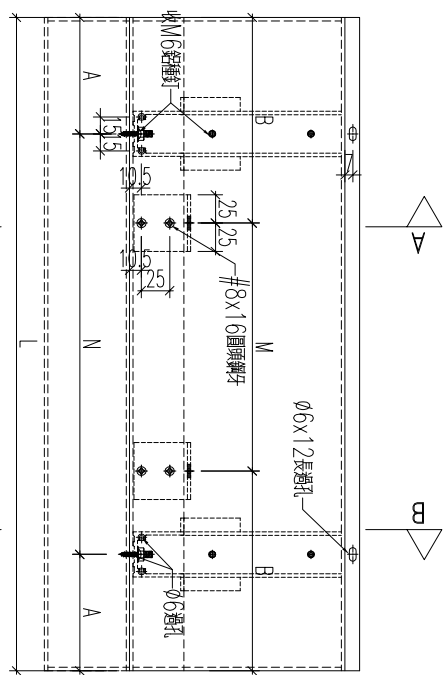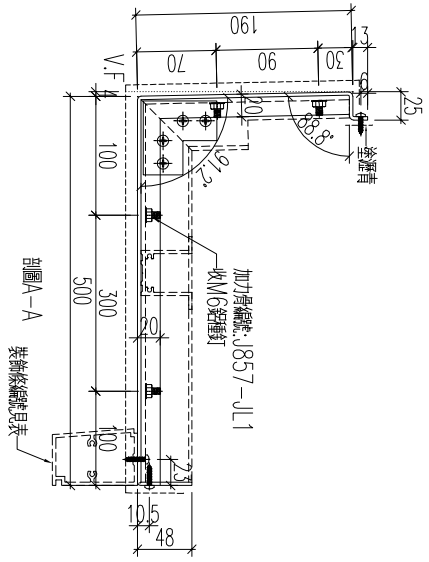

名稱	鋁板加工圖	制圖	黃漢卿	2022.12.2	修改	A
材料	3mm厚板	復核	王禮秋	2022.12.2	日期	2.23
顏色	銅色(AL1)	批准			圖號	857-GB1-AP13

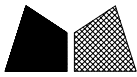

工程號	J857	地盤	啓德6552				
編號	數量	長度	N	A	裝鋁條編號	M	B
857-GB1-AP33	1	1377	4x300	88.5	857-GB1-ZS33	3x300	238.5
857-GB2-AP30	1	1483	4x300	141.5	857-GB2-ZS30	3x300	291.5
857-GB2-AP33	1	1667	5x300	83.5	857-GB2-ZS33	4x300	233.5
857-GB5-AP12	1	1715	5x300	107.5	857-GB5-ZS12	4x300	257.5
857-GB6-AP12	1	1598	5x275	111.5	857-GB6-ZS12	4x275	249
857-GB7-AP6	1	1253	4x275	76.5	857-GB7-ZS6	2x300	214
857-GB8-AP9	1	1598	5x275	111.5	857-GB8-ZS9	4x275	249

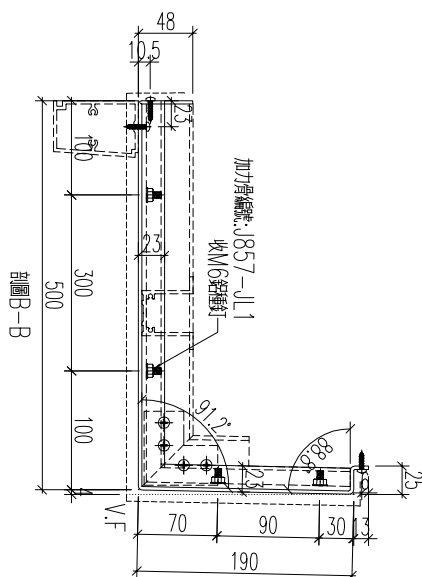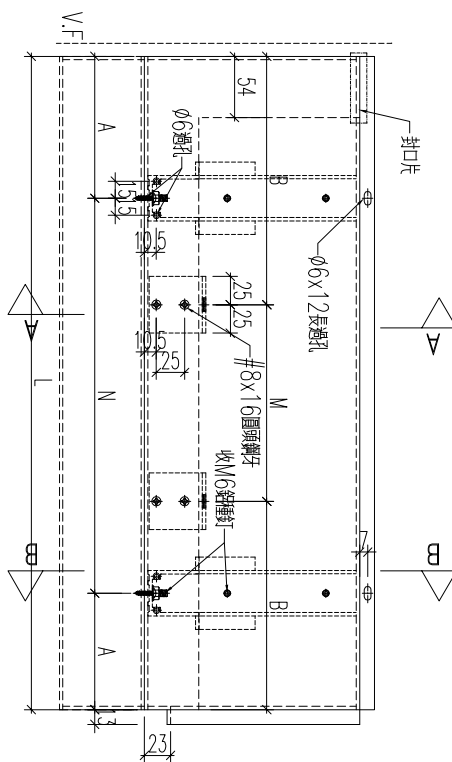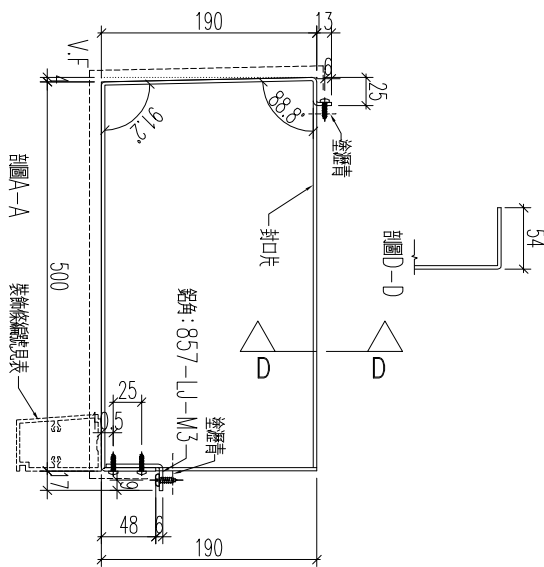




名稱	鋁板加工圖	制圖	黃漢卿	2022.12.2	修改	A	
材料	3mm厚鋁板	復核	王禮秋	2022.12.2	日期	2.23	
顏色	銅色(AL1)	批准			圖號	857-GB1-AP33	



美特鋁質 有限公司
MIDI Aluminium Fabricator Ltd.

工程號	J857	地盤	啓德6552	編號	數量	長度	N	A	裝飾條編號	M	B
				857-GB1-AP34	1	1292	4x300	46	857-GB1-ZS34	3x300	196
				857-GB2-AP2	1	1419	4x300	109.5	857-GB2-ZS2	3x300	259.5
				857-GB2-AP34	1	1572	5x275	98.5	857-GB2-ZS33	4x275	236
				857-GB3-AP8	1	1572	5x275	98.5	857-GB3-ZS8	4x275	236
				857-GB3-AP37	1	1419	4x300	109.5	857-GB3-ZS37	3x300	259.5
				857-GB4-AP5	1	1292	4x300	46	857-GB4-ZS5	3x300	196
				857-GB5-AP13	1	1625	5x300	62.5	857-GB5-ZS13	4x300	212.5
				857-GB7-AP7	2	1490	4x300	145	857-GB7-ZS7	3x300	295
				857-GB5-AP5a	1	1490	4x300	145	857-GB5-ZS5a	3x300	295
				857-GB9-AP8	1	1615	5x300	57.5	857-GB9-ZS8	4x300	207.5
				857-GB8-AP5c	1	1490	4x300	145	857-GB8-ZS5a	3x300	295

新增

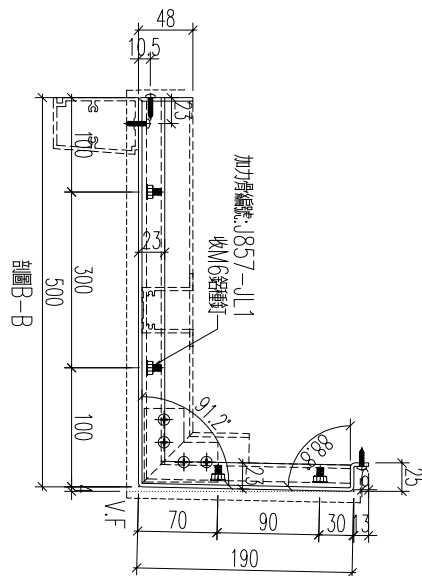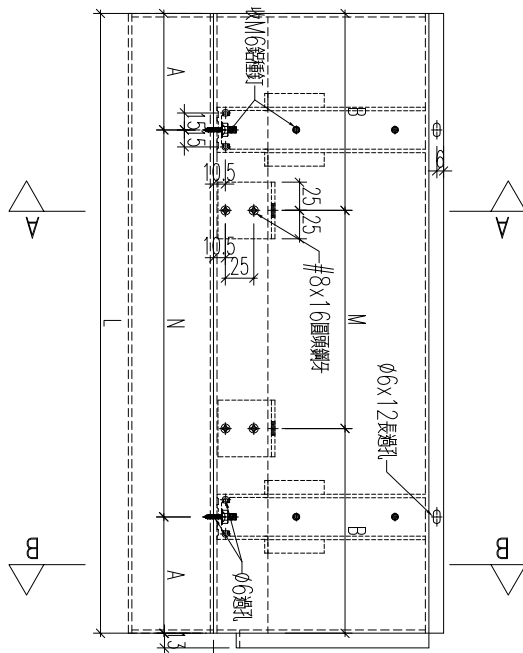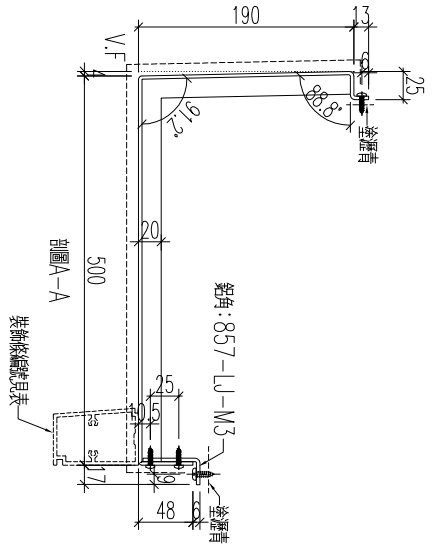

名稱	鋁板加工圖	制圖	黃漢卿	2022.12.2	修改	A	
材料	3mm厚鋁板	復核	王禮秋	2022.12.2	日期	2.23	
顏色	銅色(AL1)	批准			圖號	857-GB1-AP34	






工程號

J857

地盤

啓德6552

編號	數量	長度	L1	L2	N	A	M	B	T	C	裝飾條編號
857-GB1-AP10	1	1625	1445	180	4x300	122.5	5x300	62.5	100	40	857-GB1-ZS10
857-GB2-AP7	1	1625	1445	180	4x300	122.5	5x300	62.5	100	40	857-GB2-ZS7
857-GB3-AP20	1	1625	1477.5	147.5	4x300	138.7	5x300	62.5	80	33.7	857-GB3-ZS20
857-GB4-AP18	1	1634	1602	32	4x300	201	5x300	67	12	10	857-GB4-ZS18

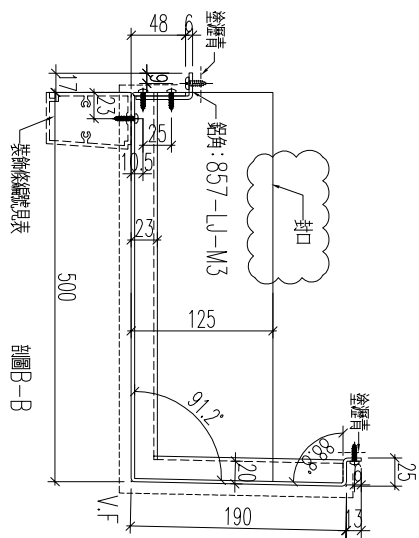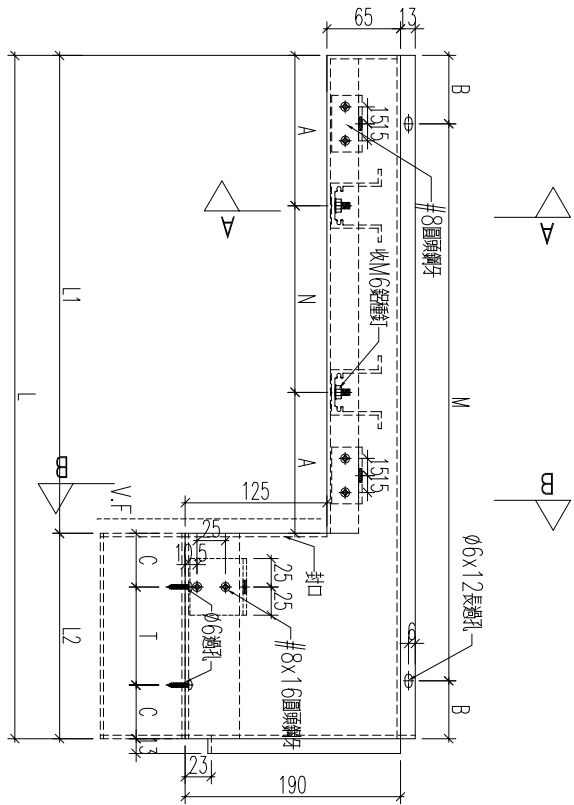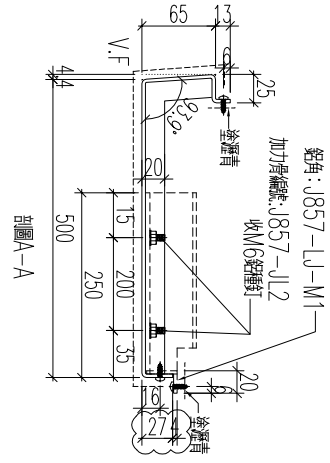




名稱	鋁板加工圖	制圖	黃漢卿	2022.12.2	修改	A	
材料	3mm磨板	復核	王禮秋	2022.12.2	日期	2.23	
顏色	銅色(AL1)	批准			圖號	857-GB1-AP10	




工程號	J857	地盤	啓德6552
-----	------	----	--------




料號	數量	長度	L1	L2	N	A	M	B	T	C	裝飾條編號
857-GB1-AP22	1	1625	1477.5	147.5	4x300	138.7	5x300	62.5	100	23.7	857-GB1-ZS22
857-GB2-AP18	1	1625	1477.5	147.5	4x300	138.7	5x300	62.5	100	23.7	857-GB2-ZS18
857-GB3-AP32	1	1625	1445	180	4x300	122.5	5x300	62.5	100	40	857-GB3-ZS32

名稱	鋁板加工圖	制圖	黃漢卿	2022.12.2	修改	A	
材料	3mm厚鋁板	復核	王禮秋	2022.12.2	日期	2.23	
顏色	銅色(AL1)	批准			圖號	857-GB1-AP22	

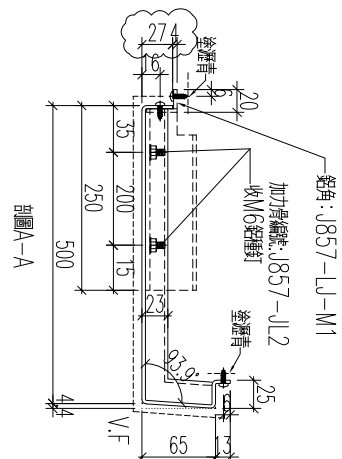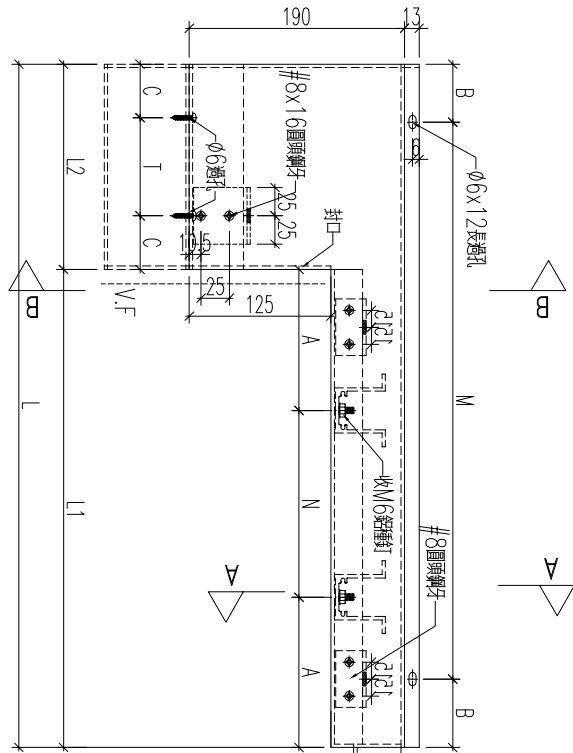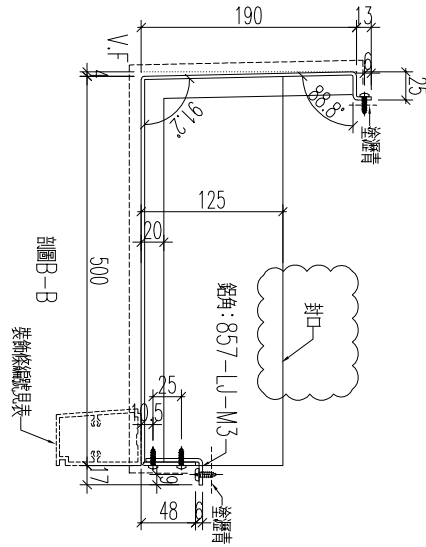

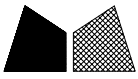


工程號	J857	地盤	啓德6552
-----	------	----	--------

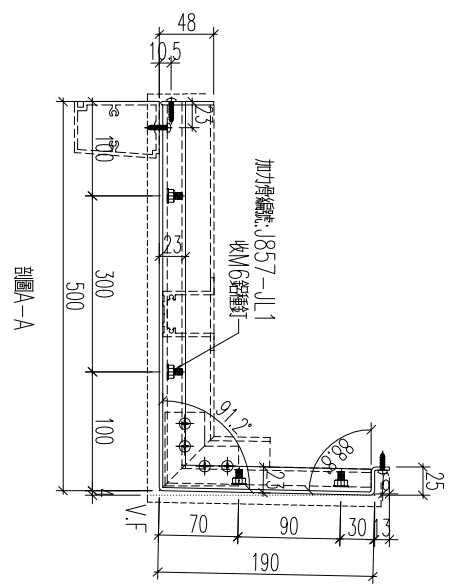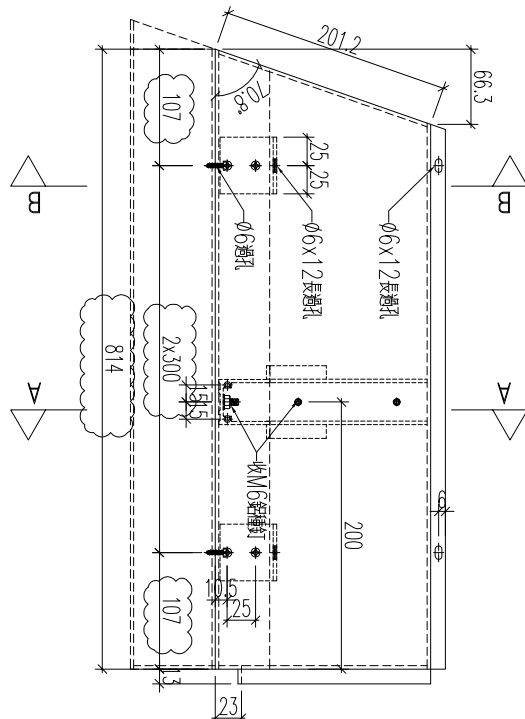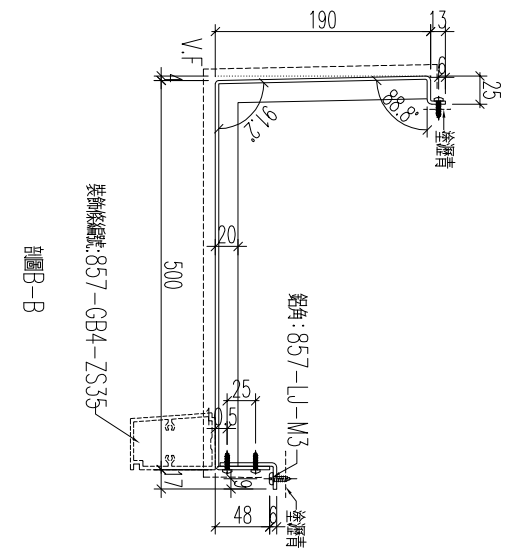

加工數量: 1支




名稱	鋁板加工圖	制圖	黃漢卿	2022.12.2	修改	A	
材料	3mm厚鋁板	復核	王禮秋	2022.12.2	日期	2.23	
顏色	銅色(AL1)	批准			圖號	857-GB4-AP35	

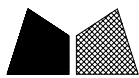

美特鋁質 有限公司
MIDI Aluminium Fabricator Ltd.

工程號	J857	地盤	啓德6552
-----	------	----	--------

編號	數量	長度	N	A
857-GB1-AP19a	1	1103	3x300	101.5
857-GB2-AP1a	1	1319	4x300	59.5
857-GB2-AP15a	1	1103	3x300	101.5
857-GB3-AP7a	1	1497	5x275	61
857-GB3-AP11a	1	1313	4x275	106.5
857-GB3-AP29a	1	1103	3x300	101.5
857-GB3-AP36a	1	1334	4x300	67
857-GB4-AP4a	1	1297	4x300	48.5
857-GB4-AP27a	1	853	2x300	126.5
857-GB6-AP10a	1	820	2x300	110
857-GB7-AP14a	1	1053	3x300	76.5
857-GB8-AP12a	1	820	2x300	110
857-GB9-AP7a	1	1515	5x275	70

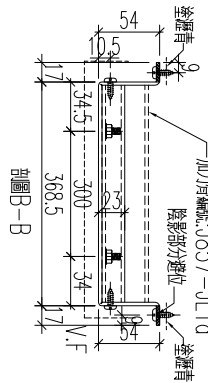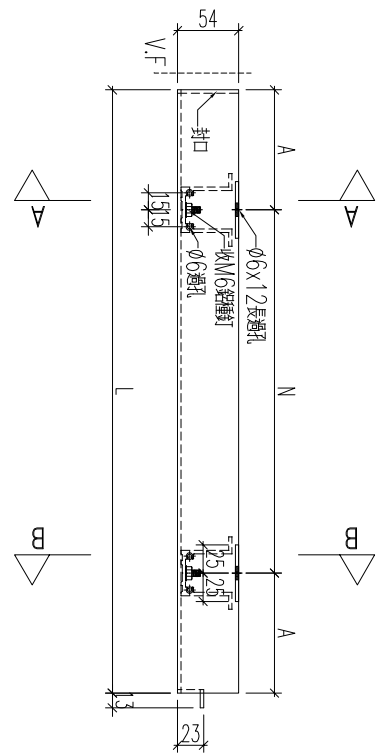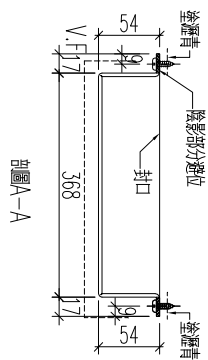




名稱	鋁板加工圖	制圖	黃漢卿	2022.12.2	修改	A
材料	3mm厚板	復核	王禮秋	2022.12.2	日期	2.23
顏色	深灰色(AL2)	批准			圖號	857-GB1-AP19a



美特鋁質 有限公司
MIDI Aluminium Fabricator Ltd.

工程號	J857	地盤	啓德6552
-----	------	----	--------

編號	數量	長度	N	A
857-GB1-AP33a	1	1377	4x300	88.5
857-GB2-AP30a	1	1483	4x300	141.5
857-GB2-AP33a	1	1667	5x300	83.5
857-GB5-AP12a	1	1715	5x300	107.5
857-GB6-AP12a	1	1598	5x275	111.5
857-GB7-AP6a	1	1253	4x275	76.5
857-GB8-AP9a	1	1598	5x275	111.5

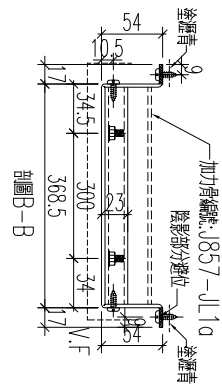
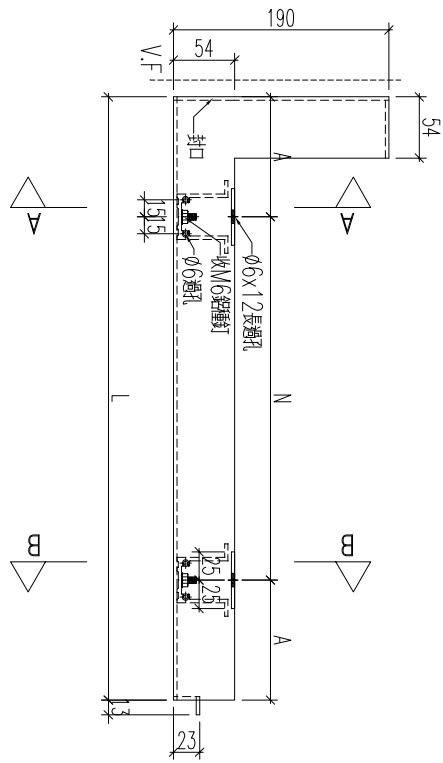
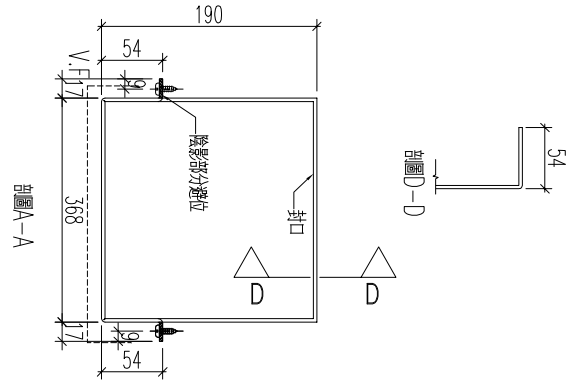


名稱	鋁板加工圖	制圖	黃漢卿	2022.12.2	修改	A	
材料	3mm厚鋁板	復核	王禮秋	2022.12.2	日期	2.23	
顏色	深灰色(AL2)	批准			圖號	857-GB1-AP33a	



工程號	J857	地盤	啓德6552	料號	數量	長度	N	A
				857-GB1-AP340	1	1292	4x300	46
				857-GB2-AP20	1	1419	4x300	109.5
				857-GB2-AP340	1	1572	5x275	98.5
				857-GB3-AP80	1	1572	5x275	98.5
				857-GB3-AP370	1	1419	4x300	109.5
				857-GB4-AP50	1	1292	4x300	46
				857-GB5-AP130	1	1625	5x300	62.5
				857-GB7-AP70	2	1490	4x300	145
				857-GB5-AP500	1	1490	4x300	145
				857-GB9-AP80	1	1615	5x300	57.5
				857-GB8-AP500	1	1490	4x300	145

新增

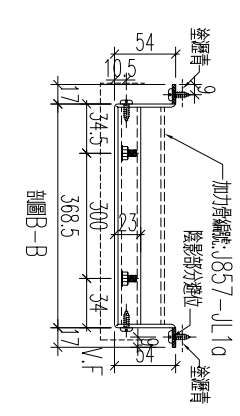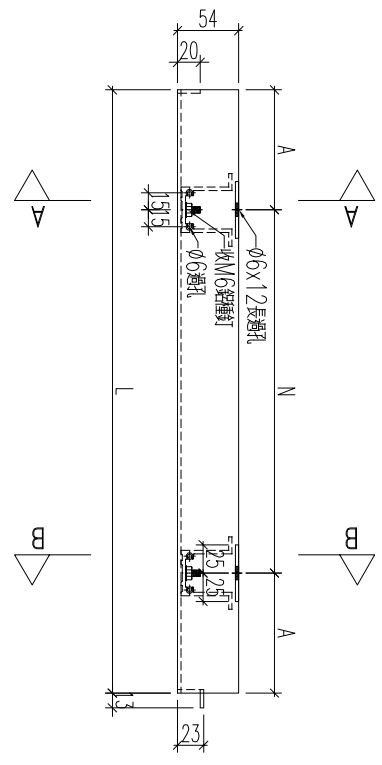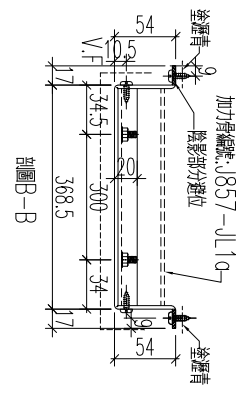


名稱	鋁板加工圖	制圖	黃漢卿	2022.12.2	修改	A	
材料	3mm磨板	復核	王禮秋	2022.12.2	日期	2.23	
顏色	深灰色(AL2)	批准			圖號	857-GB1-AP340	



工程號	J857	地盤	啓德6552
-----	------	----	--------

料號	數量	長度	L1	L2	N	A	T	C
857-GB1-AP10a	1	1625	1445	180	4x300	122.5	100	40
857-GB2-AP7a	1	1625	1445	180	4x300	122.5	100	40
857-GB3-AP20a	1	1625	1477.5	147.5	4x300	138.7	80	33.7
857-GB4-AP18a	1	1634	1602	32	4x300	201	12	10


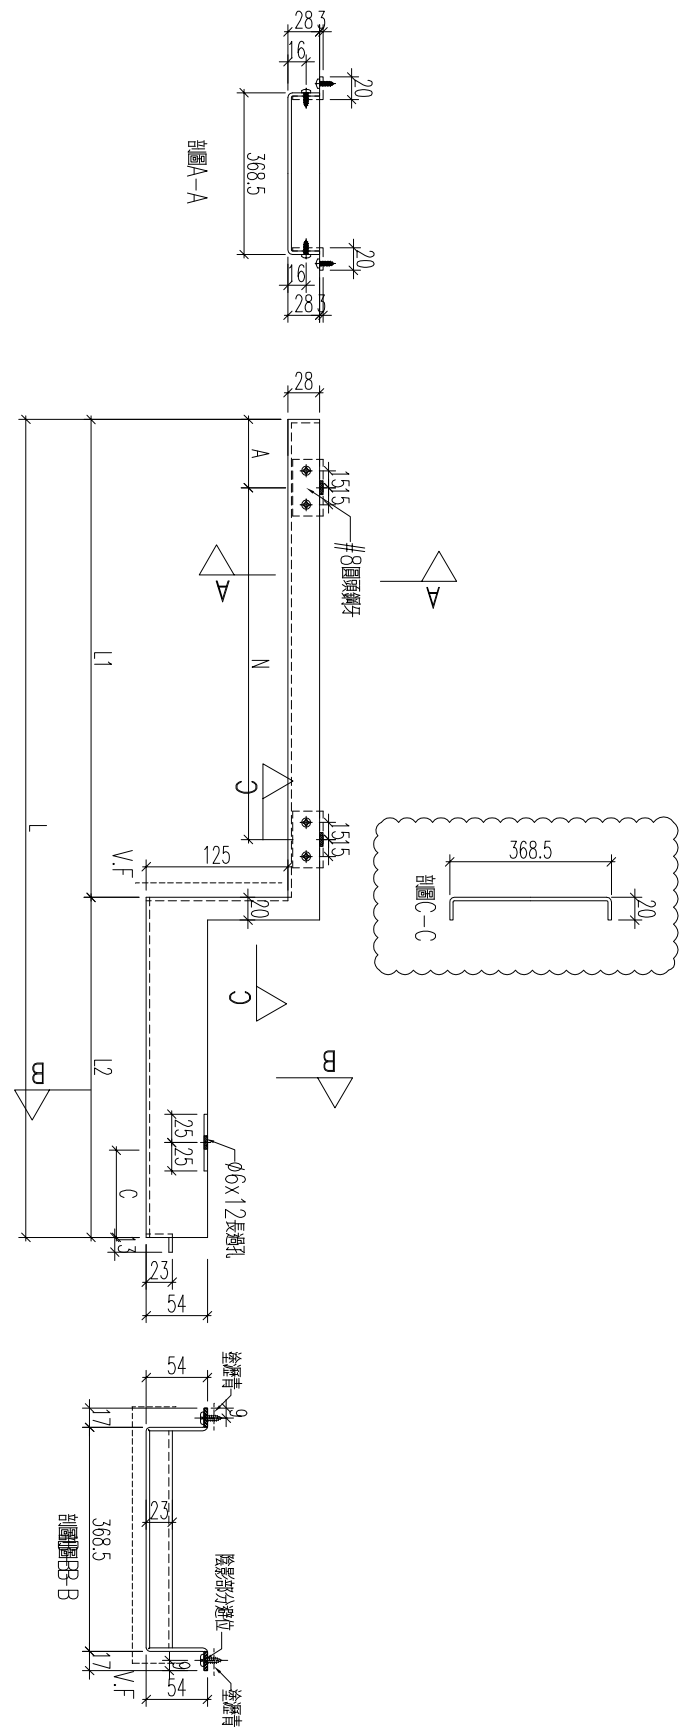


名稱	鋁板加工圖	制圖	黃漢卿	2022.12.2	修改	A		
材料	3mm厚板	復核	王禮秋	2022.12.2	日期	2.23		
顏色	深灰色(AL2)	批准			圖號	857-GB1-AP10a		



工程號	J857	地盤	啓德6552
-----	------	----	--------



編號	數量	長度	L1	L2	N	A	T	C
857-GB1-AP22a	1	1625	1477.5	147.5	4x300	138.7	100	23.7
857-GB2-AP18a	1	1625	1477.5	147.5	4x300	138.7	100	23.7
857-GB3-AP32a	1	1625	1445	180	4x300	122.5	100	40

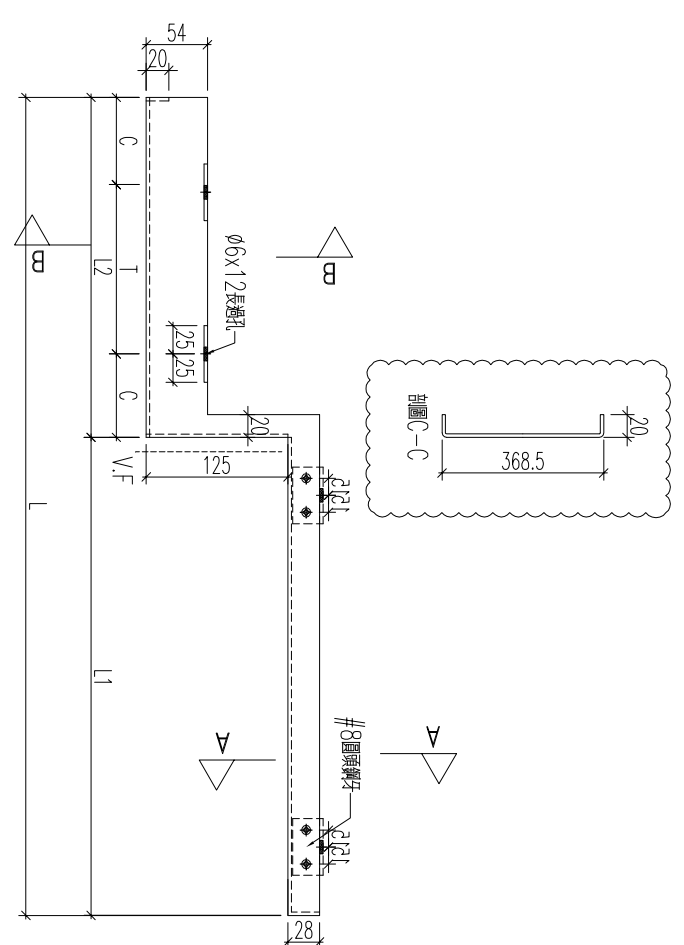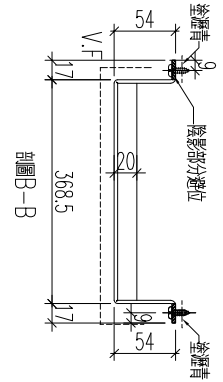

名稱	鋁板加工圖	制圖	黃漢卿	2022.12.2	修改	A	
材料	3mm厚鋁板	復核	王禮秋	2022.12.2	日期	2.23	
顏色	深灰色(AL2)	批准			圖號	857-GB1-AP22a	



工程號	J857	地盤	啓德6552
-----	------	----	--------

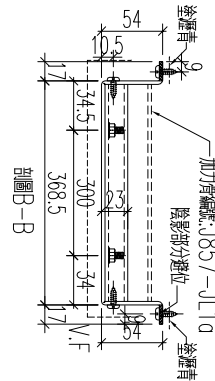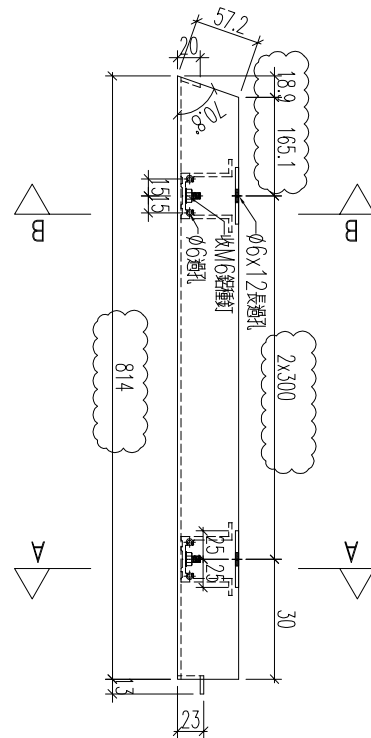

加工數量: 1支




名稱	鋁板加工圖	制圖	黃漢卿	2022.12.2	修改	A		
材料	3mm厚鋁板	復核	王禮秋	2022.12.2	日期	2.23		
顏色	深灰色(AL2)	批准			圖號	857-GB4-AP35a		



美特鋁質 有限公司
MIDI Aluminium Fabricator Ltd.

工程號	J857	地盤	啓德6552
-----	------	----	--------

線號	數量	長度	裝卸係編號
857-GB5-AP3	1	1767	857-GB5-ZS3
		6x275	
		58.5	

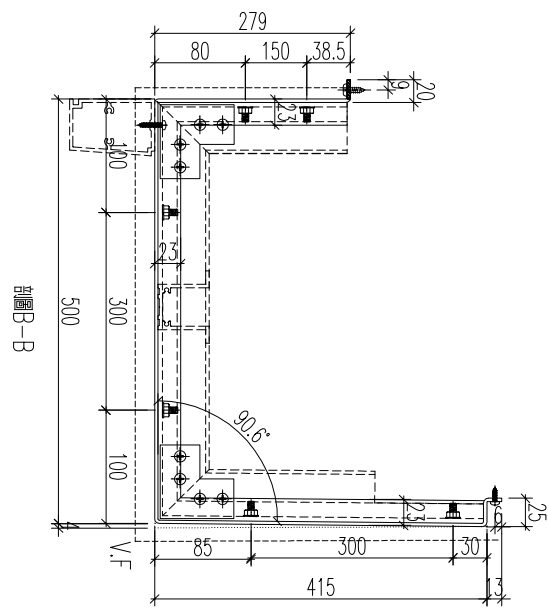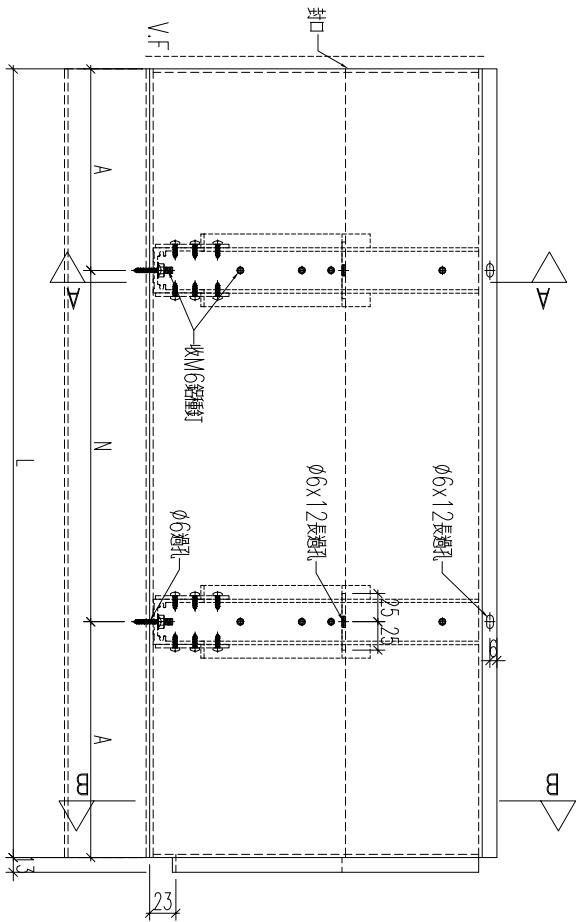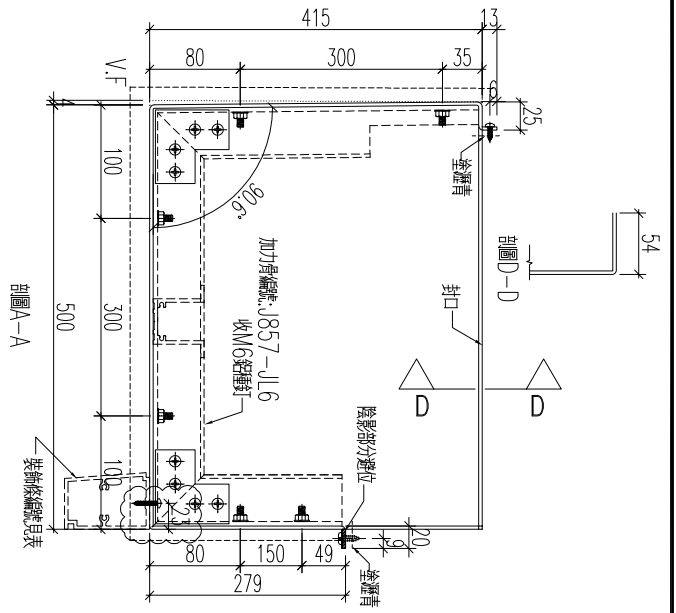




名稱	鋁板加工圖	制圖	黃漢卿	2022.12.2	修改	A	
材料	3mm厚鋁板	復核	王禮秋	2022.12.2	日期	2.23	
顏色	銅色(AL1)	批准			圖號	857-GB5-AP3	



美特鋁質 有限公司
MIDI Aluminium Fabricator Ltd.

工程號 J857 地盤 啓德6552




編號	數量	長度	N	A	裝飾條編號
857-GB5-AP4	6	1490	5x275	57.5	857-GB5-ZS4
857-GB5-AP8	6	1490	5x275	57.5	857-GB5-ZS8
857-GB6-AP17	5	1490	5x275	57.5	857-GB6-ZS17
857-GB7-AP2	5	1490	5x275	57.5	857-GB7-ZS2
857-GB8-AP5	10	1490	5x275	57.5	857-GB8-ZS5
857-GB9-AP13	4	1490	5x275	57.5	857-GB9-ZS13
857-GB9-AP17	5	1490	5x275	57.5	857-GB9-ZS17

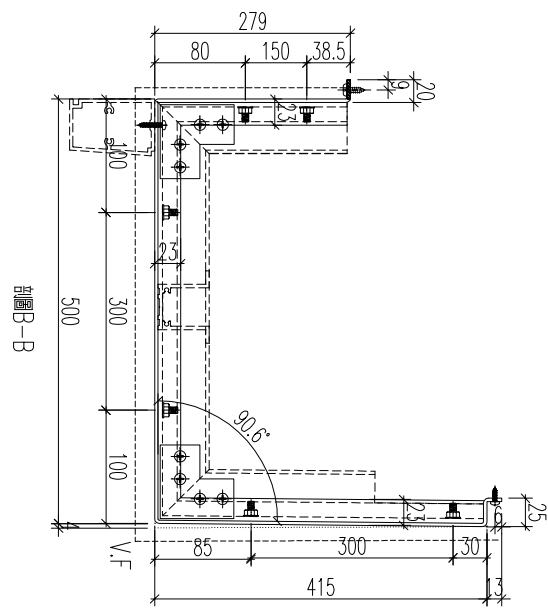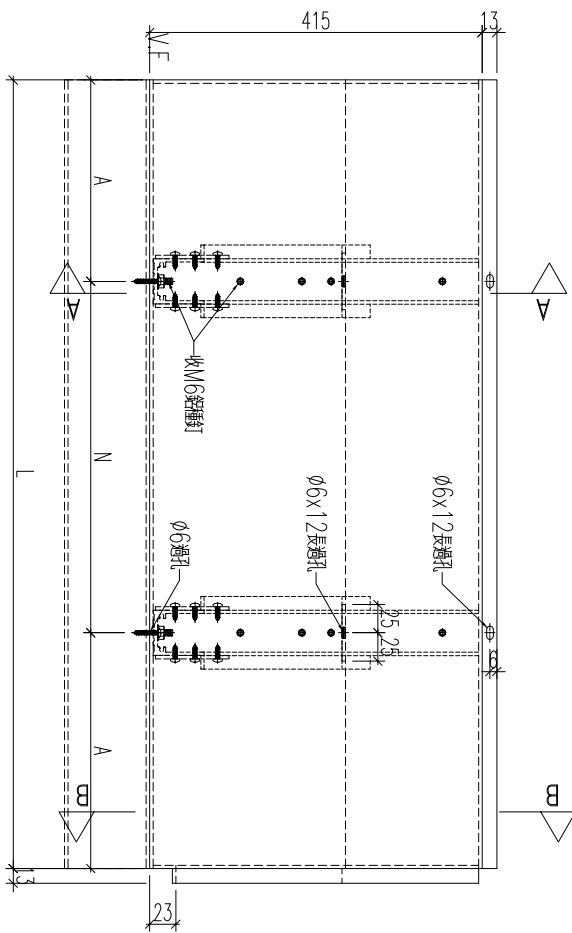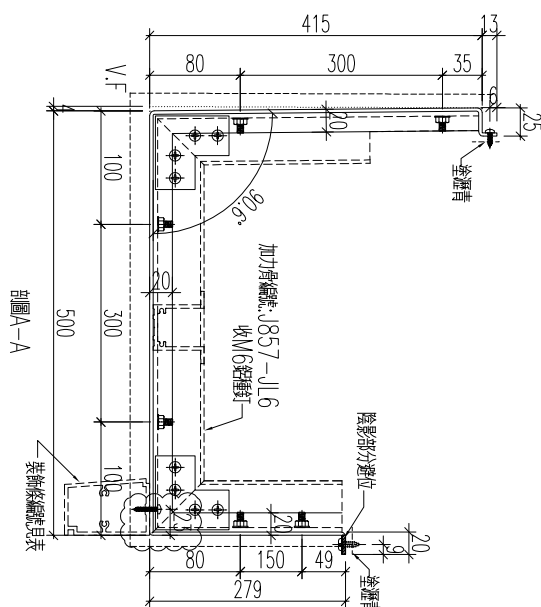

名稱	鋁板加工圖	制圖	黃漢卿	2022.12.2	修改	A
材料	3mm厚鋁板	復核	王禮秋	2022.12.2	日期	2.23
顏色	銅色(AL1)	批准			圖號	857-GB5-AP4



工程號	J857	地盤	啓德6552
-----	------	----	--------

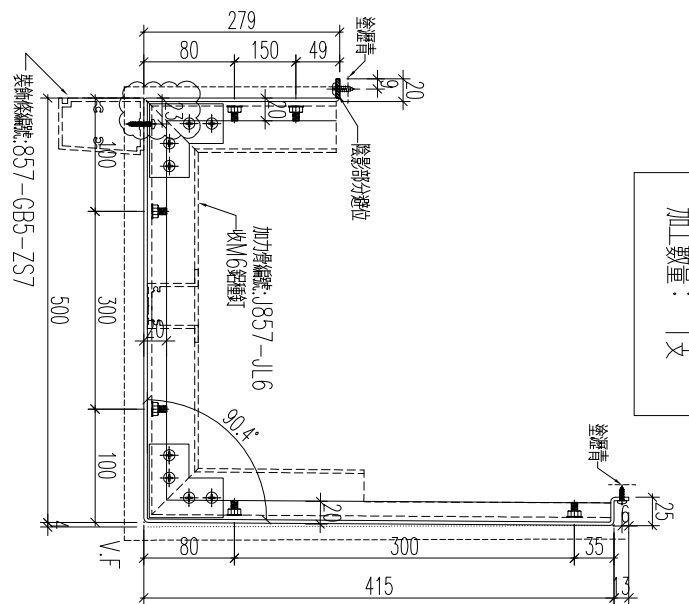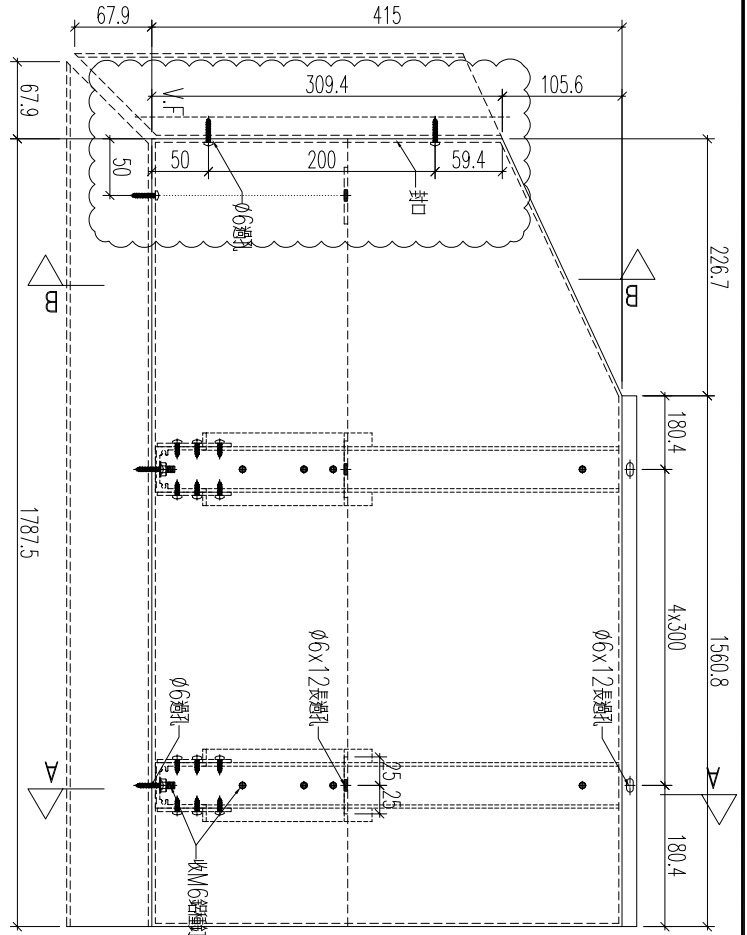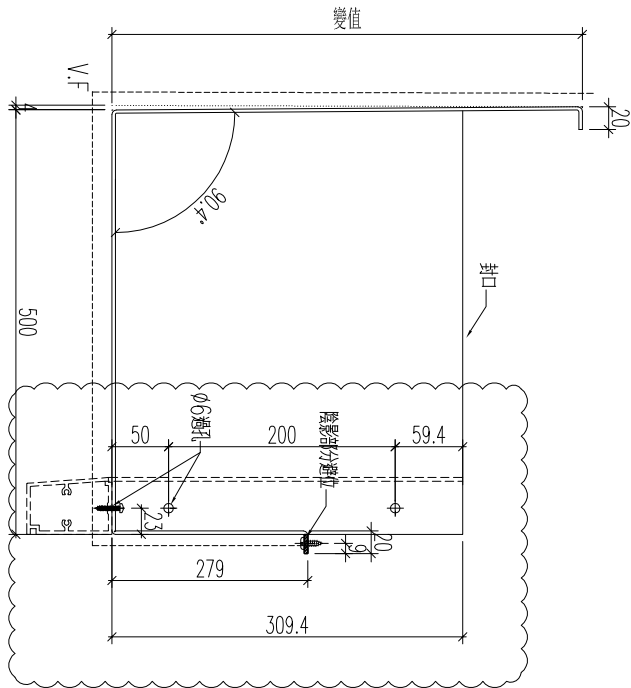

加工數量: 1支

名稱	鋁板加工圖	制圖	黃漢卿	2022.12.2	修改	A	
材料	3mm厚板	復核	王禮秋	2022.12.2	日期	2.23	
顏色	銅色(AL1)	批准			圖號	857-GB5-AP7	





工程號

J857

地盤

啓德6552

加工數量： 1支

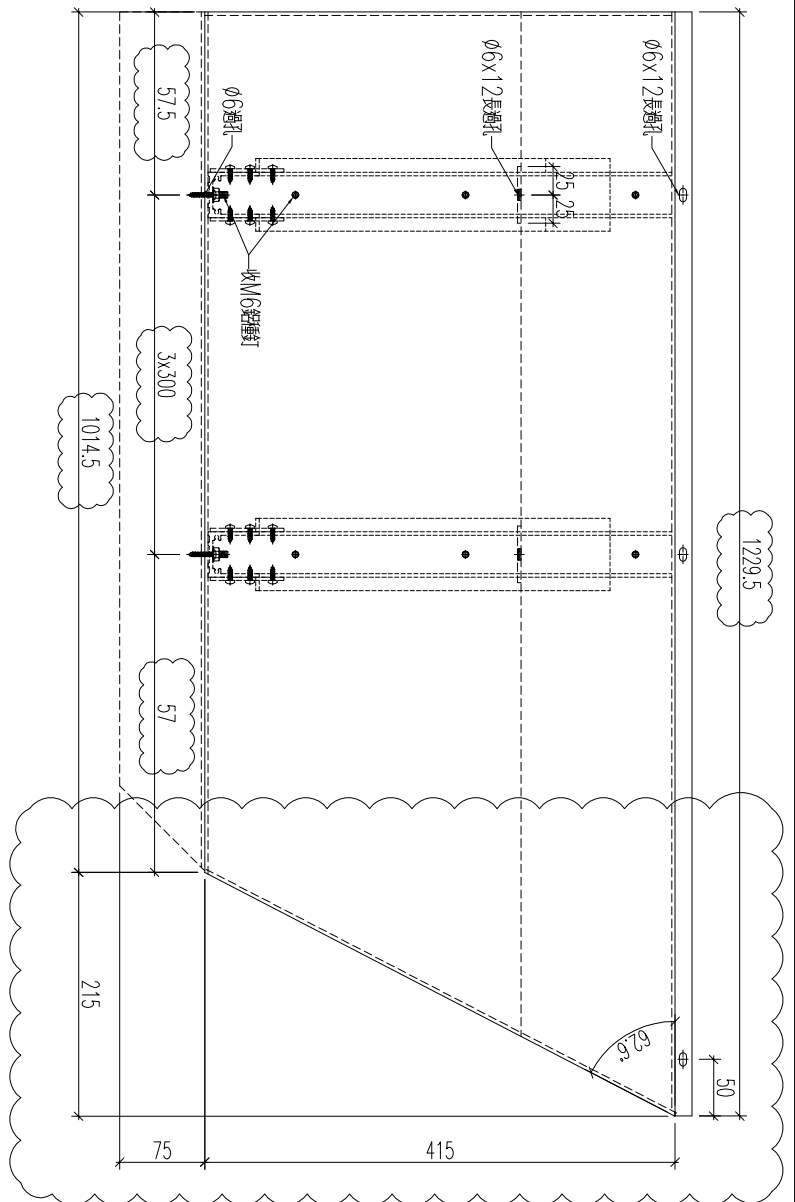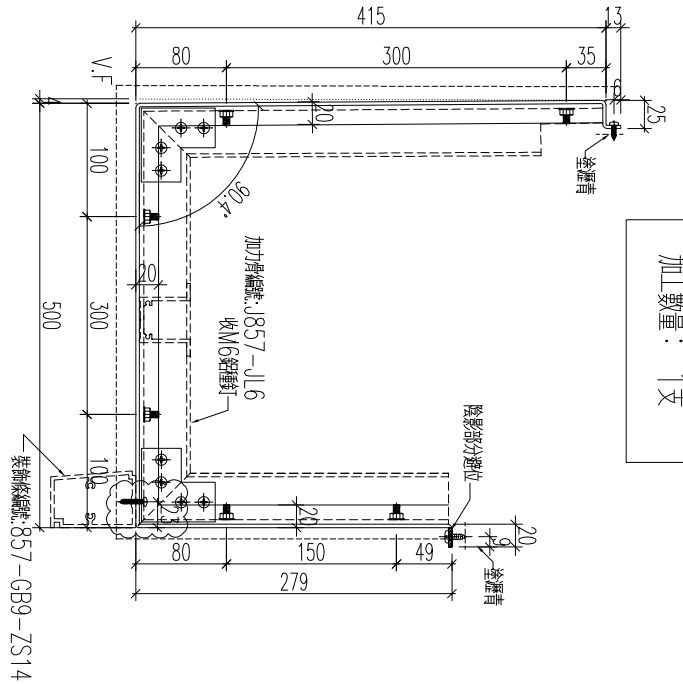


名稱	鋁板加工圖	制圖	黃漢卿	2022.12.2	修改	A	
材料	3mm厚板	復核	王禮秋	2022.12.2	日期	2.23	
顏色	銅色(AL1)	批准			圖號	857-GB9-AP14	



美特鋁質 有限公司
MIDI Aluminium Fabricator Ltd.

工程號	J857	地盤	啓德6552
-----	------	----	--------



加工數量： 1支

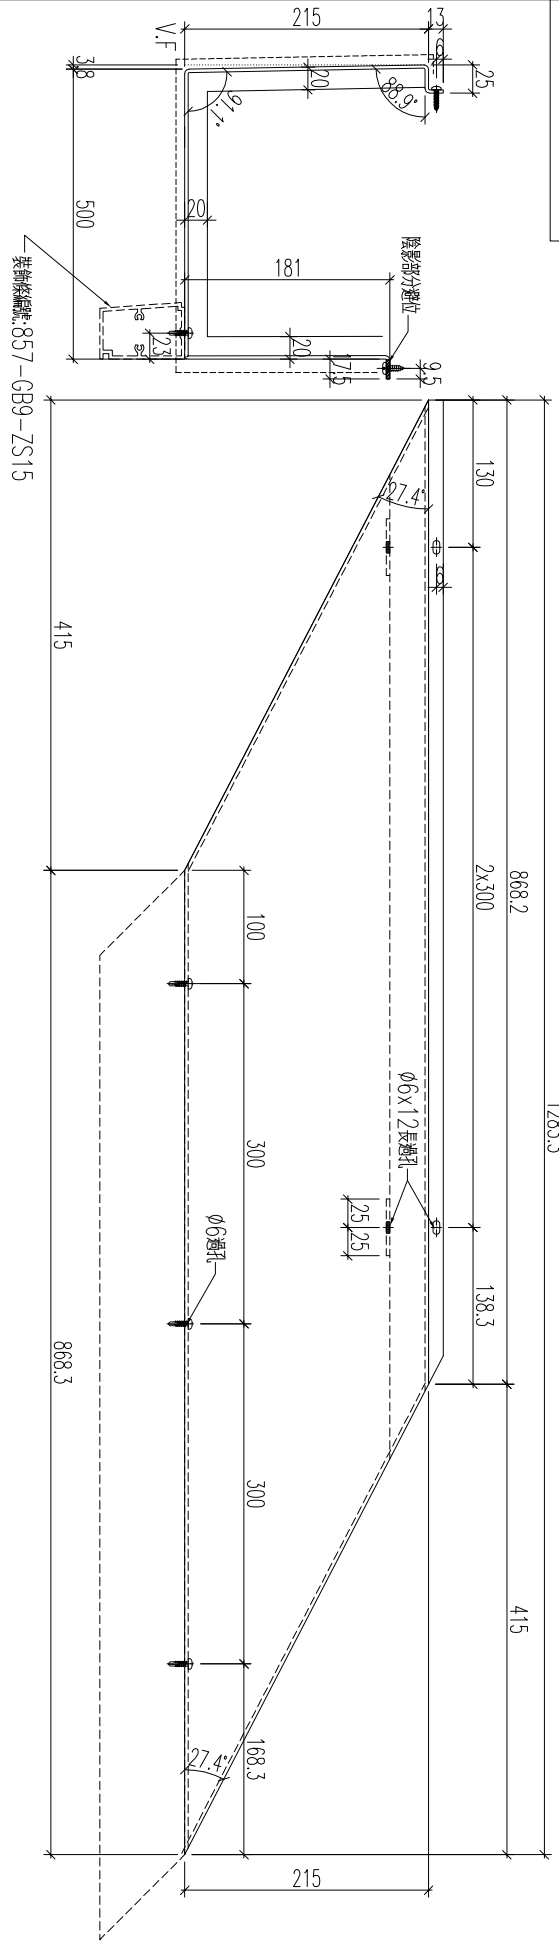

名稱	鋁板加工圖	制圖	黃漢卿	2022.12.2	修改	A
材料	3mm厚板	復核	王禮秋	2022.12.2	日期	2.23
顏色	銅色(AL1)	批准			圖號	857-GB9-AP15



工程號	J857	地盤	啓德6552
-----	------	----	--------

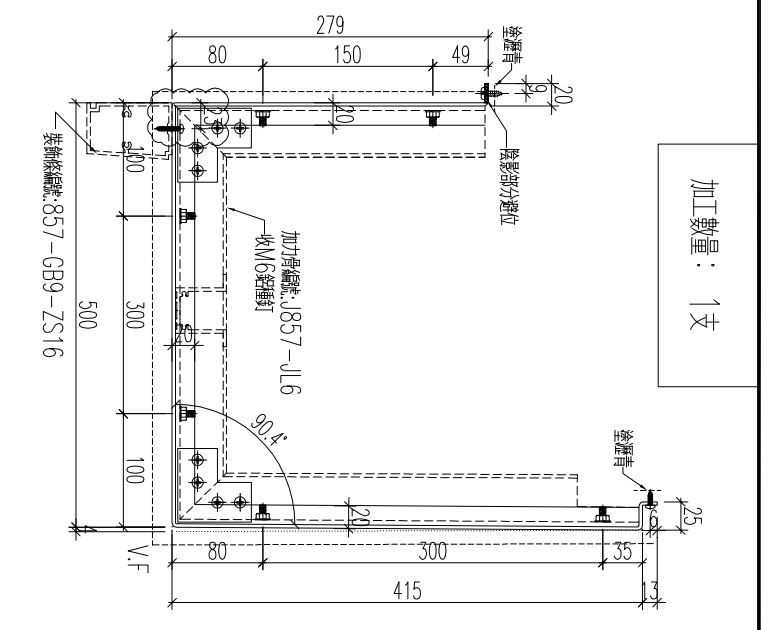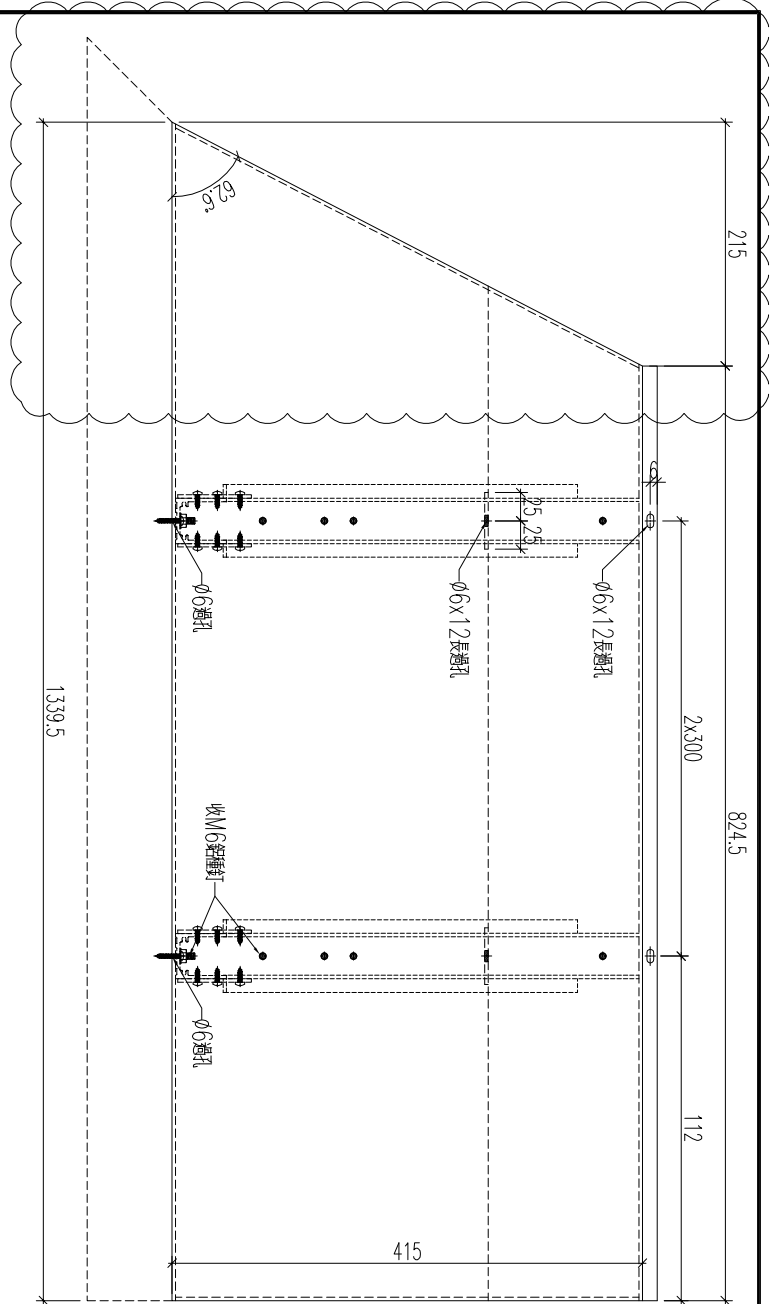

加工數量: 1支

名稱	鋁板加工圖	制圖	黃漢卿	2022.12.2	修改	A	
材料	3mm厚板	復核	王禮秋	2022.12.2	日期	2.23	
顏色	銅色(AL1)	批准			圖號	857-GB9-AP16	






美特鋁質 有限公司
MIDI Aluminium Fabricator Ltd.

工程號

J857

地盤

啓德6552

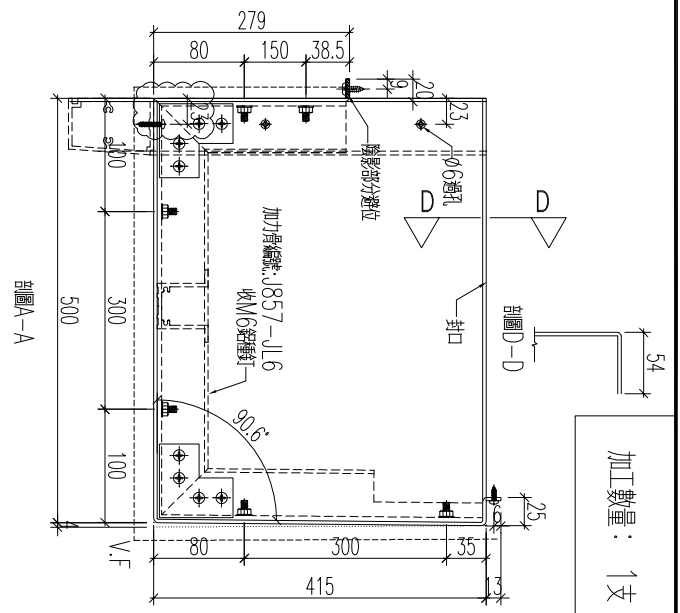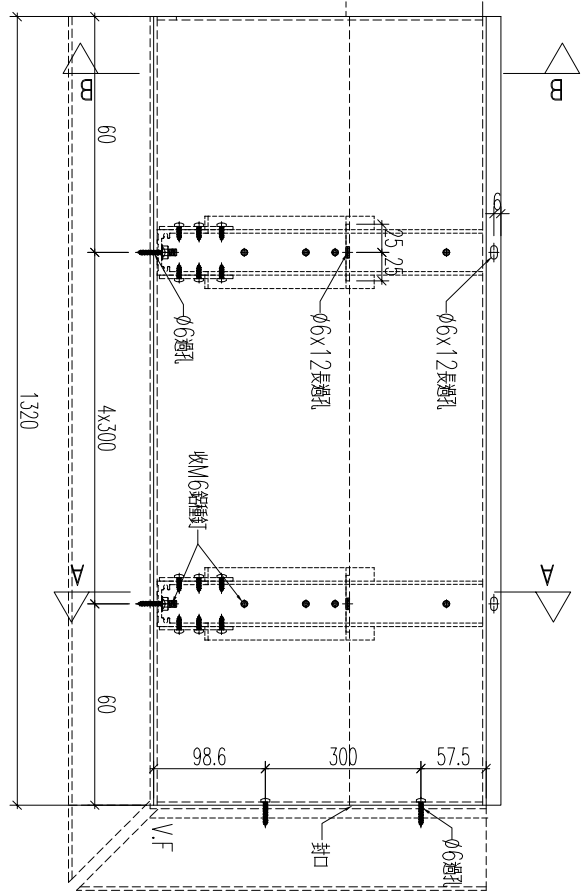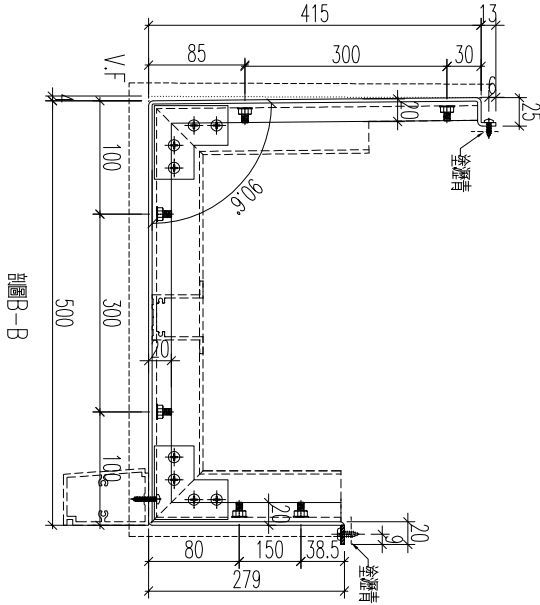




加工數量: 1支

名稱	鋁板加工圖	制圖	黃漢卿	2022.12.2	修改	A	
材料	3mm厚板	復核	王禮秋	2022.12.2	日期	2.23	
顏色	銅色(AL1)	批准			圖號	857-GB9-AP18	



美特鋁質 有限公司
MIDI Aluminium Fabricator Ltd.

工程號	J857	地盤	啓德6552
-----	------	----	--------

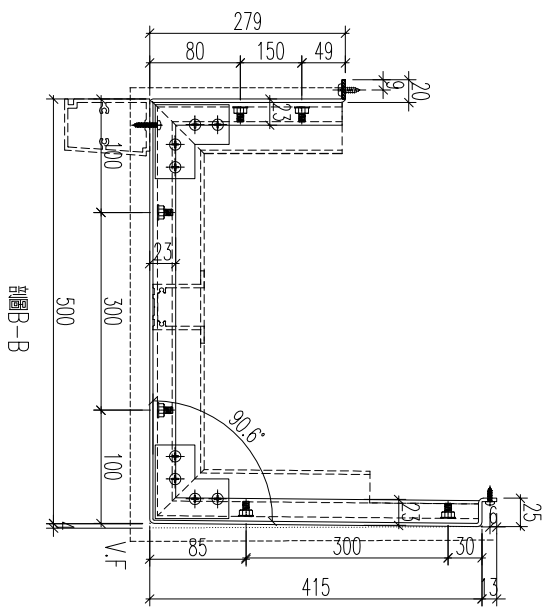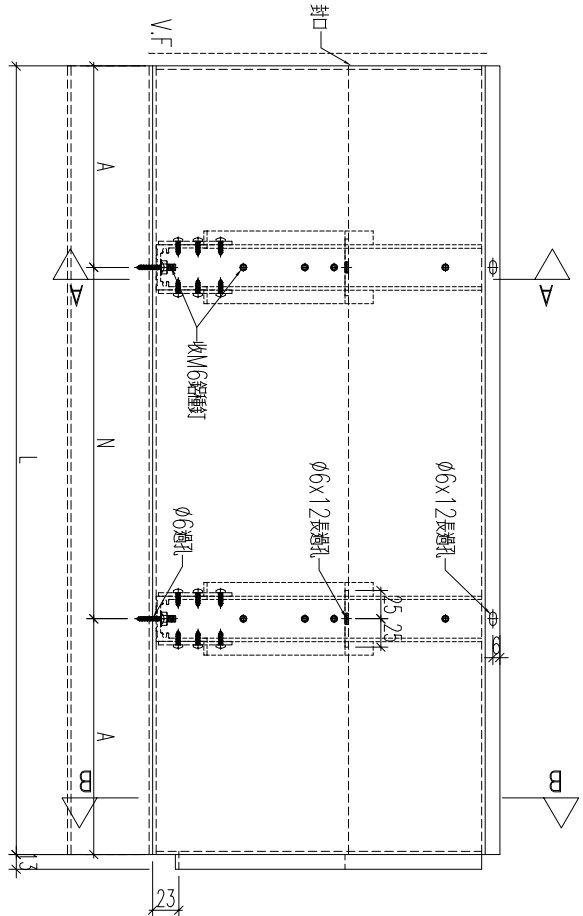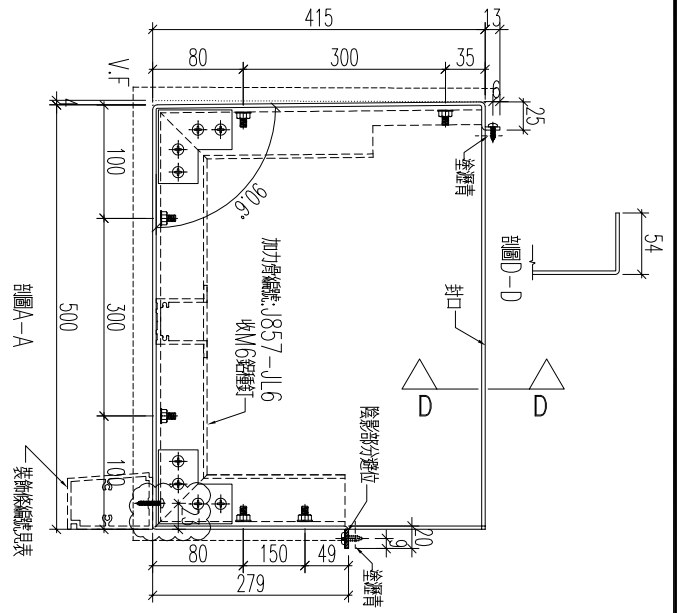

編號	數量	長度	N	A	裝飾條編號
857-TM-AP1	4	1405	4x300	102.5	857-TM-ZS1

名稱	鋁板加工圖	制圖	黃漢卿	2022.12.2	修改	A
材料	3mm厚板	復核	王禮秋	2022.12.2	日期	2.23
顏色	銅色(AL1)	批准			圖號	857-TM-AP1






工程號

J857

地盤




啓德6552

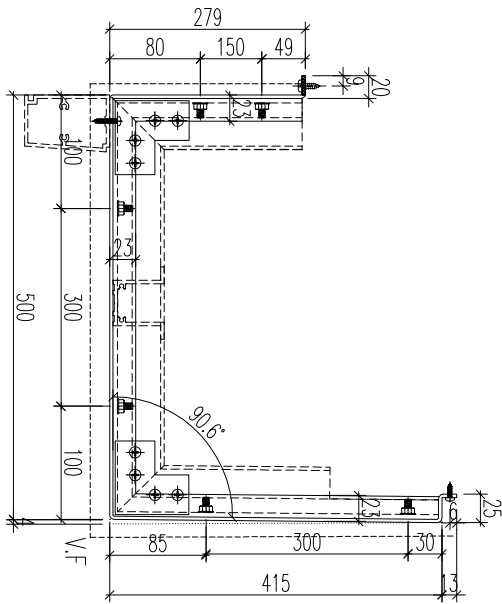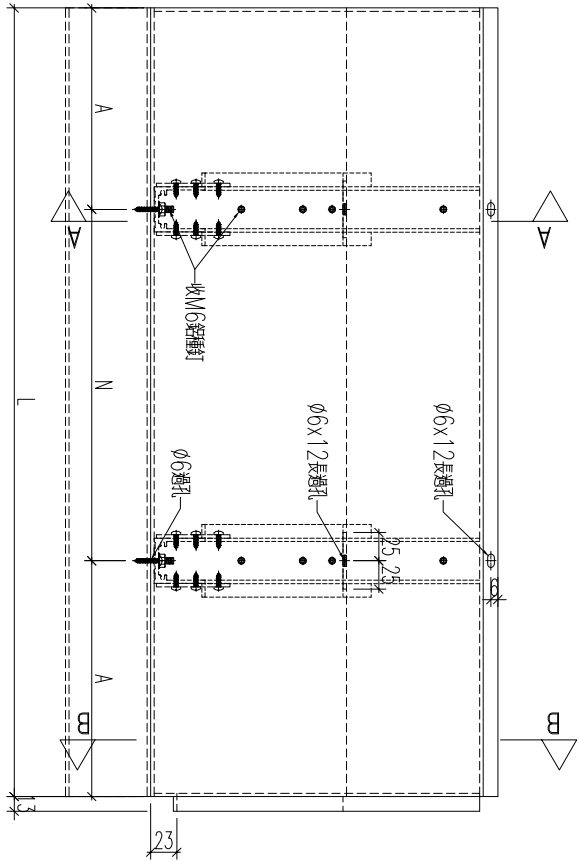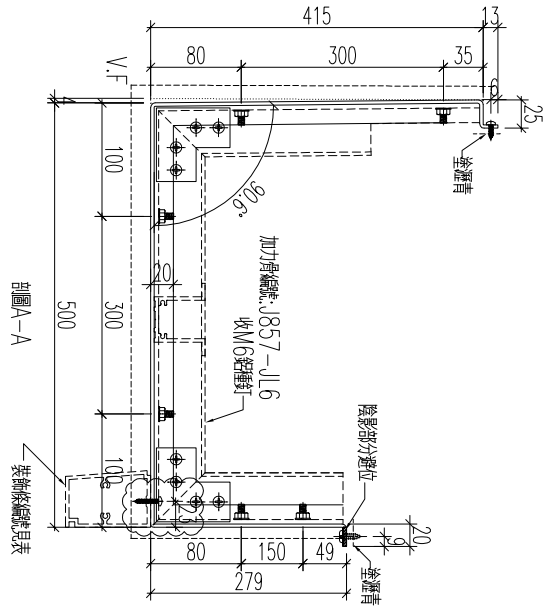

編號	數量	長度	N	A	裝飾條編號
857-TM-AP2	4	1405	4x300	102.5	857-TM-ZS1

名稱	鋁板加工圖	制圖	黃漢卿	2022.12.2	修改	A	
材料	3mm厚板	復核	王禮秋	2022.12.2	日期	2.23	
顏色	銅色(AL1)	批准			圖號	857-TM-AP2	

工程號	J857	地盤	啓德6552
-----	------	----	--------

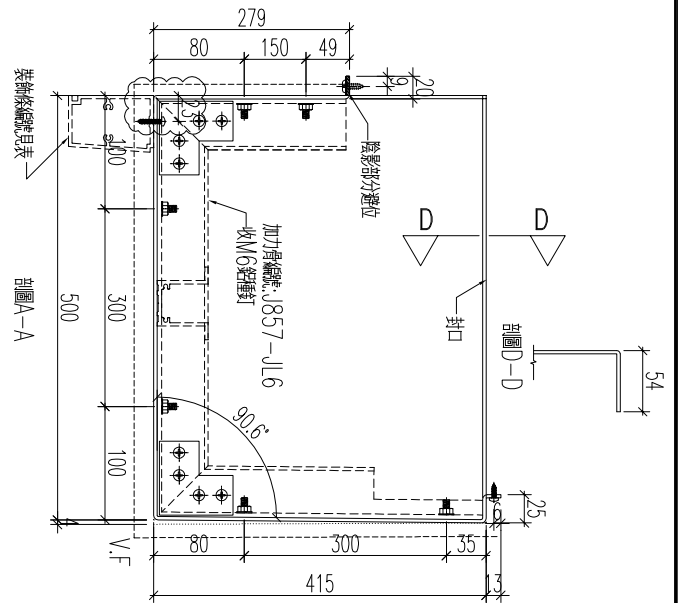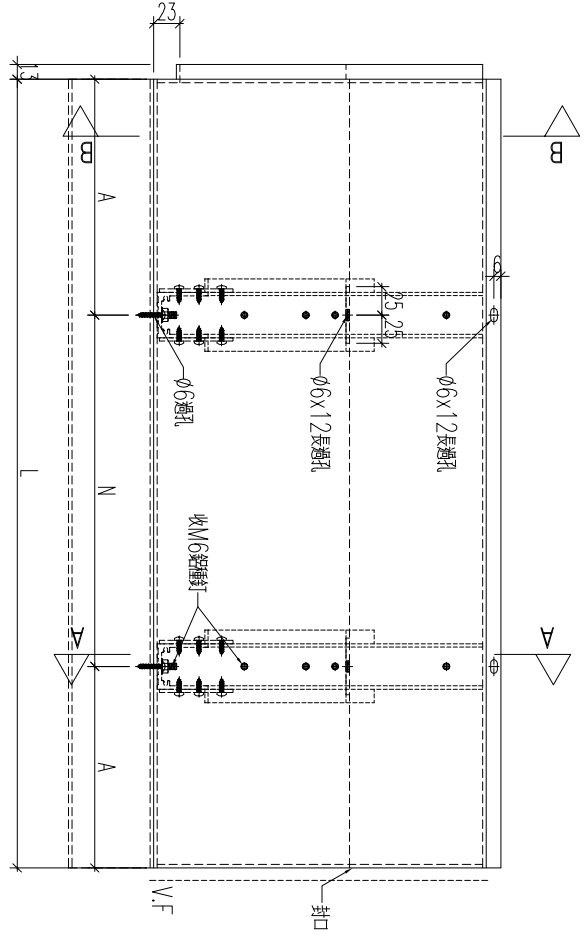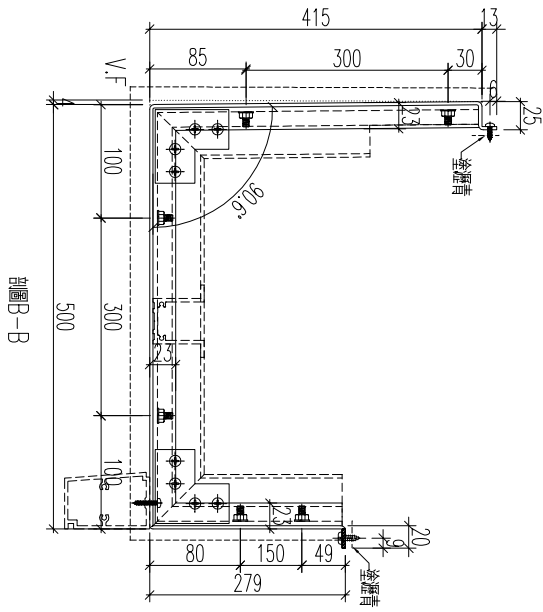




編號	數量	長度	N	A	裝飾條編號
857-TM-AP3	4	1405	4x300	102.5	857-TM-ZS1

名稱	鋁板加工圖	制圖	黃漢卿	2022.12.2	修改	A
材料	3mm厚鋁板	復核	王禮秋	2022.12.2	日期	2.23
顏色	銅色(AL1)	批准			圖號	857-TM-AP3



工程號	J857	地盤	啓德6552
-----	------	----	--------

編號	數量	長度	
857-GB5-AP3a	1	1767	
		5x275	
		196	

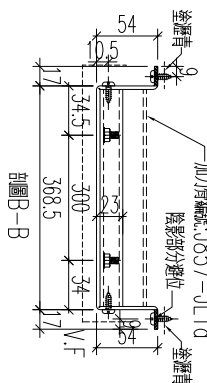
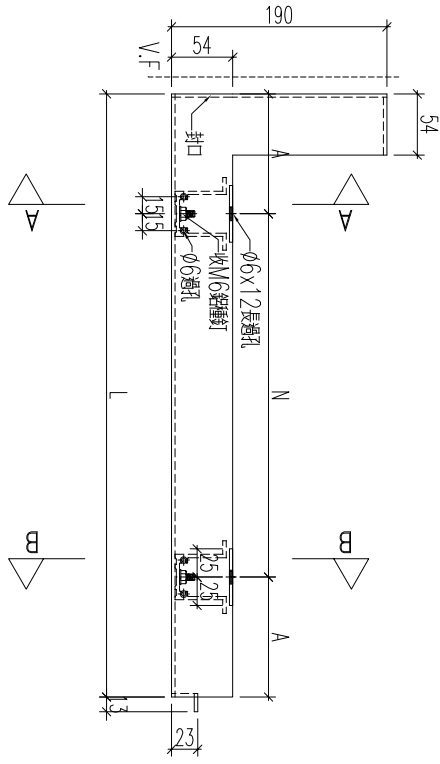
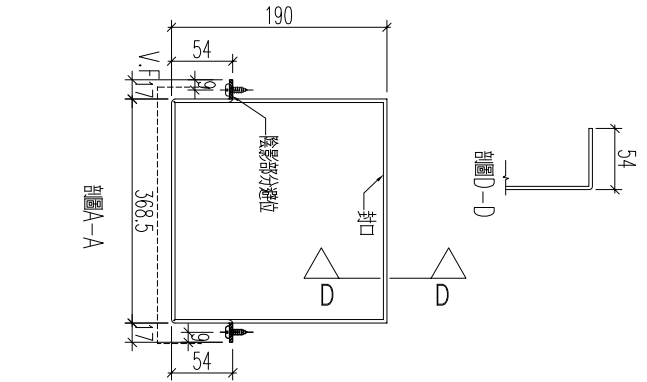


名稱	鋁板加工圖	制圖	黃漢卿	2022.12.2	修改	A	
材料	3mm厚板	復核	王禮秋	2022.12.2	日期	2.23	
顏色	深灰色(AL2)	批准			圖號	857-GB5-AP3a	



工程號 J857 地盤 啓德6552

編號	數量	長度	N	A	裝釘條號
857-GB5-AP4a	6	1490	4x275	195	857-GB5-ZS4
857-GB5-AP8a	6	1490	4x275	195	857-GB5-ZS8
857-GB6-AP17a	5	1490	4x275	195	857-GB6-ZS17
857-GB7-AP2a	5	1490	4x275	195	857-GB7-ZS2
857-GB8-AP5a	10	1490	4x275	195	857-GB8-ZS5
857-GB9-AP13a	4	1490	4x275	195	857-GB9-ZS13
857-GB9-AP17a	5	1490	4x275	195	857-GB9-ZS17

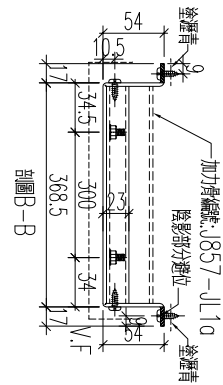
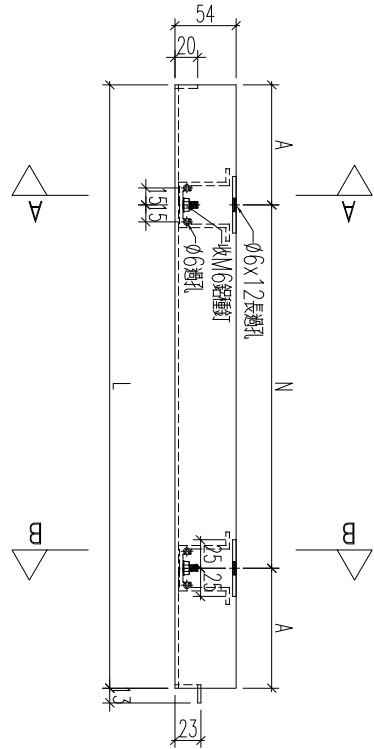
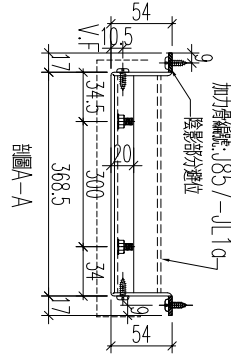


名稱	鋁板加工圖	制圖	黃漢卿	2022.12.2	修改	A	
材料	3mm厚鋁板	復核	王禮秋	2022.12.2	日期	2.23	
顏色	深灰色(AL2)	批准			圖號	857-GB5-AP4a	



美特鋁質 有限公司
MIDI Aluminium Fabricator Ltd.

工程號	J857	地盤	啓德6552
-----	------	----	--------

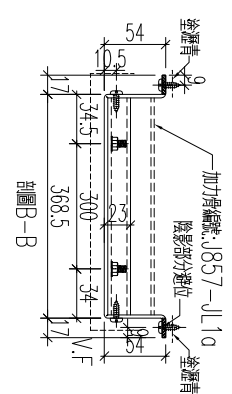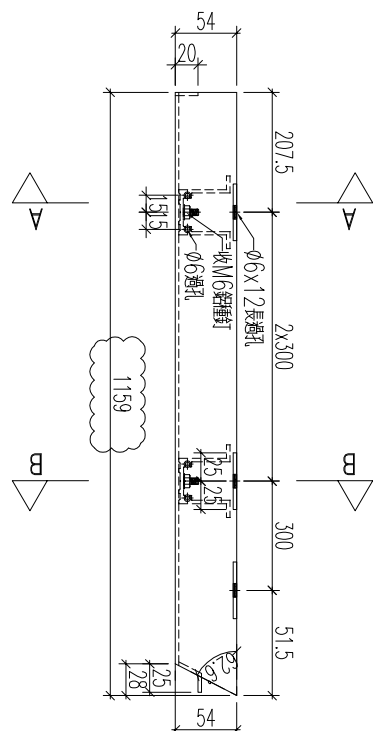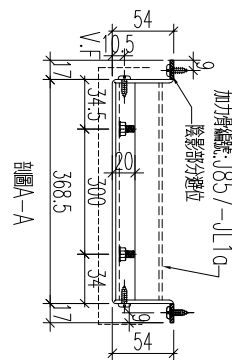


加工數量: 1支

名稱	鋁板加工圖	制圖	黃漢卿	2022.12.2	修改	A		
材料	3mm厚鋁板	復核	王禮秋	2022.12.2	日期	2.23		
顏色	深灰色(AL2)	批准			圖號	857-GB9-AP14a		



工程號	J857	地盤	啓德6552
-----	------	----	--------

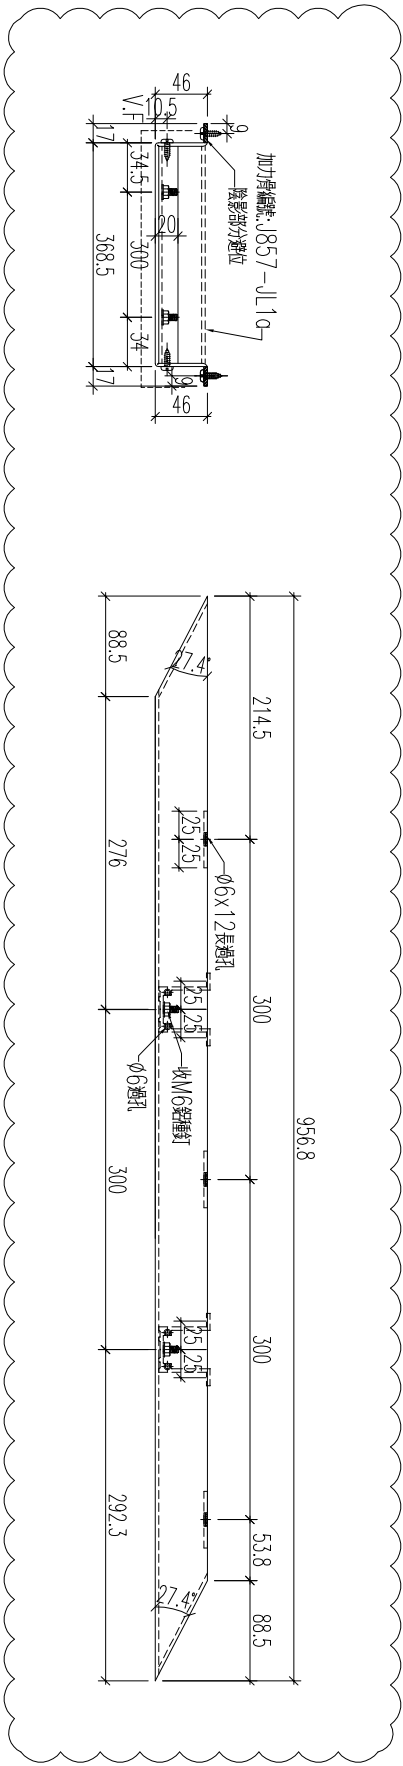




加工數量: 1支

名稱	鋁板加工圖	制圖	黃漢卿	2022.12.2	修改	A	
材料	3mm厚板	復核	王禮秋	2022.12.2	日期	2.23	
顏色	深灰色(AL2)	批准			圖號	857-GB9-AP15a	




美特鋁質 有限公司
MIDI Aluminium Fabricator Ltd.

工程號	J857	地盤	啓德6552
-----	------	----	--------

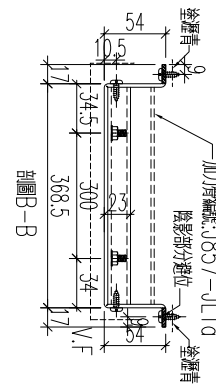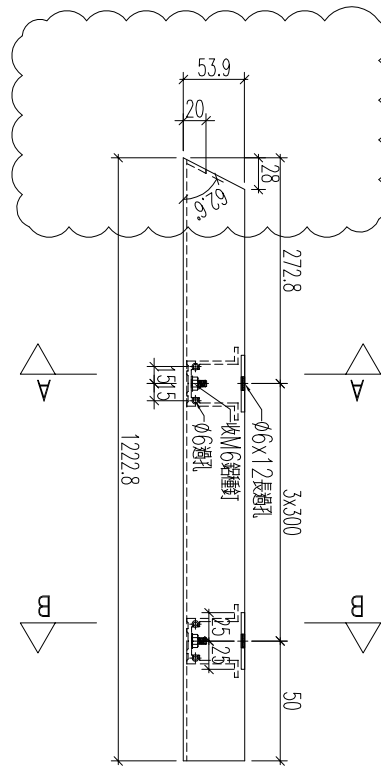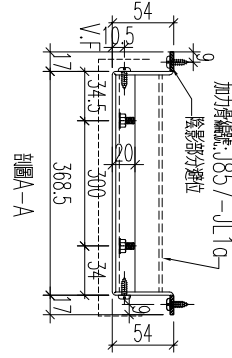


加工數量: 1支

名稱	鋁板加工圖	制圖	黃漢卿	2022.12.2	修改	A		
材料	3mm厚板	復核	王禮秋	2022.12.2	日期	2.23		
顏色	深灰色(AL2)	批准			圖號	857-GB9-AP16a		

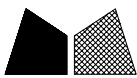

工程號	J857	地盤	啓德6552
-----	------	----	--------

編號	數量	長度	N	A
857-GB5-AP15	1	1127	2x300	263.5

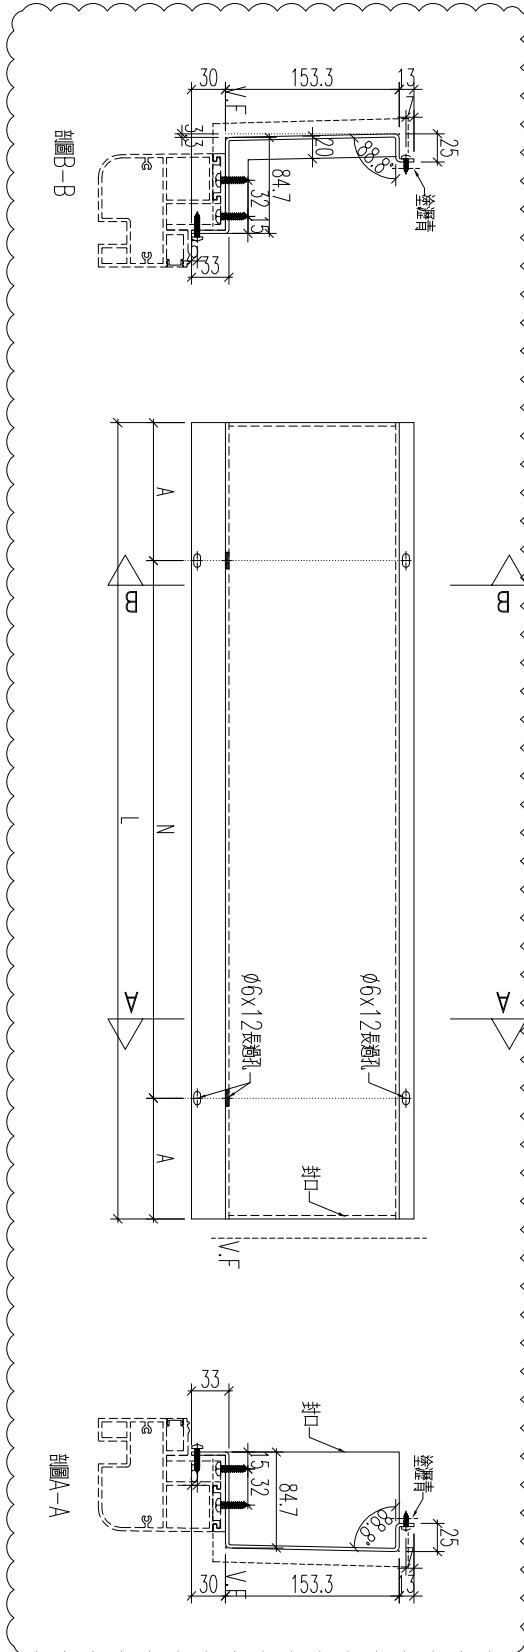

加工數量： 1支

名稱	鋁板加工圖	制圖	黃漢卿	2022.12.2	修改	A	
材料	3mm厚板	復核	王禮秋	2022.12.2	日期	2.23	
顏色	銅色(AL1)	批准			圖號	857-GB5-AP15	



美特鋁質 有限公司
MIDI Aluminium Fabricator Ltd.

工程號



J857

地盤

啓德6552

編號	數量	長度	N	A	裝飾條編號
857-GB6-AP18	1	1017	2x300	208.5	857-GB6-XS18
857-GB8-AP15	1	1403	3x300	251.5	857-GB8-XS15
857-GB9-AP21	1	1193	3x275	184	857-GB9-XS21
857-GB12-AP8	1	1410	3x300	255	857-GB12-XS8

增加

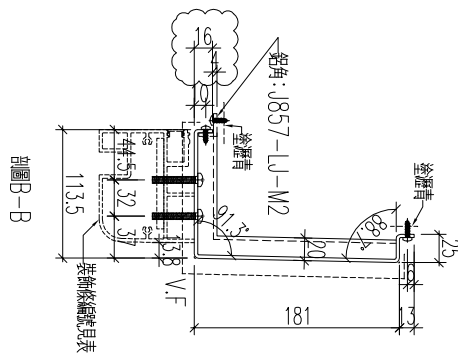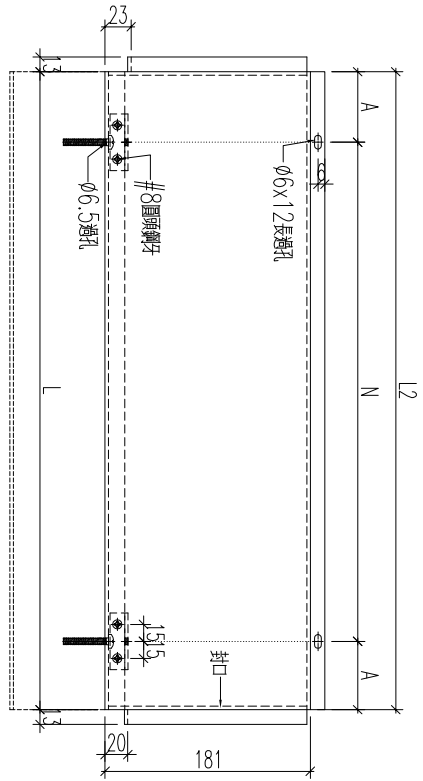

剖面B-B

名稱	鋁板加工圖	制圖	黃漢卿	2022.12.2	修改	A	
材料	3mm厚板	復核	王禮秋	2022.12.2	日期	2.23	
顏色	銅色(AL1)	批准			圖號	857-GB6-AP18	



美特鋁質 有限公司
MIDI Aluminium Fabricator Ltd.


工程號

J857

地盤

啓德6552

線號	數量	長度	N	A	裝飾條編號
857-GB5-AP16	1	1426	4x275	163	857-GB5-XS16

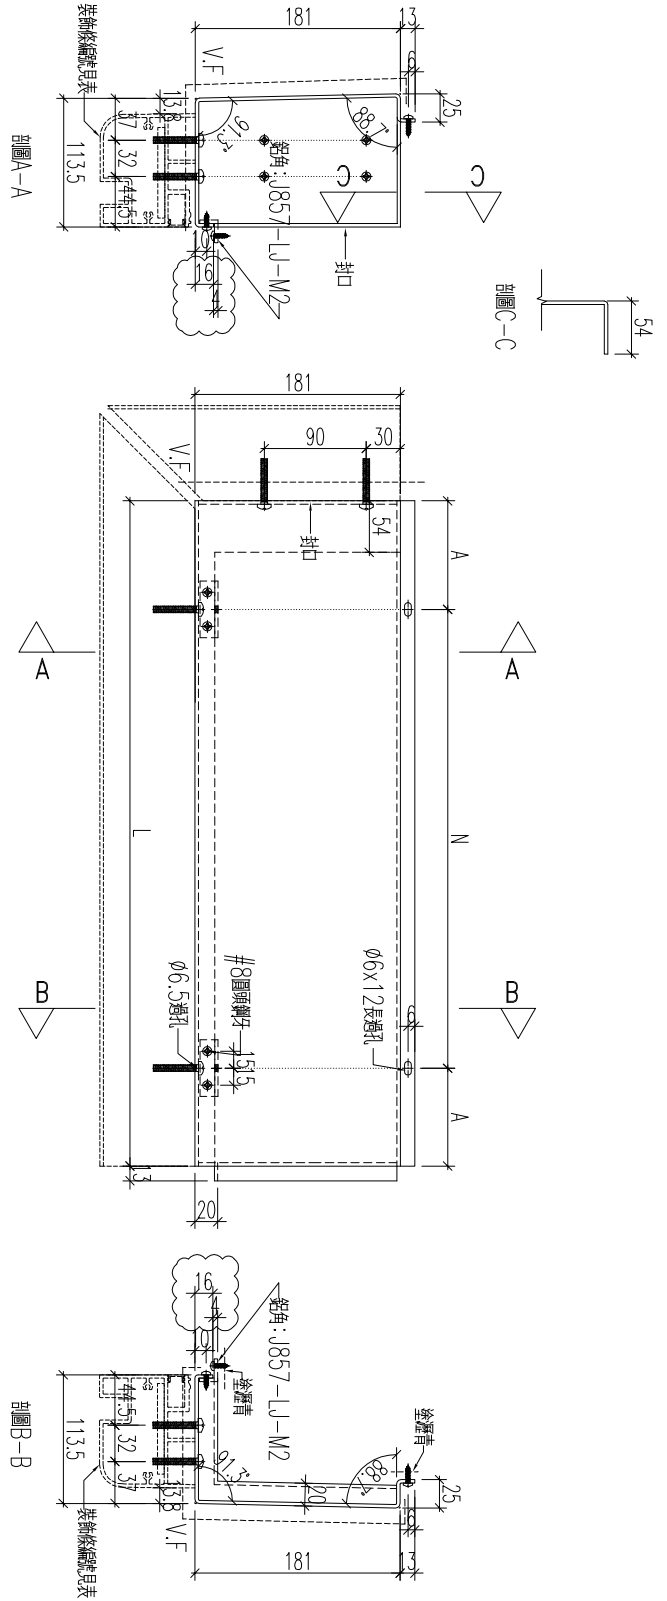

名稱	鋁板加工圖	制圖	黃漢卿	2022.12.2	修改	A	
材料	3mm厚板	復核	王禮秋	2022.12.2	日期	2.23	
顏色	銅色(AL1)	批准			圖號	857-GB5-AP16	

EG-DWG3



美特鋁質 有限公司
MIDI Aluminium Fabricator Ltd.




工程號

J857

地盤

啓德6552

編號	數量	長度	N	A	裝飾條編號
857-GB9-AP32	1	1783	5x275	204	857-GB9-XS32
857-GB12-AP9	1	1505	4x275	202.5	857-GB12-XS9
增加					

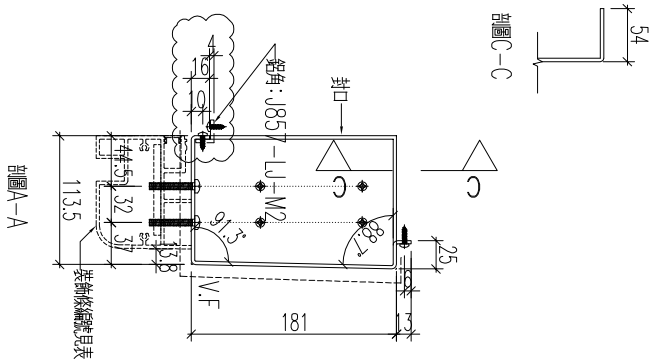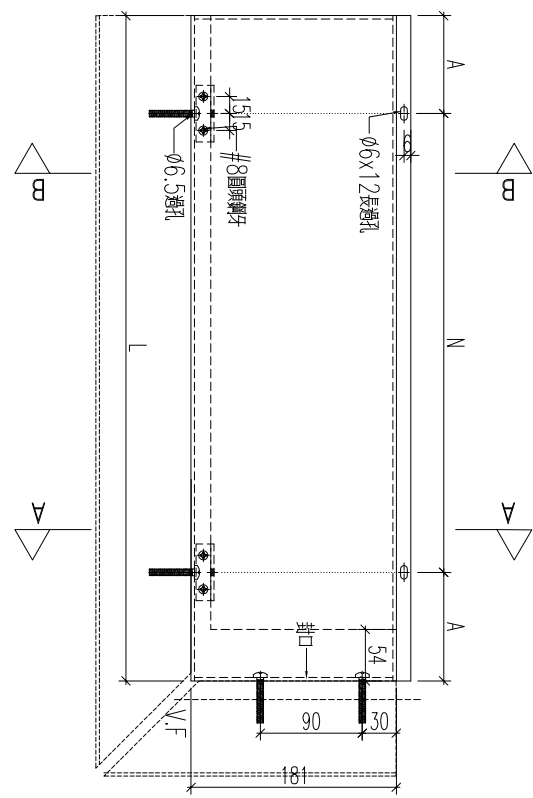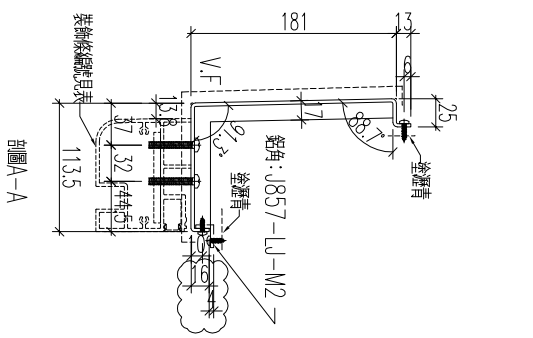


名稱	鋁板加工圖	制圖	黃漢卿	2022.12.2	修改	A
材料	3mm厚鋁板	復核	王禮秋	2022.12.2	日期	2.23
顏色	銅色(AL1)	批准			圖號	857-GB9-AP32



工程號	J857	地盤	啓德6552
-----	------	----	--------

編號	數量	長度	N	A	裝飾條編號
857-GB12-AP19	1	1580	4x300	190	857-GB12-XS19

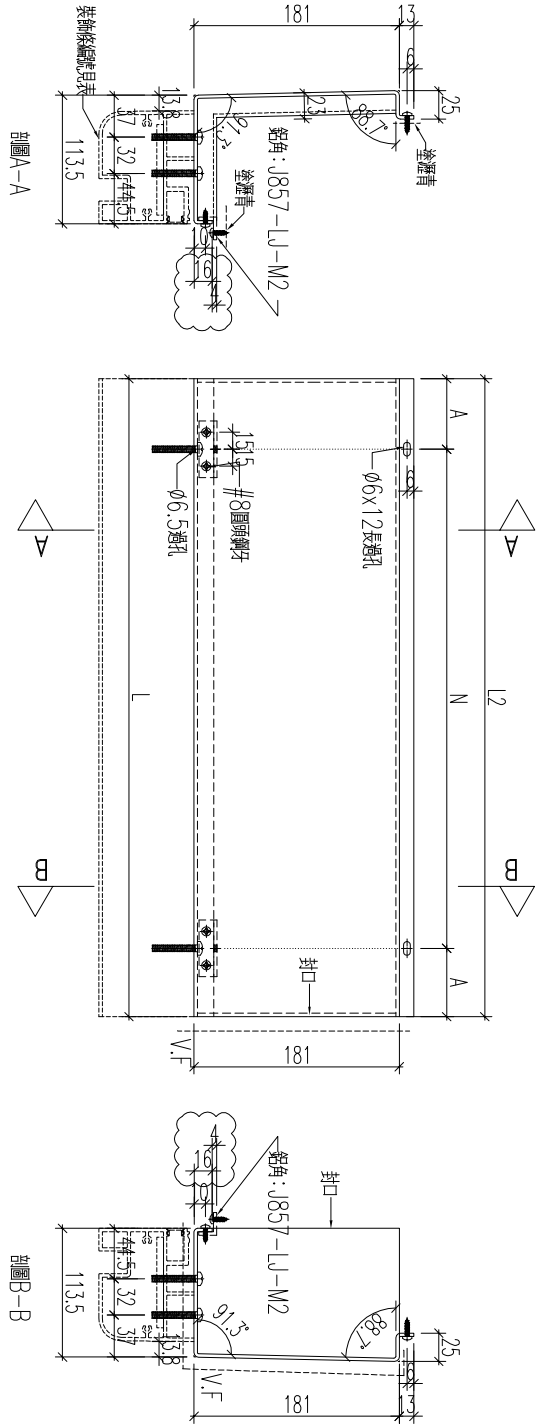


名稱	鋁板加工圖	制圖	黃漢卿	2022.12.2	修改	A
材料	3mm厚鋁板	復核	王禮秋	2022.12.2	日期	2.23
顏色	銅色(AL1)	批准			圖號	857-GB12-AP19



工程號	J857	地盤	啓德6552
-----	------	----	--------

料號	數量	長度	N	A
857-GB5-AP14	1	1127	2x300	263.5

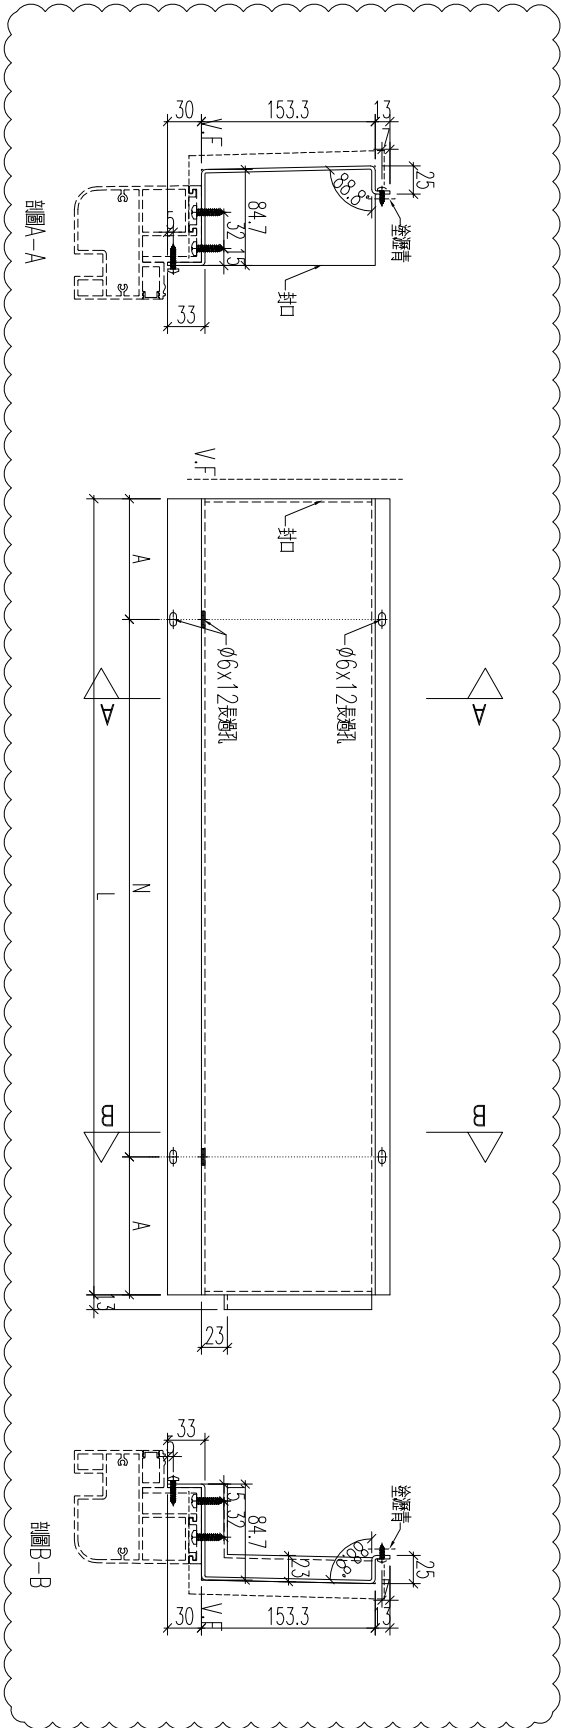


名稱	鋁板加工圖	制圖	黃漢卿	2022.12.2	修改	A		
材料	3mm厚鋁板	復核	王禮秋	2022.12.2	日期	2.23		
顏色	銅色(AL1)	批准			圖號	857-GB5-AP14		



美特鋁質 有限公司
MIDI Aluminium Fabricator Ltd.

工程號	J857	地盤	啓德6552
-----	------	----	--------

編號	數量	長度	N	A	M	B
857-GB5-AP14b	1	1127	2x300	263.5	3x300	113.5
857-GB5-AP15b	1	1127	2x300	263.5	3x300	113.5

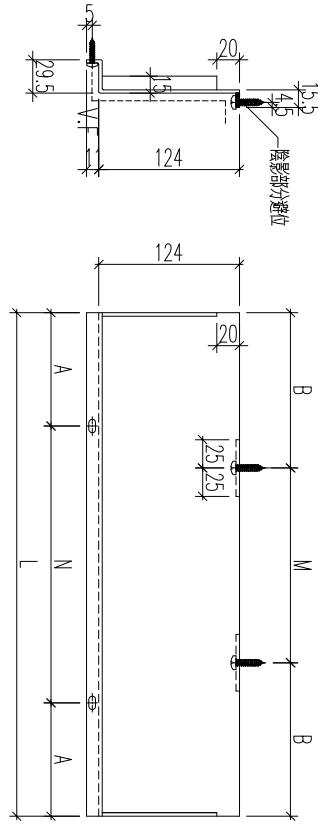

新增

名稱	鋁板加工圖	制圖	黃漢卿	2022.12.2	修改		
材料	3mm厚板	復核	王禮秋	2022.12.2	日期		
顏色	銅色(AL1)	批准			圖號	857-GB5-AP14b	




工程號

J857

地盤


啓德6552

線號	數量	長度	N	A	M	B
857-GB5-AP140	1	1127	2x300	263.5	3x300	113.5

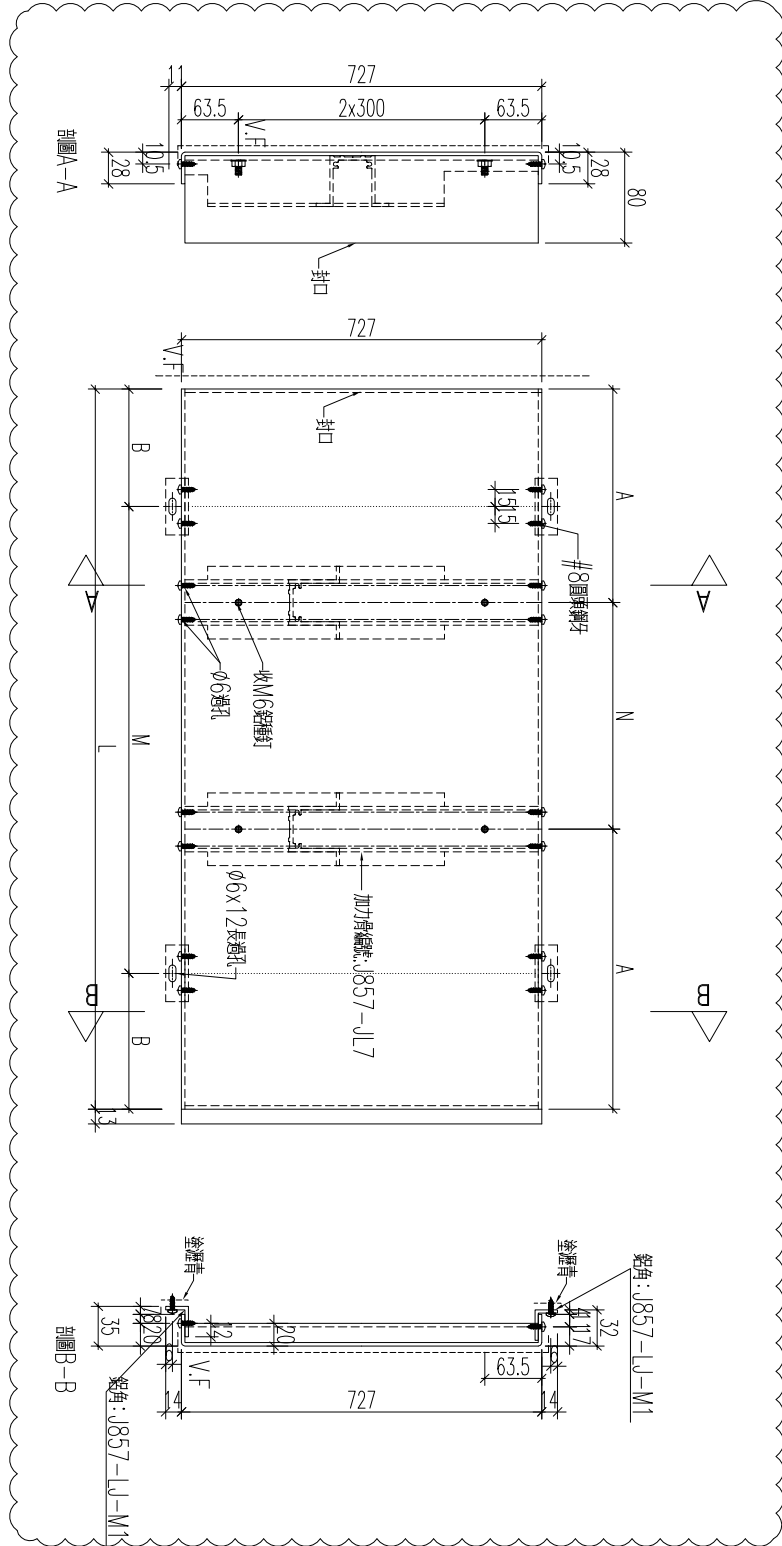

加工數量: 1支

名稱	鋁板加工圖	制圖	黃漢卿	2022.12.2	修改	A
材料	3mm厚鋁板	復核	王禮秋	2022.12.2	日期	2.23
顏色	銅色(AL1)	批准			圖號	857-GB5-AP15a

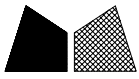

工程號




J857

地盤

啓德6552

編號	數量	長度	N	A	M	B
857-GB6-AP18a	1	1017	2x300	208.5	3x300	58.5
857-GB8-AP15a	1	1403	3x300	251.5	4x300	101.5
857-GB9-AP21a	1	1193	3x275	184	4x275	46.5
857-GB12-AP8a	1	1410	3x300	255	4x300	105

增加

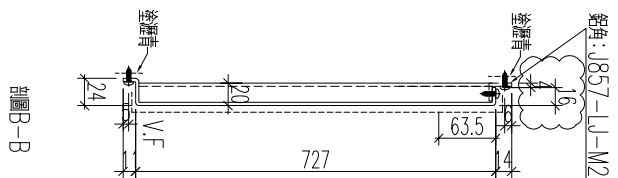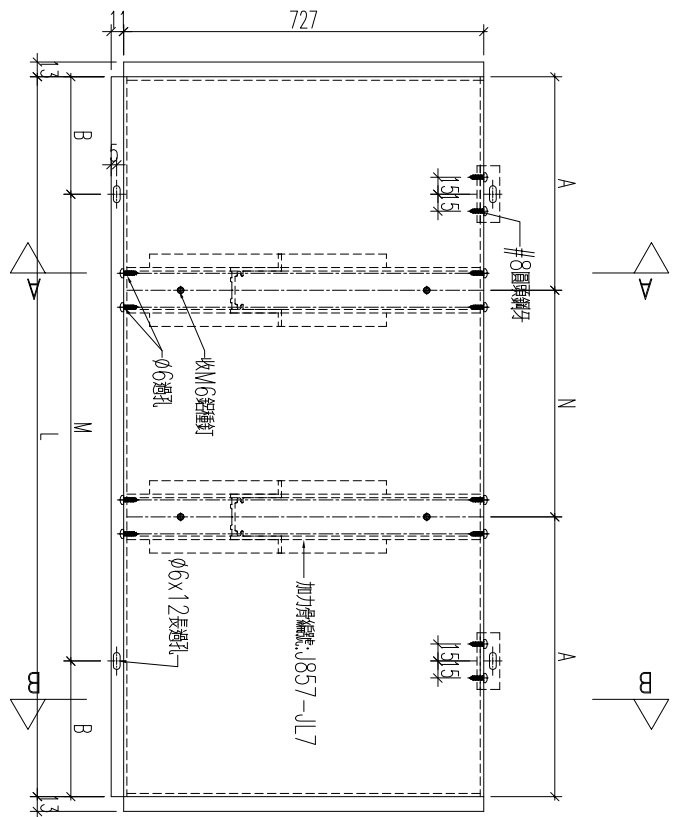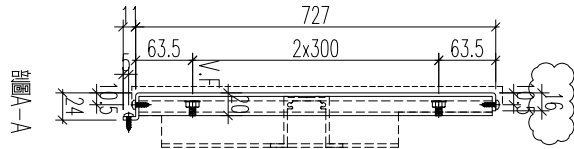




名稱	鋁板加工圖	制圖	黃漢卿	2022.12.2	修改	A	
材料	3mm厚板	復核	王禮秋	2022.12.2	日期	2.23	
顏色	銅色(AL1)	批准			圖號	857-GB6-AP18a	



美特鋁質 有限公司
MIDI Aluminium Fabricator Ltd.

工程號	J857	地盤	啓德6552
-----	------	----	--------

線號	數量	長度	N	A	M	B
857-GB5-AP16a	1	1426	4x275	163	5x275	25.5

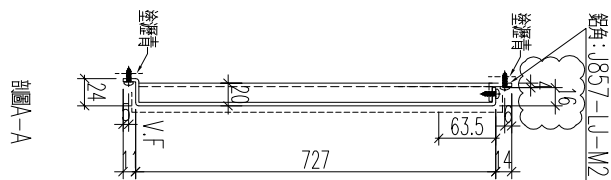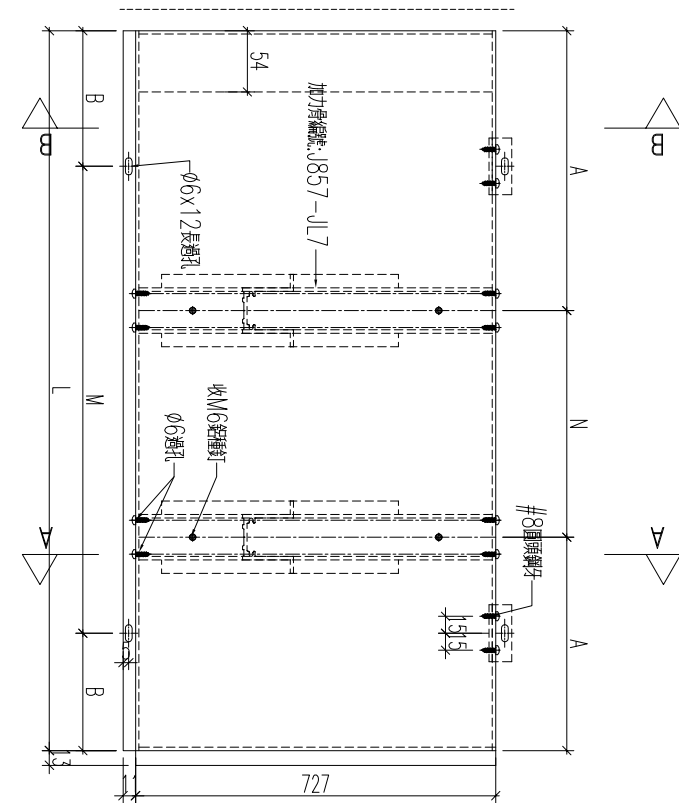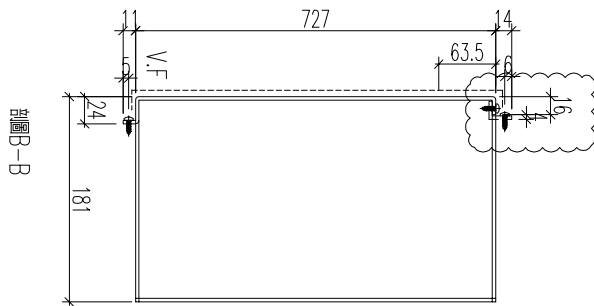

名稱	鋁板加工圖	制圖	黃漢卿	2022.12.2	修改	A	
材料	3mm厚板	復核	王禮秋	2022.12.2	日期	2.23	
顏色	銅色(AL1)	批准			圖號	857-GB5-AP16a	






美特鋁質 有限公司
MIDI Aluminium Fabricator Ltd.

工程號 J857 地盤 啓德6552

編號	數量	長度	N	A	M	B
857-GB9-AP32a	1	1783	5x275	204	6x275	66.5
857-GB12-AP9a	1	1505	4x275	202.5	5x275	65

增加

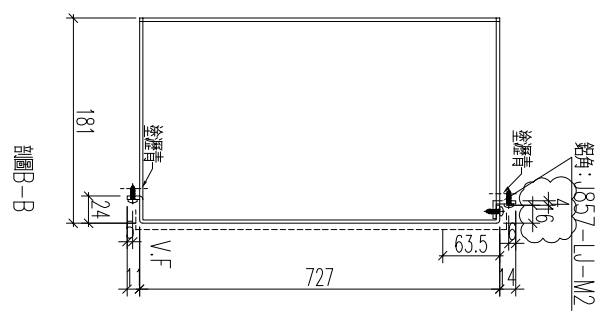
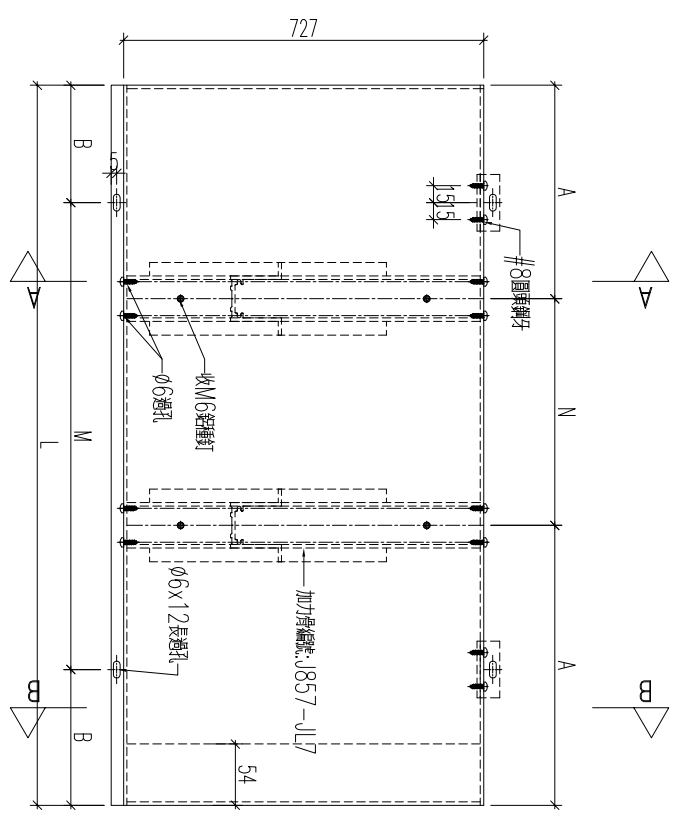
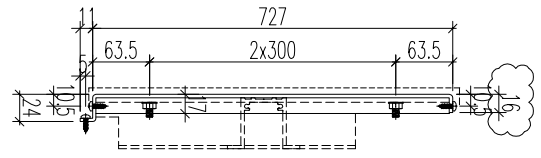


名稱	鋁板加工圖	制圖	黃漢卿	2022.12.2	修改	A	
材料	3mm厚鋁板	復核	王禮秋	2022.12.2	日期	2.23	
顏色	銅色(AL1)	批准			圖號	857-GB9-AP32a	




工程號	J857	地盤	啓德6552
-----	------	----	--------

編號	數量	長度	N	A	M	B
857-GB12-AP190	1	1580	4x300	190	5x300	40

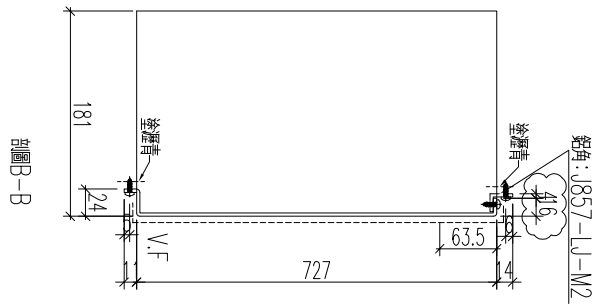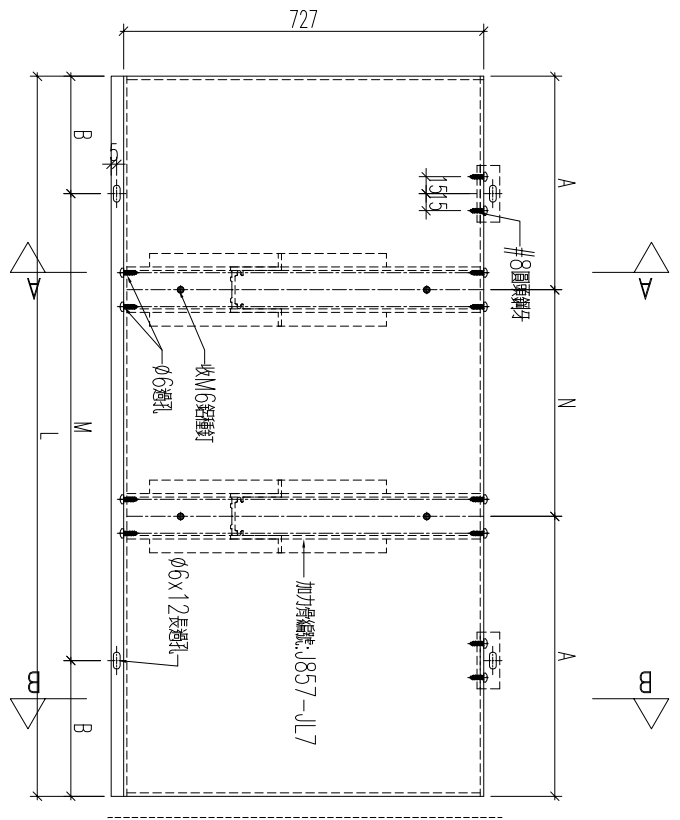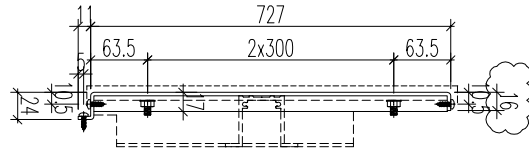

名稱	鋁板加工圖	制圖	黃漢卿	2022.12.2	修改	A	
材料	3mm厚鋁板	復核	王禮秋	2022.12.2	日期	2.23	
顏色	銅色(AL1)	批准			圖號	857-GB9-AP32a	

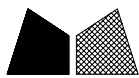


美特鋁質 有限公司
MIDI Aluminium Fabricator Ltd.


工程號	J857	地盤	啓德6552
-----	------	----	--------

編號	數量	長度	N	A	M	B
857-GB5-AP14a	1	1127	2x300	263.5	3x300	113.5

新增



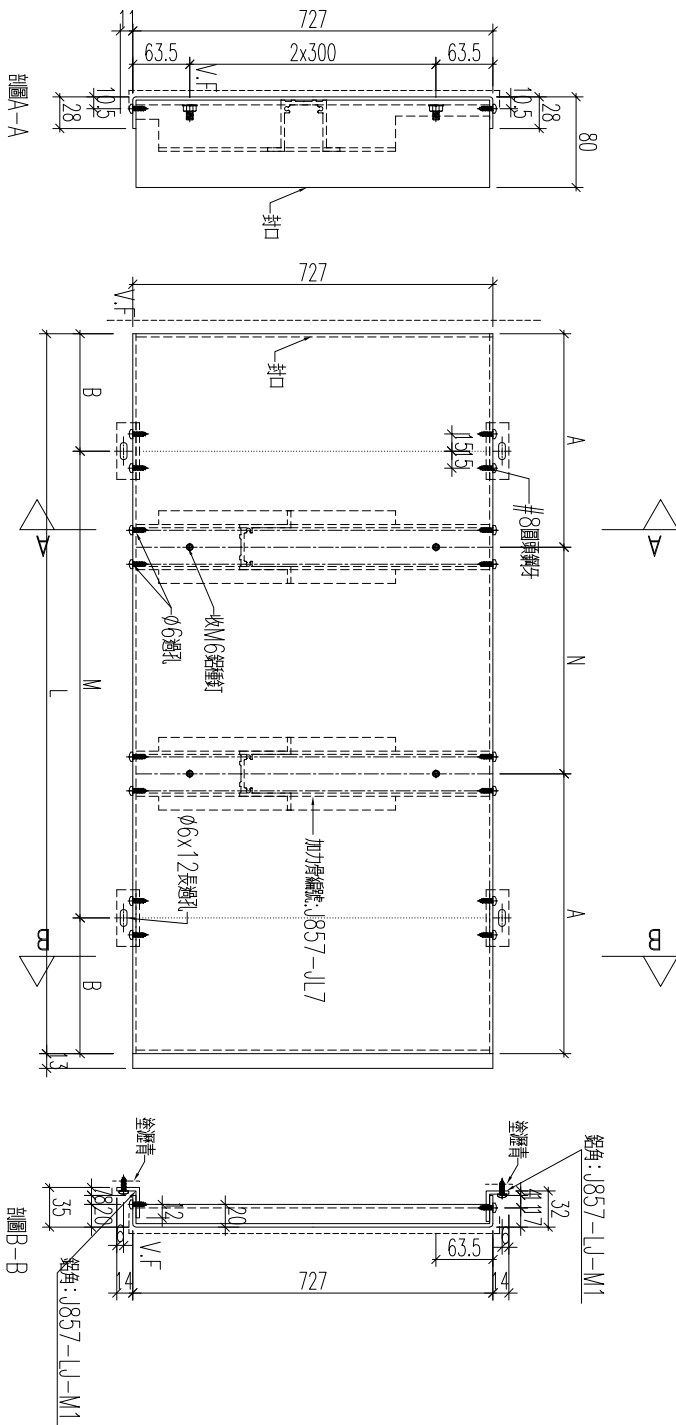


名稱	鋁板加工圖	制圖	黃漢卿	2022.12.2	修改		
材料	3mm厚鋁板	復核	王禮秋	2022.12.2	日期		
顏色	銅色(AL1)	批准			圖號	857-GB5-AP14a	

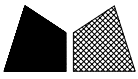

工程號	J857	地盤	啓德6552
-----	------	----	--------

料號	數量	長款	N	A	M	B
857-GB1-AP6	1	1353	3x275	264	4x275	126.5
857-GB1-AP26	1	1211	2x300	305.5	3x300	155.5
857-GB1-AP31	1	910	1x300	305	2x300	155
取消						
857-GB3-AP15	1	1718	4x300	259	5x300	109
857-GB4-AP10	1	1298	3x275	236.5	4x275	99
857-GB4-AP15	1	1306	3x275	240.5	4x275	103
857-GB4-AP40	1	1374	3x275	274.5	4x275	137
取消						
857-GB4-AP45	1	973	2x250	236.5	3x250	111.5
857-GB3-AP14	1	1258	2x300	329	3x300	179
取消						
新增						

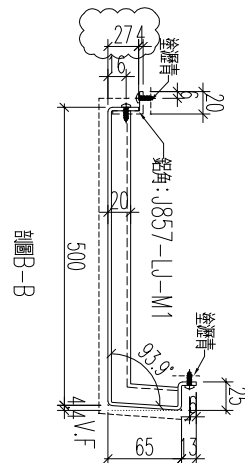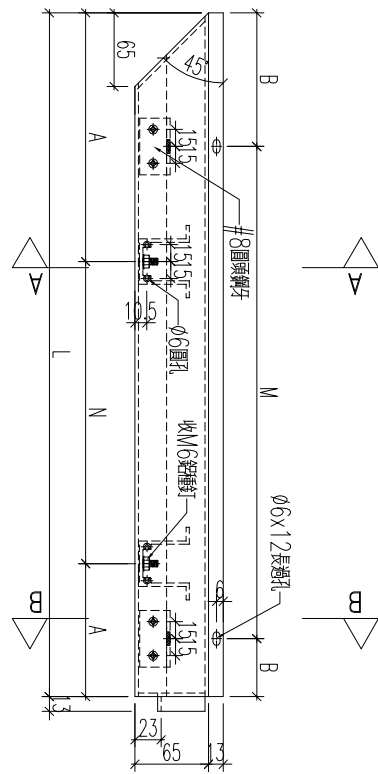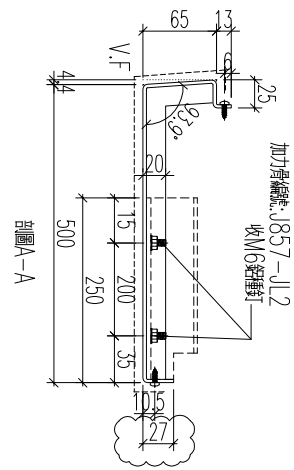

名稱	鋁板加工圖	制圖	黃漢卿	2022.12.2	修改	A
材料	3mm厚板	復核	王禮秋	2022.12.2	日期	2.23
顏色	銅色(AL1)	批准			圖號	857-GB1-AP6



美特鋁質 有限公司
MIDI Aluminium Fabricator Ltd.




工程號

J857

地盤

啓德6552

編號	數量	長度	N	A	M	B	
857-GB1-AP5	1	1522	3x300	311	4x300	161	
857-GB1-AP25	1	1318	3x275	246.5	4x275	109	
857-GB1-AP29	1	1261	2x300	330.5	3x300	180.5	
857-GB2-AP22	1	1161	2x300	280.5	3x300	130.5	取消
857-GB3-AP13	1	953	1x300	326.5	2x300	176.5	
857-GB4-AP8	1	911	1x300	305.5	2x300	155.5	
857-GB4-AP39	1	936	1x300	318	2x300	168	
857-GB4-AP44	1	1191	2x300	295.5	3x300	145.5	取消
857-GB2-AP28	1	1258	2x300	329	3x300	179	新增

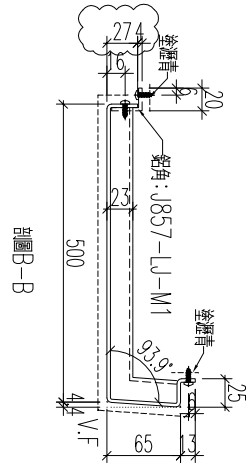
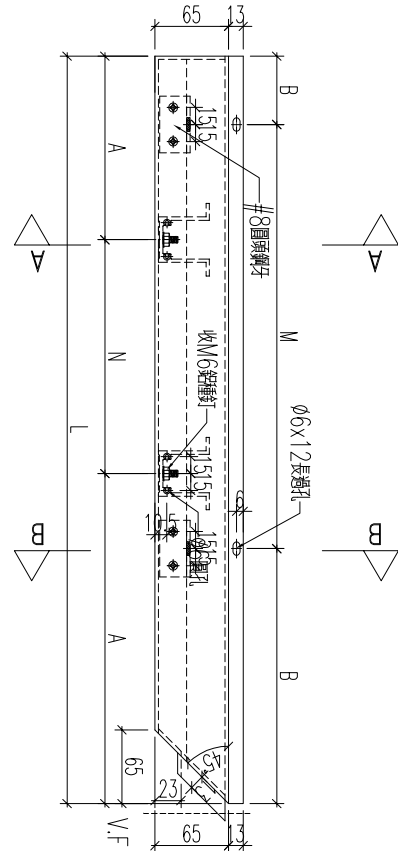
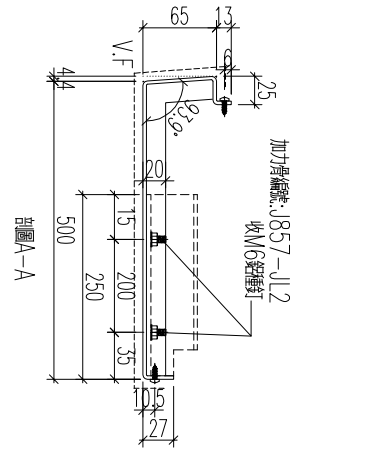


名稱	鋁板加工圖	制圖	黃漢卿	2022.12.2	修改	A	
材料	3mm厚板	復核	王禮秋	2022.12.2	日期	2.23	
顏色	銅色(AL1)	批准			圖號	857-GB1-AP5	



工程號 J857 地盤 啓德6552

編號	數量	長度	N	A	M	B	
857-GB1-AP7	1	1370	3x300	235	4x300	85	取消
857-GB1-AP8	1	1375	3x300	237.5	4x300	87.5	取消
857-GB1-AP16	2	1490	3x300	295	4x300	145	
857-GB1-AP23	1	1630	4x300	215	5x300	65	
857-GB2-AP4	1	950	2x300	175	3x300	25	取消
857-GB2-AP5	1	965	2x300	182.5	3x300	32.5	取消
857-GB2-AP12	2	1490	3x300	295	4x300	145	
857-GB2-AP19	1	1630	4x300	215	5x300	65	
857-GB2-AP36	1	968	2x300	184	3x300	34	取消
857-GB3-AP33	1	1630	4x300	215	5x300	65	
857-GB4-AP7	1	933	2x275	191.5	3x275	54	
857-GB4-AP16	1	1328	3x300	214	4x300	64	
857-GB4-AP38	2	1490	3x300	295	4x300	145	
857-GB4-AP38c	1	868	300	284	2x300	134	
857-GB9-AP20c	1	1490	3x300	295	4x300	145	
857-GB4-AP47	1	1533	4x275	216.5	5x275	158	新增

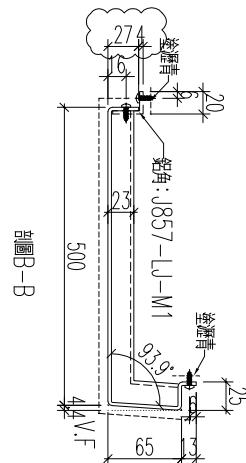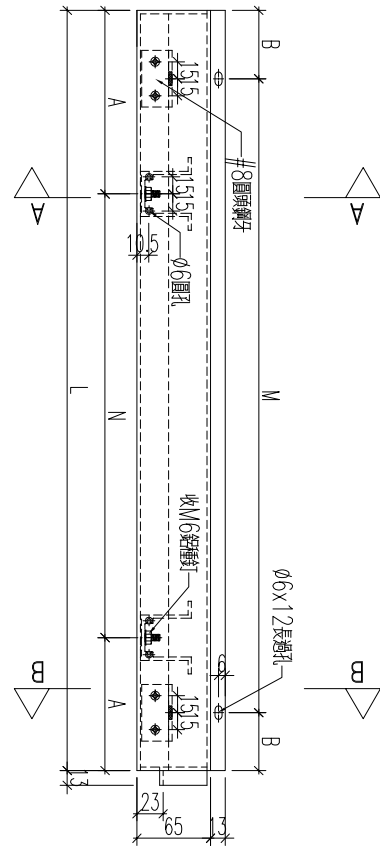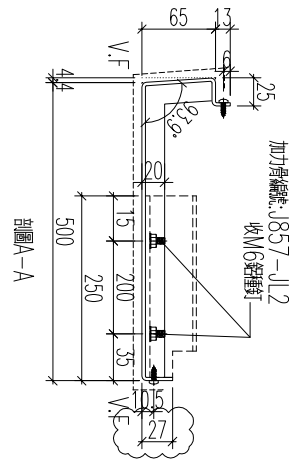

名稱	鋁板加工圖	制圖	黃漢卿	2022.12.2	修改	A
材料	3mm厚鋁板	復核	王禮秋	2022.12.2	日期	2.23
顏色	銅色(AL1)	批准			圖號	857-GB1-AP7

EG-DWG3






美特鋁質 有限公司
MIDI Aluminium Fabricator Ltd.

工程號: J857 地盤: 啓德6552

編號	數量	長度	N	A	M	B
857-GB1-AP24	1	1340	3x300	220	4x300	70
857-GB2-AP6	1	1630	4x300	215	5x300	65
857-GB3-AP19	1	1630	4x300	215	5x300	65
857-GB3-AP34	1	965	2x300	182.5	3x300	32.5
857-GB4-AP17	1	1639	4x300	219.5	5x300	69.5
857-GB1-AP9	1	1638	4x300	219	5x300	69

取消

新增

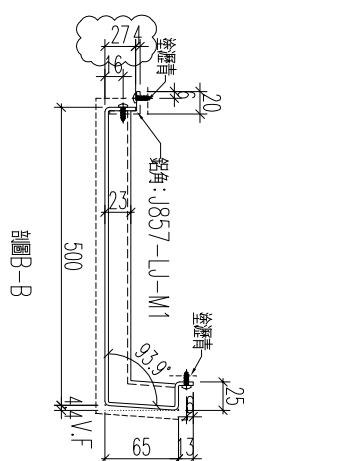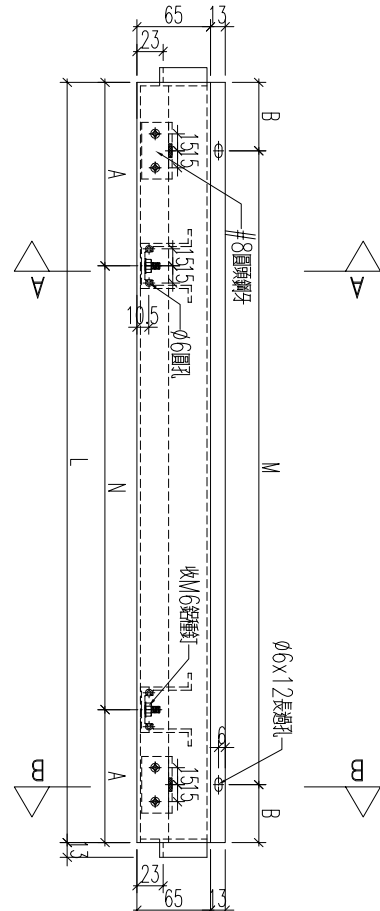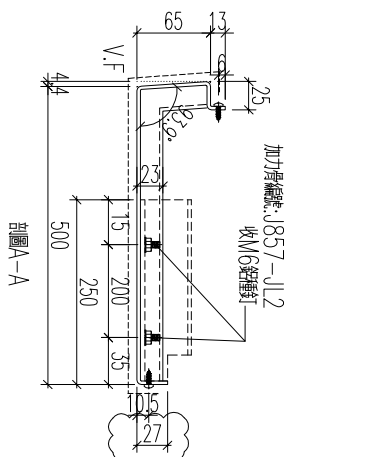

名稱	鋁板加工圖	制圖	黃漢卿	2022.12.2	修改	A	
材料	3mm厚鋁板	復核	王禮秋	2022.12.2	日期	2.23	
顏色	銅色(AL1)	批准			圖號	857-GB1-AP24	



工程號

J857




地盤

啓德6552


編號	數量	長度	N	A	M	B
857-GB1-AP32	1	933	2x270	196.5	3x270	61.5
857-GB2-AP29	1	953	2x300	176.5	3x300	26.5
857-GB2-AP32	1	485	1x300	92.5		30
857-GB3-AP6	1	961	2x300	180.5	3x300	30.5
857-GB3-AP10	1	485	1x300	92.5		30
857-GB3-AP35	1	950	2x300	175	3x300	25
857-GB4-AP44	1	1197	2x300	296	3x300	148.5

取消

新增

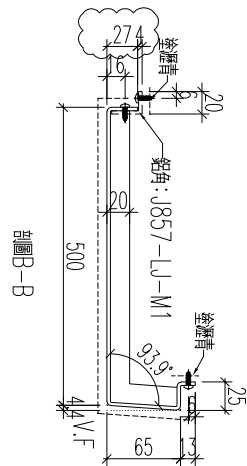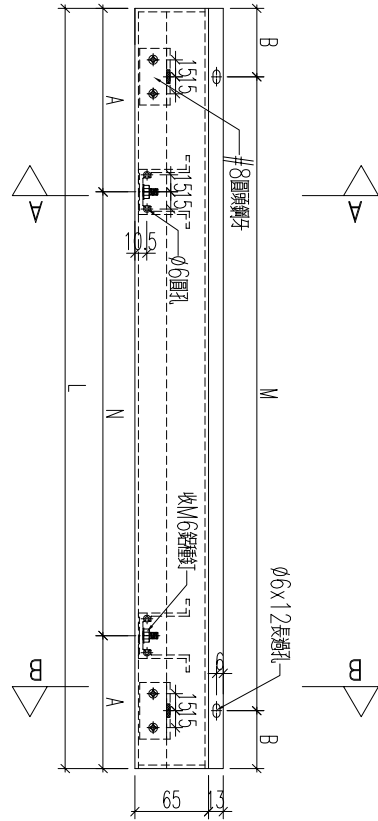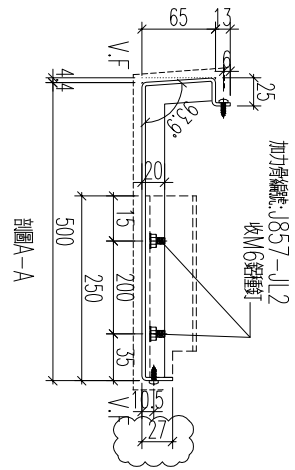

名稱	鋁板加工圖	制圖	黃漢卿	2022.12.2	修改	A
材料	3mm厚鋁板	復核	王禮秋	2022.12.2	日期	2.23
顏色	銅色(AL1)	批准			圖號	857-GB1-AP32

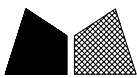


美特鋁質 有限公司
MIDI Aluminium Fabricator Ltd.

工程號

J857

地盤


啓德6552

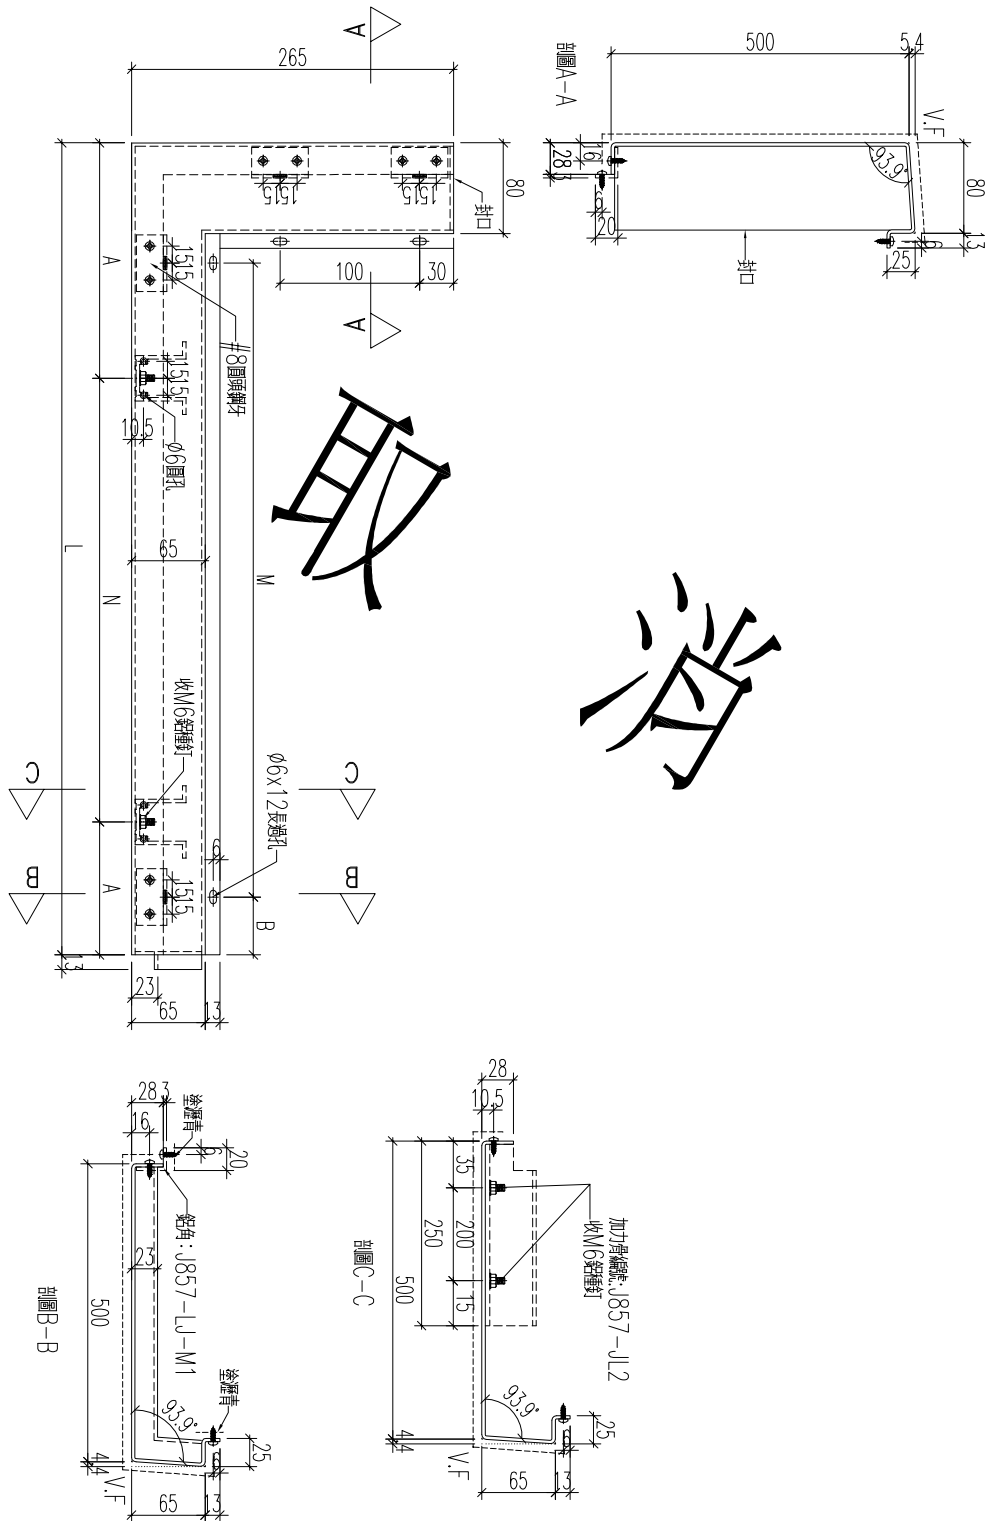

送

編號	數量	長皮	N	A	M	B
857-GB4-AP14	1	1535	4x300	167.5	4x300	30

名稱	鋁板加工圖	制圖	黃漢卿	2022.12.2	修改		
材料	3mm厚板	復核	王禮秋	2022.12.2	日期		
顏色	銅色(AL1)	批准			圖號	857-GB4-AP14	



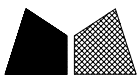


美特鋁質 有限公司
MIDI Aluminium Fabricator Ltd.

工程號 J857 地盤 啓德6552

料號	數量	長度	N	A	M	B
857-GB1-AP27	1	1306	3x275	240.5	4x275	103
857-GB4-AP10	1	1393	3x300	246.5	4x300	96.5
857-GB4-AP46	1	1068	2x300	234	3x300	84

取消

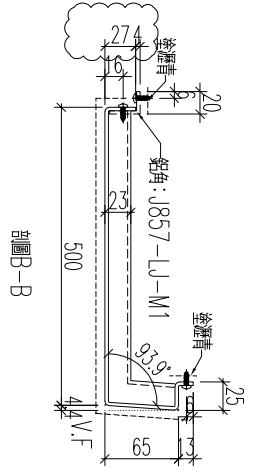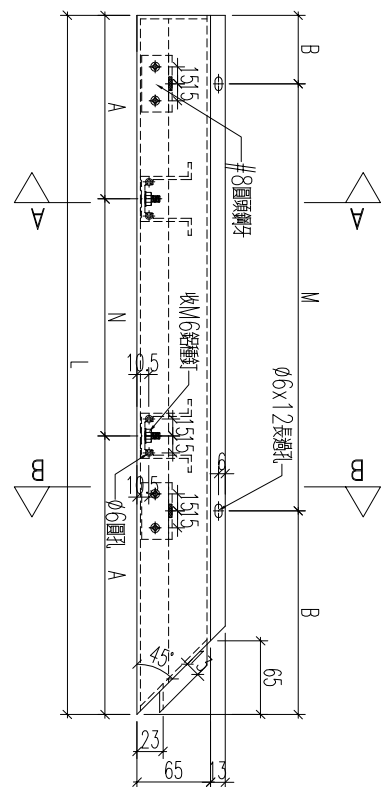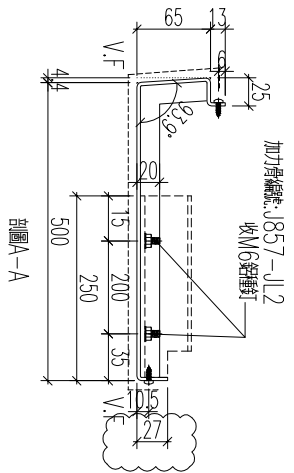

名稱	鋁板加工圖	制圖	黃漢卿	2022.12.2	修改	A
材料	3mm厚鋁板	復核	王禮秋	2022.12.2	日期	2.23
顏色	銅色(AL1)	批准			圖號	857-GB1-AP27



工程號




J857

地盤

啓德6552

編號	數量	長度	N	A	M	B
857-GB1-AP28	1	1356	3x300	228	4x300	78
857-GB2-AP21	1	1256	3x275	215.5	4x275	78
857-GB4-AP37	1	1388	3x300	244	4x300	94

取消

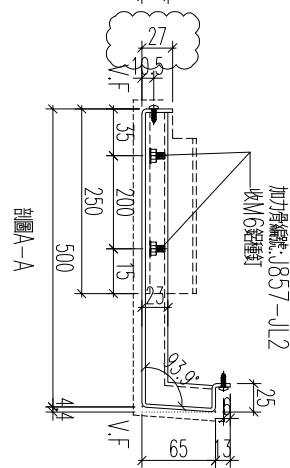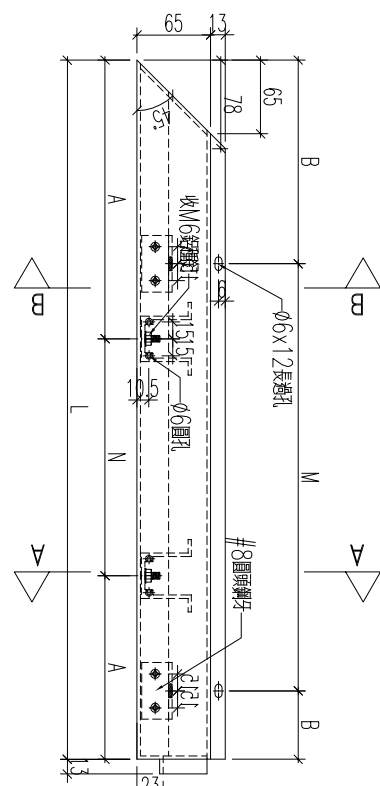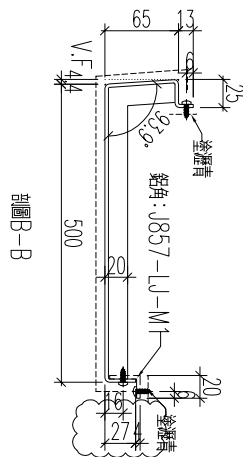




名稱	鋁板加工圖	制圖	黃漢卿	2022.12.2	修改	A	
材料	3mm厚鋁板	復核	王禮秋	2022.12.2	日期	2.23	
顏色	銅色(AL1)	批准			圖號	857-GB1-AP28	



工程號: J857 地盤: 啓德6552

編號	數量	長度	N	A	M	B
857-GB1-AP30	1	1466	3x300	283	4x300	133
857-GB2-AP28	1	1251	2x300	325.5	3x300	175.5
857-GB3-AP14	1	1251	2x300	325.5	3x300	175.5
857-GB4-AP9	1	1491	3x300	295.5	4x300	145.5

取消
取消

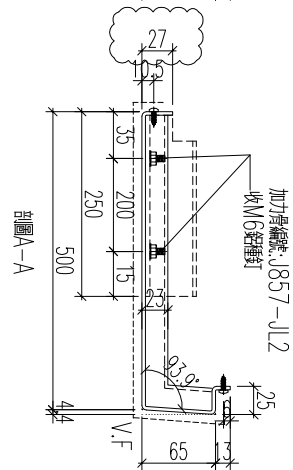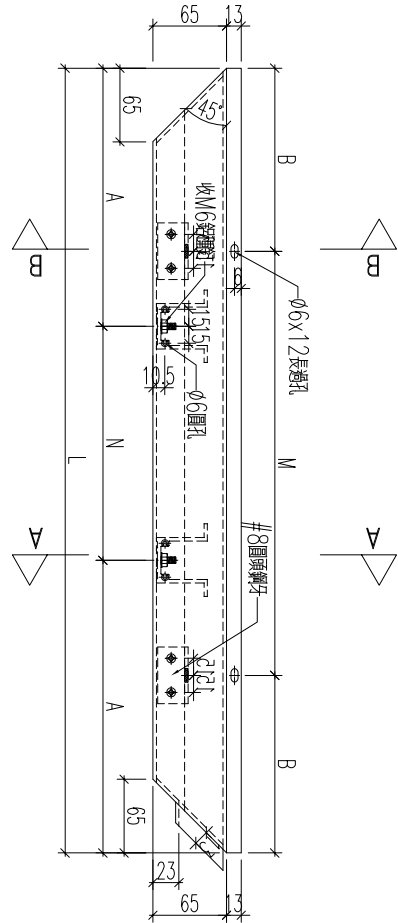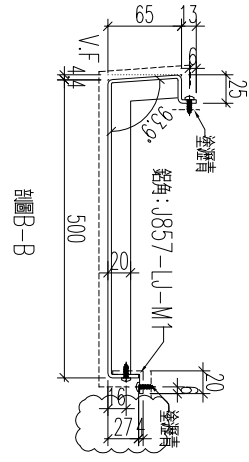

名稱	鋁板加工圖	制圖	黃漢卿	2022.12.2	修改	A	
材料	3mm厚板	復核	王禮秋	2022.12.2	日期	2.23	
顏色	銅色(AL1)	批准			圖號	857-GB1-AP30	



美特鋁質 有限公司
MIDI Aluminium Fabricator Ltd.

工程號



J857

地盤


啓德6552

編號	數量	長度	N	A	M	B
857-GB2-AP20	1	1403	3x300	251.5	4x300	101.5
857-GB3-AP1	1	1378	3x300	239	4x300	89
857-GB4-AP36	1	1428	3x300	264	4x300	114

取消

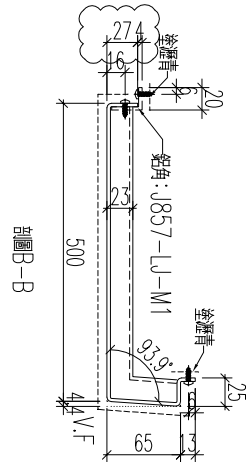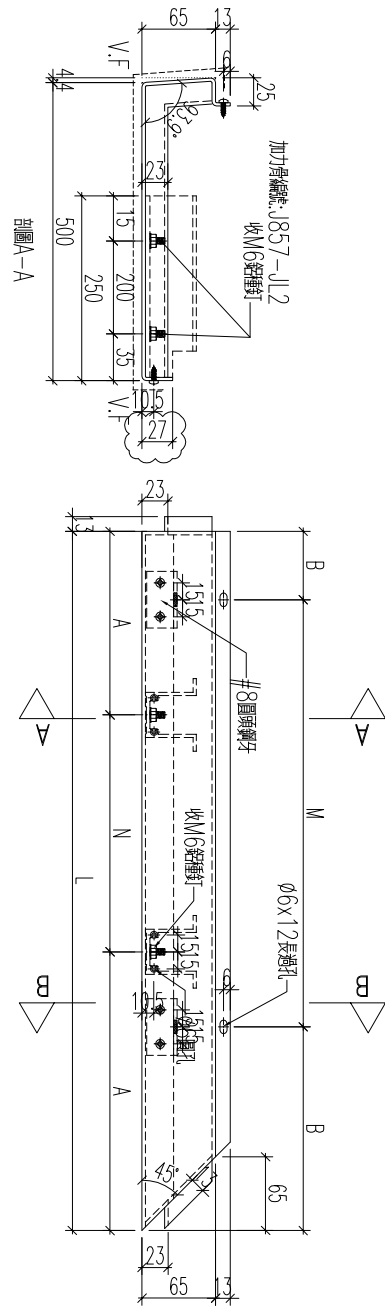

名稱	鋁板加工圖	制圖	黃漢卿	2022.12.2	修改	A	
材料	3mm厚板	復核	王禮秋	2022.12.2	日期	2.23	
顏色	銅色(AL1)	批准			圖號	857-GB2-AP20	

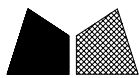




美特鋁質 有限公司
MIDI Aluminium Fabricator Ltd.

工程號	J857	地盤	啓德6552
-----	------	----	--------


線號	數量	長度	N	A	M	B
857-GB2-AP23	1	851	300	275.5	2x300	125.5

收

送

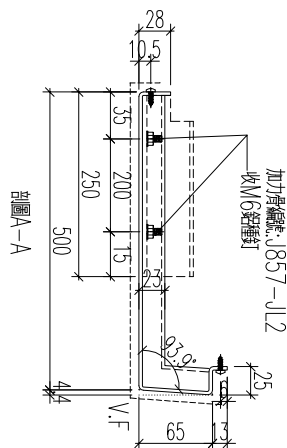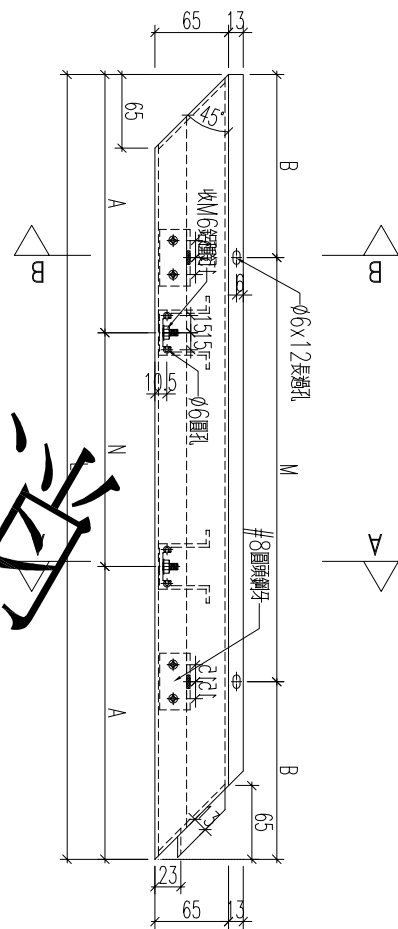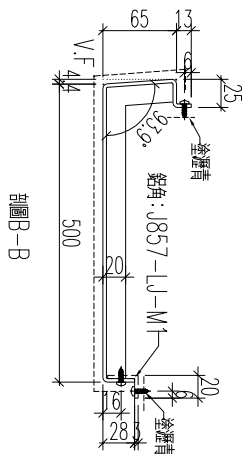


名稱	鋁板加工圖	制圖	黃漢卿	2022.12.2	修改		
材料	3mm厚板	復核	王禮秋	2022.12.2	日期		
顏色	銅色(AL1)	批准			圖號	857-GB2-AP23	

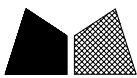

美特鋁質 有限公司
MIDI Aluminium Fabricator Ltd.

工程號	J857	地盤	啓德6552
-----	------	----	--------

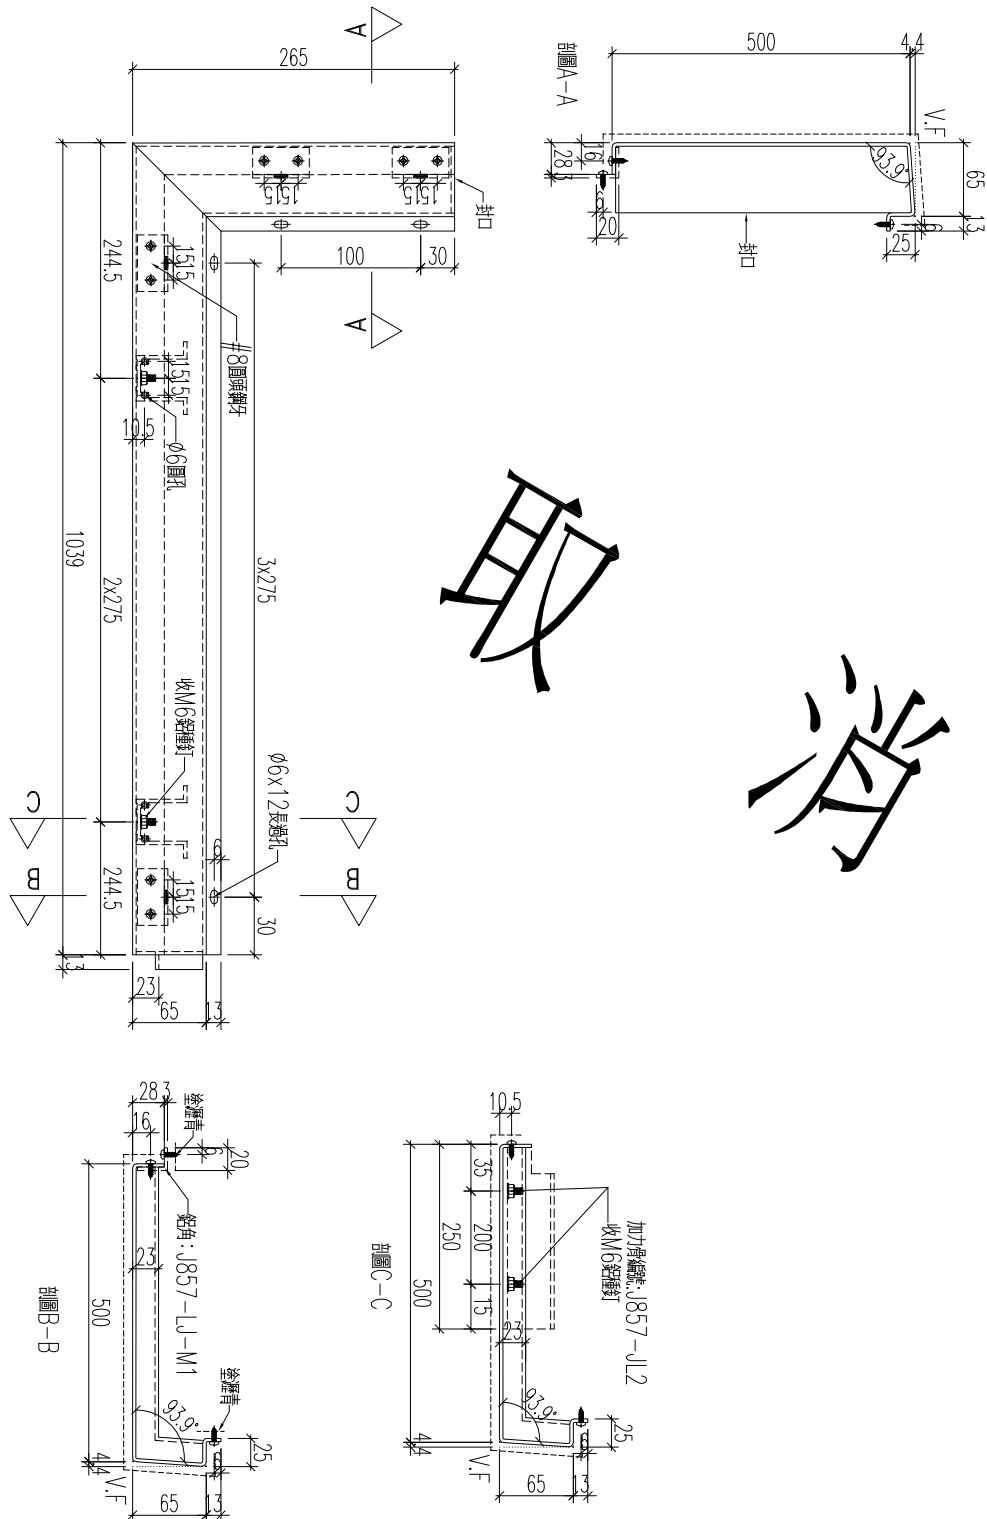

送檢





加工數量： 1支

名稱	鋁板加工圖	制圖	黃漢卿	2022.12.2	修改		
材料	3mm厚鋁板	復核	王禮秋	2022.12.2	日期		
顏色	銅色(AL1)	批准			圖號	857-GB4-AP14	



工程號	J857	地盤	啓德6552
-----	------	----	--------

線號	數量	長度	N	A	M	B
857-GB4-AP16	1					

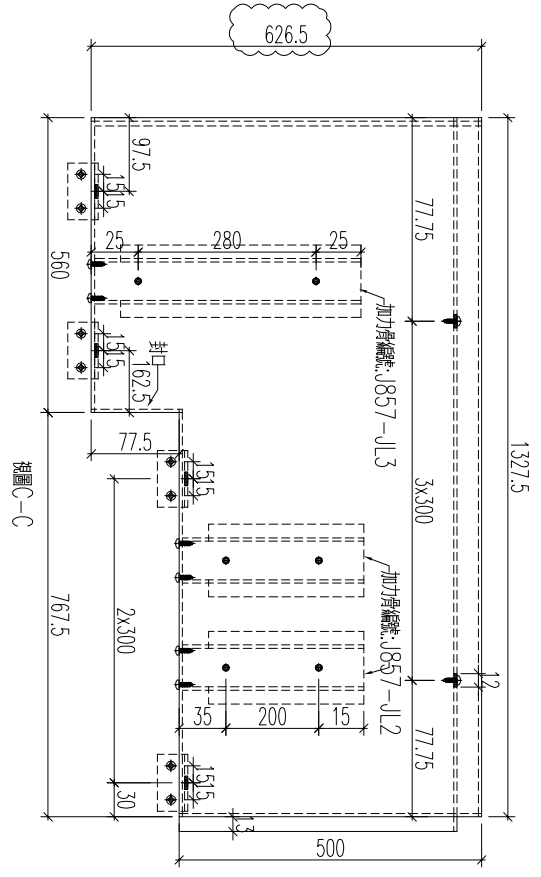
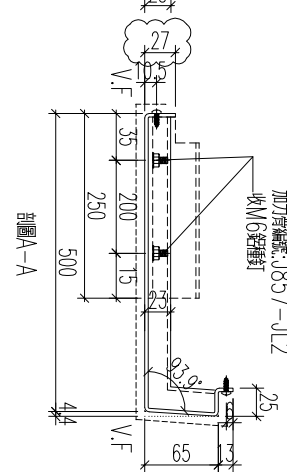
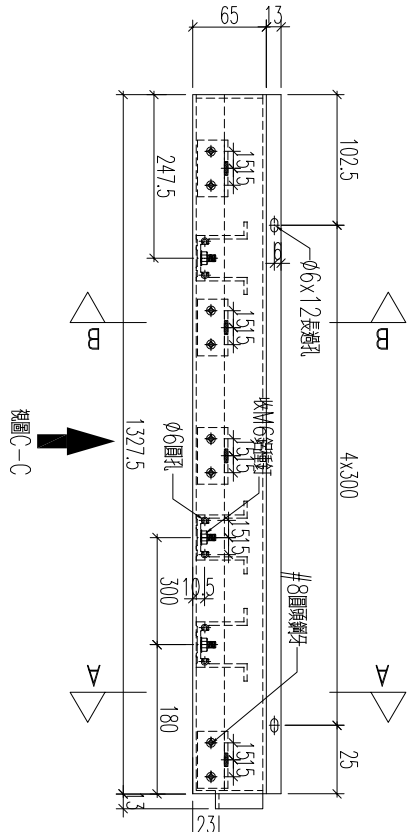
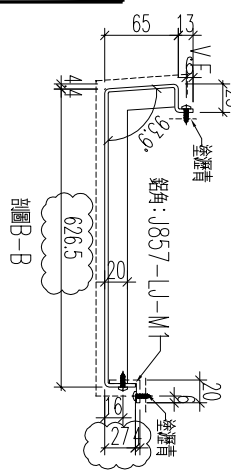


名稱	鋁板加工圖	制圖	黃漢卿	2022.12.2	修改	A	
材料	3mm厚鋁板	復核	王禮秋	2022.12.2	日期	2.23	
顏色	銅色(AL1)	批准			圖號	857-GB4-AP16	



工程號	J857	地盤	啓德6552
-----	------	----	--------

編號	數量	長度	N	A	M	B
857-GB4-AP41	1					

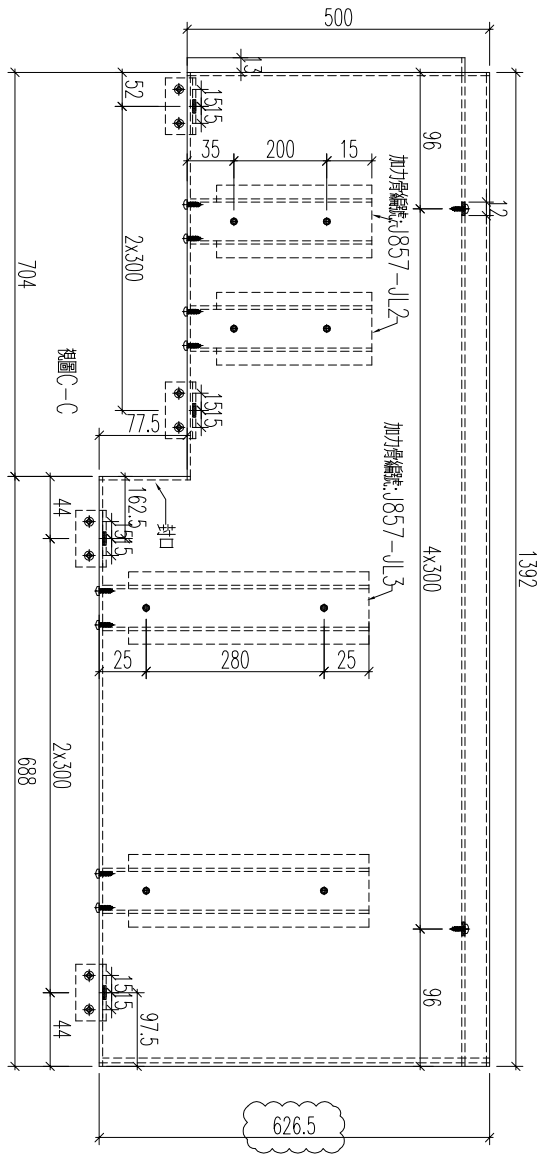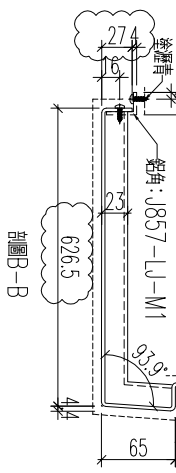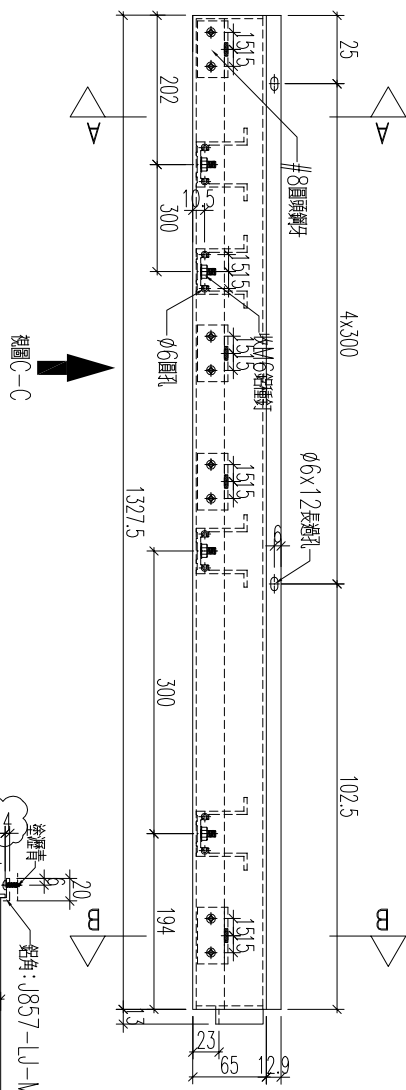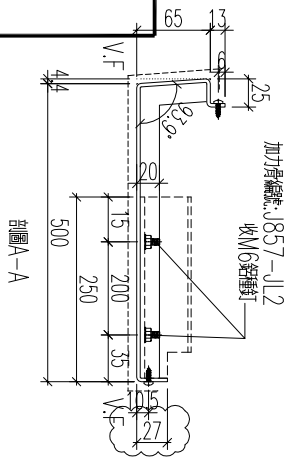

名稱	鋁板加工圖	制圖	黃漢卿	2022.12.2	修改	A	
材料	3mm厚板	復核	王禮秋	2022.12.2	日期	2.23	
顏色	銅色(AL1)	批准			圖號	857-GB4-AP41	







美特鋁質 有限公司
MIDI Aluminium Fabricator Ltd.

新增

工程號	J857	地盤	啓德6552
-----	------	----	--------

料號	數量	長度				
857-GB2-AP40	1	1668				

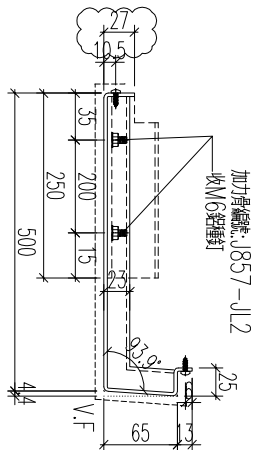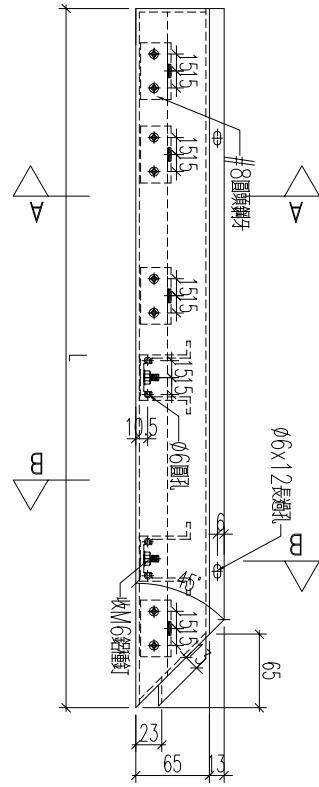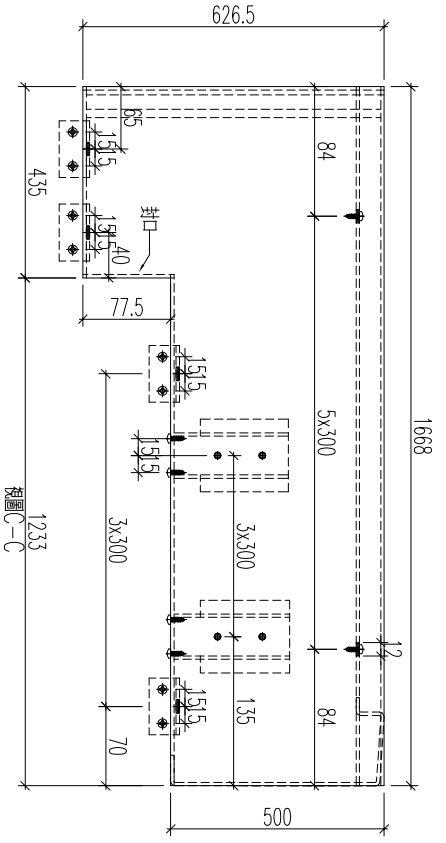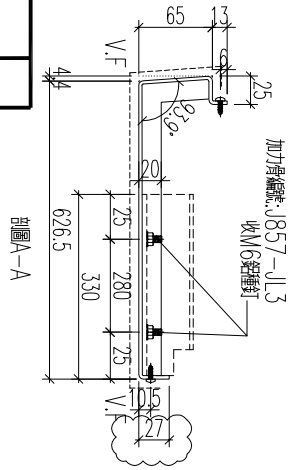




名稱	鋁板加工圖	制圖	黃漢卿	2022.12.2	修改	A	
材料	3mm厚板	復核	王禮秋	2022.12.2	日期	2.23	
顏色	銅色(AL1)	批准			圖號	857-GB2-AP40	



新增

工程號	J857	地盤	啓德6552
-----	------	----	--------

線號	數量	長度
857-GB3-AP2	1	1668

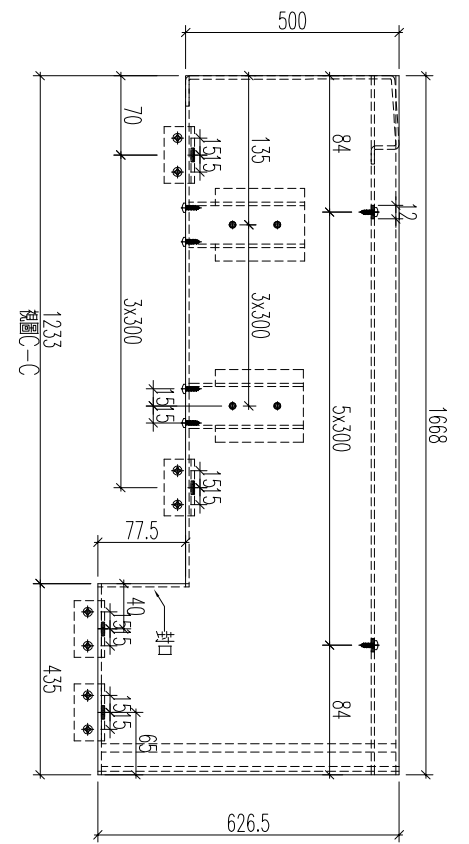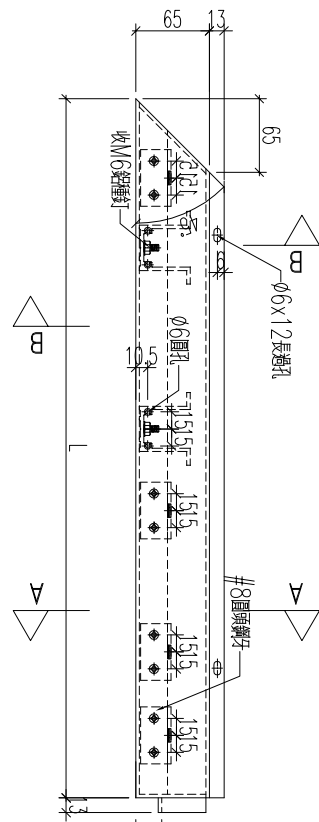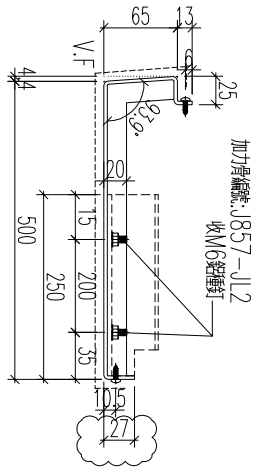

名稱	鋁板加工圖	制圖	黃漢卿	2022.12.2	修改	A
材料	3mm厚鋁板	復核	王禮秋	2022.12.2	日期	2.23
顏色	銅色(AL1)	批准			圖號	857-GB3-AP2



美特鋁質 有限公司
MIDI Aluminium Fabricator Ltd.

工程號

J857

地盤





啓德6552

料號
857-GB5-AP1


數量

1

新增

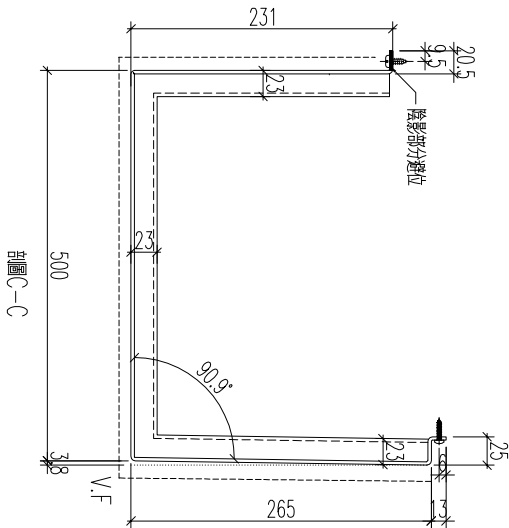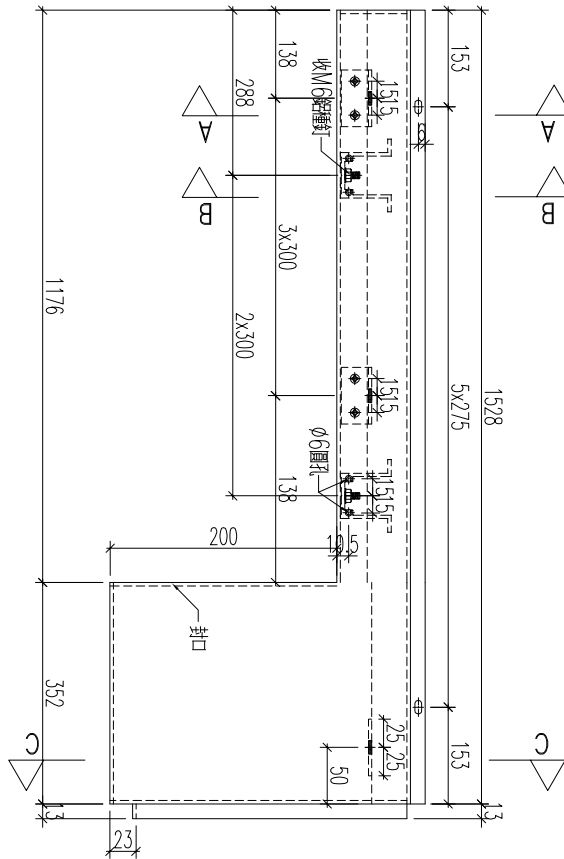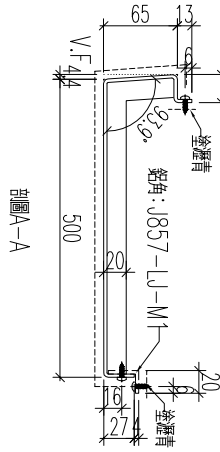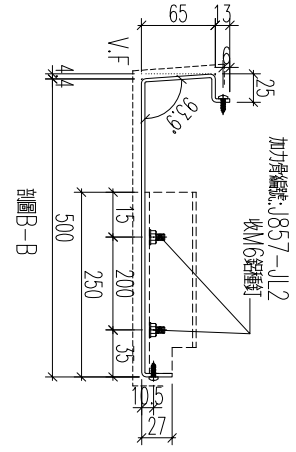




名稱	鋁板加工圖	制圖	黃漢卿	2022.12.2	修改	A	
材料	3mm厚板	復核	王禮秋	2022.12.2	日期	2.23	
顏色	銅色(AL1)	批准			圖號	857-GB5-AP1	

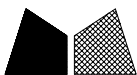

美特鋁質有限公司
MIDI Aluminium Fabricator Ltd.

工程號: 857 地盤: 啓德6552

編號	數量	長度	M	B	N	A	備註
857-GB1-AP5a	1	1485	3x300	292.5	4x300	142.5	
857-GB1-AP25a	1	1281	3x275	228	4x275	90.5	
857-GB1-AP29a	1	1224	2x300	312	3x300	162	
857-GB2-AP22a	1	1124	2x300	262	3x300	112	取消
857-GB3-AP13a	1	916	1x300	308	2x300	158	
857-GB4-AP8a	1	874	1x300	287	2x300	137	
857-GB4-AP39a	1	899	1x300	299.5	2x300	149.5	
857-GB4-AP44a	1	1154	2x300	277	3x300	127	取消
857-GB2-AP28a	1	1221	2x300	310.5	3x300	160.5	新增

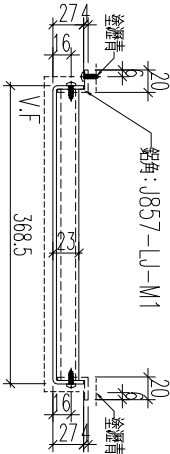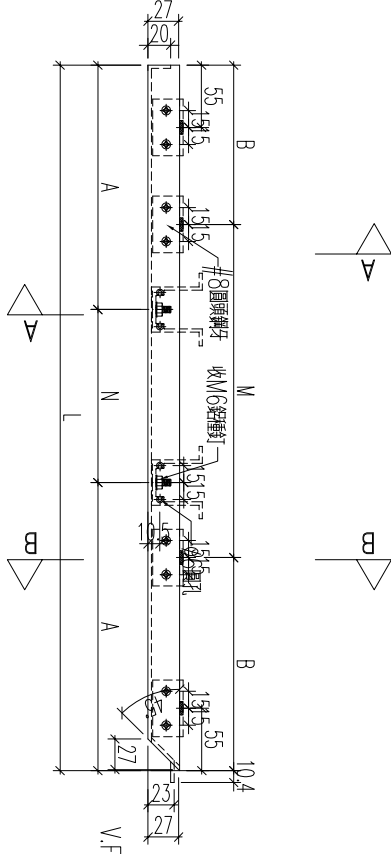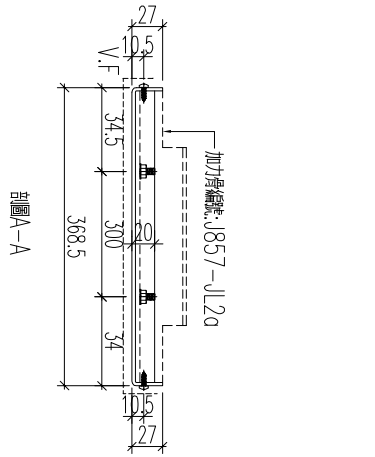

名稱	鋁板加工圖	制圖	黃漢卿	2022.12.2	修改	A	
材料	3mm厚板	復核	王禮秋	2022.12.2	日期	2.23	
顏色	深灰色(AL2)	批准			圖號	857-GB1-AP5a	




EG-DWG3



美特鋁質 有限公司
MIDI Aluminium Fabricator Ltd.

工程號	J857	地盤	啓德6552
-----	------	----	--------

料號	數量	長	M	B	N	A	
857-GB1-AP6a	1	1316	3x275	245.5	4x275	108	取消
857-GB1-AP26a	1	1174	2x300	287	3x300	137	
857-GB1-AP31a	1	873	1x300	286.5	2x300	136.5	
857-GB3-AP15a	1	1681	4x300	240.5	5x300	90.5	取消
857-GB4-AP10a	1	1261	3x275	218	4x275	80.5	
857-GB4-AP15a	1	1269	3x275	222	4x275	84.5	
857-GB4-AP40a	1	1337	3x275	256	4x275	118.5	
857-GB4-AP45a	1	936	2x250	218	3x250	93	取消
857-GB3-AP14a	1	1258	2x300	329	3x300	179	新增

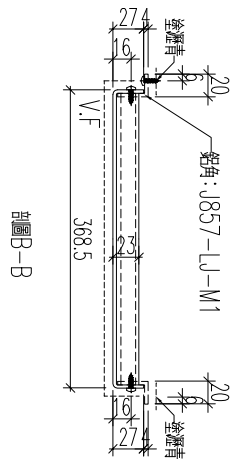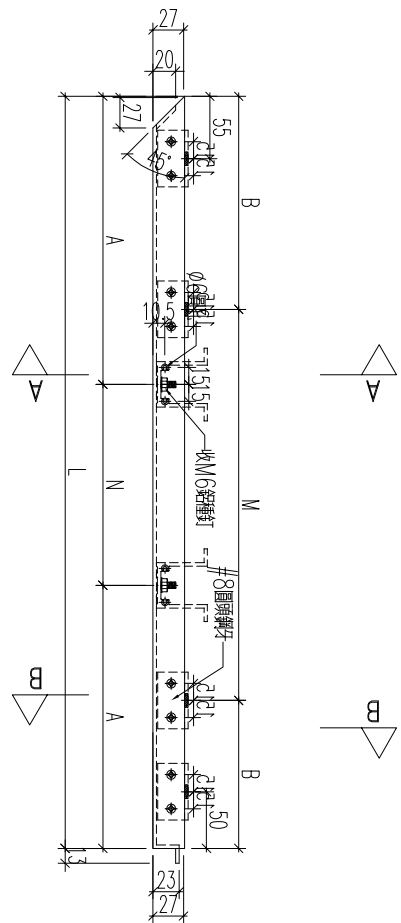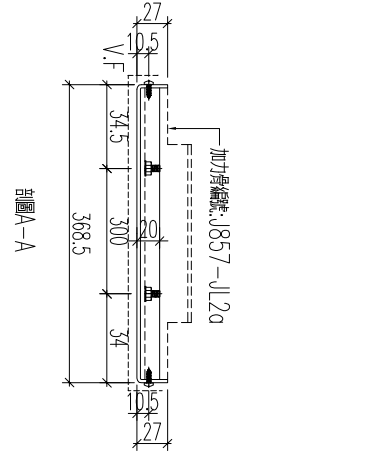




名稱	鋁板加工圖	制圖	黃漢卿	2022.12.2	修改	A	
材料	3mm磨板	復核	王禮秋	2022.12.2	日期	2.23	
顏色	深灰色(AL2)	批准			圖號	857-GB1-AP6a	



美特鋁質 有限公司
MIDI Aluminium Fabricator Ltd.

工程號 J857 地盤 啓德6552

編號	數量	長度	M	B	N	A	
857-GB1-AP7a	1	1370	3x300	235	4x300	85	取消
857-GB1-AP8a	1	1375	3x300	237.5	4x300	87.5	取消
857-GB1-AP16a	2	1490	3x300	295	4x300	145	
857-GB1-AP23a	1	1630	4x300	215	5x300	65	
857-GB2-AP4a	1	950	2x300	175	3x300	25	取消
857-GB2-AP5a	1	965	2x300	182.5	3x300	32.5	取消
857-GB2-AP12a	2	1490	3x300	295	4x300	145	
857-GB2-AP19a	1	1630	4x300	215	5x300	65	
857-GB2-AP36a	1	968	2x300	184	3x300	34	取消
857-GB3-AP33a	1	1630	4x300	215	5x300	65	
857-GB4-AP7a	1	933	2x275	191.5	3x275	54	
857-GB4-AP16a	1	1328	3x300	214	4x300	64	
857-GB4-AP38a	2	1490	3x300	295	4x300	145	
857-GB4-AP38ca	1	868	300	284	2x300	134	
857-GB9-AP20a	1	1490	3x300	295	4x300	145	
857-GB4-AP47a	1	1533	4x275	216.5	5x275	158	新增

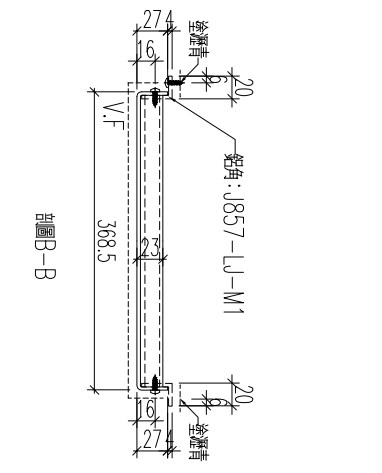
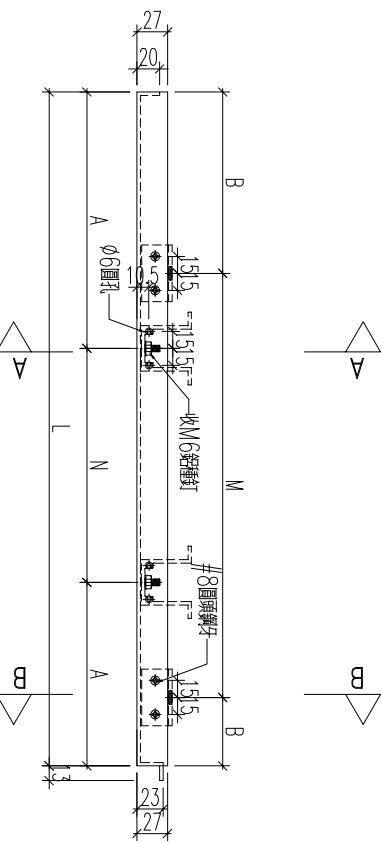
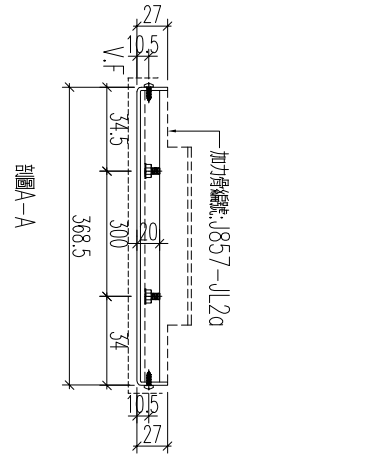


名稱	鋁板加工圖	制圖	黃漢卿	2022.12.2	修改	A
材料	3mm厚板	復核	王禮秋	2022.12.2	日期	2.23
顏色	深灰色(AL2)	批准			圖號	857-GB1-AP7a



美特鋁質 有限公司
MIDI Aluminium Fabricator Ltd.

工程號 J857 地盤 啓德6552

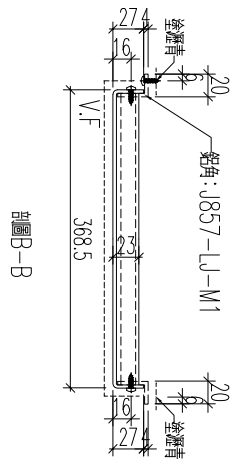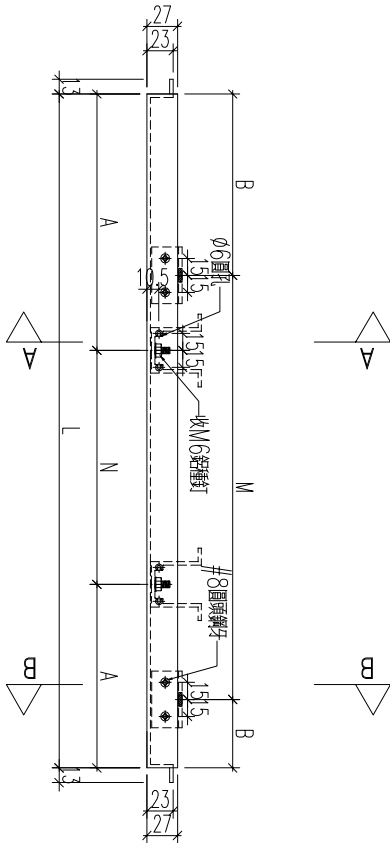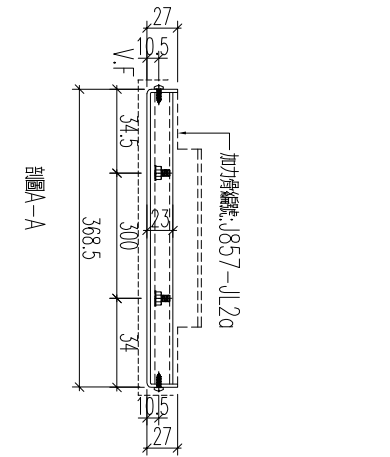

編號	數量	長度	M	B	N	A
857-GB1-AP24a	1	1340	3x300	220	4x300	70
857-GB2-AP6a	1	1630	4x300	215	5x300	65
857-GB3-AP19a	1	1630	4x300	215	5x300	65
857-GB3-AP34a	1	965	2x300	182.5	3x300	32.5
857-GB4-AP17a	1	1639	4x300	219.5	5x300	69.5
857-GB1-AP9a	1	1638	4x300	219	5x300	69

取消

新增

名稱	鋁板加工圖	制圖	黃漢卿	2022.12.2	修改	A	
材料	3mm厚板	復核	王禮秋	2022.12.2	日期	2.23	
顏色	深灰色(AL2)	批准			圖號	857-GB1-AP24a	



工程號

J857




地盤

啓德6552

編號	數量	長度	M	B	N	A
857-GB1-AP32a	1	933	2x270	196.5	3x270	61.5
857-GB2-AP29a	1	953	2x300	176.5	3x300	26.5
857-GB2-AP32a	1	485	1x300	92.5		242.5
857-GB3-AP6a	1	961	2x300	180.5	3x300	30.5
857-GB3-AP10a	1	485	1x300	92.5		242.5
857-GB3-AP35a	1	950	2x300	175	3x300	25
857-GB4-AP44a	1	1197	2x300	296	3x300	148.5

取消

新增

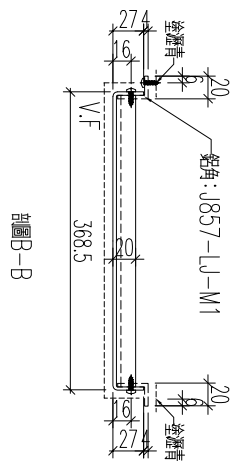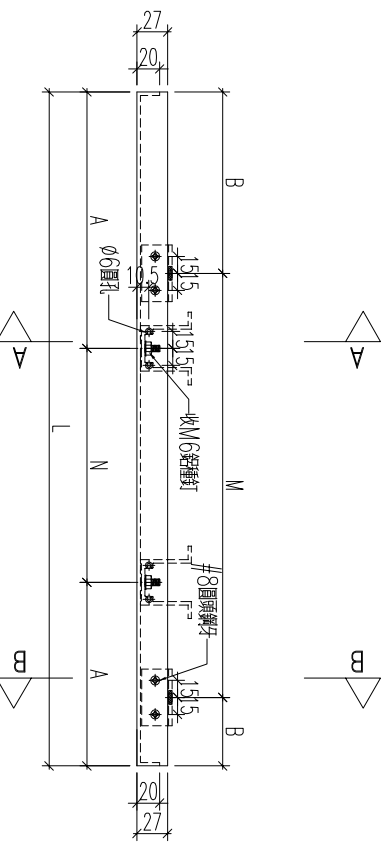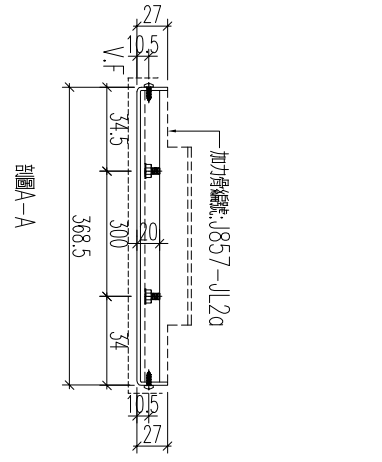


名稱	鋁板加工圖	制圖	黃漢卿	2022.12.2	修改	A
材料	3mm厚鋁板	復核	王禮秋	2022.12.2	日期	2.23
顏色	深灰色(AL2)	批准			圖號	857-GB1-AP32a



美特鋁質 有限公司
MIDI Aluminium Fabricator Ltd.

工程號	J857	地盤	啓德6552
-----	------	----	--------

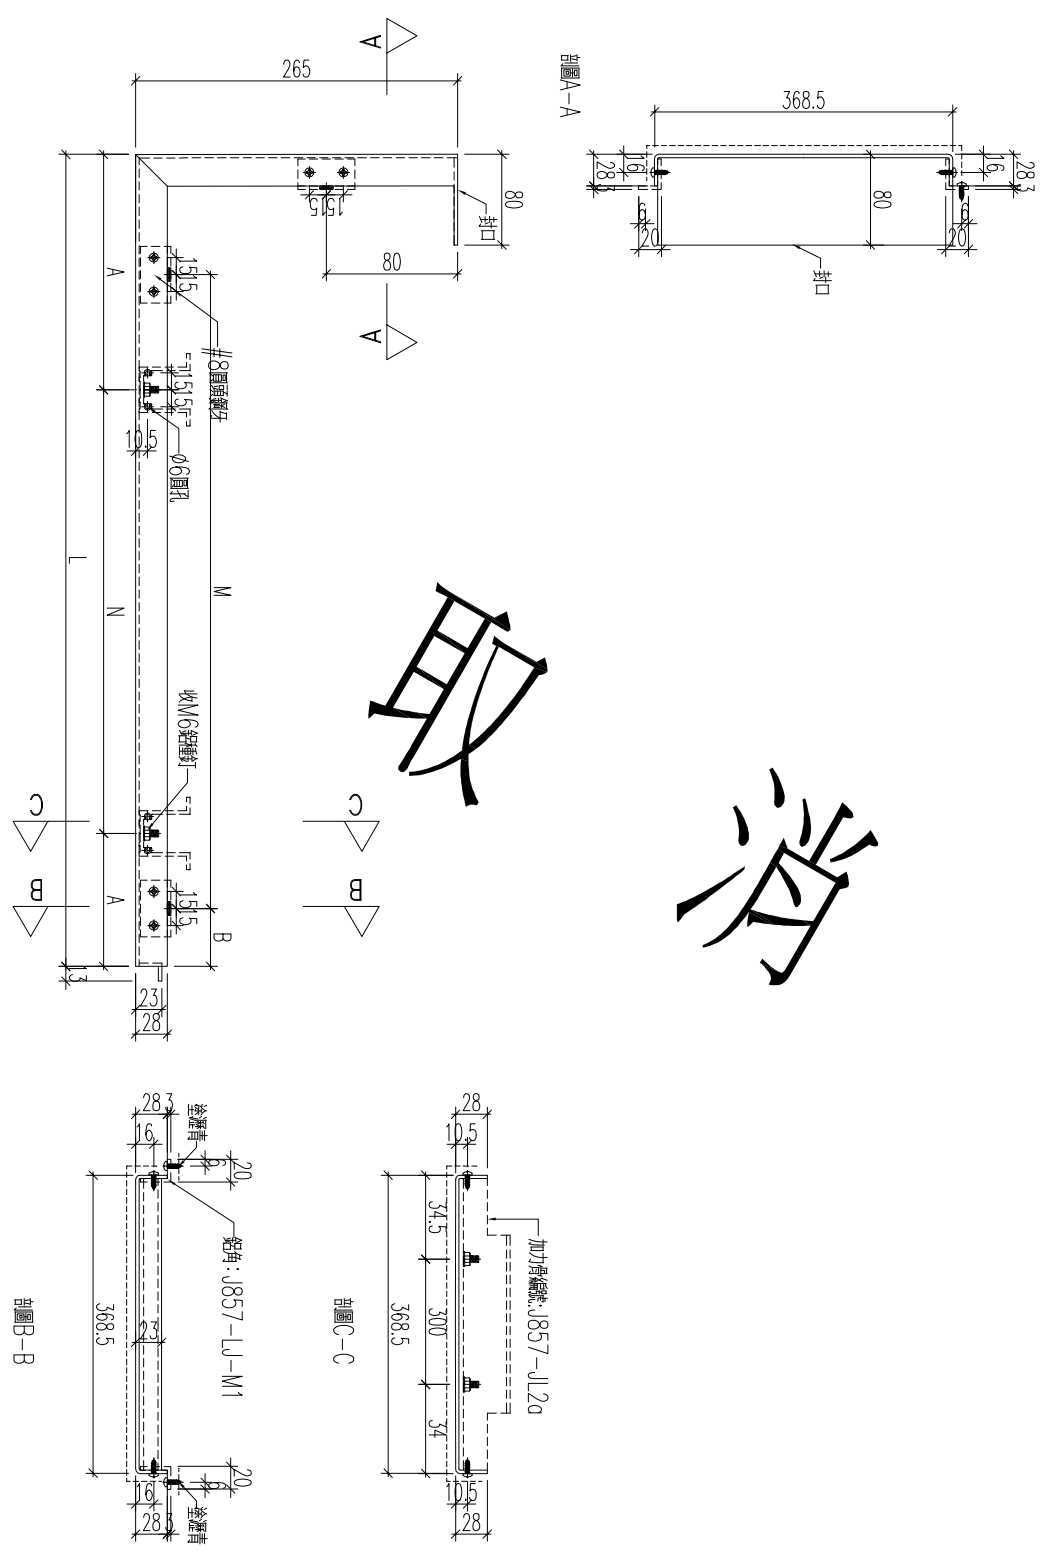

收

編號	數量	長皮 L	M	B	N	A
857-GB4-AP14a	1	1535	4x300	167.5	4x300	90

名稱	鋁板加工圖	制圖	黃漢卿	2022.12.2	修改		
材料	3mm 磨板	復核	王禮秋	2022.12.2	日期		
顏色	深灰色(AL2)	批准			圖號	857-GB4-AP14a	




美特鋁質 有限公司
MIDI Aluminium Fabricator Ltd.

工程號 J857 地盤 啓德6552

料號	數量	長度	M	B	N	A
857-GB1-AP27a	1	1306	3x275	240.5	4x275	103
857-GB4-AP10a	1	1393	3x300	246.5	4x300	96.5
857-GB4-AP46a	1	1068	2x300	234	3x300	84

取消

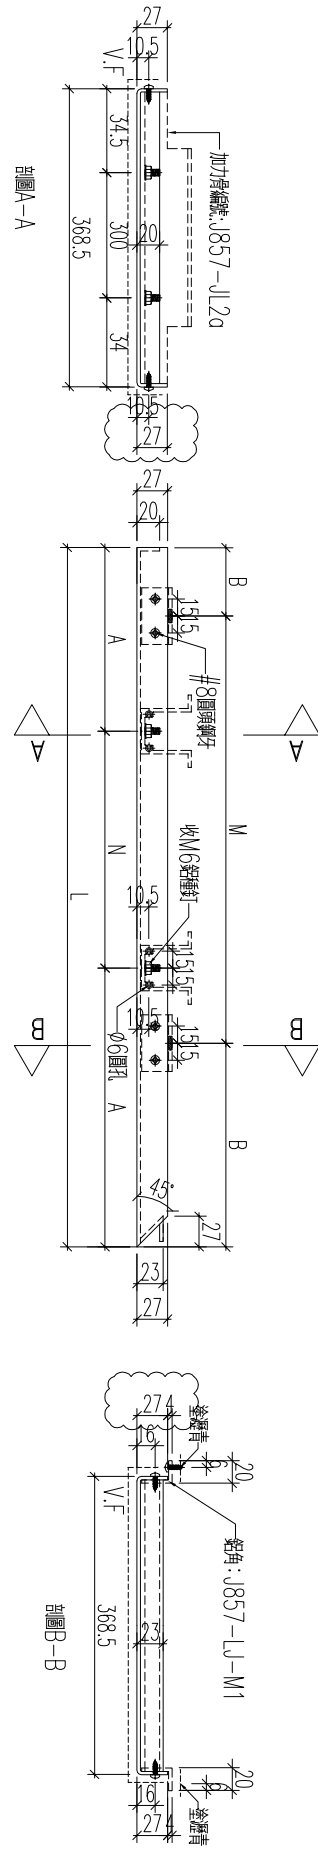

名稱	鋁板加工圖	制圖	黃漢卿	2022.12.2	修改	A	
材料	3mm厚鋁板	復核	王禮秋	2022.12.2	日期	2.23	
顏色	深灰色(AL2)	批准			圖號	857-GB1-AP27a	



美特鋁質 有限公司
MIDI Aluminium Fabricator Ltd.


工程號 J857

地盤

啓德6552

編號	數量	長度	M	B	N	A
857-GB1-AP28a	1	1356	3x300	228	4x300	78
857-GB2-AP21a	1	1256	3x275	215.5	4x275	78
857-GB4-AP37a	1	1388	3x300	244	4x300	94

取消

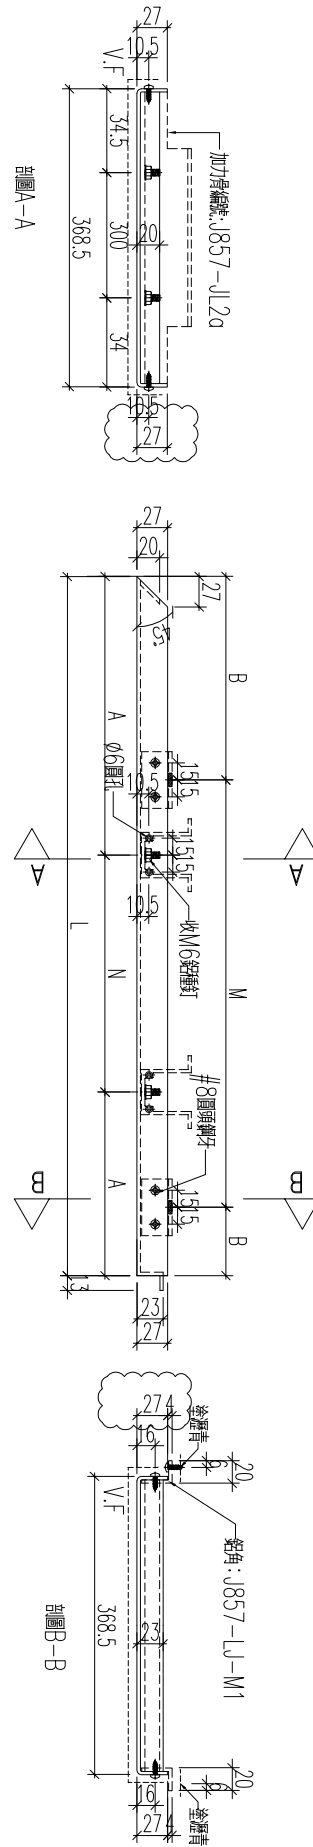

名稱	鋁板加工圖	制圖	黃漢卿	2022.12.2	修改	A	
材料	3mm厚鋁板	復核	王禮秋	2022.12.2	日期	2.23	
顏色	深灰色(AL2)	批准			圖號	857-GB1-AP28a	



工程號


J857

地盤


啓德6552

編號	數量	長度	M	B	N	A
857-GB1-AP30a	1	1390	3x300	245	4x300	95
857-GB2-AP28a	1	1251	2x300	325.5	3x300	175.5
857-GB3-AP14a	1	1251	2x300	325.5	3x300	175.5
857-GB4-AP9a	1	1415	3x300	257.5	4x300	107.5


取消
取消

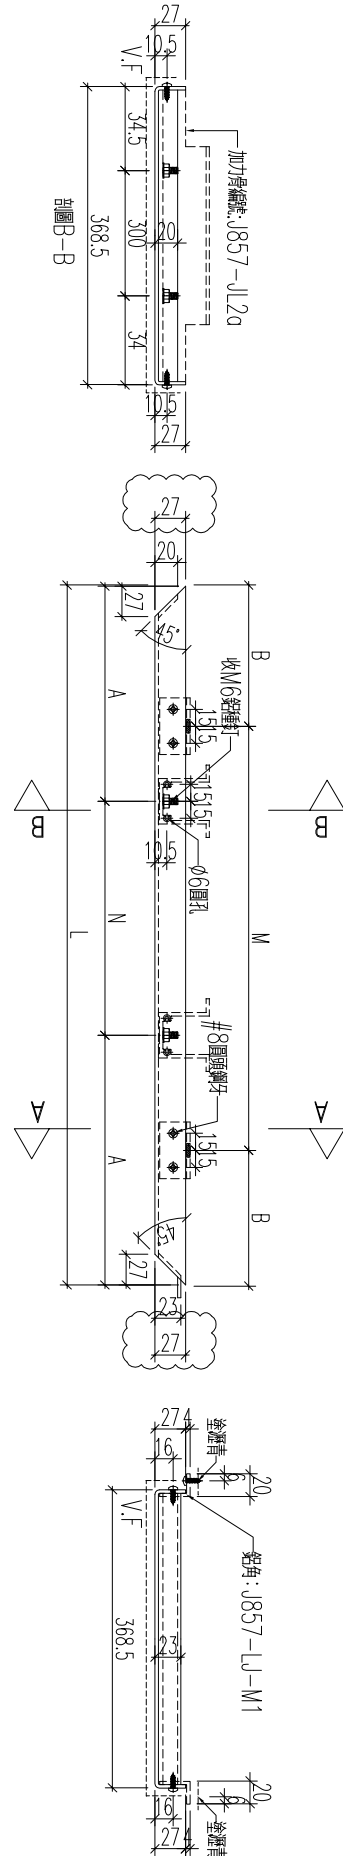

名稱	鋁板加工圖	制圖	黃漢卿	2022.12.2	修改	A	
材料	3mm厚板	復核	王禮秋	2022.12.2	日期	2.23	
顏色	深灰色(AL2)	批准			圖號	857-GB1-AP30a	

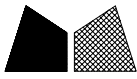


工程號	J857	地盤	啓德6552
-----	------	----	--------

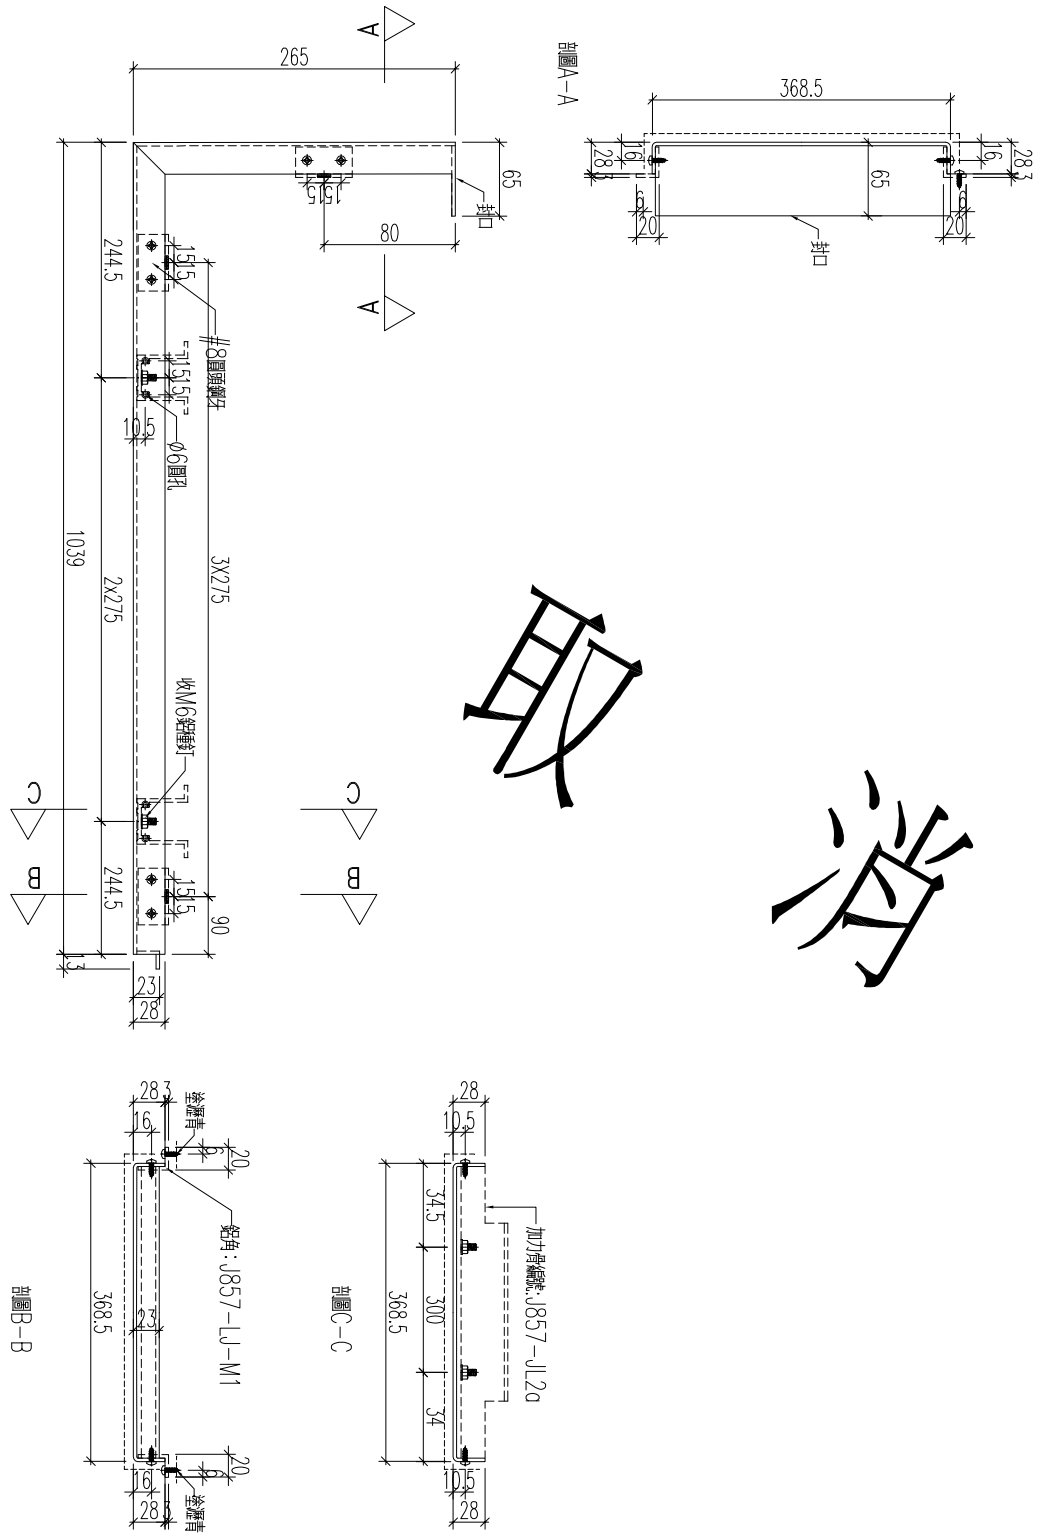

收
邊

加工數量: 1支




名稱	鋁板加工圖	制圖	黃漢卿	2022.12.2	修改			
材料	3mm厚板	復核	王禮秋	2022.12.2	日期			
顏色	深灰色(AL2)	批准			圖號	857-GB4-AP14a		

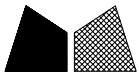

美特鋁質有限公司
MIDI Aluminium Fabricator Ltd.

工程號	J857	地盤	啓德6552
-----	------	----	--------

編號	數量	長度	M	B	N	A
857-GB4-AP16a	1	767.5	2x300	83.75	300	233.75

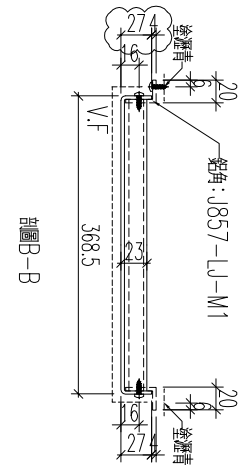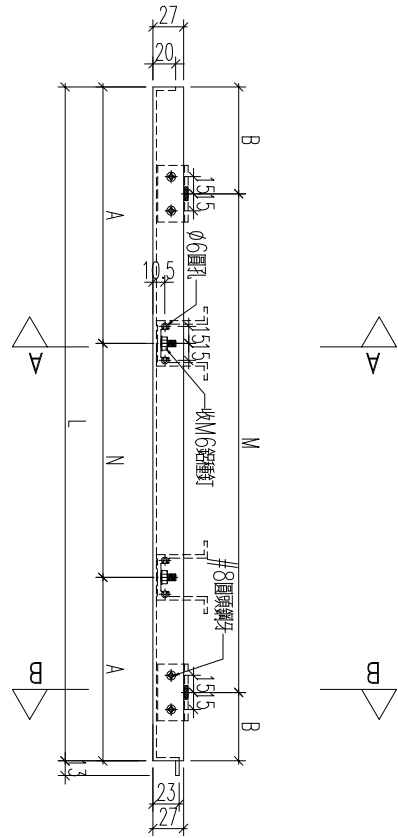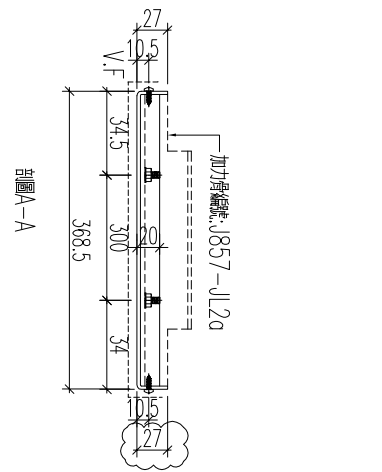




名稱	鋁板加工圖	制圖	黃漢卿	2022.12.2	修改	A
材料	3mm厚鋁板	復核	王禮秋	2022.12.2	日期	2.23
顏色	深灰色(AL2)	批准			圖號	857-GB4-AP16a



美特鋁質 有限公司
MIDI Aluminium Fabricator Ltd.

工程號	J857	地盤	啓德6552
-----	------	----	--------

編號	數量	長度	M	B	N	A
857-GB4-AP41a	1	688	2x300	44	300	194

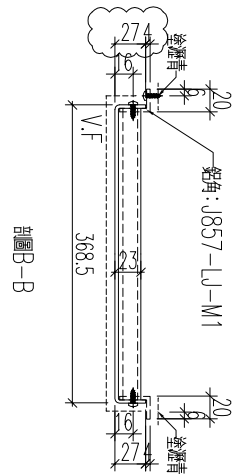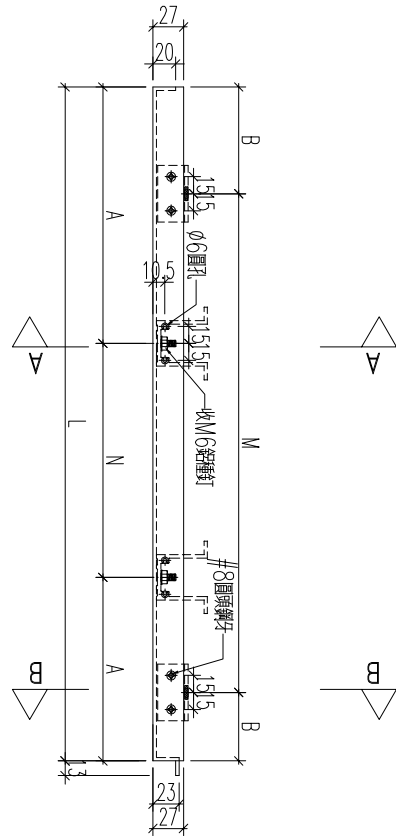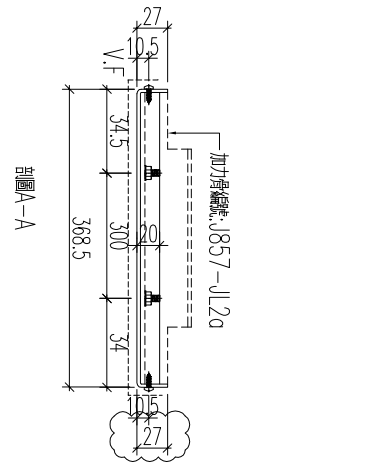

名稱	鋁板加工圖	制圖	黃漢卿	2022.12.2	修改	A	
材料	3mm厚板	復核	王禮秋	2022.12.2	日期	2.23	
顏色	深灰色(AL2)	批准			圖號	857-GB4-AP41a	



美特鋁質 有限公司
MIDI Aluminium Fabricator Ltd.

工程號

J857




地盤

啓德6552

料號
857-GB2-AP40a

數量
1

新增

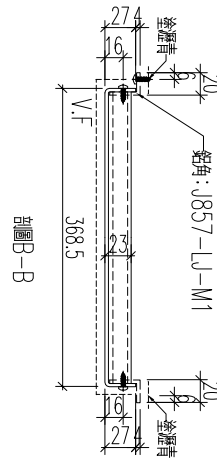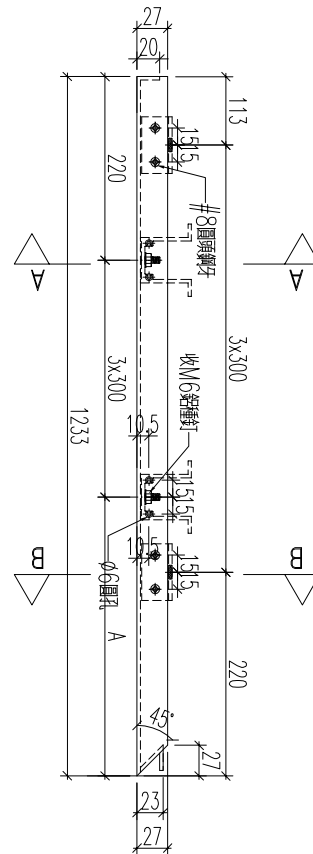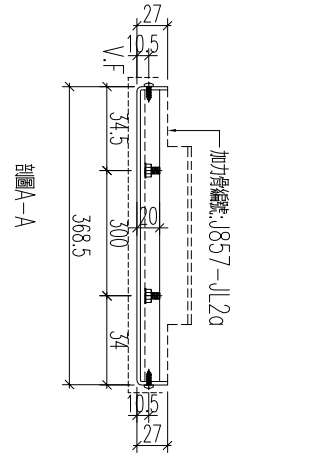

名稱	鋁板加工圖	制圖	黃漢卿	2022.12.2	修改		
材料	3mm厚板	復核	王禮秋	2022.12.2	日期		
顏色	深灰色(AL2)	批准			圖號	857-GB4-AP36a	



美特鋁質 有限公司
MIDI Aluminium Fabricator Ltd.

工程號

J857

地盤




啓德6552

料號
857-GB3-AP2a

數量

1

新增

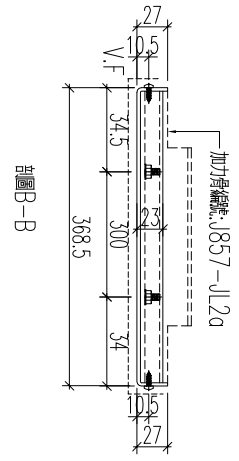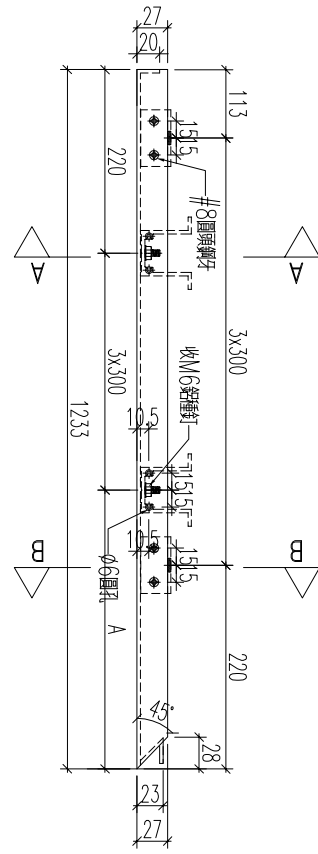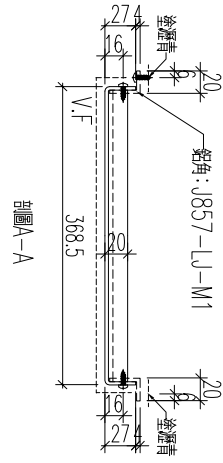




名稱	鋁板加工圖	制圖	黃漢卿	2022.12.2	修改		
材料	3mm厚鋁板	復核	王禮秋	2022.12.2	日期		
顏色	深灰色(AL2)	批准			圖號	857-GB3-AP2a	




新增

工程號	J857	地盤	啓德6552
-----	------	----	--------

編號	數量						
857-GB5-AP1a	1						

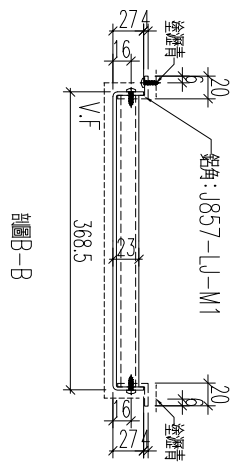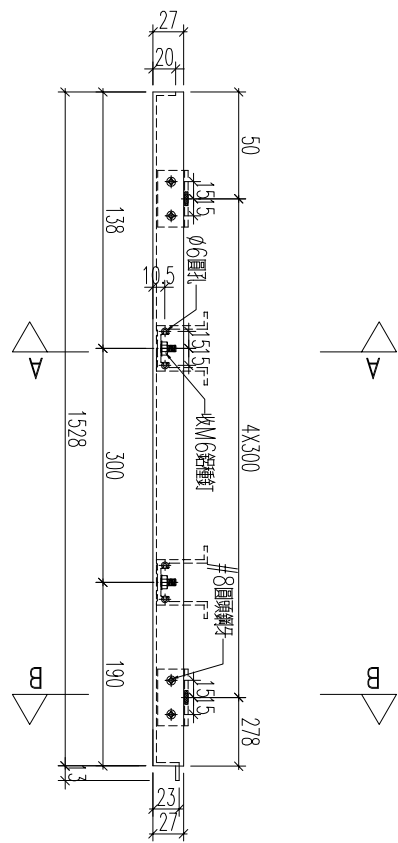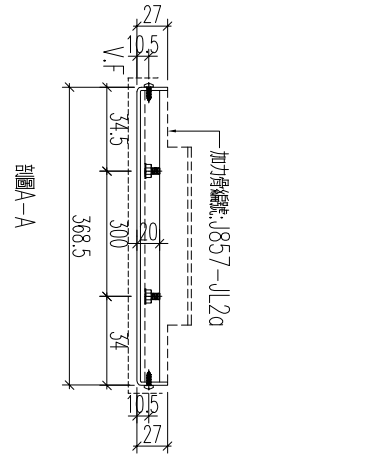

名稱	鋁板加工圖	制圖	黃漢卿	2022.12.2	修改		
材料	3mm厚板	復核	王禮秋	2022.12.2	日期		
顏色	深灰色(AL2)	批准			圖號	857-GB5-AP1a	




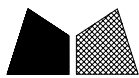


美特鋁質 有限公司
MIDI Aluminium Fabricator Ltd.

工程號	J857	地盤	啓德6552
-----	------	----	--------

編號	數量	長度	M	B	N	A
857-GB2-AP20a	1	1403	3x300	251.5	4x300	101.5
857-GB3-AP1a	1	1378	3x300	239	4x300	89

取消

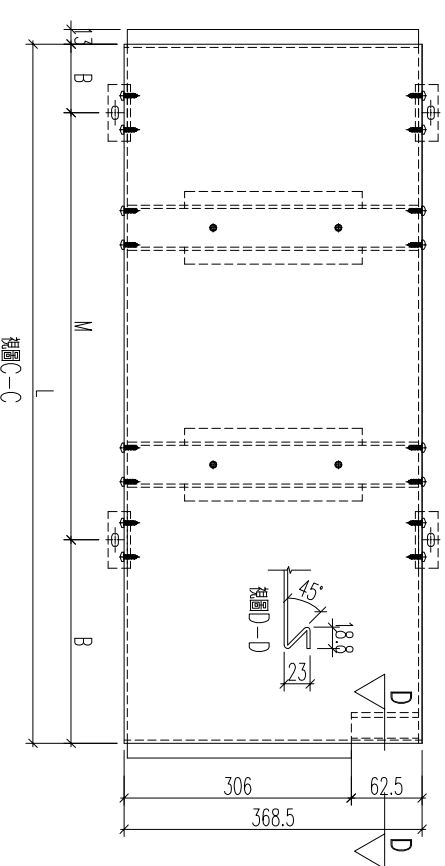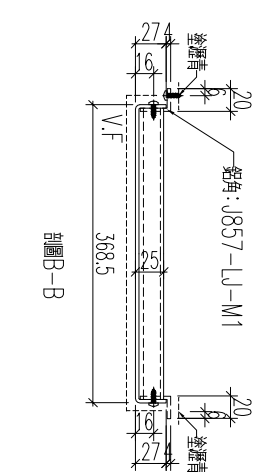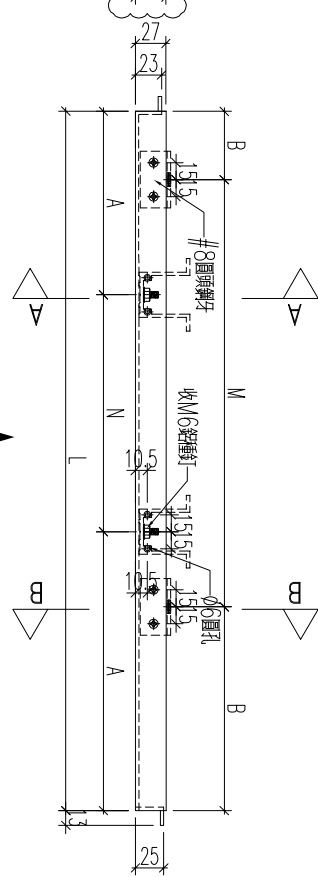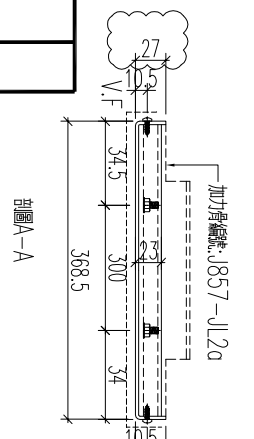

名稱	鋁板加工圖	制圖	黃漢卿	2022.12.2	修改		
材料	3mm 鋁板	復核	王禮秋	2022.12.2	日期		
顏色	深灰色(AL2)	批准			圖號	857-GB2-AP20a	




工程號

J857

地盤

啓德6552





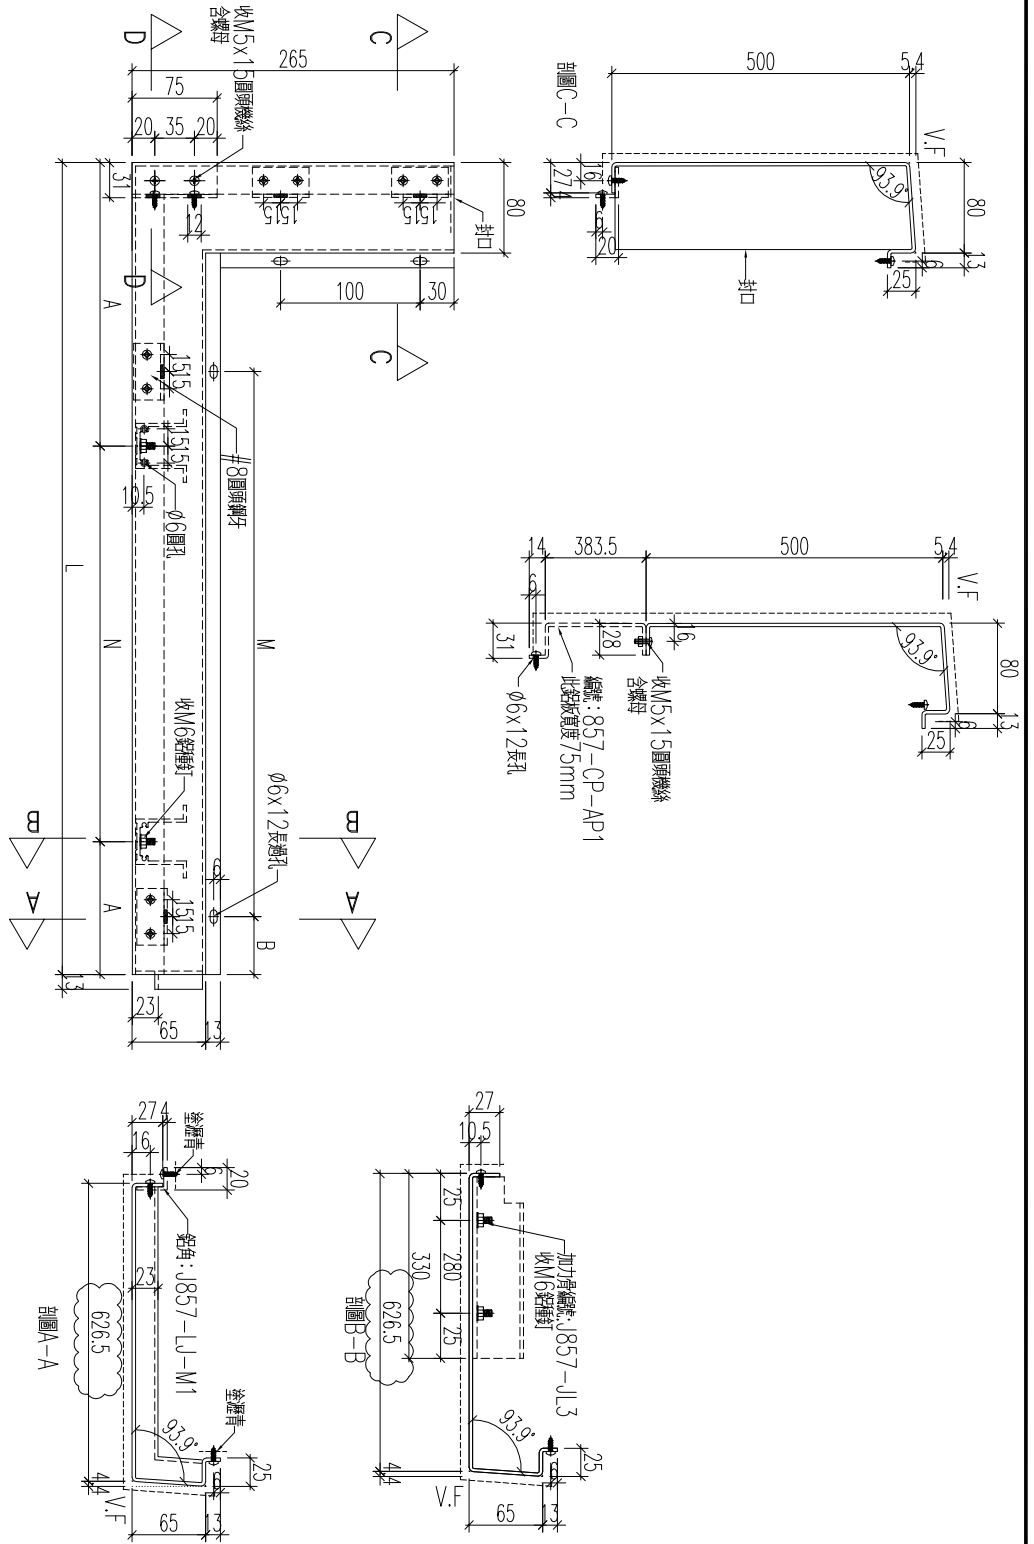


編號	數量	長度	N	A	M	B
857-GB1-AP15	1	1535	4x300	167.5	4x300	30
857-GB2-AP11a	1	1535	4x300	167.5	4x300	30
857-GB3-AP25	1	1535	4x300	167.5	4x300	30
857-GB4-AP23	1	1190	3x300	145	3x300	30
857-GB6-AP3	1	1454	4x300	127	4x300	30
857-GB7-AP10	1	1585	4x300	192.5	4x300	30
857-GB8-AP14	1	1715	4x300	257.5	5x300	30

名稱	鋁板加工圖	制圖	黃漢卿	2022.12.2	修改	A
材料	3mm磨板	復核	王禮秋	2022.12.2	日期	2.23
顏色	銅色(AL1)	批准			圖號	857-GB1-AP15



工程號	J857	地盤	啓德6552
-----	------	----	--------

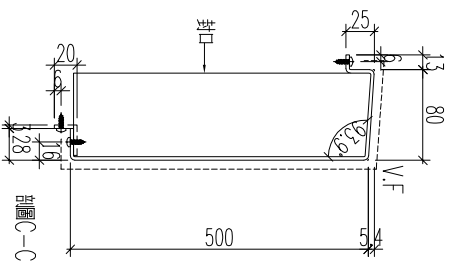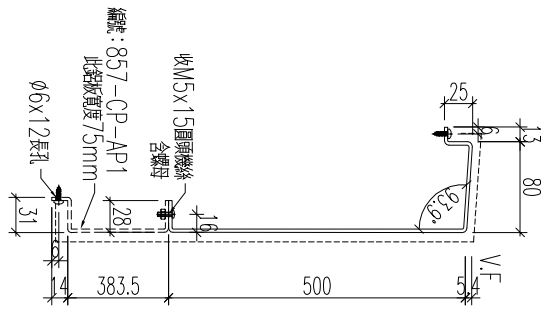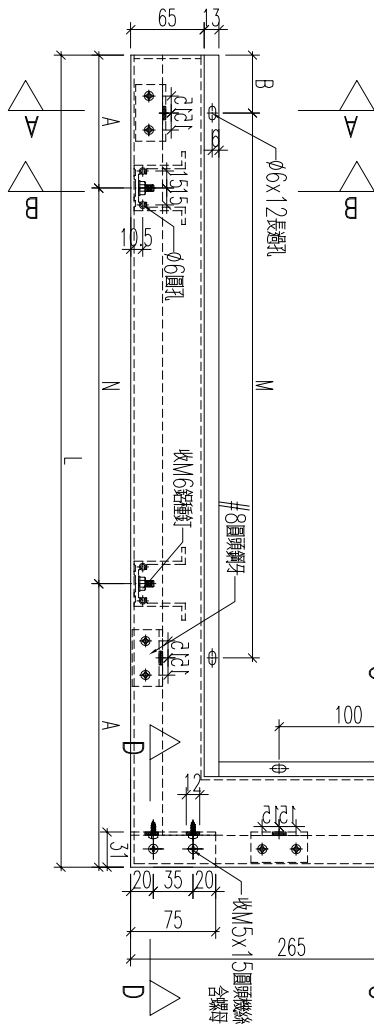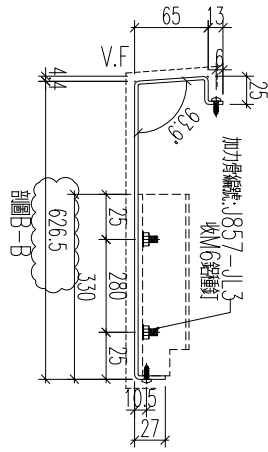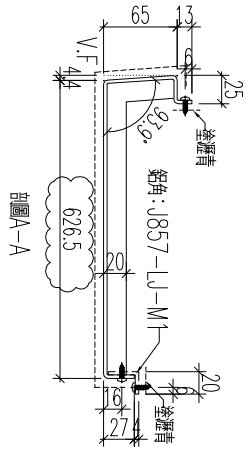

編號	數量	長寬L	N	A	M	B
857-GB1-AP17	1	1535	4x300	167.5	4x300	30
857-GB2-AP13	1	1535	4x300	167.5	4x300	30
857-GB3-AP27	1	1535	4x300	167.5	4x300	30
857-GB4-AP25	1	1190	3x300	145	3x300	30
857-GB6-AP8	1	1174	3x300	137	3x300	30
857-GB7-AP12	1	1585	4x300	192.5	4x300	30
857-GB9-AP5	1	1454	4x300	127	4x300	30

名稱	鋁板加工圖	制圖	黃漢卿	2022.12.2	修改	A
材料	3mm厚板	復核	王禮秋	2022.12.2	日期	2.23
顏色	銅色(AL1)	批准			圖號	857-GB1-AP17






美特鋁質 有限公司
MIDI Aluminium Fabricator Ltd.

工程號 J857 地盤 啓德6552

編號	數量	長度	N	A	M	B
857-GB1-AP16	2	1490	3x300	295	4x300	145
857-GB2-AP12	2	1490	3x300	295	4x300	145
857-GB3-AP26	2	1490	3x300	295	4x300	145
857-GB4-AP25	1	1090	2x300	245	3x300	95
857-GB6-AP4	1	1354	3x300	227	4x300	77
857-GB4-AP7d	1	1074	2x300	237	3x300	87
857-GB7-AP11	4	1490	3x300	295	4x300	145
857-GB9-AP4	1	1354	3x300	227	4x300	77
857-GB2-AP21	1	1182	2x300	291	3x300	141
857-GB3-AP17	1	1182	2x300	291	3x300	141




增加
增加
增加

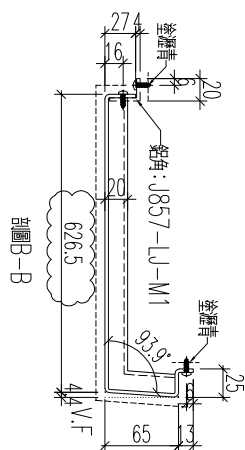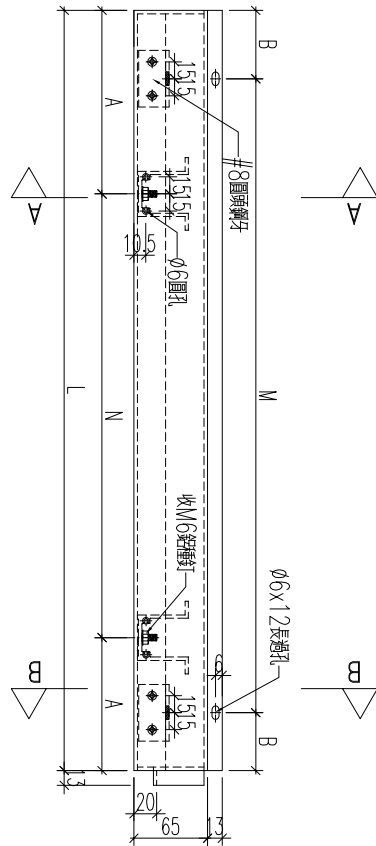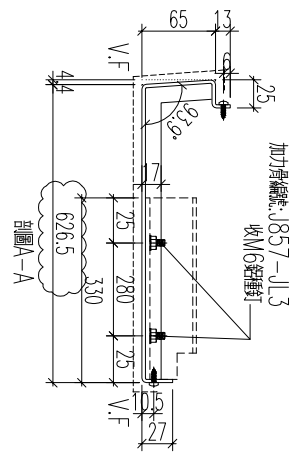

名稱	鋁板加工圖	制圖	黃漢卿	2022.12.2	修改	A
材料	3mm厚鋁板	復核	王禮秋	2022.12.2	日期	2.23
顏色	銅色(AL1)	批准			圖號	857-GB1-AP16



工程號 J857 地盤 啓德6552

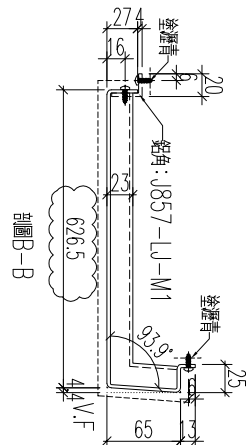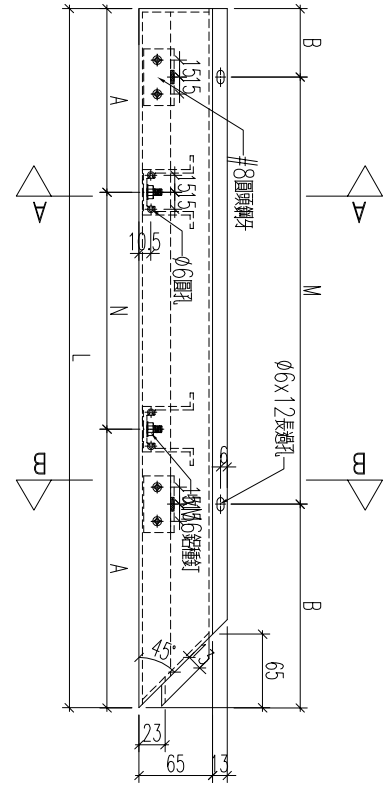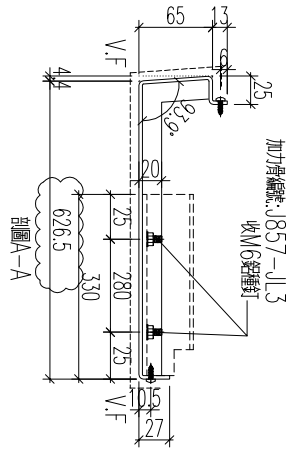

編號	數量	長規	N	A	M	B
857-GB3-AP17	1	1256	3x275	215.5	4x275	78
857-GB4-AP42	1	1470	3x300	285	4x300	135
857-GB6-AP5	1	1432	3x300	266	4x300	116
857-GB2-AP40	1	1668	4x300	234	5x300	84

取消
取消
取消

取消




名稱	鋁板加工圖	制圖	黃漢卿	2022.12.2	修改	A
材料	3mm厚板	復核	王禮秋	2022.12.2	日期	2.23
顏色	銅色(AL1)	批准			圖號	857-GB3-AP17



美特鋁質 有限公司
MIDI Aluminium Fabricator Ltd.

工程號	J857	地盤	啓德6552
-----	------	----	--------

編號	數量	長	N	A	M	B
857-GB3-AP42	1	851	300	243	2x300	93
857-GB6-AP6	1	551		243	300	93

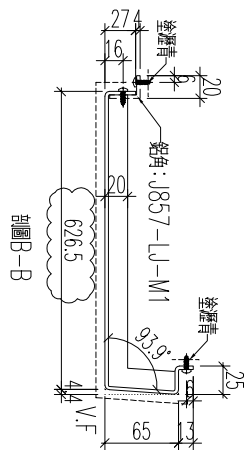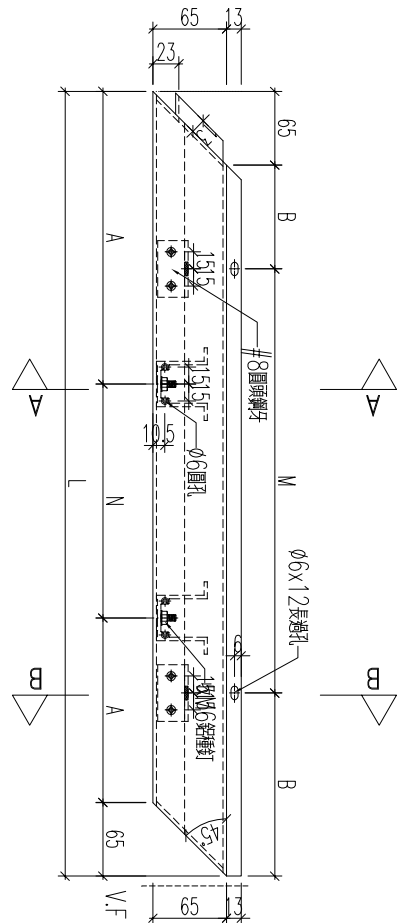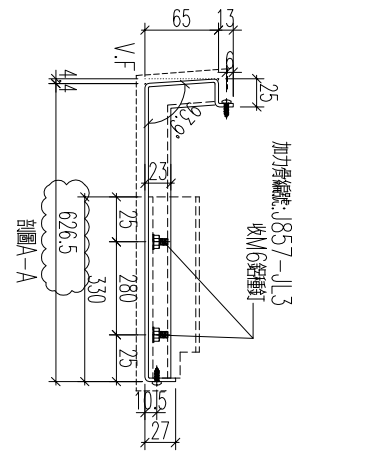




名稱	鋁板加工圖	制圖	黃漢卿	2022.12.2	修改	A
材料	3mm厚板	復核	王禮秋	2022.12.2	日期	2.23
顏色	銅色(AL1)	批准			圖號	857-GB3-AP42




美特鋁質 有限公司
MIDI Aluminium Fabricator Ltd.

工程號 J857 地盤 啓德6552

編號	數量	長度	N	A	M	B
857-GB3-AP16	1	1161	2x300	280.5	3x300	130.5
857-GB4-AP15	1	1306	3x275	290.5	4x275	153
857-GB6-AP7	1	1057	2x275	253.5	3x275	116
857-GB2-AP39	1	1573	4x275	236.5	5x275	99
857-GB3-AP4	1	528		265	300	114
增加						

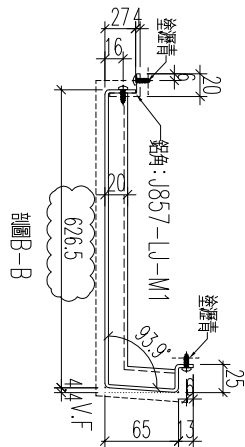
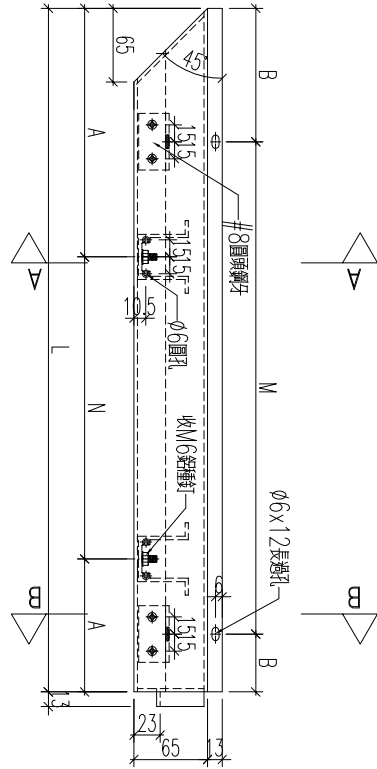
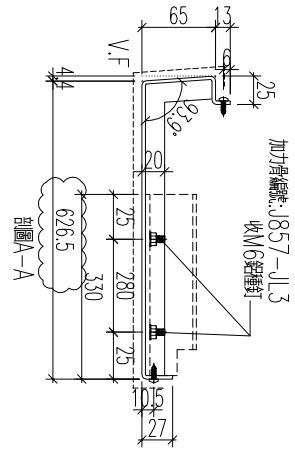


名稱	鋁板加工圖	制圖	黃漢卿	2022.12.2	修改	A	
材料	3mm厚板	復核	王禮秋	2022.12.2	日期	2.23	
顏色	銅色(AL1)	批准			圖號	857-GB3-AP16	

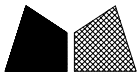

工程號	J857	地盤	啓德6552
-----	------	----	--------

編號	數量	長度	N	A	M	B	備註
857-GB3-AP4	1	601		268	300	118	取消
857-GB9-AP2	1	551		243	300	93	
857-GB2-AP23	1	851	300	243	2x300	93	增加

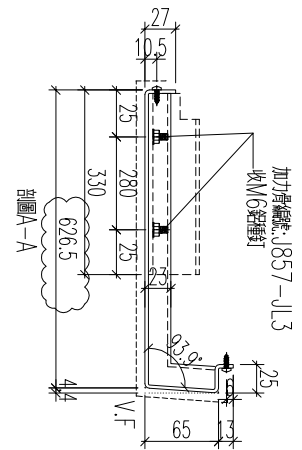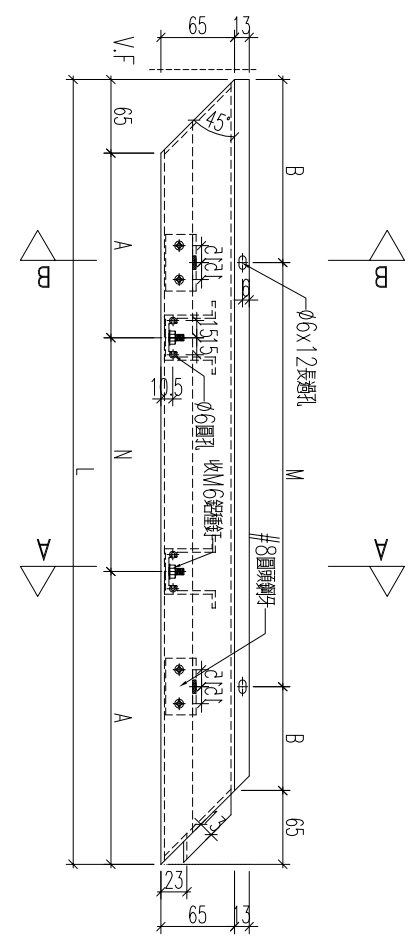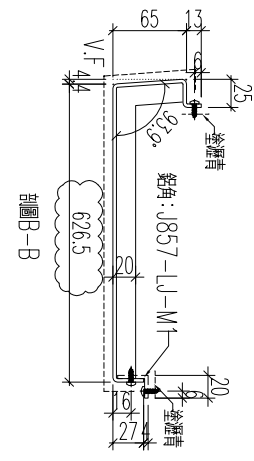

名稱	鋁板加工圖	制圖	黃漢卿	2022.12.2	修改	A	
材料	3mm厚板	復核	王禮秋	2022.12.2	日期	2.23	
顏色	銅色(AL1)	批准			圖號	857-GB3-AP4	






工程號

J857


地盤

啓德6552

編號	數量	長度	N	A	M	B
857-GB3-AP2	1	1668	4x300	234	5x300	81
857-GB9-AP3	1	1432	3x300	266	4x300	116
取消						

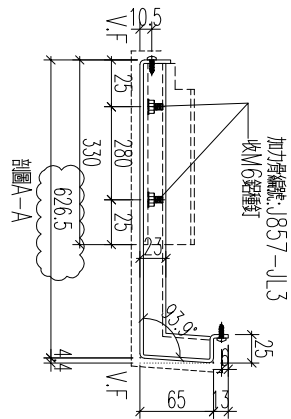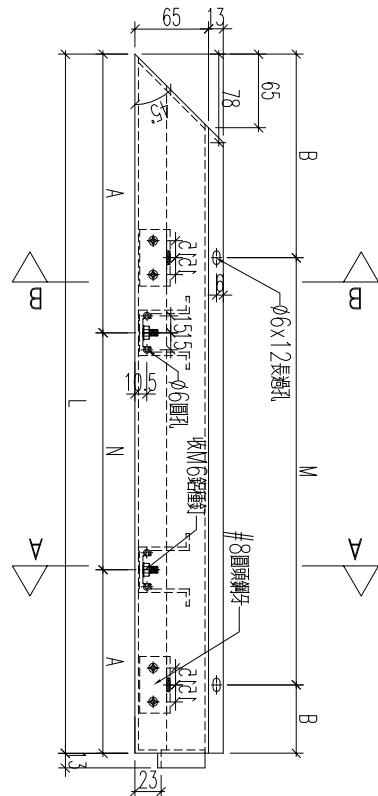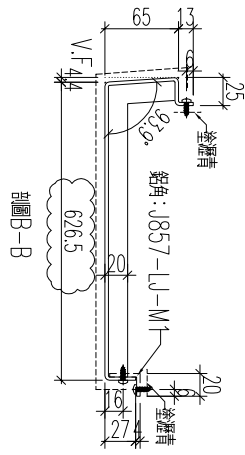




名稱	鋁板加工圖	制圖	黃漢卿	2022.12.2	修改	A
材料	3mm厚板	復核	王禮秋	2022.12.2	日期	2.23
顏色	銅色(AL1)	批准			圖號	857-GB9-AP3

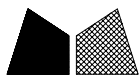


美特鋁質 有限公司
MIDI Aluminium Fabricator Ltd.

工程號 J857 地盤 啓德6552

編號	數量	長度	N	A	M	B
857-GB2-AP38	1					

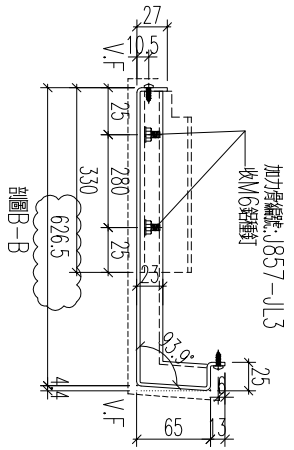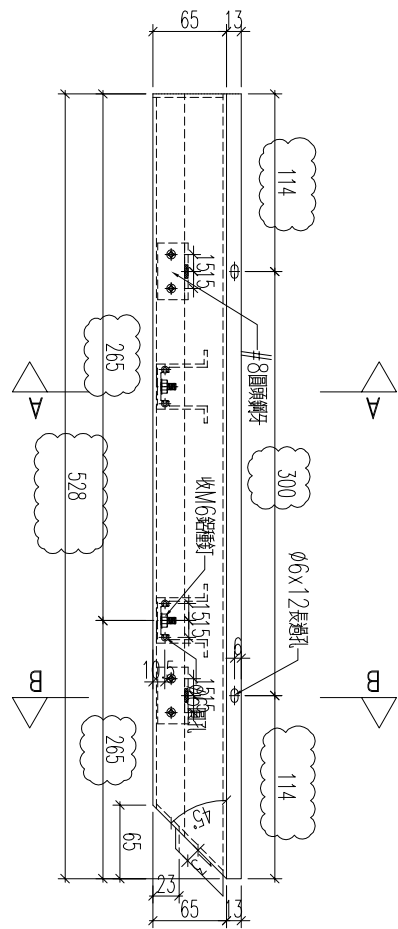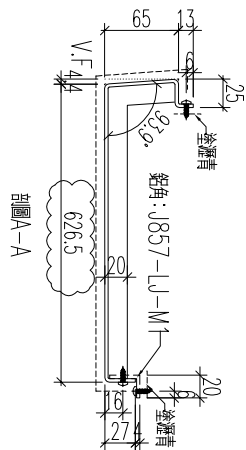


名稱	鋁板加工圖	制圖	黃漢卿	2022.12.2	修改	A	
材料	3mm厚鋁板	復核	王禮秋	2022.12.2	日期	2.23	
顏色	銅色(AL1)	批准			圖號	857-GB2-AP38	

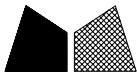

工程號	J857	地盤	啓德6552
-----	------	----	--------

編號	數量	長度	N	A	M	B
857-GB4-AP14	1					

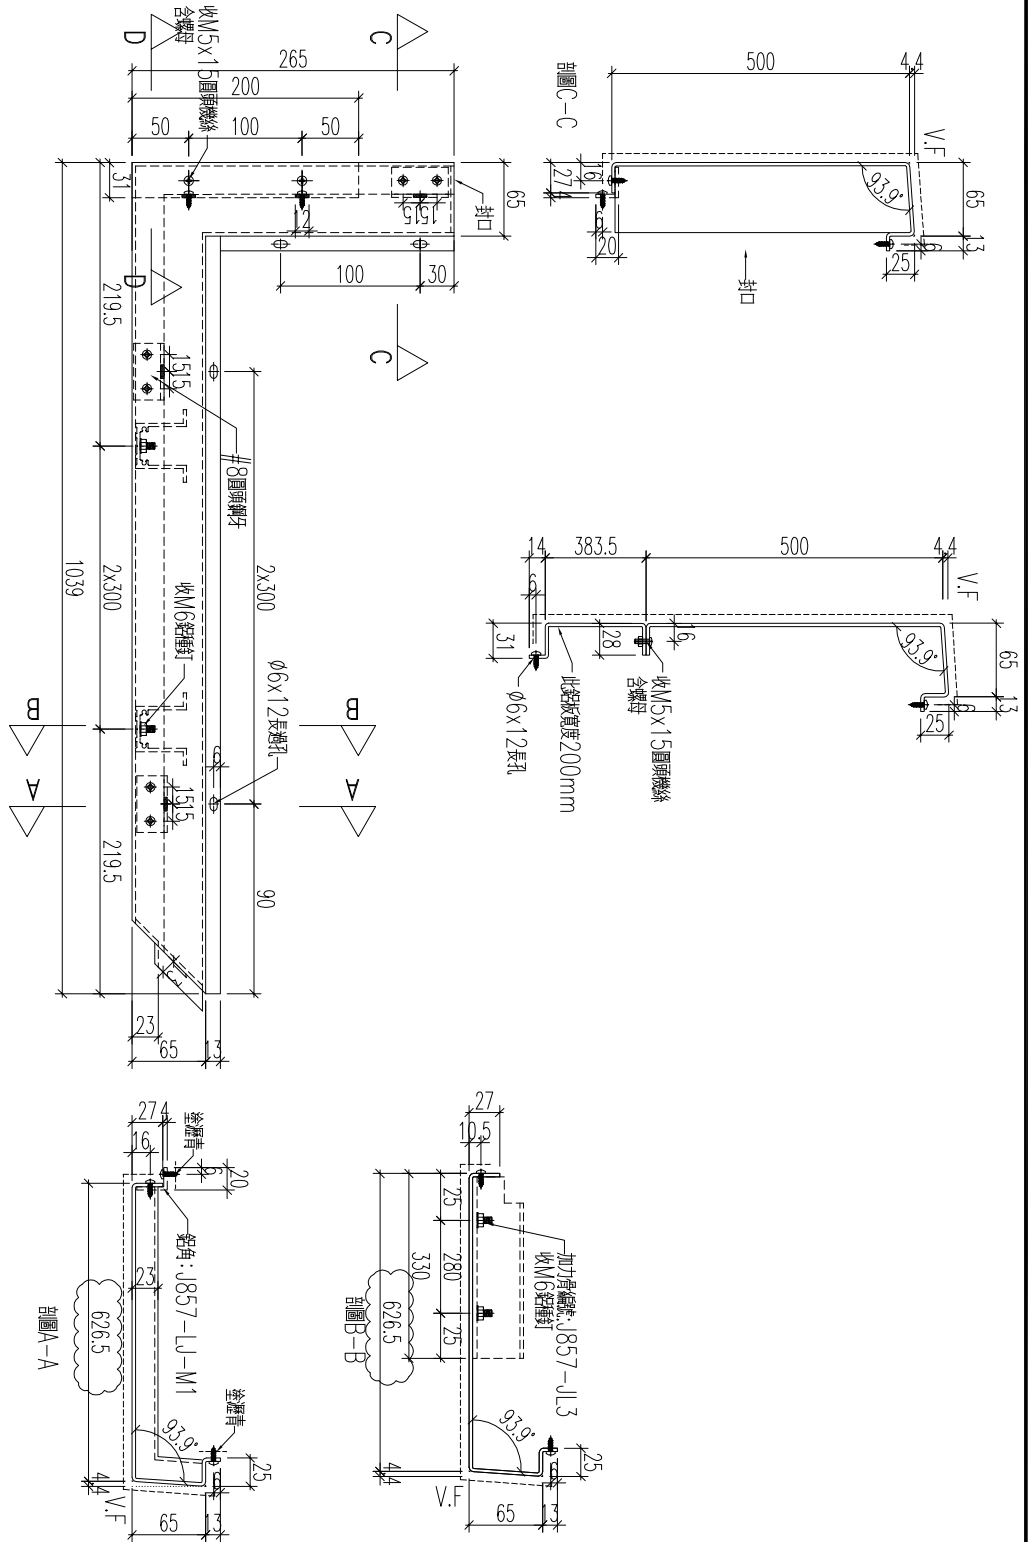





名稱	鋁板加工圖	制圖	黃漢卿	2022.12.2	修改	A	
材料	3mm厚鋁板	復核	王禮秋	2022.12.2	日期	2.23	
顏色	銅色(AL1)	批准			圖號	857-GB4-AP14	



美特鋁質 有限公司
MIDI Aluminium Fabricator Ltd.

工程號	J857	地盤	啓德6552
-----	------	----	--------

編號	數量	長度	M	B
857-GB7-AP15a	1	1473	4x300	136.5

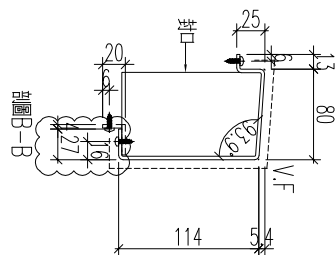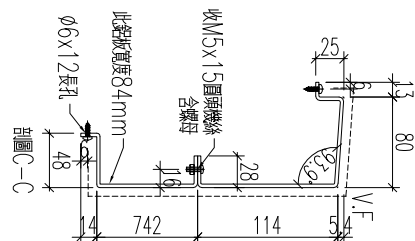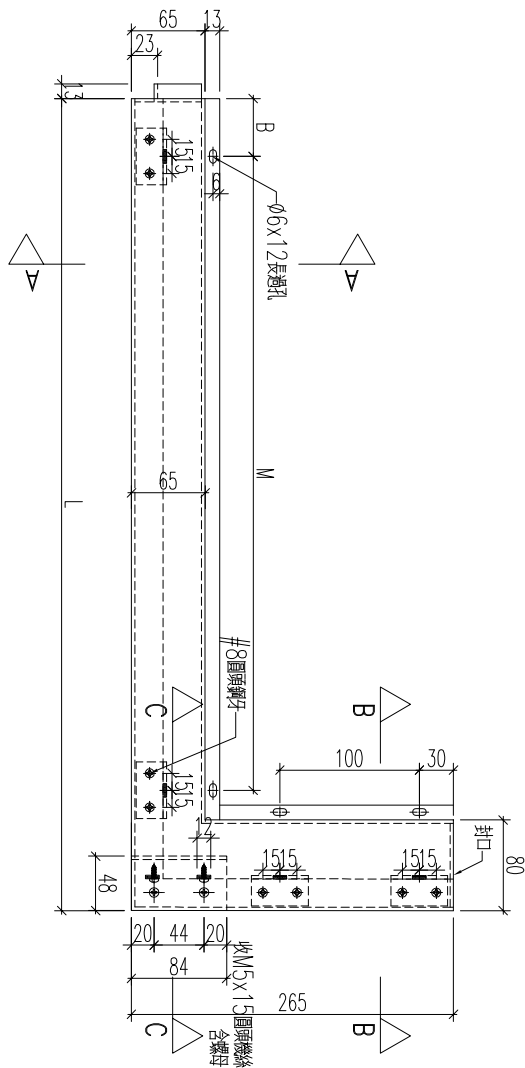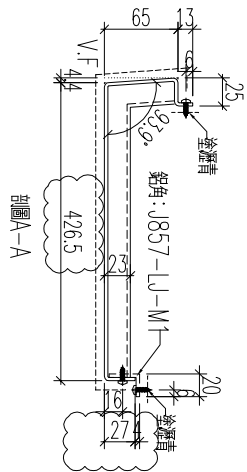

名稱	鋁板加工圖	制圖	黃漢卿	2022.12.2	修改	A
材料	3mm厚板	復核	王禮秋	2022.12.2	日期	2.23
顏色	銅色(AL1)	批准			圖號	857-GB7-AP15a






美特鋁質 有限公司
MIDI Aluminium Fabricator Ltd.


工程號 J857 地盤 啓德6552

編號	數量	長度	M	B
857-GB5-AP20	1	1595	5x300	47.5
857-GB5-AP23	1	1255	3x300	177.5
857-GB5-AP24	1	1340	4x300	70
857-GB6-AP24	2	1490	4x300	145
857-GB7-AP15	1	1490	4x300	145
857-GB8-AP166	1	1475	4x300	136.5
857-GB7-AP166	3	1490	4x300	145
857-GB9-AP26	4	1490	4x300	145

取消

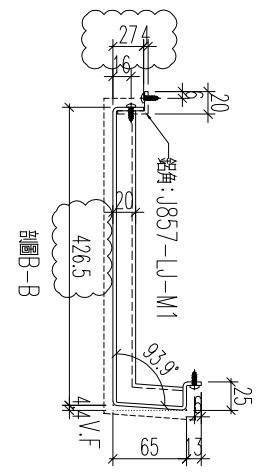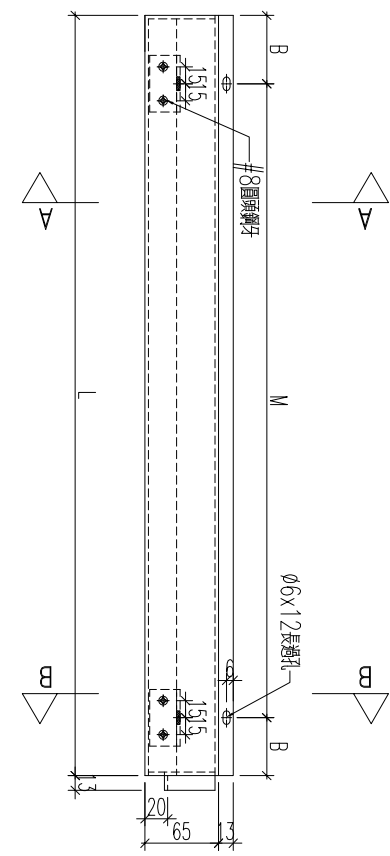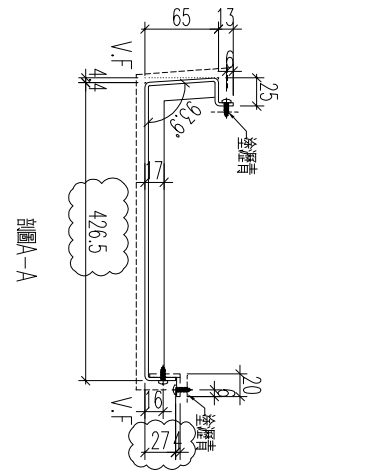

名稱	鋁板加工圖	制圖	黃漢卿	2022.12.2	修改	A
材料	3mm厚鋁板	復核	王禮秋	2022.12.2	日期	2.23
顏色	銅色(AL1)	批准			圖號	857-GB5-AP20



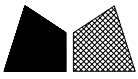


工程號

J857

地盤

啓德6552

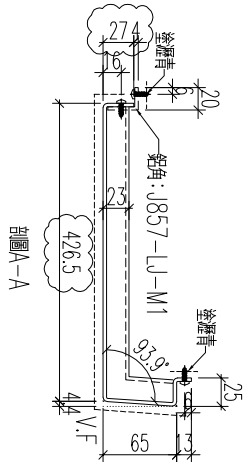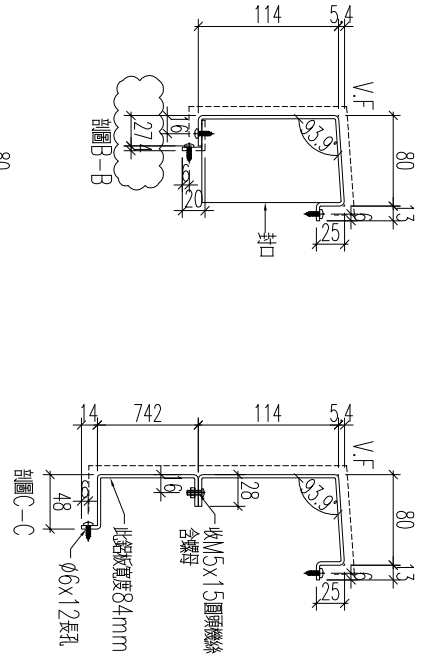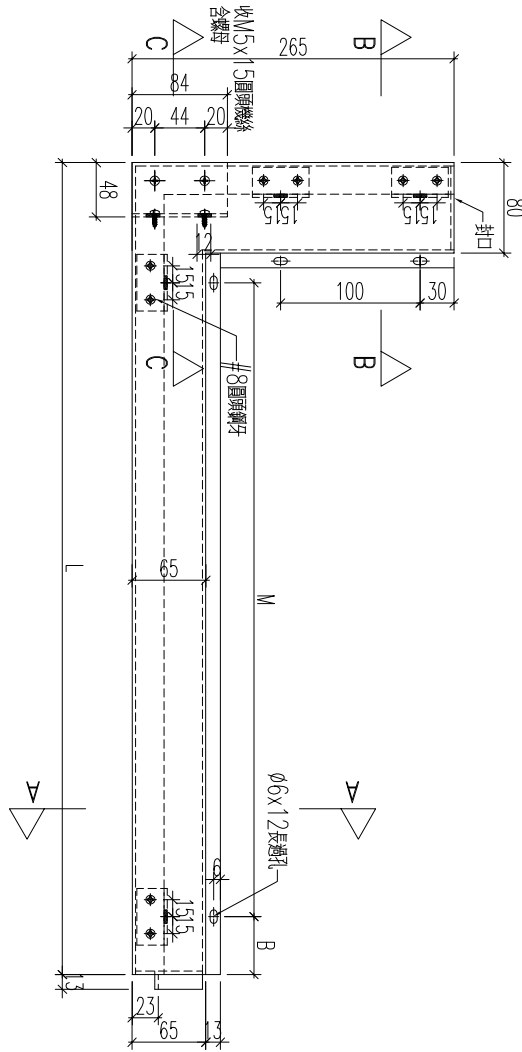





增加

編號	數量	長度	M	B
857-GB5-AP19	1	1695	5x300	30
857-GB6-AP23	1	1497	4x300	30
857-GB9-AP25	1	1460	4x300	30
857-GB8-AP16d	1	1473	4x300	136.5

名稱	鋁板加工圖	制圖	黃漢卿	2022.12.2	修改	A		
材料	3mm 鋁板	復核	王禮秋	2022.12.2	日期	2.23		
顏色	銅色(AL1)	批准			圖號	857-GB5-AP19		



工程號	J857	地盤	啓德6552
-----	------	----	--------

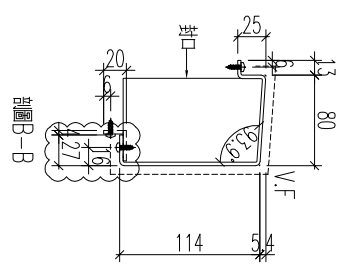
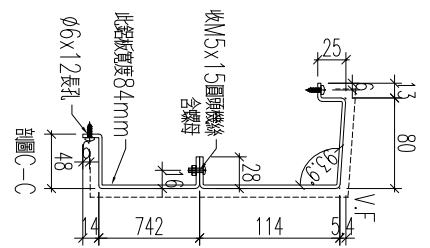
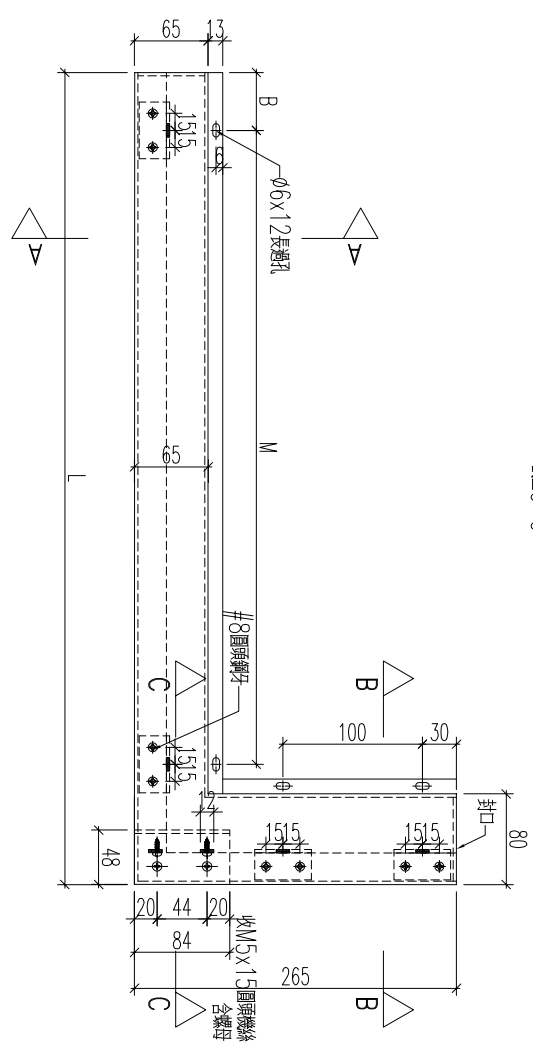
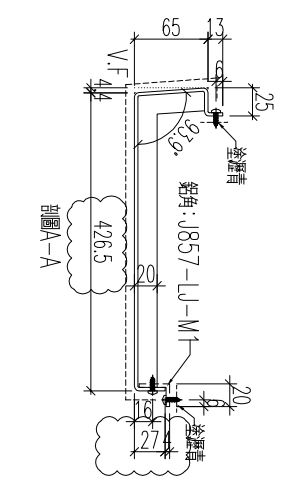


編號	數量	長寬	M	B
857-GB5-AP26	1	1345	4x300	30
857-GB8-AP17	1	1498	4x300	30
857-GB9-AP27	1	1460	4x300	30

名稱	鋁板加工圖	制圖	黃漢卿	2022.12.2	修改	A	
材料	3mm厚板	復核	王禮秋	2022.12.2	日期	2.23	
顏色	銅色(AL1)	批准			圖號	857-GB5-AP26	




工程號	J857	地盤	啓德6552
-----	------	----	--------

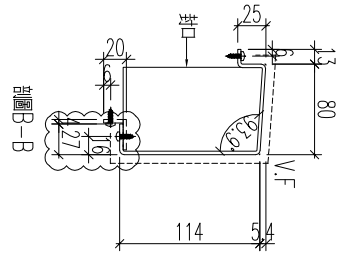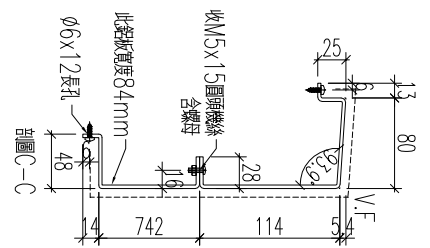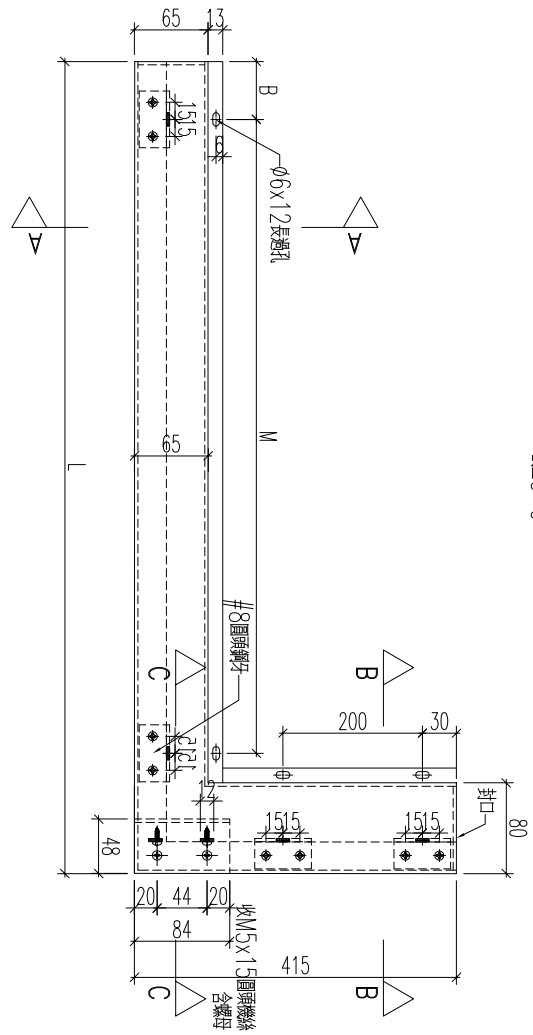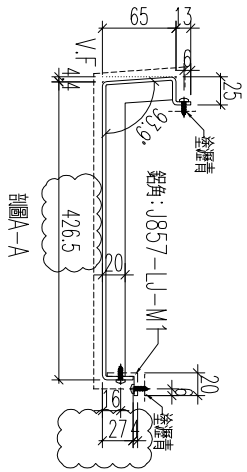

編號	數量	長皮	M	B
857-GB5-AP21	1	1680	5x300	30

名稱	鋁板加工圖	制圖	黃漢卿	2022.12.2	修改	A
材料	3mm厚板	復核	王禮秋	2022.12.2	日期	2.23
顏色	銅色(AL1)	批准			圖號	857-GB5-AP21

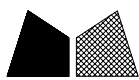

美特鋁質 有限公司
MIDI Aluminium Fabricator Ltd.

工程號




J857

地盤

啓德6552

編號	數量	長度	M	B
857-GB12-AP22	1	429	300	32

收邊

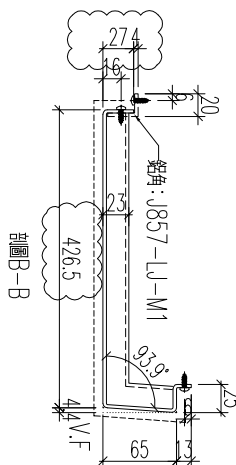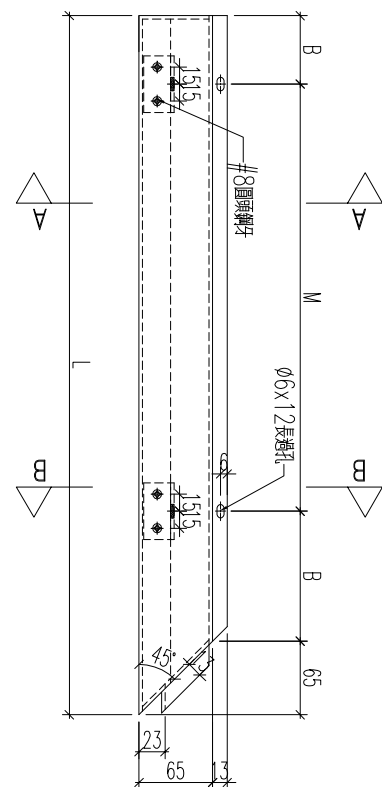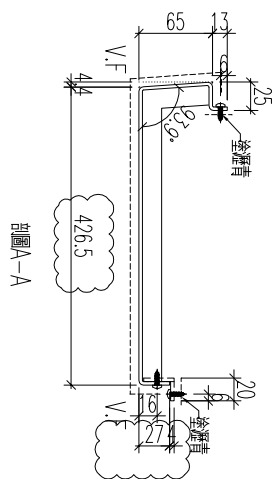

名稱	鋁板加工圖	制圖	黃漢卿	2022.12.2	修改	A	
材料	3mm厚板	復核	王禮秋	2022.12.2	日期	2.23	
顏色	銅色(AL1)	批准			圖號	857-GB3-AP17	




美特鋁質 有限公司
MIDI Aluminium Fabricator Ltd.


工程號	J857	地盤	啓德6552
-----	------	----	--------

編號	數量	長度	M	B
857-GB12-AP23	1	1226	3x300	130.5
857-GB12-AP16	1	1026	3x250	105.5

取消				
----	--	--	--	--

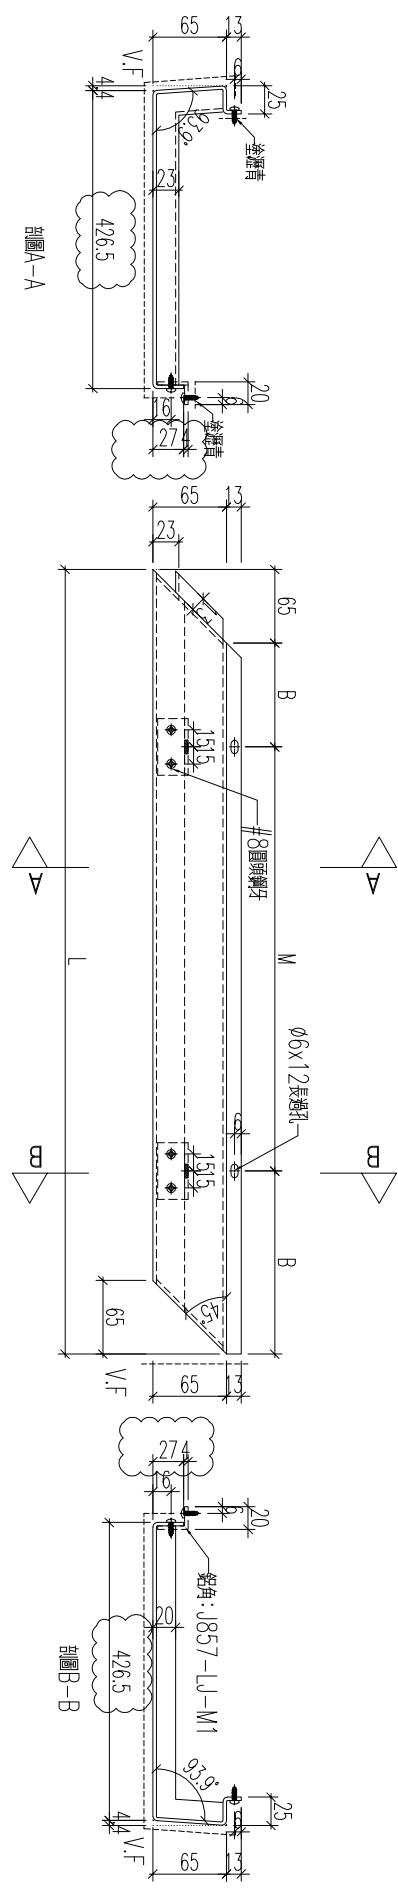


名稱	鋁板加工圖	制圖	黃漢卿	2022.12.2	修改	A	
材料	3mm厚鋁板	復核	王禮秋	2022.12.2	日期	2.23	
顏色	銅色(AL1)	批准			圖號	857-GB3-AP42	

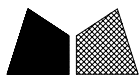


美特鋁質 有限公司
MIDI Aluminium Fabricator Ltd.

工程號	J857	地盤	啓德6552
-----	------	----	--------

編號	數量	長度	M	B
857-GB12-AP24	1	1026	3x250	105.5
857-GB12-AP17	1	1226	3x300	130.5
取消				

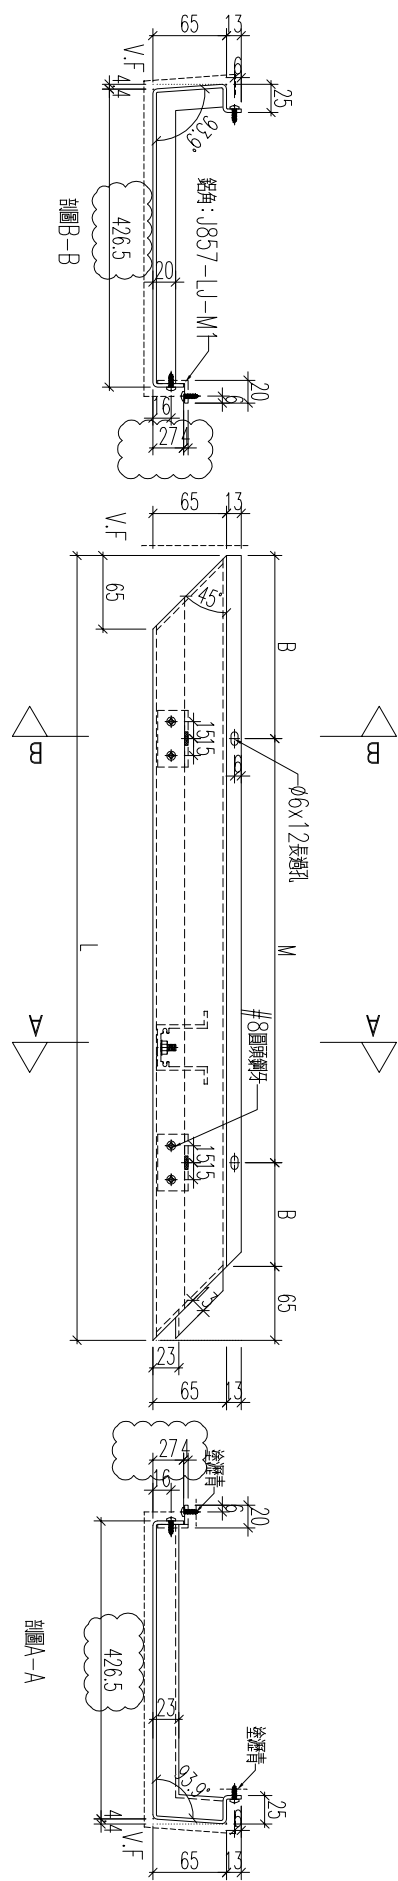

名稱	鋁板加工圖	制圖	黃漢卿	2022.12.2	修改	A	
材料	3mm厚板	復核	王禮秋	2022.12.2	日期	2.23	
顏色	銅色(AL1)	批准			圖號	857-GB12-AP24	

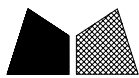




美特鋁質 有限公司
MIDI Aluminium Fabricator Ltd.

工程號	J857	地盤	啓德6552
-----	------	----	--------

編號	數量	長度	M	B
857-GB12-AP18	1	429	300	32

收

送

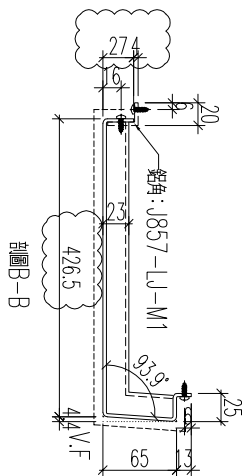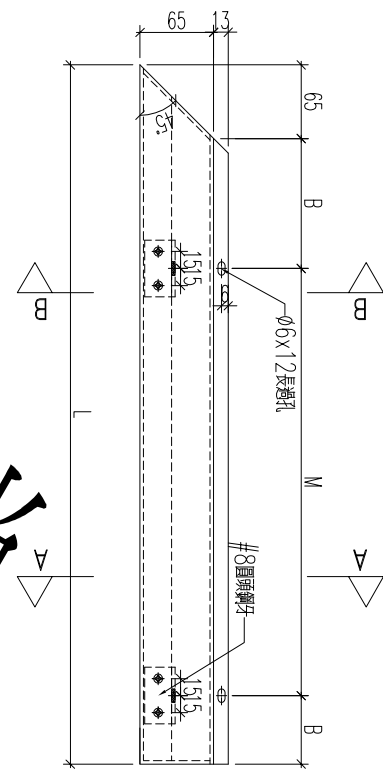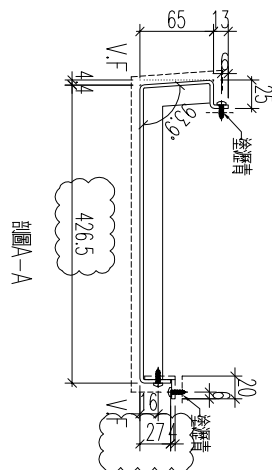


名稱	鋁板加工圖	制圖	黃漢卿	2022.12.2	修改	A
材料	3mm厚鋁板	復核	王禮秋	2022.12.2	日期	2.23
顏色	銅色(AL1)	批准			圖號	857-GB12-AP18



工程號 J857 地盤 啓德6552

新增

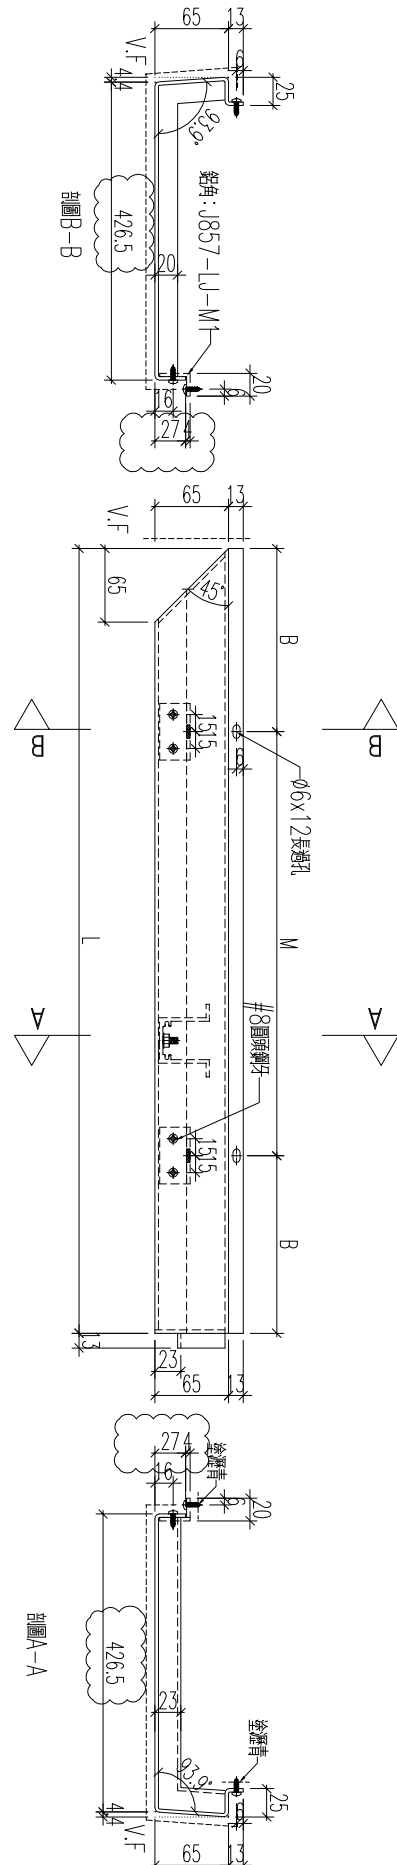

編號	數量	長度	M	B
857-GB12-AP17	1	898	2x300	149

名稱	鋁板加工圖	制圖	黃漢卿	2022.12.2	修改	A
材料	3mm厚鋁板	復核	王禮秋	2022.12.2	日期	2.23
顏色	銅色(AL1)	批准			圖號	857-GB12-AP17




美特鋁質有限公司
MIDI Aluminium Fabricator Ltd.


工程號	J857	地盤	啓德6552
-----	------	----	--------

編號	數量	長度	M	B
857-GB12-AP23	1	898	2x300	149

新增



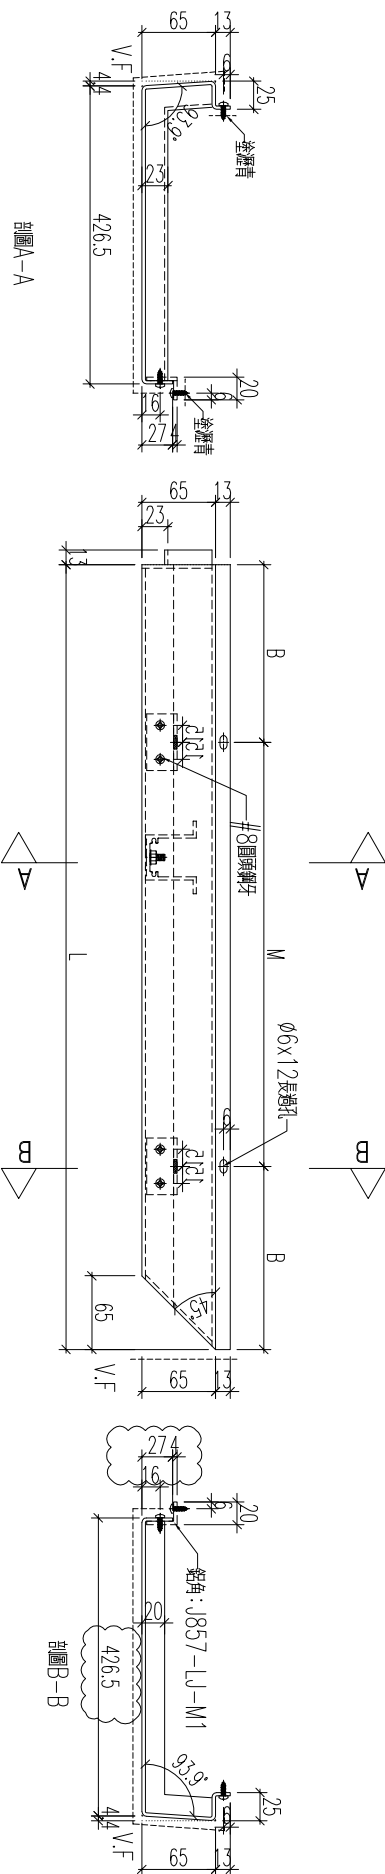


名稱	鋁板加工圖	制圖	黃漢卿	2022.12.2	修改		
材料	3mm厚鋁板	復核	王禮秋	2022.12.2	日期		
顏色	銅色(AL1)	批准			圖號	857-GB12-AP23	

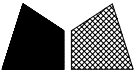

工程號 J857 地盤 啓德6552

線號	數量	長度	N	A	M	B
857-GB1-AP2a	1	700	1x300	200	2x300	100
857-GB2-AP26a	1	1170	2x300	285	3x300	135
857-GB3-AP39a	1	1170	2x300	285	3x300	135
857-GB5-AP10a	1	915	2x270	187.5	3x270	52.5
857-GB5-AP11a	1	930	2x270	195	3x270	60
857-GB6-AP11a	1	1485	3x300	292.5	4x300	142.5
857-GB6-AP14a	1	1445	3x300	272.5	4x300	122.5
857-GB6-AP15a	1	1430	3x300	265	4x300	115
857-GB7-AP4a	1	1105	2x300	252.5	3x300	102.5
857-GB7-AP5a	1	1120	2x300	260	3x300	110
857-GB8-AP2a	1	1120	2x300	260	3x300	110
857-GB8-AP3a	1	1105	2x300	252.5	3x300	102.5
857-GB8-AP7a	1	1430	3x300	265	4x300	115
857-GB8-AP8a	1	1445	3x300	272.5	4x300	122.5
857-GB8-AP11a	1	1485	3x300	292.5	4x300	142.5
857-GB9-AP10a	1	1107	2x300	253.5	3x300	103.5
857-GB9-AP11a	1	1248	3x275	211.5	4x275	74

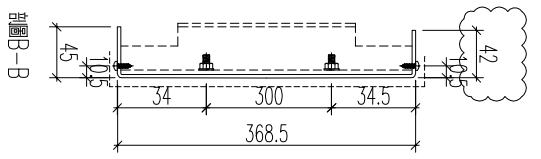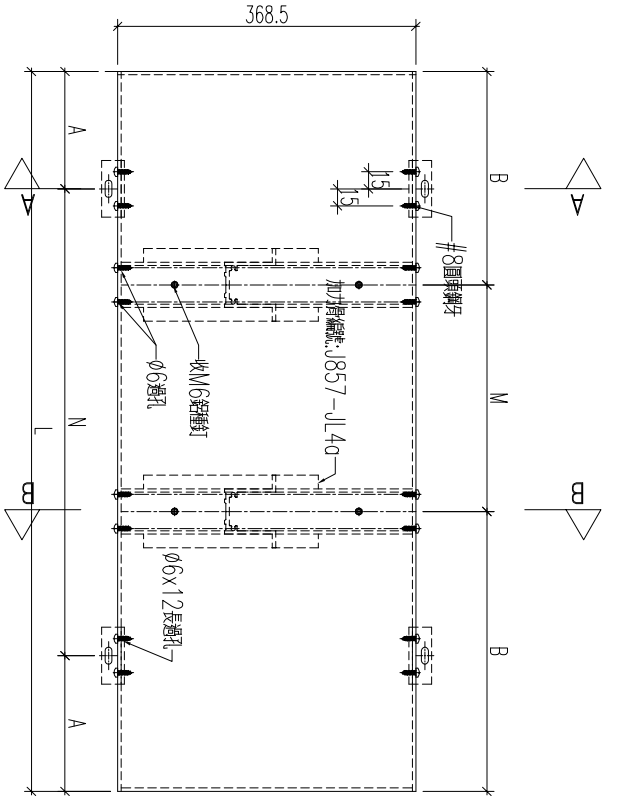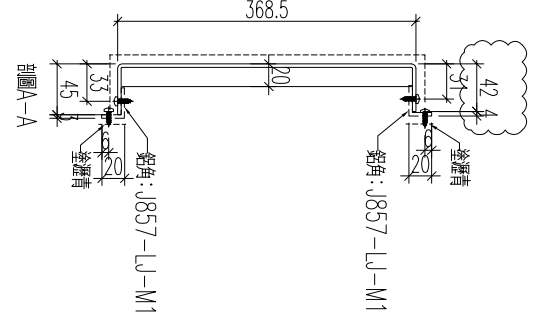




名稱	鋁板加工圖	制圖	黃漢卿	2022.12.2	修改	A
材料	3mm厚板	復核	王禮秋	2022.12.2	日期	2.23
顏色	深灰色(AL2)	批准			圖號	857-GB1-AP2a



美特鋁質 有限公司
MIDI Aluminium Fabricator Ltd.

工程號 J857 地盤 啓德6552

編號	數量	長度	N	A	M	B
857-GB1-AP2	1	700	1x300	200	2x300	100
857-GB2-AP26	1	1170	2x300	285	3x300	135
857-GB3-AP39	1	1170	2x300	285	3x300	135
857-GB5-AP10	1	915	2x270	187.5	3x270	52.5
857-GB5-AP11	1	930	2x270	195	3x270	60
857-GB6-AP11	1	1485	3x300	292.5	4x300	142.5
857-GB6-AP14	1	1445	3x300	272.5	4x300	122.5
857-GB6-AP15	1	1430	3x300	265	4x300	115
857-GB7-AP4	1	1105	2x300	252.5	3x300	102.5
857-GB7-AP5	1	1120	2x300	260	3x300	110
857-GB8-AP2	1	1120	2x300	260	3x300	110
857-GB8-AP3	1	1105	2x300	252.5	3x300	102.5
857-GB8-AP7	1	1430	3x300	265	4x300	115
857-GB8-AP8	1	1445	3x300	272.5	4x300	122.5
857-GB8-AP11	1	1485	3x300	292.5	4x300	142.5
857-GB9-AP10	1	1107	2x300	253.5	3x300	103.5
857-GB9-AP11	1	1248	3x275	211.5	4x275	74

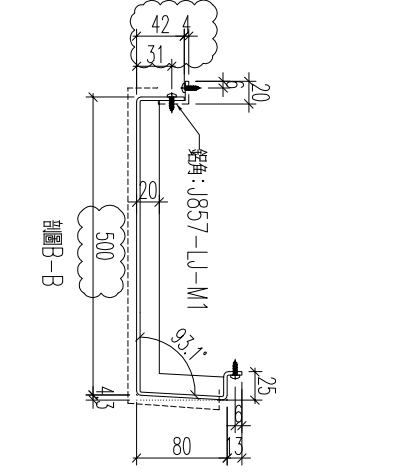
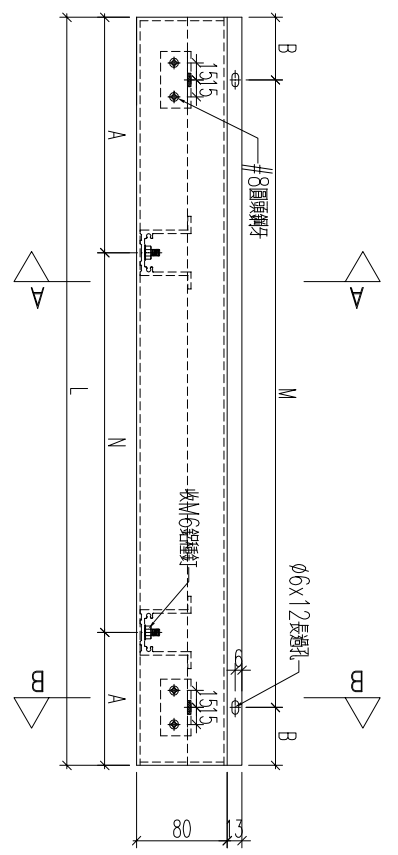
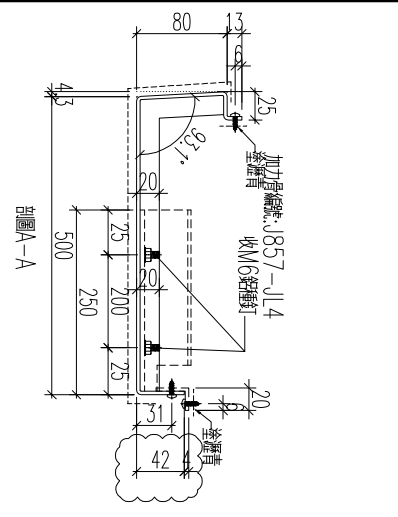


名稱	鋁板加工圖	制圖	黃漢卿	2022.12.2	修改	A
材料	3mm厚板	復核	王禮秋	2022.12.2	日期	2.23
顏色	銅色(AL1)	批准			圖號	857-GB1-AP2



工程號 J857 地盤 啓德6552

編號	數量	長度	N	A	M	B
857-GB8-AP20	1	1235	3x275	205	4x275	67.5
857-GB9-AP30	1	610	250	180	2x250	55
857-GB12-AP13	1	555	250	152.5	2x250	27.5

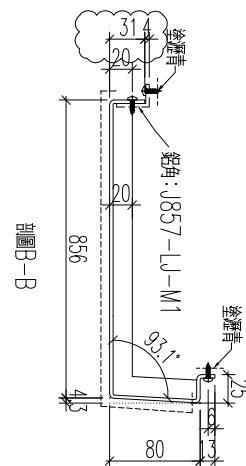
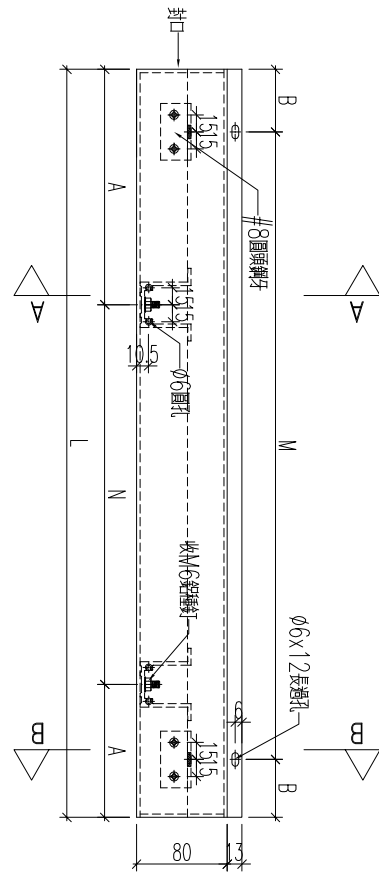
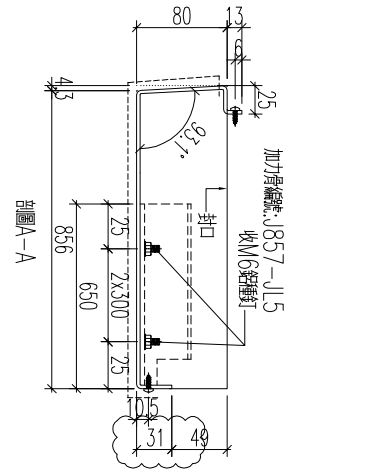


名稱	鋁板加工圖	制圖	黃漢卿	2022.12.2	修改	A	
材料	3mm厚板	復核	王禮秋	2022.12.2	日期	2.23	
顏色	銅色(AL1)	批准			圖號	857-GB8-AP20	



工程號	J857	地盤	啓德6552
-----	------	----	--------

線號	數量	長	N	A	M	B
857-GB12-AP10	1	1040	2x300	220	3x300	70

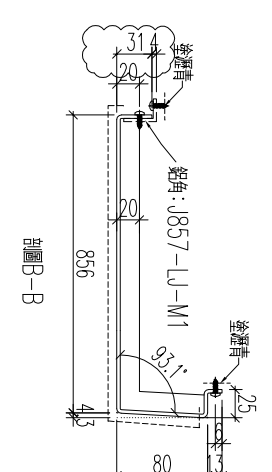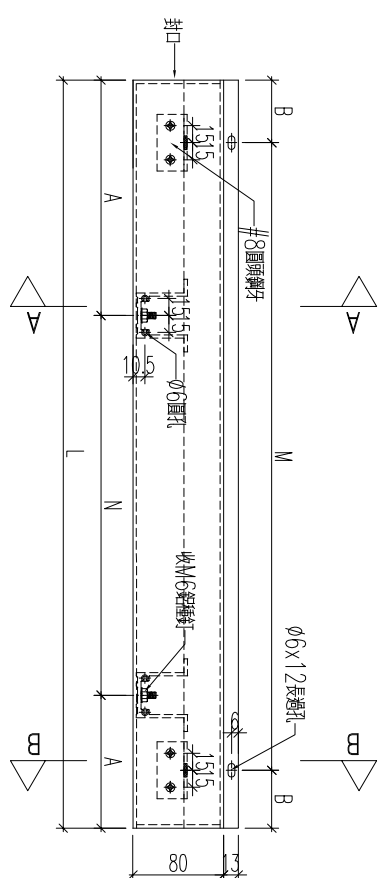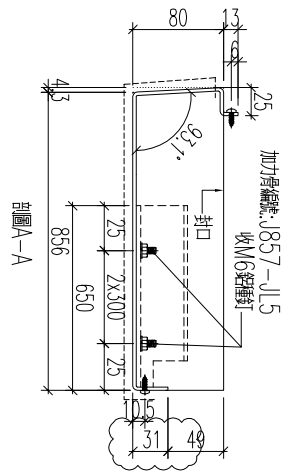

名稱	鋁板加工圖	制圖	黃漢卿	2022.12.2	修改	A	
材料	3mm厚鋁板	復核	王禮秋	2022.12.2	日期	2.23	
顏色	銅色(AL1)	批准			圖號	857-GB12-AP10	






美特鋁質 有限公司
MIDI Aluminium Fabricator Ltd.

工程號	J857	地盤	啓德6552
-----	------	----	--------

編號	數量	長度	N	A	M	B
857-GB12-AP11	1					

收

送

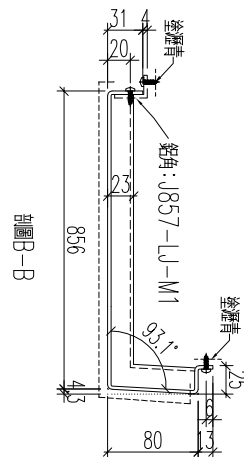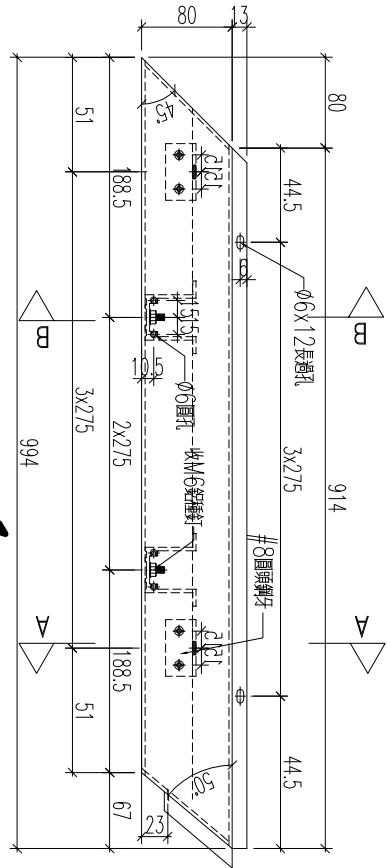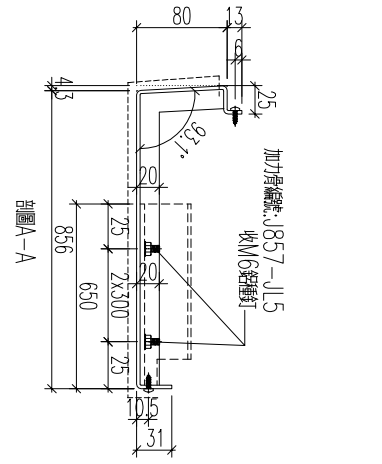




名稱	鋁板加工圖	制圖	黃漢卿	2022.12.2	修改		
材料	3mm厚板	復核	王禮秋	2022.12.2	日期		
顏色	銅色(AL1)	批准			圖號	857-GB12-AP11	



美特鋁質 有限公司
MIDI Aluminium Fabricator Ltd.

工程號	J857	地盤	啓德6552
-----	------	----	--------

編號	數量	長度	N	A	M	B
857-GB12-AP27	1	480	300	90	2x200	40

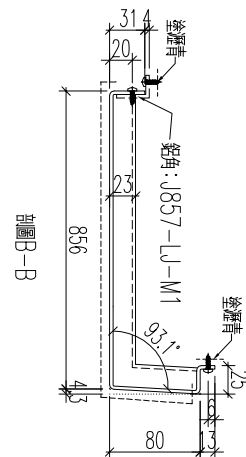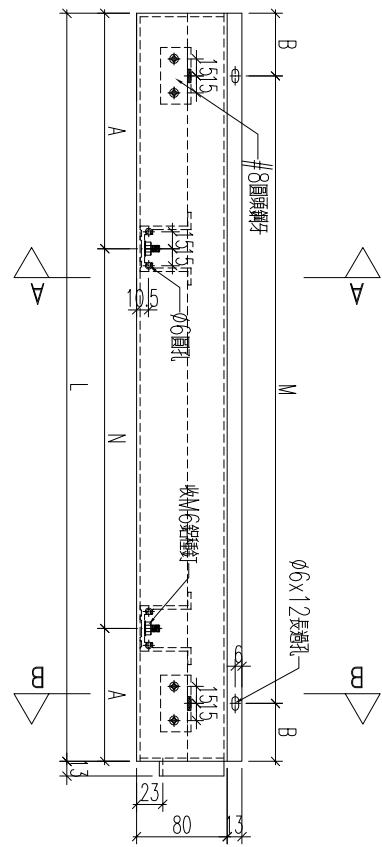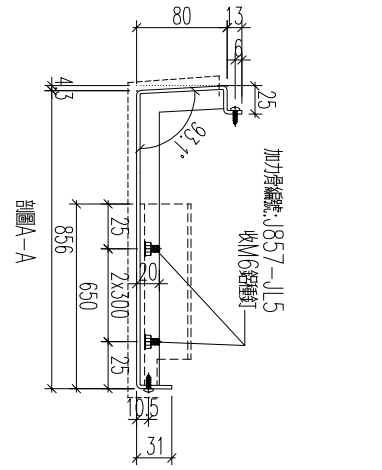




名稱	鋁板加工圖	制圖	黃漢卿	2022.12.2	修改	A	
材料	3mm厚板	復核	王禮秋	2022.12.2	日期	2.23	
顏色	銅色(AL1)	批准			圖號	857-GB12-AP27	



美特鋁質 有限公司
MIDI Aluminium Fabricator Ltd.

工程號 J857 地盤 啓德6552

料號	數量	長度	N	A	M	B
857-GB12-AP21	1	1528	4x275	214	5x275	76.5

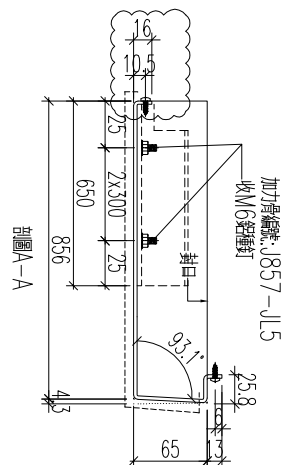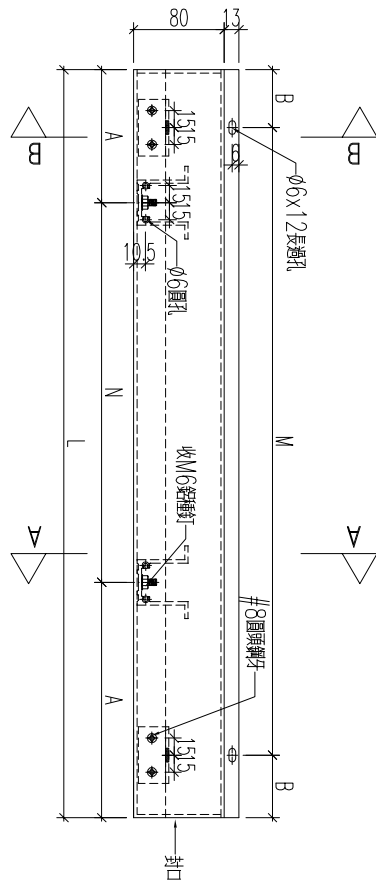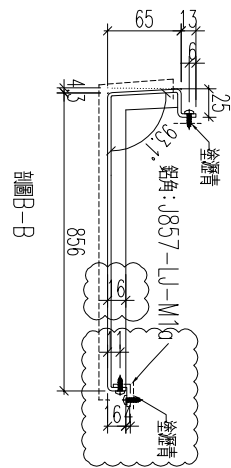


名稱	鋁板加工圖	制圖	黃漢卿	2022.12.2	修改	A	
材料	3mm厚鋁板	復核	王禮秋	2022.12.2	日期	2.23	
顏色	銅色(AL1)	批准			圖號	857-GB12-AP21	



工程號	J857	地盤	啓德6552
-----	------	----	--------

料號	數量	長度	N	A	M	B
857-GB12-AP2	1	1168	2x300	284	3x300	134
857-GB12-AP25	1	803	250	276.5	300	219

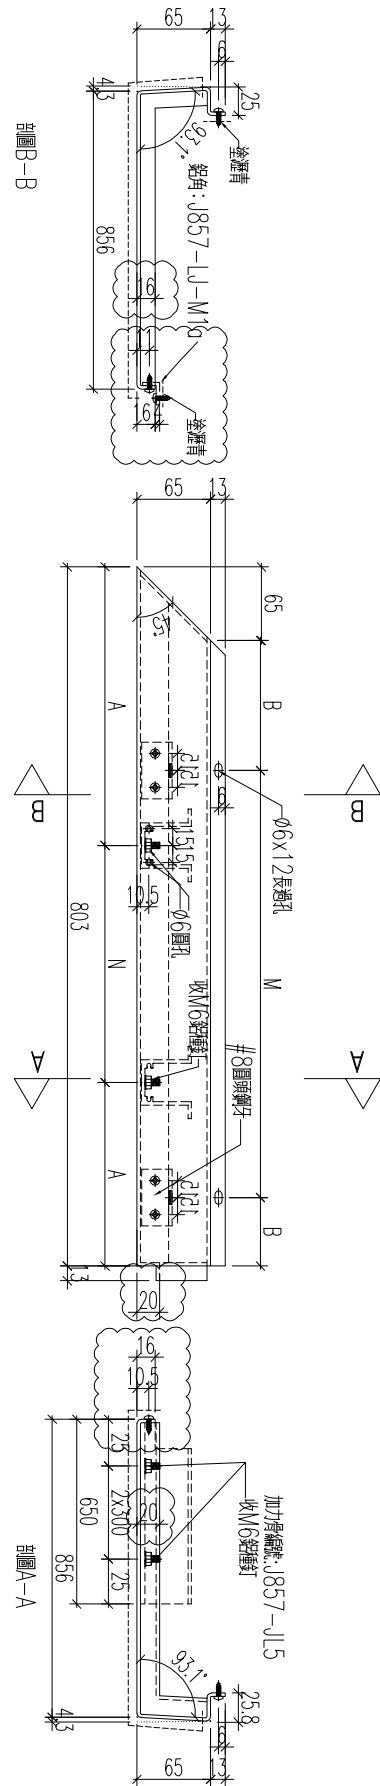

名稱	鋁板加工圖	制圖	黃漢卿	2022.12.2	修改	A	
材料	3mm厚板	復核	王禮秋	2022.12.2	日期	2.23	
顏色	銅色(AL1)	批准			圖號	857-GB12-AP2	



美特鋁質 有限公司
MIDI Aluminium Fabricator Ltd.

工程號

J857




地盤

啓德6552

受

送

編號	數量	長度	A	M	B
857-GB12-AP12	1				

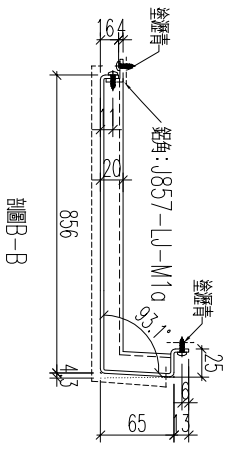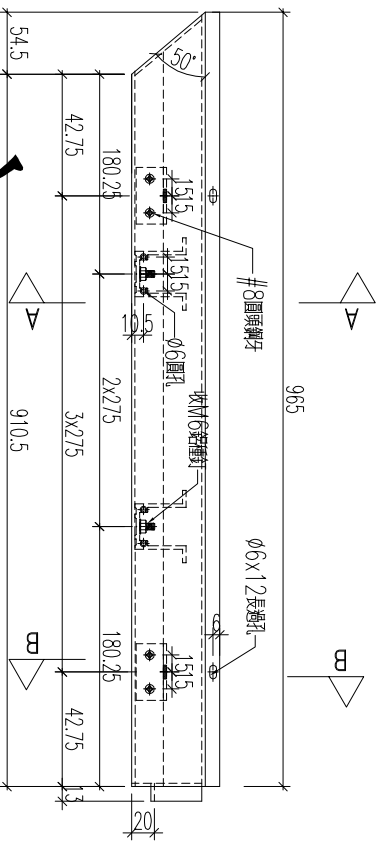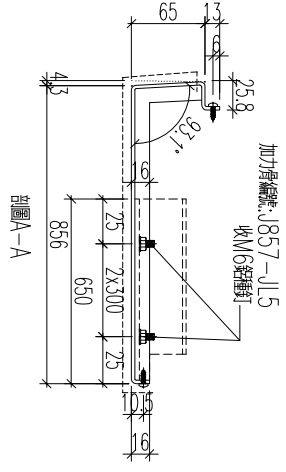




名稱	鋁板加工圖	制圖	黃漢卿	2022.12.2	修改			
材料	3mm厚板	復核	王禮秋	2022.12.2	日期			
顏色	銅色(AL1)	批准			圖號	857-GB12-AP12		



美特鋁質 有限公司
MIDI Aluminium Fabricator Ltd.

工程號 J857 地盤 啓德6552

編號	數量	長度	N	A	M	B
857-GB12-AP3	1	1095	2x300	247.5	3x300	97.5

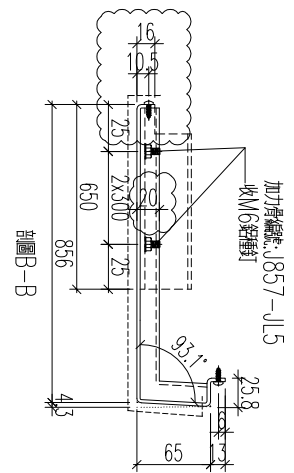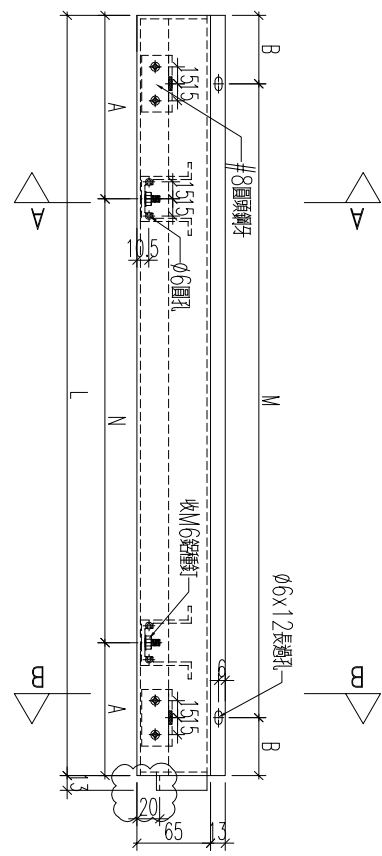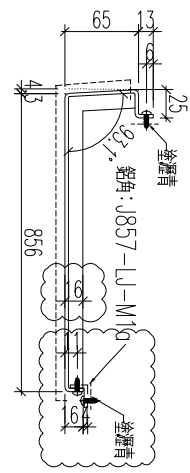



名稱	鋁板加工圖	制圖	黃漢卿	2022.12.2	修改	A	
材料	3mm厚板	復核	王禮秋	2022.12.2	日期	2.23	
顏色	銅色(AL1)	批准			圖號	857-GB12-AP3	



美特鋁質 有限公司
MIDI Aluminium Fabricator Ltd.

工程號	J857	地盤	啓德6552
-----	------	----	--------

編號	數量	長度	N	A	M	B
857-GB12-AP1	1	978	2x250	239	3x250	114

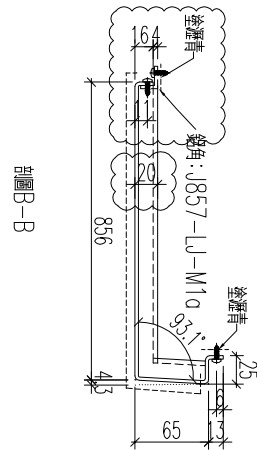
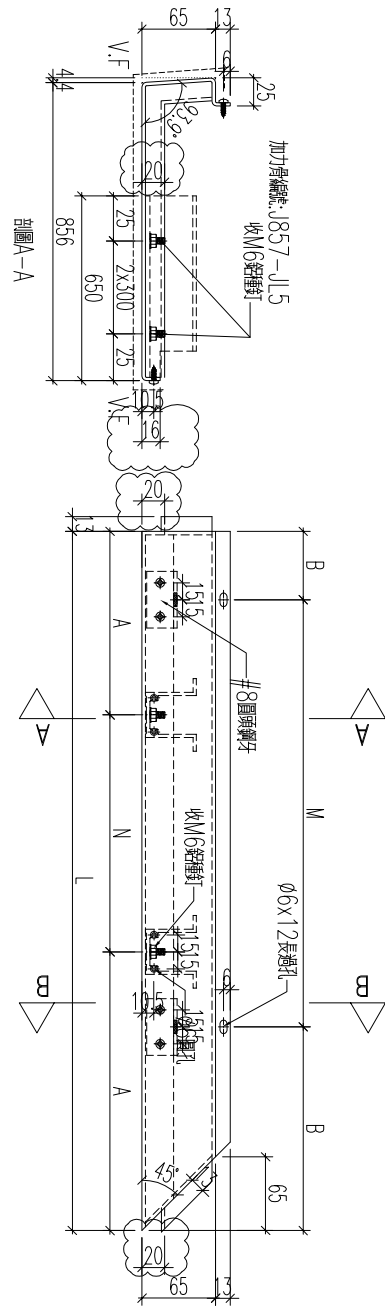


名稱	鋁板加工圖	制圖	黃漢卿	2022.12.2	修改	A	
材料	3mm厚板	復核	王禮秋	2022.12.2	日期	2.23	
顏色	銅色(AL1)	批准			圖號	857-GB12-AP1	




工程號	J857	地盤	啓德6552
-----	------	----	--------

編號	數量	長度	N	A	M	B
857-GB12-AP15	1					

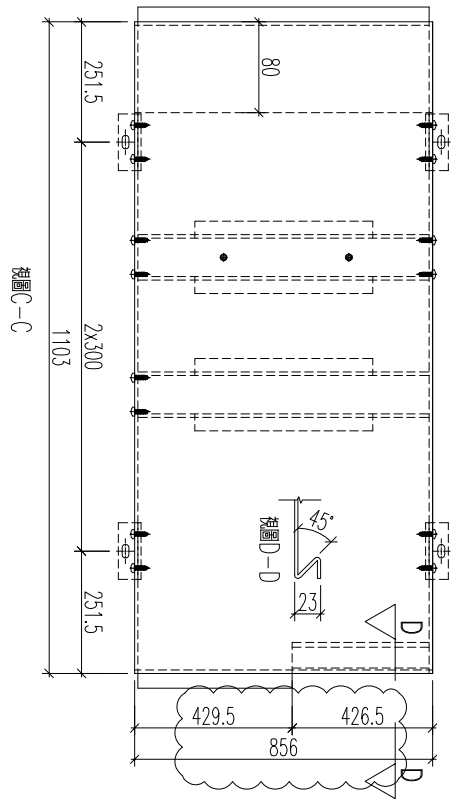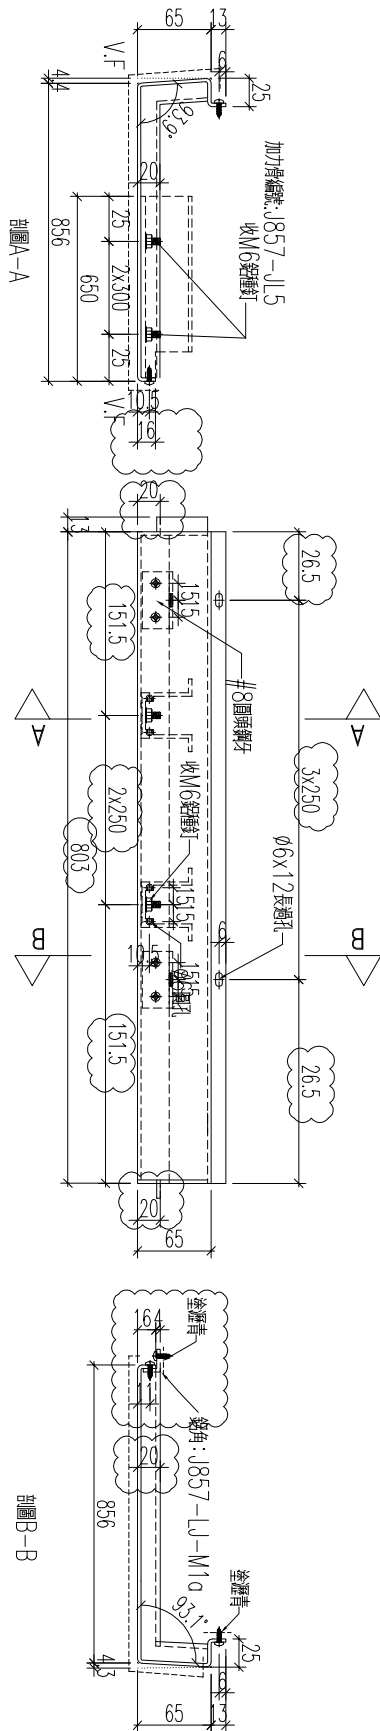

名稱	鋁板加工圖	制圖	黃漢卿	2022.12.2	修改	A	
材料	3mm厚板	復核	王禮秋	2022.12.2	日期	2.23	
顏色	銅色(AL1)	批准			圖號	857-GB12-AP15	

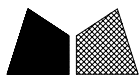

新增




工程號

J857

地盤

啓德6552

剖圖-A-A

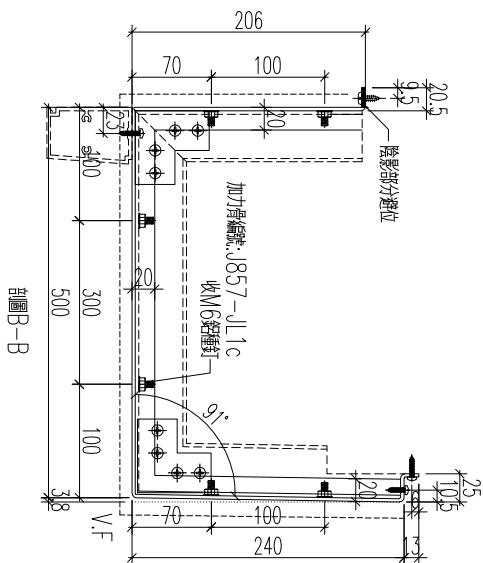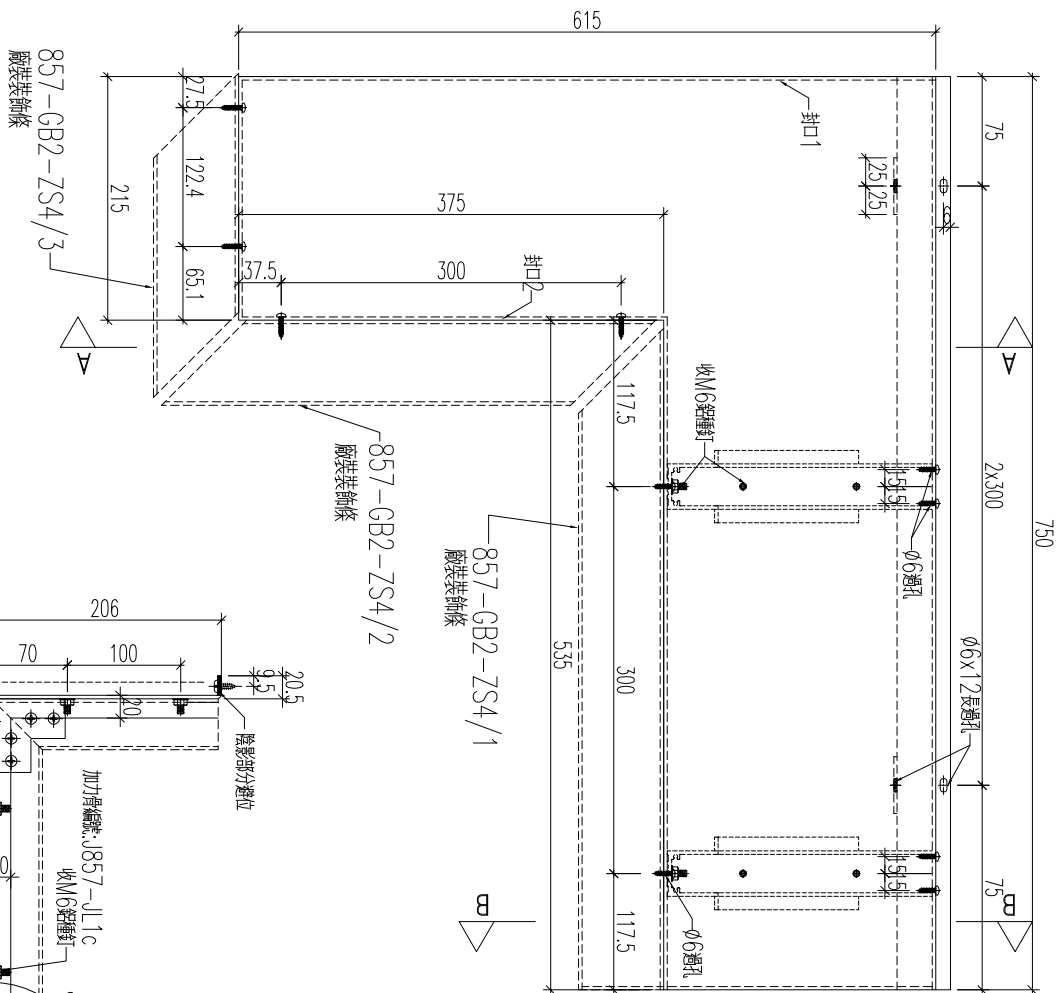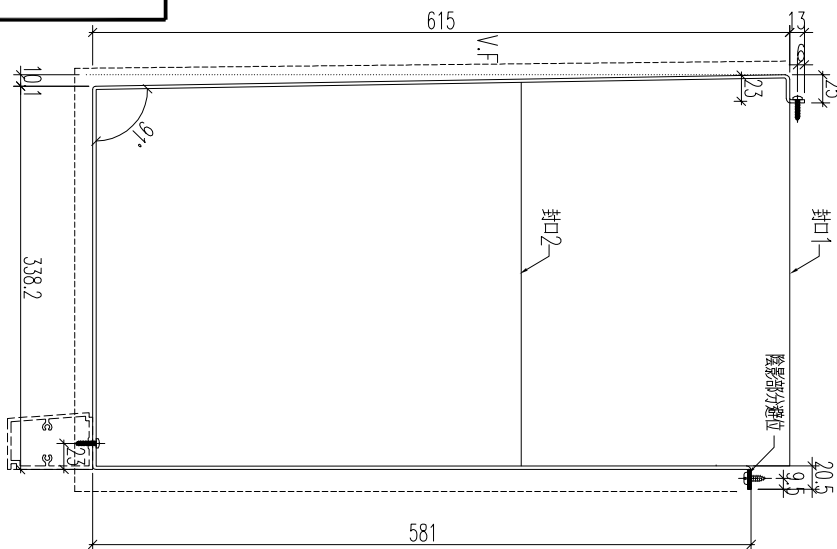


加工數量: 1

名稱	鋁板加工圖	制圖	黃漢卿	2022.12.2	修改		
材料	3mm厚鋁板	復核	王禮秋	2022.12.2	日期		
顏色	銅色(AL1)	批准			圖號	857-GB2-AP4	



新增

工程號	J857	地盤	啓德6552
-----	------	----	--------

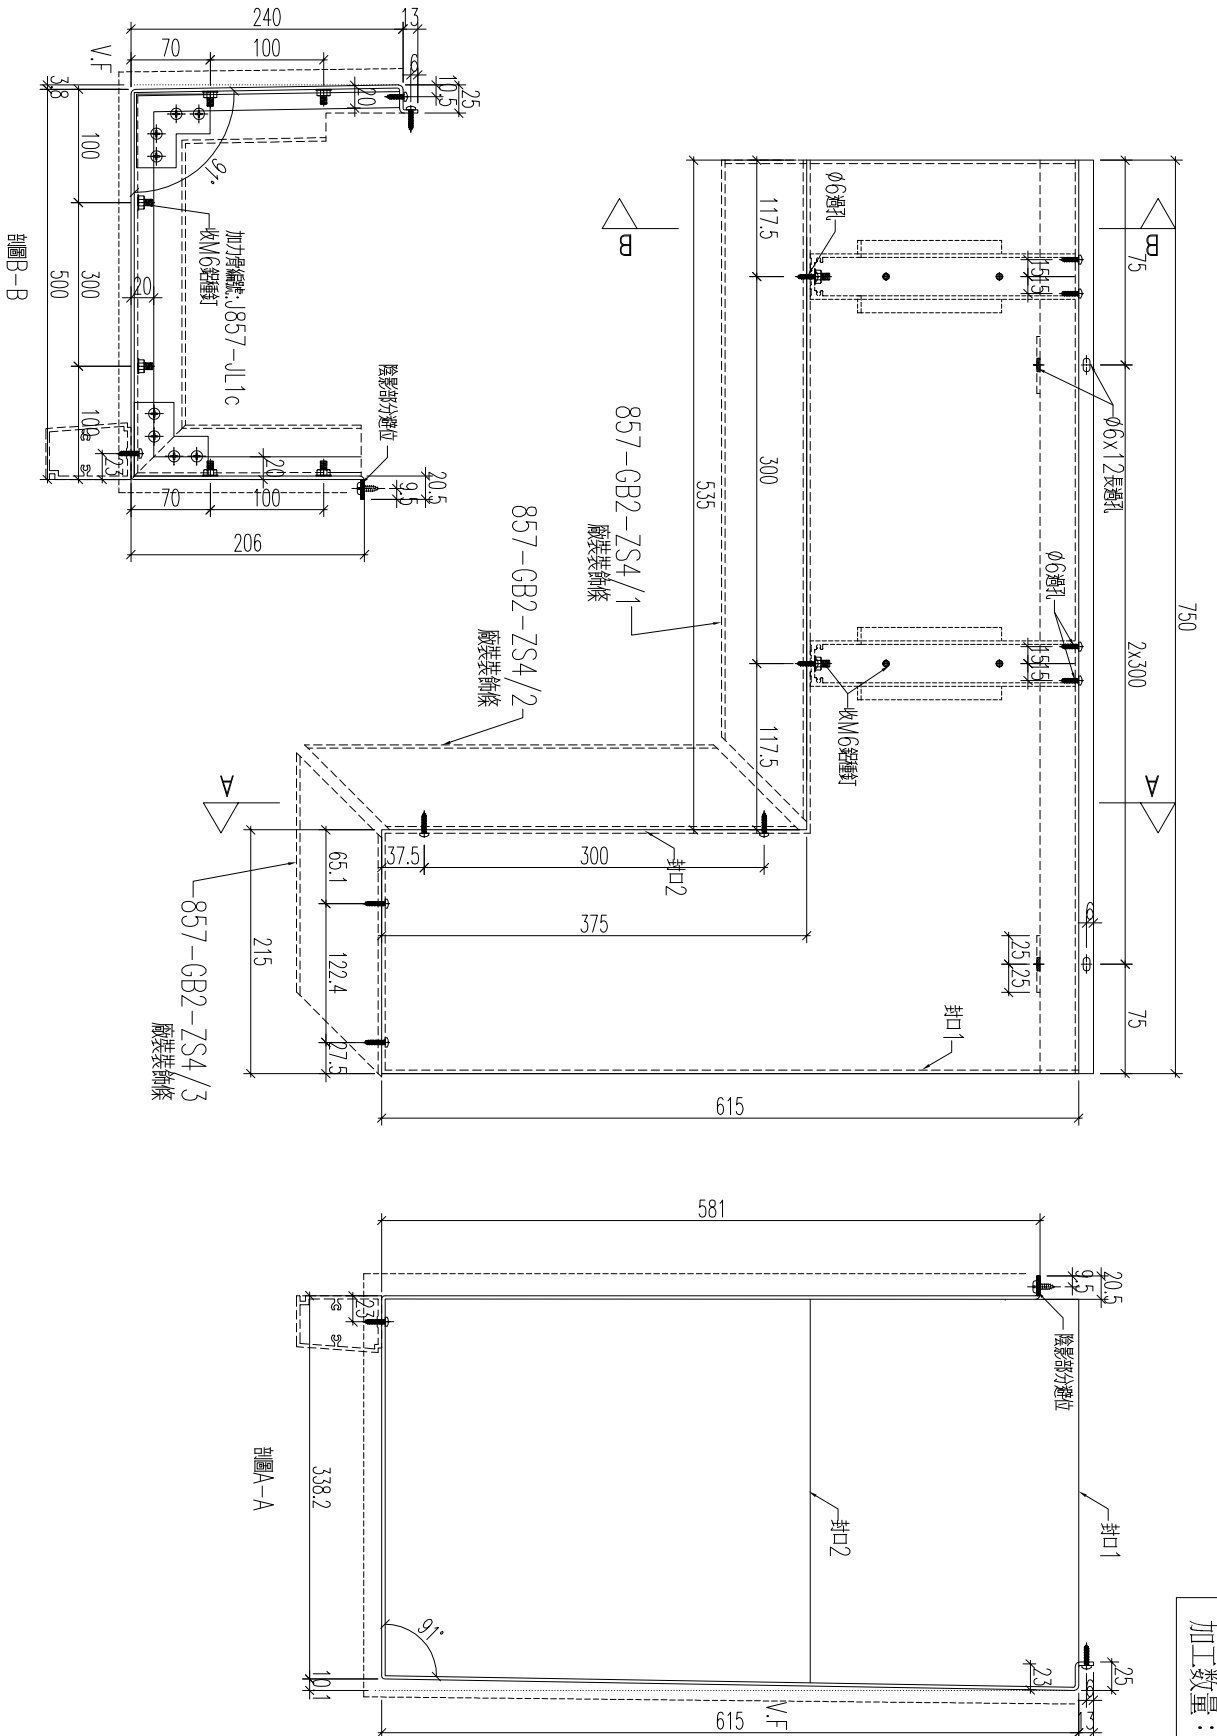




加工数量: 1

名稱	鋁板加工圖	制圖	黃漢卿	2022.12.2	修改		
材料	3mm厚鋁板	復核	王禮秋	2022.12.2	日期		
顏色	銅色(AL1)	批准			圖號	857-GB3-AP35	



工程號	J857	地盤	啓德6552
-----	------	----	--------

新增

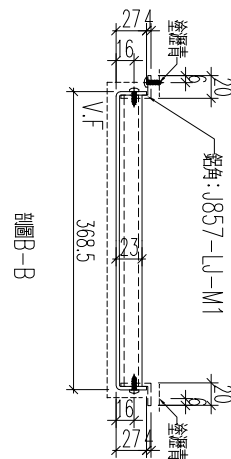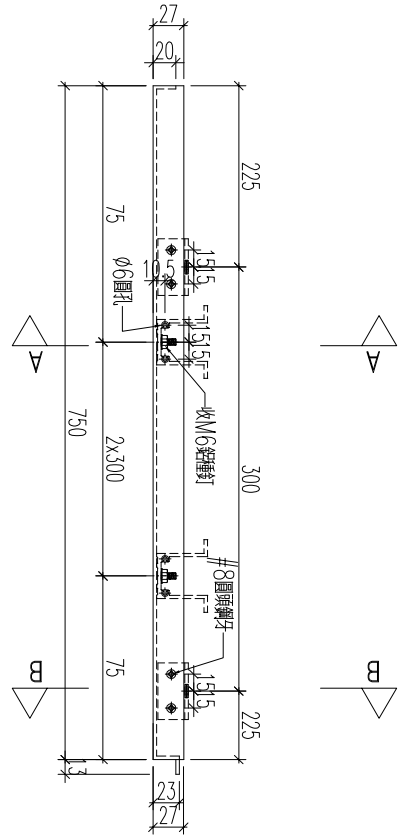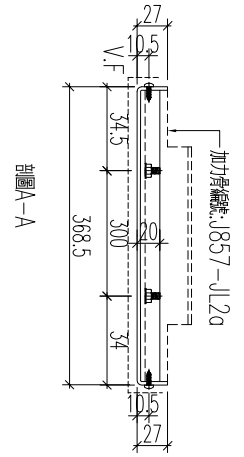




加工數量: 1

名稱	鋁板加工圖	制圖	黃漢卿	2022.12.2	修改		
材料	3mm厚鋁板	復核	王禮秋	2022.12.2	日期		
顏色	銅色(AL1)	批准			圖號	857-GB2-AP4a	



工程號	J857	地盤	啓德6552
-----	------	----	--------

新增

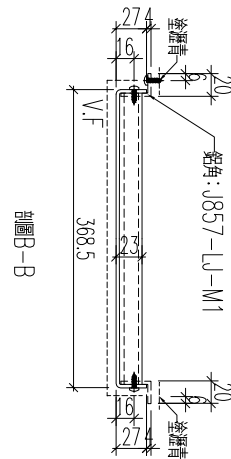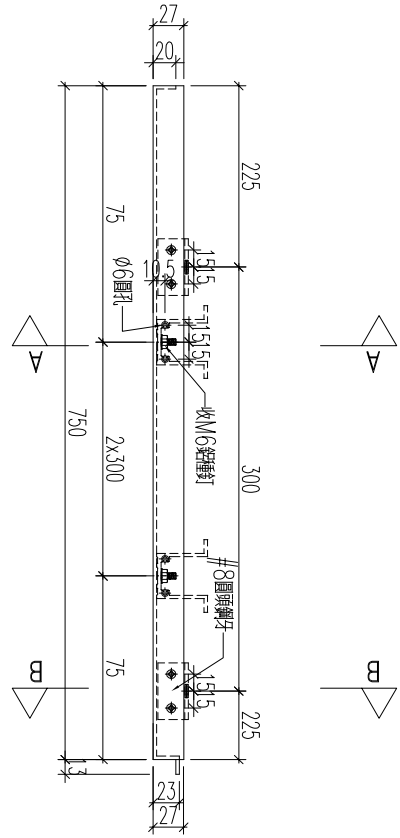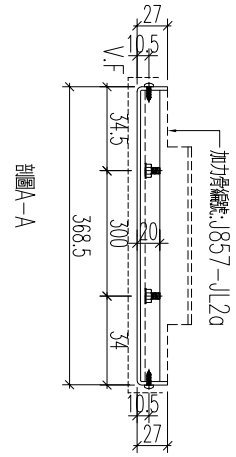

加工數量: 1

名稱	鋁板加工圖	制圖	黃漢卿	2022.12.2	修改		
材料	3mm厚鋁板	復核	王禮秋	2022.12.2	日期		
顏色	銅色(AL1)	批准			圖號	857-GB3-AP35a	



工程號

J857

地盤

啓德6552

編號
857-GB2-AP27

數量

1

長度

1650

N

4x300

A




225

M


5x300

B

75

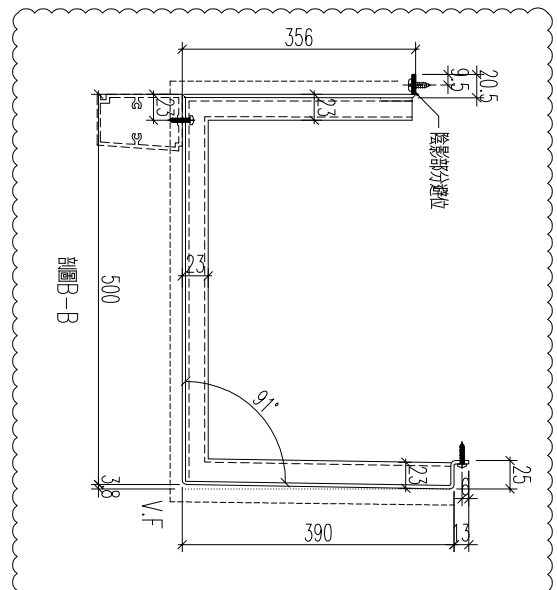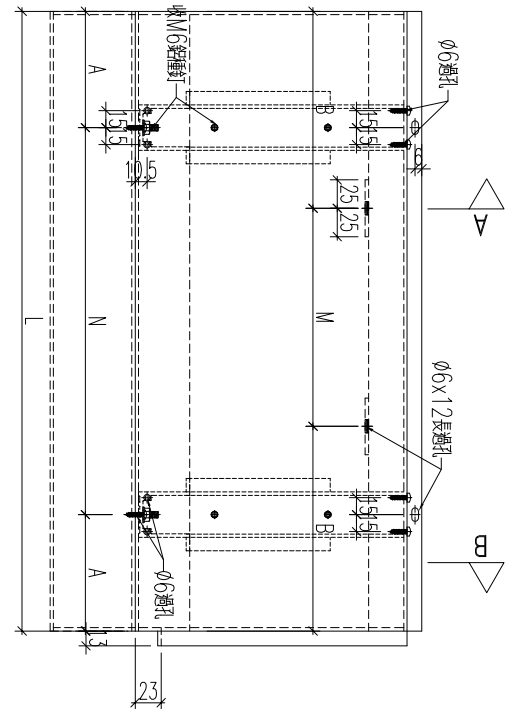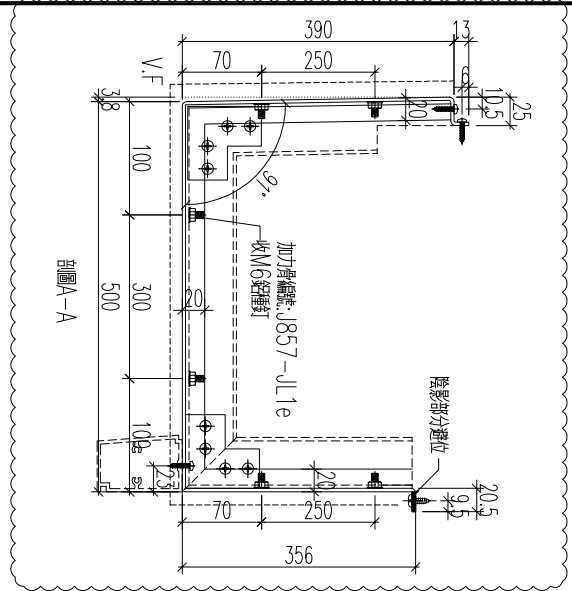




名稱	鋁板加工圖	制圖	黃漢卿	2022.12.2	修改	A	
材料	3mm厚板	復核	王禮秋	2022.12.2	日期	2.23	
顏色	銅色(AL1)	批准			圖號	857-GB2-AP27	

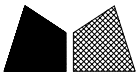

新增


工程號	J857	地盤	啓德6552
-----	------	----	--------

編號	數量	長度	N	A	M	B
857-GB3-AP15	1	1650	4x300	225	5x300	75
857-GB4-AP45	1	905	2x250	202.5	3x250	77.5

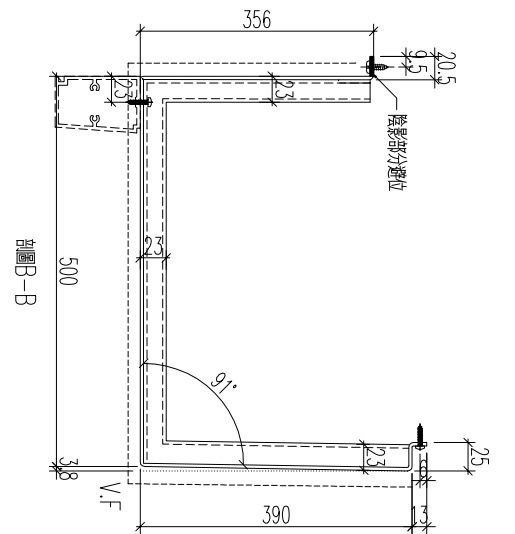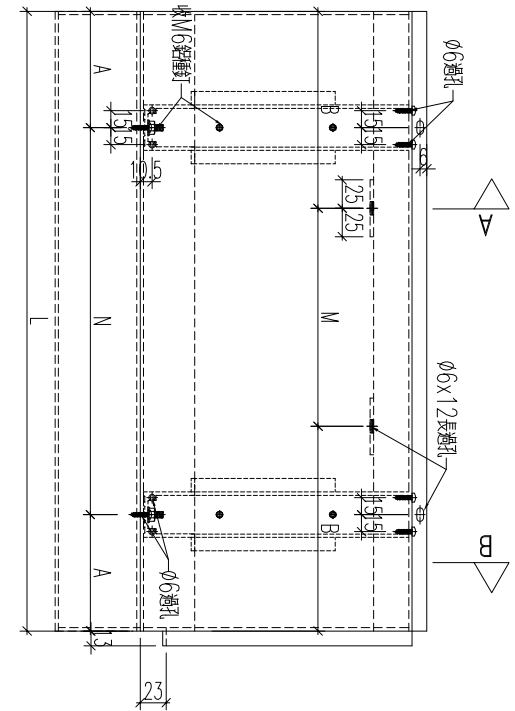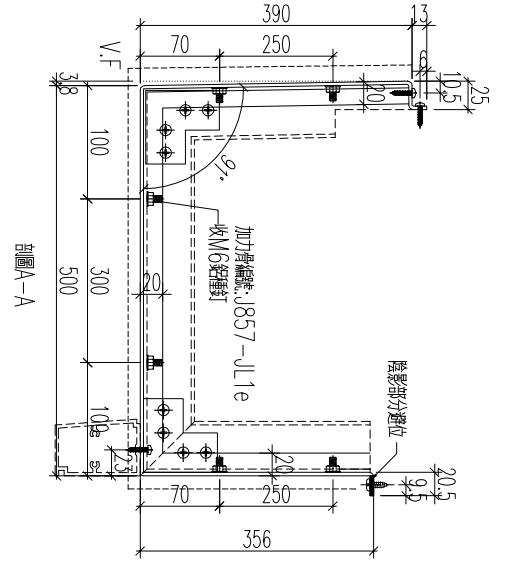

加工數量: 1

名稱	鋁板加工圖	制圖	黃漢卿	2022.12.2	修改		
材料	3mm厚鋁板	復核	王禮秋	2022.12.2	日期		
顏色	銅色(AL1)	批准			圖號	857-GB3-AP15	

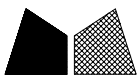

美特鋁質 有限公司
MIDI Aluminium Fabricator Ltd.




工程號

J857

地盤

啓德6552

編號	數量	長度	M	B	N	A
857-GB2-AP27a	1	1650	4x300	225	5x300	75

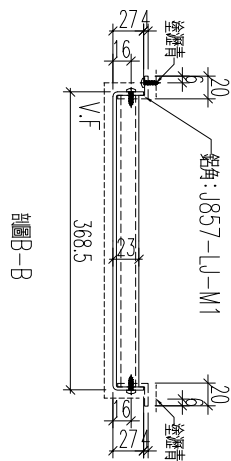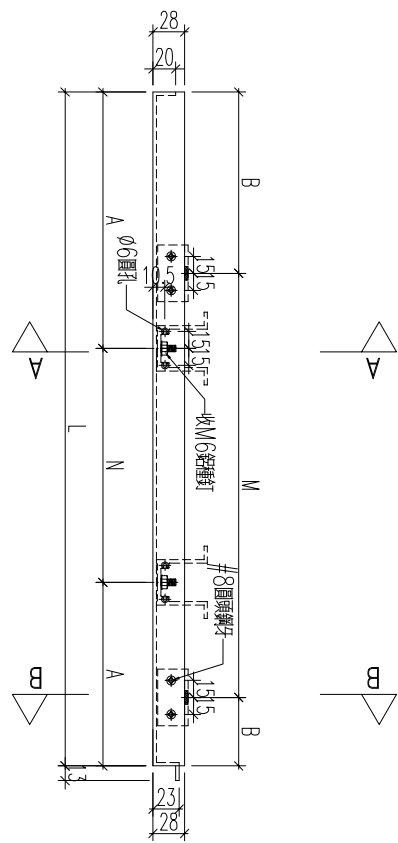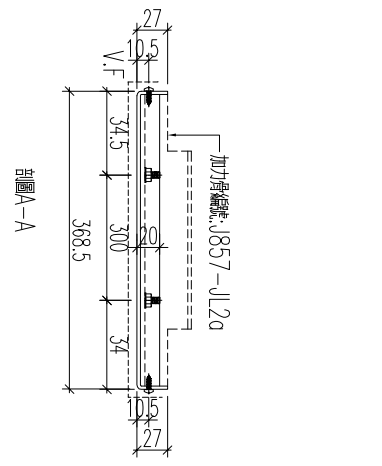

名稱	鋁板加工圖	制圖	黃漢卿	2022.12.2	修改	A		
材料	3mm厚板	復核	王禮秋	2022.12.2	日期	2.23		
顏色	深灰色(AL2)	批准			圖號	857-GB2-AP27a		



新增




工程號

J857

地盤


啓德6552

編號	數量	長度	M	B	N	A
857-GB3-AP15a	1	1650	4x300	225	5x300	75
857-GB4-AP45a	1	905	2x250	202.5	3x250	77.5

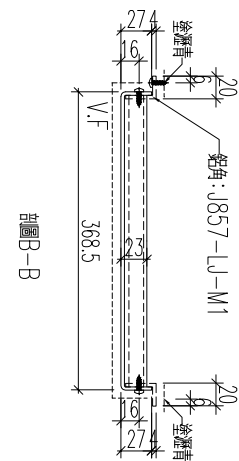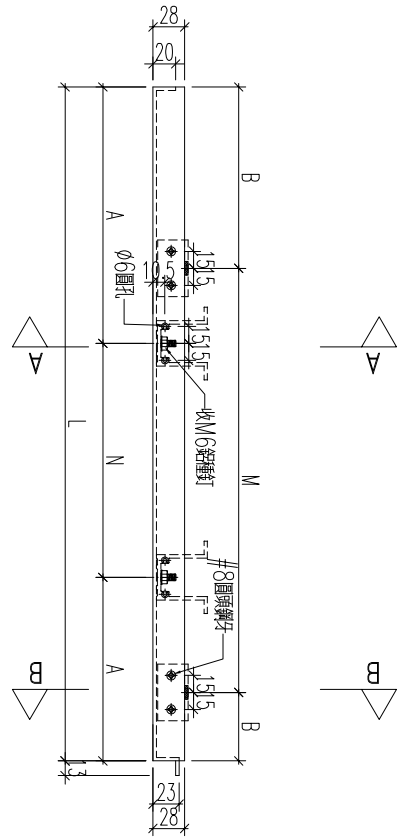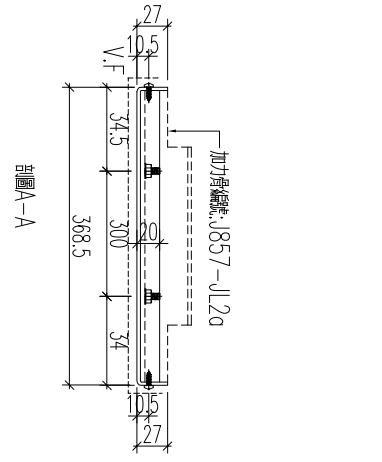

加工數量: 1

名稱	鋁板加工圖	制圖	黃漢卿	2022.12.2	修改	
材料	3mm厚板	復核	王禮秋	2022.12.2	日期	
顏色	深灰色(AL2)	批准			圖號	857-GB3-AP15a



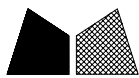


美特鋁質 有限公司
MIDI Aluminium Fabricator Ltd.

新增

工程號 J857 地盤 啓德6552

編號	數量	長度	M	B	N	A
857-GB4-AP46a	1	1075	2x300	237.5	3x300	87.5

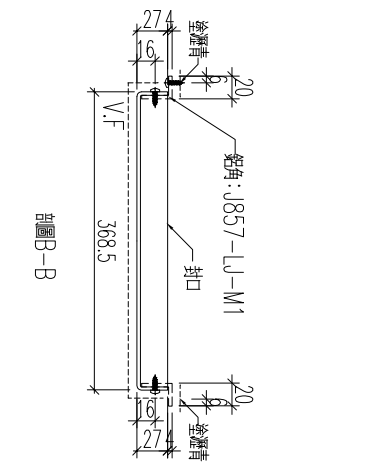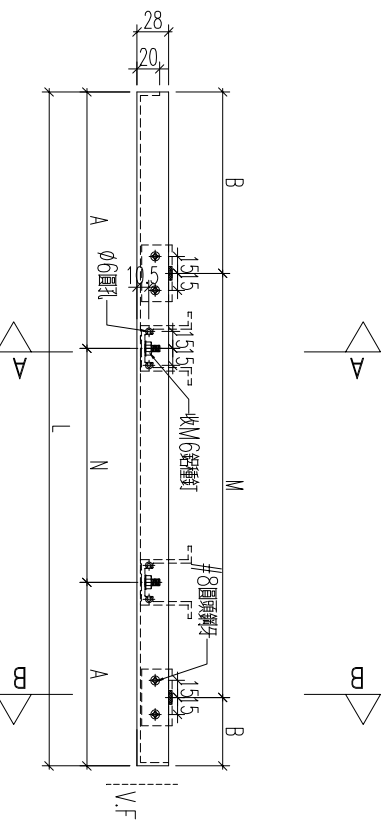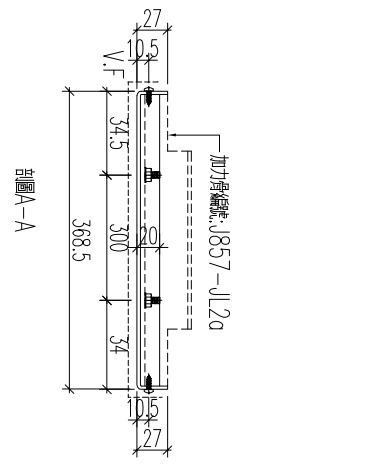

加工數量: 1




名稱	鋁板加工圖	制圖	黃漢卿	2022.12.2	修改		
材料	3mm厚鋁板	復核	王禮秋	2022.12.2	日期		
顏色	深灰色(AL2)	批准			圖號	857-GB4-AP46a	




新增

工程號	J857	地盤	啓德6552
-----	------	----	--------

料號	數量						
857-GB2-AP36	1						

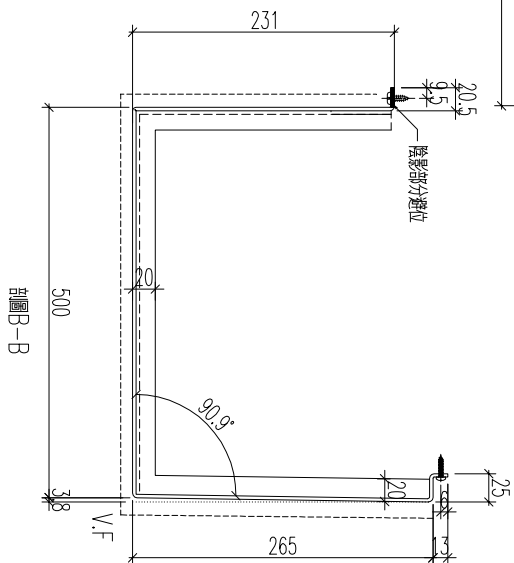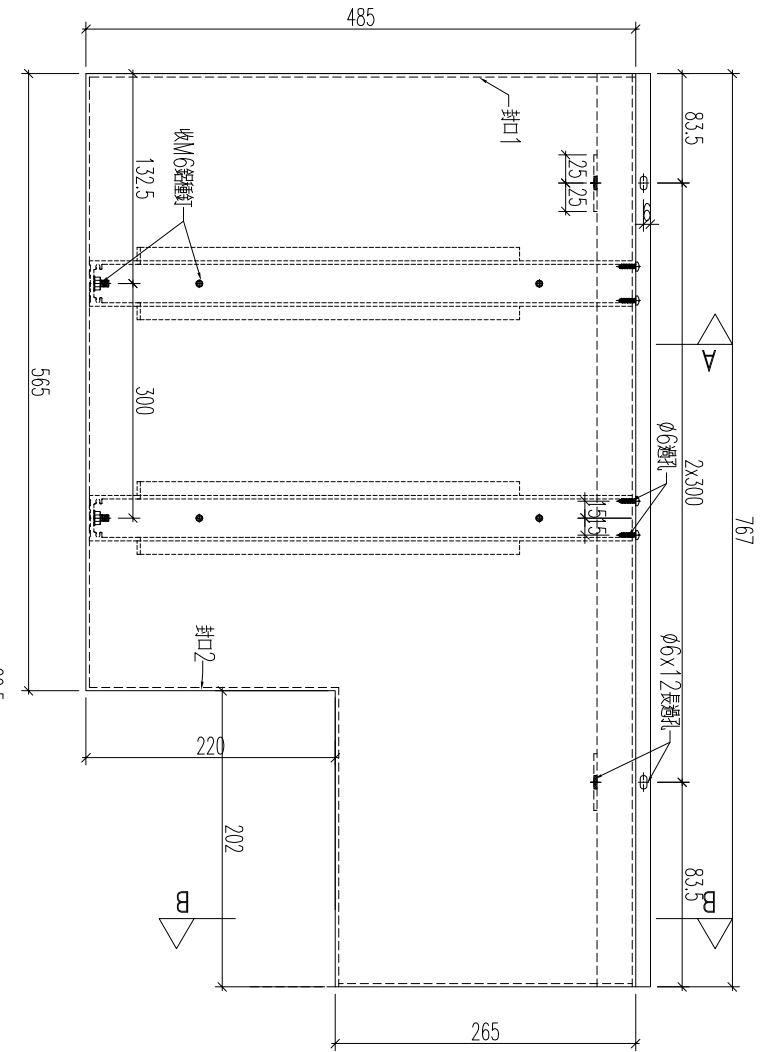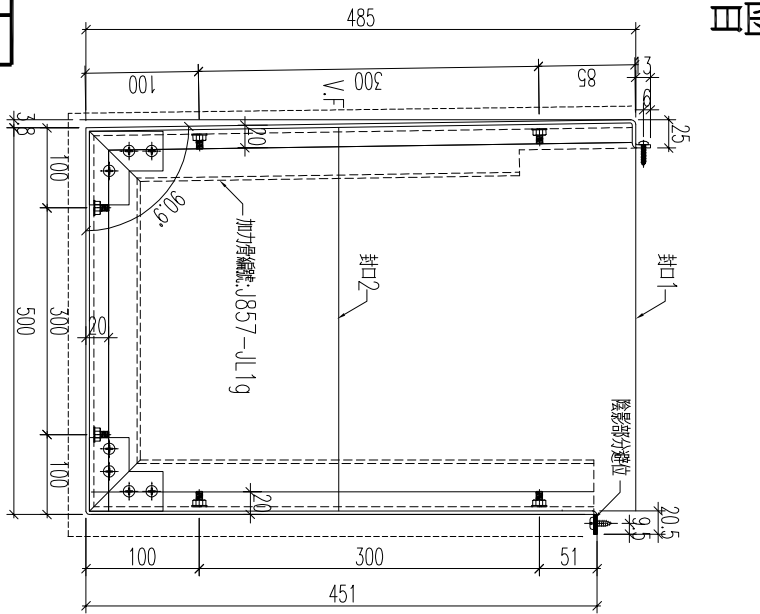

名稱	鋁板加工圖	制圖	黃漢卿	2022.12.2	修改		
材料	3mm厚板	復核	王禮秋	2022.12.2	日期		
顏色	銅色(AL1)	批准			圖號	857-GB2-AP36	



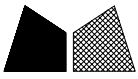


美特鋁質 有限公司
MIDI Aluminium Fabricator Ltd.

工程號	J857	地盤	啓德6552
-----	------	----	--------

料號	數量				
857-GB5-AP2	1				

新增

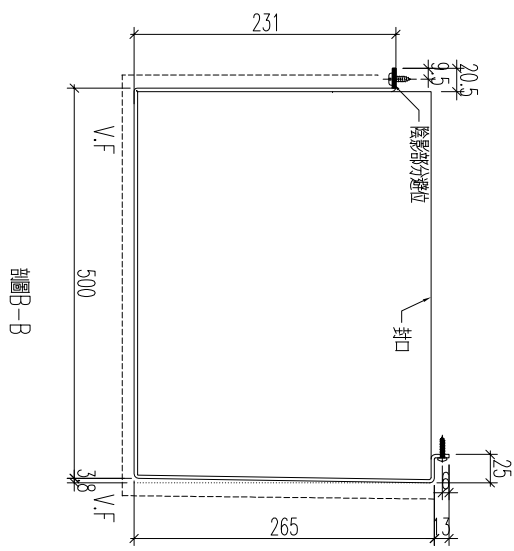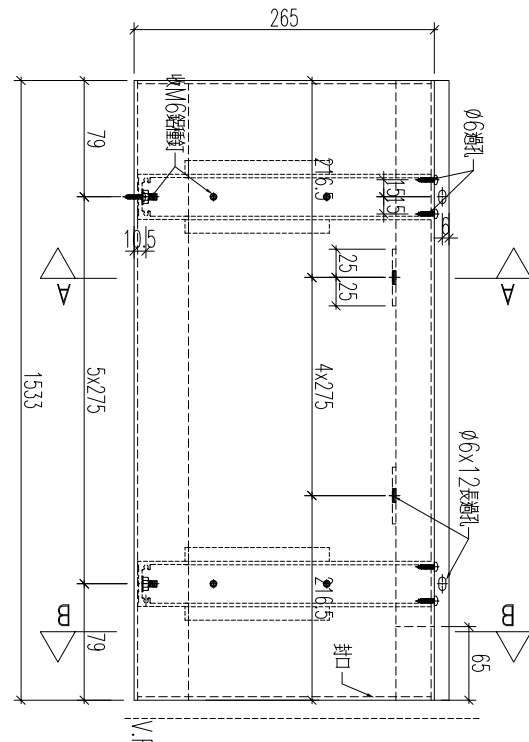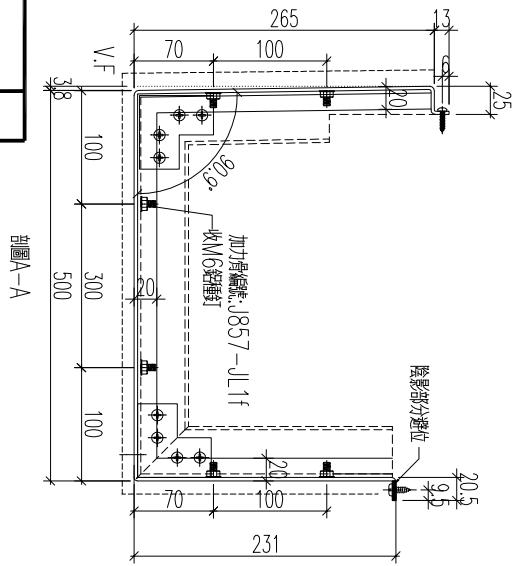

名稱	鋁板加工圖	制圖	黃漢卿	2022.12.2	修改		
材料	3mm厚板	復核	王禮秋	2022.12.2	日期		
顏色	銅色(AL1)	批准			圖號	857-GB5-AP2	






美特鋁質 有限公司
MIDI Aluminium Fabricator Ltd.

新增

工程號	J857	地盤	啓德6552
-----	------	----	--------

料號	數量						
857-GB3-AP6	1						

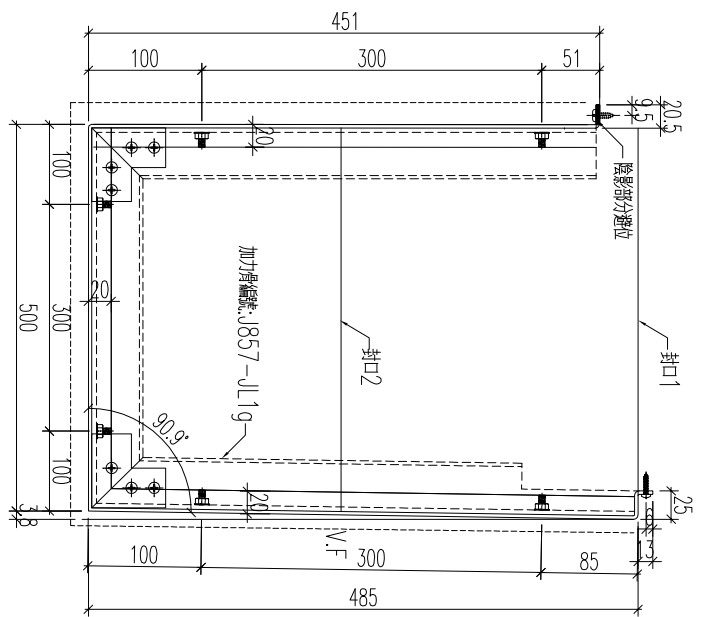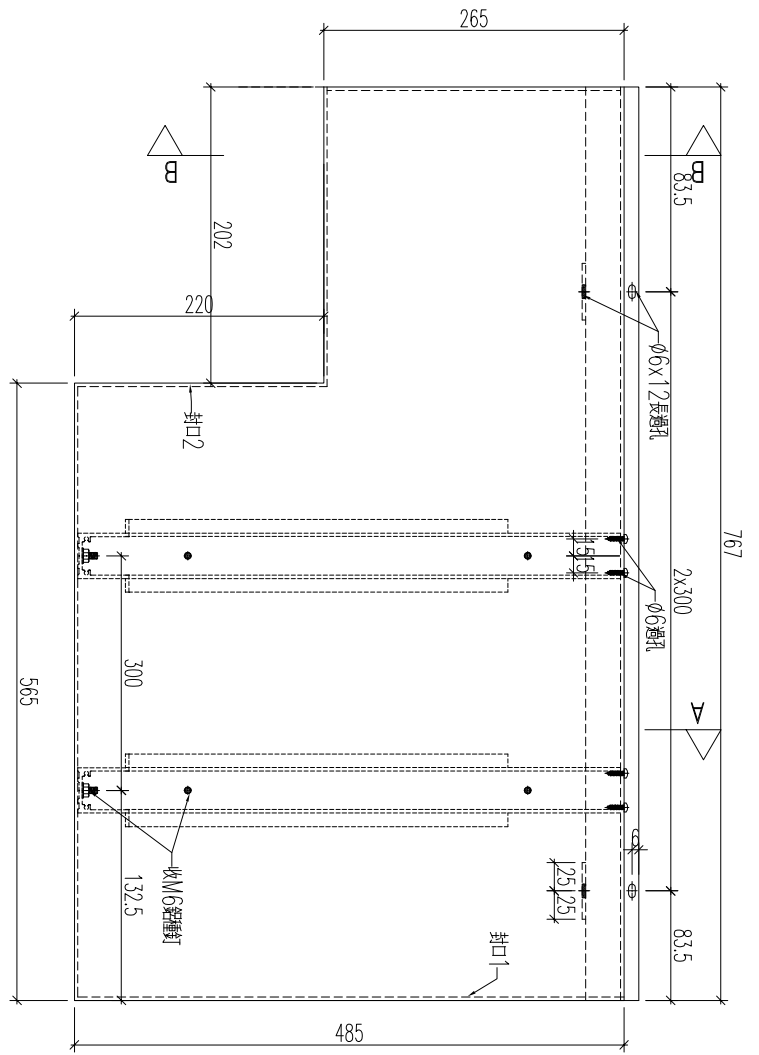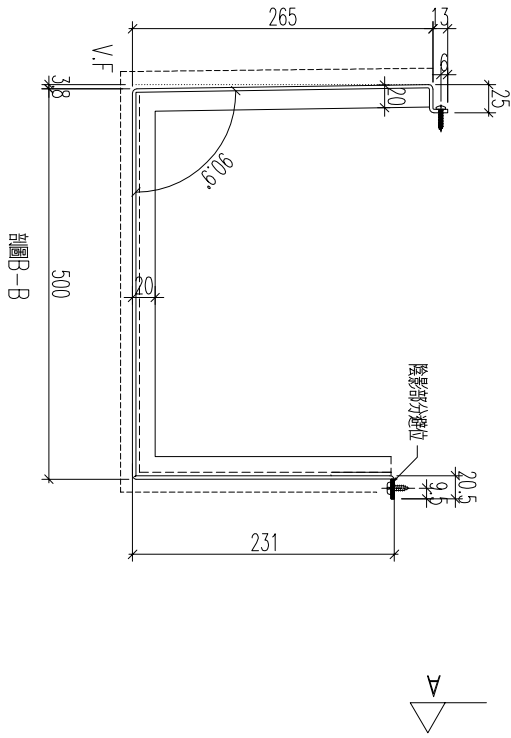

名稱	鋁板加工圖	制圖	黃漢卿	2022.12.2	修改		
材料	3mm厚鋁板	復核	王禮秋	2022.12.2	日期		
顏色	銅色(AL1)	批准			圖號	857-GB3-AP6	



工程號

J857





地盤

啓德6552

料號
857-GB2-AP37

數量

1

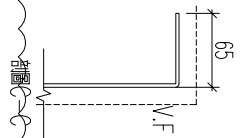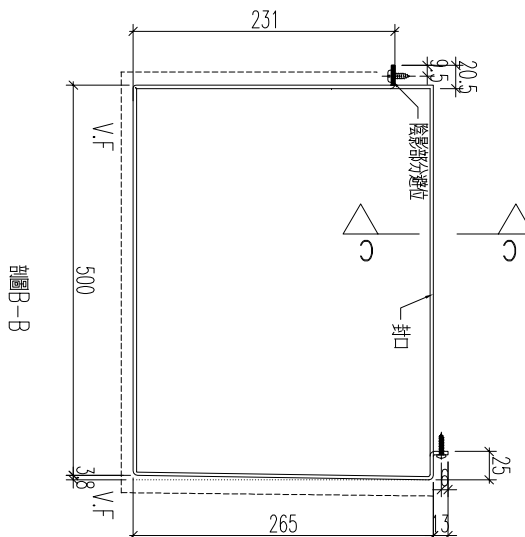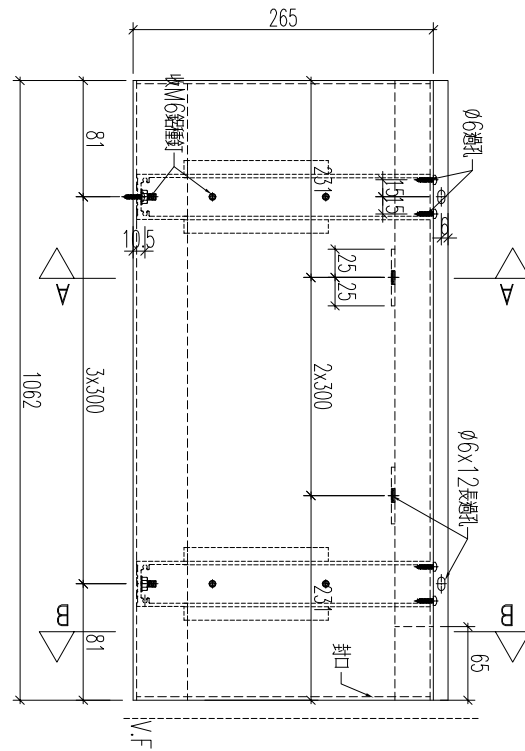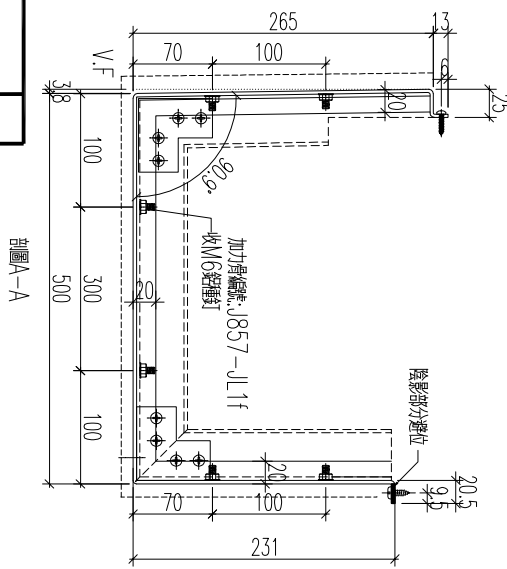

圖A-A

圖B-B




圖C-C

名稱	鋁板加工圖	制圖	黃漢卿	2022.12.2	修改	A	
材料	3mm厚鋁板	復核	王禮秋	2022.12.2	日期	2.23	
顏色	銅色(AL1)	批准			圖號	857-GB2-AP37	




工程號	J857	地盤	啓德6552
-----	------	----	--------

料號	數量						
857-GB2-AP37a	1						

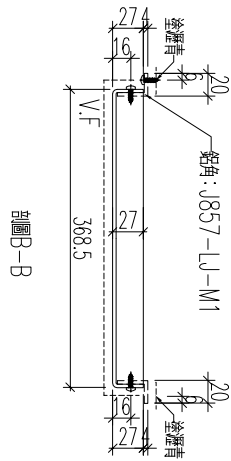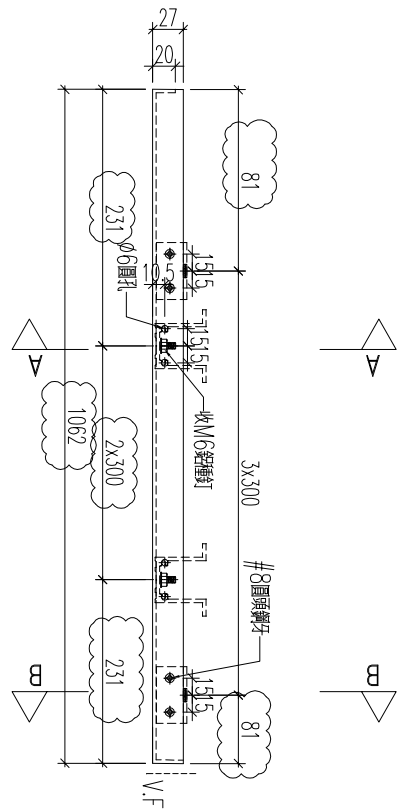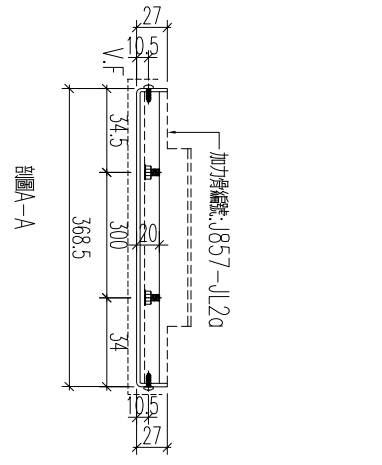




名稱	鋁板加工圖	制圖	黃漢卿	2022.12.2	修改	A	
材料	3mm厚鋁板	復核	王禮秋	2022.12.2	日期	2.23	
顏色	深灰色(AL2)	批准			圖號	857-GB2-AP37a	

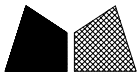

美特鋁質 有限公司
MIDI Aluminium Fabricator Ltd.

工程號 J857 地盤 啓德6552

料號	數量				
857-GB3-AP50	1				

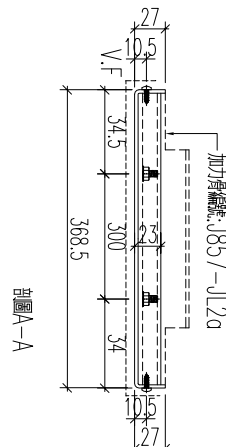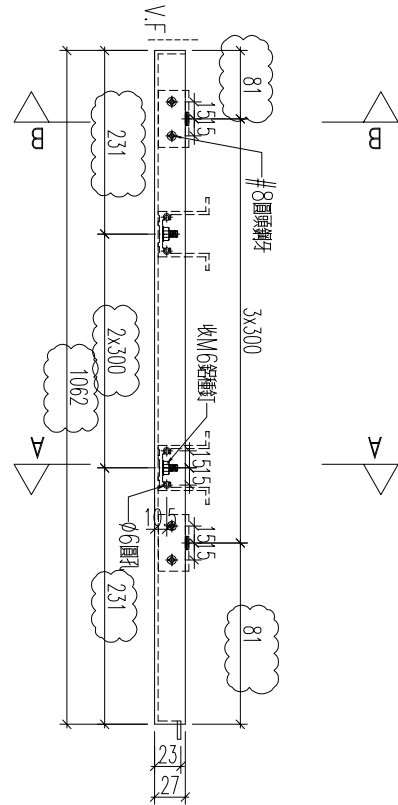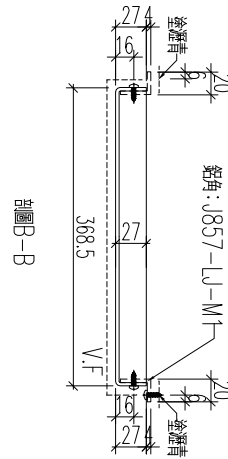




名稱	鋁板加工圖	制圖	黃漢卿	2022.12.2	修改	A	
材料	3mm厚鋁板	復核	王禮秋	2022.12.2	日期	2.23	
顏色	深灰色(AL2)	批准			圖號	857-GB2-AP37a	



工程號 J857 地盤 啓德6552

編號	數量	長度	M	B	N	A
857-GB3-AP6a	1	767	300	233.5	2x300	83.5

新增

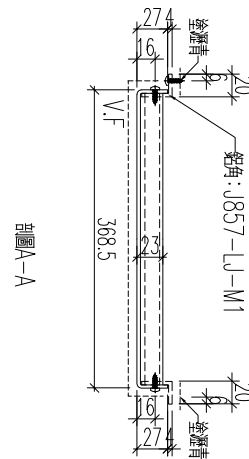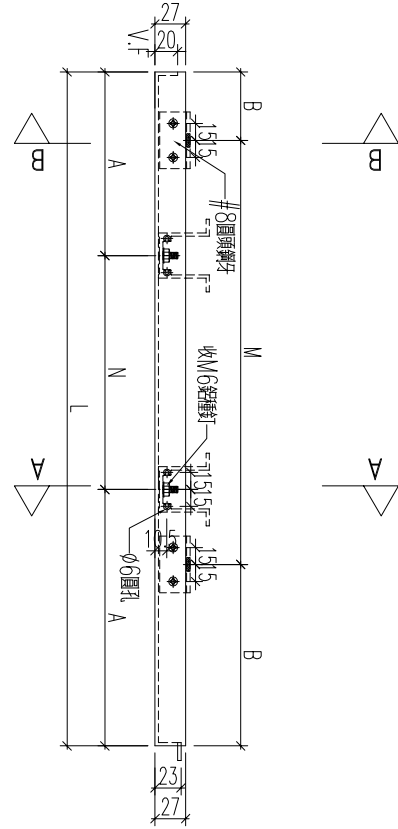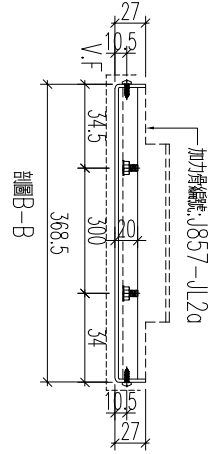


名稱	鋁板加工圖	制圖	黃漢卿	2022.12.2	修改		
材料	3mm厚鋁板	復核	王禮秋	2022.12.2	日期		
顏色	深灰色(AL2)	批准			圖號	857-GB3-AP6	



工程號 J857 地盤 啓德6552

編號	數量				
857-GB5-AP2a	1				

新增

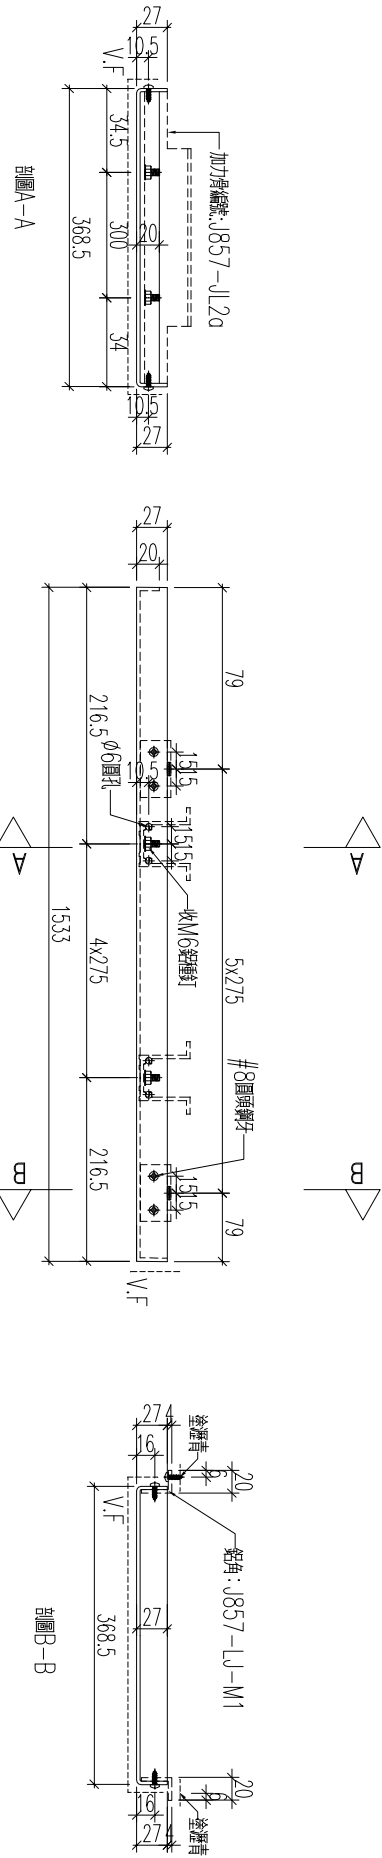

名稱	鋁板加工圖	制圖	黃漢卿	2022.12.2	修改		
材料	3mm厚鋁板	復核	王禮秋	2022.12.2	日期		
顏色	深灰色(AL2)	批准			圖號	857-GB5-AP2a	





美特鋁質 有限公司
MIDI Aluminium Fabricator Ltd.


工程號	J857	地盤	啓德6552
-----	------	----	--------

加工數量：4件

增加1件

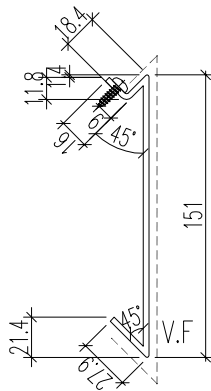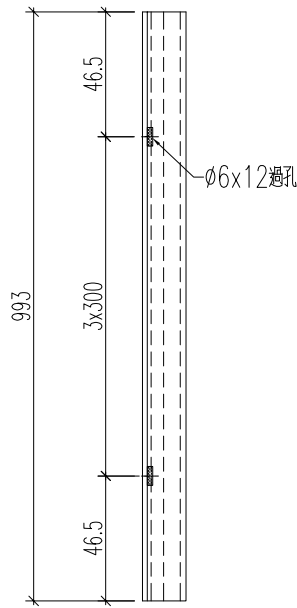

名稱	鋁板加工圖	制圖	黃漢卿	2022.12.2	修改	A		
材料	3mm厚板	復核	王禮秋	2022.12.2	日期	2.23		
顏色	銅色(AL1)	批准			圖號	857-LH-V17/2		


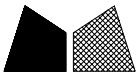


美特鋁質 有限公司
MIDI Aluminium Fabricator Ltd.

工程號	J857	地盤	啓德6552
-----	------	----	--------

加工數量：4件

增加1件

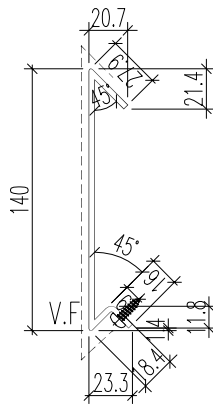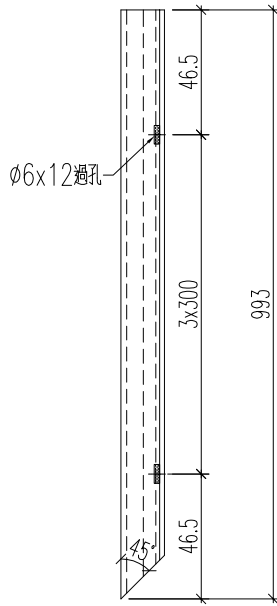

名稱	鋁板加工圖	制圖	黃漢卿	2022.12.2	修改	A		
材料	3mm厚板	復核	王禮秋	2022.12.2	日期	2.23		
顏色	銅色(AL1)	批准			圖號	857-LH-V18R/2		





美特鋁質 有限公司
MIDI Aluminium Fabricator Ltd.


工程號	J857	地盤	啓德6552
-----	------	----	--------

加工數量：4件

增加1件

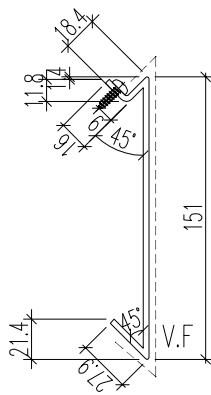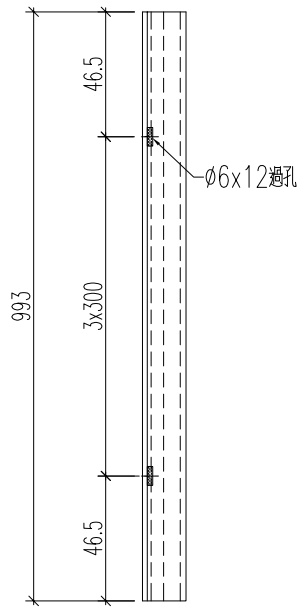

名稱	鋁板加工圖	制圖	黃漢卿	2022.12.2	修改	A		
材料	3mm厚板	復核	王禮秋	2022.12.2	日期	2.23		
顏色	銅色(AL1)	批准			圖號	857-LH-V17R/2		


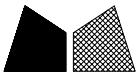


美特鋁質 有限公司
MIDI Aluminium Fabricator Ltd.


工程號	J857	地盤	啓德6552
-----	------	----	--------

加工數量：4件

增加1件

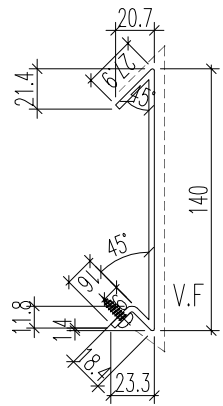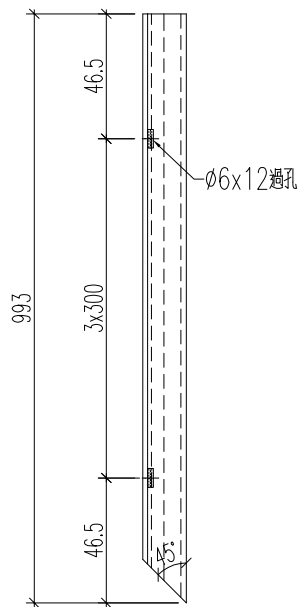

名稱	鋁板加工圖	制圖	黃漢卿	2022.12.2	修改	A		
材料	3mm厚板	復核	王禮秋	2022.12.2	日期	2.23		
顏色	銅色(AL1)	批准			圖號	857-LH-V18/2		

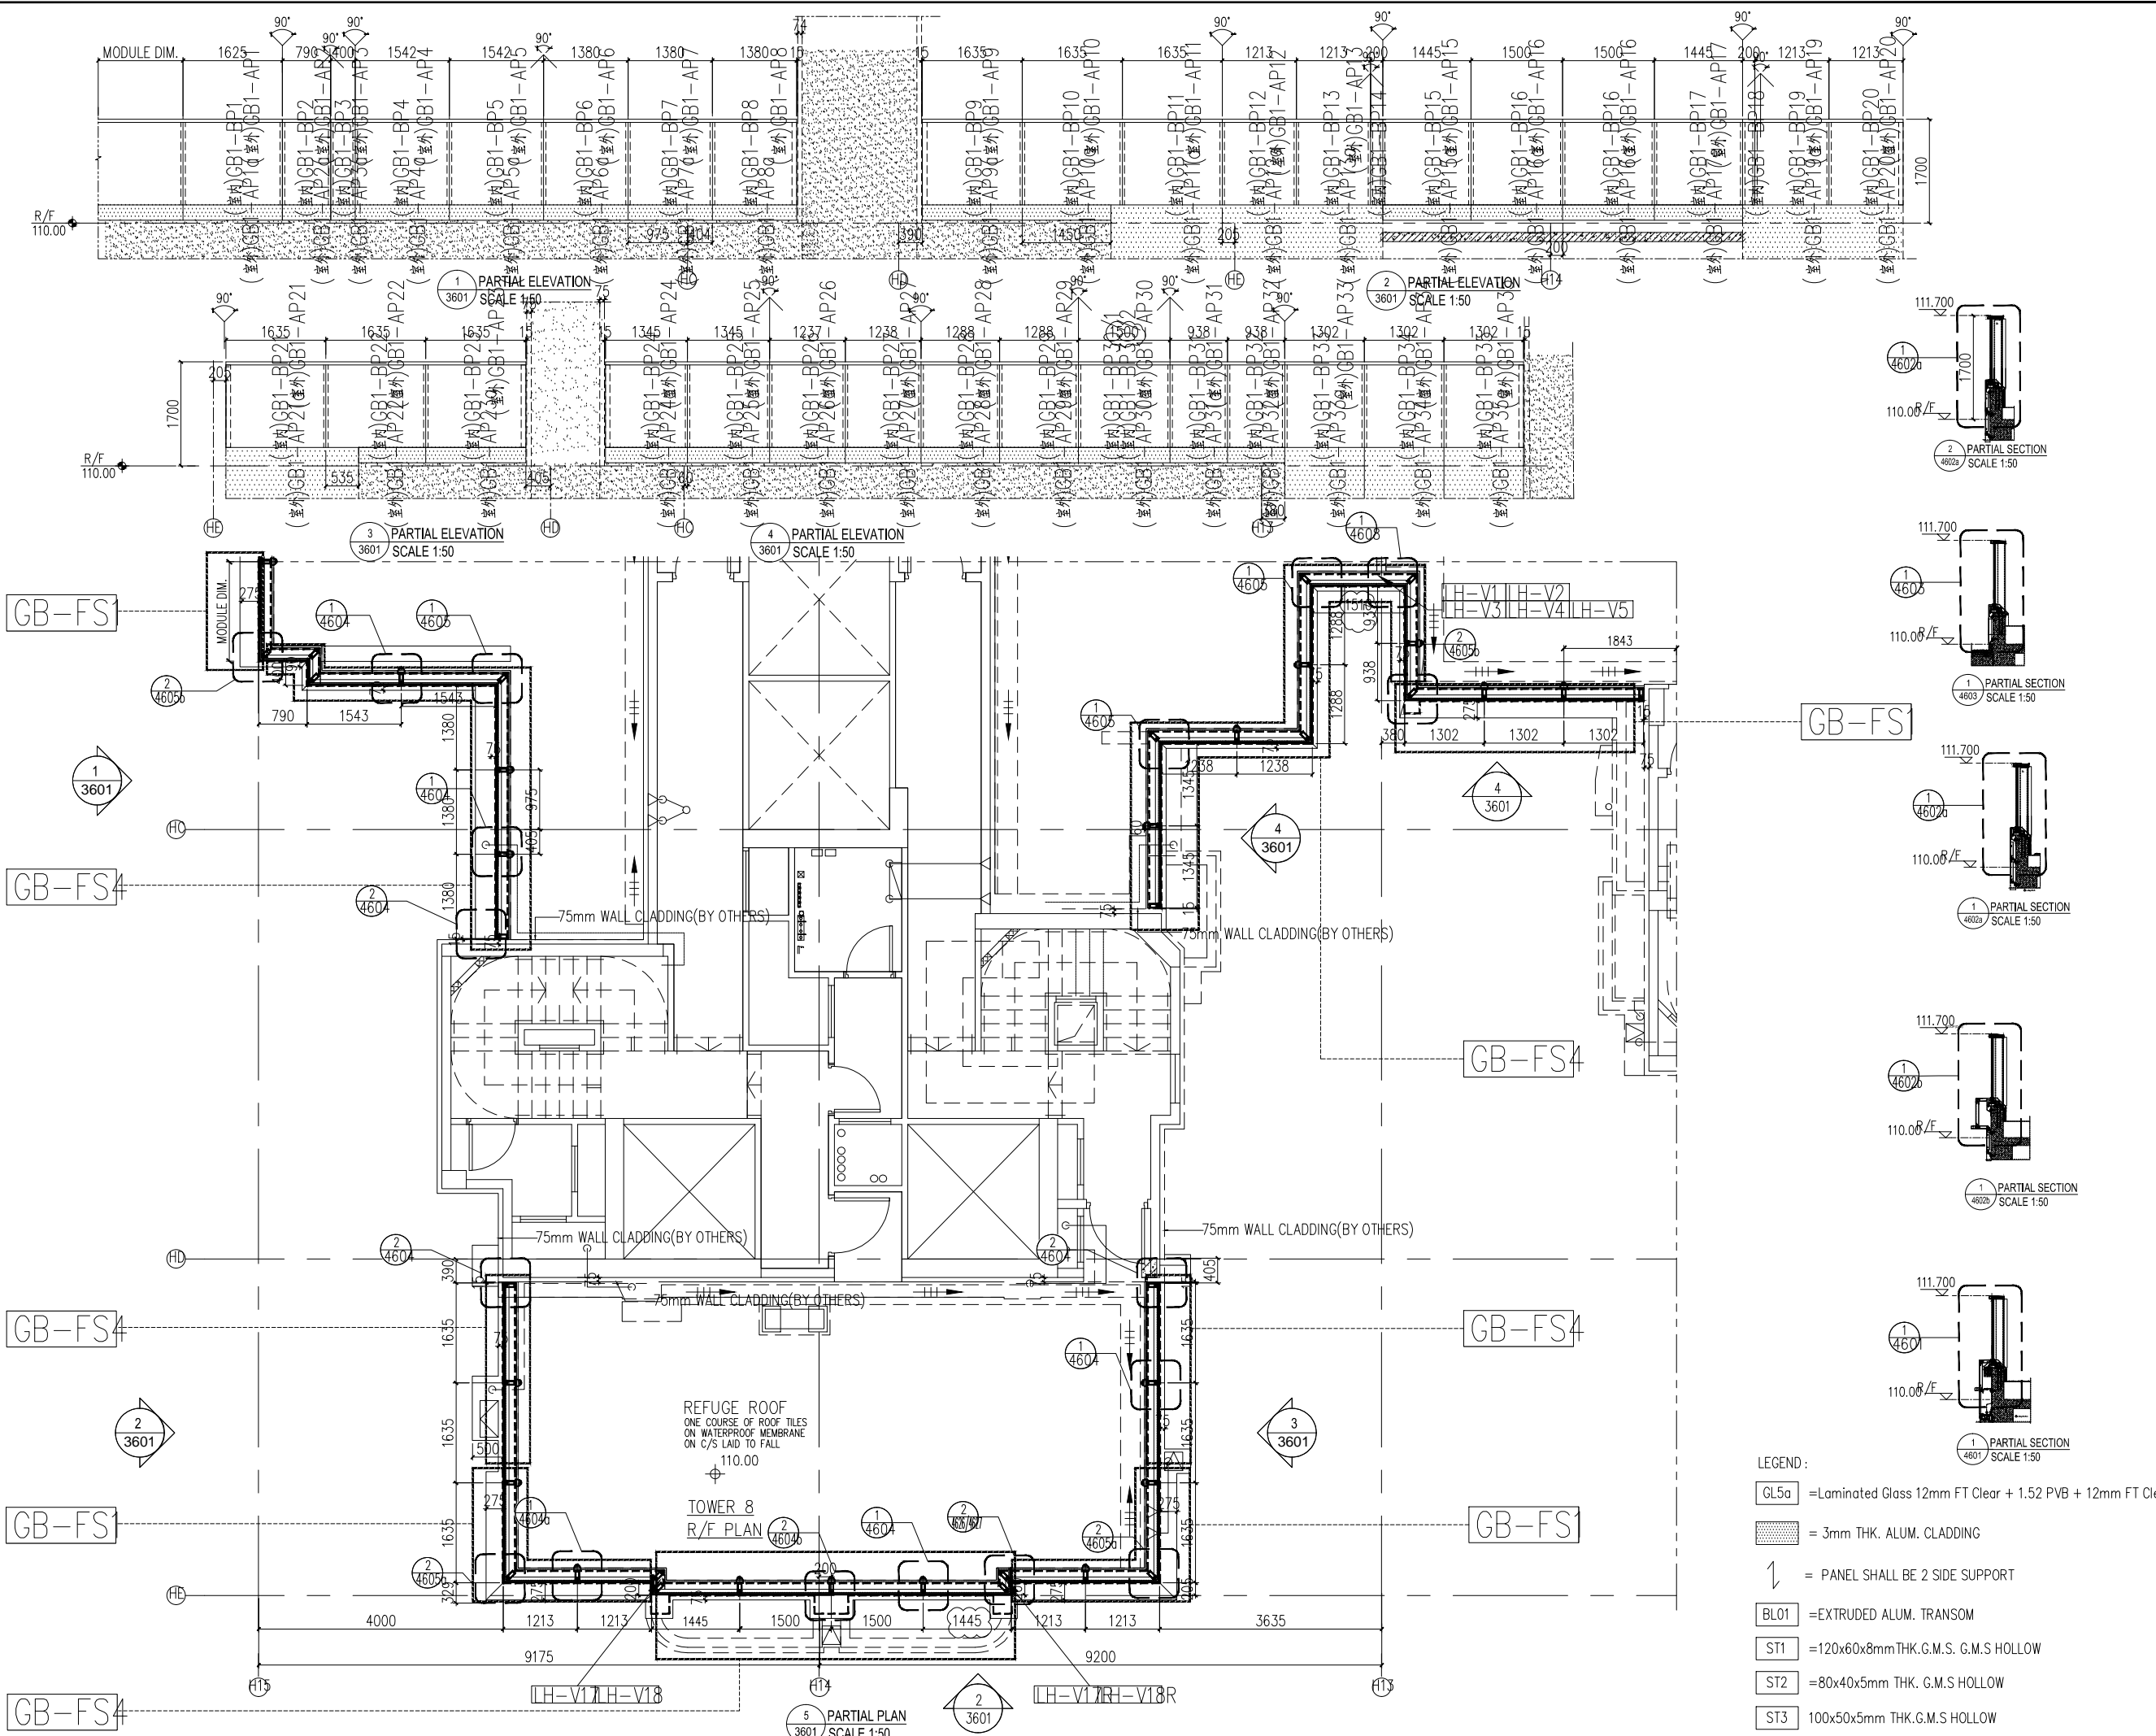

B.D. REF :
 F.S.D. REF :
 Note:
 1. All dimensions are in mm.
 2. All elevations are viewed from outside.
 3. All dimensions to be verified on site before fabrication.

GENERAL NOTES

Legend :
 1. F.F.L. --- Finished Floor Level
 2. S.F.L. --- Structural Floor Level
 3. (↔) --- Reversed Detail

X1 --- DETAIL MARK NO.
 X001 --- REFER SHEET NO.

REV.	DATE	DESCRIPTION	BY
J	28.JAN.2023	10TH SUBMISSION	
H	25.DEC.2022	9TH SUBMISSION	
G	22.OCT.2022	8TH SUBMISSION	
F	26.SEP.2022	7TH SUBMISSION	
E	22.AUG.2022	6TH SUBMISSION	
D	01.AUG.2022	5TH SUBMISSION	
C	14.JUL.2022	4TH SUBMISSION	
B	10.MAY.2022	3RD SUBMISSION	
A	13.DEC.2021	2ND SUBMISSION	
00	18.OCT.2021	1ST SUBMISSION	

CLIENT :
 MARBLE EDGE INVESTMENT LTD.

ARCHITECT :

 RONALD LU & PARTNERS
 ARCHITECTS | PLANNERS | INTERIOR DESIGNERS

STRUCTURAL ENGINEER :

 C M WONG & ASSOCIATES LTD
 110, 112, 114,1000

MAIN CONTRACTOR :
 ?????????


美特鋁質有限公司
 MIDI ALUMINIUM FABRICATOR LTD.
 Units 6-8, Sunray Industrial Centre, 1/F
 610 Cha Kwo Ling Road, Kowloon
 Tel:23489211-4 Fax:(852)27727666


PROJECT :
 PROPOSED RESIDENTIAL DEVELOPMENT AT NEW KOWLOON INLAND LOT. NO.6552

TITLE :
 PART ELEVATION FOR GLASS BALUSTRADE

JOB NO. : J-857
 DRAWN BY : AN DATE : 28 JAN.2023
 CHKD BY : SCALE A1: 1/50 A3:
 DWG. NO. : CW-PE-3601 REV. : F

- LEGEND :
- GL5a = Laminated Glass 12mm FT Clear + 1.52 PVB + 12mm FT Clear
 - [Pattern] = 3mm THK. ALUM. CLADDING
 - [Symbol] = PANEL SHALL BE 2 SIDE SUPPORT
 - BL01 = EXTRUDED ALUM. TRANSOM
 - ST1 = 120x60x8mm THK. G.M.S. G.M.S HOLLOW
 - ST2 = 80x40x5mm THK. G.M.S HOLLOW
 - ST3 = 100x50x5mm THK. G.M.S HOLLOW

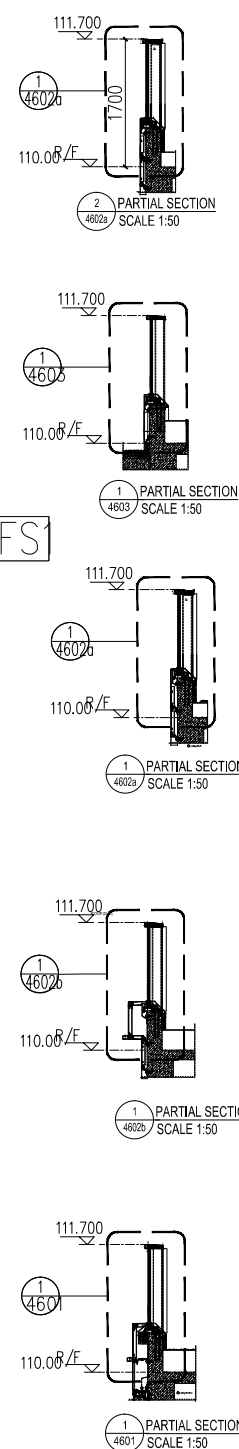

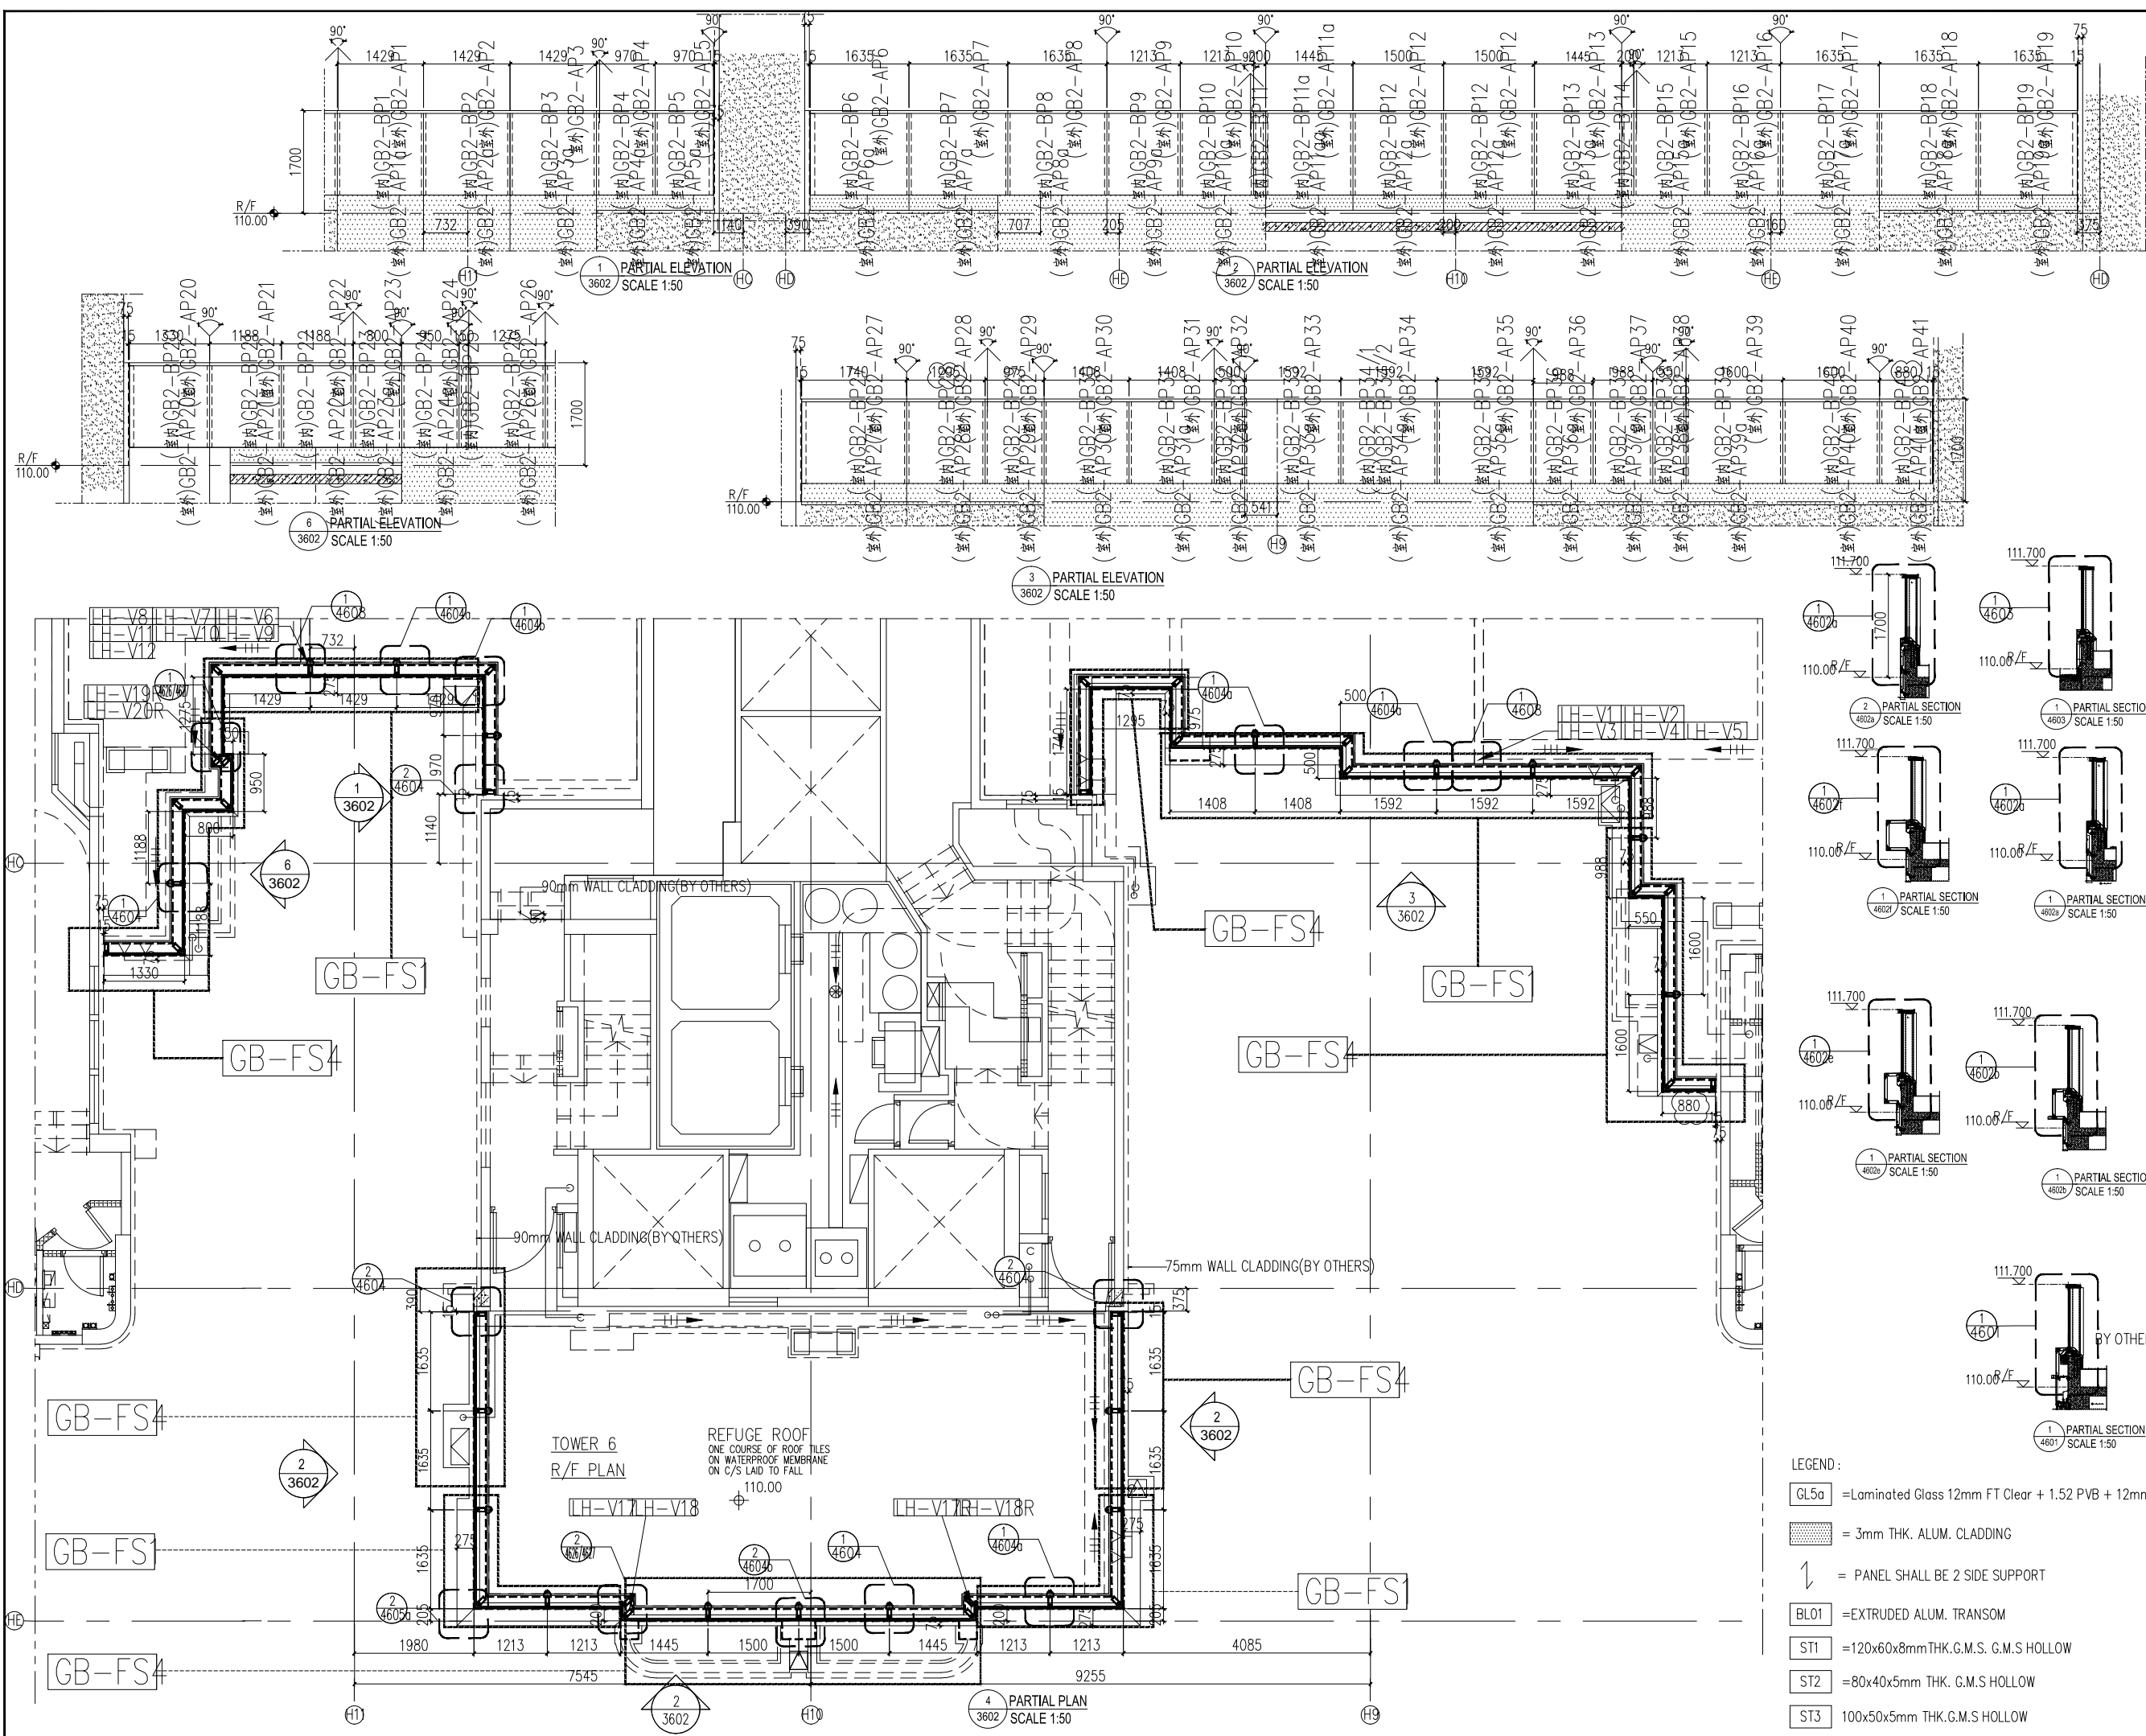

B.D. REF :
F.S.D. REF :
Note :
1. All dimensions are in mm.
2. All elevations are viewed from outside.
3. All dimensions to be verified on site before fabrication.

GENERAL NOTES

Legend :

- F.F.L. --- Finished Floor Level
- S.F.L. --- Structural Floor Level
- ↔ --- Reversed Detail

X1 --- DETAIL MARK NO.
X001 --- REFER SHEET NO.

REV.	DATE	DESCRIPTION	BY
J	28.JAN.2023	10TH SUBMISSION	
H	25.DEC.2022	9TH SUBMISSION	
G	22.OCT.2022	8TH SUBMISSION	
F	26.SEP.2022	7TH SUBMISSION	
E	22.AUG.2022	6TH SUBMISSION	
D	01.AUG.2022	5TH SUBMISSION	
C	14.JUL.2022	4TH SUBMISSION	
B	10.MAY.2022	3rd SUBMISSION	
A	13.OCT.2021	2nd SUBMISSION	
00	18.OCT.2021	1ST SUBMISSION	

CLIENT :
MARBLE EDGE INVESTMENT LTD.

ARCHITECT :
RONALD LU & PARTNERS
ARCHITECTS | PLANNERS | INTERIOR DESIGNERS

STRUCTURAL ENGINEER :
CMA C M WONG & ASSOCIATES LTD
110, 112, 114,1000


MAIN CONTRACTOR :
?????????

美特鋁質有限公司
MIDI ALUMINIUM FABRICATOR LTD.
Units 6-8, Sunray Industrial Centre, 1/F
610 Cha Kwo Ling Road, Kowloon
Tel: 23489211-4 Fax: (852) 27727666

PROJECT :
PROPOSED RESIDENTIAL DEVELOPMENT AT NEW KOWLOON INLAND LOT. NO.6552

TITLE :
PART ELEVATION FOR GLASS BALUSTRADE

JOB NO. : J-857
DRAWN BY : AN DATE : 28 JAN.2023
CHKD BY : SCALE A1: 1/250 A3:
DWG. NO. : CW-PE-3602 REV. : F

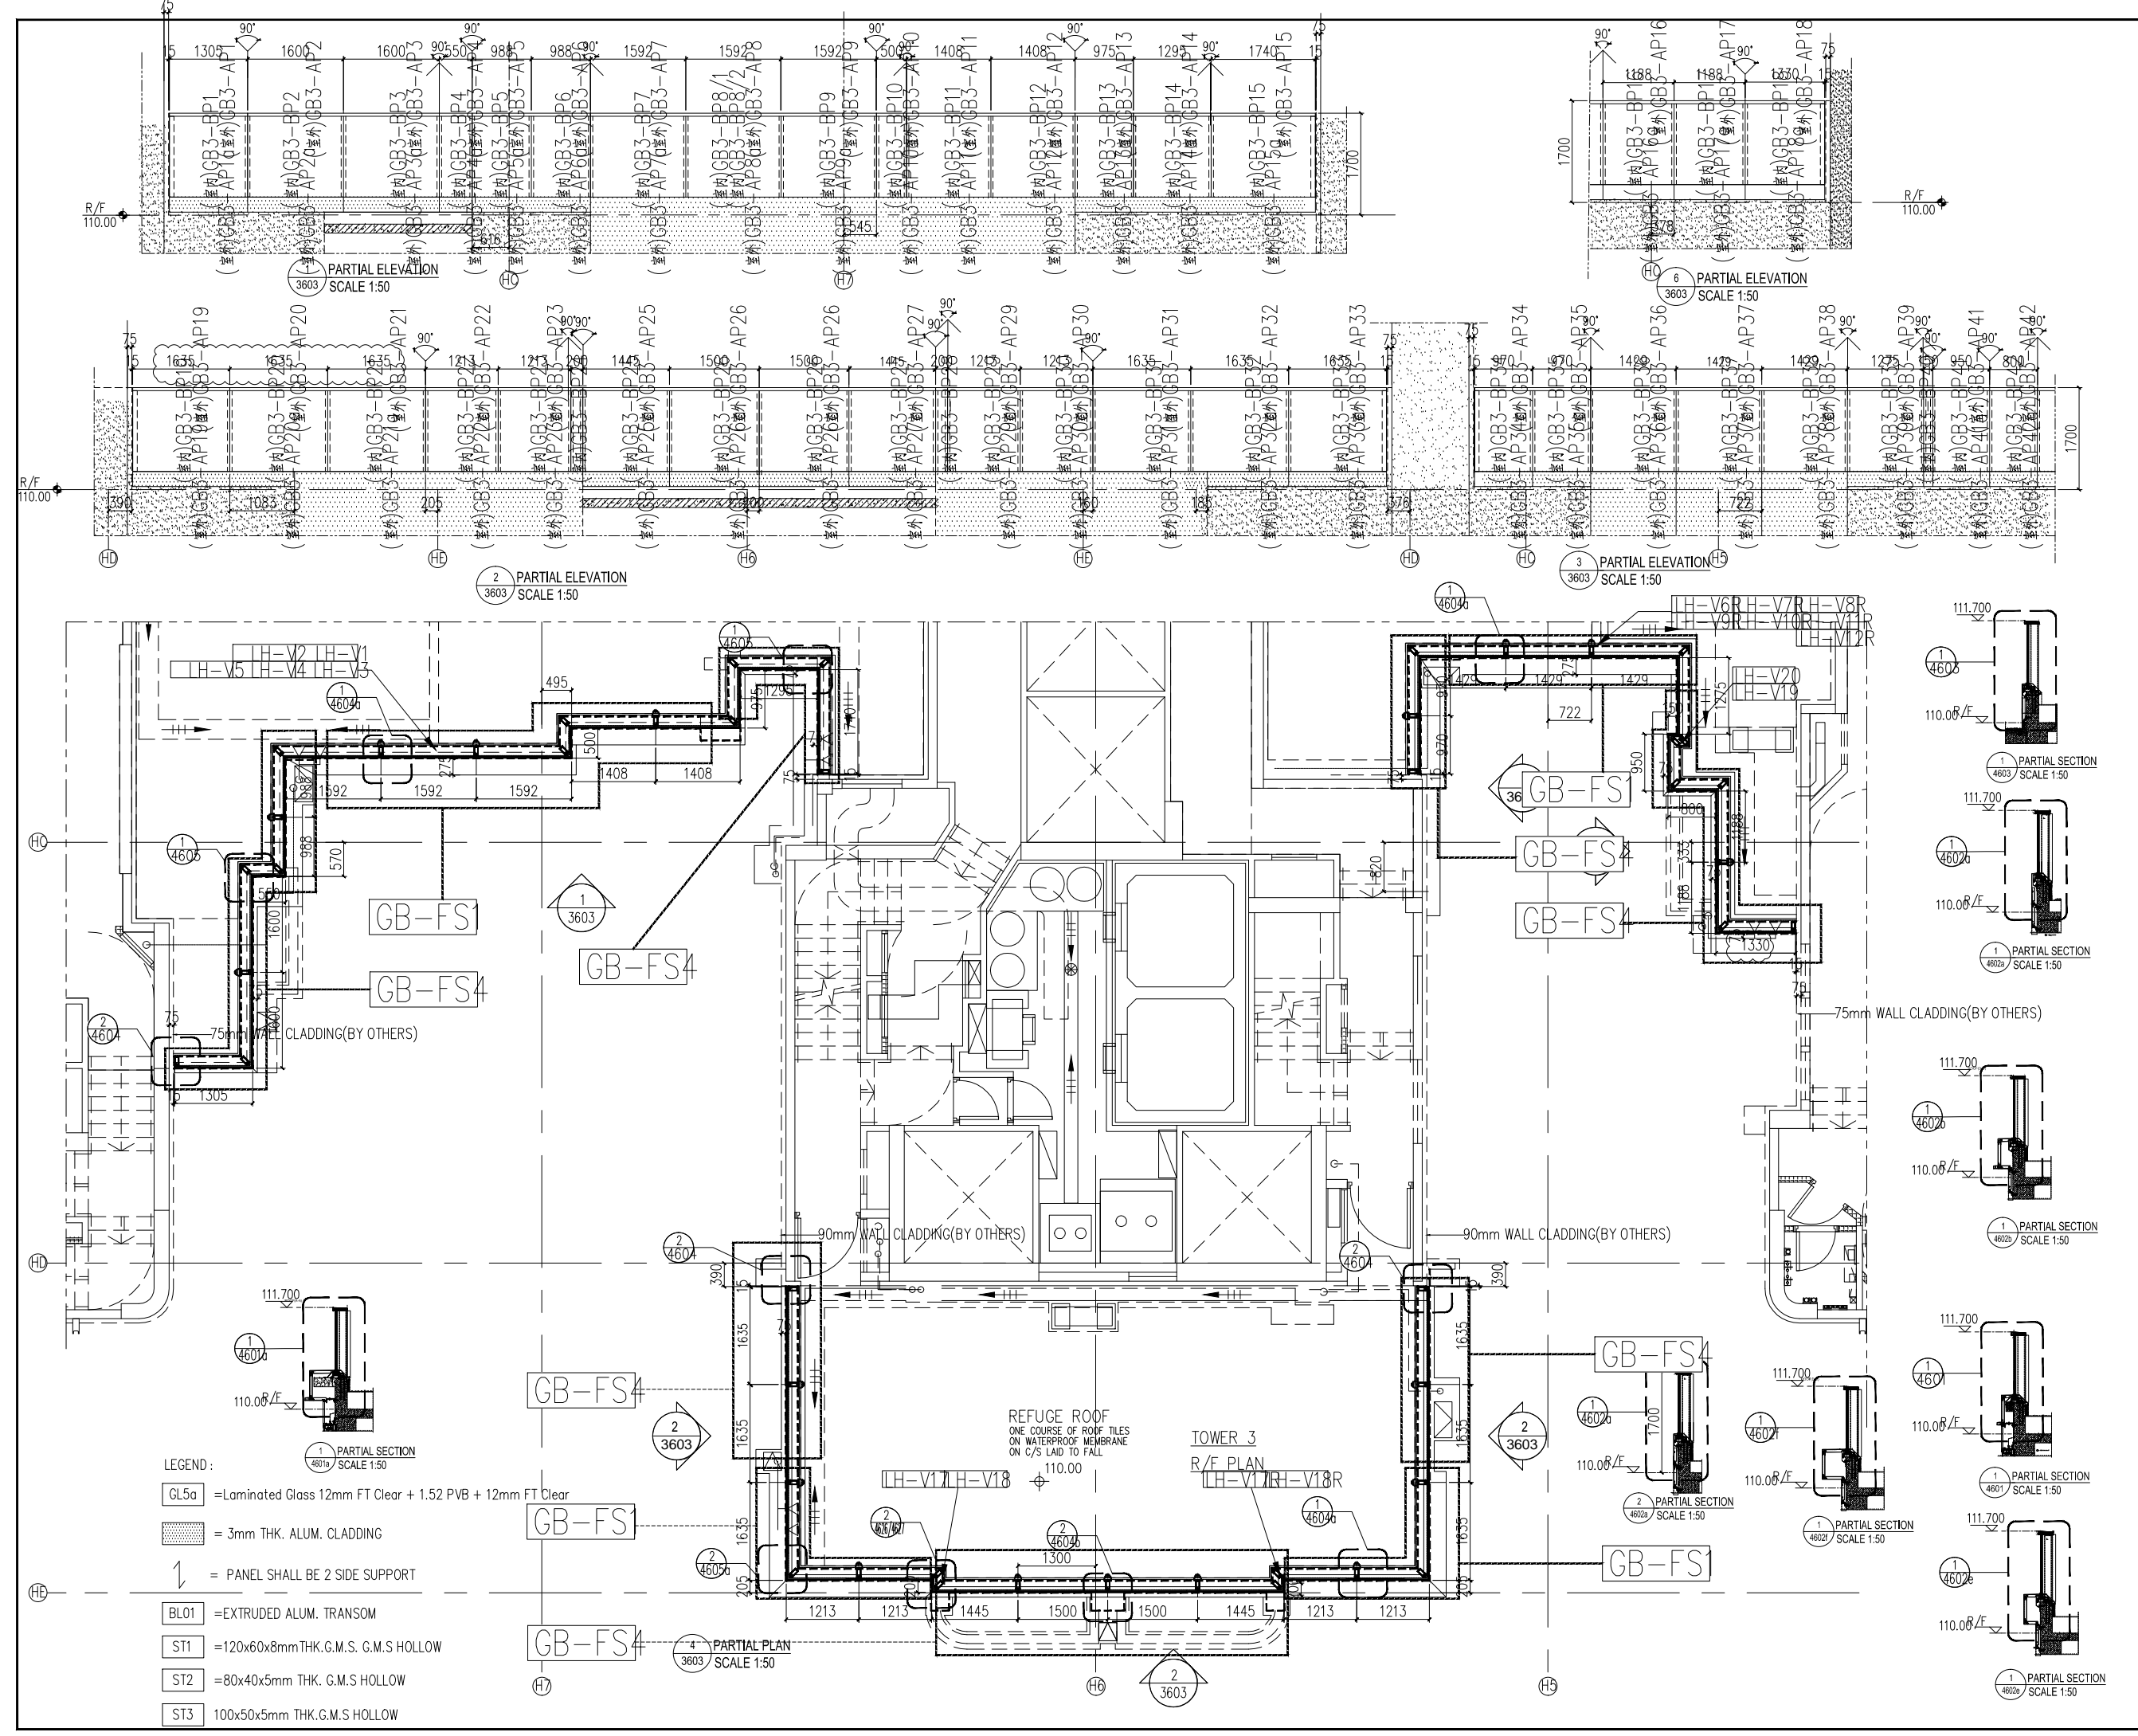

B.D. REF :
 F.S.D. REF :
 Note :
 1. All dimensions are in mm.
 2. All elevations are viewed from outside.
 3. All dimensions to be verified on site before fabrication.

GENERAL NOTES

Legend :
 1. F.F.L. --- Finished Floor Level
 2. S.F.L. --- Structural Floor Level
 3. (R) --- Reversed Detail

X1 --- DETAIL MARK NO.
 X001 --- REFER SHEET NO.

REV.	DATE	DESCRIPTION	BY
J	28.JAN.2023	10TH SUBMISSION	
H	25.DEC.2022	9TH SUBMISSION	
G	22.OCT.2022	8TH SUBMISSION	
F	26.SEP.2022	7TH SUBMISSION	
E	22.AUG.2022	6TH SUBMISSION	
D	01.AUG.2022	5TH SUBMISSION	
C	14.JUL.2022	4TH SUBMISSION	
B	10.MAY.2022	3rd SUBMISSION	
A	13.DEC.2021	2nd SUBMISSION	
00	18.OCT.2021	1ST SUBMISSION	

CLIENT :
 MARBLE EDGE INVESTMENT LTD.

ARCHITECT :
RONALD LU & PARTNERS
 ARCHITECTS | PLANNERS | INTERIOR DESIGNERS

STRUCTURAL ENGINEER :
CMA C M WONG & ASSOCIATES LTD
110, 112, 114,1000


MAIN CONTRACTOR :
 ?????????

美特鋁質有限公司
MIDI ALUMINIUM FABRICATOR LTD.
 Units 6-8, Sunray Industrial Centre, 1/F
 610 Cha Kwo Ling Road, Kowloon
 Tel:23489211-4 Fax:(852)27727666

PROJECT :
 PROPOSED RESIDENTIAL DEVELOPMENT AT NEW KOWLOON INLAND LOT. NO.6552

TITLE :
 PART ELEVATION FOR GLASS BALUSTRADE

JOB NO. : J-857
 DRAWN BY : AN DATE : 28 JAN.2023
 CHKD BY : SCALE A1: 1/50 A3:
 DWG. NO. : CW-PE-3603 REV. : F

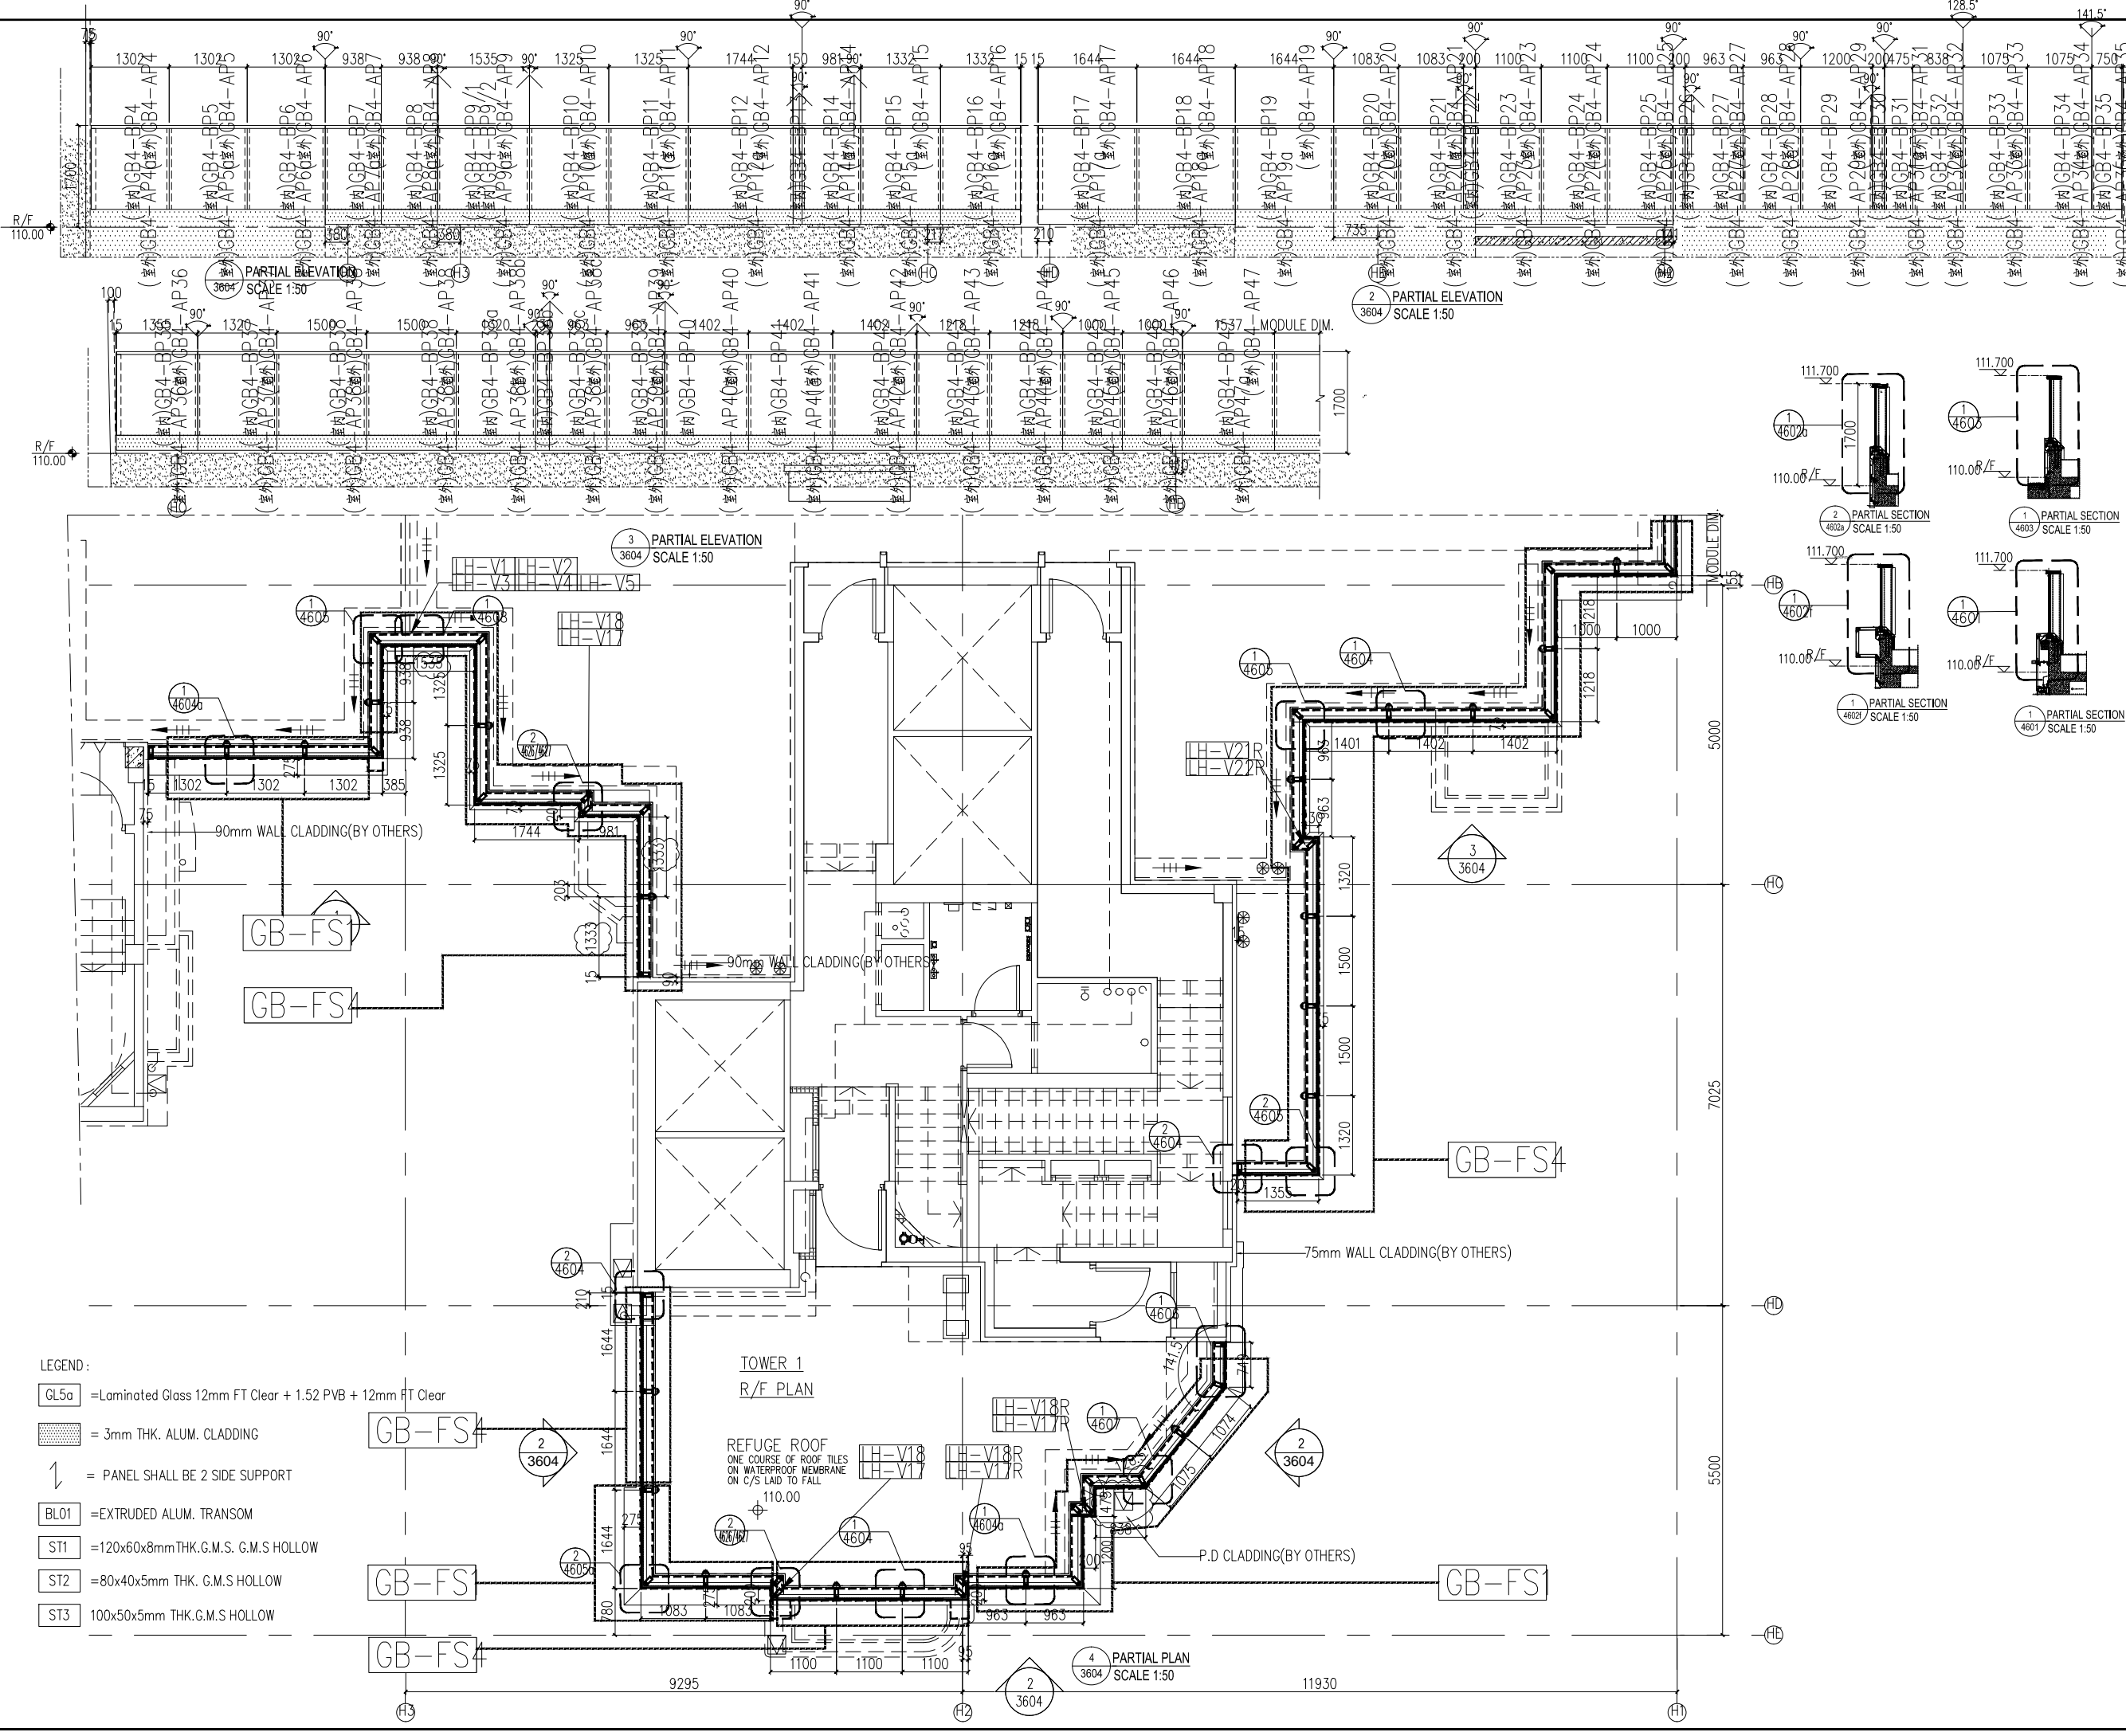

B.D. REF :
 S.D. REF :
 Note :
 1. All dimensions are in mm.
 2. All elevations are viewed from outside.
 3. All dimensions to be verified on site before fabrication.

GENERAL NOTES

Legend :
 1. F.F.L. --- Finished Floor Level
 2. S.F.L. --- Structural Floor Level
 3. /R --- Reversed Detail

X1 --- DETAIL MARK NO.
 X001 --- REFER SHEET NO.

REV.	DATE	DESCRIPTION	BY
00	18.Oct.2021	1ST SUBMISSION	
A	13.Dec.2021	2nd SUBMISSION	
B	10.May.2022	3rd SUBMISSION	
C	14.Jul.2022	4TH SUBMISSION	
D	01.Aug.2022	5TH SUBMISSION	
E	22.Aug.2022	6TH SUBMISSION	
F	26.SEP.2022	7TH SUBMISSION	
G	22.OCT.2022	8TH SUBMISSION	
H	25.DEC.2022	9TH SUBMISSION	
J	28.JAN.2023	10TH SUBMISSION	

CLIENT :
MARBLE EDGE INVESTMENT LTD.

ARCHITECT :
RONALD LU & PARTNERS
 ARCHITECTS | PLANNERS | INTERIOR DESIGNERS

STRUCTURAL ENGINEER :
CMA C M WONG & ASSOCIATES LTD


MAIN CONTRACTOR :

美特鋁質有限公司
MIDI ALUMINIUM FABRICATOR LTD.
 Units 6-8, Sunray Industrial Centre, 1/F
 610 Cha Kwo Ling Road, Kowloon
 Tel:23489211-4 Fax:(852)27727666

PROJECT :
PROPOSED RESIDENTIAL DEVELOPMENT AT NEW KOWLOON INLAND LOT. NO.6552

TITLE :
PART ELEVATION FOR GLASS BALUSTRADE


JOB NO. : J-857
 DRAWN BY : AN DATE : 28 JAN.2023
 CHKD BY : SCALE A1: 1/250 A3:
 DWG. NO. : CW-PE-3604 REV. : F

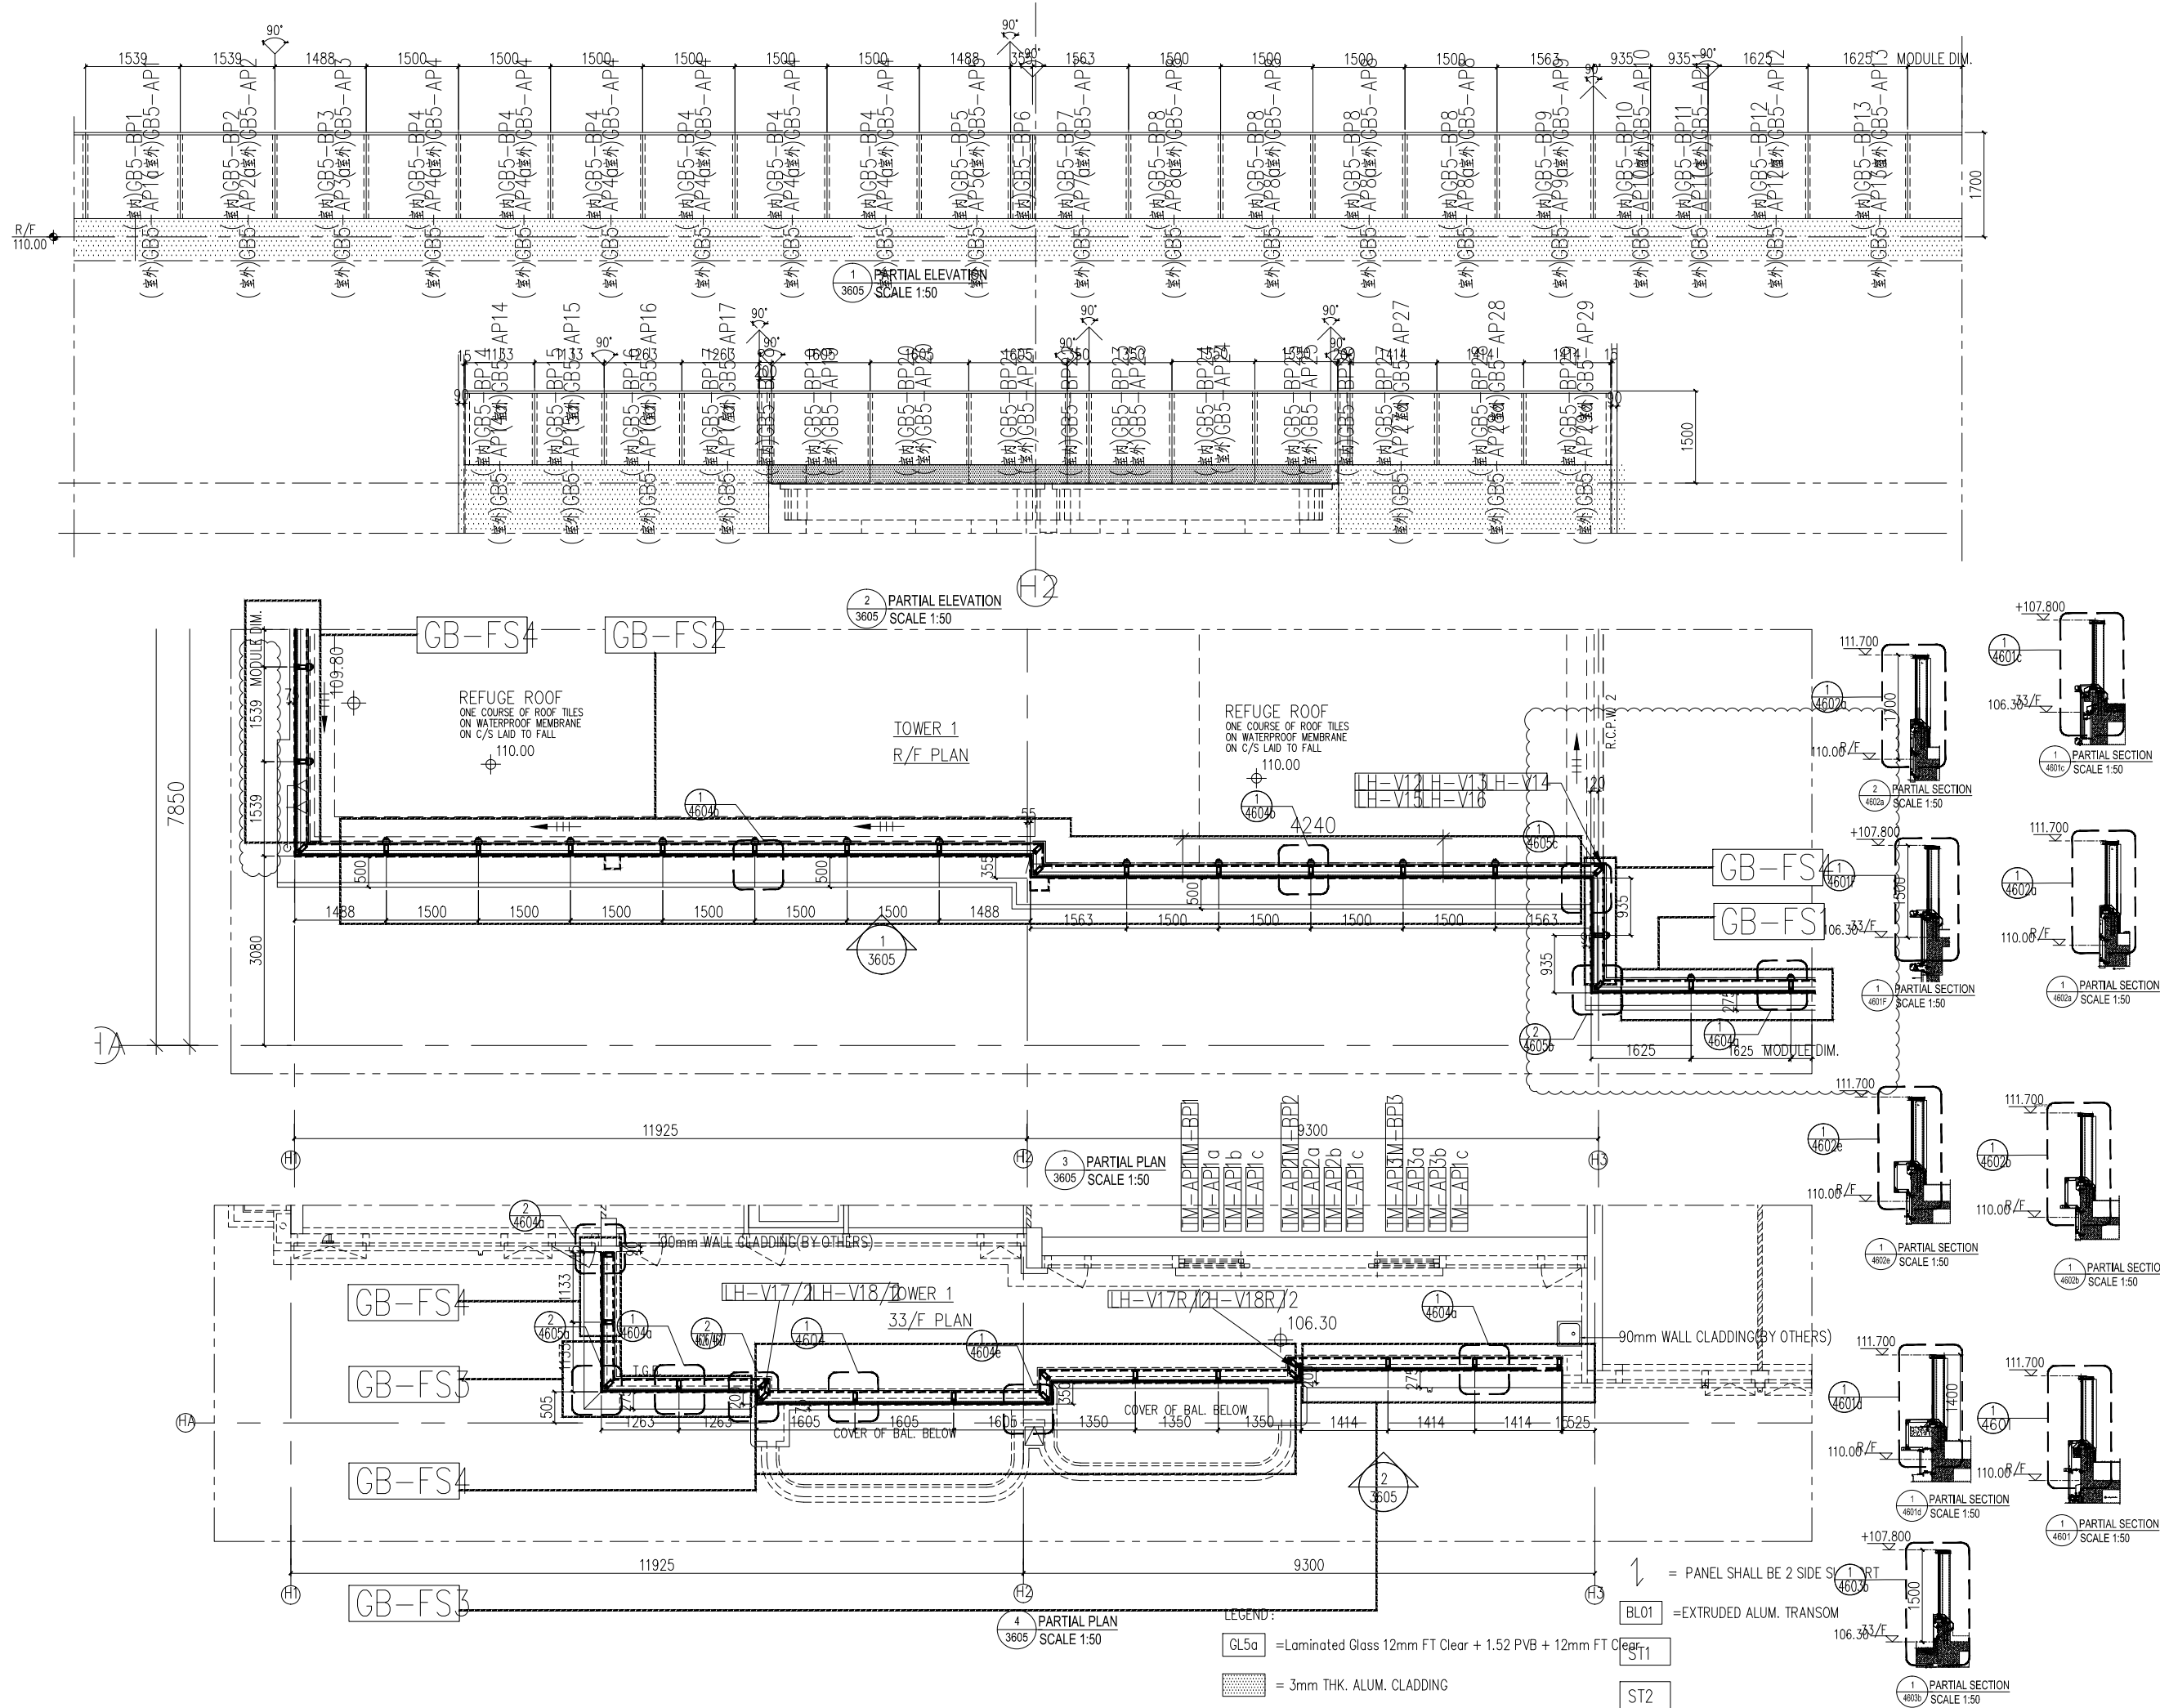

B.D. REF :
 F.S.D. REF :
 Note :
 1. All dimensions are in mm.
 2. All elevations are viewed from outside.
 3. All dimensions to be verified on site before fabrication.

GENERAL NOTES

- Legend :
- 1. F.F.L.-- Finished Floor Level
 - 2. S.F.L.-- Structural Floor Level
 - 3. (R) -- Reversed Detail

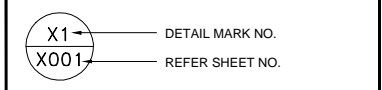

REV.	DATE	DESCRIPTION	BY
J	28.JAN.2023	10TH SUBMISSION	
H	25.DEC.2022	9TH SUBMISSION	
G	22.OCT.2022	8TH SUBMISSION	
F	26.SEP.2022	7TH SUBMISSION	
E	22.AUG.2022	6TH SUBMISSION	
D	01.AUG.2022	5TH SUBMISSION	
C	14.JUL.2022	4TH SUBMISSION	
B	10.MAY.2022	3rd SUBMISSION	
A	13.DEC.2021	2nd SUBMISSION	
00	18.OCT.2021	1ST SUBMISSION	

CLIENT :
 MARBLE EDGE INVESTMENT LTD.

ARCHITECT :

 ARCHITECTS | PLANNERS | INTERIOR DESIGNERS

STRUCTURAL ENGINEER :

 CMA C M WONG & ASSOCIATES LTD

MAIN CONTRACTOR :








MIDI ALUMINIUM FABRICATOR LTD.
 Units 6-8, Sunray Industrial Centre, 1/F
 610 Cha Kwo Ling Road, Kowloon
 Tel:23489211-4 Fax:(852)27727666

PROJECT :
 PROPOSED RESIDENTIAL DEVELOPMENT AT NEW KOWLOON INLAND LOT. NO.6552

TITLE :
 PART ELEVATION FOR GLASS BALUSTRADE

JOB NO. : J-857
 DRAWN BY : AN DATE : 28 JAN.2023
 CHKD BY : SCALE A1: 1/250 A3:
 DWG. NO. : CW-PE-3605 REV. : F

- LEGEND :
- GL5a = Laminated Glass 12mm FT Clear + 1.52 PVB + 12mm FT Clear

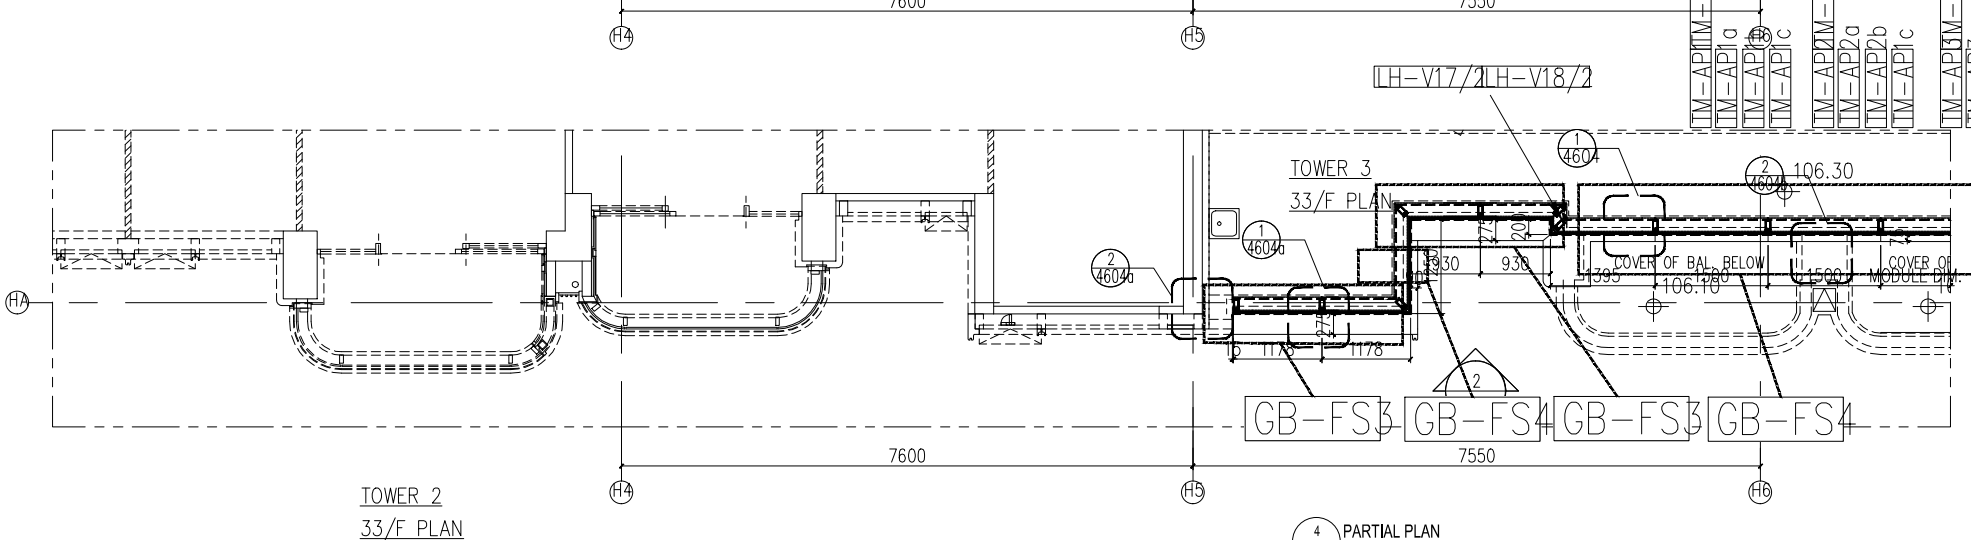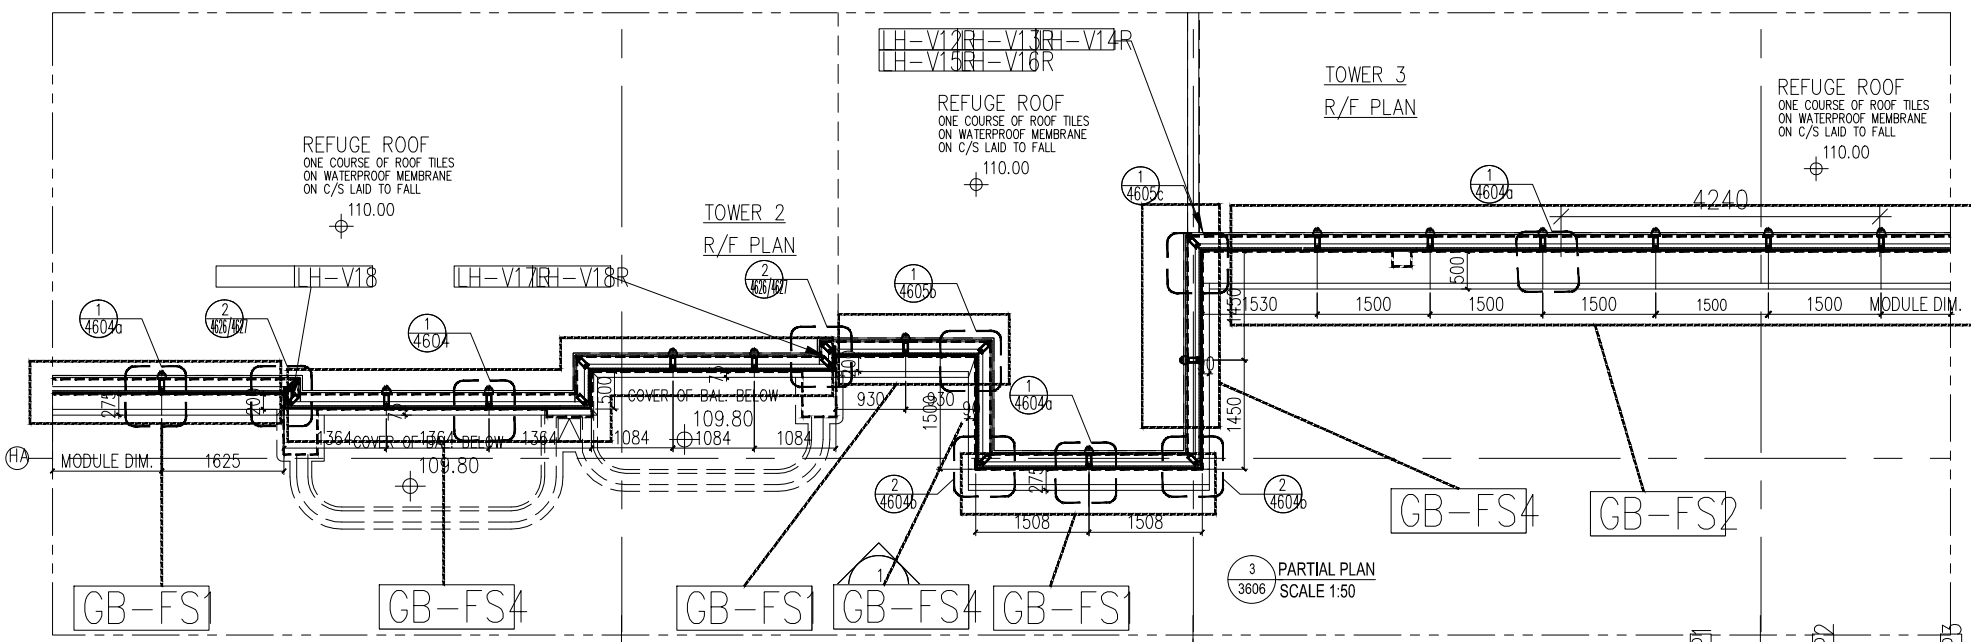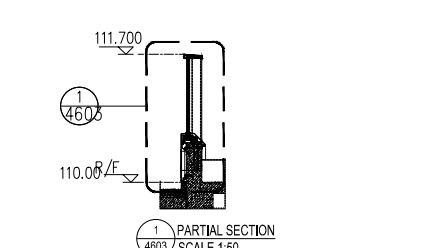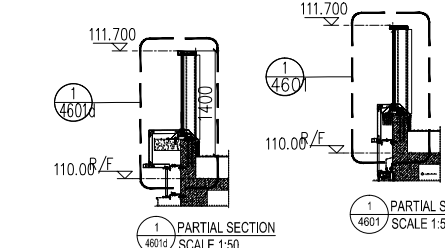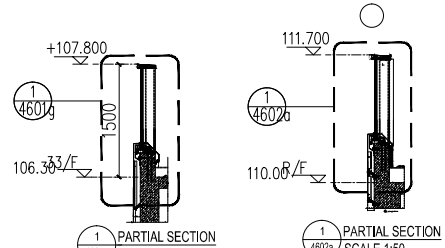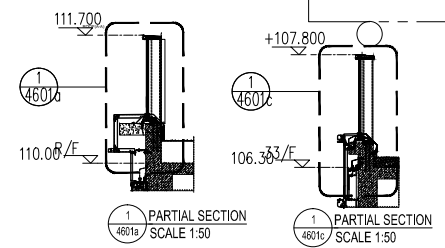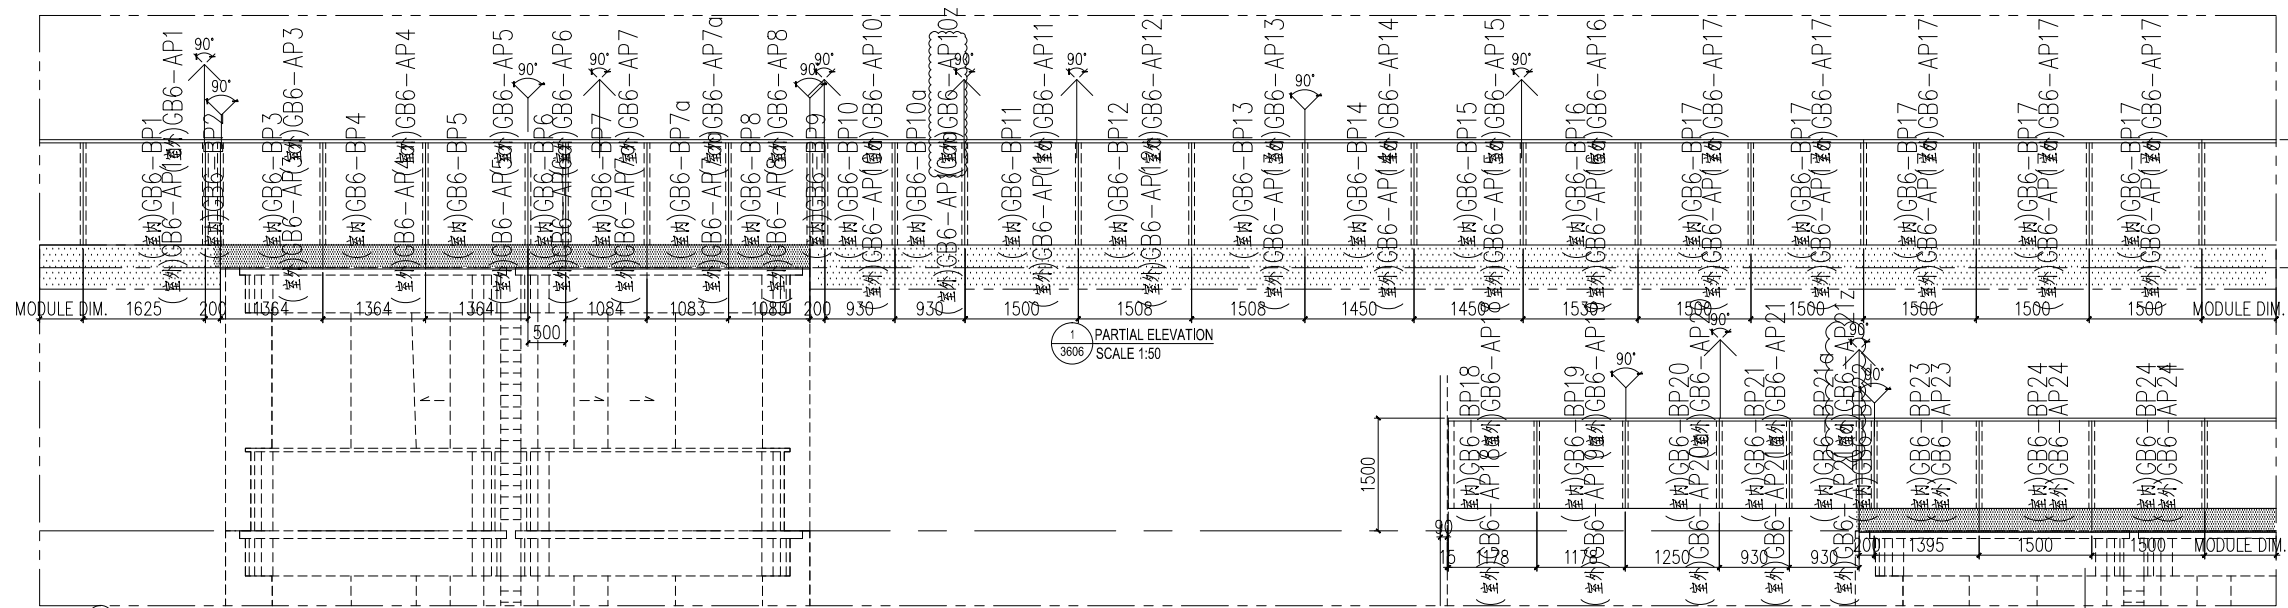

- LEGEND:
- GL5a = Laminated Glass 12mm FT Clear + 1.52 PVB + 12mm FT Clear
 - [Hatched Box] = 3mm THK. ALUM. CLADDING
 - [Arrow] = PANEL SHALL BE 2 SIDE SUPPORT
 - BL01 = EXTRUDED ALUM. TRANSOM
 - ST1 = 120x60x8mm THK. G.M.S. G.M.S HOLLOW
 - ST2 = 80x40x5mm THK. G.M.S HOLLOW
 - ST3 = 100x50x5mm THK. G.M.S HOLLOW

B.D. REF :
 F.S.D. REF :
 Note :
 1. All dimensions are in mm.
 2. All elevations are viewed from outside.
 3. All dimensions to be verified on site before fabrication.

GENERAL NOTES

Legend :

1. F.F.L. --- Finished Floor Level
2. S.F.L. --- Structural Floor Level
3. [Circle with X] --- Reversed Detail

X1 --- DETAIL MARK NO.
 X001 --- REFER SHEET NO.

REV.	DATE	DESCRIPTION	BY
J	28.JAN.2023	10TH SUBMISSION	
H	25.DEC.2022	9TH SUBMISSION	
G	22.OCT.2022	8TH SUBMISSION	
F	26.SEP.2022	7TH SUBMISSION	
E	22.AUG.2022	6TH SUBMISSION	
D	01.AUG.2022	5TH SUBMISSION	
C	14.JUL.2022	4TH SUBMISSION	
B	10.MAY.2022	3rd SUBMISSION	
A	13.DEC.2021	2nd SUBMISSION	
00	18.OCT.2021	1ST SUBMISSION	

CLIENT :
 MARBLE EDGE INVESTMENT LTD.

ARCHITECT :
RONALD LU & PARTNERS
 ARCHITECTS | PLANNERS | INTERIOR DESIGNERS

STRUCTURAL ENGINEER :
CMA C M WONG & ASSOCIATES LTD
 110, 112, 114,1000


MAIN CONTRACTOR :
 ?????????

美特鋁質有限公司
MIDI ALUMINIUM FABRICATOR LTD.
 Units 6-8, Sunray Industrial Centre, 1/F
 610 Cha Kwo Ling Road, Kowloon
 Tel: 23489211-4 Fax: (852) 27727666




PROJECT :
 PROPOSED RESIDENTIAL DEVELOPMENT AT NEW KOWLOON INLAND LOT. NO.6552

TITLE :
 PART ELEVATION FOR GLASS BALUSTRADE


JOB NO. : J-857
 DRAWN BY : AN DATE : 28 JAN.2023
 CHKD BY : SCALE A1: 1/250 A3:
 DWG. NO. : CW-PE-3606 REV. : F

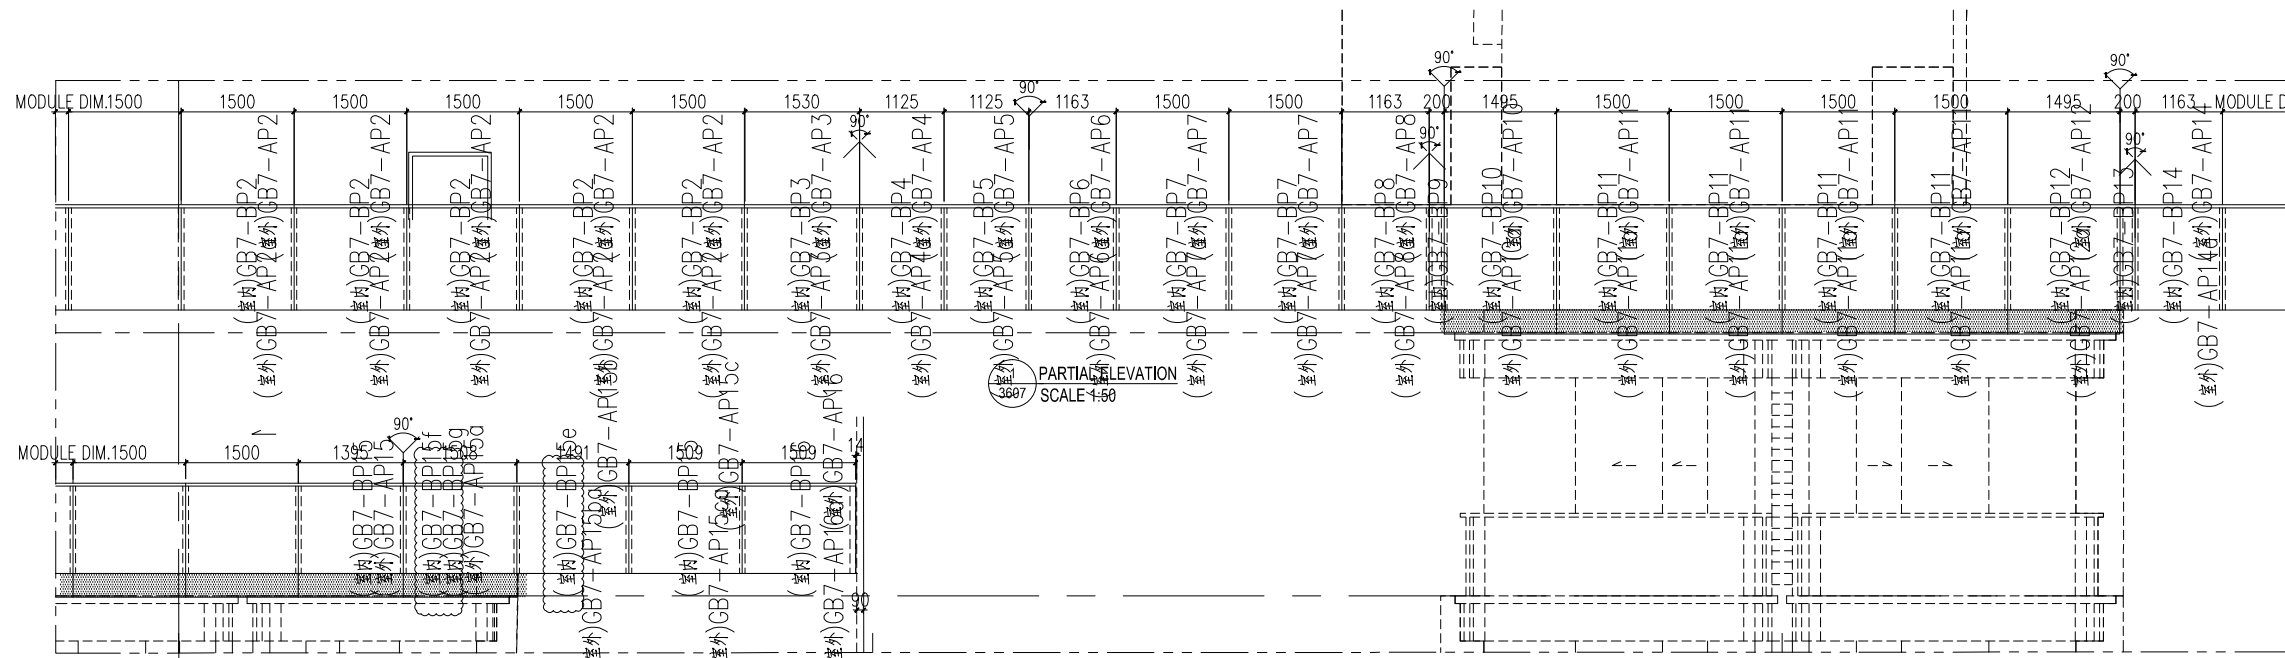

2 PARTIAL ELEVATION SCALE 1:50

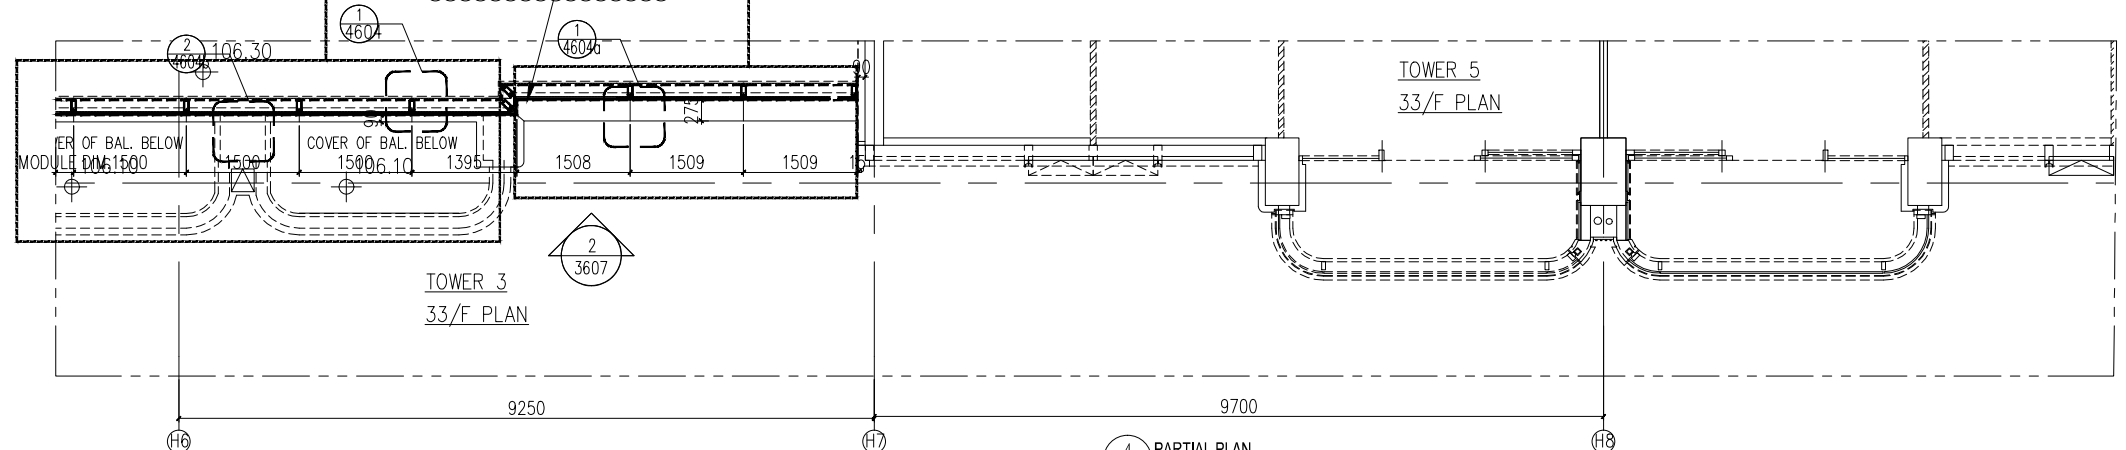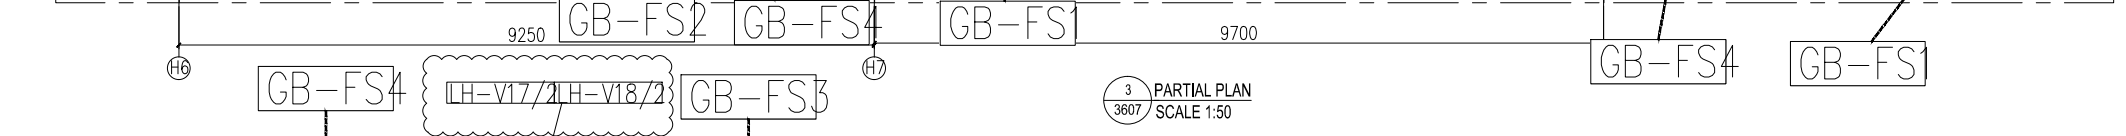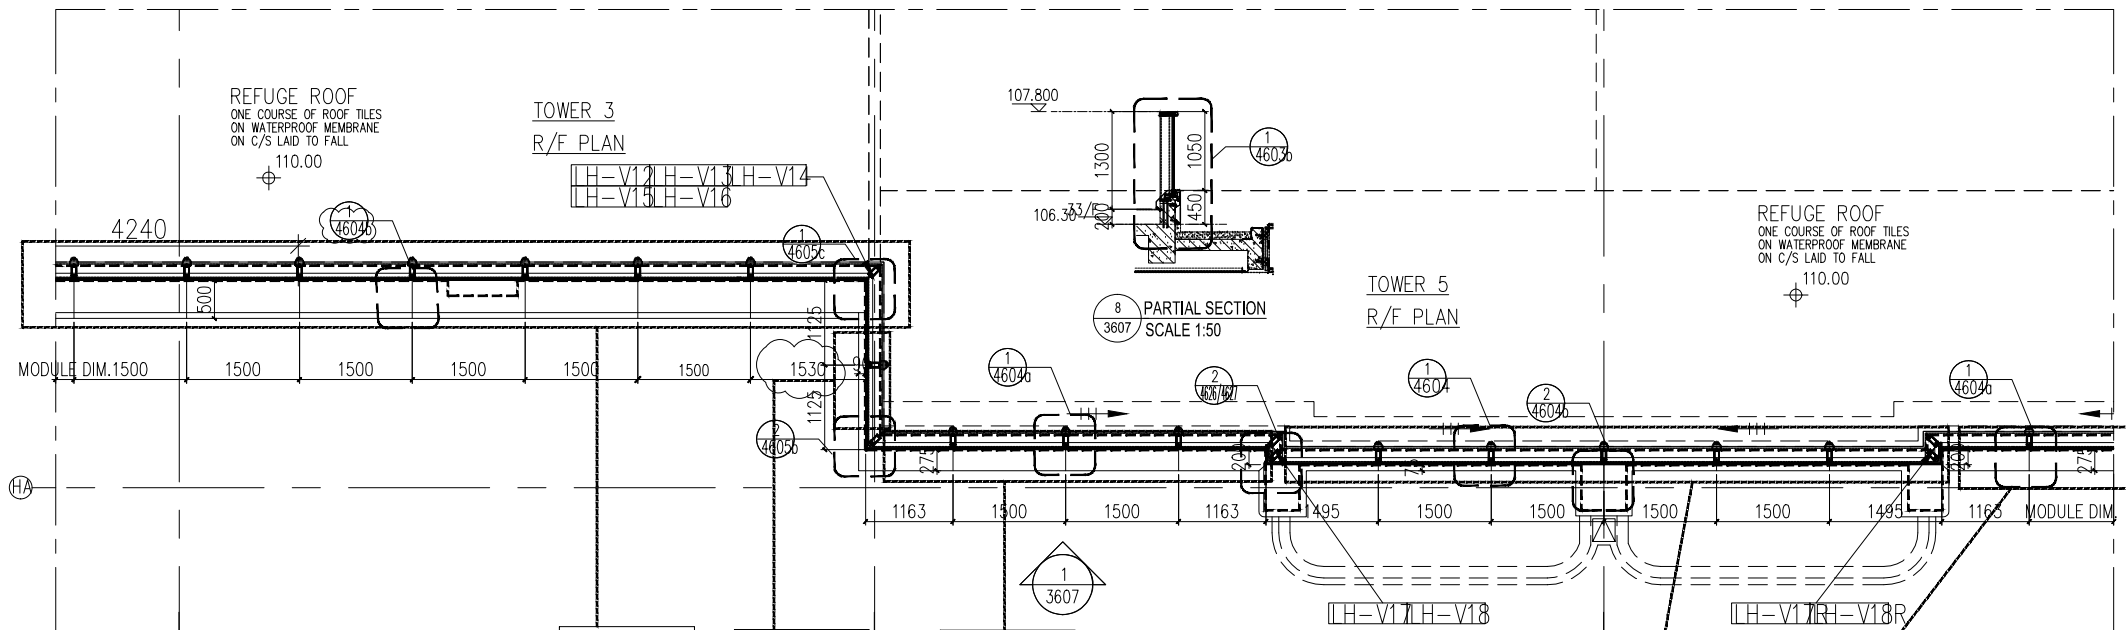

4 PARTIAL PLAN SCALE 1:50

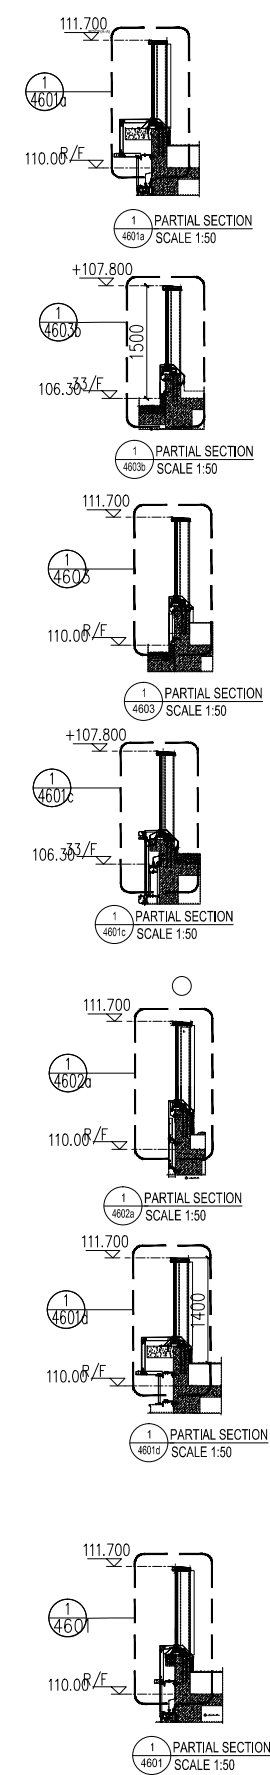

- LEGEND:
- GL5a = Laminated Glass 12mm FT Clear + 1.52 PVB + 12mm FT Clear
 - [Hatched Box] = 3mm THK. ALUM. CLADDING
 - [Arrow] = PANEL SHALL BE 2 SIDE SUPPORT
 - BL01 = EXTRUDED ALUM. TRANSOM
 - ST1 = 120x60x8mm THK. G.M.S. G.M.S HOLLOW
 - ST2 = 80x40x5mm THK. G.M.S HOLLOW
 - ST3 = 100x50x5mm THK. G.M.S HOLLOW

B.D. REF :
 F.S.D. REF :
 Note :
 1. All dimensions are in mm.
 2. All elevations are viewed from outside.
 3. All dimensions to be verified on site before fabrication.

GENERAL NOTES

Legend :

1. F.F.L.-- Finished Floor Level
2. S.F.L.-- Structural Floor Level
3. (↔) -- Reversed Detail

X1 -- DETAIL MARK NO.
 X001 -- REFER SHEET NO.

REV.	DATE	DESCRIPTION	BY
J	28.JAN.2023	10TH SUBMISSION	
H	25.DEC.2022	9TH SUBMISSION	
G	22.OCT.2022	8TH SUBMISSION	
F	26.SEP.2022	7TH SUBMISSION	
E	22.AUG.2022	6TH SUBMISSION	
D	01.AUG.2022	5TH SUBMISSION	
C	14.JUL.2022	4TH SUBMISSION	
B	10.MAY.2022	3rd SUBMISSION	
A	13.DEC.2021	2nd SUBMISSION	
00	18.OCT.2021	1ST SUBMISSION	

CLIENT :
 MARBLE EDGE INVESTMENT LTD.

ARCHITECT :
RONALD LU & PARTNERS
 ARCHITECTS | PLANNERS | INTERIOR DESIGNERS

STRUCTURAL ENGINEER :
CMA C M WONG & ASSOCIATES LTD
INCORPORATED IN HONG KONG
 E-MAIL: cma@cma.com.hk

MAIN CONTRACTOR :
 ?????????

美特鋁質有限公司
MIDI ALUMINIUM FABRICATOR LTD.
 Units 6-8, Sunray Industrial Centre, 1/F
 610 Cha Kwo Ling Road, Kowloon
 Tel:23489211-4 Fax:(852)27727666

PROJECT :
 PROPOSED RESIDENTIAL DEVELOPMENT AT NEW KOWLOON INLAND LOT. NO.6552



TITLE :
 PART ELEVATION FOR GLASS BALUSTRADE

JOB NO. : J-857

DRAWN BY : AN DATE : 28 JAN.2023

CHKD BY : SCALE A1: 1/50 A3:

DWG. NO. : CW-PE-3607 REV. : F

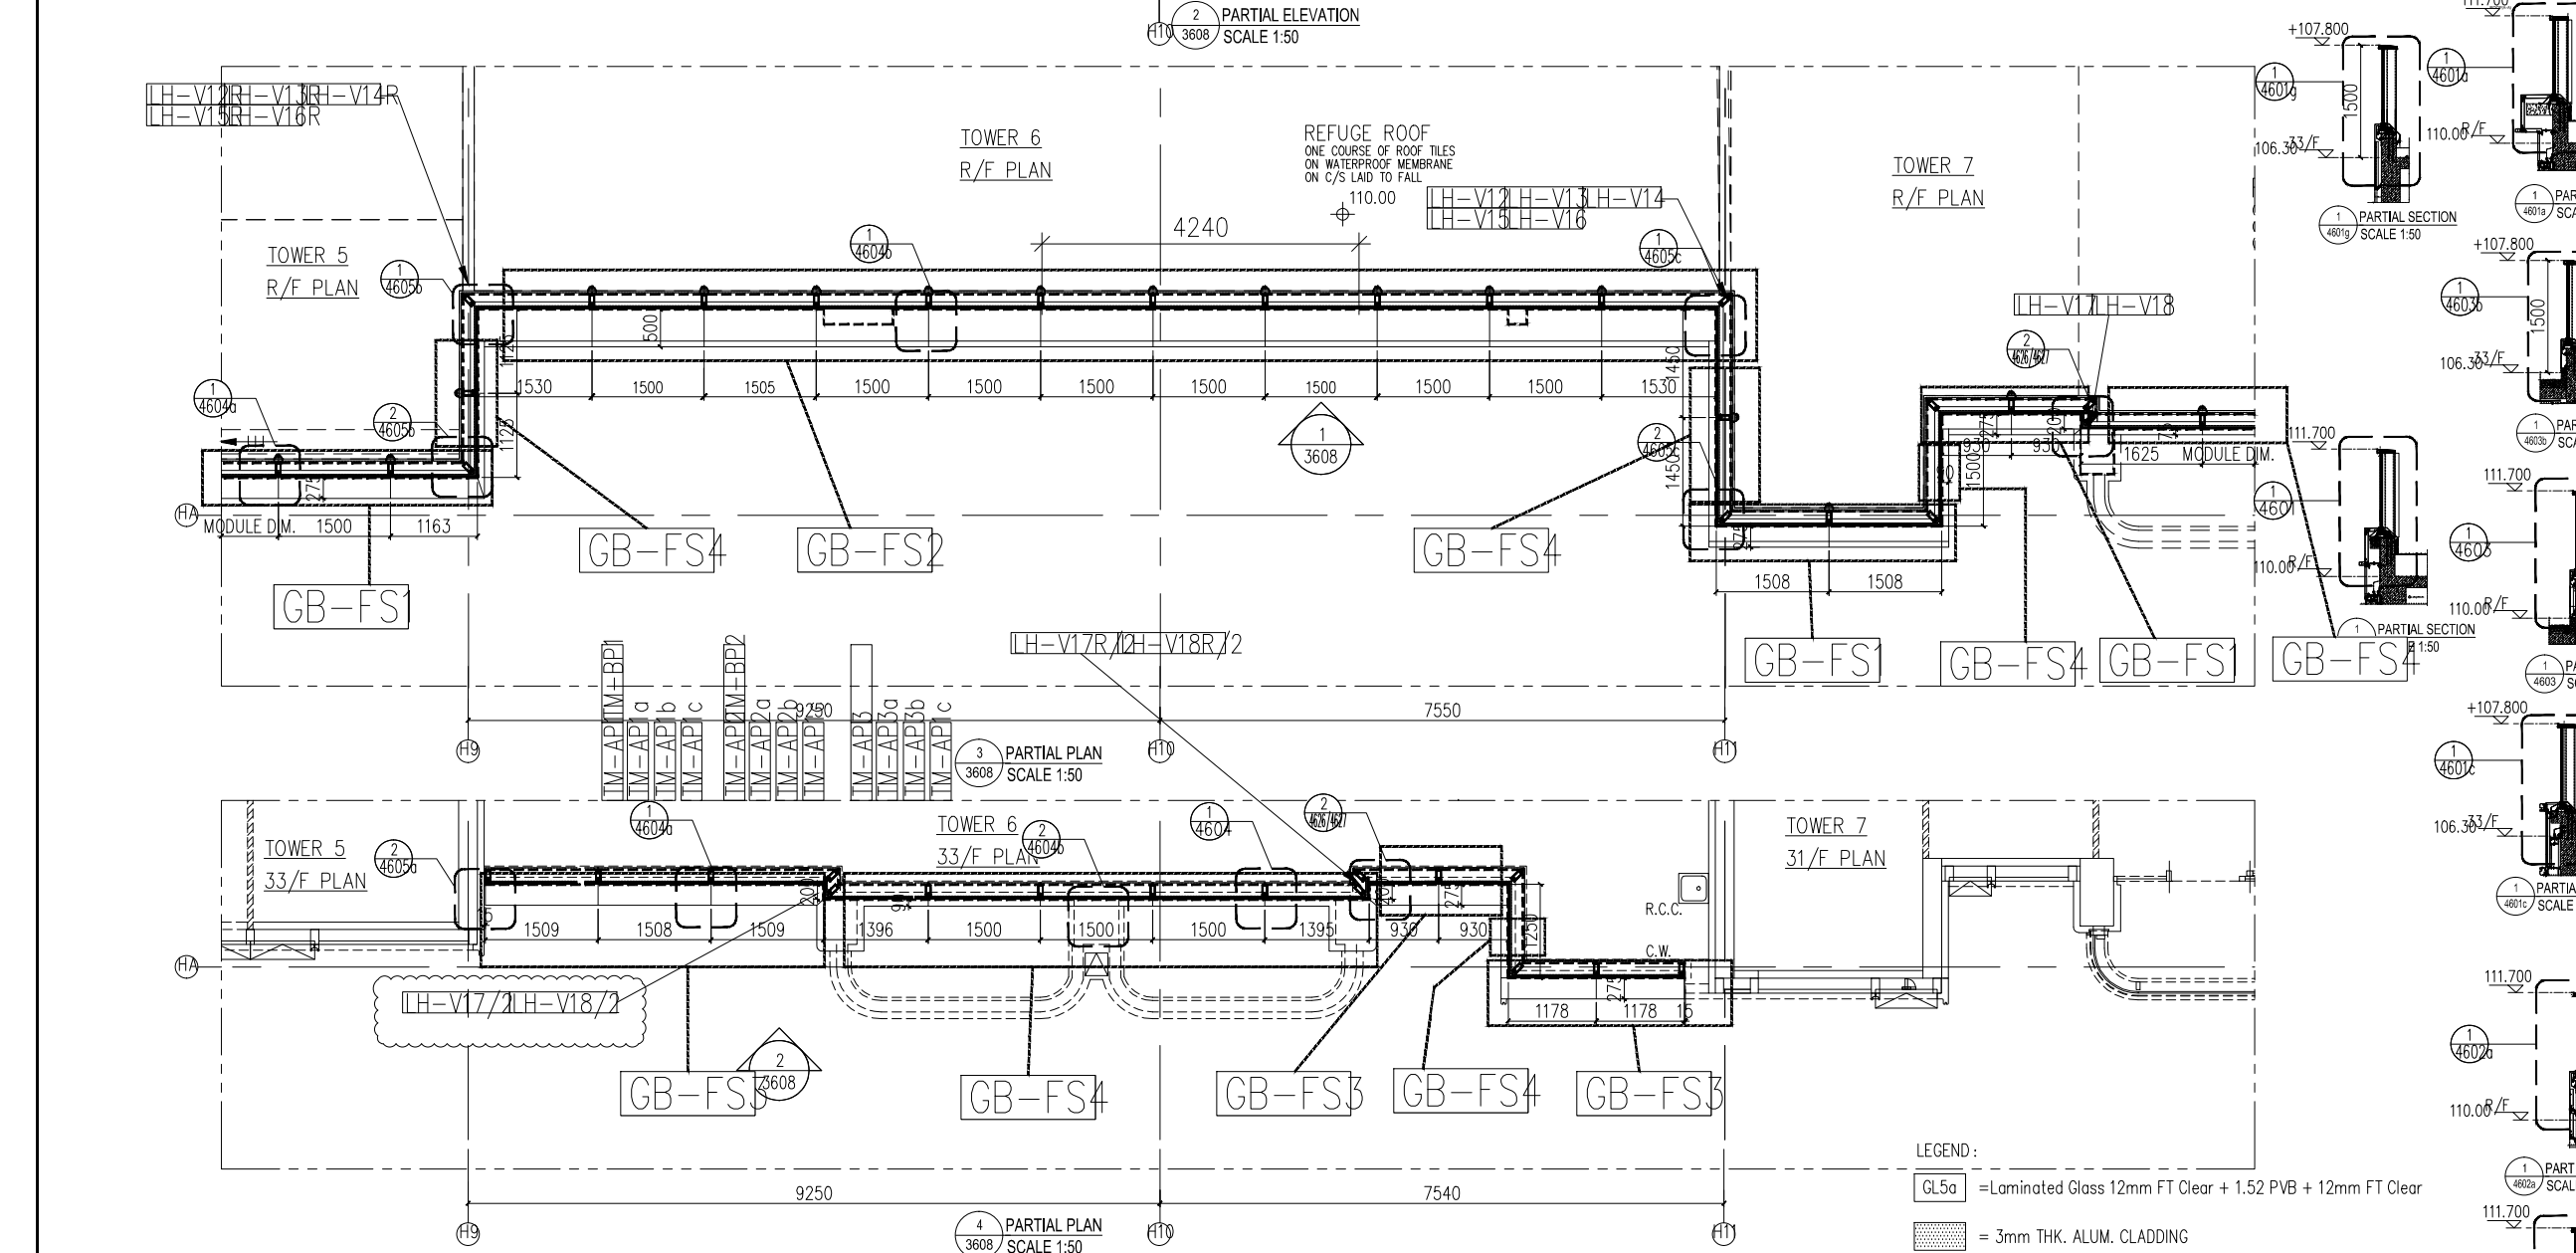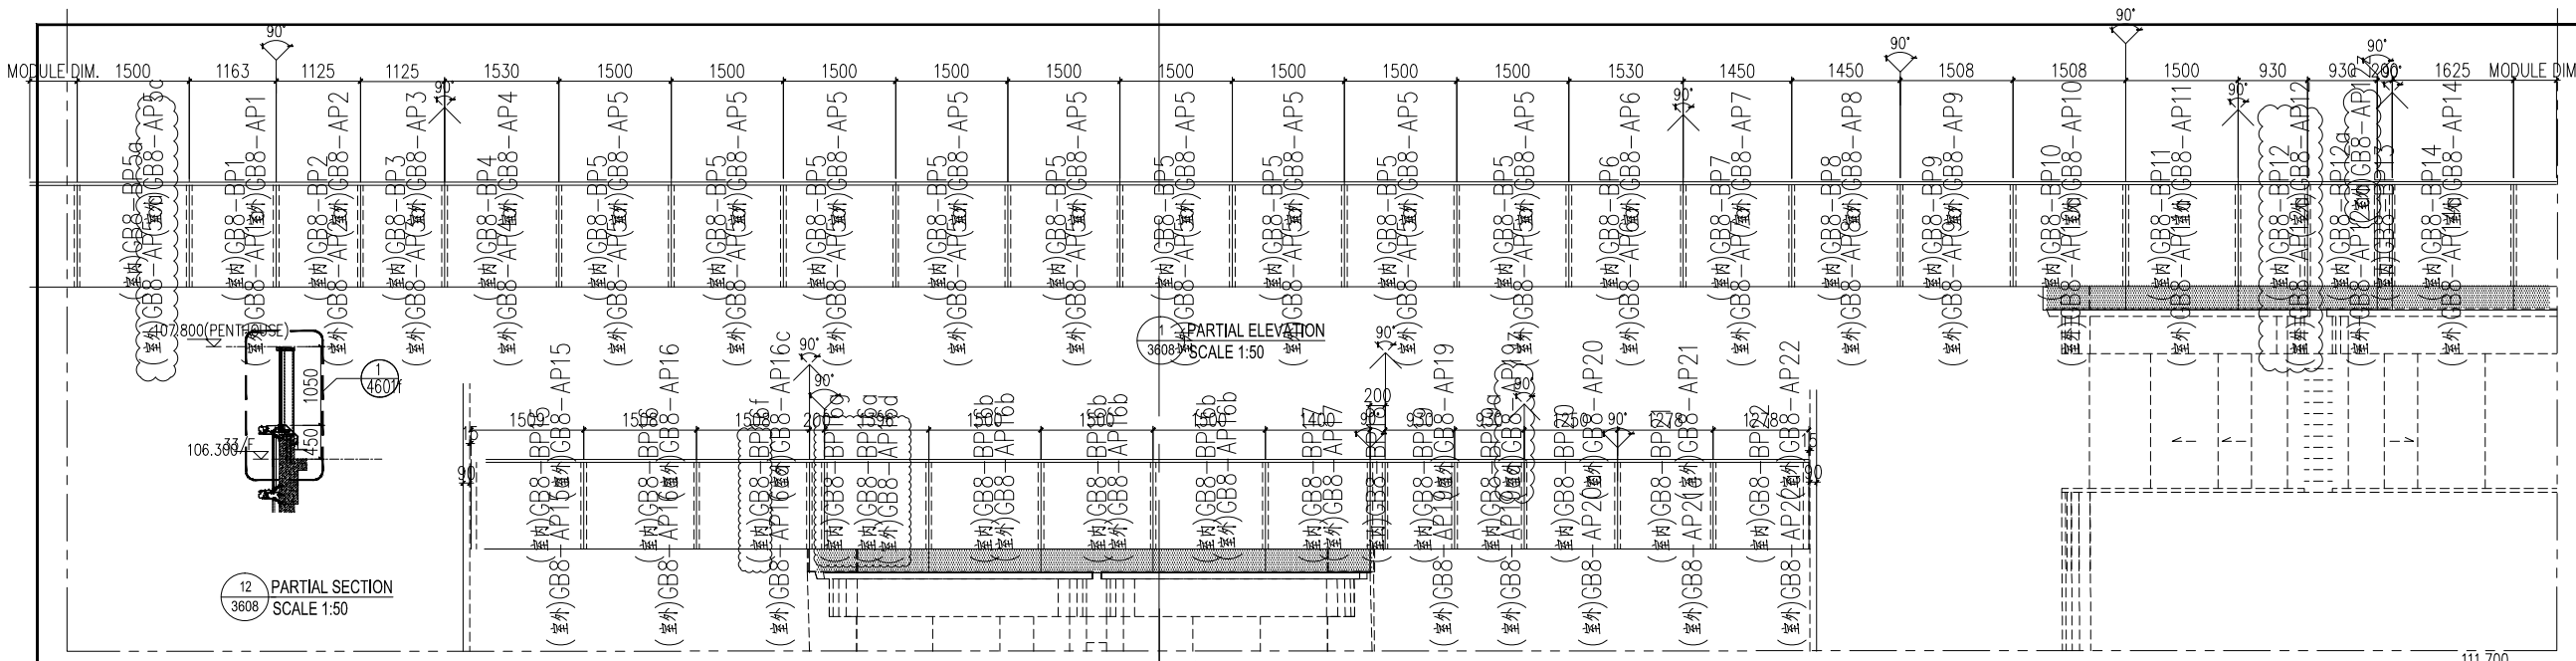

- LEGEND:
- GL5a = Laminated Glass 12mm FT Clear + 1.52 PVB + 12mm FT Clear
 - [Hatched Box] = 3mm THK. ALUM. CLADDING
 - [Arrow] = PANEL SHALL BE 2 SIDE SUPPORT
 - BL01 = EXTRUDED ALUM. TRANSOM
 - ST1 = 120x60x8mm THK. G.M.S. G.M.S HOLLOW
 - ST2 = 80x40x5mm THK. G.M.S HOLLOW
 - ST3 = 100x50x5mm THK. G.M.S HOLLOW

B.D. REF :
 F.S.D. REF :
 Note:
 1. All dimensions are in mm.
 2. All elevations are viewed from outside.
 3. All dimensions to be verified on site before fabrication.

GENERAL NOTES

Legend :

1. F.F.L. --- Finished Floor Level
2. S.F.L. --- Structural Floor Level
3. [Reversed Detail Symbol] --- Reversed Detail

X1 --- DETAIL MARK NO.
 X001 --- REFER SHEET NO.

REV.	DATE	DESCRIPTION	BY
J	28.JAN.2023	10TH SUBMISSION	
H	25.DEC.2022	9TH SUBMISSION	
G	22.OCT.2022	8TH SUBMISSION	
F	26.SEP.2022	7TH SUBMISSION	
E	22.AUG.2022	6TH SUBMISSION	
D	01.AUG.2022	5TH SUBMISSION	
C	14.JUL.2022	4TH SUBMISSION	
B	10.MAY.2022	3rd SUBMISSION	
A	13.DEC.2021	2nd SUBMISSION	
00	18.OCT.2021	1ST SUBMISSION	

CLIENT :
 MARBLE EDGE INVESTMENT LTD.

ARCHITECT :

 RONALD LU & PARTNERS
 ARCHITECTS | PLANNERS | INTERIOR DESIGNERS

STRUCTURAL ENGINEER :

 C M WONG & ASSOCIATES LTD
 110, 112, 114,1000


MAIN CONTRACTOR :
 ?????????

美特鋁質有限公司
 MIDI ALUMINIUM FABRICATOR LTD.
 Units 6-8, Sunray Industrial Centre, 1/F
 610 Cha Kwo Ling Road, Kowloon
 Tel: 23489211-4 Fax: (852) 27727666


PROJECT :
 PROPOSED RESIDENTIAL DEVELOPMENT AT NEW KOWLOON INLAND LOT. NO.6552

TITLE :
 PART ELEVATION FOR GLASS BALUSTRADE


JOB NO. : J-857
 DRAWN BY : AN DATE : 28 JAN.2023
 CHKD BY : SCALE A1: 1/250 A3:
 DWG. NO. : CW-PE-3608 REV. : F

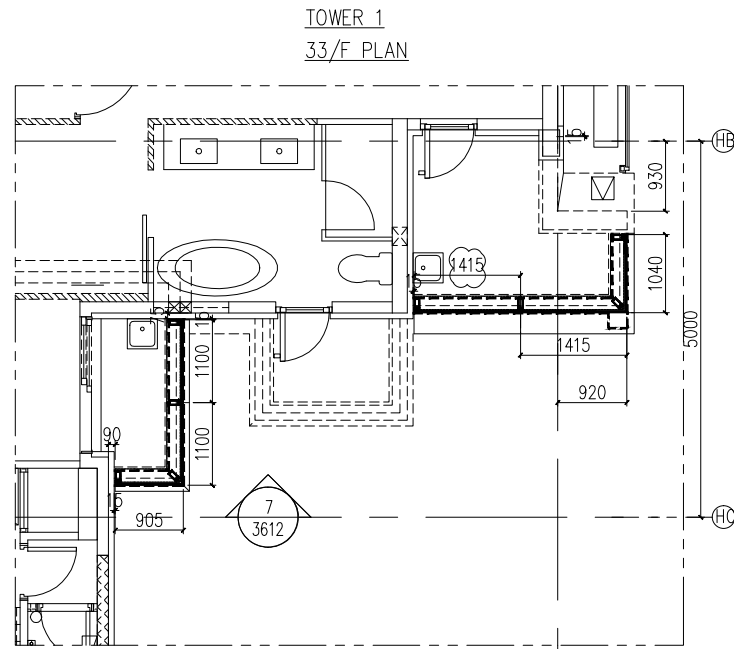

1 PARTIAL PLAN
3612 SCALE 1:50

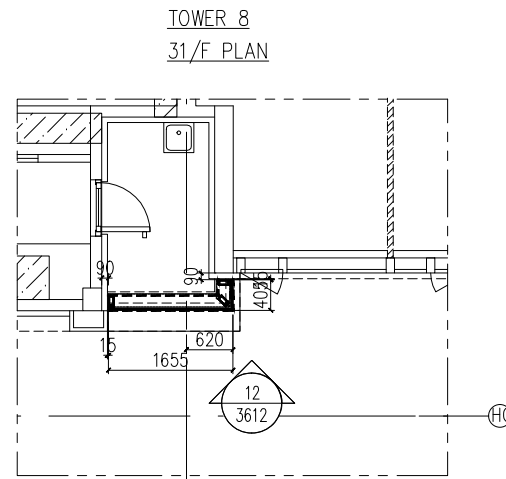

5 PARTIAL PLAN
3612 SCALE 1:50

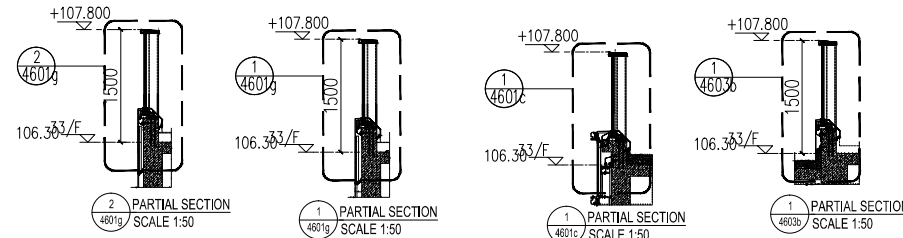


2 PARTIAL SECTION
4601g SCALE 1:50


1 PARTIAL SECTION
4601g SCALE 1:50

1 PARTIAL SECTION
4601c SCALE 1:50


1 PARTIAL SECTION

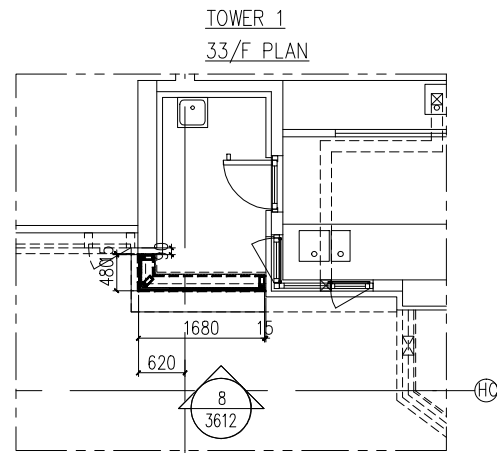


2 PARTIAL PLAN
3612 SCALE 1:50

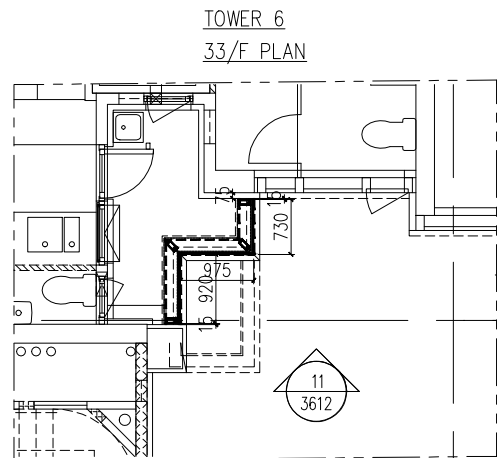


4 PARTIAL PLAN
3612 SCALE 1:50

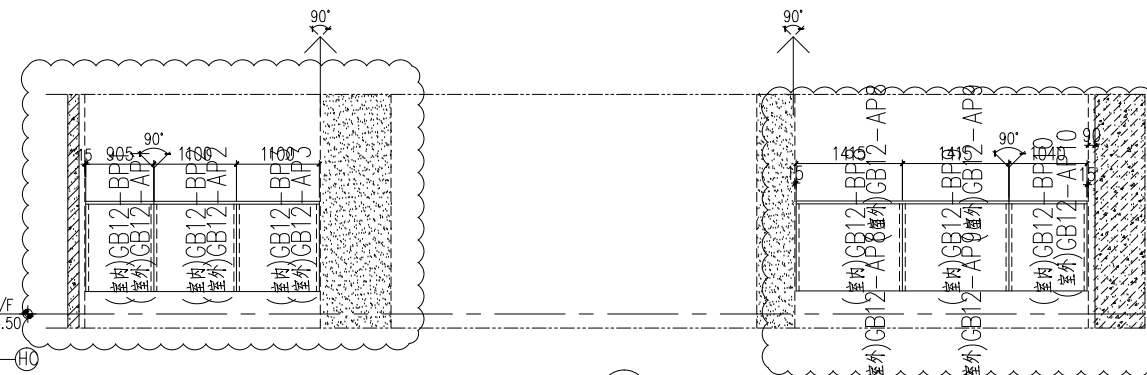


7 PARTIAL ELEVATION
3612 SCALE 1:50

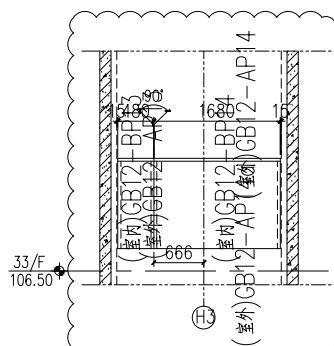


8 PARTIAL ELEVATION
3612 SCALE 1:50

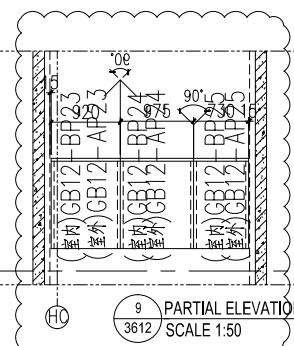


9 PARTIAL ELEVATION
3612 SCALE 1:50

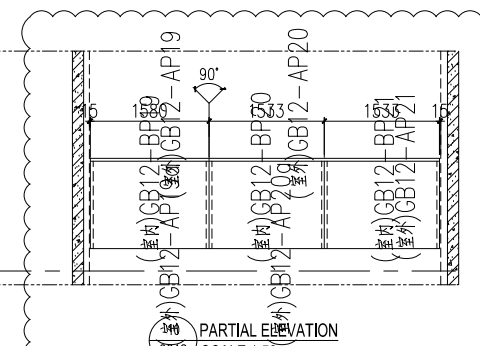


10 PARTIAL ELEVATION
3612 SCALE 1:50

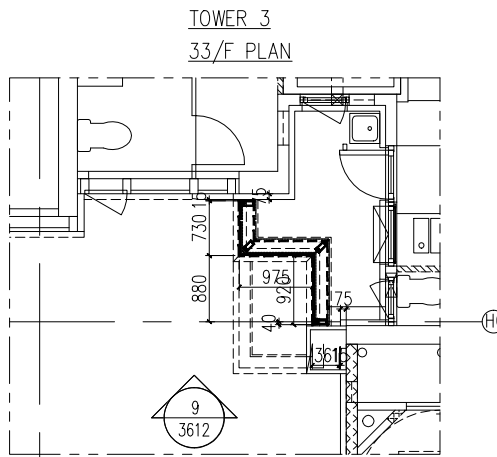


3 PARTIAL PLAN
3612 SCALE 1:50

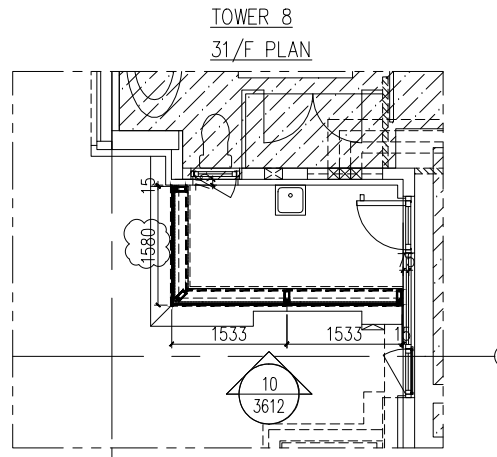

6 PARTIAL PLAN
3612 SCALE 1:50

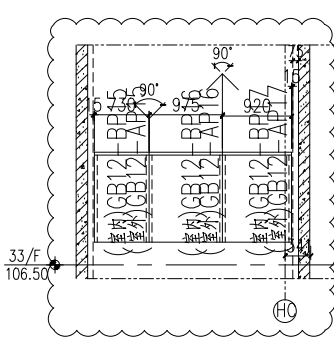

11 PARTIAL ELEVATION
3612 SCALE 1:50

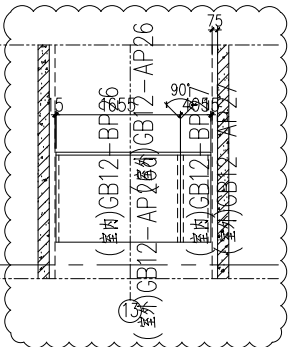

12 PARTIAL ELEVATION
3612 SCALE 1:50

- LEGEND:
- GL5a = Laminated Glass 12mm FT Clear + 1.52 PVB + 12mm FT
 - 3mm THK. ALUM. CLADDING
 - PANEL SHALL BE 2 SIDE SUPPORT
 - BL01 = EXTRUDED ALUM. TRANSOM
 - ST1 = 120x60x8mm THK. G.M.S. G.M.S HOLLOW
 - ST2 = 80x40x5mm THK. G.M.S HOLLOW
 - ST3 = 100x50x5mm THK. G.M.S HOLLOW

B.D. REF :
F.S.D. REF :
Note :
1. All dimensions are in mm.
2. All elevations are viewed from outside.
3. All dimensions to be verified on site before fabrication.

GENERAL NOTES

Legend :

1. F.F.L.-- Finished Floor Level
2. S.F.L.-- Structural Floor Level
3. (R) -- Reversed Detail

X1 -- DETAIL MARK NO.
X001 -- REFER SHEET NO.

REV.	DATE	DESCRIPTION	BY
J	28.JAN.2023	10TH SUBMISSION	
H	25.DEC.2022	9TH SUBMISSION	
G	22.OCT.2022	8TH SUBMISSION	
F	26.SEP.2022	7TH SUBMISSION	
E	22.AUG.2022	6TH SUBMISSION	
D	01.AUG.2022	5TH SUBMISSION	
C	14.JUL.2022	4TH SUBMISSION	
B	10.MAY.2022	3rd SUBMISSION	
A	13.DEC.2021	2nd SUBMISSION	
00	18.OCT.2021	1ST SUBMISSION	

CLIENT :
MARBLE EDGE INVESTMENT LTD.

ARCHITECT :
RONALD LU & PARTNERS
ARCHITECTS | PLANNERS | INTERIOR DESIGNERS

STRUCTURAL ENGINEER :
CMA C M WONG & ASSOCIATES LTD

MAIN CONTRACTOR :
?????????

美特鋁質有限公司
MIDI ALUMINIUM FABRICATOR LTD.
Units 6-8, Sunray Industrial Centre, 1/F
610 Cha Kwo Ling Road, Kowloon
Tel:23489211-4 Fax:(852)27727666

PROJECT :
PROPOSED RESIDENTIAL DEVELOPMENT AT NEW KOWLOON INLAND LOT. NO.6552

TITLE :
PART ELEVATION FOR GLASS BALUSTRADE

JOB NO. : J-857

DRAWN BY : AN DATE : 28 JAN.2023

CHKD BY : SCALE A1: 1/50 A3:

DWG. NO. : CW-PE-3612 REV. : F