

工程指示 / 要求簡箋(E.I.)

工程指示編號：EI / 4430 / 21

修改版次：-

(以此為準)

工程編號：J - 858

工程名稱：將軍澳日出康城 11

工程項目：幕牆 鋁料鋁碼模圖(7 個) (X86254, X86255, X86257, X86259, X86260, X86261, X86266)

收件人：Maggie

發件人：Renee Lo

日期：21/03/2022

□要求提供 / □確認 事項：

- | | | |
|------------------------------------|-------------------------------------|-------------------------------|
| <input type="checkbox"/> 初步鋁料 B.M. | <input type="checkbox"/> 加工拆圖，然後生產 | <input type="checkbox"/> 尺寸表 |
| <input type="checkbox"/> 正式鋁料 B.M. | <input type="checkbox"/> 技術上資料 / 指示 | <input type="checkbox"/> 報價 |
| <input type="checkbox"/> 配件 B.M. | <input type="checkbox"/> 樣辦或貨品說明書 | <input type="checkbox"/> 分判合約 |

內容：

請為幕牆開新模圖共 7 個 (X86254, X86255, X86257, X86259, X86260, X86261, X86266)

預計完成繪畫模圖日期: 23/03/2021

完成開模和試模日期: /03/2022

謝謝

請在 2022.03.23 前完成上列要求。

附：+CAD

以上項目為：

- | | | |
|---------------------------------|--------------------------------------|--------------------------------|
| <input type="checkbox"/> 原合約工程包 | <input type="checkbox"/> 原合約工程加 / 減賬 | <input type="checkbox"/> 新工程報價 |
|---------------------------------|--------------------------------------|--------------------------------|

原因：-

分發東莞各部門：

- | | | | | | | | |
|---|---|---|---|-------------------------------|------------------------------|--------------------------------|------------------------------|
| <input type="checkbox"/> 生產技術總監 | <input type="checkbox"/> 連附件 | <input type="checkbox"/> 技術部 | <input type="checkbox"/> 連附件 | <input type="checkbox"/> 生產部 | <input type="checkbox"/> 連附件 | <input type="checkbox"/> 機械設計部 | <input type="checkbox"/> 連附件 |
| <input type="checkbox"/> 採購部 | <input type="checkbox"/> 連附件 | <input checked="" type="checkbox"/> 生產統籌部 | <input checked="" type="checkbox"/> 連附件 | <input type="checkbox"/> 小羅&清 | <input type="checkbox"/> 連附件 | | |
| <input checked="" type="checkbox"/> 質檢部 | <input checked="" type="checkbox"/> 連附件 | <input type="checkbox"/> 會計部 | <input type="checkbox"/> 連附件 | <input type="checkbox"/> 報關組 | <input type="checkbox"/> 連附件 | <input type="checkbox"/> 其他 | <input type="checkbox"/> 連附件 |

分發其他分判：

分發香港各部門：

- | | | | | | | | |
|---|---|-------------------------------|------------------------------|------------------------------|------------------------------|----------------------------------|------------------------------|
| <input type="checkbox"/> 行政部 | <input type="checkbox"/> 連附件 | <input type="checkbox"/> 會計部 | <input type="checkbox"/> 連附件 | <input type="checkbox"/> 統籌部 | <input type="checkbox"/> 連附件 | <input type="checkbox"/> 工程部地盤科文 | <input type="checkbox"/> 連附件 |
| <input checked="" type="checkbox"/> 採購部 | <input checked="" type="checkbox"/> 連附件 | <input type="checkbox"/> QS 部 | <input type="checkbox"/> 連附件 | <input type="checkbox"/> 維修部 | <input type="checkbox"/> 連附件 | <input type="checkbox"/> 其他 | <input type="checkbox"/> 連附件 |

傳遞編號：


HK 0421 / 21

發件人簽署：

項目經理簽署：



美特鋁質有限公司	
承認圖面	
日期	16/3/2022

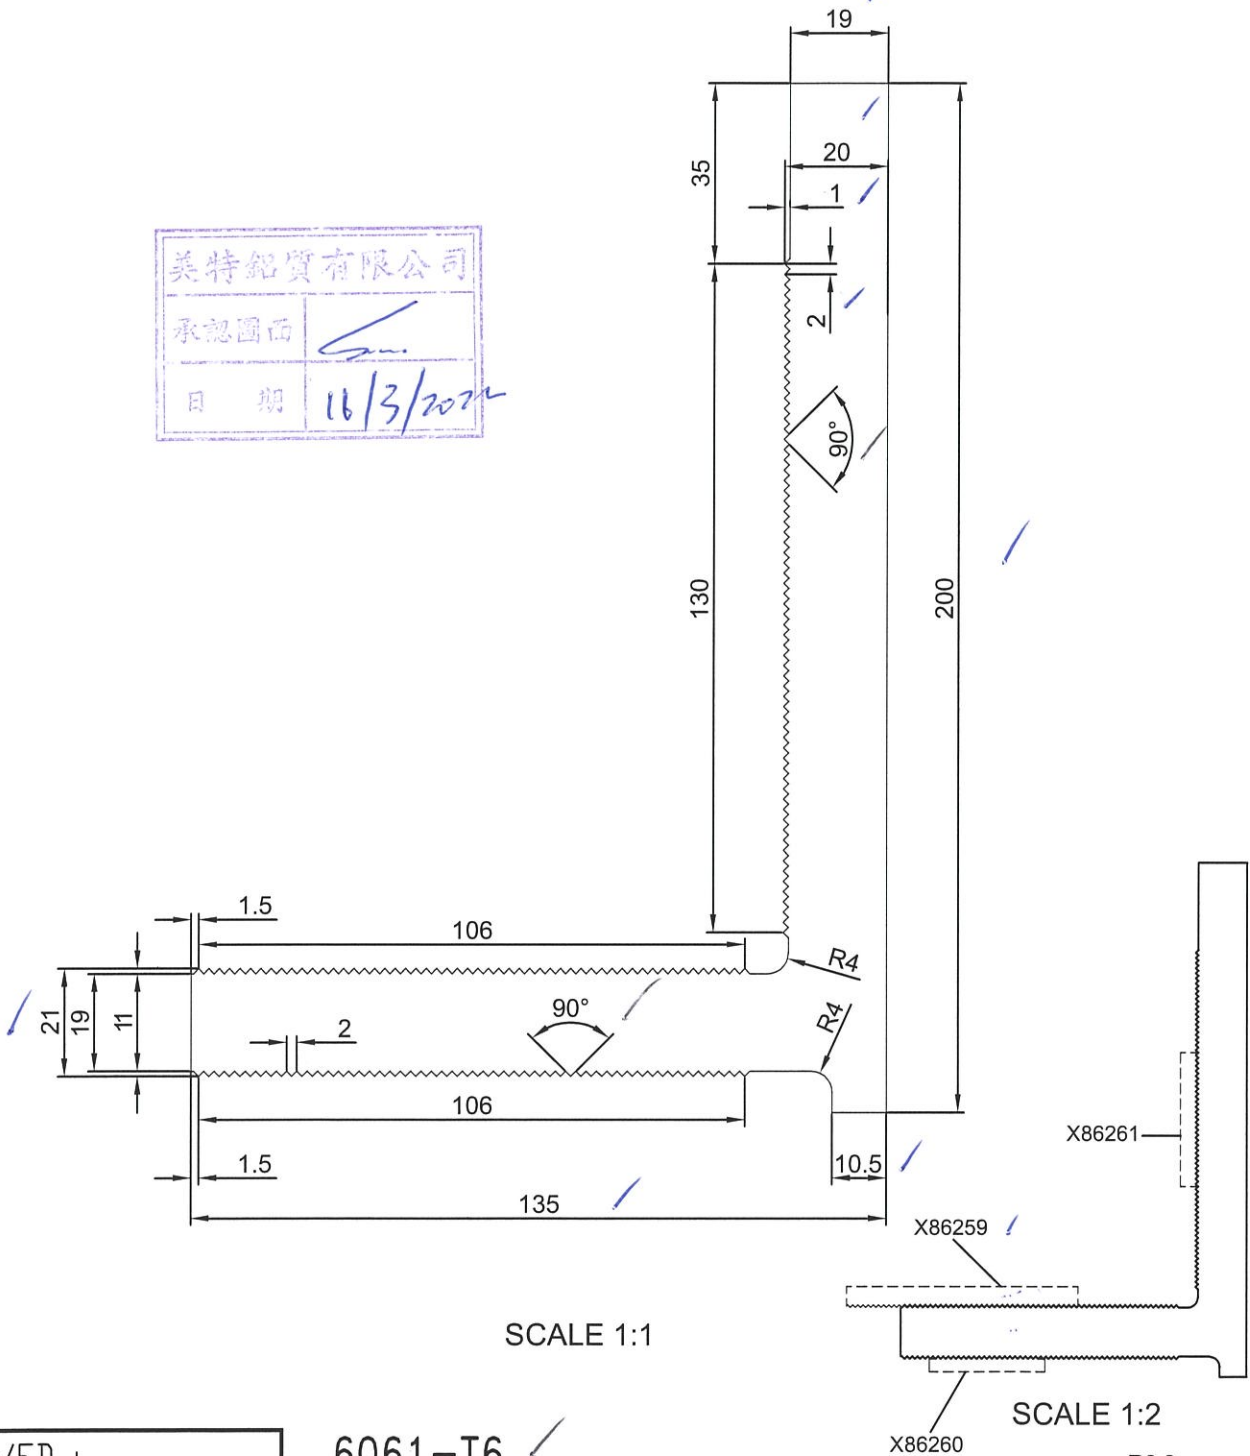

6061-T6
Unspec. Radius: R0.5

1. Important dimension: *
2. Referenced dimension: ()


a=R0.3
b=R1.0
v=R0.3XDP0.3

APPROVED :

SECTIONAL AREA	mm ²	ADDITIONAL TOLERANCE	DATE	REVISION			
				NO.	DATE	NAME	DESCRIPTION
6116.87		Thickness ± 0.1 mm	01/03/2022				
WEIGHT	KG/M	Flatness 0.1 /25mm width	SCALE				
16.58		Straightness 0.3 /300mm	1 : 1				
PERIMETER	mm	Twist 0.5° /300 mm max	DRAWN				
810.71		Angularities ± 1.0 degree	CHECK				
V.F.	mm						



美特鋁質有限公司	
承認圖面	
日期	16.3.2022

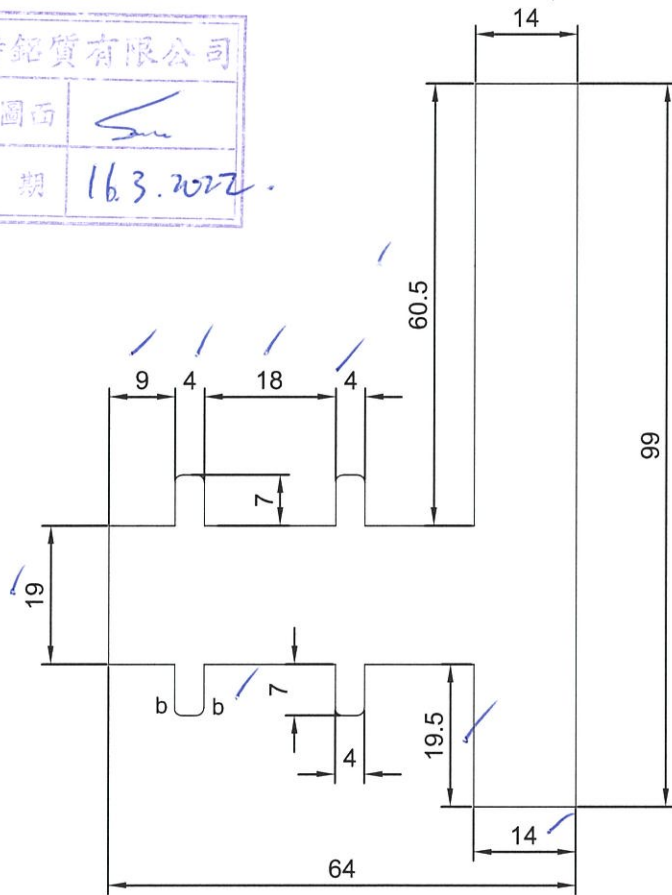

SCALE 1:1

APPROVED :

6061-T6
Unspec. Radius: R0.5

- 1. Important dimension: *
- 2. Referenced dimension: ()

a=R0.3
b=R1.0
v=R0.5XDP0.5

SECTIONAL AREA	mm ²	ADDITIONAL TOLERANCE	DATE	REVISION			
				NO.	DATE	NAME	DESCRIPTION
2446.28		Thickness ± 0.1 mm	01/03/2022				
WEIGHT	KG/M	Flatness 0.1 /25mm width	SCALE				
6.63		Straightness 0.3 /300mm	1 : 1				
PERIMETER	mm	Twist 0.5° /300 mm max	DRAWN				
378.57		Angularity ± 1.0 degree	CHECK				
V.F.	mm						




MIDI ALUMINIUM FABRICATOR LTD.

DRAWING NO.
X86257

REV.

TITLE

美特鋁質有限公司	
承認圖面	
日期	16.3.2022

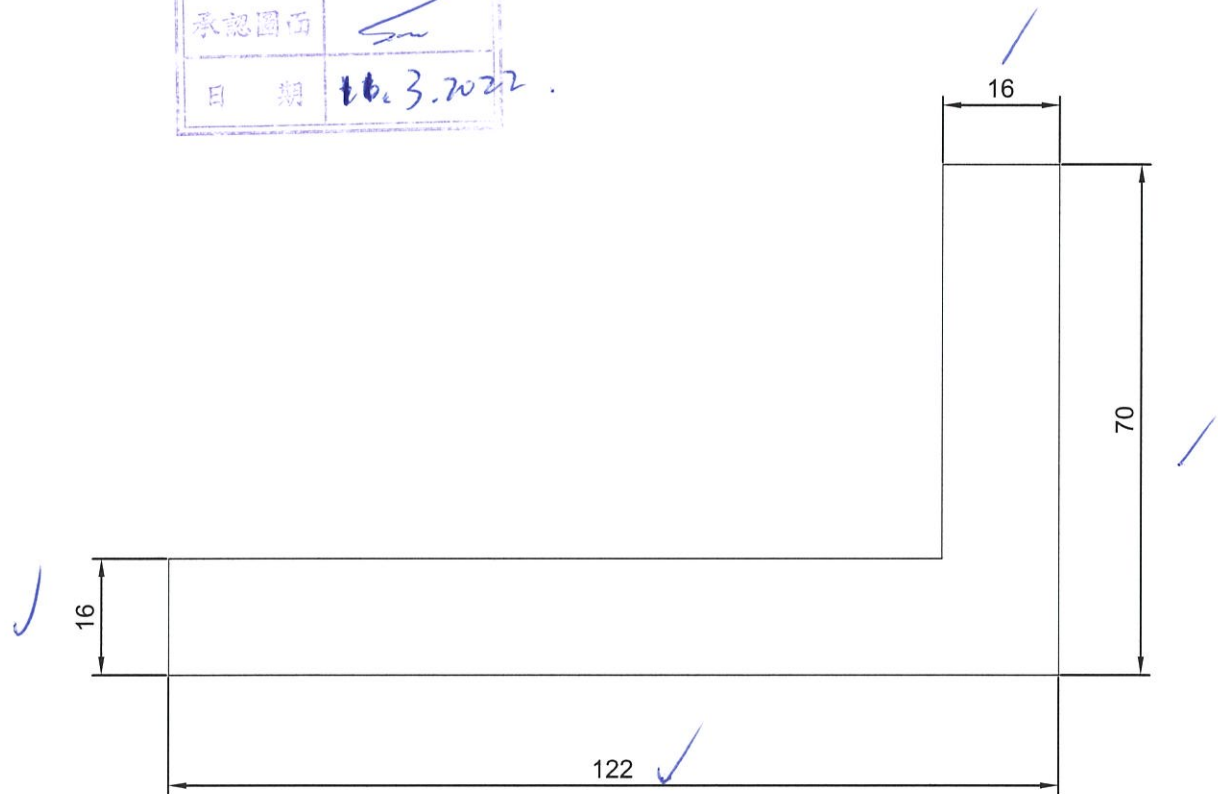

SCALE 1:1

APPROVED :

6061-T6

Unspec.Radius: R0.5
Unspec.Thickness:3.0

1.Important dimension: *
2.Referenced dimension: ()

a=R0.3
b=R1.0
v=R0.5XDP0.5

SECTIONAL AREA	mm ²	ADDITIONAL TOLERANCE	DATE	REVISION			
				NO.	DATE	NAME	DESCRIPTION
2816		Thickness ± 0.1 mm	01/03/2022				
WEIGHT	KG/M	Flatness 0.1 /25mm width	SCALE				
7.63		Straightness 0.3 /300mm	1 : 1				
PERIMETER	mm	Twist 0.5° /300 mm max	DRAWN				
384		Angularity ± 1.0 degree	CHECK				
V.F.	mm						





MIDI ALUMINIUM FABRICATOR LTD.

DRAWING NO.

X86259 ✓


REV.

TITLE

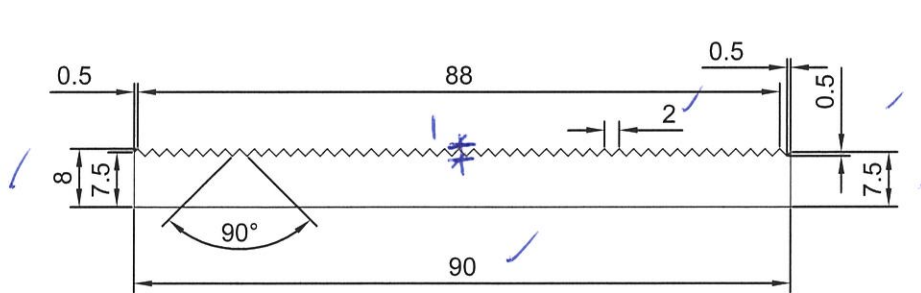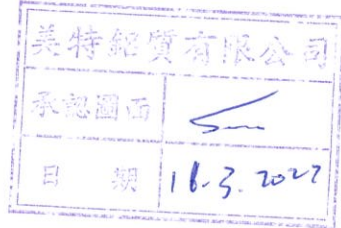

SCALE 1:1

X86254 ✓

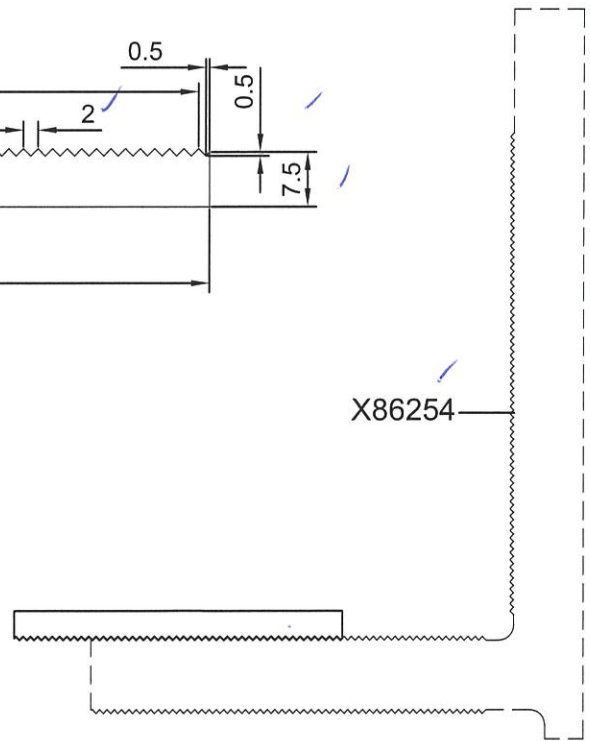

SCALE 1:2

APPROVED :

6061-T6

Unspec.Radius: R0.5
Unspec.Thickness:1.8

1.Important dimension: *
2.Referenced dimension: ()

a=R0.3
b=R1.0
e=C0.5XDP0.5

SECTIONAL AREA	mm ²	ADDITIONAL TOLERANCE	DATE	REVISION			
				NO.	DATE	NAME	DESCRIPTION
675 ✓		Thickness ± 0.1 mm	01/03/2022				
WEIGHT	KG/M	Flatness 0.1 /25mm width	SCALE				
1.83 ✓		Straightness 0.3 /300mm	1 : 1				
PERIMETER	mm	Twist 0.5° /300 mm max	DRAWN				
232.28 ✓		Angularity ± 1.0 degree	-				
V.F.	mm		CHECK				





MIDI ALUMINIUM FABRICATOR LTD.


DRAWING NO.
X86260

REV.

TITLE

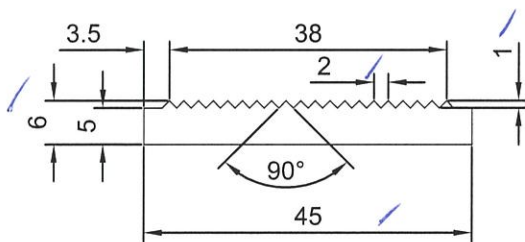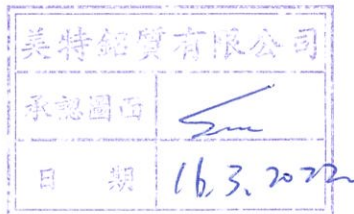

SCALE 1:1

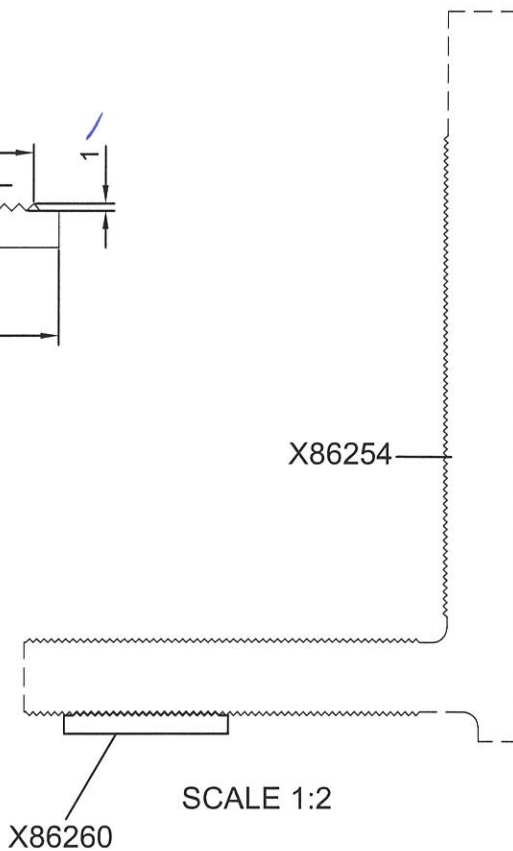

APPROVED :

6061-T6

Unspec. Radius: R0.5
Unspec. Thickness: 3.0

1. Important dimension: *
2. Referenced dimension: ()

a=R0.3
b=R1.0
v=R0.5XDP0.5

SECTIONAL AREA	mm ²	ADDITIONAL TOLERANCE	DATE	REVISION			
				NO.	DATE	NAME	DESCRIPTION
245		Thickness ± 0.1 mm	01/03/2022				
WEIGHT	KG/M	Flatness 0.1 /25mm width	SCALE				
0.66		Straightness 0.3 /300mm	1 : 1				
PERIMETER	mm	Twist 0.5° /300 mm max	DRAWN				
116.57		Angularity ± 1.0 degree	CHECK				
V.F.	mm						






MIDI ALUMINIUM FABRICATOR LTD.

DRAWING NO.
X86261

REV.

TITLE

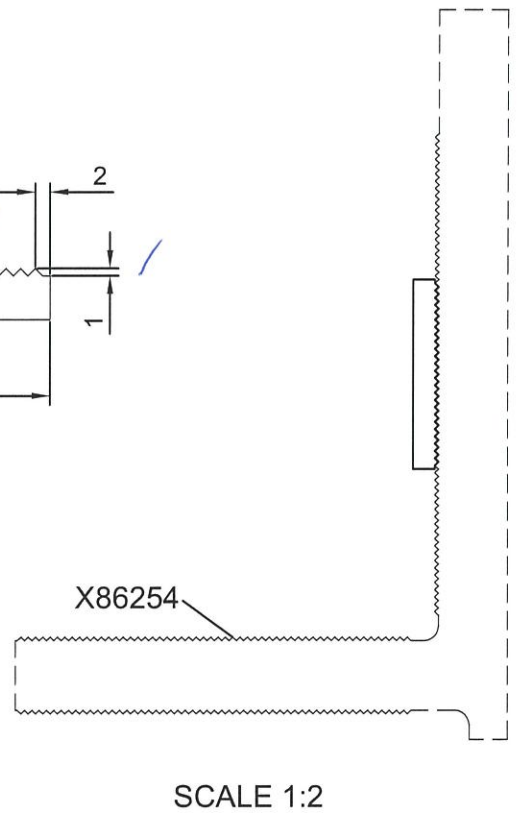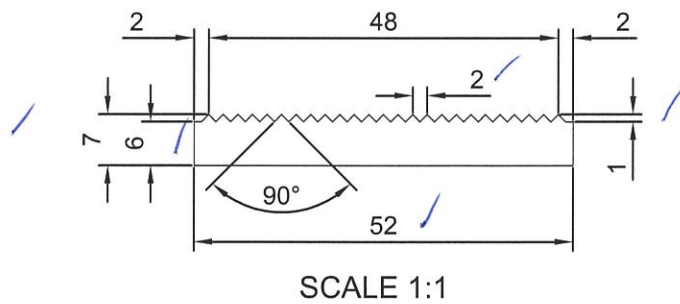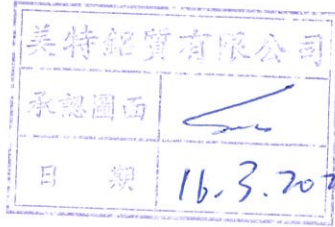

APPROVED :

6061-T6

Unspec.Radius: R0.5

Unspec.Thickness:3.0

1.Important dimension: *

2.Referenced dimension: ()

a=R0.3

b=R1.0

v=R0.5XDP0.5

SECTIONAL AREA	mm ²	ADDITIONAL TOLERANCE	DATE	REVISION			
				NO.	DATE	NAME	DESCRIPTION
337		Thickness ± 0.1 mm	01/03/2022				
WEIGHT	KG/M	Flatness 0.1 /25mm width	SCALE				
0.91		Straightness 0.3 /300mm	1 : 1				
PERIMETER	mm	Twist 0.5° /300 mm max	DRAWN				
136.71		Angularity ± 1.0 degree	-				
V.F.	mm		CHECK				



MIDI ALUMINIUM FABRICATOR LTD.


DRAWING NO.

X86262 *R266*

REV.

TITLE

美特鋁質有限公司
承認圖面
日期 16.3.2022

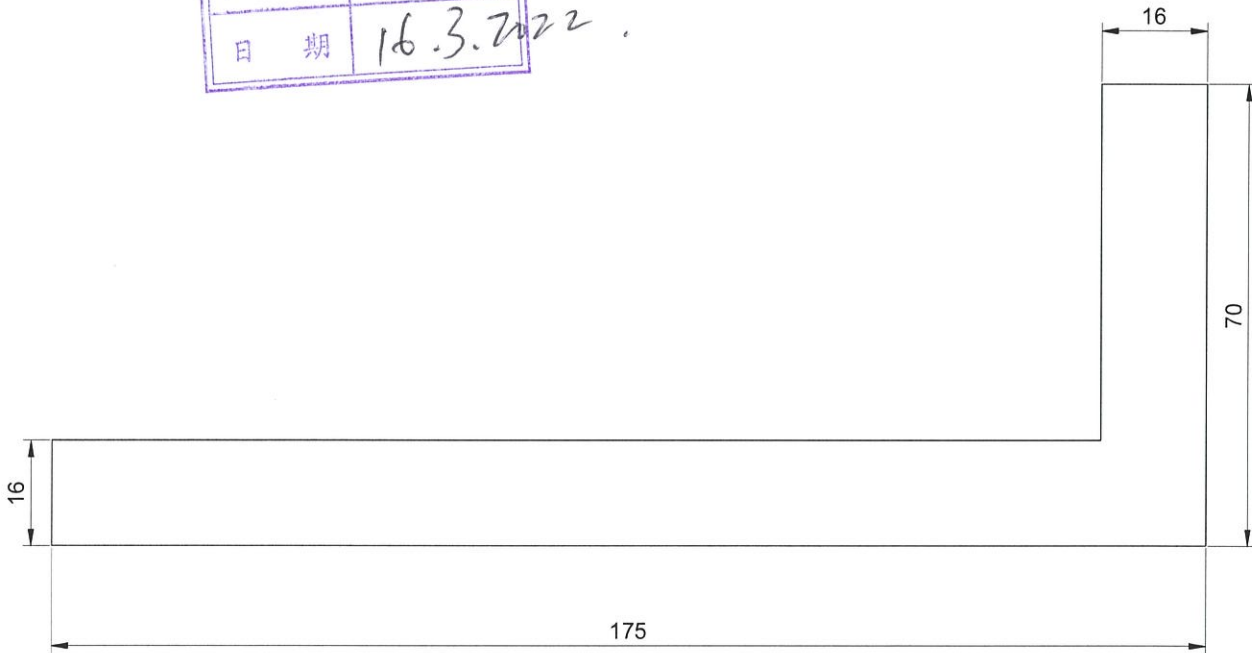

SCALE 1:1

APPROVED :

6061-T6

Unspec.Radius: R0.5
Unspec.Thickness:3.0

1.Important dimension: *
2.Referenced dimension: ()

a=R0.3
b=R1.0
v=R0.5XDP0.5

SECTIONAL AREA	mm ²	ADDITIONAL TOLERANCE	DATE	REVISION			
				NO.	DATE	NAME	DESCRIPTION
3364		Thickness ± 0.1 mm	11/03/2022				
WEIGHT	KG/M	Flatness 0.1 /25mm width	SCALE				
9.12		Straightness 0.3 /300mm	1 : 1				
PERIMETER	mm	Twist 0.5° /300 mm max	DRAWN				
490		Angularity ± 1.0 degree	-				
V.F.	mm		CHECK				