美 特 鋁 質 有 限 公 司
MIDI ALUMINIUM FABRICATOR LTD.

工程指示 / 要求簡箋(E.I.)

工程指示編號：EI / 4604 / 22　　修改版次：-

工程編號　：J - 858　　工程名稱　：將軍澳 日出康城 11

工程項目　：分判 幕牆預留碼 開墨線和測量報告

收件人　：Maggie　　發件人　：Ant Yeung　　日 期 ：19/04/2022

☐要求提供 / ☐確認 事項 ：

( ) 初步鋁料 B.M.	( ) 加工拆圖，然後生產	( ) 尺寸表
( ) 正式鋁料 B.M.	( ) 技術上資料 / 指示	( ) 報價
( ) 配件 B.M.	( ) 樣辦或貨品說明書	( ) 分判合約

內容 ：

請安排分判預留碼開線工作和　提供落石矢前的測量報告

本地盆：大判為金門　，標準層使用鋁模板。如非標準層不是鋁模，也要包.

1. 安裝預留碼工作為大判負責，本司只需要為預留碼開線工作和　提供落石矢前的測量報告給大判
2. 要確保鋁模板的開孔正確。
3. 本工程使用絲桿碼和凳仔碼，需負責分批落貨和交貨給大判
4. 留意 ： 本工程使用的絲桿碼沒有 3mm Guide plate
5. T1 (9-62/F，R/F) 共 49 層，　T2 (9-67/F，R/F)　共 53 層，　T3 (9-67/F，R/F) 共 53 層
   11/F 和 40/F 為防火層　　共 155 層
6. 預算　2022.05.13　進場　　T1 最優先起步，兩星期後 T2, T3。　其後 3 座樓同步
7. 附 Tender spec　EI4306, EI4321,EI4373, 大貨 EI4528

請在 2022.05.13 前完成上列要求。

以上項目為:

☐ 原合約工程包　☐ 原合約工程加 / 減賬　☐ 新工程報價

原因 :-

分發東莞各部門 ：

( )生產技術總監☐連附件 ( )技術部 ☐連附件 ( )生產部 ☐連附件 ( )機械設計部☐連附件

( )採購部 ☐連附件 ( )生產統籌部☐連附件 ( )小羅&清 ☐連附件

( )質檢部 ☐連附件 ( )會計部 ☐連附件 ( )報關組 ☐連附件 ( )其他 _____☐連附件

分發其他分判 ：

( )濱 ☐連附件

分發香港各部門 ：

( )行政部☐連附件 ( )會計部☐連附件 ( )統籌部☐連附件 ( )工程部地盤科文☐連附件 積哥

( )採購部☐連附件 ( )QS 部 ☐連附件 ( )維修部☐連附件 ( )其他 _____☐連附件

傳遞編號：　　發件人簽署：

HK0654 / 22　　項目經理簽署：

J858 112_ CW BD amendment submission

15-Mar-22

T1絲桿數量MO表(絲桿支數)

		T1								
	絲桿碼編號	石矢期	CA02絲桿數量(支數)	CA07絲桿數量(支數)	CA08絲桿數量(支數)	CA09	Total			
	R/F						0			
							0			
							0			
							0			
未計	R/F		未計	未計	未計		0			
未計 62/F	62/F	18-Feb-23	未計	未計	未計		0			
	61/F	07-Feb-23	48	52	16		116	MO7	4層	12月尾
	60/F	30-Jan-23	48	52	16		116			
	59/F	21-Jan-23	48	52	16		116			
	58/F	17-Jan-23	48	52	16		116			
	57/F	12-Jan-23	48	52	16		116			
	56/F	07-Jan-23	48	52	16		116			
	55/F	31-Dec-22	48	52	16		116	MO6	8層	10月尾
	53/F	24-Dec-22	48	52	16		116			
	52/F	20-Dec-22	48	52	16		116			
	51/F	15-Dec-22	48	52	16		116			
	50/F	10-Dec-22	48	52	16		116			
	49/F	06-Dec-22	48	52	16		116			
	48/F	01-Dec-22	48	52	16		116			
	47/F	26-Nov-22	48	52	16		116			
	46/F	22-Nov-22	48	52	16		116	MO5	8層	9月尾
	45/F	17-Nov-22	48	52	16		116			
	43/F	12-Nov-22	48	52	16		116			
	42/F	08-Nov-22	48	52	16		116			
	41/F	01-Nov-22	72	76	16		164			
防火層	40/F	20-Oct-22	120	126	16		262			
	39/F	27-Sep-22	48	52	16		116	MO4	8層	7月尾
	38/F	22-Sep-22	48	52	16		116			
	37/F	17-Sep-22	48	52	16		116			
	36/F	13-Sep-22	48	52	16		116			
	35/F	07-Sep-22	48	52	16		116			
	33/F	02-Sep-22	48	52	16		116			
	32/F	29-Aug-22	48	52	16		116			
	31/F	24-Aug-22	48	52	16		116	MO3	8層	6月尾
	30/F	19-Aug-22	48	52	16		116			
	29/F	15-Aug-22	48	52	16		116			
	28/F	10-Aug-22	48	52	16		116			
	27/F	05-Aug-22	48	52	16		116			
	26/F	01-Aug-22	48	52	16		116			
	25/F	27-Jul-22	48	52	16		116			
	23/F	22-Jul-22	48	52	16		116			
	22/F	18-Jul-22	48	52	16		116	MO2	8層	5月尾
	21/F	13-Jul-22	48	52	16		116			
	20/F	08-Jul-22	48	52	16		116			
	19/F	04-Jul-22	48	52	16		116			
	18/F	28-Jun-22	48	52	16		116			
	17/F	23-Jun-22	48	52	16		116			
	16/F	18-Jun-22	48	52	16		116			
	15/F	24-May-22	48	52	16		116			
	12/F	16-May-22	72	76	16		164			
防火層	11/F	30-Apr-22	120	126	16		262	MO1	4層	4月22日
	10/F	14-Apr-22	48	52	16		116			
起腳層	9/F	08-Mar-22	0	0	0		0			
	Total		2400	2588	736		5724			
	絲桿碼編號		CA02絲桿數量(支)	CA07絲桿數量(支)	CA08絲桿數量(支)		Total			

此表數量為絲桿支數(絲桿碼X2)

T1絲桿支數總數 5724 支

T1絲桿碼總數 2862 套 (每套2支絲桿)

標準層 (平層計)			48	52	16		116
			CA02絲桿數量(支數)	CA07絲桿數量(支數)	CA08絲桿數量(支數)		Total

T1凳仔碼數量MO表

		T1						
	凳仔碼編號	石矢期	CA04	CA06	Total			
未計	R/F		未計		0			
未計 62/F	62/F	18-Feb-23	未計		0			
	61/F	07-Feb-23	78		78	MO7	4層	12月尾
	60/F	30-Jan-23	78		78			
	59/F	21-Jan-23	78		78			
	58/F	17-Jan-23	78		78			
	57/F	12-Jan-23	78		78			
	56/F	07-Jan-23	78		78			
	55/F	31-Dec-22	78		78	MO6	8層	10月尾
	53/F	24-Dec-22	78		78			
	52/F	20-Dec-22	78		78			
	51/F	15-Dec-22	78		78			
	50/F	10-Dec-22	78		78			
	49/F	06-Dec-22	78		78			
	48/F	01-Dec-22	78		78			
	47/F	26-Nov-22	78		78			
	46/F	22-Nov-22	78		78	MO5	8層	9月尾
	45/F	17-Nov-22	78		78			
	43/F	12-Nov-22	78		78			
	42/F	08-Nov-22	78		78			
	41/F	01-Nov-22	39	4	43			
防火層	40/F	20-Oct-22	39	52	91			
	39/F	27-Sep-22	78		78			
	38/F	22-Sep-22	78		78			
	37/F	17-Sep-22	78		78	MO4	8層	7月尾
	36/F	13-Sep-22	78		78			
	35/F	07-Sep-22	78		78			
	33/F	02-Sep-22	78		78			
	32/F	29-Aug-22	78		78			
	31/F	24-Aug-22	78		78			
	30/F	19-Aug-22	78		78			
	29/F	15-Aug-22	78		78			
	28/F	10-Aug-22	78		78	MO3	8層	6月尾
	27/F	05-Aug-22	78		78			
	26/F	01-Aug-22	78		78			
	25/F	27-Jul-22	78		78			
	23/F	22-Jul-22	78		78			
	22/F	18-Jul-22	78		78			
	21/F	13-Jul-22	78		78			
	20/F	08-Jul-22	78		78			
	19/F	04-Jul-22	78		78	MO2	8層	5月尾
	18/F	28-Jun-22	78		78			
	17/F	23-Jun-22	78		78			
	16/F	18-Jun-22	78		78			
	15/F	24-May-22	78		78			
	12/F	16-May-22	39	4	43			
防火層	11/F	30-Apr-22	39	52	91	MO1	4層	4月22日
	10/F	14-Apr-22	78		78			
	9/F	08-Mar-22	39	58	97			
	Total		3471	170				
	凳仔碼編號		CA04	CA06	Total			

此表數量為凳仔碼數

T1凳仔碼總數	3641		

標準層	(平層計)	78	0	
		CA04	CA06	Total

J858

15-Mar-22

量MO表(絲桿支數)

	T2									
	絲桿支數	石矢期	CA02絲桿數量(支數)	CA07絲桿數量(支數)	CA08絲桿數量(支數)	CA09絲桿數量(支數)	Total			
未計	R/F		未計	未計	未計	未計	0			
未計	67/F	18-May-23	未計	未計	未計	未計	0			
	66/F	06-May-23	46	46	12	2	106			
	65/F	28-Apr-23	46	46	12	2	106			
	63/F	22-Apr-23	46	46	12	2	106			
	62/F	18-Apr-23	46	46	12	2	106	MO7	7層	12月尾
	61/F	13-Apr-23	46	46	12	2	106			
	60/F	04-Apr-23	46	46	12	2	106			
	59/F	30-Mar-23	46	46	12	2	106			
	58/F	24-Mar-23	46	46	12	2	106			
	57/F	20-Mar-23	46	46	12	2	106			
	56/F	15-Mar-23	46	46	12	2	106			
	55/F	10-Mar-23	46	46	12	2	106	MO6	8層	10月尾
	53/F	06-Mar-23	46	46	12	2	106			
	52/F	28-Feb-23	46	46	12	2	106			
	51/F	22-Feb-23	46	46	12	2	106			
	50/F	17-Feb-23	46	46	12	2	106			
	49/F	26-Jan-23	46	46	12	2	106			
	48/F	18-Jan-23	46	46	12	2	106			
	47/F	13-Jan-23	46	46	12	2	106			
	46/F	09-Jan-23	46	46	12	2	106	MO5	8層	9月尾
	45/F	03-Jan-23	46	46	12	2	106			
	43/F	28-Dec-22	46	46	12	2	106			
	42/F	21-Dec-22	46	46	12	2	106			
	41/F	14-Dec-22	68	72	12	2	154			
防火層	40/F	02-Dec-22	112	116	12	2	242			
	39/F	23-Nov-22	46	46	12	2	106			
	38/F	18-Nov-22	46	46	12	2	106			
	37/F	14-Nov-22	46	46	12	2	106	MO4	8層	7月尾
	36/F	09-Nov-22	46	46	12	2	106			
	35/F	04-Nov-22	46	46	12	2	106			
	33/F	31-Oct-22	46	46	12	2	106			
	32/F	26-Oct-22	46	46	12	2	106			
	31/F	21-Oct-22	46	46	12	2	106			
	30/F	28-Sep-22	46	46	12	2	106			
	29/F	23-Sep-22	46	46	12	2	106			
	28/F	19-Sep-22	46	46	12	2	106	MO3	8層	6月尾
	27/F	14-Sep-22	46	46	12	2	106			
	26/F	08-Sep-22	46	46	12	2	106			
	25/F	03-Sep-22	46	46	12	2	106			
	23/F	30-Aug-22	46	46	12	2	106			
	22/F	25-Aug-22	46	46	12	2	106			
	21/F	20-Aug-22	46	46	12	2	106			
	20/F	16-Aug-22	46	46	12	2	106			
	19/F	11-Aug-22	46	46	12	2	106	MO2	8層	5月尾
	18/F	06-Aug-22	46	46	12	2	106			
	17/F	02-Aug-22	46	46	12	2	106			
	16/F	28-Jul-22	46	46	12	2	106			
	15/F	21-Jul-22	46	46	12	2	106			
	12/F	13-Jul-22	68	72	12	2	154			
防火層	11/F	29-Jun-22	112	116	12	2	242	MO1	4層	4月22日
	10/F	16-Jun-22	46	46	12	2	106			
起腳層	9/F	10-May-22					0			
	Total		2476	2492	600	100	5668			
	絲桿支數		CA02絲桿數量(支數)	CA07絲桿數量(支數)	CA08絲桿數量(支數)	CA09絲桿數量(支數)	Total			

T2凳仔碼數量MO表

	T2								
	凳仔碼	石矢期	CA04	CA06	Total			
未計	R/F		未計	未計	0			
未計	67/F	18-May-23	未計	未計	0			
	66/F	06-May-23	78		78			
	65/F	28-Apr-23	78		78			
	63/F	22-Apr-23	78		78			
	62/F	18-Apr-23	78		78	MO7	7層	12月尾
	61/F	13-Apr-23	78		78			
	60/F	04-Apr-23	78		78			
	59/F	30-Mar-23	78		78			
	58/F	24-Mar-23	78		78			
	57/F	20-Mar-23	78		78			
	56/F	15-Mar-23	78		78			
	55/F	10-Mar-23	78		78	MO6	8層	10月尾
	53/F	06-Mar-23	78		78			
	52/F	28-Feb-23	78		78			
	51/F	22-Feb-23	78		78			
	50/F	17-Feb-23	78		78			
	49/F	26-Jan-23	78		78			
	48/F	18-Jan-23	78		78			
	47/F	13-Jan-23	78		78			
	46/F	09-Jan-23	78		78	MO5	8層	9月尾
	45/F	03-Jan-23	78		78			
	43/F	28-Dec-22	78		78			
	42/F	21-Dec-22	78		78			
	41/F	14-Dec-22	39	4	43			
防火層	40/F	02-Dec-22	39	52	91			
	39/F	23-Nov-22	78		78			
	38/F	18-Nov-22	78		78			
	37/F	14-Nov-22	78		78	MO4	8層	7月尾
	36/F	09-Nov-22	78		78			
	35/F	04-Nov-22	78		78			
	33/F	31-Oct-22	78		78			
	32/F	26-Oct-22	78		78			
	31/F	21-Oct-22	78		78			
	30/F	28-Sep-22	78		78			
	29/F	23-Sep-22	78		78			
	28/F	19-Sep-22	78		78	MO3	8層	6月尾
	27/F	14-Sep-22	78		78			
	26/F	08-Sep-22	78		78			
	25/F	03-Sep-22	78		78			
	23/F	30-Aug-22	78		78			
	22/F	25-Aug-22	78		78			
	21/F	20-Aug-22	78		78			
	20/F	16-Aug-22	78		78			
	19/F	11-Aug-22	78		78	MO2	8層	5月尾
	18/F	06-Aug-22	78		78			
	17/F	02-Aug-22	78		78			
	16/F	28-Jul-22	78		78			
	15/F	21-Jul-22	78		78			
	12/F	13-Jul-22	39	4	43			
防火層	11/F	29-Jun-22	39	52	91			
	10/F	16-Jun-22	78		78	MO1	4層	4月22日
起腳層	9/F	10-May-22	39	54	93			
		Total	3783	166				
	凳仔碼	石矢期	CA04	CA06	Total			

此表數量為絲桿支數(絲桿碼X2)

T2絲桿支數總 5668 支

T2絲桿碼總數 2834 套 (每套2支絲桿)

T2

標準層 (平層計)	46	46	12	2	106
絲桿支數	CA02絲桿數量(支數)	CA07絲桿數量(支數)	CA08絲桿數量(支數)	CA09絲桿數量(支數)	Total

此表數量為凳仔碼數

標準層 (平層計)	78	0	
凳仔碼	CA04	CA06	Total

J858

15-Mar-22

T3絲桿數量MO表(絲桿支數)

	T3																			
	石矢期	CA02絲桿數量(支數)	CA07絲桿數量(支數)	CA08絲桿數量(支數)	CA09絲桿數量(支數)	Total														
未計	R/F		未計	未計	未計	未計	0	R/F				未計	R/F				0	R/F			
未計	67/F	29-Apr-23	未計	未計	未計	未計	0	67/F				未計	67/F	29-Apr-23			0	67/F			
	66/F	17-Apr-23	42	48	12	2	104	66/F					66/F	17-Apr-23	78		78	66/F			
	65/F	06-Apr-23	42	48	12	2	104	65/F					65/F	06-Apr-23	78		78	65/F			
	63/F	31-Mar-23	42	48	12	2	104	63/F					63/F	31-Mar-23	78		78	63/F			
	62/F	25-Mar-23	42	48	12	2	104	62/F	MO7	7層	12月尾		62/F	25-Mar-23	78		78	62/F	MO7	7層	12月尾
	61/F	21-Mar-23	42	48	12	2	104	61/F					61/F	21-Mar-23	78		78	61/F			
	60/F	16-Mar-23	42	48	12	2	104	60/F					60/F	16-Mar-23	78		78	60/F			
	59/F	11-Mar-23	42	48	12	2	104	59/F					59/F	11-Mar-23	78		78	59/F			
	58/F	07-Mar-23	42	48	12	2	104	58/F					58/F	07-Mar-23	78		78	58/F			
	57/F	01-Mar-23	42	48	12	2	104	57/F					57/F	01-Mar-23	78		78	57/F			
	56/F	24-Feb-23	42	48	12	2	104	56/F					56/F	24-Feb-23	78		78	56/F			
	55/F	18-Feb-23	42	48	12	2	104	55/F	MO6	8層	10月尾		55/F	18-Feb-23	78		78	55/F	MO6	8層	10月尾
	53/F	14-Feb-23	42	48	12	2	104	53/F					53/F	14-Feb-23	78		78	53/F			
	52/F	09-Feb-23	42	48	12	2	104	52/F					52/F	09-Feb-23	78		78	52/F			
	51/F	04-Feb-23	42	48	12	2	104	51/F					51/F	04-Feb-23	78		78	51/F			
	50/F	30-Jan-23	42	48	12	2	104	50/F					50/F	30-Jan-23	78		78	50/F			
	49/F	04-Jan-23	42	48	12	2	104	49/F					49/F	04-Jan-23	78		78	49/F			
	48/F	29-Dec-22	42	48	12	2	104	48/F					48/F	29-Dec-22	78		78	48/F			
	47/F	22-Dec-22	42	48	12	2	104	47/F					47/F	22-Dec-22	78		78	47/F			
	46/F	17-Dec-22	42	48	12	2	104	46/F	MO5	8層	9月尾		46/F	17-Dec-22	78		78	46/F	MO5	8層	9月尾
	45/F	13-Dec-22	42	48	12	2	104	45/F					45/F	13-Dec-22	78		78	45/F			
	43/F	08-Dec-22	42	48	12	2	104	43/F					43/F	08-Dec-22	78		78	43/F			
	42/F	03-Dec-22	42	48	12	2	104	42/F					42/F	03-Dec-22	78		78	42/F			
	41/F	26-Nov-22	66	74	12	2	154	41/F					41/F	26-Nov-22	39	4	43	41/F			
防火層	40/F	15-Nov-22	114	122	12	2	250	40/F				防火層	40/F	15-Nov-22	39	52	91	40/F			
	39/F	05-Nov-22	42	48	12	2	104	39/F					39/F	05-Nov-22	78		78	39/F			
	38/F	01-Nov-22	42	48	12	2	104	38/F					38/F	01-Nov-22	78		78	38/F			
	37/F	27-Oct-22	42	48	12	2	104	37/F	MO4	8層	7月尾		37/F	27-Oct-22	78		78	37/F	MO4	8層	7月尾
	36/F	22-Oct-22	42	48	12	2	104	36/F					36/F	22-Oct-22	78		78	36/F			
	35/F	18-Oct-22	42	48	12	2	104	35/F					35/F	18-Oct-22	78		78	35/F			
	33/F	13-Oct-22	42	48	12	2	104	33/F					33/F	13-Oct-22	78		78	33/F			
	32/F	08-Oct-22	42	48	12	2	104	32/F					32/F	08-Oct-22	78		78	32/F			
	31/F	03-Oct-22	42	48	12	2	104	31/F					31/F	03-Oct-22	78		78	31/F			
	30/F	09-Sep-22	42	48	12	2	104	30/F					30/F	09-Sep-22	78		78	30/F			
	29/F	05-Sep-22	42	48	12	2	104	29/F					29/F	05-Sep-22	78		78	29/F			
	28/F	05-Sep-22	42	48	12	2	104	28/F	MO3	8層	6月尾		28/F	05-Sep-22	78		78	28/F	MO3	8層	6月尾
	27/F	26-Aug-22	42	48	12	2	104	27/F					27/F	26-Aug-22	78		78	27/F			
	26/F	22-Aug-22	42	48	12	2	104	26/F					26/F	22-Aug-22	78		78	26/F			
	25/F	17-Aug-22	42	48	12	2	104	25/F					25/F	17-Aug-22	78		78	25/F			
	23/F	12-Aug-22	42	48	12	2	104	23/F					23/F	12-Aug-22	78		78	23/F			
	22/F	08-Aug-22	42	48	12	2	104	22/F					22/F	08-Aug-22	78		78	22/F			
	21/F	03-Aug-22	42	48	12	2	104	21/F					21/F	03-Aug-22	78		78	21/F			
	20/F	29-Jul-22	42	48	12	2	104	20/F					20/F	29-Jul-22	78		78	20/F			
	19/F	25-Jul-22	42	48	12	2	104	19/F	MO2	8層	5月尾		19/F	25-Jul-22	78		78	19/F	MO2	8層	5月尾
	18/F	20-Jul-22	42	48	12	2	104	18/F					18/F	20-Jul-22	78		78	18/F			
	17/F	15-Jul-22	42	48	12	2	104	17/F					17/F	15-Jul-22	78		78	17/F			
	16/F	11-Jul-22	42	48	12	2	104	16/F					16/F	11-Jul-22	78		78	16/F			
	15/F	04-Jul-22	42	48	12	2	104	15/F					15/F	04-Jul-22	78		78	15/F			
	12/F	24-Jun-22	66	74	12	2	154	12/F					12/F	24-Jun-22	39	4	43	12/F			
防火層	11/F	11-Jun-22	114	122	12	2	250	11/F	MO1	4層	4月22日	防火層	11/F	11-Jun-22	39	52	91	11/F	MO1	4層	4月22日
	10/F	28-May-22	42	48	12	2	104	10/F					10/F	28-May-22	78		78	10/F			
起腳層	9/F	20-Apr-22					0	9/F				起腳層	9/F	20-Apr-22	39	53	92	9/F			
		Total	2292	2600	600	100	5592							Total	3783	165					

	絲桿支數	CA02絲桿數量(支)	CA07絲桿數量(支)	CA08絲桿數量(支)	CA09絲桿數量(支)	Total
T3	標準層 (平層計)	42	48	12	2	104

此表數量為絲桿支數(絲桿碼X2)

T3絲桿支數約 5592 支

T3絲桿碼總數 2796 套 (每套2支絲桿)

T3凳仔碼數量MO表

	T3																			
	石矢期	CA04	CA06	Total																
未計	R/F			0	R/F				未計	R/F				0	R/F			
未計	67/F	29-Apr-23		0	67/F				未計	67/F	29-Apr-23			0	67/F			
	66/F	17-Apr-23	78	78	66/F					66/F	17-Apr-23	78		78	66/F			
	65/F	06-Apr-23	78	78	65/F					65/F	06-Apr-23	78		78	65/F			
	63/F	31-Mar-23	78	78	63/F					63/F	31-Mar-23	78		78	63/F			
	62/F	25-Mar-23	78	78	62/F	MO7	7層	12月尾		62/F	25-Mar-23	78		78	62/F	MO7	7層	12月尾
	61/F	21-Mar-23	78	78	61/F					61/F	21-Mar-23	78		78	61/F			
	60/F	16-Mar-23	78	78	60/F					60/F	16-Mar-23	78		78	60/F			
	59/F	11-Mar-23	78	78	59/F					59/F	11-Mar-23	78		78	59/F			
	58/F	07-Mar-23	78	78	58/F					58/F	07-Mar-23	78		78	58/F			
	57/F	01-Mar-23	78	78	57/F					57/F	01-Mar-23	78		78	57/F			
	56/F	24-Feb-23	78	78	56/F					56/F	24-Feb-23	78		78	56/F			
	55/F	18-Feb-23	78	78	55/F	MO6	8層	10月尾		55/F	18-Feb-23	78		78	55/F	MO6	8層	10月尾
	53/F	14-Feb-23	78	78	53/F					53/F	14-Feb-23	78		78	53/F			
	52/F	09-Feb-23	78	78	52/F					52/F	09-Feb-23	78		78	52/F			
	51/F	04-Feb-23	78	78	51/F					51/F	04-Feb-23	78		78	51/F			
	50/F	30-Jan-23	78	78	50/F					50/F	30-Jan-23	78		78	50/F			
	49/F	04-Jan-23	78	78	49/F					49/F	04-Jan-23	78		78	49/F			
	48/F	29-Dec-22	78	78	48/F					48/F	29-Dec-22	78		78	48/F			
	47/F	22-Dec-22	78	78	47/F					47/F	22-Dec-22	78		78	47/F			
	46/F	17-Dec-22	78	78	46/F	MO5	8層	9月尾		46/F	17-Dec-22	78		78	46/F	MO5	8層	9月尾
	45/F	13-Dec-22	78	78	45/F					45/F	13-Dec-22	78		78	45/F			
	43/F	08-Dec-22	78	78	43/F					43/F	08-Dec-22	78		78	43/F			
	42/F	03-Dec-22	78	78	42/F					42/F	03-Dec-22	78		78	42/F			
	41/F	26-Nov-22	39	43	41/F					41/F	26-Nov-22	39	4	43	41/F			
防火層	40/F	15-Nov-22	39	91	40/F				防火層	40/F	15-Nov-22	39	52	91	40/F			
	39/F	05-Nov-22	78	78	39/F					39/F	05-Nov-22	78		78	39/F			
	38/F	01-Nov-22	78	78	38/F					38/F	01-Nov-22	78		78	38/F			
	37/F	27-Oct-22	78	78	37/F	MO4	8層	7月尾		37/F	27-Oct-22	78		78	37/F	MO4	8層	7月尾
	36/F	22-Oct-22	78	78	36/F					36/F	22-Oct-22	78		78	36/F			
	35/F	18-Oct-22	78	78	35/F					35/F	18-Oct-22	78		78	35/F			
	33/F	13-Oct-22	78	78	33/F					33/F	13-Oct-22	78		78	33/F			
	32/F	08-Oct-22	78	78	32/F					32/F	08-Oct-22	78		78	32/F			
	31/F	03-Oct-22	78	78	31/F					31/F	03-Oct-22	78		78	31/F			
	30/F	09-Sep-22	78	78	30/F					30/F	09-Sep-22	78		78	30/F			
	29/F	05-Sep-22	78	78	29/F					29/F	05-Sep-22	78		78	29/F			
	28/F	05-Sep-22	78	78	28/F	MO3	8層	6月尾		28/F	05-Sep-22	78		78	28/F	MO3	8層	6月尾
	27/F	26-Aug-22	78	78	27/F					27/F	26-Aug-22	78		78	27/F			
	26/F	22-Aug-22	78	78	26/F					26/F	22-Aug-22	78		78	26/F			
	25/F	17-Aug-22	78	78	25/F					25/F	17-Aug-22	78		78	25/F			
	23/F	12-Aug-22	78	78	23/F					23/F	12-Aug-22	78		78	23/F			
	22/F	08-Aug-22	78	78	22/F					22/F	08-Aug-22	78		78	22/F			
	21/F	03-Aug-22	78	78	21/F					21/F	03-Aug-22	78		78	21/F			
	20/F	29-Jul-22	78	78	20/F					20/F	29-Jul-22	78		78	20/F			
	19/F	25-Jul-22	78	78	19/F	MO2	8層	5月尾		19/F	25-Jul-22	78		78	19/F	MO2	8層	5月尾
	18/F	20-Jul-22	78	78	18/F					18/F	20-Jul-22	78		78	18/F			
	17/F	15-Jul-22	78	78	17/F					17/F	15-Jul-22	78		78	17/F			
	16/F	11-Jul-22	78	78	16/F					16/F	11-Jul-22	78		78	16/F			
	15/F	04-Jul-22	78	78	15/F					15/F	04-Jul-22	78		78	15/F			
	12/F	24-Jun-22	39	43	12/F					12/F	24-Jun-22	39	4	43	12/F			
防火層	11/F	11-Jun-22	39	91	11/F	MO1	4層	4月22日	防火層	11/F	11-Jun-22	39	52	91	11/F	MO1	4層	4月22日
	10/F	28-May-22	78	78	10/F					10/F	28-May-22	78		78	10/F			
起腳層	9/F	20-Apr-22	39	92	9/F				起腳層	9/F	20-Apr-22	39	53	92	9/F			
	Total		3783	165						Total		3783	165					

	石矢期	CA04	CA06	Total
T3	標準層 (平層計)	78	0	

此表數量為凳仔碼數

SPECIFICATION – PRELIMINARIES (Cont'd)

10.0 MAIN CONTRACTOR'S RELATIONSHIP AND DUTIES TO SUB-CONTRACTORS (Cont'd)

10.1 Main Contractor's Attendance on Nominated Sub-Contractors/Suppliers; Named Suppliers; Named Domestic Sub-Contractors; Specialist Sub-Contractors and Separate Contractors (Cont'd)

g) Any fencing, hoardings, etc. required for site safety as required and incidental to the execution of the Sub-Contract works.

h) Adequate water, lighting and electrical supplies at convenient positions throughout the Works under construction and to working and storage areas within the Site. The electrical supply shall be sized to cater for full load testing and commissioning, if required, up to and including final acceptance of the installations by the Architect/Authorities.

i) Watching over Nominated Sub-Contractors' works.

j) Vertical transportation of all necessary building materials and/or equipments, etc. from all Nominated Sub-Contractors and Separate Contractors shall be provided by the Main Contractor. Prior to the commencement of works by Nominated Sub-Contractors and Separate Contractors, the Main Contractor shall allow reasonable time for the use of vertical transportation by the Nominated Sub-Contractors and Separate Contractors to the satisfaction of the Architect.

k) Any making good on completion of work disturbed by the removal of preceding facilities.

The Main Contractor shall ascertain from each Nominated Sub-Contractor all particulars relating to his work with regard to the order of its execution and the positions in which chases, holes, mortices, etc. will be required, before the work is put in hand. No claims for work arising out of lack of liaison with the Architect and/or other Nominated Sub-Contractors will be considered.

The Nominated Sub-Contractor shall inform the Main Contractor of all 'Builder's Work' required to be carried out as early as possible and not later than three weeks before the relevant sections of work commence so that all chases, holes, openings, etc. may be cut or formed as the work proceeds.

Should the Nominated Sub-Contractor fail to give the Main Contractor reasonable notice and full particulars of the 'Builder's Work' all additional work incurred shall be at the Nominated Sub-Contractor's expense.

The Main Contractor shall ensure that the Nominated Sub-Contractor shall under their obligation and duty to accurately mark on drawings and set out on Site the position of all holes, chases, anchors, cleats and any other embedded/fix-in elements of a like nature and shall provide supervision on Site to ensure that the Works are carried out to his requirements. The Main Contractor shall be responsible for fixing in position the embedded/fix-in elements and rectifying once any off-setting problem as found deviated from the mark-up position upon being informed by the Nominated Sub-Contractor. Thereafter, any further off-setting will be rectified by the Nominated Sub-Contractor at the Main Contractor's expense.

10.0 MAIN CONTRACTOR'S RELATIONSHIP AND DUTIES TO SUB-CONTRACTORS (Cont'd)

10.1 Main Contractor's Attendance on Nominated Sub-Contractors/Suppliers; Named, Suppliers; Named Domestic Sub-Contractors; Specialist Sub-Contractors and Separate Contractors (Cont'd)

The Main Contractor shall co-ordinate with relevant Nominated Sub-contractors to incorporate and provide necessary weep holes by means of minimum Φ100mm uPVC pipes through concrete / block works walls at appropriate positions to the satisfaction of the Architect for diverting / providing proper drainage across the concerned walls, including those at the sunken slabs / trenches and channels running across such walls, etc. Any gaps between such uPVC pipes and the concerned openings at concrete / block walls shall be properly sealed and grouted. For any weep hole formed at fire rated wall or compartment wall, such weep holes shall be protected with appropriate fire collar / fire seal having a Fire Rating Period of not less than that of the respective wall in full compliance with the Buildings Ordinance / Regulations and related Code of Practice.

All embedded bracket / hooks, additional openings, holes through the building structure, partition walls and all concrete bases, supports, ducts, etc. required by the Nominated Sub-Contractor beyond those included in the Architectural or Structural drawings will also be carried out free of charge by the Main Contractor including trimming bars if required, provided that the Nominated Sub-Contractor shall submit to the Architect for approval, full details of such requirements, so that due consideration may be given before the Main Contractor commences work in the area concerned. Following approval by the Architect, the Main Contractor shall carry out such works as his work proceeds. The Nominated Sub-Contractor shall be liable for all expenses incurred that are brought about by failure to comply with the above requirements.

The Main Contractor shall attend upon all the Nominated Sub-Contractors, cut or form chases, holes and openings, etc. of all sizes and build in sleeves, supply cement mortar for fixing brackets, bed and grout behind frames including supplying cement mortar, fill around and / or seal around all pipes, ducts, cables, conduits, cable trunking, cable trays and air-ducting with approved mastic, make good all work disturbed and all other necessary work of a like nature outside all plant rooms. Proper fire collars should be provided and installed fire seal material should be grouted around all pipes, ducts, cables, conduit, cable trunking, cable trays and control panels, etc., passing through fire rated elements of construction, compartments and E&M plant rooms to maintain the required Fire Rating Period in full compliance with the Buildings Ordinance/Regulations and related Code of Practice. These sealing materials should be accompanied with relevant test certificates demonstrating their performance in achieving the required Fire Rating Period as stipulated under the Buildings Ordinance / Regulations and related Code of Practice.

美 特 鋁 質 有 限 公 司
MIDI ALUMINIUM FABRICATOR LTD.

9-12/F 記得碼

工程指示 / 要求簡箋(E.I.)

工程指示編號：EI / 4306 / 22　　修改版次：-

記錄用

工程編號　：J - 858　　工程名稱　：將軍澳日出康城 1L

工程項目　：幕牆 預留碼 (T1-T3: 9-12/F)

收件人　：Maggie　　發件人　：Eric Liu　　日　期　：18/01/2022

☐要求提供 / ☐確認 事項 ：

( ) 初步鋁料 B.M.　( ) 加工拆圖，然後生產　( ) 尺寸表

( ) 正式鋁料 B.M.　( ) 技術上資料 / 指示　( ) 報價

( ) 配件 B.M.　( ) 樣辦或貨品說明書　( ) 分判合約

內容 ：

請按 BM 先訂購幕牆 T1-T3: 9-12/F 用預留碼

2 月尾/2022 先交 1 半數量, 3 月中/2022 交 1 半數量

EI4247 已訂購 CA01, CA05 (Hilti Channel & T-bolt), 不需重覆訂購, 記錄用.

請在 2022.02.28 前完成上列要求。

附：1 頁 BM+ 2 頁加工圖+ 12 頁位置圖

以上項目為:

☐ 原合約工程包　☐ 原合約工程加 / 減賬　☐ 新工程報價

原因 : -

分發東莞各部門 ：

( )生產技術總監☐連附件 ( )技術部 ☐連附件 ( )生產部 ☐連附件 ( )機械設計部☐連附件

( )採購部 ☐連附件 ( )生產統籌部☐連附件 ( )小羅&清 ☐連附件

( )質檢部 ☐連附件 ( )會計部 ☐連附件 ( )報關組 ☐連附件 ( )其他_____ ☐連附件

分發其他分判 ：

分發香港各部門 ：

( )行政部☐連附件 ( )會計部☐連附件 ( )統籌部☐連附件 ( )工程部地盤科文☐連附件

( )採購部☐連附件 ( )QS 部 ☐連附件 ( )維修部☐連附件 ( )其他 _____☐連附件

傳遞編號：　　發件人簽署：

HK　122　　項目經理簽署：

美特鋁質有限公司 MIDI Aluminium Fabricator Ltd.		工程號：	J858	計算：		日期：		送呈:	
		地盤名稱：	康城11期	核對：		日期：		副本:	
BM編號：	預留碼樣辦	項目類別：	幕牆(預留碼)			修改：		總重量(kg):	0.0

序號	修改標示	配件圖號	物料編號	配件名稱	顏色	實用	後備	總數	單位	單件重量	總重量	備註
									件	KG		
1		EI4247 已訂	CA01	Hilti Channel HAC-70-450F		574	0	574	件			
2	暫停		CA02	轉角碼		39	0	39	件			
3		EI4247 已訂	CA05	Hilti Channel HAC-70-350F		471	0	471	件			
4			CA04	200x150x15mm鐵板	熱浸鋅	717	0	717	件			
5				60x60x8mm方鐵介子	熱浸鋅	2868	0	2868	件			1鐵板 (Item 4) 有4個方鐵介子
6				直徑16圓鐵	熱浸鋅	2868	0	2868	支			1鐵板 (Item 4) 有4個圓鐵
7			CA06	350x200x15mm鐵板	熱浸鋅	145	0	145	件			
8				60x60x8mm方鐵介子	熱浸鋅	290	0	290	件			1鐵板 (Item 7) 有2個方鐵介子
9				直徑16圓鐵	熱浸鋅	290	0	290	支			1鐵板 (Item 7) 有2個圓鐵
							總計	8262	件		0.0	

EI4306

幫仔碼 ø

美 特 鋁 質 有 限 公 司
MIDI ALUMINIUM FABRICATOR LTD.

在CA02排干

工程指示 / 要求簡箋(E.I.)

工程指示編號：EI / 4321 / 22　　修改版次：-　　T1-T3, 9-12/F

工程編號　：J - 858　　工程名稱　：將軍澳日出康城 11

工程項目　：預留碼 ~~轉角位絲桿~~ 連位 (T1-T3,9-12/F)　　要拆guide plate

收件人　：Maggie / 林哥　　發件人　：Eric Liu　　日　期：21/01/2022

☐要求提供 / ☐確認 事項 ：

( ) 初步鋁料 B.M.	( ) 加工拆圖，然後生產	( ) 尺寸表
( ) 正式鋁料 B.M.	( ) 技術上資料 / 指示	( ) 報價
( ) 配件 B.M.	( ) 樣辦或貨品說明書	( ) 分判合約

記錄用

內容 ：

請按 BM 訂購預留碼(絲桿)，T1-T3, 9-12/F 數量(共 40 套)

預 2 月尾出貨　　Stock 產計數

謝謝

請在 2022.02.28 前完成上列要求。

附：

以上項目為:

☐ 原合約工程包　　☐ 原合約工程加 / 減賬　　☐ 新工程報價

原因：-

分發東莞各部門 ：

( )生產技術總監☐連附件　( )技術部　☐連附件　( )生產部　☐連附件　( )機械設計部☐連附件

( )採購部　☐連附件　( )生產統籌部☐連附件　( )小羅&清　☐連附件

( )質檢部　☐連附件　( )會計部　☐連附件　( )報關組　☐連附件　( )其他 _____☐連附件

分發其他分判 ：

分發香港各部門 ：

( )行政部☐連附件　( )會計部☐連附件　(✓)統籌部☐連附件　( )工程部地盤科文☐連附件

(✓)採購部☐連附件　( )QS 部 ☐連附件　( )維修部☐連附件　( )其他 _____☐連附件

傳遞編號：　　發件人簽署：

HK　1/22　　項目經理簽署：


美特鋁質有限公司 MIDI Aluminium Fabricator Ltd.		工程號：	J858	計算:		日期：		送呈:	
		地盤名稱：	康城11期	核對:		日期：		副本:	
BM編號：	預留碼樣辦	項目類別:	幕牆(預留碼絲桿)(T1-T3,9-12/F)			修改：		總重量(kg):	0.0


序號	修改標示	配件圖號	物料編號	配件名稱	顏色	實用	後備	總數	單位件	單件重量 KG	總重量 KG	備註
1			CA02	300x150x3mm鐵板	熱浸鋅	40	0	40	件			見加工圖CA02
2				60x60x12mm方鐵介子	熱浸鋅	80	0	80	件			
3				M16螺紋鋼(GR8.8)	熱浸鋅	80	0	80	支			
4				M16鐵絲母(GR 10)	熱浸鋅	400	0	400	支			
5				M16鐵平介	熱浸鋅	80	0	80	支			
6				M16鐵彈介	熱浸鋅	80	0	80	支			

T2 4321

CA02 (5)

E24321. CA02改

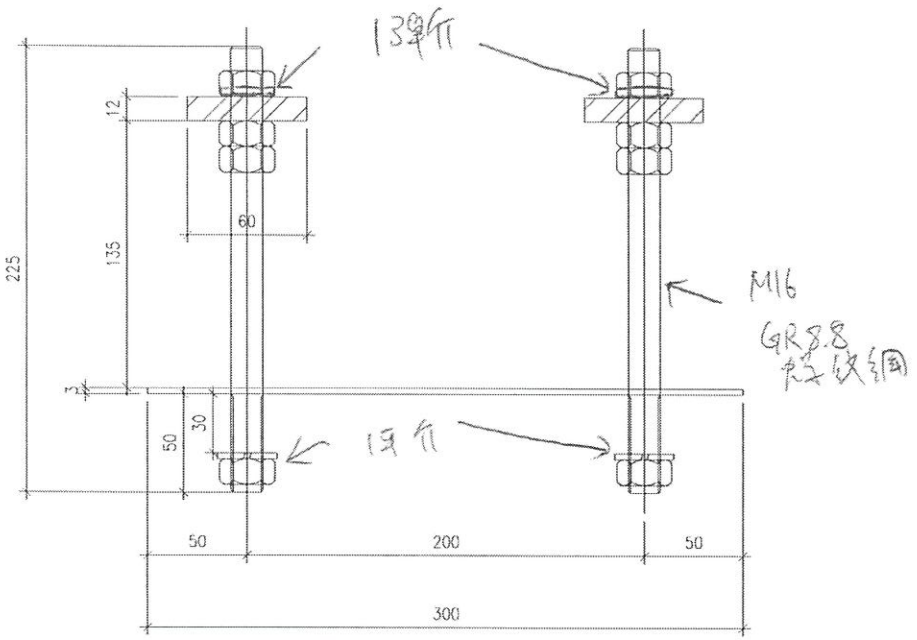

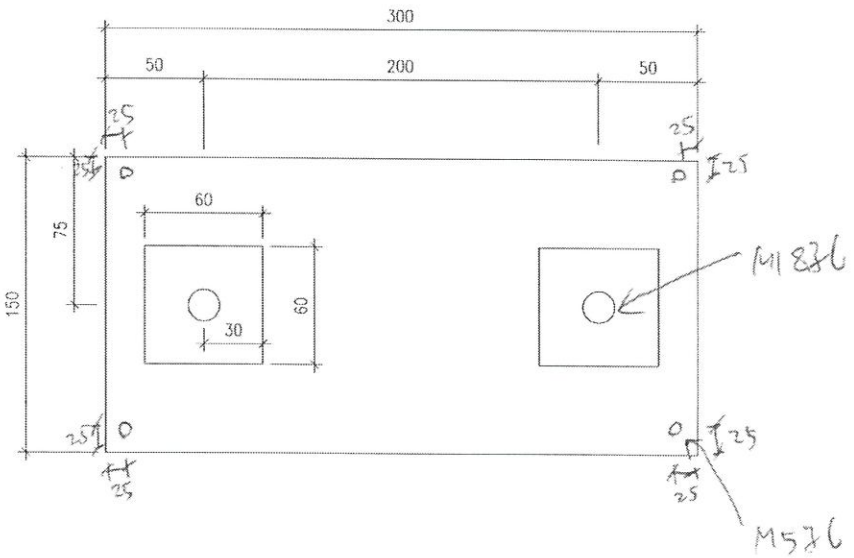

9-12件
T1: 16
T2: 12
T3: 12

支40套

图号表 = GA02

① 300×150×3mm 铁板

② 60×6×12mm 铁件子

每套10支母，1平仆，1弓仆
2支 M16 GR8.8 牙纹钢

CA02：趙生款
CA07：楊生款
CA08：鞠海

美 特 鋁 質 有 限 公 司
MIDI ALUMINIUM FABRICATOR LTD.

工程指示 / 要求簡箋(E.I.)

工程指示編號：EI / 4373 / 22　　修改版次：-

工程編號　：J - 858　　工程名稱　：將軍澳日出康城 11

工程項目　：預留碼 絲杆(channel 轉絲杆)(T1-T3, 9-12/F)

收件人　：Maggie / 林哥　　發件人　：Eric Liu　　日　期　：~~11/02/2022~~

記錄用

□要求提供 / □確認 事項 ：

( ) 初步鋁料 B.M.	( ) 加工拆圖，然後生產	( ) 尺寸表
( ) 正式鋁料 B.M.	( ) 技術上資料 / 指示	( ) 報價
( ) 配件 B.M.	( ) 樣辦或貨品說明書	( ) 分判合約

內容 ：

請按 BM 及加工圖訂購絲杆送地盤安裝用
按早前會議商討，此項目所有 channel 轉用絲杆碼 ，前 EI4247 將取消
計數已覆核，共 3 款絲杆，牆邊款, 標準款及轉角款
現先訂購 T1-T3, 9-12/F 數量，大貨數量覆核後再訂購
絲杆由鐵廠穿好出貨，預算 3 月頭到貨地盤
謝謝

今次只訂T1→T3→T2

請在 2022.03.04 前完成上列要求。

附：1 頁 BM，3 頁加工圖，3 頁位置圖

以上項目為:

□ 原合約工程包　□ 原合約工程加 / 減賬　□ 新工程報價

原因 ：-

分發東莞各部門 ：

( )生產技術總監□連附件 ( )技術部 □連附件 ( )生產部 □連附件 ( )機械設計部□連附件
( )採購部 □連附件 ( )生產統籌部□連附件 ( )小羅&清 □連附件
( )質檢部 □連附件 ( )會計部 □連附件 ( )報關組 □連附件 ( )其他 楊榮輝 □連附件

分發其他分判 ：

分發香港各部門 ：

( )行政部□連附件 ( )會計部□連附件 (✓)統籌部□連附件 ( )工程部地盤科文□連附件 猜高
(✓)採購部□連附件 ( )QS 部 □連附件 ( )維修部□連附件 ( )其他 _____□連附件


傳遞編號：　　發件人簽署：

HK　/ 22　　項目經理簽署：

美特鋁質有限公司 MIDI Aluminium Fabricator Ltd.		工程號：	J858	計算:		日期：		送呈:	
		地盤名稱：	康城11期	核對:		日期：		副本:	
BM編號：	預留碼(絲杆)	項目類別:	幕牆(預留碼)(絲杆)(9-12/F)			修改：		總重量(kg):	0.0

序號	修改標示	配件圖號	物料編號	配件名稱	顏色	實用	後備	總數	單位	單件重量	總重量	備註
									件	KG		
1		CA08		300x200x3mm鐵板	熱浸鋅	330	0	330	件			
2		CA07		468x200x3mm鐵板	熱浸鋅	410	0	410	件			
3		CA02		230x200x3mm鐵板	熱浸鋅	80	0	80	件			
4				60x60x12mm方鐵介子	熱浸鋅	1640	0	1640	件			
5				M16絲杆(GR8.8)	熱浸鋅	1640	0	1640	支			
6				M16鐵絲母(GR 10)	熱浸鋅	8200	0	8200	件			
7				M16鐵平介	熱浸鋅	1640	0	1640	件			
8				M16鐵彈介	熱浸鋅	4260	0	4260	支			
							總計	18200	件		0.0	

鞋面 ~~[illegible]~~ CA08

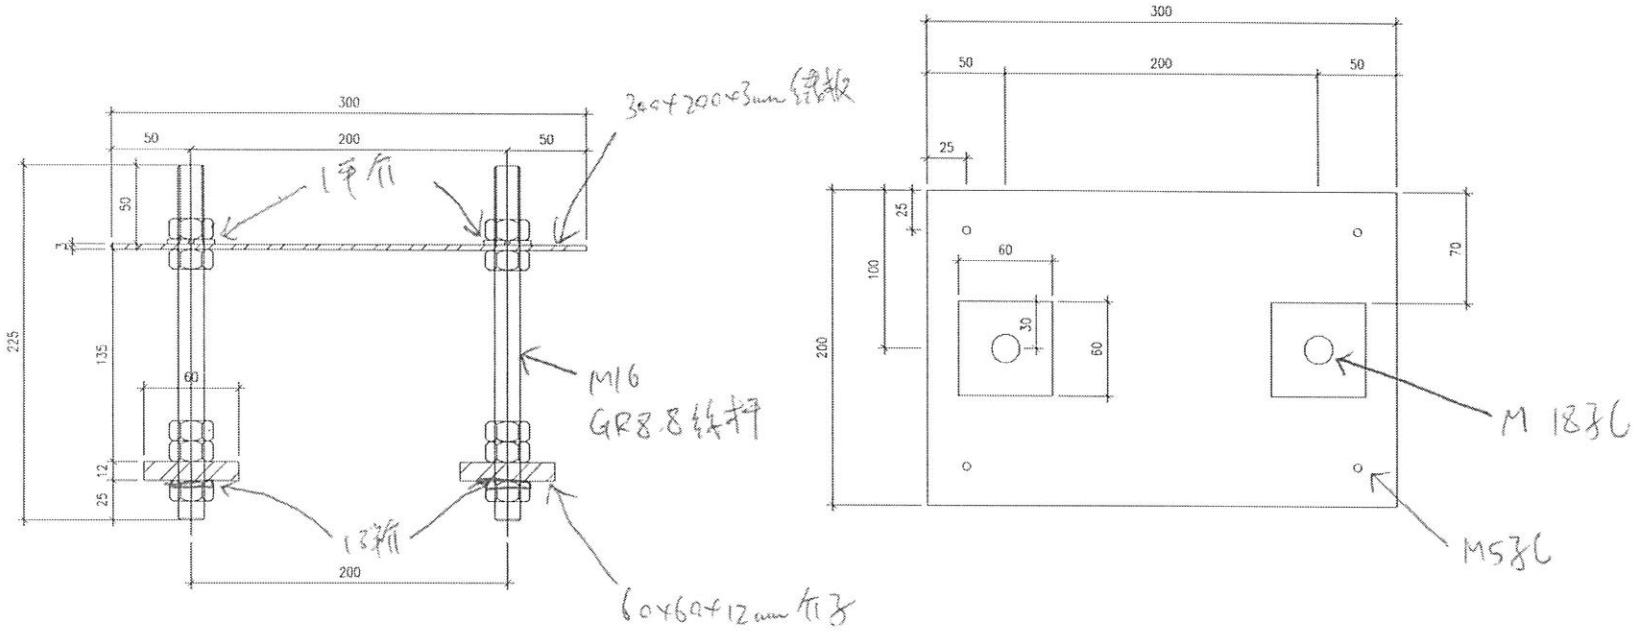

① 300x200x3mm 鉄板
② 60x60x12mm 鉄布子
③ M16 GR8.8 鉄杆


9-12/F
T1: 28x4 = 112
T2: 28x4 = 112
T3: 26x4 = 104
= 328


共330套

每套10螺母，2平仔，2弹仔
2支 M16 GR8.8 鉄杆

趙浸行

TYP CA07

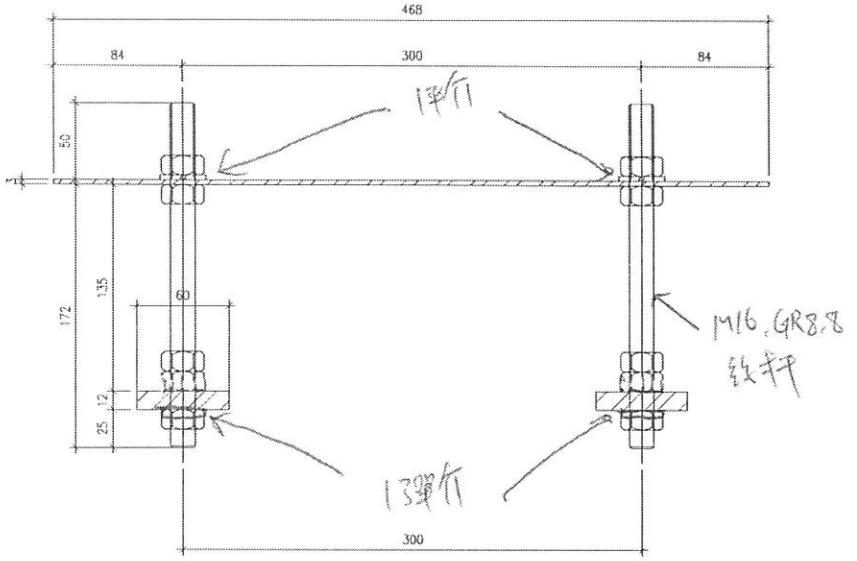

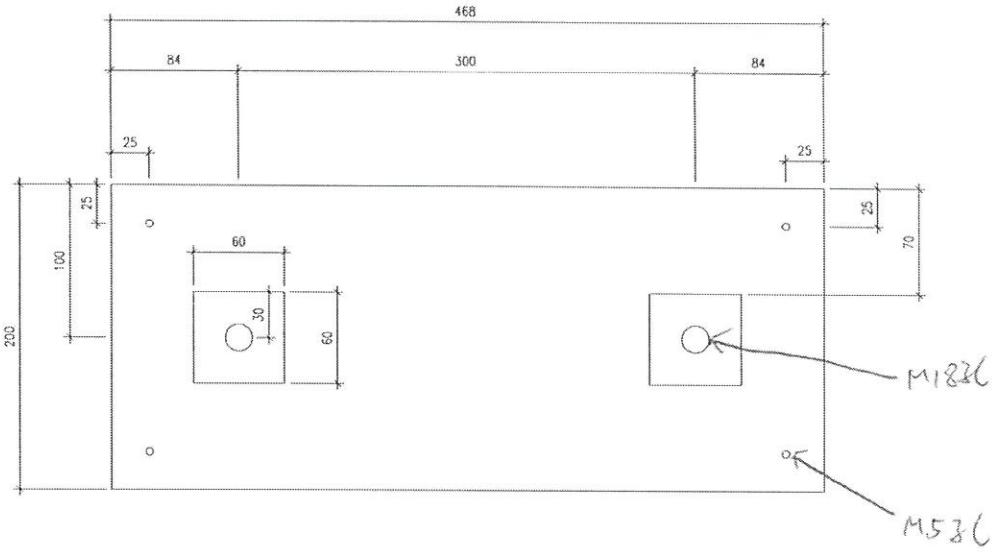

① 468×200×3mm钣金
② 60×60×12mm铁方子
③ M16 GR8.8螺杆

主设备


每套10块钢，2平片，2弹片
2支M16 GR8.8螺杆


9-12片

T1 = 36×4 = 144
T2 = 34×4 = 136
T3 = 32×4 = 128
= 408

共41套

~~[illegible]~~ CA02 精选

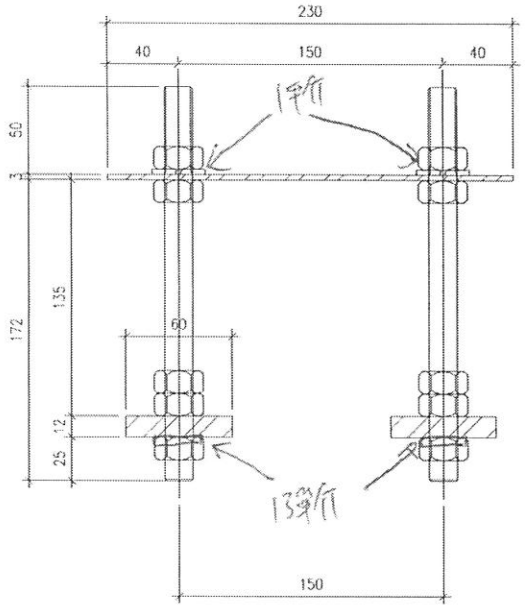

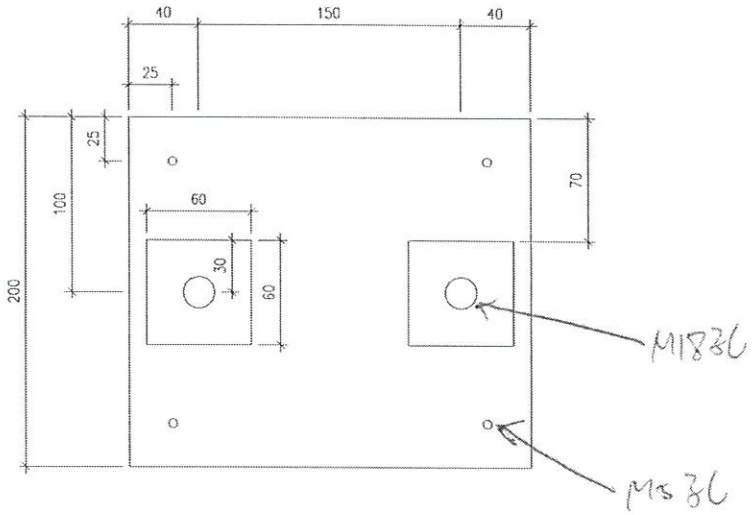

① 230×200×3mm 铁板　　垂直镀锌
② 6a×6a×12mm 铁方子
③ M16 GR 8.8 级杆

包含1个母，2手件，2弹件
2支 M16 GR 8.8 级杆

9-12件

T1：8×4 = 32
T2：6×4 = 24
T3：6×4 = 24
= 80　共80套

美 特 鋁 質 有 限 公 司
MIDI ALUMINIUM FABRICATOR LTD.

工程指示 / 要求簡箋(E.I.)

工程指示編號：**EI / 4528 / 22** 修改版次：**C**

工程編號 ：**J - 858** 工程名稱 ：**將軍澳日出康城 11**

工程項目 ：**預留碼大貨 (絲桿+凳仔碼) (T1-T3)**

收件人 ：**Maggie** 發件人 ：**Ant Yeung** 日 期 ：**06/04/2022**

記錄用

☐要求提供 / ☐確認 事項 ：

( ) 初步鋁料 B.M. ( ) 加工折圖，然後生產 ( ) 尺寸表

( ) 正式鋁料 B.M. ( ) 技術上資料 / 指示 ( ) 報價

內容 ：

C 版: 1) 為清晰加工圖紙，重新標示各項尺寸和 BM 規格。 絲桿和螺母用 Grade 8.8。
不用 3mm Guide plate 。

B 版: 1) 凳仔碼(CA06, CA04)使用 16mm 鐵板
2) 此單 EI4528 貨期為 5 月中開始出貨

A 版：增加絲桿長度 15 mm 以增加石矢縮入 Tolerance

請按 BM 及加工圖訂購預留碼送地盤安裝用 (絲桿+凳仔碼)

1. 按早前會議商討，此項目不使用 channel，轉用絲杆碼
2. 計數已覆核，共四款絲杆，牆邊款(CA02), 標準款(CA07), 轉角款(CA08)及浴室款(CA09)
兩款凳仔碼，起腳款(CA06), 趟門款(CA04)
3. 前 EI4321 和 ei 4373 絲桿已訂購 T1-T3, 9-12/F，此單已扣數
前 EI4306 凳仔碼已訂購 T1-T3, 9-12/F, 此單已扣數
4. 因現場做鋁模，絲桿碼不需要 3mm guide plate 出貨，已出電郵確認
5. 另附上分層表，內附分 MO 批次及到貨預算期
6. 絲桿(CA02,07,08,09) 由鐵廠按支穿好螺母, 鐵介子及平彈介
7. 凳仔碼需驗焊，Fillet weld, 100% Visual, 10% MPI (For Curtain Wall)
8 特色層和 R/F 未訂碼
9. 請提供 Mill cert 謝謝

請在 2022.05.15 前完成上列要求。

以上項目為:

☐ 原合約工程包 ☐ 原合約工程加 / 減賬 ☐ 新工程報價

分發東莞各部門 ：

( )生產技術總監☐連附件 ( )技術部 ☐連附件 ( )生產部 ☐連附件 ( )機械設計部☐連附件

( )採購部 ☐連附件 ( )生產統籌部☐連附件 ( )小羅&清 ☐連附件

( )質檢部 ☐連附件 ( )會計部 ☐連附件 ( )報關組 ☐連附件 ( )其他 楊榮輝 ☐連附件

分發香港各部門 ：

( )行政部☐連附件 ( )會計部☐連附件 ( )統籌部☐連附件 ( )工程部地盤科文☐連附件 ( )寶哥

( )採購部☐連附件 ( )QS 部 ☐連附件 ( )維修部☐連附件 ( )其他 _____☐連附件

傳遞編號： 發件人簽署：

HK / 22 項目經理簽署：

美特鋁質有限公司 MIDI Aluminium Fabricator Ltd.		工程號：	J858	計算：		日期：		送呈：	
		地盤名稱：	康城11期	核對：		日期：		副本：	五4528c
BM編號：	預留碼(絲杆+凳仔碼)	項目類別：	幕牆 (大貨T1-T3) (預留碼) (絲桿+凳仔碼)			修改：		總重量(kg):	0.0

序號	修改標示	配件圖號	物料編號	配件名稱	顏色	實用	後備	總數	單位件	單件重量 KG	總重量 KG	備註	
1		絲桿 支數	包含 CA (02,07,08,09)	60x60x12mm方鐵介子 S275 J0	熱浸鋅	15264	516	15780	件			按支計	絲桿支數 總訂數: 17500 EI4321 和EI 4373 已訂1720 支 現加訂15780 支
2				M16絲杆(GR8.8)	(GR8.8)	15264	516	15780	支			按支計	
3				M16鐵絲母(GR 8.8)	(GR8.8)	76320	2580	78900	件			每支絲桿5粒	
4				M16鐵平介	熱浸鋅	15264	516	15780	件			按支計	
5				M16鐵彈介	熱浸鋅	15264	516	15780	件			按支計	
6		CA04	趙門款	200x150x16mm鐵板 S275 J0	熱浸鋅	10320	223	10543	件			每套1件	CA 04 總訂數: 11260 EI4306 已訂717 件 現加訂10543 件
7	要驗焊			60x60x8mm方鐵介子S275 J0	熱浸鋅	41280	892	42172	件			每套4件	
8		4件		直徑16圓鐵 S275 J0	熱浸鋅	41280	892	42172	支			每套4支	
9		CA06	起腳款	350x200x16mm鐵板 S275 J0	熱浸鋅	356	19	375	件			每套1件	CA 06 總訂數: 520 EI4306 已訂145 件 現加訂375 件
10	要驗焊			60x60x8mm方鐵介子 S275 J0	熱浸鋅	712	38	750	件			每套2件	
11		2件		直徑16圓鐵 S275 J0	熱浸鋅	712	38	750	支			每套2支	
							總計	238782			0.0		

此單數量已減去已出單數量


此EI 絲桿總支數 **17500 = 15780 + 1720**

04 凳仔碼總數 **11260 = 10543+717**

06 凳仔碼總數 **520 = 375 +145**


樓，預留孔按此加固

美特鋁質有限公司 MIDI Aluminium Fabricator Ltd.	類別		物料號	
	制圖 LS	2022-03-16	圖號	J858-CW-ED01
修改	復核		副數	- pcs
日期	批准		位置	-

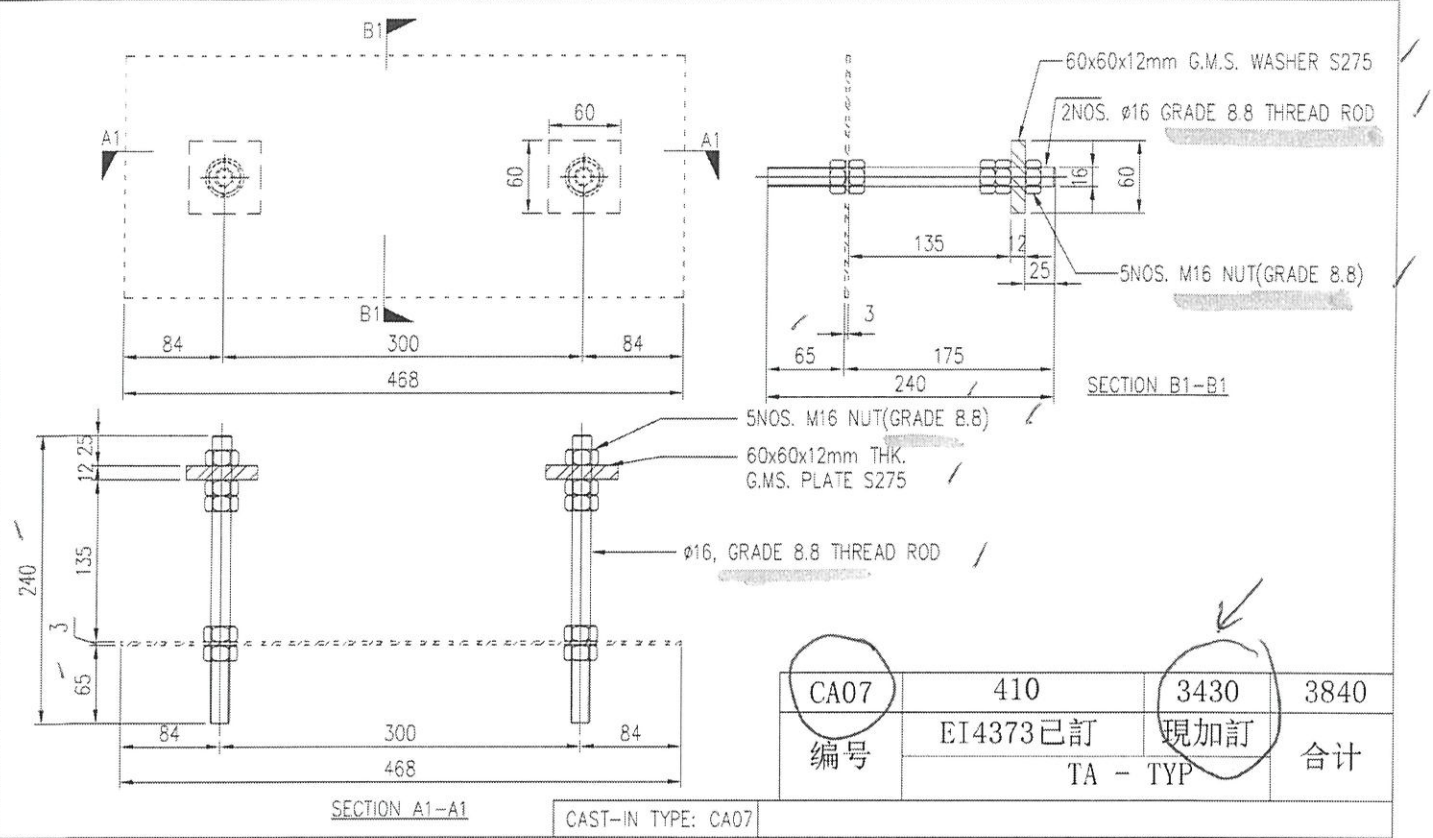

CA07	410	3430	3840
编号	EI4373已訂	現加訂	合计
	TA - TYP		

CAST-IN TYPE: CA07

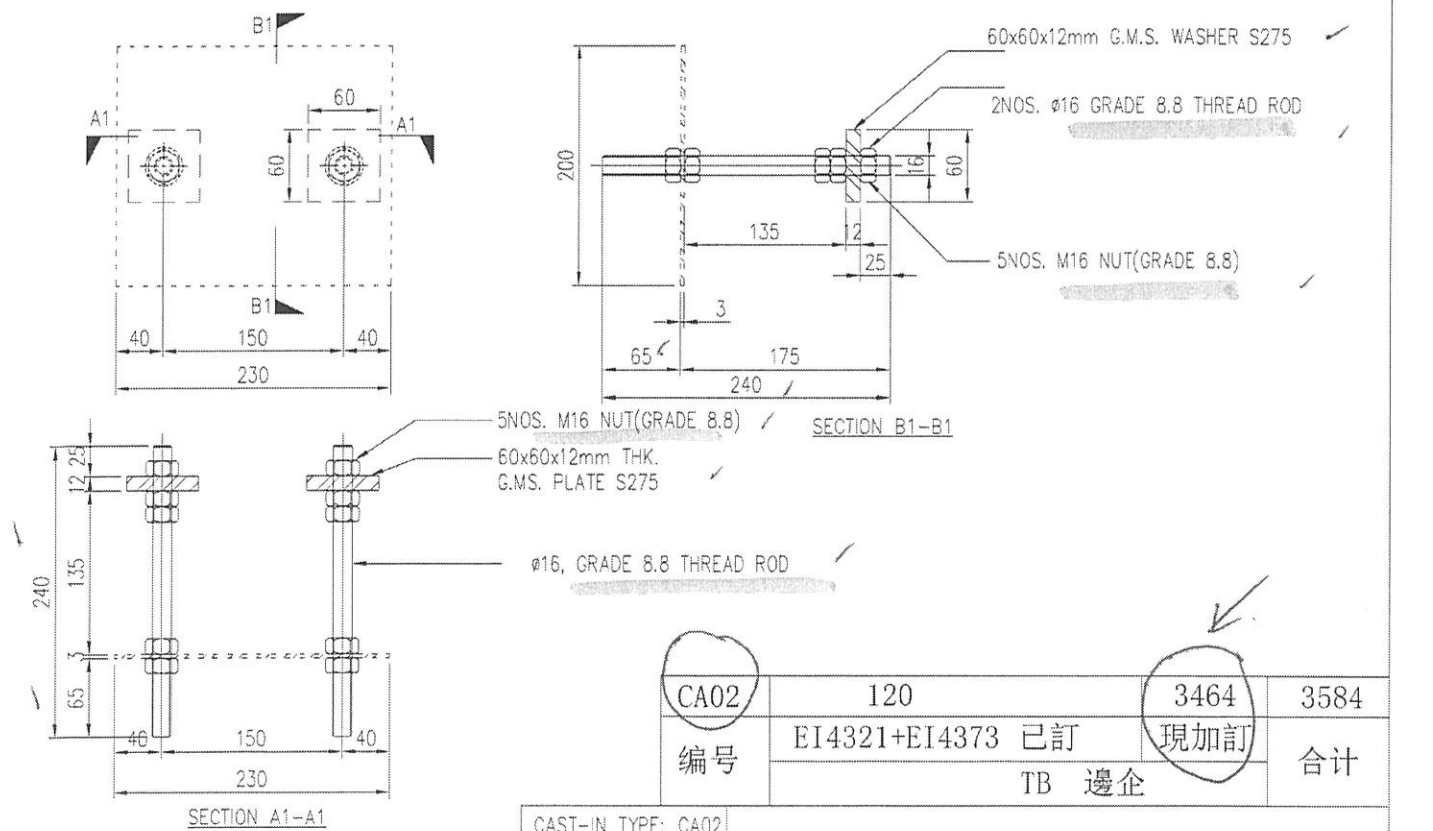


CA02	120	3464	3584
编号	EI4321+EI4373 已訂	現加訂	合计
	TB 邊企		

CAST-IN TYPE: CA02

工程號	J-858	地盤	康城11期	附件		
名稱	EMBED 加工图	採用				
材料	AS SHOWN	地盤	✓			
顏色	MILL ONLY	工廠				


T:\Job\J-858\6 Project Stru.預留埋件資料\1.加工圖\20220404 J858-CW埋留螺加工图-20220318.dwg

美特鋁質有限公司 MIDI Aluminium Fabricator Ltd.	類別		物料號	
	制圖 LS	2022-03-16	圖號	J858-CW-ED02
修改	復核		副數	– pcs
日期	批准		位置	–

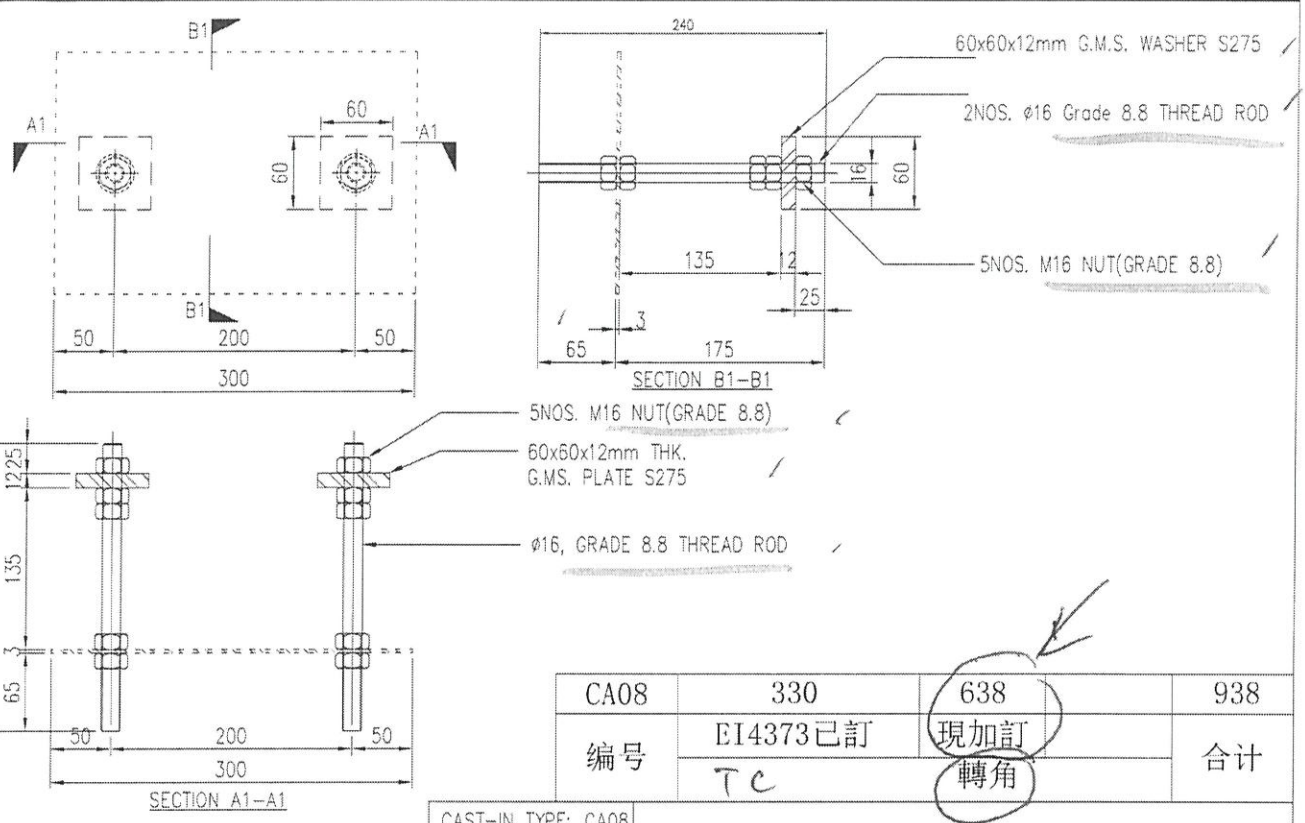

CA08	330	638	938
编号	EI4373已訂 TC	現加訂 轉角	合计

CAST-IN TYPE: CA08

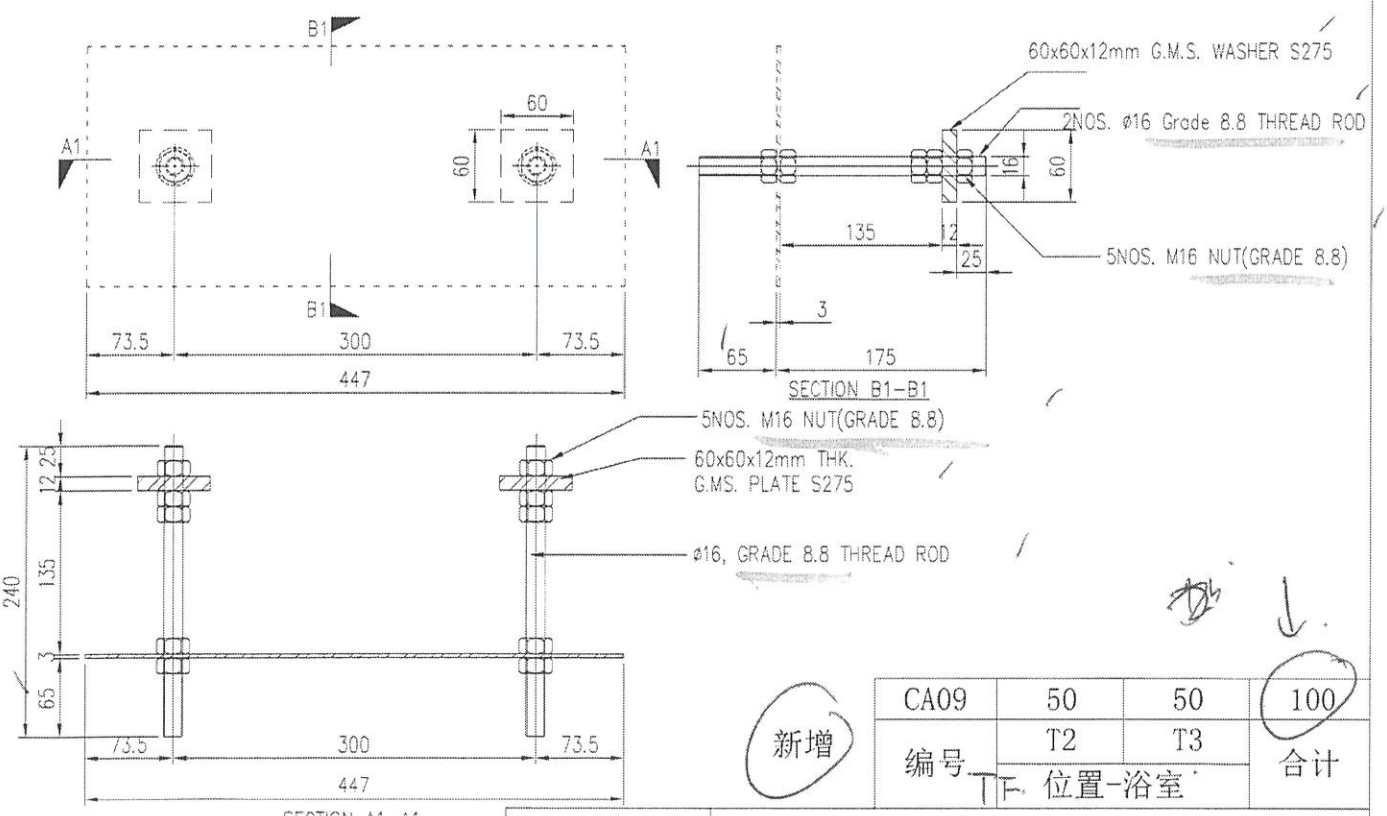

新增

CA09	50	50	100
编号	T2	T3	合计

下. 位置-浴室


CAST-IN TYPE: CA09

工程號	J-858	地盤	康城11期		
名稱	EMBED 加工图			採用	
材料	AS SHOWN			地盤	✓
顏色	H.D. GALV.			工廠	

附件

T:\康城\J-858\6 Project Staff\預留螺丝资料(公司)\工图\20220404 J858-CW預留螺加工图-20220318.dwg


美特鋁質有限公司 MIDI Aluminium Fabricator Ltd.	類別		物料號	
	制圖 LS	2022-03-16	圖號	J858-CW-ED03
修改	復核		副數	- pcs
日期	批准		位置	—

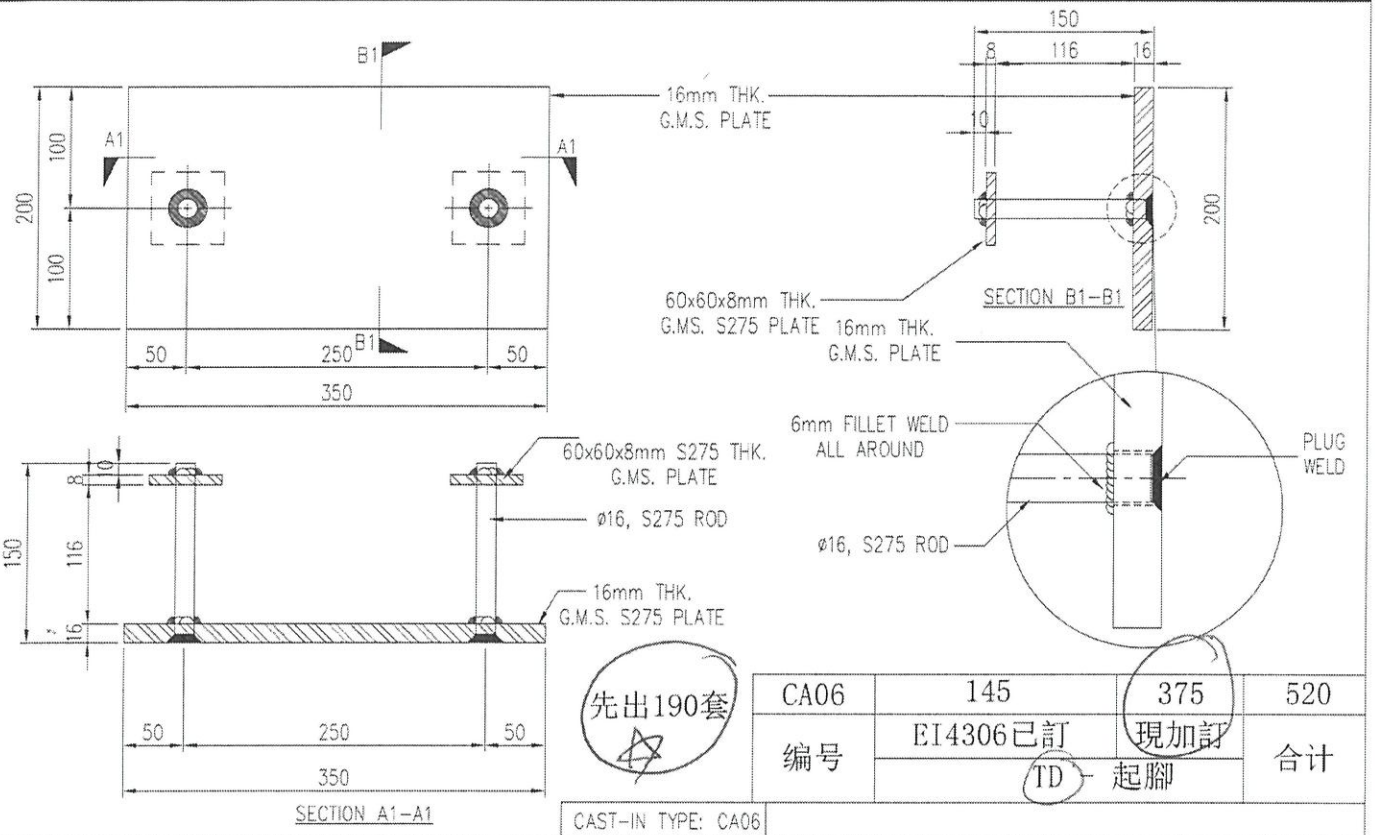

先出190套

CA06	145	375	520
编号	EI4306已訂	現加訂	合计
	TD - 起腳		

CAST-IN TYPE: CA06

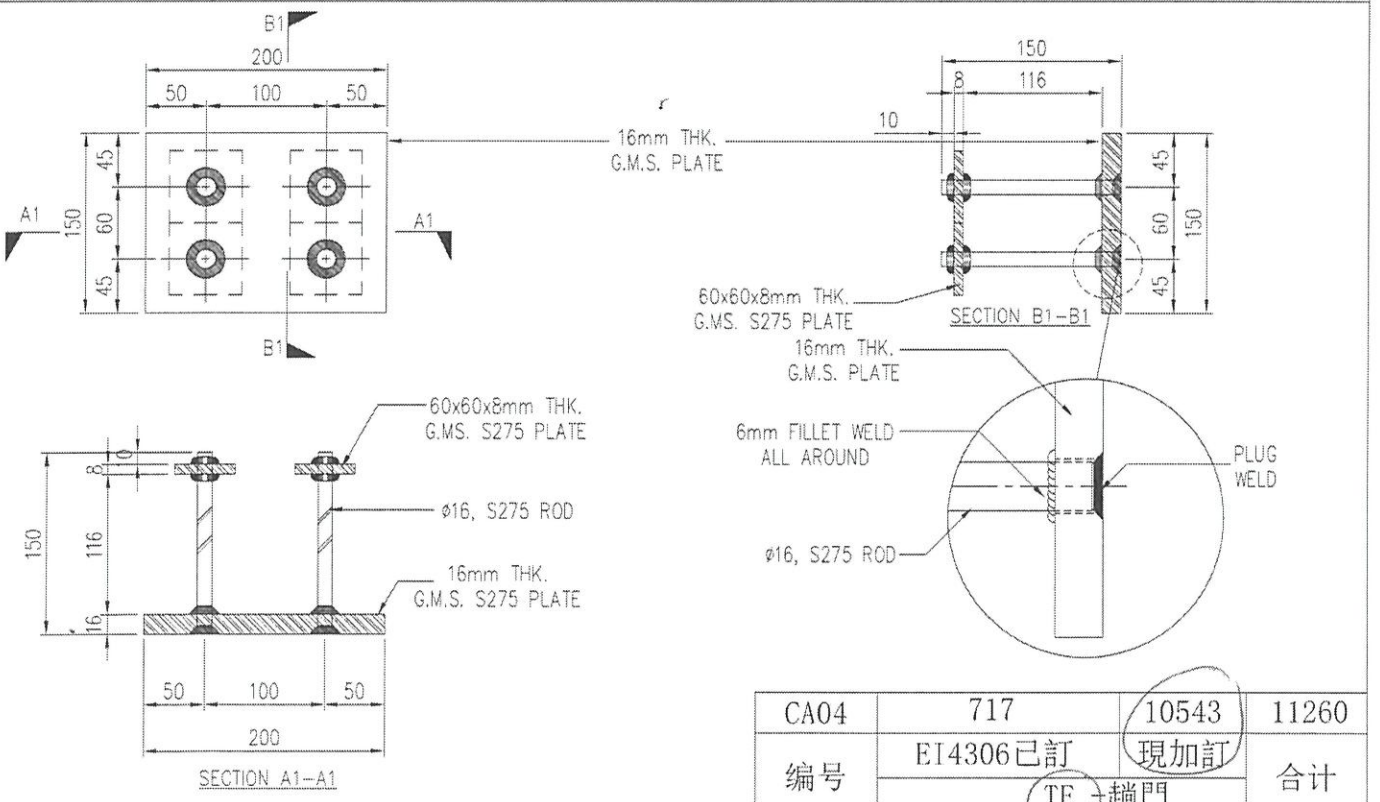

CA04	717	10543	11260
编号	EI4306已訂	現加訂	合计
	TE - 趟門		

CAST-IN TYPE: CA04

工程號	J-858	地盤	康城11期		
名稱	EMBED 加工图		採用	附件	
材料	AS SHOWN		地盤	✓	
顏色	H.D.GALV.		工廠		

I:\J858\6 Project Stuff\施工資料\加工圖\20220404 J858-CW預留螺加工图-20220318.dwg

PROJECT :

PROPOSED RESIDENTIAL DEVELOPMENT
AT TKOTL 70RP, PHASE 11,LOHAS PARK,TSEUNG KWAN O, N.T.

4A

同此計劃

2022.3.28

TITLE : CURTAIN WALL AT TOWER 1,2,& 3
SHOPDRAWING SUBMISSION


DATE: 09 -MAR- 2022

美特鋁質有限公司
MIDI ALUMINIUM FABRICATOR LTD.
Units 6-8, Sunray Industrial Centre, 1/F
610 Cha Kwo Ling Road, Kowloon
Tel:23489211-4 Fax:(852)27727666

DWG NO. : J858-CW-CP01 | REV. : C


T1 9/F


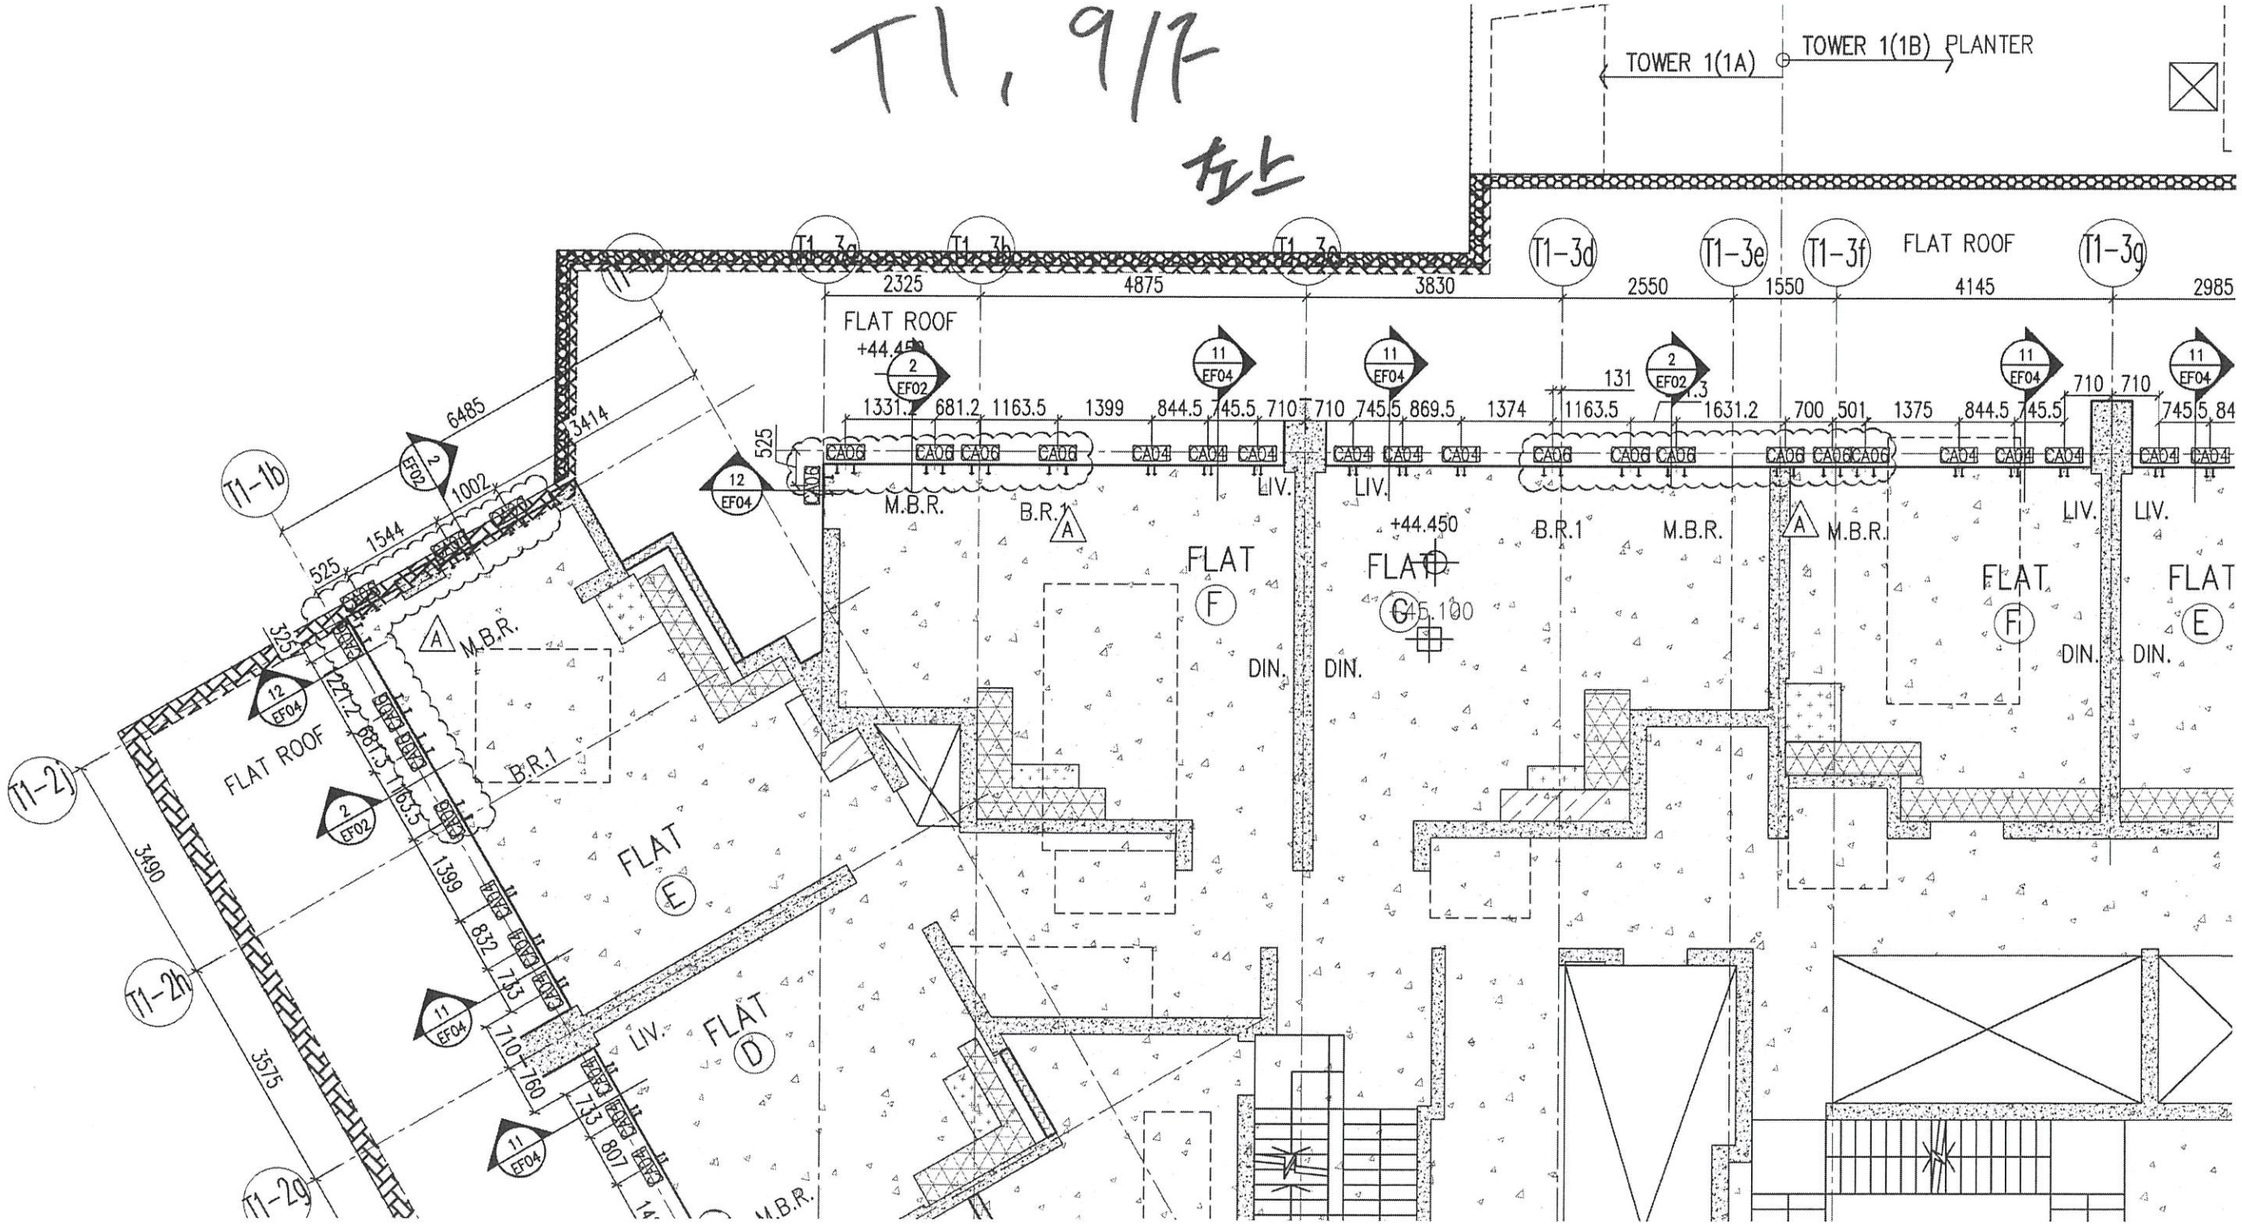
TOWER 1(1A)
TOWER 1(1B) PLANTER
FLAT ROOF
FLAT ROOF
+44.450
T1-1b
T1-2j
T1-2h
T1-2g
T1-3a
T1-3b
T1-3c
T1-3d
T1-3e
T1-3f
T1-3g
2325
4875
3830
2550
1550
4145
2985
6485
3414
1544
1002
525
3230
3490
3575
1331.2
681.2
1163.5
1399
844.5
745.5
710
869.5
1374
1631.2
700
501
1375
745.84
832
733
807
760
M.B.R.
B.R.1
LIV.
DIN.
FLAT
D
E
F
G
EF02
EF04
CA06
CA04

T1 9/F

T1, 9/F
左上

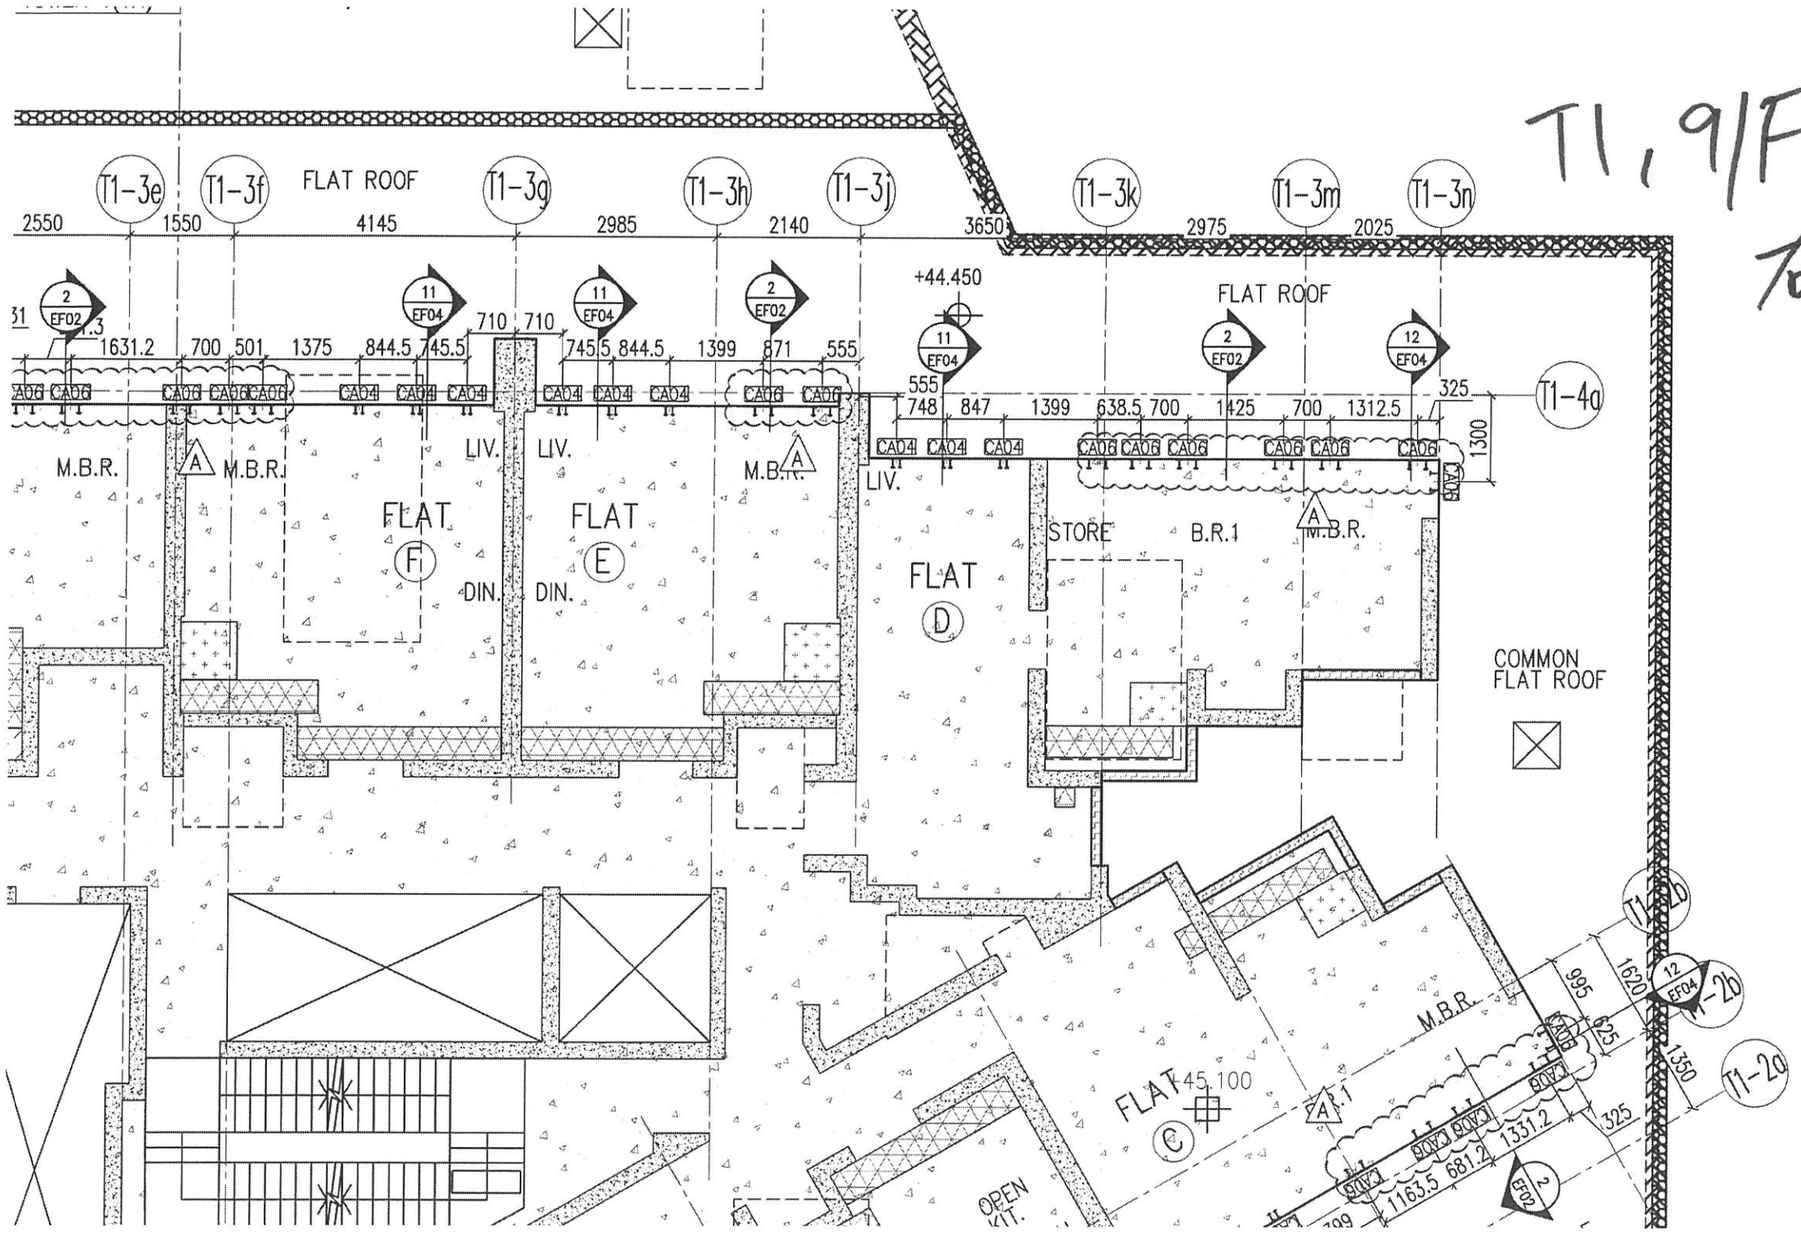

CLIENT :

信和置業有限公司
Sino Land Company Limited

ARCHITECT :

ronald lu & partners
Architects . Planners . Interior Designers
Ronald Lu & Partners (HK) Ltd.
呂元祥建築師事務所（香港）有限公司

MAIN CONTRACTOR :

Gammon


STRUCTURAL ENGINEER :

AECOM

FACADE CONSULTANT:

AECOM

NOTE :

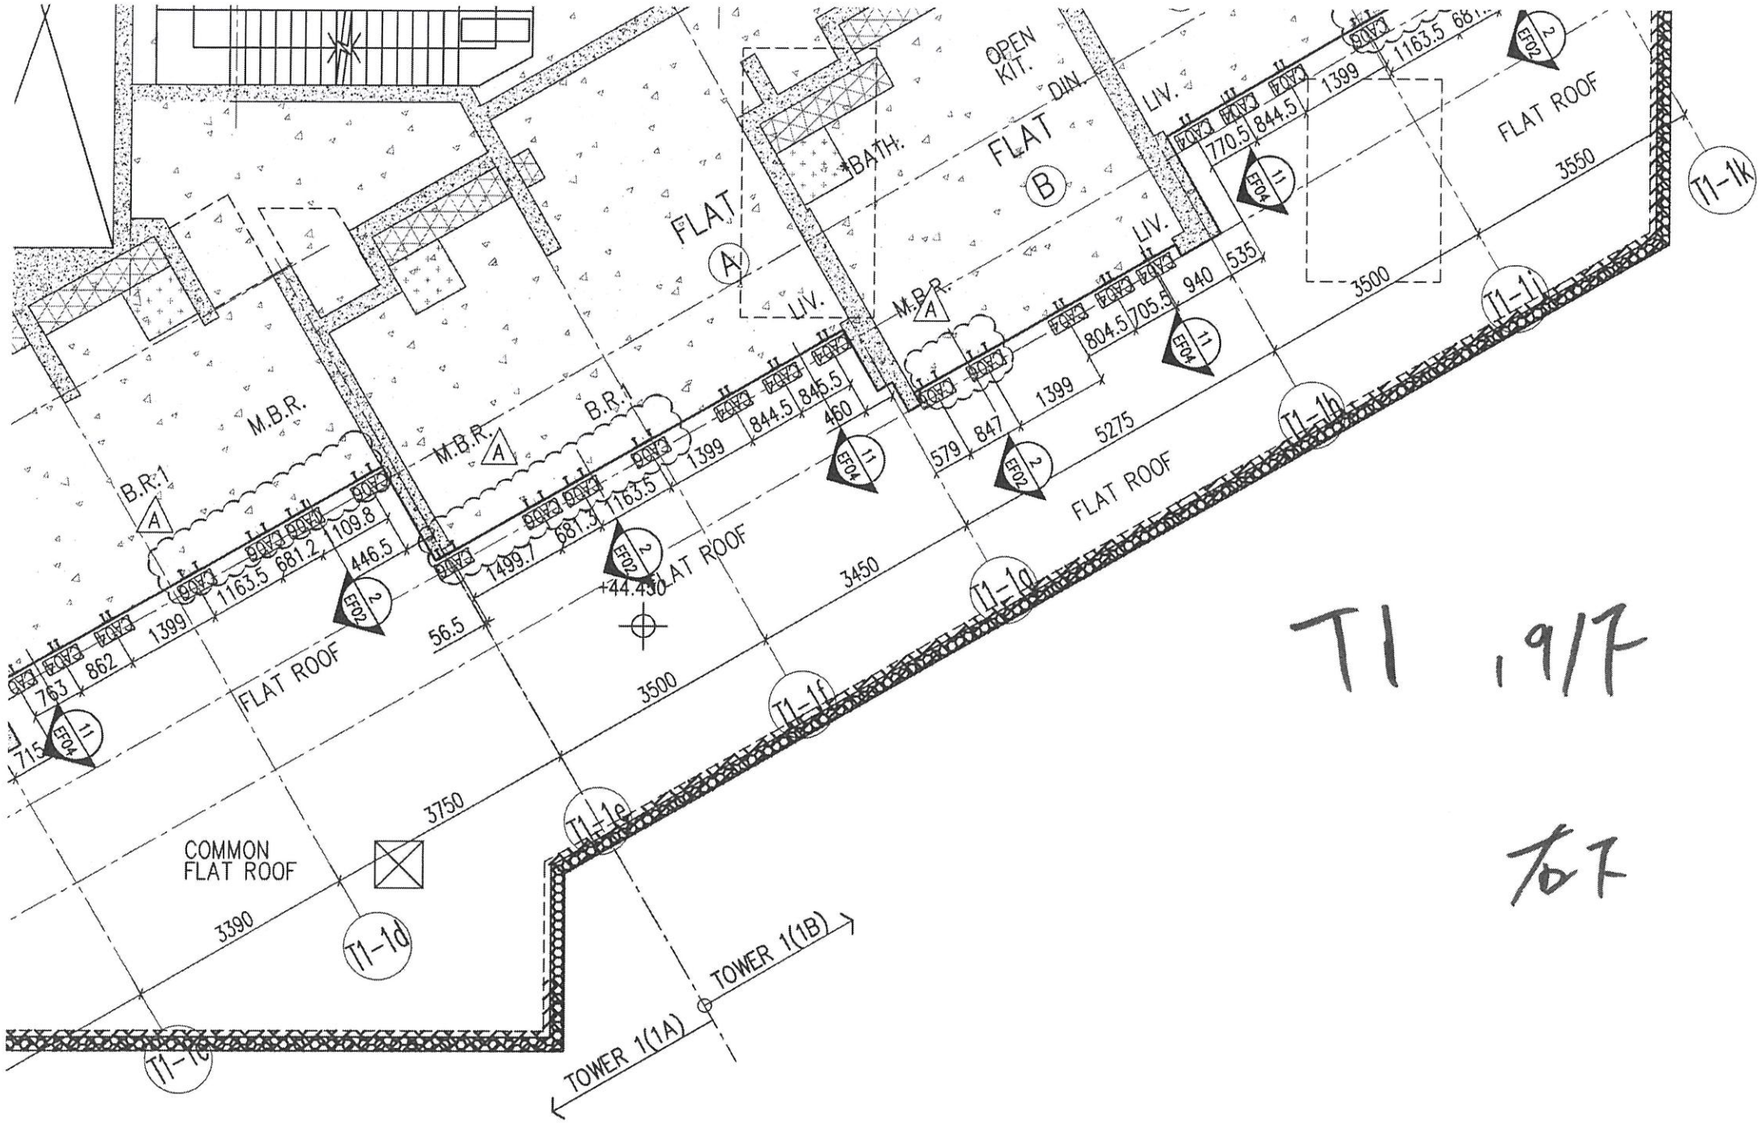

T1 1 9/F EMBED LAYOUT PLAN FOR TOWER 1(1A,1B)

T1 1,9/F

to 7

NOTE :

1. ALL DIMENSIONS ARE IN mm.
2. ALL ELEVATIONS ARE VIEWED FROM OUTSIDE.
3. ALL DIMENSIONS TO BE VERIFIED ON SITE BEFORE FABRICATION.

LEGEND :

X1 — DETAIL MARK NO.
X001 — REFER SHEET NO.

1. F.F.L. -- FINISHED FLOOR LEVEL
2. S.F.L. -- STRUCTURAL FLOOR LEVEL
3. (/R) -- REVERSED DETAIL


NO.	DATE	REVISED	BY
A	16/02/22	REVISED AS PER COMMENTS	LS

JOB NO. : J-858


PROJECT :
PROPOSED RESIDENTIAL DEVELOPMENT
AT TKOTL 70RP, PHASE 11, LOHAS PARK
TSEUNG KWAN O, N.T.

TITLE :
TYPICAL FLOOR EMBED LAYOUT PLAN

T1, 9/F

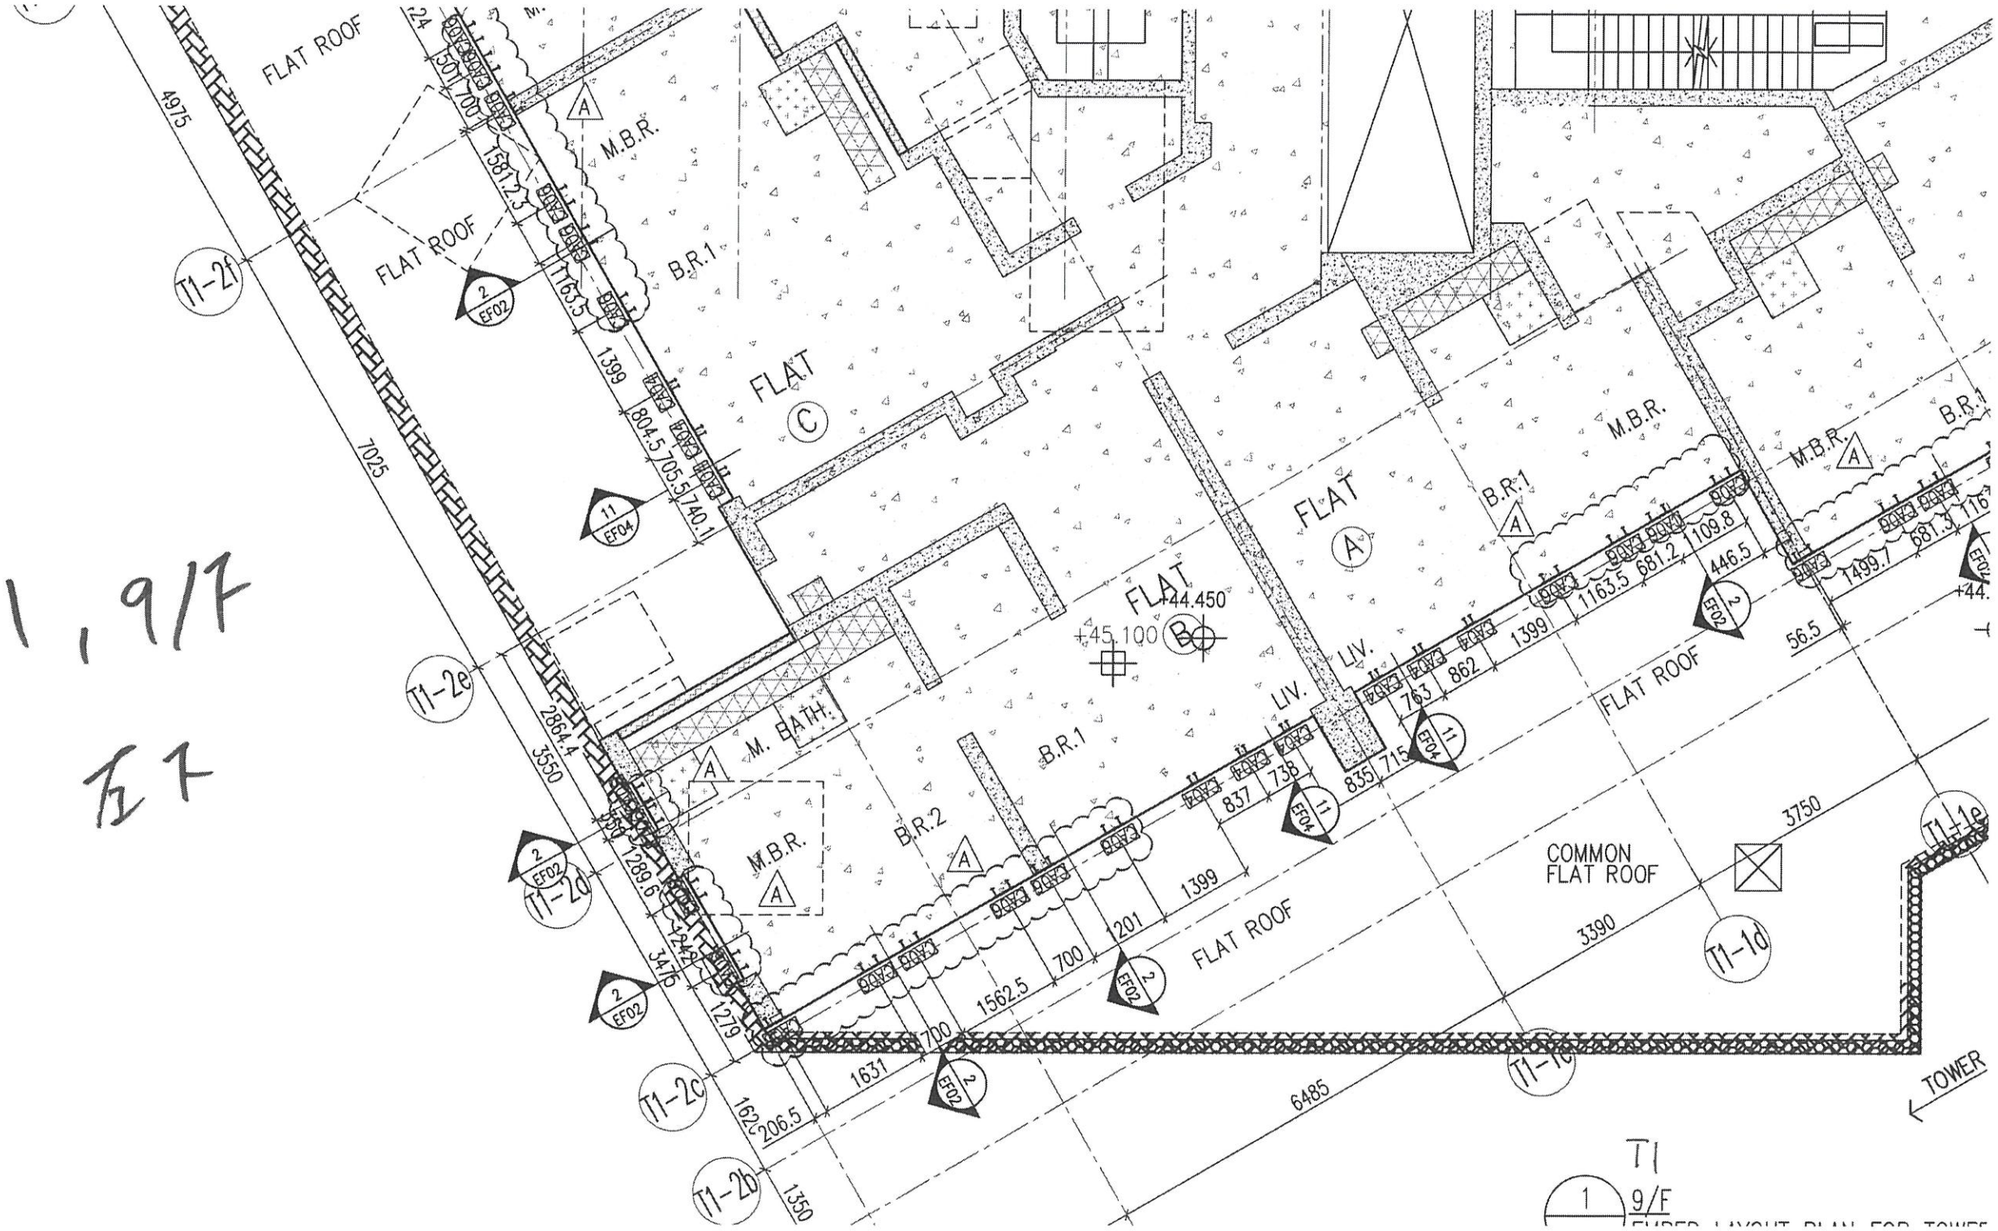

FLAT ROOF
FLAT ROOF
FLAT ROOF
FLAT ROOF
COMMON FLAT ROOF
M.B.R.
B.R.1
B.R.2
M. BATH.
LIV.
FLAT
A
B
C
+44.450
+45.100
T1-2e
T1-2d
T1-2c
T1-2b
T1-2a
T1-1e
T1-1d
T1-1c
4975
7025
2864.4
3550
3476
1350
6485
3750
3390
1399
1581.2.3
1163.5
804.5
705.5
740.1
681.2
109.8
446.5
1499.7
681.3
862
763
715
835
837
735
1562.5
700
1201
1631
206.5
1279
1289.5
56.5
TOWER
T1
1 9/F

T1 19/F, 15/F~39/F, 42/F~61/F
(13/F, 14/F, 24/F, 34/F, 44/F, 54/F Floors omitted)

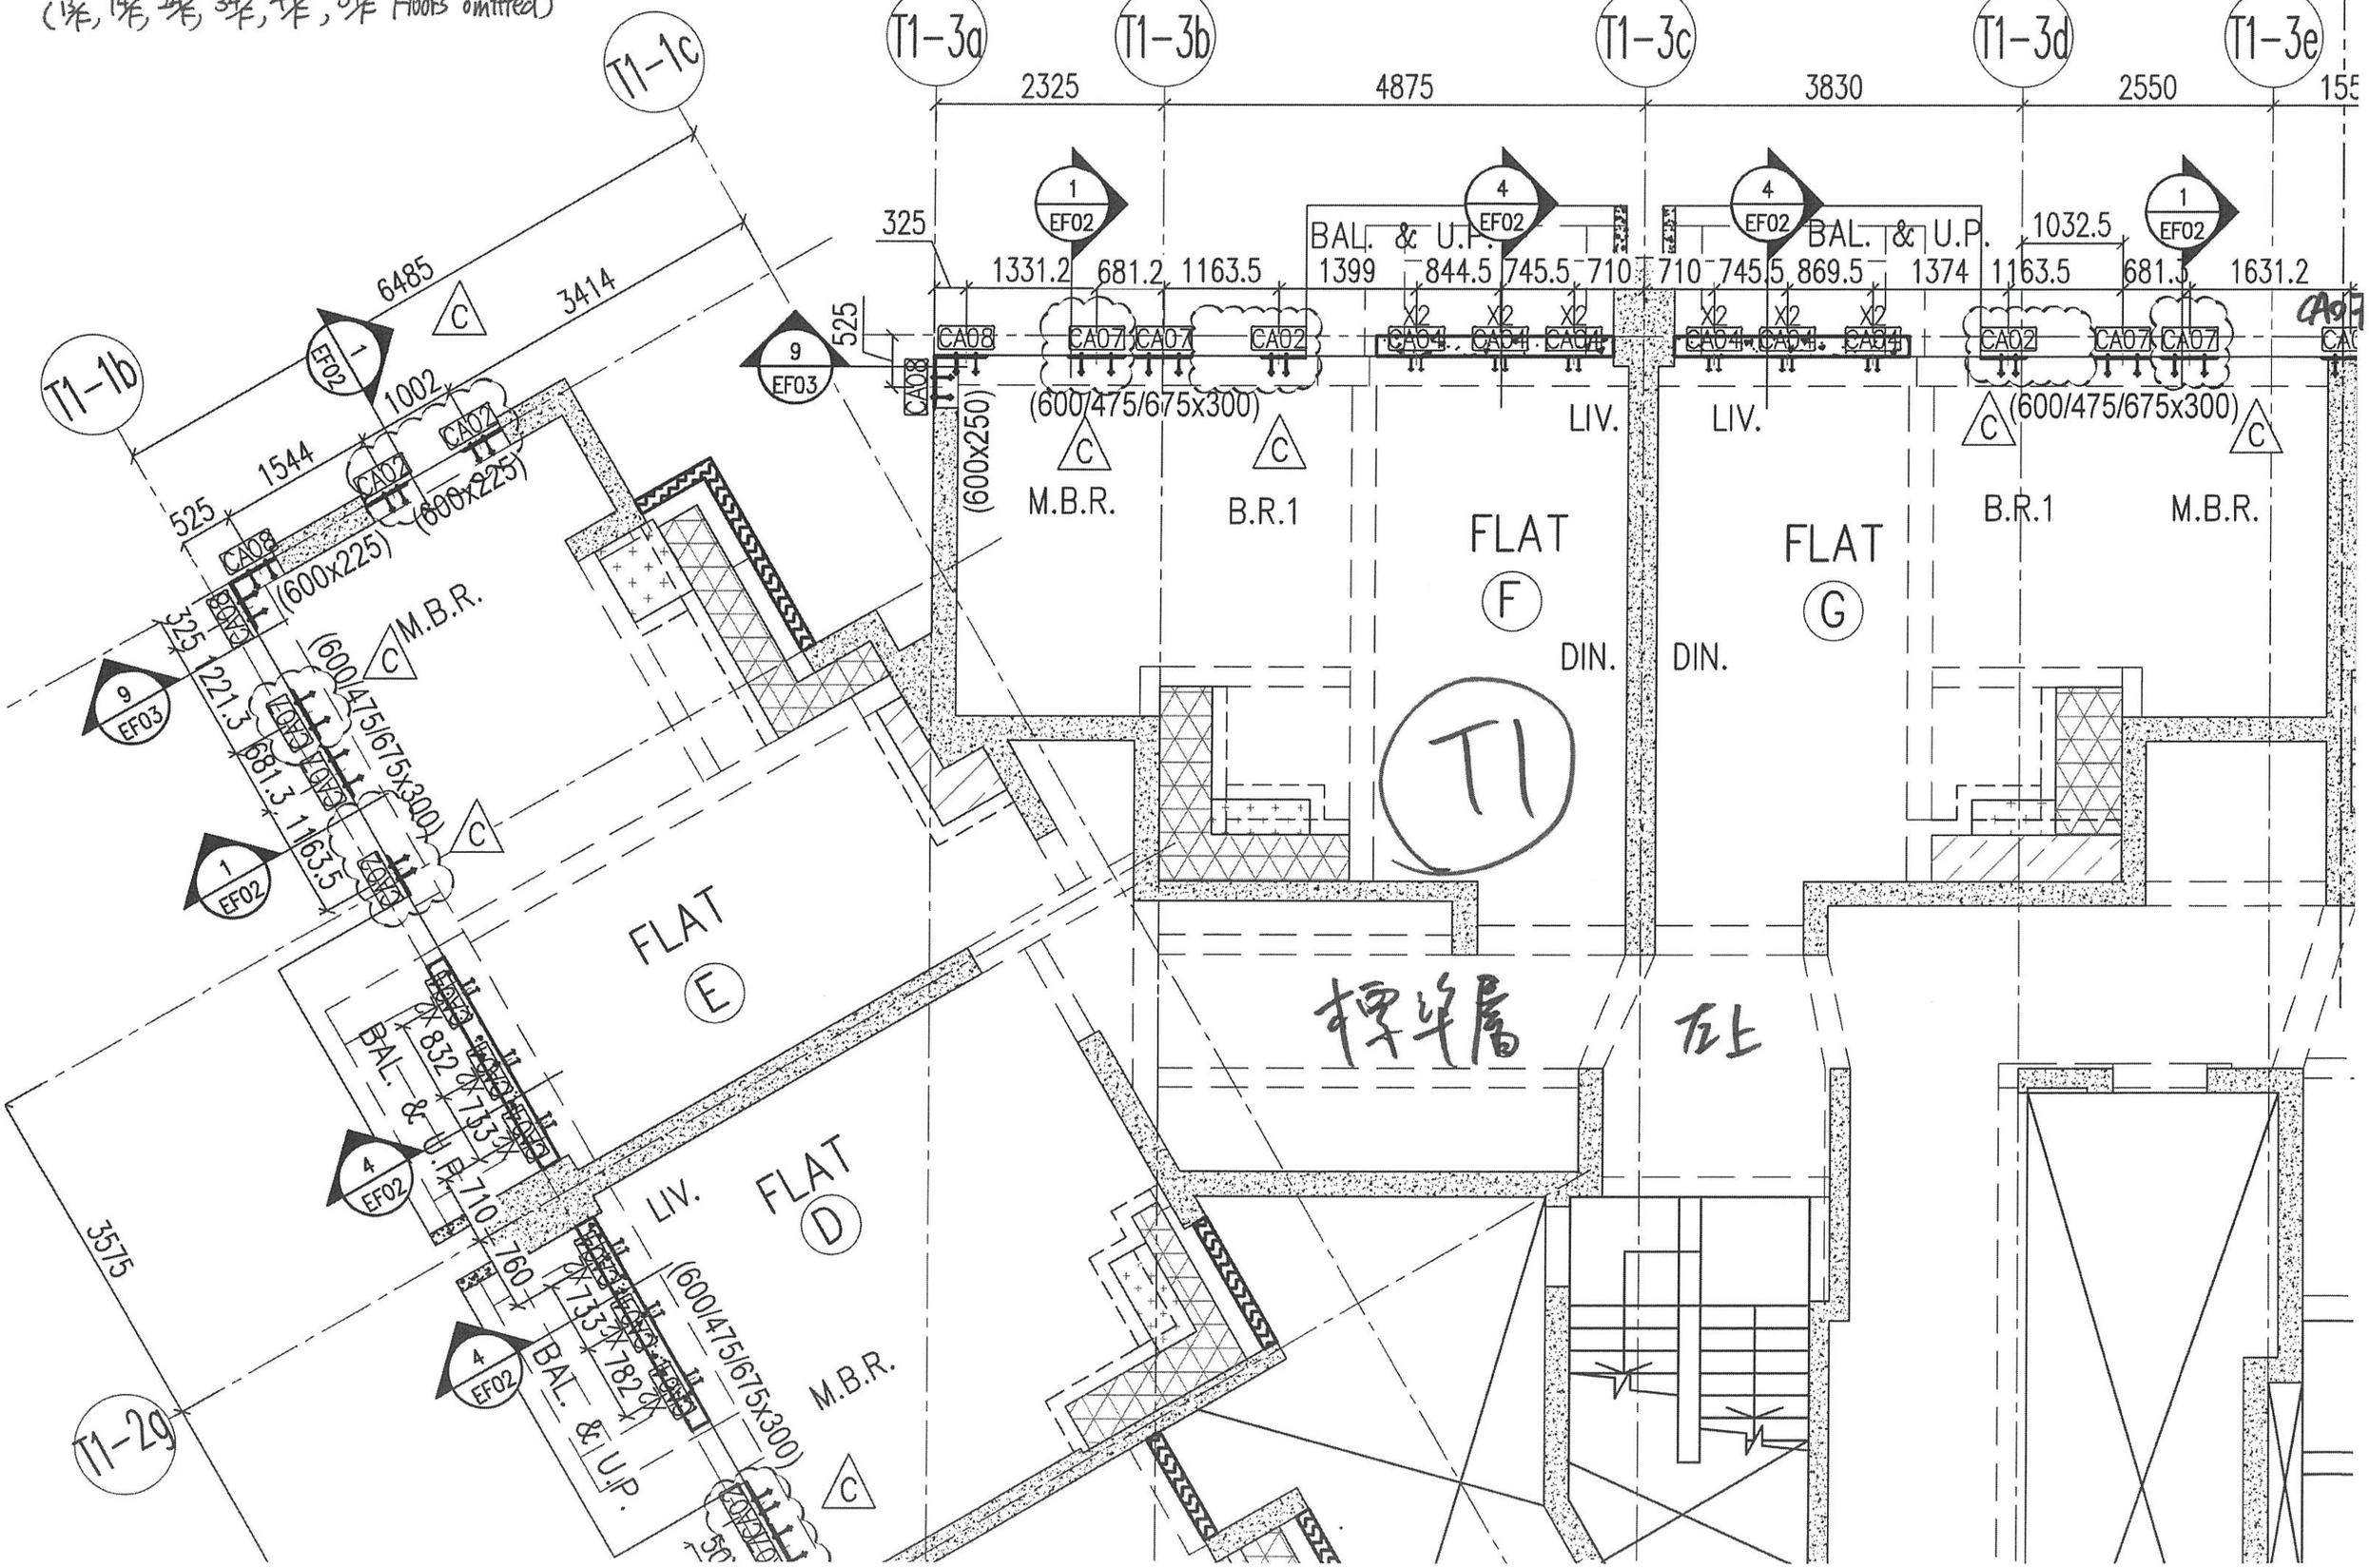

押平層 五上

1/F	+196.80
0/F	+193.50
9/F	+190.20
8/F	+186.90
7/F	+183.60
6/F	+180.30
5/F	+177.00
3/F	+173.70
2/F	+170.40
1/F	+167.10
0/F	+163.80
9/F	+160.50
8/F	+157.20
7/F	+153.90
6/F	+150.60
5/F	+147.30
3/F	+144.00
2/F	+140.70
9/F	+130.85
8/F	+127.55
7/F	+124.25
6/F	+120.95
5/F	+117.65
3/F	+114.35
2/F	+111.05
1/F	+107.75
0/F	+104.45
9/F	+101.15
8/F	+97.85
7/F	+94.55
6/F	+91.25
5/F	+87.95
3/F	+84.65
2/F	+81.35
1/F	+78.05
0/F	+74.75
9/F	+71.45

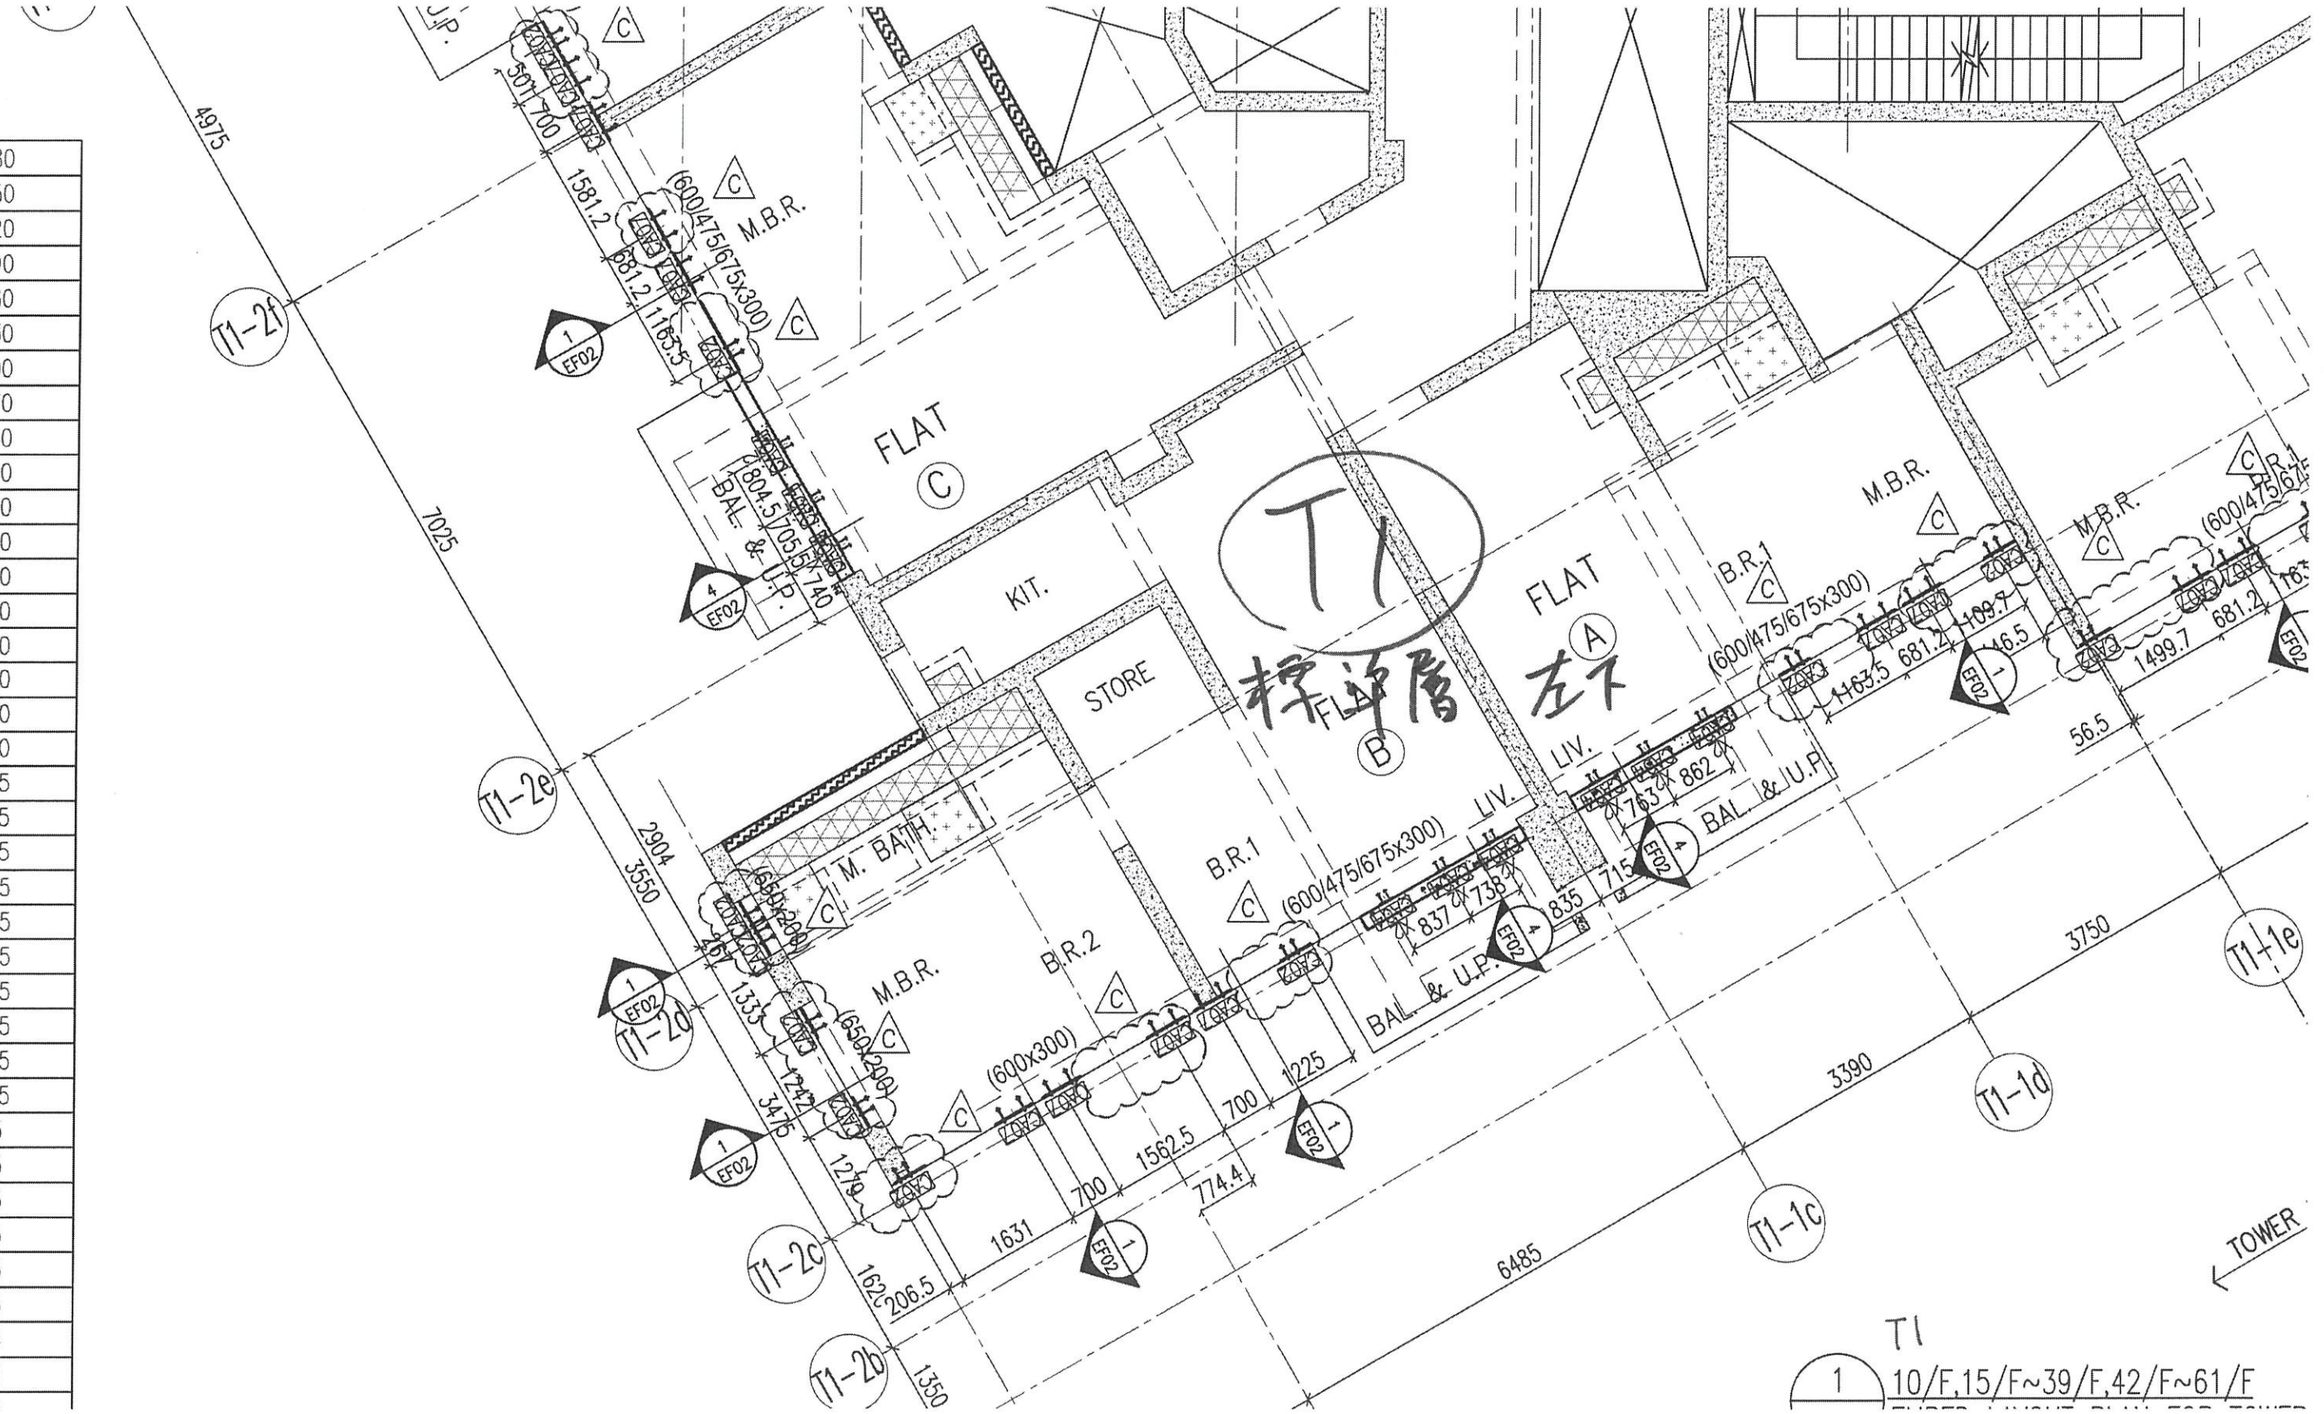

(13/F, 14/F, 24/F, 34/F, 44/F, 54/F Floors omitted)

T1-3f T1-3g T1-3h T1-3j T1-3k T1-3m T1-3n T1-4a

50 4145 2985 2140 3650 2975 2025

BAL. & U.P. BAL. & U.P. BAL. & U.P. BAL. & U.P.

700 501 1399 844.5 745.5 710 710 745.5 844.5 871 579 555 748 847 101 638.5 700 1425 700 1312.5 325

(600/475/675x300) (600/475/675x300) LIV. (600x200) (475/600x300) (600x250)

1300

M.B.R. FLAT F DIN. LIV. FLAT E DIN. M.B.R. FLAT D B.R.1 M.B.R.

T1

標準層


T1-2b T1-2b T1-2a

1620 625 1350 325

M.B.R. (600x250) (600/475/675x300) B.R.1 FLAT C 7331.2 681.2 1363.5


CLIENT : 信和 Sino

ARCHITECT : ron & pa Architects . Planners Ronald Lu 呂元祥建築師

MAIN CONTRACTOR

STRUCTURAL ENGINE

FACADE CONSULTAN

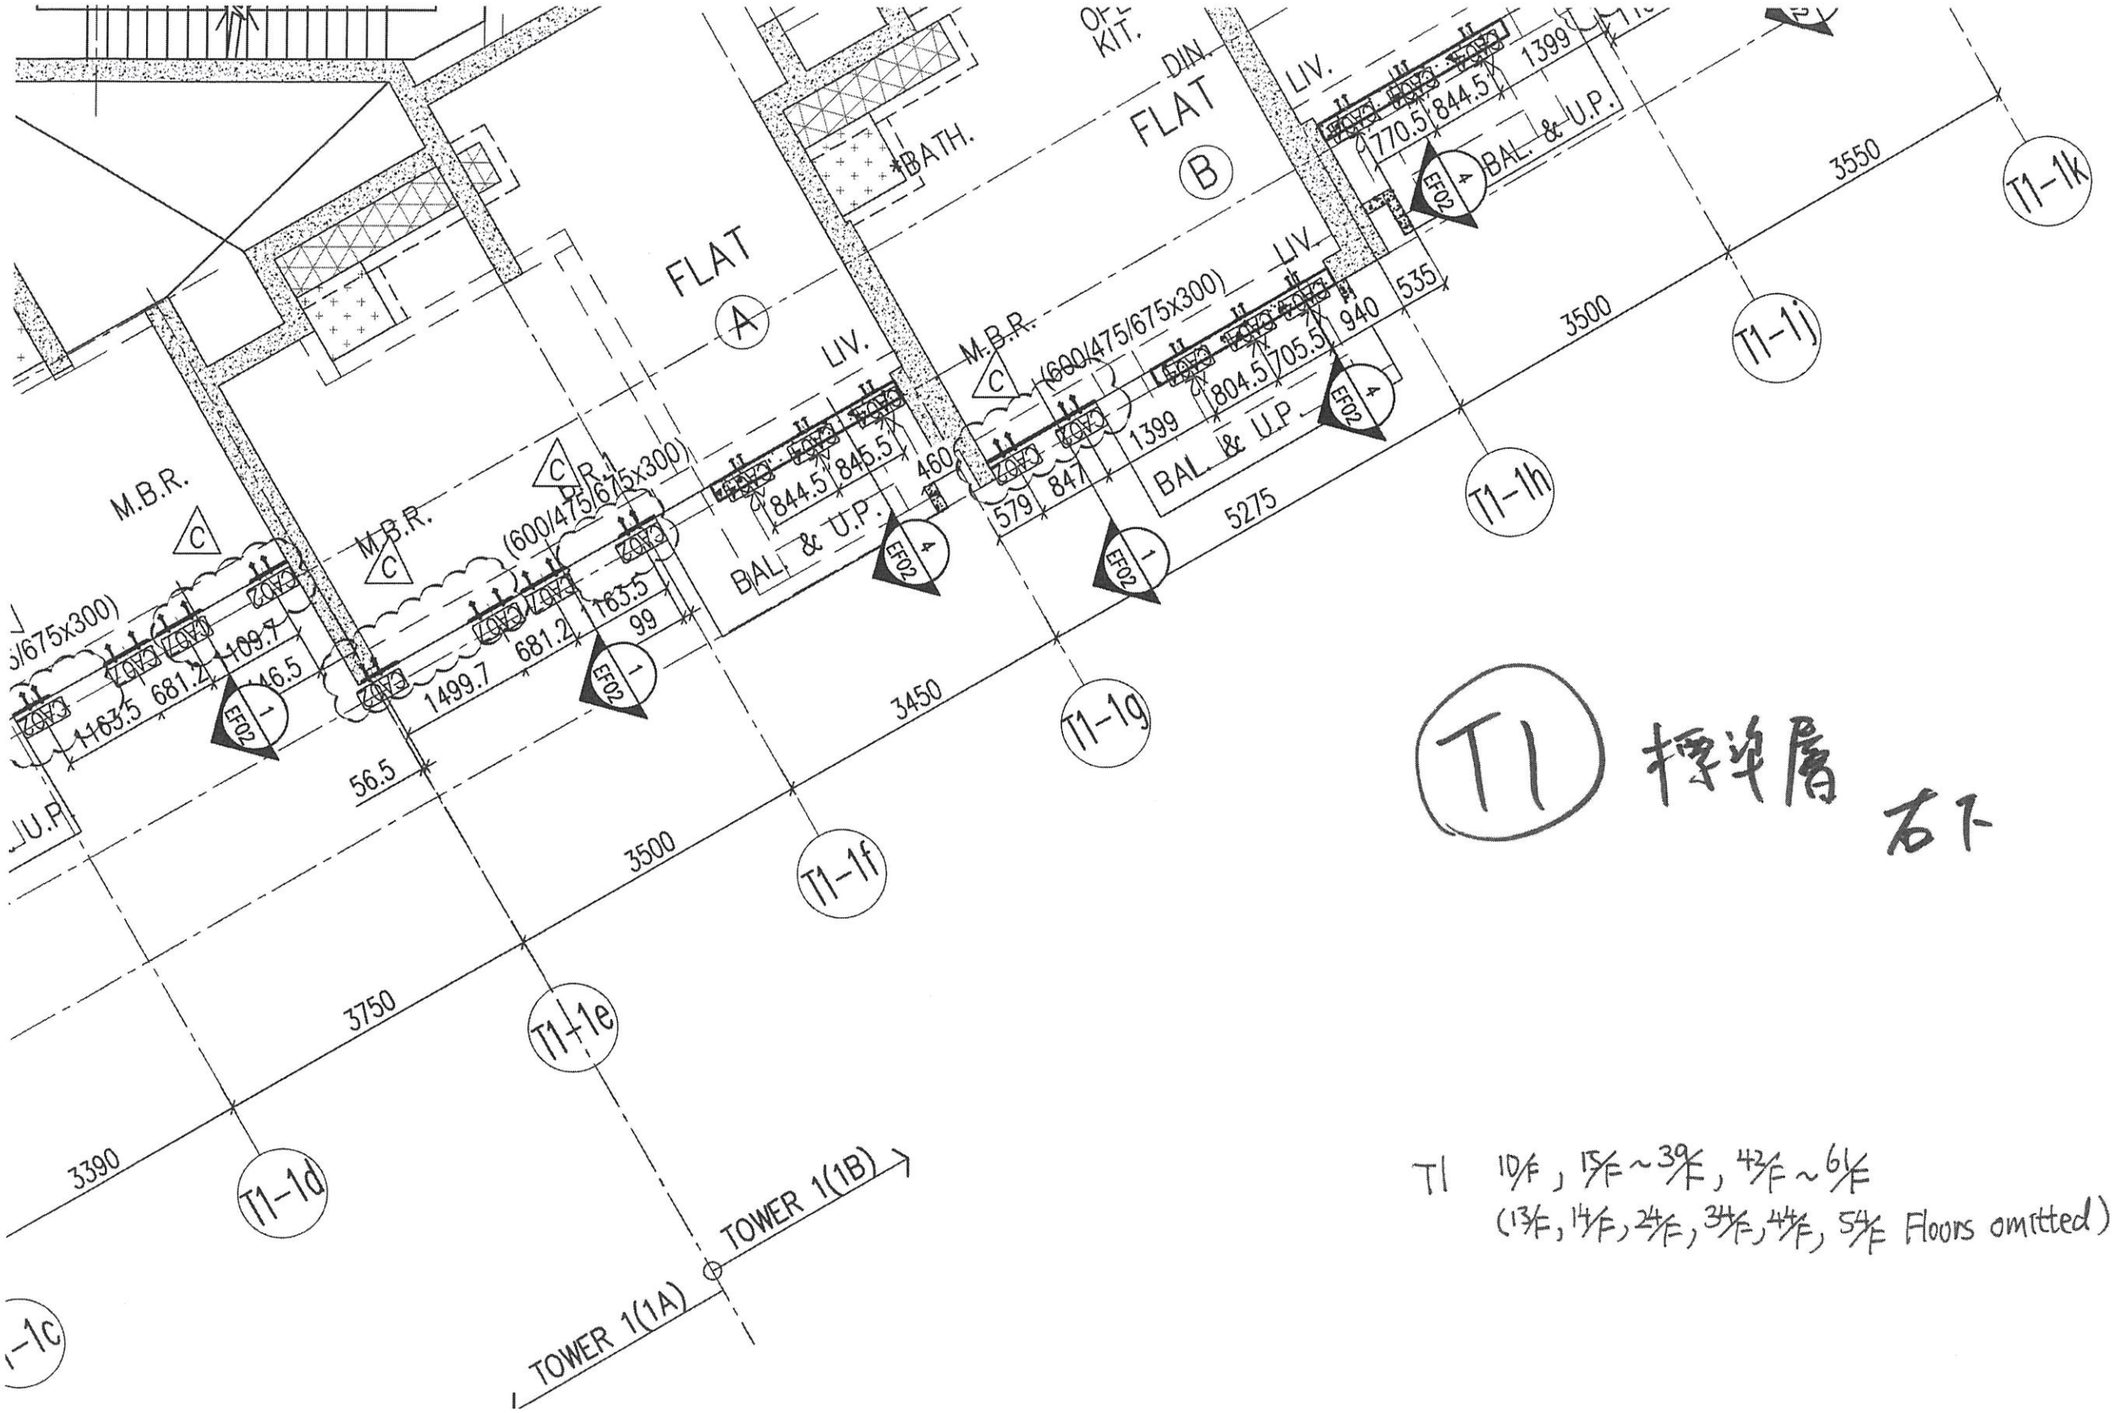

T1 標準層 右下

T1 10/F, 15/F ~ 39/F, 43/F ~ 61/F
(13/F, 14/F, 24/F, 34/F, 44/F, 54/F Floors omitted)

NOTE :

1. ALL DIMENSIONS
2. ALL ELEVATIONS
3. ALL DIMENSIONS BEFORE FABRIC

LEGEND :

X1 / X001 — DETAIL / REFER


1. F.F.L. -- FINISH
2. S.F.L. -- STRUC
3. (/R) -- REVER

NO.	DATE	
C	16/02/22	REV
B	20/12/21	REV
A	03/12/21	REV

JOB NO. :

PROJECT :
PROPOSED
AT TKOTL 7C
TSI

T1 12/F & 41/F

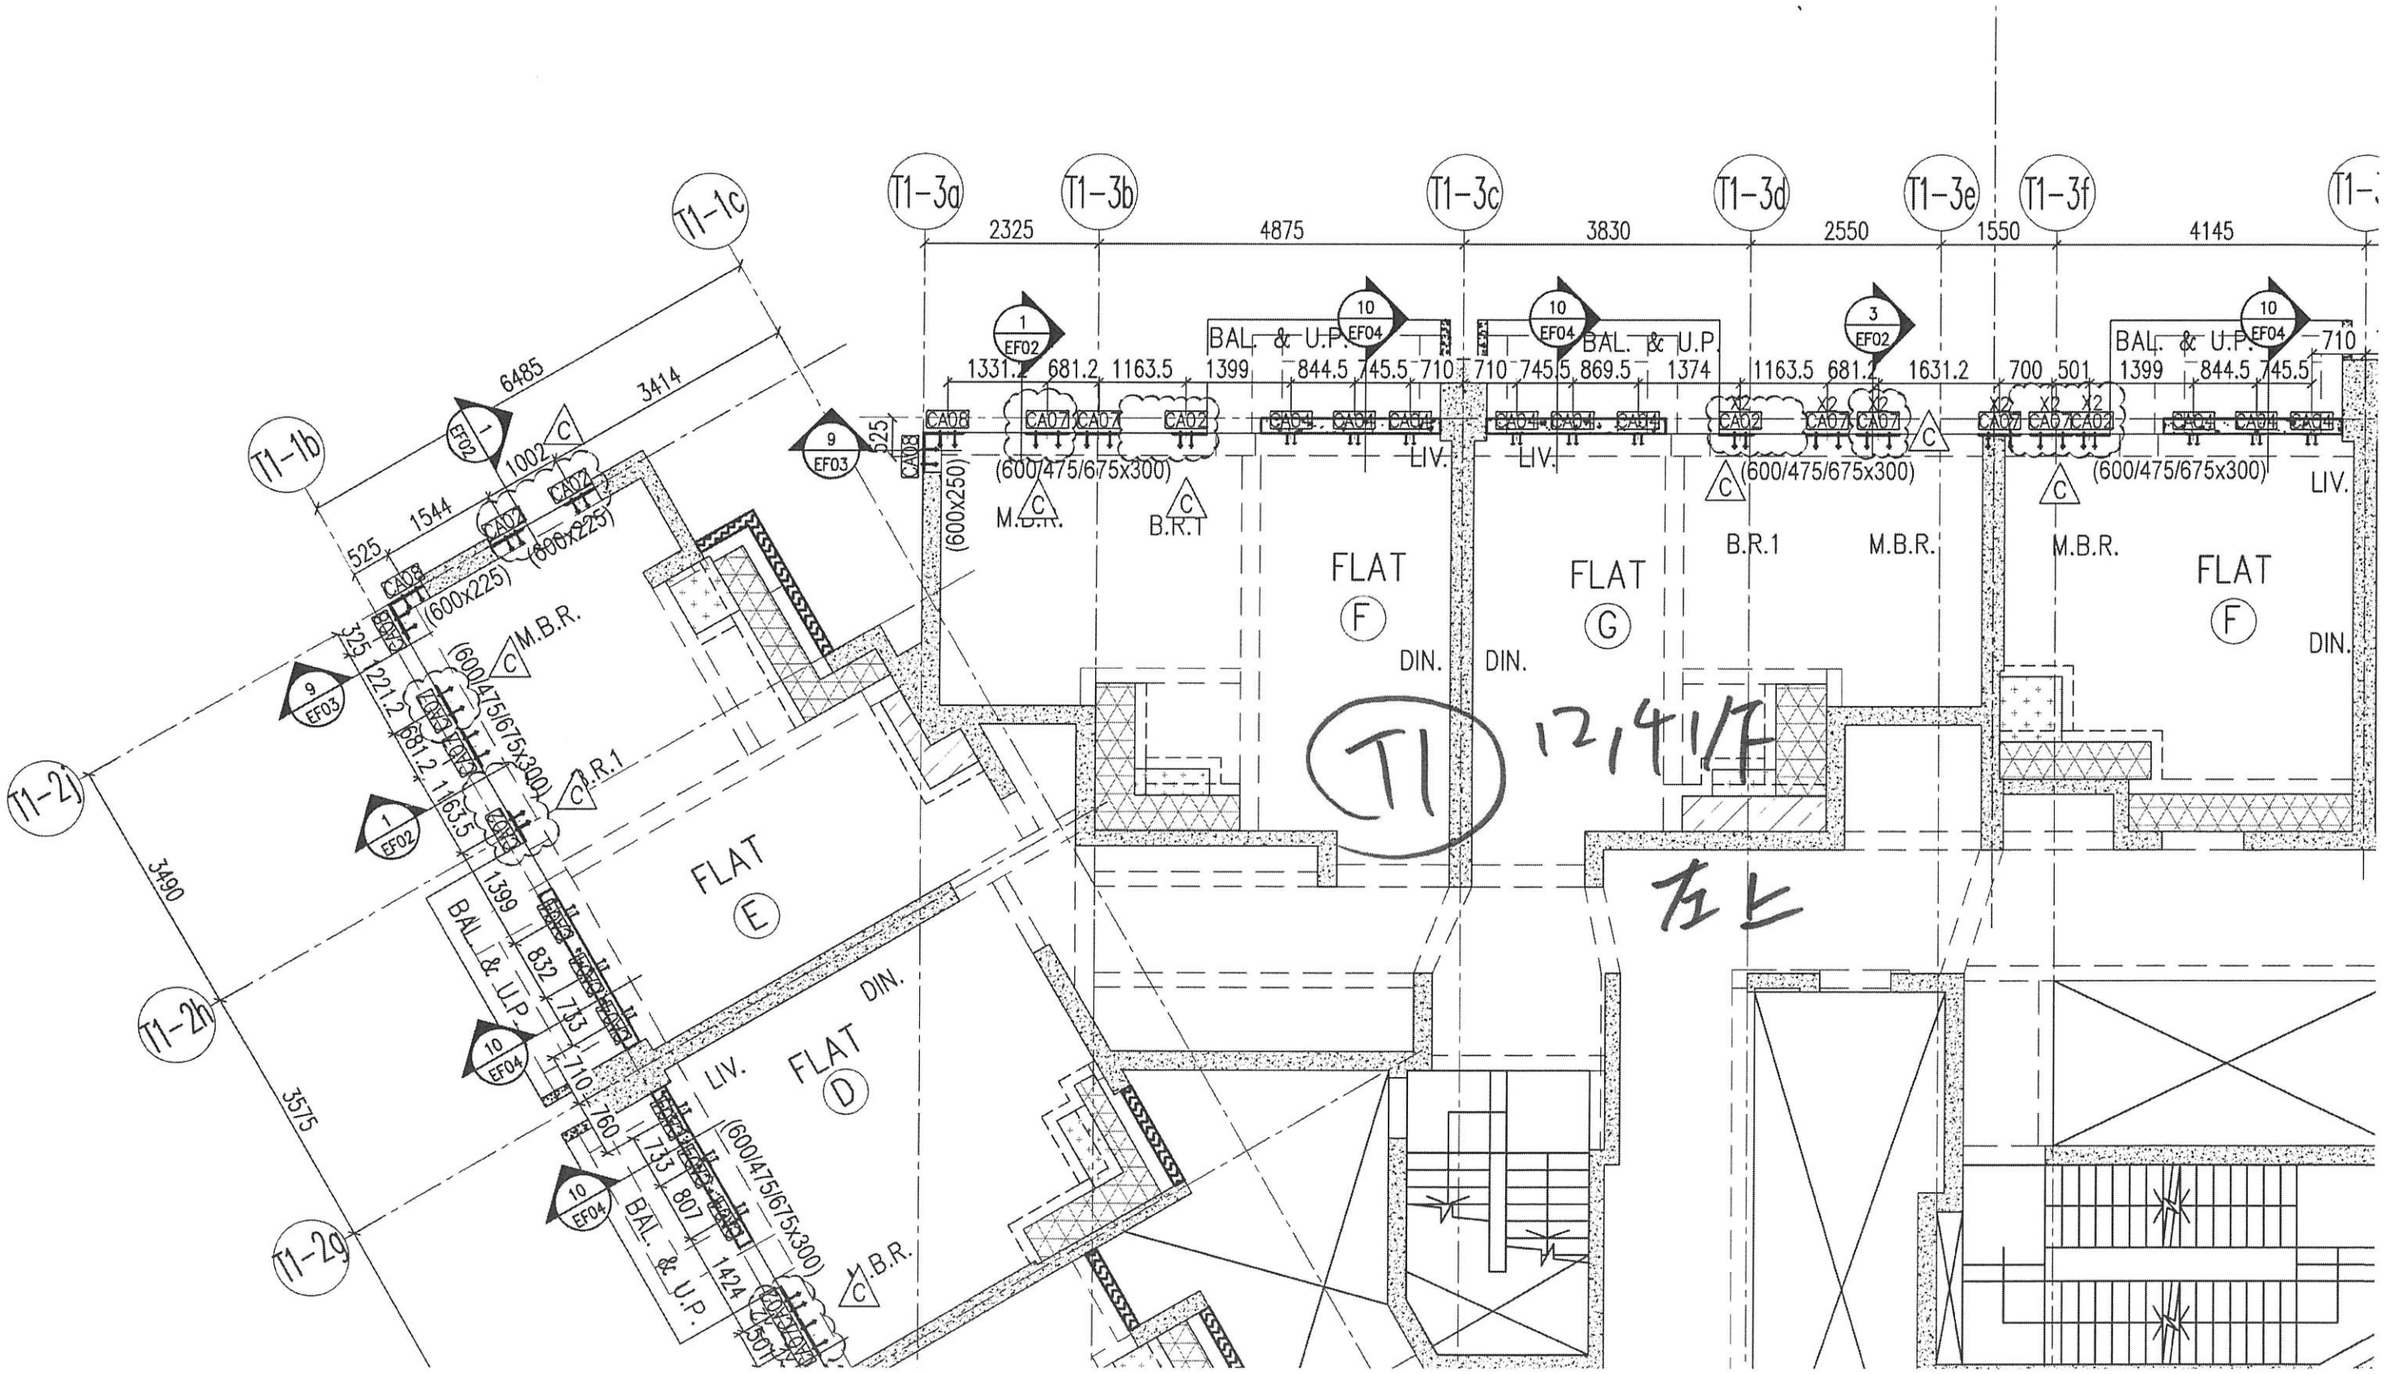

T1 12/4/F

左上


T1-3d T1-3e T1-3f T1-3g T1-3h T1-3j T1-3k T1-3m T1-3n

2550 1550 4145 2985 2140 3650 2975 2025

T1-4a

T1-2b

T1-2a

T1

12/41/F
右上

B.R.1 M.B.R. M.B.R. FLAT F DIN. LIV. FLAT E DIN. LIV. M.B.R. FLAT D B.R.1 M.B.R.

BAL. & U.P.

(600/475/675x300)

(600x200)

(475/600x300)

(600x250)

(600/475/675x800)

CLIENT :
信和 Sino


ARCHITECT :
rona & par
Architects . Planners .
Ronald Lu
呂元祥建築師

MAIN CONTRACTOR :

STRUCTURAL ENGINEI

FACADE CONSULTANT

NOTE :
1. ALL DIMENSIONS
2. ALL ELEVATIONS
3. ALL DIMENSIONS

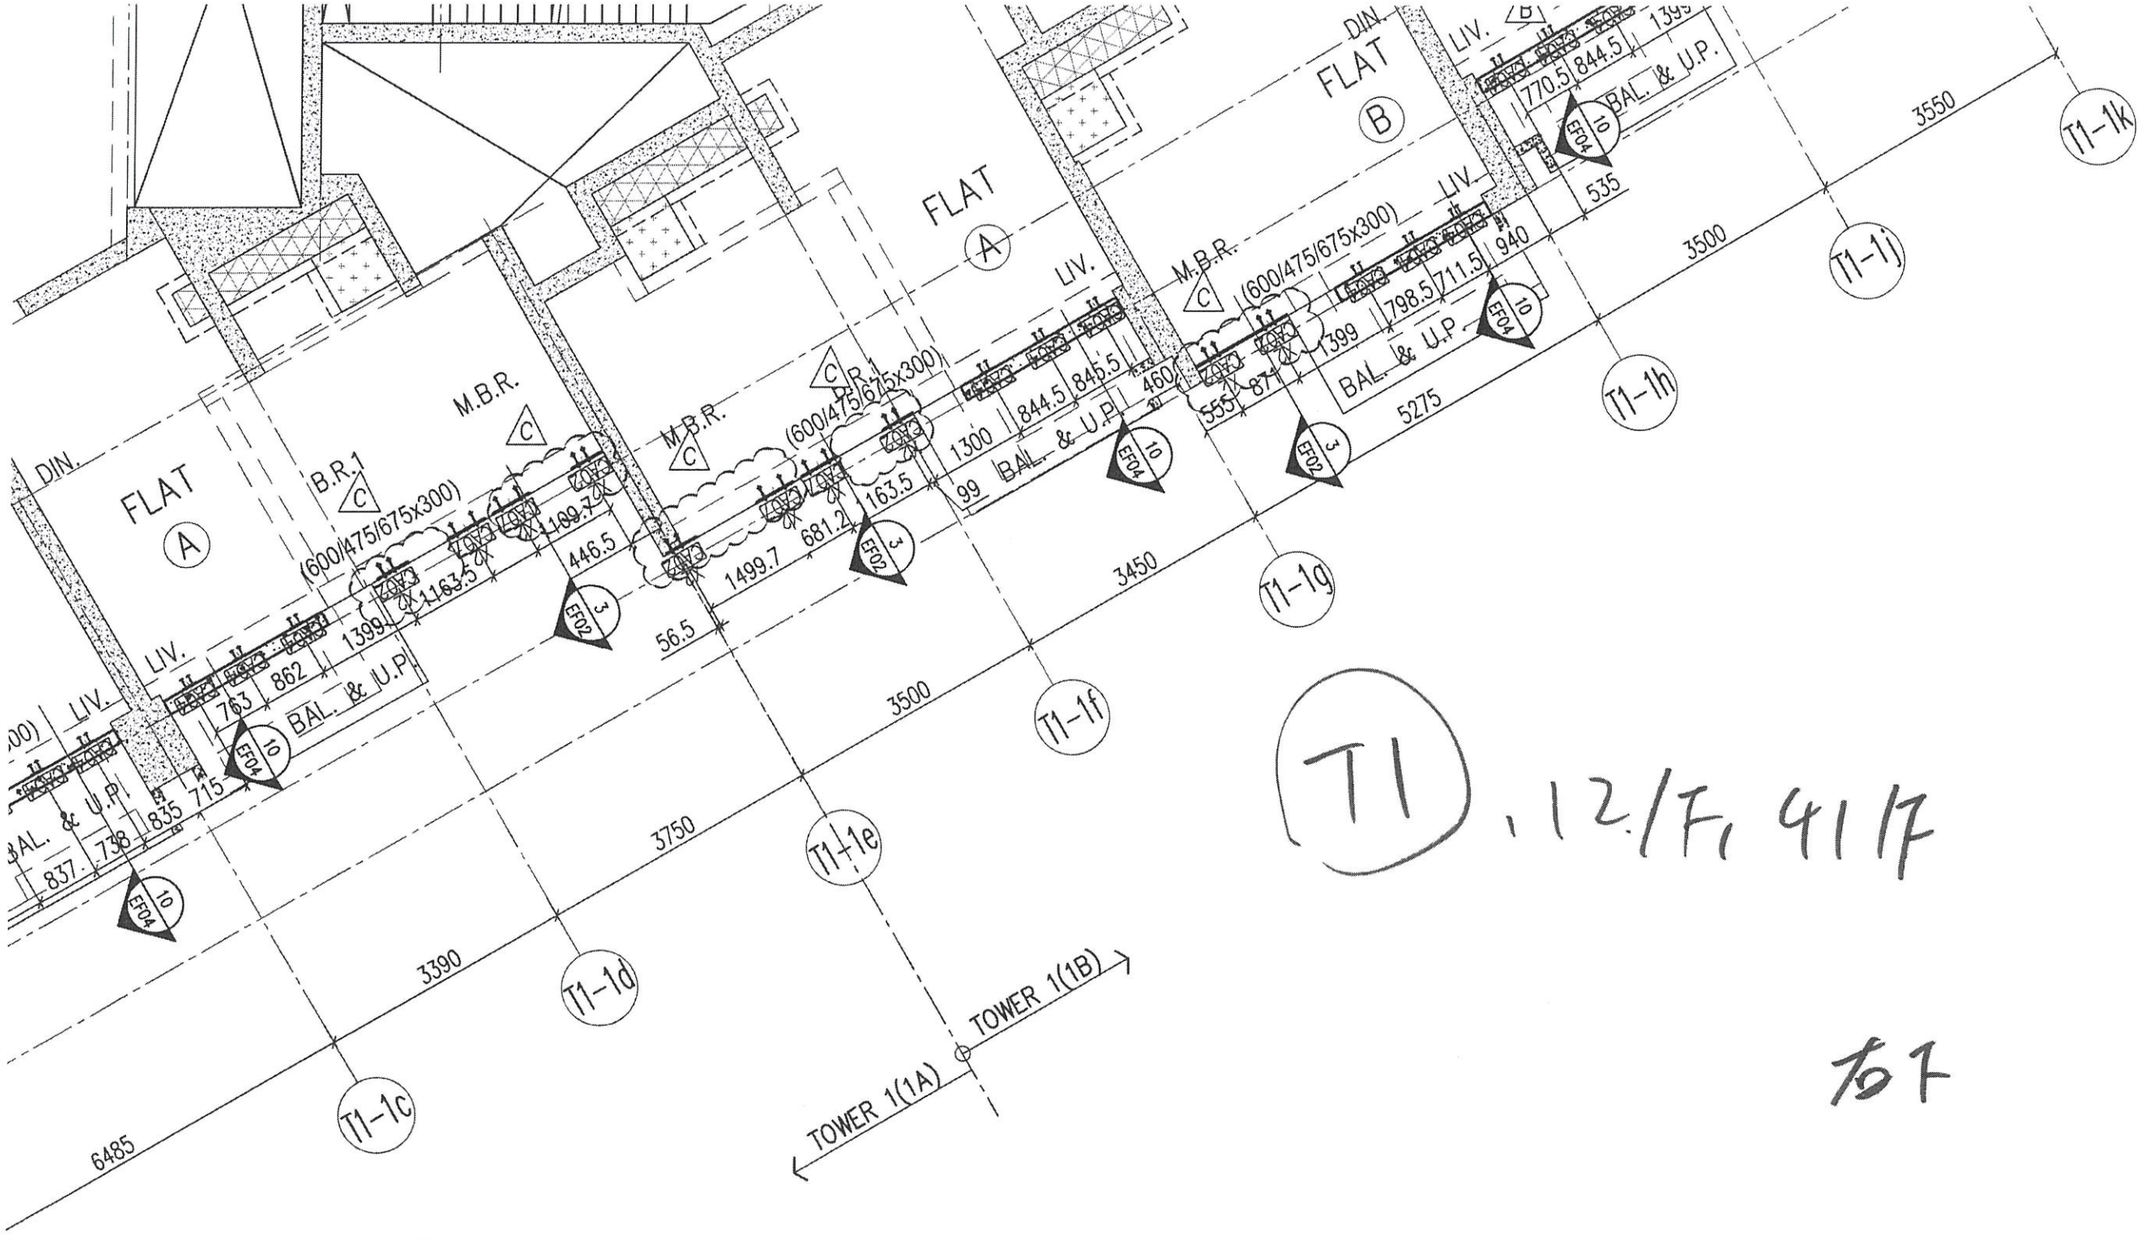

1 / – – 12/F & 41/F EMBED LAYOUT PLAN FOR TOWER 1(1:75)

1. ALL DIMENSIONS
2. ALL ELEVATIONS
3. ALL DIMENSIONS BEFORE FABRICA

LEGEND :

X1 / X001 — DETAIL / REFER

1. F.F.L. -- FINISHE
2. S.F.L. -- STRUCT
3. /R -- REVERS

NO.	DATE	
C	16/02/22	REVIS
B	20/12/21	REVIS
A	03/12/21	REVIS

JOB NO. :

PROJECT :
PROPOSED F
AT TKOTL 70R
TSEL

TITLE :
12/F & 41
AT TOWER


T1 , 12/F, 41/F


T1

12,41/F


左1

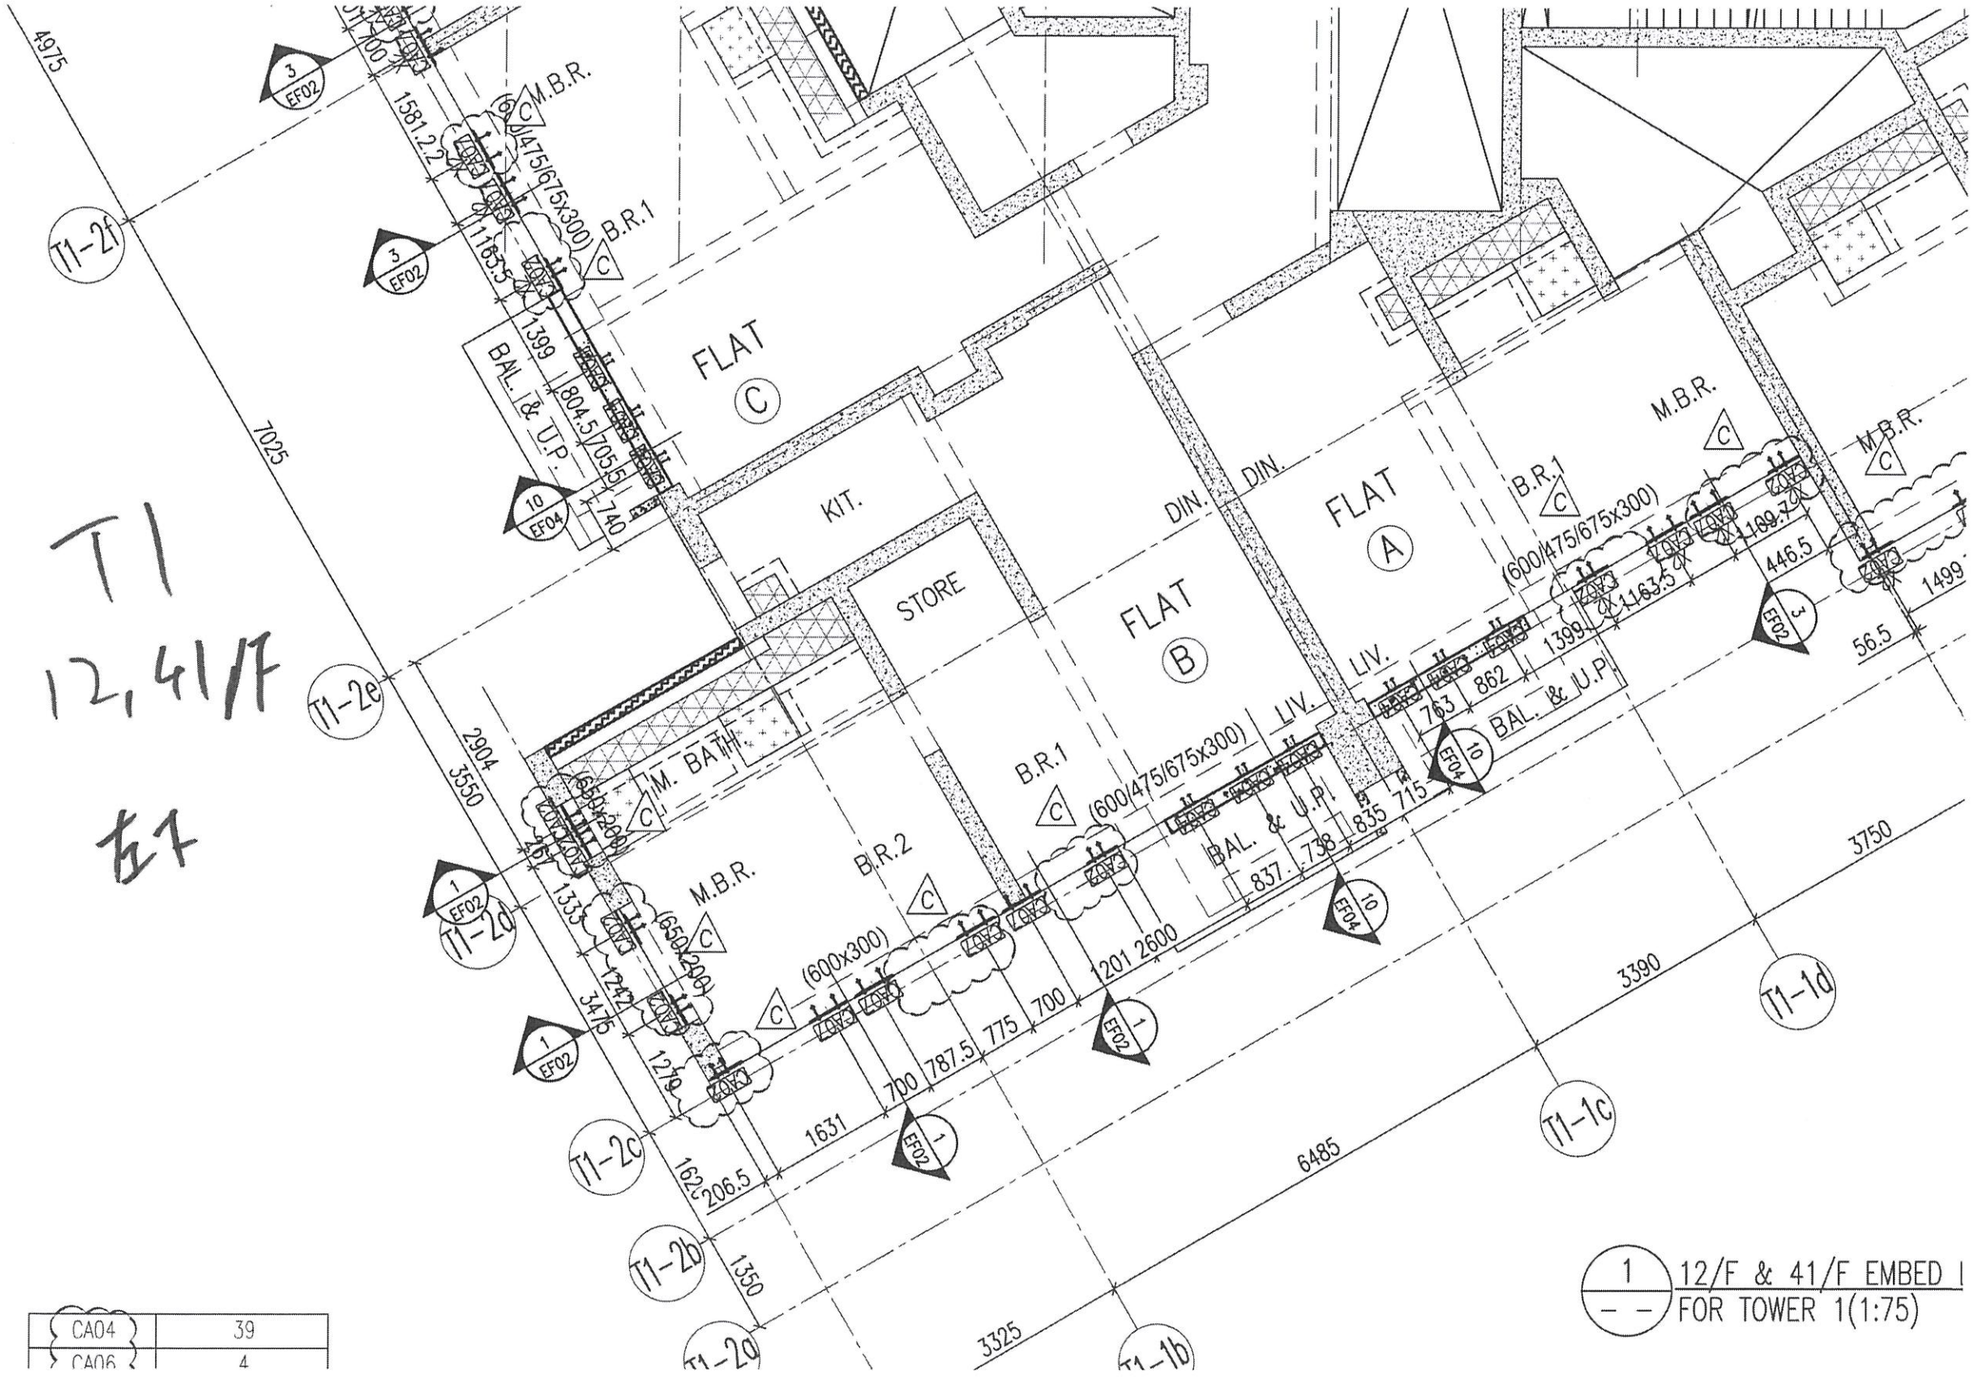


CA04	39
CA06	4

1 / – – 12/F & 41/F EMBED I FOR TOWER 1(1:75)


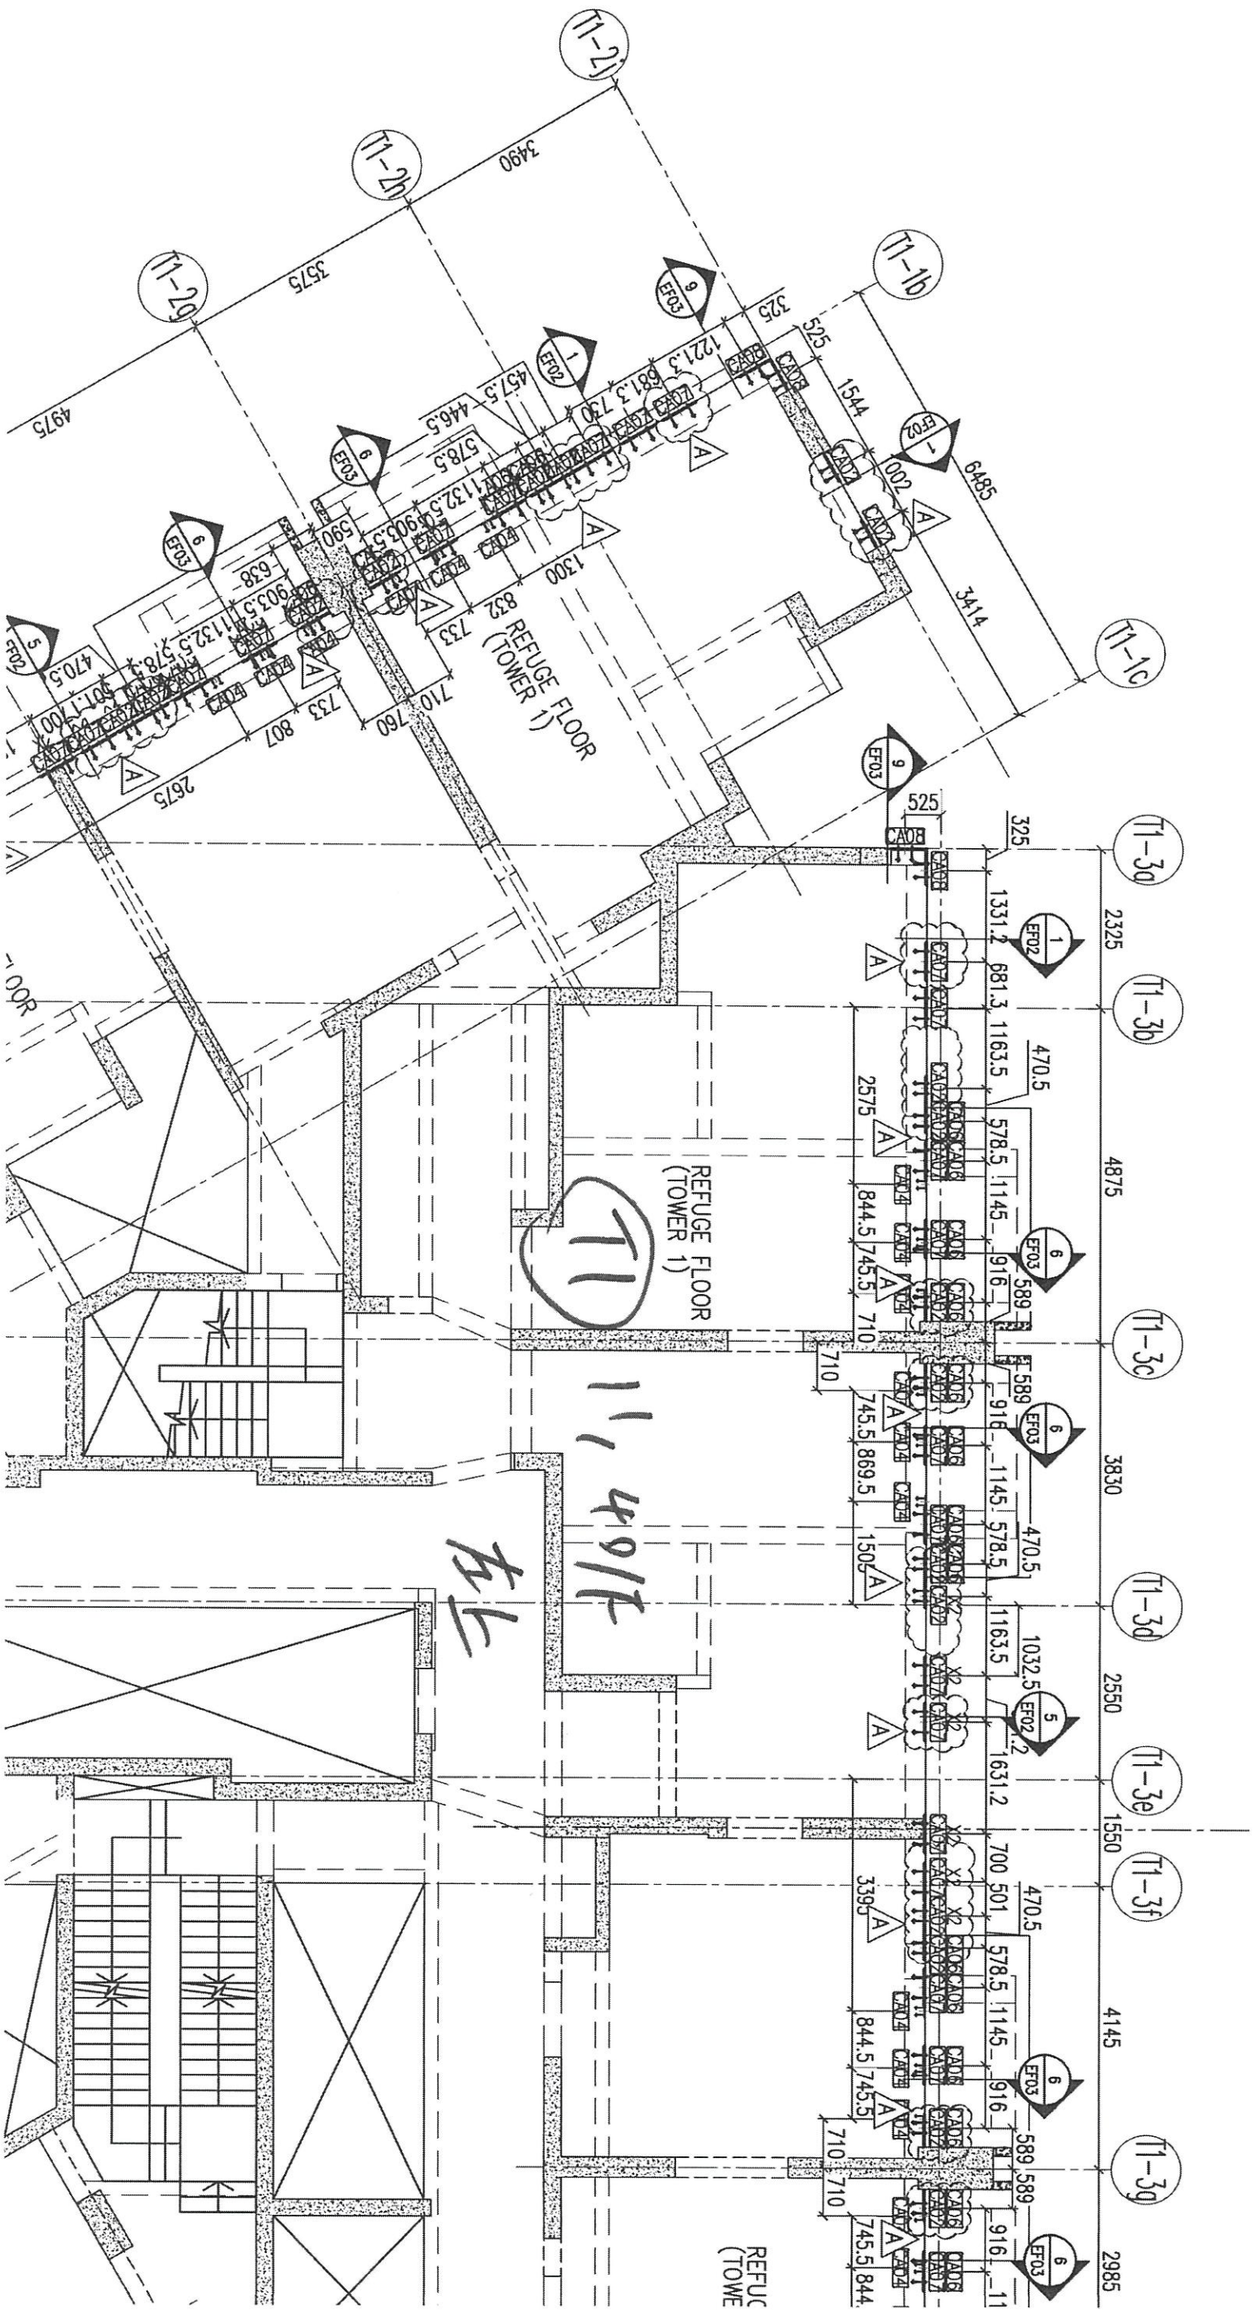
T1-2j
T1-2b
T1-2g
T1-1b
T1-1c
T1-3a
T1-3b
T1-3c
T1-3d
T1-3e
T1-3f
T1-3g
3490
3575
4975
525
1544
6485
1001
3414
2325
4875
3830
2550
1550
4145
2985
REFUGE FLOOR (TOWER 1)
T1

T1 11/F & 40/F

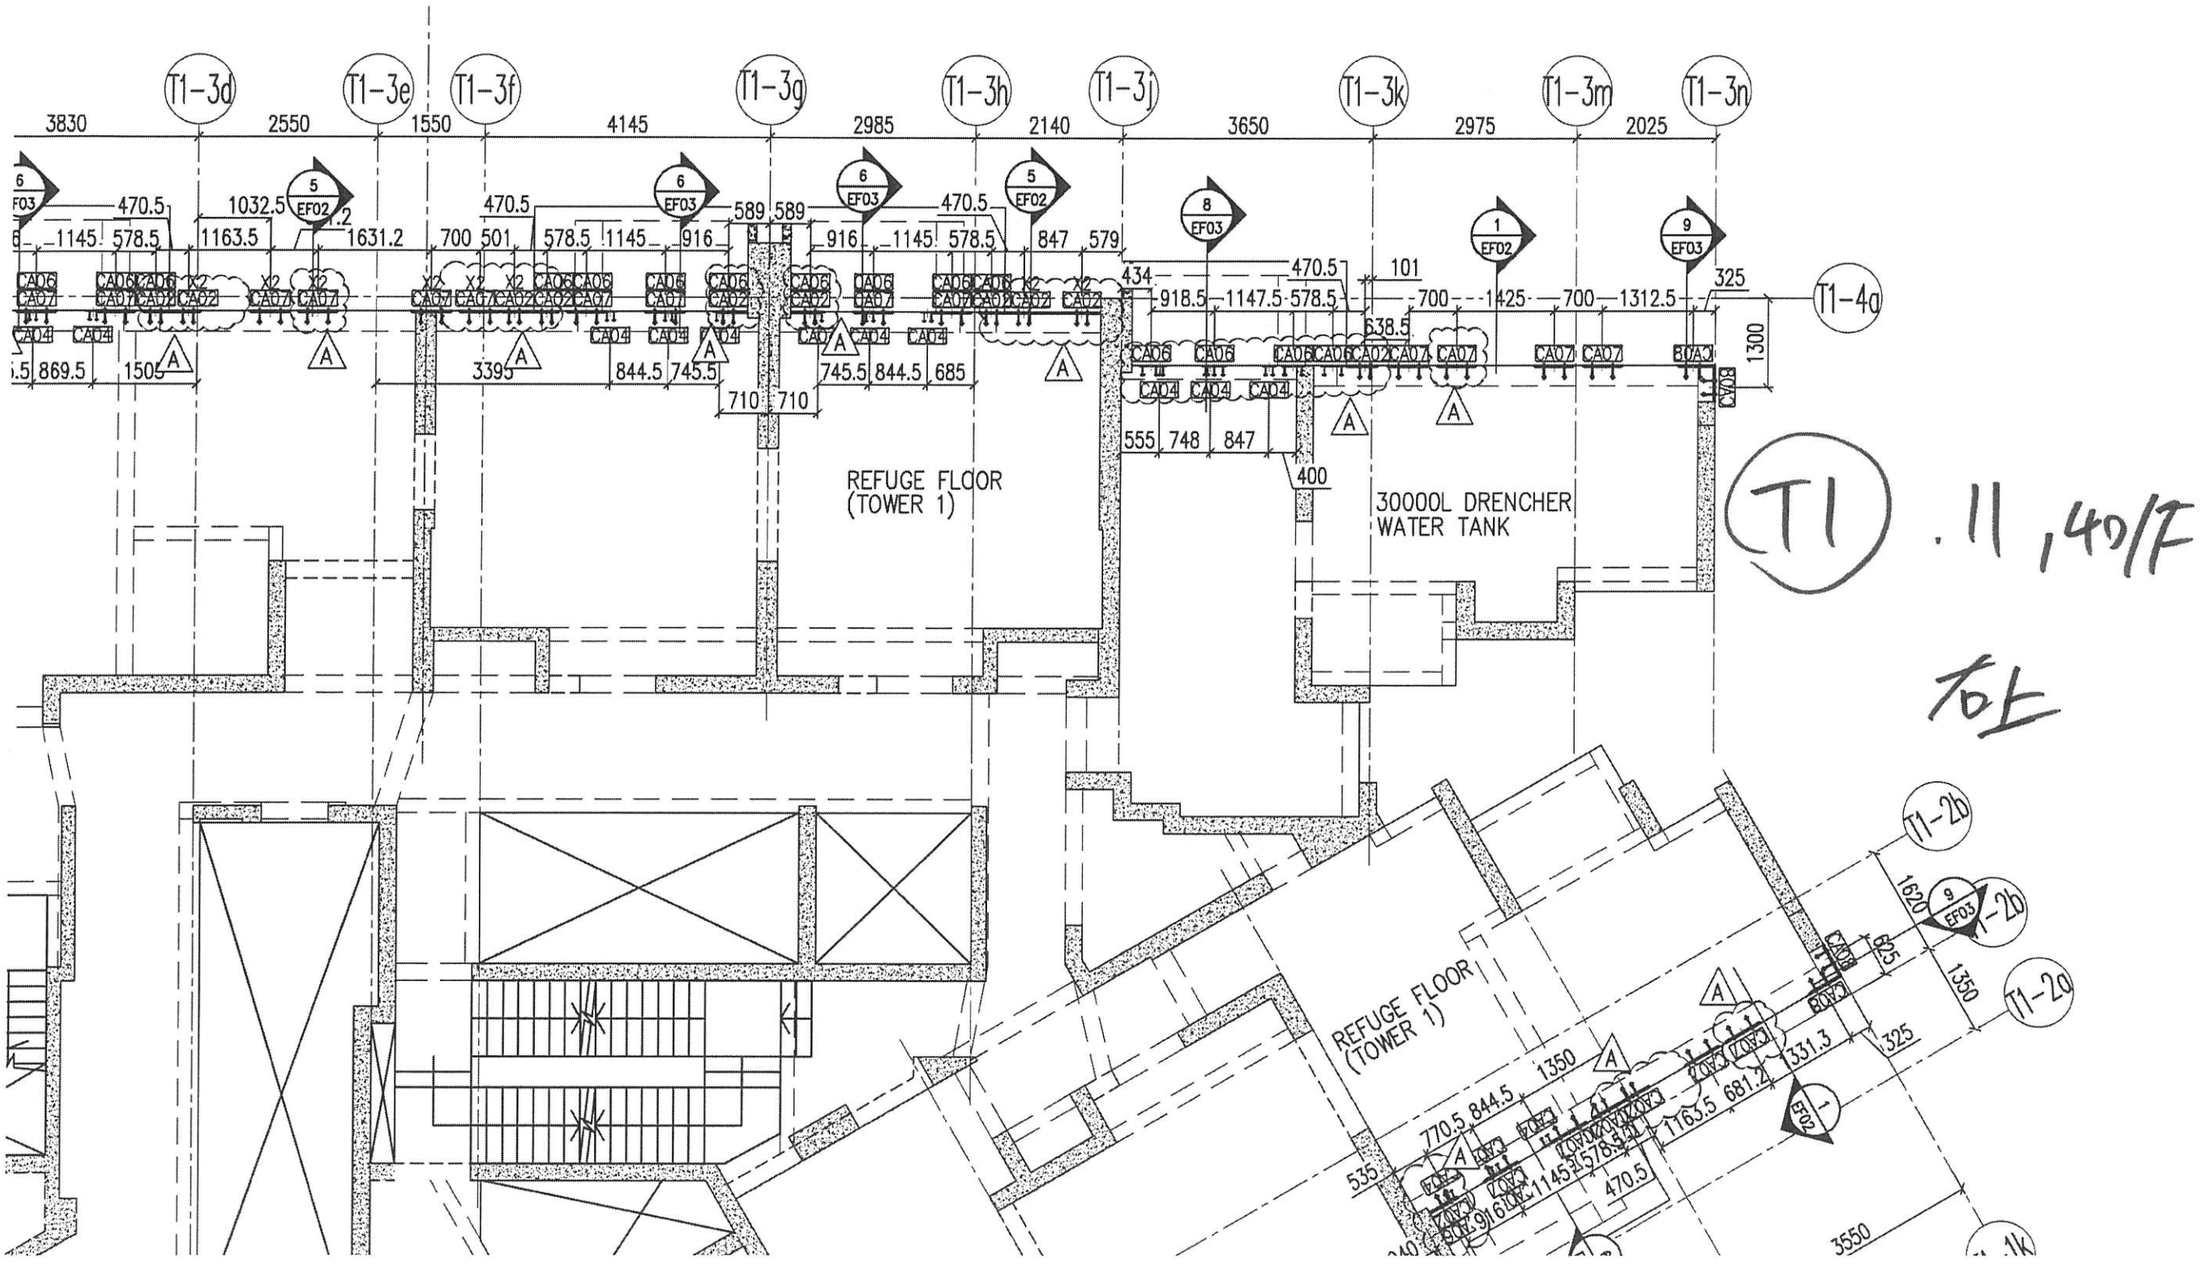

T1 .11,40/F

右上

CLIENT :
信和置業
Sino Land

ARCHITECT :
ronald l
& partner
Architects . Planners . Interior D
Ronald Lu & Pa
呂元祥建築師事務所


MAIN CONTRACTOR :
Ga

STRUCTURAL ENGINEER :
AEC

FACADE CONSULTANT:
AEC

NOTE :
1. ALL DIMENSIONS ARE IN
2. ALL ELEVATIONS ARE VI
3. ALL DIMENSIONS TO BE
BEFORE FABRICATION.

LEGEND :
X1 — DETAIL MARK I
X001 — REFER SHEET

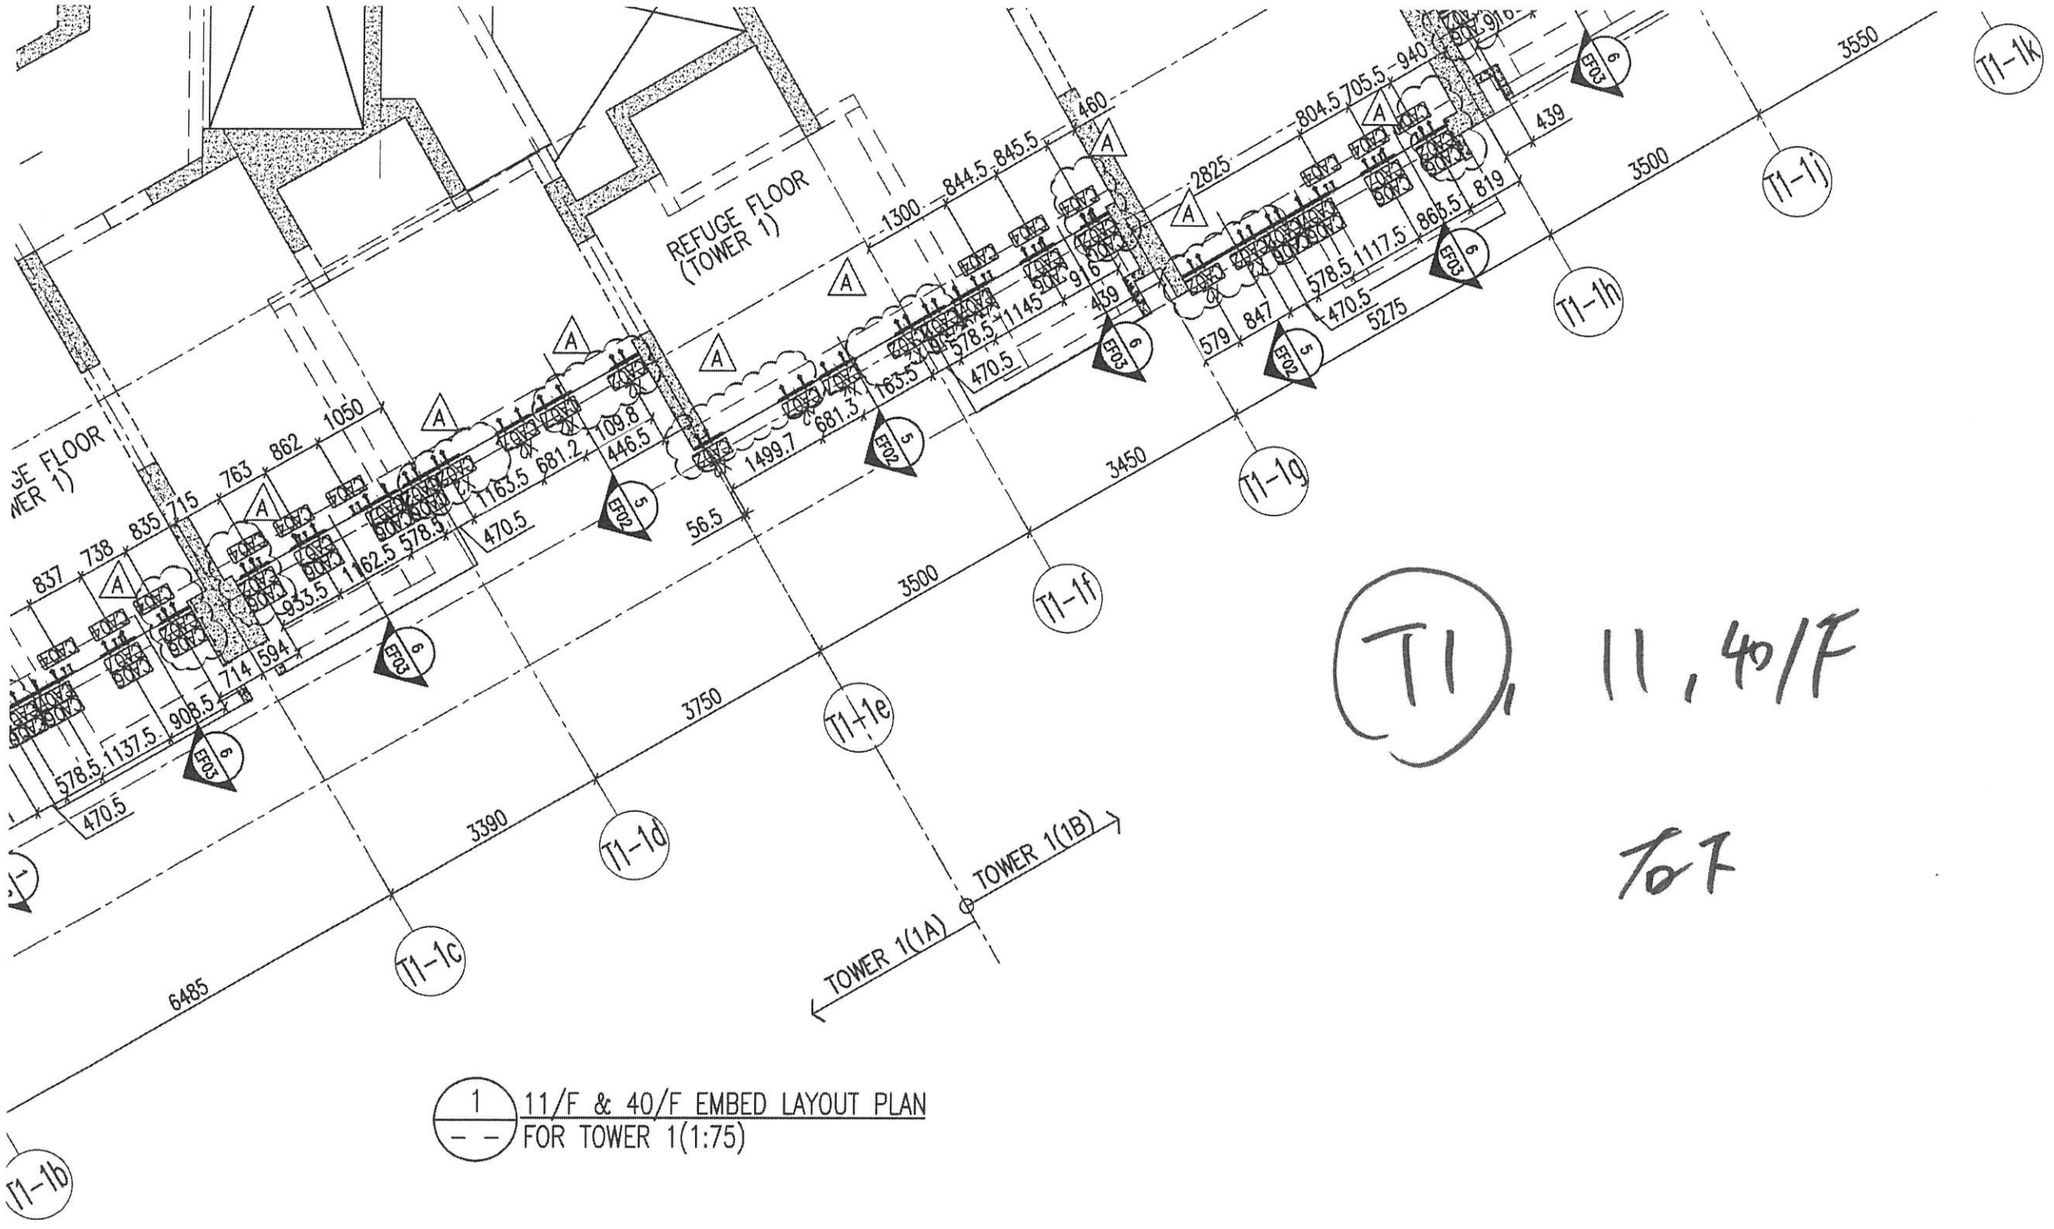

1 / – – 11/F & 40/F EMBED LAYOUT PLAN
FOR TOWER 1(1:75)

T1, 11, 40/F

To F

X1 — DETAIL MARK I
X001 — REFER SHEET

1. F.F.L. --FINISHED FLOC
2. S.F.L. --STRUCTURAL F
3. /R --REVERSED DET

NO.	DATE	
A	16/02/22	REVISED AS

JOB NO. : J–

PROJECT :
PROPOSED RESIDE
AT TKOTL 70RP, PH
TSEUNG K

TITLE :
11/F & 40/F EM
AT TOWER 1

DATE : 22–OCT–21

DRAWN BY : KY

美特
MIDI

T1

11, 40F

左7




1 11/F & 40/F EMBED LAYOUT PL
FOR TOWER 1(1:75)

40/F	+134.15
11/F	+51.7
FLOOR	FLOOR LEVEL(mPD)


CA04	39
CA06	52
CA08	8
CA02	60
CA07	63
EMBED TYPE	QTY/PER FLOOR

T2 9/F

T2
9/F
右上

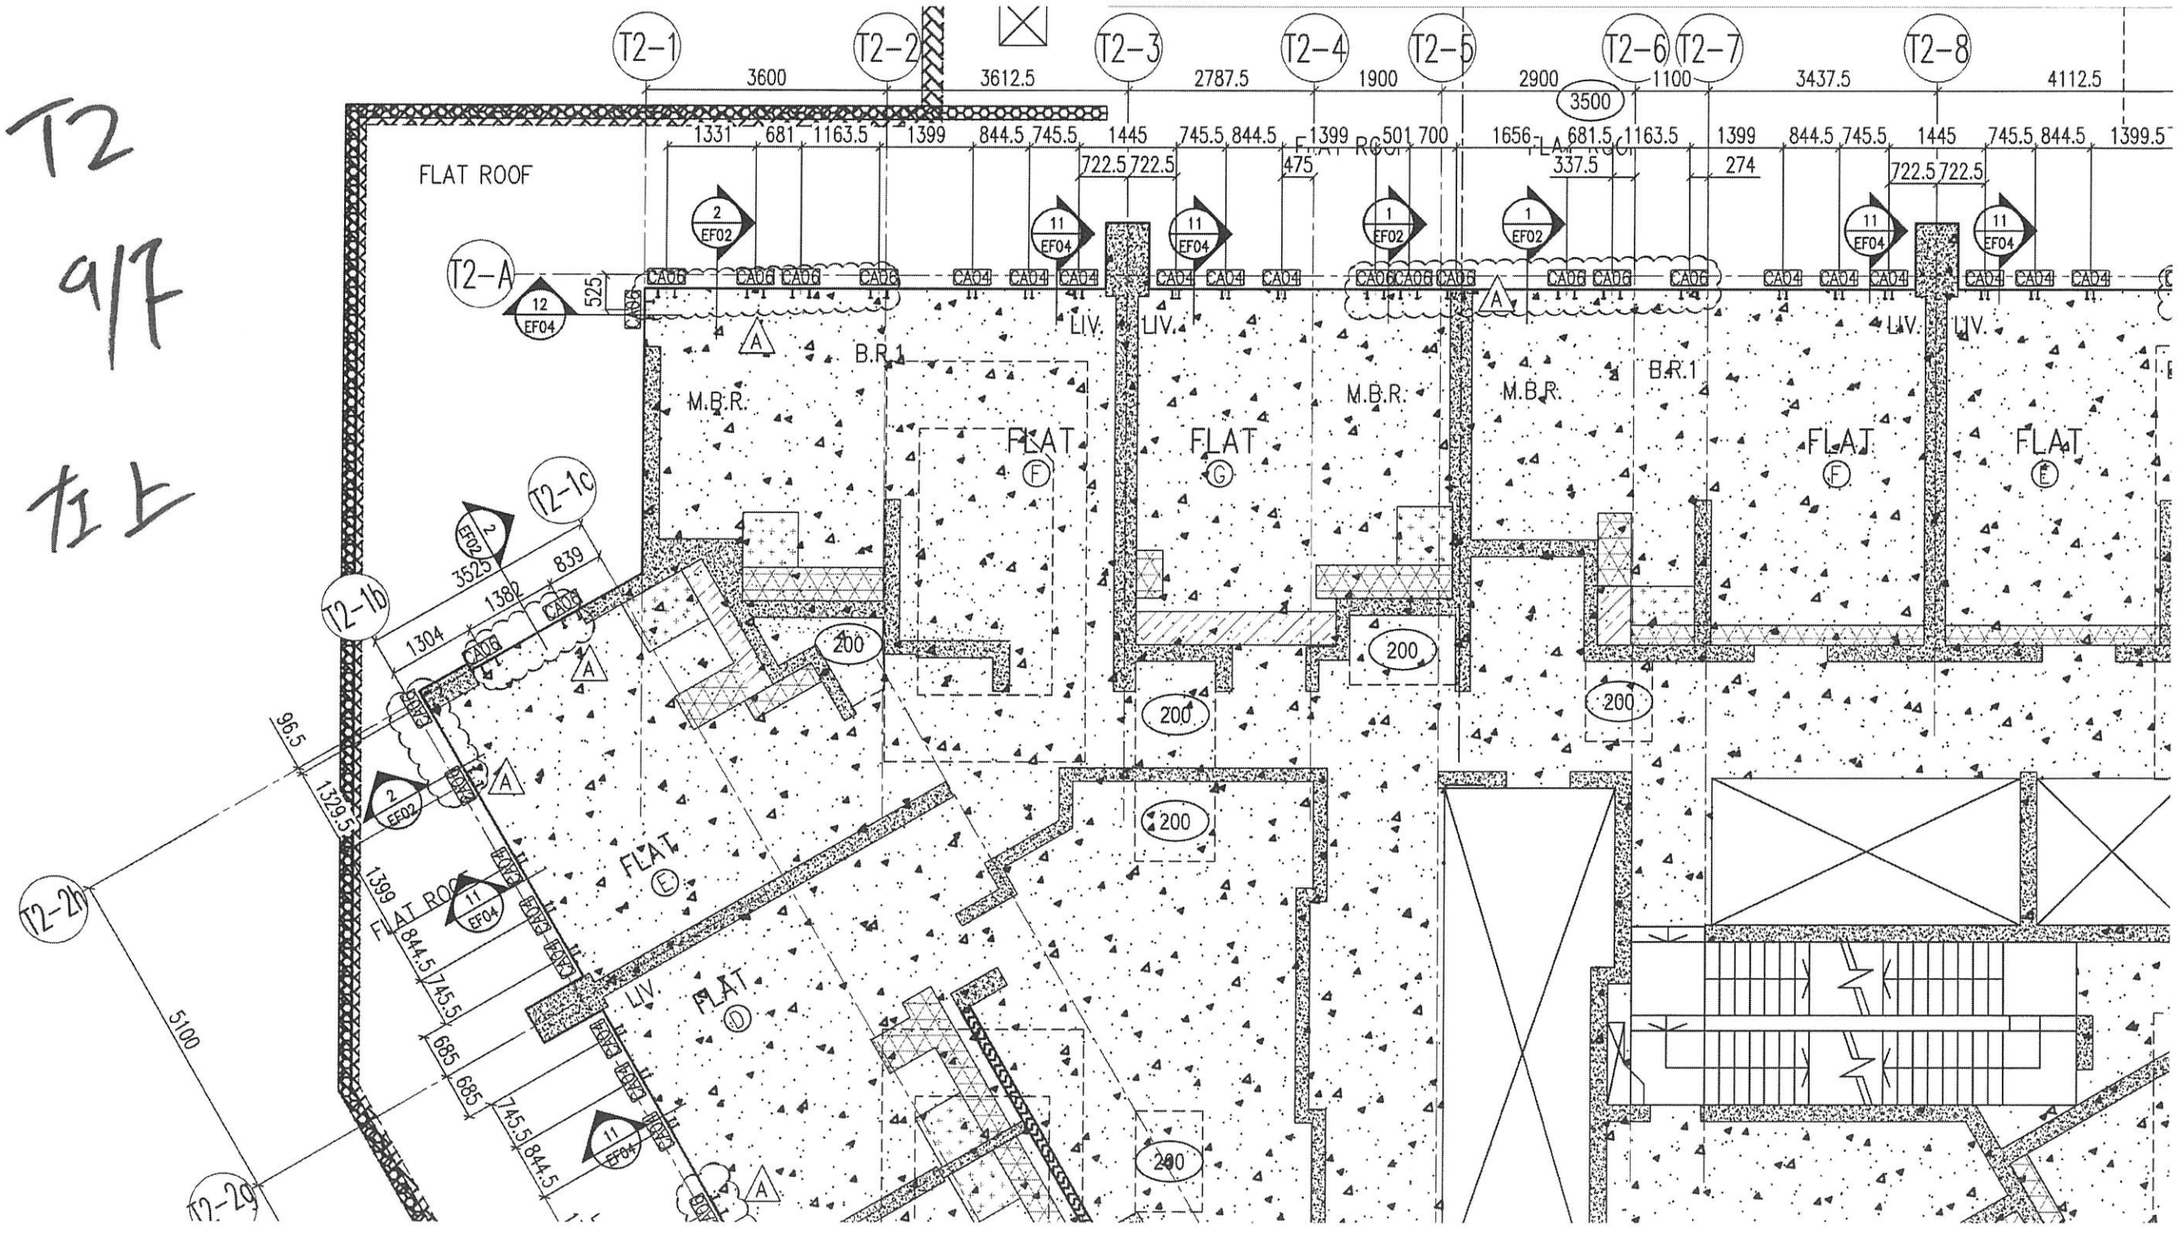
T2-1
T2-2
T2-3
T2-4
T2-5
T2-6
T2-7
T2-8
T2-A
T2-1b
T2-1c
T2-2b
T2-2c
3600
3612.5
2787.5
1900
2900
3500
1100
3437.5
4112.5
FLAT ROOF
B.R.1
M.B.R.
LIV.
FLAT
525
839
3525
1382
1304
1329.5
96.5
5100
1399
844.5
745.5
685
722.5
475
337.5
274
501
700
1656
681.5
1163.5
1445
844.5
1399.5
200
CA06
CA04
EF02
EF04

T2 9F

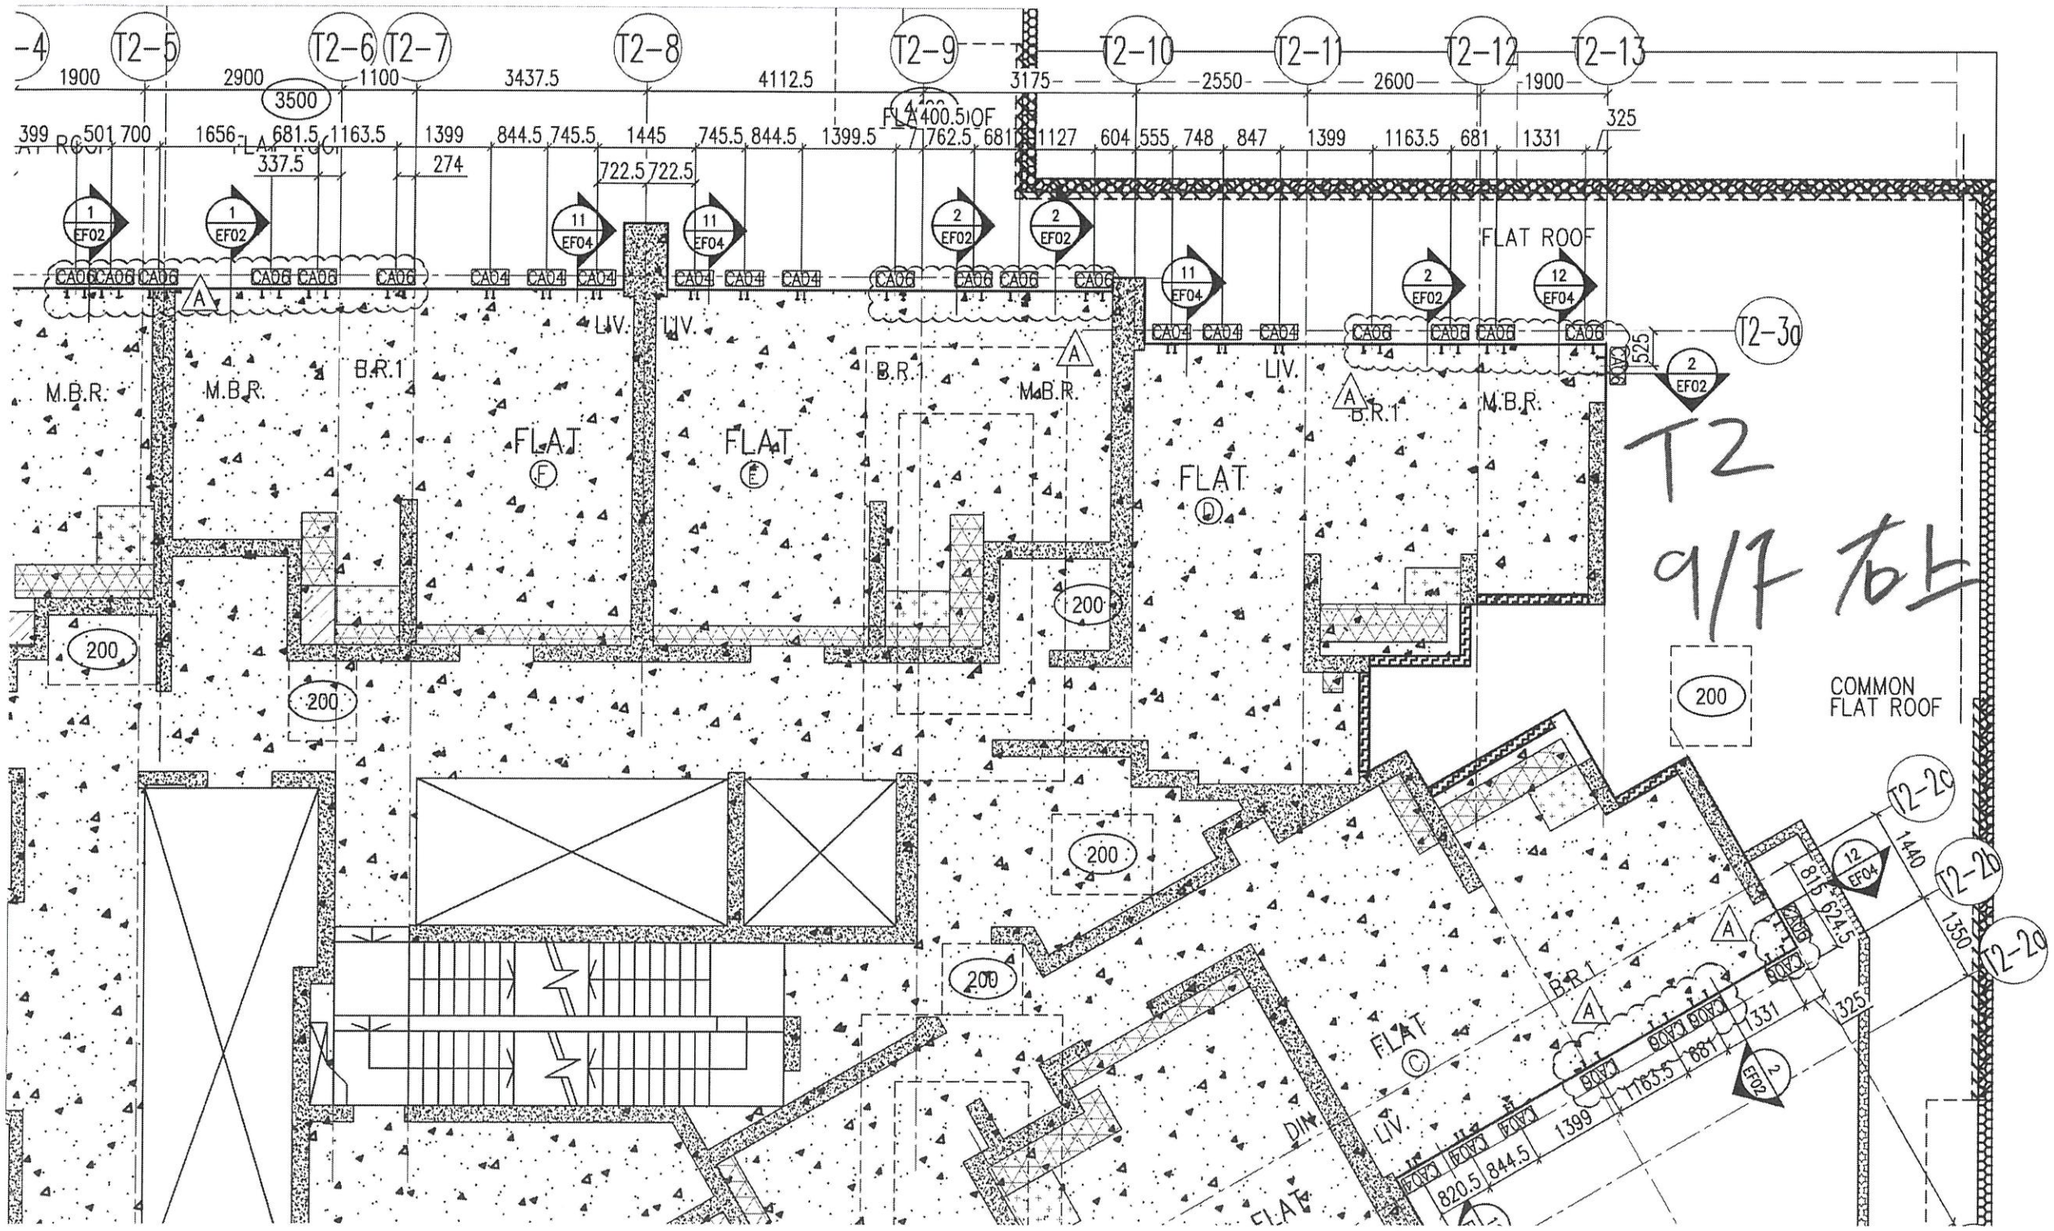

T2
9/F 右上

CLIENT :

信和置業有限公司
Sino Land Company

ARCHITECT :

ronald lu & partners
Architects . Planners . Interior Designers
Ronald Lu & Partners (HK
呂元祥建築師事務所(香港)有限

MAIN CONTRACTOR :

Gammc

STRUCTURAL ENGINEER :


AECOM

FACADE CONSULTANT:

AECOM

NOTE :

1. ALL DIMENSIONS ARE IN mm.
2. ALL ELEVATIONS ARE VIEWED FROM OI
3. ALL DIMENSIONS TO BE VERIFIED ON

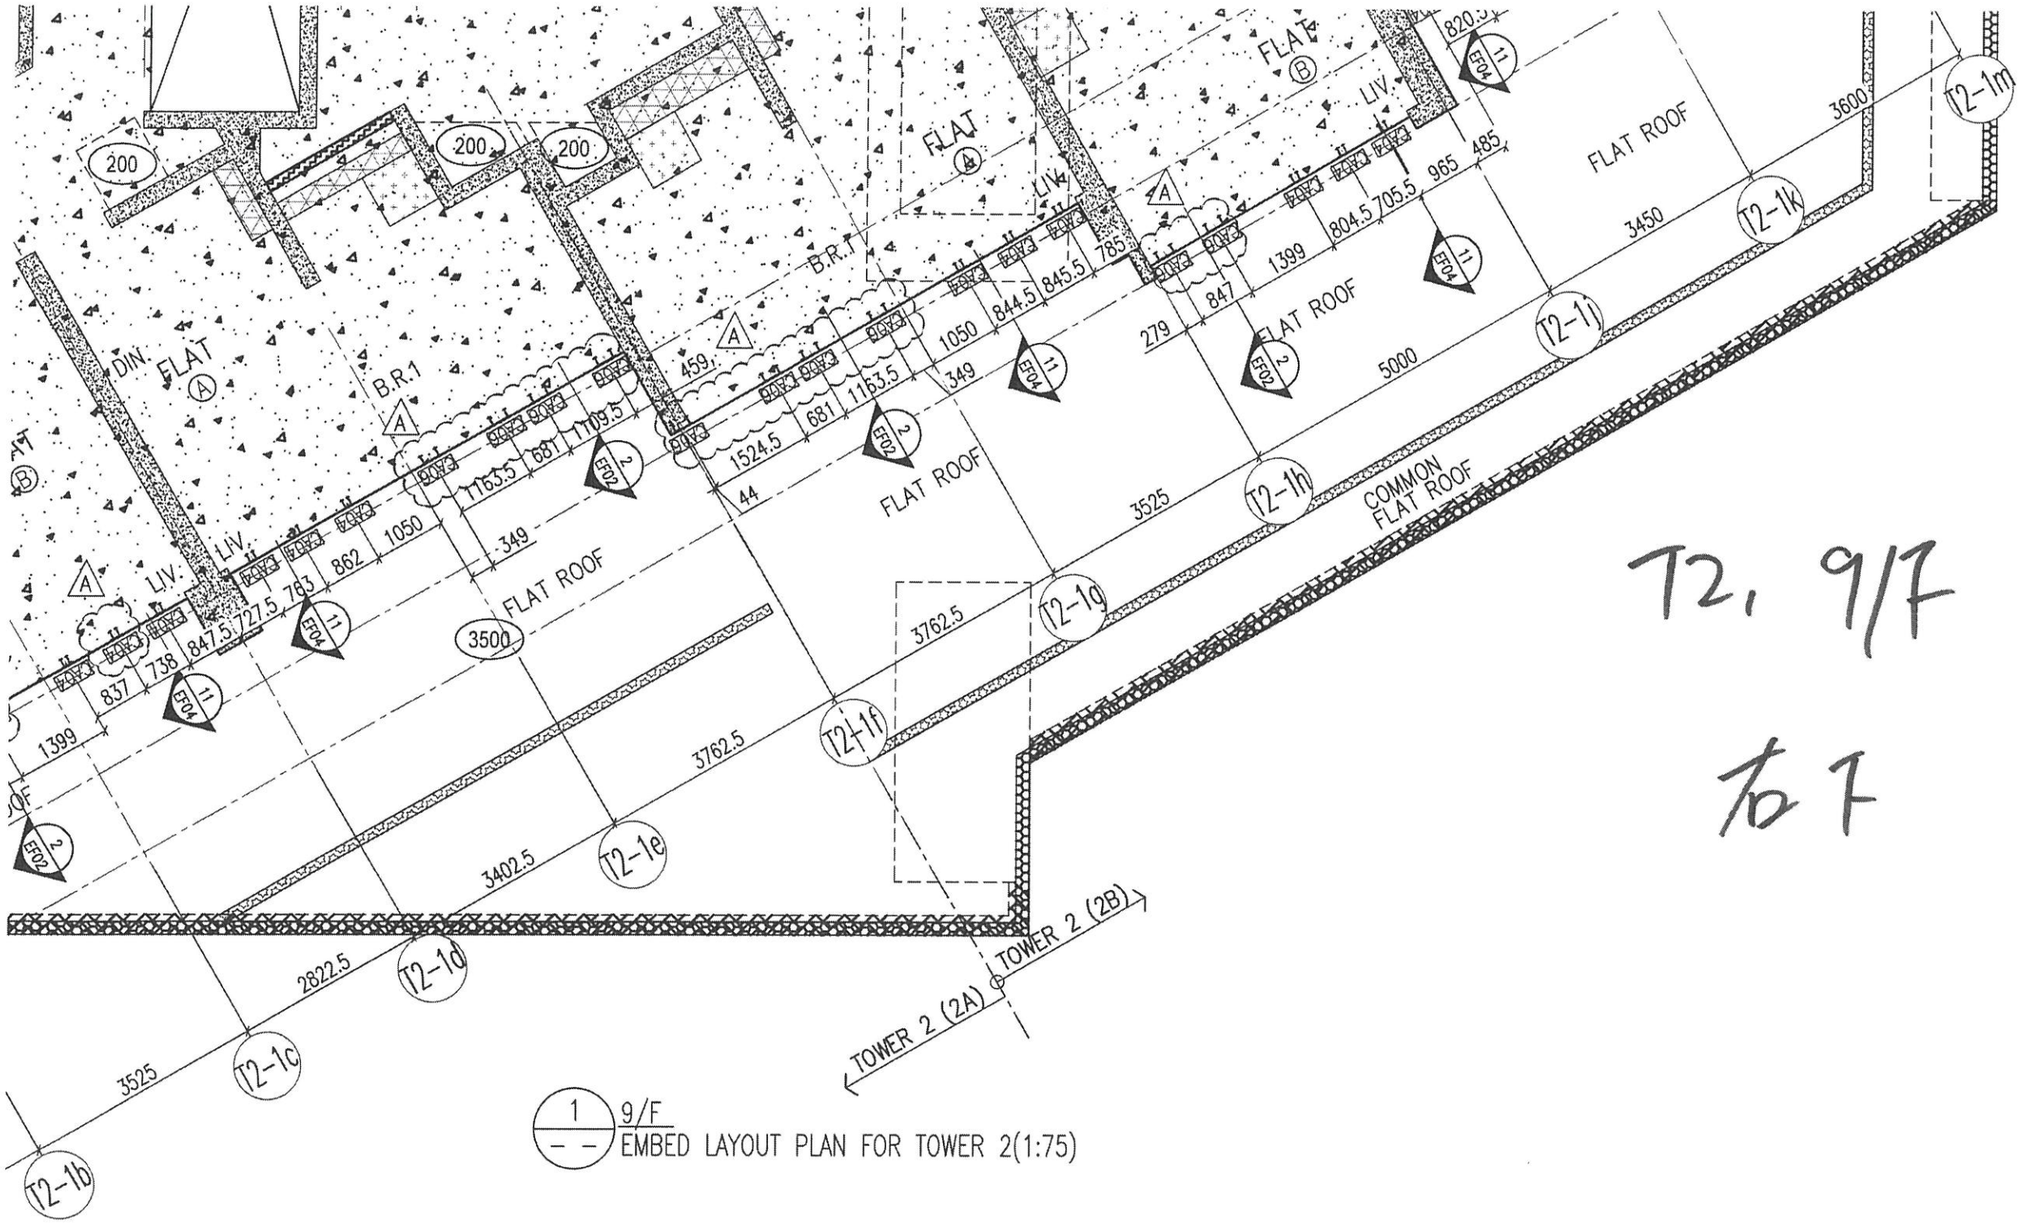

1 / 9/F
EMBED LAYOUT PLAN FOR TOWER 2(1:75)

T2, 9/7

右下

2. ALL ELEVATIONS ARE VIEWED FROM O
3. ALL DIMENSIONS TO BE VERIFIED ON BEFORE FABRICATION.

LEGEND :

X1 — DETAIL MARK NO.
X001 — REFER SHEET NO.

1. F.F.L. -- FINISHED FLOOR LEVEL
2. S.F.L. -- STRUCTURAL FLOOR LEVEL
3. (/R) -- REVERSED DETAIL

NO.	DATE	REVISED
A	16/02/22	REVISED AS PER COMMENTS

JOB NO. : J-858

PROJECT :
PROPOSED RESIDENTIAL DEVELOI
AT TKOTL 70RP, PHASE 11, LOHA
TSEUNG KWAN O, N.T.

TITLE :
TYPICAL FLOOR PLAN
AT TOWER 2

DATE : 22-OCT-21 | SCALE : 1:7

T2, 9/F

左下




9/F	+45.10
FLOOR	FLOOR LEVEL (mPD)

CA04	39
CA06	54
EMBED TYPE	QTY/PER FLOOR

T2 1/F, 15/F ~ 39/F & 42/F ~ 66/F
(13/F, 14/F, 24/F, 34/F, 44/F, 54/F Floors omitted)

T2，標準層 (左上)

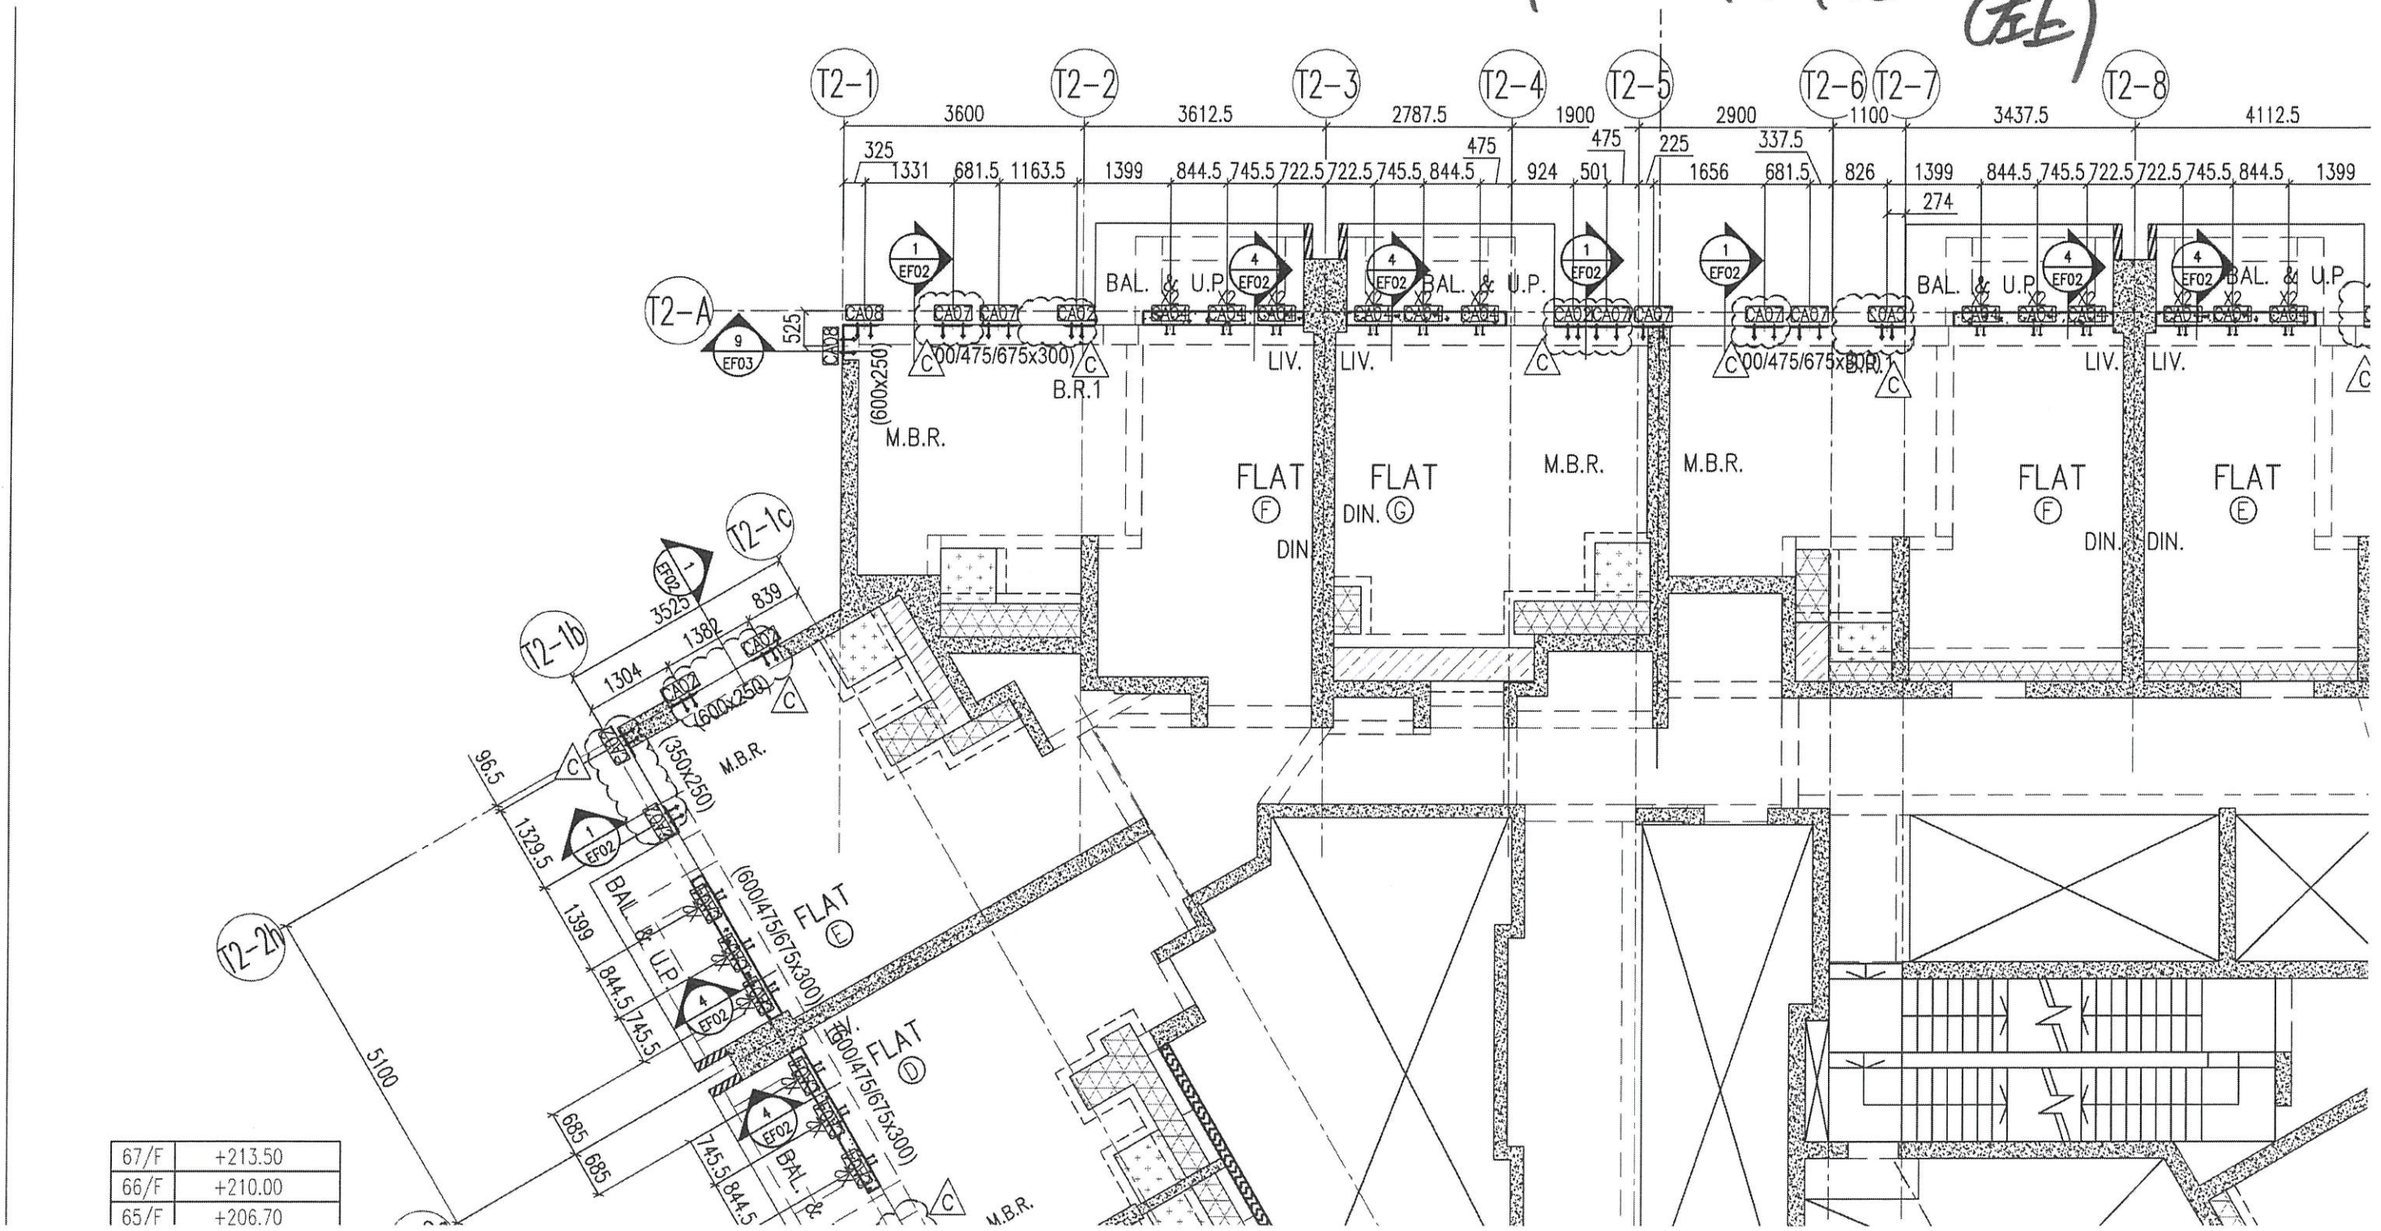


67/F	+213.50
66/F	+210.00
65/F	+206.70

T2 11/F, 15/F ~ 39/F & 42/F ~ 60/F
(13/F, 14/F, 24/F, 34/F, 44/F, 54/F Floors omitted)

T2, 標準層

右上

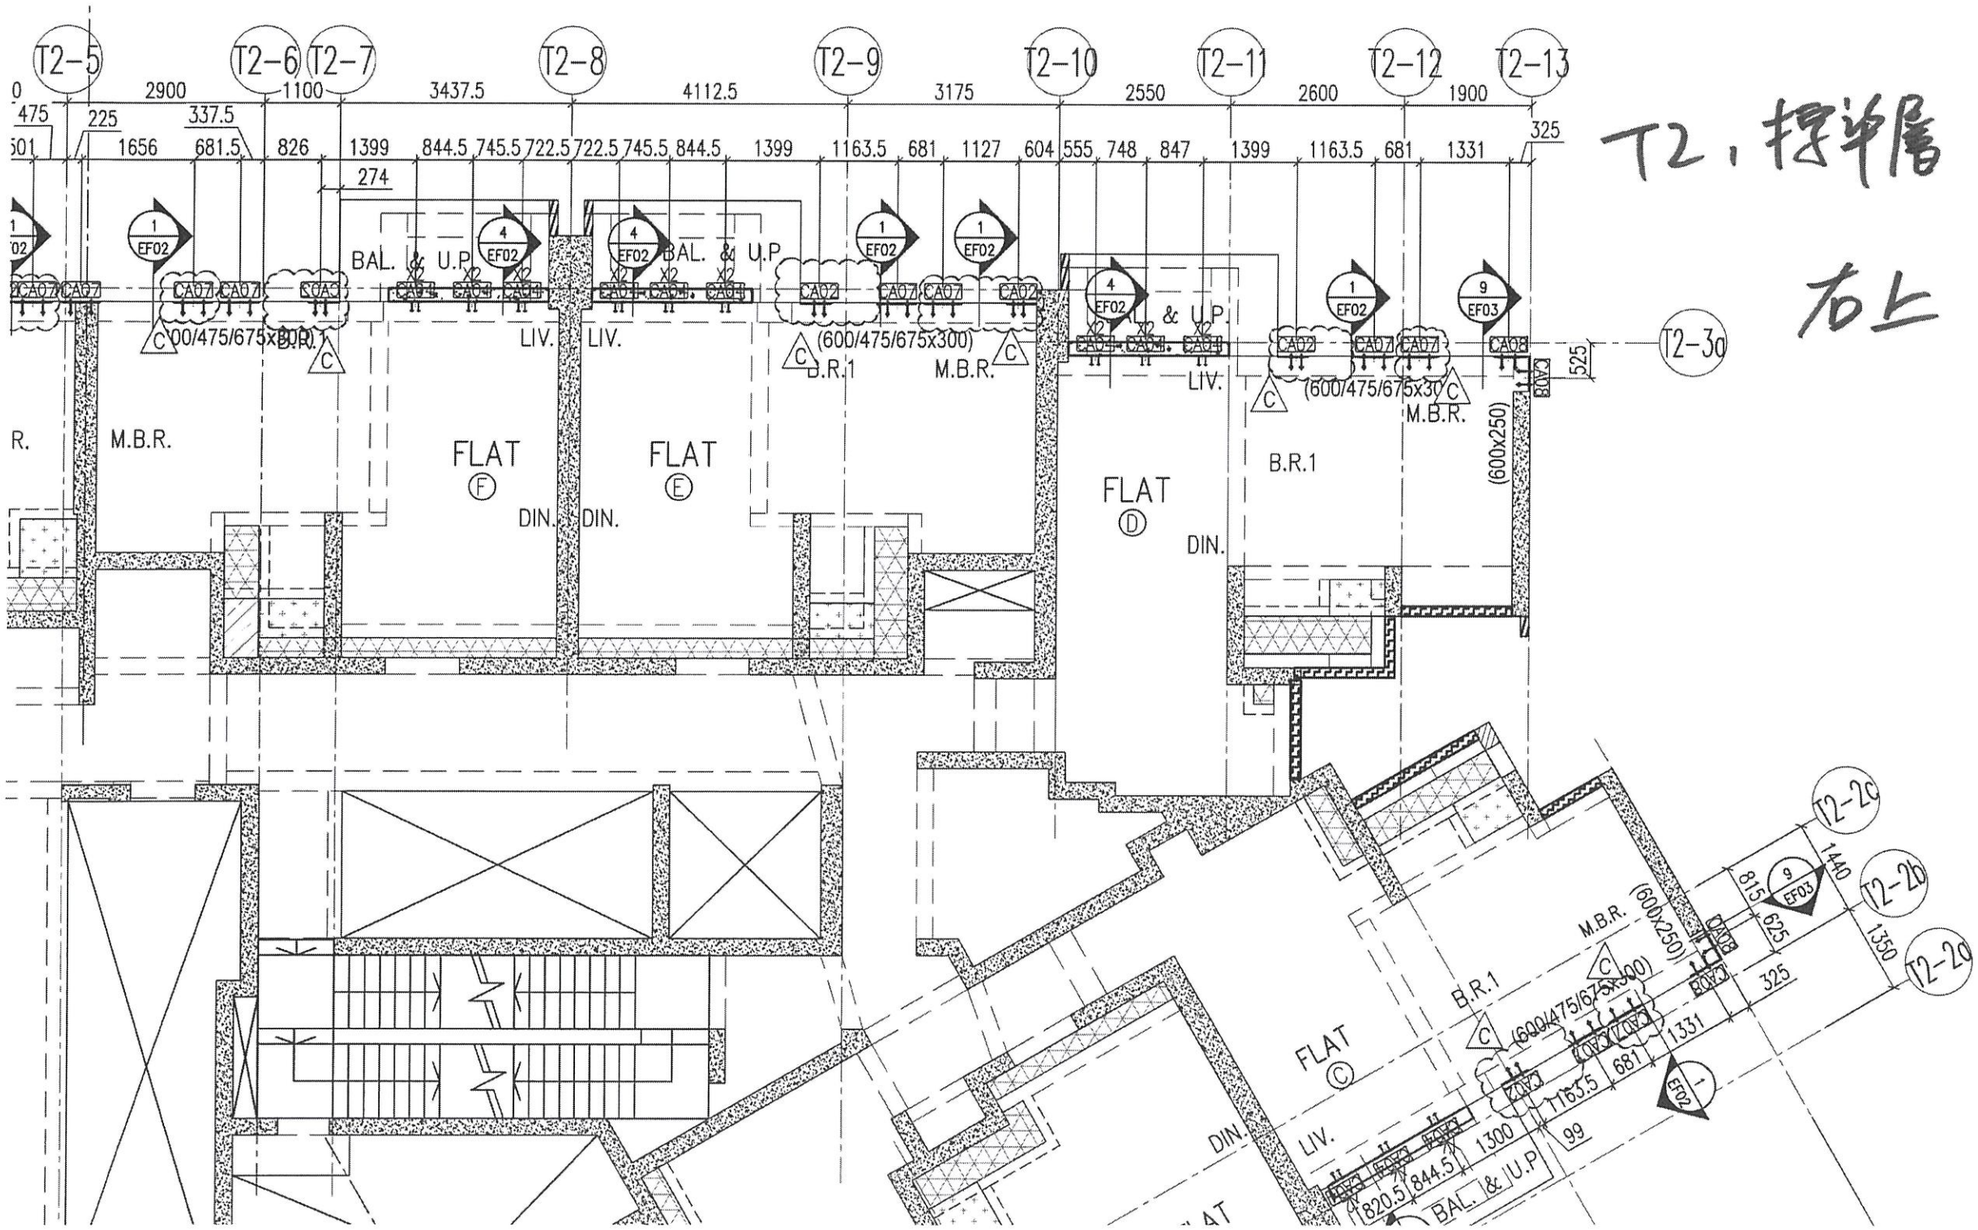

CLIENT :

信和置業有限公司
Sino Land Company Limited

ARCHITECT :

ronald lu & partners
Architects . Planners . Interior Designers
Ronald Lu & Partners (HK) Ltd.
呂元祥建築師事務所(香港)有限公司

MAIN CONTRACTOR :

Gammon

STRUCTURAL ENGINEER :


AECOM

FACADE CONSULTANT:

AECOM

NOTE :

1. ALL DIMENSIONS ARE IN mm.
2. ALL ELEVATIONS ARE VIEWED FROM OUTSIDE.
3. ALL DIMENSIONS TO BE VERIFIED ON SITE

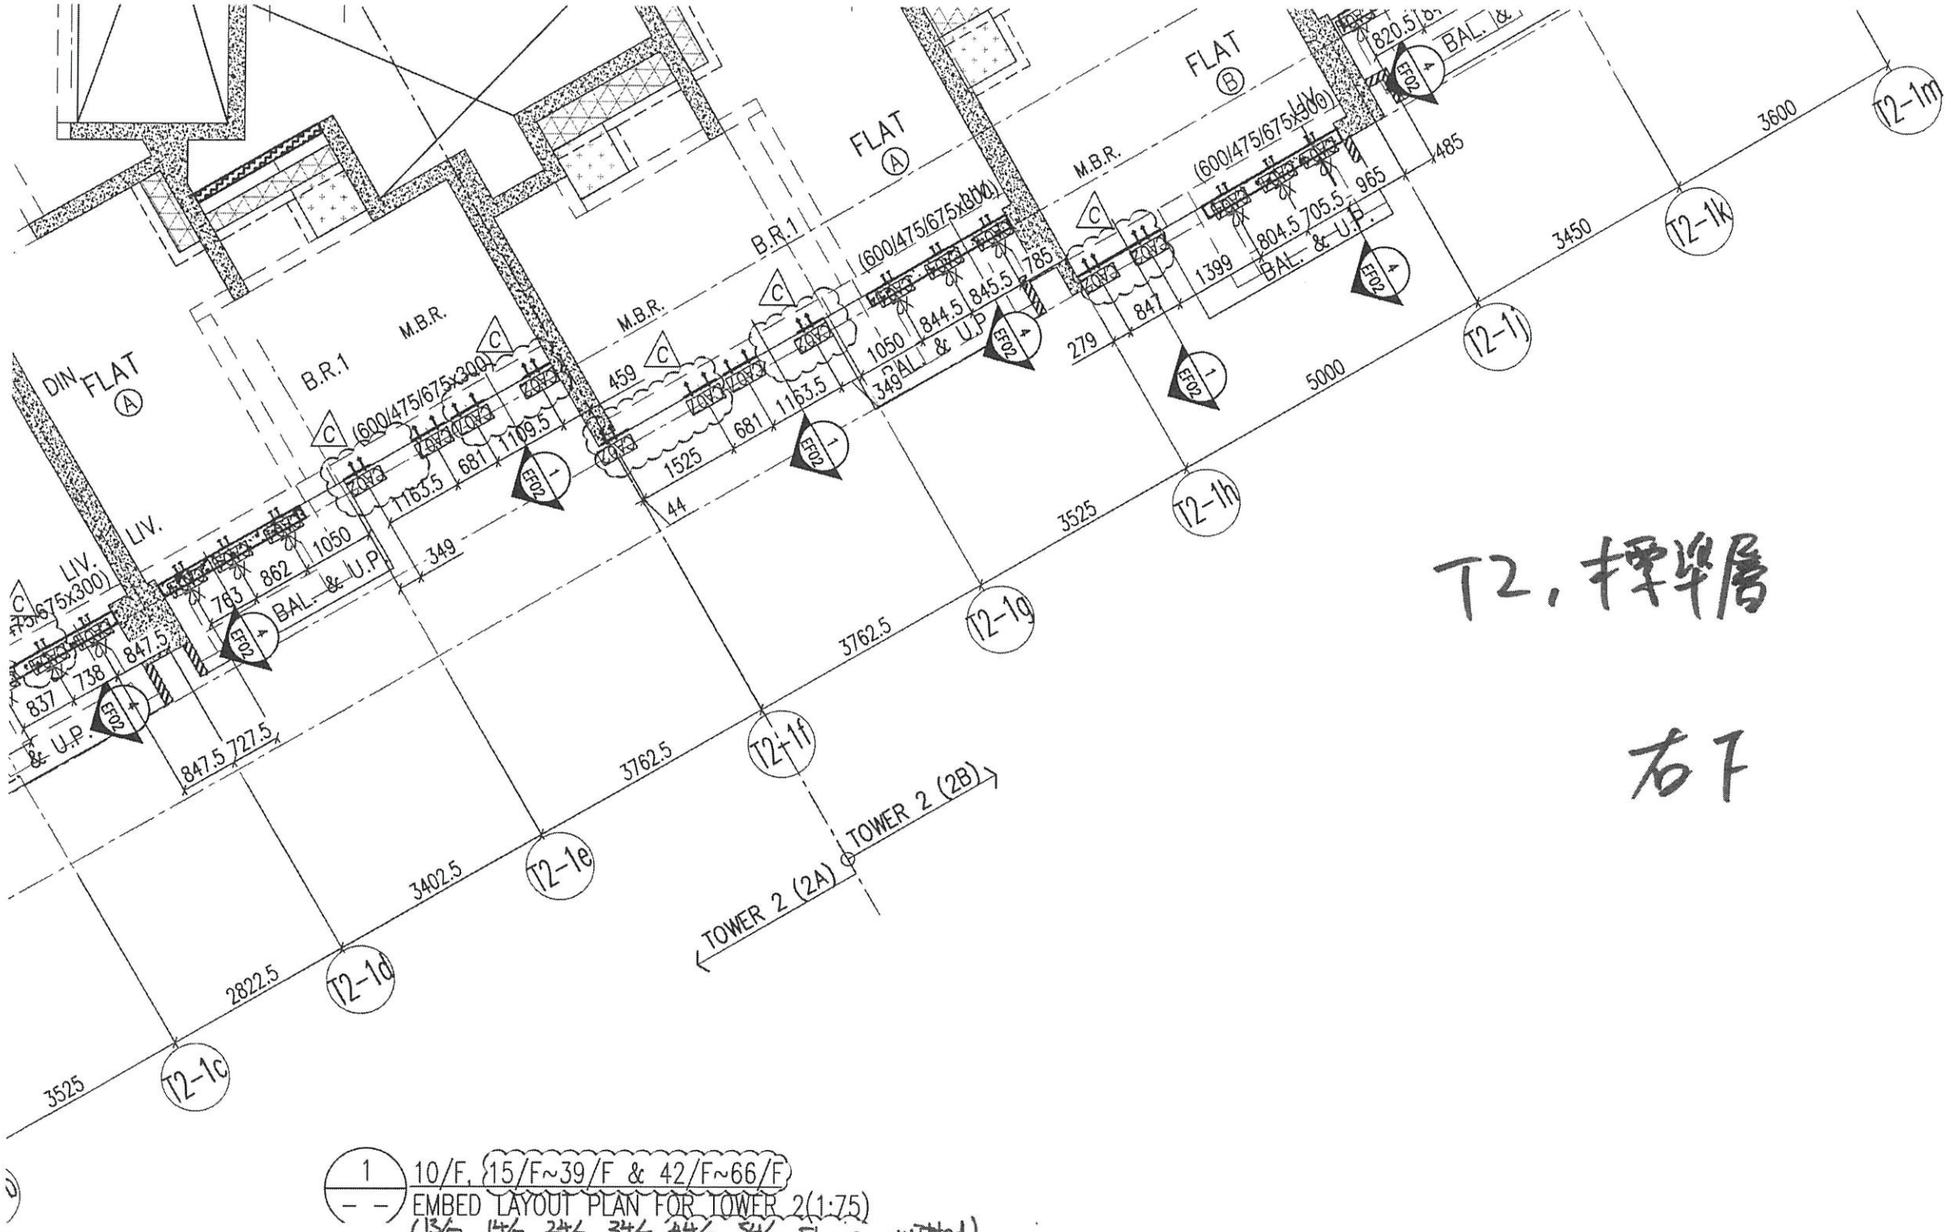

1 / – – 10/F, 15/F~39/F & 42/F~66/F EMBED LAYOUT PLAN FOR TOWER 2(1:75)
(13/F, 14/F, 24/F, 34/F, 44/F, 54/F Floors omitted)

T2, 標準層

右下

2. ALL ELEVATIONS ARE VIEWED FROM OUTSIDE.
3. ALL DIMENSIONS TO BE VERIFIED ON SITE BEFORE FABRICATION.

LEGEND :

X1 / X001 — DETAIL MARK NO. / REFER SHEET NO.

1. F.F.L. --FINISHED FLOOR LEVEL
2. S.F.L. --STRUCTURAL FLOOR LEVEL
3. (/R) --REVERSED DETAIL

NO.	DATE	REVISED
C	16/02/22	REVISED AS PER COMMENTS
B	20/12/21	REVISED AS PER COMMENTS
A	03/12/21	REVISED AS PER COMMENTS

JOB NO. : J-858

PROJECT :
PROPOSED RESIDENTIAL DEVELOPMENT
AT TKOTL 70RP, PHASE 11, LOHAS PARK
TSEUNG KWAN O, N.T.

TITLE :
TYPICAL FLOOR PLAN
AT TOWER 2

DATE : 22-OCT-21 | SCALE : 1:75(A1)

63/F	+203.40
62/F	+200.10
61/F	+196.80
60/F	+193.50
59/F	+190.20
58/F	+186.90
57/F	+183.60
56/F	+180.30
55/F	+177.00
53/F	+173.70
52/F	+170.40
51/F	+167.10
50/F	+163.80
49/F	+160.50
48/F	+157.20
47/F	+153.90
46/F	+150.60
45/F	+147.30
43/F	+144.00
42/F	+140.70
39/F	+130.85
38/F	+127.55
37/F	+124.25
36/F	+120.95
35/F	+117.65
33/F	+114.35
32/F	+111.05
31/F	+107.75
30/F	+104.45
29/F	+101.15
28/F	+97.85
27/F	+94.55
26/F	+91.25
25/F	+87.95
23/F	+84.65
22/F	+81.35
21/F	+78.05
20/F	+74.75
19/F	+71.45
18/F	+68.15

T2
標準層

左下



T2

1 / – – 10/F, 15/F~39/F & 42/F~66/F
EMBED LAYOUT PLAN FOR TOWER 2
(13/F, 14/F, 24/F, 34/F, 44/F, 54/F&


CA09 | 1

T2 12/F & 41/F

T2

12, 41/F

左上

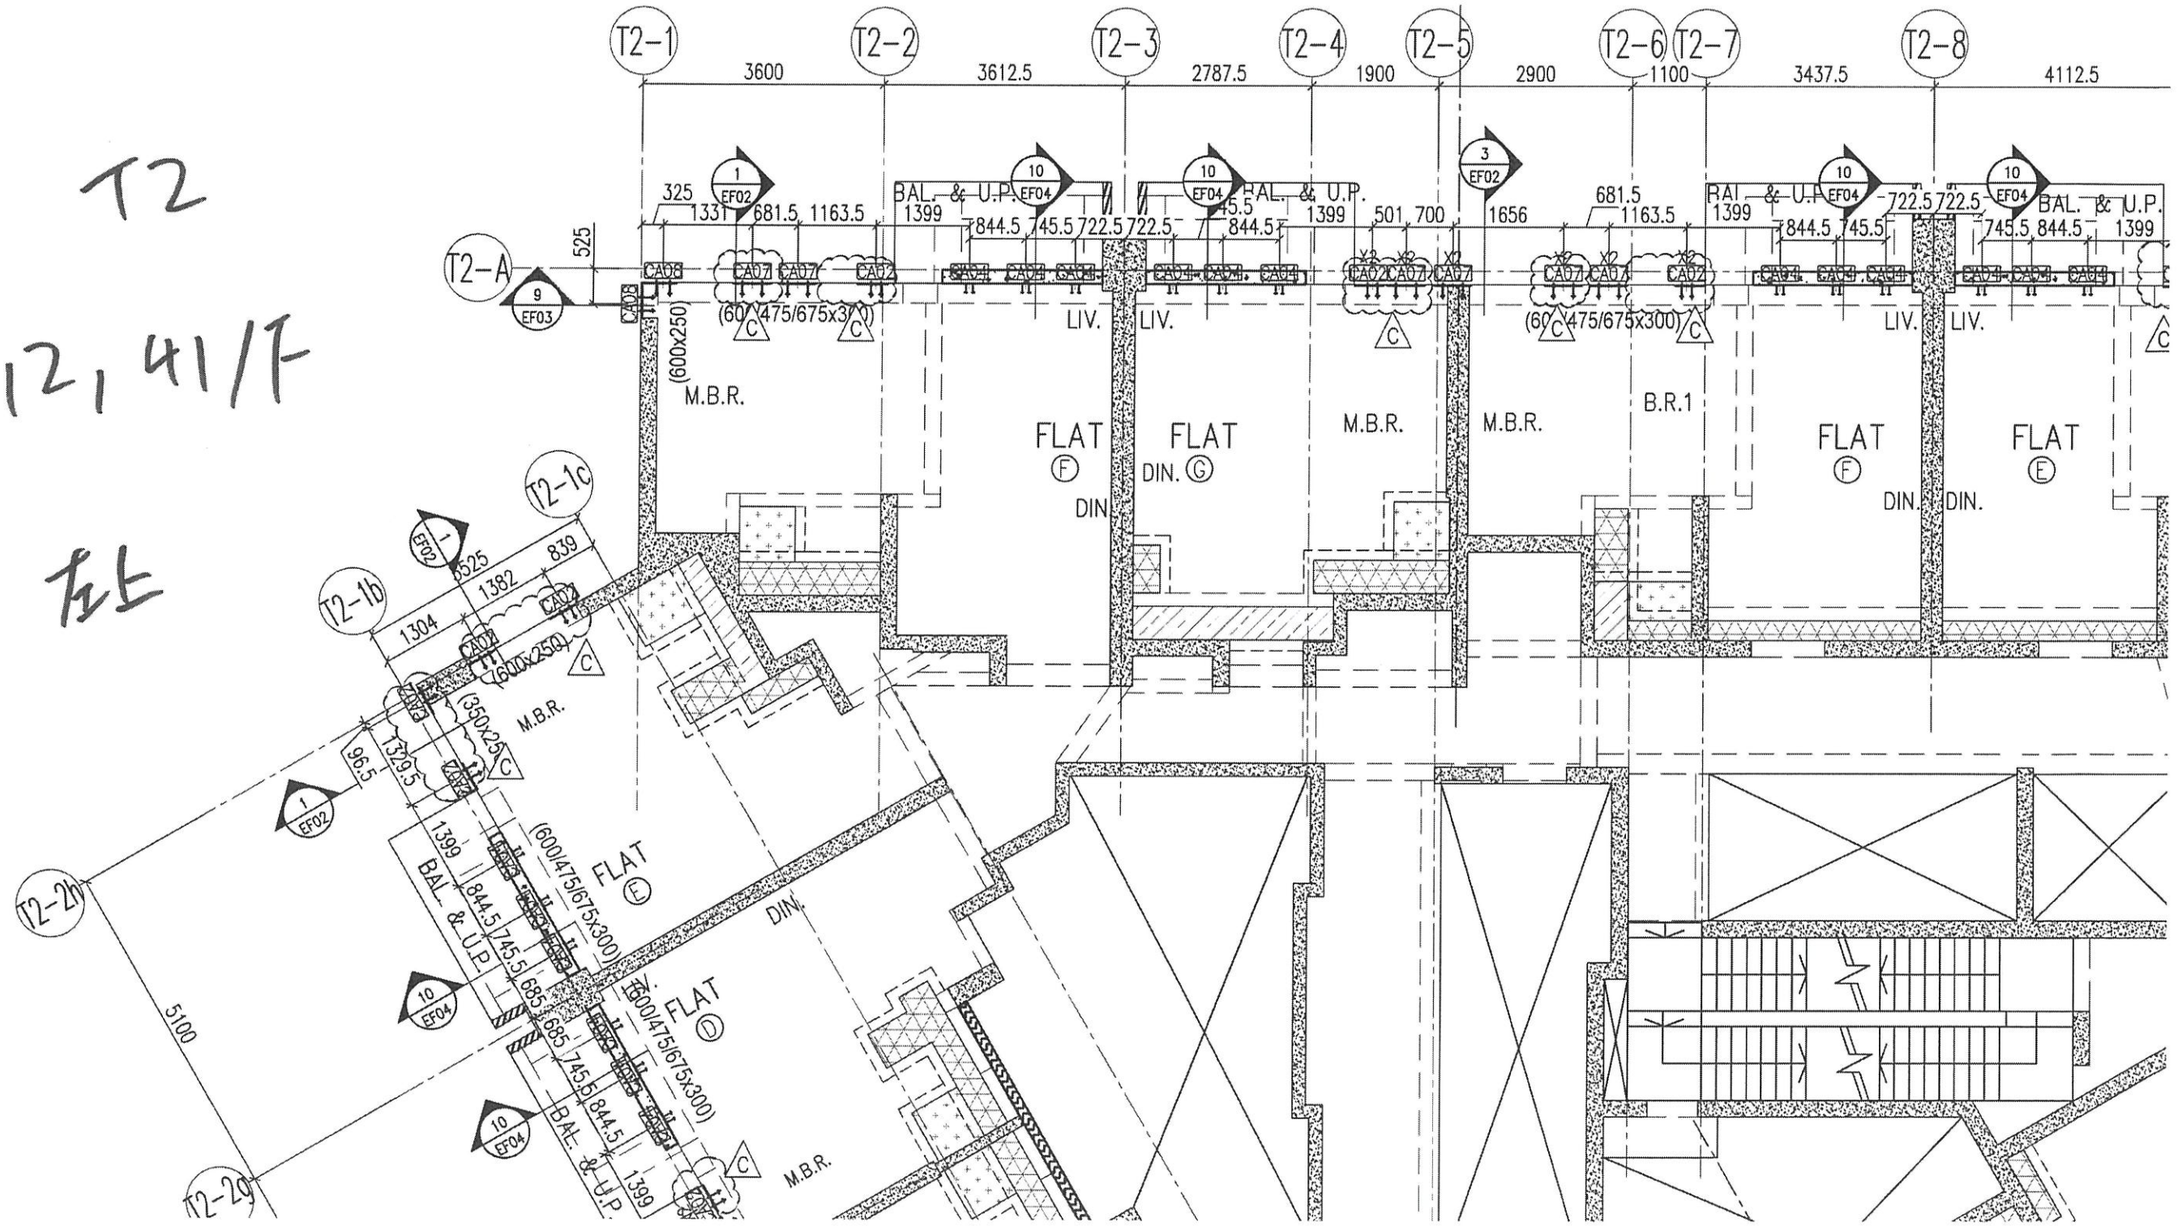

T2 12F & 41F

T2
12/F, 41/F
右上

T2-4 T2-5 T2-6 T2-7 T2-8 T2-9 T2-10 T2-11 T2-12 T2-13

1900 2900 1100 3437.5 4112.5 3175 2550 2600 1900

M.B.R. M.B.R. B.R.1 FLAT Ⓕ FLAT Ⓔ FLAT Ⓓ FLAT Ⓒ

DIN. DIN. LIV. LIV. DIN. LIV. DIN.

BAL. & U.P. BAL. & U.P. BAL. & U.P. BAL. & U.P.

(600/475/675x300) (600/475/675x300) (600/475/675x300)

(600x250)

T2-3a T2-2c T2-2b T2-2a

CLIENT :
信和置業有限公司
Sino Land Company


ARCHITECT :
ronald lu & partners
Architects . Planners . Interior Designers
Ronald Lu & Partners (HK
呂元祥建築師事務所（香港）有限

MAIN CONTRACTOR :
Gamm

STRUCTURAL ENGINEER :
AECOM

FACADE CONSULTANT:
AECOM

NOTE :
1. ALL DIMENSIONS ARE IN mm.
2. ALL ELEVATIONS ARE VIEWED FROM OU
3. ALL DIMENSIONS TO BE VERIFIED ON

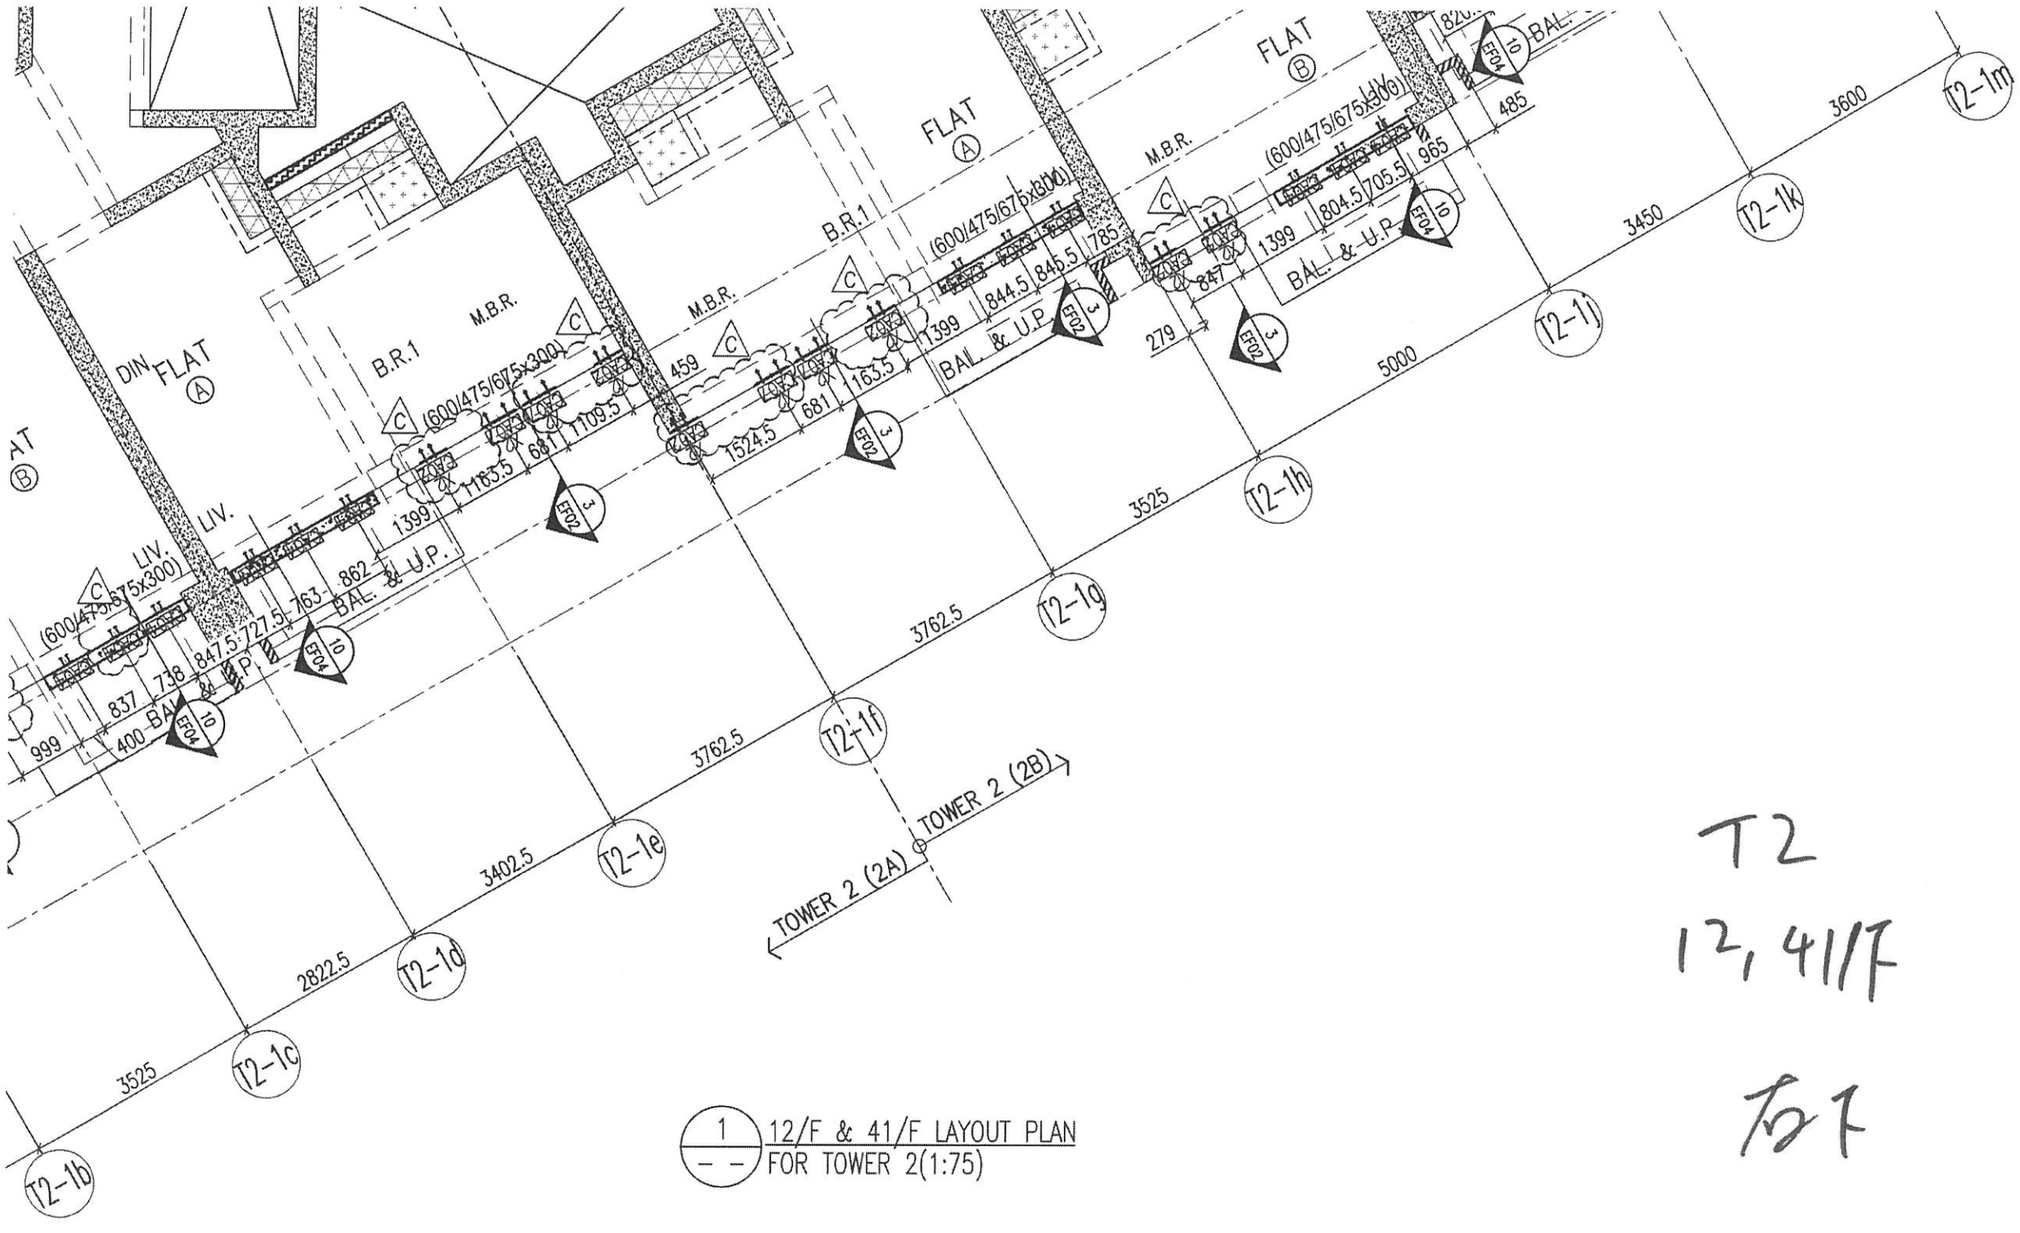

1 / – – 12/F & 41/F LAYOUT PLAN FOR TOWER 2(1:75)

T2
12, 41/F
67

2. ALL ELEVATIONS ARE VIEWED FROM O
3. ALL DIMENSIONS TO BE VERIFIED ON BEFORE FABRICATION.

LEGEND :

X1 / X001 — DETAIL MARK NO. / REFER SHEET NO.

1. F.F.L. -- FINISHED FLOOR LEVEL
2. S.F.L. -- STRUCTURAL FLOOR LEVEL
3. (/R) -- REVERSED DETAIL

NO.	DATE	REVISED
C	16/02/22	REVISED AS PER COMMENTS
B	20/12/21	REVISED AS PER COMMENTS
A	03/12/21	REVISED AS PER COMMENTS

JOB NO. : J-858

PROJECT :
PROPOSED RESIDENTIAL DEVELOI
AT TKOTL 70RP, PHASE 11, LOHA
TSEUNG KWAN O, N.T.

TITLE :
12/F & 41/F REFUGE FLOOR
AT TOWER 2

DATE : 22-OCT-21 | SCALE : 1:7

T2

12, 41/F

左下

CA09	1
CA04	39
CA06	4
CA08	6


T2 3/F & 4/F

T2 1/F & 40/F


T2

11, 40/F

左上

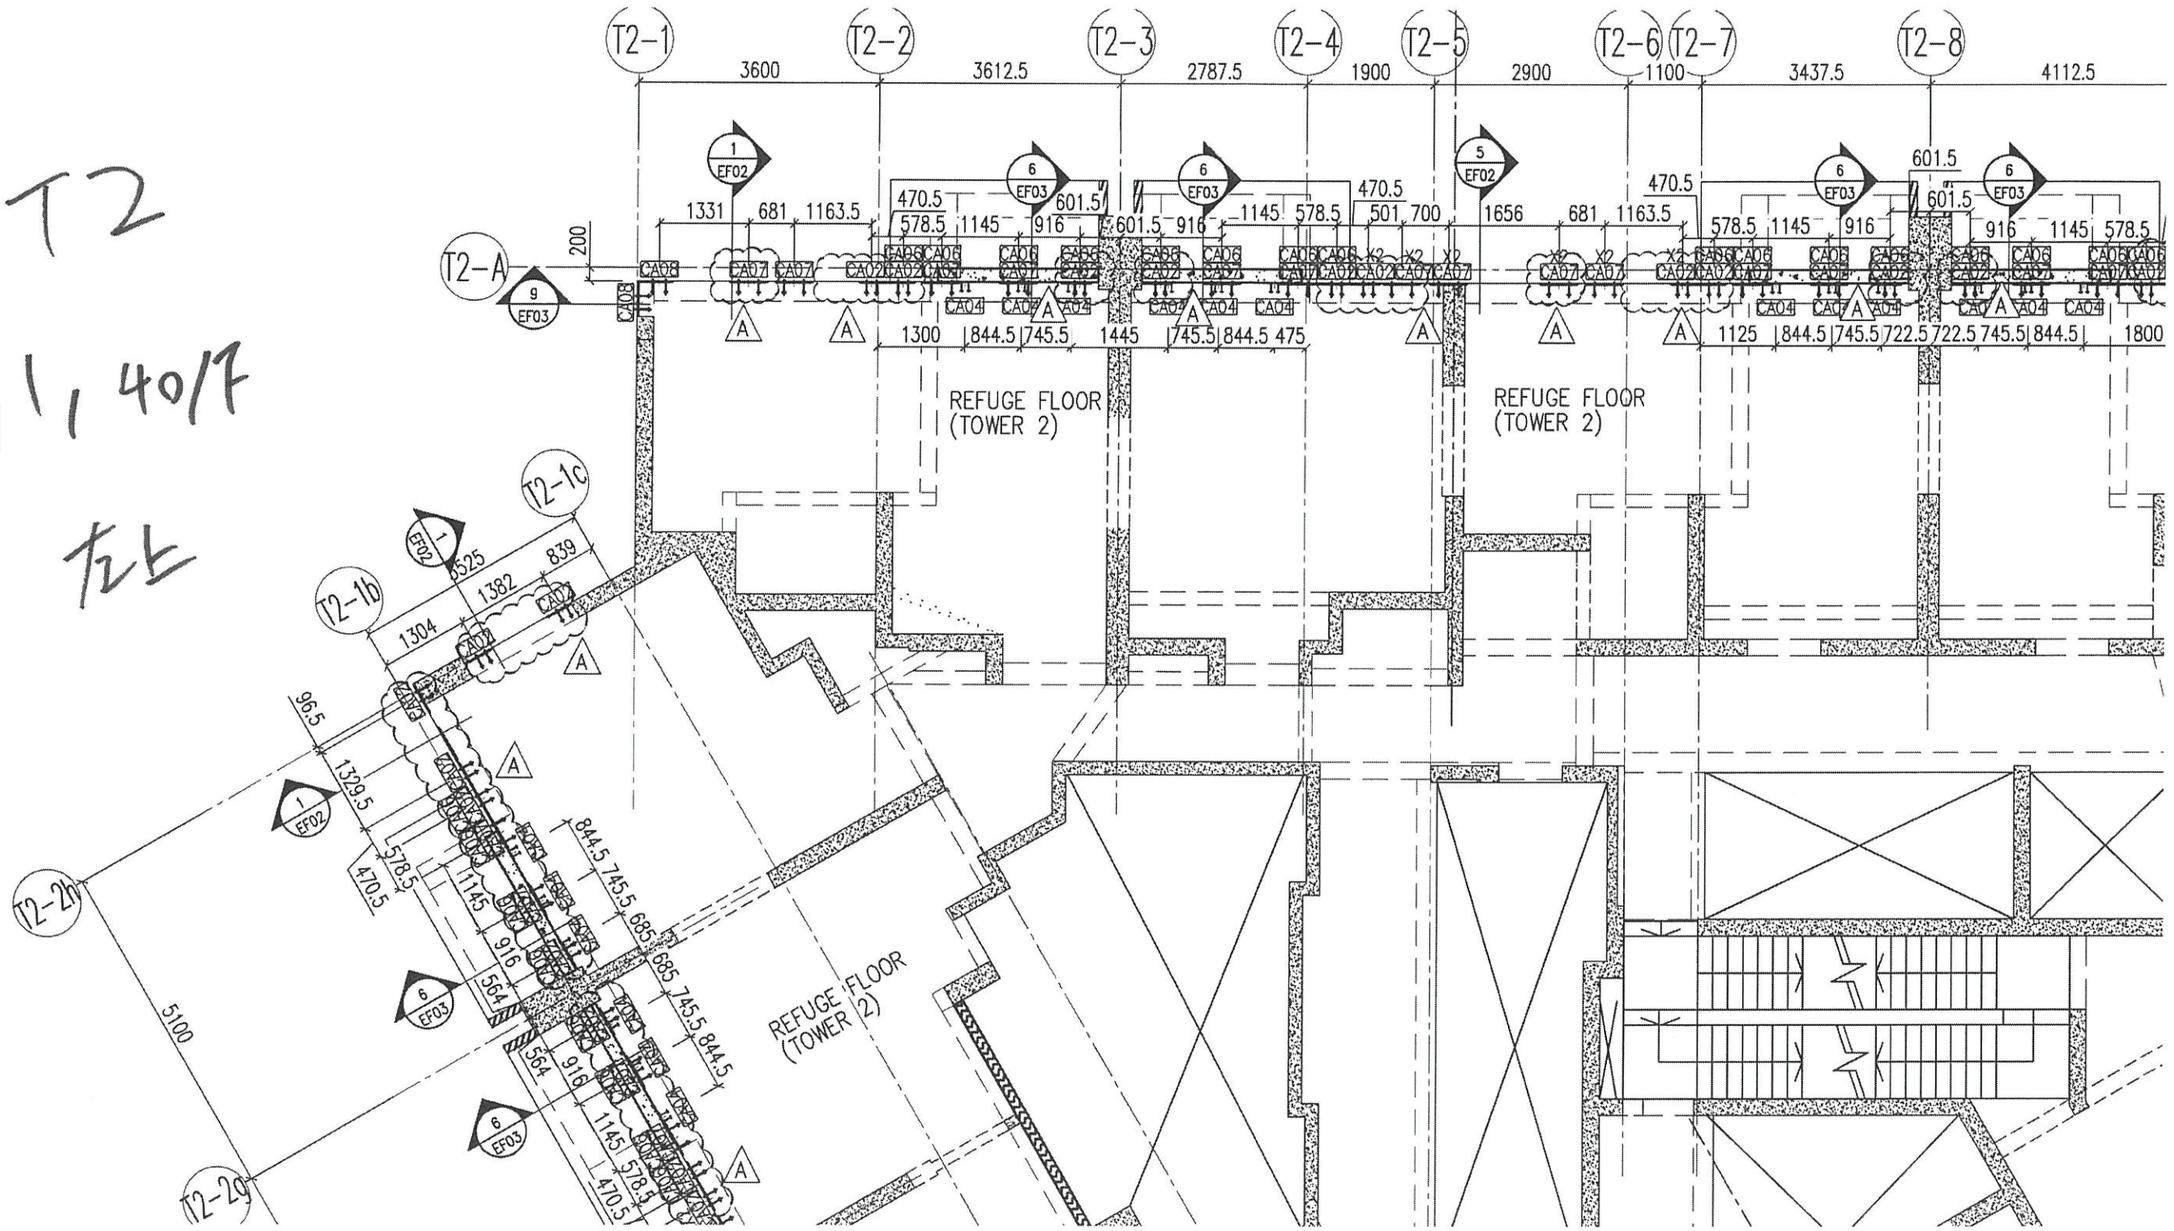

T2 11/F & 40/F

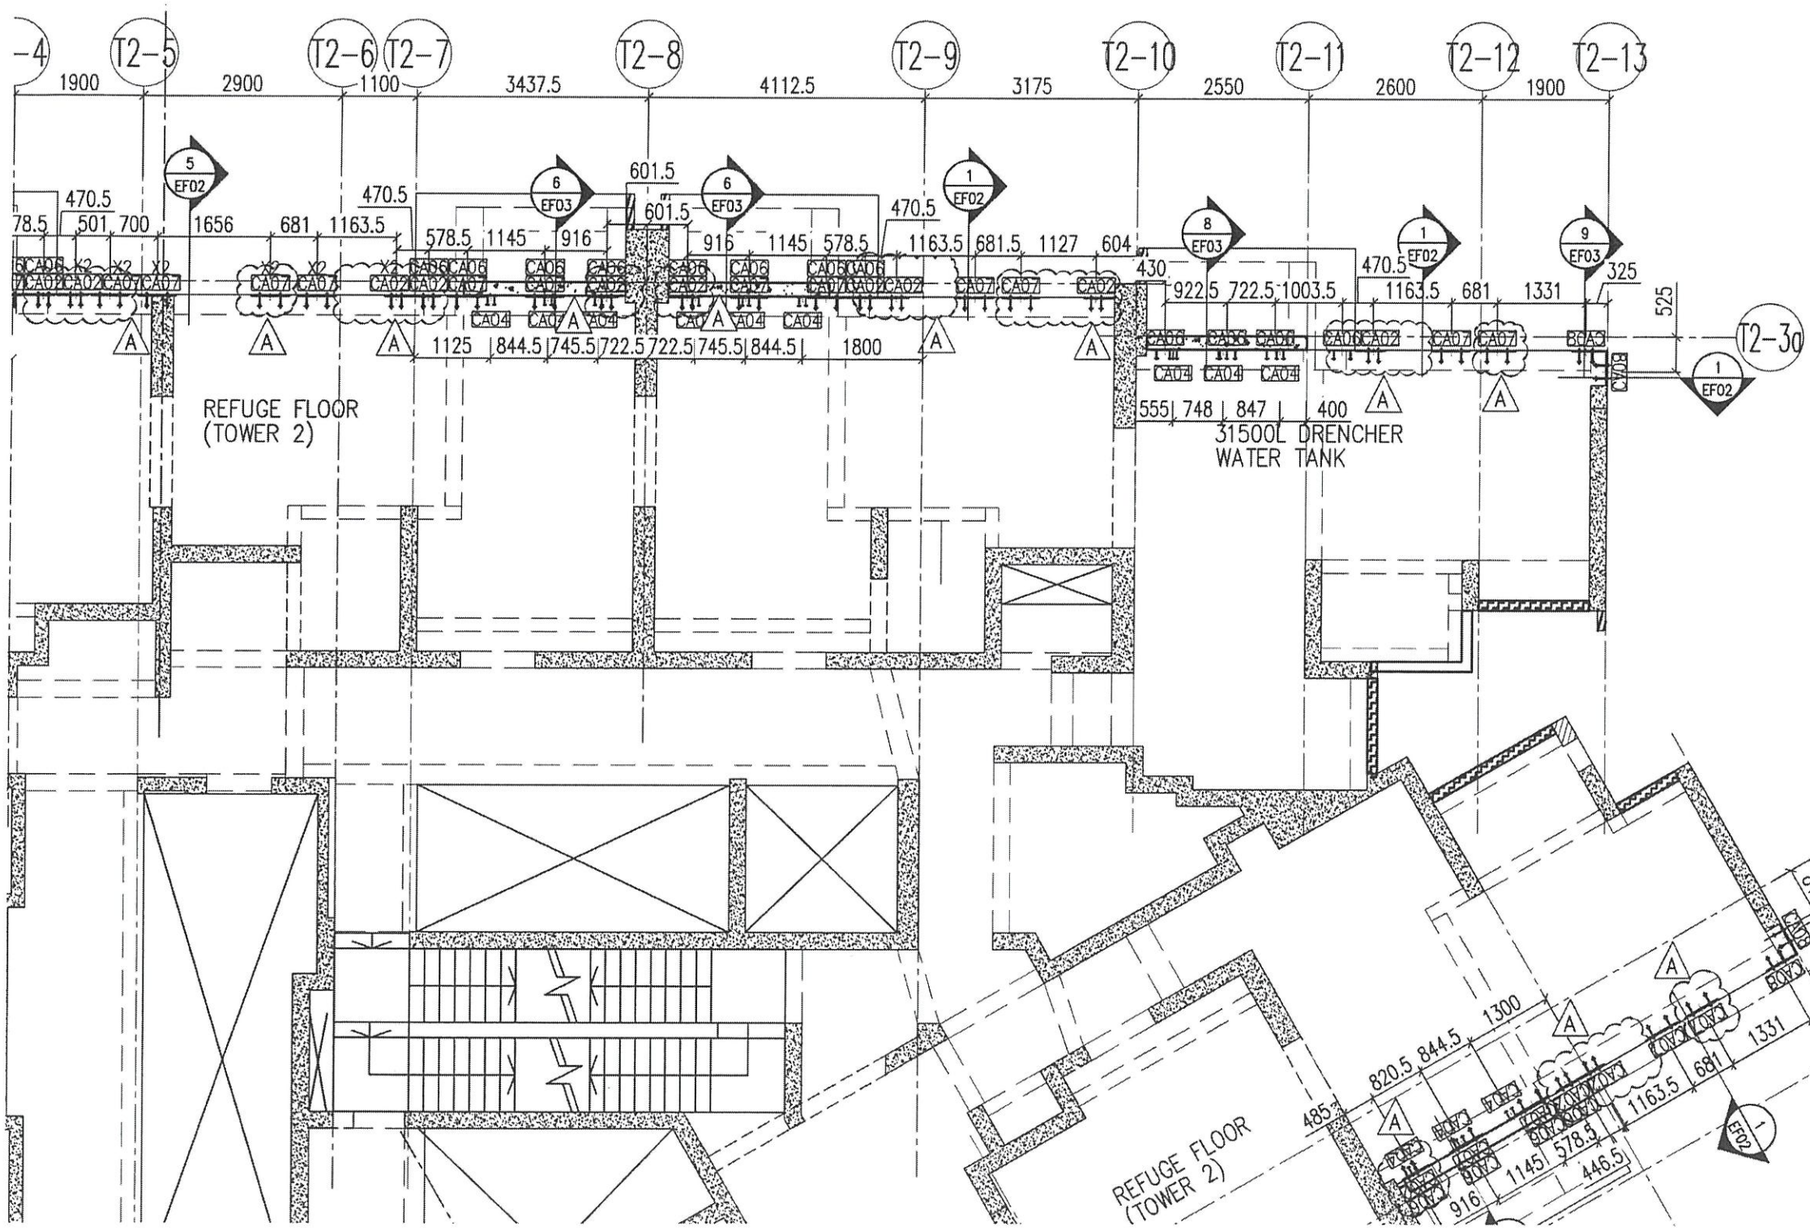

T2

11,4/F

右上

CLIENT :

信和置業有限公司
Sino Land Company

ARCHITECT :

ronald lu & partners
Architects . Planners . Interior Designers
Ronald Lu & Partners (HK
呂元祥建築師事務所(香港)有限

MAIN CONTRACTOR :

Gamm

STRUCTURAL ENGINEER :


AECOM

FACADE CONSULTANT:

AECOM

NOTE :

1. ALL DIMENSIONS ARE IN mm.
2. ALL ELEVATIONS ARE VIEWED FROM O
3. ALL DIMENSIONS TO BE VERIFIED ON

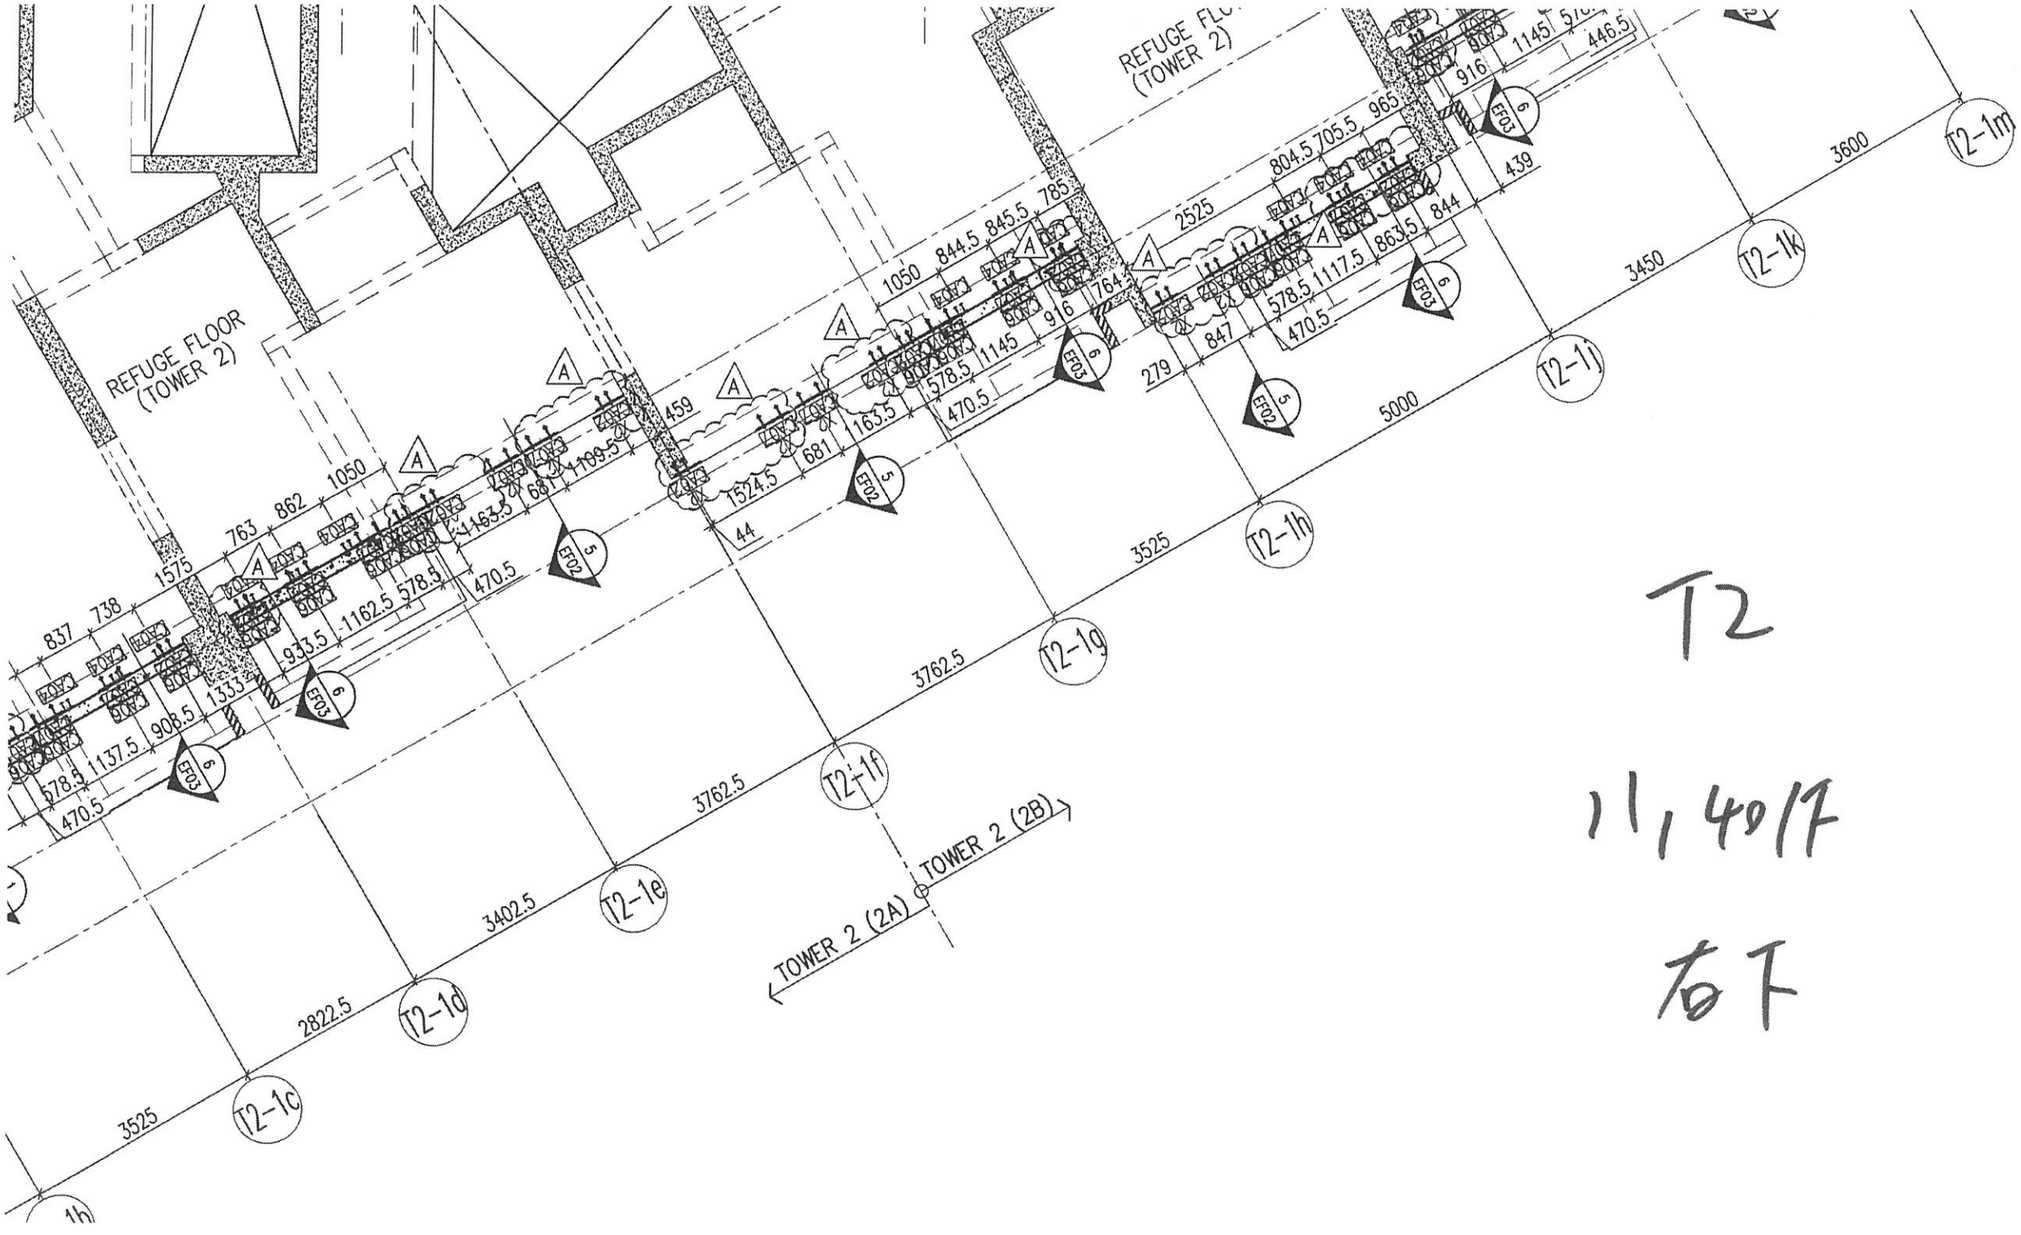

T2 1/F & 40/F

T2

11, 40/F

右下

1. ALL DIMENSIONS ARE IN mm.
2. ALL ELEVATIONS ARE VIEWED FROM O
3. ALL DIMENSIONS TO BE VERIFIED ON BEFORE FABRICATION.

LEGEND :

X1 — DETAIL MARK NO.
X001 — REFER SHEET NO.

1. F.F.L. -- FINISHED FLOOR LEVEL
2. S.F.L. -- STRUCTURAL FLOOR LEVEL
3. (/R) -- REVERSED DETAIL

NO.	DATE	REVISED
A	16/02/22	REVISED AS PER COMMENT

JOB NO. : J-858

PROJECT :
PROPOSED RESIDENTIAL DEVELO
AT TKOTL 70RP, PHASE 11, LOH
TSEUNG KWAN O, N.T.

TITLE :
11/F & 40/F REFUGE FLOOR
AT TOWER 2

T2
11, 40F
左下.




CA09	1
CA04	39

T2 4F & 40F

T3 9/F

T3 9/F 左上

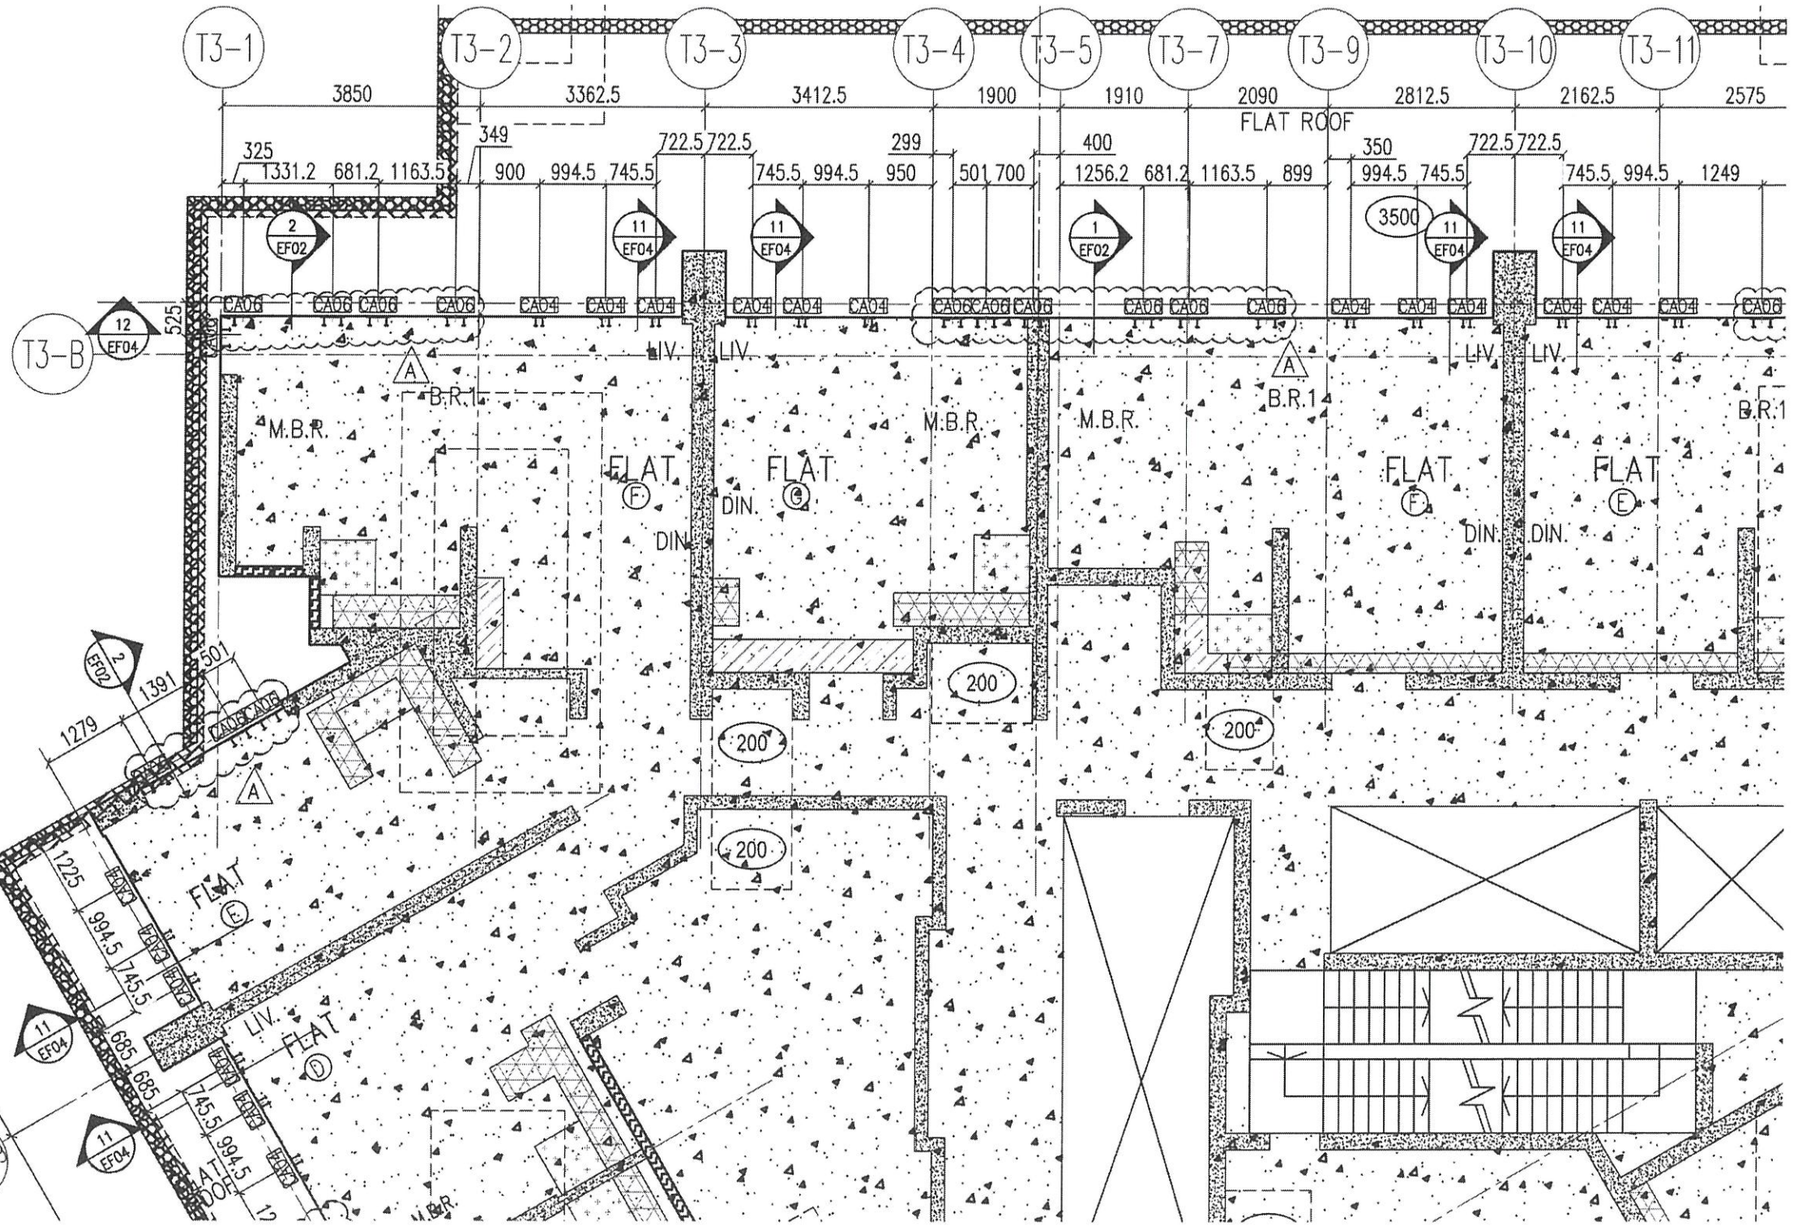
T3-1
T3-2
T3-3
T3-4
T3-5
T3-7
T3-9
T3-10
T3-11
T3-B
T3-2h
T3-2g
3850
3362.5
3412.5
1900
1910
2090
2812.5
2162.5
2575
FLAT ROOF
325
1331.2
681.2
1163.5
349
900
994.5
745.5
722.5
722.5
745.5
994.5
299
950
501
700
400
1256.2
681.2
1163.5
899
350
994.5
745.5
722.5
722.5
745.5
994.5
1249
3500
525
LIV.
B.R.1
M.B.R.
FLAT
DIN.
200
501
1391
1279
CADPLANTS
1225
994.5
745.5
685
685
745.5
994.5
3650
12
EF04
2
EF02
11
EF04
1
EF02
A

T3. 9/F

T3 9/F

左上

T3-3 T3-4 T3-5 T3-7 T3-9 T3-10 T3-11 T3-12 T3-13 T3-14 T3-15 T3-16 T3-17

3412.5 1900 1910 2090 2812.5 2162.5 2575 2550 2550 1675 2400 2225

FLAT ROOF FLAT ROOF

2.5 722.5 299 400 350 722.5 722.5 137.5 250

745.5 994.5 950 501 700 1256.2 681.2 1163.5 899 994.5 745.5 745.5 994.5 1249 1026 681.2 1127.2 604 555 748 997 999 638.5 700 1425 700 1312.5 525

3500

11 EF04 1 EF02 11 EF04 11 EF04 2 EF02 11 EF04 2 EF02 12 EF04

T3-A

525

LIV. M.B.R. FLAT DIN. B.R.1 STORE

200

COMMON FLAT ROOF

815 2500 1101 250

CLIENT :

ARCHITECT :

Architects

Ronal

呂元祥


MAIN CONTRA

STRUCTURAL

FACADE CONS

NOTE :

1. ALL DIMEN

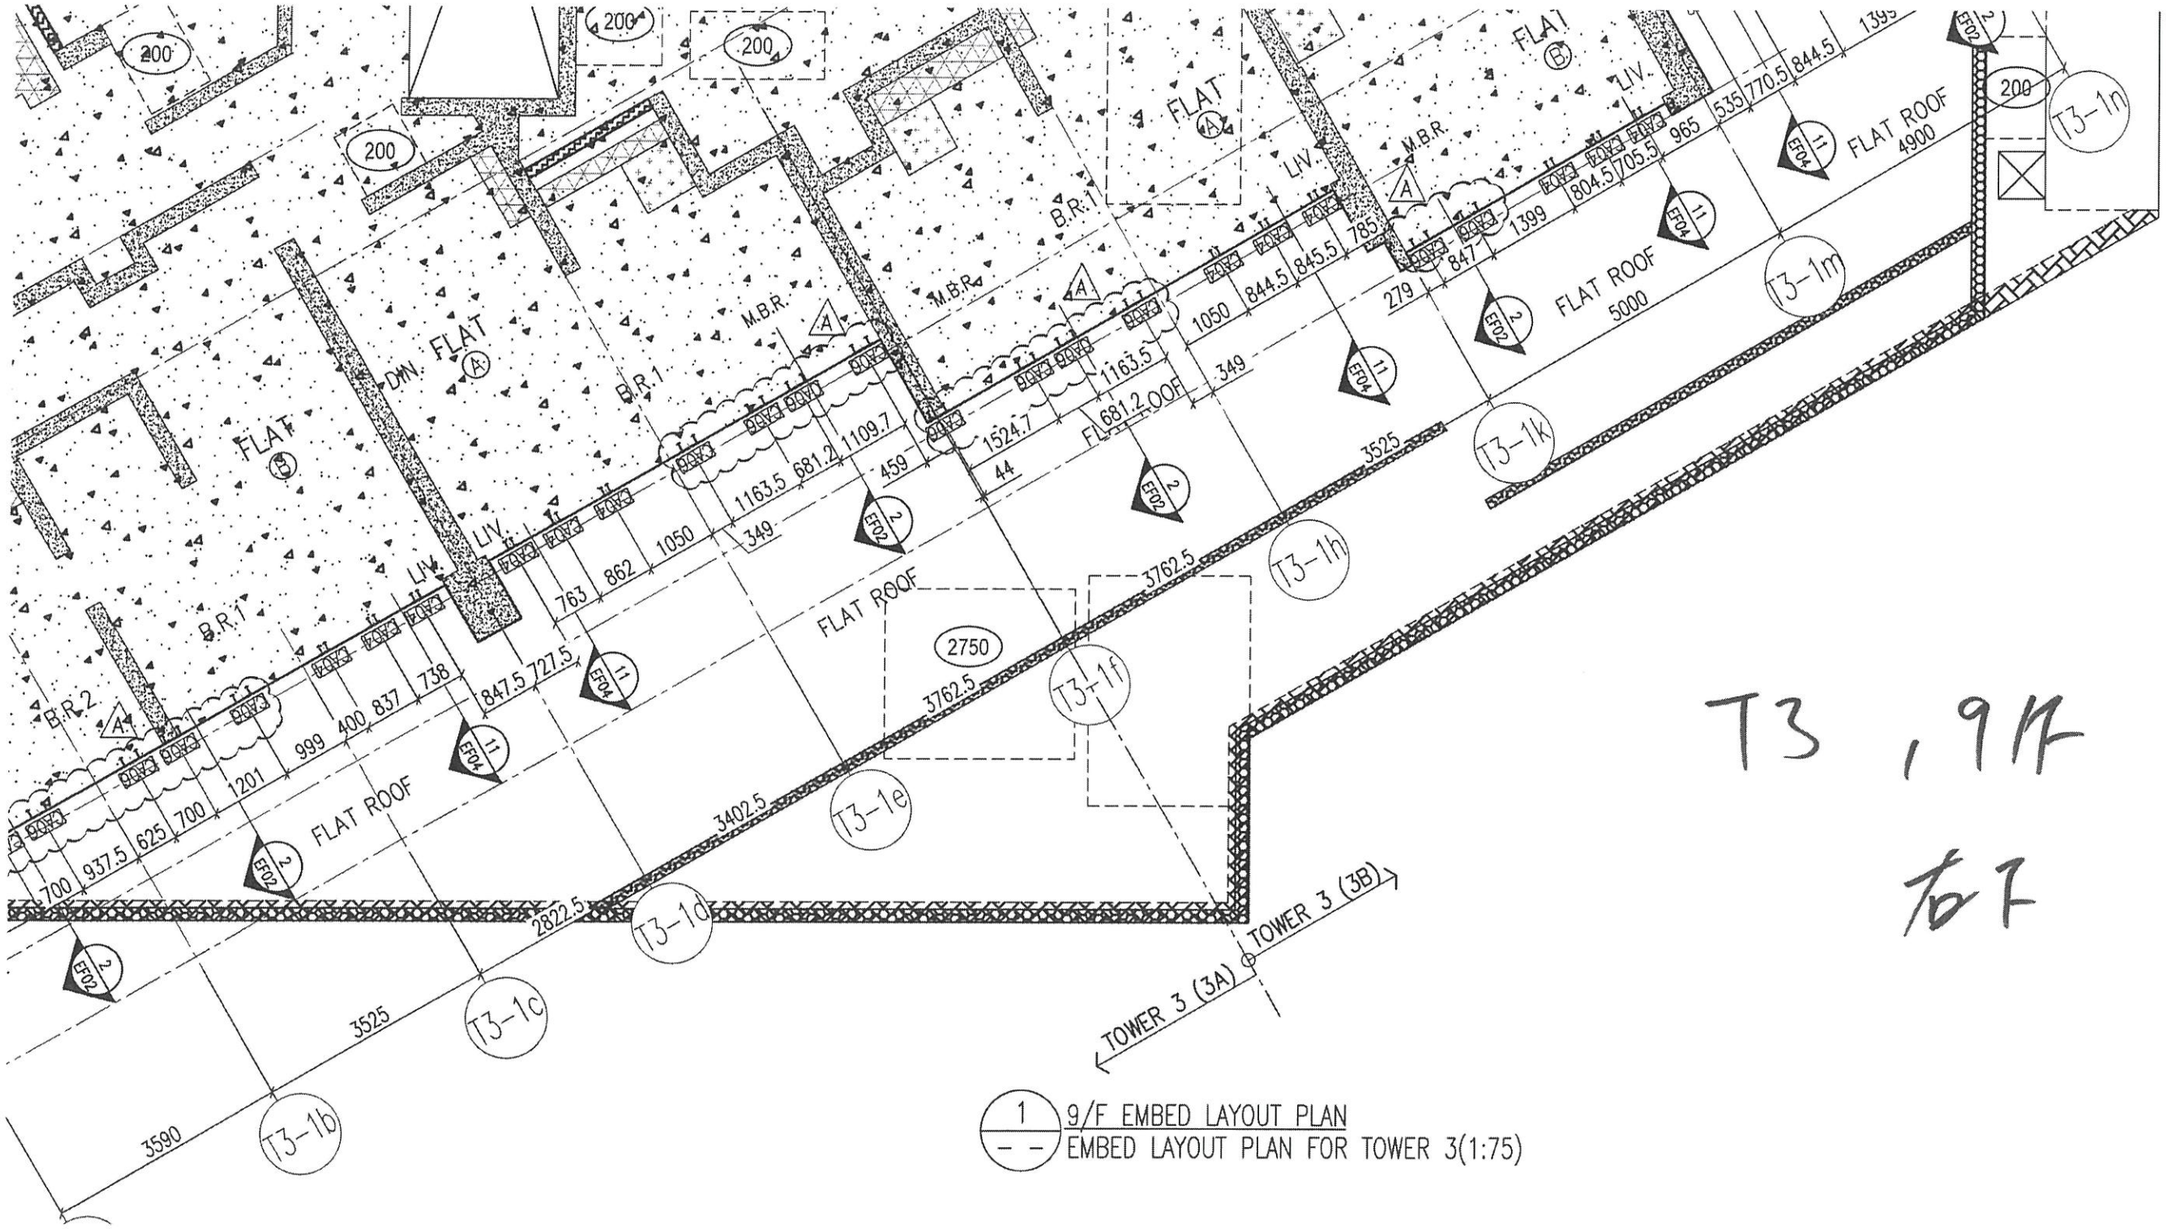

1 / – – 9/F EMBED LAYOUT PLAN
EMBED LAYOUT PLAN FOR TOWER 3(1:75)

T3, 9F
右下

2. ALL ELEV
3. ALL DIME
BEFORE F

LEGEND :

X1 / X001

1. F.F.L. --
2. S.F.L. --
3. (R) --

NO.	DATE
A	16/02/22

JOB NO. :

PROJECT :
PROP
AT TKO

TITLE :
TYPI
AT T

DATE : 22-0

T3


9/F

左下.


T3-2f
T3-2e
T3-2d
T3-2c
T3-2b
T3-2a
T3-1f
T3-1e
T3-1d
T3-1c
T3-1b
4925
4800
1950
5175
1440
1350
3590
3525
2822.5
3402.5
3762.5
2750
FLAT ROOF
FLAT Ⓒ
FLAT Ⓑ
FLAT Ⓐ
DWN
LIV.
M.B.R.
B.R.1
B.R.2
200
EF02
EF04
T3
9/F
EMBE


T3 10/F, 15/F ~ 39/F, 42/F ~ 66/F
(13/F, 14/F, 24/F, 34/F, 44/F, 54/F Floors omitted)

T3
樓梯間
左上

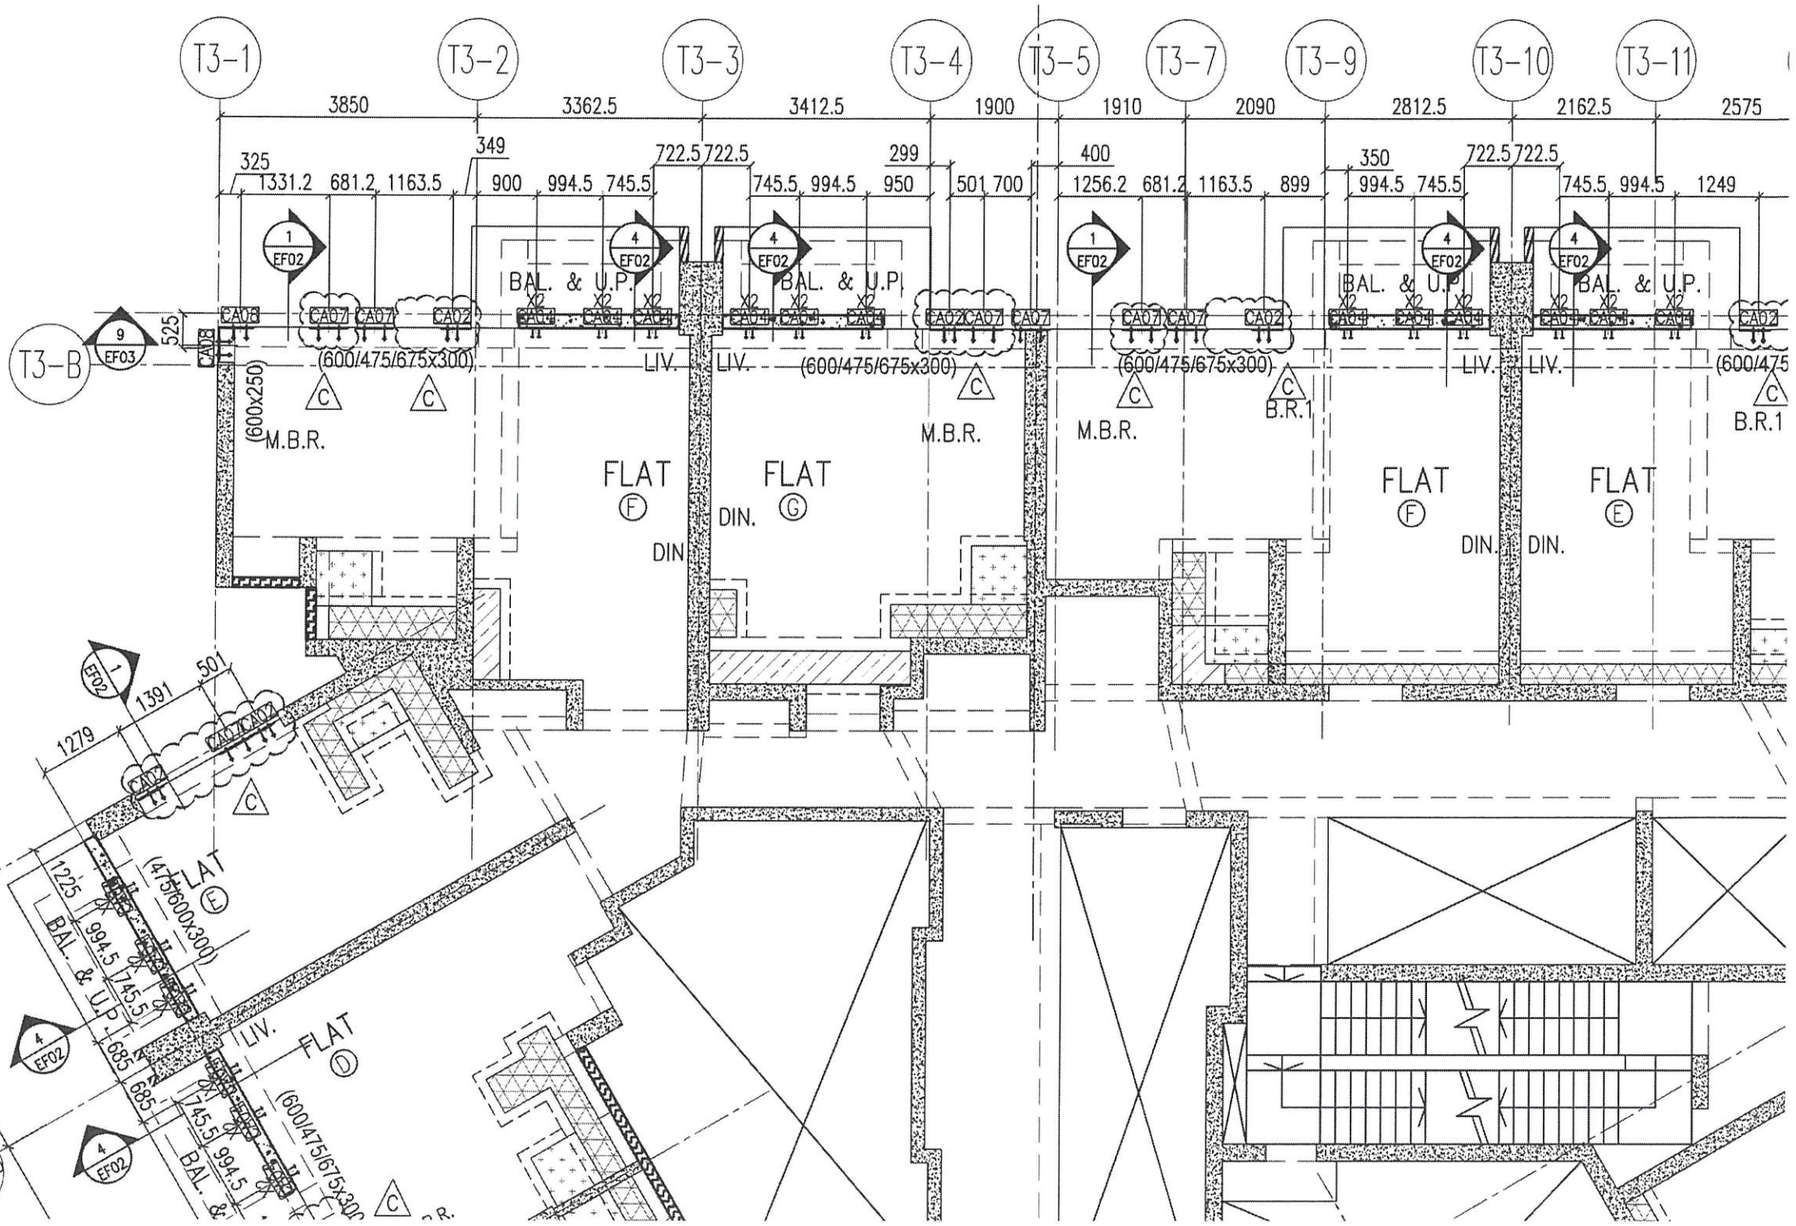

T3 10/F, 15/F ~ 39/F, 47/F ~ 66/F
(13/F, 14/F, 24/F, 34/F, 44/F, 54/F Floors omitted)

T3
標準層
右上

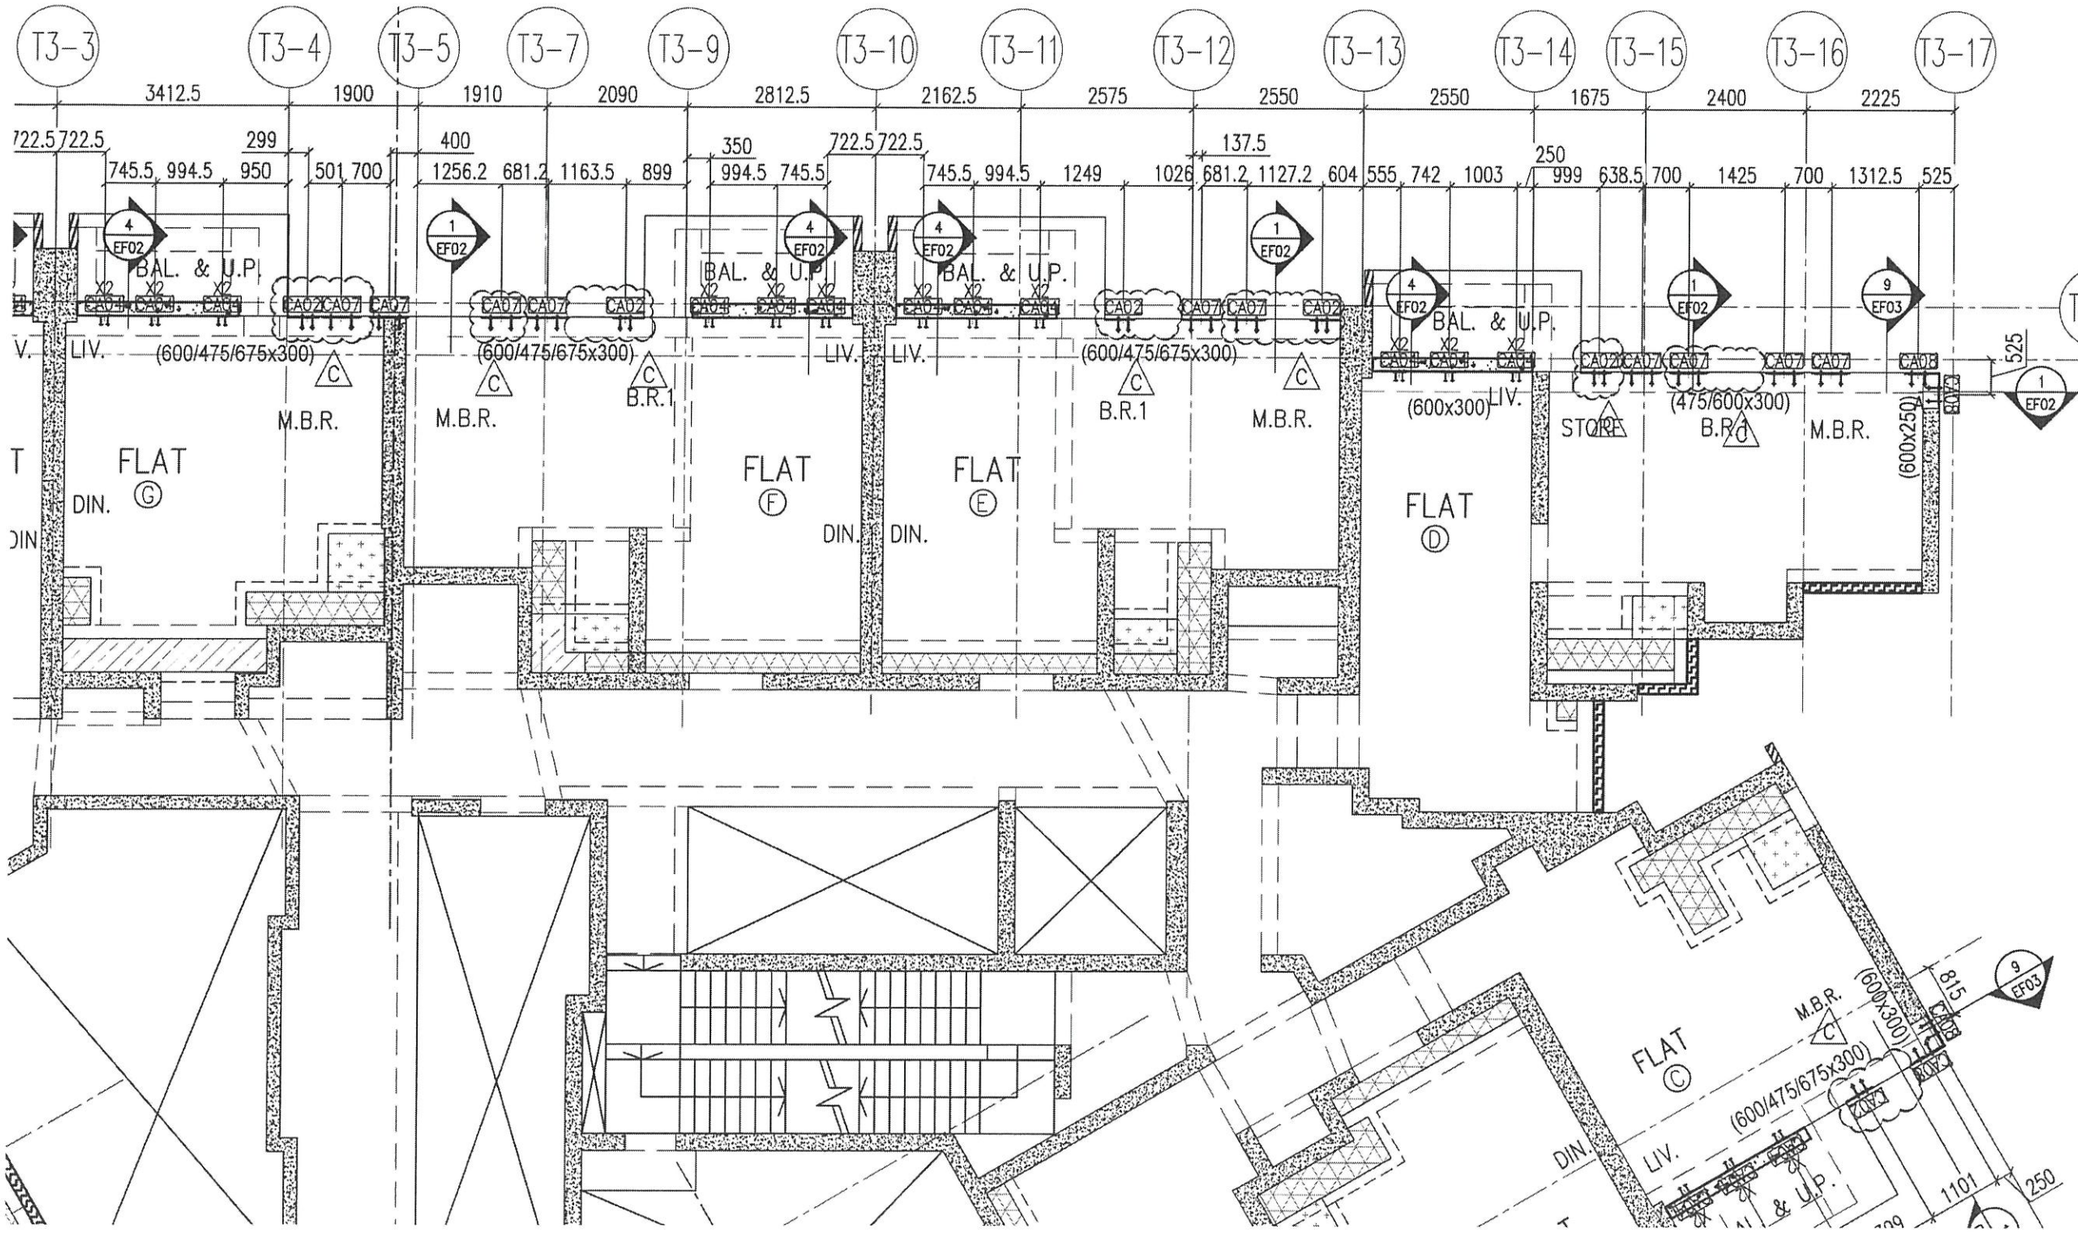

CLIENT :


ARCHITECT
Architec
Ron
呂元祥

MAIN CONT

STRUCTURA

FACADE CO

NOTE :
1. ALL DIM
2. ALL ELI

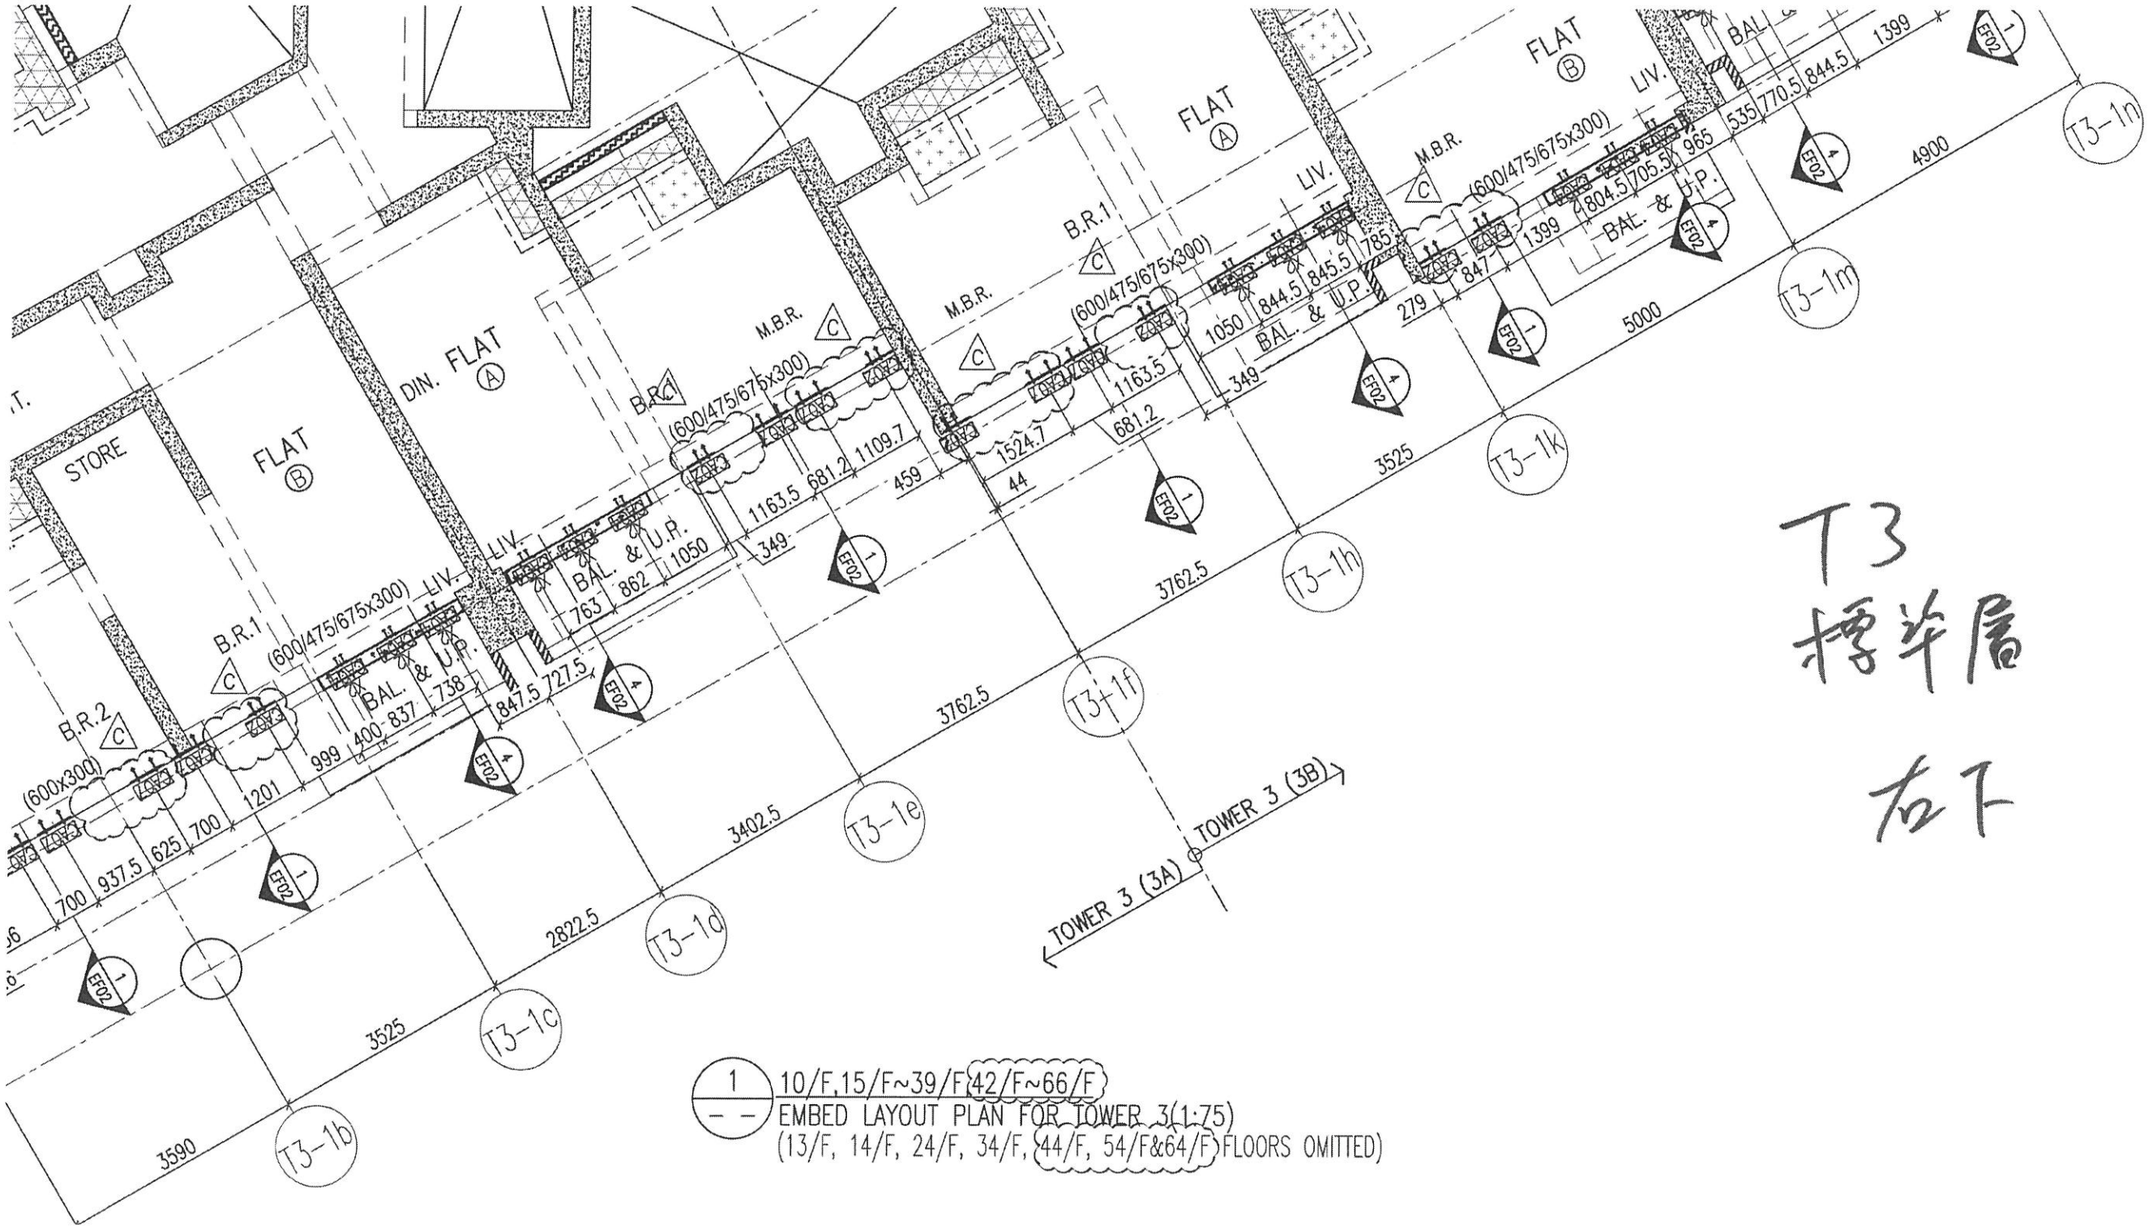

1 / -- 10/F,15/F~39/F,42/F~66/F
EMBED LAYOUT PLAN FOR TOWER 3(1:75)
(13/F, 14/F, 24/F, 34/F, 44/F, 54/F&64/F FLOORS OMITTED)

T3
標準層
右下

2. ALL EL
3. ALL DIM
BEFORE

LEGEND :

X1 / X001

1. F.F.L. –
2. S.F.L. –
3. (/R) –

NO.	DATE
C	16/02/
B	20/12/
A	03/12/

JOB NO. :

PROJECT :
PR(
AT T


TITLE :
TY
AT

DATE : 22·

65/F	+206.70
63/F	+203.40
62/F	+200.10
61/F	+196.80
60/F	+193.50
59/F	+190.20
58/F	+186.90
57/F	+183.60
56/F	+180.30
55/F	+177.00
53/F	+173.70
52/F	+170.40
51/F	+167.10
50/F	+163.80
49/F	+160.50
48/F	+157.20
47/F	+153.90
46/F	+150.60
45/F	+147.30
43/F	+144.00
42/F	+140.70
39/F	+130.85
38/F	+127.55
37/F	+124.25
36/F	+120.95
35/F	+117.65
33/F	+114.35
32/F	+111.05
31/F	+107.75
30/F	+104.45
29/F	+101.15
28/F	+97.85
27/F	+94.55
26/F	+91.25
25/F	+87.95
23/F	+84.65
22/F	+81.35
21/F	+78.05
20/F	+74.75
19/F	+71.45

T3
樓平屋

左下

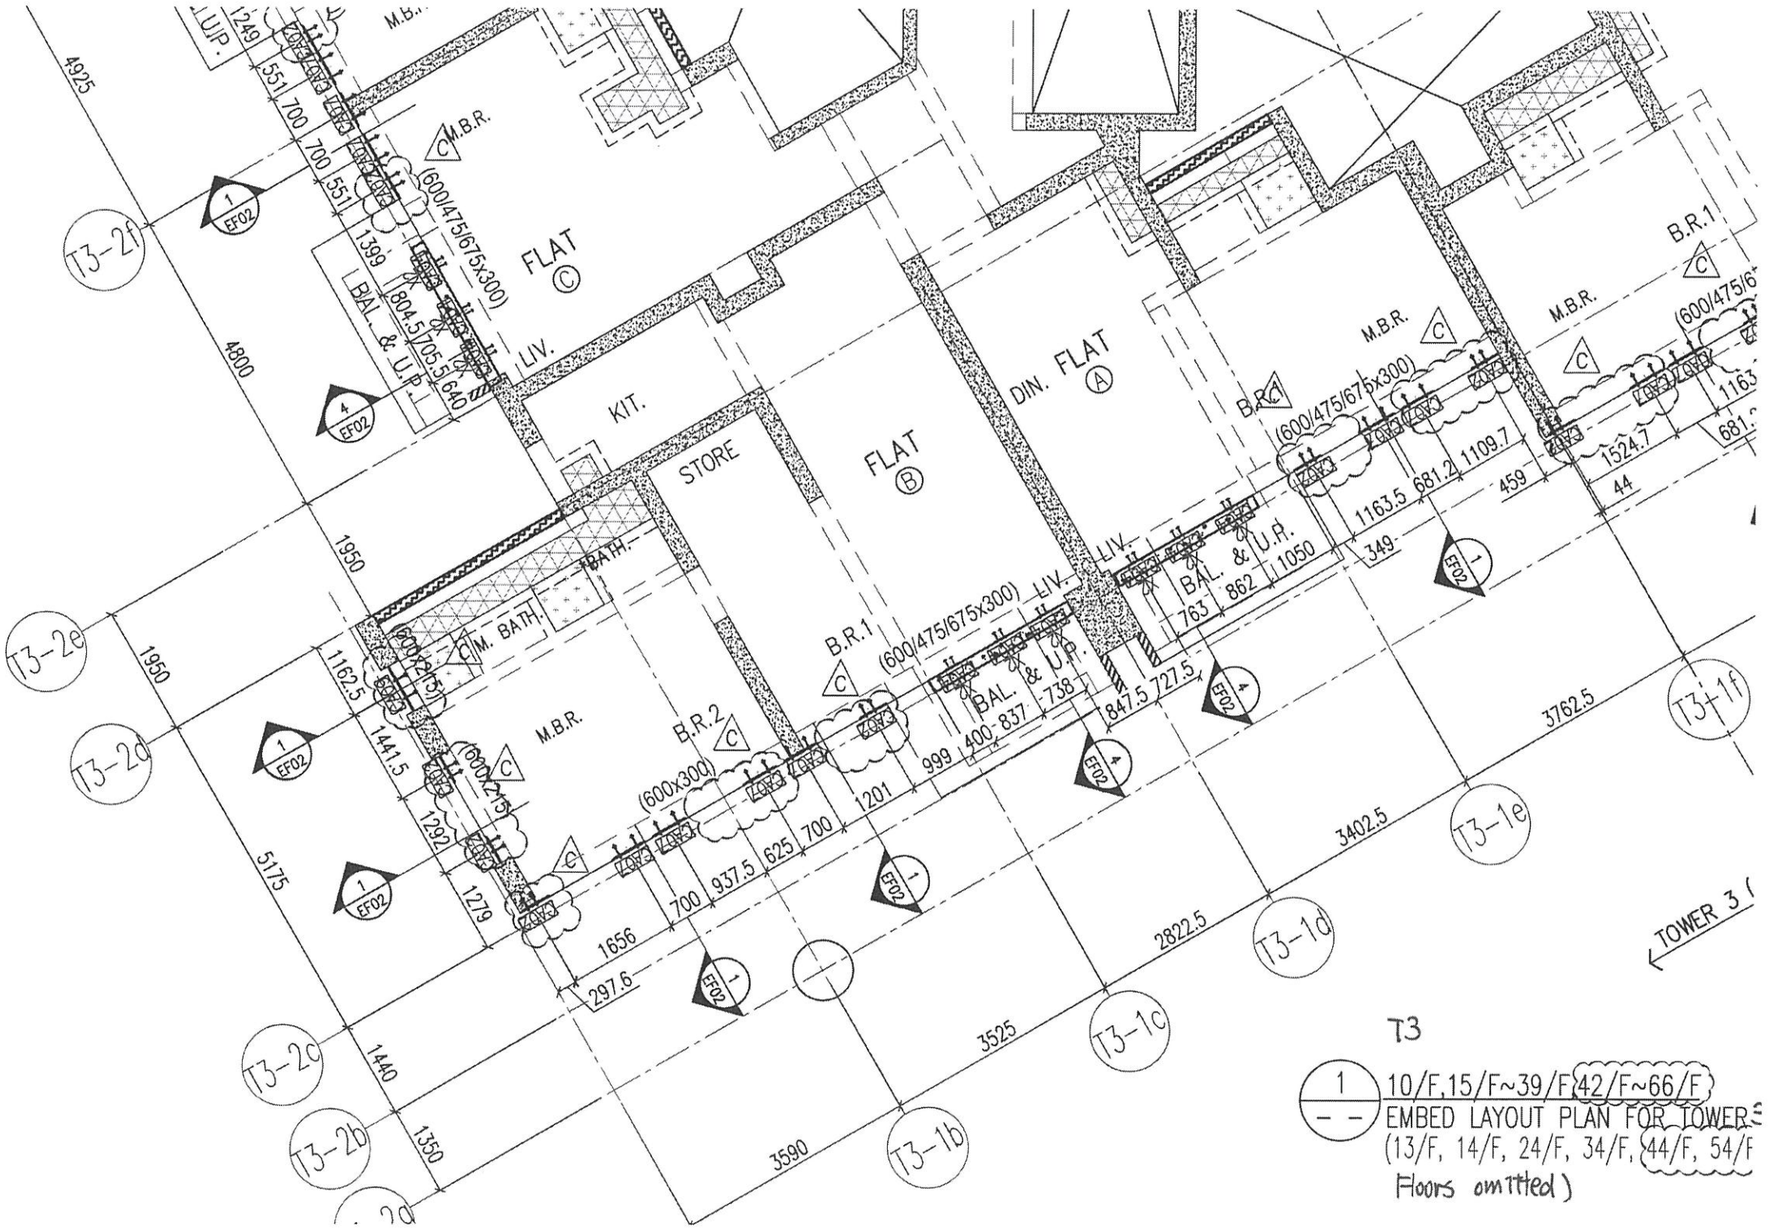

T3


1 / - - 10/F,15/F~39/F,42/F~66/F
EMBED LAYOUT PLAN FOR TOWER 3
(13/F, 14/F, 24/F, 34/F, 44/F, 54/F
Floors omitted)

T3 12/F & 4/F


T3

12, 4/F

左上

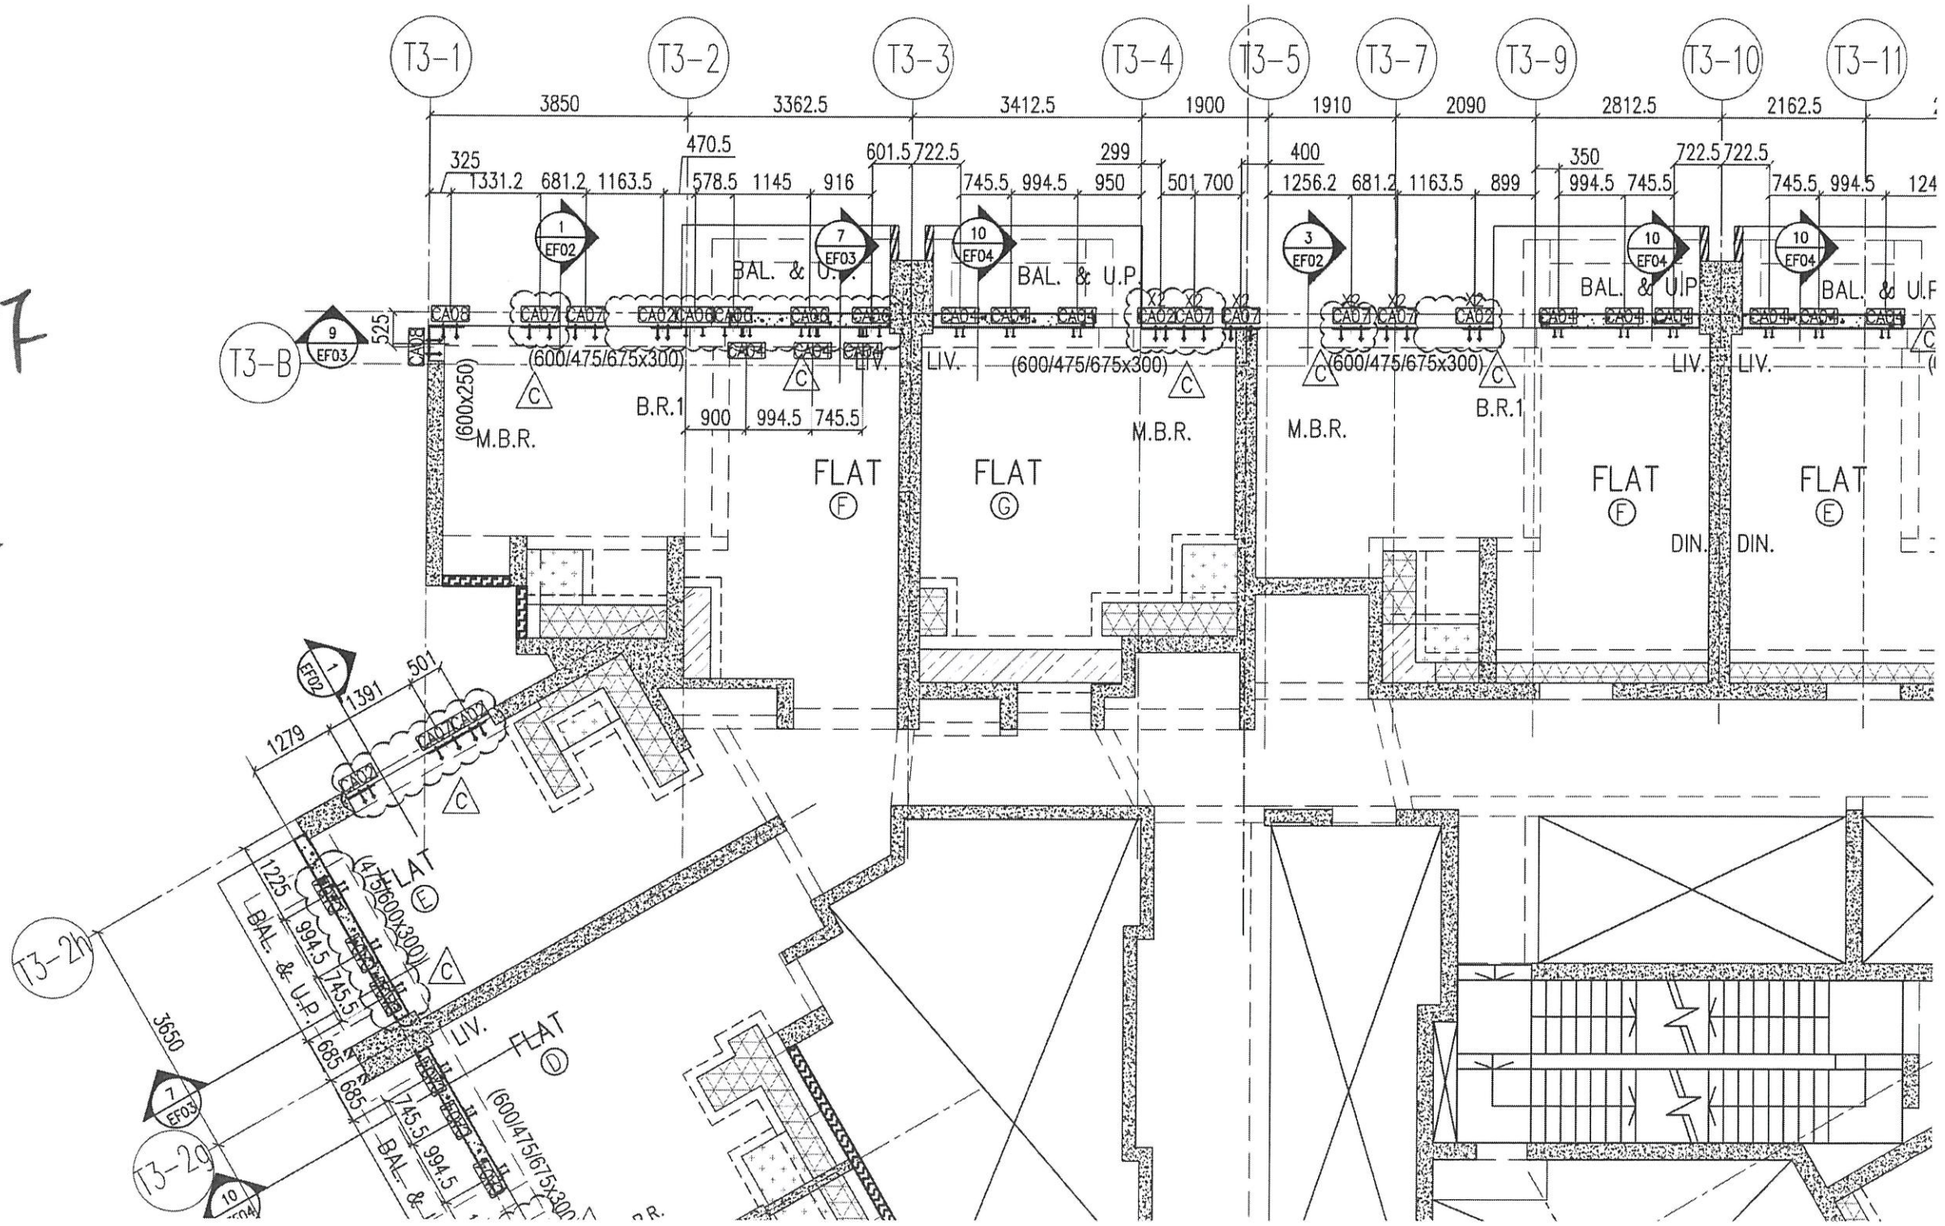

T3 13/F & 41/F

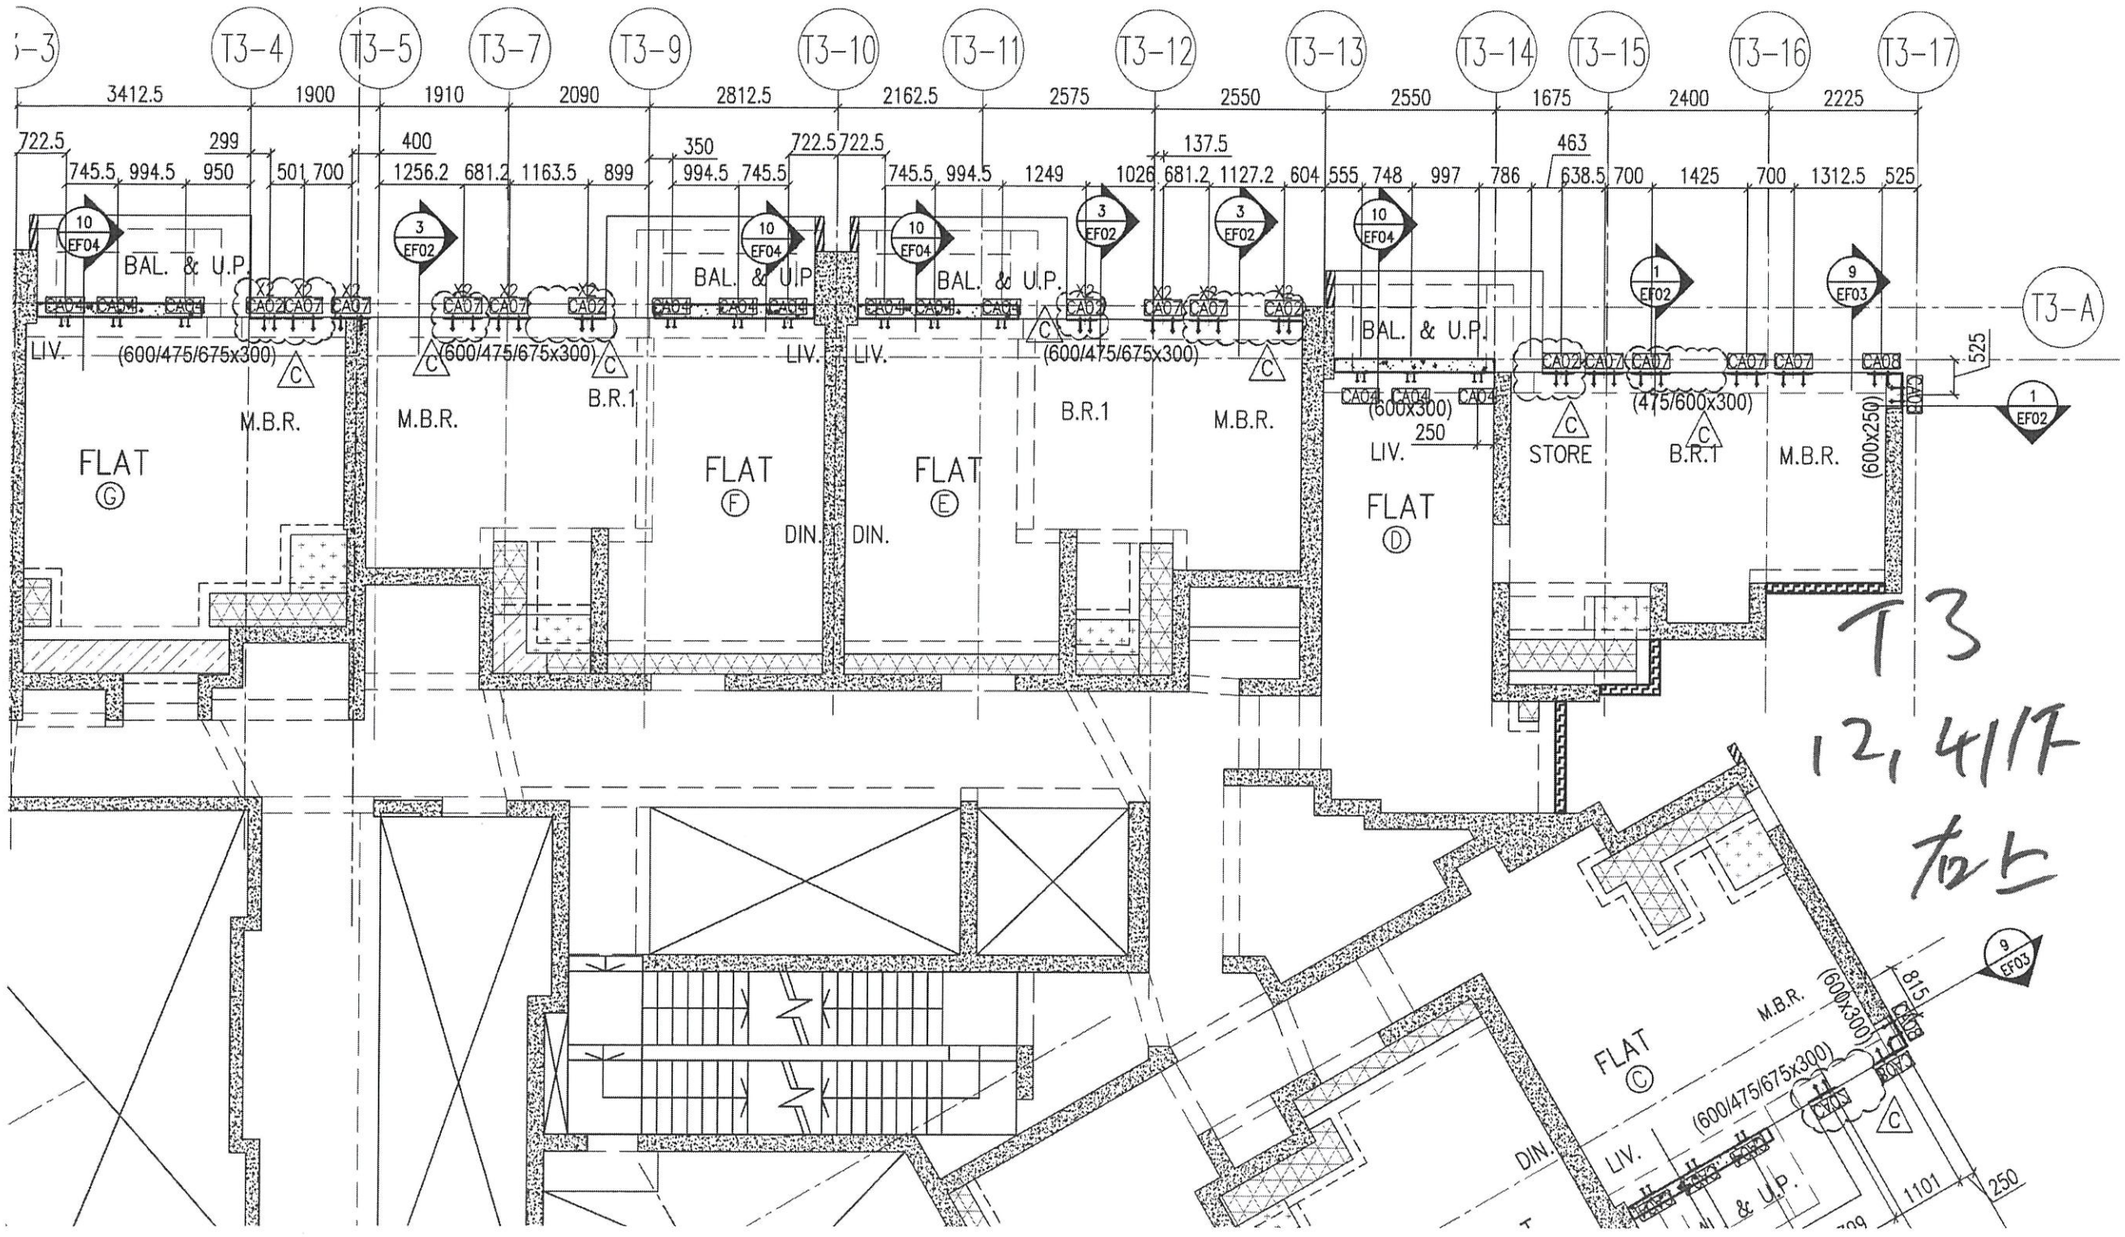

T3
12, 41/F
右上

CLIENT :
信和置業有
Sino Land Cor


ARCHITECT :
ronald lu
& partners
Architects . Planners . Interior Designe
Ronald Lu & Partne
呂元祥建築師事務所（香

MAIN CONTRACTOR :
Gam

STRUCTURAL ENGINEER :
AEC

FACADE CONSULTANT:
AEC

NOTE :
1. ALL DIMENSIONS ARE IN mm
2. ALL ELEVATIONS ARE VIEWED

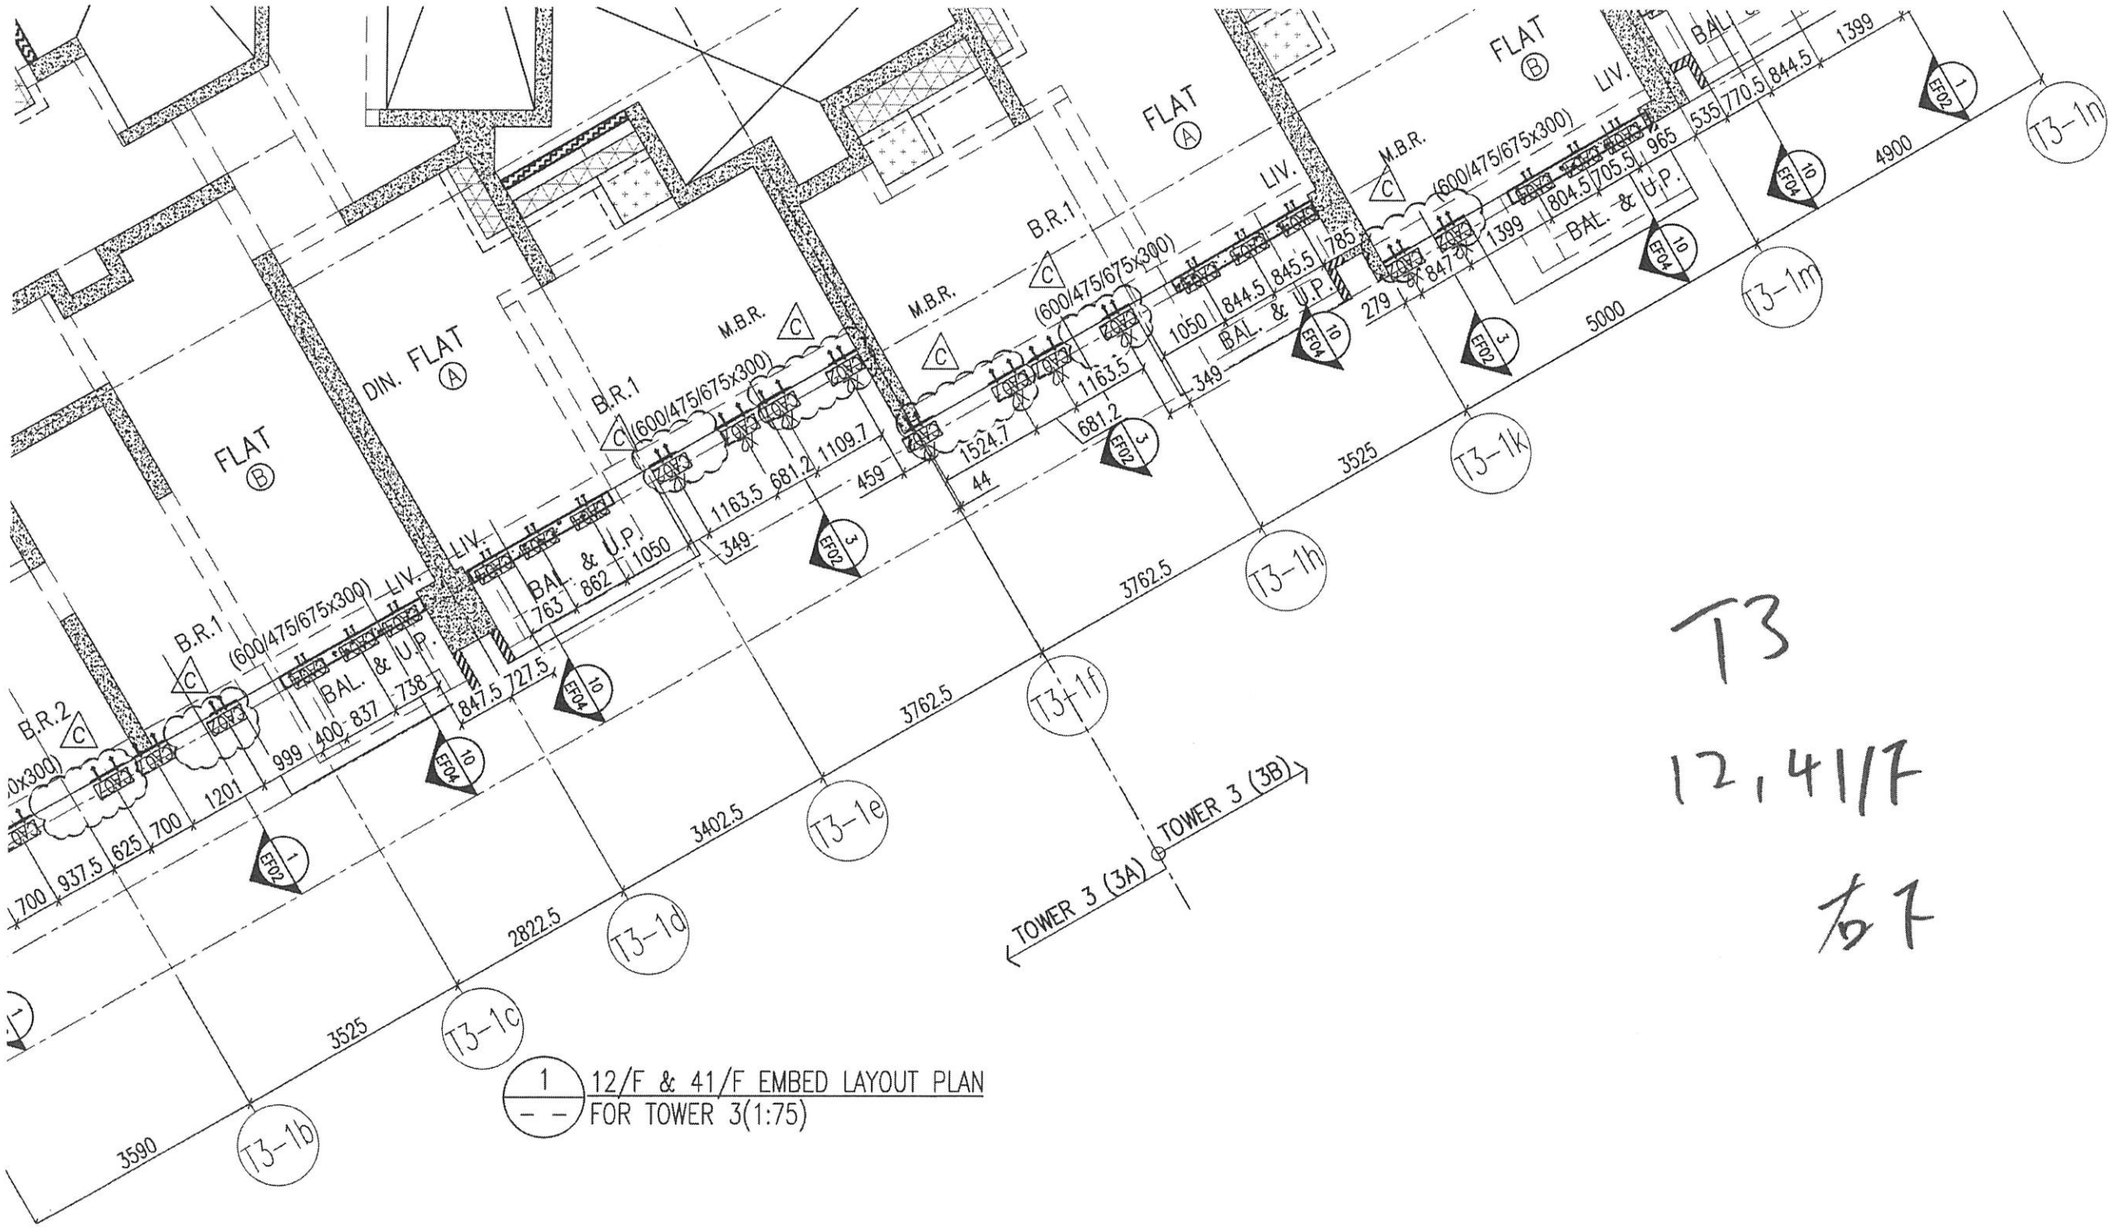

1 / – – 12/F & 41/F EMBED LAYOUT PLAN FOR TOWER 3(1:75)

T3

12,41/F

右7

2. ALL ELEVATIONS ARE VIEWED
3. ALL DIMENSIONS TO BE VERI BEFORE FABRICATION.

LEGEND :

X1 / X001 — DETAIL MARK NO. / REFER SHEET NO.

1. F.F.L. -- FINISHED FLOOR LE
2. S.F.L. -- STRUCTURAL FLOOR
3. /R -- REVERSED DETAIL

NO.	DATE	REV
C	16/02/22	REVISED AS PER
B	20/12/21	REVISED AS PER
A	03/12/21	REVISED AS PER


JOB NO. : J-858

PROJECT :
PROPOSED RESIDENTIAL
AT TKOTL 70RP, PHASE
TSEUNG KWAN

TITLE :
12/F & 41/F EMBED
AT TOWER 3

DATE : 22-OCT-21 | SCA

T3
12/41/F
左下

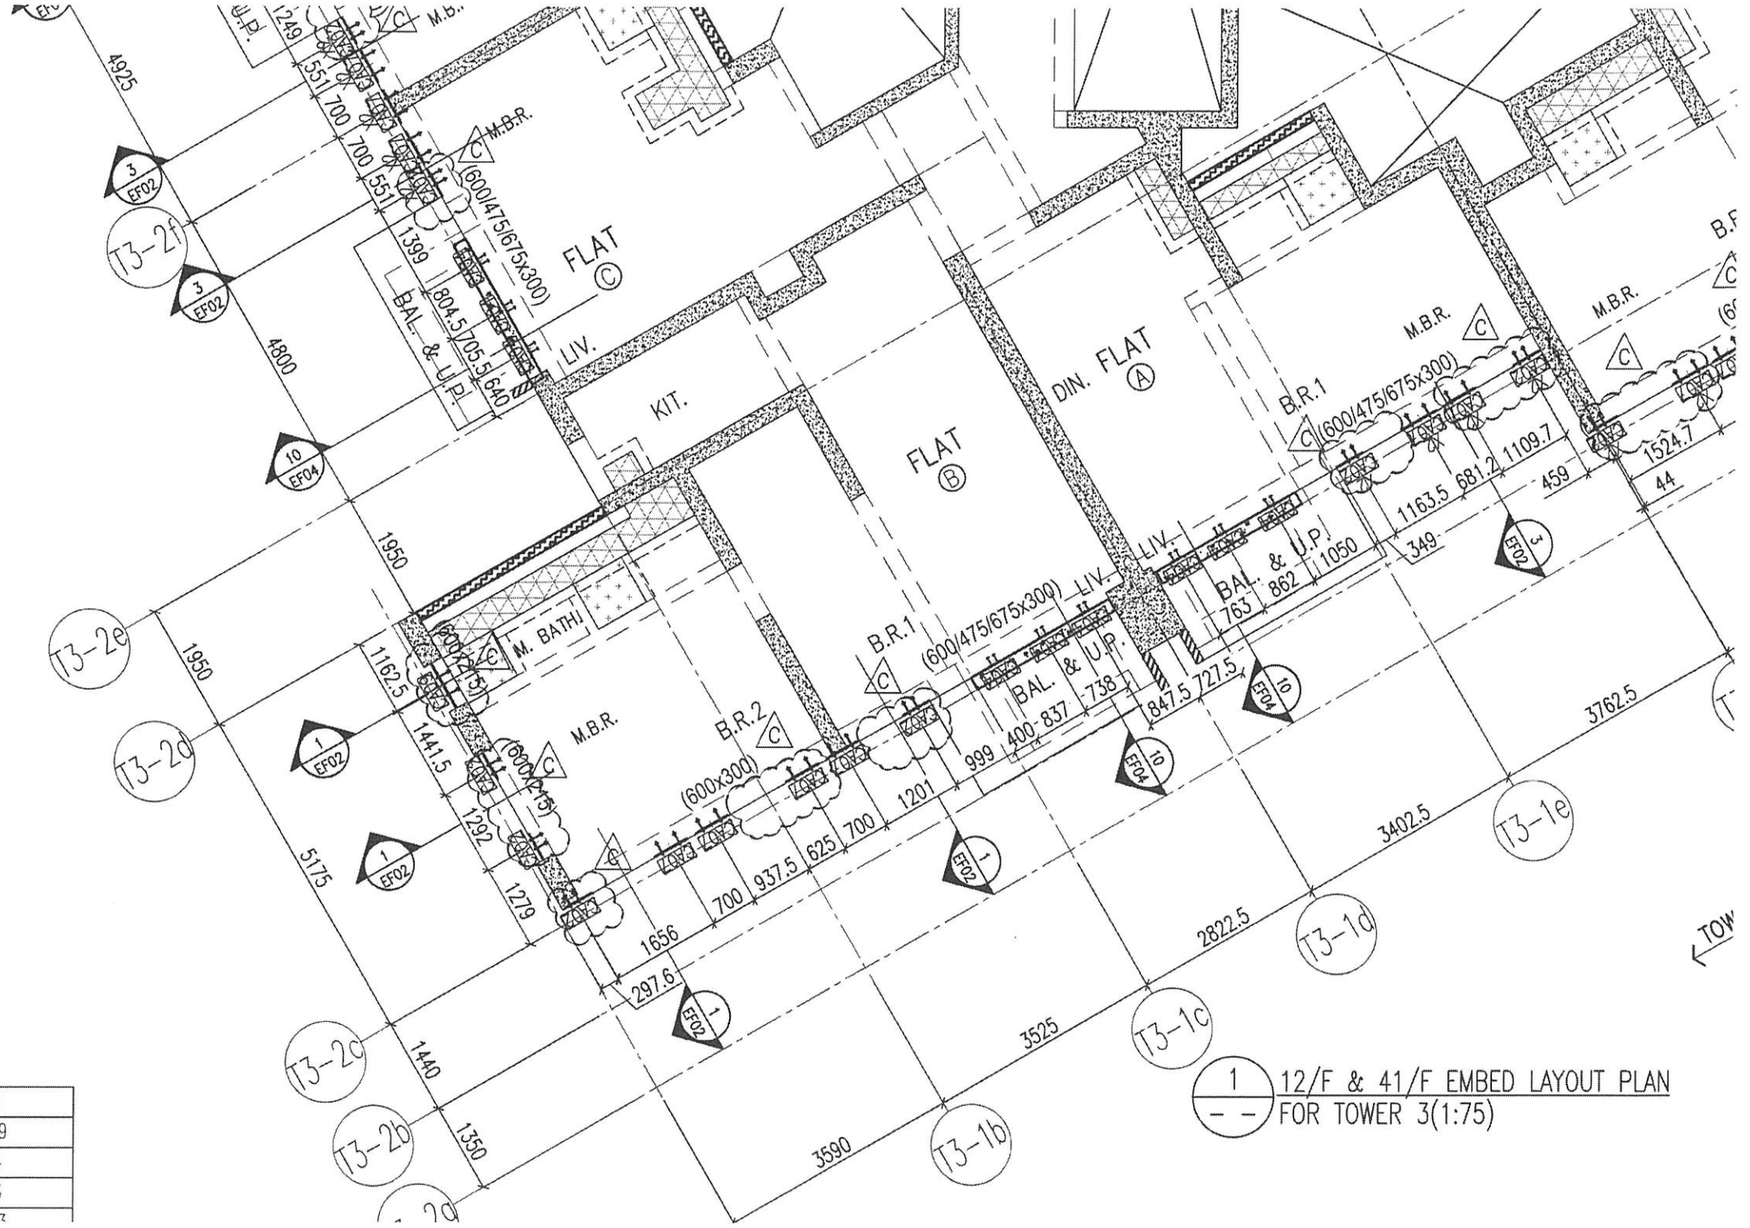


1 / – – 12/F & 41/F EMBED LAYOUT PLAN FOR TOWER 3(1:75)

CA09	1
CA04	39
CA06	4
CA08	6
CA02	33

41/F 1137.40

T3 1/F & 40/F


T3
11,401F
左上

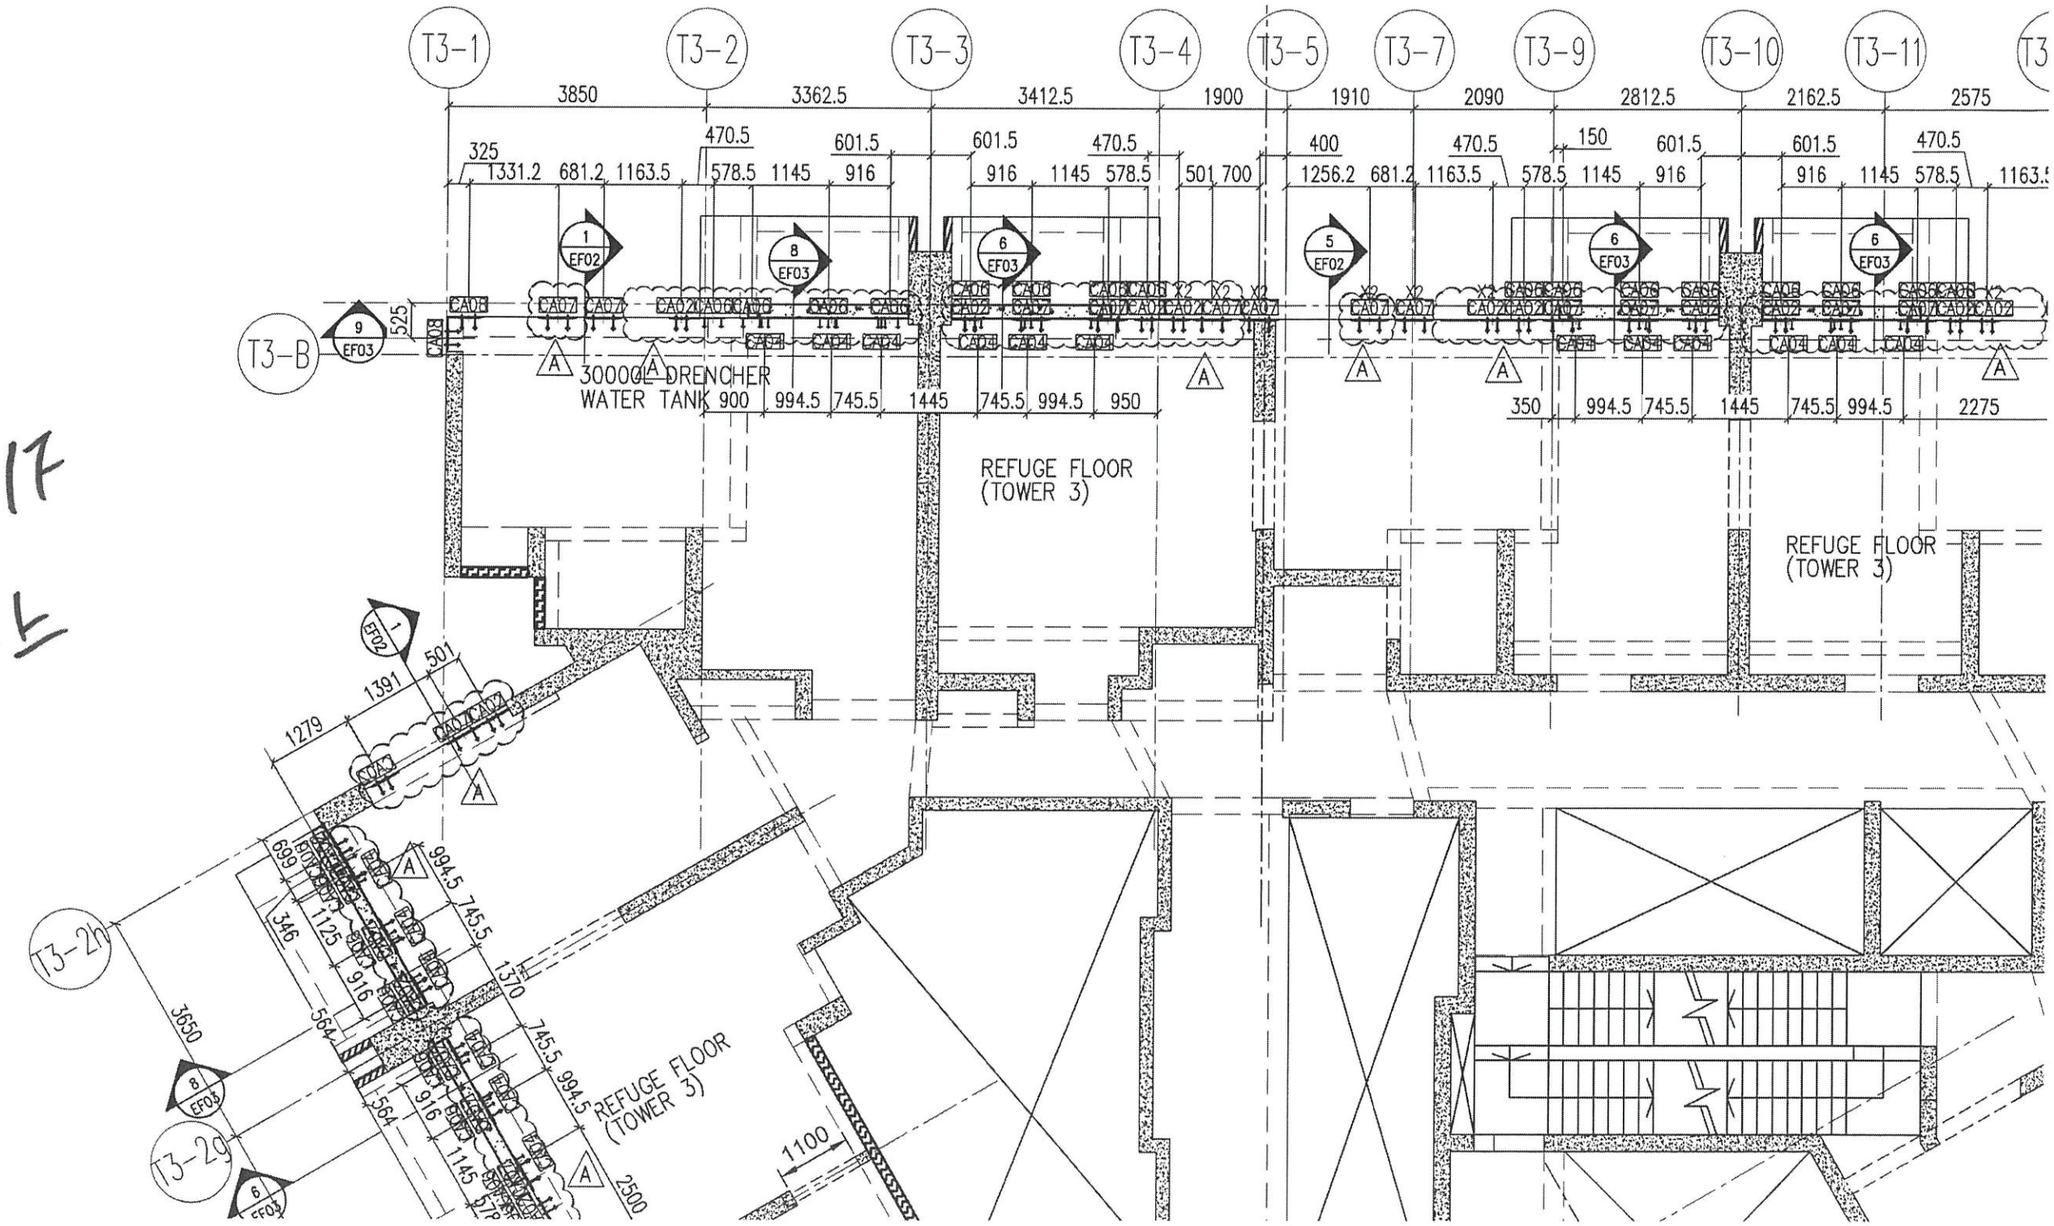

T3 1/F & 40/F

T3 11,40/F

右上

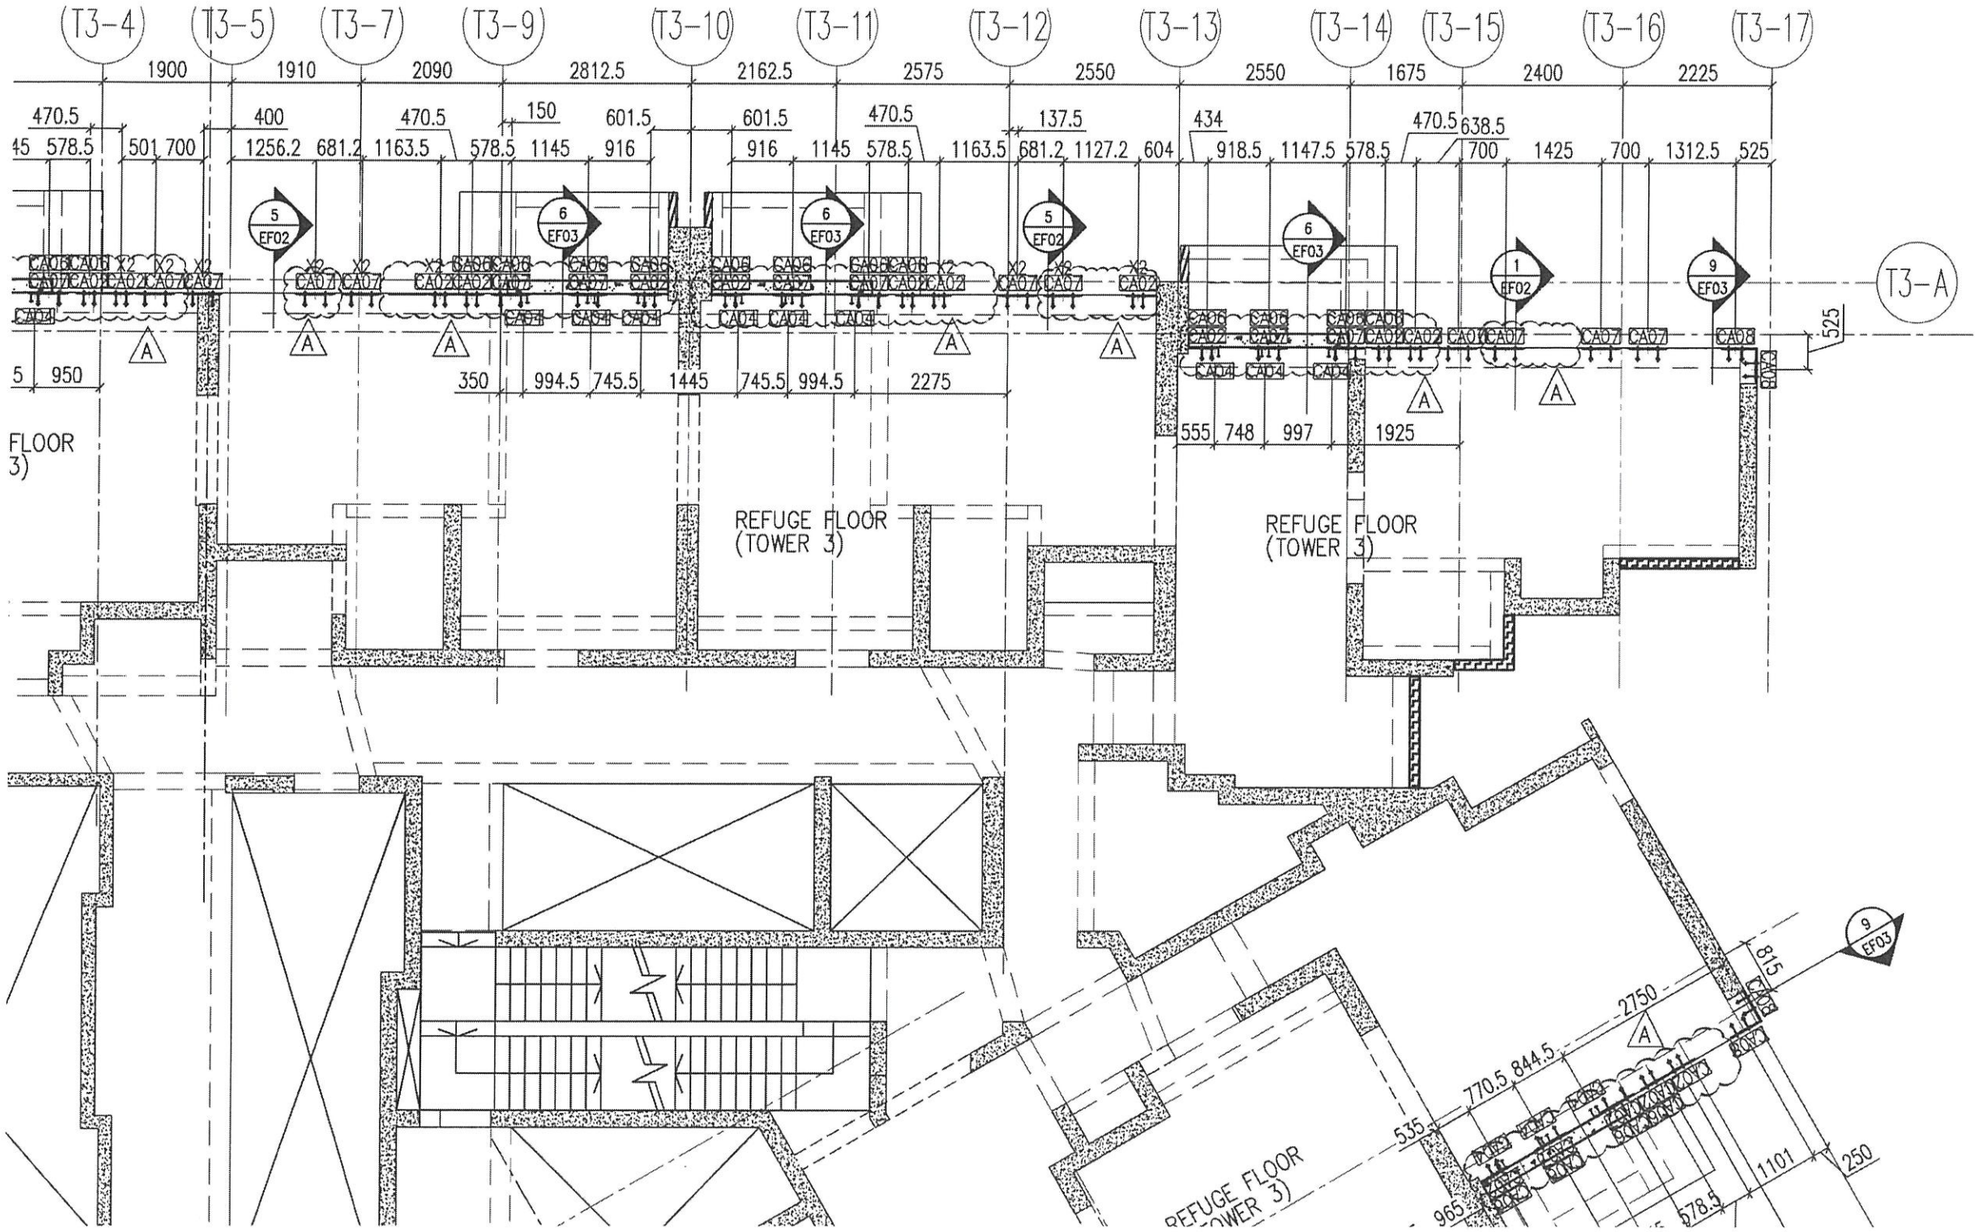

CLIENT :

信和置業有限公司
Sino Land Company Limit

ARCHITECT :

ronald lu & partners
Architects . Planners . Interior Designers
Ronald Lu & Partners (HK) Ltd
呂元祥建築師事務所(香港)有限公司

MAIN CONTRACTOR :

Gammon

STRUCTURAL ENGINEER :

AECOM

FACADE CONSULTANT:


AECOM

NOTE :

1. ALL DIMENSIONS ARE IN mm.
2. ALL ELEVATIONS ARE VIEWED FROM OUTSIDE
3. ALL DIMENSIONS TO BE VERIFIED ON SITE BEFORE FABRICATION.

LEGEND :

X1 — DETAIL MARK NO.

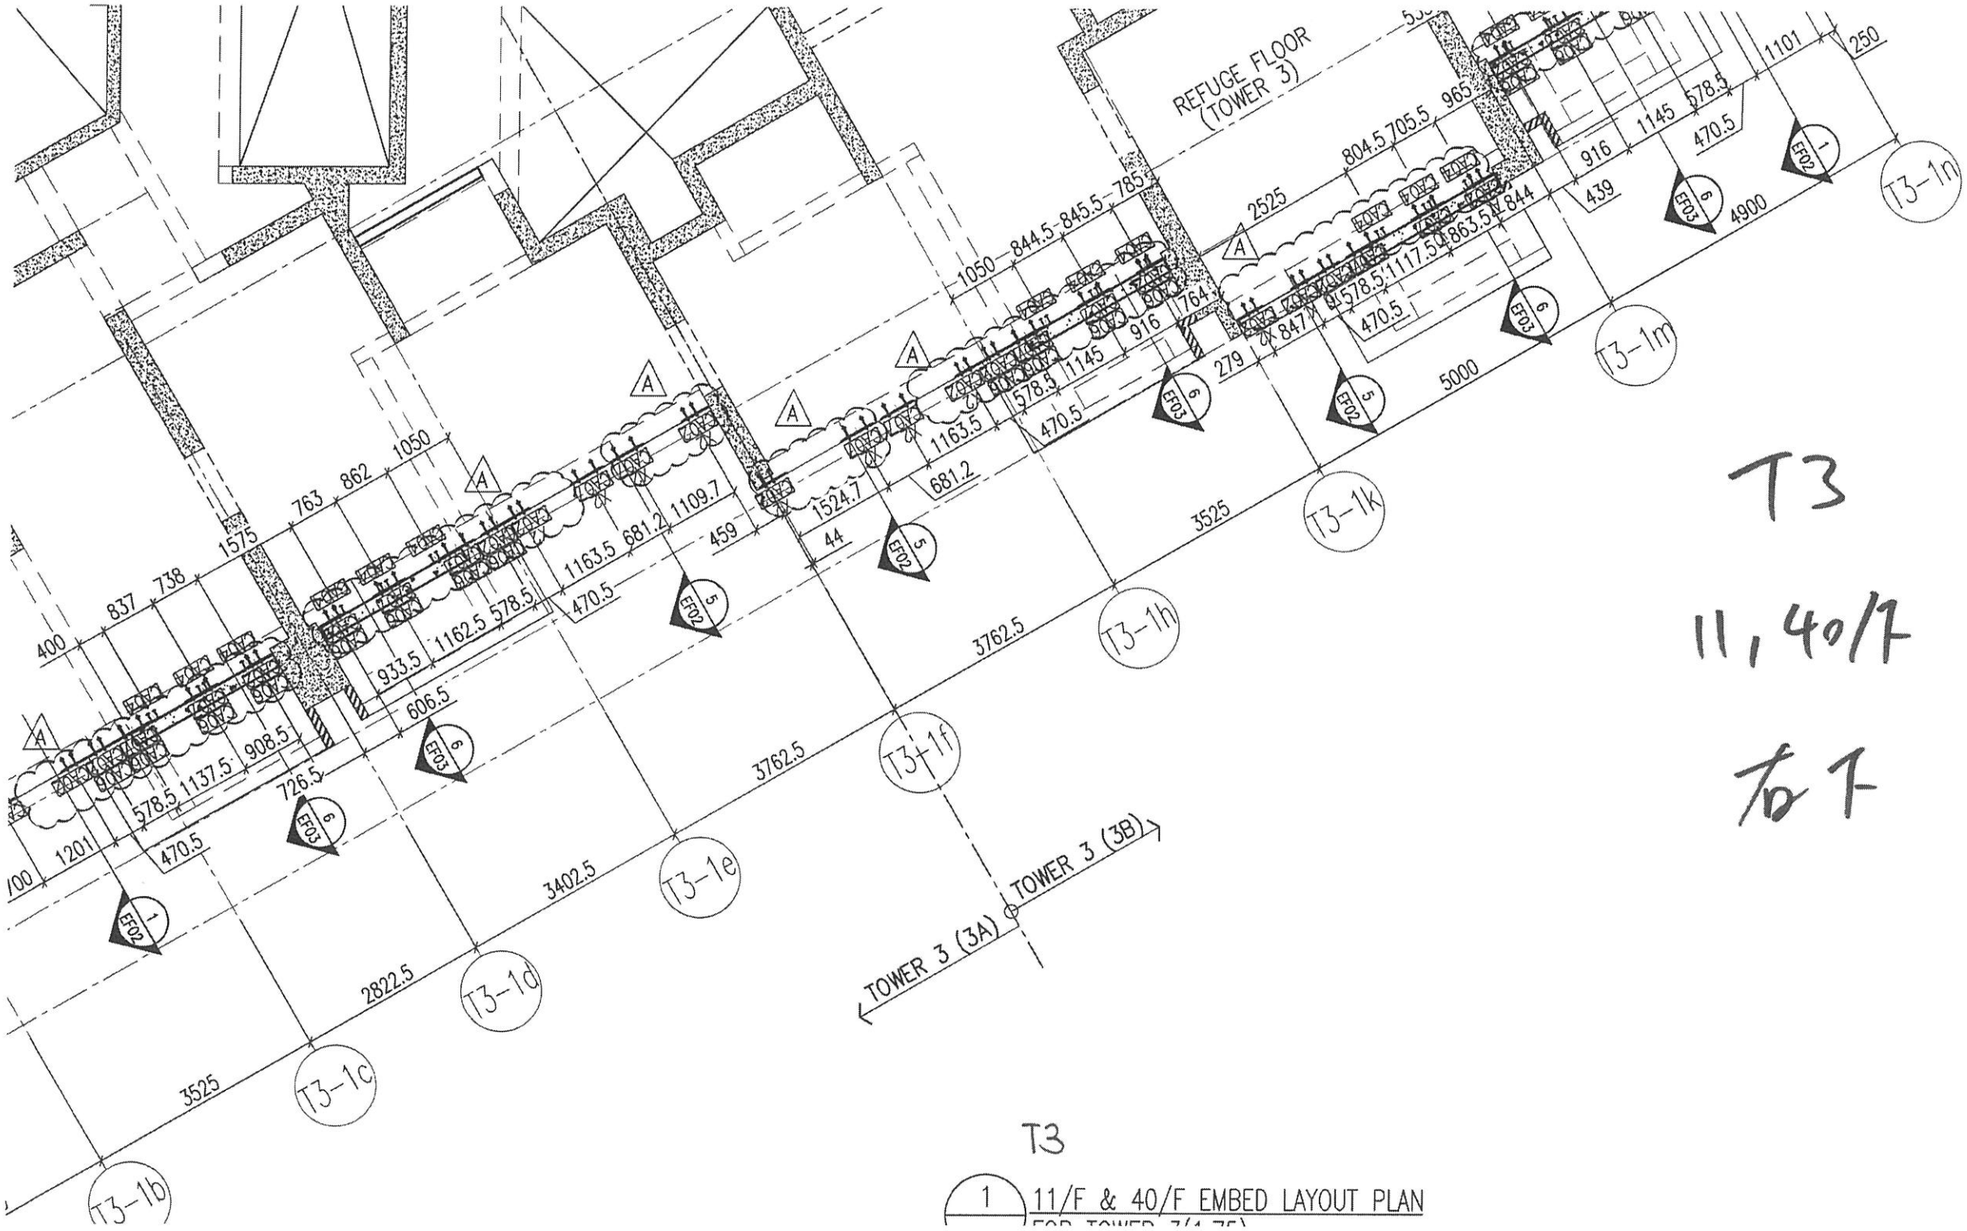

T3

11,40/F

T3

1 11/F & 40/F EMBED LAYOUT PLAN

BEFORE FABRICATION.

LEGEND :

X1 / X001 — DETAIL MARK NO. / REFER SHEET NO.

1. F.F.L. -- FINISHED FLOOR LEVEL
2. S.F.L. -- STRUCTURAL FLOOR LEVEL
3. (/R) -- REVERSED DETAIL

NO.	DATE	REVISED
A	16/02/22	REVISED AS PER COMMENTS

JOB NO. : J-858

PROJECT :
PROPOSED RESIDENTIAL DEVELOPMENT
AT TKOTL 70RP, PHASE 11, LOHAS PAR
TSEUNG KWAN O, N.T.

TITLE :
11/F & 40/F EMBED LAYOUT PLAN
AT TOWER 3

DATE : 22-OCT-21 | SCALE : 1:75(A1)

DRAWN BY : | CHECKED BY :

T3
11,901F

40/F	+134.15
11/F	+51.7
FLOOR	FLOOR LEVEL(mPD)

CA09	1
CA04	39
CA06	52
CA08	6
CA02	57
CA07	61
EMBED TYPE	QTY/PER FLOOR



T3 1/F & 40/F