



工程指示 / 要求簡箋(E.I.)

工程指示編號：EI / 5021 / 22      修改版次：-  
 工程編號      : J - 858                      工程名稱      : 將軍澳日出康城  
 工程項目      : T2 Glass Cladding 廠用玻璃 BM (9/F-65/F)  
 收件人         : 生統 / Maggie              發件人         : Ant Yeung                      日期 : 23/08/2022

要求提供 /  確認 事項 :

- |                                    |                                     |                               |
|------------------------------------|-------------------------------------|-------------------------------|
| <input type="checkbox"/> 初步鋁料 B.M. | <input type="checkbox"/> 加工拆圖，然後生產  | <input type="checkbox"/> 尺寸表  |
| <input type="checkbox"/> 正式鋁料 B.M. | <input type="checkbox"/> 技術上資料 / 指示 | <input type="checkbox"/> 報價   |
| <input type="checkbox"/> 配件 B.M.   | <input type="checkbox"/> 樣辦或貨品說明書   | <input type="checkbox"/> 分判合約 |

內容 :

請按玻璃 BM 生產玻璃送廠。 T2 (9/F -65/F)

1. 附上玻璃出貨表，請按出貨表排期生產和包箱      首批出貨到廠 2022.10.20

見玻璃出貨表 Excel

2. 11/F 和 40/F 隔火層 請獨立包箱，廠留意收貨 11/F, 40/F 的玻璃有不同。

3. T2 66/F 和 67/F 先暫停。

4. HS 單片，不用熱浸，不需熱浸標籤。

謝謝

請在 2022. 10. 20 前完成上列要求。

附：

以上項目為：

- 原合約工程包                       原合約工程加 / 減賬                       新工程報價

分發東莞各部門：

- ( ) 生產技術總監  連附件    ( ) 技術部     連附件    ( ) 生產部     連附件    ( ) 機械設計部  連附件  
 ( ) 採購部     連附件    ( ) 生產統籌部  連附件    ( ) 小羅 & 清     連附件  
 ( ) 質檢部     連附件    ( ) 會計部     連附件    ( ) 報關組     連附件    ( ) 其他 水洪  連附件

分發其他分判：

連附件 檳

分發香港各部門：

- ( ) 行政部  連附件    ( ) 會計部  連附件    ( ) 統籌部  連附件    ( ) 工程部地盤科文  連附件  
 ( ) 採購部  連附件    ( ) QS 部     連附件    ( ) 維修部  連附件    ( ) 其他 \_\_\_\_\_  連附件

傳遞編號：

HK 1397 / 22

發件人簽署：

項目經理簽署：

J858康城11期单元幕墙玻璃分层统计表 (T2-Glass Cladding)

訂理表

工程: J858康城11期 (T2)

日期: 22-Jun-22


序号	玻璃编号	玻璃类型	玻璃尺寸			单面积 (m2)	分层数量					总数量	备注		
			W(mm)	x	H(mm)		9F(10,12~16,18~20,22~25,27~29,31~33,36~38,41~42,45~47,49~51,53~56,58~60,52~65F相同, 共37层)	11F	40F	17F(21,26,30,35,39,43,48,52,57,61F相同, 共11层)	66F			67F	
1	GL03-62	GL03	592	x	2331	1.38	74			22			96	送工厂	
2	GL03-63	GL03	592	x	2281	1.35		2	2				4	送工厂	
3	GL03-64	GL03	592	x	576	0.34	74	2	2	22			100	送工厂	
4	GL03-65	GL03	773	x	2331	1.80	37			11			48	送工厂	
5	GL03-66	GL03	773	x	2281	1.76		1	1				2	送工厂	
6	GL03-67	GL03	773	x	841	0.65	37		1				38	送工厂	
7	GL03-68	GL03	773	x	576	0.45		1		11			12	送工厂	
8	GL03-76	GL03	798	x	2331	1.86	37			11			48	送工厂	
9	GL03-77	GL03	798	x	2281	1.82		1	1				2	送工厂	
10	GL03-78	GL03	798	x	841	0.67	37		1				38	送工厂	
11	GL03-84	GL03	798	x	576	0.46		1		11			12	送工厂	
12	GL03-85	GL03	823	x	2331	1.92	37			11			48	送工厂	
13	GL03-86	GL03	823	x	2281	1.88		1	1				2	送工厂	
14	GL03-87	GL03	823	x	841	0.69	37		1				38	送工厂	
15	GL03-88	GL03	823	x	311	0.26		1		11	1		13	送工厂	
16	GL03-121	GL03	592	x	2531	1.50					2		2	送工厂	
17	GL03-122	GL03	773	x	2531	1.96					1		1	送工厂	
18	GL03-123	GL03	798	x	2531	2.02					1		1	送工厂	
19	GL03-124	GL03	592	x	528	0.31					2		2	送工厂	
20	GL03-125	GL03	773	x	528	0.41					1		1	送工厂	
21	GL03-126	GL03	798	x	528	0.42					1		1	送工厂	
22	GL03-132	GL03	823	x	2531	2.08					1	1	2	送工厂	
23	GL03-133	GL03	823	x	528	0.43						1	1	送工厂	
															0.0
						总数量	370	10	10	110	10	2	512		554.5

暂停  
暂停  
暂停  
暂停  
暂停  
暂停  
暂停

注:



1	GL03	12mm clear SSC1-60T reflective heat strengthened glass (R20220324054)													



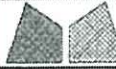

美特鋁質有限公司  
MIDI Aluminium Fabricator Ltd.

工程號	J858	類別		物料號	-		
地盘	康城11期	制圖	W. E. X	2022-05-12	圖號	J858-GL03	
修改	-	採用工廠	✓	地盤	-	數量	-
日期	-	材料顏色	-	圖紙名稱	玻璃加工圖	復核	-
		材料	-	批准	-	單件重量	- (KG)

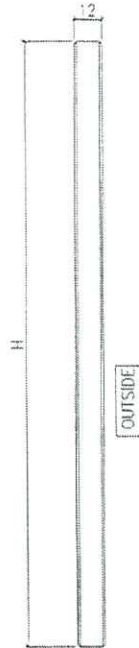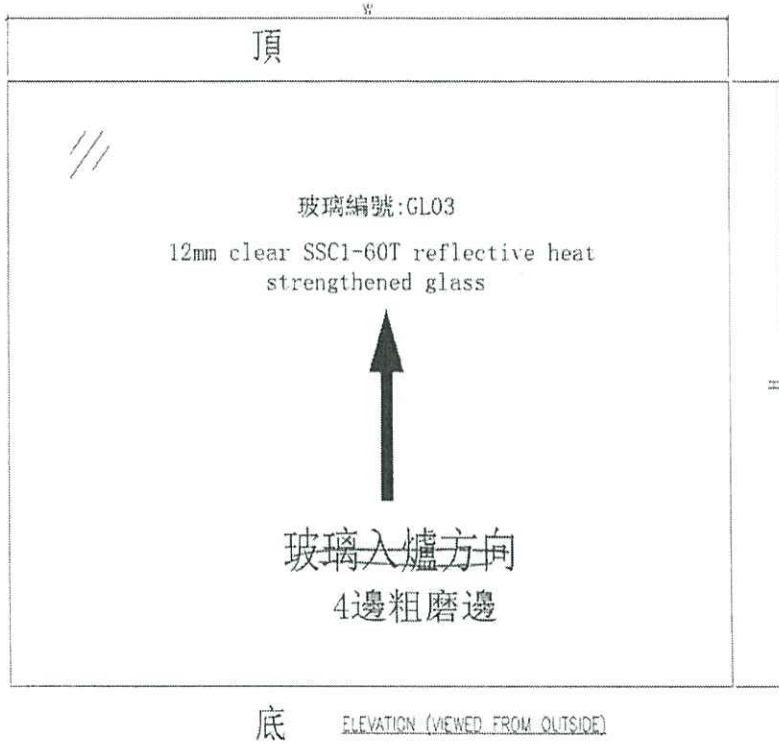

及詳

生产厂编号: R20220324054

NOTES

1. ALL DIMENSION IN mm
2. ALL EDGE CHAMFER 1x1x45°

93

J858康城11期单元幕墙玻璃分层统计表 (T2-Glass Cladding)

工程: J858康城11期 (T2)

日期: 22-Jun-22

*Handwritten signature*


序号	玻璃编号	玻璃类型	玻璃尺寸			单面积 (m2)	分层数量					总数量	备注				
			W(mm)	x	H(mm)		9F(10,12~16,18~20,22~25,27~29,31~33,36~38,41~42,45~47,49~51,53~56,58~60,52~65F相同, 共37层)										
1	GL03-62	GL03	592	x	2331	1.38	74					22	96	送工厂			
2	GL03-63	GL03	592	x	2281	1.35						2	2	4	送工厂		
3	GL03-64	GL03	592	x	576	0.34	74					2	2	22	100	送工厂	
4	GL03-65	GL03	773	x	2331	1.80	37					11			48	送工厂	
5	GL03-66	GL03	773	x	2281	1.76						1	1	2	送工厂		
6	GL03-67	GL03	773	x	841	0.65	37					1			38	送工厂	
7	GL03-68	GL03	773	x	576	0.45						1	11			12	送工厂
8	GL03-76	GL03	798	x	2331	1.86	37					11			48	送工厂	
9	GL03-77	GL03	798	x	2281	1.82						1	1	2	送工厂		
10	GL03-78	GL03	798	x	841	0.67	37					1			38	送工厂	
11	GL03-84	GL03	798	x	576	0.46						1	11			12	送工厂
12	GL03-85	GL03	823	x	2331	1.92	37					11			48	送工厂	
13	GL03-86	GL03	823	x	2281	1.88						1	1	2	送工厂		
14	GL03-87	GL03	823	x	841	0.69	37					1			38	送工厂	
15	GL03-88	GL03	823	x	311	0.26						1	11			13	送工厂
16	GL03-121	GL03	592	x	2531	1.50						2			2	送工厂	
17	GL03-122	GL03	773	x	2531	1.96						1			1	送工厂	
18	GL03-123	GL03	798	x	2531	2.02						1			1	送工厂	
19	GL03-124	GL03	592	x	528	0.31						2			2	送工厂	
20	GL03-125	GL03	773	x	528	0.41						1			1	送工厂	
21	GL03-126	GL03	798	x	528	0.42						1			1	送工厂	
22	GL03-132	GL03	823	x	2531	2.08						1	1	2	送工厂		
23	GL03-133	GL03	823	x	528	0.43						1			1	送工厂	
总数量						370	10	10	110	10	2	512					

暂停  
暂停  
暂停  
暂停  
暂停  
暂停  
暂停  
暂停


总面积 (m2)
132.5
5.4
34.1
86.5
3.5
24.7
5.3
89.3
3.6
25.5
5.5
92.1
3.8
26.3
3.3
3.0
2.0
2.0
0.6
0.4
0.4
4.2
0.4
0.0
554.5

注:

1	GL03	12mm clear SSC1-60T reflective heat strengthened glass ( 7.
---	------	---

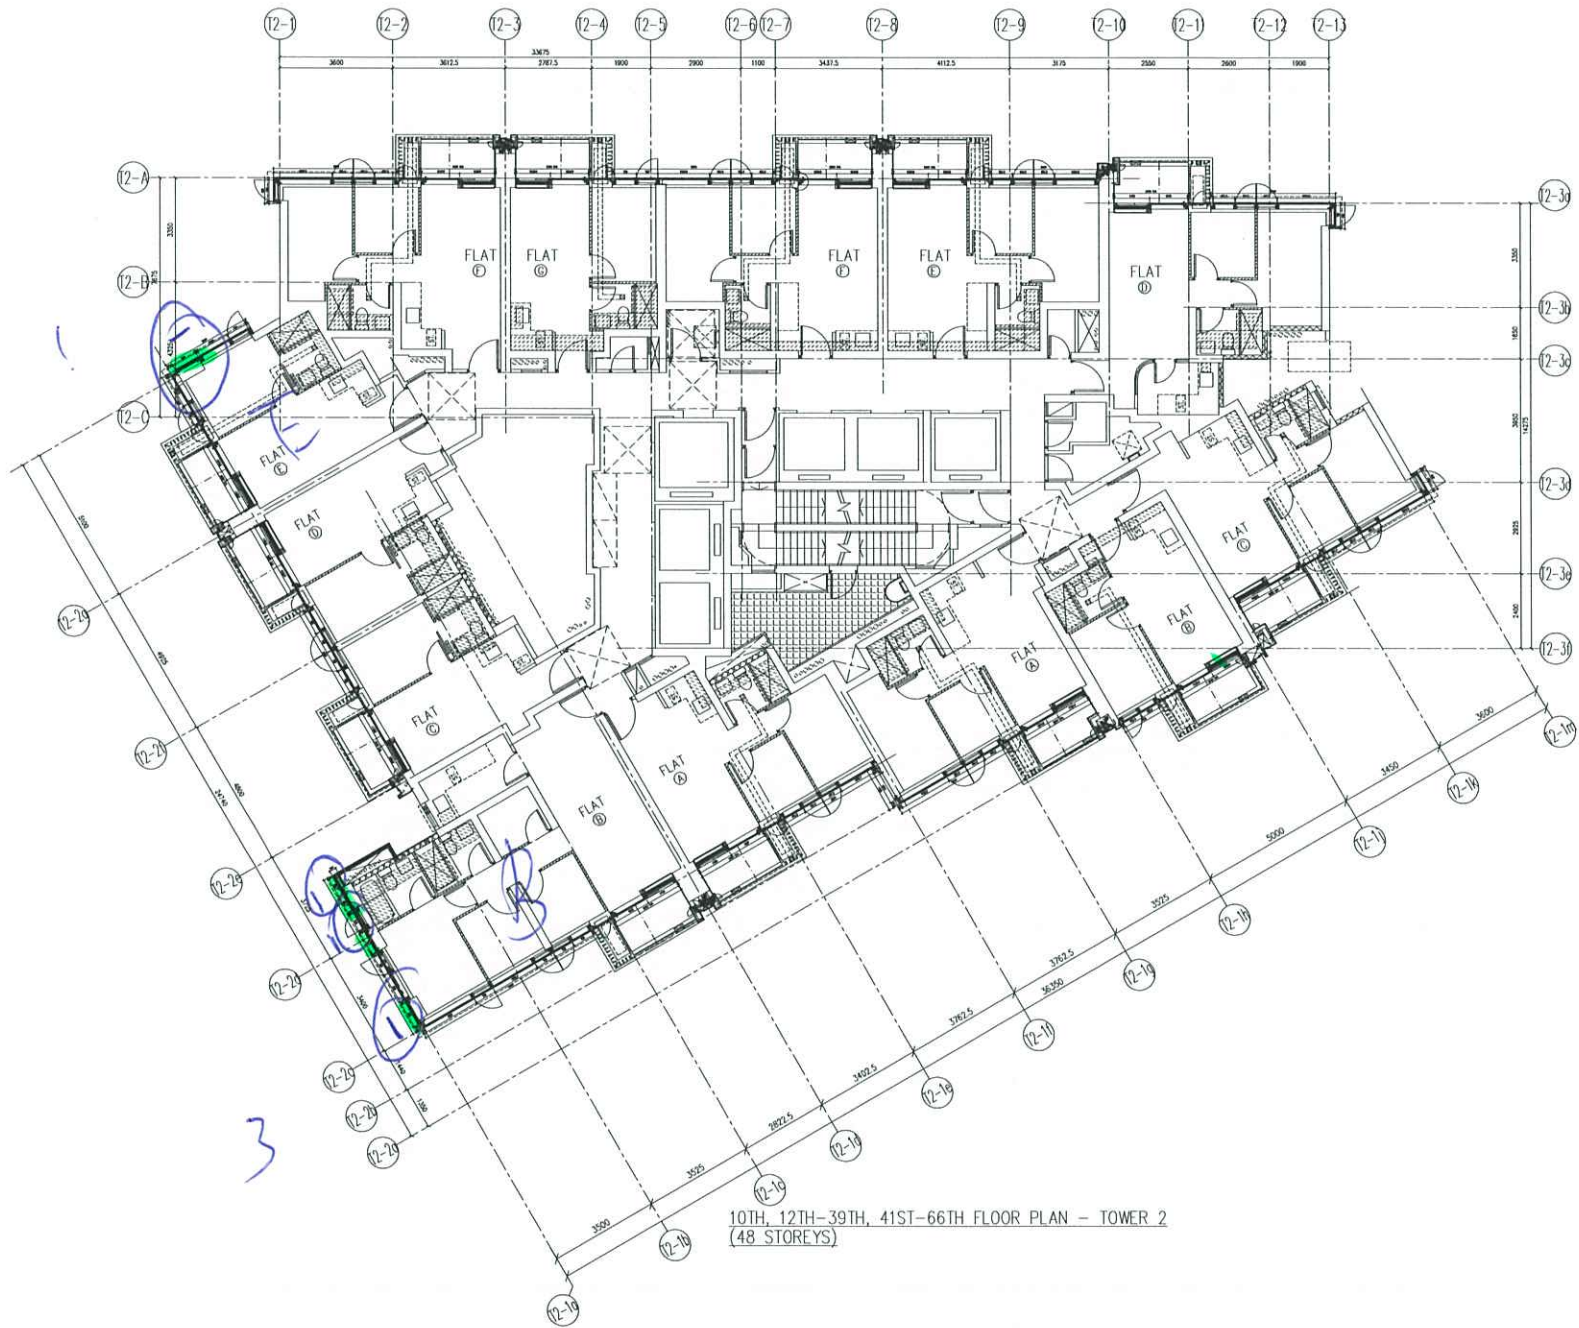

10TH, 12TH-39TH, 41ST-66TH FLOOR PLAN - TOWER 2  
 (48 STOREYS)

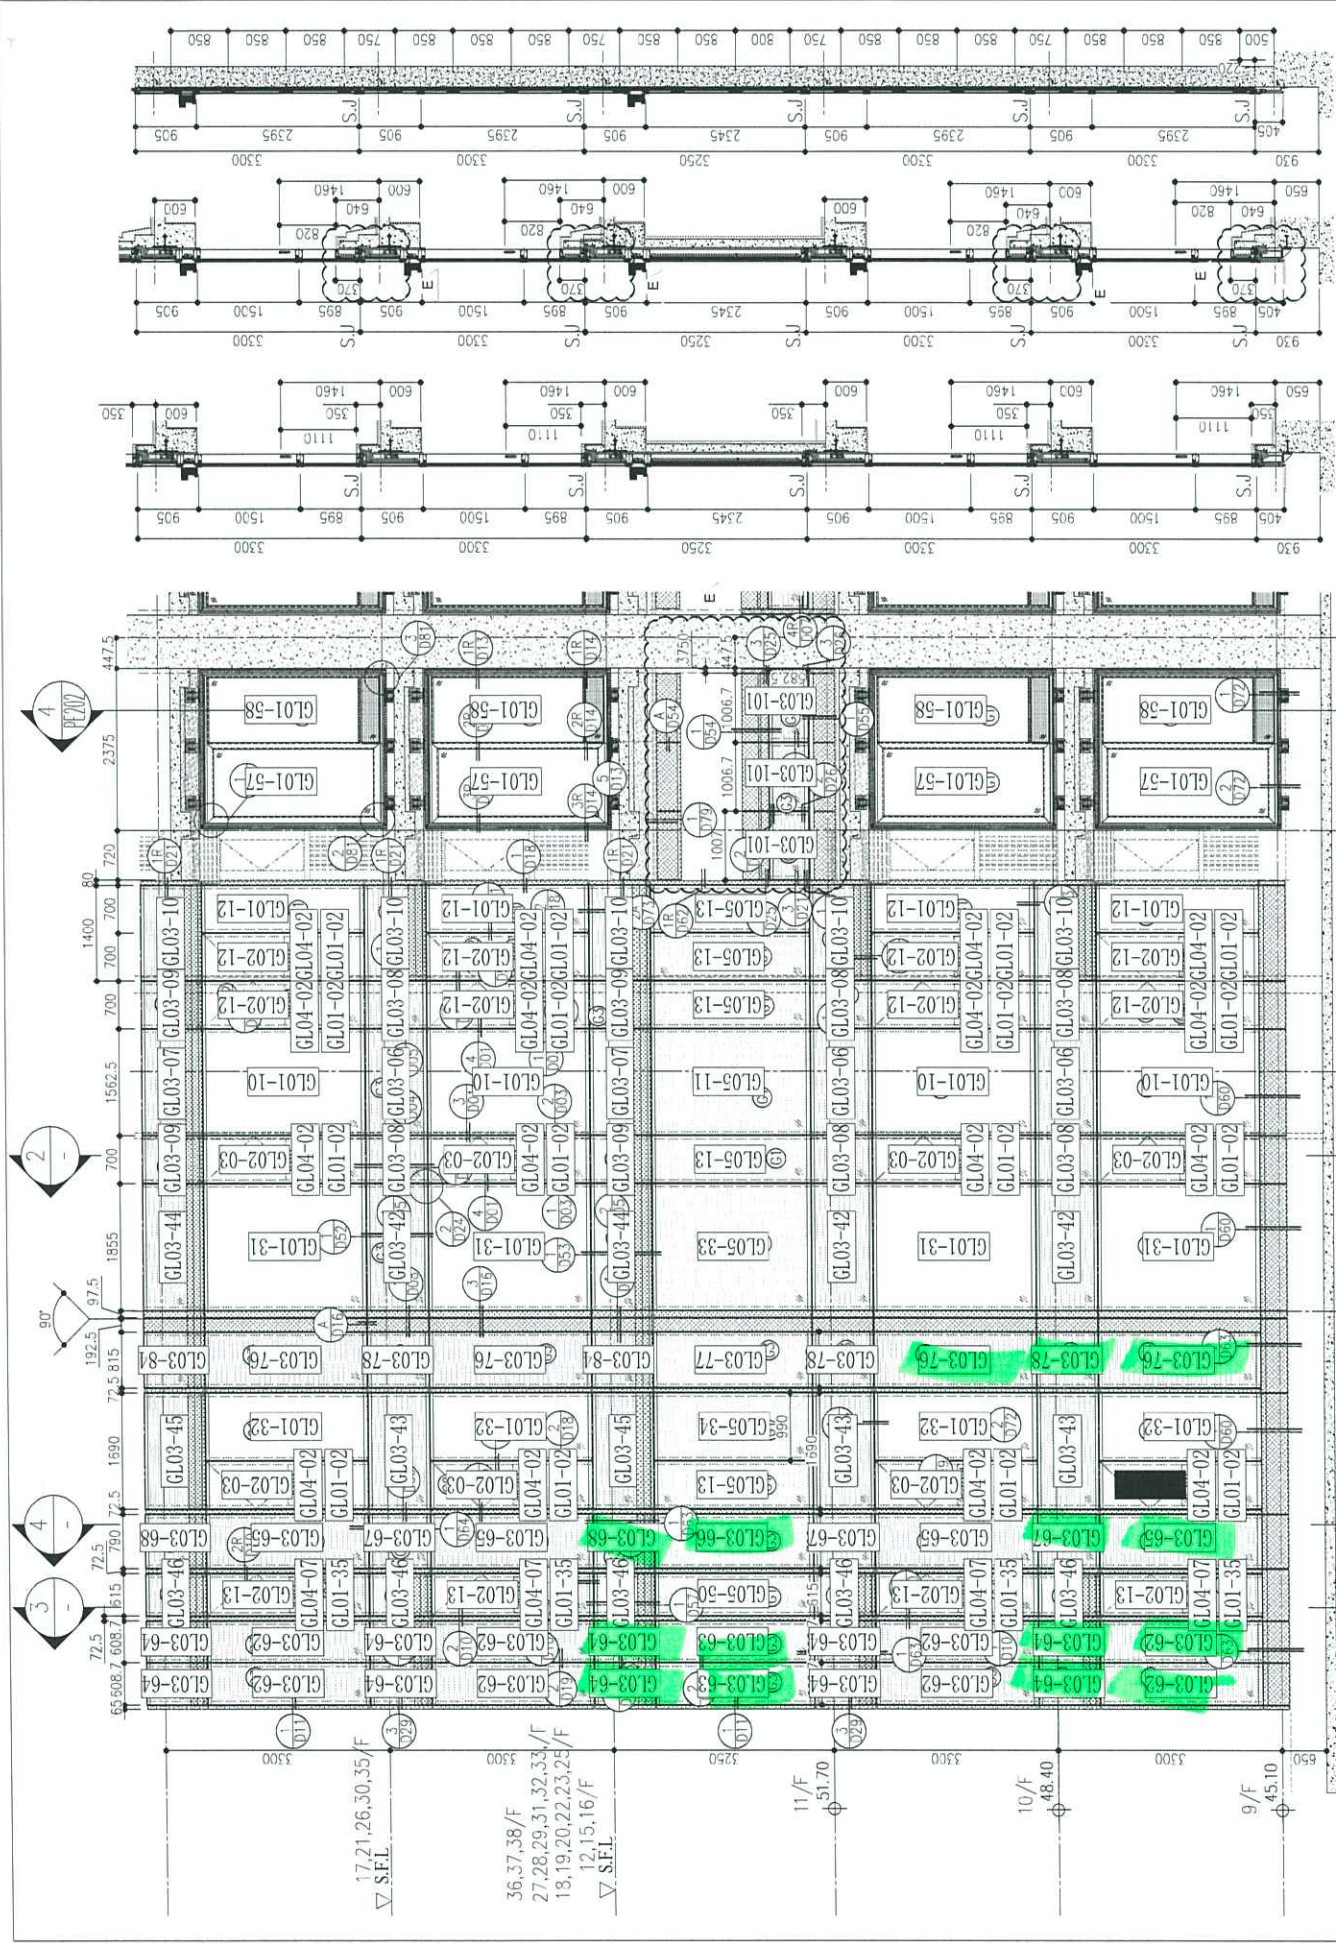


1 PART ELEVATION WALL FOR CURTAIN WALL

26/F	+91.25	39/F	+130.85	52/F	+170.40	R/F	+217.00
25/F	+87.95	38/F	+127.55	51/F	+167.10	67/F	+213.50
23/F	+84.65	37/F	+124.25	50/F	+163.80	65/F	+206.70
22/F	+81.35	36/F	+120.95	49/F	+160.50	63/F	+203.40
21/F	+78.05	35/F	+117.65	48/F	+157.20	62/F	+200.10
20/F	+74.75	33/F	+114.35	47/F	+153.90	60/F	+196.80
19/F	+71.45	32/F	+111.05	46/F	+150.60	59/F	+193.50
18/F	+68.15	31/F	+107.75	45/F	+147.30	58/F	+190.20
17/F	+64.85	30/F	+104.45	43/F	+144.00	57/F	+186.90
16/F	+61.55	29/F	+101.15	42/F	+140.70	56/F	+183.60
15/F	+58.25	28/F	+97.85	41/F	+137.40	55/F	+180.30
12/F	+54.95	27/F	+94.55	40/F	+134.15	53/F	+177.00

LEGEND:

- 10mm THK. HEAT STRENGTHENED GLASS (OUTSIDE) + 12mm AIR SPACE + 12mm THK. TEMPERED GLASS
- 10mm THK. HEAT STRENGTHENED GLASS (OUTSIDE) + 12mm AIR SPACE + 10mm THK. TEMPERED GLASS
- 12mm THK. HEAT STRENGTHENED GLASS
- 12mm THK. CLEAR TEMPERED GLASS (INTERNAL PROTECTIVE BARRIER)
- 10mm BLUETINTED HEAT STRENGTHENED GLASS
- 10mm CLEAR TEMPERED GLASS
- 8mm THK. CLEAR HEAT-STRENGTHENED GLASS + 2mm PVB + 8mm THK. CLEAR HEAT-STRENGTHENED GLASS
- 3 mm THK. ALUM. CLADDING
- 3 mm THK. ALUM. BACKPAN
- S.J. - STACK JOINT

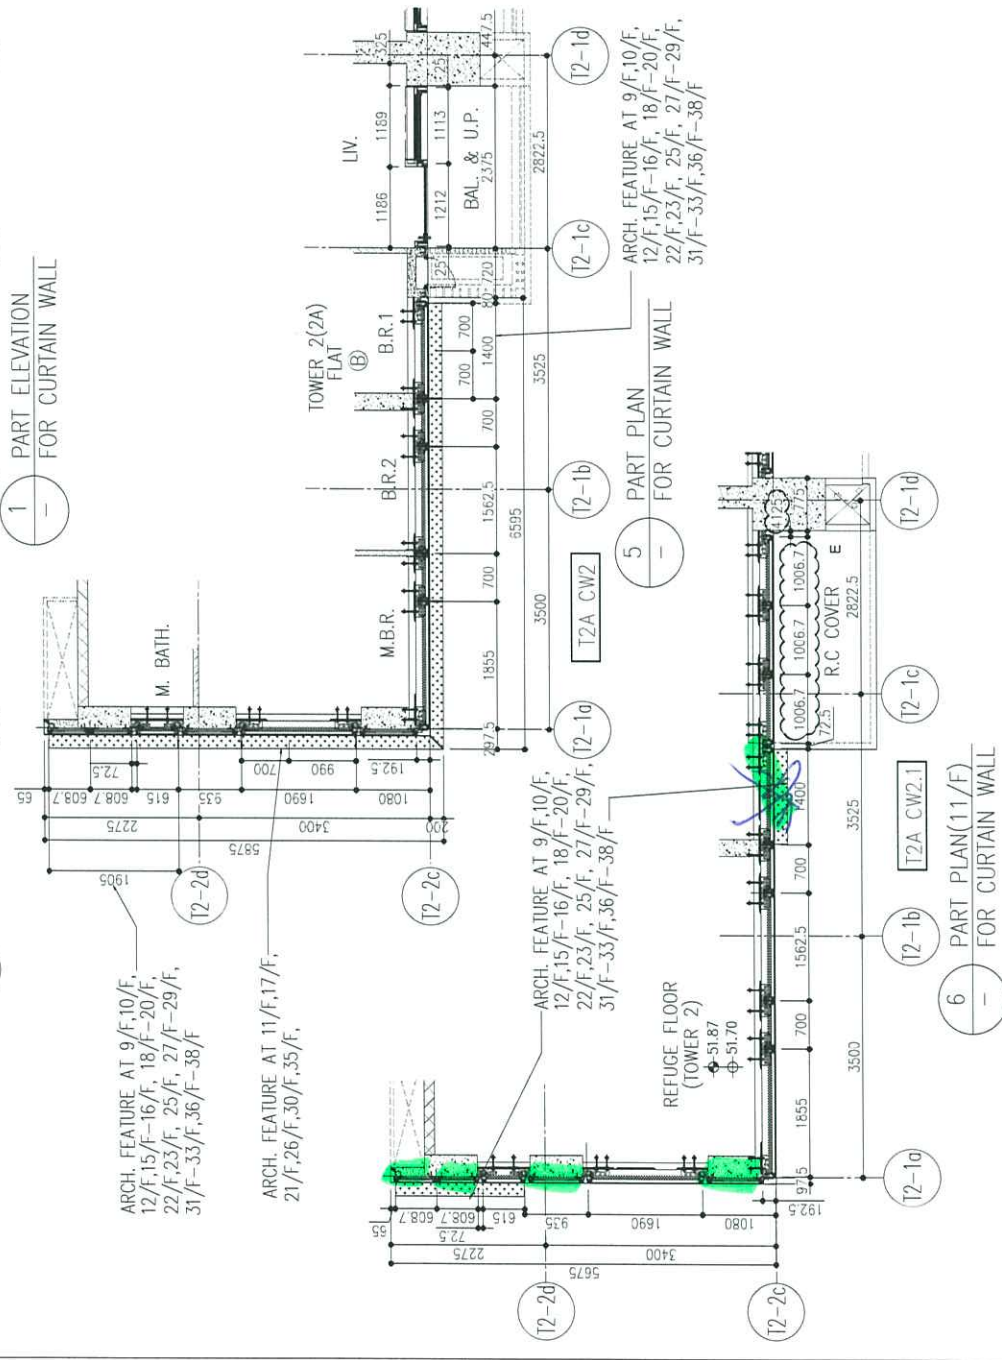

B.D. REF :

CLIENT : 信和置業有限公司 Sino Land Company Limited

ARCHITECT : Ronald Lu & Partners Architects, Planners, Interior Designers Ronald Lu & Partners (HK) Ltd. 呂元祥建築師事務所 (香港) 有限公司

MAIN CONTRACTOR : Gammon

STRUCTURAL ENGINEER : AECOM

FACADE CONSULTANT : AECOM

NOTE :

- ALL DIMENSIONS ARE IN mm.
- ALL ELEVATIONS ARE VIEWED FROM OUTSIDE.
- ALL DIMENSIONS TO BE VERIFIED ON SITE BEFORE FABRICATION.

LEGEND :

- X1 - DETAIL MARK NO.
- 1000 - REFER SHEET NO.
- F.F.L. - FINISHED FLOOR LEVEL
- S.F.L. - STRUCTURAL FLOOR LEVEL
- ⊗ - REVERSED DETAIL

E	26/05/22	REVISED AS PER COMMENTS	LS
D	06/04/22	REVISED AS PER COMMENTS	LS
C	22/01/22	REVISED AS PER COMMENTS	LS
B	20/12/21	REVISED AS PER COMMENTS	LS
A	03/12/21	REVISED AS PER COMMENTS	LS
No.	DATE	REVISED	BY

JOB NO. : J-858

PROJECT : PROPOSED RESIDENTIAL DEVELOPMENT AT TKOTL 70RP, PHASE 11, LOHAS PARK TSEUNG KWAN O, N.T.


TITLE : TYPICAL FLOOR PARTIAL ELEVATION & SECTION, PLAN FOR CURTAIN WALL (TOWER 2)

DATE : 20-OCT-21 SCALE : 1:50(A1)

DRAWN BY : CHECKED BY :

MIDI ALUMINIUM FABRICATOR LTD. 美特鋁質有限公司  
Units 6-8, Sunray Industrial Centre, 1/F  
510 Cha Kwo Ling Road, Kowloon  
Tel: 23489211-4 Fax: (852) 27727666

DWG NO. : JB58-CW-PE201 REV. : E

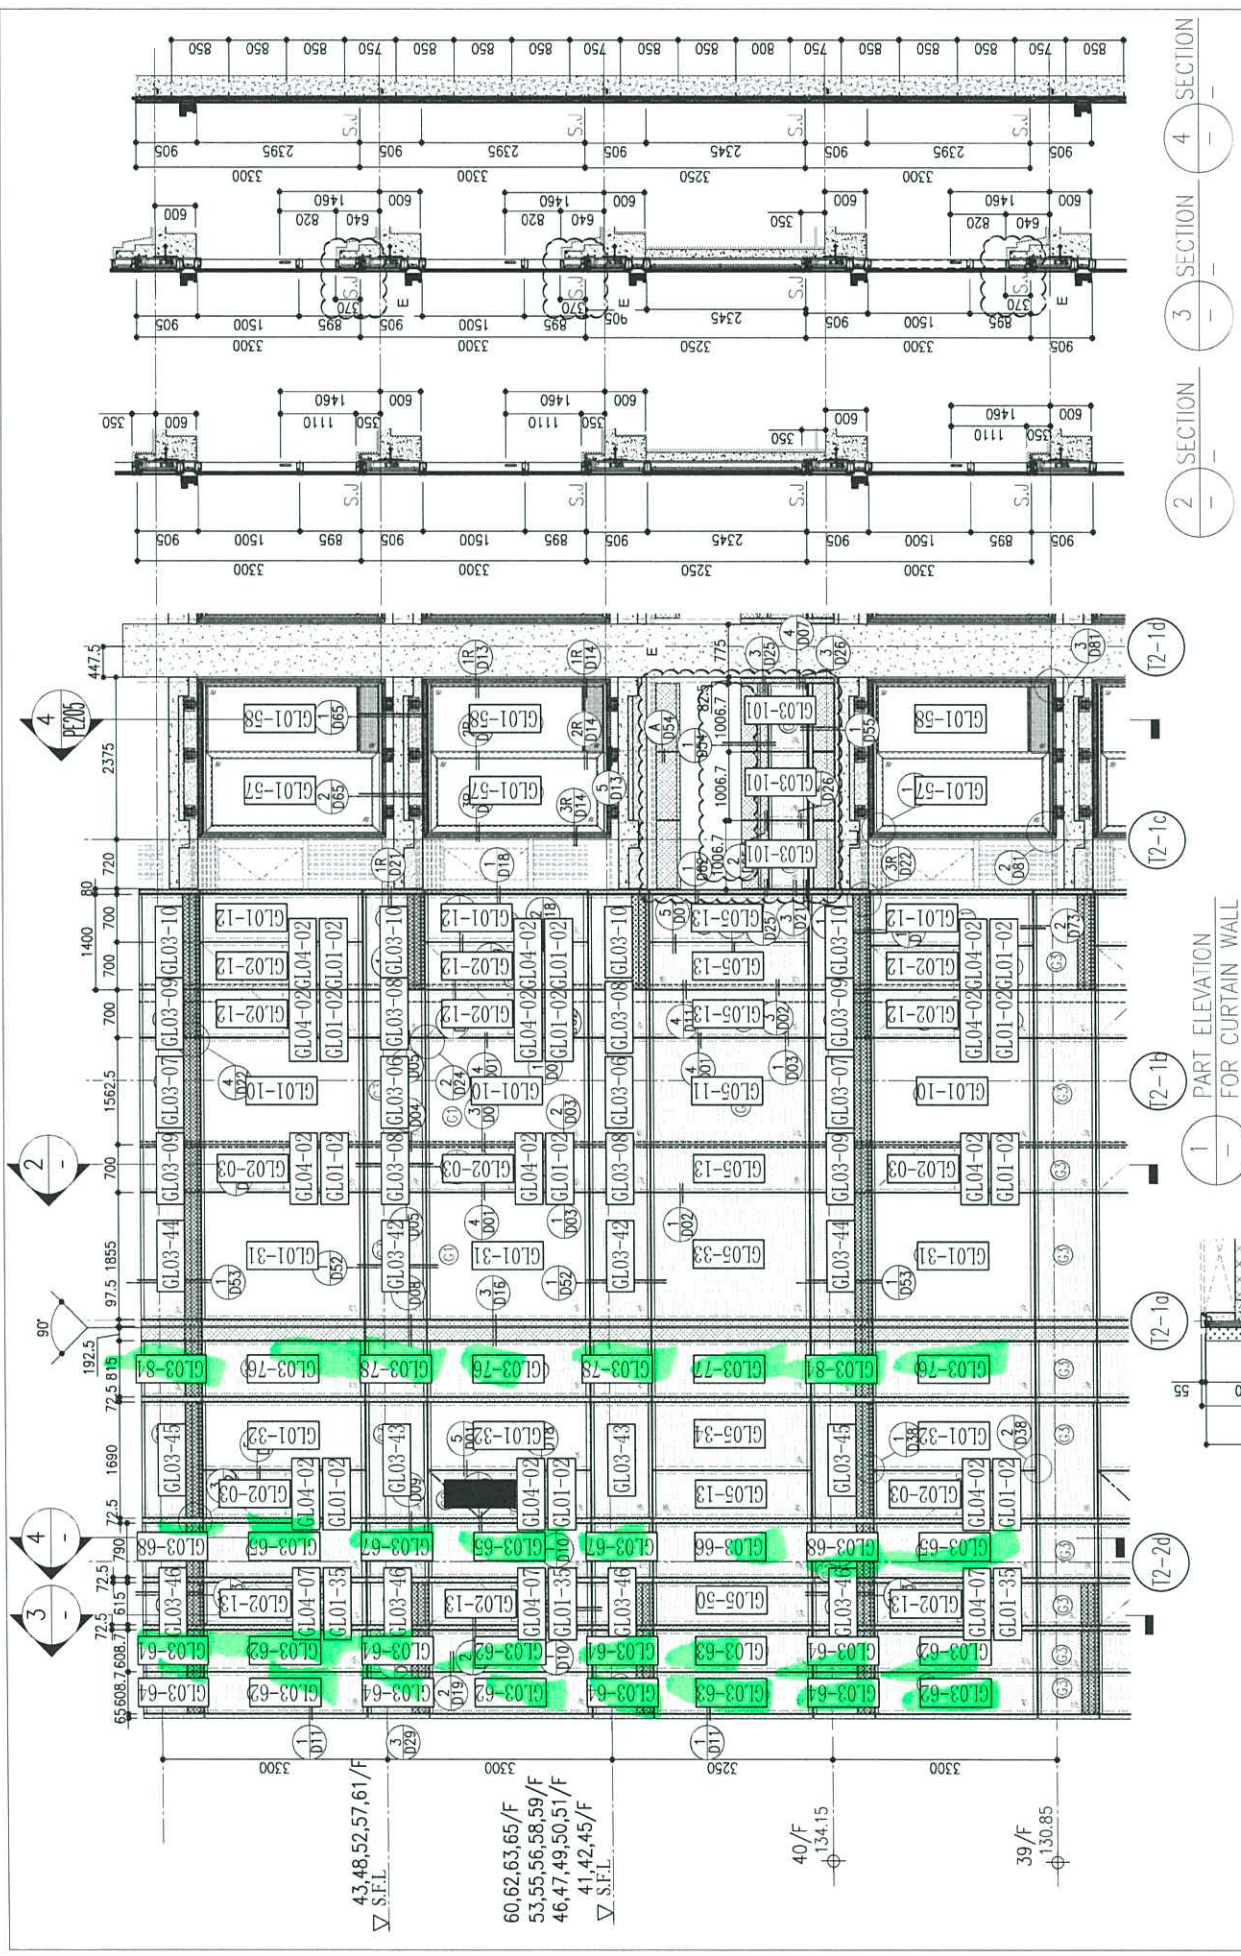

2 SECTION 3 SECTION 4 SECTION

1 PART ELEVATION FOR CURTAIN WALL

2 PART ELEVATION FOR CURTAIN WALL

3 SECTION 4 SECTION

R/F	+217.00	67/F	+213.50	66/F	+210.00	65/F	+206.70	64/F	+203.40	63/F	+200.10	62/F	+196.80	61/F	+193.50	60/F	+190.20	59/F	+186.90	58/F	+183.60	57/F	+180.30	56/F	+177.00	55/F	+173.70		

LEGEND:

- 10mm THK. HEAT STRENGTHENED GLASS (OUTSIDE) + 12mm AIR SPACE + 12mm THK. TEMPERED GLASS
- 10mm THK. HEAT STRENGTHENED GLASS (OUTSIDE) + 12mm AIR SPACE + 10mm THK. TEMPERED GLASS
- 12mm THK. HEAT STRENGTHENED GLASS
- 12mm THK. CLEAR TEMPERED GLASS (INTERNAL PROTECTIVE BARRIER)
- 10mm BUENIT HEAT STRENGTHENED GLASS
- 10mm CLEAR TEMPERED GLASS
- 8mm THK. CLEAR HEAT-STRENGTHENED GLASS + 2mm PVB + 8mm THK. CLEAR HEAT-STRENGTHENED GLASS
- 3 mm THK. ALUM. CLADDING
- 3 mm THK. ALUM. BACKPAN
- S.J. - STACK JOINT

1 PART ELEVATION FOR CURTAIN WALL





2 PART ELEVATION FOR CURTAIN WALL

3 SECTION 4 SECTION

4 SECTION 3 SECTION 4 SECTION

5 PART PLAN FOR CURTAIN WALL

6 PART PLAN FOR CURTAIN WALL

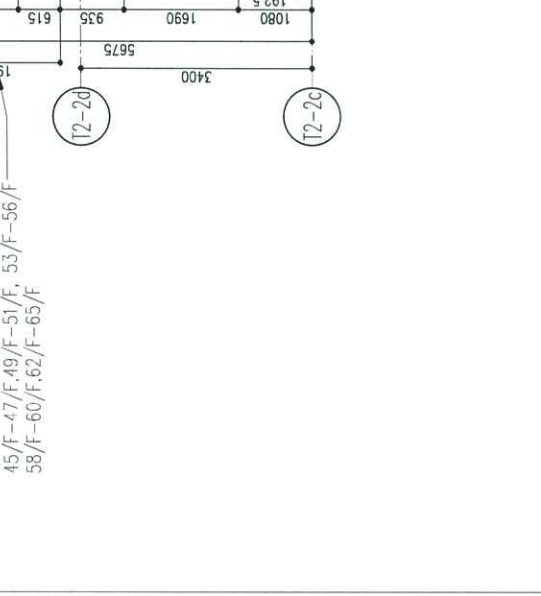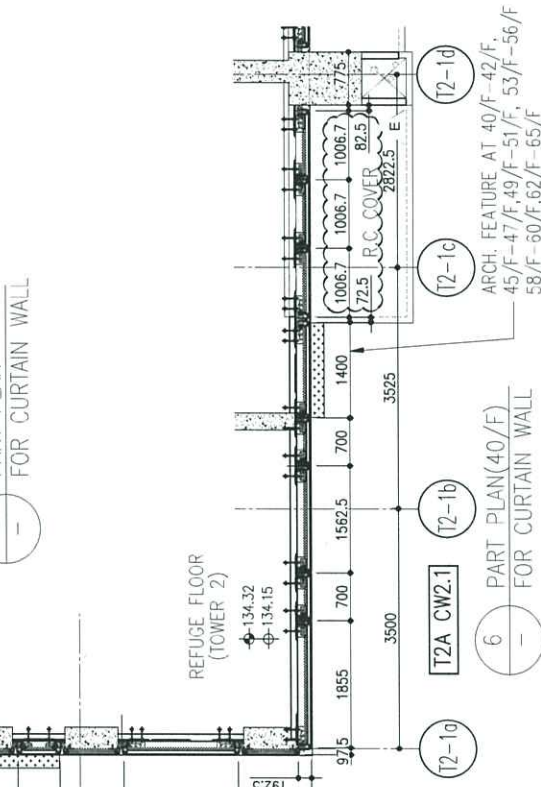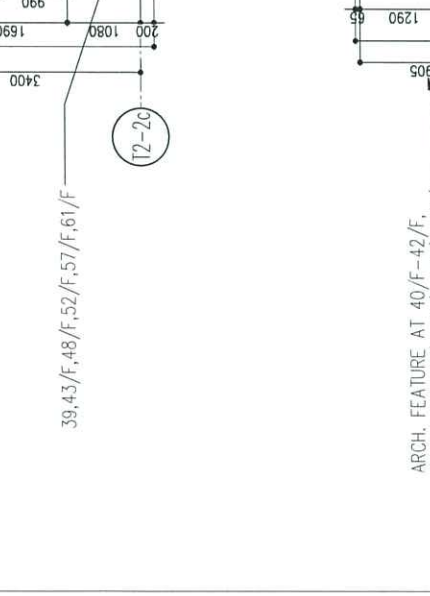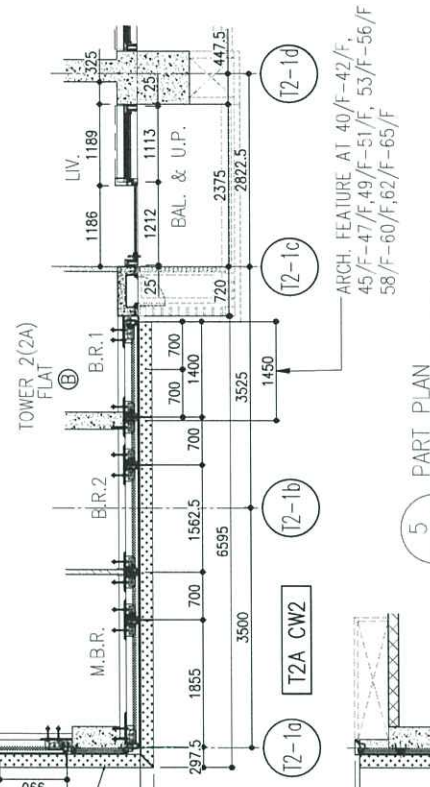

B.D. REF :

CLIENT : 信和置業有限公司 Sino Land Company Limited

ARCHITECT : Ronald Lu & partners Architects, Interior Designers Ronald Lu & Partners (HK) Ltd. 呂元祥建築師事務所 (香港) 有限公司

MAIN CONTRACTOR : Gammon

STRUCTURAL ENGINEER : AECOM

FACADE CONSULTANT : AECOM

NOTE :

- ALL DIMENSIONS ARE IN mm.
- ALL ELEVATIONS ARE VIEWED FROM OUTSIDE.
- ALL DIMENSIONS TO BE VERIFIED ON SITE BEFORE FABRICATION.

LEGEND :

- X1 - DETAIL MARK NO.
- X037 - REFER SHEET NO.
- 1. F.F.L. -- FINISHED FLOOR LEVEL
- 2. S.F.L. -- STRUCTURAL FLOOR LEVEL
- 3. -- REVERSED DETAIL

NO.	DATE	REVISED	BY
E	26/05/22	REVISED AS PER COMMENTS	LS
D	06/04/22	REVISED AS PER COMMENTS	LS
C	22/01/22	REVISED AS PER COMMENTS	LS
B	20/12/21	REVISED AS PER COMMENTS	LS
A	03/12/21	REVISED AS PER COMMENTS	LS

JOB NO. : J-858

PROJECT : PROPOSED RESIDENTIAL DEVELOPMENT AT TKOTL 70RP, PHASE 11, LOHAS PARK TSEUNG KWAN O, N.T.



TITLE : TYPICAL FLOOR PARTIAL ELEVATION & SECTION, PLAN FOR CURTAIN WALL (TOWER 2)

DATE : 20-OCT-21 SCALE : 1:50(A1)

DRAWN BY : CHECKED BY :

美特鋁質有限公司 MIDALUMINIUM FABRICATOR LTD. Units 6-8, Sunray Industrial Centre, 1/F 610 Cha Kwo Ling Road, Kowloon Tel:23489211-4 Fax:(852)2727666

DWG NO. : J858-CW-PE204 REV. : E

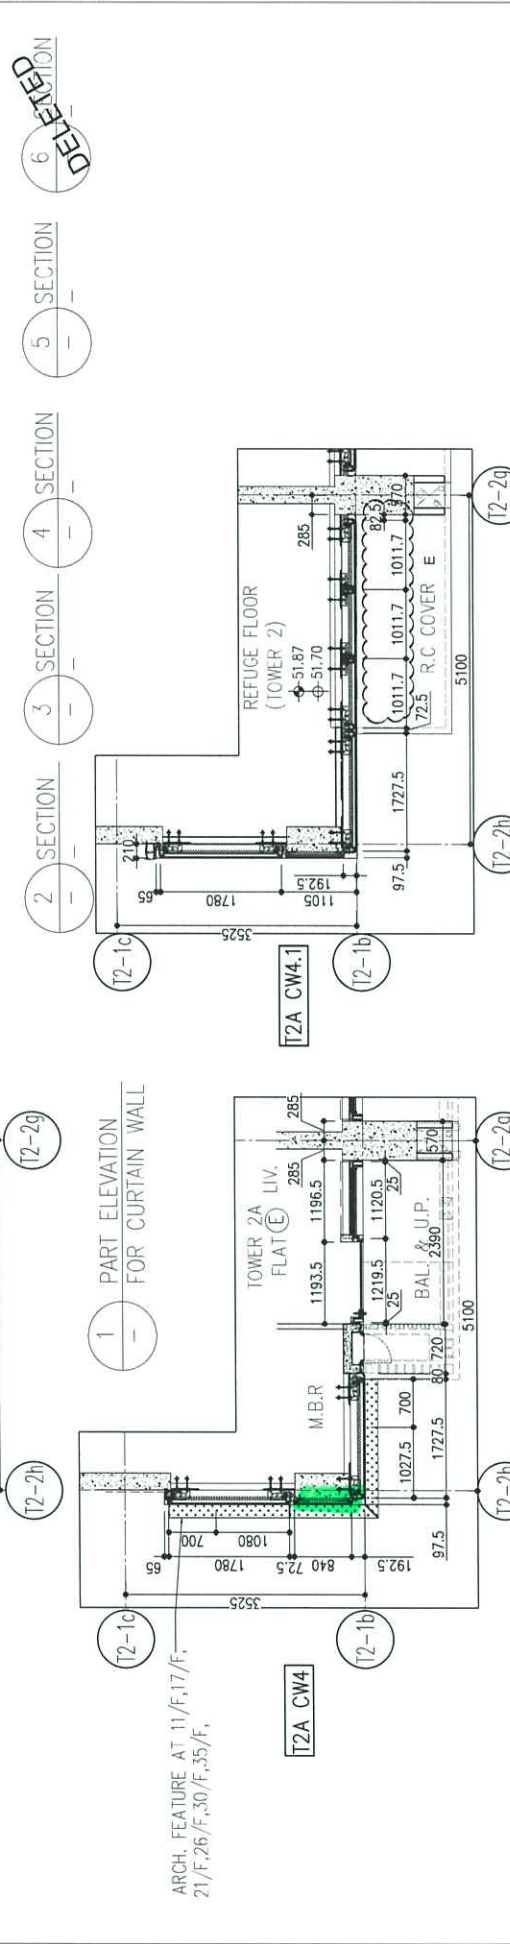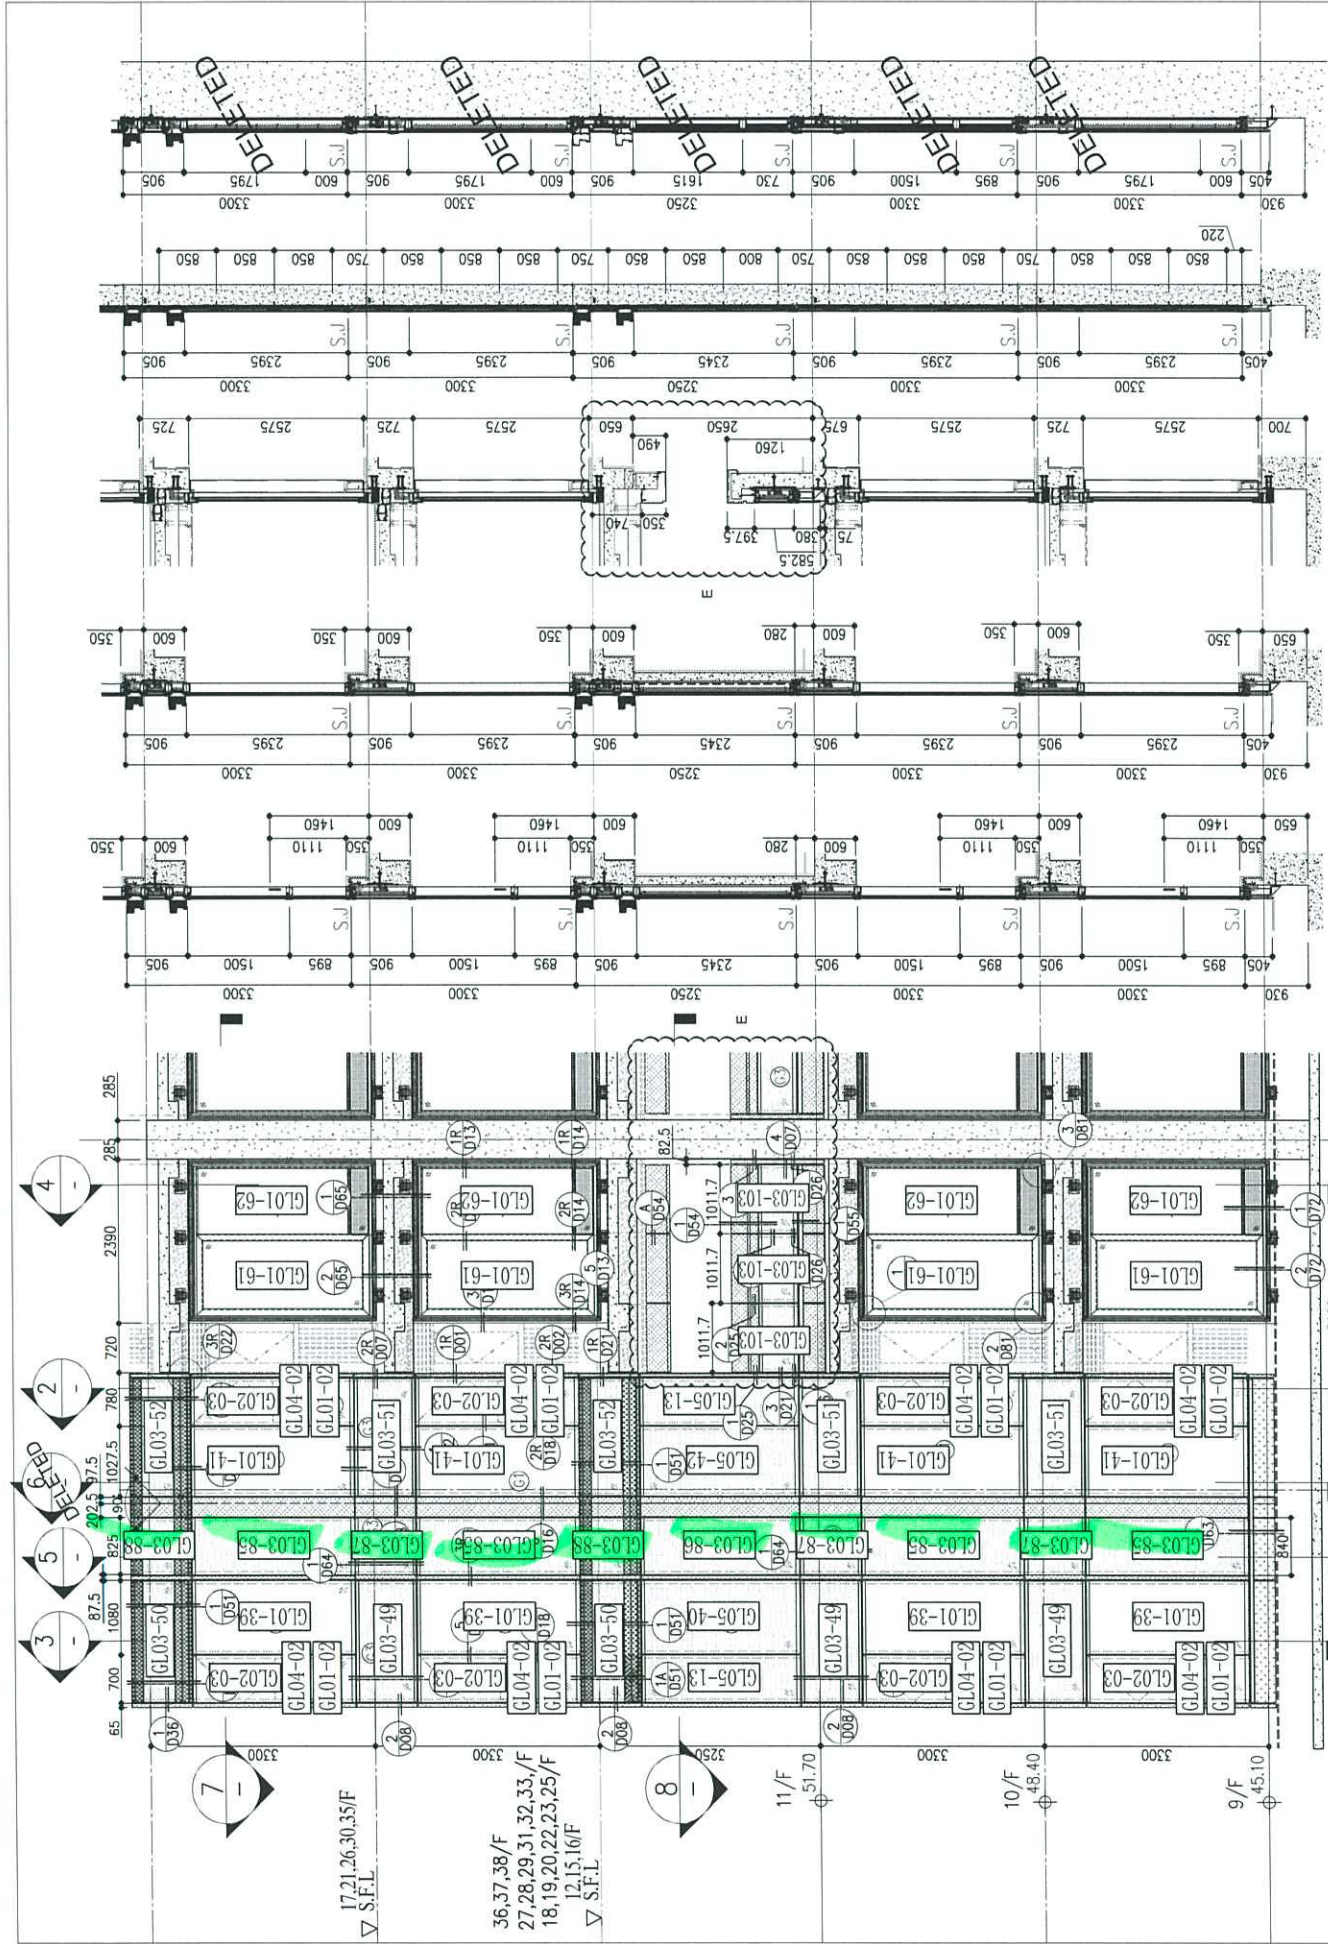

- LEGEND:
- ① 10mm THK. HEAT STRENGTHENED GLASS (OUTSIDE) + 12mm AIR SPACE + 12mm THK. TEMPERED GLASS
  - ② 10mm THK. HEAT STRENGTHENED GLASS (OUTSIDE) + 12mm AIR SPACE + 10mm THK. TEMPERED GLASS
  - ③ 12mm THK. HEAT STRENGTHENED GLASS
  - ④ 12mm THK. CLEAR TEMPERED GLASS (INTERNAL PROTECTIVE BARRIER)
  - ⑤ 10mm THK. BLUE TINTED HEAT STRENGTHENED GLASS
  - ⑥ 10mm THK. CLEAR HEAT-STRENGTHENED GLASS + 9mm AIR SPACE + 10mm CLEAR TEMPERED GLASS
  - ⑦ 8mm THK. CLEAR HEAT-STRENGTHENED GLASS + 1.52mm PVB + 8mm THK. CLEAR HEAT-STRENGTHENED GLASS
  - ⑧ 3 mm THK. ALUM. CLADDING
  - ⑨ 3 mm THK. ALUM. BACKPAN
  - S.J. - STACK JOINT

8 PART PLAN (11/F) FOR CURTAIN WALL

7 PART PLAN FOR CURTAIN WALL

NOTE:

- ALL DIMENSIONS ARE IN mm.
- ALL ELEVATIONS ARE VIEWED FROM OUTSIDE.
- ALL DIMENSIONS TO BE VERIFIED ON SITE BEFORE FABRICATION.

LEGEND:

- X1 - DETAIL MARK NO.
- R001 - REFER SHEET NO.

- F.F.L. -- FINISHED FLOOR LEVEL
- S.F.L. -- STRUCTURAL FLOOR LEVEL
- ⊖ -- REVERSED DETAIL

R/F	+217.00	+213.50	+210.00	+206.70	+203.40	+200.10	+196.80	+193.50	+190.20	+186.90	+183.60	+180.30	+177.00	+173.70	

B.D. REF :

CLIENT : 信和置業有限公司 Sino Land Company Limited

ARCHITECT : ronald lu & partners Architects, Planners, Interioy Designers Ronald Lu & Partners (HK) Ltd. 呂元祥建築師事務所 (香港) 有限公司

MAIN CONTRACTOR : Gammon

STRUCTURAL ENGINEER : AECOM

FACADE CONSULTANT : AECOM

NOTE:

- ALL DIMENSIONS ARE IN mm.
- ALL ELEVATIONS ARE VIEWED FROM OUTSIDE.
- ALL DIMENSIONS TO BE VERIFIED ON SITE BEFORE FABRICATION.

LEGEND:

- X1 - DETAIL MARK NO.
- R001 - REFER SHEET NO.

- F.F.L. -- FINISHED FLOOR LEVEL
- S.F.L. -- STRUCTURAL FLOOR LEVEL
- ⊖ -- REVERSED DETAIL

NO.	DATE	REVISED	BY
E	25/05/22	REVISED AS PER COMMENTS	LS
D	06/04/22	REVISED AS PER COMMENTS	LS
C	22/01/22	REVISED AS PER COMMENTS	LS
B	20/12/21	REVISED AS PER COMMENTS	LS
A	03/12/21	REVISED AS PER COMMENTS	LS

JOB NO. : J-858

PROJECT : PROPOSED RESIDENTIAL DEVELOPMENT AT TKOTL 70RP, PHASE 11, LOHAS PARK TSEUNG KWAN O, N.T.


TITLE : TYPICAL FLOOR PARTIAL ELEVATION & SECTION, PLAN FOR CURTAIN WALL (TOWER 2)

DATE : 20-CCT-21 SCALE : 1:50(A1)

DRAWN BY : CHECKED BY :

美特鋁質有限公司 MIDALUMINIUM FABRICATOR LTD. Units 6-8, Sunray Industrial Centre, 1/F 510 Cha Kwo Ling Road, Kowloon Tel:23489211-4 Fax:(852)2727666

DWG NO. : J858-CW-DE-115 REV. : E

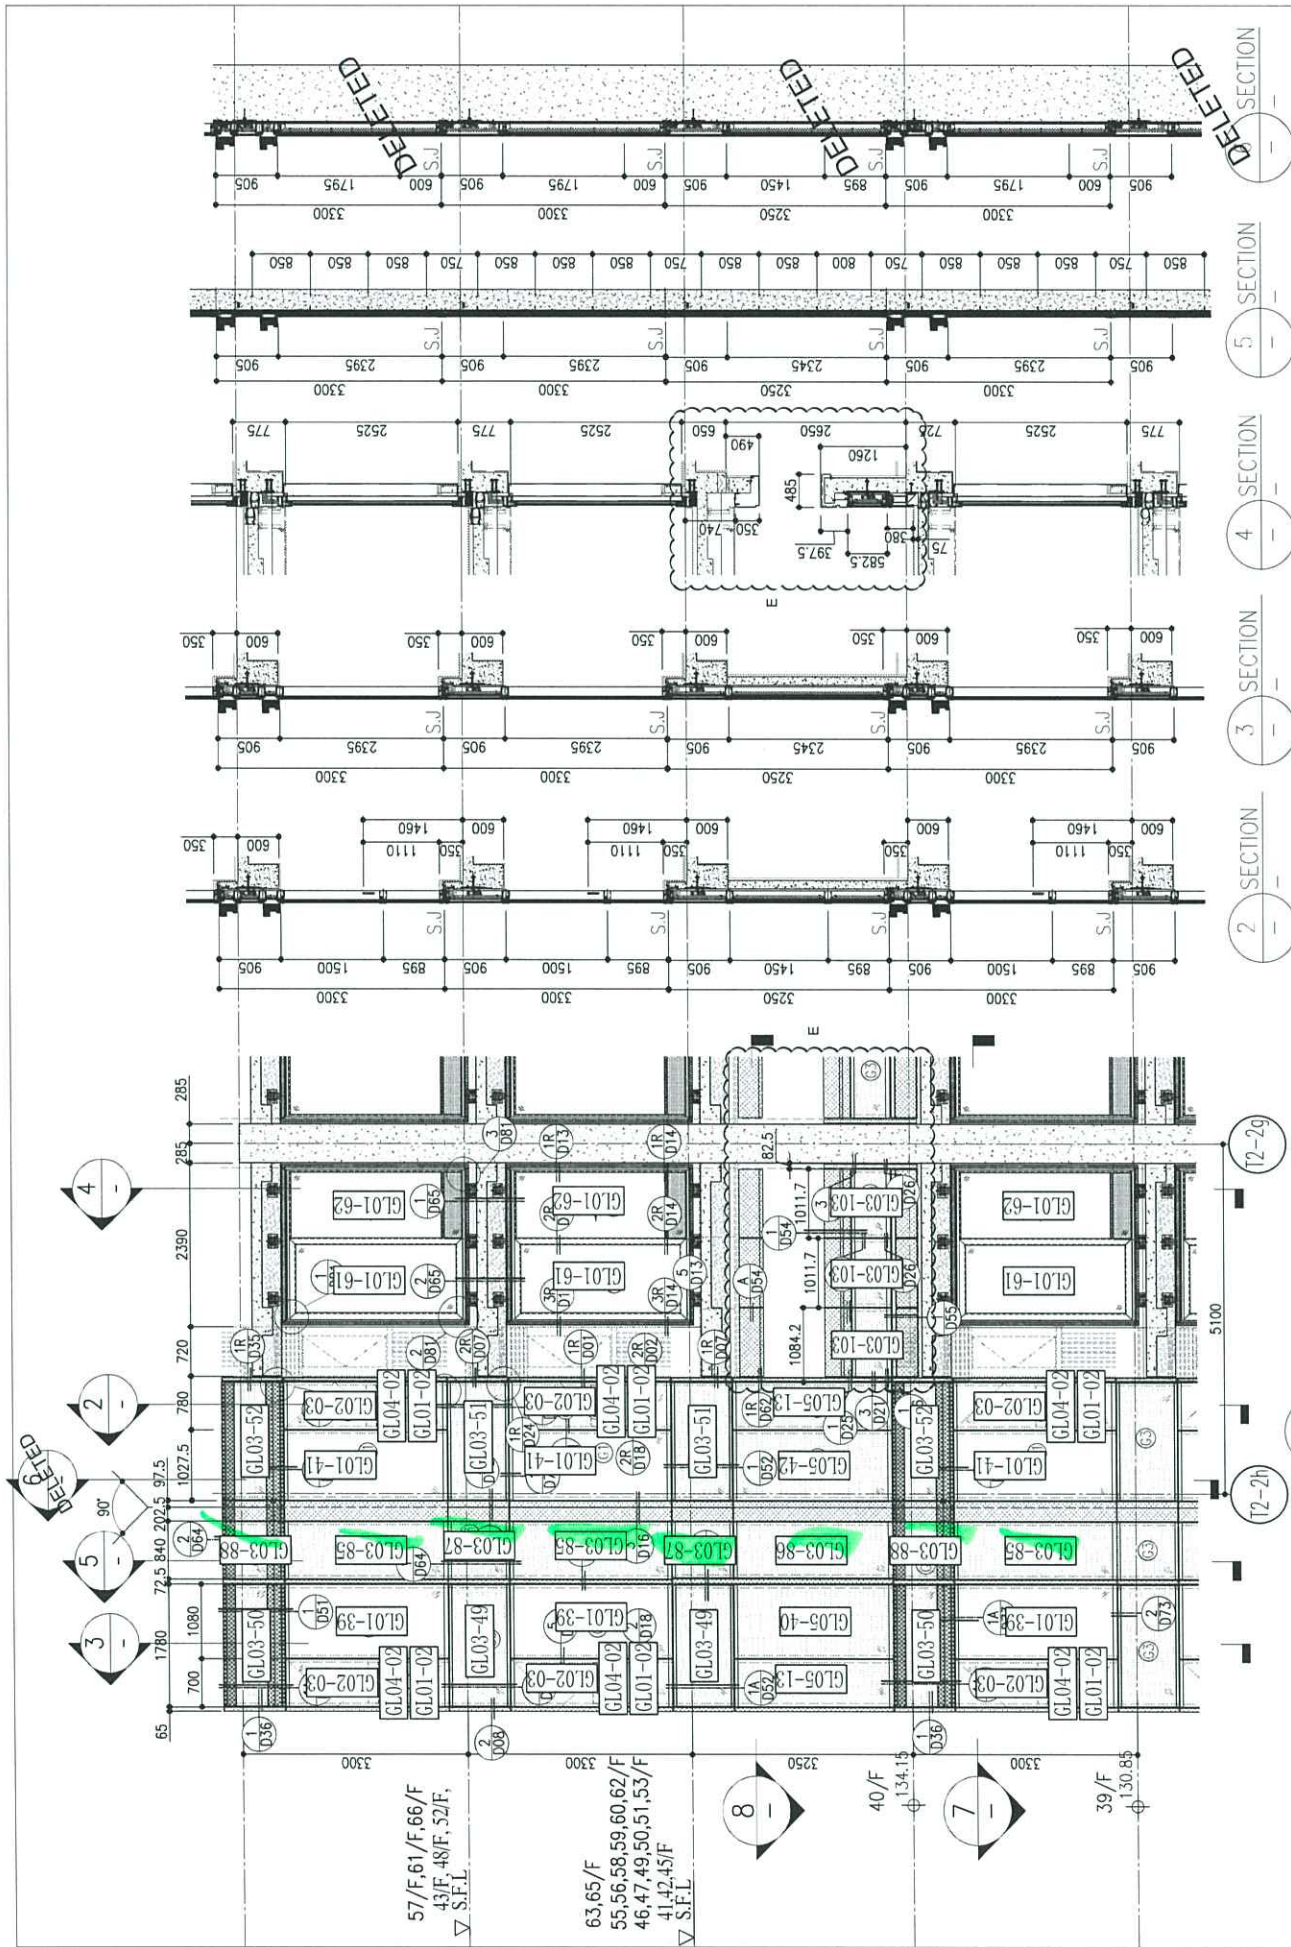

SECTION 1  
PART ELEVATION FOR CURTAIN WALL


SECTION 2  
PART ELEVATION FOR CURTAIN WALL

SECTION 3  
PART ELEVATION FOR CURTAIN WALL


SECTION 4  
PART ELEVATION FOR CURTAIN WALL

SECTION 5  
PART ELEVATION FOR CURTAIN WALL


SECTION 6  
PART ELEVATION FOR CURTAIN WALL

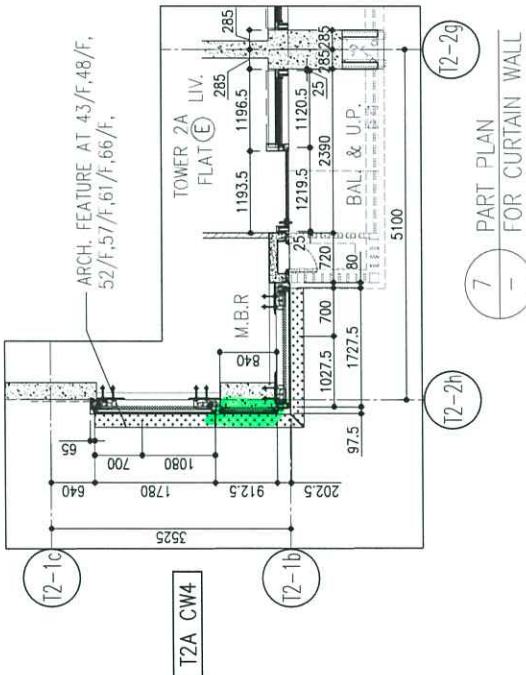

7 PART PLAN FOR CURTAIN WALL

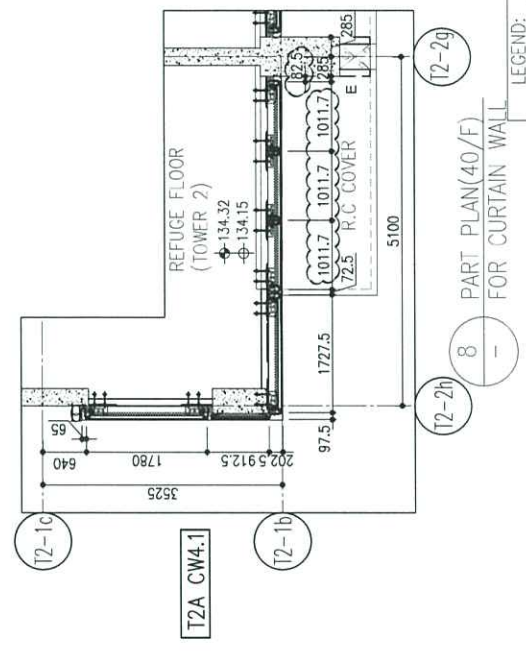

8 PART PLAN FOR CURTAIN WALL

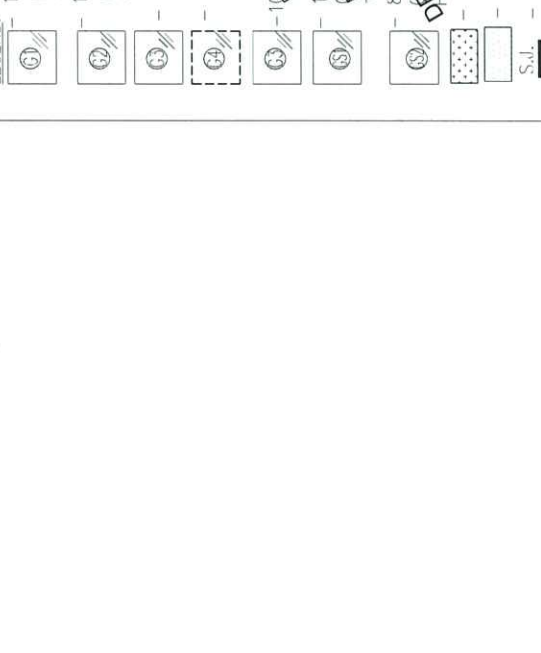


B.D. REF :

CLIENT : 信和置業有限公司 Sino Land Company Limited

ARCHITECT : ronald lu & partners Architects, Planners, Interior Designers Ronald Lu & Partners (HK) Ltd. 呂元祥建築師事務所 (香港) 有限公司

MAIN CONTRACTOR : Gammon

STRUCTURAL ENGINEER : AECOM

FACADE CONSULTANT : AECOM

NOTE :  
 1. ALL DIMENSIONS ARE IN mm.  
 2. ALL ELEVATIONS ARE VIEWED FROM OUTSIDE.  
 3. ALL DIMENSIONS TO BE VERIFIED ON SITE BEFORE FABRICATION.

LEGEND :  
 X1 - DETAIL MARK NO.  
 X001 - REFER SHEET NO.

1. F.F.L. -- FINISHED FLOOR LEVEL  
 2. S.F.L. -- STRUCTURAL FLOOR LEVEL  
 3. (R) -- REVERSED DETAIL

NO.	DATE	REVISED	BY
E	25/05/22	REVISED AS PER COMMENTS	LS
D	06/04/22	REVISED AS PER COMMENTS	LS
C	22/01/22	REVISED AS PER COMMENTS	LS
B	20/12/21	REVISED AS PER COMMENTS	LS
A	03/12/21	REVISED AS PER COMMENTS	LS

JOB NO. : J-858

PROJECT : PROPOSED RESIDENTIAL DEVELOPMENT AT TKOITL 70RP, PHASE 11, LOHAS PARK TSEUNG KWAN O, N.T.

TITLE : TYPICAL FLOOR PARTIAL ELEVATION & SECTION, PLAN FOR CURTAIN WALL (TOWER 2)


DATE : 20-OCT-21 SCALE : 1:50(A1)

DRAWN BY : CHECKED BY :

美特鋁質有限公司  
 MIDI ALUMINIUM FABRICATOR LTD.  
 Units 6-8, Sunray Industrial Centre, 1/F  
 610 Cho Kwo Ling Road, Kowloon  
 Tel:23489211-4 Fax:(852)2727666

DWG NO. : JB58-CW-PE215 REV. : E



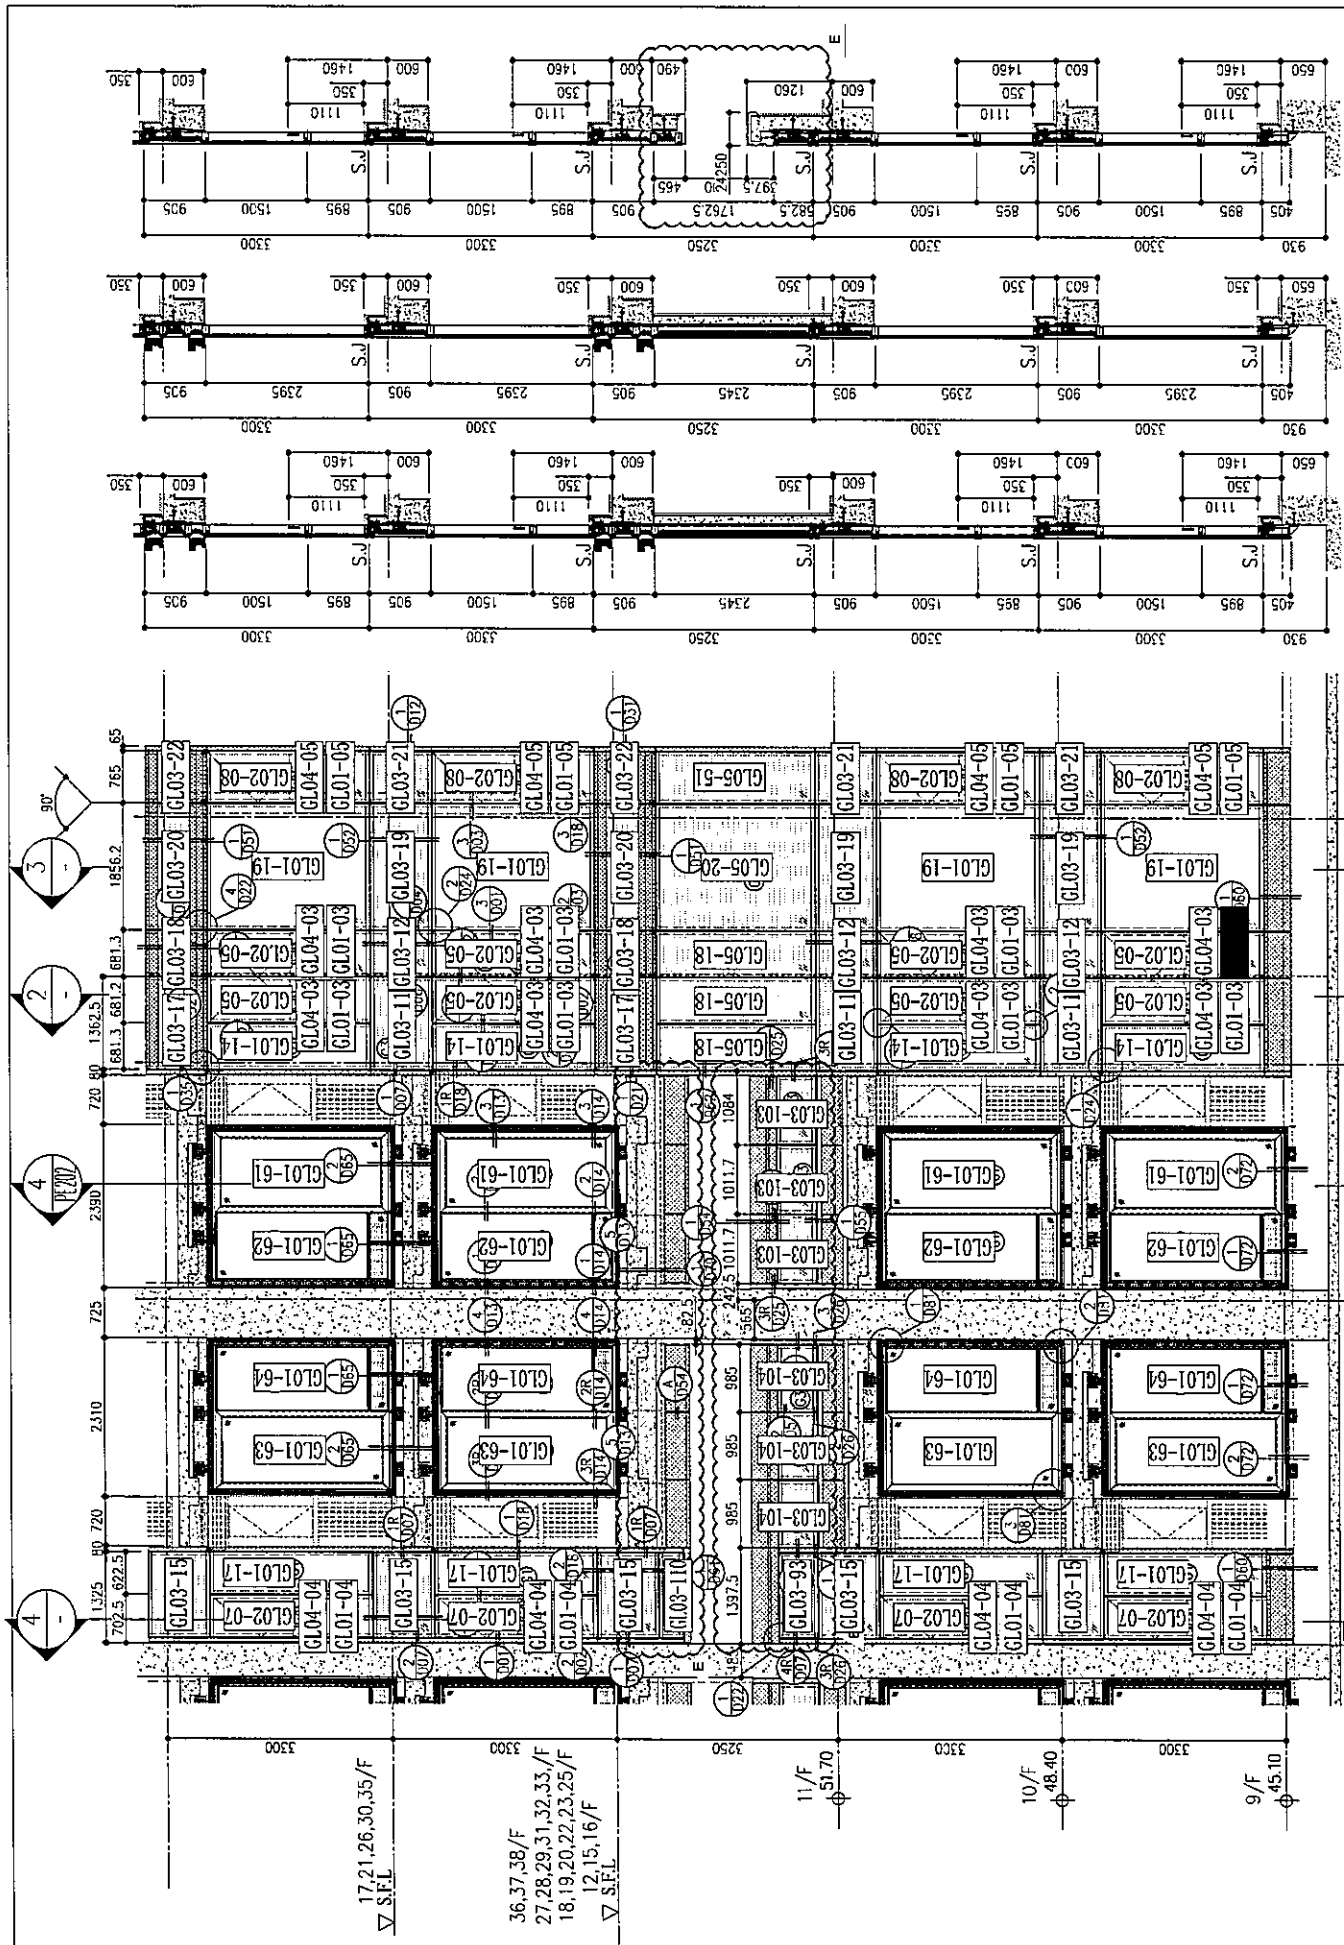

SECTION 1 - PART ELEVATION FOR CURTAIN WALL

SECTION 2 -

SECTION 3 -

SECTION 4 -

R/F	+217.00	67/F	+213.50
26/F	+91.25	39/F	+130.85
25/F	+87.95	38/F	+127.55
23/F	+84.65	37/F	+124.25
22/F	+81.35	36/F	+120.95
21/F	+78.05	35/F	+117.65
20/F	+74.75	33/F	+114.35
19/F	+71.45	32/F	+111.05
18/F	+68.15	31/F	+107.75
17/F	+64.85	30/F	+104.45
16/F	+61.55	29/F	+101.15
15/F	+58.25	28/F	+97.85
	+54.95	27/F	+94.55
		40/F	+134.15
		53/F	+173.70

LEGEND:

① 10mm THK. HEAT STRENGTHENED GLASS (OUTSIDE) + 12mm AIR SPACE + 12mm THK. TEMPERED GLASS

② 10mm THK. HEAT STRENGTHENED GLASS (OUTSIDE) + 12mm AIR SPACE + 10mm THK. TEMPERED GLASS

③ 12mm THK. HEAT STRENGTHENED GLASS

④ 12mm THK. CLEAR TEMPERED GLASS (INTERNAL PROTECTIVE BARRIER)

⑤ 10mm BLINDENED HEAT STRENGTHENED GLASS


⑥ 10mm CLEAR TEMPERED GLASS

⑦ 8mm THK. CLEAR HEAT-STRENGTHENED GLASS + 2mm PVB + 8mm THK. CLEAR HEAT-STRENGTHENED GLASS

⑧ 3 mm THK. ALUM. CLADDING

S.J. - 3 mm THK. ALUM. BACKPAN

— - STACK JOINT

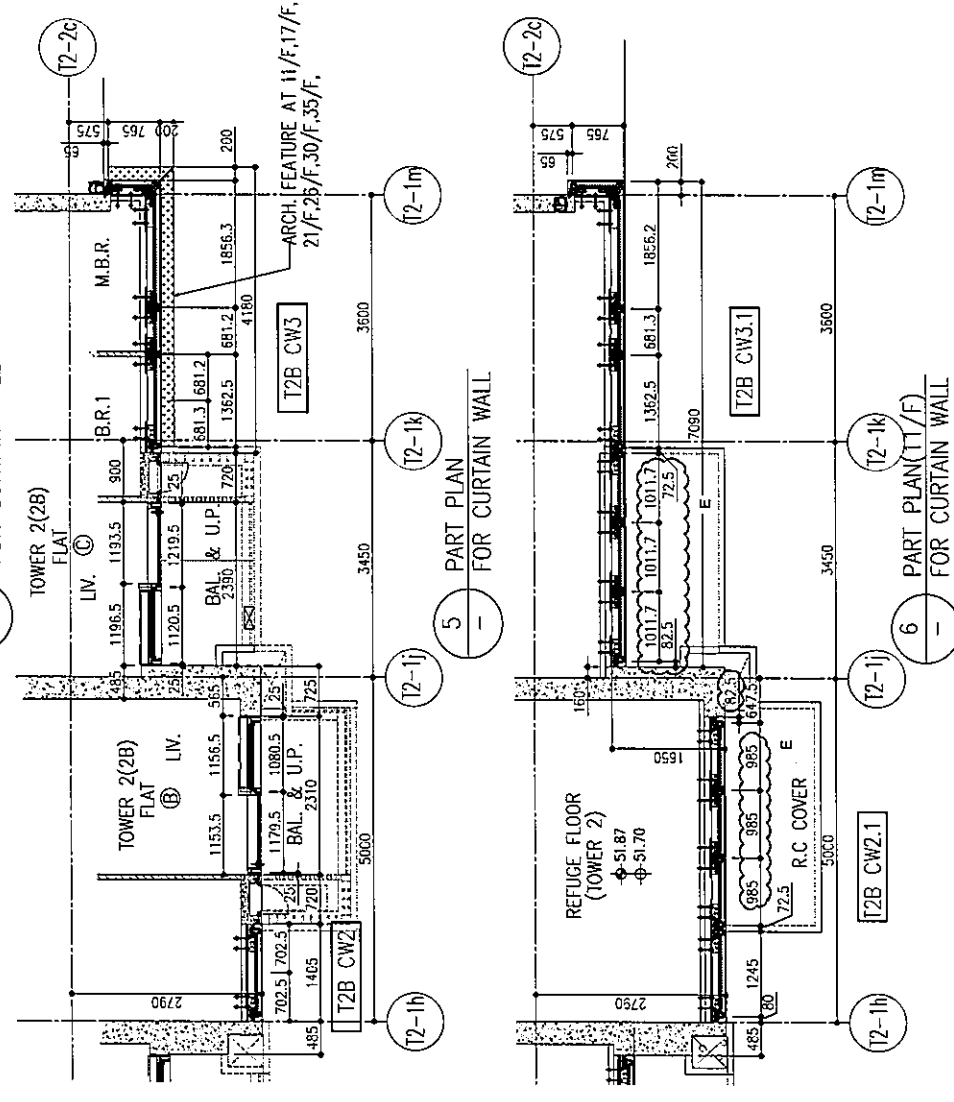

B.D. REF :

CLIENT : 和置業有限公司  
Sino Land Company Limited

ARCHITECT : Ronald Lu & Partners  
Ronald Lu & Partners (HK) Ltd.  
呂元祥建築師事務所 (香港) 有限公司

MAIN CONTRACTOR : Gammon

STRUCTURAL ENGINEER : AECOM

FAÇADE CONSULTANT : AECOM

NOTE :

- ALL DIMENSIONS ARE IN mm.
- ALL ELEVATIONS ARE VIEWED FROM OUTSIDE.
- ALL DIMENSIONS TO BE VERIFIED ON SITE BEFORE FABRICATION.

LEGEND :

X1 - DETAIL MARK NO.  
 X001 - REFER SHEET NO.

1. F.F.L. -- FINISHED FLOOR LEVEL  
 2. S.F.L. -- STRUCTURAL FLOOR LEVEL  
 3. Ⓢ -- REVERSED DETAIL

E	25/05/22	REVISED AS PER COMMENTS	LS
D	06/04/22	REVISED AS PER COMMENTS	LS
C	22/01/22	REVISED AS PER COMMENTS	LS
B	20/12/21	REVISED AS PER COMMENTS	LS
A	03/12/21	REVISED AS PER COMMENTS	LS
NO.	DATE	REVISION	BY

JOB NO. : J-858

PROJECT : PROPOSED RESIDENTIAL DEVELOPMENT AT TKOTL 70RP, PHASE 11, LOHAS PARK TSEUNG KWAN O, N.T.

TITLE : TYPICAL FLOOR PARTIAL ELEVATION & SECTION, PLAN FOR CURTAIN WALL (TOWER 2)

DATE : 20-OCT-21 SCALE : 1:50(A1)


DRAWN BY : CHECKED BY :

美特鋁質有限公司  
MIDI ALUMINIUM FABRICATOR LTD.  
Units 6-8, Sunray Industrial Centre, 1/F  
610 Cha Kwo Ling Road, Kowloon  
Tel:23489211-4 Fax:(852)2727666

DWG NO. : J858-CW-PE203 REV. : E





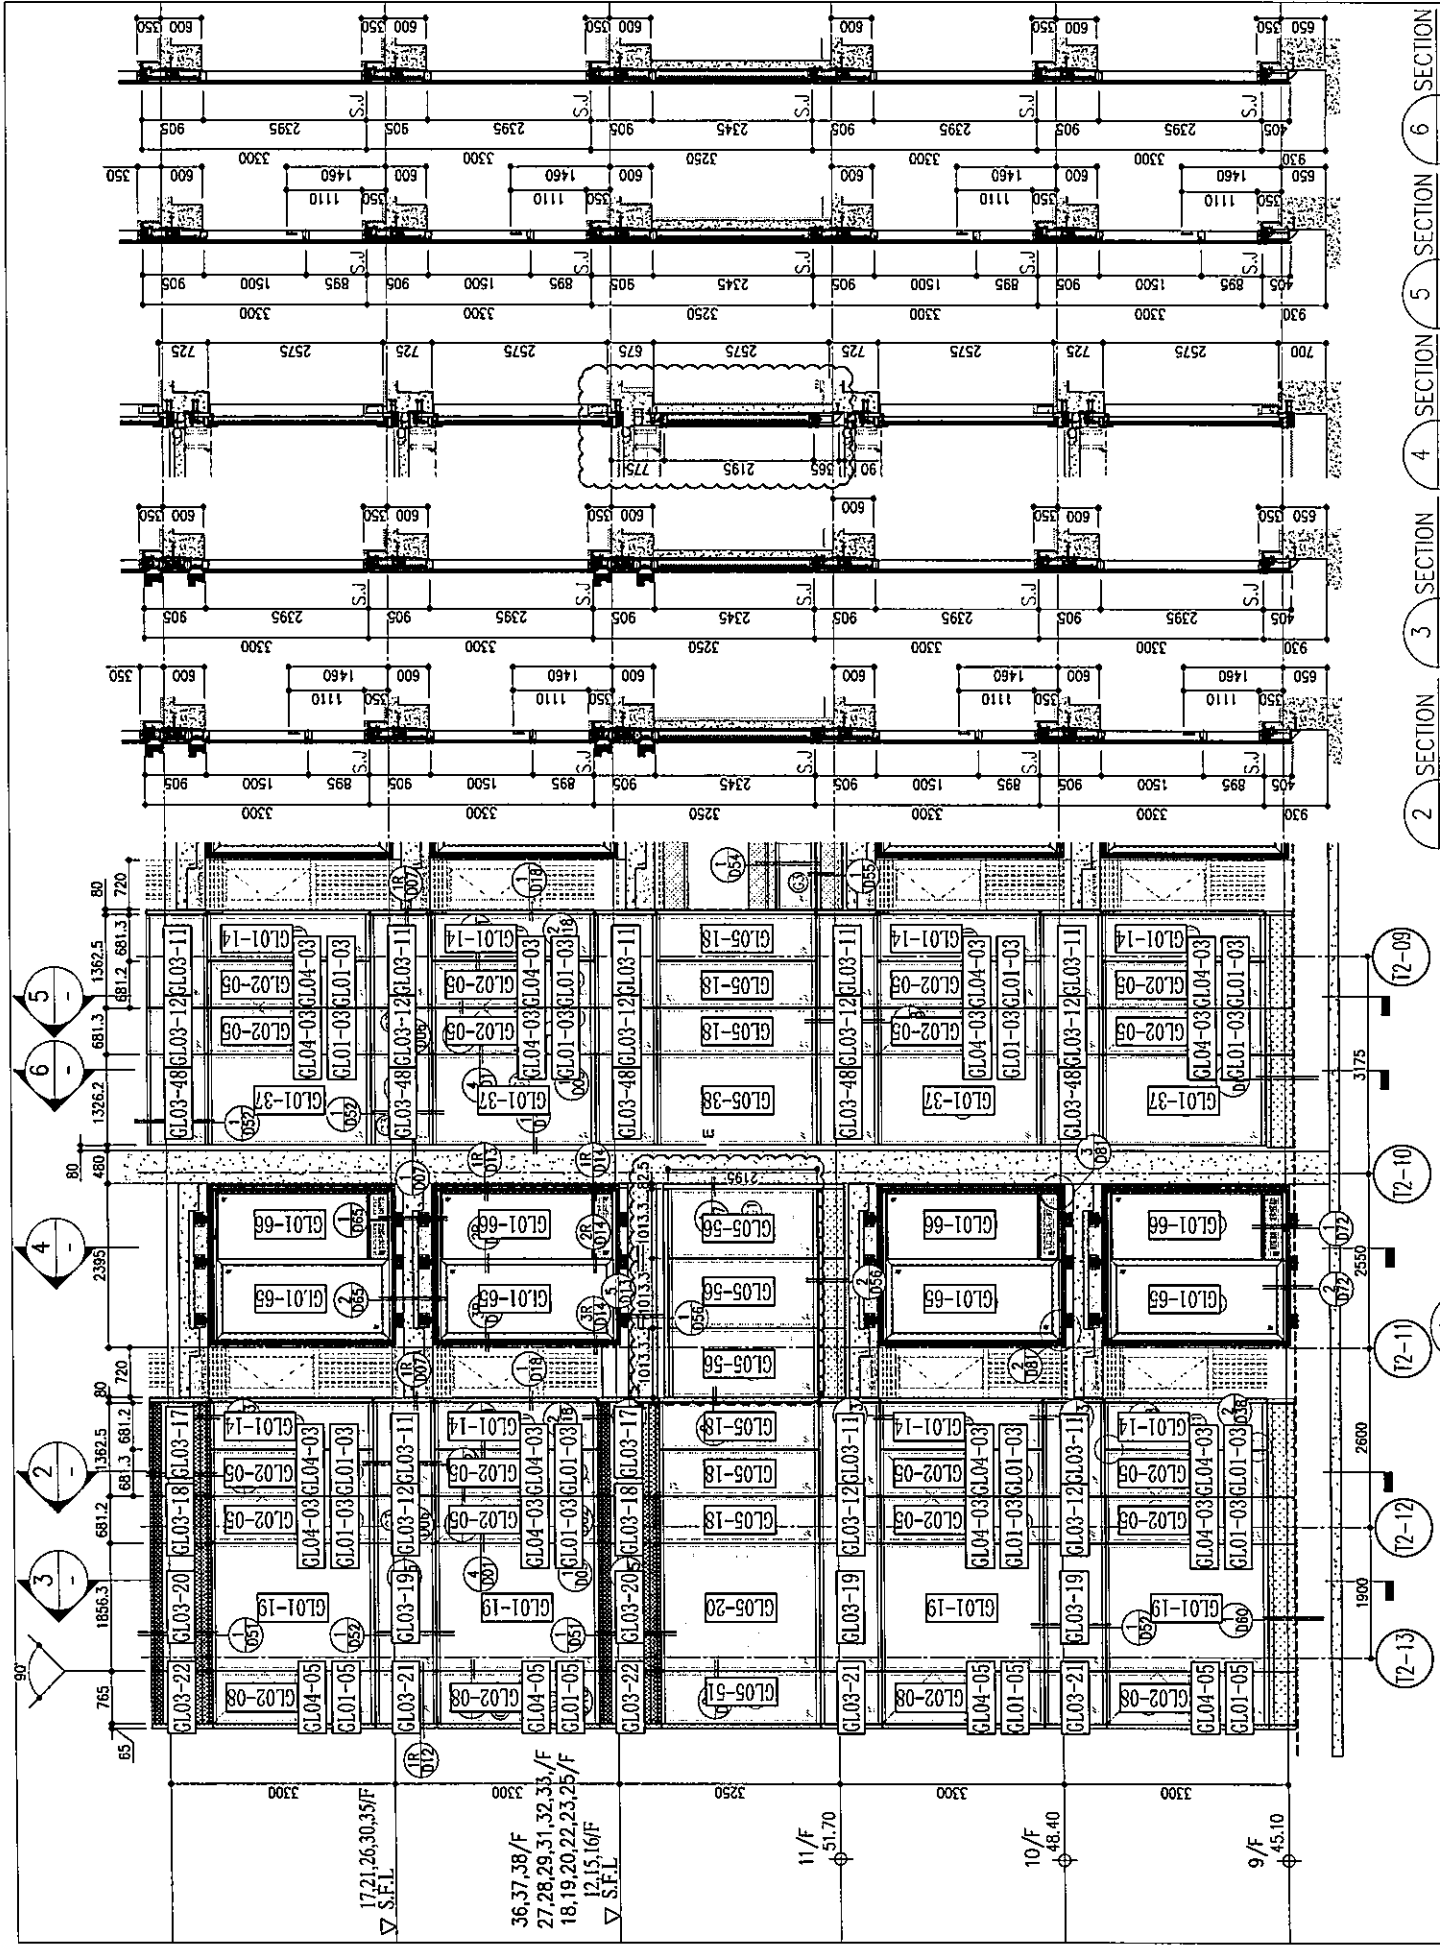


SECTION 1 SECTION 2 SECTION 3 SECTION 4 SECTION 5 SECTION 6

26/F	+91.25	39/F	+130.85	52/F	+170.40	66/F	+213.50
25/F	+87.95	38/F	+127.55	51/F	+167.10	65/F	+210.00
23/F	+84.65	37/F	+124.25	50/F	+163.80	63/F	+206.70
22/F	+81.35	36/F	+120.95	49/F	+160.50	62/F	+203.40
21/F	+78.05	35/F	+117.65	48/F	+157.20	61/F	+199.80
20/F	+74.75	33/F	+114.35	47/F	+153.90	60/F	+196.50
19/F	+71.45	32/F	+111.05	46/F	+150.60	59/F	+193.20
18/F	+68.15	31/F	+107.75	45/F	+147.30	58/F	+189.90
17/F	+64.85	30/F	+104.45	43/F	+144.00	57/F	+186.60
16/F	+61.55	29/F	+101.15	42/F	+140.70	56/F	+183.30
15/F	+58.25	28/F	+97.85	41/F	+137.40	55/F	+180.00
12/F	+54.95	27/F	+94.55	40/F	+134.15	53/F	+173.70

LEGEND:

- ① 10mm THK. HEAT STRENGTHENED GLASS (OUTSIDE) + 12mm AIR SPACE + 12mm THK. TEMPERED GLASS
- ② 10mm THK. HEAT STRENGTHENED GLASS (OUTSIDE) + 12mm AIR SPACE + 10mm THK. TEMPERED GLASS
- ③ 12mm THK. HEAT STRENGTHENED GLASS
- ④ 12mm THK. CLEAR TEMPERED GLASS (INTERNAL PROTECTIVE BARRIER)
- ⑤ 10mm BLUETINTED HEAT STRENGTHENED GLASS
- ⑥ 10mm DELETED CLEAR TEMPERED GLASS
- ⑦ 8mm THK. CLEAR HEAT-STRENGTHENED GLASS + 2mm PVB + 8mm THK. CLEAR HEAT-STRENGTHENED GLASS
- ⑧ 3 mm THK. ALUM. CLADDING
- S.J. 3 mm THK. ALUM. BACKPAN
- STACK JOINT

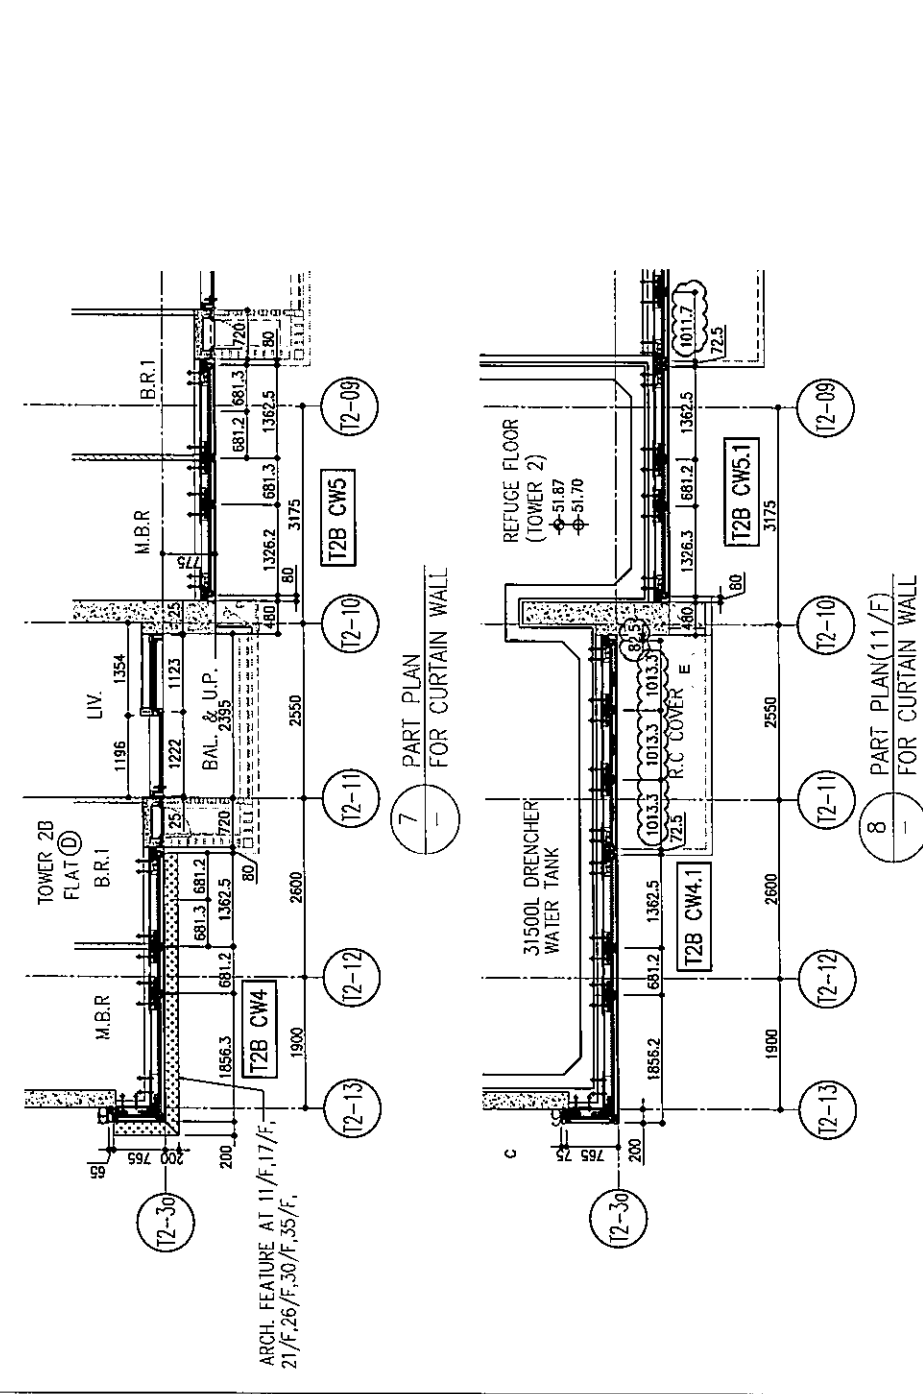

B.D. REF :

CLIENT : 信和置業有限公司 Sino Land Company Limited

ARCHITECT : ronald lu & partners Ronald Lu & Partners (HK) Ltd. 呂元祥建築師事務所 (香港) 有限公司

MAIN CONTRACTOR : Gammon

STRUCTURAL ENGINEER : AECOM

FAÇADE CONSULTANT : AECOM

NOTE :

- ALL DIMENSIONS ARE IN mm.
- ALL ELEVATIONS ARE VIEWED FROM OUTSIDE.
- ALL DIMENSIONS TO BE VERIFIED ON SITE BEFORE FABRICATION.

LEGEND :

- ① DETAIL MARK NO.
- ② REFER SHEET NO.
- 1. F.F.L. --- FINISHED FLOOR LEVEL
- 2. S.F.L. --- STRUCTURAL FLOOR LEVEL
- ③ --- REVERSED DETAIL

E	26/05/22	REVISED AS PER COMMENTS	LS
D	06/04/22	REVISED AS PER COMMENTS	LS
C	12/01/22	REVISED AS PER COMMENTS	LS
B	12/01/21	REVISED AS PER COMMENTS	LS
A	03/12/21	REVISED AS PER COMMENTS	LS
NO.	DATE	REVISION	BY

JOB NO. : J-858

PROJECT : PROPOSED RESIDENTIAL DEVELOPMENT AT TKOTL 70RP, PHASE 11, LOHAS PARK TSEUNG KWAN O, N.T.

TITLE : TYPICAL FLOOR PARTIAL ELEVATION & SECTION, PLAN FOR CURTAIN WALL (TOWER 2)

DATE : 20-CCT-21 SCALE : 1:50(A1)


DRAWN BY : CHECKED BY :

美特鋁質有限公司 MIDU ALUMINIUM FABRICATOR LTD. Units 6-8, Sunray Industrial Centre, 1/F 610 Cha Kwo Ling Road, Kowloon Tel:23489211-4 Fax:(852)2772666

DWG NO. : J858-CW-PE207 REV. : E





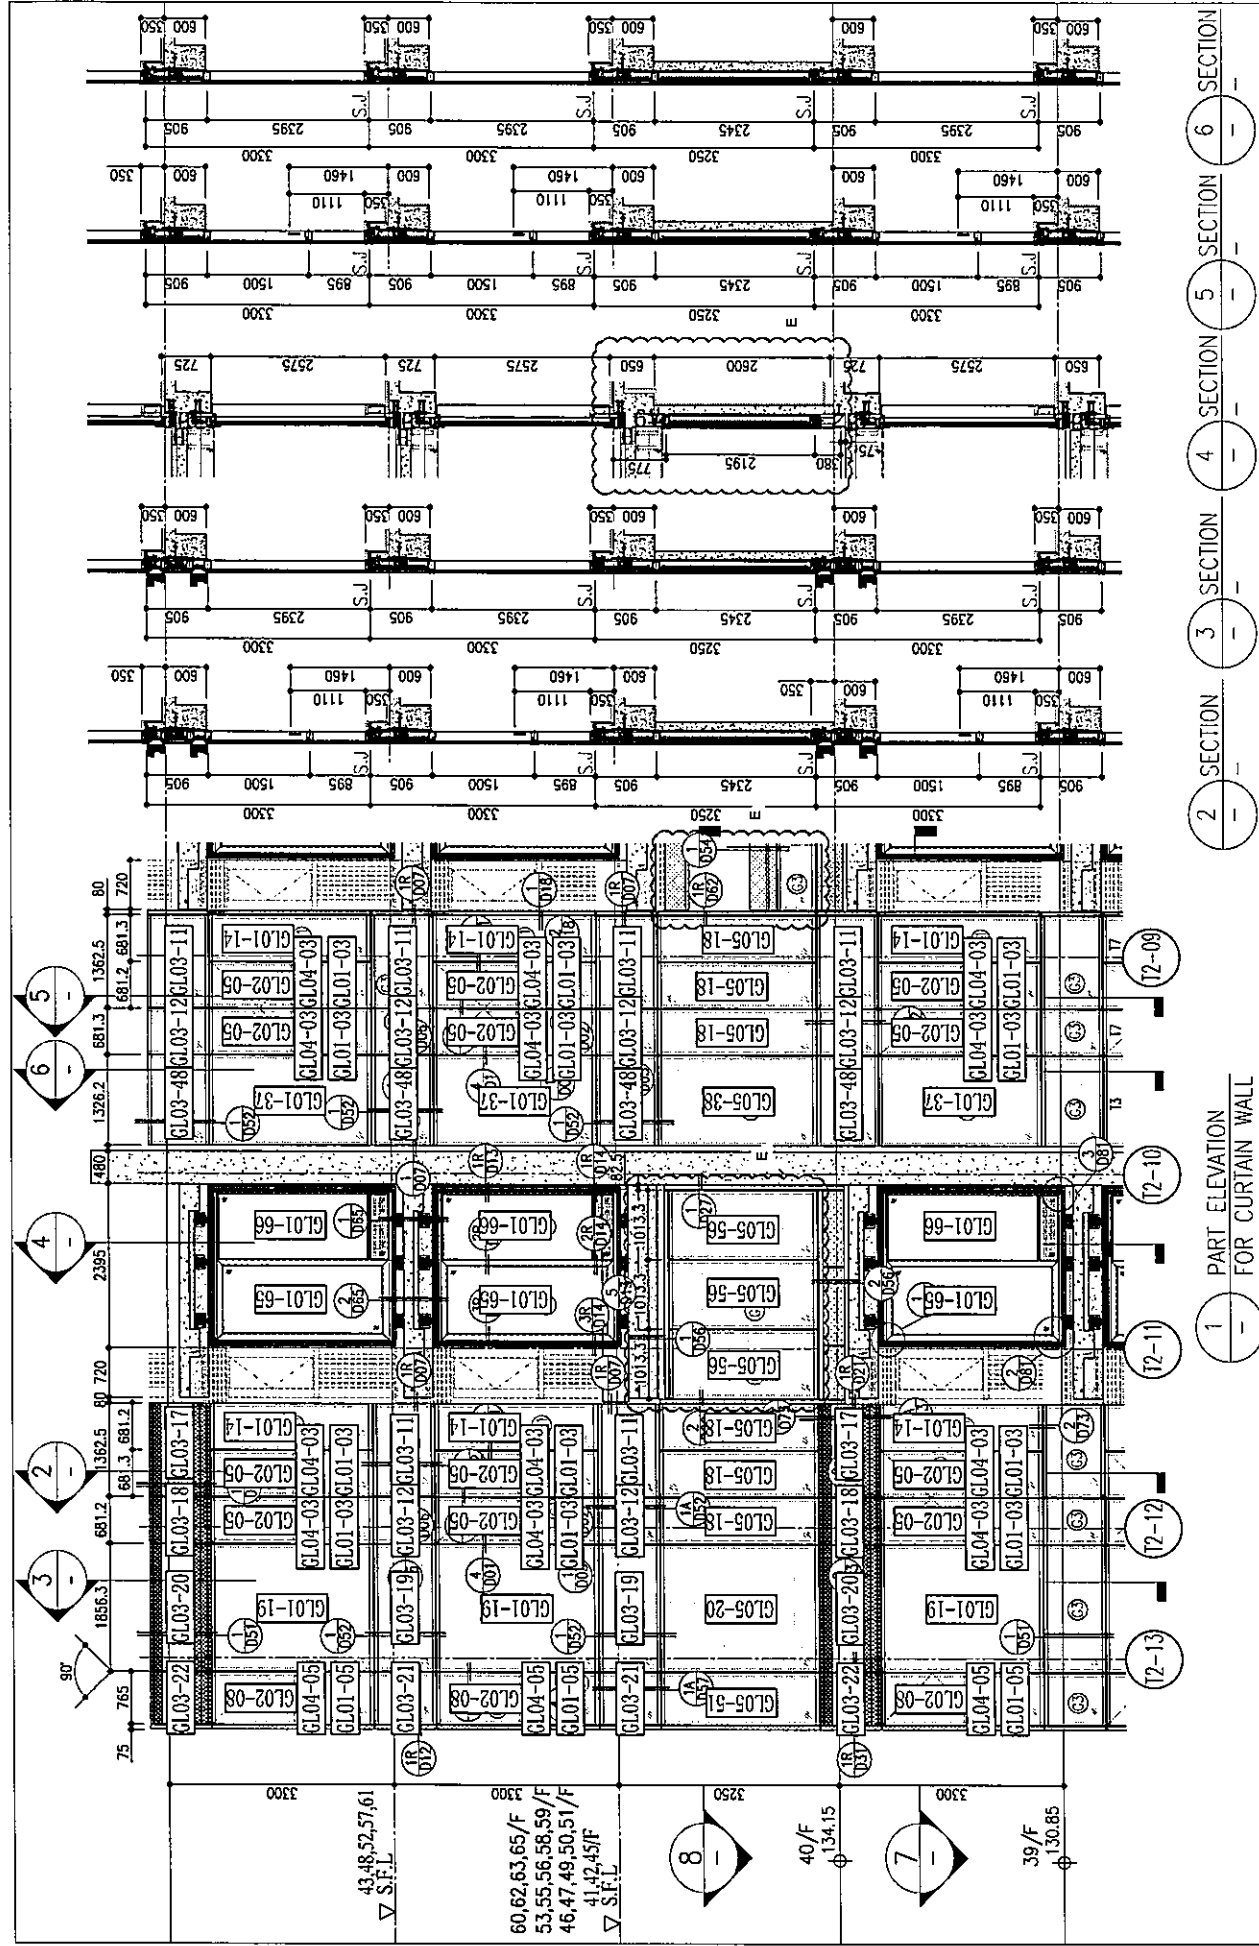

1 PART ELEVATION FOR CURTAIN WALL  
 2 SECTION 3 SECTION 4 SECTION 5 SECTION 6 SECTION

R/F	+217.00	67/F	+213.50
26/F	+91.25	39/F	+130.85
25/F	+87.95	38/F	+127.55
23/F	+84.65	37/F	+124.25
22/F	+81.35	36/F	+120.95
21/F	+78.05	35/F	+117.65
20/F	+74.75	33/F	+114.35
19/F	+71.45	32/F	+111.05
18/F	+68.15	31/F	+107.75
17/F	+64.85	30/F	+104.45
16/F	+61.55	29/F	+101.15
15/F	+58.25	28/F	+97.85
12/F	+54.95	27/F	+94.55
		40/F	+134.15
		53/F	+173.70

LEGEND:

① 10mm THK. HEAT STRENGTHENED GLASS (OUTSIDE) + 12mm AIR SPACE + 12mm THK. TEMPERED GLASS

② 10mm THK. HEAT STRENGTHENED GLASS (OUTSIDE) + 12mm AIR SPACE + 10mm THK. TEMPERED GLASS

③ 12mm THK. HEAT STRENGTHENED GLASS

④ 12mm THK. CLEAR TEMPERED GLASS (INTERNAL PROTECTIVE BARRIER)

⑤ 10mm BLUING TINTED HEAT STRENGTHENED GLASS


⑥ 10mm TINTED CLEAR TEMPERED GLASS

⑦ 8mm THK. HEAT-STRENGTHENED GLASS + 12mm PVB + 8mm THK. CLEAR HEAT-STRENGTHENED GLASS

⑧ 3 mm THK. ALUM. CLADDING

⑨ 3 mm THK. ALUM. BACKPAN

S.J. - STACK JOINT

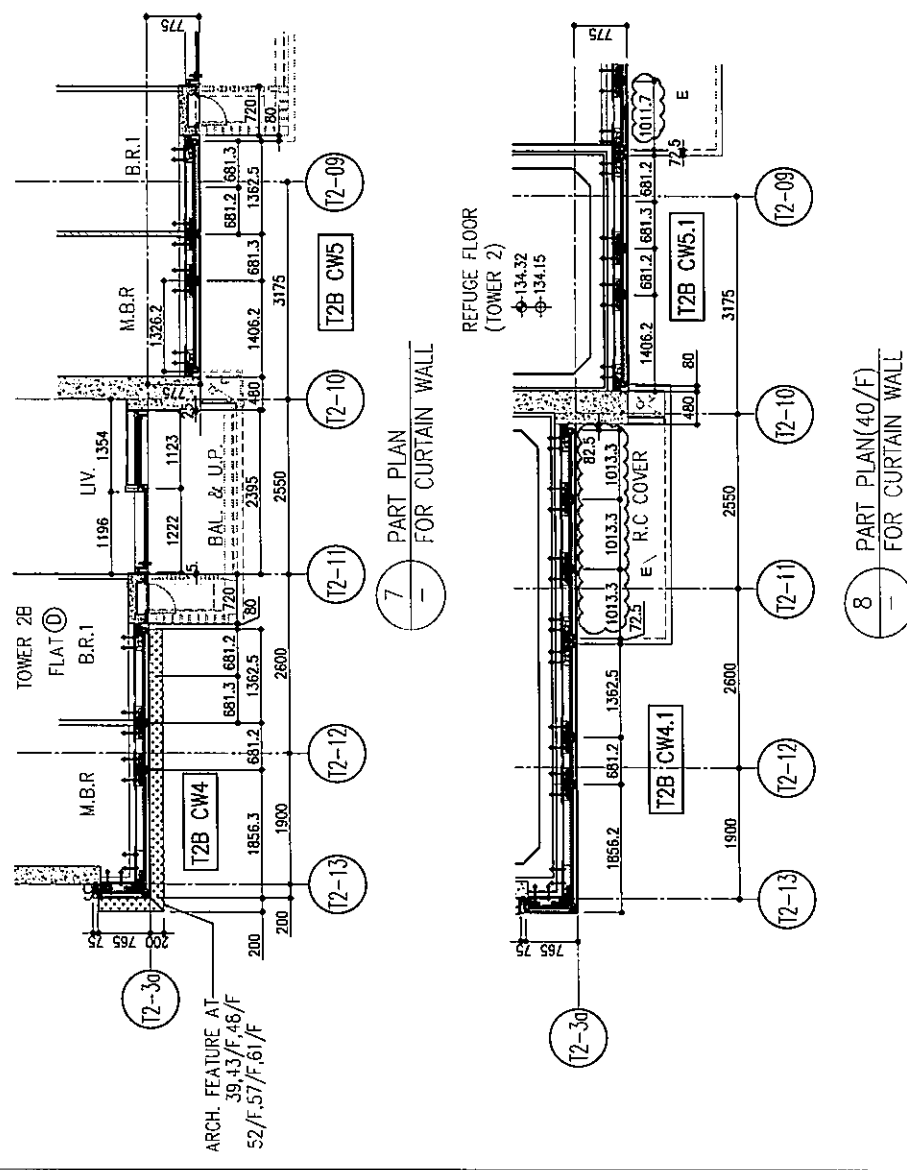

7 PART PLAN FOR CURTAIN WALL  
 8 PART PLAN (40/F) FOR CURTAIN WALL

B.D. REF :

CLIENT : 信和置業有限公司 Sino Land Company Limited

ARCHITECT : Ronald Lu & Partners Architects, Planners, Interior Designers Ronald Lu & Partners (HK) Ltd. 呂元祥建築師事務所 (香港) 有限公司

MAIN CONTRACTOR : Gammon

STRUCTURAL ENGINEER : AECOM

FACADE CONSULTANT : AECOM

NOTE :

- ALL DIMENSIONS ARE IN mm.
- ALL ELEVATIONS ARE VIEWED FROM OUTSIDE.
- ALL DIMENSIONS TO BE VERIFIED ON SITE BEFORE FABRICATION.

LEGEND :

① DETAIL MARK NO.

② REFER SHEET NO.

- F.F.L. --- FINISHED FLOOR LEVEL
- S.F.L. --- STRUCTURAL FLOOR LEVEL
- REVERSED DETAIL

E	26/05/22	REVISED AS PER COMMENTS	LS
D	06/04/22	REVISED AS PER COMMENTS	LS
C	22/01/22	REVISED AS PER COMMENTS	LS
B	20/12/21	REVISED AS PER COMMENTS	LS
A	03/12/21	REVISED AS PER COMMENTS	LS
NO.	DATE	REVISED	BY

JOB NO. : J-858

PROJECT : PROPOSED RESIDENTIAL DEVELOPMENT AT TKOIL 70RP, PHASE 11, LOHAS PARK TSEUNG KWAN O, N.T.


TITLE : TYPICAL FLOOR PARTIAL ELEVATION & SECTION, PLAN FOR CURTAIN WALL (TOWER 2)

DATE : 20-OCT-21 SCALE : 1:50(A1)

DRAWN BY : CHECKED BY :

美特鋁質有限公司 MIDI ALUMINIUM FABRICATOR LTD. Units 6-8, Sunray Industrial Centre, 1/F 610 Cho Kwo Ling Road, Kowloon Tel:23489211-4 Fax:(852)27727666

DWG NO. : J858-CW-PE210 REV. : E

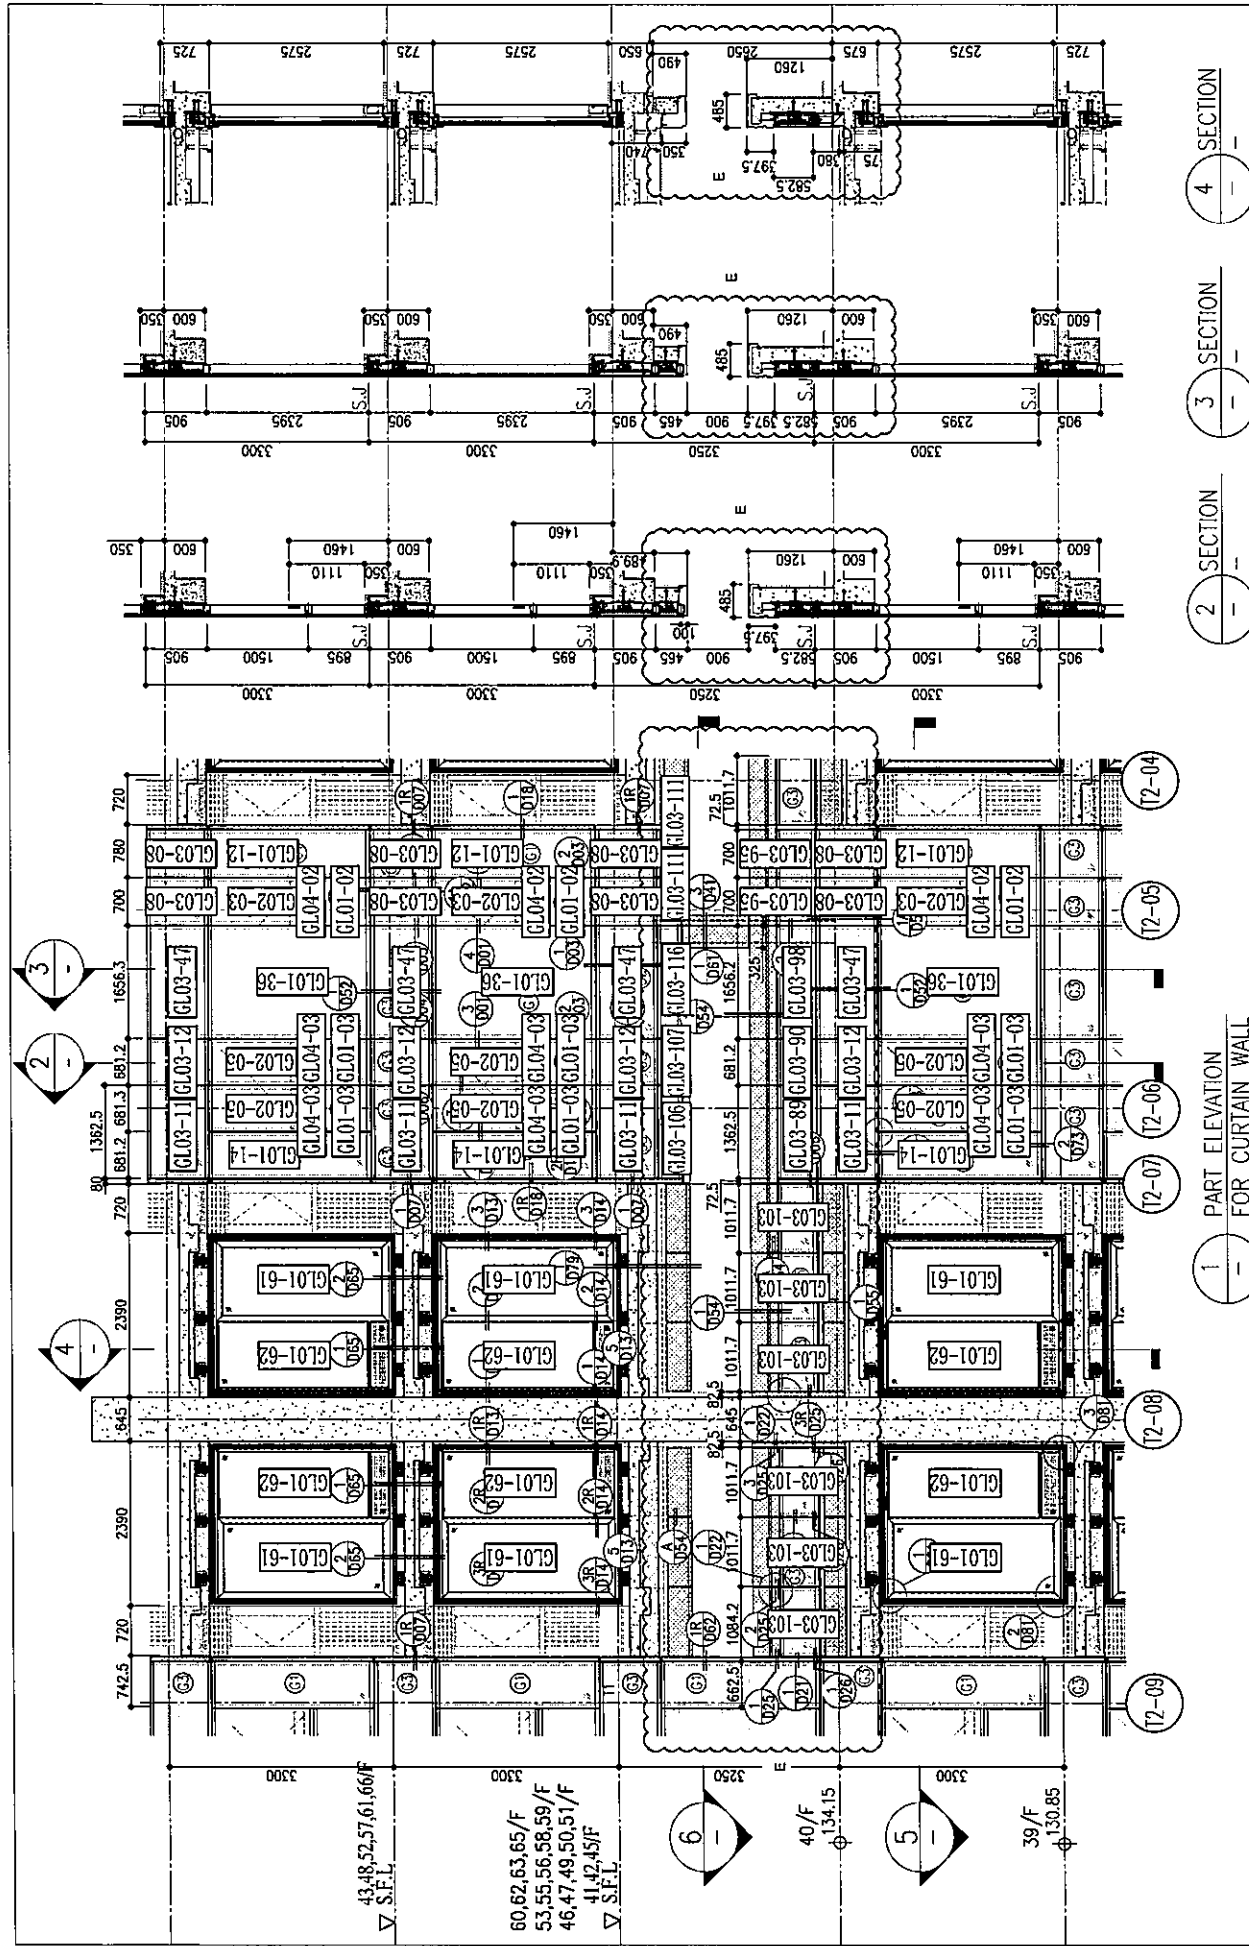

SECTION 4


SECTION 3

SECTION 2

SECTION 1 PART ELEVATION FOR CURTAIN WALL

R/F	+217.00	67/F	+213.50
26/F	+91.25	39/F	+130.85
25/F	+87.95	38/F	+127.55
23/F	+84.65	37/F	+124.25
22/F	+81.35	36/F	+120.95
21/F	+78.05	35/F	+117.65
20/F	+74.75	33/F	+114.35
19/F	+71.45	32/F	+111.05
18/F	+68.15	31/F	+107.75
17/F	+64.85	30/F	+104.45
16/F	+61.55	29/F	+101.15
15/F	+58.25	28/F	+97.85
12/F	+54.95	27/F	+94.55
		40/F	+134.15
		53/F	+173.70

- LEGEND:
- (G1) 10mm THK. HEAT STRENGTHENED GLASS (OUTSIDE) + 12mm AIR SPACE + 12mm THK. TEMPERED GLASS
  - (G2) 10mm THK. HEAT STRENGTHENED GLASS (OUTSIDE) + 12mm AIR SPACE + 10mm THK. TEMPERED GLASS
  - (G3) 12mm THK. HEAT STRENGTHENED GLASS
  - (G4) 12mm THK. CLEAR TEMPERED GLASS (INTERNAL PROTECTIVE BARRIER)
  - (G5) 10mm BLUING HEAT STRENGTHENED GLASS
  - (G6) 10mm THK. CLEAR TEMPERED GLASS
  - (G7) 8mm THK. CLEAR HEAT-STRENGTHENED GLASS + 2mm PVB + 8mm THK. CLEAR HEAT-STRENGTHENED GLASS
  - (G8) 3 mm THK. ALUM. GLASSING
  - (G9) 3 mm THK. ALUM. BACKPAN
  - S.J. - STACK JOINT

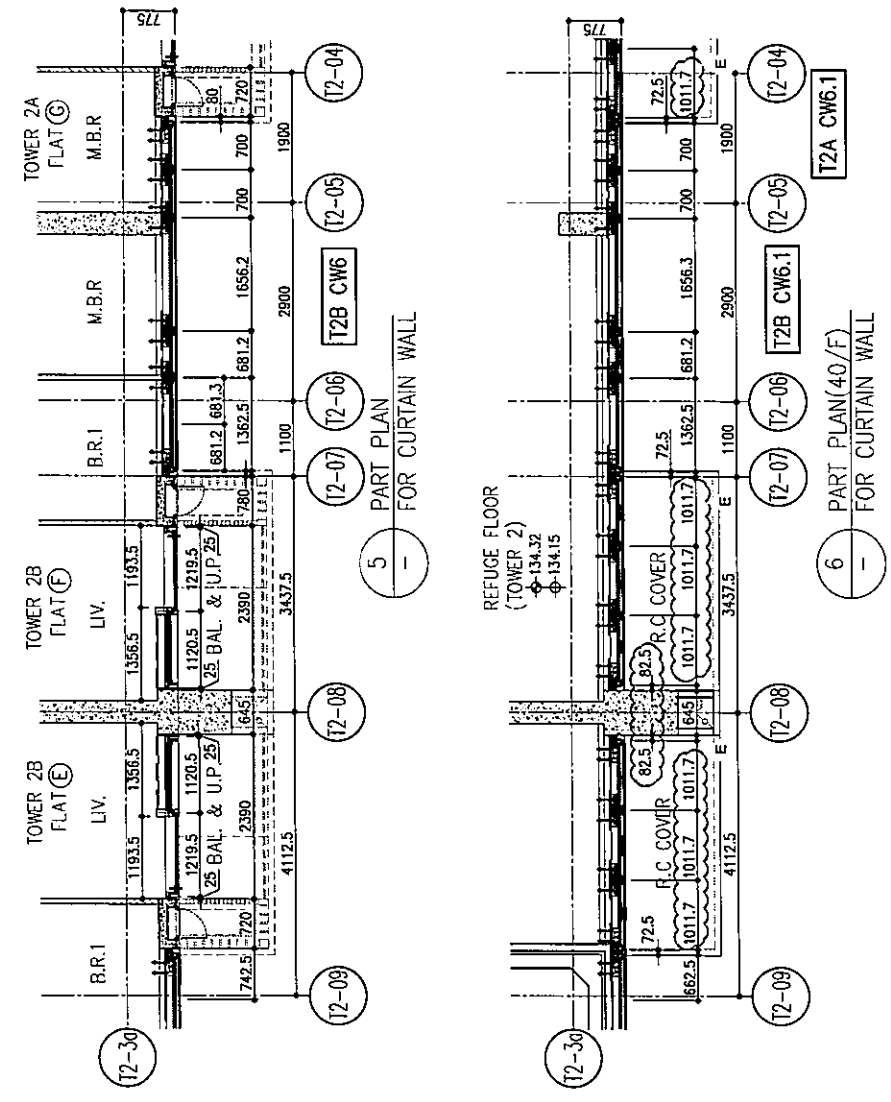

B.D. REF :

CLIENT : 信和置業有限公司 Sino Land Company Limited

ARCHITECT : ronald lu & partners  
 Ronald Lu & Partners (HK) Ltd.  
 呂元祥建築師事務所 (香港) 有限公司

MAIN CONTRACTOR : Gammon

STRUCTURAL ENGINEER : AECOM

FACADE CONSULTANT : AECOM

NOTE :  
 1. ALL DIMENSIONS ARE IN mm.  
 2. ALL ELEVATIONS ARE VIEWED FROM OUTSIDE.  
 3. ALL DIMENSIONS TO BE VERIFIED ON SITE BEFORE FABRICATION.

LEGEND :  
 X1 - DETAIL MARK NO.  
 X001 - REFER SHEET NO.  
 1. F.F.L. -- FINISHED FLOOR LEVEL  
 2. S.F.L. -- STRUCTURAL FLOOR LEVEL  
 3. (S) -- REVERSED DETAIL

E	26/05/22	REVISED AS PER COMMENTS	LS
D	06/04/22	REVISED AS PER COMMENTS	LS
C	22/01/22	REVISED AS PER COMMENTS	LS
B	12/01/21	REVISED AS PER COMMENTS	LS
A	03/12/21	REVISED AS PER COMMENTS	LS
NO.	DATE	REVISED	BY

JCB NO. : J-858

PROJECT : PROPOSED RESIDENTIAL DEVELOPMENT AT TKOIL 7DRP, PHASE 11, LOHAS PARK TSEUNG KWAN O, N.T.



TITLE : TYPICAL FLOOR PARTIAL ELEVATION & SECTION, PLAN FOR CURTAIN WALL (TOWER 2)

DATE : 20-OCT-21 SCALE : 1:50(A1)

DRAWN BY : CHECKED BY :

美特鋁質有限公司  
 MIDI ALUMINIUM FABRICATOR LTD.  
 Units 6-8, Sunray Industrial Centre, 1/F  
 610 Cho Kwo Ling Road, Kowloon  
 Tel:23489211-4 Fax:(852)2727666

DWG NO. : J858-CW-PE211 REV. : E

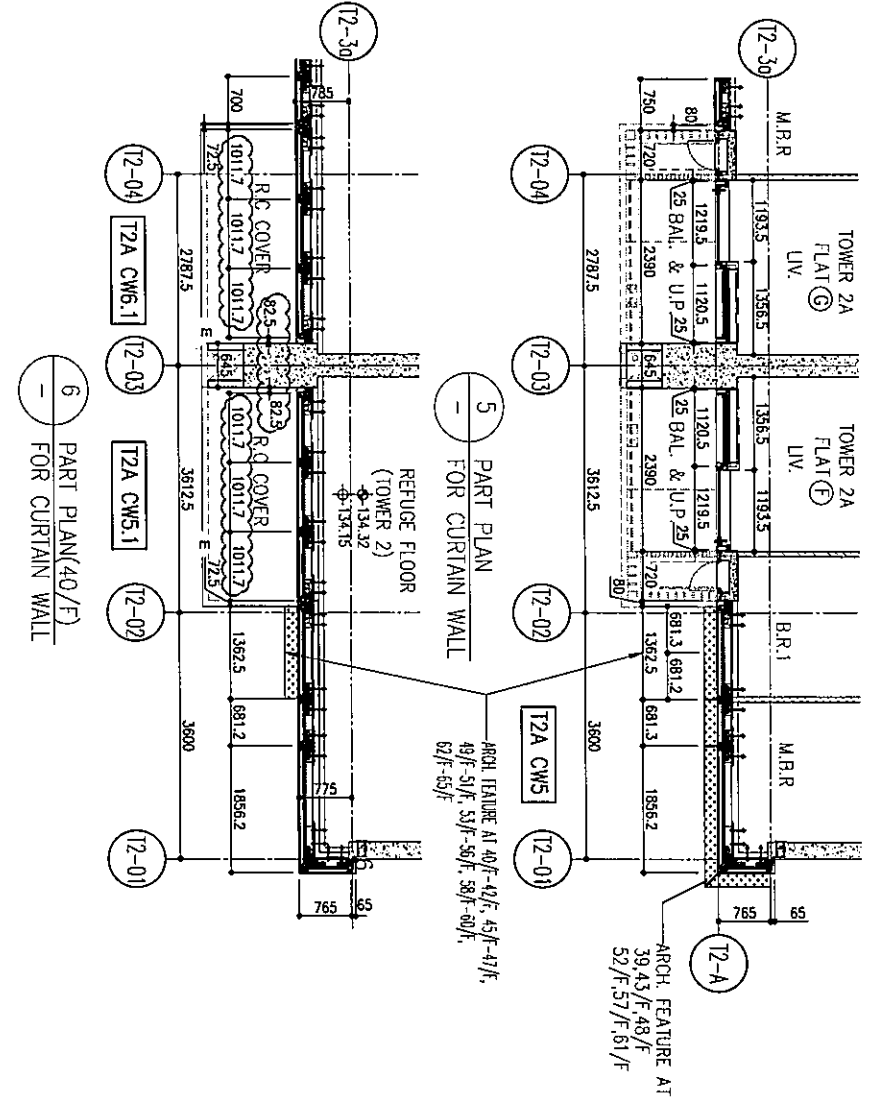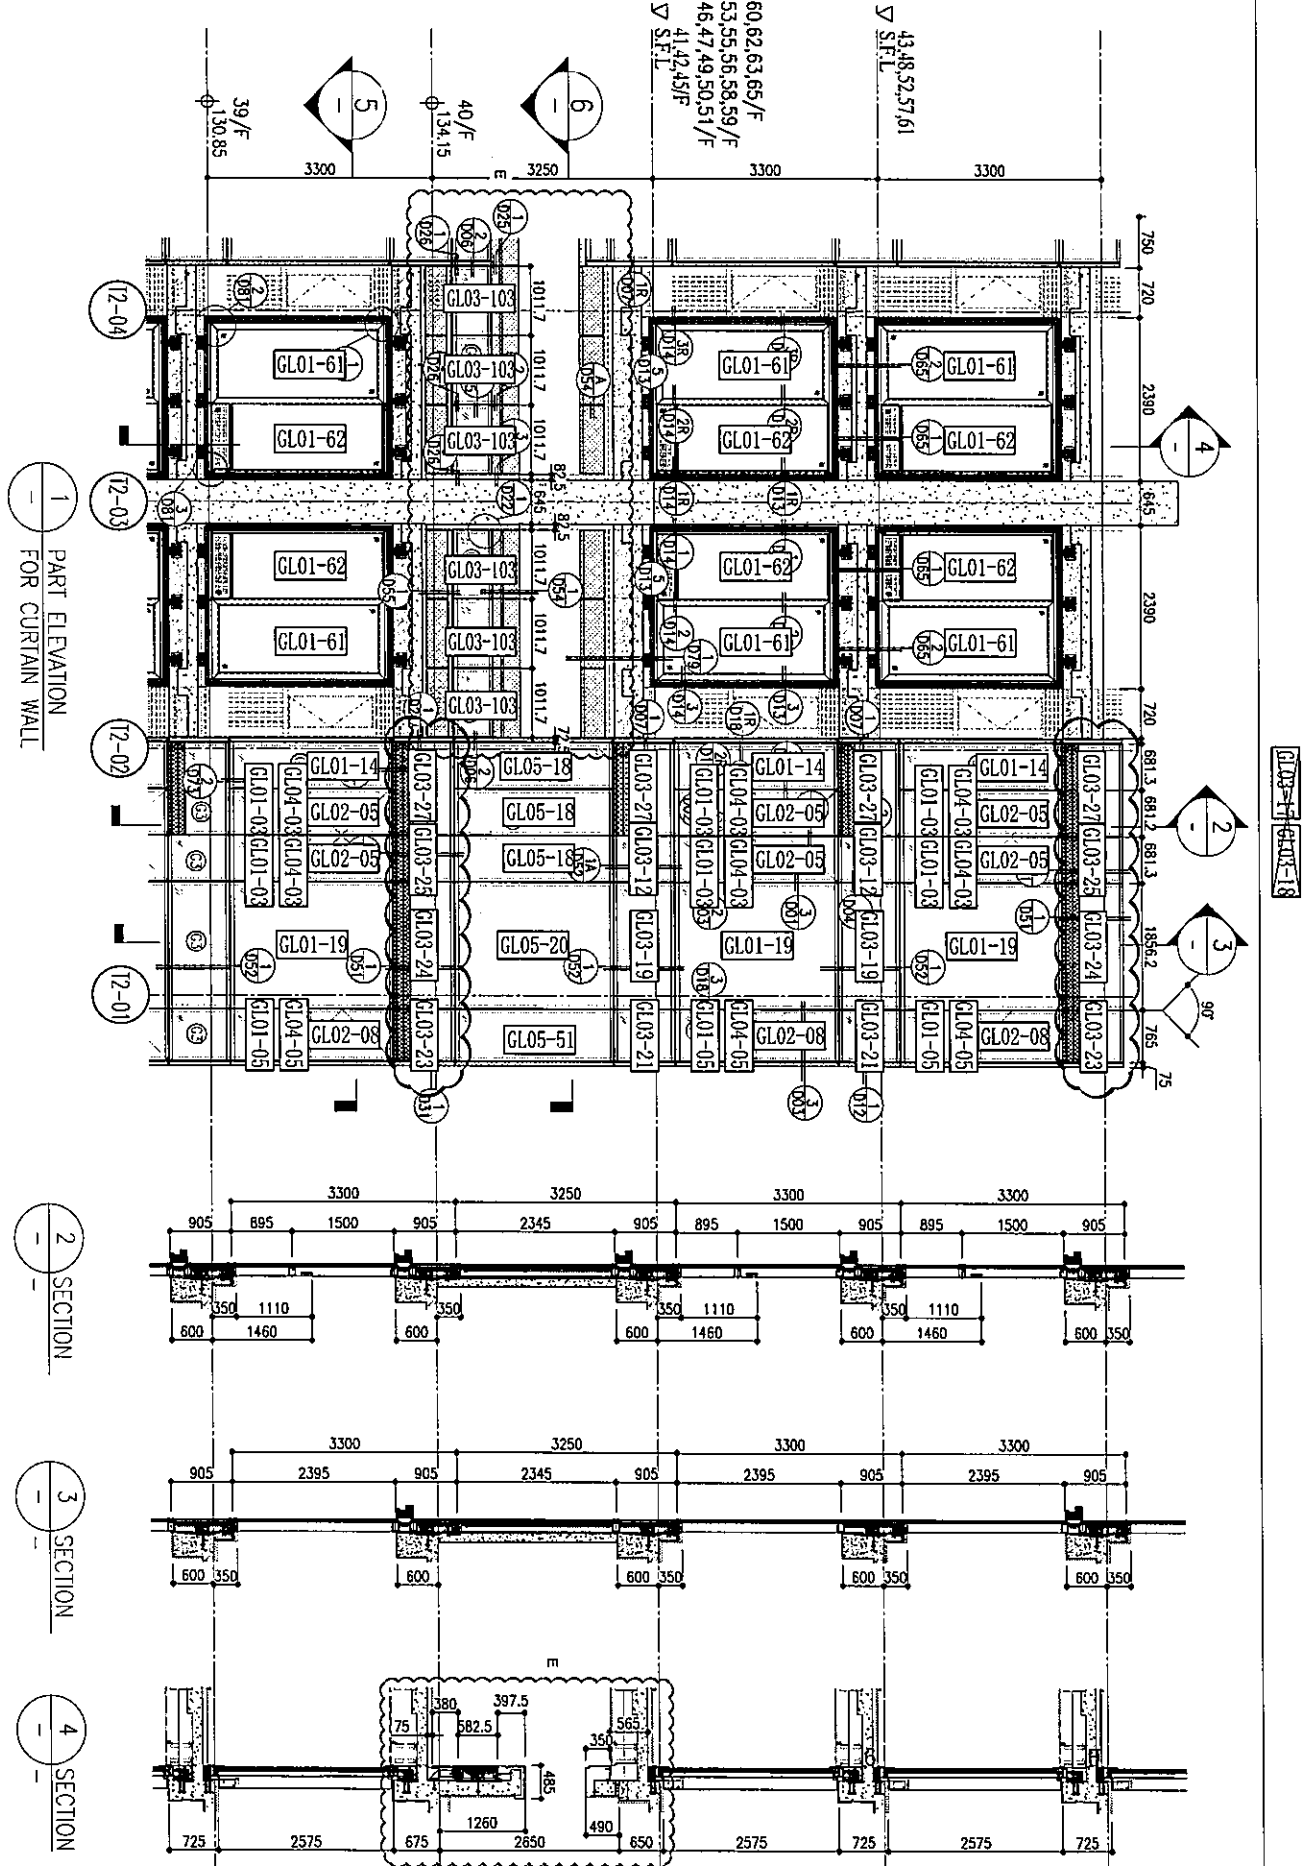

26/F	+91.25	39/F	+130.85	52/F	+170.40	66/F	+210.00
25/F	+87.95	38/F	+127.55	51/F	+167.10	65/F	+206.70
23/F	+84.65	37/F	+124.25	50/F	+163.80	63/F	+203.40
22/F	+81.35	36/F	+120.95	49/F	+160.50	62/F	+200.10
21/F	+78.05	35/F	+117.65	48/F	+157.20	61/F	+196.80
20/F	+74.75	33/F	+114.35	47/F	+153.90	60/F	+193.50
19/F	+71.45	32/F	+111.05	46/F	+150.60	59/F	+190.20
18/F	+68.15	31/F	+107.75	45/F	+147.30	58/F	+186.90
17/F	+64.85	30/F	+104.45	43/F	+144.00	57/F	+183.60
16/F	+61.55	29/F	+101.15	42/F	+140.70	56/F	+180.30
15/F	+58.25	28/F	+97.85	41/F	+137.40	55/F	+177.00
12/F	+54.95	27/F	+94.55	40/F	+134.15	53/F	+173.70

- LEGEND:
- ① 10mm THK. HEAT STRENGTHENED GLASS (OUTSIDE) +12mm AIR SPACE + 12mm THK. TEMPERED GLASS
  - ② 10mm THK. HEAT STRENGTHENED GLASS (OUTSIDE) +12mm AIR SPACE + 10mm THK. TEMPERED GLASS
  - ③ 12mm THK. CLEAR TEMPERED GLASS (INTERNAL PROTECTIVE BARRIER)
  - ④ 12mm THK. HEAT STRENGTHENED GLASS
  - ⑤ 10mm THK. CLEAR TEMPERED GLASS
  - ⑥ 10mm THK. BLUENITED HEAT STRENGTHENED GLASS
  - ⑦ 8mm THK. CLEAR HEAT-STRENGTHENED GLASS +5mm PVB + 8mm THK. CLEAR HEAT-STRENGTHENED GLASS
  - ⑧ 3 mm THK. ALUM. CLADDING
  - ⑨ 3 mm THK. ALUM. BACKPAN
  - S.L. - STACK JOINT

CLIENT: **Sho Land Company Limited**

ARCHITECT: **ronald lu & partners**  
 Ronald Lu & Partners (HK) Ltd.  
 呂克祥建築師事務所 (香港) 有限公司

MAIN CONTRACTOR: **Gammon**

STRUCTURAL ENGINEER: **AECOM**

FAÇADE CONSULTANT: **AECOM**

NOTE:

1. ALL DIMENSIONS ARE IN MM.
2. ALL ELEVATIONS ARE VIEWED FROM OUTSIDE.
3. ALL DIMENSIONS TO BE VERIFIED ON SITE BEFORE FABRICATION.

LEGEND:

- ① DETAIL MARK NO.
- ② REFER SHEET NO.
- ③ F.F.L. -- FINISHED FLOOR LEVEL.
- ④ S.F.L. -- STRUCTURAL FLOOR LEVEL.
- ⑤ -- REVERSED DETAIL.

PROJECT: PROPOSED RESIDENTIAL DEVELOPMENT AT TKOIT TOWER, PHASE 11, LOHAS PARK TSEUNG KWAN O, N.T.

TITLE: TYPICAL FLOOR PARTIAL ELEVATION & SECTION, PLAN FOR CURTAIN WALL (TOWER 2)

DATE: 20-CCT-21 SCALE: 1:50(A1)

DRAWN BY: CHECKED BY:


JOB NO.: J-858

REVISIONS:

NO.	DATE	REVISIONS
A	03/12/21	REVISED AS PER COMMENTS
B	20/12/21	REVISED AS PER COMMENTS
C	22/01/22	REVISED AS PER COMMENTS
D	06/04/22	REVISED AS PER COMMENTS
E	26/05/22	REVISED AS PER COMMENTS

DWG NO.: J858-CW-PC212 REV.: E

610 Cho Kwo Ling Road, Kowloon  
 Tel: 23489211-4 Fax: (852) 27277665  
 Units 6-8, Sunny Industrial Center, 1/F  
 AUTOMATIC FABRICATOR LTD.  
**美特製窗有限公司**

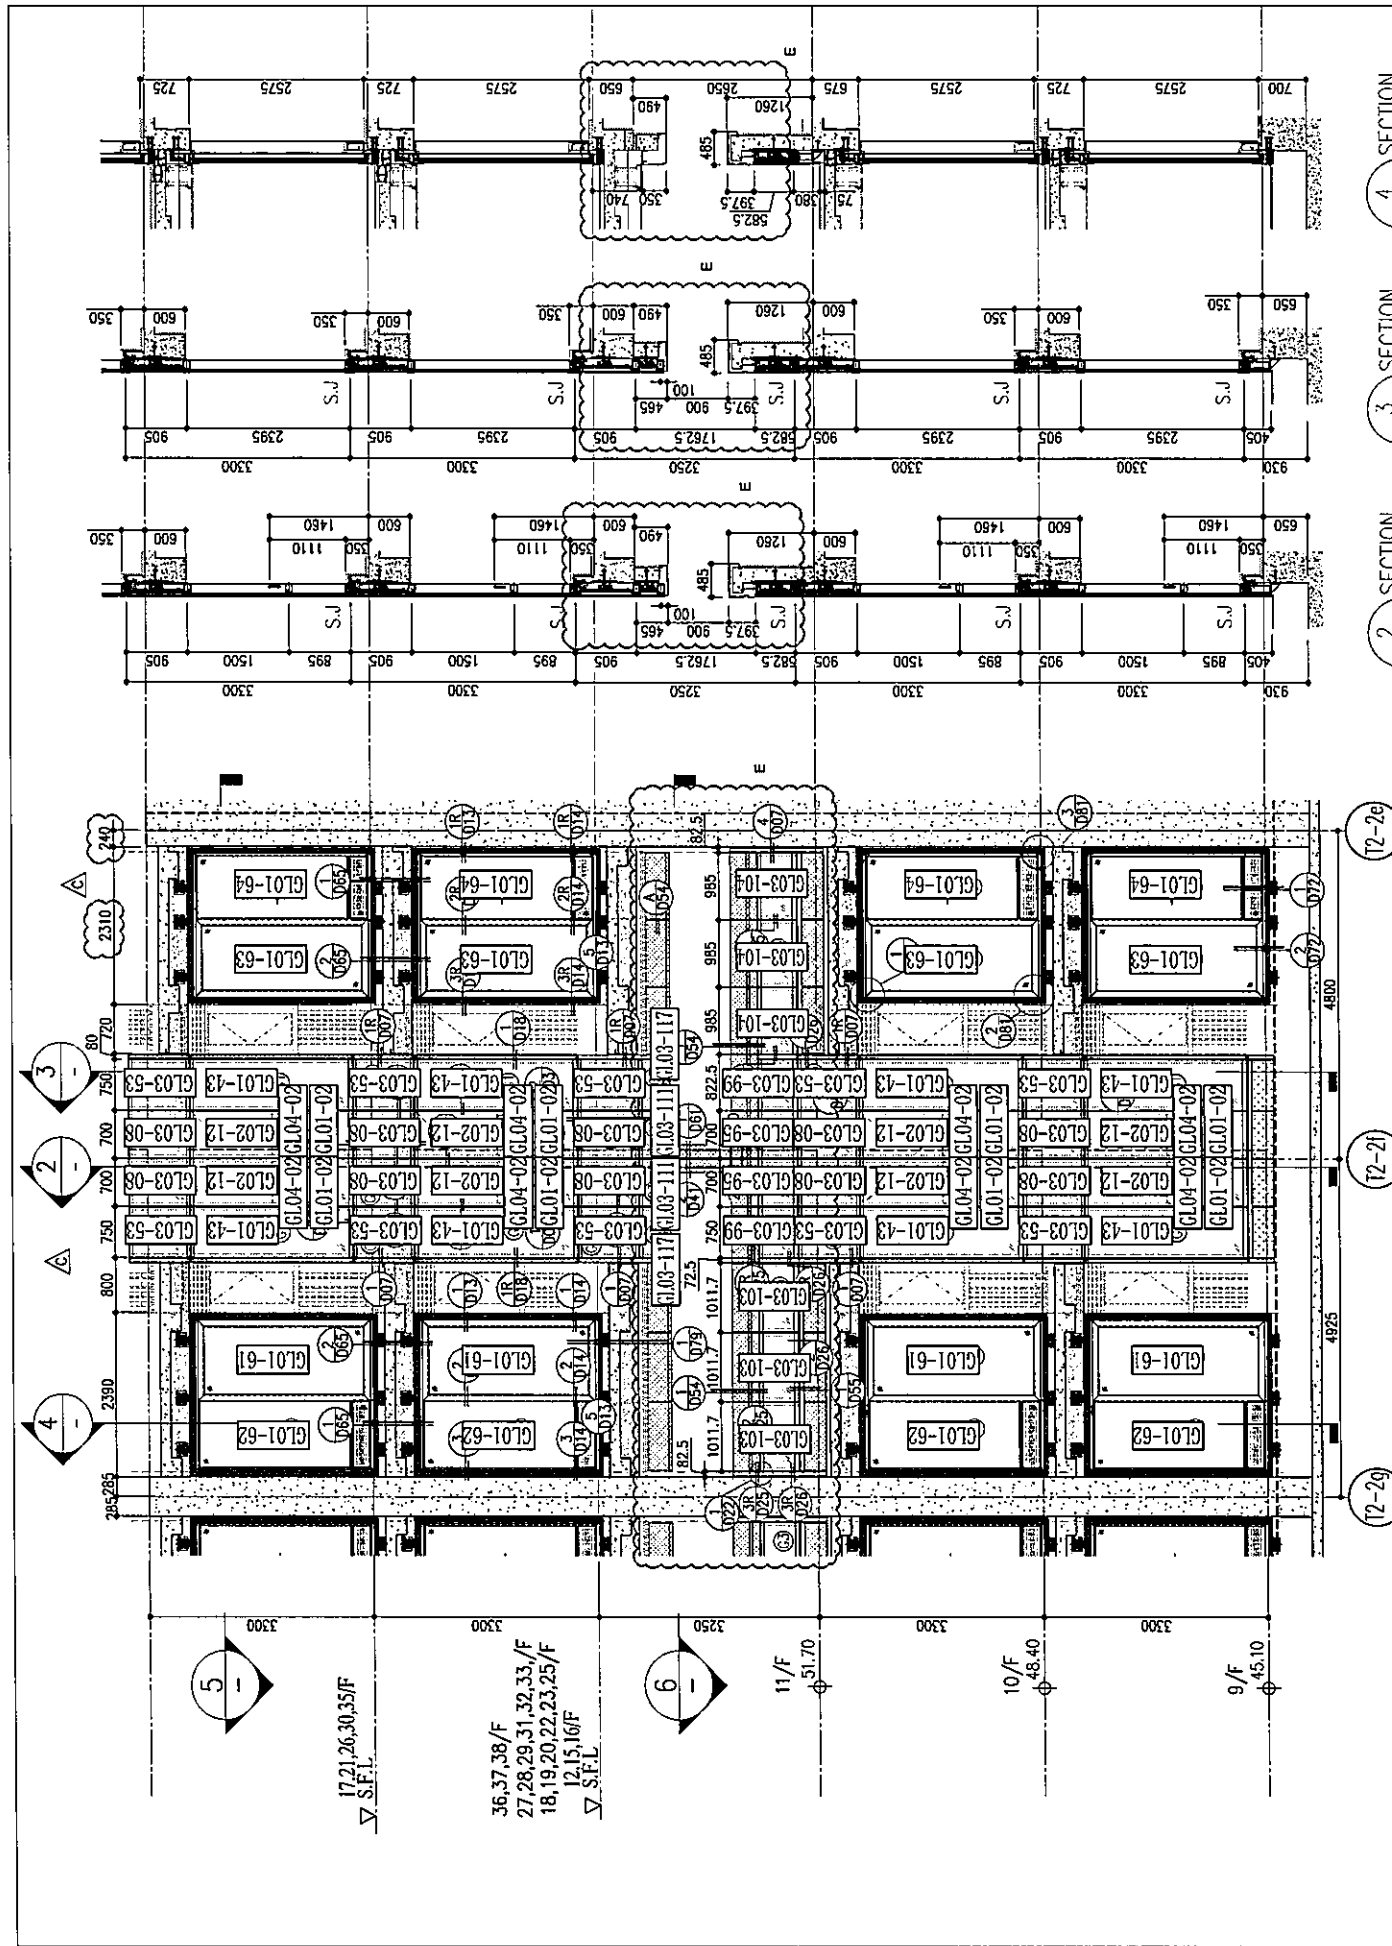


R/F	+217.00	67/F	+213.50	66/F	+210.00	65/F	+206.70	63/F	+203.40	62/F	+200.10	61/F	+196.80	60/F	+193.50	59/F	+190.20	58/F	+186.90	57/F	+183.60	56/F	+180.30	55/F	+177.00	53/F	+173.70	


LEGEND:

- 10mm THK. HEAT STRENGTHENED GLASS (OUTSIDE) + 12mm AIR SPACE + 12mm THK. TEMPERED GLASS
- 10mm THK. HEAT STRENGTHENED GLASS (OUTSIDE) + 12mm AIR SPACE + 10mm THK. TEMPERED GLASS
- 12mm THK. HEAT STRENGTHENED GLASS
- 12mm THK. CLEAR TEMPERED GLASS (INTERNAL PROTECTIVE BARRIER)
- 10mm BLUE TINTED HEAT STRENGTHENED GLASS
- 10mm THK. CLEAR HEAT-STRENGTHENED GLASS + 9mm AIR SPACE + 10mm CLEAR TEMPERED GLASS
- 8mm THK. CLEAR HEAT-STRENGTHENED GLASS + 1.52mm PVB + 8mm THK. CLEAR HEAT-STRENGTHENED GLASS
- 3 mm THK. ALUM. CLADDING
- 3 mm THK. ALUM. BACKPAN
- S.J. - STACK JOINT

1 PART ELEVATION FOR CURTAIN WALL

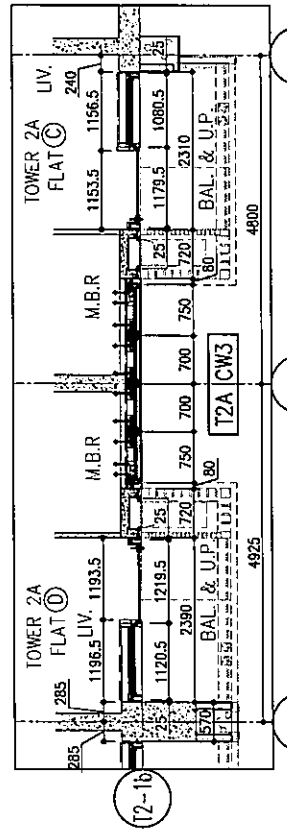

5 PART PLAN FOR CURTAIN WALL

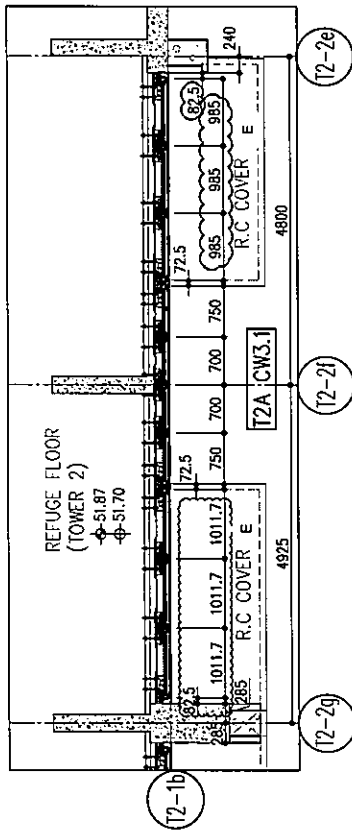

6 PART PLAN(11/F) FOR CURTAIN WALL

B.D. REF :

CLIENT : 信和置業有限公司 Sino Land Company Limited

ARCHITECT : Ronald Lu & Partners Architects, Planners, Interiors Designers Ronald Lu & Partners (HK) Ltd. 呂元祥建築師事務所 (香港) 有限公司

MAIN CONTRACTOR : Gammon

STRUCTURAL ENGINEER : AECOM

FACADE CONSULTANT : AECOM

NOTE :

- ALL DIMENSIONS ARE IN mm.
- ALL ELEVATIONS ARE VIEWED FROM OUTSIDE.
- ALL DIMENSIONS TO BE VERIFIED ON SITE BEFORE FABRICATION.

LEGEND :

- X1 - DETAIL MARK NO.
- X031 - REFER SHEET NO.
- 1. F.F.L. -- FINISHED FLOOR LEVEL
- 2. S.F.L. -- STRUCTURAL FLOOR LEVEL
- ⊖ -- REVERSED DETAIL

NO.	DATE	REVISED	BY
E	25/05/22	REVISED AS PER COMMENTS	LS
D	10/04/22	REVISED AS PER COMMENTS	LS
C	12/01/22	REVISED AS PER COMMENTS	LS
B	12/01/21	REVISED AS PER COMMENTS	LS
A	03/12/21	REVISED AS PER COMMENTS	LS

JOB NO. : J-858

PROJECT : PROPOSED RESIDENTIAL DEVELOPMENT AT TKOTL 70RP, PHASE 11, LOHAS PARK TSEUNG KWAN O, N.T.


TITLE : TYPICAL FLOOR PARTIAL ELEVATION & SECTION, PLAN FOR CURTAIN WALL (TOWER 2)

DATE : 20-OCT-21 SCALE : 1:50(A1)


DRAWN BY : CHECKED BY :

美特鋁質有限公司 MIDALUMINIUM FABRICATOR LTD. Units 6-8, Sunray Industrial Centre, 1/F 610 Cho Kwo Ling Road, Kowloon Tel:23489211-4 Fax:(852)2727666


DWG NO. : J858-CW-PE214 REV. : E

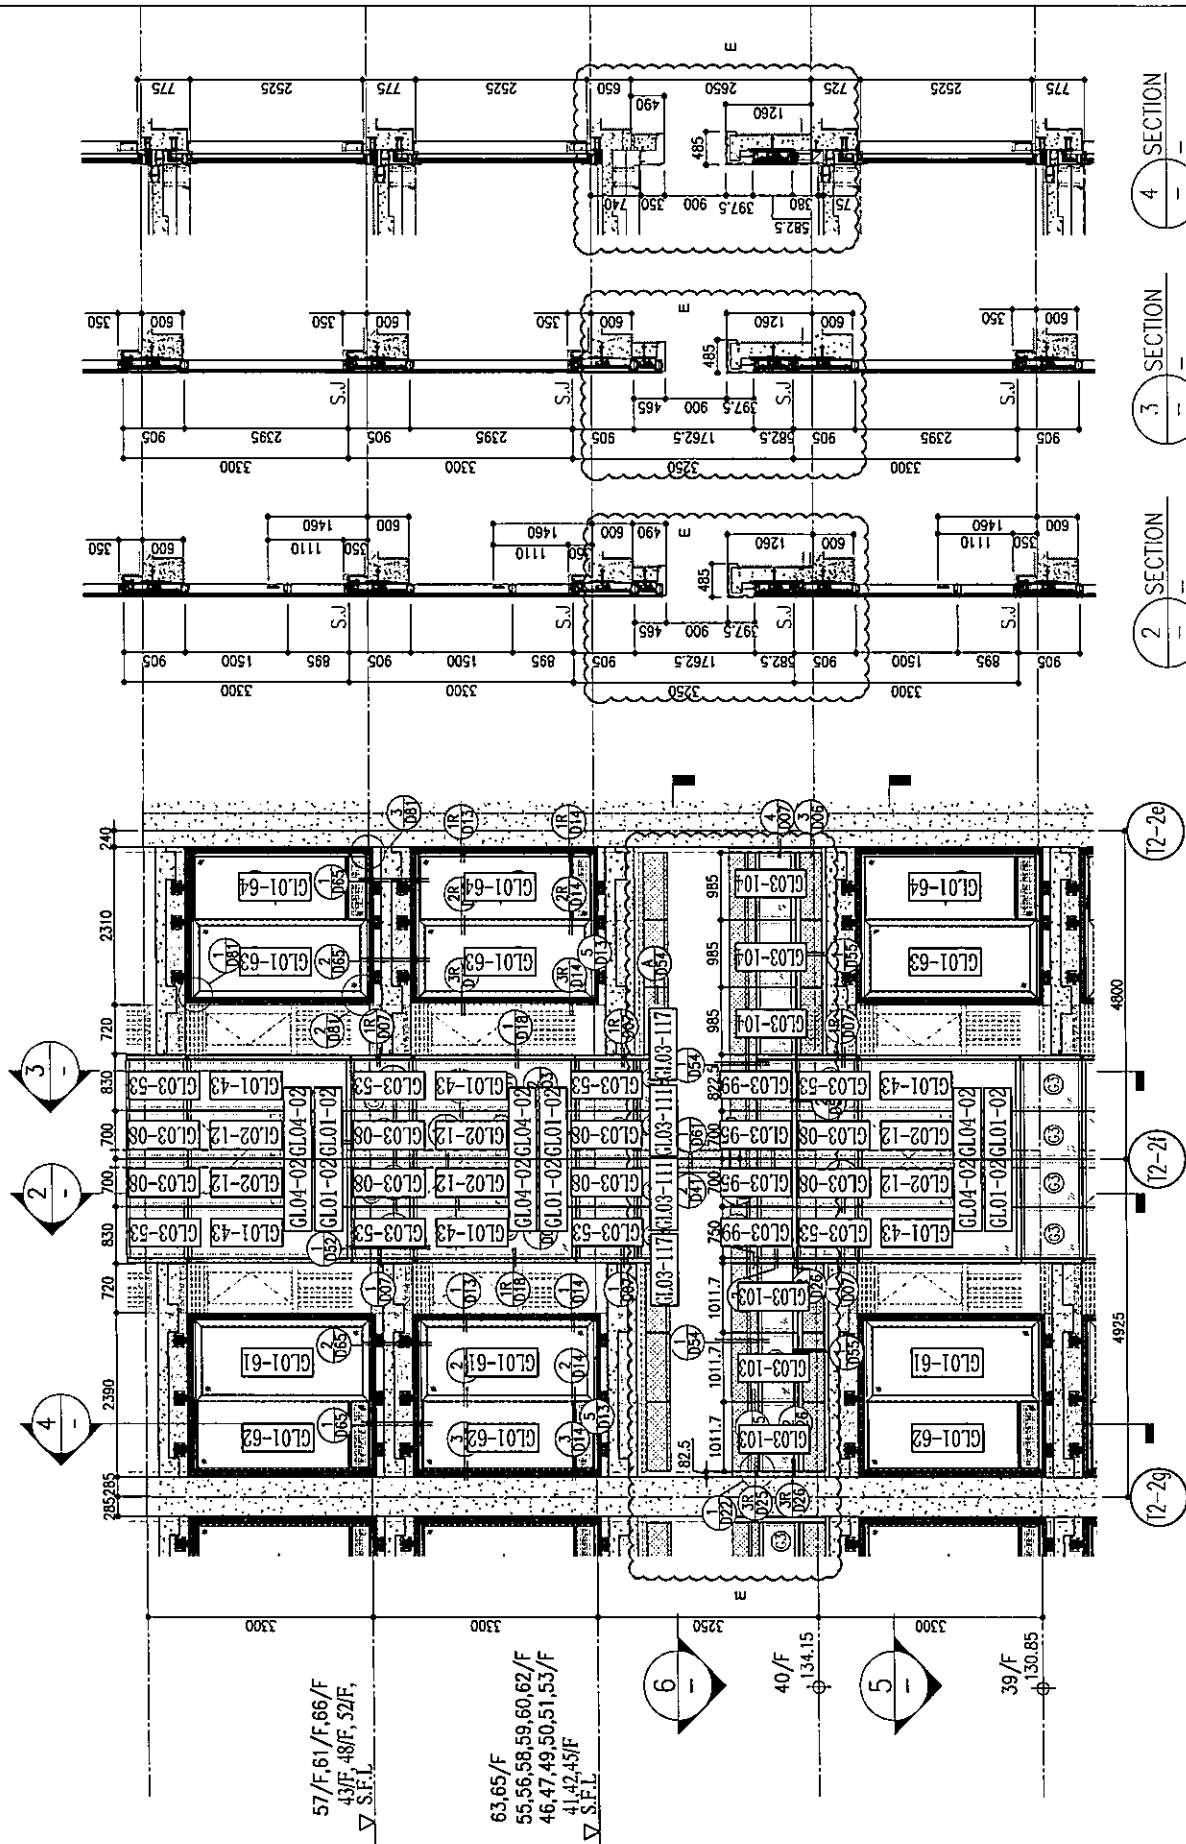

1 PART ELEVATION FOR CURTAIN WALL  
 2 SECTION  
 3 SECTION  
 4 SECTION  
 5 PART PLAN FOR CURTAIN WALL  
 6 PART PLAN (40/F) FOR CURTAIN WALL

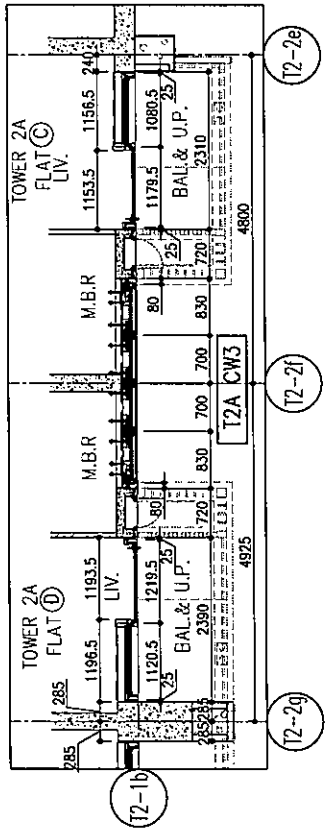

5 PART PLAN FOR CURTAIN WALL

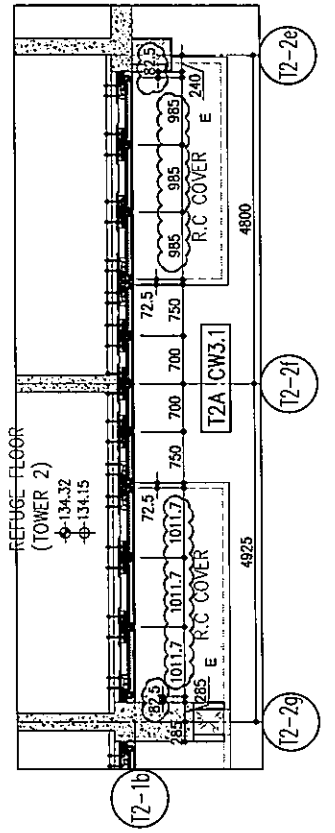

6 PART PLAN (40/F) FOR CURTAIN WALL

R/F	+217.00	67/F	+213.50	66/F	+210.00	65/F	+206.70	63/F	+203.40	62/F	+200.10	61/F	+196.80	60/F	+193.50	59/F	+190.20	58/F	+186.90	57/F	+183.60	56/F	+180.30	55/F	+177.00	53/F	+173.70

LEGEND:

- 10mm THK. HEAT STRENGTHENED GLASS (OUTSIDE) + 12mm AIR SPACE + 12mm THK. TEMPERED GLASS
- 10mm THK. HEAT STRENGTHENED GLASS (OUTSIDE) + 12mm AIR SPACE + 10mm THK. TEMPERED GLASS
- 12mm THK. HEAT STRENGTHENED GLASS
- 12mm THK. CLEAR TEMPERED GLASS (INTERNAL PROTECTIVE BARRIER)
- 10mm THK. BLUE TINTED HEAT STRENGTHENED GLASS
- 10mm THK. CLEAR HEAT-STRENGTHENED GLASS + 9mm AIR SPACE + 10mm CLEAR TEMPERED GLASS
- 8mm THK. CLEAR HEAT-STRENGTHENED GLASS + 1.52mm PVB + 8mm THK. CLEAR HEAT-STRENGTHENED GLASS
- 3 mm THK. ALUM. CLADDING
- 3 mm THK. ALUM. BACKPAN
- S.J. - STACK JOINT

B.D. REF :

CLIENT : 信和置業有限公司 Sino Land Company Limited

ARCHITECT : ronald lu & partners Ronald Lu & Partners (HK) Ltd. 呂元祥建築師事務所 (香港) 有限公司

MAIN CONTRACTOR : Gammon

STRUCTURAL ENGINEER : AECOM

FACADE CONSULTANT : AECOM

NOTE :

- ALL DIMENSIONS ARE IN mm.
- ALL ELEVATIONS ARE VIEWED FROM OUTSIDE.
- ALL DIMENSIONS TO BE VERIFIED ON SITE BEFORE FABRICATION.

LEGEND :

- (X1) DETAIL MARK NO.
- (X01) REFER SHEET NO.
- 1. F.F.L. --- FINISHED FLOOR LEVEL
- 2. S.F.L. --- STRUCTURAL FLOOR LEVEL
- ⊗ --- REVERSED DETAIL

NO.	DATE	REVISED AS PER COMMENTS	BY
E	25/05/22	REVISED AS PER COMMENTS	LS
D	06/04/22	REVISED AS PER COMMENTS	LS
C	22/01/22	REVISED AS PER COMMENTS	LS
B	20/12/21	REVISED AS PER COMMENTS	LS
A	03/12/21	REVISED AS PER COMMENTS	LS

JOB NO. : J-858

PROJECT : PROPOSED RESIDENTIAL DEVELOPMENT AT TKOTL 7ORP, PHASE 11, LOHAS PARK TSEUNG KWAN O, N.T.

TITLE : TYPICAL FLOOR PARTIAL ELEVATION & SECTION, PLAN FOR CURTAIN WALL (TOWER 2)

DATE : 20-OCT-21 SCALE : 1:50(A1)

DRAWN BY : CHECKED BY :

美特鋁質有限公司 MIDALUMINIUM FABRICATOR LTD. Units 6-8, Sunray Industrial Centre, 1/F 610 Cha Kwo Ling Road, Kowloon Tel:23489211-4 Fax:(852)2727666

DWG NO. : J858-CW-PE216 REV. : E

BD. REF :

CLIENT : 德和置業有限公司  
Sine Land Company Limited

ARCHITECT : Ronald Lu & Partners  
Ronald Lu & Partners (HK) Ltd.  
羅允祥建築師事務所 (香港) 有限公司

MAIN CONTRACTOR : Gammon

STRUCTURAL ENGINEER : AECOM

FAÇADE CONSULTANT : AECOM

NOTE:  
1. ALL DIMENSIONS ARE IN MM.  
2. ALL ELEVATIONS ARE VIEWED FROM OUTSIDE.  
3. ALL DIMENSIONS TO BE VERIFIED ON SITE BEFORE FABRICATION.  
LEGEND:  
① DETAIL MARK NO.  
② REFER SHEET NO.  
1. F.F.L. -- FINISHED FLOOR LEVEL.  
2. S.F.L. -- STRUCTURAL FLOOR LEVEL.  
3. (R) -- REVERSED DETAIL.

REVISED AS PER COMMENTS  
B 26/05/22  
REVISED AS PER COMMENTS  
A 12/04/22

REVISED  
NO. DATE

J-855

PROJECT : PROPOSED RESIDENTIAL DEVELOPMENT AT 1KOTL 709P, PHASE 11, LOHAS PARK TSEUNG KWAN O, N.T.

TITLE : PENTHOUSE FLOOR PARTIAL ELEVATION & SECTION, PLAN FOR CURTAIN WALL (TOWER 2)

DATE : 22-OCT-21  
SCALE : 1:50(A1)  
DRAWN BY :  
CHECKED BY :

MIDI 建築工程顧問有限公司  
MIDI Architectural Consultants Ltd.  
Units 5-8, Science Industrial Centre, 1/F, 619 Shek Kwoi Road, Kowloon  
Tel: 27332211-4 Fax: 27332222

DWG NO. : J85B-CW-PE217  
REV. : B

LEGEND:

G1 10mm THK. HEAT STRENGTHENED GLASS (OUTSIDE) + 12mm AIR SPACE + 12mm THK. TEMPERED GLASS

G2 10mm THK. HEAT STRENGTHENED GLASS (OUTSIDE) + 12mm AIR SPACE + 12mm THK. TEMPERED GLASS

G3 12mm THK. HEAT STRENGTHENED GLASS

G4 12mm THK. CLEAR TEMPERED GLASS (INTERNAL PROTECTIVE BARRIER)

G5 12mm CLEAR HEAT STRENGTHENED GLASS




G6 10mm THK. CLEAR HEAT-STRENGTHENED GLASS + 9mm AIR SPACE + 10mm CLEAR TEMPERED GLASS

G7 8mm THK. CLEAR HEAT-STRENGTHENED GLASS + 1.52mm PVB + 8mm THK. CLEAR HEAT-STRENGTHENED GLASS

G8 3 mm THK. ALUM. CLADDING

G9 2 mm THK. ALUM. BACKPAIN

S1 - STACK JOINT

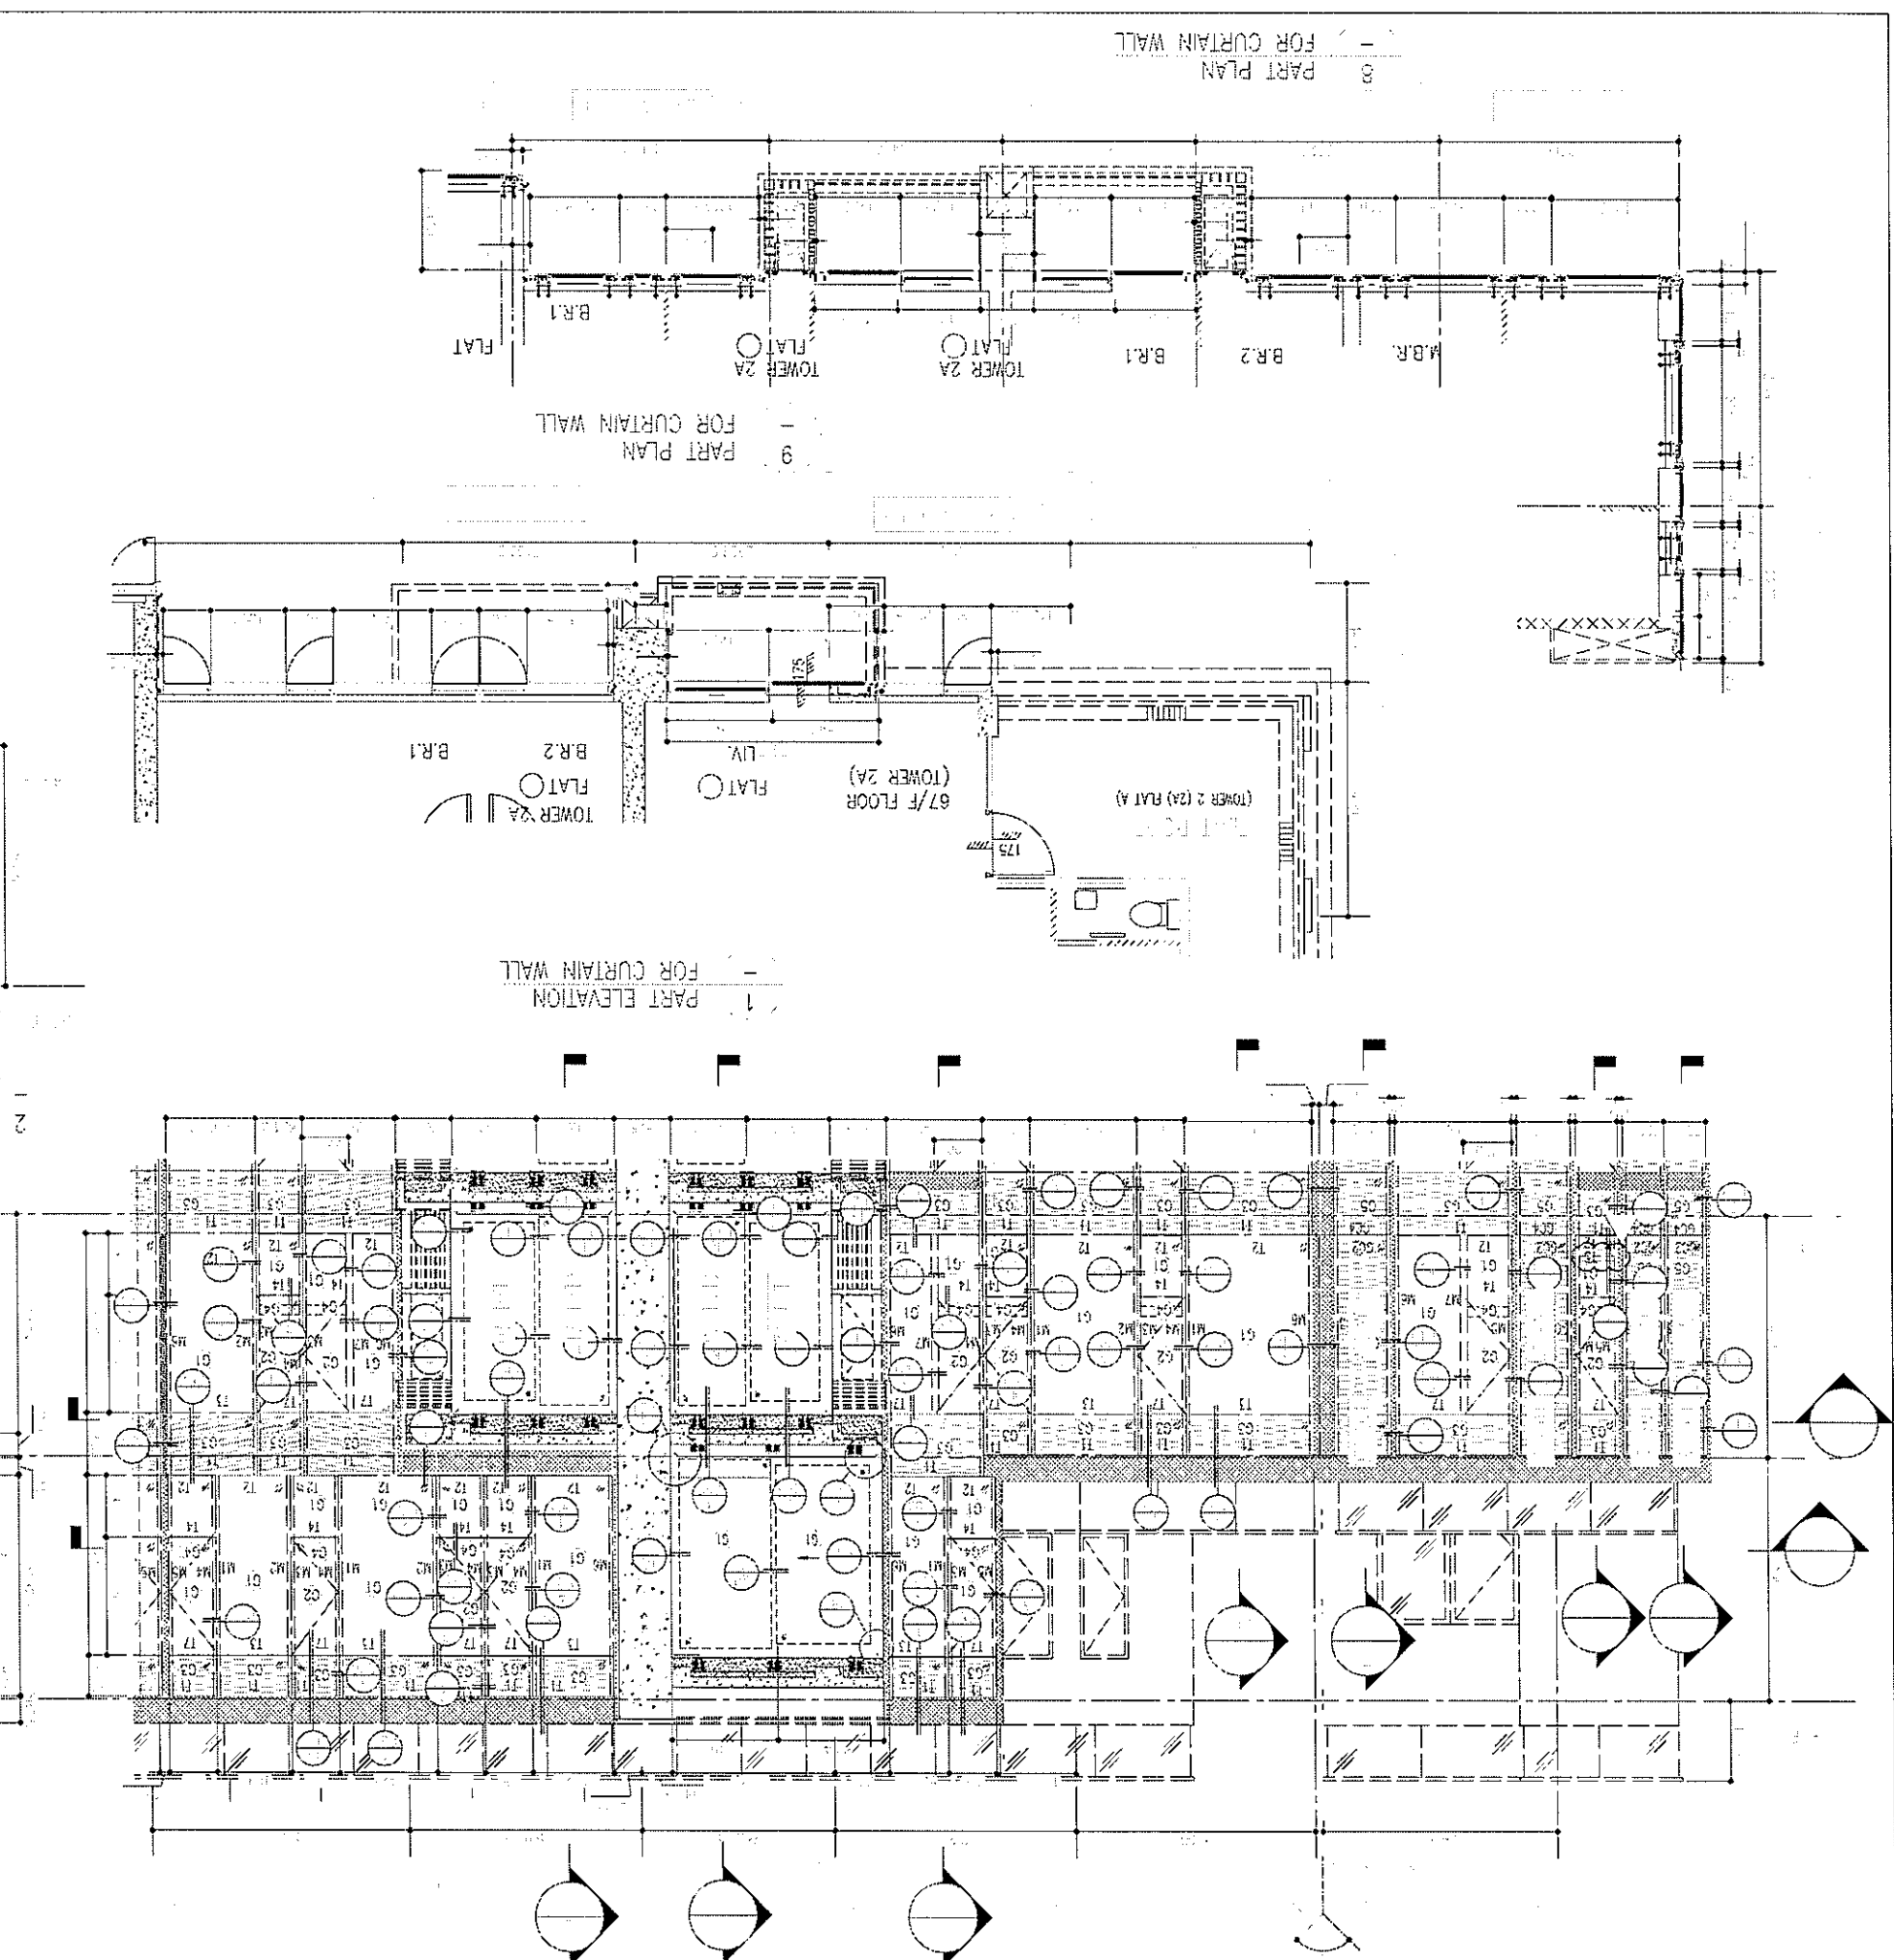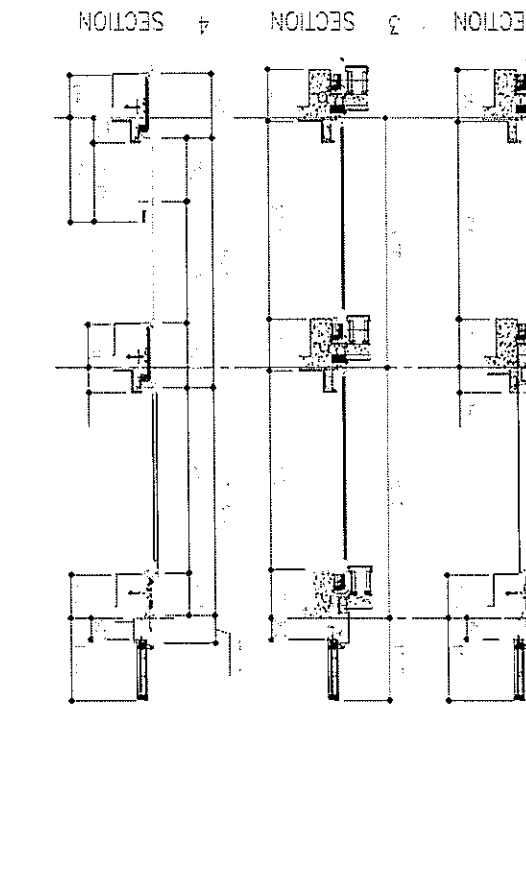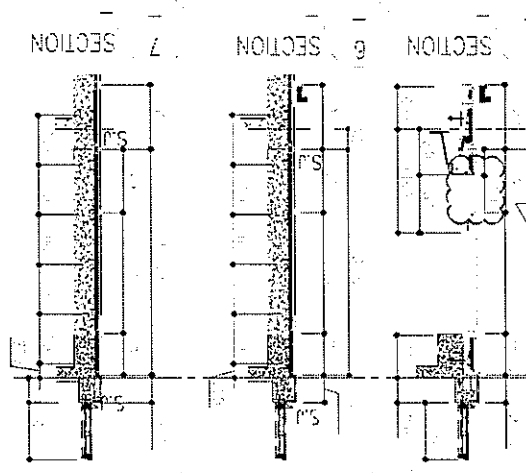








DRAWN BY:		CHECKED BY:	
DATE: 22-OCT-21		SCALE: 1:50(A1)	
TITLE: PENTHOUSE FLOOR PARTIAL ELEVATION & SECTION, PLAN FOR CURTAIN WALL (TOWER 2)			
NO. DATE REVISION		BY COMMENTS	
A		15	
<p>NOTE:</p> <p>1. ALL DIMENSIONS ARE IN MM.</p> <p>2. ALL ELEVATIONS ARE VIEWED FROM OUTSIDE.</p> <p>3. ALL DIMENSIONS TO BE VERIFIED ON SITE BEFORE FABRICATION.</p> <p>LEGEND:</p> <p>(X1) DETAIL MARK NO. REFER SHEET NO.</p> <p>(S1) FINISHED FLOOR LEVEL.</p> <p>(S.F.L.) STRUCTURAL FLOOR LEVEL.</p> <p>(R.S.) REVERSED DETAIL.</p>			
CLIENT: 信和地產有限公司		ARCHITECT: Ronald Lu & Partners (HK) Ltd. 羅元祥建築師事務所 (香港) 有限公司	
MAIN CONTRACTOR: Gammon		STRUCTURAL ENGINEER: AECOM	
FACADE CONSULTANT: AECOM		PROJECT NO.: J-558	

LEGEND:

G1	10mm THK. HEAT STRENGTHENED GLASS (OUTSIDE) + 12mm AIR SPACE + 12mm THK. TEMPERED GLASS
G2	10mm THK. HEAT STRENGTHENED GLASS (OUTSIDE) + 12mm AIR SPACE + 10mm THK. TEMPERED GLASS
G3	12mm THK. HEAT STRENGTHENED GLASS
G4	12mm THK. CLEAR TEMPERED GLASS (INTERNAL PROTECTIVE BARRIER)
G5	12mm THK. CLEAR HEAT STRENGTHENED GLASS
G6	10mm THK. CLEAR HEAT STRENGTHENED GLASS + 9mm AIR SPACE + 10mm CLEAR TEMPERED GLASS
G7	8mm THK. CLEAR HEAT STRENGTHENED GLASS + 12.5mm PVB + 8mm THK. CLEAR HEAT STRENGTHENED GLASS
G8	3 mm THK. ALUM. CLADDING
G9	3 mm THK. ALUM. BACKPAN
G10	STACK JOINT

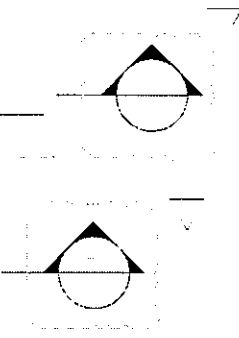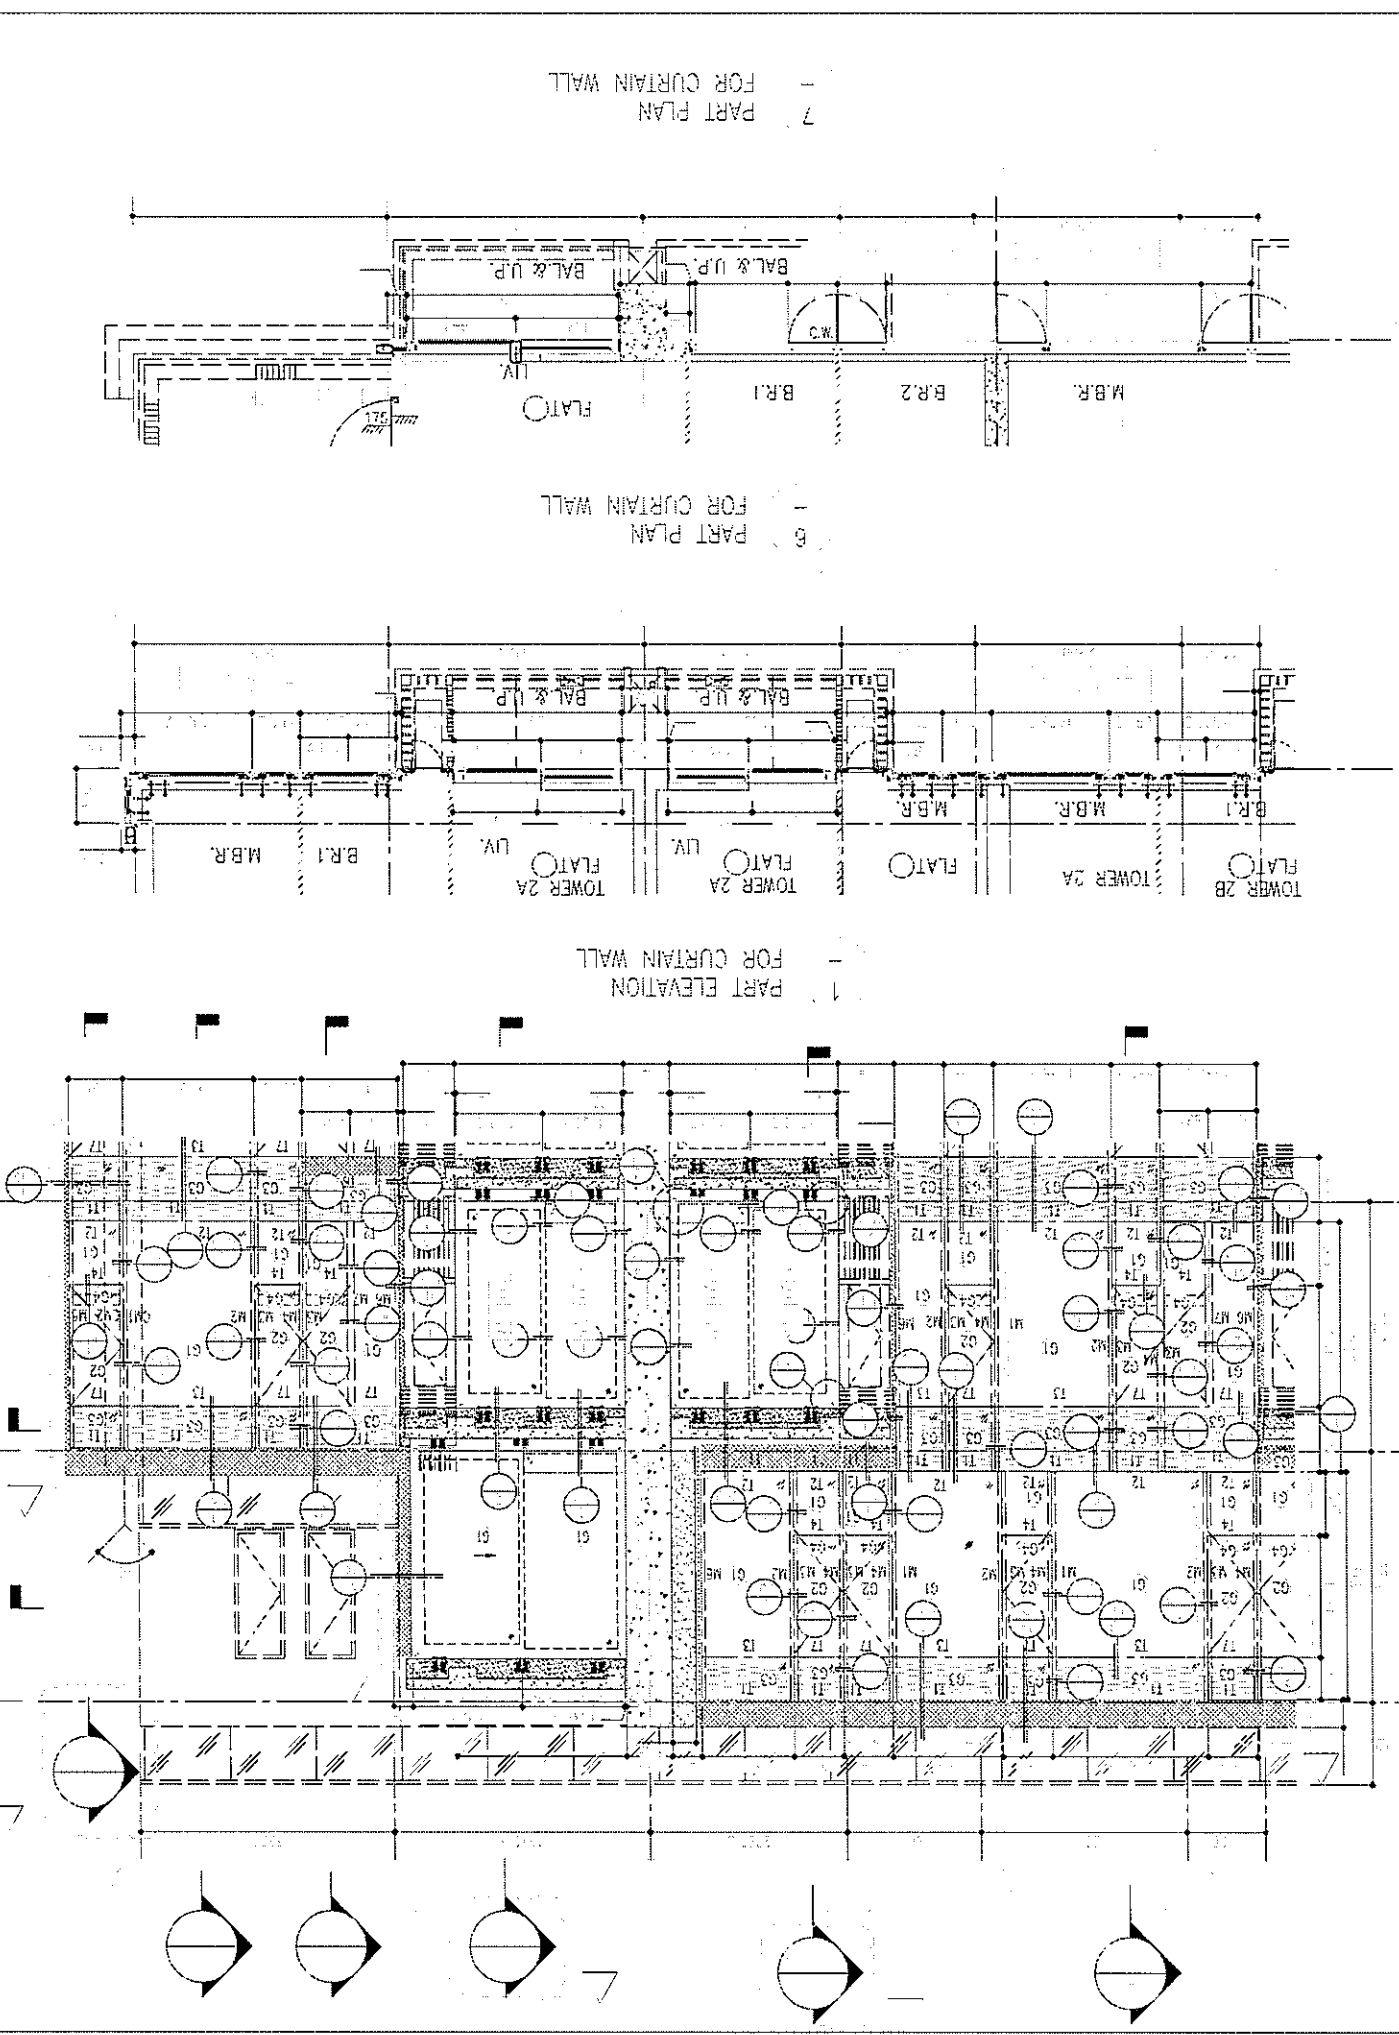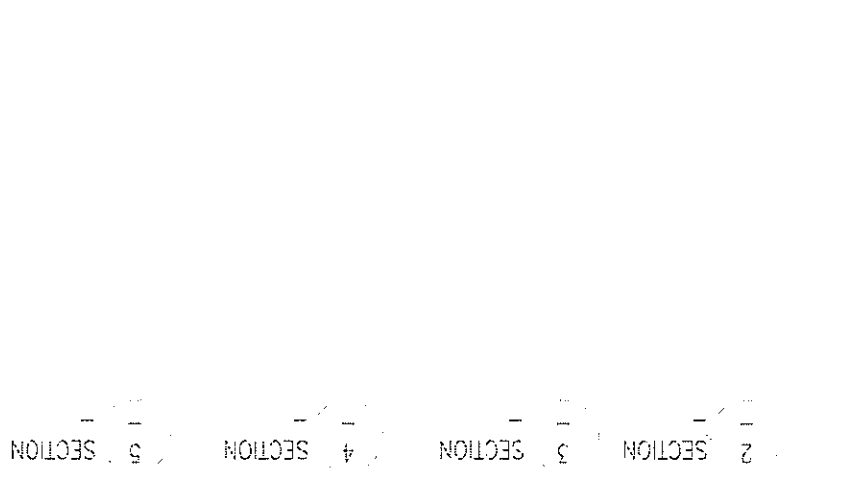

REV: A

DWG NO.: J858-CW-PE221

010 Chiu Kuo Ling Road, Kowloon  
Tel: 23492111-4 Fax: (852) 23727665

UNIT 6-8, Sunny Industrial Centre, 1/F  
MIDI ALUMINIUM FABRICATOR LTD.  
美特鋁業有限公司

DRAWN BY: \_\_\_\_\_ CHECKED BY: \_\_\_\_\_

DATE: 22-OCT-21 SCALE: 1:50(A1)

TITLE: PENTHOUSE FLOOR PARTIAL ELEVATION & SECTION, PLAN FOR CURTAIN WALL (TOWER 2)

PROJECT: PROPOSED RESIDENTIAL DEVELOPMENT AT TKOIL TOWER, PHASE 11, LOHAS PARK TSUNG KIAN O, N.T.

J-858

NO.	DATE	REVISION
A	12/04/22	REVISED AS PER COMMENTS
LS		

1. ALL DIMENSIONS ARE IN MM.  
2. ALL ELEVATIONS ARE VIEWED FROM OUTSIDE.  
3. ALL DIMENSIONS TO BE VERIFIED ON SITE.  
4. BEFORE FABRICATION.  
5. DETAIL MARK NO. (X1)  
6. REFER SHEET NO. (X2)  
7. REVERSED DETAIL (R)

1. F.F.L. -- FINISHED FLOOR LEVEL  
2. S.F.L. -- STRUCTURAL FLOOR LEVEL  
3. (R) -- REVERSED DETAIL

CLIENT: 信和置業有限公司  
Sine Land Company Limited

ARCHITECT: ronald lu & partners  
Ronald Lu & Partners (HK) Ltd.  
羅利輝建築師事務所 (香港) 有限公司

MAIN CONTRACTOR: Gammon

STRUCTURAL ENGINEER: AECOM

FACADE CONSULTANT: AECOM

NOTE: 1. ALL DIMENSIONS ARE IN MM.  
2. ALL ELEVATIONS ARE VIEWED FROM OUTSIDE.  
3. ALL DIMENSIONS TO BE VERIFIED ON SITE.  
4. BEFORE FABRICATION.  
5. DETAIL MARK NO. (X1)  
6. REFER SHEET NO. (X2)  
7. REVERSED DETAIL (R)

LEGEND:

G1	10mm THK. HEAT STRENGTHENED GLASS (OUTSIDE) + 12mm AIR SPACE + 12mm THK. TEMPERED GLASS
G2	10mm THK. HEAT STRENGTHENED GLASS (OUTSIDE) + 12mm AIR SPACE + 10mm THK. TEMPERED GLASS
G3	12mm THK. HEAT STRENGTHENED GLASS (INTERNAL PROTECTIVE BARRIER)
G4	12mm THK. CLEAR TEMPERED GLASS
G5	12mm CLEAR HEAT STRENGTHENED GLASS
G6	10mm THK. CLEAR HEAT-STRENGTHENED GLASS + 9mm AIR SPACE + 10mm CLEAR TEMPERED GLASS
G7	8mm THK. CLEAR HEAT-STRENGTHENED GLASS + 12mm PVB + 8mm THK. CLEAR HEAT-STRENGTHENED GLASS
G8	3 mm THK. ALUM. CLADDING
G9	3 mm THK. ALUM. BACKPAN

STACK JOINT

SECTION 1

SECTION 2

SECTION 3

SECTION 4

SECTION 5

6 PART PLAN FOR CURTAIN WALL

7 PART PLAN FOR CURTAIN WALL