美特鋁質有限公司
MIDI ALUMINIUM FABRICATOR LTD.

# 工程指示 / 要求簡箋 ENGINEER INSTRUCTIONS(E.I.)

| | | | |
|---|---|---|---|
| 工程指示編號: | EI- 5061 | 修改版本: | - |
| | HK- 1507 | | |
| 工程編號: | J 858 | 工程名稱: | 將軍澳日出康城11期 |
| 收件人: | 生統 | 發件人: | Renee Lo |
| 工程項目: | 幕牆 9/F,11/F,40/F水槽料<br>鋁料 生產 | 日期: | 03/09/2022 |

| | | |
|---|---|---|
| ☐ 原合約工程包 | ☐ 原合約工程加 / 減賬 QT- | ☐ 新工程報價 QT- |

| | |
|---|---|
| 信件批核號碼/圖紙參考編號: | 批核模具圖紙編號: |
| | |
| 客戶指示附件: | 管理內部批簽署: |

| | | |
|---|---|---|
| ☐ 初步鋁料 B.M. | ☐ 加工拆圖，然後生產 | ☐ 尺寸表 |
| ☐ 正式鋁料 B.M. | ☐ 技術上資料／指示 | ☐ 報價 |
| ☐ 配件 B.M. | ☐ 樣辦或貨品說明書 | ☐ 分判合約 |
| ☐ 其他: | | |

內容: 請按鋁料加工圖生產水槽料 出貨到地盤
分座包裝
先生產T1 9/F,11/F
打開料單

要配合ei491.1幾件

完成上列要求日期: 24/09/2022

## 國內

| | | | | | |
|---|---|---|---|---|---|
| ☐ 生產技術總監 | ☐ 連附件 | ☐ 技術部 | ☐ 連附件 | ☐ 生產部 | ☐ 連附件 |
| ☐ 採購部 | ☐ 連附件 | ☑ 生產統籌部 | ☑ 連附件 | ☐ 報關組 | ☐ 連附件 |
| ☐ 質檢部 | ☐ 連附件 | ☐ 會計部 | ☐ 連附件 | ☐ 機械設計部 | ☐ 連附件 |
| ☑ 其他: BUN | | | | | |

## 香港

| | | | | | | | |
|---|---|---|---|---|---|---|---|
| ☐ 行政部 | ☐ 連附件 | ☐ 會計部 | ☐ 連附件 | ☐ 統籌部 | ☐ 連附件 | ☑ 工程部 | ☑ 連附件 |
| ☐ 採購部 | ☐ 連附件 | ☐ QS部 | ☐ 連附件 | ☐ 地盤管理 | ☐ 連附件 | ☐ 維修部 | ☐ 連附件 |

| | |
|---|---|
| *發件人簽署： | *組別成員批核簽署： |
| 傳遞編號： | 項目經理簽署： |

| | 預算出貨日子 | 座數 | 樓層 |
|---|---|---|---|
| 1 | 24/09/2022 | T1 | 9/F, 11/F |
| 2 | 24/10/2022 | T2, T3 | 9/F, 11/F |
| 3 | 待地盤通知 | T1 | 40/F |
| 4 | | T2, T3 | 40/F |

按此打開料單

美特鋁質有限公司
MIDI Aluminium Fabricator Ltd.

QF005/8

# 圖則登記表
DRAWING REGISTER

| 工程名稱 Project Title: | 康城11期 |
|---|---|
| | 单元幕墙9, 11, 40/F起步料 (T1, 2, 3) |
| 工程編號 Project No: | J858 |

接收日期 Receiving Date (適用於客戶圖則)

| 年 | | | | | | | | | | |
|---|---|---|---|---|---|---|---|---|---|---|
| 月 | | | | | | | | | | |
| 日 | | | | | | | | | | |

分發予 Distributed To

| |
|---|
| |
| |
| |

發出日期 Issued Date

| 年 | 11 | | | | | | | | | |
|---|---|---|---|---|---|---|---|---|---|---|
| 月 | 8 | | | | | | | | | |
| 日 | 22 | | | | | | | | | |

| 圖則編號 Drg. No. | 圖則名稱 Drawing Title | 修訂編號 Revision No. |
|---|---|---|
| | J858单元幕墙9/F起步料位置图(T1) | - |
| | J858单元幕墙9/F起步料位置图(T2) | - |
| | J858单元幕墙9/F起步料位置图(T3) | - |
| X86279-ST01 | 起步料 | - |
| X86279-ST02 | 起步料 | - |
| X86279-ST03 | 起步料 | - |
| X86279-ST04 | 起步料 | - |
| X86279-ST05 | 起步料 | - |
| X86279-ST06 | 起步料 | - |
| X86279-ST07 | 起步料 | - |
| X86279-ST08 | 起步料 | - |
| X86279-ST09 | 起步料 | - |
| X86279-ST10 | 起步料 | - |
| X86279-ST11 | 起步料 | - |
| X86279-ST12 | 起步料 | - |
| X86279-ST13 | 起步料 | - |
| X86279-ST14 | 起步料 | - |
| X86279-ST15 | 起步料 | - |
| X86279-ST16 | 起步料 | - |
| X86279-ST17 | 起步料 | - |
| X86279-ST18 | 起步料 | - |
| X86279-ST19 | 起步料 | - |
| X86279-ST20 | 起步料 | - |
| X86279-ST21 | 起步料 | - |
| X86279-ST22 | 起步料 | - |
| X86279-ST23 | 起步料 | - |
| X86279-ST24 | 起步料 | - |
| X86279-ST25 | 起步料 | - |
| X86279-ST26 | 起步料 | - |
| X86279-ST27 | 起步料 | - |
| X86279-ST28 | 起步料 | - |

美特鋁質有限公司
MIDI Aluminium Fabricator Ltd.

QF005/8

# 圖則登記表
## DRAWING REGISTER

| 工程名稱 Project Title: | 康城11期 |
|---|---|
| | 單元幕墙9, 11, 40/F起步料 (T1, 2, 3) |
| 工程編號 Project No: | J858 |

接收日期 Receiving Date (適用於客戶圖則)

| | | | | | | | | | | |
|---|---|---|---|---|---|---|---|---|---|---|
| 年 | | | | | | | | | | |
| 月 | | | | | | | | | | |
| 日 | | | | | | | | | | |

分發予 Distributed To

| |
|---|
| |
| |
| |

發出日期 Issued Date

| | | | | | | | | | | |
|---|---|---|---|---|---|---|---|---|---|---|
| 年 | 11 | | | | | | | | | |
| 月 | 8 | | | | | | | | | |
| 日 | 22 | | | | | | | | | |

| 圖則編號 Drg. No. | 圖則名稱 Drawing Title | 修訂編號 Revision No. |
|---|---|---|
| X86279-ST29 | 起步料 | - |
| X86279-ST30 | 起步料 | - |
| X86279-ST31 | 起步料 | - |
| X86279-ST32 | 起步料 | - |
| X86279-ST33 | 起步料 | - |
| X86279-ST34 | 起步料 | - |
| X86279-ST35 | 起步料 | - |
| X86279-ST36 | 起步料 | - |
| X86279-ST37 | 起步料 | - |
| X86301-ST01 | 横外玻璃线 | - |
| X86301-ST02 | 横外玻璃线 | - |
| X86301-ST03 | 横外玻璃线 | - |
| X86303-01 | 水槽料 | - |
| X86303-02 | 水槽料 | - |
| X86303-03 | 水槽料 | - |
| X86303-04 | 水槽料 | - |
| X86303-05 | 水槽料 | - |
| ST-01 | 丝母巴加工图 | - |
| PV-S01 | 水槽料接驳位防水片加工图 | - |
| AP-ST01L | 封笃片加工图 | - |
| AP-ST01R | 封笃片加工图 | - |
| AP-ST02L | 封笃片加工图 | - |
| AP-ST02R | 封笃片加工图 | - |
| AP-ST03L | 封笃片加工图 | - |
| AP-ST03R | 封笃片加工图 | - |
| AP-ST04L | 封笃片加工图 | - |
| AP-ST04R | 封笃片加工图 | - |
| AP-ST05 | 防水片加工图 | - |

铝板 ET

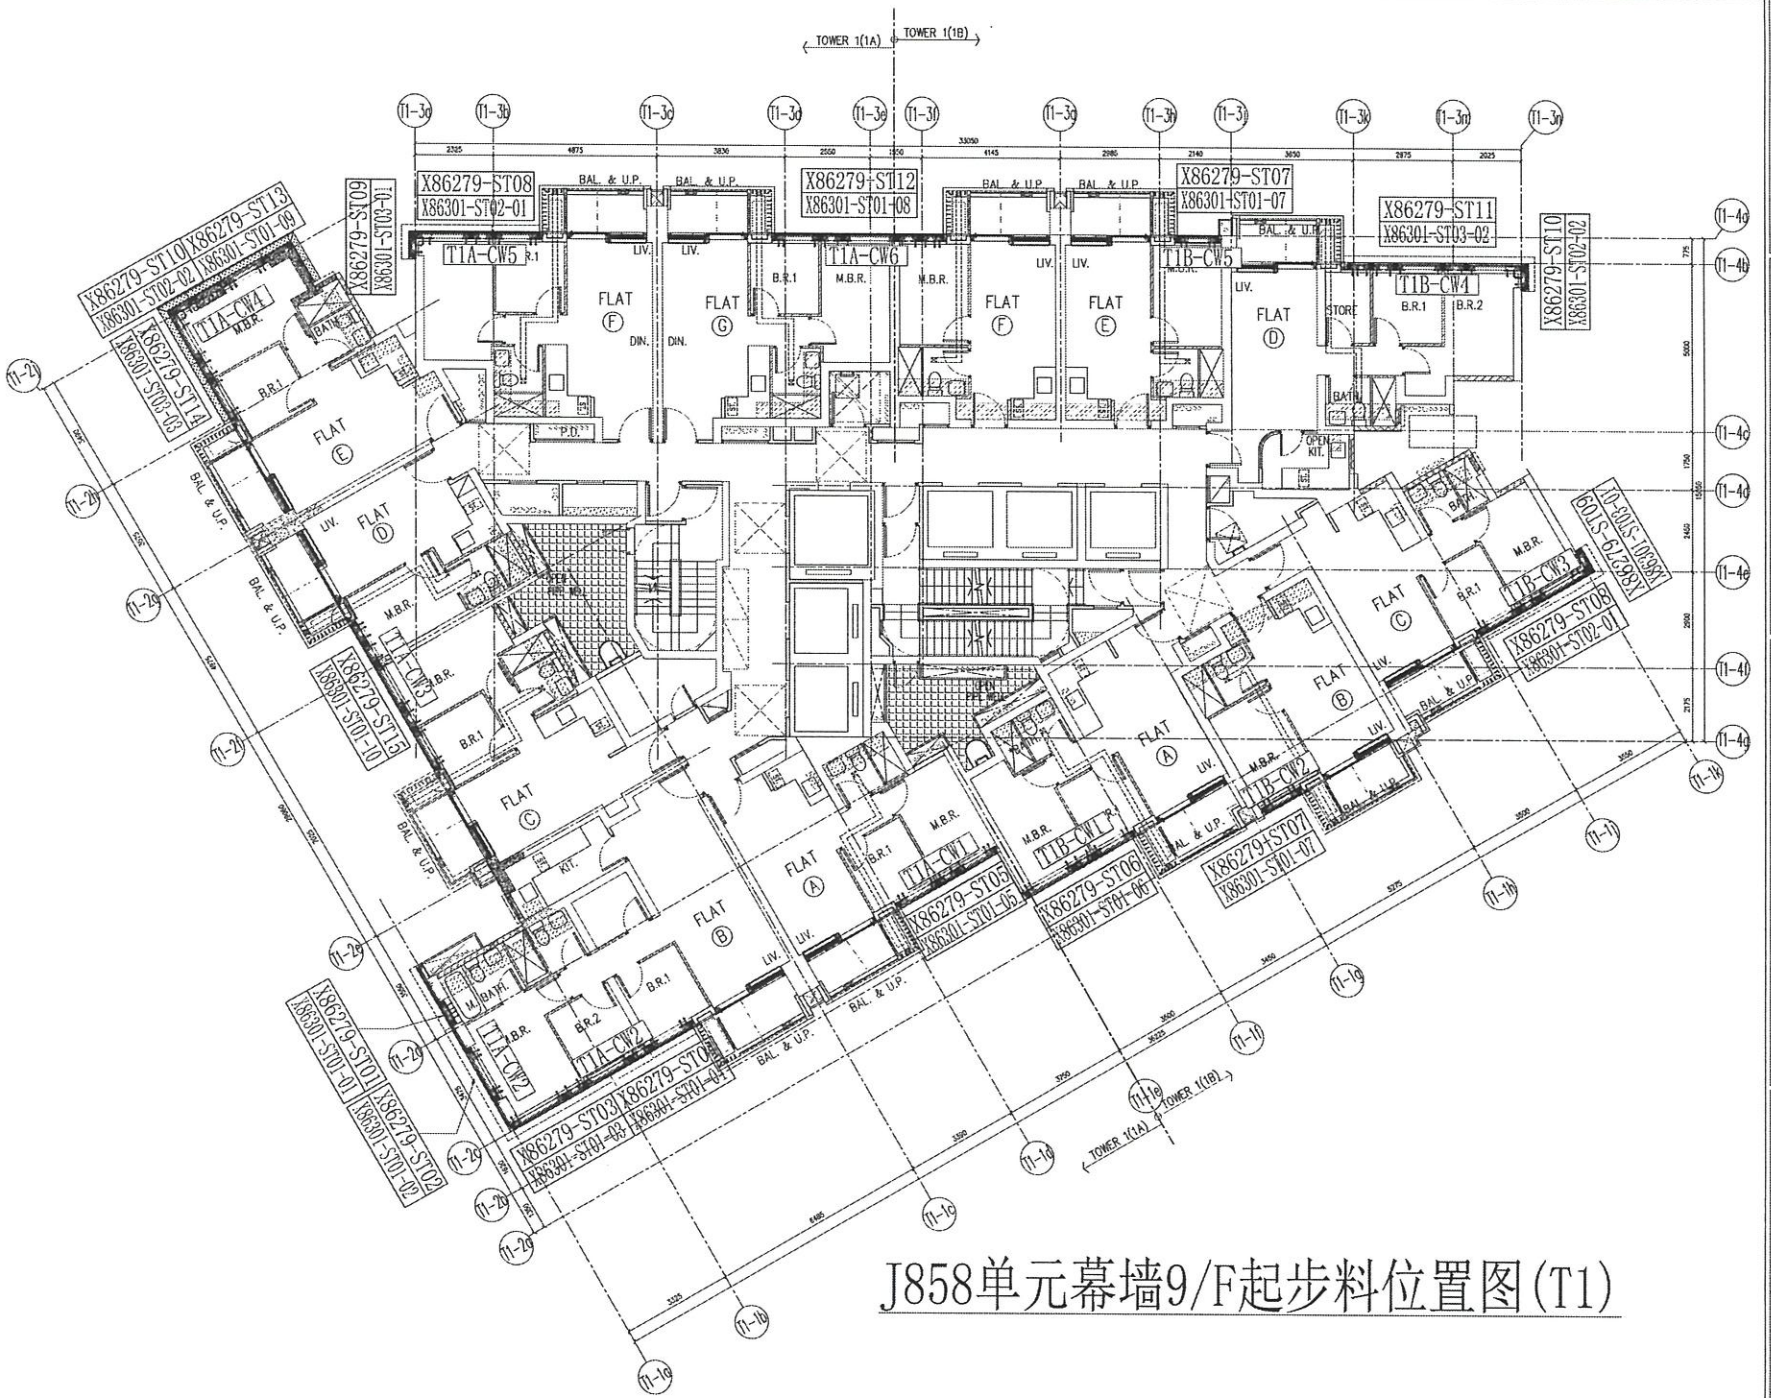


# J858单元幕墙9/F起步料位置图(T1)

B.D. REF :

CLIENT :
信和置業有限公司
Sino Land Company Limited

ARCHITECT :
ronald lu & partners
Ronald Lu & Partners (HK) Ltd.
呂元祥建築師事務所(香港)有限公司

MAIN CONTRACTOR :
Gammon

STRUCTURAL ENGINEER :
AECOM

FACADE CONSULTANT:
AECOM

NOTE :
1. ALL DIMENSIONS ARE IN mm.
2. ALL ELEVATIONS ARE VIEWED FROM OUTSIDE.
3. ALL DIMENSIONS TO BE VERIFIED ON SITE BEFORE FABRICATION.

LEGEND :
X1 / X001 — DETAIL MARK NO. / REFER SHEET NO.
1. F.F.L. — FINISHED FLOOR LEVEL
2. S.F.L. — STRUCTURAL FLOOR LEVEL
3. /R — REVERSED DETAIL

| NO. | DATE | REVISED | BY |
|---|---|---|---|
| - | - | - | - |

JOB NO. : J-858

PROJECT :
PROPOSED RESIDENTIAL DEVELOPMENT
AT TKOTL 70RP, PHASE 11, LOHAS PARK
TSEUNG KWAN O, N.T.

TITLE :
TYPICAL FLOOR PLAN
AT TOWER 1

DATE : 14-Jun-22 | SCALE : 1:75(A1)

DRAWN BY : KY | CHECKED BY : YB

美特鋁質有限公司
MIDI ALUMINIUM FABRICATOR LTD.
Units 6-8, Sunray Industrial Centre, 1/F
610 Cha Kwo Ling Road, Kowloon
Tel:23489211-4 Fax:(852)27727666

DWG NO. : J858-CW-WZ-101 | REV. : -

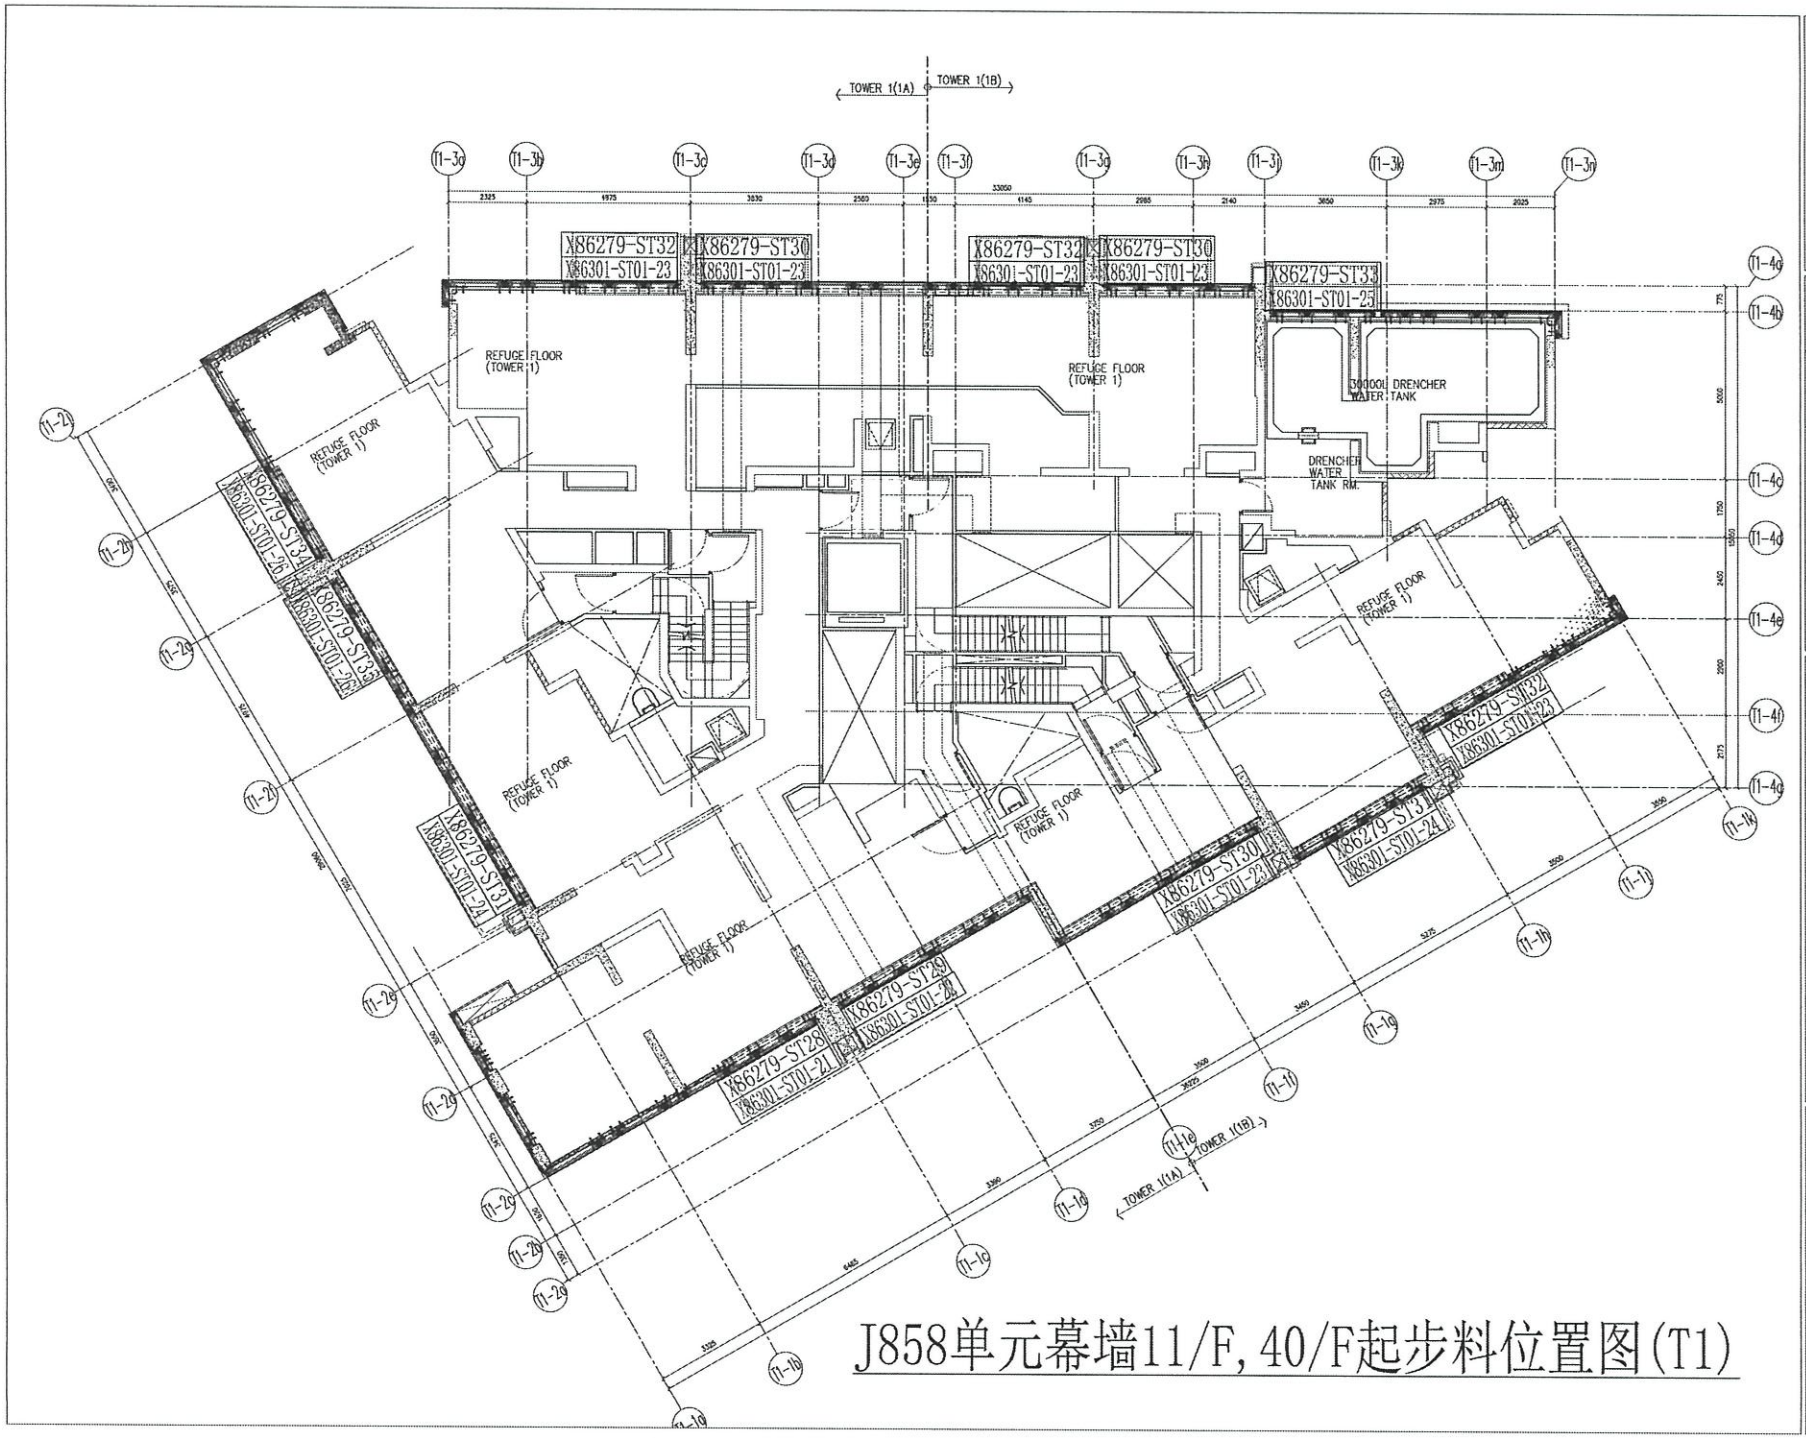


# J858单元幕墙11/F, 40/F起步料位置图(T1)

B.O. REF :

CLIENT :
信和置業有限公司
Sino Land Company Limited

ARCHITECT :
ronald lu & partners
Ronald Lu & Partners (HK) Ltd.
呂元祥建築師事務所(香港)有限公司

MAIN CONTRACTOR :
Gammon

STRUCTURAL ENGINEER :
AECOM

FACADE CONSULTANT:
AECOM

NOTE :
1. ALL DIMENSIONS ARE IN mm.
2. ALL ELEVATIONS ARE VIEWED FROM OUTSIDE.
3. ALL DIMENSIONS TO BE VERIFIED ON SITE BEFORE FABRICATION.

LEGEND :
X1 — DETAIL MARK NO.
X001 — REFER SHEET NO.
1. F.F.L. --FINISHED FLOOR LEVEL
2. S.F.L. --STRUCTURAL FLOOR LEVEL
3. (/R) --REVERSED DETAIL

| NO. | DATE | REVISED | BY |
|---|---|---|---|
| - | - | - | - |

JOB NO. : J-858

PROJECT :
PROPOSED RESIDENTIAL DEVELOPMENT
AT TKOTL 70RP, PHASE 11, LOHAS PARK
TSEUNG KWAN O, N.T.

TITLE :
TYPICAL FLOOR PLAN
AT TOWER 1

DATE : 14-Jun-22 | SCALE : 1:75(A1)

DRAWN BY : KY | CHECKED BY : YB

美特鋁質有限公司
MIDI ALUMINIUM FABRICATOR LTD.
Units 6-8, Sunray Industrial Centre, 1/F
610 Cha Kwo Ling Road, Kowloon
Tel:23489211-4 Fax:(852)27727666

DWG NO. : J858-CW-WZ-102 | REV : -

# J858单元幕墙9/F起步料位置图(T2)

B.O. REF :

CLIENT :
信和置業有限公司
Sino Land Company Limited

ARCHITECT :
ronald lu & partners
Ronald Lu & Partners (HK) Ltd.
呂元祥建築師事務所(香港)有限公司

MAIN CONTRACTOR :
Gammon

STRUCTURAL ENGINEER :
AECOM

FACADE CONSULTANT:
AECOM

NOTE :
1. ALL DIMENSIONS ARE IN mm.
2. ALL ELEVATIONS ARE VIEWED FROM OUTSIDE.
3. ALL DIMENSIONS TO BE VERIFIED ON SITE BEFORE FABRICATION.

LEGEND :
X1 — DETAIL MARK NO.
X001 — REFER SHEET NO.
1. F.F.L. --FINISHED FLOOR LEVEL
2. S.F.L. --STRUCTURAL FLOOR LEVEL
3. /2B --REVERSED DETAIL

| NO. | DATE | REVISED | BY |
|---|---|---|---|
| - | - | - | - |

JOB NO. : J-858

PROJECT :
PROPOSED RESIDENTIAL DEVELOPMENT
AT TKOTL 70RP, PHASE 11, LOHAS PARK
TSEUNG KWAN O, N.T.

TITLE :
TYPICAL FLOOR PLAN
AT TOWER 2

DATE : 14-Jun-22 | SCALE : 1:75(A1)

DRAWN BY : KY | CHECKED BY : YB


美特鋁質有限公司
MIDI ALUMINIUM FABRICATOR LTD.
Units 6-8, Sunray Industrial Centre, 1/F
610 Cha Kwo Ling Road, Kowloon
Tel:23489211-4 Fax:(852)27727666


DWG NO. : J858-CW-WZ-201 | REV. : -

# J858单元幕墙11/F, 40/F起步料位置图(T2)

B.D. REF :

CLIENT :
信和置業有限公司
Sino Land Company Limited

ARCHITECT :
ronald lu & partners
Ronald Lu & Partners (HK) Ltd.
呂元祥建築師事務所(香港)有限公司

MAIN CONTRACTOR :
Gammon

STRUCTURAL ENGINEER :
AECOM

FACADE CONSULTANT:
AECOM

NOTE :
1. ALL DIMENSIONS ARE IN mm.
2. ALL ELEVATIONS ARE VIEWED FROM OUTSIDE.
3. ALL DIMENSIONS TO BE VERIFIED ON SITE BEFORE FABRICATION.

LEGEND :
X1 — DETAIL MARK NO.
X001 — REFER SHEET NO.
1. F.F.L. --FINISHED FLOOR LEVEL
2. S.F.L. --STRUCTURAL FLOOR LEVEL
3. /R --REVERSED DETAIL

| NO. | DATE | REVISED | BY |
|---|---|---|---|
| - | - | - | - |

JOB NO. : J-858

PROJECT :
PROPOSED RESIDENTIAL DEVELOPMENT
AT TKOTL 70RP, PHASE 11, LOHAS PARK
TSEUNG KWAN O, N.T.

TITLE :
11/F & 40/F REFUGE FLOOR PLAN
AT TOWER 2

DATE : 14-Jun-22 | SCALE : 1:75(A1)

DRAWN BY : KY | CHECKED BY : YB


美特鋁質有限公司
MIDI ALUMINIUM FABRICATOR LTD.
Units 6-8, Sunray Industrial Centre, 1/F
510 Cha Kwo Ling Road, Kowloon
Tel:23489211-4 Fax:(852)27727666


DWG NO. : J858-CW-WZ-202 | REV. : -

# J858单元幕墙9/F起步料位置图(T3)

B.D. REF :

CLIENT :
信和置業有限公司
Sino Land Company Limited

ARCHITECT :
ronald lu & partners
Ronald Lu & Partners (HK) Ltd.
呂元祥建築師事務所(香港)有限公司

MAIN CONTRACTOR :
Gammon

STRUCTURAL ENGINEER :
AECOM

FACADE CONSULTANT:
AECOM

NOTE :
1. ALL DIMENSIONS ARE IN mm.
2. ALL ELEVATIONS ARE VIEWED FROM OUTSIDE.
3. ALL DIMENSIONS TO BE VERIFIED ON SITE BEFORE FABRICATION.

LEGEND :
- X1 / X001 — DETAIL MARK NO. / REFER SHEET NO.
1. F.F.L. — FINISHED FLOOR LEVEL
2. S.F.L. — STRUCTURAL FLOOR LEVEL
3. (YR) — REVERSED DETAIL

| NO. | DATE | REVISED | BY |
|---|---|---|---|
| - | - | - | - |

JOB NO. : J-858

PROJECT :
PROPOSED RESIDENTIAL DEVELOPMENT
AT TKOTL 70RP, PHASE 11, LOHAS PARK
TSEUNG KWAN O, N.T.

TITLE :
TYPICAL FLOOR PLAN
AT TOWER 3

DATE : 14-Jun-22 | SCALE : 1:75(A1)

DRAWN BY : KY | CHECKED BY : YB


美特鋁質有限公司
MIDI ALUMINIUM FABRICATOR LTD.
Units 6-8, Sunray Industrial Centre, 1/F
610 Cha Kwo Ling Road, Kowloon
Tel:23489211-4 Fax:(852)27727665


DWG NO. : J858-CW-WZ-301 | REV. : -

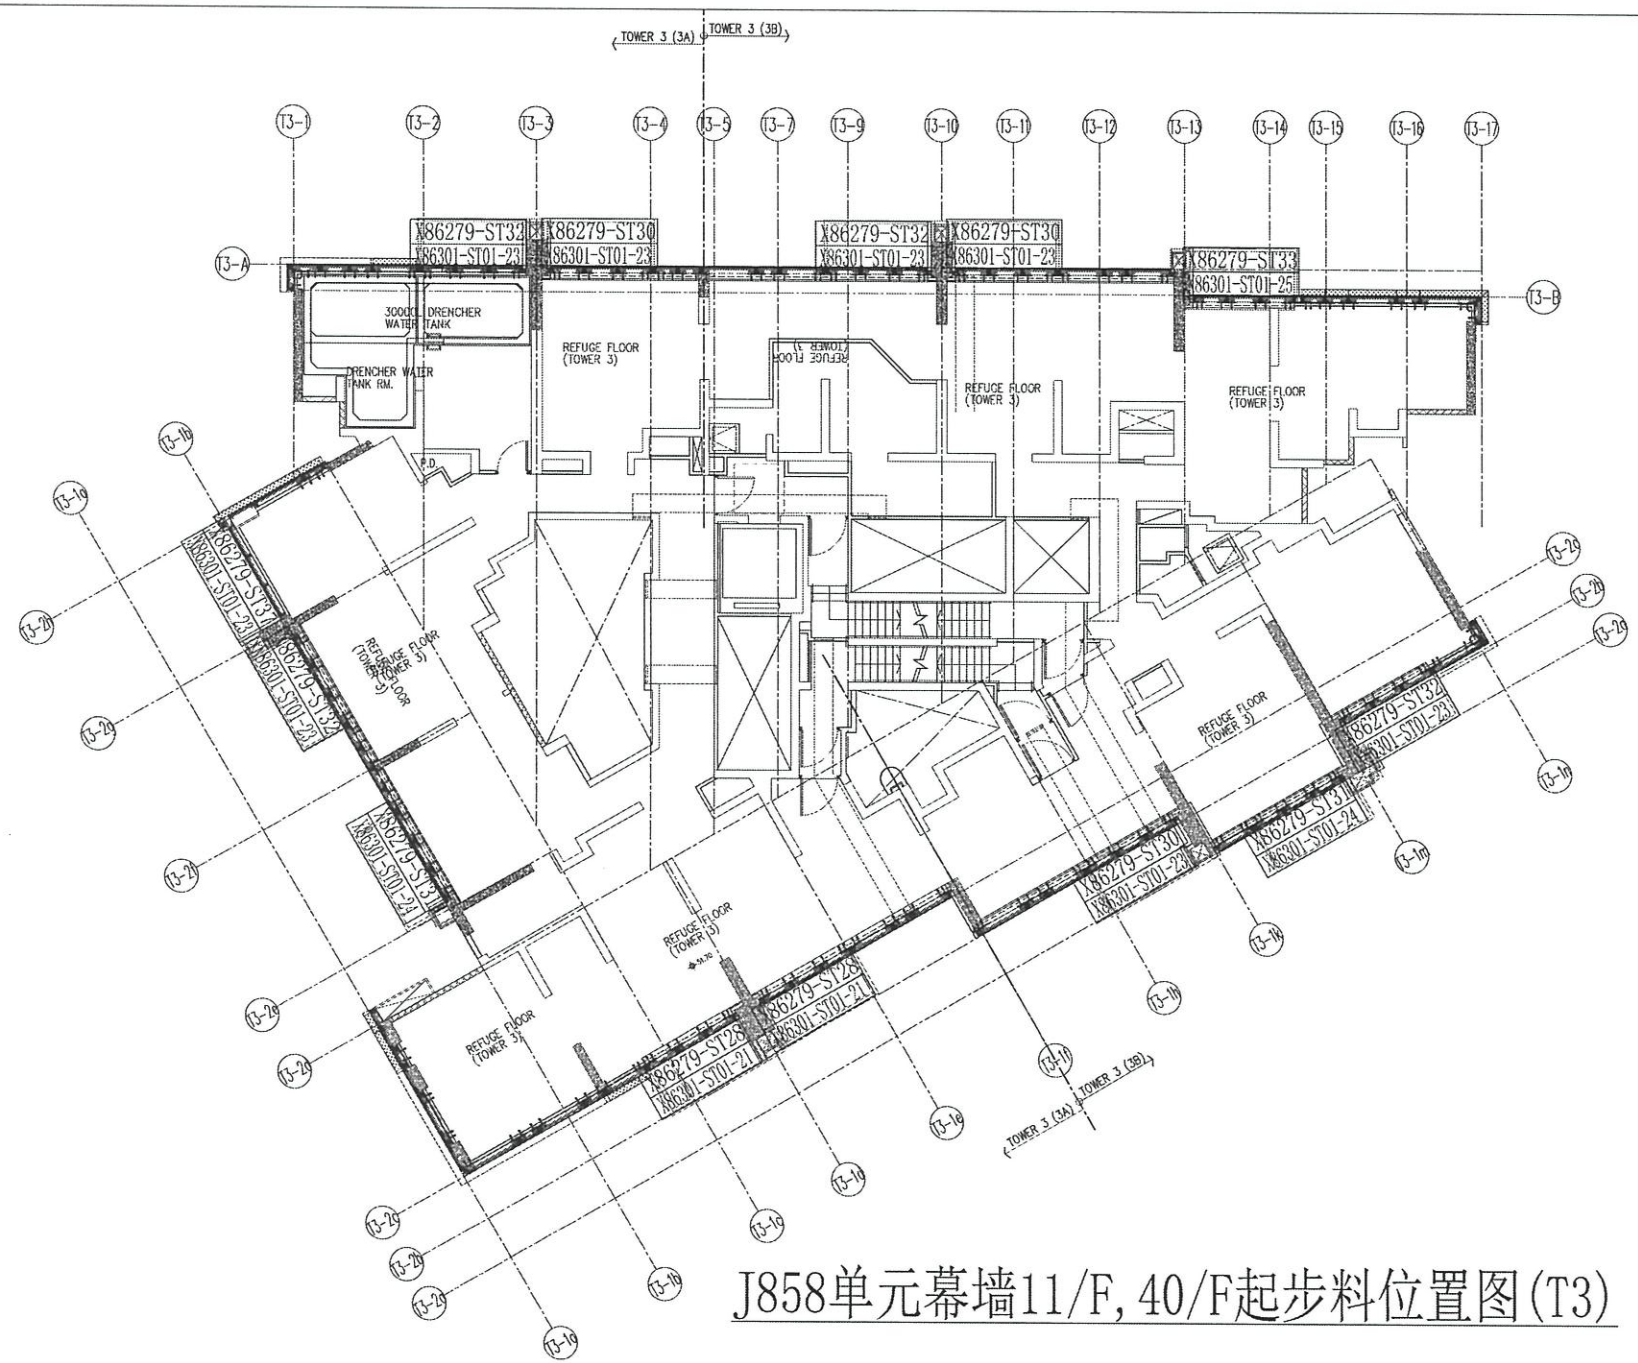


# J858单元幕墙11/F, 40/F起步料位置图(T3)

B.D. REF :

CLIENT :
信和置業有限公司
Sino Land Company Limited

ARCHITECT :
ronald lu & partners
Ronald Lu & Partners (HK) Ltd.
呂元祥建築師事務所(香港)有限公司

MAIN CONTRACTOR :
Gammon

STRUCTURAL ENGINEER :
AECOM

FACADE CONSULTANT:
AECOM

NOTE :
1. ALL DIMENSIONS ARE IN mm.
2. ALL ELEVATIONS ARE VIEWED FROM OUTSIDE.
3. ALL DIMENSIONS TO BE VERIFIED ON SITE BEFORE FABRICATION.

LEGEND :
X1 / X901 — DETAIL MARK NO. / REFER SHEET NO.
1. F.F.L. --FINISHED FLOOR LEVEL
2. S.F.L. --STRUCTURAL FLOOR LEVEL
3. /R --REVERSED DETAIL

| NO. | DATE | REVISED | BY |
|---|---|---|---|
| -- | -- | -- | -- |

JOB NO. : J-858

PROJECT :
PROPOSED RESIDENTIAL DEVELOPMENT
AT TKOTL 70RP, PHASE 11, LOHAS PARK
TSEUNG KWAN O, N.T.

TITLE :
11/F & 40/F REFUGE FLOOR PLAN
AT TOWER 3

DATE : 14-Jun-22 | SCALE : 1:75(A1)
DRAWN BY : KY | CHECKED BY : YB

美特鋁質有限公司
MIDI ALUMINIUM FABRICATOR LTD.
Units 6-8, Sunray Industrial Centre, 1/F
610 Cha Kwo Ling Road, Kowloon
Tel:23489211-4 Fax:(852)27727665

DWG NO. : J858-CW-WZ-302 | REV : --

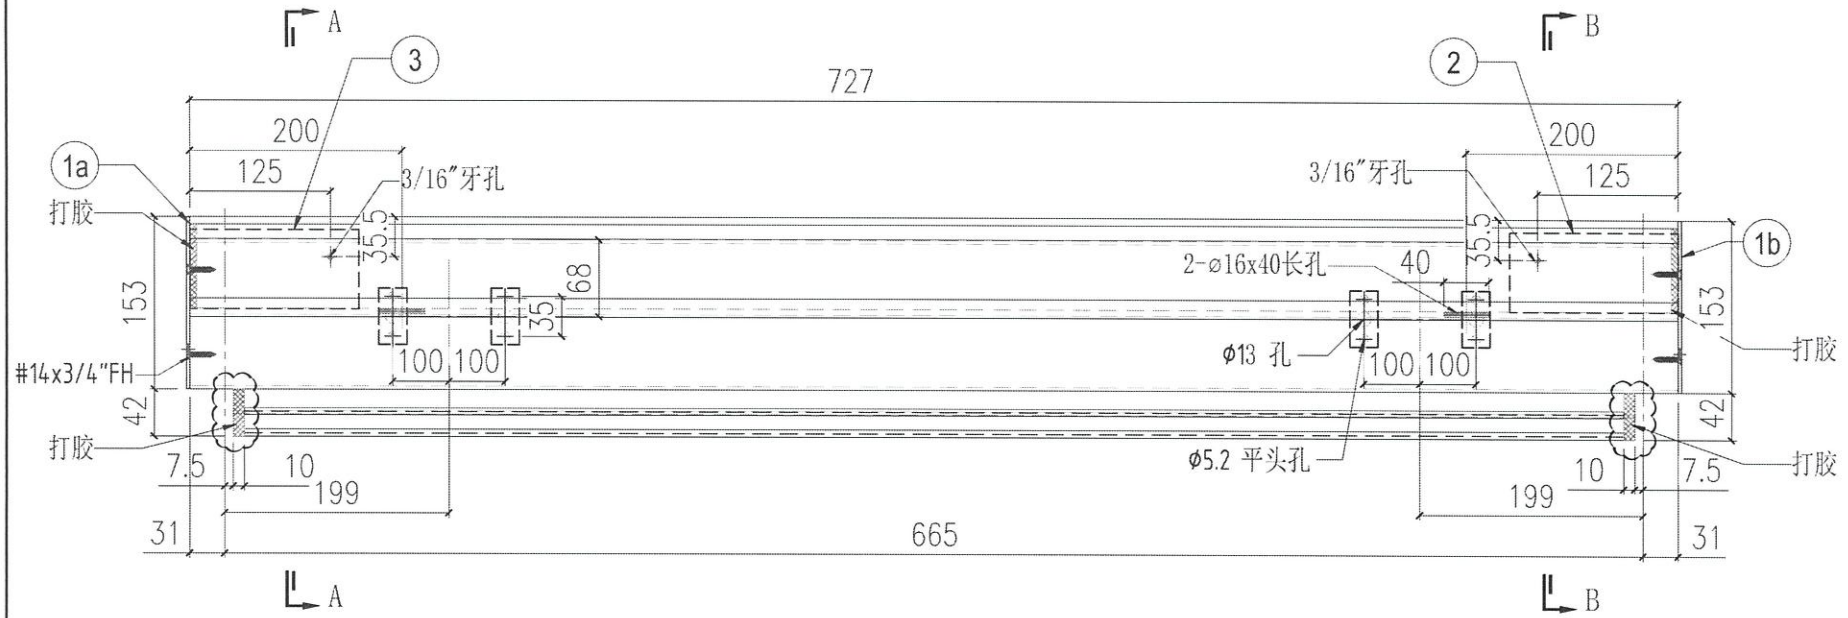


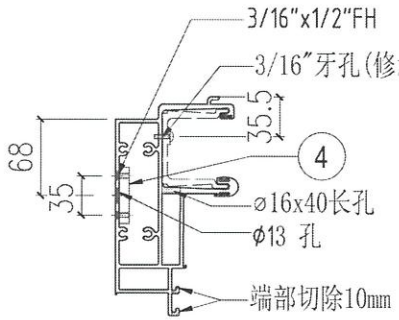


SECTION A-A

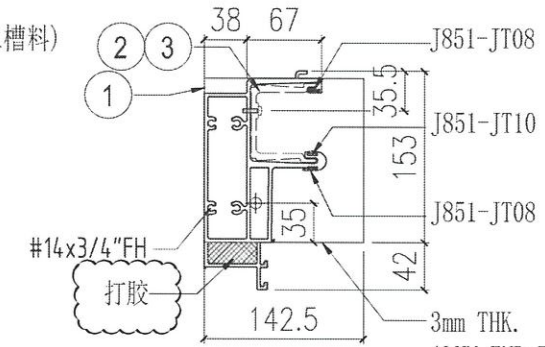


SECTION B-B

FOR :T1A-CW2

| S/N | 部件编号 | L | QTY |
|---|---|---|---|
| 4 | ST-01 | - | 4 |
| 3 | X86303-03 | 150 | 1 |
| 2 | X86303-02 | 150 | 1 |
| 1b | AP-ST01R | - | 1 |
| 1a | AP-ST01L | - | 1 |

| 修改 | 日期 |
|---|---|
| - | - |
| - | - |
| - | - |

美特鋁質有限公司
MDI Aluminium Fabricator Ltd.

| 材料顏色 | 採用 | 工廠 |
|---|---|---|
| 香檳金 (KD03Y1009 95-15F1) | 地盤 | ✓ |

| 工程號 | J858 |
|---|---|
| 地盤 | 康城11期 |
| 圖紙名稱 | 鋁料加工圖 |
| 材料 | X86279 |

| 類別 | |
|---|---|
| 制圖 | W.E.X |
| 復核 | - |
| 批准 | - |

| 物料號 | - |
|---|---|
| 2022-06-10 | - |
| - | - |

| 圖號 | X86279-ST01 |
|---|---|
| 數量 | 1 |
| 單件重量 | - (KG) |

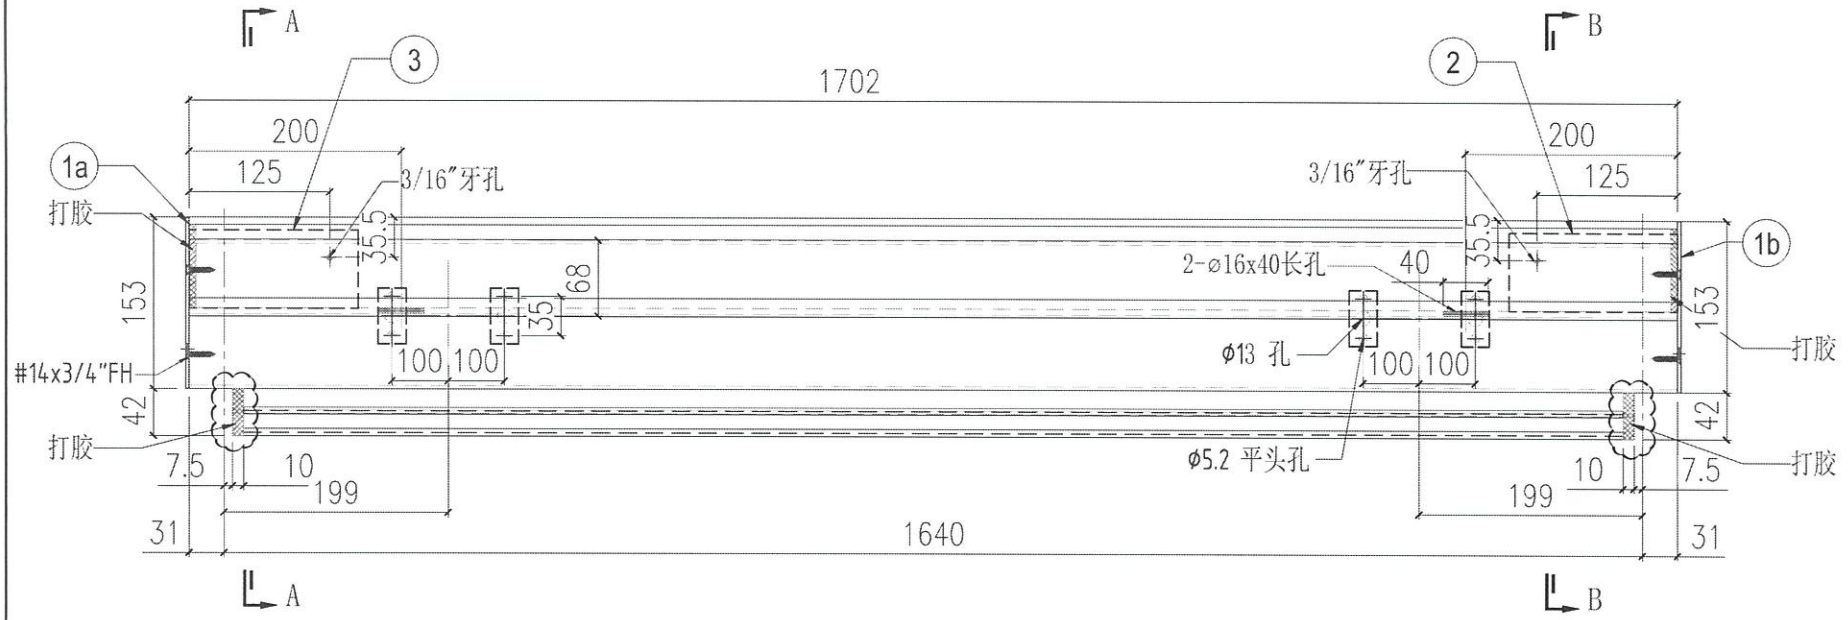


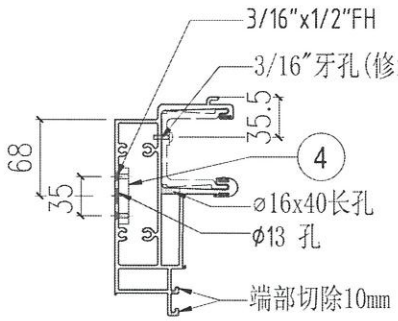


SECTION A-A

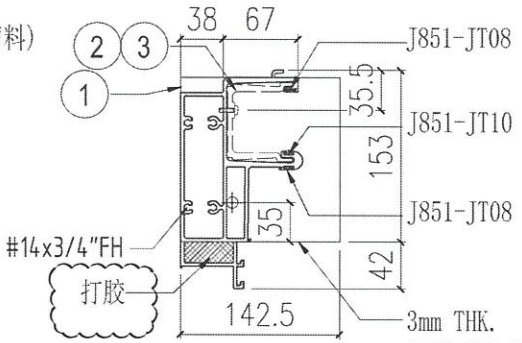


SECTION B-B

FOR :T1A-CW2

| S/N | 部件编号 | L | QTY |
|---|---|---|---|
| 4 | ST-01 | - | 4 |
| 3 | X86303-03 | 150 | 1 |
| 2 | X86303-02 | 150 | 1 |
| 1b | AP-ST01R | - | 1 |
| 1a | AP-ST01L | - | 1 |

| 修改 | 日期 |
|---|---|
| - | - |
| - | - |
| - | - |

美特鋁質有限公司
MDI Aluminium Fabricator Ltd.

| 採用工廠 | 地盤 ✓ |
|---|---|
| 材料顏色 | 香檳金 (EQ03/1009 QS-WF1) |

| | |
|---|---|
| 工程號 | J858 |
| 地盤 | 康城11期 |
| 圖紙名称 | 铝料加工图 |
| 材料 | X86279 |
| 類別 | |
| 制圖 | W.E.X |
| 復核 | - |
| 批准 | - |
| 物料號 | - |
| 2022-06-10 | |
| - | |
| 圖號 | X86279-ST02 |
| 數量 | 1 |
| 單件重量 | - (KG) |

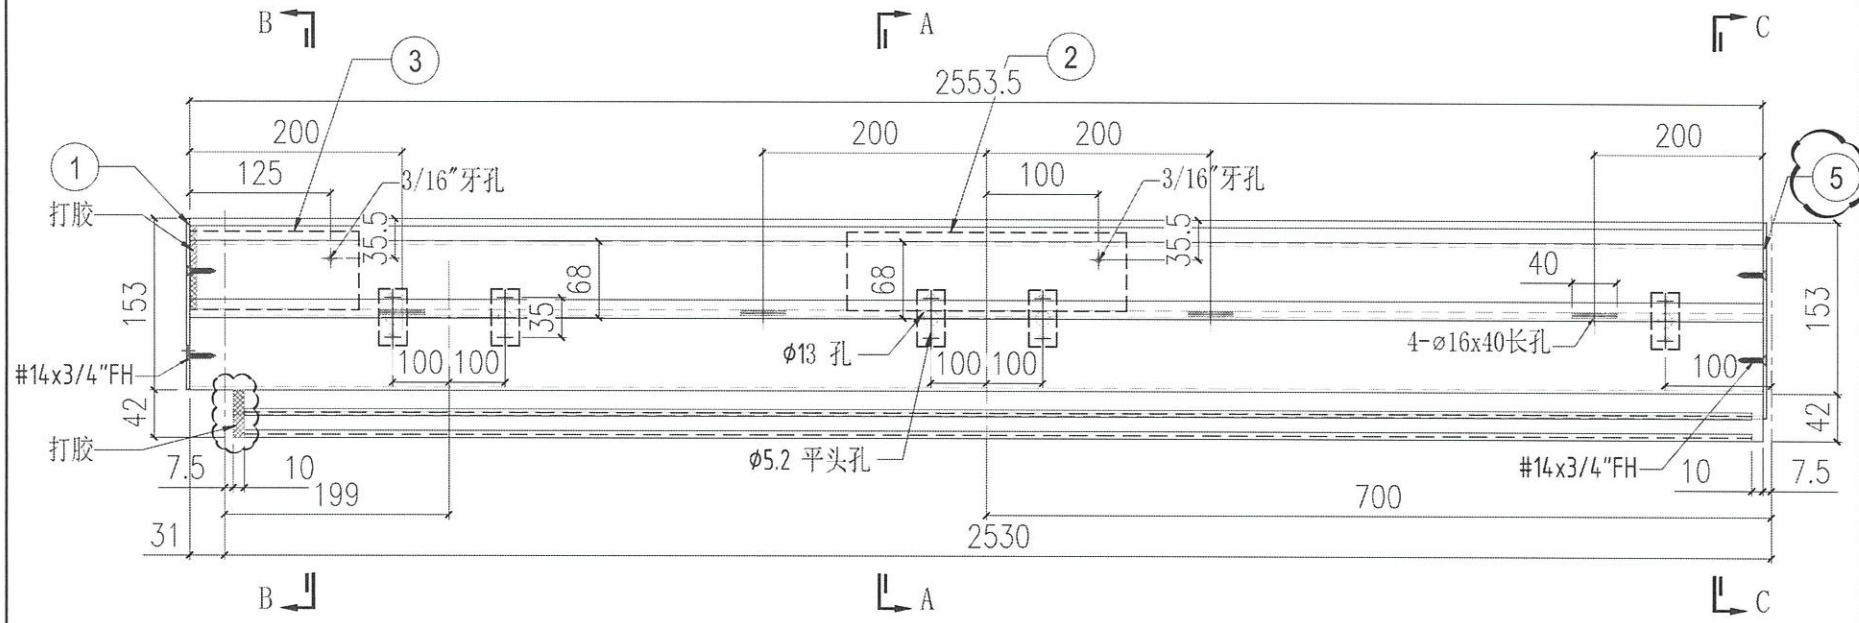


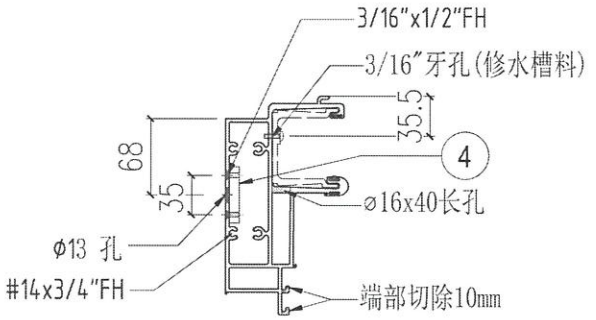


SECTION A-A

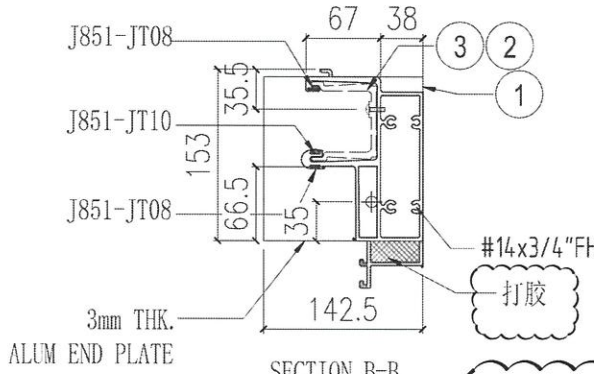


SECTION B-B

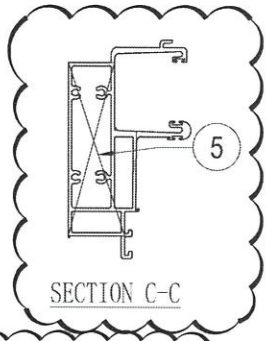


SECTION C-C

FOR :T1A-CW2

| S/N | 部件编号 | L | QTY |
|---|---|---|---|
| 5 | AP-ST03R | - | 1 |
| 4 | ST-01 | - | 5 |
| 3 | X86303-03 | 150 | 1 |
| 2 | X86303-01 | 300 | 1 |
| 1 | AP-ST01L | - | 1 |

| 修改日期 | | | | |
|---|---|---|---|---|
| - | - | - | - | - |
| 材料颜色 | 採用 | 工廠 | 地盤 | ✓ |

美特鋁質有限公司
MDI Aluminium Fabricator Ltd.

| | |
|---|---|
| 工程號 | J858 |
| 圖紙名称 | 康城11期 |
| 材料 | 铝料加工图 |
| X86279 | |

| | |
|---|---|
| 類別 | |
| 制圖 | W.E.X |
| 復核 | - |
| 批准 | - |

| | |
|---|---|
| 物料號 | - |
| 圖號 | X86279-ST03 |
| 數量 | 1 |
| 單件重量 | - (KG) |

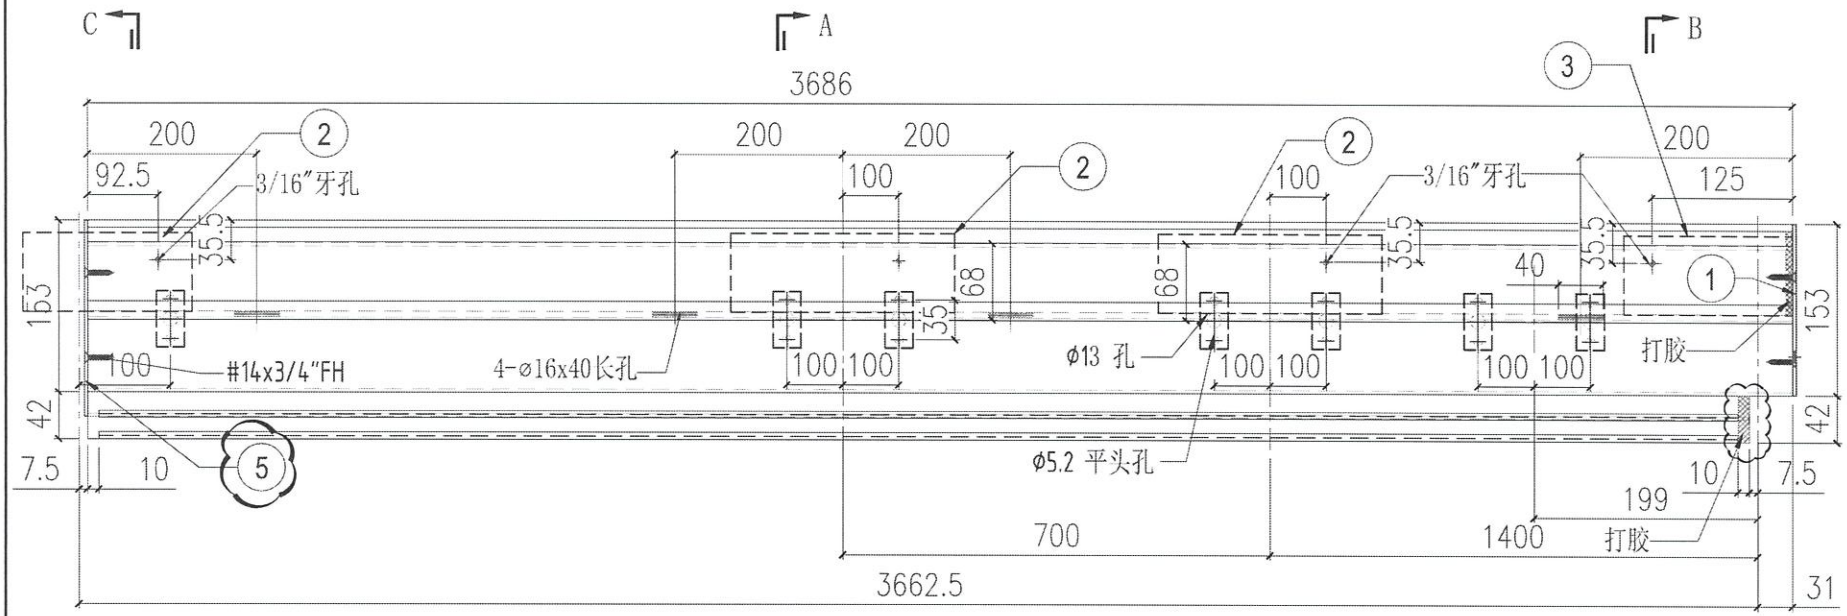


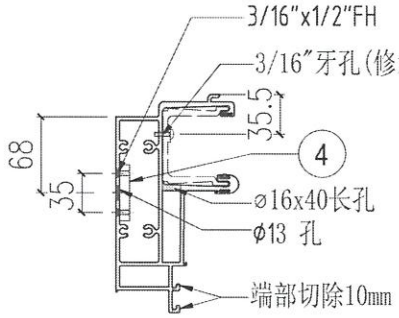


SECTION A-A

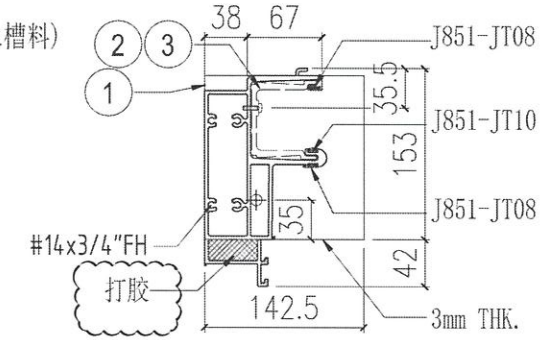


SECTION B-B

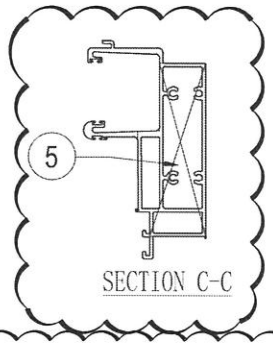


SECTION C-C

FOR :T1A-CW2

FOR :T2A-CW2

FOR :T3A-CW2

| S/N | 部件编号 | L | QTY |
|---|---|---|---|
| 5 | AP-ST03L | - | 1 |
| 4 | ST-01 | - | 7 |
| 3 | X86303-02 | 150 | 1 |
| 2 | X86303-01 | 300 | 3 |
| 1 | AP-ST01R | - | 1 |

| 修改日期 | | | | | |
|---|---|---|---|---|---|
| | - | - | - | - | - |
| 材料颜色 | 採用 | 工廠 | 地盤 | 香槟金 (EB3/1003 98-3F1) | ✓ |

美特鋁質有限公司
MDI Aluminium Fabricator Ltd.

| 材料 | X86279 |
|---|---|
| 图纸名称 | 铝料加工图 |
| 工程號 | J858 |
| 地盘 | 康城11期 |
| 類別 | |
| 制圖 | W.E.X |
| 復核 | - |
| 批准 | - |
| 物料號 | - |
| 制圖 | 2022-06-10 |
| 數量 | X86279-ST04 |
| 單件重量 | 3 |
| | - (KG) |

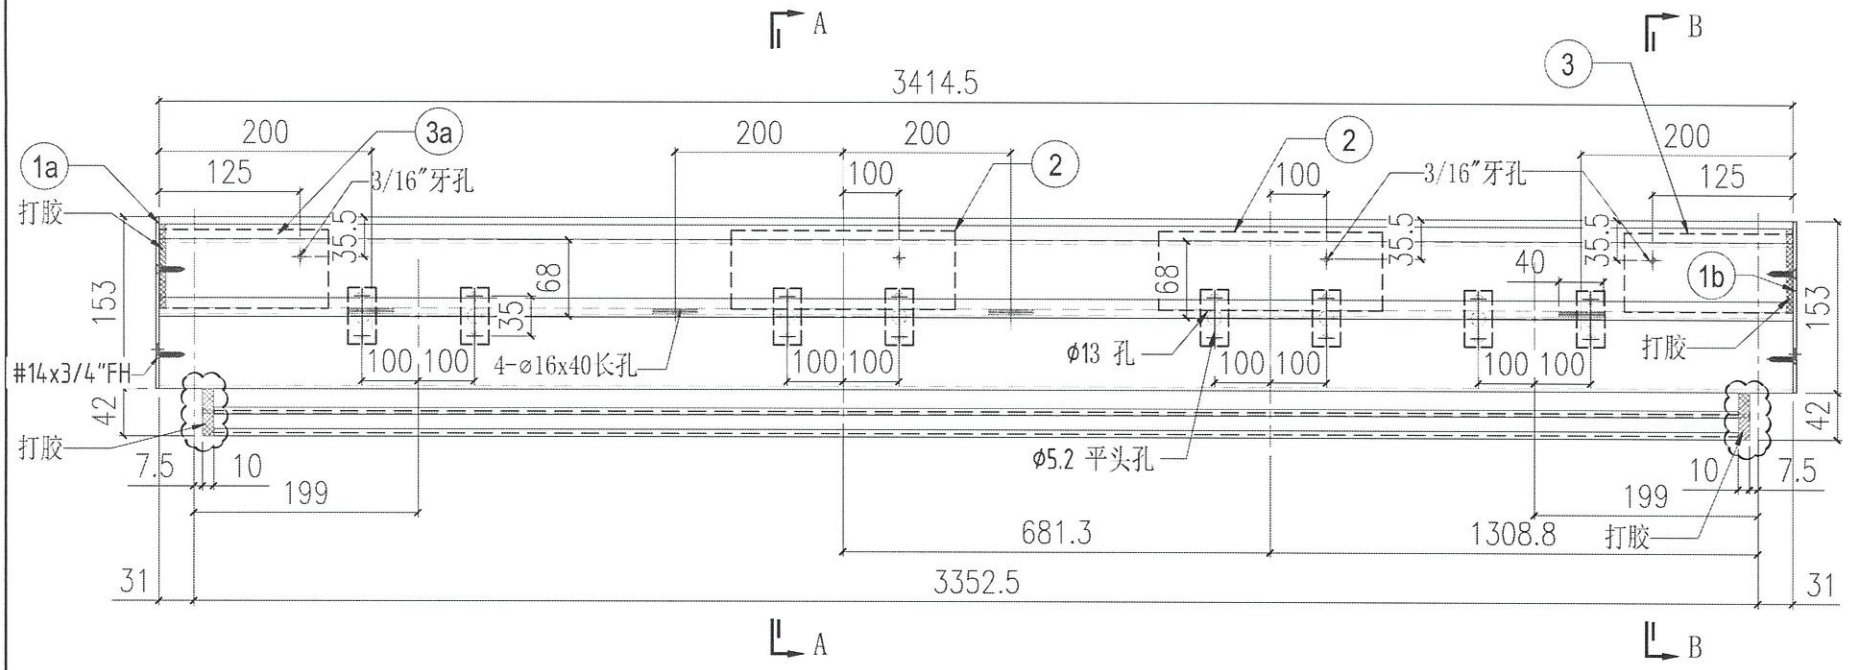


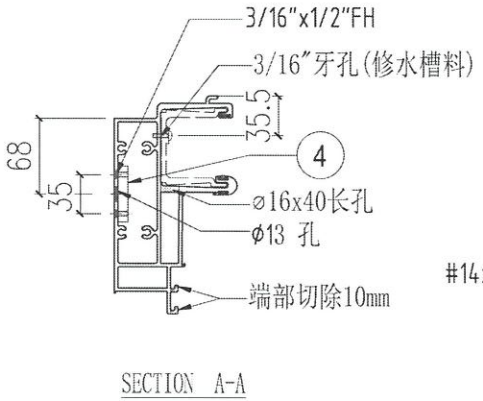


SECTION A-A

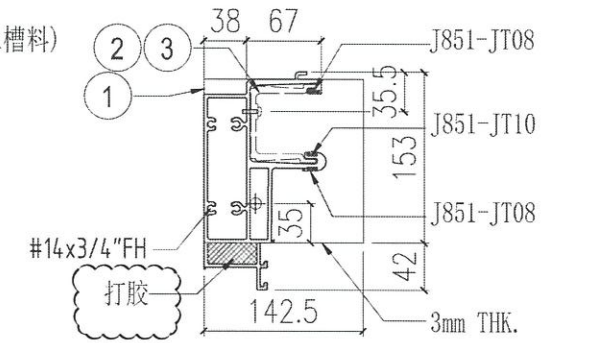


SECTION B-B

FOR :T1A-CW1

FOR :T2A-CW1

FOR :T3A-CW1

| S/N | 部件编号 | L | QTY |
|---|---|---|---|
| 4 | ST-01 | - | 9 |
| 3a | X86303-03 | 150 | 1 |
| 3 | X86303-02 | 150 | 1 |
| 2 | X86303-01 | 300 | 2 |
| 1b | AP-ST01R | - | 1 |
| 1a | AP-ST01L | - | 1 |

| 修改日期 | | | | |
|---|---|---|---|---|
| - | - | - | - | - |
| 材料/顏色 | 採用工廠 | 地盤 ✓ | | |
| | 香槟金(EQ03\1009 95-7EF) | | | |

美特鋁質有限公司
MDI Aluminium Fabricator Ltd.

| | | | |
|---|---|---|---|
| 工程號 | J858 | 類別 | - |
| 圖紙名称 | 康城11期 | 制圖 | W.E.X |
| 材料 | 地盤 | 復核 | - |
| | 鋁料加工圖 | 批准 | - |
| | X86279 | | |

| | |
|---|---|
| 物料號 | - |
| 圖號 | X86279-ST05 |
| 數量 | 3 |
| 單件重量 | - (KG) |

| | |
|---|---|
| 2022-06-10 | |
| - | |
| - | |

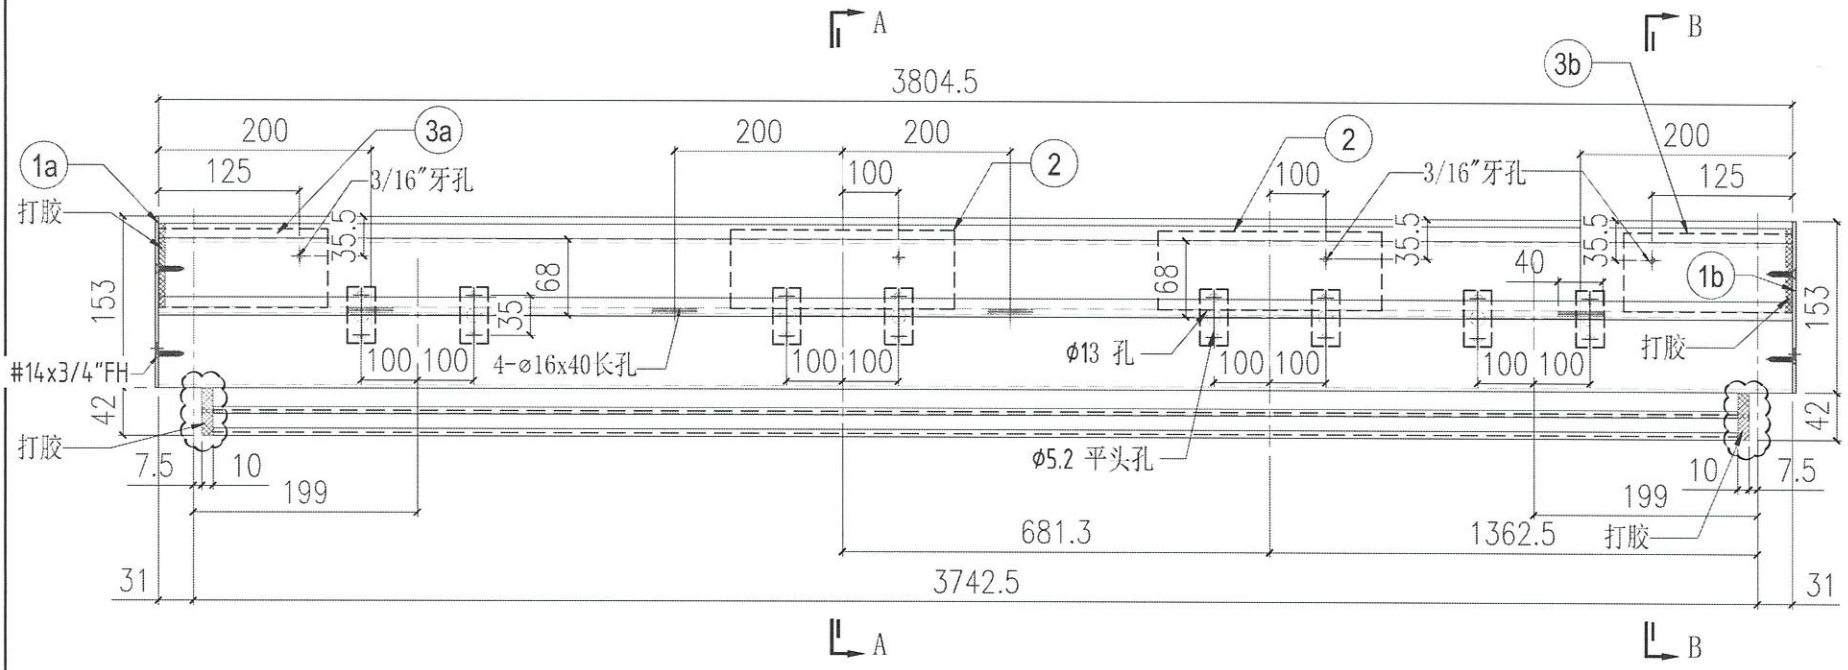


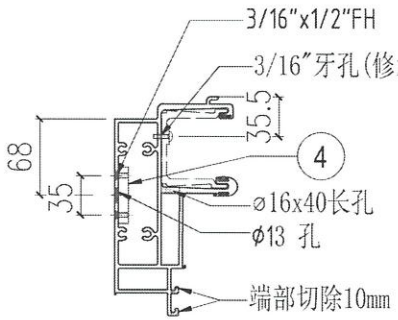


SECTION A-A

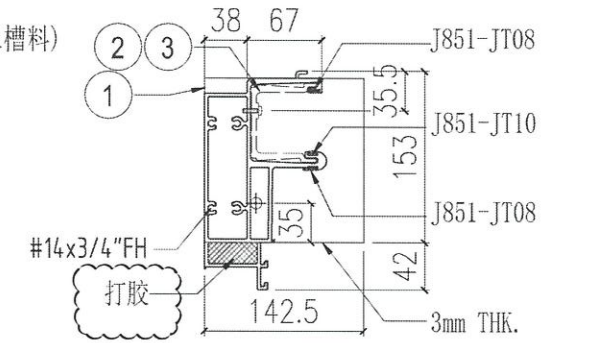


SECTION B-B

FOR :T1B-CW1

| S/N | 部件编号 | L | QTY |
|---|---|---|---|
| 4 | ST-01 | - | 9 |
| 3b | X86303-02 | 150 | 1 |
| 3a | X86303-03 | 150 | 1 |
| 2 | X86303-01 | 300 | 2 |
| 1b | AP-ST01R | - | 1 |
| 1a | AP-ST01L | - | 1 |

| 修改日期 | | | |
|---|---|---|---|
| - | - | - | - |
| - | - | - | - |
| - | - | - | - |

美特鋁質有限公司
MDI Aluminium Fabricator Ltd.

| 材料/顏色 | 採用工廠 | 地盤 ✓ |
|---|---|---|
| | 香港金(EQX1009 98-3F1) | |

| | |
|---|---|
| 工程號 | J858 |
| 圖紙名稱 | 康城11期 |
| 材料 | 鋁料加工圖 |
| X86279 | |

| | |
|---|---|
| 類別 | - |
| 制圖 | W.E.X |
| 復核 | - |
| 批准 | - |

| | |
|---|---|
| 物料號 | 2022-06-10 |
| | - |
| | - |

| | |
|---|---|
| 圖號 | X86279-ST06 |
| 數量 | 1 |
| 單件重量 | - (KG) |

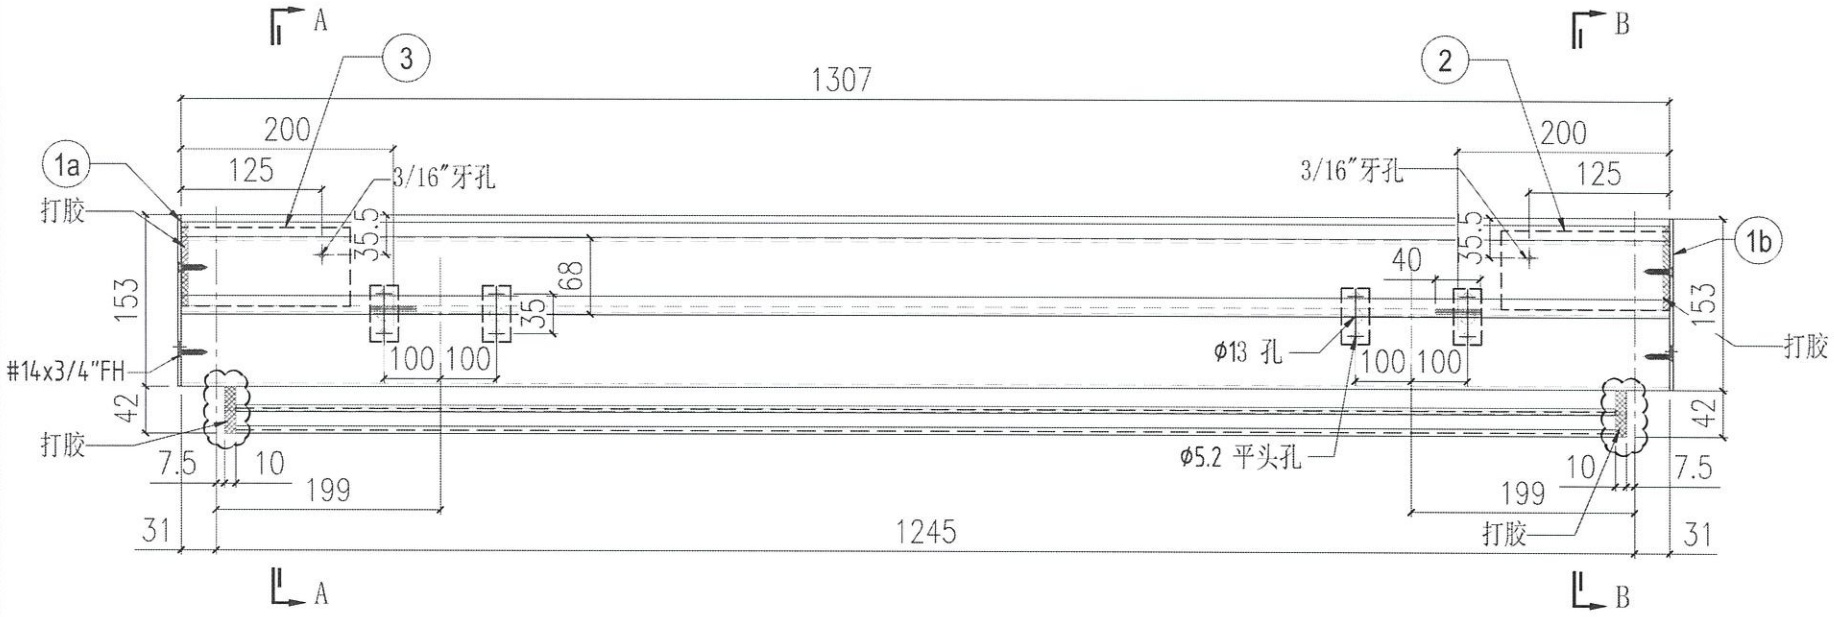


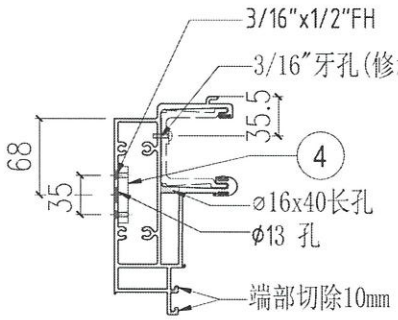


SECTION A-A

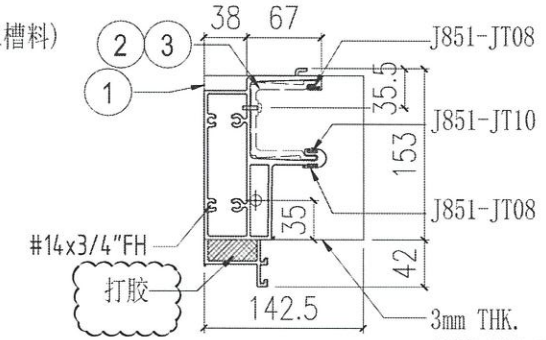


SECTION B-B

FOR :T1B-CW2
FOR :T1B-CW5
FOR :T2B-CW2
FOR :T3B-CW2

| S/N | 部件编号 | L | QTY |
|---|---|---|---|
| 4 | ST-01 | - | 4 |
| 3 | X86303-03 | 150 | 1 |
| 2 | X86303-02 | 150 | 1 |
| 1b | AP-ST01R | - | 1 |
| 1a | AP-ST01L | - | 1 |

| 修改日期 | - | - | - | - |
|---|---|---|---|---|
| 材料/顏色 | 採用工廠 | 地盤 ✓ | | |
| | 香檳金 (EQ03Y.009 95-EF1) | | | |

美特鋁質有限公司
MDI Aluminium Fabricator Ltd.

| 材料 | X86279 | 工程號 | J858 | 類別 | | 物料號 | - |
|---|---|---|---|---|---|---|---|
| | | 地盤 | 康城1I期 | 制圖 | W.E.X | 圖號 | X86279-ST07 |
| | | 圖紙名称 | 铝料加工图 | 復核 | - | 數量 | 4 |
| | | | | 批准 | - | 單件重量 | - (KG) |

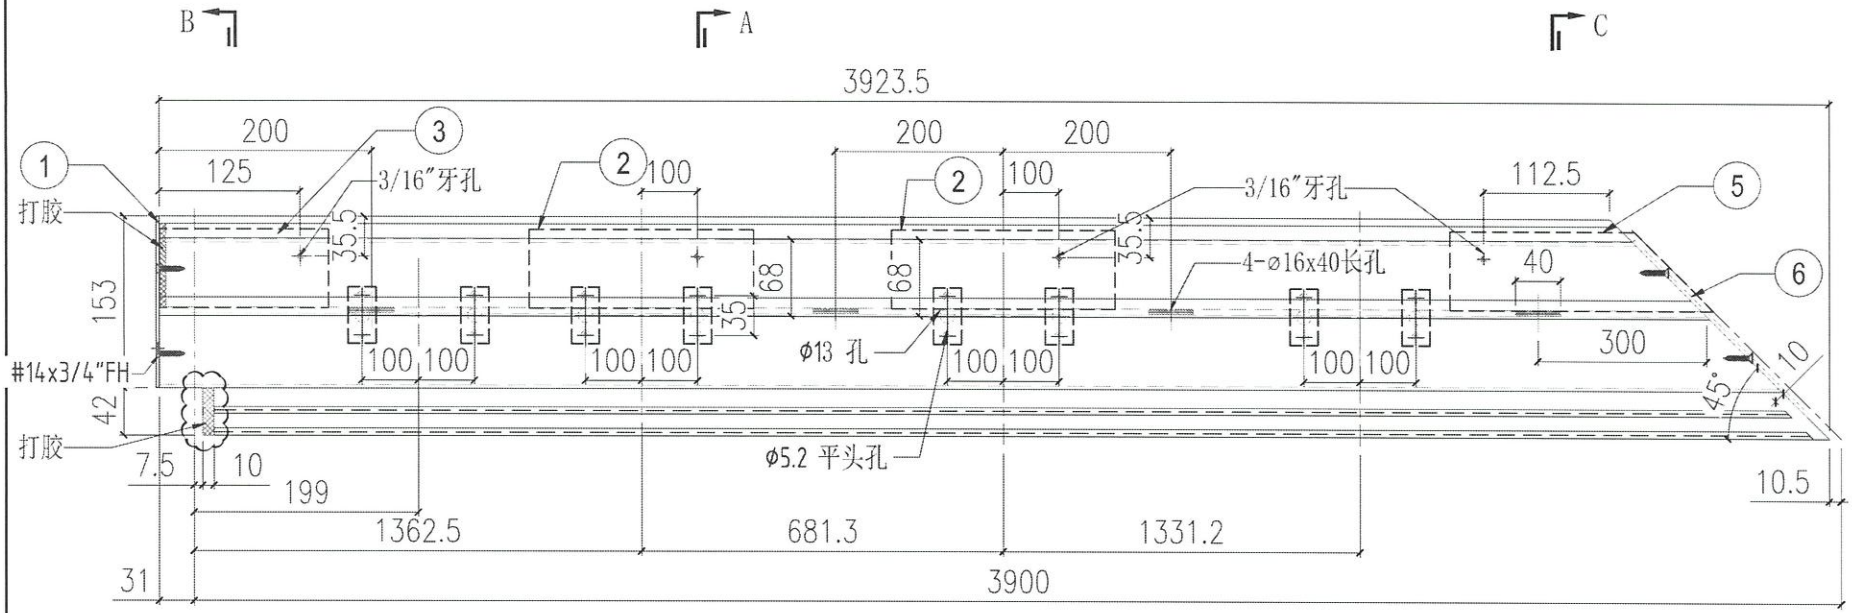


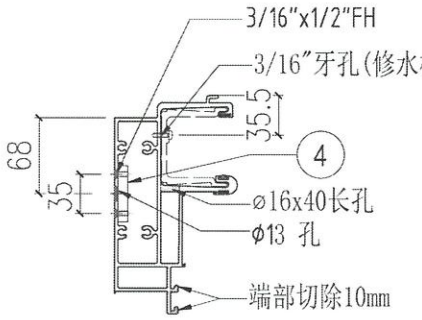


SECTION A-A

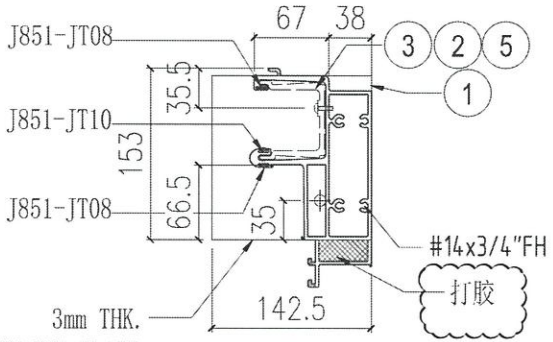


SECTION B-B

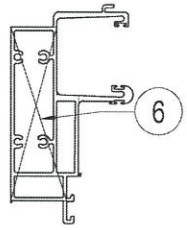


SECTION C-C

FOR :T1B-CW3
FOR :T1A-CW5
FOR :T2B-CW3
FOR :T2A-CW5
FOR :T3A-CW5

| S/N | 部件编号 | L | QTY |
|---|---|---|---|
| 6 | AP-ST02R | - | 1 |
| 5 | X86303-05 | - | 1 |
| 4 | ST-01 | - | 8 |
| 3 | X86303-03 | 150 | 1 |
| 2 | X86303-01 | 300 | 2 |
| 1 | AP-ST01L | - | 1 |

美特鋁質有限公司
MDI Aluminium Fabricator Ltd.

| 修改日期 | | | |
|---|---|---|---|
| - | - | - | - |
| - | - | - | - |

材料顏色 | 採用工廠 | 地盤 ✓
香槟金 (EC03\1009 9S-3EF1)

| | | | |
|---|---|---|---|
| 工程號 | J858 | 類別 | |
| 圖紙名稱 | 康城11期 | 制圖 | W.E.X |
| 材料 | 鋁料加工圖 | 復核 | - |
| X86279 | 地盤 | 批准 | - |

| | |
|---|---|
| 物料號 | - |
| 圖號 | X86279-ST08 |
| 數量 | 5 |
| 單件重量 | - (KG) |

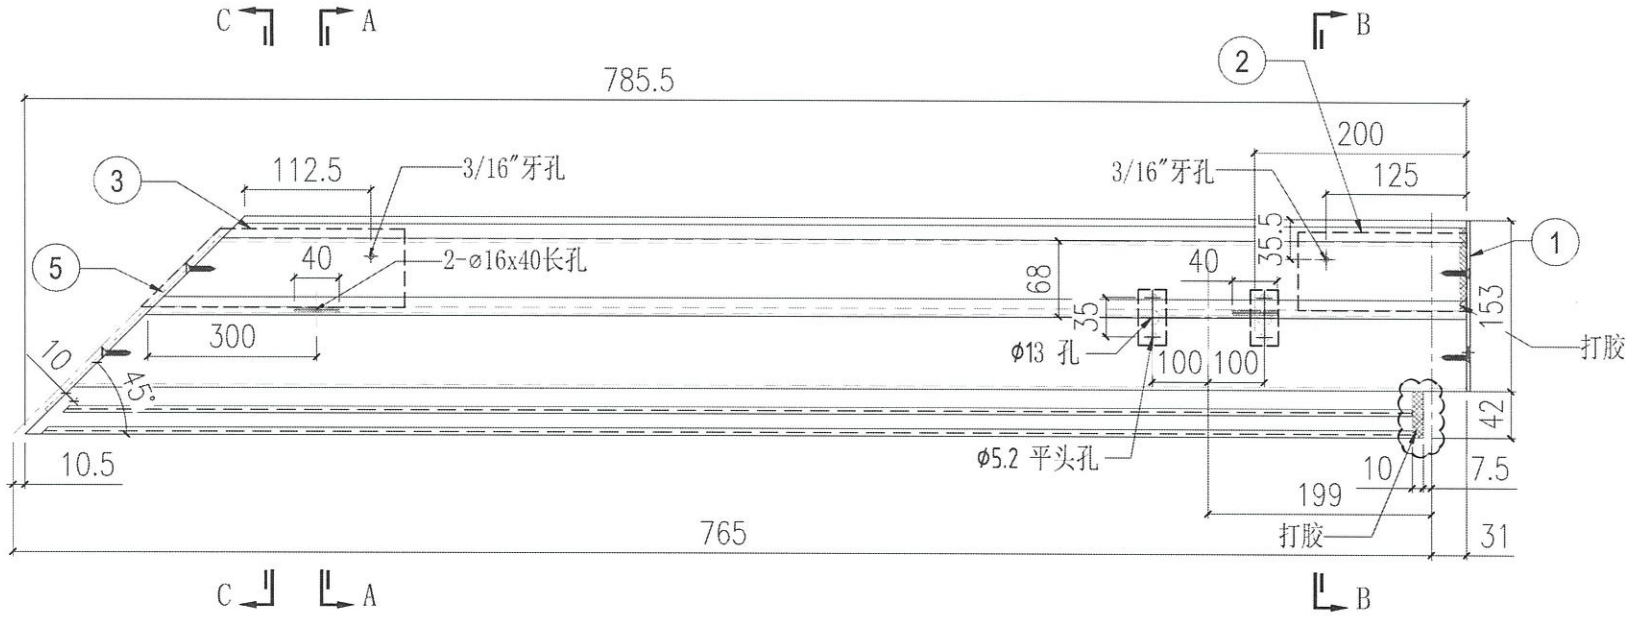


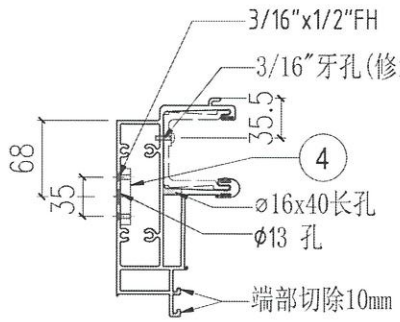


SECTION A-A

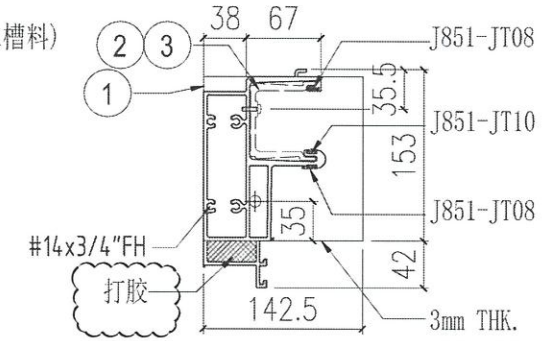


SECTION B-B

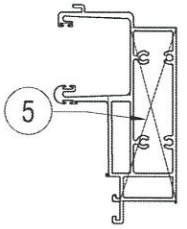


SECTION C-C

FOR :T1B-CW3
FOR :T1A-CW5
FOR :T2B-CW3
FOR :T2A-CW5
FOR :T3B-CW3
FOR :T3A-CW5

| S/N | 部件编号 | L | QTY |
|---|---|---|---|
| 5 | AP-ST02L | - | 1 |
| 4 | ST-01 | - | 2 |
| 3 | X86303-04 | 150 | 1 |
| 2 | X86303-02 | 150 | 1 |
| 1 | AP-ST01R | - | 1 |

| 修改日期 | | | |
|---|---|---|---|
| - | - | - | - |
| - | - | - | - |
| - | - | - | - |

美特鋁質有限公司
MDI Aluminium Fabricator Ltd.

| 材料/顏色 | 採用工廠 | 地盤 ✓ |
|---|---|---|
| | 香港金 (EQSX1009 95-3F1) | |

| 材料 | 圖紙名称 | 工程號 | J858 |
|---|---|---|---|
| X86279 | 铝料加工图 | 地盤 | 康城11期 |
| | | 制圖 | W.E.X |
| | | 復核 | - |
| | | 批准 | - |

| 類別 | | 物料號 | - |
|---|---|---|---|
| | | 圖號 | X86279-ST09 |
| | | 數量 | 6 |
| | | 單件重量 | - (KG) |

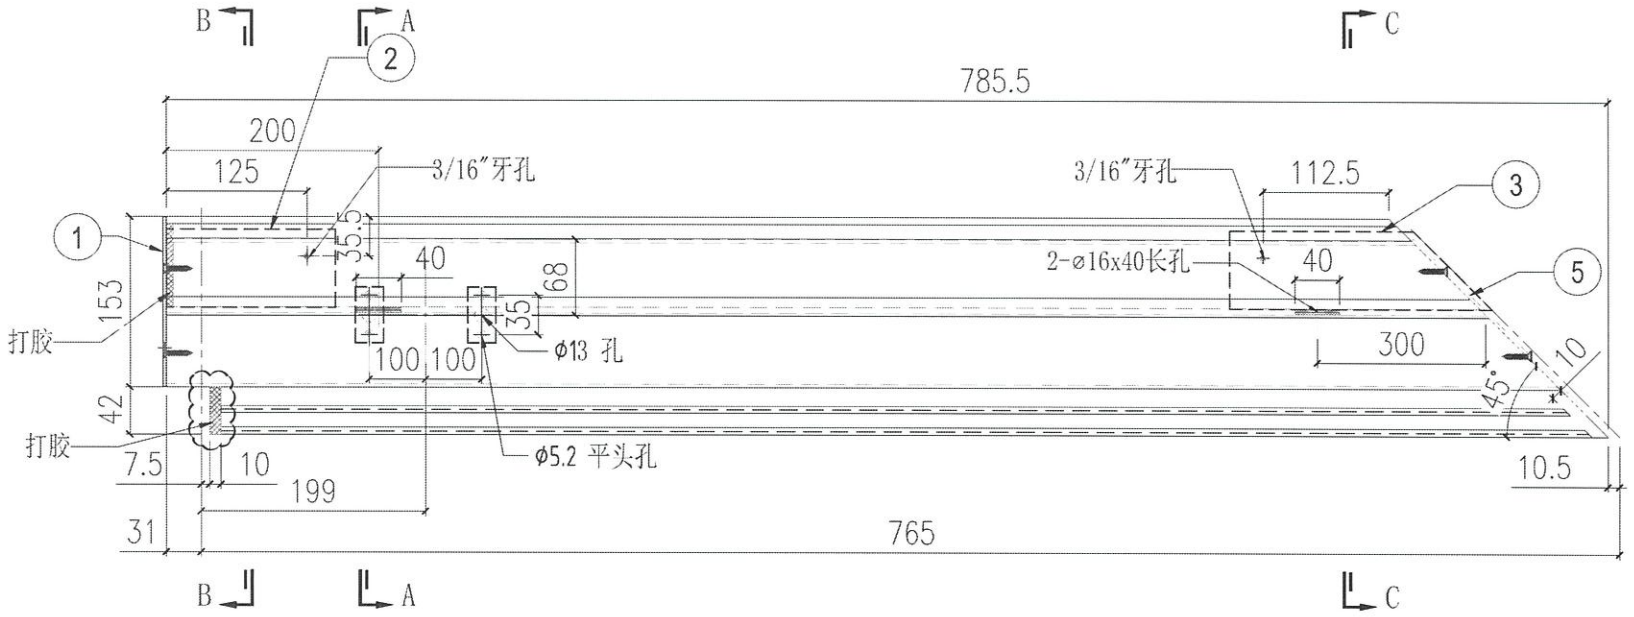


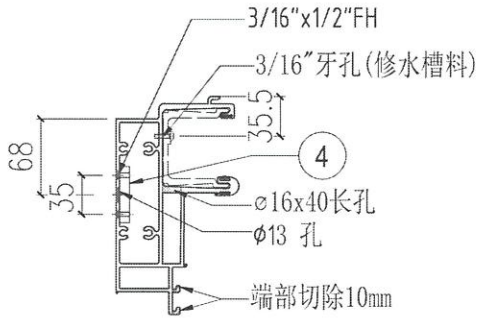


SECTION A-A

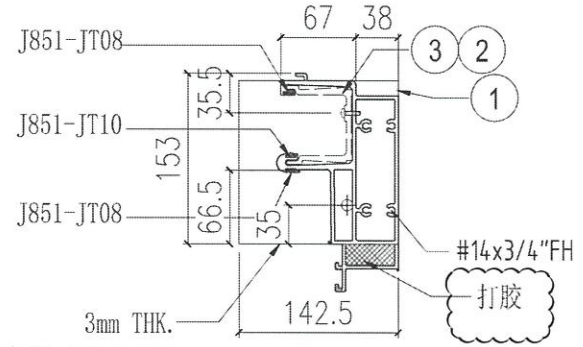


SECTION B-B

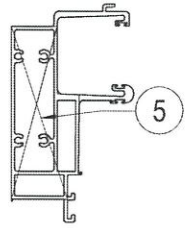


SECTION C-C

FOR :T1B-CW4

FOR :T1A-CW4

FOR :T2B-CW4

FOR :T3B-CW4

| S/N | 部件编号 | L | QTY |
|---|---|---|---|
| 5 | AP-ST02R | - | 1 |
| 4 | ST-01 | - | 2 |
| 3 | X86303-05 | 150 | 1 |
| 2 | X86303-03 | 150 | 1 |
| 1 | AP-ST01L | - | 1 |

| 修改日期 | | | |
|---|---|---|---|
| - | - | - | - |
| - | - | - | - |

美特鋁質有限公司
MDJ Aluminium Fabricator Ltd.

| 材料/顏色 | 採用工廠 | 地盤 ✓ |
|---|---|---|
| | 香槟金 (EQSX1009 9S-3N1) | |

| 工程號 | J858 |
|---|---|
| 圖紙名稱 | 地盤 |
| 材料 | 鋁料加工圖 |
| X86279 | 康城11期 |

| 類別 | |
|---|---|
| 制圖 | W.E.X |
| 復核 | - |
| 批准 | - |

| 物料號 | - |
|---|---|
| 2022-06-10 | - |
| - | - |

| 圖號 | X86279-ST10 |
|---|---|
| 數量 | 4 |
| 單件重量 | - (KG) |

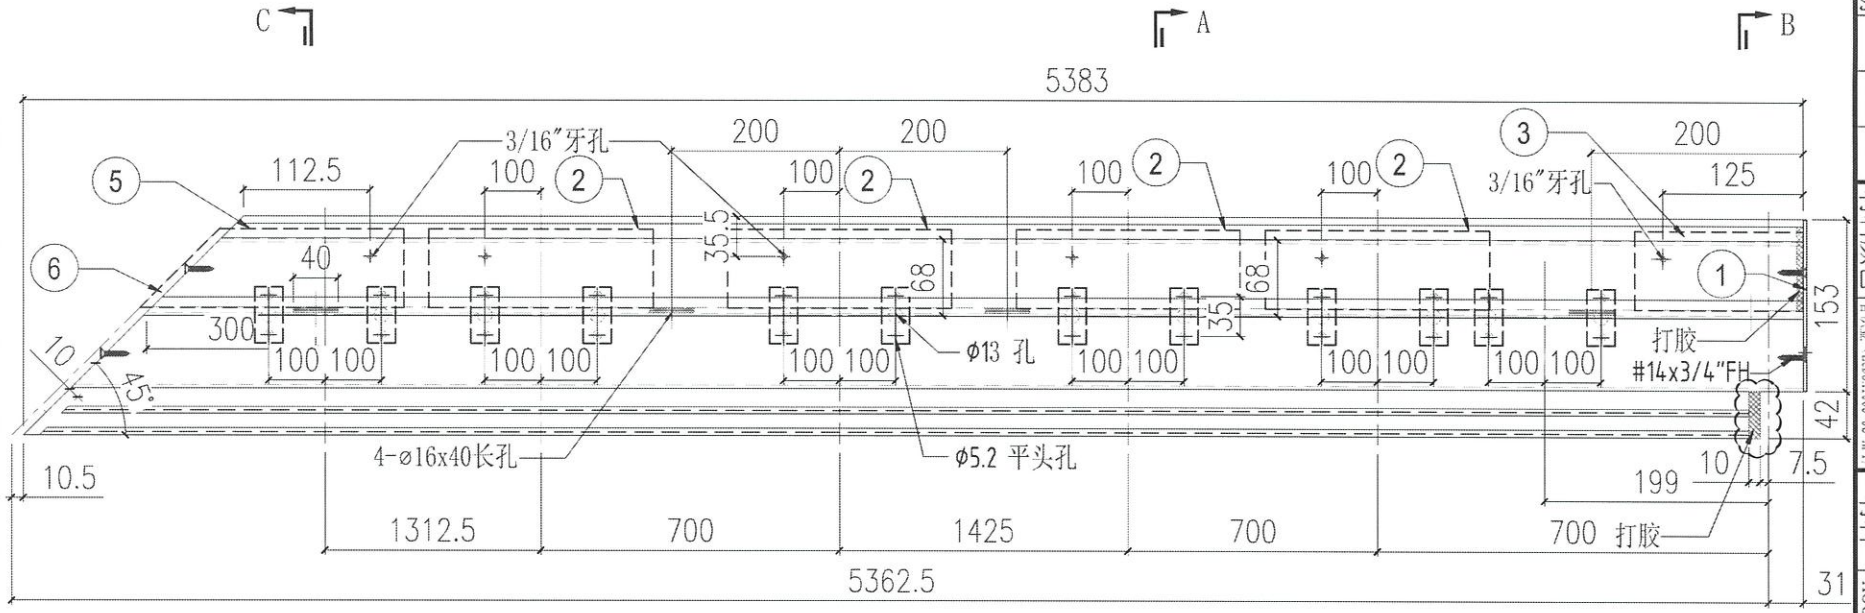


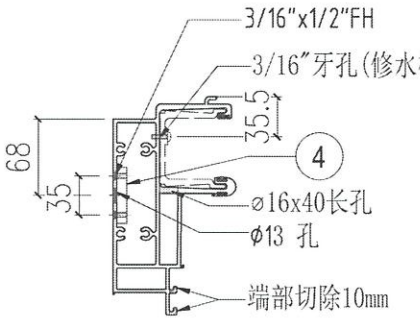


SECTION A-A

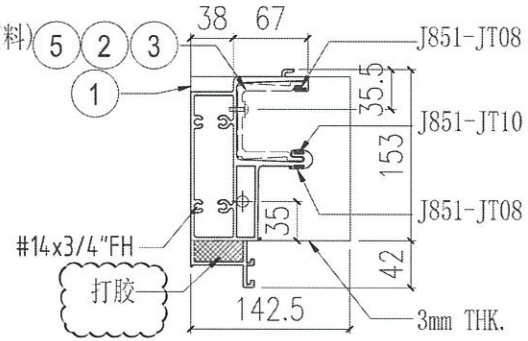


SECTION B-B

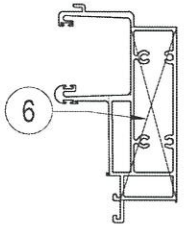

SECTION C-C

FOR :T1B-CW4

FOR :T3B-CW4

| S/N | 部件编号 | L | QTY |
|---|---|---|---|
| 6 | AP-ST02L | - | 1 |
| 5 | X86303-04 | - | 1 |
| 4 | ST-01 | - | 12 |
| 3 | X86303-02 | 150 | 1 |
| 2 | X86303-01 | 300 | 4 |
| 1 | AP-ST01R | - | 1 |

美特鋁質有限公司
MDI Aluminium Fabricator Ltd.

| 修改日期 | - | - | - |
|---|---|---|---|
| 採用工廠 | | | 地盤 ✓ |
| 材料顏色 | 香槟金 (EQSX1009 9S-3F1) | | |
| 材料 | X86279 | 图纸名称 | 铝料加工图 |
| 工程號 | J858 | 類別 | |
| 地盤 | 康城11期 | 制圖 | W.E.X |
| 復核 | - | 物料號 | - |
| 批准 | - | 2022-06-10 | X86279-ST11 |
| 單件重量 | - (KG) | 數量 | 2 |

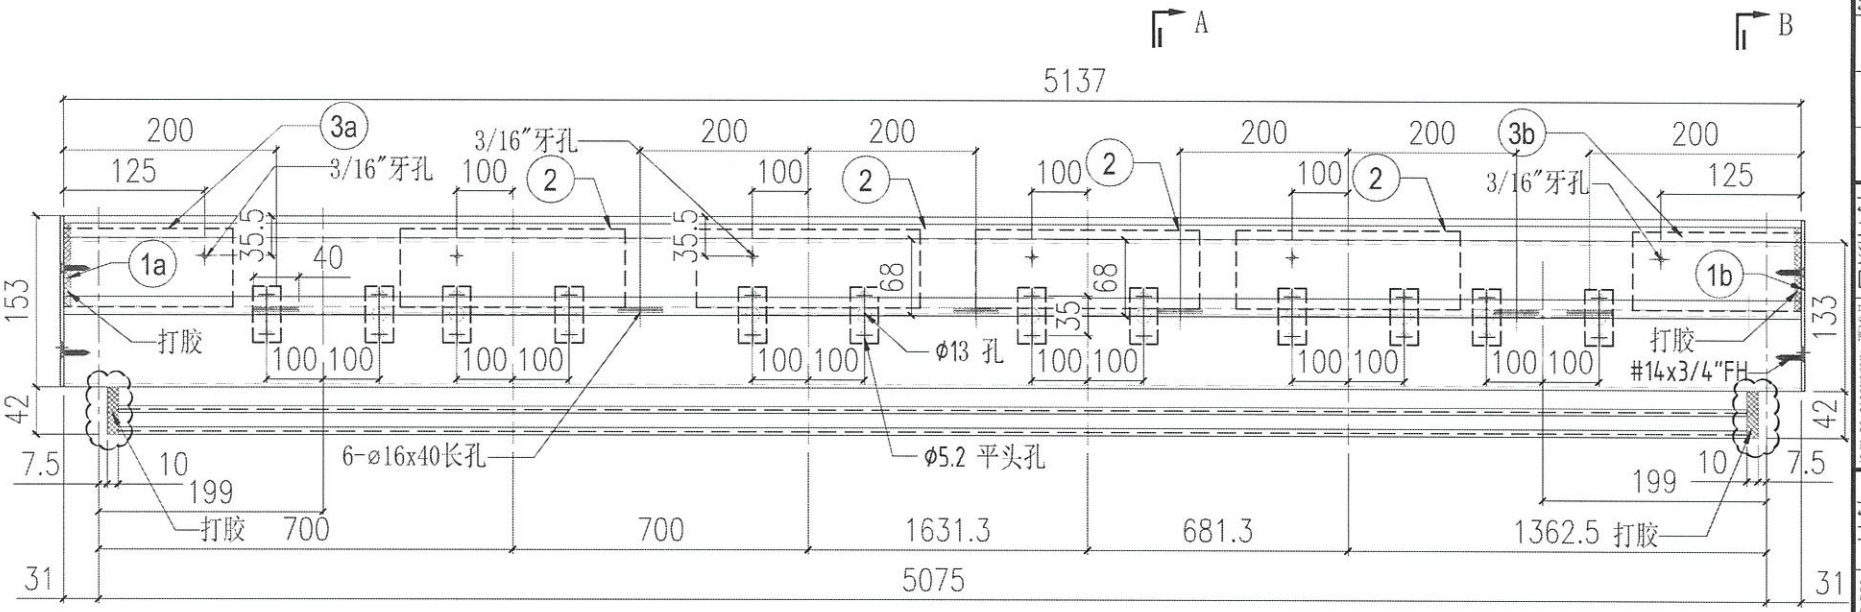


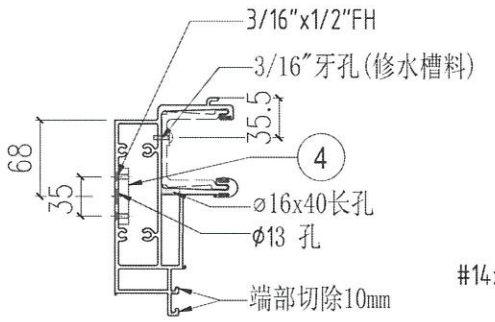


SECTION A-A

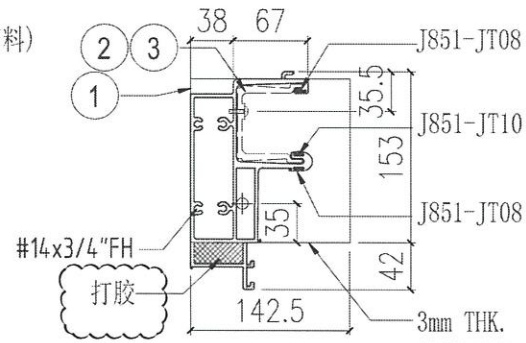


SECTION B-B

FOR :T1A-CW6

| S/N | 部件编号 | L | QTY |
|---|---|---|---|
| 4 | ST-01 | - | 12 |
| 3b | X86303-02 | 150 | 1 |
| 3a | X86303-03 | 150 | 1 |
| 2 | X86303-01 | 300 | 4 |
| 1b | AP-ST01R | - | 1 |
| 1a | AP-ST01L | - | 1 |

| 修改 | | | |
|---|---|---|---|
| 日期 | - | - | - |
| | - | - | - |
| 材料颜色 | 採用 | 工廠 | 地盤 ✓ |

美特鋁質有限公司
MDI Aluminium Fabricator Ltd.

| | |
|---|---|
| 工程號 | J858 |
| 地盤 | 康城11期 |
| 图纸名称 | 铝料加工图 |
| 材料 | X86279 |
| 類別 | |
| 制圖 | W.E.X |
| 復核 | - |
| 批准 | - |
| 物料號 | - |
| 2022-06-10 | |
| 圖號 | X86279-ST12 |
| 數量 | 1 |
| 單件重量 | - (KG) |

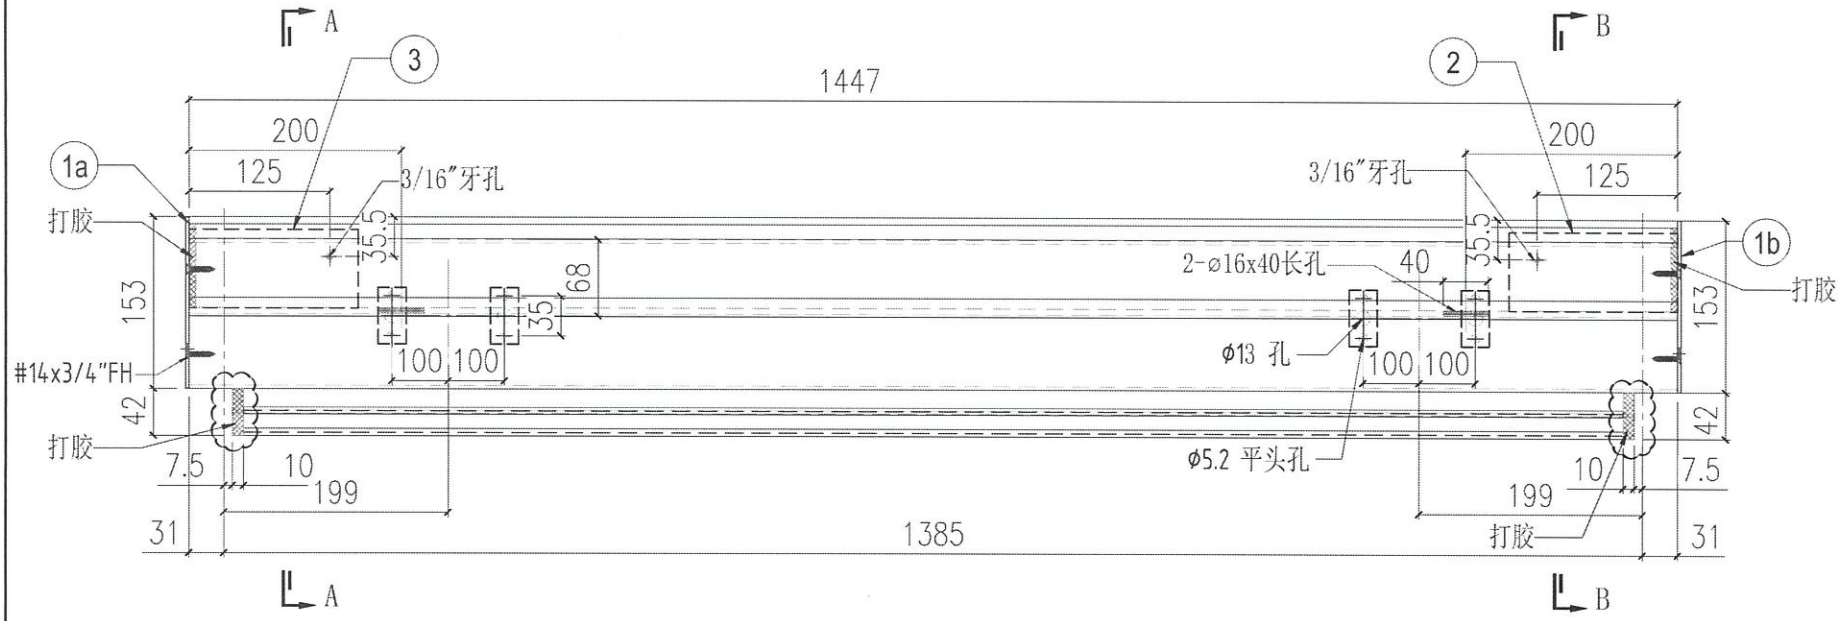


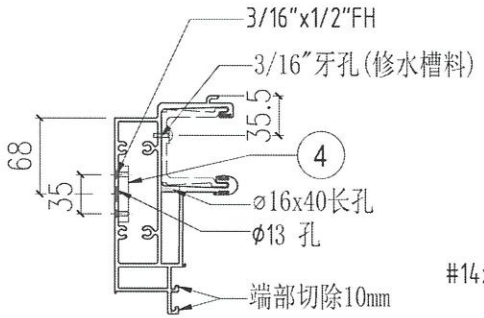


SECTION A-A

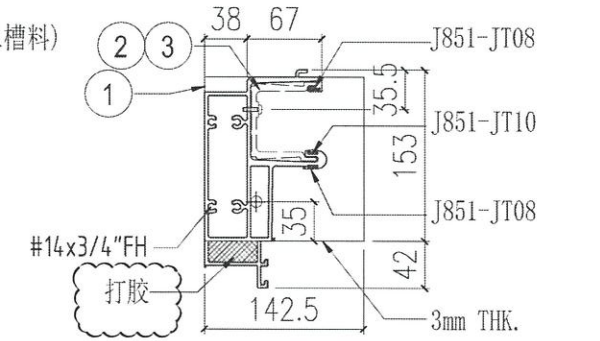


SECTION B-B

FOR :T1A-CW4

| S/N | 部件编号 | L | QTY |
|---|---|---|---|
| 4 | ST-01 | - | 4 |
| 3 | X86303-03 | 150 | 1 |
| 2 | X86303-02 | 150 | 1 |
| 1b | AP-ST01R | - | 1 |
| 1a | AP-ST01L | - | 1 |

美特鋁質有限公司
MDI Aluminium Fabricator Ltd.

| 修改日期 | - | - | - | - |
|---|---|---|---|---|
| 材料/顏色 | 採用工廠 | 地盤 ✓ | | |
| 香槟金 (ECD31009 95-XF1) | | | | |

| 工程號 | J858 | 類別 | | - |
|---|---|---|---|---|
| 地盤 | 康城11期 | 制圖 | W.E.X | 圖號 X86279-ST13 |
| 圖紙名称 | 铝料加工图 | 復核 | - | 數量 1 |
| 材料 | X86279 | 批准 | - | 單件重量 - (KG) |
| | | | | 物料號 2022-06-10 |

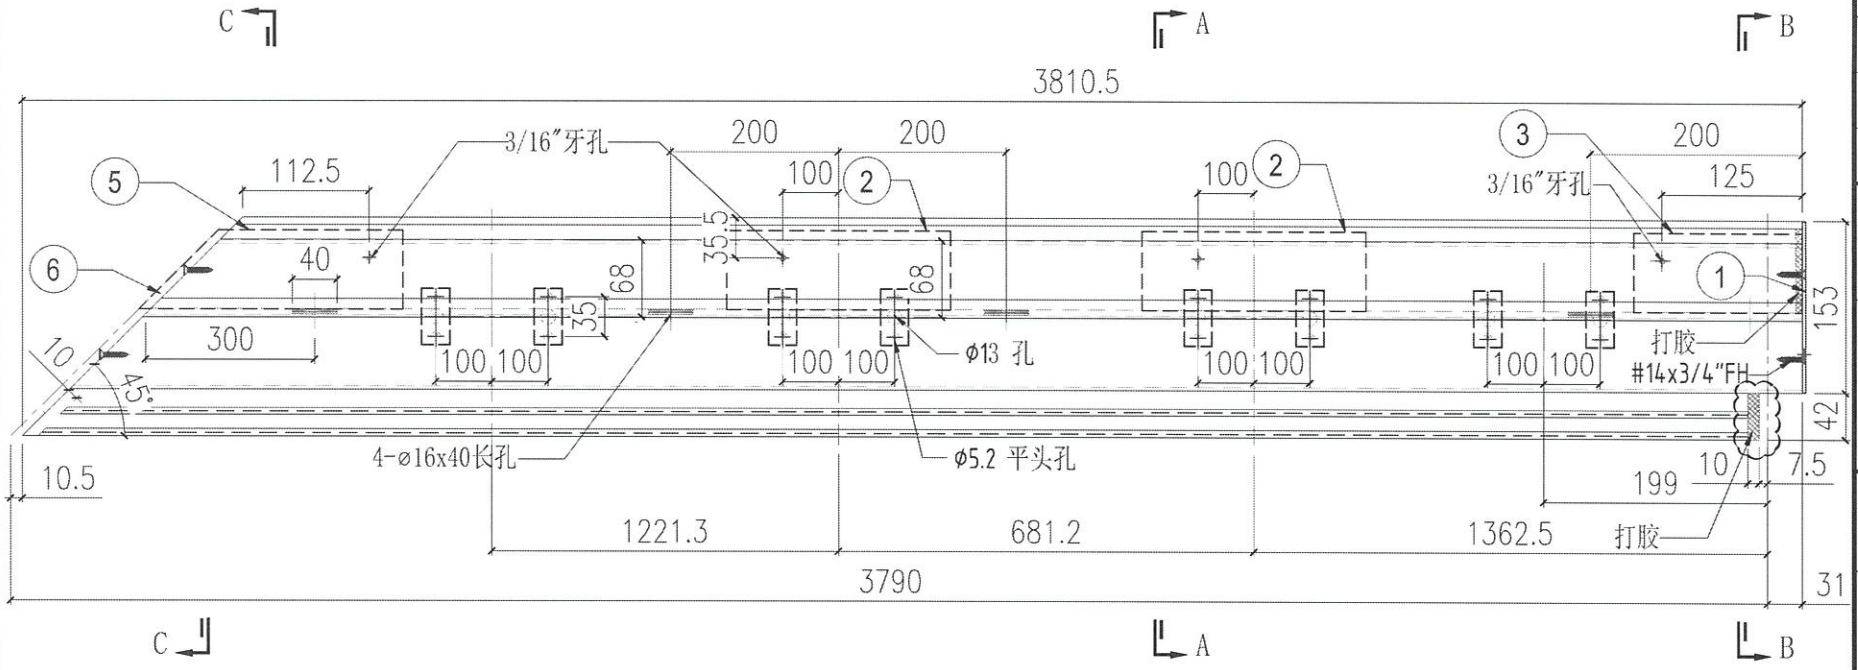


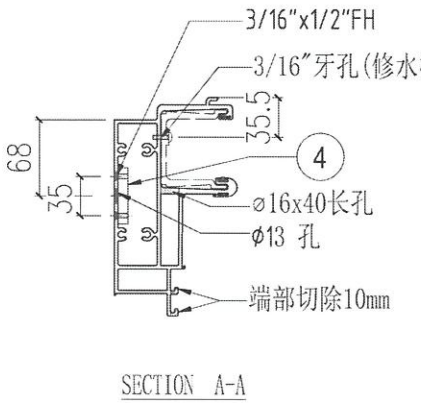


SECTION A-A

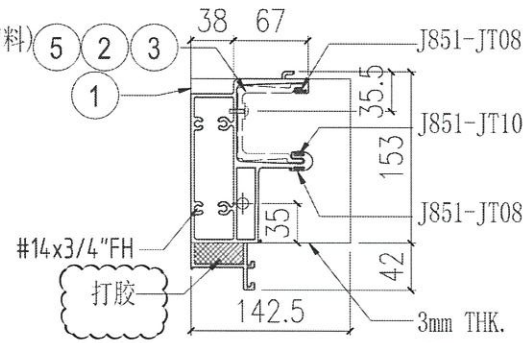


SECTION B-B

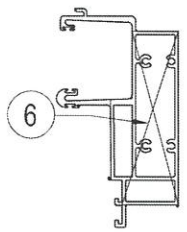

SECTION C-C

FOR :T1B-CW4

| S/N | 部件编号 | L | QTY |
|---|---|---|---|
| 6 | AP-ST02L | - | 1 |
| 5 | X86303-04 | - | 1 |
| 4 | ST-01 | - | 8 |
| 3 | X86303-02 | 150 | 1 |
| 2 | X86303-01 | 300 | 2 |
| 1 | AP-ST01R | - | 1 |

| 修改日期 | | | |
|---|---|---|---|
| - | - | - | - |
| - | - | - | - |
| - | - | - | - |
| 材料/颜色 | 採用 | 工廠 | 地盤 |
| | 香槟金(EC03(1009 95-AF1)) | | ✓ |

美特鋁質有限公司
MDI Aluminium Fabricator Ltd.

| | |
|---|---|
| 工程號 | J858 |
| 图纸名称 | 康城11期 |
| 材料 | 铝料加工图 |
| 制圖 | W.E.X |
| 復核 | - |
| 批准 | - |
| 圖號 | X86279-ST14 |
| 數量 | 1 |
| 單件重量 | - (KG) |
| 地盘 | X86279 |
| 類別 | |
| 物料號 | - |
| | 2022-06-10 |

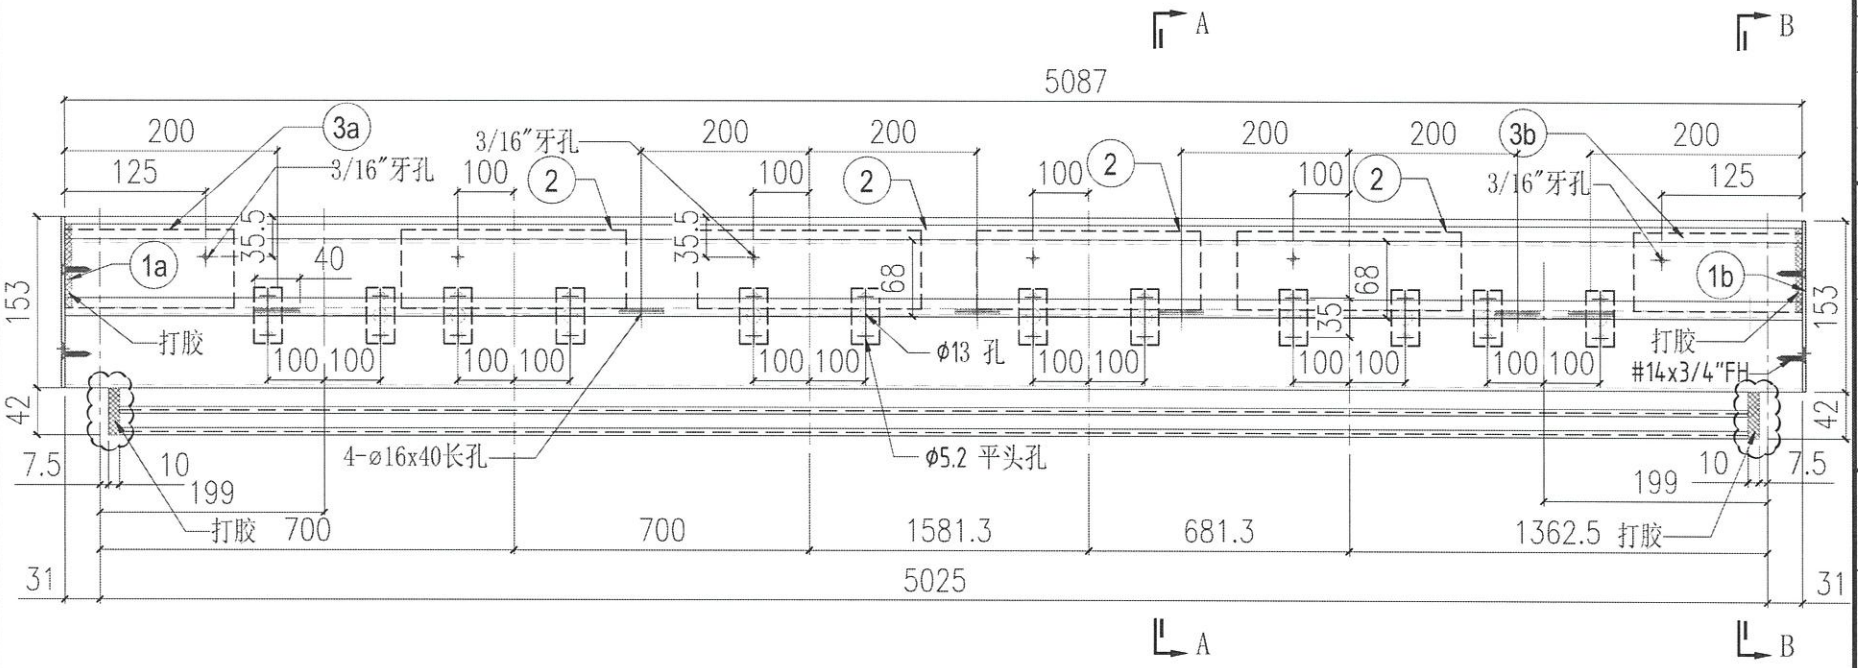


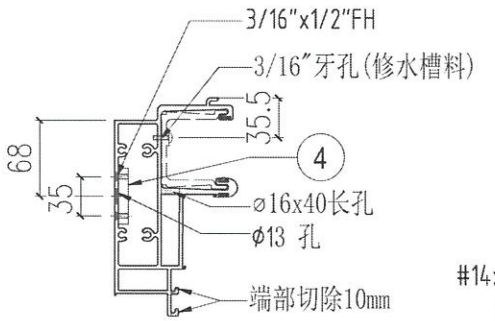


SECTION A-A

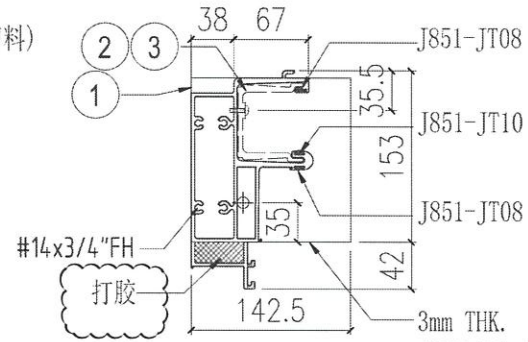


SECTION B-B

FOR :T1A-CW3

| S/N | 部件编号 | L | QTY |
|---|---|---|---|
| 4 | ST-01 | - | 12 |
| 3b | X86303-03 | 150 | 1 |
| 3a | X86303-02 | 150 | 1 |
| 2 | X86303-01 | 300 | 4 |
| 1b | AP-ST01R | - | 1 |
| 1a | AP-ST01L | - | 1 |

| 修改日期 | | | |
|---|---|---|---|
| - | - | - | - |
| - | - | - | - |
| - | - | - | - |

美特鋁質有限公司
MIDI Aluminium Fabricator Ltd.

| 材料/颜色 | 香槟金(EC031109 96-AF1) | 採用 | 工廠 | 地盤 | ✓ |
|---|---|---|---|---|---|

| 工程號 | J858 |
|---|---|
| 图纸名称 | 康城11期 |
| 材料 | 铝料加工图 |
| 地盘 | |
| X86279 | |

| 類別 | |
|---|---|
| 制圖 | W.E.X |
| 復核 | - |
| 批准 | - |

| 物料號 | - |
|---|---|
| 制圖 | 2022-06-10 |
| - | - |
| - | - |

| 圖號 | X86279-ST15 |
|---|---|
| 數量 | 1 |
| 單件重量 | - (KG) |

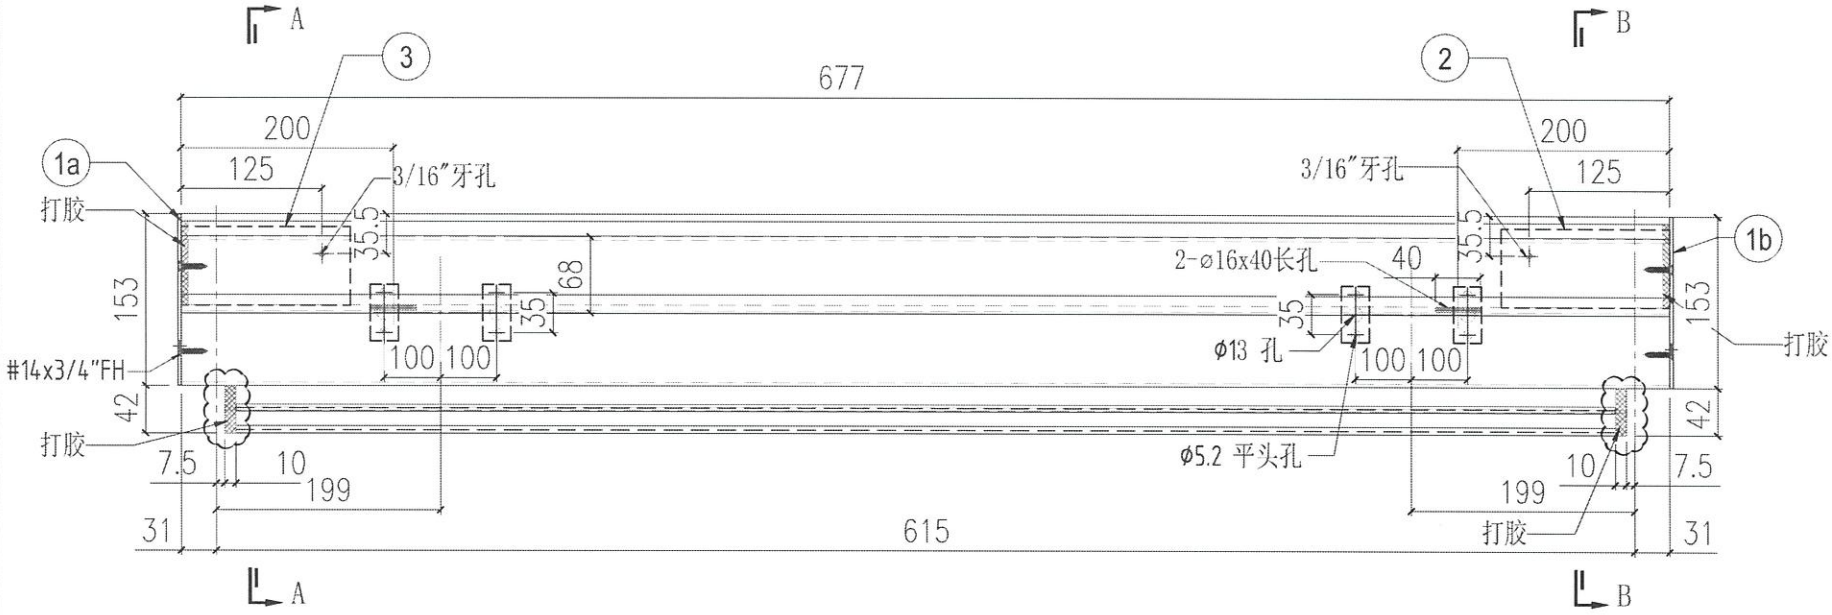


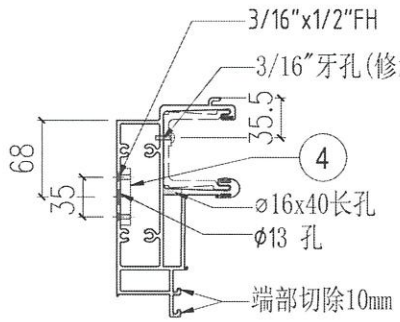


SECTION A-A

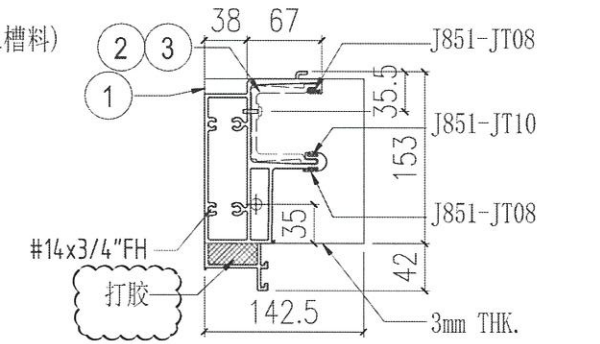


SECTION B-B

FOR :T2A-CW2

FOR :T3A-CW2

| S/N | 部件编号 | L | QTY |
|---|---|---|---|
| 4 | ST-01 | - | 4 |
| 3 | X86303-03 | 150 | 1 |
| 2 | X86303-02 | 150 | 1 |
| 1b | AP-ST01R | - | 1 |
| 1a | AP-ST01L | - | 1 |

| 修改日期 | | | |
|---|---|---|---|
| - | - | - | - |
| - | - | - | - |
| 材料顏色 | 採用 | 工廠 | 地盤 |
| | 看該金 (ECO3X1009 95-XF1) | | ✓ |

美特鋁質有限公司
MDI Aluminium Fabricator Ltd.

| | | | |
|---|---|---|---|
| 工程號 | J858 | 類別 | - |
| 地盤 | 康城11期 | | |
| 圖紙名稱 | 鋁料加工圖 | 制圖 | W.E.X |
| 材料 | X86279 | 復核 | - |
| | | 批准 | - |

| | |
|---|---|
| 物料號 | - |
| 圖號 | X86279-ST16 |
| 數量 | 2 |
| 單件重量 | - (KG) |

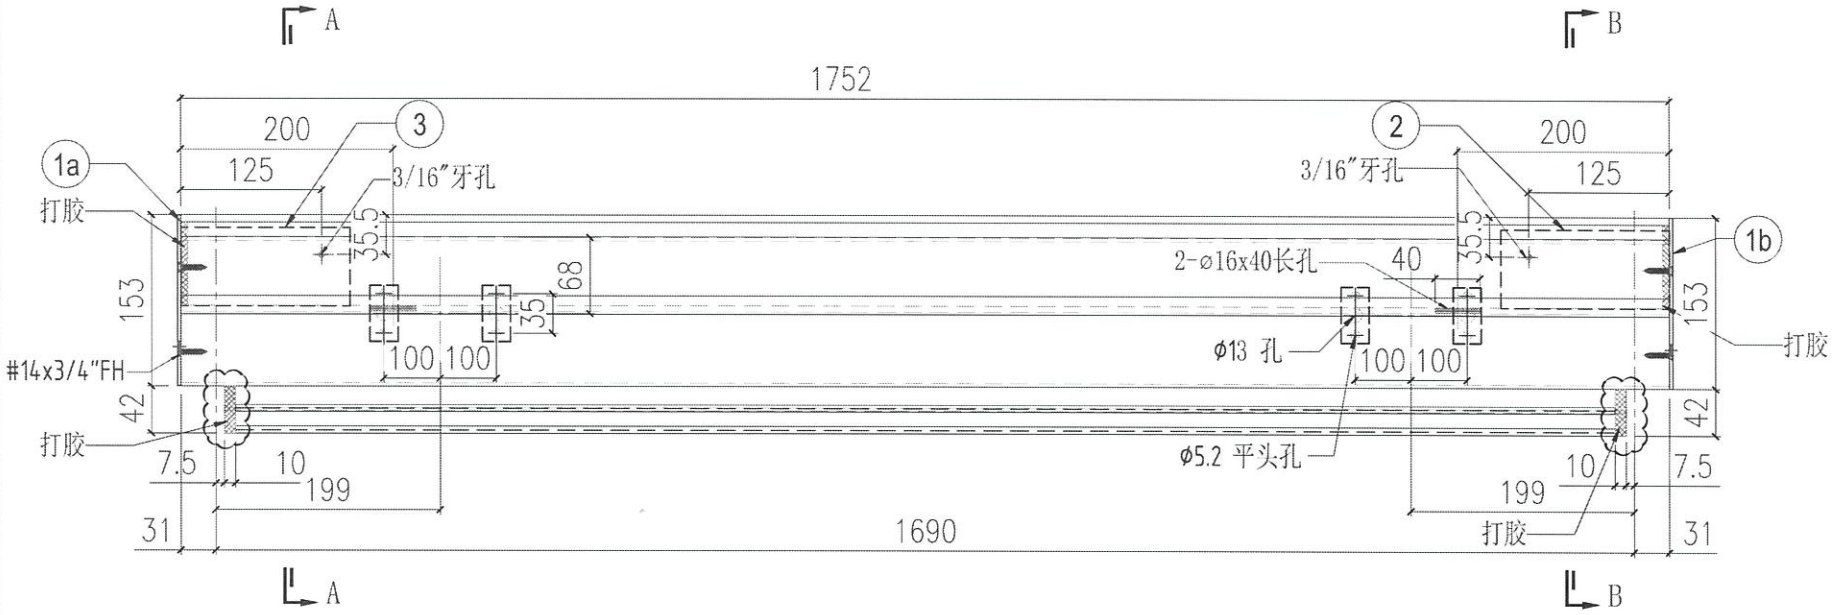


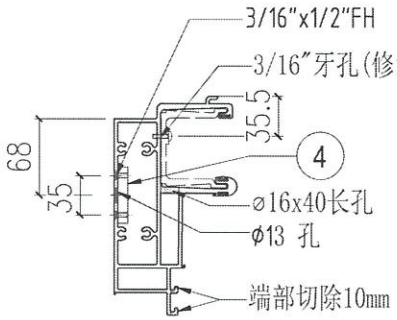


SECTION A-A

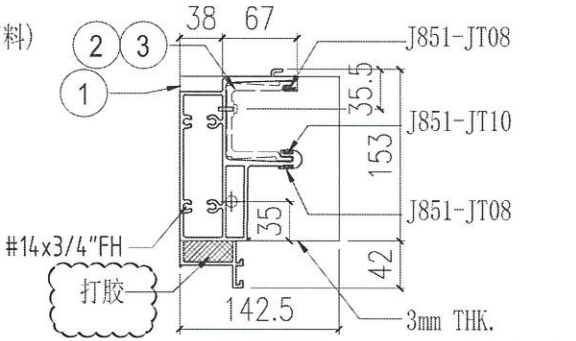


SECTION B-B

FOR :T2A-CW2
FOR :T3A-CW2

| S/N | 部件编号 | L | QTY |
|---|---|---|---|
| 4 | ST-01 | - | 4 |
| 3 | X86303-03 | 150 | 1 |
| 2 | X86303-02 | 150 | 1 |
| 1b | AP-ST01R | - | 1 |
| 1a | AP-ST01L | - | 1 |

| 修改日期 | | | |
|---|---|---|---|
| - | - | - | - |
| - | - | - | - |
| - | - | - | - |

| 材料/颜色 | 采用 | 工厂 | 地盤 |
|---|---|---|---|
| | 香槟金(EC03/1009 95-AF1) | | ✓ |

美特鋁質有限公司
MDI Aluminium Fabricator Ltd.

| 工程號 | J858 | 類別 | | - |
|---|---|---|---|---|
| 地盤 | 康城11期 | 制圖 | W.E.X | 物料號 |
| 图纸名称 | 铝料加工图 | 復核 | - | 2022-06-10 |
| 材料 | X86279 | 批准 | - | - |
| | | | | 圖號 X86279-ST17 |
| | | | | 數量 2 |
| | | | | 單件重量 - (KG) |

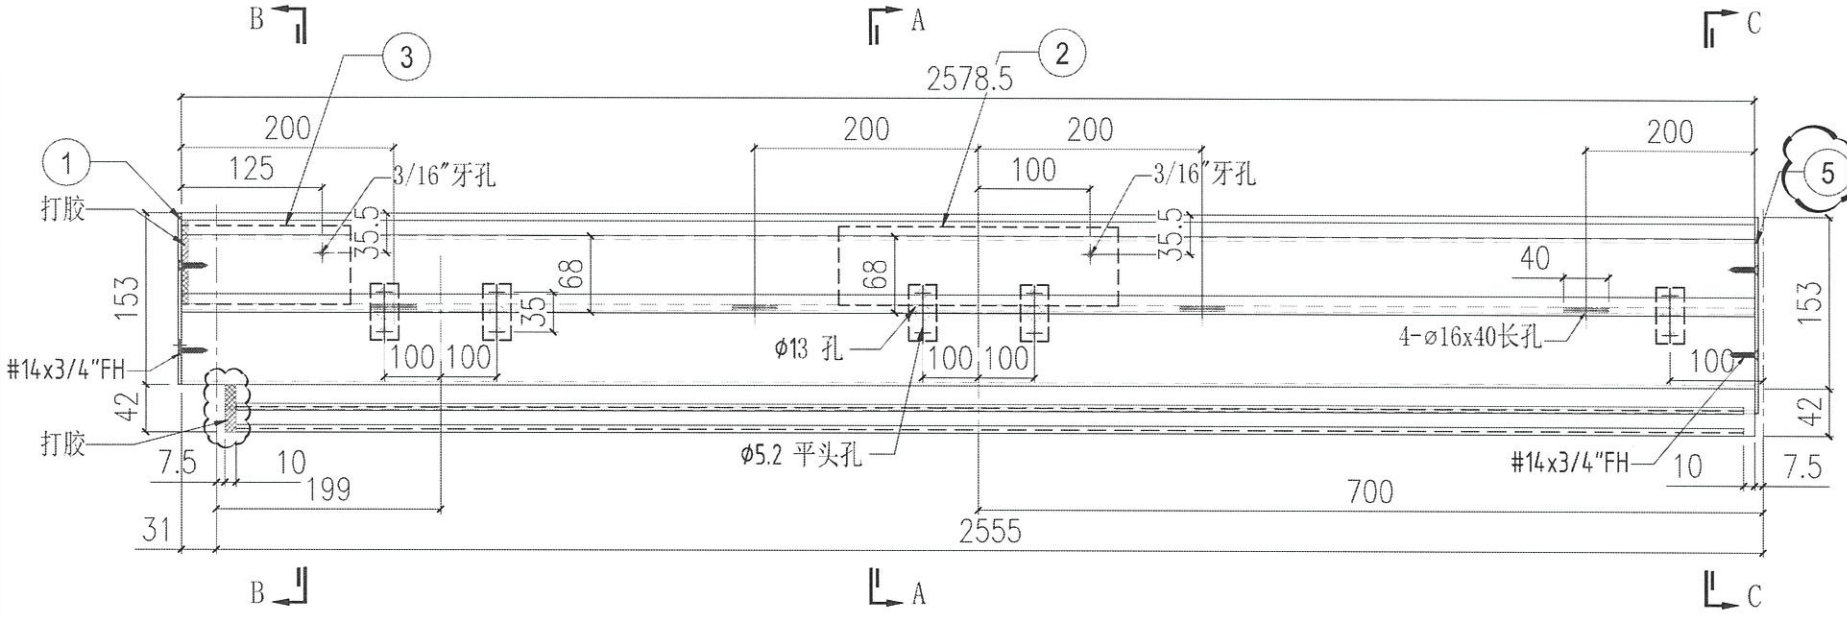


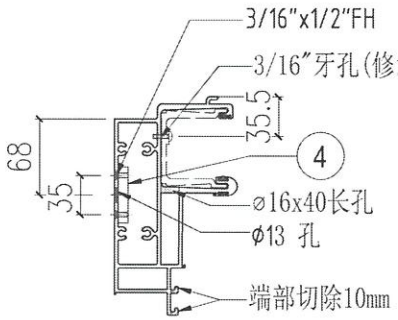


SECTION A-A

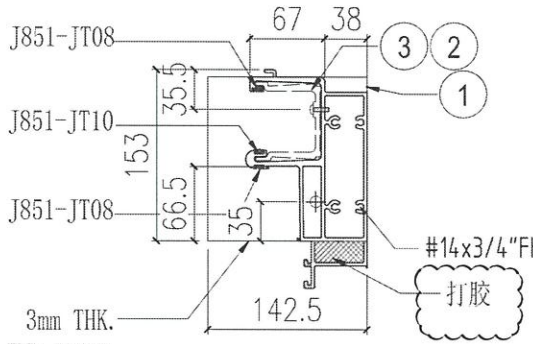


SECTION B-B

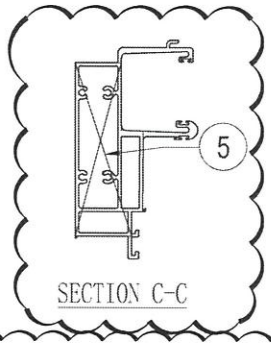


SECTION C-C

FOR :T2A-CW2

FOR :T3A-CW2

| S/N | 部件编号 | L | QTY |
|---|---|---|---|
| 5 | AP-ST03R | - | 1 |
| 4 | ST-01 | - | 5 |
| 3 | X86303-03 | 150 | 1 |
| 2 | X86303-01 | 300 | 1 |
| 1 | AP-ST01L | - | 1 |

| 修改 | | | |
|---|---|---|---|
| 日期 | - | - | - |
| 材料/顏色 | 採用 | 工廠 | 地盤 |
| | 香槟金 (EC03/109 98-3EP1) | | ✓ |

美特鋁質有限公司
MDI Aluminium Fabricator Ltd.

| | |
|---|---|
| 工程號 | J858 |
| 圖紙名称 | 康城11期 |
| 材料 | 铝料加工图 |
| 制圖 | W. E. X |
| 復核 | - |
| 批准 | - |
| 物料號 | 2022-06-10 |
| 圖號 | X86279-ST18 |
| 數量 | 2 |
| 單件重量 | - (KG) |
| 類別 | - |
| 地盤 | |
| 图纸名称 | X86279 |

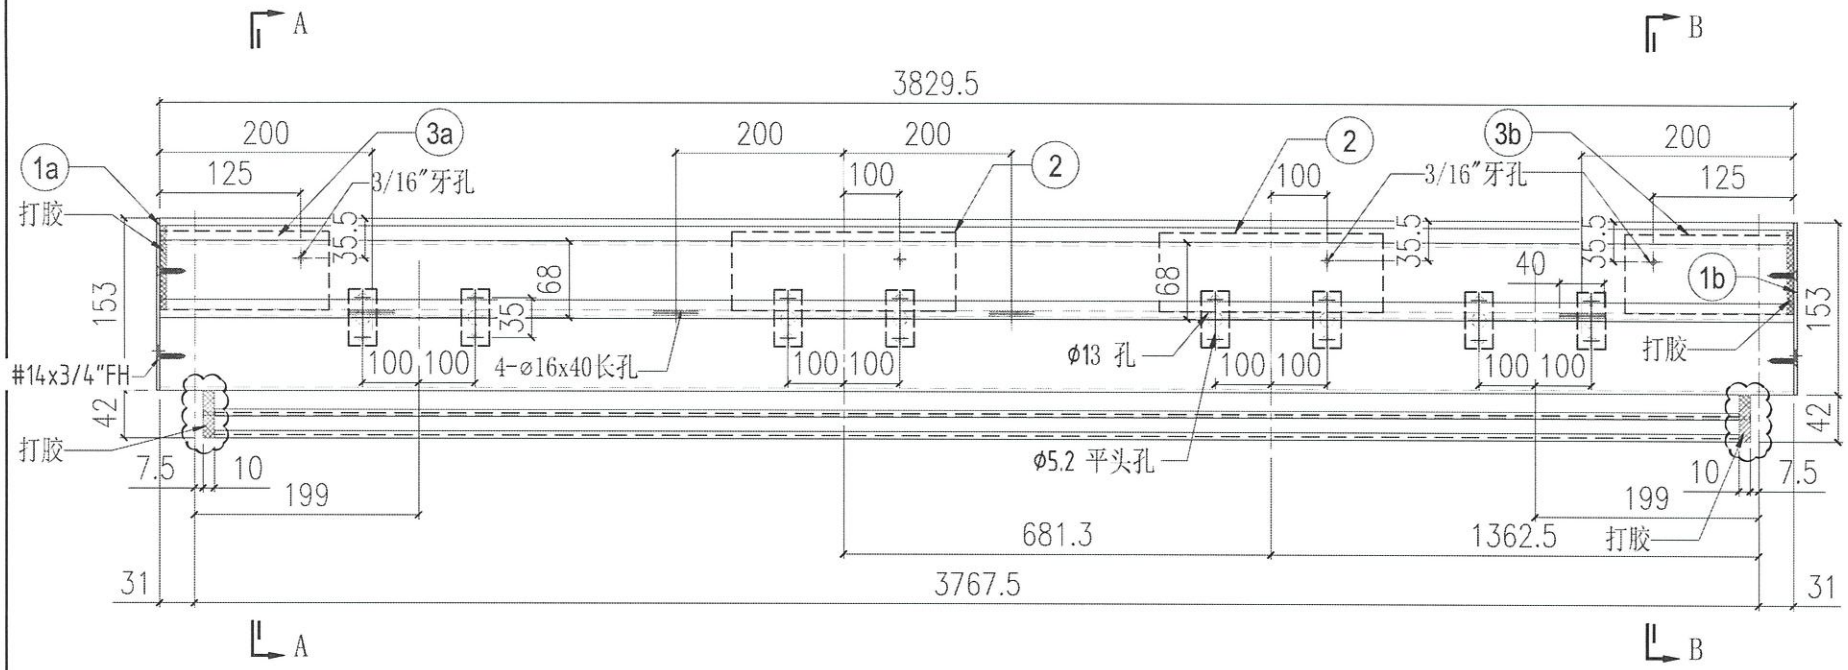


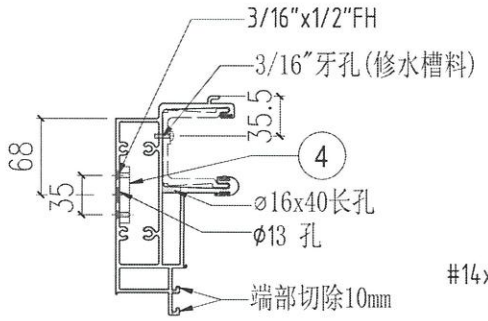


SECTION A-A

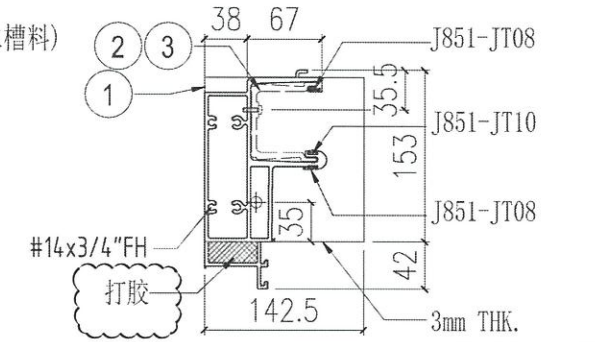


SECTION B-B

FOR :T2B-CW1
FOR :T3B-CW1

| S/N | 部件编号 | L | QTY |
|---|---|---|---|
| 4 | ST-01 | - | 9 |
| 3b | X86303-02 | 150 | 1 |
| 3a | X86303-03 | 150 | 1 |
| 2 | X86303-01 | 300 | 2 |
| 1b | AP-ST01R | - | 1 |
| 1a | AP-ST01L | - | 1 |

| 修改日期 | - | - | - |
|---|---|---|---|
| 材料/颜色 | 採用 | 工廠 | 地盤 |
| | 系統金 (EQ031009 9S-3EP) | | ✓ |
| 材料 | 图纸名称 | 地盘 | 工程號 |
| X86279 | 铝料加工图 | 康城11期 | J858 |
| | 制圖 | W.E.X | 2022-06-10 |
| | 復核 | - | - |
| | 批准 | - | - |
| | | | 類別 |
| | | | 物料號 |
| | | | 圖號 |
| | | | 數量 |
| | | | 單件重量 |
| | | | - |
| | | | X86279-ST19 |
| | | | 2 |
| | | | (KG) |

美特鋁質有限公司
MDI Aluminium Fabricator Ltd.

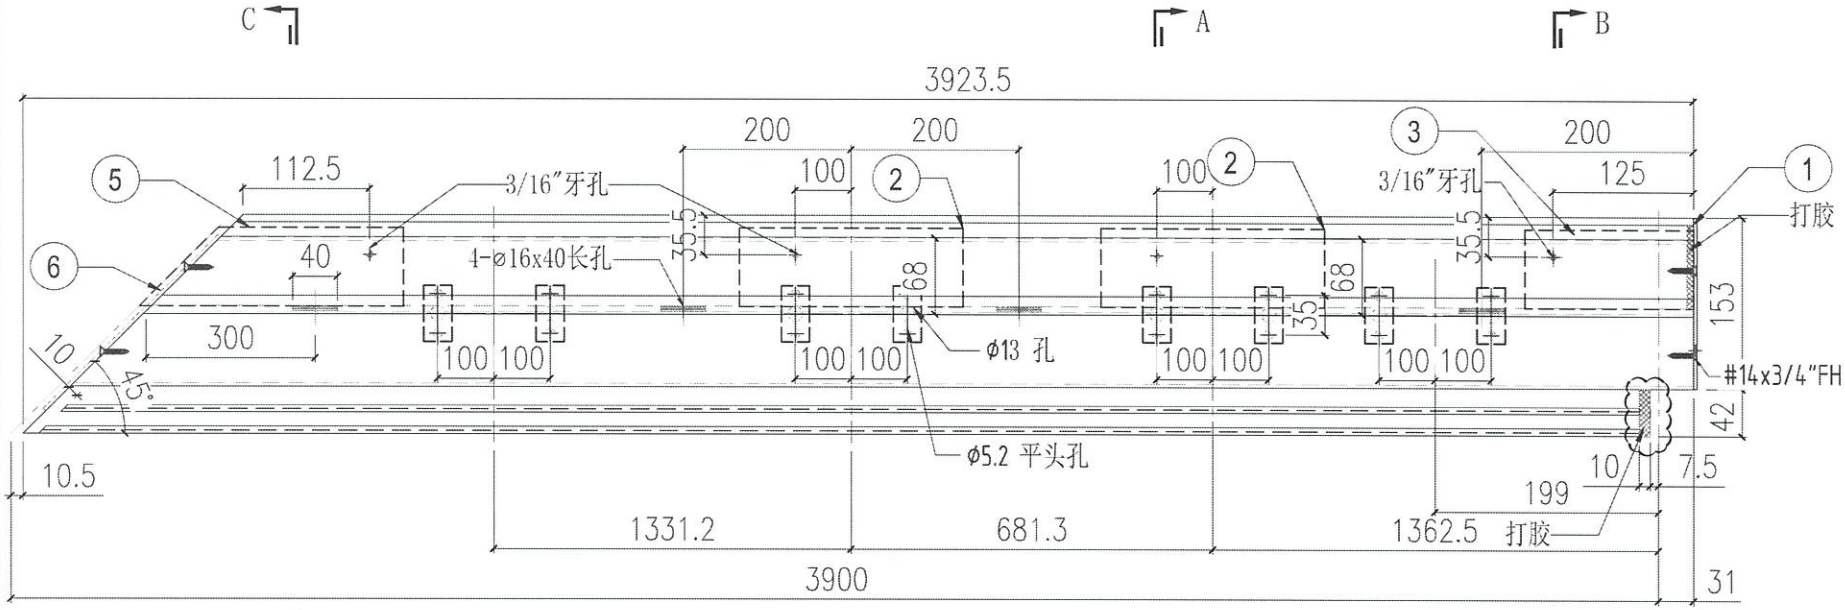


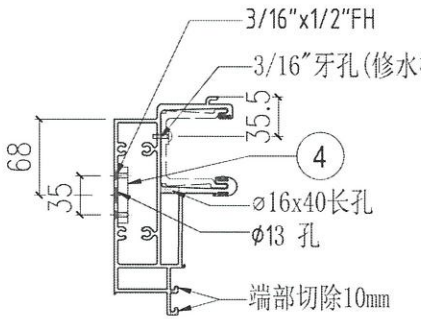


SECTION A-A

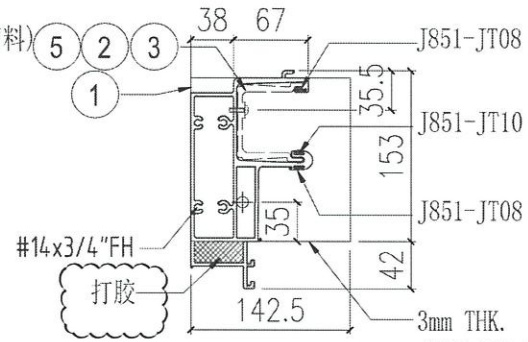


SECTION B-B

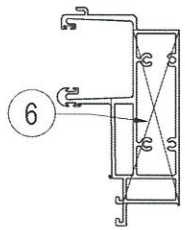

SECTION C-C

| S/N | 部件编号 | L | QTY |
|---|---|---|---|
| 6 | AP-ST02L | - | 1 |
| 5 | X86303-04 | - | 1 |
| 4 | ST-01 | - | 8 |
| 3 | X86303-02 | 150 | 1 |
| 2 | X86303-01 | 300 | 2 |
| 1 | AP-ST01R | - | 1 |

FOR :T2B-CW4

| 修改日期 | | | |
|---|---|---|---|
| - | - | - | - |
| - | - | - | - |
| 材料/顏色 | 採用 | 工廠 | 地盤 |
| 香槟金 (EQ03\1009 9S-AF1) | | | ✓ |

美特鋁質有限公司
MDI Aluminium Fabricator Ltd.

| | |
|---|---|
| 工程號 | J858 |
| 圖紙名称 | 康城1期 |
| 材料 | 铝料加工图 |
| 類別 | |
| 制圖 | W.E.X |
| 復核 | - |
| 批准 | - |
| 物料號 | - |
| 圖號 | X86279-ST20 |
| 數量 | 1 |
| 單件重量 | - (KG) |

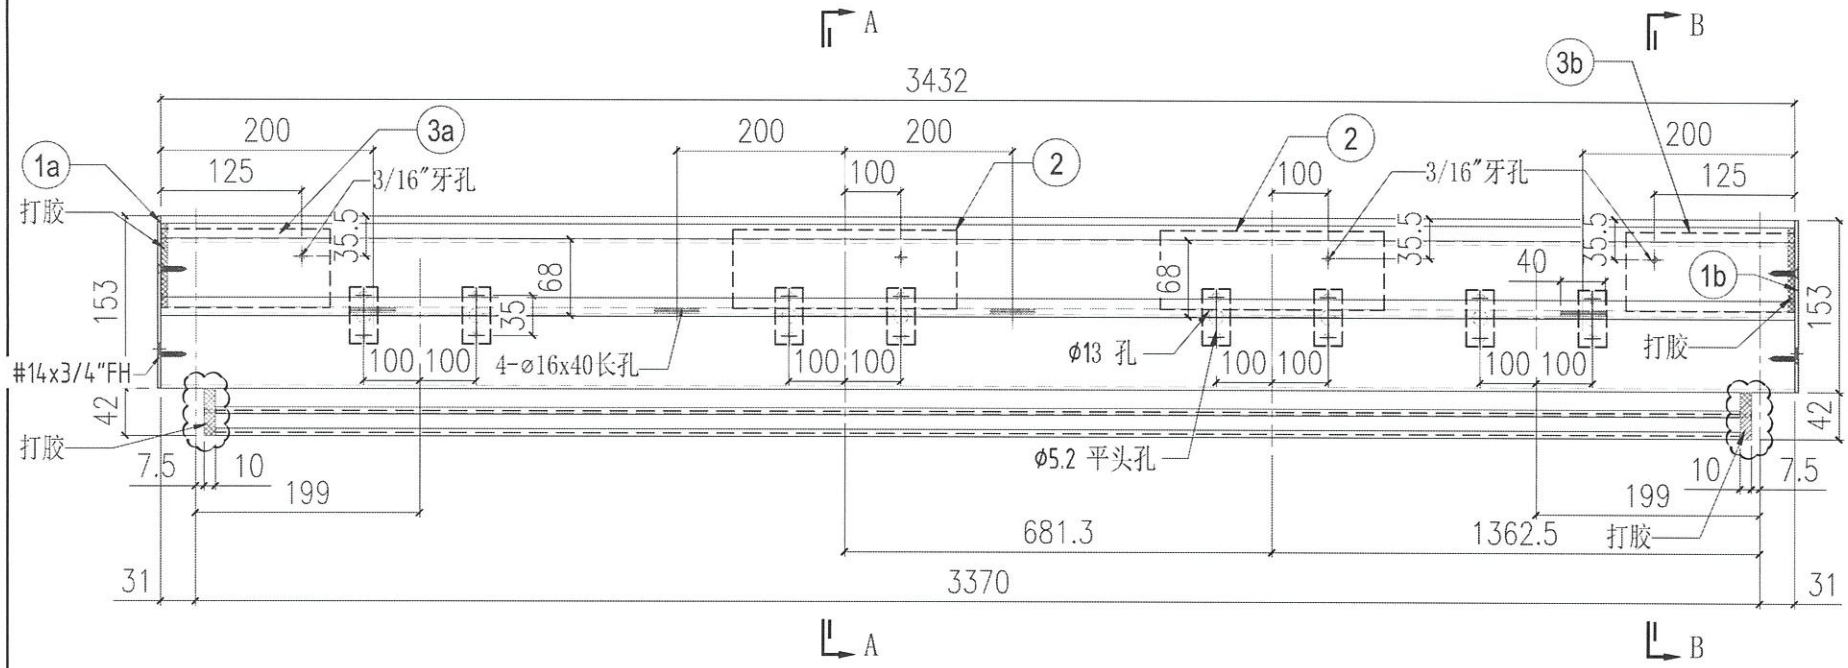


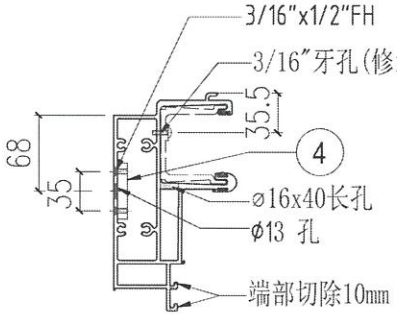


SECTION A-A

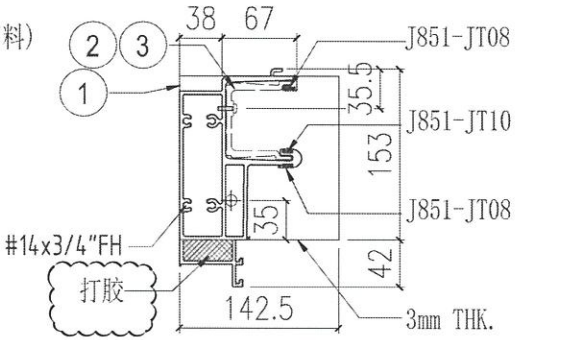


SECTION B-B

FOR :T2B-CW5

FOR :T3B-CW5

| S/N | 部件编号 | L | QTY |
|---|---|---|---|
| 4 | ST-01 | - | 9 |
| 3b | X86303-02 | 150 | 1 |
| 3a | X86303-03 | 150 | 1 |
| 2 | X86303-01 | 300 | 2 |
| 1b | AP-ST01R | - | 1 |
| 1a | AP-ST01L | - | 1 |

| 修改 | | | |
|---|---|---|---|
| 日期 | - | - | - |
| | - | - | - |
| 材料/顏色 | 採用 | 工廠 | |
| | 香槟金 (EC031009 95-AF1) | 地盤 | ✓ |

美特鋁質有限公司
MDI Aluminium Fabricator Ltd.

| | | | |
|---|---|---|---|
| 工程號 | J858 | | |
| 地盤 | 康城11期 | 類別 | |
| 圖紙名称 | 铝料加工图 | 制圖 | W.E.X |
| 材料 | X86279 | 復核 | - |
| | | 批准 | - |
| | | 物料號 | - |
| | | 圖號 | X86279-ST21 |
| | | 數量 | 2 |
| | | 單件重量 | - (KG) |

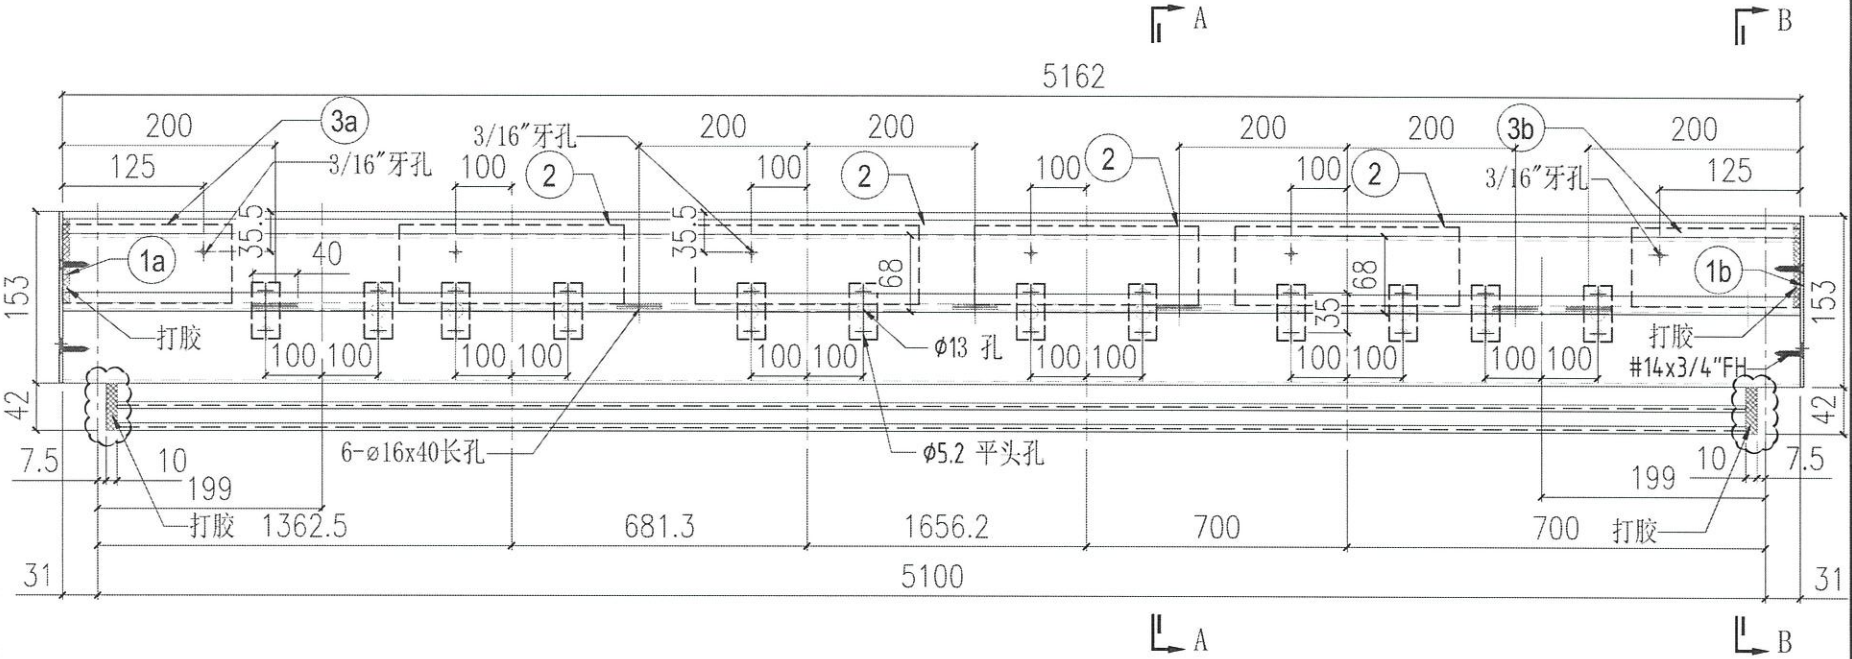


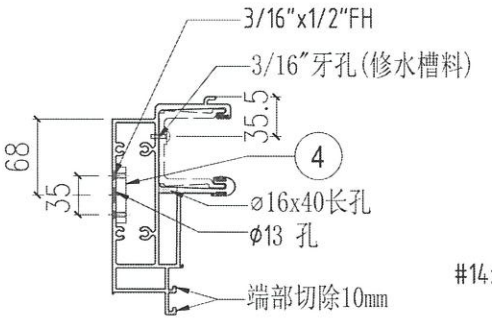


SECTION A-A

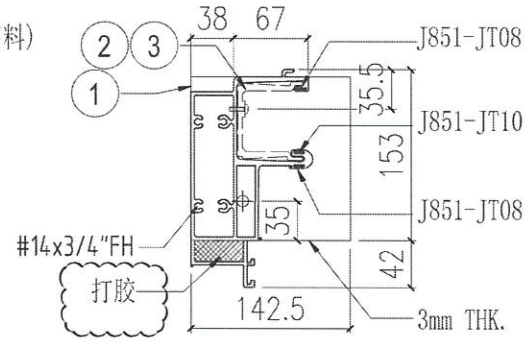


SECTION B-B

FOR :T2B-CW6

FOR :T3B-CW6

| S/N | 部件编号 | L | QTY |
|---|---|---|---|
| 4 | ST-01 | - | 12 |
| 3b | X86303-02 | 150 | 1 |
| 3a | X86303-03 | 150 | 1 |
| 2 | X86303-01 | 300 | 4 |
| 1b | AP-ST01R | - | 1 |
| 1a | AP-ST01L | - | 1 |

| 修改日期 | | | |
|---|---|---|---|
| - | - | - | - |
| - | - | - | - |
| 材料/颜色 | 採用 | 工廠 | 地盤 |
| | 系統金 (EQ03\1009 96-3FP) | | ✓ |

美特鋁質有限公司
MDI Aluminium Fabricator Ltd.

| | |
|---|---|
| 工程號 | J858 |
| 圖紙名称 | 康城11期 |
| 材料 | 铝料加工图 |
| 類別 | |
| 制圖 | W. E. X |
| 復核 | - |
| 批准 | - |
| 物料號 | - |
| 圖號 | X86279-ST22 |
| 數量 | 2 |
| 單件重量 | - (KG) |
| 地盤 | X86279 |

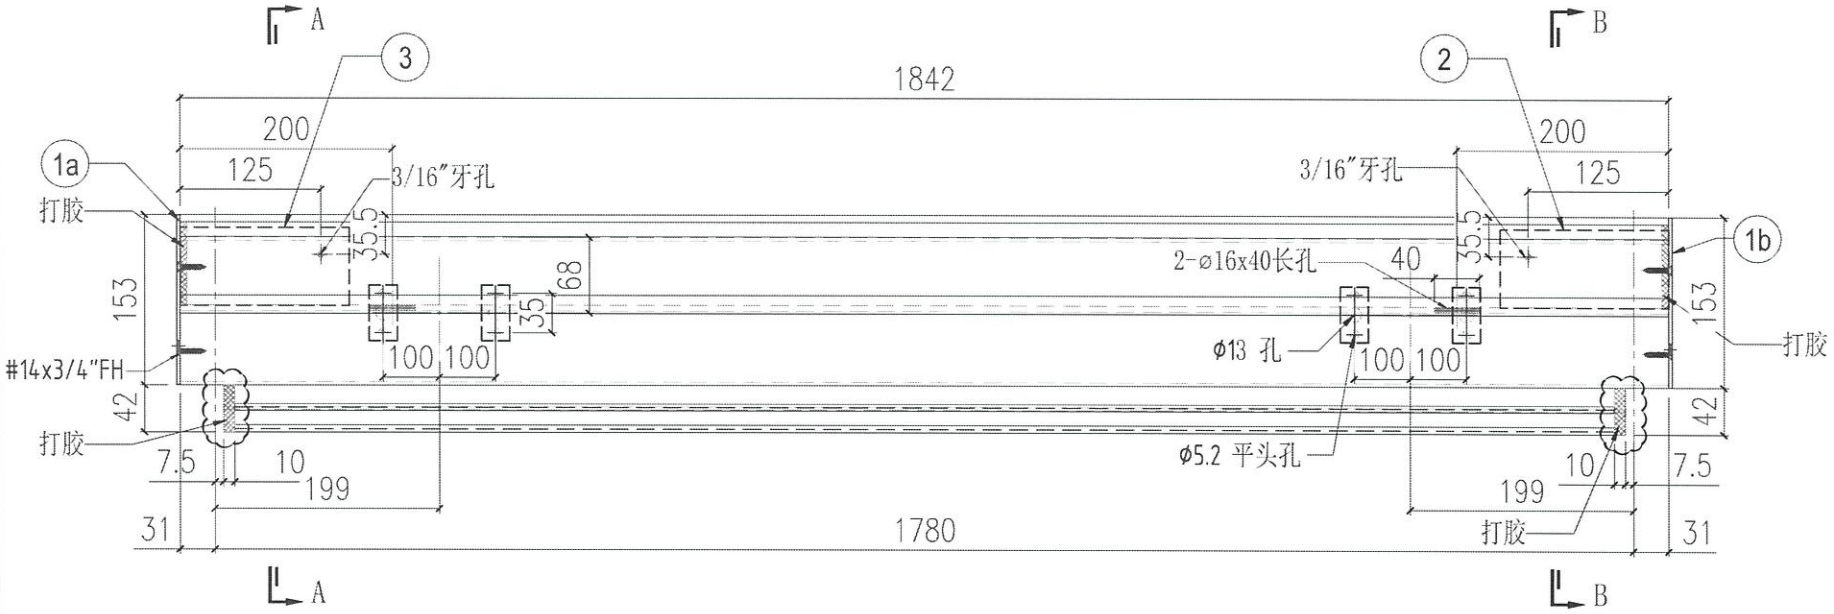


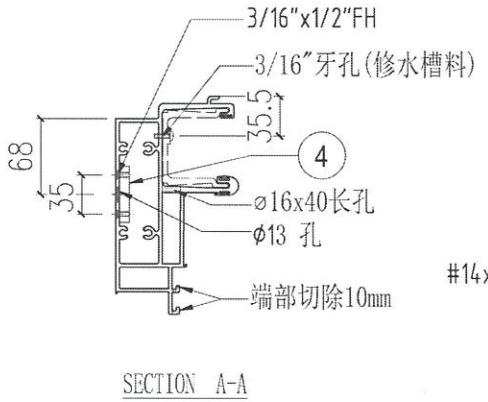


SECTION A-A

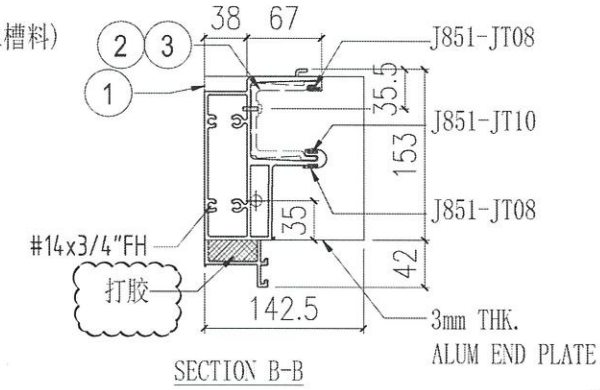


SECTION B-B

FOR :T2A-CW4

| S/N | 部件编号 | L | QTY |
|---|---|---|---|
| 4 | ST-01 | - | 4 |
| 3 | X86303-03 | 150 | 1 |
| 2 | X86303-02 | 150 | 1 |
| 1b | AP-ST01R | - | 1 |
| 1a | AP-ST01L | - | 1 |

| 修改 | | | |
|---|---|---|---|
| 日期 | - | - | - |
| | - | - | - |
| | - | - | - |
| 材料顏色 | 採用 | 工廠 | 地盤 |
| | 香槟金 (EQ031009 98-SP1) | | ✓ |

美特鋁質有限公司
MDI Aluminium Fabricator Ltd.

| | | | |
|---|---|---|---|
| 工程號 | J858 | 類別 | |
| 圖紙名称 | 康城11期 | 制圖 | W. E. X |
| 材料 | 铝料加工图 | 復核 | - |
| | X86279 | 批准 | - |
| 物料號 | - | | |
| 圖號 | X86279-ST23 | | |
| 數量 | 1 | | |
| 單件重量 | - (KG) | | |

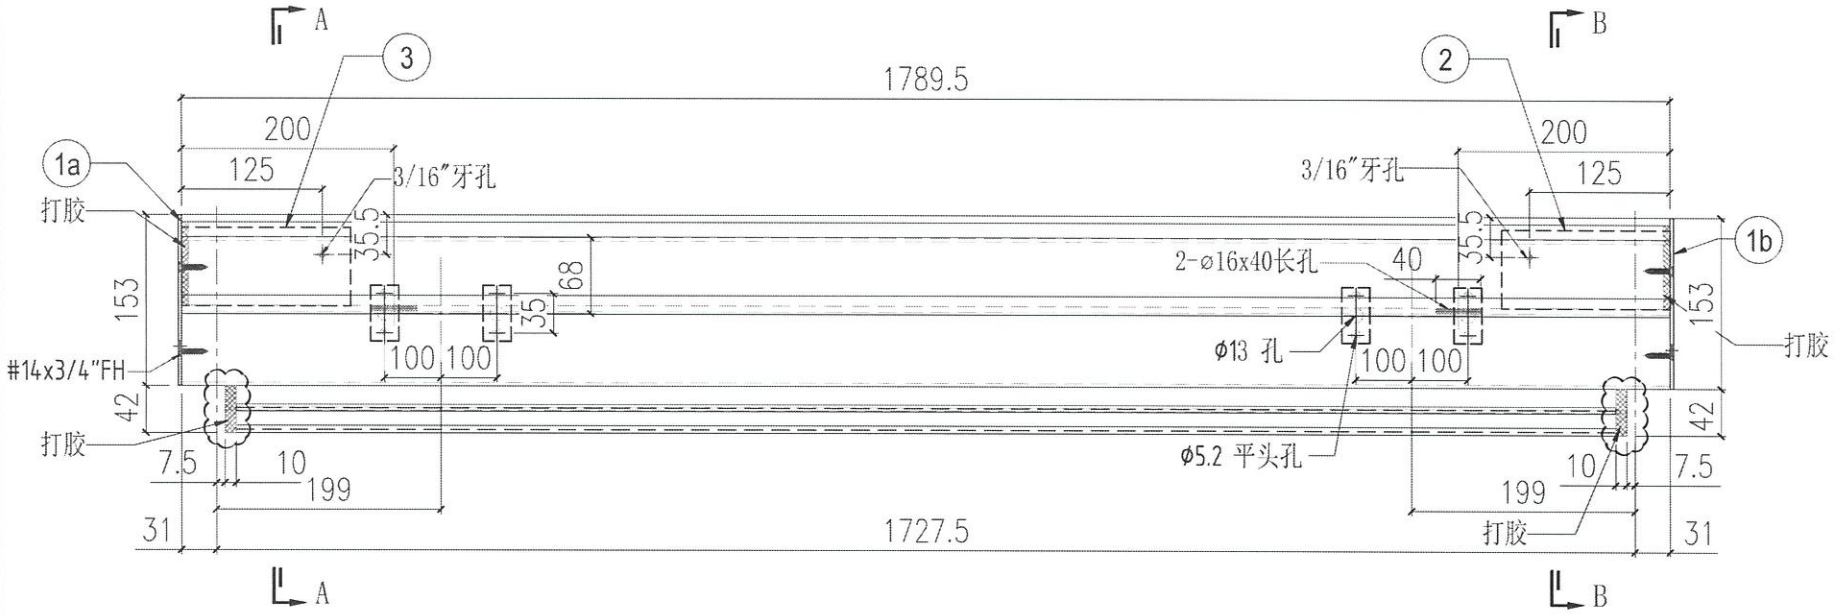


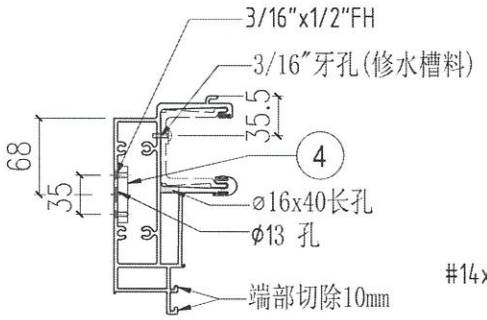


SECTION A-A

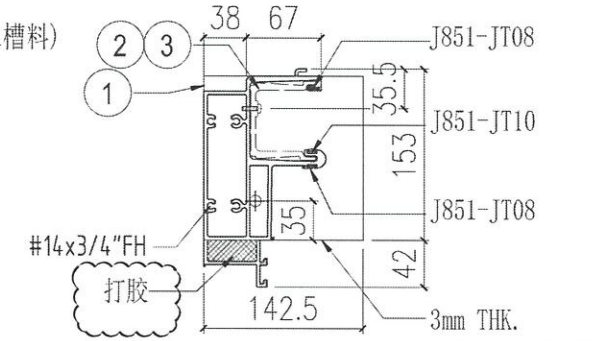


SECTION B-B

FOR :T2A-CW4

| S/N | 部件编号 | L | QTY |
|---|---|---|---|
| 4 | ST-01 | - | 4 |
| 3 | X86303-03 | 150 | 1 |
| 2 | X86303-02 | 150 | 1 |
| 1b | AP-ST01R | - | 1 |
| 1a | AP-ST01L | - | 1 |

| 修改日期 | | | |
|---|---|---|---|
| - | - | - | - |
| - | - | - | - |
| 材料颜色 | 采用 | 工廠 | 地盤 |
| | 香槟金(EC031009 95-A21) | | ✓ |

美特鋁質有限公司
MDI Aluminium Fabricator Ltd.

| | |
|---|---|
| 工程號 | J858 |
| 图纸名称 | 康城11期 |
| 材料 | 铝料加工图 |
| 制圖 | W.E.X |
| 復核 | - |
| 批准 | - |
| 物料號 | 2022-06-10 |
| 圖號 | X86279-ST24 |
| 數量 | 1 |
| 單件重量 | - (KG) |
| 地盤 | X86279 |
| 類別 | - |

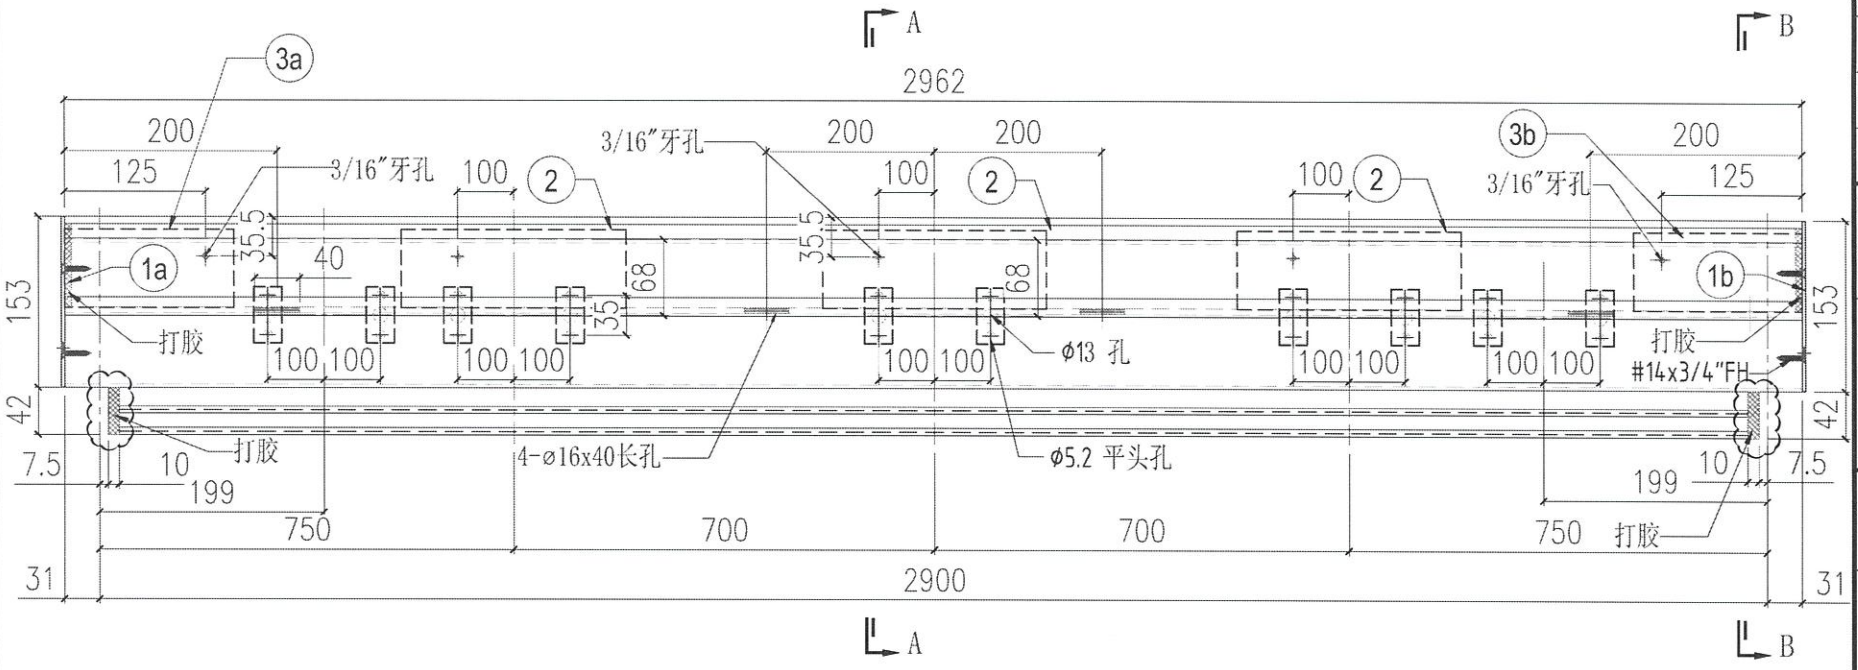


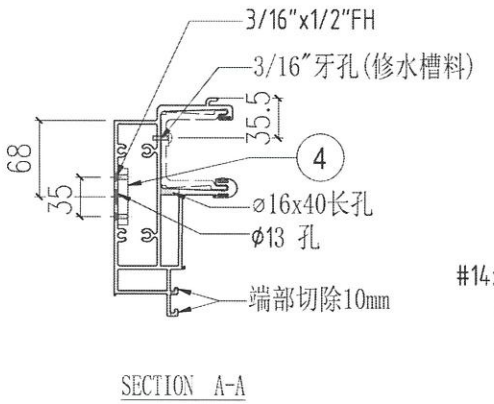


SECTION A-A

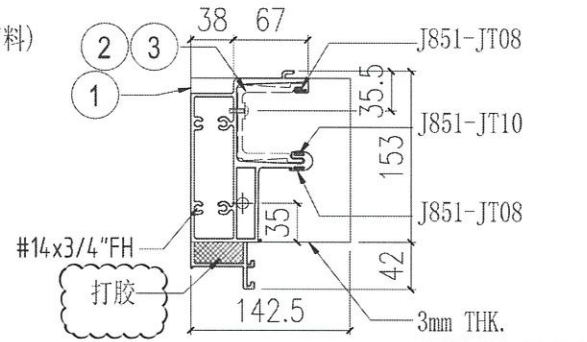


SECTION B-B

FOR :T2A-CW3

FOR :T3A-CW3

| S/N | 部件编号 | L | QTY |
|---|---|---|---|
| 4 | ST-01 | - | 10 |
| 3b | X86303-02 | 150 | 1 |
| 3a | X86303-03 | 150 | 1 |
| 2 | X86303-01 | 300 | 3 |
| 1b | AP-ST01R | - | 1 |
| 1a | AP-ST01L | - | 1 |

| 修改日期 | - | - | - | - |
|---|---|---|---|---|
| 材料/颜色 | 采用 | 工厂 | 地盘 | ✓ |
| 表面处理 | 氟碳喷涂 (ECCA1.009 96-AF1) | | | |

美特铝質有限公司
MDI Aluminium Fabricator Ltd.

| 工程號 | J858 | 類別 | | 物料號 | - |
|---|---|---|---|---|---|
| 地盤 | 康城11期 | 制圖 | W. E. X | 2022-06-10 | 圖號 | X86279-ST25 |
| 圖紙名称 | 铝料加工图 | 復核 | - | - | 數量 | 2 |
| 材料 | X86279 | 批准 | - | - | 單件重量 | - (KG) |

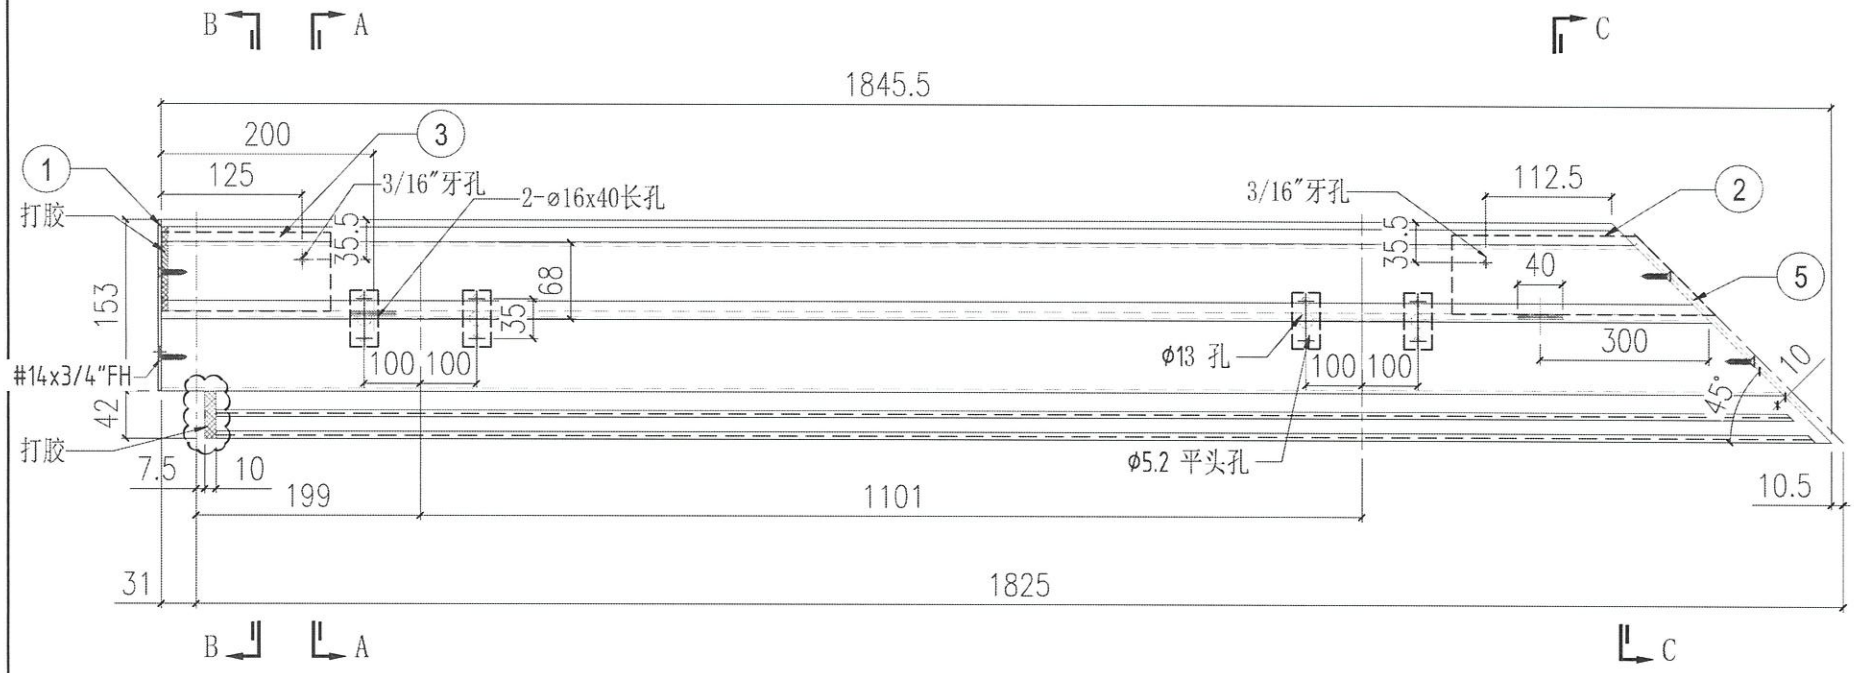


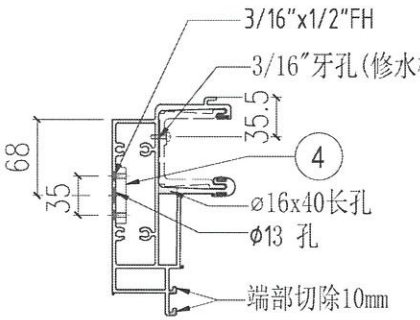


SECTION A-A

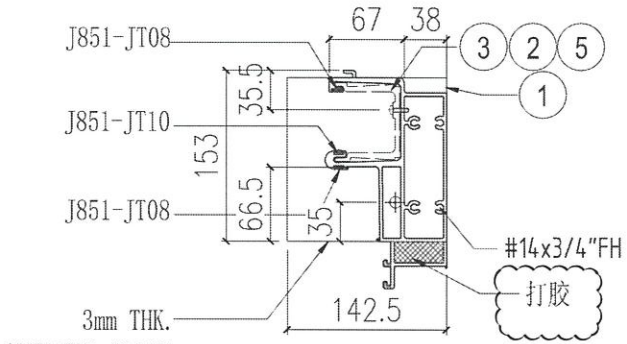


SECTION B-B

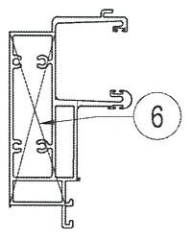


SECTION C-C

FOR :T3B-CW3

| S/N | 部件编号 | L | QTY |
|---|---|---|---|
| 5 | AP-ST02R | - | 1 |
| 4 | ST-01 | - | 4 |
| 3 | X86303-03 | 150 | 1 |
| 2 | X86303-05 | 150 | 1 |
| 1 | AP-ST01L | - | 1 |

美特鋁質有限公司
MDI Aluminium Fabricator Ltd.

| 修改日期 | - | - | - | - |
|---|---|---|---|---|
| 材料颜色 | 採用 | 工廠 | 地盤 | ✓ |
| 表面金 (EQ03\009 SS-XFD) | | | | |

| 工程號 | J858 | 類別 | | 物料號 | - |
|---|---|---|---|---|---|
| 图纸名称 | 地盘 康城11期 铝料加工图 | 制圖 | W.E.X | 2022-06-10 | X86279-ST26 |
| 材料 | X86279 | 復核 | - | - | 1 |
| | | 批准 | - | - | - |
| | | | | 單件重量 | (KG) |

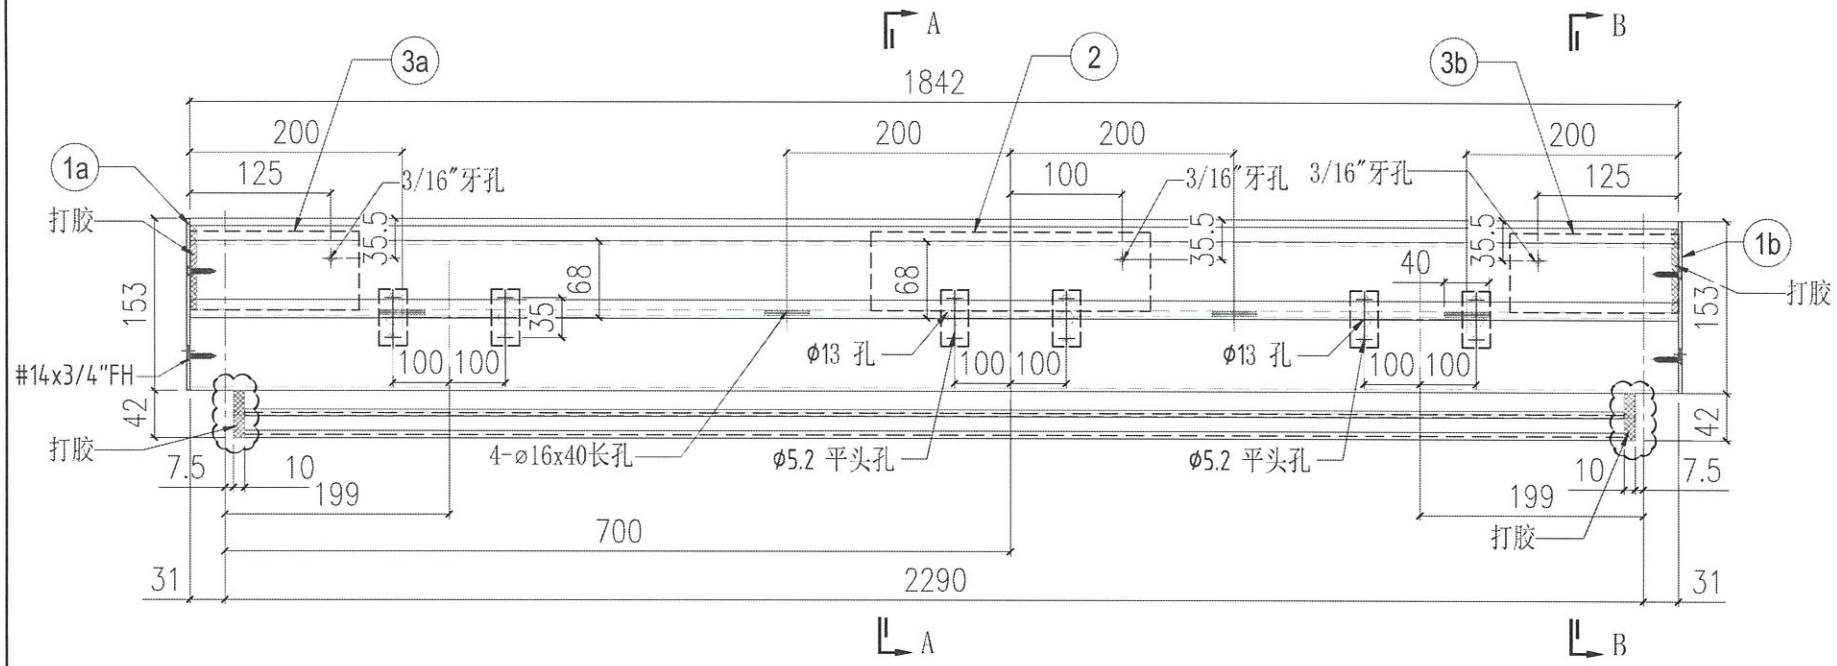


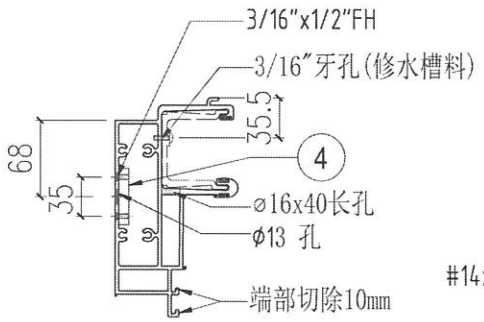


SECTION A-A

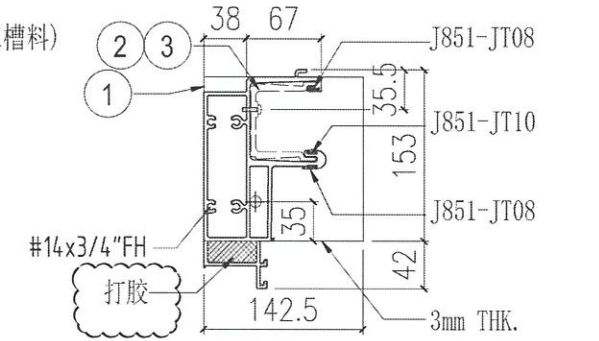


SECTION B-B

FOR :T3A-CW4

| S/N | 部件编号 | L | QTY |
|---|---|---|---|
| 4 | ST-01 | - | 6 |
| 3b | X86303-03 | 150 | 1 |
| 3a | X86303-02 | 150 | 1 |
| 2 | X86303-01 | 300 | 1 |
| 1b | AP-ST01R | - | 1 |
| 1a | AP-ST01L | - | 1 |

| 修改日期 | | | |
|---|---|---|---|
| - | - | | |
| - | - | | |
| - | - | 採用 | 工廠 |
| 材料顏色 | 香檳金 (ECD31.009 GS-AF1) | | 地盤 ✓ |

美特鋁質有限公司
MDI Aluminium Fabricator Ltd.

| | |
|---|---|
| 工程號 | J858 |
| 地盤 | 康城11期 |
| 圖紙名称 | 铝料加工图 |
| 材料 | X86279 |
| 類別 | |
| 制圖 | W.E.X |
| 復核 | - |
| 批准 | - |
| 物料號 | - |
| 2022-06-10 | |
| 圖號 | X86279-ST27 |
| 數量 | 1 |
| 單件重量 | - (KG) |

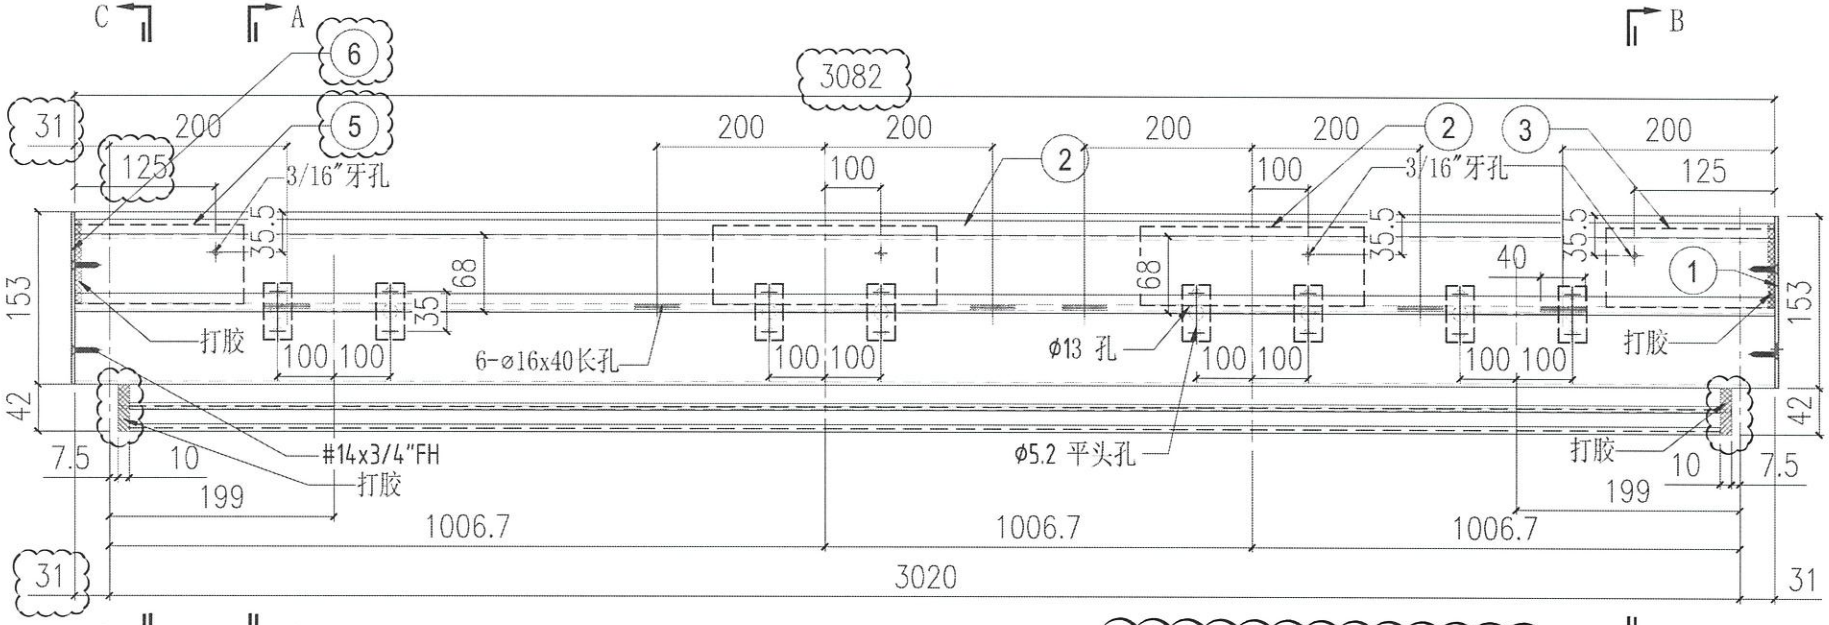


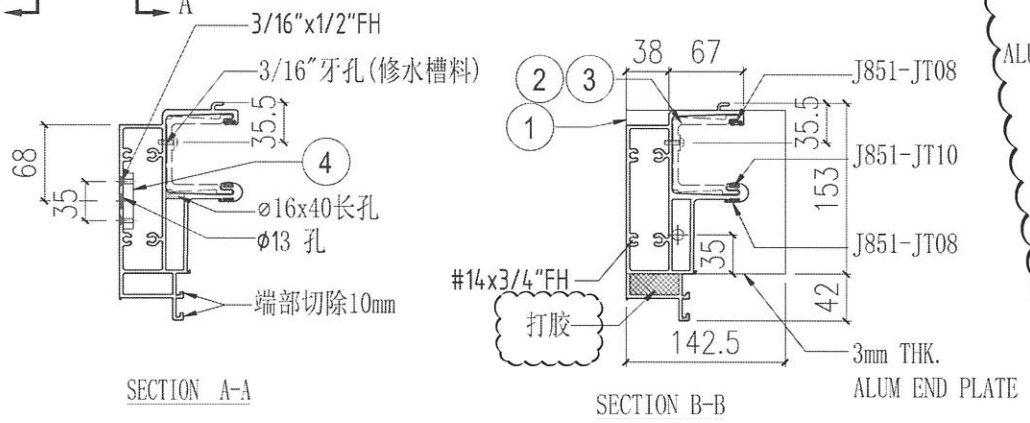


FOR :T1A-CW2.1(11/F,40/F)
FOR :T2A-CW2.1(11/F,40/F)
FOR :T3A-CW2.1(11/F,40/F)

| S/N | 部件编号 | L | QTY |
|---|---|---|---|
| 6 | AP-ST04L | - | 1 |
| 5 | X86303-03 | 150 | 1 |
| 4 | ST-01 | - | 8 |
| 3 | X86303-02 | 150 | 1 |
| 2 | X86303-01 | 300 | 2 |
| 1 | AP-ST01R | - | 1 |

美特鋁質有限公司
MDI Aluminium Fabricator Ltd.

| 修改日期 | | | |
|---|---|---|---|
| - | - | - | - |
| - | - | - | - |

| 材料/顏色 | 採用 | 工廠 | 地盤 |
|---|---|---|---|
| | 黏接金 (EC031109-SS-AP01) | | ✓ |

| | |
|---|---|
| 工程號 | J858 |
| 地盤 | 康城11期 |
| 圖紙名稱 | 鋁料加工圖 |
| 材料 | X86279 |
| 類別 | |
| 制圖 | W.E.X |
| 復核 | - |
| 批准 | - |
| 物料號 | - |
| 2022-06-10 | |
| - | |
| 圖號 | X86279-ST28 |
| 數量 | 6 |
| 單件重量 | - (KG) |

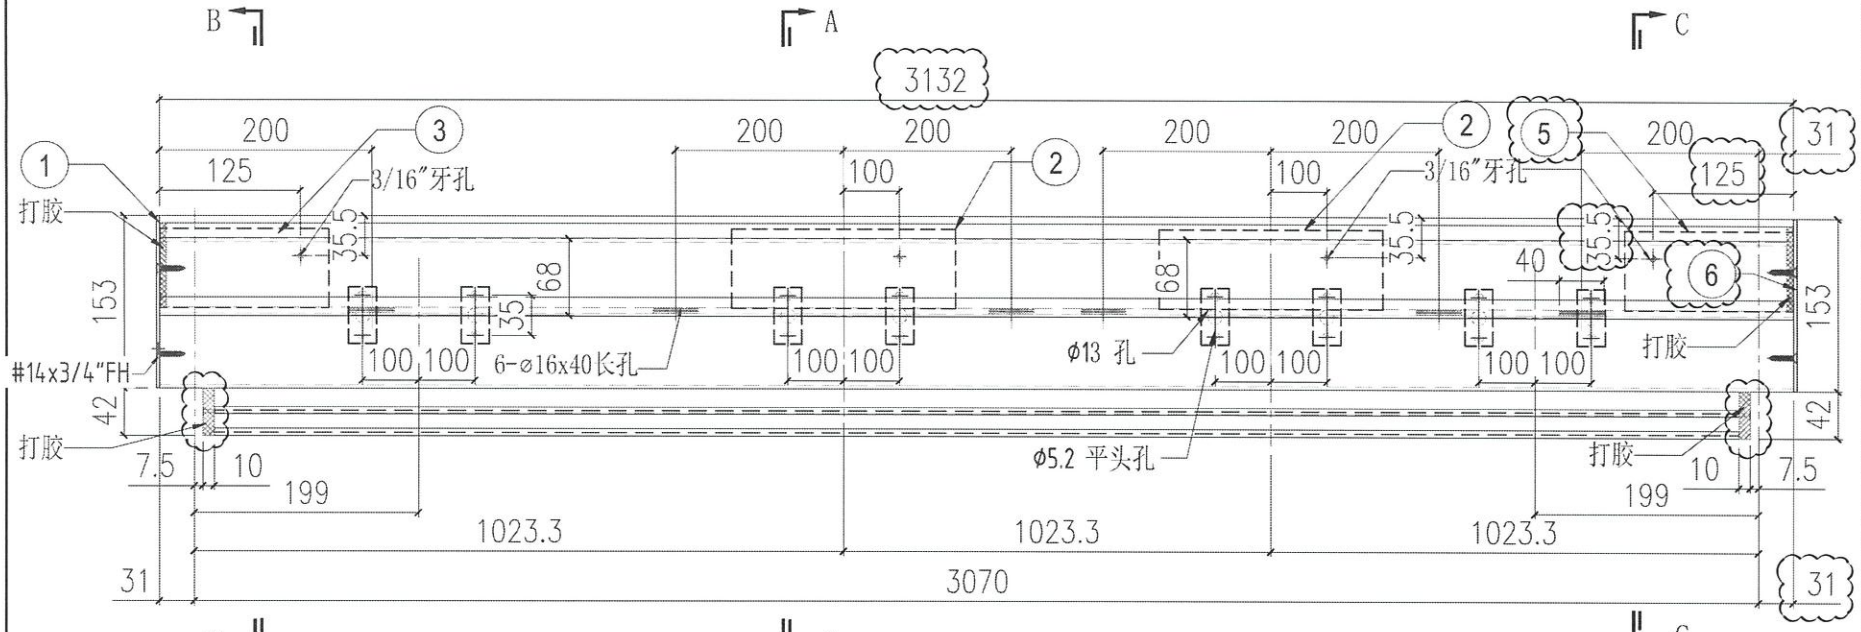


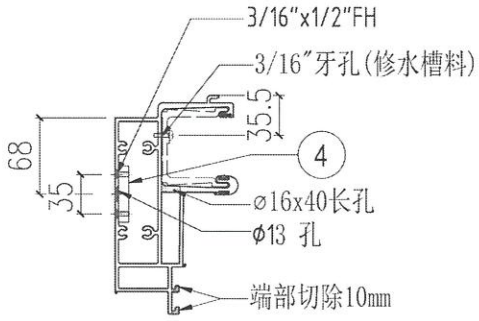


SECTION A-A

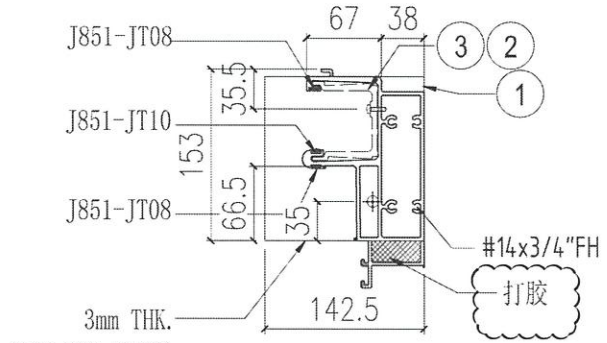


SECTION B-B

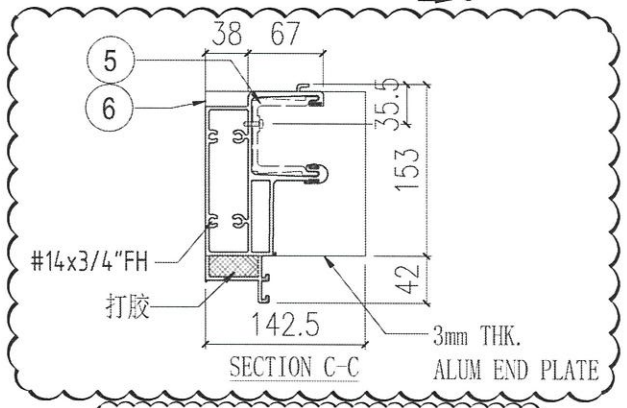


SECTION C-C

FOR :T1A-CW1.1(11/F,40/F)
FOR :T2A-CW1.1(11/F,40/F)
FOR :T3A-CW1.1(11/F,40/F)

| S/N | 部件编号 | L | QTY |
|---|---|---|---|
| 6 | AP-ST04R | - | 1 |
| 5 | X86303-02 | 150 | 1 |
| 4 | ST-01 | - | 8 |
| 3 | X86303-03 | 150 | 1 |
| 2 | X86303-01 | 300 | 2 |
| 1 | AP-ST01L | - | 1 |

| 修改日期 | | | |
|---|---|---|---|
| - | - | - | - |
| - | - | - | - |
| 材料/颜色 | 採用 | 工廠 | 地盤 |
| 香槟金 (EC03/100 95-30P1) | | | ✓ |

美特鋁質有限公司
MDL Aluminium Fabricator Ltd.

| | |
|---|---|
| 工程號 | J858 |
| 图纸名称 | 康城11期 |
| 材料 | 铝料加工图 |
| 地盤 | X86279 |

| | |
|---|---|
| 類別 | |
| 制圖 | W.E.X |
| 復核 | - |
| 批准 | - |

| | |
|---|---|
| 物料號 | - |
| 2022-06-10 | - |

| | |
|---|---|
| 圖號 | X86279-ST29 |
| 數量 | 6 |
| 單件重量 | - (KG) |

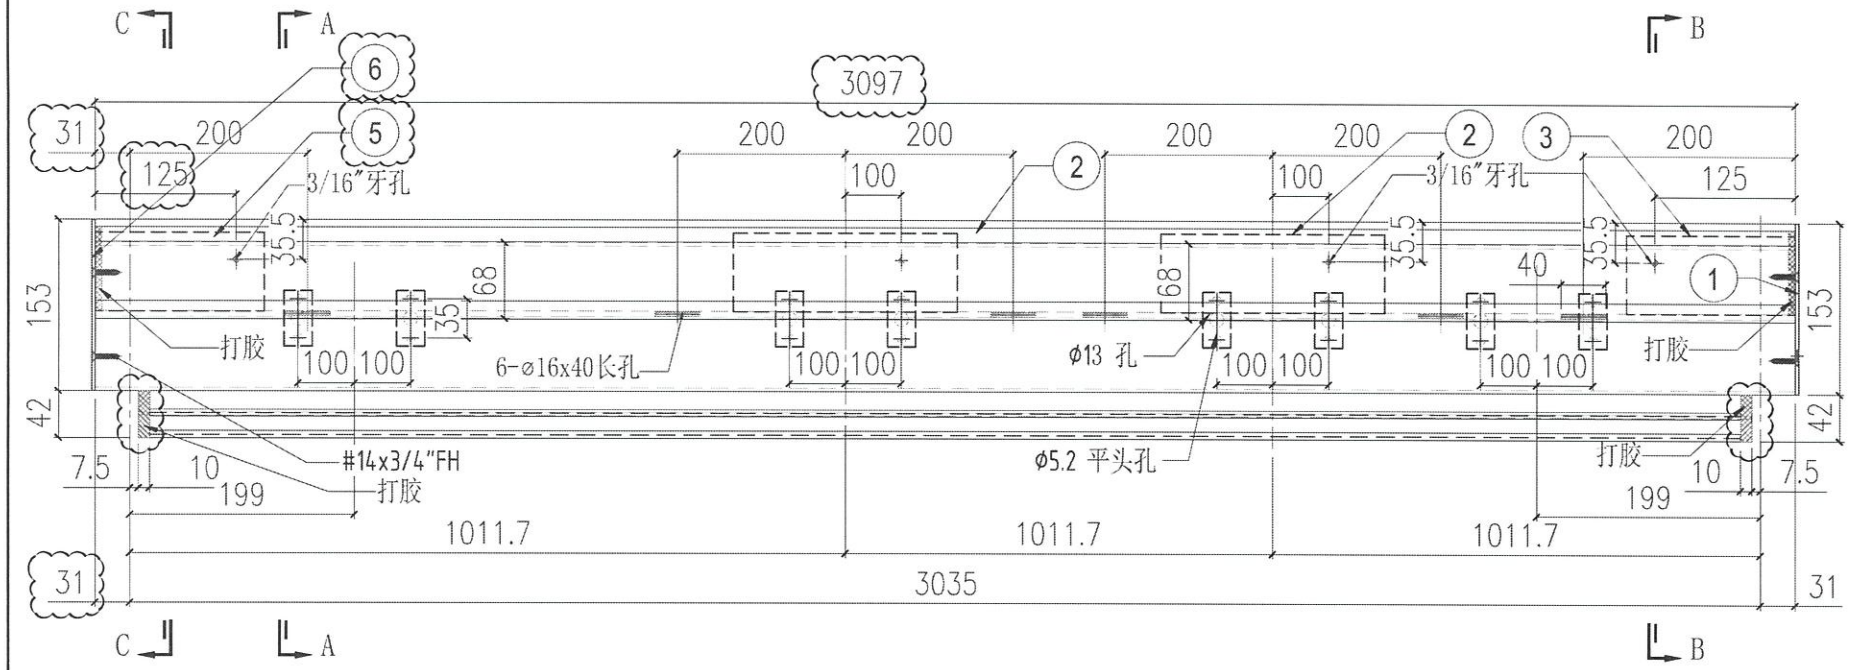


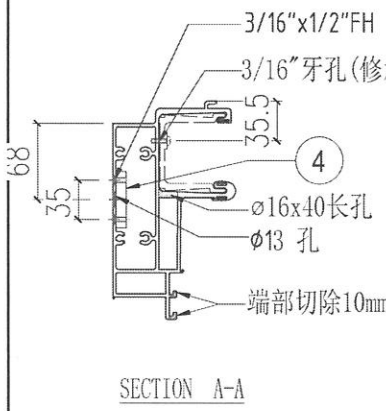


SECTION A-A

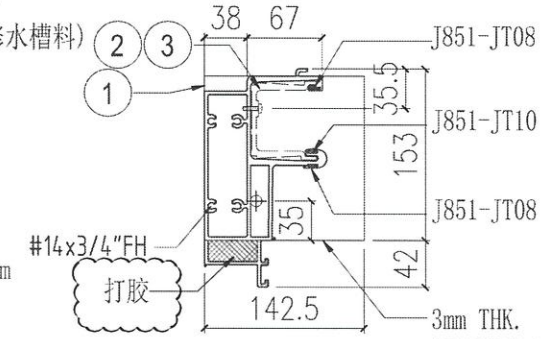


SECTION B-B

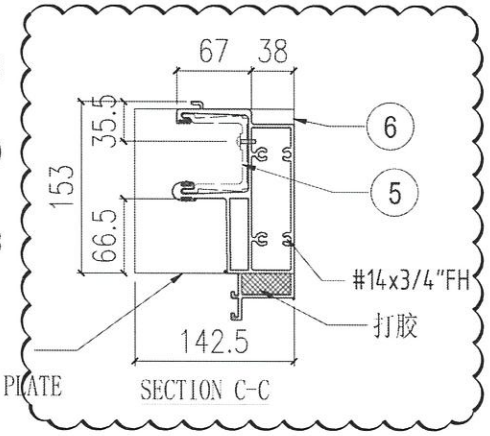


SECTION C-C

FOR :T1B-CW1.1(11/F,40/F)
FOR :T1B-CW5.1(11/F,40/F)
FOR :T1A-CW6.1(11/F,40/F)
FOR :T2B-CW1.1(11/F,40/F)
FOR :T2B-CW5.1(11/F,40/F)
FOR :T2A-CW5.1(11/F,40/F)
FOR :T2A-CW4.1(11/F,40/F)
FOR :T3B-CW1.1(11/F,40/F)
FOR :T3B-CW5.1(11/F,40/F)
FOR :T3A-CW6.1(11/F,40/F)

| S/N | 部件编号 | L | QTY |
|---|---|---|---|
| 4 | ST-01 | - | 8 |
| 3 | X86303-02 | 150 | 1 |
| 2 | X86303-01 | 300 | 2 |
| 1 | AP-ST01R | - | 1 |

| | | | |
|---|---|---|---|
| 6 | AP-ST04L | - | 1 |
| 5 | X86303-03 | 150 | 1 |

| 修改日期 | | | |
|---|---|---|---|
| - | - | - | - |
| 材料颜色 | 采用 | 工厂 | 地盘 |
| 香槟金 (EC03/1009 SS-EF) | | | ✓ |

美特鋁質有限公司
MDI Aluminium Fabricator Ltd.

| | |
|---|---|
| 工程號 | J858 |
| 图纸名称 | 康城1期 |
| 材料 | 铝料加工图 |
| 地盘 | |
| X86279 | |

| | |
|---|---|
| 類別 | |
| 制圖 | W.E.X |
| 復核 | - |
| 批准 | - |

| | |
|---|---|
| 物料號 | - |
| | 2022-06-10 |
| | - |
| | - |

| | |
|---|---|
| 圖號 | X86279-ST30 |
| 數量 | 20 |
| 單件重量 | - (KG) |

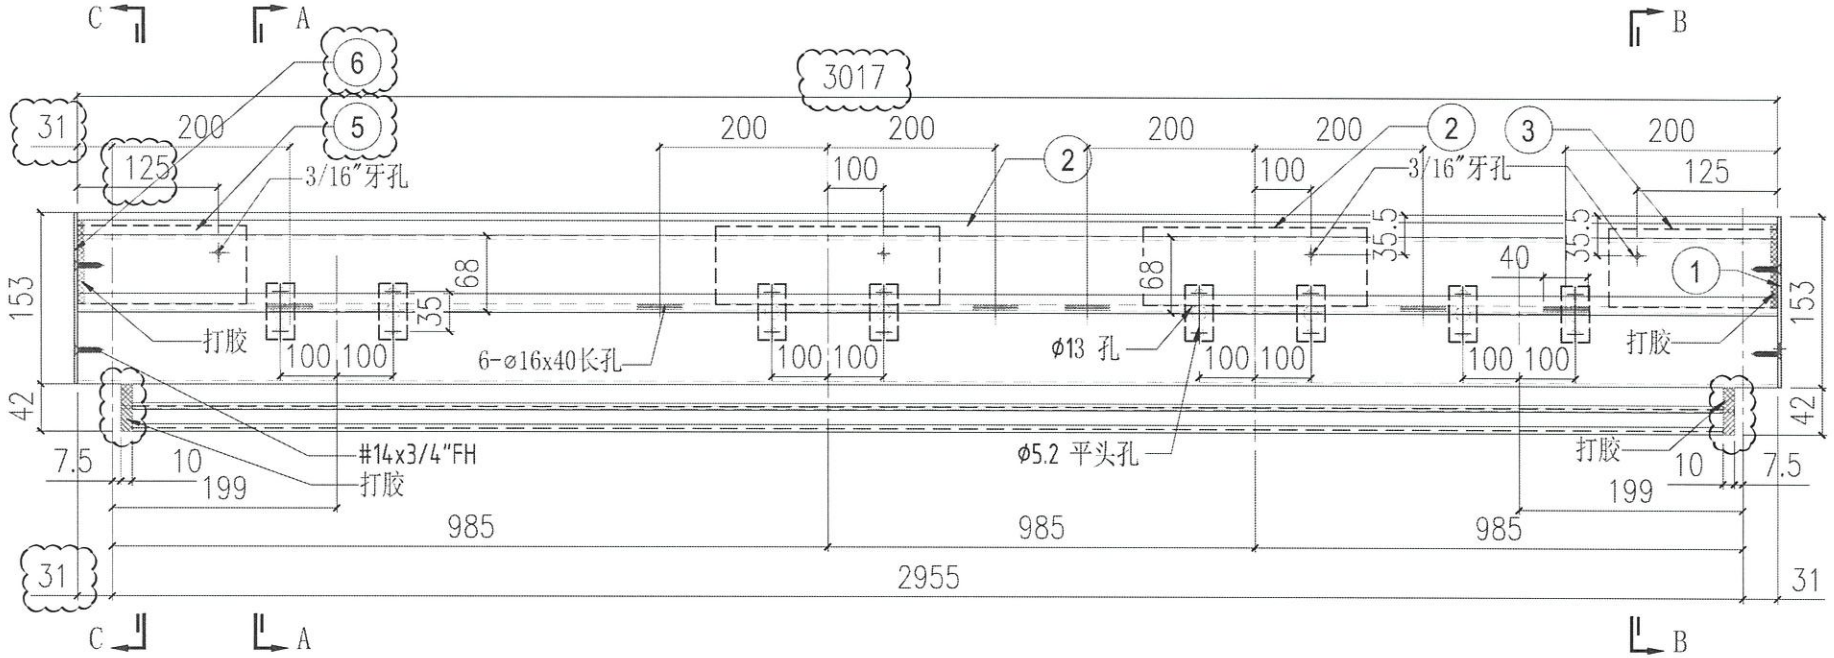


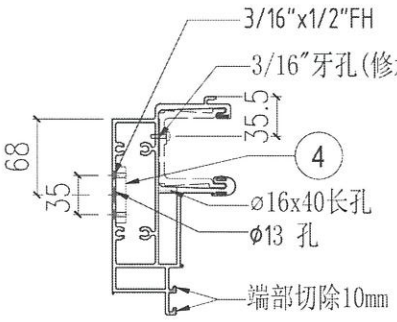


SECTION A-A

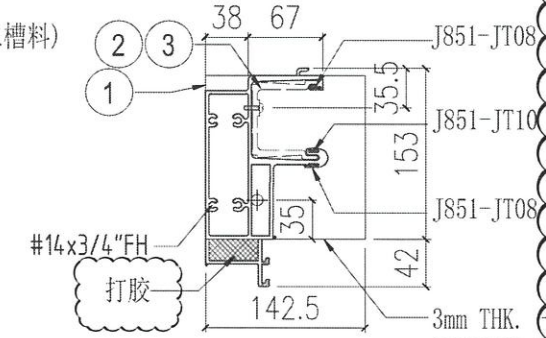


SECTION B-B

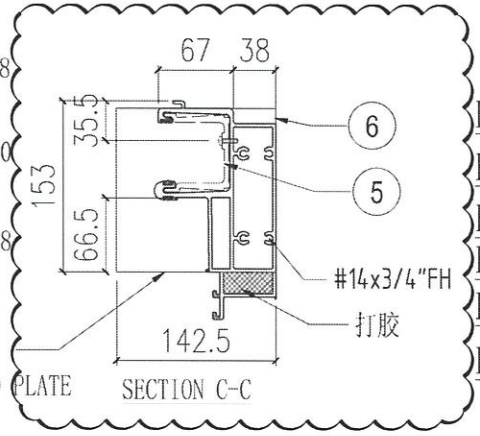


SECTION C-C

FOR :T1B-CW2.1(11/F,40/F)
FOR :T1A-CW7.1(11/F,40/F)
FOR :T2B-CW2.1(11/F,40/F)
FOR :T2A-CW3.1(11/F,40/F)
FOR :T3B-CW2.1(11/F,40/F)
FOR :T3A-CW3.1(11/F,40/F)

| S/N | 部件编号 | L | QTY |
|---|---|---|---|
| 4 | ST-01 | - | 8 |
| 3 | X86303-02 | 150 | 1 |
| 2 | X86303-01 | 300 | 2 |
| 1 | AP-ST01R | - | 1 |

| S/N | 部件编号 | L | QTY |
|---|---|---|---|
| 6 | AP-ST04L | - | 1 |
| 5 | X86303-03 | 150 | 1 |

美特鋁質有限公司
MDI Aluminium Fabricator Ltd.

| 修改日期 | - | - | - | - |
|---|---|---|---|---|
| 材料.顏色 | 採用 | 工廠 | 地盤 | ✓ |
| 香槟金(EC031/009 95-AF1) | | | | |

| | |
|---|---|
| 工程號 | J858 |
| 地盤 | 康城1期 |
| 圖紙名称 | 铝料加工图 |
| 材料 | X86279 |
| 類別 | |
| 制圖 | W.E.X |
| 復核 | - |
| 批准 | - |
| 物料號 | - |
| 圖號 | X86279-ST31 |
| 數量 | 12 |
| 單件重量 | - (KG) |

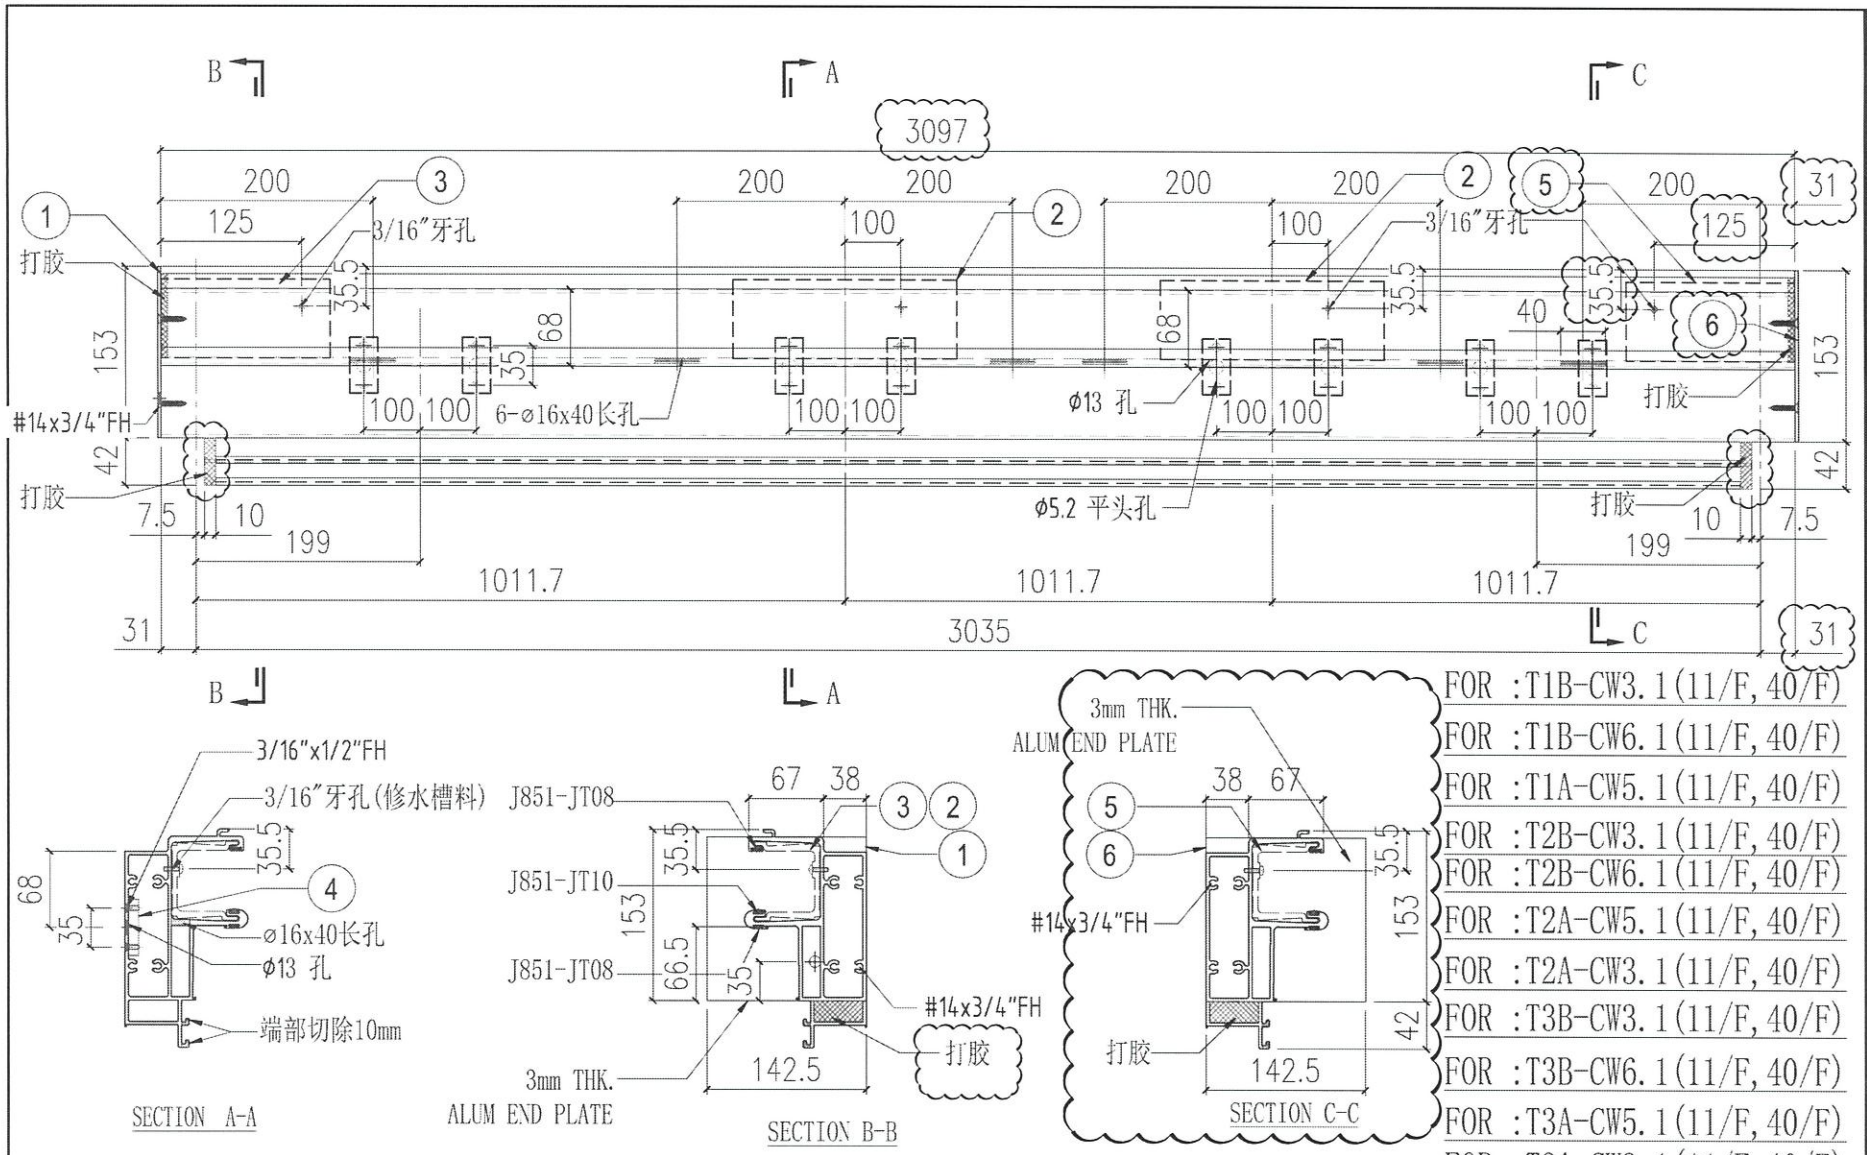








FOR :T1B-CW3.1(11/F,40/F)
FOR :T1B-CW6.1(11/F,40/F)
FOR :T1A-CW5.1(11/F,40/F)
FOR :T2B-CW3.1(11/F,40/F)
FOR :T2B-CW6.1(11/F,40/F)
FOR :T2A-CW5.1(11/F,40/F)
FOR :T2A-CW3.1(11/F,40/F)
FOR :T3B-CW3.1(11/F,40/F)
FOR :T3B-CW6.1(11/F,40/F)
FOR :T3A-CW5.1(11/F,40/F)
FOR :T3A-CW3.1(11/F,40/F)

| S/N | 部件编号 | L | QTY |
|---|---|---|---|
| 4 | ST-01 | - | 8 |
| 3 | X86303-03 | 150 | 1 |
| 2 | X86303-01 | 300 | 2 |
| 1 | AP-ST01L | - | 1 |

| | | | |
|---|---|---|---|
| 6 | AP-ST04R | - | 1 |
| 5 | X86303-02 | 150 | 1 |

| 修改日期 | | | |
|---|---|---|---|
| - | - | - | - |
| - | - | - | - |

美特鋁質有限公司
MDI Aluminium Fabricator Ltd.

| 材料/顏色 | 表面處理 (EQ/SS1009 96-AF01) | 採用工廠 | 地盤 ✓ |
|---|---|---|---|

| | | | |
|---|---|---|---|
| 工程號 | J858 | 類別 | |
| 圖紙名称 | 铝料加工图 | 制圖 | W.E.X |
| 地盤 | 康城11期 | 復核 | - |
| 材料 | X86279 | 批准 | - |
| 物料號 | - | | |
| 圖號 | X86279-ST32 | | |
| 數量 | 22 | | |
| 單件重量 | - (KG) | | |
| | | 2022-06-10 | |

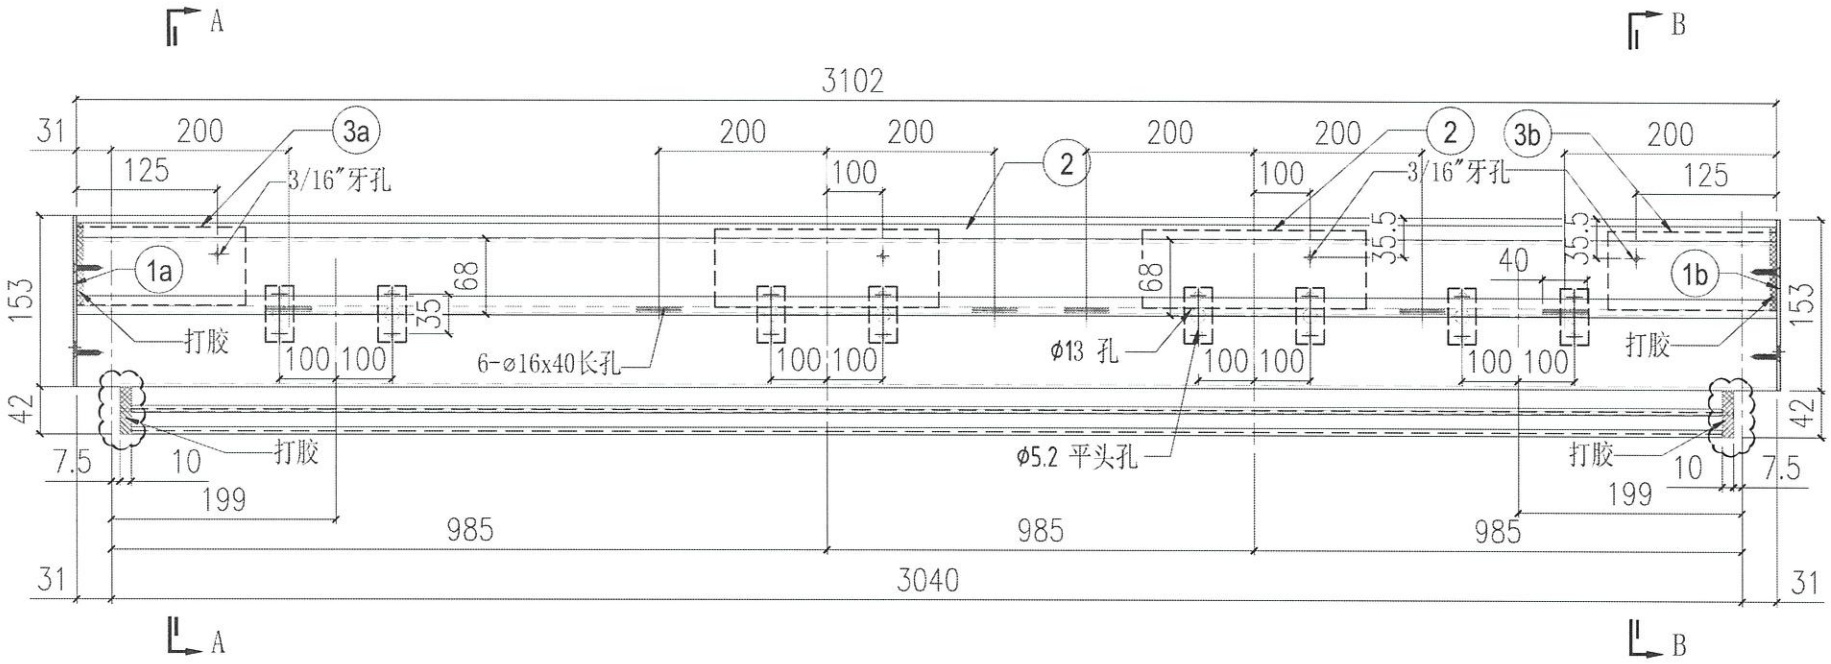


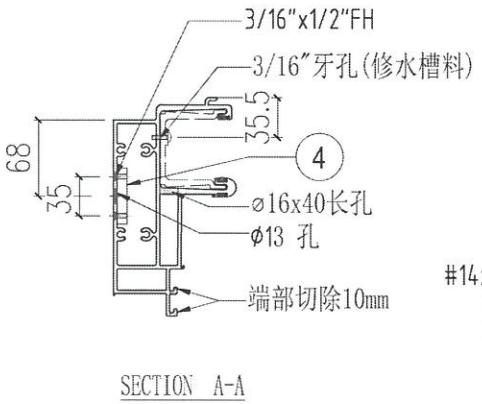


SECTION A-A

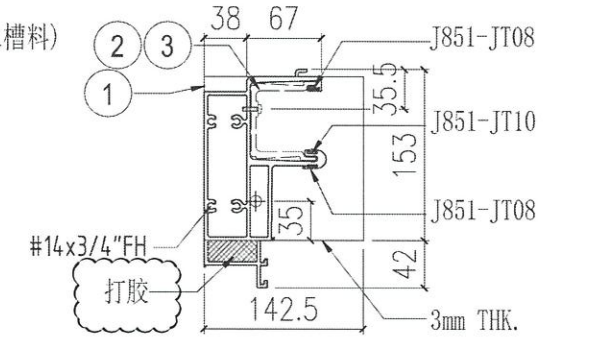


SECTION B-B

FOR :T1B-CW4.1(11/F,40/F)

FOR :T3B-CW4.1(11/F,40/F)

| S/N | 部件编号 | L | QTY |
|---|---|---|---|
| 4 | ST-01 | - | 8 |
| 3b | X86303-02 | 150 | 1 |
| 3a | X86303-03 | 150 | 1 |
| 2 | X86303-01 | 300 | 2 |
| 1b | AP-ST01R | - | 1 |
| 1a | AP-ST01L | - | 1 |

| 修改日期 | | | | |
|---|---|---|---|---|
| - | - | - | - | - |
| - | - | - | - | - |
| - | - | - | - | - |

美特鋁質有限公司
MDL Aluminium Fabricator Ltd.

| 材料/顏色 | 採用 | 工廠 | 地盤 ✓ |
|---|---|---|---|
| 香槟金 (EQ03\1009 9S-EF1) | | | |

| 工程號 | J858 |
|---|---|
| 地盤 | 康城1期 |
| 圖紙名稱 | 铝料加工图 |
| 材料 | X86279 |

| 類別 | |
|---|---|
| 制圖 | W.E.X |
| 復核 | - |
| 批准 | - |

| 物料號 | - |
|---|---|
| 2022-06-10 | |
| - | |

| 圖號 | X86279-ST33 |
|---|---|
| 數量 | 4 |
| 單件重量 | - (KG) |

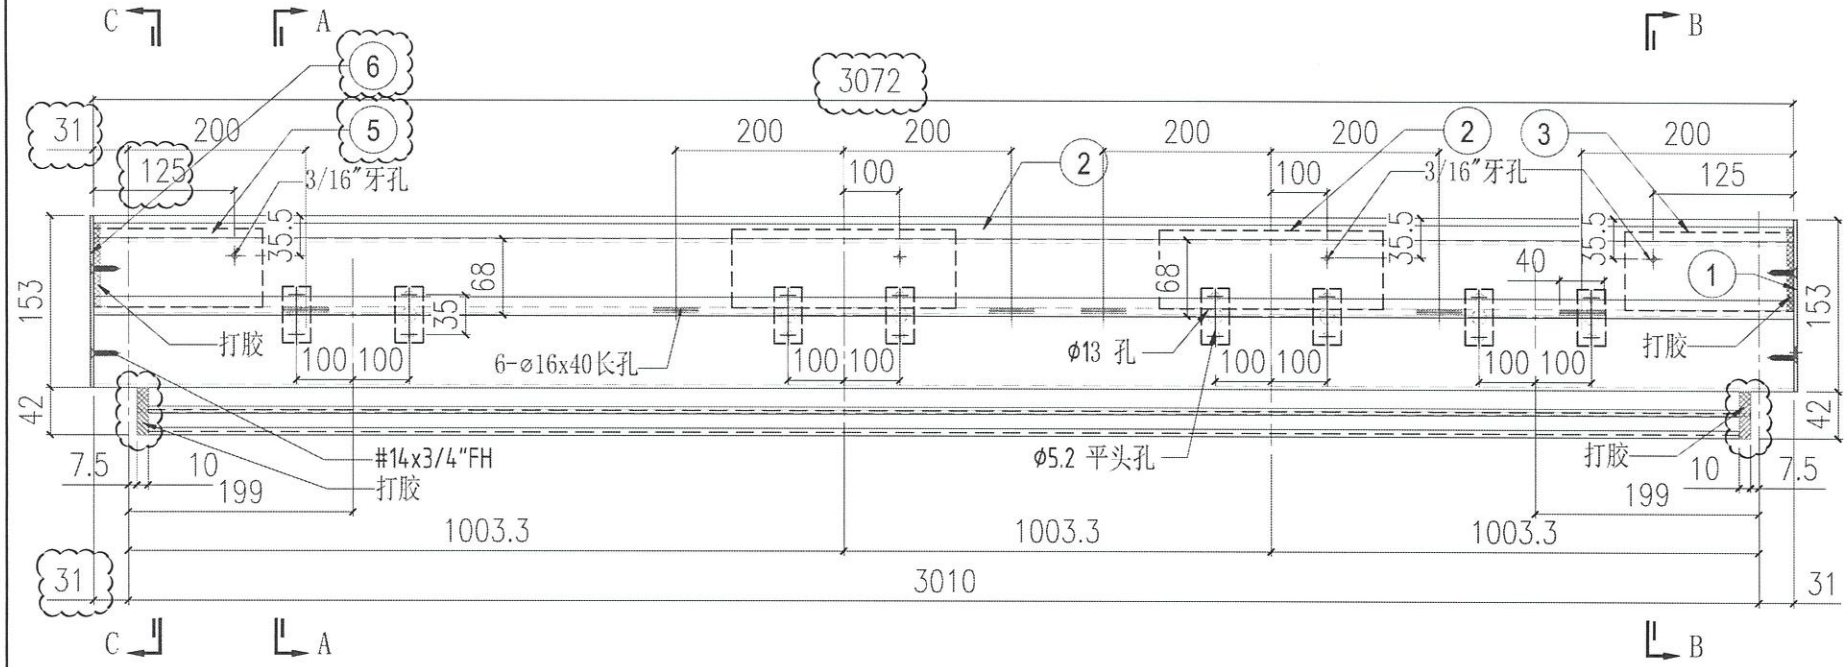


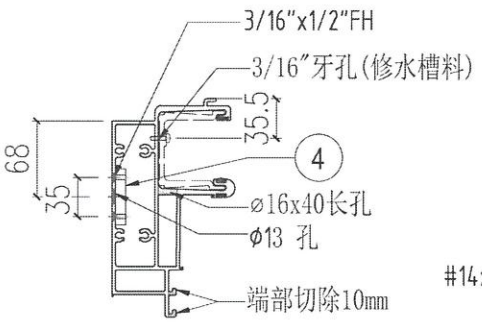


SECTION A-A

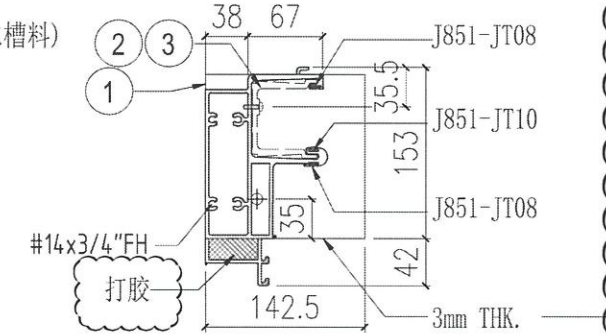


SECTION B-B

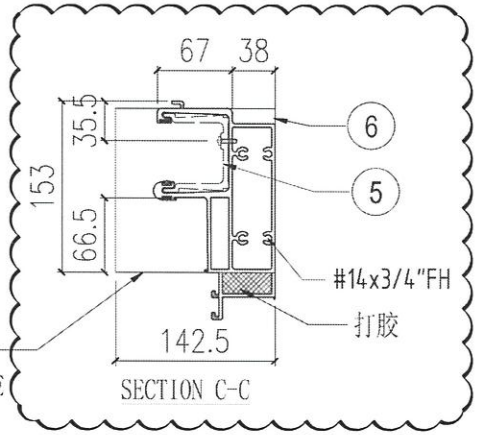


SECTION C-C

FOR :T1A-CW4.1(11/F,40/F)

| S/N | 部件编号 | L | QTY |
|---|---|---|---|
| 4 | ST-01 | - | 8 |
| 3 | X86303-02 | 150 | 1 |
| 2 | X86303-01 | 300 | 2 |
| 1 | AP-ST01R | - | 1 |

| | | | |
|---|---|---|---|
| 6 | AP-ST04L | - | 1 |
| 5 | X86303-03 | 150 | 1 |

| 修改日期 | | | |
|---|---|---|---|
| - | - | - | - |
| 材料/颜色 | 采用 | 工厂 | 地盘 ✓ |

美特铝質有限公司
MDI Aluminium Fabricator Ltd.

| | |
|---|---|
| 工程號 | J858 |
| 地盘图纸名称 | 康城11期 铝料加工图 |
| 材料 | X86279 |
| 類別 | |
| 制圖 | W.E.X |
| 復核 | - |
| 批准 | - |
| 物料號 | 2022-06-10 |
| 圖號 | X86279-ST34 |
| 數量 | 2 |
| 單件重量 | - (KG) |

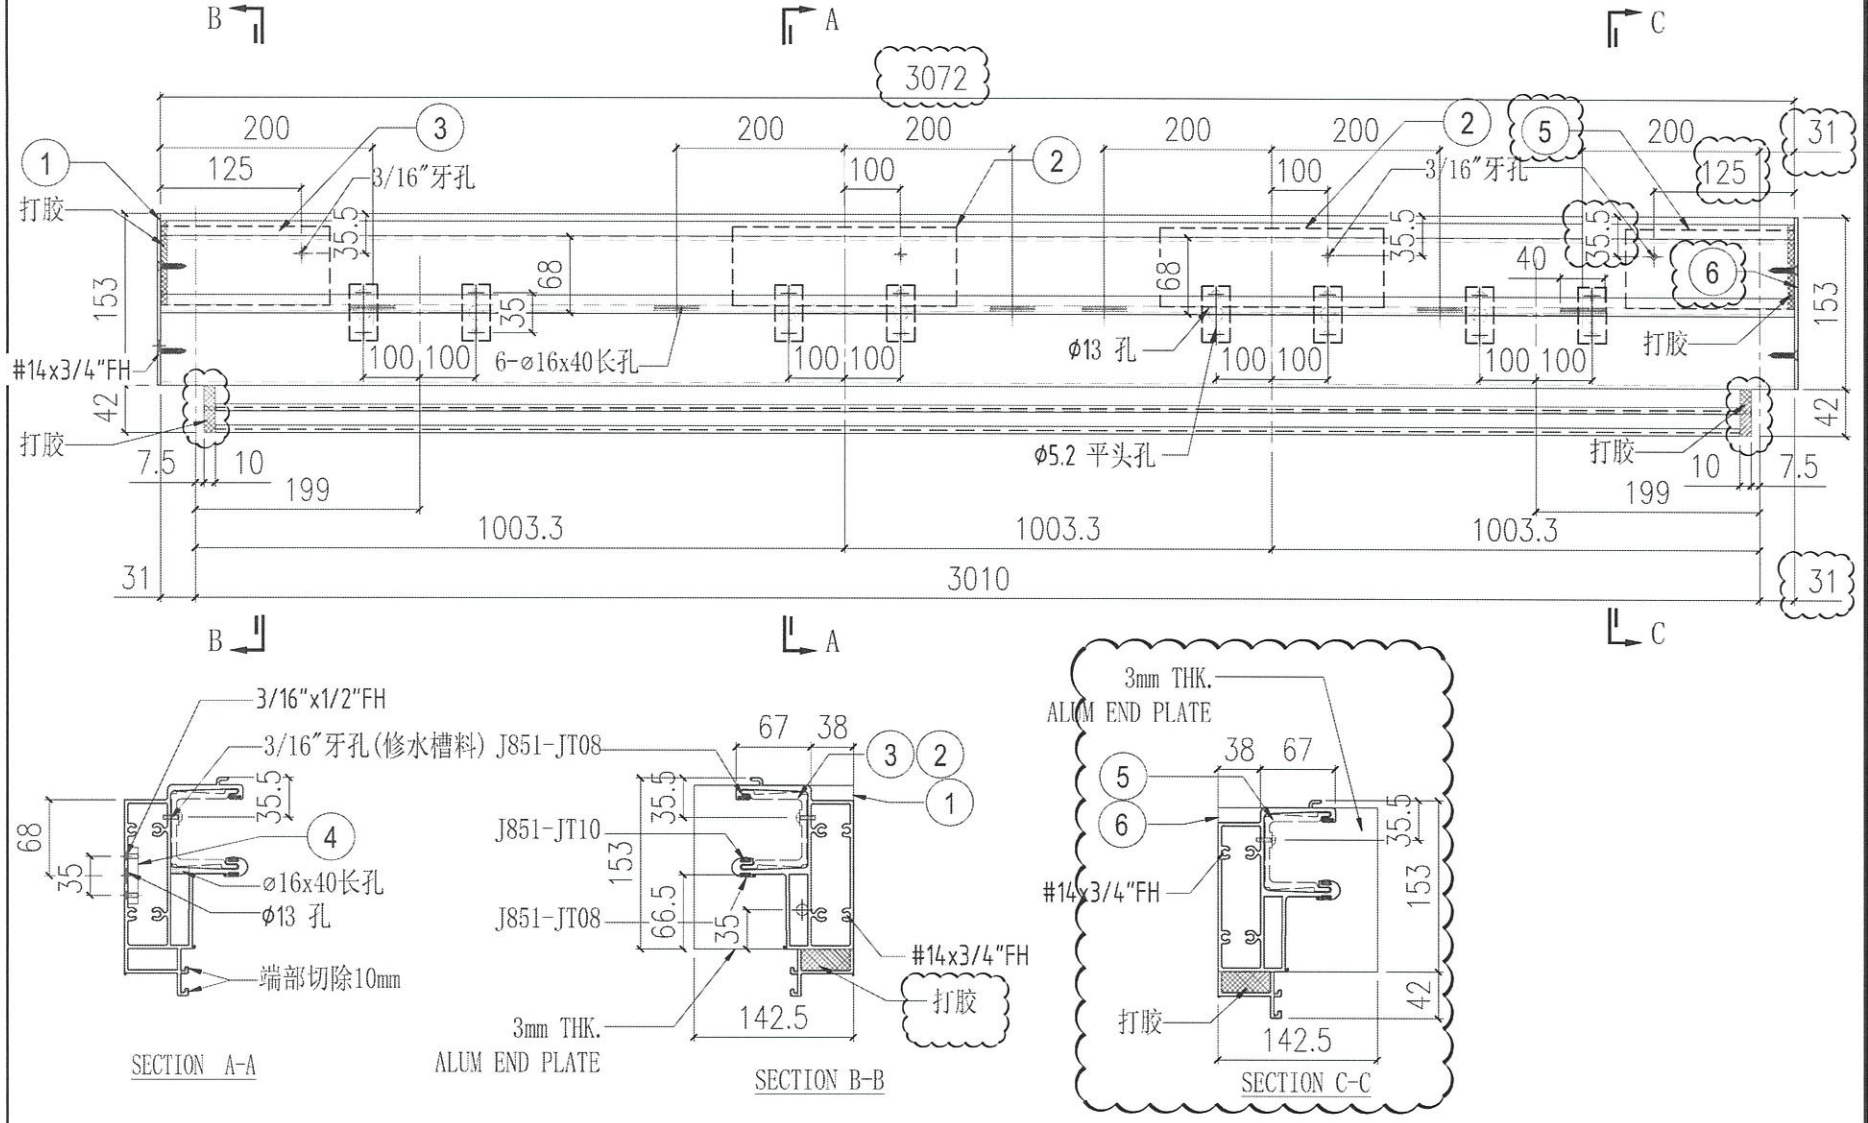





SECTION A-A




SECTION B-B




SECTION C-C

FOR :T1A-CW3.1(11/F,40/F)

| S/N | 部件编号 | L | QTY |
|---|---|---|---|
| 4 | ST-01 | - | 8 |
| 3 | X86303-03 | 150 | 1 |
| 2 | X86303-01 | 300 | 2 |
| 1 | AP-ST01L | - | 1 |

| | | | |
|---|---|---|---|
| 6 | AP-ST04R | - | 1 |
| 5 | X86303-02 | 150 | 1 |

美特铝質有限公司
MDI Aluminium Fabricator Ltd.

| 修改日期 | | | |
|---|---|---|---|
| - | - | - | - |
| - | - | - | - |

| 材料/颜色 | 系统仓(EQ031009 9S-AF1) | 採用工廠 | 地盤 ✓ |
|---|---|---|---|

| | |
|---|---|
| 工程號 | J858 |
| 地盤 | 康城11期 |
| 图纸名称 | 铝料加工图 |
| 材料 | X86279 |
| 制圖 | W.E.X |
| 復核 | - |
| 批准 | - |
| 類別 | |
| 物料號 | - |
| 圖號 | X86279-ST35 |
| 數量 | 2 |
| 單件重量 | - (KG) |
| 日期 | 2022-06-10 |

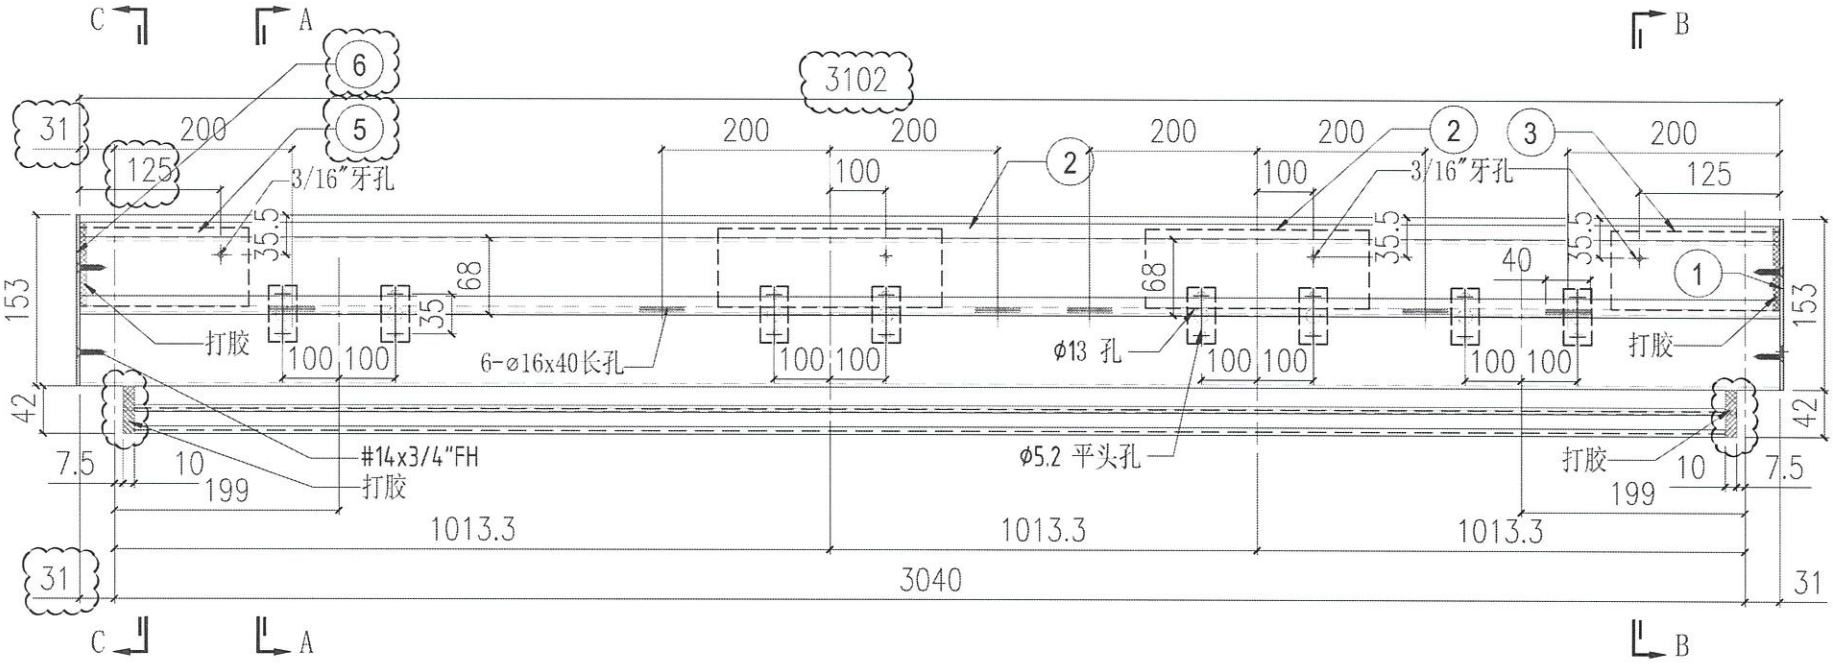


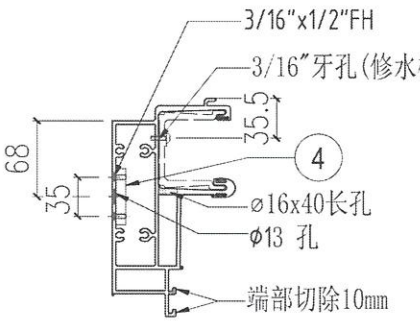


SECTION A-A

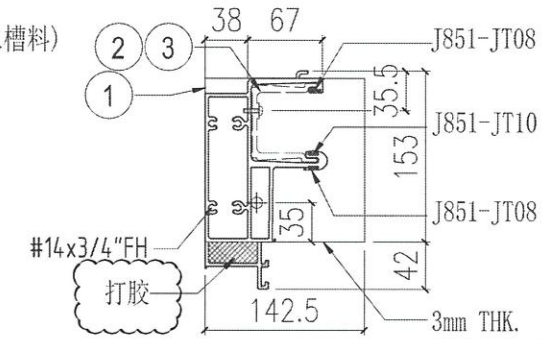


SECTION B-B

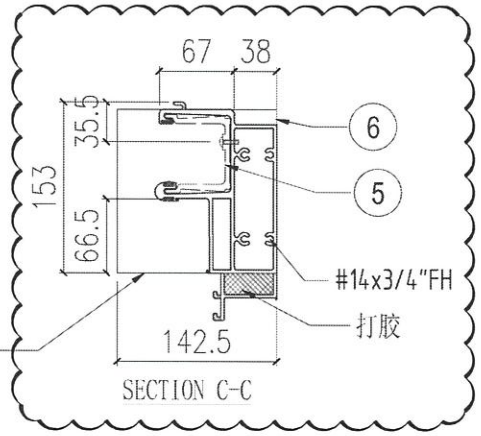


SECTION C-C

FOR :T2B-CW4.1(11/F,40/F)

| S/N | 部件编号 | L | QTY |
|---|---|---|---|
| 4 | ST-01 | - | 8 |
| 3 | X86303-02 | 150 | 1 |
| 2 | X86303-01 | 300 | 2 |
| 1 | AP-ST01R | - | 1 |

| | | | |
|---|---|---|---|
| 6 | AP-ST04L | - | 1 |
| 5 | X86303-03 | 150 | 1 |

美特鋁質有限公司
MDL Aluminium Fabricator Ltd.

| 修改 | - | - | - | - |
|---|---|---|---|---|
| 日期 | - | - | - | - |

| 採用 | 工廠 | 地盤 | ✓ |
|---|---|---|---|
| 材料顏色 | 香槟金 (EQB31009 QS-XF01) | | |

| 工程號 | J858 | 類別 | | 物料號 | - |
|---|---|---|---|---|---|
| 地盤 | 康城1期 | 制圖 | W.E.X | 圖號 | X86279-ST36 |
| 圖紙名称 | 铝料加工图 | 復核 | - | 數量 | 2 |
| 材料 | X86279 | 批准 | - | 單件重量 | - (KG) |

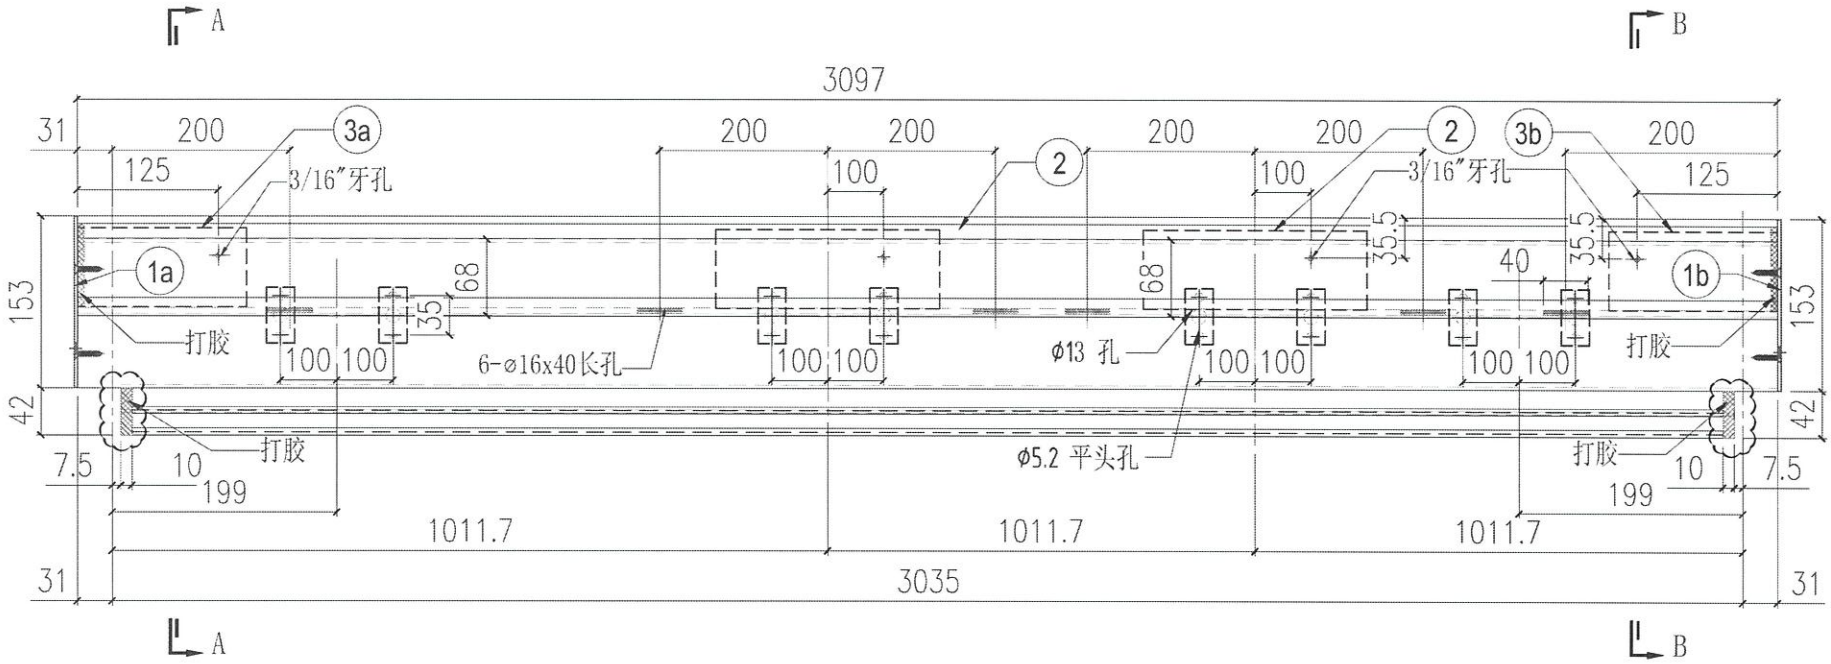


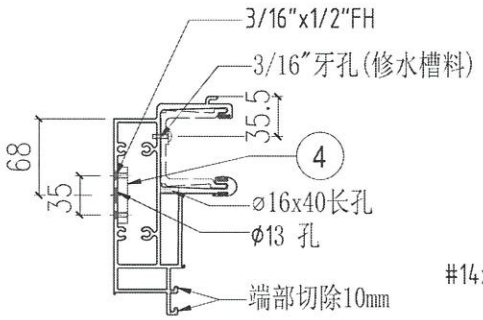


SECTION A-A

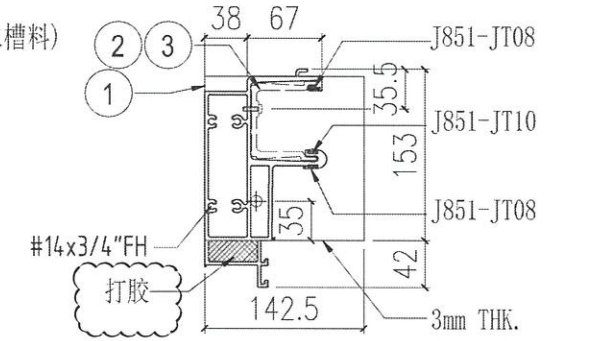


SECTION B-B

FOR :T3A-CW4.1(11/F,40/F)

| S/N | 部件编号 | L | QTY |
|---|---|---|---|
| 4 | ST-01 | - | 8 |
| 3b | X86303-02 | 150 | 1 |
| 3a | X86303-03 | 150 | 1 |
| 2 | X86303-01 | 300 | 2 |
| 1b | AP-ST01R | - | 1 |
| 1a | AP-ST01L | - | 1 |

| 修改日期 | | | |
|---|---|---|---|
| - | - | - | - |
| - | - | - | - |
| 材料颜色 | 採用 | 工廠 | 地盤 |
| | 香槟金 (EQ03\1009 SS-3EF) | | ✓ |

美特鋁質有限公司
MIDI Aluminium Fabricator Ltd.

| | |
|---|---|
| 工程號 | J858 |
| 地盤 | 康城11期 |
| 圖紙名称 | 铝料加工图 |
| 材料 | X86279 |

| | |
|---|---|
| 類別 | |
| 制圖 | W.E.X |
| 復核 | - |
| 批准 | - |

| | |
|---|---|
| 物料號 | - |
| 2022-06-10 | |
| - | |

| | |
|---|---|
| 圖號 | X86279-ST37 |
| 數量 | 2 |
| 單件重量 | - (KG) |

| 美特鋁質有限公司 MIDI Aluminium Fabricator Ltd. | | | | | | | | | | | | |
|---|---|---|---|---|---|---|---|---|---|---|---|---|
| | | | | | 工程號 | J858 | 類別 | | 物料號 | - | | |
| | | | | | 地盘 | 康城11期 | 制圖 | W.E.X | 2022-06-10 | 圖號 | X86301-ST01 | |
| 修改 | - | - | - | 採用 工廠 | | 地盤 ✓ | 图纸名称 | 铝料加工图 | 復核 | - | - | 數量 | - | |
| 日期 | - | - | - | 材料颜色 | 深铜色(ECD3W0497 6S-XF1) | | 材料 | X86301 - | 批准 | - | - | 單件重量 | - | (KG) |

| 部件编号 | L | 数量 | 位置 |
|---|---|---|---|
| X86301-ST01-01 | 650 | 1 | T1A-CW2 |
| X86301-ST01-02 | 1625 | 1 | T1A-CW2 |
| X86301-ST01-03 | 2515 | 1 | T1A-CW2 |
| X86301-ST01-04 | 3647.5 | 3 | T1A-CW2/T2A-CW2/T3A-CW2 |
| X86301-ST01-05 | 3337.5 | 3 | T1A-CW1/T2A-CW1/T3A-CW1 |
| X86301-ST01-06 | 3727.5 | 1 | T1B-CW1 |
| X86301-ST01-07 | 1230 | 4 | T1B-CW2/T1B-CW5<br>T2A-CW2/T3B-CW2 |
| X86301-ST01-08 | 5060 | 1 | T1A-CW6 |
| X86301-ST01-09 | 1370 | 1 | T1A-CW4 |
| X86301-ST01-10 | 5010 | 1 | T1A-CW3 |
| X86301-ST01-11 | 600 | 2 | T2A-CW2/T3A-CW2 |
| X86301-ST01-12 | 1675 | 2 | T2A-CW2/T3A-CW2 |
| X86301-ST01-13 | 2540 | 2 | T2A-CW2/T3A-CW2 |
| X86301-ST01-14 | 3752.5 | 2 | T2B-CW1/T3B-CW1 |
| X86301-ST01-15 | 3355 | 2 | T2B-CW5/T3B-CW5 |
| X86301-ST01-16 | 5085 | 2 | T2B-CW6/T3B-CW6 |
| X86301-ST01-17 | 1765 | 1 | T2A-CW4 |
| X86301-ST01-18 | 1712.5 | 1 | T2A-CW4 |
| X86301-ST01-19 | 2885 | 2 | T2A-CW3/T3A-CW3 |
| X86301-ST01-20 | 2275 | 1 | T3A-CW4 |

| 部件编号 | L | 数量 | 位置 |
|---|---|---|---|
| X86301-ST01-21 | 3005 | 6 | T1A-CW2.1/T2A-CW2.1/T3A-CW2.1 |
| X86301-ST01-22 | 3055 | 6 | T1A-CW1.1/T2A-CW1.1/T3A-CW1.1 |
| X86301-ST01-23 | 3020 | 44 | T1B-CW1.1/T2B-CW1.1/T3B-CW1.1 |
| | | | T1B-CW5.1/T2B-CW5.1/T3B-CW5.1 |
| | | | T1A-CW6.1/T2A-CW5.1/T2A-CW4.1/T3A-CW6.1 |
| | | | T1B-CW3.1/T2B-CW3.1/T3B-CW3.1 |
| | | | T1B-CW6.1/T2B-CW6.1/T2B-CW6.1 |
| | | | T1A-CW5.1/T2A-CW5.1/T3A-CW5.1 |
| | | | T2A-CW3.1/T3A-CW3.1/T3A-CW4.1 |
| X86301-ST01-24 | 2940 | 12 | T1B-CW2.1/T2B-CW2.1/T3B-CW2.1 |
| | | | T1A-CW7.1/T2A-CW3.1/T3A-CW3.1 |
| X86301-ST01-25 | 3025 | 6 | T1B-CW4.1/T2B-CW4.1/T3B-CW4.1 |
| X86301-ST01-26 | 2995 | 4 | T1A-CW4.1/T1A-CW3.1 |

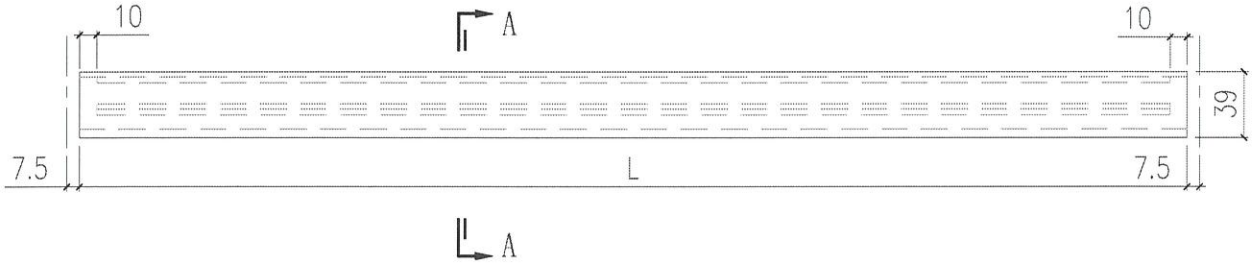


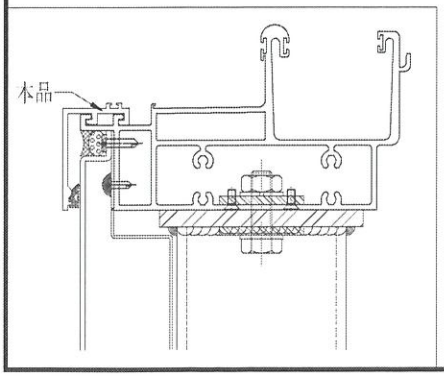


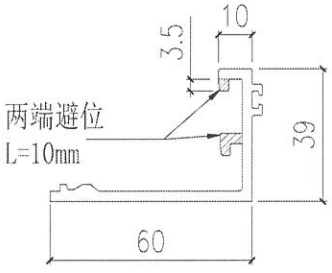


SECTION A-A

| 美特鋁質有限公司 MIDI Aluminium Fabricator Ltd. | | | | | | | | | | | | | |
|---|---|---|---|---|---|---|---|---|---|---|---|---|---|
| | | | | | 工程號 | J858 | 類別 | | 物料號 | - | | | |
| | | | | | 地盘 | 康城11期 | 制圖 | W.E.X | 2022-06-10 | 圖號 | X86301-ST02 | | |
| 修改 | - | - | - | 採用 工廠 | | 地盤 ✓ | 图纸名称 | 铝料加工图 | 復核 | - | - | 數量 | - | |
| 日期 | - | - | - | 材料颜色 | 深铜色(ECD3HO497 6S-XF1) | | 材料 | X86301 | 批准 | - | - | 單件重量 | - | (KG) |

| 部件编号 | L | L1 | 数量 | 位置 |
|---|---|---|---|---|
| X86301-ST02-01 | 3900 | 3882 | 5 | T1B-CW3/T1A-CW5/T2B-CW3/T2A-CW5/T3A-CW5 |
| X86301-ST02-02 | 765 | 747 | 4 | T1B-CW4/T1A-CW4/T2B-CW4/T3B-CW4 |
| X86301-ST02-03 | 1825 | 1807 | 1 | T3B-CW3 |

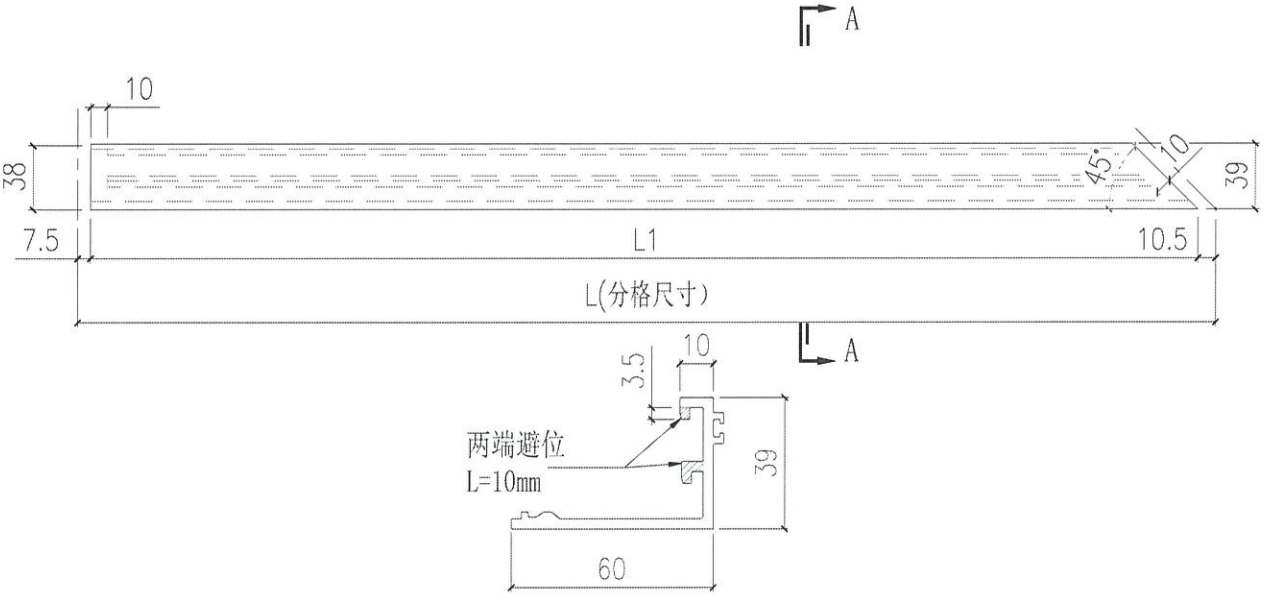





SECTION A-A

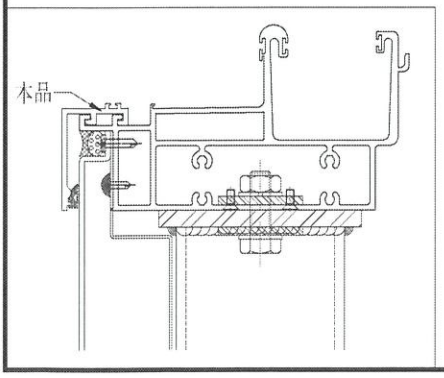

| 美特鋁質有限公司 MIDI Aluminium Fabricator Ltd. | | | | | | | | | | | | | |
|---|---|---|---|---|---|---|---|---|---|---|---|---|---|
| 修改 | – | – | – | 採用 | 工廠 | | 地盤 | ✓ | 工程號 | J858 | 類別 | | 物料號 | – |
| 日期 | – | – | – | 材料顏色 | 深铜色(ECD3W0497 6S-XF1) | | | | 地盘 | 康城11期 | 制圖 | W.E.X | 2022-06-10 | 圖號 X86301-ST03 |
| | | | | | | | | | 图纸名称 | 铝料加工图 | 復核 | – | – | 數量 – |
| | | | | | | | | | 材料 | X86301 | 批准 | – | – | 單件重量 – (KG) |

| 部件编号 | L | L1 | 数量 | 位置 |
|---|---|---|---|---|
| X86301-ST03-01 | 765 | 747 | 6 | T1B-CW3/T1A-CW5/T2B-CW3/T2A-CW5/T3B-CW3/T3A-CW5 |
| X86301-ST03-02 | 5362.5 | 5344.5 | 2 | T1B-CW4/T3B-CW4 |
| X86301-ST03-03 | 3790 | 3772 | 1 | T1B-CW4 |
| X86301-ST03-04 | 3900 | 3882 | 1 | T2B-CW4 |

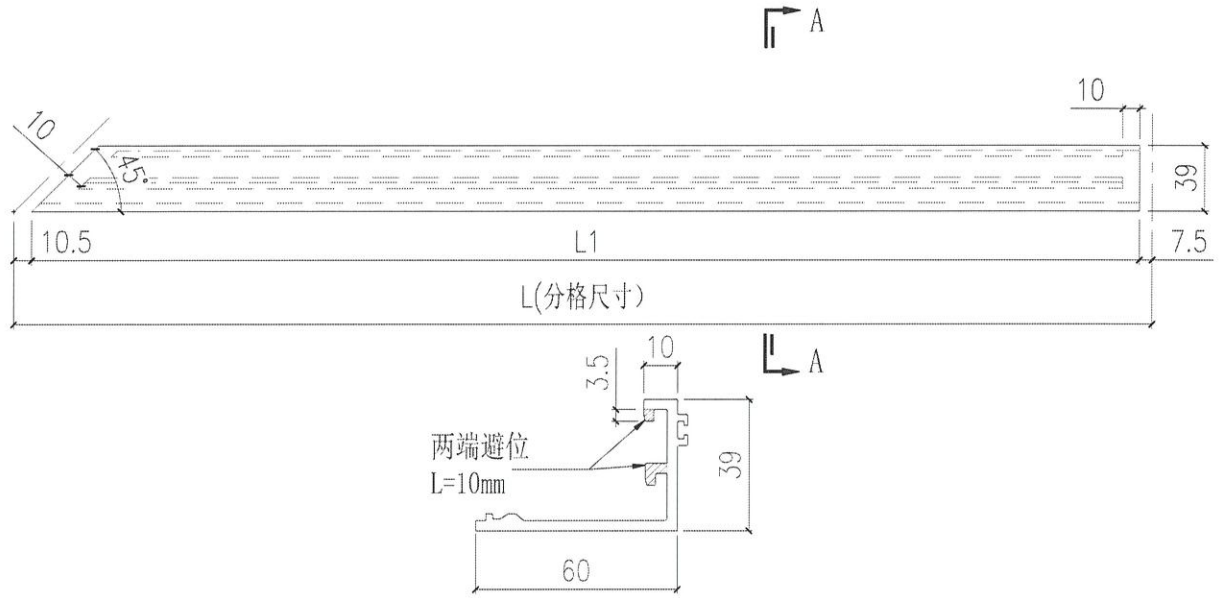


SECTION A-A

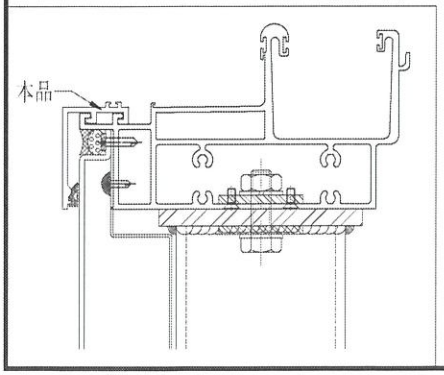

| 美特鋁質有限公司 MIDI Aluminium Fabricator Ltd. | | | | 工程號 | J858 | 類別 | | 物料號 | - | | |
|---|---|---|---|---|---|---|---|---|---|---|---|
| | | | | 地盘 | 康城11期 | 制圖 | W.E.X | 2022-05-13 | 圖號 | X86303-01 | |
| 修改 | - | - | - | 採用 工廠 ✓ 地盤 | | 图纸名称 | 水槽料加工图 | 復核 | - | - | 數量 | 229 |
| 日期 | - | - | - | 材料颜色 | CHROMATE | 材料 | X86303 | 批准 | - | - | 單件重量 | - (KG) |

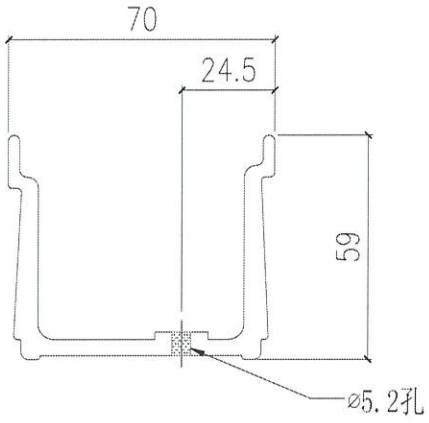


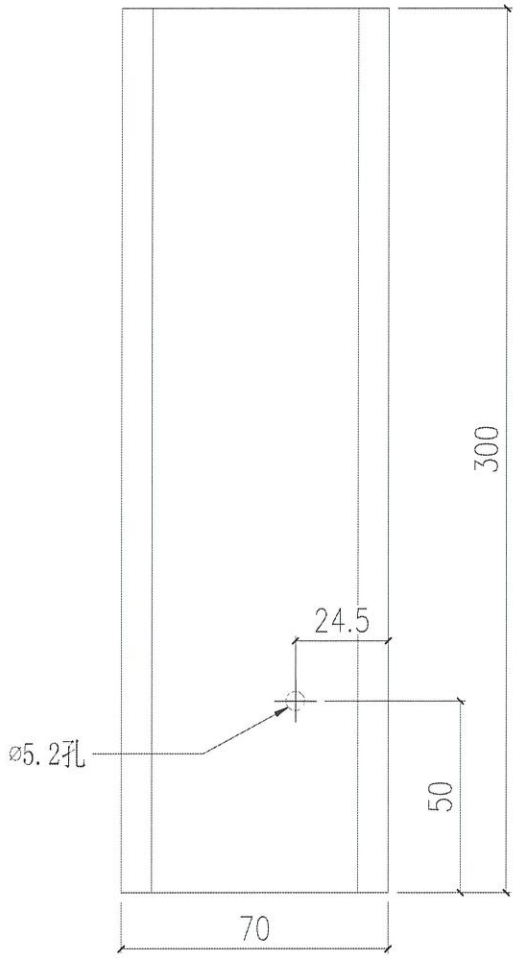

| 美特鋁質有限公司 MIDI Aluminium Fabricator Ltd. | | | | 工程號 | J858 | 類別 | | 物料號 | - | | |
|---|---|---|---|---|---|---|---|---|---|---|---|
| | | | | 地盘 | 康城11期 | 制圖 | W.E.X | 2022-05-13 | 圖號 | X86303-02 | |
| 修改 | - | - | - | 採用 工廠 ✓ 地盤 | | 图纸名称 | 水槽料加工图 | 復核 | - | - | 數量 | 119 |
| 日期 | - | - | - | 材料颜色 | CHROMATE | 材料 | X86303 | 批准 | - | - | 單件重量 | (KG) |

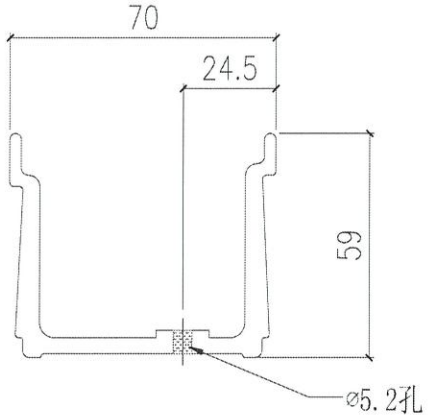


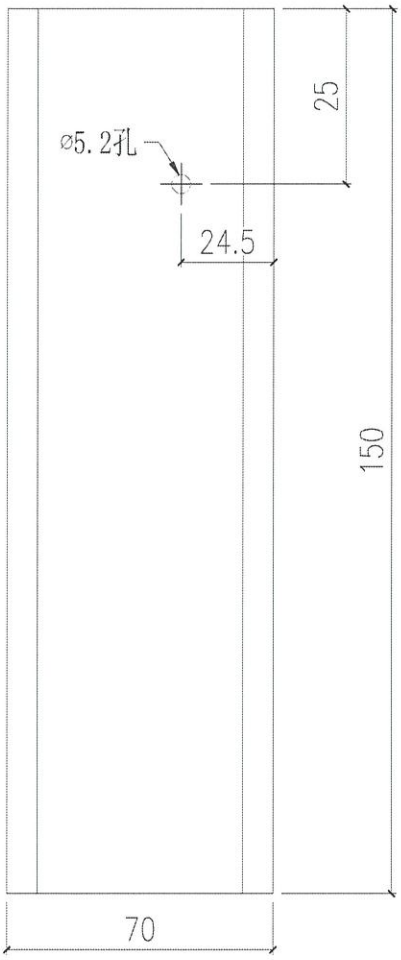

| 美特鋁質有限公司 MIDI Aluminium Fabricator Ltd. | | | | 工程號 | J858 | 類別 | | 物料號 | - | | |
|---|---|---|---|---|---|---|---|---|---|---|---|
| | | | | 地盘 | 康城11期 | 制圖 | W.E.X | 2022-05-13 | 圖號 | X86303-03 | |
| 修改 | -- | -- | -- | 採用 | 工廠 ✓ 地盤 | 图纸名称 | 水槽料加工图 | 復核 | - | - | 數量 | 119 |
| 日期 | - | - | - | 材料颜色 | CHROMATE | 材料 | X86303 | 批准 | - | - | 單件重量 | - (KG) |

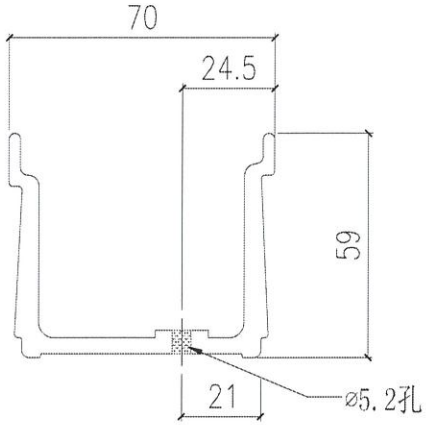


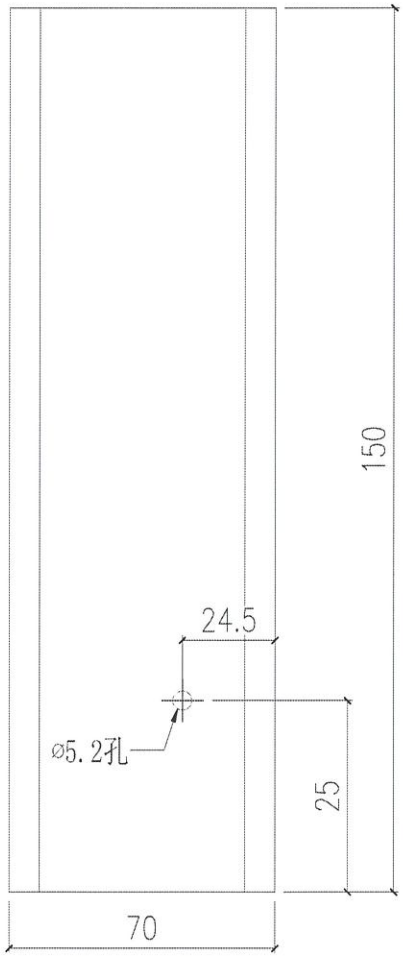

| 美特鋁質有限公司 MIDI Aluminium Fabricator Ltd. | | | | 工程號 | J858 | 類別 | | 物料號 | - | | |
|---|---|---|---|---|---|---|---|---|---|---|---|
| | | | | 地盘 | 康城11期 | 制圖 | W.E.X | 2022-05-13 | 圖號 | X86303-04 | |
| 修改 | - | - | - | 採用工廠 | ✓地盤 | 图纸名称 | 水槽料加工图 | 復核 | - | - | 數量 | 10 |
| 日期 | - | - | - | 材料颜色 | CHROMATE | 材料 | X86303 | 批准 | - | - | 單件重量 | - (KG) |

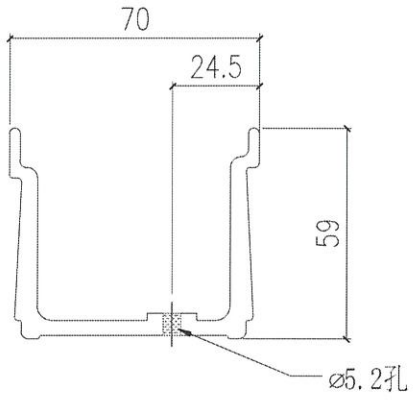


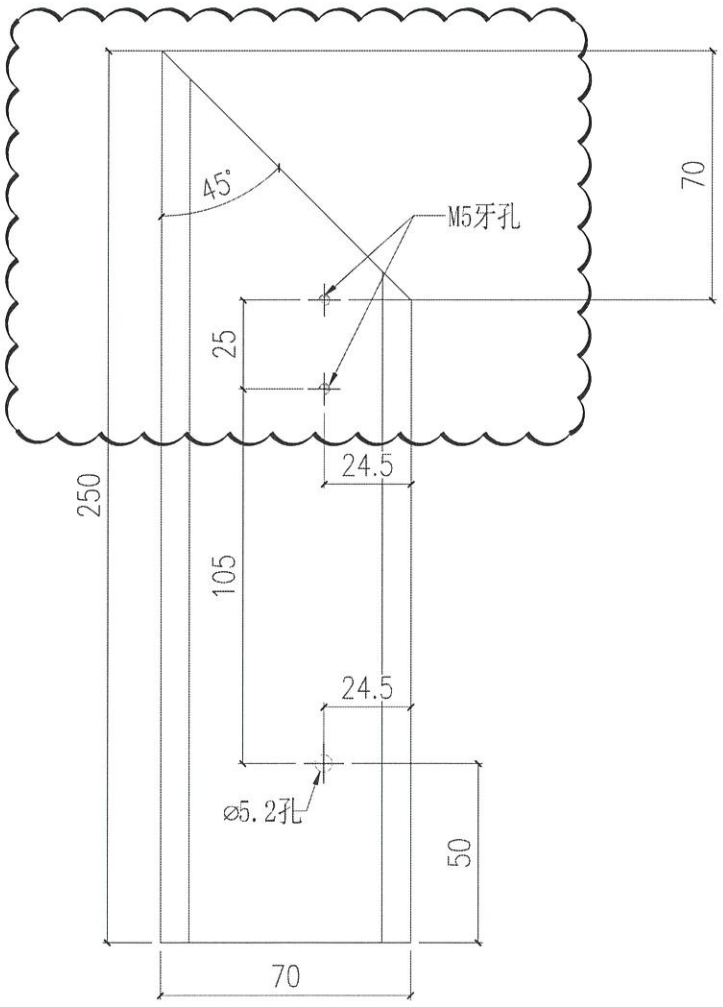

| 美特鋁質有限公司 MIDI Aluminium Fabricator Ltd. | | | | | 工程號 | J858 | 類別 | | 物料號 | - | | |
|---|---|---|---|---|---|---|---|---|---|---|---|---|
| | | | | | 地盘 | 康城11期 | 制圖 | W.E.X | 2022-05-13 | 圖號 | X86303-05 | |
| 修改 | - | - | - | 採用工廠 ✓ 地盤 | 图纸名称 | 水槽料加工图 | 復核 | - | - | 數量 | 10 | |
| 日期 | - | - | - | 材料顏色 CHROMATE | 材料 | X86303 | 批准 | - | - | 單件重量 | - | (KG) |