

工程指示 / 要求簡箋(E.I.)

工程指示編號：EI/5400 / 22

修改版次：-

工程編號：J - 858

工程名稱：將軍澳日出康城

工程項目：樣板層 T1 單元件 廠用玻璃 bm 改倉 (T1A/G+T1B/F) / (T1A/C+T1A/D) 32 件

收件人：生統 / Maggie

發件人：Ant Yeung

日期：30/11/2022

要求提供 /  確認 事項：

- |                                    |                                     |                               |
|------------------------------------|-------------------------------------|-------------------------------|
| <input type="checkbox"/> 初步鋁料 B.M. | <input type="checkbox"/> 加工拆圖，然後生產  | <input type="checkbox"/> 尺寸表  |
| <input type="checkbox"/> 正式鋁料 B.M. | <input type="checkbox"/> 技術上資料 / 指示 | <input type="checkbox"/> 報價   |
| <input type="checkbox"/> 配件 B.M.   | <input type="checkbox"/> 樣辦或貨品說明書   | <input type="checkbox"/> 分判合約 |

內容：

則師已批修改倉改後尺寸。

現先訂樣板層急需的 32 件玻璃。包含(12/F 起腳 +12,15,16/F 單元) 共 16 件梗單元的 32 件玻璃  
此(4 個派倉) 共 16 件單元

請按玻璃 BM 生產玻璃送廠。儘快安排熱浸。儘快出貨。

玻璃加工圖跟大貨。

請在 2022. 12. 10 前完成上列要求。

附：

以上項目為：

- |                                 |                                      |                                |
|---------------------------------|--------------------------------------|--------------------------------|
| <input type="checkbox"/> 原合約工程包 | <input type="checkbox"/> 原合約工程加 / 減賬 | <input type="checkbox"/> 新工程報價 |
|---------------------------------|--------------------------------------|--------------------------------|

分發東莞各部門：

- |                                 |                                |                               |                                |
|---------------------------------|--------------------------------|-------------------------------|--------------------------------|
| <input type="checkbox"/> 生產技術總監 | <input type="checkbox"/> 技術部   | <input type="checkbox"/> 生產部  | <input type="checkbox"/> 機械設計部 |
| <input type="checkbox"/> 採購部    | <input type="checkbox"/> 生產統籌部 | <input type="checkbox"/> 小羅&清 |                                |
| <input type="checkbox"/> 質檢部    | <input type="checkbox"/> 會計部   | <input type="checkbox"/> 報關組  | <input type="checkbox"/> 其他 水洪 |

分發其他分判：

連附件 檳

分發香港各部門：

- |                              |                               |                              |                                  |
|------------------------------|-------------------------------|------------------------------|----------------------------------|
| <input type="checkbox"/> 行政部 | <input type="checkbox"/> 會計部  | <input type="checkbox"/> 統籌部 | <input type="checkbox"/> 工程部地盤科文 |
| <input type="checkbox"/> 採購部 | <input type="checkbox"/> QS 部 | <input type="checkbox"/> 維修部 | <input type="checkbox"/> 其他      |

傳遞編號：

HK 2134 / 22

發件人簽署：

項目經理簽署：

# 58康城11期单元幕墙玻璃分层统计表 (T1 单元幕墙)

工程: J858康城11期 (T1)

日期: 30/11

序号	玻璃编号	玻璃类型	玻璃尺寸			总数量	总面积	备注
			W(mm)	x	H(mm)			
12	GL01-12FG	GL01	738	x	2332	3	5.2	送工厂
8	GL03-08FG	GL03	738	x	843	4	2.5	送工厂
55	GL03-111FG	GL03	738	x	308	1	0.2	送工厂
21	GL01-21FG	GL01	1519	x	2332	3	10.6	送工厂
26	GL03-28FG	GL03	1519	x	843	4	5.1	送工厂
56	GL03-112FG	GL03	1519	x	308	1	0.5	送工厂
12	GL01-12CD	GL01	713	x	2332	3	5.0	送工厂
8	GL03-08CD	GL03	713	x	843	4	2.4	送工厂
55	GL03-111CD	GL03	713	x	308	1	0.2	送工厂
28	GL01-29CD	GL01	1494	x	2332	3	10.5	送工厂
36	GL03-40CD	GL03	1494	x	843	4	5.0	送工厂
57	GL03-113CD	GL03	1494	x	308	1	0.5	送工厂

32 47.7

玻璃  
编号  
如上  
FG  
或CD尾  
以免混乱

注:	玻璃类型						
1	GL01						(R20220114001)
3	GL03						(R20220324054)

16 件單元 - 32 件玻璃

12 件起腳 - 12, 15, 16 件

T1A⑨

B(F)

T1A⑩⑪


778

1586


+FG瓦

+CD瓦


1531

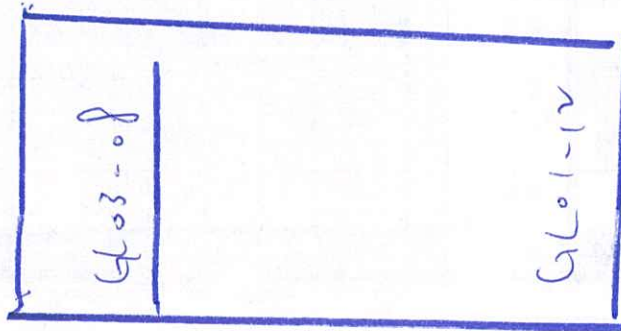


3x

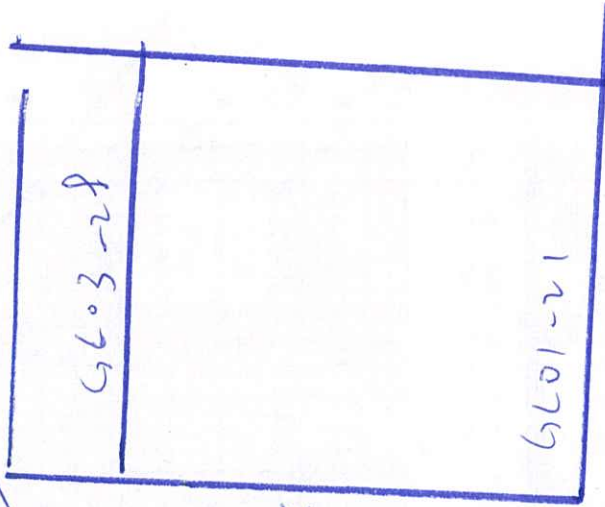


3x

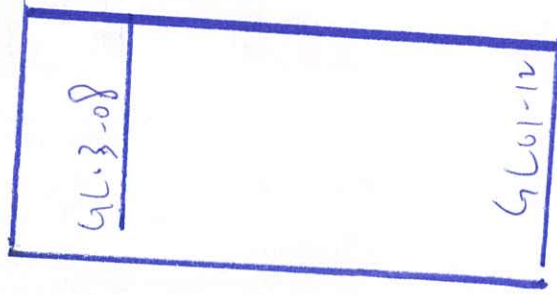


3x

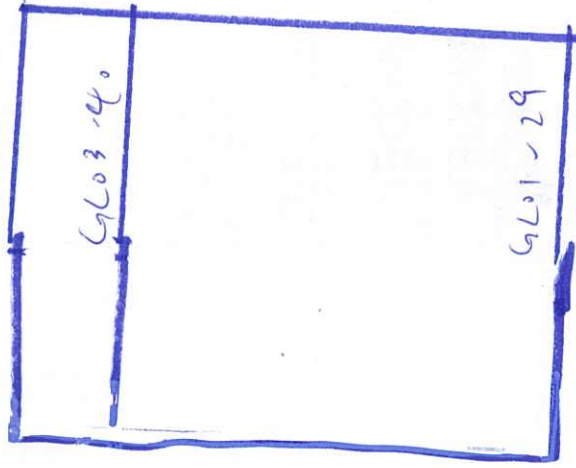


3x

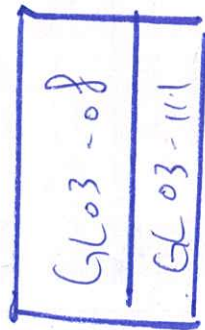


1x

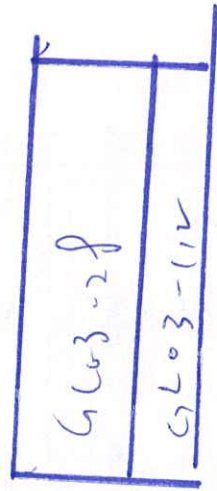



1x

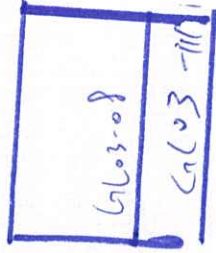

1x

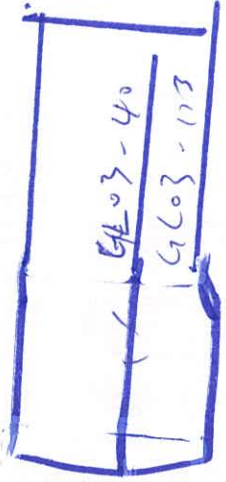


1x

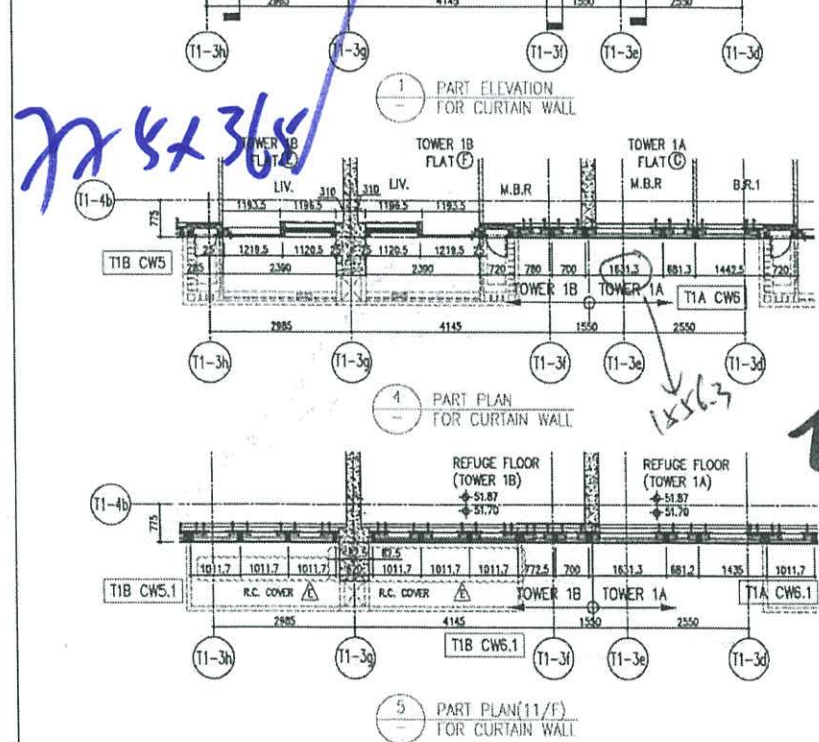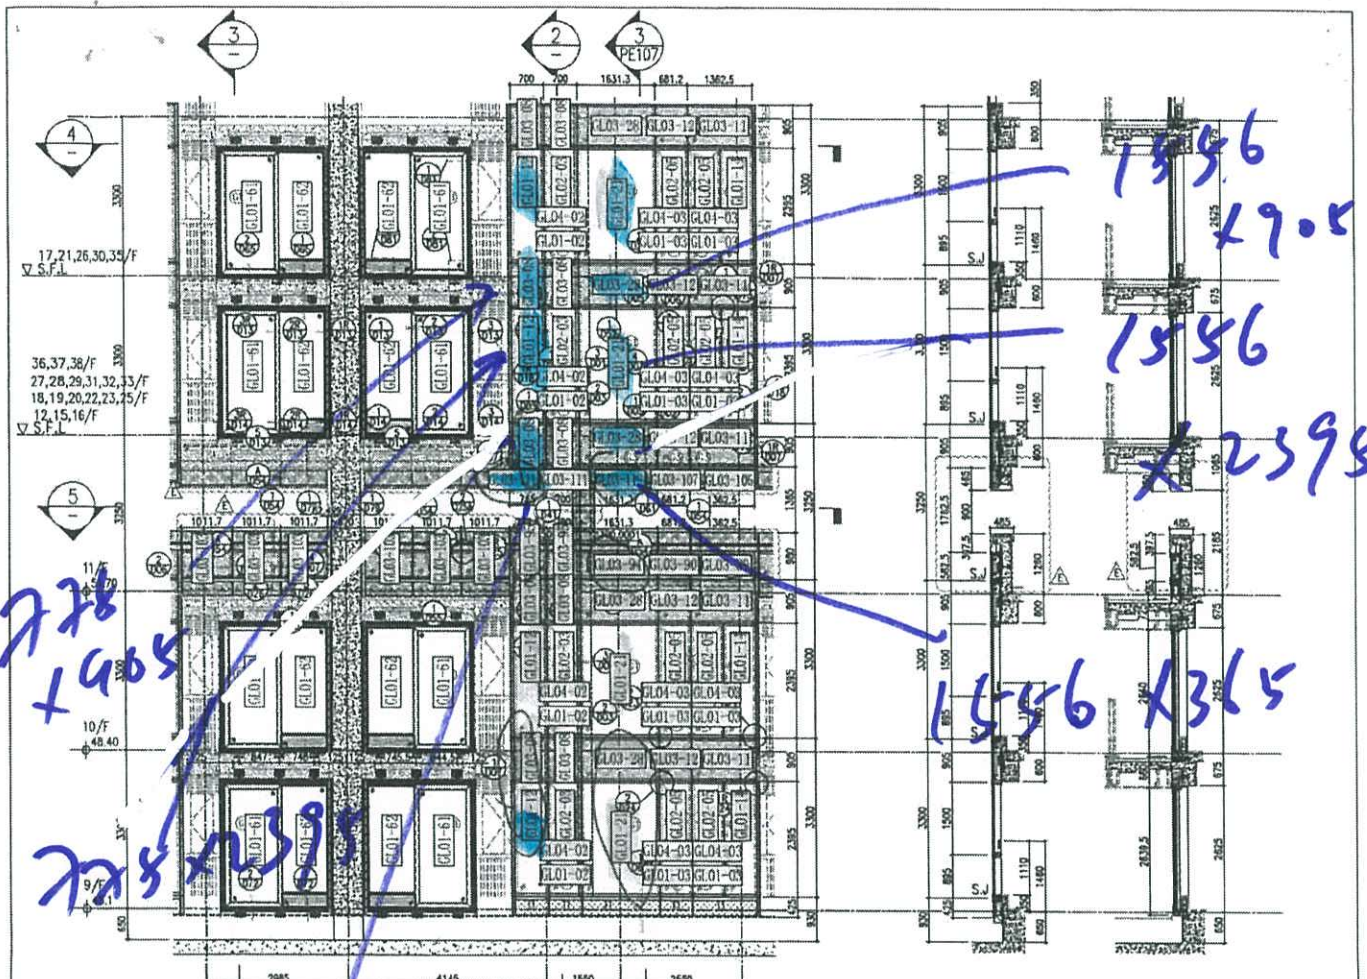

26/F	+91.25	39/F	+130.85	52/F	+170.40		
25/F	+87.95	38/F	+127.55	51/F	+167.10	R/F	+203.80
23/F	+84.65	37/F	+124.25	50/F	+163.80	62/F	+200.30
22/F	+81.35	36/F	+120.95	49/F	+160.50	61/F	+196.80
21/F	+78.05	35/F	+117.65	48/F	+157.20	60/F	+193.30
20/F	+74.75	33/F	+114.35	47/F	+153.90	59/F	+190.20
19/F	+71.45	32/F	+111.05	46/F	+150.60	58/F	+186.90
18/F	+68.15	31/F	+107.75	45/F	+147.30	57/F	+183.60
17/F	+64.85	30/F	+104.45	43/F	+144.00	56/F	+180.30
16/F	+61.55	29/F	+101.15	42/F	+140.70	55/F	+177.00
15/F	+58.25	28/F	+97.85	41/F	+137.40	53/F	+173.70
12/F	+48.95	27/F	+94.55	40/F	+134.10		

- LEGEND:**
- 10mm THK. HEAT STRENGTHENED GLASS (OUTSIDE) + 12mm AIR SPACE + 12mm THK. TEMPERED GLASS
  - 12mm THK. HEAT STRENGTHENED GLASS (OUTSIDE) + 12mm AIR SPACE + 10mm THK. TEMPERED GLASS
  - 12mm THK. HEAT STRENGTHENED GLASS
  - 12mm THK. CLEAR TEMPERED GLASS (INTERNAL PROTECTIVE BARRIER)
  - 12mm CLEAR HEAT STRENGTHENED GLASS
  - 10mm THK. CLEAR TEMPERED GLASS
  - 8mm THK. CLEAR HEAT-STRENGTHENED GLASS + 1.52mm PVB + 8mm THK. CLEAR HEAT-STRENGTHENED GLASS
  - 3 mm THK. ALUM. CLADDING
  - 3 mm THK. ALUM. BACKPAN
  - STACK JOINT

<p><b>PROJECT:</b> PROPOSED RESIDENTIAL DEVELOPMENT AT NORTH YORK, PHASE 11, LAMAS PARK, ISHONG KWAN O, N.T.</p> <p><b>TITLE:</b> TYPICAL FLOOR PARTIAL ELEVATION &amp; SECTION, PLAN FOR CURTAIN WALL (TOWER 1)</p> <p>DATE: 22-05-21 SCALE: 1:50(A1)</p> <p>DRAWN BY: [Signature] CHECKED BY: [Signature]</p>	<p><b>JOB NO.:</b> J-858</p> <p><b>REV.:</b></p> <table border="1"> <tr><th>NO.</th><th>DESCRIPTION</th><th>DATE</th></tr> <tr><td>1</td><td>ISSUED AS PER CONDITIONS</td><td>15</td></tr>
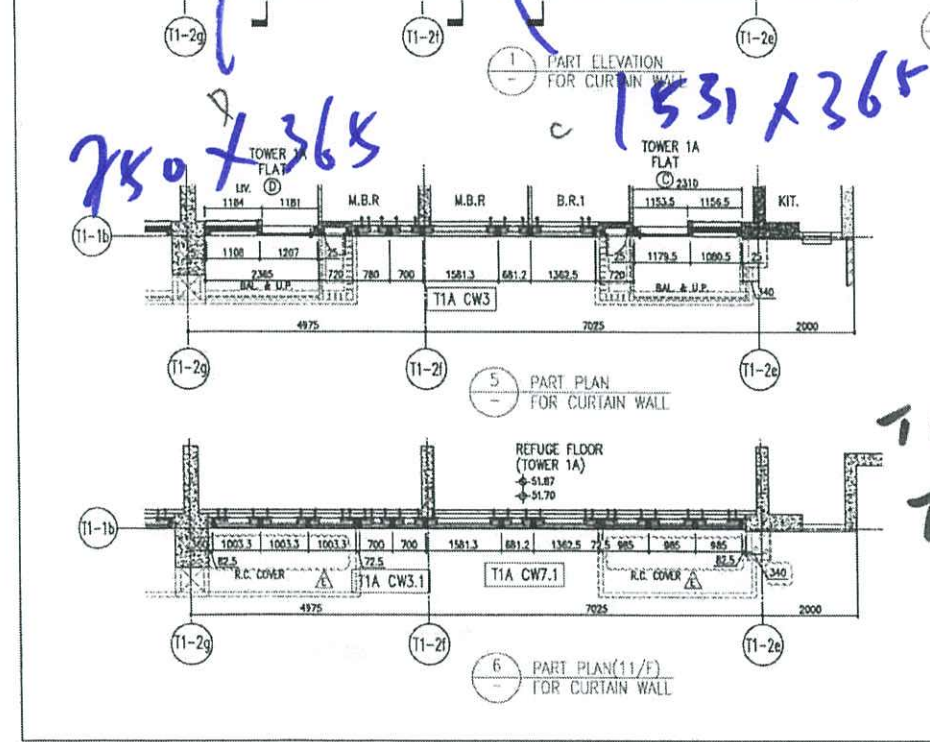

26/F	+91.25	39/F	+130.88	52/F	+170.40		
25/F	+87.95	38/F	+127.58	51/F	+167.10	R/F	+203.80
23/F	+84.65	37/F	+124.28	50/F	+163.80	62/F	+200.30
22/F	+81.35	36/F	+120.95	49/F	+160.50	61/F	+196.80
21/F	+78.05	35/F	+117.65	48/F	+157.20	60/F	+193.30
20/F	+74.75	33/F	+114.35	47/F	+153.90	59/F	+190.20
19/F	+71.45	32/F	+111.05	46/F	+150.60	58/F	+186.90
18/F	+68.15	31/F	+107.75	45/F	+147.30	57/F	+183.60
17/F	+64.85	30/F	+104.45	43/F	+144.00	56/F	+180.30
16/F	+61.55	29/F	+101.15	42/F	+140.70	55/F	+177.00
15/F	+58.25	28/F	+97.85	41/F	+137.40	54/F	+173.70
12/F	+54.95	27/F	+94.55	40/F	+134.15		

- LEGEND:**
- 10mm THK. HEAT STRENGTHENED GLASS
  - 1015mm x 12mm AIR SPACE + 10mm THK. TEMPERED GLASS
  - 10mm THK. HEAT STRENGTHENED GLASS
  - OUTSIDE + 12mm AIR SPACE + 10mm THK. TEMPERED GLASS
  - 10mm THK. HEAT STRENGTHENED GLASS
  - 10mm THK. CLEAR TEMPERED GLASS (WITH PROTECTIVE BARRIER)
  - 10mm BLUE TINTED HEAT STRENGTHENED GLASS
  - 10mm THK. CLEAR TEMPERED GLASS
  - 8mm THK. CLEAR HEAT STRENGTHENED GLASS + 1.52mm x 4 8mm THK. CLEAR HEAT-STRENGTHENED GLASS
  - 3 mm THK. ALUM. CLADDING
  - 3 mm THK. ALUM. BACKPAN
  - STACK JOINT

**CLIENT:** 德祥置業有限公司  
Sino Land Company Limited

**PROJECT:** Ronald Yu & Partners  
Ronald Yu & Partners (HK) Ltd.  
吳元亮建築師事務所 (香港) 有限公司

**ARCHITECTURAL ENGINEER:** Gammon  
**AECOM**

**STRUCTURAL ENGINEER:** Gammon  
**AECOM**

**PROJECT CONSULTANT:** AECOM

**DATE:** 22-05-21

**SCALE:** 1:500(A1)


**TITLE:** TYPICAL FLOOR PARTIAL ELEVATION & SECTION, PLAN FOR CURTAIN WALL (TOWER 1)


**DESIGNER:** J.-B.S.


**REVISIONS:**

NO.	DATE	DESCRIPTION
1	12/02/21	ISSUED FOR PERMIT
2	12/02/21	ISSUED FOR PERMIT
3	17/02/21	ISSUED FOR PERMIT
4	17/02/21	ISSUED FOR PERMIT
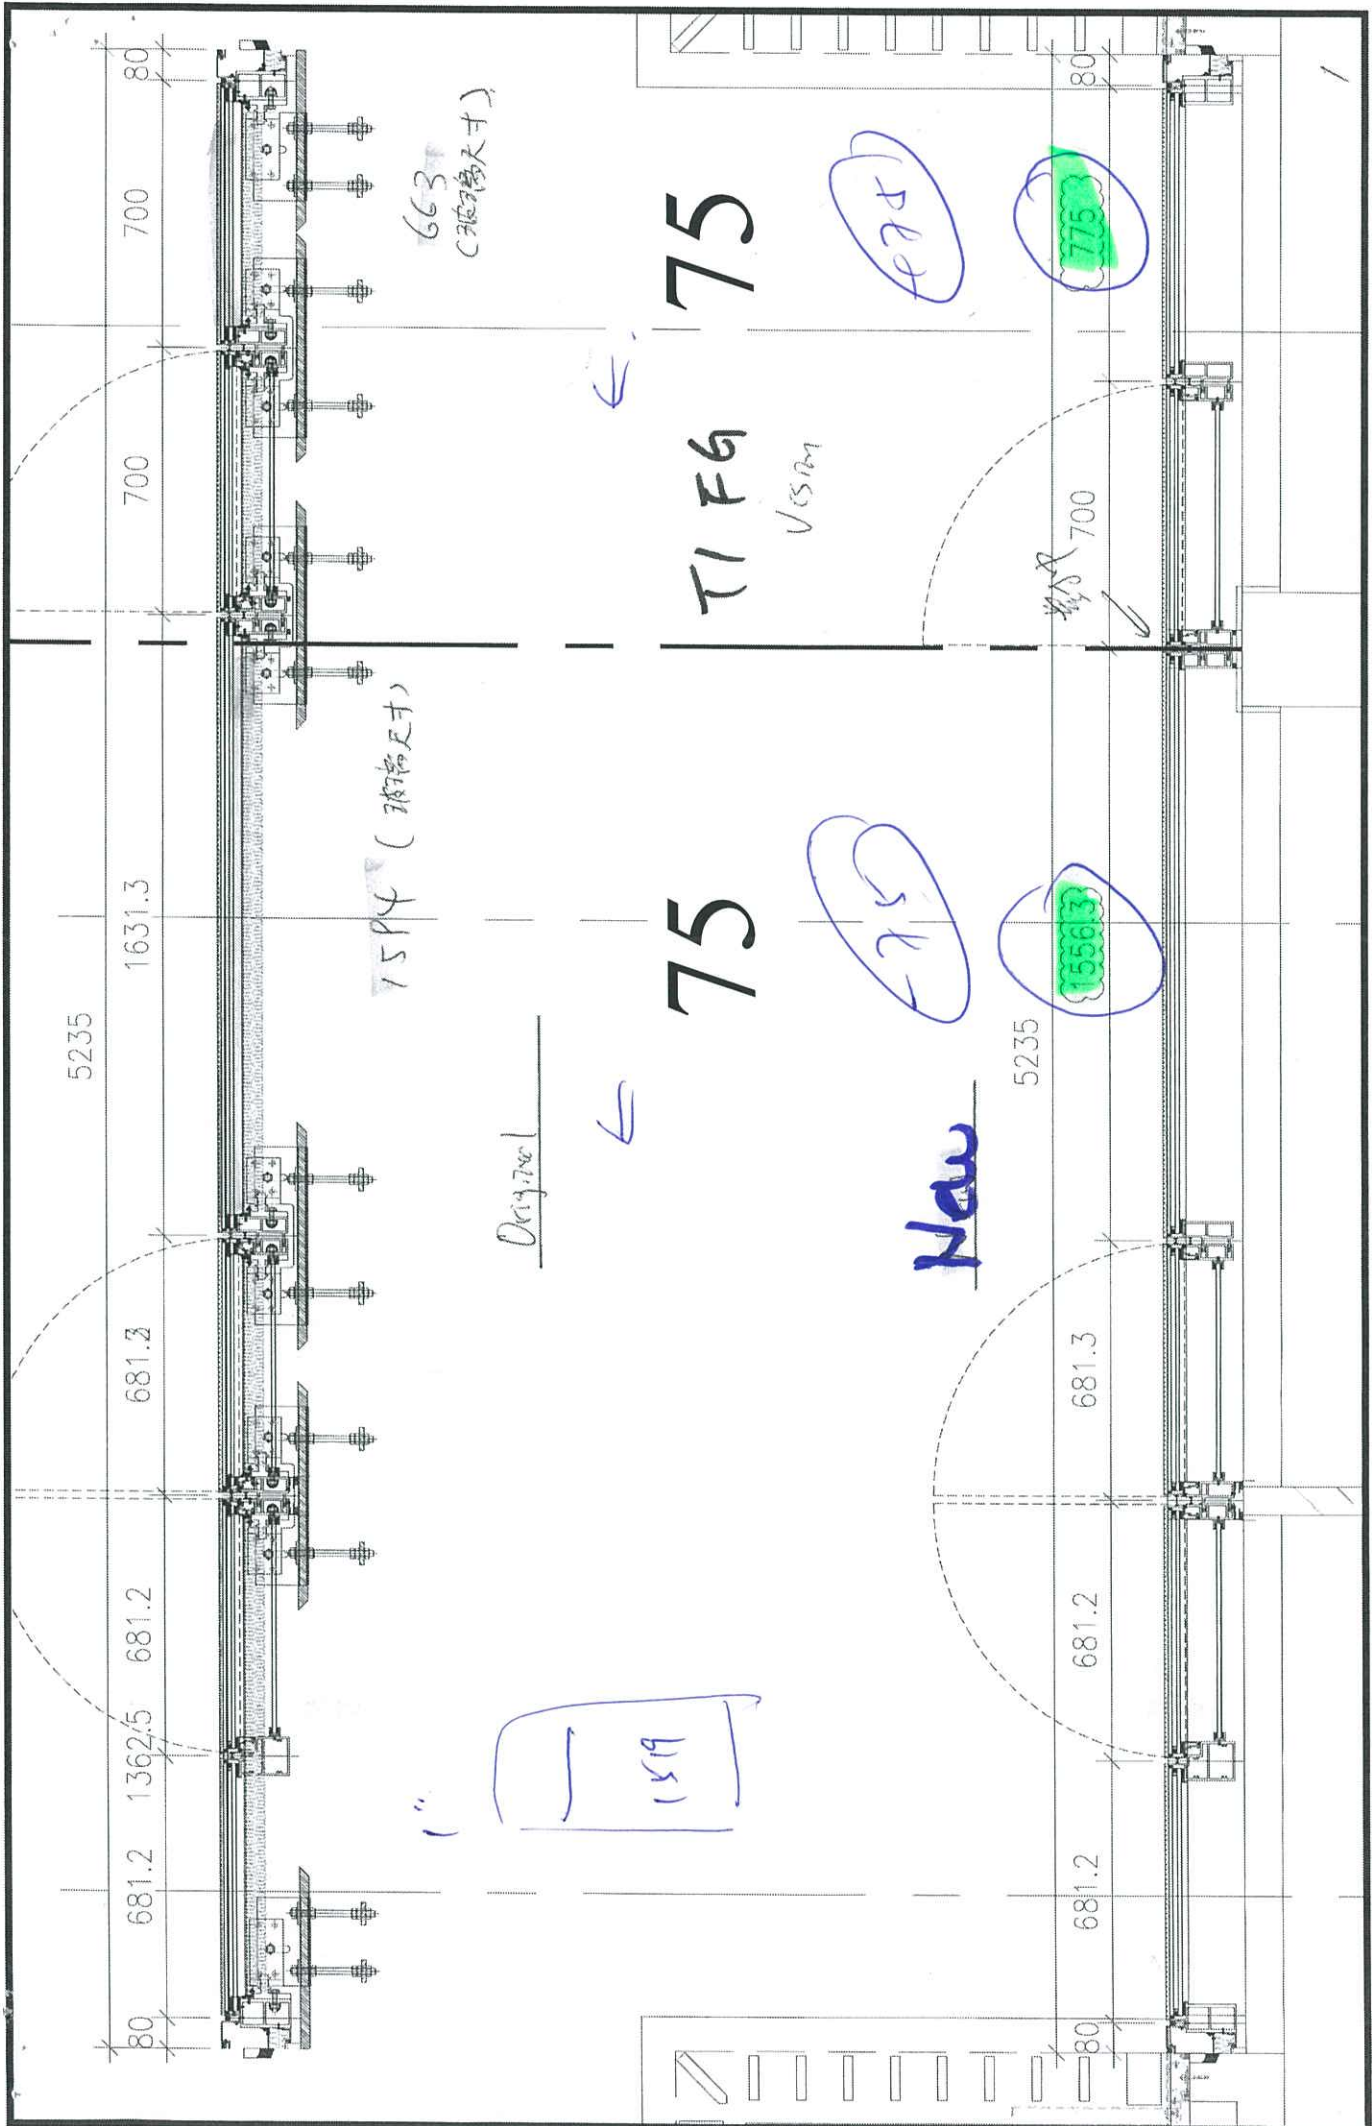

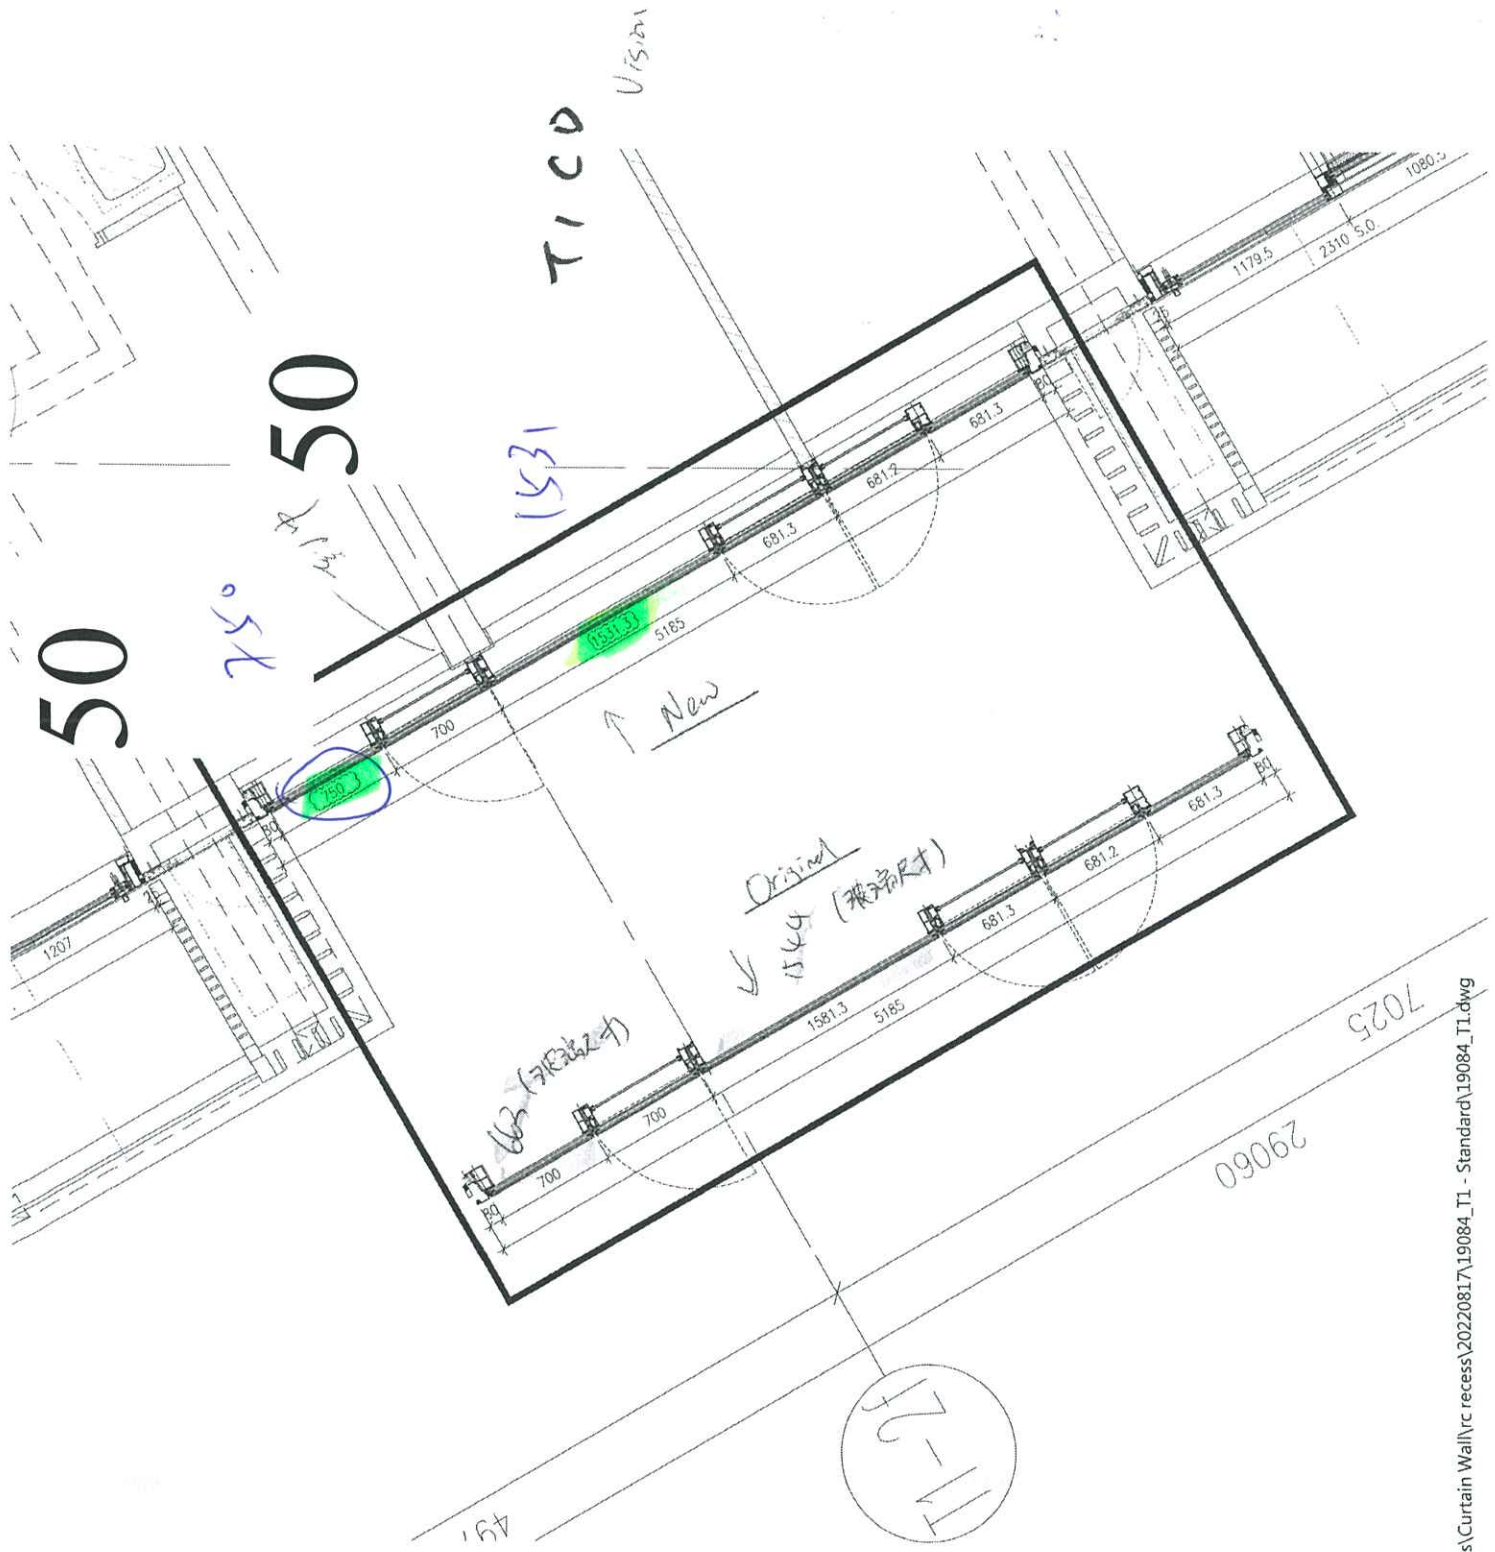

*From:* j858@midiltd.com.hk <j858@midiltd.com.hk>  
*To:* "Matthew. CK. Wong@gammonconstruction.com" <Matthew. CK. Wong@gammonconstruction.com>, "Paco. Ma@gammonconstruction.com" <Paco. Ma@gammonconstruction.com>, "Brian. Ng@gammonconstruction.com" <KaHei. Wong@gammonconstruction.com>, "Woody. Wong@gammonconstruction.com" <Donny. Lo@gammonconstruction.com>, "j3931@gammonconstruction.com" <Terry. KT. Leung@gammonconstruction.com>, "andywchan@sino.com" <andywchan@sino.com>, "kennethleung@sino.com" <kennethleung@sino.com>, "Ginny CHAU [RLPHK]" <ginnychau@rlp.asia>, "P19084@rlphk.com" <P19084@rlphk.com>, "ryan. ko@aecom.com" <ryan. ko@aecom.com>, "cole. li@aecom.com" <cole. li@aecom.com>, "daisy. lau@aecom.com" <daisy. lau@aecom.com>, "crystal. wong@aecom.com" <crystal. wong@aecom.com>, "Wallace NG [RLPHK]" <wallaceng@rlp.asia>, "Florence CHEUNG [RLPHK]" <florencecheung@rlp.asia>, "Marina TONG [RLPHK]" <marinatong@rlp.asia>  
*Subject:* Re: LP11 - MC/41602/858 : 有關則師疑問, 改動單元件分倉setting-out 對應 sales broch  
*Copies to:* "jason. lcs.midi@gmail.com" <jason. lcs.midi@gmail.com>, "bernard. lhf.midi@gmail.com" <ant. ysy.midi@gmail.com> <ant. ysy.midi@gmail.com>  
*Date sent:* Wed, 30 Nov 2022 14:28:14 +0800

Dear Marina Tong

(Reminder )

Please issue AI to cover the changes for setting out..

Thanks

Best regards

Yuen

---

*From:* "Marina TONG [RLPHK]" <marinatong@rlp.asia>  
*To:* "j858@midiltd.com.hk" <j858@midiltd.com.hk>, "Matthew. CK. Wong@gammonconstruction.com" <Matthew. CK. Wong@gammonconstruction.com>, "Jun. Tsui@gammonconstruction.com" <Jun. Tsui@gammonconstruction.com>, "Paco. Ma@gammonconstruction.com" <Paco. Ma@gammonconstruction.com>, "Brian. Ng@gammonconstruction.com" <Brian. Ng@gammonconstruction.com>, "KaHei. Wong@gammonconstruction.com" <KaHei. Wong@gammonconstruction.com>, "Woody. Wong@gammonconstruction.com" <Woody. Wong@gammonconstruction.com>, "Donny. Lo@gammonconstruction.com" <Donny. Lo@gammonconstruction.com>, "j3931@gammonconstruction.com" <j3931@gammonconstruction.com>, "Terry. KT. Leung@gammonconstruction.com" <Terry. KT. Leung@gammonconstruction.com>, "terrywan@sino.com" <terrywan@sino.com>, "andywchan@sino.com" <andywchan@sino.com>, "kennethleung@sino.com" <kennethleung@sino.com>, "Ginny CHAU [RLPHK]" <ginnychau@rlp.asia>

midi@midiltd.com.hk

**From:** "Marina TONG [RLPHK]" <marinatong@rlp.asia>  
**To:** "j858@midiltd.com.hk" <j858@midiltd.com.hk>,  
"Matthew. CK. Wong@gammonconstruction.com"  
<Matthew. CK. Wong@gammonconstruction.com>,  
"Jun. Tsui@gammonconstruction.com"  
<Jun. Tsui@gammonconstruction.com>,  
"Paco. Ma@gammonconstruction.com"  
<Paco. Ma@gammonconstruction.com>,  
"Brian. Ng@gammonconstruction.com"  
<Brian. Ng@gammonconstruction.com>,  
"KaHei. Wong@gammonconstruction.com"  
<KaHei. Wong@gammonconstruction.com>,  
"Woody. Wong@gammonconstruction.com"  
<Woody. Wong@gammonconstruction.com>,  
"Donny. Lo@gammonconstruction.com"  
<Donny. Lo@gammonconstruction.com>,  
"j3931@gammonconstruction.com"  
<j3931@gammonconstruction.com>,  
"Terry. KT. Leung@gammonconstruction.com"  
<Terry. KT. Leung@gammonconstruction.com>,  
"terrywan@sino.com"  
<terrywan@sino.com>,  
"andywchan@sino.com" <andywchan@sino.com>,  
"kennethleung@sino.com" <kennethleung@sino.com>,  
"Ginny CHAU [RLPHK]"  
<ginnychau@rlp.asia>,  
"P19084@rlphk.com" <P19084@rlphk.com>,  
"ryan.ko@aecom.com" <ryan.ko@aecom.com>,  
"cole.li@aecom.com"  
<cole.li@aecom.com>,  
"daisy.lau@aecom.com" <daisy.lau@aecom.com>,  
"crystal.wong@aecom.com" <crystal.wong@aecom.com>,  
"Wallace NG [RLPHK]"  
<wallaceng@rlp.asia>,  
"Florence CHEUNG [RLPHK]" <florencecheung@rlp.asia>  
**Copies to:** "jason.lcs.midi@gmail.com" <jason.lcs.midi@gmail.com>,  
"bernard.lhf.midi@gmail.com" <bernard.lhf.midi@gmail.com>,  
"ant.ysy.midi@gmail.com" <ant.ysy.midi@gmail.com>

**Subject:** RE: LP11 - MC/41602/858 : 有關則師疑  
問, 改動單元件分倉setting-out  
對應 sales brochure  
**Date sent:** Fri, 25 Nov 2022 07:25:09 +0000

Dear Jason (Midi),

Please find our reply to your Appendix 6 at the link below for your further action:

[20221125 shop drawing for CW window division rectification](#)

Regards,  
Marina Tong  
T: 3189 9252

**From:** j858@midiltd.com.hk <j858@midiltd.com.hk>  
**Sent:** Thursday, 24 November 2022 4:50 pm



美特鋁質有限公司  
MIDI ALUMINIUM FABRICATOR LTD.

編號.: MC/41602/858

2022年11月24日

金門建築有限公司  
官塘海濱道77號  
海濱匯1座22樓

電郵及郵遞

收件人: 王振健先生

項目: 日出康城11期地盤  
有關則師疑問, 改動單元件分倉 setting-out 對應 sales brochure

您們好!

現回覆Lohas P11 - Rectification of Curtain Wall Window Division between 2 Flats  
(二零二二年十一月二十一日)

本公司已按Comment 修改和批圖生產, 現修改將涉及 Abortive materials and works。和涉及額外時間重新生產。如需確認進行更改, 請發出A.I 確認。

- 附件 1. (2022.01.18) 3rd Shop Drawing Comment (SD/A/122(Rev.2) - 企料置中)  
附件 2. (2022.02.17) E-mail Comment Shop Drawing (700 and 700 EQ 分倉和企料不置中)  
附件 3. (2022.03.23) 4Ath Shop Dwg 按 Comment 修改和批核 (700 and 700 EQ 分倉和企料不置中)  
附件 4. (2022.09.22) 7th Shop Dwg (MC41408 已批核 - 700 and 700 EQ 分倉和企料不置中)

涉及 Abortive materials and works, 詳見附件 5。

1. 玻璃見光 (IGU) 和 玻璃(Spandrel area)
2. 鋁料單元件
3. 已落石矢位置: 需進行修補方案(打拉爆)/打石矢凹坑 供掛碼 / 油黑油
4. 未落石矢位置: 需改石矢鋁模供留碼

改動需涉及額外時期, 重新加工, 訂購玻璃。預算需時 4 個月, 2023 年 3 月 22 日才能到貨單元件。

本幕牆工程為單元件式安裝, 會因為 1 倉改動尺寸不能安裝, 導致整柱不能安裝。如導致樣板層無法起貨, 或大貨阻礙其他判頭進度, 恕本公司無法承擔責任。





美特鋁質有限公司  
MIDI ALUMINIUM FABRICATOR LTD.

編號.: MC/41602/858

2022年11月24日

第二頁

附件6，為修改後尺寸。如需改動，請發出 A.I 確認修改後尺寸。

報價將另外附上，如有問題可直接聯絡本司。

此謝

美特鋁質有限公司


譚劍文  
董事

附件：共四十二頁

抄送：金門	- Mr. Jun Tsui / Mr. Brian Ng	(電郵)
信和	- Mr. Terry Wan / Mr. Andy Chan / Mr. Kenneth Leung	(電郵)
呂元祥建築	- Ms. Marina Tong / Ms. Ginny Chau	(電郵)
Aecom	- Mr. Ryan Ko / Mr. Cole Li	(電郵)
	- Ms. Daisy Lau / Ms. Crystal Wong	(電郵)

FM/MT/DW/JL/BL/AY/yl




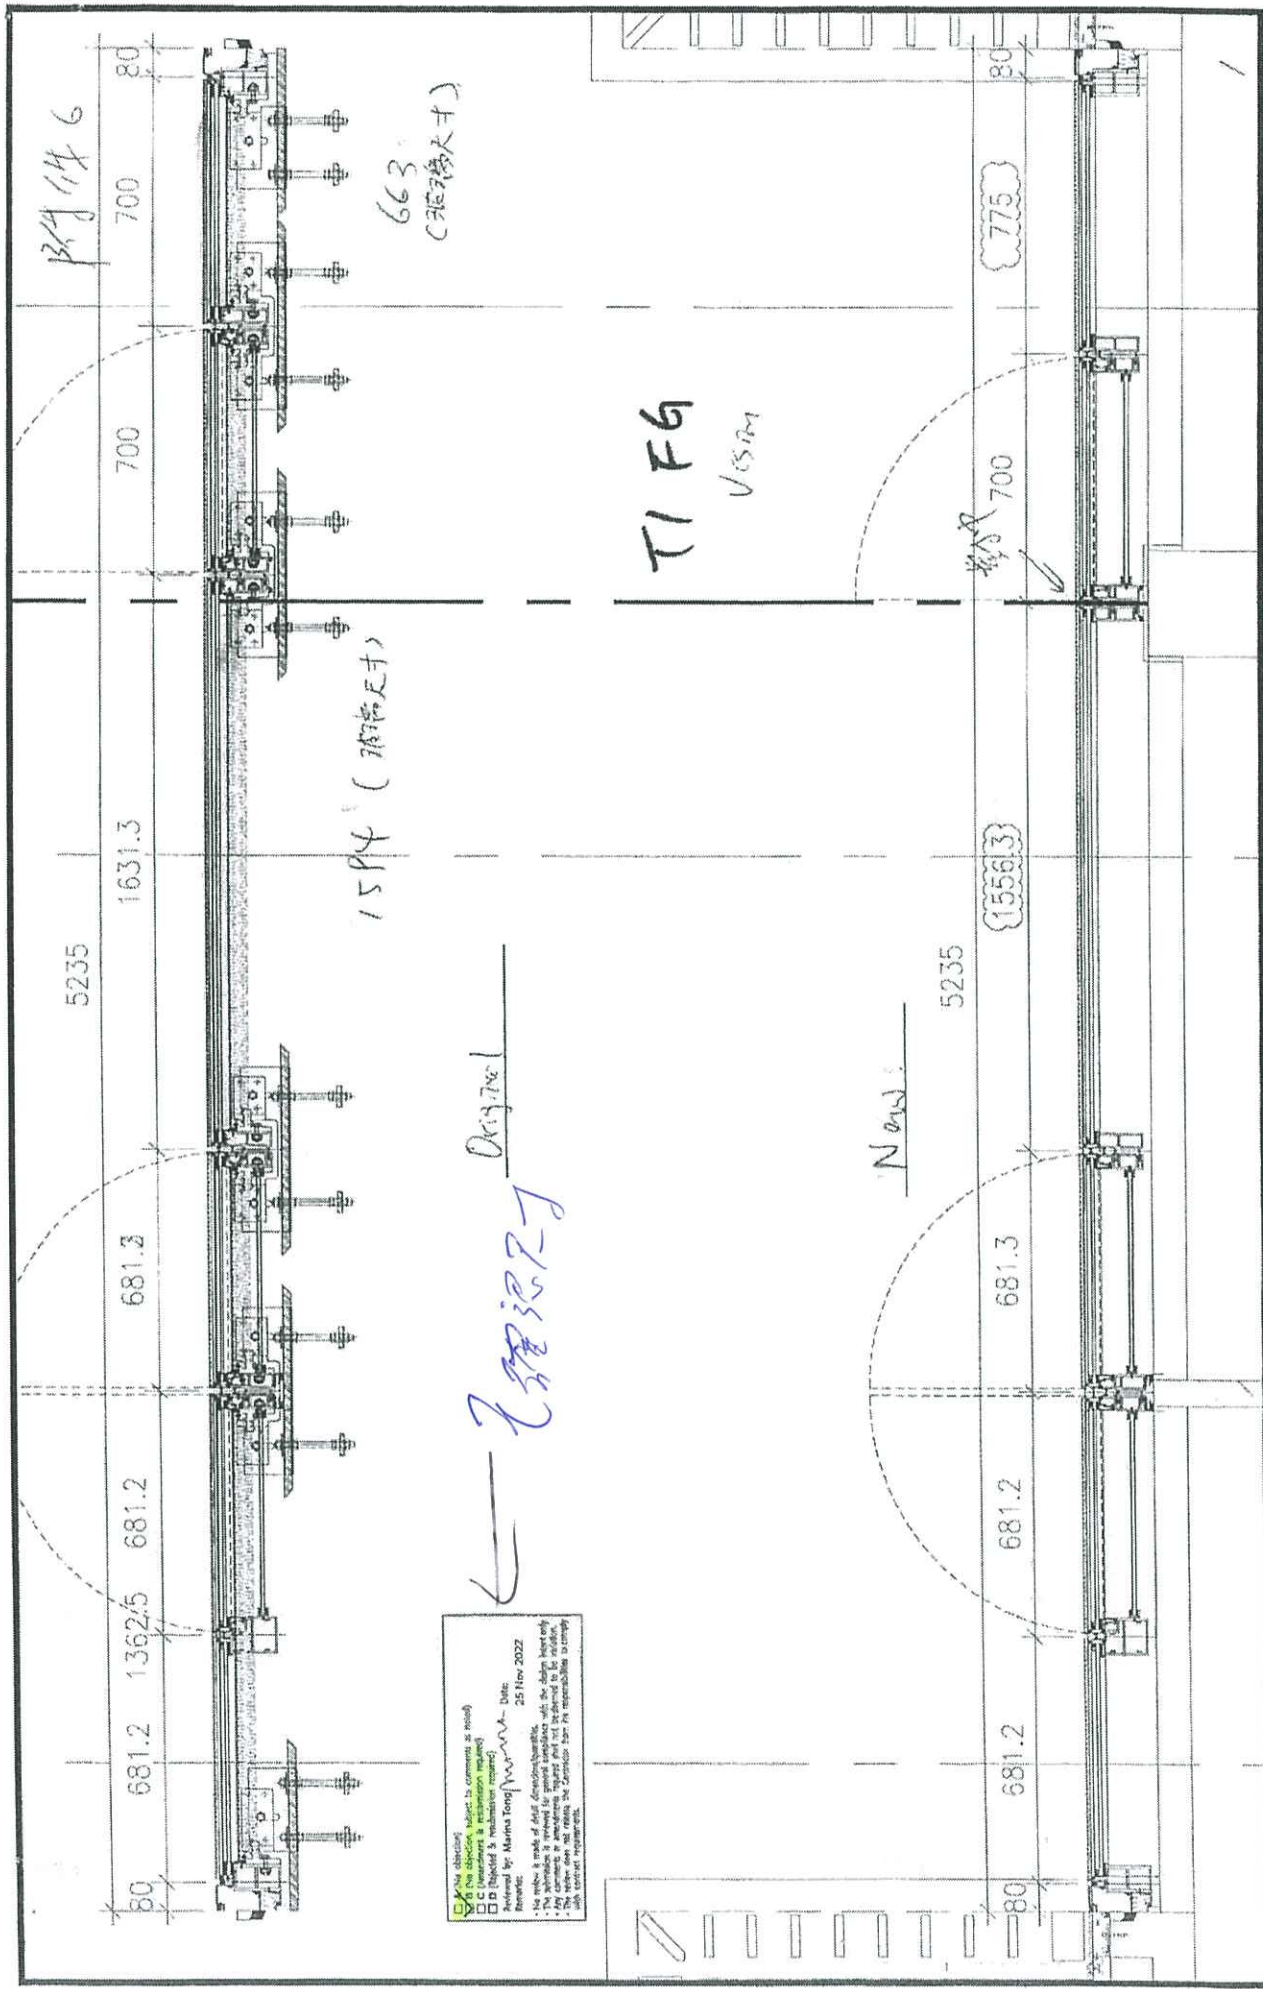

No objection  



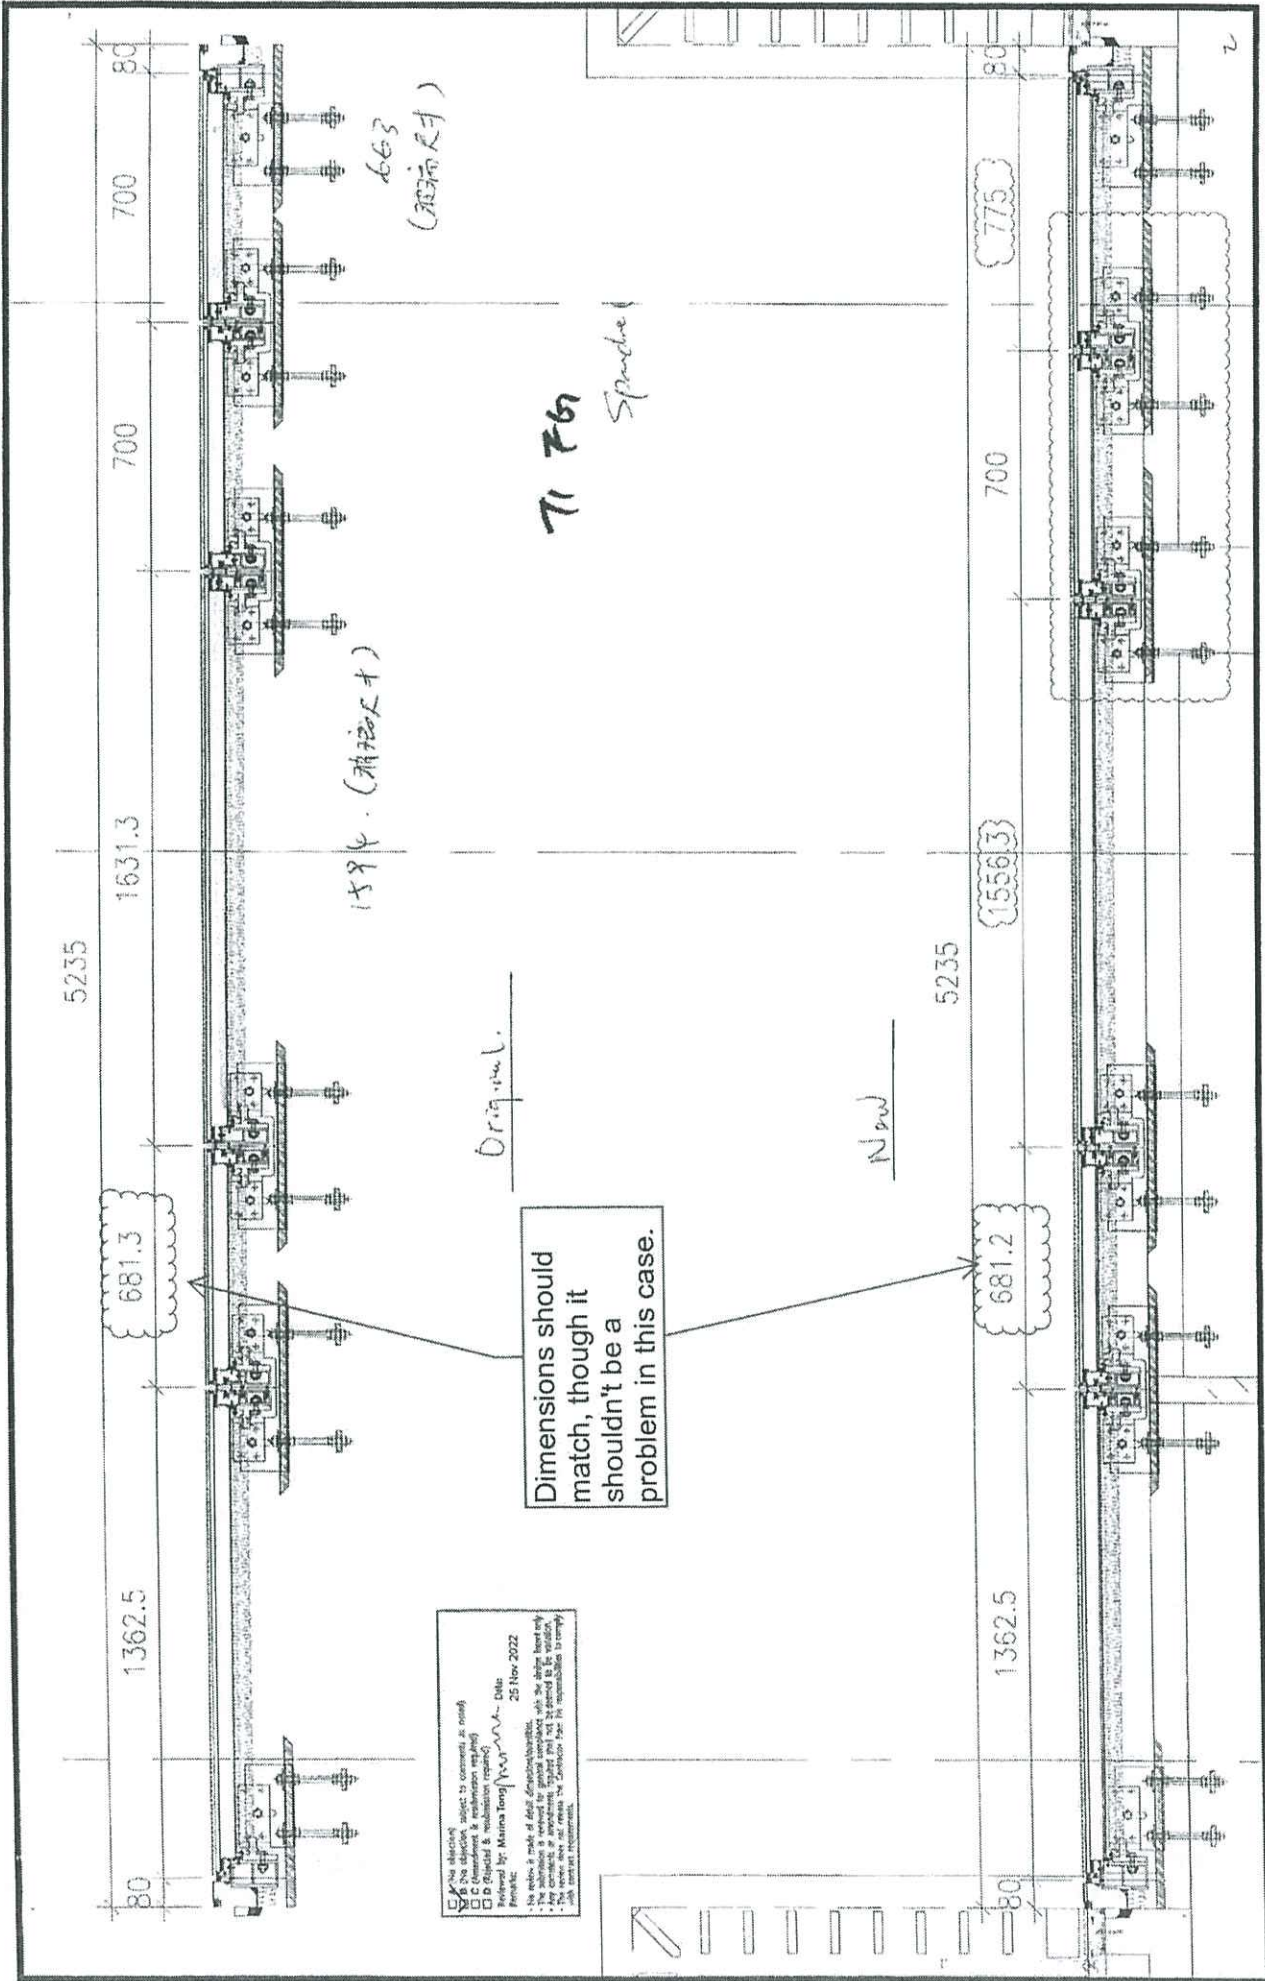


No objection, subject to comment, as noted  

Dimensions should match, though it shouldn't be a problem in this case.

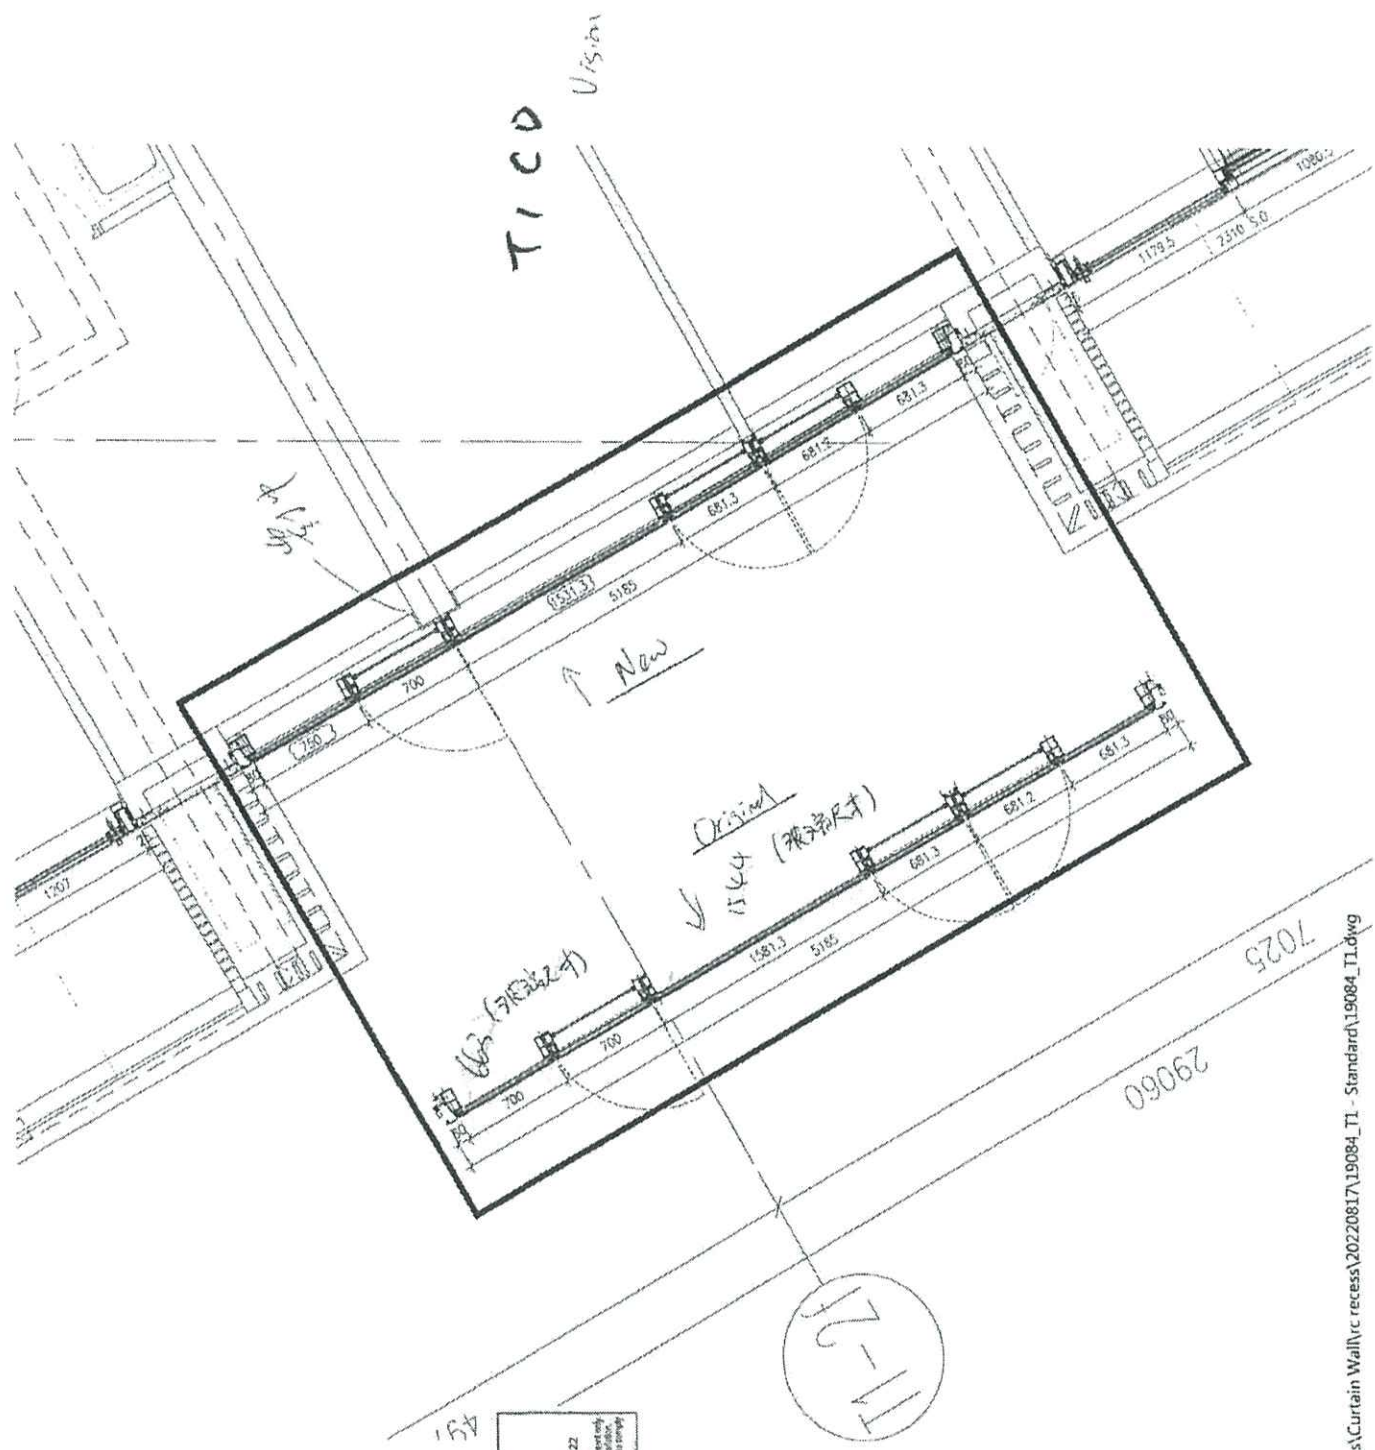

No objection  
 In the objection, subject to comment, as noted  
 Remarks:  



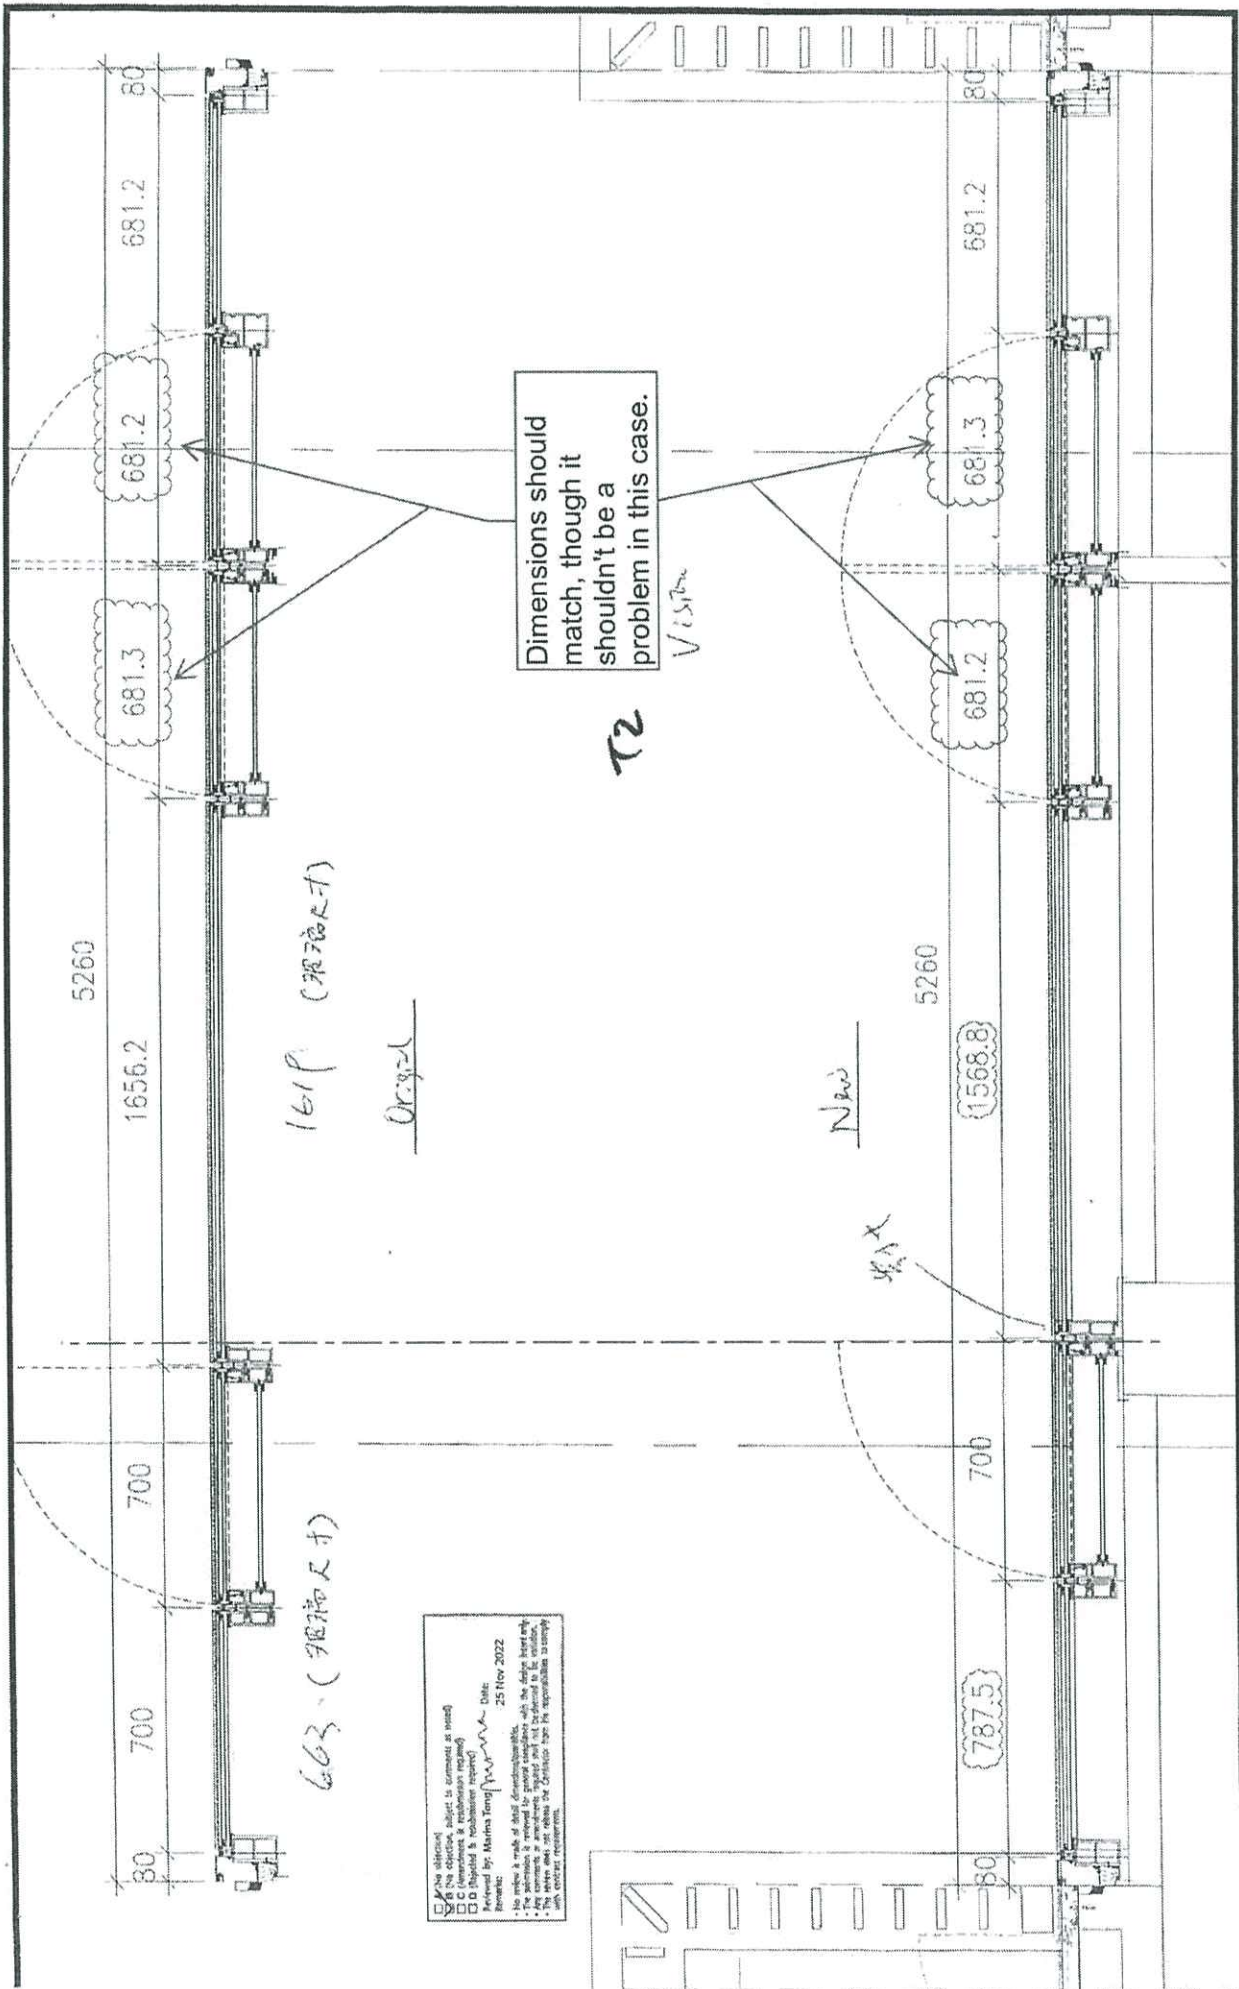

All additional  
 of the object, subject to comment as noted  
 Reviewed by: Marina King Date: 25 Nov 2022  
 Remarks:  





