美 特 鋁 質 有 限 公 司
MIDI ALUMINIUM FABRICATOR LTD.

工程指示 / 要求簡箋(E.I.)

工程指示編號：**EI / 5595 / 23** 修改版次：**A**

工程編號 ：**J - 858** 工程名稱 ：將軍澳日出康城

工程項目 ：幕牆 單元件地盆用鋁碼 (因應試水箱改後 28mm 避位) 整合版本

收件人 ：生統 發件人 ： Ant Yeung 日 期 ：**17/01/2023**

內容 ：

A:1. 本 EI 為 EI4917 和 EI5595 的整合版本 (因應試水箱改後 28mm 避位)
附最後加工圖、位置圖、分層數量表。

A:2. 原版本為 EI4917。已在生產 T1 MO1 MO2 MO3 10-21/F, 22-32/F 33-43/F
已在生產 T2 T3 MO1 MO2 10-21/F, 22-32/F

A:3. 所有原版本 EI4917 T1 MO1 MO2 MO3 / T2 T3 MO1 MO2 保持生產

A:4. 本 EI 5595 T1 MO1 MO2 MO3 / T2 T3 MO1 MO2 BK-帶 A 字尾 只需生產大鋁碼 X86254
其餘大鋁碼上的鋁叉碼、鋁介子。不用重新生產，在地盆更換即可。

A:5. 其後，T1 MO4 MO5 / T2 T3 MO3 MO4 MO5 需要按本 EI 的分層數量表排產
BK-帶 A 字尾也要組裝。

A:6. 鋁碼已鉻化不需油灑青油

A:7. BK01L 和 BK01R 因無開孔，是一樣的 / BK01La 和 BK01Ra 因無開孔，是一樣的

A:8 記錄 2023.01.13 已出貨一次 T1 按 EI5595 a 字尾 MO1 X86254 62 件
圖紙 A: 9. BK03-La 和 X86254 -03La 圖紙跟返加每邊 25mm ，其餘圖紙沒有修改

A: 按現在出貨記錄 T1 (MO1-MO2 10-32/F) T2 , T3 (MO1 10-21/F) (補5吋鋁料)
安裝進度記錄 (T1 22/F, T2 20/F T3 17/F)

請按加工圖生產和組裝鋁碼供地盆使用。

1. 因應使用絲桿，鋁碼靠牆身的孔不開，現場開 2. 分座分層包扎

請在 **2023. 02. 06** 前完成上列要求。

附：

以上項目為:

☐ 原合約工程包 ☐ 原合約工程加 / 減賬 ☐ 新工程報價

分發東莞各部門 ：

( )生產技術總監☐連附件 ( )技術部 ☐連附件 ( )生產部 ☐連附件 ( )機械設計部☐連附件

( )採購部 ☐連附件 (✓)生產統籌部☑連附件 (✓)小羅&清 ☑連附件

( )質檢部 ☐連附件 ( )會計部 ☐連附件 ( )報關組 ☐連附件 (✓)其他 水洪 ☑連附件

分發香港各部門 ：

( )行政部☐連附件 ( )會計部☐連附件 ( )統籌部☐連附件 (✓)工程部地盤科文 積哥 ☑連附件

( )採購部☐連附件 ( )QS 部 ☐連附件 ( )維修部☐連附件 ( )其他 _____☐連附件

傳遞編號：

HK 0094 / 23

發件人簽署：

項目經理簽署：

EI4917A (比色等)

鋁碼預算完成生產日子 (10層1批)

EI4917			T1				T2 / T3	
					2	R/F	Mo6	2023/05/29
					1	67/F		
			Mo5	2023/03/31	10	66/F	Mo5	2023/05/15
					9	65/F		
8	48	R/F			8	63/F		
7	47	62/F			7	62/F		
6	46	61/F			6	61/F		
5	45	60/F			5	60/F		
4	44	59/F			4	59/F		
3	43	58/F			3	58/F		
2	42	57/F			2	57/F		
1	41	56/F			1	56/F		
10	40	55/F	Mo4	2023/02/14	10	55/F	Mo4	2023/03/31
9	39	53/F			9	53/F		
8	38	52/F			8	52/F		
7	37	51/F			7	51/F		
6	36	50/F			6	50/F		
5	35	49/F			5	49/F		
4	34	48/F			4	48/F		
3	33	47/F			3	47/F		
2	32	46/F			2	46/F		
1	31	45/F			1	45/F		
10	30	43/F	Mo3	2022/11/10	10	43/F	Mo3	2023/02/14
9	29	42/F			9	42/F		
8	28	41/F			8	41/F		
7	27	40/F			7	40/F		
6	26	39/F			6	39/F		
5	25	38/F			5	38/F		
4	24	37/F			4	37/F		
3	23	36/F			3	36/F		
2	22	35/F			2	35/F		
1	21	33/F			1	33/F		
10	20	32/F	Mo2	2022/09/26	10	32/F	Mo2	2022/11/10
9	19	31/F			9	31/F		
8	18	30/F			8	30/F		
7	17	29/F			7	29/F		
6	16	28/F			6	28/F		
5	15	27/F			5	27/F		
4	14	26/F			4	26/F		
3	13	25/F			3	25/F		
2	12	23/F			2	23/F		
1	11	22/F			1	22/F		
10	10	21/F	Mo1	2022/08/12	10	21/F	Mo1	2022/09/26
9	9	20/F			9	20/F		
8	8	19/F			8	19/F		
7	7	18/F			7	18/F		
6	6	17/F			6	17/F		
5	5	16/F			5	16/F		
4	4	15/F			4	15/F		
3	3	12/F			3	12/F		
2	2	11/F			2	11/F		
1	1	10/F			1	10/F		

9/1起開. 不是鋁碼: 34/1作第一層

Mo1.23 T1 10-21 22 32 33-03/下

Mo1.2 T23 10-21 22 32/下

按EI4917生產

和EI5595的BK-A字尾 H×86×54

地盤: 積哥、二寶

有飾線單元件及如果不是兩邊邊企料。需要使用有 28mm 避位的大鋁碼，與廠用鐵件 EI5561 配套。即是鋁碼附帶"A 字尾"。見 EI5595 黃色螢光位置。(樓層用踩腳計)

美特鋁質有限公司
MIDI Aluminium Fabricator Ltd.

QF005/8

圖則登記表
DRAWING REGISTER

工程名稱 Project Title:	康城11期 单元幕墙墙身码(T1, 2, 3)
工程編號 Project No:	J858

分發予 Distributed To

	接收日期 Receiving Date (適用於客戶)						
年							
月							
日							

	發出日期 Issued Date						
年	22						
月	6						
日	22						

圖則編號 Drg. No.	圖則名稱 Drawing Title		修訂編號 Revision No.
J858-CW-BR-101	J858单元幕墙墙身码位置图(T1)	1	-
J858-CW-BR-102	J858单元幕墙墙身码位置图(T1)	2	-
J858-CW-BR-103	J858单元幕墙墙身码位置图(T1)	3	-
J858-CW-BR-104	J858单元幕墙墙身码位置图(T1)	4	-
J858-CW-BR-201	J858单元幕墙墙身码位置图(T2)	5	-
J858-CW-BR-202	J858单元幕墙墙身码位置图(T2)	6	-
J858-CW-BR-203	J858单元幕墙墙身码位置图(T2)	7	-
J858-CW-BR-204	J858单元幕墙墙身码位置图(T2)	8	-
J858-CW-BR-301	J858单元幕墙墙身码位置图(T3)	9	-
J858-CW-BR-302	J858单元幕墙墙身码位置图(T3)	10	-
J858-CW-BR-303	J858单元幕墙墙身码位置图(T3)	11	-
J858-CW-BR-304	J858单元幕墙墙身码位置图(T3)	12	-
BK-01L	墙身码组装图 ~~411~~ 413	13	-
BK-01R	墙身码组装图 413	14	-
BK-02L	墙身码组装图 413	15	-
BK-02R	墙身码组装图 413	16	-
BK-03L	墙身码组装图 230	17	-
BK-03R	墙身码组装图 230	18	-
BK-04	墙身码组装图 468	19	-
BK-05	墙身码组装图 447	20	-
X86254-01L	铝固定码加工图	21	-
X86254-01R	铝固定码加工图	22	-
X86254-02L	铝固定码加工图	23	-
X86254-02R	铝固定码加工图	24	-
X86254-03L	铝固定码加工图	25	-
X86254-03R	铝固定码加工图	26	-
X86254-04	铝固定码加工图	27	-
X86254-05	铝固定码加工图	28	-
X86257-01L	铝固定码加工图	29	-
X86257-01R	铝固定码加工图	30	-
X86266-01L	铝固定码加工图	31	-
X86266-01R	铝固定码加工图	32	-

BK01a
BK01Ra
BK02La
BK03La
BK04a

美特鋁質有限公司
MIDI Aluminium Fabricator Ltd.

QF005/8

圖則登記表
DRAWING REGISTER

工程名稱 Project Title:	康城11期 单元幕墙墙身码(T1, 2, 3)
工程編號 Project No:	J858

分發予 Distributed To


接收日期 Receiving Date (適用於客戶)							
年							
月							
日							

發出日期 Issued Date							
年	22						
月	6						
日	22						

圖則編號 Drg. No.	圖則名稱 Drawing Title	修訂編號 Revision No.						
X86259-01L	铝介子加工图	33	-					
X86259-01R	铝介子加工图	34	-					
X86260	铝介子加工图	35	-					
X86261	铝介子加工图	36	-					


e14917

美特鋁質有限公司 MIDI Aluminium Fabricator Ltd.							工程號	J858	類別		物料號	-		
							地盤	康城11期	制圖	W.E.X	2022-06-14	圖號	BK-01L	
修改	-	-	-	採用工廠		地盤 ✓	图纸名称	墙身码组装图	復核	-	-	数量	197	
日期	-	-	-	材料顏色	-		材料	-	批准	-	-	單件重量	-	(KG)

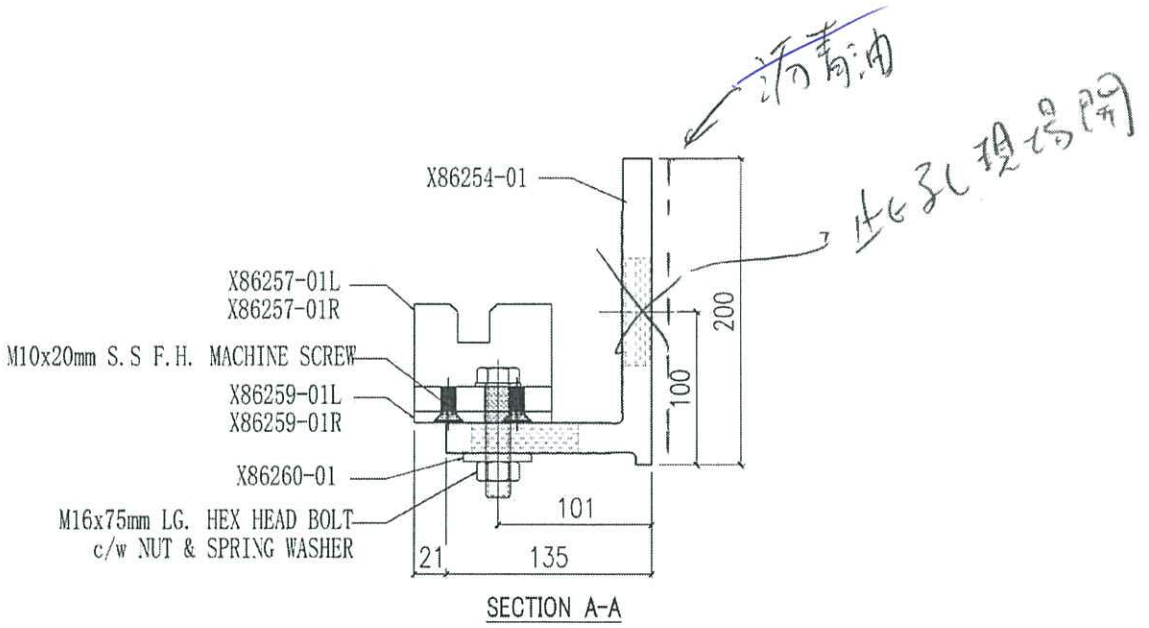


SECTION A-A


X86260-01	2
X86259-01R	1
X86259-01L	1
X86257-01R	1
X86257-01L	1
X86254-01L	1
编号	数量

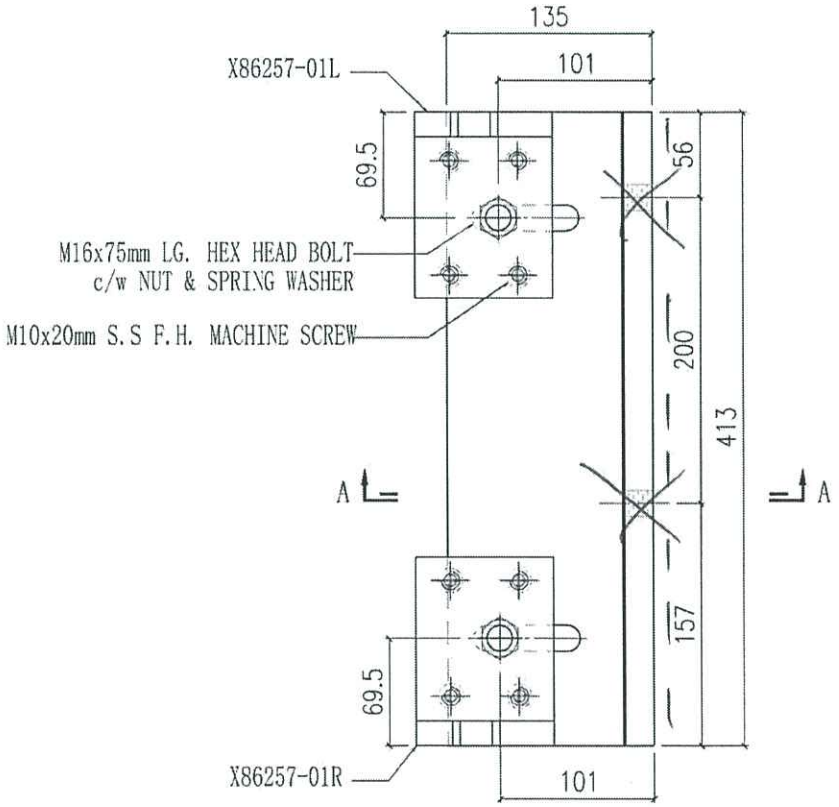

美特鋁質有限公司 MIDI Aluminium Fabricator Ltd.						工程號	J858	類別		物料號	-		
						地盘	康城11期	制圖	W.E.X	2022-06-14	圖號	BK-01R	
修改	-	-	-	採用工廠	地盤 ✓	图纸名称	墙身码组装图	復核	-	-	數量	298	
日期	-	-	-	材料颜色	-	材料	-	批准	-	-	單件重量	-	(KG)

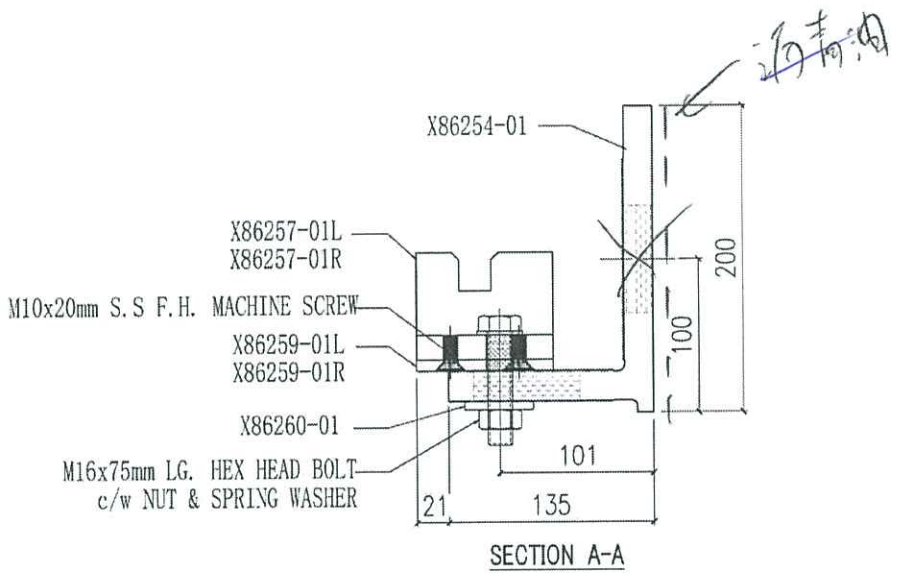


SECTION A-A

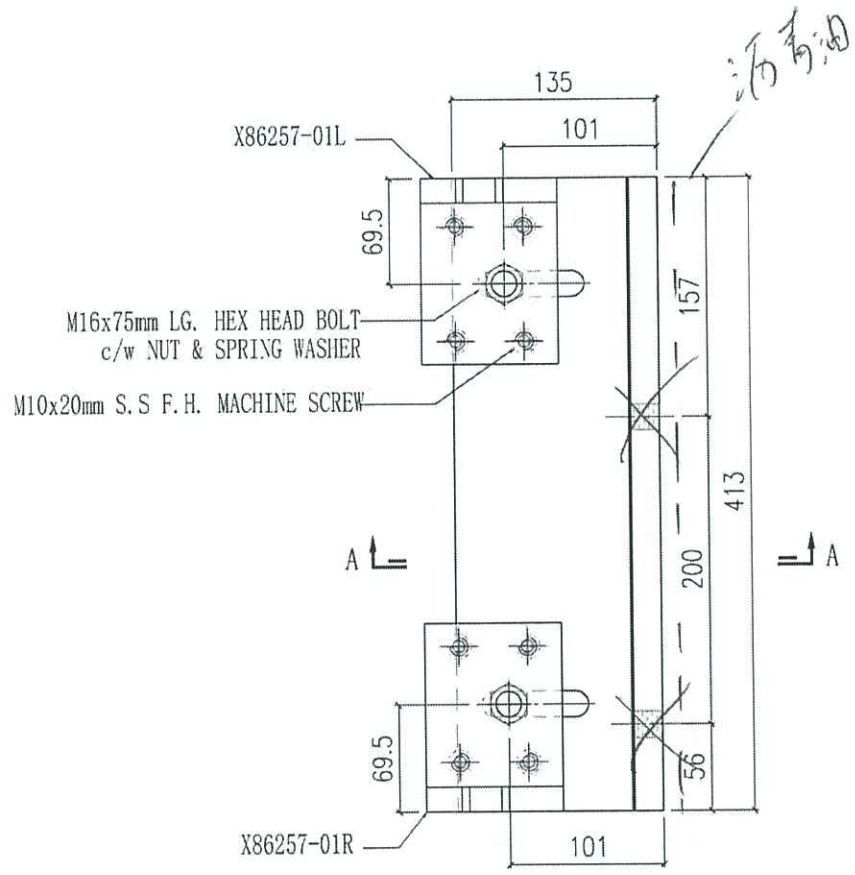

编号	数量
X86260-01	2
X86259-01R	1
X86259-01L	1
X86257-01R	1
X86257-01L	1
X86254-01R	1


2.

美特鋁質有限公司 MIDI Aluminium Fabricator Ltd.							工程號	J858	類別		物料號	-		
							地盘	康城11期	制圖	W.E.X	2022-06-14	圖號	BK-02L	
修改	-	-	-	採用	工廠	地盤 ✓	图纸名称	墙身码组装图	復核	-	-	数量	197	
日期	-	-	-	材料颜色	-		材料	-	批准	-	-	單件重量	-	(KG)

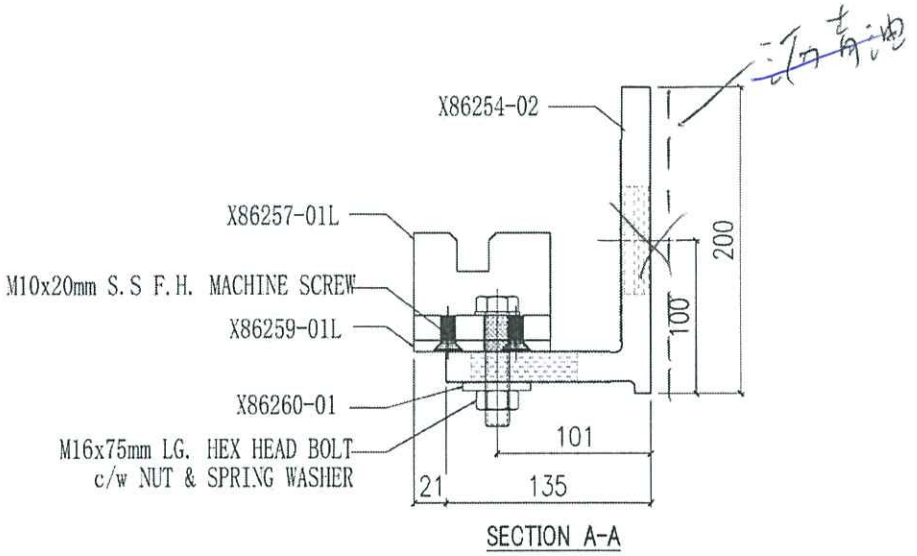


SECTION A-A

编号	数量
X86260-01	1
X86259-01L	1
X86257-01L	1
X86254-02L	1

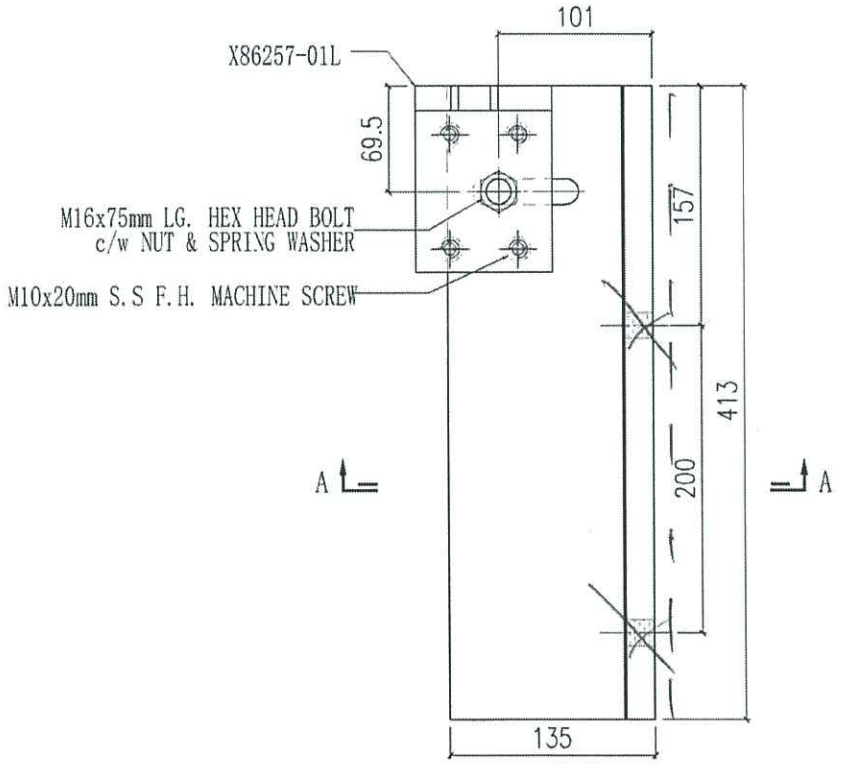


美特鋁質有限公司 MIDI Aluminium Fabricator Ltd.								工程號	J858	類別		物料號	-		
								地盘	康城11期	制圖	W.E.X	2022-06-14	圖號	BK-02R	
修改	-	-	-	採用	工廠		地盤 ✓	图纸名称	墙身码组装图	復核	-	-	數量	298	
日期	-	-	-	材料颜色	-			材料	-	批准	-	-	單件重量	-	(KG)

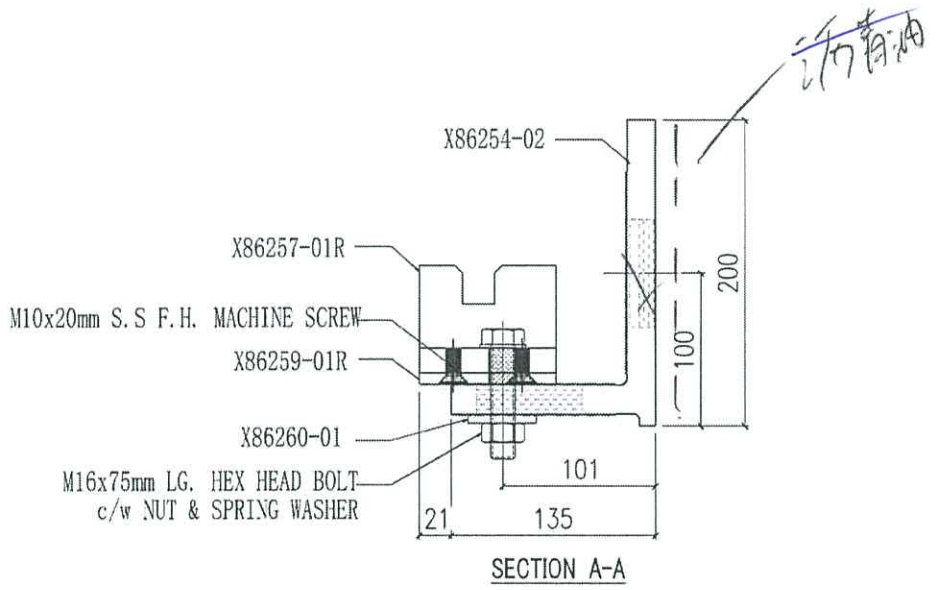

SECTION A-A

X86260-01	1
X86259-01R	1
X86257-01R	1
X86254-02R	1
编号	数量

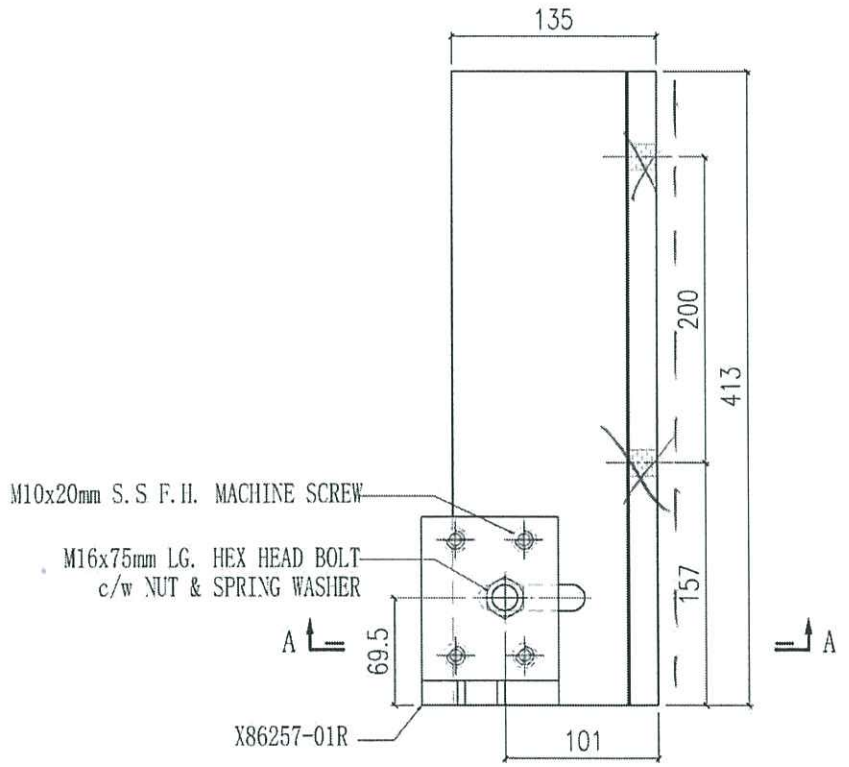


4


et 69178

美特鋁質有限公司 MIDI Aluminium Fabricator Ltd.					工程號	J858	類別		物料號	-		
					地盤	康城11期	制圖	W.E.X	2022-06-14	圖號	BK-03L	
修改	X	-	-	採用工廠 地盤 ✓	图纸名称	墙身码组装图	復核	-	-	數量	1900	
日期	-	-	-	材料颜色 -	材料	-	批准	-	-	單件重量	-	(KG)

X

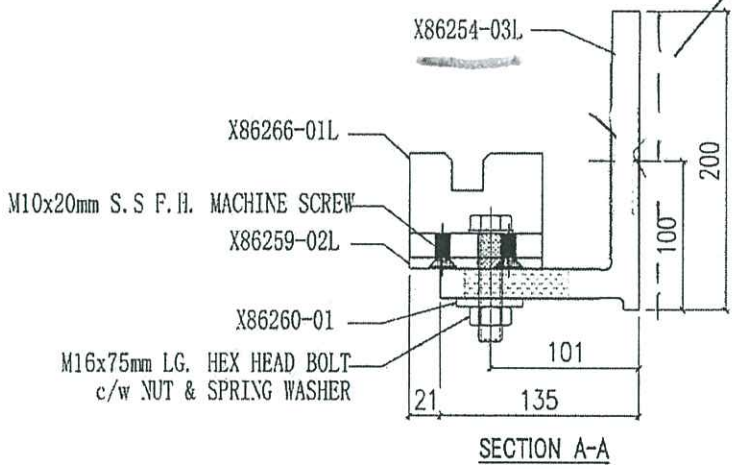

SECTION A-A

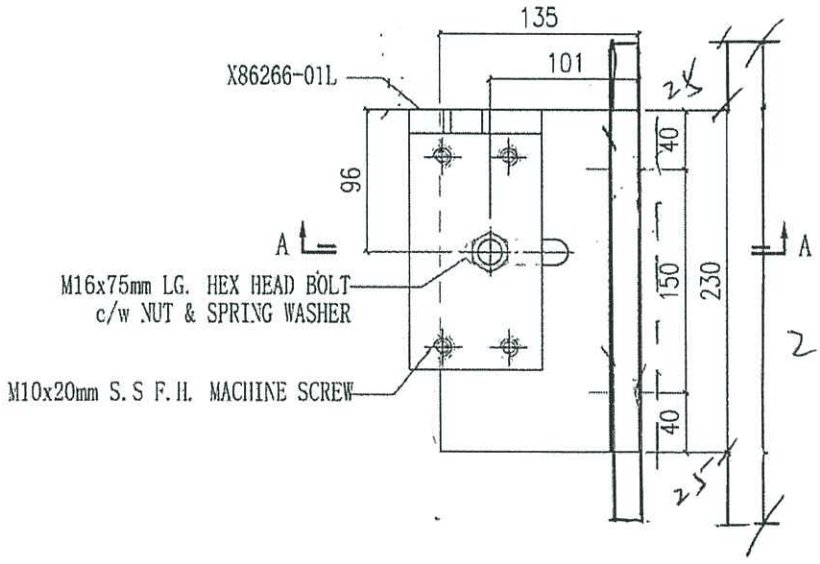


编号	数量
X86260-01	1
X86259-02L	1
X86266-01L	1
X86254-03L	1

e14917B

美特鋁質有限公司 MIDI Aluminium Fabricator Ltd.					工程號	J858	類別		物料號	-		
					地盤	康城11期	制圖	W.E.X	2022-06-14	圖號	BK-03R	
修改	A	-	-	採用工廠	地盤 ✓	图纸名称	墙身码组装图	復核	-	-	數量	1799
日期	-	-	-	材料颜色	-	材料	-	批准	-	-	單件重量	- (KG)


A

M02 開始改

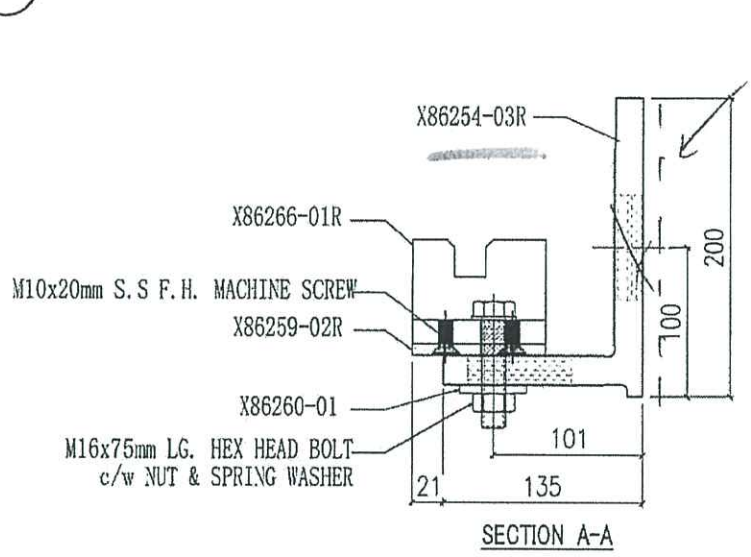

SECTION A-A


編号	数量
X86260-01	1
X86259-02R	1
X86266-01R	1
X86254-03R	1

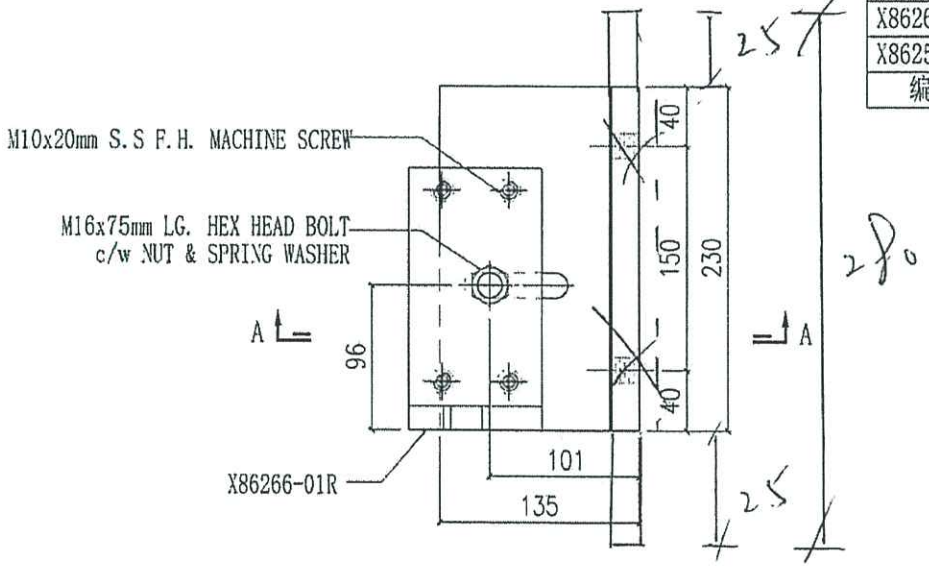

靠牆兩側 加25


6.

美特鋁質有限公司 MIDI Aluminium Fabricator Ltd.							工程號	J858	類別		物料號	-		
							地盘	康城11期	制圖	W.E.X	2022-06-14	圖號	BK-04	
修改	-	-	-	採用	工廠		地盤	✓	图纸名称	墙身码组装图	復核	-	-	數量	3999
日期	-	-	-	材料颜色	-				材料	-	批准	-	-	單件重量	- (KG)

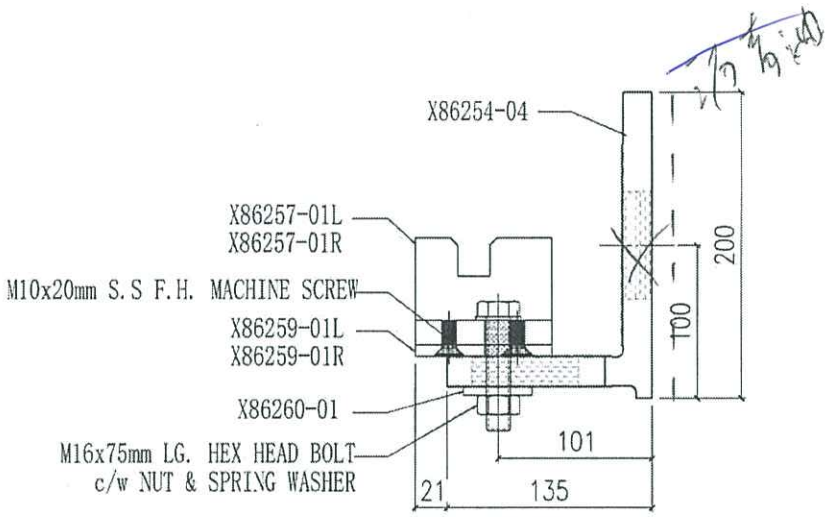


SECTION A-A

编号	数量
X86260-01	2
X86259-01R	1
X86259-01L	1
X86257-01R	1
X86257-01L	1
X86254-04	1

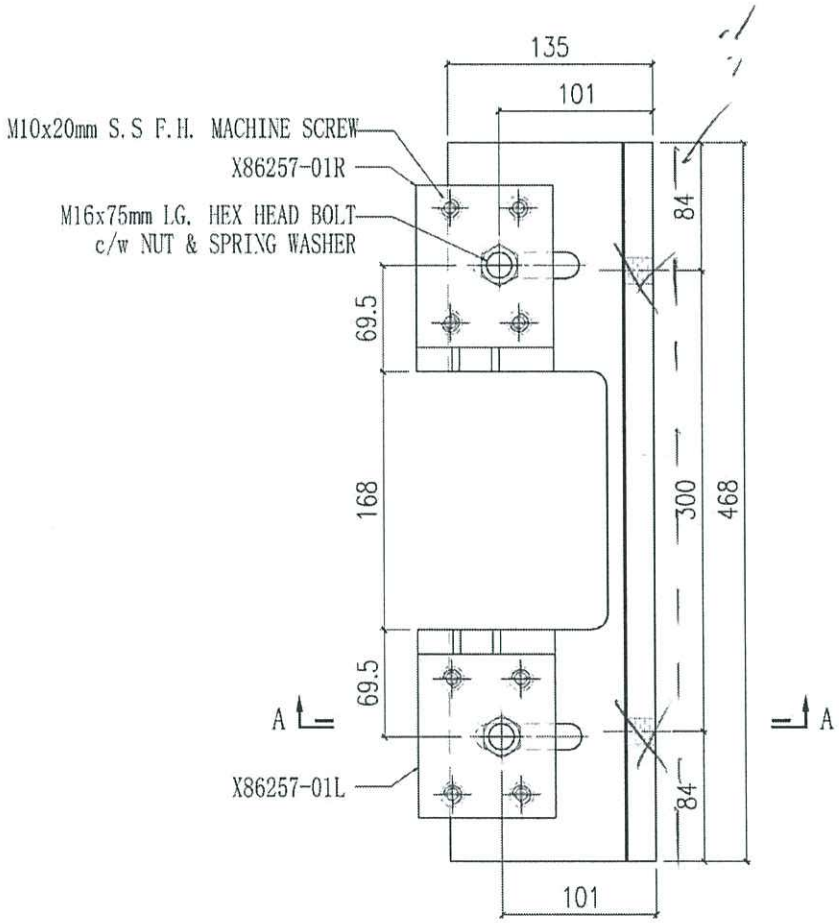


美特鋁質有限公司 MIDI Aluminium Fabricator Ltd.							工程號	J858	類別		物料號	-		
							地盘	康城11期	制圖	W.E.X	2022-06-14	圖號	BK-05	
修改	-	-	-	採用	工廠	地盤 ✓	图纸名称	墙身码组装图	復核	-	-	數量	102	
日期	-	-	-	材料颜色	-		材料	-	批准	-	-	單件重量	-	(KG)

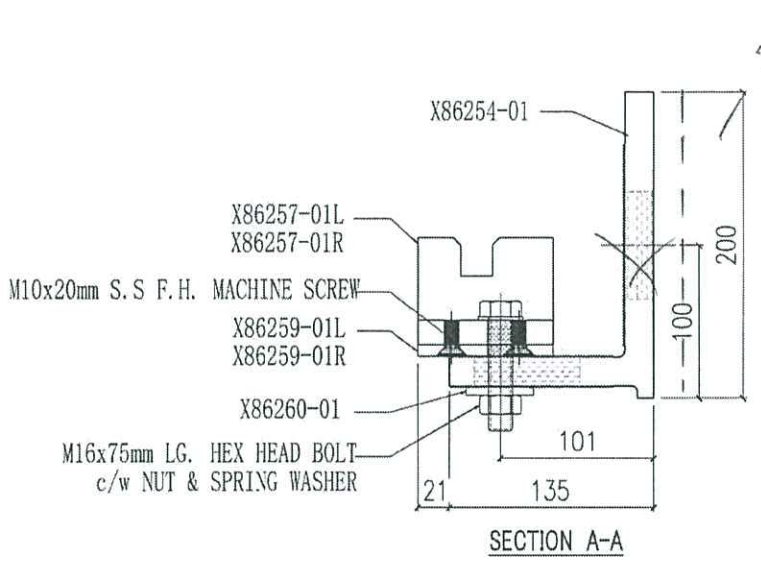


SECTION A-A


编号	数量
X86260-01	2
X86259-01R	1
X86259-01L	1
X86257-01R	1
X86257-01L	1
X86254-05	1

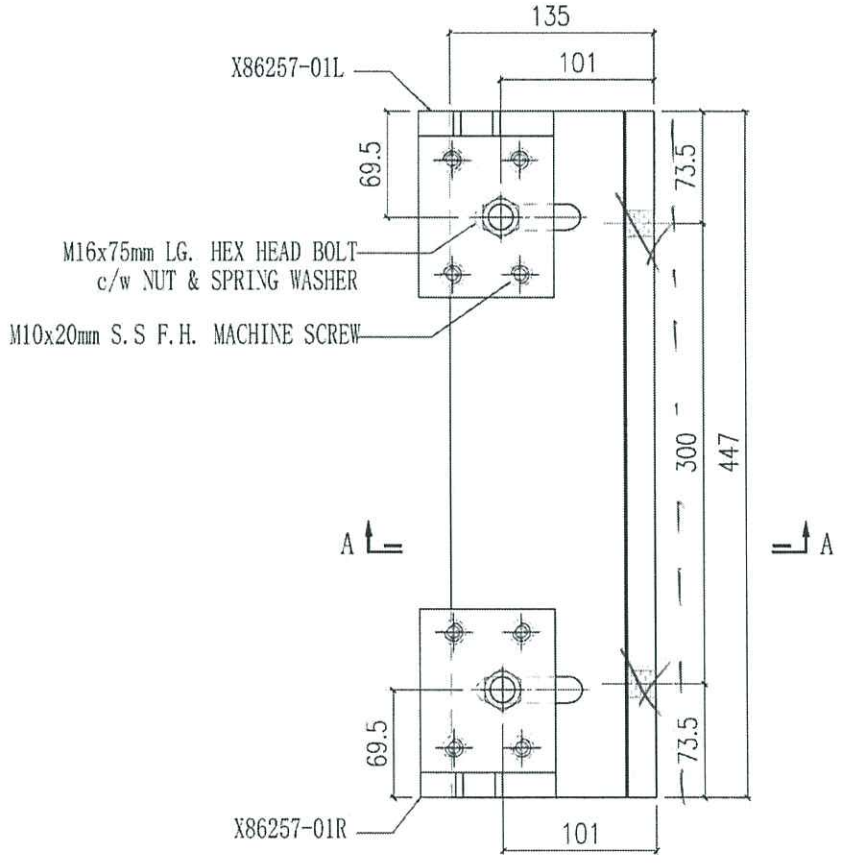


美特鋁質有限公司 MIDI Aluminium Fabricator Ltd.						工程號	J858	類別		物料號	-		
						地盤	康城11期	制圖	W.E.X	2022-06-14	圖號	X86254-01L	
修改	-	-	-	採用	工廠 ✓ 地盤 -	图纸名称	铝固定码加工图	復核	-	-	數量	197	
日期	-	-	-	材料顏色	CHROMATE	材料	X86254	批准	-	-	單件重量	-	(KG)

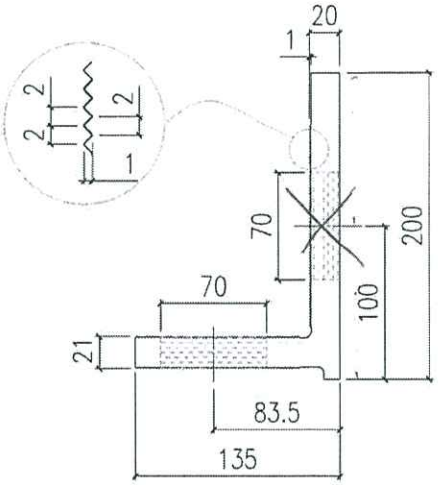


SECTION A-A

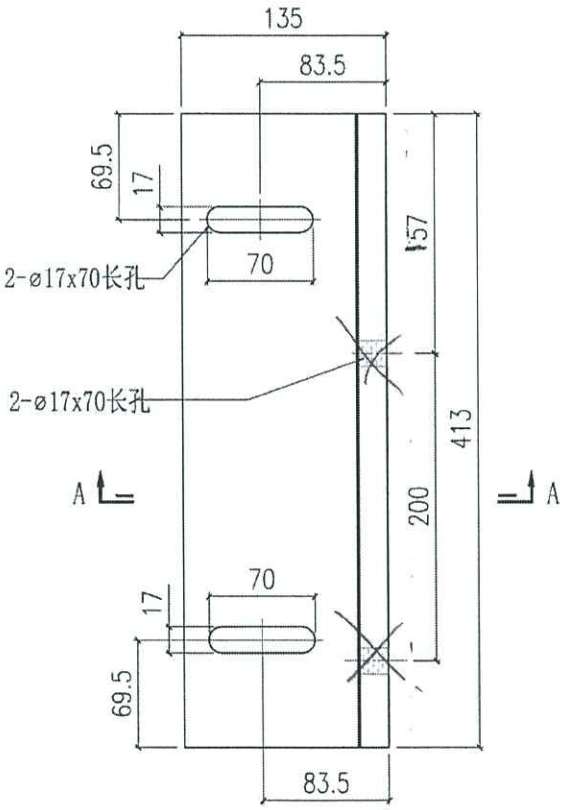


美特鋁質有限公司 MIDI Aluminium Fabricator Ltd.							工程號	J858	類別		物料號	-		
							地盤	康城11期	制圖	W.E.X	2022-06-14	圖號	X86254-01R	
修改	-	-	-	採用	工廠	✓	地盤	-	图纸名称	铝固定码加工图	復核	-	-	數量	298
日期	-	-	-	材料顏色	CHROMATE				材料	X86254	批准	-	-	單件重量	- (KG)

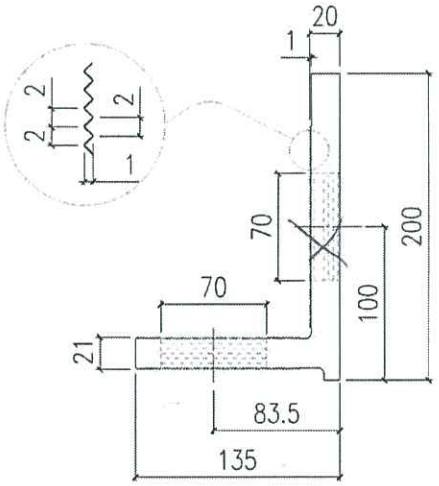


SECTION A-A

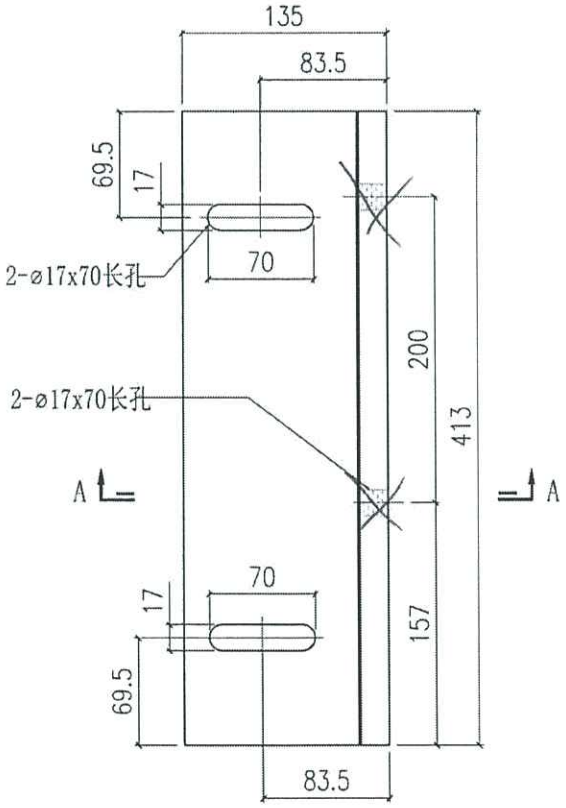


美特鋁質有限公司 MIDI Aluminium Fabricator Ltd.							工程號	J858	類別		物料號	-		
							地盘	康城11期	制圖	W.E.X	2022-06-14	圖號	X86254-02L	
修改	-	-	-	採用	工廠	✓	地盤	-	图纸名称	铝固定码加工图	復核	-	-	數量	197
日期	-	-	-	材料顏色	CHROMATE				材料	X86254	批准	-	-	單件重量	- (KG)

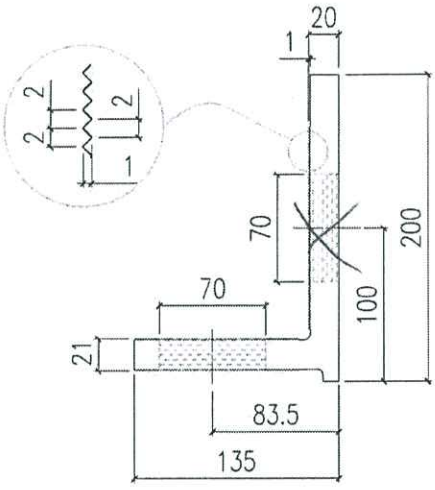


SECTION A-A

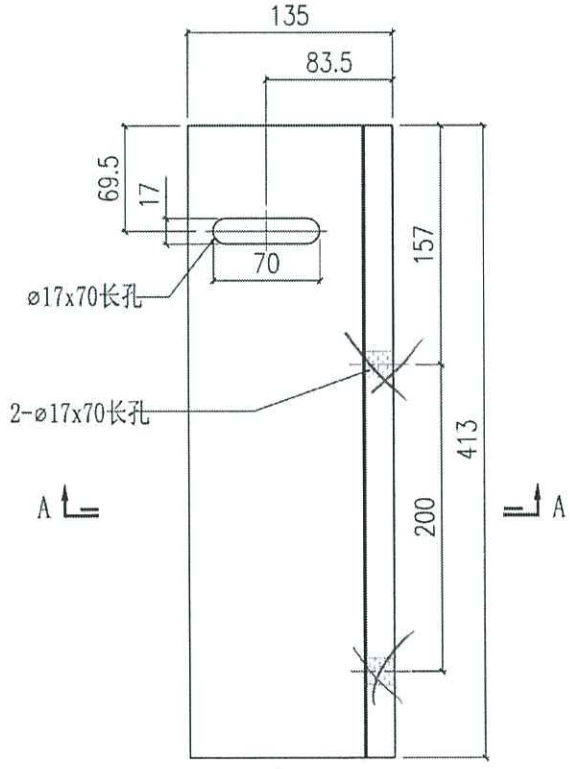

美特鋁質有限公司 MIDI Aluminium Fabricator Ltd.													
						工程號	J858	類別		物料號	-		
						地盘	康城11期	制圖	W.E.X	2022-06-14	圖號	X86254-02R	
修改	-	-	-	採用工廠	✓ 地盤 -	图纸名称	铝固定码加工图	復核	-	-	数量	298	
日期	-	-	-	材料顏色	CHROMATE	材料	X86254	批准	-	-	單件重量	-	(KG)

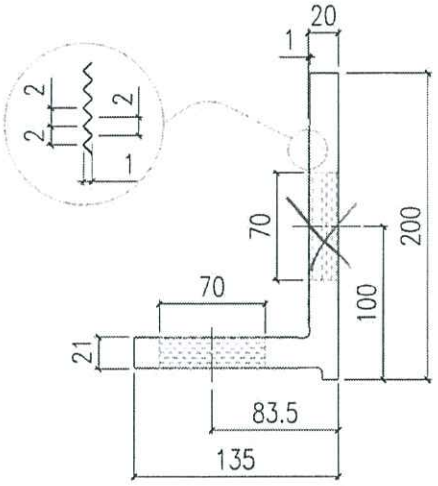


SECTION A-A

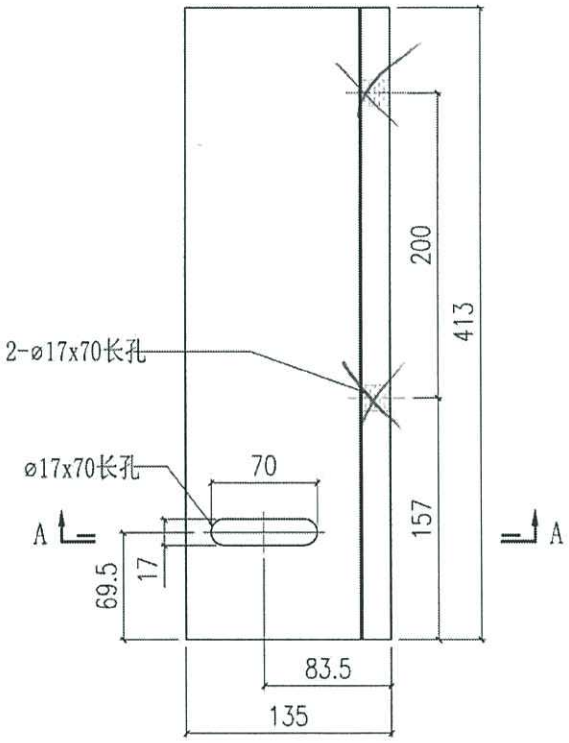


e:69178

美特鋁質有限公司 MIDI Aluminium Fabricator Ltd.						工程號	J858	類別		物料號	-		
						地盘	康城11期	制圖	W.E.X	2022-06-14	圖號	X86254-03L	
修改	A	-	-	採用工廠	✓	地盤	-	图纸名称	铝固定码加工图	復核	-	-	數量	1900	
日期	-	-	-	材料顏色	CHROMATE			材料	X86254	批准	-	-	單件重量	-	(KG)

A

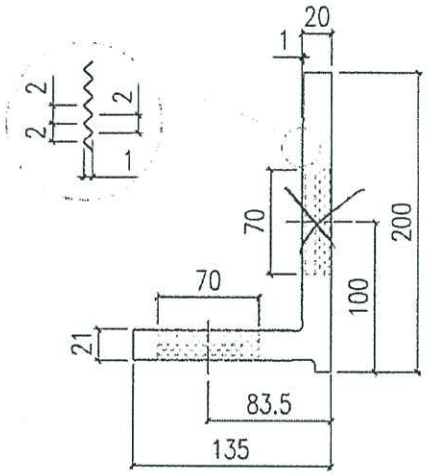


SECTION A-A

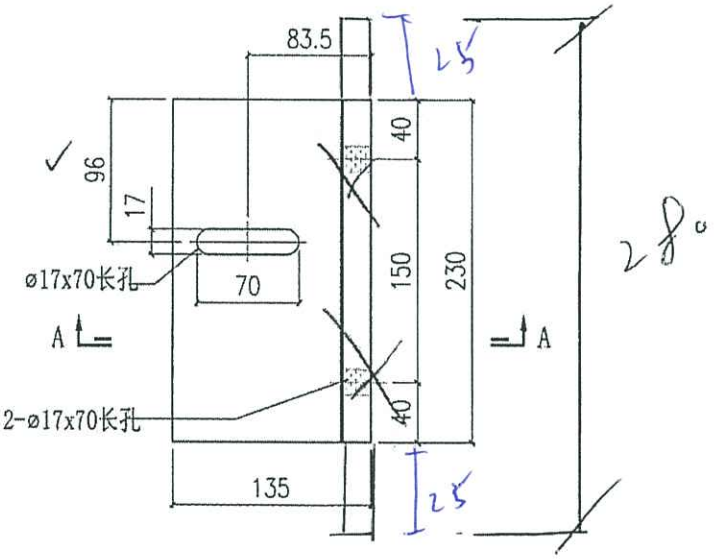


13


美特鋁質有限公司 MIDI Aluminium Fabricator Ltd.							工程號	J858	類別		物料號	-		
							地盘	康城11期	制圖	W.E.X	2022-06-14	圖號	X86254-03R	
修改	A	-	-	採用工廠	✓	地盤	-	图纸名称	铝固定码加工图	復核	-	-	數量	1799
日期	-	-	-	材料颜色	CHROMATE			材料	X86254	批准	-	-	單件重量	- (KG)

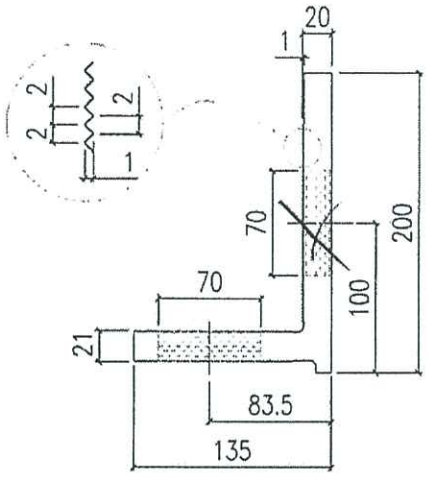


SECTION A-A

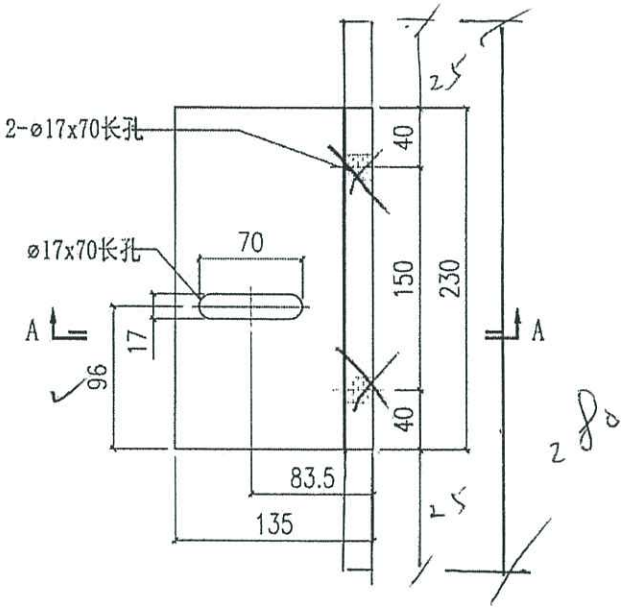


美特鋁質有限公司 MIDI Aluminium Fabricator Ltd.							工程號	J858	類別		物料號	-		
							地盘	康城11期	制圖	W.E.X	2022-06-14	圖號	X86254-04	
修改	-	-	-	採用	工廠	✓ 地盤 -	图纸名称	铝固定码加工图	復核	-	-	數量	3999	
日期	-	-	-	材料颜色	CHROMATE		材料	X86254	批准	-	-	單件重量	-	(KG)

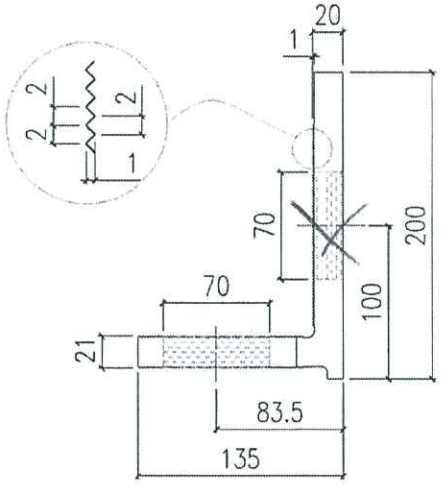


SECTION A-A

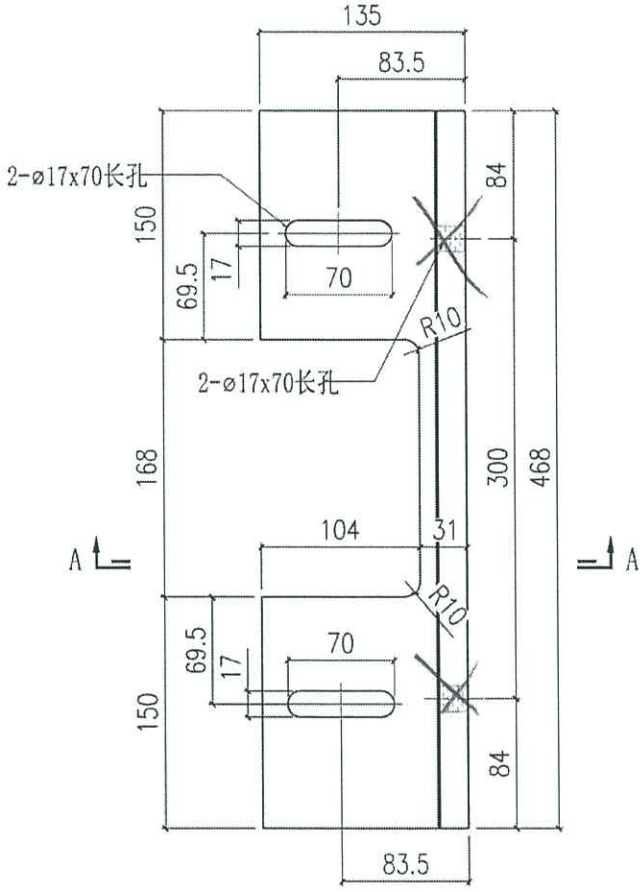


美特鋁質有限公司 MIDI Aluminium Fabricator Ltd.							工程號	J858	類別		物料號	-		
							地盤	康城11期	制圖	W.E.X	2022-06-14	圖號	X86254-05	
修改	-	-	-	採用	工廠	✓	地盤	-	图纸名称	铝固定码加工图	復核	-	-	數量	102
日期	-	-	-	材料颜色	CHROMATE				材料	X86254	批准	-	-	單件重量	- (KG)

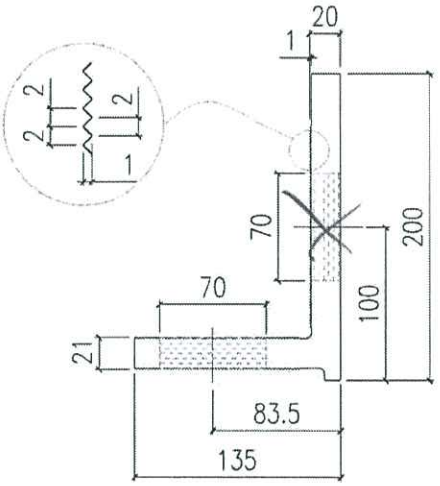



SECTION A-A

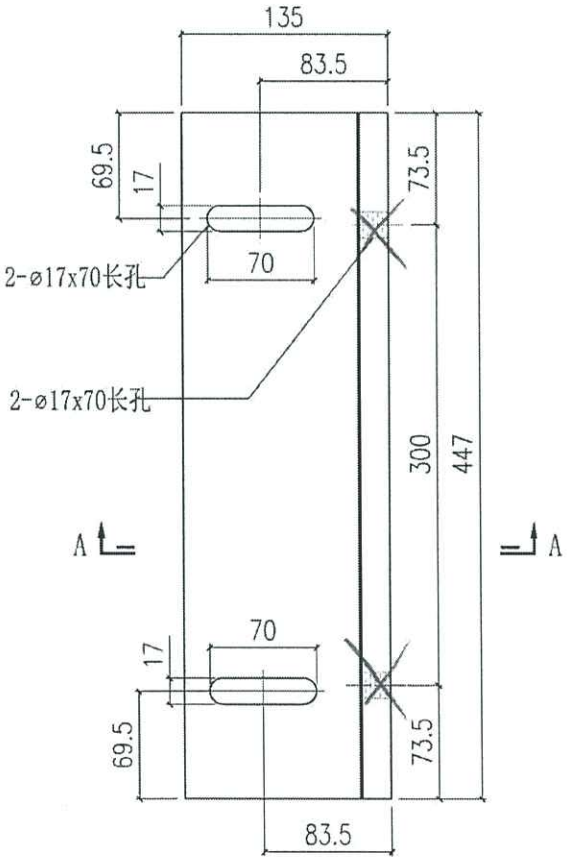


美特鋁質有限公司 MIDI Aluminium Fabricator Ltd.					工程號	J858	類別		物料號	-		
					地盘	康城11期	制圖	W.E.X	2022-06-14	圖號	X86257-01L	
修改	-	-	-	採用工廠 ✓ 地盤 -	图纸名称	铝固定码加工图	復核	-	-	數量	4793	
日期	-	-	-	材料颜色 CHROMATE	材料	X86257	批准	-	-	單件重量	-	(KG)

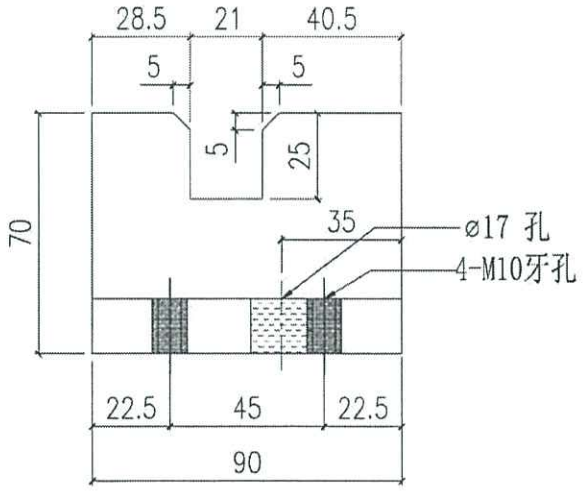


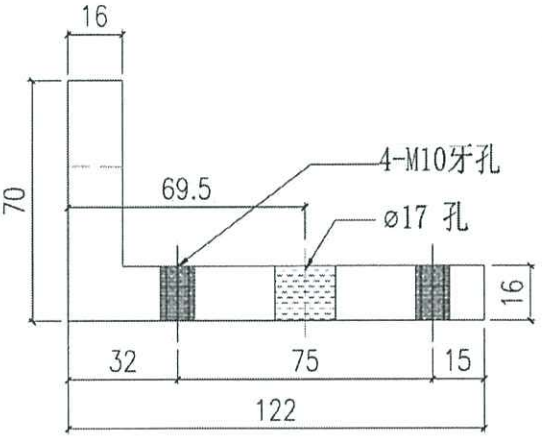


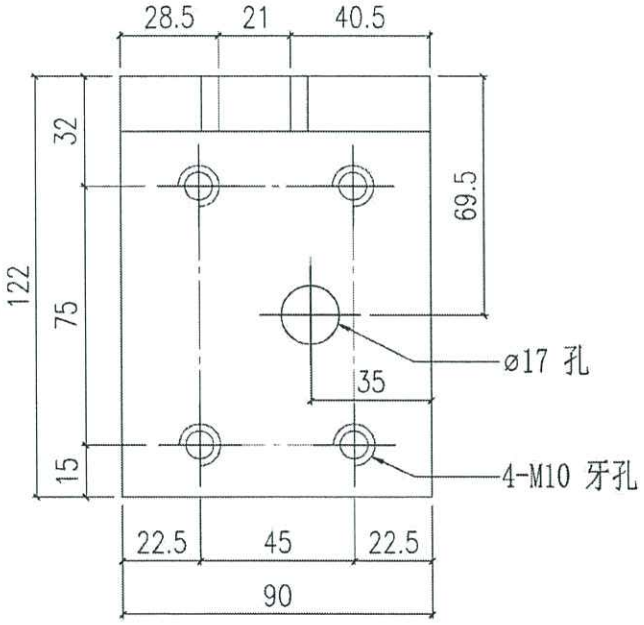

美特鋁質有限公司 MIDI Aluminium Fabricator Ltd.							工程號	J858	類別		物料號	-		
							地盘	康城11期	制圖	W.E.X	2022-06-14	圖號	X86257-01R	
修改	-	-	-	採用	工廠	✓ 地盤 -	图纸名称	铝固定码加工图	復核	-	-	數量	4894	
日期	-	-	-	材料顏色	CHROMATE		材料	X86257	批准	-	-	單件重量	-	(KG)

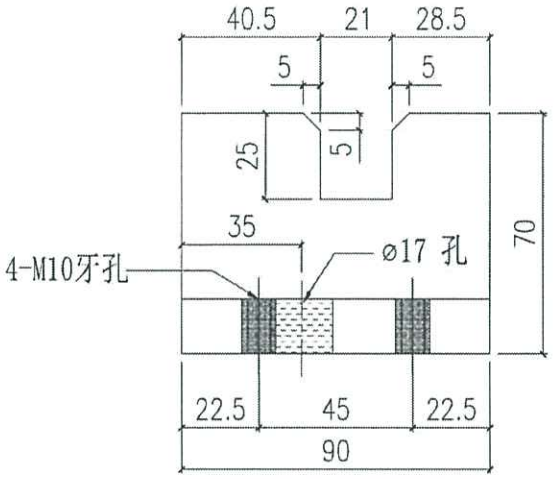


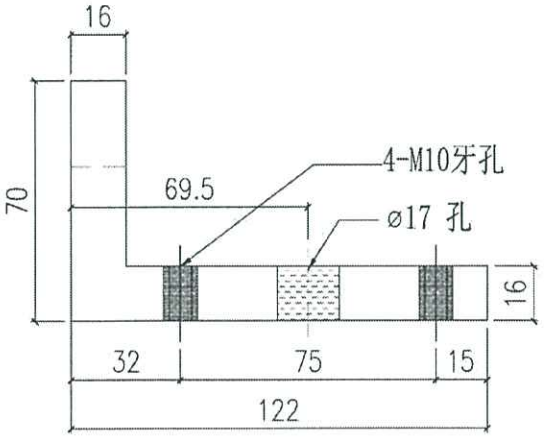


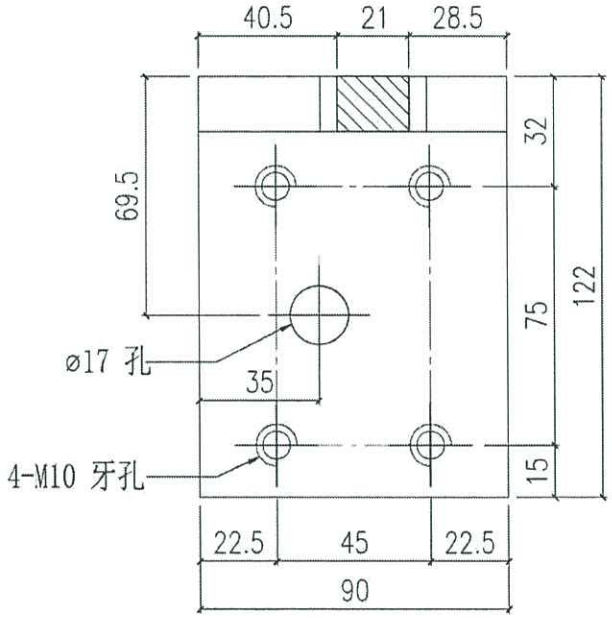


18.


美特鋁質有限公司 MIDI Aluminium Fabricator Ltd.						工程號	J858	類別		物料號	-		
						地盘	康城11期	制圖	W.E.X	2022-06-14	圖號	X86266-01L	
修改	-	-	-	採用	工廠 ✓ 地盤 -	图纸名称	铝固定码加工图	復核	-	-	數量	1900	
日期	-	-	-	材料颜色	CHROMATE	材料	X86266	批准	-	-	單件重量	-	(KG)

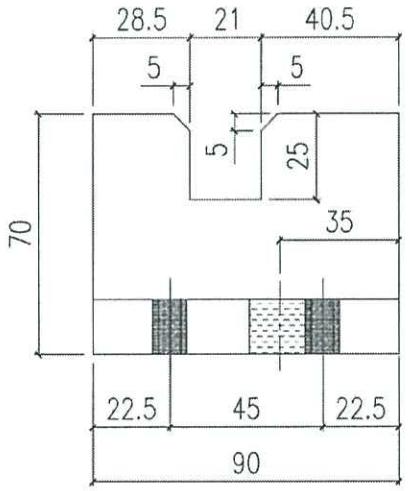


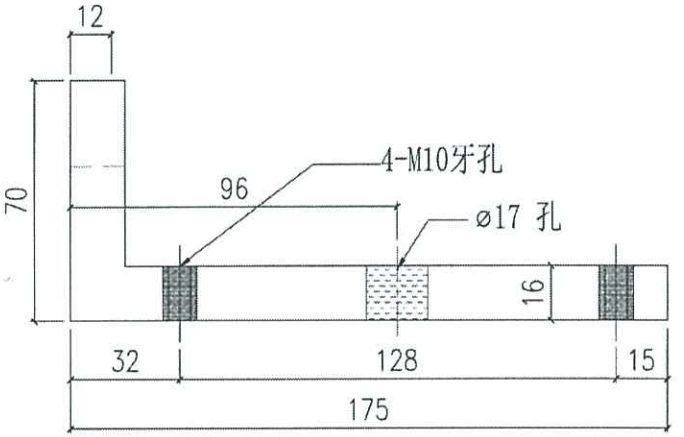


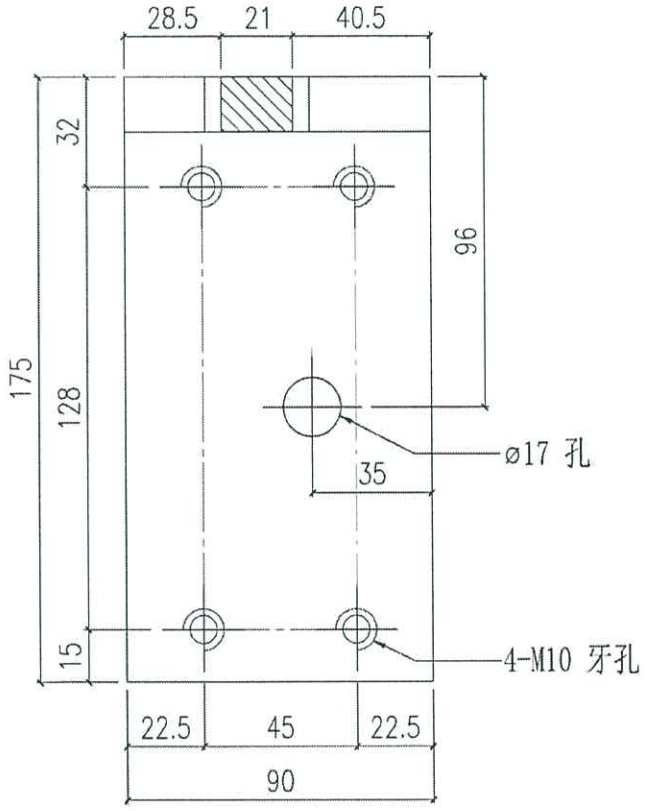


美特鋁質有限公司 MIDI Aluminium Fabricator Ltd.							工程號	J858	類別		物料號	-		
							地盘	康城11期	制圖	W.E.X	2022-06-14	圖號	X86266-01R	
修改	-	-	-	採用	工廠	✓ 地盤 -	图纸名称	铝固定码加工图	復核	-	-	数量	1799	
日期	-	-	-	材料颜色	CHROMATE		材料	X86266	批准	-	-	單件重量	-	(KG)

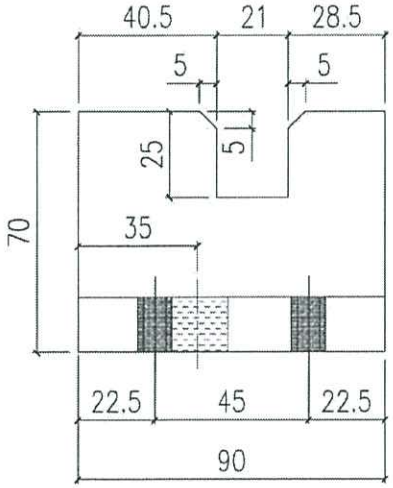


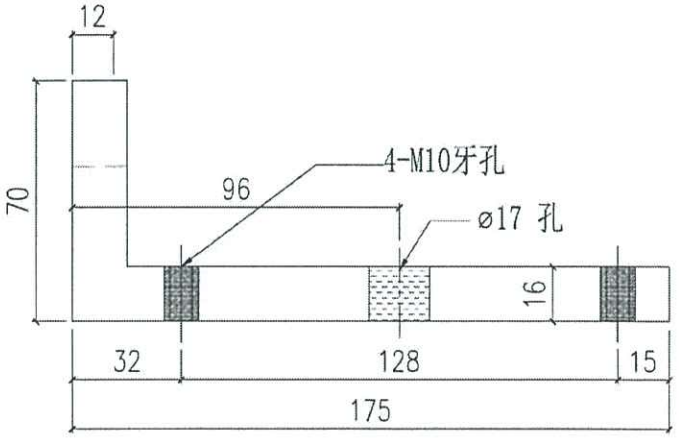

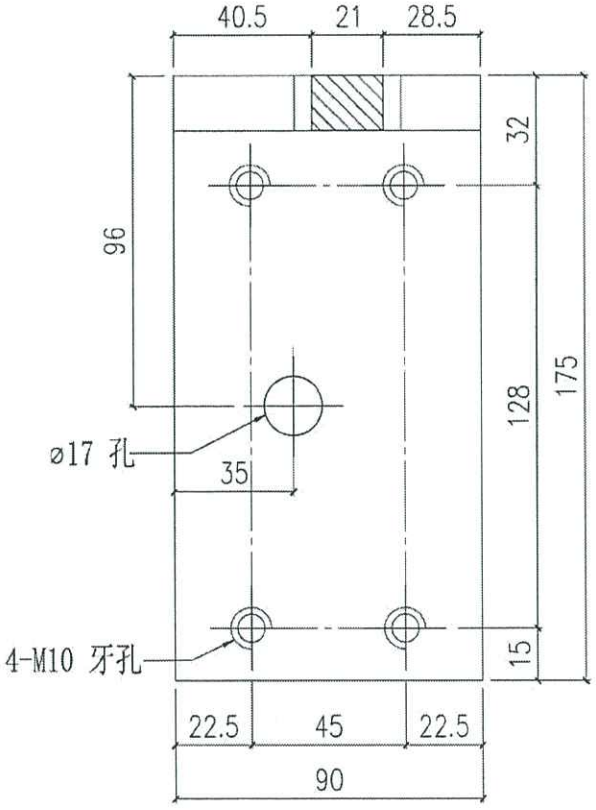



美特鋁質有限公司 MIDI Aluminium Fabricator Ltd.								工程號	J858	類別		物料號	-		
								地盘	康城11期	制圖	W.E.X	2022-06-14	圖號	X86259-01L	
修改	-	-	-	採用	工廠	✓	地盤 -	图纸名称	铝介子加工图	復核	-	-	數量	4793	
日期	-	-	-	材料颜色	CHROMATE			材料	X86259	批准	-	-	單件重量	-	(KG)

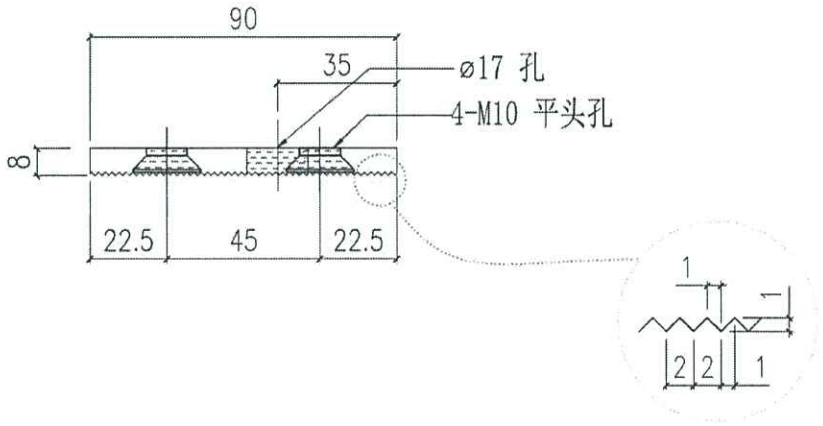

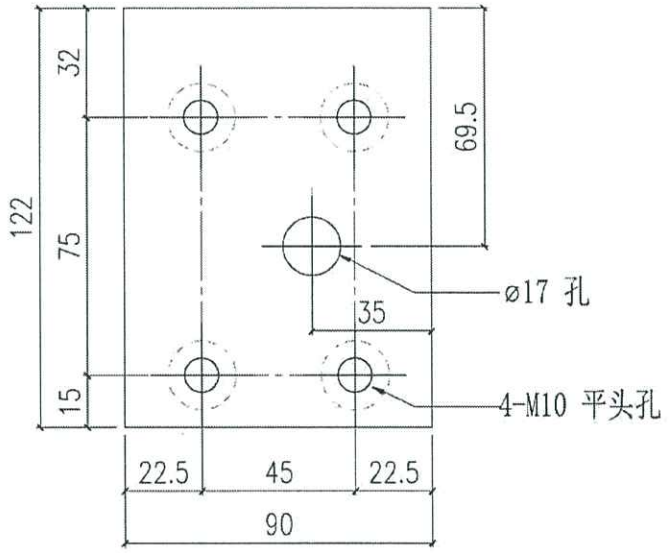



美特鋁質有限公司 MIDI Aluminium Fabricator Ltd.						工程號	J858	類別		物料號	-		
						地盘	康城11期	制圖	W.E.X	2022-06-14	圖號	X86259-01R	
修改	-	-	-	採用	工廠 ✓ 地盤 -	图纸名称	铝介子加工图	復核	-	-	數量	4894	
日期	-	-	-	材料颜色	CHROMATE	材料	X86259	批准	-	-	單件重量	-	(KG)

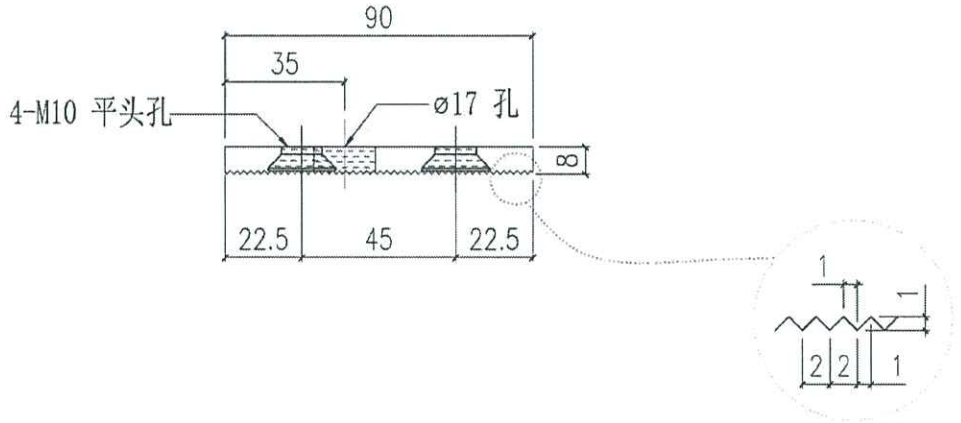

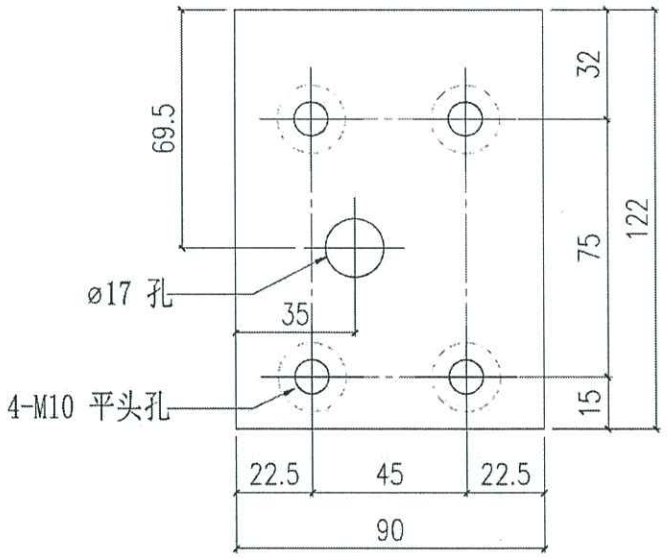



美特鋁質有限公司 MIDI Aluminium Fabricator Ltd.						工程號	J858	類別		物料號	-		
						地盘	康城11期	制圖	W.E.X	2022-06-14	圖號	X86259-02L	
修改	-	-	-	採用	工廠 ✓ 地盤 -	图纸名称	铝介子加工图	復核	-	-	數量	1900	
日期	-	-	-	材料颜色	CHROMATE	材料	X86259	批准	-	-	單件重量	-	(KG)

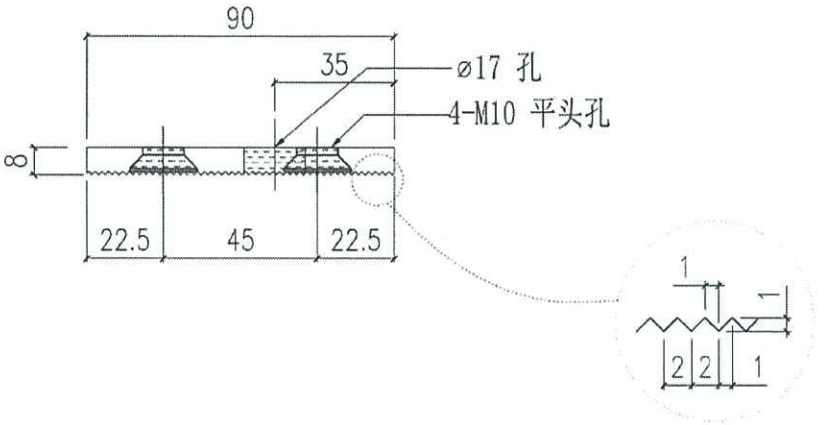

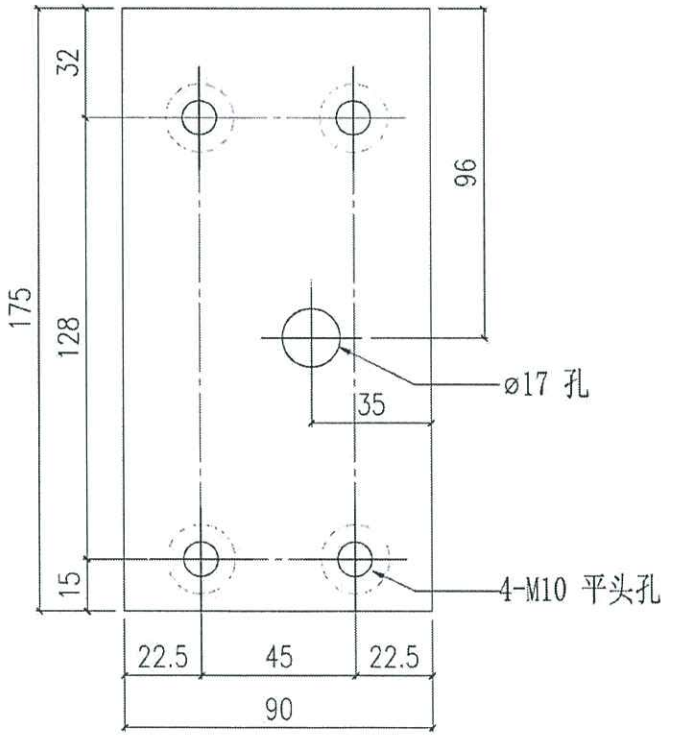


美特鋁質有限公司 MIDI Aluminium Fabricator Ltd.							工程號	J858	類別		物料號	-		
							地盘	康城11期	制圖	W.E.X	2022-06-14	圖號	X86259-02R	
修改	-	-	-	採用	工廠	✓	地盤	-	图纸名称	铝介子加工图	復核	-	-	數量	1799
日期	-	-	-	材料颜色	CHROMATE				材料	X86259	批准	-	-	單件重量	- (KG)

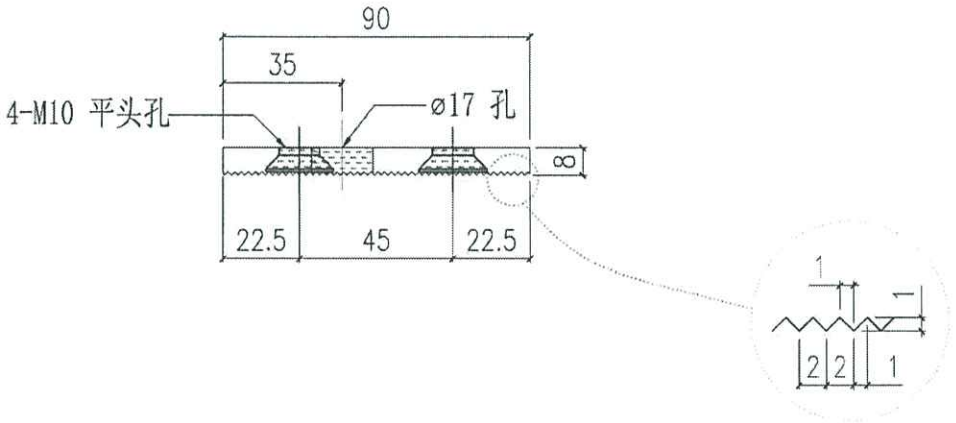

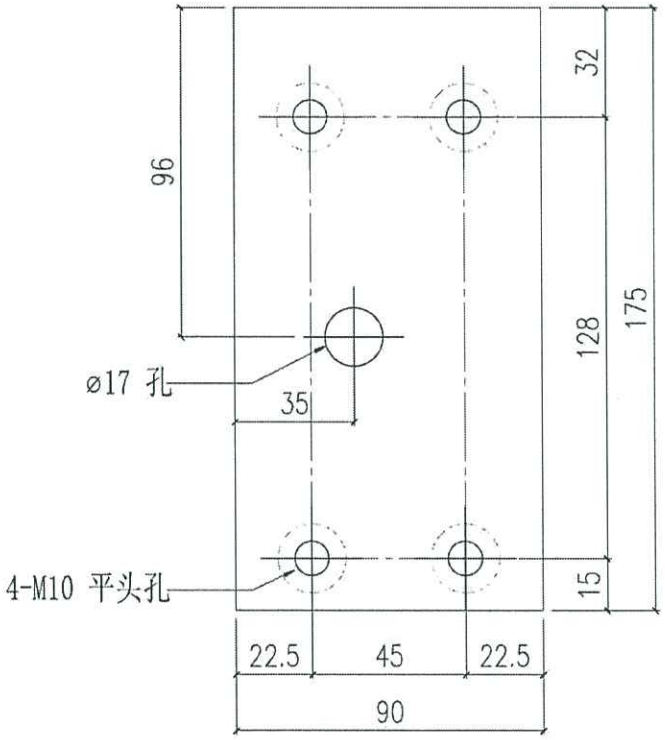



美特鋁質有限公司 MIDI Aluminium Fabricator Ltd.					工程號	J858	類別		物料號	-		
					地盘	康城11期	制圖	W.E.X	2022-06-14	圖號	X86260-01	
修改	-	-	-	採用工廠 ✓ 地盤	图纸名称	铝介子加工图	復核	-	-	數量	13600	
日期	-	-	-	材料顏色 CHROMATE	材料	X86260	批准	-	-	單件重量	-	(KG)

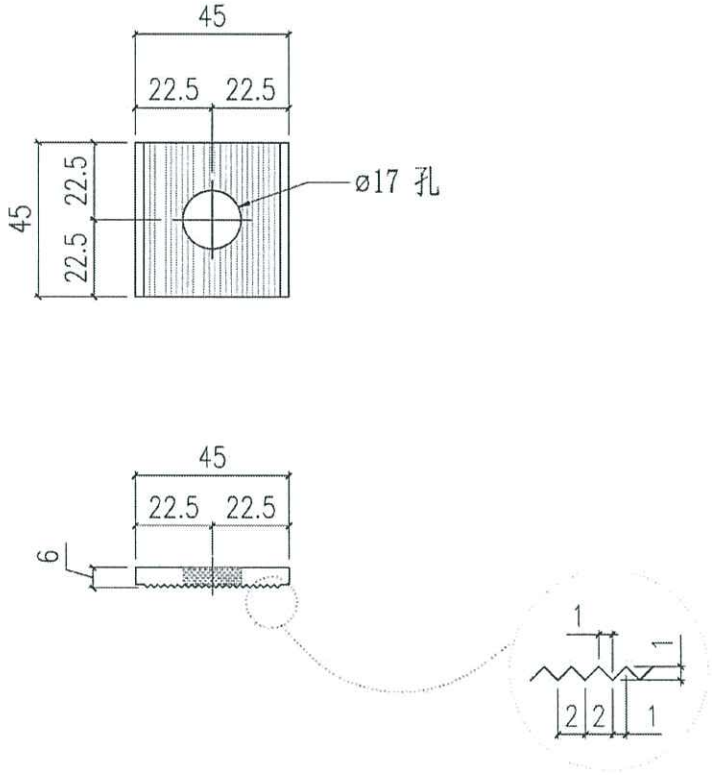


美特鋁質有限公司 MIDI Aluminium Fabricator Ltd.							工程號	J858	類別		物料號	-		
							地盘	康城11期	制圖	W.E.X	2022-06-14	圖號	X86261-01	
修改	-	-	-	採用	工廠	地盤 ✓	图纸名称	铝介子加工图	復核	-	-	數量	17800	
日期	-	-	-	材料颜色	CHROMATE		材料	X86261	批准	-	-	單件重量	-	(KG)

和墙身码一起出地盘

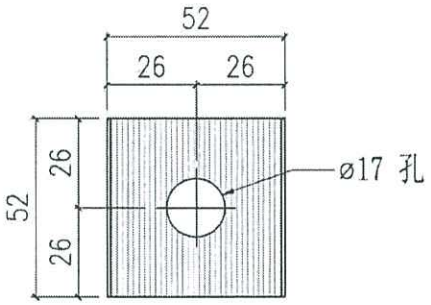

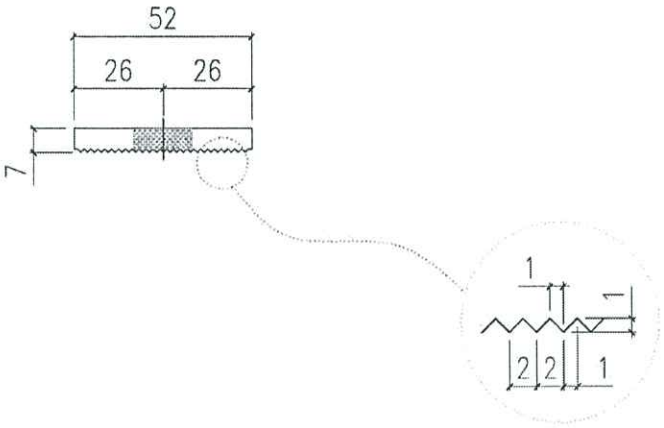

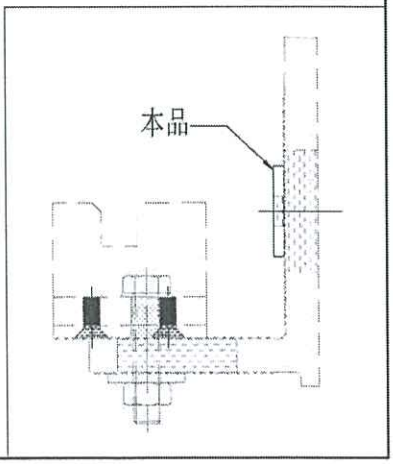

26.


記錄 Only

此頁前圖紙為 EI4917

此頁後圖紙為 EI5595(帶 A 字尾)


美特鋁質有限公司 MIDI Aluminium Fabricator Ltd.						工程號	J858	類別		物料號	-		
						地盘	康城11期	制圖	Jack	2023-01-04	圖號	BK-01La	
修改		-	-	採用	工廠	地盤 ✓	图纸名称	墙身码组装图	復核	-	-	數量	-
日期		-	-	材料顏色	-		材料	-	批准	-	-	單件重量	- (KG)

新增.

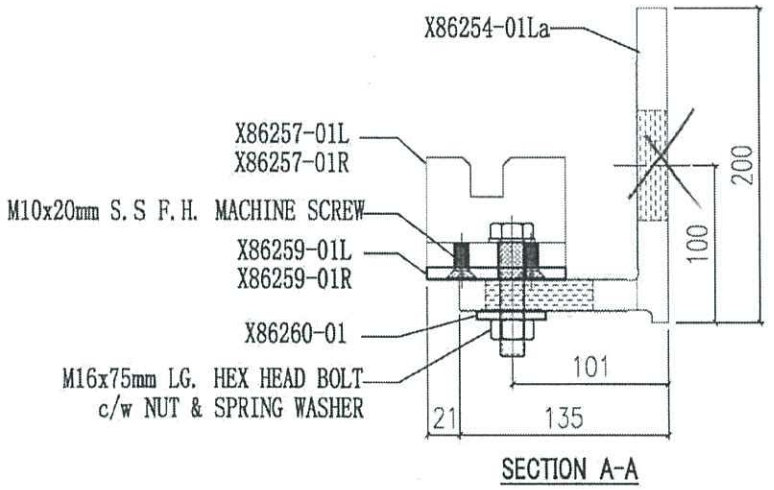

SECTION A-A


X86260-01	2
X86259-01R	1
X86259-01L	1
X86257-01R	1
X86257-01L	1
X86254-01La	1
编号	数量

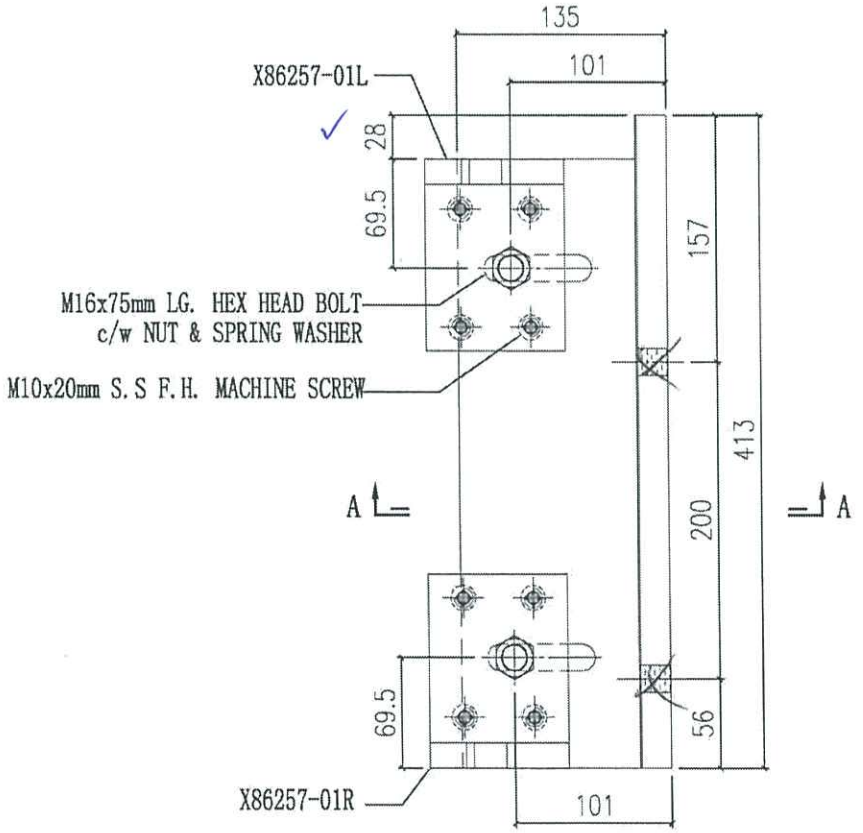

e15595


美特鋁質有限公司 MIDI Aluminium Fabricator Ltd.						工程號	J858	類別		物料號	-		
						地盘	康城11期	制圖	Jack	2023-01-04	圖號	BK-01Ra	
修改		-	-	採用	工廠	地盤 ✓	图纸名称	墙身码组装图	復核	-	-	數量	-
日期		-	-	材料顏色	-		材料	-	批准	-	-	單件重量	- (KG)

新增.

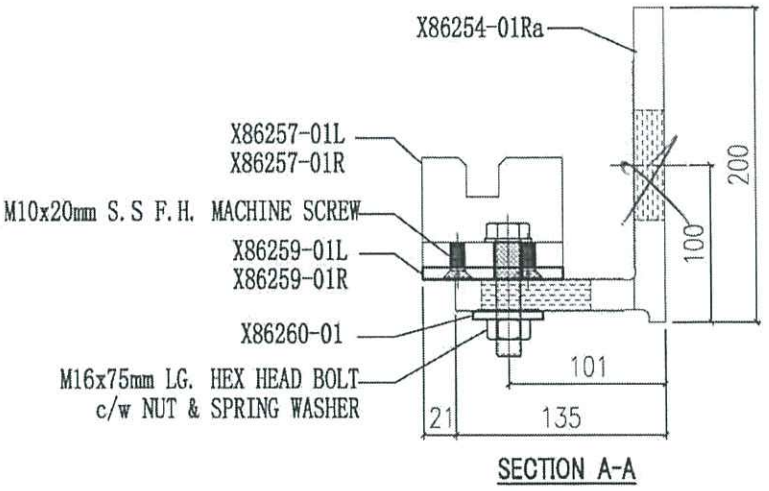

SECTION A-A


X86260-01	2
X86259-01R	1
X86259-01L	1
X86257-01R	1
X86257-01L	1
X86254-01Ra	1
编号	数量

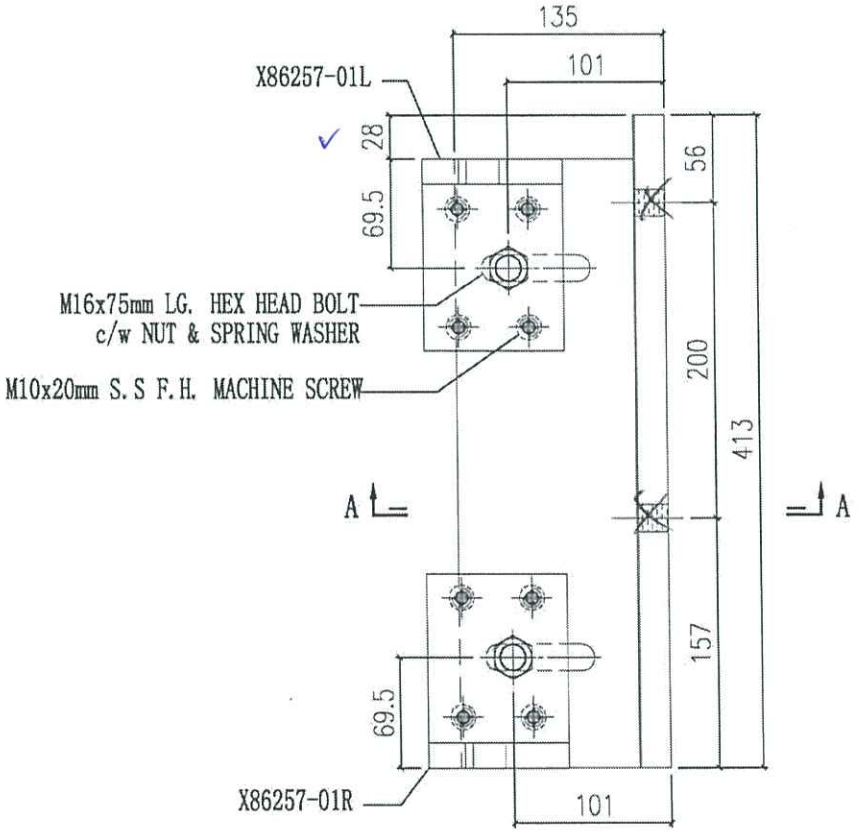


2

ei5598

美特鋁質有限公司 MIDI Aluminium Fabricator Ltd.						工程號	J858	類別		物料號	-		
						地盤	康城11期	制圖	Jack	2023-01-04	圖號	BK-02La	
修改		-	-	採用工廠	地盤 ✓	图纸名称	墙身码组装图	復核	-	-	數量	-	
日期		-	-	材料顏色	-	材料	-	批准	-	-	單件重量	-	(KG)

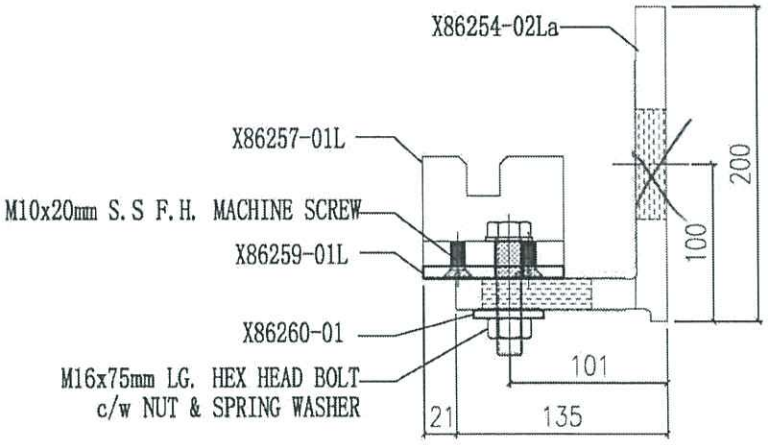


SECTION A-A

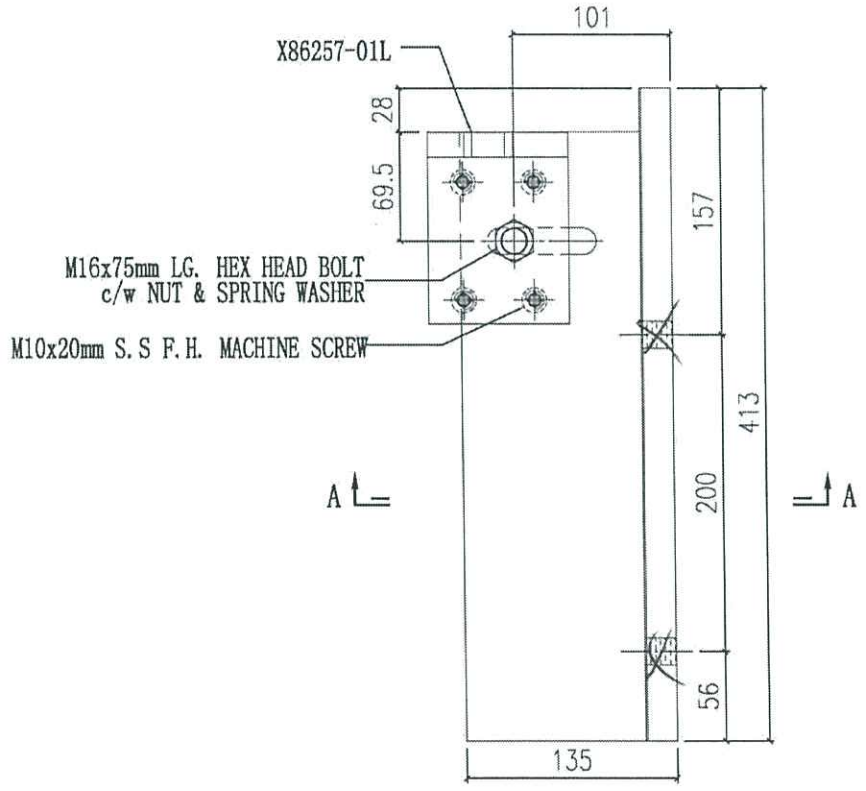


编号	数量
X86260-01	1
X86259-01L	1
X86257-01L	1
X86254-02La	1

美特鋁質有限公司 MIDI Aluminium Fabricator Ltd.						工程號	J858	類別		物料號	-		
						地盤	康城11期	制圖	Jack	2023-01-04	圖號	BK-03La	
修改		-	-	採用工廠		地盤 ✓	图纸名称 墙身码组装图	復核	-	-	數量	-	
日期		-	-	材料颜色	-		材料 -	批准	-	-	單件重量	-	(KG)

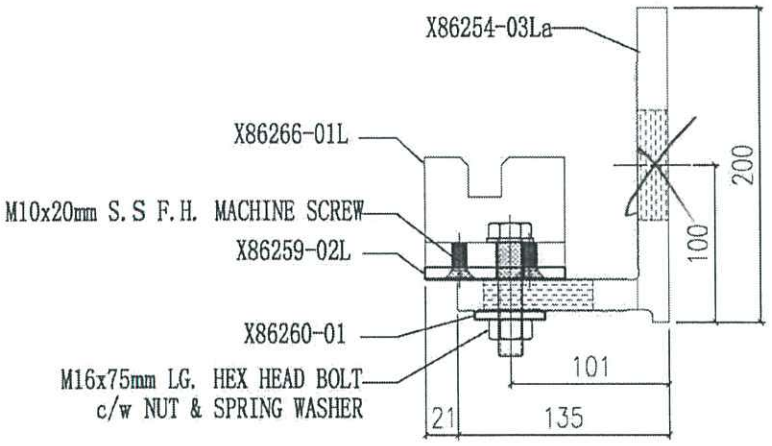


SECTION A-A

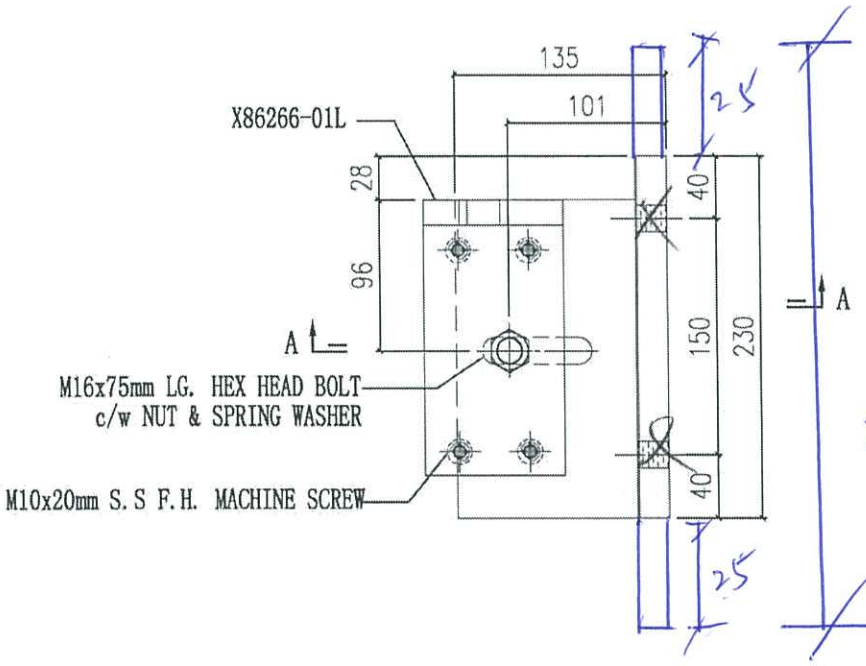


编号	数量
X86260-01	1
X86259-02L	1
X86266-01L	1
X86254-03La	1

美特鋁質有限公司 MIDI Aluminium Fabricator Ltd.					工程號	J858	類別		物料號	-		
					地盘	康城11期	制圖	Jack	2023-01-04	圖號	BK-04a	
修改		-	-	採用工廠 地盤 ✓	图纸名称	墙身码组装图	復核	-	-	數量	-	
日期		-	-	材料颜色 -	材料	-	批准	-	-	單件重量	-	(KG)

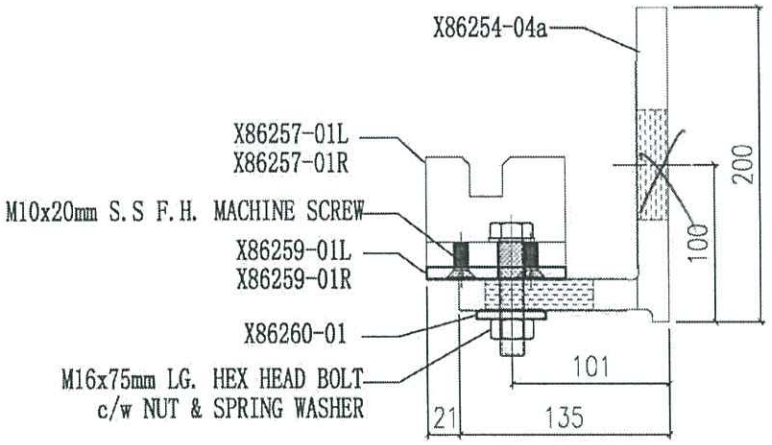


SECTION A-A

编号	数量
X86260-01	2
X86259-01R	1
X86259-01L	1
X86257-01R	1
X86257-01L	1
X86254-04a	1

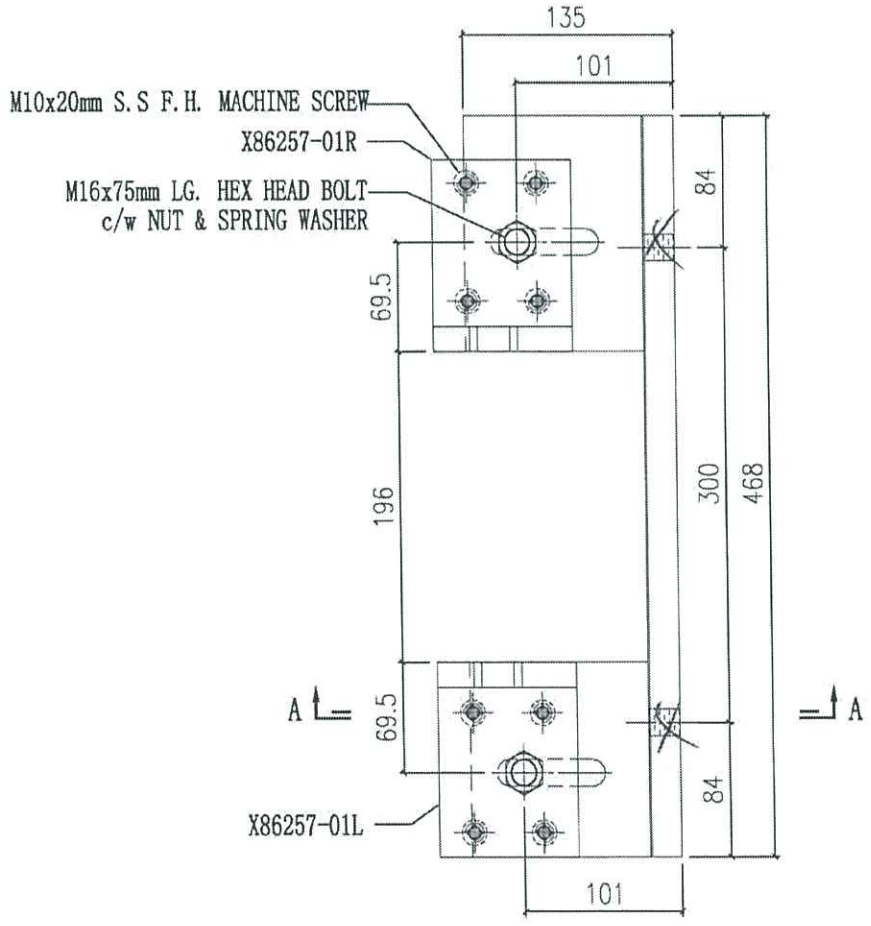


e:5595

美特鋁質有限公司 MIDI Aluminium Fabricator Ltd.						工程號	J858	類別		物料號	-		
						地盘	康城11期	制圖	Jack	2023-01-04	圖號	X86254-01La	
修改		-	-	採用工廠	✓	地盤	-	图纸名称	铝固定码加工图	復核	-	-	數量	-	
日期		-	-	材料颜色	CHROMATE			材料	X86254	批准	-	-	單件重量	-	(KG)

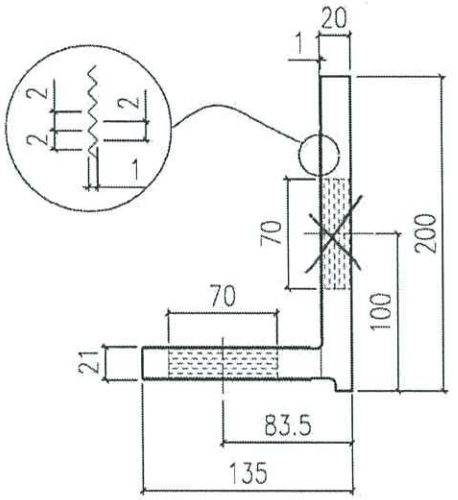


SECTION A-A

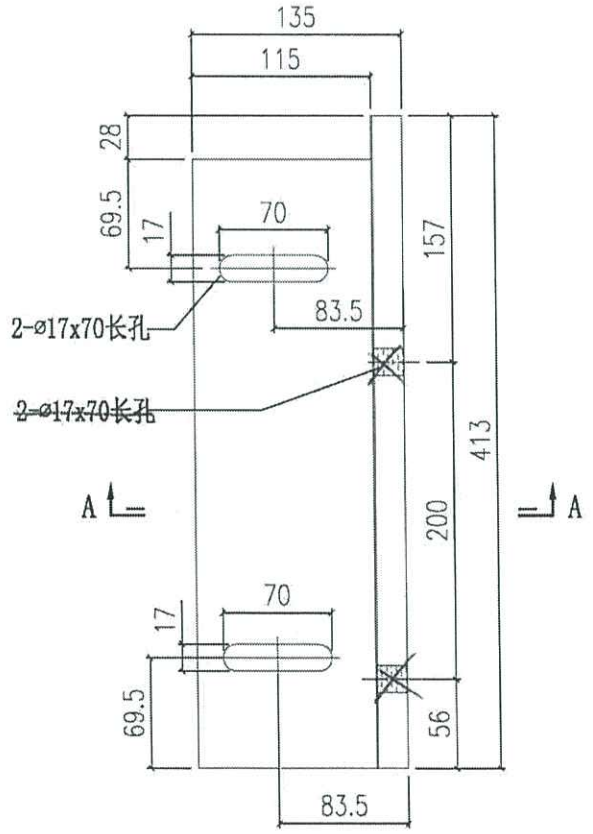


6

美特鋁質有限公司 MIDI Aluminium Fabricator Ltd.							工程號	J858	類別		物料號	-		
							地盘	康城11期	制圖	Jack	2023-01-04	圖號	X86254-01Ra	
修改		-	-	採用	工廠	✓	地盤	-	图纸名称	铝固定码加工图	復核	-	-	數量	-	
日期		-	-	材料颜色	CHROMATE				材料	X86254	批准	-	-	單件重量	-	(KG)

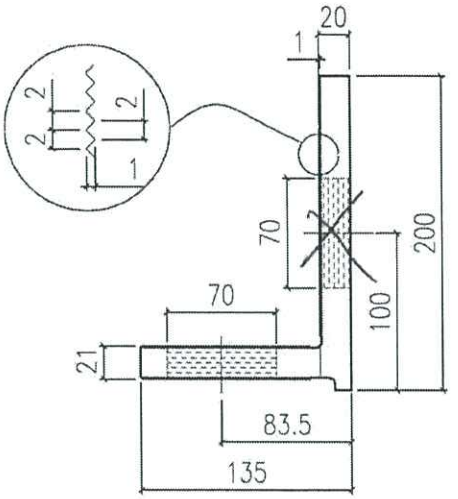


SECTION A-A

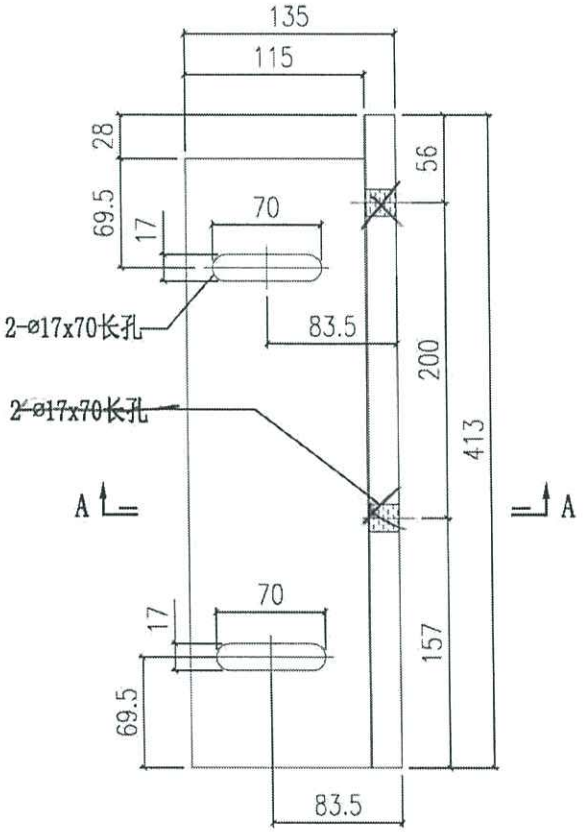


018595

美特鋁質有限公司 MIDI Aluminium Fabricator Ltd.						工程號	J858	類別		物料號	-		
						地盤	康城11期	制圖	Jack	2023-01-04	圖號	X86254-02La	
修改		-	-	採用工廠	✓	地盤	-	图纸名称	铝固定码加工图	復核	-	-	數量	-	
日期		-	-	材料顏色	CHROMATE			材料	X86254	批准	-	-	單件重量	-	(KG)

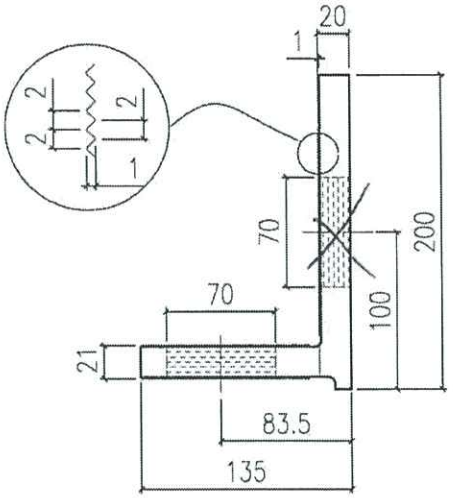


SECTION A-A

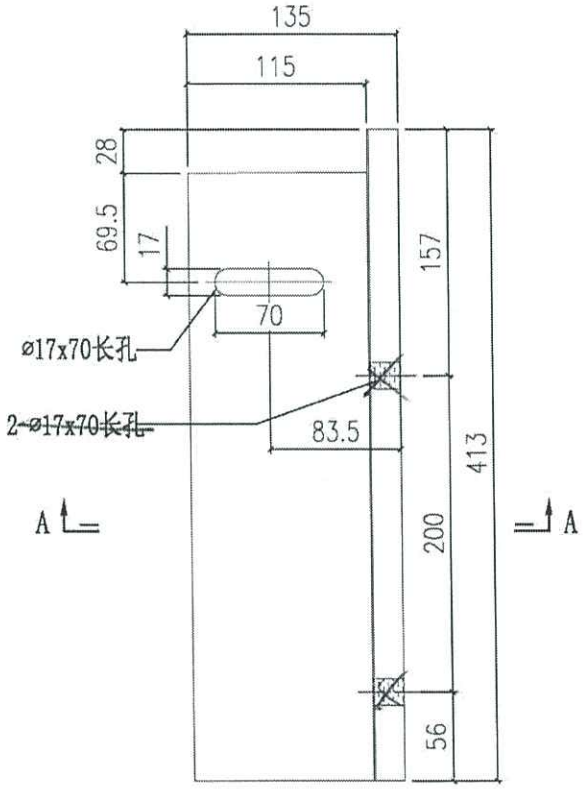


8


美特鋁質有限公司 MIDI Aluminium Fabricator Ltd.						工程號	J858	類別		物料號	-		
						地盤	康城11期	制圖	Jack	2023-01-04	圖號	X86254-03La	
修改		-	-	採用	工廠 ✓	地盤 -	图纸名称	铝固定码加工图	復核	-	-	數量	-
日期		-	-	材料颜色	CHROMATE		材料	X86254	批准	-	-	單件重量	- (KG)

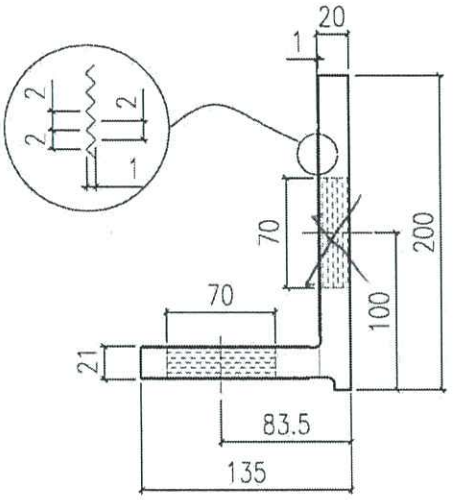

SECTION A-A

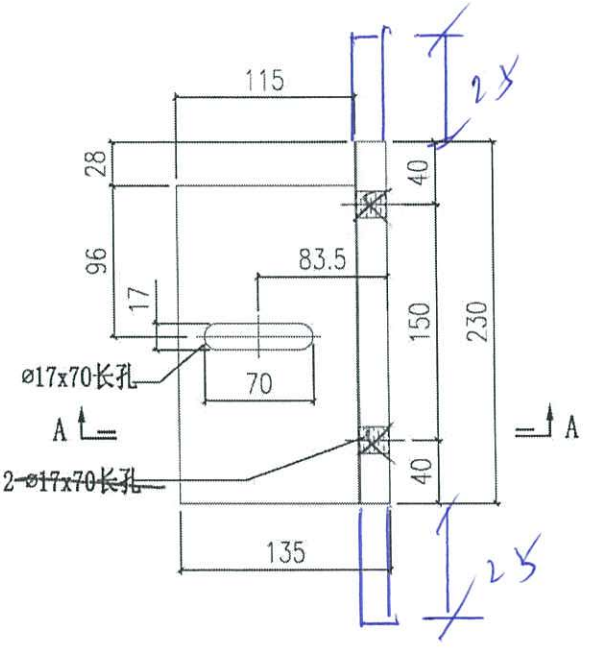


美特鋁質有限公司 MIDI Aluminium Fabricator Ltd.						工程號	J858	類別		物料號	-		
						地盤	康城11期	制圖	Jack	2023-01-04	圖號	X86254-04a	
修改		-	-	採用工廠	✓	地盤	-	图纸名称	铝固定码加工图	復核	-	-	數量	-	
日期		-	-	材料颜色	CHROMATE			材料	X86254	批准	-	-	單件重量	-	(KG)

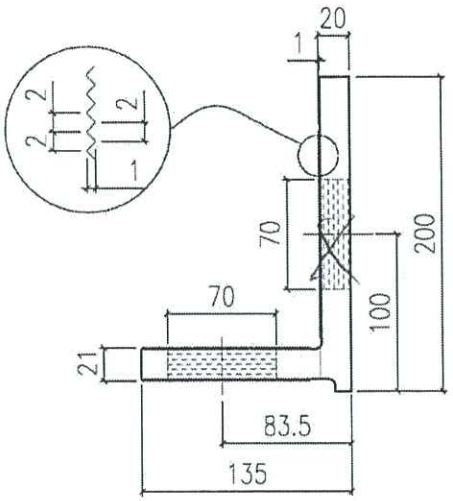

SECTION A-A

新增.

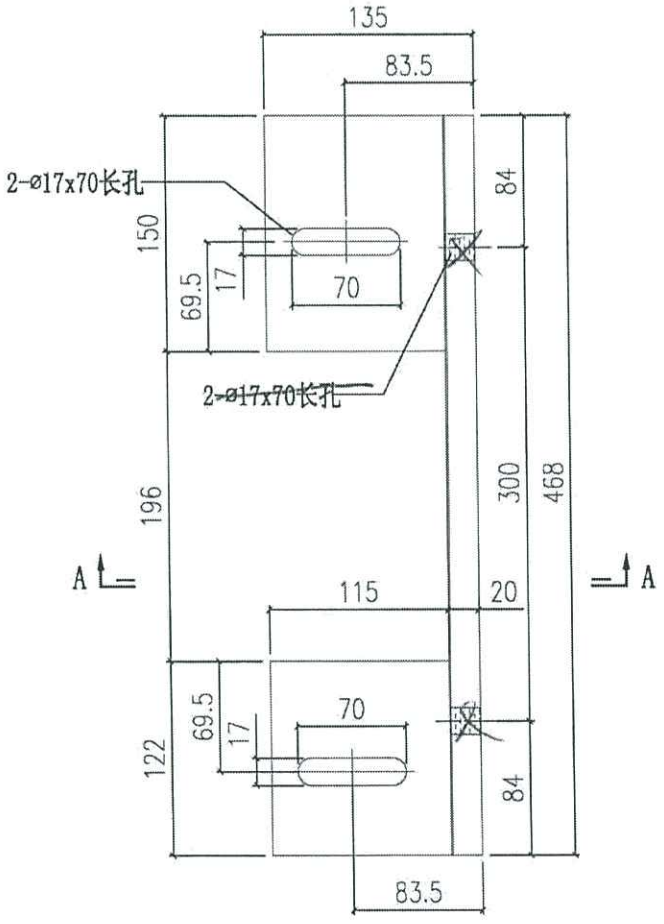

e:5595

10

J858康城11期T1单元幕墙墙身码数量分层统计表

工程:J858康城11期(T1)

日期:04-Jan-23 A版

序号	部件图编号	楼层																										
		10F	11F	12F	15F	16F	17F	18F	19F	20F	21F	22F	23F	25F	26F	27F	28F	29F	30F	31F	32F	33F	35F	36F	37F	38F	39F	40F
1	BK-01L	2	2	0	2	2	2	0	2	2	2	0	2	2	2	0	2	2	2	0	2	2	2	0	2	2	2	0
2	BK-01R	2	2	0	2	2	2	0	2	2	2	0	2	2	2	0	2	2	2	0	2	2	2	0	2	2	2	0
3	BK-02L	2	2	0	2	2	2	0	2	2	2	0	2	2	2	0	2	2	2	0	2	2	2	0	2	2	2	0
4	BK-02R	2	2	2	2	2	2	2	2	2	2	2	2	2	2	2	2	2	2	2	2	2	2	2	2	2	2	2
5	BK-03L	11	29	15	11	11	11	9	11	11	11	9	11	11	11	9	11	11	11	9	11	11	11	9	11	11	11	27
6	BK-03R	12	30	18	12	12	12	12	12	12	12	12	12	12	12	12	12	12	12	12	12	12	12	12	12	12	12	30
7	BK-04	25	61	24	25	25	25	12	25	25	25	12	25	25	25	12	25	25	25	12	25	25	25	12	25	25	25	48
8	BK-01La			2				2				2				2				2				2				2
9	BK-01Ra			2				2				2				2				2				2				2
10	BK-02La			2				2				2				2				2				2				2
11	BK-03La	1	1	3	1	1	1	3	1	1	1	3	1	1	1	3	1	1	1	3	1	1	1	3	1	1	1	3
12	BK-04a	1	1	14	1	1	1	14	1	1	1	14	1	1	1	14	1	1	1	14	1	1	1	14	1	1	1	14
13	X86261-01	116	260	164	116	116	116	116	116	116	116	116	116	116	116	116	116	116	116	116	116	116	116	116	116	116	116	260
	分层数量	174	390	246	174	174	174	174	174	174	174	174	174	174	174	174	174	174	174	174	174	174	174	174	174	174	174	390

J858康城11期T1单元幕墙墙身码数量分层统计表

工程:J858康城11

日期:04-Jan-23

序号	部件图编号	41F	42F	43F	45F	46F	47F	48F	49F	50F	51F	52F	53F	55F	56F	57F	58F	59F	60F	61F	62F	RF	总数量	备注
1	BK-01L	2	2	2	0	2	2	2	0	2	2	2	0	2	2	2	0	2	2	2	0	0	70	送地盘
2	BK-01R	2	2	2	0	2	2	2	0	2	2	2	0	2	2	2	0	2	2	2	0	1	71	送地盘
3	BK-02L	2	2	2	0	2	2	2	0	2	2	2	0	2	2	2	0	2	2	2	0	1	71	送地盘
4	BK-02R	2	2	2	2	2	2	2	2	2	2	2	2	2	2	2	2	2	2	2	2	0	94	送地盘
5	BK-03L	17	11	11	9	11	11	11	9	11	11	11	9	11	11	11	9	11	11	11	9	8	549	送地盘
6	BK-03R	18	12	12	12	12	12	12	12	12	12	12	12	12	12	12	12	12	12	12	12	9	621	送地盘
7	BK-04	37	25	25	12	25	25	25	12	25	25	25	12	25	25	25	12	25	25	25	12	33	1148	送地盘
8	BK-01La				2				2				2				2				2		24	送地盘
9	BK-01Ra				2				2				2				2				2		24	送地盘
10	BK-02La				2				2				2				2				2		24	送地盘
11	BK-03La	1 ✓	1	1	3	1	1	1	3	1	1	1	3	1	1	1	3	1	1	1	3		71	送地盘
12	BK-04a	1 ✓	1	1	14	1	1	1	14	1	1	1	14	1	1	1	14	1	1	1	14		203	送地盘
13	X86261-01	164	116	116	116	116	116	116	116	116	116	116	116	116	116	116	116	116	116	116	116	104	5940	送地盘
	分层数量	246	174	174	174	174	174	174	174	174	174	174	174	174	174	174	174	174	174	174	174	156	8910	

2

J858康城11期T2单元幕墙墙身码数量分层统计表

工程 J858康城11期(T2)

日期 04-Jan-23　　A版

序号	部件图编号	楼层																												
		10F	11F	12F	15F	16F	17F	18F	19F	20F	21F	22F	23F	25F	26F	27F	28F	29F	30F	31F	32F	33F	35F	36F	37F	38F	39F	40F	41F	42F
1	BK-01L	2	2	0	2	2	2	0	2	2	2	0	2	2	2	0	2	2	2	0	2	2	2	0	2	2	2	0	2	2
2	BK-01R	1	1	0	1	1	1	0	1	1	1	0	1	1	1	0	1	1	1	0	1	1	1	0	1	1	1	0	1	1
3	BK-02L	1	1	0	1	1	1	0	1	1	1	0	1	1	1	0	1	1	1	0	1	1	1	0	1	1	1	0	1	1
4	BK-02R	2	2	2	2	2	2	2	2	2	2	2	2	2	2	2	2	2	2	2	2	2	2	2	2	2	2	2	2	2
5	BK-03L	11	28	14	11	11	11	9	11	11	11	9	11	11	11	9	11	11	11	9	11	11	11	9	11	11	11	26	16	11
6	BK-03R	11	28	16	11	11	11	11	11	11	11	11	11	11	11	11	11	11	11	11	11	11	11	11	11	11	11	28	16	11
7	BK-04	22	57	24	22	22	22	13	22	22	22	13	22	22	22	13	22	22	22	13	22	22	22	13	22	22	22	48	33	22
8	BK-05	1	1	1	1	1	1	1	1	1	1	1	1	1	1	1	1	1	1	1	1	1	1	1	1	1	1	1	1	1
8	BK-01La			2				2				2				2				2				2				2		
9	BK-01Ra			1				1				1				1				1				1				1		
10	BK-02La			1				1				1				1				1				1				1		
11	BK-03La	1	1	3	1	1	1	3	1	1	1	3	1	1	1	3	1	1	1	3	1	1	1	3	1	1	1	3	1	1
12	BK-04a	1	1	10	1	1	1	10	1	1	1	10	1	1	1	10	1	1	1	10	1	1	1	10	1	1	1	10	1	1
13	X86261-01	106	244	148	106	106	106	106	106	106	106	106	106	106	106	106	106	106	106	106	106	106	106	106	106	106	106	244	148	106
	分层数量	159	366	222	159	159	159	159	159	159	159	159	159	159	159	159	159	159	159	159	159	159	159	159	159	159	159	366	222	159

3

J858康城11期T2单元幕墙墙身码数量分层统计表

工程 J858康城11期

日期 04-Jan-23

序号	部件图编号	43F	45F	46F	47F	48F	49F	50F	51F	52F	53F	55F	56F	57F	58F	59F	60F	61F	62F	63F	65F	66F	67F	RF	总数量	备注
1	BK-01L	2	0	2	2	2	0	2	2	2	0	2	2	2	0	2	2	2	0	2	2	2	0	0	76	送地盘
2	BK-01R	1	0	1	1	1	0	1	1	1	0	1	1	1	0	1	1	1	0	1	1	1	0	0	38	送地盘
3	BK-02L	1	0	1	1	1	0	1	1	1	0	1	1	1	0	1	1	1	0	1	1	1	0	0	38	送地盘
4	BK-02R	2	2	2	2	2	2	2	2	2	2	2	2	2	2	2	2	2	2	2	2	2	2	0	102	送地盘
5	BK-03L	11	9	11	11	11	9	11	11	11	9	11	11	11	9	11	11	11	9	11	11	11	9	9	588	送地盘
6	BK-03R	11	11	11	11	11	11	11	11	11	11	11	11	11	11	11	11	11	11	11	11	11	11	9	614	送地盘
7	BK-04	22	13	22	22	22	13	22	22	22	13	22	22	22	13	22	22	22	13	22	22	22	13	30	1127	送地盘
8	BK-05	1	1	1	1	1	1	1	1	1	1	1	1	1	1	1	1	1	1	1	1	1	1	0	51	送地盘
8	BK-01La		2				2				2				2				2				2		26	送地盘
9	BK-01Ra		1				1				1				1				1				1		13	送地盘
10	BK-02La		1				1				1				1				1				1		13	送地盘
11	BK-03La	1	3	1	1	1	3	1	1	1	3	1	1	1	3	1	1	1	3	1	1	1	3		77	送地盘
12	BK-04a	1	10	1	1	1	10	1	1	1	10	1	1	1	10	1	1	1	10	1	1	1	10		168	送地盘
13	X86261-01	106	106	106	106	106	106	106	106	106	106	106	106	106	106	106	106	106	106	106	106	106	106	96	5862	送地盘
	分层数量	159	159	159	159	159	159	159	159	159	159	159	159	159	159	159	159	159	159	159	159	159	159	144	8793	

J858康城11期T3单元幕墙墙身码数量分层统计表

工程 J858康城11期(T3)

日期 04-Jan-23　A版


序号	部件图编号	楼层																												
		10F	11F	12F	15F	16F	17F	18F	19F	20F	21F	22F	23F	25F	26F	27F	28F	29F	30F	31F	32F	33F	35F	36F	37F	38F	39F	40F	41F	42F
1	BK-01L	2	2	0	2	2	2	0	2	2	2	0	2	2	2	0	2	2	2	0	2	2	2	0	2	2	2	0	2	2
2	BK-01R	1	1	0	1	1	1	0	1	1	1	0	1	1	1	0	1	1	1	0	1	1	1	0	1	1	1	0	1	1
3	BK-02L	1	1	0	1	1	1	0	1	1	1	0	1	1	1	0	1	1	1	0	1	1	1	0	1	1	1	0	1	1
4	BK-02R	2	2	2	2	2	2	2	2	2	2	2	2	2	2	2	2	2	2	2	2	2	2	2	2	2	2	2	2	2
5	BK-03L	10	27	13	10	10	10	7	10	10	10	7	10	10	10	7	10	10	10	7	10	10	10	7	10	10	10	24	16	10
6	BK-03R	10	27	16	10	10	10	10	10	10	10	10	10	10	10	10	10	10	10	10	10	10	10	10	10	10	10	27	16	10
7	BK-04	23	59	26	23	23	23	13	23	23	23	13	23	23	23	13	23	23	23	13	23	23	23	13	23	23	23	49	36	23
8	BK-05	1	1	1	1	1	1	1	1	1	1	1	1	1	1	1	1	1	1	1	1	1	1	1	1	1	1	1	1	1
8	BK-01La			2				2				2				2				2				2				2		
9	BK-01Ra			1				1				1				1				1				1				1		
10	BK-02La			1				1				1				1				1				1				1		
11	BK-03La	1	1	4	1	1	1	4	1	1	1	4	1	1	1	4	1	1	1	4	1	1	1	4	1	1	1	4	1	1
12	BK-04a	1	1	11	1	1	1	11	1	1	1	11	1	1	1	11	1	1	1	11	1	1	1	11	1	1	1	11	1	1
13	X86261-01	104	244	154	104	104	104	104	104	104	104	104	104	104	104	104	104	104	104	104	104	104	104	104	104	104	104	244	154	104
	分层数量	156	366	231	156	156	156	156	156	156	156	156	156	156	156	156	156	156	156	156	156	156	156	156	156	156	156	366	231	156

J858康城11期T3单元幕墙墙身码数量分层统计表

工程 J858康城11期

日期 04-Jan-23

序号	部件图编号	43F	45F	46F	47F	48F	49F	50F	51F	52F	53F	55F	56F	57F	58F	59F	60F	61F	62F	63F	65F	66F	67F	RF	总数量	备注
1	BK-01L	2	0	2	2	2	0	2	2	2	0	2	2	2	0	2	2	2	0	2	2	2	0	0	76	送地盘
2	BK-01R	1	0	1	1	1	0	1	1	1	0	1	1	1	0	1	1	1	0	1	1	1	0	0	38	送地盘
3	BK-02L	1	0	1	1	1	0	1	1	1	0	1	1	1	0	1	1	1	0	1	1	1	0	0	38	送地盘
4	BK-02R	2	2	2	2	2	2	2	2	2	2	2	2	2	2	2	2	2	2	2	2	2	2	0	102	送地盘
5	BK-03L	10	7	10	10	10	7	10	10	10	7	10	10	10	7	10	10	10	7	10	10	10	7	8	525	送地盘
6	BK-03R	10	10	10	10	10	10	10	10	10	10	10	10	10	10	10	10	10	10	10	10	10	10	8	564	送地盘
7	BK-04	23	13	23	23	23	13	23	23	23	13	23	23	23	13	23	23	23	13	23	23	23	13	31	1172	送地盘
8	BK-05	1	1	1	1	1	1	1	1	1	1	1	1	1	1	1	1	1	1	1	1	1	1	0	51	送地盘
8	BK-01La		2				2				2				2				2				2		26	送地盘
9	BK-01Ra		1				1				1				1				1				1		13	送地盘
10	BK-02La		1				1				1				1				1				1		13	送地盘
11	BK-03La	1	4	1	1	1	4	1	1	1	4	1	1	1	4	1	1	1	4	1	1	1	4		90	送地盘
12	BK-04a	1	11	1	1	1	11	1	1	1	11	1	1	1	11	1	1	1	11	1	1	1	11		181	送地盘
13	X86261-01	104	104	104	104	104	104	104	104	104	104	104	104	104	104	104	104	104	104	104	104	104	104	94	5778	送地盘
	分层数量	156	156	156	156	156	156	156	156	156	156	156	156	156	156	156	156	156	156	156	156	156	156	141	8667	

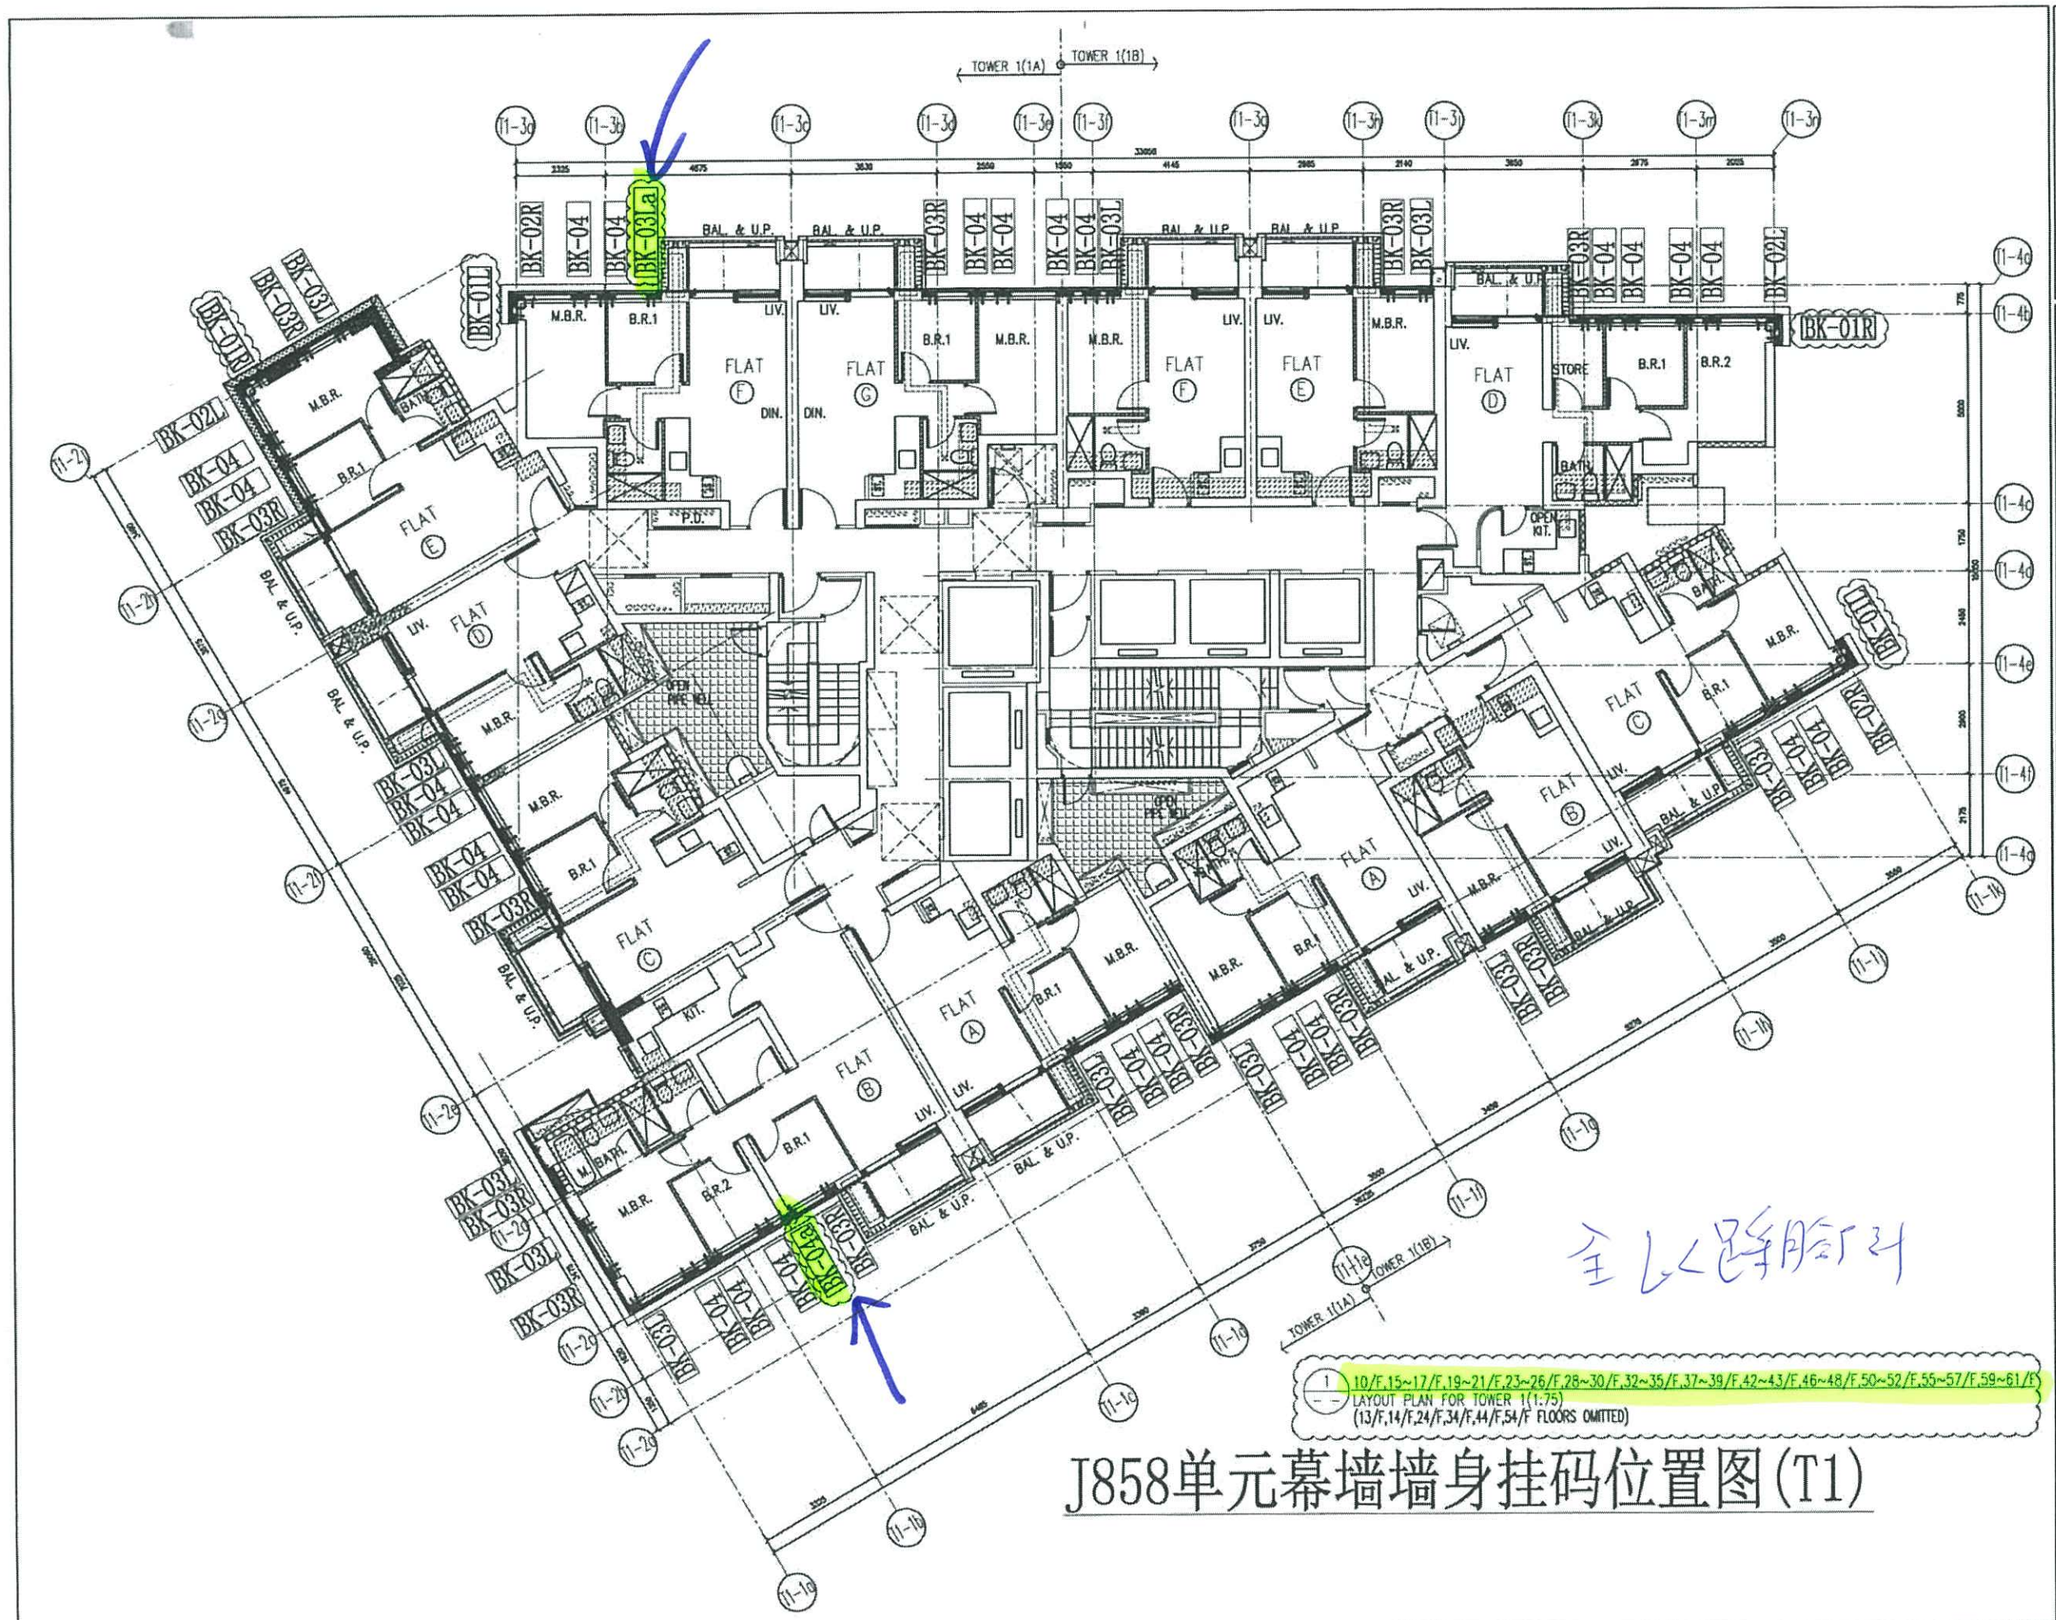

J858单元幕墙墙身挂码位置图(T1)

B.D. REF :

9:7895

CLIENT :
信和置業有限公司
Sino Land Company Limited

ARCHITECT :
ronald lu & partners
Ronald Lu & Partners (HK) Ltd.
呂元祥建築師事務所(香港)有限公司

MAIN CONTRACTOR :
Gammon

STRUCTURAL ENGINEER :
AECOM

FACADE CONSULTANT:
AECOM

NOTE :
1. ALL DIMENSIONS ARE IN mm.
2. ALL ELEVATIONS ARE VIEWED FROM OUTSIDE.
3. ALL DIMENSIONS TO BE VERIFIED ON SITE BEFORE FABRICATION.

LEGEND :
X1 — DETAIL MARK NO.
X001 — REFER SHEET NO.
1. F.F.L. --FINISHED FLOOR LEVEL
2. S.F.L. --STRUCTURAL FLOOR LEVEL
3. (FR) --REVERSED DETAIL

NO.	DATE	REMARKS	BY
-	-	-	-

JOB NO. : J-858

PROJECT :
PROPOSED RESIDENTIAL DEVELOPMENT
AT TKOTL 70RP, PHASE 11, LOHAS PARK
TSEUNG KWAN O, N.T.

TITLE :
TYPICAL FLOOR PLAN
AT TOWER 1

DATE : 14-Jun-22 | SCALE : 1:75(A1)

DRAWN BY : KY | CHECKED BY : YB


美特鋁質有限公司
MIDI ALUMINIUM FABRICATOR LTD.
Units 6-8, Sunray Industrial Centre, 1/F
610 Cha Kwo Ling Road, Kowloon
Tel:23489211-4 Fax:(852)27727666

DWG NO. : J858-CW-BR-101 | REV. : A

全玻璃肋

(2)

(1)

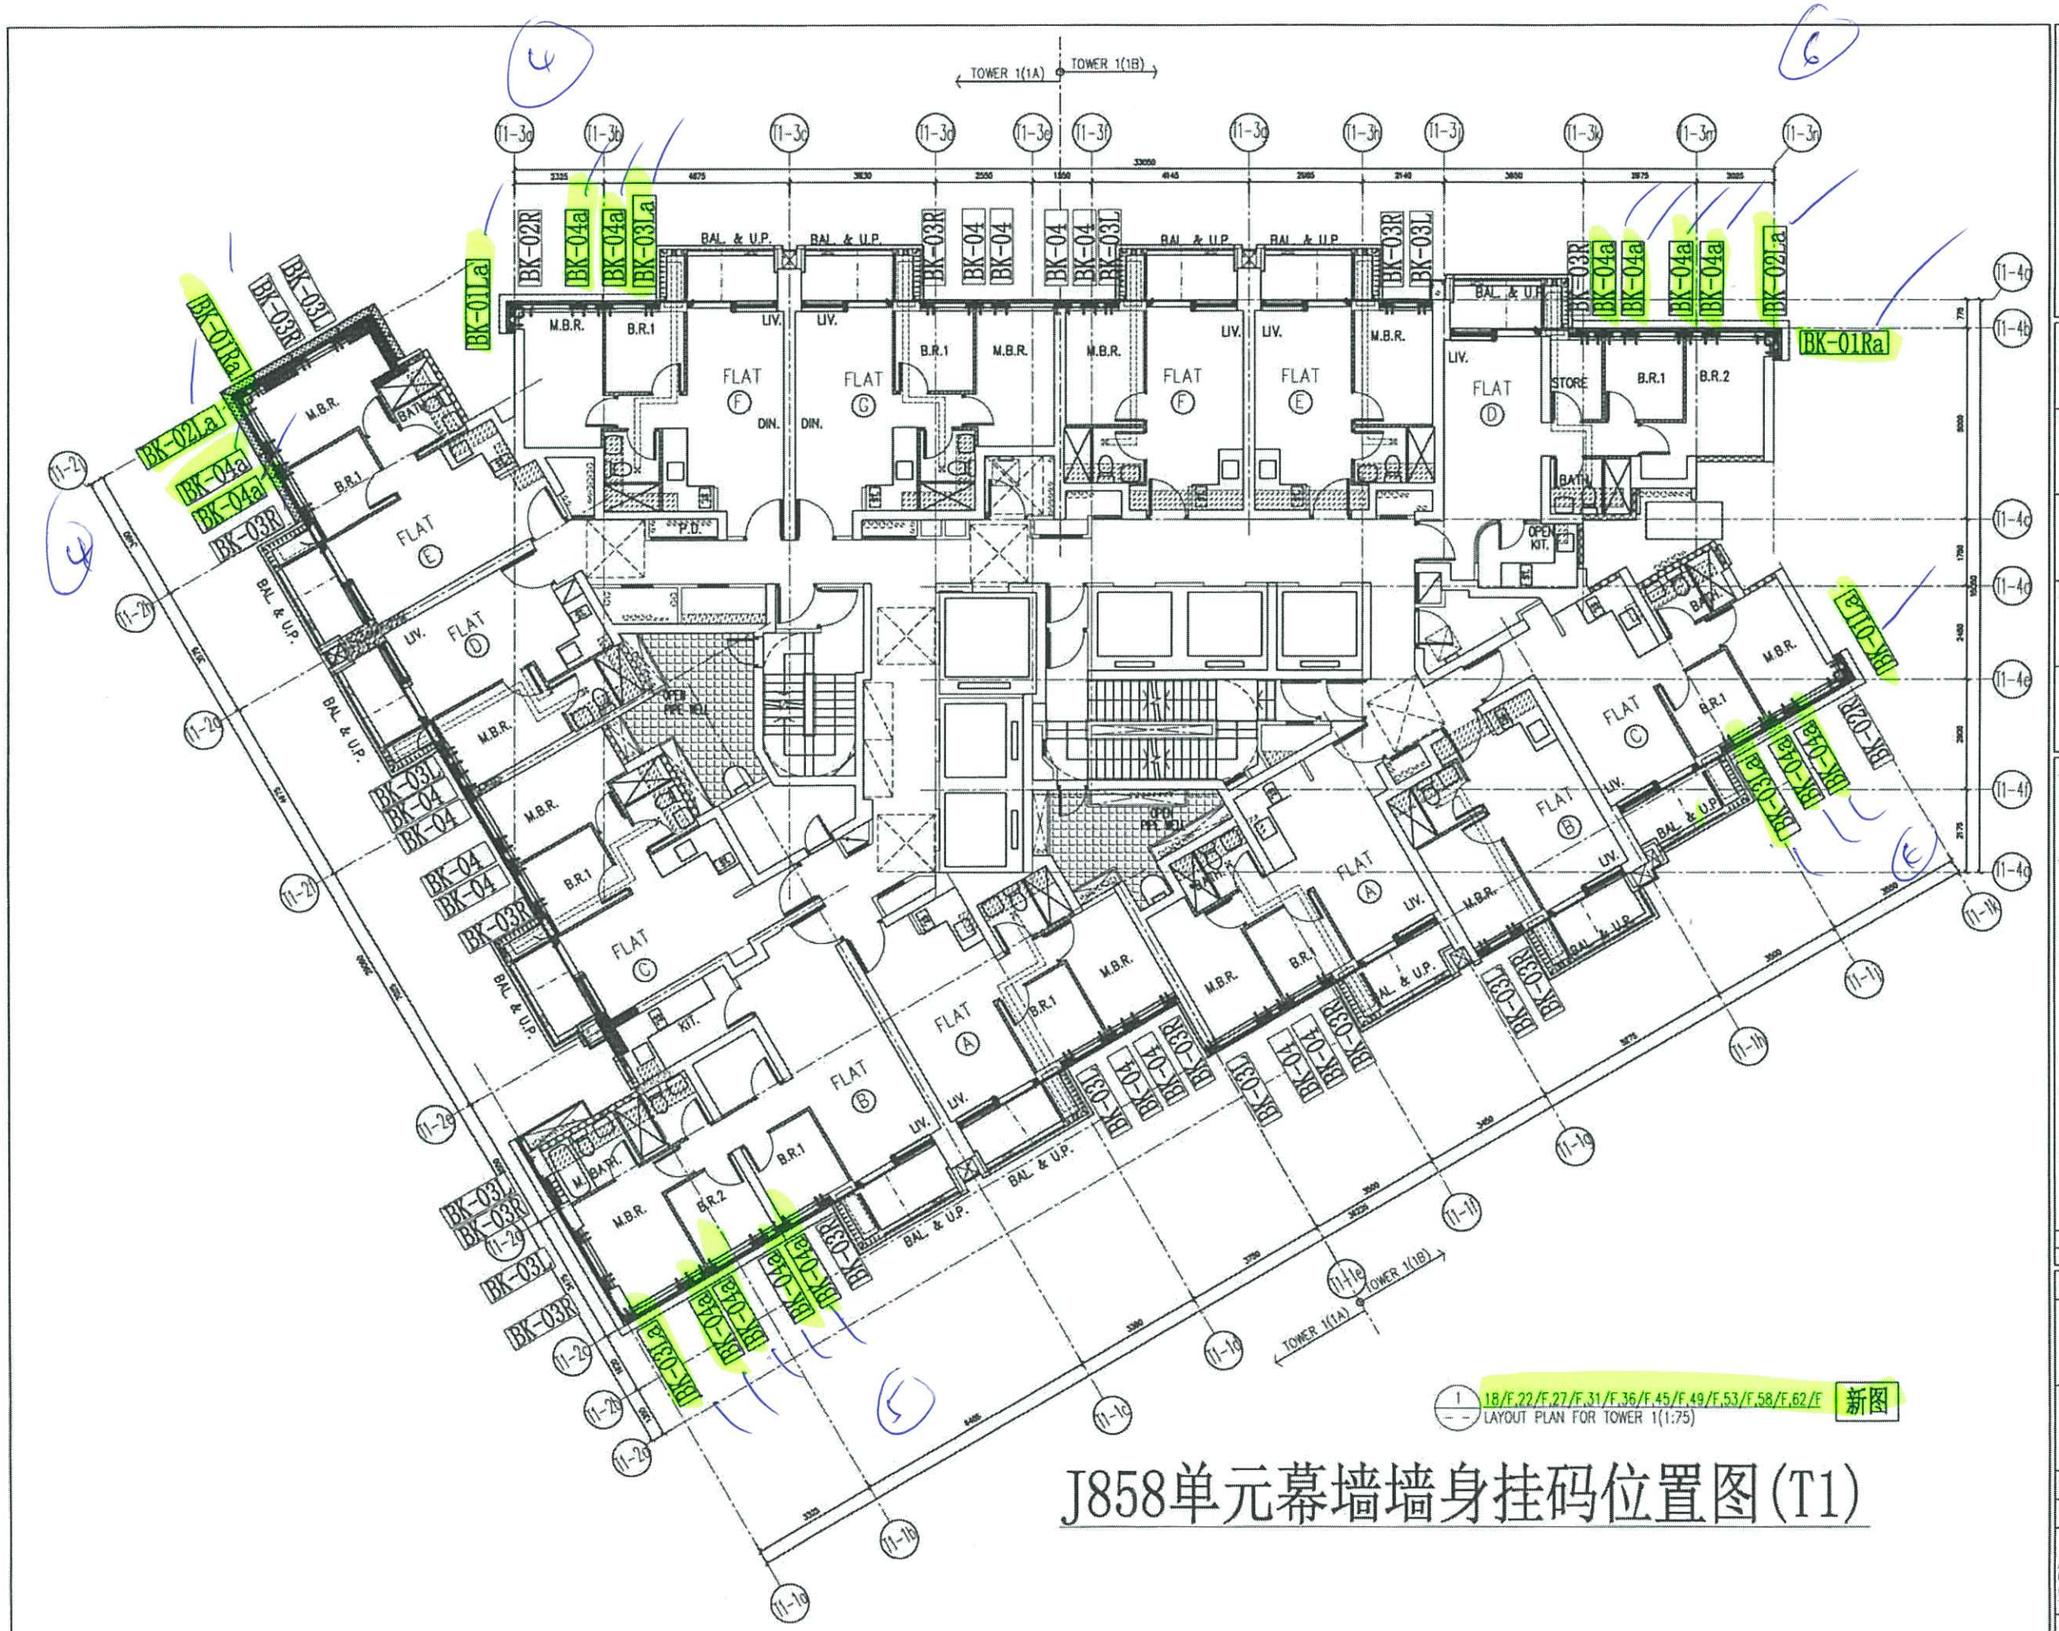

1 LAYOUT PLAN FOR TOWER 1(1:75)

18/F,22/F,27/F,31/F,36/F,45/F,49/F,53/F,58/F,62/F 新图

J858单元幕墙墙身挂码位置图(T1)

B.D. REF :

CLIENT :
信和置業有限公司
Sino Land Company Limited

ARCHITECT :
ronald lu & partners
Ronald Lu & Partners (HK) Ltd.
呂元祥建築師事務所(香港)有限公司

MAIN CONTRACTOR :
Gammon

STRUCTURAL ENGINEER :
AECOM

FACADE CONSULTANT:
AECOM

NOTE :
1. ALL DIMENSIONS ARE IN mm.
2. ALL ELEVATIONS ARE VIEWED FROM OUTSIDE.
3. ALL DIMENSIONS TO BE VERIFIED ON SITE BEFORE FABRICATION.

LEGEND :
X1 — DETAIL MARK NO.
XD01 — REFER SHEET NO.
1. F.F.L. — FINISHED FLOOR LEVEL
2. S.F.L. — STRUCTURAL FLOOR LEVEL
3. (YB) — REVERSED DETAIL

NO.	DATE	REMARKS	BY
–	–	–	–

JOB NO. : J-858

PROJECT :
PROPOSED RESIDENTIAL DEVELOPMENT
AT TKOTL 70RP, PHASE 11, LOHAS PARK
TSEUNG KWAN O, N.T.


TITLE :
TYPICAL FLOOR PLAN
AT TOWER 1

DATE : 14-Jun-22 | SCALE : 1:75(A1)

DRAWN BY : KY | CHECKED BY : YB

美特鋁質有限公司
MIDI ALUMINIUM FABRICATOR LTD.
Units 6-8, Sunray Industrial Centre, 1/F
610 Cha Kwo Ling Road, Kowloon
Tel:23489211-4 Fax:(852)27727666

DWG NO. : J858-CW-BR-101a | REV. : –

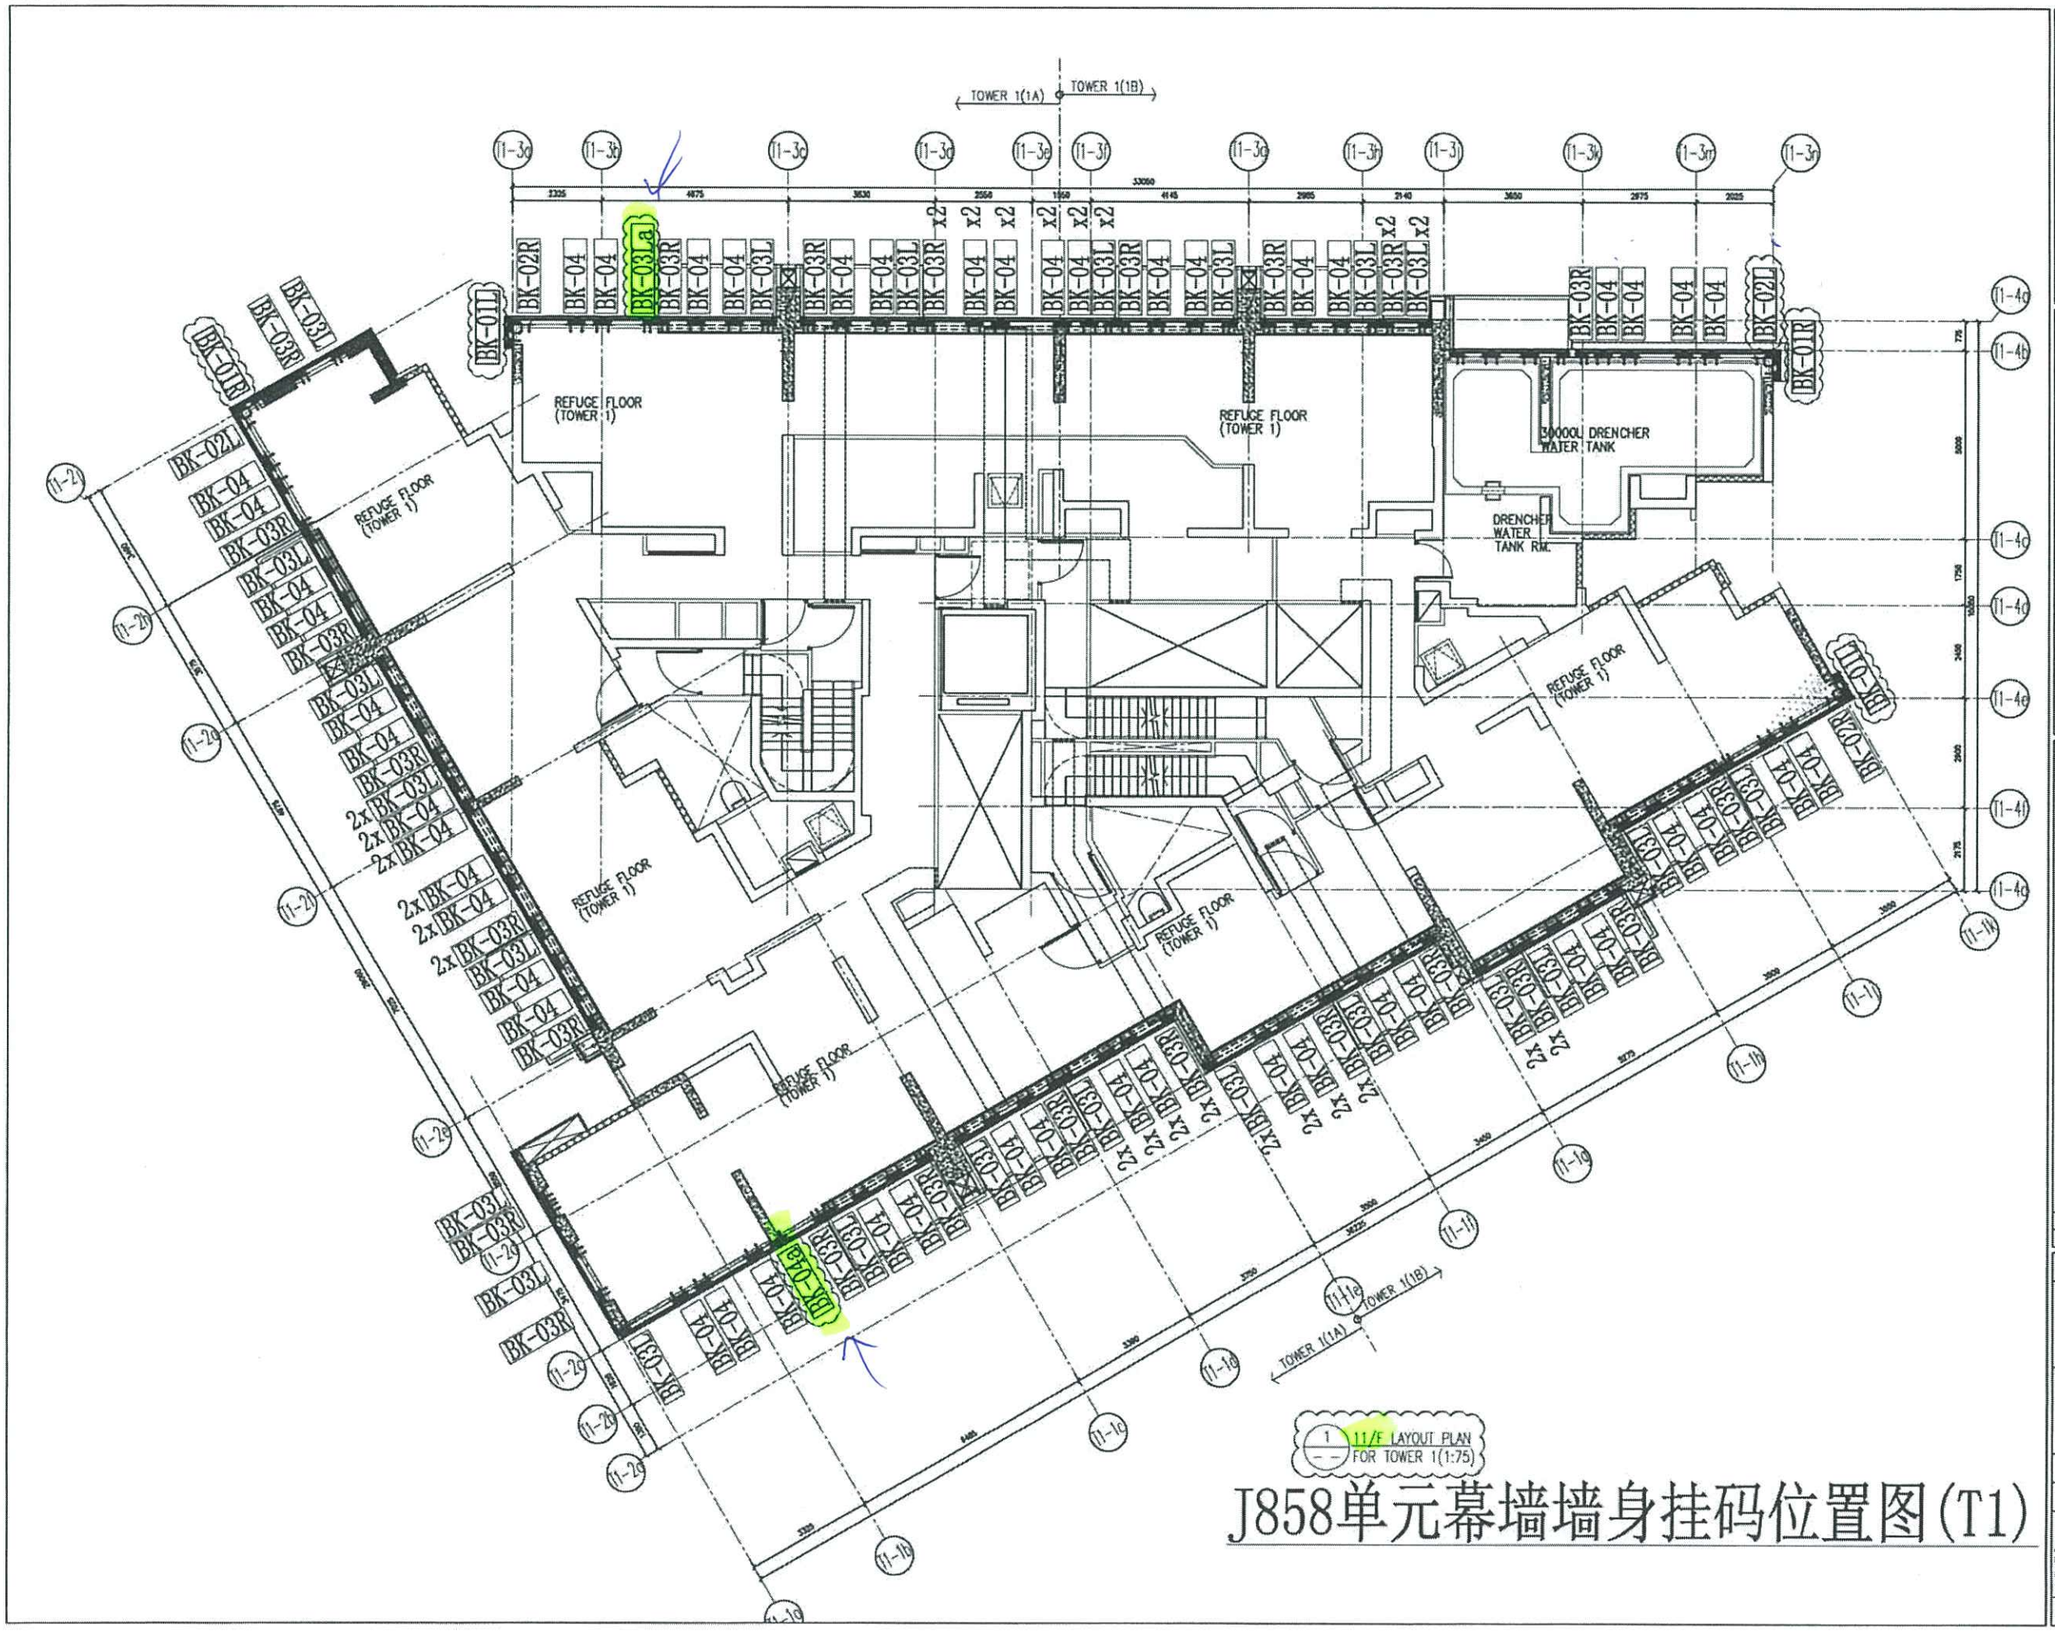

J858单元幕墙墙身挂码位置图(T1)

B.D. REF :

CLIENT :
信和置業有限公司
Sino Land Company Limited

ARCHITECT :
ronald lu & partners
Ronald Lu & Partners (HK) Ltd.
呂元祥建築師事務所(香港)有限公司

MAIN CONTRACTOR :
Gammon

STRUCTURAL ENGINEER :
AECOM

FACADE CONSULTANT:
AECOM

NOTE :
1. ALL DIMENSIONS ARE IN mm.
2. ALL ELEVATIONS ARE VIEWED FROM OUTSIDE.
3. ALL DIMENSIONS TO BE VERIFIED ON SITE BEFORE FABRICATION.

LEGEND :
X1 — DETAIL MARK NO.
XD01 — REFER SHEET NO.
1. F.F.L. — FINISHED FLOOR LEVEL
2. S.F.L. — STRUCTURAL FLOOR LEVEL
3. (YB) — REVERSED DETAIL

NO.	DATE	REVISED	BY
-	-	-	-

JOB NO. : J-858

PROJECT :
PROPOSED RESIDENTIAL DEVELOPMENT
AT TKOTL 70RP, PHASE 11, LOHAS PARK
TSEUNG KWAN O, N.T.


TITLE :
11/F REFUGE FLOOR PLAN AT TOWER 1

DATE : 14-Jun-22 | SCALE : 1:75(A1)

DRAWN BY : KY | CHECKED BY : YB

美特鋁質有限公司
MIDI ALUMINIUM FABRICATOR LTD.
Units 6-8, Sunray Industrial Centre, 1/F
610 Cha Kwa Ling Road, Kowloon
Tel:23489211-4 Fax:(852)27727666

DWG NO. : J858-CW-BR-102 | REV. : A

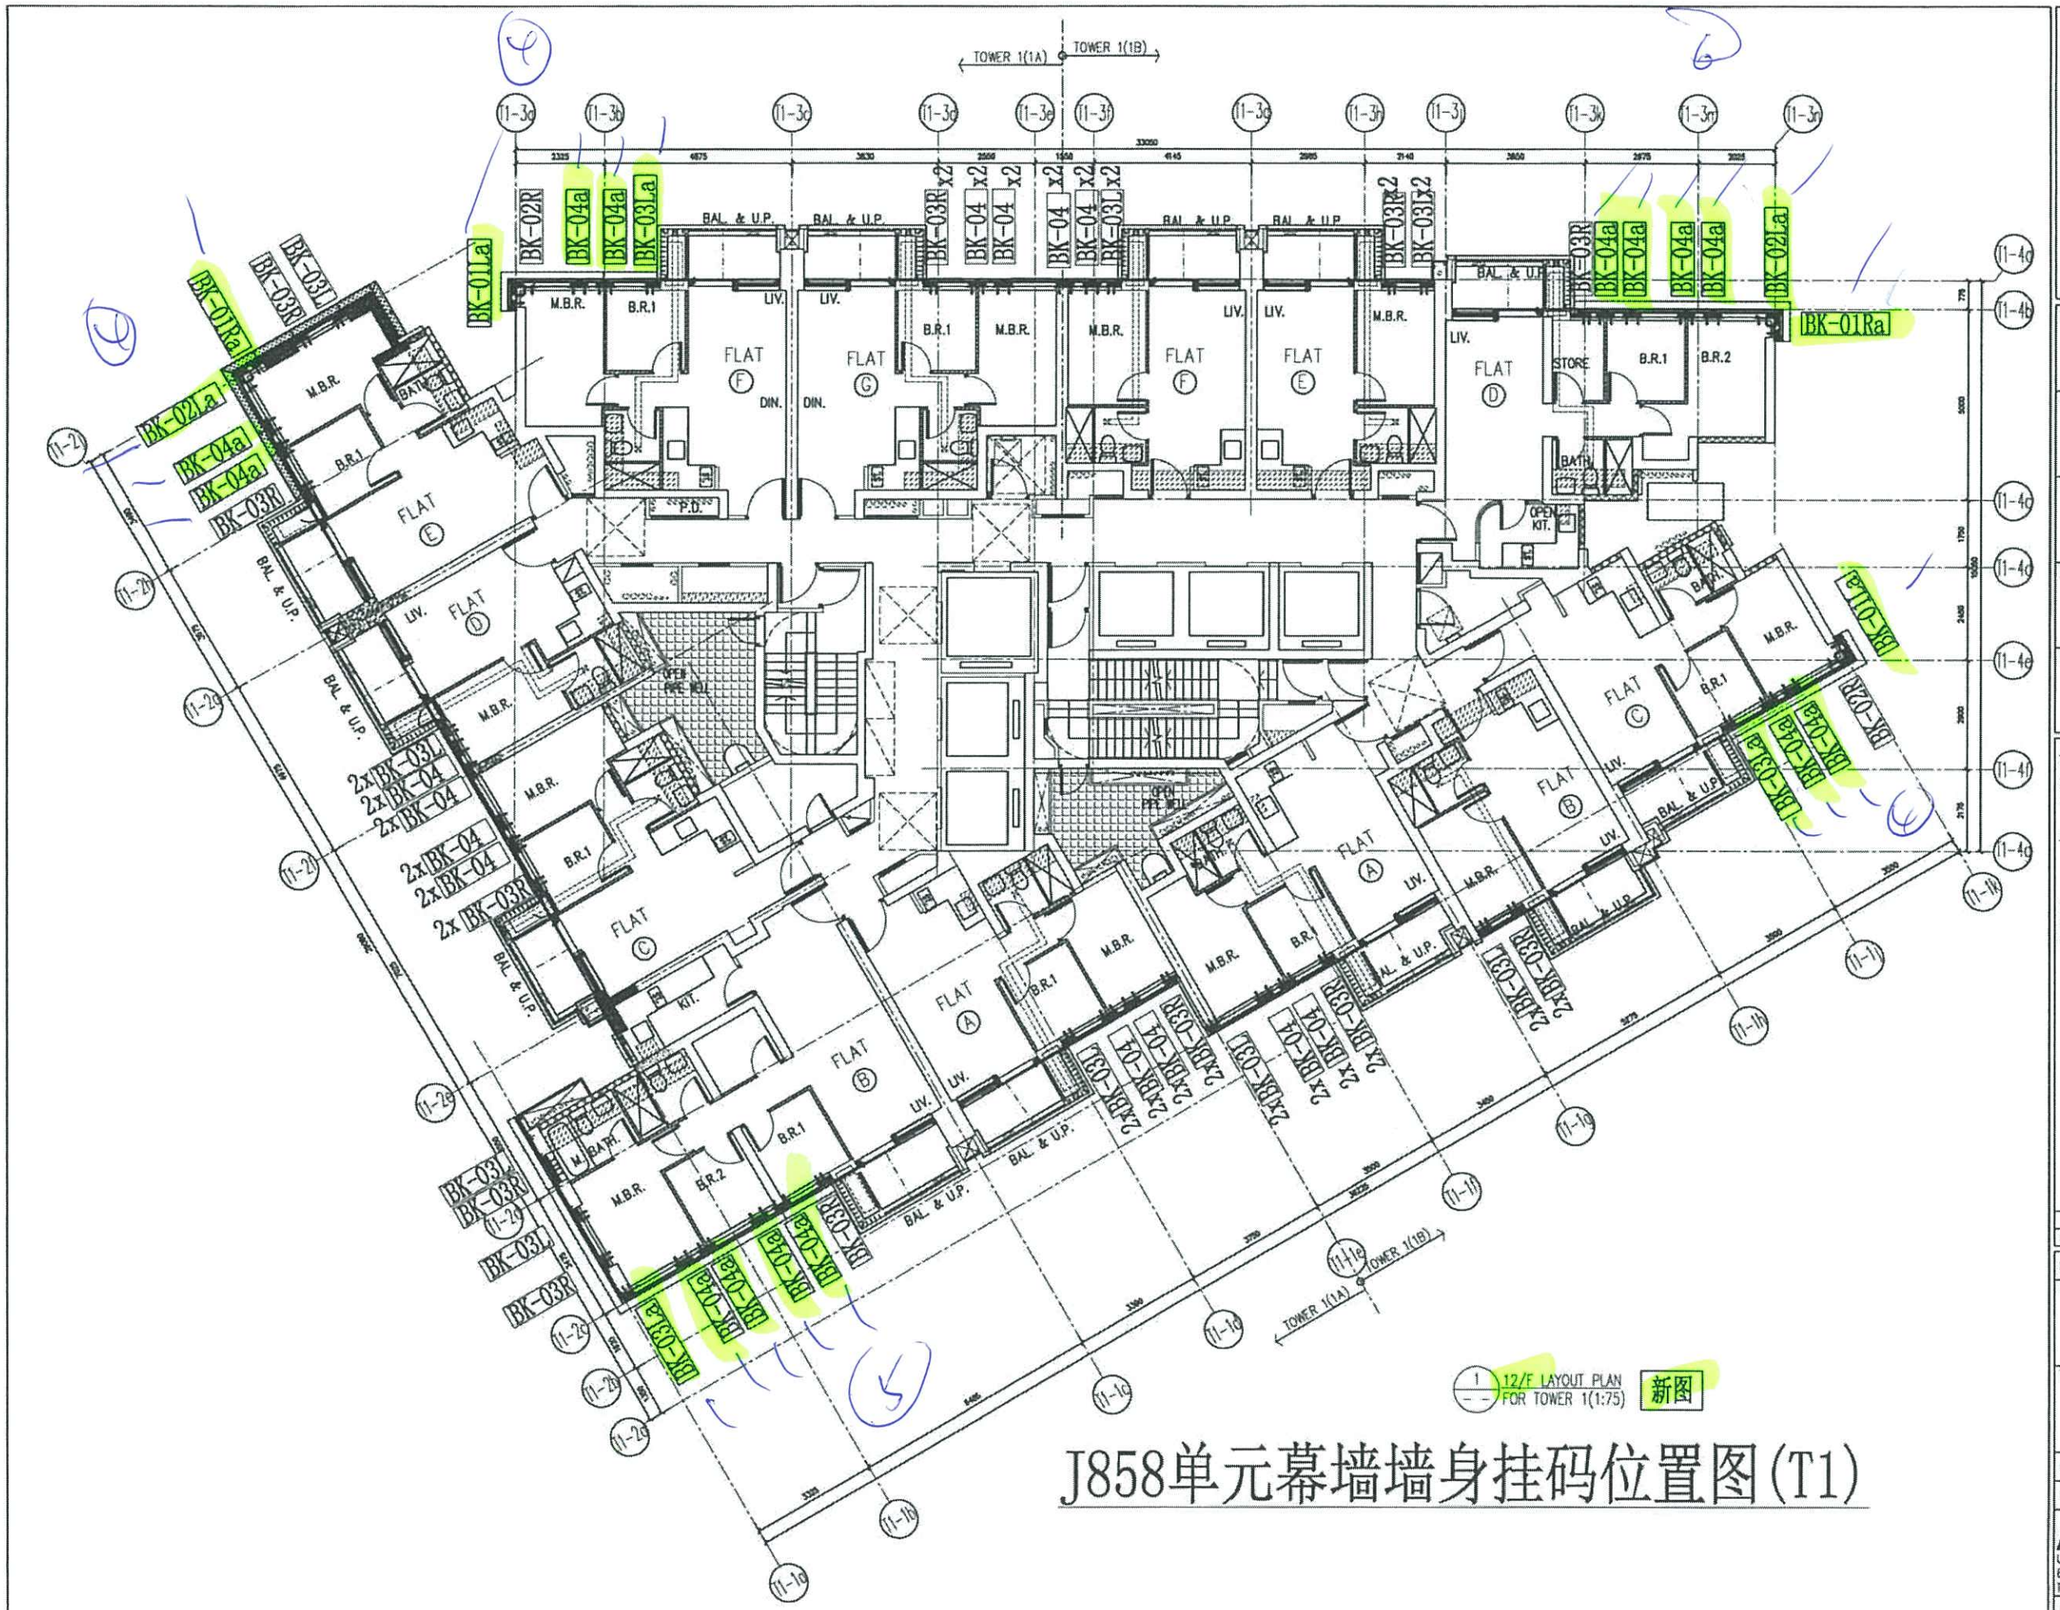

1 12/F LAYOUT PLAN FOR TOWER 1(1:75) 新图

J858单元幕墙墙身挂码位置图(T1)

B.D. REF :

CLIENT :
信和置業有限公司
Sino Land Company Limited

ARCHITECT :
ronald lu & partners
Ronald Lu & Partners (HK) Ltd.
呂元祥建築師事務所(香港)有限公司

MAIN CONTRACTOR :
Gammon

STRUCTURAL ENGINEER :
AECOM

FACADE CONSULTANT:
AECOM

NOTE :
1. ALL DIMENSIONS ARE IN mm.
2. ALL ELEVATIONS ARE VIEWED FROM OUTSIDE.
3. ALL DIMENSIONS TO BE VERIFIED ON SITE BEFORE FABRICATION.

LEGEND :
X1 — DETAIL MARK NO.
X001 — REFER SHEET NO.
1. F.F.L. --- FINISHED FLOOR LEVEL
2. S.F.L. --- STRUCTURAL FLOOR LEVEL
3. (R) --- REVERSED DETAIL

NO.	DATE	REMARK	BY
-	-	-	-

JOB NO. : J-858

PROJECT :
PROPOSED RESIDENTIAL DEVELOPMENT
AT TKOTL 70RP, PHASE 11, LOHAS PARK
TSEUNG KWAN O, N.T.

TITLE :
12/F FLOOR PLAN
AT TOWER 1

DATE : 14-Jun-22	SCALE : 1:75(A1)
DRAWN BY : KY	CHECKED BY : YB

美特鋁製有限公司
MIDI ALUMINIUM FABRICATOR LTD.
Units 6-8, Sunray Industrial Centre, 1/F
610 Cha Kwo Ling Road, Kowloon
Tel:23489211-4 Fax:(852)27727666

DWG NO. : J858-CW-BR-103a | REV. : -

TOWER 1(1A) TOWER 1(1B)

REFUGE FLOOR (TOWER 1)

30000L DRENCHER WATER TANK

DRENCHER WATER TANK RM.

1 40/F LAYOUT PLAN FOR TOWER 1(1:75)

新图

J858单元幕墙墙身挂码位置图(T1)

B.D. REF :

CLIENT :
信和置業有限公司
Sino Land Company Limited

ARCHITECT :
ronald lu & partners
Ronald Lu & Partners (HK) Ltd.
呂元祥建築師事務所(香港)有限公司

MAIN CONTRACTOR :
Gammon

STRUCTURAL ENGINEER :
AECOM

FACADE CONSULTANT:
AECOM

NOTE :
1. ALL DIMENSIONS ARE IN mm.
2. ALL ELEVATIONS ARE VIEWED FROM OUTSIDE.
3. ALL DIMENSIONS TO BE VERIFIED ON SITE BEFORE FABRICATION.

LEGEND :
X1 — DETAIL MARK NO.
R001 — REFER SHEET NO.
1. F.F.L. — FINISHED FLOOR LEVEL
2. S.F.L. — STRUCTURAL FLOOR LEVEL
3. (/R) — REVERSED DETAIL

NO.	DATE	REVISED	BY
-	-	-	-

JOB NO. : J-858

PROJECT :
PROPOSED RESIDENTIAL DEVELOPMENT
AT TKOTL 70RP, PHASE 11, LOHAS PARK
TSEUNG KWAN O, N.T.


TITLE :
40/F REFUGE FLOOR PLAN
AT TOWER 1

DATE : 14-Jun-22 | SCALE : 1:75(A1)

DRAWN BY : KY | CHECKED BY : YB

美特鋁質有限公司
MIDI ALUMINUM FABRICATOR LTD.
Units 6-8, Sunray Industrial Centre, 1/F
610 Cha Kwo Ling Road, Kowloon
Tel:23489211-4 Fax:(852)27727666

DWG NO. : J858-CW-BR-102a | REV. : -

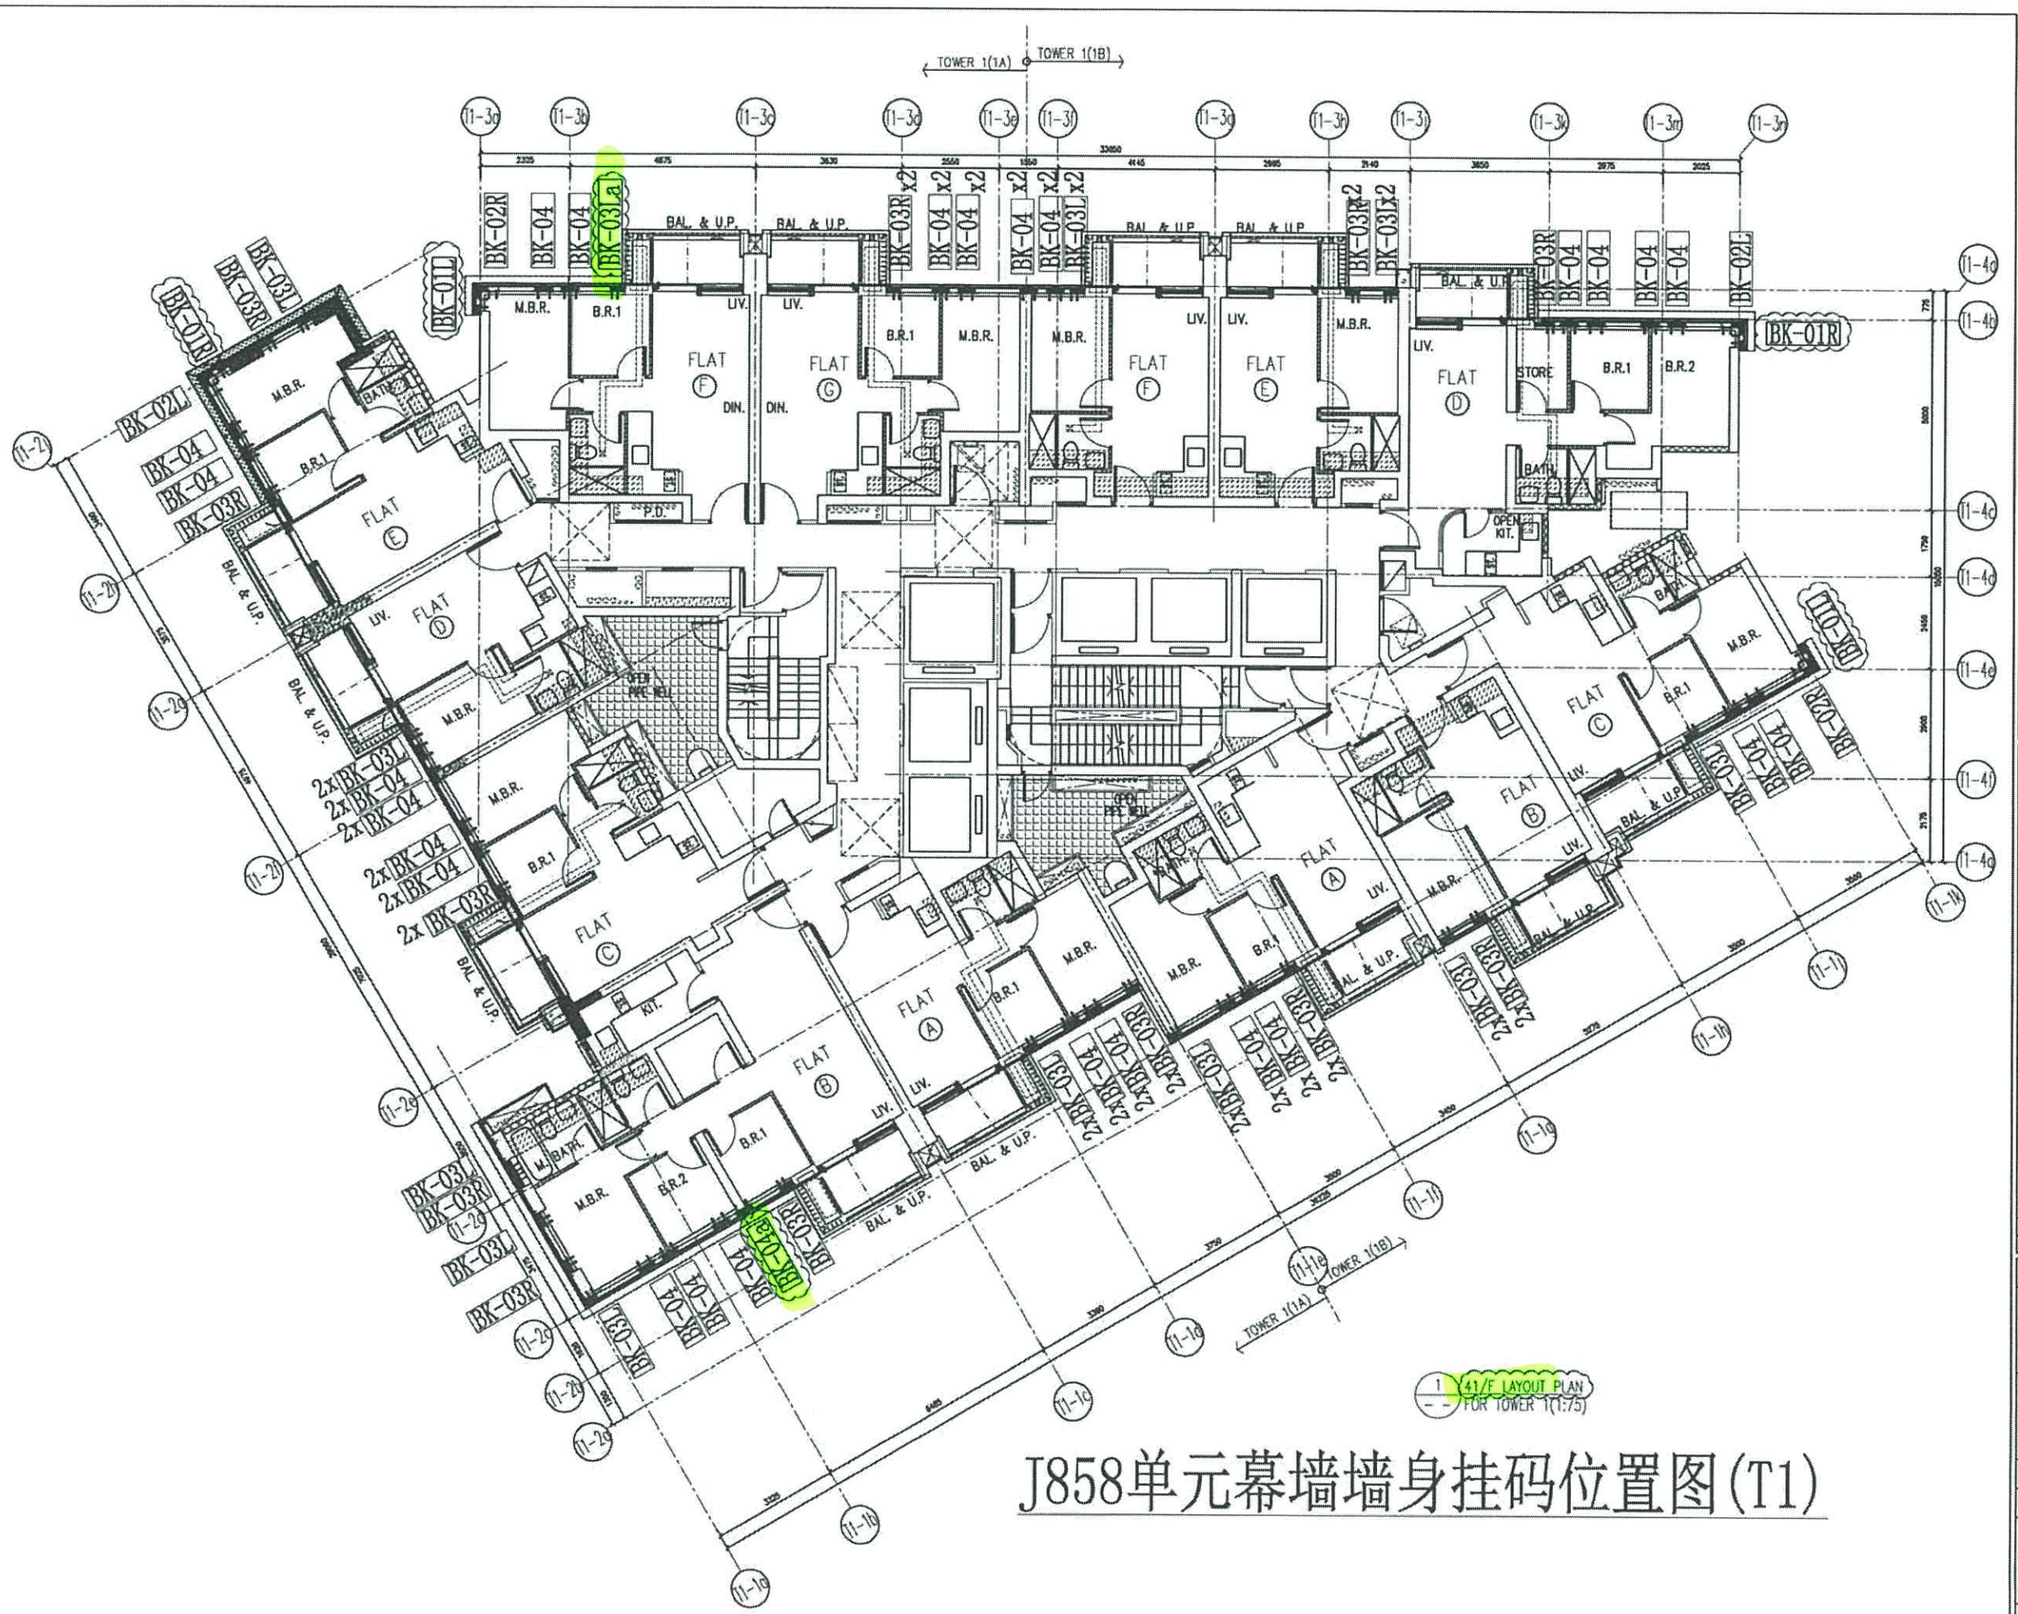

1 41/F LAYOUT PLAN
FOR TOWER 1(1:75)

J858单元幕墙墙身挂码位置图(T1)

B.D. REF :

CLIENT :
信和置業有限公司
Sino Land Company Limited

ARCHITECT :
ronald lu & partners
Ronald Lu & Partners (HK) Ltd.
呂元祥建築師事務所(香港)有限公司

MAIN CONTRACTOR :
Gammon

STRUCTURAL ENGINEER :
AECOM

FACADE CONSULTANT:
AECOM

NOTE :
1. ALL DIMENSIONS ARE IN mm.
2. ALL ELEVATIONS ARE VIEWED FROM OUTSIDE.
3. ALL DIMENSIONS TO BE VERIFIED ON SITE BEFORE FABRICATION.

LEGEND :
X1 — DETAIL MARK NO.
X001 — REFER SHEET NO.
1. F.F.L. — FINISHED FLOOR LEVEL
2. S.F.L. — STRUCTURAL FLOOR LEVEL
3. (R) — REVERSED DETAIL

2

NO.	DATE	REVISED	BY
-	-	-	-

JOB NO. : J-858

PROJECT :
PROPOSED RESIDENTIAL DEVELOPMENT
AT TKOTL 70RP, PHASE 11, LOHAS PARK
TSEUNG KWAN O, N.T.


TITLE :
41/F FLOOR PLAN AT TOWER 1

DATE : 14-Jun-22	SCALE : 1:75(A1)
DRAWN BY : KY	CHECKED BY : YB

美特鋁質有限公司
MIDI ALUMINIUM FABRICATOR LTD.
Units 6-8, Sunray Industrial Centre, 1/F
610 Cha Kwo Ling Road, Kowloon
Tel:23489211-4 Fax:(852)27727666

DWG NO. : J858-CW-BR-103	REV. : A

6

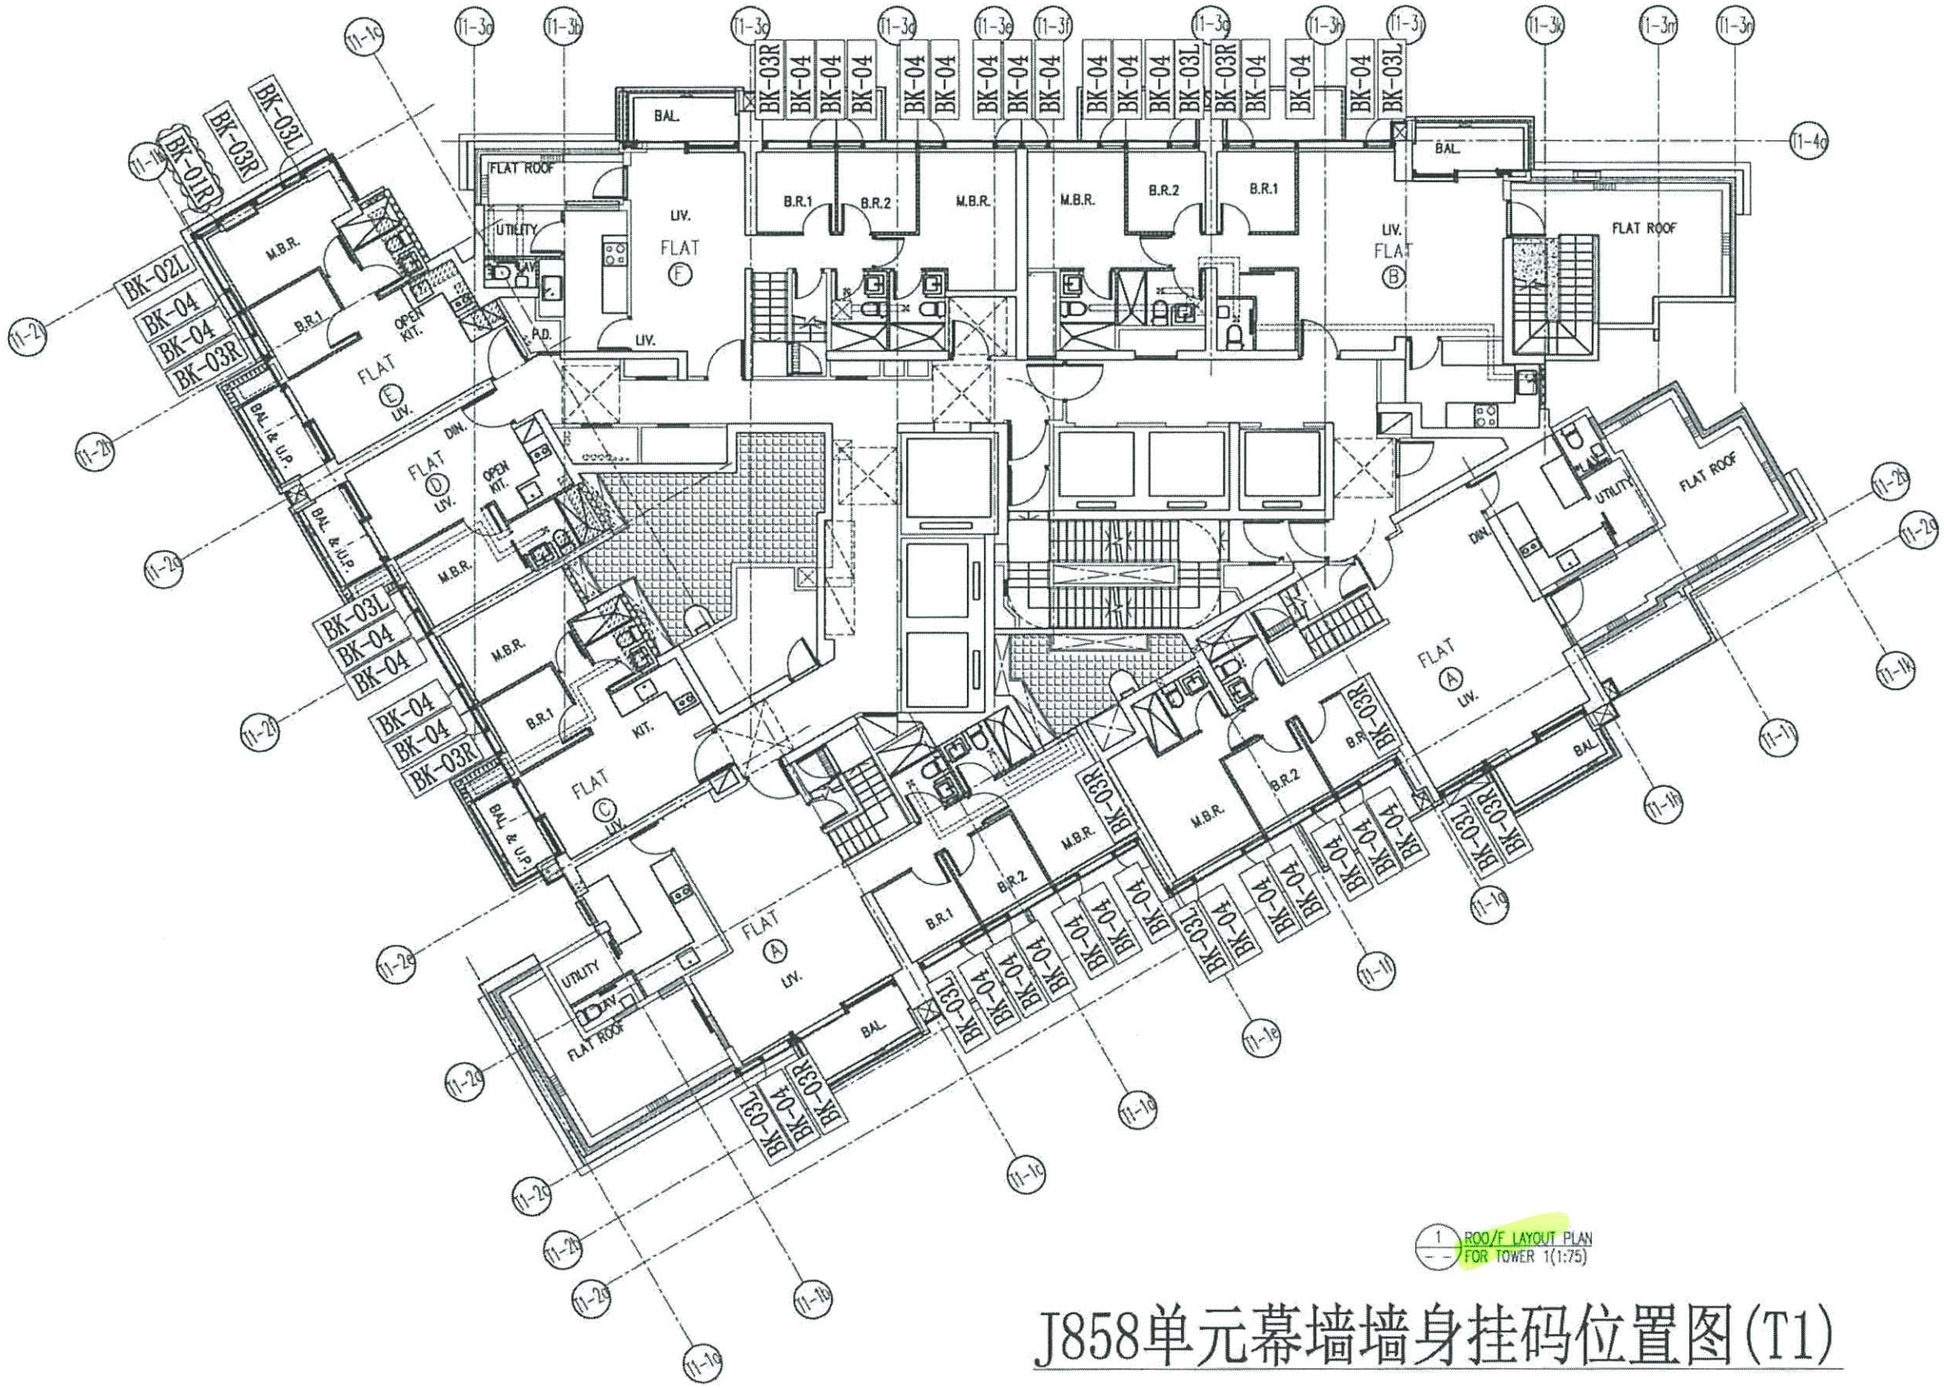

1 ROOF LAYOUT PLAN
FOR TOWER 1(1:75)

J858单元幕墙墙身挂码位置图(T1)

B.D. REF :

CLIENT :
信和置業有限公司
Sino Land Company Limited

ARCHITECT :
ronald lu & partners
Ronald Lu & Partners (HK) Ltd.
呂元祥建築師事務所(香港)有限公司

MAIN CONTRACTOR :
Gammon

STRUCTURAL ENGINEER :
AECOM

FACADE CONSULTANT:
AECOM

NOTE :
1. ALL DIMENSIONS ARE IN mm.
2. ALL ELEVATIONS ARE VIEWED FROM OUTSIDE.
3. ALL DIMENSIONS TO BE VERIFIED ON SITE BEFORE FABRICATION.

LEGEND :
X1 — DETAIL MARK NO.
X001 — REFER SHEET NO.
1. F.F.L. --FINISHED FLOOR LEVEL
2. S.F.L. --STRUCTURAL FLOOR LEVEL
3. (R) --REVERSED DETAIL

NO.	DATE	REMARK	BY
-	-	-	-

JOB NO. : J-858

PROJECT :
PROPOSED RESIDENTIAL DEVELOPMENT
AT TKOTL 70RP, PHASE 11, LOHAS PARK
TSEUNG KWAN O, N.T.


TITLE :
ROOF FLOOR PLAN
AT TOWER 1

DATE : 14-Jun-22	SCALE : 1:75(A1)
DRAWN BY : KY	CHECKED BY : YB

美特鋁質有限公司
MIDI ALUMINIUM FABRICATOR LTD.
Units 6-8, Sunray Industrial Centre, 1/F
610 Cha Kwa Ling Road, Kowloon
Tel:23489211-4 Fax:(852)27727666

DWG NO. : J858-CW-BR-104 | REV. : A

(7)

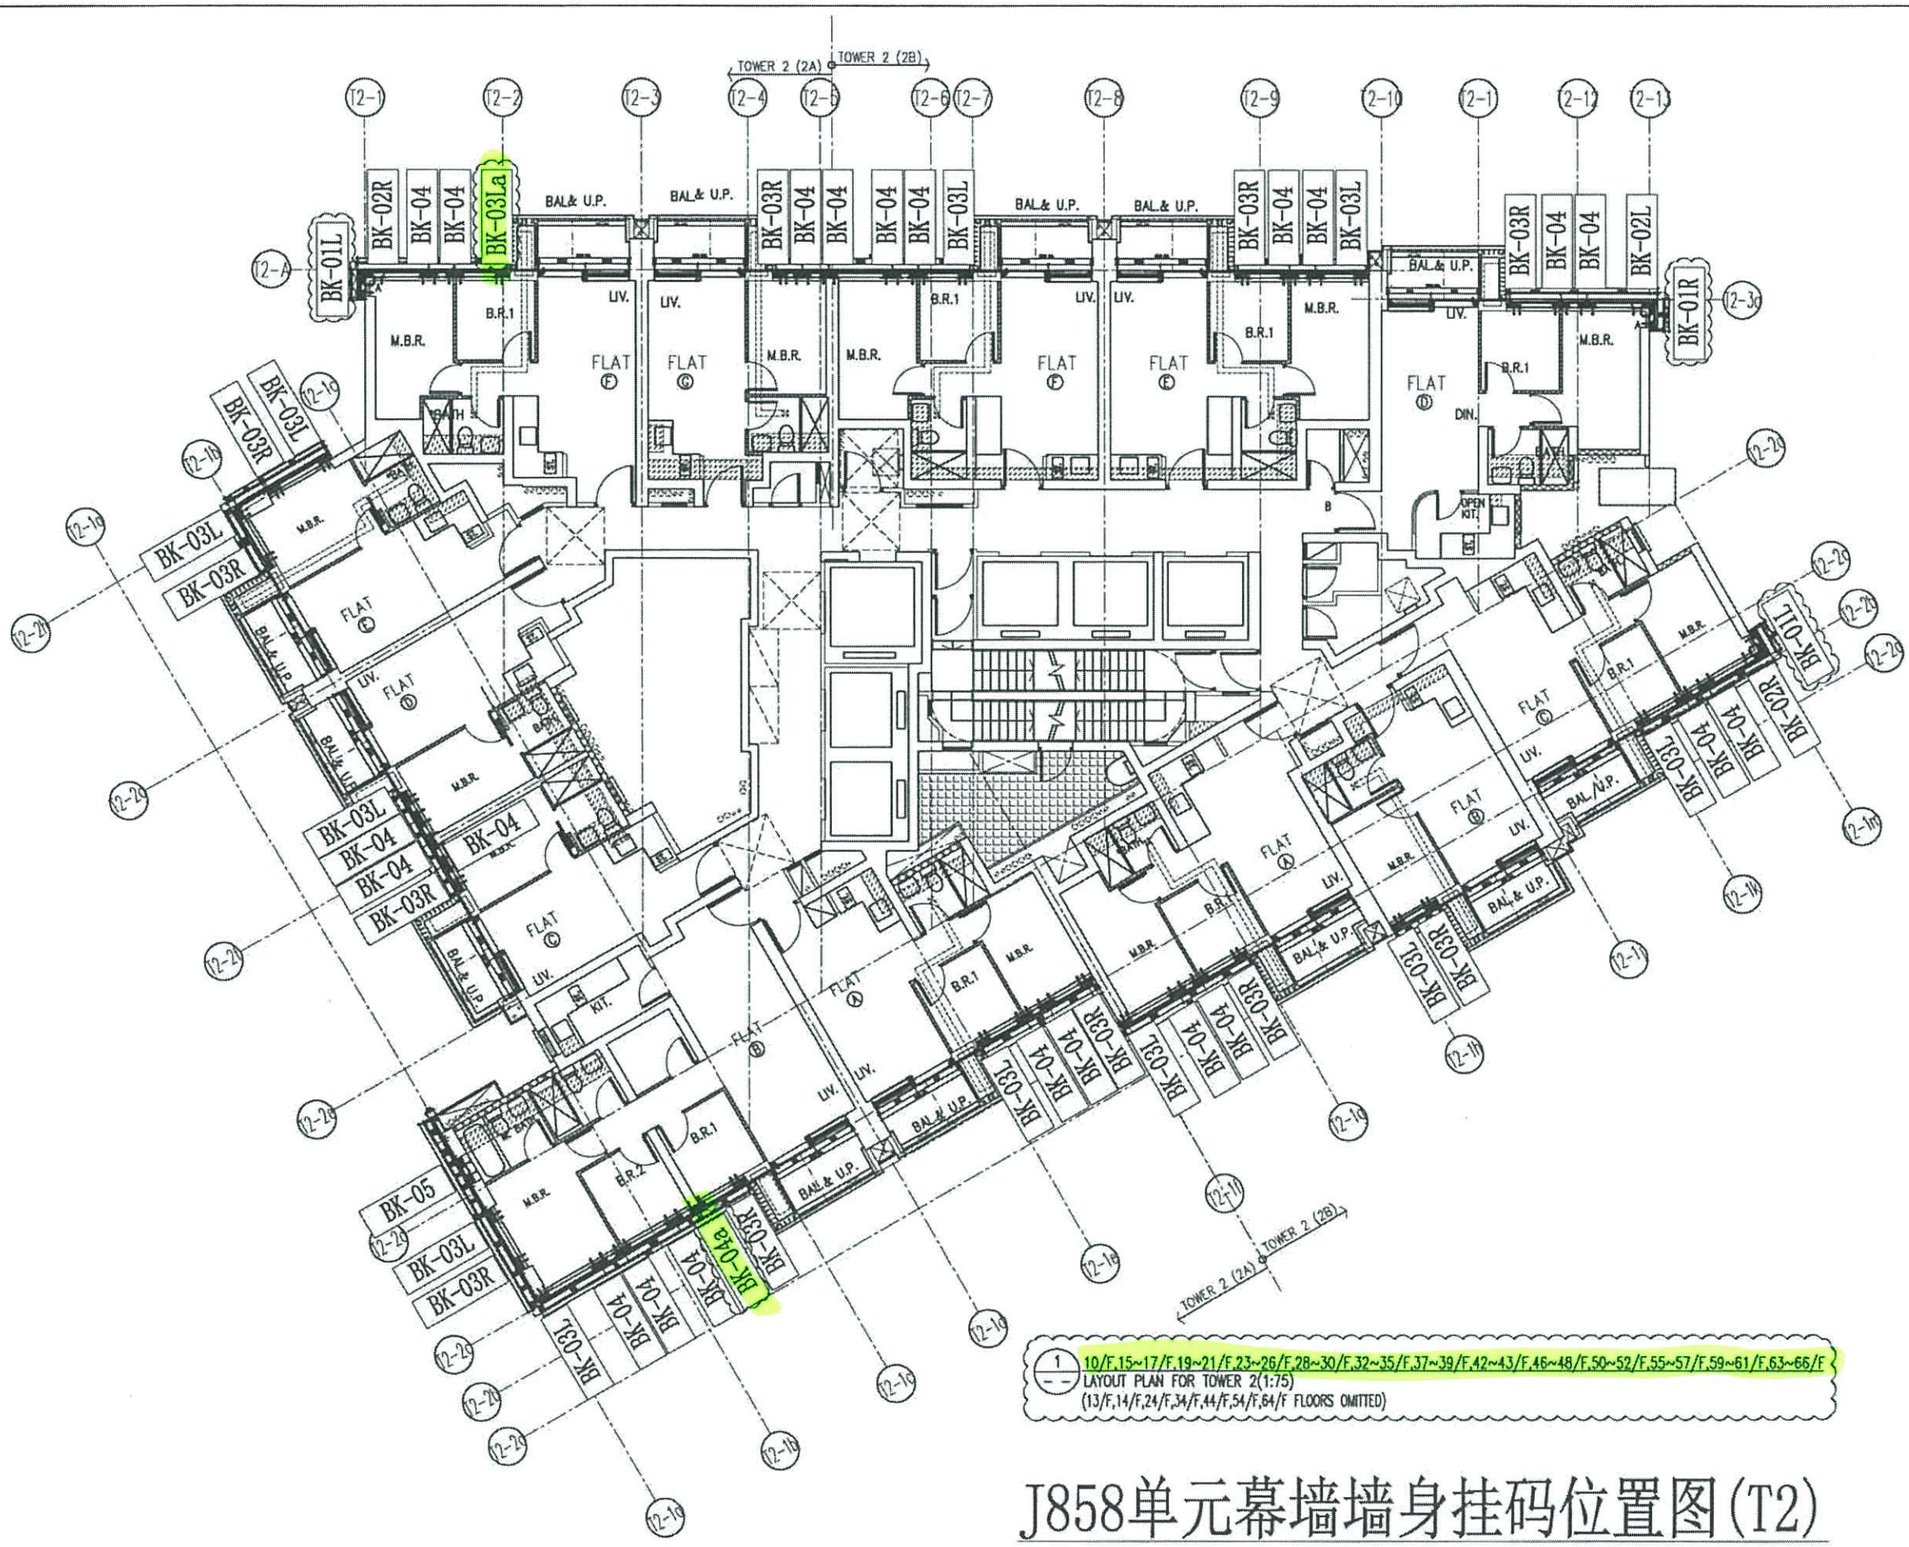

1 — 10/F,15~17/F,19~21/F,23~26/F,28~30/F,32~35/F,37~39/F,42~43/F,46~48/F,50~52/F,55~57/F,59~61/F,63~66/F
LAYOUT PLAN FOR TOWER 2(1:75)
(13/F,14/F,24/F,34/F,44/F,54/F,64/F FLOORS OMITTED)

J858单元幕墙墙身挂码位置图(T2)

B.D. REF :

CLIENT :
信和置業有限公司
Sino Land Company Limited

ARCHITECT :
ronald lu & partners
Ronald Lu & Partners (HK) Ltd.
呂元祥建築師事務所(香港)有限公司

MAIN CONTRACTOR :
Gammon

STRUCTURAL ENGINEER :
AECOM

FACADE CONSULTANT:
AECOM

NOTE :
1. ALL DIMENSIONS ARE IN mm.
2. ALL ELEVATIONS ARE VIEWED FROM OUTSIDE.
3. ALL DIMENSIONS TO BE VERIFIED ON SITE BEFORE FABRICATION.

LEGEND :
(X1) / (X001) — DETAIL MARK NO. / REFER SHEET NO.
1. F.F.L. --FINISHED FLOOR LEVEL
2. S.F.L. --STRUCTURAL FLOOR LEVEL
3. (FR) --REVERSED DETAIL

2

NO.	DATE	REVISED	BY
-	-	-	-

JOB NO. : J-858

PROJECT :
PROPOSED RESIDENTIAL DEVELOPMENT
AT TKOTL 70RP, PHASE 11, LOHAS PARK
TSEUNG KWAN O, N.T.

TITLE :
TYPICAL FLOOR PLAN
AT TOWER 2


DATE : 14-Jun-22 | SCALE : 1:75(A1)

DRAWN BY : KY | CHECKED BY : YB

美特鋁質有限公司
MIDI ALUMINIUM FABRICATOR LTD.
Units 6-8, Sunray Industrial Centre, 1/F
610 Cha Kwo Ling Road, Kowloon
Tel:23489211-4 Fax:(852)27727666

DWG NO. : J858-CW-BR-201 | REV. : A

8

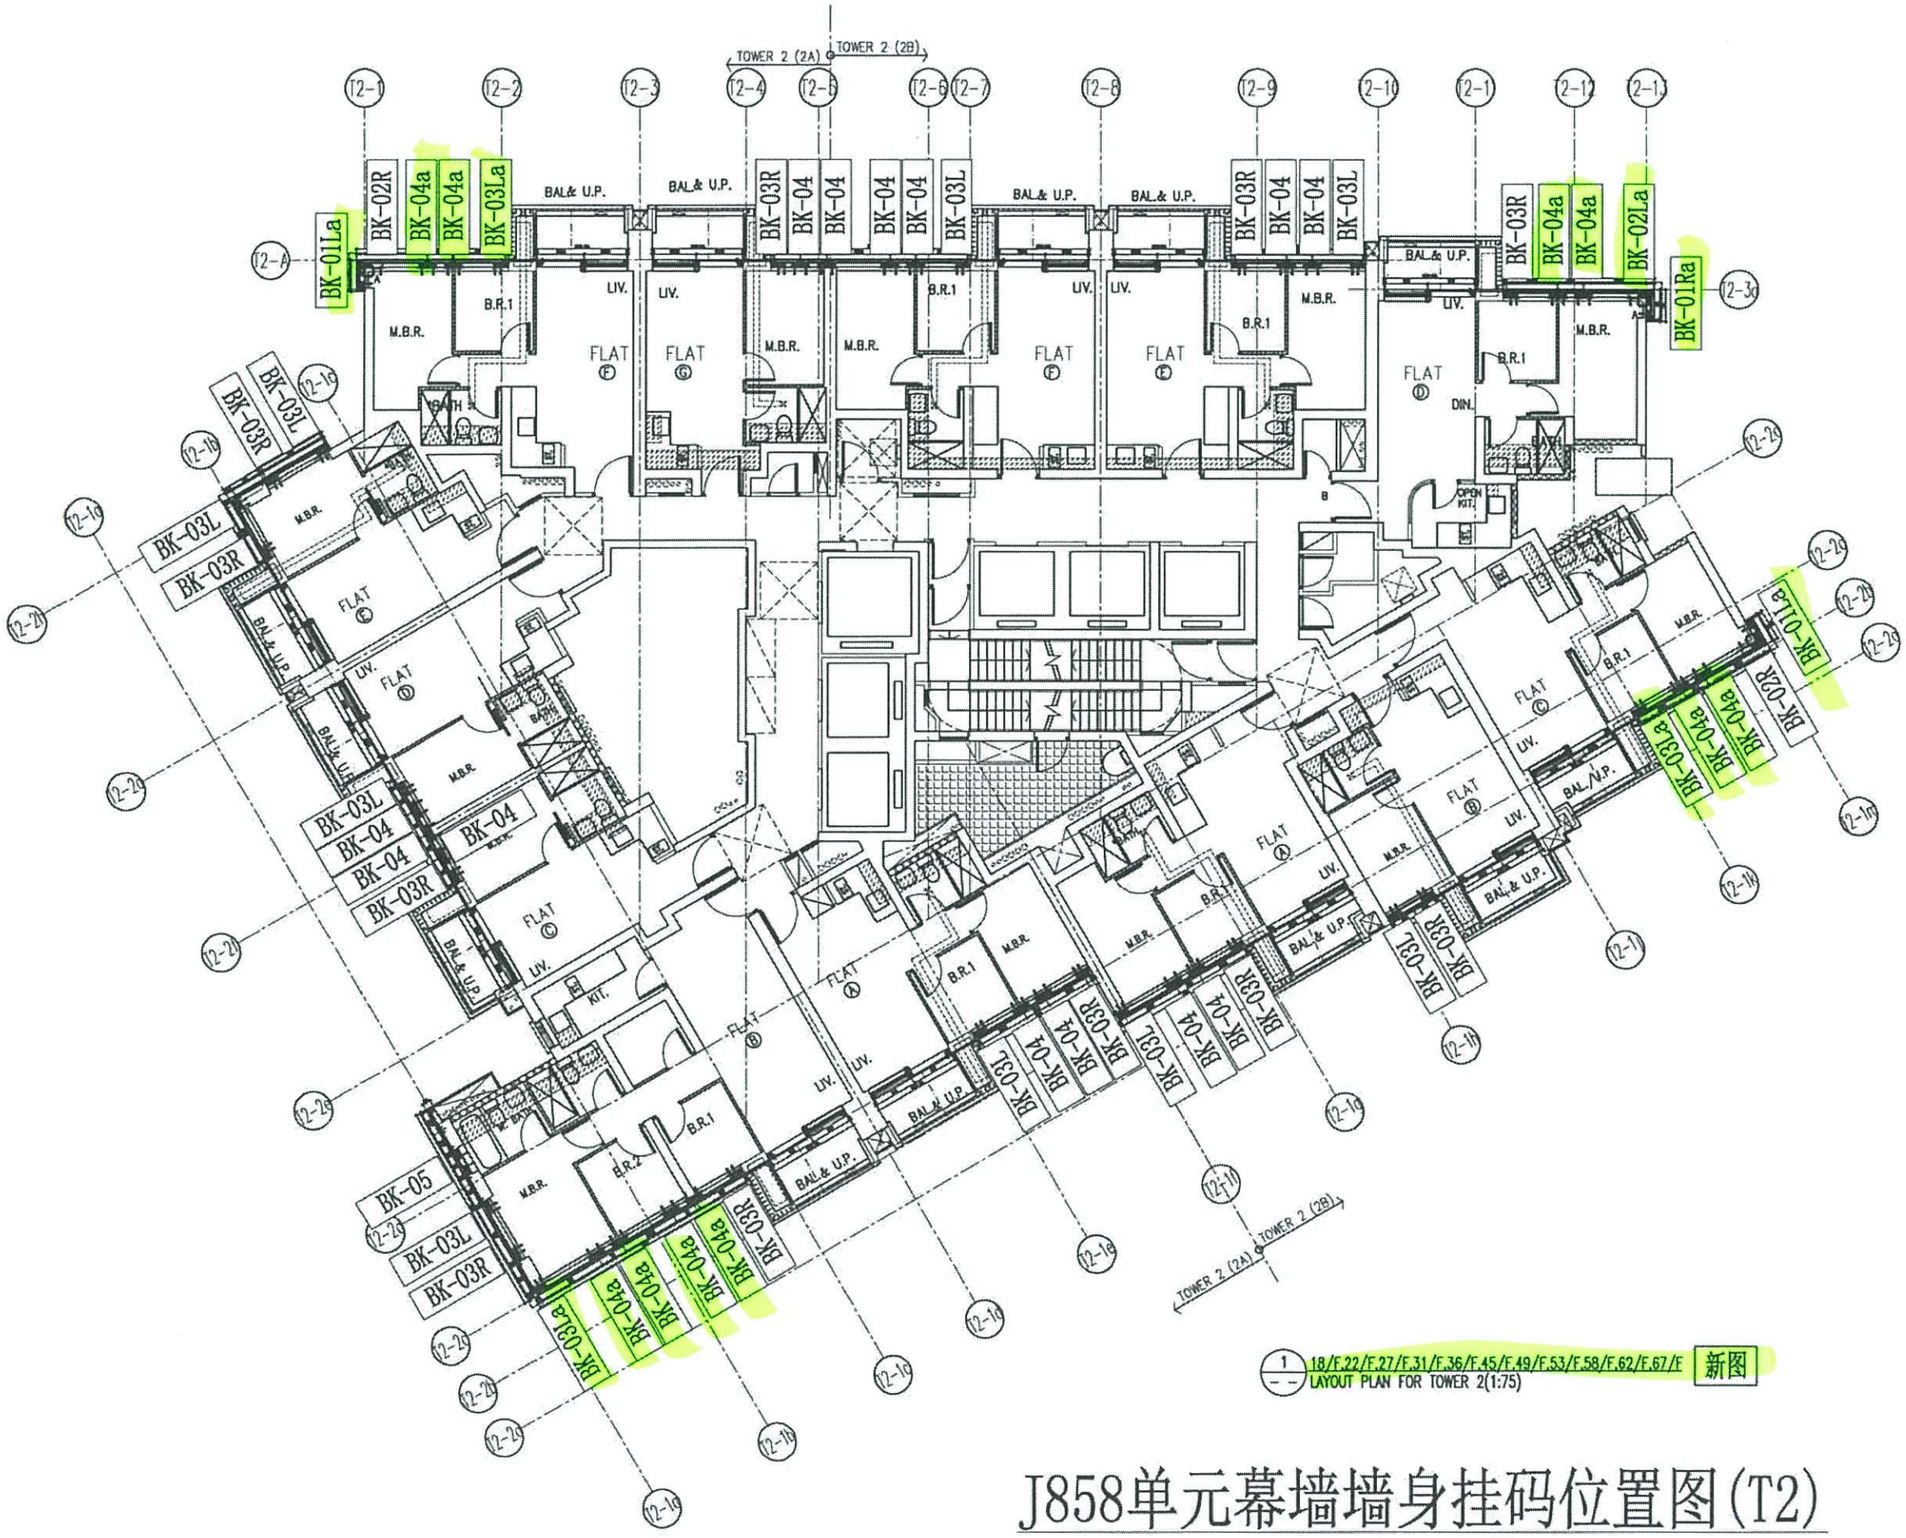

1 18/F,22/F,27/F,31/F,36/F,45/F,49/F,53/F,58/F,62/F,67/F LAYOUT PLAN FOR TOWER 2(1:75) 新图

J858单元幕墙墙身挂码位置图(T2)

B.D. REF :

CLIENT :
信和置業有限公司
Sino Land Company Limited

ARCHITECT :
ronald lu & partners
Ronald Lu & Partners (HK) Ltd.
呂元祥建築師事務所(香港)有限公司

MAIN CONTRACTOR :
Gammon

STRUCTURAL ENGINEER :
AECOM

FACADE CONSULTANT:
AECOM

NOTE :
1. ALL DIMENSIONS ARE IN mm.
2. ALL ELEVATIONS ARE VIEWED FROM OUTSIDE.
3. ALL DIMENSIONS TO BE VERIFIED ON SITE BEFORE FABRICATION.

LEGEND :
X1 — DETAIL MARK NO.
X001 — REFER SHEET NO.
1. F.F.L. — FINISHED FLOOR LEVEL
2. S.F.L. — STRUCTURAL FLOOR LEVEL
3. (YB) — REVERSED DETAIL

17.

NO.	DATE	REMARKS	BY
–	–	–	–

JOB NO. : J-858

PROJECT :
PROPOSED RESIDENTIAL DEVELOPMENT
AT TKOTL 70RP, PHASE 11, LOHAS PARK
TSEUNG KWAN O, N.T.


TITLE :
TYPICAL FLOOR PLAN
AT TOWER 2

DATE : 14-Jun-22	SCALE : 1:75(A1)
DRAWN BY : KY	CHECKED BY : YB

美特鋁質有限公司
MIDI ALUMINIUM FABRICATOR LTD.
Units 6-8, Sunray Industrial Centre, 1/F
610 Cha Kwa Ling Road, Kowloon
Tel:23489211-4 Fax:(852)27727666

DWG NO. : J858-CW-BR-201a | REV. : –

(9)

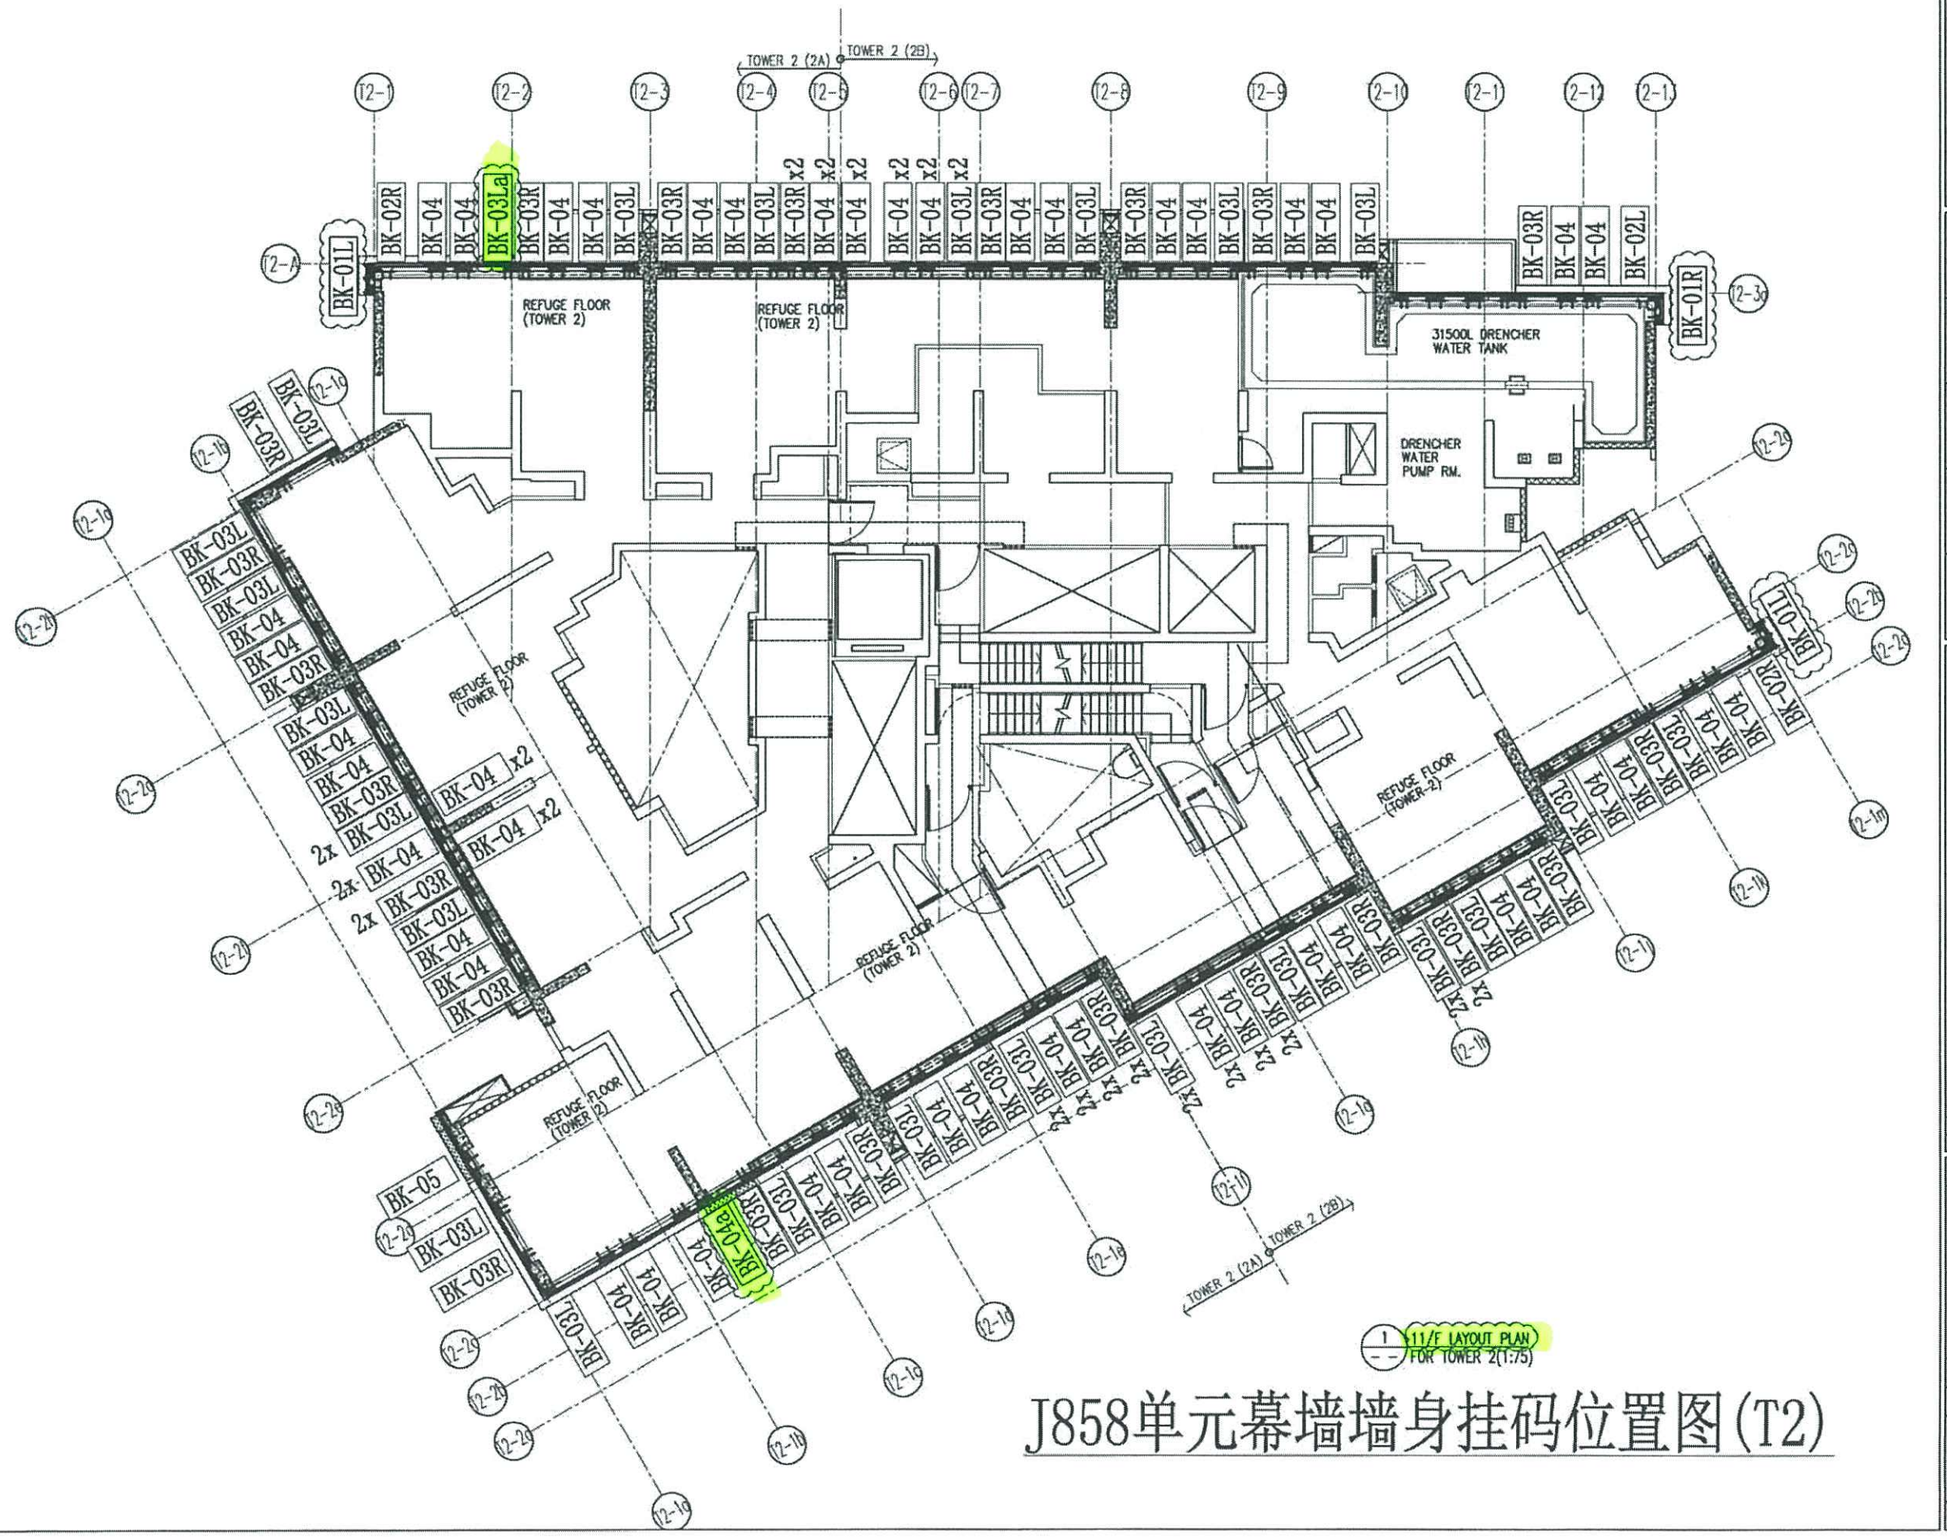

1 11/F LAYOUT PLAN FOR TOWER 2(1:75)

J858单元幕墙墙身挂码位置图(T2)

B.D. REF :

CLIENT :
信和置業有限公司
Sino Land Company Limited

ARCHITECT :
ronald lu & partners
Ronald Lu & Partners (HK) Ltd.
呂元祥建築師事務所(香港)有限公司

MAIN CONTRACTOR :
Gammon

STRUCTURAL ENGINEER :
AECOM

FACADE CONSULTANT:
AECOM

NOTE :
1. ALL DIMENSIONS ARE IN mm.
2. ALL ELEVATIONS ARE VIEWED FROM OUTSIDE.
3. ALL DIMENSIONS TO BE VERIFIED ON SITE BEFORE FABRICATION.

LEGEND :
X1 — DETAIL MARK NO.
X001 — REFER SHEET NO.
1. F.F.L. — FINISHED FLOOR LEVEL
2. S.F.L. — STRUCTURAL FLOOR LEVEL
3. (R) — REVERSED DETAIL

NO.	DATE	REMARKS	BY
-	-	-	-

JOB NO. : J-858

PROJECT :
PROPOSED RESIDENTIAL DEVELOPMENT
AT TKOTL 70RP, PHASE 11, LOHAS PARK
TSEUNG KWAN O, N.T.

TITLE :
11/F REFUGE FLOOR PLAN AT TOWER 2


DATE : 14-Jun-22 | SCALE : 1:75(A1)

DRAWN BY : KY | CHECKED BY : YB

美特鋁質有限公司
MIDI ALUMINIUM FABRICATOR LTD.
Units 6-8, Sunray Industrial Centre, 1/F
610 Cha Kwo Ling Road, Kowloon
Tel:23489211-4 Fax:(852)27727666

DWG NO. : J858-CW-BR-202 | REV. : A

10

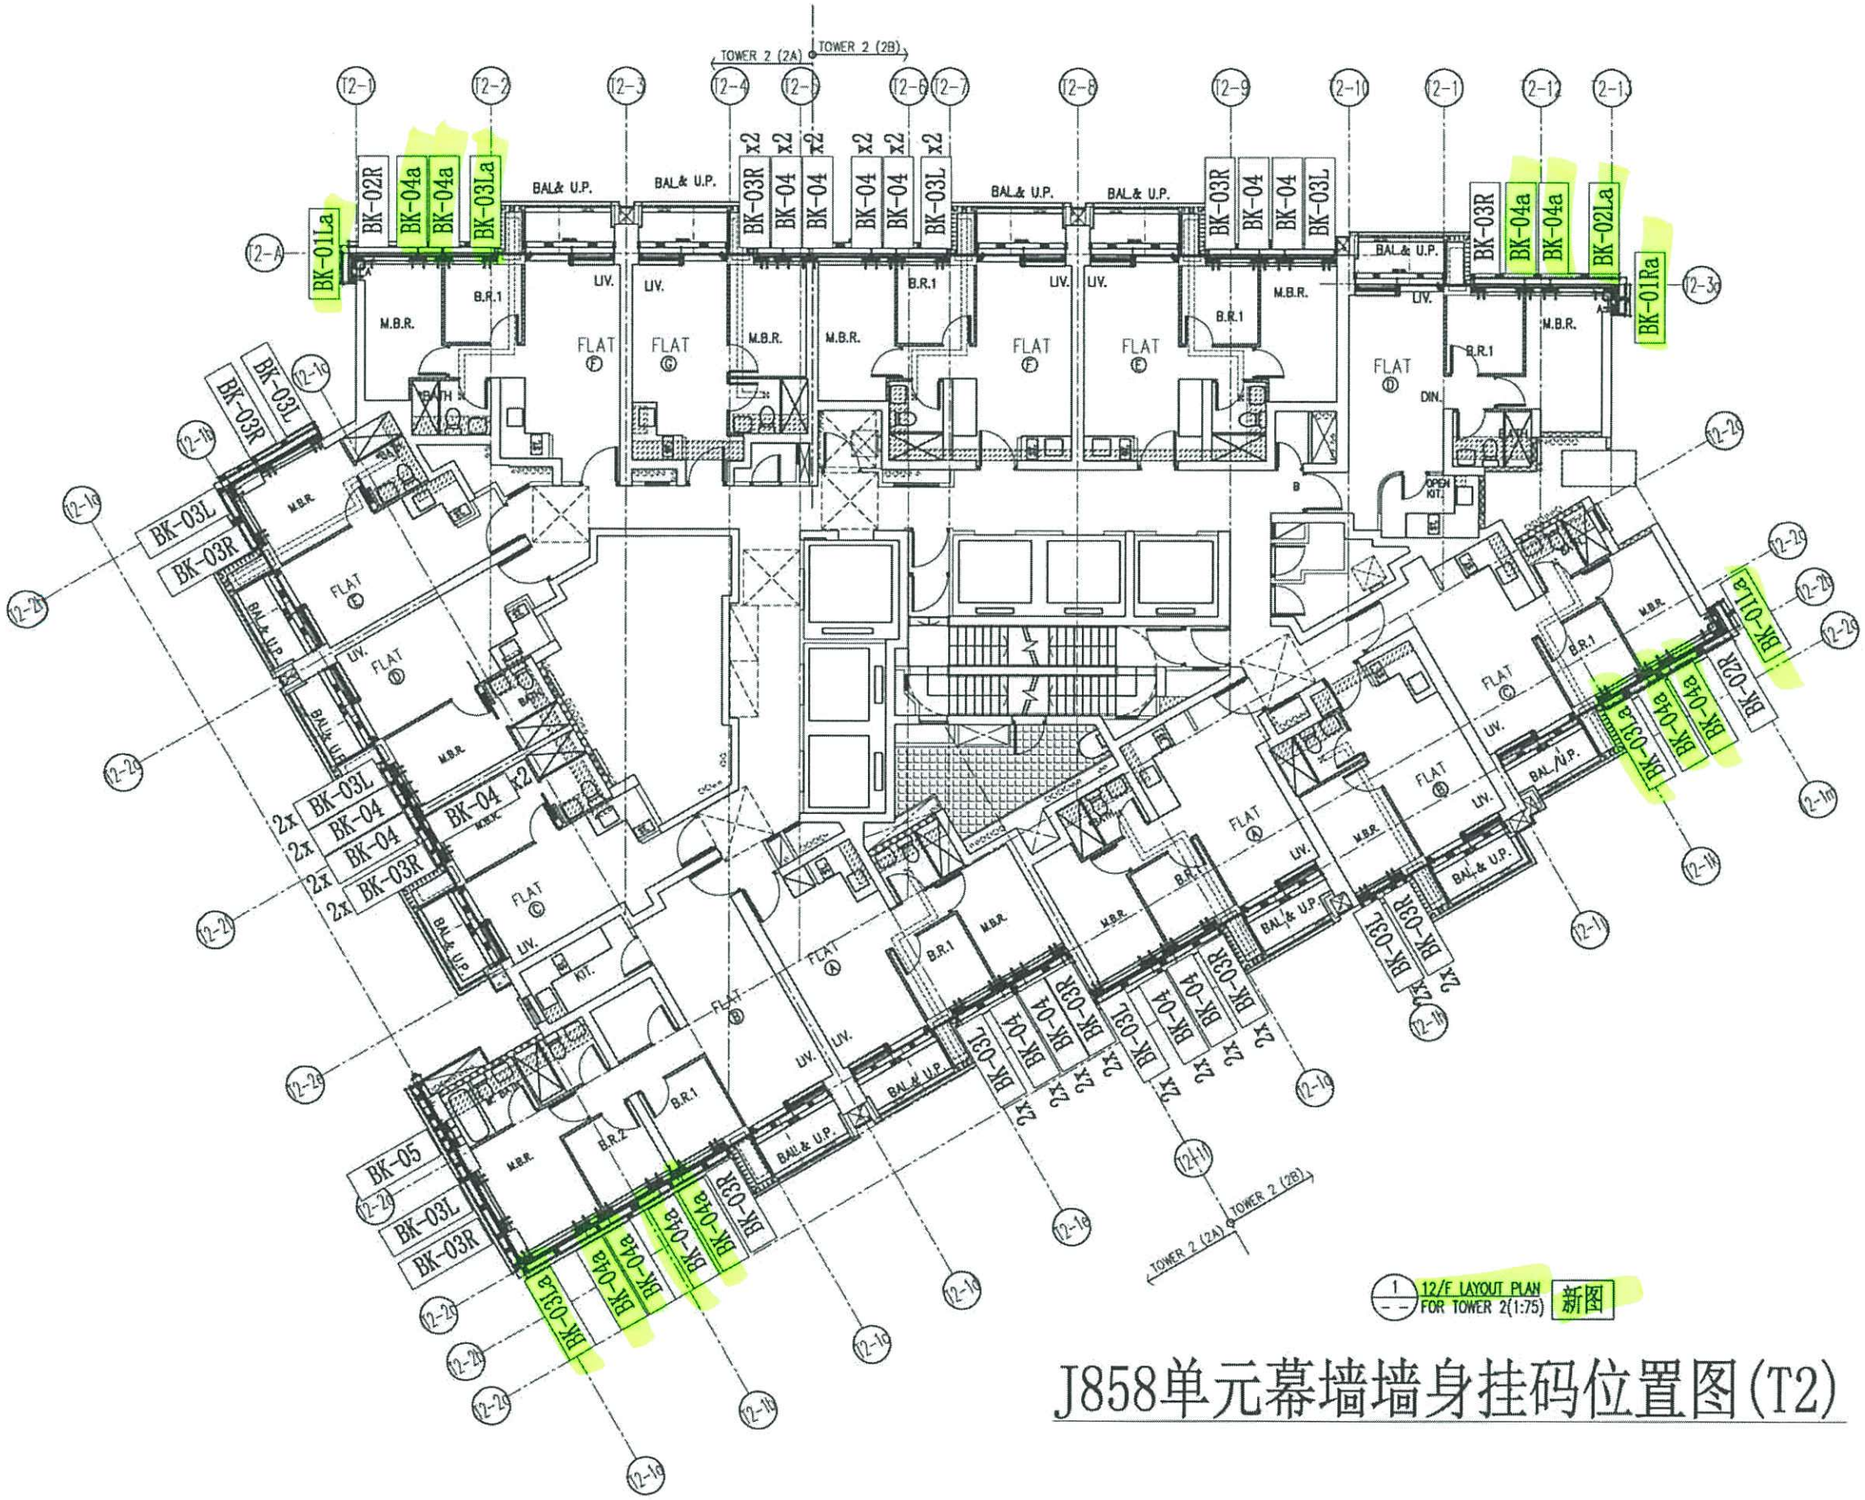

1 / -- 12/F LAYOUT PLAN FOR TOWER 2(1:75) 新图

J858单元幕墙墙身挂码位置图(T2)

B.D. REF :

CLIENT :
信和置業有限公司
Sino Land Company Limited

ARCHITECT :
ronald lu & partners
Ronald Lu & Partners (HK) Ltd.
呂元祥建築師事務所(香港)有限公司

MAIN CONTRACTOR :
Gammon

STRUCTURAL ENGINEER :
AECOM

FACADE CONSULTANT:
AECOM

NOTE :
1. ALL DIMENSIONS ARE IN mm.
2. ALL ELEVATIONS ARE VIEWED FROM OUTSIDE.
3. ALL DIMENSIONS TO BE VERIFIED ON SITE BEFORE FABRICATION.

LEGEND :
X1 — DETAIL MARK NO.
XD01 — REFER SHEET NO.
1. F.F.L. — FINISHED FLOOR LEVEL
2. S.F.L. — STRUCTURAL FLOOR LEVEL
3. (R) — REVERSED DETAIL

17

NO.	DATE	REVISED	BY
-	-	-	-

JOB NO. : J-858

PROJECT :
PROPOSED RESIDENTIAL DEVELOPMENT
AT TKOTL 70RP, PHASE 11, LOHAS PARK
TSEUNG KWAN O, N.T.


TITLE :
12/F FLOOR PLAN
AT TOWER 2

DATE : 14-Jun-22	SCALE : 1:75(A1)
DRAWN BY : KY	CHECKED BY : YB

美特鋁質有限公司
MIDI ALUMINIUM FABRICATOR LTD.
Units 6-8, Sunray Industrial Centre, 1/F
610 Cha Kwa Ling Road, Kowloon
Tel:23489211-4 Fax:(852)27727666

DWG NO. : J858-CW-BR-203a | REV. : -

11

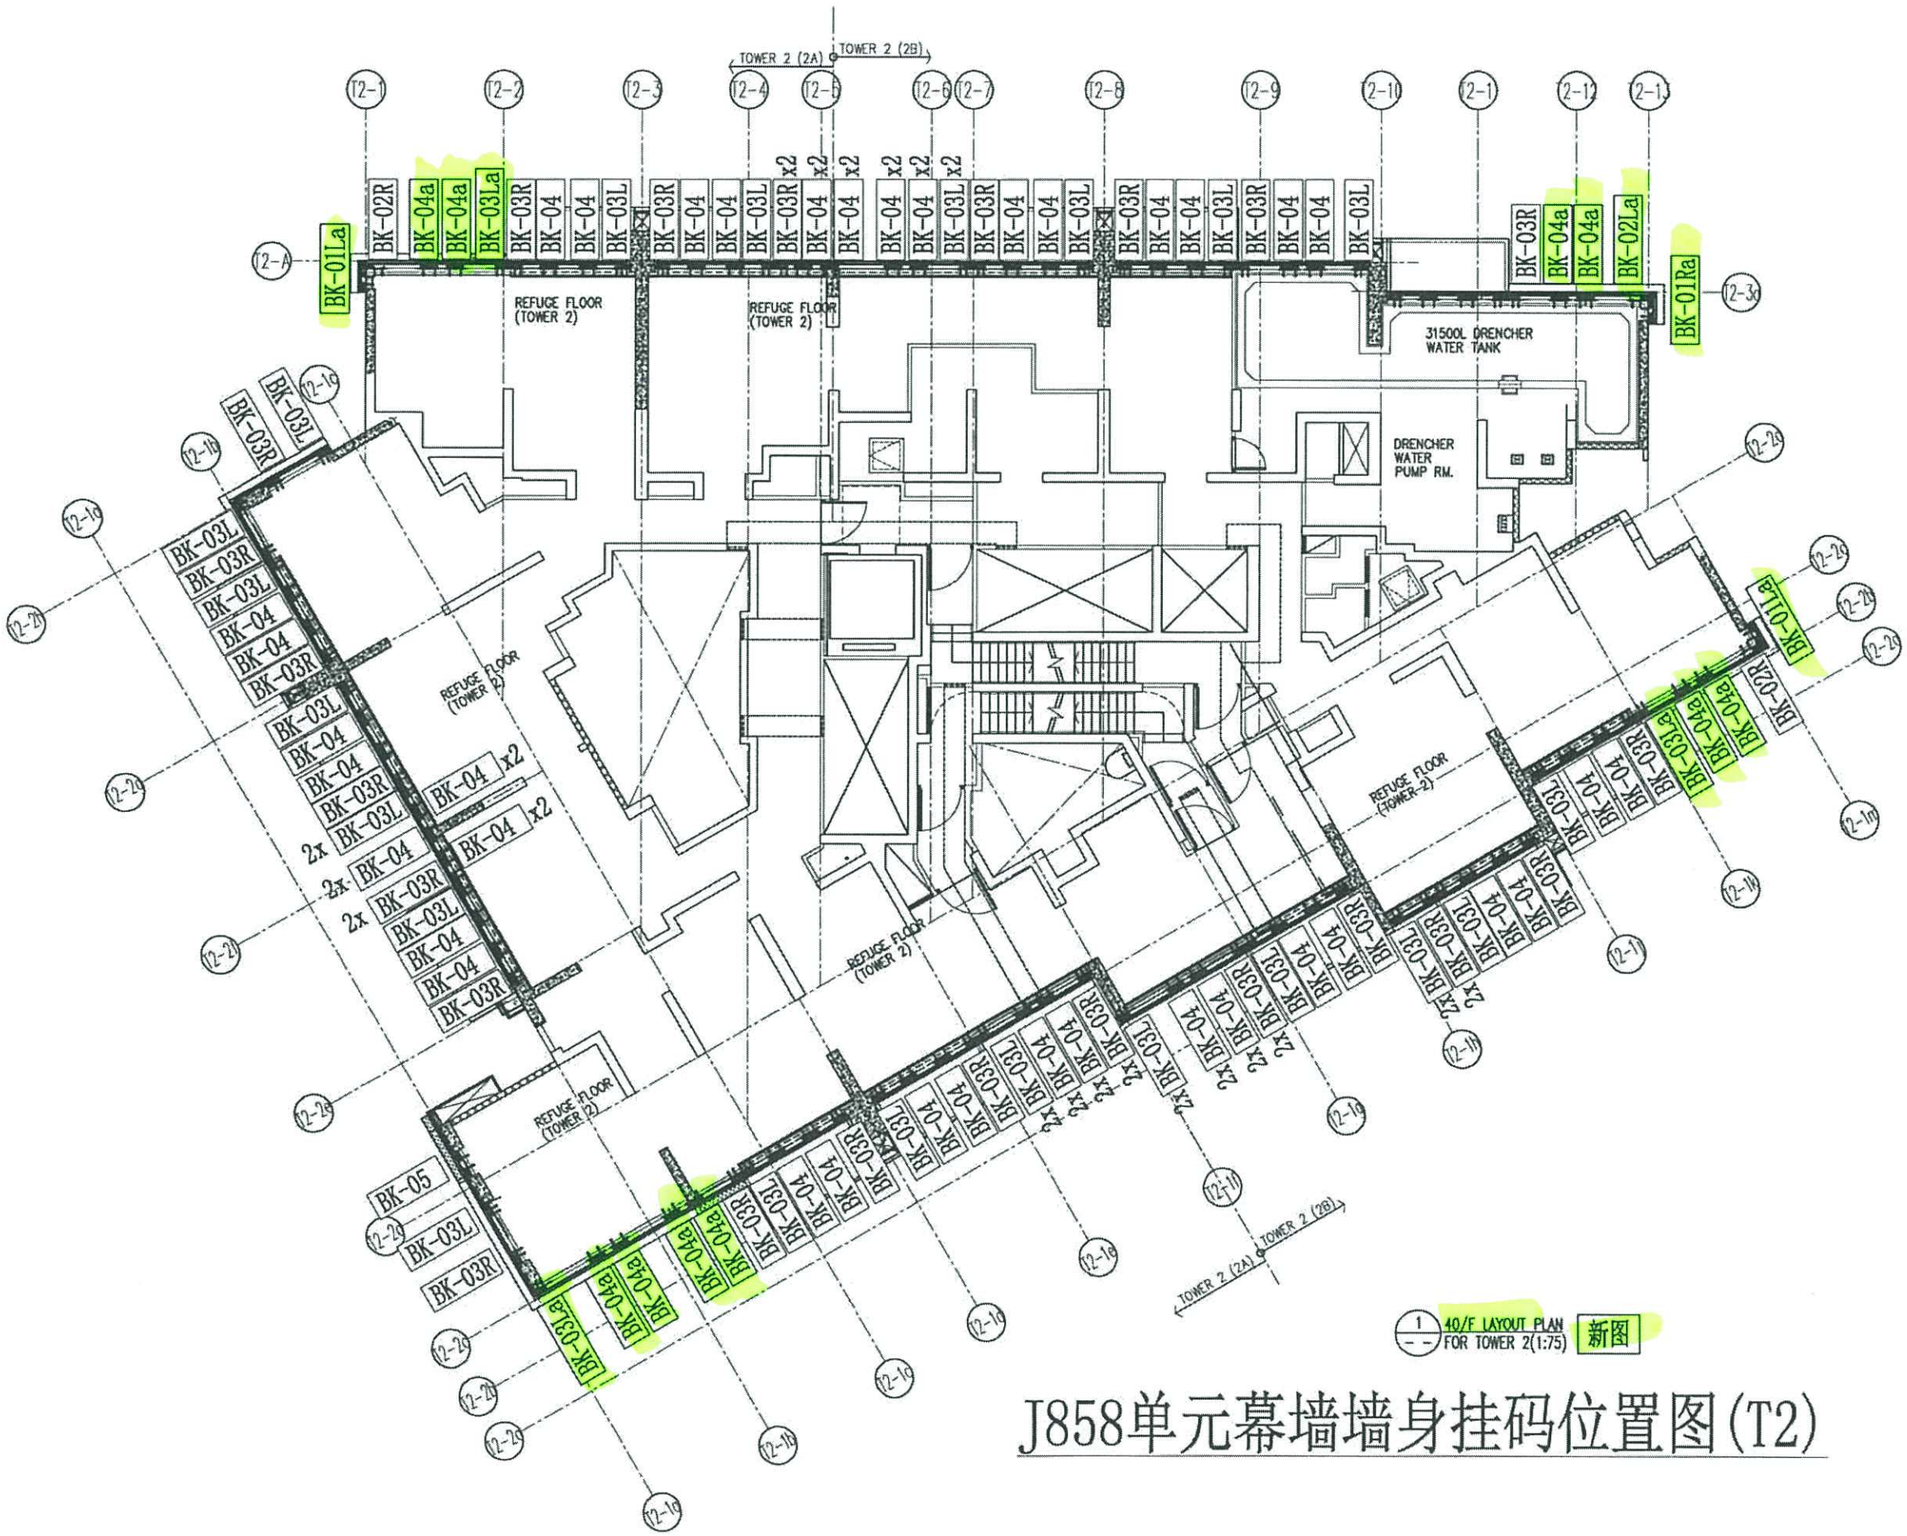

1 40/F LAYOUT PLAN FOR TOWER 2(1:75) 新图

J858单元幕墙墙身挂码位置图(T2)

B.D. REF :

CLIENT :
信和置業有限公司
Sino Land Company Limited

ARCHITECT :
ronald lu & partners
Ronald Lu & Partners (HK) Ltd.
呂元祥建築師事務所(香港)有限公司

MAIN CONTRACTOR :
Gammon

STRUCTURAL ENGINEER :
AECOM

FACADE CONSULTANT:
AECOM

NOTE :
1. ALL DIMENSIONS ARE IN mm.
2. ALL ELEVATIONS ARE VIEWED FROM OUTSIDE.
3. ALL DIMENSIONS TO BE VERIFIED ON SITE BEFORE FABRICATION.

LEGEND :
X1 — DETAIL MARK NO.
XD01 — REFER SHEET NO.
1. F.F.L. — FINISHED FLOOR LEVEL
2. S.F.L. — STRUCTURAL FLOOR LEVEL
3. (YR) — REVERSED DETAIL

17

NO.	DATE	REMARKS	BY
-	-	-	-

JOB NO. : J--858

PROJECT :
PROPOSED RESIDENTIAL DEVELOPMENT
AT TKOTL 70RP, PHASE 11, LOHAS PARK
TSEUNG KWAN O, N.T.

TITLE :
40/F REFUGE FLOOR PLAN
AT TOWER 2


DATE : 14-Jun-22 | SCALE : 1:75(A1)

DRAWN BY : KY | CHECKED BY : YB

美特鋁製有限公司
MIDI ALUMINIUM FABRICATOR LTD.
Units 6-8, Sunray Industrial Centre, 1/f
610 Cha Kwo Ling Road, Kowloon
Tel:23489211-4 Fax:(852)27727666

DWG NO. : J858-CW-BR-202a | REV. : -

12

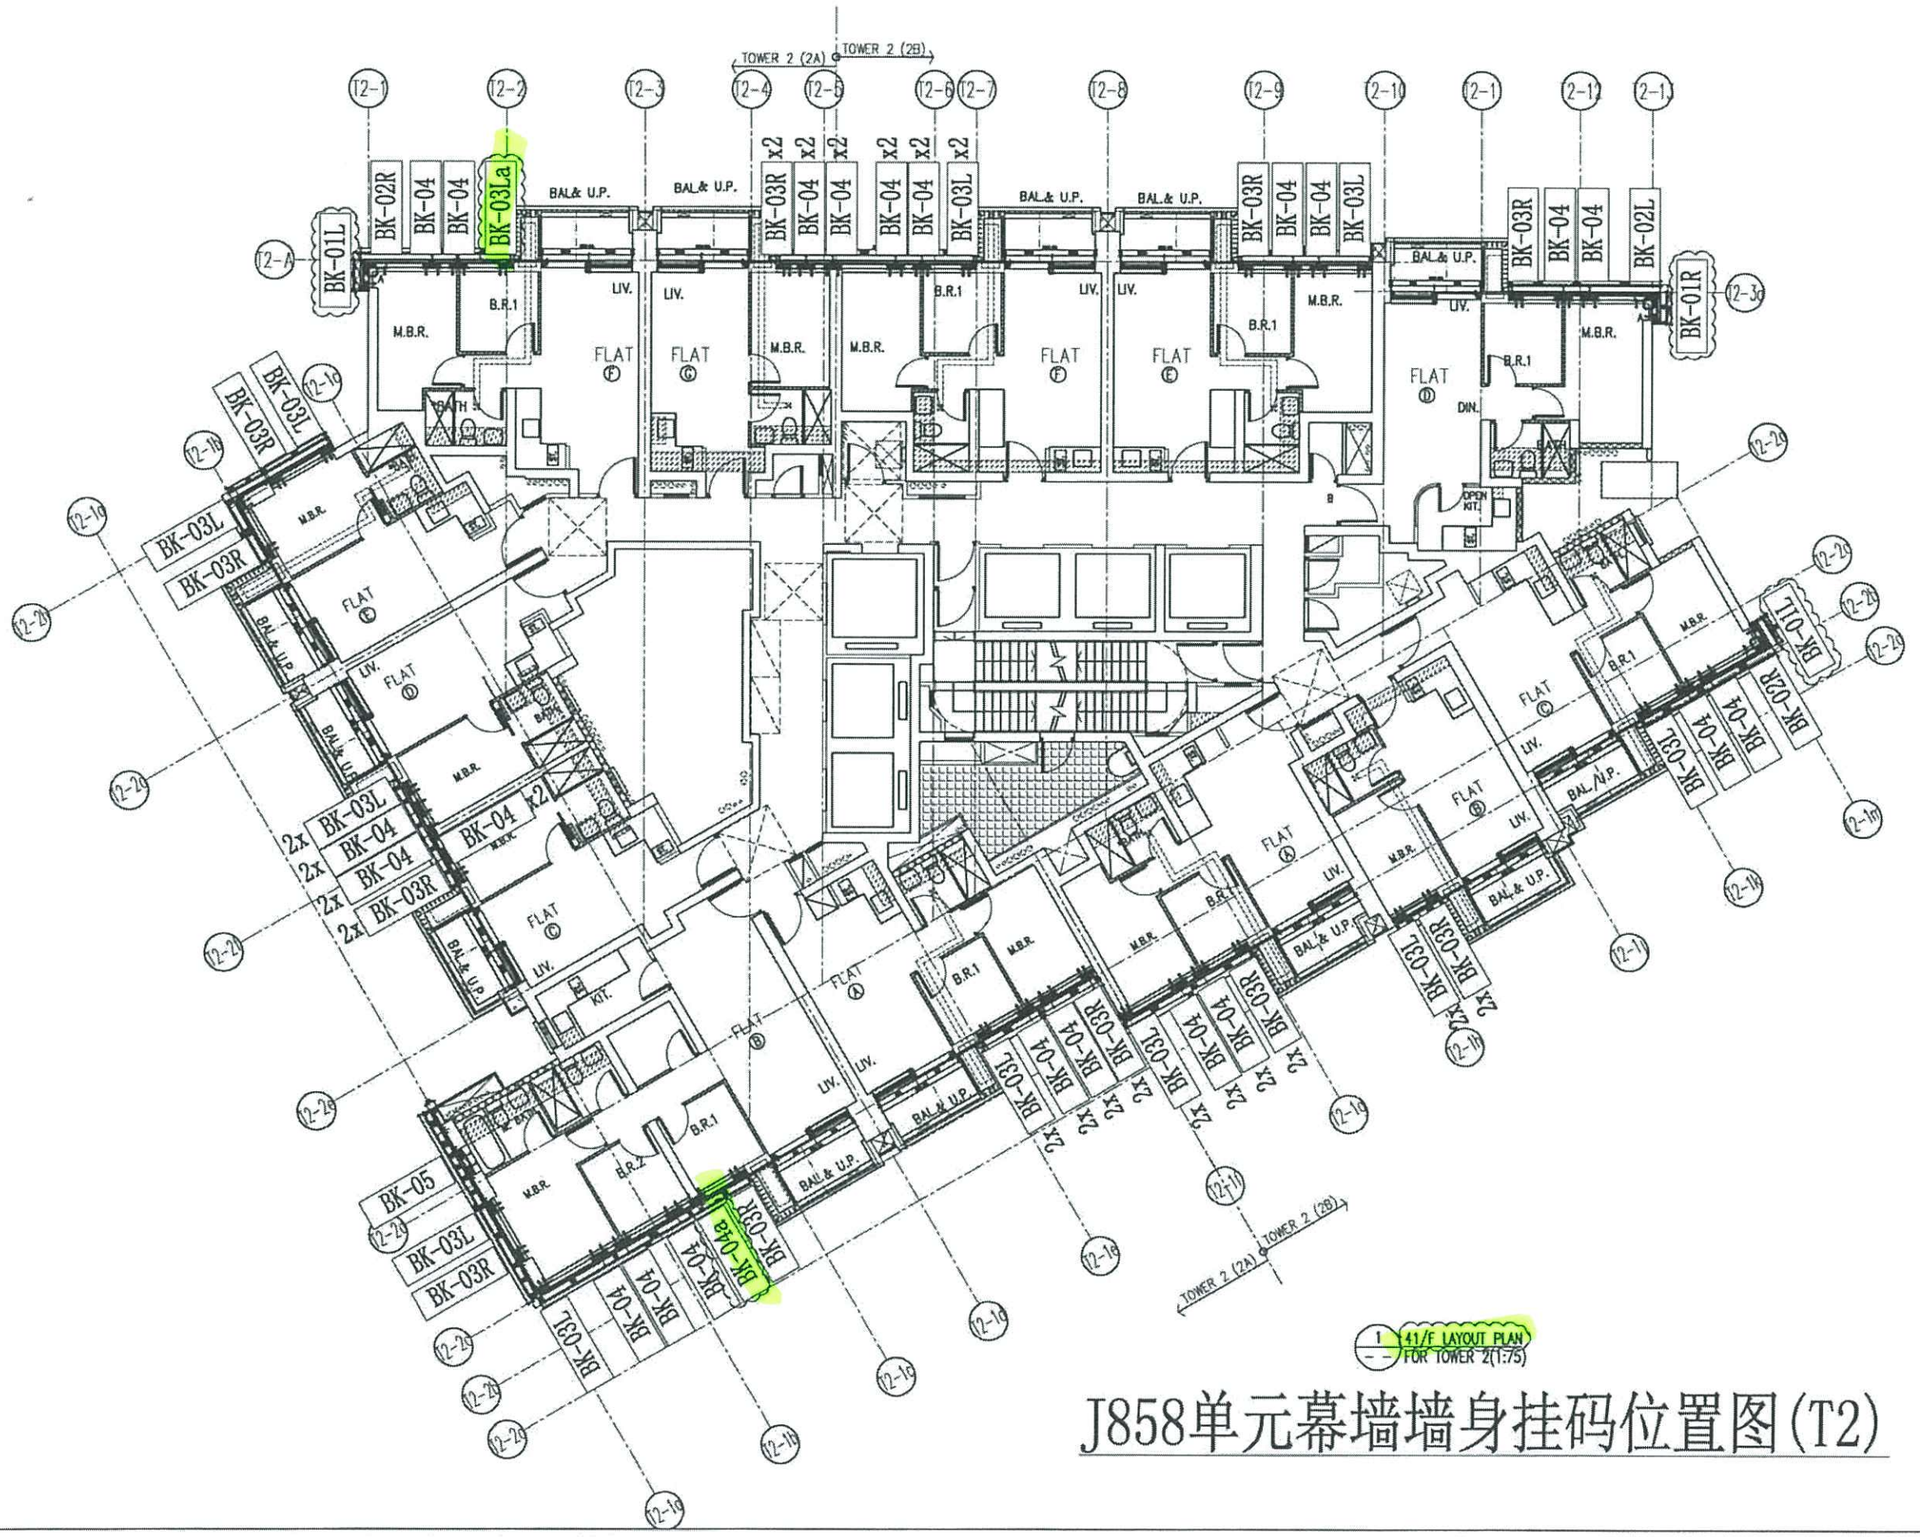

1 41/F LAYOUT PLAN FOR TOWER 2(1:75)

J858单元幕墙墙身挂码位置图(T2)

B.D. REF :

CLIENT :
信和置業有限公司
Sino Land Company Limited

ARCHITECT :
ronald lu & partners
Ronald Lu & Partners (HK) Ltd.
呂元祥建築師事務所(香港)有限公司

MAIN CONTRACTOR :
Gammon

STRUCTURAL ENGINEER :
AECOM

FACADE CONSULTANT:
AECOM

NOTE :
1. ALL DIMENSIONS ARE IN mm.
2. ALL ELEVATIONS ARE VIEWED FROM OUTSIDE.
3. ALL DIMENSIONS TO BE VERIFIED ON SITE BEFORE FABRICATION.

LEGEND :
X1 — DETAIL MARK NO.
2001 — REFER SHEET NO.
1. F.F.L. — FINISHED FLOOR LEVEL
2. S.F.L. — STRUCTURAL FLOOR LEVEL
3. (R) — REVERSED DETAIL

2

NO.	DATE	REVISED	BY
-	-	-	-

JOB NO. : J-858

PROJECT :
PROPOSED RESIDENTIAL DEVELOPMENT
AT TKOTL 70RP, PHASE 11, LOHAS PARK
TSEUNG KWAN O, N.T.

TITLE :
41/F FLOOR PLAN AT TOWER 2


DATE : 14-Jun-22 | SCALE : 1:75(A1)

DRAWN BY : KY | CHECKED BY : YB

美特鋁質有限公司
MIDI ALUMINIUM FABRICATOR LTD.
Units 6-8, Sunray Industrial Centre, 1/F
610 Cha Kwo Ling Road, Kowloon
Tel:23489211-4 Fax:(852)27727666

DWG NO. : J858-CW-BR-203 | REV. : A

13

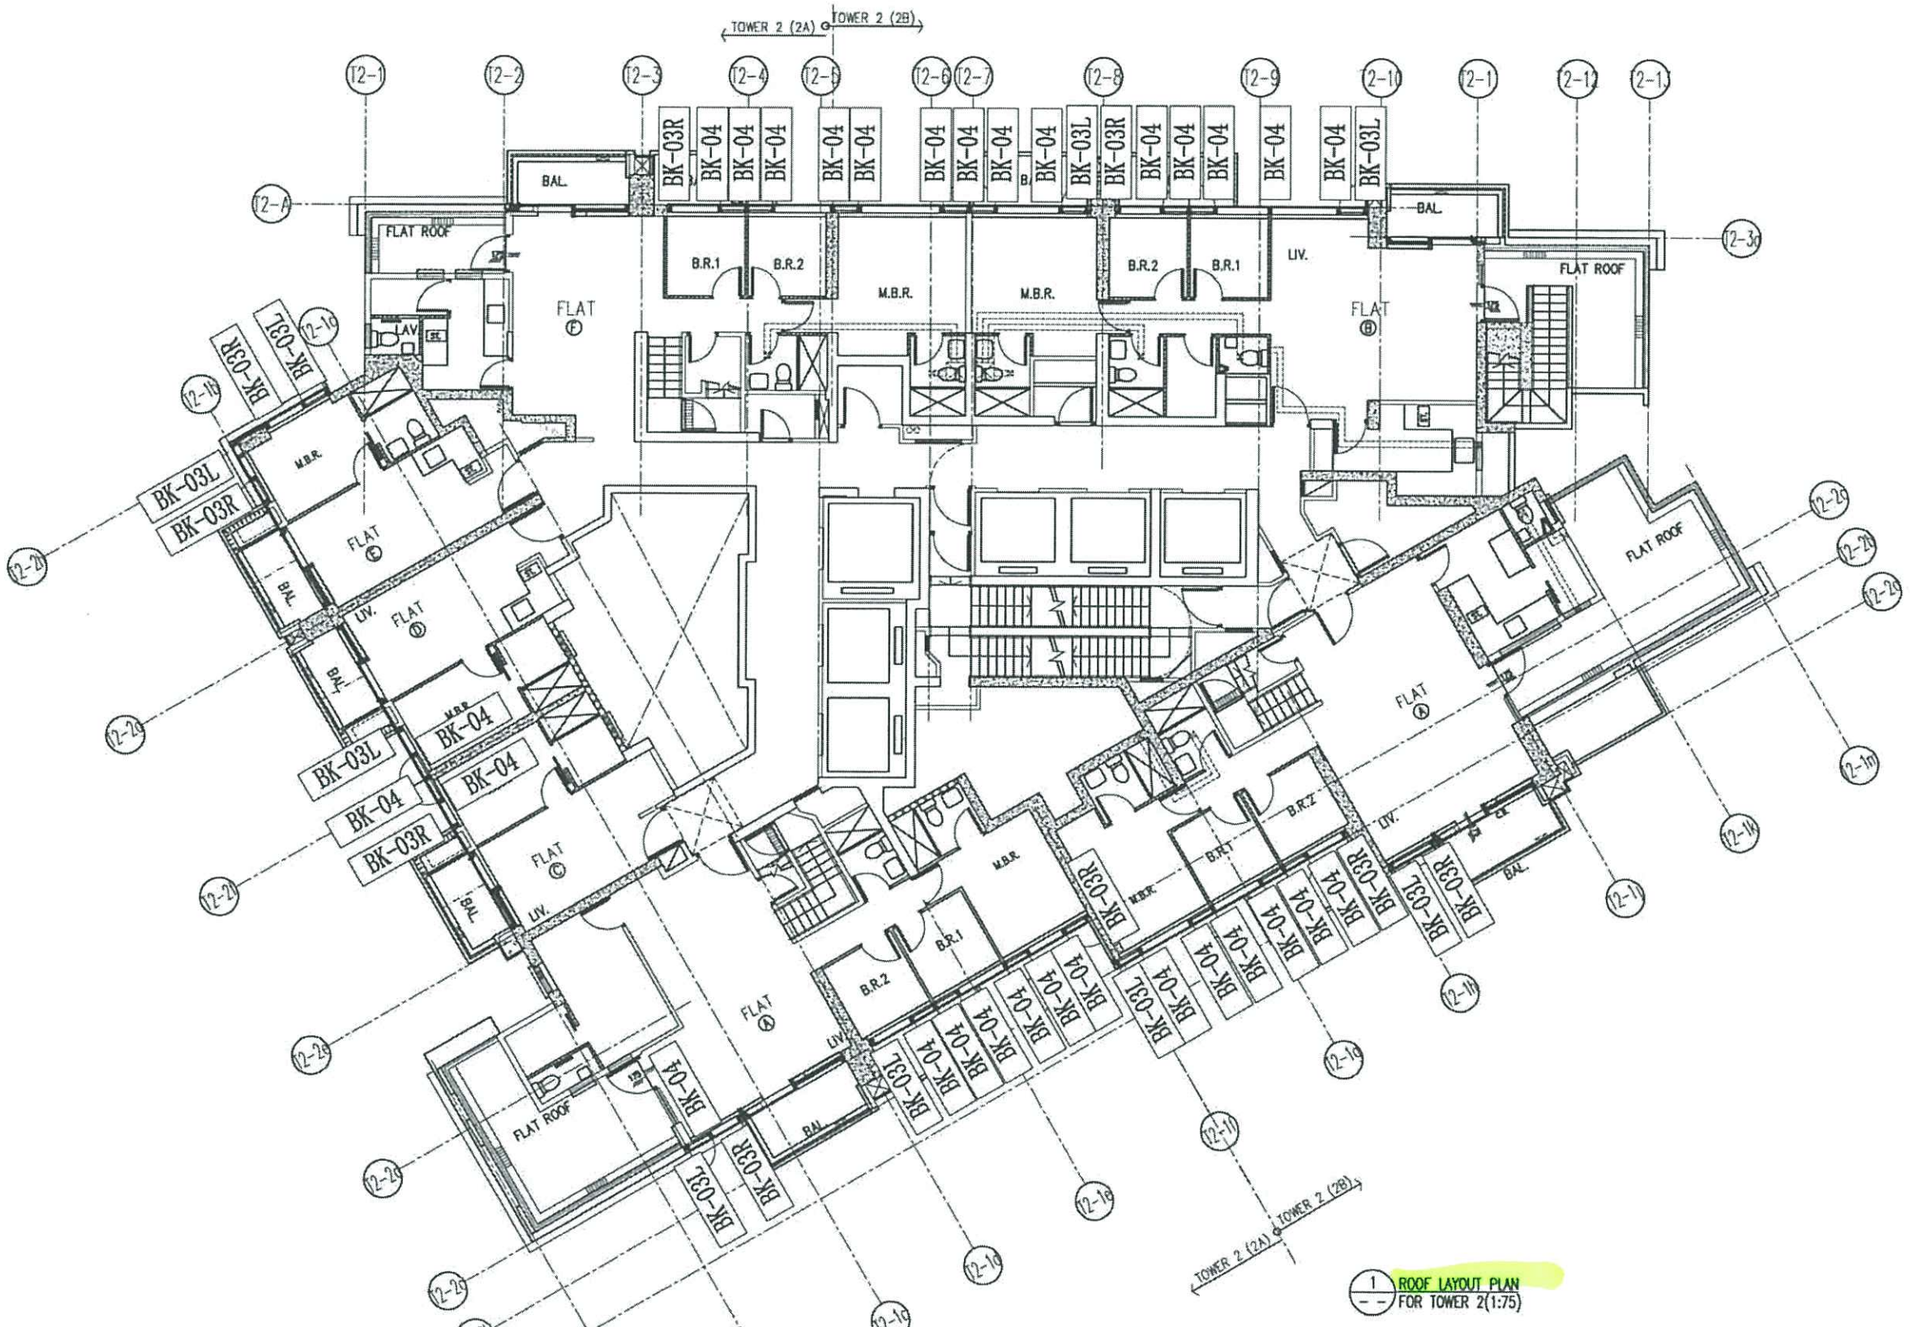

1 ROOF LAYOUT PLAN
FOR TOWER 2(1:75)

J858单元幕墙墙身挂码位置图(T2)

B.D. REF :

CLIENT :
信和置業有限公司
Sino Land Company Limited

ARCHITECT :
ronald lu & partners
Ronald Lu & Partners (HK) Ltd.
呂元祥建築師事務所(香港)有限公司

MAIN CONTRACTOR :
Gammon

STRUCTURAL ENGINEER :
AECOM

FACADE CONSULTANT:
AECOM

NOTE :
1. ALL DIMENSIONS ARE IN mm.
2. ALL ELEVATIONS ARE VIEWED FROM OUTSIDE.
3. ALL DIMENSIONS TO BE VERIFIED ON SITE BEFORE FABRICATION.

LEGEND :
X1 — DETAIL MARK NO.
X001 — REFER SHEET NO.
1. F.F.L. --FINISHED FLOOR LEVEL
2. S.F.L. --STRUCTURAL FLOOR LEVEL
3. (R) --REVERSED DETAIL

NO.	DATE	REVISED	BY
-	-	-	-

JOB NO. : J-858

PROJECT :
PROPOSED RESIDENTIAL DEVELOPMENT
AT TKOTL 70RP, PHASE 11, LOHAS PARK
TSEUNG KWAN O, N.T.

TITLE :
ROOF FLOOR PLAN
AT TOWER 2

DATE : 14-Jun-22	SCALE : 1:75(A1)
DRAWN BY : KY	CHECKED BY : YB

美特鋁質有限公司
MIDI ALUMINIUM FABRICATOR LTD.
Units 6-8, Sunray Industrial Centre, 1/F
610 Cha Kwo Ling Road, Kowloon
Tel:23489211-4 Fax:(852)27727666

DWG NO. : J858-CW-BR-204 REV. : A



1 10/F,15~17/F,19~21/F,23~26/F,28~30/F,32~35/F,37~39/F,42~43/F,46~48/F,50~52/F,55~57/F,59~61/F,63~66/F
LAYOUT PLAN FOR TOWER 3(1:75)
(13/F,14/F,24/F,34/F,44/F,54/F,64/F FLOORS OMITTED)

J858单元幕墙墙身挂码位置图(T3)

B.D. REF :

CLIENT :
信和置業有限公司
Sino Land Company Limited

ARCHITECT :
ronald lu & partners
Ronald Lu & Partners (HK) Ltd.
呂元祥建築師事務所(香港)有限公司

MAIN CONTRACTOR :
Gammon

STRUCTURAL ENGINEER :
AECOM

FACADE CONSULTANT:
AECOM

NOTE :
1. ALL DIMENSIONS ARE IN mm.
2. ALL ELEVATIONS ARE VIEWED FROM OUTSIDE.
3. ALL DIMENSIONS TO BE VERIFIED ON SITE BEFORE FABRICATION.

LEGEND :
X1 — DETAIL MARK NO.
X001 — REFER SHEET NO.
1. F.F.L. — FINISHED FLOOR LEVEL
2. S.F.L. — STRUCTURAL FLOOR LEVEL
3. (R) — REVERSED DETAIL

2

NO.	DATE	REMARKS	BY
-	-	-	-

JOB NO. : J-858

PROJECT :
PROPOSED RESIDENTIAL DEVELOPMENT
AT TKOTL 70RP, PHASE 11, LOHAS PARK
TSEUNG KWAN O, N.T.


TITLE :
TYPICAL FLOOR PLAN
AT TOWER 3

DATE : 14-Jun-22	SCALE : 1:75(A1)
DRAWN BY : KY	CHECKED BY : YB

美特鋁質有限公司
MIDI ALUMINIUM FABRICATOR LTD.
Units 6-8, Sunray Industrial Centre, 1/F
610 Cha Kwo Ling Road, Kowloon
Tel:23489211-4 Fax:(852)27727666

DWG NO. : J858-CW-BR-301 REV. : A

(1F)

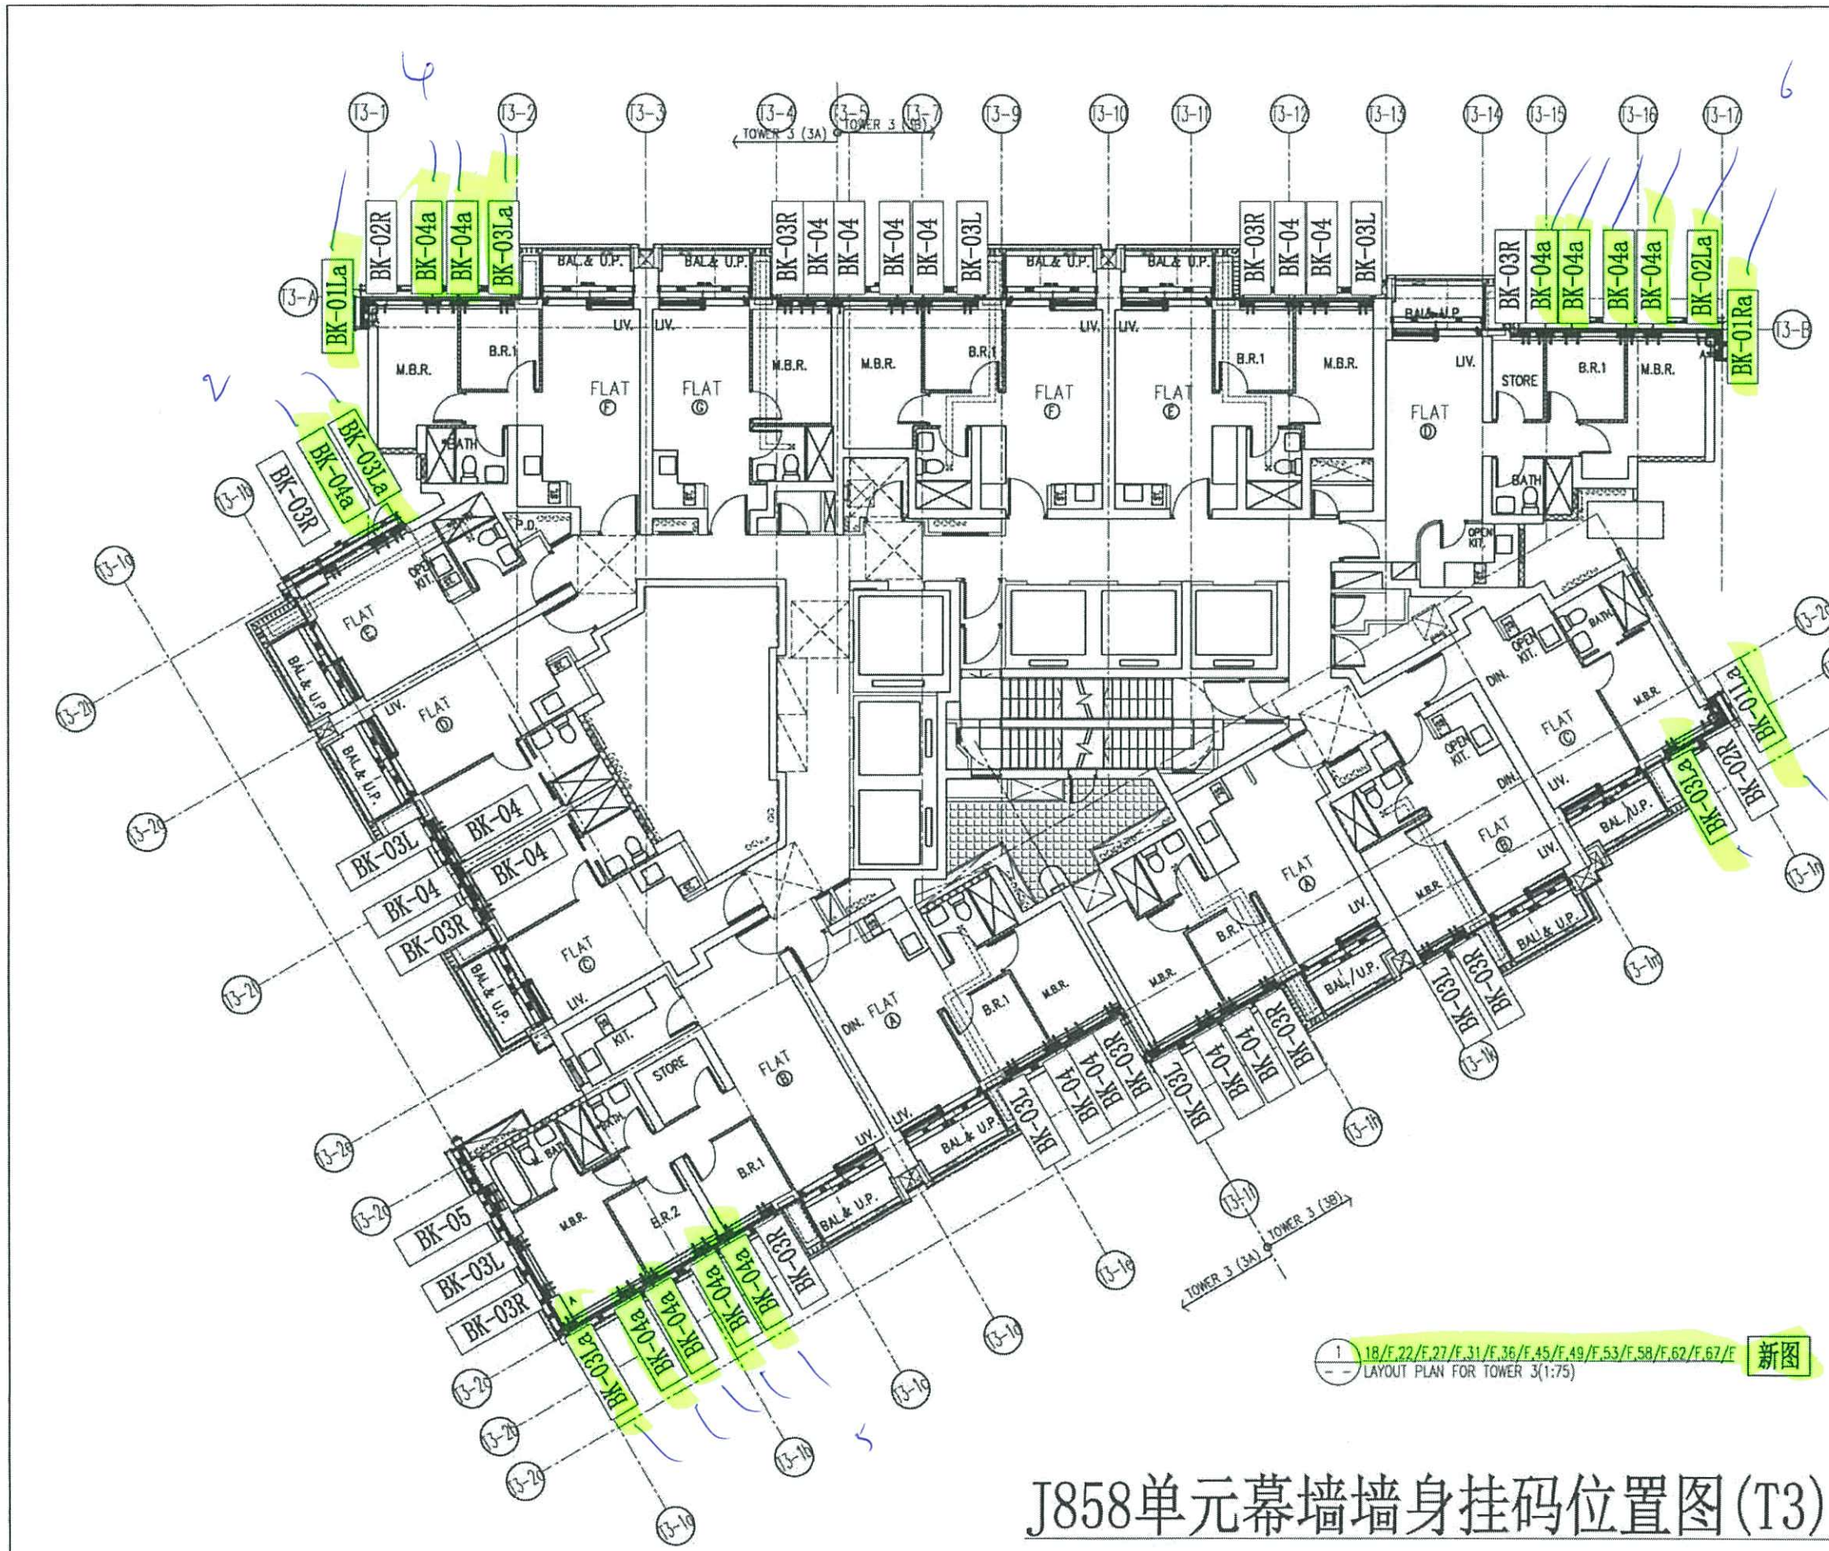

1 18/F,22/F,27/F,31/F,36/F,45/F,49/F,53/F,58/F,62/F,67/F LAYOUT PLAN FOR TOWER 3(1:75) 新图

J858单元幕墙墙身挂码位置图(T3)

B.D. REF :

CLIENT :
信和置業有限公司
Sino Land Company Limited

ARCHITECT :
ronald lu & partners
Ronald Lu & Partners (HK) Ltd.
呂元祥建築師事務所(香港)有限公司

MAIN CONTRACTOR :
Gammon

STRUCTURAL ENGINEER :
AECOM

FACADE CONSULTANT:
AECOM

NOTE :
1. ALL DIMENSIONS ARE IN mm.
2. ALL ELEVATIONS ARE VIEWED FROM OUTSIDE.
3. ALL DIMENSIONS TO BE VERIFIED ON SITE BEFORE FABRICATION.

LEGEND :
- X1 / XXX1 — DETAIL MARK NO. / REFER SHEET NO.
1. F.F.L. — FINISHED FLOOR LEVEL
2. S.F.L. — STRUCTURAL FLOOR LEVEL
3. (R) — REVERSED DETAIL

NO.	DATE	REVISED	BY
-	-	-	-

JOB NO. : J-858

PROJECT :
PROPOSED RESIDENTIAL DEVELOPMENT
AT TKOTL 70RP, PHASE 11, LOHAS PARK
TSEUNG KWAN O, N.T.


TITLE :
TYPICAL FLOOR PLAN
AT TOWER 3

DATE : 14-Jun-22 | SCALE : 1:75(A1)

DRAWN BY : KY | CHECKED BY : YB

美特鋁質有限公司
MIDI ALUMINUM FABRICATOR LTD.
Units 6-8, Sunray Industrial Centre, 1/F
610 Cha Kwa Ling Road, Kowloon
Tel:23489211-4 Fax:(852)27727666

DWG NO. : J858-CW-BR-301a | REV. : -

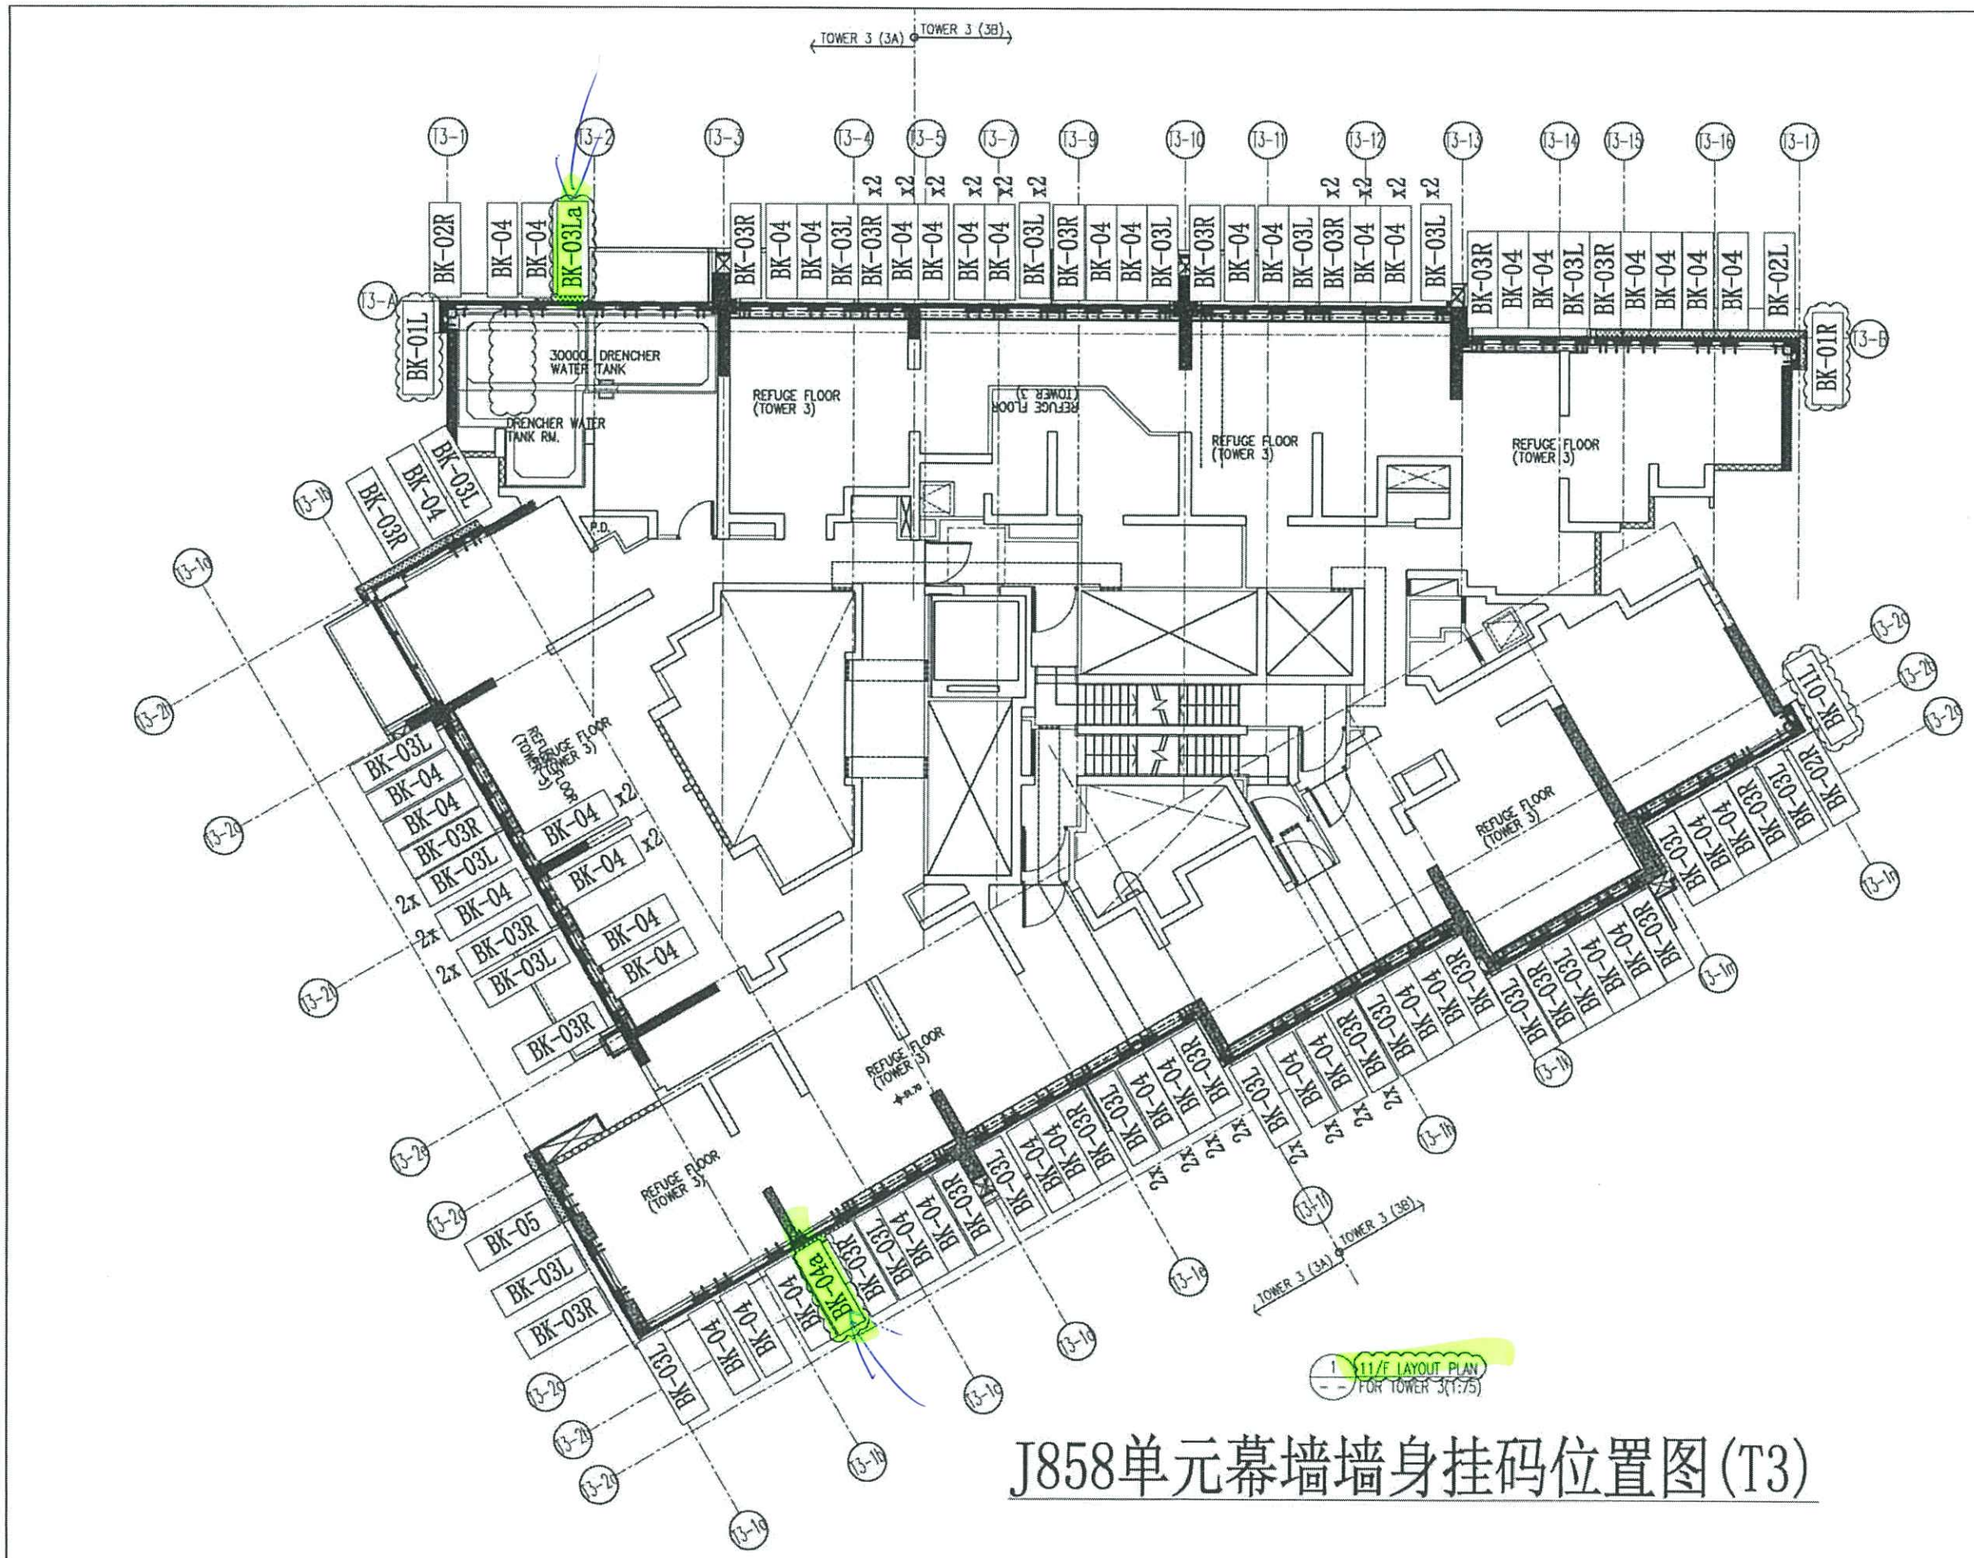

J858单元幕墙墙身挂码位置图(T3)

B.D. REF :

CLIENT :
信和置業有限公司
Sino Land Company Limited

ARCHITECT :
ronald lu & partners
Ronald Lu & Partners (HK) Ltd.
呂元祥建築師事務所(香港)有限公司

MAIN CONTRACTOR :
Gammon

STRUCTURAL ENGINEER :
AECOM

FACADE CONSULTANT:
AECOM

NOTE :
1. ALL DIMENSIONS ARE IN mm.
2. ALL ELEVATIONS ARE VIEWED FROM OUTSIDE.
3. ALL DIMENSIONS TO BE VERIFIED ON SITE BEFORE FABRICATION.

LEGEND :
X1 / 2001 — DETAIL MARK NO. / REFER SHEET NO.
1. F.F.L. — FINISHED FLOOR LEVEL
2. S.F.L. — STRUCTURAL FLOOR LEVEL
3. (YB) — REVERSED DETAIL

NO.	DATE	REVISED	BY
-	-	-	-

JOB NO. : J-858

PROJECT :
PROPOSED RESIDENTIAL DEVELOPMENT
AT TKOTL 70RP, PHASE 11, LOHAS PARK
TSEUNG KWAN O, N.T.

TITLE :
11/F REFUGE FLOOR PLAN AT TOWER 3


DATE : 14-Jun-22 | SCALE : 1:75(A1)


DRAWN BY : KY | CHECKED BY : YB

美特鋁質有限公司
MIDI ALUMINUM FABRICATOR LTD.
Units 6-8, Sunray Industrial Centre, 1/F
610 Cha Kwo Ling Road, Kowloon
Tel:23489211-4 Fax:(852)27727666

DWG NO. : J858-CW-BR-302 | REV. : A

(17)

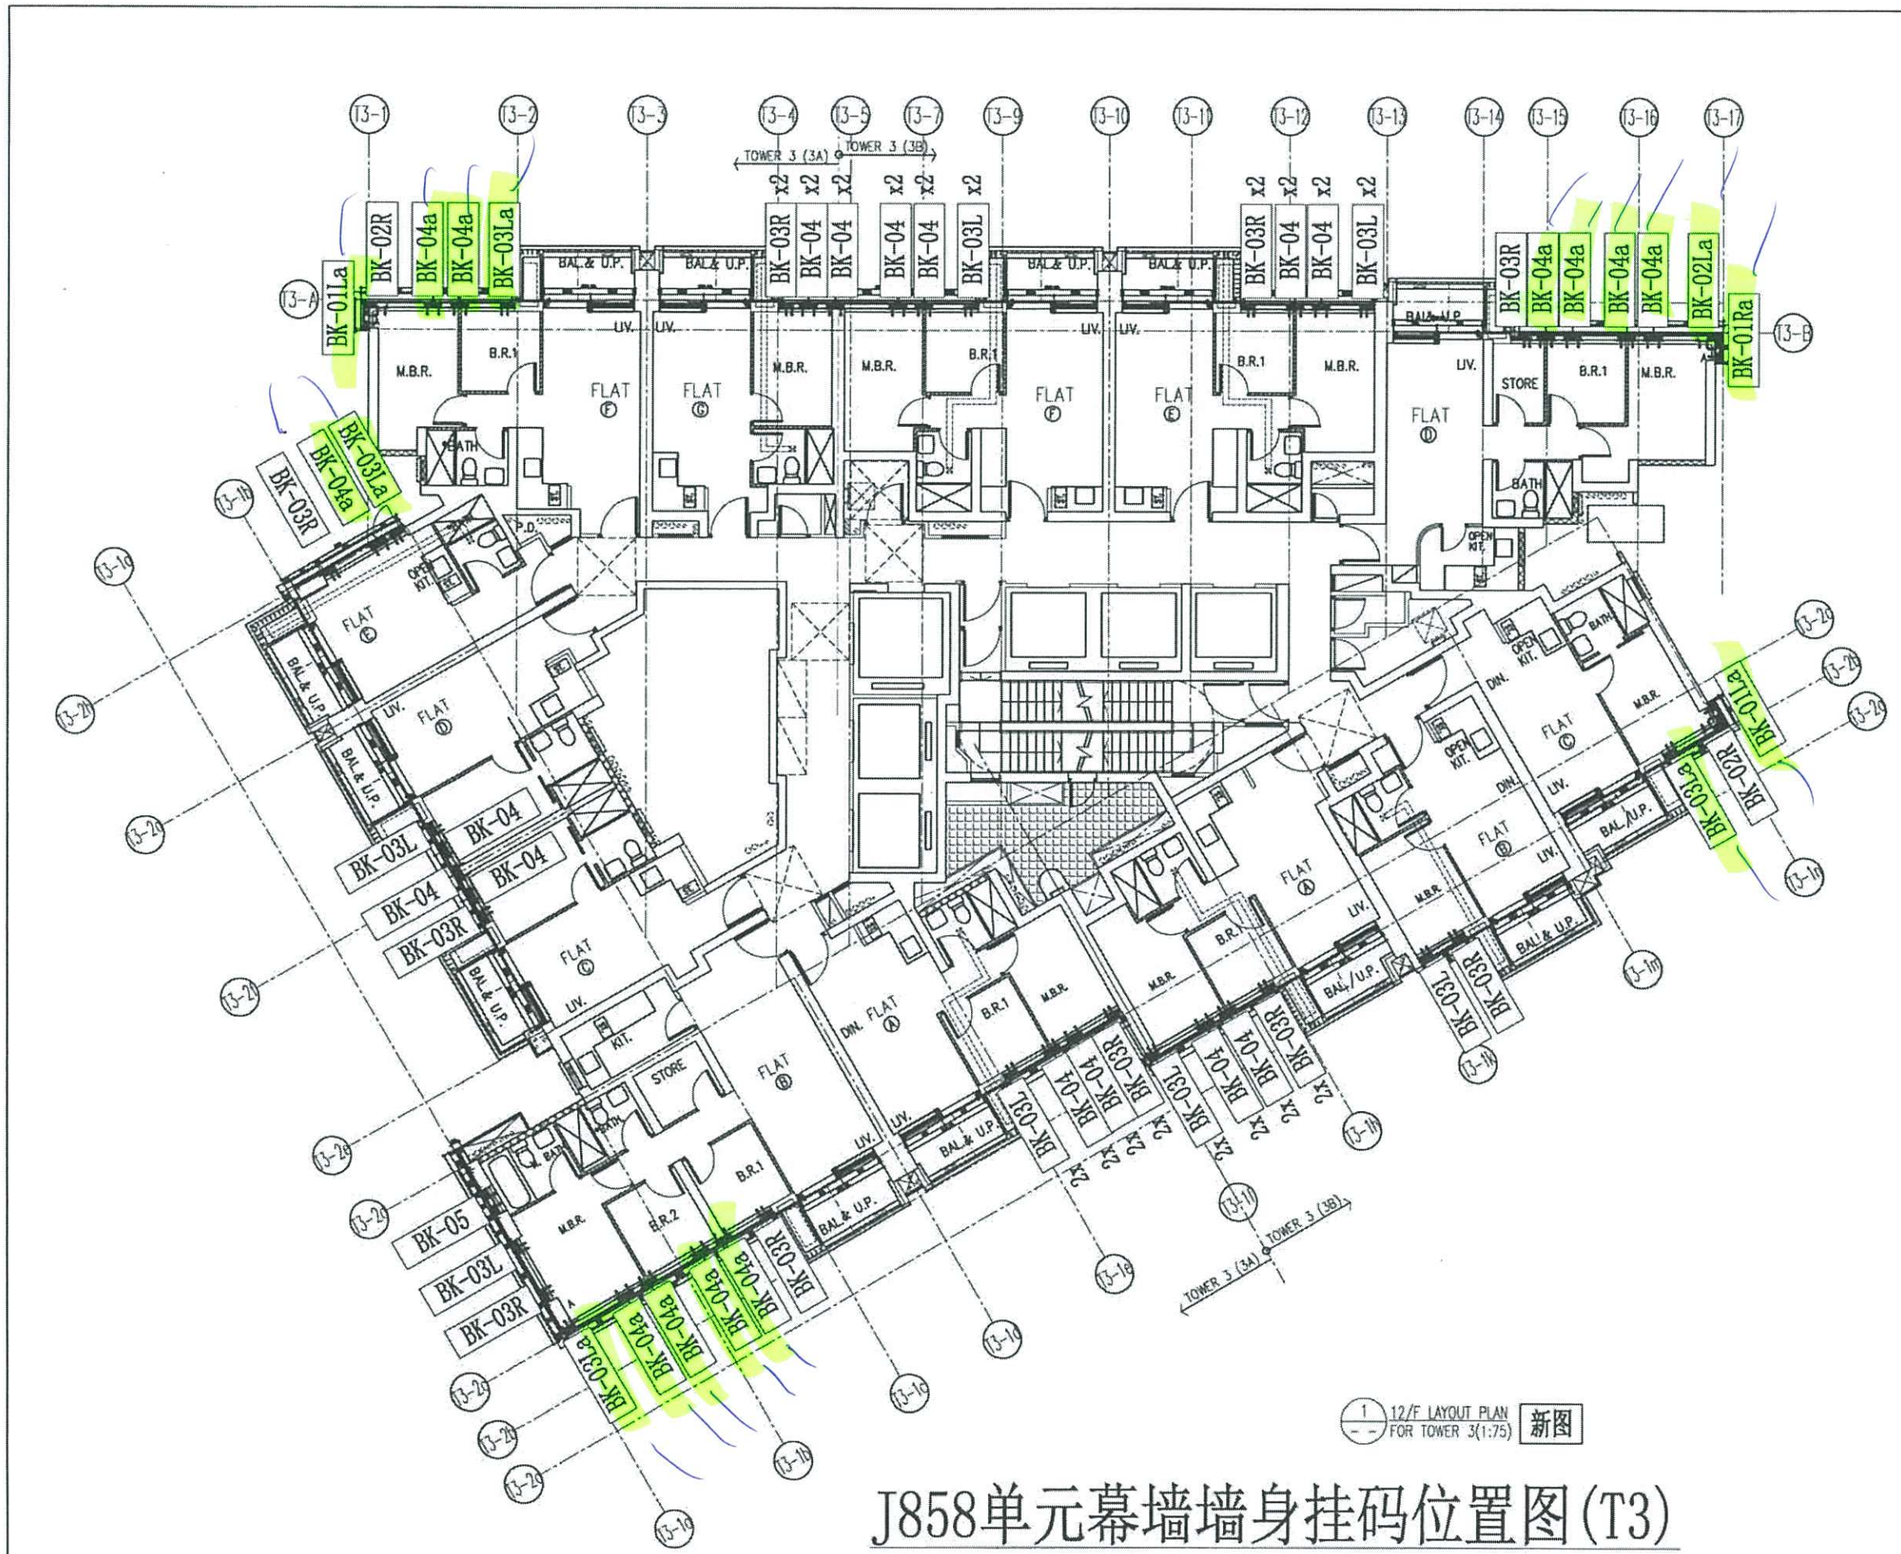
TOWER 3 (3A)
TOWER 3 (3B)
TOWER 3 (3A)
TOWER 3 (3B)
BK-01La
BK-02R
BK-04a
BK-04a
BK-03La
BK-03R
BK-04a
BK-03La
BK-04
BK-04
BK-03L
BK-04
BK-04
BK-03R
BK-05
BK-03L
BK-03R
BK-04a
BK-04a
BK-04a
BK-04a
BK-03L
BK-04
BK-04
BK-03R
BK-04a
BK-04a
BK-04a
BK-04a
BK-02La
BK-01Ra
BK-01La
BK-02R
BK-03La
BK-04a
BK-04a
BK-03L
BK-04
BK-04
BK-03R
BK-04
BK-04
BK-03R
BK-04
BK-04
BK-03L

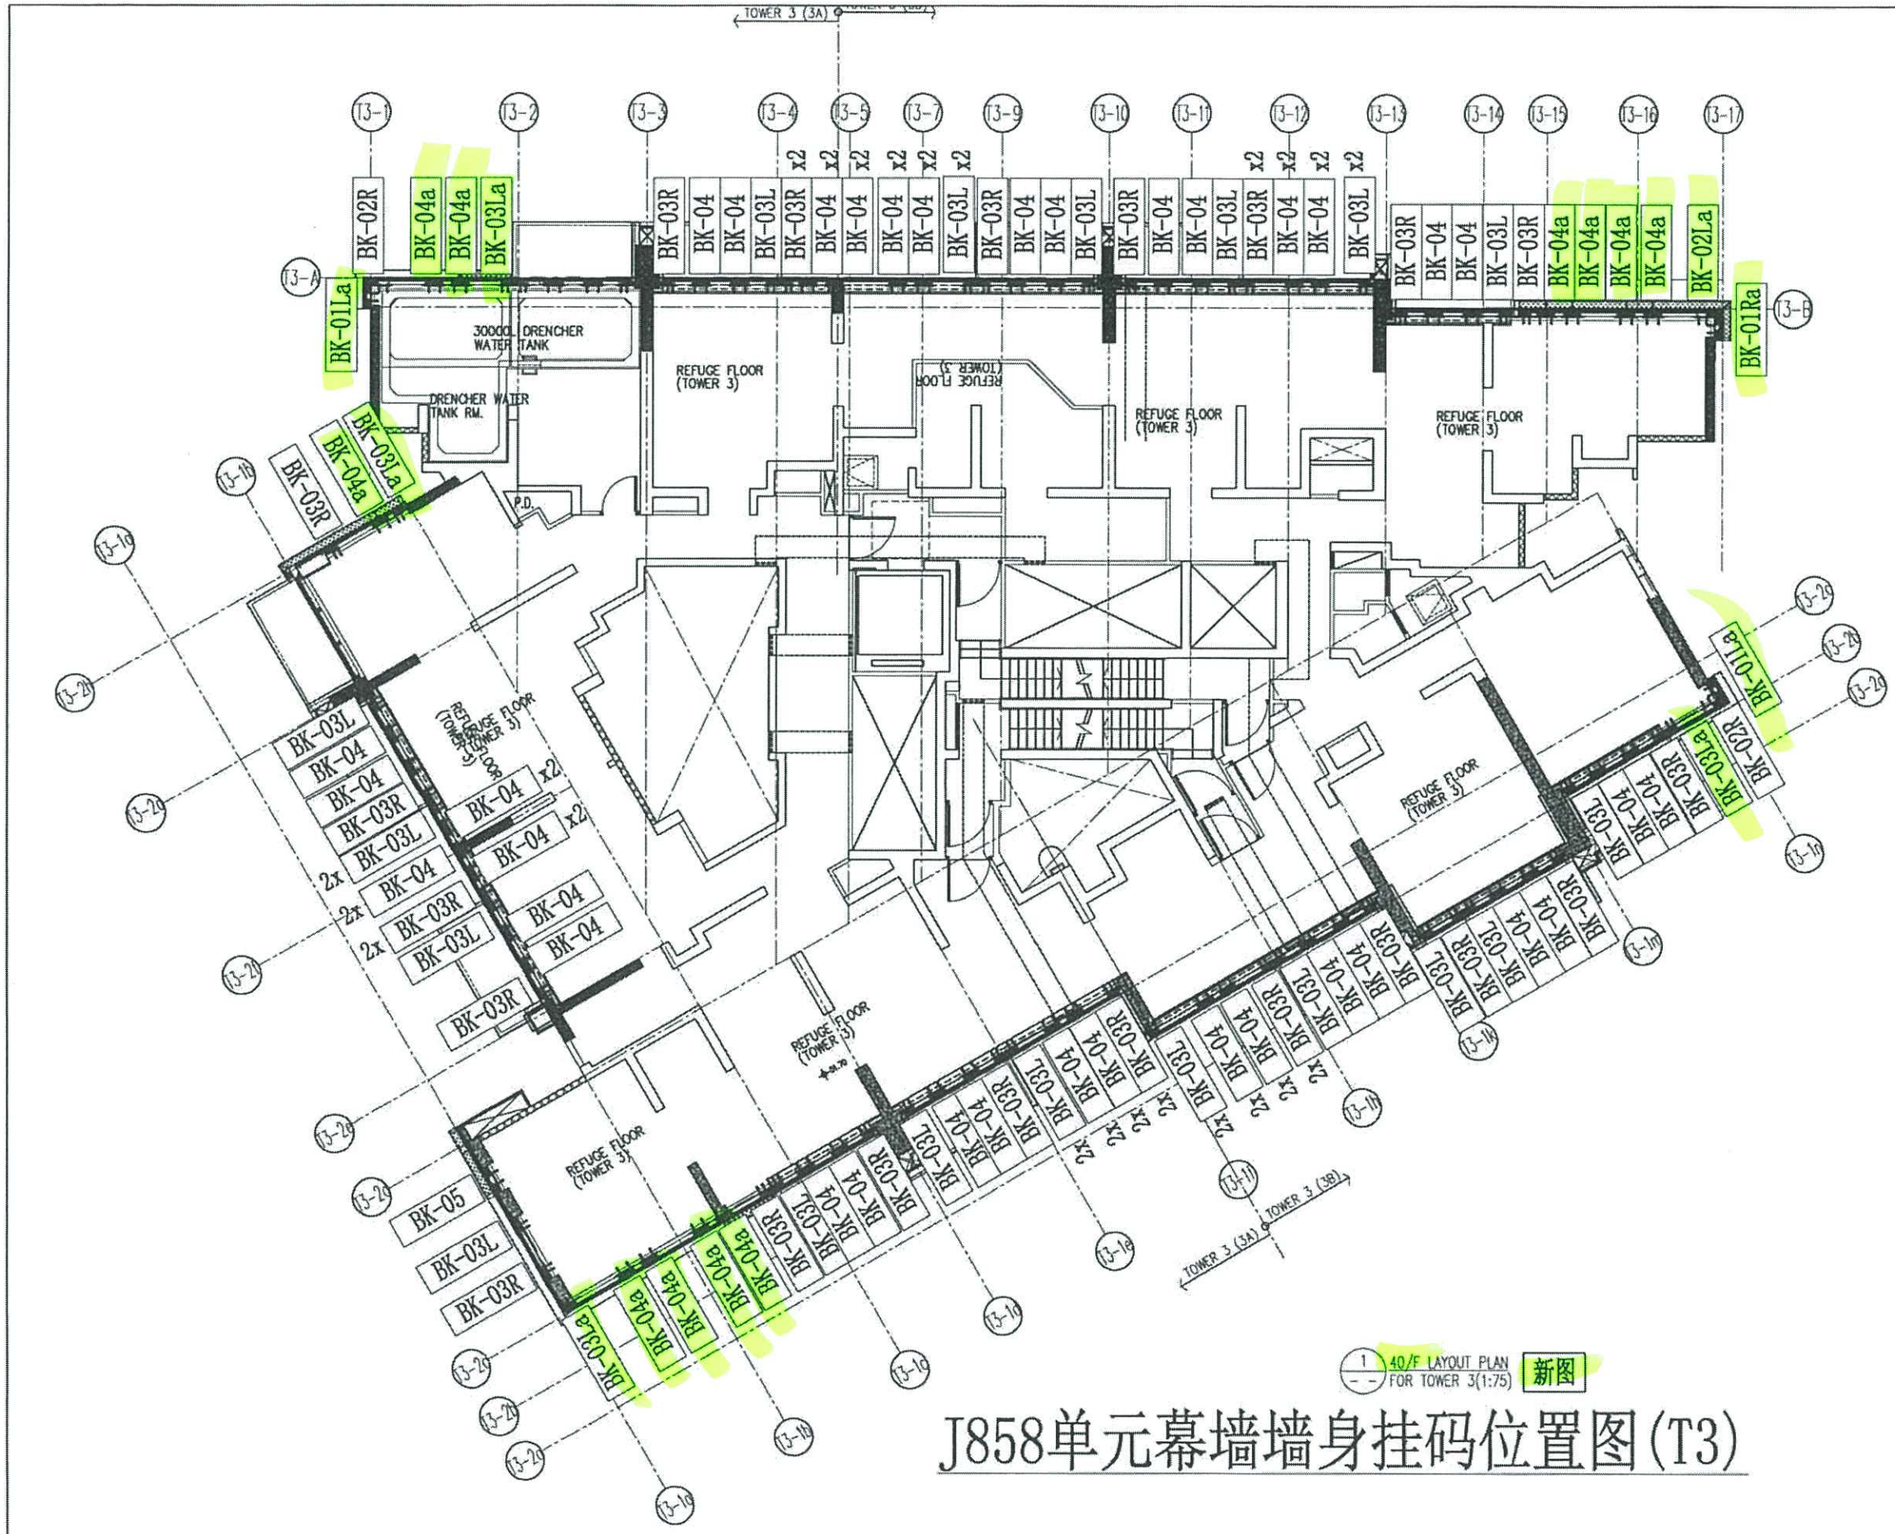

1 40/F LAYOUT PLAN FOR TOWER 3(1:75) 新图

J858单元幕墙墙身挂码位置图(T3)

B.D. REF :

CLIENT :
信和置業有限公司
Sino Land Company Limited

ARCHITECT :
ronald lu & partners
Ronald Lu & Partners (HK) Ltd.
呂元祥建築師事務所(香港)有限公司

MAIN CONTRACTOR :
Gammon

STRUCTURAL ENGINEER :
AECOM

FACADE CONSULTANT:
AECOM

NOTE :
1. ALL DIMENSIONS ARE IN mm.
2. ALL ELEVATIONS ARE VIEWED FROM OUTSIDE.
3. ALL DIMENSIONS TO BE VERIFIED ON SITE BEFORE FABRICATION.

LEGEND :
X1 — DETAIL MARK NO.
XD01 — REFER SHEET NO.
1. F.F.L. --- FINISHED FLOOR LEVEL
2. S.F.L. --- STRUCTURAL FLOOR LEVEL
3. (R) --- REVERSED DETAIL

19

NO.	DATE	REMARKS	BY
-	-	-	-

JOB NO. : J-858

PROJECT :
PROPOSED RESIDENTIAL DEVELOPMENT
AT TKOTL 70RP, PHASE 11, LOHAS PARK
TSEUNG KWAN O, N.T.

TITLE :
40/F REFUGE FLOOR PLAN
AT TOWER 3


DATE : 14-Jun-22 | SCALE : 1:75(A1)

DRAWN BY : KY | CHECKED BY : YB

美特鋁質有限公司
MIDI ALUMINIUM FABRICATOR LTD.
Units 6-8, Sunray Industrial Centre, 1/F
610 Cha Kwo Ling Road, Kowloon
Tel:23489211-4 Fax:(852)27727666

DWG NO. : J858-CW-BR-302a | REV. : -

19

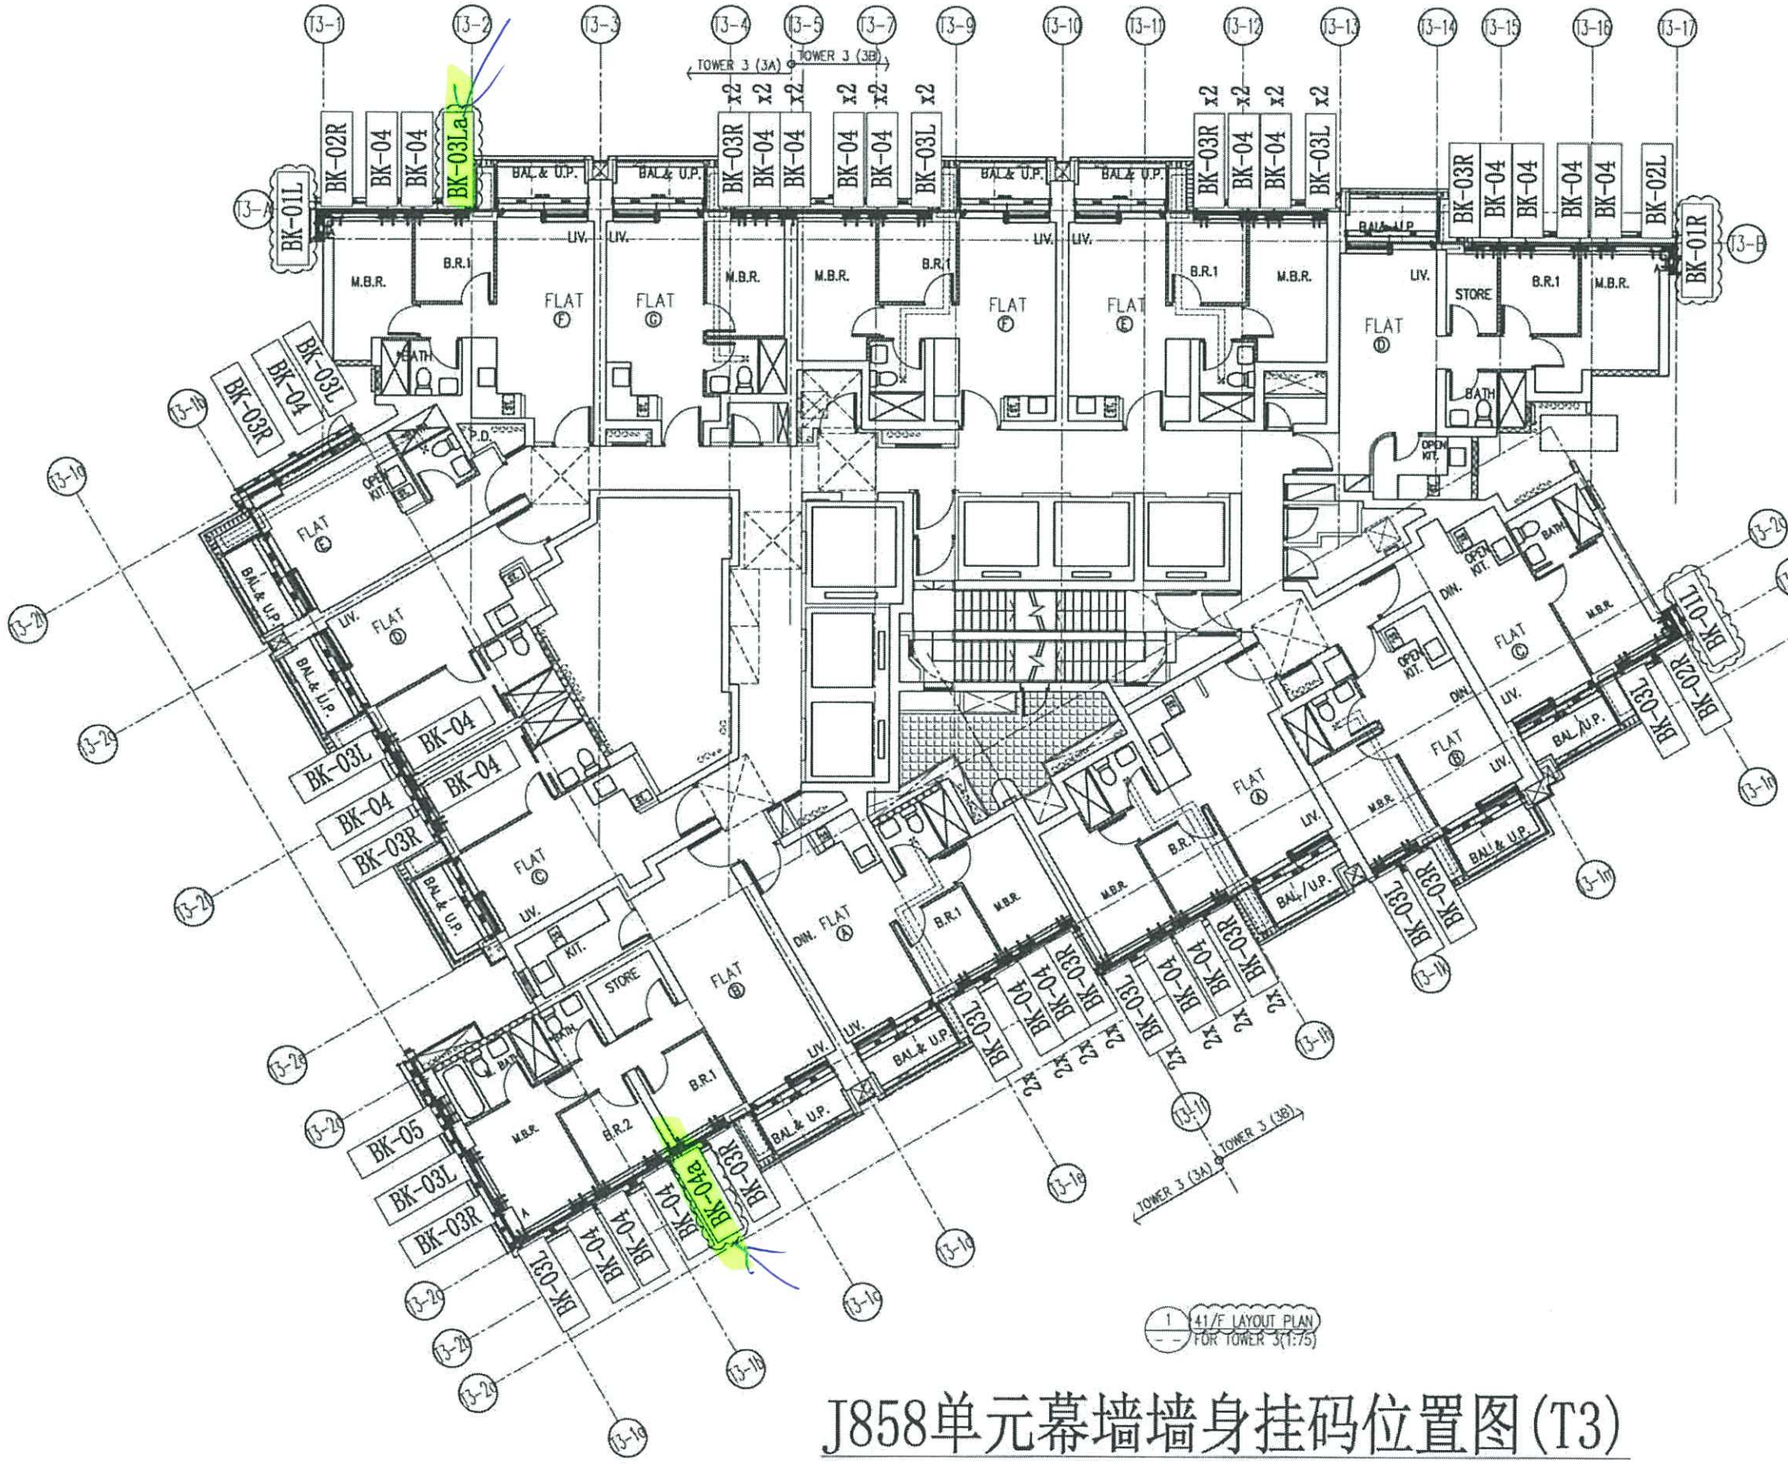

1 41/F LAYOUT PLAN FOR TOWER 3 (1:75)

J858单元幕墙墙身挂码位置图(T3)

B.D. REF :

CLIENT :
信和置業有限公司
Sino Land Company Limited

ARCHITECT :
ronald lu & partners
Ronald Lu & Partners (HK) Ltd.
呂元祥建築師事務所(香港)有限公司

MAIN CONTRACTOR :
Gammon

STRUCTURAL ENGINEER :
AECOM

FACADE CONSULTANT:
AECOM

NOTE :
1. ALL DIMENSIONS ARE IN mm.
2. ALL ELEVATIONS ARE VIEWED FROM OUTSIDE.
3. ALL DIMENSIONS TO BE VERIFIED ON SITE BEFORE FABRICATION.

LEGEND :
X1 — DETAIL MARK NO.
X001 — REFER SHEET NO.
1. F.F.L. — FINISHED FLOOR LEVEL
2. S.F.L. — STRUCTURAL FLOOR LEVEL
3. (R) — REVERSED DETAIL

2

NO.	DATE	REVISED	BY
-	-	-	-

JOB NO. : J-858

PROJECT :
PROPOSED RESIDENTIAL DEVELOPMENT
AT TKOTL 70RP, PHASE 11, LOHAS PARK
TSEUNG KWAN O, N.T.

TITLE :
41/F FLOOR PLAN AT TOWER 3


DATE : 14-Jun-22 | SCALE : 1:75(A1)

DRAWN BY : KY | CHECKED BY : YB

美特鋁質有限公司
MIDI ALUMINIUM FABRICATOR LTD.
Units 6-8, Sunray Industrial Centre, 1/F
610 Cha Kwo Ling Road, Kowloon
Tel:23489211-4 Fax:(852)27727666

DWG NO. : J858-CW-BR-303 | REV. : A

20

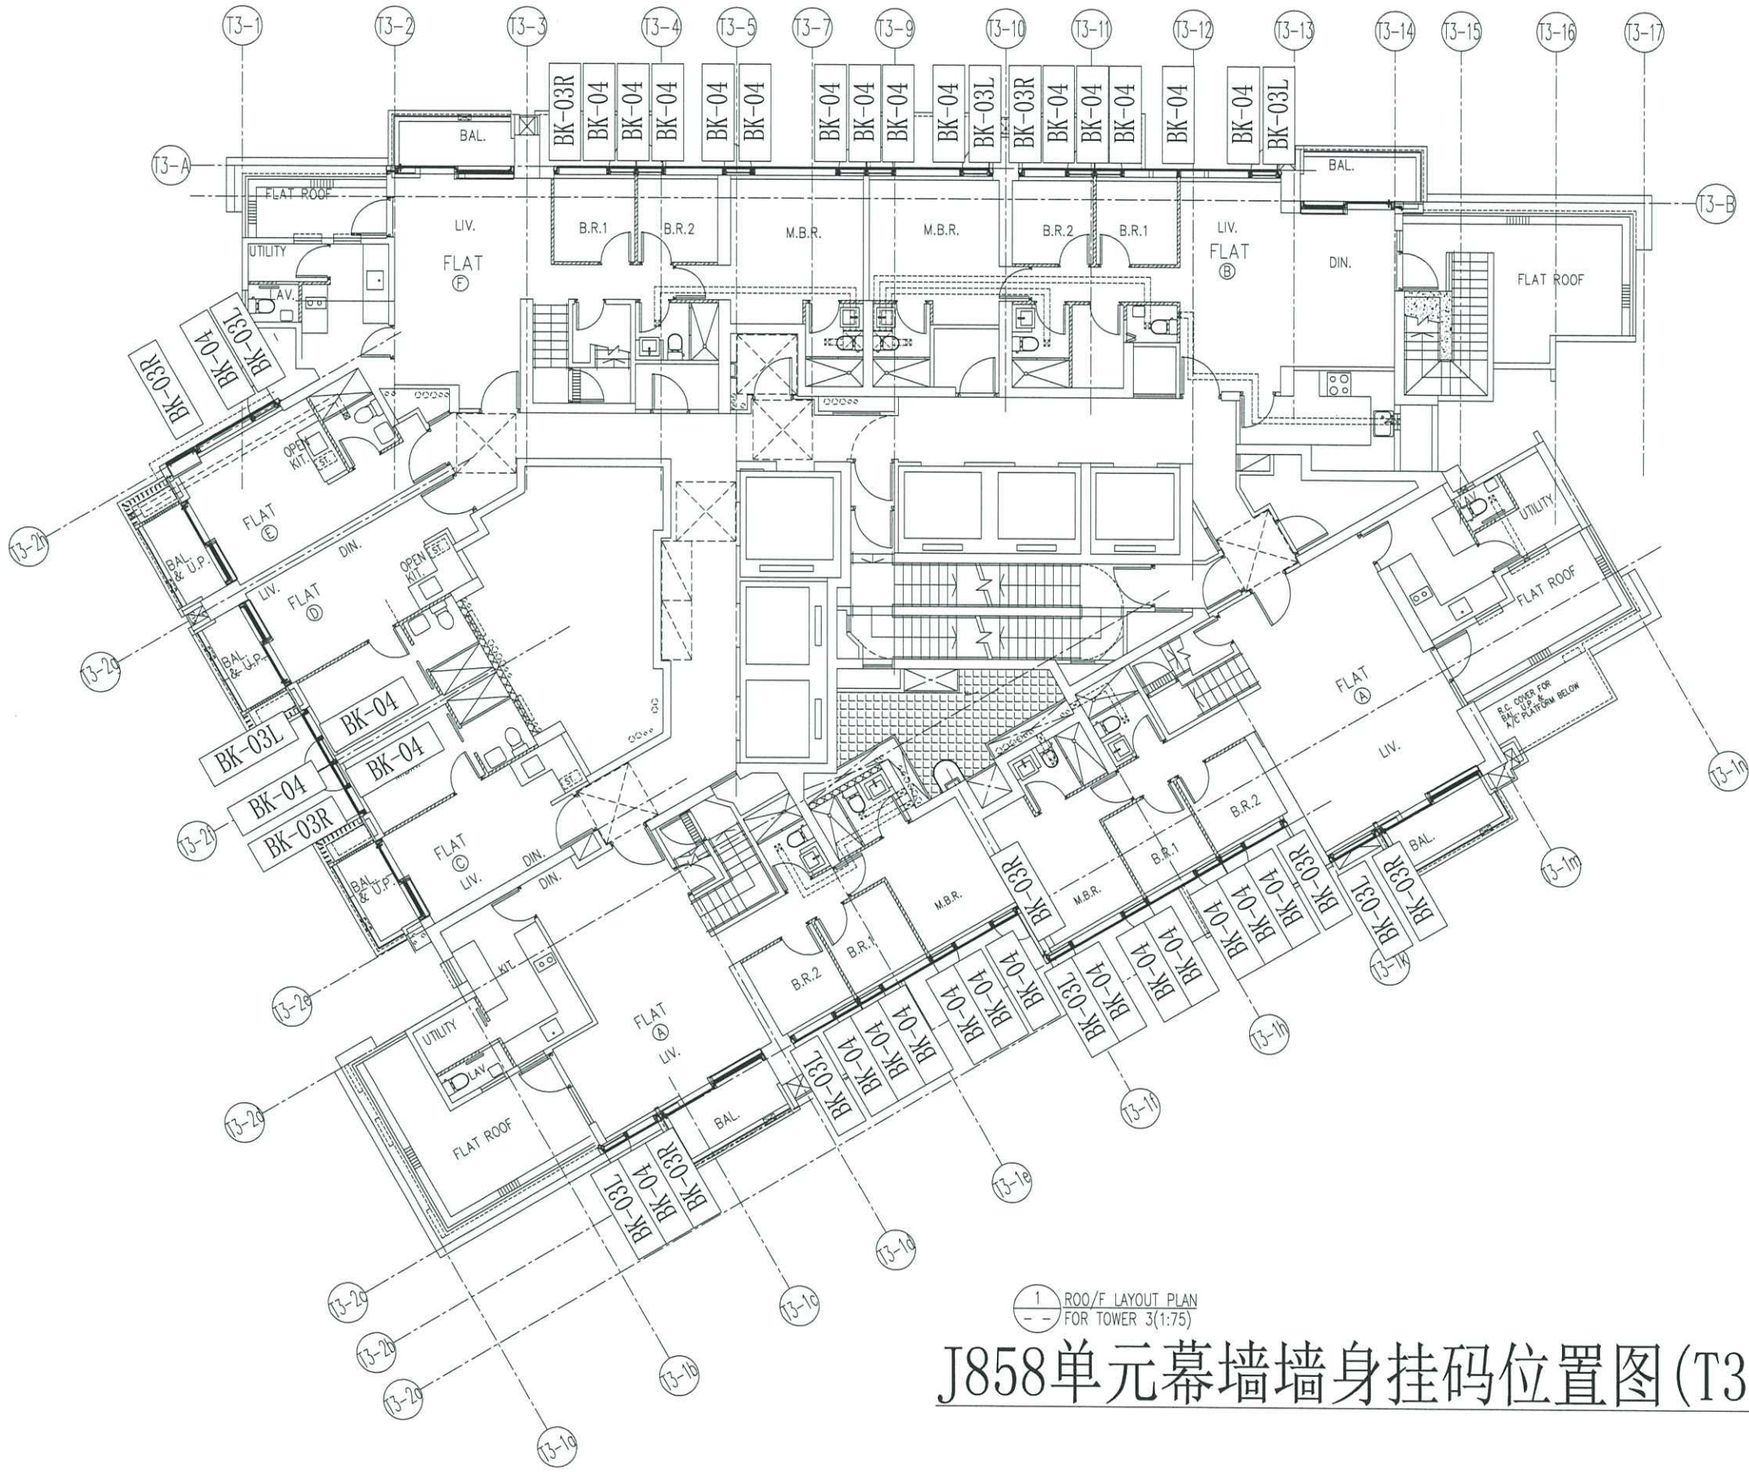

1 ROO/F LAYOUT PLAN FOR TOWER 3(1:75)

J858单元幕墙墙身挂码位置图(T3)

B.D. REF :

CLIENT :
信和置業有限公司
Sino Land Company Limited

ARCHITECT :
ronald lu & partners
Architects . Planners . Interior Designers
Ronald Lu & Partners (HK) Ltd.
呂元祥建築師事務所(香港)有限公司

MAIN CONTRACTOR :
Gammon

STRUCTURAL ENGINEER :
AECOM

FACADE CONSULTANT:
AECOM

NOTE :
1. ALL DIMENSIONS ARE IN mm.
2. ALL ELEVATIONS ARE VIEWED FROM OUTSIDE.
3. ALL DIMENSIONS TO BE VERIFIED ON SITE BEFORE FABRICATION.

LEGEND :
X1 — DETAIL MARK NO.
X001 — REFER SHEET NO.

1. F.F.L. -- FINISHED FLOOR LEVEL
2. S.F.L. -- STRUCTURAL FLOOR LEVEL
3. (R) -- REVERSED DETAIL

NO.	DATE	REVISED	BY
–	–	–	–

JOB NO. : J-858

PROJECT :
PROPOSED RESIDENTIAL DEVELOPMENT
AT TKOTL 70RP, PHASE 11, LOHAS PARK
TSEUNG KWAN O, N.T.

TITLE :
ROOF FLOOR PLAN
AT TOWER 3

DATE : 14-Jun-22 | SCALE : 1:75(A1)

DRAWN BY : KY | CHECKED BY : YB

美特鋁製有限公司
MIDI ALUMINIUM FABRICATOR LTD.
Units 6-8, Sunray Industrial Centre, 1/F
610 Cha Kwo Ling Road, Kowloon
Tel:23489211-4 Fax:(852)27727666

DWG NO. : J858-CW-BR-304 | REV. : –

美特鋁質有限公司

工程 J858- LP-11 日出康成11 期

2023-01-17

T1 - 幕牆 棚前工作進度表

樓層	工序	AA								AB								AC								AD								物料到貨			金門交場
		1 墨線	2 測量報告	3 安裝鐵碼 (4件)	4 回焊 (4件)	5 驗焊 (4件)	6 裝起底水槽	7 鋁碼 (4件)	8 裝防火綿插	1 墨線	2 測量報告	3 安裝鐵碼 (10件)	4 回焊 (10件)	5 驗焊 (10件)	6 裝起底水槽	7 鋁碼 (10件)	8 裝防火綿插	1 墨線	2 測量報告	3 安裝鐵碼 (3件)	4 回焊 (3件)	5 驗焊 (3件)	6 裝起底水槽	7 鋁碼 (3件)	8 裝防火綿插	1 墨線	2 測量報告	3 安裝鐵碼 (3件)	4 回焊 (3件)	5 驗焊 (3件)	6 裝起底水槽	7 鋁碼 (3件)	8 裝防火綿插	鐵料	鋁型材	防火綿插	
30/F	預算完工期	2023-02-27	2023-03-01					2023-03-16	2023-03-18	2023-02-27	2023-03-01					2023-03-16	2023-03-18	2023-02-27	2023-03-01					2023-03-16	2023-03-18	2023-02-27	2023-03-01					2023-03-16	2023-03-18				
	實際完工期																																				
	完成比率																																				
29/F	預算完工期	2023-02-17	2023-02-19					2023-03-06	2023-03-08	2023-02-17	2023-02-19					2023-03-06	2023-03-08	2023-02-17	2023-02-19					2023-03-06	2023-03-08	2023-02-17	2023-02-19					2023-03-06	2023-03-08				
	實際完工期																																				
	完成比率																																				
28/F	預算完工期	2023-02-07	2023-02-09					2023-02-24	2023-02-26	2023-02-07	2023-02-09					2023-02-24	2023-02-26	2023-02-07	2023-02-09					2023-02-24	2023-02-26	2023-02-07	2023-02-09					2023-02-24	2023-02-26				
	實際完工期	2023-01-11	2023-01-13							2023-01-11	2023-01-13							2023-01-11	2023-01-13							2023-01-11	2023-01-13										
	完成比率	100%	100%							100%	100%							100%	100%							100%	100%										
27/F	預算完工期	2023-01-28	2023-01-30					2023-02-14	2023-02-16	2023-01-28	2023-01-30					2023-02-14	2023-02-16	2023-01-28	2023-01-30					2023-02-14	2023-02-16	2023-01-28	2023-01-30					2023-02-14	2023-02-16				
	實際完工期	2023-01-11	2023-01-13							2023-01-11	2023-01-13							2023-01-11	2023-01-13							2023-01-11	2023-01-13										
	完成比率	100%	100%							100%	100%							100%	100%							100%	100%										
26/F	預算完工期	2023-01-18	2023-01-20					2023-02-04	2023-02-06	2023-01-18	2023-01-20					2023-02-04	2023-02-06	2023-01-18	2023-01-20					2023-02-04	2023-02-06	2023-01-18	2023-01-20					2023-02-04	2023-02-06				
	實際完工期	2023-01-11	2023-01-13							2023-01-11	2023-01-13							2023-01-11	2023-01-13							2023-01-11	2023-01-13										
	完成比率	100%	100%							100%	100%							100%	100%							100%	100%										
25/F	預算完工期	2023-01-08	2023-01-10					2023-01-25	2023-01-27	2023-01-08	2023-01-10					2023-01-25	2023-01-27	2023-01-08	2023-01-10					2023-01-25	2023-01-27	2023-01-08	2023-01-10					2023-01-25	2023-01-27				
	實際完工期	2023-01-03	2023-01-04							2023-01-03	2023-01-04							2023-01-03	2023-01-04							2023-01-03	2023-01-04										
	完成比率	100%	100%							100%	100%							100%	100%							100%	100%										
23/F	預算完工期	2022-12-29	2022-12-31					2023-01-15	2023-01-17	2022-12-29	2022-12-31					2023-01-15	2023-01-17	2022-12-29	2022-12-31					2023-01-15	2023-01-17	2022-12-29	2022-12-31					2023-01-15	2023-01-17				
	實際完工期	2022-12-28	2022-12-29							2022-12-28	2022-12-29							2022-12-28	2022-12-29							2022-12-28	2022-12-29										
	完成比率	100%	100%							100%	100%							100%	100%							100%	100%										
22/F	預算完工期	2022-12-19	2022-12-21					2023-01-05	2023-01-07	2022-12-19	2022-12-21					2023-01-05	2023-01-07	2022-12-19	2022-12-21					2023-01-05	2023-01-07	2022-12-19	2022-12-21					2023-01-05	2023-01-07				
	實際完工期	2022-12-09	2022-12-15					2023-01-03		2022-12-09	2022-12-15							2022-12-09	2022-12-15							2022-12-09	2022-12-15										
	完成比率	100%	100%					100%		100%	100%							100%	100%							100%	100%										
21/F	預算完工期	2022-12-09	2022-12-11					2022-12-26	2022-12-28	2022-12-09	2022-12-11					2022-12-26	2022-12-28	2022-12-09	2022-12-11					2022-12-26	2022-12-28	2022-12-09	2022-12-11					2022-12-26	2022-12-28				
	實際完工期	2022-12-09	2022-12-15					2022-12-23		2022-12-09	2022-12-15							2022-12-09	2022-12-15					2022-12-23		2022-12-09	2022-12-15					2022-12-23					
	完成比率	100%	100%					100%		100%	100%					50%		100%	100%					100%		100%	100%					100%					
20/F	預算完工期	2022-11-04	2022-11-06					2022-11-30	2022-12-02	2022-11-04	2022-11-06					2022-11-30	2022-12-02	2022-11-04	2022-11-06					2022-11-30	2022-12-02	2022-11-04	2022-11-06					2022-11-08	2022-11-10				
	實際完工期	2022-11-02	2022-11-04					2022-11-26		2022-11-02	2022-11-04					2022-11-26		2022-11-03	2022-11-04					2022-11-26		2022-11-02	2022-11-04					2022-11-05					
	完成比率	100%	100%					100%		100%	100%					100%		100%	100%					100%		100%	100%					100%					
19/F	預算完工期	2022-10-28	2022-10-30					2022-11-01	2022-11-02	2022-10-28	2022-10-30					2022-11-01	2022-11-02	2022-10-28	2022-10-30					2022-11-01	2022-11-02	2022-10-28	2022-10-30					2022-11-01	2022-11-02				
	實際完工期	2022-10-26	2022-10-28					2022-10-29	2022-10-30	2022-10-25	2022-10-28					2022-10-28	2022-10-30	2022-10-25	2022-10-27					2022-10-28	2022-10-30	2022-10-26	2022-10-28					2022-10-30	2022-10-30		已到	已到	
	完成比率	100%	100%					100%	10000%	100%	100%					100%	100%	100%	100%					100%	100%	100%	100%					100%	100%				
18/F	預算完工期	2022-10-24	2022-10-26					Monorail	2022-10-31	2022-10-24	2022-10-26					2022-10-30	2022-10-31	2022-10-24	2022-10-26					Monorail	2022-10-31	2022-10-24	2022-10-26					Monorail	2022-10-31				
	實際完工期	2022-10-22	2022-10-24					2022-10-28	2022-10-31	2022-10-22	2022-10-24					2022-10-28	2022-10-28	2022-10-22	2022-10-24					2022-10-28	2022-10-29	2022-10-22	2022-10-23					2022-10-26	2022-10-29		已到	已到	
	完成比率	100%	100%					100%	100%	100%	100%					100%	1900-04-09	100%	100%					100%	100%	100%	100%					100%	100%				
17/F	預算完工期	2022-10-19	2022-10-21					2022-10-29	2022-10-29	2022-10-19	2022-10-21					2022-10-29	2022-10-29	2022-10-19	2022-10-21					2022-10-29	2022-10-29	2022-10-19	2022-10-21					2022-10-29	2022-10-29				
	實際完工期	2022-10-19	2022-10-21					2022-10-26	2022-10-27	2022-10-19	2022-10-21					2022-10-24	2022-10-27	2022-10-19	2022-10-21					2022-10-25	2022-10-27	2022-10-19	2022-10-21					2022-10-23	2022-10-25		已到	已到	
	完成比率	100%	100%					100%	100%	100%	100%					100%	100%	100%	100%					100%	100%	100%	100%					100%	100%				
16/F	預算完工期	2022-10-15	2022-10-17					2022-10-27	2022-10-28	2022-10-15	2022-10-17					2022-10-27	2022-10-28	2022-10-15	2022-10-17					2022-10-27	2022-10-28	2022-10-15	2022-10-17					2022-10-27	2022-10-28				
	實際完工期	2022-10-15	2022-10-17					2022-10-22	2022-10-25	2022-10-15	2022-10-17					2022-10-23	2022-10-25	2022-10-15	2022-10-17					2022-10-25	2022-10-26	2022-10-15	2022-10-17					2022-10-24	2022-10-25		已到	已到	
	完成比率	100%	100%					100%	100%	100%	100%					100%	100%	100%	100%					100%	100%	100%	100%					100%	100%				
15/F	預算完工期	2022-10-10	2022-10-11					2022-10-25	2022-10-27	2022-10-10	2022-10-11					2022-10-25	2022-10-27	2022-10-10	2022-10-11					2022-10-25	2022-10-27	2022-10-10	2022-10-11					2022-10-25	2022-10-27				
	實際完工期	2022-10-10	2022-10-11					2022-10-22	2022-10-24	2022-10-10	2022-10-11					2022-10-22	2022-10-25	2022-10-10	2022-10-11					2022-10-23	2022-10-24	2022-10-10	2022-10-11					2022-10-23	2022-10-24		已到	已到	
	完成比率	100%	100%					100%	100%	100%	100%					100%	100%	100%	100%					100%	100%	100%	100%					100%	100%				
12/F	預算完工期	2022-10-06	2022-10-07					2022-10-23	2022-10-26	2022-10-06	2022-10-07					2022-10-23	2022-10-26	2022-10-06	2022-10-07					2022-10-23	2022-10-26	2022-10-06	2022-10-07					2022-10-23	2022-10-26				
	實際完工期	2022-10-06	2022-10-07					2022-10-21	2022-10-24	2022-10-06	2022-10-07					2022-10-21	2022-10-24	2022-10-06	2022-10-07					2022-10-21	2022-10-23	2022-10-06	2022-10-07					2022-10-21	2022-10-24		已到	已到	
	完成比率	100%	100%					100%	100%	100%	100%					100%	100%	100%	100%					100%	100%	100%	100%					100%	100%				
11/F (Refuge)	預算完工期	2022-10-03	2022-10-05					2022-10-21	2022-10-25	2022-10-03	2022-10-05					2022-10-21	2022-10-25	2022-10-03	2022-10-05					2022-10-21	2022-10-25	2022-10-03	2022-10-05					2022-10-21	2022-10-25				
	實際完工期	2022-09-28	2022-09-30					2022-10-18	2022-10-23	2022-09-28	2022-09-29					2022-10-18	2022-10-23	2022-10-28	2022-10-29					2022-10-19	2022-10-23	2022-10-03	2022-10-04					2022-10-19	2022-10-22		已到	已到	
	完成比率	100%	100%					100%	100%	100%	100%					100%	100%	100%	100%					100%	100%	100%	100%					100%	100%				
10/F	預算完工期	2022-09-29	2022-09-30					2022-10-19	2022-10-24	2022-09-29	2022-09-30					2022-10-19	2022-10-24	2022-09-29	2022-09-30					2022-10-19	2022-10-24	2022-09-29	2022-09-30					2022-10-19	2022-10-24				
	實際完工期	2022-09-29	2022-09-30					2022-10-19	2022-10-22	2022-09-29	2022-09-30					2022-10-19	2022-10-22	2022-09-29	2022-09-30					2022-10-19	2022-10-22	2022-09-29	2022-09-30					2022-10-17	2022-10-21		已到	已到	
	完成比率	100%	100%					100%	100%	100%	100%					100%	100%	100%	100%					100%	100%	100%	100%					100%	100%				
9/F	預算完工期	2022-09-22	2022-09-23	2022-10-17	2022-10-22	2022-10-25	2022-10-29			2022-09-22	2022-09-23	2022-10-17	2022-10-22	2022-10-25	2022-10-29			2022-09-22	2022-09-23	2022-10-17	2022-10-22	2022-10-25	2022-10-29			2022-09-22	2022-09-23	2022-10-17	2022-10-22	2022-10-25	2022-10-29						
	實際完工期	2022-09-22	2022-09-23	2022-10-17	2022-10-22	2022-10-25	2022-10-29		2022-12-12	2022-09-22	2022-09-23	2022-10-17	2022-10-22	2022-10-25	2022-10-29		2022-12-12	2022-09-22	2022-09-23	2022-10-17	2022-10-22	2022-10-25	2022-10-29		2022-12-12	2022-09-22	2022-09-23	2022-10-17	2022-10-22	2022-10-25	2022-10-29		2022-12-12	已到			
	完成比率	100%	100%	100%	100%	100%	100%		100%	100%	100%	100%	100%	100%	100%		100%	100%	100%	100%	100%	100%	100%		100%	100%	100%	100%	100%	100%	100%		100%				

美特鋁質有限公司

工程 J858- LP-11 日出康成11 期

2023-01-17

T1 - 幕牆 棚前工作進度表

樓層	工序	AE								AF								AG														物料/到貨			金門交場
		1 墨線	2 測量報告	3 安裝鐵碼 (7件)	4 回焊 (7件)	5 驗焊 (7件)	6 裝起底水槽	7 鋁碼 (7件)	8 裝防火綿插	1 墨線	2 測量報告	3 安裝鐵碼 (5件)	4 回焊 (5件)	5 驗焊 (5件)	6 裝起底水槽	7 鋁碼 (5件)	8 裝防火綿插	1 墨線	2 測量報告	3 安裝鐵碼 (3件)	4 回焊 (3件)	5 驗焊 (3件)	6 裝起底水槽	7 鋁碼 (3件)	8 裝防火綿插									鐵料	鋁型材	防水片	
30/F	預算完工期	2023-02-27	2023-03-01					2023-03-16	2023-03-18	2023-02-27	2023-03-01					2023-03-16	2023-03-18	2023-02-27	2023-03-01					2023-03-16	2023-03-18												
	實際完工期																																		
	完成比率																																		
29/F	預算完工期	2023-02-17	2023-02-19					2023-03-06	2023-03-08	2023-02-17	2023-02-19					2023-03-06	2023-03-08	2023-02-17	2023-02-19					2023-03-06	2023-03-08												
	實際完工期																																		
	完成比率																																		
28/F	預算完工期	2023-02-07	2023-02-09					2023-02-24	2023-02-26	2023-02-07	2023-02-09					2023-02-24	2023-02-26	2023-02-07	2023-02-09					2023-02-24	2023-02-26												
	實際完工期	2023-01-11	2023-01-13							2023-01-11	2023-01-13							2023-01-11	2023-01-13																		
	完成比率	100%	100%							100%	100%							100%	100%																		
27/F	預算完工期	2023-01-28	2023-01-30					2023-02-14	2023-02-16	2023-01-28	2023-01-30					2023-02-14	2023-02-16	2023-01-28	2023-01-30					2023-02-14	2023-02-16												
	實際完工期	2023-01-11	2023-01-13							2023-01-11	2023-01-13							2023-01-11	2023-01-13																		
	完成比率	100%	100%							100%	100%							100%	100%																		
26/F	預算完工期	2023-01-18	2023-01-20					2023-02-04	2023-02-06	2023-01-18	2023-01-20					2023-02-04	2023-02-06	2023-01-18	2023-01-20					2023-02-04	2023-02-06												
	實際完工期	2023-01-11	2023-01-13							2023-01-11	2023-01-13							2023-01-11	2023-01-13																		
	完成比率	100%	100%							100%	100%							100%	100%																		
25/F	預算完工期	2023-01-08	2023-01-10					2023-01-25	2023-01-27	2023-01-08	2023-01-10					2023-01-25	2023-01-27	2023-01-08	2023-01-10					2023-01-25	2023-01-27												
	實際完工期	2023-01-03	2023-01-04							2023-01-03	2023-01-04							2023-01-03	2023-01-04																		
	完成比率	100%	100%							100%	100%							100%	100%																		
23/F	預算完工期	2022-12-29	2022-12-31					2023-01-15	2023-01-17	2022-12-29	2022-12-31					2023-01-15	2023-01-17	2022-12-29	2022-12-31					2023-01-15	2023-01-17												
	實際完工期	2022-12-28	2022-12-29							2022-12-28	2022-12-29							2022-12-28	2022-12-29																		
	完成比率	100%	100%							100%	100%							100%	100%																		
22/F	預算完工期	2022-12-19	2022-12-21					2023-01-05	2023-01-07	2022-12-19	2022-12-21					2023-01-05	2023-01-07	2022-12-19	2022-12-21					2023-01-05	2023-01-07												
	實際完工期	2022-12-09	2022-12-15							2022-12-09	2022-12-15							2022-12-09	2022-12-15					2023-01-03													
	完成比率	100%	100%					50%		100%	100%					50%		100%	100%					100%													
21/F	預算完工期	2022-12-09	2022-12-11					2022-12-26	2022-12-28	2022-12-09	2022-12-11					2022-12-26	2022-12-28	2022-12-09	2022-12-11					2022-12-26	2022-12-28												
	實際完工期	2022-12-09	2022-12-15					2022-12-23		2022-12-09	2022-12-15					2022-12-23		2022-12-09	2022-12-15					2022-12-23													
	完成比率	100%	100%					100%		100%	100%					100%		100%	100%					100%													
20/F	預算完工期	2022-11-04	2022-11-06					2022-11-01	2022-11-03	2022-11-04	2022-11-06					2022-10-28	2022-11-22	2022-11-04	2022-11-06					2022-11-30	2022-12-02												
	實際完工期	2022-11-02	2022-11-04					2022-10-30		2022-11-01	2022-11-03					2022-10-26	2022-11-18	2022-11-02	2022-11-04					2022-11-26													
	完成比率	100%	100%					100%		100%	100%					100%	100%	100%	100%					100%													
19/F	預算完工期	2022-10-28	2022-10-30					2022-10-30	2022-10-31	2022-10-28	2022-10-30					2022-10-30	2022-10-31	2022-10-28	2022-10-30					2022-10-30	2022-10-31												
	實際完工期	2022-10-25	2022-10-28					2022-10-28	2022-10-29	2022-10-26	2022-10-28					2022-10-28	2022-10-29	2022-10-25	2022-10-28					2022-10-28	2022-10-29										已到	已到	
	完成比率	100%	100%					100%	100%	100%	100%					100%	100%	100%	100%					100%	100%												
18/F	預算完工期	2022-10-24	2022-10-26					Monorail	2022-10-31	2022-10-24	2022-10-26					2022-10-30	2022-10-31	2022-10-24	2022-10-26					Monorail	2022-10-31												
	實際完工期	2022-10-22	2022-10-23					2022-10-28	2022-10-29	2022-10-22	2022-10-24					2022-10-27	2022-10-29	2022-10-22	2022-10-24					2022-10-27	2022-10-29										已到	已到	
	完成比率	100%	100%					100%	100%	100%	100%					100%	100%	100%	100%					100%	100%												
17/F	預算完工期	2022-10-19	2022-10-21					2022-10-29	2022-10-30	2022-10-19	2022-10-21					2022-10-29	2022-10-30	2022-10-19	2022-10-21					2022-10-29	2022-10-30												
	實際完工期	2022-10-19	2022-10-21					2022-10-25	2022-10-28	2022-10-19	2022-10-21					2022-10-26	2022-10-25	2022-10-19	2022-10-21					2022-10-26	2022-10-28										已到	已到	
	完成比率	100%	100%					100%	100%	100%	100%					100%	100%	100%	100%					100%	100%												
16/F	預算完工期	2022-10-15	2022-10-17					2022-10-27	2022-10-28	2022-10-15	2022-10-17					2022-10-27	2022-10-28	2022-10-15	2022-10-17					2022-10-27	2022-10-28												
	實際完工期	2022-10-15	2022-10-17					2022-10-23	2022-10-24	2022-10-15	2022-10-17					2022-10-24	2022-10-25	2022-10-15	2022-10-17					2022-10-24	2022-10-25										已到	已到	
	完成比率	100%	100%					100%	50%	100%	100%					100%	100%	100%	100%					100%	100%												
15/F	預算完工期	2022-10-10	2022-10-11					2022-10-25	2022-10-26	2022-10-10	2022-10-11					2022-10-25	2022-10-26	2022-10-10	2022-10-11					2022-10-25	2022-10-26												
	實際完工期	2022-10-10	2022-10-11					2022-10-23	2022-10-24	2022-10-10	2022-10-11					2022-10-22	2022-10-23	2022-10-10	2022-10-11					2022-10-22	2022-10-23										已到	已到	
	完成比率	100%	100%					100%	100%	100%	100%					100%	100%	100%	100%					100%	100%												
12/F	預算完工期	2022-10-06	2022-10-07					2022-10-23	2022-10-24	2022-10-06	2022-10-07					2022-10-23	2022-10-24	2022-10-06	2022-10-07					2022-10-23	2022-10-24												
	實際完工期	2022-10-06	2022-10-07					2022-10-19	2022-10-19	2022-10-06	2022-10-07					2022-10-20	2022-10-22	2022-10-06	2022-10-07					2022-10-20	2022-10-21										已到	已到	
	完成比率	100%	100%					100%	100%	100%	100%					100%	100%	100%	100%					100%	100%												
11/F (Refuge)	預算完工期	2022-10-03	2022-10-05					2022-10-21	2022-10-22	2022-10-03	2022-10-05					2022-10-21	2022-10-22	2022-10-03	2022-10-05					2022-10-21	2022-10-22												
	實際完工期	2022-10-03	2022-10-04					2022-10-19	2022-10-20	2022-10-03	2022-10-04					2022-10-19	2022-10-20	2022-10-03	2022-10-04					2022-10-20	2022-10-22										已到	已到	
	完成比率	100%	100%					100%	100%	100%	100%					100%	100%	100%	100%					100%	100%												
10/F	預算完工期	2022-09-29	2022-09-30					2022-10-19	2022-10-21	2022-09-29	2022-09-30					2022-10-19	2022-10-21	2022-09-29	2022-09-30					2022-10-19	2022-10-21												
	實際完工期	2022-09-29	2022-09-30					2022-10-19	2022-10-20	2022-09-29	2022-09-30					2022-10-19	2022-10-19	2022-09-29	2022-09-30					2022-10-19	2022-10-19										已到	已到	
	完成比率	100%	100%					100%	100%	100%	100%					100%	100%	100%	100%					100%	100%												
9/F	預算完工期	2022-09-22	2022-09-23	2022-10-17	2022-10-22	2022-10-25	2022-10-29			2022-09-22	2022-09-23	2022-10-17	2022-10-22	2022-10-25	2022-10-29			2022-09-22	2022-09-23	2022-10-17	2022-10-22	2022-10-25	2022-10-29												
	實際完工期	2022-09-22	2022-09-23	2022-10-17	2022-10-22	2022-10-25	2022-10-29		2022-12-12	2022-09-22	2022-09-23	2022-10-17	2022-10-22	2022-10-25	2022-10-29		2022-12-12	2022-09-22	2022-09-23	2022-10-17	2022-10-22	2022-10-25	2022-10-29		2022-12-12								已到			
	完成比率	100%	100%	100%	100%	100%	100%		100%	100%	100%	100%	100%	100%	100%		100%	100%	100%	100%	100%	100%	100%		100%											

2

美特鋁質有限公司

工程 J858- LP-11 日出康成11 期

2023-01-17

T1 - 幕牆 棚前工作進度表

樓層	工序	BA								BB								BC								BD								物料/到貨			金門交編
		1 墨線	2 測量報告	3 安裝鐵碼 (4件)	4 回焊 (4件)	5 驗焊 (4件)	6 裝起底水槽	7 鋁碼 (4件)	8 裝防火綿插	1 墨線	2 測量報告	3 安裝鐵碼 (2件)	4 回焊 (2件)	5 驗焊 (2件)	6 裝起底水槽	7 鋁碼 (2件)	8 裝防火綿插	1 墨線	2 測量報告	3 安裝鐵碼 (5件)	4 回焊 (5件)	5 驗焊 (5件)	6 裝起底水槽	7 鋁碼 (5件)	8 裝防火綿插	1 墨線	2 測量報告	3 安裝鐵碼 (7件)	4 回焊 (7件)	5 驗焊 (7件)	6 裝起底水槽	7 鋁碼 (7件)	8 裝防火綿插	鐵料	鋁型材	防火綿插	
30/F	預算完工期	2023-02-27	2023-03-01					2023-03-16	2023-03-18	2023-02-27	2023-03-01					2023-03-16	2023-03-18	2023-02-27	2023-03-01					2023-03-16	2023-03-18	2023-02-27	2023-03-01					2023-03-16	2023-03-18				
	實際完工期																																				
	完成比率																																				
29/F	預算完工期	2023-02-17	2023-02-19					2023-03-06	2023-03-08	2023-02-17	2023-02-19					2023-03-06	2023-03-08	2023-02-17	2023-02-19					2023-03-06	2023-03-08	2023-02-17	2023-02-19					2023-03-06	2023-03-08				
	實際完工期																																				
	完成比率																																				
28/F	預算完工期	2023-02-07	2023-02-09					2023-02-24	2023-02-26	2023-02-07	2023-02-09					2023-02-24	2023-02-26	2023-02-07	2023-02-09					2023-02-24	2023-02-26	2023-02-07	2023-02-09					2023-02-24	2023-02-26				
	實際完工期	11/01/2023	13/01/2023							11/01/2023	13/01/2023							11/01/2023	13/01/2023							11/01/2023	13/01/2023										
	完成比率	100%	100%							100%	100%							100%	100%							100%	100%										
27/F	預算完工期	2023-01-28	2023-01-30					2023-02-14	2023-02-16	2023-01-28	2023-01-30					2023-02-14	2023-02-16	2023-01-28	2023-01-30					2023-02-14	2023-02-16	2023-01-28	2023-01-30					2023-02-14	2023-02-16				
	實際完工期	11/01/2023	13/01/2023							11/01/2023	13/01/2023							11/01/2023	13/01/2023							11/01/2023	13/01/2023										
	完成比率	100%	100%							100%	100%							100%	100%							100%	100%										
26/F	預算完工期	2023-01-18	2023-01-20					2023-02-04	2023-02-06	2023-01-18	2023-01-20					2023-02-04	2023-02-06	2023-01-18	2023-01-20					2023-02-04	2023-02-06	2023-01-18	2023-01-20					2023-02-04	2023-02-06				
	實際完工期	11/01/2023	13/01/2023							11/01/2023	13/01/2023							11/01/2023	13/01/2023							11/01/2023	13/01/2023										
	完成比率	100%	100%							100%	100%							100%	100%							100%	100%										
25/F	預算完工期	2023-01-08	2023-01-10					2023-01-25	2023-01-27	2023-01-08	2023-01-10					2023-01-25	2023-01-27	2023-01-08	2023-01-10					2023-01-25	2023-01-27	2023-01-08	2023-01-10					2023-01-25	2023-01-27				
	實際完工期	03/01/2023	04/01/2023							03/01/2023	04/01/2023							03/01/2023	04/01/2023							03/01/2023	04/01/2023										
	完成比率	100%	100%							100%	100%							100%	100%							100%	100%										
23/F	預算完工期	2022-12-29	2022-12-31					2023-01-15	2023-01-17	2022-12-29	2022-12-31					2023-01-15	2023-01-17	2022-12-29	2022-12-31					2023-01-15	2023-01-17	2022-12-29	2022-12-31					2023-01-15	2023-01-17				
	實際完工期	28/12/2022	29/12/2022							28/12/2022	29/12/2022							28/12/2022	29/12/2022							28/12/2022	29/12/2022										
	完成比率	100%	100%							100%	100%							100%	100%							100%	100%										
22/F	預算完工期	2022-12-19	2022-12-21					2023-01-05	2023-01-07	2022-12-19	2022-12-21					2023-01-05	2023-01-07	2022-12-19	2022-12-21					2023-01-05	2023-01-07	2022-12-19	2022-12-21					2023-01-05	2023-01-07				
	實際完工期	2022-12-09	2022-12-15					2023-01-03		2022-12-09	2022-12-15					2023-01-03		2022-12-09	2022-12-15							2022-12-09	2022-12-15										
	完成比率	100%	100%					100%		100%	100%					100%		100%	100%							100%	100%										
21/F	預算完工期	2022-12-09	2022-12-11					2022-12-26	2022-12-28	2022-12-09	2022-12-11					2022-12-26	2022-12-28	2022-12-09	2022-12-11					2022-12-26	2022-12-28	2022-12-09	2022-12-11					2022-12-26	2022-12-28				
	實際完工期	2022-12-09	2022-12-15					2022-12-23		2022-12-09	2022-12-15					2022-12-23		2022-12-09	2022-12-15					2022-12-23		2022-12-09	2022-12-15										
	完成比率	100%	100%					100%		100%	100%					100%		100%	100%					100%		100%	100%										
20/F	預算完工期	2022-11-04	2022-11-06					2022-11-30	2022-12-02	2022-11-04	2022-11-06					2022-11-30	2022-12-02	2022-11-04	2022-11-06					2022-11-30	2022-12-02	2022-11-04	2022-11-06					2022-11-30	2022-12-02				
	實際完工期	2022-11-01	2022-11-04					2022-11-26		2022-11-01	2022-11-04					2022-11-26		2022-11-01	2022-11-04					2022-11-26		2022-11-01	2022-11-03					2022-10-28					
	完成比率	100%	100%					100%		100%	100%					100%		100%	100%					100%		100%	100%					100%	50%				
19/F	預算完工期	2022-10-28	2022-10-30					2022-11-01	2022-11-02	2022-10-28	2022-10-30					2022-11-01	2022-11-02	2022-10-28	2022-10-30					2022-11-01	2022-11-02	2022-10-28	2022-10-30					2022-10-30	2022-11-02				
	實際完工期	2022-10-25	2022-10-27					2022-10-28	2022-10-31	2022-10-25	2022-10-28					2022-10-28	2022-10-31	2022-10-25	2022-10-28					2022-10-29	2022-10-31	2022-10-26	2022-10-28					2022-10-28	2022-10-31		已到	已到	
	完成比率	100%	100%					100%	100%	100%	100%					100%	100%	100%	100%					100%	100%	100%	100%					100%	100%				
18/F	預算完工期	2022-10-24	2022-10-26					Monorail	2022-10-31	2022-10-24	2022-10-26					Monorail	2022-10-31	2022-10-24	2022-10-26					2022-10-30	2022-10-31	2022-10-24	2022-10-26					2022-10-30	2022-10-31				
	實際完工期	2022-10-22	2022-10-24					2022-10-29	2022-10-29	2022-10-22	2022-10-24					2022-10-28	2022-10-29	2022-10-22	2022-10-24					2022-10-28	2022-10-29	2022-10-22	2022-10-20					2022-10-28	2022-10-29		已到	已到	
	完成比率	100%	100%					100%	100%	100%	100%					100%	100%	100%	100%					100%	100%	100%	100%					100%	100%				
17/F	預算完工期	2022-10-19	2022-10-21					2022-10-29	2022-10-29	2022-10-19	2022-10-21					2022-10-29	2022-10-29	2022-10-19	2022-10-21					2022-10-29	2022-10-29	2022-10-19	2022-10-21					2022-10-29	2022-10-29				
	實際完工期	2022-10-19	2022-10-21					2022-10-27	2022-10-29	2022-10-19	2022-10-21					2022-10-27	2022-10-28	2022-10-19	2022-10-21					2022-10-28	2022-10-29	2022-10-19	2022-10-21					2022-10-26	2022-10-27		已到	已到	
	完成比率	100%	100%					100%	100%	100%	100%					100%	100%	100%	100%					100%	100%	100%	100%					100%	100%				
16/F	預算完工期	2022-10-15	2022-10-17					2022-10-27	2022-10-28	2022-10-15	2022-10-17					2022-10-27	2022-10-28	2022-10-15	2022-10-17					2022-10-27	2022-10-28	2022-10-15	2022-10-17					2022-10-27	2022-10-28				
	實際完工期	2022-10-15	2022-10-17					2022-10-25	2022-10-26	2022-10-15	2022-10-17					2022-10-24	2022-10-26	2022-10-15	2022-10-17					2022-10-25	2022-10-27	2022-10-15	2022-10-17					2022-10-25	2022-10-26		已到	已到	
	完成比率	100%	100%					100%	100%	100%	100%					100%	100%	100%	100%					100%	100%	100%	100%					100%	100%				
15/F	預算完工期	2022-10-10	2022-10-11					2022-10-25	2022-10-27	2022-10-10	2022-10-11					2022-10-25	2022-10-27	2022-10-10	2022-10-11					2022-10-25	2022-10-27	2022-10-10	2022-10-11					2022-10-25	2022-10-27				
	實際完工期	2022-10-10	2022-10-11						2022-10-26	2022-10-10	2022-10-11					2022-10-22	2022-10-26	2022-10-10	2022-10-11					2022-10-22	2022-10-25	2022-10-10	2022-10-11					2022-10-22	2022-10-25		已到	已到	
	完成比率	100%	100%					50%	100%	100%	100%					100%	100%	100%	100%					100%	100%	100%	100%					100%	100%				
12/F	預算完工期	2022-10-06	2022-10-07					2022-10-23	2022-10-26	2022-10-06	2022-10-07					2022-10-23	2022-10-26	2022-10-06	2022-10-07					2022-10-23	2022-10-26	2022-10-06	2022-10-07					2022-10-23	2022-10-26				
	實際完工期	2022-10-06	2022-10-07					2022-10-21	2022-10-23	2022-10-06	2022-10-07					2022-10-21	2022-10-23	2022-10-06	2022-10-07					2022-10-20	2022-10-23	2022-10-06	2022-10-07					2022-10-21	2022-10-24		已到	已到	
	完成比率	100%	100%					100%	100%	100%	100%					100%	100%	100%	100%					100%	100%	100%	100%					100%	100%				
11/F (Refuge)	預算完工期	2022-10-03	2022-10-05					2022-10-21	2022-10-25	2022-10-03	2022-10-05					2022-10-21	2022-10-25	2022-10-03	2022-10-05					2022-10-21	2022-10-25	2022-10-03	2022-10-05					2022-10-21	2022-10-25				
	實際完工期	2022-09-29	2022-10-03					2022-10-18	2022-10-23	2022-09-28	2022-09-29					2022-10-18	**2022-10-23**	2022-10-28	2022-10-29					2022-10-19	2022-10-23	2022-10-03	2022-10-04					2022-10-18	2022-10-22		已到	已到	
	完成比率	100%	100%					100%	100%	100%	100%					100%	100%	100%	100%					100%	100%	100%	100%					100%	100%				
10/F	預算完工期	2022-09-29	2022-09-30					2022-10-19	2022-10-24	2022-09-29	2022-09-30					2022-10-19	2022-10-24	2022-09-29	2022-09-30					2022-10-19	2022-10-24	2022-09-29	2022-09-30					2022-10-19	2022-10-24				
	實際完工期	2022-09-29	2022-09-30					2022-10-19	2022-10-22	2022-09-29	2022-09-30					2022-10-19	2022-10-21	2022-09-29	2022-09-30					2022-10-19	2022-10-22	2022-09-29	2022-09-30					2022-10-19	2022-10-22		已到	已到	
	完成比率	100%	100%					100%	100%	100%	100%					100%	100%	100%	100%					100%	100%	100%	100%					100%	100%				
9/F	預算完工期	2022-09-22	2022-09-23	2022-10-17	2022-10-22	2022-10-25	2022-10-29			2022-09-22	2022-09-23	2022-10-17	2022-10-22	2022-10-25	2022-10-29			2022-09-22	2022-09-23	2022-10-17	2022-10-22	2022-10-25	2022-10-29			2022-09-22	2022-09-23	2022-10-17	2022-10-22	2022-10-25	2022-10-29						
	實際完工期	2022-09-22	2022-09-23	2022-10-17	2022-10-22	2022-10-25	2022-10-29		2022-12-12	2022-09-22	2022-09-23	2022-10-17	2022-10-22	2022-10-25	2022-10-29		2022-12-12	2022-09-22	2022-09-23	2022-10-17	2022-10-22	2022-10-25	2022-10-29		2022-12-12	2022-09-22	2022-09-23	2022-10-17	2022-10-22	2022-10-25	2022-10-29		2022-12-12	已到			
	完成比率	100%	100%	100%	100%	100%	100%		100%	100%	100%	100%	100%	100%	100%		100%	100%	100%	100%	100%	100%	100%		100%	100%	100%	100%	100%	100%	100%		100%				

3

美特鋁質有限公司

工程 J858- LP-11 日出康成11 期

2023-01-17

T1 - 幕牆 棚前工作進度表

樓層	工序	BE								BF																				物料/到貨			金門交場
		1 墨線	2 測量報告	3 安裝鐵碼 (2件)	4 回焊 (2件)	5 驗焊 (2件)	6 裝起底水槽	7 鋁碼 (2件)	8 裝防火綿插	1 墨線	2 測量報告	3 安裝鐵碼 (3件)	4 回焊 (3件)	5 驗焊 (3件)	6 裝起底水槽	7 鋁碼 (3件)	8 裝防火綿插															鐵料	鋁型材	防火綿插	
30/F	預算完工期	2023-02-27	2023-03-01					2023-03-16	2023-03-18	2023-02-27	2023-03-01					2023-03-16	2023-03-18																
	實際完工期																																
	完成比率																																
29/F	預算完工期	2023-02-17	2023-02-19					2023-03-06	2023-03-08	2023-02-17	2023-02-19					2023-03-06	2023-03-08																
	實際完工期																																
	完成比率																																
28/F	預算完工期	2023-02-07	2023-02-09					2023-02-24	2023-02-26	2023-02-07	2023-02-09					2023-02-24	2023-02-26																
	實際完工期	11/01/2023	13/01/2023							11/01/2023	13/01/2023																						
	完成比率	100%	100%							100%	100%																						
27/F	預算完工期	2023-01-28	2023-01-30					2023-02-14	2023-02-16	2023-01-28	2023-01-30					2023-02-14	2023-02-16																
	實際完工期	11/01/2023	13/01/2023							11/01/2023	13/01/2023																						
	完成比率	100%	100%							100%	100%																						
26/F	預算完工期	2023-01-18	2023-01-20					2023-02-04	2023-02-06	2023-01-18	2023-01-20					2023-02-04	2023-02-06																
	實際完工期	11/01/2023	13/01/2023							11/01/2023	13/01/2023																						
	完成比率	100%	100%							100%	100%																						
25/F	預算完工期	2023-01-08	2023-01-10					2023-01-25	2023-01-27	2023-01-08	2023-01-10					2023-01-25	2023-01-27																
	實際完工期	03/01/2023	04/01/2023							03/01/2023	04/01/2023																						
	完成比率	100%	100%							100%	100%																						
23/F	預算完工期	2022-12-29	2022-12-31					2023-01-15	2023-01-17	2022-12-29	2022-12-31					2023-01-15	2023-01-17																
	實際完工期	28/12/2022	29/12/2022							28/12/2022	29/12/2022																						
	完成比率	100%	100%							100%	100%																						
22/F	預算完工期	2022-12-19	2022-12-21					2023-01-05	2023-01-07	2022-12-19	2022-12-21					2023-01-05	2023-01-07																
	實際完工期	2022-12-09	2022-12-15					2023-01-03		2022-12-09	2022-12-15																						
	完成比率	100%	100%					100%		100%	100%					50%																	
21/F	預算完工期	2022-12-09	2022-12-11					2022-12-26	2022-12-28	2022-12-09	2022-12-11					2022-12-26	2022-12-28																
	實際完工期	2022-12-09	2022-12-15					2023-12-23		2022-12-09	2022-12-15																						
	完成比率	100%	100%					100%		100%	100%					50%																	
20/F	預算完工期	2022-11-04	2022-11-06					2022-11-30	2022-12-02	2022-11-04	2022-11-06					2022-11-30	2022-12-02																
	實際完工期	2022-11-02	2022-11-03							2022-11-01	2022-11-03					2022-10-29																	
	完成比率	100%	100%					50%		100%	100%					100%																	
19/F	預算完工期	2022-10-28	2022-10-30					2022-10-30	2022-11-02	2022-10-28	2022-10-30					2022-10-30	2022-11-02																
	實際完工期	2022-10-25	2022-10-28					2022-10-27	2022-10-31	2022-10-26	2022-10-28					2022-10-28	2022-10-30															已到	已到	
	完成比率	100%	100%					100%	100%	100%	100%					100%	100%																
18/F	預算完工期	2022-10-24	2022-10-26					Monorail	2022-10-31	2022-10-24	2022-10-26					2022-10-30	2022-10-31																
	實際完工期	2022-10-22	2022-10-23					2022-10-27	2022-10-28	2022-10-22	2022-10-24					2022-10-28	2022-10-29															已到	已到	
	完成比率	100%	100%					100%	100%	100%	100%					100%	100%																
17/F	預算完工期	2022-10-19	2022-10-21					2022-10-29	2022-10-29	2022-10-19	2022-10-21					2022-10-29	2022-10-29																
	實際完工期	2022-10-19	2022-10-21					2022-10-25	2022-10-26	2022-10-19	2022-10-21					2022-10-25	2022-10-26															已到	已到	
	完成比率	100%	100%					100%	100%	100%	100%					100%	100%																
16/F	預算完工期	2022-10-15	2022-10-17					2022-10-27	2022-10-28	2022-10-15	2022-10-17					2022-10-27	2022-10-28																
	實際完工期	2022-10-15	2022-10-17					2022-10-24	2022-10-25	2022-10-15	2022-10-17					2022-10-25	2022-10-26															已到	已到	
	完成比率	100%	100%					100%	100%	100%	100%					100%	100%																
15/F	預算完工期	2022-10-10	2022-10-11					2022-10-25	2022-10-27	2022-10-10	2022-10-11					2022-10-25	2022-10-27																
	實際完工期	2022-10-10	2022-10-11					2022-10-22	2022-10-24	2022-10-10	2022-10-11					2022-10-23	2022-10-24															已到	已到	
	完成比率	100%	100%					100%	100%	100%	100%					100%	100%																
12/F	預算完工期	2022-10-06	2022-10-07					2022-10-23	2022-10-26	2022-10-06	2022-10-07					2022-10-23	2022-10-26																
	實際完工期	2022-10-06	2022-10-07					2022-10-20	2022-10-24	2022-10-06	2022-10-07					2022-10-20	2022-10-23															已到	已到	
	完成比率	100%	100%					100%	100%	100%	100%					100%	100%																
11/F (Refuge)	預算完工期	2022-10-03	2022-10-05					2022-10-21	2022-10-25	2022-10-03	2022-10-05					2022-10-21	2022-10-25																
	實際完工期	2022-10-03	2022-10-04					2022-10-19		2022-10-03	2022-10-04					2022-10-19	2022-10-23															已到	已到	
	完成比率	100%	100%					100%		100%	100%					100%	100%																
10/F	預算完工期	2022-09-29	2022-09-30					2022-10-19	2022-10-24	2022-09-29	2022-09-30					2022-10-19	2022-10-24																
	實際完工期	2022-09-29	2022-09-30					2022-10-19	2022-10-22	2022-09-29	2022-09-30					2022-10-19	2022-10-22															已到	已到	
	完成比率	100%	100%					100%	100%	100%	100%					100%	100%																
9/F	預算完工期	2022-09-22	2022-09-23	2022-10-17	2022-10-22	2022-10-25	2022-10-29			2022-09-22	2022-09-23	2022-10-17	2022-10-22	2022-10-25	2022-10-29																		
	實際完工期	2022-09-22	2022-09-23	2022-10-17	2022-10-22	2022-10-25	2022-10-29		2022-12-12	2022-09-22	2022-09-23	2022-10-17	2022-10-22	2022-10-25	2022-10-29		2022-12-12														已到		
	完成比率	100%	100%	100%	100%	100%	100%		100%	100%	100%	100%	100%	100%	100%		100%															

4

美特鋁質有限公司

工程 J858- LP-11 日出康成11 期

2023-01-17

T2 - 幕牆 棚前工作進度表

樓層	工序	AA								AB								AC								AD								物料到貨			金門交場
		1 墨線	2 測量報告	3 安裝鐵碼 (4件)	4 回焊 (4件)	5 驗焊 (4件)	6 裝起底水槽	7 鋁碼 (4件)	8 裝防火綿插	1 墨線	2 測量報告	3 安裝鐵碼 (10件)	4 回焊 (10件)	5 驗焊 (10件)	6 裝起底水槽	7 鋁碼 (10件)	8 裝防火綿插	1 墨線	2 測量報告	3 安裝鐵碼 (3件)	4 回焊 (3件)	5 驗焊 (3件)	6 裝起底水槽	7 鋁碼 (3件)	8 裝防火綿插	1 墨線	2 測量報告	3 安裝鐵碼 (3件)	4 回焊 (3件)	5 驗焊 (3件)	6 裝起底水槽	7 鋁碼 (3件)	8 裝防火綿插	鐵料	鋁型材	防火綿插	
30/F	預算完工期	2023-02-22	2023-02-24					2023-03-02	2023-03-05	2023-02-22	2023-02-24					2023-03-02	2023-03-05	2023-02-22	2023-02-24					2023-03-02	2023-03-05	2023-02-22	2023-02-24					2023-03-02	2023-03-05				
	實際完工期																																				
	完成比率																																				
29/F	預算完工期	2023-02-16	2023-02-18					2023-02-25	2023-02-28	2023-02-16	2023-02-18					2023-02-25	2023-02-28	2023-02-16	2023-02-18					2023-02-25	2023-02-28	2023-02-16	2023-02-18					2023-02-25	2023-02-28				
	實際完工期																																				
	完成比率																																				
28/F	預算完工期	2023-02-10	2023-02-12					2023-02-20	2023-02-23	2023-02-10	2023-02-12					2023-02-20	2023-02-23	2023-02-10	2023-02-12					2023-02-20	2023-02-23	2023-02-10	2023-02-12					2023-02-20	2023-02-23				
	實際完工期																																				
	完成比率																																				
27/F	預算完工期	2023-02-04	2023-02-06					2023-02-15	2023-02-18	2023-02-04	2023-02-06					2023-02-15	2023-02-18	2023-02-04	2023-02-06					2023-02-15	2023-02-18	2023-02-04	2023-02-06					2023-02-15	2023-02-18				
	實際完工期																																				
	完成比率																																				
26/F	預算完工期	2023-01-29	2023-01-31					2023-02-10	2023-02-13	2023-01-29	2023-01-31					2023-02-10	2023-02-13	2023-01-29	2023-01-31					2023-02-10	2023-02-13	2023-01-29	2023-01-31					2023-02-10	2023-02-13				
	實際完工期																																				
	完成比率																																				
25/F	預算完工期	2023-01-18	2023-01-20					2023-02-05	2023-02-08	2023-01-18	2023-01-20					2023-02-05	2023-02-08	2023-01-18	2023-01-20					2023-02-05	2023-02-08	2023-01-18	2023-01-20					2023-02-05	2023-02-08				
	實際完工期																																				
	完成比率																																				
23/F	預算完工期	2023-01-12	2023-01-14					2023-01-31	2023-02-03	2023-01-12	2023-01-14					2023-01-31	2023-02-03	2023-01-12	2023-01-14					2023-01-31	2023-02-03	2023-01-12	2023-01-14					2023-01-31	2023-02-03				
	實際完工期																																				
	完成比率																																				
22/F	預算完工期	2023-01-06	2023-01-08					2023-01-21	2023-01-24	2023-01-06	2023-01-08					2023-01-21	2023-01-24	2023-01-06	2023-01-08					2023-01-21	2023-01-24	2023-01-06	2023-01-08					2023-01-21	2023-01-24				
	實際完工期																																				
	完成比率																																				
21/F	預算完工期	2022-12-31	2023-01-02					2023-01-16	2023-01-19	2022-12-31	2023-01-02					2023-01-16	2023-01-19	2022-12-31	2023-01-02					2023-01-16	2023-01-19	2022-12-31	2023-01-02					2023-01-16	2023-01-19				
	實際完工期																																				
	完成比率																																				
20/F	預算完工期	2022-12-25	2022-12-27					2023-01-11	2023-01-14	2022-12-25	2022-12-27					2023-01-11	2023-01-14	2022-12-25	2022-12-27					2023-01-11	2023-01-14	2022-12-25	2022-12-27					2023-01-11	2023-01-14		已到	已到	
	實際完工期	2022-12-23	2022-12-24					2023-01-09	2022-12-28	2022-12-23	2022-12-24					2023-01-09	2022-12-28	2022-12-23	2022-12-24					2023-01-09	2022-12-28	2022-12-23	2022-12-24					2023-01-09	2022-12-28				
	完成比率	100%	100%					100%	100%	100%	100%					100%	100%	100%	100%					100%	100%	100%	100%					100%	100%				
19/F	預算完工期	2022-12-19	2022-12-21					2023-01-07	2023-01-10	2022-12-19	2022-12-21					2023-01-07	2023-01-10	2022-12-19	2022-12-21					2023-01-07	2023-01-10	2022-12-19	2022-12-21					2023-01-07	2023-01-10		已到	已到	
	實際完工期	2022-12-17	2022-12-19					2023-01-04	2022-12-21	2022-12-17	2022-12-18					2023-01-04	2022-12-21	2022-12-17	2022-12-18					2023-01-04	2022-12-21	2022-12-17	2022-12-18					2023-01-04	2022-12-21				
	完成比率	100%	100%					100%	100%	100%	100%					100%	100%	100%	100%					100%	100%	100%	100%					100%	100%				
18/F	預算完工期	2022-12-13	2022-12-15					2023-01-03	2023-01-06	2022-12-13	2022-12-15					2023-01-03	2023-01-06	2022-12-13	2022-12-15					2023-01-03	2023-01-06	2022-12-13	2022-12-15					2023-01-03	2023-01-06		已到	已到	
	實際完工期	2022-12-11	2022-12-13					2022-12-31	2022-12-21	2022-12-11	2022-12-12					2022-12-31	2022-12-21	2022-12-11	2022-12-12					2022-12-31	2022-12-21	2022-12-11	2022-12-12					2022-12-31	2022-12-21				
	完成比率	100%	100%					100%	100%	100%	100%					100%	100%	100%	100%					100%	100%	100%	100%					100%	100%				
17/F	預算完工期	2022-12-07	2022-12-09					2022-12-30	2023-01-02	2022-12-07	2022-12-09					2022-12-30	2023-01-02	2022-12-07	2022-12-09					2022-12-30	2023-01-02	2022-12-07	2022-12-09					2022-12-30	2023-01-02		已到	已到	
	實際完工期	2022-12-05	2022-12-07					2022-12-21	2022-12-15	2022-12-05	2022-12-06					2022-12-16	2022-12-15	2022-12-05	2022-12-06					2022-12-16	2022-12-15	2022-12-05	2022-12-06					2022-12-16	2022-12-15				
	完成比率	100%	100%					100%	100%	100%	100%					100%	100%	100%	100%					100%	100%	100%	100%					100%	100%				
16/F	預算完工期	2022-12-01	2022-12-03					2022-12-26	2022-12-29	2022-12-01	2022-12-03					2022-12-26	2022-12-29	2022-12-01	2022-12-03					2022-12-26	2022-12-29	2022-12-01	2022-12-03					2022-12-26	2022-12-29		已到	已到	
	實際完工期	2022-11-27	2022-11-30					2022-12-13	2022-12-14	2022-11-27	2022-11-28					2022-12-13	2022-12-14	2022-11-27	2022-11-28					2022-12-13	2022-12-14	2022-11-27	2022-11-28					2022-12-13	2022-12-14				
	完成比率	100%	100%					100%	100%	100%	100%					100%	100%	100%	100%					100%	100%	100%	100%					100%	100%				
15/F	預算完工期	2022-11-25	2022-11-26					2022-12-22	2022-12-25	2022-11-25	2022-11-26					2022-12-22	2022-12-25	2022-11-25	2022-11-26					2022-12-22	2022-12-25	2022-11-25	2022-11-26					2022-12-22	2022-12-25		已到	已到	
	實際完工期	2022-11-23	2022-11-24					2022-12-09	2022-12-14	2022-11-23	2022-11-24					2022-12-09	2022-12-14	2022-11-23	2022-11-24					2022-12-09	2022-12-14	2022-11-23	2022-11-24					2022-12-09	2022-12-14				
	完成比率	100%	100%					100%	100%	100%	100%					100%	100%	100%	100%					100%	100%	100%	100%					100%	100%				
12/F	預算完工期	2022-11-19	2022-11-20					2022-12-18	2022-12-21	2022-11-19	2022-11-20					2022-12-18	2022-12-21	2022-11-19	2022-11-20					2022-12-18	2022-12-21	2022-11-19	2022-11-20					2022-12-18	2022-12-21		已到	已到	
	實際完工期	2022-11-16	2022-11-18					2022-12-06	2022-12-14	2022-11-16	2022-11-17					2022-12-06	2022-12-14	2022-11-16	2022-11-17					2022-12-06	2022-12-14	2022-11-16	2022-11-17					2022-12-06	2022-12-14				
	完成比率	100%	100%					100%	100%	100%	100%					100%	100%	100%	100%					100%	100%	100%	100%					100%	100%				
11/F (Refuge)	預算完工期	2022-11-11	2022-11-13					2022-12-14	2022-12-17	2022-11-11	2022-11-13					2022-12-14	2022-12-17	2022-11-11	2022-11-13					2022-12-14	2022-12-17	2022-11-11	2022-11-13					2022-12-14	2022-12-17		已到	已到	
	實際完工期	2022-11-09	2022-11-10					2022-12-09	2022-12-14	2022-11-09	2022-11-10					2022-12-10	2022-12-14	2022-11-09	2022-11-10					2022-12-10	2022-12-14	2022-11-09	2022-11-10					2022-12-10	2022-12-14				
	完成比率	100%	100%					100%	100%	100%	100%					100%	100%	100%	100%					100%	100%	100%	100%					100%	100%				
10/F	預算完工期	2022-11-04	2022-11-05					2022-12-10	2022-12-13	2022-11-04	2022-11-05					2022-12-10	2022-12-13	2022-11-04	2022-11-05					2022-12-10	2022-12-13	2022-11-04	2022-11-05					2022-12-10	2022-12-13		已到	已到	
	實際完工期	2022-11-02	2022-11-03					2022-12-02	2022-12-09	2022-11-02	2022-11-03					2022-12-02	2022-12-09	2022-11-02	2022-11-03					2022-12-02	2022-12-09	2022-11-02	2022-11-03					2022-12-02	2022-12-09				
	完成比率	100%	100%					100%	100%	100%	100%					100%	100%	100%	100%					100%	100%	100%	100%					100%	100%				
9/F	預算完工期	2022-10-29	2022-10-30	2022-11-23	2022-11-28	2022-12-01	2022-12-05			2022-10-29	2022-10-30	2022-11-23	2022-11-28	2022-12-01	2022-12-05			2022-10-29	2022-10-30	2022-11-23	2022-11-28	2022-12-01	2022-12-05			2022-10-29	2022-10-30	2022-11-23	2022-11-28	2022-12-01	2022-12-05			已到			
	實際完工期	2022-10-27	2022-10-28					09/12/2022		2022-10-27	2022-10-28					2022-12-09	2022-10-26	2022-10-28						2022-12-09	2022-10-26	2022-10-27						2022-12-09				
	完成比率	100%	100%						100%	100%	100%					100%	100%	100%						100%	100%	100%						100%				

美特鋁質有限公司

工程 J858- LP-11 日出康成11 期

2023-01-17

T2 - 幕牆 棚前工作進度表

樓層	工序	AE								AF								AG																物料/到貨			金門交場
		1 墨線	2 測量報告	3 安裝鐵碼 (7件)	4 回焊 (7件)	5 驗焊 (7件)	6 裝起底水槽	7 鋁碼 (7件)	8 裝防火綿插	1 墨線	2 測量報告	3 安裝鐵碼 (5件)	4 回焊 (5件)	5 驗焊 (5件)	6 裝起底水槽	7 鋁碼 (5件)	8 裝防火綿插	1 墨線	2 測量報告	3 安裝鐵碼 (3件)	4 回焊 (3件)	5 驗焊 (3件)	6 裝起底水槽	7 鋁碼 (3件)	8 裝防火綿插									鐵料	鋁型材	防水片	
30/F	預算完工期	2023-02-22	2023-02-24					2023-03-02	2023-03-05	2023-02-22	2023-02-24					2023-03-02	2023-03-05	2023-02-22	2023-02-24					2023-03-02	2023-03-05												
	實際完工期																																				
	完成比率																																				
29/F	預算完工期	2023-02-16	2023-02-18					2023-02-25	2023-02-28	2023-02-16	2023-02-18					2023-02-25	2023-02-28	2023-02-16	2023-02-18					2023-02-25	2023-02-28												
	實際完工期																																				
	完成比率																																				
28/F	預算完工期	2023-02-10	2023-02-12					2023-02-20	2023-02-23	2023-02-10	2023-02-12					2023-02-20	2023-02-23	2023-02-10	2023-02-12					2023-02-20	2023-02-23												
	實際完工期																																				
	完成比率																																				
27/F	預算完工期	2023-02-04	2023-02-06					2023-02-15	2023-02-18	2023-02-04	2023-02-06					2023-02-15	2023-02-18	2023-02-04	2023-02-06					2023-02-15	2023-02-18												
	實際完工期																																				
	完成比率																																				
26/F	預算完工期	2023-01-29	2023-01-31					2023-02-10	2023-02-13	2023-01-29	2023-01-31					2023-02-10	2023-02-13	2023-01-29	2023-01-31					2023-02-10	2023-02-13												
	實際完工期																																				
	完成比率																																				
25/F	預算完工期	2023-01-18	2023-01-20					2023-02-05	2023-02-08	2023-01-18	2023-01-20					2023-02-05	2023-02-08	2023-01-18	2023-01-20					2023-02-05	2023-02-08												
	實際完工期																																				
	完成比率																																				
23/F	預算完工期	2023-01-12	2023-01-14					2023-01-31	2023-02-03	2023-01-12	2023-01-14					2023-01-31	2023-02-03	2023-01-12	2023-01-14					2023-01-31	2023-02-03												
	實際完工期																																				
	完成比率																																				
22/F	預算完工期	2023-01-06	2023-01-08					2023-01-21	2023-01-24	2023-01-06	2023-01-08					2023-01-21	2023-01-24	2023-01-06	2023-01-08					2023-01-21	2023-01-24												
	實際完工期																																				
	完成比率																																				
21/F	預算完工期	2022-12-31	2023-01-02					2023-01-16	2023-01-19	2022-12-31	2023-01-02					2023-01-16	2023-01-19	2022-12-31	2023-01-02					2023-01-16	2023-01-19												
	實際完工期																																				
	完成比率																																				
20/F	預算完工期	2022-12-25	2022-12-27					2023-01-11	2023-01-14	2022-12-25	2022-12-27					2023-01-11	2023-01-14	2022-12-25	2022-12-27					2023-01-11	2023-01-14										已到	已到	
	實際完工期	2022-12-23	2022-12-24					2023-01-09	2022-12-28	2022-12-23	2022-12-24					2023-01-09	2022-12-28	2022-12-23	2022-12-24						2022-12-28												
	完成比率	100%	100%					100%	100%	100%	100%					100%	100%	100%	100%					50%	100%												
19/F	預算完工期	2022-12-19	2022-12-21					2023-01-07	2023-01-10	2022-12-19	2022-12-21					2023-01-07	2023-01-10	2022-12-19	2022-12-21					2023-01-07	2023-01-10										已到	已到	
	實際完工期	2022-12-17	2022-12-19					2023-01-04	2022-12-21	2022-12-17	2022-12-19					2023-01-04	2022-12-21	2022-12-17	2022-12-19					2023-01-04	2022-12-21												
	完成比率	100%	100%					100%	100%	100%	100%					100%	100%	100%	100%					100%	100%												
18/F	預算完工期	2022-12-13	2022-12-15					2023-01-03	2023-01-06	2022-12-13	2022-12-15					2023-01-03	2023-01-06	2022-12-13	2022-12-15					2023-01-03	2023-01-06										已到	已到	
	實際完工期	2022-12-11	2022-12-13					2022-12-31	2022-12-21	2022-12-11	2022-12-13					2022-12-31	2022-12-21	2022-12-11	2022-12-13					2022-12-31	2022-12-21												
	完成比率	100%	100%					100%	100%	100%	100%					100%	100%	100%	100%					100%	100%												
17/F	預算完工期	2022-12-07	2022-12-09					2022-12-30	2023-01-02	2022-12-07	2022-12-09					2022-12-30	2023-01-02	2022-12-07	2022-12-09					2022-12-30	2023-01-02										已到	已到	
	實際完工期	2022-12-05	2022-12-07					2022-12-21	2022-12-15	2022-12-05	2022-12-07					2022-12-21	2022-12-15	2022-12-05	2022-12-07					2022-12-21	2022-12-15												
	完成比率	100%	100%					100%	100%	100%	100%					100%	100%	100%	100%					100%	100%												
16/F	預算完工期	2022-12-01	2022-12-03					2022-12-26	2022-12-29	2022-12-01	2022-12-03					2022-12-26	2022-12-29	2022-12-01	2022-12-03					2022-12-26	2022-12-29										已到	已到	
	實際完工期	2022-11-27	2022-11-30					2022-12-13	2022-12-14	2022-11-27	2022-11-30					2022-12-13	2022-12-14	2022-11-27	2022-11-30					2022-12-13	2022-12-14												
	完成比率	100%	100%					100%	100%	100%	100%					100%	100%	100%	100%					100%	100%												
15/F	預算完工期	2022-11-25	2022-11-26					2022-12-22	2022-12-25	2022-11-25	2022-11-26					2022-12-22	2022-12-25	2022-11-25	2022-11-26					2022-12-22	2022-12-25										已到	已到	
	實際完工期	2022-11-23	2022-11-24					2022-12-09	2022-12-14	2022-11-23	2022-11-24					2022-12-09	2022-12-14	2022-11-23	2022-11-24					2022-12-09	2022-12-14												
	完成比率	100%	100%					100%	100%	100%	100%					100%	100%	100%	100%					100%	100%												
12/F	預算完工期	2022-11-19	2022-11-20					2022-12-18	2022-12-21	2022-11-19	2022-11-20					2022-12-18	2022-12-21	2022-11-19	2022-11-20					2022-12-18	2022-12-21										已到	已到	
	實際完工期	2022-11-16	2022-11-18					2022-12-06	2022-12-14	2022-11-16	2022-11-18					2022-12-06	2022-12-14	2022-11-16	2022-11-18					2022-12-06	2022-12-14												
	完成比率	100%	100%					100%	100%	100%	100%					100%	100%	100%	100%					100%	100%												
11/F (Refuge)	預算完工期	2022-11-11	2022-11-13					2022-12-14	2022-12-17	2022-11-11	2022-11-13					2022-12-14	2022-12-17	2022-11-11	2022-11-13					2022-12-14	2022-12-17										已到	已到	
	實際完工期	2022-11-09	2022-11-10					2022-12-09	2022-12-14	2022-11-09	2022-11-10					2022-12-09	2022-12-14	2022-11-09	2022-11-10					2022-12-09	2022-12-14												
	完成比率	100%	100%					100%	100%	100%	100%					100%	100%	100%	100%					100%	100%												
10/F	預算完工期	2022-11-04	2022-11-05					2022-12-10	2022-12-13	2022-11-04	2022-11-05					2022-12-10	2022-12-13	2022-11-04	2022-11-05					2022-12-10	2022-12-13										已到	已到	
	實際完工期	2022-11-02	2022-11-03					2022-12-02	2022-12-09	2022-11-02	2022-11-03					2022-12-02	2022-12-09	2022-11-02	2022-11-03					2022-12-02	2022-12-09												
	完成比率	100%	100%					100%	100%	100%	100%					100%	100%	100%	100%					100%	100%												
9/F	預算完工期	2022-10-29	2022-10-30	2022-11-23	2022-11-28	2022-12-01	2022-12-05			2022-10-29	2022-10-30	2022-11-23	2022-11-28	2022-12-01	2022-12-05			2022-10-29	2022-10-30	2022-11-23	2022-11-28	2022-12-01	2022-12-05														
	實際完工期	2022-10-26	2022-10-28						2022-12-12	2022-10-26	2022-10-28						2022-12-09	2022-10-26	2022-10-28						2022-12-12									已到			
	完成比率	100%	100%						100%	100%	100%						100%	100%	100%						100%												

(6)

美特鋁質有限公司

工程 J858- LP-11 日出康成11 期

2023-01-17

T2 - 幕牆 棚前工作進度表

樓層	工序	BA								BB								BC								BD								物料到貨			金門交場
		1 墨線	2 測量報告	3 安裝鐵碼 (4件)	4 回焊 (4件)	5 驗焊 (4件)	6 裝起底水槽	7 鋁碼 (4件)	8 裝防火綿插	1 墨線	2 測量報告	3 安裝鐵碼 (2件)	4 回焊 (2件)	5 驗焊 (2件)	6 裝起底水槽	7 鋁碼 (2件)	8 裝防火綿插	1 墨線	2 測量報告	3 安裝鐵碼 (5件)	4 回焊 (5件)	5 驗焊 (5件)	6 裝起底水槽	7 鋁碼 (5件)	8 裝防火綿插	1 墨線	2 測量報告	3 安裝鐵碼 (7件)	4 回焊 (7件)	5 驗焊 (7件)	6 裝起底水槽	7 鋁碼 (7件)	8 裝防火綿插	鐵料	鋁型材	防火綿插	
30/F	預算完工期	2023-02-22	2023-02-24					2023-03-02	2023-03-05	2023-02-22	2023-02-24					2023-03-02	2023-03-05	2023-02-22	2023-02-24					2023-03-02	2023-03-05	2023-02-22	2023-02-24					2023-03-02	2023-03-05		TBC	TBC	
	實際完工期																																				
	完成比率																																				
29/F	預算完工期	2023-02-16	2023-02-18					2023-02-25	2023-02-28	2023-02-16	2023-02-18					2023-02-25	2023-02-28	2023-02-16	2023-02-18					2023-02-25	2023-02-28	2023-02-16	2023-02-18					2023-02-25	2023-02-28		TBC	TBC	
	實際完工期																																				
	完成比率																																				
28/F	預算完工期	2023-02-10	2023-02-12					2023-02-20	2023-02-23	2023-02-10	2023-02-12					2023-02-20	2023-02-23	2023-02-10	2023-02-12					2023-02-20	2023-02-23	2023-02-10	2023-02-12					2023-02-20	2023-02-23		TBC	TBC	
	實際完工期																																				
	完成比率																																				
27/F	預算完工期	2023-02-04	2023-02-06					2023-02-15	2023-02-18	2023-02-04	2023-02-06					2023-02-15	2023-02-18	2023-02-04	2023-02-06					2023-02-15	2023-02-18	2023-02-04	2023-02-06					2023-02-15	2023-02-18		TBC	TBC	
	實際完工期																																				
	完成比率																																				
26/F	預算完工期	2023-01-29	2023-01-31					2023-02-10	2023-02-13	2023-01-29	2023-01-31					2023-02-10	2023-02-13	2023-01-29	2023-01-31					2023-02-10	2023-02-13	2023-01-29	2023-01-31					2023-02-10	2023-02-13		TBC	TBC	
	實際完工期																																				
	完成比率																																				
25/F	預算完工期	2023-01-18	2023-01-20					2023-02-05	2023-02-08	2023-01-18	2023-01-20					2023-02-05	2023-02-08	2023-01-18	2023-01-20					2023-02-05	2023-02-08	2023-01-18	2023-01-20					2023-02-05	2023-02-08		TBC	TBC	
	實際完工期																																				
	完成比率																																				
23/F	預算完工期	2023-01-12	2023-01-14					2023-01-31	2023-02-03	2023-01-12	2023-01-14					2023-01-31	2023-02-03	2023-01-12	2023-01-14					2023-01-31	2023-02-03	2023-01-12	2023-01-14					2023-01-31	2023-02-03		TBC	TBC	
	實際完工期																																				
	完成比率																																				
22/F	預算完工期	2023-01-06	2023-01-08					2023-01-21	2023-01-24	2023-01-06	2023-01-08					2023-01-21	2023-01-24	2023-01-06	2023-01-08					2023-01-21	2023-01-24	2023-01-06	2023-01-08					2023-01-21	2023-01-24		TBC	TBC	
	實際完工期																																				
	完成比率																																				
21/F	預算完工期	2022-12-31	2023-01-02					2023-01-16	2023-01-19	2022-12-31	2023-01-02					2023-01-16	2023-01-19	2022-12-31	2023-01-02					2023-01-16	2023-01-19	2022-12-31	2023-01-02					2023-01-16	2023-01-19		TBC	TBC	
	實際完工期																																				
	完成比率																																				
20/F	預算完工期	2022-12-25	2022-12-27					2023-01-11	2023-01-14	2022-12-25	2022-12-27					2023-01-11	2023-01-14	2022-12-25	2022-12-27					2023-01-11	2023-01-14	2022-12-25	2022-12-27					2023-01-11	2023-01-14		TBC	TBC	
	實際完工期	2022-12-23	2022-12-24					2023-01-09	2022-12-28	2022-12-23	2022-12-24					2023-01-09	2022-12-28	2022-12-23	2022-12-24					2023-01-09	2022-12-28	2022-12-23	2022-12-24					2023-01-09	2022-12-28				
	完成比率	100%	100%					100%	100%	100%	100%					100%	100%	100%	100%					100%	100%	100%	100%					100%	100%				
19/F	預算完工期	2022-12-19	2022-12-21					2023-01-07	2023-01-10	2022-12-19	2022-12-21					2023-01-07	2023-01-10	2022-12-19	2022-12-21					2023-01-07	2023-01-10	2022-12-19	2022-12-21					2023-01-07	2023-01-10				
	實際完工期	2022-12-17	2022-12-19					2023-01-06	2022-12-21	2022-12-17	2022-12-19					2023-01-06	2022-12-21	2022-12-17	2022-12-19					2023-01-06	2022-12-21	2022-12-17	2022-12-19					2023-01-06	2022-12-21		已到	已到	
	完成比率	100%	100%					100%	100%	100%	100%					100%	100%	100%	100%					100%	100%	100%	100%					100%	100%				
18/F	預算完工期	2022-12-13	2022-12-15					2023-01-03	2023-01-06	2022-12-13	2022-12-15					2023-01-03	2023-01-06	2022-12-13	2022-12-15					2023-01-03	2023-01-06	2022-12-13	2022-12-15					2023-01-03	2023-01-06				
	實際完工期	2022-12-11	2022-12-13					2022-12-31	2022-12-21	2022-12-11	2022-12-13					2022-12-31	2022-12-21	2022-12-11	2022-12-13					2022-12-31	2022-12-21	2022-12-11	2022-12-13					2022-12-31	2022-12-21		已到	已到	
	完成比率	100%	100%					100%	100%	100%	100%					100%	100%	100%	100%					100%	100%	100%	100%					100%	100%				
17/F	預算完工期	2022-12-07	2022-12-09					2022-12-30	2023-01-02	2022-12-07	2022-12-09					2022-12-30	2023-01-02	2022-12-07	2022-12-09					2022-12-30	2023-01-02	2022-12-07	2022-12-09					2022-12-30	2023-01-02				
	實際完工期	2022-12-05	2022-12-07					2022-12-21	2022-12-15	2022-12-05	2022-12-07					2022-12-21	2022-12-15	2022-12-05	2022-12-07					2022-12-21	2022-12-15	2022-12-05	2022-12-07					2022-12-21	2022-12-15		已到	已到	
	完成比率	100%	100%					100%	100%	100%	100%					100%	100%	100%	100%					100%	100%	100%	100%					100%	100%				
16/F	預算完工期	2022-12-01	2022-12-03					2022-12-26	2022-12-29	2022-12-01	2022-12-03					2022-12-26	2022-12-29	2022-12-01	2022-12-03					2022-12-26	2022-12-29	2022-12-01	2022-12-03					2022-12-26	2022-12-29				
	實際完工期	2022-11-27	2022-11-30					2022-12-13	2022-12-14	2022-11-27	2022-11-30					2022-12-13	2022-12-14	2022-11-27	2022-11-30					2022-12-13	2022-12-14	2022-11-27	2022-11-30					2022-12-13	2022-12-14		已到	已到	
	完成比率	100%	100%					100%	100%	100%	100%					100%	100%	100%	100%					100%	100%	100%	100%					100%	100%				
15/F	預算完工期	2022-11-25	2022-11-26					2022-12-22	2022-12-25	2022-11-25	2022-11-26					2022-12-22	2022-12-25	2022-11-25	2022-11-26					2022-12-22	2022-12-25	2022-11-25	2022-11-26					2022-12-22	2022-12-25				
	實際完工期	2022-11-23	2022-11-24					2022-12-09	2022-12-14	2022-11-23	2022-11-24					2022-12-09	2022-12-14	2022-11-23	2022-11-24					2022-12-09	2022-12-14	2022-11-23	2022-11-24					2022-12-09	2022-12-14		已到	已到	
	完成比率	100%	100%					100%	100%	100%	100%					100%	100%	100%	100%					100%	100%	100%	100%					100%	100%				
12/F	預算完工期	2022-11-19	2022-11-20					2022-12-18	2022-12-21	2022-11-19	2022-11-20					2022-12-18	2022-12-21	2022-11-19	2022-11-20					2022-12-18	2022-12-21	2022-11-19	2022-11-20					2022-12-18	2022-12-21				
	實際完工期	2022-11-16	2022-11-18					2022-12-06	2022-12-14	2022-11-16	2022-11-18					2022-12-06	2022-12-14	2022-11-16	2022-11-18					2022-12-06	2022-12-14	2022-11-16	2022-11-18					2022-12-06	2022-12-14		已到	已到	
	完成比率	100%	100%					100%	100%	100%	100%					100%	100%	100%	100%					100%	100%	100%	100%					100%	100%				
11/F (Refuge)	預算完工期	2022-11-11	2022-11-13					2022-12-14	2022-12-17	2022-11-11	2022-11-13					2022-12-14	2022-12-17	2022-11-11	2022-11-13					2022-12-14	2022-12-17	2022-11-11	2022-11-13					2022-12-14	2022-12-17				
	實際完工期	2022-11-09	2022-11-10					2022-12-09	2022-12-14	2022-11-09	2022-11-10					2022-12-09	2022-12-14	2022-11-09	2022-11-10					2022-12-09	2022-12-14	2022-11-09	2022-11-10					2022-12-09	2022-12-14		已到	已到	
	完成比率	100%	100%					100%	100%	100%	100%					100%	100%	100%	100%					100%	100%	100%	100%					100%	100%				
10/F	預算完工期	2022-11-04	2022-11-05					2022-12-10	2022-12-13	2022-11-04	2022-11-05					2022-12-10	2022-12-13	2022-11-04	2022-11-05					2022-12-10	2022-12-13	2022-11-04	2022-11-05					2022-12-10	2022-12-13				
	實際完工期	2022-11-02	2022-11-03					2022-12-02	2022-12-09	2022-11-02	2022-11-03					2022-12-02	2022-12-09	2022-11-02	2022-11-03					2022-12-02	2022-12-09	2022-11-02	2022-11-03					2022-12-02	2022-12-09		已到	已到	
	完成比率	100%	100%					100%	100%	100%	100%					100%	100%	100%	100%					100%	100%	100%	100%					100%	100%				
9/F	預算完工期	2022-10-29	2022-10-30	2022-11-23	2022-11-28	2022-12-01	2022-12-05			2022-10-29	2022-10-30	2022-11-23	2022-11-28	2022-12-01	2022-12-05			2022-10-29	2022-10-30	2022-11-23	2022-11-28	2022-12-01	2022-12-05			2022-10-29	2022-10-30	2022-11-23	2022-11-28	2022-12-01	2022-12-05						
	實際完工期	2022-10-27	2022-10-28					2022-12-09		2022-10-26	2022-10-28					2022-12-09		2022-10-26	2022-10-28					2022-12-09		2022-10-26	2022-10-28					2022-12-09		已到			
	完成比率	100%	100%					100%		100%	100%					100%		100%	100%					100%		100%	100%					100%					

(7)

美特鋁質有限公司

工程 J858- LP-11 日出康成11 期

2023-01-17

T2 - 幕牆 棚前工作進度表

樓層	工序	BE								BF								物料到貨			金門交場
		1 墨線	2 測量報告	3 安裝鐵碼 (2件)	4 回焊 (2件)	5 驗焊 (2件)	6 裝起底水槽	7 鋁碼 (2件)	8 裝防火綿插	1 墨線	2 測量報告	3 安裝鐵碼 (3件)	4 回焊 (3件)	5 驗焊 (3件)	6 裝起底水槽	7 鋁碼 (3件)	8 裝防火綿插	鐵料	鋁型材	防火綿插	
30/F	預算完工期	2023-02-22	2023-02-24					2023-03-02	2023-03-05	2023-02-22	2023-02-24					2023-03-02	2023-03-05		TBC	TBC	
	實際完工期																				
	完成比率																				
29/F	預算完工期	2023-02-16	2023-02-18					2023-02-25	2023-02-28	2023-02-16	2023-02-18					2023-02-25	2023-02-28		TBC	TBC	
	實際完工期																				
	完成比率																				
28/F	預算完工期	2023-02-10	2023-02-12					2023-02-20	2023-02-23	2023-02-10	2023-02-12					2023-02-20	2023-02-23		TBC	TBC	
	實際完工期																				
	完成比率																				
27/F	預算完工期	2023-02-04	2023-02-06					2023-02-15	2023-02-18	2023-02-04	2023-02-06					2023-02-15	2023-02-18		TBC	TBC	
	實際完工期																				
	完成比率																				
26/F	預算完工期	2023-01-29	2023-01-31					2023-02-10	2023-02-13	2023-01-29	2023-01-31					2023-02-10	2023-02-13		TBC	TBC	
	實際完工期																				
	完成比率																				
25/F	預算完工期	2023-01-18	2023-01-20					2023-02-05	2023-02-08	2023-01-18	2023-01-20					2023-02-05	2023-02-08		TBC	TBC	
	實際完工期																				
	完成比率																				
23/F	預算完工期	2023-01-12	2023-01-14					2023-01-31	2023-02-03	2023-01-12	2023-01-14					2023-01-31	2023-02-03		TBC	TBC	
	實際完工期																				
	完成比率																				
22/F	預算完工期	2023-01-06	2023-01-08					2023-01-21	2023-01-24	2023-01-06	2023-01-08					2023-01-21	2023-01-24		TBC	TBC	
	實際完工期																				
	完成比率																				
21/F	預算完工期	2022-12-31	2023-01-02					2023-01-16	2023-01-19	2022-12-31	2023-01-02					2023-01-16	2023-01-19		TBC	TBC	
	實際完工期																				
	完成比率																				
20/F	預算完工期	2022-12-25	2022-12-27					2023-01-11	2023-01-14	2022-12-25	2022-12-27					2023-01-11	2023-01-14		TBC	TBC	
	實際完工期	2022-12-23	2022-12-24					2023-01-09	2022-12-28	2022-12-23	2022-12-24					2023-01-09	2022-12-28				
	完成比率	100%	100%					100%	100%	100%	100%					100%	100%				
19/F	預算完工期	2022-12-19	2022-12-21					2023-01-07	2023-01-10	2022-12-19	2022-12-21					2023-01-07	2023-01-10				
	實際完工期	2022-12-17	2022-12-19					2023-01-06	2022-12-21	2022-12-17	2022-12-19					2023-01-06	2022-12-21		已到	已到	
	完成比率	100%	100%					100%	100%	100%	100%					100%	100%				
18/F	預算完工期	2022-12-13	2022-12-15					2023-01-03	2023-01-06	2022-12-13	2022-12-15					2023-01-03	2023-01-06				
	實際完工期	2022-12-11	2022-12-13					2022-12-31	2022-12-21	2022-12-11	2022-12-13					2022-12-31	2022-12-21		已到	已到	
	完成比率	100%	100%					100%	100%	100%	100%					100%	100%				
17/F	預算完工期	2022-12-07	2022-12-09					2022-12-30	2023-01-02	2022-12-07	2022-12-09					2022-12-30	2023-01-02				
	實際完工期	2022-12-05	2022-12-07					2022-12-21	2022-12-15	2022-12-05	2022-12-07					2022-12-21	2022-12-15		已到	已到	
	完成比率	100%	100%					100%	100%	100%	100%					100%	100%				
16/F	預算完工期	2022-12-01	2022-12-03					2022-12-26	2022-12-29	2022-12-01	2022-12-03					2022-12-26	2022-12-29				
	實際完工期	2022-11-27	2022-11-30					2022-12-13	2022-12-14	2022-11-27	2022-11-30					2022-12-13	2022-12-14		已到	已到	
	完成比率	100%	100%					100%	100%	100%	100%					100%	100%				
15/F	預算完工期	2022-11-25	2022-11-26					2022-12-22	2022-12-25	2022-11-25	2022-11-26					2022-12-22	2022-12-25				
	實際完工期	2022-11-23	2022-11-24					2022-12-09	2022-12-14	2022-11-23	2022-11-24					2022-12-09	2022-12-14		已到	已到	
	完成比率	100%	100%					100%	100%	100%	100%					100%	100%				
12/F	預算完工期	2022-11-19	2022-11-20					2022-12-18	2022-12-21	2022-11-19	2022-11-20					2022-12-18	2022-12-21				
	實際完工期	2022-11-16	2022-11-18					2022-12-06	2022-12-14	2022-11-16	2022-11-18					2022-12-06	2022-12-14		已到	已到	
	完成比率	100%	100%					100%	100%	100%	100%					100%	100%				
11/F (Refuge)	預算完工期	2022-11-11	2022-11-13					2022-12-14	2022-12-17	2022-11-11	2022-11-13					2022-12-14	2022-12-17				
	實際完工期	2022-11-09	2022-11-10					2022-12-09	2022-12-14	2022-11-09	2022-11-10					2022-12-09	2022-12-14		已到	已到	
	完成比率	100%	100%					100%	100%	100%	100%					100%	100%				
10/F	預算完工期	2022-11-04	2022-11-05					2022-12-10	2022-12-13	2022-11-04	2022-11-05					2022-12-10	2022-12-13				
	實際完工期	2022-11-02	2022-11-03					2022-12-02	2022-12-09	2022-11-02	2022-11-03					2022-12-02	2022-12-09		已到	已到	
	完成比率	100%	100%					100%	100%	100%	100%					100%	100%				
9/F	預算完工期	2022-10-29	2022-10-30	2022-11-23	2022-11-28	2022-12-01	2022-12-05			2022-10-29	2022-10-30	2022-11-23	2022-11-28	2022-12-01	2022-12-05						
	實際完工期	2022-10-26	2022-10-28						2022-12-09	2022-10-26	2022-10-28						2022-12-09	已到			
	完成比率	100%	100%						100%	100%	100%						100%				

美特鋁質有限公司

工程 J858- LP-11 日出康成11 期

2023-01-17

T3 - 幕牆 棚前工作進度表

樓層	工序	AA								AB								AC								AD								物料/到貨			金門交通
		1 墨線	2 測量報告	3 安裝鐵碼 (4件)	4 回焊 (4件)	5 驗焊 (4件)	6 裝起底水槽	7 鋁碼 (4件)	8 裝防火綿插	1 墨線	2 測量報告	3 安裝鐵碼 (10件)	4 回焊 (10件)	5 驗焊 (10件)	6 裝起底水槽	7 鋁碼 (10件)	8 裝防火綿插	1 墨線	2 測量報告	3 安裝鐵碼 (3件)	4 回焊 (3件)	5 驗焊 (3件)	6 裝起底水槽	7 鋁碼 (3件)	8 裝防火綿插	1 墨線	2 測量報告	3 安裝鐵碼 (3件)	4 回焊 (3件)	5 驗焊 (3件)	6 裝起底水槽	7 鋁碼 (3件)	8 裝防火綿插	鐵料	鋁型材	防火綿插	
30/F	預算完工期	2023-04-06	2023-04-08					2023-04-17	2023-04-20	2023-04-06	2023-04-08					2023-04-17	2023-04-20	2023-04-06	2023-04-08					2023-04-17	2023-04-20	2023-04-06	2023-04-08					2023-04-17	2023-04-20				
	實際完工期																																				
	完成比率																																				
29/F	預算完工期	2023-03-31	2023-04-02					2023-04-11	2023-04-14	2023-03-31	2023-04-02					2023-04-11	2023-04-14	2023-03-31	2023-04-02					2023-04-11	2023-04-14	2023-03-31	2023-04-02					2023-04-11	2023-04-14				
	實際完工期																																				
	完成比率																																				
28/F	預算完工期	2023-03-25	2023-03-27					2023-04-05	2023-04-08	2023-03-25	2023-03-27					2023-04-05	2023-04-08	2023-03-25	2023-03-27					2023-04-05	2023-04-08	2023-03-25	2023-03-27					2023-04-05	2023-04-08				
	實際完工期																																				
	完成比率																																				
27/F	預算完工期	2023-03-19	2023-03-21					2023-03-30	2023-04-02	2023-03-19	2023-03-21					2023-03-30	2023-04-02	2023-03-19	2023-03-21					2023-03-30	2023-04-02	2023-03-19	2023-03-21					2023-03-30	2023-04-02				
	實際完工期																																				
	完成比率																																				
26/F	預算完工期	2023-03-13	2023-03-15					2023-03-24	2023-03-27	2023-03-13	2023-03-15					2023-03-24	2023-03-27	2023-03-13	2023-03-15					2023-03-24	2023-03-27	2023-03-13	2023-03-15					2023-03-24	2023-03-27				
	實際完工期																																				
	完成比率																																				
25/F	預算完工期	2023-03-07	2023-03-09					2023-03-18	2023-03-21	2023-03-07	2023-03-09					2023-03-18	2023-03-21	2023-03-07	2023-03-09					2023-03-18	2023-03-21	2023-03-07	2023-03-09					2023-03-18	2023-03-21				
	實際完工期																																				
	完成比率																																				
23/F	預算完工期	2023-03-01	2023-03-03					2023-03-12	2023-03-15	2023-03-01	2023-03-03					2023-03-12	2023-03-15	2023-03-01	2023-03-03					2023-03-12	2023-03-15	2023-03-01	2023-03-03					2023-03-12	2023-03-15				
	實際完工期																																				
	完成比率																																				
22/F	預算完工期	2023-02-23	2023-02-25					2023-03-06	2023-03-09	2023-02-23	2023-02-25					2023-03-06	2023-03-09	2023-02-23	2023-02-25					2023-03-06	2023-03-09	2023-02-23	2023-02-25					2023-03-06	2023-03-09				
	實際完工期																																				
	完成比率																																				
21/F	預算完工期	2023-02-17	2023-02-19					2023-02-28	2023-03-03	2023-02-17	2023-02-19					2023-02-28	2023-03-03	2023-02-17	2023-02-19					2023-02-28	2023-03-03	2023-02-17	2023-02-19					2023-02-28	2023-03-03				
	實際完工期																																				
	完成比率	50%								50%								50%								50%											
20/F	預算完工期	2023-02-11	2023-02-13					2023-02-22	2023-02-25	2023-02-11	2023-02-13					2023-02-22	2023-02-25	2023-02-11	2023-02-13					2023-02-22	2023-02-25	2023-02-11	2023-02-13					2023-02-22	2023-02-25				
	實際完工期																																				
	完成比率	50%								50%								50%								50%											
19/F	預算完工期	2023-02-05	2023-02-07					2023-02-16	2023-02-19	2023-02-05	2023-02-07					2023-02-16	2023-02-19	2023-02-05	2023-02-07					2023-02-16	2023-02-19	2023-02-05	2023-02-07					2023-02-16	2023-02-19				
	實際完工期																																				
	完成比率	50%								50%								50%								50%											
18/F	預算完工期	2023-01-30	2023-02-01					2023-02-10	2023-02-13	2023-01-30	2023-02-01					2023-02-10	2023-02-13	2023-01-30	2023-02-01					2023-02-10	2023-02-13	2023-01-30	2023-02-01					2023-02-10	2023-02-13				
	實際完工期																																				
	完成比率	50%								50%								50%								50%											
17/F	預算完工期	2023-01-13	2023-01-15					2023-01-21	2023-01-24	2023-01-13	2023-01-15					2023-01-21	2023-01-24	2023-01-13	2023-01-15					2023-01-21	2023-01-24	2023-01-13	2023-01-15					2023-01-21	2023-01-24				
	實際完工期	2023-01-04	2023-01-06							2023-01-04	2023-01-06							2023-01-04	2023-01-06							2023-01-04	2023-01-06										
	完成比率	100%	100%					50%		100%	100%					50%		100%	100%					50%		100%	100%					50%					
16/F	預算完工期	2023-01-07	2023-01-09					2023-01-17	2023-01-20	2023-01-07	2023-01-09					2023-01-17	2023-01-20	2023-01-07	2023-01-09					2023-01-17	2023-01-20	2023-01-07	2023-01-09					2023-01-17	2023-01-20				
	實際完工期	2023-01-04	2023-01-06							2023-01-04	2023-01-06							2023-01-04	2023-01-06							2023-01-04	2023-01-06										
	完成比率	100%	100%					50%		100%	100%					50%		100%	100%					50%		100%	100%					50%					
15/F	預算完工期	2023-01-01	2023-01-02					2023-01-13	2023-01-16	2023-01-01	2023-01-02					2023-01-13	2023-01-16	2023-01-01	2023-01-02					2023-01-13	2023-01-16	2023-01-01	2023-01-02					2023-01-13	2023-01-16				
	實際完工期	2022-12-22	2022-12-24					2023-01-11		2022-12-22	2022-12-24					2023-01-11		2022-12-22	2022-12-24					2023-01-11		2022-12-22	2022-12-24					2023-01-11					
	完成比率	100%	100%					100%		100%	100%					100%		100%	100%					100%		100%	100%					100%					
12/F	預算完工期	2022-12-26	2022-12-27					2023-01-09	2023-01-12	2022-12-26	2022-12-27					2023-01-09	2023-01-12	2022-12-26	2022-12-27					2023-01-09	2023-01-12	2022-12-26	2022-12-27					2023-01-09	2023-01-12				
	實際完工期	2022-12-22	2022-12-24					2023-01-04		2022-12-22	2022-12-24					2023-01-04		2022-12-22	2022-12-24					2023-01-04		2022-12-22	2022-12-24					2023-01-04					
	完成比率	100%	100%					100%		100%	100%					100%		100%	100%					100%		100%	100%					100%					
11/F (Refuge)	預算完工期	2022-12-19	2022-12-21					2023-01-05	2023-01-08	2022-12-19	2022-12-21					2023-01-05	2023-01-08	2022-12-19	2022-12-21					2023-01-05	2023-01-08	2022-12-19	2022-12-21					2023-01-05	2023-01-08				
	實際完工期																																				
	完成比率	50%								50%								50%								50%											
10/F	預算完工期	2022-12-12	2022-12-13					2023-01-01	2023-01-04	2022-12-12	2022-12-13					2023-01-01	2023-01-04	2022-12-12	2022-12-13					2023-01-01	2023-01-04	2022-12-12	2022-12-13					2023-01-01	2023-01-04				
	實際完工期	2022-11-28	2022-11-29					2022-12-31		2022-11-28	2022-11-29					2022-12-31		2022-11-28	2022-11-29					2022-12-31		2022-11-28	2022-11-29					2022-12-31					
	完成比率	100%	100%					100%		100%	100%					100%		100%	100%					100%		100%	100%					100%					
9/F	預算完工期	2022-12-05	2022-12-06	2022-12-26	2022-12-31	2023-01-02	2023-01-06			2022-12-05	2022-12-06	2022-12-26	2022-12-31	2023-01-02	2023-01-06			2022-12-05	2022-12-06	2022-12-26	2022-12-31	2023-01-02	2023-01-06			2022-12-05	2022-12-06	2022-12-26	2022-12-31	2023-01-02	2023-01-06						
	實際完工期	2022-11-26	2022-11-28							2022-11-26	2022-11-28							2022-11-26	2022-11-28							2022-11-26	2022-11-28										
	完成比率	100%	100%							100%	100%							100%	100%							100%	100%										

9

美特鋁質有限公司

工程 J858- LP-11 日出康成11 期

2023-01-17

T3 - 幕牆 棚前工作進度表

樓層	工序	AE								AF								AG														物料/到貨			金門交場
		1 墨線	2 測量報告	3 安裝鐵碼 (7件)	4 回焊 (7件)	5 驗焊 (7件)	6 裝起底水槽	7 鋁碼 (7件)	8 裝防火綿插	1 墨線	2 測量報告	3 安裝鐵碼 (5件)	4 回焊 (5件)	5 驗焊 (5件)	6 裝起底水槽	7 鋁碼 (5件)	8 裝防火綿插	1 墨線	2 測量報告	3 安裝鐵碼 (3件)	4 回焊 (3件)	5 驗焊 (3件)	6 裝起底水槽	7 鋁碼 (3件)	8 裝防火綿插									鐵料	鋁型材	防水片	
30/F	預算完工期	2023-04-06	2023-04-08					2023-04-17	2023-04-20	2023-04-06	2023-04-08					2023-04-17	2023-04-20	2023-04-06	2023-04-08					2023-04-17	2023-04-20												
	實際完工期																																		
	完成比率																																		
29/F	預算完工期	2023-03-31	2023-04-02					2023-04-11	2023-04-14	2023-03-31	2023-04-02					2023-04-11	2023-04-14	2023-03-31	2023-04-02					2023-04-11	2023-04-14												
	實際完工期																																		
	完成比率																																		
28/F	預算完工期	2023-03-25	2023-03-27					2023-04-05	2023-04-08	2023-03-25	2023-03-27					2023-04-05	2023-04-08	2023-03-25	2023-03-27					2023-04-05	2023-04-08												
	實際完工期																																		
	完成比率																																		
27/F	預算完工期	2023-03-19	2023-03-21					2023-03-30	2023-04-02	2023-03-19	2023-03-21					2023-03-30	2023-04-02	2023-03-19	2023-03-21					2023-03-30	2023-04-02												
	實際完工期																																		
	完成比率																																		
26/F	預算完工期	2023-03-13	2023-03-15					2023-03-24	2023-03-27	2023-03-13	2023-03-15					2023-03-24	2023-03-27	2023-03-13	2023-03-15					2023-03-24	2023-03-27												
	實際完工期																																		
	完成比率																																		
25/F	預算完工期	2023-03-07	2023-03-09					2023-03-18	2023-03-21	2023-03-07	2023-03-09					2023-03-18	2023-03-21	2023-03-07	2023-03-09					2023-03-18	2023-03-21												
	實際完工期																																		
	完成比率																																		
23/F	預算完工期	2023-03-01	2023-03-03					2023-03-12	2023-03-15	2023-03-01	2023-03-03					2023-03-12	2023-03-15	2023-03-01	2023-03-03					2023-03-12	2023-03-15												
	實際完工期																																		
	完成比率																																		
22/F	預算完工期	2023-02-23	2023-02-25					2023-03-06	2023-03-09	2023-02-23	2023-02-25					2023-03-06	2023-03-09	2023-02-23	2023-02-25					2023-03-06	2023-03-09												
	實際完工期																																		
	完成比率																																		
21/F	預算完工期	2023-02-17	2023-02-19					2023-02-28	2023-03-03	2023-02-17	2023-02-19					2023-02-28	2023-03-03	2023-02-17	2023-02-19					2023-02-28	2023-03-03												
	實際完工期																																		
	完成比率	50%								50%								50%																	
20/F	預算完工期	2023-02-11	2023-02-13					2023-02-22	2023-02-25	2023-02-11	2023-02-13					2023-02-22	2023-02-25	2023-02-11	2023-02-13					2023-02-22	2023-02-25												
	實際完工期																																		
	完成比率	50%								50%								50%																	
19/F	預算完工期	2023-02-05	2023-02-07					2023-02-16	2023-02-19	2023-02-05	2023-02-07					2023-02-16	2023-02-19	2023-02-05	2023-02-07					2023-02-16	2023-02-19												
	實際完工期																																		
	完成比率	50%								50%								50%																	
18/F	預算完工期	2023-01-30	2023-02-01					2023-02-10	2023-02-13	2023-01-30	2023-02-01					2023-02-10	2023-02-13	2023-01-30	2023-02-01					2023-02-10	2023-02-13												
	實際完工期																																		
	完成比率	50%								50%								50%																	
17/F	預算完工期	2023-01-13	2023-01-15					2023-01-21	2023-01-24	2023-01-13	2023-01-15					2023-01-21	2023-01-24	2023-01-13	2023-01-15					2023-01-21	2023-01-24												
	實際完工期	2023-01-04	2023-01-06							2023-01-04	2023-01-06							2023-01-04	2023-01-06																
	完成比率	100%	100%							100%	100%							100%	100%																
16/F	預算完工期	2023-01-07	2023-01-09					2023-01-17	2023-01-20	2023-01-07	2023-01-09					2023-01-17	2023-01-20	2023-01-07	2023-01-09					2023-01-17	2023-01-20												
	實際完工期	2023-01-04	2023-01-06							2023-01-04	2023-01-06							2023-01-04	2023-01-06																
	完成比率	100%	100%					50%		100%	100%					50%		100%	100%					50%											
15/F	預算完工期	2023-01-01	2023-01-02					2023-01-13	2023-01-16	2023-01-01	2023-01-02					2023-01-13	2023-01-16	2023-01-01	2023-01-02					2023-01-13	2023-01-16												
	實際完工期	2022-12-29	2022-12-31					2023-01-11		2022-12-22	2022-12-24					2023-01-11		2022-12-22	2022-12-24					2023-01-11											
	完成比率	100%	100%					100%		100%	100%					100%		100%	100%					100%											
12/F	預算完工期	2022-12-26	2022-12-27					2023-01-09	2023-01-12	2022-12-26	2022-12-27					2023-01-09	2023-01-12	2022-12-26	2022-12-27					2023-01-09	2023-01-12												
	實際完工期	2022-12-22	2022-12-23					2023-01-04		2022-12-22	2022-12-24					2023-01-04		2022-12-22	2022-12-24					2023-01-04											
	完成比率	100%	100%					100%		100%	100%					100%		100%	100%					100%											
11/F (Refuge)	預算完工期	2022-12-19	2022-12-21					2023-01-05	2023-01-08	2022-12-19	2022-12-21					2023-01-05	2023-01-08	2022-12-19	2022-12-21					2023-01-05	2023-01-08												
	實際完工期																																		
	完成比率	50%								50%								50%																	
10/F	預算完工期	2022-12-12	2022-12-13					2023-01-01	2023-01-04	2022-12-12	2022-12-13					2023-01-01	2023-01-04	2022-12-12	2022-12-13					2023-01-01	2023-01-04												
	實際完工期	2022-12-03	2022-12-05					2022-12-31		2022-11-28	2022-11-29					2022-12-31		2022-11-28	2022-11-29																
	完成比率	100%	100%					100%		100%	100%					100%		100%	100%					50%											
9/F	預算完工期	2022-12-05	2022-12-06	2022-12-26	2022-12-31	2023-01-02	2023-01-06			2022-12-05	2022-12-06	2022-12-26	2022-12-31	2023-01-02	2023-01-06			2022-12-05	2022-12-06	2022-12-26	2022-12-31	2023-01-02	2023-01-06												
	實際完工期	2022-12-01	2022-12-03							2022-11-26	2022-11-28							2022-11-26	2022-11-28																
	完成比率	100%	100%							100%	100%							100%	100%																

10

美特鋁質有限公司

工程 J858- LP-11 日出康成11 期

2023-01-17

T3 - 幕牆 棚前工作進度表

樓層	工序	BA								BB								BC								BD								物料/到貨			金門交場
		1 墨線	2 測量報告	3 安裝鐵碼 (4件)	4 回焊 (4件)	5 驗焊 (4件)	6 裝起底水槽	7 鋁碼 (4件)	8 裝防火綿插	1 墨線	2 測量報告	3 安裝鐵碼 (2件)	4 回焊 (2件)	5 驗焊 (2件)	6 裝起底水槽	7 鋁碼 (2件)	8 裝防火綿插	1 墨線	2 測量報告	3 安裝鐵碼 (5件)	4 回焊 (5件)	5 驗焊 (5件)	6 裝起底水槽	7 鋁碼 (5件)	8 裝防火綿插	1 墨線	2 測量報告	3 安裝鐵碼 (7件)	4 回焊 (7件)	5 驗焊 (7件)	6 裝起底水槽	7 鋁碼 (7件)	8 裝防火綿插	鐵料	鋁型材	防火綿插	
30/F	預算完工期	2023-04-06	2023-04-08					2023-04-17	2023-04-20	2023-04-06	2023-04-08					2023-04-17	2023-04-20	2023-04-06	2023-04-08					2023-04-17	2023-04-20	2023-04-06	2023-04-08					2023-04-17	2023-04-20				
	實際完工期																																				
	完成比率																																				
29/F	預算完工期	2023-03-31	2023-04-02					2023-04-11	2023-04-14	2023-03-31	2023-04-02					2023-04-11	2023-04-14	2023-03-31	2023-04-02					2023-04-11	2023-04-14	2023-03-31	2023-04-02					2023-04-11	2023-04-14				
	實際完工期																																				
	完成比率																																				
28/F	預算完工期	2023-03-25	2023-03-27					2023-04-05	2023-04-08	2023-03-25	2023-03-27					2023-04-05	2023-04-08	2023-03-25	2023-03-27					2023-04-05	2023-04-08	2023-03-25	2023-03-27					2023-04-05	2023-04-08				
	實際完工期																																				
	完成比率																																				
27/F	預算完工期	2023-03-19	2023-03-21					2023-03-30	2023-04-02	2023-03-19	2023-03-21					2023-03-30	2023-04-02	2023-03-19	2023-03-21					2023-03-30	2023-04-02	2023-03-19	2023-03-21					2023-03-30	2023-04-02				
	實際完工期																																				
	完成比率																																				
26/F	預算完工期	2023-03-13	2023-03-15					2023-03-24	2023-03-27	2023-03-13	2023-03-15					2023-03-24	2023-03-27	2023-03-13	2023-03-15					2023-03-24	2023-03-27	2023-03-13	2023-03-15					2023-03-24	2023-03-27				
	實際完工期																																				
	完成比率																																				
25/F	預算完工期	2023-03-07	2023-03-09					2023-03-18	2023-03-21	2023-03-07	2023-03-09					2023-03-18	2023-03-21	2023-03-07	2023-03-09					2023-03-18	2023-03-21	2023-03-07	2023-03-09					2023-03-18	2023-03-21				
	實際完工期																																				
	完成比率																																				
23/F	預算完工期	2023-03-01	2023-03-03					2023-03-12	2023-03-15	2023-03-01	2023-03-03					2023-03-12	2023-03-15	2023-03-01	2023-03-03					2023-03-12	2023-03-15	2023-03-01	2023-03-03					2023-03-12	2023-03-15				
	實際完工期																																				
	完成比率																																				
22/F	預算完工期	2023-02-23	2023-02-25					2023-03-06	2023-03-09	2023-02-23	2023-02-25					2023-03-06	2023-03-09	2023-02-23	2023-02-25					2023-03-06	2023-03-09	2023-02-23	2023-02-25					2023-03-06	2023-03-09				
	實際完工期																																				
	完成比率																																				
21/F	預算完工期	2023-02-17	2023-02-19					2023-02-28	2023-03-03	2023-02-17	2023-02-19					2023-02-28	2023-03-03	2023-02-17	2023-02-19					2023-02-28	2023-03-03	2023-02-17	2023-02-19					2023-02-28	2023-03-03		TBC	TBC	
	實際完工期																																				
	完成比率	50%								50%								50%								50%											
20/F	預算完工期	2023-02-11	2023-02-13					2023-02-22	2023-02-25	2023-02-11	2023-02-13					2023-02-22	2023-02-25	2023-02-11	2023-02-13					2023-02-22	2023-02-25	2023-02-11	2023-02-13					2023-02-22	2023-02-25		TBC	TBC	
	實際完工期																																				
	完成比率	50%								50%								50%								50%											
19/F	預算完工期	2023-02-05	2023-02-07					2023-02-16	2023-02-19	2023-02-05	2023-02-07					2023-02-16	2023-02-19	2023-02-05	2023-02-07					2023-02-16	2023-02-19	2023-02-05	2023-02-07					2023-02-16	2023-02-19				
	實際完工期																																		已到	已到	
	完成比率	50%								50%								50%								50%											
18/F	預算完工期	2023-01-30	2023-02-01					2023-02-10	2023-02-13	2023-01-30	2023-02-01					2023-02-10	2023-02-13	2023-01-30	2023-02-01					2023-02-10	2023-02-13	2023-01-30	2023-02-01					2023-02-10	2023-02-13				
	實際完工期																																		已到	已到	
	完成比率	50%								50%								50%								50%											
17/F	預算完工期	2023-01-13	2023-01-15					2023-01-21	2023-01-24	2023-01-13	2023-01-15					2023-01-21	2023-01-24	2023-01-13	2023-01-15					2023-01-21	2023-01-24	2023-01-13	2023-01-15					2023-01-21	2023-01-24				
	實際完工期	2023-01-04	2023-01-06							2023-01-04	2023-01-06							2023-01-04	2023-01-06							2023-01-04	2023-01-06								已到	已到	
	完成比率	100%	100%							100%	100%							100%	100%							100%	100%										
16/F	預算完工期	2023-01-07	2023-01-09					2023-01-17	2023-01-20	2023-01-07	2023-01-09					2023-01-17	2023-01-20	2023-01-07	2023-01-09					2023-01-17	2023-01-20	2023-01-07	2023-01-09					2023-01-17	2023-01-20				13/10 拆頂
	實際完工期	2023-01-04	2023-01-06							2023-01-04	2023-01-06							2023-01-04	2023-01-06							2023-01-04	2023-01-06								已到	已到	
	完成比率	100%	100%					50%		100%	100%					50%		100%	100%					50%		100%	100%					50%					
15/F	預算完工期	2023-01-01	2023-01-02					2023-01-13	2023-01-16	2023-01-01	2023-01-02					2023-01-13	2023-01-16	2023-01-01	2023-01-02					2023-01-13	2023-01-16	2023-01-01	2023-01-02					2023-01-13	2023-01-16				05/10/2022
	實際完工期	2022-12-22	2022-12-24					2023-01-11		2022-12-22	2022-12-24					2023-01-11		2022-12-22	2022-12-24					2023-01-11		2022-12-22	2022-12-24					2023-01-11			已到	已到	
	完成比率	100%	100%					100%		100%	100%					100%		100%	100%					100%		100%	100%					100%					
12/F	預算完工期	2022-12-26	2022-12-27					2023-01-09	2023-01-12	2022-12-26	2022-12-27					2023-01-09	2023-01-12	2022-12-26	2022-12-27					2023-01-09	2023-01-12	2022-12-26	2022-12-27					2023-01-09	2023-01-12				28/09/2022
	實際完工期	2022-12-22	2022-12-24					2023-01-04		2022-12-22	2022-12-24					2023-01-04		2022-12-22	2022-12-24					2023-01-04		2022-12-22	2022-12-24					2023-01-04			已到	已到	
	完成比率	100%	100%					100%		100%	100%					100%		100%	100%					100%		100%	100%					100%					
11/F (Refuge)	預算完工期	2022-12-19	2022-12-21					2023-01-05	2023-01-08	2022-12-19	2022-12-21					2023-01-05	2023-01-08	2022-12-19	2022-12-21					2023-01-05	2023-01-08	2022-12-19	2022-12-21					2023-01-05	2023-01-08				
	實際完工期																																		已到	已到	
	完成比率	50%								50%								50%								50%											
10/F	預算完工期	2022-12-12	2022-12-13					2023-01-01	2023-01-04	2022-12-12	2022-12-13					2023-01-01	2023-01-04	2022-12-12	2022-12-13					2023-01-01	2023-01-04	2022-12-12	2022-12-13					2023-01-01	2023-01-04				30/08/2022
	實際完工期	2022-11-28	2022-11-29					2022-12-31		2022-11-28	2022-11-29					2022-12-31		2022-11-28	2022-11-29					2022-12-31		2022-11-28	2022-11-29					2022-12-31			已到	已到	
	完成比率	100%	100%					100%		100%	100%					100%		100%	100%					100%		100%	100%					100%					
9/F	預算完工期	2022-12-05	2022-12-06	2022-12-26	2022-12-31	2023-01-02	2023-01-06			2022-12-05	2022-12-06	2022-12-26	2022-12-31	2023-01-02	2023-01-06			2022-12-05	2022-12-06	2022-12-26	2022-12-31	2023-01-02	2023-01-06			2022-12-05	2022-12-06	2022-12-26	2022-12-31	2023-01-02	2023-01-06						21/08/2022
	實際完工期	2022-11-26	2022-11-28							2022-11-26	2022-11-28							2022-11-26	2022-11-28							2022-11-26	2022-11-28							已到			
	完成比率	100%	100%							100%	100%							100%	100%							100%	100%										

11

美特鋁質有限公司

工程 J858- LP-11 日出康成11 期

2023-01-17

T3 - 幕牆 棚前工作進度表

樓層	工序	BE								BF																				物料/到貨			金門交通
		1 墨線	2 測量報告	3 安裝鐵碼 (2件)	4 回焊 (2件)	5 驗焊 (2件)	6 裝起底水槽	7 鋁碼 (2件)	8 裝防火綿插	1 墨線	2 測量報告	3 安裝鐵碼 (3件)	4 回焊 (3件)	5 驗焊 (3件)	6 裝起底水槽	7 鋁碼 (3件)	8 裝防火綿插															鐵料	鋁型材	防火綿插	
30/F	預算完工期	2023-01-06	2023-04-08					2023-04-17	2023-04-20	2023-01-06	2023-04-08					2023-01-17	2023-04-20																
	實際完工期																																
	完成比率																																
29/F	預算完工期	2023-03-31	2023-04-02					2023-04-11	2023-04-14	2023-03-31	2023-04-02					2023-01-11	2023-04-14																
	實際完工期																																
	完成比率																																
28/F	預算完工期	2023-03-25	2023-03-27					2023-04-05	2023-04-08	2023-03-25	2023-03-27					2023-01-05	2023-04-08																
	實際完工期																																
	完成比率																																
27/F	預算完工期	2023-03-19	2023-03-21					2023-03-30	2023-04-02	2023-03-19	2023-03-21					2023-03-30	2023-04-02																
	實際完工期																																
	完成比率																																
26/F	預算完工期	2023-03-13	2023-03-15					2023-03-24	2023-03-27	2023-03-13	2023-03-15					2023-03-24	2023-03-27																
	實際完工期																																
	完成比率																																
25/F	預算完工期	2023-03-07	2023-03-09					2023-03-18	2023-03-21	2023-03-07	2023-03-09					2023-03-18	2023-03-21																
	實際完工期																																
	完成比率																																
23/F	預算完工期	2023-03-01	2023-03-03					2023-03-12	2023-03-15	2023-03-01	2023-03-03					2023-03-12	2023-03-15																
	實際完工期																																
	完成比率																																
22/F	預算完工期	2023-02-23	2023-02-25					2023-03-06	2023-03-09	2023-02-23	2023-02-25					2023-03-06	2023-03-09																
	實際完工期																																
	完成比率																																
21/F	預算完工期	2023-02-17	2023-02-19					2023-02-28	2023-03-03	2023-02-17	2023-02-19					2023-02-28	2023-03-03																
	實際完工期																																
	完成比率	50%								50%																							
20/F	預算完工期	2023-02-11	2023-02-13					2023-02-22	2023-02-25	2023-02-11	2023-02-13					2023-02-22	2023-02-25															TBC	TBC	
	實際完工期																																
	完成比率	50%								50%																							
19/F	預算完工期	2023-02-05	2023-02-07					2023-02-16	2023-02-19	2023-02-05	2023-02-07					2023-02-16	2023-02-19																
	實際完工期																															已到	已到	
	完成比率	50%								50%																							
18/F	預算完工期	2023-01-30	2023-02-01					2023-02-10	2023-02-13	2023-01-30	2023-02-01					2023-02-10	2023-02-13																
	實際完工期																															已到	已到	
	完成比率	50%								50%																							
17/F	預算完工期	2023-01-13	2023-01-15					2023-01-21	2023-01-24	2023-01-13	2023-01-15					2023-01-21	2023-01-24																
	實際完工期	2023-01-04	2023-01-06							2023-01-04	2023-01-06																					已到	已到	
	完成比率	100%	100%							100%	100%					50%																	
16/F	預算完工期	2023-01-07	2023-01-09					2023-01-17	2023-01-20	2023-01-07	2023-01-09					2023-01-17	2023-01-20																負荷頂未拆
	實際完工期	2023-01-04	2023-01-06							2023-01-04	2023-01-06																					已到	已到	
	完成比率	100%	100%					50%		100%	100%					50%																	
15/F	預算完工期	2023-01-01	2023-01-02					2023-01-13	2023-01-16	2023-01-01	2023-01-02					2023-01-13	2023-01-16																05/10/2022
	實際完工期	2022-12-22	2022-12-24					2023-01-11		2022-12-22	2022-12-24					2023-01-11																已到	已到	
	完成比率	100%	100%					100%		100%	100%					100%																	
12/F	預算完工期	2022-12-26	2022-12-27					2023-01-09	2023-01-12	2022-12-26	2022-12-27					2023-01-09	2023-01-12																28/09/2022
	實際完工期	2022-12-22	2022-12-24					2023-01-04		2022-12-22	2022-12-24					2023-01-04																已到	已到	
	完成比率	100%	100%					100%		100%	100%					100%																	
11/F (Refuge)	預算完工期	2022-12-19	2022-12-21					2023-01-05	2023-01-08	2022-12-19	2022-12-21					2023-01-05	2023-01-08																
	實際完工期																															已到	已到	
	完成比率	50%								50%																							
10/F	預算完工期	2022-12-12	2022-12-13					2023-01-01	2023-01-04	2022-12-12	2022-12-13					2023-01-01	2023-01-04																30/08/2022
	實際完工期	2022-11-28	2022-11-29					2022-12-31		2022-11-28	2022-11-29					2022-12-31																已到	已到	
	完成比率	100%	100%					100%		100%	100%					100%																	
9/F	預算完工期	2022-12-05	2022-12-06	2022-12-26	2022-12-31	2023-01-02	2023-01-06			2022-12-05	2022-12-06	2022-12-26	2022-12-31	2023-01-02	2023-01-06																		21/08/2022
	實際完工期	2022-11-26	2022-11-28							2022-11-26	2022-11-28																					已到		
	完成比率	100%	100%							100%	100%																							

12