



工程指示 / 要求簡箋(E.I.)

工程指示編號：EI / 5635 / 23

修改版次：H

工程編號：J - 858

工程名稱：將軍澳日出康城 11

工程項目：幕牆 收口鋁板 大貨

派位置：清拆

收件人：生統

發件人：Paul Wong

日期：02/06/2023

要求提供 / 確認 事項  
內容

H 版：由於先前的派位圖漏掉鋁板編號，現更新派位圖以便派倉。

G 版：因應地盤需要，所有鋁板出貨，需分型號，分 CW 分柱號來包裝/打扎。

F 版：因應業主 Comment，轉角位置的顏色，先停噴色 AQ-14,15,19,20,37。

E 版：因應顧問要求避免收口鋁板的螺絲鑽穿水槽料的封口片。(不在此 300mm 範圍)；

1. 收口鋁板加工圖修改 AQ-09, AQ-10, AQ-34L, AQ-34R 摺腳螺絲孔位置變更。

E 版：2. T2 T3 9-20/F 鋁板如已生產，請更正用新孔，原子灰蓋舊孔

E 版：3. 如 T1 已出貨的，請重新加做

D 版：1. 取消暫停(AQ56-AQ71)，只暫停(AQ51-AQ55, 9/F 起腳,覆尺後生產)

D 版：2. 此單全為地盆用，取消廠”剔號”

D 版：3. AQ82-AQ90 更正 6x20 長孔去水孔

請在 2023.06.14 前完成上列要求。

附： 頁  
分發東莞各部門：

- ( ) 生產技術總監 連附件 ( ) 技術部 連附件 ( ) 生產部 連附件 ( ) 機械設計部 連附件  
( ) 採購部 連附件 (✓) 生產統籌部 連附件 (✓) 小羅&清 連附件  
( ) 質檢部 連附件 ( ) 會計部 連附件 ( ) 報關組 連附件 ( ) 其他 \_\_\_\_\_ 連附件

分發香港各部門：


- ( ) 行政部 連附件 ( ) 會計部 連附件 ( ) 統籌部 連附件 (✓) 工程部地盤科文 積哥 連附件  
( ) 採購部 連附件 ( ) QS 部 連附件 ( ) 維修部 連附件 ( ) 其他 \_\_\_\_\_ 連附件

傳遞編號：

HK 1261 / 23

發件人簽署：

項目經理簽署：

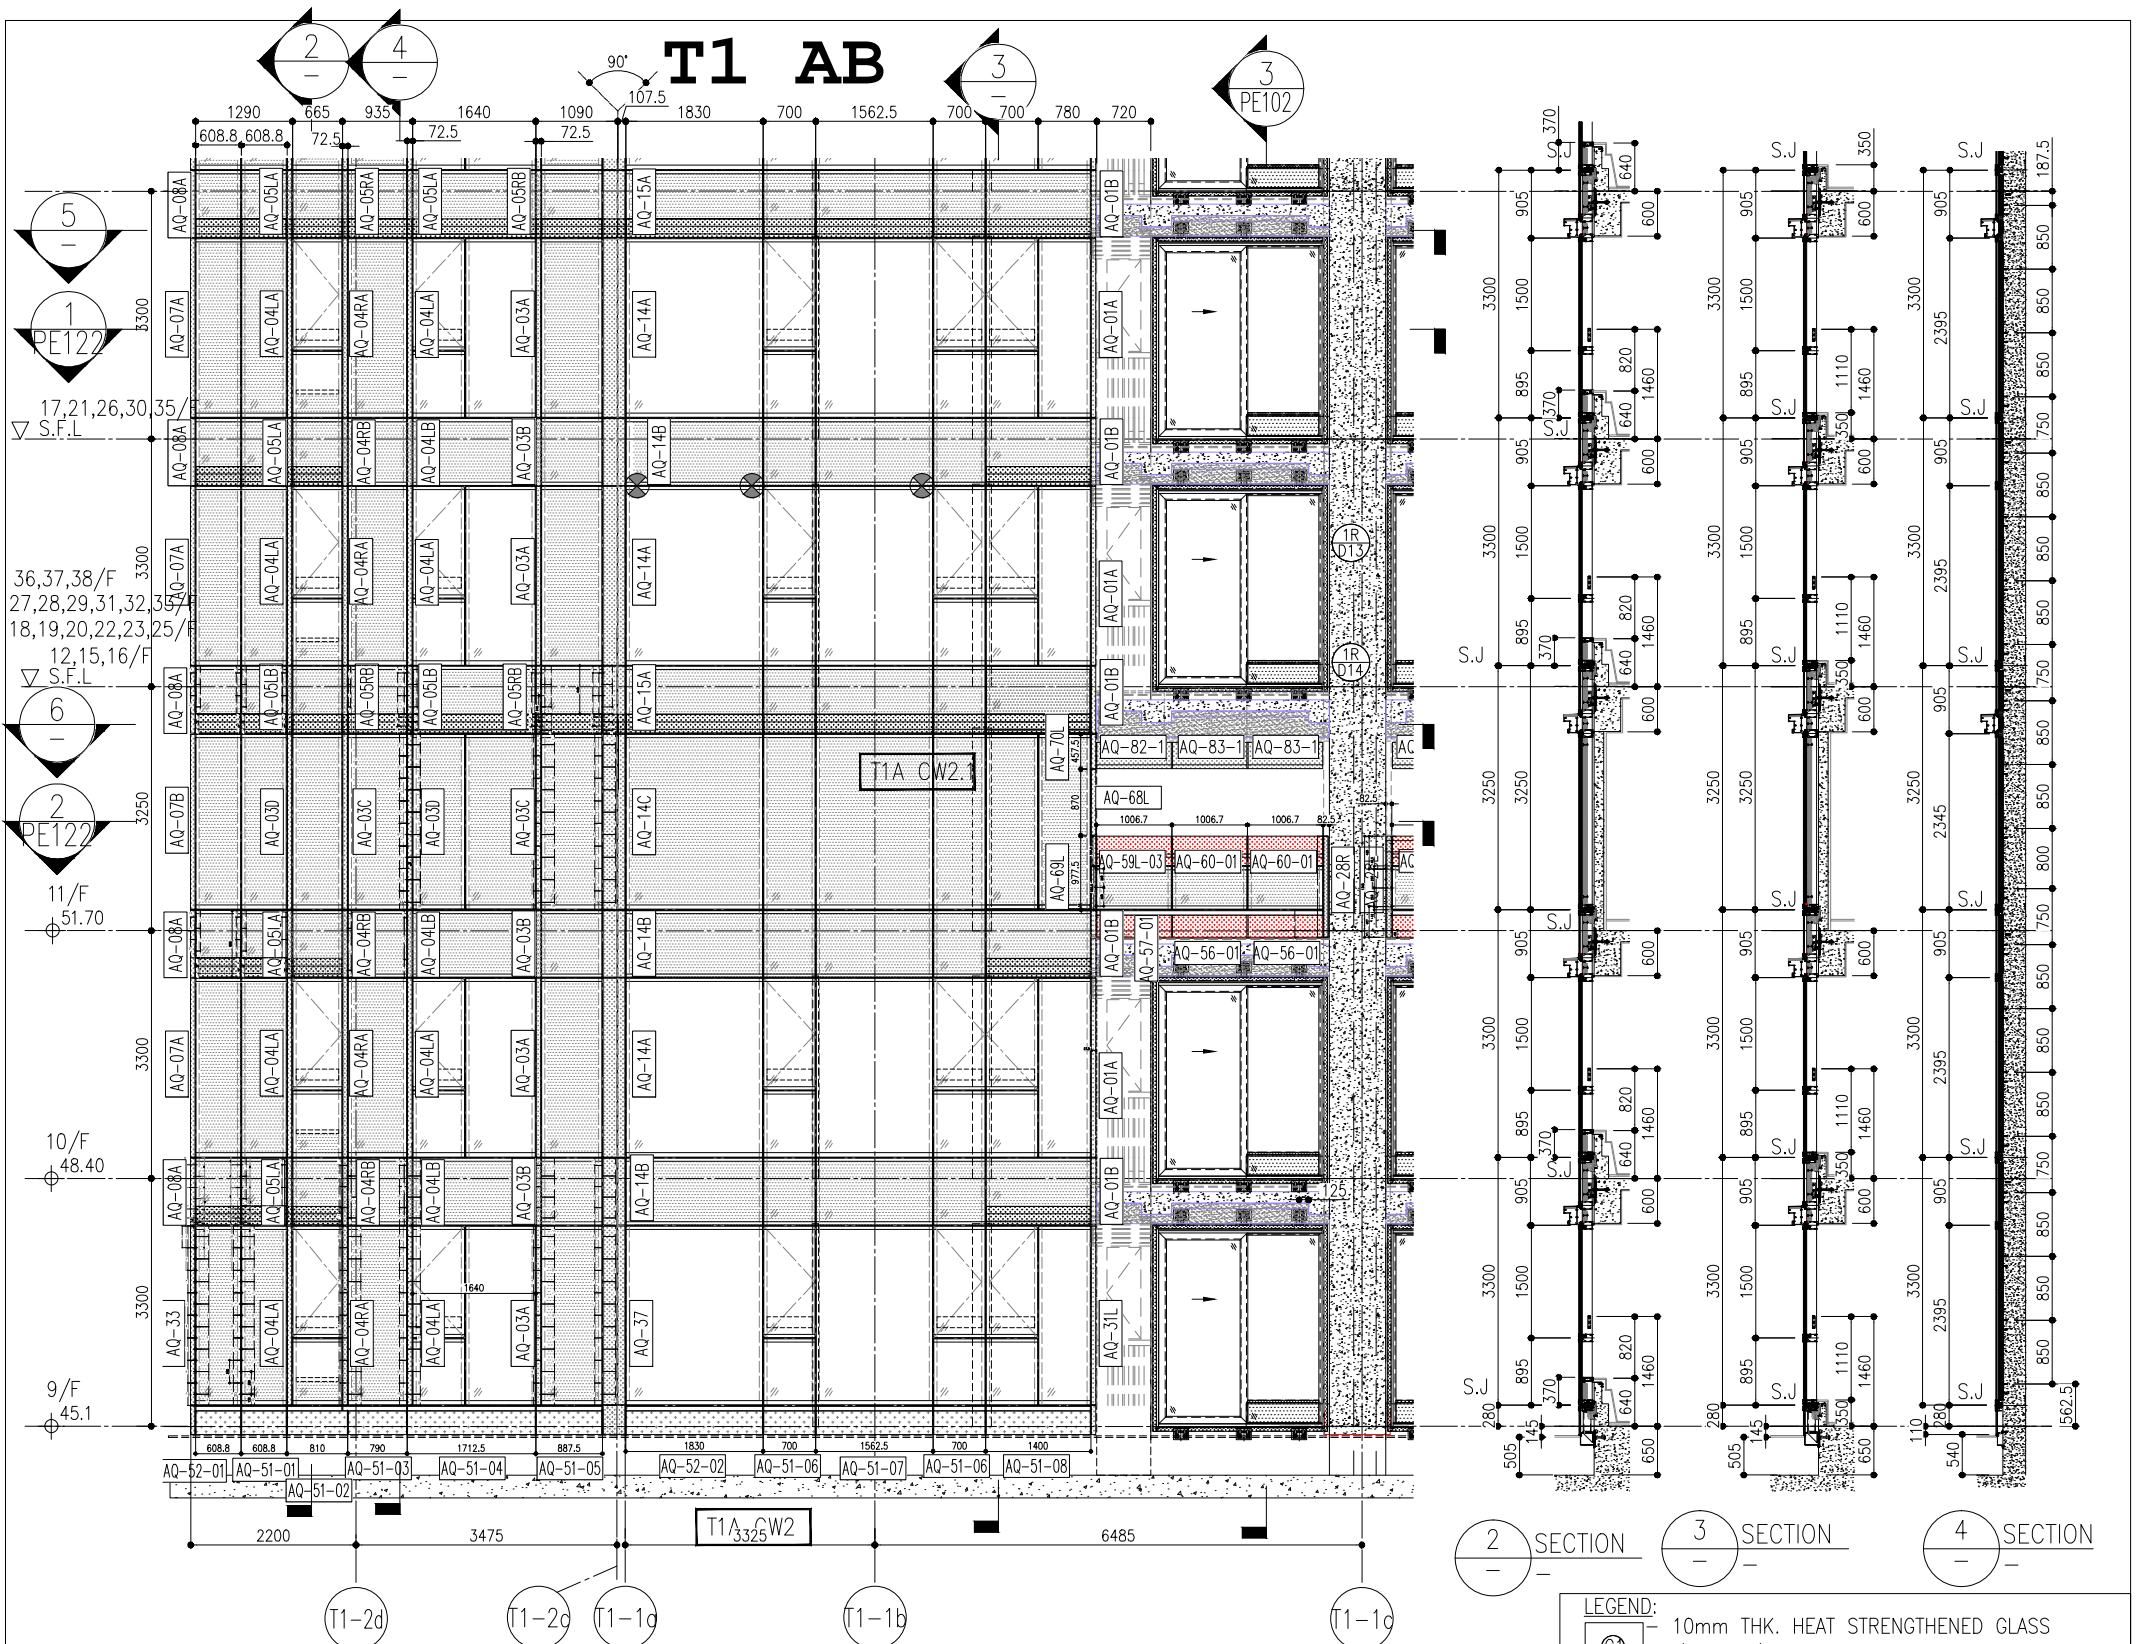

1 PART ELEVATION FOR CURTAIN WALL


2 SECTION 3 SECTION 4 SECTION

ARCH. FEATURE AT 11/F, 17/F, 21/F, 26/F, 30/F, 35/F,

ARCH. FEATURE AT 9/F, 10/F, 12/F, 15/F-16/F, 18/F-20/F, 22/F, 23/F, 25/F, 27/F-29/F, 31/F-33/F, 36/F-38/F,

26/F +91.25	39/F +130.85	52/F +170.40	R/F +203.80
25/F +87.95	38/F +127.55	51/F +167.10	62/F +200.30
23/F +84.65	37/F +124.25	50/F +163.80	61/F +196.80
22/F +81.35	36/F +120.95	49/F +160.50	60/F +193.50
21/F +78.05	35/F +117.65	48/F +157.20	59/F +190.20
20/F +74.75	33/F +114.35	47/F +153.90	58/F +186.90
19/F +71.45	32/F +111.05	46/F +150.60	57/F +183.60
18/F +68.15	31/F 107.75	45/F +147.30	56/F +180.30
17/F +64.85	30/F +104.45	43/F +144.00	55/F +177.00
16/F +61.55	29/F +101.15	42/F +140.70	53/F +173.70
15/F +58.25	28/F +97.85	41/F +137.40	
12/F +54.95	27/F +94.55	40/F +134.15	

ARCH. FEATURE AT 9/F, 10/F, 12/F, 15/F-16/F, 18/F-20/F, 22/F, 23/F, 25/F, 27/F-29/F, 31/F-33/F, 36/F-38/F,

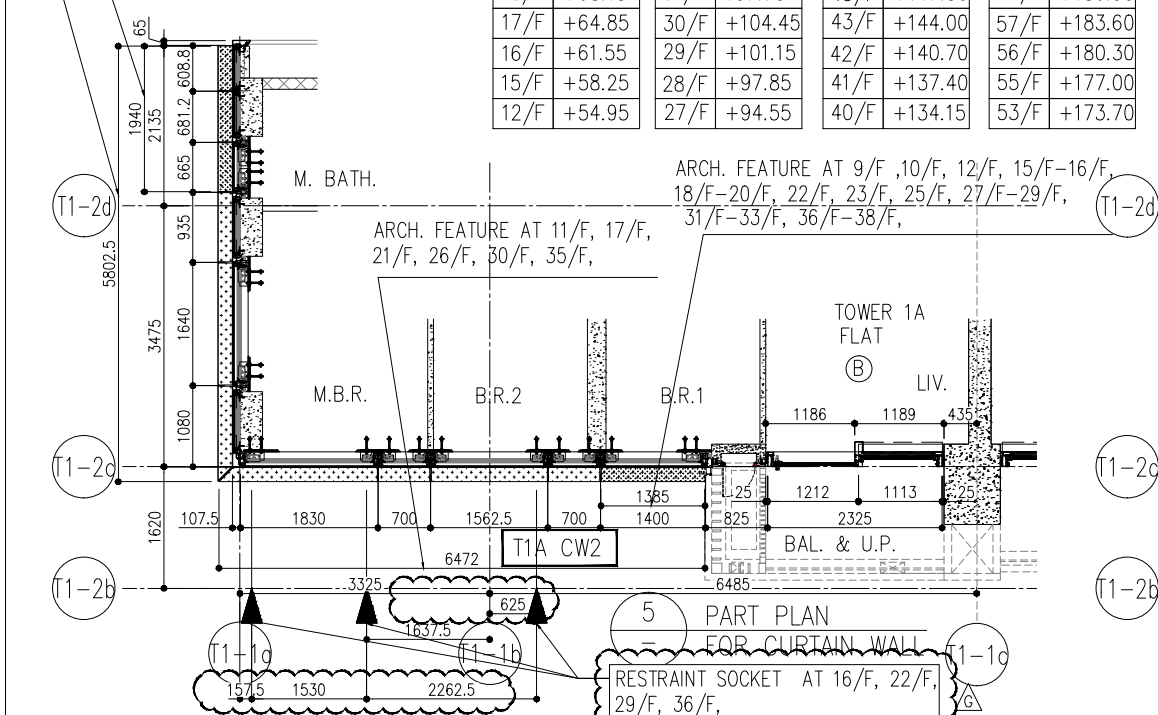

5 PART PLAN FOR CURTAIN WALL

6 PART PLAN(11/F) FOR CURTAIN WALL

- LEGEND:
- 10mm THK. HEAT STRENGTHENED GLASS (OUTSIDE) +12mm AIR SPACE + 12mm THK. TEMPERED GLASS
  - 10mm THK. HEAT STRENGTHENED GLASS (OUTSIDE) +12mm AIR SPACE + 10mm THK. TEMPERED GLASS
  - 12mm THK. HEAT STRENGTHENED GLASS
  - 12mm THK. CLEAR TEMPERED GLASS ( INTERNAL PROTECTIVE BARRIER )
  - 10mm THK. HEAT STRENGTHENED GLASS (OUTSIDE) +12mm AIR SPACE + 12mm THK. TEMPERED GLASS WITH REFLECTIVE COATING
  - 10mm THK. CLEAR TEMPERED GLASS
  - 8mm THK. CLEAR HEAT STRENGTHENED GLASS +1.52mm PVB + 8mm THK. CLEAR HEAT-STRENGTHENED GLASS
  - 3 mm THK. ALUM. CLADDING
  - 3 mm THK. ALUM. BACKPAN
  - S.J. - STACK JOINT
  - RESTRAINT SOCKET

NOTE:

- ALL DIMENSIONS ARE IN mm.
- ALL ELEVATIONS ARE VIEWED FROM OUTSIDE.
- ALL DIMENSIONS TO BE VERIFIED ON SITE BEFORE FABRICATION.

LEGEND:

- DETAIL MARK NO.
- REFER SHEET NO.
- F.F.L. - FINISHED FLOOR LEVEL
- S.F.L. - STRUCTURAL FLOOR LEVEL
- R/L - REVERSED DETAIL

JOB NO.: J-854

PROJECT: PROPOSED RESIDENTIAL AT T101 70RP, PHASE TSEUNG KWAN

TITLE: TYPICAL FLOOR ELEVATION & SECTION FOR CURTAIN WALL

DATE: 22-OCT-21

DWG NO.: J858-CW-PE101

REV.: G

1	17/08/22	REVISED AS PER COMMENTS	LS
2	26/07/22	REVISED AS PER COMMENTS	LS
3	23/05/22	REVISED AS PER COMMENTS	LS
4	06/04/22	REVISED AS PER COMMENTS	LS
5	20/01/22	REVISED AS PER COMMENTS	LS
6	03/12/21	REVISED AS PER COMMENTS	LS

CLIENT: 信和置業有限公司  
Sino Land Company Limited

ARCHITECT: ronaid lu & partners  
Ronald Lu & Partners (HK) Ltd.  
呂允輝建築師事務所 (香港) 有限公司


MAIN CONTRACTOR: Gammon

STRUCTURAL ENGINEER: AECOM


FAÇADE CONSULTANT: AECOM

B.D. REF.:


PE101

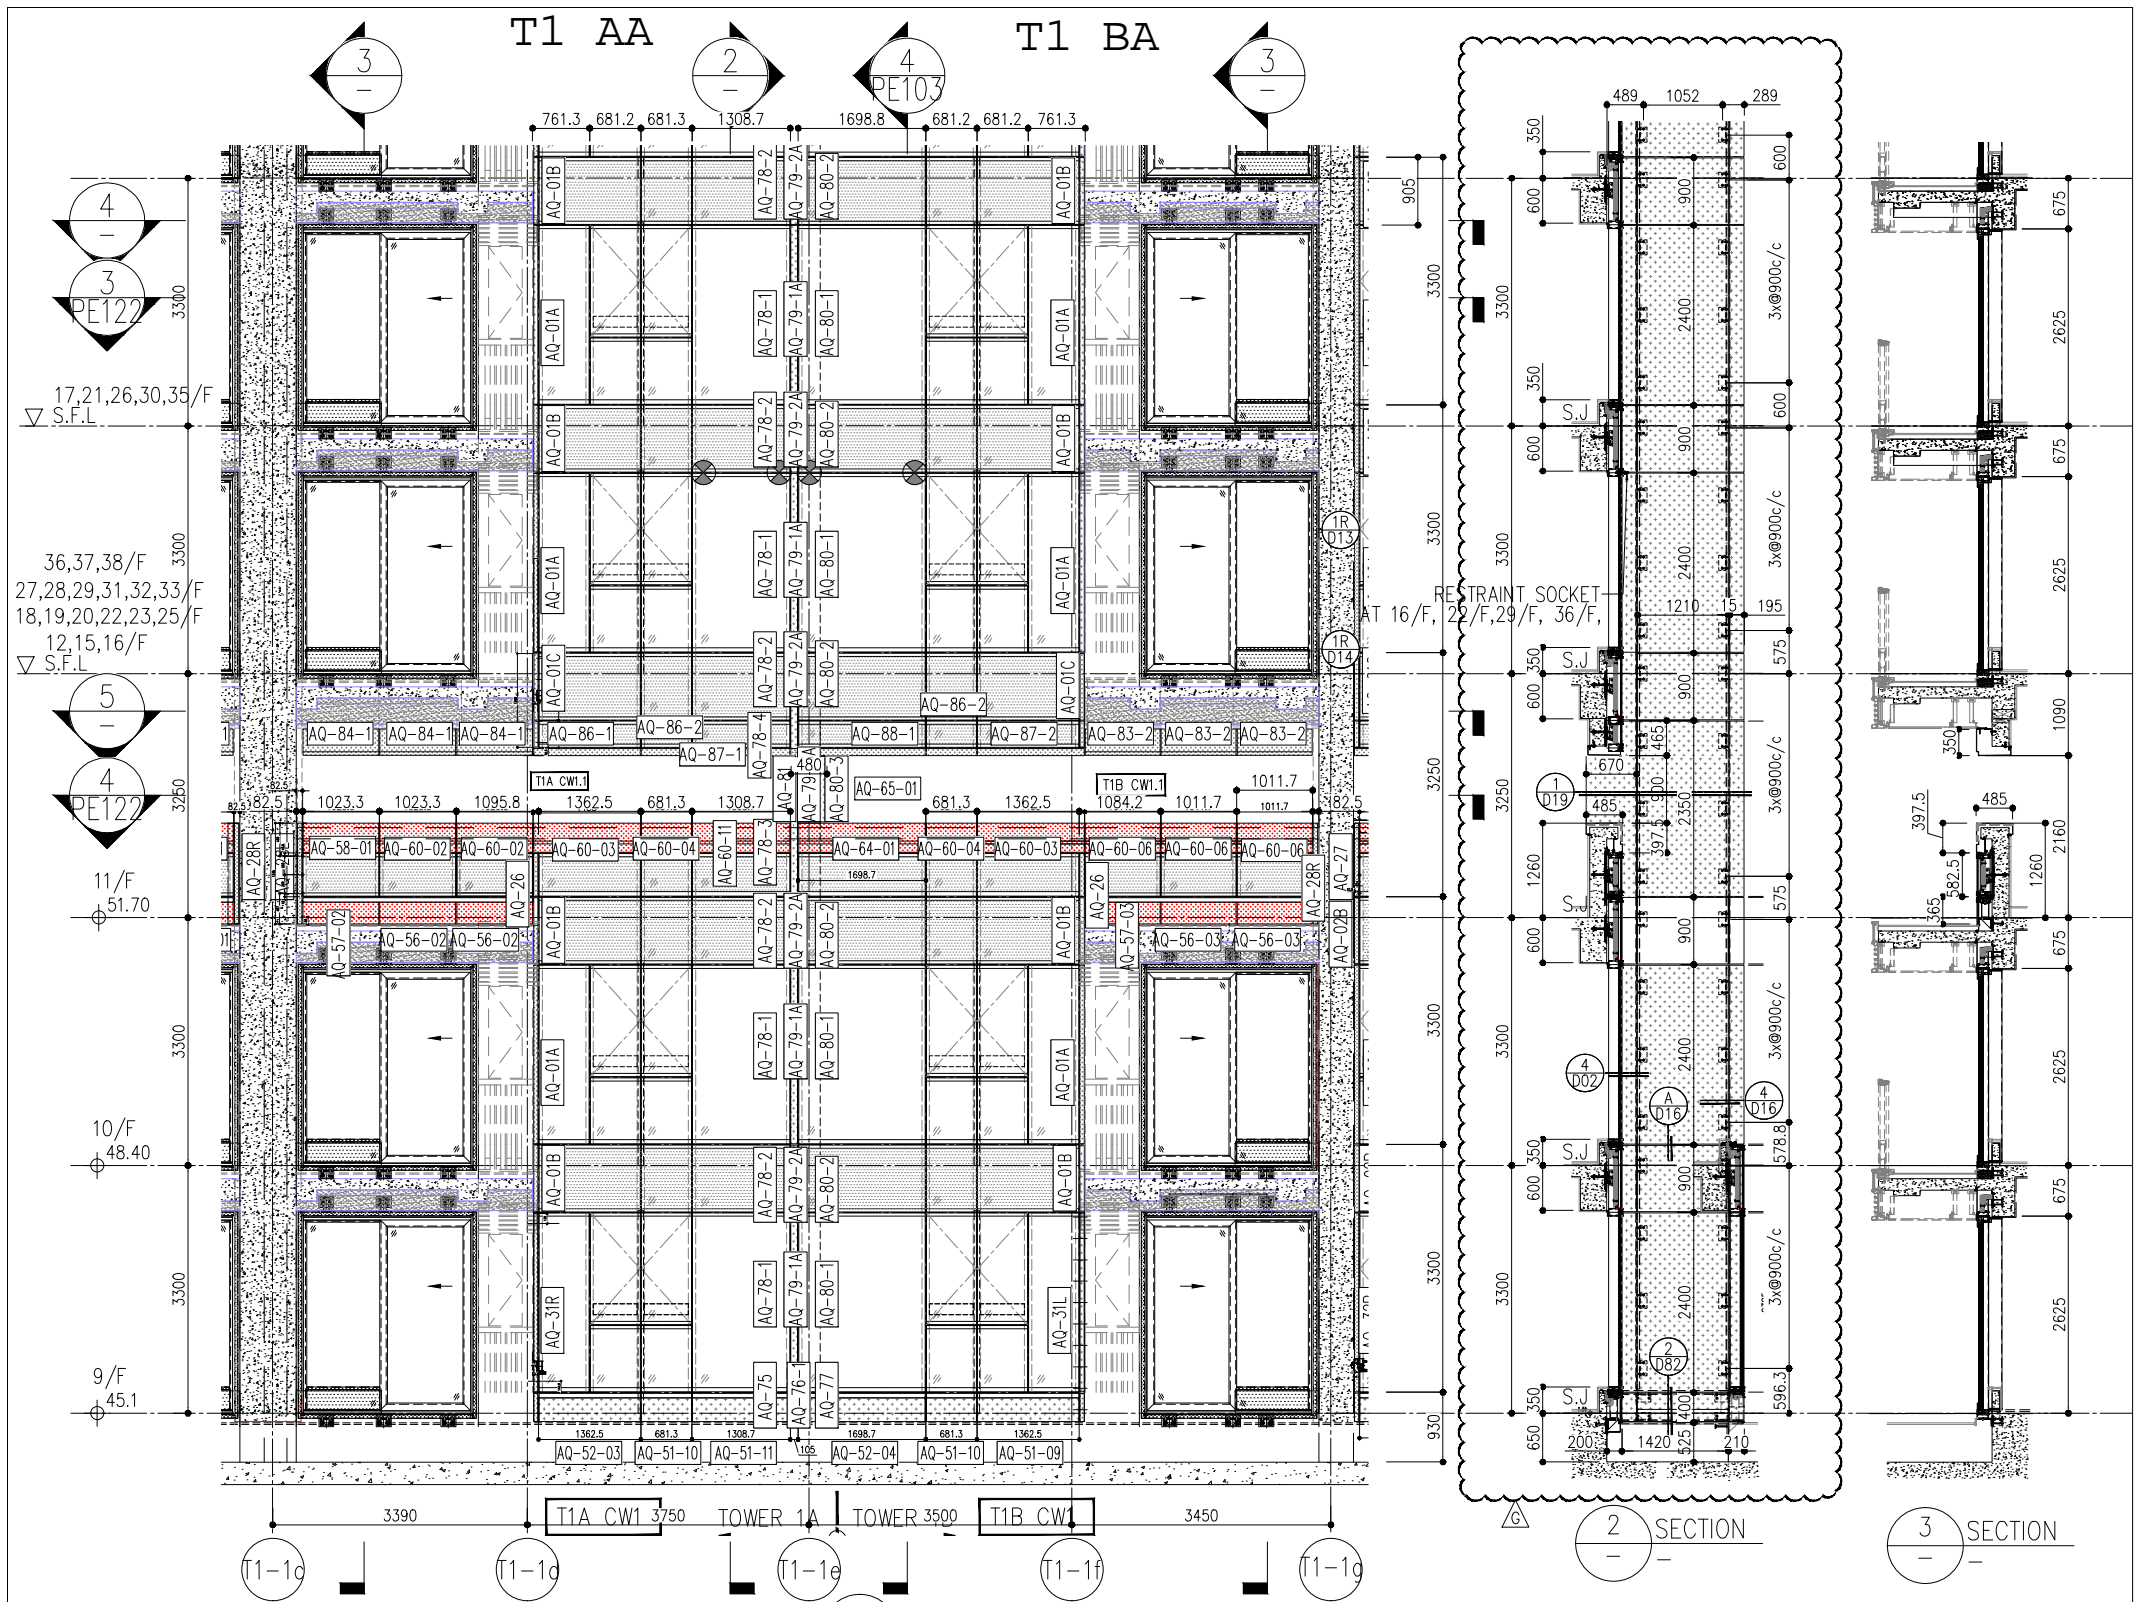

1 PART ELEVATION FOR CURTAIN WALL

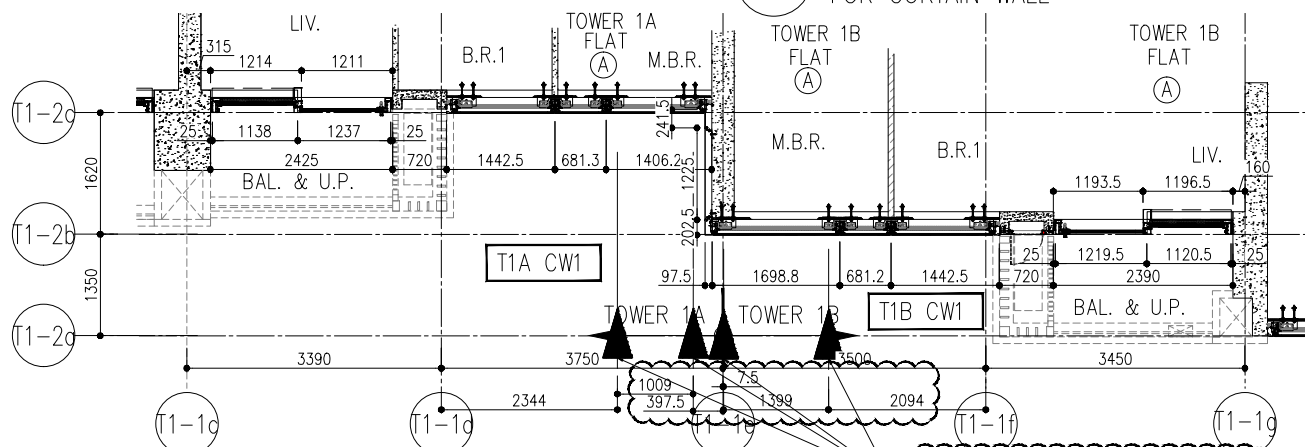

4 PART PLAN FOR CURTAIN WALL

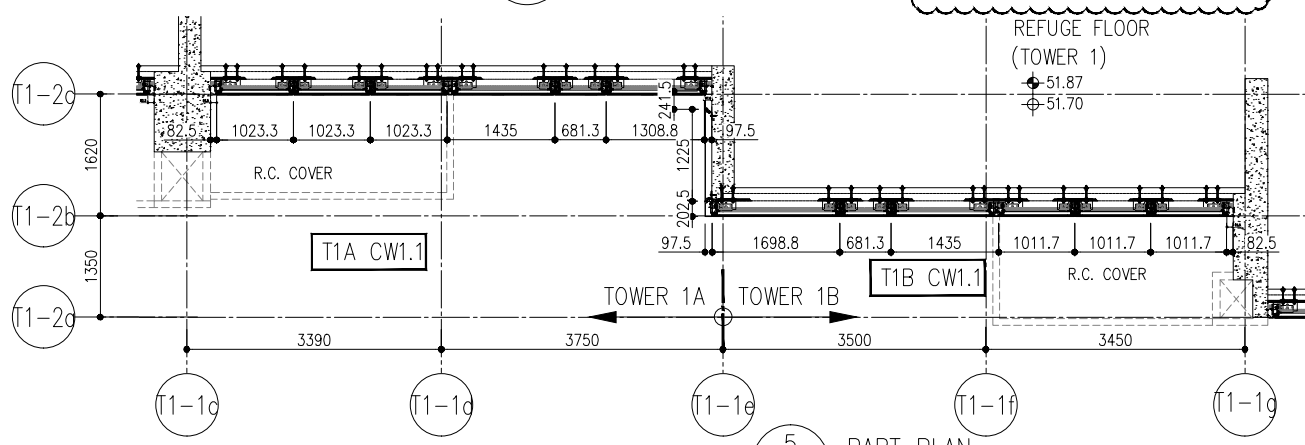


5 PART PLAN FOR CURTAIN WALL (11/F)

26/F	+91.25	39/F	+130.85	52/F	+170.40
25/F	+87.95	38/F	+127.55	51/F	+167.10
23/F	+84.65	37/F	+124.25	50/F	+163.80
22/F	+81.35	36/F	+120.95	49/F	+160.50
21/F	+78.05	35/F	+117.65	48/F	+157.20
20/F	+74.75	33/F	+114.35	47/F	+153.90
19/F	+71.45	32/F	+111.05	46/F	+150.60
18/F	+68.15	31/F	+107.75	45/F	+147.30
17/F	+64.85	30/F	+104.45	43/F	+144.00
16/F	+61.55	29/F	+101.15	42/F	+140.70
15/F	+58.25	28/F	+97.85	41/F	+137.40
12/F	+54.95	27/F	+94.55	40/F	+134.15
				R/F	+203.80
				62/F	+200.30
				61/F	+196.80
				60/F	+193.50
				59/F	+190.20
				58/F	+186.90
				57/F	+183.60
				56/F	+180.30
				55/F	+177.00
				53/F	+173.70

- LEGEND:
- 10mm THK. HEAT STRENGTHENED GLASS (OUTSIDE) + 12mm AIR SPACE + 12mm THK. TEMPERED GLASS
  - 10mm THK. HEAT STRENGTHENED GLASS (OUTSIDE) + 12mm AIR SPACE + 10mm THK. TEMPERED GLASS
  - 12mm THK. HEAT STRENGTHENED GLASS
  - 12mm THK. CLEAR TEMPERED GLASS ( INTERNAL PROTECTIVE BARRIER )
  - 10mm THK. HEAT STRENGTHENED GLASS (OUTSIDE) + 12mm AIR SPACE + 12mm THK. TEMPERED GLASS WITH REFLECTIVE COATING
  - 10mm THK. CLEAR TEMPERED GLASS
  - 8mm THK. CLEAR HEAT STRENGTHENED GLASS + 1.52mm AIR SPACE + 8mm THK. CLEAR HEAT-STRENGTHENED GLASS
  - 3 mm THK. ALUM. CLADDING
  - 3 mm THK. ALUM. BACKPAN
  - S.J. - STACK JOINT
  - RESTRAINT SOCKET

<p>美特 鋁質有限公司 MIDI Aluminium Fabricator Ltd. Units 6-8, Sunray Industrial Centre, 1/F 610 Cho Kwong Road, Kowloon Tel: 23489211-4 Fax: (852) 27727666</p>	<p>PROJECT: PROPOSED RESIDENTIAL AT TQOT 709P, PHASE TSLUNG KWAN</p>	<p>JOB NO.: J-854</p>	<p>DATE: 22-OCT-21</p>	<p>TITLE: TYPICAL FLOOR ELEVATION &amp; SECTION FOR CURTAIN WALL</p>	<p>DATE: 22-OCT-21</p>	<p>REV: G</p>	<p>PE102</p>	<p>NOTE: 1. ALL DIMENSIONS ARE IN mm. 2. ALL ELEVATIONS ARE VIEWED FROM OUTSIDE. 3. ALL DIMENSIONS TO BE VERIFIED ON SITE BEFORE FABRICATION.</p>	<p>LEGEND: ① - DETAIL MARK NO. ② - REFER SHEET NO. ③ - F.F.L. - FINISHED FLOOR LEVEL ④ - S.F.L. - STRUCTURAL FLOOR LEVEL ⑤ - REVERSED DETAIL</p>	<p>ARCHITECT:  ronaldi &amp; partners Ronald Li &amp; Partners (HK) Ltd. 呂允梓建築師事務所 (香港) 有限公司</p>	<p>CLIENT:  信和置業有限公司 Sino Land Company Limited</p>	<p>STRUCTURAL ENGINEER:  Gammion</p>	<p>FAÇADE CONSULTANT:  AECOM</p>	<p>B.D. REF.:</p>

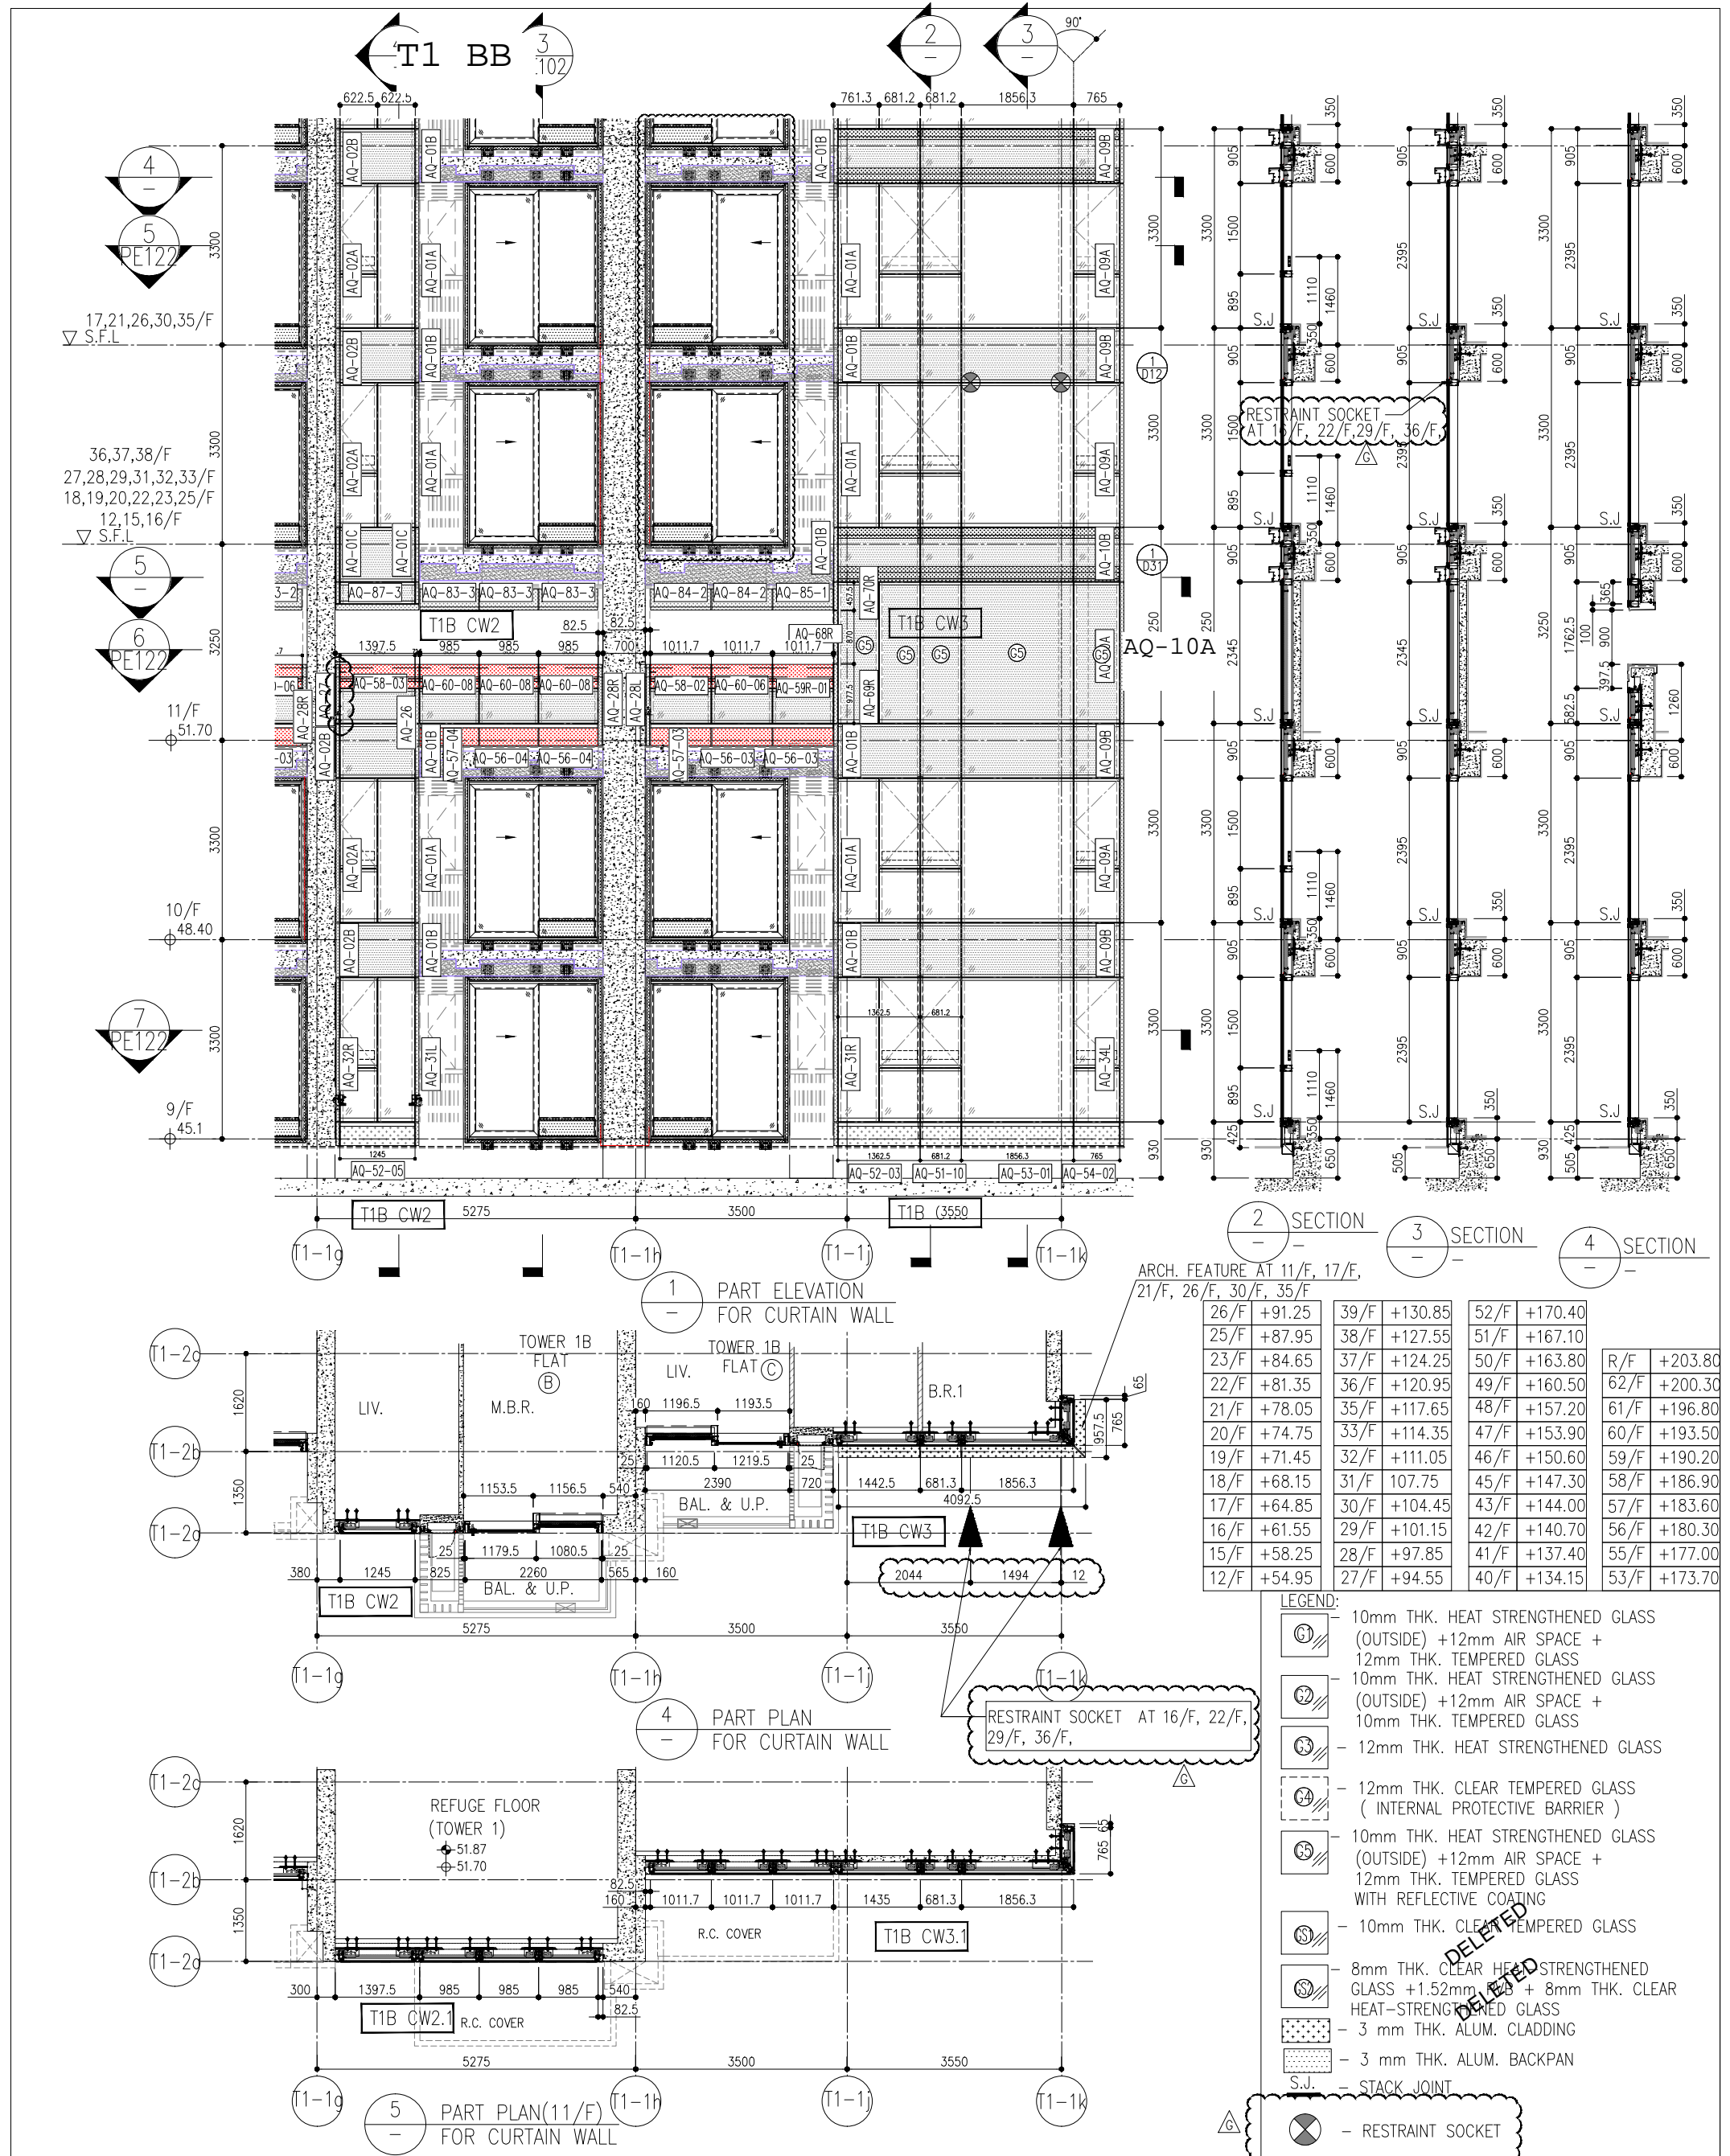

ARCH. FEATURE AT 11/F, 17/F, 21/F, 26/F, 30/F, 35/F

26/F	+91.25	39/F	+130.85	52/F	+170.40
25/F	+87.95	38/F	+127.55	51/F	+167.10
23/F	+84.65	37/F	+124.25	50/F	+163.80
22/F	+81.35	36/F	+120.95	49/F	+160.50
21/F	+78.05	35/F	+117.65	48/F	+157.20
20/F	+74.75	33/F	+114.35	47/F	+153.90
19/F	+71.45	32/F	+111.05	46/F	+150.60
18/F	+68.15	31/F	+107.75	45/F	+147.30
17/F	+64.85	30/F	+104.45	43/F	+144.00
16/F	+61.55	29/F	+101.15	42/F	+140.70
15/F	+58.25	28/F	+97.85	41/F	+137.40
12/F	+54.95	27/F	+94.55	40/F	+134.15
				61/F	+196.80
				60/F	+193.50
				59/F	+190.20
				58/F	+186.90
				57/F	+183.60
				56/F	+180.30
				55/F	+177.00
				53/F	+173.70

- LEGEND:
- 10mm THK. HEAT STRENGTHENED GLASS (OUTSIDE) + 12mm AIR SPACE + 12mm THK. TEMPERED GLASS
  - 10mm THK. HEAT STRENGTHENED GLASS (OUTSIDE) + 12mm AIR SPACE + 10mm THK. TEMPERED GLASS
  - 12mm THK. HEAT STRENGTHENED GLASS
  - 12mm THK. CLEAR TEMPERED GLASS ( INTERNAL PROTECTIVE BARRIER )
  - 10mm THK. HEAT STRENGTHENED GLASS (OUTSIDE) + 12mm THK. TEMPERED GLASS WITH REFLECTIVE COATING
  - 10mm THK. CLEAR TEMPERED GLASS
  - 3 mm THK. ALUM. CLADDING
  - 3 mm THK. ALUM. BACKPAN
  - S.J. - STACK JOINT
  - RESTRAINT SOCKET

**PE103**

TITLE: TYPICAL FLOOR ELEVATION & SECTION FOR CURTAIN WALL

DATE: 22-OCT-21

DRAWN BY: SC

PROJECT: PROPOSED RESIDENTIAL AT TKOIL 70RP, PHASE TSIUNG KWAN

JOB NO.: J-854

NO. DATE REVISIONS

A	03/12/21	REVISED AS PER COMMENTS	US
B	20/12/21	REVISED AS PER COMMENTS	US
C	24/01/22	REVISED AS PER COMMENTS	US
D	06/04/22	REVISED AS PER COMMENTS	US
E	23/05/22	REVISED AS PER COMMENTS	US
F	26/07/22	REVISED AS PER COMMENTS	US
G	12/08/22	REVISED AS PER COMMENTS	US

NOTE:

- ALL DIMENSIONS ARE IN mm.
- ALL ELEVATIONS ARE VIEWED FROM OUTSIDE.
- ALL DIMENSIONS TO BE VERIFIED ON SITE BEFORE FABRICATION.

LEGEND:

- DETAIL MARK NO.
- REFER SHEET NO.
- F.F.L. -- FINISHED FLOOR LEVEL
- S.F.L. -- STRUCTURAL FLOOR LEVEL
- R -- REVERSED DETAIL

ARCHITECT: **ronaldu & partners**  
Ronald Liu & Partners (HK) Ltd.  
呂允祥建築師事務所 (香港) 有限公司


CLIENT: 信和置業有限公司  
Sino Land Company Limited

STRUCTURAL ENGINEER: **Gammon**

FAÇADE CONSULTANT: **AECOM**

B.D. REF.:

T1 AB (高層)

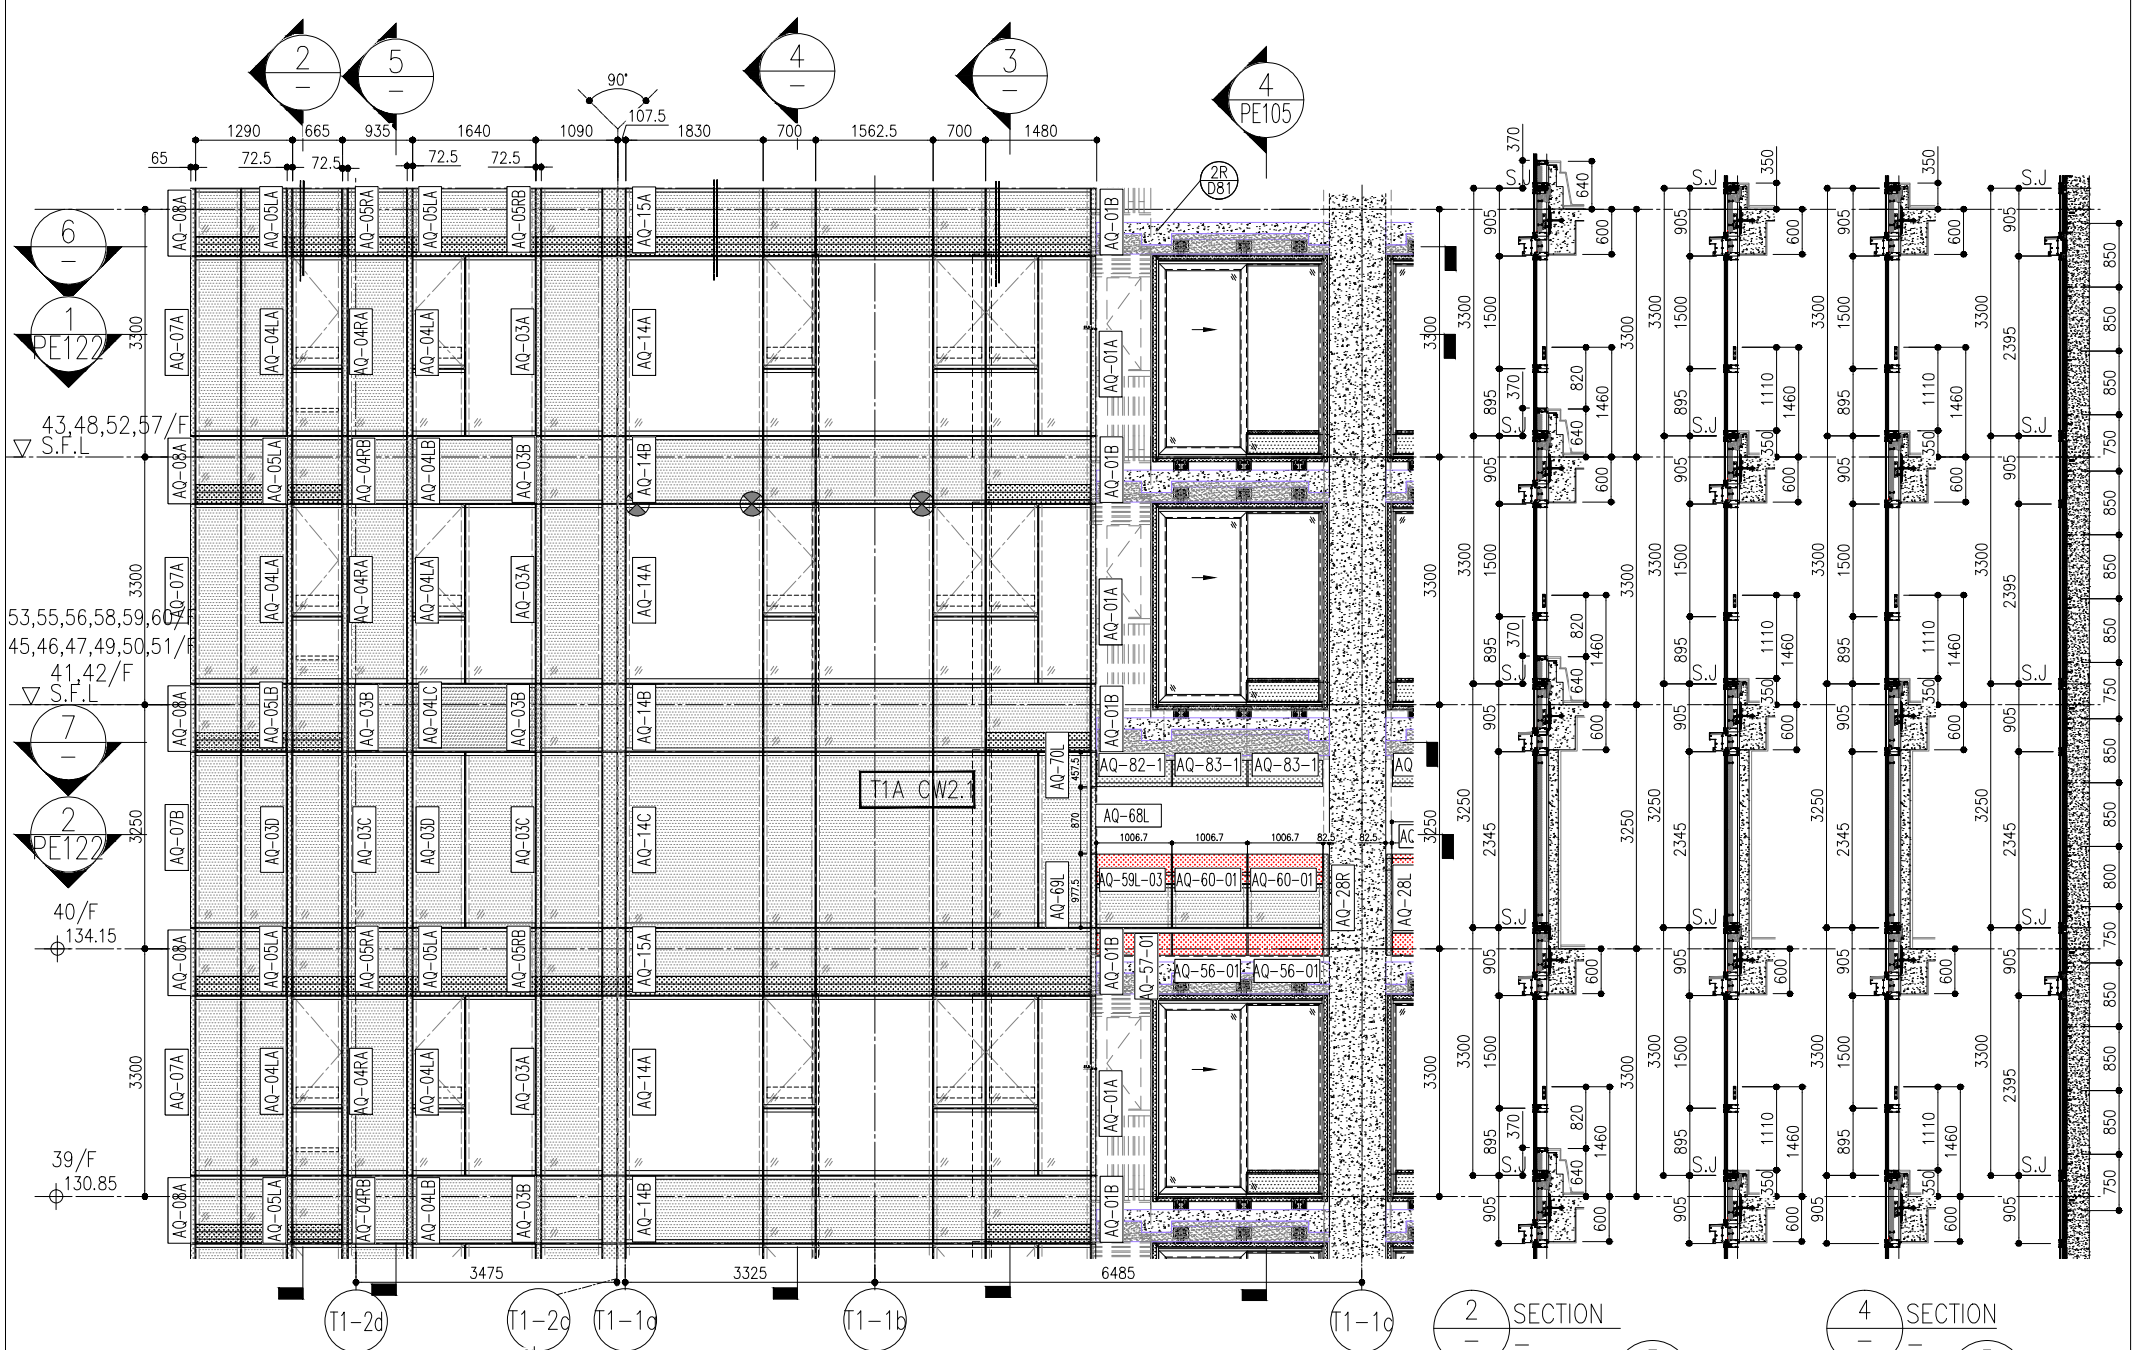

ARCH. FEATURE AT 40/F-42/F,  
45/F-47/F, 49/F-51/F, 53/F-56/F,  
58/F-60/F


1 PART ELEVATION  
FOR CURTAIN WALL

ARCH. FEATURE AT 39/F  
43/F, 48/F, 52/F, 57/F

6 PART PLAN  
FOR CURTAIN WALL

ARCH. FEATURE AT 39/F  
43/F, 48/F, 52/F, 57/F

7 PART PLAN(40/F)  
FOR CURTAIN WALL

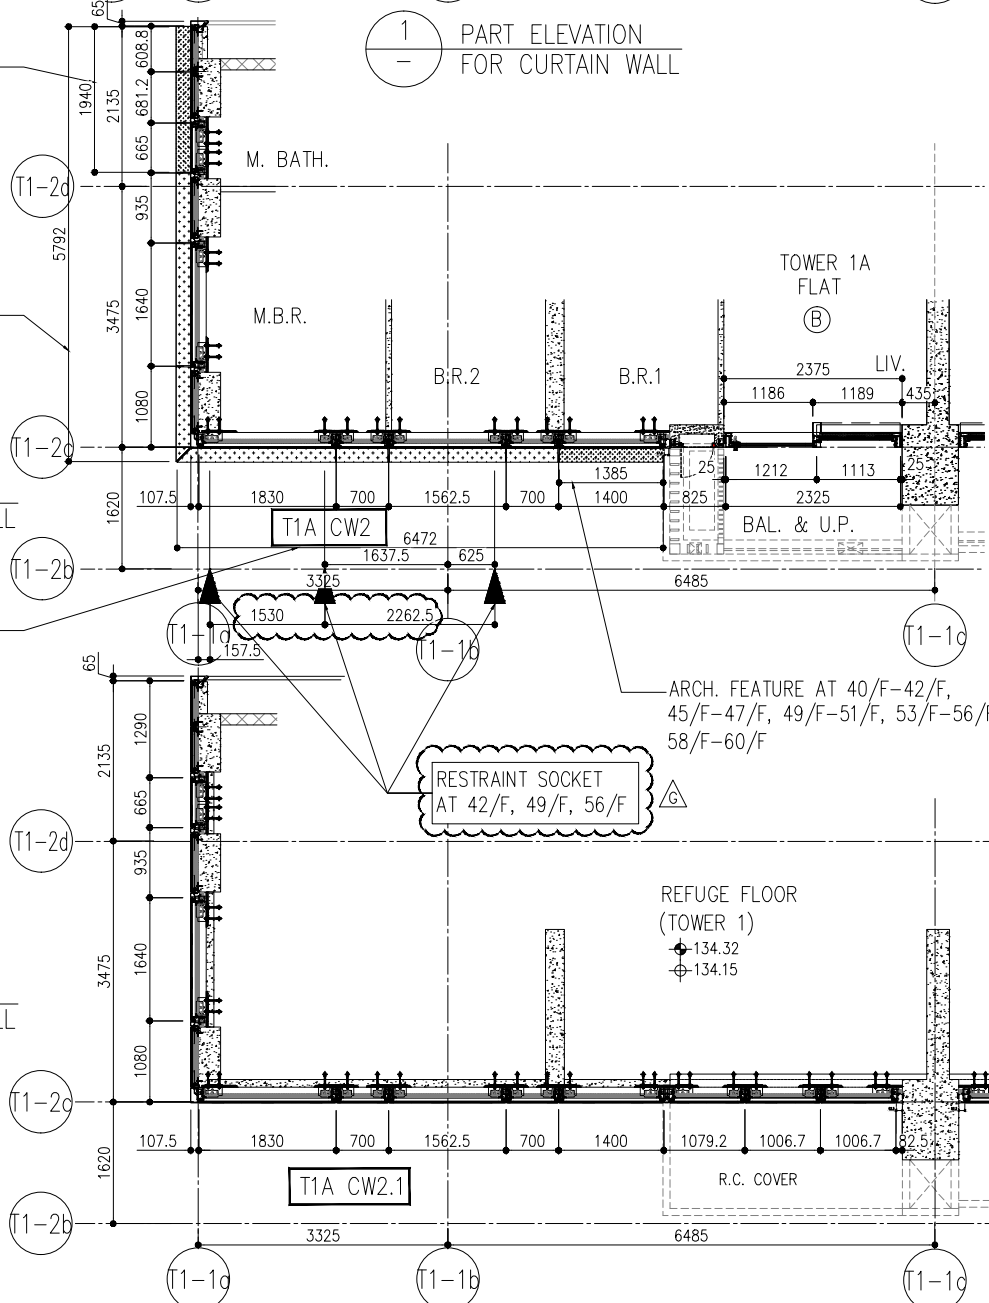


26/F	+91.25	39/F	+130.85	52/F	+170.40
25/F	+87.95	38/F	+127.55	51/F	+167.10
23/F	+84.65	37/F	+124.25	50/F	+163.80
22/F	+81.35	36/F	+120.95	49/F	+160.50
21/F	+78.05	35/F	+117.65	48/F	+157.20
20/F	+74.75	33/F	+114.35	47/F	+153.90
19/F	+71.45	32/F	+111.05	46/F	+150.60
18/F	+68.15	31/F	107.75	45/F	+147.30
17/F	+64.85	30/F	+104.45	43/F	+144.00
16/F	+61.55	29/F	+101.15	42/F	+140.70
15/F	+58.25	28/F	+97.85	41/F	+137.40
12/F	+54.95	27/F	+94.55	40/F	+134.15
				R/F	+203.80
				62/F	+200.30
				61/F	+196.80
				60/F	+193.50
				59/F	+190.20
				58/F	+186.90
				57/F	+183.60
				56/F	+180.30
				55/F	+177.00
				53/F	+173.70

- LEGEND:
- 10mm THK. HEAT STRENGTHENED GLASS (OUTSIDE) + 12mm AIR SPACE + 12mm THK. TEMPERED GLASS
  - 10mm THK. HEAT STRENGTHENED GLASS (OUTSIDE) + 12mm AIR SPACE + 10mm THK. TEMPERED GLASS
  - 12mm THK. HEAT STRENGTHENED GLASS
  - 12mm THK. CLEAR TEMPERED GLASS ( INTERNAL PROTECTIVE BARRIER )
  - 10mm THK. HEAT STRENGTHENED GLASS (OUTSIDE) + 12mm AIR SPACE + 12mm THK. TEMPERED GLASS WITH REFLECTIVE COATING
  - 10mm THK. CLEAR TEMPERED GLASS
  - 8mm THK. CLEAR HEAT-STRENGTHENED GLASS + 1.52mm PVB + 8mm THK. CLEAR HEAT-STRENGTHENED GLASS
  - 3 mm THK. ALUM. CLADDING
  - 3 mm THK. ALUM. BACKPAN
  - S.J. - STACK JOINT
  - RESTRAINT SOCKET


<p>DWG NO. : J858-CW-PE104</p> <p>REV. : G</p>	<p>DATE : 22-OCT-21</p> <p>SCALE : AS SHOWN</p>	<p>TITLE : TYPICAL FLOOR ELEVATION &amp; SECTION FOR CURTAIN WALL</p>	<p>PROJECT : PROPOSED RESIDENTIAL AT TKOIL ZONE, PHASE TSEUNG KWAN</p>	<p>JOB NO. : J-854</p> <p>DATE : 03/12/21</p>	<p>NOTE : 1. ALL DIMENSIONS ARE IN mm. 2. ALL ELEVATIONS ARE VIEWED FROM OUTSIDE. 3. ALL DIMENSIONS TO BE VERIFIED ON SITE BEFORE FABRICATION.</p>	<p>LEGEND : (X) DETAIL MARK NO. 
--	---	---	--	---	--	---	--	--	---	--------------------

PE104


4 T1 AA (高層) PE106 3 T1 BA (高層)

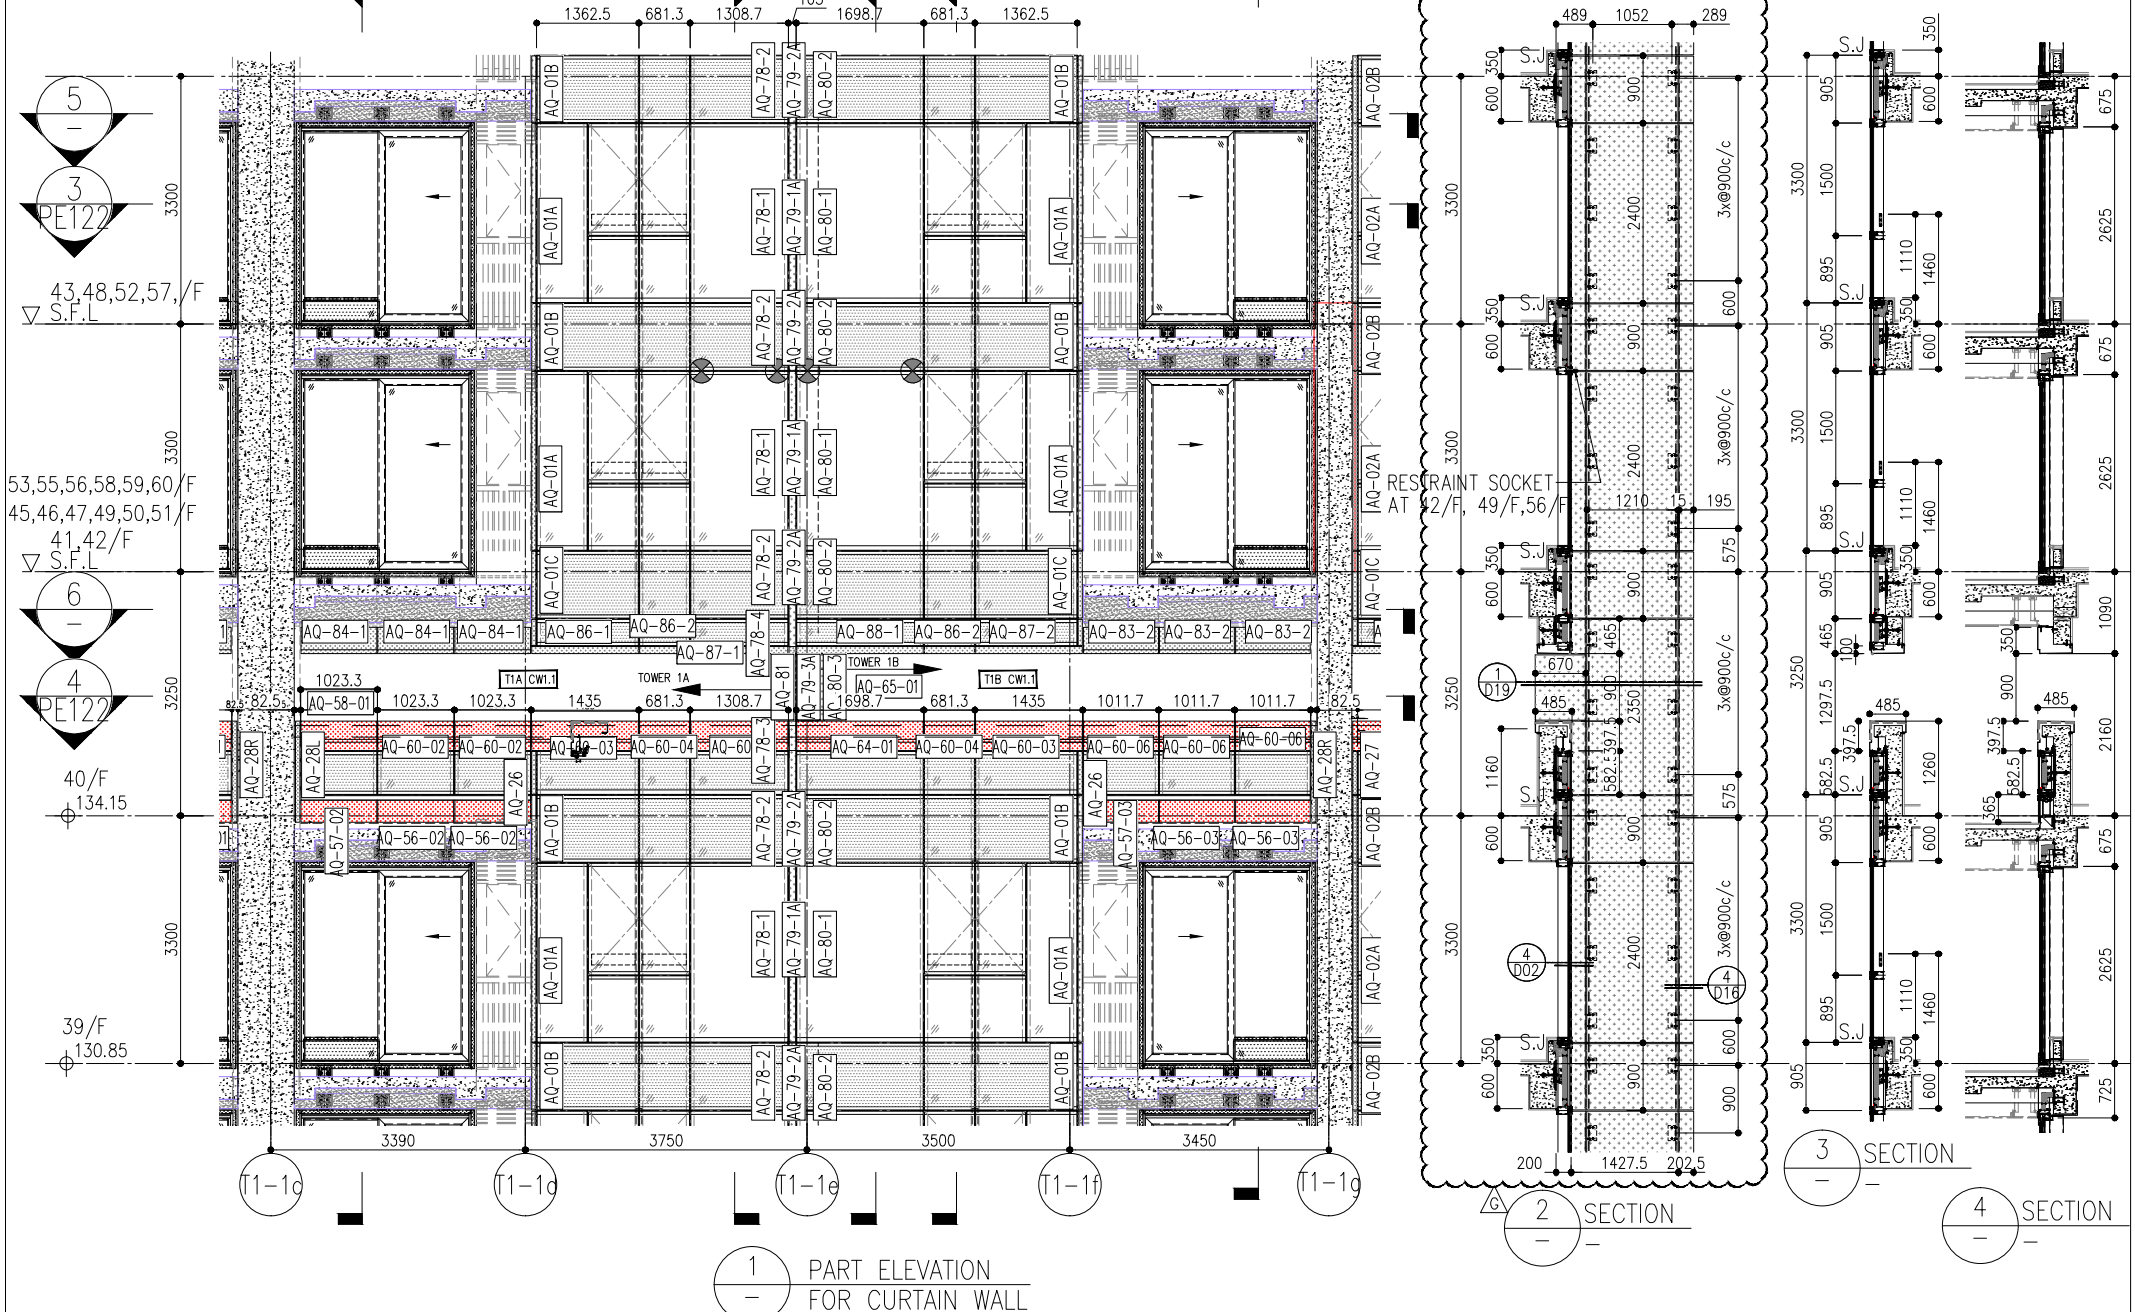

1 PART ELEVATION FOR CURTAIN WALL

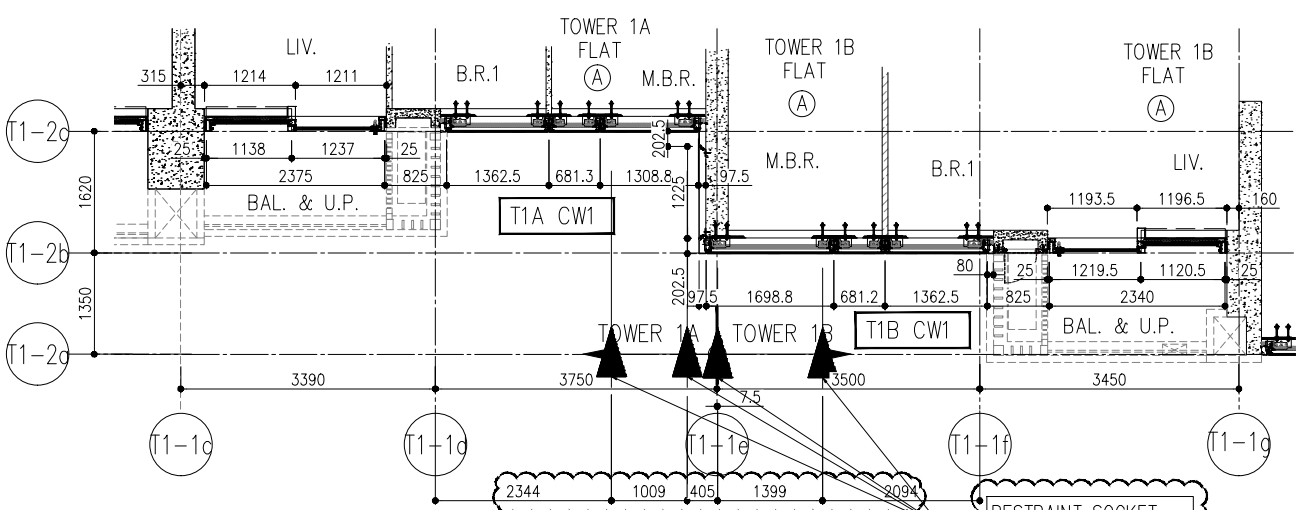

5 PART PLAN FOR CURTAIN WALL

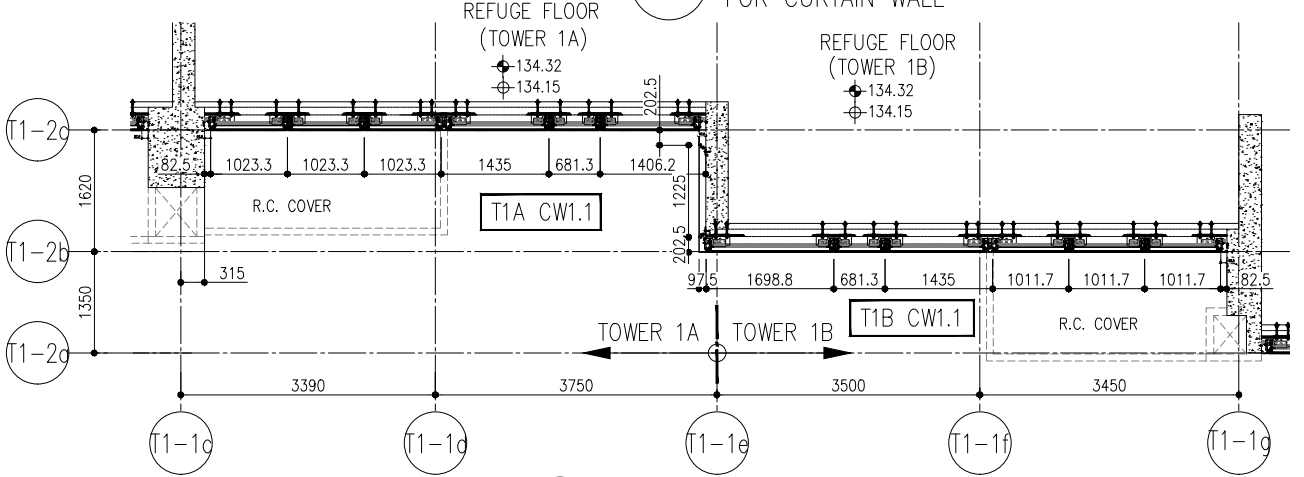

6 PART PLAN (40/F) FOR CURTAIN WALL

26/F +91.25	39/F +130.85	52/F +170.40	
25/F +87.95	38/F +127.55	51/F +167.10	
23/F +84.65	37/F +124.25	50/F +163.80	R/F +203.80
22/F +81.35	36/F +120.95	49/F +160.50	62/F +200.30
21/F +78.05	35/F +117.65	48/F +157.20	61/F +196.80
20/F +74.75	33/F +114.35	47/F +153.90	60/F +193.50
19/F +71.45	32/F +111.05	46/F +150.60	59/F +190.20
18/F +68.15	31/F 107.75	45/F +147.30	58/F +186.90
17/F +64.85	30/F +104.45	43/F +144.00	57/F +183.60
16/F +61.55	29/F +101.15	42/F +140.70	56/F +180.30
15/F +58.25	28/F +97.85	41/F +137.40	55/F +177.00
12/F +54.95	27/F +94.55	40/F +134.15	53/F +173.70

- LEGEND:
- 10mm THK. HEAT STRENGTHENED GLASS (OUTSIDE) +12mm AIR SPACE + 12mm THK. TEMPERED GLASS
  - 10mm THK. HEAT STRENGTHENED GLASS (OUTSIDE) +12mm AIR SPACE + 10mm THK. TEMPERED GLASS
  - 12mm THK. HEAT STRENGTHENED GLASS
  - 12mm THK. CLEAR TEMPERED GLASS ( INTERNAL PROTECTIVE BARRIER )
  - 10mm THK. HEAT STRENGTHENED GLASS (OUTSIDE) +12mm AIR SPACE + 12mm THK. TEMPERED GLASS WITH REFLECTIVE COATING
  - 10mm THK. CLEAR TEMPERED GLASS
  - 8mm THK. CLEAR HEAT-STRENGTHENED GLASS +1.52mm PVB + 8mm THK. CLEAR HEAT-STRENGTHENED GLASS
  - 3 mm THK. ALUM. CLADDING
  - 3 mm THK. ALUM. BACKPAN
  - S.J. - STACK JOINT
  - RESTRAINT SOCKET

**PE105**

TITLE: TYPICAL FLOOR ELEVATION & SECTION FOR CURTAIN WALL

DATE: 22-OCT-21

PROJECT: PROPOSED RESIDENTIAL AT TKOIL 70RP, PHASE TSEUNG KWAN

JOB NO.: J-854

REVISIONS:

NO.	DATE	REVISIONS
A	03/12/21	REVISED AS PER COMMENTS
B	20/12/21	REVISED AS PER COMMENTS
C	24/01/22	REVISED AS PER COMMENTS
D	06/04/22	REVISED AS PER COMMENTS
E	23/05/22	REVISED AS PER COMMENTS
F	26/07/22	REVISED AS PER COMMENTS
G	17/08/22	REVISED AS PER COMMENTS

NOTE:

- ALL DIMENSIONS ARE IN mm.
- ALL ELEVATIONS ARE VIEWED FROM OUTSIDE.
- ALL DIMENSIONS TO BE VERIFIED ON SITE BEFORE FABRICATION.

LEGEND:

- X1 - DETAIL MARK NO.
- X00 - REFER SHEET NO.
- 1. F.F.L. - FINISHED FLOOR LEVEL
- 2. S.F.L. - STRUCTURAL FLOOR LEVEL
- 3. (R) - REVERSED DETAIL

CLIENT: 信和置業有限公司  
Sino Land Company Limited

ARCHITECT: ronaldi & partners  
Ronald Lu & Partners (HK) Ltd.  
呂允梓建築師事務所 (香港) 有限公司



MAIN CONTRACTOR: Gammon

STRUCTURAL ENGINEER: AECOM

FAÇADE CONSULTANT: AECOM


T1 BB (高層)

T1 BC (高層)

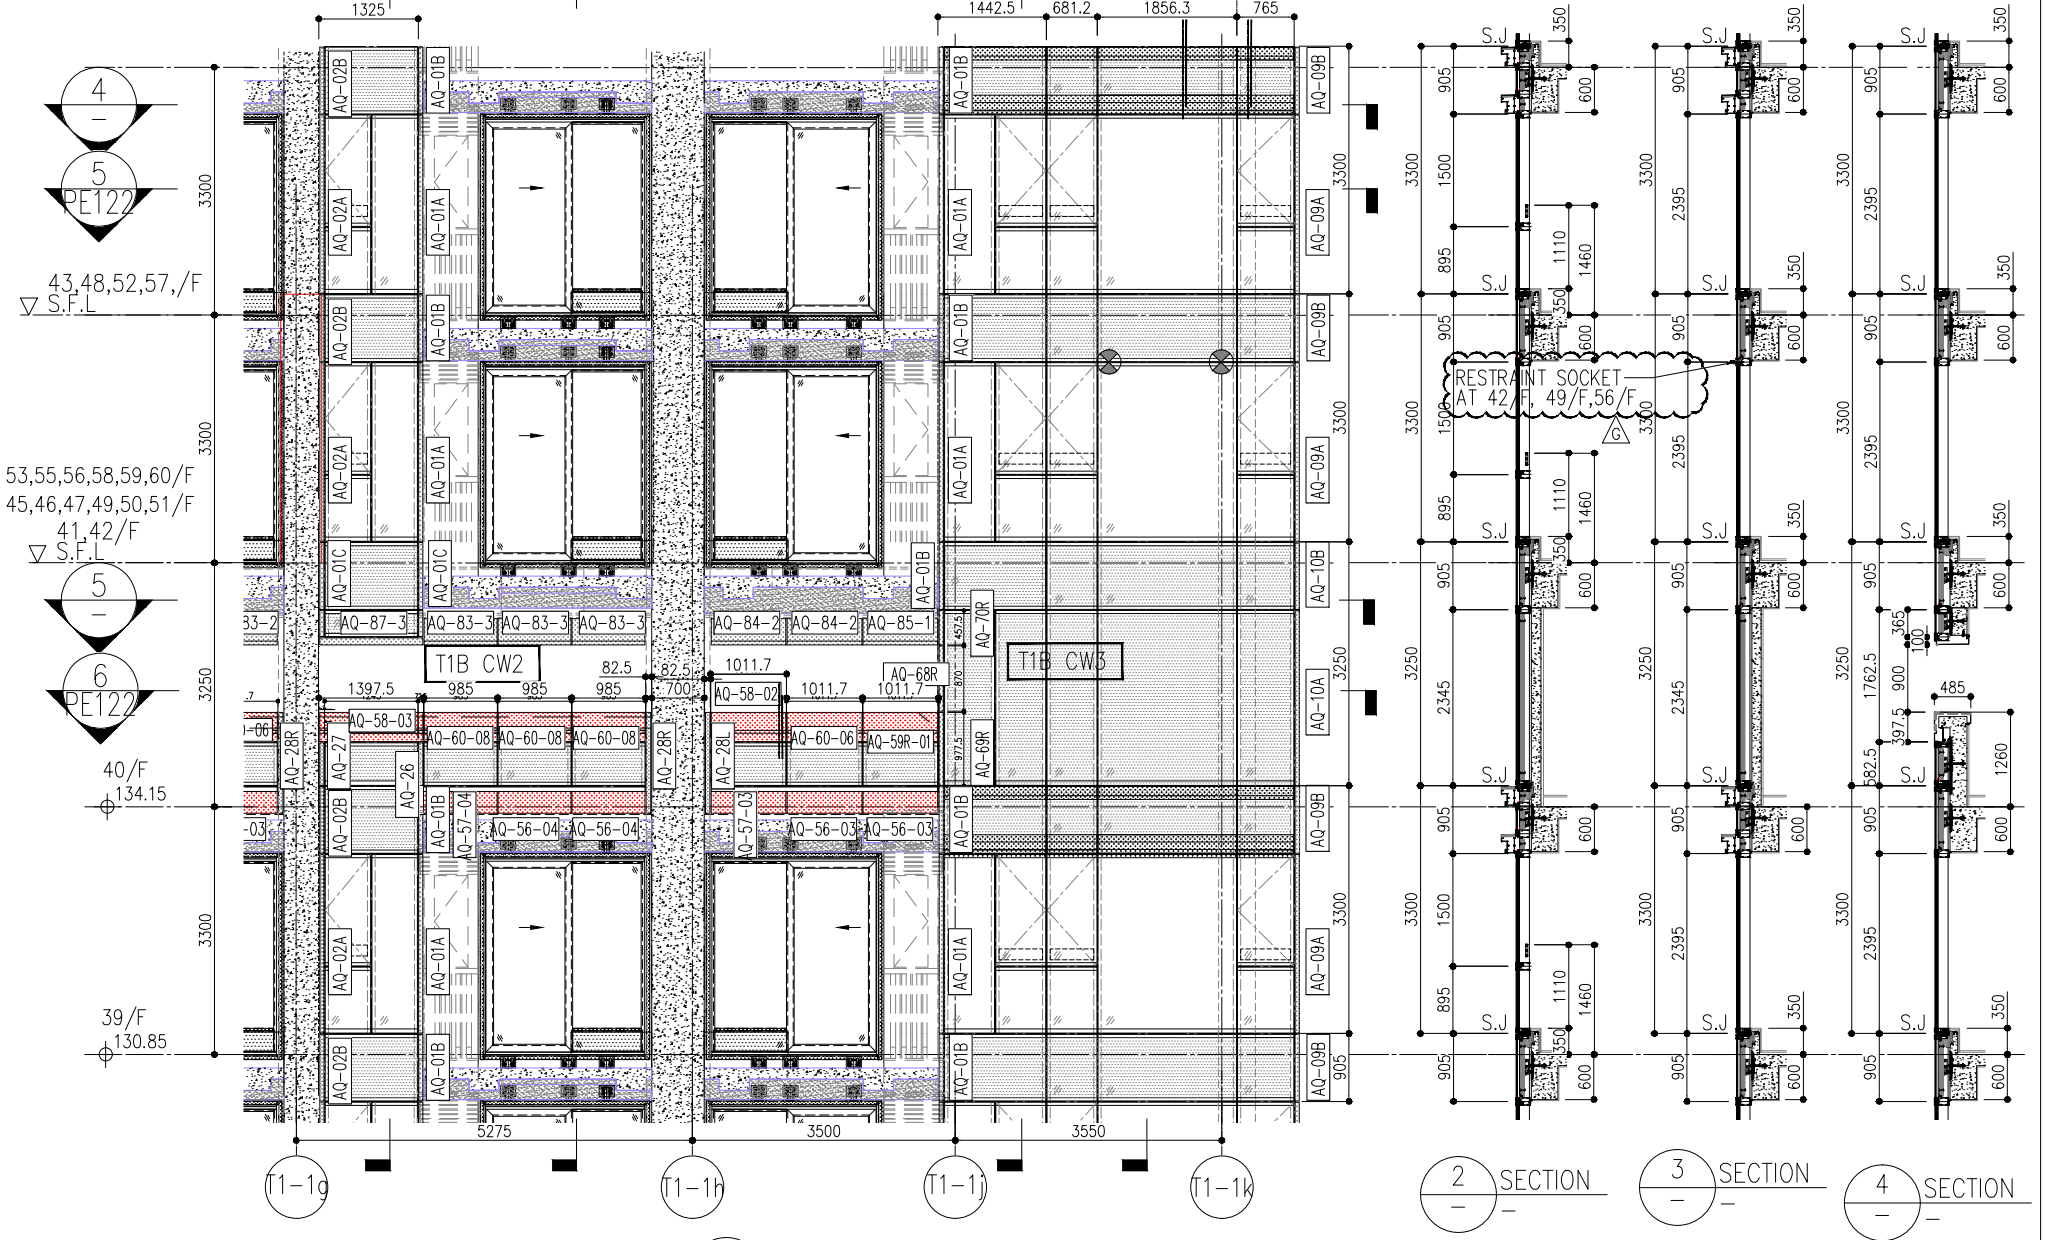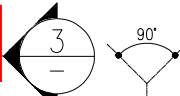


1 PART ELEVATION FOR CURTAIN WALL

2 SECTION  
3 SECTION  
4 SECTION

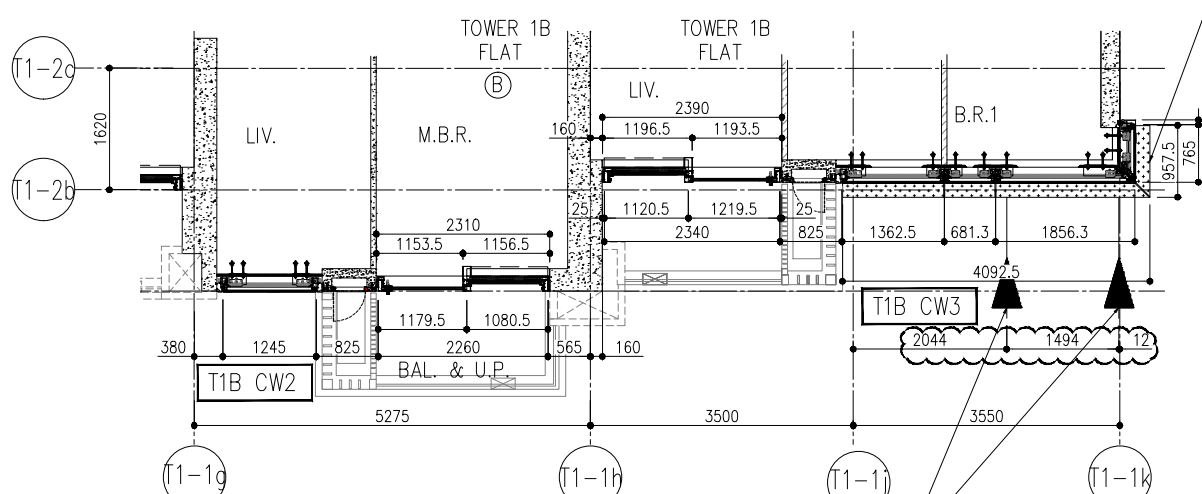

4 PART PLAN FOR CURTAIN WALL

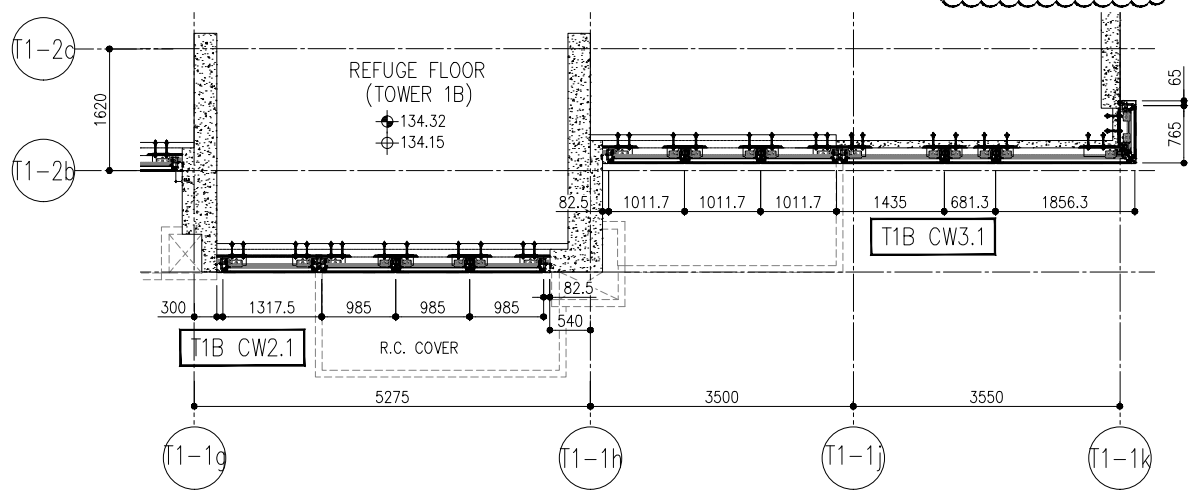

5 PART PLAN (40/F) FOR CURTAIN WALL

ARCH. FEATURE AT 39/F, 43/F, 48/F, 52/F, 57/F

26/F	+91.25	39/F	+130.85	52/F	+170.40		
25/F	+87.95	38/F	+127.55	51/F	+167.10		
23/F	+84.65	37/F	+124.25	50/F	+163.80	R/F	+203.80
22/F	+81.35	36/F	+120.95	49/F	+160.50	62/F	+200.30
21/F	+78.05	35/F	+117.65	48/F	+157.20	61/F	+196.80
20/F	+74.75	33/F	+114.35	47/F	+153.90	60/F	+193.50
19/F	+71.45	32/F	+111.05	46/F	+150.60	59/F	+190.20
18/F	+68.15	31/F	+107.75	45/F	+147.30	58/F	+186.90
17/F	+64.85	30/F	+104.45	43/F	+144.00	57/F	+183.60
16/F	+61.55	29/F	+101.15	42/F	+140.70	56/F	+180.30
15/F	+58.25	28/F	+97.85	41/F	+137.40	55/F	+177.00
12/F	+54.95	27/F	+94.55	40/F	+134.15	53/F	+173.70

LEGEND:

- ① 10mm THK. HEAT STRENGTHENED GLASS (OUTSIDE) + 12mm AIR SPACE + 12mm THK. TEMPERED GLASS
- ② 10mm THK. HEAT STRENGTHENED GLASS (OUTSIDE) + 12mm AIR SPACE + 10mm THK. TEMPERED GLASS
- ③ 12mm THK. HEAT STRENGTHENED GLASS
- ④ 12mm THK. CLEAR TEMPERED GLASS ( INTERNAL PROTECTIVE BARRIER )
- ⑤ 10mm THK. HEAT STRENGTHENED GLASS (OUTSIDE) + 12mm AIR SPACE + 12mm THK. TEMPERED GLASS WITH REFLECTIVE COATING
- ⑥ 10mm THK. CLEAR TEMPERED GLASS
- ⑦ 8mm THK. CLEAR HEAT-STRENGTHENED GLASS + 1.52mm PVB + 8mm THK. CLEAR HEAT-STRENGTHENED GLASS
- ⑧ 3 mm THK. ALUM. CLADDING
- ⑨ 3 mm THK. ALUM. BACKPAN
- S.J. - STACK JOINT
- ⊗ - RESTRAINT SOCKET

UNIT NO. : J-854

PROJECT : PROPOSED RESIDENTIAL AT TKOIL 70RP, PHASE TSEUNG KWAN

TITLE : TYPICAL FLOOR ELEVATION & SECTION FOR CURTAIN WALL

DATE : 22-OCT-21

DRAWN BY : SC

CHK BY : CH

DWG NO. : J858-CW-PE106

REV. : G

NOTE:

- ALL DIMENSIONS ARE IN mm.
- ALL ELEVATIONS ARE VIEWED FROM OUTSIDE.
- ALL DIMENSIONS TO BE VERIFIED ON SITE BEFORE FABRICATION.

LEGEND:

(X1) DETAIL MARK NO.

(X2) REFER SHEET NO.

(X3) F.F.L. -- FINISHED FLOOR LEVEL

(X4) S.F.L. -- STRUCTURAL FLOOR LEVEL

(X5) R -- REVERSED DETAIL

FAÇADE CONSULTANT:

**AECOM**

STRUCTURAL ENGINEER:

**Gammou**

ARCHITECT:

**ronaldu & partners**

Ronald Lu & Partners (HK) Ltd.

呂允達建築師事務所 (香港) 有限公司


MAIN CONTRACTOR:

**信和置業有限公司**

Sino Land Company Limited


B.D. REF. :

PE106

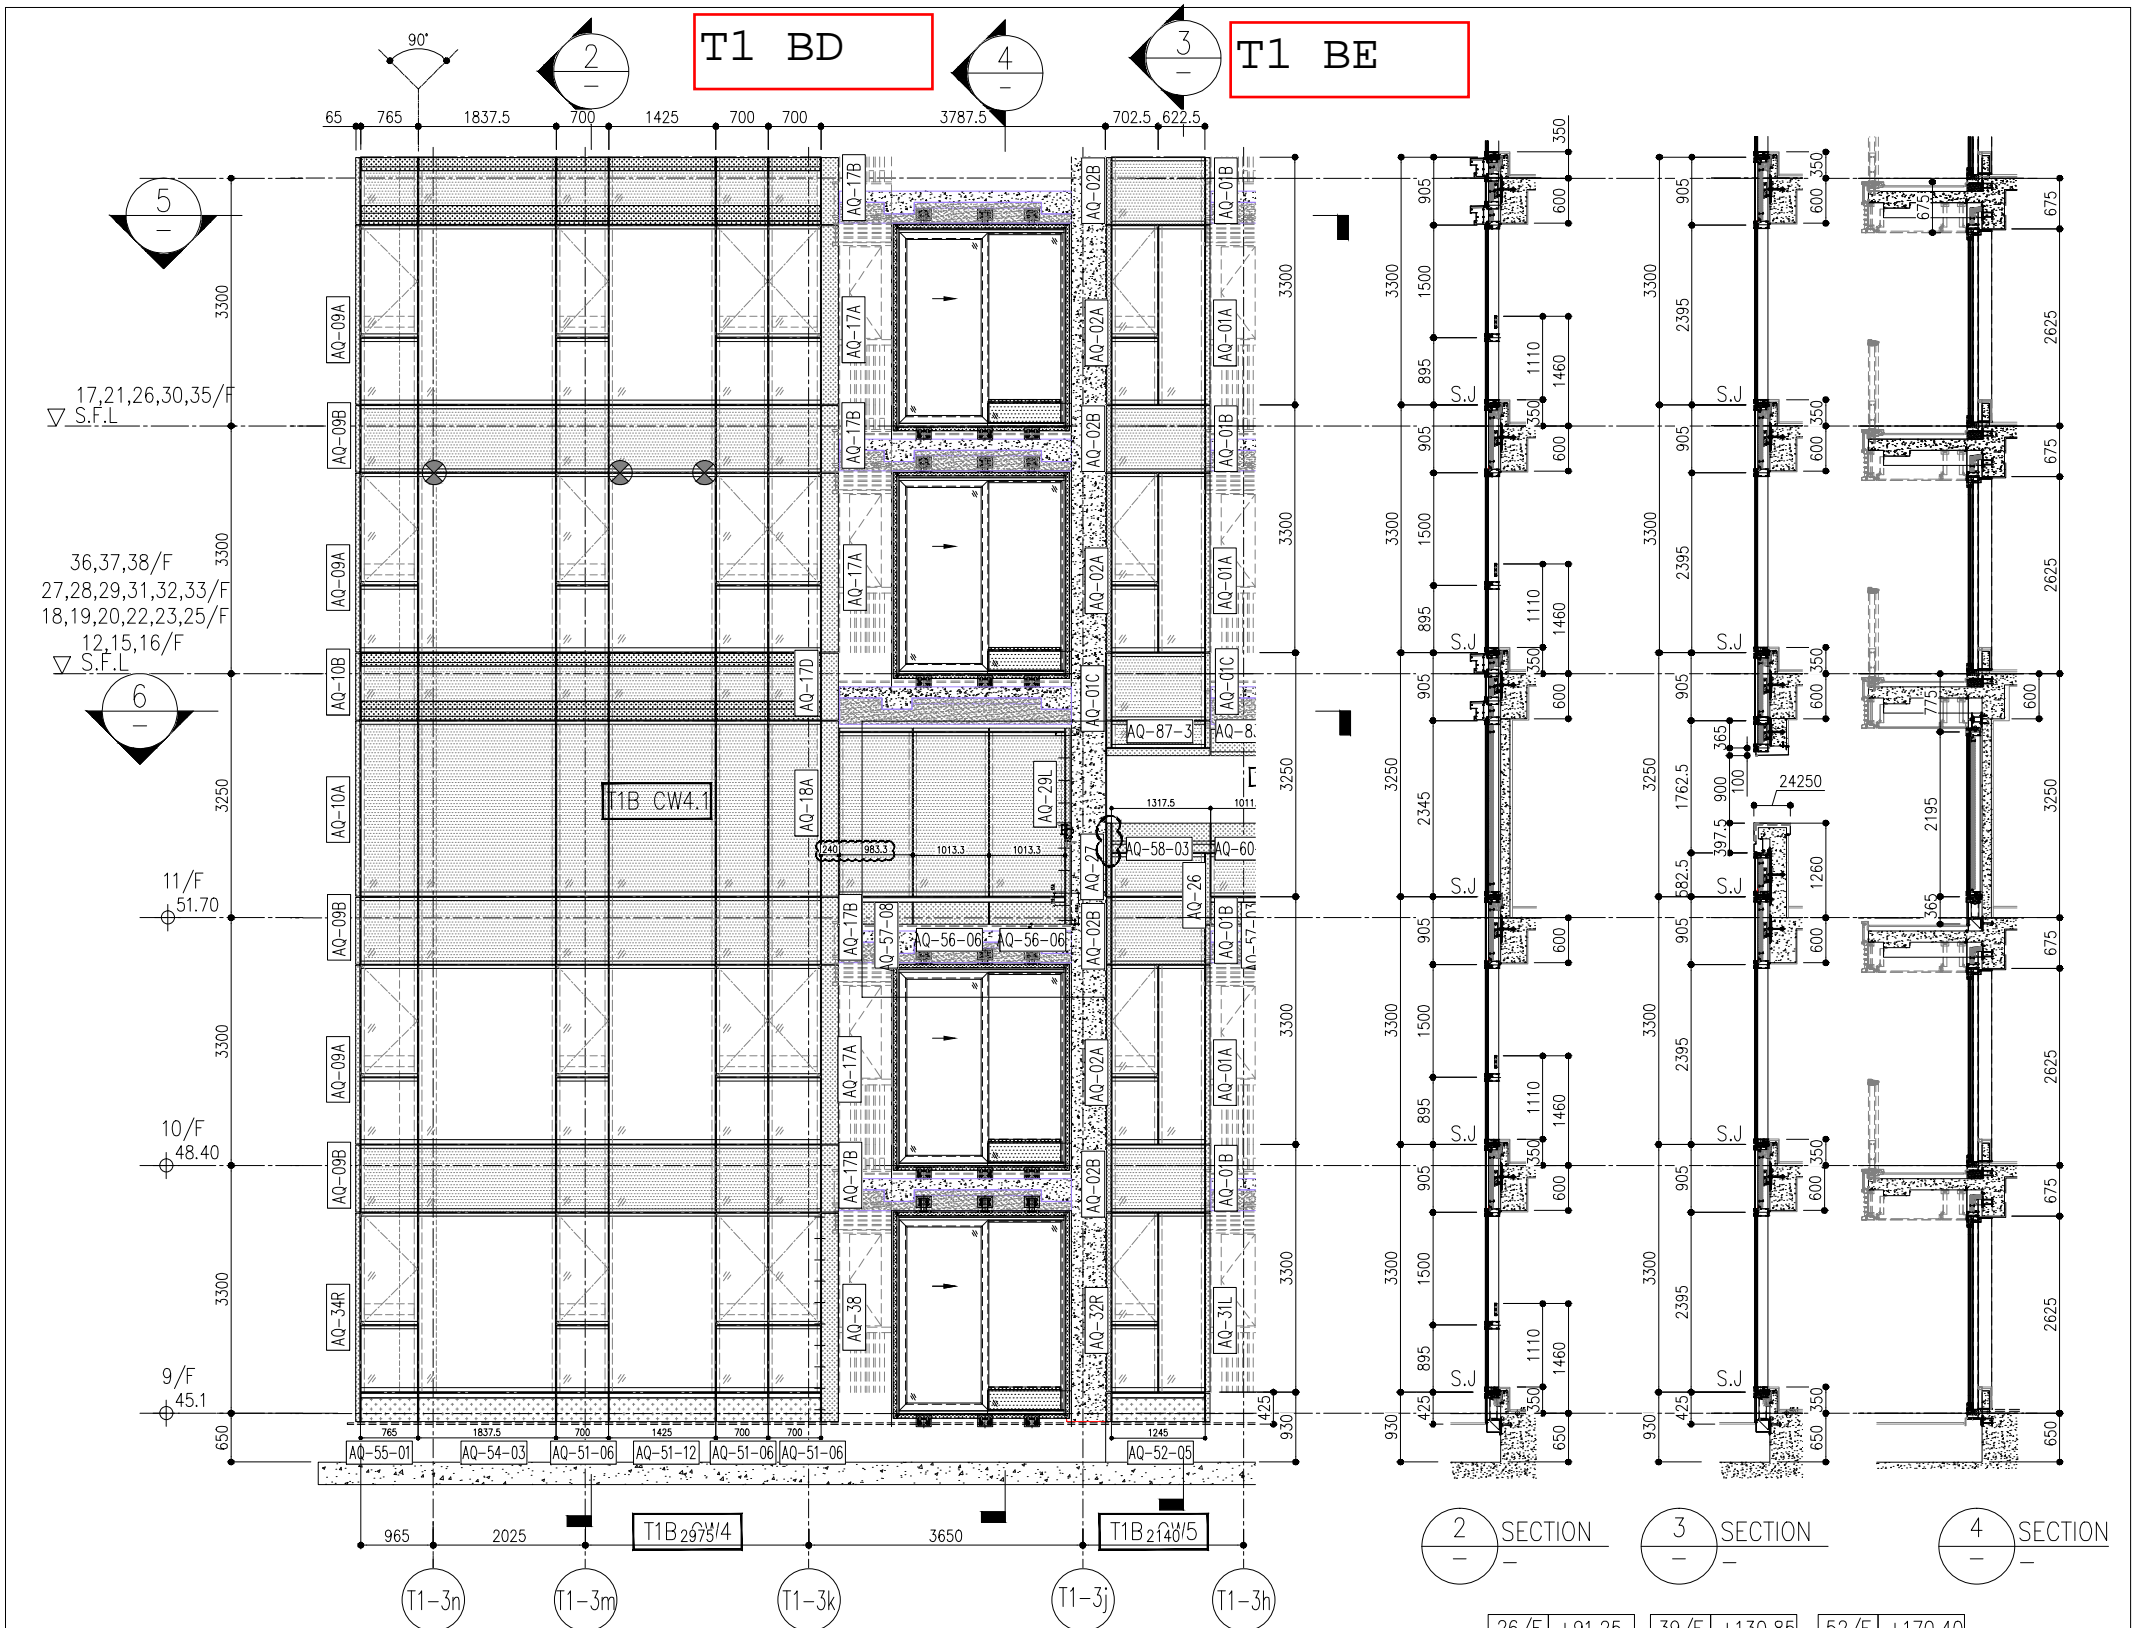


ARCH. FEATURE AT 11/F, 17/F, 21/F, 26/F, 30/F, 35/F

1 PART ELEVATION FOR CURTAIN WALL

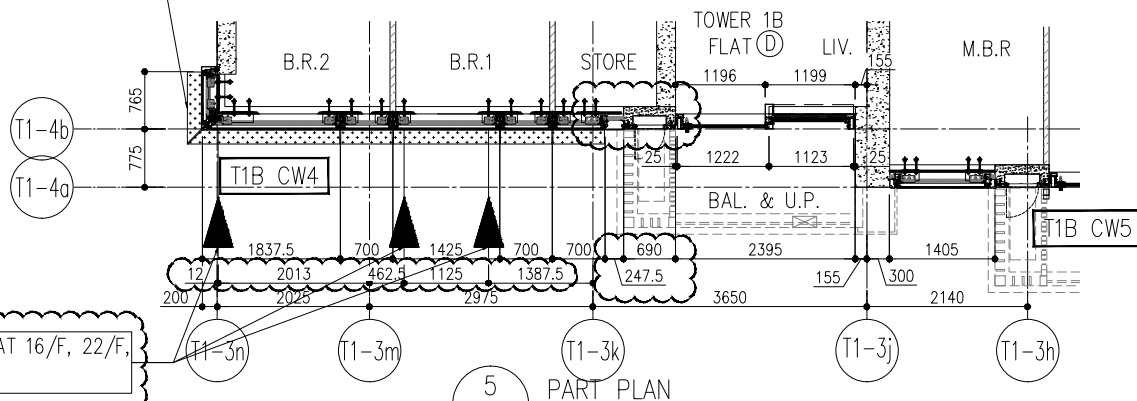

5 PART PLAN FOR CURTAIN WALL

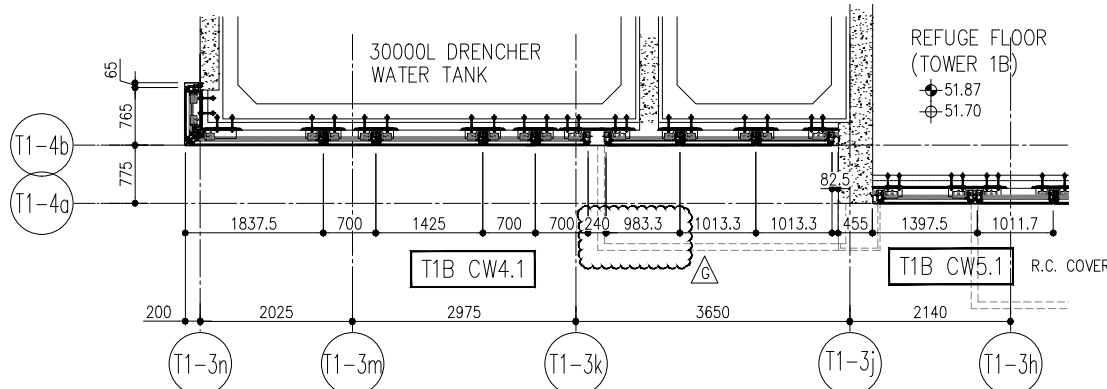

6 PART PLAN(11/F) FOR CURTAIN WALL

26/F	+91.25	39/F	+130.85	52/F	+170.40
25/F	+87.95	38/F	+127.55	51/F	+167.10
23/F	+84.65	37/F	+124.25	50/F	+163.80
22/F	+81.35	36/F	+120.95	49/F	+160.50
21/F	+78.05	35/F	+117.65	48/F	+157.20
20/F	+74.75	33/F	+114.35	47/F	+153.90
19/F	+71.45	32/F	+111.05	46/F	+150.60
18/F	+68.15	31/F	+107.75	45/F	+147.30
17/F	+64.85	30/F	+104.45	43/F	+144.00
16/F	+61.55	29/F	+101.15	42/F	+140.70
15/F	+58.25	28/F	+97.85	41/F	+137.40
12/F	+54.95	27/F	+94.55	40/F	+134.15
				R/F	+203.80
				62/F	+200.30
				61/F	+196.80
				60/F	+193.50
				59/F	+190.20
				58/F	+186.90
				57/F	+183.60
				56/F	+180.30
				55/F	+177.00
				53/F	+173.70

LEGEND:

- 10mm THK. HEAT STRENGTHENED GLASS (OUTSIDE) +12mm AIR SPACE + 12mm THK. TEMPERED GLASS
- 10mm THK. HEAT STRENGTHENED GLASS (OUTSIDE) +12mm AIR SPACE + 10mm THK. TEMPERED GLASS
- 12mm THK. HEAT STRENGTHENED GLASS
- 12mm THK. CLEAR TEMPERED GLASS ( INTERNAL PROTECTIVE BARRIER )
- 10mm THK. HEAT STRENGTHENED GLASS (OUTSIDE) +12mm AIR SPACE + 12mm THK. TEMPERED GLASS WITH REFLECTIVE COATING
- 10mm THK. CLEAR TEMPERED GLASS
- 8mm THK. CLEAR HEAT-STRENGTHENED GLASS +1.52mm PVB + 8mm THK. CLEAR HEAT-STRENGTHENED GLASS
- 3 mm THK. ALUM. CLADDING
- 3 mm THK. ALUM. BACKPAN
- S.J. - STACK JOINT
- RESTRAINT SOCKET



<p>DWG NO. : JB58-CW-PE107</p> <p>REV. : G</p>	<p>DATE : 22-OCT-21</p> <p>SCALE : AS SHOWN</p>	<p>TITLE : TYPICAL FLOOR ELEVATION &amp; SECTION FOR CURTAIN WALL</p>	<p>PROJECT : PROPOSED RESIDENTIAL AT TKOIL 70RP, PHASE TSEUNG KWAN</p>	<p>JOB NO. : J-854</p>	<p>NO. DATE REVISION</p> <table border="1" style="width: 100%; border-collapse: collapse;"> <tr> <td>A</td> <td>03/12/21</td> <td>REVISED AS PER COMMENTS</td> </tr> <tr> <td>B</td> <td>20/01/22</td> <td>REVISED AS PER COMMENTS</td> </tr> <tr> <td>C</td> <td>24/01/22</td> <td>REVISED AS PER COMMENTS</td> </tr> <tr> <td>D</td> <td>06/04/22</td> <td>REVISED AS PER COMMENTS</td> </tr> <tr> <td>E</td> <td>23/05/22</td> <td>REVISED AS PER COMMENTS</td> </tr> <tr> <td>F</td> <td>26/07/22</td> <td>REVISED AS PER COMMENTS</td> </tr> <tr> <td>G</td> <td>17/08/22</td> <td>REVISED AS PER COMMENTS</td> </tr> </table>	A	03/12/21	REVISED AS PER COMMENTS	B	20/01/22	REVISED AS PER COMMENTS	C	24/01/22	REVISED AS PER COMMENTS	D	06/04/22	REVISED AS PER COMMENTS	E	23/05/22	REVISED AS PER COMMENTS	F	26/07/22	REVISED AS PER COMMENTS	G	17/08/22	REVISED AS PER COMMENTS	<p>NOTE:</p> <ol style="list-style-type: none"> <li>ALL DIMENSIONS ARE IN mm.</li> <li>ALL ELEVATIONS ARE VIEWED FROM OUTSIDE.</li> <li>ALL DIMENSIONS TO BE VERIFIED ON SITE BEFORE FABRICATION.</li> </ol> <p>LEGEND:</p> <ul style="list-style-type: none"> <li> (X1) - DETAIL MARK NO.</li> <li> (X00) - REFER SHEET NO.</li> <li>1. F.F.L. - FINISHED FLOOR LEVEL</li> <li>2. S.F.L. - STRUCTURAL FLOOR LEVEL</li> <li>3. (R) - REVERSED DETAIL</li> </ul>	<p>ARCHITECT : ronaldi &amp; partners</p> <p>Principal Architects: Ronald Liu &amp; Partners (HK) Ltd. 呂允祥建築師事務所 (香港) 有限公司</p> <p>MAIN CONTRACTOR : Sino Land Company Limited</p>	<p>CLIENT : 信和置業有限公司 Sino Land Company Limited</p>	<p>STRUCTURAL ENGINEER : Gammon</p> <p>FAÇADE CONSULTANT : AECOM</p>	<p>B.D. REF. :</p>
A	03/12/21	REVISED AS PER COMMENTS																													
B	20/01/22	REVISED AS PER COMMENTS																													
C	24/01/22	REVISED AS PER COMMENTS																													
D	06/04/22	REVISED AS PER COMMENTS																													
E	23/05/22	REVISED AS PER COMMENTS																													
F	26/07/22	REVISED AS PER COMMENTS																													
G	17/08/22	REVISED AS PER COMMENTS																													

PE107




T1 AG

T1 AF

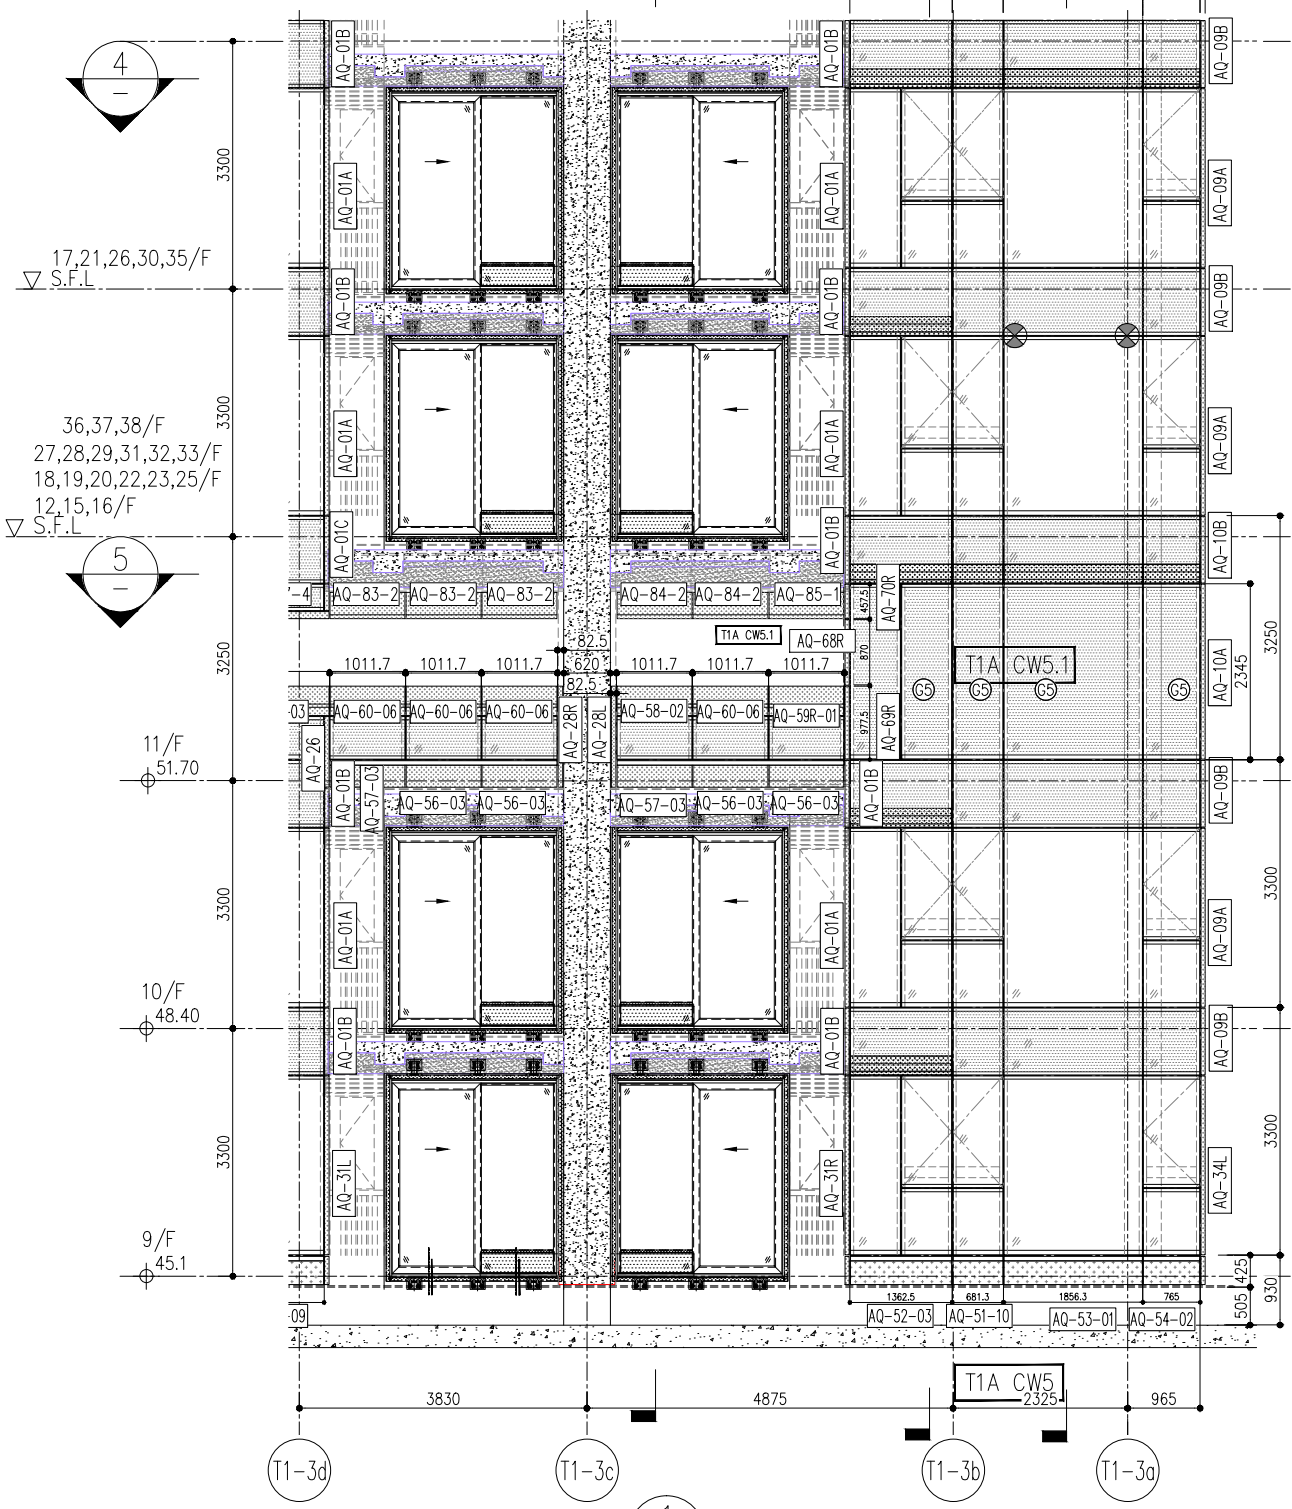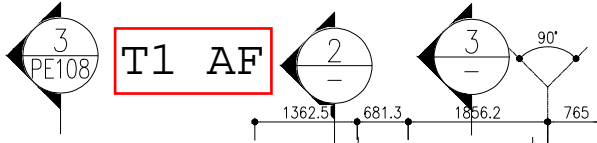


1 PART ELEVATION FOR CURTAIN WALL

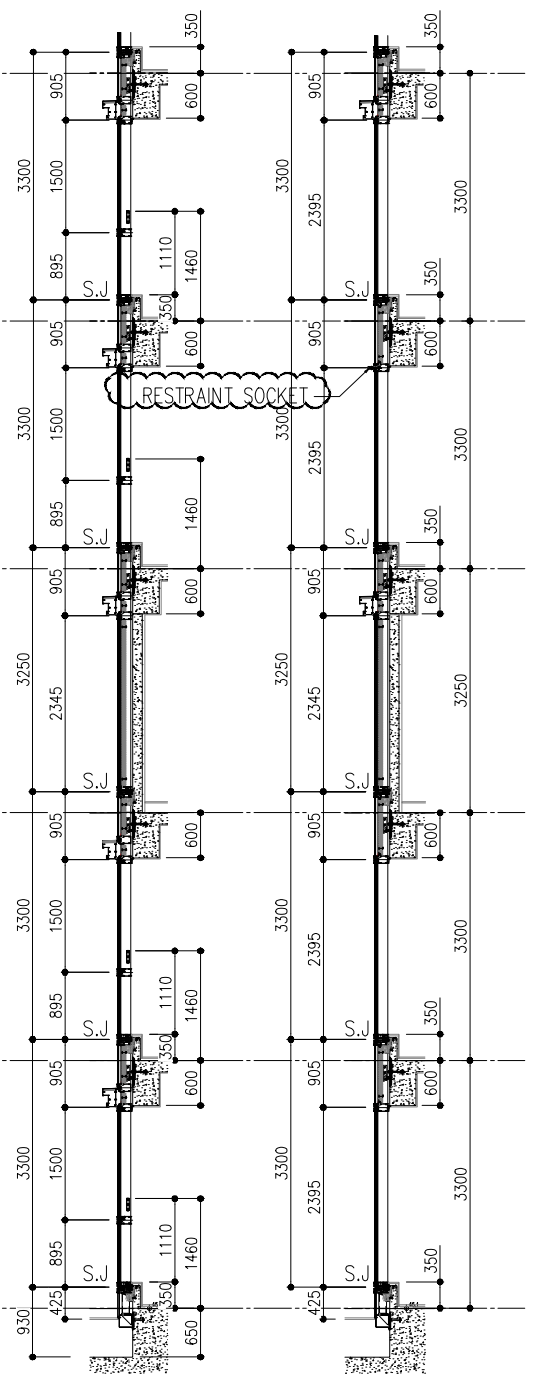


2 SECTION, 3 SECTION

26/F	+91.25	39/F	+130.85	52/F	+170.40
25/F	+87.95	38/F	+127.55	51/F	+167.10
23/F	+84.65	37/F	+124.25	50/F	+163.80
22/F	+81.35	36/F	+120.95	49/F	+160.50
21/F	+78.05	35/F	+117.65	48/F	+157.20
20/F	+74.75	33/F	+114.35	47/F	+153.90
19/F	+71.45	32/F	+111.05	46/F	+150.60
18/F	+68.15	31/F	+107.75	45/F	+147.30
17/F	+64.85	30/F	+104.45	43/F	+144.00
16/F	+61.55	29/F	+101.15	42/F	+140.70
15/F	+58.25	28/F	+97.85	41/F	+137.40
12/F	+54.95	27/F	+94.55	40/F	+134.15
				R/F	+203.80
				62/F	+200.30
				61/F	+196.80
				60/F	+193.50
				59/F	+190.20
				58/F	+186.90
				57/F	+183.60
				56/F	+180.30
				55/F	+177.00
				53/F	+173.70

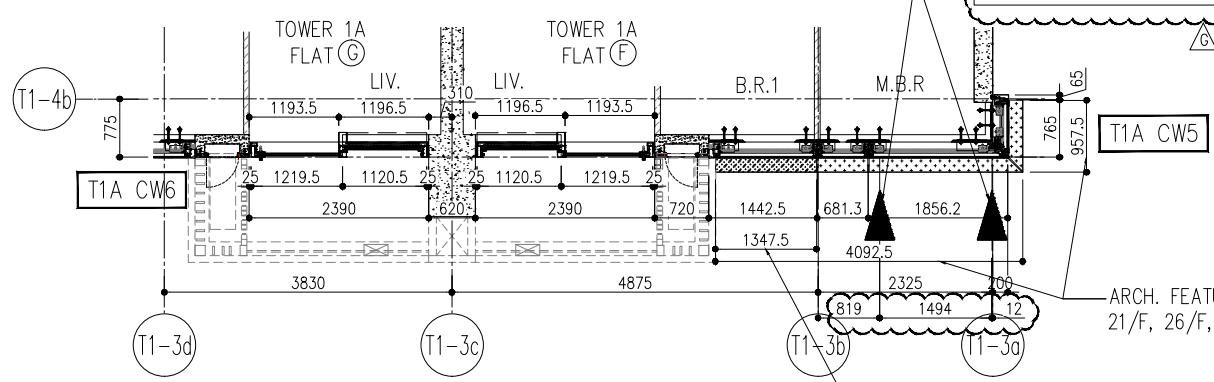

4 PART PLAN FOR CURTAIN WALL

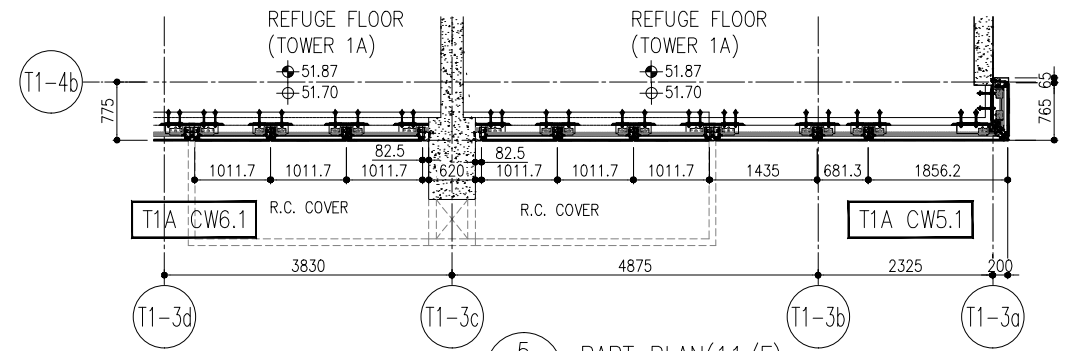

5 PART PLAN (11/F) FOR CURTAIN WALL

- LEGEND:
- (G1) 10mm THK. HEAT STRENGTHENED GLASS (OUTSIDE) + 12mm AIR SPACE + 12mm THK. TEMPERED GLASS
  - (G2) 10mm THK. HEAT STRENGTHENED GLASS (OUTSIDE) + 12mm AIR SPACE + 10mm THK. TEMPERED GLASS
  - (G3) 12mm THK. HEAT STRENGTHENED GLASS
  - (G4) 12mm THK. CLEAR TEMPERED GLASS ( INTERNAL PROTECTIVE BARRIER )
  - (G5) 10mm THK. HEAT STRENGTHENED GLASS (OUTSIDE) + 12mm AIR SPACE + 12mm THK. TEMPERED GLASS WITH REFLECTIVE COATING
  - (G6) 10mm THK. CLEAR TEMPERED GLASS
  - (G7) 8mm THK. CLEAR HEAT-STRENGTHENED GLASS + 1.52mm ALVB + 8mm THK. CLEAR HEAT-STRENGTHENED GLASS
  - (G8) 3 mm THK. ALUM. CLADDING
  - (G9) 3 mm THK. ALUM. BACKPAN
  - S.J. - STACK JOINT
  - (RS) - RESTRAINT SOCKET

JOB NO.: J-854

PROJECT: PROPOSED RESIDENTIAL AT TKOIL 70RP, PHASE TSEUNG KWAN

TITLE: TYPICAL FLOOR ELEVATION & SECTION FOR CURTAIN WALL

DATE: 22-OCT-21

DRAWN BY: SC

PE109

NO.	DATE	REVISIONS	BY
A	03/12/21	REVISED AS PER COMMENTS	LS
B	20/12/21	REVISED AS PER COMMENTS	LS
C	16/02/22	REVISED AS PER COMMENTS	LS
D	06/04/22	REVISED AS PER COMMENTS	LS
E	23/05/22	REVISED AS PER COMMENTS	LS
F	26/07/22	REVISED AS PER COMMENTS	LS
G	17/08/22	REVISED AS PER COMMENTS	LS

NOTE:

- ALL DIMENSIONS ARE IN mm.
- ALL ELEVATIONS ARE VIEWED FROM OUTSIDE.
- ALL DIMENSIONS TO BE VERIFIED ON SITE BEFORE FABRICATION.

LEGEND:

- (X1) DETAIL MARK NO.
- (X2) REFER SHEET NO.
- (F.F.L.) FINISHED FLOOR LEVEL
- (S.F.L.) STRUCTURAL FLOOR LEVEL
- (R) REVERSED DETAIL


FAÇADE CONSULTANT: **AECOM**

STRUCTURAL ENGINEER: **Gammon**

ARCHITECT: **ronaldu & partners**  
Ronald Lu & Partners (HK) Ltd.  
呂允祥建築師事務所 (香港) 有限公司


CLIENT: 信和置業有限公司  
Sino Land Company Limited

B.D. REF.:

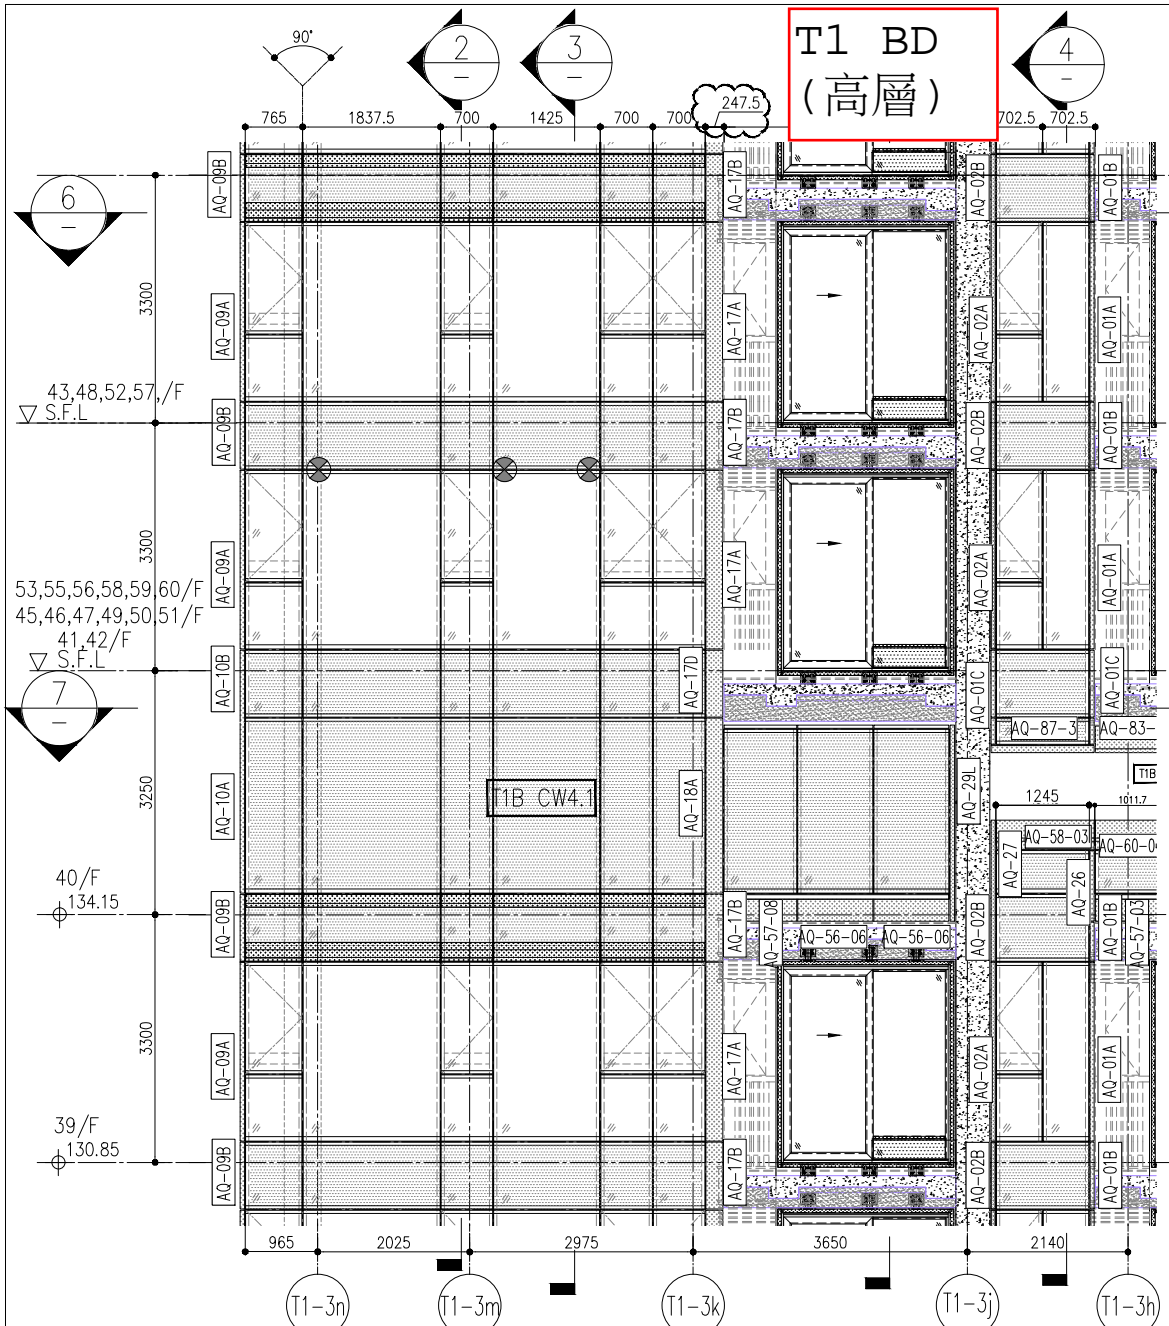


1 PART ELEVATION FOR CURTAIN WALL

ARCH. FEATURE AT 39/F, 43/F, 48/F, 52/F, 57/F

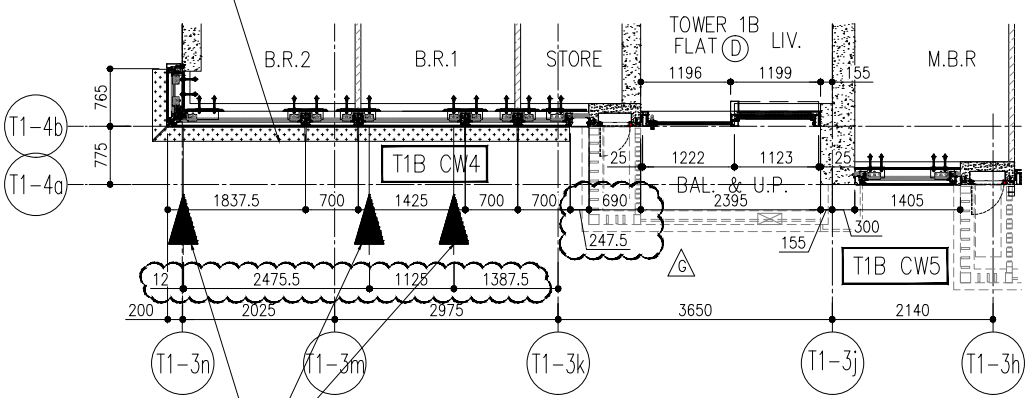


6 PART PLAN FOR CURTAIN WALL

RESTRAINT SOCKET AT 42/F, 49/F, 56/F

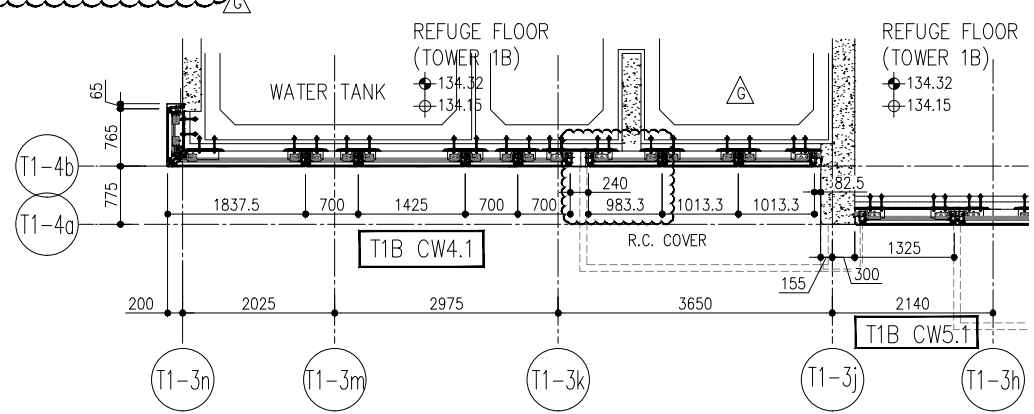

7 PART PLAN (40/F) FOR CURTAIN WALL

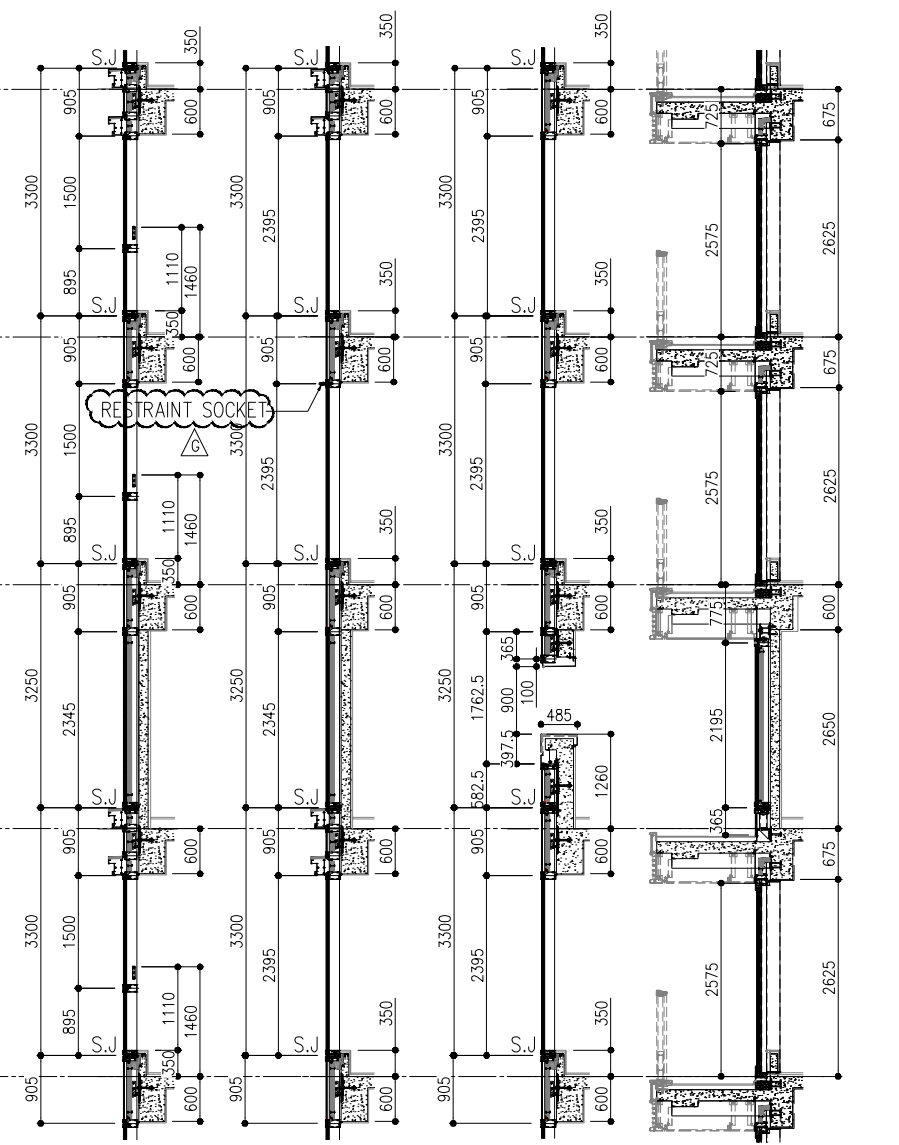

2 SECTION 3 SECTION 4 SECTION 5 SECTION

26/F +91.25	39/F +130.85	52/F +170.40	
25/F +87.95	38/F +127.55	51/F +167.10	
23/F +84.65	37/F +124.25	50/F +163.80	R/F +203.80
22/F +81.35	36/F +120.95	49/F +160.50	62/F +200.30
21/F +78.05	35/F +117.65	48/F +157.20	61/F +196.80
20/F +74.75	33/F +114.35	47/F +153.90	60/F +193.50
19/F +71.45	32/F +111.05	46/F +150.60	59/F +190.20
18/F +68.15	31/F 107.75	45/F +147.30	58/F +186.90
17/F +64.85	30/F +104.45	43/F +144.00	57/F +183.60
16/F +61.55	29/F +101.15	42/F +140.70	56/F +180.30
15/F +58.25	28/F +97.85	41/F +137.40	55/F +177.00
12/F +54.95	27/F +94.55	40/F +134.15	53/F +173.70

- LEGEND:
- 10mm THK. HEAT STRENGTHENED GLASS (OUTSIDE) +12mm AIR SPACE + 12mm THK. TEMPERED GLASS
  - 10mm THK. HEAT STRENGTHENED GLASS (OUTSIDE) +12mm AIR SPACE + 10mm THK. TEMPERED GLASS
  - 12mm THK. HEAT STRENGTHENED GLASS
  - 12mm THK. CLEAR TEMPERED GLASS ( INTERNAL PROTECTIVE BARRIER )
  - 10mm THK. HEAT STRENGTHENED GLASS (OUTSIDE) +12mm AIR SPACE + 12mm THK. TEMPERED GLASS WITH REFLECTIVE COATING
  - 10mm THK. CLEAR TEMPERED GLASS
  - 8mm THK. CLEAR HEAT-STRENGTHENED GLASS +1.52mm PVB + 8mm THK. CLEAR HEAT-STRENGTHENED GLASS
  - 3 mm THK. ALUM. CLADDING
  - 3 mm THK. ALUM. BACKPAN
  - S.J. = STACK JOINT
  - RESTRAINT SOCKET

**PE110**

TITLE: TYPICAL FLOOR ELEVATION & SECTION FOR CURTAIN WALL

DATE: 22-OCT-21

DRAWN BY: SC

CHECKED BY: CH

JOB NO.: J-854

PROJECT: PROPOSED RESIDENTIAL AT TKOIL ZONE, PHASE TSEUNG KWAN

NO.	DATE	REVISION
A	03/12/21	REVISED AS PER COMMENTS
B	20/12/21	REVISED AS PER COMMENTS
C	16/02/22	REVISED AS PER COMMENTS
D	06/04/22	REVISED AS PER COMMENTS
E	23/05/22	REVISED AS PER COMMENTS
F	26/07/22	REVISED AS PER COMMENTS
G	17/08/22	REVISED AS PER COMMENTS

NOTE:  
 1. ALL DIMENSIONS ARE IN mm.  
 2. ALL ELEVATIONS ARE VIEWED FROM OUTSIDE.  
 3. ALL DIMENSIONS TO BE VERIFIED ON SITE BEFORE FABRICATION.

LEGEND:  
 (X) DETAIL MARK NO.  
 (X00) REFER SHEET NO.  
 1. F.F.L. -- FINISHED FLOOR LEVEL  
 2. S.F.L. -- STRUCTURAL FLOOR LEVEL  
 3. (R) -- REVERSED DETAIL

FAÇADE CONSULTANT: **AECOM**

STRUCTURAL ENGINEER: **Gammou**

PROJECT: Ronald Lu & Partners Architects (HK) Ltd. 呂元仲建築師事務所 (香港) 有限公司


CLIENT: 信和置業有限公司 Sino Land Company Limited

B.D. REF.:

T1 BE (高層)


T1 BF (高層)

T1 AG (高層)

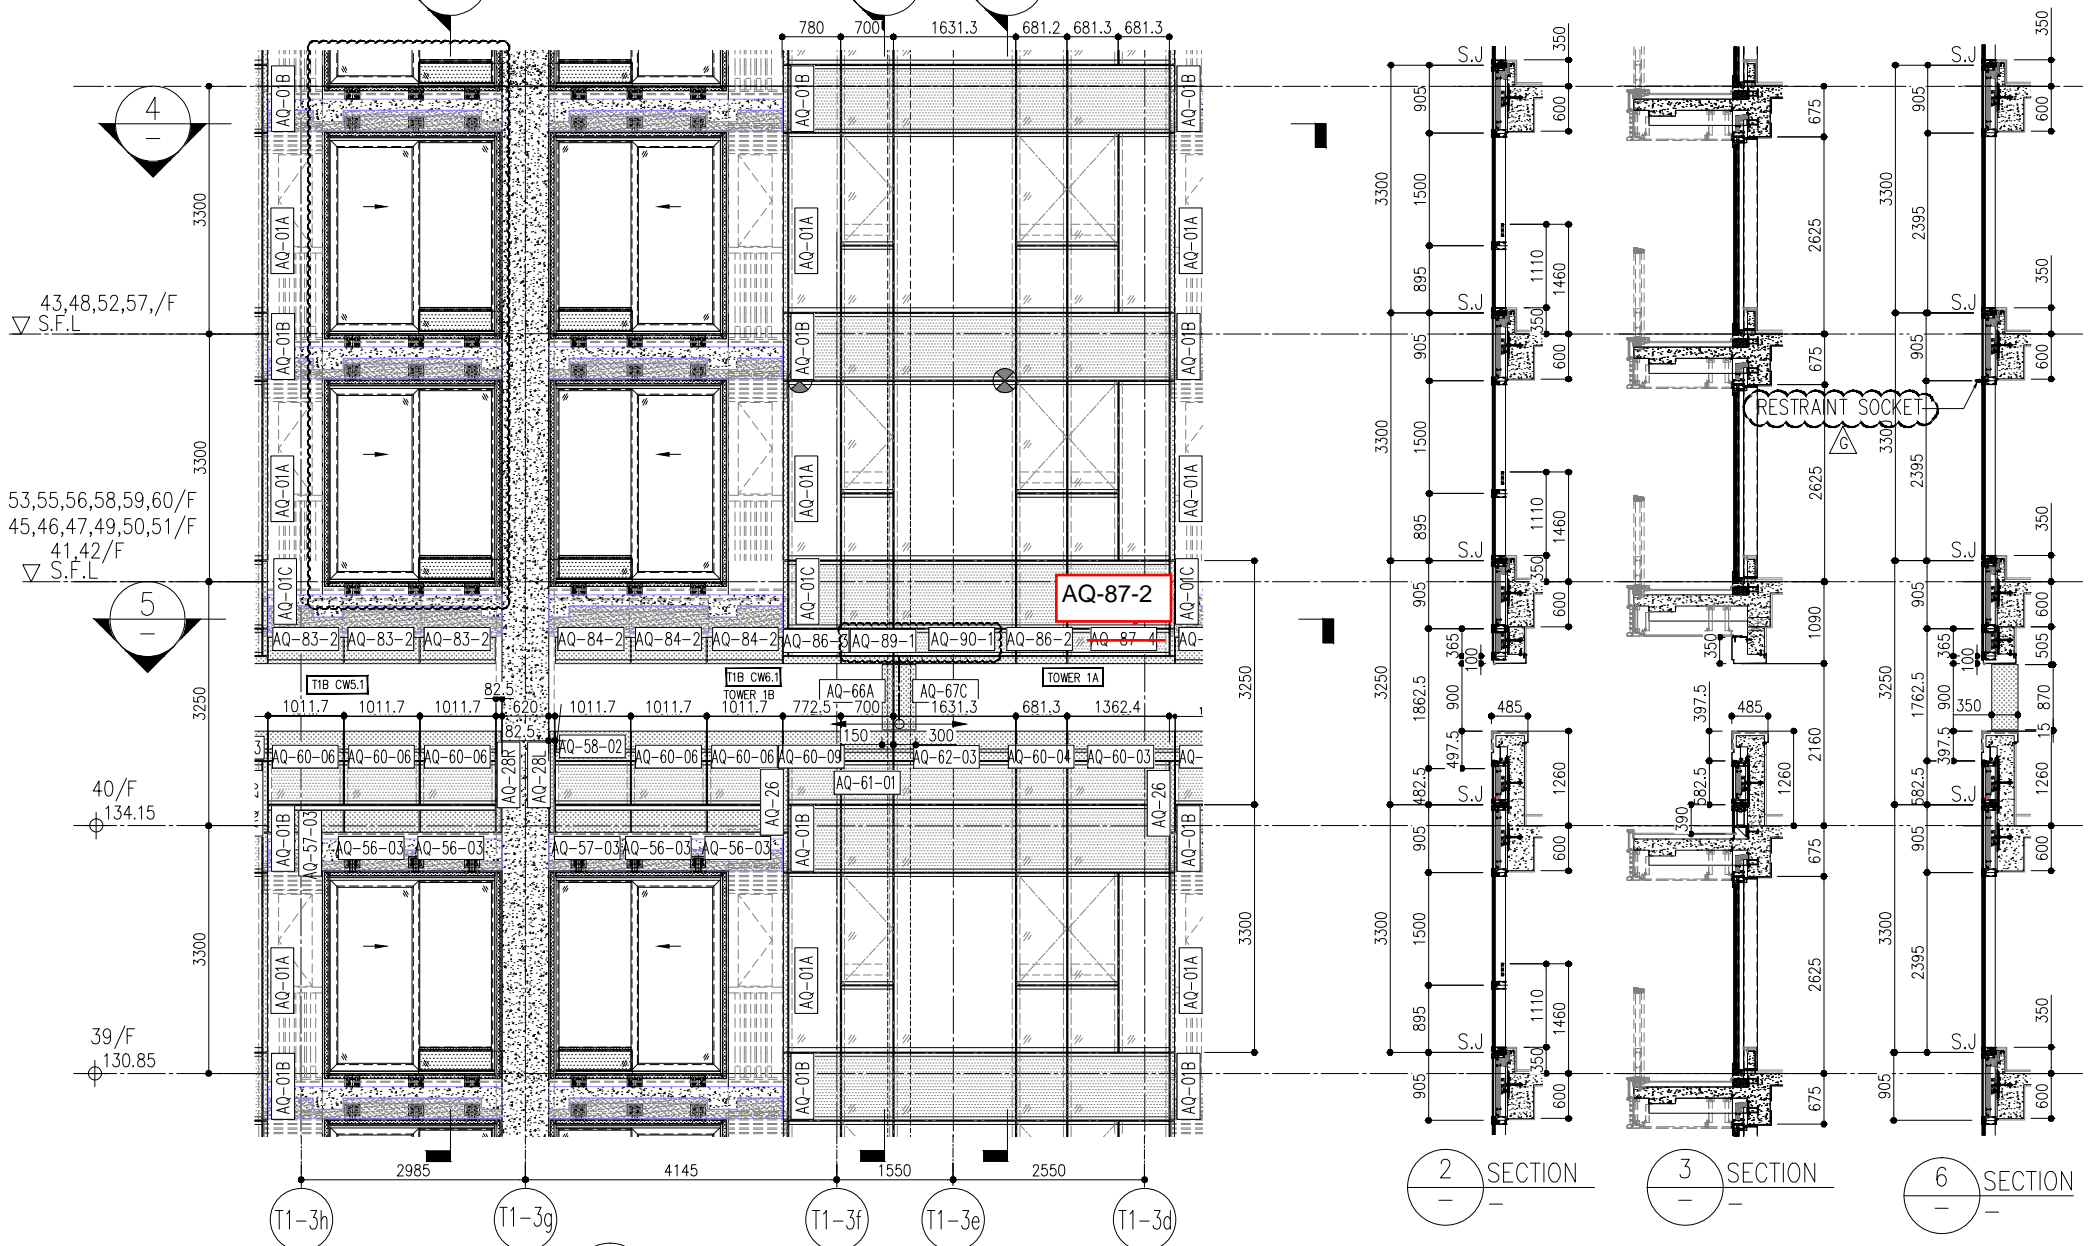


1 PART ELEVATION FOR CURTAIN WALL

2 SECTION  
3 SECTION  
6 SECTION

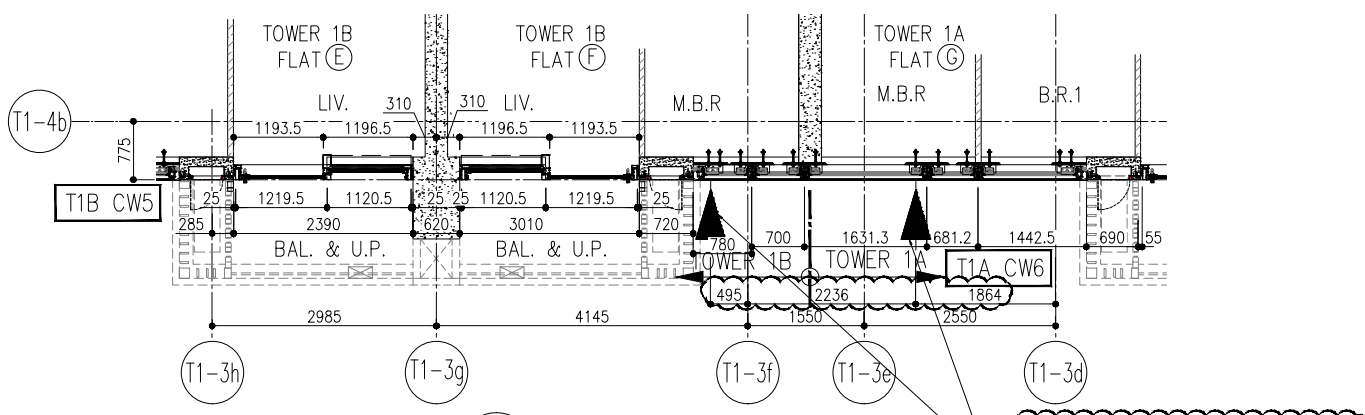

4 PART PLAN FOR CURTAIN WALL

RESTRAINT SOCKET AT 42/F, 49/F, 56/F

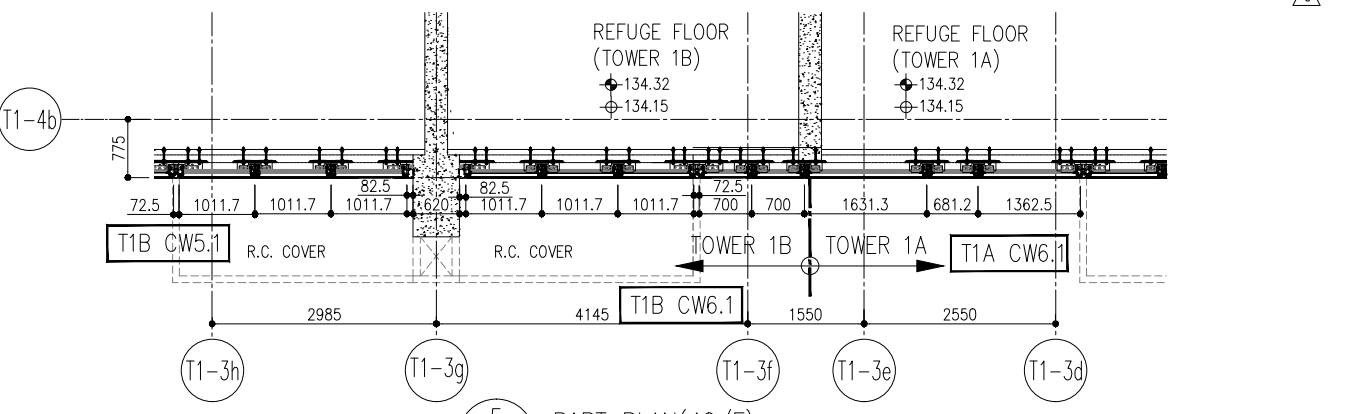

5 PART PLAN (40/F) FOR CURTAIN WALL


26/F +91.25	39/F +130.85	52/F +170.40	
25/F +87.95	38/F +127.55	51/F +167.10	
23/F +84.65	37/F +124.25	50/F +163.80	R/F +203.80
22/F +81.35	36/F +120.95	49/F +160.50	62/F +200.30
21/F +78.05	35/F +117.65	48/F +157.20	61/F +196.80
20/F +74.75	33/F +114.35	47/F +153.90	60/F +193.50
19/F +71.45	32/F +111.05	46/F +150.60	59/F +190.20
18/F +68.15	31/F 107.75	45/F +147.30	58/F +186.90
17/F +64.85	30/F +104.45	43/F +144.00	57/F +183.60
16/F +61.55	29/F +101.15	42/F +140.70	56/F +180.30
15/F +58.25	28/F +97.85	41/F +137.40	55/F +177.00
12/F +54.95	27/F +94.55	40/F +134.15	53/F +173.70

- LEGEND:
- 10mm THK. HEAT STRENGTHENED GLASS (OUTSIDE) +12mm AIR SPACE + 12mm THK. TEMPERED GLASS
  - 10mm THK. HEAT STRENGTHENED GLASS (OUTSIDE) +12mm AIR SPACE + 10mm THK. TEMPERED GLASS
  - 12mm THK. HEAT STRENGTHENED GLASS
  - 12mm THK. CLEAR TEMPERED GLASS ( INTERNAL PROTECTIVE BARRIER )
  - 10mm THK. HEAT STRENGTHENED GLASS (OUTSIDE) +12mm AIR SPACE + 12mm THK. TEMPERED GLASS WITH REFLECTIVE COATING
  - 10mm THK. CLEAR TEMPERED GLASS
  - 8mm THK. CLEAR HEAT-STRENGTHENED GLASS +1.52mm PVB + 8mm THK. CLEAR HEAT-STRENGTHENED GLASS
  - 3 mm THK. ALUM. CLADDING
  - 3 mm THK. ALUM. BACKPAN
  - S.J. = STACK JOINT
  - RESTRAINT SOCKET

<p>DWG NO. : JB58-CW-PE111</p> <p>REV. : G</p>	<p>DATE : 22-OCT-21</p> <p>SCALE : 1/10</p>	<p>TITLE : TYPICAL FLOOR ELEVATION &amp; SECTION FOR CURTAIN WALL</p>	<p>PROJECT : PROPOSED RESIDENTIAL AT TKOIL ZONE, PHASE TSEUNG KWAN</p>	<p>JOB NO. : J-854</p>	<p>NO. DATE</p> <p>A 03/12/21 REVISION AS PER</p> <p>B 20/12/21 REVISION AS PER</p> <p>C 16/02/22 REVISION AS PER COMMENTS</p> <p>D 06/04/22 REVISION AS PER COMMENTS</p> <p>E 23/05/22 REVISION AS PER COMMENTS</p> <p>F 26/07/22 REVISION AS PER COMMENTS</p> <p>G 17/08/22 REVISION AS PER COMMENTS</p>	<p>1. ALL DIMENSIONS ARE IN mm.</p> <p>2. ALL ELEVATIONS ARE VIEWED FROM OUTSIDE.</p> <p>3. ALL DIMENSIONS TO BE VERIFIED ON SITE BEFORE FABRICATION.</p>	<p>LEGEND:</p> <p>(X1) DETAIL MARK NO.</p> <p>(X00) REFER SHEET NO.</p> <p>1. F.F.L. -- FINISHED FLOOR LEVEL</p> <p>2. S.F.L. -- STRUCTURAL FLOOR LEVEL</p> <p>3. (R) -- REVERSED DETAIL</p>	<p>STRUCTURAL ENGINEER : <b>AECOM</b></p> <p>FAÇADE CONSULTANT : <b>AECOM</b></p> <p>PROJECT : <b>ronald lu &amp; partners</b> Ronald Lu &amp; Partners (HK) Ltd. 呂允祥建築師事務所 (香港) 有限公司</p> <p>CLIENT : <b>信和置業有限公司</b> Sino Land Company Limited</p>	<p>B.D. REF. :</p>
					<p>PE111</p>				

T1 AG (高層)


T1 AF (高層)

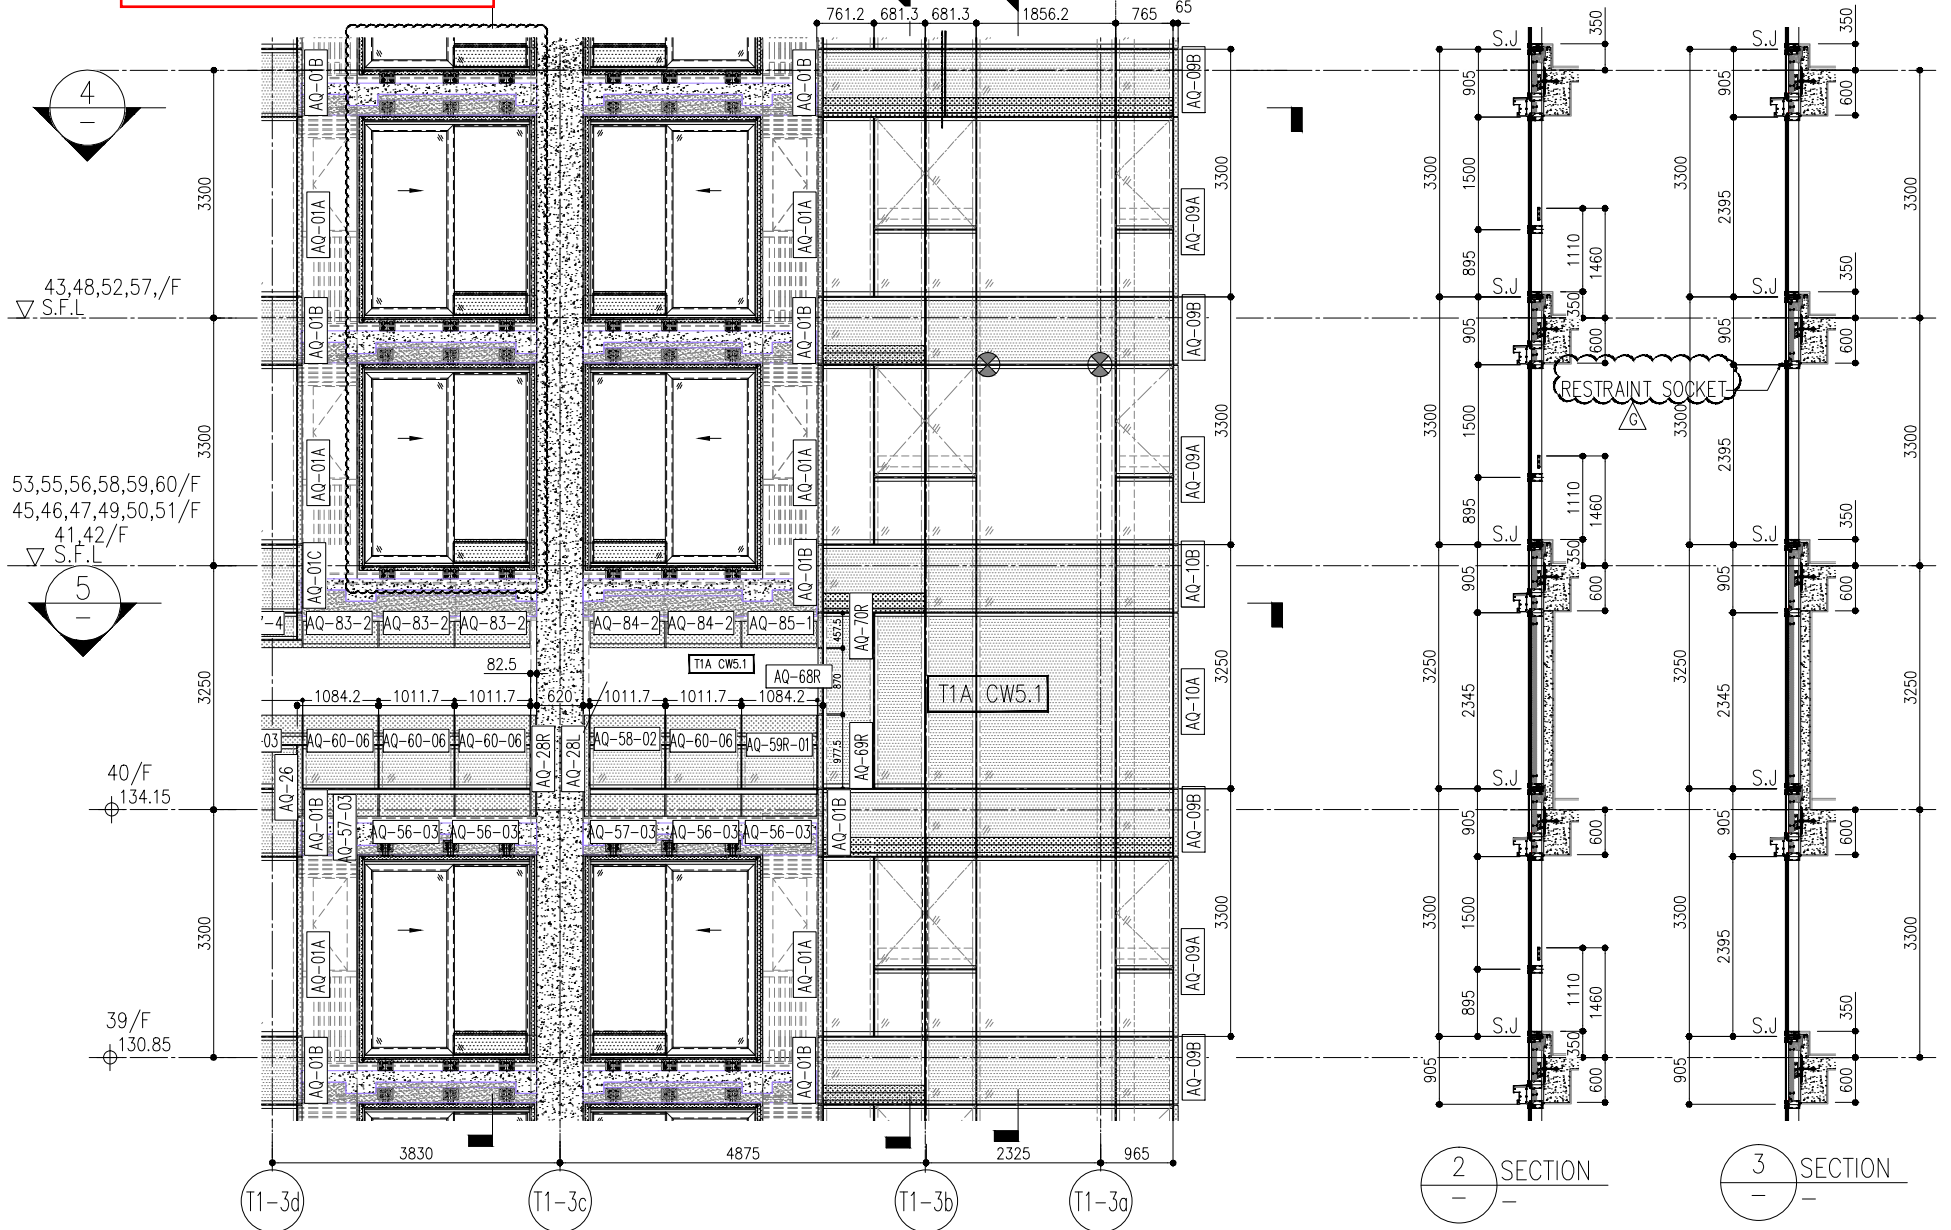

1 PART ELEVATION FOR CURTAIN WALL

2 SECTION

3 SECTION

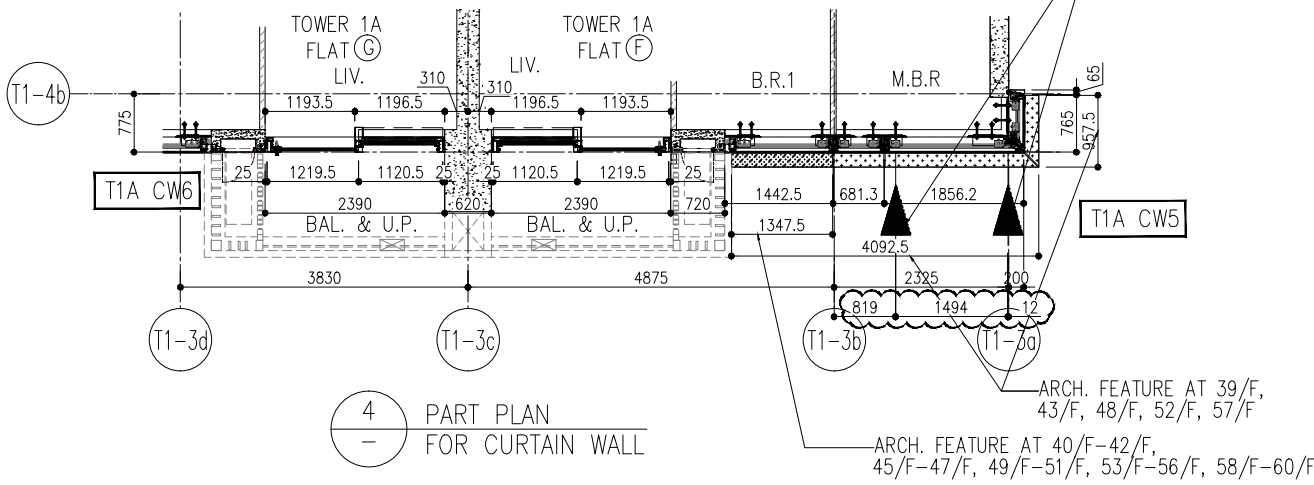


4 PART PLAN FOR CURTAIN WALL

RESTRAINT SOCKET AT 42/F, 49/F, 56/F

ARCH. FEATURE AT 39/F, 43/F, 48/F, 52/F, 57/F  
ARCH. FEATURE AT 40/F-42/F, 45/F-47/F, 49/F-51/F, 53/F-56/F, 58/F-60/F

26/F +91.25	39/F +130.85	52/F +170.40	
25/F +87.95	38/F +127.55	51/F +167.10	
23/F +84.65	37/F +124.25	50/F +163.80	R/F +203.80
22/F +81.35	36/F +120.95	49/F +160.50	62/F +200.30
21/F +78.05	35/F +117.65	48/F +157.20	61/F +196.80
20/F +74.75	33/F +114.35	47/F +153.90	60/F +193.50
19/F +71.45	32/F +111.05	46/F +150.60	59/F +190.20
18/F +68.15	31/F 107.75	45/F +147.30	58/F +186.90
17/F +64.85	30/F +104.45	43/F +144.00	57/F +183.60
16/F +61.55	29/F +101.15	42/F +140.70	56/F +180.30
15/F +58.25	28/F +97.85	41/F +137.40	55/F +177.00
12/F +54.95	27/F +94.55	40/F +134.15	53/F +173.70





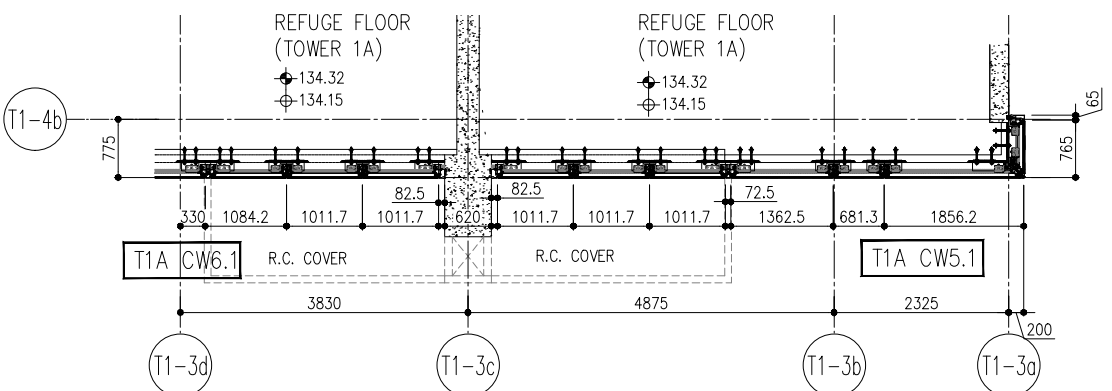


5 PART PLAN(40/F) FOR CURTAIN WALL

- LEGEND:
- 10mm THK. HEAT STRENGTHENED GLASS (OUTSIDE) +12mm AIR SPACE + 12mm THK. TEMPERED GLASS
  - 10mm THK. HEAT STRENGTHENED GLASS (OUTSIDE) +12mm AIR SPACE + 10mm THK. TEMPERED GLASS
  - 12mm THK. HEAT STRENGTHENED GLASS
  - 12mm THK. CLEAR TEMPERED GLASS ( INTERNAL PROTECTIVE BARRIER )
  - 10mm THK. HEAT STRENGTHENED GLASS (OUTSIDE) +12mm AIR SPACE + 12mm THK. TEMPERED GLASS WITH REFLECTIVE COATING
  - 10mm THK. CLEAR TEMPERED GLASS
  - 8mm THK. CLEAR HEAT-STRENGTHENED GLASS +1.52mm PVB + 8mm THK. CLEAR HEAT-STRENGTHENED GLASS
  - 3 mm THK. ALUM. CLADDING
  - 3 mm THK. ALUM. BACKPAN
  - S.J. = STACK JOINT
  - RESTRAINT SOCKET

DELETED

<p>美特鋁業有限公司 MIDI ALUMINIUM FABRICATOR LTD. Units 6-8, Sunray Industrial Centre, Kwailoon 610 Cho Kwai Ling Road, Kwailoon Tel:23489211-4 Fax:(852)27272666</p>	<p>DWG NO. : J858-CW-PE112</p>	<p>REV. : G</p>	<p>DATE : 22-OCT-21</p>	<p>SCALE : 1/1</p>	<p>TITLE : TYPICAL FLOOR ELEVATION &amp; SECTION FOR CURTAIN WALL</p>	<p>PROJECT : PROPOSED RESIDENTIAL AT TKOIL ZONE, PHASE TSEUNG KWAN</p>	<p>JOB NO. : J-854</p>	<p>NO. DATE</p> <table border="1"> <tr> <td>A</td> <td>03/12/21</td> <td>REVISED AS PER COMMENTS</td> <td>US</td> </tr> <tr> <td>B</td> <td>20/12/21</td> <td>REVISED AS PER COMMENTS</td> <td>US</td> </tr> <tr> <td>C</td> <td>16/02/22</td> <td>REVISED AS PER COMMENTS</td> <td>US</td> </tr> <tr> <td>D</td> <td>06/04/22</td> <td>REVISED AS PER COMMENTS</td> <td>US</td> </tr> <tr> <td>E</td> <td>23/05/22</td> <td>REVISED AS PER COMMENTS</td> <td>US</td> </tr> <tr> <td>F</td> <td>26/07/22</td> <td>REVISED AS PER COMMENTS</td> <td>US</td> </tr> <tr> <td>G</td> <td>17/08/22</td> <td>REVISED AS PER COMMENTS</td> <td>US</td> </tr> </table>	A	03/12/21	REVISED AS PER COMMENTS	US	B	20/12/21	REVISED AS PER COMMENTS	US	C	16/02/22	REVISED AS PER COMMENTS	US	D	06/04/22	REVISED AS PER COMMENTS	US	E	23/05/22	REVISED AS PER COMMENTS	US	F	26/07/22	REVISED AS PER COMMENTS	US	G	17/08/22	REVISED AS PER COMMENTS	US	<p>NOTE: 1. ALL DIMENSIONS ARE IN mm. 2. ALL ELEVATIONS ARE VIEWED FROM OUTSIDE. 3. ALL DIMENSIONS TO BE VERIFIED ON SITE BEFORE FABRICATION.</p>	<p>LEGEND:  DETAIL MARK NO.  REFER SHEET NO. 1. F.F.L. -- FINISHED FLOOR LEVEL 2. S.F.L. -- STRUCTURAL FLOOR LEVEL 3. R/R -- REVERSED DETAIL</p>	<p>FAÇADE CONSULTANT: <b>AECOM</b></p>	<p>STRUCTURAL ENGINEER: <b>Gammon</b></p>	<p>PROJECT: <b>ronald lu &amp; partners</b> Ronald Lu &amp; Partners (HK) Ltd. 呂元仲建築師事務所 (香港) 有限公司</p>	<p>CLIENT: <b>信和置業有限公司</b> Sino Land Company Limited</p>	<p>B.D. REF. :</p>
									A	03/12/21	REVISED AS PER COMMENTS	US																															
B	20/12/21	REVISED AS PER COMMENTS	US	
C	16/02/22	REVISED AS PER COMMENTS	US	
D	06/04/22	REVISED AS PER COMMENTS	US	
E	23/05/22	REVISED AS PER COMMENTS	US	
F	26/07/22	REVISED AS PER COMMENTS	US	
G	17/08/22	REVISED AS PER COMMENTS	US	
<p>PE112</p>	

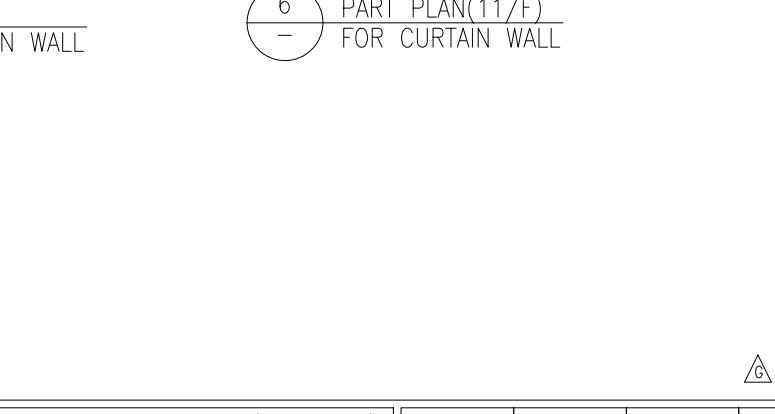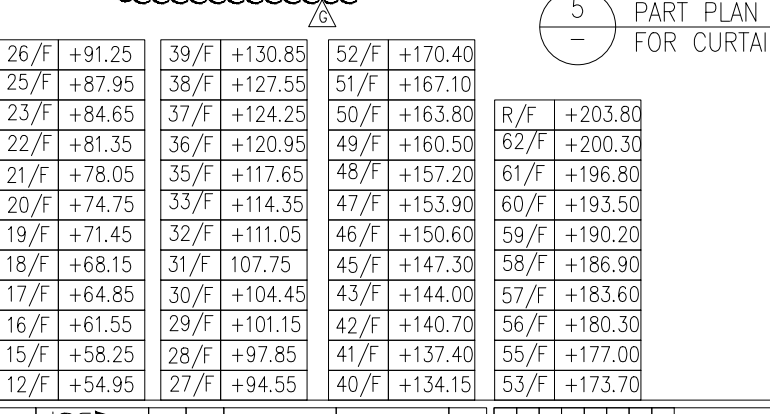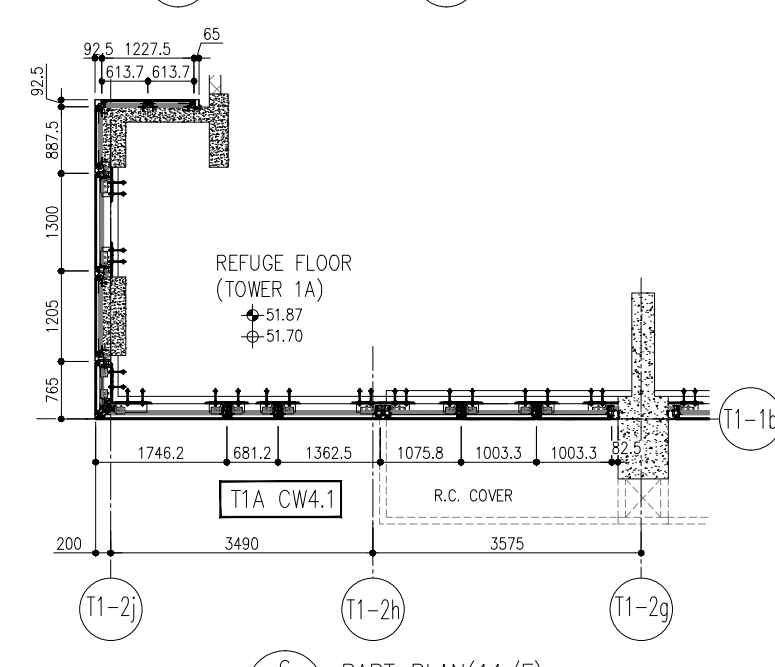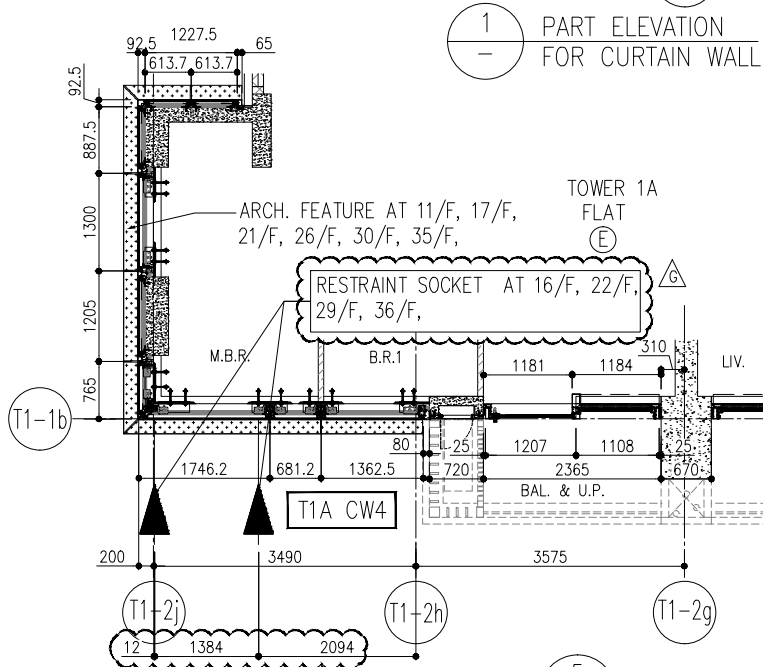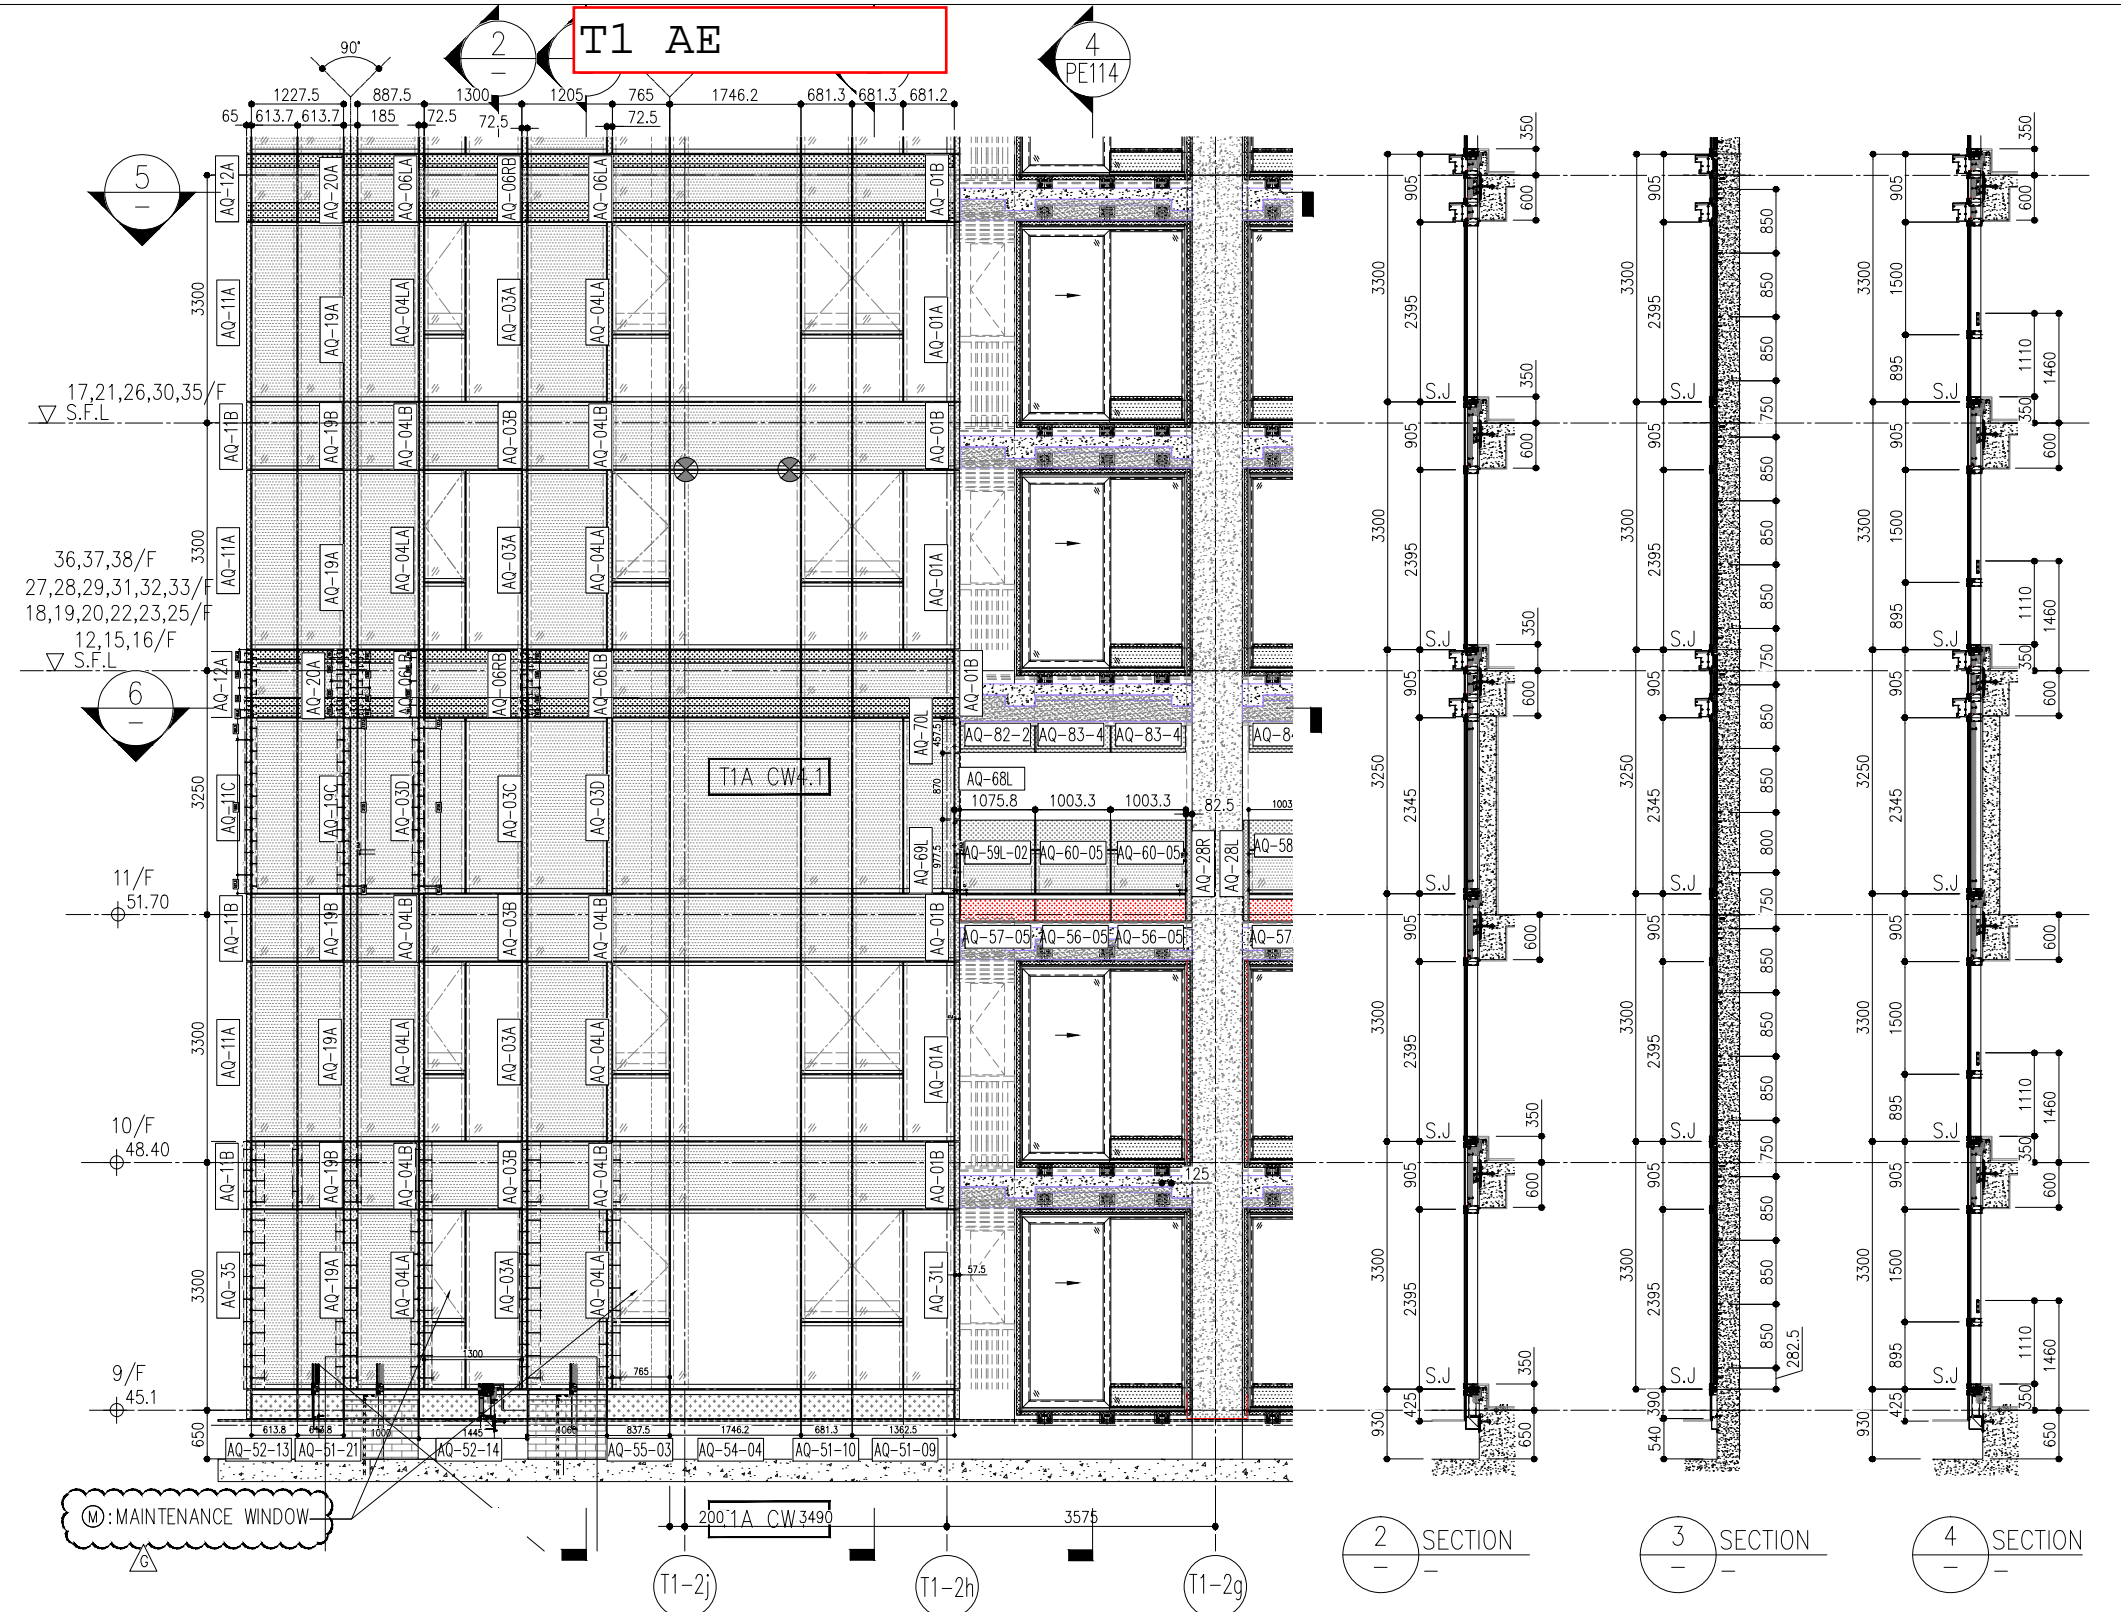

26/F	+91.25	39/F	+130.85	52/F	+170.40
25/F	+87.95	38/F	+127.55	51/F	+167.10
23/F	+84.65	37/F	+124.25	50/F	+163.80
22/F	+81.35	36/F	+120.95	49/F	+160.50
21/F	+78.05	35/F	+117.65	48/F	+157.20
20/F	+74.75	33/F	+114.35	47/F	+153.90
19/F	+71.45	32/F	+111.05	46/F	+150.60
18/F	+68.15	31/F	+107.75	45/F	+147.30
17/F	+64.85	30/F	+104.45	43/F	+144.00
16/F	+61.55	29/F	+101.15	42/F	+140.70
15/F	+58.25	28/F	+97.85	41/F	+137.40
12/F	+54.95	27/F	+94.55	40/F	+134.15
				R/F	+203.80
				62/F	+200.30
				61/F	+196.80
				60/F	+193.50
				59/F	+190.20
				58/F	+186.90
				57/F	+183.60
				56/F	+180.30
				55/F	+177.00
				53/F	+173.70

- LEGEND:**
- 10mm THK. HEAT STRENGTHENED GLASS (OUTSIDE) +12mm AIR SPACE + 12mm THK. TEMPERED GLASS
  - 10mm THK. HEAT STRENGTHENED GLASS (OUTSIDE) +12mm AIR SPACE + 10mm THK. TEMPERED GLASS
  - 12mm THK. HEAT STRENGTHENED GLASS
  - 12mm THK. CLEAR TEMPERED GLASS ( INTERNAL PROTECTIVE BARRIER )
  - 10mm THK. HEAT STRENGTHENED GLASS (OUTSIDE) +12mm AIR SPACE + 12mm THK. TEMPERED GLASS WITH REFLECTIVE COATING
  - 10mm THK. CLEAR TEMPERED GLASS
  - 8mm THK. CLEAR HEAT-STRENGTHENED GLASS +1.52mm CLEAR + 8mm THK. CLEAR HEAT-STRENGTHENED GLASS
  - 3 mm THK. ALUM. SLIDING
  - 3 mm THK. ALUM. BACKPAN
  - S.J. - STACK JOINT
  - RESTRAINT SOCKET

**PE113**

DATE: 22-OCT-21

PROJECT: PROPOSED RESIDENTIAL AT TKOIL 70RP, PHASE TSEUNG KWAN

UOB NO.: J-854

1. F.F.L. -- FINISHED FLOOR LEVEL

2. S.F.L. -- STRUCTURAL FLOOR LEVEL

3. -- REVERSED DETAIL

NOTE: ALL DIMENSIONS ARE IN mm.

1. ALL ELEVATIONS ARE VIEWED FROM OUTSIDE.

2. ALL DIMENSIONS TO BE VERIFIED ON SITE BEFORE FABRICATION.

ARCHITECT: ronaidiu & partners

Structural Engineer: Gammon


FAÇADE CONSULTANT: AECOM

CLIENT: 信和置業有限公司

Sino Land Company Limited



**T1 AE (高層)**

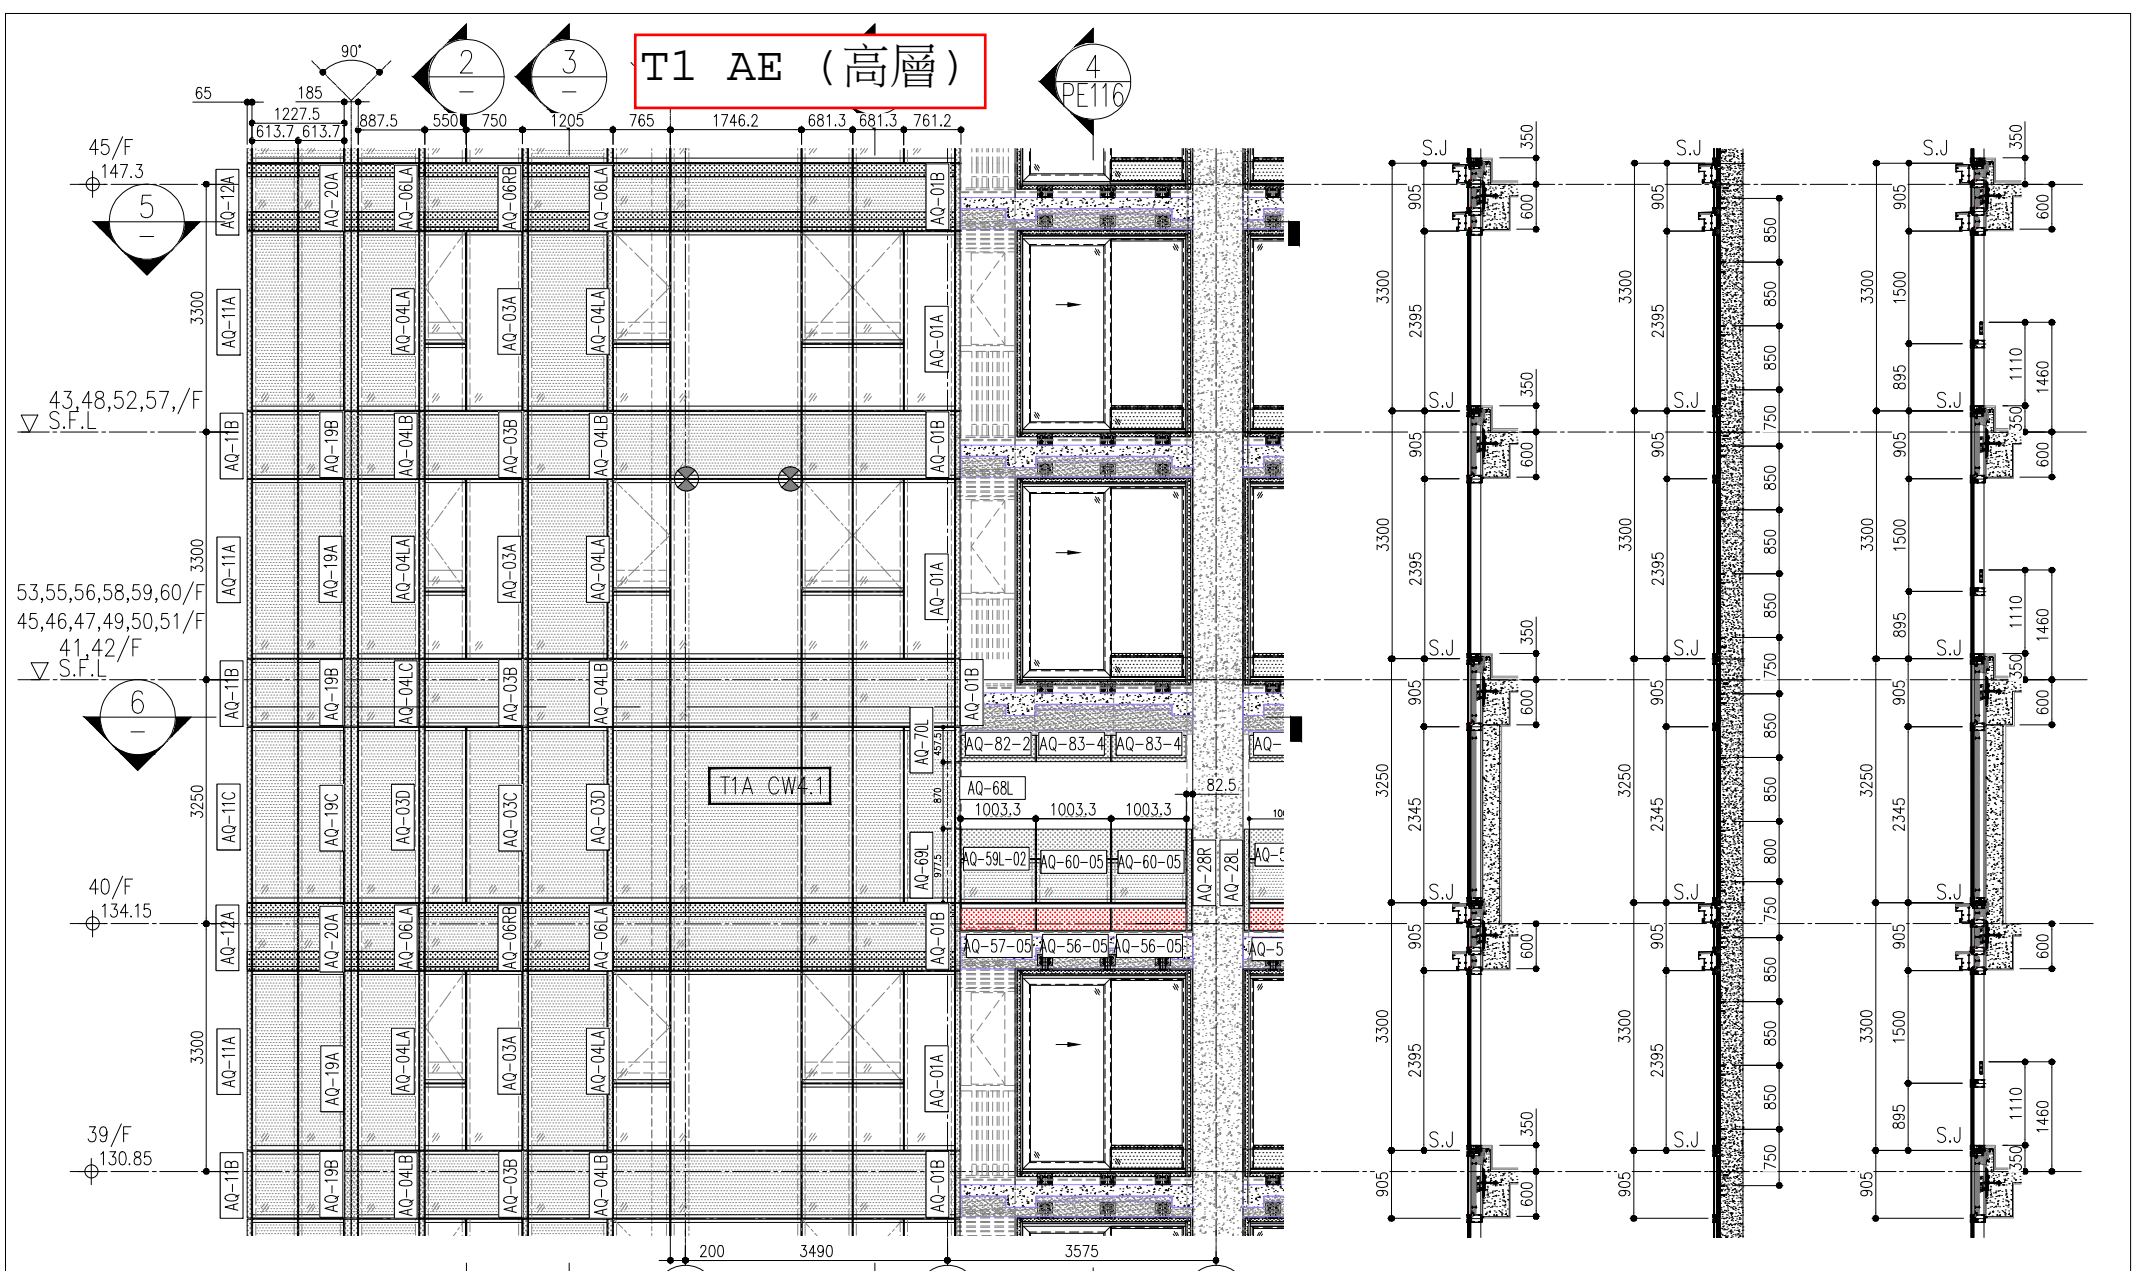


1 PART ELEVATION FOR CURTAIN WALL

2 SECTION

3 SECTION

4 SECTION

ARCH. FEATURE AT 39/F, 43/F, 48/F, 52/F, 57/F

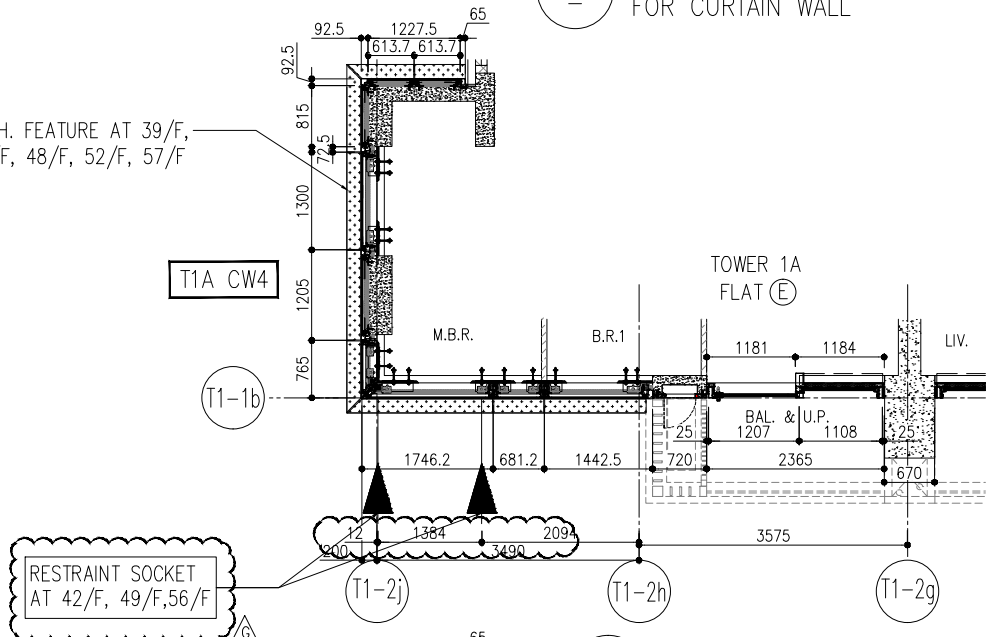


5 PART PLAN FOR CURTAIN WALL

6 PART PLAN (40/F) FOR CURTAIN WALL

26/F	+91.25	39/F	+130.85	52/F	+170.40		
25/F	+87.95	38/F	+127.55	51/F	+167.10		
23/F	+84.65	37/F	+124.25	50/F	+163.80	R/F	+203.80
22/F	+81.35	36/F	+120.95	49/F	+160.50	62/F	+200.30
21/F	+78.05	35/F	+117.65	48/F	+157.20	61/F	+196.80
20/F	+74.75	33/F	+114.35	47/F	+153.90	60/F	+193.50
19/F	+71.45	32/F	+111.05	46/F	+150.60	59/F	+190.20
18/F	+68.15	31/F	107.75	45/F	+147.30	58/F	+186.90
17/F	+64.85	30/F	+104.45	43/F	+144.00	57/F	+183.60
16/F	+61.55	29/F	+101.15	42/F	+140.70	56/F	+180.30
15/F	+58.25	28/F	+97.85	41/F	+137.40	55/F	+177.00
12/F	+54.95	27/F	+94.55	40/F	+134.15	53/F	+173.70


- LEGEND:**
- 10mm THK. HEAT STRENGTHENED GLASS (OUTSIDE) + 12mm AIR SPACE + 12mm THK. TEMPERED GLASS
  - 10mm THK. HEAT STRENGTHENED GLASS (OUTSIDE) + 12mm AIR SPACE + 10mm THK. TEMPERED GLASS
  - 12mm THK. HEAT STRENGTHENED GLASS
  - 12mm THK. CLEAR TEMPERED GLASS ( INTERNAL PROTECTIVE BARRIER )
  - 10mm THK. HEAT STRENGTHENED GLASS (OUTSIDE) + 12mm AIR SPACE + 12mm THK. TEMPERED GLASS WITH REFLECTIVE COATING
  - 10mm THK. CLEAR TEMPERED GLASS
  - 8mm THK. CLEAR HEAT-STRENGTHENED GLASS + 1.52mm PVB + 8mm THK. CLEAR HEAT-STRENGTHENED GLASS
  - 3 mm THK. ALUM. GLASSING
  - 3 mm THK. ALUM. BACKPAN
  - S.J. - STACK JOINT
  - RESTRAINT SOCKET

<p><b>PE115</b></p>	<p><b>REVISIONS:</b></p> <table border="1" style="width: 100%; border-collapse: collapse;"> <thead> <tr> <th>NO.</th> <th>DATE</th> <th>REVISIONS AS PER</th> <th>BY</th> </tr> </thead> <tbody> <tr> <td>A</td> <td>03/12/21</td> <td>REVISED AS PER COMMENTS</td> <td>LS</td> </tr> <tr> <td>B</td> <td>20/12/21</td> <td>REVISED AS PER COMMENTS</td> <td>LS</td> </tr> <tr> <td>C</td> <td>17/02/22</td> <td>REVISED AS PER COMMENTS</td> <td>LS</td> </tr> <tr> <td>D</td> <td>06/04/22</td> <td>REVISED AS PER COMMENTS</td> <td>LS</td> </tr> <tr> <td>E</td> <td>23/05/22</td> <td>REVISED AS PER COMMENTS</td> <td>LS</td> </tr> <tr> <td>F</td> <td>26/07/22</td> <td>REVISED AS PER COMMENTS</td> <td>LS</td> </tr> <tr> <td>G</td> <td>17/08/22</td> <td>REVISED AS PER COMMENTS</td> <td>LS</td> </tr> </tbody> </table>	NO.	DATE	REVISIONS AS PER	BY	A	03/12/21	REVISED AS PER COMMENTS	LS	B	20/12/21	REVISED AS PER COMMENTS	LS	C	17/02/22	REVISED AS PER COMMENTS	LS	D	06/04/22	REVISED AS PER COMMENTS	LS	E	23/05/22	REVISED AS PER COMMENTS	LS	F	26/07/22	REVISED AS PER COMMENTS	LS	G	17/08/22	REVISED AS PER COMMENTS	LS	<p><b>NOTE:</b></p> <ol style="list-style-type: none"> <li>ALL DIMENSIONS ARE IN mm.</li> <li>ALL ELEVATIONS ARE VIEWED FROM OUTSIDE.</li> <li>ALL DIMENSIONS TO BE VERIFIED ON SITE BEFORE FABRICATION.</li> </ol>	<p><b>ARCHITECT:</b> ronald lu &amp; partners Ronald Lu &amp; Partners (HK) Ltd. 呂允輝建築師事務所 (香港) 有限公司</p> <p><b>CLIENT:</b> 信和置業有限公司 Sino Land Company Limited</p> <p><b>STRUCTURAL ENGINEER:</b> Gammorn AECOM</p> <p><b>FAÇADE CONSULTANT:</b> AECOM</p>
NO.	DATE	REVISIONS AS PER	BY																																
A	03/12/21	REVISED AS PER COMMENTS	LS																																
B	20/12/21	REVISED AS PER COMMENTS	LS																																
C	17/02/22	REVISED AS PER COMMENTS	LS																																
D	06/04/22	REVISED AS PER COMMENTS	LS																																
E	23/05/22	REVISED AS PER COMMENTS	LS																																
F	26/07/22	REVISED AS PER COMMENTS	LS																																
G	17/08/22	REVISED AS PER COMMENTS	LS																																
<p><b>PROJECT:</b> PROPOSED RESIDENTIAL AT TKOIL ZONE, PHASE TSEUNG KWAN</p> <p><b>JOB NO.:</b> J-854</p> <p><b>DATE:</b> 22-OCT-21</p> <p><b>DRAWN BY:</b> SC</p>	<p><b>TITLE:</b> TYPICAL FLOOR ELEVATION &amp; SECTION FOR CURTAIN WALL</p>	<p><b>REVISIONS:</b></p> <p><b>LEGEND:</b></p> <p>(X1) DETAIL MARK NO. (X00) REFER SHEET NO. 1. F.F.L. -- FINISHED FLOOR LEVEL 2. S.F.L. -- STRUCTURAL FLOOR LEVEL 3. (R) -- REVERSED DETAIL</p>	<p><b>MAIN CONTRACTOR:</b> Sino Land Company Limited</p>																																

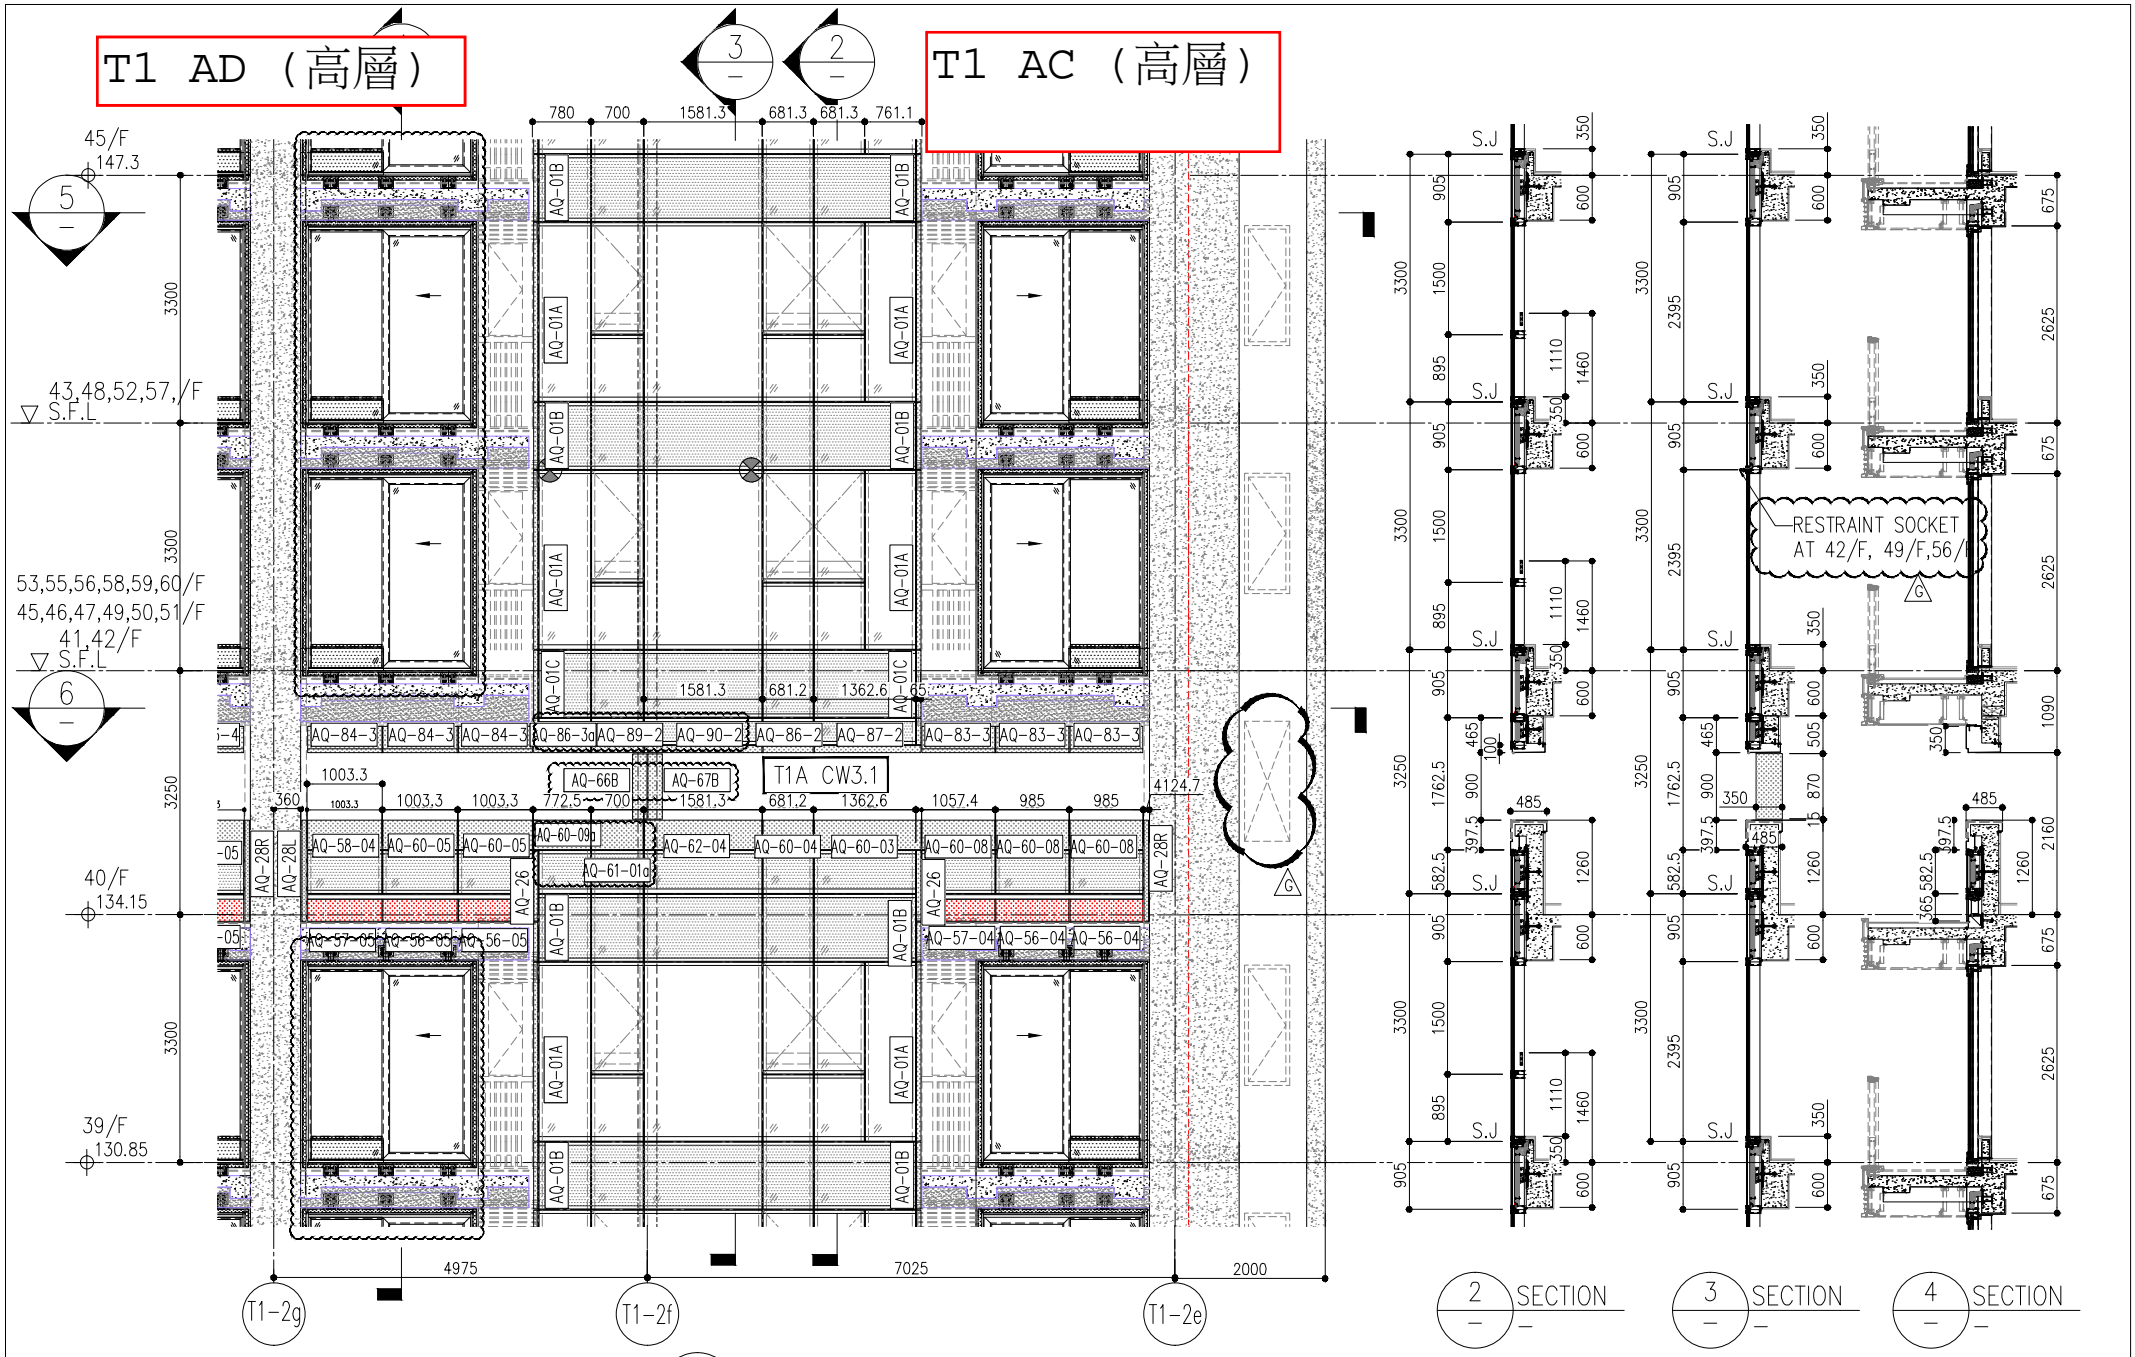


1 PART ELEVATION FOR CURTAIN WALL

2 SECTION  
3 SECTION  
4 SECTION

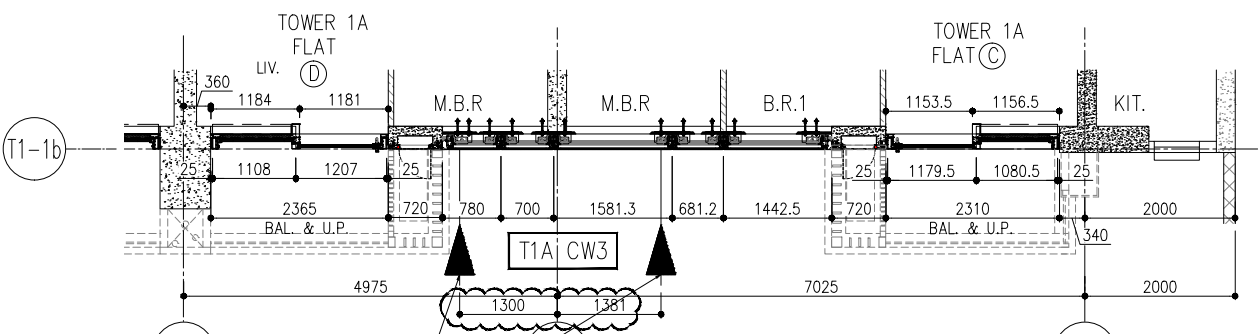

5 PART PLAN FOR CURTAIN WALL

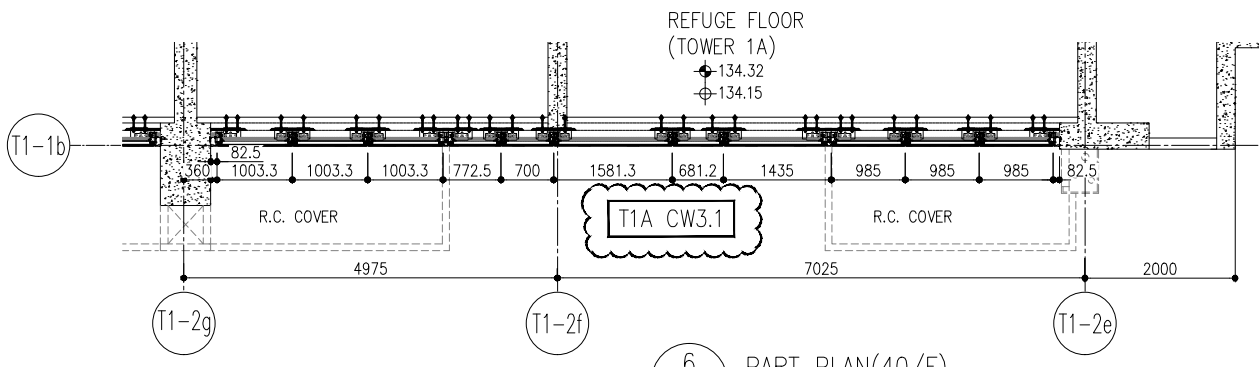

6 PART PLAN (40/F) FOR CURTAIN WALL

26/F +91.25	39/F +130.85	52/F +170.40	
25/F +87.95	38/F +127.55	51/F +167.10	
23/F +84.65	37/F +124.25	50/F +163.80	R/F +203.80
22/F +81.35	36/F +120.95	49/F +160.50	62/F +200.30
21/F +78.05	35/F +117.65	48/F +157.20	61/F +196.80
20/F +74.75	33/F +114.35	47/F +153.90	60/F +193.50
19/F +71.45	32/F +111.05	46/F +150.60	59/F +190.20
18/F +68.15	31/F 107.75	45/F +147.30	58/F +186.90
17/F +64.85	30/F +104.45	43/F +144.00	57/F +183.60
16/F +61.55	29/F +101.15	42/F +140.70	56/F +180.30
15/F +58.25	28/F +97.85	41/F +137.40	55/F +177.00
12/F +54.95	27/F +94.55	40/F +134.15	53/F +173.70

- LEGEND:
- 10mm THK. HEAT STRENGTHENED GLASS (OUTSIDE) +12mm AIR SPACE + 12mm THK. TEMPERED GLASS
  - 10mm THK. HEAT STRENGTHENED GLASS (OUTSIDE) +12mm AIR SPACE + 10mm THK. TEMPERED GLASS
  - 12mm THK. HEAT STRENGTHENED GLASS
  - 12mm THK. CLEAR TEMPERED GLASS ( INTERNAL PROTECTIVE BARRIER )
  - 10mm THK. HEAT STRENGTHENED GLASS (OUTSIDE) +12mm AIR SPACE + 12mm THK. TEMPERED GLASS WITH REFLECTIVE COATING
  - 10mm THK. CLEAR TEMPERED GLASS
  - 8mm THK. CLEAR HEAT-STRENGTHENED GLASS +1.52mm PVB + 8mm THK. CLEAR HEAT-STRENGTHENED GLASS
  - 3 mm THK. ALUM. CLADDING
  - 3 mm THK. ALUM. BACKPAN
  - S.J. - STACK JOINT
  - RESTRAINT SOCKET

DWG NO. : J858-CW-PE116

REV. : G

DATE : 22-OCT-21

PROJECT : PROPOSED RESIDENTIAL AT TKOIL ZONE, PHASE TSEUNG KWAN

TITLE : TYPICAL FLOOR ELEVATION & SECTION FOR CURTAIN WALL

JOB NO. : J-858

ARCHITECT : ronaldi lu & partners

ARCHITECT : Ronald Lu & Partners (香港) 有限公司

MAIN CONTRACTOR : Sino Land Company Limited

STRUCTURAL ENGINEER : Gammon

FAÇADE CONSULTANT : AECOM

NOTE:



- ALL DIMENSIONS ARE IN mm.
- ALL ELEVATIONS ARE VIEWED FROM OUTSIDE.
- ALL DIMENSIONS TO BE VERIFIED ON SITE BEFORE FABRICATION.

LEGEND:

- DETAIL MARK NO.
- REFER SHEET NO.
- 1. F.F.L. - FINISHED FLOOR LEVEL
- 2. S.F.L. - STRUCTURAL FLOOR LEVEL
- 3. (R) - REVERSED DETAIL

NO.	DATE	REVISION
A	03/12/21	REVISED AS PER COMMENTS
B	20/12/21	REVISED AS PER COMMENTS
C	17/01/22	REVISED AS PER COMMENTS
D	06/04/22	REVISED AS PER COMMENTS
E	23/05/22	REVISED AS PER COMMENTS
F	26/07/22	REVISED AS PER COMMENTS
G	17/08/22	REVISED AS PER COMMENTS

# PE116

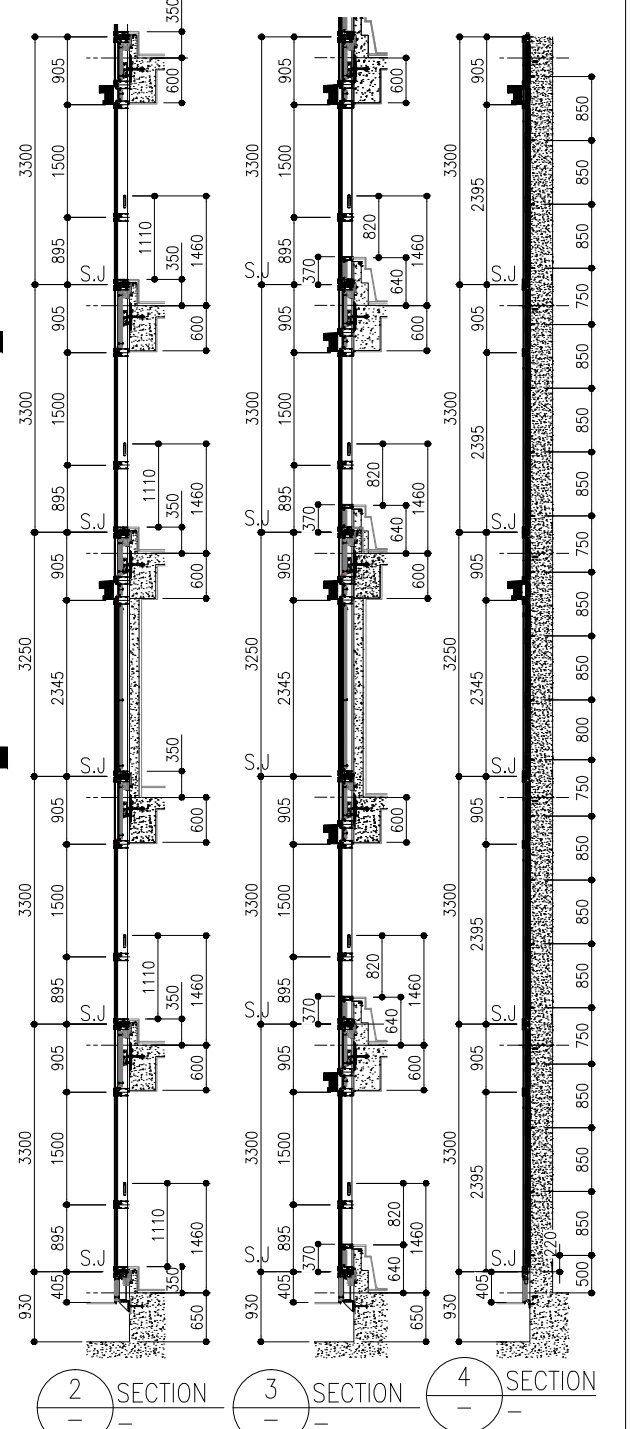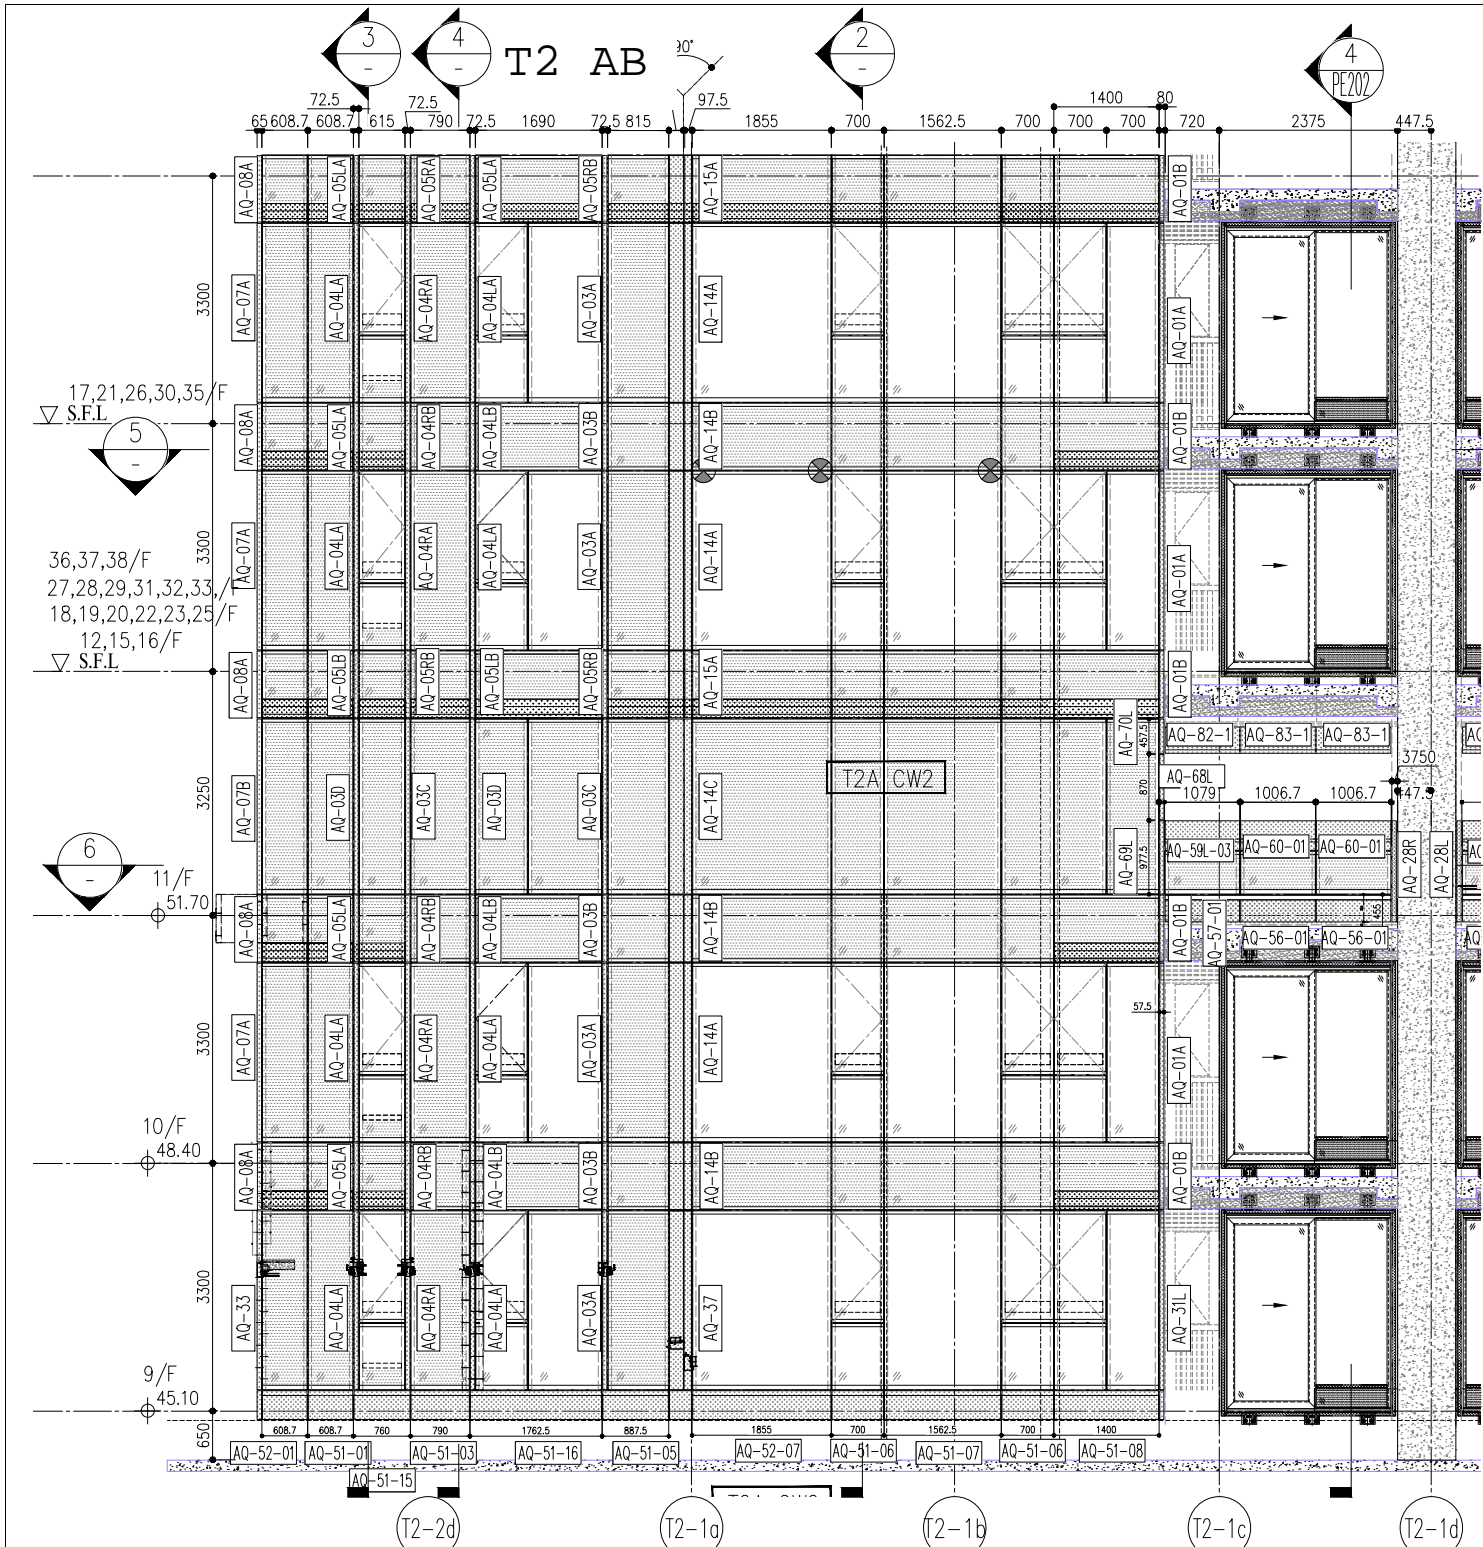

1 PART ELEVATION FOR CURTAIN WALL

R/F	+217.00
67/F	+213.50
26/F	+91.25
25/F	+87.95
23/F	+84.65
22/F	+81.35
21/F	+78.05
20/F	+74.75
19/F	+71.45
18/F	+68.15
17/F	+64.85
16/F	+61.55
15/F	+58.25
12/F	+54.95
39/F	+130.85
38/F	+127.55
36/F	+120.95
35/F	+117.65
33/F	+114.35
32/F	+111.05
31/F	+107.75
29/F	+101.15
28/F	+97.85
27/F	+94.55
52/F	+170.40
51/F	+167.10
50/F	+163.80
49/F	+160.50
48/F	+157.20
47/F	+153.90
46/F	+150.60
45/F	+147.30
43/F	+144.00
42/F	+140.70
41/F	+137.40
40/F	+134.15
66/F	+210.00
65/F	+206.70
63/F	+203.40
62/F	+200.10
61/F	+196.80
60/F	+193.50
59/F	+190.20
58/F	+186.90
57/F	+183.60
56/F	+180.30
55/F	+177.00
53/F	+173.70

ARCH. FEATURE AT 9/F,10/F, 12/F,15/F-16/F, 18/F-20/F, 22/F,23/F, 25/F, 27/F-29/F, 31/F-33/F,36/F-38/F


ARCH. FEATURE AT 11/F,17/F, 21/F,26/F,30/F,35/F,

ARCH. FEATURE AT 9/F,10/F, 12/F,15/F-16/F, 18/F-20/F, 22/F,23/F, 25/F, 27/F-29/F, 31/F-33/F,36/F-38/F

ARCH. FEATURE AT 9/F,10/F, 12/F,15/F-16/F, 18/F-20/F, 22/F,23/F, 25/F, 27/F-29/F, 31/F-33/F,36/F-38/F

RESTRAINT SOCKET AT 12/F, 20/F 27/F, 33/F

- LEGEND:
- (G1) 10mm THK. HEAT STRENGTHENED GLASS (OUTSIDE) +12mm AIR SPACE + 12mm THK. TEMPERED GLASS
  - (G2) 10mm THK. HEAT STRENGTHENED GLASS (OUTSIDE) +12mm AIR SPACE + 10mm THK. TEMPERED GLASS
  - (G3) 12mm THK. HEAT STRENGTHENED GLASS
  - (G4) 12mm THK. CLEAR TEMPERED GLASS ( INTERNAL PROTECTIVE BARRIER )
  - (G5) 10mm THK. HEAT STRENGTHENED GLASS (OUTSIDE) +12mm AIR SPACE + 12mm THK. TEMPERED GLASS WITH REFLECTIVE COATING
  - (G6) 10mm THK. CLEAR TEMPERED GLASS
  - (G7) 8mm THK. CLEAR HEAT-STRENGTHENED GLASS +1.5mm PVB + 8mm THK. CLEAR HEAT-STRENGTHENED GLASS
  - (G8) 3 mm THK. ALUM. CLADDING
  - (G9) 3 mm THK. ALUM. BACKPAN
  - S.J. - STACK JOINT
  - (RS) - RESTRAINT SOCKET

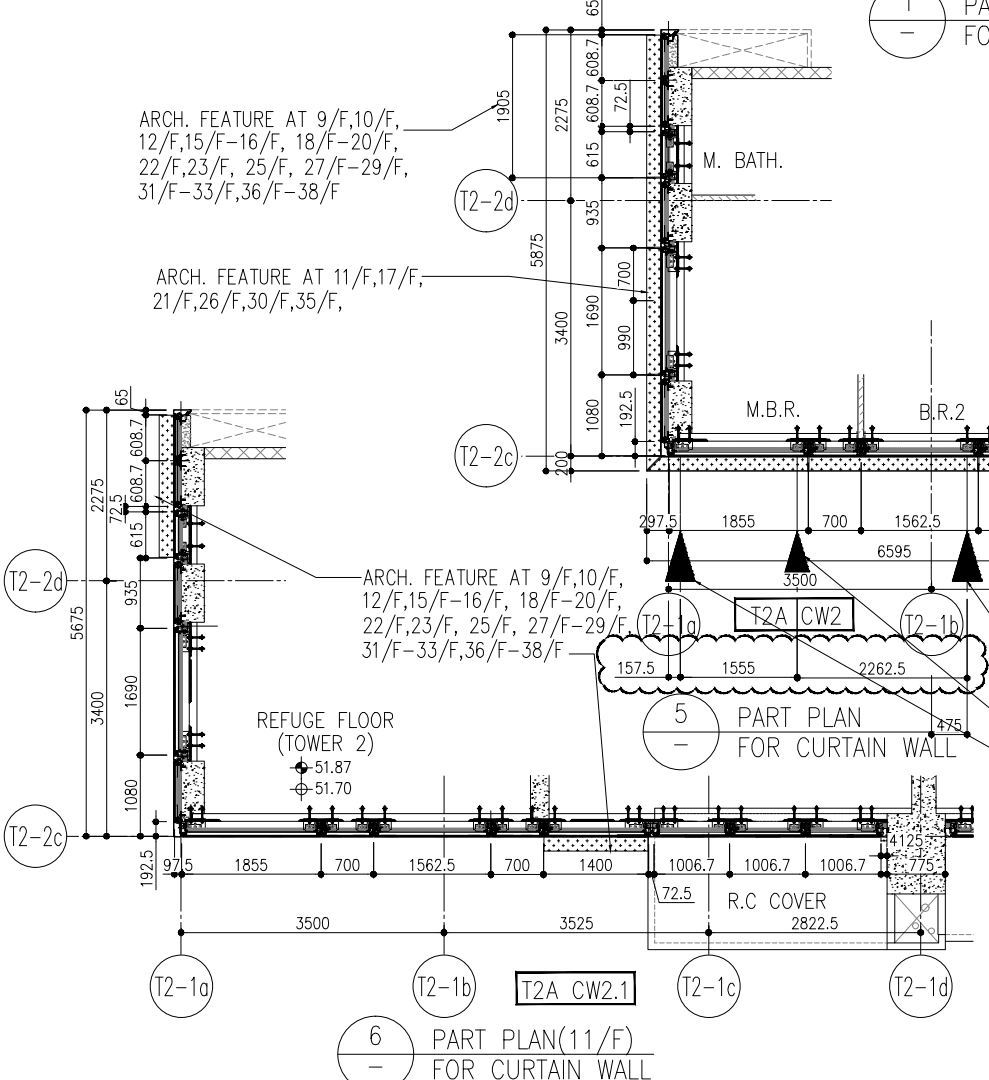

6 PART PLAN(11/F) FOR CURTAIN WALL

PROJECT: DEVELOPMENT OF 1, LOHAS PARK D, N.T.

DATE: 03/12/21

REVISIONS:

NO.	DATE	REVISIONS
A	03/12/21	REVISED AS PER COMMENTS
B	20/12/21	REVISED AS PER COMMENTS
C	22/01/22	REVISED AS PER COMMENTS
D	06/04/22	REVISED AS PER COMMENTS
E	26/07/22	REVISED AS PER COMMENTS
F	26/07/22	REVISED AS PER COMMENTS
G	18/08/22	REVISED AS PER COMMENTS

**PE201**

ARCHITECT: ronaldi & partners

CLIENT: 信和置業有限公司 Sino Land Company Limited

STRUCTURAL ENGINEER: Gammon

FAÇADE CONSULTANT: AECOM


LEGEND:

- (X1) DETAIL MARK NO.
- (X20) REFER SHEET NO.
- 1. F.F.L. -- FINISHED FLOOR LEVEL
- 2. S.F.L. -- STRUCTURAL FLOOR LEVEL
- 3. (R) -- REVERSED DETAIL

NOTE:

1. ALL DIMENSIONS ARE IN mm.
2. ALL ELEVATIONS ARE VIEWED FROM OUTSIDE.
3. ALL DIMENSIONS TO BE VERIFIED ON SITE BEFORE FABRICATION.

B.D. REF.:


CLIENT: 信和置業有限公司 Sino Land Company Limited

ARCHITECT: ronaldi & partners


STRUCTURAL ENGINEER: Gammon

FAÇADE CONSULTANT: AECOM



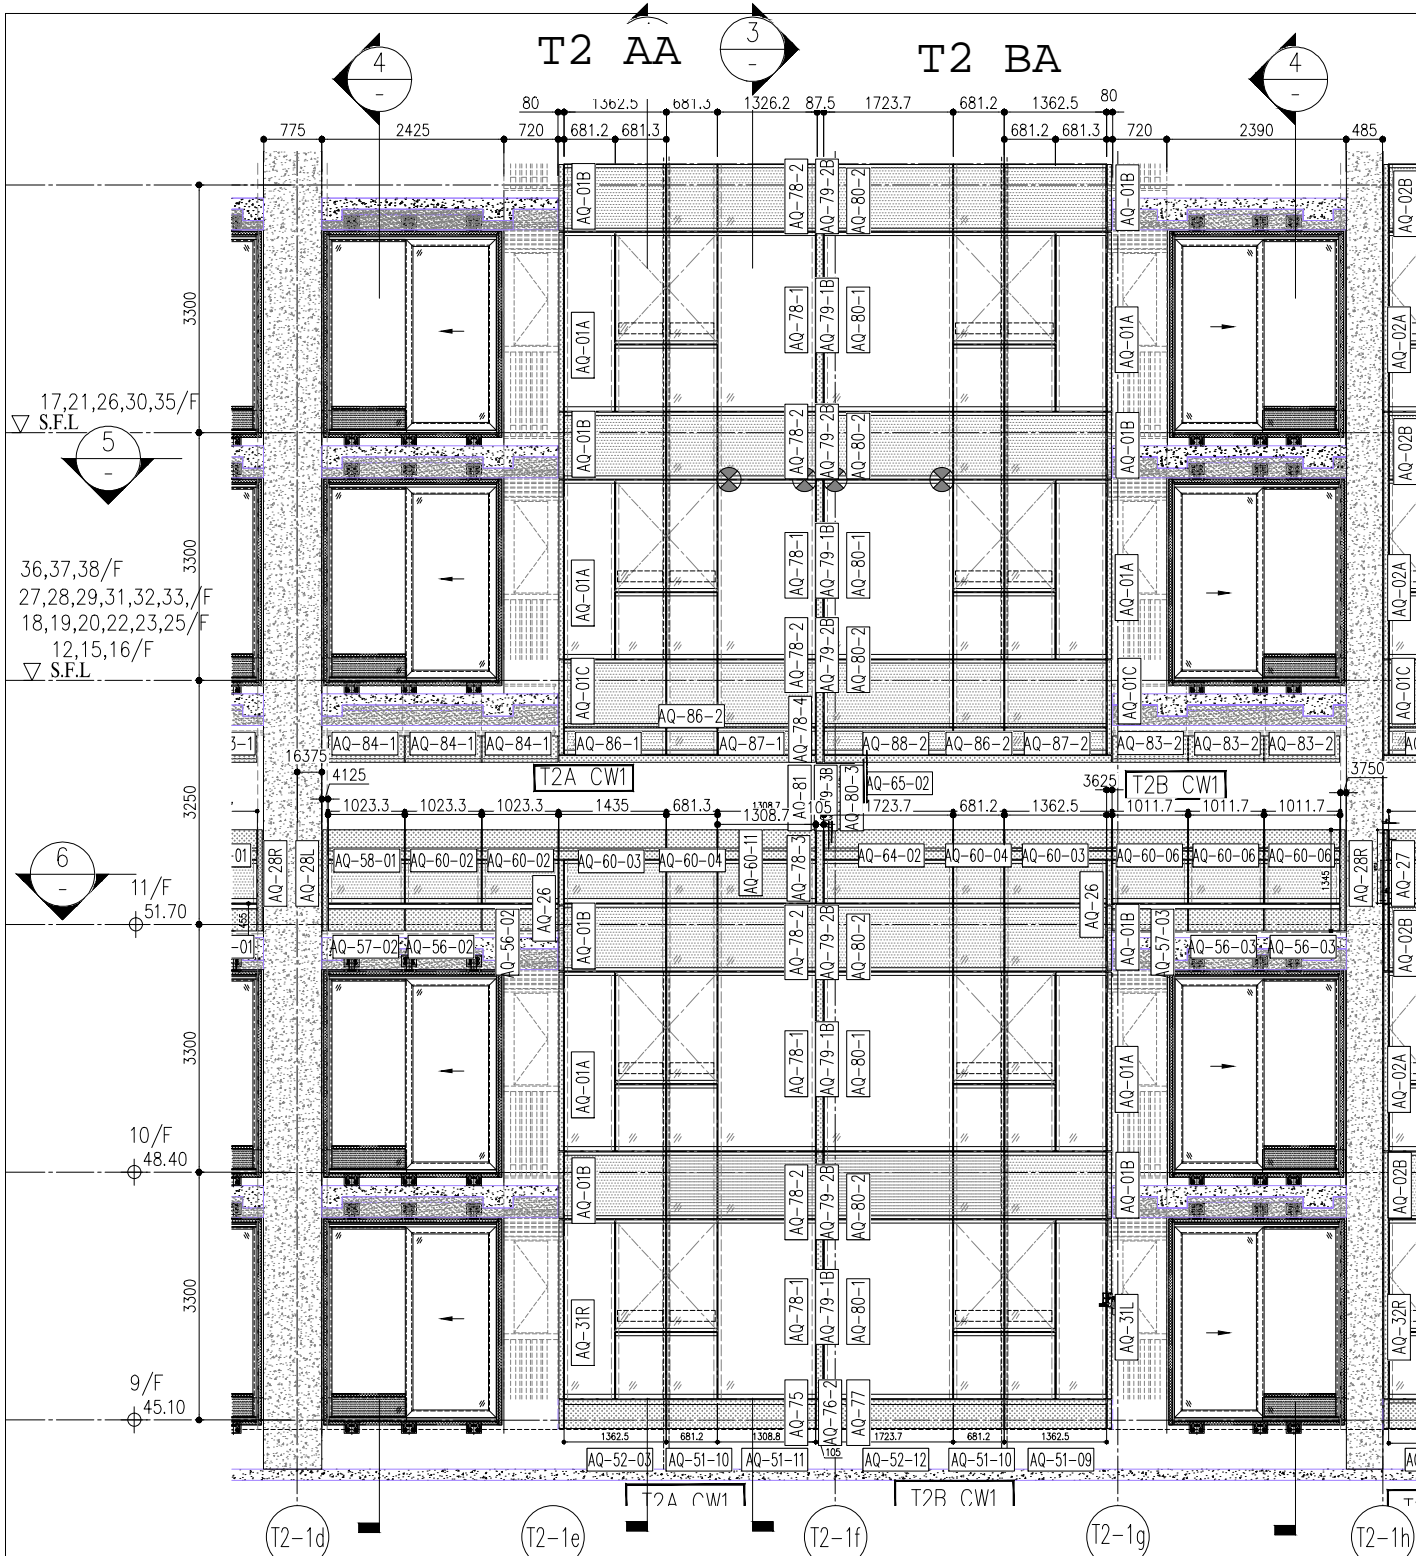


1 PART ELEVATION FOR CURTAIN WALL

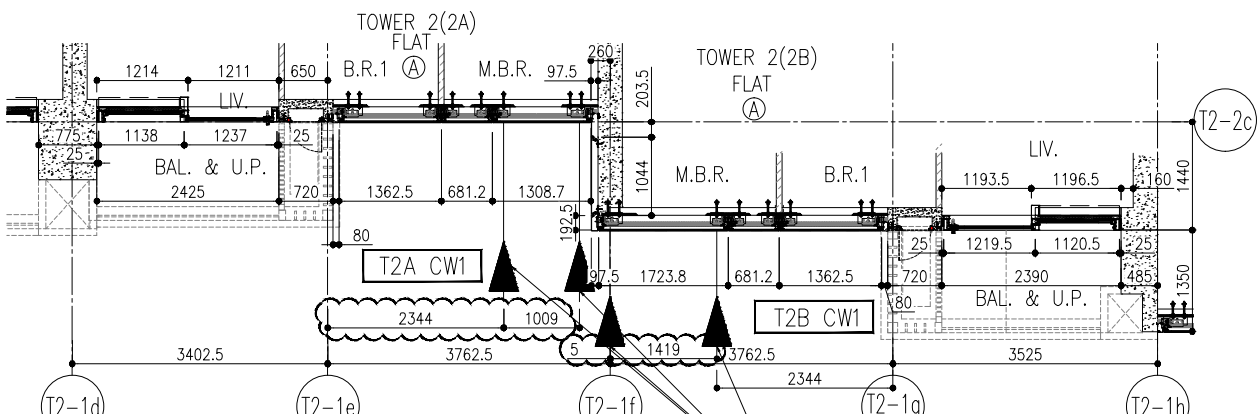

5 PART PLAN FOR CURTAIN WALL

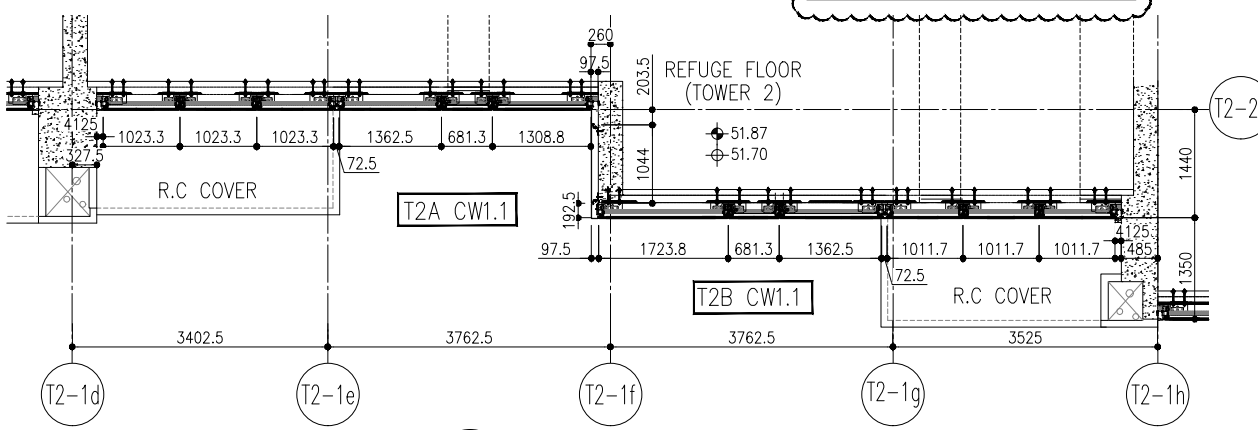

6 PART PLAN(11/F) FOR CURTAIN WALL

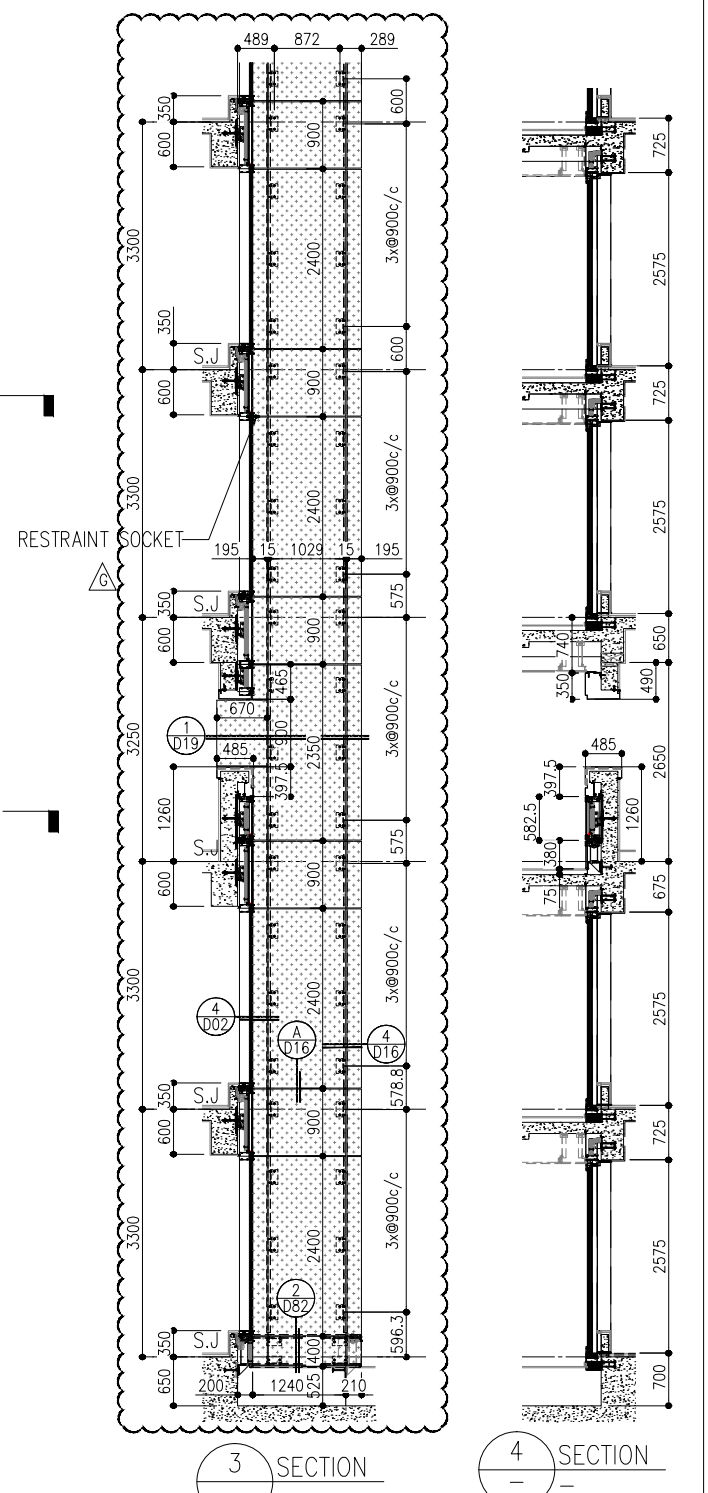

3 SECTION

4 SECTION

R/F	+217.00	+213.50
26/F	+91.25	39/F +130.85
25/F	+87.95	38/F +127.55
23/F	+84.65	37/F +124.25
22/F	+81.35	36/F +120.95
21/F	+78.05	35/F +117.65
20/F	+74.75	33/F +114.35
19/F	+71.45	32/F +111.05
18/F	+68.15	31/F 107.75
17/F	+64.85	30/F +104.45
16/F	+61.55	29/F +101.15
15/F	+58.25	28/F +97.85
12/F	+54.95	27/F +94.55
		40/F +134.15
		52/F +170.40
		51/F +167.10
		50/F +163.80
		49/F +160.50
		48/F +157.20
		47/F +153.90
		46/F +150.60
		45/F +147.30
		43/F +144.00
		42/F +140.70
		41/F +137.40
		55/F +177.00
		53/F +173.70
		66/F +210.00
		65/F +206.70
		63/F +203.40
		62/F +200.10
		61/F +196.80
		60/F +193.50
		59/F +190.20
		58/F +186.90
		57/F +183.60
		56/F +180.30
		55/F +177.00
		53/F +173.70

- LEGEND:
- (1) 10mm THK. HEAT STRENGTHENED GLASS (OUTSIDE) +12mm AIR SPACE + 12mm THK. TEMPERED GLASS
  - (2) 10mm THK. HEAT STRENGTHENED GLASS (OUTSIDE) +12mm AIR SPACE + 10mm THK. TEMPERED GLASS
  - (3) 12mm THK. HEAT STRENGTHENED GLASS
  - (4) 12mm THK. CLEAR TEMPERED GLASS ( INTERNAL PROTECTIVE BARRIER )
  - (5) 10mm THK. HEAT STRENGTHENED GLASS (OUTSIDE) +12mm AIR SPACE + 12mm THK. TEMPERED GLASS WITH REFLECTIVE COATING
  - (6) 10mm THK. CLEAR TEMPERED GLASS
  - (7) 8mm THK. CLEAR HEAT-STRENGTHENED GLASS +1.52mm PVB + 8mm THK. CLEAR HEAT-STRENGTHENED GLASS
  - (8) 3 mm THK. ALUM. CLADDING
  - (9) 3 mm THK. ALUM. BACKPAN
  - S.J. - STACK JOINT
  - (10) - RESTRAINT SOCKET

DWG NO. : JB58-CW-PE202

REV. : G

**PE202**

PROJECT : DEVELOPMENT AT TKC

TITLE : PARTIAL CURTAIN WALL PLAN (TOWER 2)

DATE : 20/12/21

SCALE : 1:50(A1)

DESIGNED BY : [Signature]

CHECKED BY : [Signature]

PROJECT NO. : 1, LOHAS PARK, N.T.

ARCHITECT : ronaldi & partners

ARCHITECT : Ronald Lu & Partners (HK) Ltd.

MAIN CONTRACTOR : [Signature]

NOTE:

- ALL DIMENSIONS ARE IN mm.
- ALL ELEVATIONS ARE VIEWED FROM OUTSIDE.
- ALL DIMENSIONS TO BE VERIFIED ON SITE BEFORE FABRICATION.

LEGEND:

- (X1) DETAIL MARK NO.
- (X2) REFER SHEET NO.
- (1) F.F.L. -- FINISHED FLOOR LEVEL
- (2) S.F.L. -- STRUCTURAL FLOOR LEVEL
- (R) -- REVERSED DETAIL

NO.	DATE	REVISION
A	03/12/21	REVISED AS PER COMMENTS
B	20/12/21	REVISED AS PER COMMENTS
C	22/01/22	REVISED AS PER COMMENTS
D	06/04/22	REVISED AS PER COMMENTS
E	26/05/22	REVISED AS PER COMMENTS
F	26/07/22	REVISED AS PER COMMENTS
G	18/08/22	REVISED AS PER COMMENTS

CLIENT : 信和置業有限公司  
Sino Land Company Limited


ARCHITECT : ronaldi & partners  
Ronald Lu & Partners (HK) Ltd.  
呂元仲建築師事務所 (香港) 有限公司

MAIN CONTRACTOR : [Signature]

STRUCTURAL ENGINEER : Gammon


FAÇADE CONSULTANT : AECOM

B.D. REF. :

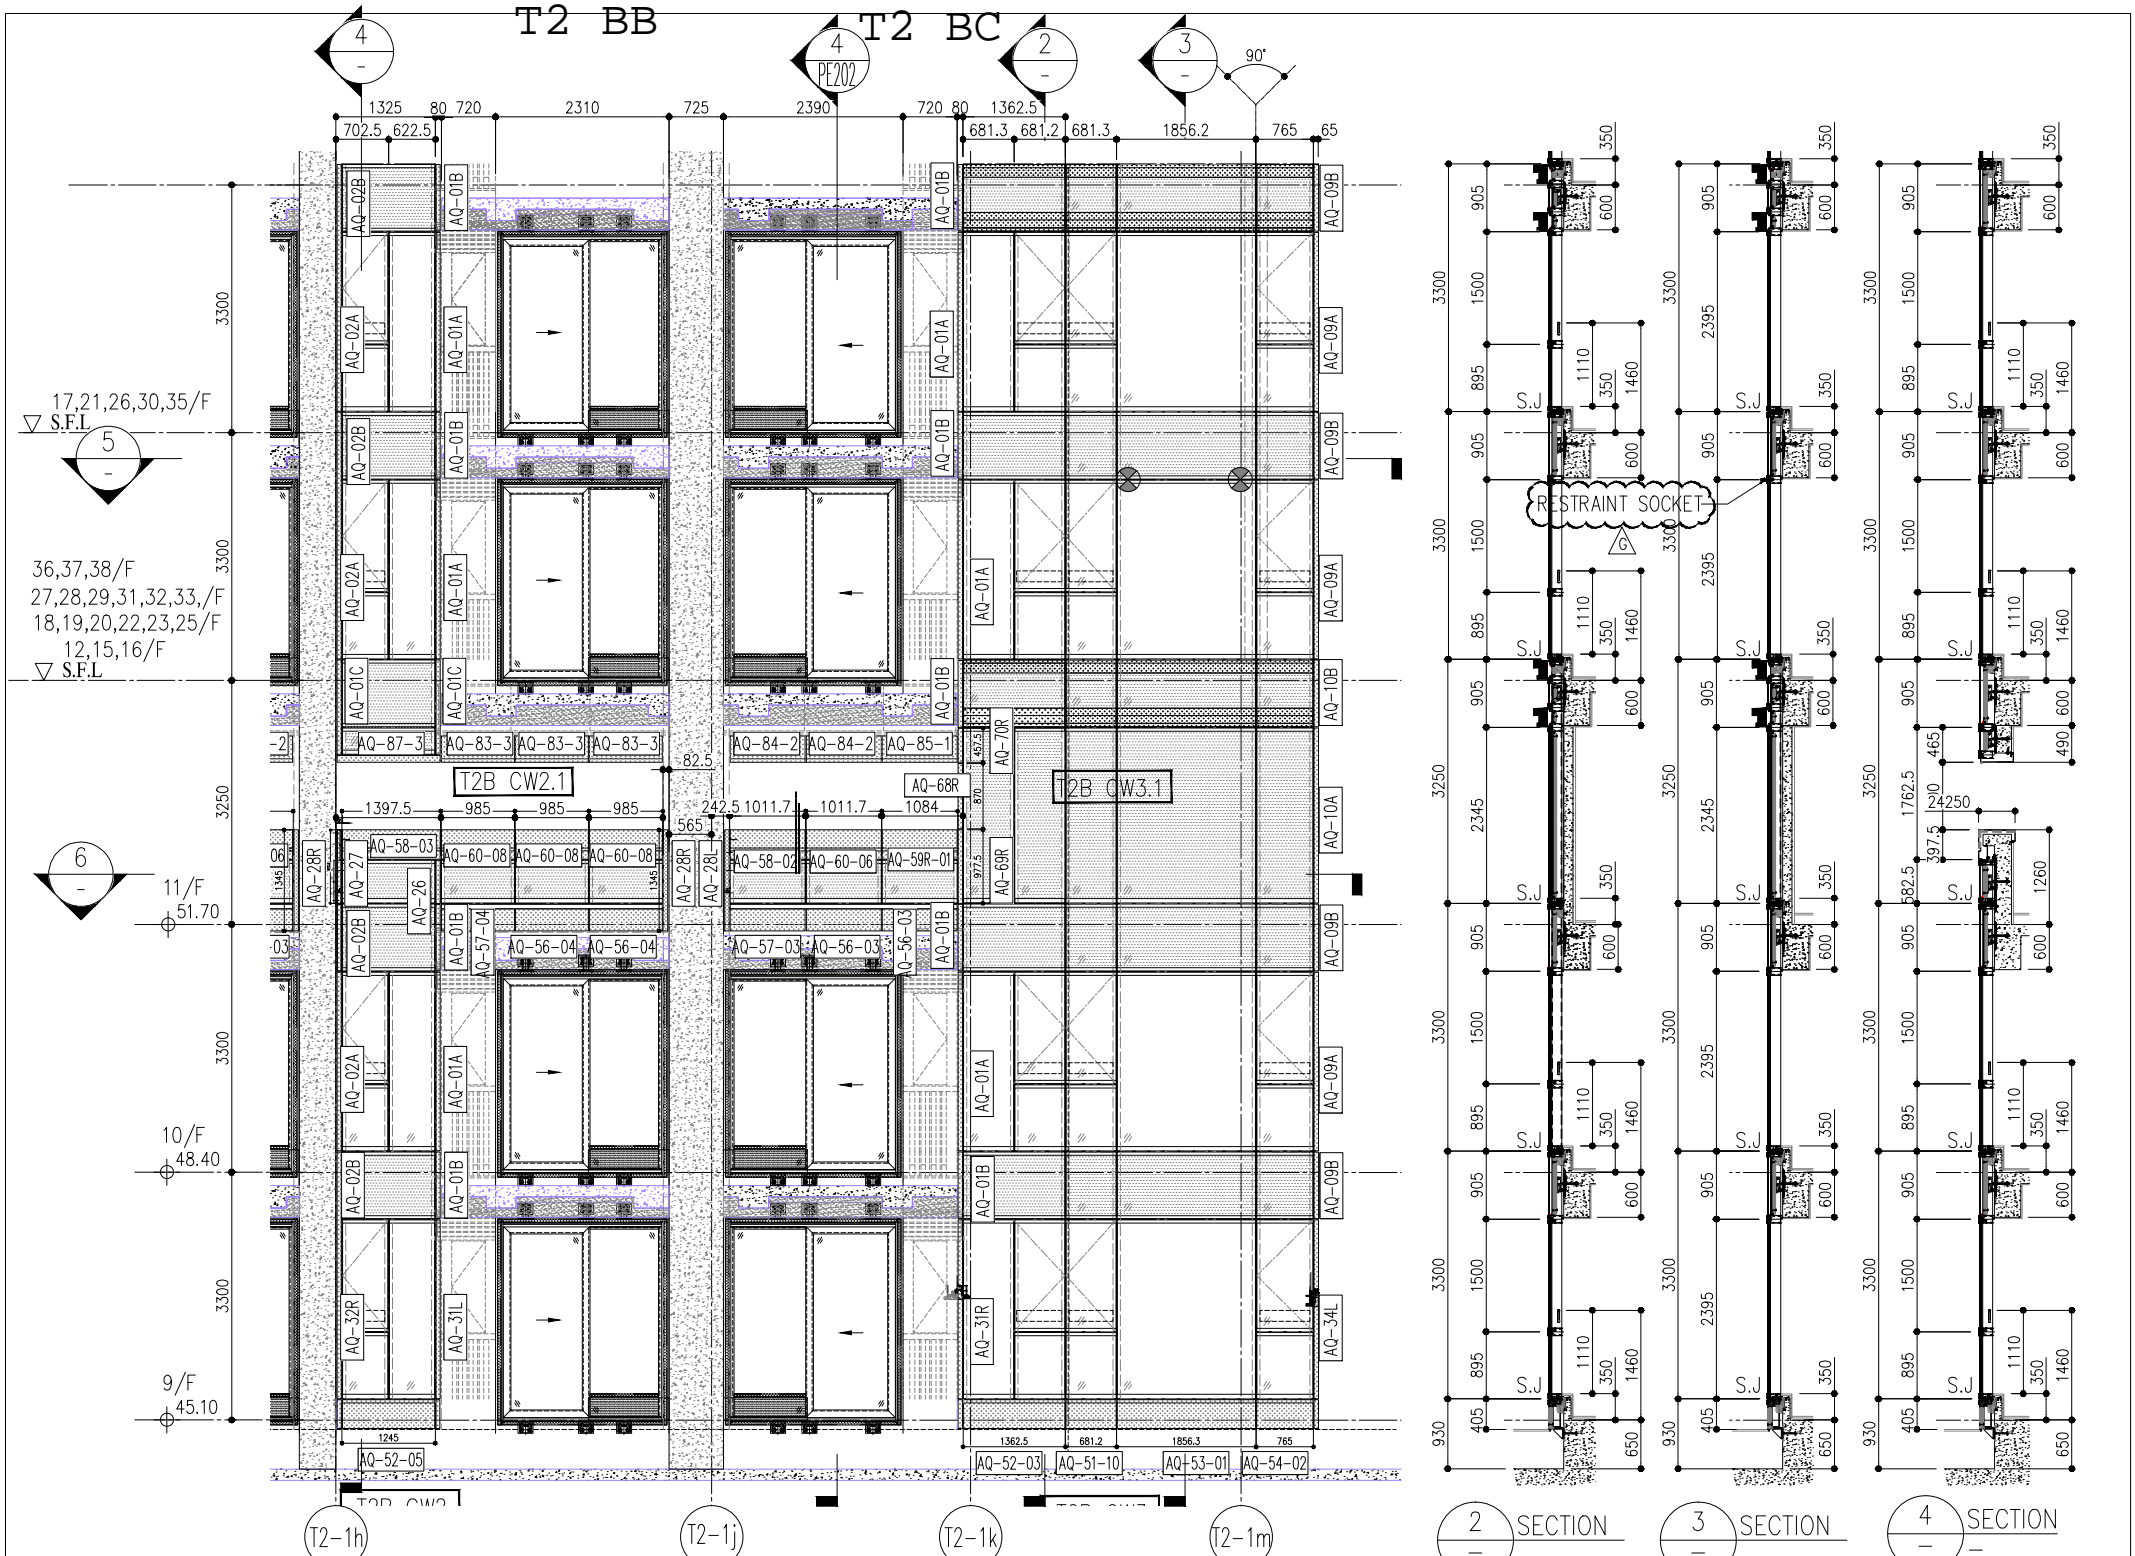


SECTION 2 SECTION 3 SECTION 4

1 PART ELEVATION FOR CURTAIN WALL

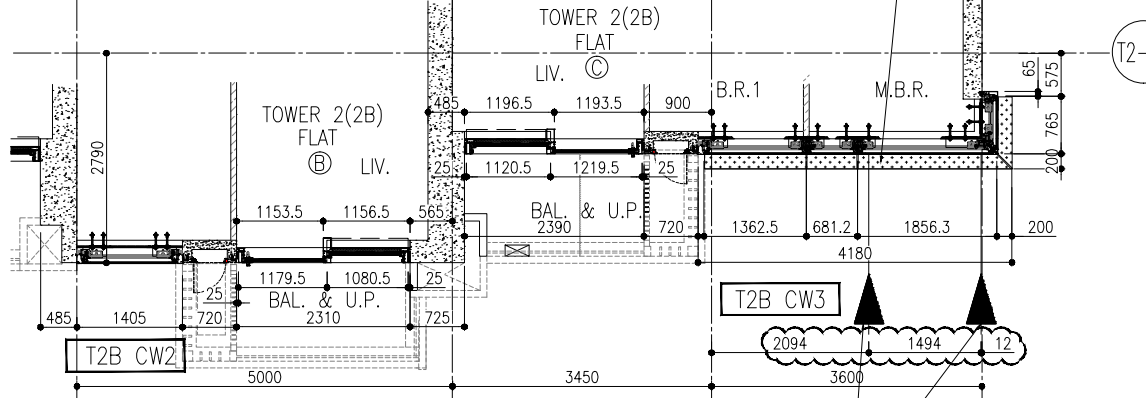

5 PART PLAN FOR CURTAIN WALL

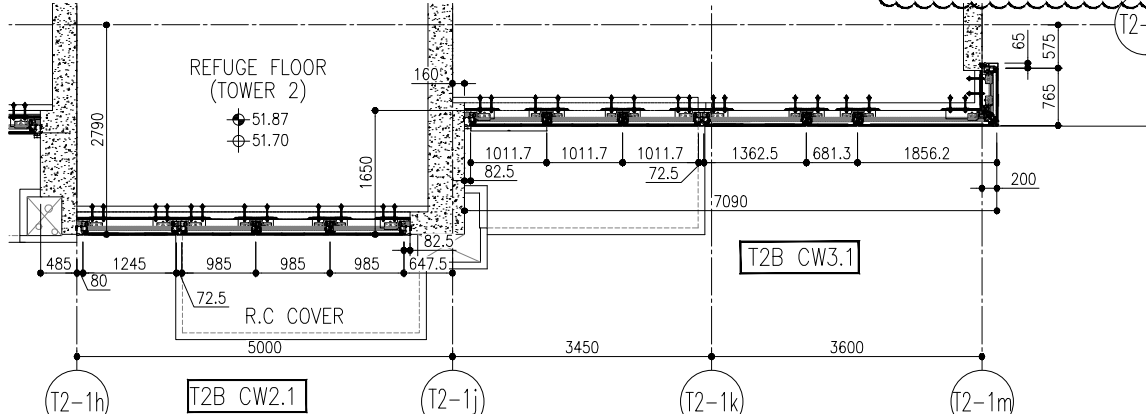

6 PART PLAN (11/F) FOR CURTAIN WALL

R/F	+217.00
67/F	+213.50
26/F	+91.25
25/F	+87.95
23/F	+84.65
22/F	+81.35
21/F	+78.05
20/F	+74.75
19/F	+71.45
18/F	+68.15
17/F	+64.85
16/F	+61.55
15/F	+58.25
12/F	+54.95
39/F	+130.85
37/F	+124.25
36/F	+120.95
35/F	+117.65
33/F	+114.35
32/F	+111.05
31/F	+107.75
30/F	+104.45
29/F	+101.15
28/F	+97.85
27/F	+94.55
52/F	+170.40
51/F	+167.10
50/F	+163.80
49/F	+160.50
48/F	+157.20
47/F	+153.90
46/F	+150.60
45/F	+147.30
43/F	+144.00
42/F	+140.70
41/F	+137.40
40/F	+134.15
66/F	+210.00
65/F	+206.70
63/F	+203.40
62/F	+200.10
61/F	+196.80
60/F	+193.50
59/F	+190.20
58/F	+186.90
57/F	+183.60
56/F	+180.30
55/F	+177.00
53/F	+173.70

- LEGEND:
- (G1) 10mm THK. HEAT STRENGTHENED GLASS (OUTSIDE) + 12mm AIR SPACE + 12mm THK. TEMPERED GLASS
  - (G2) 10mm THK. HEAT STRENGTHENED GLASS (OUTSIDE) + 12mm AIR SPACE + 10mm THK. TEMPERED GLASS
  - (G3) 12mm THK. HEAT STRENGTHENED GLASS
  - (G4) 12mm THK. CLEAR TEMPERED GLASS ( INTERNAL PROTECTIVE BARRIER )
  - (G5) 10mm THK. HEAT STRENGTHENED GLASS (OUTSIDE) + 12mm AIR SPACE + 12mm THK. TEMPERED GLASS WITH REFLECTIVE COATING
  - (G6) 10mm THK. CLEAR TEMPERED GLASS
  - (G7) 8mm THK. CLEAR HEAT-STRENGTHENED GLASS + 1.52mm PVB + 8mm THK. CLEAR HEAT-STRENGTHENED GLASS
  - (G8) 3 mm THK. ALUM. CLADDING
  - (G9) 3 mm THK. ALUM. BACKPAN
  - S.J. - STACK JOINT
  - (RS) - RESTRAINT SOCKET

DWG NO. : JB58 - CW - PE203

DATE : 26/07/22

PROJECT : DEVELOPMENT AT TKC

TITLE : PARTIAL CURTAIN WALL PLAN (TOWER 2)

1, LOHAS PARK

**PE203**

REVISIONS:

NO.	DATE	REVISIONS
G	18/08/22	REVISED AS PER COMMENTS
F	26/07/22	REVISED AS PER COMMENTS
E	26/05/22	REVISED AS PER COMMENTS
D	06/04/22	REVISED AS PER COMMENTS
C	22/01/22	REVISED AS PER COMMENTS
B	20/12/21	REVISED AS PER COMMENTS
A	03/12/21	REVISED AS PER COMMENTS

NOTE:

- ALL DIMENSIONS ARE IN mm.
- ALL ELEVATIONS ARE VIEWED FROM OUTSIDE.
- ALL DIMENSIONS TO BE VERIFIED ON SITE BEFORE FABRICATION.

LEGEND:

- (X1) DETAIL MARK NO.
- (X20) REFER SHEET NO.
- (F.F.L.) FINISHED FLOOR LEVEL
- (S.F.L.) STRUCTURAL FLOOR LEVEL
- (R) REVERSED DETAIL

ARCHITECT: ronaldi & partners

RONALDI & PARTNERS (HK) LTD.

ARCHITECTURAL ENGINEER: Gammon



FAÇADE CONSULTANT: AECOM

CLIENT: 信和置業有限公司 Sino Land Company Limited

MAIN CONTRACTOR: 呂元梓建築師事務所 (香港) 有限公司

B.D. REF. :


T2 BB 高層

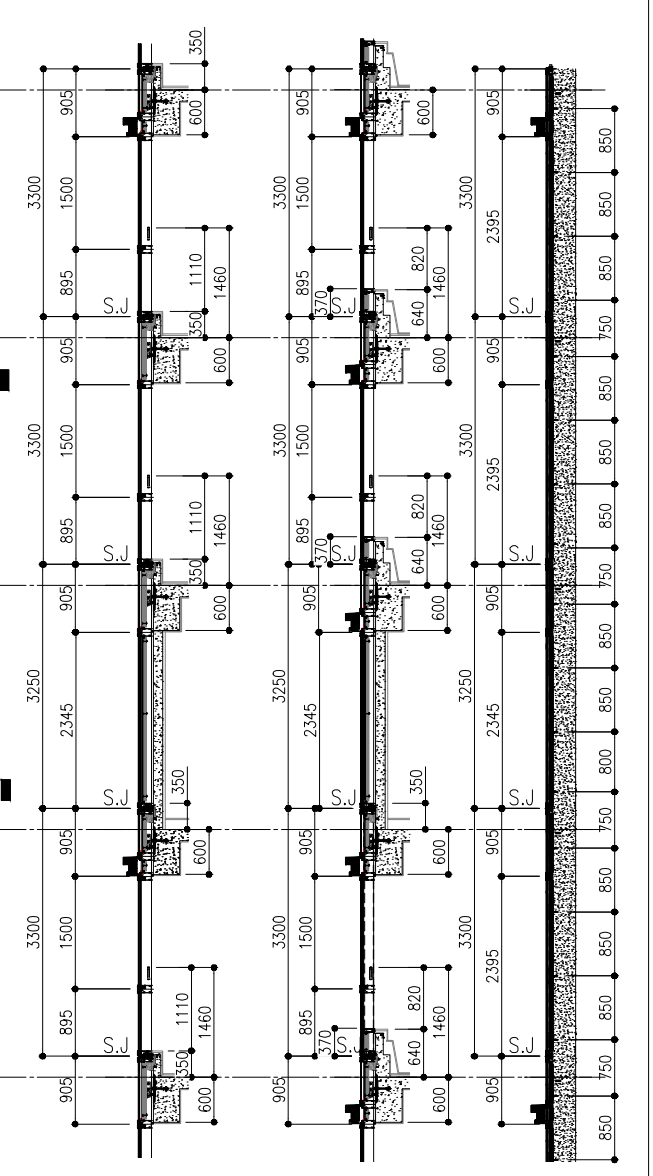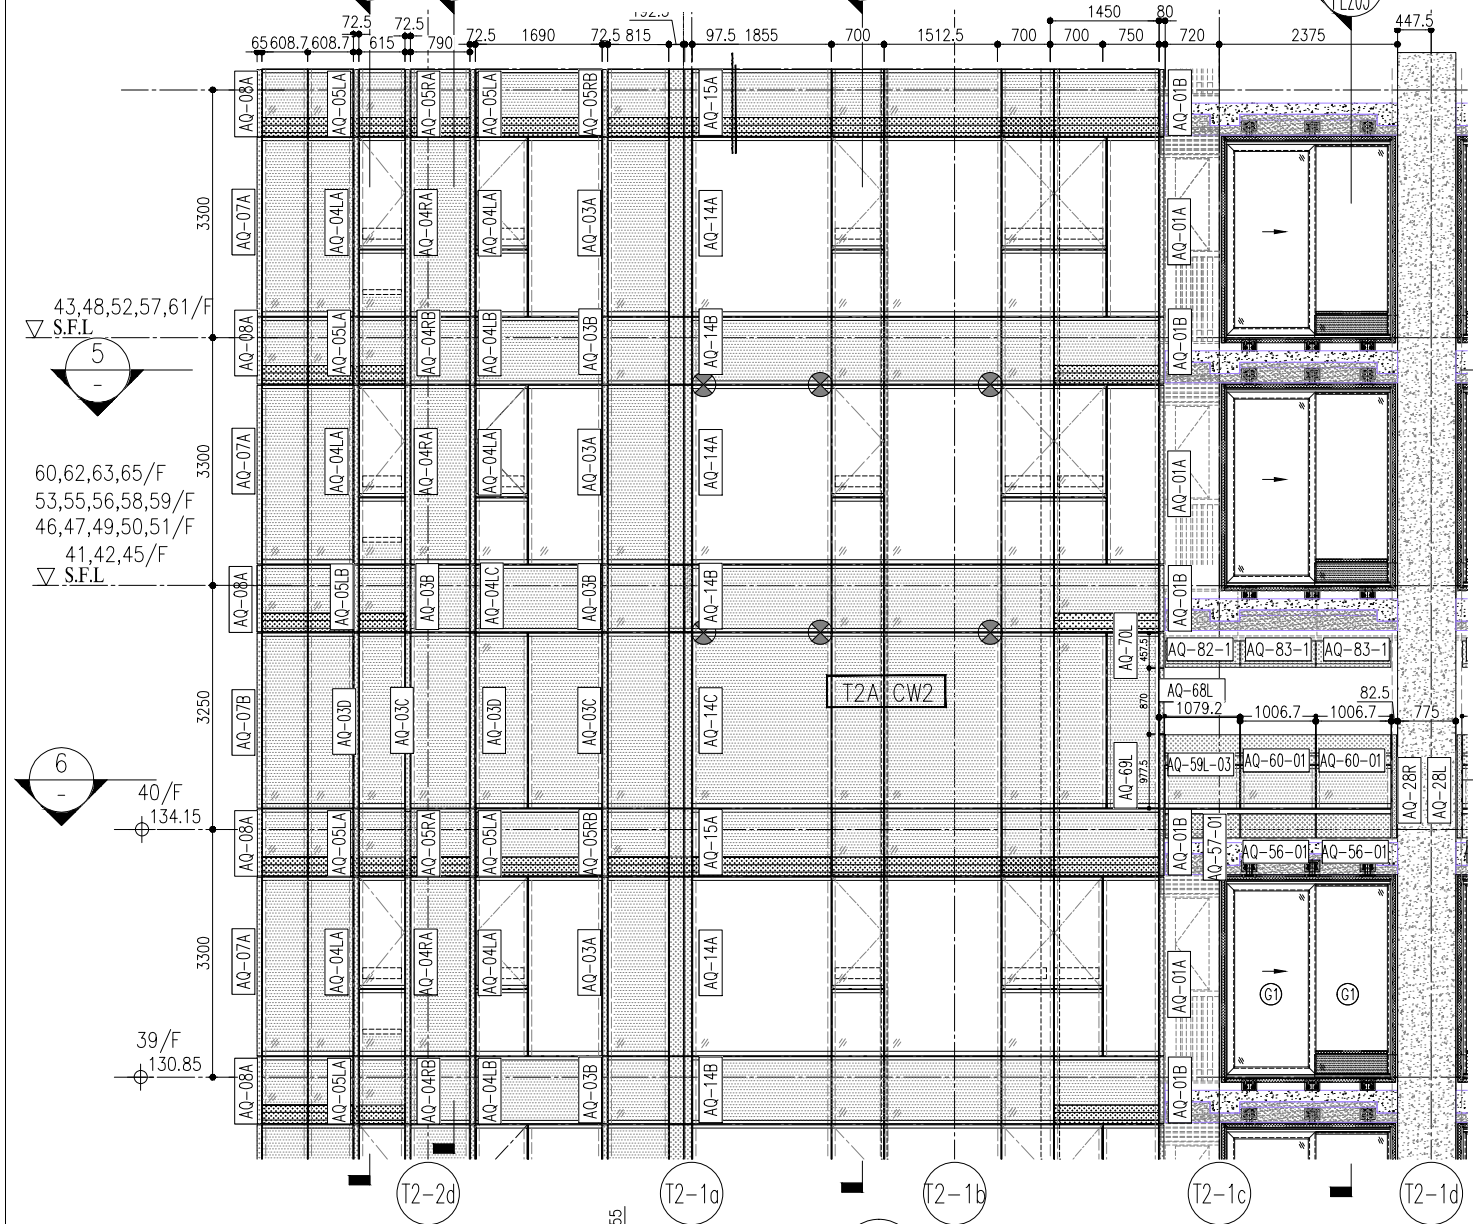

1 PART ELEVATION FOR CURTAIN WALL

2 SECTION 3 SECTION 4 SECTION


ARCH. FEATURE AT 40/F-42/F, 45/F-47/F, 49/F-51/F, 53/F-56/F, 58/F-60/F, 62/F-65/F

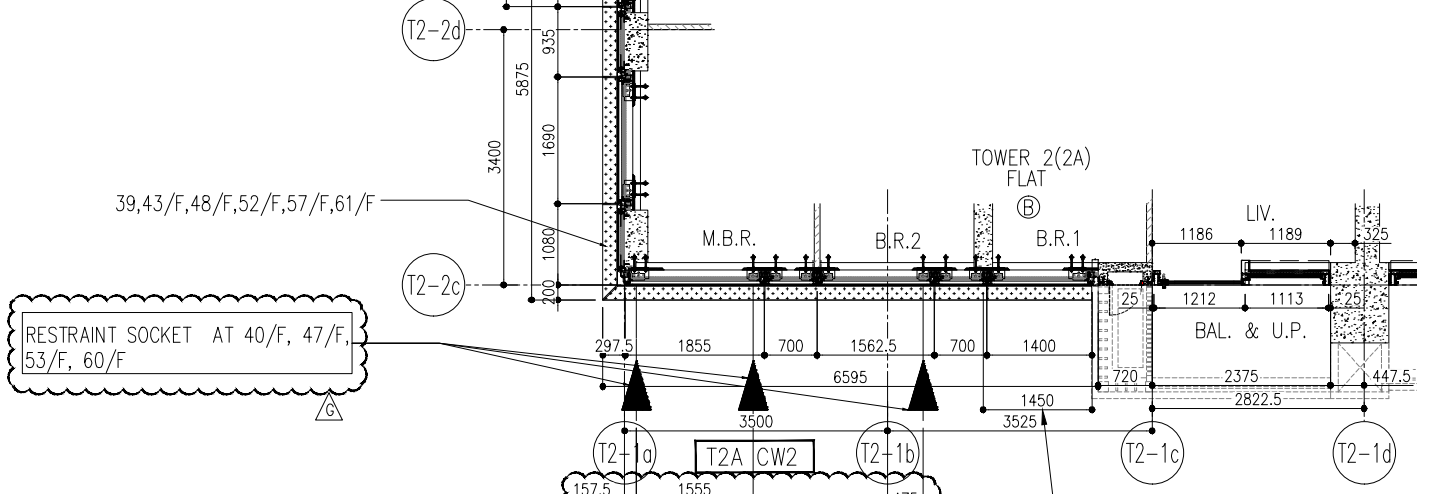

5 PART PLAN FOR CURTAIN WALL

ARCH. FEATURE AT 40/F-42/F, 45/F-47/F, 49/F-51/F, 53/F-56/F, 58/F-60/F, 62/F-65/F

ARCH. FEATURE AT 40/F-42/F, 45/F-47/F, 49/F-51/F, 53/F-56/F, 58/F-60/F, 62/F-65/F

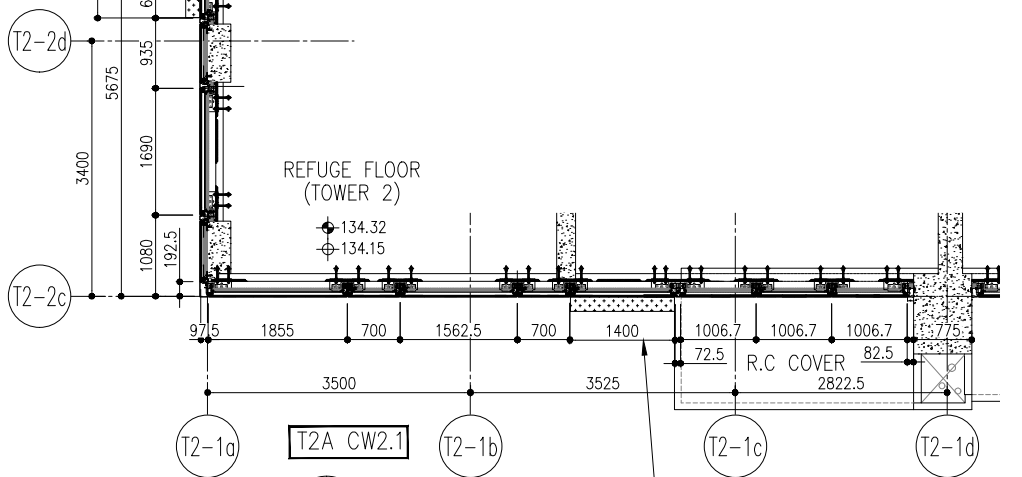

6 PART PLAN (40/F) FOR CURTAIN WALL

ARCH. FEATURE AT 40/F-42/F, 45/F-47/F, 49/F-51/F, 53/F-56/F, 58/F-60/F, 62/F-65/F

R/F	+217.00
67/F	+213.50
26/F	+91.25
25/F	+87.95
23/F	+84.65
22/F	+81.35
21/F	+78.05
20/F	+74.75
19/F	+71.45
18/F	+68.15
17/F	+64.85
16/F	+61.55
15/F	+58.25
12/F	+54.95
39/F	+130.85
38/F	+127.55
37/F	+124.25
36/F	+120.95
35/F	+117.65
33/F	+114.35
32/F	+111.05
31/F	+107.75
30/F	+104.45
29/F	+101.15
28/F	+97.85
27/F	+94.55
52/F	+170.40
51/F	+167.10
50/F	+163.80
49/F	+160.50
48/F	+157.20
47/F	+153.90
46/F	+150.60
45/F	+147.30
43/F	+144.00
42/F	+140.70
41/F	+137.40
40/F	+134.15
66/F	+210.00
65/F	+206.70
63/F	+203.40
62/F	+200.10
61/F	+196.80
60/F	+193.50
59/F	+190.20
58/F	+186.90
57/F	+183.60
56/F	+180.30
55/F	+177.00
53/F	+173.70

- LEGEND:
- (G1) 10mm THK. HEAT STRENGTHENED GLASS (OUTSIDE) +12mm AIR SPACE + 12mm THK. TEMPERED GLASS
  - (G2) 10mm THK. HEAT STRENGTHENED GLASS (OUTSIDE) +12mm AIR SPACE + 10mm THK. TEMPERED GLASS
  - (G3) 12mm THK. HEAT STRENGTHENED GLASS
  - (G4) 12mm THK. CLEAR TEMPERED GLASS ( INTERNAL PROTECTIVE BARRIER )
  - (G5) 10mm THK. HEAT STRENGTHENED GLASS (OUTSIDE) +12mm AIR SPACE + 12mm THK. TEMPERED GLASS WITH REFLECTIVE COATING
  - (G6) 10mm THK. CLEAR TEMPERED GLASS
  - (G7) 8mm THK. CLEAR HEAT-STRENGTHENED GLASS +1.52mm PVB + 8mm THK. CLEAR HEAT-STRENGTHENED GLASS
  - (G8) 3 mm THK. ALUM. CLADDING
  - (G9) 3 mm THK. ALUM. BACKPAN
  - S.J. - STACK JOINT
  - (RS) - RESTRAINT SOCKET

DWG NO. : JB58-CW-PE204

REV. : G

**PE204**

PROJECT : DEVELOPMENT AT TKC

TITLE : PARTIAL CURTAIN WALL PLAN (TOWER 2)

DATE : 20/12/21

SCALE : 1:50(A1)

DESIGNED BY : [Signature]

CHECKED BY : [Signature]

DATE : 03/12/21

REVISIONS:

NO.	DATE	REVISION
A	03/12/21	REVISED AS PER COMMENTS
B	20/12/21	REVISED AS PER COMMENTS
C	22/10/22	REVISED AS PER COMMENTS
D	06/04/22	REVISED AS PER COMMENTS
E	26/05/22	REVISED AS PER COMMENTS
F	26/07/22	REVISED AS PER COMMENTS
G	18/08/22	REVISED AS PER COMMENTS

NOTE:

- ALL DIMENSIONS ARE IN mm.
- ALL ELEVATIONS ARE VIEWED FROM OUTSIDE.
- ALL DIMENSIONS TO BE VERIFIED ON SITE BEFORE FABRICATION.

LEGEND:

- (X1) DETAIL MARK NO.
- (X20) REFER SHEET NO.
- 1. F.F.L. -- FINISHED FLOOR LEVEL
- 2. S.F.L. -- STRUCTURAL FLOOR LEVEL
- 3. (R) -- REVERSED DETAIL

ARCHITECT: **ronaldu & partners**

ARCHITECT: **信和置業有限公司**  
Sino Land Company Limited

STRUCTURAL ENGINEER: **Gammorn**



FAÇADE CONSULTANT: **AECOM**

MAIN CONTRACTOR: **吳兆祥建築師事務所 (香港) 有限公司**

CLIENT: **信和置業有限公司**  
Sino Land Company Limited

B.D. REF. :


T2 AA (高層) T2 BA (高層)

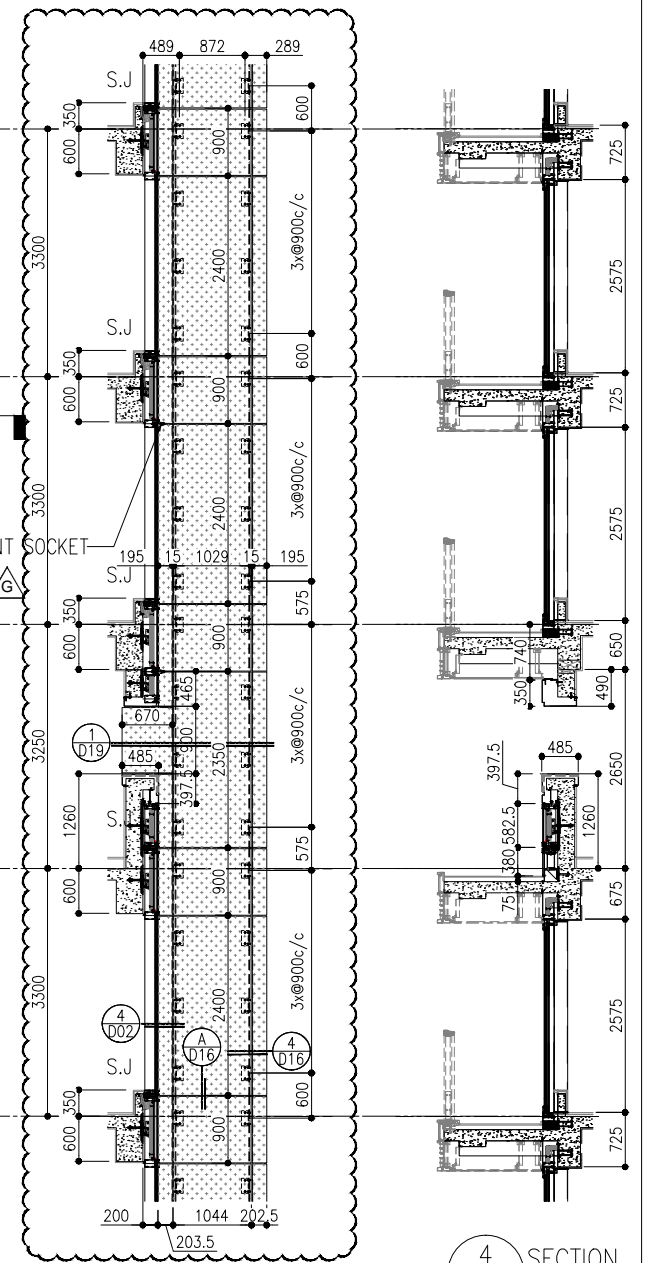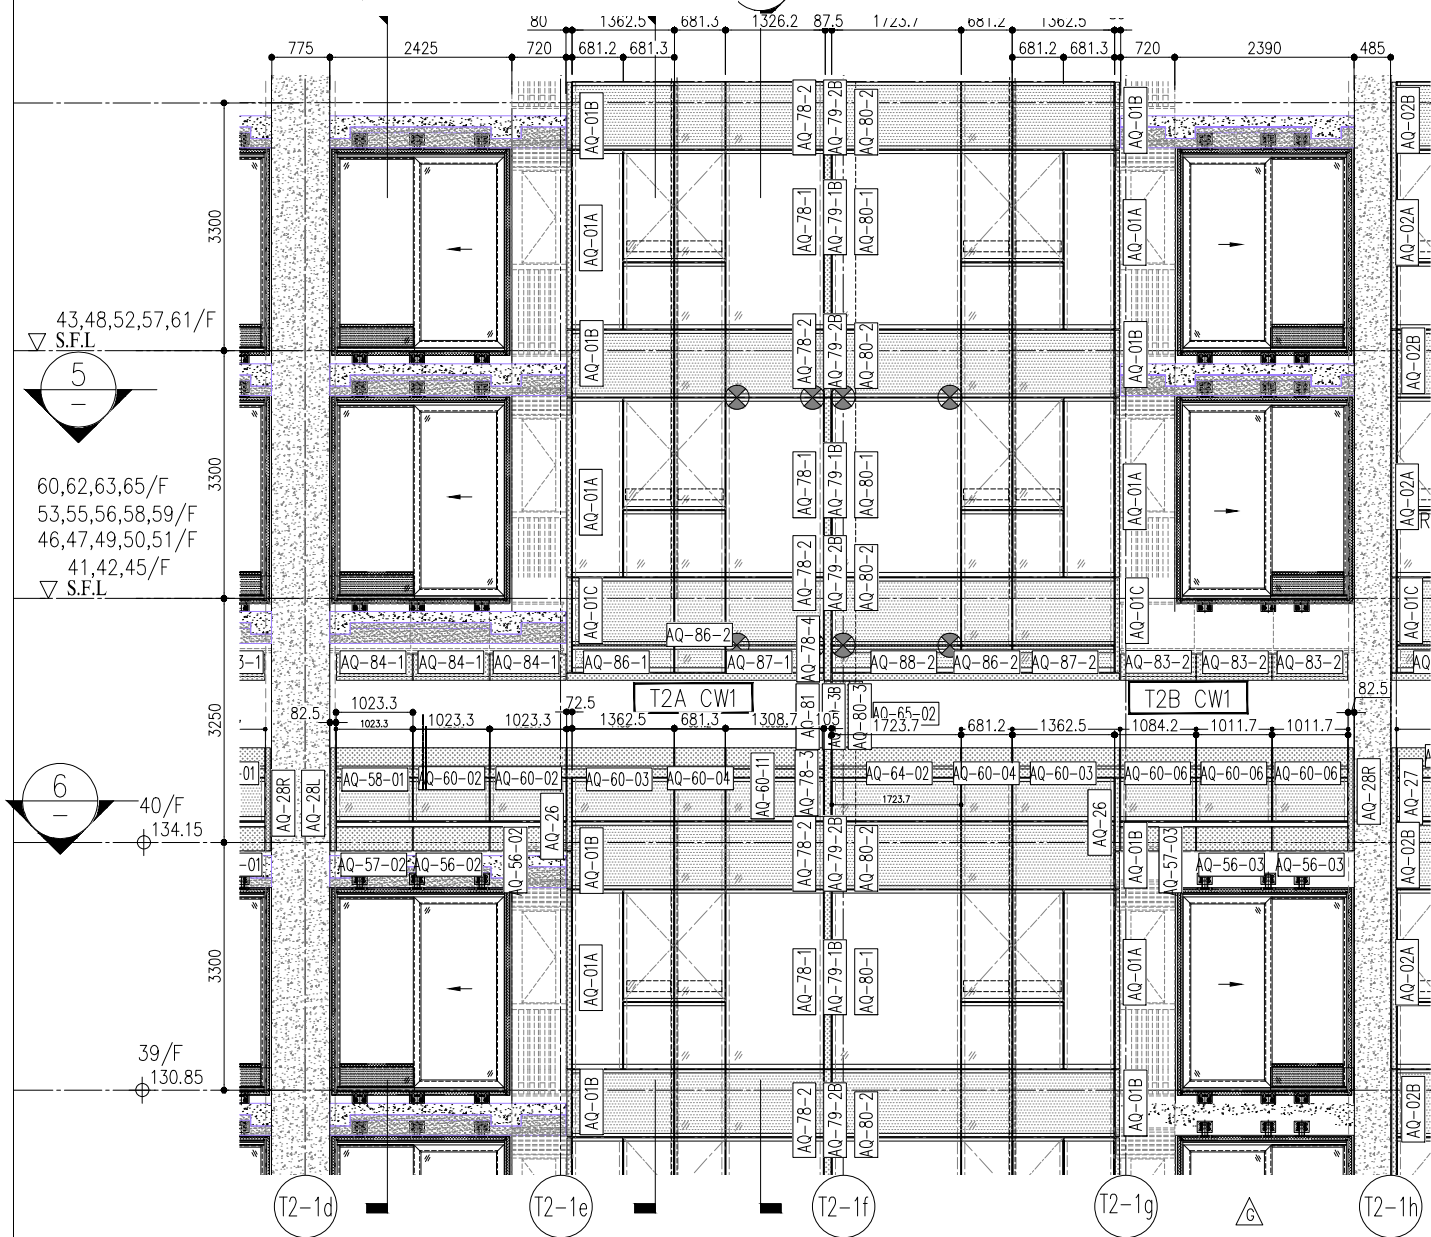


1 PART ELEVATION FOR CURTAIN WALL

3 SECTION

4 SECTION

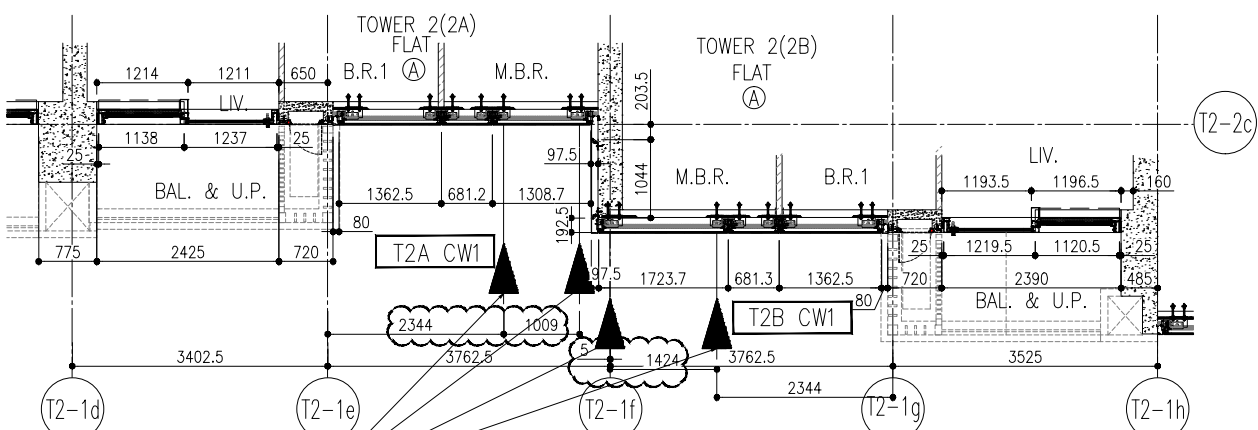

5 PART PLAN(39/F) FOR CURTAIN WALL

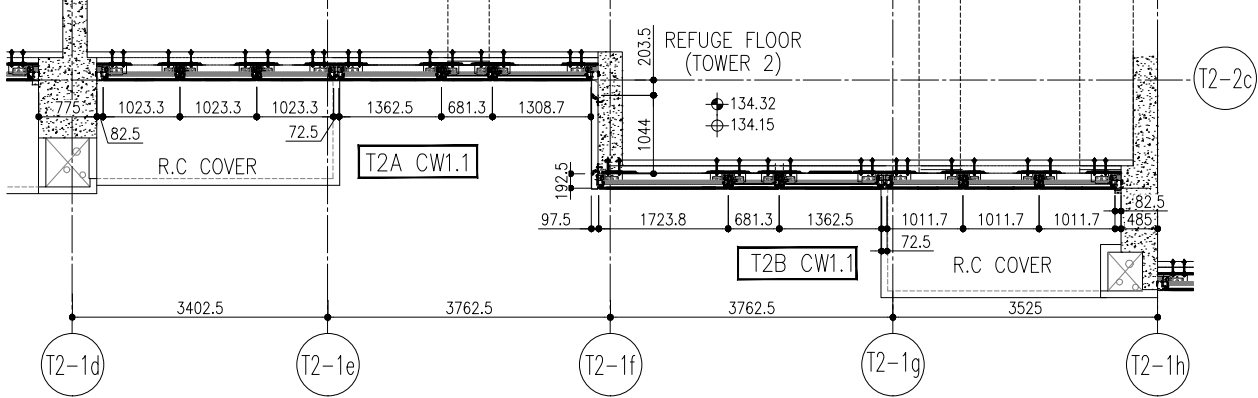

6 PART PLAN(40/F) FOR CURTAIN WALL

R/F	+217.00			
67/F	+213.50			
26/F	+91.25	39/F +130.85	52/F +170.40	66/F +210.00
25/F	+87.95	38/F +127.55	51/F +167.10	65/F +206.70
23/F	+84.65	37/F +124.25	50/F +163.80	63/F +203.40
22/F	+81.35	36/F +120.95	49/F +160.50	62/F +200.10
21/F	+78.05	35/F +117.65	48/F +157.20	61/F +196.80
20/F	+74.75	33/F +114.35	47/F +153.90	60/F +193.50
19/F	+71.45	32/F +111.05	46/F +150.60	59/F +190.20
18/F	+68.15	31/F 107.75	45/F +147.30	58/F +186.90
17/F	+64.85	30/F +104.45	43/F +144.00	57/F +183.60
16/F	+61.55	29/F +101.15	42/F +140.70	56/F +180.30
15/F	+58.25	28/F +97.85	41/F +137.40	55/F +177.00
12/F	+54.95	27/F +94.55	40/F +134.15	53/F +173.70

- LEGEND:
- (G1) 10mm THK. HEAT STRENGTHENED GLASS (OUTSIDE) +12mm AIR SPACE + 12mm THK. TEMPERED GLASS
  - (G2) 10mm THK. HEAT STRENGTHENED GLASS (OUTSIDE) +12mm AIR SPACE + 10mm THK. TEMPERED GLASS
  - (G3) 12mm THK. HEAT STRENGTHENED GLASS
  - (G4) 12mm THK. CLEAR TEMPERED GLASS ( INTERNAL PROTECTIVE BARRIER )
  - (G5) 10mm THK. HEAT STRENGTHENED GLASS (OUTSIDE) +12mm AIR SPACE + 12mm THK. TEMPERED GLASS WITH REFLECTIVE COATING
  - (G6) 10mm THK. CLEAR TEMPERED GLASS
  - (G7) 8mm THK. CLEAR HEAT-STRENGTHENED GLASS +1.52mm PVB + 8mm THK. CLEAR HEAT-STRENGTHENED GLASS
  - (G8) 3 mm THK. ALUM. CLADDING
  - (G9) 3 mm THK. ALUM. BACKPAN
  - S.J. - STACK JOINT
  - (RS) - RESTRAINT SOCKET

DWG NO. : J858-CW-PE205

REV. : G

**PE205**

PROJECT : DEVELOPMENT AT TKO

TITLE : PARTIAL CURTAIN WALL PLAN (TOWER 2)

DATE : 20/12/21

DRAWN BY : [Signature]

DATE : 20/12/21

REVISIONS:

NO.	DATE	REVISION
A	03/12/21	REVISED AS PER COMMENTS
B	20/12/21	REVISED AS PER COMMENTS
C	22/01/22	REVISED AS PER COMMENTS
D	06/04/22	REVISED AS PER COMMENTS
E	26/05/22	REVISED AS PER COMMENTS
F	26/07/22	REVISED AS PER COMMENTS
G	18/08/22	REVISED AS PER COMMENTS

NOTE:

- ALL DIMENSIONS ARE IN mm.
- ALL ELEVATIONS ARE VIEWED FROM OUTSIDE.
- ALL DIMENSIONS TO BE VERIFIED ON SITE BEFORE FABRICATION.

LEGEND:

- (X1) DETAIL MARK NO.
- (X00) REFER SHEET NO.
- 1. F.F.L. -- FINISHED FLOOR LEVEL
- 2. S.F.L. -- STRUCTURAL FLOOR LEVEL
- 3. (R) -- REVERSED DETAIL

ARCHITECT: **ronaldu & partners**


Ronald Lu & Partners (HK) Ltd.

呂冠廷建築師事務所 (香港) 有限公司

MAIN CONTRACTOR: [Blank]

CLIENT: **信和置業有限公司**


Sino Land Company Limited

STRUCTURAL ENGINEER: **Gammorn**

FAÇADE CONSULTANT: **AECOM**

B.D. REF. :

T2 BB (高層) T2 BC (高層)

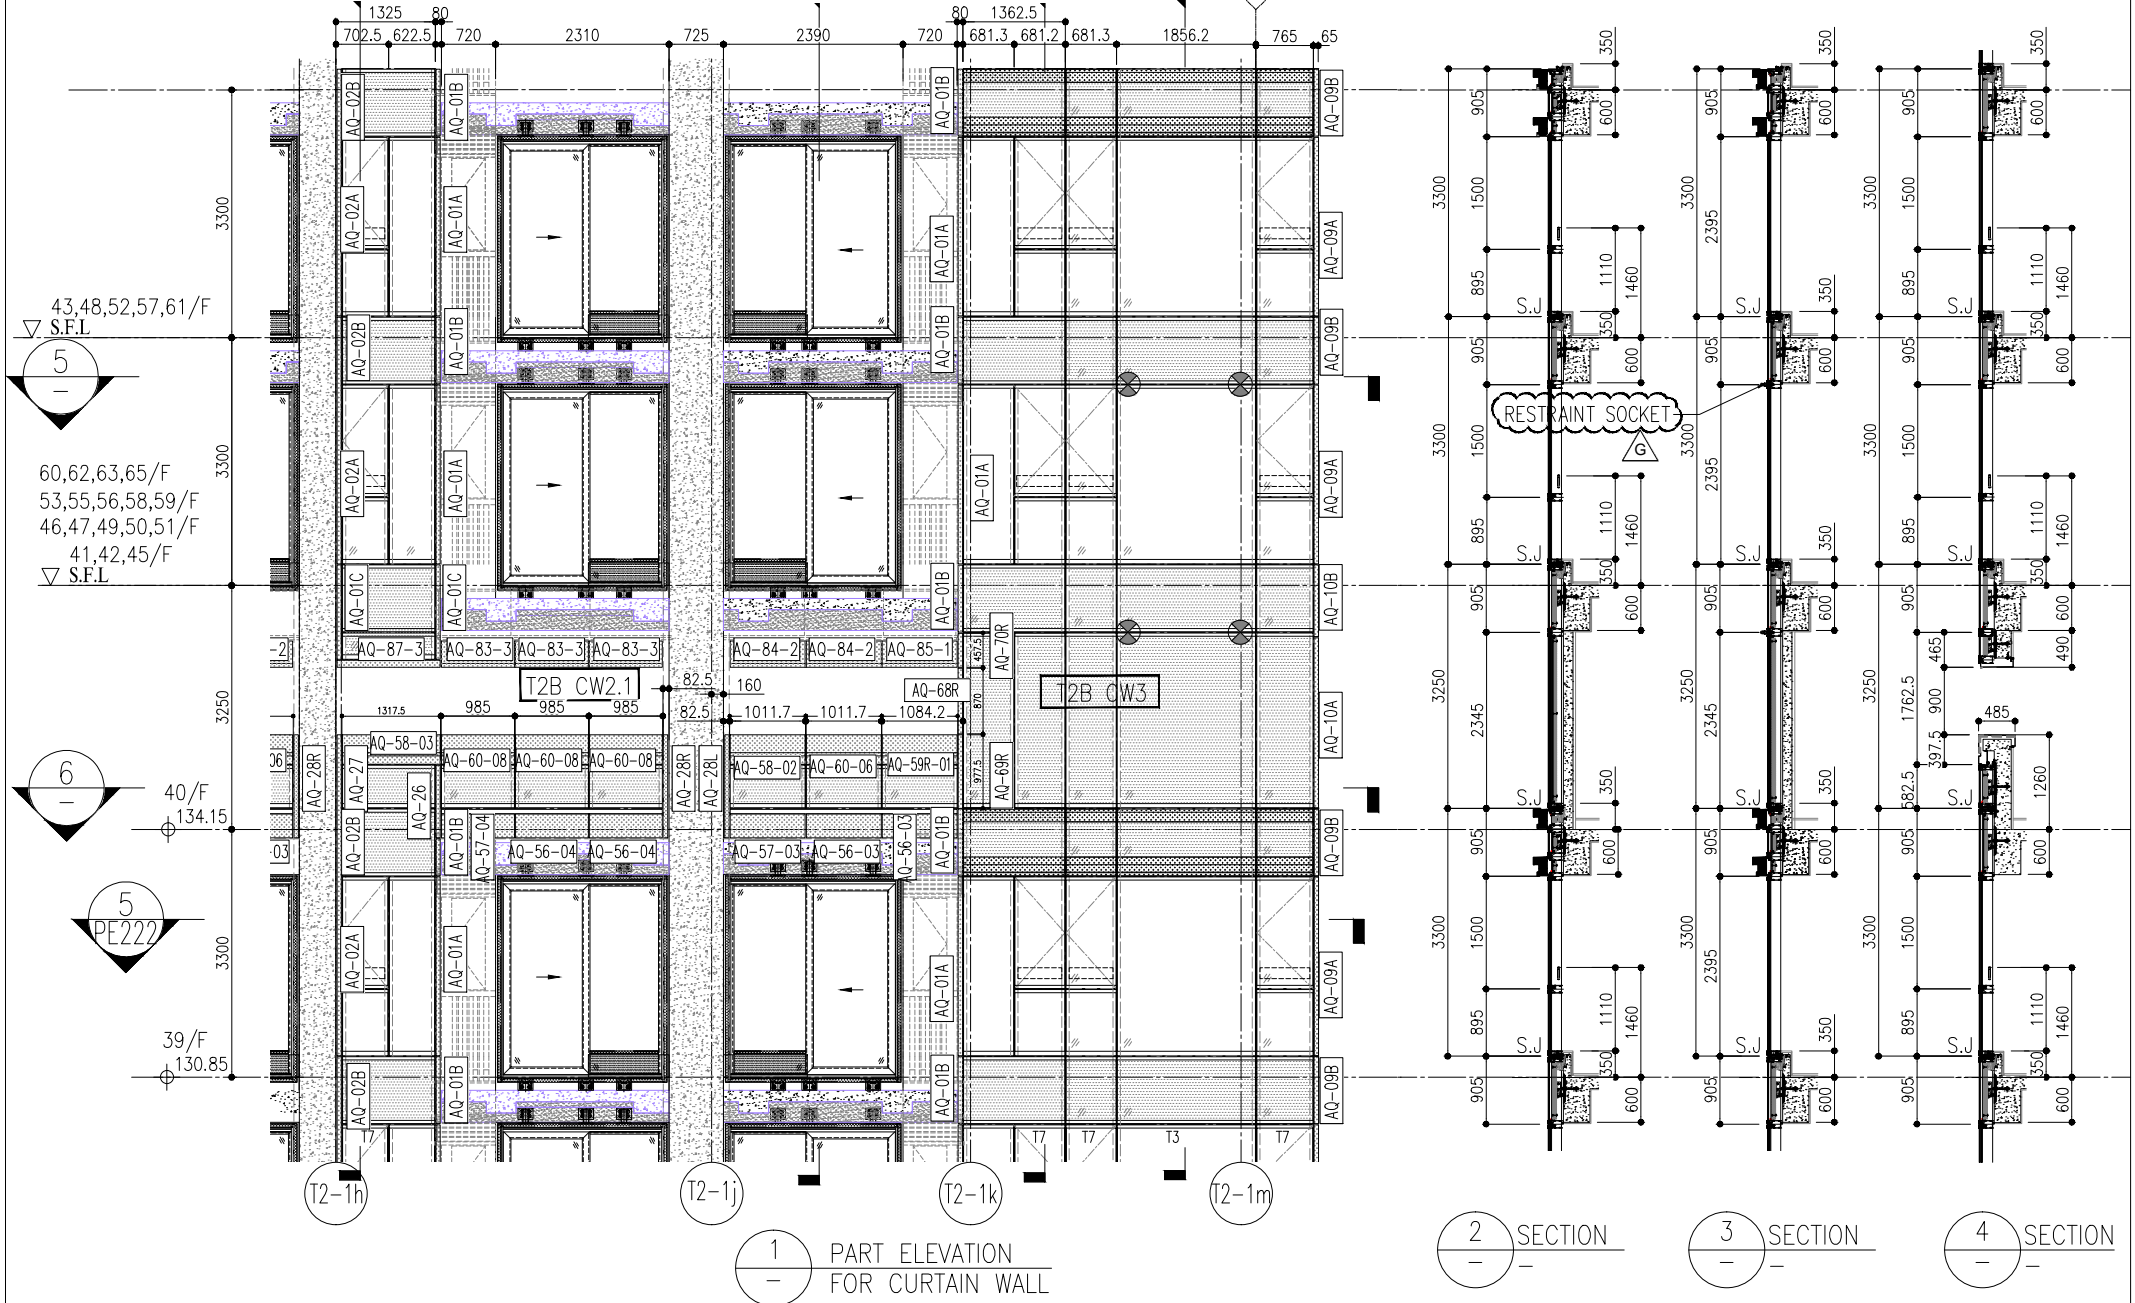


1 PART ELEVATION FOR CURTAIN WALL


2 SECTION

3 SECTION

4 SECTION

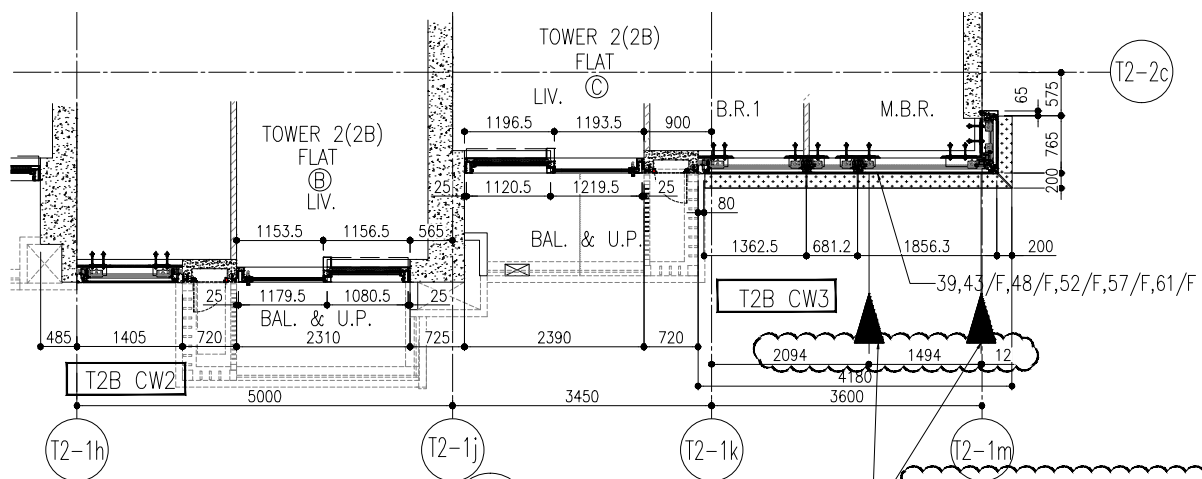

5 PART PLAN(39/F) FOR CURTAIN WALL

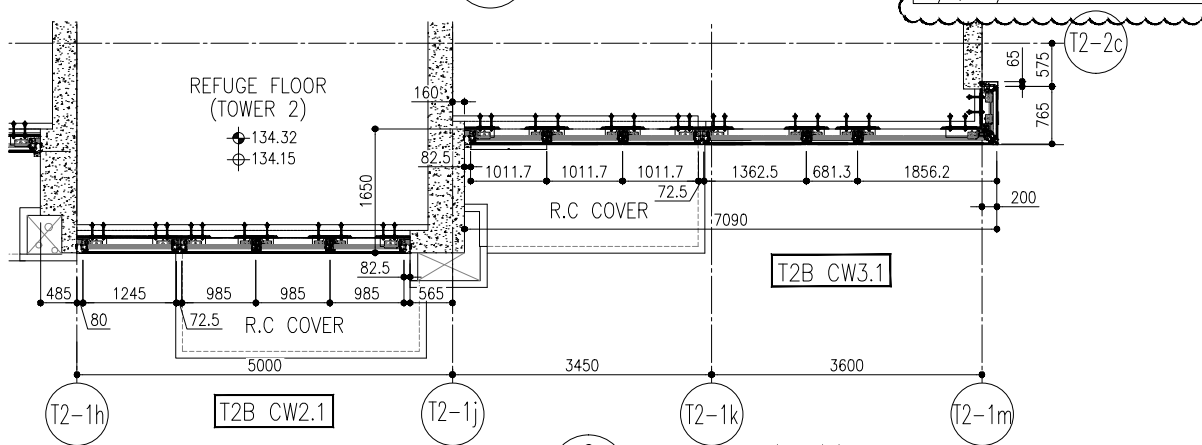

6 PART PLAN(40/F) FOR CURTAIN WALL

R/F	+217.00				
67/F	+213.50				
26/F	+91.25	39/F	+130.85	52/F	+170.40
25/F	+87.95	38/F	+127.55	51/F	+167.10
23/F	+84.65	37/F	+124.25	50/F	+163.80
22/F	+81.35	36/F	+120.95	49/F	+160.50
21/F	+78.05	35/F	+117.65	48/F	+157.20
20/F	+74.75	33/F	+114.35	47/F	+153.90
19/F	+71.45	32/F	+111.05	46/F	+150.60
18/F	+68.15	31/F	+107.75	45/F	+147.30
17/F	+64.85	30/F	+104.45	43/F	+144.00
16/F	+61.55	29/F	+101.15	42/F	+140.70
15/F	+58.25	28/F	+97.85	41/F	+137.40
12/F	+54.95	27/F	+94.55	40/F	+134.15
				53/F	+173.70

- LEGEND:
- (G1) 10mm THK. HEAT STRENGTHENED GLASS (OUTSIDE) +12mm AIR SPACE + 12mm THK. TEMPERED GLASS
  - (G2) 10mm THK. HEAT STRENGTHENED GLASS (OUTSIDE) +12mm AIR SPACE + 10mm THK. TEMPERED GLASS
  - (G3) 12mm THK. HEAT STRENGTHENED GLASS
  - (G4) 12mm THK. CLEAR TEMPERED GLASS ( INTERNAL PROTECTIVE BARRIER )
  - (G5) 10mm THK. HEAT STRENGTHENED GLASS (OUTSIDE) +12mm AIR SPACE + 12mm THK. TEMPERED GLASS WITH REFLECTIVE COATING
  - (G6) 10mm THK. CLEAR TEMPERED GLASS
  - (G7) 8mm THK. CLEAR HEAT-STRENGTHENED GLASS +1.52mm PVB + 8mm THK. CLEAR HEAT-STRENGTHENED GLASS
  - (G8) 3 mm THK. ALUM. CLADDING
  - (G9) 3 mm THK. ALUM. BACKPAN
  - S.J. - STACK JOINT
  - (G10) - RESTRAINT SOCKET


DWG NO. : J858-CW-PE206  
 DATE : 20/12/21  
 TITLE : PARTIAL CURTAIN WALL ELEVATION, PLAN (TOWER 2)  
 PROJECT : DEVELOPMENT OF 1, LOHAS PARK D, N.T.  
**PE206**  
 PE FABRICATOR LTD.

NO.	DATE	REVISION
A	03/12/21	REVISED AS PER COMMENTS
B	20/12/21	REVISED AS PER COMMENTS
C	22/01/22	REVISED AS PER COMMENTS
D	06/04/22	REVISED AS PER COMMENTS
E	26/07/22	REVISED AS PER COMMENTS
F	26/07/22	REVISED AS PER COMMENTS
G	18/08/22	REVISED AS PER COMMENTS

NOTE:  
 1. ALL DIMENSIONS ARE IN mm.  
 2. ALL ELEVATIONS ARE VIEWED FROM OUTSIDE.  
 3. ALL DIMENSIONS TO BE VERIFIED ON SITE BEFORE FABRICATION.

LEGEND:  
 (X1) DETAIL MARK NO.  
 (X00) REFER SHEET NO.  
 1. F.F.L. -- FINISHED FLOOR LEVEL  
 2. S.F.L. -- STRUCTURAL FLOOR LEVEL  
 3. (R) -- REVERSED DETAIL


ARCHITECT : ronaid lu & partners  
 Ronald Lu & Partners (HK) Ltd.  
 呂元仲建築師事務所 (香港) 有限公司  
 MAIN CONTRACTOR :  
 CLIENT : 信和置業有限公司  
 Sino Land Company Limited  
 STRUCTURAL ENGINEER : Gammon  
 FACADE CONSULTANT : AECOM  
 B.D. REF. :

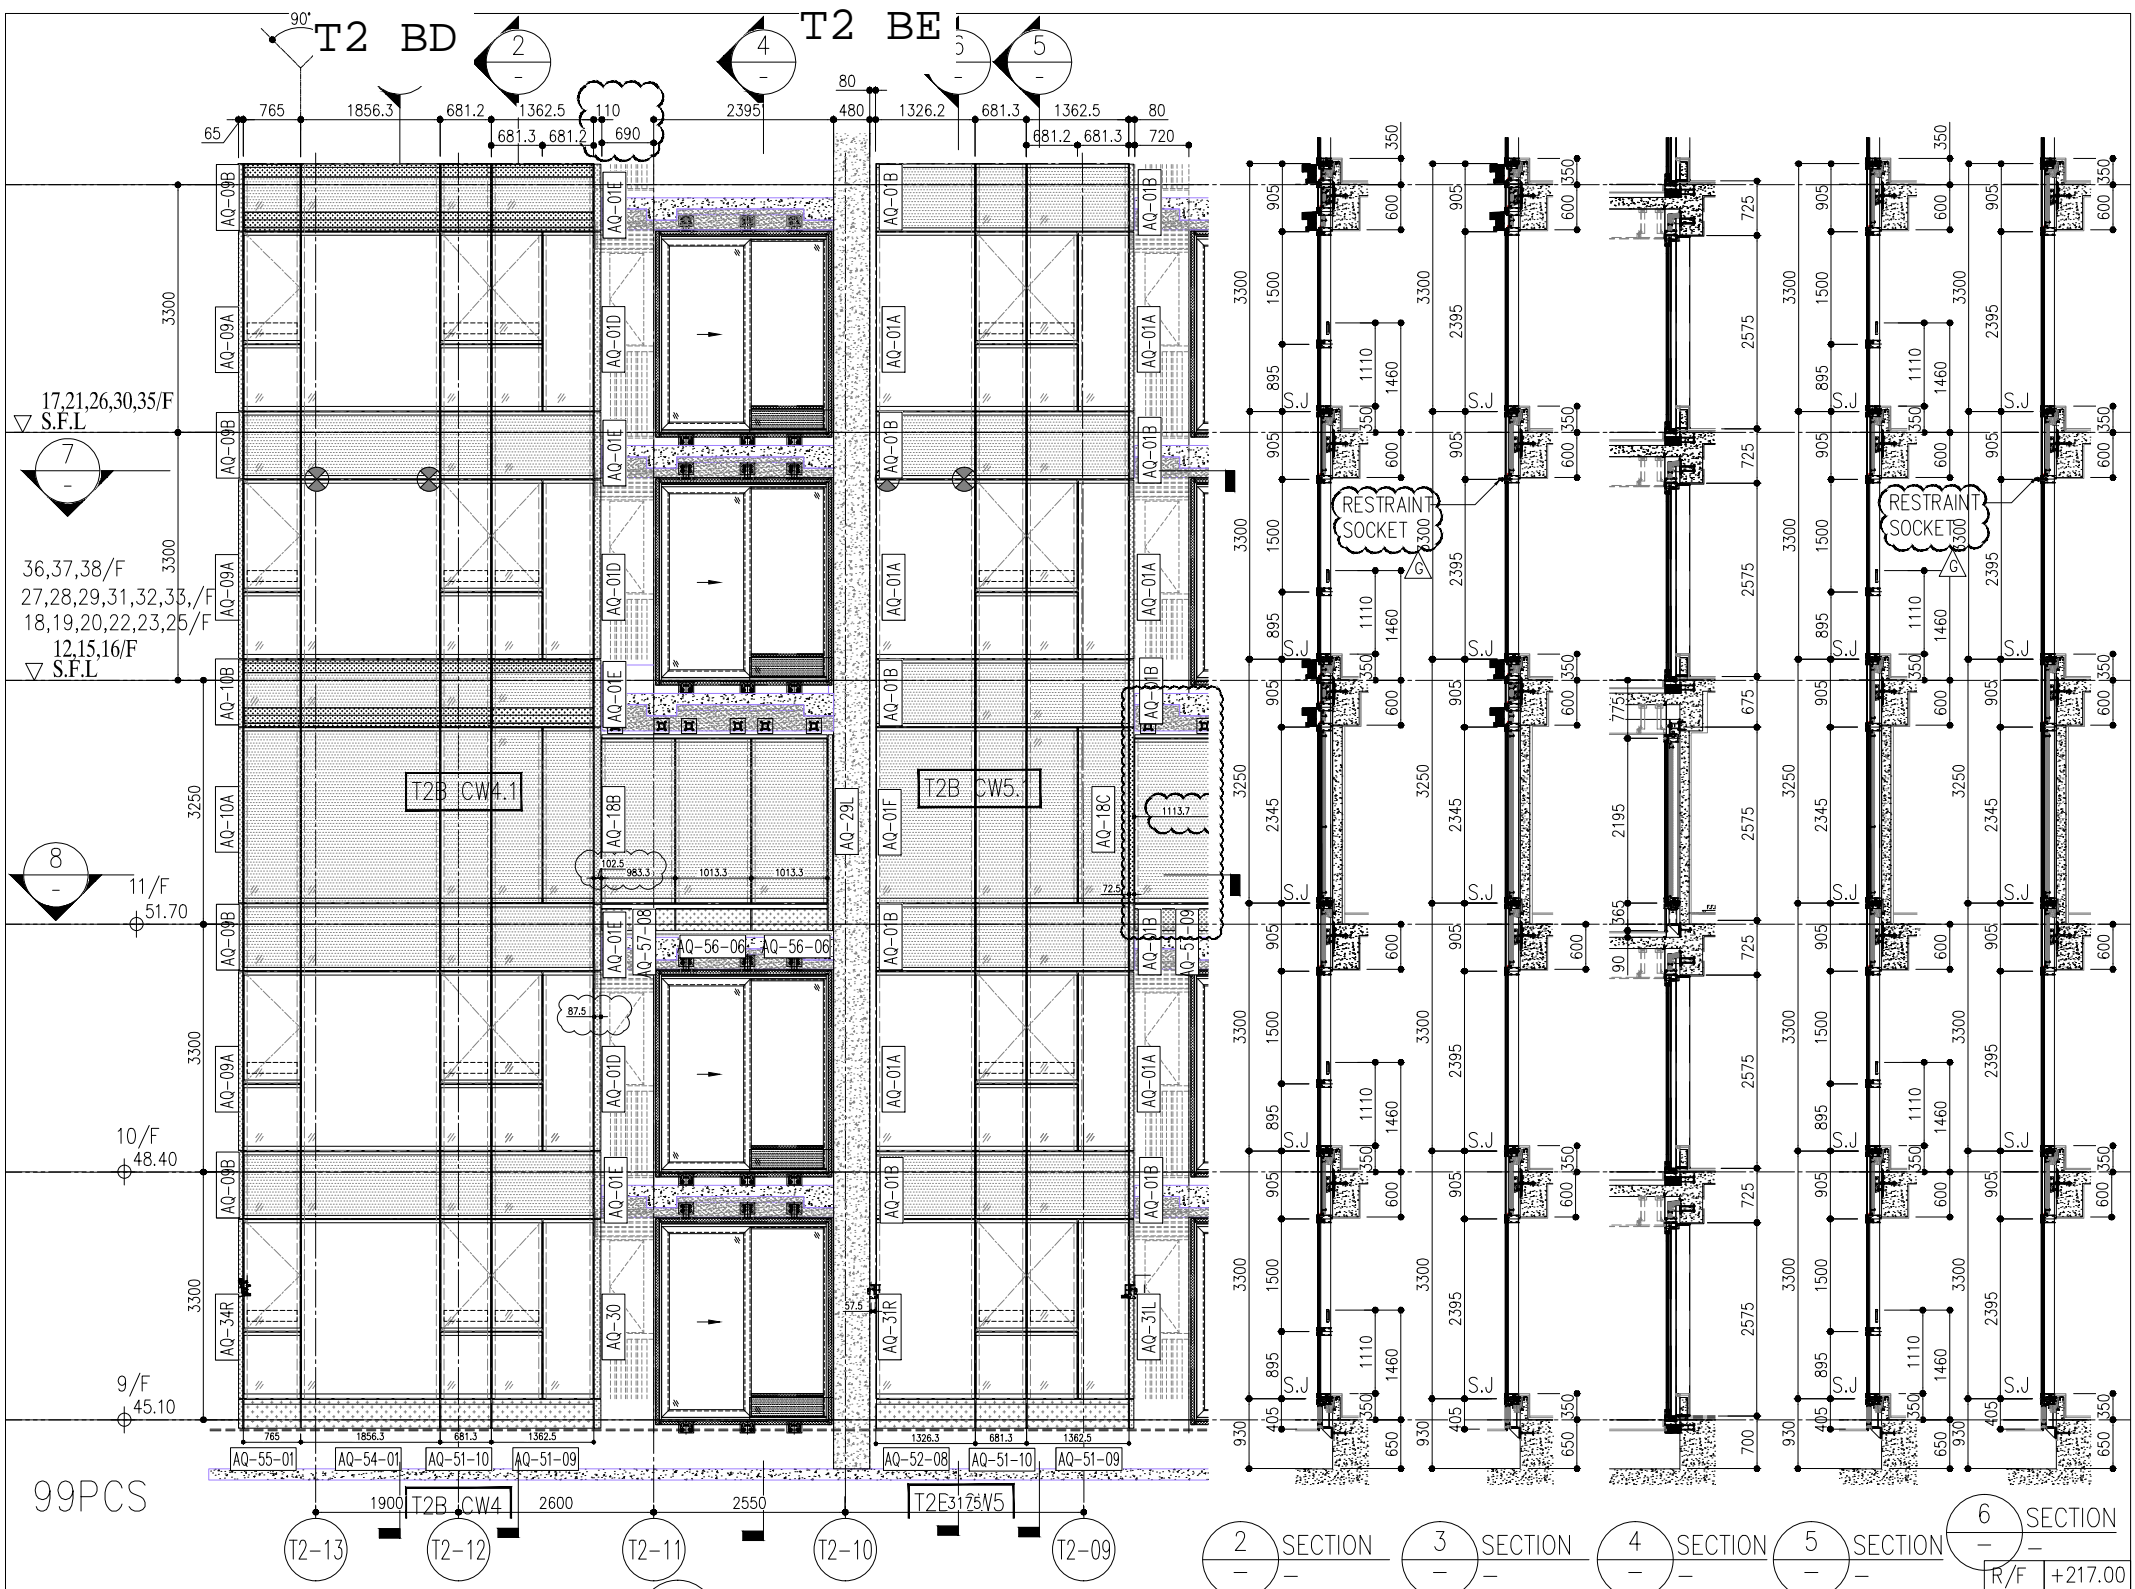


1 PART ELEVATION FOR CURTAIN WALL

2 SECTION 3 SECTION 4 SECTION 5 SECTION 6 SECTION

R/F	+217.00				
67/F	+213.50				
26/F	+91.25	39/F	+130.85	52/F	+170.40
25/F	+87.95	38/F	+127.55	51/F	+167.10
23/F	+84.65	37/F	+124.25	50/F	+163.80
22/F	+81.35	36/F	+120.95	49/F	+160.50
21/F	+78.05	35/F	+117.65	48/F	+157.20
20/F	+74.75	33/F	+114.35	47/F	+153.90
19/F	+71.45	32/F	+111.05	46/F	+150.60
18/F	+68.15	31/F	+107.75	45/F	+147.30
17/F	+64.85	30/F	+104.45	43/F	+144.00
16/F	+61.55	29/F	+101.15	42/F	+140.70
15/F	+58.25	28/F	+97.85	41/F	+137.40
12/F	+54.95	27/F	+94.55	40/F	+134.15
		66/F	+210.00	65/F	+206.70
		63/F	+203.40	62/F	+200.10
		61/F	+196.80	60/F	+193.50
		59/F	+190.20	58/F	+186.90
		57/F	+183.60	56/F	+180.30
		55/F	+177.00	53/F	+173.70

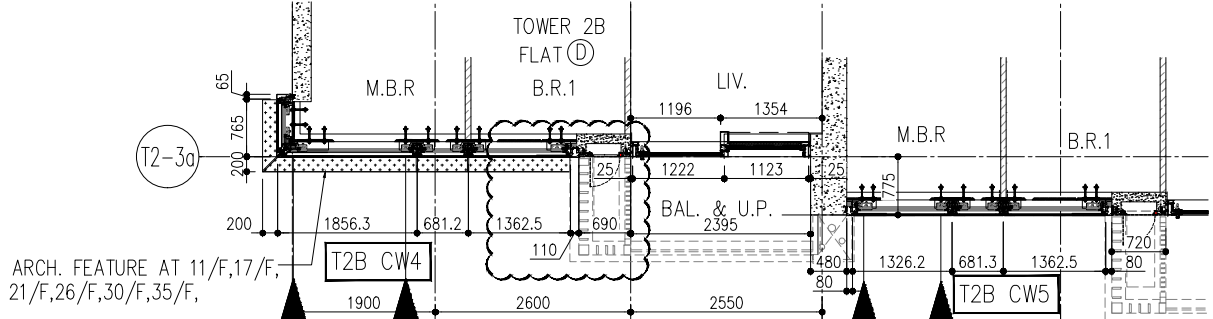

7 PART PLAN FOR CURTAIN WALL

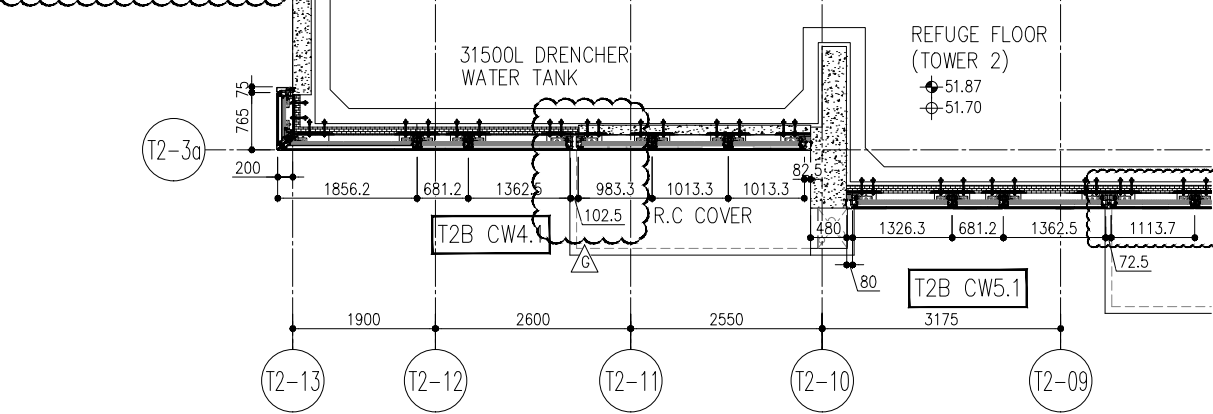

8 PART PLAN(11/F) FOR CURTAIN WALL

- LEGEND:
- (1) 10mm THK. HEAT STRENGTHENED GLASS (OUTSIDE) +12mm AIR SPACE + 12mm THK. TEMPERED GLASS
  - (2) 10mm THK. HEAT STRENGTHENED GLASS (OUTSIDE) +12mm AIR SPACE + 10mm THK. TEMPERED GLASS
  - (3) 12mm THK. HEAT STRENGTHENED GLASS
  - (4) 12mm THK. CLEAR TEMPERED GLASS ( INTERNAL PROTECTIVE BARRIER )
  - (5) 10mm THK. HEAT STRENGTHENED GLASS (OUTSIDE) +12mm AIR SPACE + 12mm THK. TEMPERED GLASS WITH REFLECTIVE COATING
  - (6) 10mm THK. CLEAR TEMPERED GLASS
  - (7) 8mm THK. CLEAR HEAT-STRENGTHENED GLASS + 52mm PVB + 8mm THK. CLEAR HEAT-STRENGTHENED GLASS
  - (8) 3 mm THK. ALUM. CLADDING
  - (9) 3 mm THK. ALUM. BACKPAN
  - S.J. - STACK JOINT
  - (10) - RESTRAINT SOCKET

DWG NO. : JB58-CW-PE207

REV. : G

**PE207**

PROJECT : DEVELOPMENT AT TKC

TITLE : PARTIAL CURTAIN WALL PLAN (TOWER 2)

DATE : 26/07/22

DRAWN BY : [Signature]

DATE : 26/07/22

SCALE : 1:50(A1)

PROJECT : DEVELOPMENT AT TKC

TITLE : PARTIAL CURTAIN WALL PLAN (TOWER 2)

DATE : 26/07/22

DRAWN BY : [Signature]

DATE : 26/07/22

SCALE : 1:50(A1)

NOTE:

- ALL DIMENSIONS ARE IN mm.
- ALL ELEVATIONS ARE VIEWED FROM OUTSIDE.
- ALL DIMENSIONS TO BE VERIFIED ON SITE BEFORE FABRICATION.

LEGEND:

- (X1) DETAIL MARK NO.
- (X2) REFER SHEET NO.
- (X3) F.F.L. -- FINISHED FLOOR LEVEL
- (X4) S.F.L. -- STRUCTURAL FLOOR LEVEL
- (X5) -- REVERSED DETAIL

NO.	DATE	REVISION	BY
A	03/12/21	REVISED AS PER COMMENTS	LS
B	20/12/21	REVISED AS PER COMMENTS	LS
C	22/01/22	REVISED AS PER COMMENTS	LS
D	06/04/22	REVISED AS PER COMMENTS	LS
E	26/05/22	REVISED AS PER COMMENTS	LS
F	26/07/22	REVISED AS PER COMMENTS	LS
G	18/08/22	REVISED AS PER COMMENTS	LS

ARCHITECT : ronaldi & partners

PROJECT PARTNERS FOR COMPETITION : Ronaldi & Partners (HK) Ltd. 呂允梓建築師事務所 (香港) 有限公司

MAIN CONTRACTOR :


CLIENT : 信和置業有限公司 Sino Land Company Limited

STRUCTURAL ENGINEER : Gammon

FAÇADE CONSULTANT : AECOM


B.D. REF. :



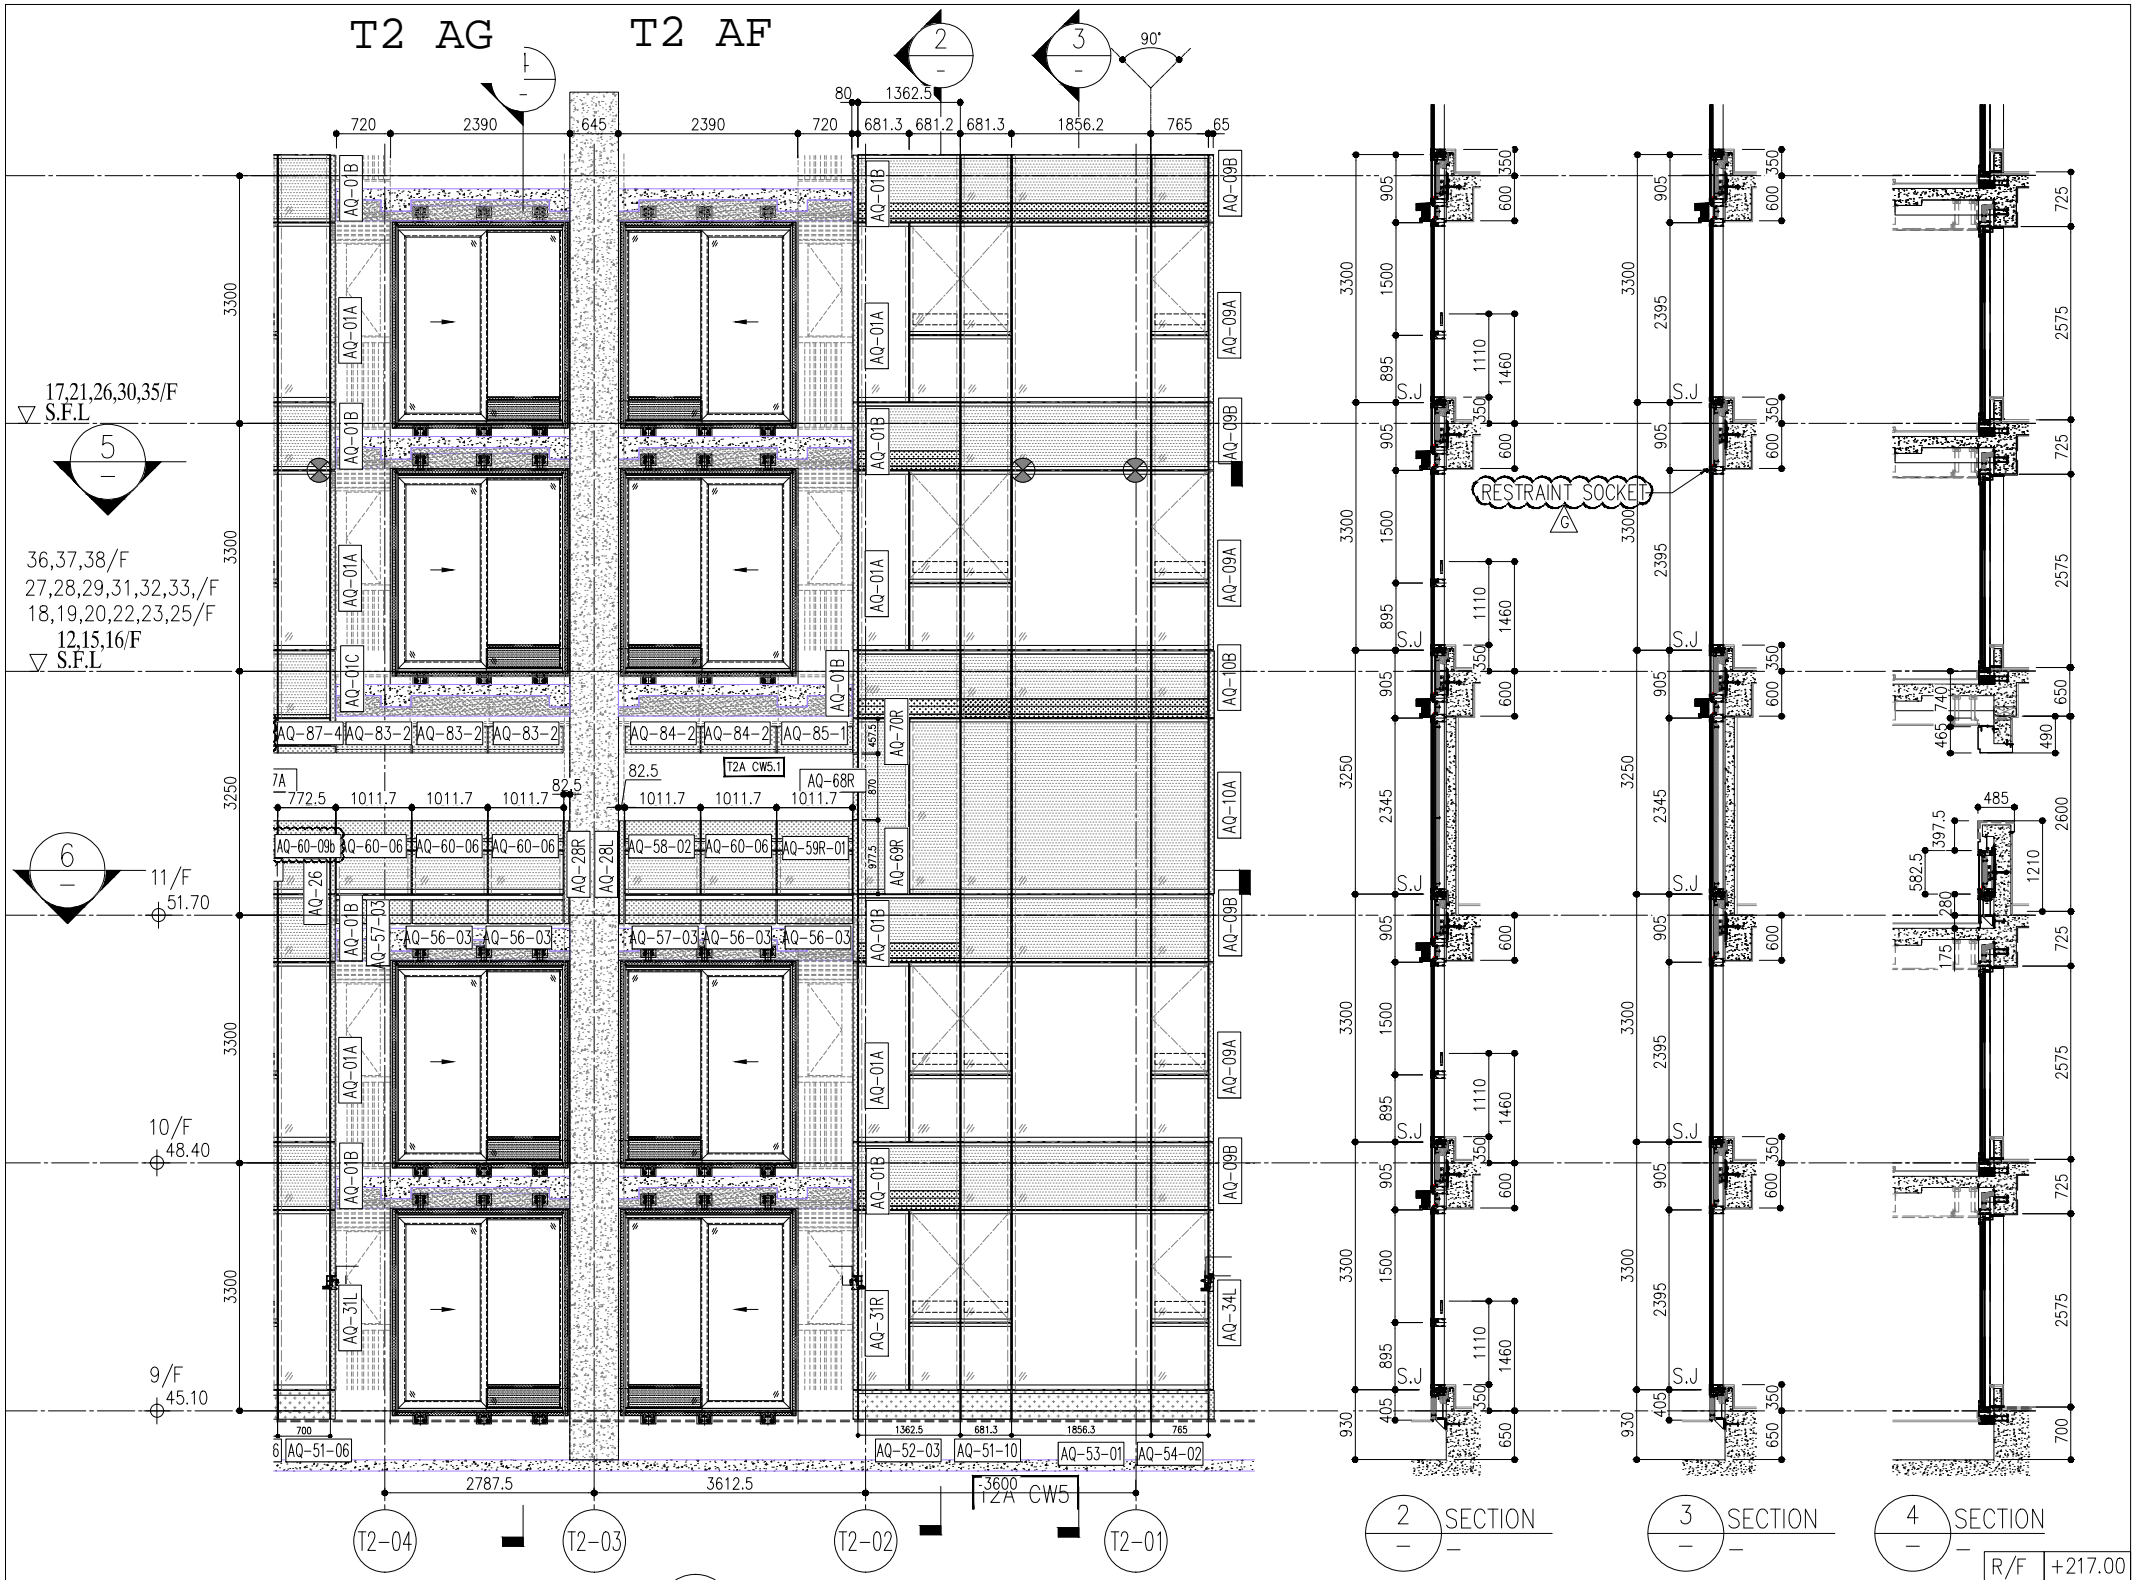


1 PART ELEVATION FOR CURTAIN WALL

2 SECTION 3 SECTION 4 SECTION

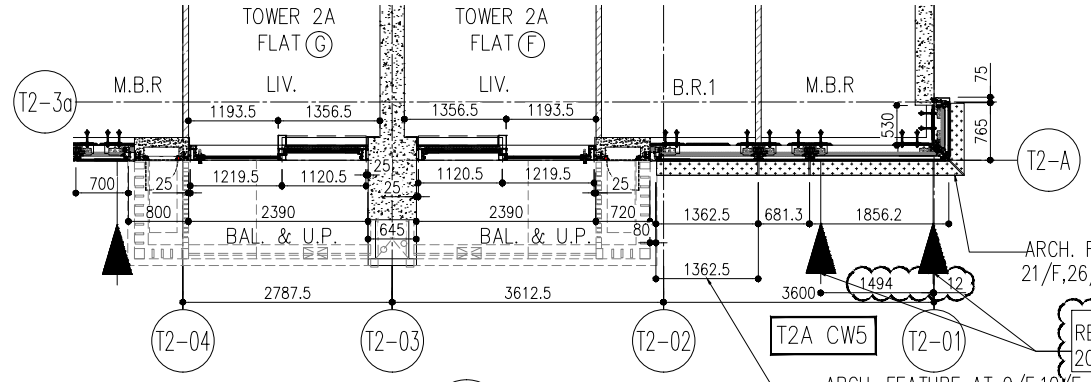

5 PART PLAN FOR CURTAIN WALL

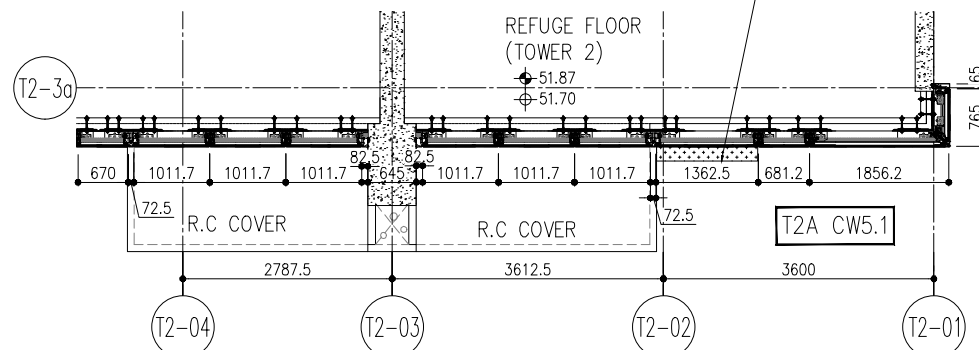

6 PART PLAN(11/F) FOR CURTAIN WALL

R/F	+217.00				
67/F	+213.50				
26/F	+91.25	39/F	+130.85	52/F	+170.40
25/F	+87.95	38/F	+127.55	51/F	+167.10
23/F	+84.65	37/F	+124.25	50/F	+163.80
22/F	+81.35	36/F	+120.95	49/F	+160.50
21/F	+78.05	35/F	+117.65	48/F	+157.20
20/F	+74.75	33/F	+114.35	47/F	+153.90
19/F	+71.45	32/F	+111.05	46/F	+150.60
18/F	+68.15	31/F	+107.75	45/F	+147.30
17/F	+64.85	30/F	+104.45	43/F	+144.00
16/F	+61.55	29/F	+101.15	42/F	+140.70
15/F	+58.25	28/F	+97.85	41/F	+137.40
12/F	+54.95	27/F	+94.55	40/F	+134.15
				53/F	+173.70

- LEGEND:
- (G1) 10mm THK. HEAT STRENGTHENED GLASS (OUTSIDE) +12mm AIR SPACE + 12mm THK. TEMPERED GLASS
  - (G2) 10mm THK. HEAT STRENGTHENED GLASS (OUTSIDE) +12mm AIR SPACE + 10mm THK. TEMPERED GLASS
  - (G3) 12mm THK. HEAT STRENGTHENED GLASS
  - (G4) 12mm THK. CLEAR TEMPERED GLASS ( INTERNAL PROTECTIVE BARRIER )
  - (G5) 10mm THK. HEAT STRENGTHENED GLASS (OUTSIDE) +12mm AIR SPACE + 12mm THK. TEMPERED GLASS WITH REFLECTIVE COATING
  - (G6) 10mm THK. CLEAR TEMPERED GLASS
  - (G7) 8mm THK. CLEAR HEAT-STRENGTHENED GLASS + 52mm PVB + 8mm THK. CLEAR HEAT-STRENGTHENED GLASS
  - (G8) 3 mm THK. ALUM. CLADDING
  - (G9) 3 mm THK. ALUM. BACKPAN
  - S.J. - STACK JOINT
  - (RS) - RESTRAINT SOCKET

DWG NO. : JB58-CW-PE209

DATE : 20/12/21

PROJECT : DEVELOPMENT AT TKC

TITLE : PARTIAL CURTAIN WALL PLAN (TOWER 2)

SCALE : 1:50(A1)

**PE209**

PE 209

REVISIONS:

NO.	DATE	REVISION
A	03/12/21	REVISED AS PER COMMENTS
B	20/12/21	REVISED AS PER COMMENTS
C	22/01/22	REVISED AS PER COMMENTS
D	06/04/22	REVISED AS PER COMMENTS
E	26/05/22	REVISED AS PER COMMENTS
F	26/07/22	REVISED AS PER COMMENTS
G	18/08/22	REVISED AS PER COMMENTS

NOTE:

- ALL DIMENSIONS ARE IN mm.
- ALL ELEVATIONS ARE VIEWED FROM OUTSIDE.
- ALL DIMENSIONS TO BE VERIFIED ON SITE BEFORE FABRICATION.

LEGEND:

- (X1) DETAIL MARK NO.
- (X20) REFER SHEET NO.
- 1. F.F.L. -- FINISHED FLOOR LEVEL
- 2. S.F.L. -- STRUCTURAL FLOOR LEVEL
- 3. (R) -- REVERSED DETAIL

ARCHITECT: ronaidiu & partners

PROJECT PARTNERS: ronaidiu & partners (HK) Ltd.

CLIENT: 信和置業有限公司 Sino Land Company Limited



STRUCTURAL ENGINEER: Gammon

FAÇADE CONSULTANT: AECOM

MAIN CONTRACTOR: 昂元建築有限公司 (香港) 有限公司

B.D. REF. :

T2 BD (高層) T2 BE (高層)

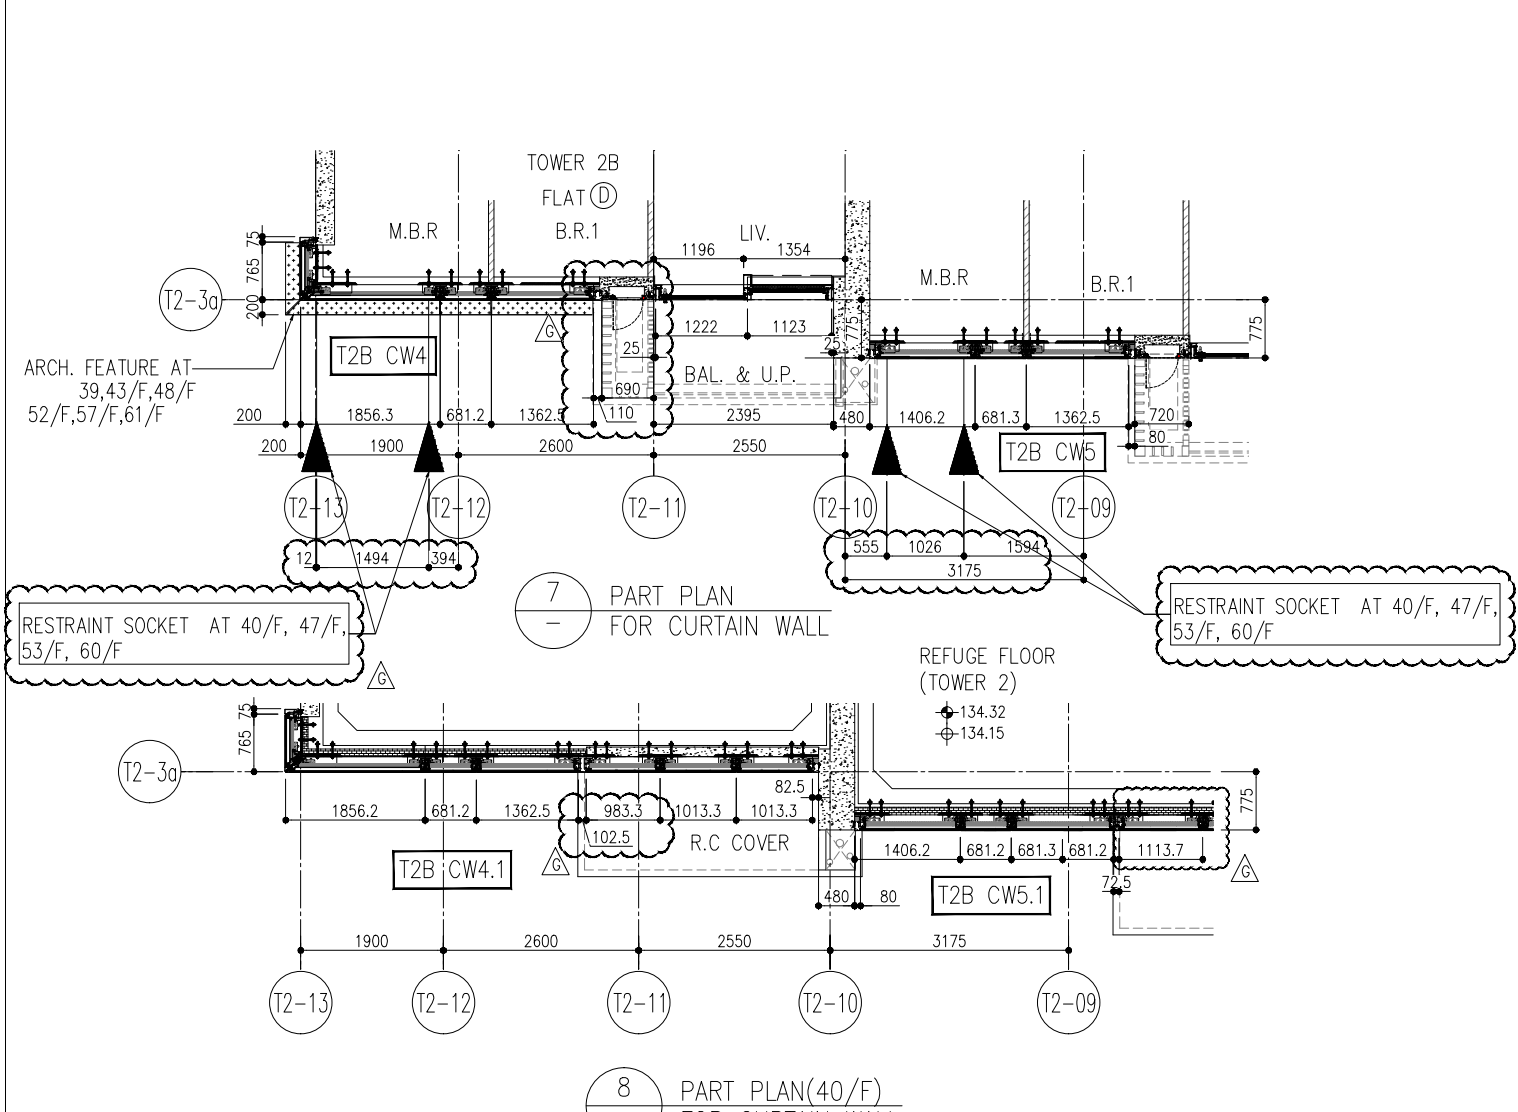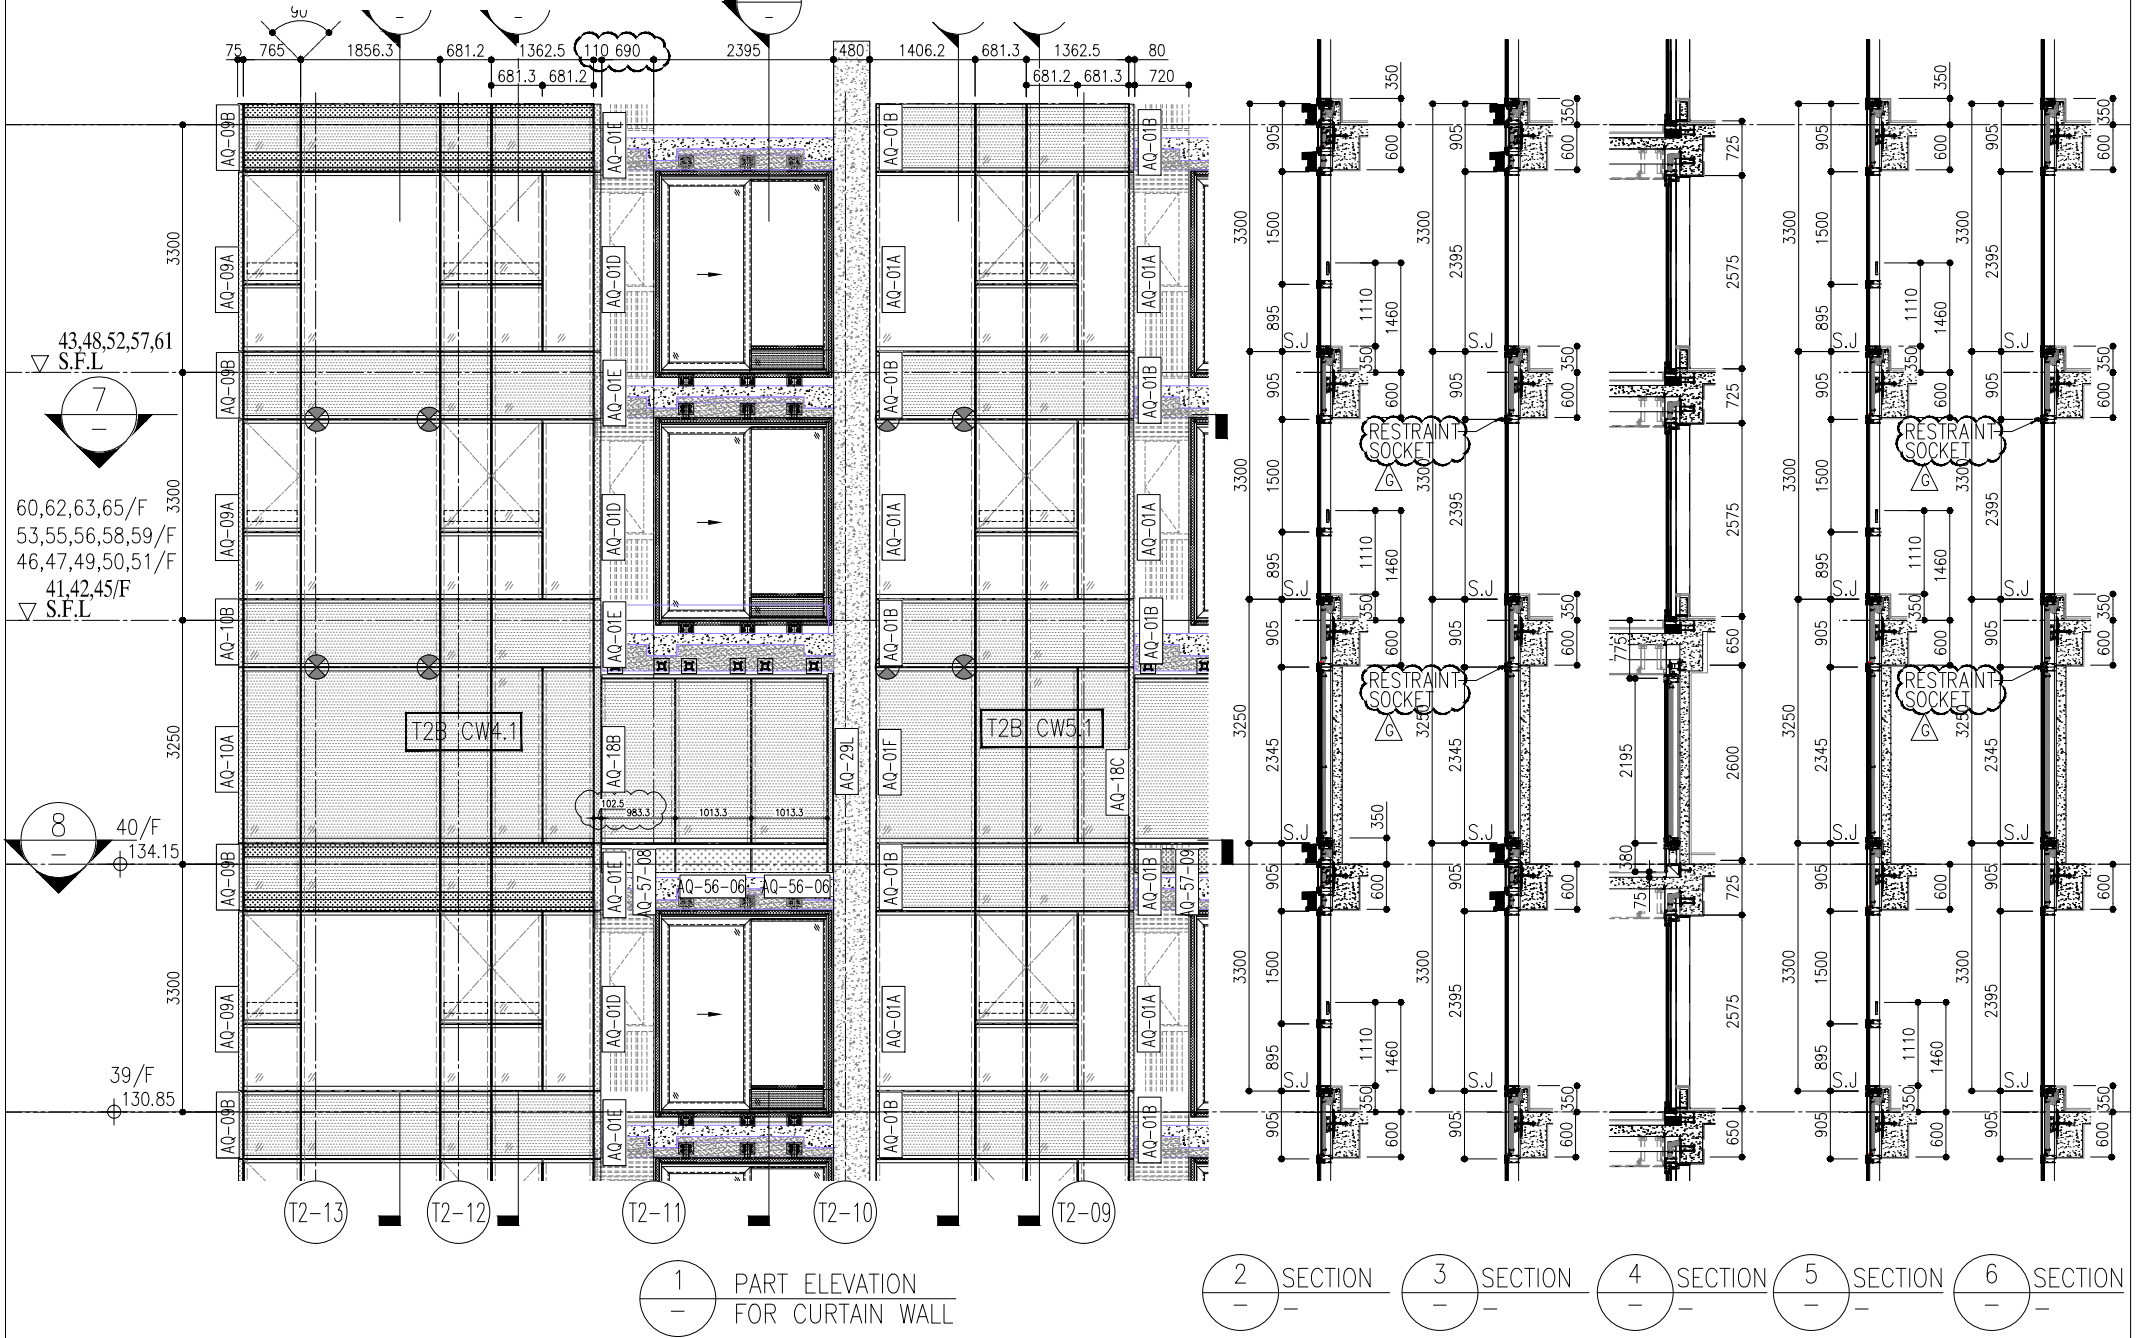

	R/F	+217.00
	67/F	+213.50
26/F	+91.25	39/F +130.85
25/F	+87.95	38/F +127.55
23/F	+84.65	37/F +124.25
22/F	+81.35	36/F +120.95
21/F	+78.05	35/F +117.65
20/F	+74.75	33/F +114.35
19/F	+71.45	32/F +111.05
18/F	+68.15	31/F 107.75
17/F	+64.85	30/F +104.45
16/F	+61.55	29/F +101.15
15/F	+58.25	28/F +97.85
12/F	+54.95	27/F +94.55
	52/F	+170.40
	51/F	+167.10
	50/F	+163.80
	49/F	+160.50
	48/F	+157.20
	47/F	+153.90
	46/F	+150.60
	45/F	+147.30
	43/F	+144.00
	42/F	+140.70
	41/F	+137.40
	40/F	+134.15
	66/F	+210.00
	65/F	+206.70
	63/F	+203.40
	62/F	+200.10
	61/F	+196.80
	60/F	+193.50
	59/F	+190.20
	58/F	+186.90
	57/F	+183.60
	56/F	+180.30
	55/F	+177.00
	53/F	+173.70

- LEGEND:
- ① 10mm THK. HEAT STRENGTHENED GLASS (OUTSIDE) +12mm AIR SPACE + 12mm THK. TEMPERED GLASS
  - ② 10mm THK. HEAT STRENGTHENED GLASS (OUTSIDE) +12mm AIR SPACE + 10mm THK. TEMPERED GLASS
  - ③ 12mm THK. HEAT STRENGTHENED GLASS
  - ④ 12mm THK. CLEAR TEMPERED GLASS ( INTERNAL PROTECTIVE BARRIER )
  - ⑤ 10mm THK. HEAT STRENGTHENED GLASS (OUTSIDE) +12mm AIR SPACE + 12mm THK. TEMPERED GLASS WITH REFLECTIVE COATING
  - ⑥ 10mm THK. CLEAR TEMPERED GLASS
  - ⑦ 8mm THK. CLEAR HEAT-STRENGTHENED GLASS + 52mm PVB + 8mm THK. CLEAR HEAT-STRENGTHENED GLASS
  - ⑧ 3 mm THK. ALUM. CLADDING
  - ⑨ 3 mm THK. ALUM. BACKPAN
  - S.J. - STACK JOINT
  - ⊗ - RESTRAINT SOCKET

**PE210**

PROJECT: PARTIAL CONSTRUCTION PLAN (TOWER 2)

DATE: 20/07/22

REVISIONS:

NO.	DATE	REVISIONS
A	03/12/21	REVISED AS PER COMMENTS
B	20/12/21	REVISED AS PER COMMENTS
C	22/01/22	REVISED AS PER COMMENTS
D	06/04/22	REVISED AS PER COMMENTS
E	26/05/22	REVISED AS PER COMMENTS
F	26/07/22	REVISED AS PER COMMENTS
G	18/08/22	REVISED AS PER COMMENTS

ARCHITECT: Ronald Lu & Partners


STRUCTURAL ENGINEER: Gammon

FAÇADE CONSULTANT: AECOM

CLIENT: 信和置業有限公司

PROJECT: DEVELOPMENT OF 1, LOHAS PARK

T2 BE(高層) T2 BF(高層) T2 AG(高層)

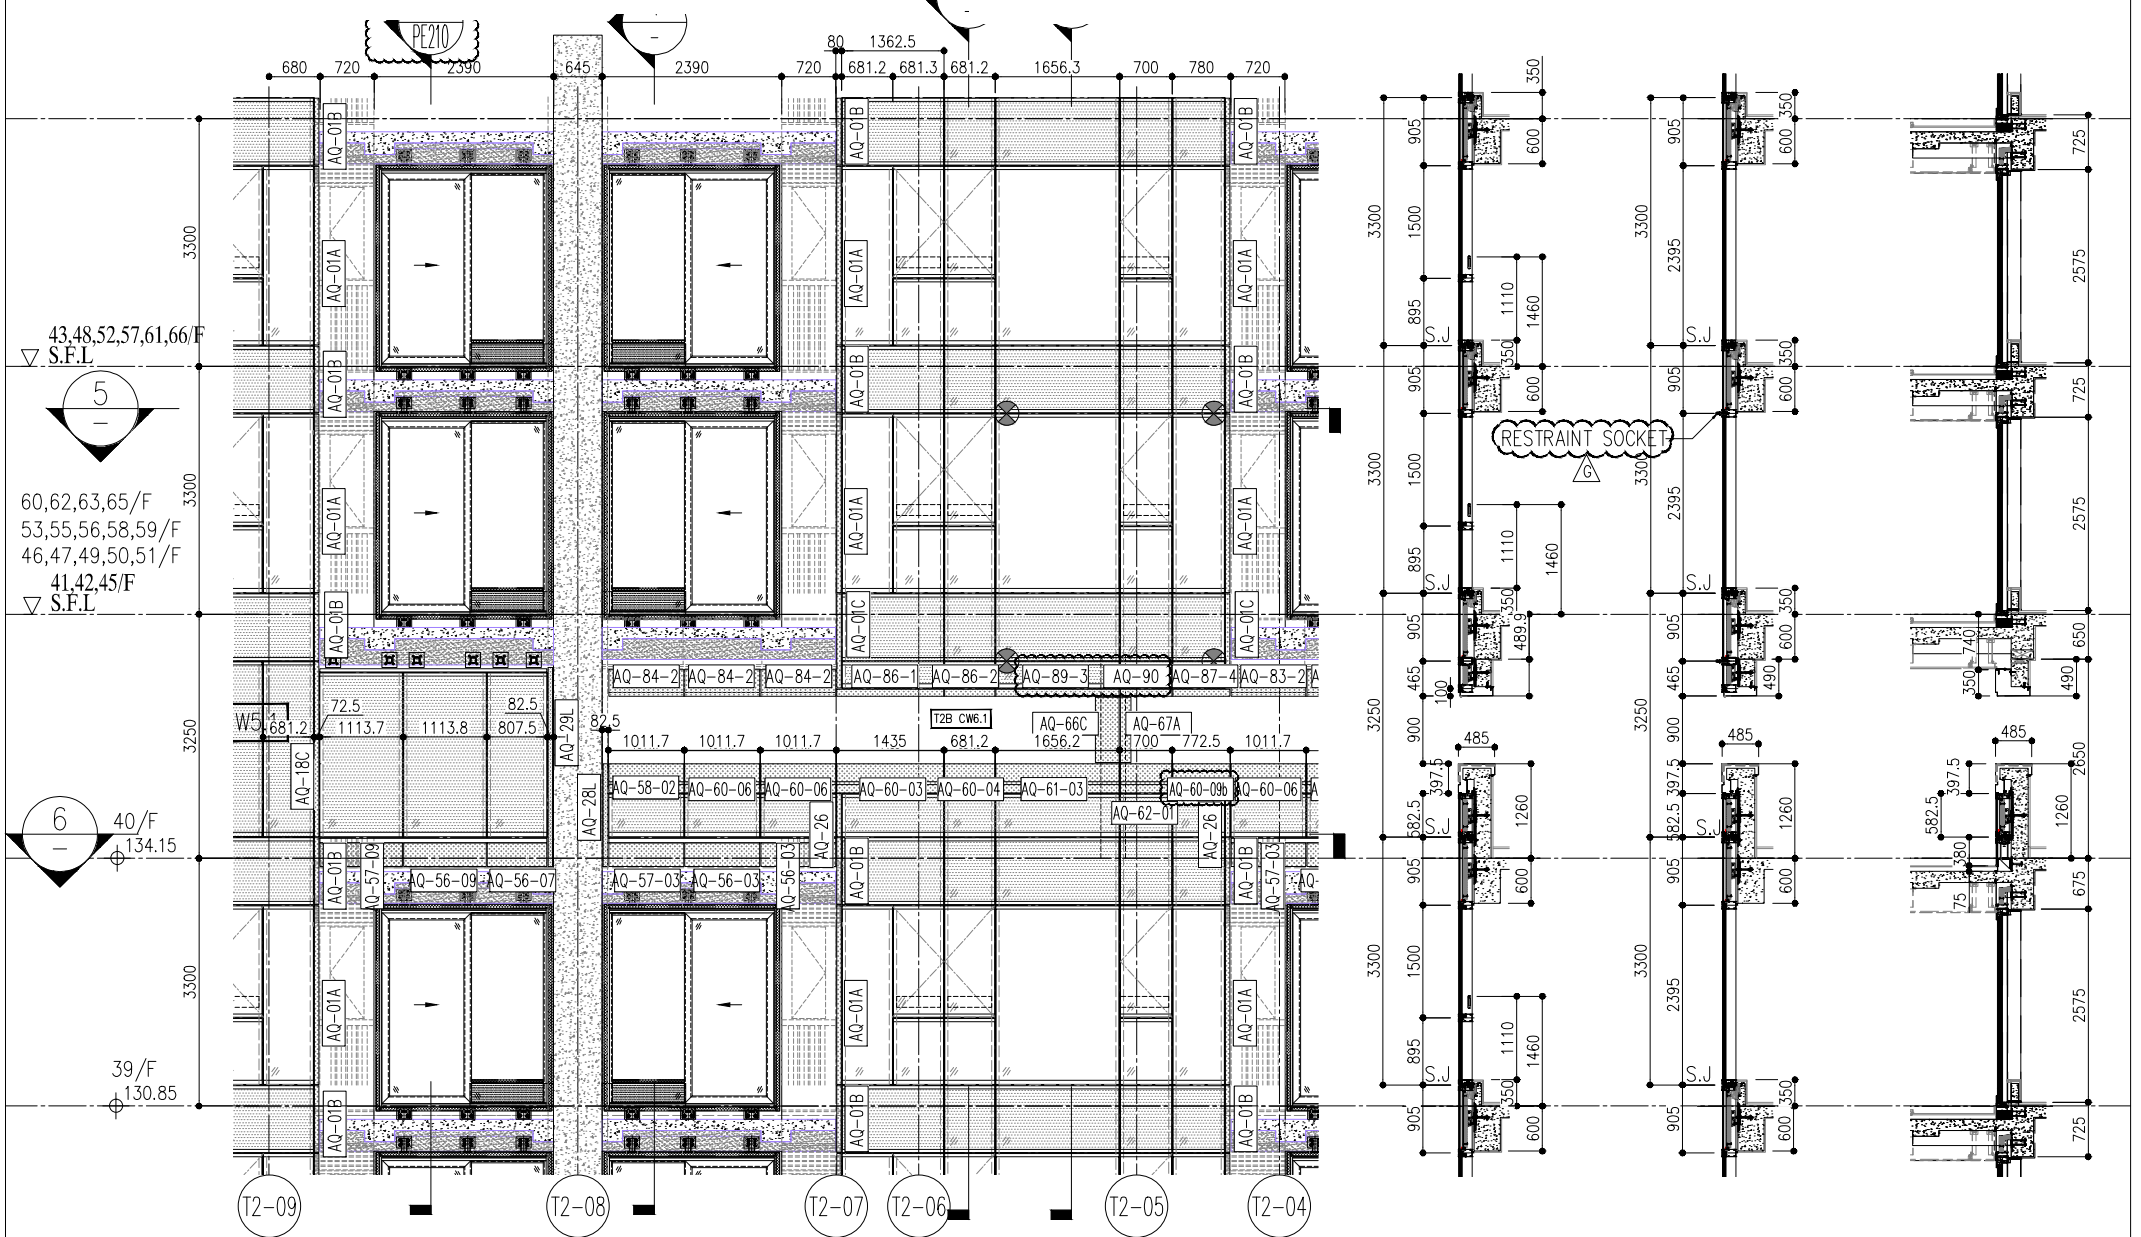

1 PART ELEVATION FOR CURTAIN WALL


2 SECTION

3 SECTION


4 SECTION

R/F	+217.00
67/F	+213.50

26/F	+91.25	39/F	+130.85	52/F	+170.40	66/F	+210.00
25/F	+87.95	38/F	+127.55	51/F	+167.10	65/F	+206.70
23/F	+84.65	37/F	+124.25	50/F	+163.80	63/F	+203.40
22/F	+81.35	36/F	+120.95	49/F	+160.50	62/F	+200.10
21/F	+78.05	35/F	+117.65	48/F	+157.20	61/F	+196.80
20/F	+74.75	33/F	+114.35	47/F	+153.90	60/F	+193.50
19/F	+71.45	32/F	+111.05	46/F	+150.60	59/F	+190.20
18/F	+68.15	31/F	+107.75	45/F	+147.30	58/F	+186.90
17/F	+64.85	30/F	+104.45	43/F	+144.00	57/F	+183.60
16/F	+61.55	29/F	+101.15	42/F	+140.70	56/F	+180.30
15/F	+58.25	28/F	+97.85	41/F	+137.40	55/F	+177.00
12/F	+54.95	27/F	+94.55	40/F	+134.15	53/F	+173.70

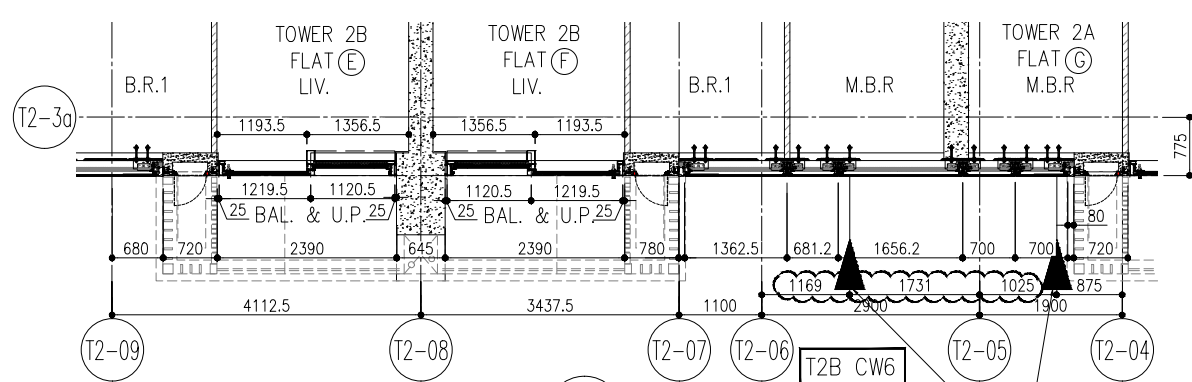

5 PART PLAN FOR CURTAIN WALL

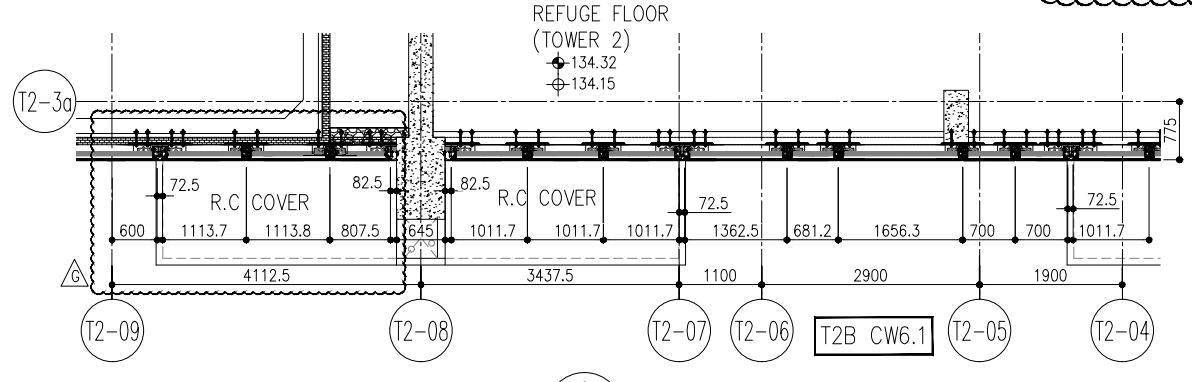

6 PART PLAN(40/F) FOR CURTAIN WALL

- LEGEND:
- (G1) 10mm THK. HEAT STRENGTHENED GLASS (OUTSIDE) +12mm AIR SPACE + 12mm THK. TEMPERED GLASS
  - (G2) 10mm THK. HEAT STRENGTHENED GLASS (OUTSIDE) +12mm AIR SPACE + 10mm THK. TEMPERED GLASS
  - (G3) 12mm THK. HEAT STRENGTHENED GLASS
  - (G4) 12mm THK. CLEAR TEMPERED GLASS ( INTERNAL PROTECTIVE BARRIER )
  - (G5) 10mm THK. HEAT STRENGTHENED GLASS (OUTSIDE) +12mm AIR SPACE + 12mm THK. TEMPERED GLASS WITH REFLECTIVE COATING
  - (G6) 10mm THK. CLEAR TEMPERED GLASS
  - (G7) 8mm THK. CLEAR HEAT-STRENGTHENED GLASS + 52mm PVB + 8mm THK. CLEAR HEAT-STRENGTHENED GLASS
  - (G8) 3 mm THK. ALUM. CLADDING
  - (G9) 3 mm THK. ALUM. BACKPAN
  - S.J. - STACK JOINT
  - (RS) - RESTRAINT SOCKET

DWG NO. : JB58-CW-PE211

REV. : G

**PE211**

PROJECT : DEVELOPMENT AT TKC

TITLE : PARTIAL CURTAIN WALL PLAN (TOWER 2)

DATE : 20/07/22

DRAWN BY : [Signature]

DATE : 20/07/22

SCALE : 1:50(A1)

PROJECT NO. : 1, LOHAS PARK

CLIENT : 信和置業有限公司 Sino Land Company Limited

ARCHITECT : ronaidiu & partners

ARCHITECT : Ronaidiu & Partners (HK) Ltd. 呂允祥建築師事務所 (香港) 有限公司

MAIN CONTRACTOR : [Signature]

STRUCTURAL ENGINEER : Gammon

FAÇADE CONSULTANT : AECOM

NOTE:

- ALL DIMENSIONS ARE IN mm.
- ALL ELEVATIONS ARE VIEWED FROM OUTSIDE.
- ALL DIMENSIONS TO BE VERIFIED ON SITE BEFORE FABRICATION.

LEGEND:

- (X1) DETAIL MARK NO.
- (X20) REFER SHEET NO.
- (F.F.L.) FINISHED FLOOR LEVEL
- (S.F.L.) STRUCTURAL FLOOR LEVEL
- (R) REVERSED DETAIL

NO.	DATE	REVISION	BY
A	03/12/21	REVISED AS PER COMMENTS	LS
B	20/07/22	REVISED AS PER COMMENTS	LS
C	22/01/22	REVISED AS PER COMMENTS	LS
D	06/04/22	REVISED AS PER COMMENTS	LS
E	26/05/22	REVISED AS PER COMMENTS	LS
F	26/07/22	REVISED AS PER COMMENTS	LS
G	18/08/22	REVISED AS PER COMMENTS	LS

B.D. REF. :

CLIENT : 信和置業有限公司 Sino Land Company Limited

ARCHITECT : ronaidiu & partners



ARCHITECT : Ronaidiu & Partners (HK) Ltd. 呂允祥建築師事務所 (香港) 有限公司

MAIN CONTRACTOR : [Signature]

STRUCTURAL ENGINEER : Gammon

FAÇADE CONSULTANT : AECOM

T2 AG(高層) T2 AF(高層)

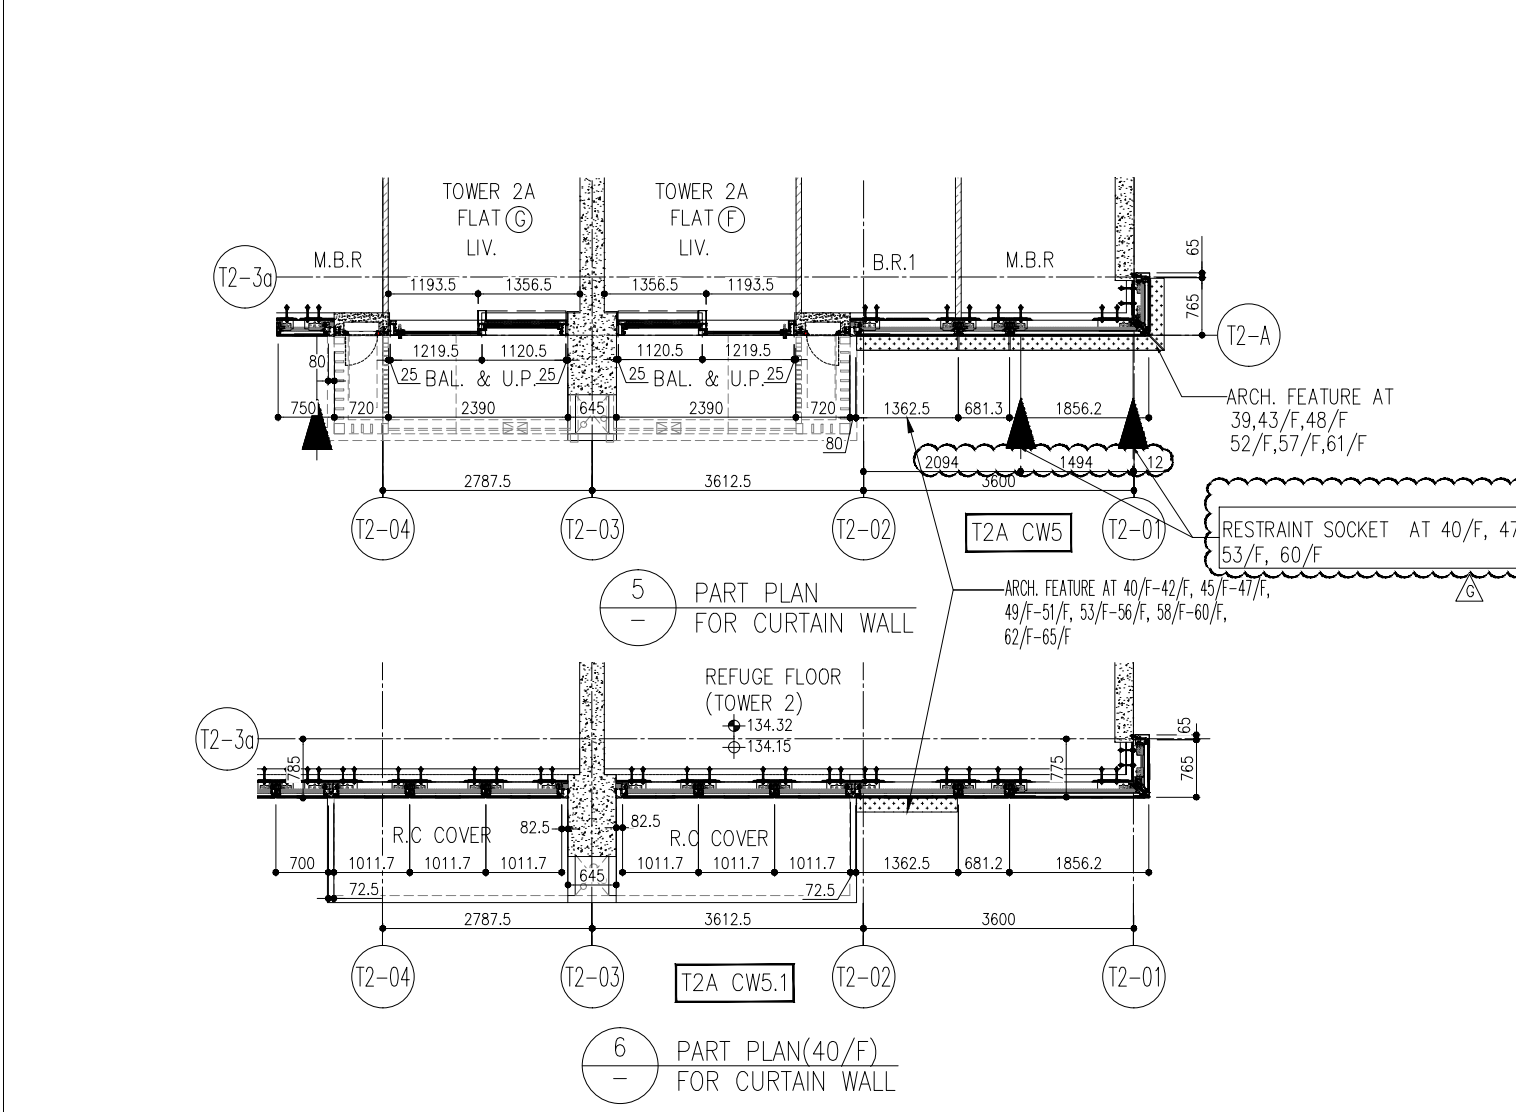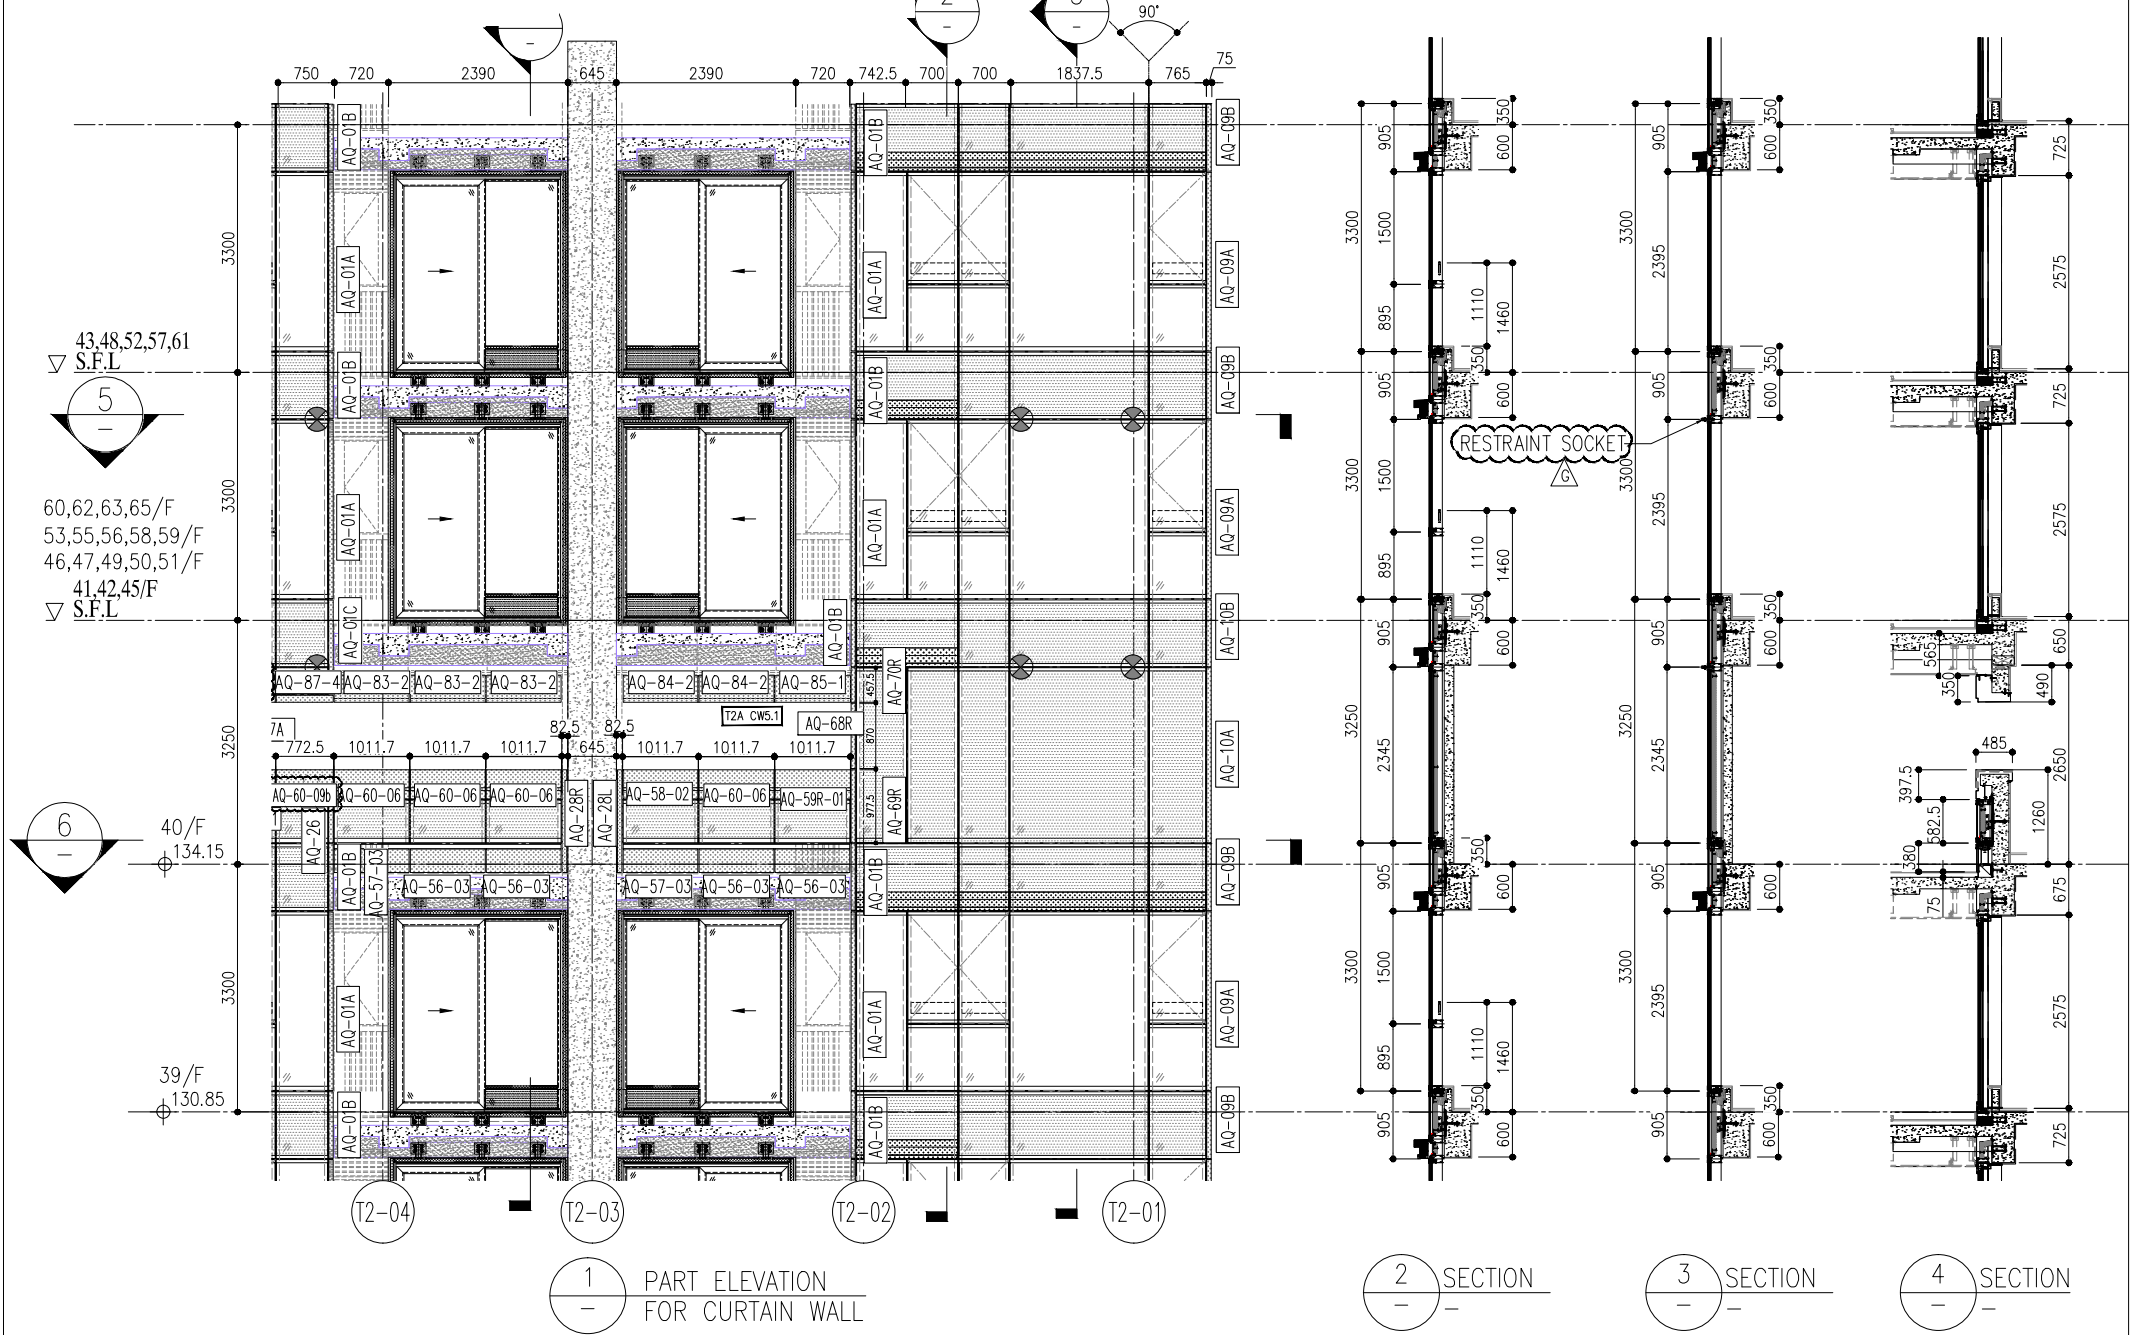

R/F	+217.00						
67/F	+213.50						
26/F	+91.25	39/F	+130.85	52/F	+170.40	66/F	+210.00
25/F	+87.95	38/F	+127.55	51/F	+167.10	65/F	+206.70
23/F	+84.65	37/F	+124.25	50/F	+163.80	63/F	+203.40
22/F	+81.35	36/F	+120.95	49/F	+160.50	62/F	+200.10
21/F	+78.05	35/F	+117.65	48/F	+157.20	61/F	+196.80
20/F	+74.75	33/F	+114.35	47/F	+153.90	60/F	+193.50
19/F	+71.45	32/F	+111.05	46/F	+150.60	59/F	+190.20
18/F	+68.15	31/F	+107.75	45/F	+147.30	58/F	+186.90
17/F	+64.85	30/F	+104.45	43/F	+144.00	57/F	+183.60
16/F	+61.55	29/F	+101.15	42/F	+140.70	56/F	+180.30
15/F	+58.25	28/F	+97.85	41/F	+137.40	55/F	+177.00
12/F	+54.95	27/F	+94.55	40/F	+134.15	53/F	+173.70

- LEGEND:
- (G1) 10mm THK. HEAT STRENGTHENED GLASS (OUTSIDE) + 12mm AIR SPACE + 12mm THK. TEMPERED GLASS
  - (G2) 10mm THK. HEAT STRENGTHENED GLASS (OUTSIDE) + 12mm AIR SPACE + 10mm THK. TEMPERED GLASS
  - (G3) 12mm THK. HEAT STRENGTHENED GLASS
  - (G4) 12mm THK. CLEAR TEMPERED GLASS ( INTERNAL PROTECTIVE BARRIER )
  - (G5) 10mm THK. HEAT STRENGTHENED GLASS (OUTSIDE) + 12mm THK. TEMPERED GLASS WITH REFLECTIVE COATING
  - (G6) 10mm THK. CLEAR TEMPERED GLASS
  - (G7) 8mm THK. CLEAR HEAT-STRENGTHENED GLASS + 52mm PVB + 8mm THK. CLEAR HEAT-STRENGTHENED GLASS
  - (G8) 3 mm THK. ALUM. CLADDING
  - (G9) 3 mm THK. ALUM. BACKPAN
  - S.J. - STACK JOINT
  - (RS) - RESTRAINT SOCKET

DWG NO. : JB58-CW-PE212  
 DATE : 20/12/21  
 TITLE : PARTIAL CURTAIN WALL ELEVATION, PLAN (TOWER 2)  
 PROJECT : DEVELOPMENT OF 1, LOHAS PARK, N.T.  
**PE212**  

NOTE:

- ALL DIMENSIONS ARE IN mm.
- ALL ELEVATIONS ARE VIEWED FROM OUTSIDE.
- ALL DIMENSIONS TO BE VERIFIED ON SITE BEFORE FABRICATION.

LEGEND:

- (X1) DETAIL MARK NO.
- (X2) REFER SHEET NO.
- 1. F.F.L. -- FINISHED FLOOR LEVEL
- 2. S.F.L. -- STRUCTURAL FLOOR LEVEL
- 3. (R) -- REVERSED DETAIL

NO.	DATE	REVISION	BY
A	03/12/21	REVISED AS PER COMMENTS	LS
B	20/12/21	REVISED AS PER COMMENTS	LS
C	22/01/22	REVISED AS PER COMMENTS	LS
D	06/04/22	REVISED AS PER COMMENTS	LS
E	26/05/22	REVISED AS PER COMMENTS	LS
F	26/07/22	REVISED AS PER COMMENTS	LS
G	18/08/22	REVISED AS PER COMMENTS	LS







B.D. REF. :

T2 AE

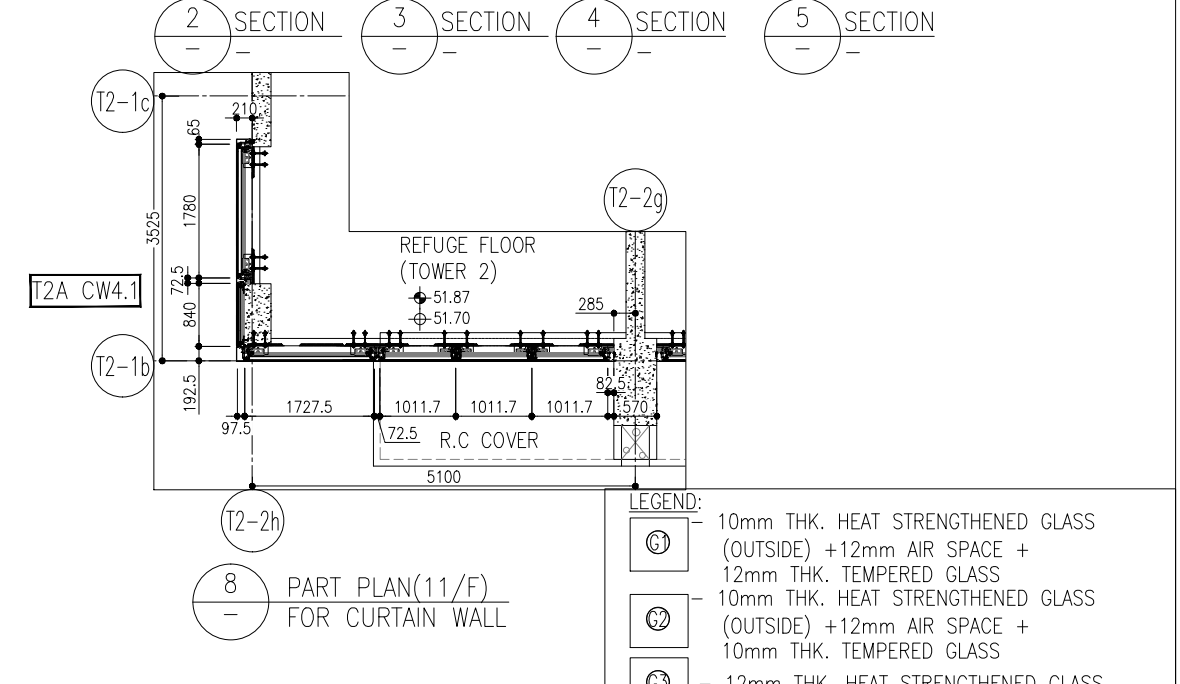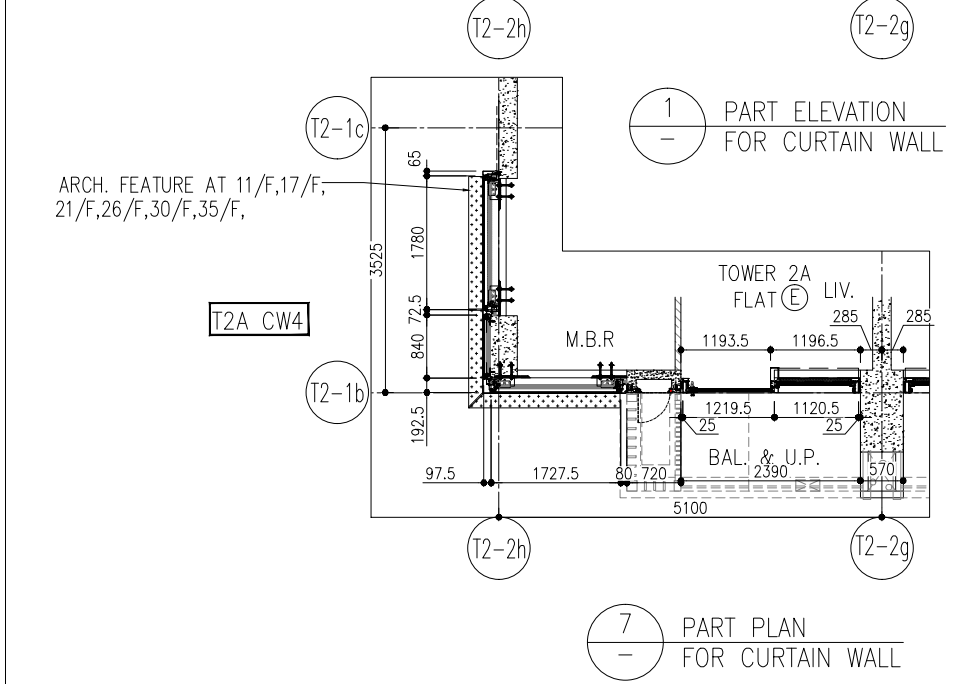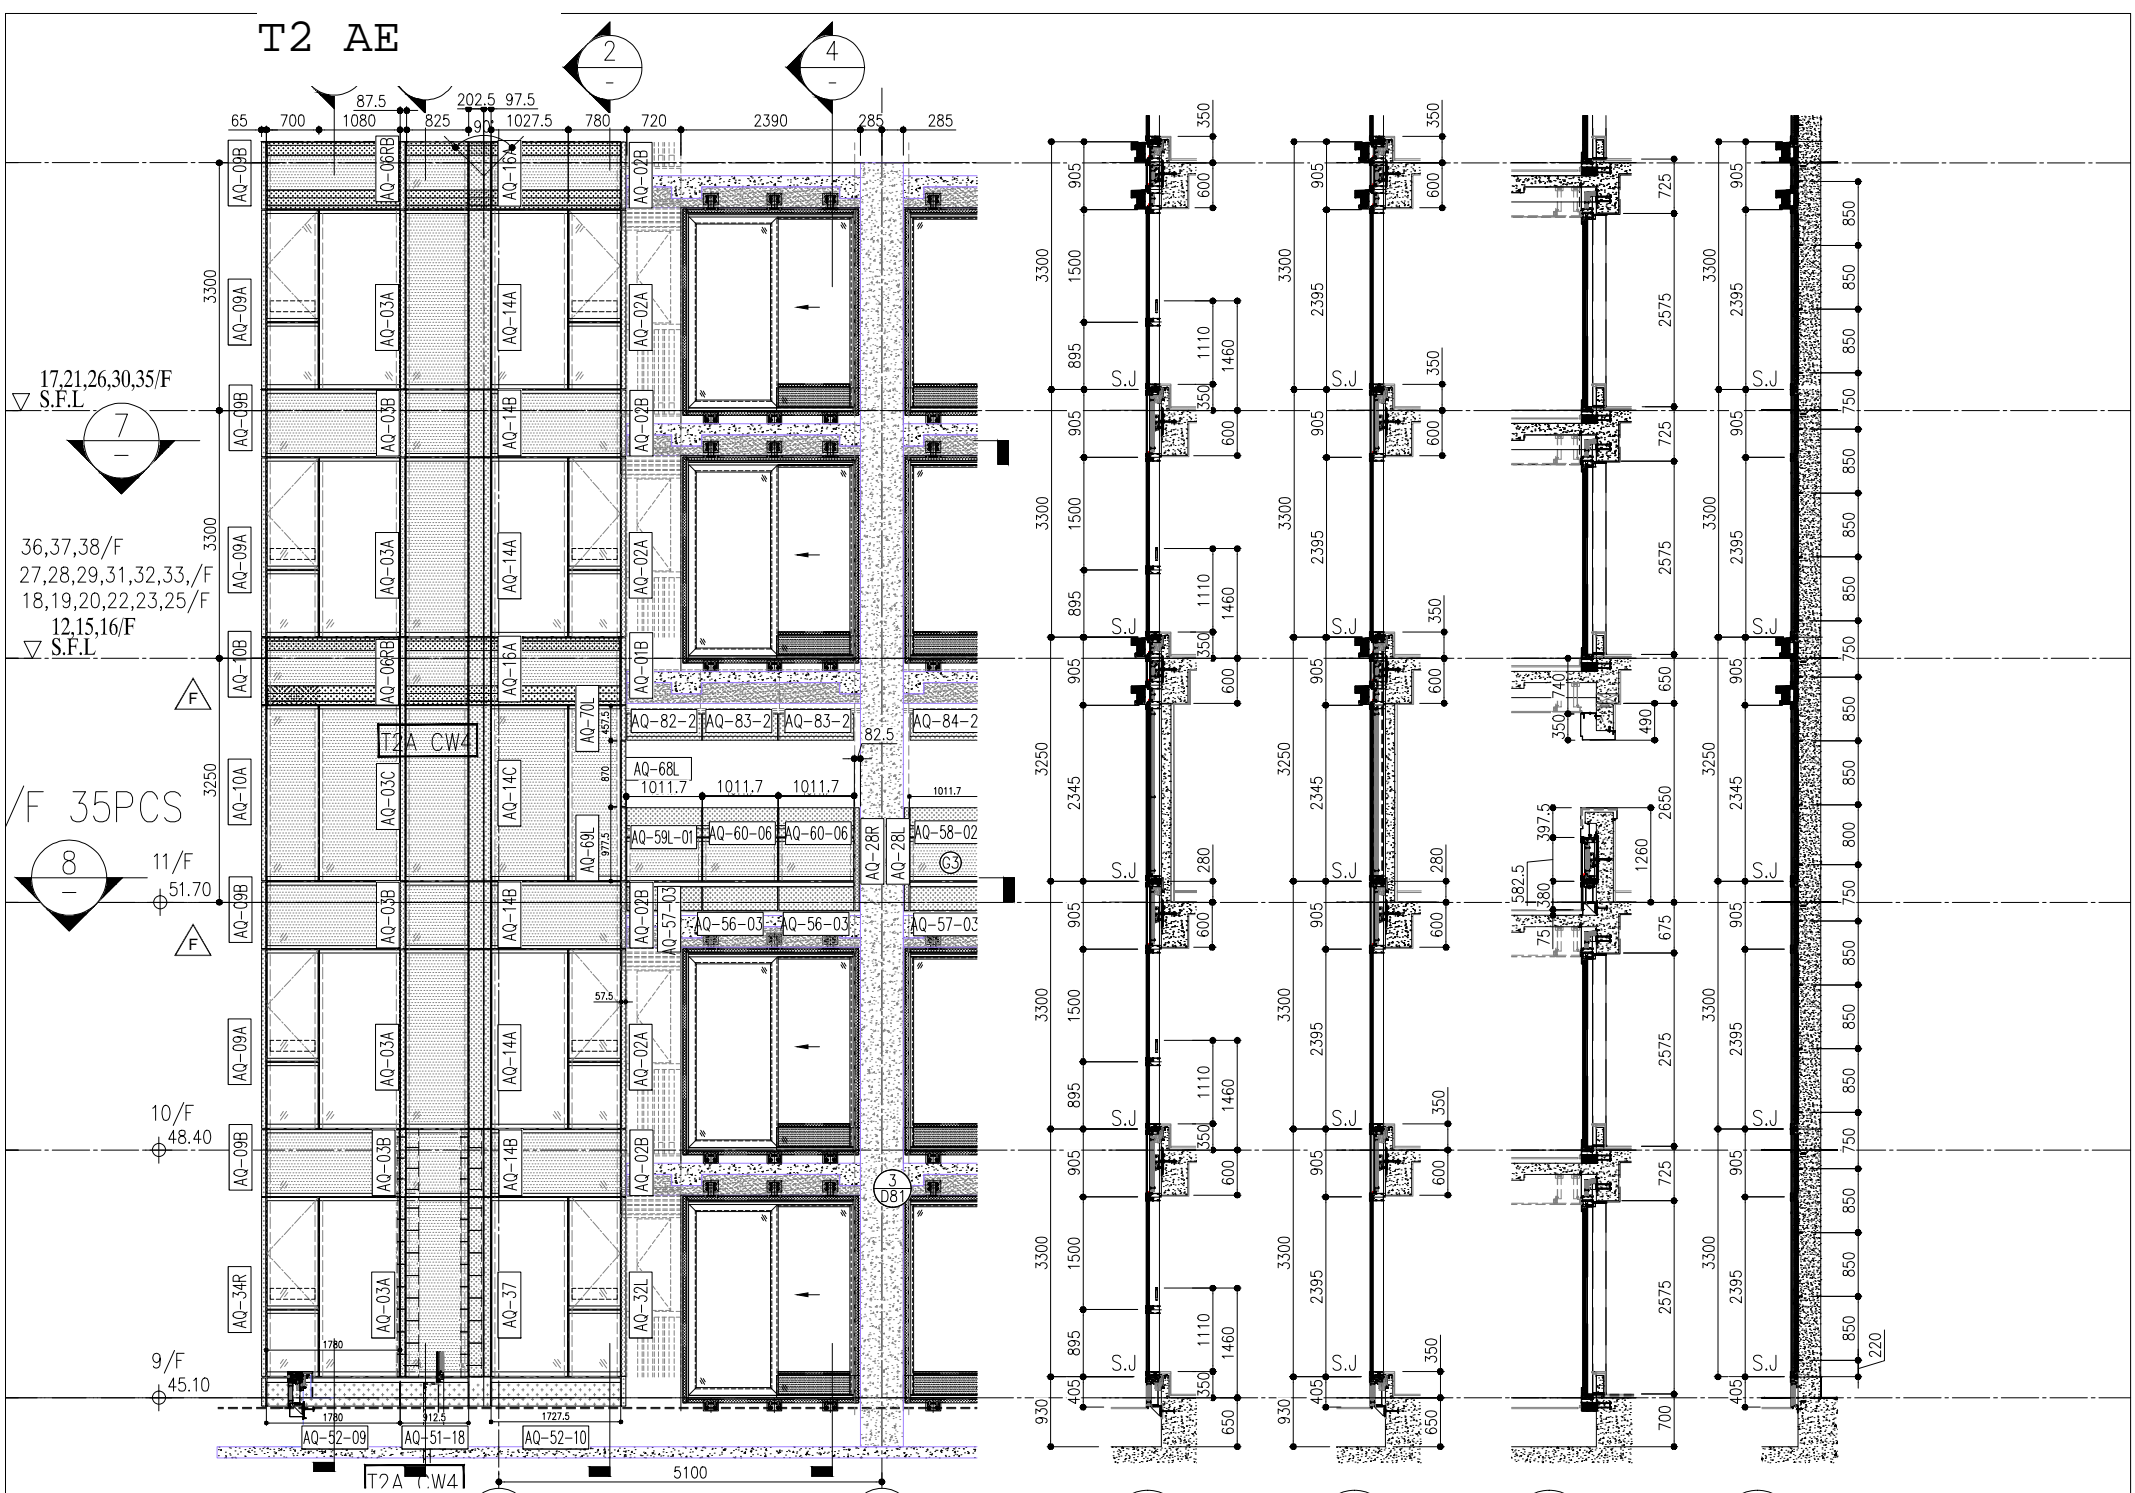

			R/F	+217.00			
			67/F	+213.50			
26/F	+91.25	39/F	+130.85	52/F	+170.40	66/F	+210.00
25/F	+87.95	38/F	+127.55	51/F	+167.10	65/F	+206.70
23/F	+84.65	37/F	+124.25	50/F	+163.80	63/F	+203.40
22/F	+81.35	36/F	+120.95	49/F	+160.50	62/F	+200.10
21/F	+78.05	35/F	+117.65	48/F	+157.20	61/F	+196.80
20/F	+74.75	33/F	+114.35	47/F	+153.90	60/F	+193.50
19/F	+71.45	32/F	+111.05	46/F	+150.60	59/F	+190.20
18/F	+68.15	31/F	+107.75	45/F	+147.30	58/F	+186.90
17/F	+64.85	30/F	+104.45	43/F	+144.00	57/F	+183.60
16/F	+61.55	29/F	+101.15	42/F	+140.70	56/F	+180.30
15/F	+58.25	28/F	+97.85	41/F	+137.40	55/F	+177.00
12/F	+54.95	27/F	+94.55	40/F	+134.15	53/F	+173.70

- LEGEND:
- (G1) 10mm THK. HEAT STRENGTHENED GLASS (OUTSIDE) + 12mm AIR SPACE + 12mm THK. TEMPERED GLASS
  - (G2) 10mm THK. HEAT STRENGTHENED GLASS (OUTSIDE) + 12mm AIR SPACE + 10mm THK. TEMPERED GLASS
  - (G3) 12mm THK. HEAT STRENGTHENED GLASS
  - (G4) 12mm THK. CLEAR TEMPERED GLASS ( INTERNAL PROTECTIVE BARRIER )
  - (G5) 10mm THK. HEAT STRENGTHENED GLASS (OUTSIDE) + 12mm AIR SPACE + 12mm THK. TEMPERED GLASS WITH REFLECTIVE COATING
  - (G6) 10mm THK. CLEAR TEMPERED GLASS
  - (G7) 8mm THK. CLEAR HEAT-STRENGTHENED GLASS + 1.52mm PVB + 8mm THK. CLEAR HEAT-STRENGTHENED GLASS
  - (G8) 3 mm THK. ALUM. CLADDING
  - (G9) 3 mm THK. ALUM. BACKPAN
  - S.J. - STACK JOINT
  - (RS) - RESTRAINT SOCKET








NO.	DATE	REVISION
1	26/07/22	REVISED AS PER COMMENTS
2	26/07/22	REVISED AS PER COMMENTS
3	22/01/22	REVISED AS PER COMMENTS
4	20/12/21	REVISED AS PER COMMENTS
5	03/12/21	REVISED AS PER COMMENTS

CLIENT: 信和置業有限公司 Sino Land Company Limited

ARCHITECT: ronaldi & partners


STRUCTURAL ENGINEER: Gammon

FAÇADE CONSULTANT: AECOM


NOTE: 1. ALL DIMENSIONS ARE IN mm. 2. ALL ELEVATIONS ARE VIEWED FROM OUTSIDE. 3. ALL DIMENSIONS TO BE VERIFIED ON SITE BEFORE FABRICATION.

LEGEND: (X1) DETAIL MARK NO. (X20) REFER SHEET NO. 1. F.F.L. -- FINISHED FLOOR LEVEL 2. S.F.L. -- STRUCTURAL FLOOR LEVEL 3. (R) -- REVERSED DETAIL


T2 AD T2 AC

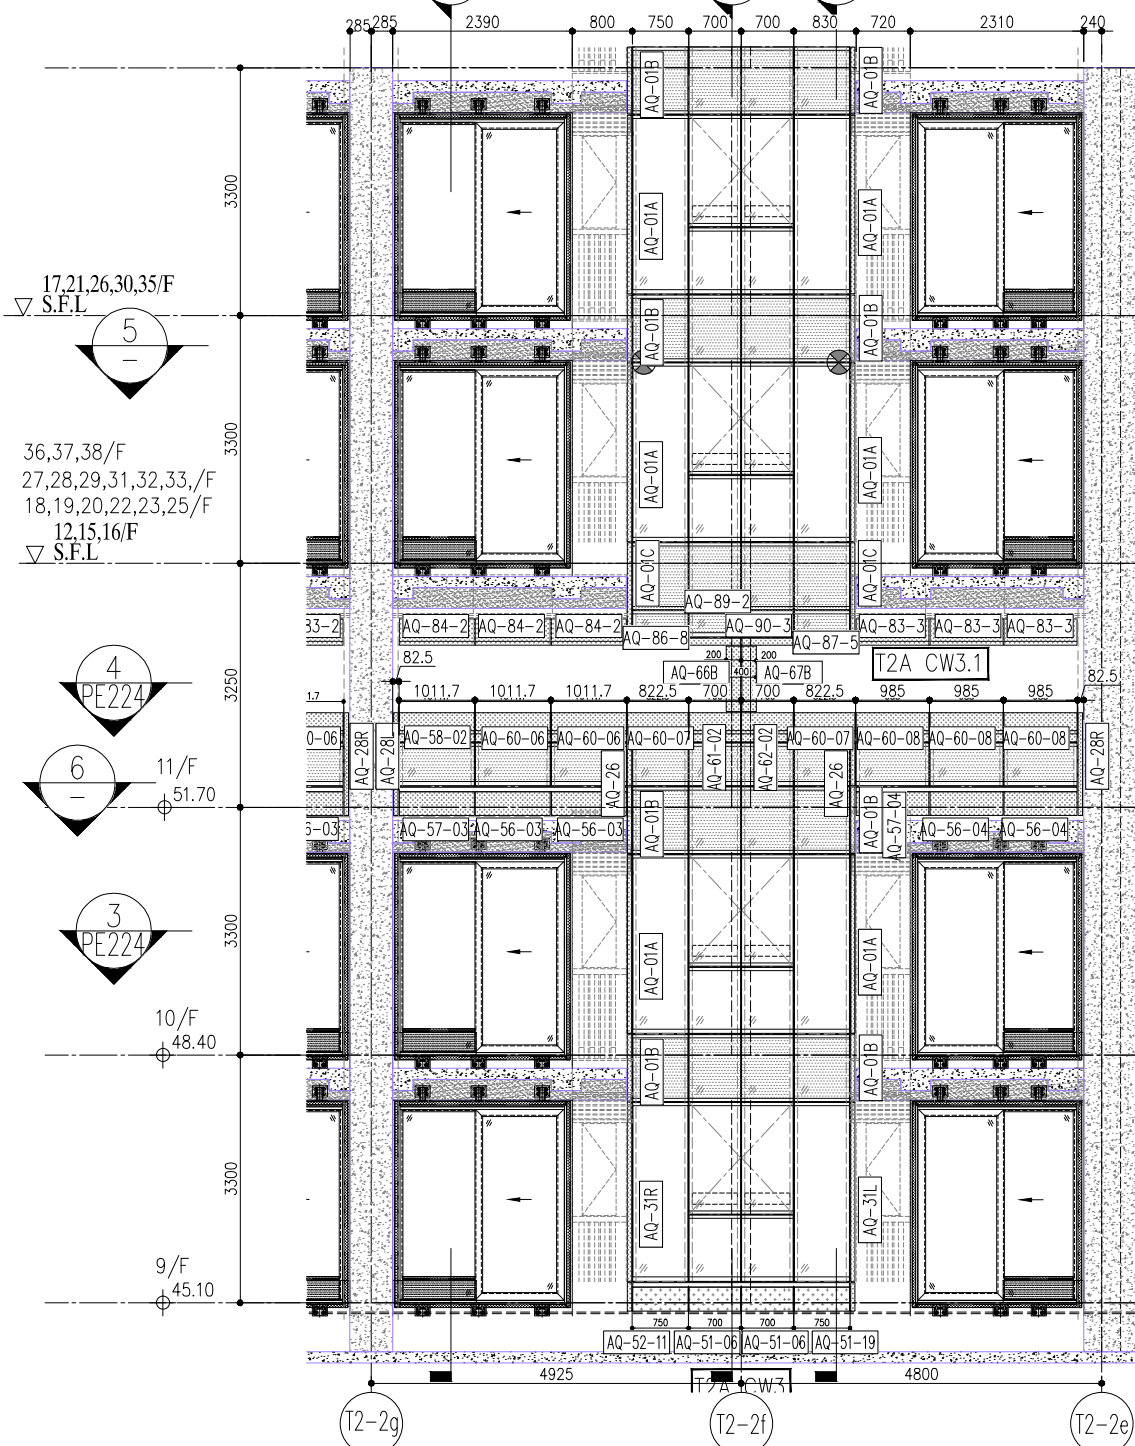


1 PART ELEVATION FOR CURTAIN WALL

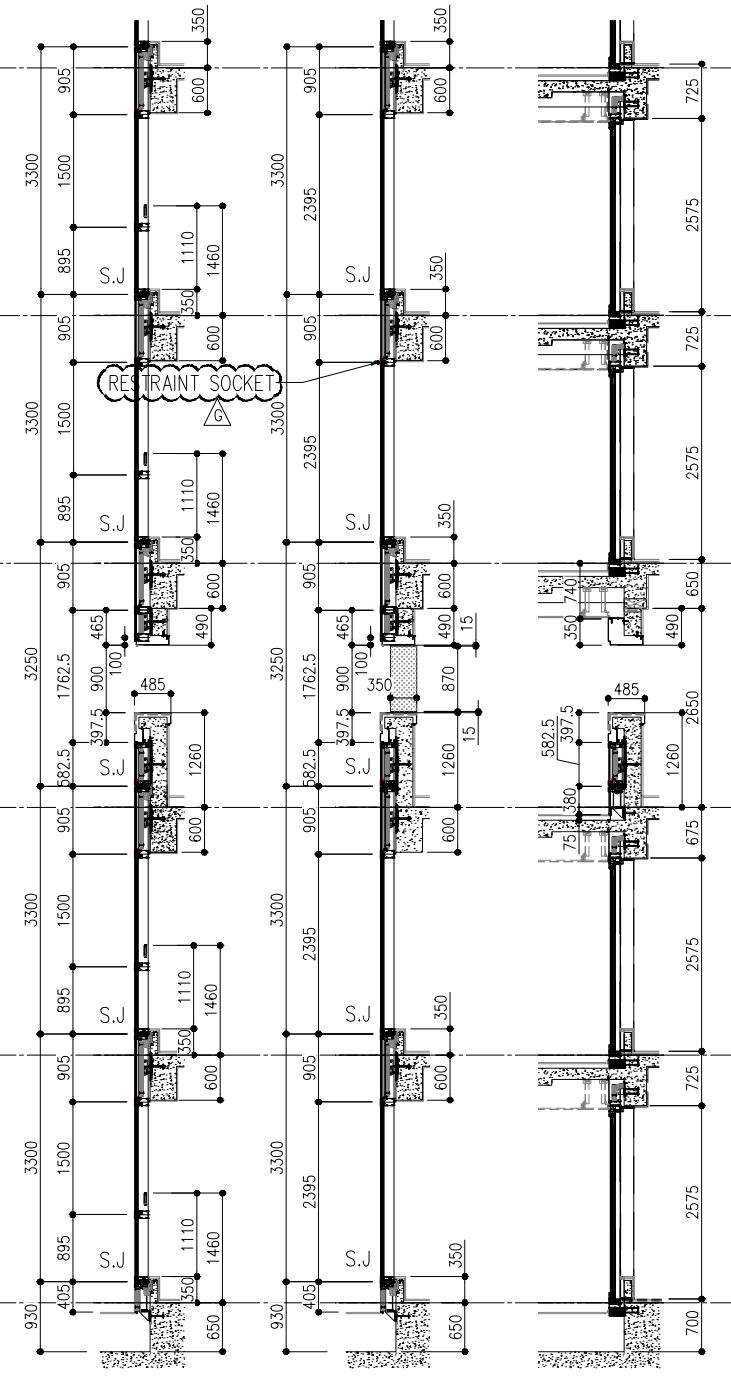

2 SECTION 3 SECTION 4 SECTION

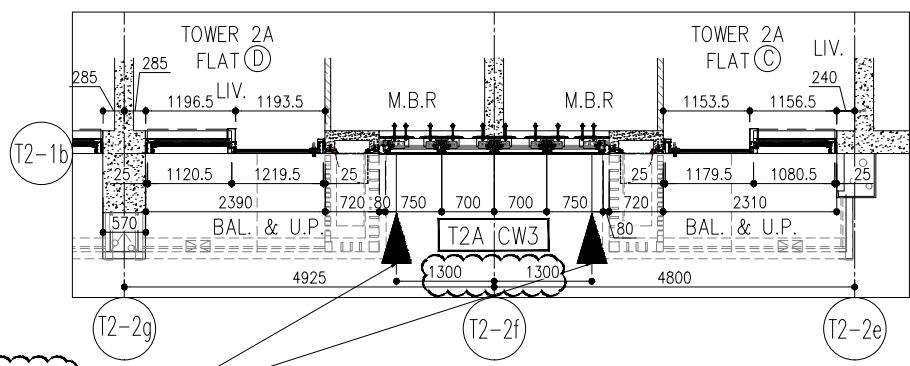

5 PART PLAN FOR CURTAIN WALL

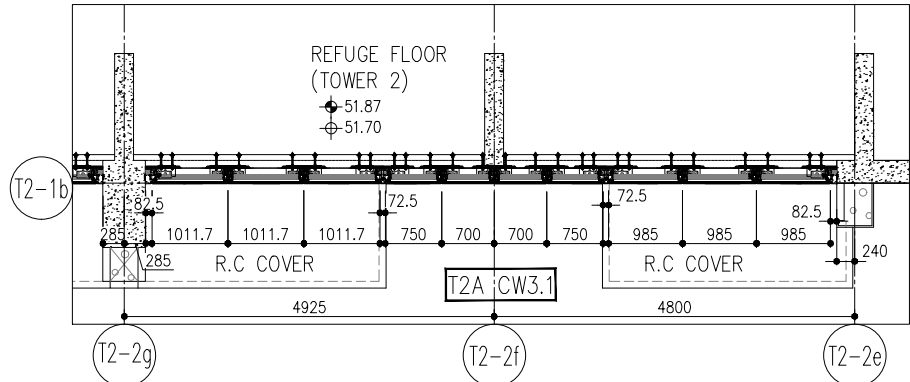

6 PART PLAN(11/F) FOR CURTAIN WALL

R/F	+217.00				
67/F	+213.50				
26/F	+91.25	39/F	+130.85	52/F	+170.40
25/F	+87.95	38/F	+127.55	51/F	+167.10
23/F	+84.65	37/F	+124.25	50/F	+163.80
22/F	+81.35	36/F	+120.95	49/F	+160.50
21/F	+78.05	35/F	+117.65	48/F	+157.20
20/F	+74.75	33/F	+114.35	47/F	+153.90
19/F	+71.45	32/F	+111.05	46/F	+150.60
18/F	+68.15	31/F	+107.75	45/F	+147.30
17/F	+64.85	30/F	+104.45	43/F	+144.00
16/F	+61.55	29/F	+101.15	42/F	+140.70
15/F	+58.25	28/F	+97.85	41/F	+137.40
12/F	+54.95	27/F	+94.55	40/F	+134.15
				53/F	+173.70

- LEGEND:
- (1) 10mm THK. HEAT STRENGTHENED GLASS (OUTSIDE) +12mm AIR SPACE + 12mm THK. TEMPERED GLASS
  - (2) 10mm THK. HEAT STRENGTHENED GLASS (OUTSIDE) +12mm AIR SPACE + 10mm THK. TEMPERED GLASS
  - (3) 12mm THK. HEAT STRENGTHENED GLASS
  - (4) 12mm THK. CLEAR TEMPERED GLASS ( INTERNAL PROTECTIVE BARRIER )
  - (5) 10mm THK. HEAT STRENGTHENED GLASS (OUTSIDE) +12mm AIR SPACE + 12mm THK. TEMPERED GLASS WITH REFLECTIVE COATING
  - (6) 10mm THK. CLEAR TEMPERED GLASS
  - (7) 8mm THK. CLEAR HEAT-STRENGTHENED GLASS +1.52mm PVB + 8mm THK. CLEAR HEAT-STRENGTHENED GLASS
  - (8) 3 mm THK. ALUM. CLADDING
  - (9) 3 mm THK. ALUM. BACKPAN
  - S.J. - STACK JOINT
  - (10) - RESTRAINT SOCKET

**PE214**

DATE : 20/12/21  
 DRAWN BY :  
 CHECKED BY :  
 TITLE : PARTIAL CURTAIN WALL PLAN (TOWER 2)  
 PROJECT : DEVELOPMENT AT TKO  
 JOB NO. : J858-CW-PE214  
 DWG NO. : J858-CW-PE214

NO.	DATE	REVISION
A	03/12/21	REVISED AS PER COMMENTS
B	20/12/21	REVISED AS PER COMMENTS
C	22/01/22	REVISED AS PER COMMENTS
D	06/04/22	REVISED AS PER COMMENTS
E	25/05/22	REVISED AS PER COMMENTS
F	26/07/22	REVISED AS PER COMMENTS
G	18/08/22	REVISED AS PER COMMENTS

NOTE:  
 1. ALL DIMENSIONS ARE IN mm.  
 2. ALL ELEVATIONS ARE VIEWED FROM OUTSIDE.  
 3. ALL DIMENSIONS TO BE VERIFIED ON SITE BEFORE FABRICATION.

LEGEND:  
 (X1) DETAIL MARK NO.  
 (X20) REFER SHEET NO.  
 (R) REVERSED DETAIL

ARCHITECT: **ronald lu & partners**  
 Ronald Lu & Partners (HK) Ltd.  
 呂元仲建築師事務所 (香港) 有限公司


CLIENT: **信和置業有限公司**  
 Sino Land Company Limited

STRUCTURAL ENGINEER: **Gammon**

FAÇADE CONSULTANT: **AECOM**


B.D. REF. :

# T2 AE(高層)

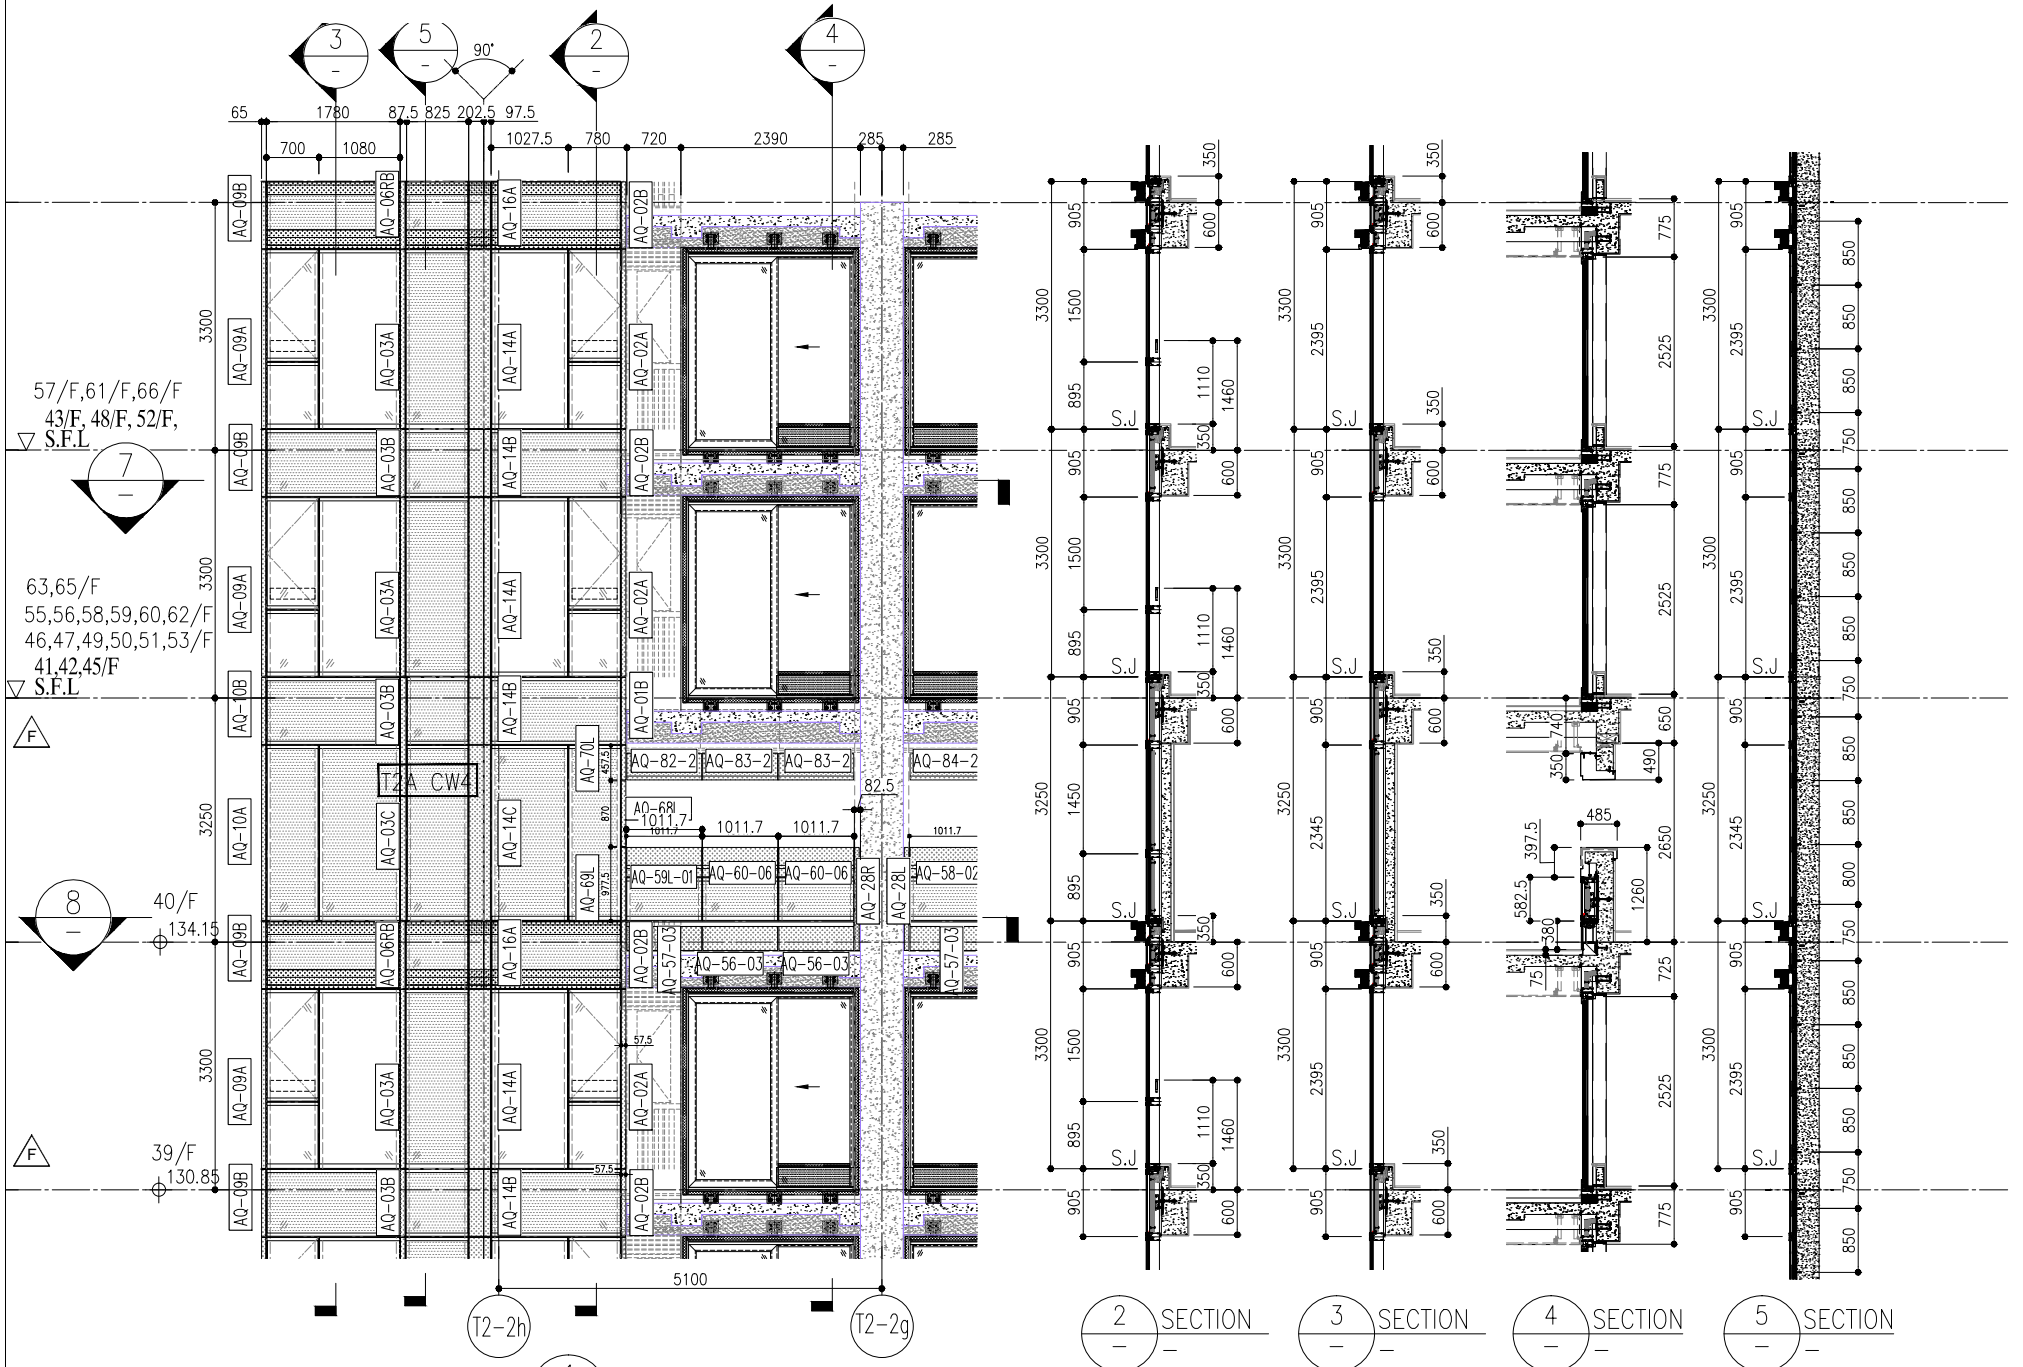


1 PART ELEVATION FOR CURTAIN WALL

2 SECTION 3 SECTION 4 SECTION 5 SECTION

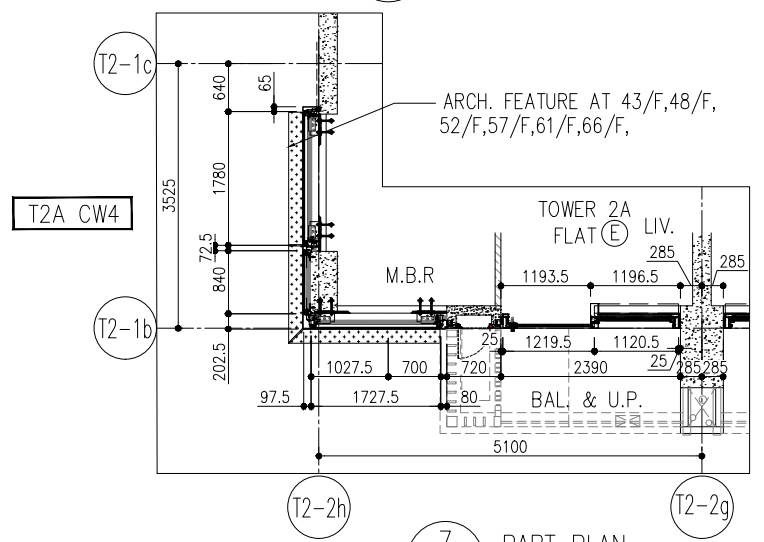

7 PART PLAN FOR CURTAIN WALL

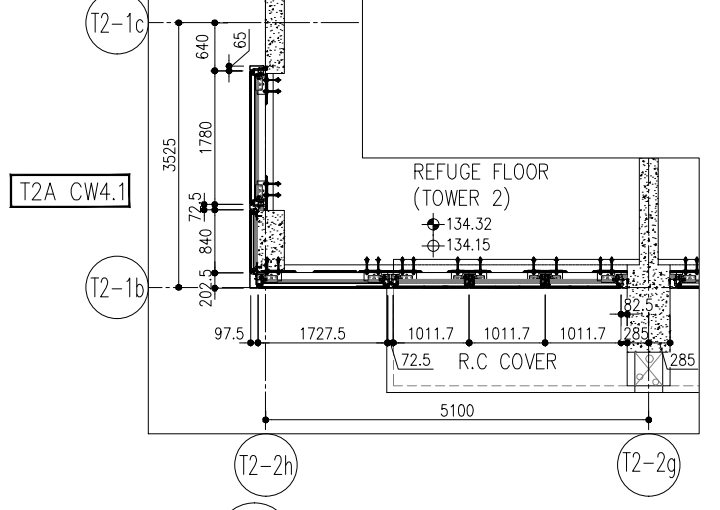

8 PART PLAN(40/F) FOR CURTAIN WALL

**LEGEND:**

- (G1) 10mm THK. HEAT STRENGTHENED GLASS (OUTSIDE) + 12mm AIR SPACE + 12mm THK. TEMPERED GLASS
- (G2) 10mm THK. HEAT STRENGTHENED GLASS (OUTSIDE) + 12mm AIR SPACE + 10mm THK. TEMPERED GLASS
- (G3) 12mm THK. HEAT STRENGTHENED GLASS
- (G4) 12mm THK. CLEAR TEMPERED GLASS ( INTERNAL PROTECTIVE BARRIER )
- (G5) 10mm THK. HEAT STRENGTHENED GLASS (OUTSIDE) + 12mm AIR SPACE + 12mm THK. TEMPERED GLASS WITH REFLECTIVE COATING
- (G6) 10mm THK. CLEAR TEMPERED GLASS
- (G7) 8mm THK. CLEAR HEAT-STRENGTHENED GLASS + 1.52mm PVB + 8mm THK. CLEAR HEAT-STRENGTHENED GLASS
- (G8) 3 mm THK. ALUM. CLADDING
- (G9) 3 mm THK. ALUM. BACKPAN
- S.J. STACK JOINT
- (RS) RESTRAINT SOCKET

	R/F	+217.00		
26/F	+91.25	39/F +130.85	52/F +170.40	67/F +213.50
25/F	+87.95	38/F +127.55	51/F +167.10	66/F +210.00
23/F	+84.65	37/F +124.25	50/F +163.80	63/F +203.40
22/F	+81.35	36/F +120.95	49/F +160.50	62/F +200.10
21/F	+78.05	35/F +117.65	48/F +157.20	61/F +196.80
20/F	+74.75	33/F +114.35	47/F +153.90	60/F +193.50
19/F	+71.45	32/F +111.05	46/F +150.60	59/F +190.20
18/F	+68.15	31/F 107.75	45/F +147.30	58/F +186.90
17/F	+64.85	30/F +104.45	43/F +144.00	57/F +183.60
16/F	+61.55	29/F +101.15	42/F +140.70	56/F +180.30
15/F	+58.25	28/F +97.85	41/F +137.40	55/F +177.00
12/F	+54.95	27/F +94.55	40/F +134.15	53/F +173.70

**PE215**

PROJECT: PARTIAL CURTAIN WALL (TOWER 2)  
 TITLE: DEVELOPMENT AT TKO, 1, LOHAS PARK D, N.T.  
 DATE: 26/07/22  
 DRAWN BY: [Signature]  
 CHECKED BY: [Signature]  
 SCALE: 1:150(A1)  
 UNIT: 6-8/F, 610 Chd, Tel: 23488666  

NO.	DATE	REVISION
A	03/12/21	REVISED AS PER COMMENTS
B	20/12/21	REVISED AS PER COMMENTS
C	22/01/22	REVISED AS PER COMMENTS
D	06/04/22	REVISED AS PER COMMENTS
E	26/05/22	REVISED AS PER COMMENTS
F	26/07/22	REVISED AS PER COMMENTS

NOTE:  
 1. ALL DIMENSIONS ARE IN mm.  
 2. ALL ELEVATIONS ARE VIEWED FROM OUTSIDE.  
 3. ALL DIMENSIONS TO BE VERIFIED ON SITE BEFORE FABRICATION.

LEGEND:  
 (X1) DETAIL MARK NO.  
 (X00) REFER SHEET NO.  
 1. F.F.L. -- FINISHED FLOOR LEVEL  
 2. S.F.L. -- STRUCTURAL FLOOR LEVEL  
 3. (R) -- REVERSED DETAIL

ARCHITECT: **ronaldu & partners**  
 Ronald Lu & Partners (HK) Ltd.  
 呂元仲建築師事務所 (香港) 有限公司

CLIENT: **信和置業有限公司**  
 Sino Land Company Limited

STRUCTURAL ENGINEER: **Gammon**

FAÇADE CONSULTANT: **AECOM**


MAIN CONTRACTOR: [Blank]

B.D. REF: [Blank]





T3 AB T3 AA T3 BA

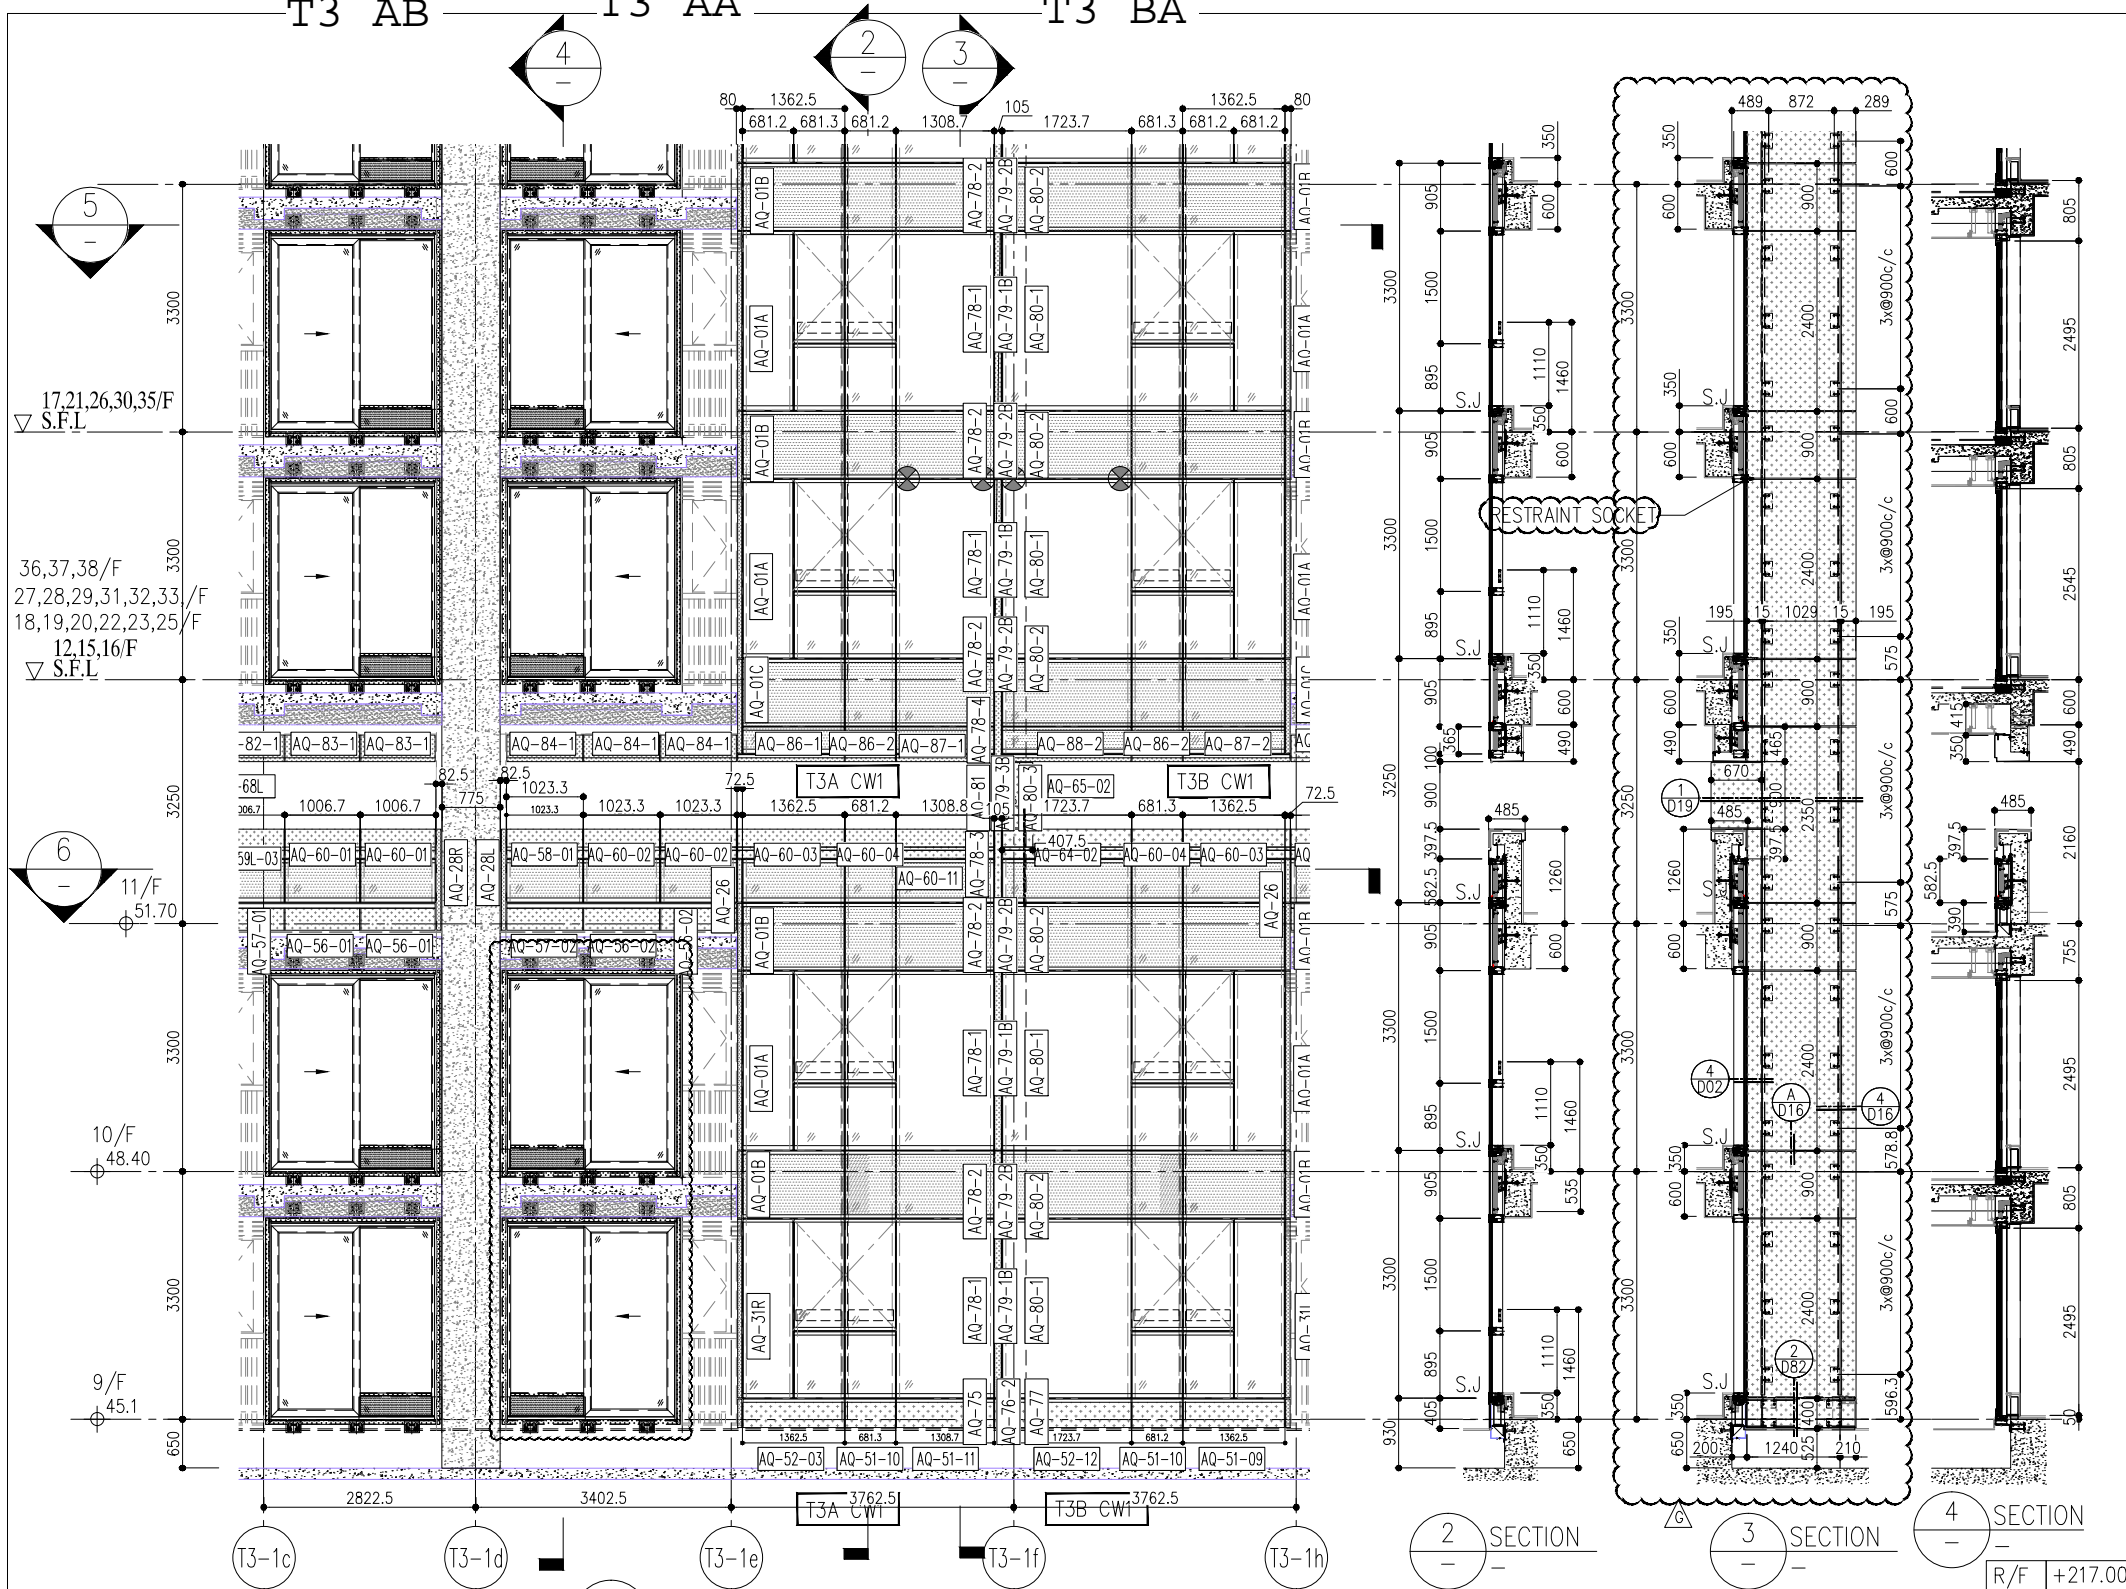

1 PART ELEVATION FOR CURTAIN WALL

2 SECTION


3 SECTION

4 SECTION

R/F	+217.00
67/F	+213.50

26/F	+91.25	39/F	+130.85	52/F	+170.40	66/F	+210.00
25/F	+87.95	38/F	+127.55	51/F	+167.10	65/F	+206.70
23/F	+84.65	37/F	+124.25	50/F	+163.80	63/F	+203.40
22/F	+81.35	36/F	+120.95	49/F	+160.50	62/F	+200.10
21/F	+78.05	35/F	+117.65	48/F	+157.20	61/F	+196.80
20/F	+74.75	33/F	+114.35	47/F	+153.90	60/F	+193.50
19/F	+71.45	32/F	+111.05	46/F	+150.60	59/F	+190.20
18/F	+68.15	31/F	+107.75	45/F	+147.30	58/F	+186.90
17/F	+64.85	30/F	+104.45	43/F	+144.00	57/F	+183.60
16/F	+61.55	29/F	+101.15	42/F	+140.70	56/F	+180.30
15/F	+58.25	28/F	+97.85	41/F	+137.40	55/F	+177.00
12/F	+54.95	27/F	+94.55	40/F	+134.15	53/F	+173.70

- LEGEND:
- (1) 10mm THK. HEAT STRENGTHENED GLASS (OUTSIDE) + 12mm AIR SPACE + 12mm THK. TEMPERED GLASS
  - (2) 10mm THK. HEAT STRENGTHENED GLASS (OUTSIDE) + 12mm AIR SPACE + 10mm THK. TEMPERED GLASS
  - (3) 12mm THK. HEAT STRENGTHENED GLASS
  - (4) 12mm THK. CLEAR TEMPERED GLASS ( INTERNAL PROTECTIVE BARRIER )
  - (5) 10mm THK. HEAT STRENGTHENED GLASS (OUTSIDE) + 12mm AIR SPACE + 12mm THK. TEMPERED GLASS WITH REFLECTIVE COATING
  - (6) 10mm THK. CLEAR TEMPERED GLASS
  - (7) 8mm THK. CLEAR HEAT-STRENGTHENED GLASS + 1.52mm PVB + 8mm THK. CLEAR HEAT-STRENGTHENED GLASS
  - (8) 3 mm THK. ALUM. CLADDING
  - (9) 3 mm THK. ALUM. BACKPAN
  - S.J. = STACK JOINT
  - (10) RESTRAINT SOCKET

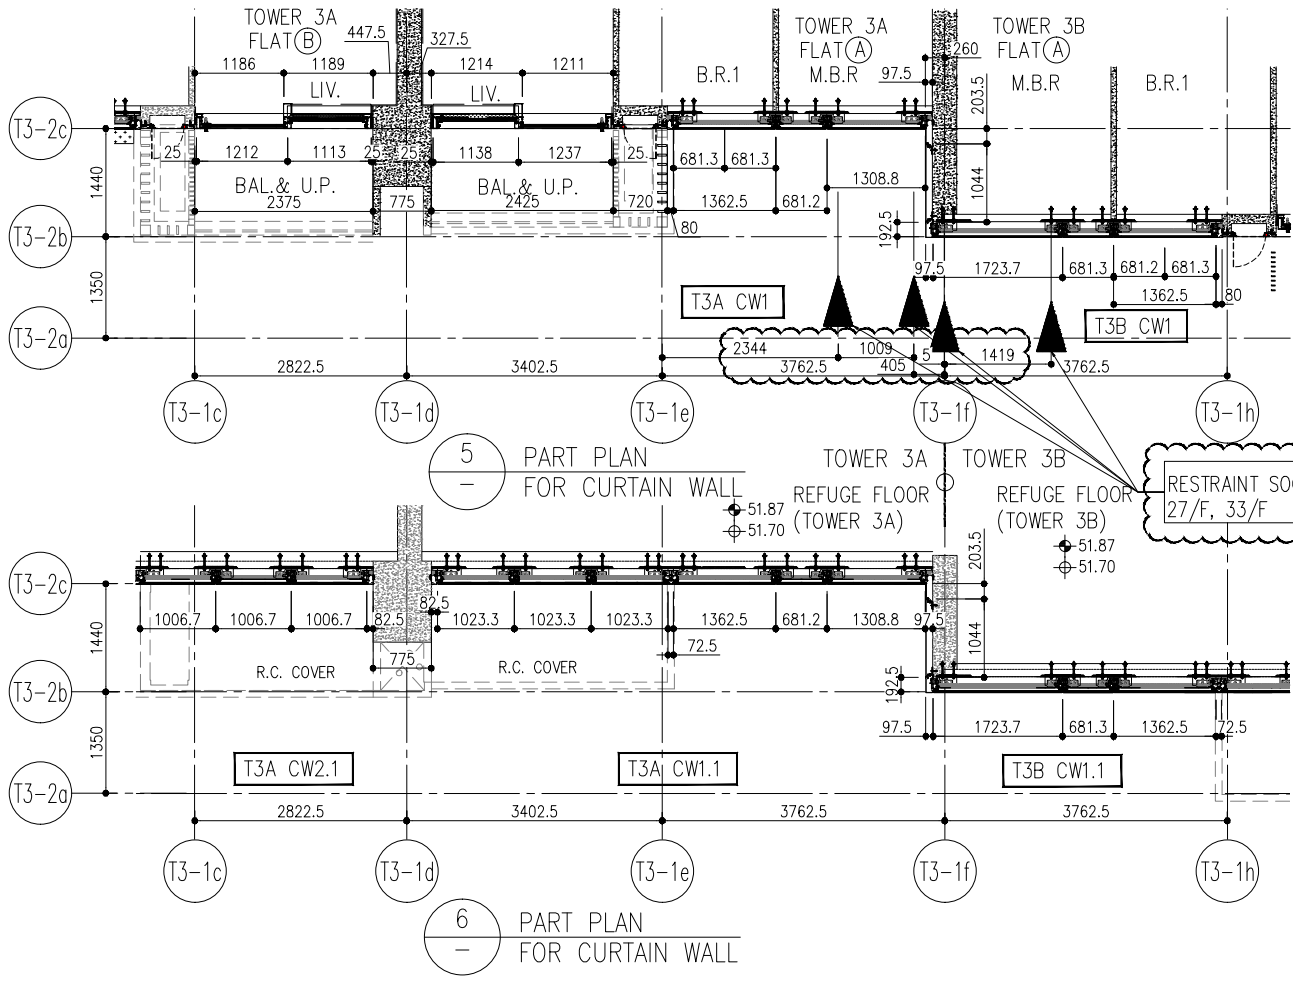

5 PART PLAN FOR CURTAIN WALL

6 PART PLAN FOR CURTAIN WALL

DWG NO. : JB58-CW-PE302

REV. : G

**PE302**

PROJECT : DEVELOPMENT AT LOHAS PARK N.T.

TITLE : PARTIAL CURTAIN WALL PLAN (TOWER 3)

DATE : 2

DRAWN BY :

DATE : 1:50(A1)

SCALE : 1/10

DESIGNED BY :

DATE :

REVISIONS:

NO.	DATE	REVISIONS
A	03/12/21	REVISED AS PER COMMENTS
B	20/12/21	REVISED AS PER COMMENTS
C	22/01/22	REVISED AS PER COMMENTS
D	22/04/06	REVISED AS PER COMMENTS
E	25/05/22	REVISED AS PER COMMENTS
F	26/07/22	REVISED AS PER COMMENTS
G	18/08/22	REVISED AS PER COMMENTS

NOTE:

- ALL DIMENSIONS ARE IN mm.
- ALL ELEVATIONS ARE VIEWED FROM OUTSIDE.
- ALL DIMENSIONS TO BE VERIFIED ON SITE BEFORE FABRICATION.

LEGEND:

- (X1) DETAIL MARK NO.
- (X00) REFER SHEET NO.
- 1. F.F.L. -- FINISHED FLOOR LEVEL
- 2. S.F.L. -- STRUCTURAL FLOOR LEVEL
- 3. (R) -- REVERSED DETAIL

ARCHITECT: ronaldi & partners

Structural Engineer: Gammon


CLIENT: 信和置業有限公司 Sino Land Company Limited

MAIN CONTRACTOR: Ronald & Partners (China) Limited 呂元梓建築師事務所 (香港) 有限公司

FAÇADE CONSULTANT: AECOM


STRUCTURAL ENGINEER: Gammon

B.D. REF. :

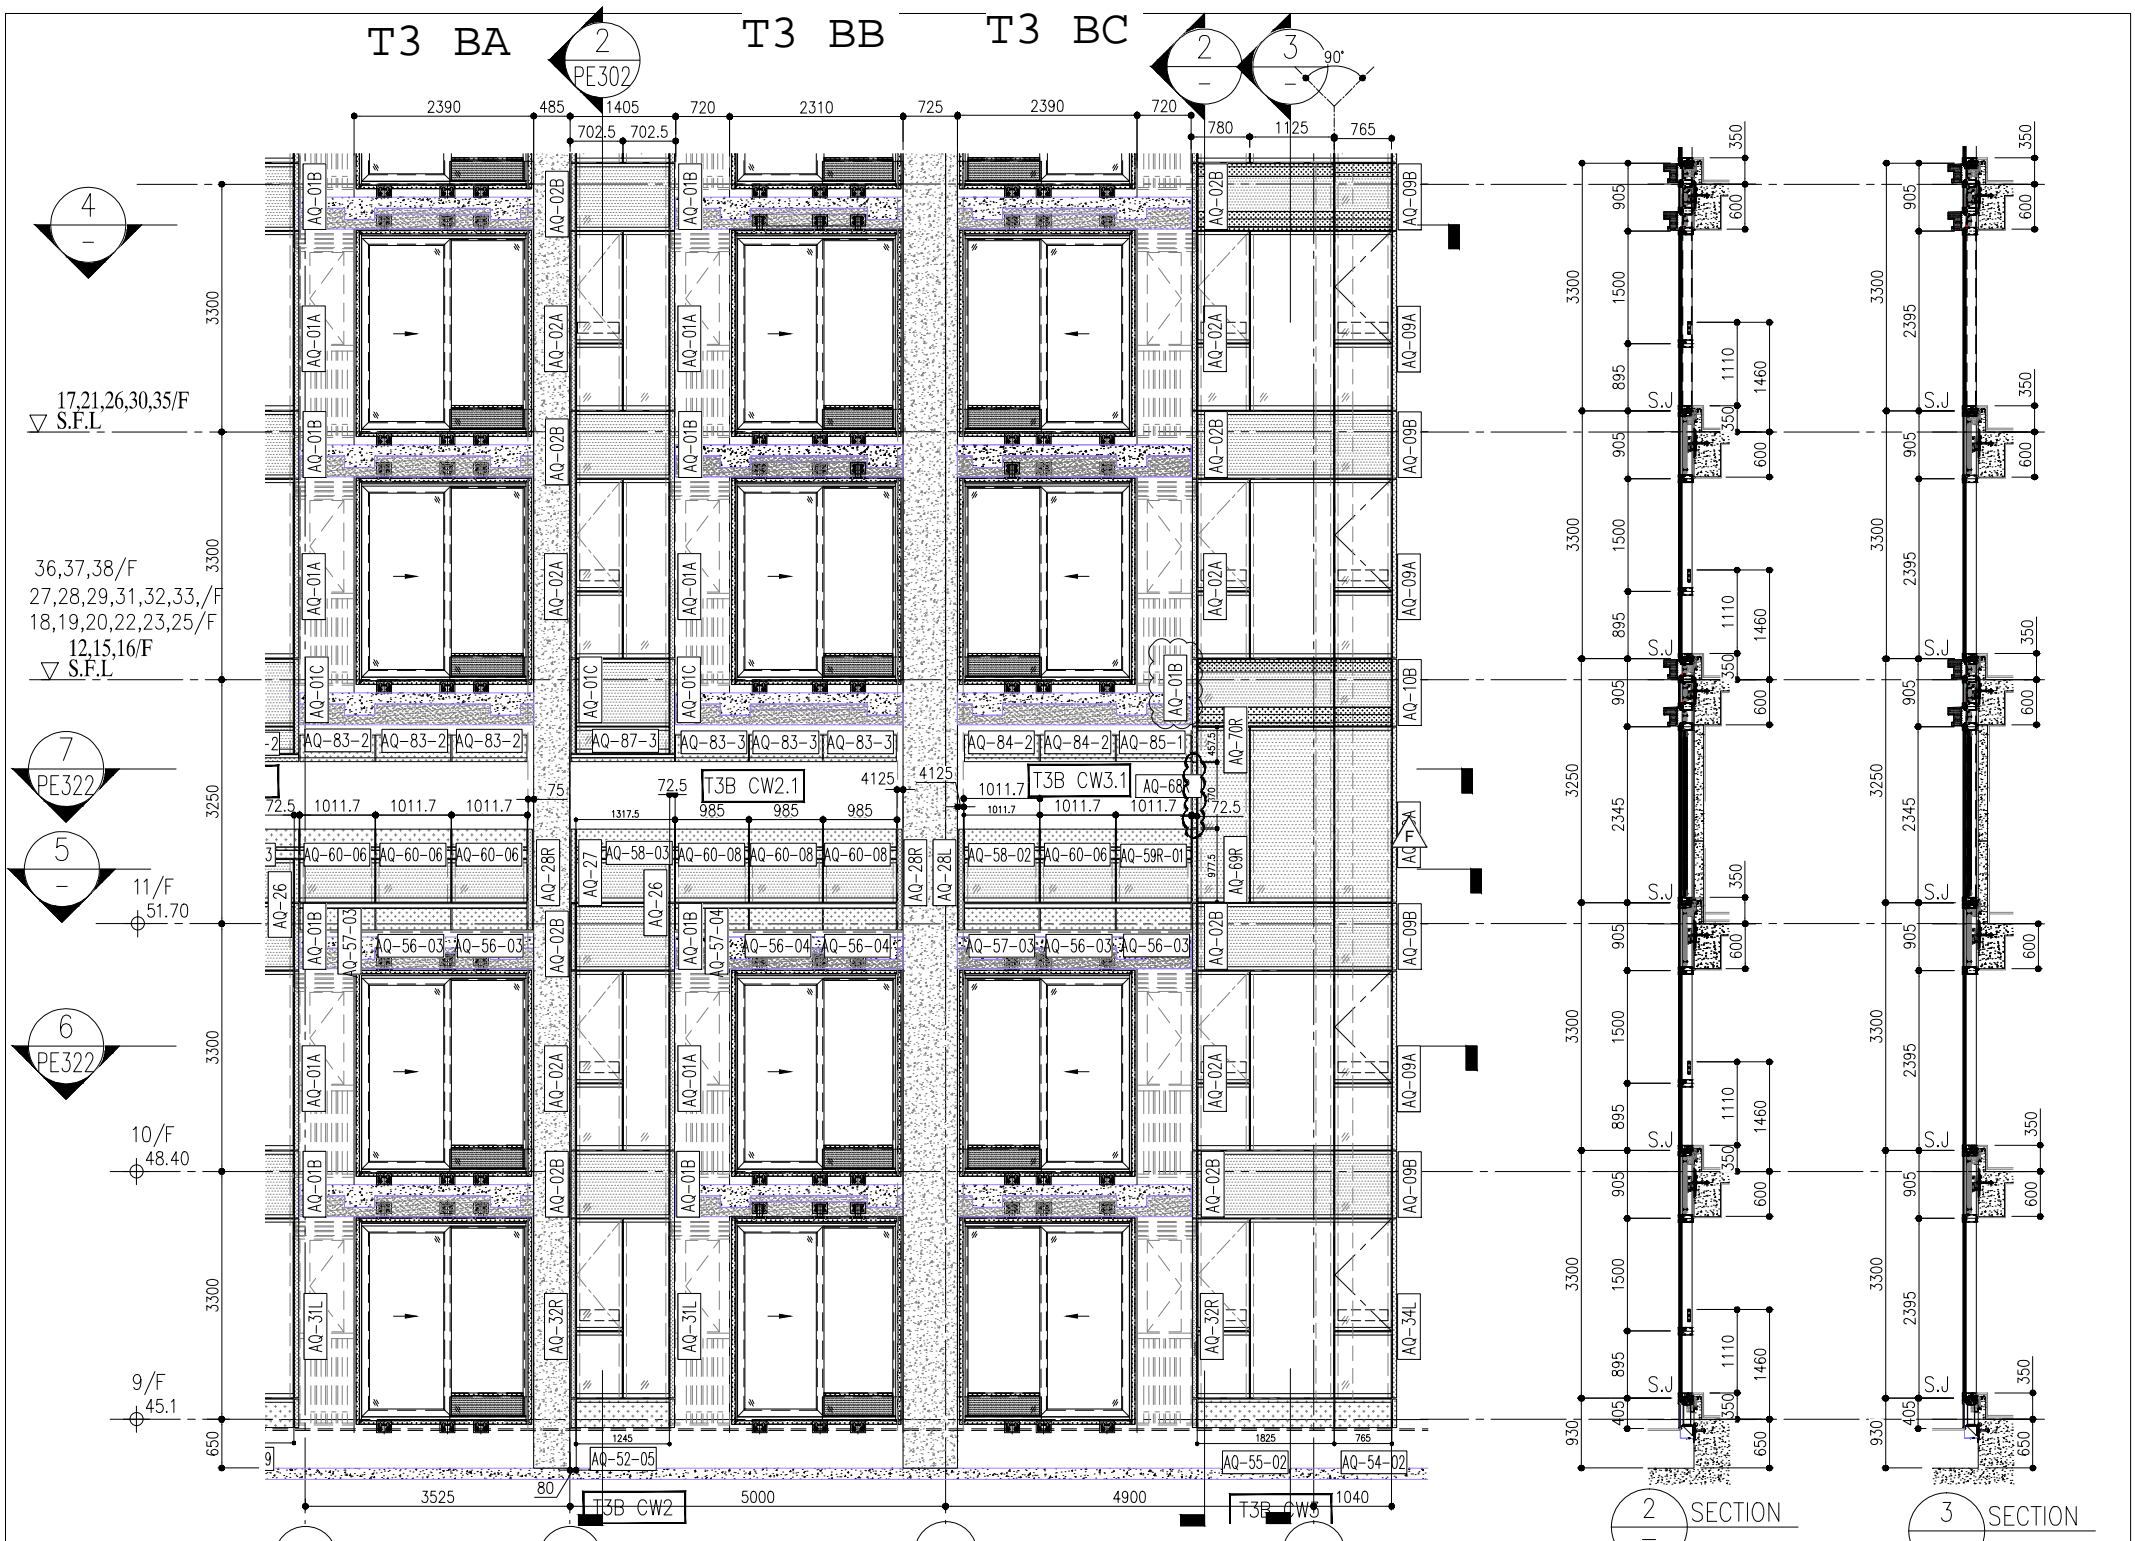


R/F	+217.00	R/F	+213.50
26/F	+91.25	39/F	+130.85
25/F	+87.95	38/F	+127.55
23/F	+84.65	37/F	+124.25
22/F	+81.35	36/F	+120.95
21/F	+78.05	35/F	+117.65
20/F	+74.75	33/F	+114.35
19/F	+71.45	32/F	+111.05
18/F	+68.15	31/F	+107.75
17/F	+64.85	30/F	+104.45
16/F	+61.55	29/F	+101.15
15/F	+58.25	28/F	+97.85
12/F	+54.95	27/F	+94.55
		40/F	+134.15
		52/F	+170.40
		51/F	+167.10
		50/F	+163.80
		49/F	+160.50
		48/F	+157.20
		47/F	+153.90
		46/F	+150.60
		45/F	+147.30
		43/F	+144.00
		42/F	+140.70
		41/F	+137.40
		40/F	+134.15
		53/F	+173.70

1 PART ELEVATION FOR CURTAIN WALL

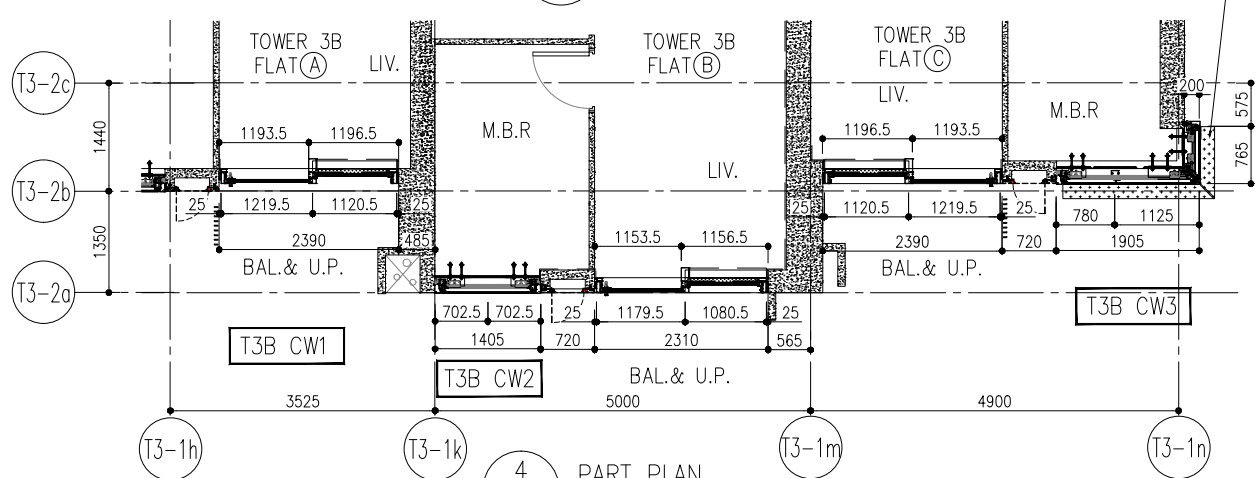

4 PART PLAN FOR CURTAIN WALL

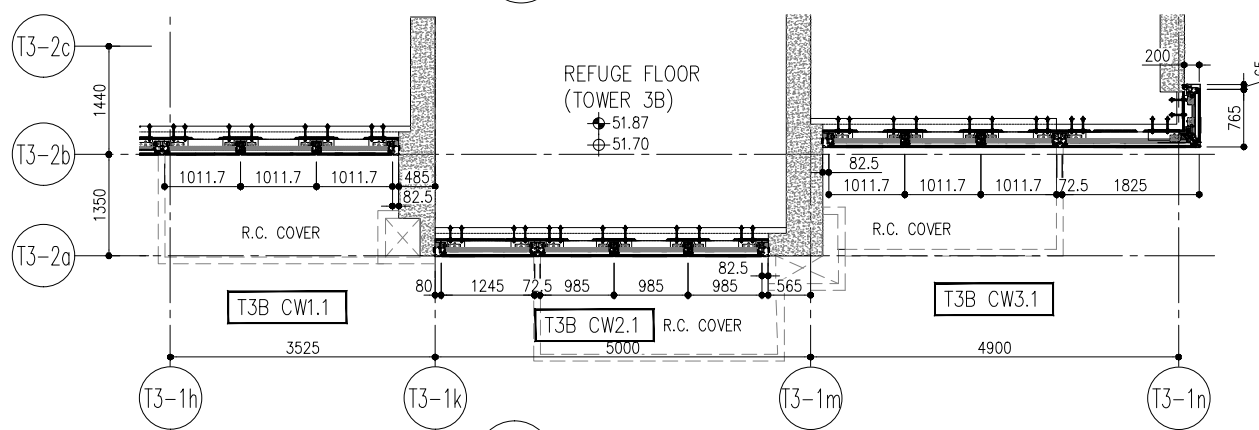

5 PART PLAN FOR CURTAIN WALL

- LEGEND:
- (1) 10mm THK. HEAT STRENGTHENED GLASS (OUTSIDE) + 12mm AIR SPACE + 12mm THK. TEMPERED GLASS
  - (2) 10mm THK. HEAT STRENGTHENED GLASS (OUTSIDE) + 12mm AIR SPACE + 10mm THK. TEMPERED GLASS
  - (3) 12mm THK. HEAT STRENGTHENED GLASS
  - (4) 12mm THK. CLEAR TEMPERED GLASS ( INTERNAL PROTECTIVE BARRIER )
  - (5) 10mm THK. HEAT STRENGTHENED GLASS (OUTSIDE) + 12mm AIR SPACE + 12mm THK. TEMPERED GLASS WITH REFLECTIVE COATING
  - (6) 10mm THK. CLEAR TEMPERED GLASS
  - (7) 8mm THK. CLEAR HEAT-STRENGTHENED GLASS + 1.52mm PVB + 8mm THK. CLEAR HEAT-STRENGTHENED GLASS
  - (8) 3 mm THK. ALUM. CLADDING
  - (9) 3 mm THK. ALUM. BACKPAN
  - S.J. - STACK JOINT
  - (10) - RESTRAINT SOCKET

DWG NO. : JB58-CW-PE303

DATE : 2

PROJECT : DEVELOPMENT OF LOHAS PARK N.T.

TITLE : PARTIAL CURTAIN WALL PLAN (TOWER 3)

**PE303**

REVISIONS:

NO.	DATE	REVISION
A	03/12/21	REVISED AS PER COMMENTS
B	20/12/21	REVISED AS PER COMMENTS
C	22/01/22	REVISED AS PER COMMENTS
D	22/04/06	REVISED AS PER COMMENTS
E	26/05/22	REVISED AS PER COMMENTS
F	26/07/22	REVISED AS PER COMMENTS

NOTE:

- ALL DIMENSIONS ARE IN mm.
- ALL ELEVATIONS ARE VIEWED FROM OUTSIDE.
- ALL DIMENSIONS TO BE VERIFIED ON SITE BEFORE FABRICATION.

LEGEND:

- (X1) DETAIL MARK NO.
- (X00) REFER SHEET NO.
- 1. F.F.L. -- FINISHED FLOOR LEVEL
- 2. S.F.L. -- STRUCTURAL FLOOR LEVEL
- 3. (R) -- REVERSED DETAIL

ARCHITECT: ronaldi & partners

Structural Engineer: Gammon


FAÇADE CONSULTANT: AECOM

CLIENT: 信和置業有限公司 Sino Land Company Limited

MAIN CONTRACTOR: Ronald Lu & Partners (HK) Ltd. 呂允祥建築師事務所 (香港) 有限公司


B.D. REF. :

T3 AB (高層)

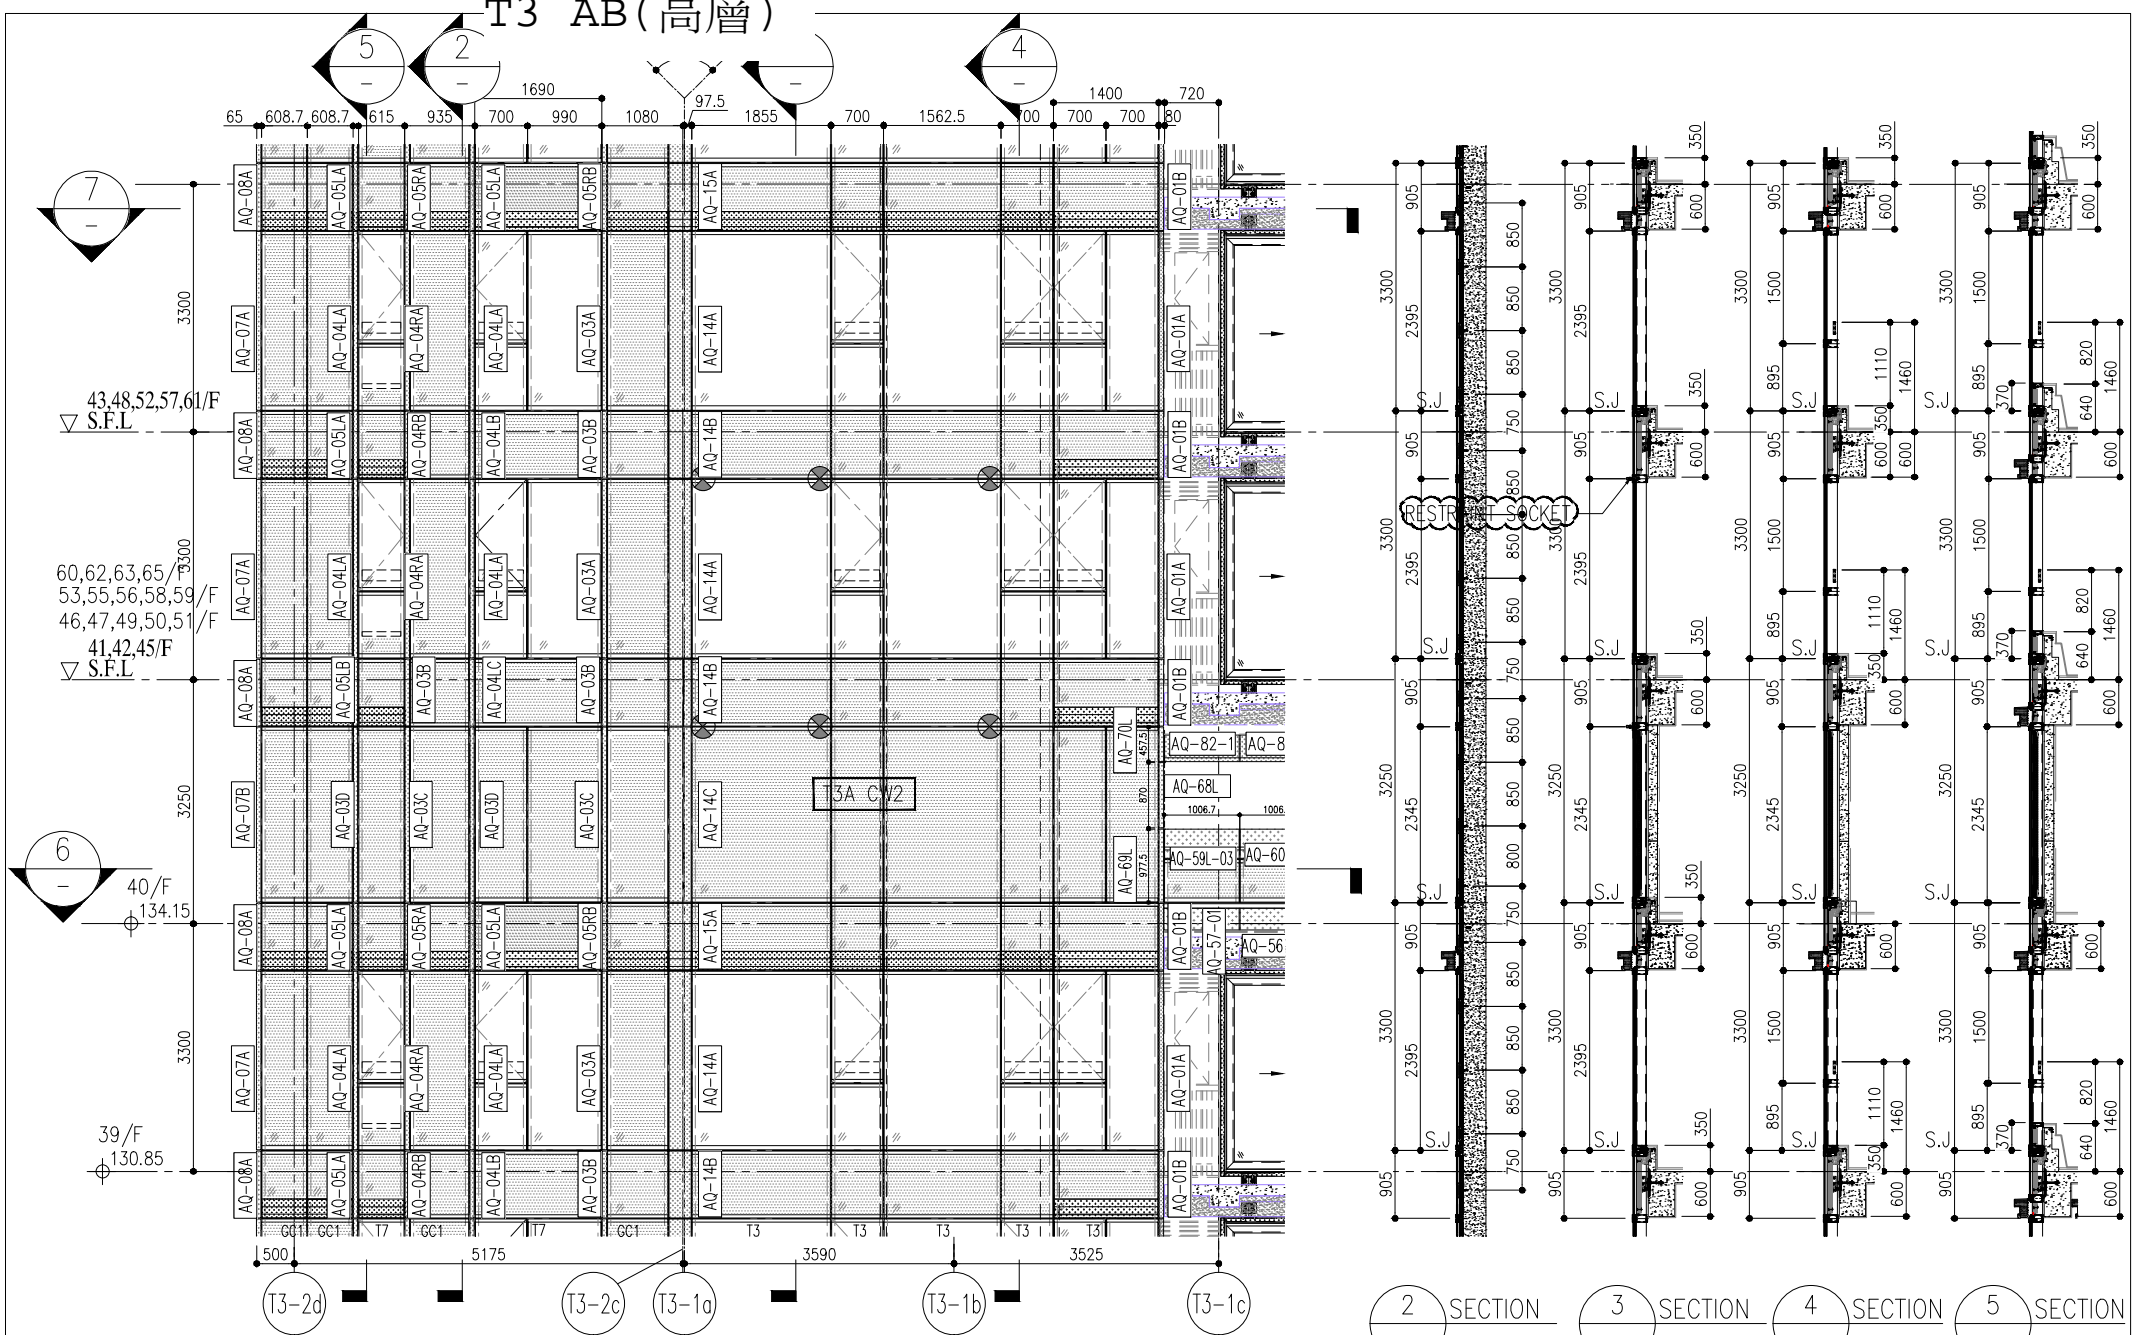


1 PART ELEVATION FOR CURTAIN WALL

2 SECTION 3 SECTION 4 SECTION 5 SECTION

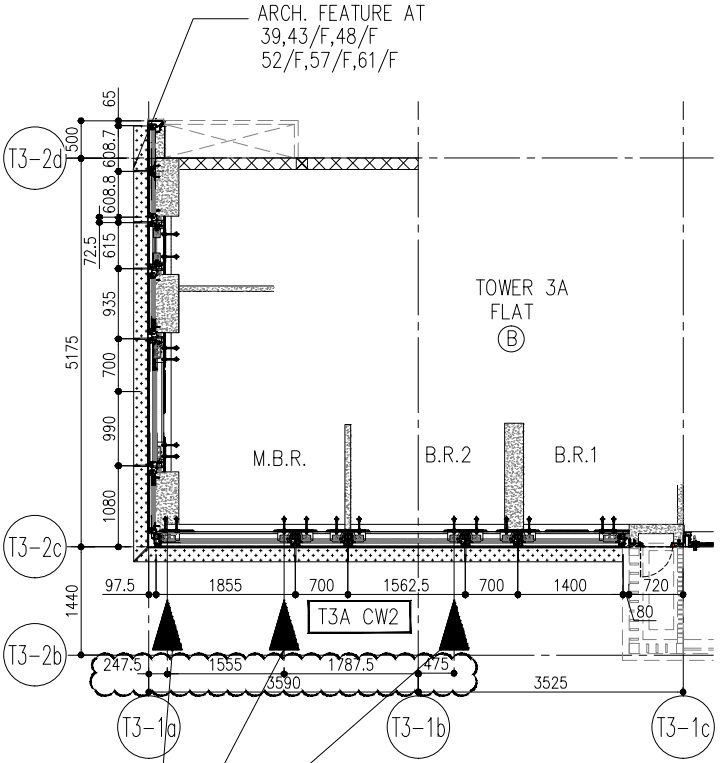

7 PART PLAN FOR CURTAIN WALL

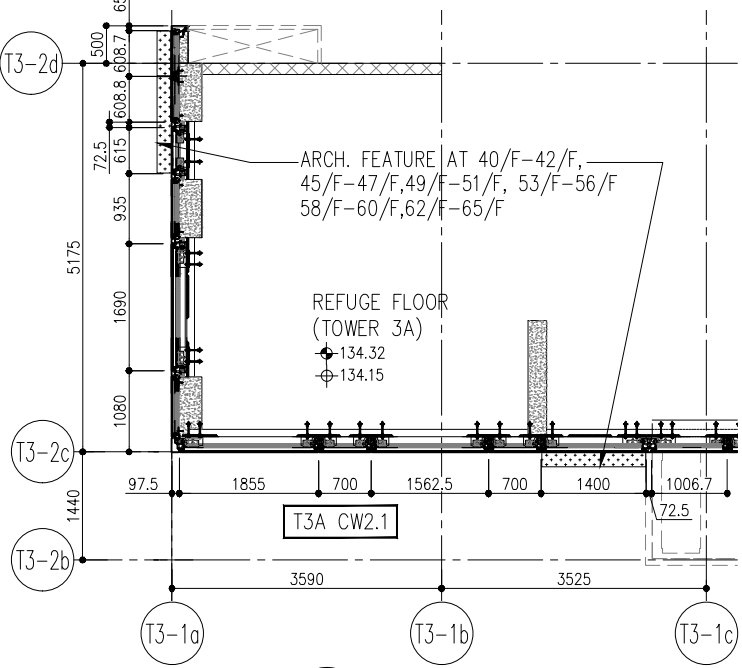

6 PART PLAN FOR CURTAIN WALL

R/F	+217.00						
67/F	+213.50						
26/F	+91.25	39/F	+130.85	52/F	+170.40	66/F	+210.00
25/F	+87.95	38/F	+127.55	51/F	+167.10	65/F	+206.70
23/F	+84.65	37/F	+124.25	50/F	+163.80	63/F	+203.40
22/F	+81.35	36/F	+120.95	49/F	+160.50	62/F	+200.10
21/F	+78.05	35/F	+117.65	48/F	+157.20	61/F	+196.80
20/F	+74.75	33/F	+114.35	47/F	+153.90	60/F	+193.50
19/F	+71.45	32/F	+111.05	46/F	+150.60	59/F	+190.20
18/F	+68.15	31/F	+107.75	45/F	+147.30	58/F	+186.90
17/F	+64.85	30/F	+104.45	43/F	+144.00	57/F	+183.60
16/F	+61.55	29/F	+101.15	42/F	+140.70	56/F	+180.30
15/F	+58.25	28/F	+97.85	41/F	+137.40	55/F	+177.00
12/F	+54.95	27/F	+94.55	40/F	+134.15	53/F	+173.70

- LEGEND:
- (G1) 10mm THK. HEAT STRENGTHENED GLASS (OUTSIDE) + 12mm AIR SPACE + 12mm THK. TEMPERED GLASS
  - (G2) 10mm THK. HEAT STRENGTHENED GLASS (OUTSIDE) + 12mm AIR SPACE + 10mm THK. TEMPERED GLASS
  - (G3) 12mm THK. HEAT STRENGTHENED GLASS
  - (G4) 12mm THK. CLEAR TEMPERED GLASS ( INTERNAL PROTECTIVE BARRIER )
  - (G5) 10mm THK. HEAT STRENGTHENED GLASS (OUTSIDE) + 12mm THK. TEMPERED GLASS WITH REFLECTIVE COATING
  - (G6) 10mm THK. CLEAR TEMPERED GLASS
  - (G7) 8mm THK. CLEAR HEAT-STRENGTHENED GLASS + 1.52mm PVB + 8mm THK. CLEAR HEAT-STRENGTHENED GLASS
  - (G8) 3 mm THK. ALUM. CLADDING
  - (G9) 3 mm THK. ALUM. BACKPAN
  - S.J. - STACK JOINT
  - (RS) - RESTRAINT SOCKET

PE304

UNITED FABRICATOR LTD.

DATE : 20/07/22

REVISIONS:

NO.	DATE	REVISIONS
A	03/12/21	REVISED AS PER COMMENTS
B	22/01/22	REVISED AS PER COMMENTS
C	22/04/06	REVISED AS PER COMMENTS
D	22/04/06	REVISED AS PER COMMENTS
E	26/05/22	REVISED AS PER COMMENTS
F	26/07/22	REVISED AS PER COMMENTS
G	18/08/22	REVISED AS PER COMMENTS

NOTE:

- ALL DIMENSIONS ARE IN mm.
- ALL ELEVATIONS ARE VIEWED FROM OUTSIDE.
- ALL DIMENSIONS TO BE VERIFIED ON SITE BEFORE FABRICATION.

LEGEND:

- (X1) DETAIL MARK NO.
- (X00) REFER SHEET NO.
- 1. F.F.L. -- FINISHED FLOOR LEVEL
- 2. S.F.L. -- STRUCTURAL FLOOR LEVEL
- 3. (R) -- REVERSED DETAIL

ARCHITECT: ronaid lu & partners

RONALD LU & PARTNERS (HK) LTD.

MAIN CONTRACTOR: 呂允梓建築師事務所 (香港) 有限公司


CLIENT: 信和置業有限公司

Sino Land Company Limited

STRUCTURAL ENGINEER: Gammon

FAÇADE CONSULTANT: AECOM

B.D. REF.:

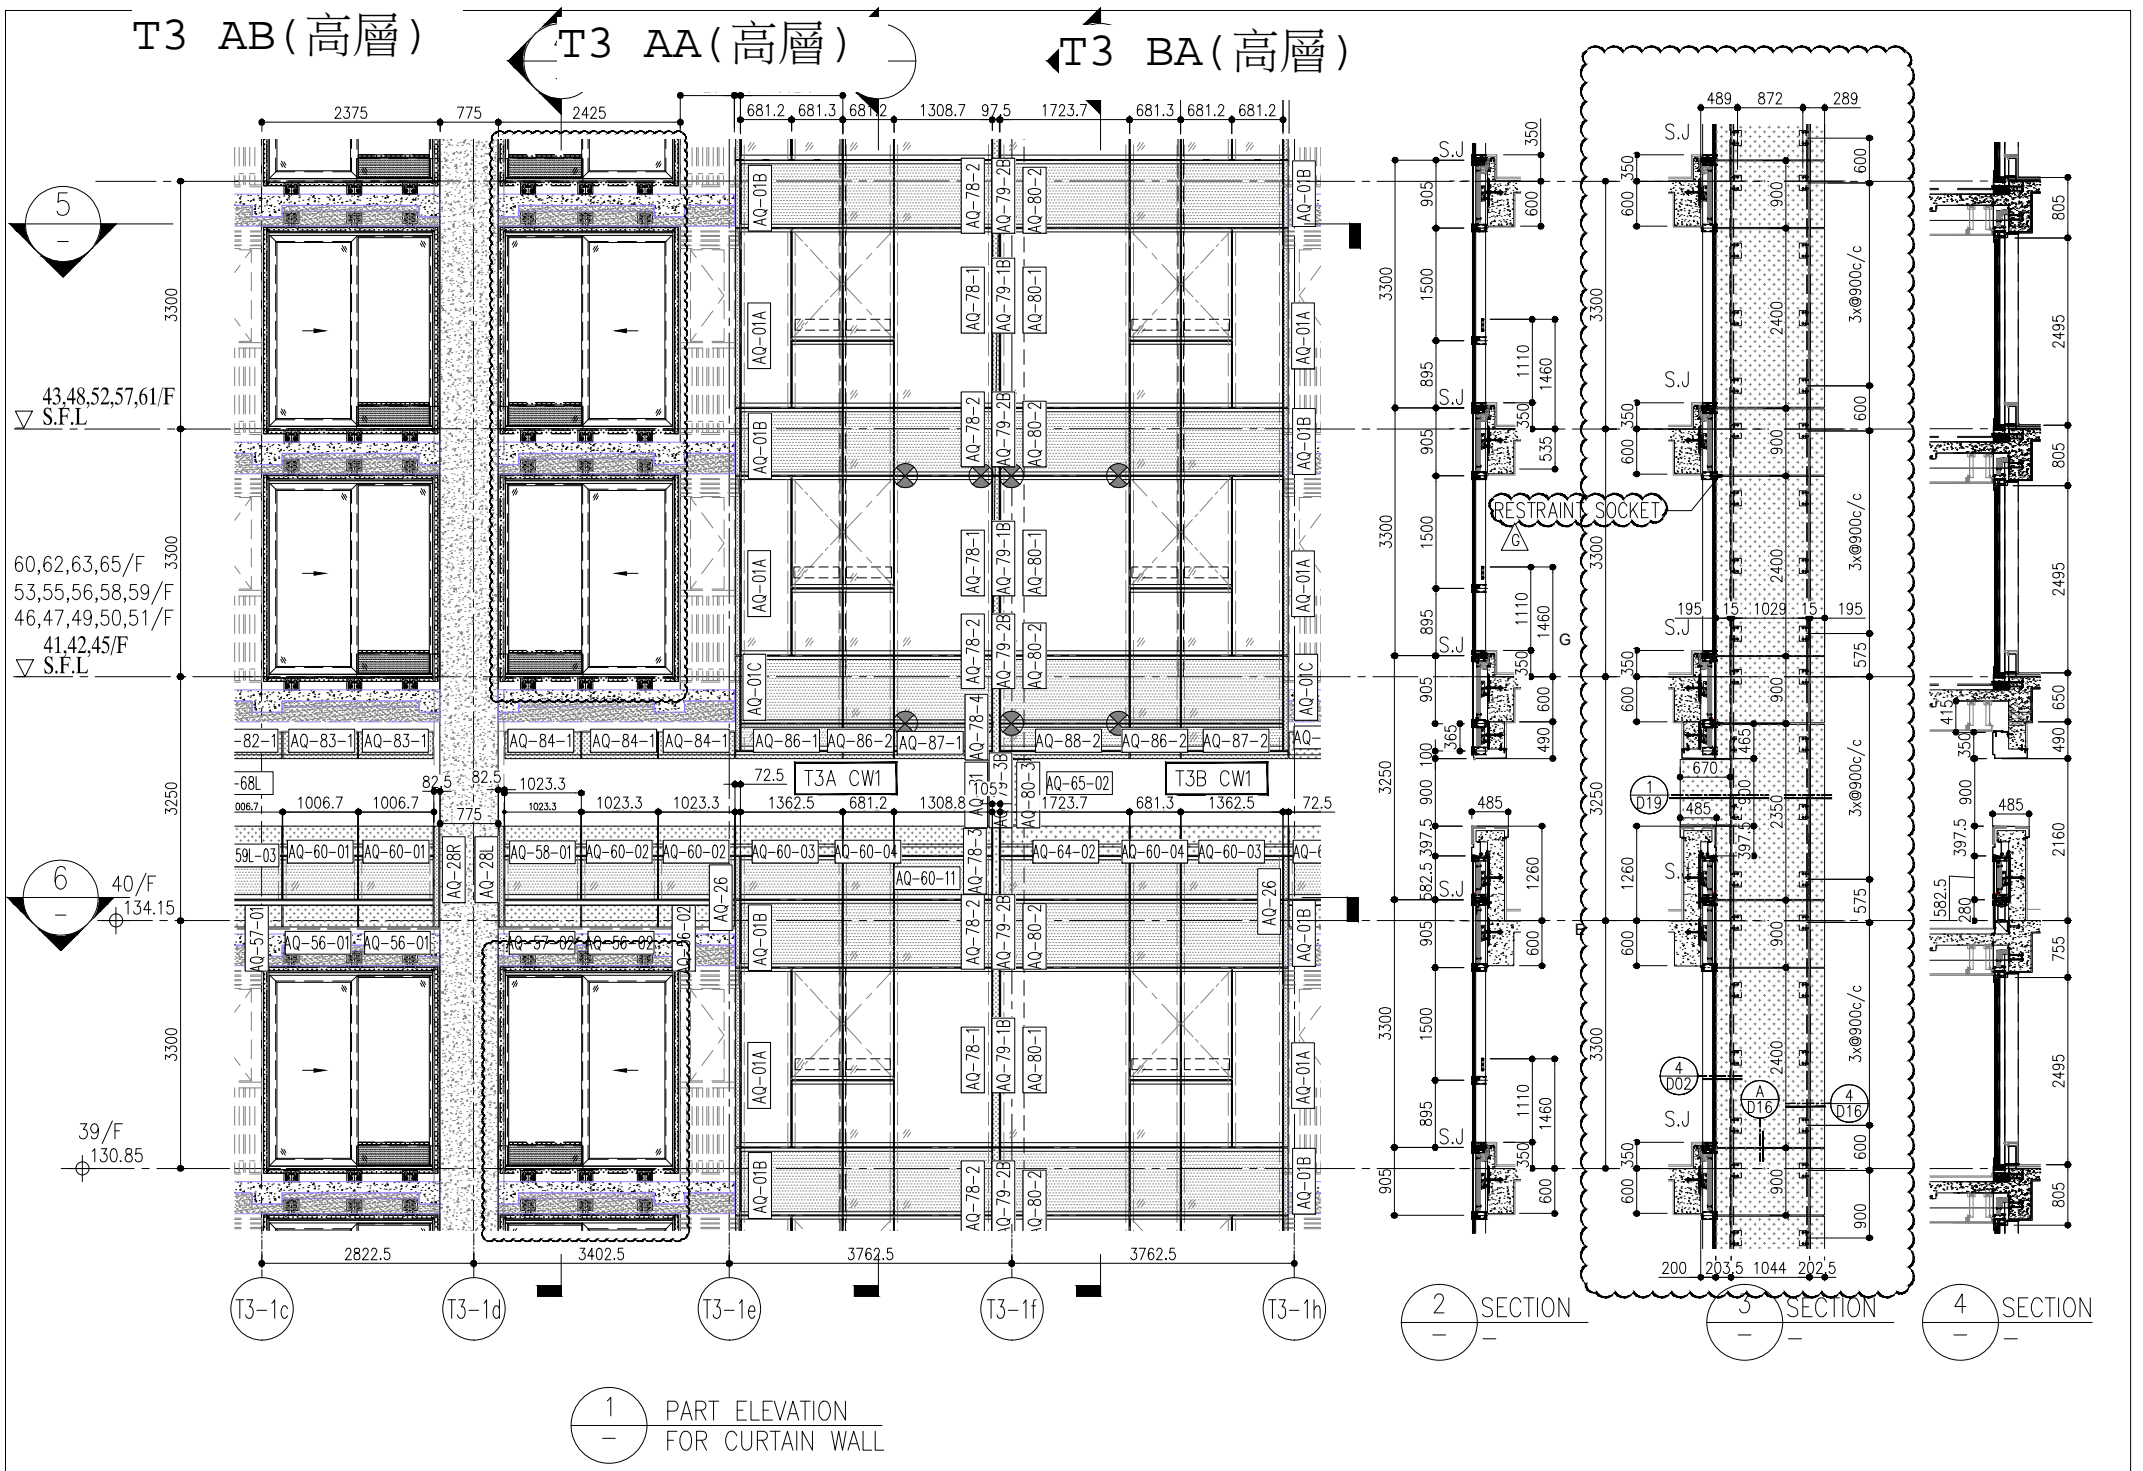


1 PART ELEVATION FOR CURTAIN WALL


2 SECTION

3 SECTION

4 SECTION

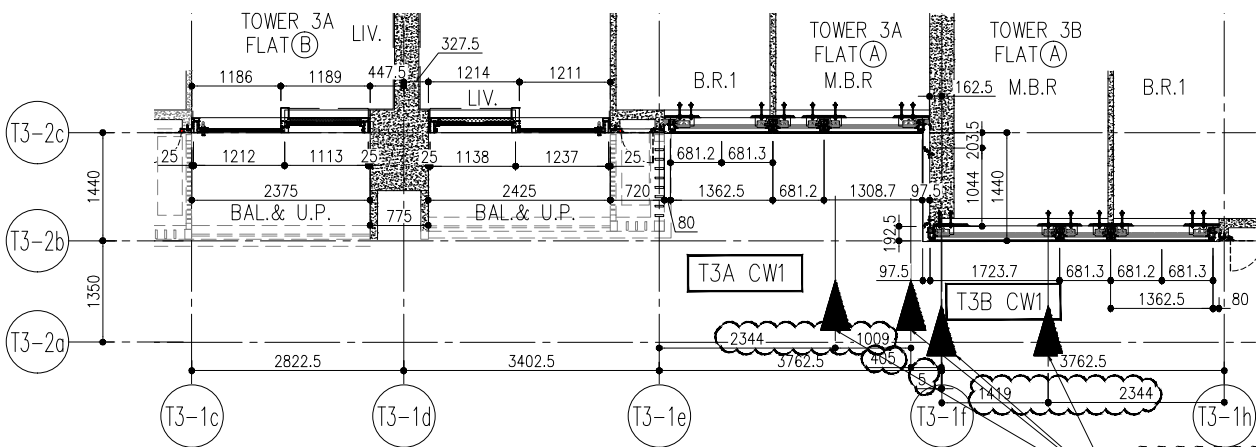

5 PART PLAN FOR CURTAIN WALL

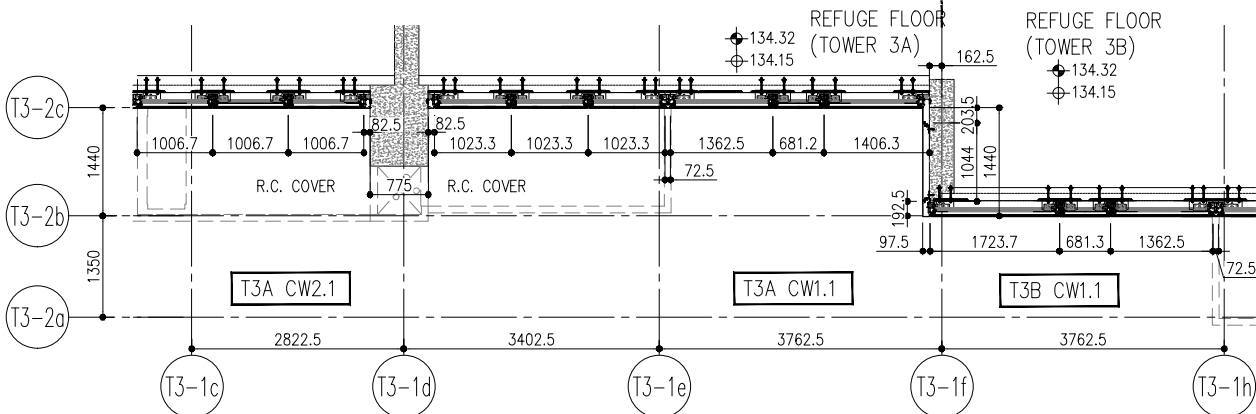

6 PART PLAN FOR CURTAIN WALL

R/F	+217.00
67/F	+213.50
26/F	+91.25
25/F	+87.95
23/F	+84.65
22/F	+81.35
21/F	+78.05
20/F	+74.75
19/F	+71.45
18/F	+68.15
17/F	+64.85
16/F	+61.55
15/F	+58.25
12/F	+54.95
39/F	+130.85
38/F	+127.55
37/F	+124.25
36/F	+120.95
35/F	+117.65
33/F	+114.35
32/F	+111.05
31/F	107.75
30/F	+104.45
29/F	+101.15
28/F	+97.85
27/F	+94.55
52/F	+170.40
51/F	+167.10
50/F	+163.80
49/F	+160.50
48/F	+157.20
47/F	+153.90
46/F	+150.60
45/F	+147.30
43/F	+144.00
42/F	+140.70
41/F	+137.40
40/F	+134.15
66/F	+210.00
65/F	+206.70
63/F	+203.40
62/F	+200.10
61/F	+196.80
60/F	+193.50
59/F	+190.20
58/F	+186.90
57/F	+183.60
56/F	+180.30
55/F	+177.00
53/F	+173.70

- LEGEND:
- (1) 10mm THK. HEAT STRENGTHENED GLASS (OUTSIDE) + 12mm AIR SPACE + 12mm THK. TEMPERED GLASS
  - (2) 10mm THK. HEAT STRENGTHENED GLASS (OUTSIDE) + 12mm AIR SPACE + 10mm THK. TEMPERED GLASS
  - (3) 12mm THK. HEAT STRENGTHENED GLASS
  - (4) 12mm THK. CLEAR TEMPERED GLASS ( INTERNAL PROTECTIVE BARRIER )
  - (5) 10mm THK. HEAT STRENGTHENED GLASS (OUTSIDE) + 12mm AIR SPACE + 12mm THK. TEMPERED GLASS WITH REFLECTIVE COATING
  - (6) 10mm THK. CLEAR TEMPERED GLASS
  - (7) 8mm THK. CLEAR HEAT-STRENGTHENED GLASS + 1.52mm PVB + 8mm THK. CLEAR HEAT-STRENGTHENED GLASS
  - (8) 3 mm THK. ALUM. CLADDING
  - (9) 3 mm THK. ALUM. BACKPAN
  - S.J. - STACK JOINT
  - (10) - RESTRAINT SOCKET

PROJECT: PE 305  
 TITLE: PARTIAL CURTAIN WALL PLAN (TOWER 3)  
 DATE: 20/12/21  
 SCALE: 1:50(A1)  
 PROJECT LOCATION: LOHAS PARK, N.T.  
 CLIENT: 信和置業有限公司 (Sino Land Company Limited)  
 ARCHITECT: Ronald Lu & Partners (Ronald Lu & Partners (HK) Ltd.)  
 MAIN CONTRACTOR: 吳允祥建築師事務所 (香港) 有限公司

REVISIONS:

NO.	DATE	REVISIONS
A	03/12/21	REVISED AS PER COMMENTS
B	20/12/21	REVISED AS PER COMMENTS
C	22/04/06	REVISED AS PER COMMENTS
D	22/04/06	REVISED AS PER COMMENTS
E	25/05/22	REVISED AS PER COMMENTS
F	26/07/22	REVISED AS PER COMMENTS
G	18/08/22	REVISED AS PER COMMENTS

NOTE:  
 1. ALL DIMENSIONS ARE IN mm.  
 2. ALL ELEVATIONS ARE VIEWED FROM OUTSIDE.  
 3. ALL DIMENSIONS TO BE VERIFIED ON SITE BEFORE FABRICATION.

LEGEND:  
 (X1) DETAIL MARK NO.  
 (X00) REFER SHEET NO.  
 1. F.F.L. -- FINISHED FLOOR LEVEL  
 2. S.F.L. -- STRUCTURAL FLOOR LEVEL  
 3. (R) -- REVERSED DETAIL

FAÇADE CONSULTANT: **AECOM**

STRUCTURAL ENGINEER: **Gammon**


CLIENT: 信和置業有限公司 (Sino Land Company Limited)

ARCHITECT: **Ronald Lu & Partners**

MAIN CONTRACTOR: 吳允祥建築師事務所 (香港) 有限公司

B.D. REF.:


T3 BA (高層) T3 BB (高層) T3 BC (高層)

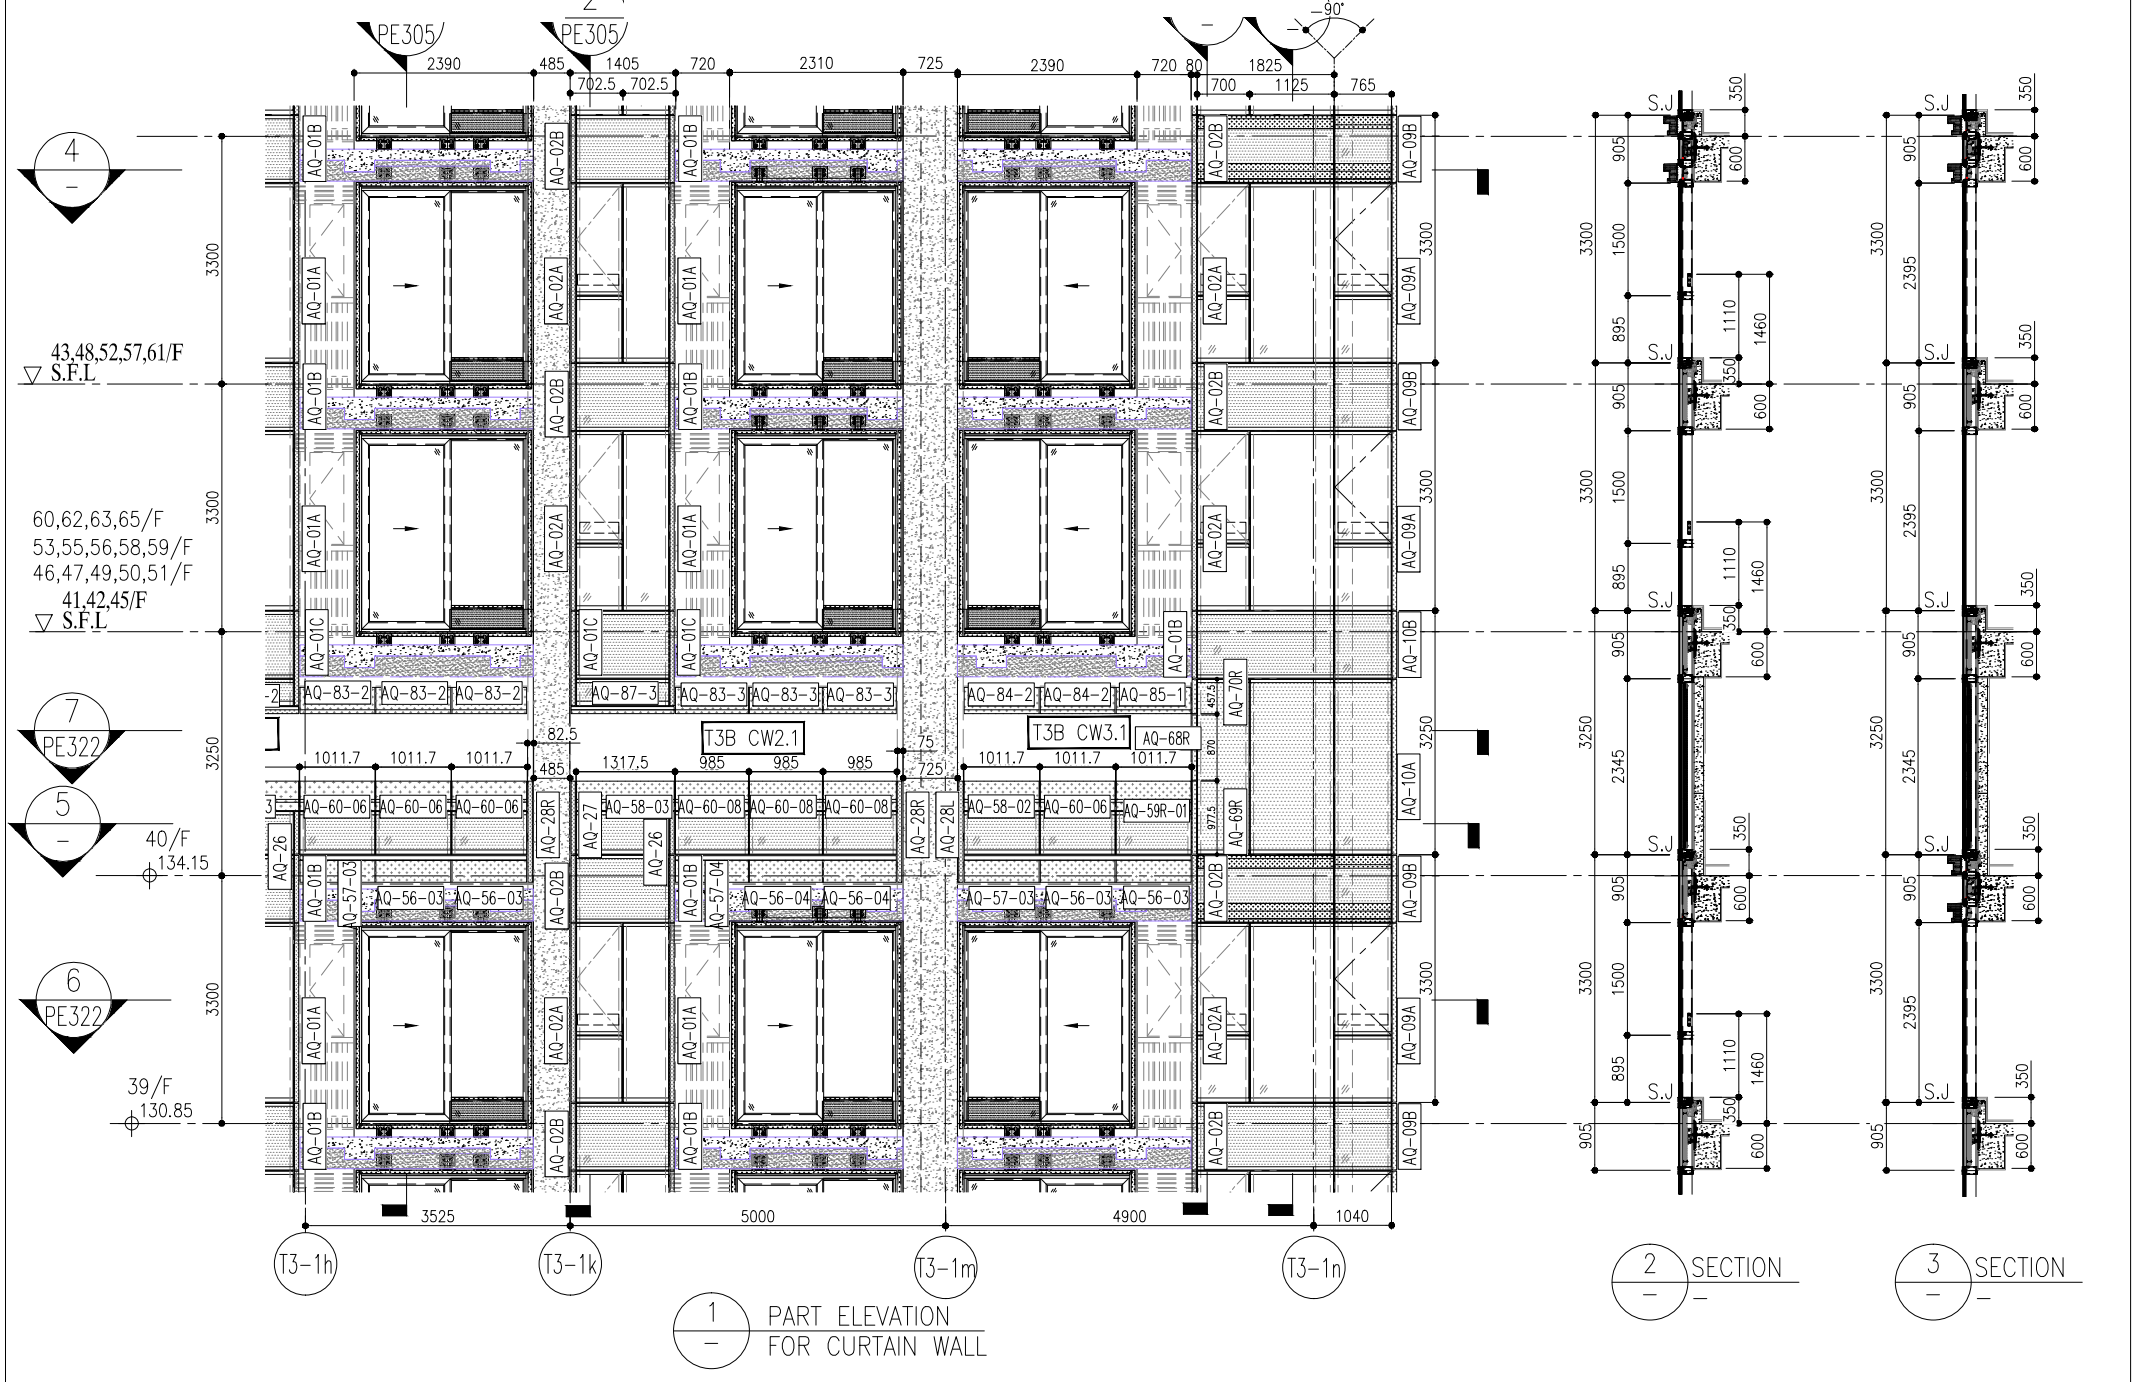


1 PART ELEVATION FOR CURTAIN WALL

2 SECTION

3 SECTION

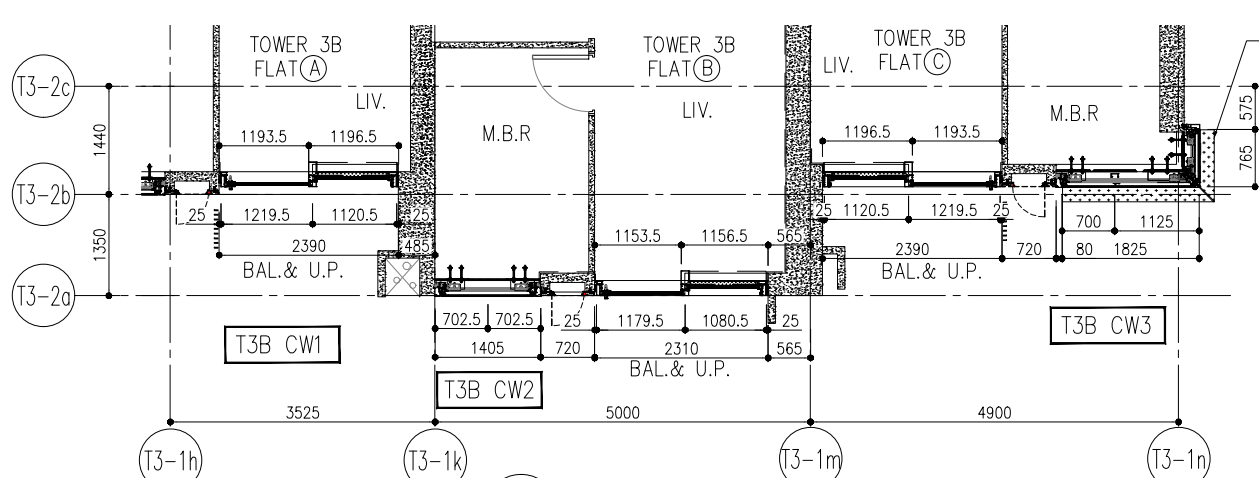

4 PART PLAN FOR CURTAIN WALL

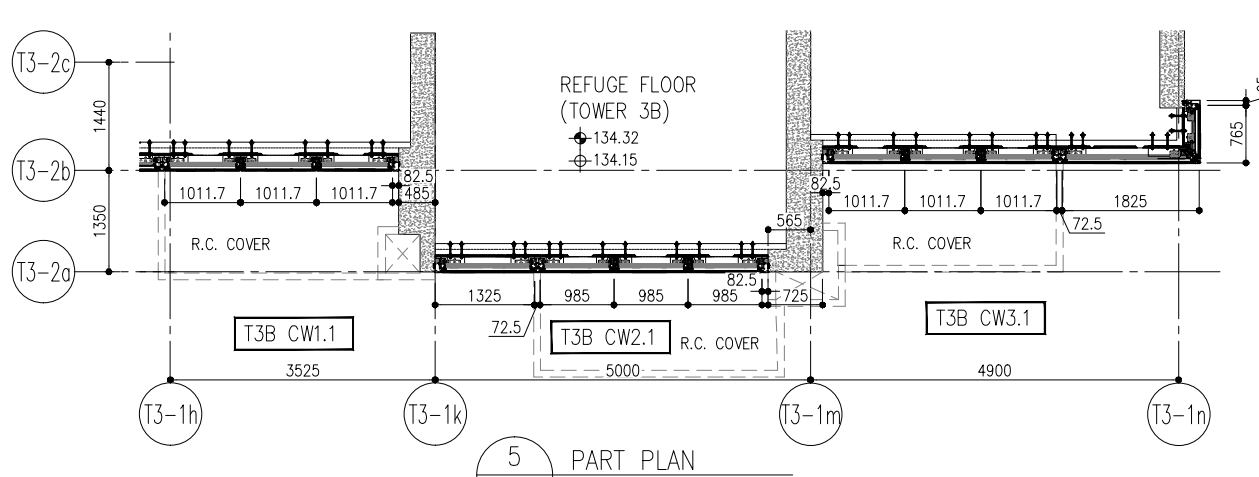

5 PART PLAN FOR CURTAIN WALL

ARCH. FEATURE AT  
39, 43/F, 48/F  
52/F, 57/F, 61/F

R/F	+217.00
67/F	+213.50
66/F	+210.00
65/F	+206.70
63/F	+203.40
62/F	+200.10
61/F	+196.80
60/F	+193.50
59/F	+190.20
58/F	+186.90
57/F	+183.60
56/F	+180.30
55/F	+177.00
53/F	+173.70
40/F	+134.15
39/F	+130.85

- LEGEND:
- (1) 10mm THK. HEAT STRENGTHENED GLASS (OUTSIDE) + 12mm AIR SPACE + 12mm THK. TEMPERED GLASS
  - (2) 10mm THK. HEAT STRENGTHENED GLASS (OUTSIDE) + 12mm AIR SPACE + 10mm THK. TEMPERED GLASS
  - (3) 12mm THK. HEAT STRENGTHENED GLASS
  - (4) 12mm THK. CLEAR TEMPERED GLASS ( INTERNAL PROTECTIVE BARRIER )
  - (5) 10mm THK. HEAT STRENGTHENED GLASS (OUTSIDE) + 12mm AIR SPACE + 12mm THK. TEMPERED GLASS WITH REFLECTIVE COATING
  - (6) 10mm THK. CLEAR TEMPERED GLASS
  - (7) 8mm THK. CLEAR HEAT-STRENGTHENED GLASS + 1.52mm PVB + 8mm THK. CLEAR HEAT-STRENGTHENED GLASS
  - (8) 3 mm THK. ALUM. CLADDING
  - (9) 3 mm THK. ALUM. BACKPAN
  - S.J. STACK JOINT
  - (10) RESTRAINT SOCKET

DWG NO. : J858-CW-PE306

DATE : 2

PROJECT : DEVELOPMENT OF LOHAS PARK

TITLE : PARTIAL CURTAIN WALL PLAN (TOWER 3)

**PE 306**

REVISIONS:

NO.	DATE	REVISION
A	03/12/21	REVISED AS PER COMMENTS
B	20/12/21	REVISED AS PER COMMENTS
C	22/01/22	REVISED AS PER COMMENTS
D	22/04/22	REVISED AS PER COMMENTS
E	26/05/22	REVISED AS PER COMMENTS
F	26/07/22	REVISED AS PER COMMENTS

NOTE:

- ALL DIMENSIONS ARE IN mm.
- ALL ELEVATIONS ARE VIEWED FROM OUTSIDE.
- ALL DIMENSIONS TO BE VERIFIED ON SITE BEFORE FABRICATION.

LEGEND:

- (X1) DETAIL MARK NO.
- (X20) REFER SHEET NO.
- 1. F.F.L. -- FINISHED FLOOR LEVEL
- 2. S.F.L. -- STRUCTURAL FLOOR LEVEL
- 3. (R) -- REVERSED DETAIL

ARCHITECT: ronaid lu & partners

Structural Engineer: Gammon


FAÇADE CONSULTANT: AECOM

CLIENT: 信和置業有限公司 Sino Land Company Limited

MAIN CONTRACTOR: Ronald Lu & Partners (香港) 有限公司

B.D. REF. :

T3 BD (高層) T3 BE (高層)

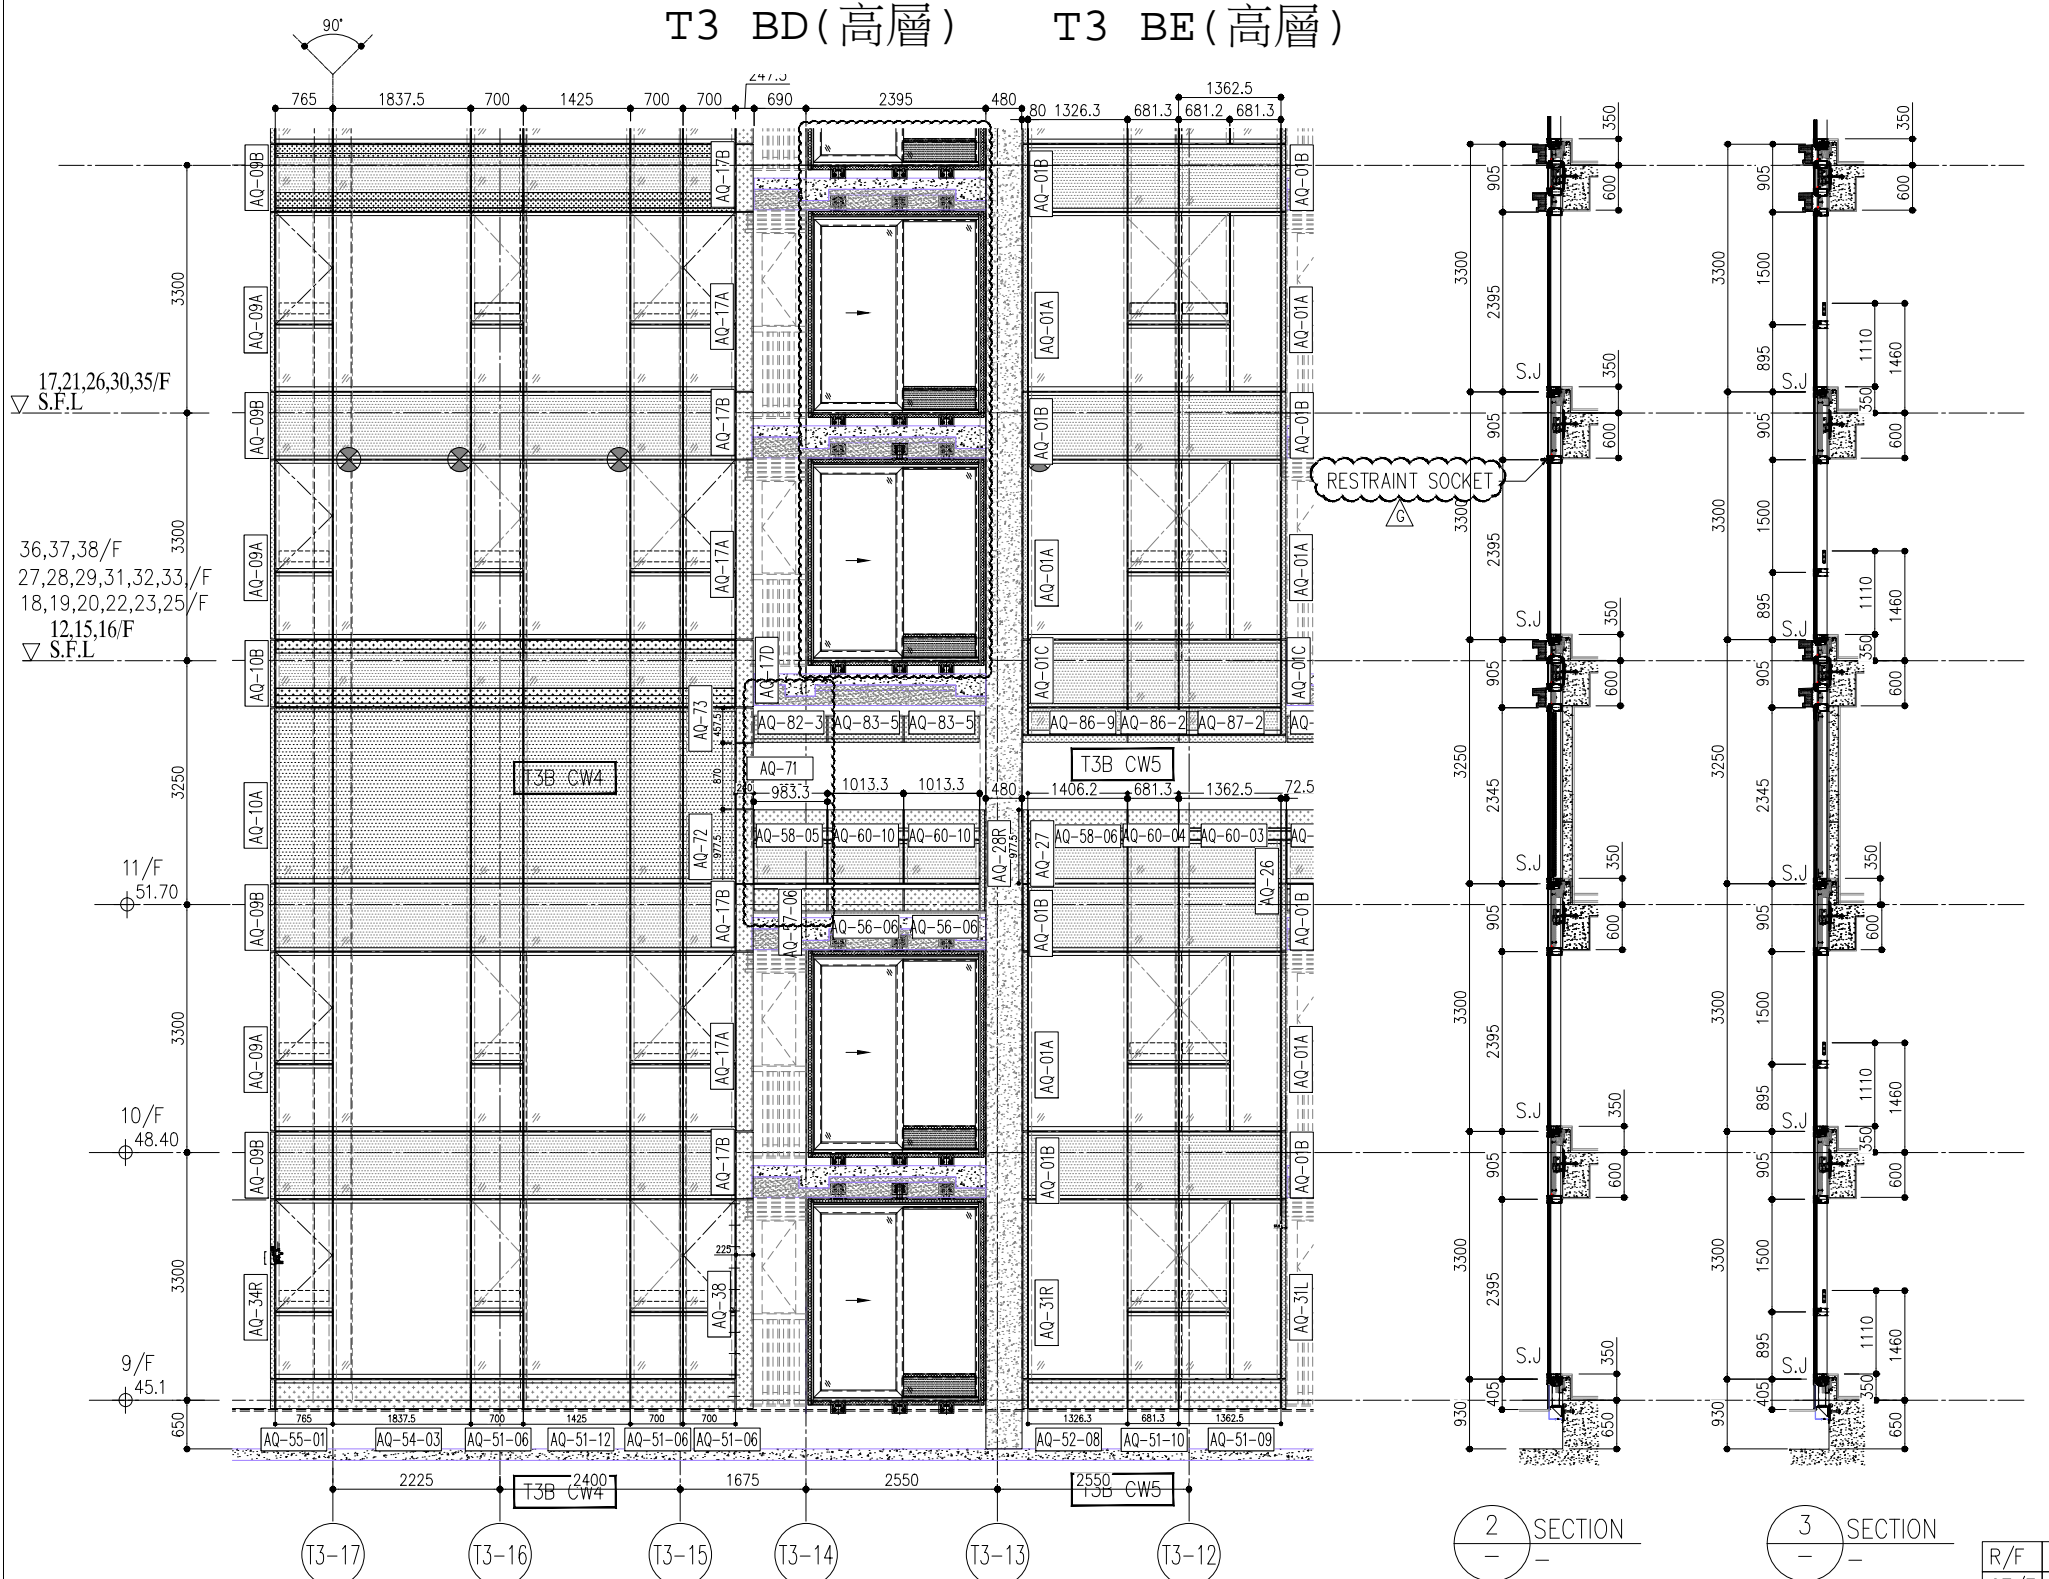


1 PART ELEVATION FOR CURTAIN WALL

2 SECTION

3 SECTION

ARCH. FEATURE AT 11/F, 17/F, 21/F, 26/F, 30/F, 35/F,

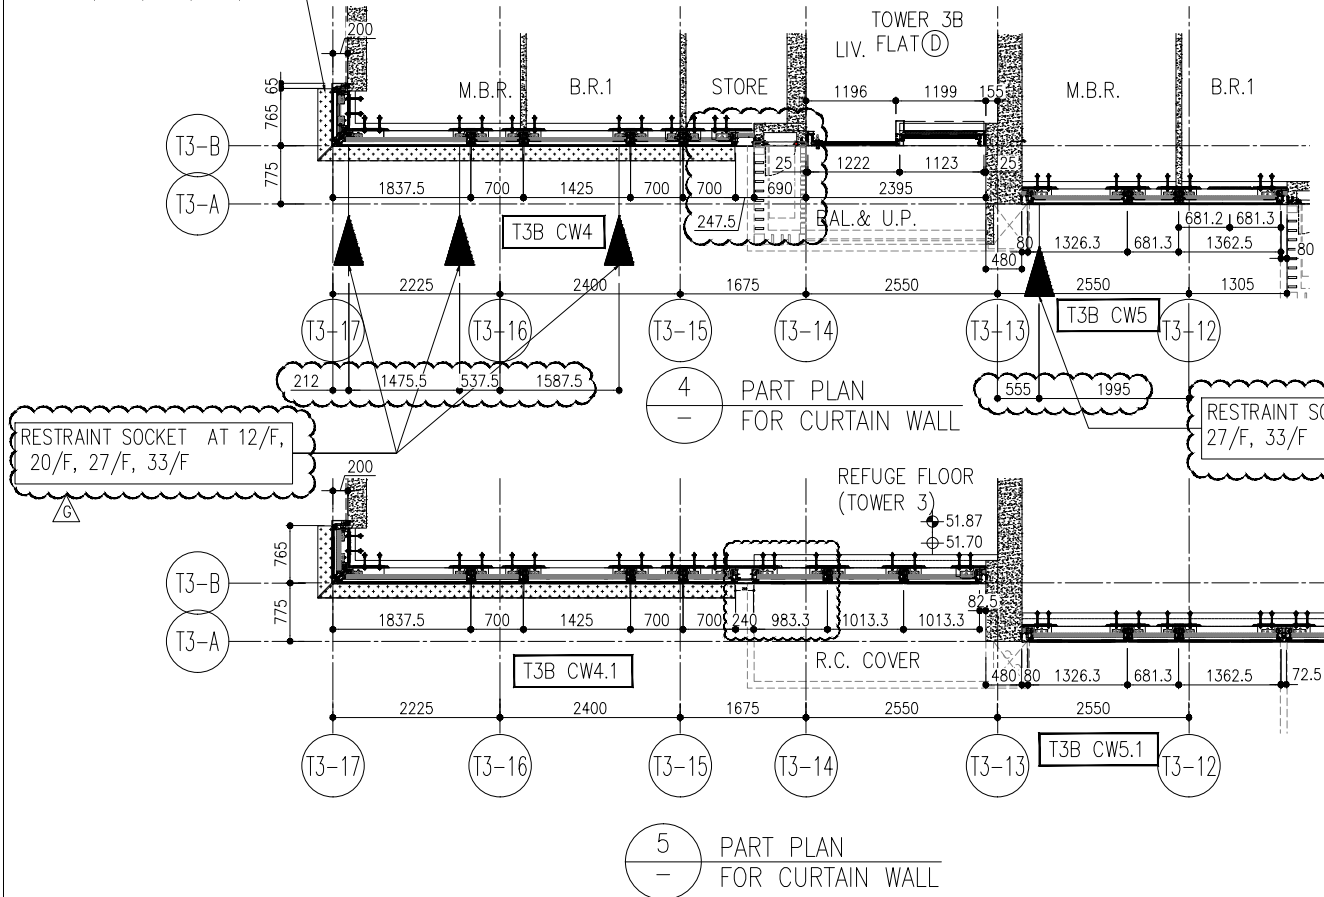

4 PART PLAN FOR CURTAIN WALL

5 PART PLAN FOR CURTAIN WALL

R/F	+217.00	+213.50	+210.00	+206.70	+203.40	+200.10	+196.80	+193.50	+190.20	+186.90	+183.60	+180.30	+177.00	+173.70
26/F	+91.25	39/F	+130.85	52/F	+170.40	66/F	+210.00							
25/F	+87.95	38/F	+127.55	51/F	+167.10	65/F	+206.70							
23/F	+84.65	37/F	+124.25	50/F	+163.80	63/F	+203.40							
22/F	+81.35	36/F	+120.95	49/F	+160.50	62/F	+200.10							
21/F	+78.05	35/F	+117.65	48/F	+157.20	61/F	+196.80							
20/F	+74.75	33/F	+114.35	47/F	+153.90	60/F	+193.50							
19/F	+71.45	32/F	+111.05	46/F	+150.60	59/F	+190.20							
18/F	+68.15	31/F	+107.75	45/F	+147.30	58/F	+186.90							
17/F	+64.85	30/F	+104.45	43/F	+144.00	57/F	+183.60							
16/F	+61.55	29/F	+101.15	42/F	+140.70	56/F	+180.30							
15/F	+58.25	28/F	+97.85	41/F	+137.40	55/F	+177.00							
12/F	+54.95	27/F	+94.55	40/F	+134.15	53/F	+173.70							

LEGEND:

- ① 10mm THK. HEAT STRENGTHENED GLASS (OUTSIDE) +12mm AIR SPACE + 12mm THK. TEMPERED GLASS
- ② 10mm THK. HEAT STRENGTHENED GLASS (OUTSIDE) +12mm AIR SPACE + 10mm THK. TEMPERED GLASS
- ③ 12mm THK. HEAT STRENGTHENED GLASS
- ④ 12mm THK. CLEAR TEMPERED GLASS ( INTERNAL PROTECTIVE BARRIER )
- ⑤ 10mm THK. HEAT STRENGTHENED GLASS (OUTSIDE) +12mm AIR SPACE + 12mm THK. TEMPERED GLASS WITH REFLECTIVE COATING
- ⑥ 10mm THK. CLEAR TEMPERED GLASS
- ⑦ 8mm THK. CLEAR HEAT-STRENGTHENED GLASS + 52mm PVB + 8mm THK. CLEAR HEAT-STRENGTHENED GLASS
- ⑧ 3 mm THK. ALUM. CLADDING
- ⑨ 3 mm THK. ALUM. BACKPAN
- S.J. - STACK JOINT
- ⊗ - RESTRAINT SOCKET

DELETED

DWG NO. : JB58-CW-PE307  
 DATE : 2  
 DRAWN BY :  
 TITLE : PARTIAL CURTAIN WALL PLAN (TOWER 3)  
 PROJECT : DEVELOPMENT OF LOHAS PARK N.T.  
 JOB NO. :  
 PROJECT :  
 AT :  
 DATE : 1:50(A1)  
 KEED BY :  
 PE 307  
 有限公司  
 FABRICATOR LTD.  
 1/F  
 TEL: 23488566  
 REV. : G

NOTE:

- ALL DIMENSIONS ARE IN mm.
- ALL ELEVATIONS ARE VIEWED FROM OUTSIDE.
- ALL DIMENSIONS TO BE VERIFIED ON SITE BEFORE FABRICATION.

LEGEND:

- (X1) DETAIL MARK NO.
- (X00) REFER SHEET NO.
- 1. F.F.L. - FINISHED FLOOR LEVEL
- 2. S.F.L. - STRUCTURAL FLOOR LEVEL
- 3. (R) - REVERSED DETAIL

NO.	DATE	REVISION
A	03/12/21	REVISED AS PER COMMENTS
B	20/12/21	REVISED AS PER COMMENTS
C	22/01/22	REVISED AS PER COMMENTS
D	22/04/06	REVISED AS PER COMMENTS
E	25/05/22	REVISED AS PER COMMENTS
F	26/07/22	REVISED AS PER COMMENTS
G	18/08/22	REVISED AS PER COMMENTS

ARCHITECT: ronaid lu & partners  
 Ronald Lu & Partners (HK) Ltd.  
 呂元仲建築師事務所 (香港) 有限公司

CLIENT: 信和置業有限公司  
 Sino Land Company Limited

MAIN CONTRACTOR: 有限公司

STRUCTURAL ENGINEER: Gammon


FAÇADE CONSULTANT: AECOM

B.D. REF. :


T3 BE (高層)

T3 BF (高層)


T3 AG (高層)

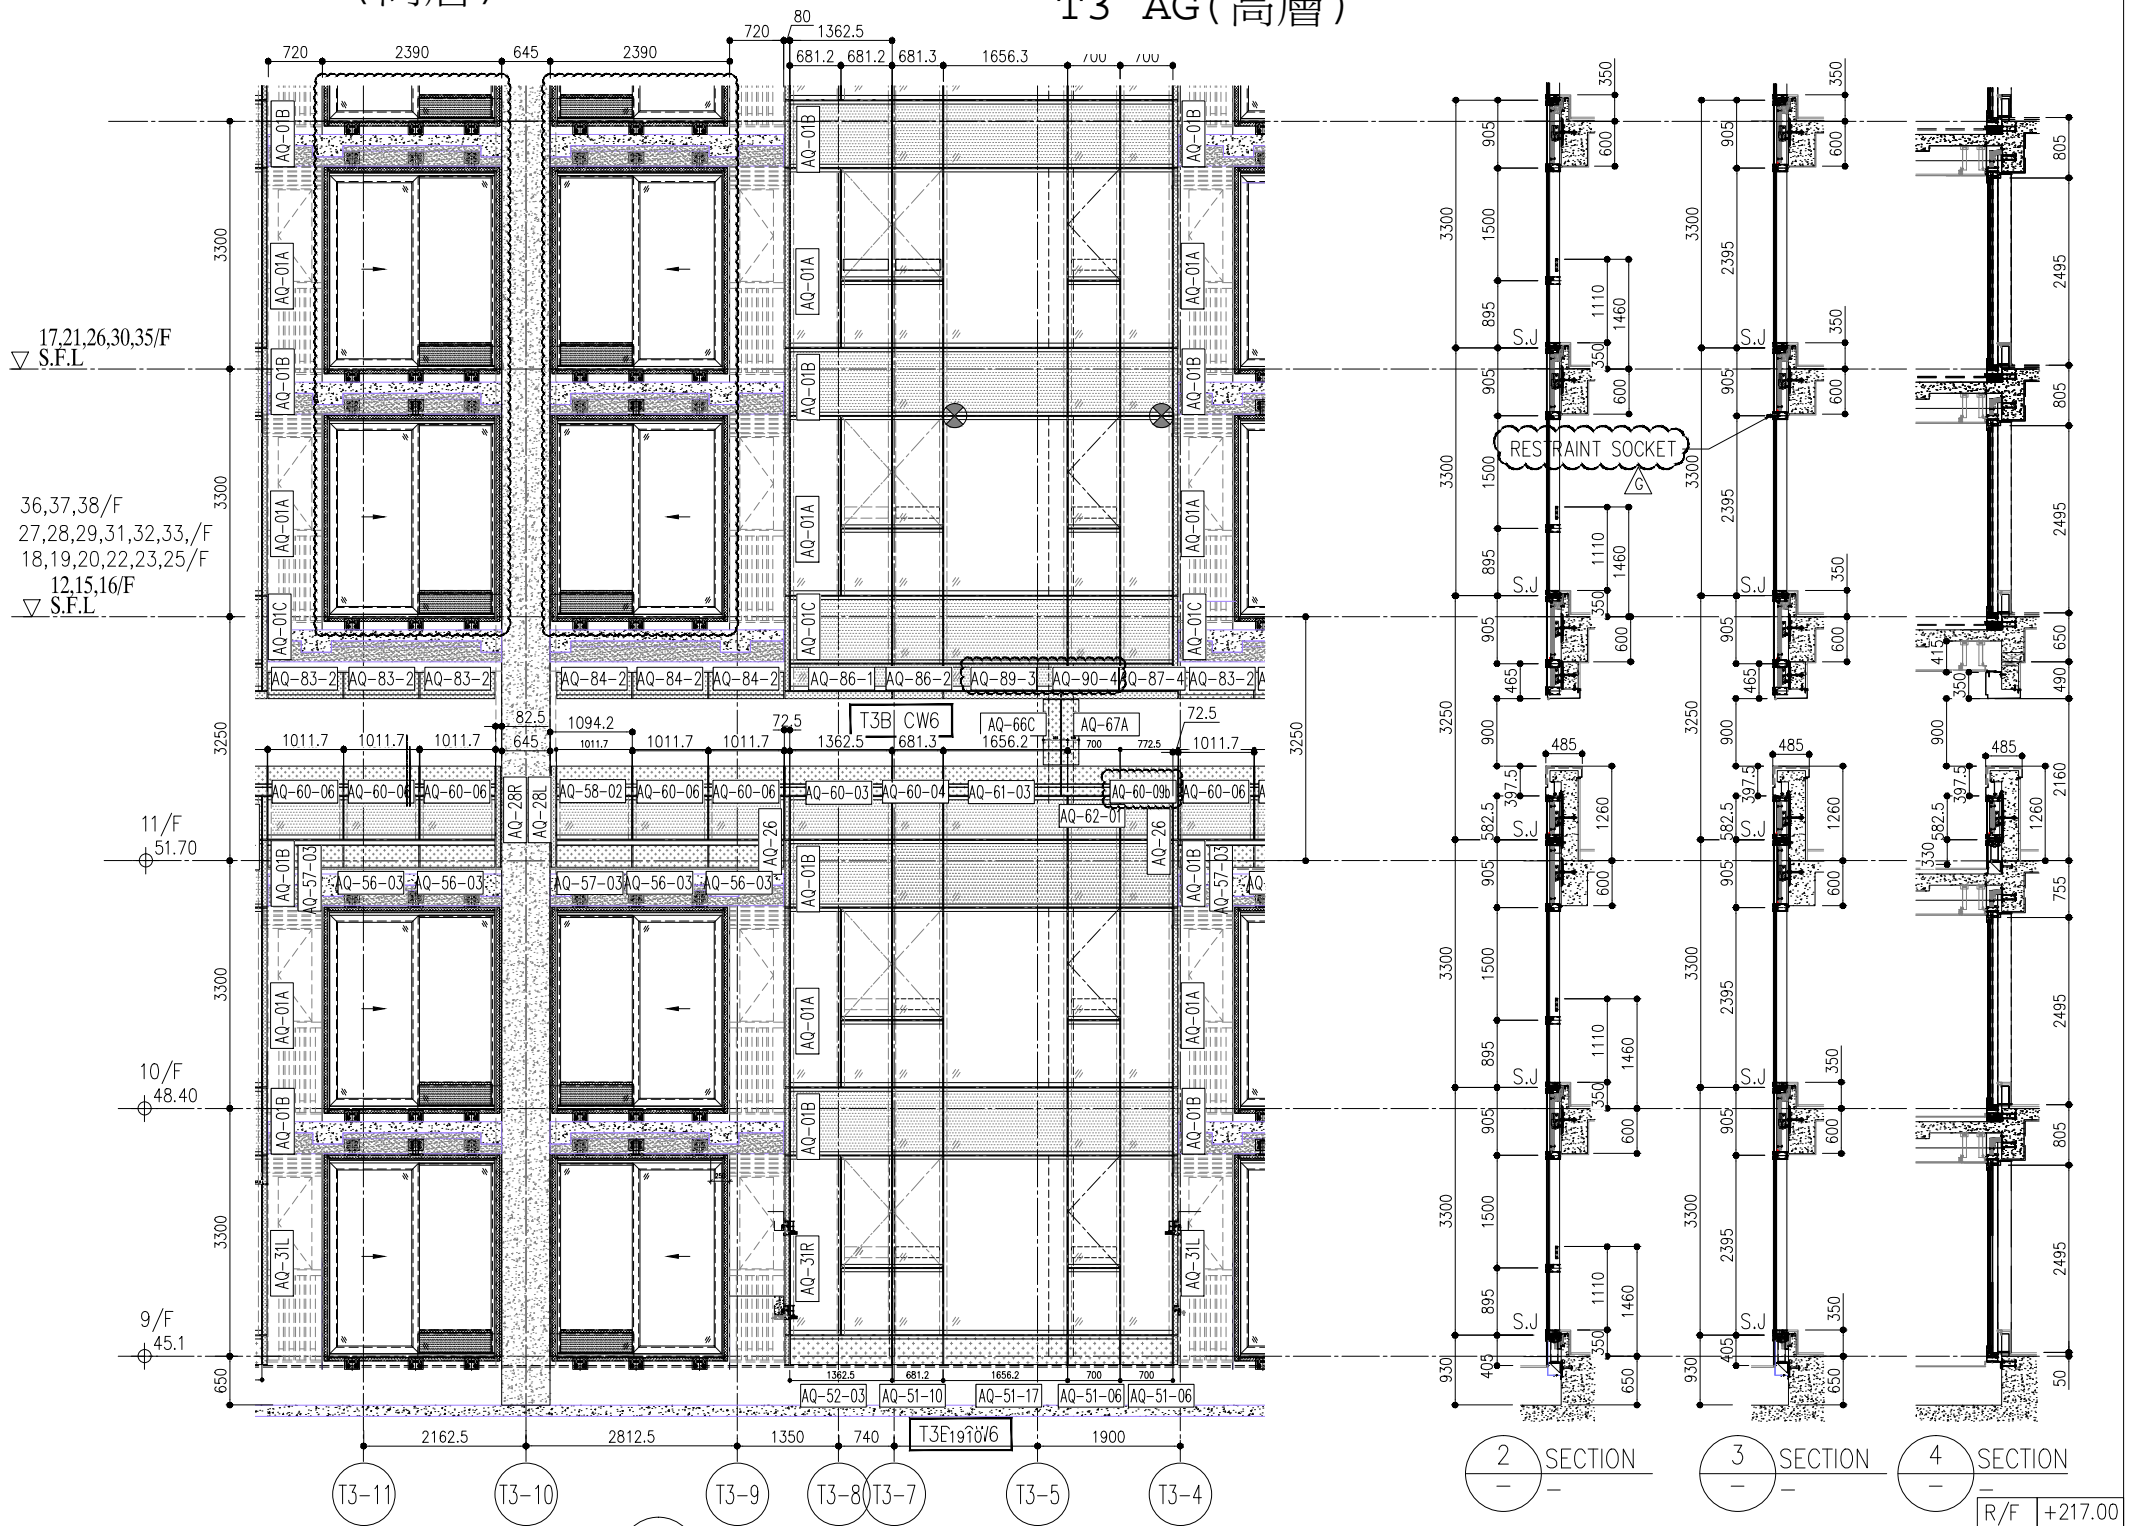

1 PART ELEVATION FOR CURTAIN WALL

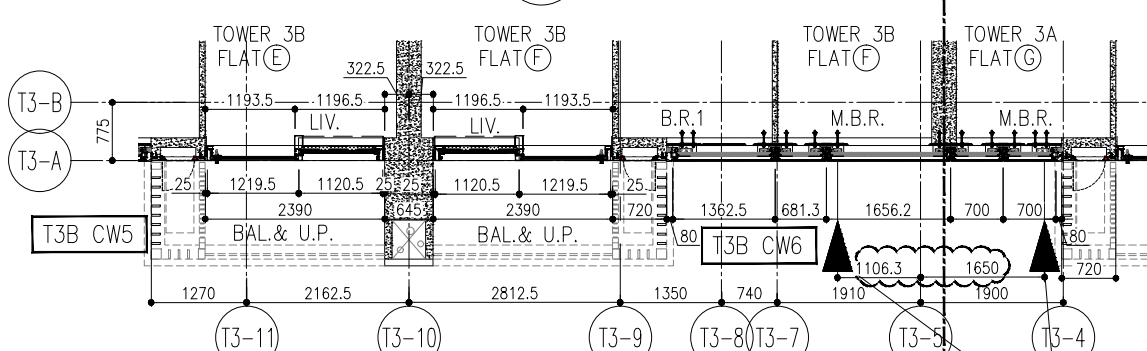

5 PART PLAN FOR CURTAIN WALL

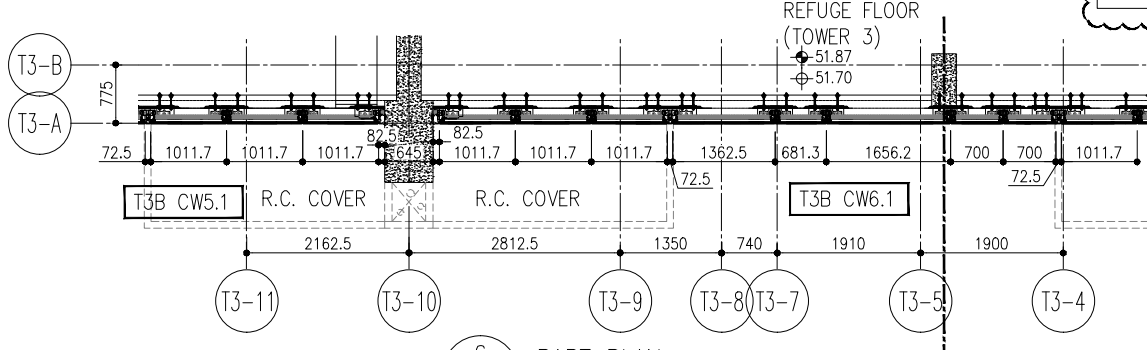

6 PART PLAN FOR CURTAIN WALL

R/F	+217.00	+213.50	+210.00	+206.70	+203.40	+200.10	+196.80	+193.50	+190.20	+186.90	+183.60	+180.30	+177.00	+173.70
26/F	+91.25	39/F	+130.85	52/F	+170.40	66/F	+210.00							
25/F	+87.95	38/F	+127.55	51/F	+167.10	65/F	+206.70							
23/F	+84.65	37/F	+124.25	50/F	+163.80	63/F	+203.40							
22/F	+81.35	36/F	+120.95	49/F	+160.50	62/F	+200.10							
21/F	+78.05	35/F	+117.65	48/F	+157.20	61/F	+196.80							
20/F	+74.75	33/F	+114.35	47/F	+153.90	60/F	+193.50							
19/F	+71.45	32/F	+111.05	46/F	+150.60	59/F	+190.20							
18/F	+68.15	31/F	+107.75	45/F	+147.30	58/F	+186.90							
17/F	+64.85	30/F	+104.45	43/F	+144.00	57/F	+183.60							
16/F	+61.55	29/F	+101.15	42/F	+140.70	56/F	+180.30							
15/F	+58.25	28/F	+97.85	41/F	+137.40	55/F	+177.00							
12/F	+54.95	27/F	+94.55	40/F	+134.15	53/F	+173.70							

- LEGEND:
- (G1) 10mm THK. HEAT STRENGTHENED GLASS (OUTSIDE) + 12mm AIR SPACE + 12mm THK. TEMPERED GLASS
  - (G2) 10mm THK. HEAT STRENGTHENED GLASS (OUTSIDE) + 12mm AIR SPACE + 10mm THK. TEMPERED GLASS
  - (G3) 12mm THK. HEAT STRENGTHENED GLASS
  - (G4) 12mm THK. CLEAR TEMPERED GLASS ( INTERNAL PROTECTIVE BARRIER )
  - (G5) 10mm THK. HEAT STRENGTHENED GLASS (OUTSIDE) + 12mm AIR SPACE + 12mm THK. TEMPERED GLASS WITH REFLECTIVE COATING
  - (G6) 10mm THK. CLEAR TEMPERED GLASS
  - (G7) 8mm THK. CLEAR HEAT-STRENGTHENED GLASS + 52mm PVB + 8mm THK. CLEAR HEAT-STRENGTHENED GLASS
  - (G8) 3 mm THK. ALUM. CLADDING
  - (G9) 3 mm THK. ALUM. BACKPAN
  - S.J. - STACK JOINT
  - (RS) - RESTRAINT SOCKET

DWG NO. : JB58-CW-PE308

DATE : 2

PROJECT : AT

TITLE : PARTIAL CURTAIN WALL PLAN (TOWER 3)

PE 308

REVISIONS:

NO.	DATE	REVISION
A	03/12/21	REVISED AS PER COMMENTS
B	20/12/21	REVISED AS PER COMMENTS
C	22/01/22	REVISED AS PER COMMENTS
D	22/04/06	REVISED AS PER COMMENTS
E	25/05/22	REVISED AS PER COMMENTS
F	25/07/22	REVISED AS PER COMMENTS
G	18/08/22	REVISED AS PER COMMENTS

NOTE:

- ALL DIMENSIONS ARE IN mm.
- ALL ELEVATIONS ARE VIEWED FROM OUTSIDE.
- ALL DIMENSIONS TO BE VERIFIED ON SITE BEFORE FABRICATION.

LEGEND:

- (X1) DETAIL MARK NO.
- (X20) REFER SHEET NO.
- 1. F.F.L. -- FINISHED FLOOR LEVEL
- 2. S.F.L. -- STRUCTURAL FLOOR LEVEL
- 3. (R) -- REVERSED DETAIL

ARCHITECT: ronaid lu & partners

CLIENT: 信和置業有限公司  
Sino Land Company Limited

STRUCTURAL ENGINEER: Gammon



FAÇADE CONSULTANT: AECOM

MAIN CONTRACTOR: Ronald Lu & Partners (HK) Ltd.

B.D. REF. :



# T3 BD (高層)

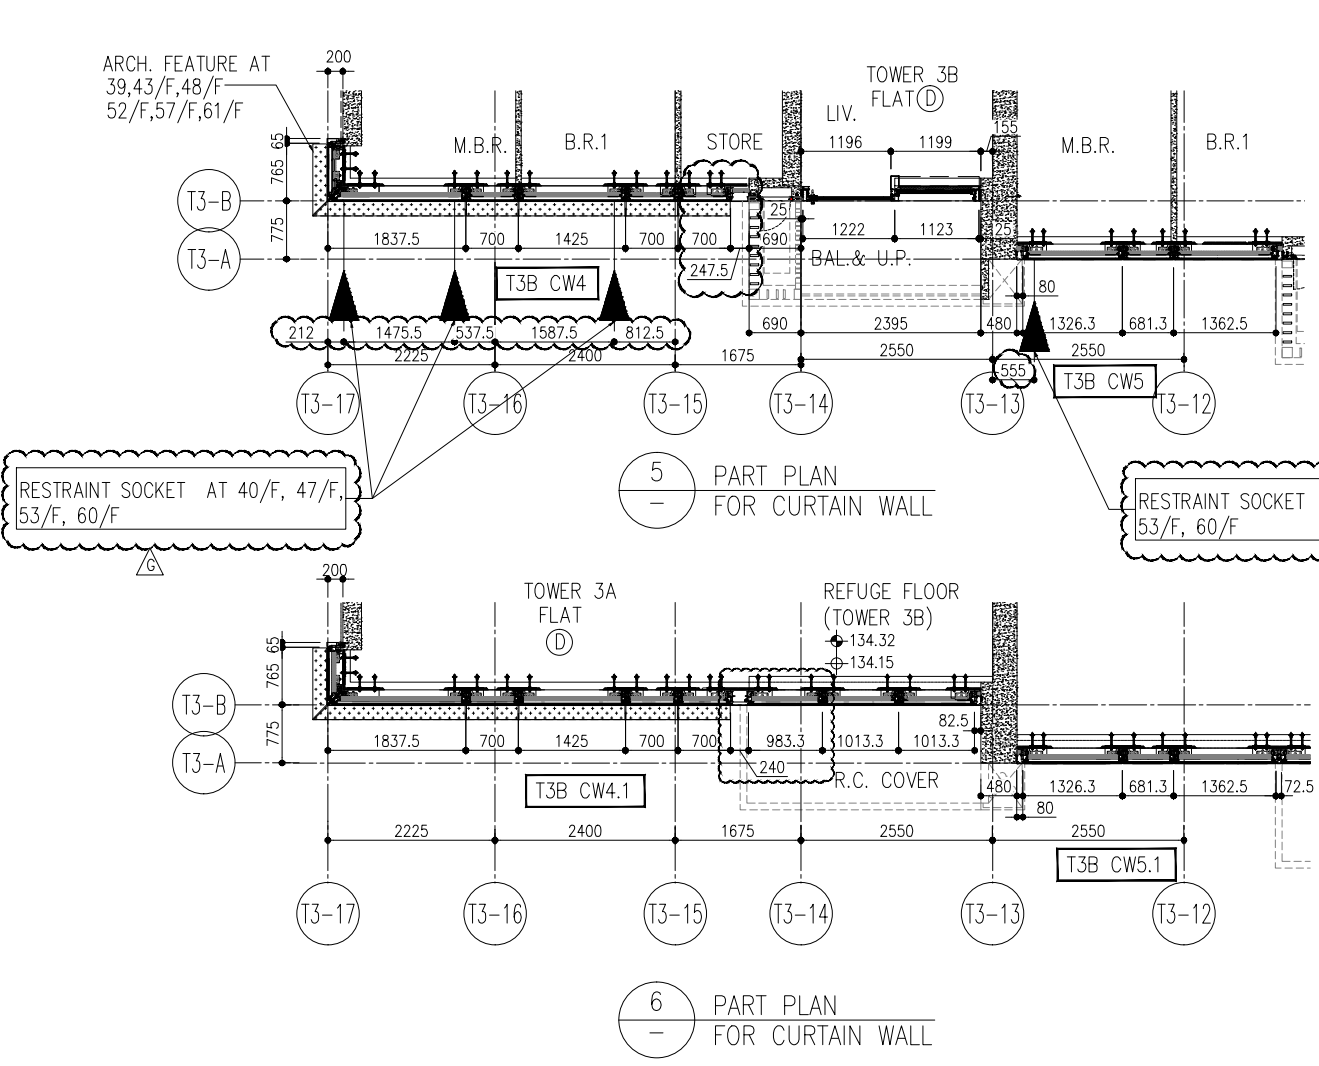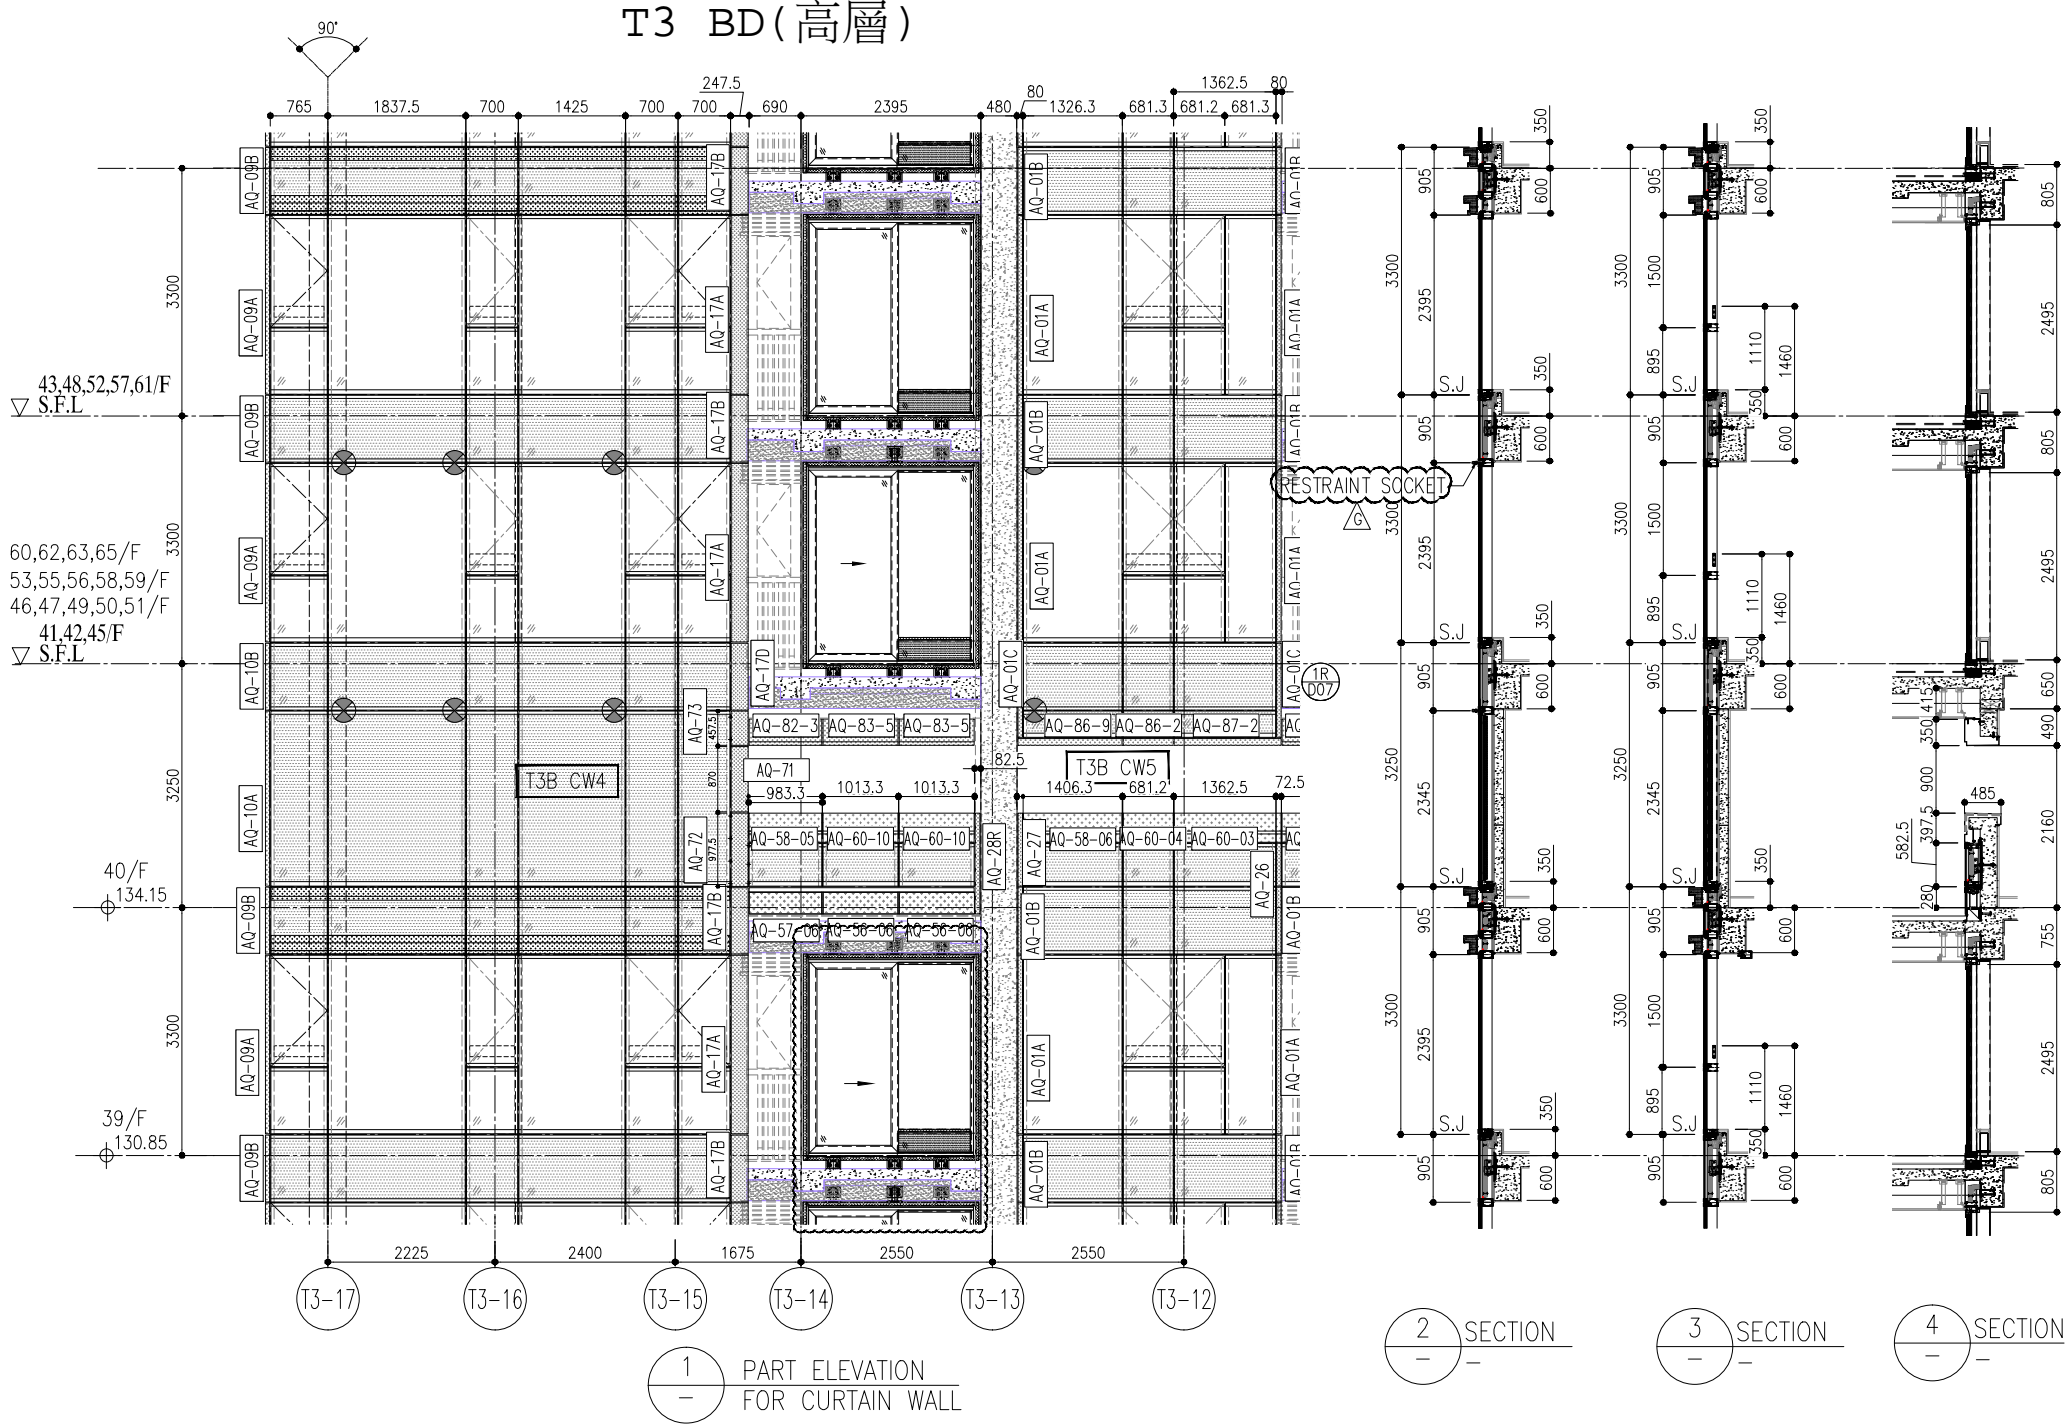

R/F	+217.00				
67/F	+213.50				
26/F	+91.25	39/F	+130.85	52/F	+170.40
25/F	+87.95	38/F	+127.55	51/F	+167.10
23/F	+84.65	37/F	+124.25	50/F	+163.80
22/F	+81.35	36/F	+120.95	49/F	+160.50
21/F	+78.05	35/F	+117.65	48/F	+157.20
20/F	+74.75	33/F	+114.35	47/F	+153.90
19/F	+71.45	32/F	+111.05	46/F	+150.60
18/F	+68.15	31/F	+107.75	45/F	+147.30
17/F	+64.85	30/F	+104.45	43/F	+144.00
16/F	+61.55	29/F	+101.15	42/F	+140.70
15/F	+58.25	28/F	+97.85	41/F	+137.40
12/F	+54.95	27/F	+94.55	40/F	+134.15
		53/F	+173.70		

- LEGEND:**
- (G1) 10mm THK. HEAT STRENGTHENED GLASS (OUTSIDE) + 12mm AIR SPACE + 12mm THK. TEMPERED GLASS
  - (G2) 10mm THK. HEAT STRENGTHENED GLASS (OUTSIDE) + 12mm AIR SPACE + 10mm THK. TEMPERED GLASS
  - (G3) 12mm THK. HEAT STRENGTHENED GLASS
  - (G4) 12mm THK. CLEAR TEMPERED GLASS ( INTERNAL PROTECTIVE BARRIER )
  - (G5) 10mm THK. HEAT STRENGTHENED GLASS (OUTSIDE) + 12mm AIR SPACE + 12mm THK. TEMPERED GLASS WITH REFLECTIVE COATING
  - (G6) 10mm THK. CLEAR TEMPERED GLASS
  - (G7) 8mm THK. CLEAR HEAT-STRENGTHENED GLASS + 52mm PVB + 8mm THK. CLEAR HEAT-STRENGTHENED GLASS
  - (G8) 3 mm THK. ALUM. CLADDING
  - (G9) 3 mm THK. ALUM. BACKPAN
  - S.J. - STACK JOINT
  - (RS) - RESTRAINT SOCKET

DWG NO. : J858-CW-PE310

REV. : G

**PE310**

PROJECT : DEVELOPMENT OF LOHAS PARK N.T.

TITLE : PARTIAL CURTAIN WALL PLAN (TOWER 3)

DATE : 20/12/21

SCALE : 1:50(A1)

DESIGNED BY : [Signature]

CHECKED BY : [Signature]

DATE : 03/12/21

REVISIONS:

NO.	DATE	REVISION
A	03/12/21	REVISED AS PER COMMENTS
B	20/12/21	REVISED AS PER COMMENTS
C	22/01/22	REVISED AS PER COMMENTS
D	22/04/06	REVISED AS PER COMMENTS
E	25/05/22	REVISED AS PER COMMENTS
F	26/07/22	REVISED AS PER COMMENTS
G	18/08/22	REVISED AS PER COMMENTS

**NOTE:**

- ALL DIMENSIONS ARE IN mm.
- ALL ELEVATIONS ARE VIEWED FROM OUTSIDE.
- ALL DIMENSIONS TO BE VERIFIED ON SITE BEFORE FABRICATION.

**LEGEND:**

- (X1) DETAIL MARK NO.
- (X20) REFER SHEET NO.
- 1. F.F.L. -- FINISHED FLOOR LEVEL
- 2. S.F.L. -- STRUCTURAL FLOOR LEVEL
- 3. (R) -- REVERSED DETAIL

ARCHITECT : **ronaldu & partners**

PROJECT PARTNERS (COMPANY) **Ronald Lu & Partners (HK) Ltd.**

MAIN CONTRACTOR : 呂元梓建築師事務所 (香港) 有限公司



CLIENT : 信和置業有限公司  
Sino Land Company Limited

STRUCTURAL ENGINEER : **Gammon**

FAÇADE CONSULTANT : **AECOM**

B.D. REF. :

T3 BE(高層) T3 BF(高層) T3 AG(高層)

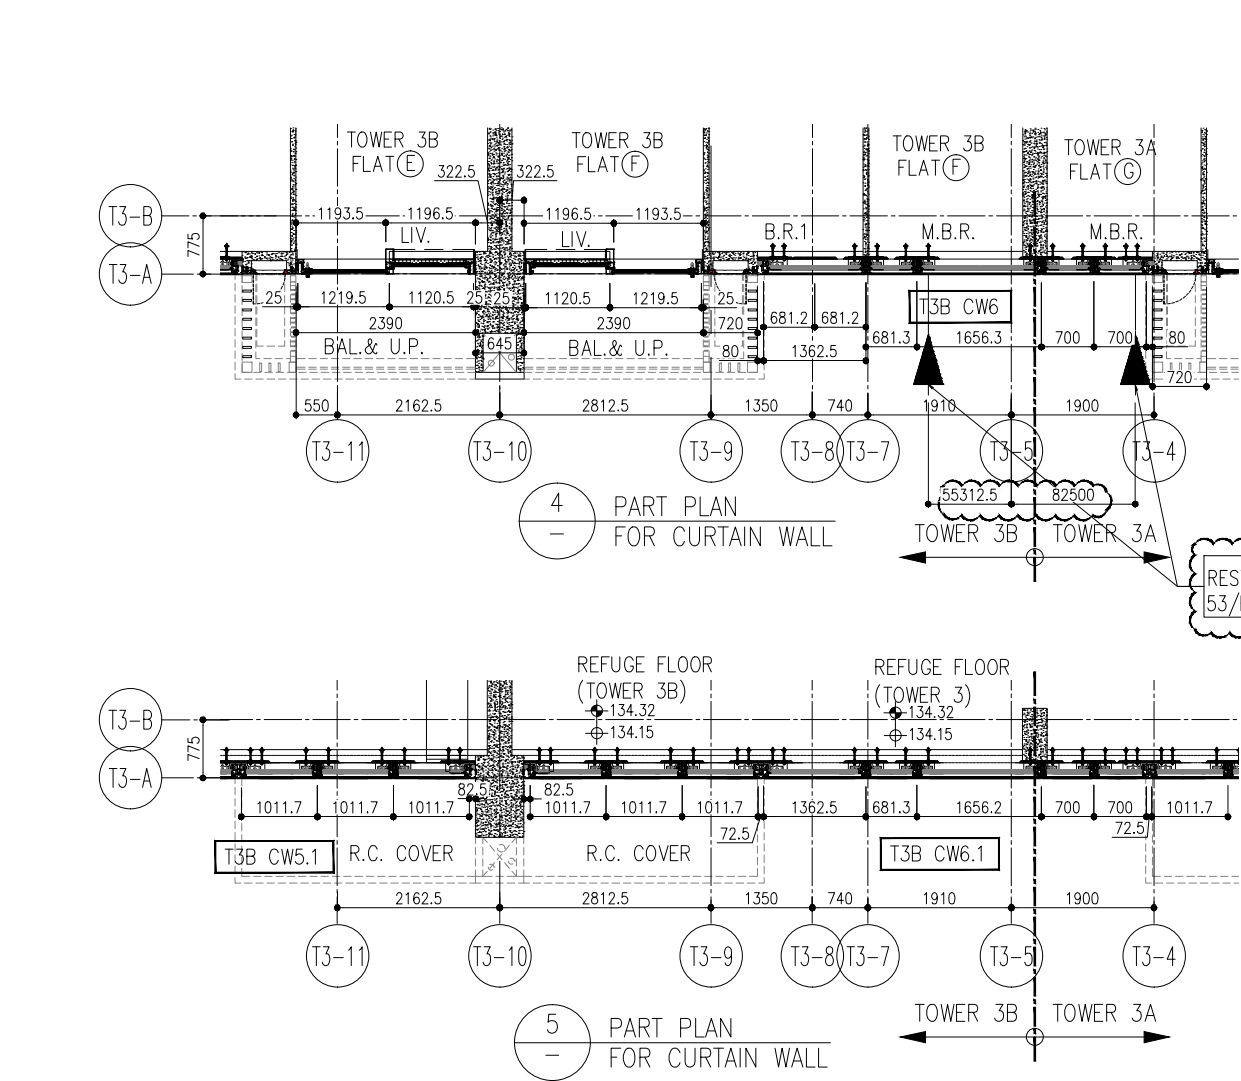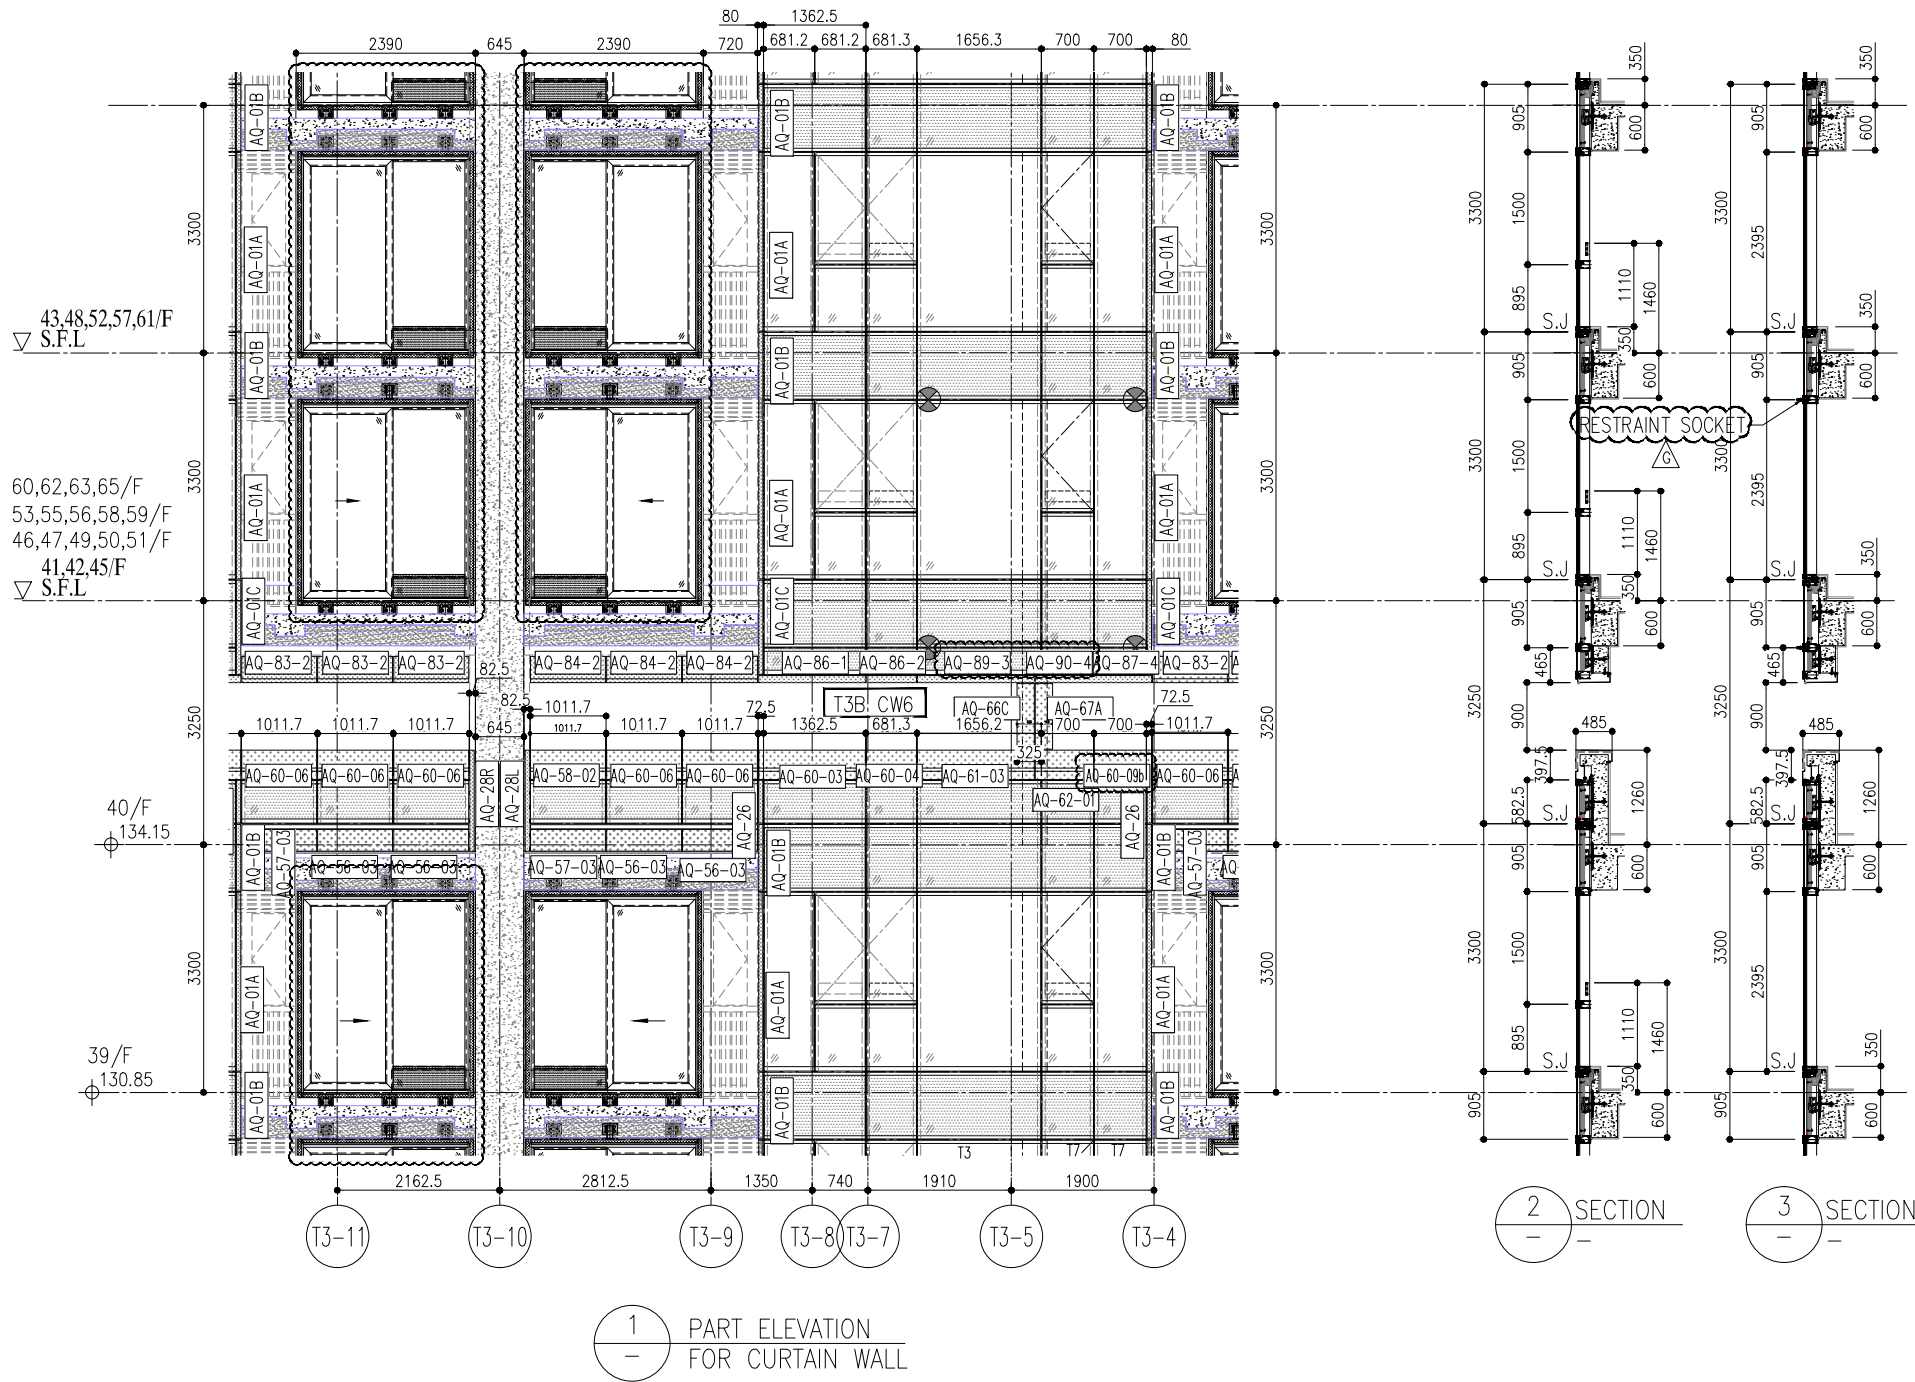

R/F	+217.00
67/F	+213.50
26/F	+91.25
25/F	+87.95
23/F	+84.65
22/F	+81.35
21/F	+78.05
20/F	+74.75
19/F	+71.45
18/F	+68.15
17/F	+64.85
16/F	+61.55
15/F	+58.25
12/F	+54.95
39/F	+130.85
38/F	+127.55
37/F	+124.25
36/F	+120.95
35/F	+117.65
33/F	+114.35
32/F	+111.05
31/F	107.75
30/F	+104.45
29/F	+101.15
28/F	+97.85
27/F	+94.55
52/F	+170.40
51/F	+167.10
50/F	+163.80
49/F	+160.50
48/F	+157.20
47/F	+153.90
46/F	+150.60
45/F	+147.30
43/F	+144.00
42/F	+140.70
41/F	+137.40
40/F	+134.15
66/F	+210.00
65/F	+206.70
63/F	+203.40
62/F	+200.10
61/F	+196.80
60/F	+193.50
59/F	+190.20
58/F	+186.90
57/F	+183.60
56/F	+180.30
55/F	+177.00
53/F	+173.70

- LEGEND:
- (G1) 10mm THK. HEAT STRENGTHENED GLASS (OUTSIDE) +12mm AIR SPACE + 12mm THK. TEMPERED GLASS
  - (G2) 10mm THK. HEAT STRENGTHENED GLASS (OUTSIDE) +12mm AIR SPACE + 10mm THK. TEMPERED GLASS
  - (G3) 12mm THK. HEAT STRENGTHENED GLASS
  - (G4) 12mm THK. CLEAR TEMPERED GLASS ( INTERNAL PROTECTIVE BARRIER )
  - (G5) 10mm THK. HEAT STRENGTHENED GLASS (OUTSIDE) +12mm AIR SPACE + 12mm THK. TEMPERED GLASS WITH REFLECTIVE COATING
  - (G6) 10mm THK. CLEAR TEMPERED GLASS
  - (G7) 8mm THK. CLEAR HEAT-STRENGTHENED GLASS + 52mm PVB + 8mm THK. CLEAR HEAT-STRENGTHENED GLASS
  - (G8) 3 mm THK. ALUM. CLADDING
  - (G9) 3 mm THK. ALUM. BACKPAN
  - S.J. - STACK JOINT
  - (RS) - RESTRAINT SOCKET

DWG NO. : JB58-CW-PE311

DATE : 2

TITLE : PARTIAL CURTAIN WALL ELEVATION AND PLAN (TOWER 3)

PROJECT : DEVELOPMENT OF LOHAS PARK N.T.

CLIENT : 信和置業有限公司  
Sino Land Company Limited

ARCHITECT : ronaidiu & partners  
Ronald Liu & Partners (HK) Ltd.  
呂允祥建築師事務所 (香港) 有限公司

MAIN CONTRACTOR : Gammon

STRUCTURAL ENGINEER : AECOM

FAÇADE CONSULTANT : AECOM

PE311

REVISIONS:

NO.	DATE	REVISION
G	18/08/22	REVISED AS PER COMMENTS
F	26/07/22	REVISED AS PER COMMENTS
E	25/05/22	REVISED AS PER COMMENTS
D	22/04/06	REVISED AS PER COMMENTS
C	22/01/22	REVISED AS PER COMMENTS
B	20/12/21	REVISED AS PER COMMENTS
A	03/12/21	REVISED AS PER COMMENTS

NOTE:

- ALL DIMENSIONS ARE IN mm.
- ALL ELEVATIONS ARE VIEWED FROM OUTSIDE.
- ALL DIMENSIONS TO BE VERIFIED ON SITE BEFORE FABRICATION.

LEGEND:

- (X1) DETAIL MARK NO.
- (X20) REFER SHEET NO.
- 1. F.F.L. -- FINISHED FLOOR LEVEL
- 2. S.F.L. -- STRUCTURAL FLOOR LEVEL
- 3. (R) -- REVERSED DETAIL

B.D. REF. :

ARCHITECT : ronaidiu & partners  
Ronald Liu & Partners (HK) Ltd.  
呂允祥建築師事務所 (香港) 有限公司


CLIENT : 信和置業有限公司  
Sino Land Company Limited

STRUCTURAL ENGINEER : AECOM

FAÇADE CONSULTANT : AECOM


MAIN CONTRACTOR : Gammon

T3 AG(高層) T3 AF(高層)

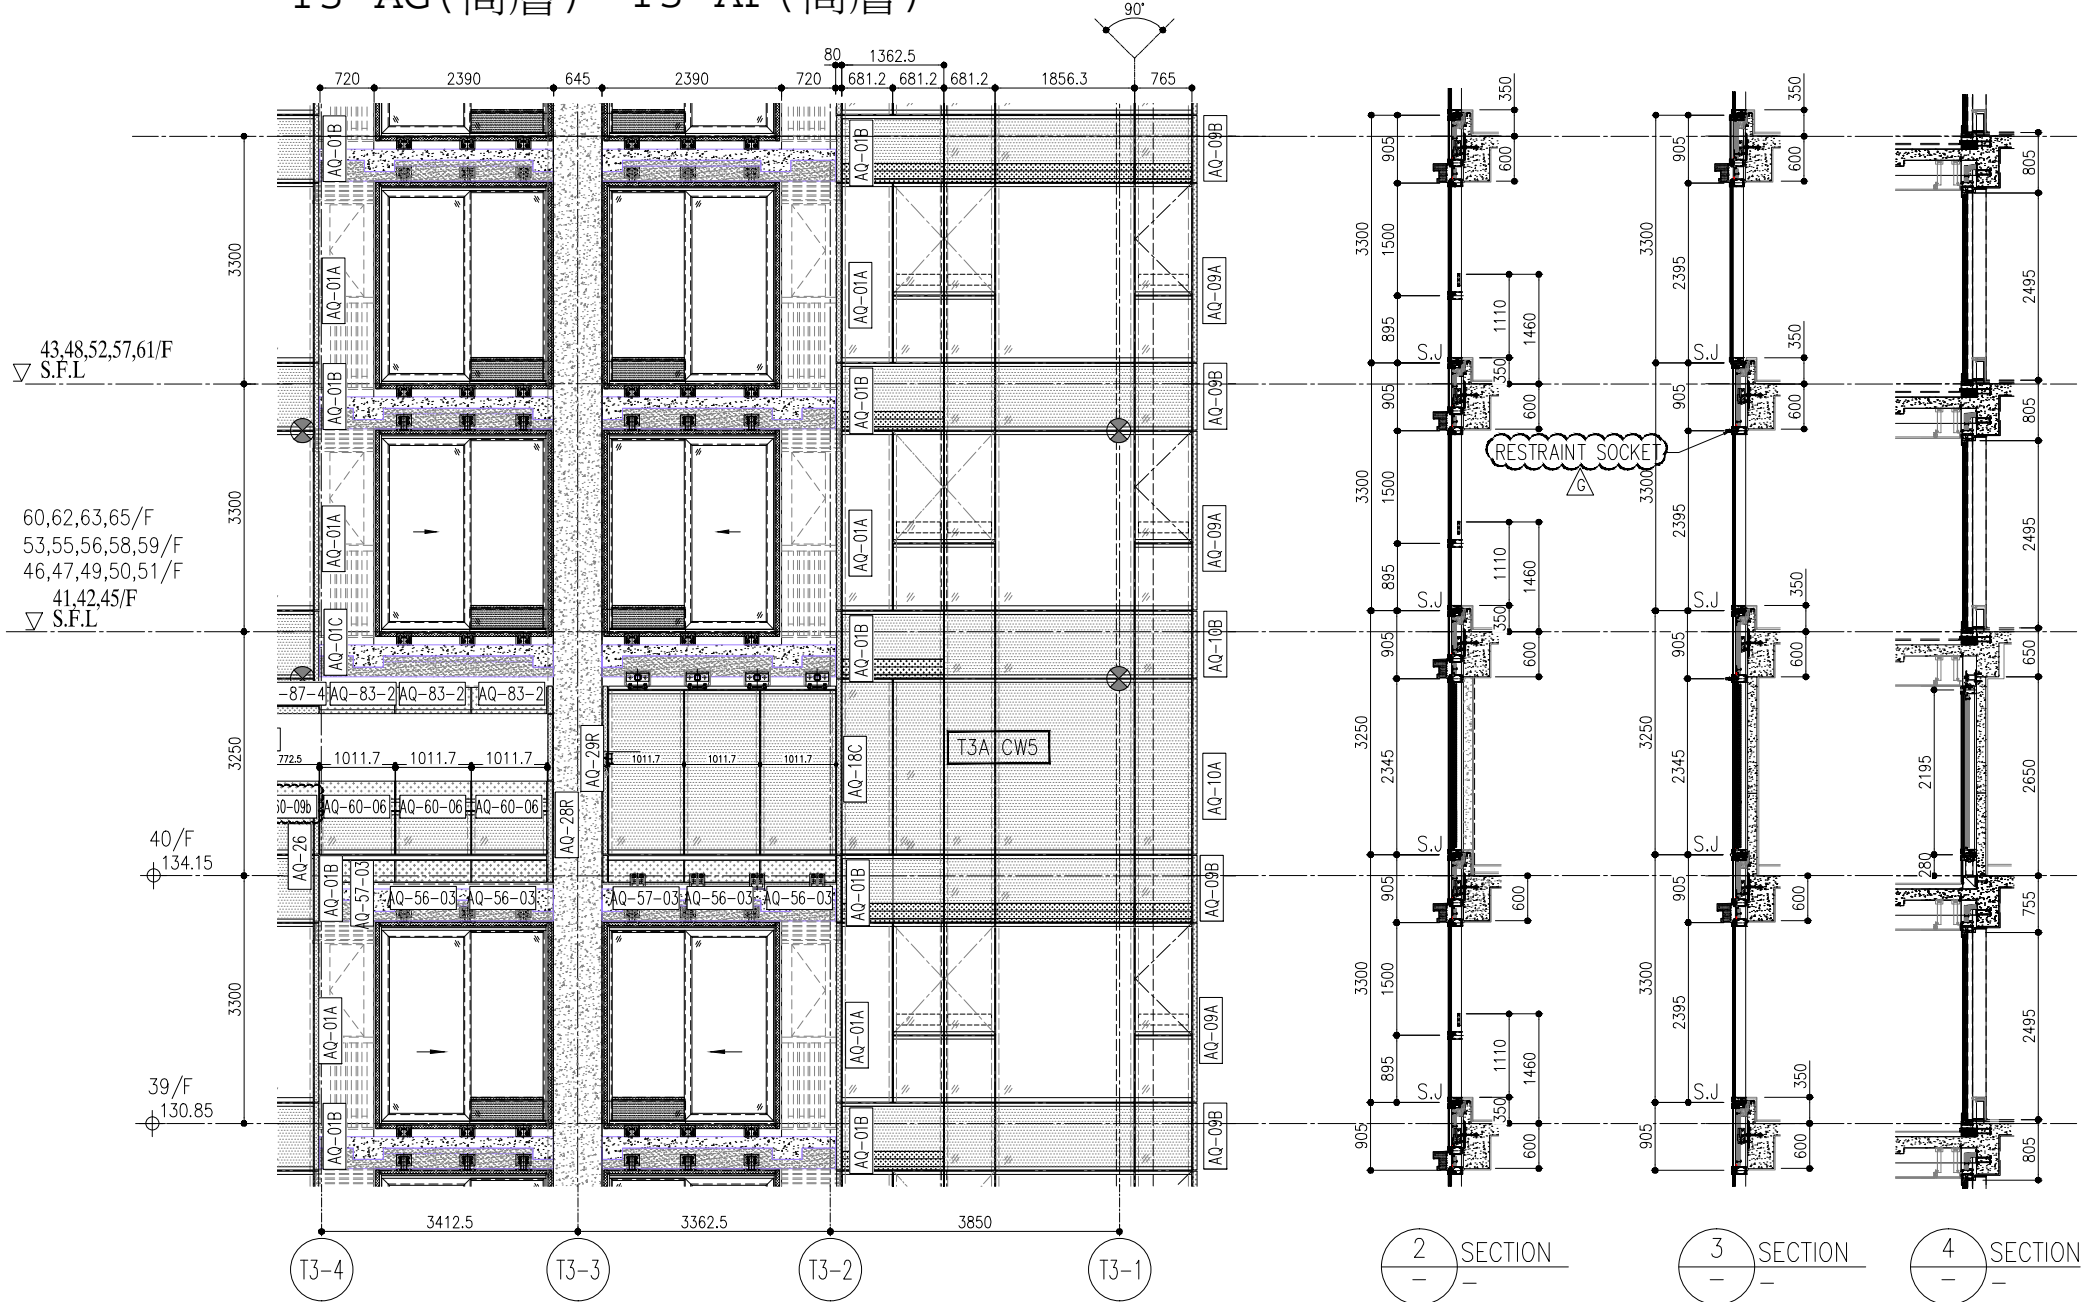


1 PART ELEVATION FOR CURTAIN WALL

2 SECTION  
3 SECTION  
4 SECTION

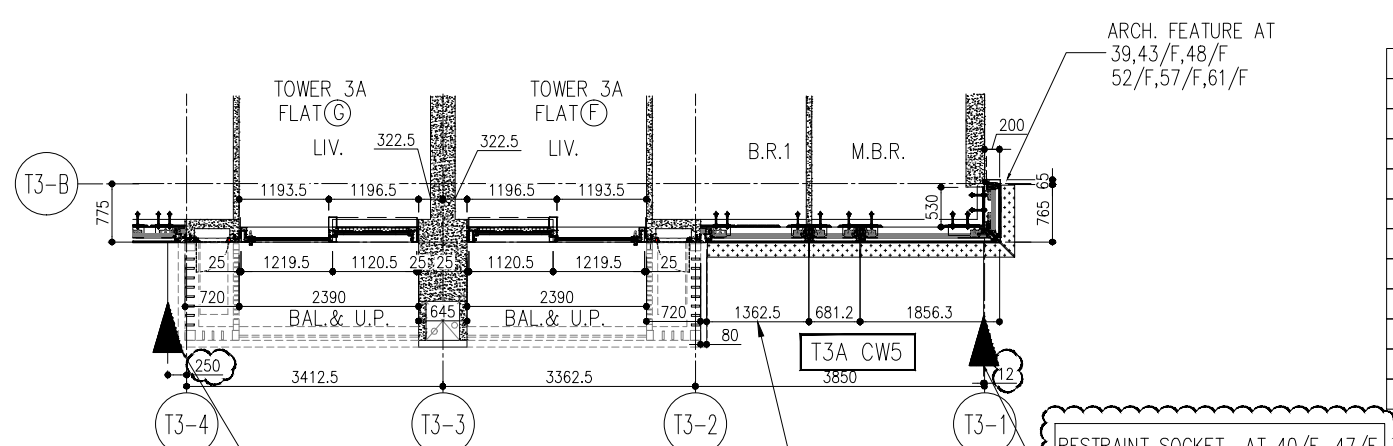

5 PART PLAN FOR CURTAIN WALL

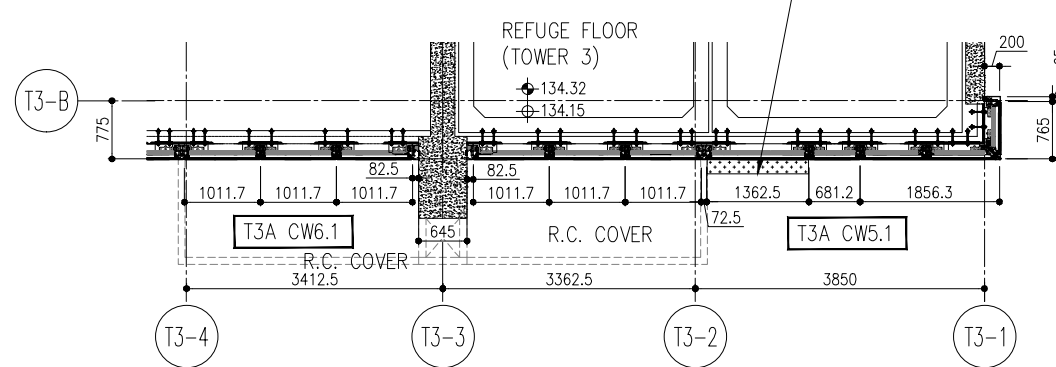

6 PART PLAN FOR CURTAIN WALL

R/F	+217.00				
67/F	+213.50				
26/F	+91.25	39/F	+130.85	52/F	+170.40
25/F	+87.95	38/F	+127.55	51/F	+167.10
23/F	+84.65	37/F	+124.25	50/F	+163.80
22/F	+81.35	36/F	+120.95	49/F	+160.50
21/F	+78.05	35/F	+117.65	48/F	+157.20
20/F	+74.75	33/F	+114.35	47/F	+153.90
19/F	+71.45	32/F	+111.05	46/F	+150.60
18/F	+68.15	31/F	+107.75	45/F	+147.30
17/F	+64.85	30/F	+104.45	43/F	+144.00
16/F	+61.55	29/F	+101.15	42/F	+140.70
15/F	+58.25	28/F	+97.85	41/F	+137.40
12/F	+54.95	27/F	+94.55	40/F	+134.15
		53/F	+177.00	55/F	+173.70

- LEGEND:
- (G1) 10mm THK. HEAT STRENGTHENED GLASS (OUTSIDE) + 12mm AIR SPACE + 12mm THK. TEMPERED GLASS
  - (G2) 10mm THK. HEAT STRENGTHENED GLASS (OUTSIDE) + 12mm AIR SPACE + 10mm THK. TEMPERED GLASS
  - (G3) 12mm THK. HEAT STRENGTHENED GLASS
  - (G4) 12mm THK. CLEAR TEMPERED GLASS ( INTERNAL PROTECTIVE BARRIER )
  - (G5) 10mm THK. HEAT STRENGTHENED GLASS (OUTSIDE) + 12mm AIR SPACE + 12mm THK. TEMPERED GLASS WITH REFLECTIVE COATING
  - (G6) 10mm THK. CLEAR TEMPERED GLASS
  - (G7) 8mm THK. CLEAR HEAT-STRENGTHENED GLASS + 52mm PVB + 8mm THK. CLEAR HEAT-STRENGTHENED GLASS
  - (G8) 3 mm THK. ALUM. CLADDING
  - (G9) 3 mm THK. ALUM. BACKPAN
  - S.J. - STACK JOINT
  - (RS) - RESTRAINT SOCKET

B.D. REF. :

CLIENT : 信和置業有限公司  
Sino Land Company Limited

ARCHITECT : ronaidiu & partners  
Ronald Liu & Partners (HK) Ltd.  
呂允祥建築師事務所 (香港) 有限公司

MAIN CONTRACTOR :

STRUCTURAL ENGINEER : Gammon

FAÇADE CONSULTANT : AECOM

NOTE :

- ALL DIMENSIONS ARE IN mm.
- ALL ELEVATIONS ARE VIEWED FROM OUTSIDE.
- ALL DIMENSIONS TO BE VERIFIED ON SITE BEFORE FABRICATION.

LEGEND :

- (X1) DETAIL MARK NO.
- (X20) REFER SHEET NO.
- 1. F.F.L. -- FINISHED FLOOR LEVEL
- 2. S.F.L. -- STRUCTURAL FLOOR LEVEL
- 3. (R) -- REVERSED DETAIL

NO.	DATE	REVISION	BY
A	03/12/21	REVISED AS PER COMMENTS	LS
B	20/12/21	REVISED AS PER COMMENTS	LS
C	22/01/22	REVISED AS PER COMMENTS	LS
D	22/04/06	REVISED AS PER COMMENTS	LS
E	25/05/22	REVISED AS PER COMMENTS	LS
F	26/07/22	REVISED AS PER COMMENTS	LS
G	18/08/22	REVISED AS PER COMMENTS	LS

DWG NO. : JB58-CW-PE312

REV. : G



DATE : 2

PROJECT : DEVELOPMENT AT LOHAS PARK N.T.

TITLE : PARTIAL CURTAIN WALL PLAN (TOWER 3)

**PE312**

信和置業有限公司  
SINO LAND COMPANY LIMITED

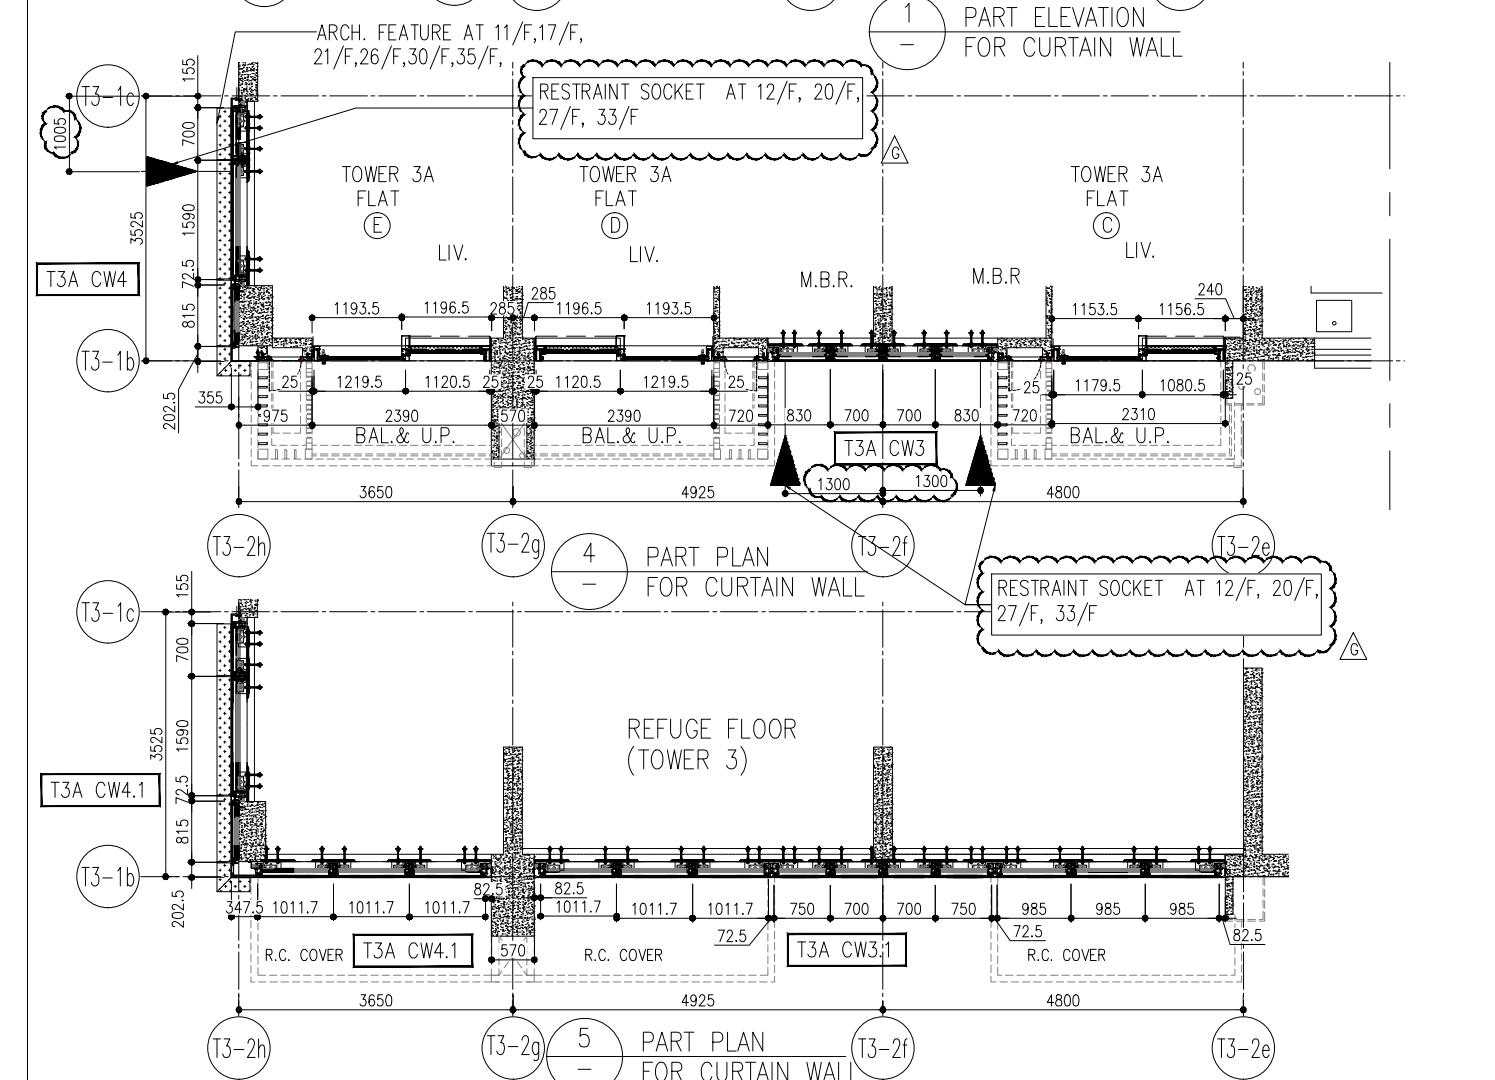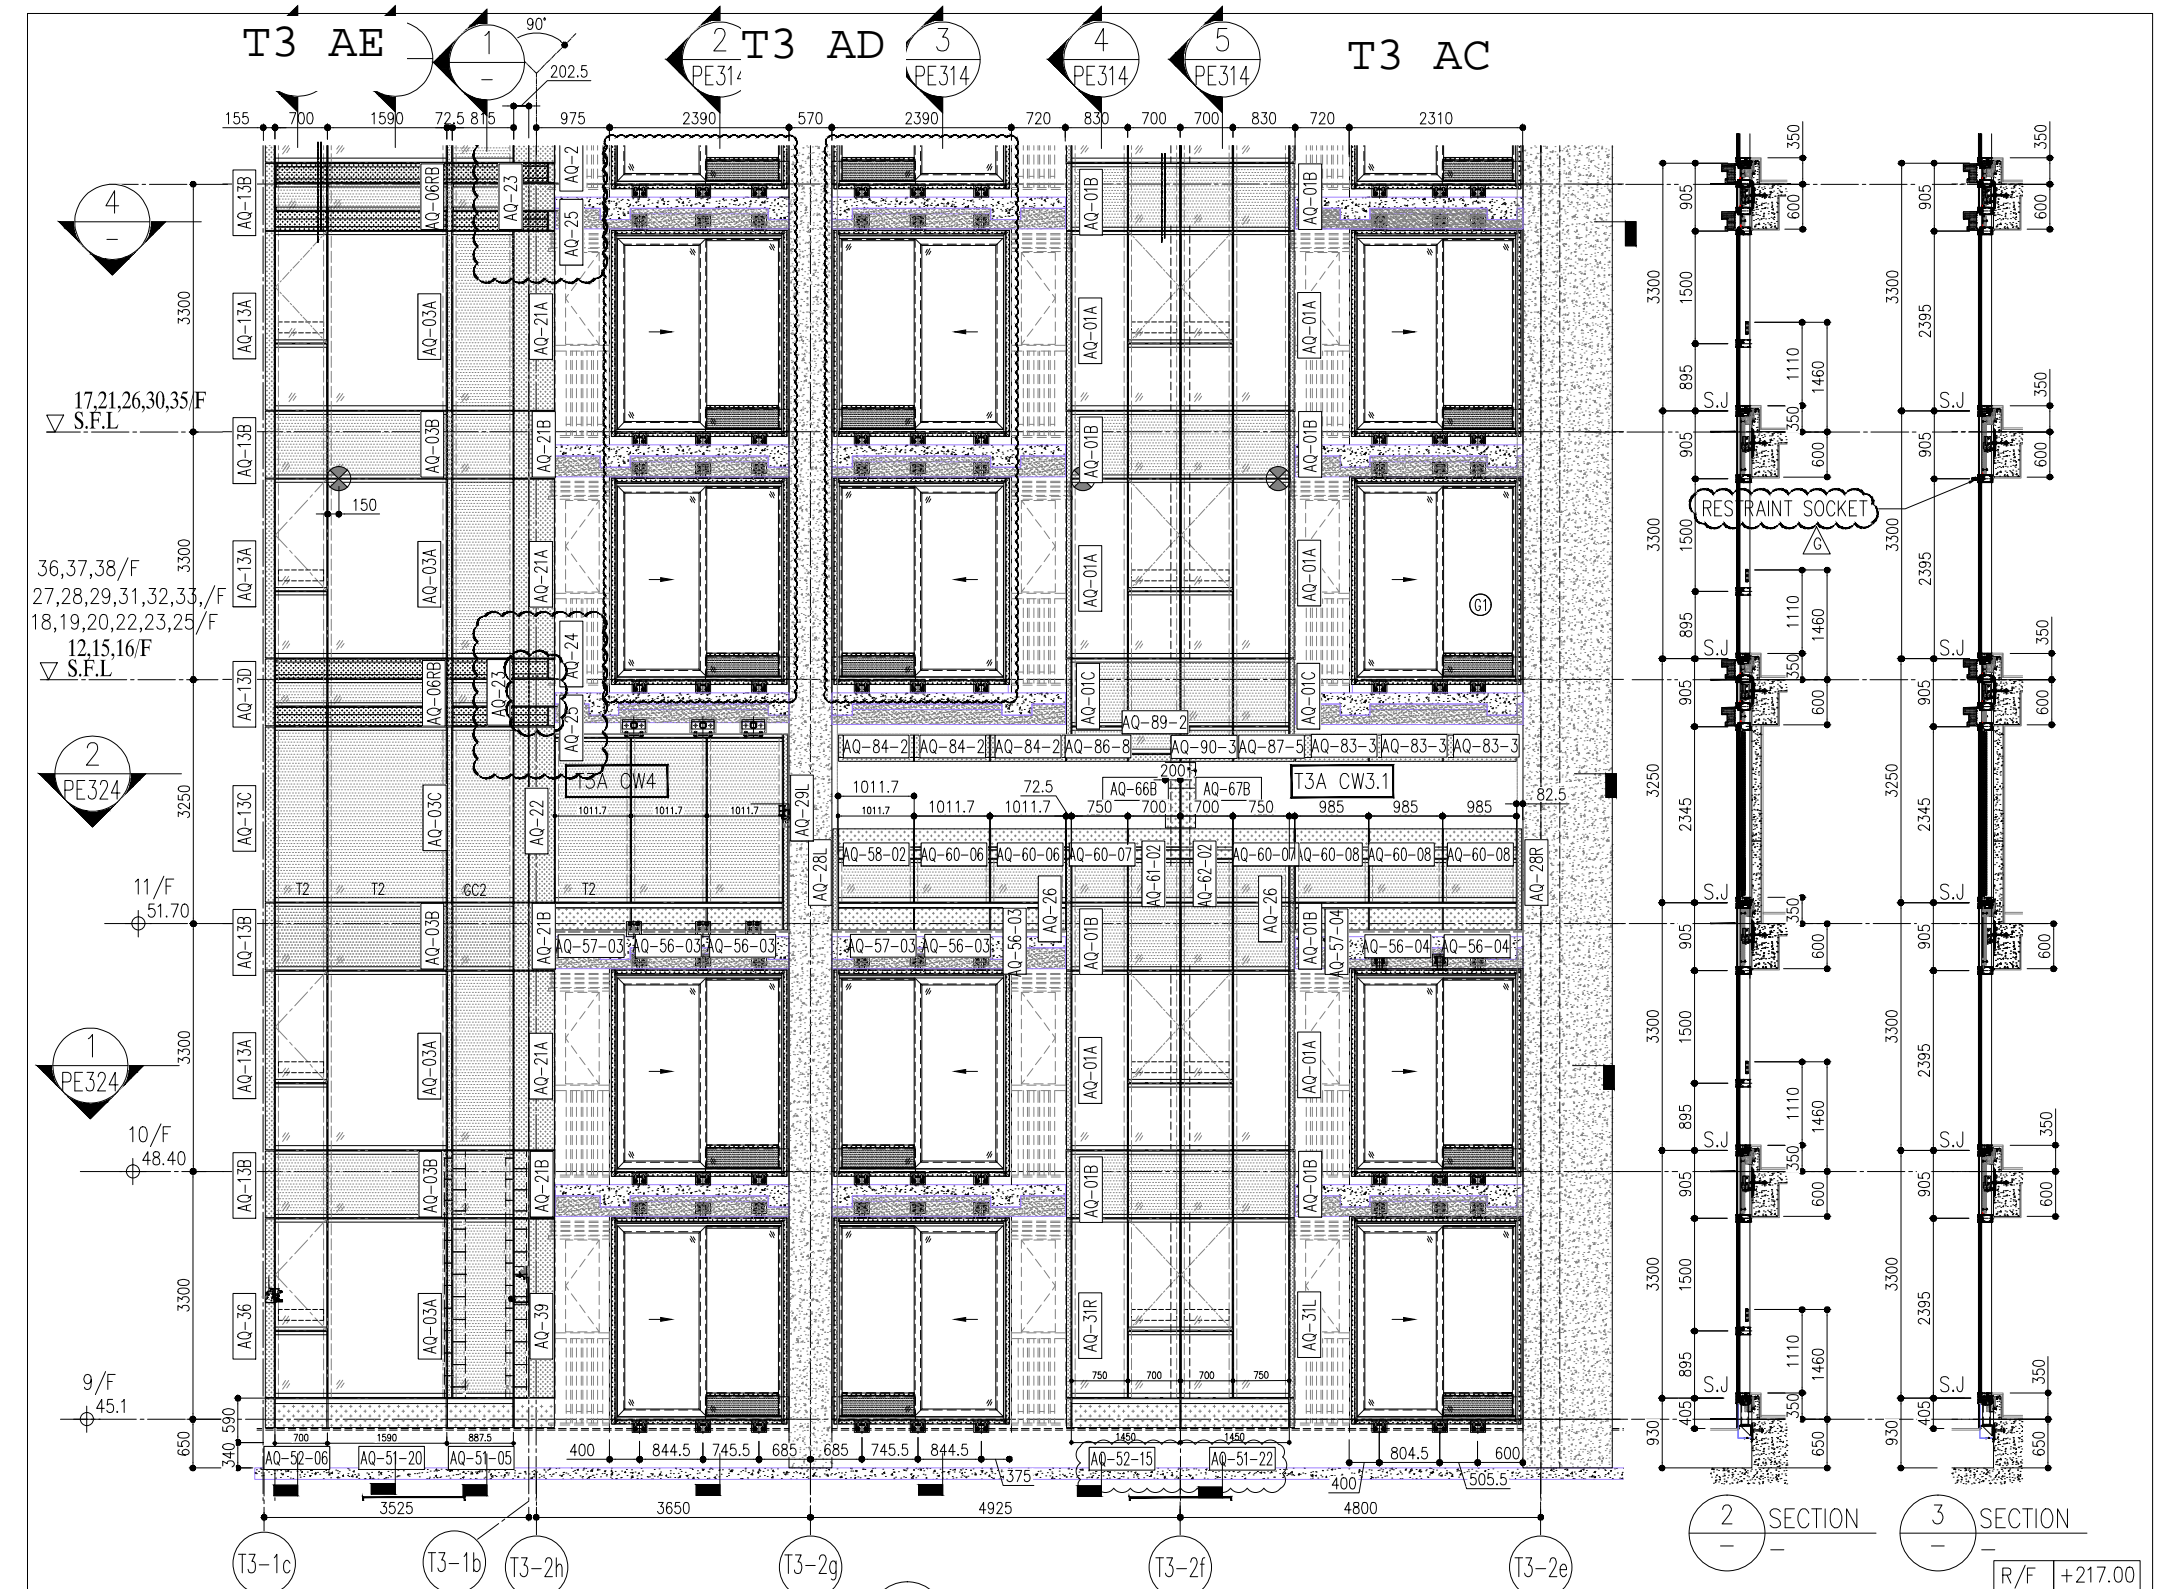

R/F	+217.00
67/F	+213.50
26/F	+91.25
25/F	+87.95
23/F	+84.65
22/F	+81.35
21/F	+78.05
20/F	+74.75
19/F	+71.45
18/F	+68.15
17/F	+64.85
16/F	+61.55
15/F	+58.25
12/F	+54.95
39/F	+130.85
38/F	+127.55
37/F	+124.25
36/F	+120.95
35/F	+117.65
33/F	+114.35
32/F	+111.05
31/F	+107.75
30/F	+104.45
29/F	+101.15
28/F	+97.85
27/F	+94.55
52/F	+170.40
51/F	+167.10
50/F	+163.80
49/F	+160.50
48/F	+157.20
47/F	+153.90
46/F	+150.60
45/F	+147.30
43/F	+144.00
42/F	+140.70
41/F	+137.40
40/F	+134.15
66/F	+210.00
65/F	+206.70
63/F	+203.40
62/F	+200.10
61/F	+196.80
60/F	+193.50
59/F	+190.20
58/F	+186.90
57/F	+183.60
56/F	+180.30
55/F	+177.00
53/F	+173.70

- LEGEND:**
- ① 10mm THK. HEAT STRENGTHENED GLASS (OUTSIDE) + 12mm AIR SPACE + 12mm THK. TEMPERED GLASS
  - ② 10mm THK. HEAT STRENGTHENED GLASS (OUTSIDE) + 12mm AIR SPACE + 10mm THK. TEMPERED GLASS
  - ③ 12mm THK. HEAT STRENGTHENED GLASS
  - ④ 12mm THK. CLEAR TEMPERED GLASS ( INTERNAL PROTECTIVE BARRIER )
  - ⑤ 10mm THK. HEAT STRENGTHENED GLASS (OUTSIDE) + 12mm THK. TEMPERED GLASS WITH REFLECTIVE COATING
  - ⑥ 10mm THK. CLEAR TEMPERED GLASS
  - ⑦ 8mm THK. CLEAR HEAT-STRENGTHENED GLASS + 1.52mm PVB + 8mm THK. CLEAR HEAT-STRENGTHENED GLASS
  - ⑧ 3 mm THK. ALUM. CLADDING
  - ⑨ 3 mm THK. ALUM. BACKPAN
  - S.J. - STACK JOINT
  - ⊗ - RESTRAINT SOCKET

DWG NO. : JB58-CW-PE313

REV. : G

# PE313

PROJECT : DEVELOPMENT OF LOHAS PARK N.T.

TITLE : PARTIAL CURTAIN WALL PLAN (TOWER 3)

DATE : 2012/12/21

SCALE : 1:50(A1)







**REVISIONS:**

NO.	DATE	REVISIONS AS PER COMMENTS	BY
A	03/12/21	REVISED AS PER COMMENTS	LS
B	20/12/21	REVISED AS PER COMMENTS	LS
C	22/04/06	REVISED AS PER COMMENTS	LS
D	25/05/22	REVISED AS PER COMMENTS	LS
E	26/07/22	REVISED AS PER COMMENTS	LS
F	18/08/22	REVISED AS PER COMMENTS	LS
G	18/08/22	REVISED AS PER COMMENTS	LS

**NOTE:**

- ALL DIMENSIONS ARE IN mm.
- ALL ELEVATIONS ARE VIEWED FROM OUTSIDE.
- ALL DIMENSIONS TO BE VERIFIED ON SITE BEFORE FABRICATION.

**LEGEND:**

- (X1) DETAIL MARK NO.
- (X00) REFER SHEET NO.
- 1. F.F.L. -- FINISHED FLOOR LEVEL
- 2. S.F.L. -- STRUCTURAL FLOOR LEVEL
- 3. (R) -- REVERSED DETAIL

**ARCHITECT:** ronaid lu & partners

**ARCHITECT:** Ronald Lu & Partners (HK) Ltd.

**MAIN CONTRACTOR:** 呂元梓建築師事務所 (香港) 有限公司

**CLIENT:** 信和置業有限公司

**CLIENT:** Sino Land Company Limited

**STRUCTURAL ENGINEER:** Gammon


**FAÇADE CONSULTANT:** AECOM

**B.D. REF.:**

T3 AE (高層)


T3 AD (高層)

T3 AC (高層)

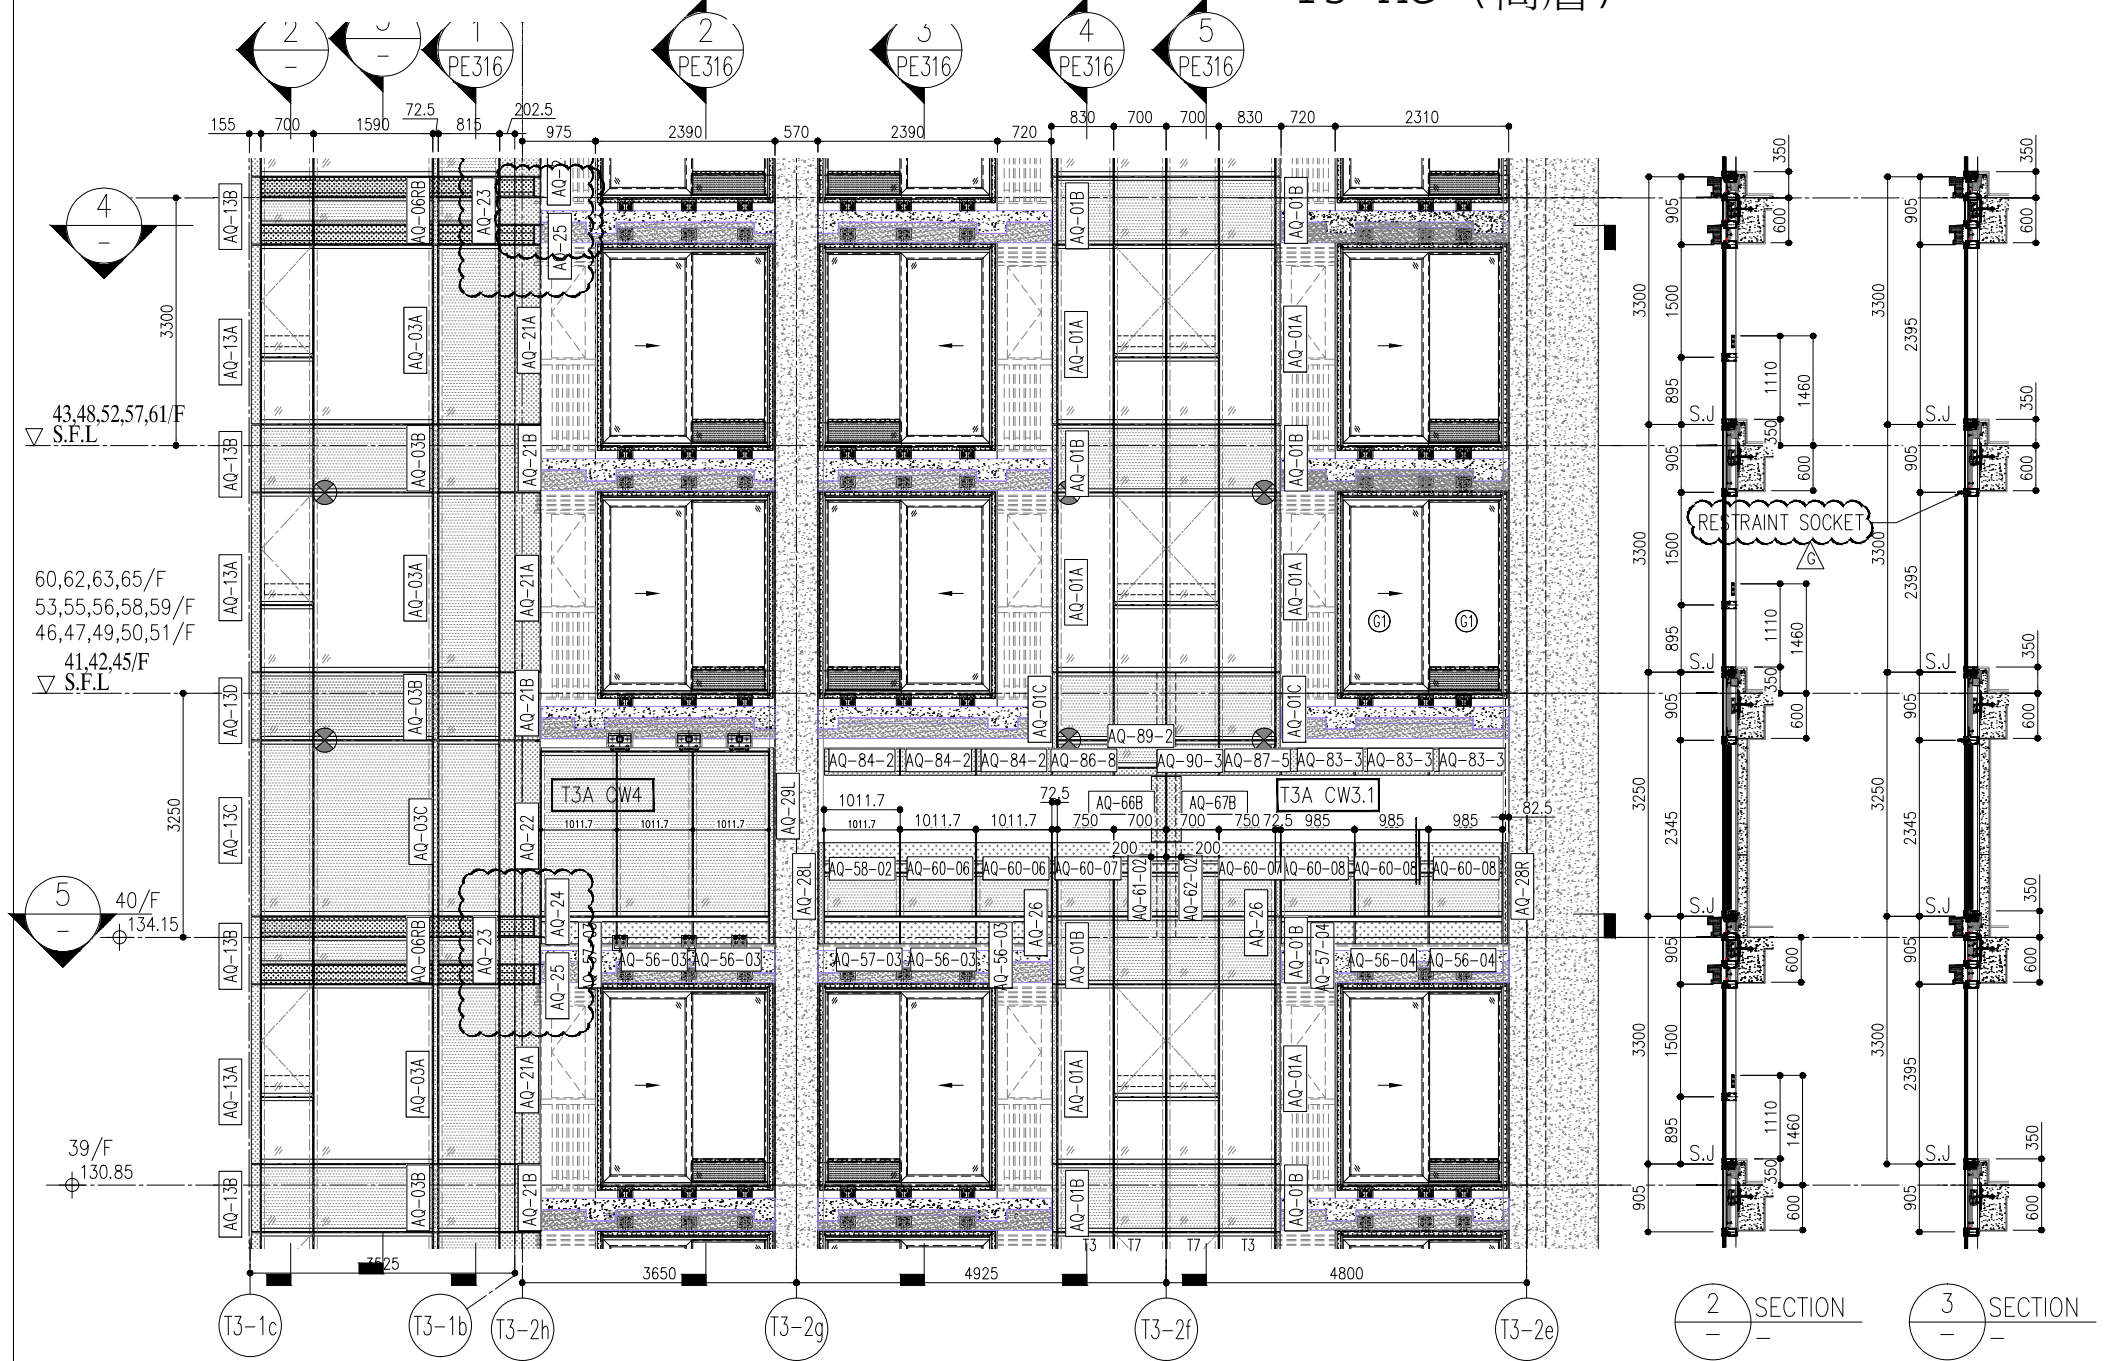


1 PART ELEVATION FOR CURTAIN WALL

2 SECTION  
3 SECTION

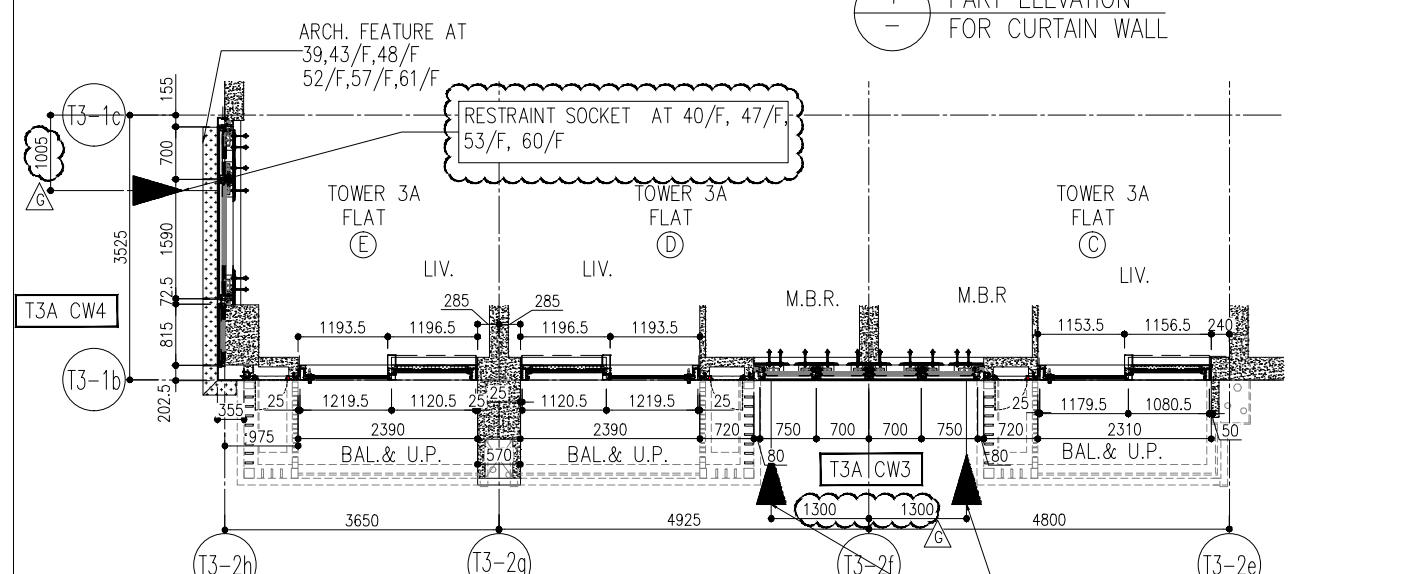

4 PART PLAN FOR CURTAIN WALL

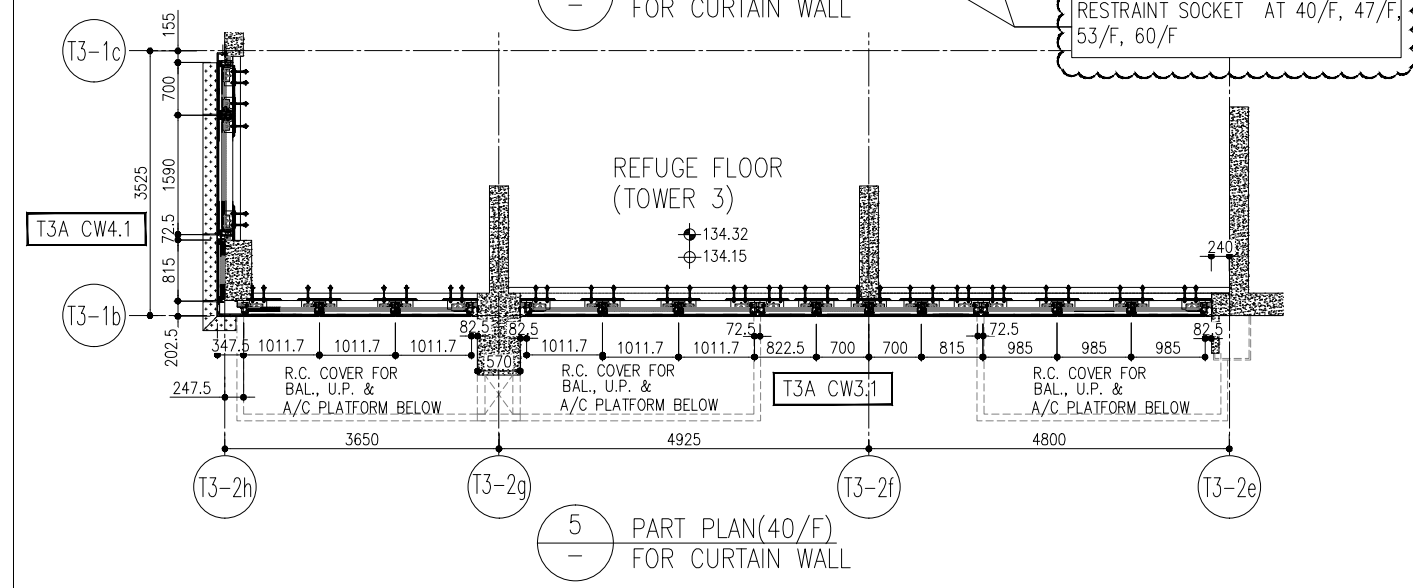

5 PART PLAN (40/F) FOR CURTAIN WALL

R/F	+217.00
67/F	+213.50
26/F	+91.25
25/F	+87.95
23/F	+84.65
22/F	+81.35
21/F	+78.05
20/F	+74.75
19/F	+71.45
18/F	+68.15
17/F	+64.85
16/F	+61.55
15/F	+58.25
12/F	+54.95
39/F	+130.85
37/F	+124.25
36/F	+120.95
35/F	+117.65
33/F	+114.35
32/F	+111.05
31/F	107.75
30/F	+104.45
29/F	+101.15
28/F	+97.85
27/F	+94.55
52/F	+170.40
51/F	+167.10
50/F	+163.80
49/F	+160.50
48/F	+157.20
47/F	+153.90
46/F	+150.60
45/F	+147.30
43/F	+144.00
42/F	+140.70
41/F	+137.40
40/F	+134.15
66/F	+210.00
65/F	+206.70
63/F	+203.40
62/F	+200.10
61/F	+196.80
60/F	+193.50
59/F	+190.20
58/F	+186.90
57/F	+183.60
56/F	+180.30
55/F	+177.00
53/F	+173.70

- LEGEND:
- (G1) - 10mm THK. HEAT STRENGTHENED GLASS (OUTSIDE) + 12mm AIR SPACE + 12mm THK. TEMPERED GLASS
  - (G2) - 10mm THK. HEAT STRENGTHENED GLASS (OUTSIDE) + 12mm AIR SPACE + 10mm THK. TEMPERED GLASS
  - (G3) - 12mm THK. HEAT STRENGTHENED GLASS
  - (G4) - 12mm THK. CLEAR TEMPERED GLASS ( INTERNAL PROTECTIVE BARRIER )
  - (G5) - 10mm THK. HEAT STRENGTHENED GLASS (OUTSIDE) + 12mm THK. TEMPERED GLASS WITH REFLECTED COATING
  - (G6) - 10mm THK. CLEAR TEMPERED GLASS
  - (G7) - 8mm THK. CLEAR HEAT-STRENGTHENED GLASS + 1.52mm PVB + 8mm THK. CLEAR HEAT-STRENGTHENED GLASS
  - (G8) - 3 mm THK. ALUM. CLADDING
  - (G9) - 3 mm THK. ALUM. BACKPAN
  - S.J. - STACK JOINT
  - (RS) - RESTRAINT SOCKET

DWG NO.: J858-CW-PE315

DATE: 2

TITLE: PARTIAL CURTAIN WALL PLAN (TOWER 3)

PROJECT: DEVELOPMENT OF LOHAS PARK N.T.

PE315

REVISIONS:

NO.	DATE	REVISION
A	03/12/21	REVISED AS PER COMMENTS
B	20/01/22	REVISED AS PER COMMENTS
C	22/04/06	REVISED AS PER COMMENTS
D	22/04/06	REVISED AS PER COMMENTS
E	25/05/22	REVISED AS PER COMMENTS
F	26/07/22	REVISED AS PER COMMENTS
G	18/08/22	REVISED AS PER COMMENTS

NOTE:

- ALL DIMENSIONS ARE IN mm.
- ALL ELEVATIONS ARE VIEWED FROM OUTSIDE.
- ALL DIMENSIONS TO BE VERIFIED ON SITE BEFORE FABRICATION.

LEGEND:

- (X1) - DETAIL MARK NO.
- (X20) - REFER SHEET NO.
- 1. F.F.L. - FINISHED FLOOR LEVEL
- 2. S.F.L. - STRUCTURAL FLOOR LEVEL
- 3. (R) - REVERSED DETAIL

ARCHITECT: ronaid lu & partners

ARCHITECT: 信和置業有限公司 Sino Land Company Limited

STRUCTURAL ENGINEER: Gammon

FAÇADE CONSULTANT: AECOM

CLIENT: 信和置業有限公司 Sino Land Company Limited

MAIN CONTRACTOR: Ronald Lu & Partners (香港) 有限公司

B.D. REF.: