美 特 鋁 質 有 限 公 司
MIDI ALUMINIUM FABRICATOR LTD.

工程指示 / 要求簡箋(E.I.)

工程指示編號：EI / 5635 / 23　　修改版次： -

工程編號　：J - 858　　工程名稱　：將軍澳日出康城 11

工程項目　：幕牆 收口鋁板 大貨 (放行 T1　9-17/F 共 8 層)

收件人　：生統　　發件人　：Helen Chak　　日　期　：12/01/2023

☐要求提供 / ☐確認 事項 ：

( ) 初步鋁料 B.M.　( ) 加工拆圖，然後生產　( ) 尺寸表

( ) 正式鋁料 B.M.　( ) 技術上資料 / 指示　( ) 報價

( ) 配件 B.M.　( ) 樣辦或貨品說明書　( ) 分判合約

內容 ：

請按加工圖生產鋁板送地盆， 包括 AB 座大鋁板 (圖紙 AQ75-AQ90)

1. 顏色為 ECD3X10099-JF2 香檳金
2. (放行 T1　9-17/F　共 8 層) ，其餘大貨 備原片，備油漆
3. 請最優先生產 T1 的 12,15,16/ F 供樣板層起貨
4. 附 BM excel ，分層數量表 excel ， 圖則表 excel，位置圖
5. 注意：有使用鋁料 N00814 和鋁料 X86319 加力骨
   如鋁角 N00814 (20x16x3mm) 鋁料未有料，請使用倉存料介 (EI5617A 已 訂料)
   如加力骨 X86319 鋁料未有料，請使用鋁板摺 (EI5617 已訂料)
6. 鋁角收鋁板位置有修平頭螺絲
7. 有特急 15 件。請優先。
8. AQ51-AQ73 (9,11,40/F 的鋁板，待通知才生產) 先暫停。
9. 隔火層鋁板去水孔為 6x20 長孔 mm。

請在 2023.02.21 前完成上列要求。

附： 頁

☐ 原合約工程包　☐ 原合約工程加 / 減賬　☐ 新工程報價

☑Bun

分發東莞各部門 ：

( )生產技術總監☐連附件　( )技術部　☐連附件　( )生產部　☐連附件　( )機械設計部☐連附件

( )採購部　☐連附件　(✓)生產統籌部☑連附件　(✓)小羅&清　☑連附件

( )質檢部　☐連附件　( )會計部　☐連附件　( )報關組　☐連附件　(✓)其他 楊榮輝 ☑連附件

分發香港各部門 ：

( )行政部☐連附件　( )會計部☐連附件　( )統籌部☐連附件　(✓)工程部地盤科文 積哥 ☑連附件

( )採購部☐連附件　( )QS 部 ☐連附件　( )維修部☐連附件　( )其他 _____☐連附件

傳遞編號：

HK 0075 / 23

發件人簽署：

項目經理簽署：

美特鋁質 有限公司 MIDI Aluminium Fabricator Ltd.	工程號: J-858	計算: L.S	日期:	20/12/2022		送呈:
	地盤名稱:康城11期	核對:	日期:			副本:
廠用鋁板B.M.表	項目類別: T1,T2,T3收口鋁板	批准:	日期:			
BM編號:	修改版次: A	ECD3X10099S-JF2 香檳金	總V.F.:	4374.5	總重量: 30873.9	此BM依據拆圖資料計算

序號	修改內容	鋁板圖號	鋁板名稱	顏色	實用	後備	總數	總重量	單件展開面積	總展開面積	單件V.F.	總V.F.	備註
									平方米		平方米		
1		AQ-01A	3mm厚鋁板	ECD3X10099S-JF2	1597		1597	4266.2	0.329	524.748	0.329	524.748	
2		AQ-01B	3mm厚鋁板	ECD3X10099S-JF2	1658		1658	1709.7	0.127	210.290	0.127	210.290	
3		AQ-01C	3mm厚鋁板	ECD3X10099S-JF2	56		56	80.1	0.176	9.852	0.176	9.852	
4		AQ-01D	3mm厚鋁板	ECD3X10099S-JF2	47		47	205.1	0.537	25.225	0.537	25.225	
5		AQ-01E	3mm厚鋁板	ECD3X10099S-JF2	50		50	83.1	0.204	10.222	0.204	10.222	
6		AQ-01F	3mm厚鋁板	ECD3X10099S-JF2	2		2	5.2	0.322	0.644	0.322	0.644	
7		AQ-02A	3mm厚鋁板	ECD3X10099S-JF2	274		274	766.3	0.344	94.252	0.344	94.252	
8		AQ-02B	3mm厚鋁板	ECD3X10099S-JF2	280		280	299.9	0.132	36.886	0.132	36.886	
9		AQ-03A	3mm厚鋁板	ECD3X10099S-JF2	279		279	852.6	0.376	104.868	0.376	104.868	
10		AQ-03B	3mm厚鋁板	ECD3X10099S-JF2	225		225	271.9	0.149	33.440	0.149	33.440	
11		AQ-03C	3mm厚鋁板	ECD3X10099S-JF2	18		18	53.9	0.368	6.629	0.368	6.629	
12		AQ-03D	3mm厚鋁板	ECD3X10099S-JF2	16		16	47.9	0.368	5.893	0.368	5.893	
13		AQ-04LA	3mm厚鋁板	ECD3X10099S-JF2	367		367	1171.4	0.393	144.086	0.393	144.086	
14		AQ-04LB	3mm厚鋁板	ECD3X10099S-JF2	177		177	222.8	0.155	27.409	0.155	27.409	
15		AQ-04LC	3mm厚鋁板	ECD3X10099S-JF2	4		4	4.8	0.149	0.594	0.149	0.594	
16		AQ-04RA	3mm厚鋁板	ECD3X10099S-JF2	140		140	446.9	0.393	54.965	0.393	54.965	
17		AQ-04RB	3mm厚鋁板	ECD3X10099S-JF2	108		108	136.0	0.155	16.724	0.155	16.724	
18		AQ-05LA	3mm厚鋁板	ECD3X10099S-JF2	172		172	216.5	0.155	26.635	0.155	26.635	
19		AQ-05LB	3mm厚鋁板	ECD3X10099S-JF2	9		9	10.8	0.148	1.332	0.148	1.332	
20		AQ-05RA	3mm厚鋁板	ECD3X10099S-JF2	32		32	40.3	0.155	4.955	0.155	4.955	

美特鋁質 有限公司 MIDI Aluminium Fabricator Ltd.	工程號: J-858	計算: L.S	日期:	20/12/2022		送呈:
	地盤名稱:康城11期	核對:	日期:			副本:
廠用鋁板B.M.表	項目類別: T1,T2,T3收口鋁板	批准:	日期:			
BM編號:	修改版次: A	ECD3X10099S-JF2 香檳金	總V.F.:	4374.5	總重量: 30873.9	此BM依據拆圖資料計算

序號	修改內容	鋁板圖號	鋁板名稱	顏色	實用	後備	總數	總重量	單件展開面積	總展開面積	單件V.F.	總V.F.	備註
									平方米		平方米		
21		AQ-05RB	3mm厚鋁板	ECD3X10099S-JF2	38		38	45.7	0.148	5.625	0.148	5.625	
22		AQ-06LA	3mm厚鋁板	ECD3X10099S-JF2	20		20	25.2	0.155	3.097	0.155	3.097	
23		AQ-06LB	3mm厚鋁板	ECD3X10099S-JF2	2		2	2.4	0.148	0.296	0.148	0.296	
24		AQ-06RB	3mm厚鋁板	ECD3X10099S-JF2	35		35	42.1	0.148	5.181	0.148	5.181	
25		AQ-07A	3mm厚鋁板	ECD3X10099S-JF2	137		137	911.8	0.819	112.155	0.819	112.155	
26		AQ-07B	3mm厚鋁板	ECD3X10099S-JF2	6		6	39.1	0.802	4.813	0.802	4.813	
27		AQ-08A	3mm厚鋁板	ECD3X10099S-JF2	146		146	383.3	0.323	47.143	0.323	47.143	
28		AQ-09A	3mm厚鋁板	ECD3X10099S-JF2	458		458	2782.4	0.747	342.242	0.747	342.242	
29		AQ-09B	3mm厚鋁板	ECD3X10099S-JF2	468		468	1133.9	0.298	139.465	0.298	139.465	
30		AQ-10A	3mm厚鋁板	ECD3X10099S-JF2	20		20	115.6	0.711	14.221	0.711	14.221	
31		AQ-10B	3mm厚鋁板	ECD3X10099S-JF2	20		20	46.7	0.287	5.739	0.287	5.739	
32		AQ-11A	3mm厚鋁板	ECD3X10099S-JF2	43		43	172.8	0.494	21.249	0.494	21.249	
33		AQ-11B	3mm厚鋁板	ECD3X10099S-JF2	35		35	55.5	0.195	6.822	0.195	6.822	
34		AQ-11C	3mm厚鋁板	ECD3X10099S-JF2	2		2	7.9	0.484	0.968	0.484	0.968	
35		AQ-12A	3mm厚鋁板	ECD3X10099S-JF2	11		11	17.4	0.195	2.144	0.195	2.144	
36		AQ-13C	3mm厚鋁板	ECD3X10099S-JF2	2		2	9.6	0.590	1.179	0.590	1.179	

美特鋁質 有限公司 MIDI Aluminium Fabricator Ltd.	工程號: J-858	計算: L.S	日期:	20/12/2022		送呈:
	地盤名稱:康城11期	核對:	日期:			副本:
廠用鋁板B.M.表	項目類別: T1,T2,T3收口鋁板	批准:	日期:			
BM編號:	修改版次: A	ECD3X10099S-JF2 香檳金	總V.F.:	4374.5	總重量: 30873.9	此BM依據拆圖資料計算

序號	修改內容	鋁板圖號	鋁板名稱	顏色	實用	後備	總數	總重量	單件展開面積	總展開面積	單件V.F.	總V.F.	備註
									平方米		平方米		
37		AQ-13D	3mm厚鋁板	ECD3X10099S-JF2	2		2	3.9	0.238	0.476	0.238	0.476	
38		AQ-13A	3mm厚鋁板	ECD3X10099S-JF2	47		47	236.3	0.619	29.070	0.619	29.070	
39		AQ-13B	3mm厚鋁板	ECD3X10099S-JF2	48		48	95.3	0.244	11.725	0.244	11.725	
40		AQ-14A	3mm厚鋁板	ECD3X10099S-JF2	184		184	1419.3	0.949	174.574	0.943	173.500	
41		AQ-14B	3mm厚鋁板	ECD3X10099S-JF2	149		149	442.5	0.365	54.425	0.359	53.556	
42		AQ-14C	3mm厚鋁板	ECD3X10099S-JF2	8		8	60.4	0.929	7.435	0.923	7.388	
43		AQ-15A	3mm厚鋁板	ECD3X10099S-JF2	35		35	103.9	0.365	12.784	0.359	12.580	
44		AQ-16A	3mm厚鋁板	ECD3X10099S-JF2	12		12	35.6	0.365	4.383	0.359	4.313	
45		AQ-17A	3mm厚鋁板	ECD3X10099S-JF2	90		90	653.2	0.893	80.341	0.887	79.847	
46		AQ-17B	3mm厚鋁板	ECD3X10099S-JF2	92		92	257.1	0.344	31.618	0.338	31.113	
47		AQ-17D	3mm厚鋁板	ECD3X10099S-JF2	4		4	7.3	0.337	1.348	0.332	1.327	
48		AQ-18A	3mm厚鋁板	ECD3X10099S-JF2	2		2	8.3	0.767	1.534	0.762	1.524	
49		AQ-18B	3mm厚鋁板	ECD3X10099S-JF2	2		2	4.8	0.446	0.892	0.446	0.892	
50		AQ-18C	3mm厚鋁板	ECD3X10099S-JF2	4		4	8.1	0.373	1.493	0.373	1.493	
51		AQ-19A	3mm厚鋁板	ECD3X10099S-JF2	44		44	152.4	0.639	28.117	0.635	27.944	
52		AQ-19B	3mm厚鋁板	ECD3X10099S-JF2	35		35	46.7	0.246	8.611	0.242	8.473	
53		AQ-19C	3mm厚鋁板	ECD3X10099S-JF2	2		2	6.8	0.626	1.252	0.622	1.244	
54		AQ-20A	3mm厚鋁板	ECD3X10099S-JF2	11		11	14.7	0.246	2.706	0.242	2.663	

美特鋁質 有限公司 MIDI Aluminium Fabricator Ltd.	工程號: J-858	計算: L.S	日期:	20/12/2022		送呈:
	地盤名稱:康城11期	核對:	日期:			副本:
廠用鋁板B.M.表	項目類別: T1,T2,T3收口鋁板	批准:	日期:			
BM編號:	修改版次: A	ECD3X10099S-JF2 香檳金	總V.F.:	4374.5	總重量: 30873.9	此BM依據拆圖資料計算

序號	修改內容	鋁板圖號	鋁板名稱	顏色	實用	後備	總數	總重量	單件展開面積	總展開面積	單件V.F.	總V.F.	備註
									平方米		平方米		
55		AQ-21A	3mm厚鋁板	ECD3X10099S-JF2	47		47	389.4	1.529	71.845	1.520	71.433	
56		AQ-21B	3mm厚鋁板	ECD3X10099S-JF2	38		38	121.1	0.588	22.349	0.579	22.015	
57		AQ-22	3mm厚鋁板	ECD3X10099S-JF2	2		2	16.3	1.502	3.004	1.493	2.986	
58		AQ-23	3mm厚鋁板	ECD3X10099S-JF2	12		12	17.2	0.265	3.183	0.248	2.972	
59		AQ-24	3mm厚鋁板	ECD3X10099S-JF2	12		12	3.2	0.050	0.596	0.047	0.569	
60		AQ-25	3mm厚鋁板	ECD3X10099S-JF2	12		12	3.1	0.047	0.567	0.047	0.567	
61		AQ-26	3mm厚鋁板	ECD3X10099S-JF2	46		46	25.6	0.103	4.720	0.103	4.720	
62		AQ-27	3mm厚鋁板	ECD3X10099S-JF2	10		10	7.8	0.144	1.444	0.144	1.444	
63		AQ-28L	3mm厚鋁板	ECD3X10099S-JF2	28		28	29.6	0.195	5.459	0.195	5.459	
64		AQ-28R	3mm厚鋁板	ECD3X10099S-JF2	40		40	42.3	0.195	7.798	0.195	7.798	
65		AQ-29L	3mm厚鋁板	ECD3X10099S-JF2	8		8	16.0	0.368	2.946	0.368	2.946	
66		AQ-29R	3mm厚鋁板	ECD3X10099S-JF2	2		2	4.0	0.368	0.737	0.368	0.737	
67		AQ-30	3mm厚鋁板	ECD3X10099S-JF2	1		1	3.4	0.624	0.624	0.624	0.624	
68		AQ-31L	3mm厚鋁板	ECD3X10099S-JF2	19		19	39.3	0.381	7.246	0.381	7.246	
69		AQ-31R	3mm厚鋁板	ECD3X10099S-JF2	16		16	33.1	0.381	6.102	0.381	6.102	
70		AQ-32L	3mm厚鋁板	ECD3X10099S-JF2	1		1	2.2	0.401	0.401	0.401	0.401	
71		AQ-32R	3mm厚鋁板	ECD3X10099S-JF2	5		5	10.9	0.401	2.006	0.401	2.006	
72		AQ-33	3mm厚鋁板	ECD3X10099S-JF2	3		3	15.4	0.948	2.845	0.948	2.845	
73		AQ-34L	3mm厚鋁板	ECD3X10099S-JF2	6		6	28.1	0.865	5.189	0.865	5.189	
74		AQ-34R	3mm厚鋁板	ECD3X10099S-JF2	4		4	18.7	0.865	3.459	0.865	3.459	

美特鋁質 有限公司 MIDI Aluminium Fabricator Ltd.	工程號: J-858	計算: L.S	日期:	20/12/2022		送呈:
	地盤名稱:康城11期	核對:	日期:			副本:
廠用鋁板B.M.表	項目類別: T1,T2,T3收口鋁板	批准:	日期:			
BM編號:	修改版次: A	ECD3X10099S-JF2 香檳金	總V.F.:	4374.5	總重量: 30873.9	此BM依據拆圖資料計算

序號	修改內容	鋁板圖號	鋁板名稱	顏色	實用	後備	總數	總重量	單件展開面積	總展開面積	單件V.F.	總V.F.	備註
									平方米		平方米		
75		AQ-35	3mm厚鋁板	ECD3X10099S-JF2	1		1	3.1	0.572	0.572	0.572	0.572	
76		AQ-36	3mm厚鋁板	ECD3X10099S-JF2	1		1	3.8	0.697	0.697	0.697	0.697	
77		AQ-37	3mm厚鋁板	ECD3X10099S-JF2	4		4	24.0	1.108	4.431	1.096	4.384	
78		AQ-38	3mm厚鋁板	ECD3X10099S-JF2	2		2	11.3	1.042	2.084	1.031	2.062	
79		AQ-39	3mm厚鋁板	ECD3X10099S-JF2	1		1	9.7	1.784	1.784	1.767	1.767	
80		AQ-51-01	3mm厚鋁板	ECD3X10099S-JF2	3		3	4.3	0.264	0.792	0.240	0.721	
81		AQ-51-02	3mm厚鋁板	ECD3X10099S-JF2	1		1	1.9	0.346	0.346	0.317	0.317	
82		AQ-51-03	3mm厚鋁板	ECD3X10099S-JF2	3		3	5.5	0.338	1.013	0.309	0.928	
83		AQ-51-04	3mm厚鋁板	ECD3X10099S-JF2	1		1	3.9	0.715	0.715	0.660	0.660	
84		AQ-51-05	3mm厚鋁板	ECD3X10099S-JF2	3		3	6.1	0.378	1.133	0.346	1.039	
85		AQ-51-06	3mm厚鋁板	ECD3X10099S-JF2	20		20	32.6	0.301	6.021	0.275	5.502	
86		AQ-51-07	3mm厚鋁板	ECD3X10099S-JF2	3		3	10.6	0.653	1.960	0.603	1.810	
87		AQ-51-08	3mm厚鋁板	ECD3X10099S-JF2	3		3	9.5	0.587	1.761	0.541	1.624	
88		AQ-51-09	3mm厚鋁板	ECD3X10099S-JF2	9		9	27.9	0.572	5.145	0.527	4.745	
89		AQ-51-10	3mm厚鋁板	ECD3X10099S-JF2	19		19	30.2	0.293	5.573	0.268	5.090	
90		AQ-51-11	3mm厚鋁板	ECD3X10099S-JF2	3		3	8.9	0.550	1.650	0.507	1.520	
91		AQ-51-12	3mm厚鋁板	ECD3X10099S-JF2	2		2	6.5	0.597	1.194	0.551	1.102	
92		AQ-51-13	3mm厚鋁板	ECD3X10099S-JF2	1		1	3.7	0.681	0.681	0.629	0.629	
93		AQ-51-14	3mm厚鋁板	ECD3X10099S-JF2	1		1	3.6	0.661	0.661	0.610	0.610	
94		AQ-51-15	3mm厚鋁板	ECD3X10099S-JF2	2		2	3.5	0.326	0.651	0.298	0.596	

美特鋁質 有限公司 MIDI Aluminium Fabricator Ltd.	工程號: J-858	計算: L.S	日期:	20/12/2022		送呈:
	地盤名稱:康城11期	核對:	日期:			副本:
廠用鋁板B.M.表	項目類別: T1,T2,T3收口鋁板	批准:	日期:			
BM編號:	修改版次: A	ECD3X10099S-JF2 香檳金	總V.F.:	4374.5	總重量: 30873.9	此BM依據拆圖資料計算

序號	修改內容	鋁板圖號	鋁板名稱	顏色	實用	後備	總數	總重量	單件展開面積	總展開面積	單件V.F.	總V.F.	備註
									平方米		平方米		
95		AQ-51-16	3mm厚鋁板	ECD3X10099S-JF2	1		1	4.0	0.735	0.735	0.679	0.679	
96		AQ-51-17	3mm厚鋁板	ECD3X10099S-JF2	2		2	7.5	0.692	1.383	0.639	1.278	
97		AQ-51-18	3mm厚鋁板	ECD3X10099S-JF2	1		1	2.1	0.388	0.388	0.356	0.356	
98		AQ-51-19	3mm厚鋁板	ECD3X10099S-JF2	1		1	1.7	0.321	0.321	0.294	0.294	
99		AQ-51-20	3mm厚鋁板	ECD3X10099S-JF2	1		1	3.6	0.665	0.665	0.614	0.614	
100		AQ-51-21	3mm厚鋁板	ECD3X10099S-JF2	1		1	1.4	0.266	0.266	0.242	0.242	
101		AQ-51-22	3mm厚鋁板	ECD3X10099S-JF2	1		1	0.0	0.000	0.000	0.000	0.000	
102		AQ-51-23	3mm厚鋁板	ECD3X10099S-JF2	1		1	1.9	0.348	0.348	0.319	0.319	
103		AQ-52-01	3mm厚鋁板	ECD3X10099S-JF2	3		3	4.4	0.270	0.811	0.241	0.724	
104		AQ-52-02	3mm厚鋁板	ECD3X10099S-JF2	1		1	4.2	0.769	0.769	0.706	0.706	
105		AQ-52-03	3mm厚鋁板	ECD3X10099S-JF2	10		10	31.3	0.578	5.782	0.528	5.279	
106		AQ-52-04	3mm厚鋁板	ECD3X10099S-JF2	1		1	3.9	0.716	0.716	0.656	0.656	
107		AQ-52-05	3mm厚鋁板	ECD3X10099S-JF2	4		4	11.5	0.530	2.121	0.483	1.933	
108		AQ-52-06	3mm厚鋁板	ECD3X10099S-JF2	3		3	5.0	0.308	0.923	0.276	0.828	
109		AQ-52-07	3mm厚鋁板	ECD3X10099S-JF2	2		2	8.4	0.779	1.559	0.715	1.431	
110		AQ-52-08	3mm厚鋁板	ECD3X10099S-JF2	2		2	6.1	0.563	1.127	0.514	1.028	
111		AQ-52-09	3mm厚鋁板	ECD3X10099S-JF2	1		1	4.1	0.749	0.749	0.687	0.687	
112		AQ-52-10	3mm厚鋁板	ECD3X10099S-JF2	1		1	3.9	0.727	0.727	0.667	0.667	
113		AQ-52-11	3mm厚鋁板	ECD3X10099S-JF2	1		1	1.8	0.328	0.328	0.295	0.295	
114		AQ-52-12	3mm厚鋁板	ECD3X10099S-JF2	2		2	7.9	0.726	1.452	0.665	1.331	

美特鋁質 有限公司 MIDI Aluminium Fabricator Ltd.	工程號: J-858	計算: L.S	日期:	20/12/2022		送呈:
	地盤名稱:康城11期	核對:	日期:			副本:
廠用鋁板B.M.表	項目類別: T1,T2,T3收口鋁板	批准:	日期:			
BM編號:	修改版次: A	ECD3X10099S-JF2 香檳金	總V.F.:	4374.5	總重量: 30873.9	此BM依據拆圖資料計算

序號	修改內容	鋁板圖號	鋁板名稱	顏色	實用	後備	總數	總重量	單件展開面積	總展開面積	單件V.F.	總V.F.	備註
									平方米		平方米		
115		AQ-52-13	3mm厚鋁板	ECD3X10099S-JF2	1		1	1.5	0.272	0.272	0.243	0.243	
116		AQ-52-14	3mm厚鋁板	ECD3X10099S-JF2	1		1	3.3	0.612	0.612	0.559	0.559	
117		AQ-52-15	3mm厚鋁板	ECD3X10099S-JF2	1		1	3.3	0.614	0.614	0.561	0.561	
118		AQ-53-01	3mm厚鋁板	ECD3X10099S-JF2	5		5	21.0	0.776	3.880	0.717	3.587	
119		AQ-54-01	3mm厚鋁板	ECD3X10099S-JF2	1		1	4.2	0.777	0.777	0.718	0.718	
120		AQ-54-02	3mm厚鋁板	ECD3X10099S-JF2	6		6	10.8	0.331	1.985	0.303	1.817	
121		AQ-54-03	3mm厚鋁板	ECD3X10099S-JF2	2		2	8.3	0.769	1.538	0.711	1.422	
122		AQ-54-04	3mm厚鋁板	ECD3X10099S-JF2	1		1	4.2	0.772	0.772	0.714	0.714	
123		AQ-55-01	3mm厚鋁板	ECD3X10099S-JF2	3		3	5.5	0.337	1.010	0.303	0.909	
124		AQ-55-02	3mm厚鋁板	ECD3X10099S-JF2	1		1	4.2	0.770	0.770	0.706	0.706	
125		AQ-55-03	3mm厚鋁板	ECD3X10099S-JF2	1		1	2.0	0.366	0.366	0.331	0.331	
126		AQ-56-01	3mm厚鋁板	ECD3X10099S-JF2	12		12	26.0	0.400	4.804	0.366	4.394	
127		AQ-56-02	3mm厚鋁板	ECD3X10099S-JF2	12		12	26.4	0.407	4.878	0.372	4.462	
128		AQ-56-03	3mm厚鋁板	ECD3X10099S-JF2	84		84	183.2	0.402	33.792	0.368	30.907	
129		AQ-56-04	3mm厚鋁板	ECD3X10099S-JF2	24		24	51.0	0.392	9.406	0.358	8.600	
130		AQ-56-05	3mm厚鋁板	ECD3X10099S-JF2	8		8	17.3	0.399	3.191	0.365	2.918	
131		AQ-56-06	3mm厚鋁板	ECD3X10099S-JF2	12		12	26.2	0.403	4.832	0.368	4.420	
132		AQ-56-07	3mm厚鋁板	ECD3X10099S-JF2	2		2	3.5	0.324	0.648	0.295	0.590	
133		AQ-56-09	3mm厚鋁板	ECD3X10099S-JF2	2		2	4.8	0.441	0.882	0.404	0.808	
134		AQ-57-01	3mm厚鋁板	ECD3X10099S-JF2	6		6	13.2	0.407	2.439	0.367	2.201	

美特鋁質 有限公司 MIDI Aluminium Fabricator Ltd.	工程號: J-858	計算: L.S	日期:	20/12/2022		送呈:
	地盤名稱:康城11期	核對:	日期:			副本:
廠用鋁板B.M.表	項目類別: T1,T2,T3收口鋁板	批准:	日期:			
BM編號:	修改版次: A	ECD3X10099S-JF2 香檳金	總V.F.:	4374.5	總重量: 30873.9	此BM依據拆圖資料計算

序號	修改內容	鋁板圖號	鋁板名稱	顏色	實用	後備	總數	總重量	單件展開面積	總展開面積	單件V.F.	總V.F.	備註
									平方米		平方米		
135		AQ-57-02	3mm厚鋁板	ECD3X10099S-JF2	6		6	13.4	0.413	2.476	0.373	2.235	
136		AQ-57-03	3mm厚鋁板	ECD3X10099S-JF2	42		42	93.0	0.408	17.154	0.369	15.483	
137		AQ-57-04	3mm厚鋁板	ECD3X10099S-JF2	12		12	25.9	0.398	4.777	0.359	4.309	
138		AQ-57-05	3mm厚鋁板	ECD3X10099S-JF2	4		4	8.8	0.405	1.620	0.365	1.462	
139		AQ-57-06	3mm厚鋁板	ECD3X10099S-JF2	2		2	4.4	0.409	0.818	0.369	0.738	
140		AQ-57-08	3mm厚鋁板	ECD3X10099S-JF2	4		4	8.6	0.397	1.589	0.358	1.433	
141		AQ-57-09	3mm厚鋁板	ECD3X10099S-JF2	2		2	4.8	0.447	0.894	0.405	0.809	
142		AQ-58-01	3mm厚鋁板	ECD3X10099S-JF2	6		6	41.0	1.260	7.560	1.215	7.288	
143		AQ-58-02	3mm厚鋁板	ECD3X10099S-JF2	20		20	135.2	1.247	24.942	1.202	24.038	
144		AQ-58-03	3mm厚鋁板	ECD3X10099S-JF2	8		8	69.6	1.605	12.839	1.556	12.448	
145		AQ-58-04	3mm厚鋁板	ECD3X10099S-JF2	2		2	13.4	1.237	2.473	1.191	2.383	
146		AQ-58-05	3mm厚鋁板	ECD3X10099S-JF2	2		2	13.2	1.213	2.426	1.168	2.337	
147		AQ-58-06	3mm厚鋁板	ECD3X10099S-JF2	2		2	17.5	1.615	3.230	1.566	3.132	
148		AQ-59L-01	3mm厚鋁板	ECD3X10099S-JF2	2		2	16.5	1.526	3.052	1.474	2.948	
149		AQ-59L-02	3mm厚鋁板	ECD3X10099S-JF2	2		2	16.4	1.515	3.031	1.464	2.928	
150		AQ-59L-03	3mm厚鋁板	ECD3X10099S-JF2	6		6	49.4	1.520	9.120	1.468	8.811	
151		AQ-59R-01	3mm厚鋁板	ECD3X10099S-JF2	10		10	81.7	1.508	15.082	1.473	14.731	
152		AQ-60-01	3mm厚鋁板	ECD3X10099S-JF2	12		12	79.8	1.227	14.726	1.198	14.381	
153		AQ-60-02	3mm厚鋁板	ECD3X10099S-JF2	12		12	81.0	1.246	14.951	1.217	14.603	
154		AQ-60-03	3mm厚鋁板	ECD3X10099S-JF2	22		22	206.1	1.728	38.025	1.694	37.278	

美特鋁質 有限公司 MIDI Aluminium Fabricator Ltd.	工程號: J-858	計算: L.S	日期:	20/12/2022		送呈:
	地盤名稱:康城11期	核對:	日期:			副本:
廠用鋁板B.M.表	項目類別: T1,T2,T3收口鋁板	批准:	日期:			
BM編號:	修改版次: A	ECD3X10099S-JF2 香檳金	總V.F.:	4374.5	總重量: 30873.9	此BM依據拆圖資料計算

序號	修改內容	鋁板圖號	鋁板名稱	顏色	實用	後備	總數	總重量	單件展開面積	總展開面積	單件V.F.	總V.F.	備註
									平方米		平方米		
155		AQ-60-04	3mm厚鋁板	ECD3X10099S-JF2	22		22	100.8	0.845	18.600	0.821	18.053	
156		AQ-60-05	3mm厚鋁板	ECD3X10099S-JF2	8		8	53.0	1.223	9.780	1.194	9.550	
157		AQ-60-06	3mm厚鋁板	ECD3X10099S-JF2	82		82	548.0	1.233	101.111	1.204	98.744	
158		AQ-60-07	3mm厚鋁板	ECD3X10099S-JF2	8		8	43.8	1.011	8.089	0.985	7.877	
159		AQ-60-08	3mm厚鋁板	ECD3X10099S-JF2	36		36	234.4	1.201	43.252	1.173	42.225	
160		AQ-60-09	3mm厚鋁板	ECD3X10099S-JF2	2		2	11.3	1.040	2.081	1.014	2.027	
161		AQ-60-09a	3mm厚鋁板	ECD3X10099S-JF2	2		2	11.0	1.011	2.022	0.985	1.969	
162		AQ-60-09b	3mm厚鋁板	ECD3X10099S-JF2	4		4	22.9	1.055	4.220	1.028	4.112	
163		AQ-60-10	3mm厚鋁板	ECD3X10099S-JF2	4		4	26.8	1.234	4.937	1.205	4.821	
164		AQ-60-11	3mm厚鋁板	ECD3X10099S-JF2	6		6	51.4	1.581	9.485	1.548	9.291	
165		AQ-61-01	3mm厚鋁板	ECD3X10099S-JF2	2		2	9.4	0.864	1.728	0.839	1.678	
166		AQ-61-02	3mm厚鋁板	ECD3X10099S-JF2	6		6	28.1	0.864	5.185	0.839	5.035	
167		AQ-61-03	3mm厚鋁板	ECD3X10099S-JF2	4		4	40.8	1.881	7.525	1.846	7.383	
168		AQ-62-01	3mm厚鋁板	ECD3X10099S-JF2	4		4	19.1	0.882	3.527	0.840	3.361	
169		AQ-62-02	3mm厚鋁板	ECD3X10099S-JF2	4		4	19.1	0.882	3.527	0.840	3.361	
170		AQ-62-03	3mm厚鋁板	ECD3X10099S-JF2	2		2	20.4	1.884	3.768	1.832	3.665	
171		AQ-62-04	3mm厚鋁板	ECD3X10099S-JF2	2		2	20.1	1.855	3.710	1.803	3.607	
172		AQ-64-01	3mm厚鋁板	ECD3X10099S-JF2	2		2	22.2	2.052	4.103	1.998	3.996	
173		AQ-64-02	3mm厚鋁板	ECD3X10099S-JF2	4		4	45.1	2.081	8.323	2.027	8.108	
174		AQ-65-01	3mm厚鋁板	ECD3X10099S-JF2	2		2	10.2	0.938	1.876	0.910	1.820	

美特鋁質 有限公司 MIDI Aluminium Fabricator Ltd.	工程號: J-858	計算: L.S	日期:	20/12/2022		送呈:
	地盤名稱:康城11期	核對:	日期:			副本:
廠用鋁板B.M.表	項目類別: T1,T2,T3收口鋁板	批准:	日期:			
BM編號:	修改版次: A	ECD3X10099S-JF2 香檳金	總V.F.:	4374.5	總重量: 30873.9	此BM依據拆圖資料計算

序號	修改內容	鋁板圖號	鋁板名稱	顏色	實用	後備	總數	總重量	單件展開面積	總展開面積	單件V.F.	總V.F.	備註
									平方米		平方米		
175		AQ-65-02	3mm厚鋁板	ECD3X10099S-JF2	4		4	20.8	0.961	3.846	0.933	3.731	
176		AQ-66A	3mm厚鋁板	ECD3X10099S-JF2	2		2	6.6	0.608	1.217	0.590	1.180	
177		AQ-66B	3mm厚鋁板	ECD3X10099S-JF2	6		6	19.0	0.585	3.509	0.567	3.404	
178		AQ-66C	3mm厚鋁板	ECD3X10099S-JF2	4		4	13.4	0.620	2.480	0.602	2.406	
179		AQ-67A	3mm厚鋁板	ECD3X10099S-JF2	4		4	13.4	0.620	2.480	0.602	2.406	
180		AQ-67B	3mm厚鋁板	ECD3X10099S-JF2	6		6	19.0	0.585	3.509	0.567	3.404	
181		AQ-67C	3mm厚鋁板	ECD3X10099S-JF2	2		2	6.6	0.608	1.217	0.590	1.180	
182		AQ-68L	3mm厚鋁板	ECD3X10099S-JF2	10		10	41.3	0.762	7.624	0.762	7.624	
183		AQ-68R	3mm厚鋁板	ECD3X10099S-JF2	10		10	41.3	0.762	7.624	0.762	7.624	
184		AQ-69L	3mm厚鋁板	ECD3X10099S-JF2	10		10	8.9	0.165	1.648	0.165	1.648	
185		AQ-69R	3mm厚鋁板	ECD3X10099S-JF2	10		10	8.9	0.165	1.648	0.165	1.648	
186		AQ-70L	3mm厚鋁板	ECD3X10099S-JF2	10		10	3.8	0.069	0.693	0.069	0.693	
187		AQ-70R	3mm厚鋁板	ECD3X10099S-JF2	10		10	3.8	0.069	0.693	0.069	0.693	
188		AQ-71	3mm厚鋁板	ECD3X10099S-JF2	2		2	10.0	0.922	1.843	0.922	1.843	
189		AQ-72	3mm厚鋁板	ECD3X10099S-JF2	2		2	3.3	0.305	0.610	0.305	0.610	
190		AQ-73	3mm厚鋁板	ECD3X10099S-JF2	2		2	1.7	0.157	0.314	0.157	0.314	
191		AQ-75	3mm厚鋁板	ECD3X10099S-JF2	3		3	2.0	0.125	0.374	0.106	0.319	
192		AQ-76-1	3mm厚鋁板	ECD3X10099S-JF2	1		1	3.1	0.564	0.564	0.517	0.517	
193		AQ-76-2	3mm厚鋁板	ECD3X10099S-JF2	2		2	5.2	0.484	0.969	0.442	0.884	
194		AQ-77	3mm厚鋁板	ECD3X10099S-JF2	3		3	2.5	0.153	0.460	0.138	0.414	

美特鋁質 有限公司 MIDI Aluminium Fabricator Ltd.	工程號: J-858	計算: L.S	日期:	20/12/2022		送呈:
	地盤名稱:康城11期	核對:	日期:			副本:
廠用鋁板B.M.表	項目類別: T1,T2,T3收口鋁板	批准:	日期:			
BM編號:	修改版次: A	ECD3X10099S-JF2 香檳金	總V.F.:	4374.5	總重量: 30873.9	此BM依據拆圖資料計算

序號	修改內容	鋁板圖號	鋁板名稱	顏色	實用	後備	總數	總重量	單件展開面積	總展開面積	單件V.F.	總V.F.	備註
									平方米		平方米		
195		AQ-78-1	3mm厚鋁板	ECD3X10099S-JF2	140		140	468.0	0.617	86.354	0.613	85.858	
196		AQ-78-2	3mm厚鋁板	ECD3X10099S-JF2	146		146	187.8	0.237	34.648	0.234	34.131	
197		AQ-78-3	3mm厚鋁板	ECD3X10099S-JF2	6		6	8.0	0.246	1.473	0.242	1.452	
198		AQ-78-4	3mm厚鋁板	ECD3X10099S-JF2	6		6	3.3	0.102	0.612	0.098	0.591	
199		AQ-79-1A	3mm厚鋁板	ECD3X10099S-JF2	44		44	725.6	3.043	133.875	3.025	133.107	
200		AQ-79-2A	3mm厚鋁板	ECD3X10099S-JF2	46		46	291.9	1.171	53.849	1.153	53.045	
201		AQ-79-3A	3mm厚鋁板	ECD3X10099S-JF2	2		2	32.3	2.980	5.960	2.963	5.926	
202		AQ-79-1B	3mm厚鋁板	ECD3X10099S-JF2	96		96	1354.8	2.604	249.963	2.589	248.528	
203		AQ-79-2B	3mm厚鋁板	ECD3X10099S-JF2	100		100	543.0	1.002	100.178	0.987	98.683	
204		AQ-79-3B	3mm厚鋁板	ECD3X10099S-JF2	4		4	55.3	2.550	10.202	2.535	10.142	
205		AQ-80-1	3mm厚鋁板	ECD3X10099S-JF2	140		140	651.2	0.858	120.145	0.853	119.455	
206		AQ-80-2	3mm厚鋁板	ECD3X10099S-JF2	146		146	261.3	0.330	48.206	0.325	47.486	
207		AQ-80-3	3mm厚鋁板	ECD3X10099S-JF2	6		6	27.3	0.841	5.043	0.836	5.014	
208		AQ-81	3mm厚鋁板	ECD3X10099S-JF2	6		6	41.2	1.266	7.597	1.234	7.406	
209		AQ-82-1	3mm厚鋁板	ECD3X10099S-JF2	6		6	39.6	1.219	7.314	1.158	6.946	
210		AQ-82-2	3mm厚鋁板	ECD3X10099S-JF2	4		4	26.5	1.224	4.896	1.162	4.650	
211		AQ-82-3	3mm厚鋁板	ECD3X10099S-JF2	2		2	13.0	1.196	2.392	1.135	2.270	
212		AQ-83-1	3mm厚鋁板	ECD3X10099S-JF2	12		12	66.9	1.028	12.340	0.986	11.828	
213		AQ-83-2	3mm厚鋁板	ECD3X10099S-JF2	52		52	291.2	1.033	53.728	0.990	51.504	
214		AQ-83-3	3mm厚鋁板	ECD3X10099S-JF2	36		36	196.5	1.007	36.257	0.965	34.744	

美特鋁質 有限公司 MIDI Aluminium Fabricator Ltd.	工程號: J-858	計算: L.S	日期:	20/12/2022		送呈:
	地盤名稱:康城11期	核對:	日期:			副本:
廠用鋁板B.M.表	項目類別: T1,T2,T3收口鋁板	批准:	日期:			
BM編號:	修改版次: A	ECD3X10099S-JF2 香檳金	總V.F.:	4374.5	總重量: 30873.9	此BM依據拆圖資料計算

序號	修改內容	鋁板圖號	鋁板名稱	顏色	實用	後備	總數	總重量	單件展開面積	總展開面積	單件V.F.	總V.F.	備註
									平方米		平方米		
215		AQ-83-4	3mm厚鋁板	ECD3X10099S-JF2	4		4	22.2	1.025	4.099	0.982	3.929	

美特鋁質 有限公司 MIDI Aluminium Fabricator Ltd.	工程號: J-858	計算: L.S	日期:	20/12/2022		送呈:
	地盤名稱:康城11期	核對:	日期:			副本:
廠用鋁板B.M.表	項目類別: T1,T2,T3收口鋁板	批准:	日期:			
BM編號:	修改版次: A	ECD3X10099S-JF2 香檳金	總V.F.:	4374.5	總重量: 30873.9	此BM依據拆圖資料計算

序號	修改內容	鋁板圖號	鋁板名稱	顏色	實用	後備	總數	總重量	單件展開面積	總展開面積	單件V.F.	總V.F.	備註
									平方米		平方米		
216		AQ-83-5	3mm厚鋁板	ECD3X10099S-JF2	4		4	22.4	1.035	4.139	0.992	3.968	
217		AQ-84-1	3mm厚鋁板	ECD3X10099S-JF2	18		18	102.0	1.045	18.811	1.002	18.035	
218		AQ-84-2	3mm厚鋁板	ECD3X10099S-JF2	50		50	280.6	1.035	51.767	0.993	49.626	
219		AQ-84-3	3mm厚鋁板	ECD3X10099S-JF2	6		6	33.4	1.027	6.162	0.984	5.906	
220		AQ-85-1	3mm厚鋁板	ECD3X10099S-JF2	10		10	64.3	1.187	11.868	1.140	11.397	
221		AQ-86-1	3mm厚鋁板	ECD3X10099S-JF2	10		10	58.8	1.086	10.856	1.034	10.344	
222		AQ-86-2	3mm厚鋁板	ECD3X10099S-JF2	22		22	63.2	0.530	11.658	0.500	10.997	
223		AQ-86-3	3mm厚鋁板	ECD3X10099S-JF2	2		2	7.1	0.653	1.305	0.618	1.236	
224		AQ-86-3a	3mm厚鋁板	ECD3X10099S-JF2	2		2	6.9	0.634	1.268	0.600	1.200	
225		AQ-86-8	3mm厚鋁板	ECD3X10099S-JF2	4		4	13.7	0.634	2.537	0.600	2.401	
226		AQ-86-9	3mm厚鋁板	ECD3X10099S-JF2	2		2	11.5	1.059	2.117	1.009	2.017	
227		AQ-87-1	3mm厚鋁板	ECD3X10099S-JF2	6		6	32.6	1.004	6.023	0.946	5.675	
228		AQ-87-2	3mm厚鋁板	ECD3X10099S-JF2	10		10	59.4	1.097	10.967	1.035	10.351	
229		AQ-87-3	3mm厚鋁板	ECD3X10099S-JF2	8		8	46.1	1.063	8.508	1.003	8.026	
230		AQ-87-4	3mm厚鋁板	ECD3X10099S-JF2	6		6	19.8	0.608	3.650	0.565	3.393	
231		AQ-87-5	3mm厚鋁板	ECD3X10099S-JF2	4		4	14.0	0.645	2.581	0.601	2.404	
232		AQ-88-1	3mm厚鋁板	ECD3X10099S-JF2	2		2	13.8	1.269	2.537	1.221	2.441	
233		AQ-88-2	3mm厚鋁板	ECD3X10099S-JF2	4		4	27.9	1.287	5.149	1.238	4.953	
234		AQ-89-1	3mm厚鋁板	ECD3X10099S-JF2	2		2	5.9	0.544	1.088	0.513	1.027	
235		AQ-89-2	3mm厚鋁板	ECD3X10099S-JF2	6		6	17.7	0.544	3.263	0.513	3.080	

美特鋁質 有限公司 MIDI Aluminium Fabricator Ltd.	工程號: J-858	計算: L.S	日期:	20/12/2022		送呈:
	地盤名稱:康城11期	核對:	日期:			副本:
廠用鋁板B.M.表	項目類別: T1,T2,T3收口铝板	批准:	日期:			
BM編號:	修改版次: A	ECD3X10099S-JF2 香檳金	總V.F.:	4374.5	總重量: 30873.9	此BM依據拆圖資料計算

序號	修改內容	鋁板圖號	鋁板名稱	顏色	實用	後備	總數	總重量	單件展開面積	總展開面積	單件V.F.	總V.F.	備註
									平方米		平方米		
236		AQ-89-3	3mm厚鋁板	ECD3X10099S-JF2	4		4	25.7	1.184	4.736	1.129	4.516	
237		AQ-90-1	3mm厚鋁板	ECD3X10099S-JF2	2		2	12.7	1.175	2.350	1.120	2.240	
238		AQ-90-2	3mm厚鋁板	ECD3X10099S-JF2	2		2	12.5	1.156	2.313	1.102	2.205	
239		AQ-90-3	3mm厚鋁板	ECD3X10099S-JF2	4		4	11.8	0.544	2.176	0.513	2.053	
240		AQ-90-4	3mm厚鋁板	ECD3X10099S-JF2	4		4	11.8	0.544	2.176	0.513	2.053	
241		LJ-01	3mm厚鋁板	鉻化	4742		4742	89.5	0.003	16.507	0.000	0.000	
242		LJ-02	3mm厚鋁板	鉻化	4880		4880	92.1	0.003	16.987	0.000	0.000	
243		LJ-03	3mm厚鋁板	鉻化	2444		2444	46.1	0.003	8.508	0.000	0.000	
						總計	22096	30874		4467		4374	

特急

A Q B I C　2件


O2 A　3件

O2 B　3件

O1 A　3件

O1 B　3件

87-3　1件

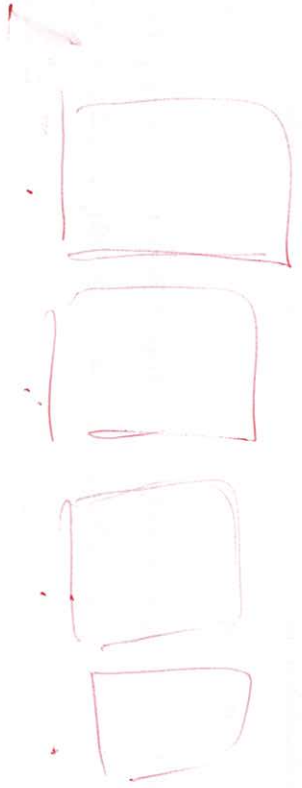

★特急

15件

15件

頂
11, 12, 15, 16/下

TIB-0E　その他発送件数

AQ01 - AQ21 撐漆

~~AQ22 - 29 11.4°/t~~

AG30 - 39 9/t

橫 AQ51 - 55 9/t

同 AQ56 - 73 11.4°/t

A-B 整大釘板

AQ75 - 90

美特鋁質有限公司
MIDI Aluminium Fabricator Ltd.

QF005/8

圖則登記表
DRAWING REGISTER

工程名稱 Project Title:	康城11期
	单元幕墙标准层收口铝板（室外）(T1, 2, 3)
工程編號 Project No:	J858

接收日期 Receiving Date (適用於客戶圖則)

年								
月								
日								

分發予 Distributed To

發出日期 Issued Date

年	22	22						
月	12	12						
日	01	20						

圖則編號 Drg. No.	圖則名稱 Drawing Title		修訂編號 Revision No.							
J858-CW-PE101	室外收口铝板位置图T1	1	-	-						
J858-CW-PE102	室外收口铝板位置图T1	2	-	-						
J858-CW-PE103	室外收口铝板位置图T1	3	-	-						
J858-CW-PE104	室外收口铝板位置图T1	4	-	-						
J858-CW-PE105	室外收口铝板位置图T1	5	-	-						
J858-CW-PE106	室外收口铝板位置图T1	6	-	-						
J858-CW-PE107	室外收口铝板位置图T1	7	-	-						
J858-CW-PE108	室外收口铝板位置图T1	8	-	A						
J858-CW-PE109	室外收口铝板位置图T1	9	-	-						
J858-CW-PE110	室外收口铝板位置图T1	10	-	-						
J858-CW-PE111	室外收口铝板位置图T1	11	-	A						
J858-CW-PE112	室外收口铝板位置图T1	12	-	-						
J858-CW-PE113	室外收口铝板位置图T1	13	-	-						
J858-CW-PE114	室外收口铝板位置图T1	14	-	A						
J858-CW-PE115	室外收口铝板位置图T1	15	-	-						
J858-CW-PE116	室外收口铝板位置图T1	16	-	A						
J858-CW-PE201	室外收口铝板位置图T2	17	-	-						
J858-CW-PE202	室外收口铝板位置图T2	18	-	-						
J858-CW-PE203	室外收口铝板位置图T2	19	-	-						
J858-CW-PE204	室外收口铝板位置图T2	20	-	-						
J858-CW-PE205	室外收口铝板位置图T2	21	-	-						
J858-CW-PE206	室外收口铝板位置图T2	22	-	-						
J858-CW-PE207	室外收口铝板位置图T2	23	-	-						
J858-CW-PE208	室外收口铝板位置图T2	24	-	A						
J858-CW-PE209	室外收口铝板位置图T2	25	-	-						
J858-CW-PE210	室外收口铝板位置图T2	26	-	-						
J858-CW-PE211	室外收口铝板位置图T2	27	-	A						
J858-CW-PE212	室外收口铝板位置图T2	28	-	-						
J858-CW-PE213	室外收口铝板位置图T2	29	-	-						
J858-CW-PE214	室外收口铝板位置图T2	30	-	A						
J858-CW-PE215	室外收口铝板位置图T2	31	-	-						
J858-CW-PE216	室外收口铝板位置图T2	32	-	A						

美特鋁質有限公司
MIDI Aluminium Fabricator Ltd. QF005/8

圖則登記表
DRAWING REGISTER

工程名稱 Project Title:	康城11期
	单元幕墙标准层收口铝板（室外）(T1, 2, 3)
工程編號 Project No:	J858

分發予 Distributed To

	接收日期 Receiving Date (適用於客戶圖則)							
年								
月								
日								

	發出日期 Issued Date							
年	22	22						
月	12	12						
日	01	20						

圖則編號 Drg. No.	圖則名稱 Drawing Title		修訂編號 Revision No.							
J858-CW-PE301	室外收口铝板位置图T3	33	-	-						
J858-CW-PE302	室外收口铝板位置图T3	34	-	-						
J858-CW-PE303	室外收口铝板位置图T3	35	-	-						
J858-CW-PE304	室外收口铝板位置图T3	36	-	-						
J858-CW-PE305	室外收口铝板位置图T3	37	-	-						
J858-CW-PE306	室外收口铝板位置图T3	38	-	-						
J858-CW-PE307	室外收口铝板位置图T3	39	-	-						
J858-CW-PE308	室外收口铝板位置图T3	40	-	A						
J858-CW-PE309	室外收口铝板位置图T3	41	-	-						
J858-CW-PE310	室外收口铝板位置图T3	42	-	-						
J858-CW-PE311	室外收口铝板位置图T3	43	-	A						
J858-CW-PE312	室外收口铝板位置图T3	44	-	-						
J858-CW-PE313	室外收口铝板位置图T3	45	-	A						
J858-CW-PE315	室外收口铝板位置图T3	46	-	A						
AQ-01	室外收口铝板加工图	47	-							
AQ-01D/E	室外收口铝板加工图	48	-	-						
AQ-02	室外收口铝板加工图	49	-	-						
AQ-03	室外收口铝板加工图	50	-	-						
AQ-04L	室外收口铝板加工图	51	-	-						
AQ-04R	室外收口铝板加工图	52	-	-						
AQ-05L	室外收口铝板加工图	53	-	-						
AQ-05R	室外收口铝板加工图	54	-	-						
AQ-06L	室外收口铝板加工图	55	-	-						
AQ-06R	室外收口铝板加工图	56	-	-						
AQ-07	室外收口铝板加工图	57	-	-						
AQ-08	室外收口铝板加工图	58	-	-						
AQ-09	室外收口铝板加工图	59	-	-						
AQ-10	室外收口铝板加工图	60	-	-						
AQ-11	室外收口铝板加工图	61	-	-						
AQ-12	室外收口铝板加工图	62	-	-						
AQ-13	室外收口铝板加工图	63	-	-						
AQ-14	室外收口铝板加工图	64	-	-						

57.5mm

美特鋁質有限公司
MIDI Aluminium Fabricator Ltd.

圖則登記表
DRAWING REGISTER

工程名稱 Project Title:	康城11期
	单元幕墙标准层收口铝板（室外）(T1, 2, 3)
工程編號 Project No:	J858

分發予 Distributed To

	接收日期 Receiving Date (適用於客戶圖則)							
年								
月								
日								

	發出日期 Issued Date							
年	22	22						
月	12	12						
日	01	20						

圖則編號 Drg. No.	圖則名稱 Drawing Title		修訂編號 Revision No.							
AQ-15	室外收口铝板加工图	65	-	-						
AQ-16	室外收口铝板加工图	66	-	-						
AQ-17	室外收口铝板加工图	67	-	-						
AQ-18	室外收口铝板加工图	68	-	-						
AQ-19	室外收口铝板加工图	69	-	-						
AQ-20	室外收口铝板加工图	70	-	-						
AQ-21	室外收口铝板加工图	71								
AQ-22	室外收口铝板加工图	72	-	-						
AQ-23	室外收口铝板加工图	73	-	-						
AQ-24	室外收口铝板加工图	74	-	-						
AQ-25	室外收口铝板加工图	75	-	-						
AQ-26	室外收口铝板加工图	76	-	-						
AQ-27	室外收口铝板加工图	77	-	-						
AQ-28L	室外收口铝板加工图	78	-	-						
AQ-28R	室外收口铝板加工图	79	-	-						
AQ-29L	室外收口铝板加工图	80	-	-						
AQ-29R	室外收口铝板加工图	81	-	-						
AQ-30	室外收口铝板加工图	82	-	-						
AQ-31L	室外收口铝板加工图	83	-	-						
AQ-31R	室外收口铝板加工图	84	-	-						
AQ-32L	室外收口铝板加工图	85	-	-						
AQ-32R	室外收口铝板加工图	86	-	-						
AQ-33	室外收口铝板加工图	87	-	-						
AQ-34L	室外收口铝板加工图	88	-	-						
AQ-34R	室外收口铝板加工图	89	-	-						
AQ-35	室外收口铝板加工图	90	-	-						
AQ-36	室外收口铝板加工图	91	-	-						
AQ-37	室外收口铝板加工图	92	-	-						
AQ-38	室外收口铝板加工图	93	-	-						
AQ-39	室外收口铝板加工图	94	-	-						
AQ-51	室外收口铝板加工图	95	-	-						
AQ-52	室外收口铝板加工图	96	-	-						

美特鋁質有限公司
MIDI Aluminium Fabricator Ltd.

QF005/8

圖則登記表
DRAWING REGISTER

工程名稱 Project Title:	康城11期
	单元幕墙标准层收口铝板（室外）(T1, 2, 3)
工程編號 Project No:	J858

接收日期 Receiving Date (適用於客戶圖則)

年								
月								
日								

分發予 Distributed To

發出日期 Issued Date

年	22	22						
月	12	12						
日	01	20						

圖則編號 Drg. No.	圖則名稱 Drawing Title		修訂編號 Revision No.							
AQ-53	室外收口铝板加工图	97	-	-						
AQ-54	室外收口铝板加工图	98	-	-						
AQ-55	室外收口铝板加工图	99	-	-						
AQ-56	室外收口铝板加工图	100	-	-						
AQ-57	室外收口铝板加工图	101	-	-						
AQ-58	室外收口铝板加工图	102	-	-						
AQ-59L	室外收口铝板加工图	103	-	-						
AQ-59R	室外收口铝板加工图	104	-	-						
AQ-60	室外收口铝板加工图	105	-	A						
AQ-61	室外收口铝板加工图	106	-	A						
AQ-62	室外收口铝板加工图	107	-	A						
AQ-64	室外收口铝板加工图	108	-	-						
AQ-65	室外收口铝板加工图	109	-	-						
AQ-66	室外收口铝板加工图	110	-	A						
AQ-67	室外收口铝板加工图	111	-	A						
AQ-68L	室外收口铝板加工图	112	-	-						
AQ-68R	室外收口铝板加工图	113	-	-						
AQ-69L	室外收口铝板加工图	114	-	-						
AQ-69R	室外收口铝板加工图	115	-	-						
AQ-70L	室外收口铝板加工图	116	-	-						
AQ-70R	室外收口铝板加工图	117	-	-						
AQ-71	室外收口铝板加工图	118	-	-						
AQ-72	室外收口铝板加工图	119	-	-						
AQ-73	室外收口铝板加工图	120	-	-						
AQ-75	室外收口铝板加工图	121	-	-						
AQ-76	室外收口铝板加工图	122	-	-						
AQ-77	室外收口铝板加工图	123	-	-						
AQ-78	室外收口铝板加工图	124	-	-						
AQ-79	室外收口铝板加工图	125	-	-						
AQ-80	室外收口铝板加工图	126	-	-						
AQ-81	室外收口铝板加工图	127	-	-						
AQ-82	室外收口铝板加工图	128	-	-						

美特鋁質有限公司
MIDI Aluminium Fabricator Ltd. **QF005/8**

圖則登記表
DRAWING REGISTER

工程名稱 Project Title:	康城11期
	单元幕墙标准层收口铝板（室外）(T1, 2, 3)
工程編號 Project No:	J858

分發予 Distributed To

	接收日期 Receiving Date (適用於客戶圖則)							
年								
月								
日								

	發出日期 Issued Date							
年	22	22						
月	12	12						
日	01	20						

圖則編號 Drg. No.	圖則名稱 Drawing Title		修訂編號 Revision No.							
AQ-83	室外收口铝板加工图	129	-	-						
AQ-84	室外收口铝板加工图	130								
AQ-85	室外收口铝板加工图	131		-						
AQ-86	室外收口铝板加工图	132	-	A						
AQ-87	室外收口铝板加工图	133	-	A						
AQ-88	室外收口铝板加工图	134	-	-						
AQ-89	室外收口铝板加工图	135		-						
AQ-90	室外收口铝板加工图	136		-						

J858康城11期标准层收口铝板数量分层统计表(T1)

工程: J858康城11期

日期: 29-Nov-22

| 序号 | 铝板编号 | 楼层 | | |

J858康城11期标准层收口铝板数量分层统计表(T1)

工程: J858康城11期

日期: 29-Nov-22

| 序号 | 铝板编号 | 楼层 | | |

J858康城11期标准层收口铝板数量分层统计表(T1)

工程: J858康城11期

日期: 29-Nov-22

| 序号 | 铝板编号 | 楼层 | | |

J858康城11期标准层收口铝板数量分层统计表(T1)

工程: J858康城11期

日期: 29-Nov-22

| 序号 | 铝板编号 | 楼层 | | |

J858康城11期标准层收口铝板数量分层统计表(T1)

工程: J858康城11期

日期: 29-Nov-22

| 序号 | 铝板编号 | 楼层 | | |

J858康城11期标准层收口铝板数量分层统计表(T2)

工程: J858康城11期

日期: 29-Nov-22

| 序号 | 铝板编号 | 楼层 | | |

J858康城11期标准层收口铝板数量分层统计表(T2)

工程：J858康城11期

日期：29-Nov-22

| 序号 | 铝板编号 | 楼层 | | |

J858康城11期标准层收口铝板数量分层统计表(T2)

工程：J858康城11期

日期：29-Nov-22

| 序号 | 铝板编号 | 楼层 | | |

J858康城11期标准层收口铝板数量分层统计表(T2)

工程: J858康城11期

日期: 29-Nov-22

| 序号 | 铝板编号 | 楼层 | | |

J858康城11期标准层收口铝板数量分层统计表(T2)

工程: J858康城11期

日期: 29-Nov-22

| 序号 | 铝板编号 | 楼层 | | |

J858康城11期标准层收口铝板数量分层统计表(T3)

工程：J858康城11期

日期：29-Nov-22

| 序号 | 铝板编号 | 楼层 | | |

J858康城11期标准层收口铝板数量分层统计表(T3)

工程: J858康城11期

日期: 29-Nov-22

| 序号 | 铝板编号 | 楼层 | | |

J858康城11期标准层收口铝板数量分层统计表(T3)

工程: J858康城11期

日期: 29-Nov-22

| 序号 | 铝板编号 | 楼层 | | |

J858康城11期标准层收口铝板数量分层统计表(T3)

工程: J858康城11期

日期: 29-Nov-22

| 序号 | 铝板编号 | 楼层 | | |

J858康城11期标准层收口铝板数量分层统计表(T3)

工程: J858康城11期

日期: 29-Nov-22

| 序号 | 铝板编号 | 楼层 | | |

J858康城11期标准层收口铝板总数量统计表(T1，2，3)

工程：　J858康城11期

日期：　20-Dec-22

序号	铝板编号	T1	T2	T3	总数量	备注
1	AQ-01A	516	564	517	1597	
2	AQ-01B	536	588	534	1658	
3	AQ-01C	20	16	20	56	
4	AQ-01D		47		47	
5	AQ-01E		50		50	
6	AQ-01F		2		2	
7	AQ-02A	86	94	94	274	
8	AQ-02B	88	96	96	280	
9	AQ-03A	88	96	95	279	
10	AQ-03B	71	77	77	225	
11	AQ-03C	6	6	6	18	
12	AQ-03D	8	4	4	16	
13	AQ-04LA	176	96	95	367	
14	AQ-04LB	103	37	37	177	
15	AQ-04LC	2	1	1	4	
16	AQ-04RA	44	48	48	140	
17	AQ-04RB	34	37	37	108	
18	AQ-05LA	54	59	59	172	
19	AQ-05LB	3	3	3	9	
20	AQ-05RA	10	11	11	32	
21	AQ-05RB	12	13	13	38	
22	AQ-06LA	20			20	
23	AQ-06LB	2			2	
24	AQ-06RA					
25	AQ-06RB	11	12	12	35	
26	AQ-07A	43	47	47	137	
27	AQ-07B	2	2	2	6	
28	AQ-08A	46	50	50	146	
29	AQ-09A	129	188	141	458	
30	AQ-09B	132	192	144	468	
31	AQ-10A	6	8	6	20	
32	AQ-10B	6	8	6	20	
33	AQ-11A	43			43	
34	AQ-11B	35			35	
35	AQ-11C	2			2	
36	AQ-12A	11			11	
37	AQ-13A			47	47	
38	AQ-13B			48	48	
39	AQ-13C			2	2	
40	AQ-13D			2	2	
41	AQ-14A	43	94	47	184	
42	AQ-14B	35	76	38	149	
43	AQ-14C	2	4	2	8	
44	AQ-15A	11	12	12	35	
45	AQ-16A		12		12	
46	AQ-17A	43		47	90	
47	AQ-17B	44		48	92	
48	AQ-17D	2		2	4	
49	AQ-18A	2			2	
50	AQ-18B		2		2	
51	AQ-18C		2	2	4	
52	AQ-19A	44			44	16/24
53	AQ-19B	35			35	
54	AQ-19C	2			2	

铝角数量(工厂组装)					
N00814-01		N00814-02		N00814-03	
单件数量	合计	单件数量	合计	单件数量	合计
9	14373	9	14373		
4	6632	4	6632		
5	280	5	280		
9	423	9	423		
4	200	4	200		
9	18	9	18		
		9	2466	9	2466
		4	1120	4	1120
16	4464				
7	1575				
16	288				
17	272				
8	2936			9	3303
3	531			4	708
7	28				
7	980			9	1260
3	324			4	432
3	516			4	688
7	63				0
3	96			4	128
7	266				
3	60			4	80
7	14				
7	245				
16	2192				
16	96				
7	1022				
9	4122			9	4122
4	1872			4	1872
18	360				
8	160				
16	688				
7	245				
16	32				
7	77				
9	423			9	423
4	192			4	192
18	36				
8	16				
17	3128				
7	1043				
17	136				
7	245				
7	84				
9	810			9	810
4	368			4	368
8	32				
18	36				
18	36				
18	72				
15	660				
6	210				
15	30				

J858康城11期标准层收口铝板总数量统计表(T1，2，3)

工程：　J858康城11期

日期：　20-Dec-22

序号	铝板编号	T1	T2	T3	总数量	备注
55	AQ-20A	11			11	
56	AQ-21A			47	47	
57	AQ-21B			38	38	
58	AQ-22			2	2	
59	AQ-23			12	12	
60	AQ-24			12	12	
61	AQ-25			12	12	
62	AQ-26	16	14	16	46	
63	AQ-27	4	2	4	10	
64	AQ-28L	10	10	8	28	
65	AQ-28R	14	12	14	40	
66	AQ-29L	2	4	2	8	
67	AQ-29R			2	2	
68	AQ-30		1		1	
69	AQ-31L	7	6	6	19	
70	AQ-31R	5	6	5	16	
71	AQ-32L		1		1	
72	AQ-32R	2	1	2	5	
73	AQ-33	1	1	1	3	
74	AQ-34L	2	2	2	6	
75	AQ-34R	1	2	1	4	
76	AQ-35	1			1	
77	AQ-36			1	1	
78	AQ-37	1	2	1	4	
79	AQ-38	1		1	2	
80	AQ-39			1	1	
81	AQ-51-01	1	1	1	3	
82	AQ-51-02	1			1	
83	AQ-51-03	1	1	1	3	
84	AQ-51-04	1			1	
85	AQ-51-05	1	1	1	3	
86	AQ-51-06	7	6	7	20	
87	AQ-51-07	1	1	1	3	
88	AQ-51-08	1	1	1	3	
89	AQ-51-09	4	3	2	9	
90	AQ-51-10	7	7	5	19	
91	AQ-51-11	1	1	1	3	
92	AQ-51-12	1		1	2	
93	AQ-51-13	1			1	
94	AQ-51-14	1			1	
95	AQ-51-15		1	1	2	
96	AQ-51-16		1		1	
97	AQ-51-17		1	1	2	
98	AQ-51-18		1		1	
99	AQ-51-19		1		1	
100	AQ-51-20			1	1	
101	AQ-51-21	1			1	
102	AQ-51-22			1	1	
103	AQ-51-23			1	1	
104	AQ-52-01	1	1	1	3	
105	AQ-52-02	1			1	17/24
106	AQ-52-03	3	4	3	10	
107	AQ-52-04	1			1	

铝角数量(工厂组装)					
N00814-01		N00814-02		N00814-03	
单件数量	合计	单件数量	合计	单件数量	合计
6	66				
17	799				
7	266				
17	34				
4	48				
4	48				
4	48				
4	184				
3	30	4	40		
3	84	5	140		
3	120	5	200		
8	64	9	72		
8	16	9	18		
10	10	10	10		
10	190	10	190		
10	160	10	160		
10	10			10	10
10	50			10	50
19	57				
10	60			10	60
10	40			10	40
19	19				
20	20				
17	68				
10	20			10	20
19	19				

J858康城11期标准层收口铝板总数量统计表(T1，2，3)

工程：　J858康城11期

日期：　20-Dec-22

序号	铝板编号	T1	T2	T3	总数量	备注
108	AQ-52-05	2	1	1	**4**	
109	AQ-52-06	2		1	**3**	
110	AQ-52-07		1	1	**2**	
111	AQ-52-08		1	1	**2**	
112	AQ-52-09		1		**1**	
113	AQ-52-10		1		**1**	
114	AQ-52-11		1		**1**	
115	AQ-52-12		1	1	**2**	
116	AQ-52-13	1			**1**	
117	AQ-52-14	1			**1**	
118	AQ-52-15			1	**1**	
119	AQ-53-01	2	2	1	**5**	
120	AQ-54-01		1		**1**	
121	AQ-54-02	2	2	2	**6**	
122	AQ-54-03	1		1	**2**	
123	AQ-54-04	1			**1**	
124	AQ-55-01	1	1	1	**3**	
125	AQ-55-02			1	**1**	
126	AQ-55-03	1			**1**	
127	AQ-56-01	4	4	4	**12**	
128	AQ-56-02	4	4	4	**12**	
129	AQ-56-03	24	28	32	**84**	
130	AQ-56-04	8	8	8	**24**	
131	AQ-56-05	8			**8**	
132	AQ-56-06	4	4	4	**12**	
133	AQ-56-07		2		**2**	
134	AQ-56-08					
135	AQ-56-09		2		**2**	
136	AQ-57-01	2	2	2	**6**	
137	AQ-57-02	2	2	2	**6**	
138	AQ-57-03	12	14	16	**42**	
139	AQ-57-04	4	4	4	**12**	
140	AQ-57-05	4			**4**	
141	AQ-57-06			2	**2**	
142	AQ-57-07					
143	AQ-57-08	2	2		**4**	
144	AQ-57-09		2		**2**	
145	AQ-58-01	2	2	2	**6**	
146	AQ-58-02	6	8	6	**20**	
147	AQ-58-03	4	2	2	**8**	
148	AQ-58-04	2			**2**	
149	AQ-58-05			2	**2**	
150	AQ-58-06			2	**2**	
151	AQ-59L-01		2		**2**	
152	AQ-59L-02	2			**2**	
153	AQ-59L-03	2	2	2	**6**	
154	AQ-59R-01	4	4	2	**10**	
155	AQ-60-01	4	4	4	**12**	
156	AQ-60-02	4	4	4	**12**	
157	AQ-60-03	8	6	8	**22**	
158	AQ-60-04	8	6	8	**22**	18/24
159	AQ-60-05	8			**8**	
160	AQ-60-06	26	28	28	**82**	

铝角数量(工厂组装)					
N00814-01		N00814-02		N00814-03	
单件数量	合计	单件数量	合计	单件数量	合计

J858康城11期标准层收口铝板总数量统计表(T1，2，3)

工程： J858康城11期

日期： 20-Dec-22

序号	铝板编号	T1	T2	T3	总数量	备注
161	AQ-60-07		4	4	8	
162	AQ-60-08	12	12	12	36	
163	AQ-60-09	2			2	
164	AQ-60-09a	2			2	
165	AQ-60-09b		2	2	4	
166	AQ-60-10			4	4	
167	AQ-60-11	2	2	2	6	
168	AQ-61-01	2			2	
169	AQ-61-02	2	2	2	6	
170	AQ-61-03		2	2	4	
171	AQ-62-01		2	2	4	
172	AQ-62-02		2	2	4	
173	AQ-62-03	2			2	
174	AQ-62-04	2			2	
175	AQ-64-01	2			2	
176	AQ-64-02		2	2	4	
177	AQ-65-01	2			2	
178	AQ-65-02		2	2	4	
179	AQ-66A	2			2	
180	AQ-66B	2	2	2	6	
181	AQ-66C		2	2	4	
182	AQ-67A		2	2	4	
183	AQ-67B	2	2	2	6	
184	AQ-67C	2			2	
185	AQ-67D				0	
186	AQ-68L	4	4	2	10	
187	AQ-68R	4	4	2	10	
188	AQ-69L	4	4	2	10	
189	AQ-69R	4	4	2	10	
190	AQ-70L	4	4	2	10	
191	AQ-70R	4	4	2	10	
192	AQ-71			2	2	
193	AQ-72			2	2	
194	AQ-73			2	2	
195	AQ-75	1	1	1	3	
196	AQ-76-1	1			1	
197	AQ-76-2		1	1	2	
198	AQ-77	1	1	1	3	
199	AQ-78-1	44	48	48	140	
200	AQ-78-2	46	50	50	146	
201	AQ-78-3	2	2	2	6	
202	AQ-78-4	2	2	2	6	
203	AQ-79-1A	44			44	
204	AQ-79-1B		48	48	96	
205	AQ-79-2A	46			46	
206	AQ-79-2B		50	50	100	
207	AQ-79-3A	2			2	
208	AQ-79-3B		2	2	4	
209	AQ-80-1	44	48	48	140	
210	AQ-80-2	46	50	50	146	19/24
211	AQ-80-3	2	2	2	6	
212	AQ-81	2	2	2	6	

铝角数量(工厂组装)					
N00814-01		N00814-02		N00814-03	
单件数量	合计	单件数量	合计	单件数量	合计
3	24				
4	144				
3	6				
3	6				
3	12				
4	16				
5	30				
3	6				
3	18				
6	24				
3	12				
3	12				
5	10				
5	10				
5	10				
5	20				
6	12				
6	24				
6	12				
6	36				
6	24				
6	24				
6	36				
6	12				
6	0				
6	60				
6	60				
7	70				
7	70				
2	20	1	10		
2	20	1	10		
6	12				
7	14				
2	4	1	2		
16	2240				
6	876				
8	48				
4	24				
16	704				
16	1536				
6	276				
6	600				
16	32				
16	64				
16	2240				
6	876				
16	96				
7	42				

J858康城11期标准层收口铝板总数量统计表(T1，2，3)						
工程： J858康城11期						
日期： 20-Dec-22						
序号	铝板编号	T1	T2	T3	总数量	备注
213	AQ-82-1	2	2	2	6	
214	AQ-82-2	2	2		4	
215	AQ-82-3			2	2	
216	AQ-83-1	4	4	4	12	
217	AQ-83-2	18	16	18	52	
218	AQ-83-3	12	12	12	36	
219	AQ-83-4	4			4	
220	AQ-83-5			4	4	
221	AQ-84-1	6	6	6	18	
222	AQ-84-2	14	20	16	50	
223	AQ-84-3	6			6	
224	AQ-85-1	4	4	2	10	
225	AQ-86-1	2	4	4	10	
226	AQ-86-2	8	6	8	22	
227	AQ-86-3	2			2	
228	AQ-86-3a	2			2	
229	AQ-86-4					
230	AQ-86-5					
231	AQ-86-6					
232	AQ-86-7					
233	AQ-86-8		2	2	4	
234	AQ-86-9			2	2	
235	AQ-87-1	2	2	2	6	
236	AQ-87-2	4	2	4	10	
237	AQ-87-3	4	2	2	8	
238	AQ-87-4	2	2	2	6	
239	AQ-87-5		2	2	4	
240	AQ-88-1	2			2	
241	AQ-88-2		2	2	4	
242	AQ-89-1	2			2	
243	AQ-89-2	2	2	2	6	
244	AQ-89-3		2	2	4	
245	AQ-90-1	2			2	
246	AQ-90-2	2			2	
247	AQ-90-3		2	2	4	
248	AQ-90-4		2	2	4	
	分层数量	3347	3378	3305	10030	

铝角数量(工厂组装)					
N00814-01		N00814-02		N00814-03	
单件数量	合计	单件数量	合计	单件数量	合计

J858康城11期标准层幕墙铝板总数量(T1，2，3)						
工程： J858康城11期						
日期： 29-Nov-22						
序号	铝板编号	T1	T2	T3	总数量	备注
1	AQ-21A			47	47	
2	AQ-21B			38	38	
58	AQ-22			2	2	
59	AQ-23			12	12	
80	AQ-39			1	1	
81	AQ-51-01	1	1	1	3	
82	AQ-51-02	1			1	
83	AQ-51-03	1	1	1	3	
84	AQ-51-04	1			1	
85	AQ-51-05	1	1	1	3	
86	AQ-51-06	7	6	7	20	
87	AQ-51-07	1	1	1	3	
88	AQ-51-08	1	1	1	3	
89	AQ-51-09	4	3	2	9	
90	AQ-51-10	7	7	5	19	
91	AQ-51-11	1	1	1	3	
92	AQ-51-12	1		1	2	
93	AQ-51-13	1			1	
94	AQ-51-14	1			1	
95	AQ-51-15		1	1	2	
96	AQ-51-16		1		1	
97	AQ-51-17		1	1	2	
98	AQ-51-18		1		1	
99	AQ-51-19		1		1	
100	AQ-51-20			1	1	
101	AQ-51-21	1			1	
102	AQ-51-22			1	1	
103	AQ-51-23			1	1	
104	AQ-52-01	1	1	1	3	
105	AQ-52-02	1			1	
106	AQ-52-03	3	4	3	10	
107	AQ-52-04	1			1	
108	AQ-52-05	2	1	1	4	
109	AQ-52-06	2		1	3	
110	AQ-52-07		1	1	2	
111	AQ-52-08		1	1	2	
112	AQ-52-09		1		1	
113	AQ-52-10		1		1	
114	AQ-52-11		1		1	
115	AQ-52-12		1	1	2	
116	AQ-52-13	1			1	
117	AQ-52-14	1			1	
118	AQ-52-15			1	1	
119	AQ-53-01	2	2	1	5	
120	AQ-54-01		1		1	
121	AQ-54-02	2	2	2	6	
122	AQ-54-03	1		1	2	
123	AQ-54-04	1			1	
124	AQ-55-01	1	1	1	3	
125	AQ-55-02			1	1	
126	AQ-55-03	1			1	

铝背骨X86319 数量统计		
每块铝板背骨数量(支)	单件长度（mm）	合计数量(米)
9	535	37.72
4	535	13.55
9	535	1.61
1	535	1.07
10	535	0.89
1	594	0.30
1	795	0.13
1	775	0.39
1	1697.5	0.28
1	872.5	0.44
1	685	2.28
1	1547.5	0.77
1	1385	0.69
1	1347.5	2.02
1	666	2.11
1	1294	0.65
1	1410	0.47
1	1616	0.27
1	1566	0.26
1	745	0.25
1	1747.5	0.29
1	1641	0.55
1	897.5	0.15
1	735	0.12
1	1575	0.26
1	599	0.10
1	1435	0.24
1	800	0.13
1	594	0.30
1	1815	0.30
1	1347.5	2.25
1	1684	0.28
1	1230	0.82
1	685	0.34
1	1840	0.61
1	1311	0.44
1	1765	0.29
1	1712.5	0.29
1	735	0.12
1	1709	0.57
1	599	0.10
1	1430	0.24
1	1435	0.24
1	1838	1.53
1	1838	0.31
1	747	0.75
1	1819	0.61
1	1828	0.30
1	747	0.37
1	1807	0.30
1	819.5	0.14

背骨铝连接片数量(工厂组装)					
LJ-01		LJ-02		LJ-03	
单件数量	合计	单件数量	合计	单件数量	合计
18	846				
8	304				
18	36				
2	24				
20	20				

J858康城11期标准层幕墙铝板总数量(T1，2，3)

工程：　J858康城11期

日期：　29-Nov-22

序号	铝板编号	T1	T2	T3	总数量	备注
127	AQ-56-01	4	4	4	12	
128	AQ-56-02	4	4	4	12	
129	AQ-56-03	24	28	32	84	
130	AQ-56-04	8	8	8	24	
131	AQ-56-05	8			8	
132	AQ-56-06	4	4	4	12	
133	AQ-56-07		2		2	
134	AQ-56-08					
135	AQ-56-09		2		2	
136	AQ-57-01	2	2	2	6	
137	AQ-57-02	2	2	2	6	
138	AQ-57-03	12	14	16	42	
139	AQ-57-04	4	4	4	12	
140	AQ-57-05	4			4	
141	AQ-57-06			2	2	
142	AQ-57-07					
143	AQ-57-08	2	2		4	
144	AQ-57-09		2		2	
145	AQ-58-01	2	2	2	6	
146	AQ-58-02	6	8	6	20	
147	AQ-58-03	4	2	2	8	
148	AQ-58-04	2			2	
149	AQ-58-05			2	2	
150	AQ-58-06			2	2	
151	AQ-59L-01		2		2	
152	AQ-59L-02	2			2	
153	AQ-59L-03	2	2	2	6	
154	AQ-59R-01	4	4	2	10	
155	AQ-60-01	4	4	4	12	
156	AQ-60-02	4	4	4	12	
157	AQ-60-03	8	6	8	22	
158	AQ-60-04	8	6	8	22	
159	AQ-60-05	8			8	
160	AQ-60-06	26	28	28	82	
161	AQ-60-07		4	4	8	
162	AQ-60-08	12	12	12	36	
163	AQ-60-09	2			2	
163	AQ-60-09a	2			2	
163	AQ-60-09b		2	2	4	
164	AQ-60-10			4	4	
165	AQ-60-11	2	2	2	6	
166	AQ-61-01	2			2	
167	AQ-61-02	2	2	2	6	
168	AQ-61-03		2	2	4	
169	AQ-62-01		2	2	4	
170	AQ-62-02		2	2	4	
171	AQ-62-03	2			2	
172	AQ-62-04	2			2	
173	AQ-64-01	2			2	
174	AQ-64-02		2	2	4	
175	AQ-65-01	2			2	
176	AQ-65-02		2	2	4	

铝背骨X86319 数量统计

每块铝板背骨数量(支)	单件长度（mm）	合计数量(米)
1	992	1.98
1	1008	2.02
1	997	13.96
1	970	3.88
1	988	1.32
1	998	2.00
1	792.5	0.26
1	1098	0.37
1	992	0.99
1	1008	1.01
1	997	6.98
1	970	1.94
1	988	0.66
1	998	0.33
1	968	0.65
1	1098	0.37
4	949	3.80
4	949	12.65
5	949	6.33
4	949	1.27
4	949	1.27
5	949	1.58
4	949	1.27
4	949	1.27
4	949	3.80
4	949	6.33
4	949	7.59
4	949	7.59
5	949	17.40
3	949	10.44
4	949	5.06
4	949	51.88
3	949	3.80
4	949	22.78
3	949	0.95
3	949	0.95
3	949	1.90
4	949	2.53
5	949	4.75
2	949	0.63
2	949	1.90
5	949	3.16
2	949	1.27
2	949	1.27
5	949	1.58
5	949	1.58
	949	0.00
5	949	1.58
5	949	3.16
3	920	0.92
3	945	1.89

背骨铝连接片数量(工厂组装)

LJ-01		LJ-02		LJ-03	
单件数量	合计	单件数量	合计	单件数量	合计
		8	48	8	48
		8	160	8	160
		10	80	10	80
		8	16	8	16
		8	16	8	16
		10	20	10	20
		8	16	8	16
		8	16	8	16
		8	48	8	48
		8	80	8	80
		8	96	8	96
		8	96	8	96
		10	220	10	220
		6	132	6	132
		8	64	8	64
		8	656	8	656
		6	48	6	48
		8	288	8	288
		6	12	6	12
		6	12	6	12
		6	24	6	24
		8	32	8	32
		10	60	10	60
		4	8	4	8
		4	24	4	24
		10	40	10	40
		4	16	4	16
		4	16	4	16
		10	20	10	20
		10	20	10	20
		10	20	10	20
		10	40	10	40
18	36				
18	72				

J858康城11期标准层幕墙铝板总数量(T1，2，3)						
工程：	J858康城11期					
日期：	29-Nov-22					
序号	铝板编号	T1	T2	T3	总数量	备注
177	AQ-66A	2			2	
178	AQ-66B	2	2	2	6	
179	AQ-66C		2	2	4	
180	AQ-67A		2	2	4	
181	AQ-67B	2	2	2	6	
182	AQ-67C	2			2	
183	AQ-67D				0	
184	AQ-68L	4	4	2	10	
185	AQ-68R	4	4	2	10	
186	AQ-71			2	2	
187	AQ-75	1	1	1	3	
188	AQ-76-1	1			1	
189	AQ-76-2		1	1	2	
190	AQ-77	1	1	1	3	
191	AQ-78-1	44	48	48	140	
192	AQ-78-2	46	50	50	146	
193	AQ-78-3	2	2	2	6	
194	AQ-78-4	2	2	2	6	
195	AQ-79-1A	44			44	
196	AQ-79-1B		48	48	96	
197	AQ-79-2A	46			46	
198	AQ-79-2B		50	50	100	
199	AQ-79-3A	2			2	
200	AQ-79-3B		2	2	4	
201	AQ-80-1	44	48	48	140	
202	AQ-80-2	46	50	50	146	
203	AQ-80-3	2	2	2	6	
204	AQ-81	2	2	2	6	
205	AQ-82-1	2	2	2	6	
206	AQ-82-2	2	2		4	
207	AQ-82-3			2	2	
208	AQ-83-1	4	4	4	12	
209	AQ-83-2	18	16	18	52	
210	AQ-83-3	12	12	12	36	
211	AQ-83-4	4			4	
212	AQ-83-5			4	4	
213	AQ-84-1	6	6	6	18	
214	AQ-84-2	14	20	16	50	
215	AQ-84-3	6			6	
216	AQ-85-1	4	4	2	10	
217	AQ-86-1	2	4	4	10	
218	AQ-86-2	8	6	8	22	
219	AQ-86-3	2			2	
220	AQ-86-3a	2			2	
221	AQ-86-4				0	
222	AQ-86-5				0	
223	AQ-86-6				0	
224	AQ-86-7				0	
225	AQ-86-8		2	2	4	
226	AQ-86-9			2	2	
227	AQ-87-1	2	2	2	6	
228	AQ-87-2	4	2	4	10	

铝背骨X86319 数量统计		
每块铝板背骨数量(支)	单件长度（mm）	合计数量(米)
3	567.5	0.57
3	542.5	1.63
3	580	1.16
3	580	1.16
3	542.5	1.63
3	567.5	0.57
0	0	0.00
3	485	2.43
3	485	2.43
4	377.5	0.25
4	377.5	0.50
7	229	37.40
3	229	16.72
3	229	0.69
7	1210	62.11
7	1030	115.36
3	1210	27.83
3	1030	51.50
7	1210	2.82
7	1030	4.81
7	285	46.55
3	285	20.81
7	285	2.00
3	820	2.46
4	800	3.20
4	800	2.13
4	800	1.07
4	800	6.40
4	800	27.73
4	800	19.20
4	800	2.13
4	800	2.13
4	800	9.60
4	800	26.67
4	800	3.20
4	800	5.33
5	542.5	4.52
3	542.5	5.97
3	542.5	0.54
3	542.5	0.54
	542.5	0.00
	542.5	0.00
	542.5	0.00
	542.5	0.00
3	542.5	1.09
5	542.5	0.90
5	542.5	2.71
5	542.5	4.52

背骨铝连接片数量(工厂组装)					
LJ-01		LJ-02		LJ-03	
单件数量	合计	单件数量	合计	单件数量	合计
6	12				
6	36				
6	24				
6	24				
6	36				
6	12				
0	0				
6	12				
16	2240				
6	876				
16	96				
6	36				
		8	48		
		8	32		
		8	16		
		8	96		
		8	416		
		8	288		
		8	32		
		8	32		
		8	144		
		8	400		
		8	48		
		8	80		
		10	100		
		6	132		
		6	12		
		6	12		
			0		
			0		
			0		
			0		
		6	24		
		10	20		
		10	60		
		10	100		


J858康城11期标准层幕墙铝板总数量(T1，2，3)						
工程：	J858康城11期					
日期：	29-Nov-22					
序号	铝板编号	T1	T2	T3	总数量	备注
229	AQ-87-3	4	2	2	8	
230	AQ-87-4	2	2	2	6	
231	AQ-87-5		2	2	4	
232	AQ-88-1	2			2	
233	AQ-88-2		2	2	4	
234	AQ-89-1	2			2	
235	AQ-89-2	2	2	2	6	
236	AQ-89-3		2	2	4	
237	AQ-90-1	2			2	
238	AQ-90-2	2			2	
239	AQ-90-3		2	2	4	
240	AQ-90-4		2	2	4	
	分层数量	645	644	751	2040	

铝背骨X86319 数量统计		
每块铝板背骨数量(支)	单件长度（mm）	合计数量(米)
5	542.5	3.62
3	542.5	1.63
3	542.5	1.09
5	542.5	0.90
5	542.5	1.81
2	542.5	0.36
2	542.5	1.09
5	542.5	1.81
5	542.5	0.90
5	542.5	0.90
2	542.5	0.72
2	542.5	0.72
		862.80

背骨铝连接片数量(工厂组装)					
LJ-01		LJ-02		LJ-03	
单件数量	合计	单件数量	合计	单件数量	合计
		10	80		
		6	36		
		6	24		
		10	20		
		10	40		
		4	8		
		4	24		
		10	40		
		10	20		
		10	20		
		4	16		
		4	16		
	4742		4880		2444

美特鋁質有限公司 MIDI Aluminium Fabricator Ltd.				工程號	J858	類別		物料號	-		
				地盤	康城11期	制圖	W.E.X	2022-08-11	圖號	AQ-01	
修改	-	-	-	採用工廠		地盤 ✓	图纸名称	铝折件	復核	-	-	數量	-	
日期	-	-	-	材料颜色	PVF2（香槟金）		材料	3.0mm 铝板	批准	-	-	單件重量	-	(KG)

表面處理: PVF2 (香檳金ECD3X10099S-JF2

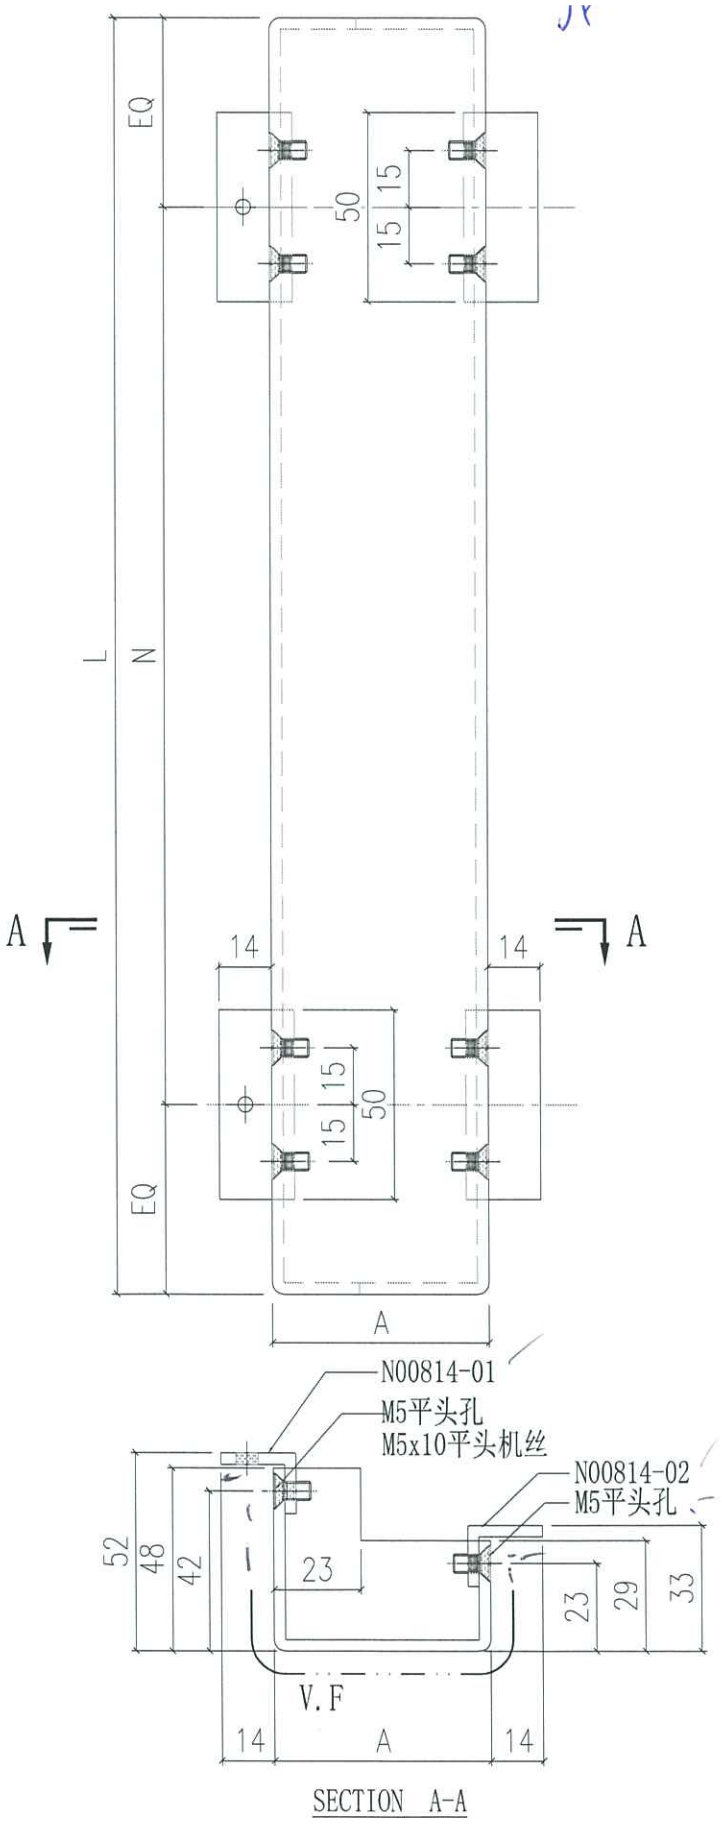


SECTION A-A


编号	L	A	N	合计数量
AQ-01A	2385	57.5	@285c/cx8	1597
AQ-01B	885	57.5	@260c/cx3	1658
AQ-01C	1250	57.5	@285c/cx4	56
AQ-01F	2335	57.5	@280c/cx8	2

美特鋁質有限公司 MIDI Aluminium Fabricator Ltd.													
						工程號	J858	類別		物料號	-		
						地盘	康城11期	制圖	W.E.X	2022-08-11	圖號	AQ-01D/E	
修改	-	-	-	採用	工廠		地盤 ✓	图纸名称	铝折件	復核	-	-	數量	-	
日期	-	-	-	材料颜色	PVF2（香槟金）			材料	3.0mm 铝板	批准	-	-	單件重量	-	(KG)

表面處理: PVF2 (香檳金ECD3X10099S-JF2

编号	L	N	合计数量
AQ-01D	2385	@285c/cx8	47
AQ-01E	885	@260c/cx3	50

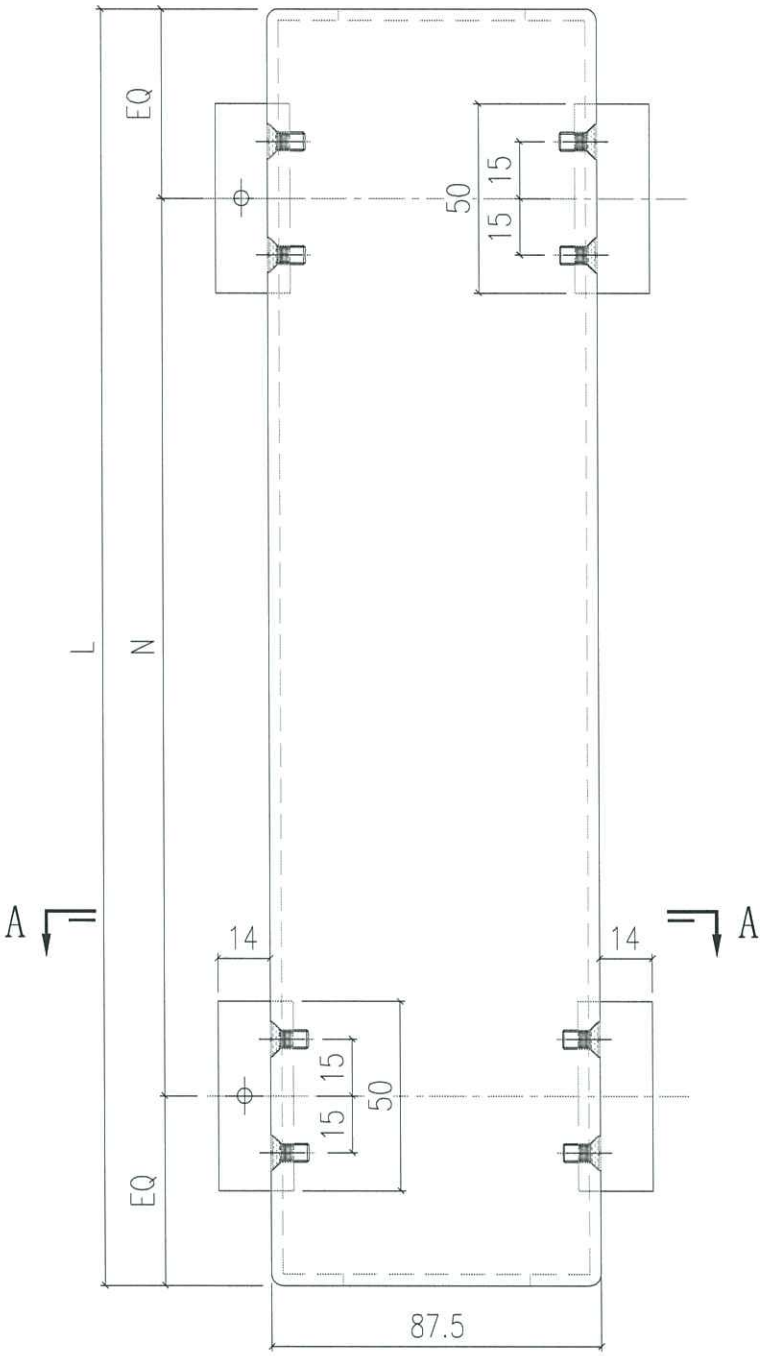

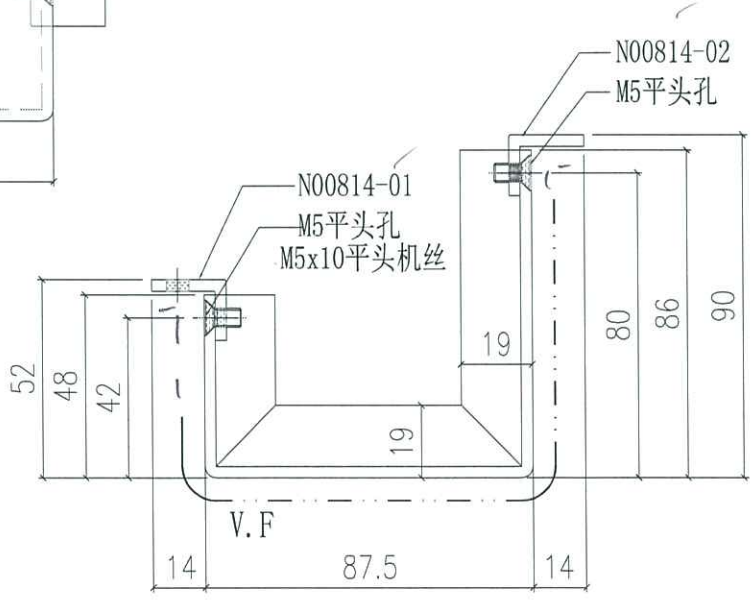


SECTION A-A

美特鋁質有限公司 MIDI Aluminium Fabricator Ltd.				工程號	J858	類別		物料號	-		
				地盘	康城11期	制圖	W.E.X	2022-08-11	圖號	AQ-02	
修改	-	-	-	採用工廠		地盤 ✓	图纸名称	铝折件	復核	-	-	數量	-
日期	-	-	-	材料颜色	PVF2（香槟金）		材料	3.0mm 铝板	批准	-	-	單件重量	- (KG)


表面處理: PVF2 (香檳金ECD3X10099S-JF2

编号	L	N	合计数量
AQ-02A	2385	@285c/cx8	274
AQ-02B	885	@260c/cx3	280

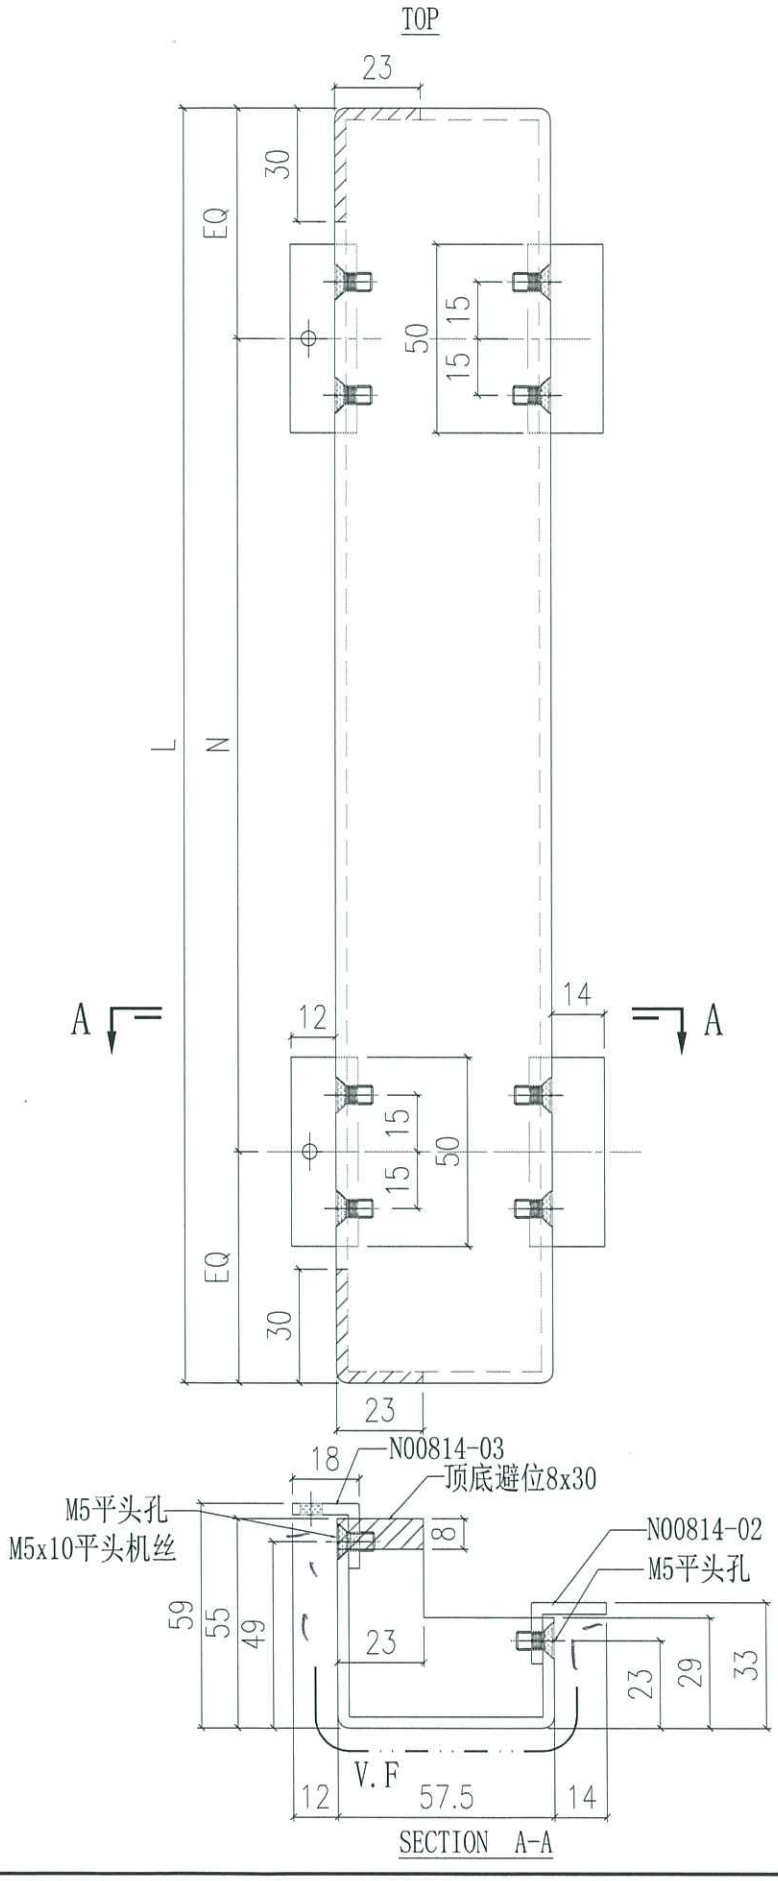


美特鋁質有限公司 MIDI Aluminium Fabricator Ltd.													
					工程號	J858	類別		物料號	-			
					地盘	康城11期	制圖	W.E.X	2022-08-11	圖號	AQ-03		
修改	-	-	-	採用 工廠		地盤 ✓	图纸名称	铝折件	復核	-	-	数量	-	
日期	-	-	-	材料颜色	PVF2（香槟金）		材料	3.0mm 铝板	批准	-	-	單件重量	-	(KG)

表面處理: PVF2 (香檳金ECD3X10099S-JF2

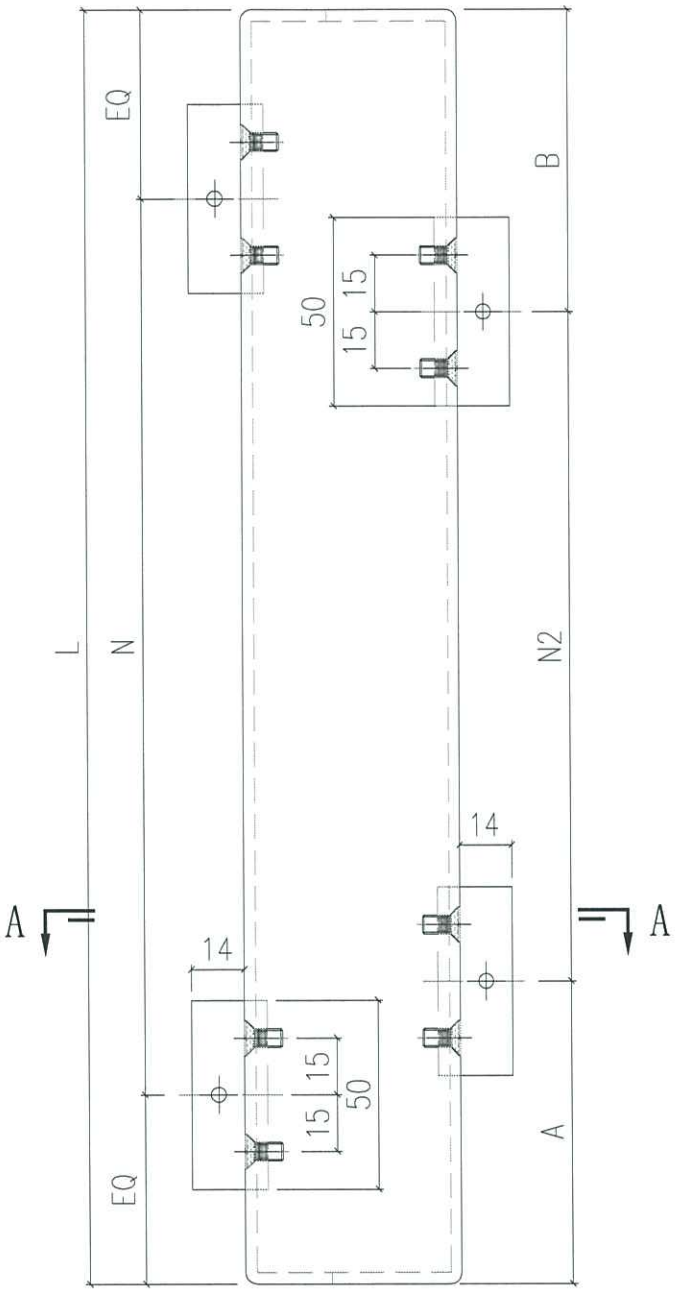


编号	L	N	N2	A	B	合计数量
AQ-03A	2385	@285c/cx8	@300c/cx6	297.5	287.5	279
AQ-03B	885	@260c/cx3	@280c/cx2	232.5	92.5	225
AQ-03C	2335	@280c/cx8	@300c/cx6	247.5	287.5	18
AQ-03D	2335	@280c/cx8	@300c/cx7	97.5	137.5	16

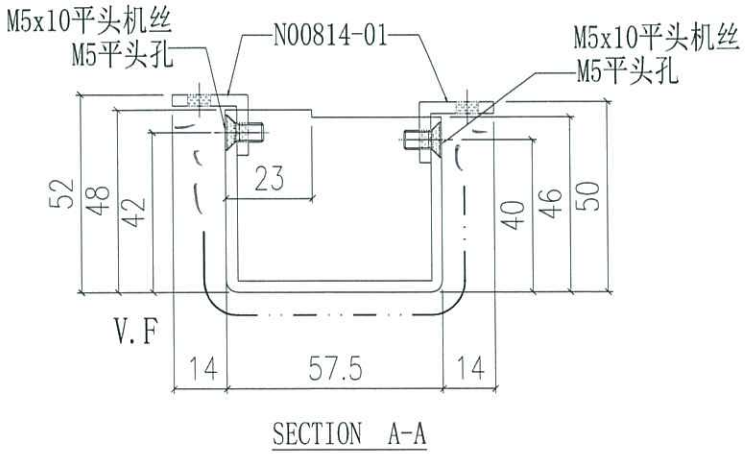


SECTION A-A

美特鋁質有限公司 MIDI Aluminium Fabricator Ltd.													
						工程號	J858	類別		物料號	-		
						地盘	康城11期	制圖	W.E.X	2022-08-11	圖號	AQ-04L	
修改	-	-	-	採用	工廠		地盤 ✓	图纸名称	铝折件	復核	-	-	數量	-	
日期	-	-	-	材料颜色	PVF2（香槟金）			材料	3.0mm 铝板	批准	-	-	單件重量	-	(KG)

表面處理: PVF2 (香檳金ECD3X10099S-JF2

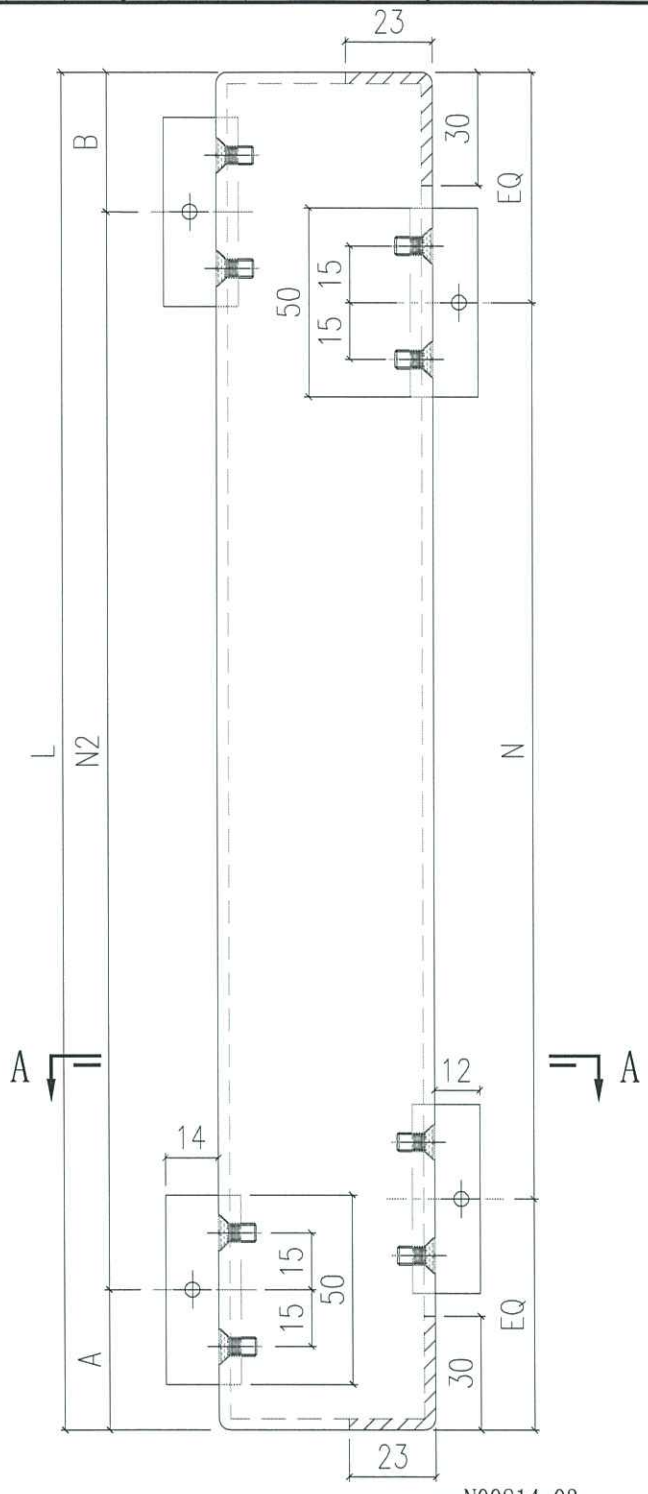


编号	L	N	N2	A	B	合计数量
AQ-04LA	2385	@285c/cx8	@300c/cx7	147.5	137.5	367
AQ-04LB	885	@260c/cx3	@280c/cx2	92.5	232.5	177

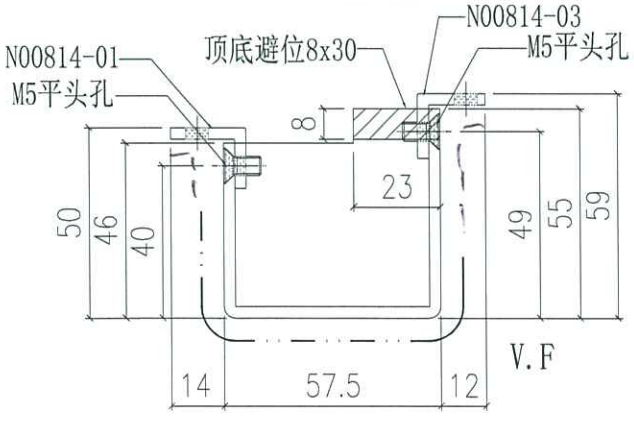


SECTION A-A

美特鋁質有限公司 MIDI Aluminium Fabricator Ltd.													
						工程號	J858	類別		物料號	-		
						地盤	康城11期	制圖	W.E.X	2022-08-11	圖號	AQ-04R	
修改	-	-	-	採用	工廠		地盤 ✓	图纸名称	铝折件	復核	-	-	數量	-	
日期	-	-	-	材料颜色	PVF2（香槟金）			材料	3.0mm 铝板	批准	-	-	單件重量	-	(KG)

表面處理: PVF2 (香檳金ECD3X10099S-JF2

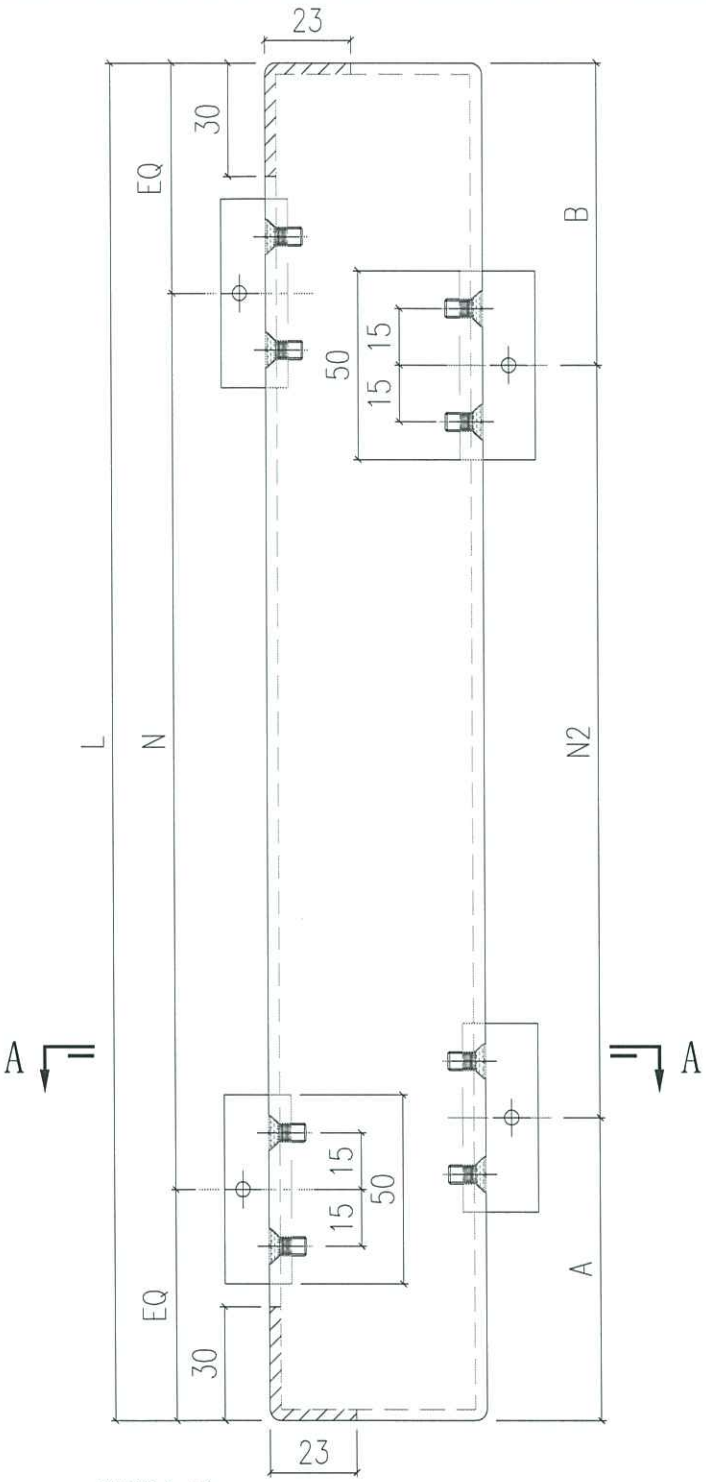

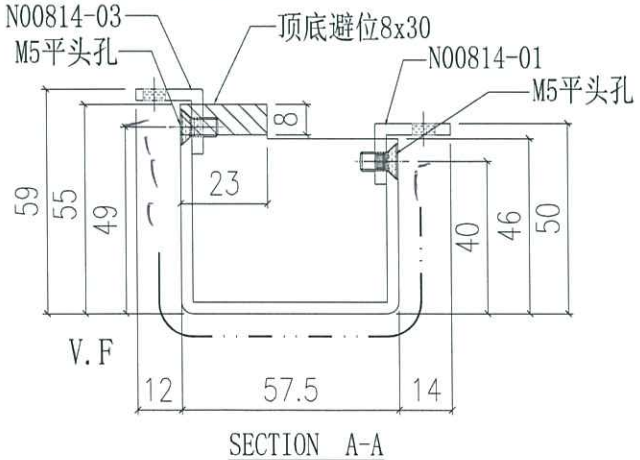


SECTION A-A


编号	L	N	N2	A	B	合计数量
AQ-04RA	2385	@285c/cx8	@300c/cx6	297.5	287.5	140
AQ-04RB	885	@260c/cx3	@280c/cx2	232.5	92.5	108

美特鋁質有限公司 MIDI Aluminium Fabricator Ltd.													
						工程號	J858	類別		物料號	-		
						地盤	康城11期	制圖	W.E.X	2022-08-11	圖號	AQ-05LA	
修改	-	-	-	採用	工廠		地盤 ✓	图纸名称	铝折件	復核	-	-	數量	-	
日期	-	-	-	材料颜色	PVF2（香槟金）			材料	3.0mm 铝板	批准	-	-	單件重量	-	(KG)

表面處理: PVF2 (香檳金ECD3X10099S-JF2

编号	合计数量
AQ-05LA	172

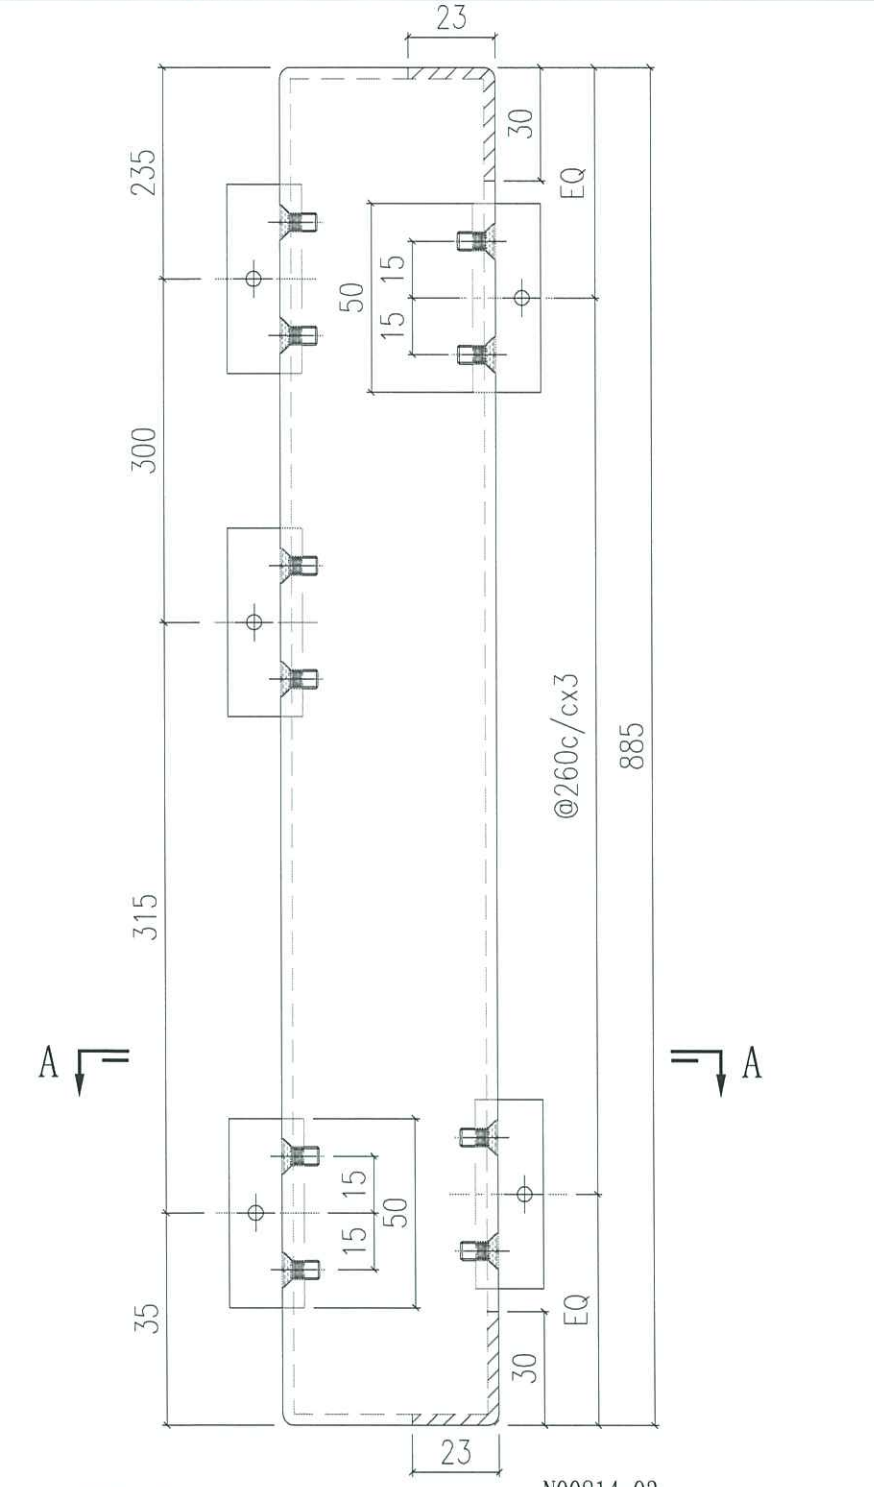


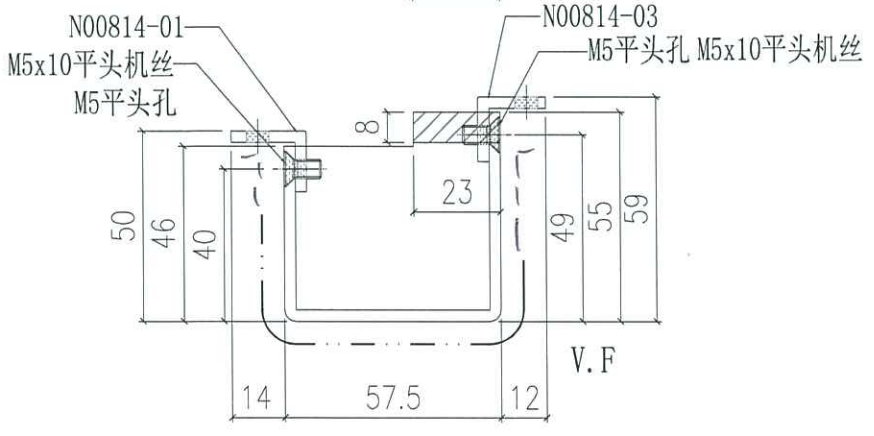


SECTION A-A

美特鋁質有限公司 MIDI Aluminium Fabricator Ltd.						工程號	J858	類別		物料號	-		
						地盤	康城11期	制圖	W.E.X	2022-08-11	圖號	AQ-05LB	
修改	-	-	-	採用	工廠		地盤 ✓	图纸名称	铝折件	復核	-	-	數量	-	
日期	-	-	-	材料颜色	PVF2（香槟金）			材料	3.0mm 铝板	批准	-	-	單件重量	-	(KG)

表面處理: PVF2 (香檳金ECD3X10099S-JF2

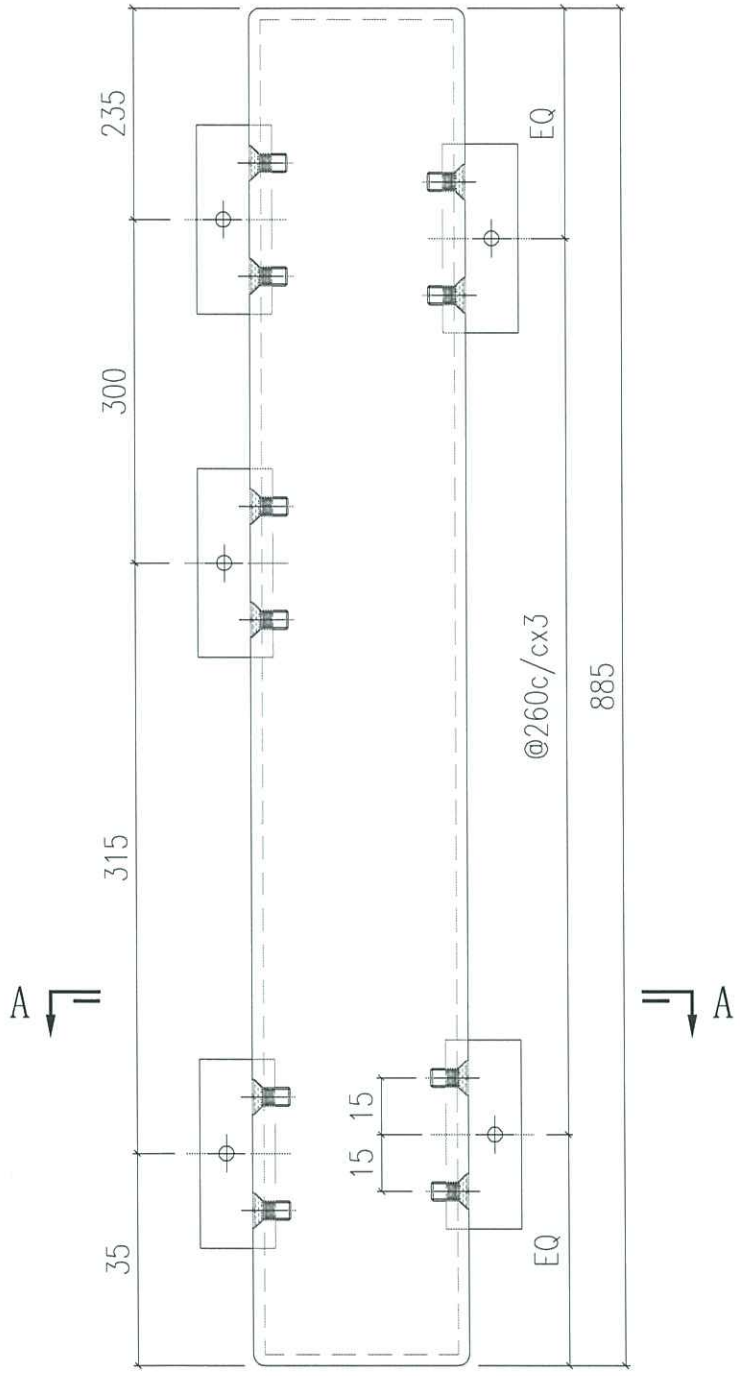

编号	合计数量
AQ-05LB	6

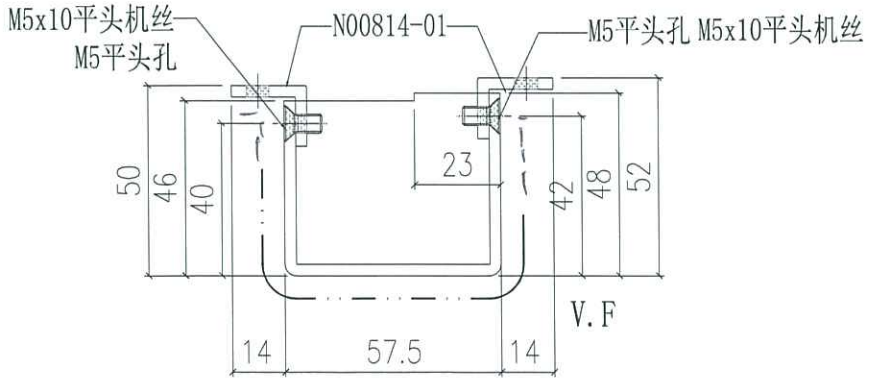



SECTION A-A

美特鋁質有限公司 MIDI Aluminium Fabricator Ltd.													
						工程號	J858	類別		物料號	-		
						地盘	康城11期	制圖	W.E.X	2022-08-11	圖號	AQ-05RA	
修改	-	-	-	採用	工廠		地盤 ✓	图纸名称	铝折件	復核	-	-	数量	-	
日期	-	-	-	材料颜色	PVF2（香槟金）			材料	3.0mm 铝板	批准	-	-	單件重量	-	(KG)

表面處理: PVF2 (香檳金ECD3X10099S-JF2

编号	合计数量
AQ-05RA	32

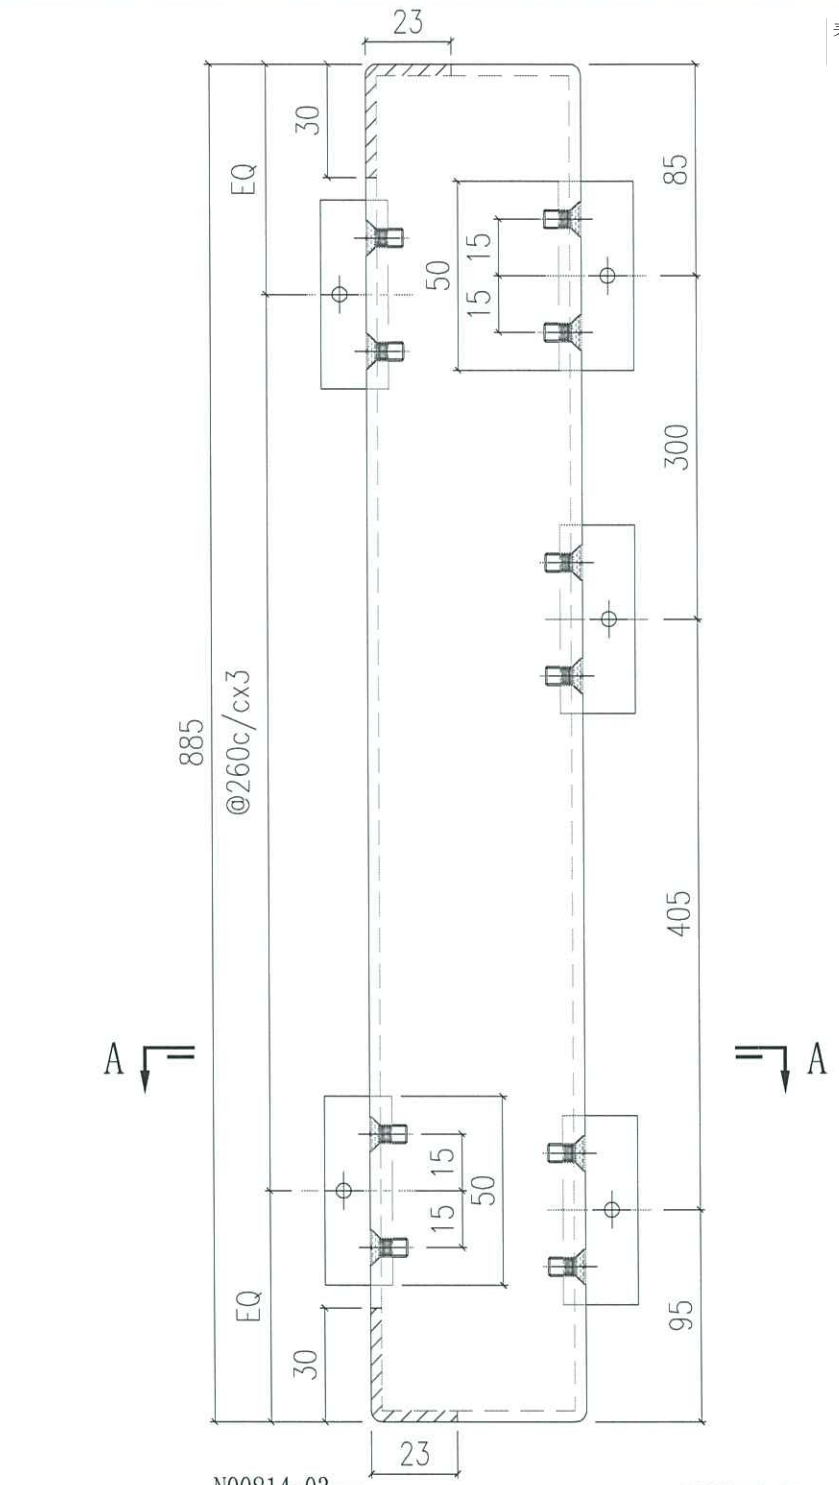

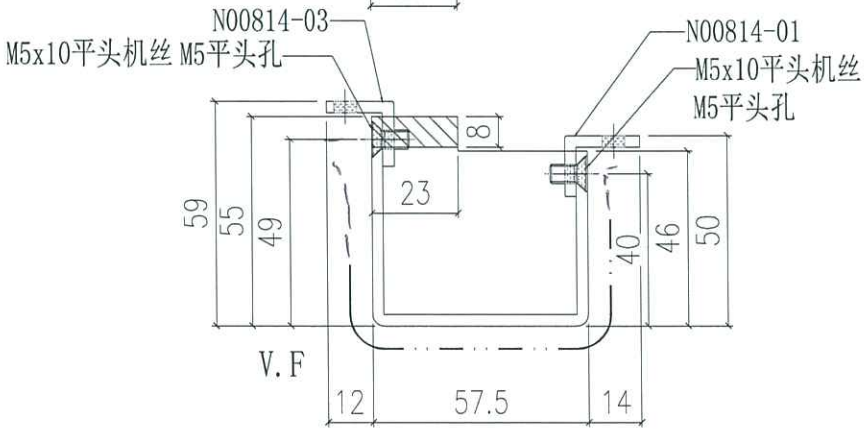



SECTION A-A

美特鋁質有限公司 MIDI Aluminium Fabricator Ltd.						工程號	J858	類別		物料號	-		
						地盘	康城11期	制圖	W.E.X	2022-08-11	圖號	AQ-05RB	
修改	-	-	-	採用	工廠		地盤 ✓	图纸名称	铝折件	復核	-	-	数量	-	
日期	-	-	-	材料颜色	PVF2（香槟金）			材料	3.0mm 铝板	批准	-	-	單件重量	-	(KG)

表面處理: PVF2 (香檳金ECD3X10099S-JF2

编号	合计数量
AQ-05RB	6

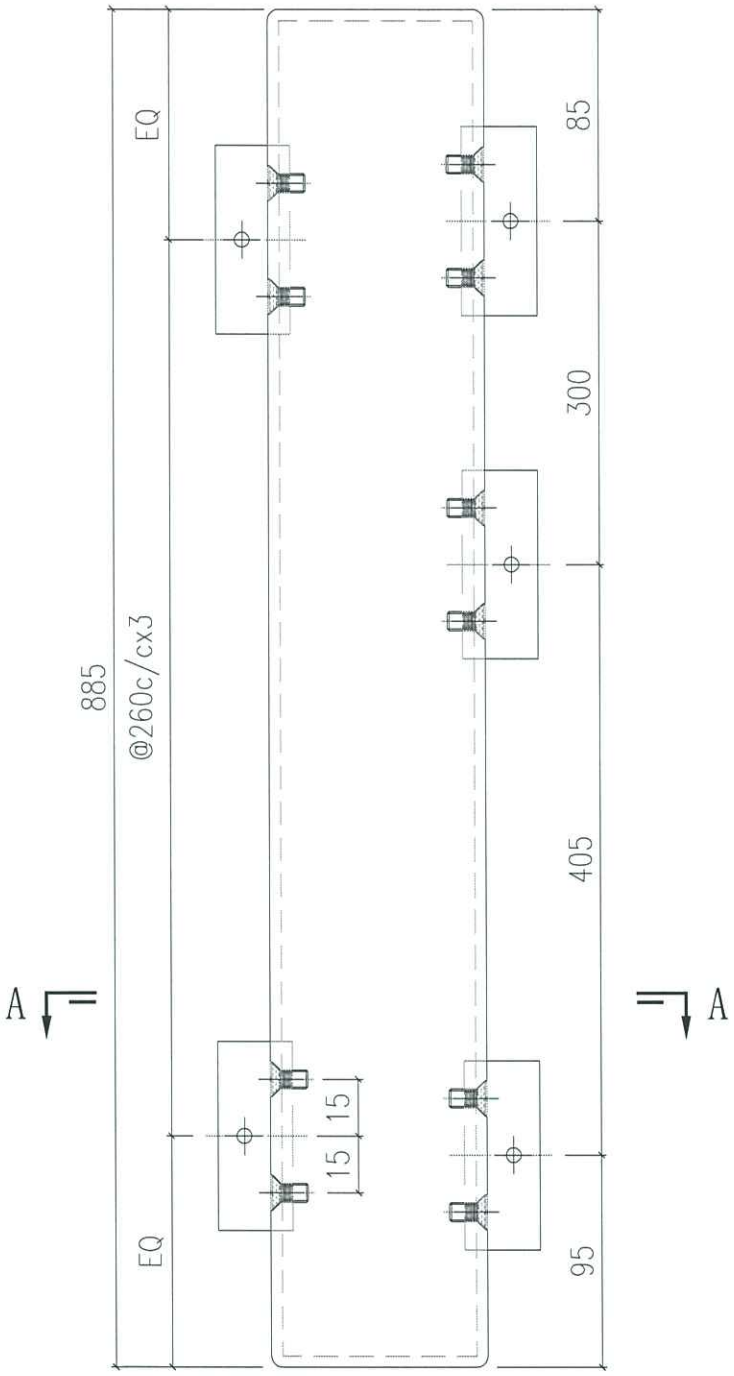

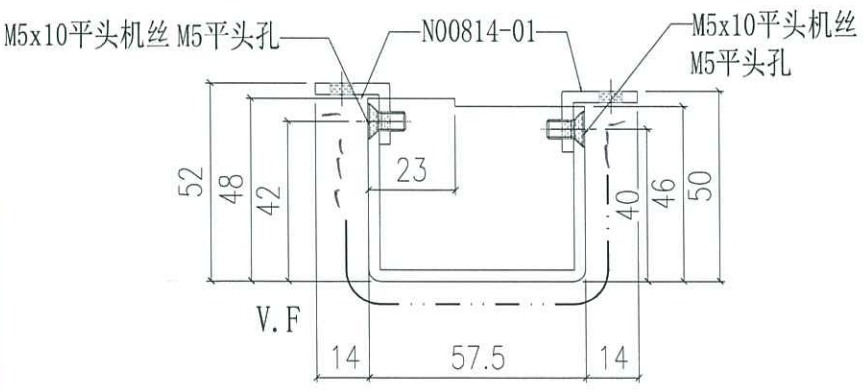



SECTION A-A

美特鋁質有限公司 MIDI Aluminium Fabricator Ltd.													
						工程號	J858	類別		物料號	-		
						地盘	康城11期	制圖	W.E.X	2022-08-11	圖號	AQ-06LA	
修改	-	-	-	採用	工廠		地盤 ✓	图纸名称	铝折件	復核	-	-	數量	-	
日期	-	-	-	材料颜色	PVF2（香槟金）			材料	3.0mm 铝板	批准	-	-	單件重量	-	(KG)

表面處理: PVF2 (香檳金ECD3X10099S-JF2

编号	数量
AQ-06LA	20

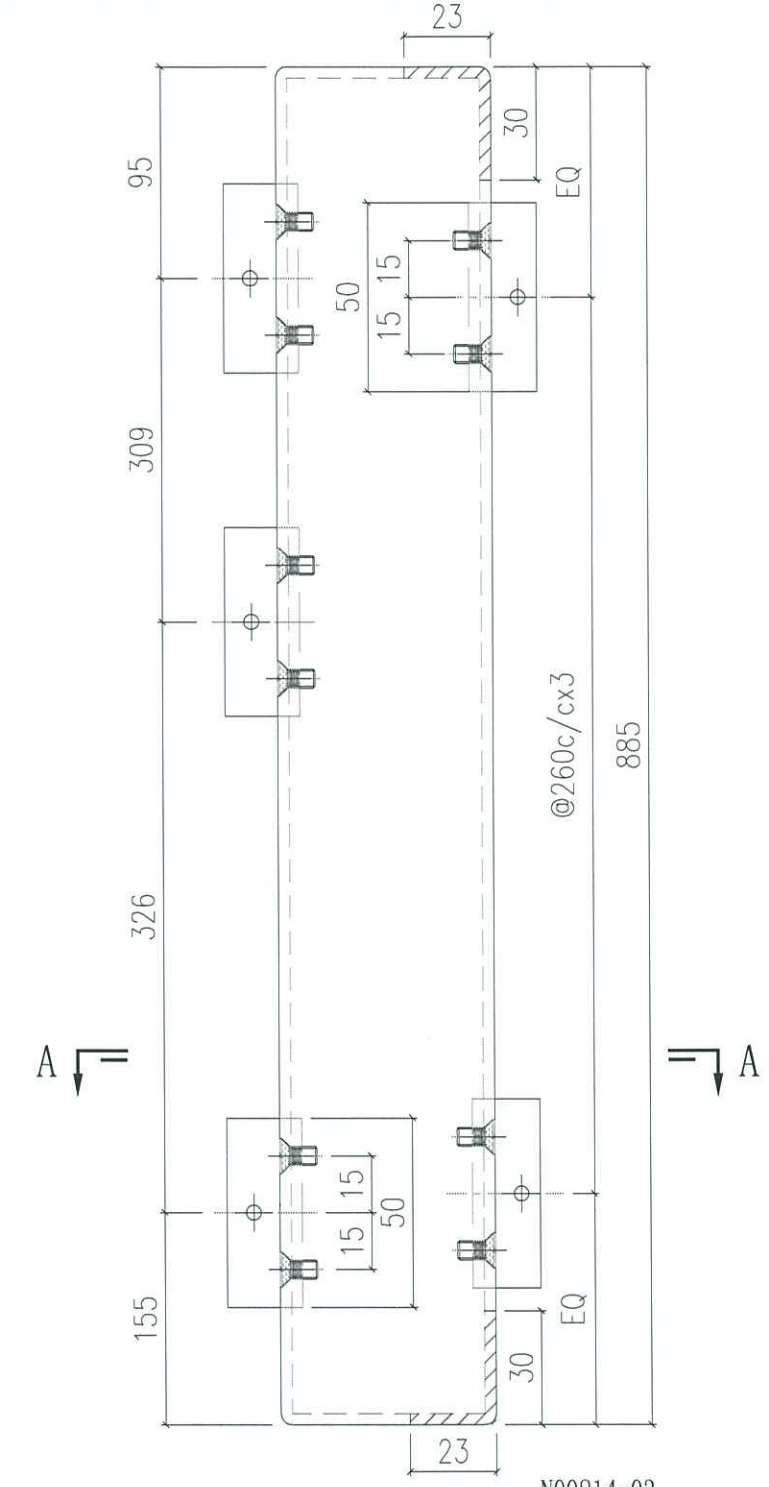


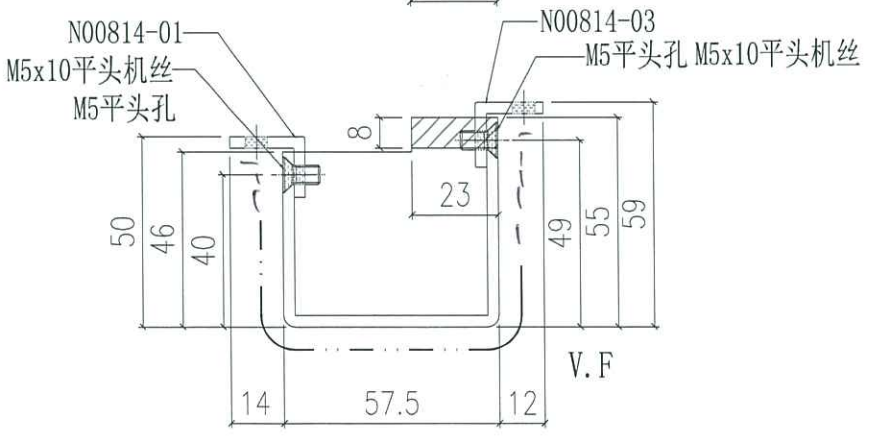


SECTION A-A

美特鋁質有限公司 MIDI Aluminium Fabricator Ltd.													
					工程號	J858	類別		物料號	-			
					地盘	康城11期	制圖	W.E.X	2022-08-11	圖號	AQ-06LB		
修改	-	-	-	採用 工廠		地盤 ✓	图纸名称	铝折件	復核	-	-	數量	-	
日期	-	-	-	材料颜色	PVF2（香槟金）		材料	3.0mm 铝板	批准	-	-	單件重量	-	(KG)

表面處理: PVF2 (香檳金ECD3X10099S-JF2

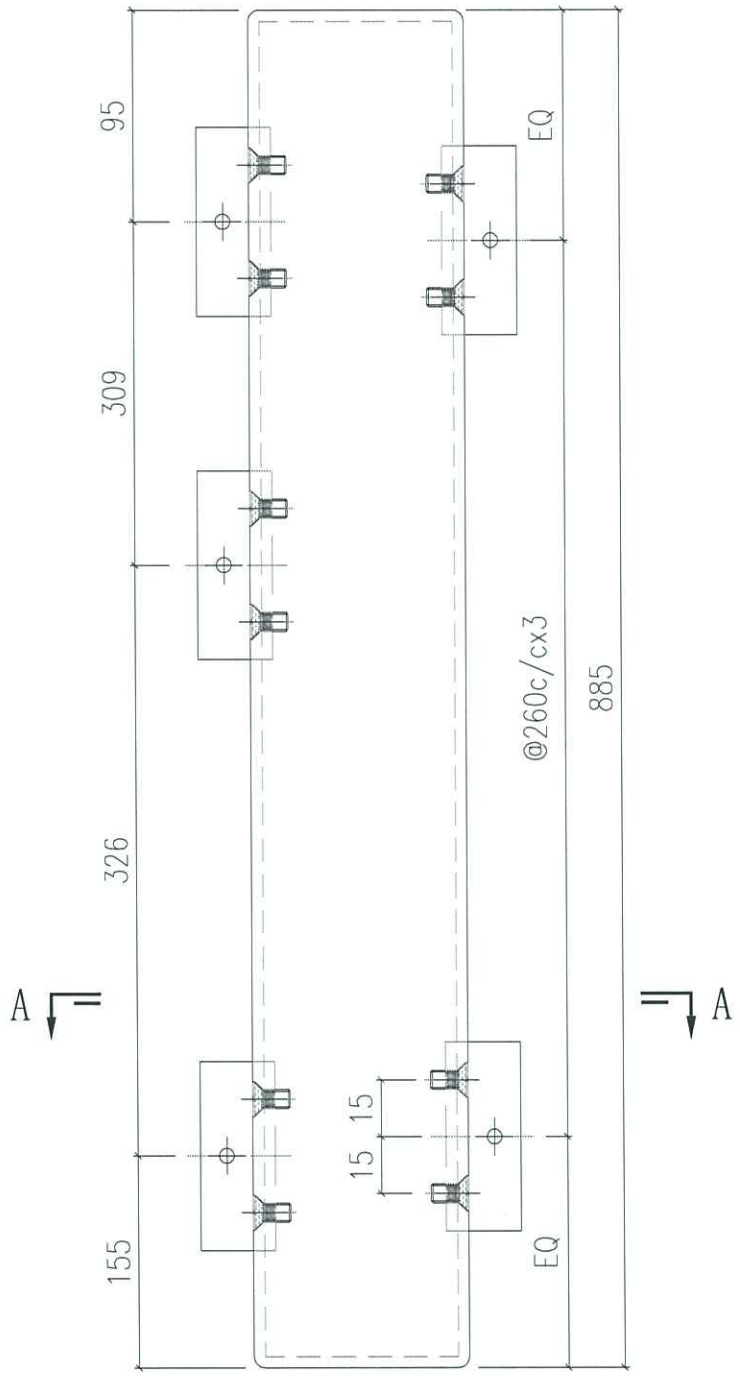

编号	数量
AQ-06LB	20

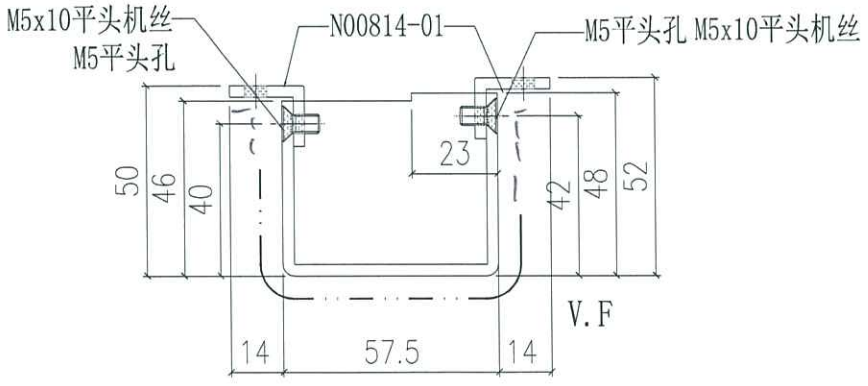



SECTION A-A

美特鋁質有限公司 MIDI Aluminium Fabricator Ltd.													
					工程號	J858	類別		物料號	-			
					地盤	康城11期	制圖	W.E.X	2022-08-11	圖號	AQ-06RA		
修改	-	-	-	採用 工廠		地盤 ✓	图纸名称	铝折件	復核	-	-	数量	-	
日期	-	-	-	材料颜色	PVF2（香槟金）		材料	3.0mm 铝板	批准	-	-	單件重量	-	(KG)

表面處理: PVF2 (香檳金ECD3X10099S-JF2

编号	数量
AQ-06RA	-

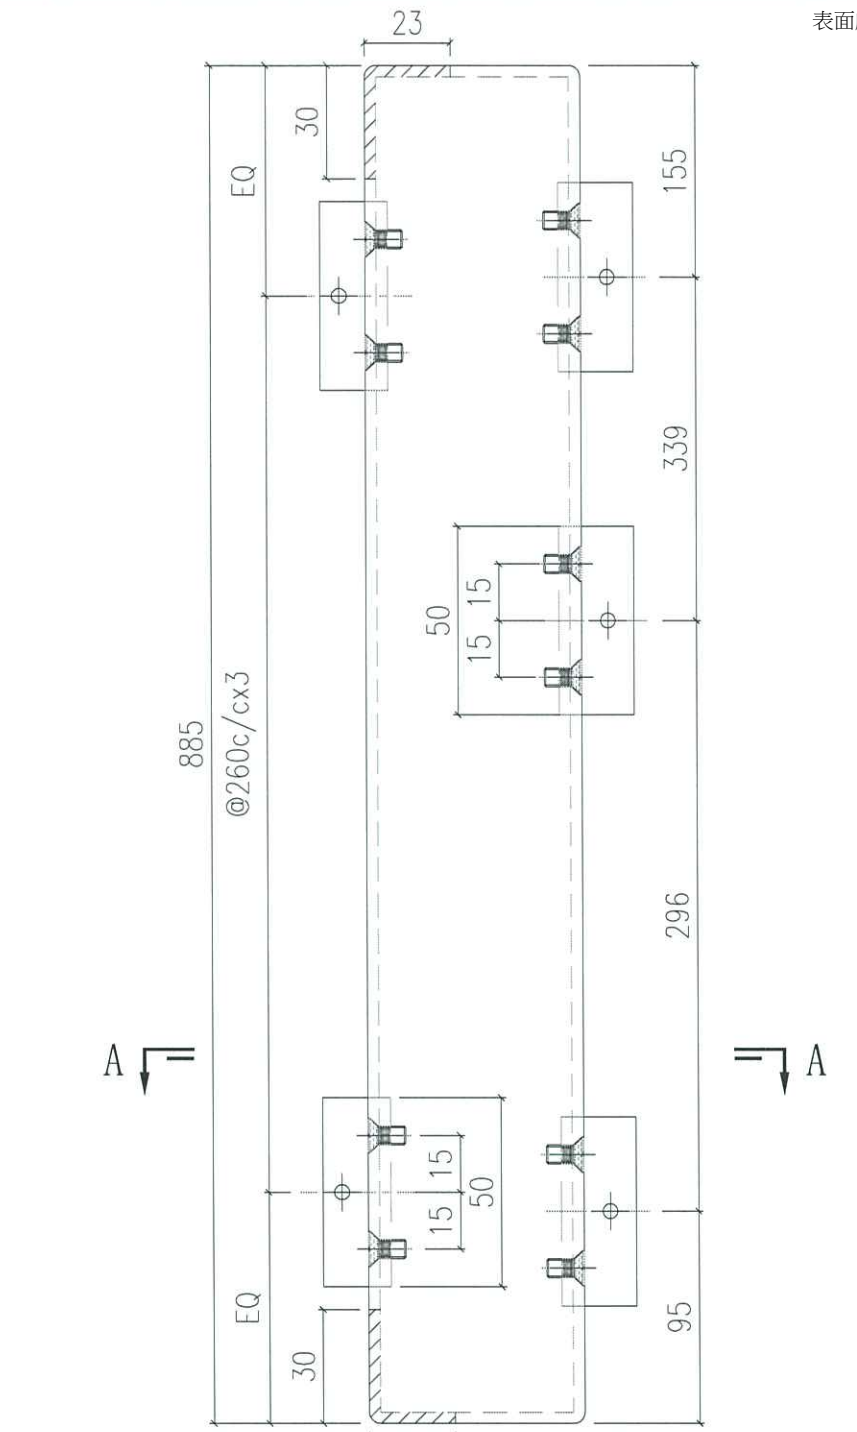


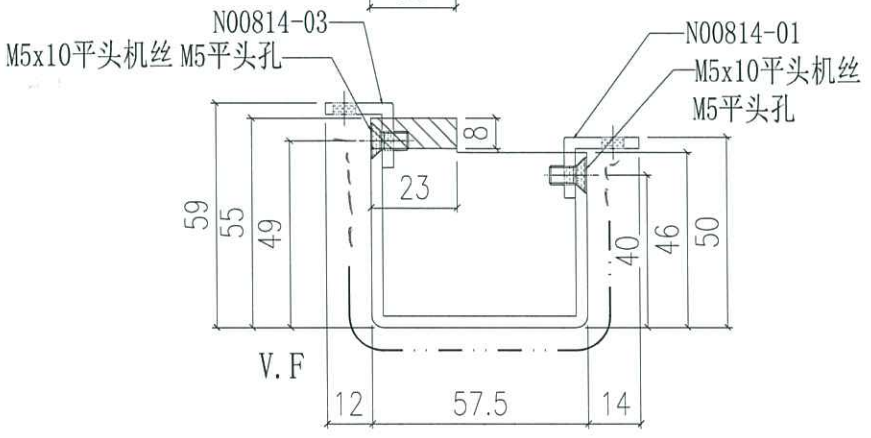


SECTION A-A

美特鋁質有限公司 MIDI Aluminium Fabricator Ltd.						工程號	J858	類別		物料號	-		
						地盘	康城11期	制圖	W.E.X	2022-08-11	圖號	AQ-06RB	
修改	-	-	-	採用	工廠		地盤 ✓	图纸名称	铝折件	復核	-	-	数量	-	
日期	-	-	-	材料颜色	PVF2（香槟金）			材料	3.0mm 铝板	批准	-	-	單件重量	-	(KG)

表面處理: PVF2 (香檳金ECD3X10099S-JF2

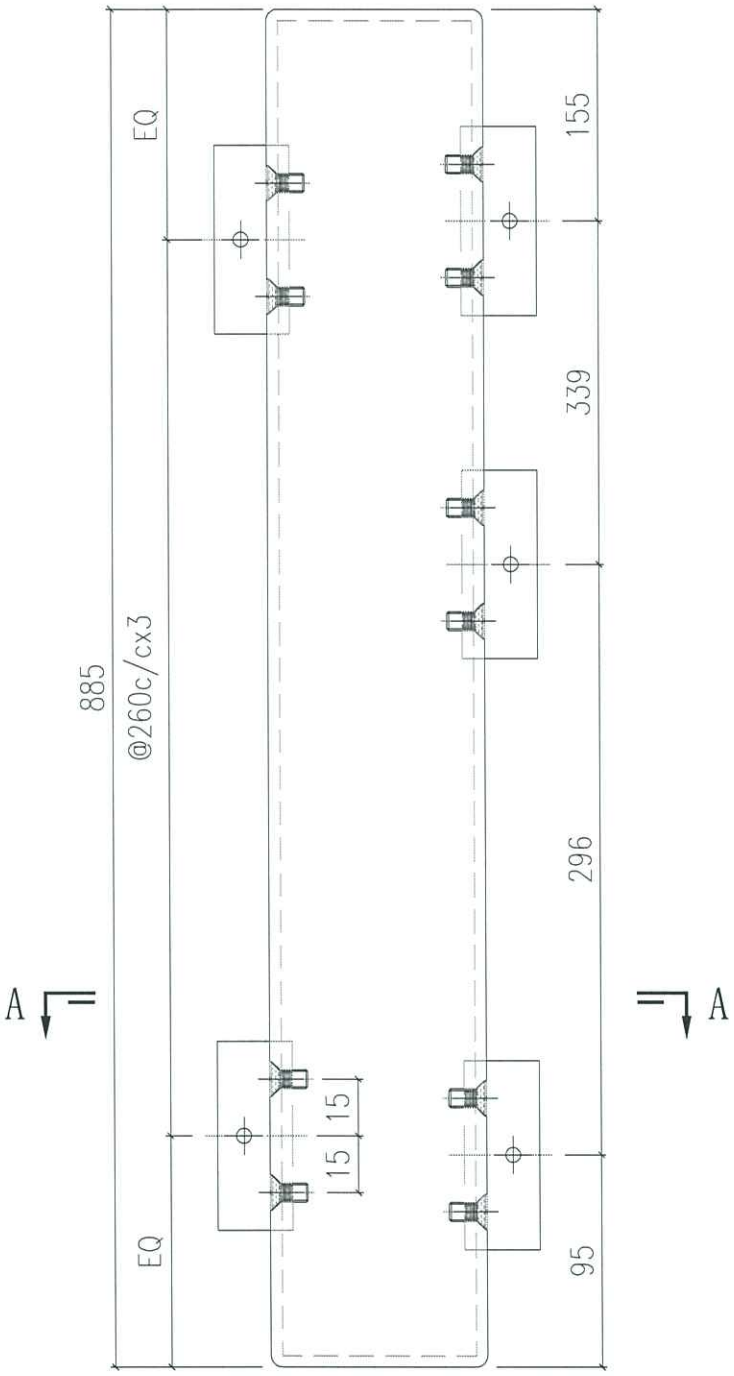

编号	数量
AQ-06RB	-

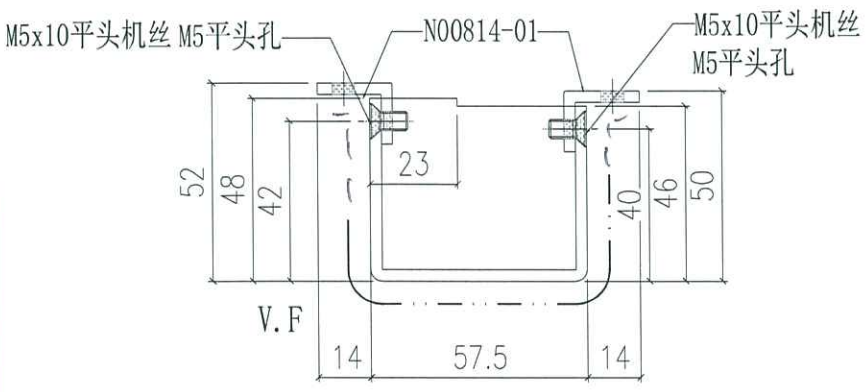



SECTION A-A

美特鋁質有限公司 MIDI Aluminium Fabricator Ltd.				工程號	J858	類別		物料號	-		
				地盤	康城11期	制圖	W.E.X	2022-08-11	圖號	AQ-07	
修改	-	-	-	採用工廠		地盤 ✓	图纸名称	铝折件	復核	-	-	數量	-	
日期	-	-	-	材料颜色	PVF2（香槟金）		材料	3.0mm 铝板	批准	-	-	單件重量	-	(KG)

表面處理: PVF2 (香檳金ECD3X10099S-JF2

编号	L	N	N2			
AQ-07A	2385	@285c/cx8	@300c/cx6	297.5	287.5	137
AQ-07B	2335	@280c/cx8	@300c/cx6	247.5	287.5	6

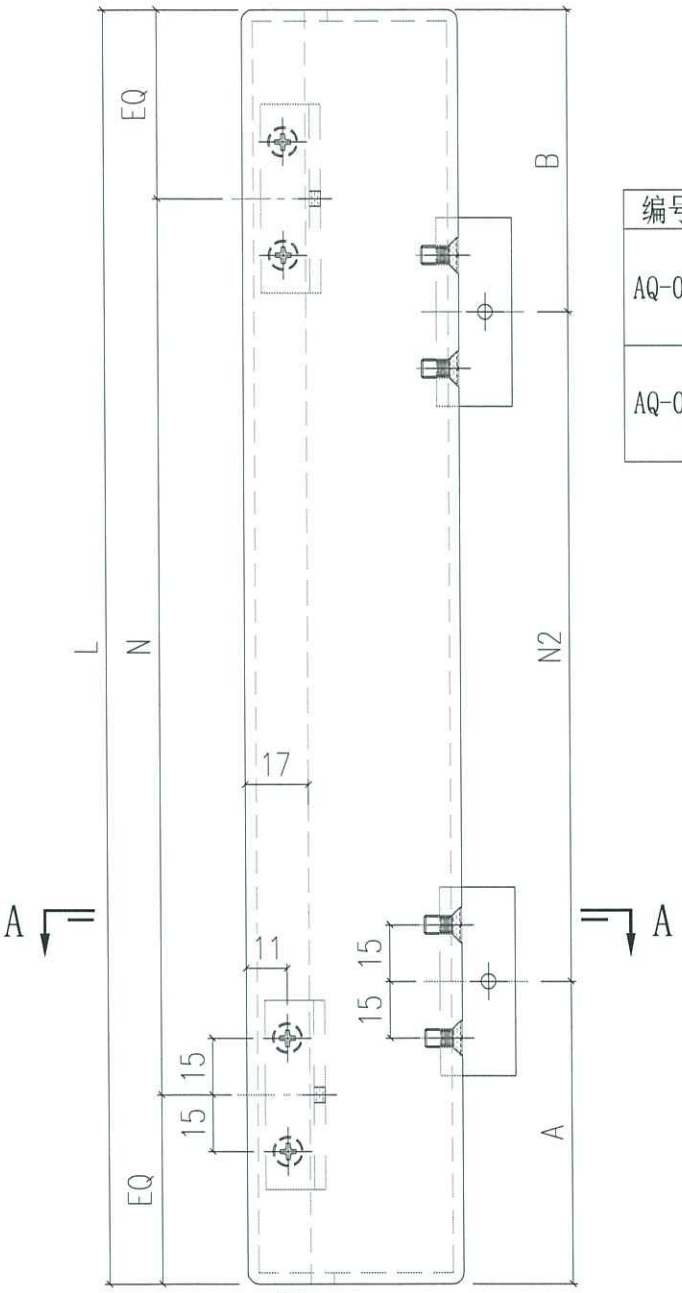

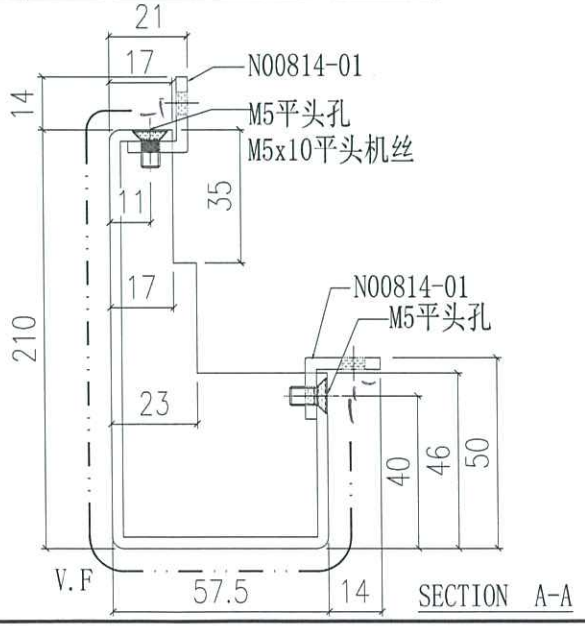



detail
P11

美特鋁質有限公司 MIDI Aluminium Fabricator Ltd.													
				工程號	J858	類別		物料號	-				
				地盘	康城11期	制圖	W.E.X	2022-08-11	圖號	AQ-08			
修改	-	-	-	採用工廠		地盤 ✓	图纸名称	铝折件	復核	-	-	數量	-	
日期	-	-	-	材料颜色	PVF2（香槟金）		材料	3.0mm 铝板	批准	-	-	單件重量	-	(KG)

表面處理: PVF2 (香檳金ECD3X10099S-JF2

编号	L	合计数量
AQ-08A	885	146

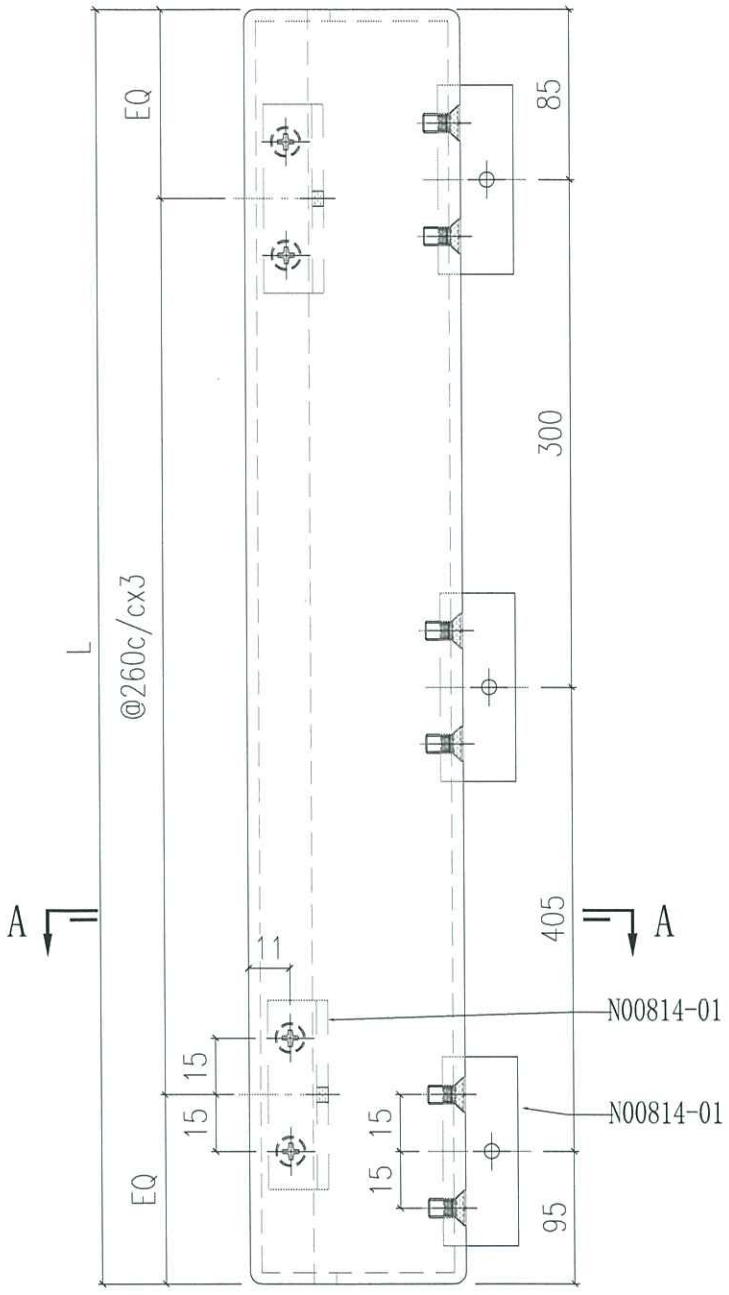


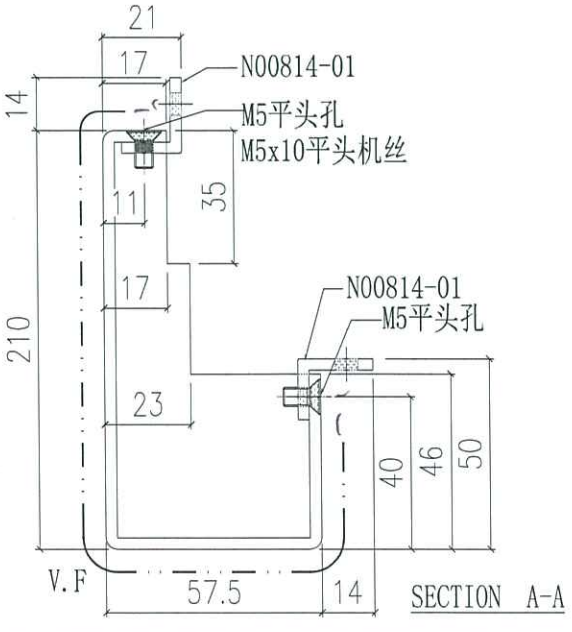

美特鋁質有限公司 MIDI Aluminium Fabricator Ltd.													
				工程號	J858	類別		物料號	-				
				地盘	康城11期	制圖	W.E.X	2022-08-11	圖號	AQ-09			
修改	-	-	-	採用	工廠		地盤 ✓	图纸名称	铝折件	復核	-	-	數量	-	
日期	-	-	-	材料颜色	PVF2（香槟金）			材料	3.0mm 铝板	批准	-	-	單件重量	-	(KG)

表面處理: PVF2 (香檳金ECD3X10099S-JF2

编号	L	N	合计数量
Q-09A	2385	@285c/cx8	458
AQ-09B	885	@260c/cx3	468

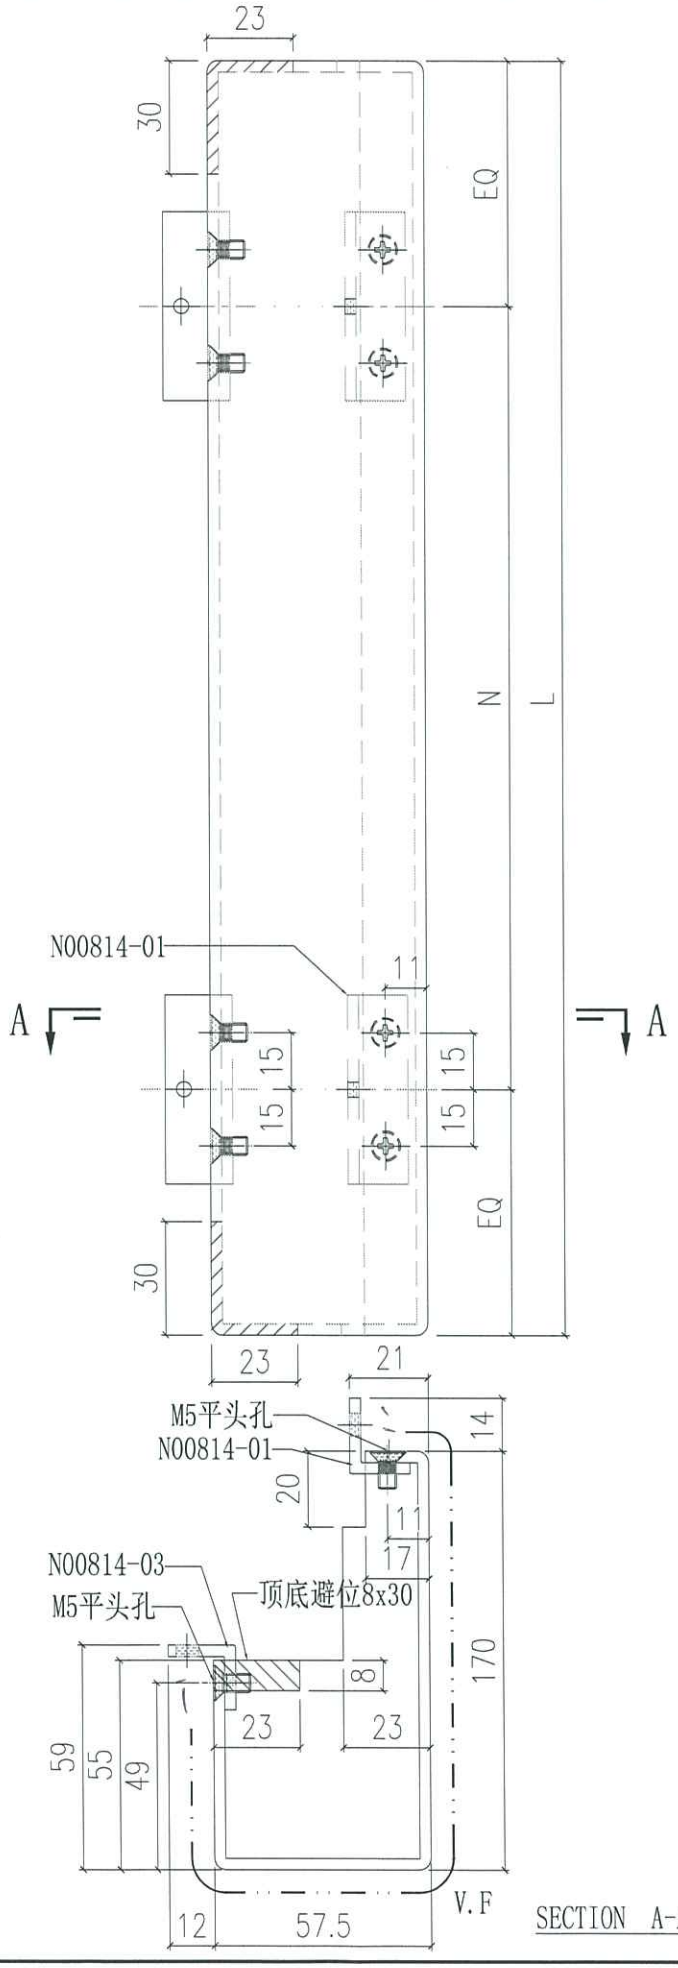


SECTION A-A

美特鋁質有限公司 MIDI Aluminium Fabricator Ltd.				工程號	J858	類別		物料號	-		
				地盤	康城11期	制圖	W.E.X	2022-08-11	圖號	AQ-10	
修改	-	-	-	採用 工廠		地盤 ✓	图纸名称	铝折件	復核	-	-	數量	-	
日期	-	-	-	材料颜色	PVF2（香槟金）		材料	3.0mm 铝板	批准	-	-	單件重量	-	(KG)

表面處理: PVF2 (香檳金ECD3X10099S-JF2

编号	L	N	楼层	数量
AQ-10A	2335	@280c/cx8	11,40/F	20
AQ-10B	885	@260c/cx3	11,40/F	20

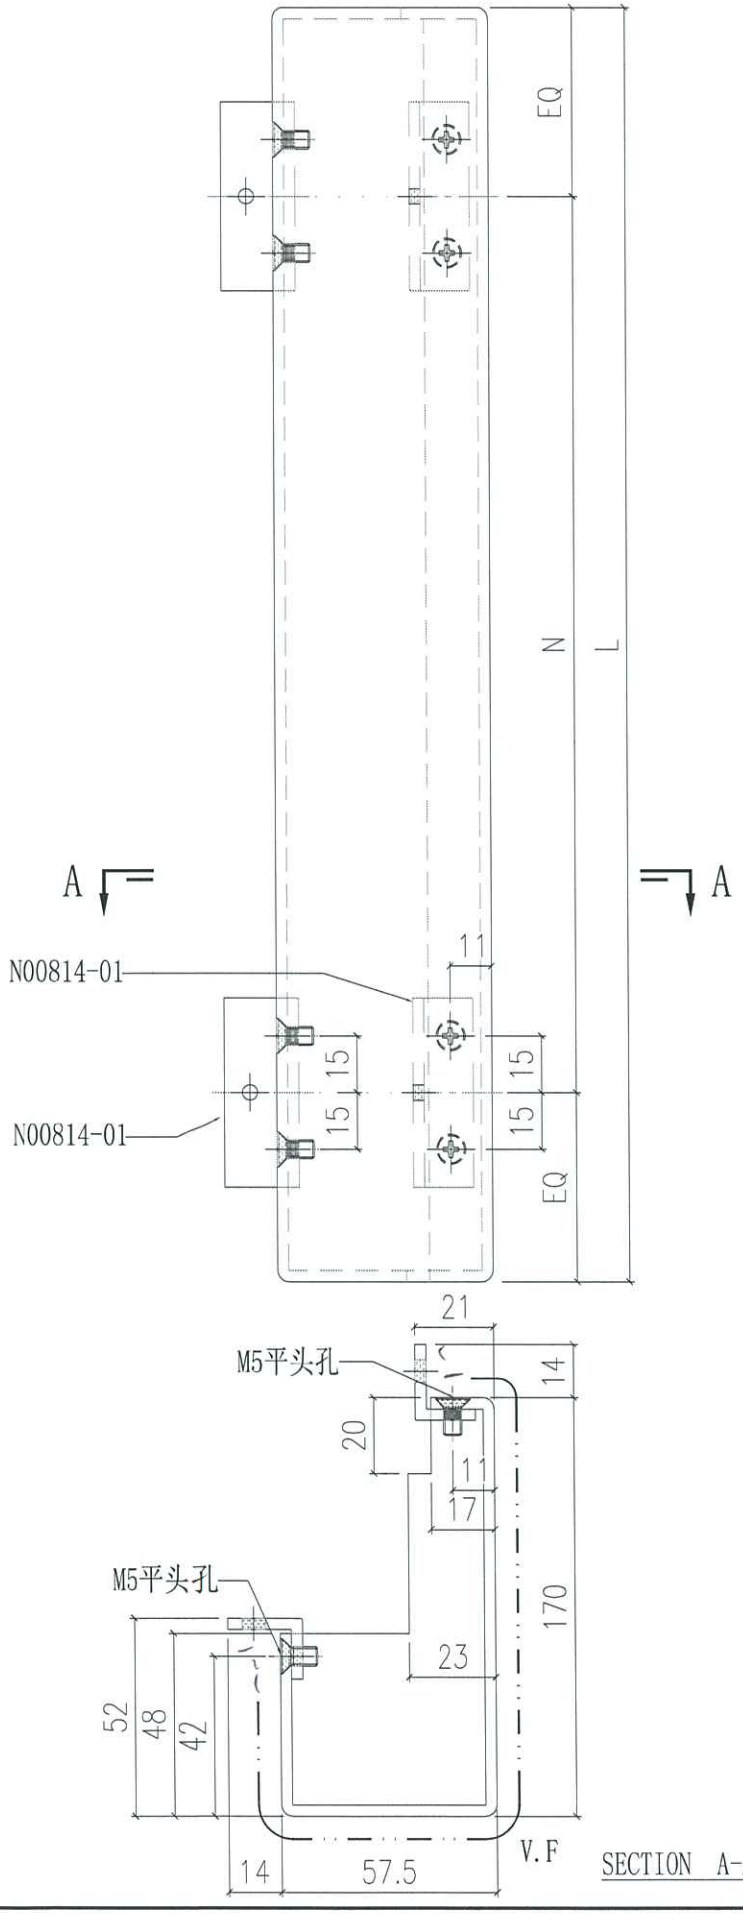



SECTION A-A

美特鋁質有限公司 MIDI Aluminium Fabricator Ltd.							工程號	J858	類別		物料號	-		
							地盘	康城11期	制圖	W.E.X	2022-08-11	圖號	AQ-11	
修改	-	-	-	採用	工廠		地盤	✓	图纸名称	铝折件	復核	-	-	數量	-	
日期	-	-	-	材料颜色	PVF2（香槟金）				材料	3.0mm 铝板	批准	-	-	單件重量	-	(KG)

表面處理: PVF2 (香檳金ECD3X10099S-JF2

编号	L	N	N2	A	B	数量
AQ-11A	2385	@285c/cx8	@300c/cx6	297.5	287.5	43
AQ-11B	885	@260c/cx3	@280c/cx2	232.5	92.5	35
AQ-11C	2335	@280c/cx8	@300c/cx6	247.5	287.5	2

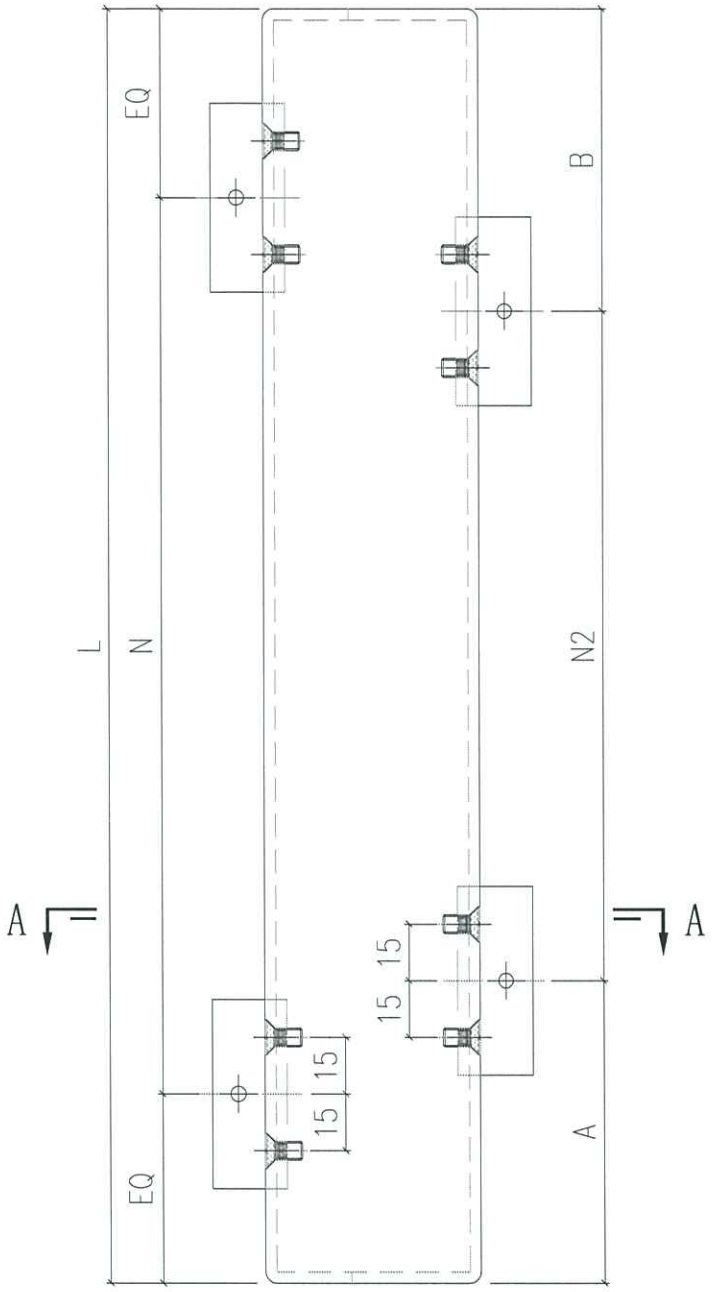

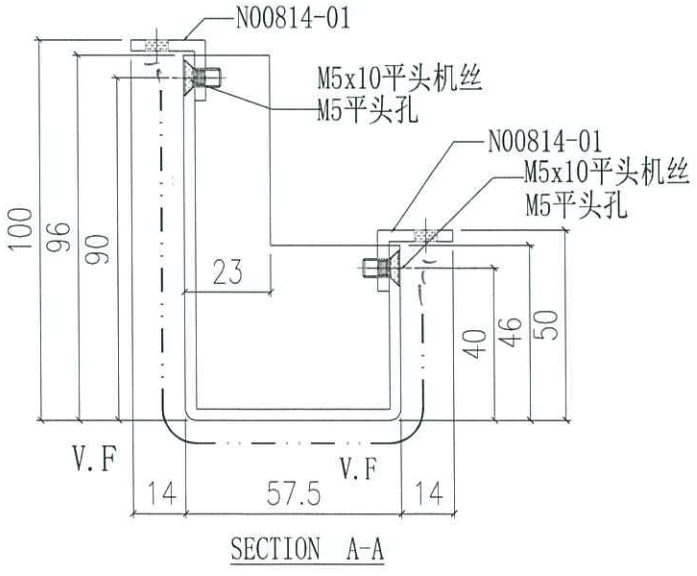



SECTION A-A

美特鋁質有限公司 MIDI Aluminium Fabricator Ltd.				工程號	J858	類別		物料號	-		
				地盘	康城11期	制圖	W.E.X	2022-08-11	圖號	AQ-12	
修改	-	-	-	採用工廠		地盤 ✓	图纸名称	铝折件	復核	-	-	數量	-
日期	-	-	-	材料颜色	PVF2（香槟金）		材料	3.0mm 铝板	批准	-	-	單件重量	- (KG)

表面處理: PVF2 (香檳金ECD3X10099S-JF2

编号	数量
AQ-12A	11

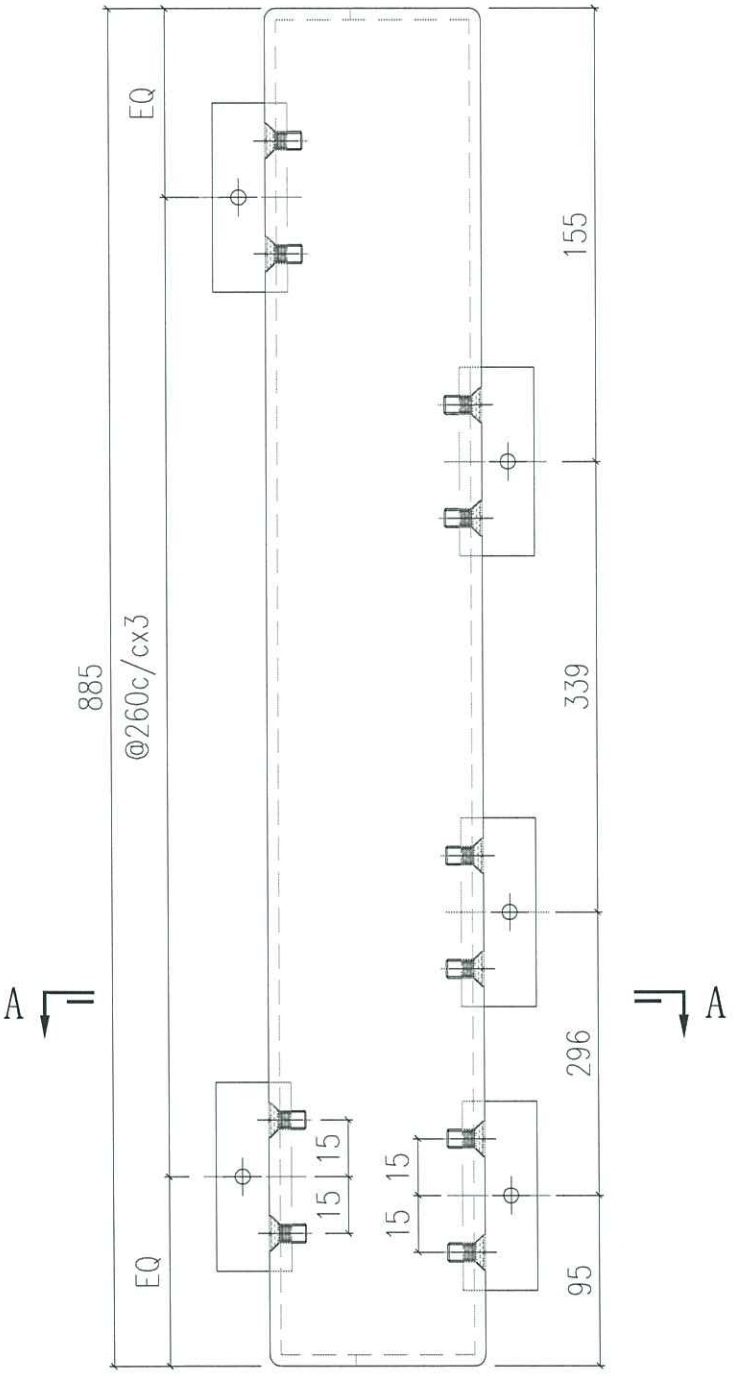

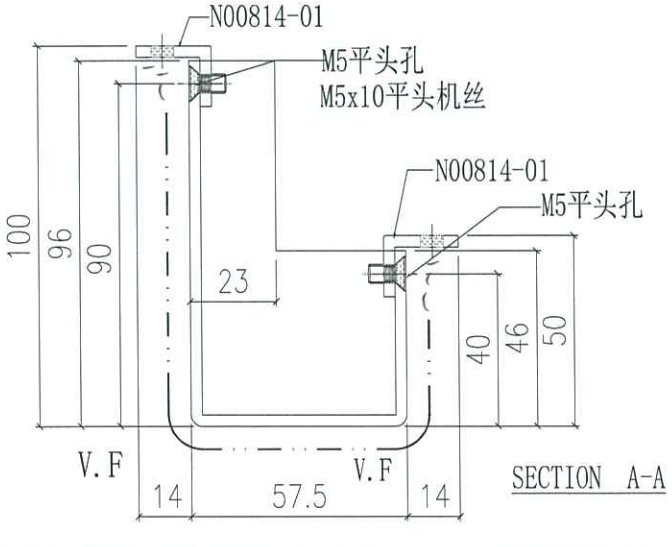



美特鋁質有限公司 MIDI Aluminium Fabricator Ltd.				工程號	J858	類別		物料號	-		
				地盘	康城11期	制圖	W.E.X	2022-08-11	圖號	AQ-13C/D	
修改	✓	-	-	採用工廠		地盤	图纸名称	铝折件	復核	-	-	數量	-
日期	-	-	-	材料颜色	PVF2（香槟金）		材料	3.0mm 铝板	批准	-	-	單件重量	- (KG)

表面處理: PVF2 (香檳金ECD3X10099S-JF2

-13

编号	L	N	数量
AQ-13C	2335	@280c/cx8	2
AQ-13D	885	@260c/cx3	2

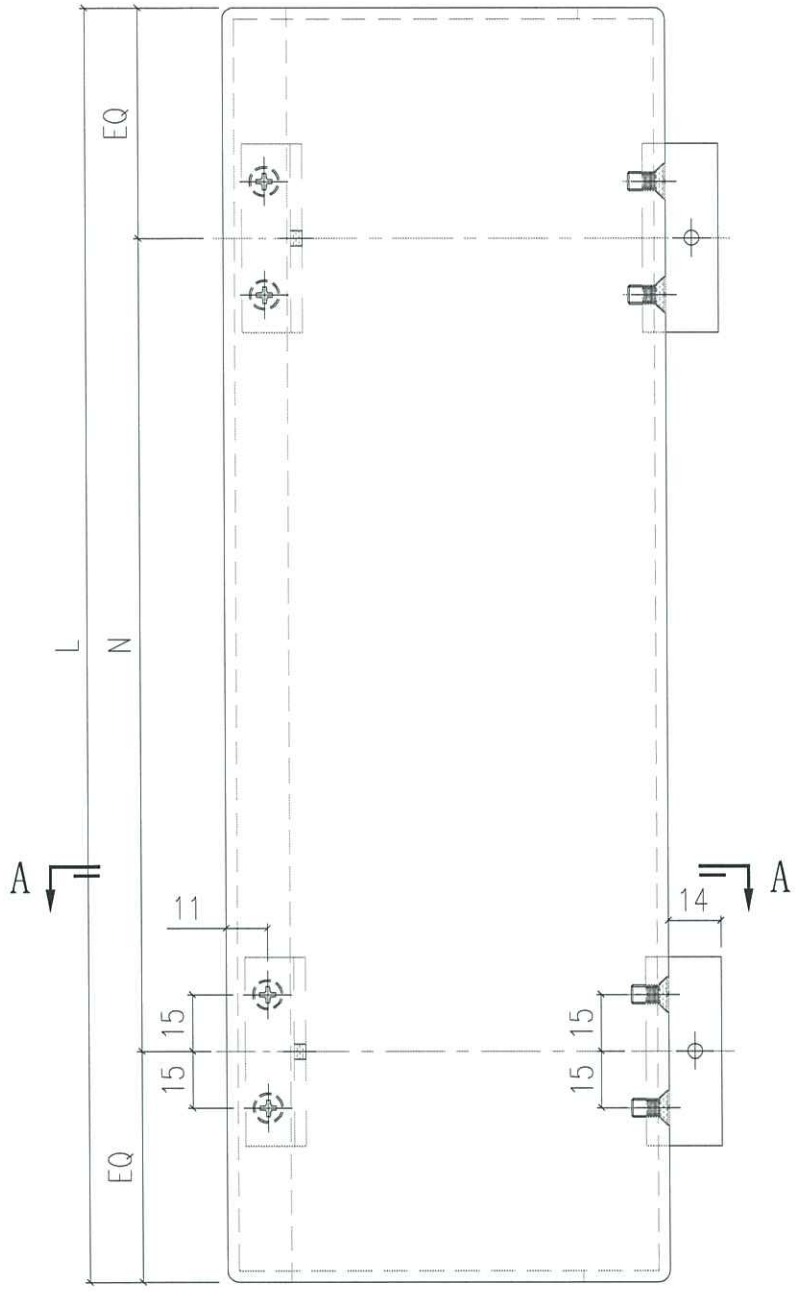

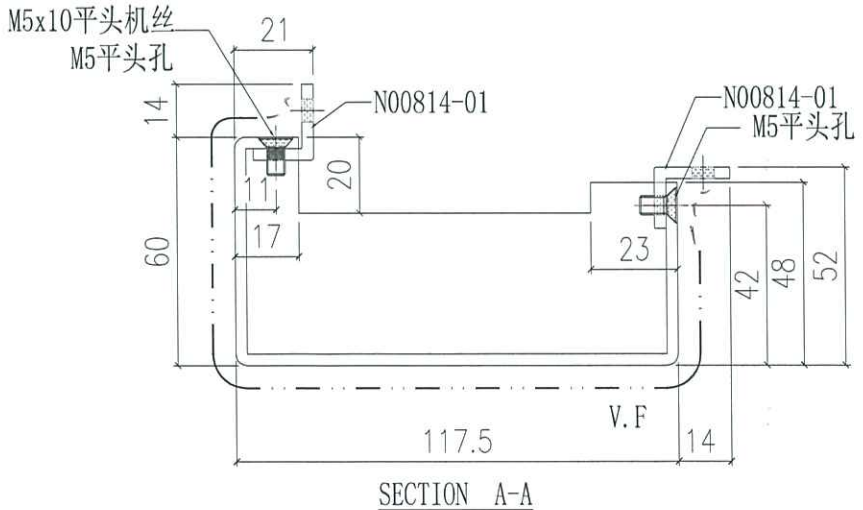


SECTION A-A


美特鋁質有限公司 MIDI Aluminium Fabricator Ltd.				工程號	J858	類別		物料號	-		
				地盘	康城11期	制圖	W.E.X	2022-08-11	圖號	AQ-13A/B	
修改	✓	-	-	採用工廠		地盤	图纸名称	铝折件	復核	-	-	數量	-
日期	-	-	-	材料颜色	PVF2（香槟金）		材料	3.0mm 铝板	批准	-	-	單件重量	- (KG)

表面處理: PVF2 (香檳金ECD3X10099S-JF2

编号	L		
AQ-13A	2385	@285c/cx8	47
AQ-13B	885	@260c/cx3	48

13

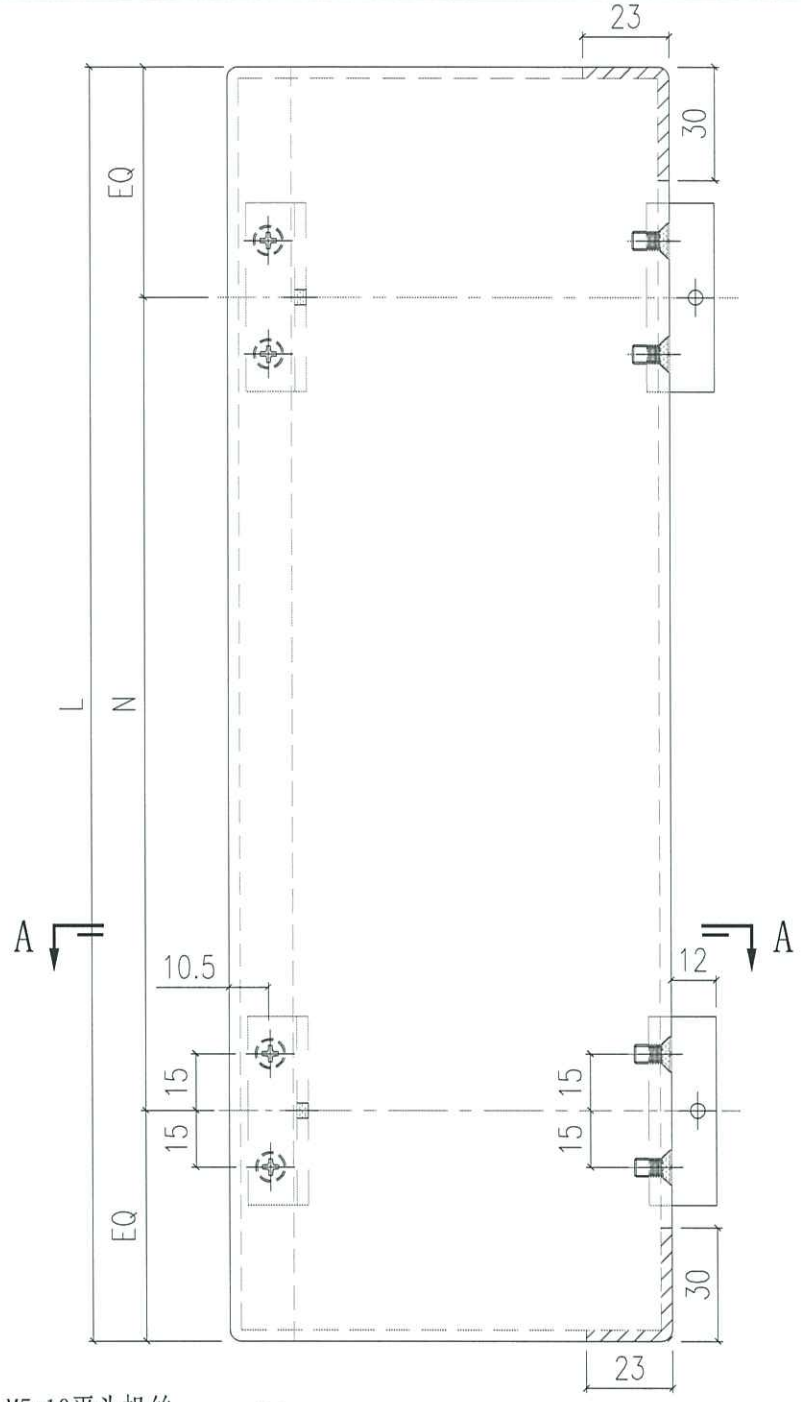


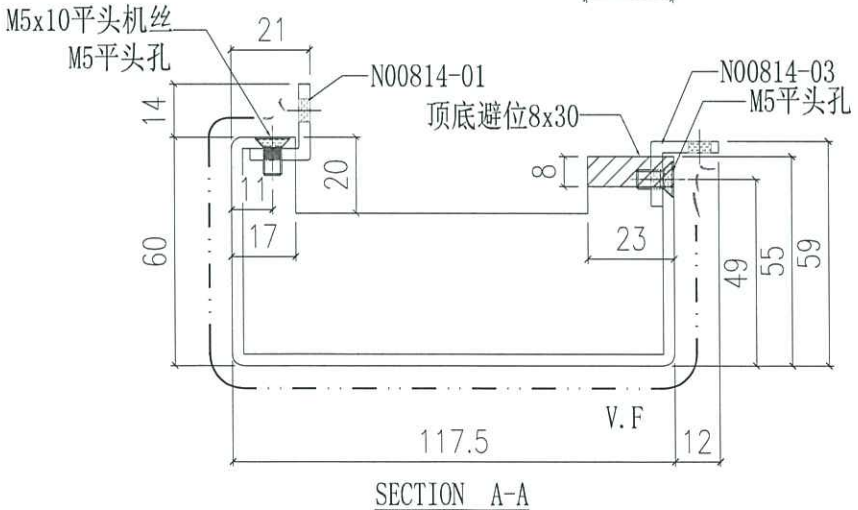

SECTION A-A

美特鋁質有限公司 MIDI Aluminium Fabricator Ltd.				工程號	J858	類別		物料號	-		
				地盘	康城11期	制圖	W.E.X	2022-08-11	圖號	AQ-14	
修改	-	-	-	採用工廠		地盤 ✓	图纸名称	铝折件	復核	-	-	數量	-
日期	-	-	-	材料颜色	PVF2（香槟金）		材料	3.0mm 铝板	批准	-	-	單件重量	- (KG)

表面處理: PVF2 (香檳金ECD3X10099S-JF2

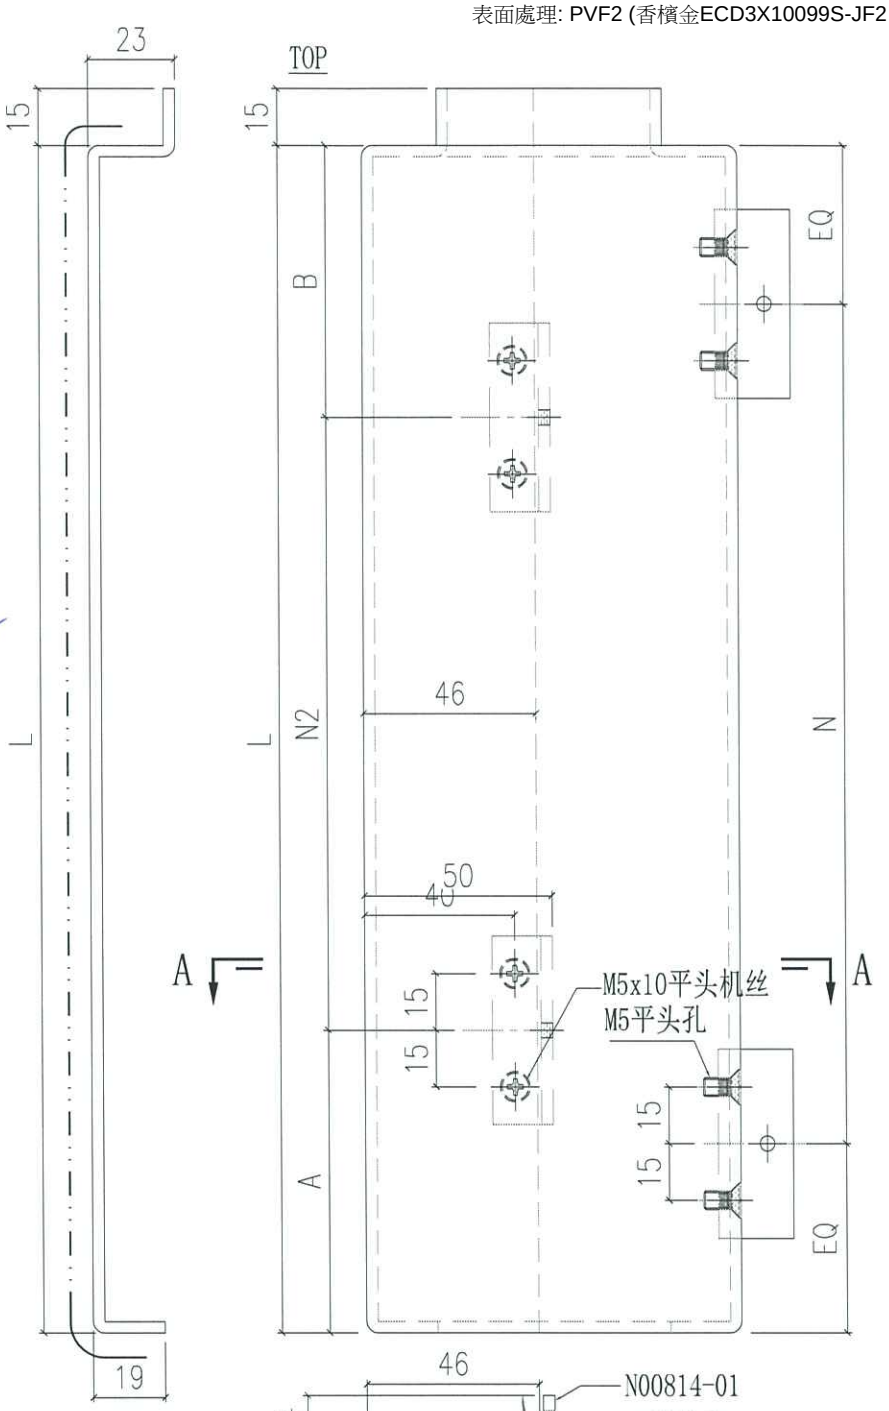


SECTION A-A

编号	L	N	N2	A	B	合计数量
AQ-14A	2385	@285c/cx8	@300c/cx7	147.5	137.5	184
AQ-14B	885	@260c/cx3	@280c/cx2	92.5	232.5	149
AQ-14C	2335	@280c/cx8	@300c/cx7	97.5	137.5	8

美特鋁質有限公司 MIDI Aluminium Fabricator Ltd.				工程號	J858	類別		物料號	-		
				地盘	康城11期	制圖	W.E.X	2022-08-11	圖號	AQ-15	
修改	-	-	-	採用工廠		地盤 ✓	图纸名称	铝折件	復核	-	-	數量	-	
日期	-	-	-	材料颜色	PVF2（香槟金）		材料	3.0mm 铝板	批准	-	-	單件重量	-	(KG)

表面處理: PVF2 (香檳金ECD3X10099S-JF2

编号	合计数量
AQ-15A	35

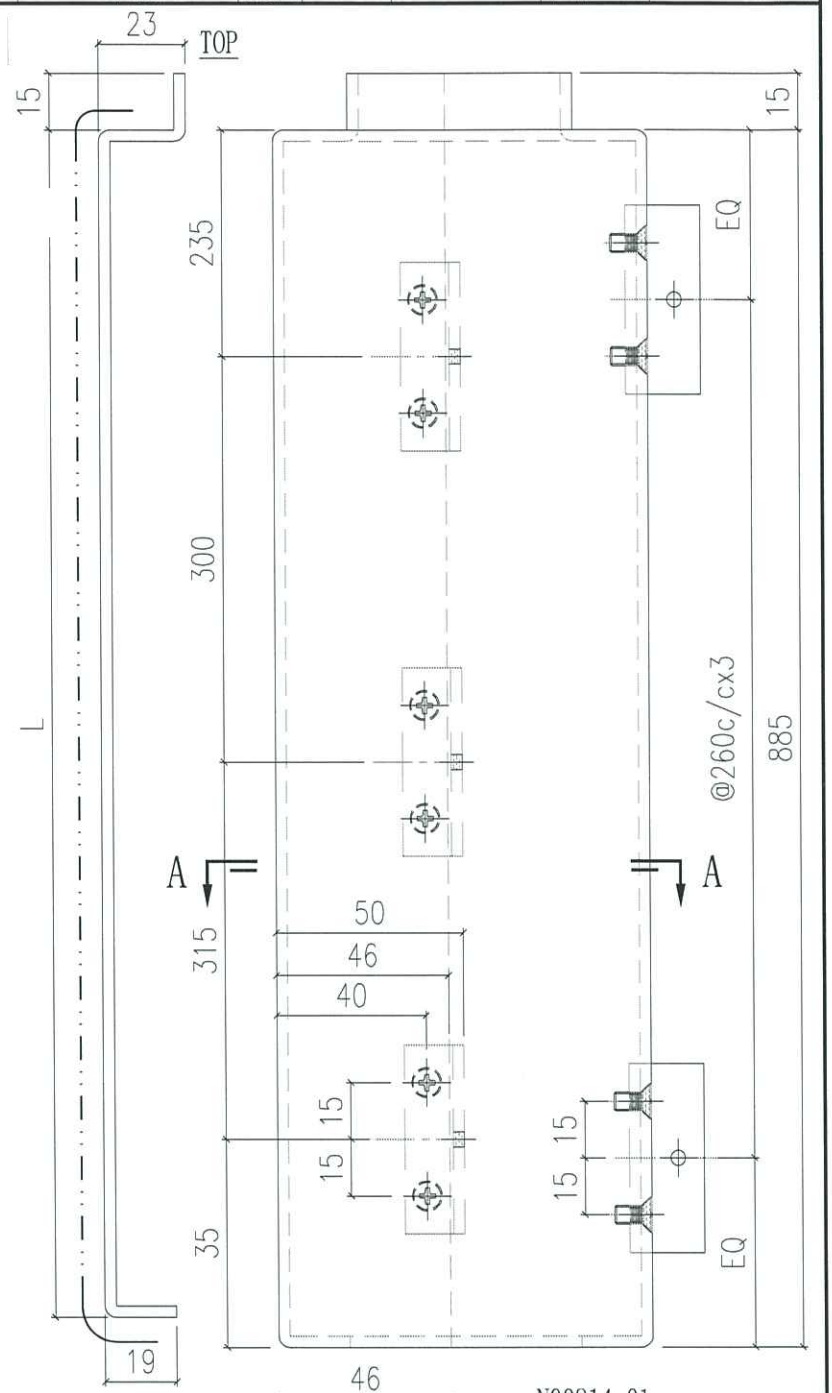


SECTION A-A

美特鋁質有限公司 MIDI Aluminium Fabricator Ltd.				工程號	J858	類別		物料號	-		
				地盘	康城11期	制圖	W.E.X	2022-08-11	圖號	AQ-16	
修改	-	-	-	採用工廠	地盤 ✓	图纸名称	铝折件	復核	-	-	數量	-
日期	-	-	-	材料颜色	PVF2（香槟金）	材料	3.0mm 铝板	批准	-	-	單件重量	- (KG)

表面處理: PVF2 (香檳金ECD3X10099S-JF2


编号	数量
AQ-16A	12

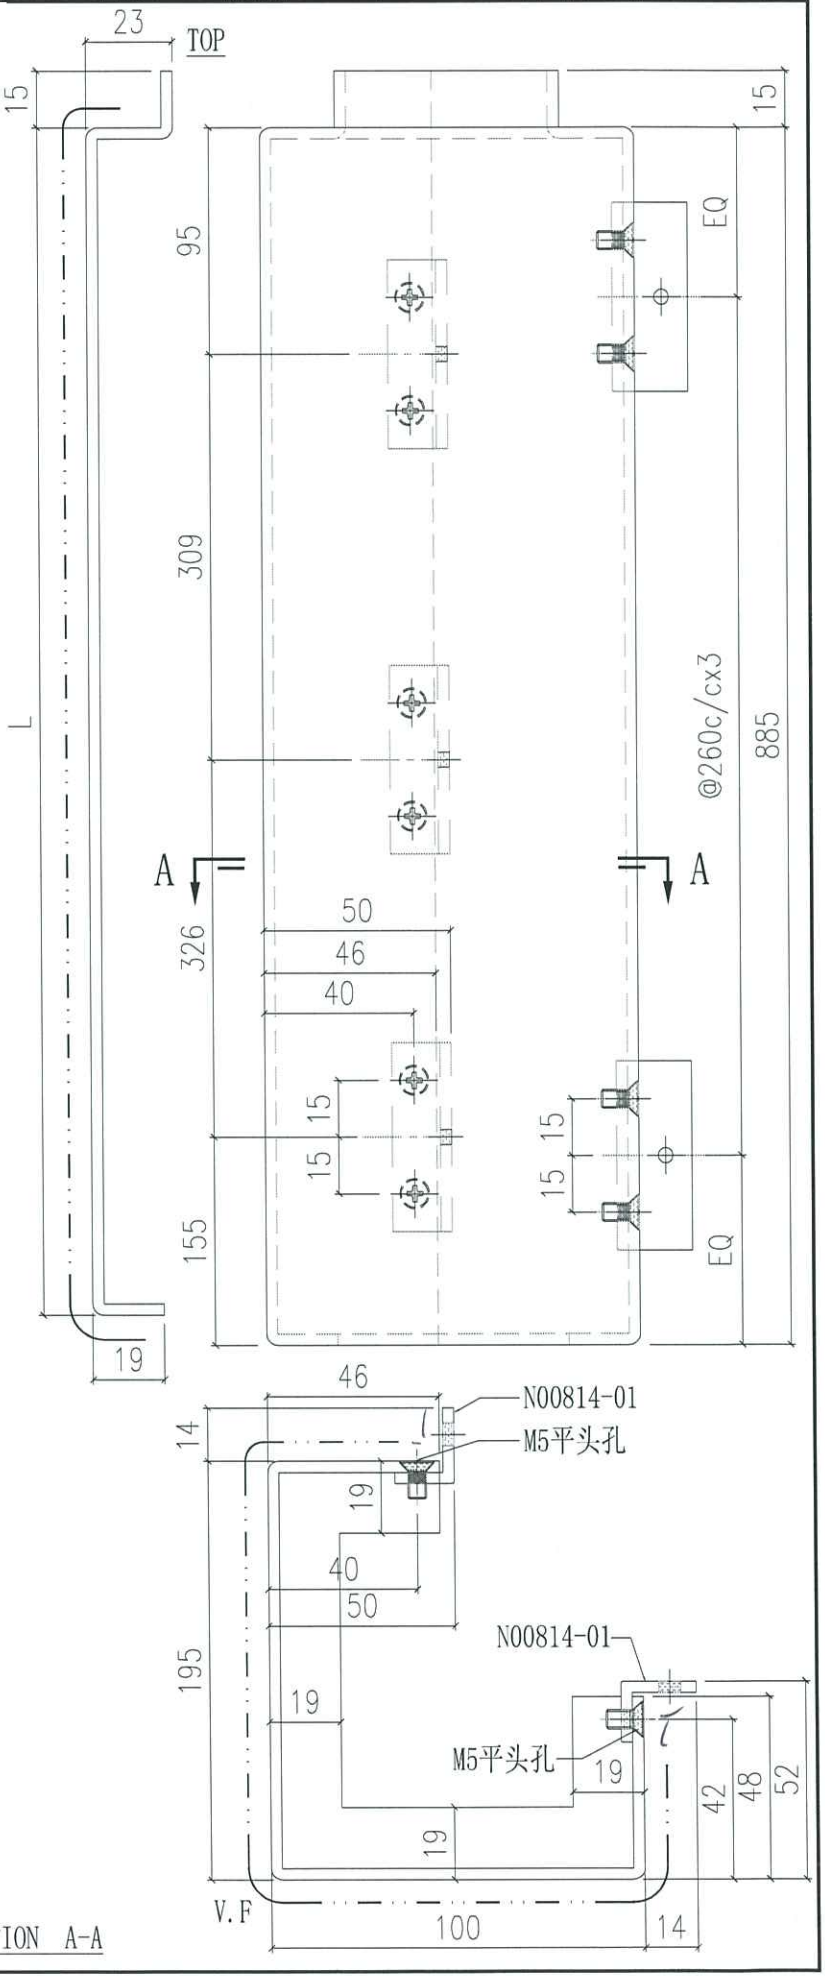


SECTION A-A

美特鋁質有限公司 MIDI Aluminium Fabricator Ltd.				工程號	J858	類別		物料號	-		
				地盘	康城11期	制圖	W.E.X	2022-08-11	圖號	AQ-17A/B	
修改	-	-	-	採用 工廠	地盤 ✓	图纸名称	铝折件	復核	-	-	數量	-	
日期	-	-	-	材料颜色	PVF2（香槟金）	材料	3.0mm 铝板	批准	-	-	單件重量	-	(KG)

表面處理: PVF2 (香檳金ECD3X10099S-JF2

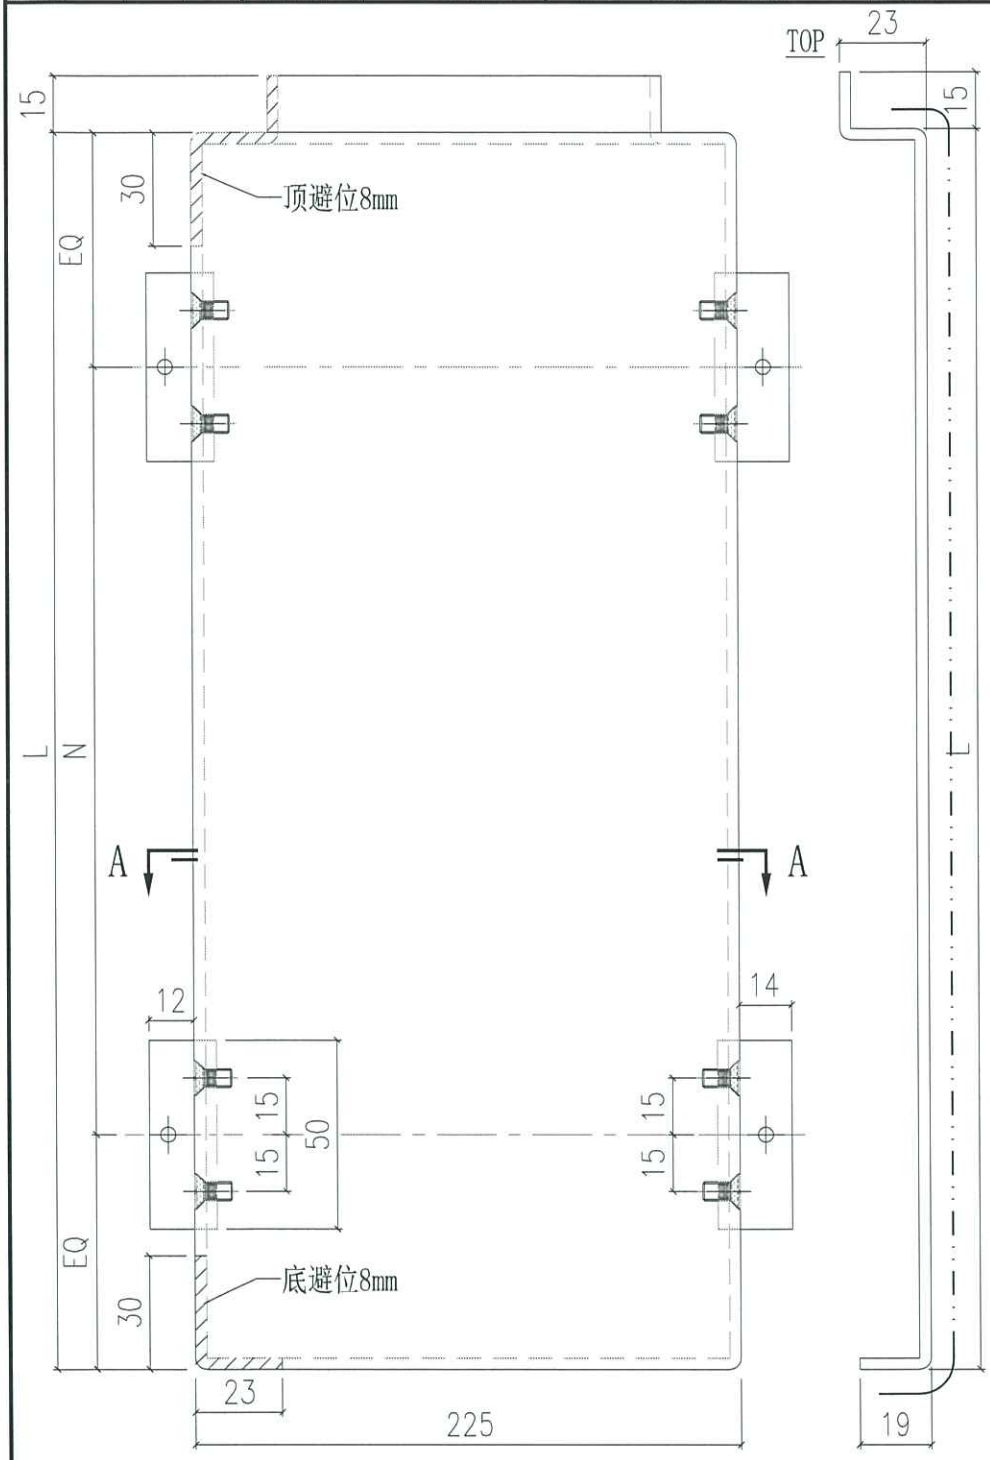


编号	L	N	数量
AQ-17A	2385	@285c/cx8	90
AQ-17B	885	@260c/cx3	92

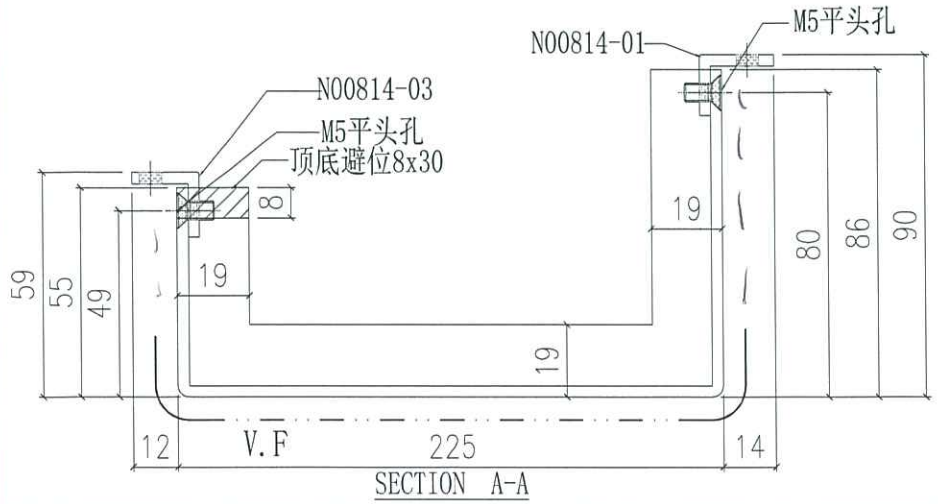


美特鋁質有限公司 MIDI Aluminium Fabricator Ltd.													
				工程號	J858	類別		物料號	-				
				地盘	康城11期	制圖	W.E.X	2022-08-11	圖號	AQ-17D			
修改	-	-	-	採用	工廠		地盤	✓	图纸名称	铝折件	復核	-	-	數量	-		
日期	-	-	-	材料颜色	PVF2（香槟金）				材料	3.0mm 铝板	批准	-	-	單件重量	-	(KG)	

表面處理: PVF2 (香檳金ECD3X10099S-JF2

编号	L	N	数量
AQ-17D	885	@260c/cx3	2

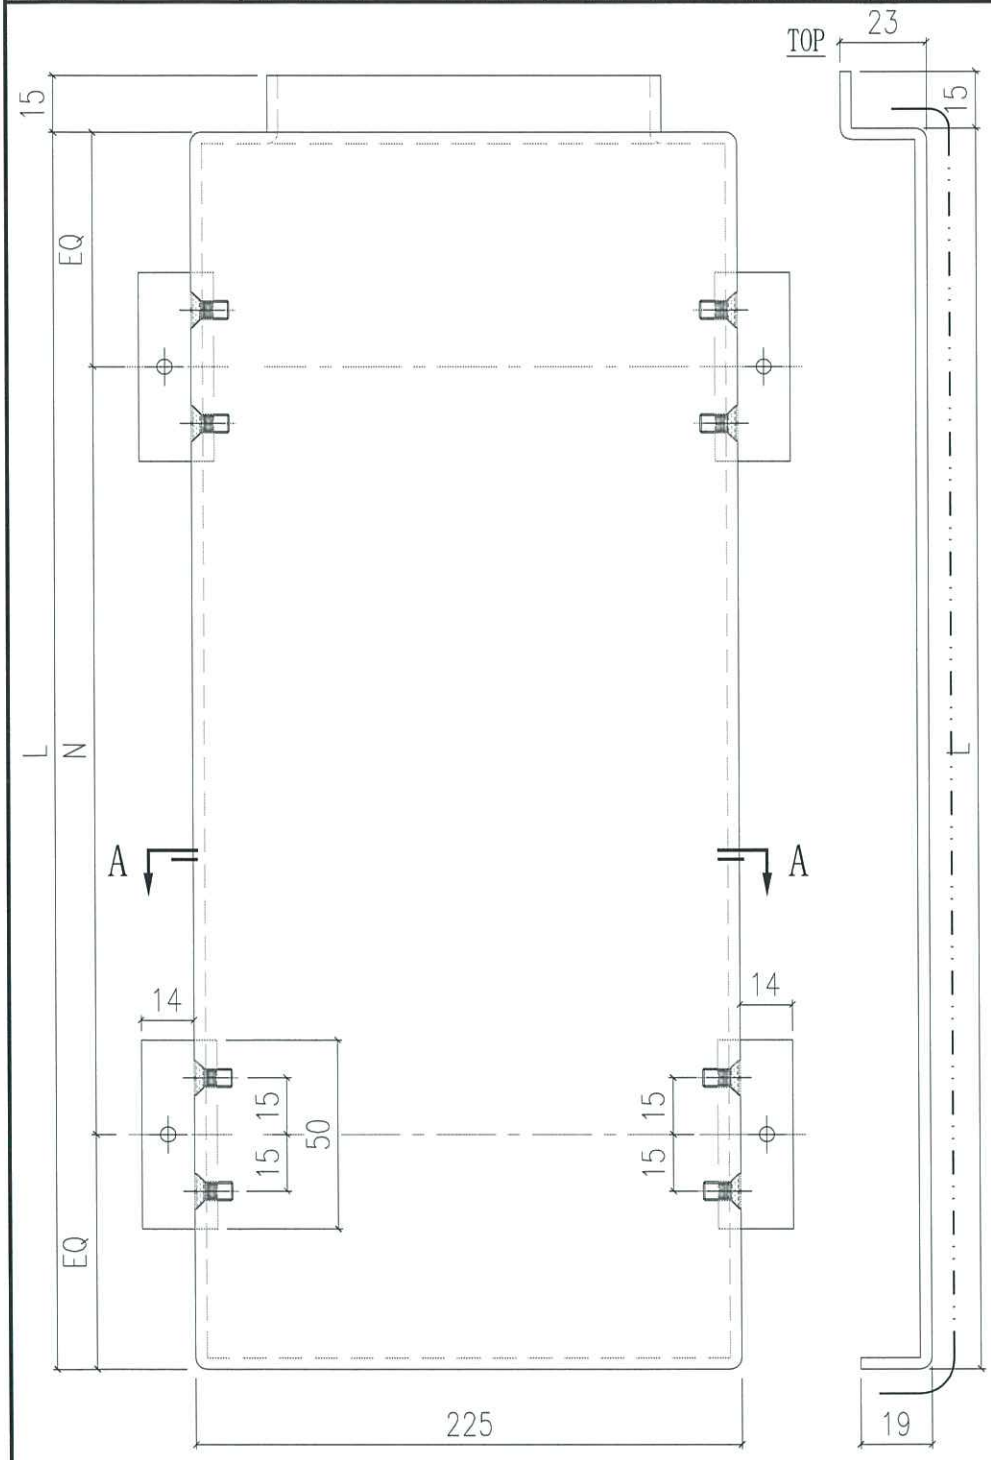


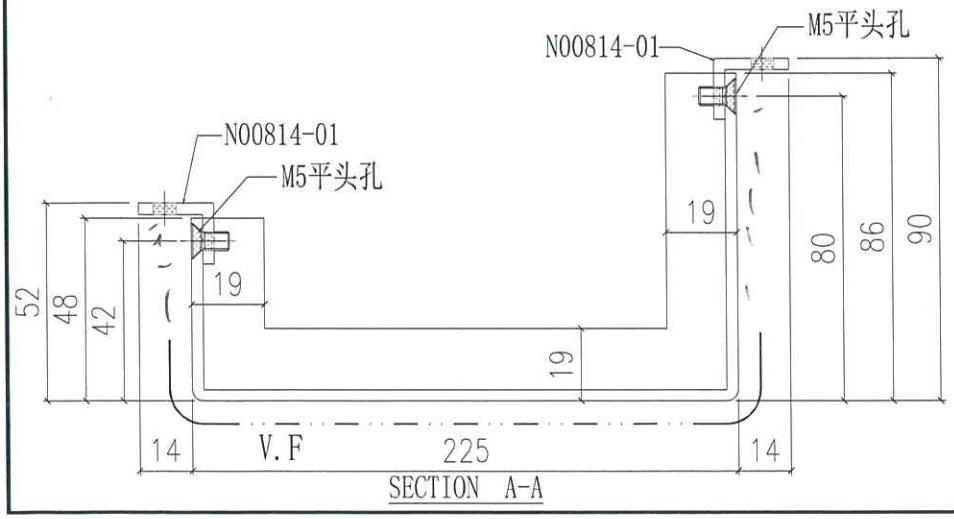


美特鋁質有限公司 MIDI Aluminium Fabricator Ltd.				工程號	J858	類別		物料號	-		
				地盘	康城11期	制圖	W.E.X	2022-08-11	圖號	AQ-18A	
修改	-	-	-	採用工廠		地盤 ✓	图纸名称	铝折件	復核	-	-	數量	-
日期	-	-	-	材料颜色	PVF2（香槟金）		材料	3.0mm 铝板	批准	-	-	單件重量	- (KG)

表面處理: PVF2 (香檳金ECD3X10099S-JF2

编号	数量
AQ-18A	2

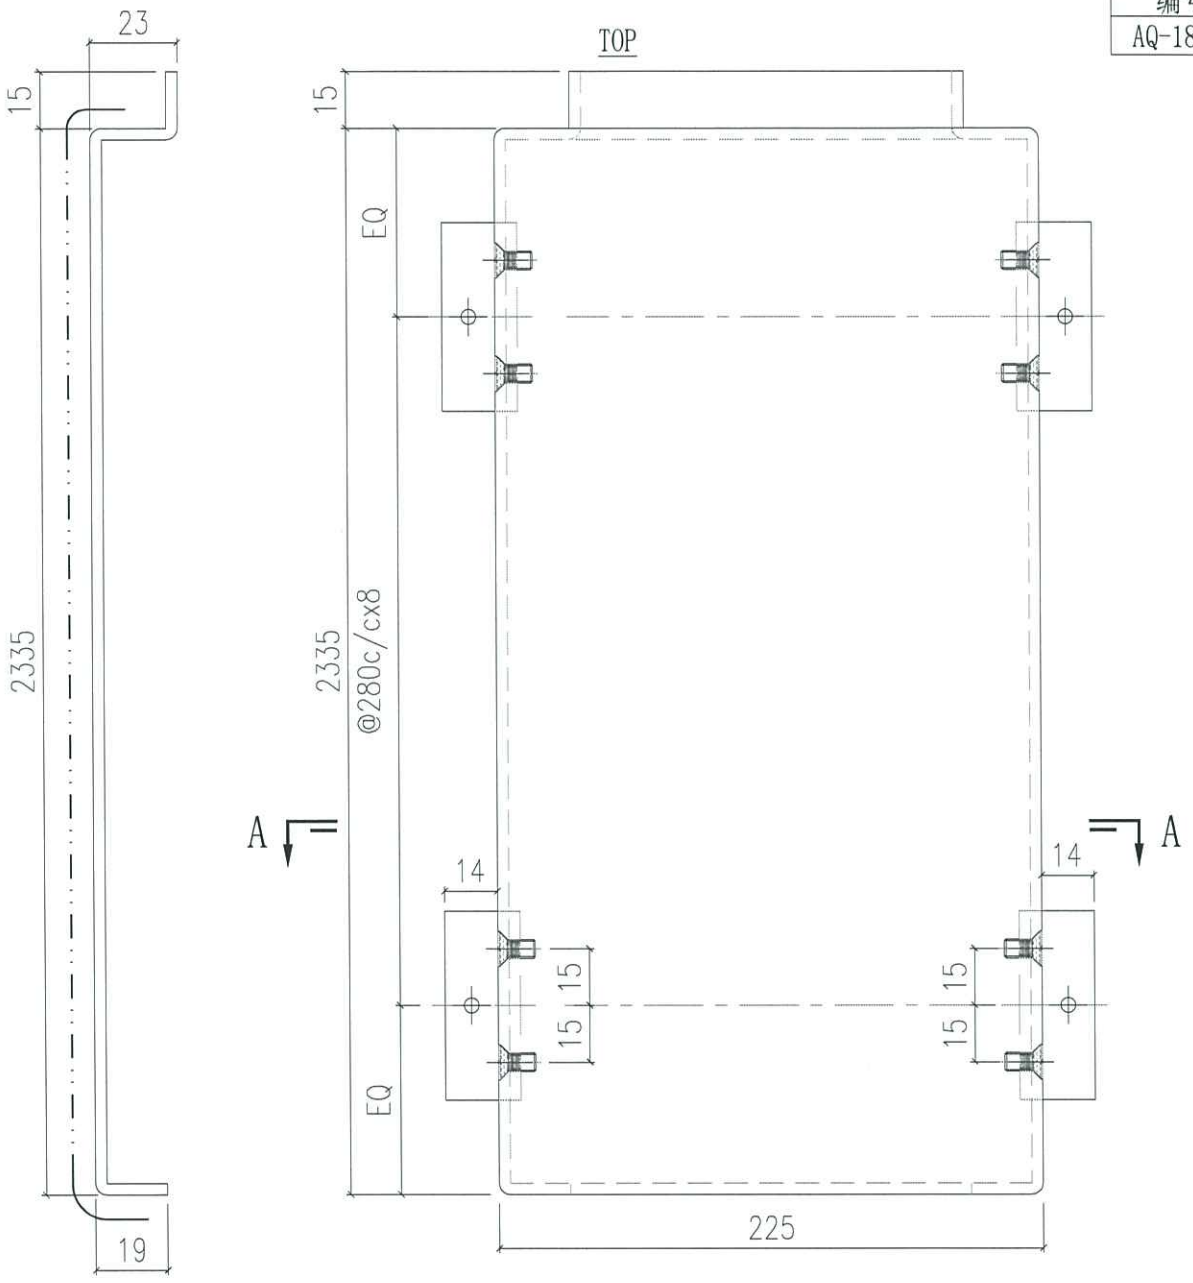

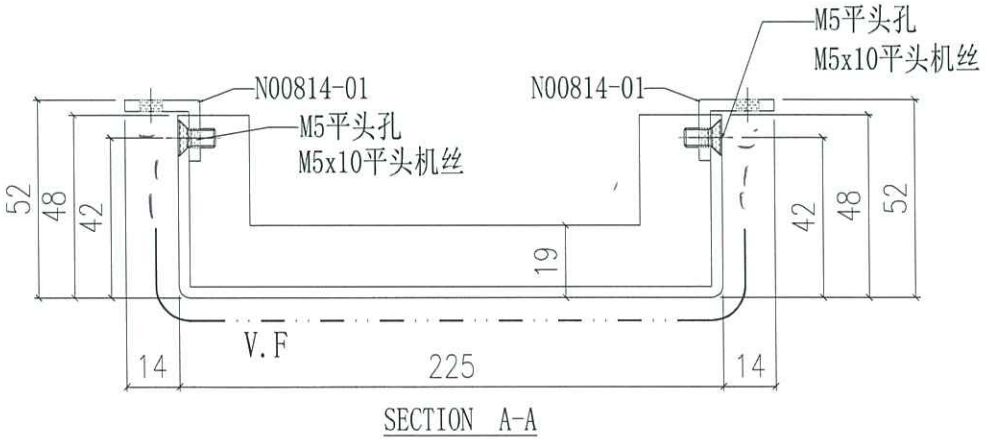



SECTION A-A

美特鋁質有限公司 MIDI Aluminium Fabricator Ltd.													
				工程號	J858	類別		物料號	-				
				地盘	康城11期	制圖	W.E.X	2022-08-11	圖號	AQ-18B/C			
修改	-	-	-	採用工廠		地盤 ✓	图纸名称	铝折件	復核	-	-	數量	-
日期	-	-	-	材料颜色	PVF2（香槟金）		材料	3.0mm 铝板	批准	-	-	單件重量	- (KG)

表面處理: PVF2 (香檳金ECD3X10099S-JF2

编号	A	数量
AQ-18B	87.5	2
AQ-18C	57.5	4

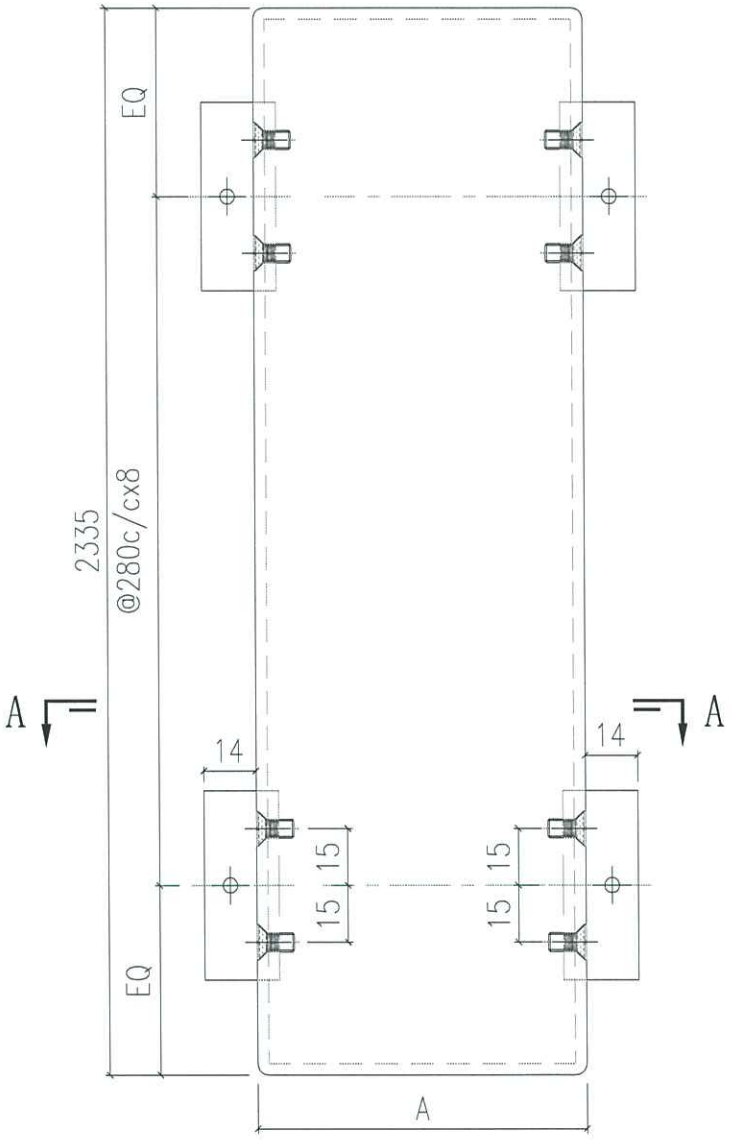

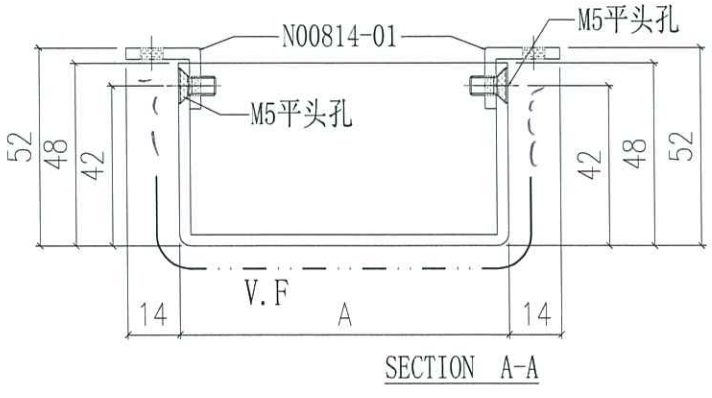


SECTION A-A

美特鋁質有限公司 MIDI Aluminium Fabricator Ltd.													
				工程號	J858	類別		物料號	-				
				地盘	康城11期	制圖	W.E.X	2022-08-11	圖號	AQ-19			
修改	-	-	-	採用工廠		地盤 ✓	图纸名称	铝折件	復核	-	-	數量	-
日期	-	-	-	材料颜色	PVF2（香槟金）		材料	3.0mm 铝板	批准	-	-	單件重量	- (KG)

表面處理: PVF2 (香檳金ECD3X10099S-JF2


编号	L	N1	N2	A	B	C	D	数量
AQ-19A	2385	@300c/cx7	@300c/cx6	147.5	137.5	297.5	287.5	44
AQ-19B	885	@280c/cx2	@280c/cx2	92.5	232.5	232.5	92.5	35
AQ-19C	2335	@300c/cx7	@300c/cx6	97.5	137.5	247.5	287.5	2

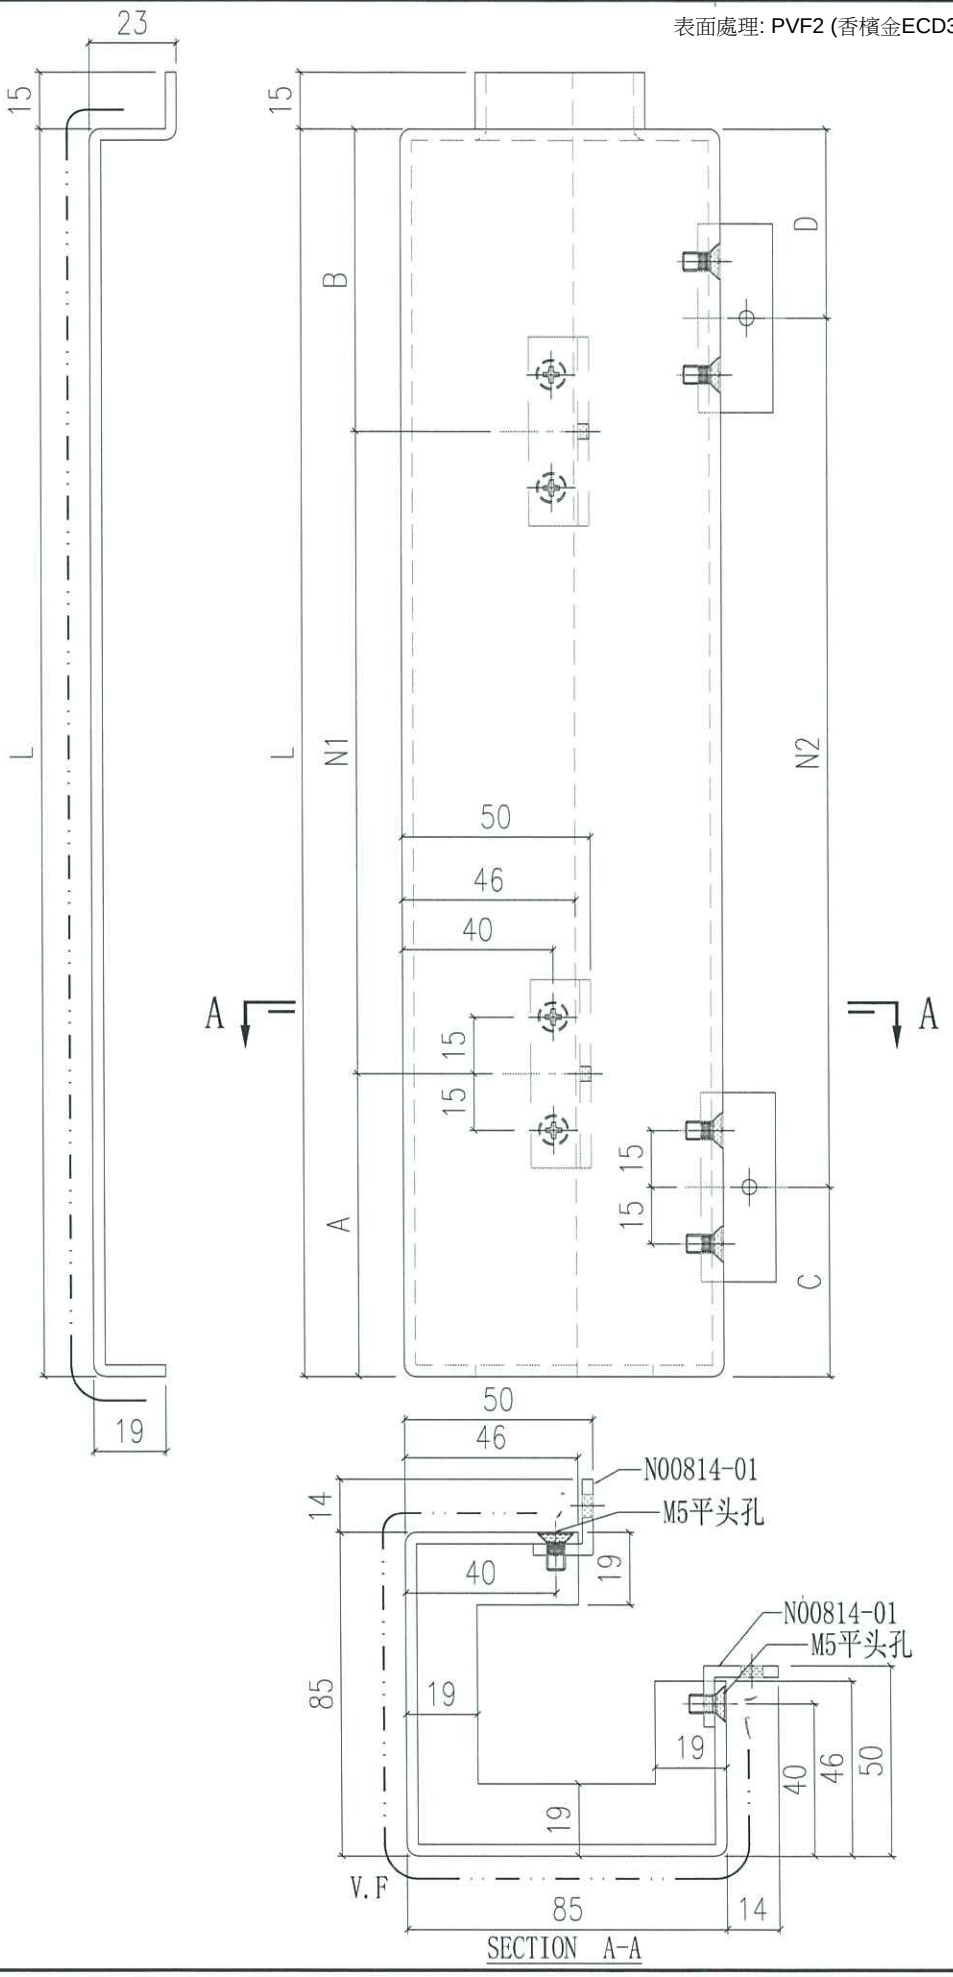


美特鋁質有限公司 MIDI Aluminium Fabricator Ltd.				工程號	J858	類別		物料號	-		
				地盘	康城11期	制圖	W.E.X	2022-08-11	圖號	AQ-20	
修改	-	-	-	採用工廠		地盤 ✓	图纸名称	铝折件	復核	-	-	數量	-
日期	-	-	-	材料颜色	PVF2（香槟金）		材料	3.0mm 铝板	批准	-	-	單件重量	- (KG)

表面處理: PVF2 (香檳金ECD3X10099S-JF2


编号	数量
AQ-20A	11

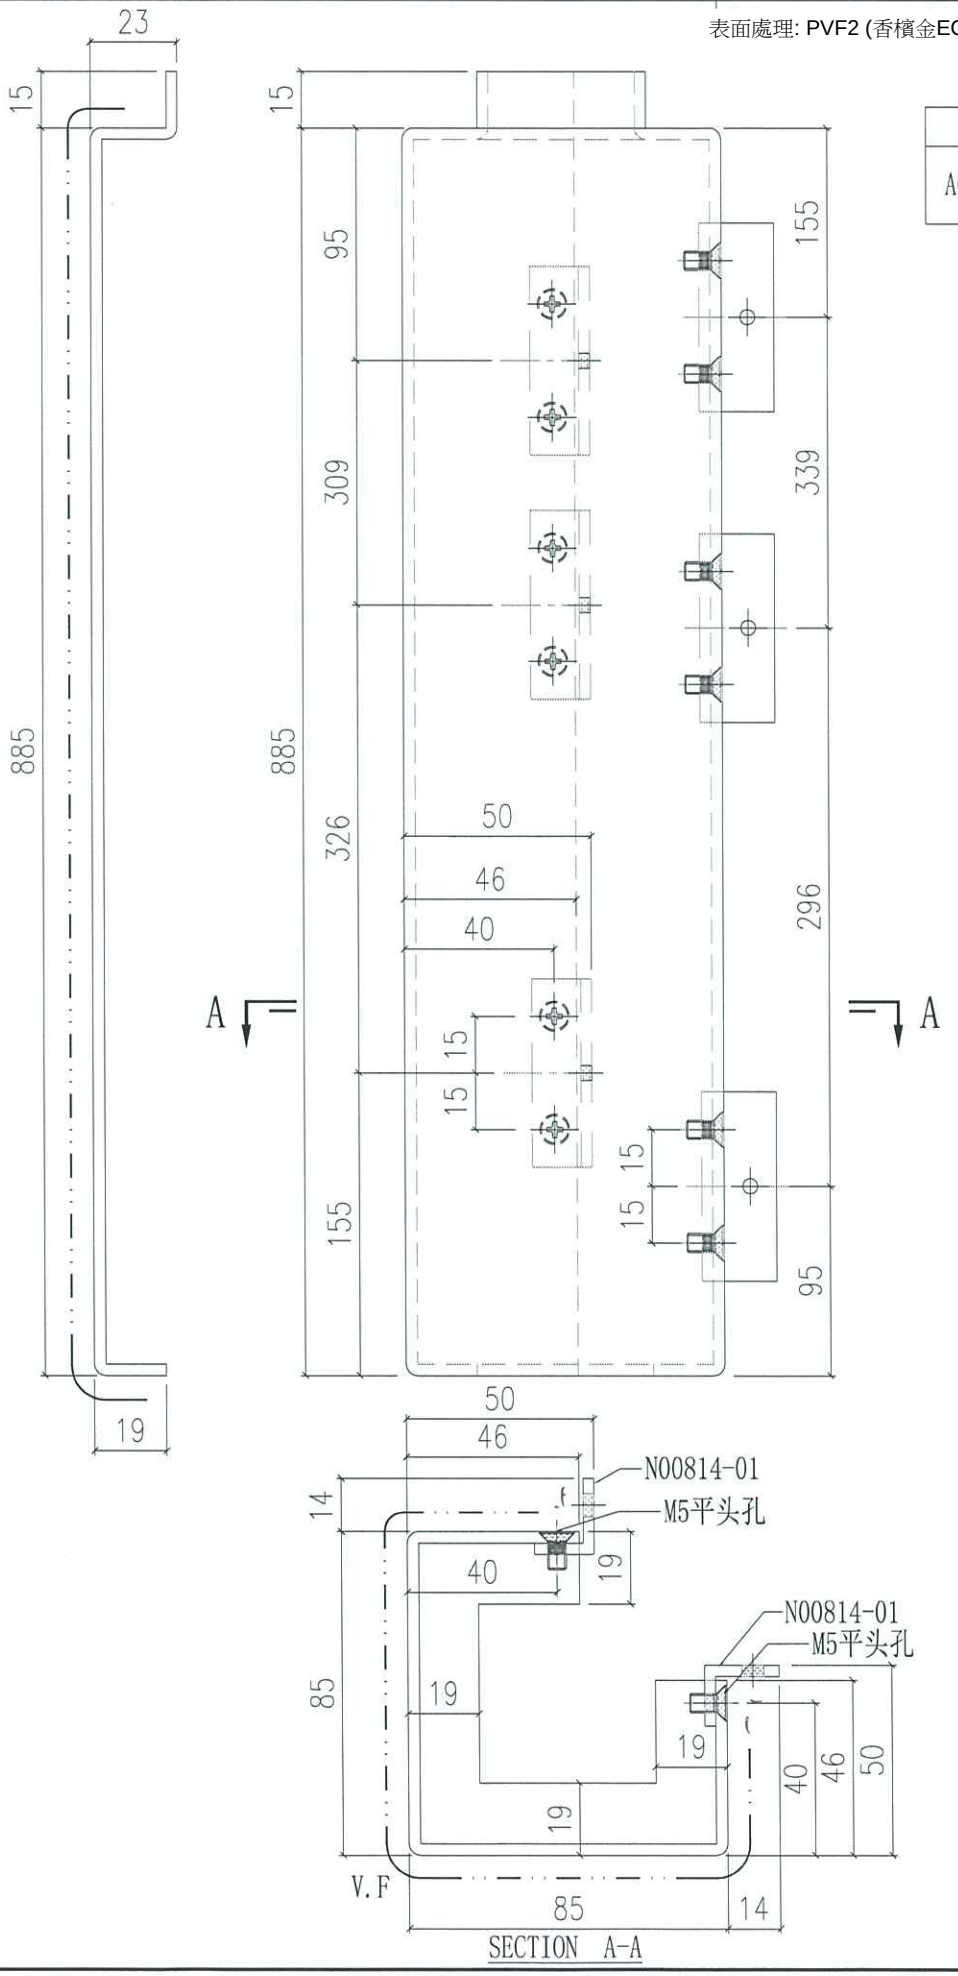


美特鋁質有限公司 MIDI Aluminium Fabricator Ltd.				工程號	J858	類別		物料號	-		
				地盤	康城11期	制圖	W.E.X	2022-08-11	圖號	AQ-21	
修改	-	-	-	採用工廠		地盤 ✓	图纸名称	铝板加工图	復核	-	-	數量	-
日期	-	-	-	材料顏色	PVF2 (香槟金)		- 材料	3mm THK.铝板	批准	-	-	單件重量	- (KG)

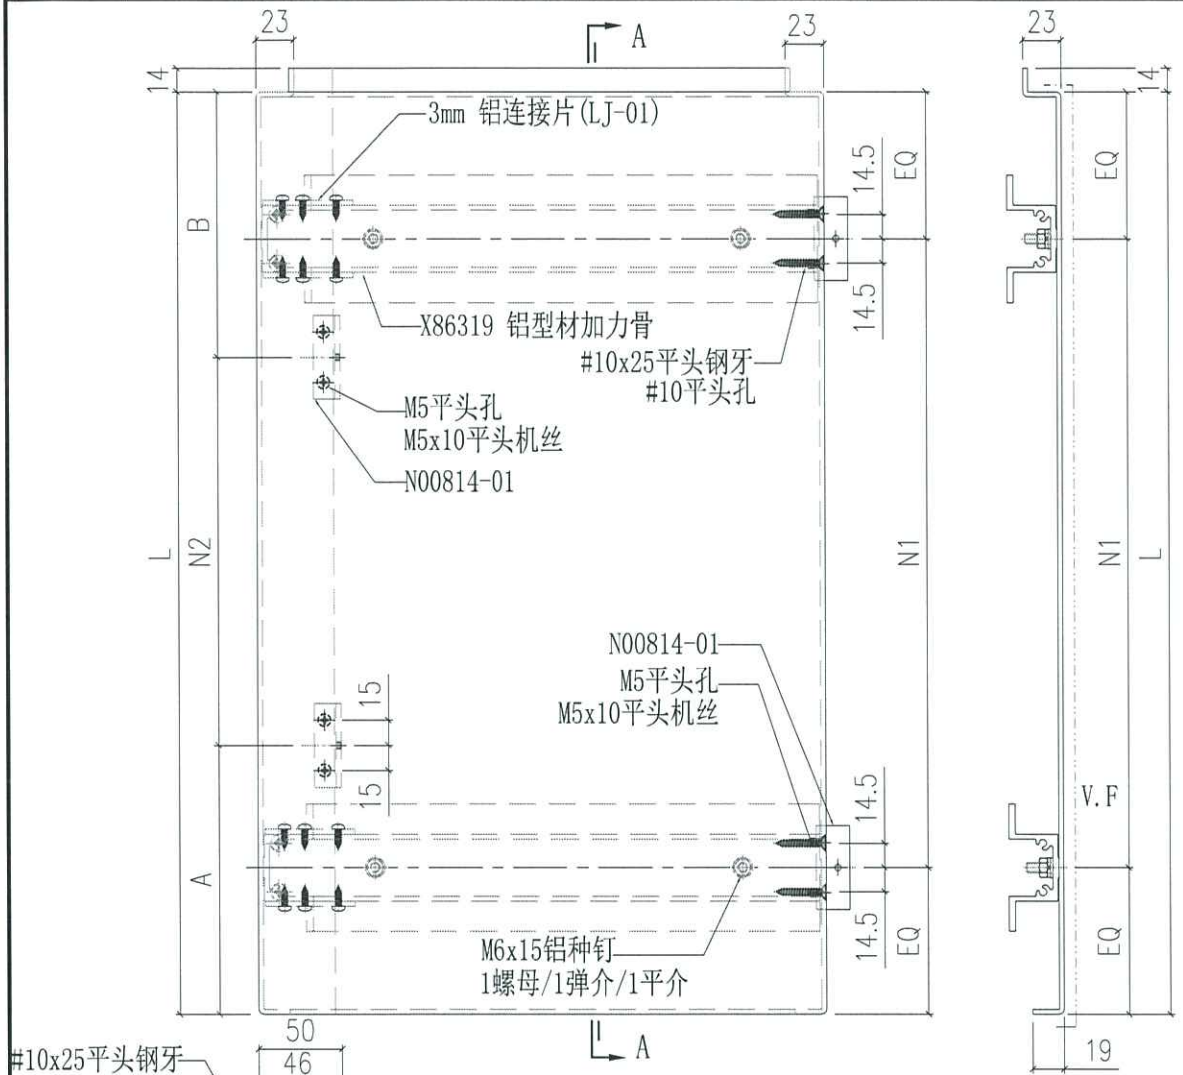

SECTION A-A

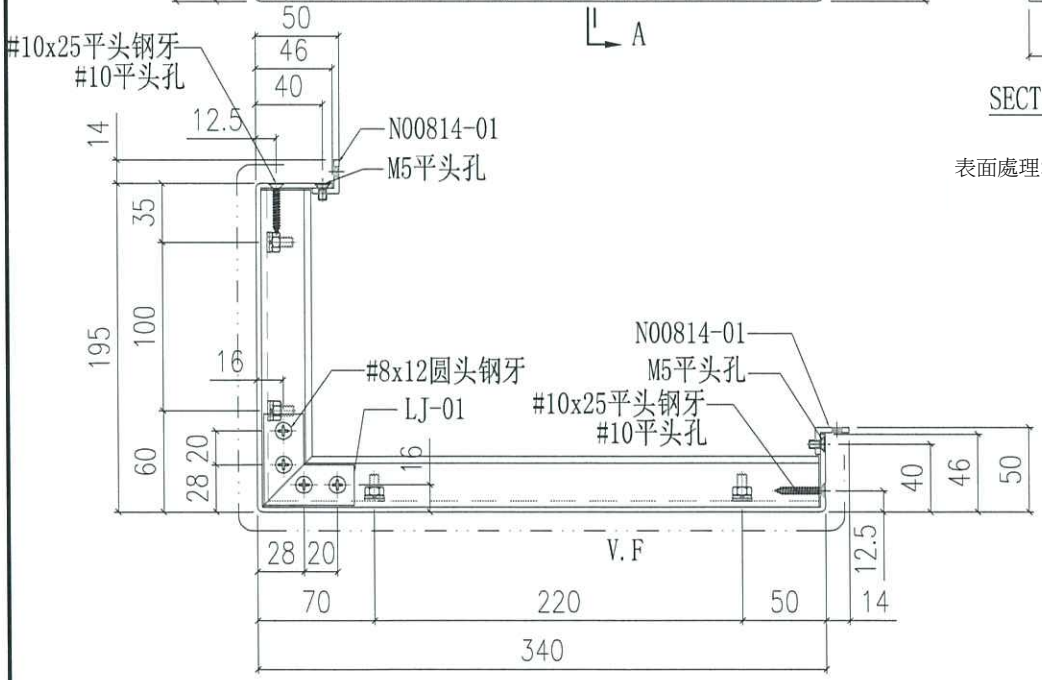


表面處理: PVF2 (香檳金ECD3X10099S-JF2

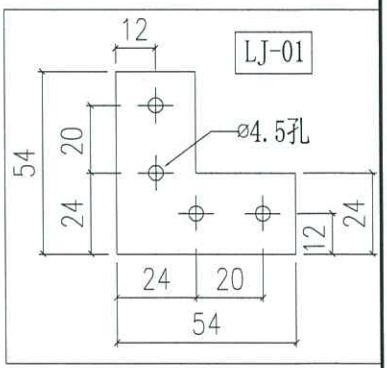

编号	L	N1	N2	A	B	数量
AQ-21A	2385	@285c/cx8	@300c/cx7	147.5	137.5	47
AQ-21B	885	@260c/cx3	@280c/cx2	92.5	232.5	38


美特鋁質有限公司 MIDI Aluminium Fabricator Ltd.													
						工程號	J858	類別		物料號	-		
						地盤	康城11期	制圖	W.E.X	2022-08-11	圖號	AQ-22	
修改	-	-	-	採用	工廠		地盤 ✓	图纸名称	铝板加工图	復核	-	-	數量	-	
日期	-	-	-	材料顏色	PVF2（香槟金）			材料-	3mm THK.铝板	批准	-	-	單件重量	-	(KG)

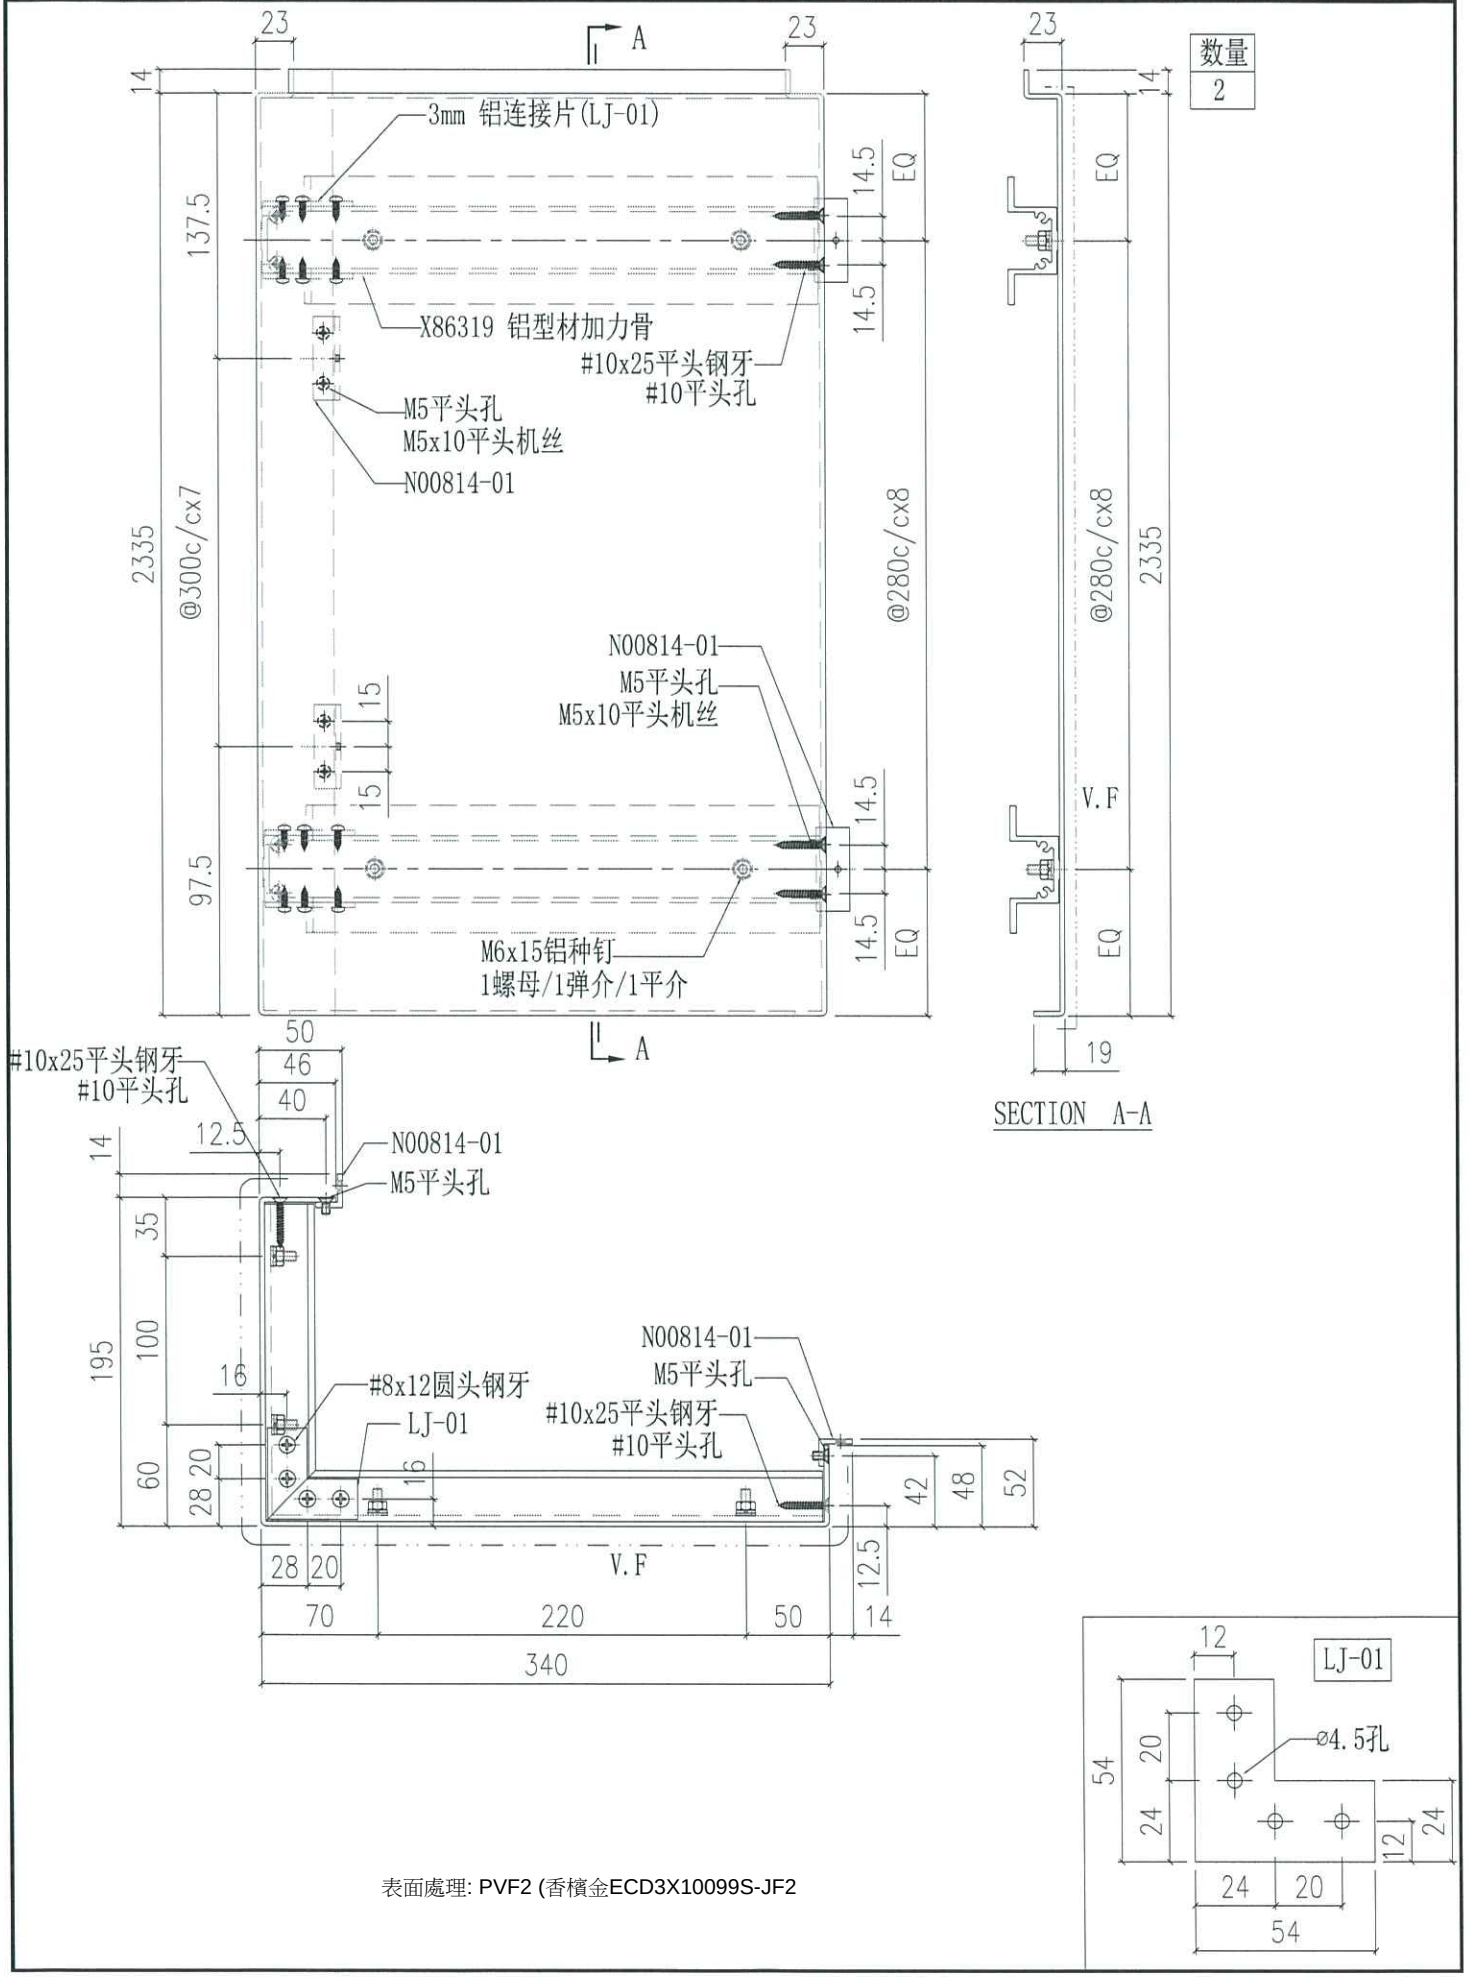


表面處理: PVF2 (香檳金ECD3X10099S-JF2


美特鋁質有限公司 MIDI Aluminium Fabricator Ltd.														
						工程號	J858	類別		物料號	-			
						地盘	康城11期	制圖	W.E.X	2022-08-11	圖號	AQ-23		
修改	-	-	-	採用	工廠		地盤 ✓	图纸名称	铝板加工图	復核	-	-	數量	-	
日期	-	-	-	材料颜色	PVF2（香槟金）			材料-	3mm THK.铝板	批准	-	-	單件重量	-	(KG)

数量
12

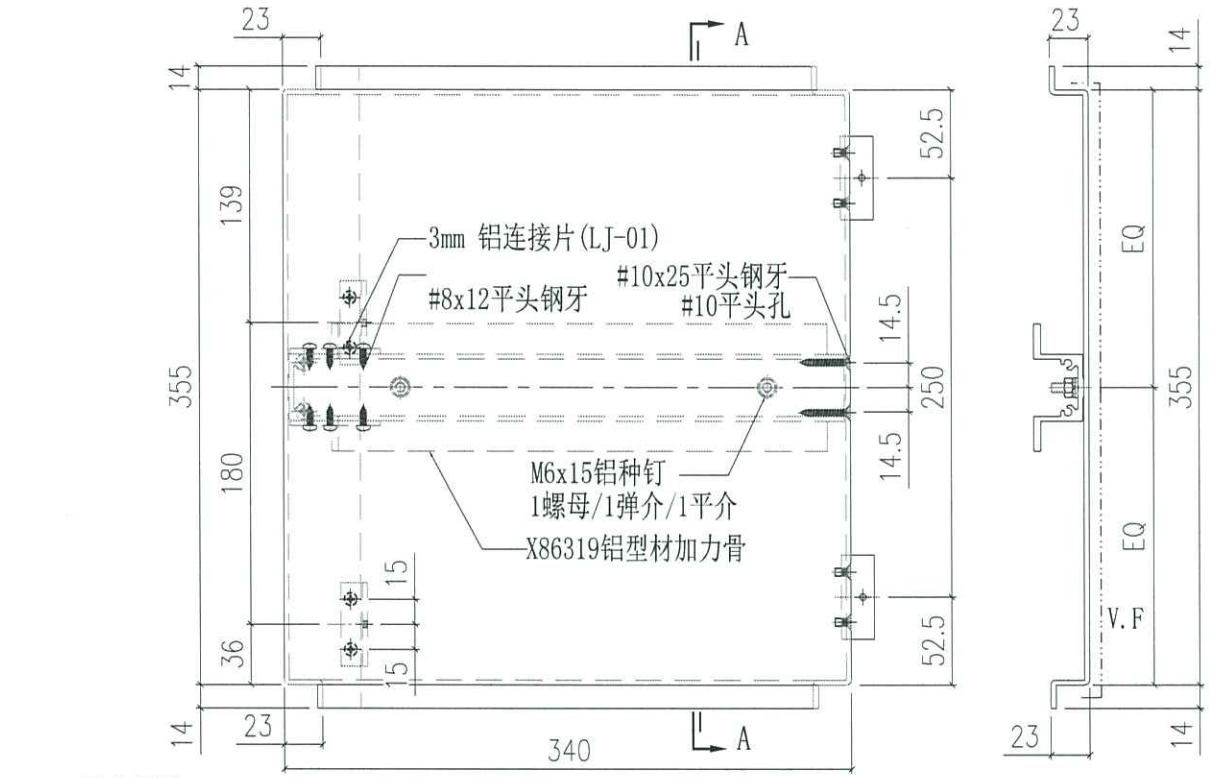

SECTION A-A

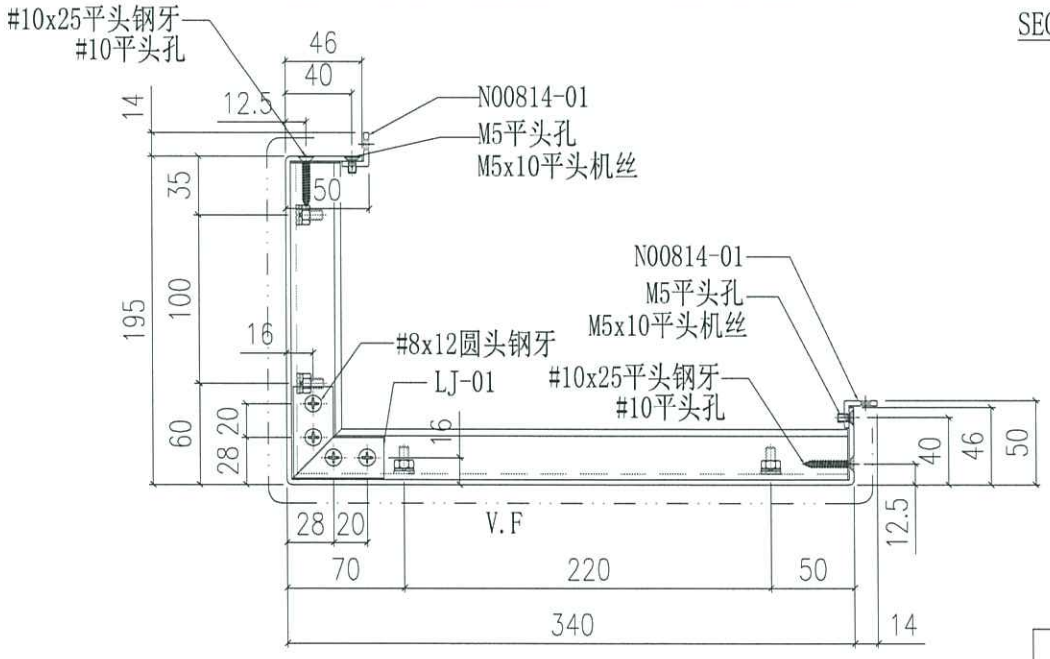

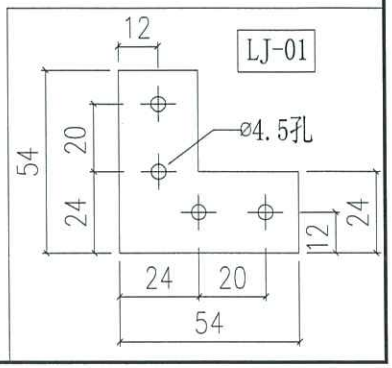


表面處理: PVF2 (香檳金ECD3X10099S-JF2

美特鋁質有限公司 MIDI Aluminium Fabricator Ltd.							工程號	J858	類別		物料號	-		
							地盘	康城11期	制圖	W.E.X	2022-08-11	圖號	AQ-24	
修改	-	-	-	採用	工廠	地盤 ✓	图纸名称	铝板加工图	復核	-	-	數量	-	
日期	-	-	-	材料颜色	PVF2（香槟金）		材料-	3mm THK.铝板	批准	-	-	單件重量	-	(KG)

表面處理: PVF2 (香檳金ECD3X10099S-JF2


数量
12

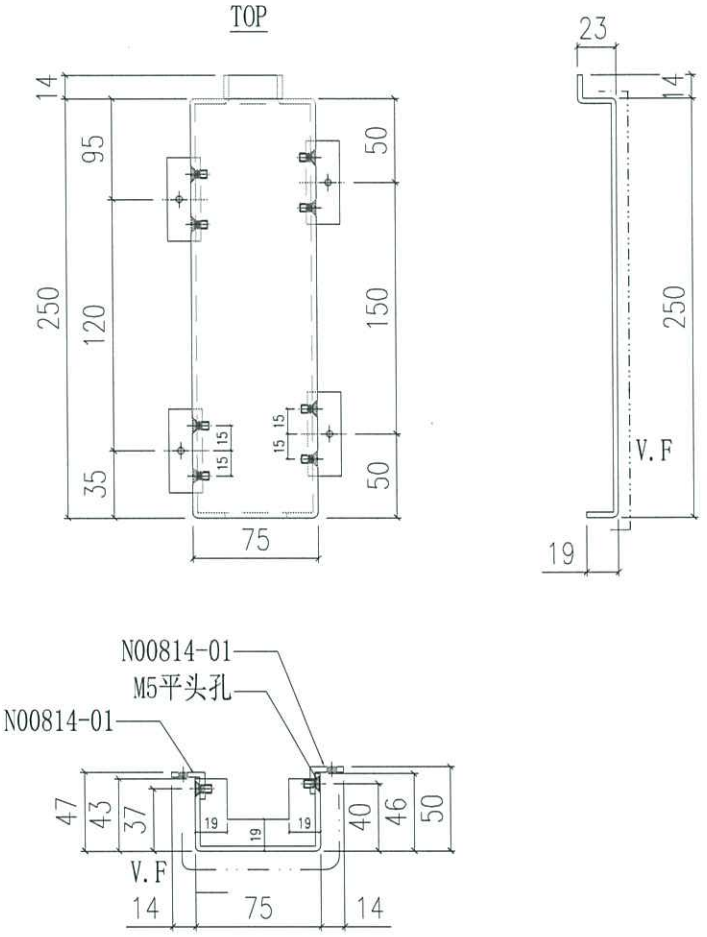


美特鋁質有限公司 MIDI Aluminium Fabricator Ltd.								工程號	J858	類別		物料號	-		
								地盘	康城11期	制圖	W.E.X	2022-08-11	圖號	AQ-25	
修改	-	-	-	採用	工廠		地盤 ✓	图纸名称	铝板加工图	復核	-	-	數量	-	
日期	-	-	-	材料颜色	PVF2（香槟金）			材料-	3mm THK.铝板	批准	-	-	單件重量	-	(KG)

表面處理: PVF2 (香檳金ECD3X10099S-JF2

数量
12

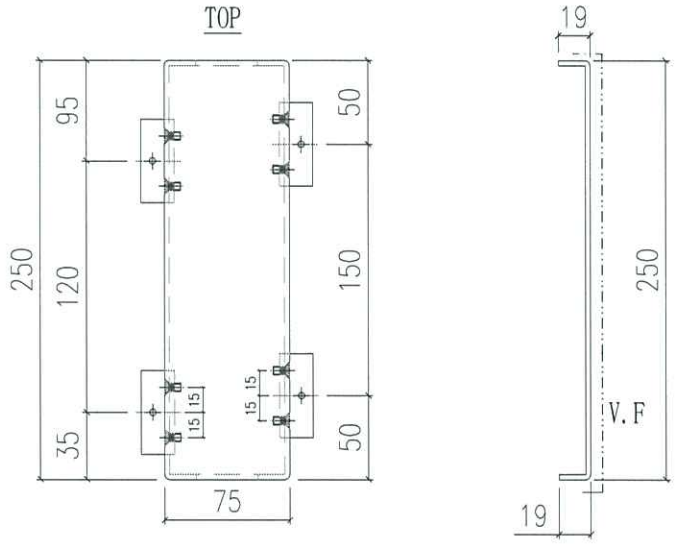


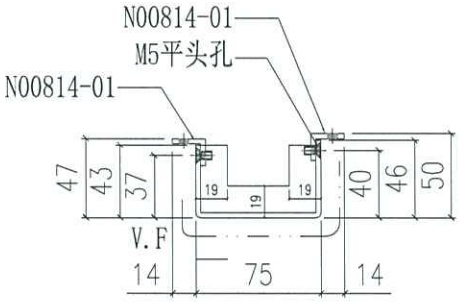


美特鋁質有限公司 MIDI Aluminium Fabricator Ltd.													
				工程號	J858	類別		物料號	-				
				地盘	康城11期	制圖	W.E.X	2022-08-11	圖號	AQ-26			
修改	-	-	-	採用工廠		地盤 ✓	图纸名称	铝折件	復核	-	-	數量	-	
日期	-	-	-	材料颜色	PVF2（香槟金）		材料	3.0mm 铝板	批准	-	-	單件重量	-	(KG)

表面處理: PVF2 (香檳金ECD3X10099S-JF2

编号	合计数量
AQ-26	46

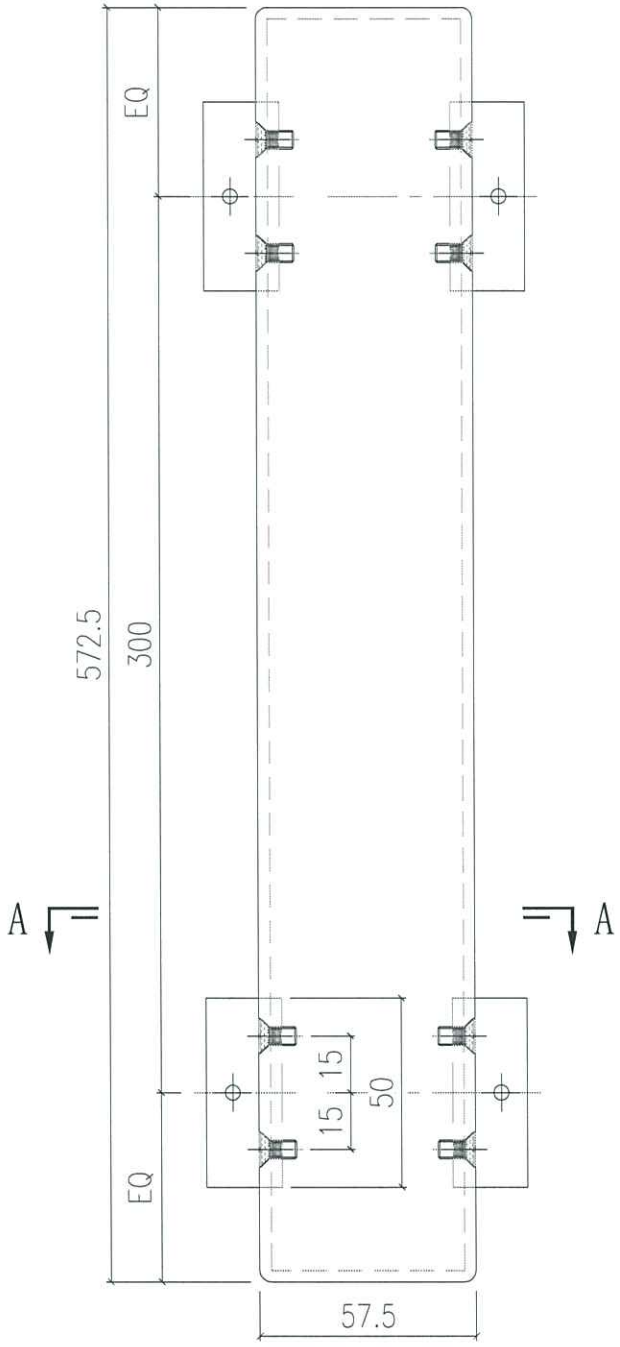


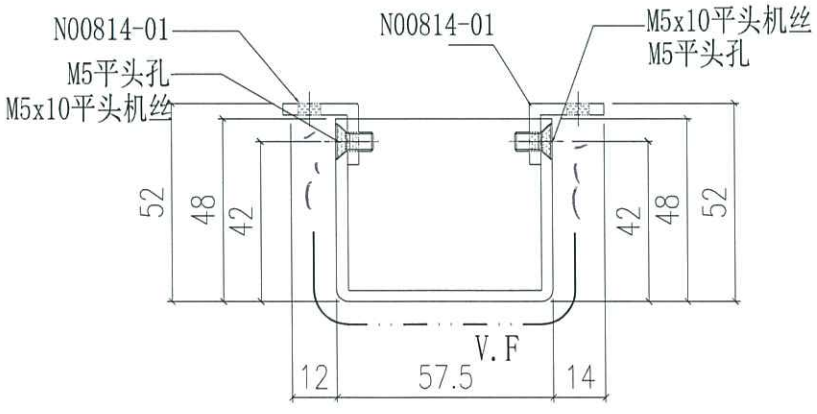


SECTION A-A

美特鋁質有限公司 MIDI Aluminium Fabricator Ltd.												
				工程號	J858	類別		物料號	-			
				地盘	康城11期	制圖	W.E.X	2022-08-11	圖號	AQ-27		
修改	-	-	-	採用工廠		地盤 ✓	图纸名称	铝折件	復核	-	-	數量	-	
日期	-	-	-	材料颜色	PVF2（香槟金）		材料	3.0mm 铝板	批准	-	-	單件重量	-	(KG)


表面處理: PVF2 (香檳金ECD3X10099S-JF2

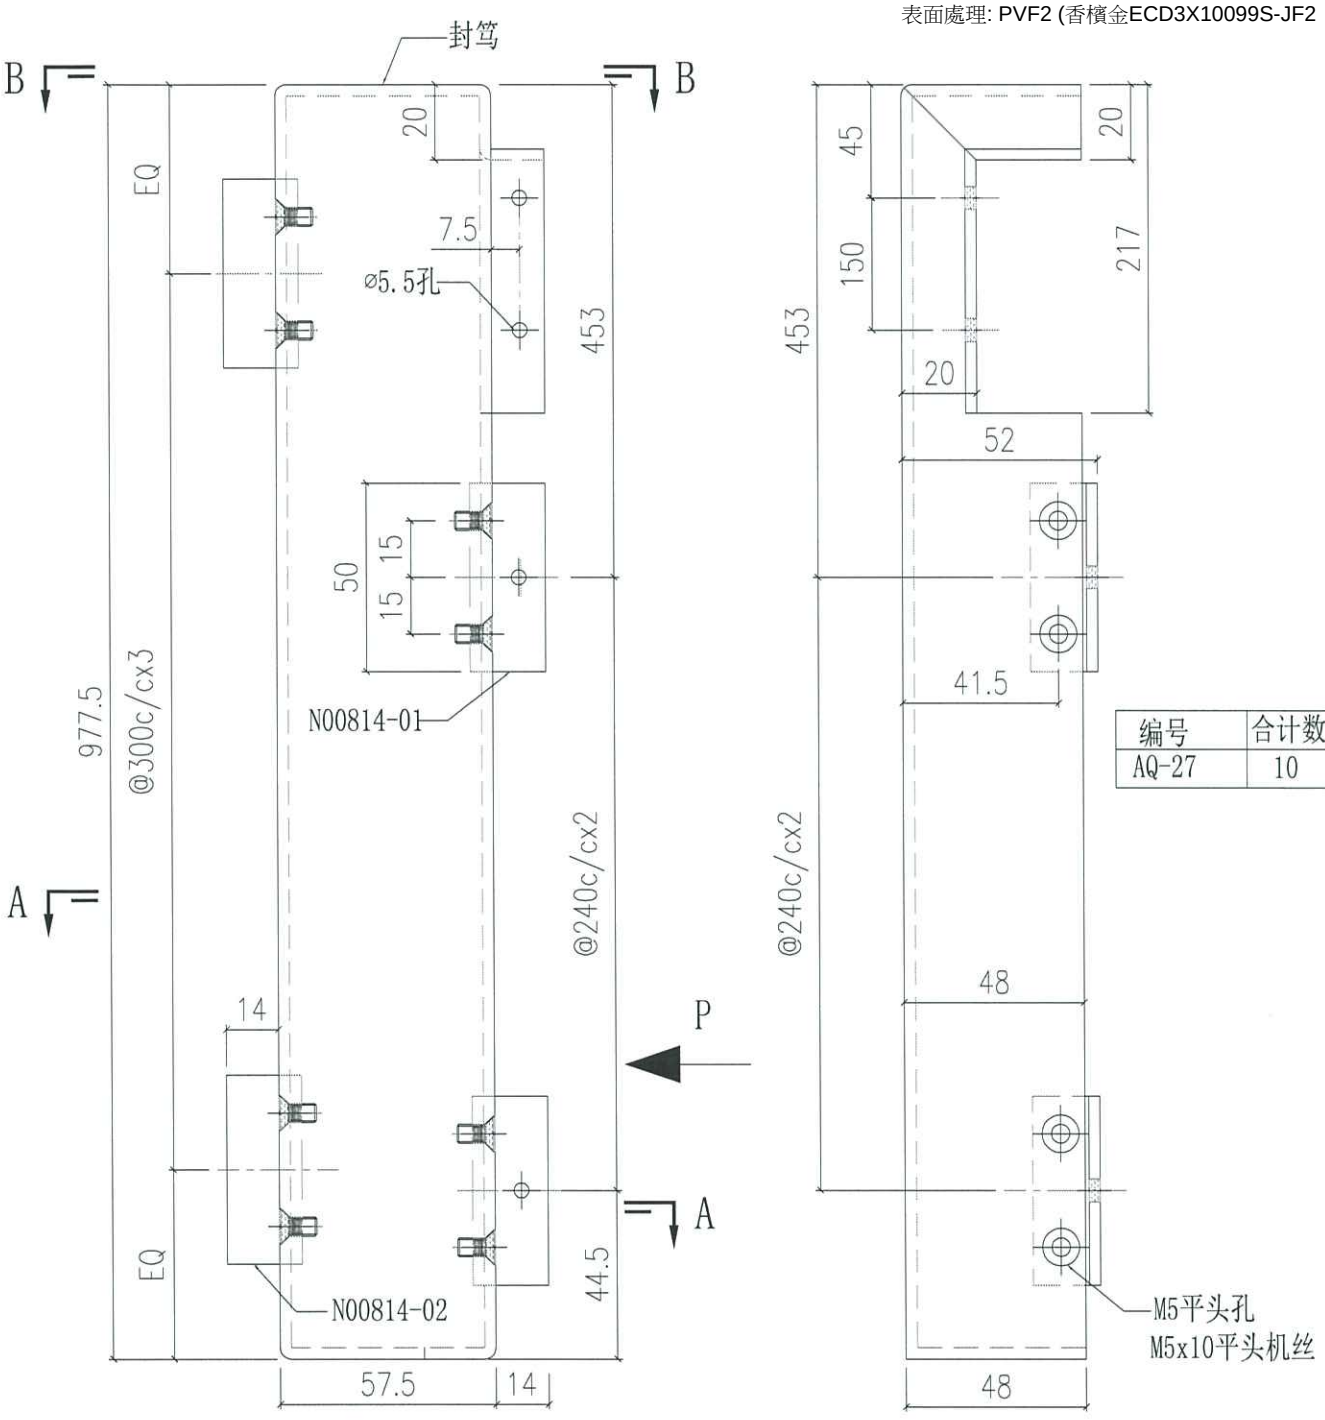

编号	合计数量
AQ-27	10

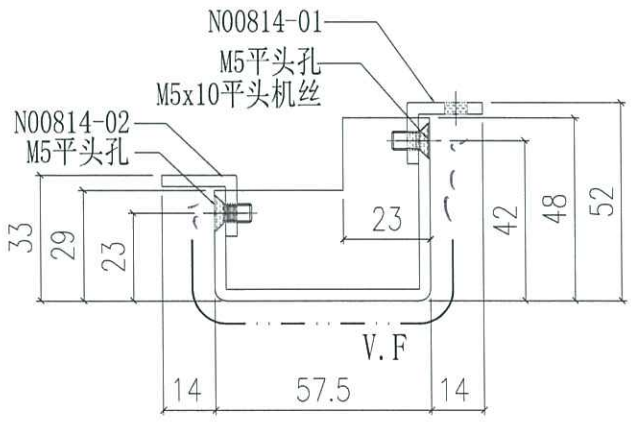


SECTION A-A

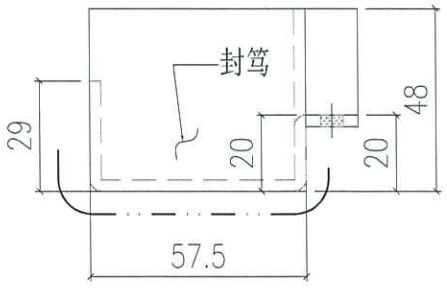

SECTION B-B

美特鋁質有限公司 MIDI Aluminium Fabricator Ltd.													
				工程號	J858	類別		物料號	-				
				地盘	康城11期	制圖	W.E.X	2022-08-11	圖號	AQ-28L			
修改	-	-	-	採用	工廠		地盘 ✓	图纸名称	铝折件	復核	-	-	數量	-	
日期	-	-	-	材料颜色	PVF2（香槟金）			材料	3.0mm 铝板	批准	-	-	單件重量	-	(KG)


表面處理: PVF2 (香檳金ECD3X10099S-JF2

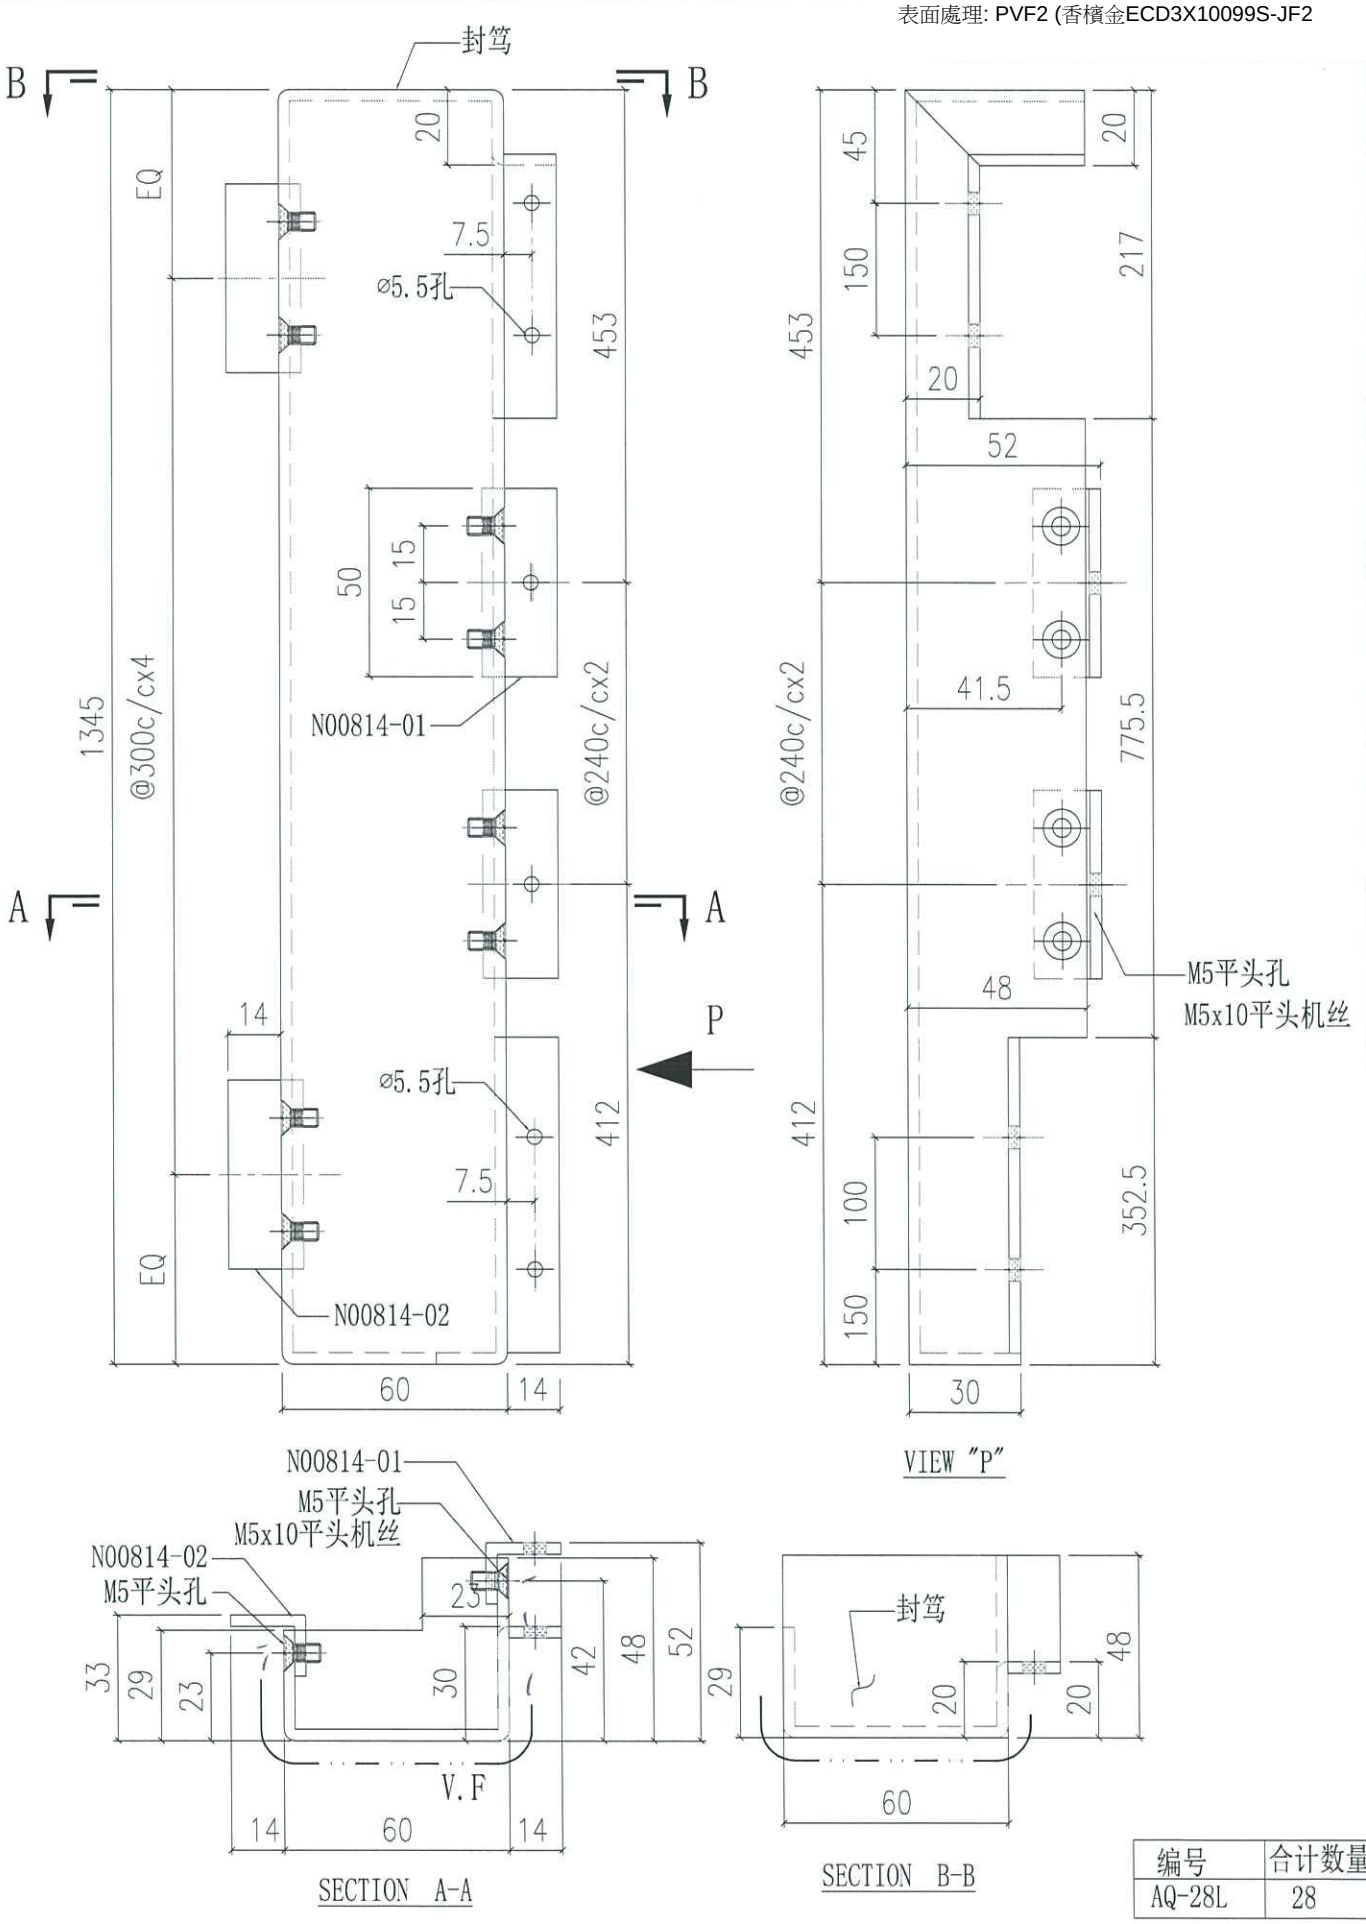

编号	合计数量
AQ-28L	28

美特鋁質有限公司 MIDI Aluminium Fabricator Ltd.													
				工程號	J858	類別		物料號	-				
				地盤	康城11期	制圖	W.E.X	2022-08-11	圖號	AQ-28R			
修改	-	-	-	採用工廠		地盤 ✓	图纸名称	铝折件	復核	-	-	數量	-	
日期	-	-	-	材料颜色	PVF2（香槟金）		材料	3.0mm 铝板	批准	-	-	單件重量	-	(KG)


表面處理: PVF2 (香檳金ECD3X10099S-JF2

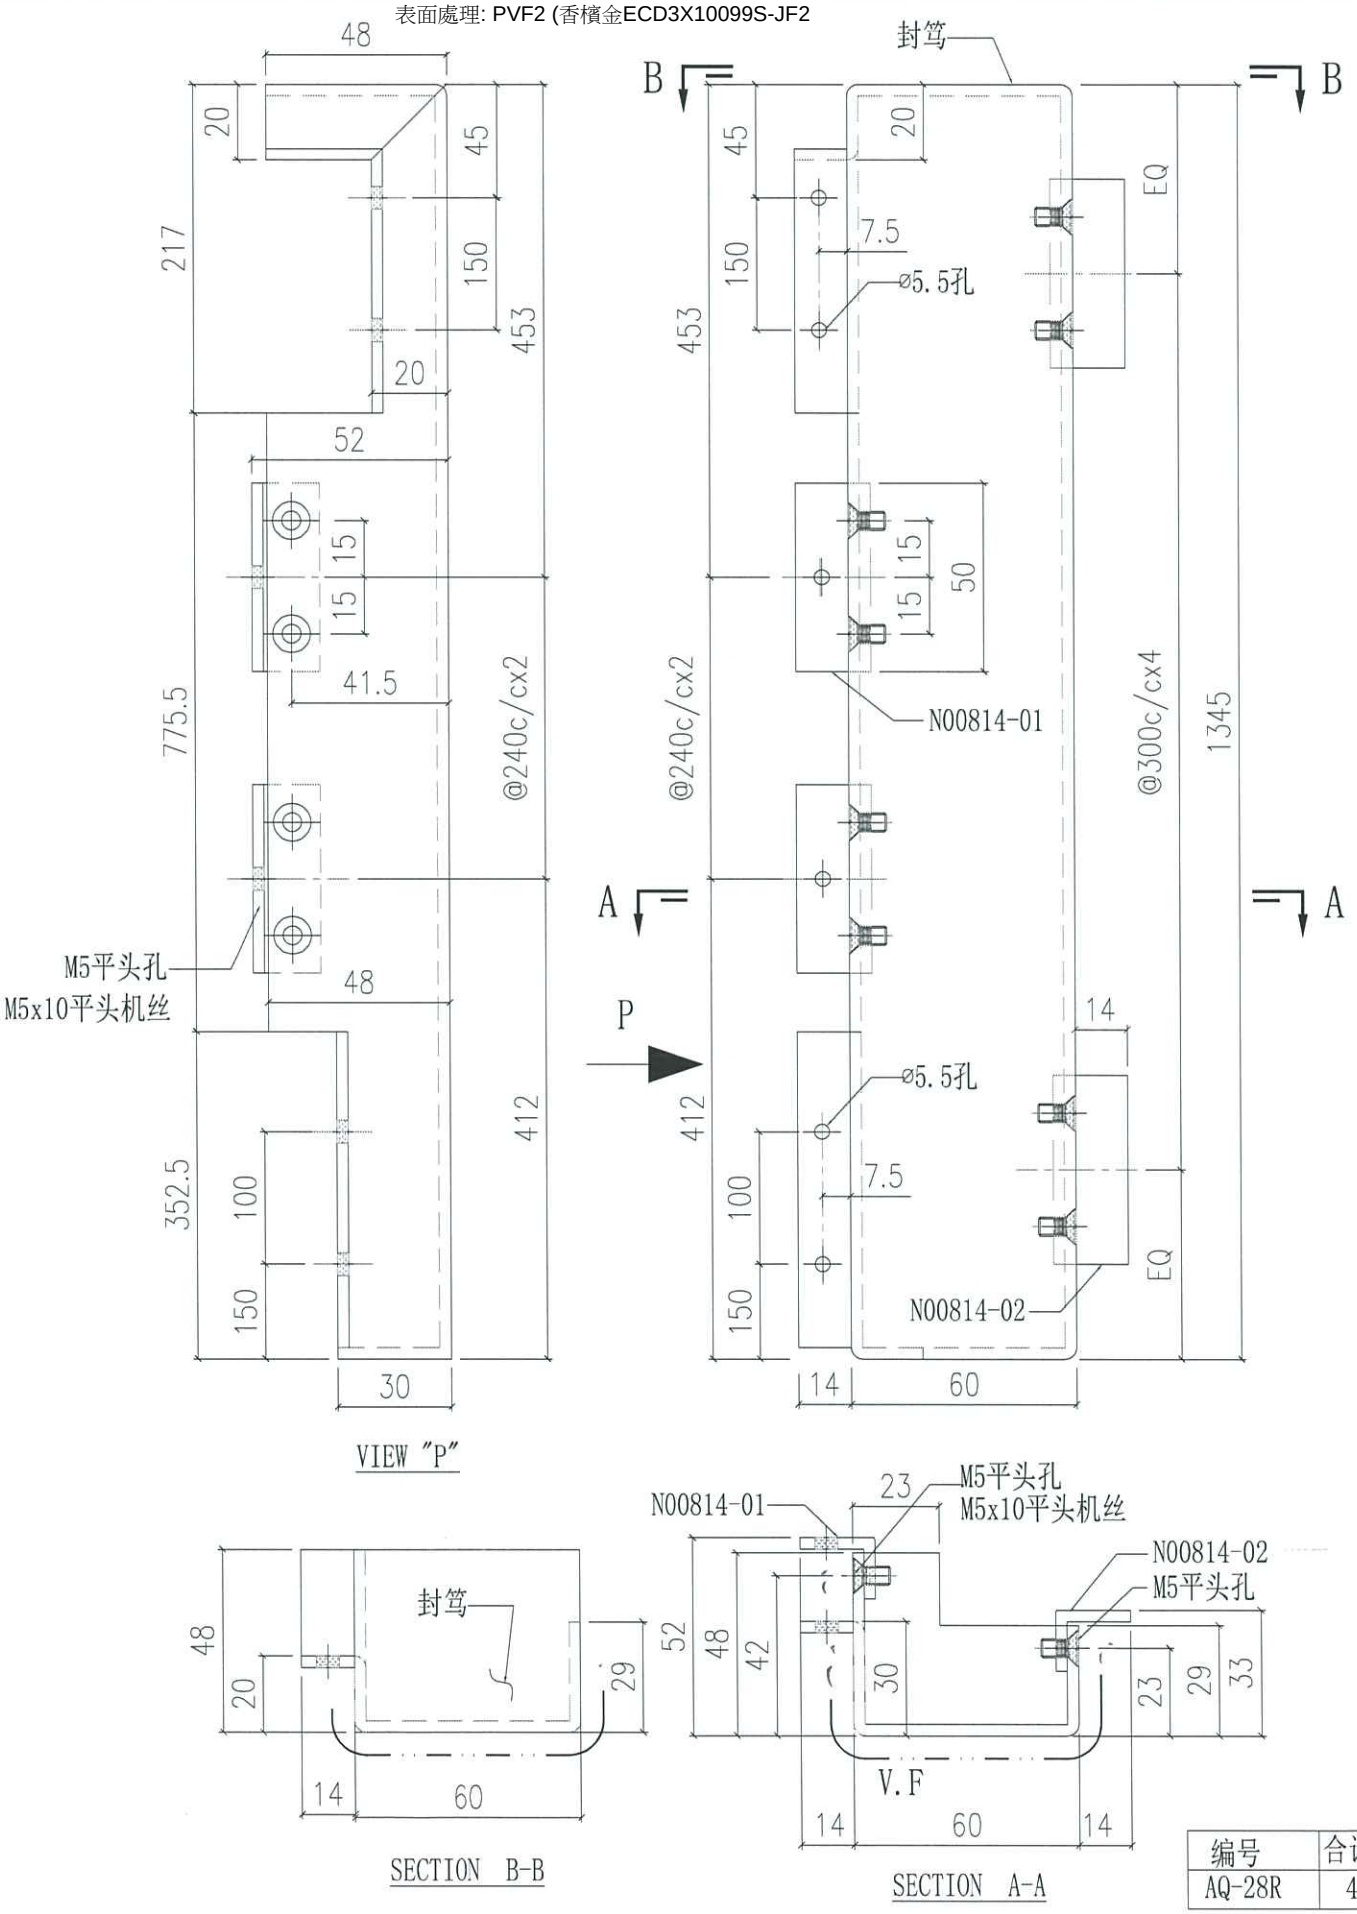

编号	合计数量
AQ-28R	40

美特鋁質有限公司 MIDI Aluminium Fabricator Ltd.													
工程號	J858		類別		物料號	-							
地盘	康城11期		制圖	W.E.X	2022-08-11	圖號	AQ-29L						
修改	-	-	-	採用工廠		地盤 ✓	图纸名称	铝折件	復核	-	-	數量	-		
日期	-	-	-	材料颜色	PVF2（香槟金）		材料	3.0mm 铝板	批准	-	-	單件重量	-	(KG)	


表面處理: PVF2 (香檳金ECD3X10099S-JF2

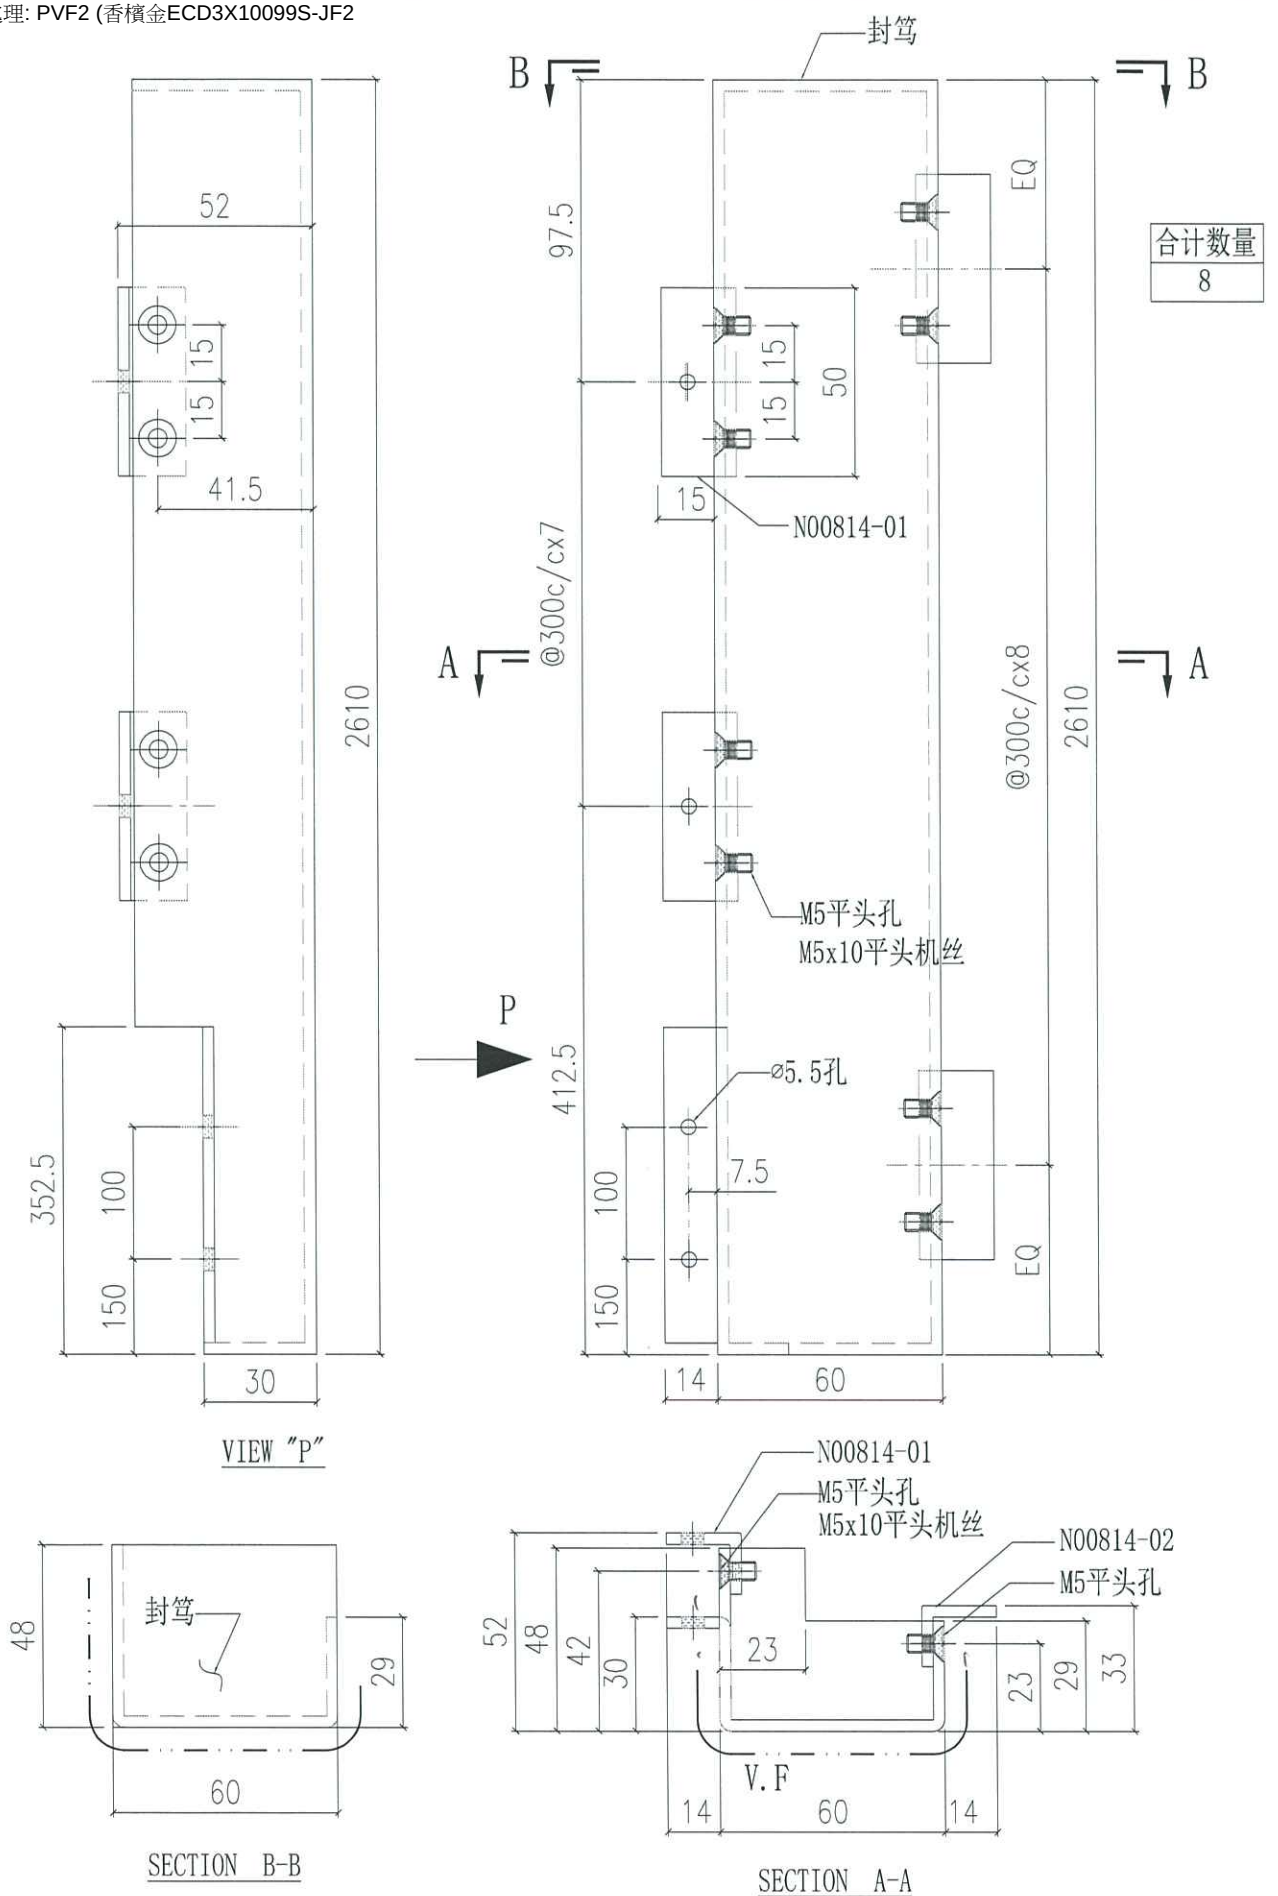

美特鋁質有限公司 MIDI Aluminium Fabricator Ltd.													
						工程號	J858	類別		物料號	-		
						地盤	康城11期	制圖	W.E.X	2022-08-11	圖號	AQ-29R	
修改	-	-	-	採用	工廠		地盤 ✓	图纸名称	铝折件	復核	-	-	數量	-	
日期	-	-	-	材料颜色	PVF2（香槟金）			材料	3.0mm 铝板	批准	-	-	單件重量	-	(KG)

表面處理: PVF2 (香檳金ECD3X10099S-JF2

合计数量
2

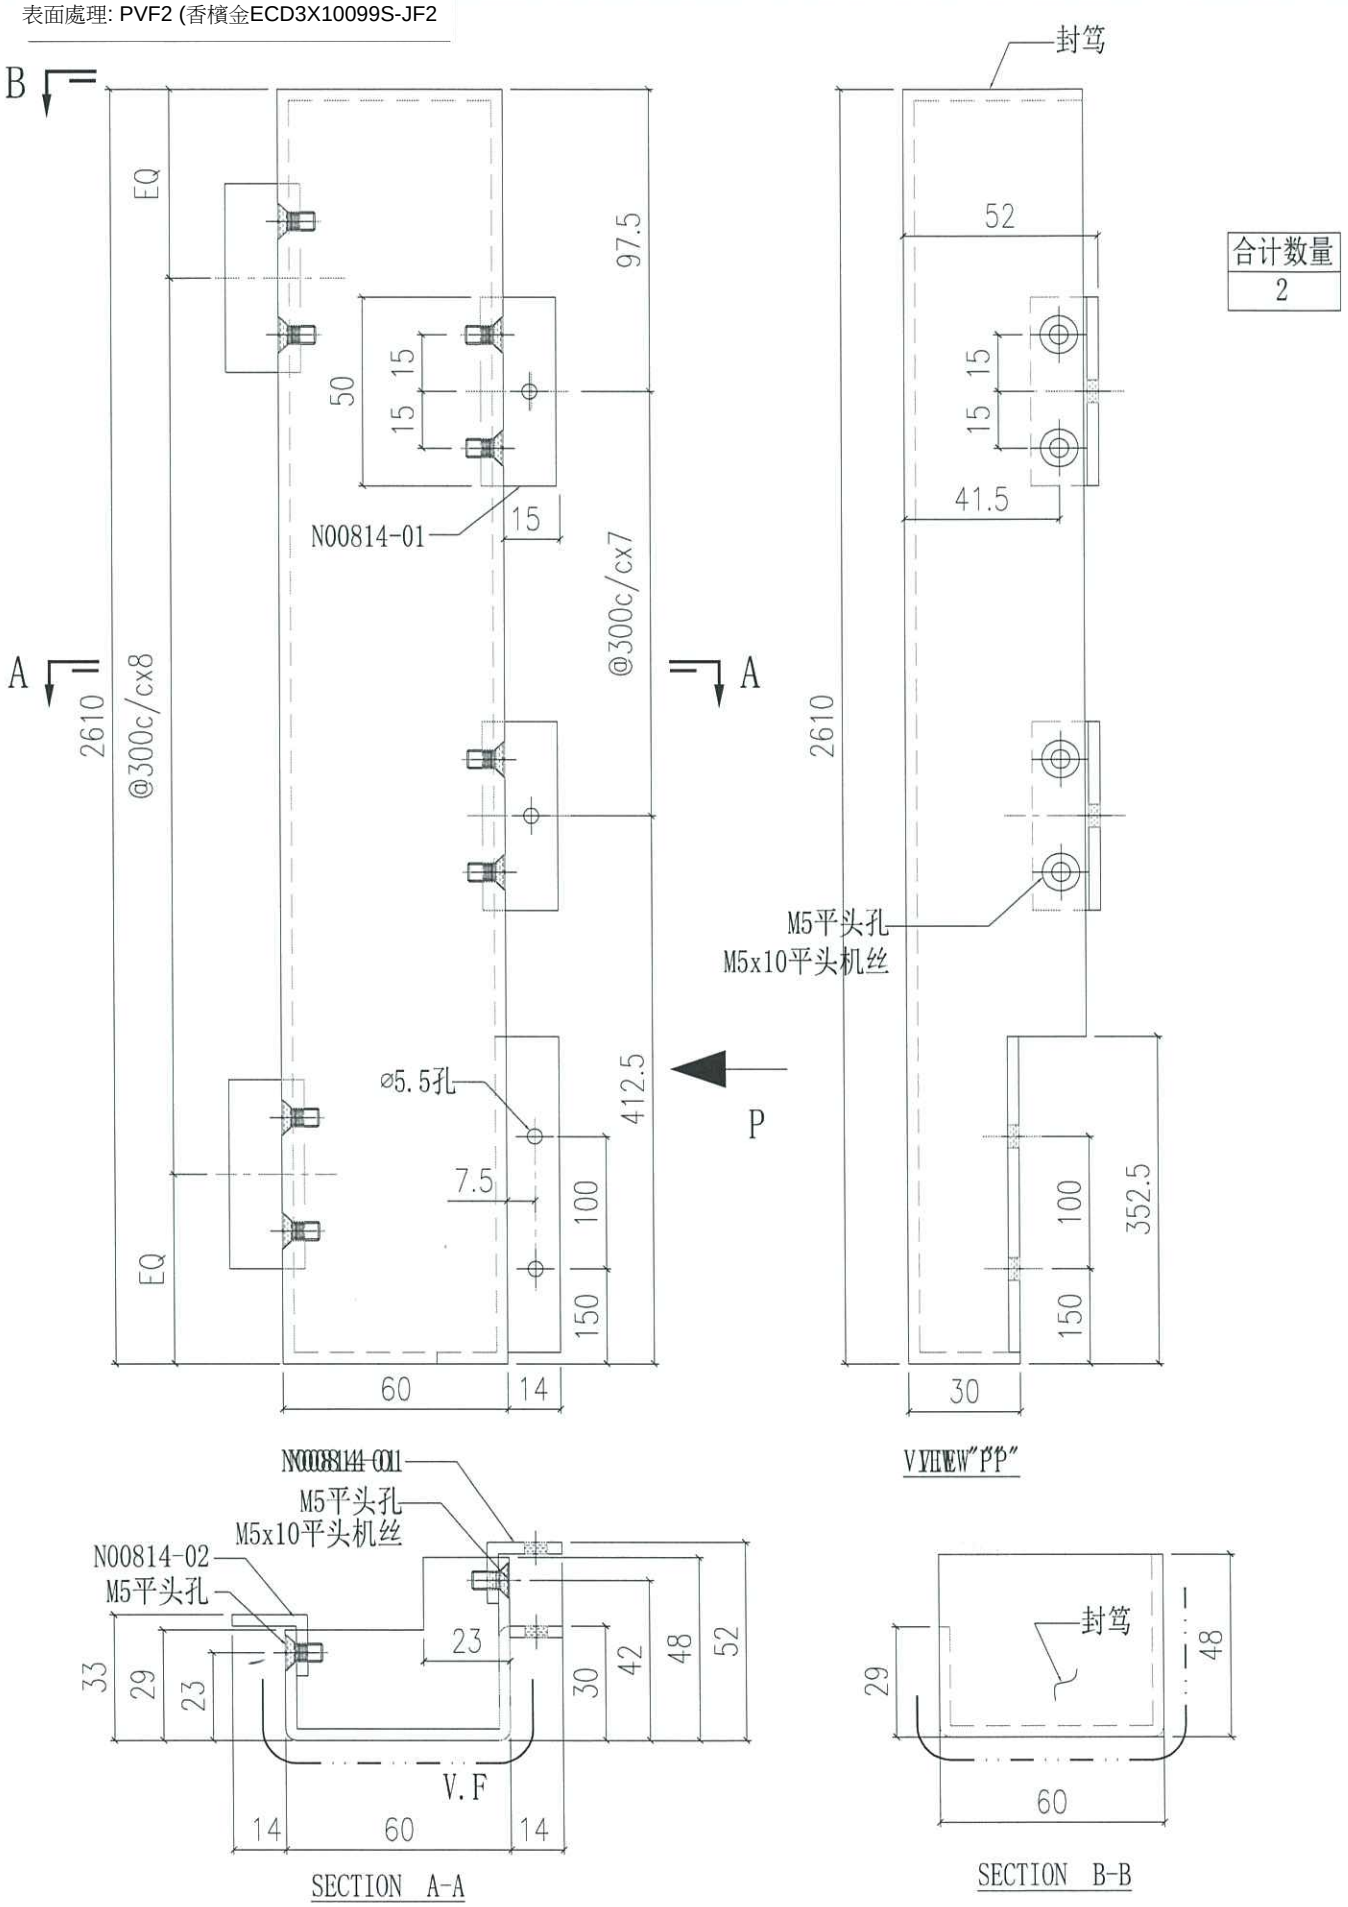

VIEW "P"


SECTION A-A


SECTION B-B

美特鋁質有限公司 MIDI Aluminium Fabricator Ltd.													
				工程號	J858	類別		物料號	-				
				地盘	康城11期	制圖	W.E.X	2022-08-11	圖號	AQ-30			
修改	-	-	-	採用工廠		地盤 ✓	图纸名称	铝折件	復核	-	-	數量	-
日期	-	-	-	材料颜色	PVF2（香槟金）		材料	3.0mm 铝板	批准	-	-	單件重量	- (KG)

TOP

合计数量
1

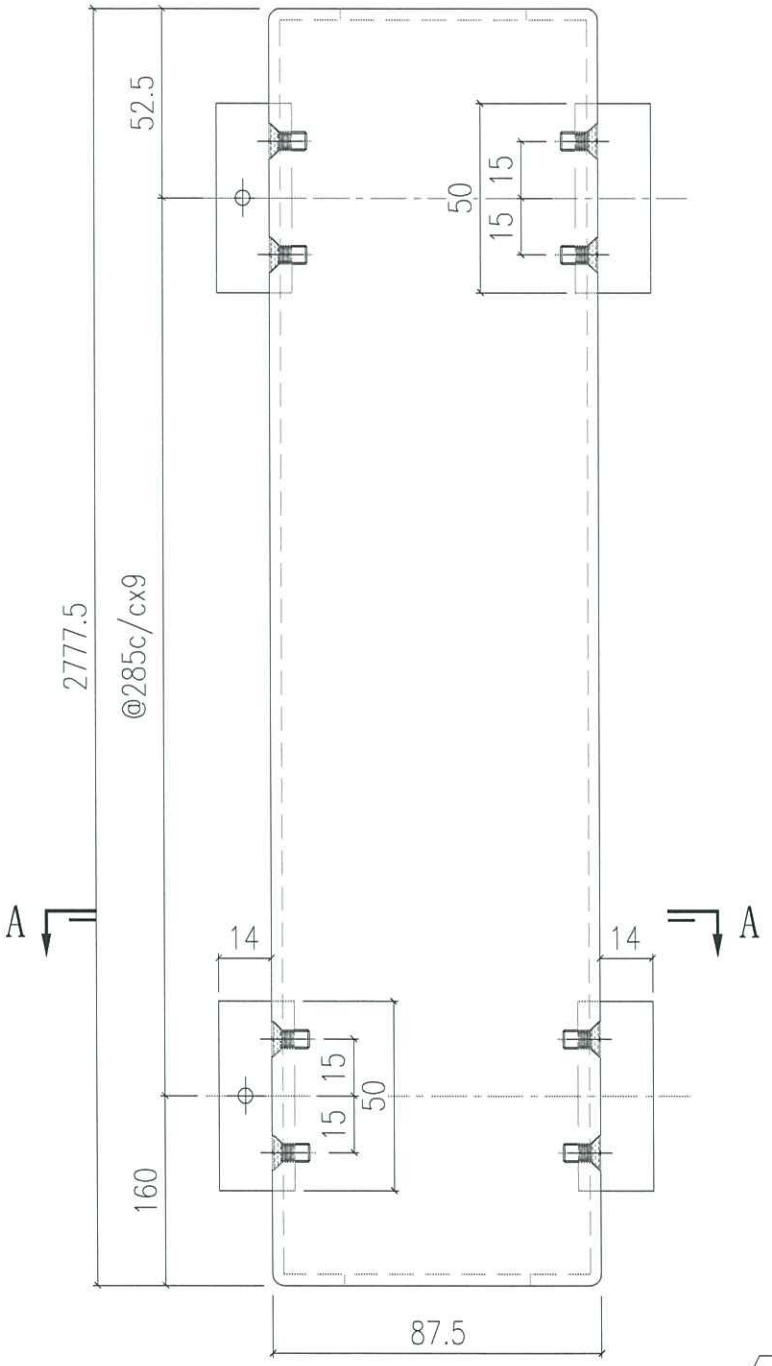

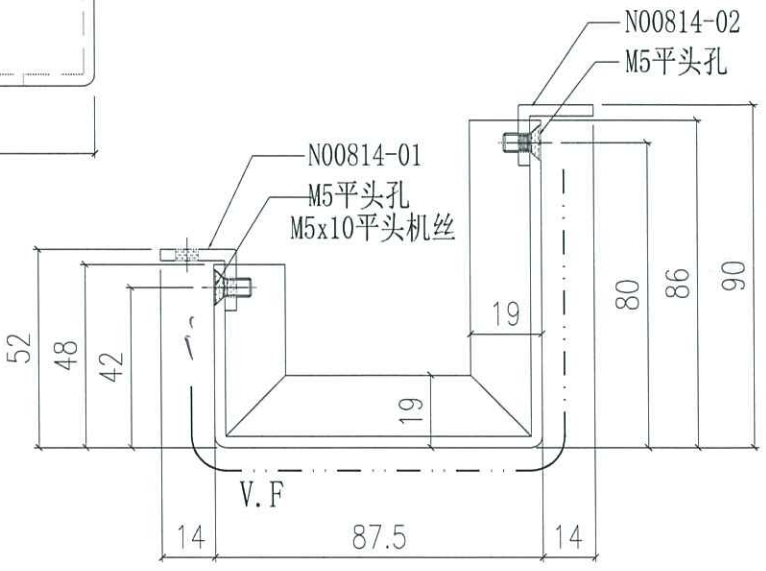



SECTION A-A

美特鋁質有限公司 MIDI Aluminium Fabricator Ltd.														
						工程號	J858	類別		物料號	-			
						地盘	康城11期	制圖	W.E.X	2022-08-11	圖號	AQ-31L		
修改	-	-	-	採用	工廠		地盤 ✓	图纸名称	铝折件	復核	-	-	數量	-	
日期	-	-	-	材料颜色	PVF2（香槟金）			材料	3.0mm 铝板	批准	-	-	單件重量	-	(KG)

合计数量
19

TOP

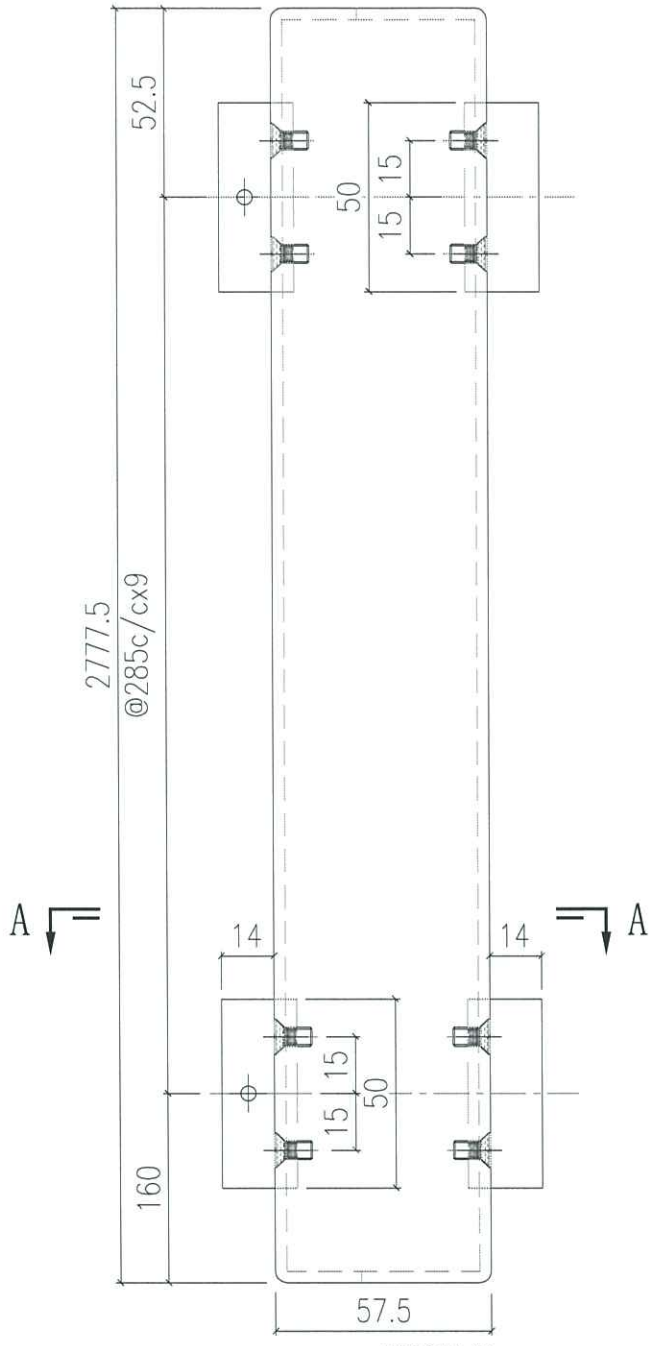

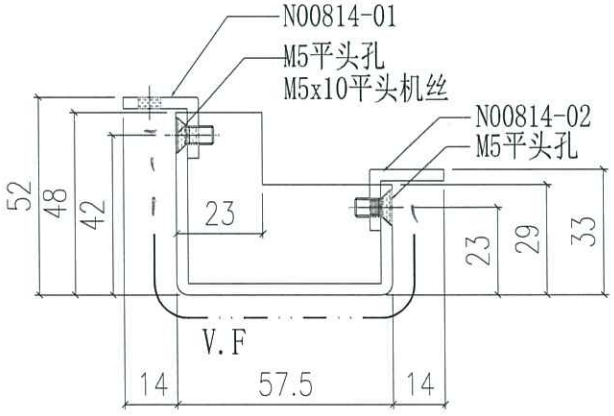



SECTION A-A

美特鋁質有限公司 MIDI Aluminium Fabricator Ltd.				工程號	J858	類別		物料號	-		
				地盘	康城11期	制圖	W.E.X	2022-08-11	圖號	AQ-31R	
修改	-	-	-	採用 工廠		地盤 ✓	图纸名称	铝折件	復核	-	-	數量	-
日期	-	-	-	材料颜色	PVF2（香槟金）		材料	3.0mm 铝板	批准	-	-	單件重量	- (KG)

TOP


合计数量
16

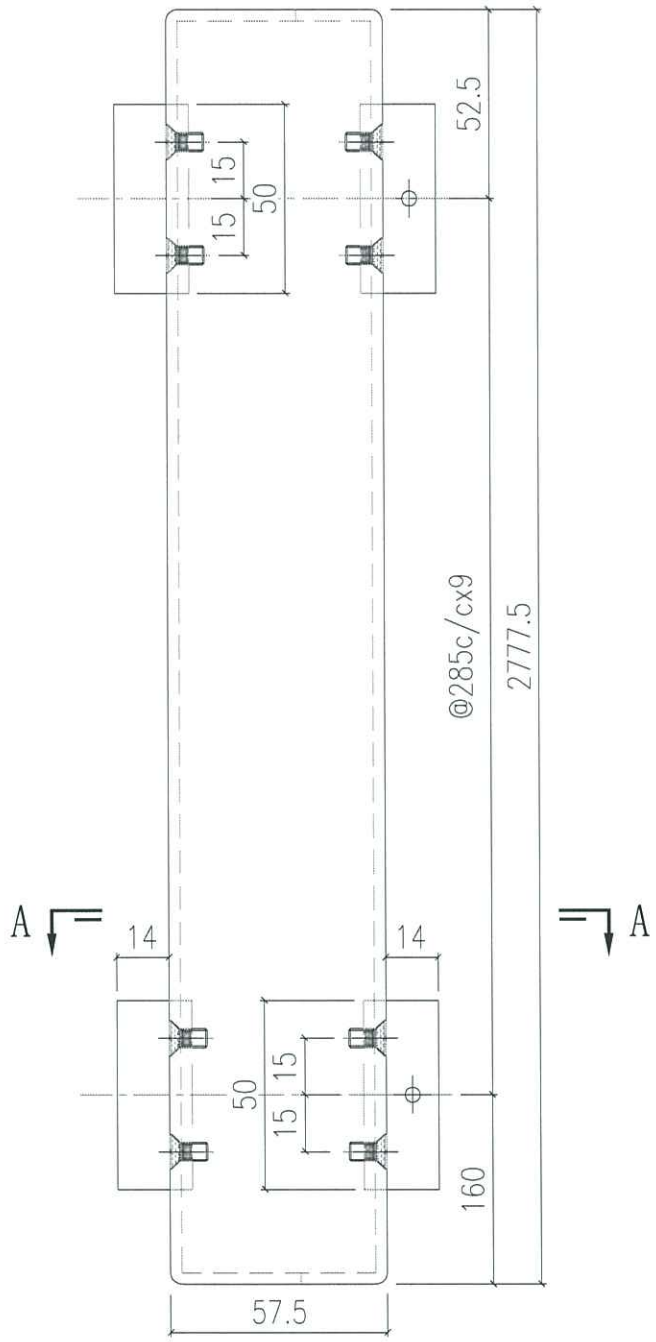

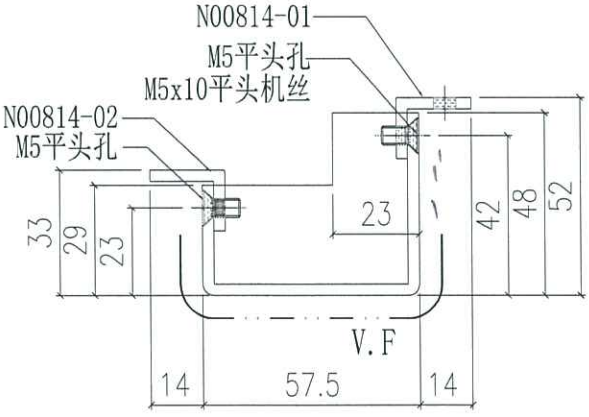


SECTION A-A


美特鋁質有限公司 MIDI Aluminium Fabricator Ltd.													
							工程號	J858	類別		物料號	-	
							地盘	康城11期	制圖	W.E.X	2022-08-11	圖號	AQ-32L
修改	-	-	-	採用	工廠		地盤	✓	图纸名称	铝折件	復核	-	-	數量	-
日期	-	-	-	材料颜色	PVF2（香槟金）				材料	3.0mm 铝板	批准	-	-	單件重量	- (KG)

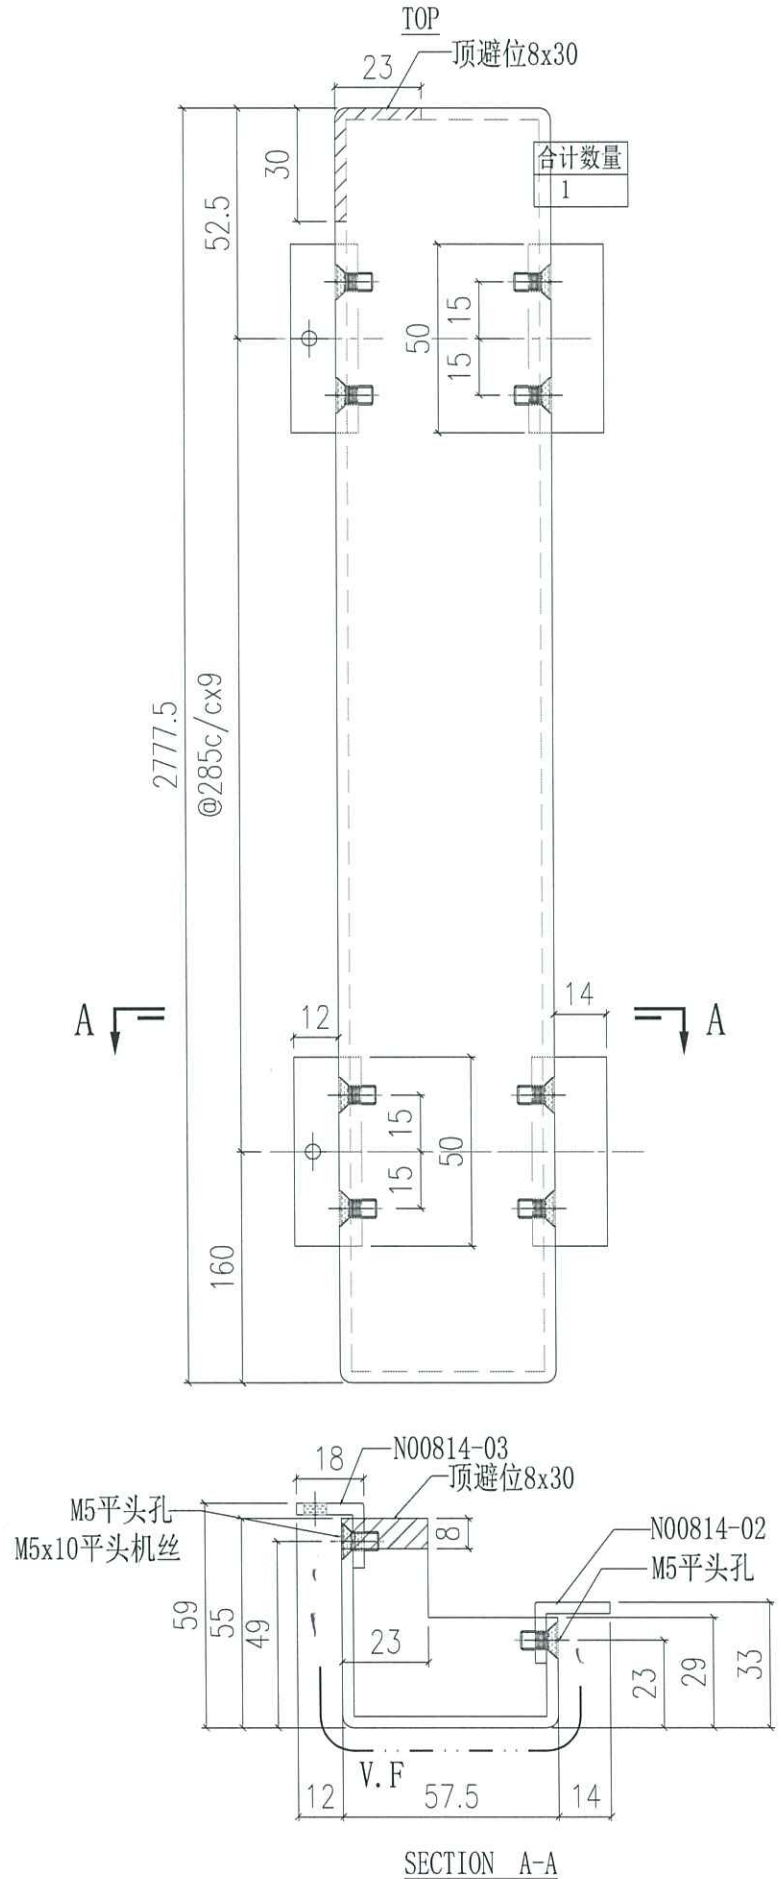

美特鋁質有限公司 MIDI Aluminium Fabricator Ltd.													
					工程號	J858	類別		物料號	-			
					地盘	康城11期	制圖	W.E.X	2022-08-11	圖號	AQ-32R		
修改	-	-	-	採用工廠		地盤 ✓	图纸名称	铝折件	復核	-	-	數量	-	
日期	-	-	-	材料颜色	PVF2（香槟金）		材料	3.0mm 铝板	批准	-	-	單件重量	-	(KG)

合计数量
5

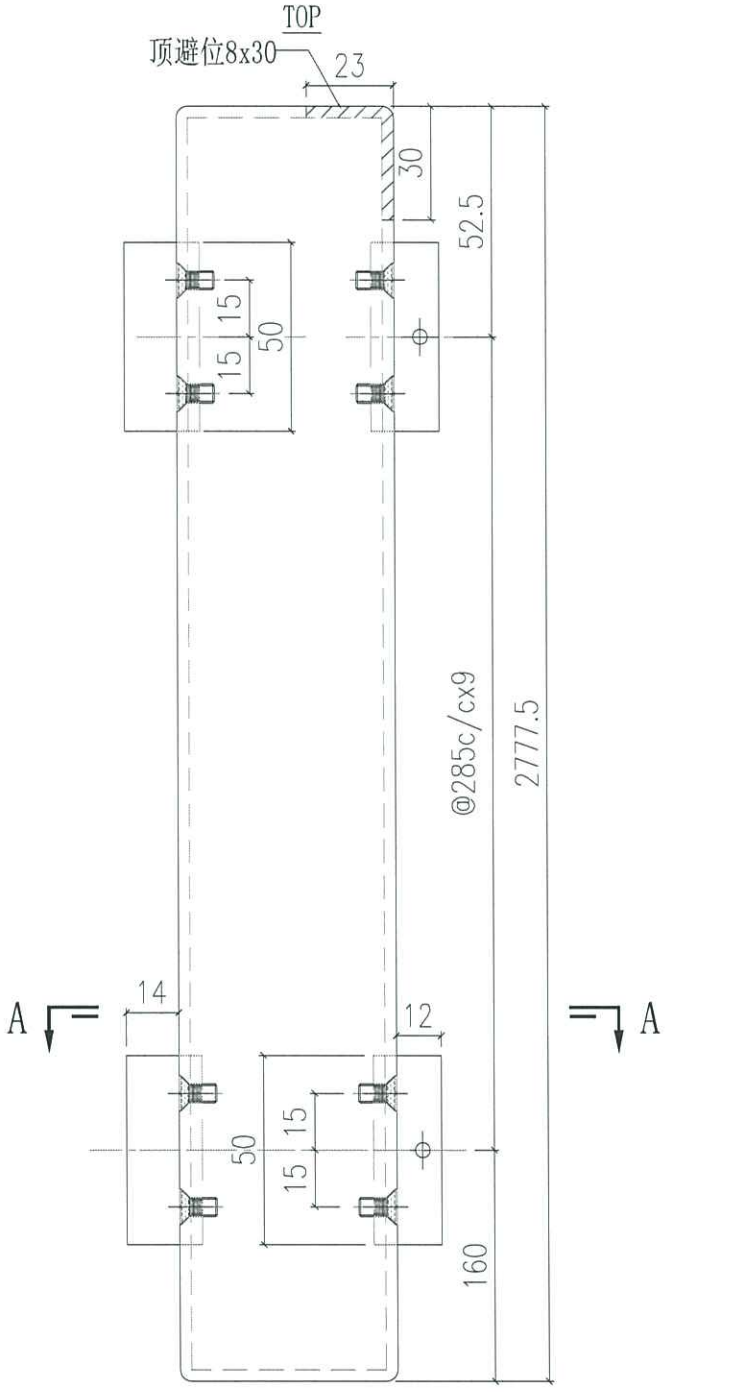

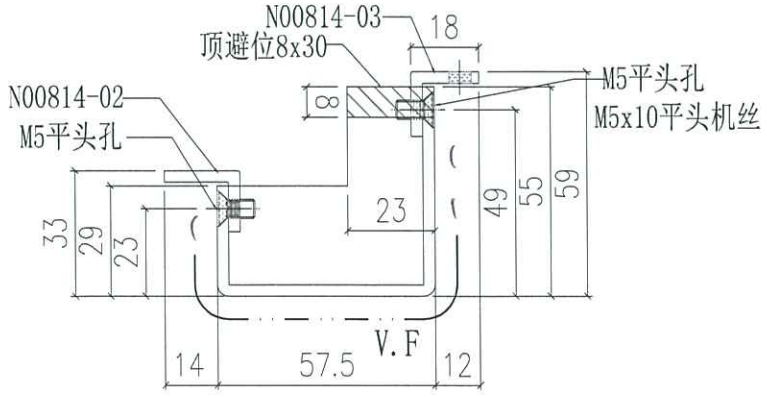



SECTION A-A

美特鋁質有限公司 MIDI Aluminium Fabricator Ltd.														
						工程號	J858	類別		物料號	-			
						地盘	康城11期	制圖	W.E.X	2022-08-11	圖號	AQ-33		
修改	-	-	-	採用	工廠		地盤 ✓	图纸名称	铝折件	復核	-	-	數量	-	
日期	-	-	-	材料颜色	PVF2（香槟金）			材料	3.0mm 铝板	批准	-	-	單件重量	-	(KG)

TOP

合计数量
3

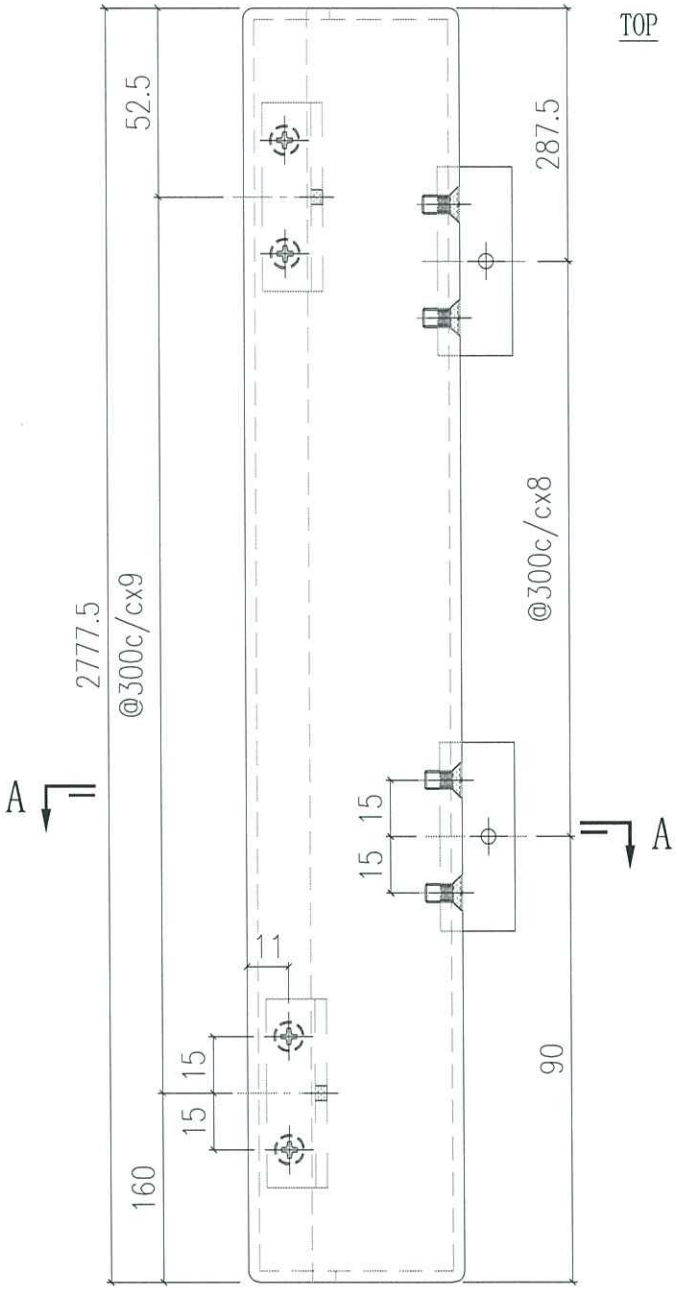


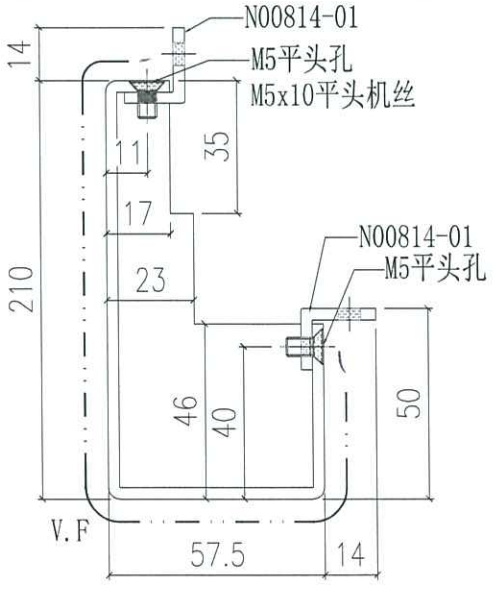


SECTION A-A

美特鋁質有限公司 MIDI Aluminium Fabricator Ltd.														
							工程號	J858	類別		物料號	-		
							地盘	康城11期	制圖	W.E.X	2022-08-11	圖號	AQ-34L	
修改	-	-	-	採用	工廠		地盤	✓	图纸名称	铝折件	復核	-	-	數量	-	
日期	-	-	-	材料颜色	PVF2（香槟金）				材料	3.0mm 铝板	批准	-	-	單件重量	-	(KG)

合计数量
6

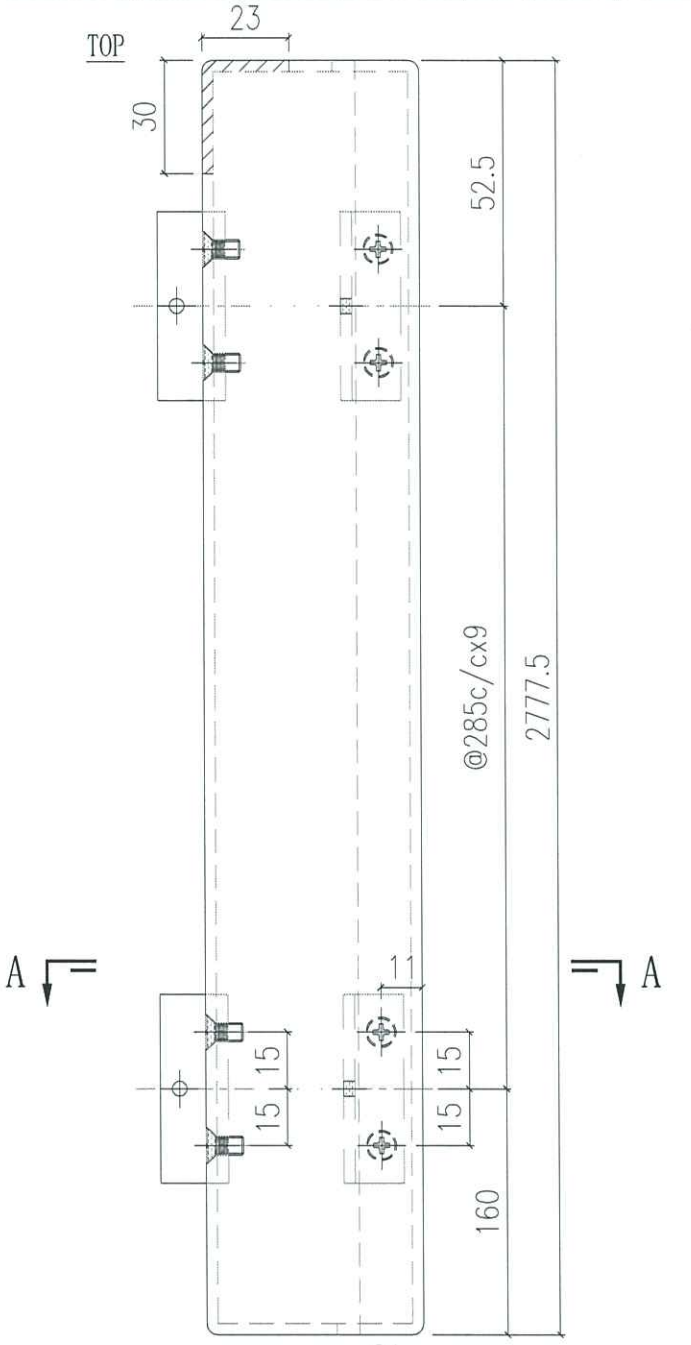


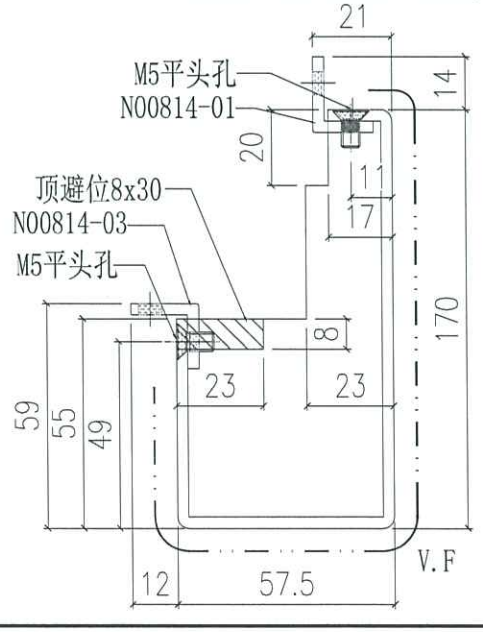


SECTION A-A

美特鋁質有限公司 MIDI Aluminium Fabricator Ltd.				工程號	J858	類別		物料號	-		
				地盤	康城11期	制圖	W.E.X	2022-08-11	圖號	AQ-34R	
修改	-	-	-	採用 工廠	地盤 ✓	图纸名称	铝折件	復核	-	-	數量	-
日期	-	-	-	材料顏色	PVF2（香槟金）	材料	3.0mm 铝板	批准	-	-	單件重量	- (KG)

合计数量
4

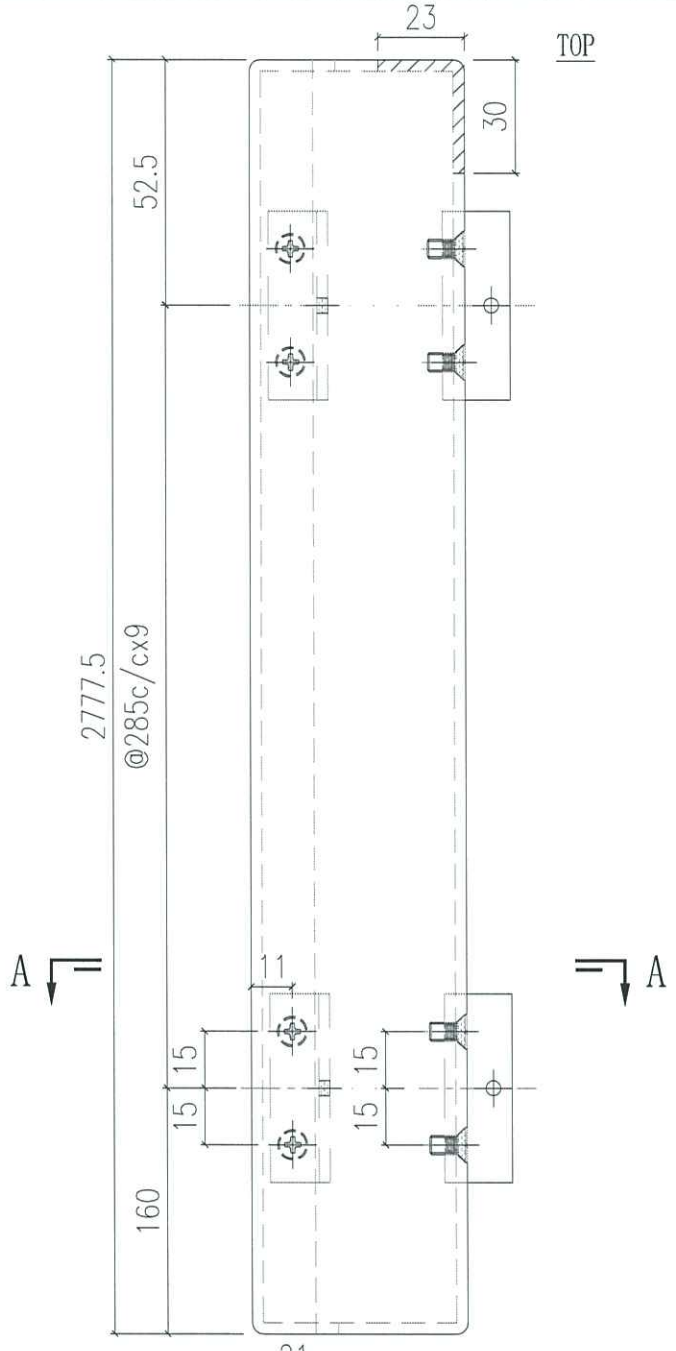


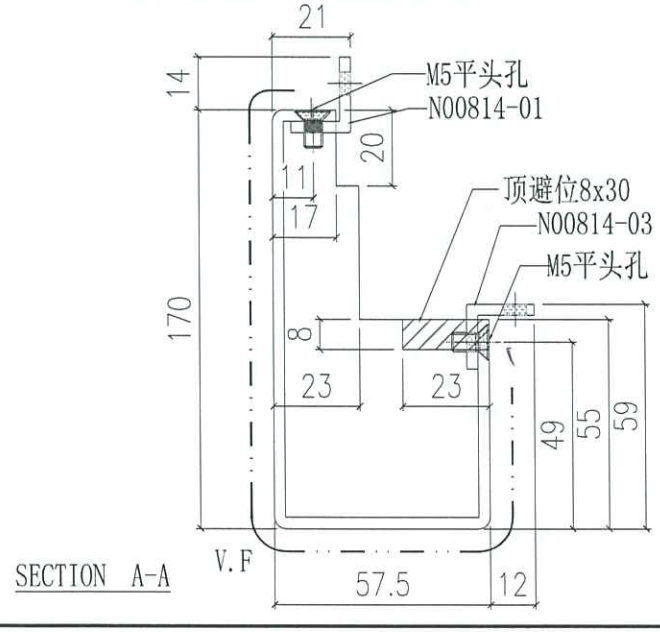


SECTION A-A

美特鋁質有限公司 MIDI Aluminium Fabricator Ltd.				工程號	J858	類別		物料號	-		
				地盘	康城11期	制圖	W.E.X	2022-08-11	圖號	AQ-35	
修改	-	-	-	採用工廠	地盤 ✓	图纸名称	铝折件	復核	-	-	數量	-
日期	-	-	-	材料颜色	PVF2（香槟金）	材料	3.0mm 铝板	批准	-	-	單件重量	- (KG)

合计数量
1

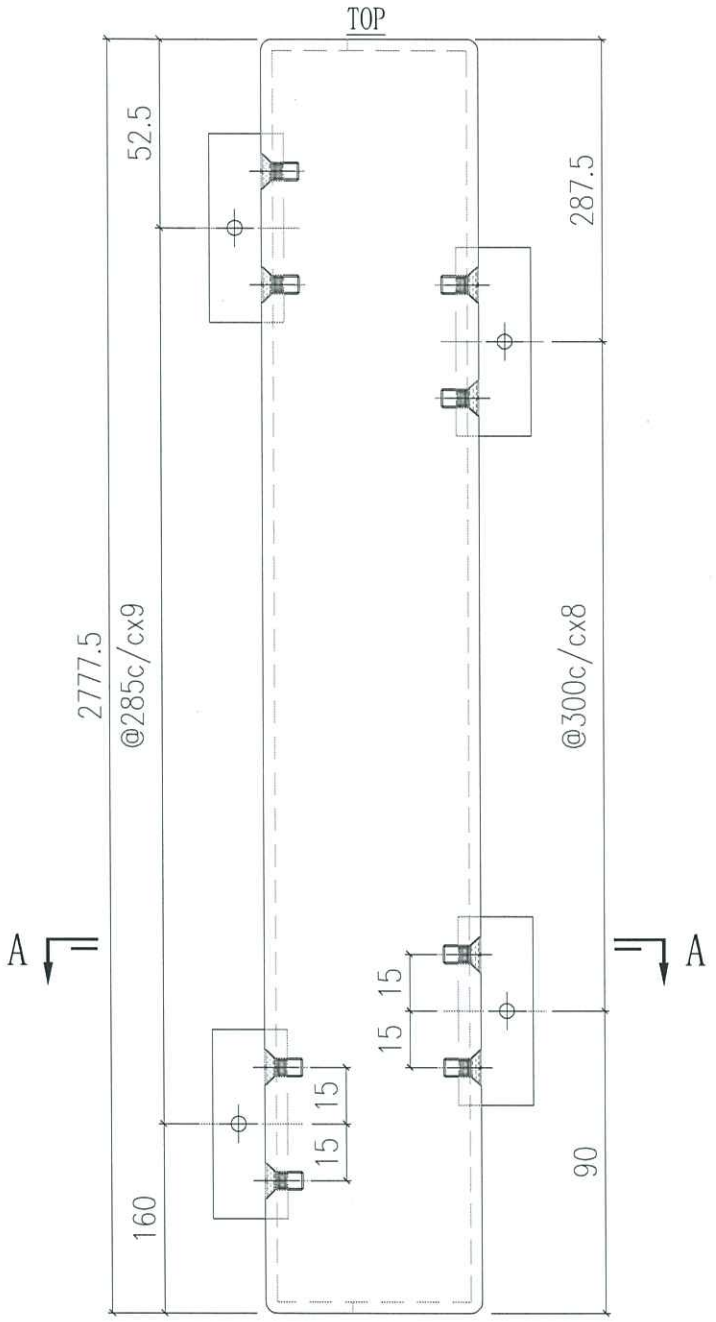

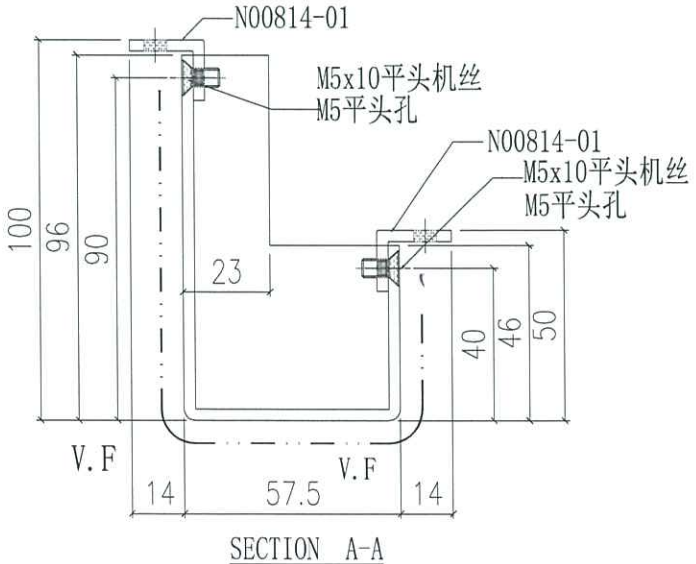



SECTION A-A

美特鋁質有限公司 MIDI Aluminium Fabricator Ltd.				工程號	J858	類別		物料號	-		
				地盘	康城11期	制圖	W.E.X	2022-08-11	圖號	AQ-36	
修改	-	-	-	採用 工廠	地盤 ✓	图纸名称	铝折件	復核	-	-	數量	-	
日期	-	-	-	材料颜色	PVF2（香槟金）	材料	3.0mm 铝板	批准	-	-	單件重量	-	(KG)

合计数量
1


TOP

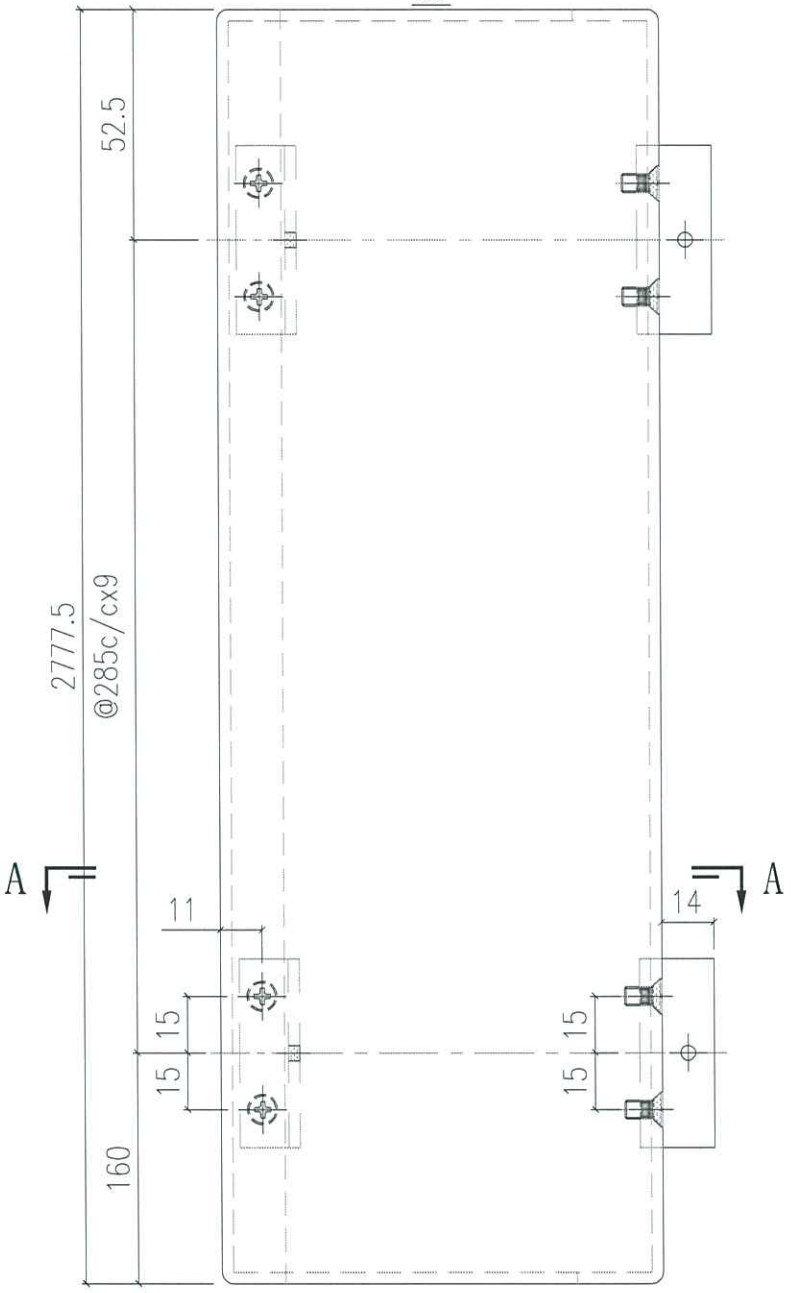


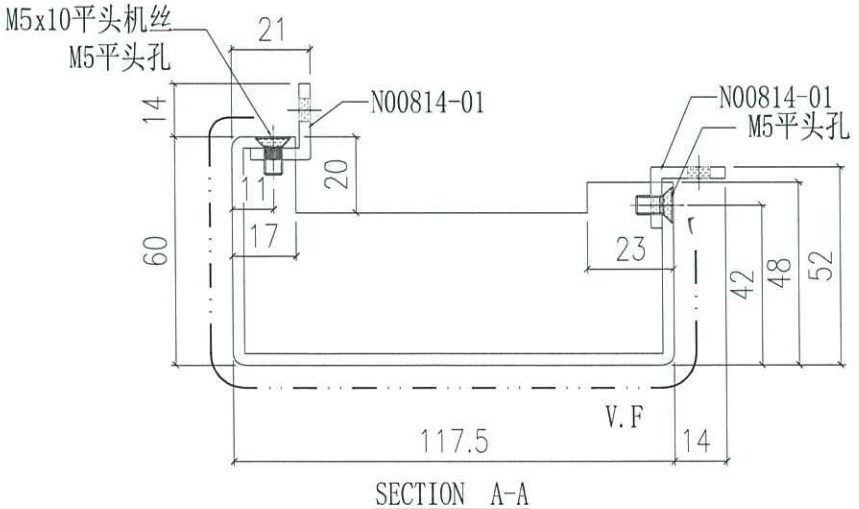


SECTION A-A


美特鋁質有限公司 MIDI Aluminium Fabricator Ltd.													
工程號	J858	類別		物料號	-								
地盤	康城11期	制圖	W.E.X	2022-08-11	圖號	AQ-37							
修改	-	-	-	採用	工廠		地盤	✓	图纸名称	铝折件	復核	-	-	數量	-	
日期	-	-	-	材料颜色	PVF2（香槟金）				材料	3.0mm 铝板	批准	-	-	單件重量	-	(KG)

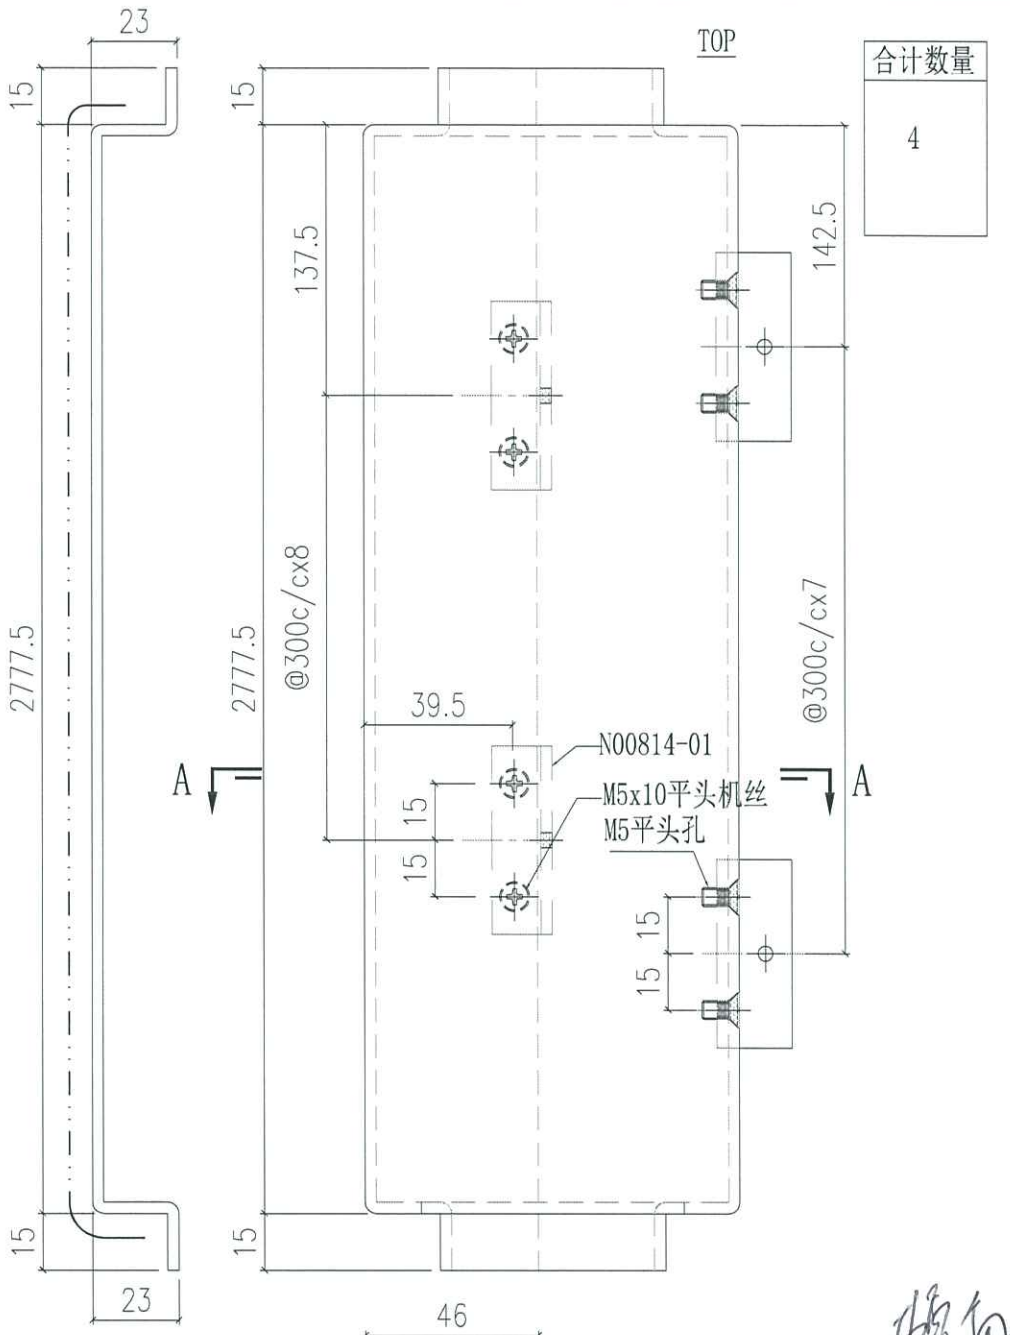

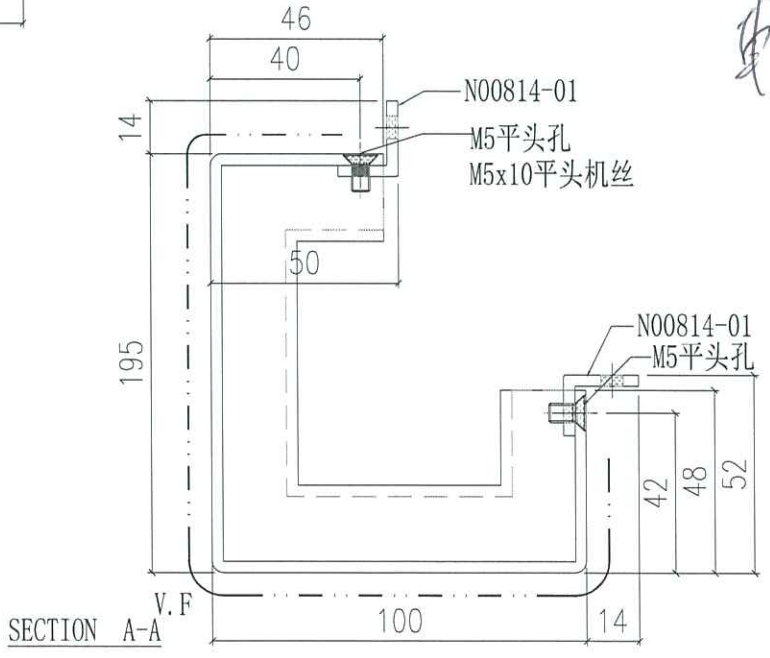


美特鋁質有限公司 MIDI Aluminium Fabricator Ltd.													
						工程號	J858	類別		物料號	-		
						地盤	康城11期	制圖	W.E.X	2022-08-11	圖號	AQ-38	
修改	-	-	-	採用	工廠		地盤 ✓	图纸名称	铝折件	復核	-	-	數量	-	
日期	-	-	-	材料颜色	PVF2（香槟金）			材料	3.0mm 铝板	批准	-	-	單件重量	-	(KG)

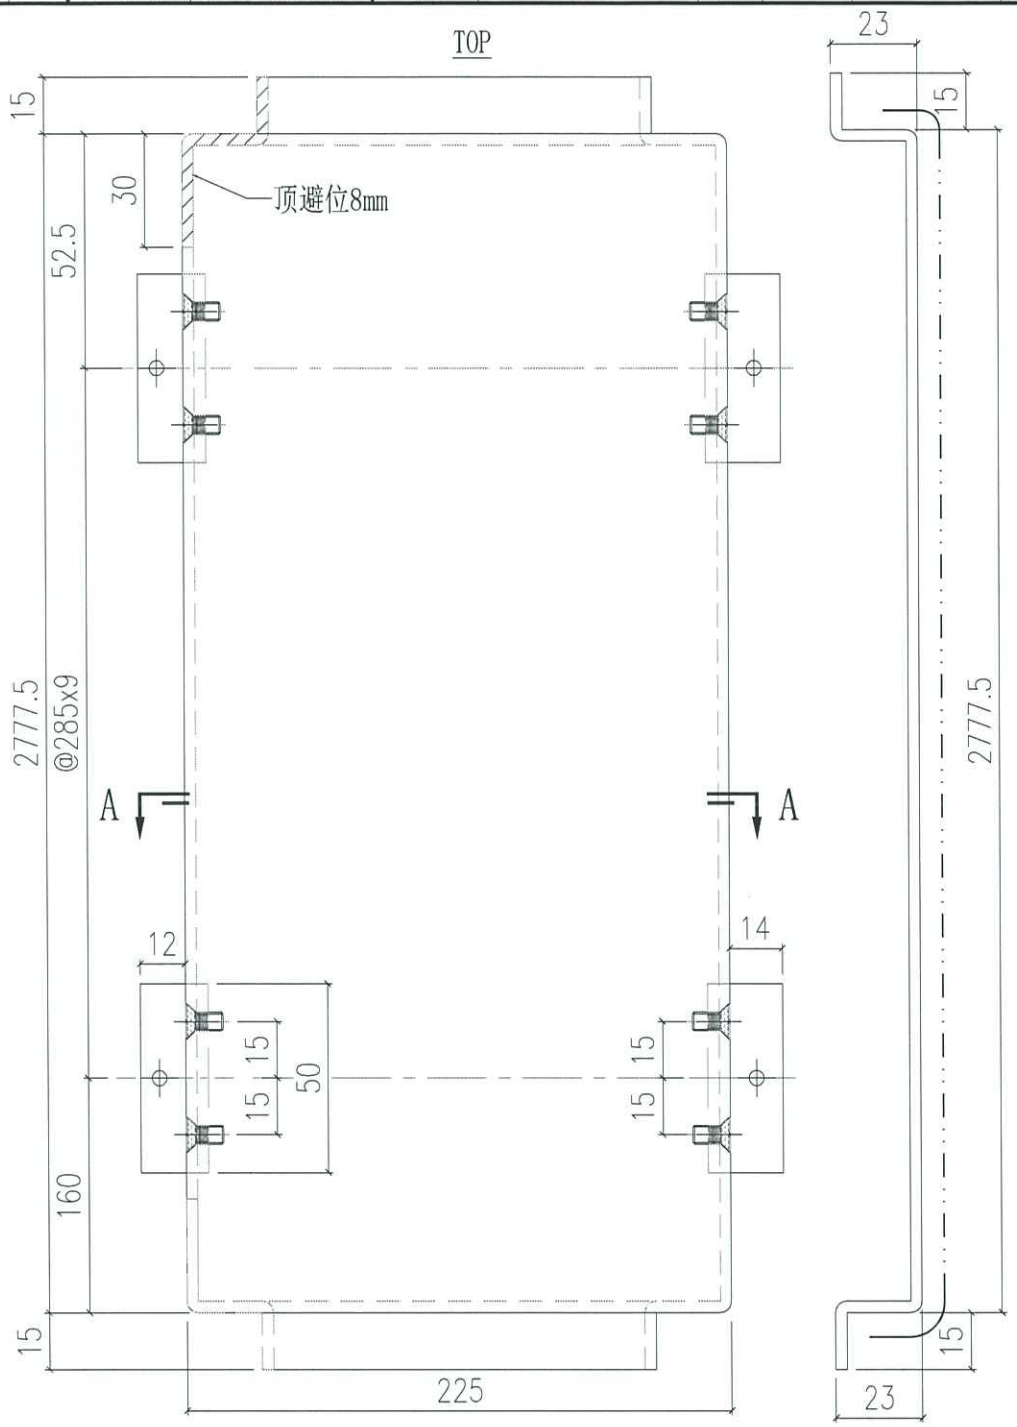

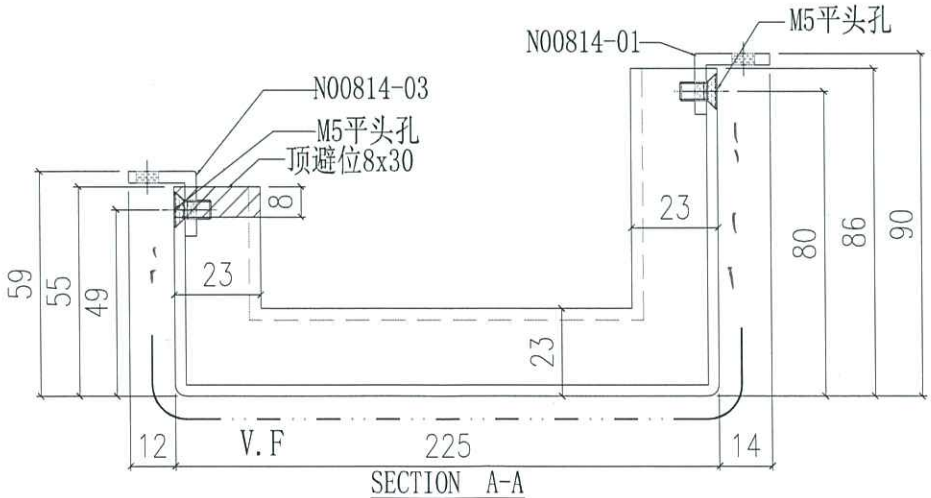


合计数量
2

美特鋁質有限公司 MIDI Aluminium Fabricator Ltd.													
修改	-	-	-	採用	工廠		地盤	✓	工程號	J858	類別		物料號	-
日期	-	-	-	材料顏色	PVF2（香槟金）				地盘	康城11期	制圖	W.E.X	2022-08-11	圖號 AQ-39
									图纸名称	铝板加工图	復核	-	-	數量 -
									- 材料	3mm THK.铝板	批准	-	-	單件重量 - (KG)

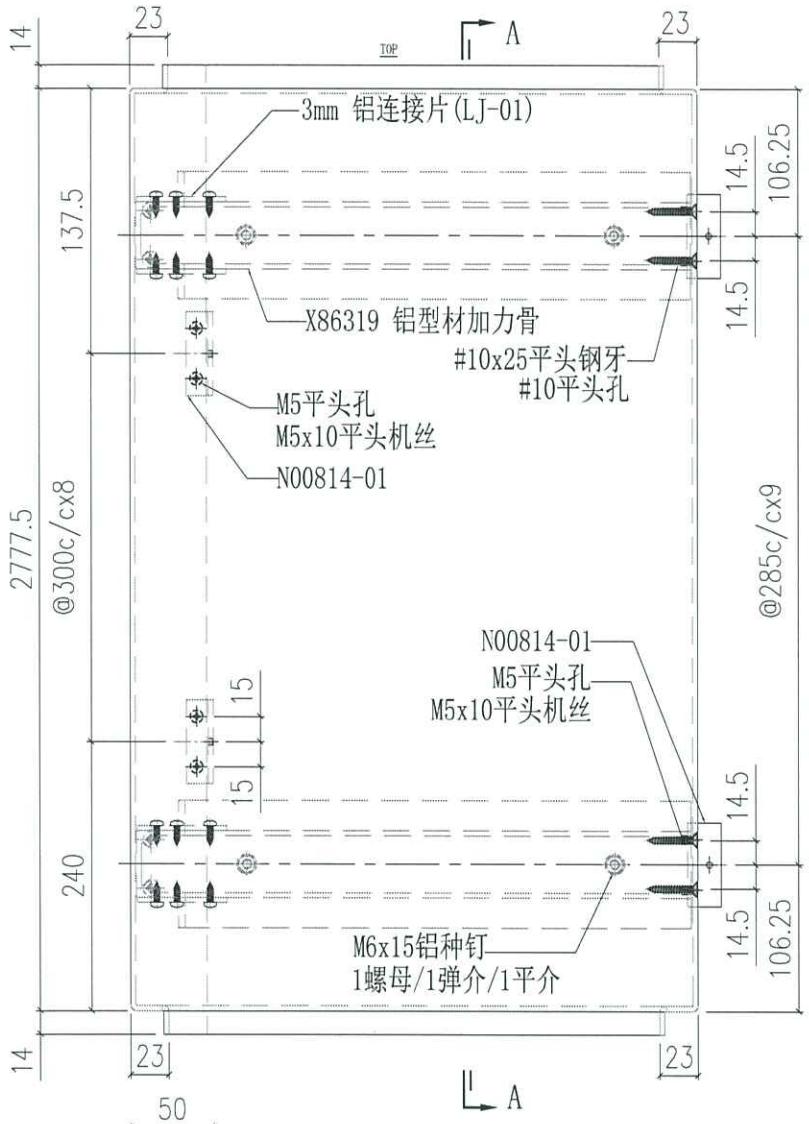




SECTION A-A

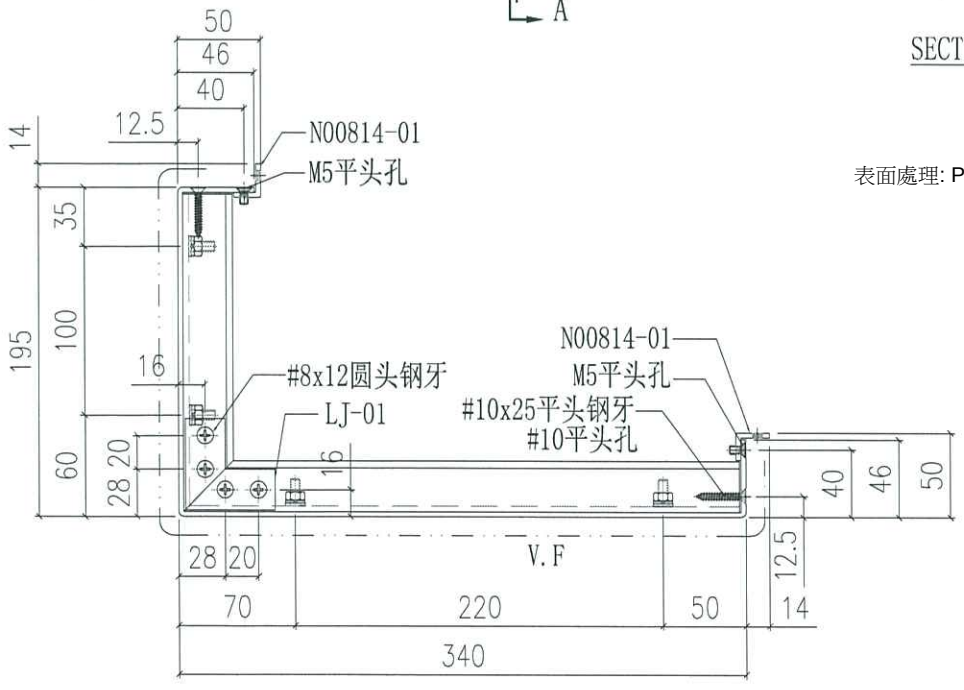


表面處理: PVF2 (香檳金ECD3X10099S-JF2

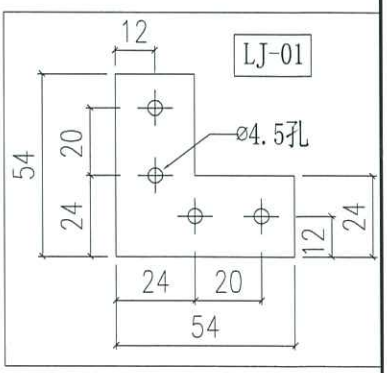

数量
1

美特鋁質有限公司 MIDI Aluminium Fabricator Ltd.				工程號	J858	類別		物料號	-		
				地盤	康城11期	制圖	W.E.X	2022-11-11	圖號	AQ-51	
修改	-	-	-	採用工廠 ✓ 地盤		图纸名称	铝板加工图	復核	-	-	數量	-	
日期	-	-	-	材料颜色 PVF2 (香槟金)		材料	3.0mm 铝板	批准	-	-	單件重量	- (KG)	

暫停

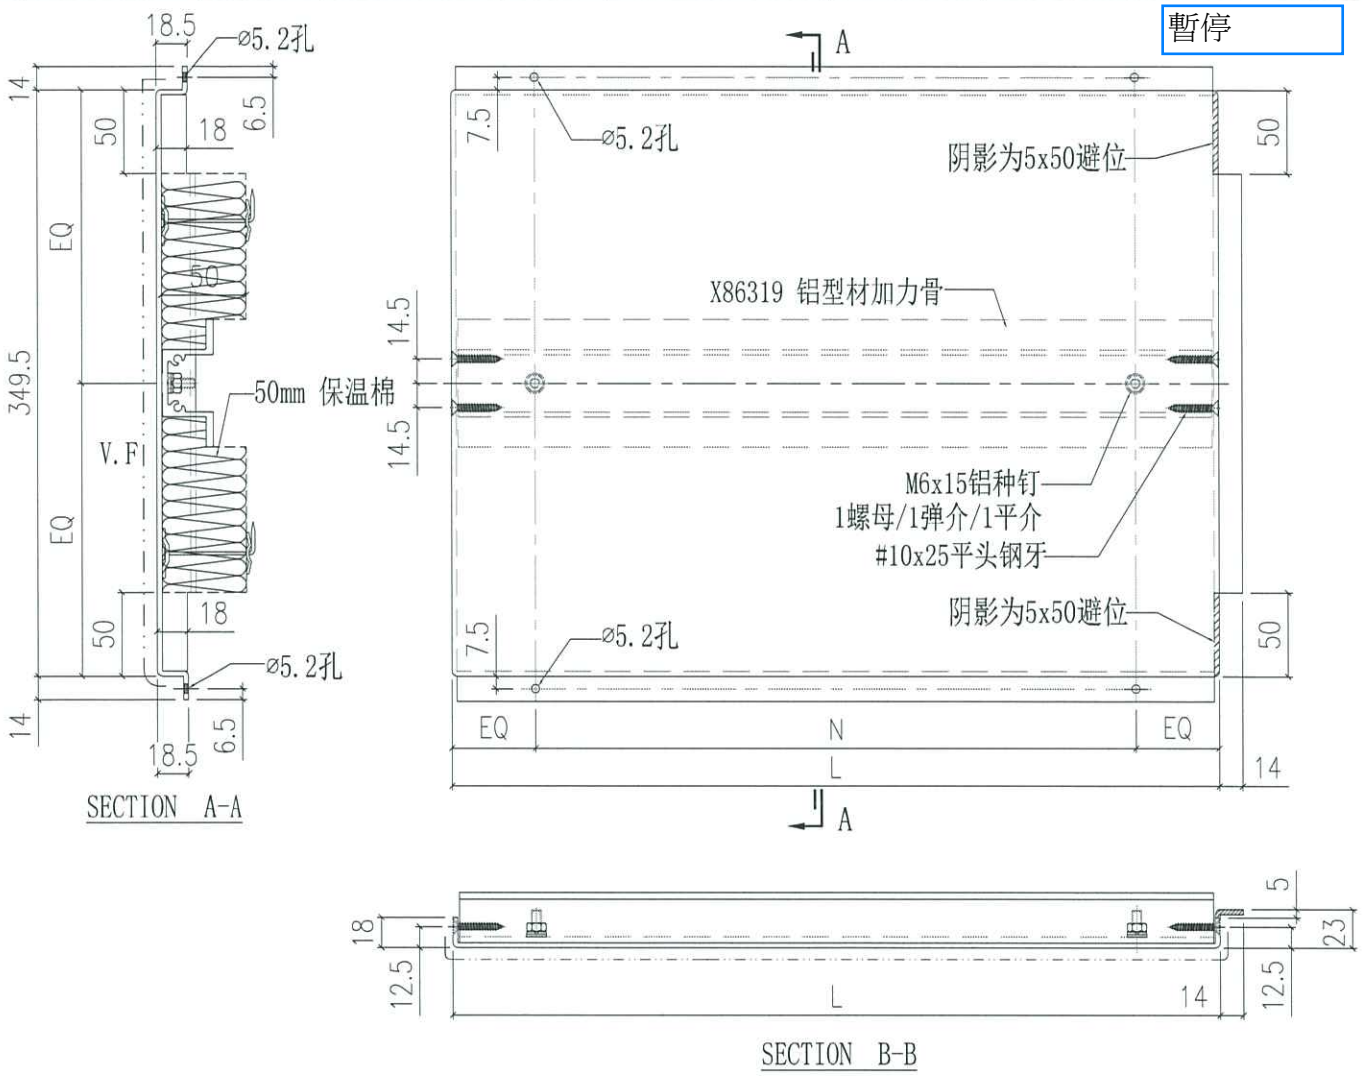


AQ-51-23	800	@300c/cx2	1
AQ-51-22	-	-	-
AQ-51-21	599	@250c/cx2	1
AQ-51-20	1575	@300c/cx5	1
AQ-51-19	735	@300c/cx2	2
AQ-51-18	897.5	@300c/cx2	1
AQ-51-17	1641	@300c/cx5	2
AQ-51-16	1747.5	@300c/cx5	1
AQ-51-15	745	@300c/cx2	2
AQ-51-14	1566	@300c/cx5	1
AQ-51-13	1616	@300c/cx5	1
AQ-51-12	1410	@300c/cx4	2
AQ-51-11	1294	@300c/cx4	3
AQ-51-10	666	@300c/cx2	19
AQ-51-09	1347.5	@300c/cx4	9
AQ-51-08	1385	@300c/cx4	3
AQ-51-07	1547.5	@280c/cx5	3
AQ-51-06	685	@300c/cx2	20
AQ-51-05	872.5	@300c/cx2	3
AQ-51-04	1697.5	@300c/cx5	1
AQ-51-03	775	@300c/cx2	3
AQ-51-02	795	@300c/cx2	1
AQ-51-01	594	@250c/cx2	3
编号	L	N	合计数量

暫停

detail
8/6°
9/F

美特鋁質有限公司 MIDI Aluminium Fabricator Ltd.				工程號	J858	類別		物料號	-		
				地盤	康城11期	制圖	W.E.X	2022-11-11	圖號	AQ-52	
修改	-	-	-	採用 工廠 ✓ 地盤		图纸名称	铝板加工图	復核	-	-	數量	-	
日期	-	-	-	材料颜色 PVF2 (香槟金)		材料	3.0mm 铝板	批准	-	-	單件重量	-	(KG)

暫停

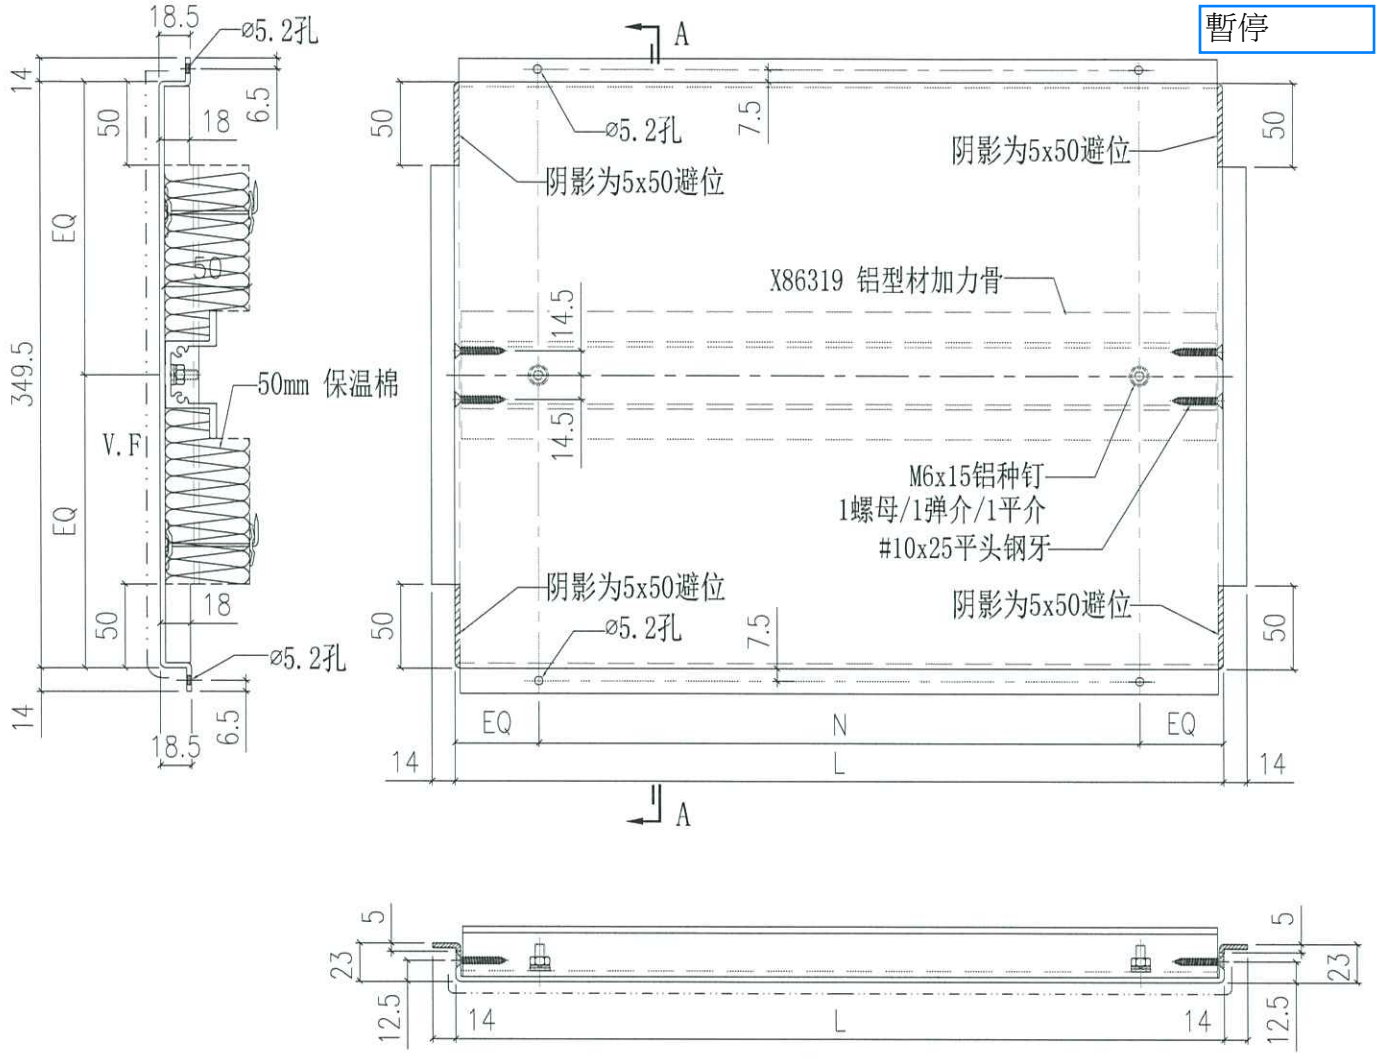


SECTION B-B

AQ-52-15	1435	@300c/cx4	1	
AQ-52-14	1430	@300c/cx4	1	暫停
AQ-52-13	599	@250c/cx2	1	
AQ-52-12	1709	@300c/cx5	2	
AQ-52-11	735	@300c/cx2	1	
AQ-52-10	1712.5	@300c/cx5	1	
AQ-52-09	1765	@300c/cx5	1	
AQ-52-08	1311	@300c/cx4	2	
AQ-52-07	1840	@280c/cx6	2	
AQ-52-06	685	@300c/cx2	3	
AQ-52-05	1230	@280c/cx4	4	
AQ-52-04	1684	@300c/cx5	1	
AQ-52-03	1347.5	@300c/cx4	10	
AQ-52-02	1815	@280c/cx6	1	
AQ-52-01	594	@250c/cx2	3	
编号	L	N	合计数量	

detail
P60

美特鋁質有限公司 MIDI Aluminium Fabricator Ltd.				工程號	J858	類別		物料號	-		
				地盘	康城11期	制圖	W.E.X	2022-11-11	圖號	AQ-53	
修改	-	-	-	採用 工廠 ✓ 地盤		图纸名称	铝板加工图	復核	-	-	數量	-	
日期	-	-	-	材料颜色	PVF2 (香槟金)	材料	3.0mm 铝板	批准	-	-	單件重量	-	(KG)

暫停

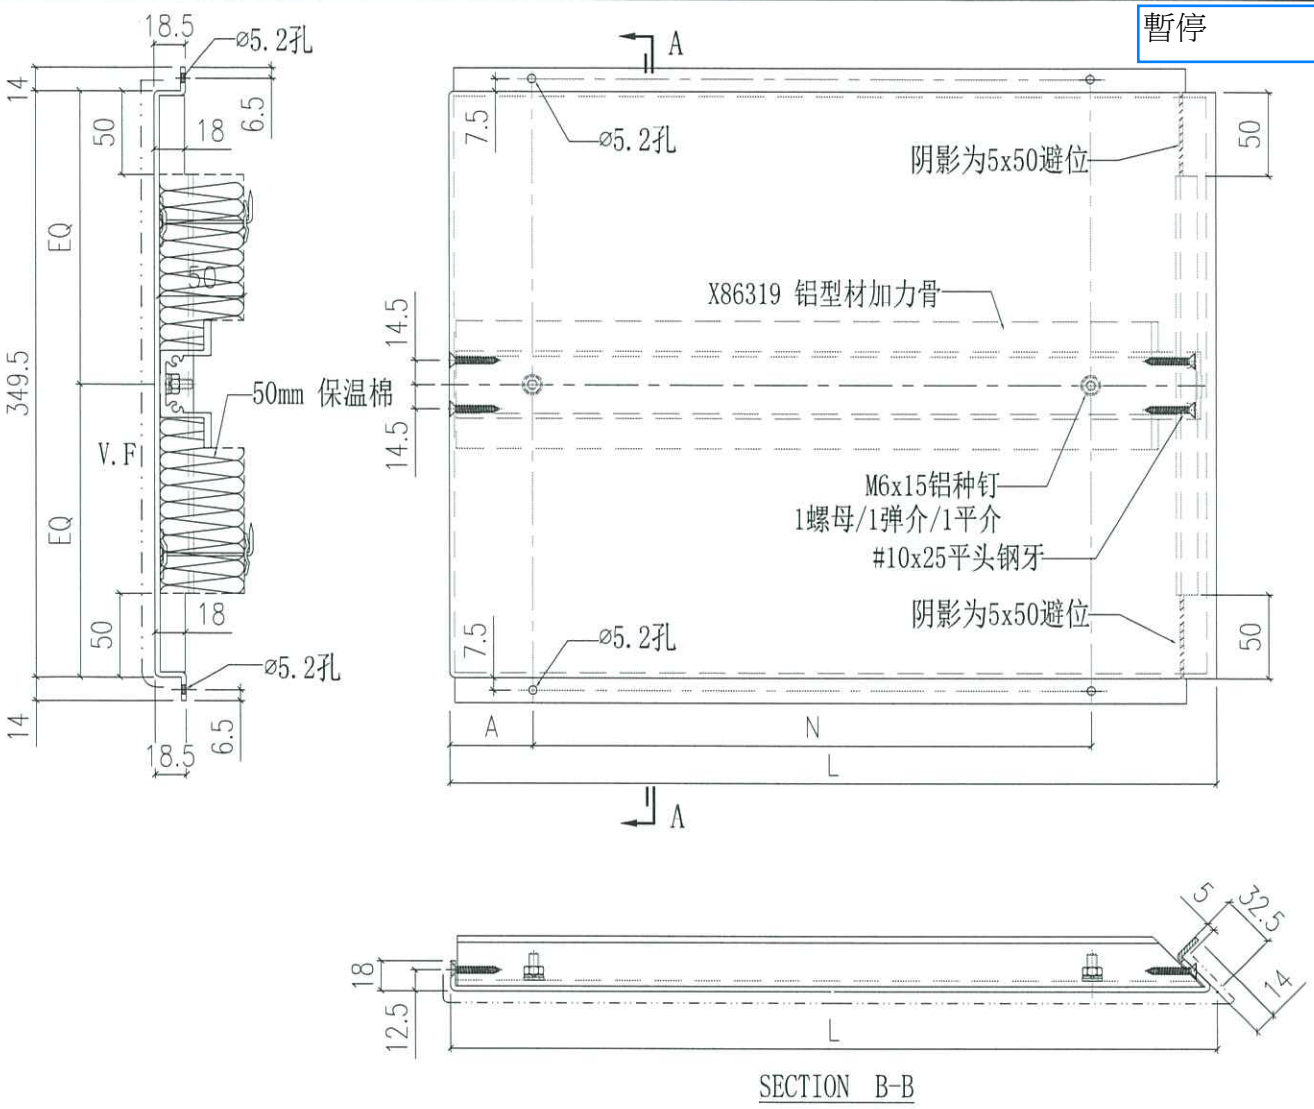


SECTION B-B


AQ-53-01	1838	@280c/cx6	75	5
编号	L	N	A	合计数量


美特鋁質有限公司 MIDI Aluminium Fabricator Ltd.											
修改	-	-	-	採用	工廠	✓	地盤	图纸名称	铝板加工图	复核	-
日期	-	-	-	材料颜色	PVF2 (香槟金)			材料	3.0mm 铝板	批准	-

工程號	J858	類別		物料號	-		
地盘	康城11期	制圖	W.E.X	2022-11-11	圖號	AQ-54	
图纸名称	铝板加工图	復核	-	-	數量	-	
材料	3.0mm 铝板	批准	-	-	單件重量	-	(KG)

暫停

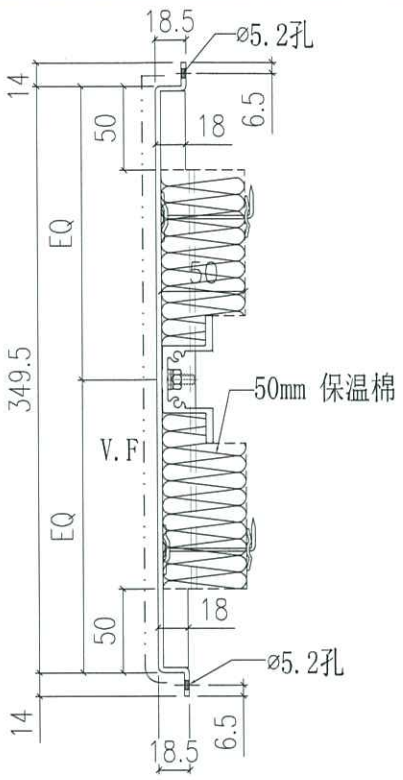

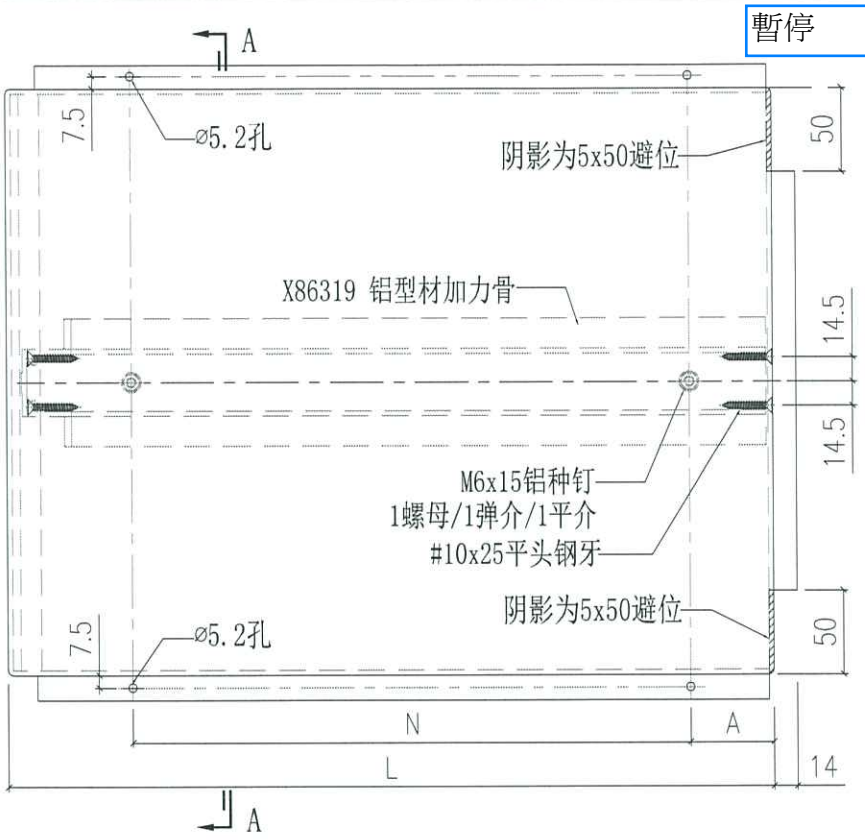

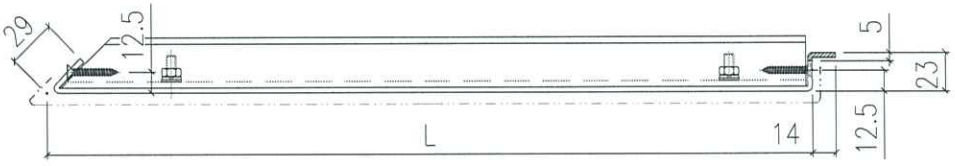



SECTION B-B

AQ-54-04	1828	@280c/cx6	75	1
AQ-54-03	1819	@280c/cx6	75	2
AQ-54-02	747	@300c/cx2	75	6
AQ-54-01	1838	@280c/cx6	75	1
编号	L	N	A	楼层

美特鋁質有限公司 MIDI Aluminium Fabricator Ltd.				工程號	J858	類別		物料號	-		
				地盤	康城11期	制圖	W.E.X	2022-11-11	圖號	AQ-55	
修改	-	-	-	採用 工廠 ✓ 地盤		图纸名称	铝板加工图	復核	-	-	數量	-	
日期	-	-	-	材料颜色	PVF2 (香槟金)	材料	3.0mm 铝板	批准	-	-	單件重量	-	(KG)

暫停

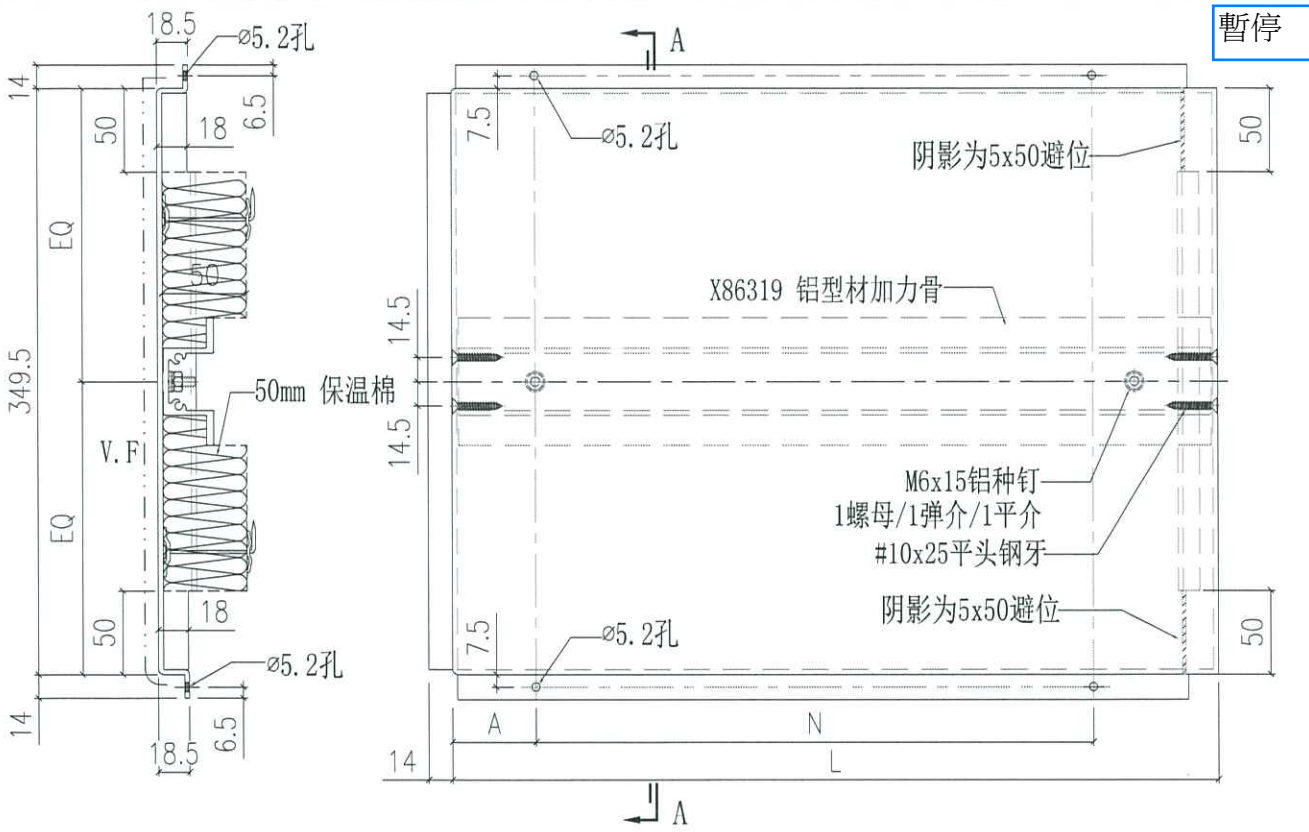

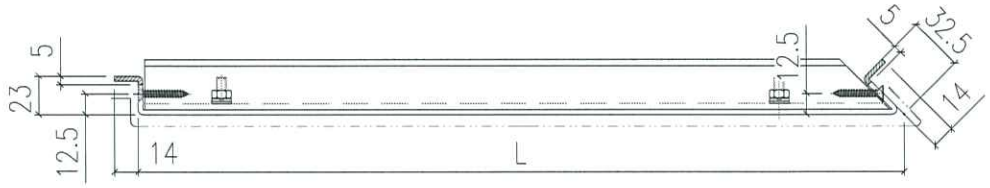


SECTION B-B

detail
DTS


AQ-55-03	819.5	@300c/cx2	75	1	暫停
AQ-55-02	1807	@280c/cx6	75	1	
AQ-55-01	747	@300c/cx2	75	3	
编号	L	N	A	楼层	


美特鋁質有限公司 MIDI Aluminium Fabricator Ltd.													
修改	-	-	-	採用	工廠	✓	地盤	工程號	J858	類別		物料號	-
日期	-	-	-	材料顏色	PVF2 (香檳金)			地盘	康城11期	制圖	W.E.X	2022-11-11	圖號 AQ-56
								图纸名称	铝板加工图	復核	-	-	數量 -
								材料	3.0mm 铝板	批准	-	-	單件重量 - (KG)

暫停

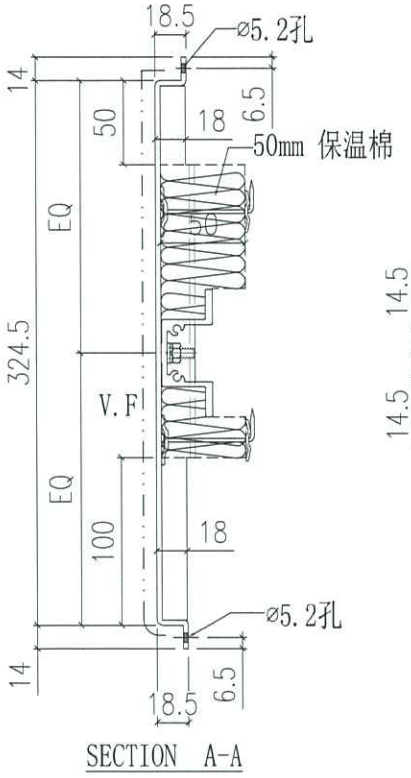

SECTION A-A

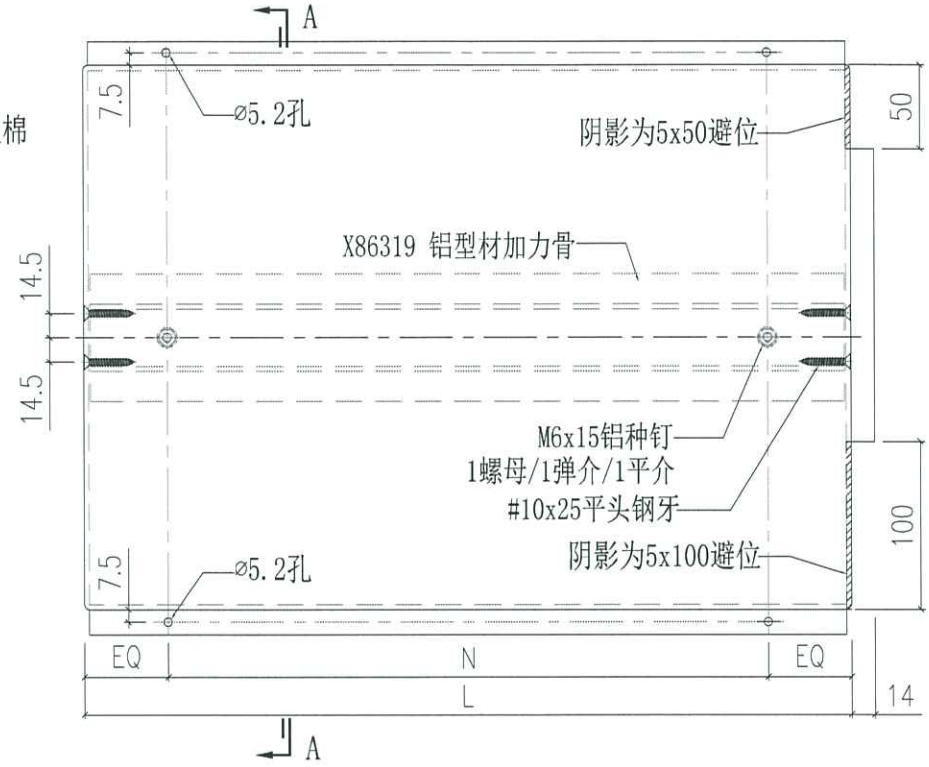

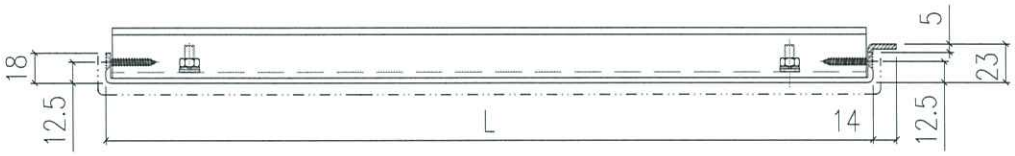


SECTION B-B

AQ-56-09	1098	@300c/cx3	2
AQ-56-08	-	-	-
AQ-56-07	792.5	@300c/cx2	2
AQ-56-06	998	@300c/cx3	12
AQ-56-05	988	@300c/cx3	8
AQ-56-04	970	@300c/cx3	24
AQ-56-03	997	@300c/cx3	84
AQ-56-02	1008	@300c/cx3	12
AQ-56-01	992	@300c/cx3	12
编号	L	N1	数量

美特鋁質有限公司 MIDI Aluminium Fabricator Ltd.													
修改	-	-	-	採用	工廠	✓	地盤	工程號	J858	類別		物料號	-		
日期	-	-	-	材料颜色	PVF2 (香槟金)			地盘	康城11期	制圖	W.E.X	2022-11-11	圖號	AQ-57
								图纸名称	铝板加工图	復核	-	-	數量	-
								材料	3.0mm 铝板	批准	-	-	單件重量	- (KG)

暫停

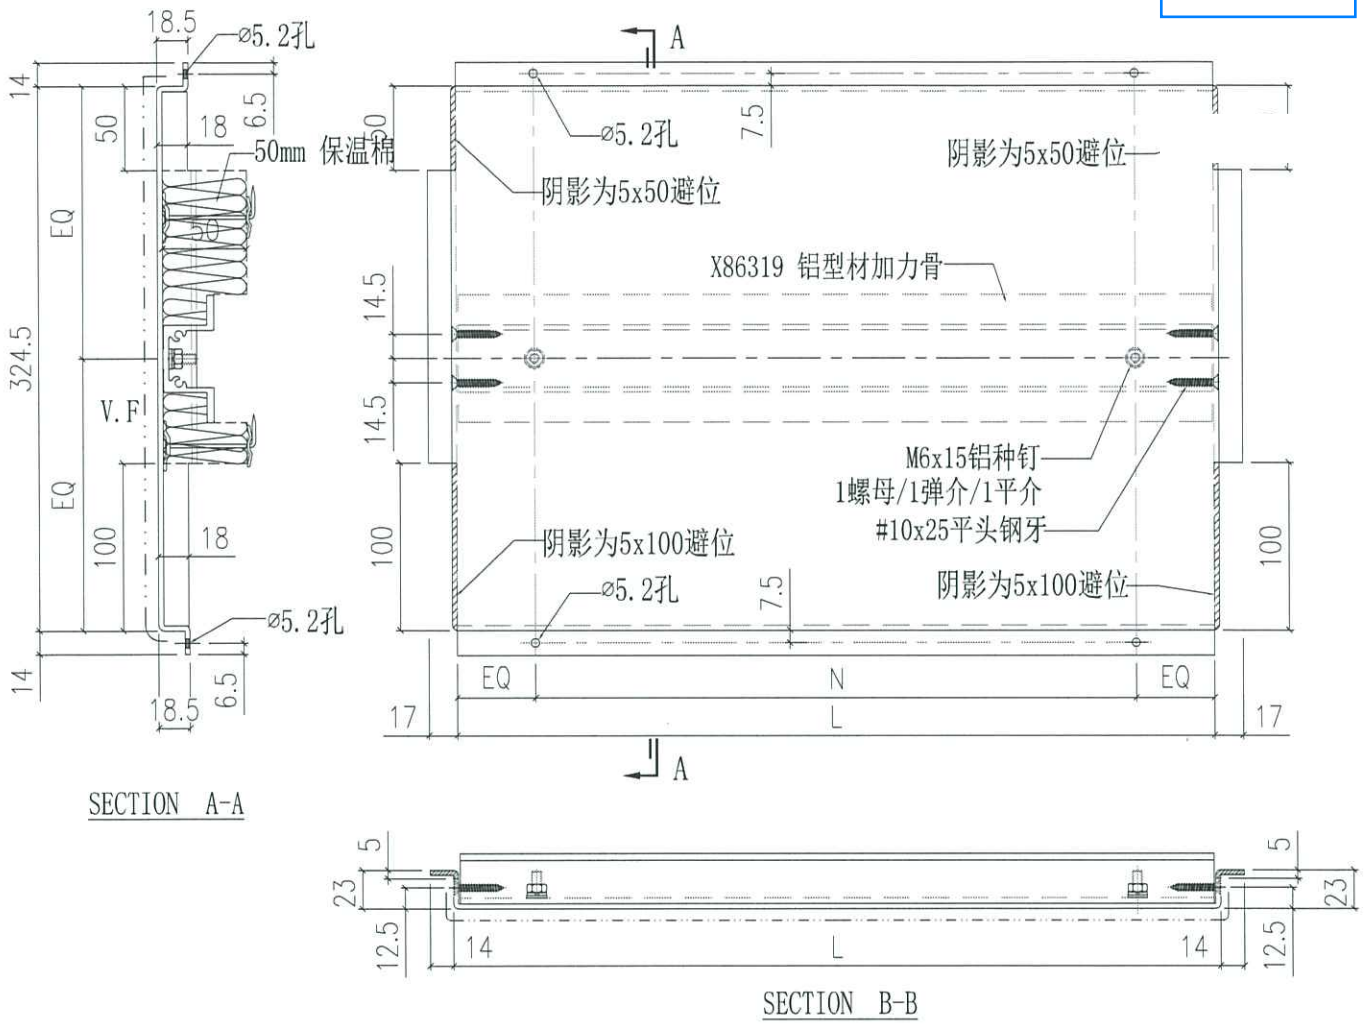

SECTION A-A


SECTION B-B

AQ-57-09	1098	@300c/cx3	2
AQ-57-08	968	@300c/cx3	4
AQ-57-07	-	-	-
AQ-57-06	998	@300c/cx3	4
AQ-57-05	988	@300c/cx3	4
AQ-57-04	970	@300c/cx3	12
AQ-57-03	997	@300c/cx3	42
AQ-57-02	1008	@300c/cx3	6
AQ-57-01	992	@300c/cx3	6
编号	L	N1	数量


美特鋁質有限公司 MIDI Aluminium Fabricator Ltd.													
修改	-	-	-	採用	工廠		地盤	✓	图纸名称	铝板加工图	复核	-	-
日期	-	-	-	材料颜色	PVF2（香槟金）				材料-	3mm THK.铝板	批准	-	-

工程號	J858	類別		物料號	-		
地盤	康城11期	制圖	W.E.X	2022-08-11	圖號	AQ-58	
		復核	-	-	數量	-	
		批准	-	-	單件重量	-	(KG)

暫停

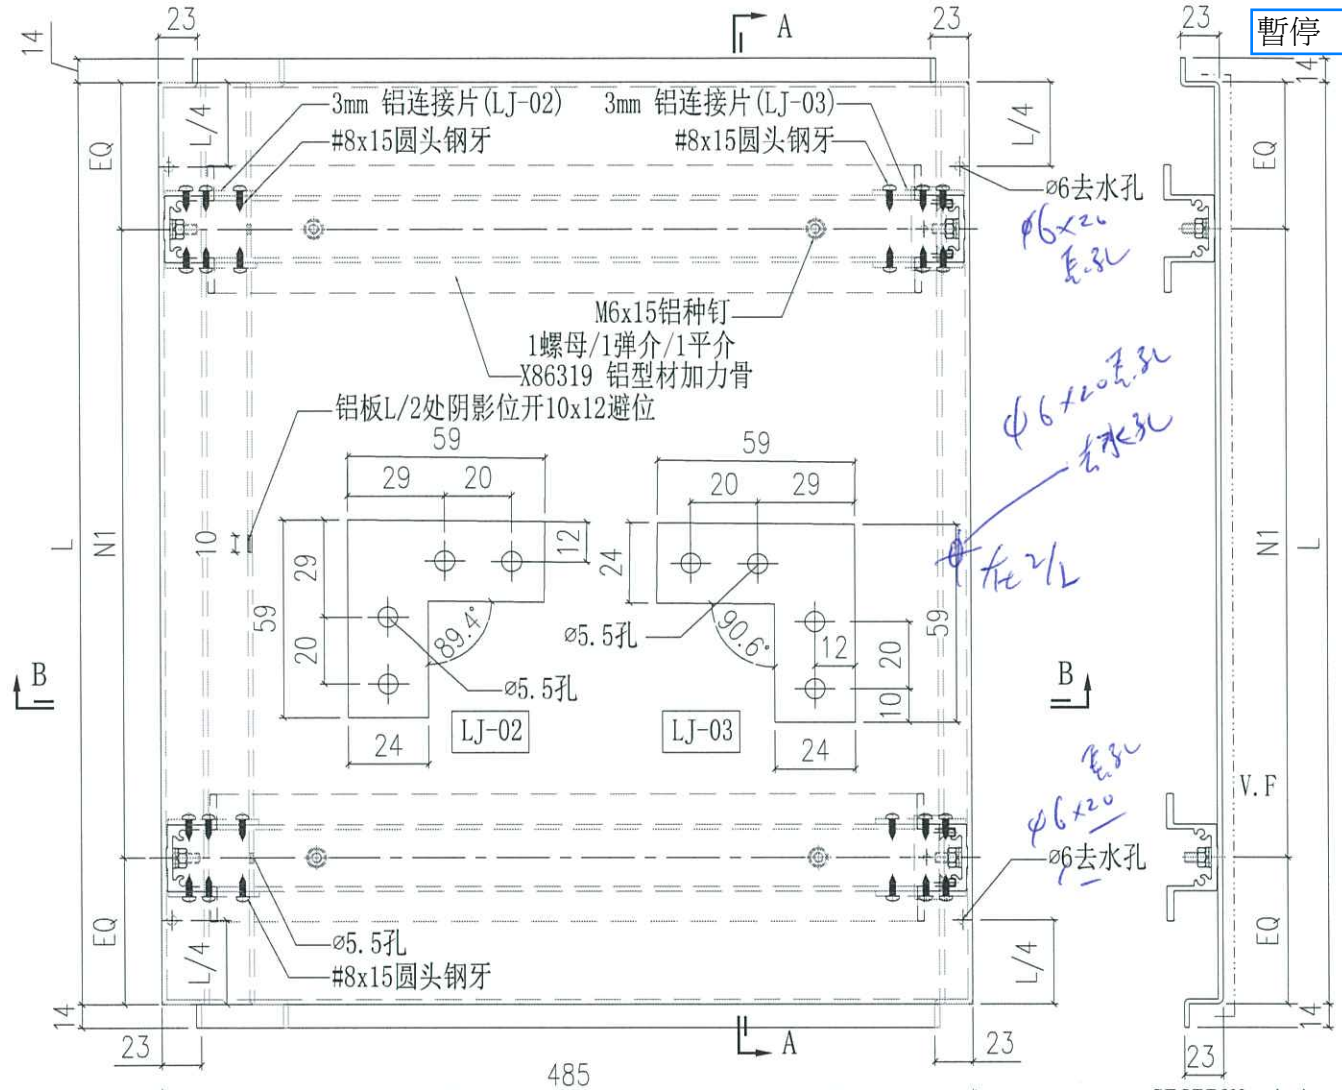

SECTION A-A

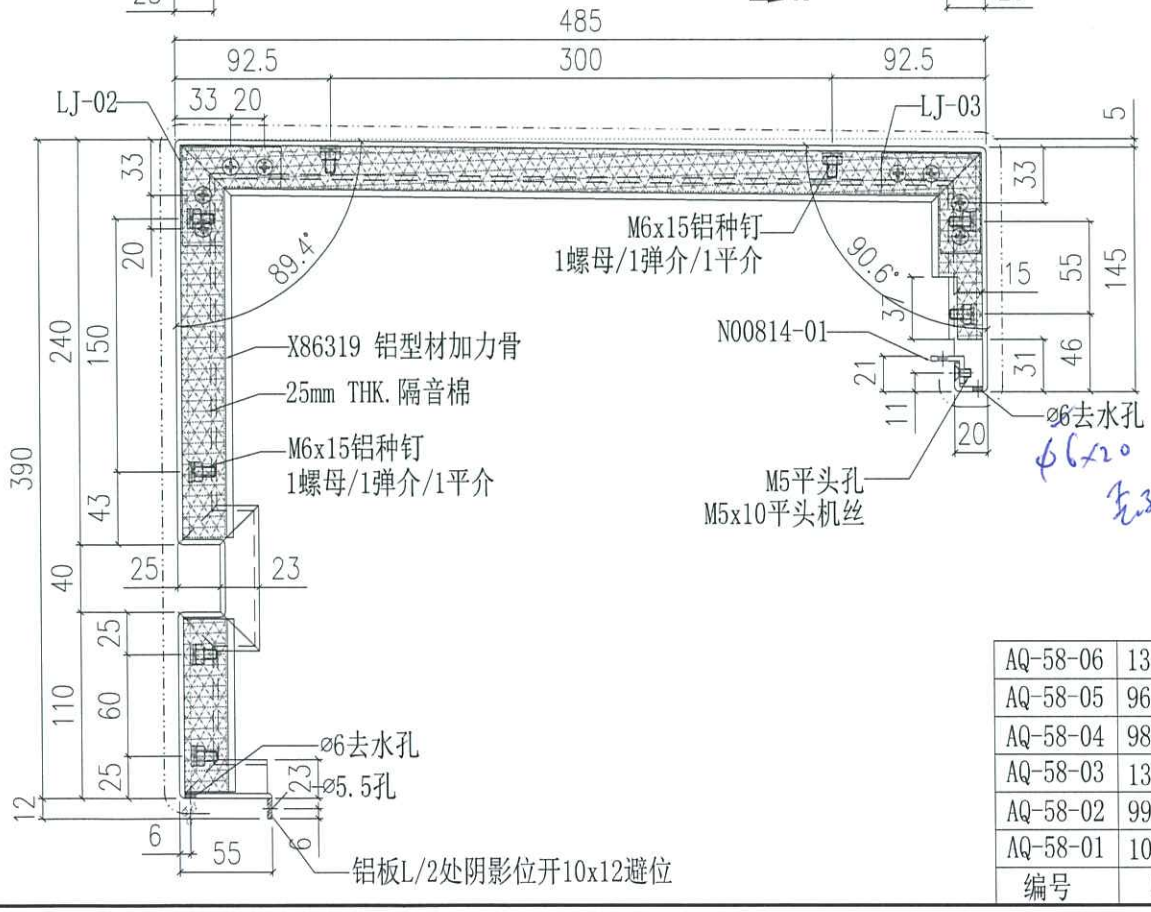


SECTION B-B


编号	L	N1	数量
AQ-58-06	1311	@300c/cx4	2
AQ-58-05	968	@280c/cx3	2
AQ-58-04	988	@300c/cx3	2
AQ-58-03	1302.5	@300c/cx4	8
AQ-58-02	997	@300c/cx3	20
AQ-58-01	1008	@300c/cx3	6

美特鋁質有限公司 MIDI Aluminium Fabricator Ltd.													
修改	-	-	-	採用	工廠		地盤	✓	工程號	J858	類別		物料號	-
日期	-	-	-	材料顏色	PVF2（香槟金）				地盘	康城11期	制圖	W.E.X	2022-08-11	圖號 AQ-59L
									图纸名称	铝板加工图	復核	-	-	數量 -
									材料	3mm THK.铝板	批准	-	-	單件重量 - (KG)

编号	L1	L2	N1	N2	合计数量
AQ-59L-01	1087	997	@300c/cx3	@300c/cx3	2
AQ-59L-02	1078	988	@300c/cx3	@300c/cx3	2
AQ-59L-03	1082	992	@300c/cx3	@300c/cx3	6


暂停

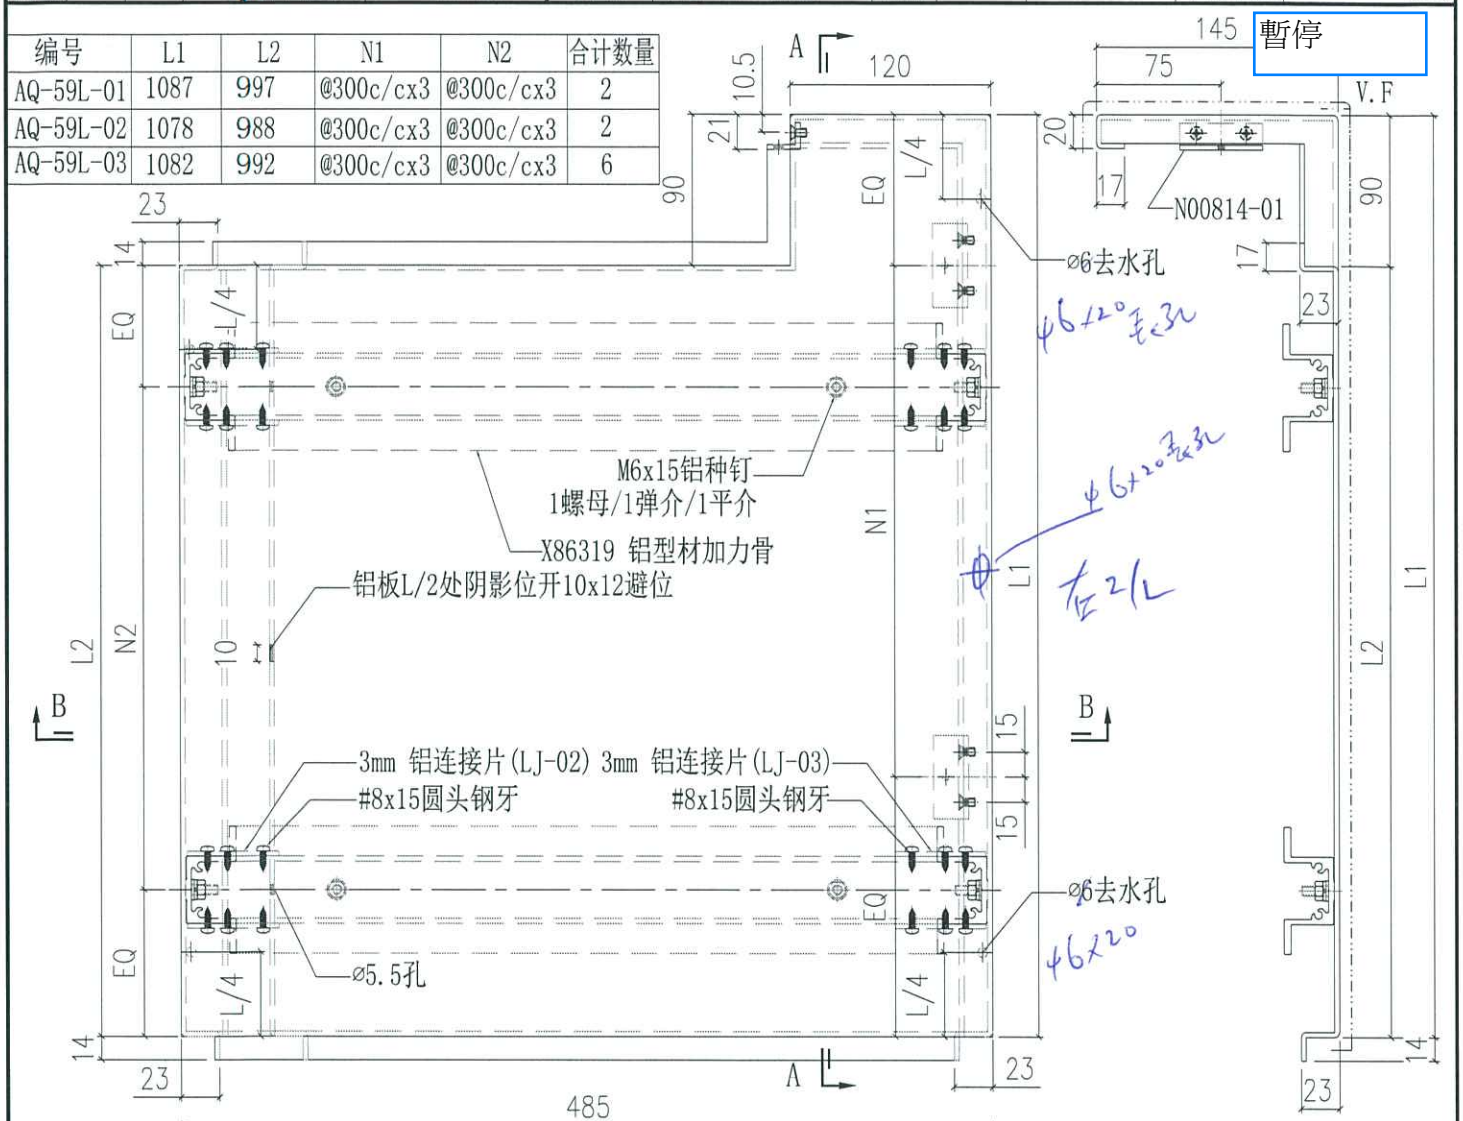

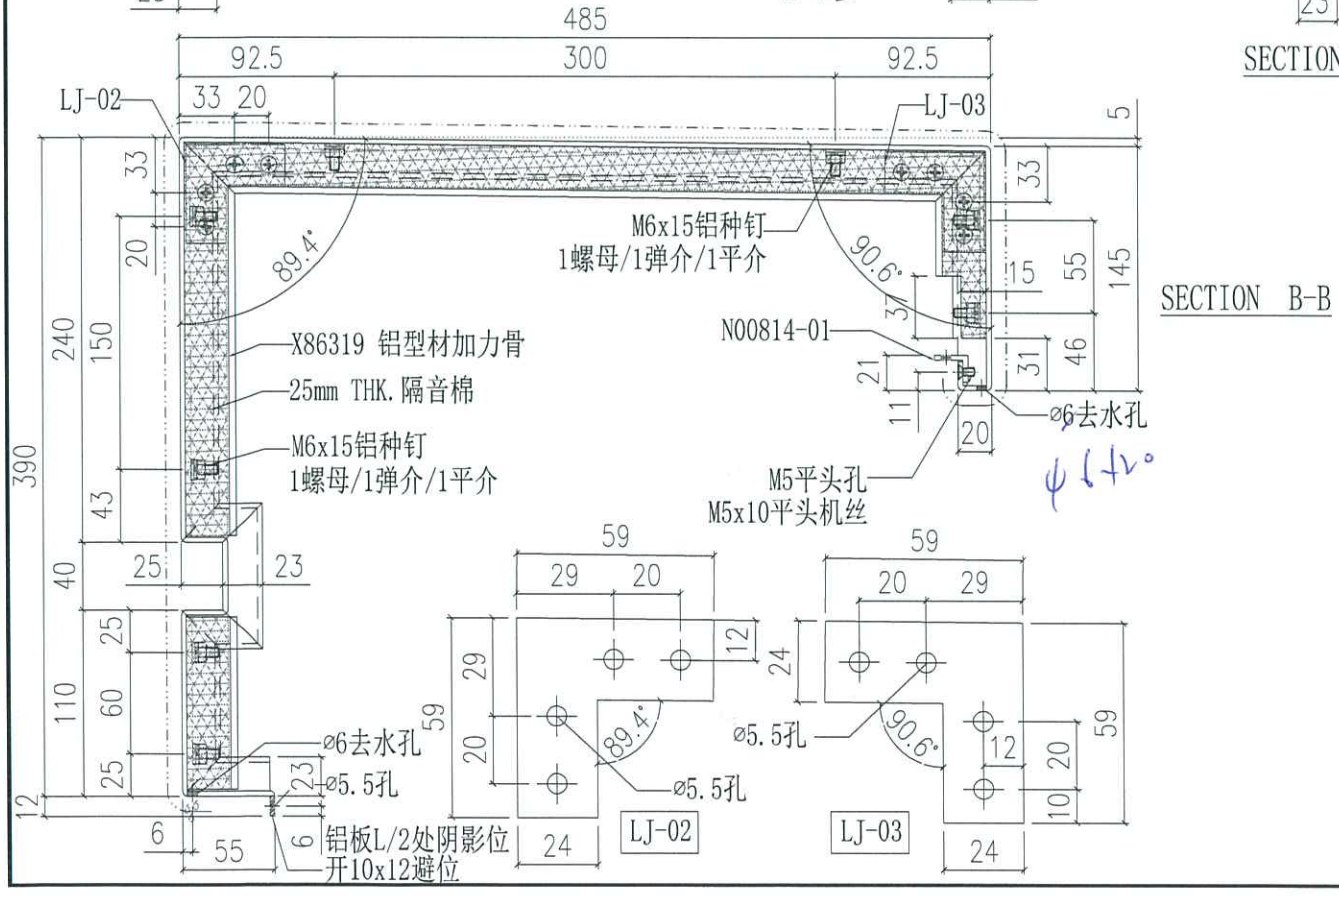

暂停


美特鋁質有限公司 MIDI Aluminium Fabricator Ltd.													
工程號	J858	類別		物料號	-								
地盤	康城11期	制圖	W.E.X	2022-08-11	圖號	AQ-59R							
修改	-	-	-	採用工廠		地盤 ✓	图纸名称	铝板加工图	復核	-	-	數量	-
日期	-	-	-	材料颜色	PVF2（香槟金）		材料	3mm THK.铝板	批准	-	-	單件重量	- (KG)

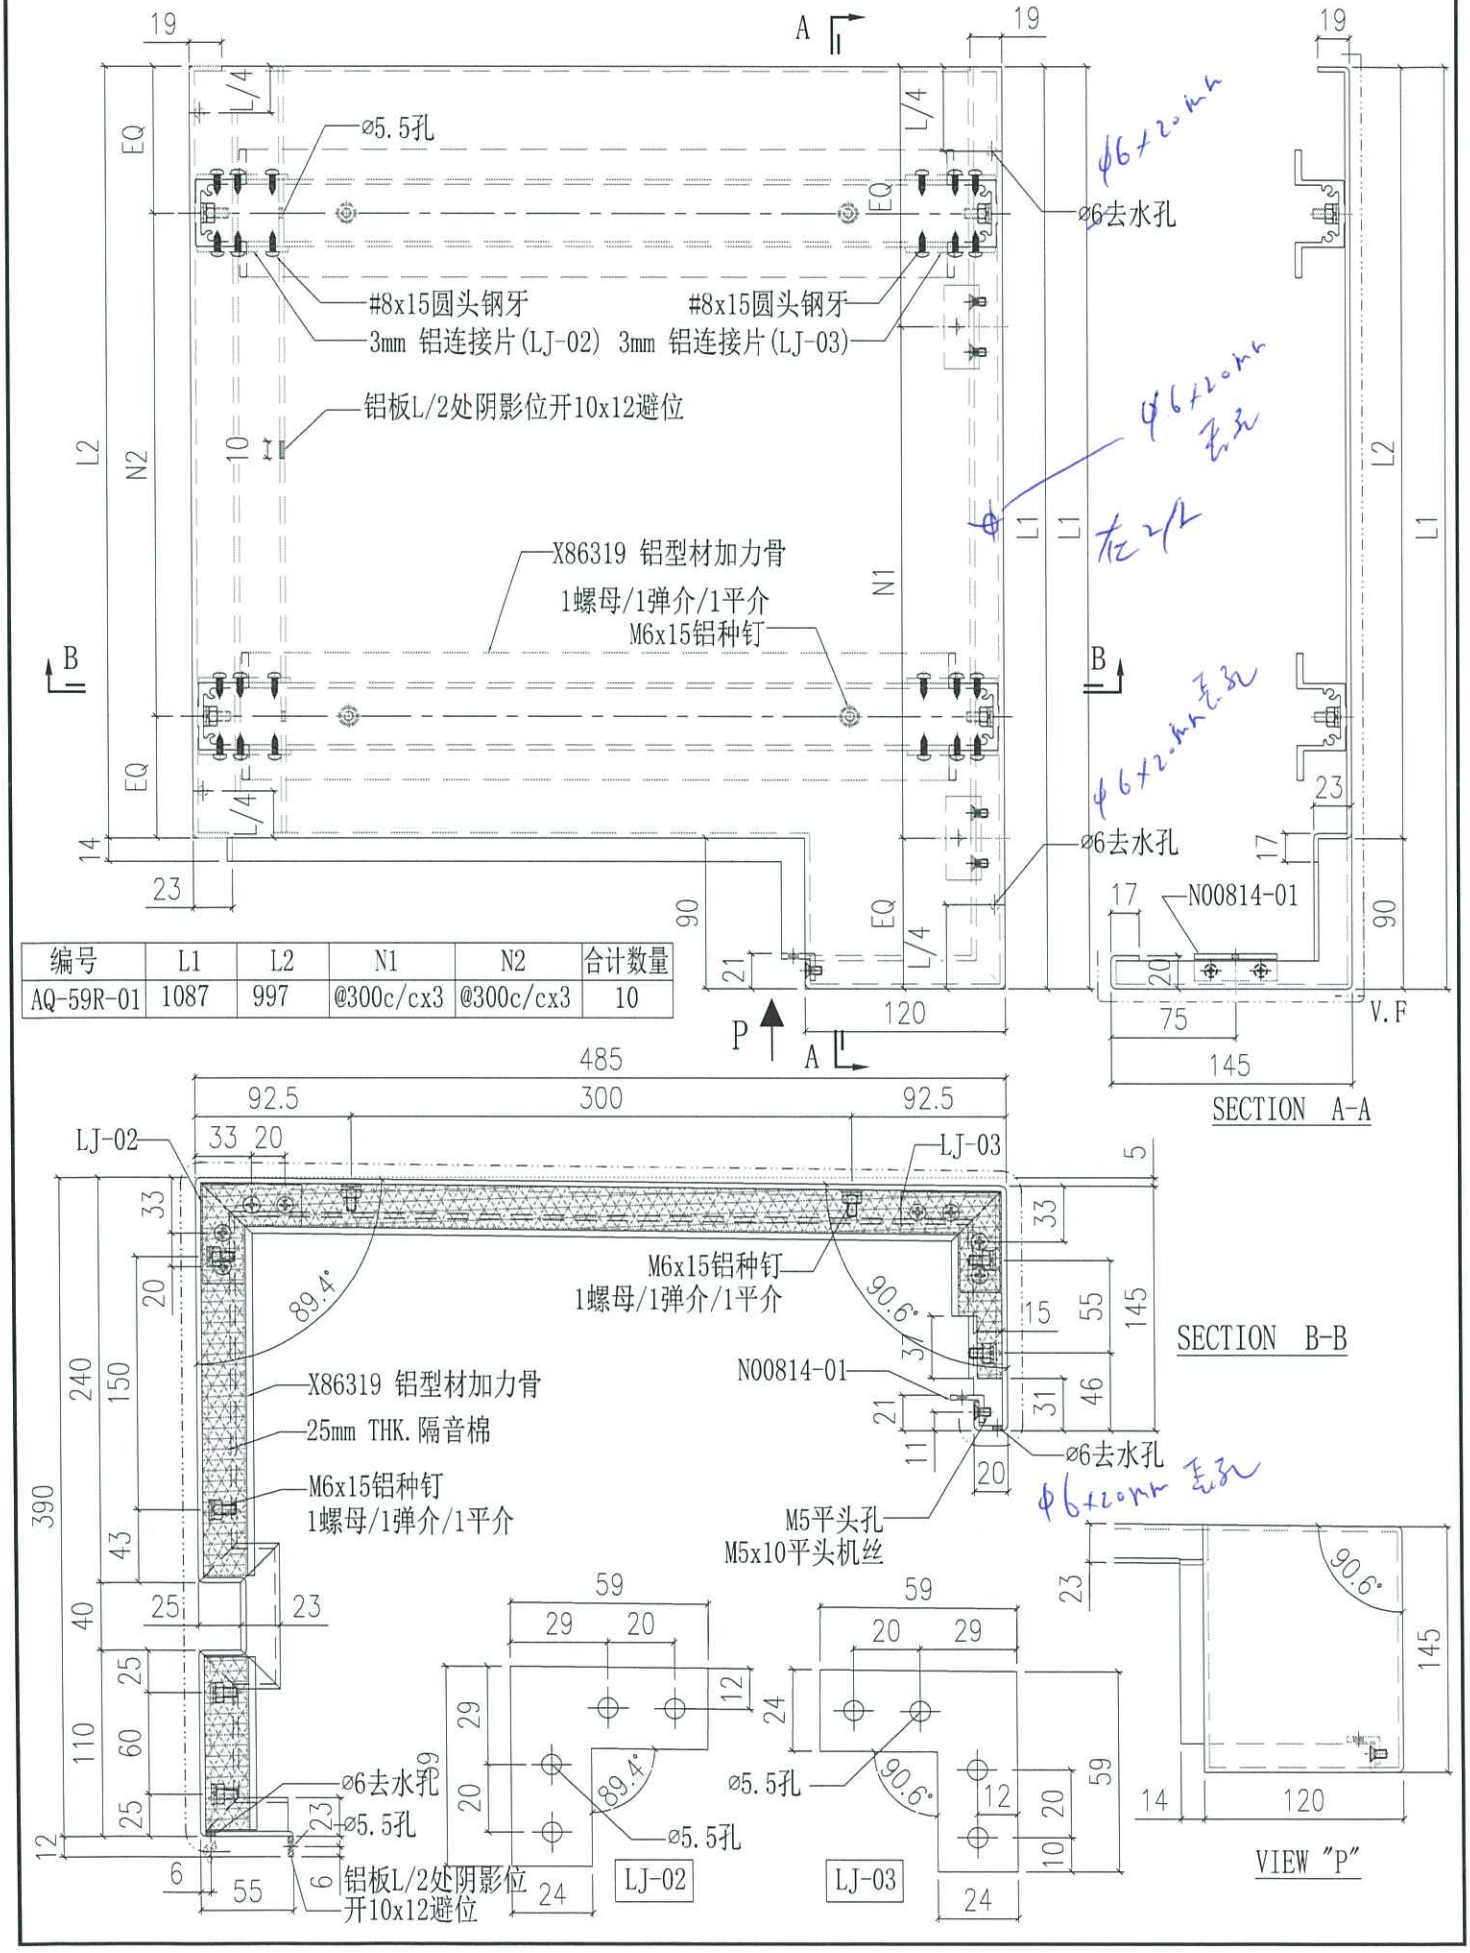

编号	L1	L2	N1	N2	合计数量
AQ-59R-01	1087	997	@300c/cx3	@300c/cx3	10

暂停


美特鋁質有限公司 MIDI Aluminium Fabricator Ltd.				工程號	J858	類別		物料號	-		
				地盤	康城11期	制圖	W.E.X	2022-08-11	圖號	AQ-60	
修改	A			採用工廠	地盤 ✓	图纸名称	铝板加工图	復核	-	-	數量	-
日期	18/12/22			材料颜色	PVF2（香槟金）	材料-	3mm THK.铝板	批准	-	-	單件重量	- (KG)

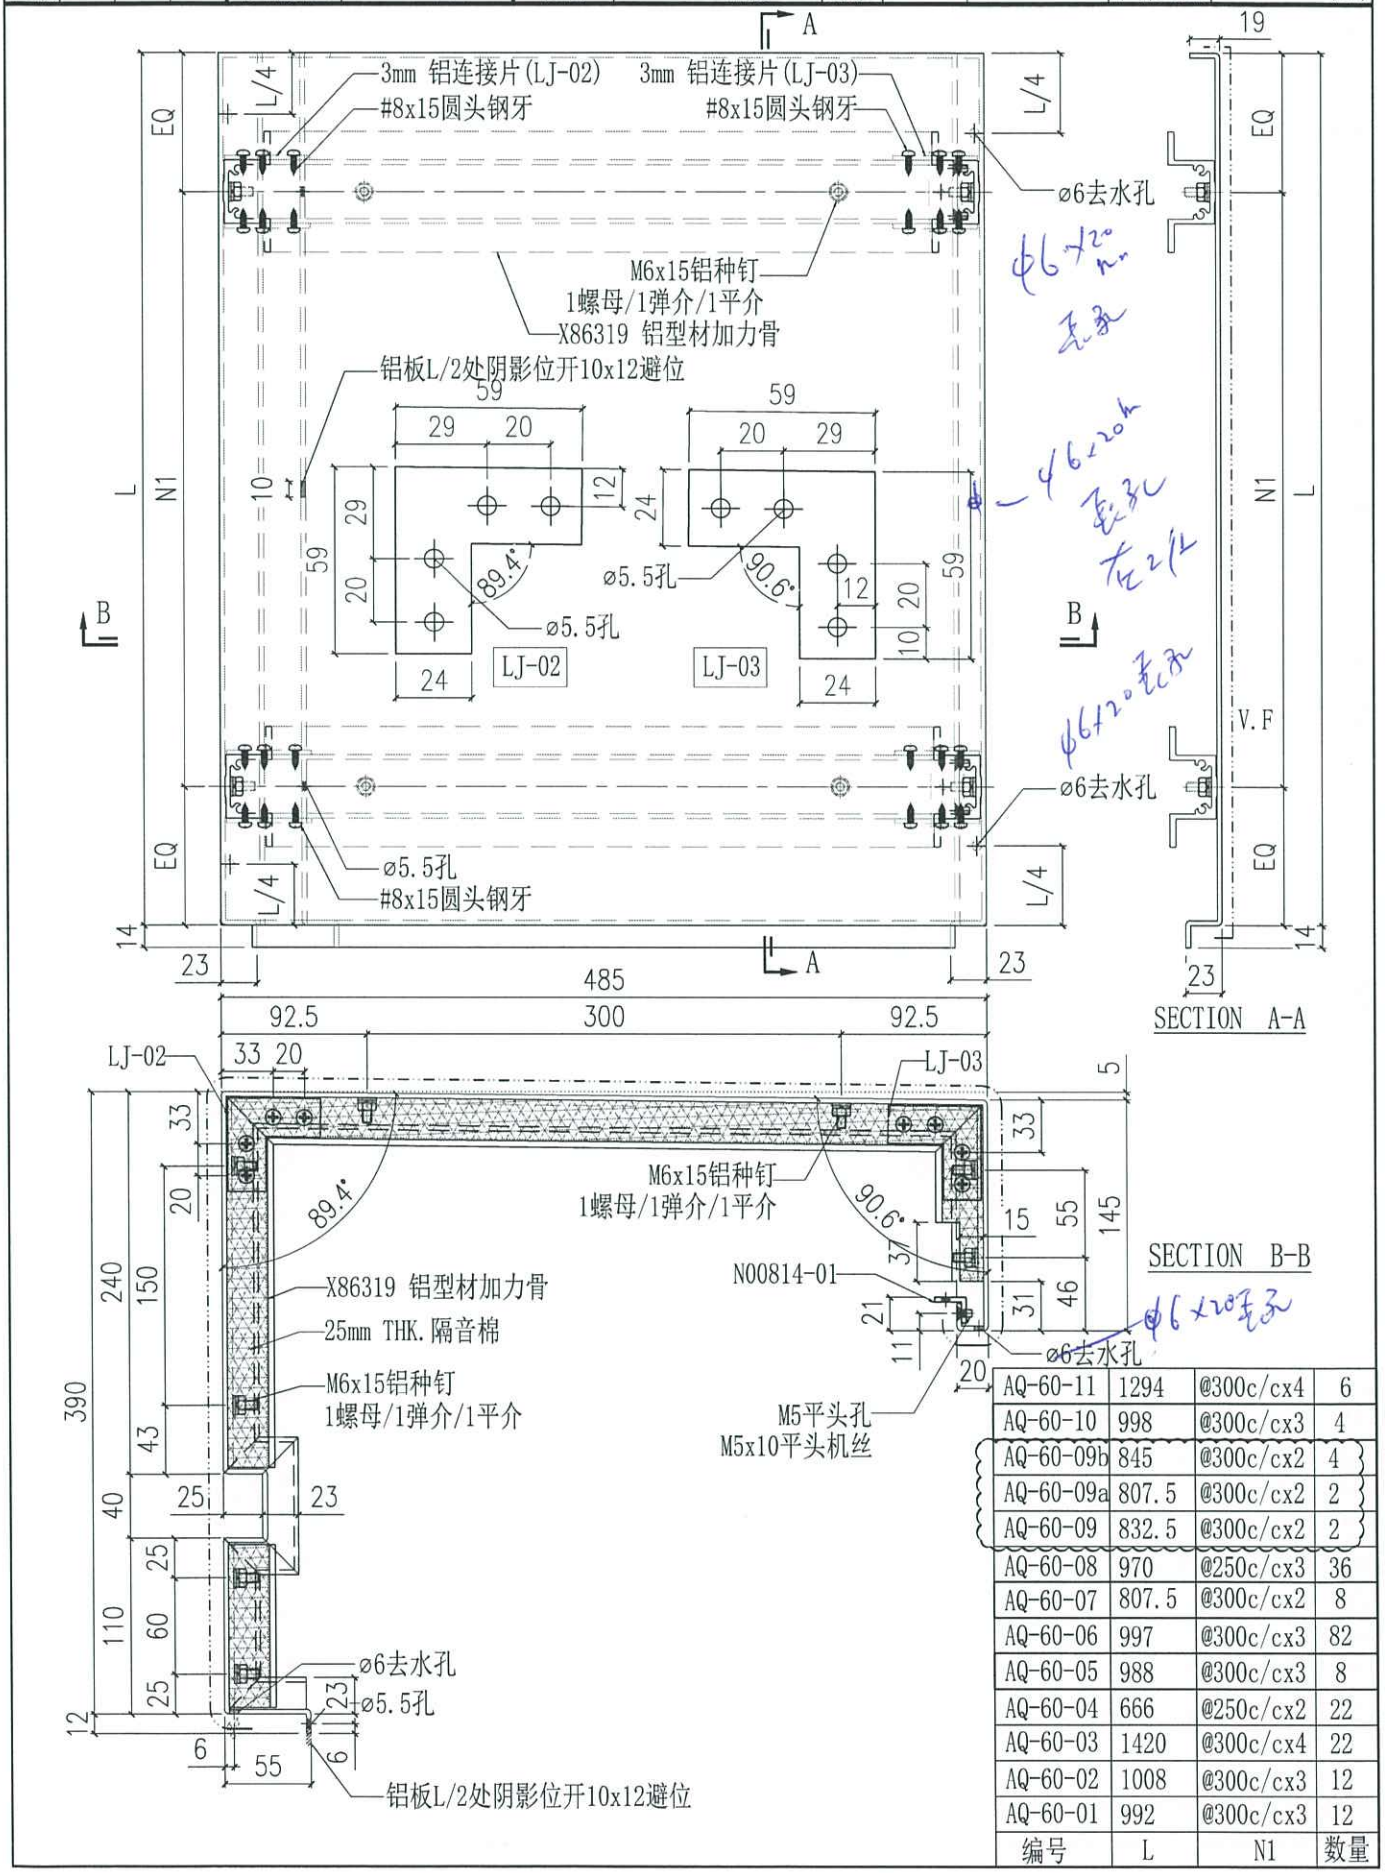


编号	L	N1	数量
AQ-60-11	1294	@300c/cx4	6
AQ-60-10	998	@300c/cx3	4
AQ-60-09b	845	@300c/cx2	4
AQ-60-09a	807.5	@300c/cx2	2
AQ-60-09	832.5	@300c/cx2	2
AQ-60-08	970	@250c/cx3	36
AQ-60-07	807.5	@300c/cx2	8
AQ-60-06	997	@300c/cx3	82
AQ-60-05	988	@300c/cx3	8
AQ-60-04	666	@250c/cx2	22
AQ-60-03	1420	@300c/cx4	22
AQ-60-02	1008	@300c/cx3	12
AQ-60-01	992	@300c/cx3	12

暂停

美特鋁質有限公司 MIDI Aluminium Fabricator Ltd.					工程號	J858	類別		物料號	-		
					地盤	康城11期	制圖	W.E.X	2022-08-11	圖號	AQ-61	
修改	A			採用工廠		地盤 ✓	图纸名称	铝板加工图	復核	-	-	數量	-
日期	18/12/22			材料颜色	PVF2（香槟金）		材料-	3mm THK.铝板	批准	-	-	單件重量	- (KG)

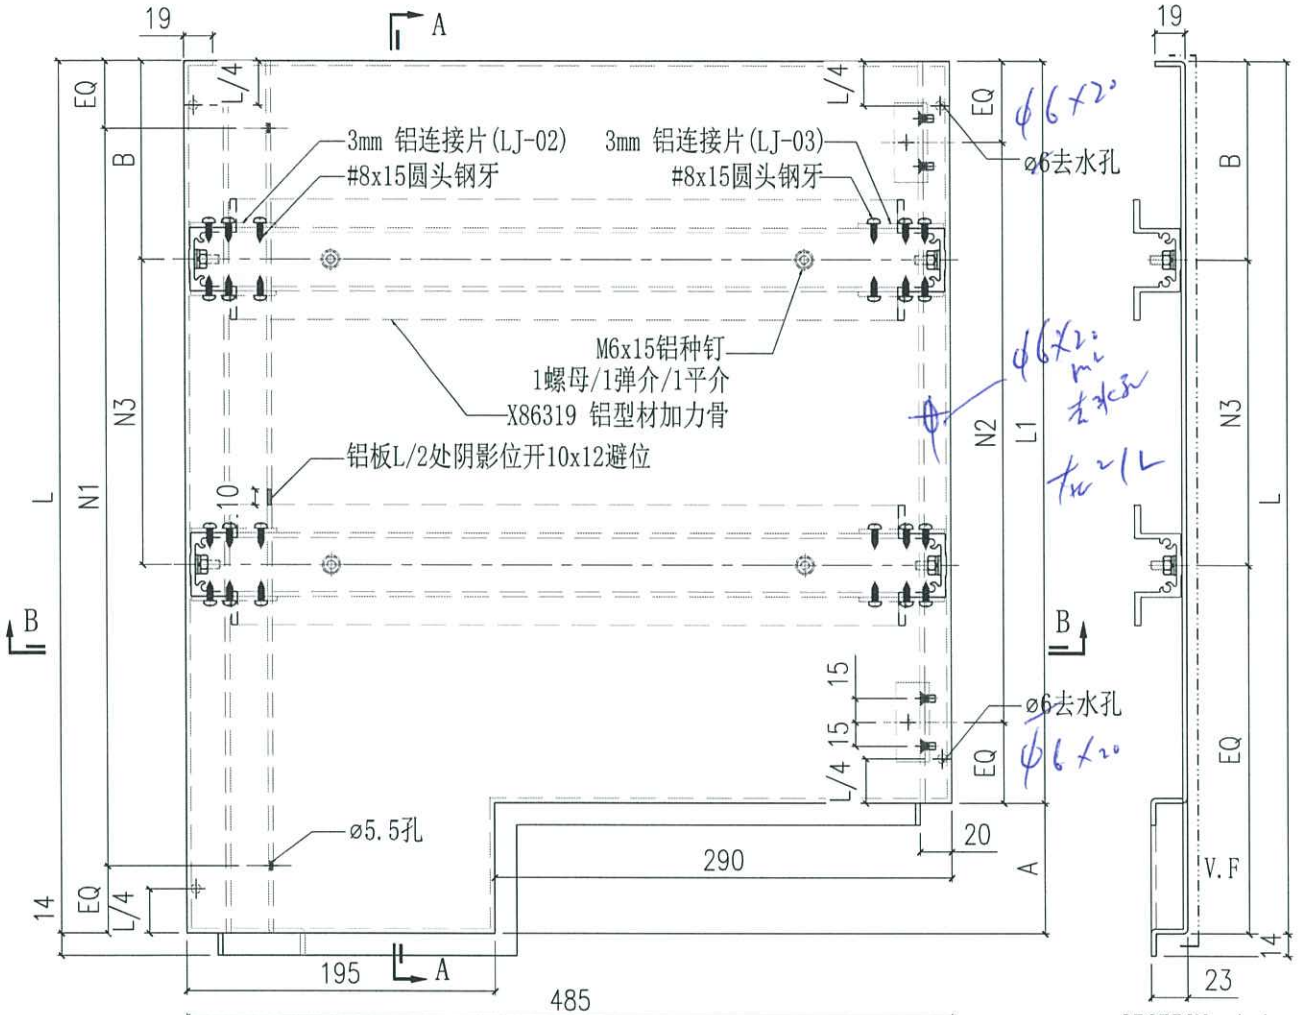


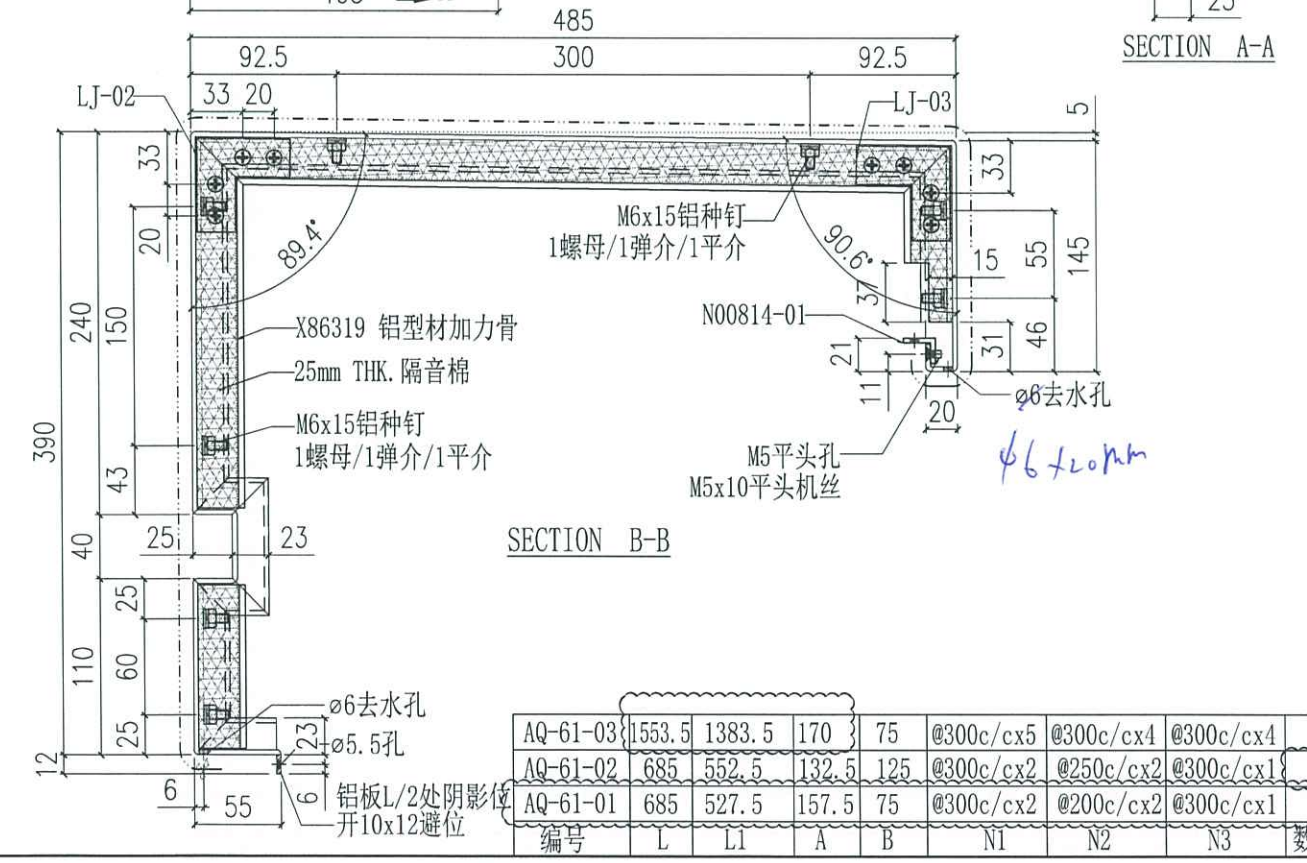


编号	L	L1	A	B	N1	N2	N3	数量
AQ-61-03	1553.5	1383.5	170	75	@300c/cx5	@300c/cx4	@300c/cx4	4
AQ-61-02	685	552.5	132.5	125	@300c/cx2	@250c/cx2	@300c/cx1	6
AQ-61-01	685	527.5	157.5	75	@300c/cx2	@200c/cx2	@300c/cx1	2

暂停

美特鋁質有限公司 MIDI Aluminium Fabricator Ltd.											
				工程號	J858	類別		物料號	-		
				地盤	康城11期	制圖	W.E.X	2022-08-11	圖號	AQ-62	
修改	A			图纸名称	铝板加工图	復核	-	-	數量	-	
日期	18/12/22			材料-	3mm THK.铝板	批准	-	-	單件重量	-	(KG)
採用工廠		地盤 ✓									
材料顏色	PVF2（香槟金）										

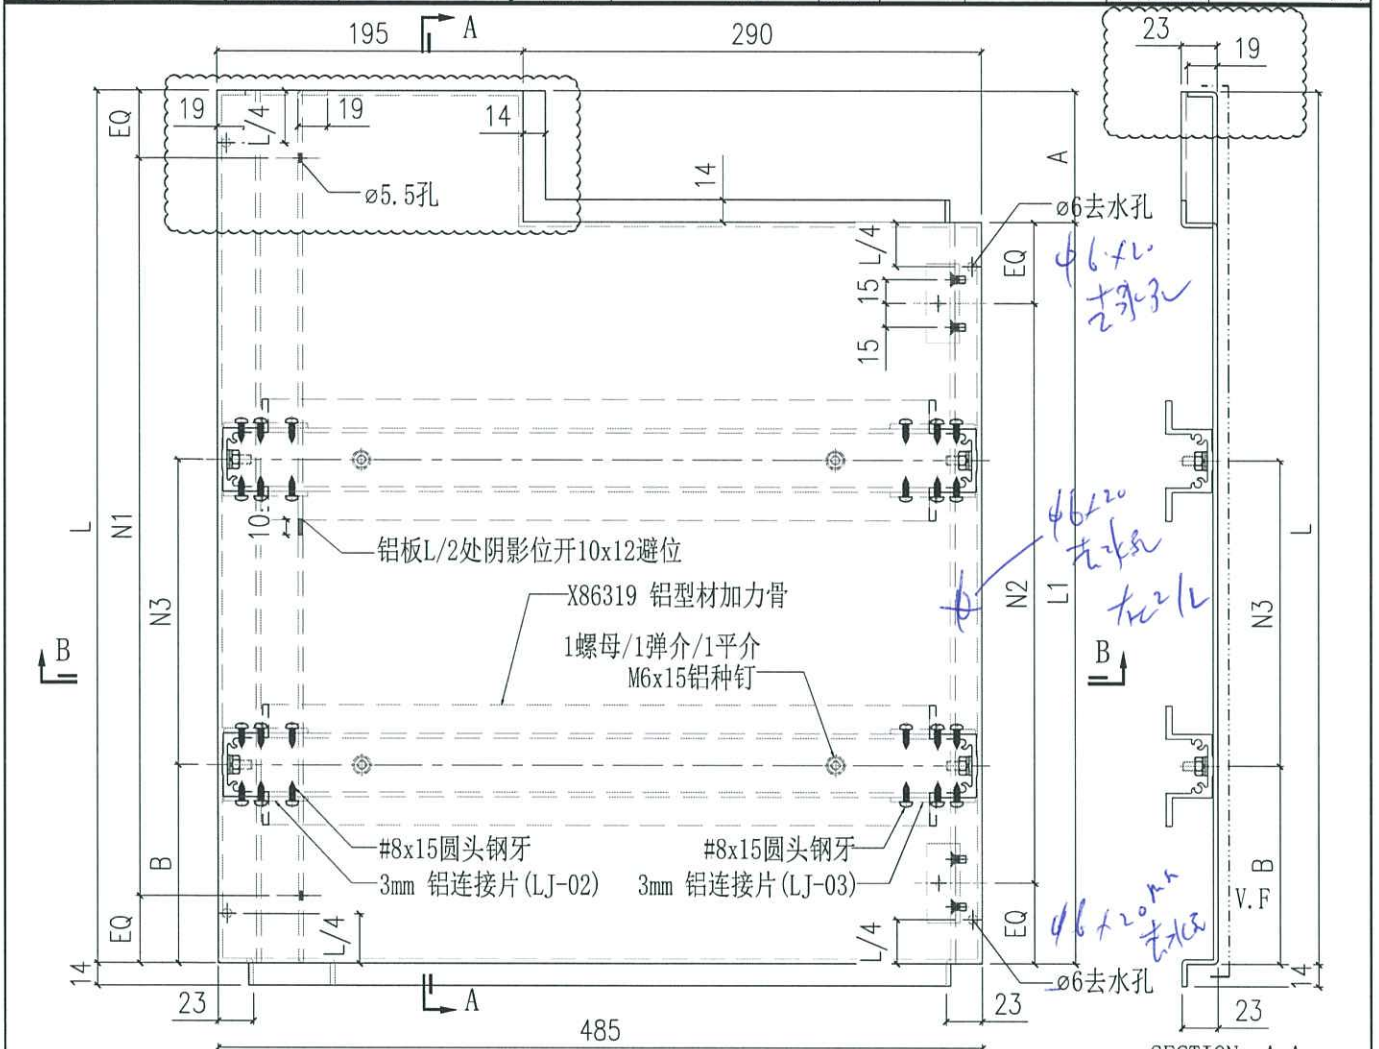


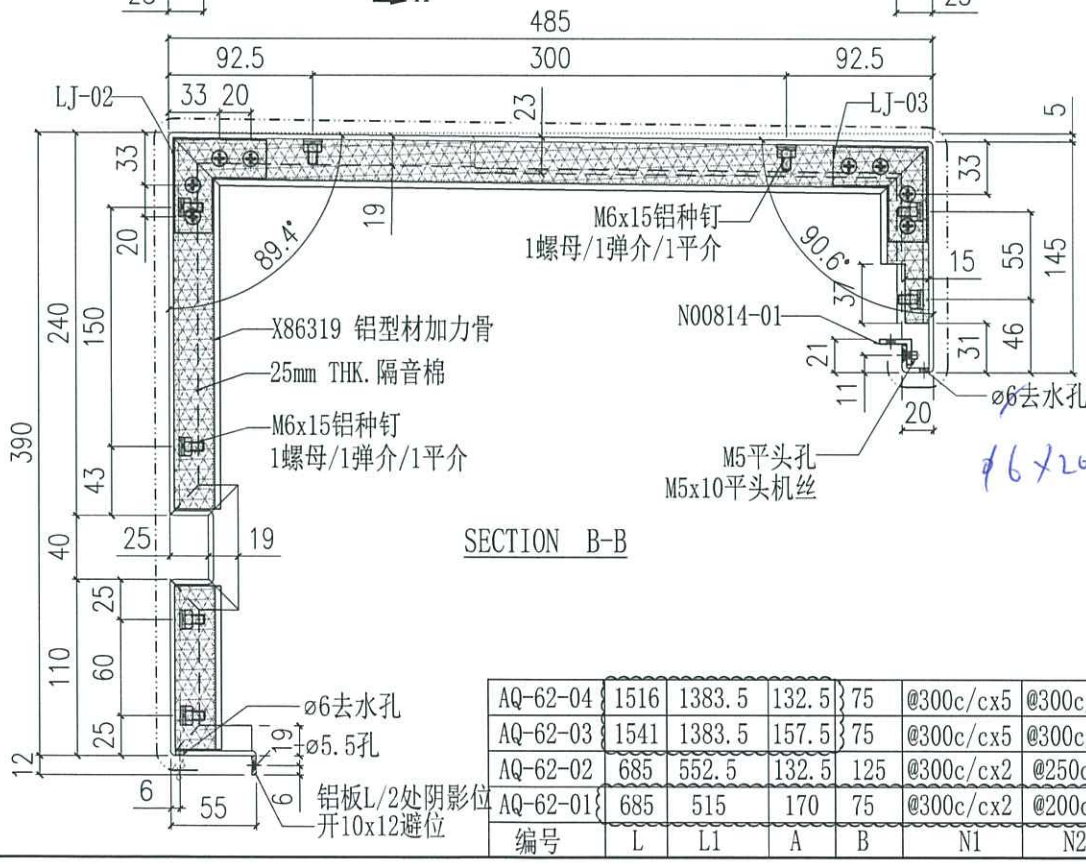


编号	L	L1	A	B	N1	N2	N3	数量
AQ-62-04	1516	1383.5	132.5	75	@300c/cx5	@300c/cx4	@300c/cx4	2
AQ-62-03	1541	1383.5	157.5	75	@300c/cx5	@300c/cx4	@300c/cx4	2
AQ-62-02	685	552.5	132.5	125	@300c/cx2	@250c/cx2	@300c/cx1	4
AQ-62-01	685	515	170	75	@300c/cx2	@200c/cx2	@300c/cx1	4

暂停

美特鋁質有限公司 MIDI Aluminium Fabricator Ltd.											
工程號	J858	類別		物料號	-						
地盘	康城11期	制圖	W.E.X	2022-08-11	圖號	AQ-64					
修改	-	-	-	採用	工廠		地盤	✓	图纸名称	铝板加工图	復核	-	-	數量	-		
日期	-	-	-	材料颜色	PVF2（香槟金）				材料-	3mm THK.铝板	批准	-	-	單件重量	-	(KG)	

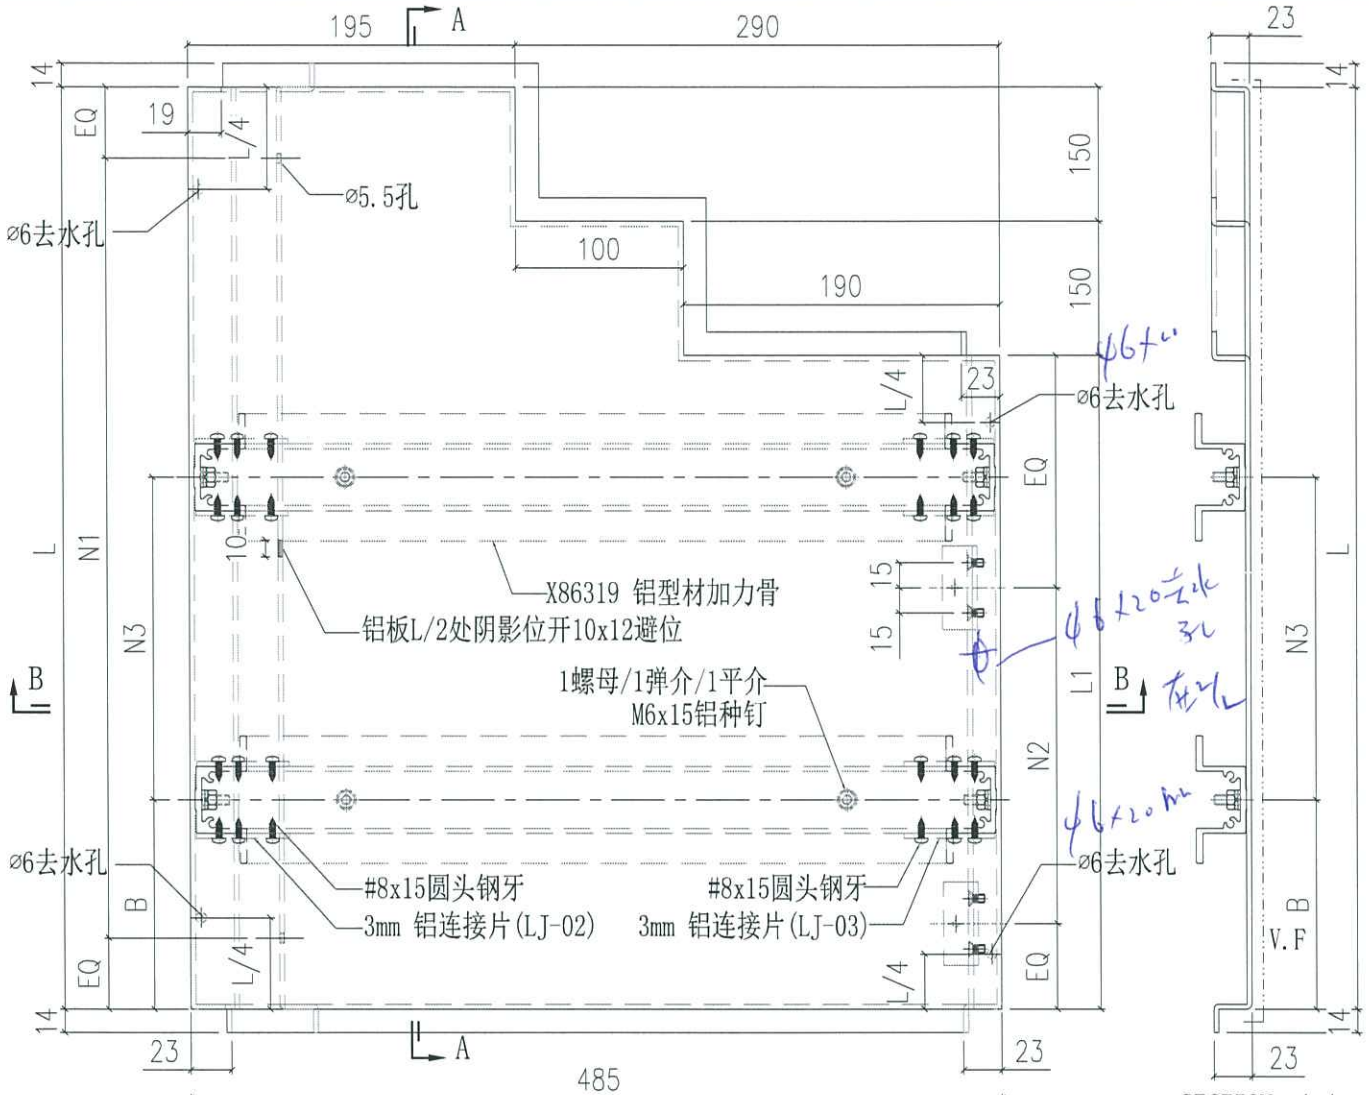


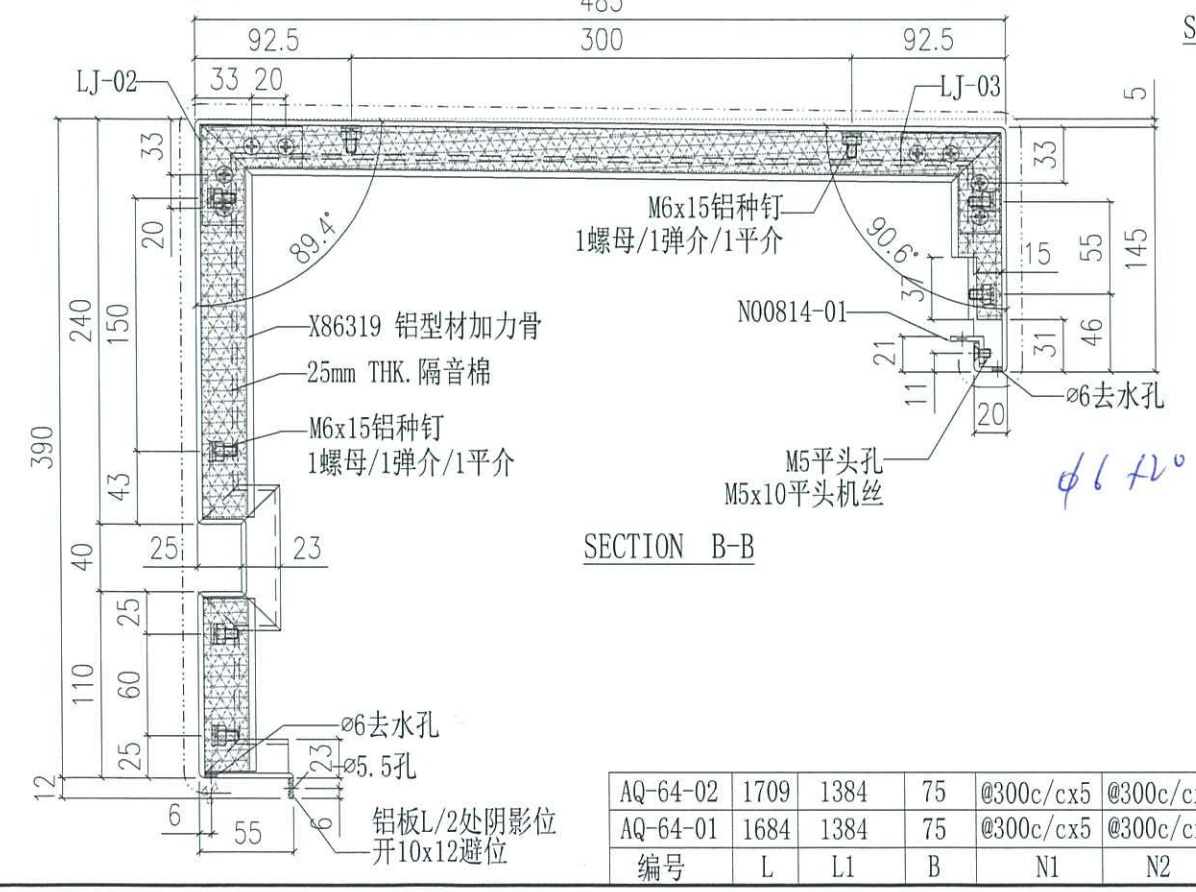

编号	L	L1	B	N1	N2	N3	数量
AQ-64-02	1709	1384	75	@300c/cx5	@300c/cx4	@300c/cx4	4
AQ-64-01	1684	1384	75	@300c/cx5	@300c/cx4	@300c/cx4	2

暂停


美特鋁質有限公司 MIDI Aluminium Fabricator Ltd.												
					工程號	J858	類別		物料號	-		
					地盤	康城11期	制圖	W.E.X	2022-08-11	圖號	AQ-65	
修改	-	-	-	採用工廠		地盤 ✓	图纸名称	铝板加工图	復核	-	-	數量	-	
日期	-	-	-	材料颜色	PVF2（香槟金）		材料-	3mm THK. 铝板	批准	-	-	單件重量	-	(KG)

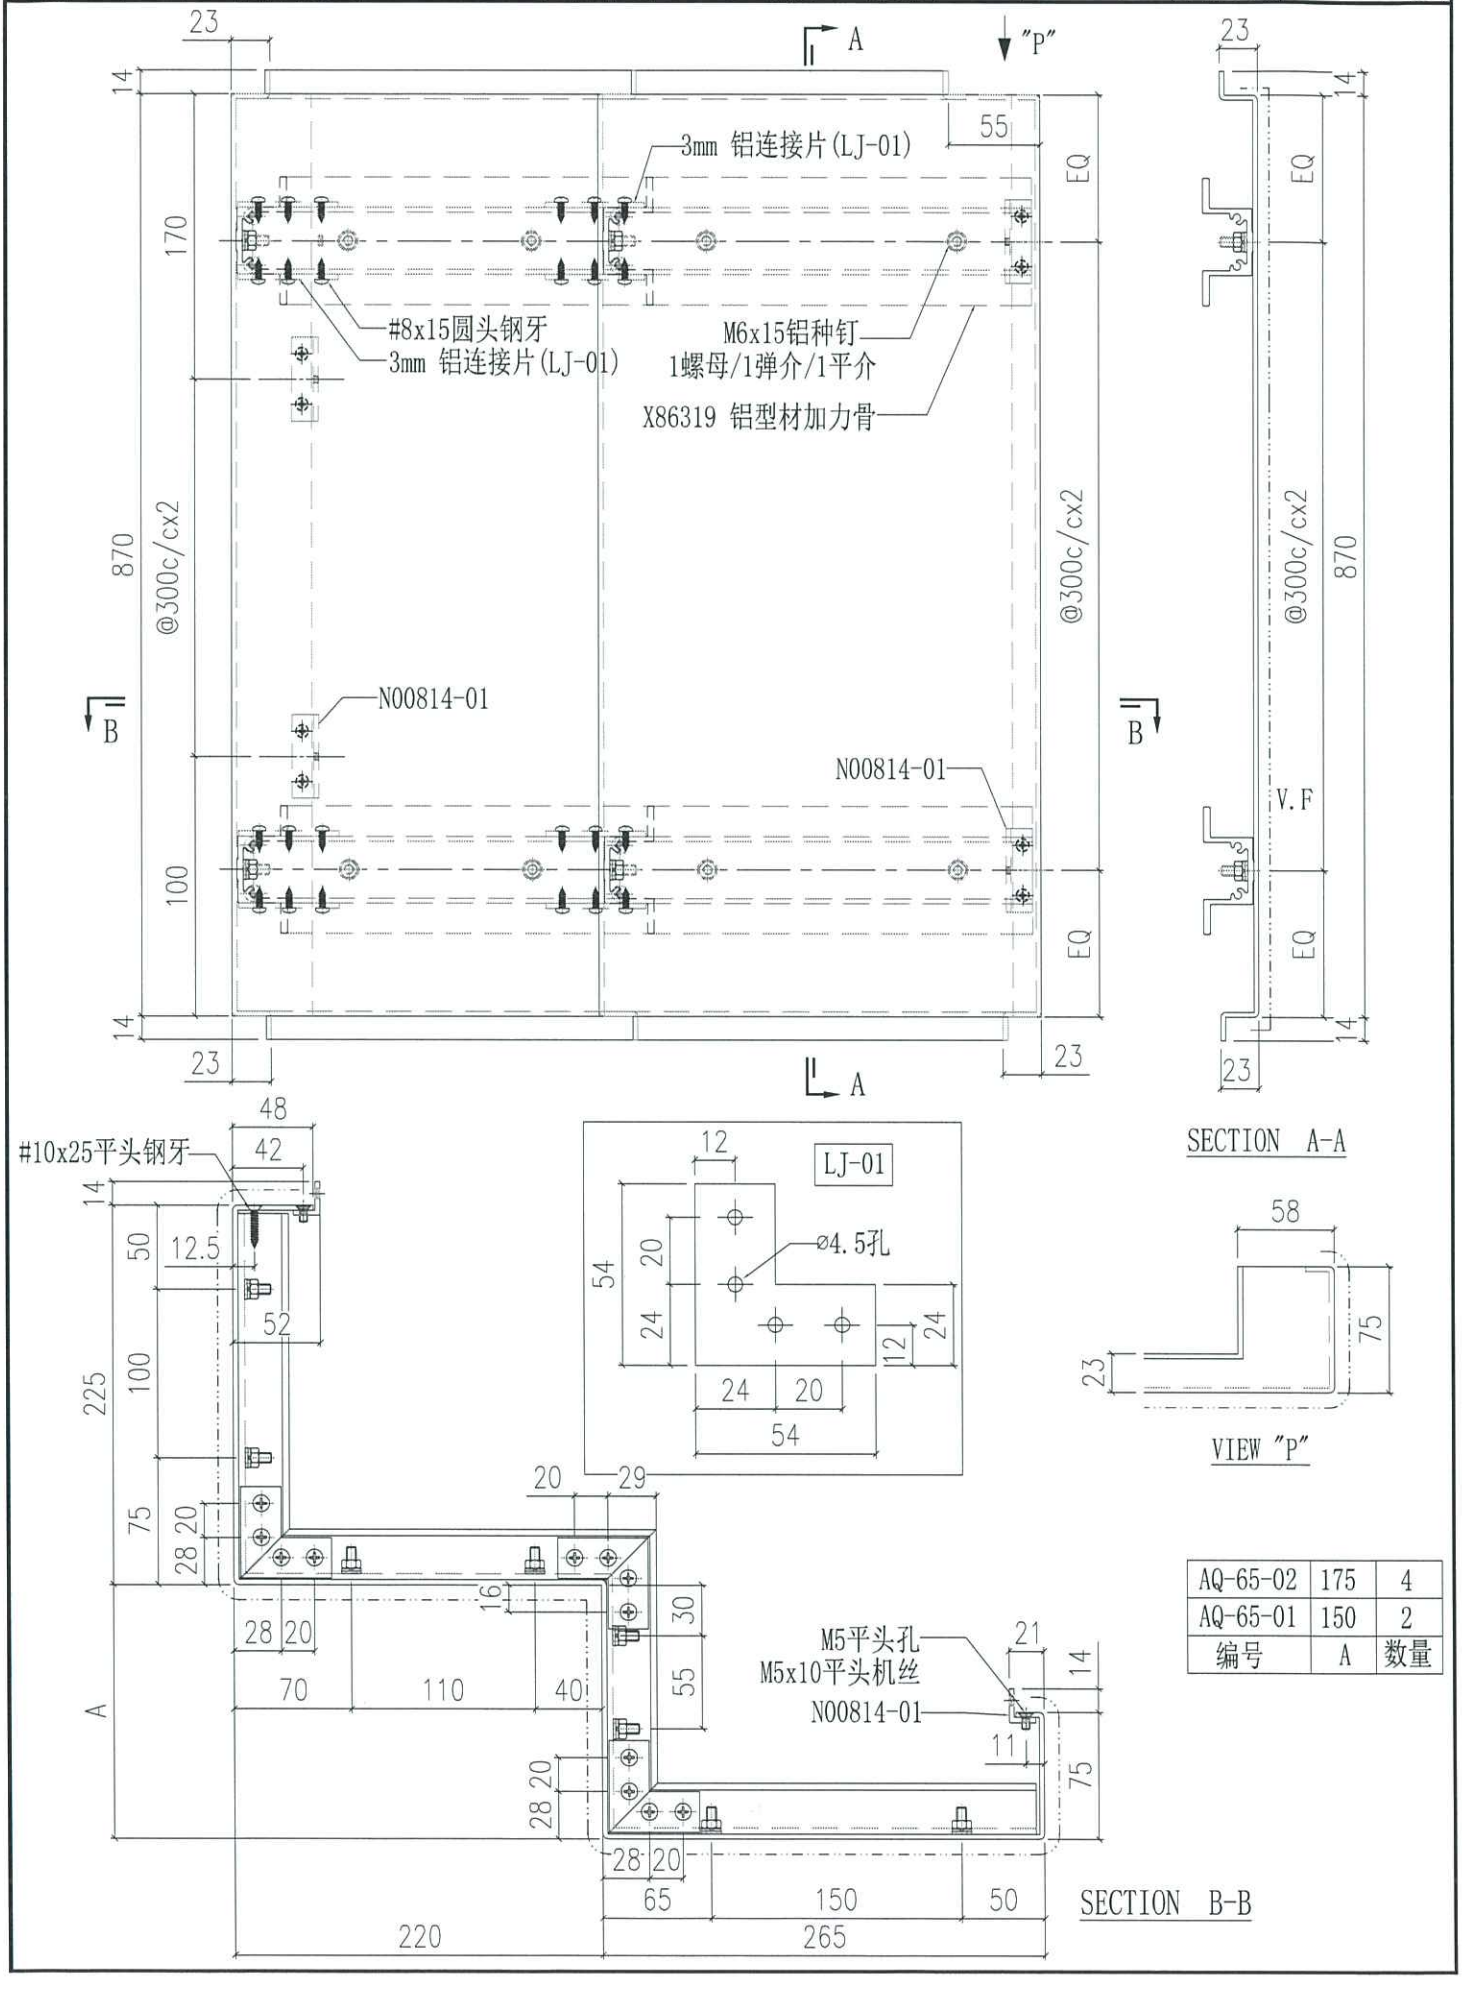


AQ-65-02	175	4
AQ-65-01	150	2
编号	A	数量

暂停


美特鋁質有限公司 MIDI Aluminium Fabricator Ltd.												
				工程號	J858	類別		物料號	-			
				地盘	康城11期	制圖	W.E.X	2022-08-11	圖號	AQ-66		
修改	A			採用工廠		地盤 ✓	图纸名称	铝板加工图	復核	-	-	數量	-	
日期	18/12/22			材料颜色	PVF2（香槟金）		- 材料	3mm THK. 铝板	批准	-	-	單件重量	-	(KG)

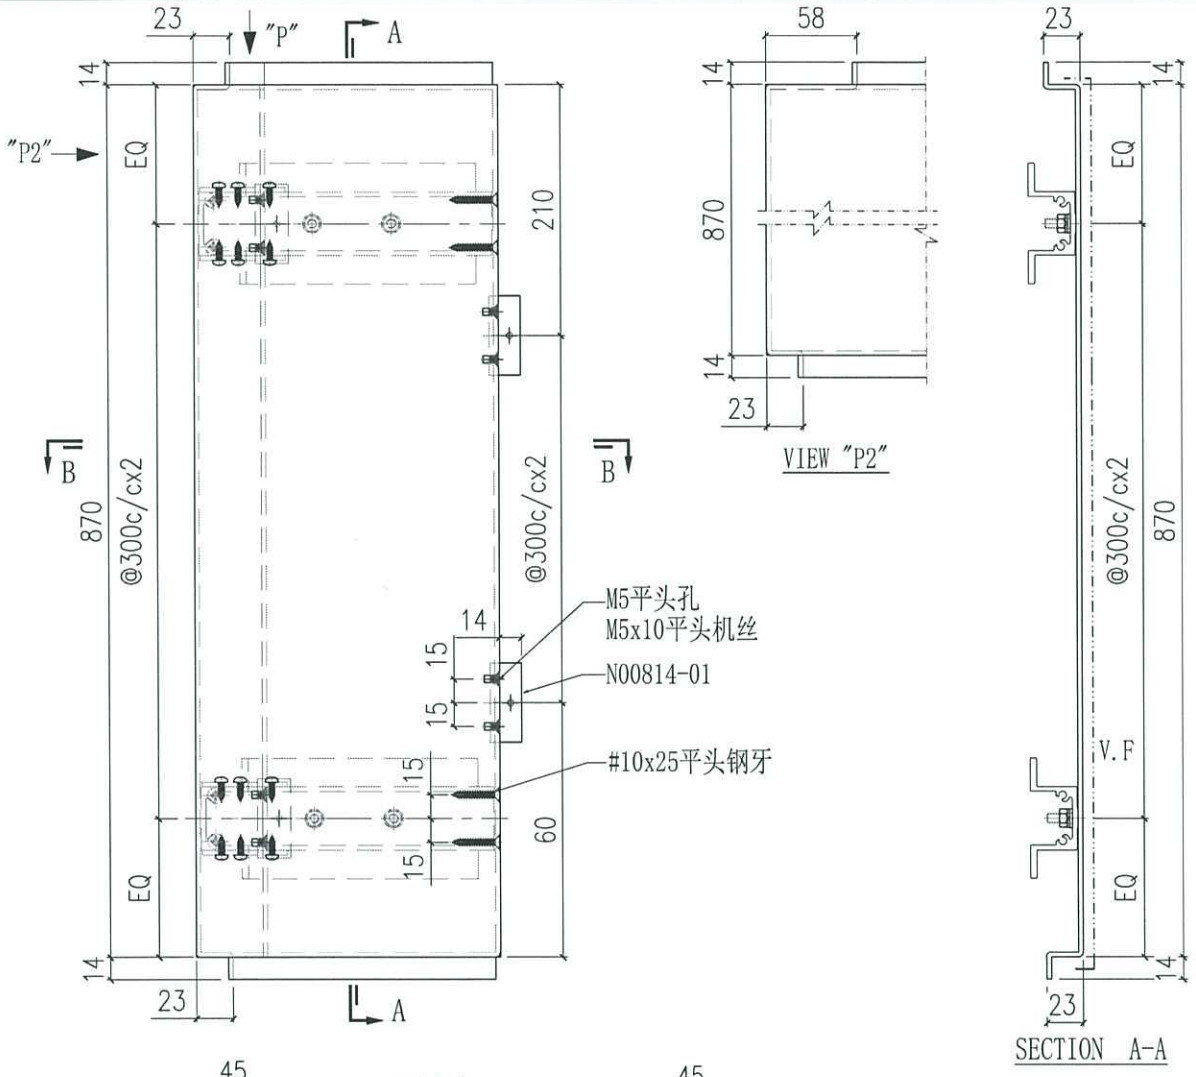

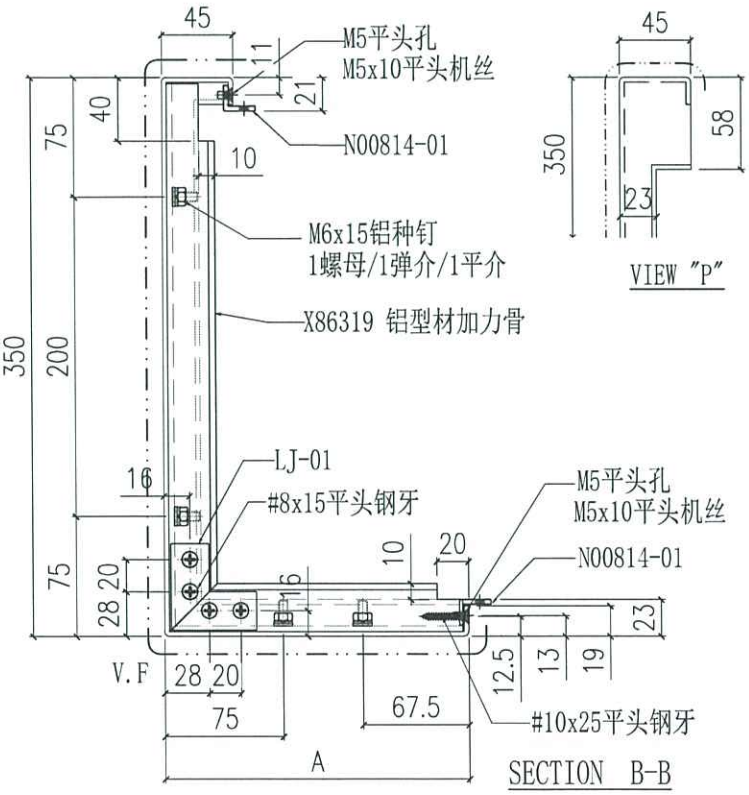

编号	A	数量
AQ-66A	217.5	2
AQ-66B	192.5	6
AQ-66C	230	4


表面處理: PVF2 (香檳金ECD3X10099S-JF2

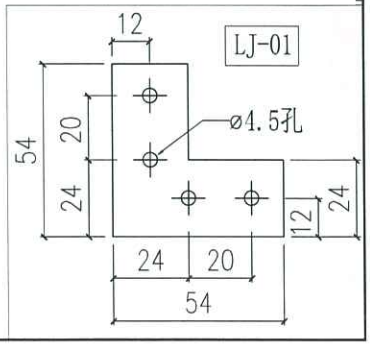


暂停

美特鋁質有限公司 MIDI Aluminium Fabricator Ltd.											
				工程號	J858	類別		物料號	-		
				地盤	康城11期	制圖	W.E.X	2022-08-11	圖號	AQ-67	
修改	A		採用工廠	地盤 ✓	图纸名称	铝板加工图	復核	-	-	數量	-
日期	18/12/22		材料颜色	PVF2（香槟金）	材料	3mm THK.铝板	批准	-	-	單件重量	- (KG)


表面处理：PVF2（香槟金ECD3X10099S-XF1）

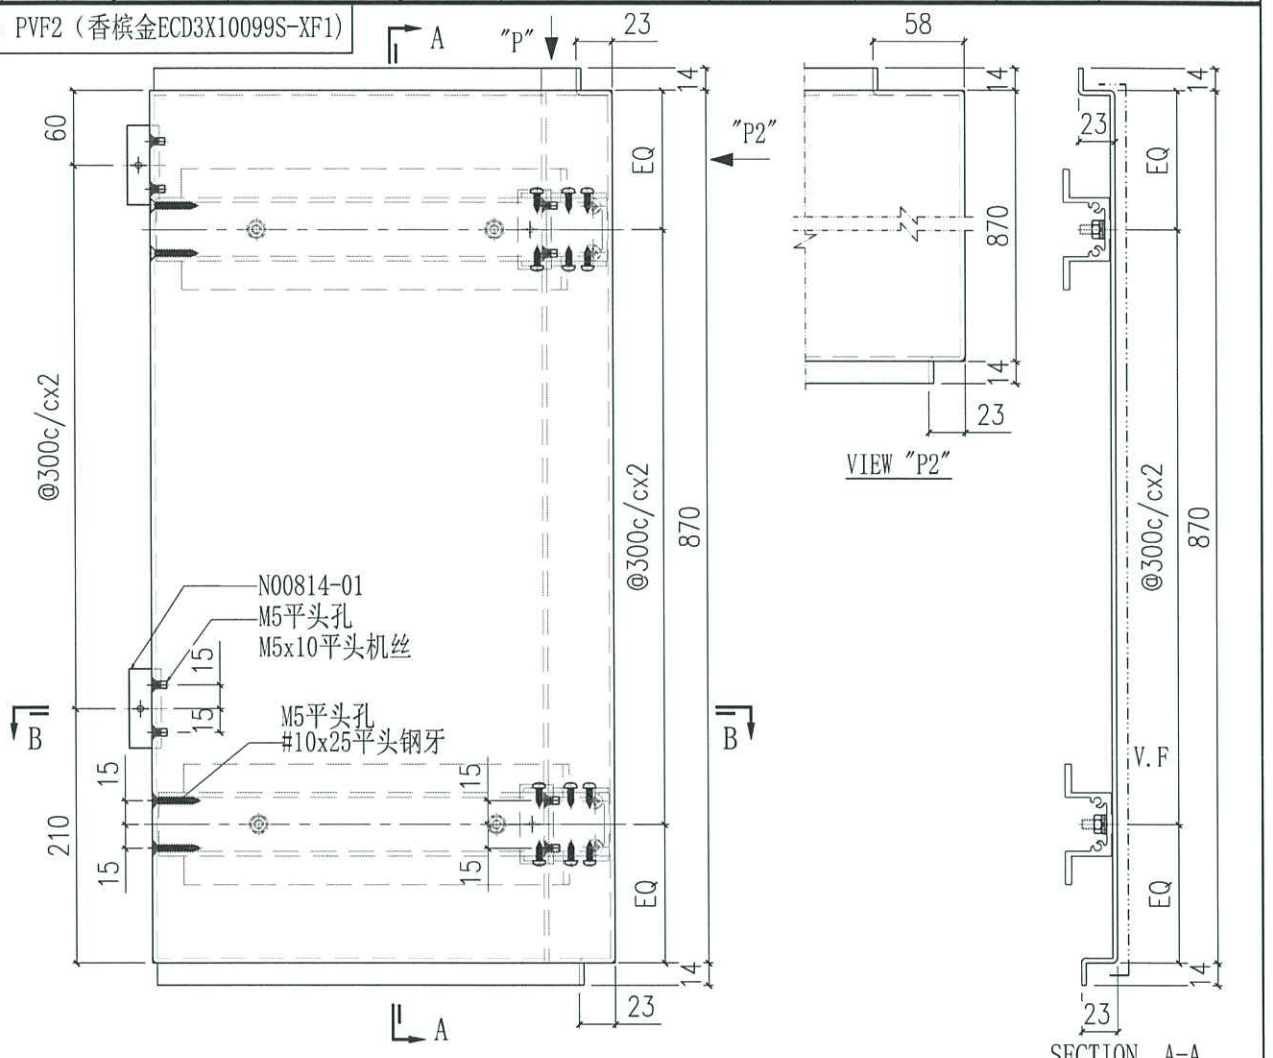

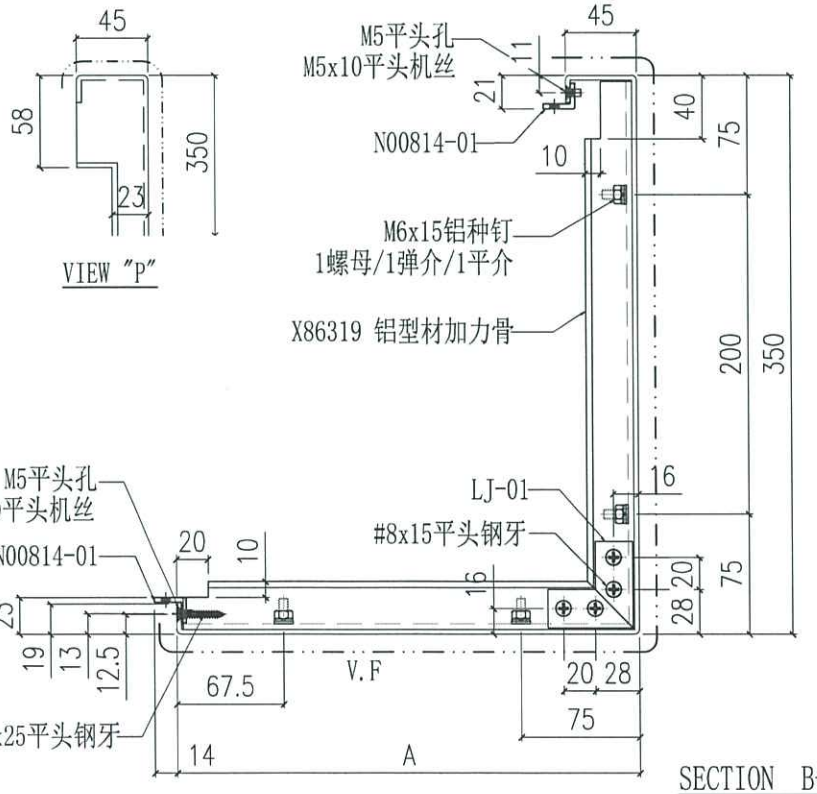

编号	A	数量
AQ-67A	230	4
AQ-67B	192.5	6
AQ-67C	217.5	2
~~AQ-67D~~	~~242.5~~	~~2~~


取消

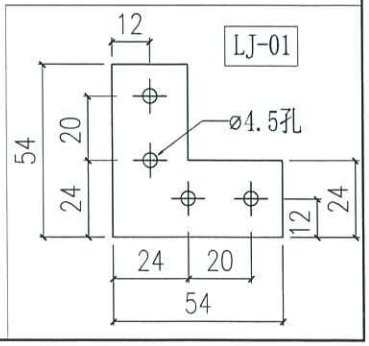


暂停


美特鋁質有限公司 MIDI Aluminium Fabricator Ltd.											
工程號	J858	類別		物料號	-						
地盘	康城11期	制圖	W.E.X	2022-08-11	圖號	AQ-68L					
修改	-	-	-	採用	工廠		地盤	✓	图纸名称	铝板加工图	復核	-	-	數量	-		
日期	-	-	-	材料颜色	PVF2 (香槟金)				材料-	3mm THK. 铝板	批准	-	-	單件重量	-	(KG)	

数量 10

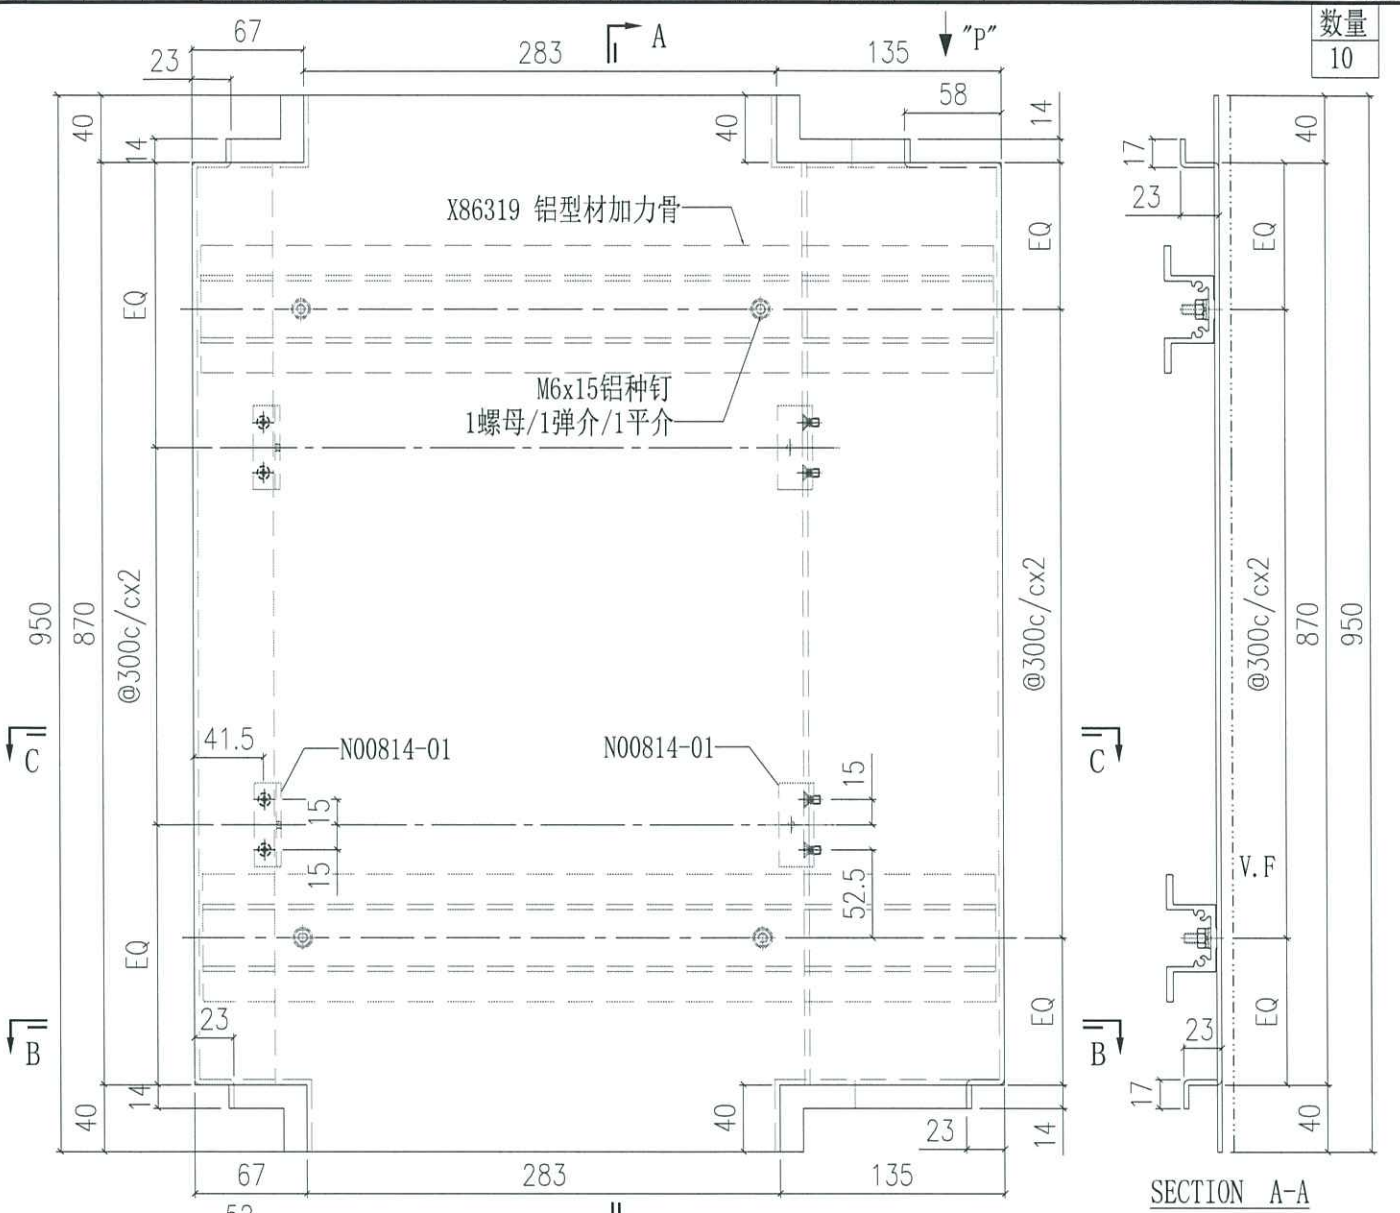



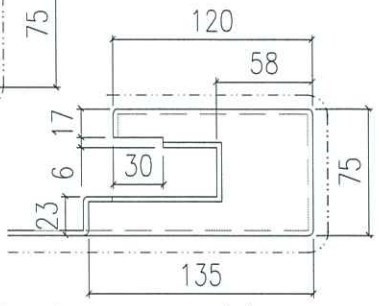

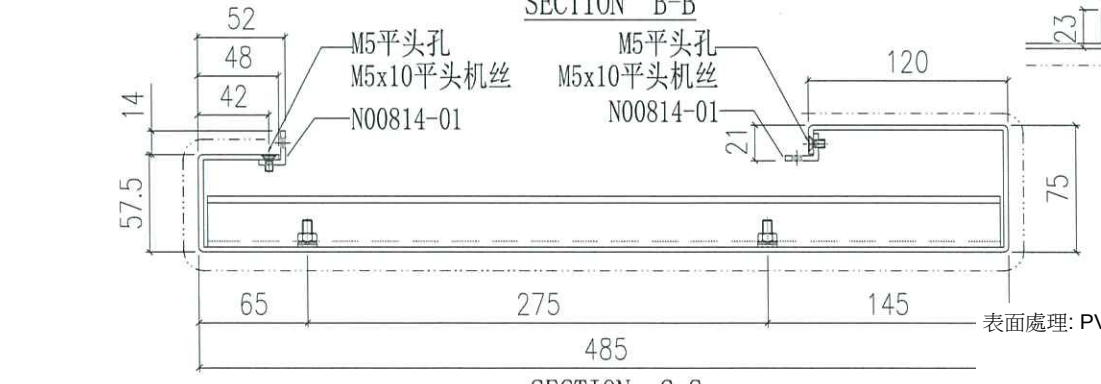


表面處理: PVF2 (香檳金ECD3X10099S-JF2

暂停

美特鋁質有限公司 MIDI Aluminium Fabricator Ltd.											
工程號	J858	類別		物料號	-						
地盘	康城11期	制圖	W.E.X	2022-08-11	圖號	AQ-68R					
修改	-	-	-	採用	工廠		地盤 ✓	图纸名称	铝板加工图	復核	-	-	数量	-	
日期	-	-	-	材料颜色	PVF2（香槟金）			材料-	3mm THK. 铝板	批准	-	-	單件重量	-	(KG)

数量 10

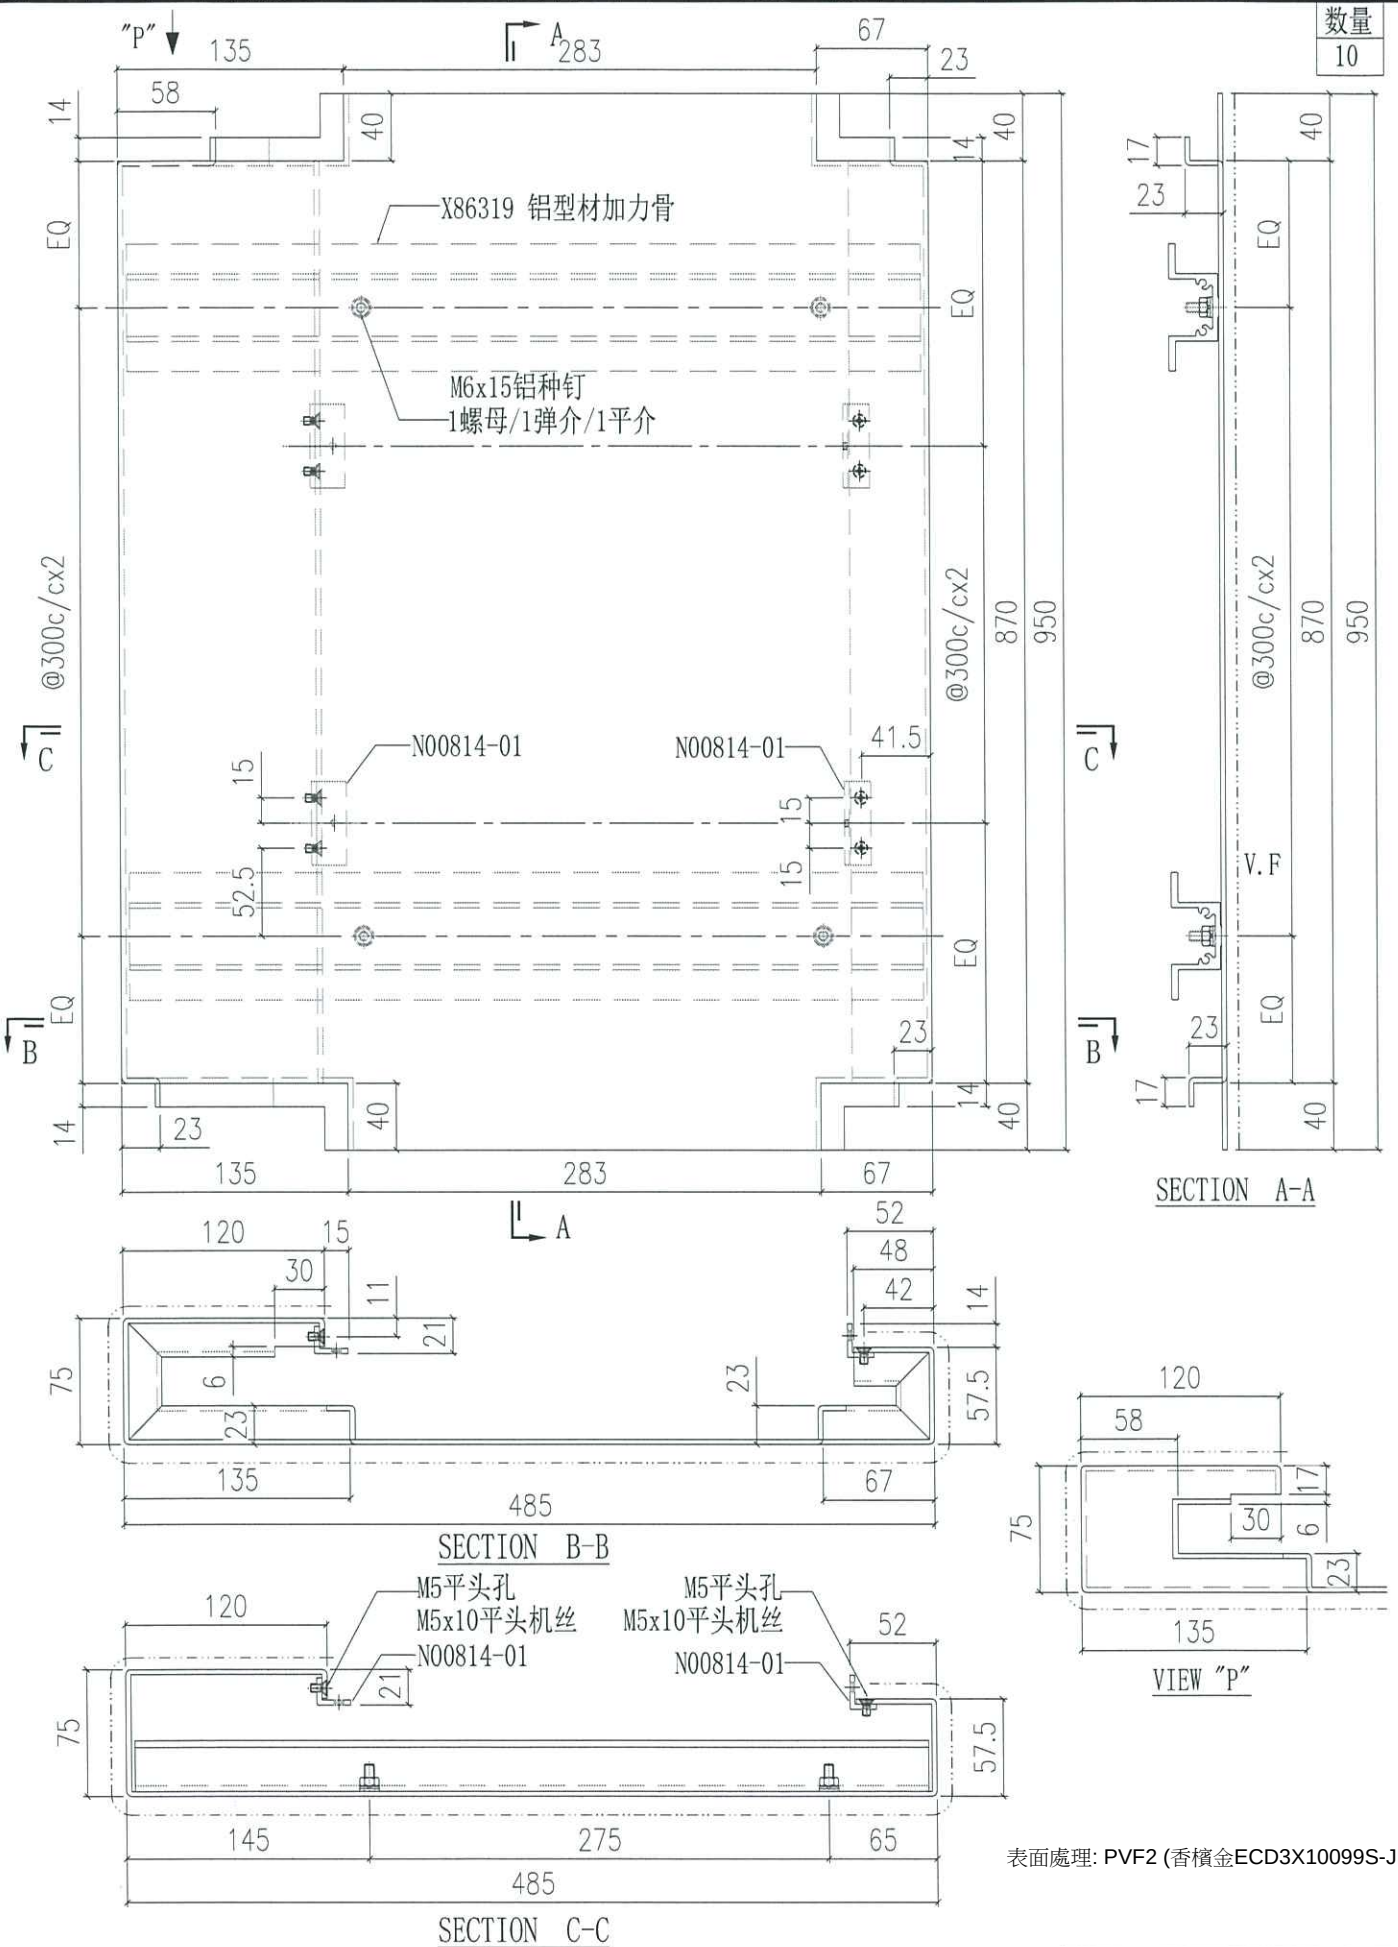


表面處理: PVF2 (香檳金ECD3X10099S-JF2

暂停

美特鋁質有限公司 MIDI Aluminium Fabricator Ltd.											
工程號	J858	類別		物料號	-						
地盘	康城11期	制圖	W.E.X	2022-08-11	圖號	AQ-69L					
修改	-	-	-	採用工廠		地盤 ✓	图纸名称	铝折件	復核	-	-	數量	-		
日期	-	-	-	材料颜色	PVF2（香槟金）		材料	3.0mm 铝板	批准	-	-	單件重量	-	(KG)	

48 表面处理：PVF2（香槟金ECD3X10099S-XF1）

数量 10

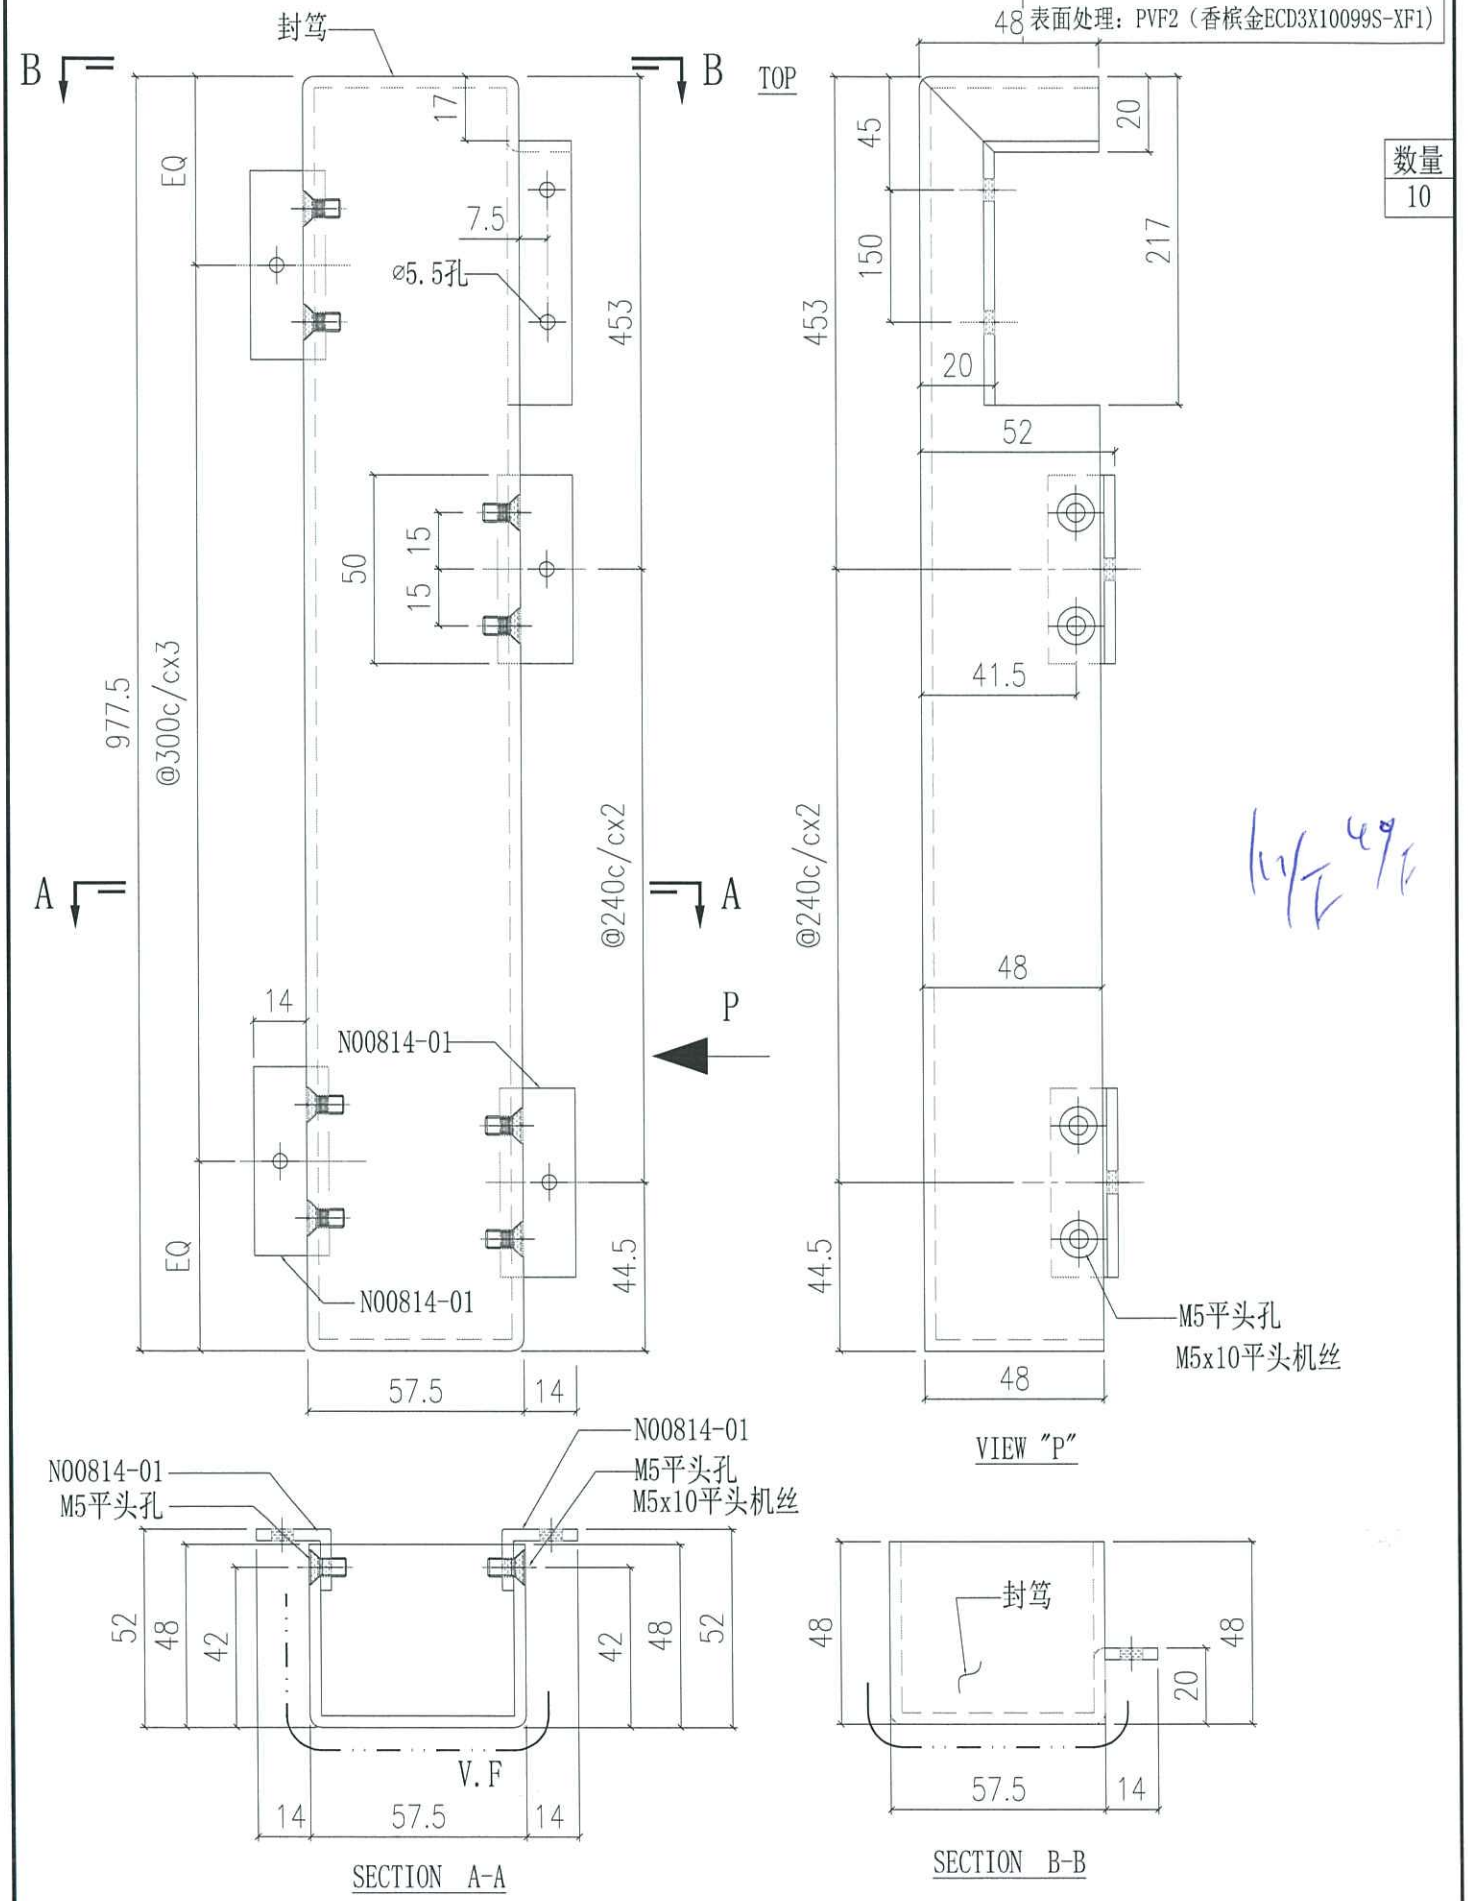


暫停

美特鋁質有限公司 MIDI Aluminium Fabricator Ltd.											
工程號	J858	類別		物料號	-						
地盤	康城11期	制圖	W.E.X	2022-08-11	圖號	AQ-69R					
修改	-	-	-	採用	工廠		地盤	✓	图纸名称	铝折件	復核	-	-	數量	-		
日期	-	-	-	材料颜色	PVF2（香槟金）				材料	3.0mm 铝板	批准	-	-	單件重量	-	(KG)	

表面處理: PVF2 (香檳金ECD3X10099S-JF2

數量
10

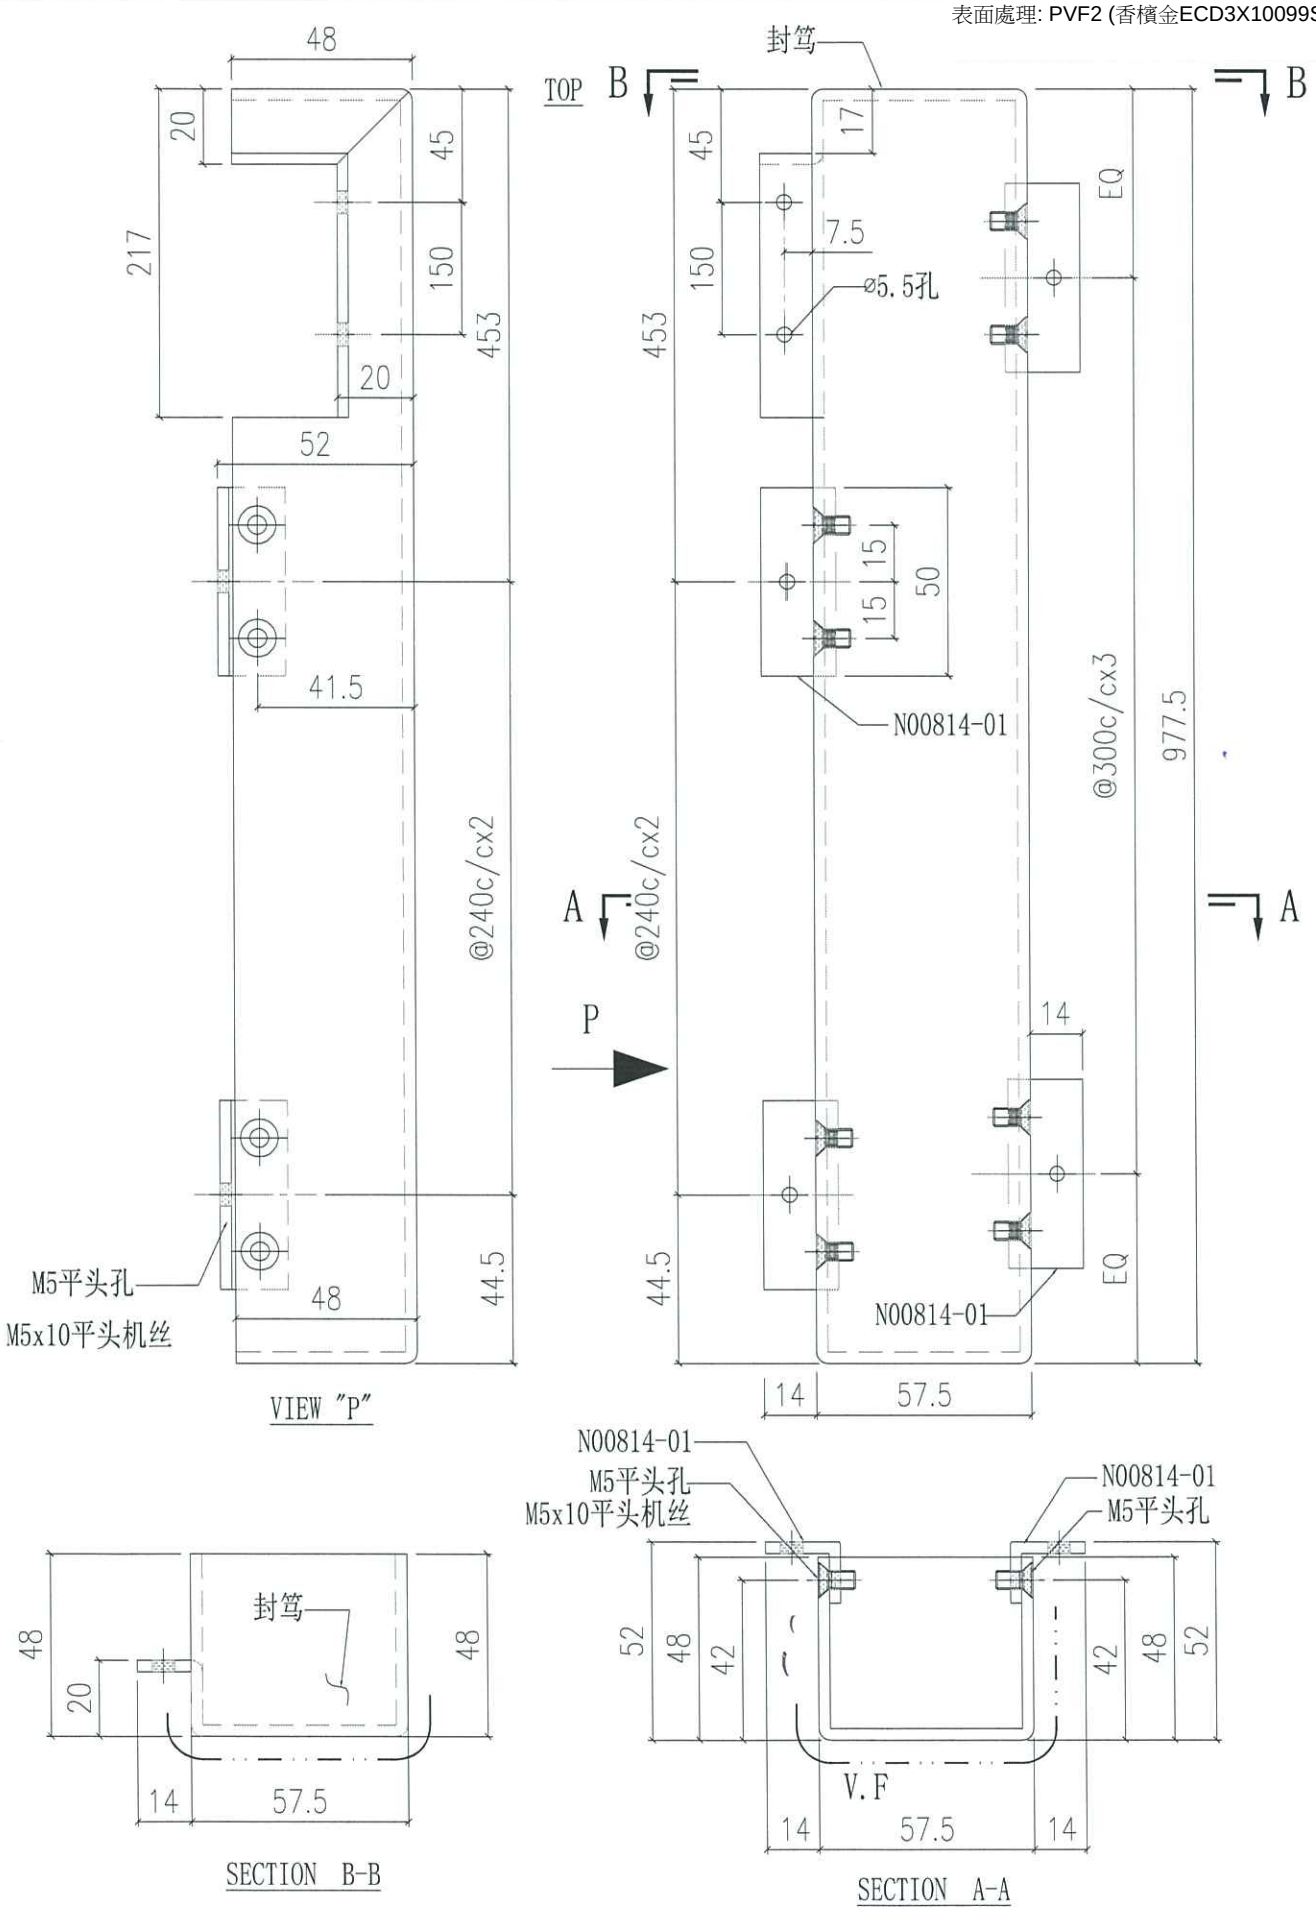



暫停

美特鋁質有限公司 MIDI Aluminium Fabricator Ltd.											
工程號	J858	類別		物料號	-						
地盤	康城11期	制圖	W.E.X	2022-08-11	圖號	AQ-70L					
修改	-	-	-	採用	工廠		地盤	✓	图纸名称	铝折件	復核	-	-	數量	-		
日期	-	-	-	材料颜色	PVF2（香槟金）				材料	3.0mm 铝板	批准	-	-	單件重量	-	(KG)	


表面处理：PVF2（香槟金ECD3X10099S-XF1）

数量
10

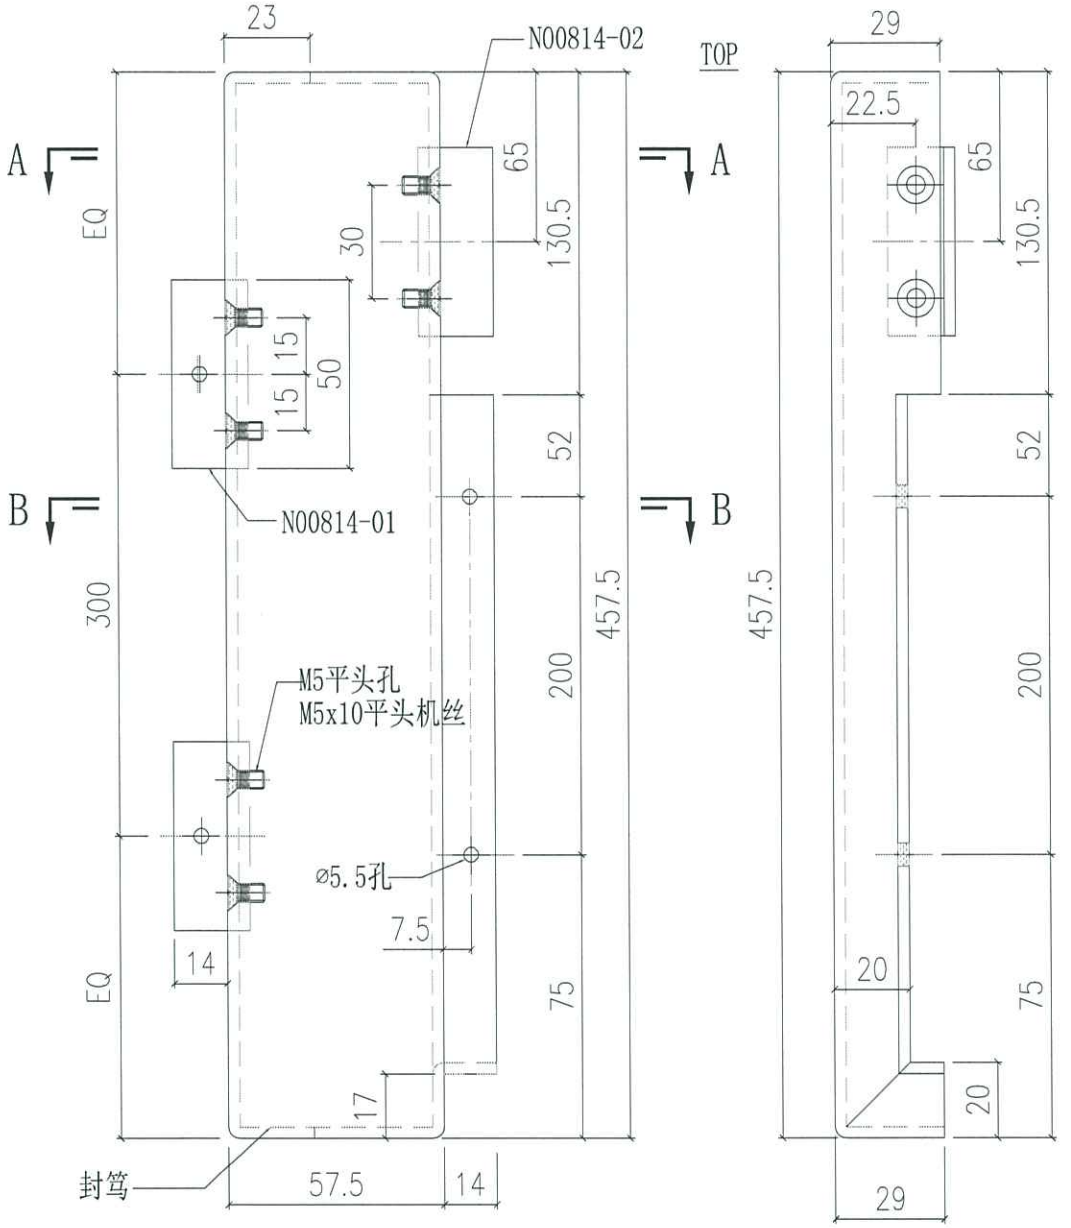

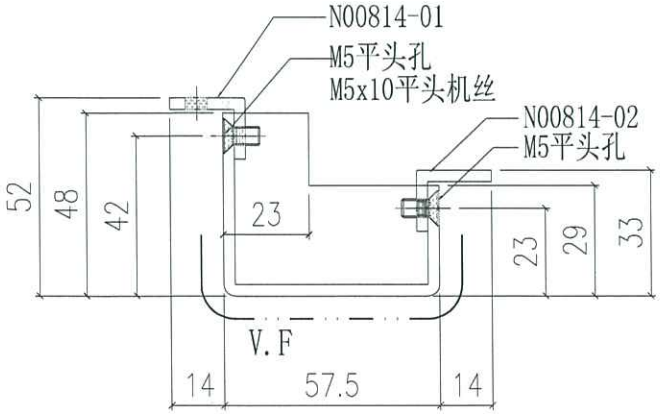

SECTION A-A

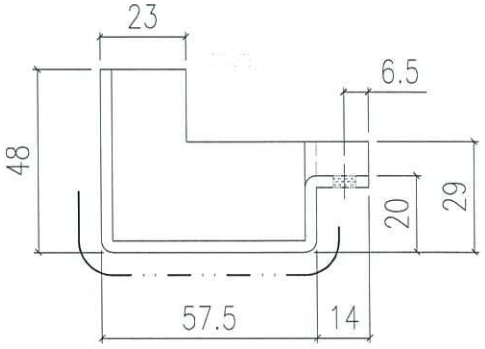


SECTION B-B


暂停

美特鋁質有限公司 MIDI Aluminium Fabricator Ltd.												
工程號	J858	類別		物料號	-							
地盘	康城11期	制圖	W.E.X	2022-08-11	圖號	AQ-70R						
修改	-	-	-	採用	工廠		地盤	✓	图纸名称	铝折件	復核	-	-	數量	-		
日期	-	-	-	材料颜色	PVF2（香槟金）				材料	3.0mm 铝板	批准	-	-	單件重量	-	(KG)	


表面处理：PVF2（香槟金ECD3X10099S-XF1）

数量
10

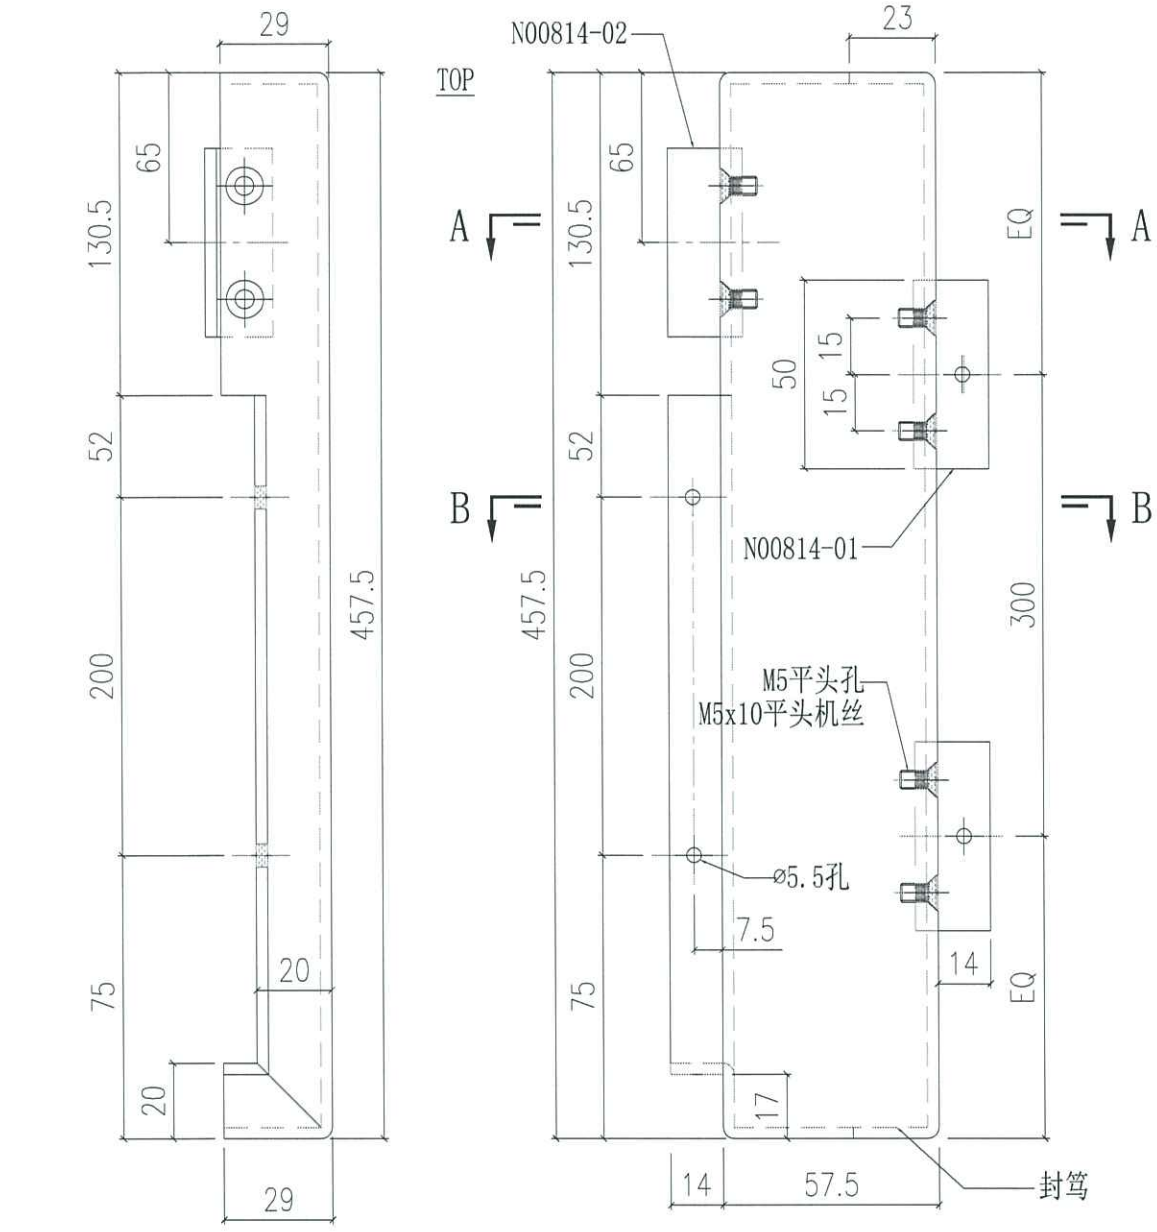

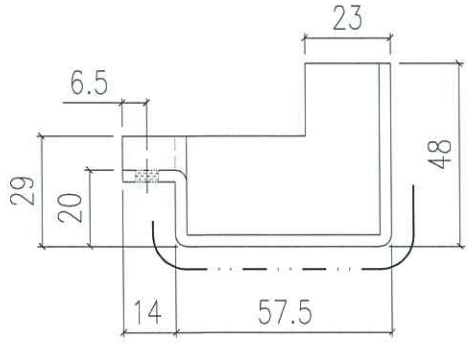

SECTION B-B

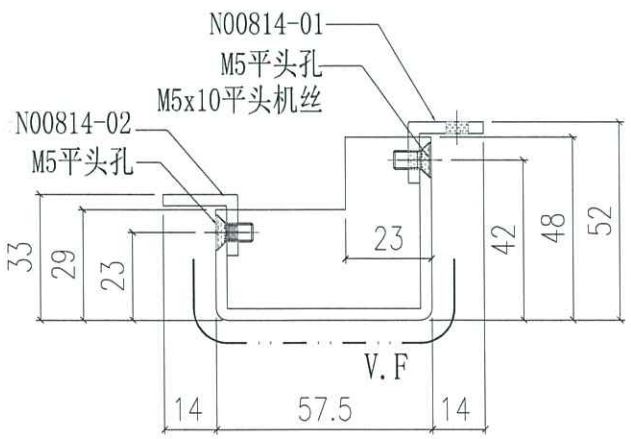


SECTION A-A

暂停

美特鋁質有限公司 MIDI Aluminium Fabricator Ltd.				工程號	J858	類別		物料號	-		
				地盘	康城11期	制圖	W.E.X	2022-08-11	圖號	AQ-71	
修改	-	-	-	採用工廠	地盤 ✓	图纸名称	铝板加工图	復核	-	-	數量	-
日期	-	-	-	材料颜色	PVF2（香槟金）	材料-	3mm THK.铝板	批准	-	-	單件重量	- (KG)


数量 2

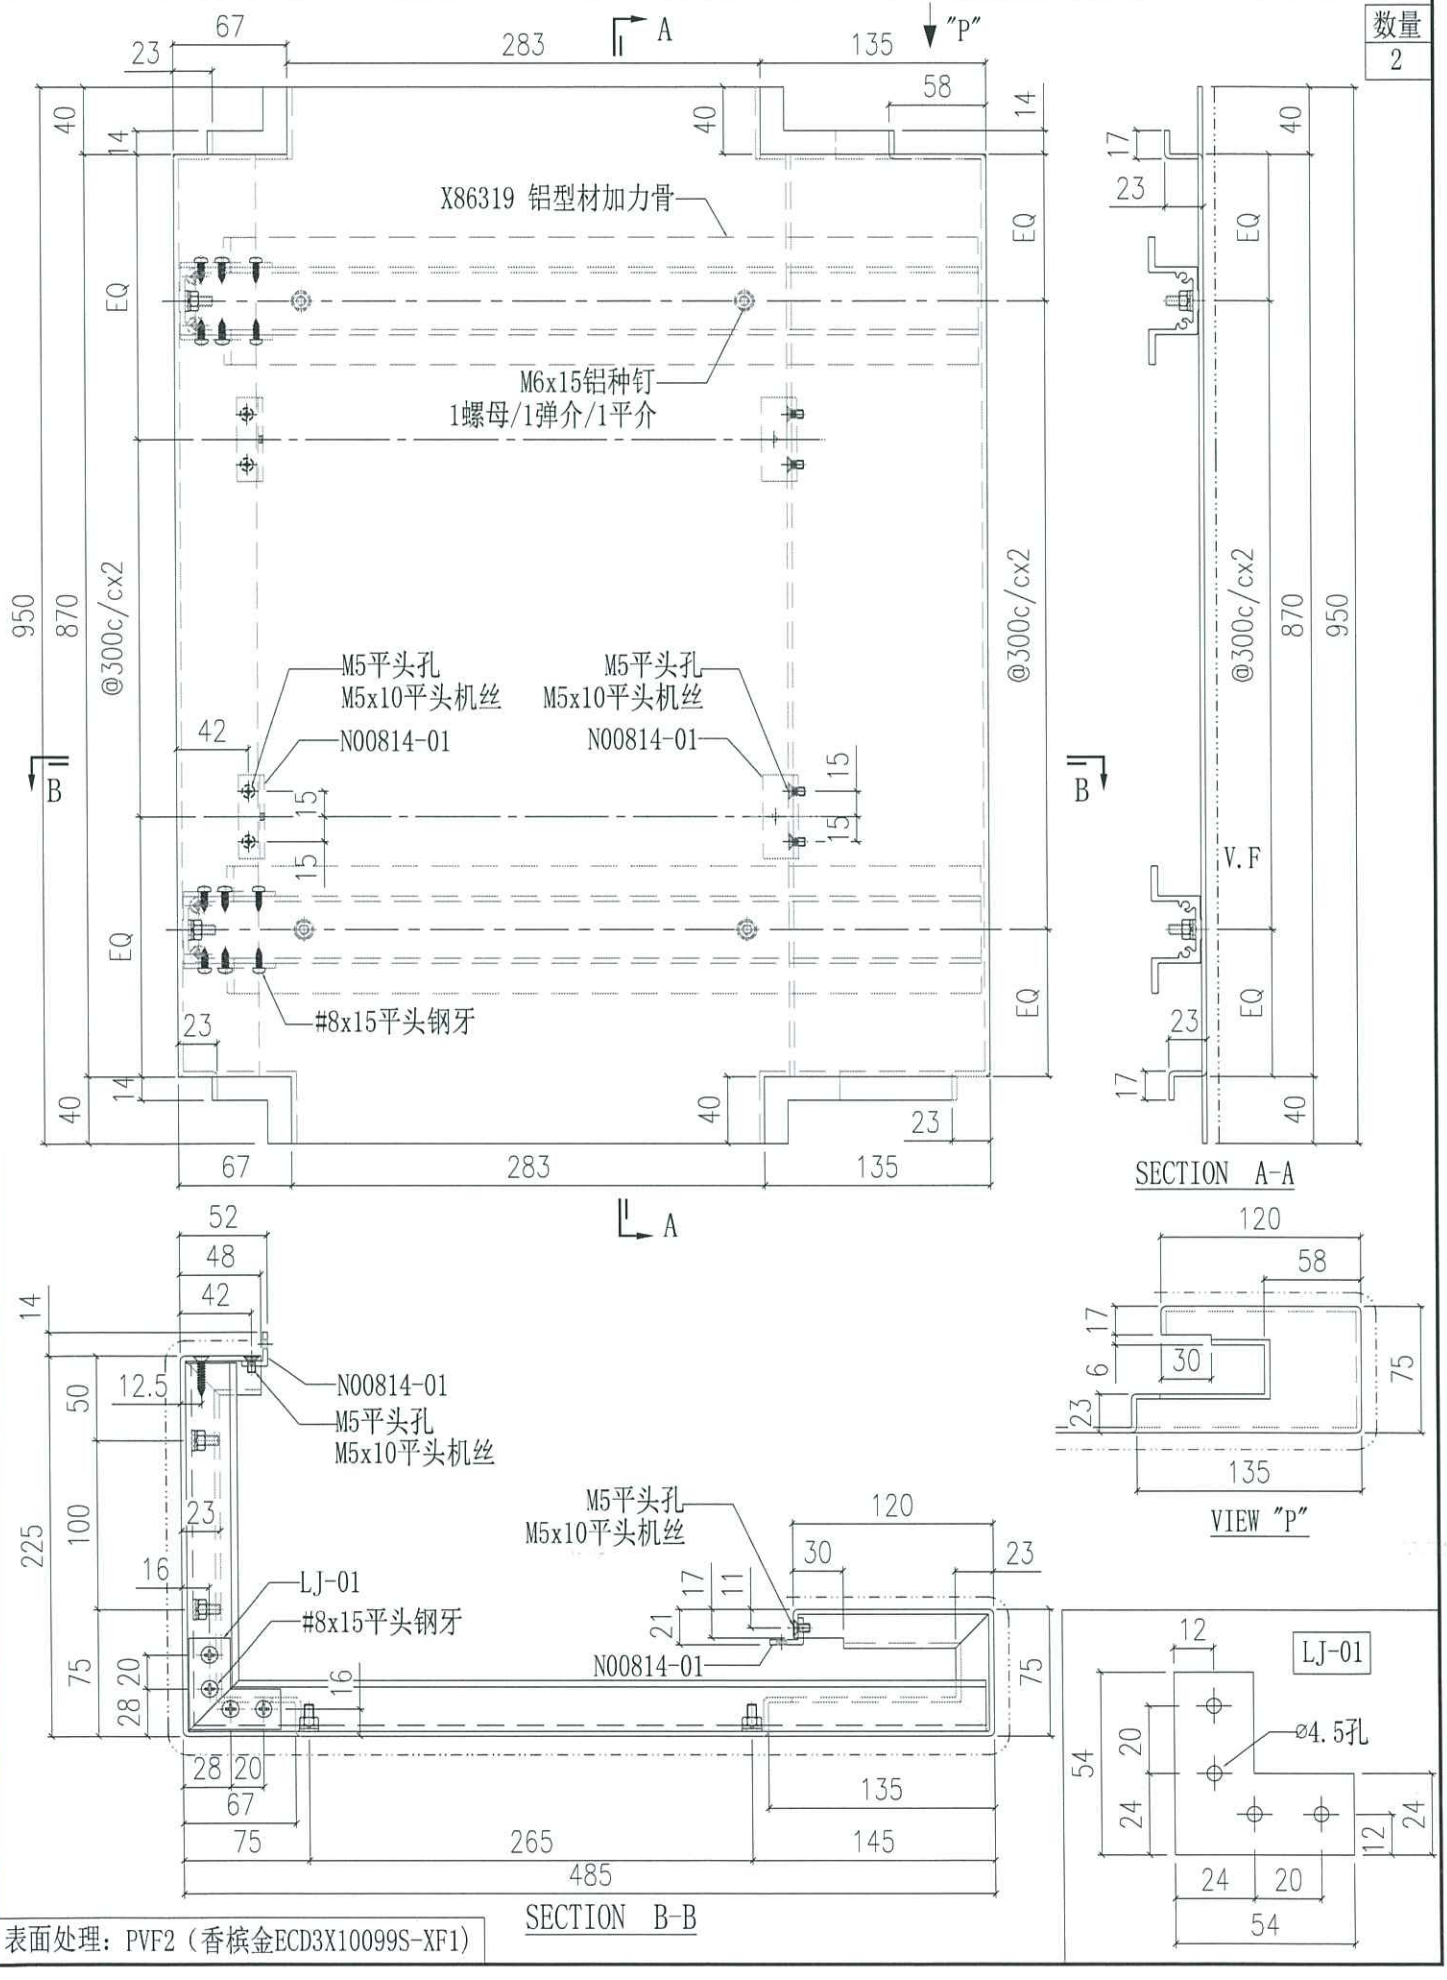

表面处理：PVF2（香槟金ECD3X10099S-XF1）

美特鋁質有限公司 MIDI Aluminium Fabricator Ltd.				工程號	J858	類別		物料號	-		
				地盘	康城11期	制圖	W.E.X	2022-08-11	圖號	AQ-72	
修改	-	-	-	採用 工廠	地盤 ✓	图纸名称	铝折件	復核	-	-	數量	-	
日期	-	-	-	材料颜色	PVF2（香槟金）	材料	3.0mm 铝板	批准	-	-	單件重量	-	(KG)


表面處理: PVF2 (香檳金ECD3X10099S-JF2

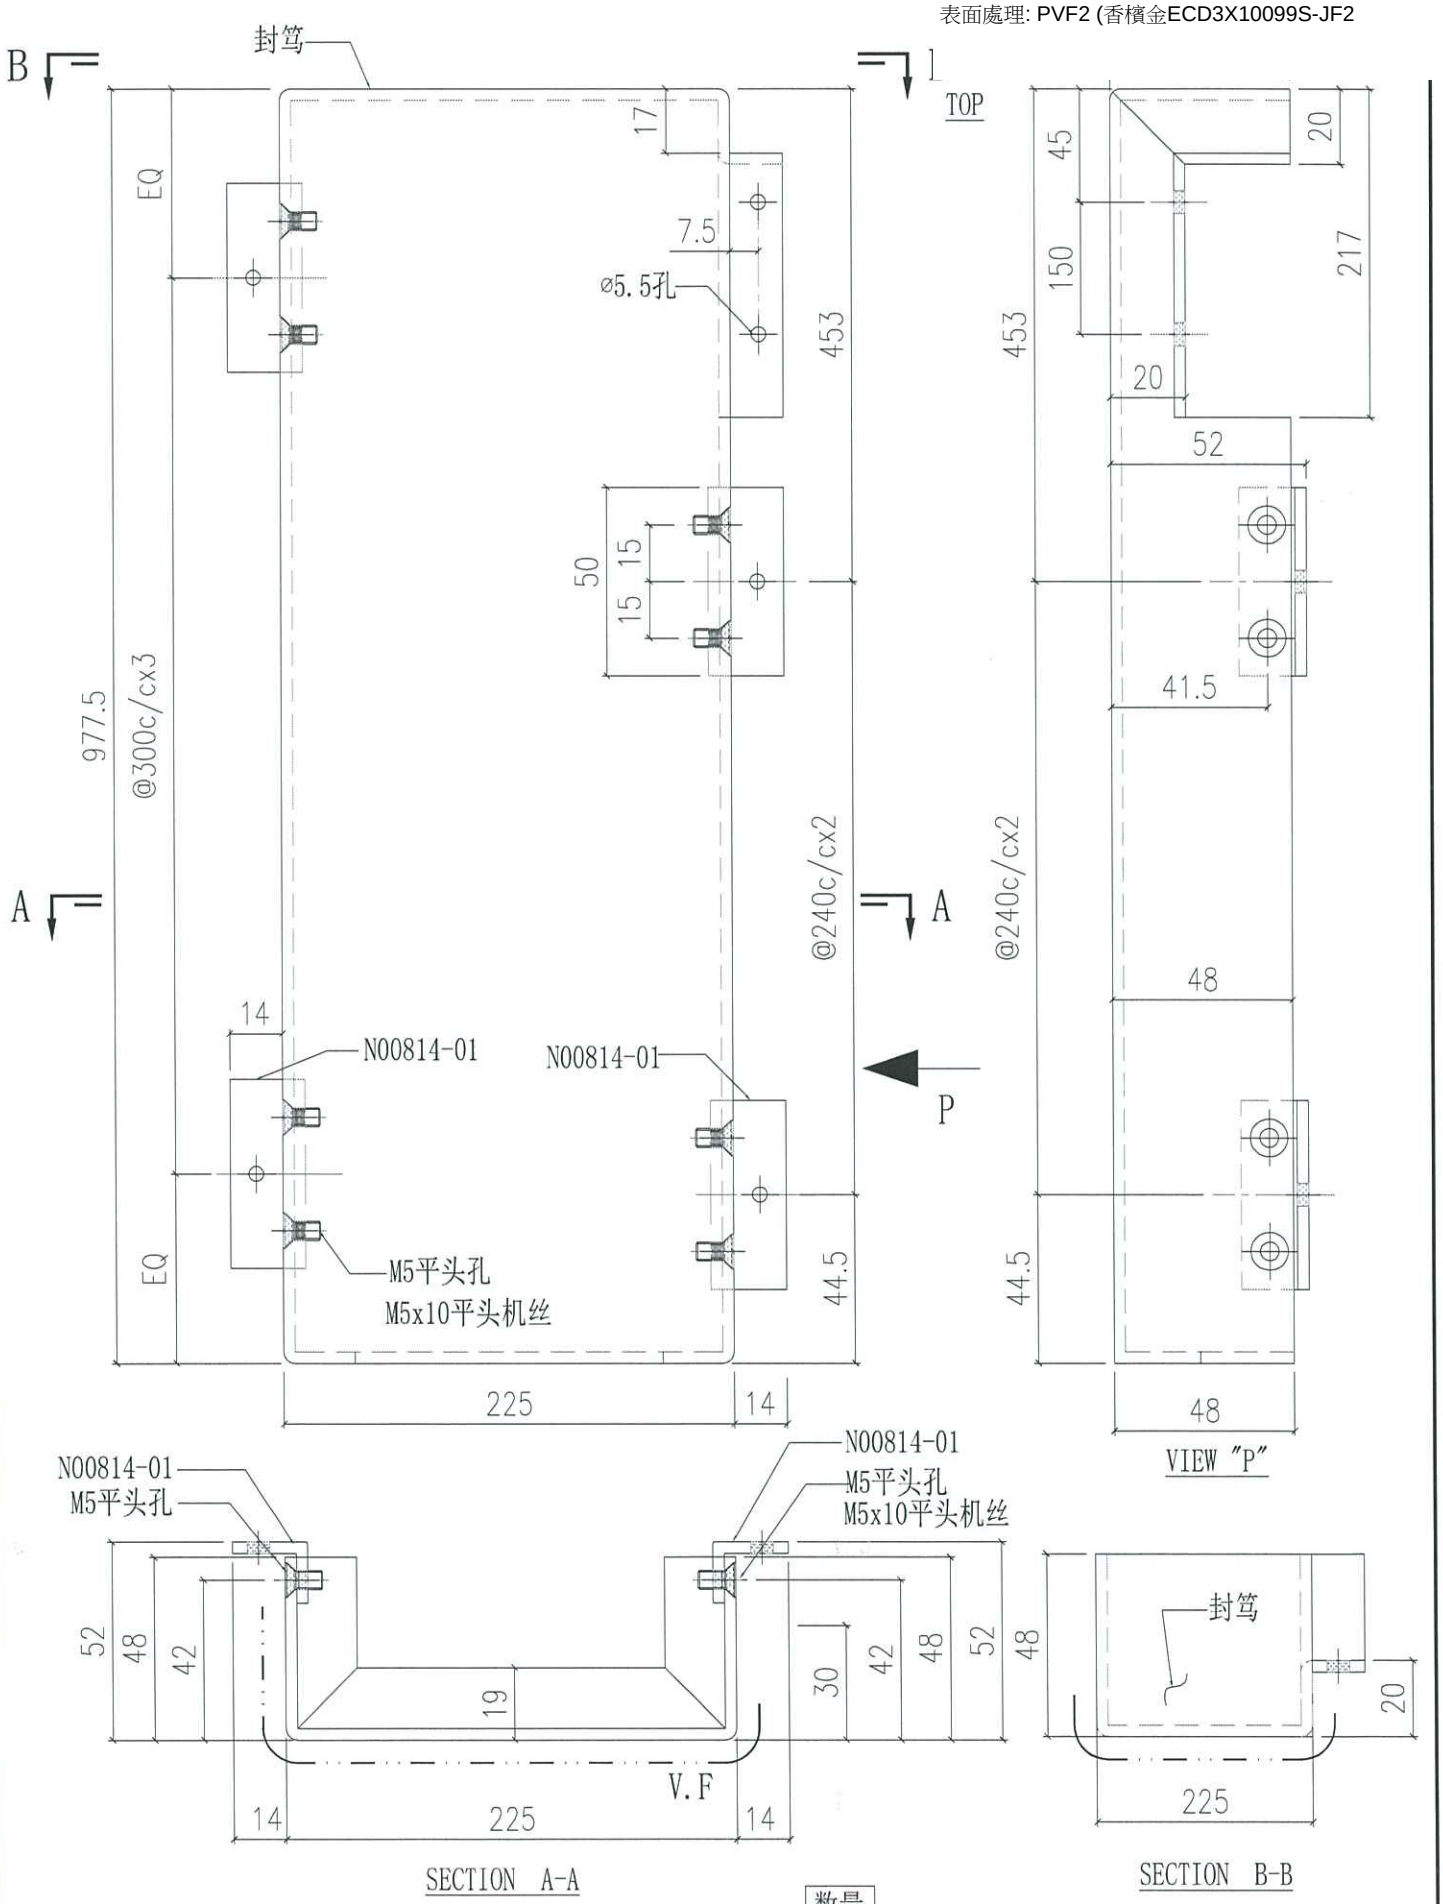

数量
2


美特鋁質有限公司 MIDI Aluminium Fabricator Ltd.					工程號	J858	類別		物料號	-		
					地盤	康城11期	制圖	W.E.X	2022-08-11	圖號	AQ-73	
修改	-	-	-	採用 工廠		地盤 ✓	图纸名称	铝折件	復核	-	-	數量	-
日期	-	-	-	材料顏色	PVF2（香槟金）		材料	3.0mm 铝板	批准	-	-	單件重量	- (KG)

表面處理: PVF2 (香檳金ECD3X10099S-JF2

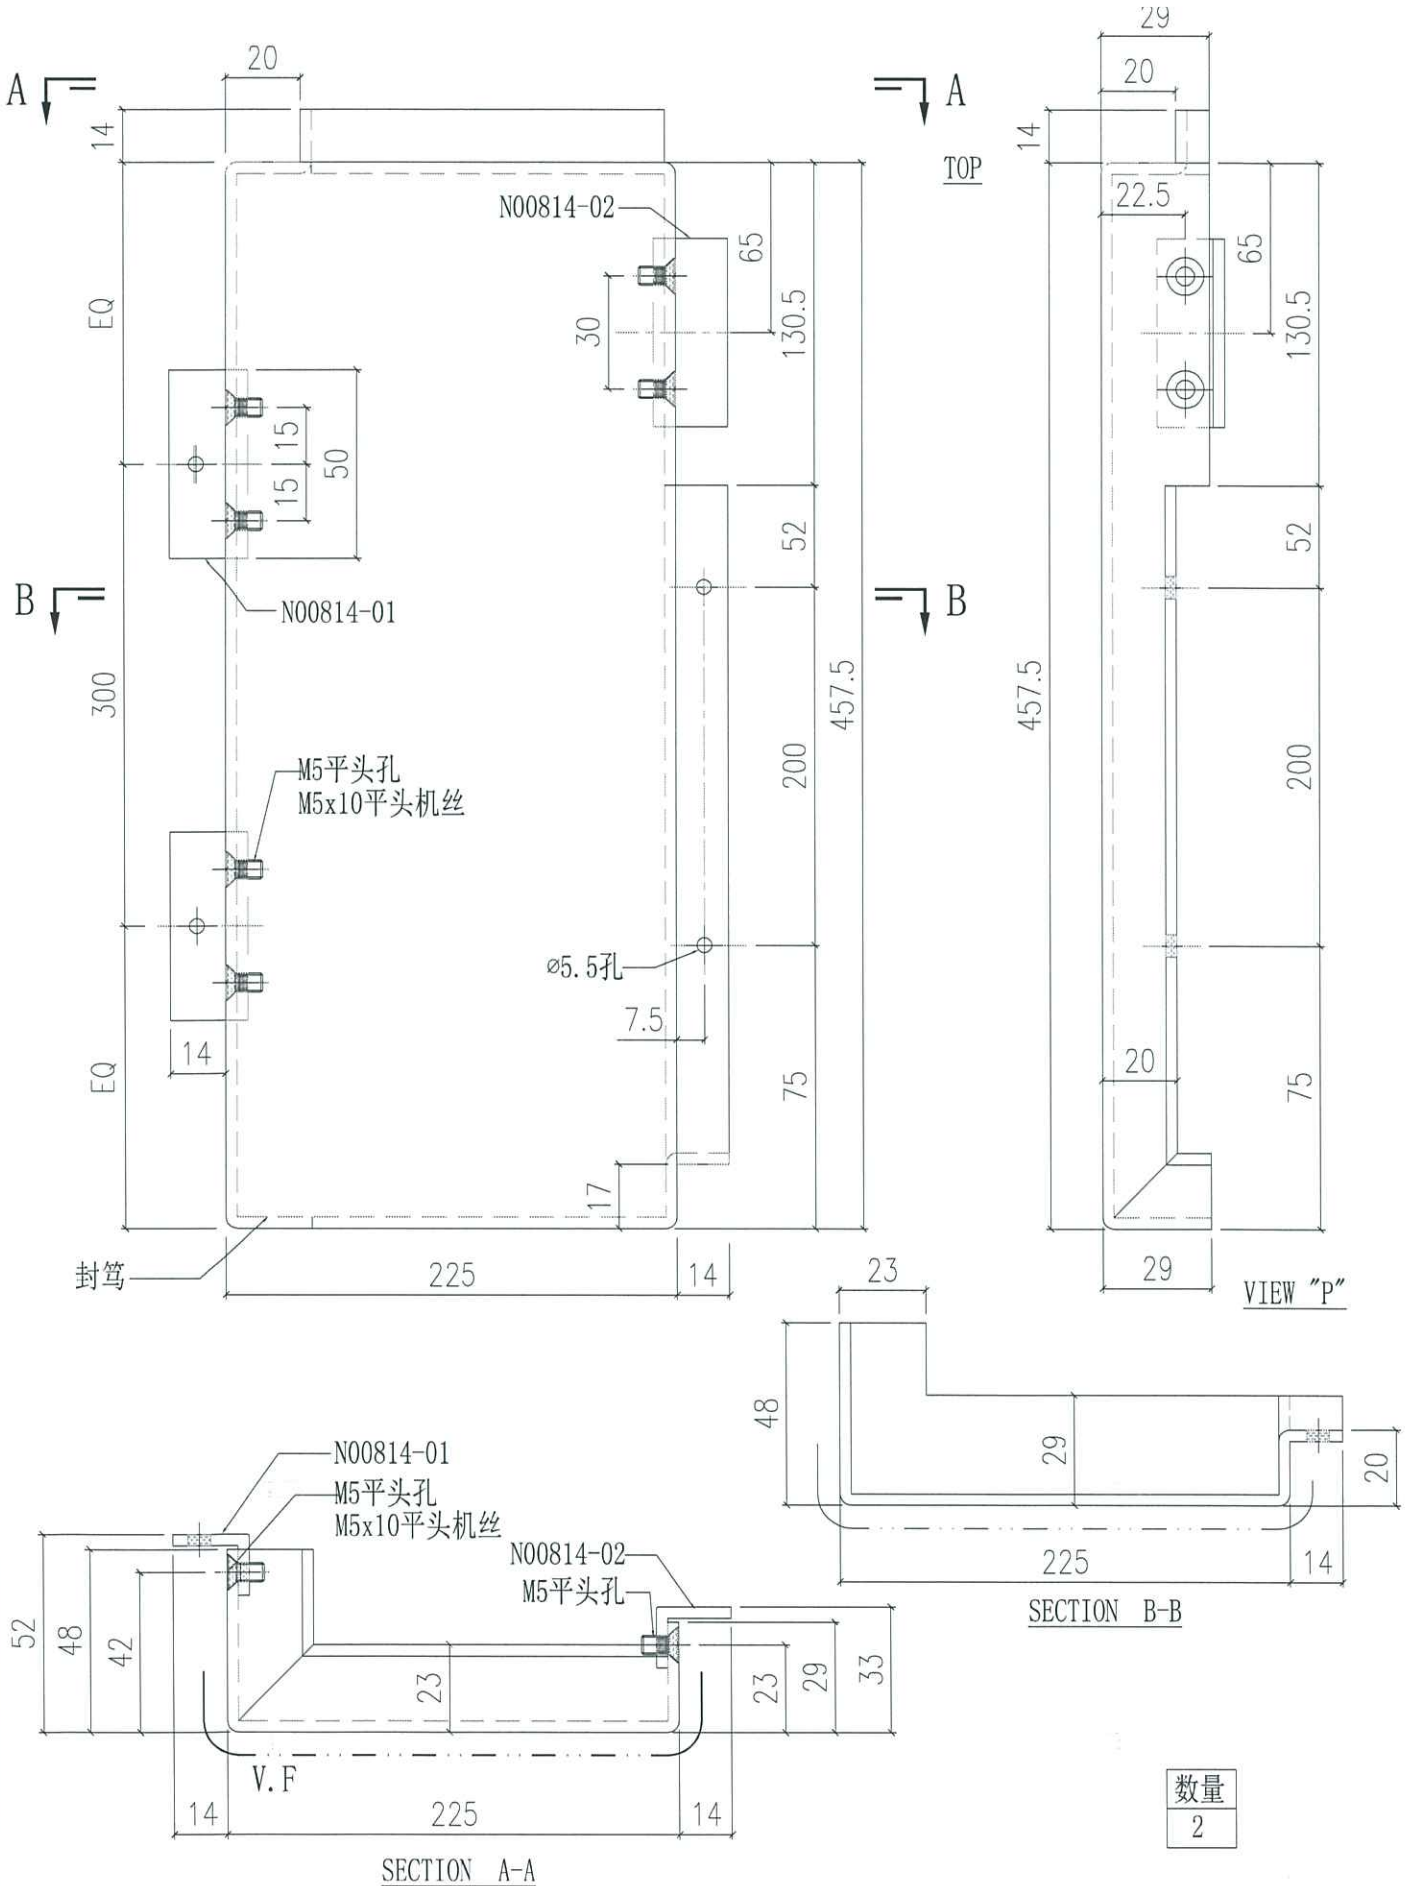

美特鋁質有限公司 MIDI Aluminium Fabricator Ltd.													
工程號	J858	類別		物料號	-								
地盘	康城11期	制圖	Z.	2022-11-26	圖號	AQ-75							
修改	-	-	-	採用	工廠	✓	地盤	图纸名称	铝板加工图	復核	-	-	數量	-	
日期	-	-	-	材料颜色	PVF2 (香槟金)			材料	3.0mm 铝板	批准	-	-	單件重量	-	(KG)

表面處理: PVF2 (香檳金ECD3X10099S-JF2

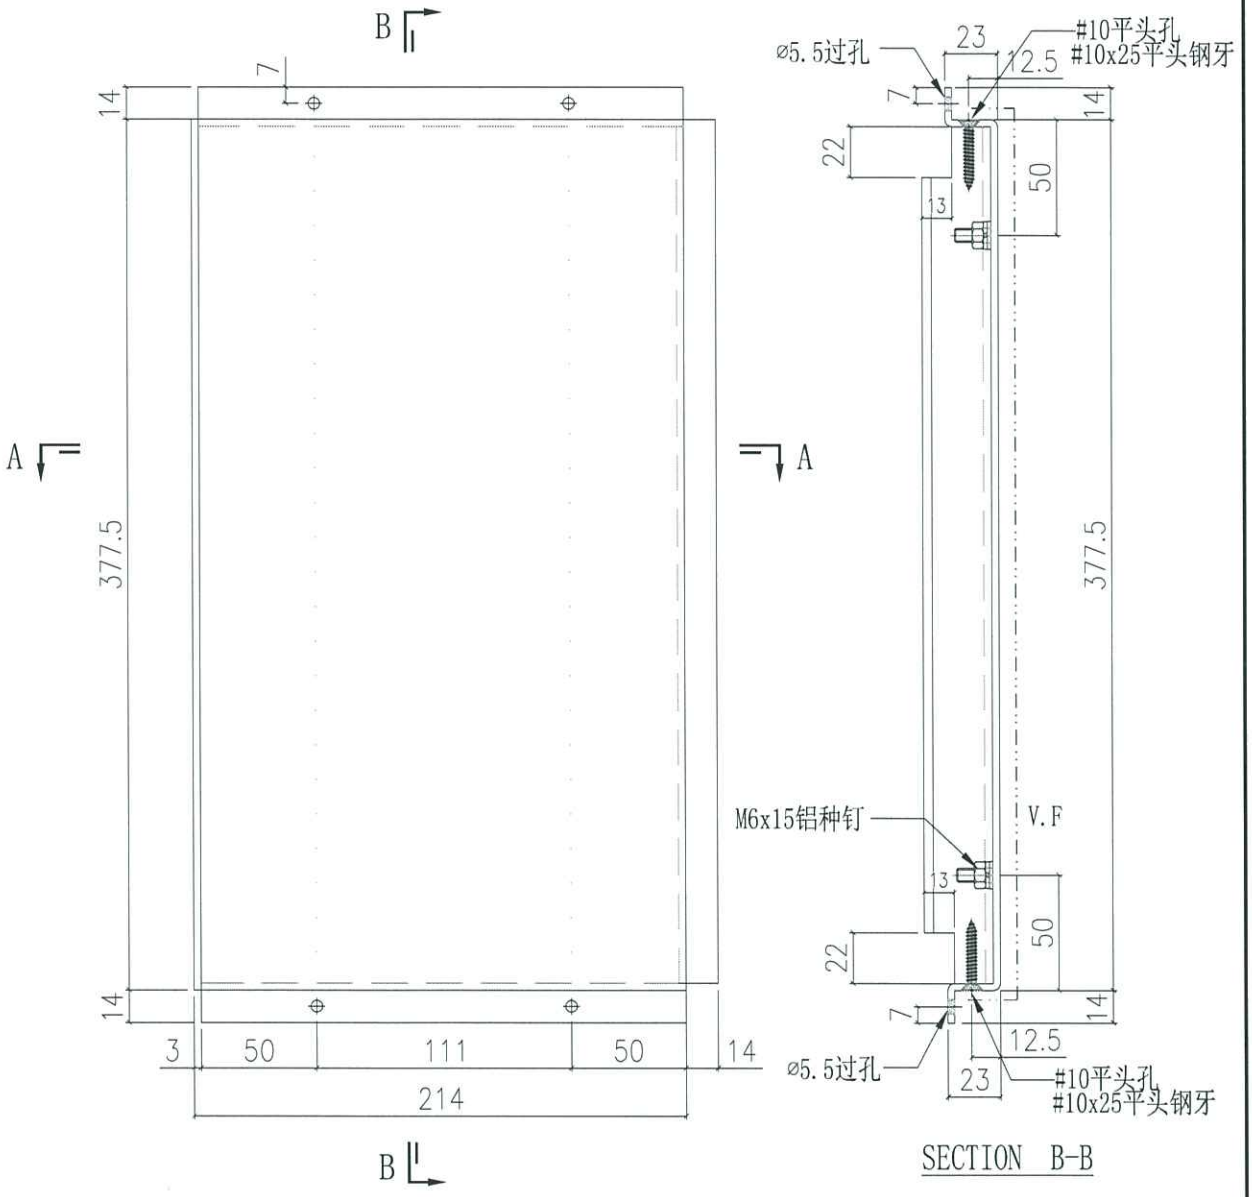

SECTION B-B




SECTION A-A

A-B 套

3	T1, T2, T3 9/F
数量	使用位置

美特鋁質有限公司 MIDI Aluminium Fabricator Ltd.				工程號	J858	類別		物料號	-		
				地盘	康城11期	制圖	Z.	2022-11-26	圖號	AQ-76	
修改	-	-	-	採用 工廠 ✓ 地盤		图纸名称	铝板加工图	復核	-	-	數量	-	
日期	-	-	-	材料颜色	PVF2 (香槟金)	材料	3.0mm 铝板	批准	-	-	單件重量	-	(KG)

表面處理: PVF2 (香檳金ECD3X10099S-JF2)

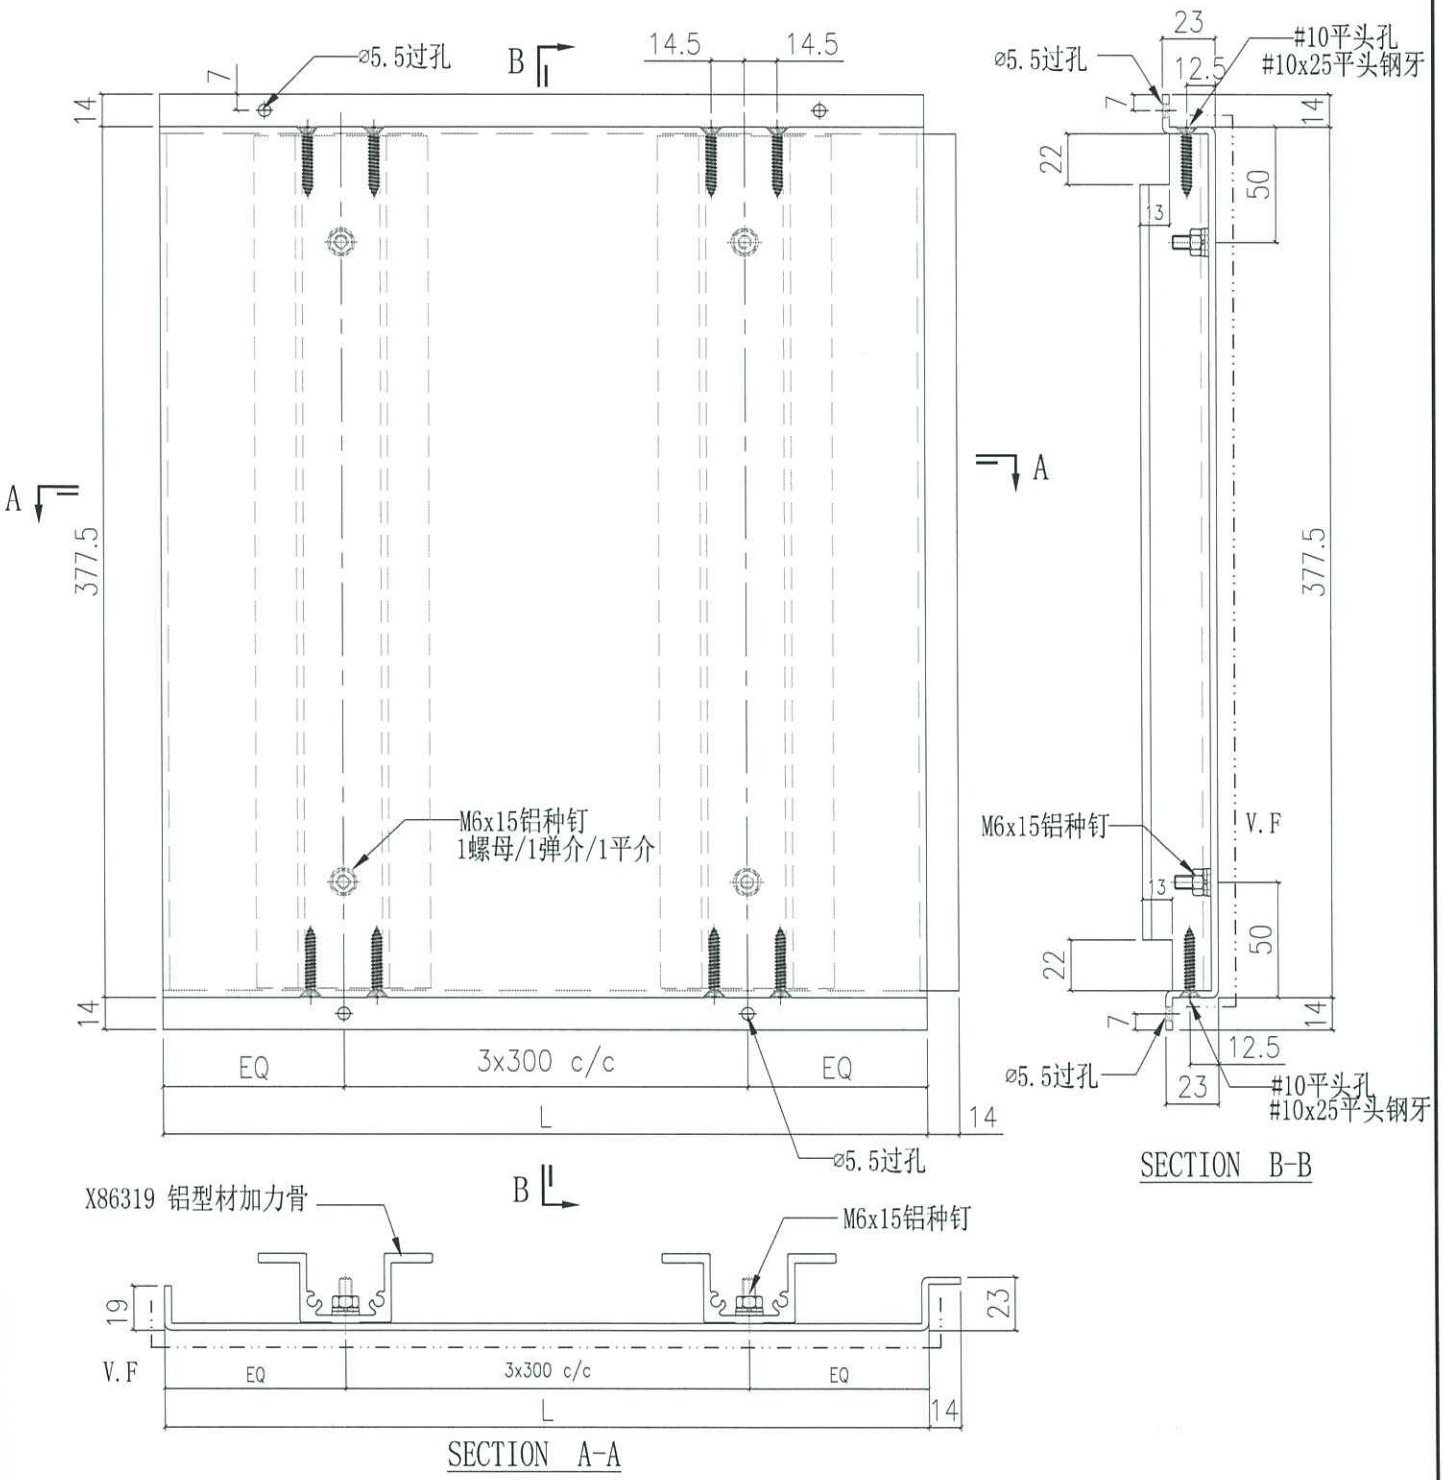



AQ-76-1	1210	1	T1 9/F
编号	L	数量	使用位置

AQ-76-2	1030	2	T2, T3 9/F
编号	L	数量	使用位置


美特鋁質有限公司 MIDI Aluminium Fabricator Ltd.				工程號	J858	類別		物料號	-		
				地盘	康城11期	制圖	Z.	2022-11-26	圖號	AQ-77	
修改	-	-	-	採用 工廠 ✓ 地盤		图纸名称	铝板加工图	復核	-	-	數量	-	
日期	-	-	-	材料颜色	PVF2 (香槟金)	材料	3.0mm 铝板	批准	-	-	單件重量	-	(KG)

表面處理: PVF2 (香檳金ECD3X10099S-JF2

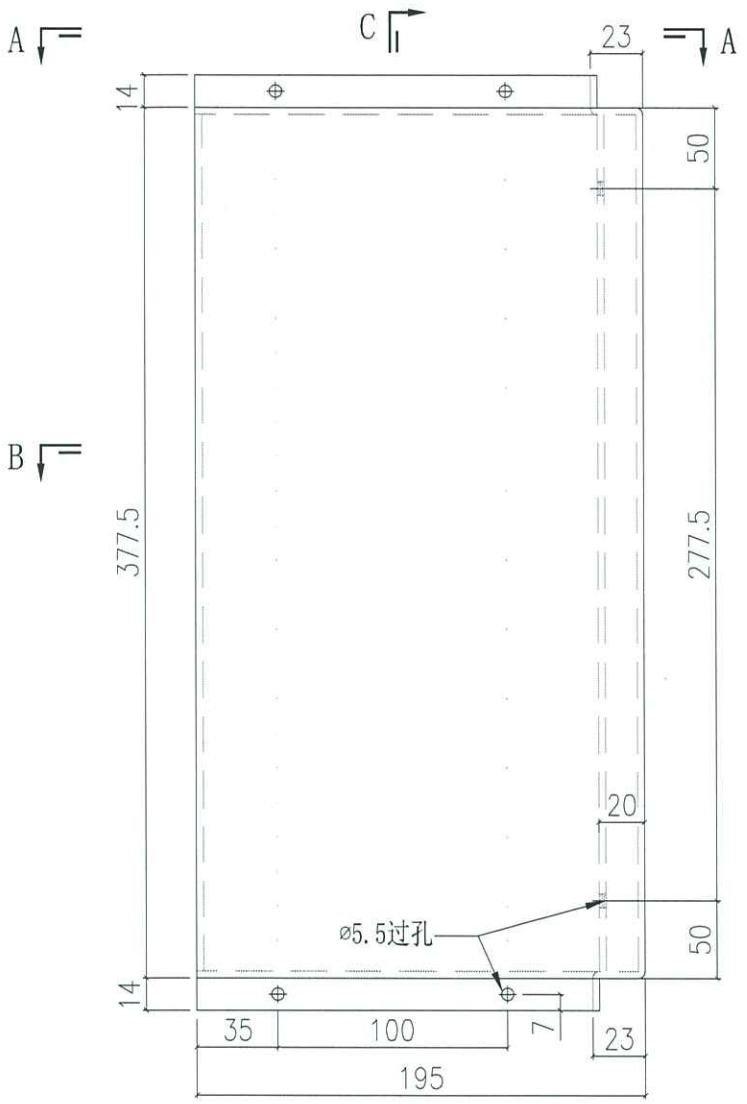


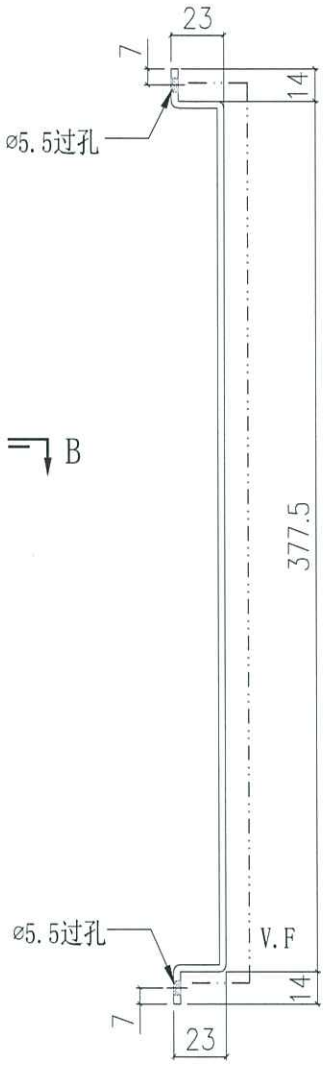

SECTION C-C

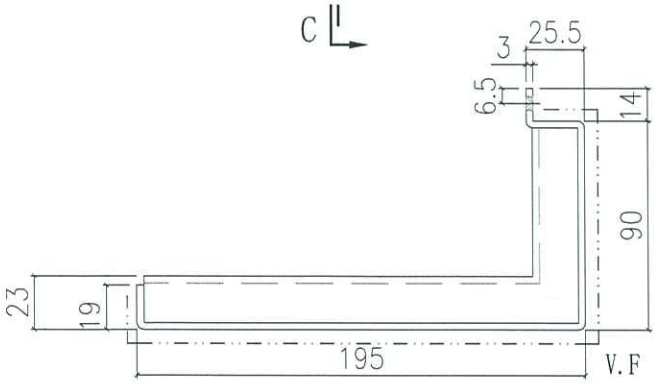

SECTION B-B

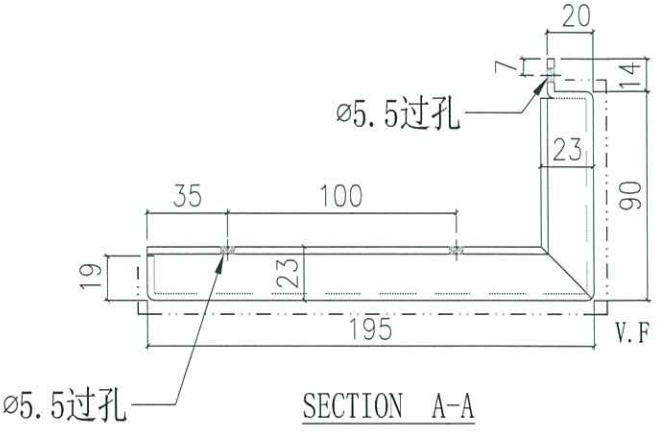


SECTION A-A

3	T1, T2, T3 9/F
数量	使用位置

美特鋁質有限公司 MIDI Aluminium Fabricator Ltd.				工程號	J858	類別		物料號	-		
				地盘	康城11期	制圖	Z.	2022-11-26	圖號	AQ-78	
修改	-	-	-	採用 工廠 ✓ 地盤		图纸名称	铝板加工图	復核	-	-	數量	-	
日期	-	-	-	材料颜色	PVF2 (香檳金)	材料	3.0mm 铝板	批准	-	-	單件重量	-	(KG)


表面處理: PVF2 (香檳金ECD3X10099S-JF2

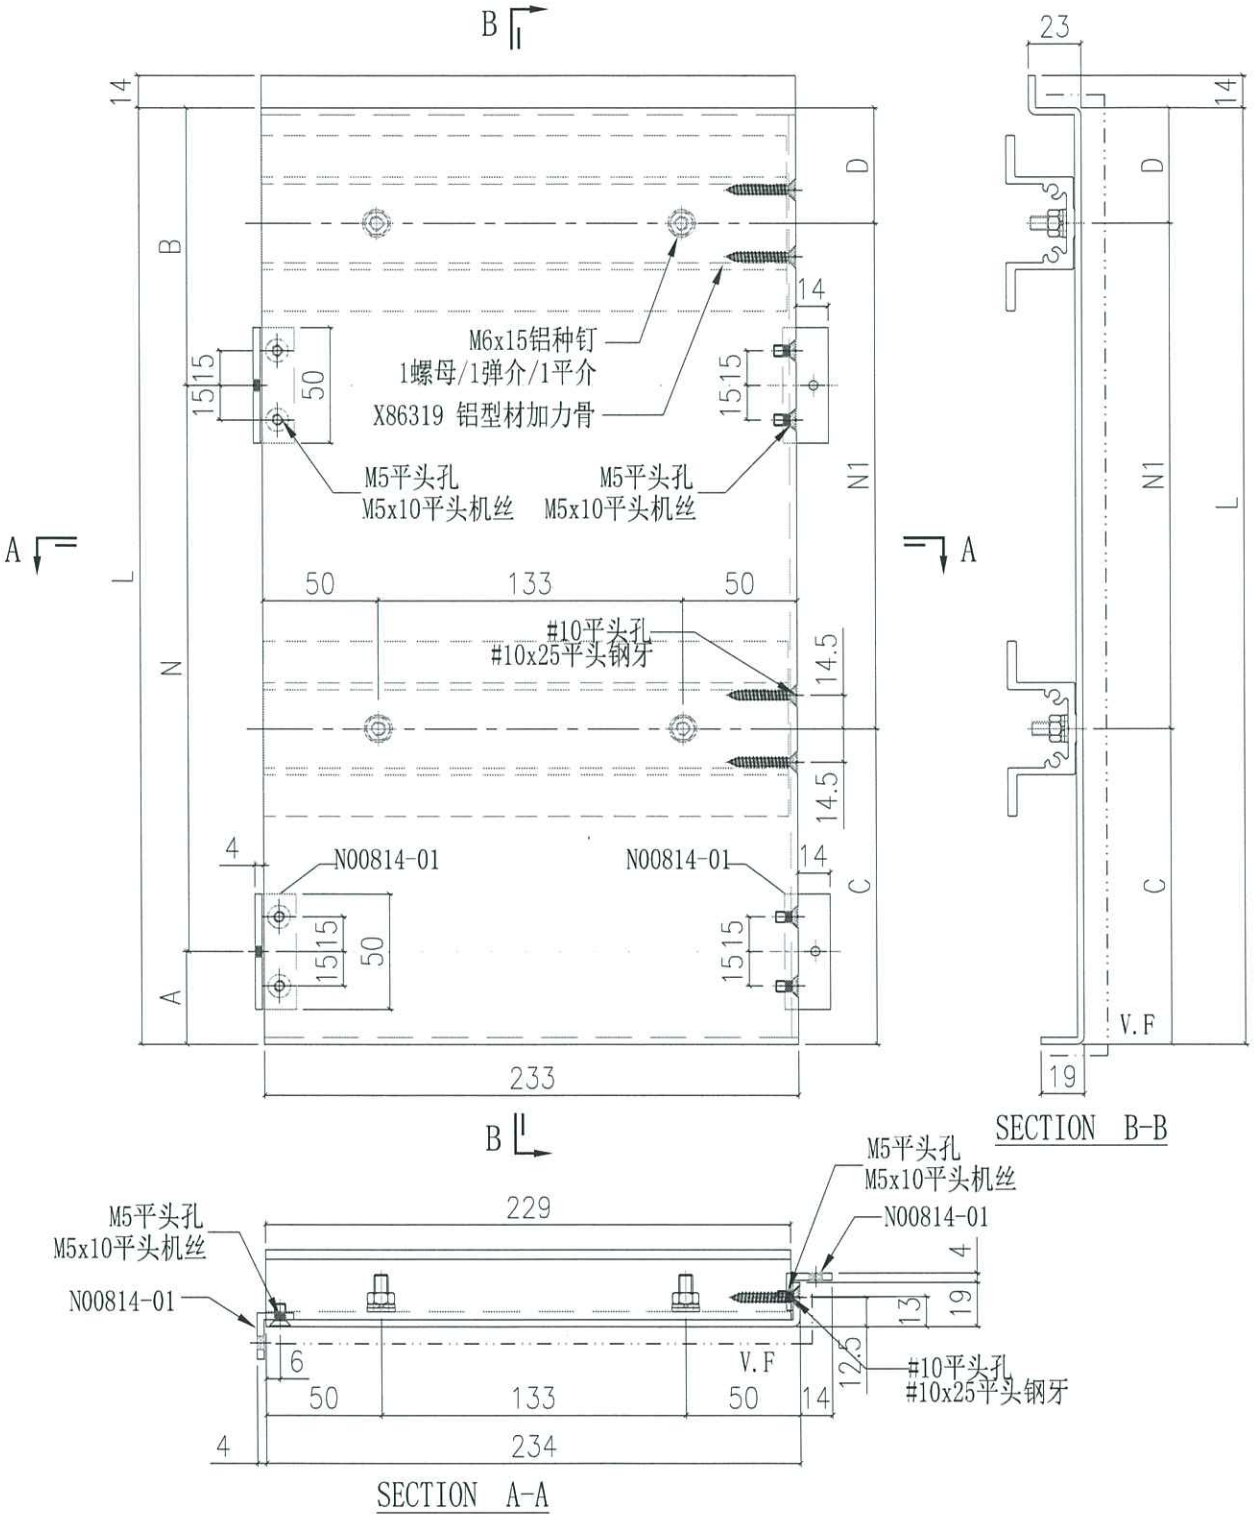

编号	L	N	A	B	C	D	N1	数量	使用位置
AQ-78-4	350	1x250 c/c	50	50	-	-	-	6	T1, T2, T3 AB座之间
AQ-78-3	917.5	3x270 c/c	40	67.5	175	202.5	2x270 c/c	6	T1, T2, T3 AB座之间
AQ-78-2	885	2x300 c/c	107.5	177.5	50	235	2x300 c/c	146	T1, T2, T3 AB座之间
AQ-78-1	2385	7x300 c/c	107.5	177.5	240	327.5	6x300 c/c	140	T1, T2, T3 AB座之间

美特鋁質有限公司 MIDI Aluminium Fabricator Ltd.				工程號	J858	類別		物料號	-		
				地盤	康城11期	制圖	Z.	2022-11-26	圖號	AQ-79	
修改	-	-	-	採用 工廠 ✓ 地盤		图纸名称	铝板加工图	復核	-	-	數量	-	
日期	-	-	-	材料颜色	PVF2 (香槟金)	材料	3.0mm 铝板	批准	-	-	單件重量	-	(KG)

表面處理: PVF2 (香檳金ECD3X10099S-JF2

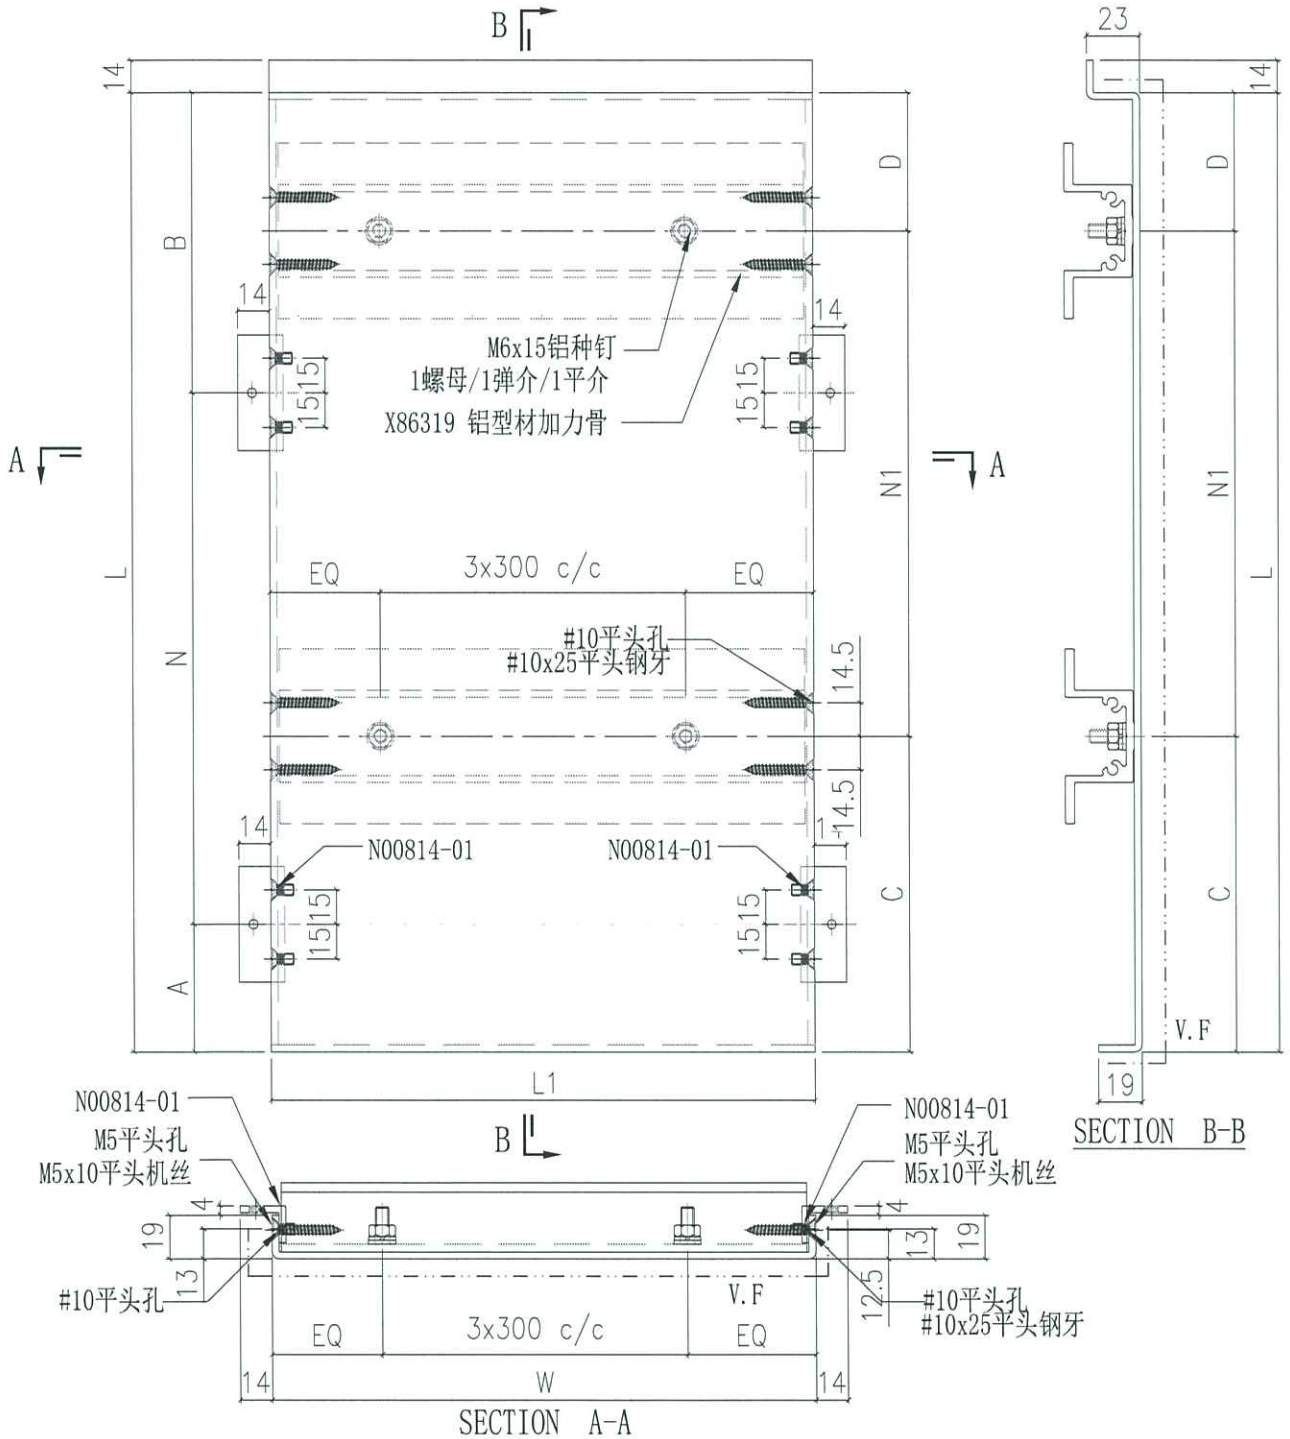


AQ-79-3B	1030	2335	7x300 c/c	108	127	258	277	6x300 c/c	4	T2, T3
AQ-79-2B	1030	885	2x300 c/c	177.5	107.5	77.5	207.5	2x300 c/c	100	T2, T3
AQ-79-1B	1030	2385	7x300 c/c	177.5	107.5	327.5	257.5	6x300 c/c	96	T2, T3
编号	W	L	N	A	B	C	D	N1	数量	位置


AQ-79-3A	1210	2335	7x300 c/c	108	127	258	277	6x300 c/c	2	T1
AQ-79-2A	1210	885	2x300 c/c	177.5	107.5	77.5	207.5	2x300 c/c	46	T1
AQ-79-1A	1210	2385	7x300 c/c	177.5	107.5	327.5	257.5	6x300 c/c	44	T1
编号	W	L	N	A	B	C	D	N1	数量	位置

美特鋁質有限公司 MIDI Aluminium Fabricator Ltd.				工程號	J858	類別		物料號	-		
				地盘	康城11期	制圖	Z.	2022-11-26	圖號	AQ-80	
修改	-	-	-	图纸名称	铝板加工图	復核	-	-	數量	-	
日期	-	-	-	材料	3.0mm 铝板	批准	-	-	單件重量	-	(KG)

表面處理: PVF2 (香檳金ECD3X10099S-JF2

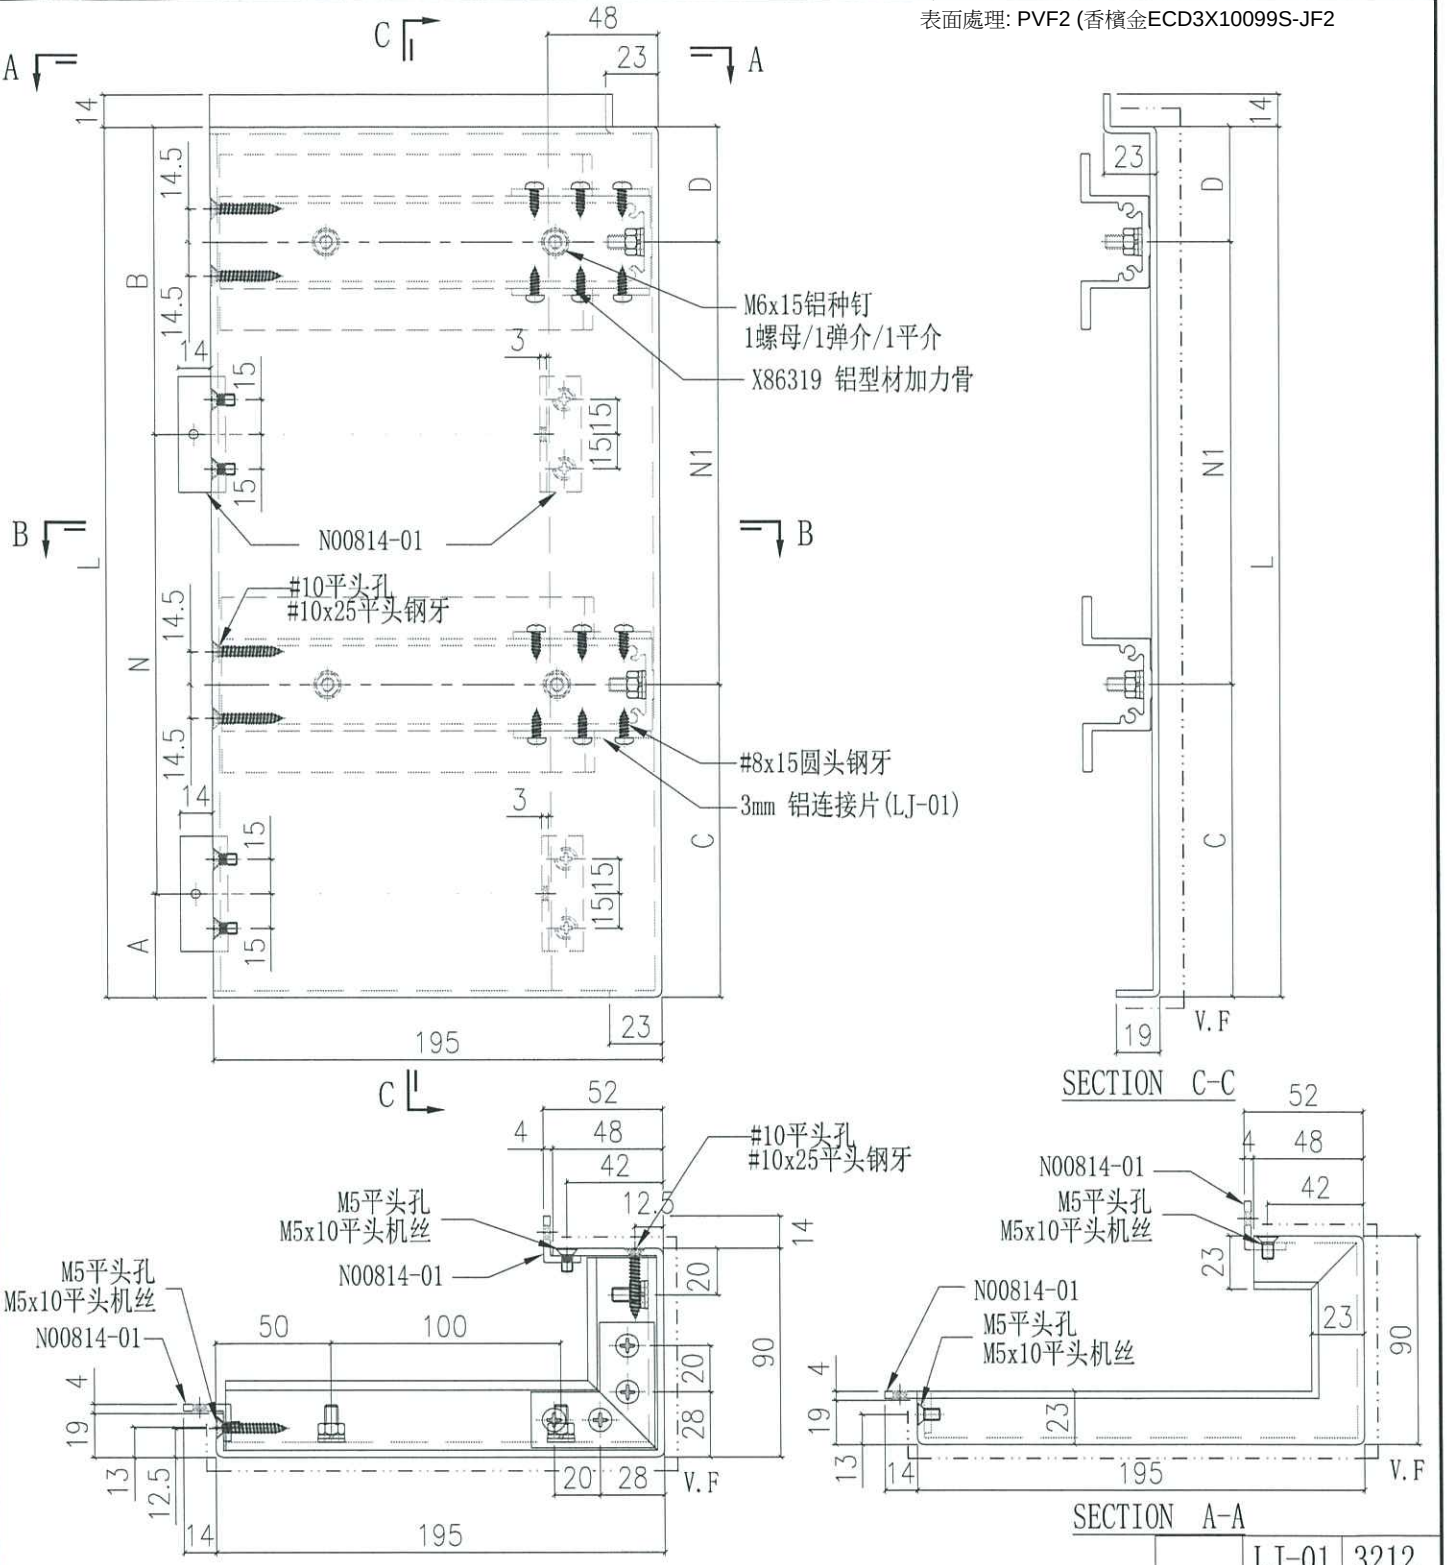


LJ-01	3212
编号	数量

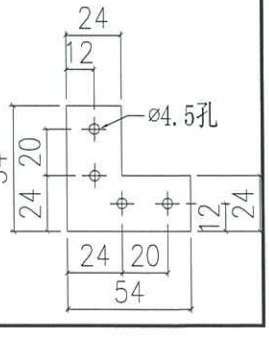

编号	L	N	A	B	C	D	N1	数量	使用位置
AQ-80-3	2335	7x300 c/c	38	197	188	347	6x300 c/c	6	T1, T2, T3
AQ-80-2	885	2x300 c/c	107.5	177.5	50	235	2x300 c/c	146	T1, T2, T3
AQ-80-1	2385	7x300 c/c	107.5	177.5	240	327.5	6x300 c/c	140	T1, T2, T3

美特鋁質有限公司 MIDI Aluminium Fabricator Ltd.				工程號	J858	類別		物料號	-		
				地盘	康城11期	制圖	Z.	2022-11-26	圖號	AQ-81	
修改	-	-	-	採用 工廠 ✓ 地盤		图纸名称	铝板加工图	復核	-	-	数量	-
日期	-	-	-	材料颜色	PVF2 (香槟金)	材料	3.0mm 铝板	批准	-	-	單件重量	- (KG)

表面處理: PVF2 (香檳金ECD3X10099S-JF2

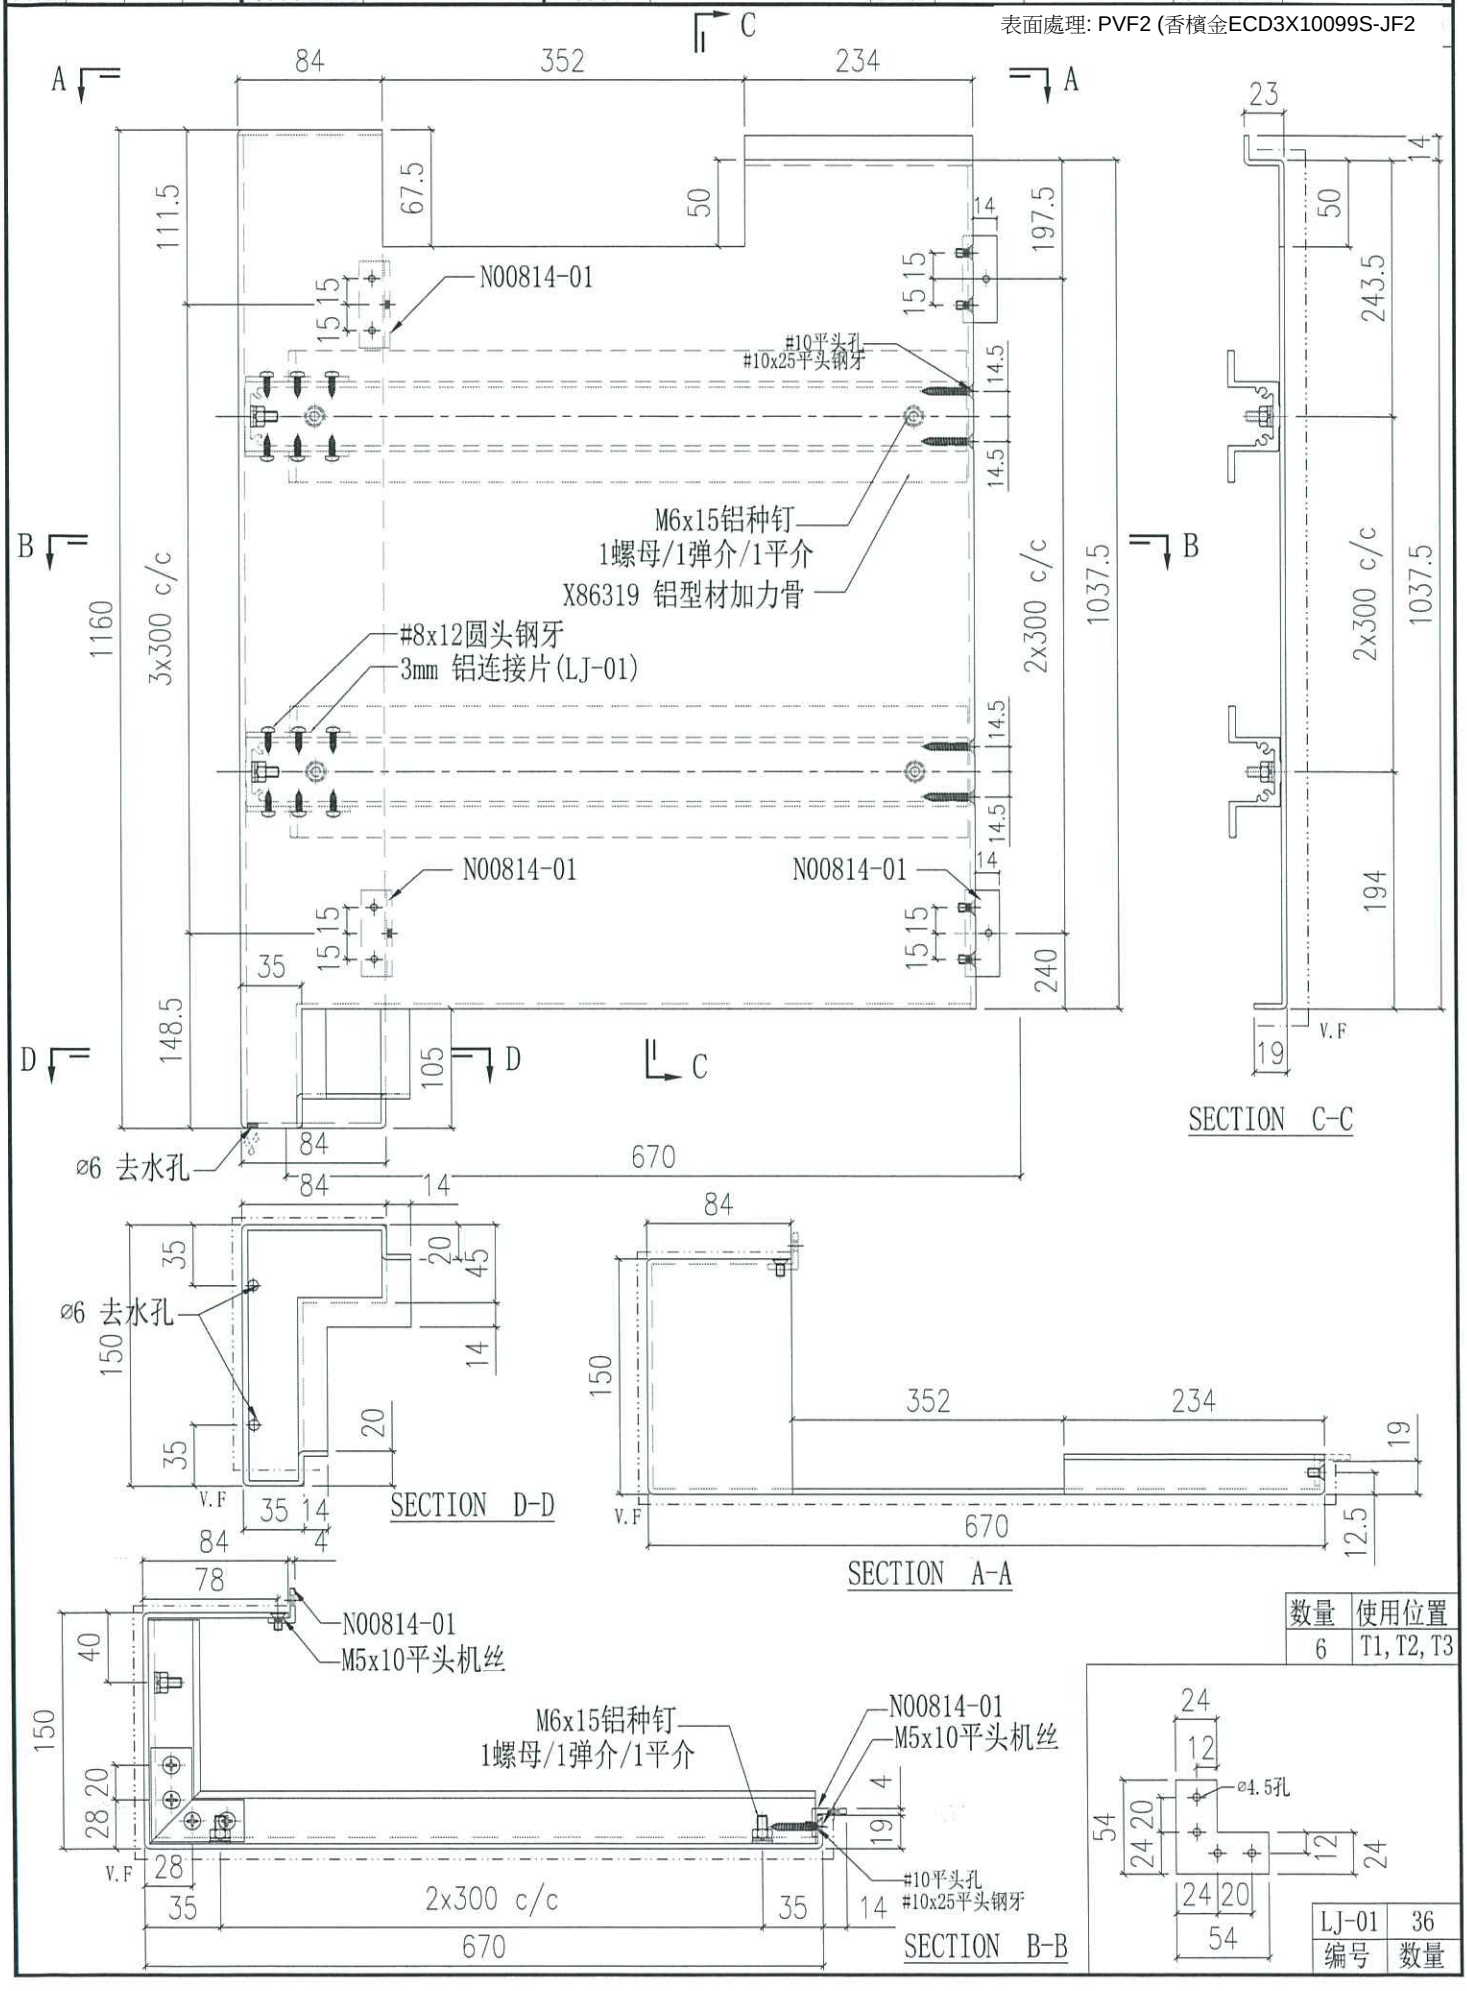


数量	使用位置
6	T1, T2, T3

LJ-01	36
编号	数量

美特鋁質有限公司 MIDI Aluminium Fabricator Ltd.				工程號	J858	類別		物料號	-		
				地盘	康城11期	制圖	W.E.X	2022-08-11	圖號	AQ-82	
修改	-	-	-	採用工廠		地盤 ✓	图纸名称	铝板加工图	復核	-	-	數量	-	
日期	-	-	-	材料颜色	PVF2 (香槟金)		材料	3mm THK.铝板	批准	-	-	單件重量	-	(KG)


表面處理: PVF2 (香檳金ECD3X10099S-JF2

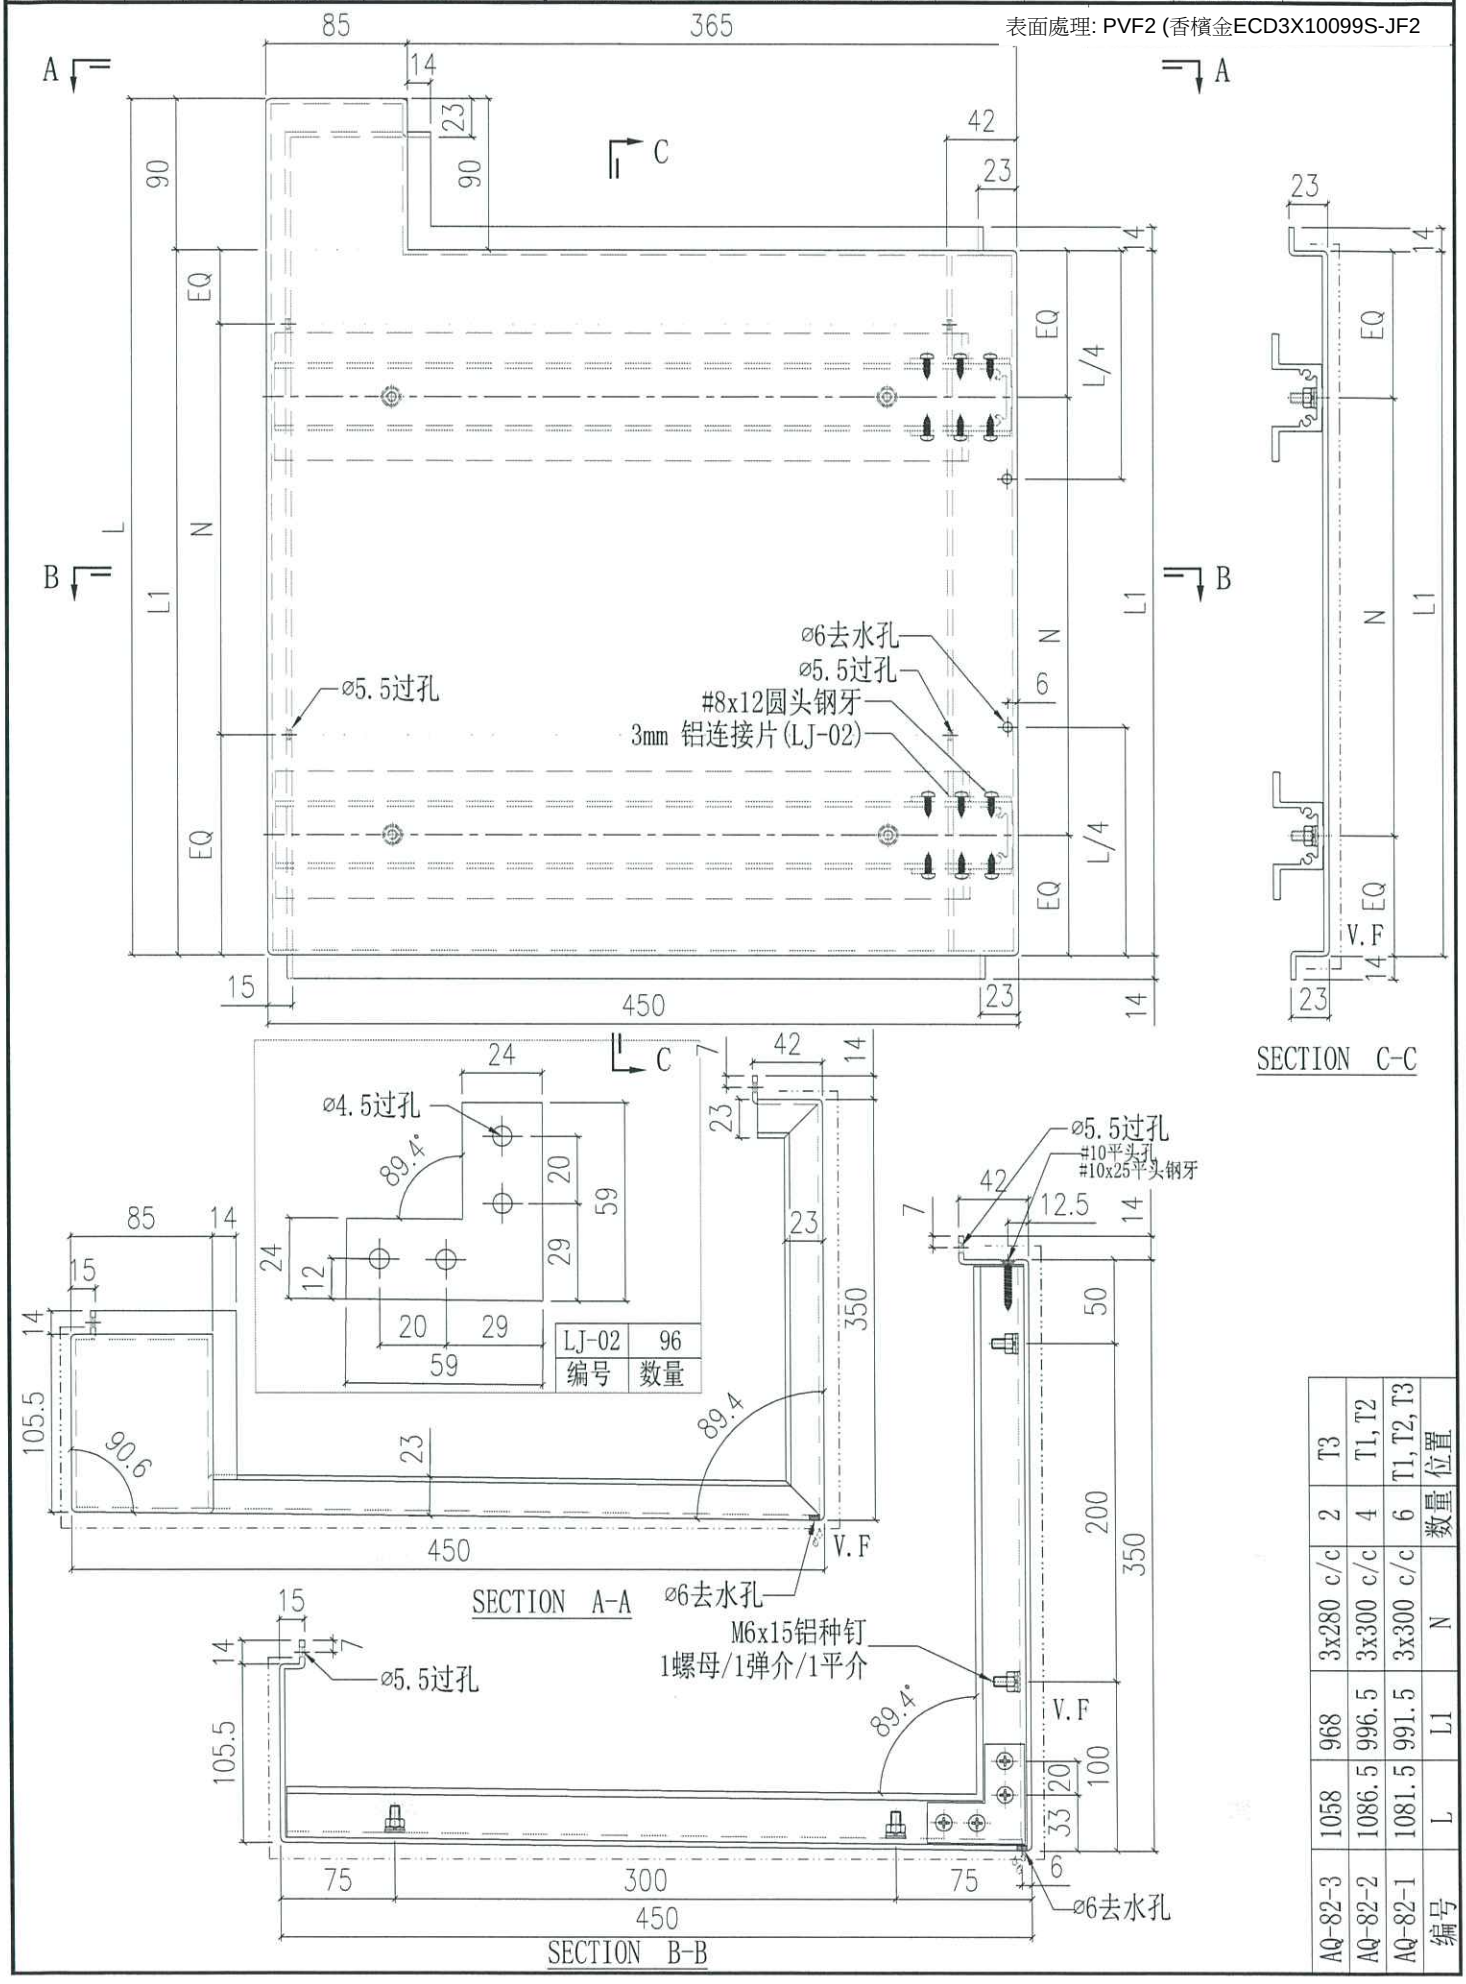


				T3		
		3x280 c/c	2	T1, T2		
1058	968	3x300 c/c	4	T1, T2, T3		
1086.5	996.5	3x300 c/c	6	数量	位置	
1081.5	991.5	N				
L	L1					
AQ-82-3	AQ-82-2	AQ-82-1				
编号						

美特鋁質有限公司 MIDI Aluminium Fabricator Ltd.				工程號	J858	類別		物料號	-		
				地盘	康城11期	制圖	W.E.X	2022-08-11	圖號	AQ-83	
修改 SECTION D-D	採用	工廠	地盤 ✓	图纸名称	铝板加工图	復核	-	-	數量	-	
日期 - - -	材料颜色	PVF2 (香槟金)		材料-	3mm THK. 铝板	批准	-	-	單件重量	-	(KG)

表面處理: PVF2 (香檳金ECD3X10099S-JF2

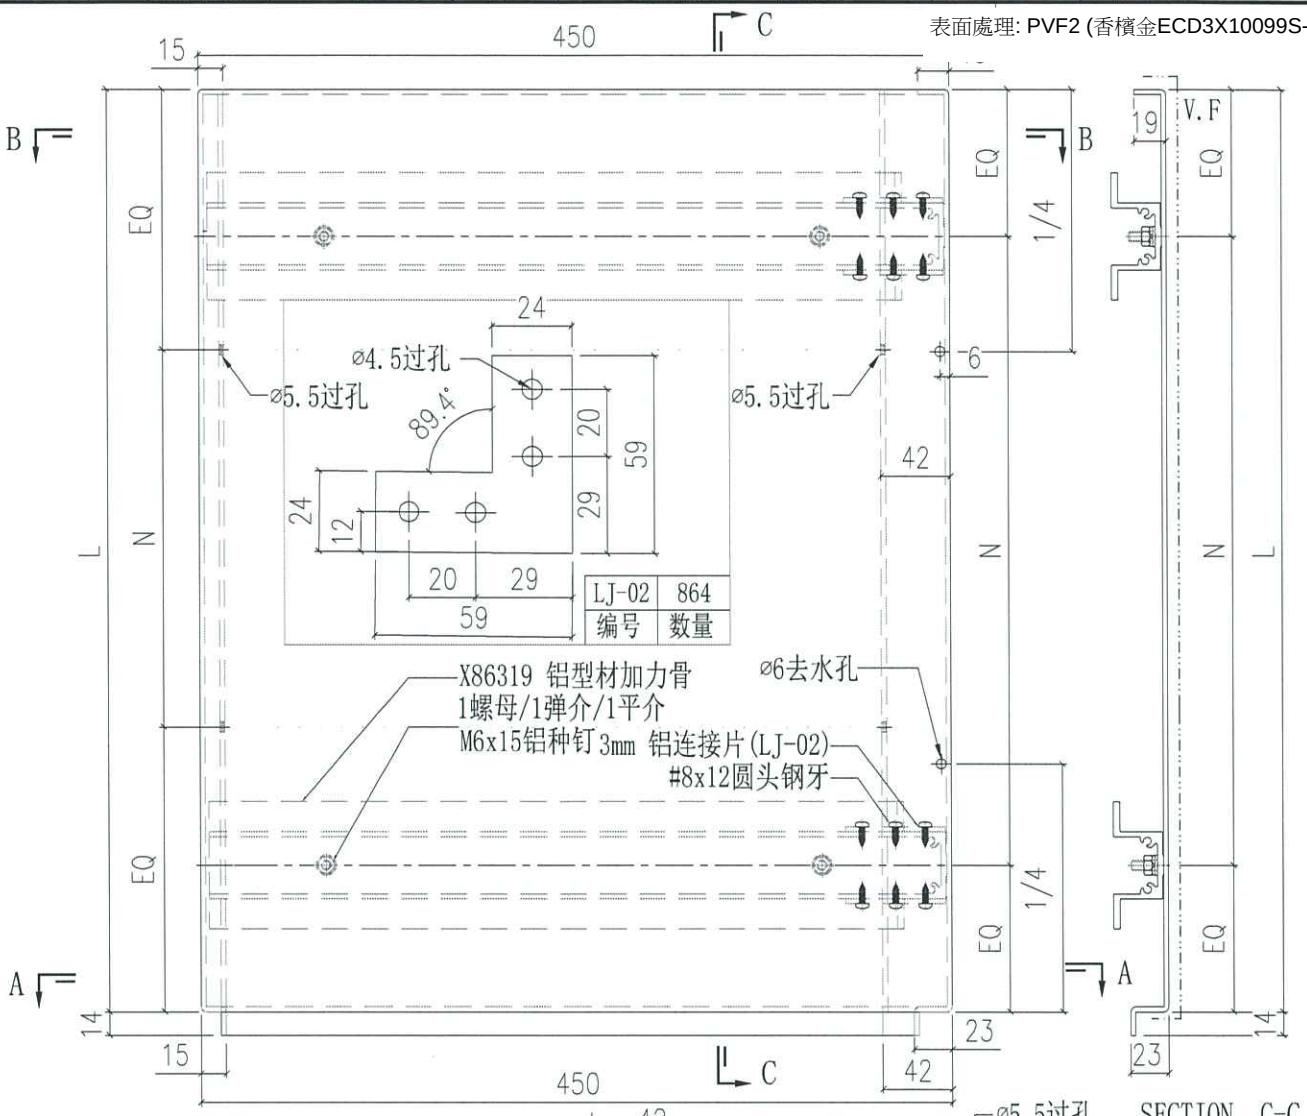

SECTION C-C

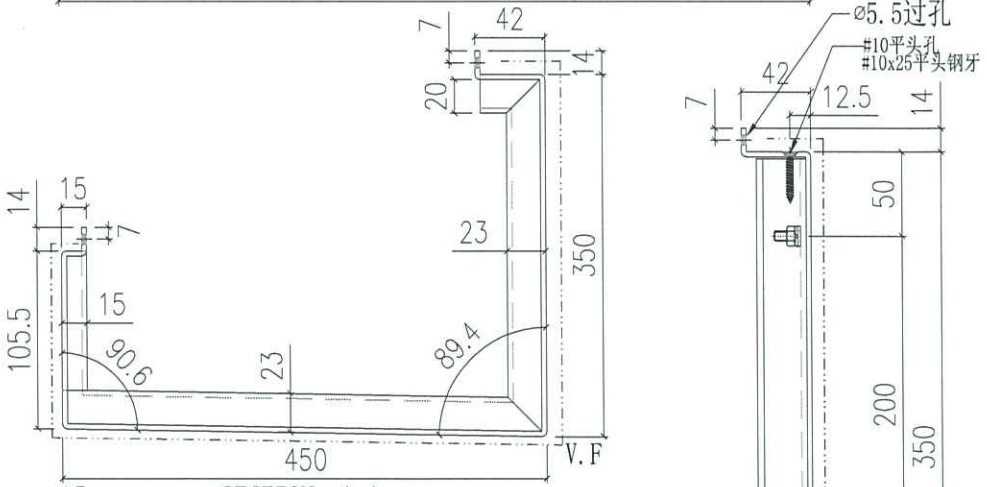


SECTION A-A

SECTION B-B


编号	L	N	数量	位置
AQ-83-5	998	3x300 c/c	4	T3
AQ-83-4	988	3x300 c/c	4	T1
AQ-83-3	970	3x280 c/c	36	T1, T2, T3
AQ-83-2	996.5	3x300 c/c	52	T1, T2, T3
AQ-83-1	991.5	3x300 c/c	12	T1, T2, T3

美特鋁質有限公司 MIDI Aluminium Fabricator Ltd.					工程號	J858	類別		物料號	-		
					地盤	康城11期	制圖	W.E.X	2022-08-11	圖號	AQ-84	
修改	-	-	-	採用 工廠		地盤 ✓	图纸名称	铝板加工图	復核	-	-	数量	-	
日期	-	-	-	材料颜色	PVF2（香槟金）		材料-	3mm THK. 铝板	批准	-	-	單件重量	-	(KG)


表面處理: PVF2 (香檳金ECD3X10099S-JF2

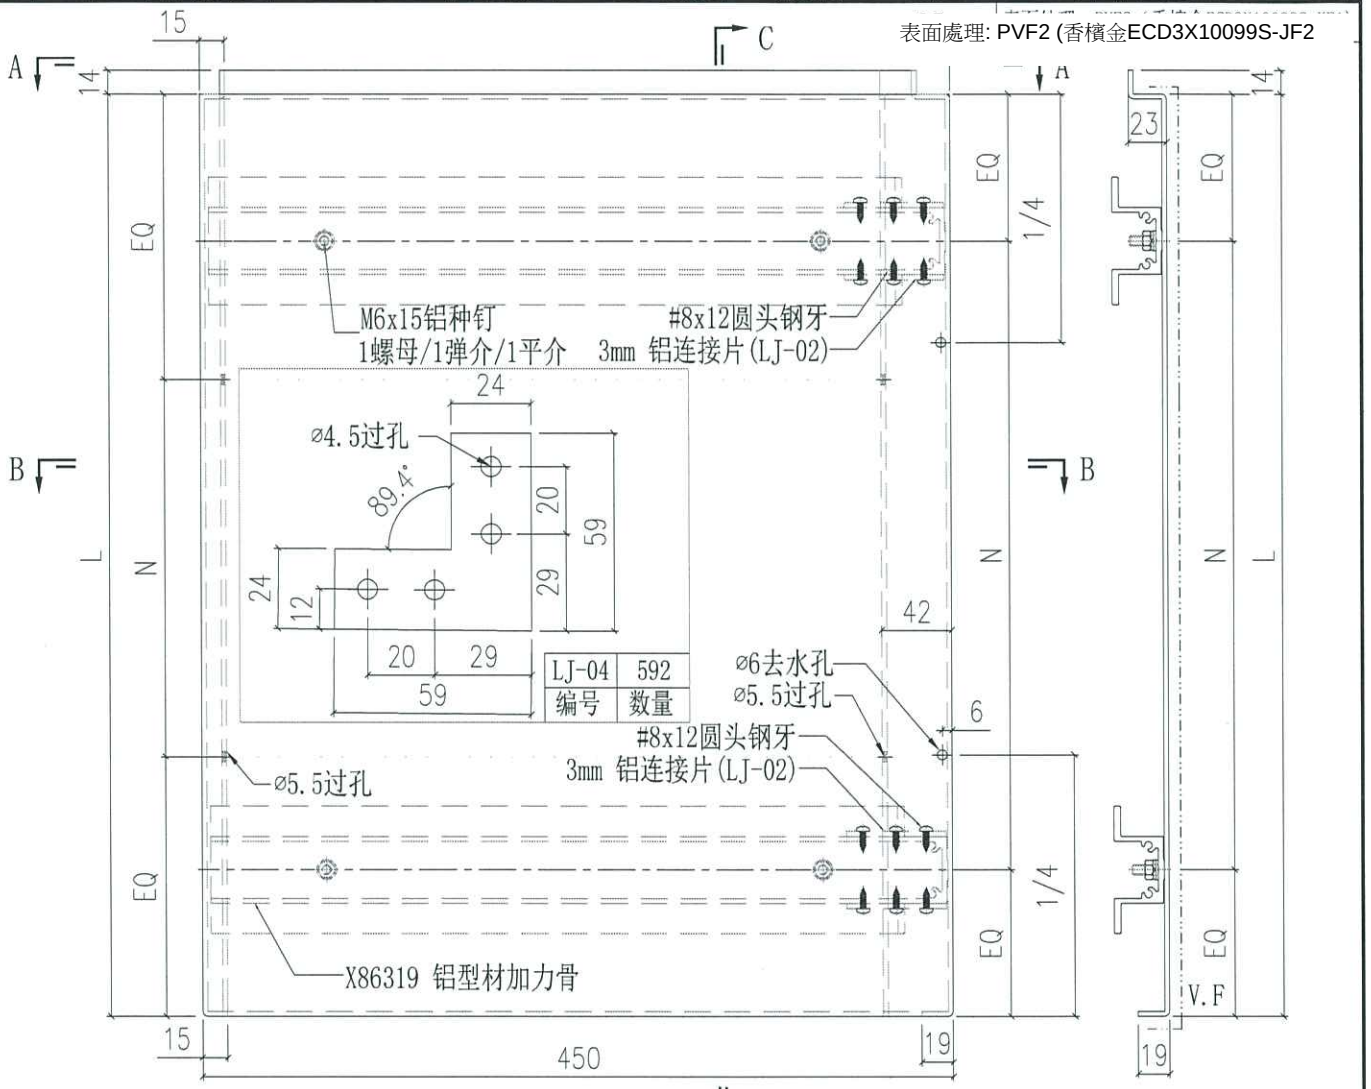


SECTION C-C

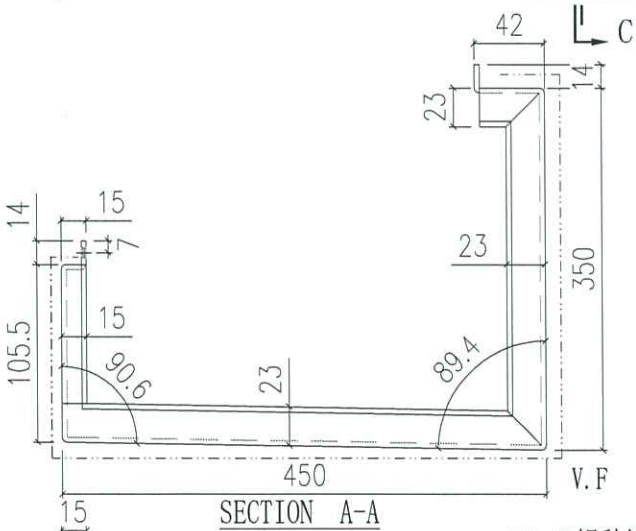

SECTION A-A

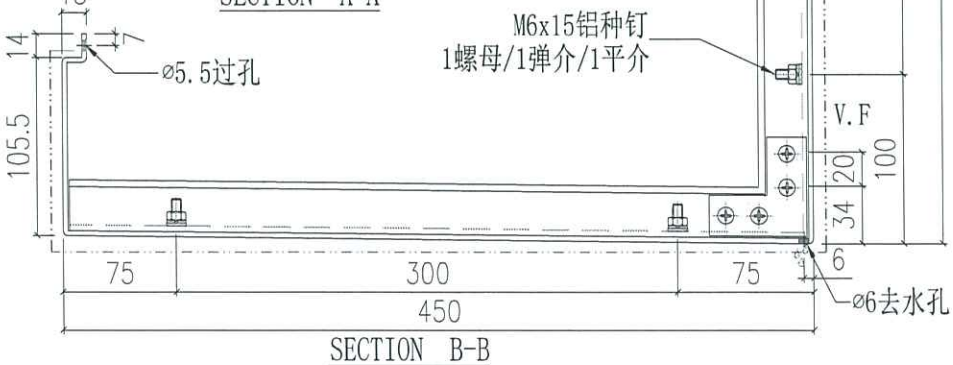


SECTION B-B

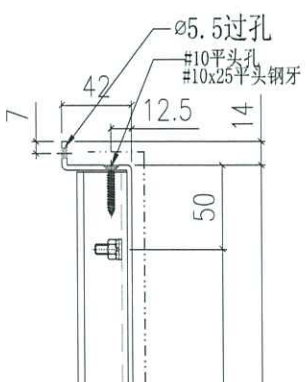



编号	L	N	数量	位置
AQ-84-3	988	3x300 c/c	6	T1
AQ-84-2	996.5	3x300 c/c	50	T1, T2, T3
AQ-84-1	1008.5	3x300 c/c	18	T1, T2, T3

美特鋁質有限公司 MIDI Aluminium Fabricator Ltd.														
工程號	J858	類別		物料號	-									
地盤	康城11期	制圖	W.E.X	2022-08-11	圖號	AQ-85								
修改	-	-	-	採用	工廠		地盤	✓	图纸名称	铝板加工图	復核	-	-	數量	-	
日期	-	-	-	材料颜色	PVF2 (香槟金)				材料	3mm THK.铝板	批准	-	-	單件重量	-	(KG)

表面處理: PVF2 (香檳金ECD3X10099S-JF2

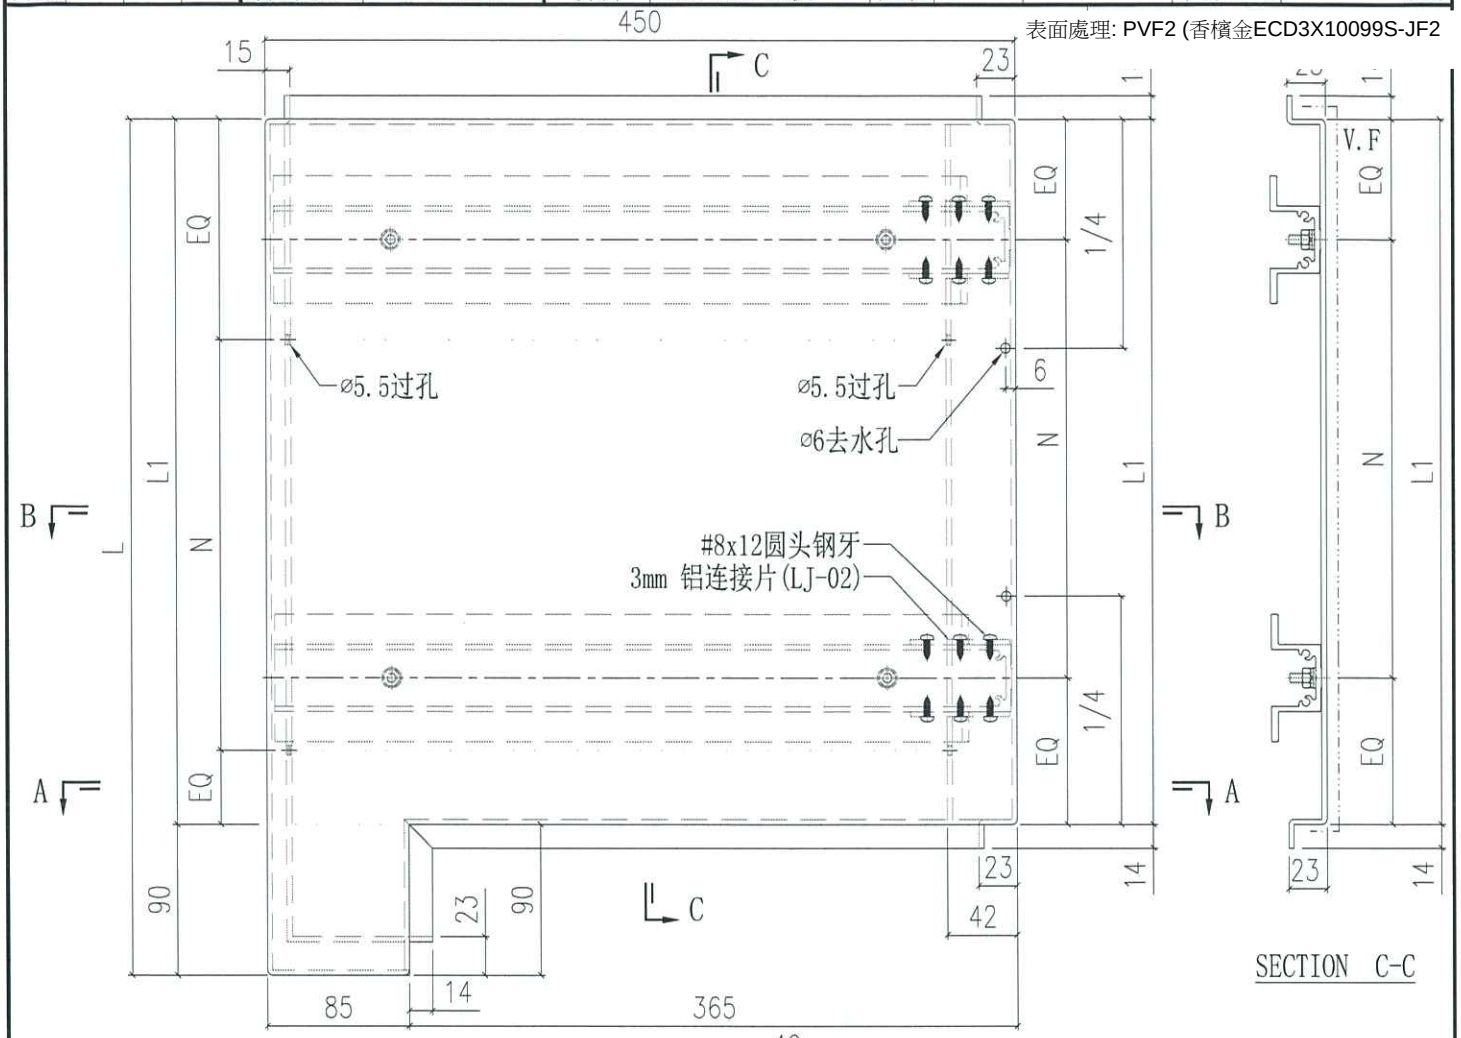

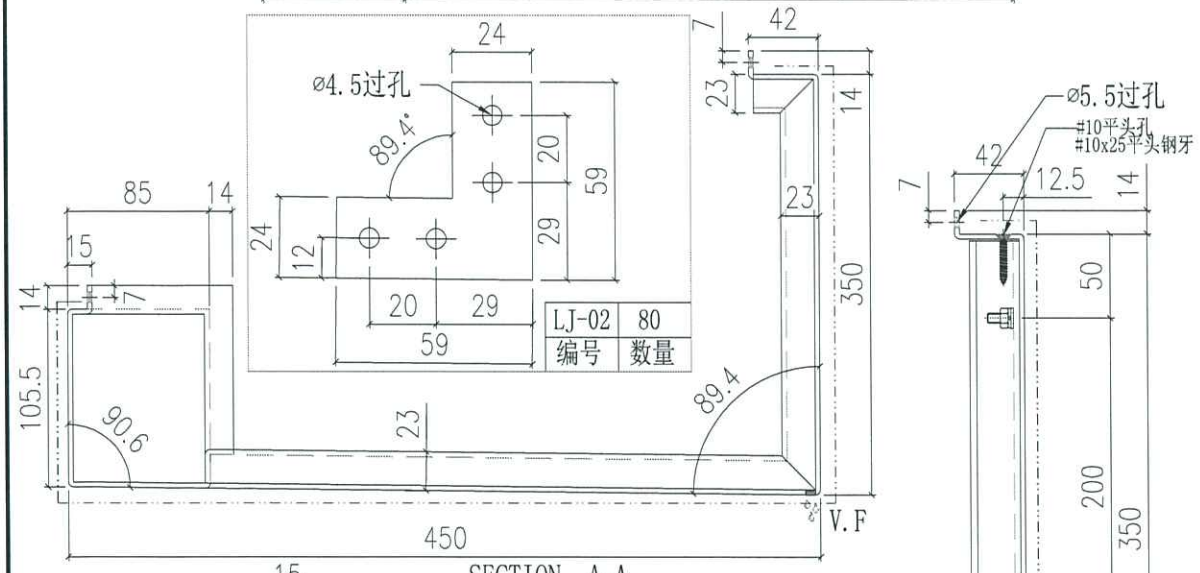


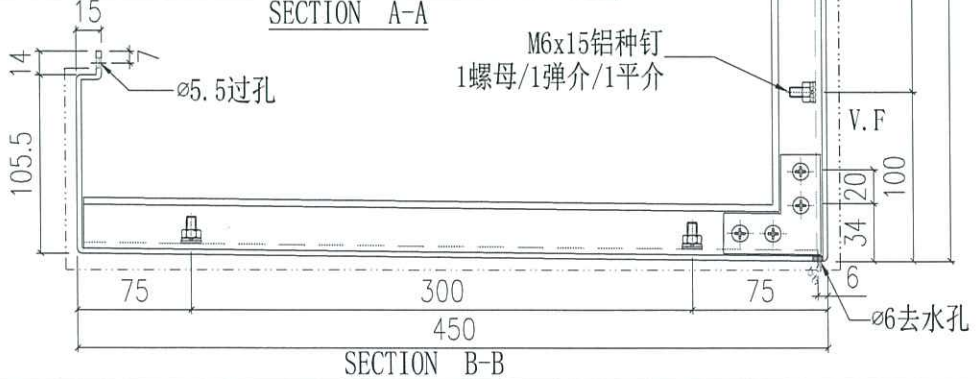

编号	L	L1	N	3x300 c/c	数量	T1, T2, T3	位置
AQ-85-1	1086.5	996.5			10		

美特鋁質有限公司 MIDI Aluminium Fabricator Ltd.					工程號	J858	類別		物料號	-		
					地盤	康城11期	制圖	W.E.X	2022-08-11	圖號	AQ-86	
修改	A			採用工廠		地盤 ✓	图纸名称	铝板加工图	復核	-	-	數量	-
日期	18/12/22			材料颜色	PVF2 (香槟金)		材料	3mm THK.铝板	批准	-	-	單件重量	- (KG)


表面處理: PVF2 (香檳金ECD3X10099S-JF2)

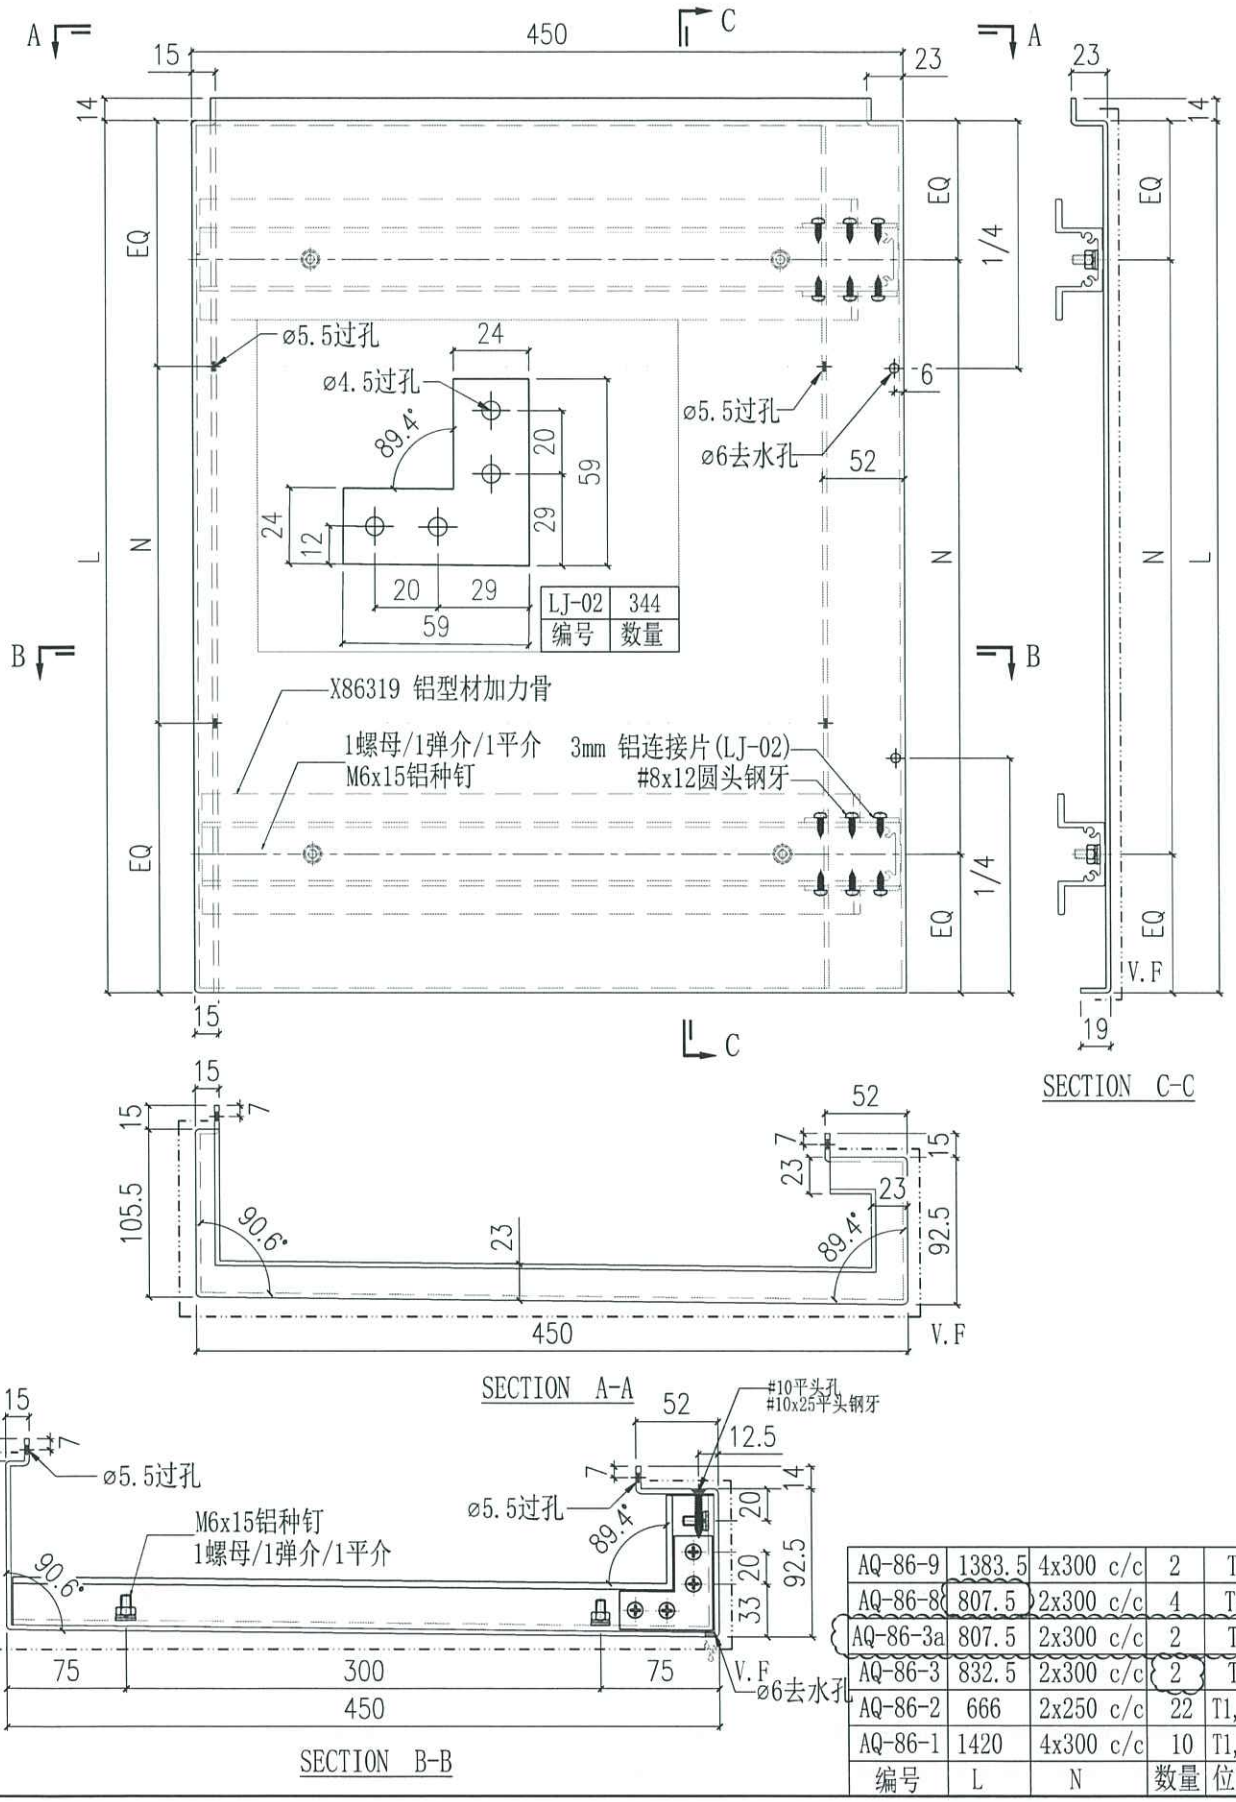

编号	L	N	数量	位置
AQ-86-9	1383.5	4x300 c/c	2	T3
AQ-86-8	807.5	2x300 c/c	4	T2,T3
AQ-86-3a	807.5	2x300 c/c	2	T1
AQ-86-3	832.5	2x300 c/c	2	T1
AQ-86-2	666	2x250 c/c	22	T1,T2,T3
AQ-86-1	1420	4x300 c/c	10	T1,T2,T3

美特鋁質有限公司 MIDI Aluminium Fabricator Ltd.					工程號	J858	類別		物料號	-		
					地盤	康城11期	制圖	W.E.X	2022-08-11	圖號	AQ-87	
修改			採用工廠		地盤 ✓	图纸名称	铝板加工图	復核	-	-	數量	-
日期			材料顏色	PVF2 (香槟金)		材料-	3mm THK.铝板	批准	-	-	單件重量	- (KG)


表面處理: PVF2 (香檳金ECD3X10099S-JF2

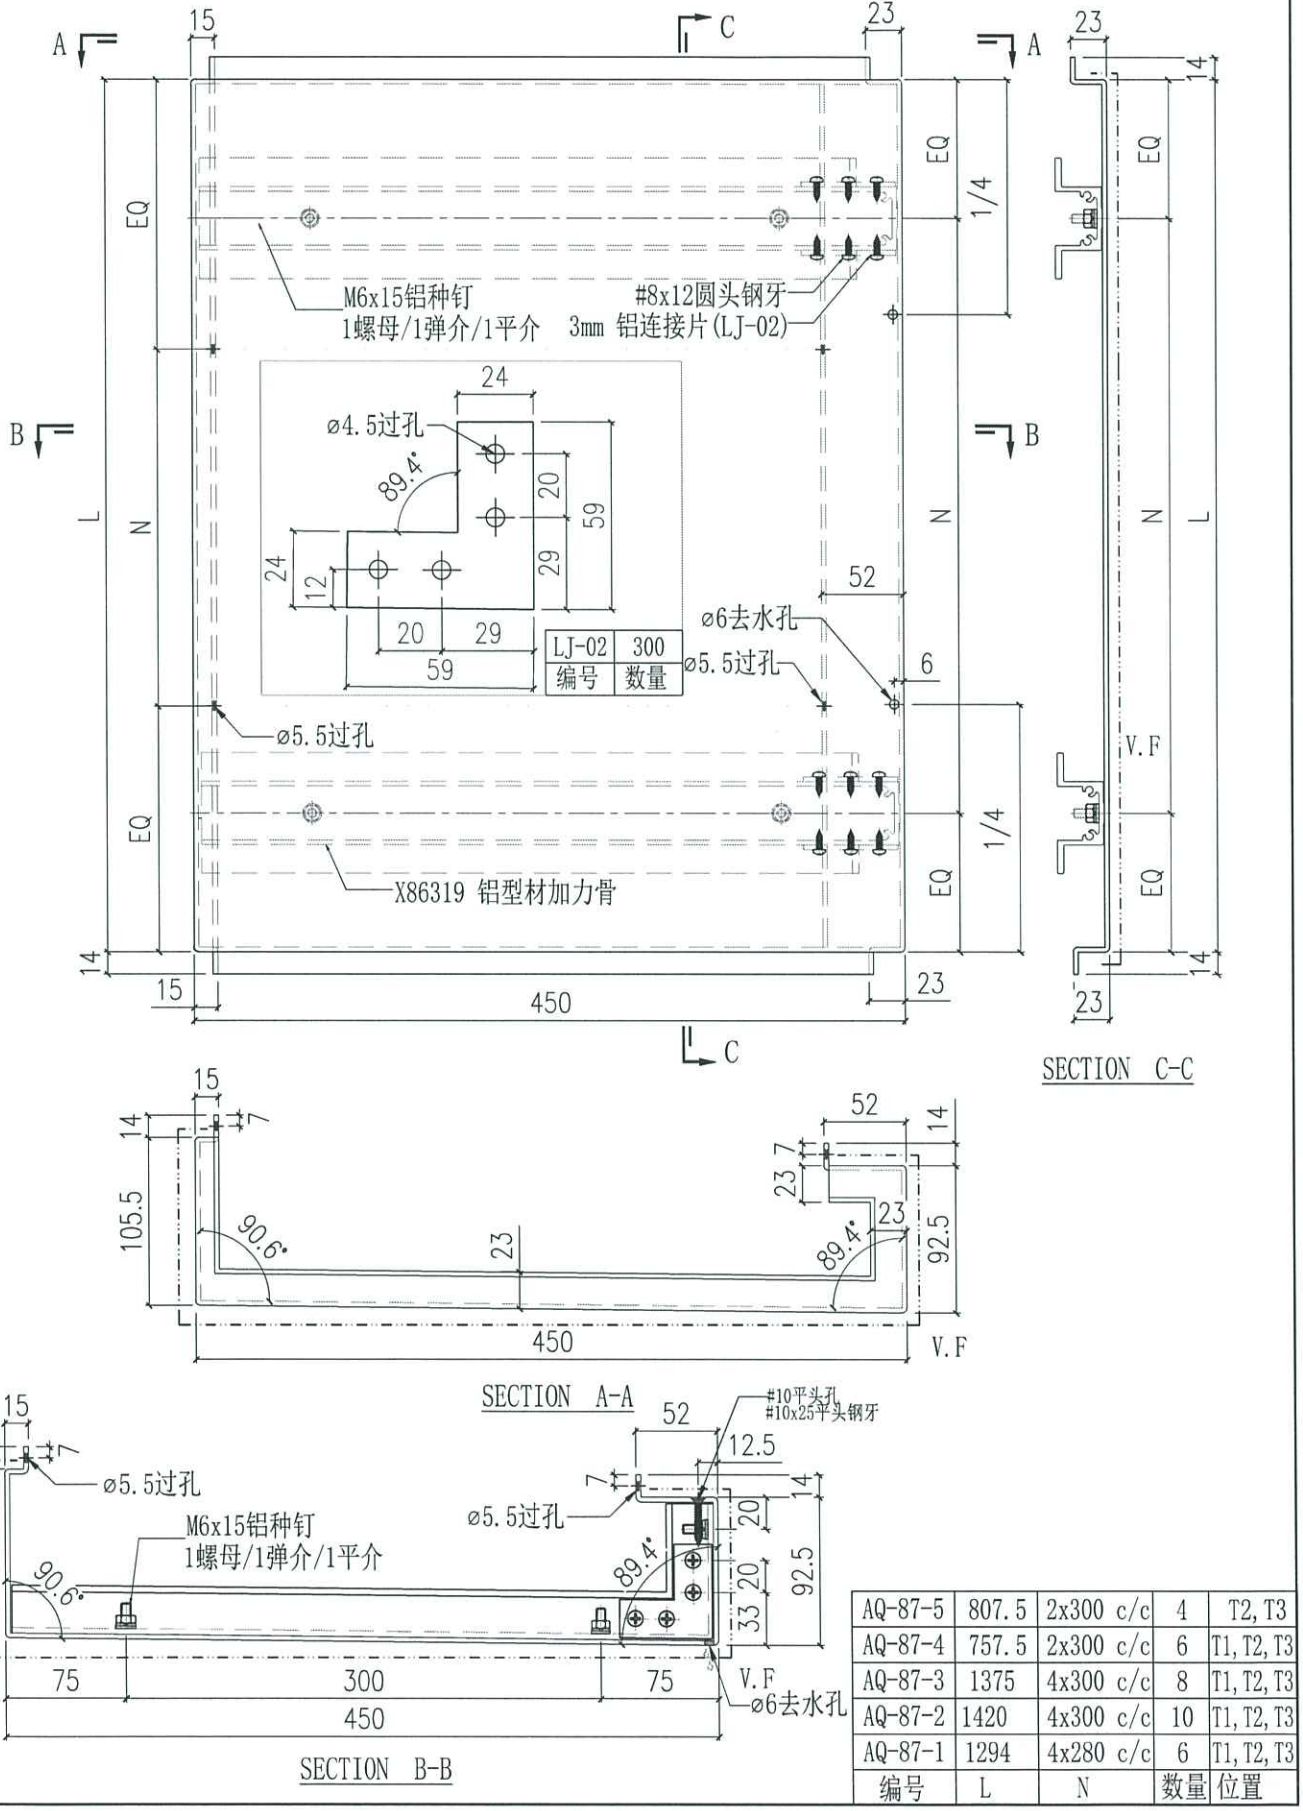


编号	L	N	数量	位置
AQ-87-5	807.5	2x300 c/c	4	T2, T3
AQ-87-4	757.5	2x300 c/c	6	T1, T2, T3
AQ-87-3	1375	4x300 c/c	8	T1, T2, T3
AQ-87-2	1420	4x300 c/c	10	T1, T2, T3
AQ-87-1	1294	4x280 c/c	6	T1, T2, T3


美特鋁質有限公司 MIDI Aluminium Fabricator Ltd.													
修改	-	-	-	採用	工廠		地盤	✓	工程號	J858	類別		物料號	-
日期	-	-	-	材料顏色	PVF2 (香槟金)				地盘	康城11期	制圖	W.E.X	2022-08-11	圖號 AQ-88
									图纸名称	铝板加工图	復核	-	-	數量 -
									材料-	3mm THK.铝板	批准	-	-	單件重量 - (KG)

表面處理: PVF2 (香檳金ECD3X10099S-JF2

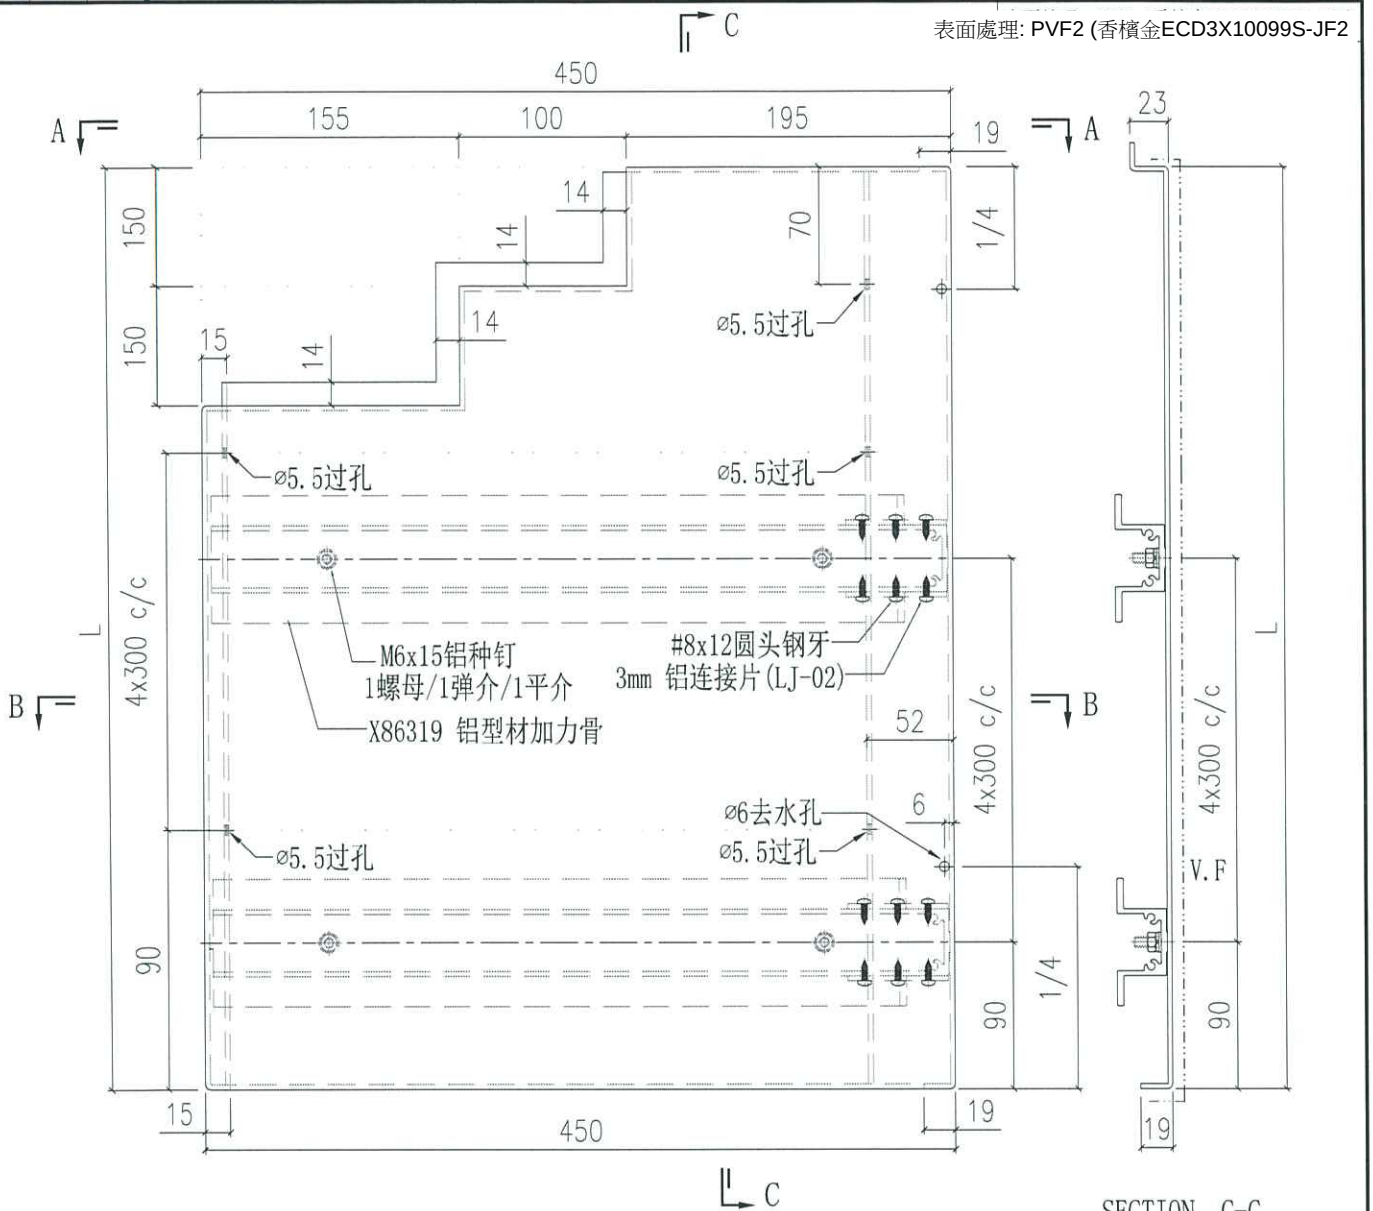


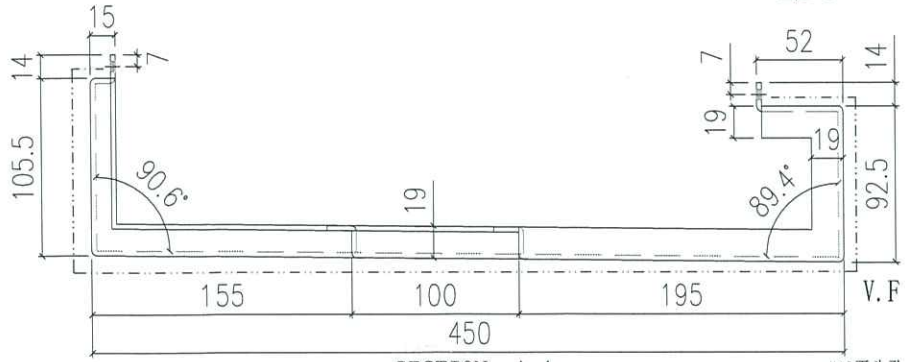

SECTION A-A

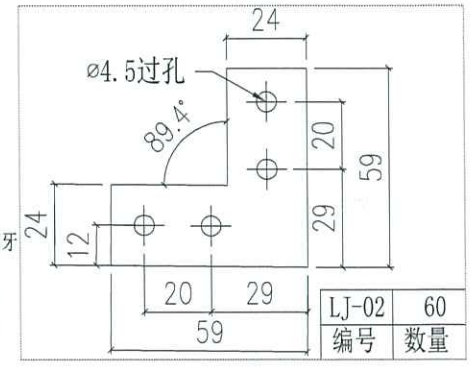

LJ-02	60
编号	数量

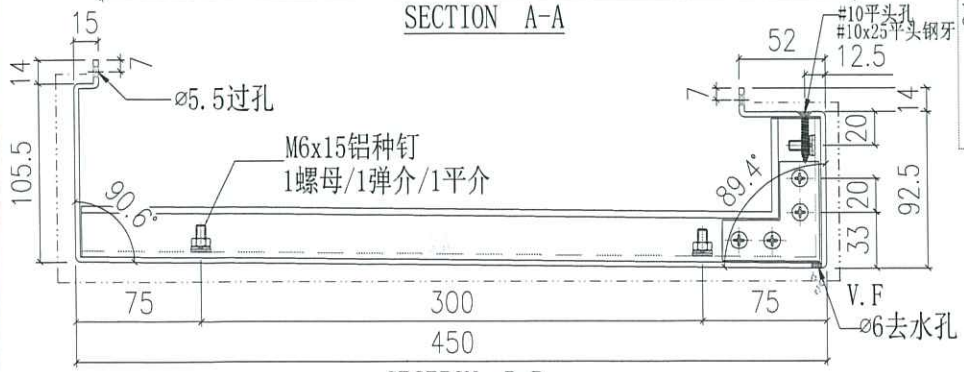


SECTION B-B

AQ-88-2	1708.5	4x300 c/c	4	T2,T3
AQ-88-1	1683.5	4x300 c/c	2	T1
编号	L	N	数量	位置

美特鋁質有限公司 MIDI Aluminium Fabricator Ltd.					工程號	J858	類別		物料號	-		
					地盤	康城11期	制圖	W.E.X	2022-08-11	圖號	AQ-89	
修改				採用工廠 地盤 ✓	图纸名称	铝板加工图	復核	-	-	數量	-	
日期				材料颜色 PVF2（香槟金）	材料-	3mm THK.铝板	批准	-	-	單件重量	-	(KG)

新图

表面處理: PVF2 (香檳金ECD3X10099S-JF2

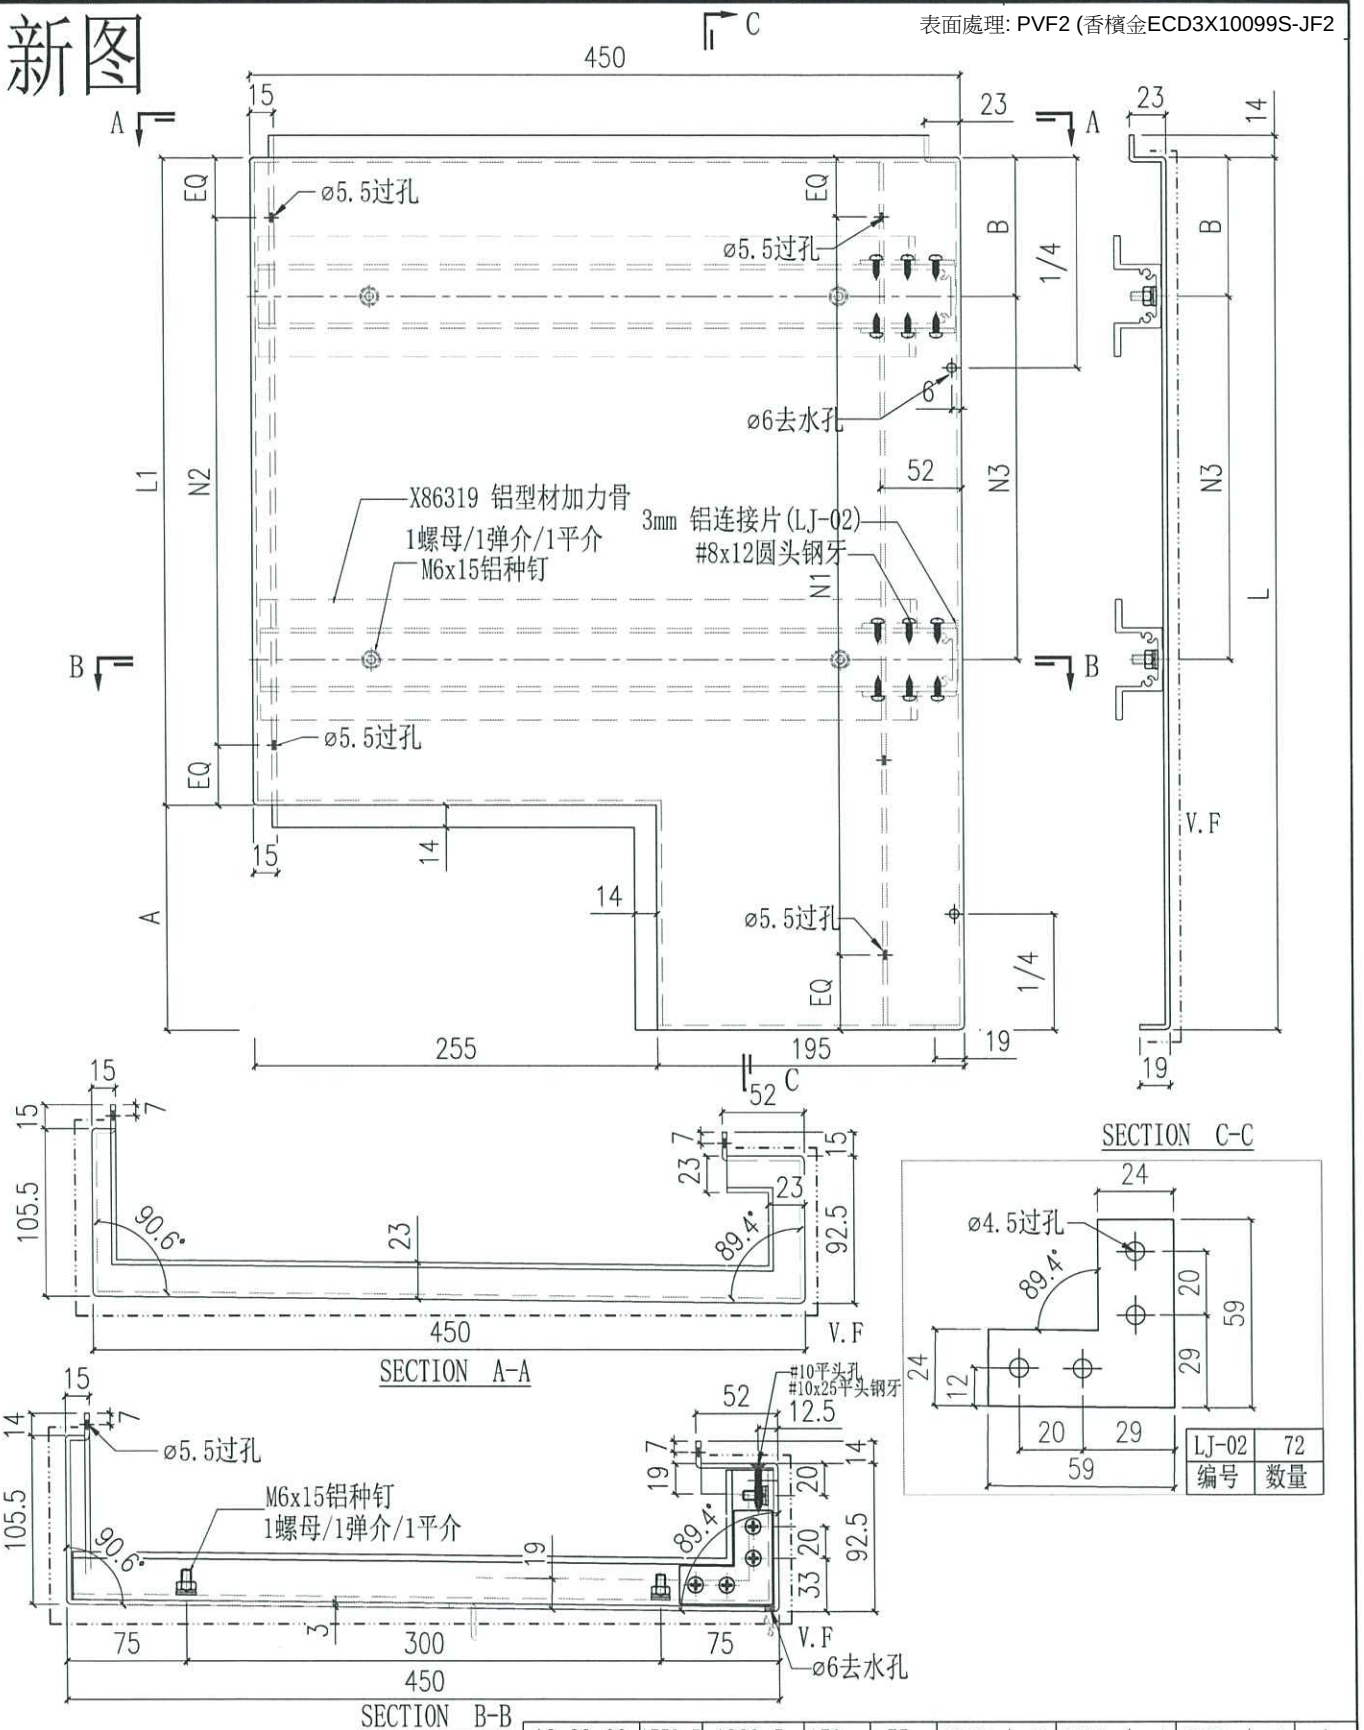


编号	L	L1	A	B	N1	N2	N3	数量
AQ-89-03	1553.5	1383.5	170	75	@300c/cx5	@300c/cx4	@300c/cx4	4
AQ-89-02	685	552.5	132.5	125	@300c/cx2	@250c/cx2	@300c/cx1	6
AQ-89-01	685	527.5	157.5	75	@300c/cx2	@200c/cx2	@300c/cx1	2


美特鋁質有限公司 MIDI Aluminium Fabricator Ltd.					工程號	J858	類別		物料號	-		
					地盤	康城11期	制圖	W.E.X	2022-08-11	圖號	AQ-90	
修改			採用工廠	地盤 ✓	图纸名称	铝板加工图	復核	-	-	數量	-	
日期			材料颜色	PVF2（香槟金）	材料-	3mm THK.铝板	批准	-	-	單件重量	-	(KG)

新图


表面處理: PVF2 (香檳金ECD3X10099S-JF2

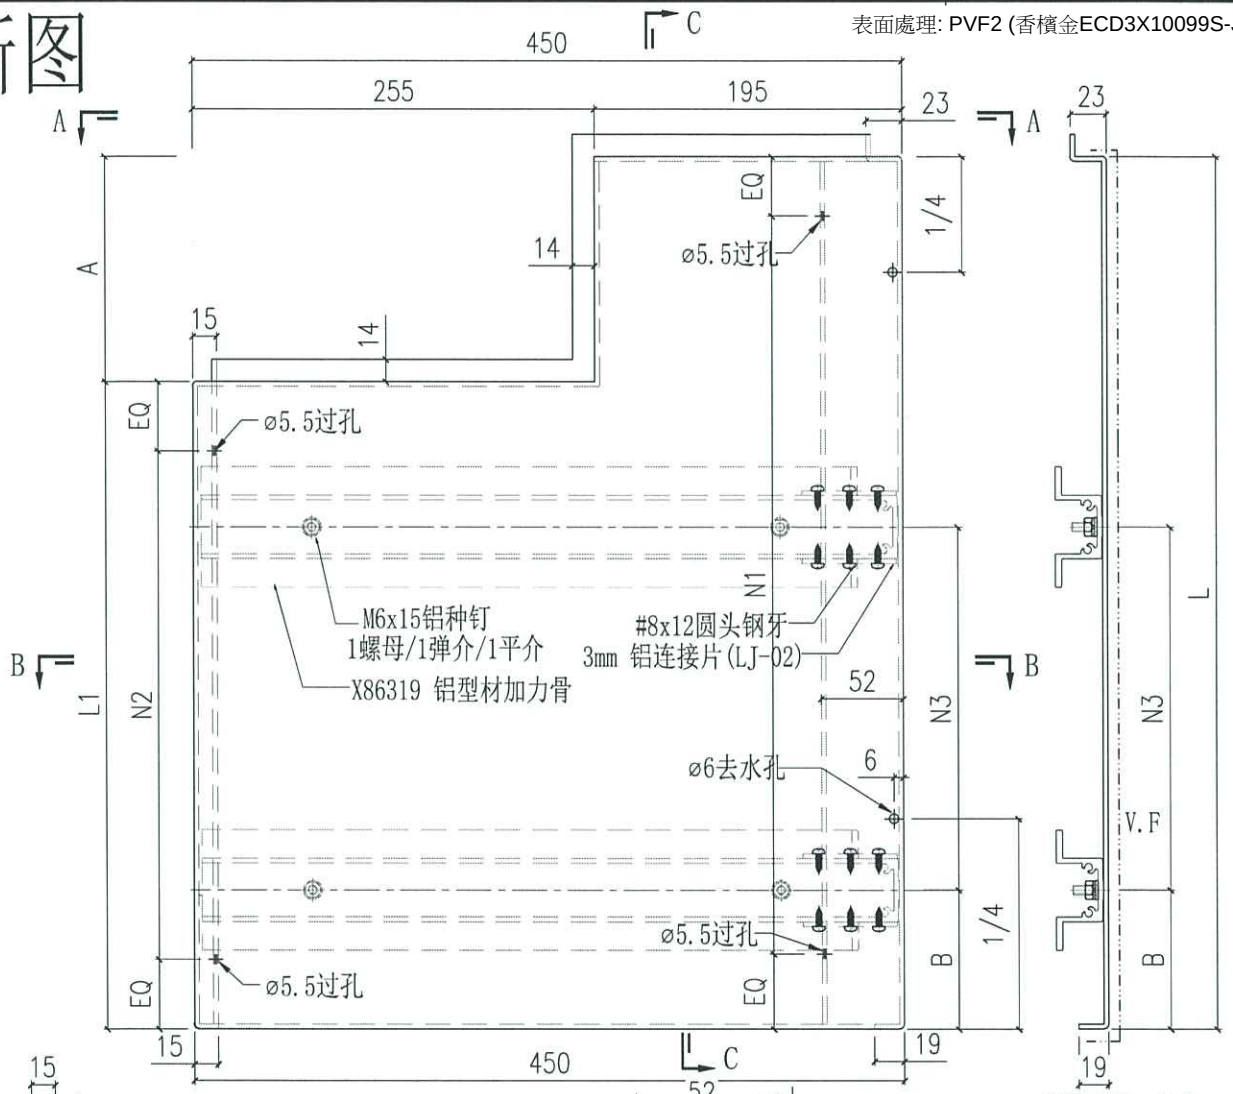


SECTION C-C

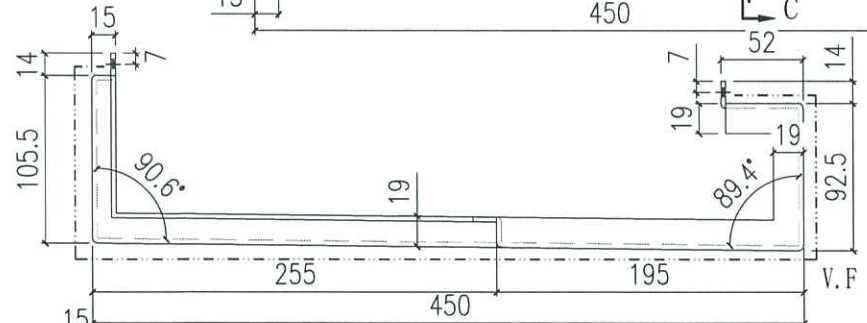

SECTION A-A

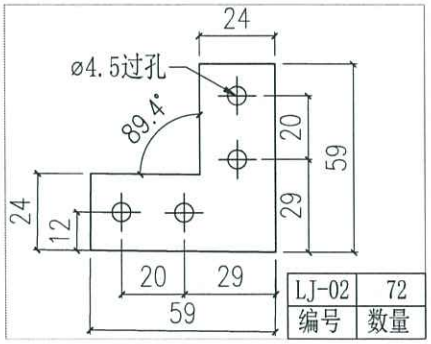

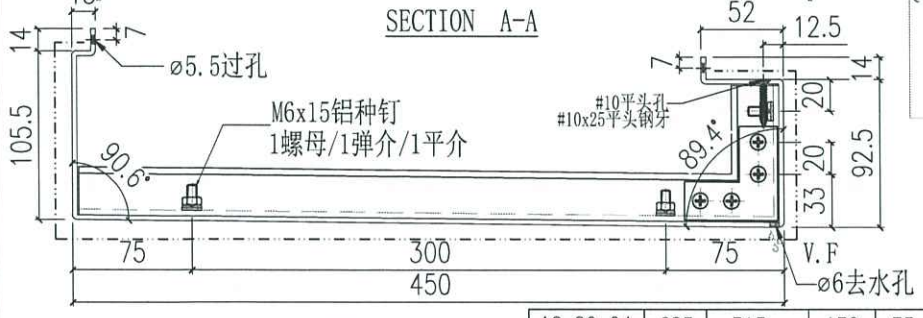


SECTION B-B


编号	L	L1	A	B	N1	N2	N3	数量
AQ-90-04	685	515	170	75	@300c/cx2	@200c/cx2	@300c/cx1	4
AQ-90-03	685	552.5	132.5	125	@300c/cx2	@250c/cx2	@300c/cx1	4
AQ-90-02	1516	1383.5	132.5	75	@300c/cx5	@300c/cx4	@300c/cx4	2
AQ-90-01	1541	1383.5	157.5	75	@300c/cx5	@300c/cx4	@300c/cx4	2

美特鋁質有限公司 MIDI Aluminium Fabricator Ltd.													
工程號	J858	類別		物料號	-								
地盘	康城11期	制圖	W.E.X	2022-08-11	圖號	N00814-01							
修改	-	-	-	採用	工廠		地盤	✓	图纸名称	铝角加工图	復核	-	-	數量	-
日期	-	-	-	材料颜色	络化				材料	N00814	批准	-	-	單件重量	- (KG)





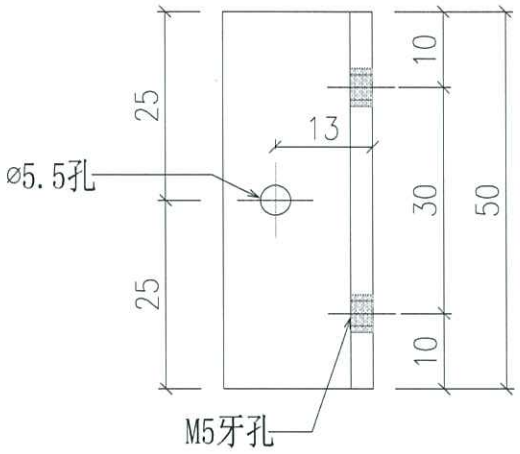

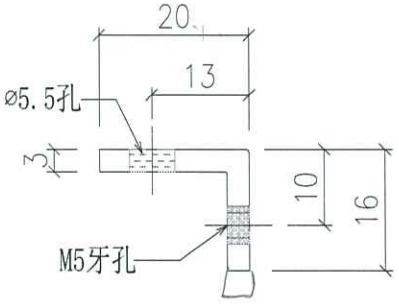



美特鋁質有限公司 MIDI Aluminium Fabricator Ltd.													
							工程號	J858	類別		物料號	-	
							地盘	康城11期	制圖	W.E.X	2022-08-11	圖號	N00814-02
修改	-	-	-	採用	工廠		地盤	✓	图纸名称	铝角加工图	復核	-	-	数量	-
日期	-	-	-	材料颜色	络化				材料	N00814	批准	-	-	單件重量	- (KG)

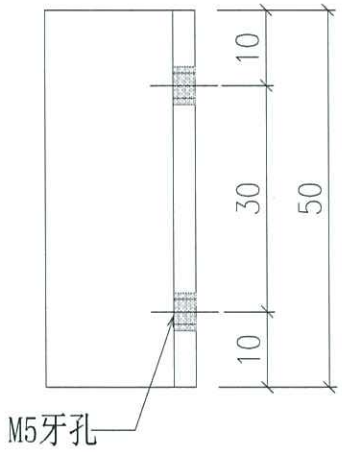


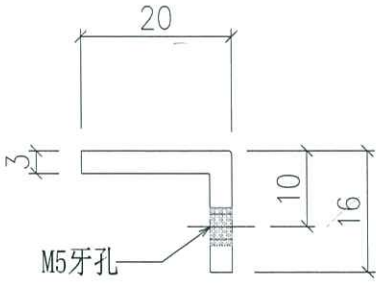

美特鋁質有限公司 MIDI Aluminium Fabricator Ltd.							工程號	J858	類別		物料號	-		
							地盤	康城11期	制圖	W.E.X	2022-08-11	圖號	N00814-03	
修改	-	-	-	採用	工廠		地盤	✓	图纸名称	铝角加工图	復核	-	-	數量	-	
日期	-	-	-	材料颜色	络化				材料	N00814铝角	批准	-	-	單件重量	-	(KG)

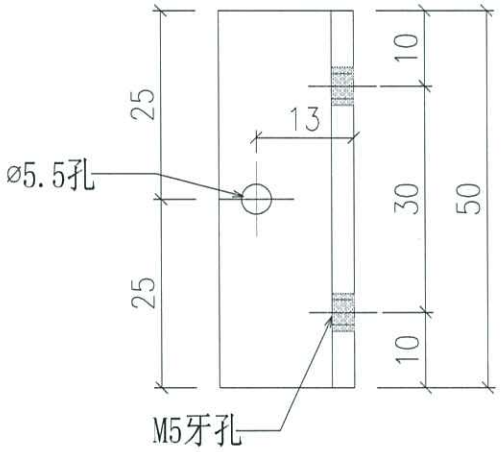

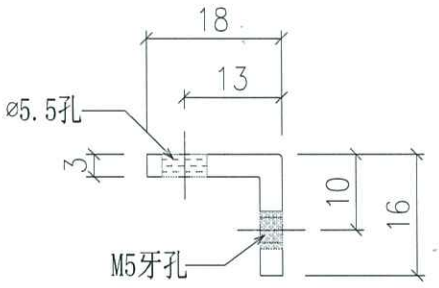

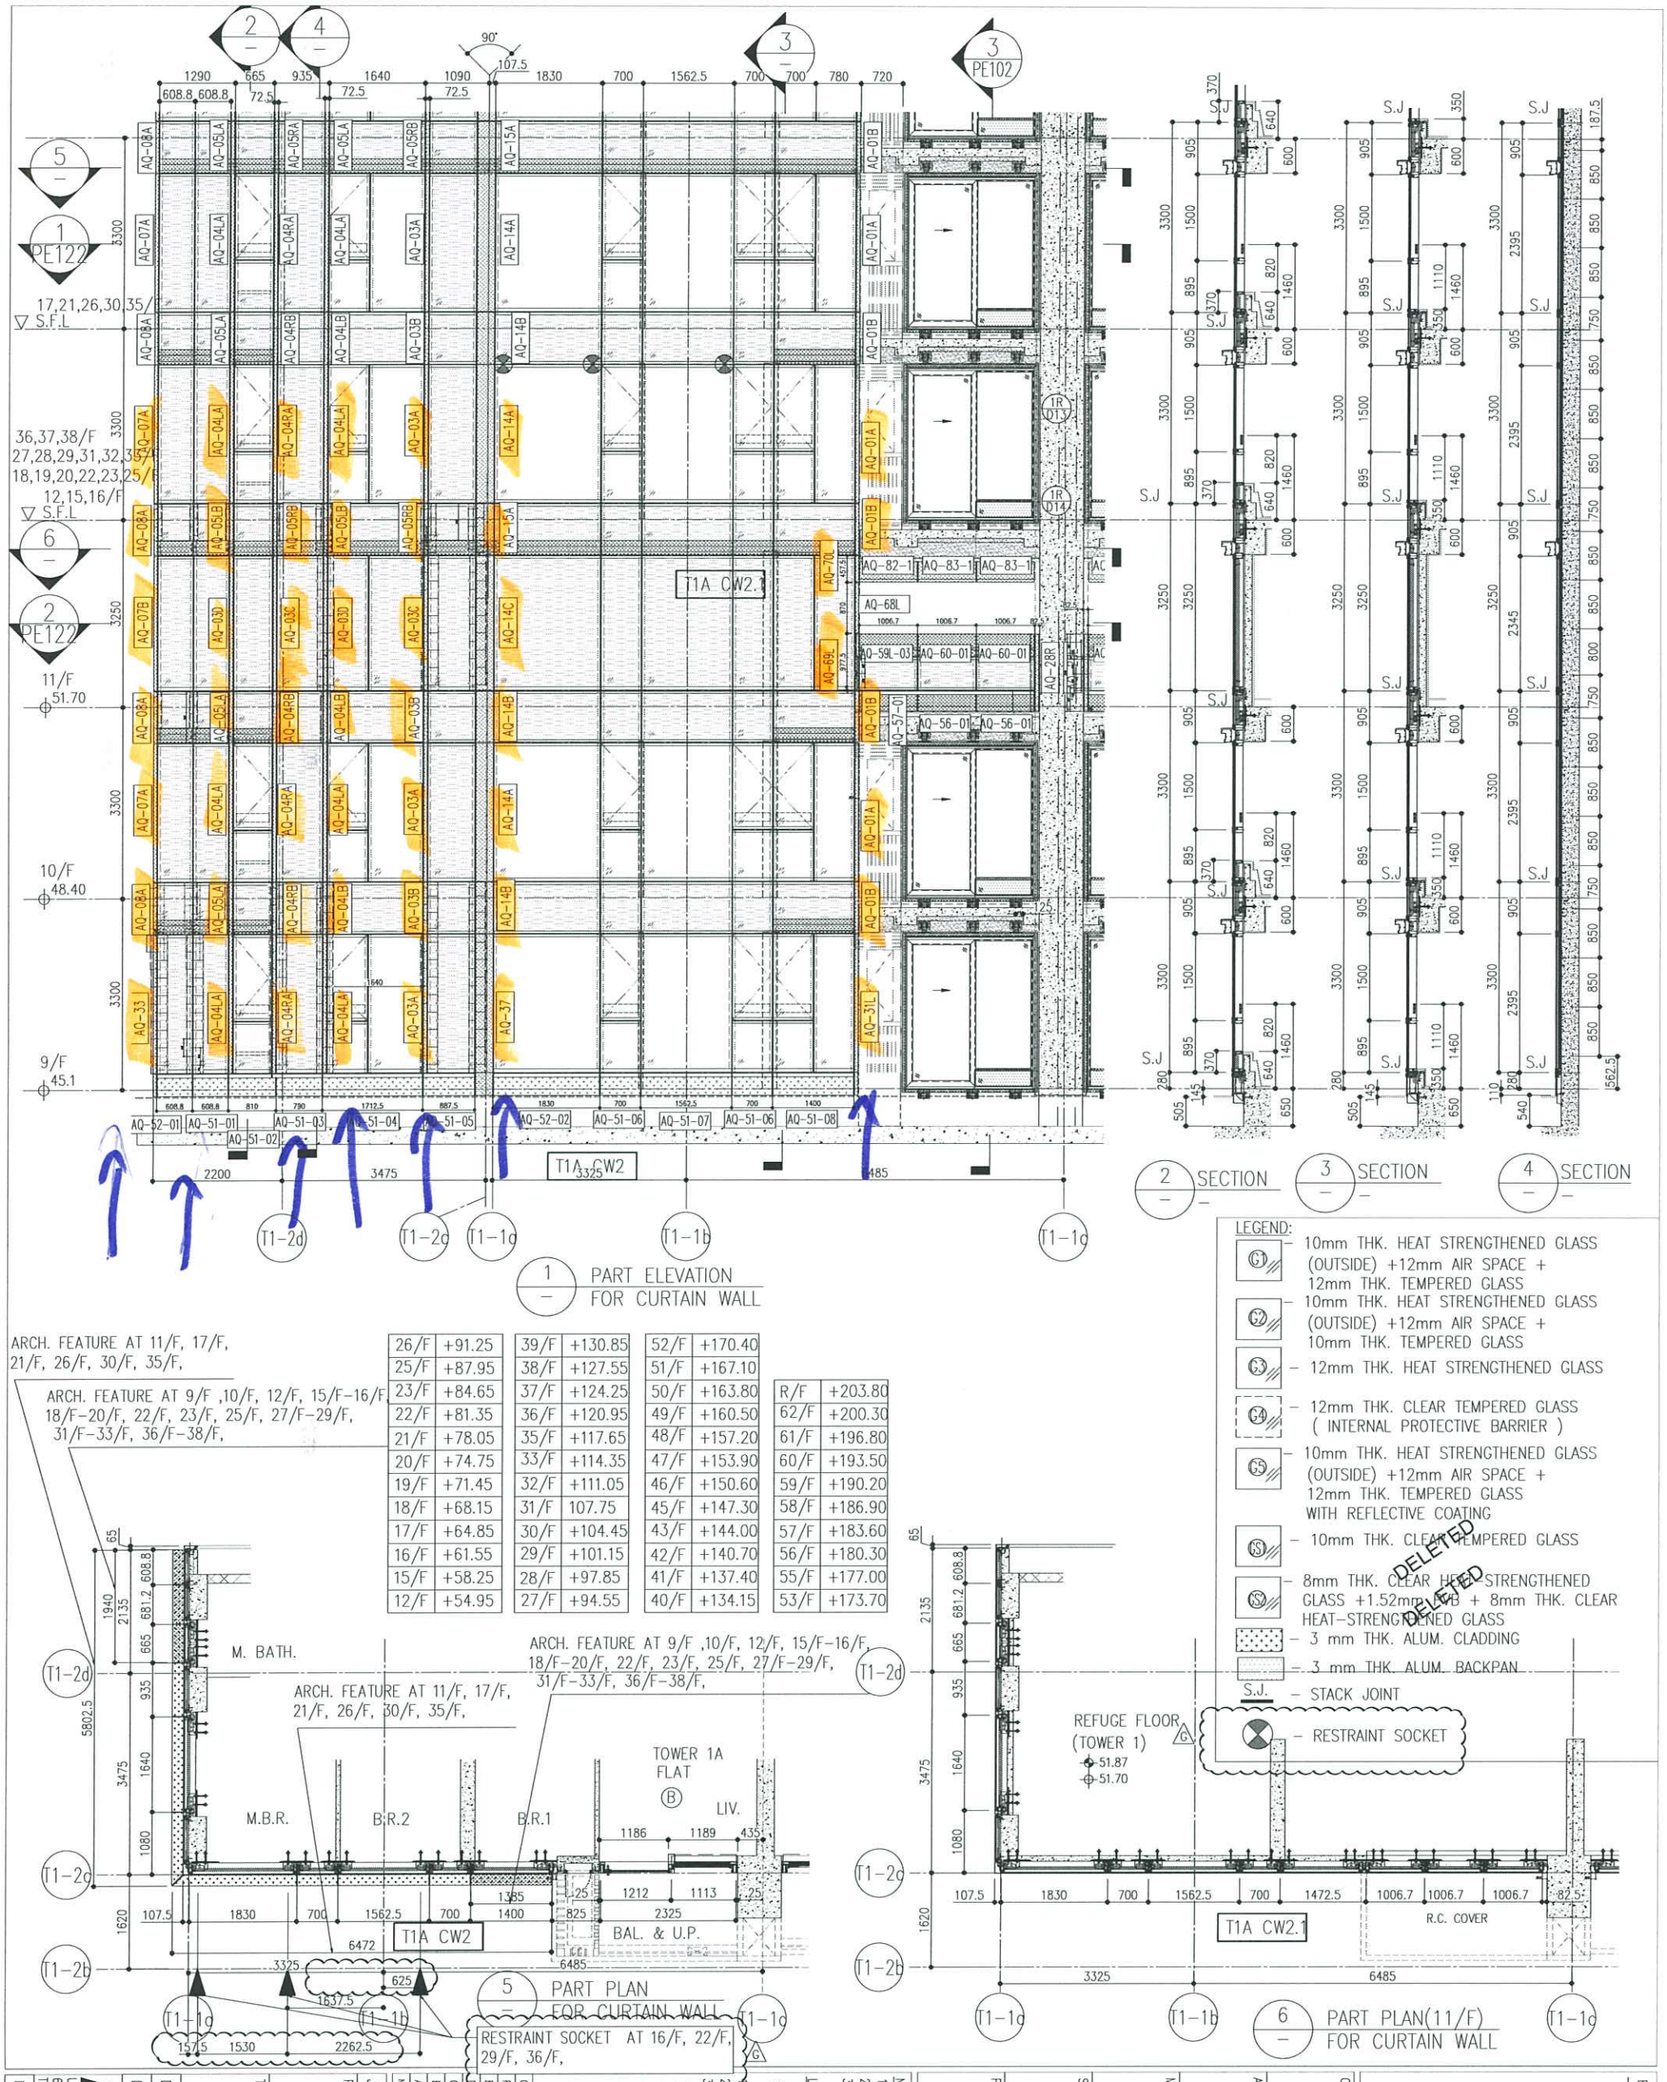

26/F	+91.25	39/F	+130.85	52/F	+170.40	R/F	+203.80
25/F	+87.95	38/F	+127.55	51/F	+167.10	62/F	+200.30
23/F	+84.65	37/F	+124.25	50/F	+163.80	61/F	+196.80
22/F	+81.35	36/F	+120.95	49/F	+160.50	60/F	+193.50
21/F	+78.05	35/F	+117.65	48/F	+157.20	59/F	+190.20
20/F	+74.75	33/F	+114.35	47/F	+153.90	58/F	+186.90
19/F	+71.45	32/F	+111.05	46/F	+150.60	57/F	+183.60
18/F	+68.15	31/F	107.75	45/F	+147.30	56/F	+180.30
17/F	+64.85	30/F	+104.45	43/F	+144.00	55/F	+177.00
16/F	+61.55	29/F	+101.15	42/F	+140.70	53/F	+173.70
15/F	+58.25	28/F	+97.85	41/F	+137.40		
12/F	+54.95	27/F	+94.55	40/F	+134.15		

LEGEND:

- G1 – 10mm THK. HEAT STRENGTHENED GLASS (OUTSIDE) +12mm AIR SPACE + 12mm THK. TEMPERED GLASS
- G2 – 10mm THK. HEAT STRENGTHENED GLASS (OUTSIDE) +12mm AIR SPACE + 10mm THK. TEMPERED GLASS
- G3 – 12mm THK. HEAT STRENGTHENED GLASS
- G4 – 12mm THK. CLEAR TEMPERED GLASS (INTERNAL PROTECTIVE BARRIER)
- G5 – 10mm THK. HEAT STRENGTHENED GLASS (OUTSIDE) +12mm AIR SPACE + 12mm THK. TEMPERED GLASS WITH REFLECTIVE COATING
- G6 – 10mm THK. CLEAR TEMPERED GLASS
- G7 – 8mm THK. CLEAR HEAT STRENGTHENED GLASS +1.52mm PVB + 8mm THK. CLEAR HEAT-STRENGTHENED GLASS
- 3 mm THK. ALUM. CLADDING
- 3 mm THK. ALUM. BACKPAN
- S.J. – STACK JOINT
- G – RESTRAINT SOCKET

NOTE :
1. ALL DIMENSIONS ARE IN mm.
2. ALL ELEVATIONS ARE VIEWED FROM OUTSIDE.
3. ALL DIMENSIONS TO BE VERIFIED ON SITE BEFORE FABRICATION.

LEGEND :
- X1 / X001 — DETAIL MARK NO. / REFER SHEET NO.
- F.F.L. --- FINISHED FLOOR LEVEL
- S.F.L. --- STRUCTURAL FLOOR LEVEL
- 2/R — --- REVERSED DETAIL

NO.	DATE	REMARK	BY
3	17/08/22	REVISED AS PER COMMENTS	LS
2	26/07/22	REVISED AS PER COMMENTS	LS
1	23/05/22	REVISED AS PER COMMENTS	LS
E	06/04/22	REVISED AS PER COMMENTS	LS
D	24/01/22	REVISED AS PER COMMENTS	LS
C	20/12/21	REVISED AS PER COMMENTS	LS
B	03/12/21	REVISED AS PER COMMENTS	LS
A	03/12/21	REVISED AS PER COMMENTS	LS

JOB NO. : J-858

PROJECT :
PROPOSED RESIDENTIAL DEVELOPMENT AT TKOTL 70RP, PHASE 11, LOHAS PARK TSEUNG KWAN O, N.T.

TITLE :
TYPICAL FLOOR PARTIAL ELEVATION & SECTION, PLAN FOR CURTAIN WALL (TOWER 1)

DATE : 22-OCT-21 | SCALE : 1:50(A1)
DRAWN BY : | CHECKED BY :
DWG NO. : J858-CW-PE101 | REV. : 3

美特鋁廠有限公司 MIDI ALUMINIUM FABRICATOR LTD.
Units 6-8, Sunray Industrial Centre, 1/F
610 Cha Kwo Ling Road, Kowloon
Tel:23489211-4 Fax:(852)27727666

CLIENT : 信和置業有限公司 Sino Land Company Limited

ARCHITECT : ronald lu & partners Architects Planners Interior Designers
Ronald Lu & Partners (HK) Ltd. 呂元祥建築師事務所(香港)有限公司

MAIN CONTRACTOR : Gammon


STRUCTURAL ENGINEER : AECOM

FACADE CONSULTANT : AECOM

B.D. REF :

T1A

(B)

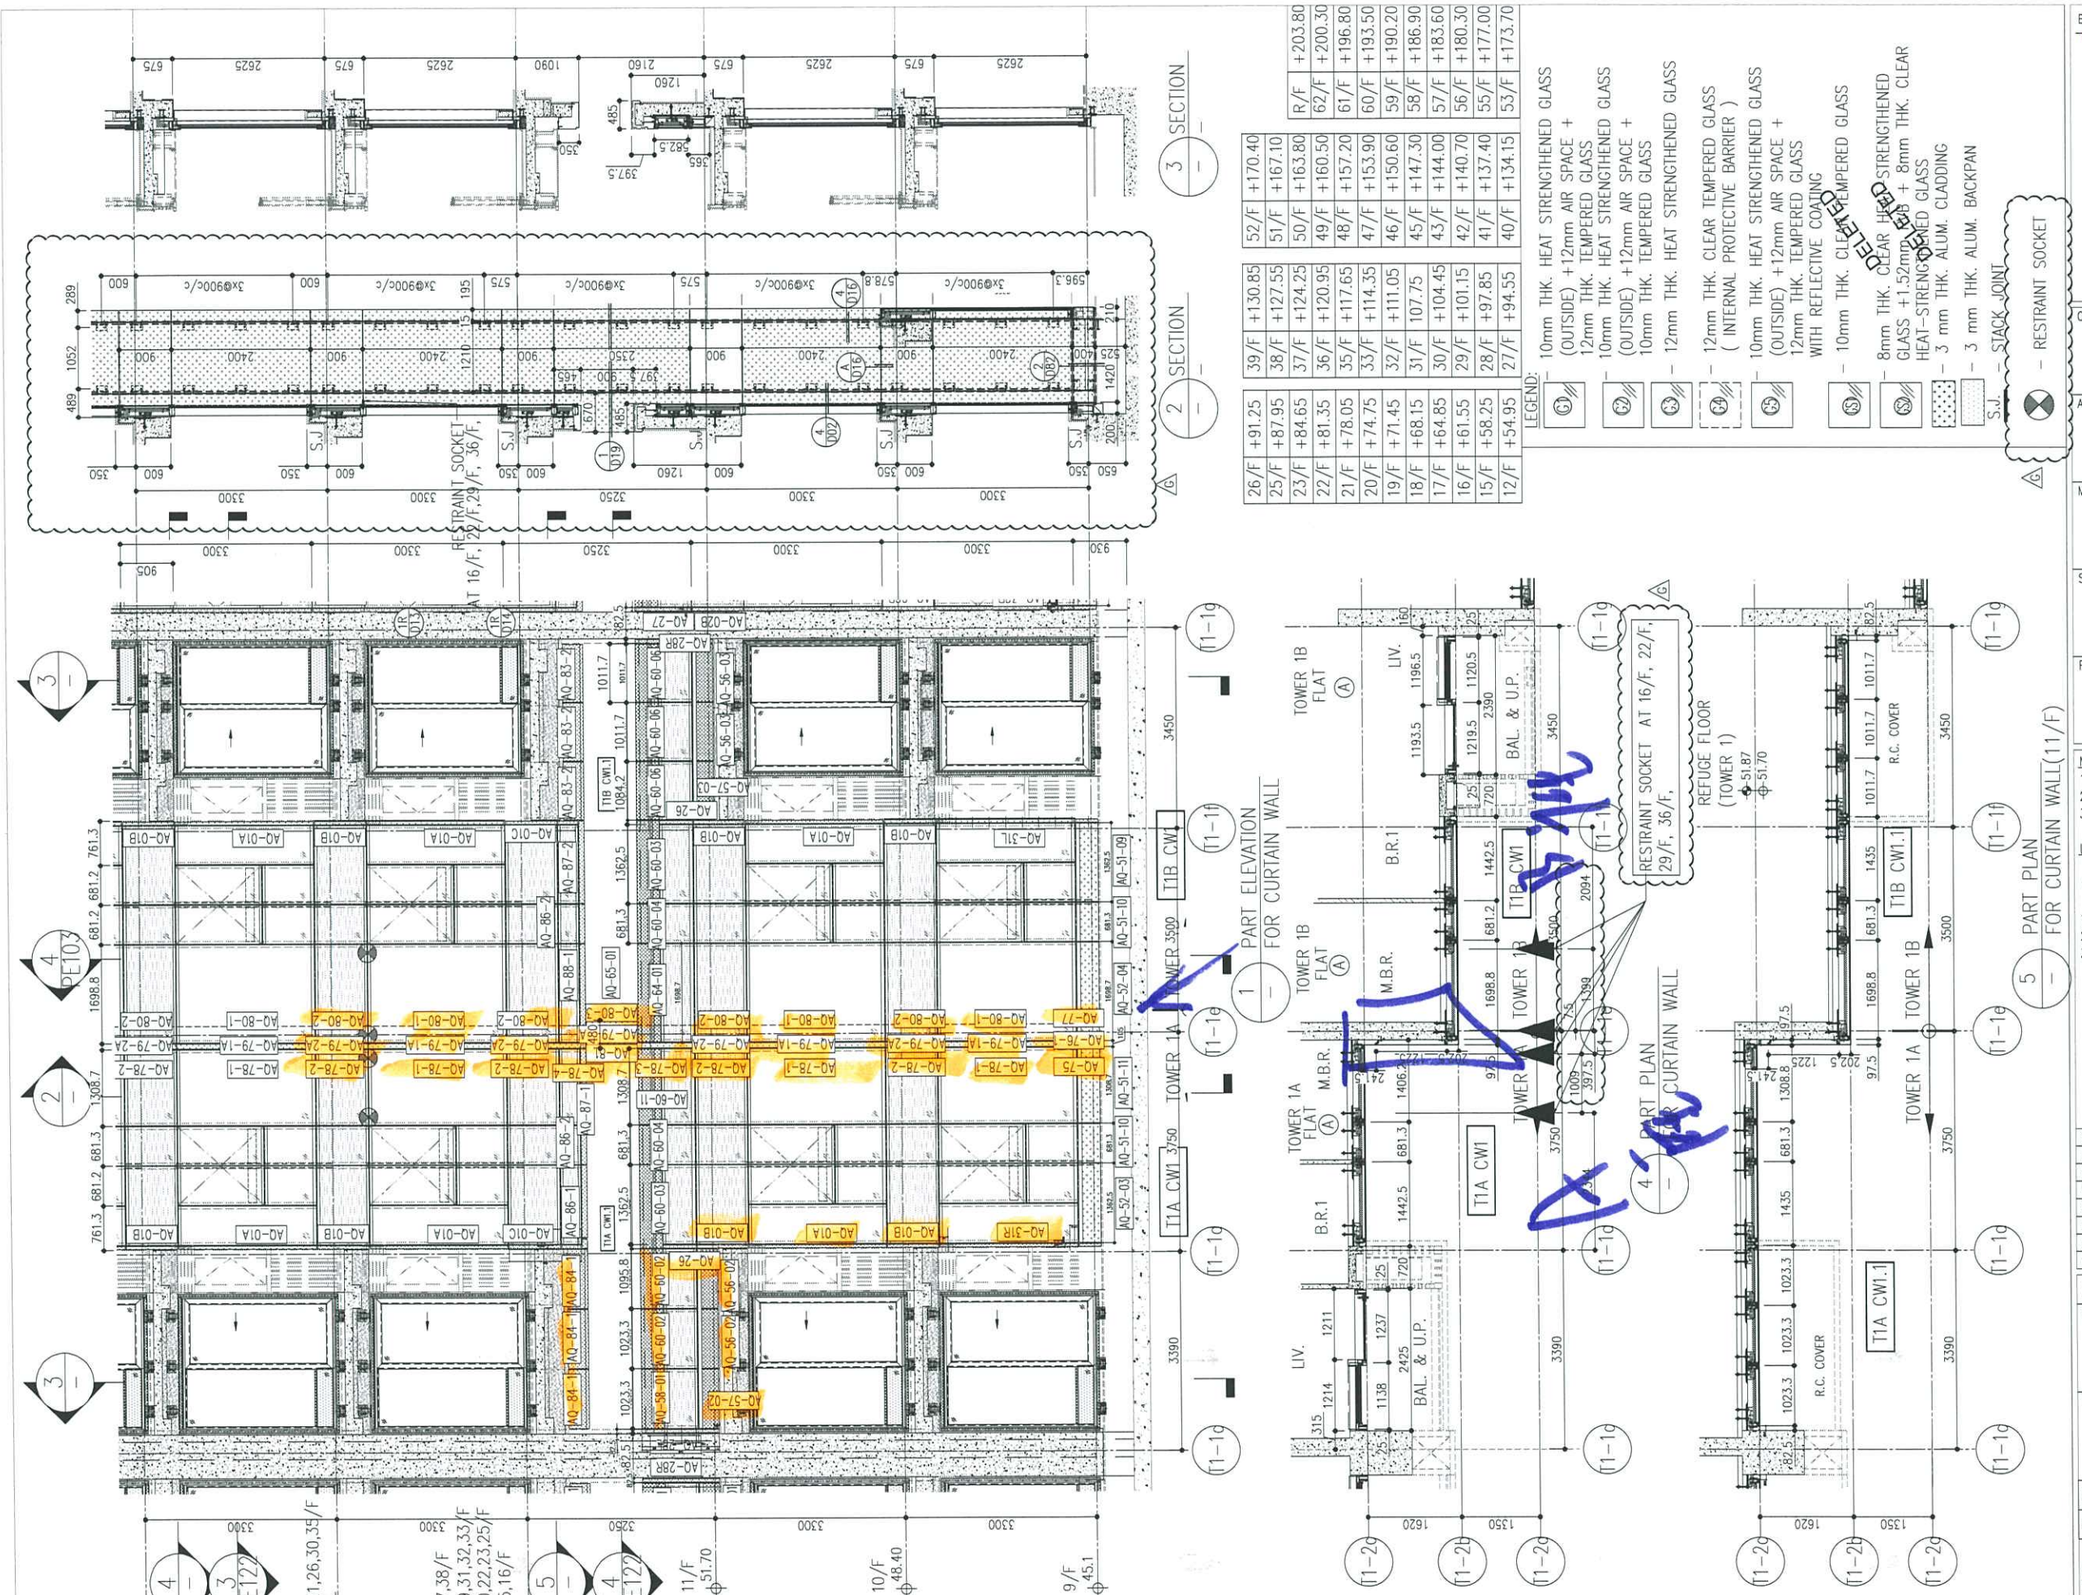

R/F	+203.80
62/F	+200.30
61/F	+196.80
60/F	+193.50
59/F	+190.20
58/F	+186.90
57/F	+183.60
56/F	+180.30
55/F	+177.00
53/F	+173.70

52/F	+170.40
51/F	+167.10
50/F	+163.80
49/F	+160.50
48/F	+157.20
47/F	+153.90
46/F	+150.60
45/F	+147.30
43/F	+144.00
42/F	+140.70
41/F	+137.40
40/F	+134.15

39/F	+130.85
38/F	+127.55
37/F	+124.25
36/F	+120.95
35/F	+117.65
33/F	+114.35
32/F	+111.05
31/F	107.75
30/F	+104.45
29/F	+101.15
28/F	+97.85
27/F	+94.55

26/F	+91.25
25/F	+87.95
23/F	+84.65
22/F	+81.35
21/F	+78.05
20/F	+74.75
19/F	+71.45
18/F	+68.15
17/F	+64.85
16/F	+61.55
15/F	+58.25
12/F	+54.95

LEGEND:

- 10mm THK. HEAT STRENGTHENED GLASS (OUTSIDE) +12mm AIR SPACE + 12mm THK. TEMPERED GLASS
- 10mm THK. HEAT STRENGTHENED GLASS (OUTSIDE) +12mm AIR SPACE + 10mm THK. TEMPERED GLASS
- 12mm THK. HEAT STRENGTHENED GLASS
- 12mm THK. CLEAR TEMPERED GLASS (INTERNAL PROTECTIVE BARRIER)
- 10mm THK. HEAT STRENGTHENED GLASS (OUTSIDE) +12mm AIR SPACE + 12mm THK. TEMPERED GLASS WITH REFLECTIVE COATING
- 10mm THK. CLEAR TEMPERED GLASS
- 8mm THK. CLEAR HEAT STRENGTHENED GLASS +1.52mm PVB + 8mm THK. CLEAR HEAT-STRENGTHENED GLASS
- 3 mm THK. ALUM. CLADDING
- 3 mm THK. ALUM. BACKPAN
- S.J. STACK JOINT
- RESTRAINT SOCKET

B.D. REF :

CLIENT :
信和置業有限公司
Sino Land Company Limited

ARCHITECT :
ronald lu & partners
Architects Planners Interior Designers
Ronald Lu & Partners (HK) Ltd.
呂元祥建築師事務所(香港)有限公司

MAIN CONTRACTOR :
Gammon

STRUCTURAL ENGINEER :
AECOM

FACADE CONSULTANT:
AECOM

NOTE :
1. ALL DIMENSIONS ARE IN mm.
2. ALL ELEVATIONS ARE VIEWED FROM OUTSIDE.
3. ALL DIMENSIONS TO BE VERIFIED ON SITE BEFORE FABRICATION.

LEGEND :
- X1 / X001 — DETAIL MARK NO. / REFER SHEET NO.
1. F.F.L. --FINISHED FLOOR LEVEL
2. S.F.L. --STRUCTURAL FLOOR LEVEL
3. (R) --REVERSED DETAIL

NO.	DATE	REVISED	BY
G	17/08/22	REVISED AS PER COMMENTS	LS
F	26/07/22	REVISED AS PER COMMENTS	LS
E	23/05/22	REVISED AS PER COMMENTS	LS
D	06/04/22	REVISED AS PER COMMENTS	LS
C	24/01/22	REVISED AS PER COMMENTS	LS
B	20/12/21	REVISED AS PER COMMENTS	LS
A	03/12/21	REVISED AS PER COMMENTS	LS

JOB NO. : J-858

PROJECT :
PROPOSED RESIDENTIAL DEVELOPMENT
AT TKOTL 70RP, PHASE 11, LOHAS PARK
TSEUNG KWAN O, N.T.


TITLE :
TYPICAL FLOOR PARTIAL
ELEVATION & SECTION, PLAN
FOR CURTAIN WALL (TOWER 1)

DATE : 22-OCT-21 | SCALE : 1:50(A1)

DRAWN BY : | CHECKED BY :

美特鋁質有限公司
MIDI ALUMINIUM FABRICATOR LTD.
Units 6-8, Sunray Industrial Centre, 1/F
610 Cha Kwo Ling Road, Kowloon
Tel:23489211-4 Fax:(852)27727666

DWG NO. : J858-CW-PE102 | REV. : G

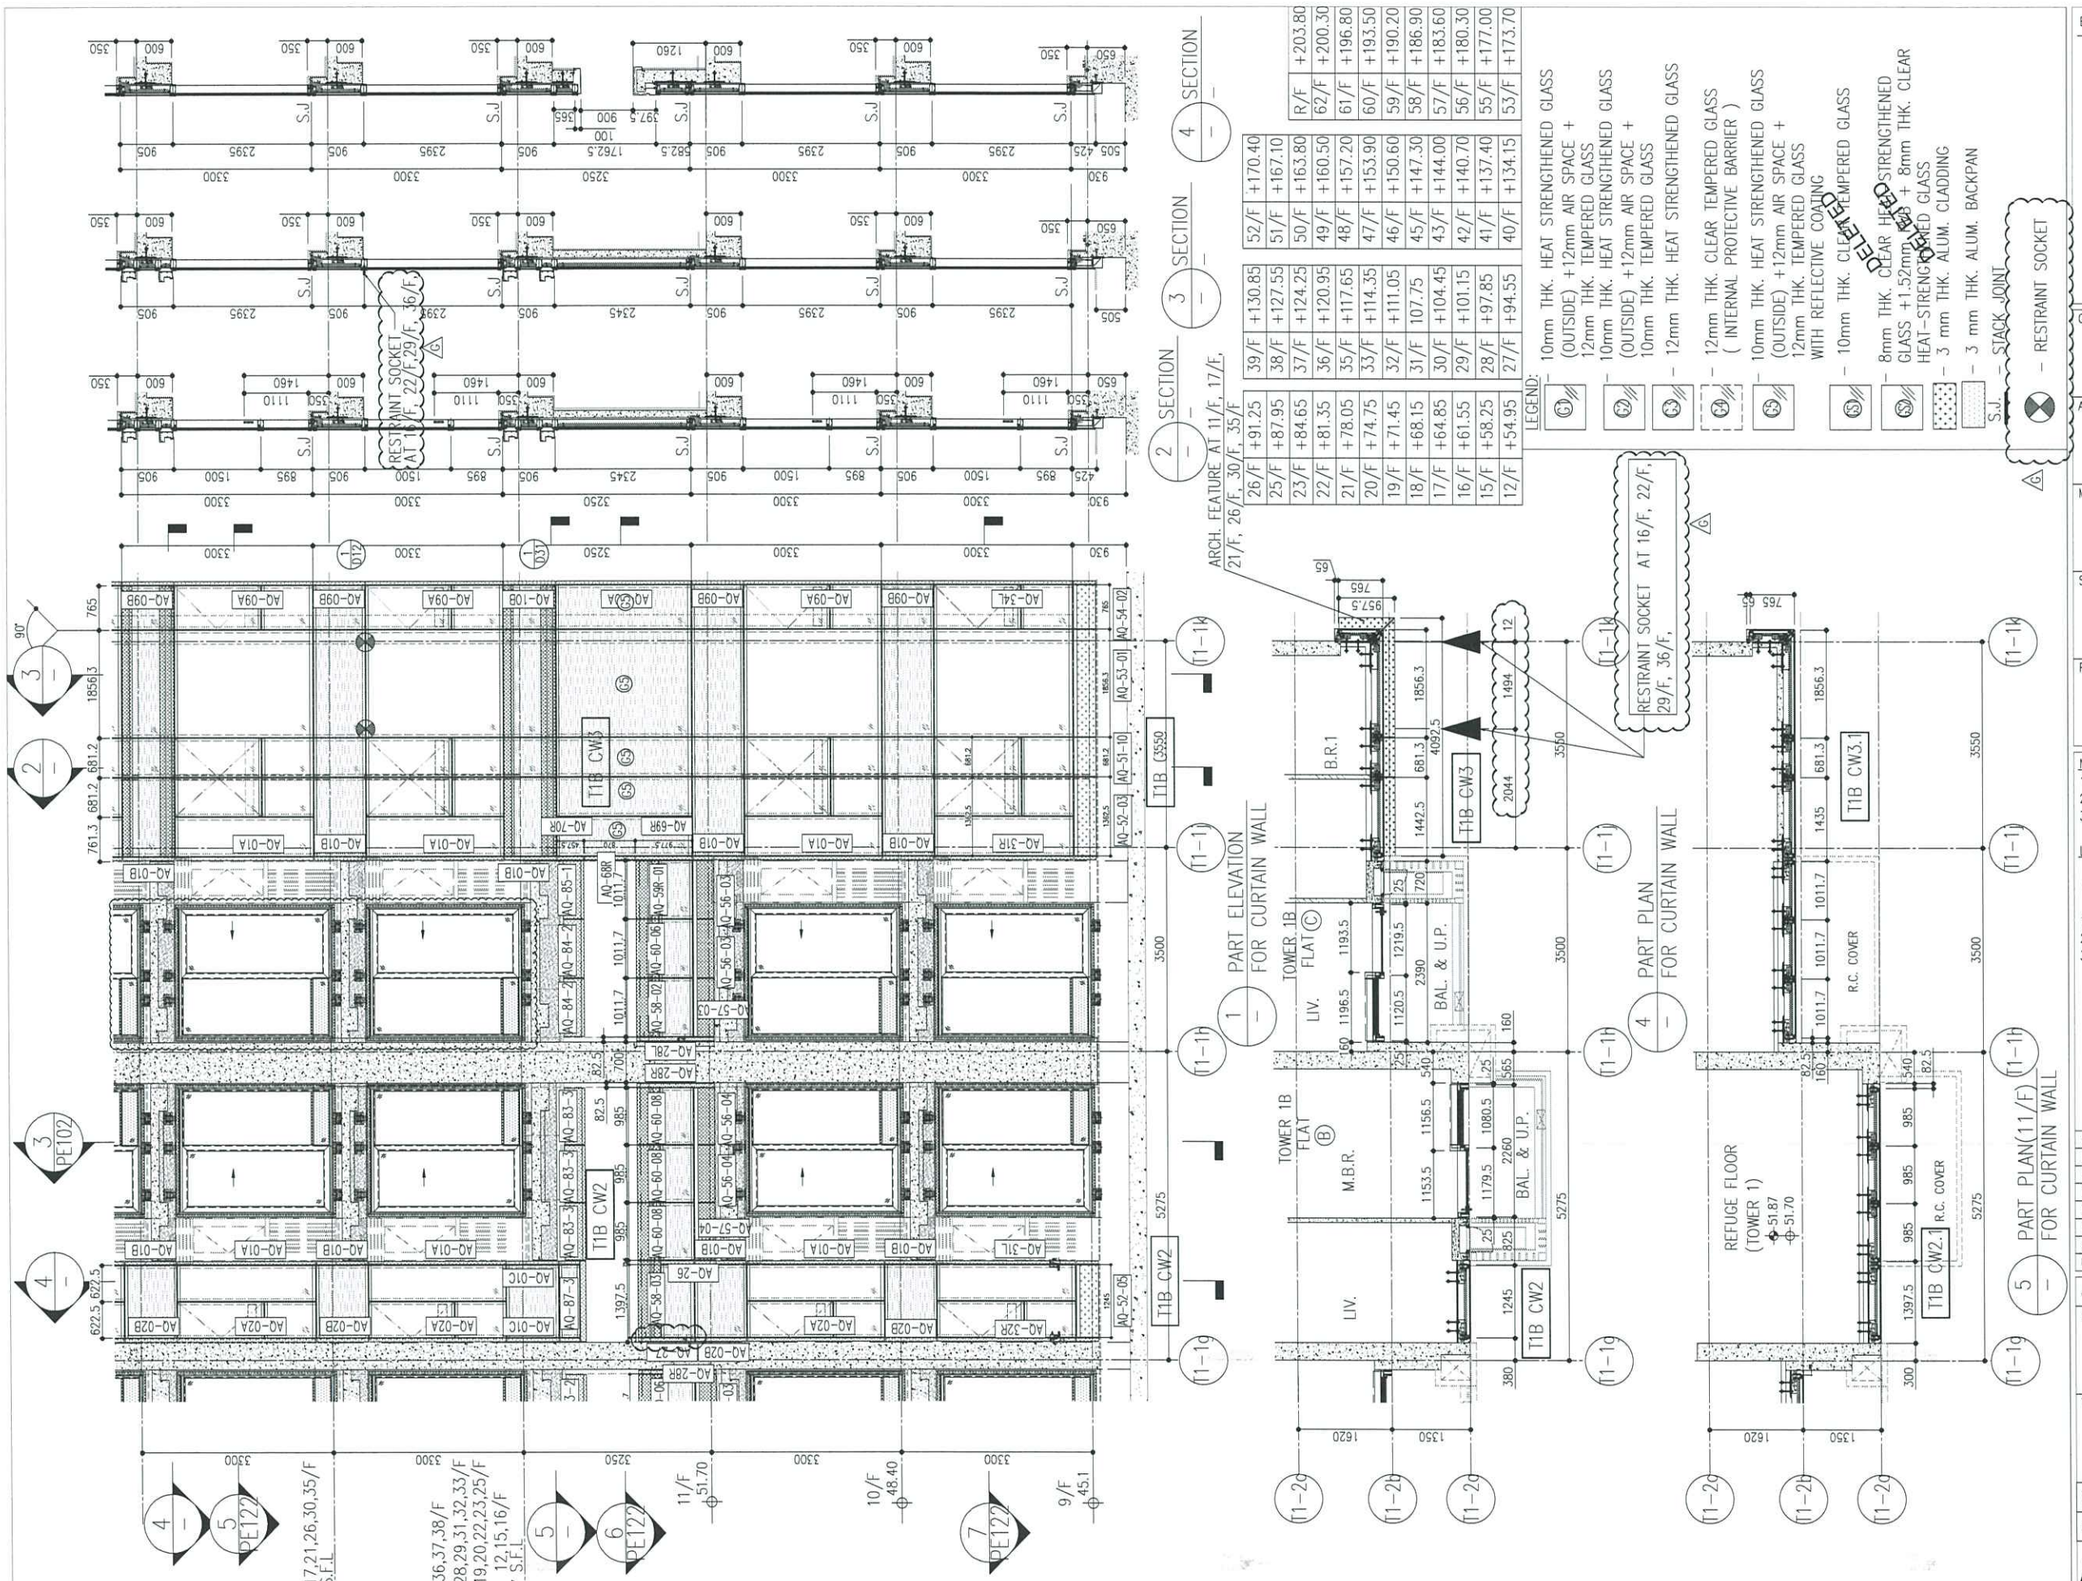

R/F	+203.80	
62/F	+200.30	
61/F	+196.80	
60/F	+193.50	
59/F	+190.20	
58/F	+186.90	
57/F	+183.60	
56/F	+180.30	
55/F	+177.00	
53/F	+173.70	
52/F	+170.40	
51/F	+167.10	
50/F	+163.80	
49/F	+160.50	
48/F	+157.20	
47/F	+153.90	
46/F	+150.60	
45/F	+147.30	
43/F	+144.00	
42/F	+140.70	
41/F	+137.40	
40/F	+134.15	
39/F	+130.85	
38/F	+127.55	
37/F	+124.25	
36/F	+120.95	
35/F	+117.65	
33/F	+114.35	
32/F	+111.05	
31/F	107.75	
30/F	+104.45	
29/F	+101.15	
28/F	+97.85	
27/F	+94.55	
26/F	+91.25	
25/F	+87.95	
24/F	+84.65	
22/F	+81.35	
21/F	+78.05	
20/F	+74.75	
19/F	+71.45	
18/F	+68.15	
17/F	+64.85	
16/F	+61.55	
15/F	+58.25	
12/F	+54.95	

LEGEND:
- 10mm THK. HEAT STRENGTHENED GLASS (OUTSIDE) +12mm AIR SPACE + 12mm THK. TEMPERED GLASS
- 10mm THK. HEAT STRENGTHENED GLASS (OUTSIDE) +12mm AIR SPACE + 10mm THK. TEMPERED GLASS
- 12mm THK. HEAT STRENGTHENED GLASS
- 12mm THK. CLEAR TEMPERED GLASS (INTERNAL PROTECTIVE BARRIER)
- 10mm THK. HEAT STRENGTHENED GLASS (OUTSIDE) +12mm AIR SPACE + 12mm THK. TEMPERED GLASS WITH REFLECTIVE COATING
- 10mm THK. CLEAR TEMPERED GLASS
- 8mm THK. CLEAR HEAT STRENGTHENED GLASS +1.52mm PVB + 8mm THK. CLEAR HEAT-STRENGTHENED GLASS
- 3 mm THK. ALUM. CLADDING
- 3 mm THK. ALUM. BACKPAN
- S.J. - STACK JOINT
- RESTRAINT SOCKET

DELETED

B.D. REF :

T1B T1B

CLIENT :
信和置業有限公司
Sino Land Company Limited

ARCHITECT :
ronald lu & partners
Architects Planners Interior Designers
Ronald Lu & Partners (HK) Ltd.
呂元祥建築師事務所(香港)有限公司

MAIN CONTRACTOR :
Gammon

STRUCTURAL ENGINEER :
AECOM

FACADE CONSULTANT:
AECOM

NOTE :
1. ALL DIMENSIONS ARE IN mm.
2. ALL ELEVATIONS ARE VIEWED FROM OUTSIDE.
3. ALL DIMENSIONS TO BE VERIFIED ON SITE BEFORE FABRICATION.

LEGEND :
- X1 / X001 — DETAIL MARK NO. / REFER SHEET NO.
1. F.F.L. --FINISHED FLOOR LEVEL
2. S.F.L. --STRUCTURAL FLOOR LEVEL
3. (R) --REVERSED DETAIL

NO.	DATE	REVISED	BY
G	12/08/22	REVISED AS PER COMMENTS	LS
F	26/07/22	REVISED AS PER COMMENTS	LS
E	23/05/22	REVISED AS PER COMMENTS	LS
D	06/04/22	REVISED AS PER COMMENTS	LS
C	24/01/22	REVISED AS PER COMMENTS	LS
B	20/12/21	REVISED AS PER COMMENTS	LS
A	03/12/21	REVISED AS PER COMMENTS	LS

JOB NO. : J-858

PROJECT :
PROPOSED RESIDENTIAL DEVELOPMENT AT TKOTL 70RP, PHASE 11, LOHAS PARK TSEUNG KWAN O, N.T.

TITLE :
TYPICAL FLOOR PARTIAL ELEVATION & SECTION, PLAN FOR CURTAIN WALL (TOWER 1)


DATE : 22-OCT-21 | SCALE : 1:50(A1)

DRAWN BY : | CHECKED BY :

美特鋁質有限公司
MIDI ALUMINIUM FABRICATOR LTD.
Units 6-8, Sunray Industrial Centre, 1/F
610 Cha Kwo Ling Road, Kowloon
Tel:23489211-4 Fax:(852)27727666

DWG NO. : J858-CW-PE103 | REV. : G

3.

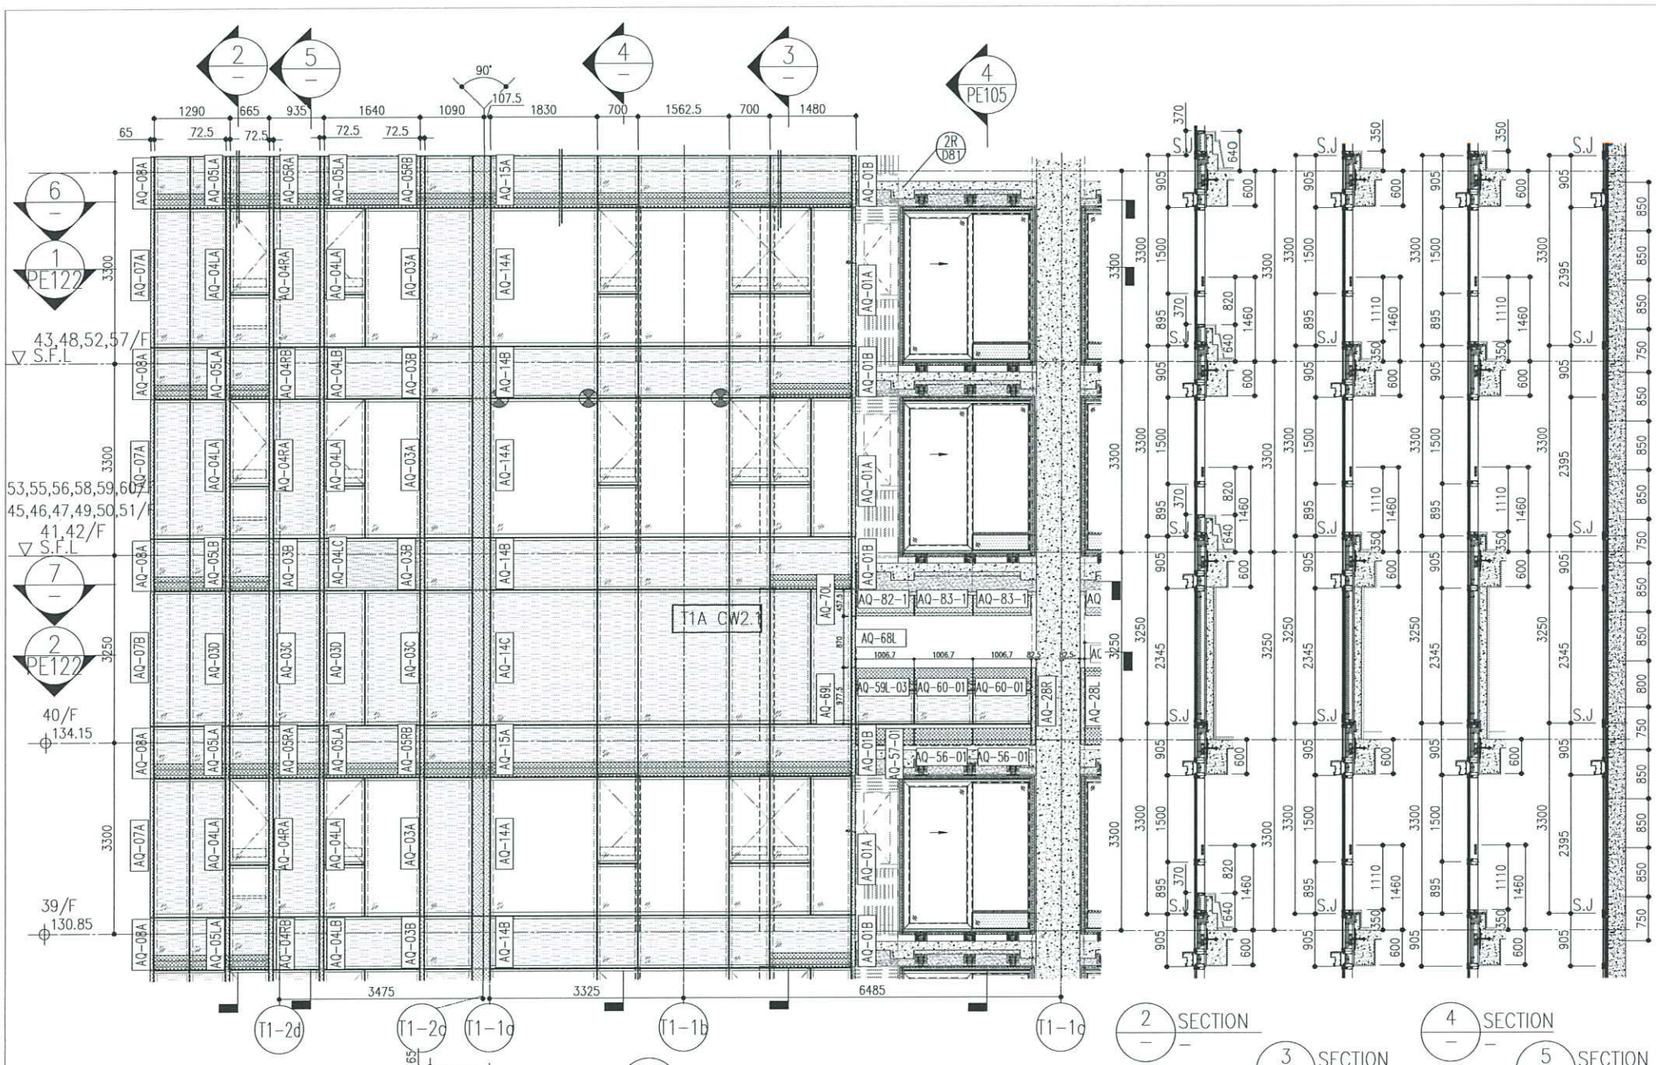


1 / – PART ELEVATION FOR CURTAIN WALL

2 / – SECTION

3 / – SECTION

4 / – SECTION

5 / – SECTION

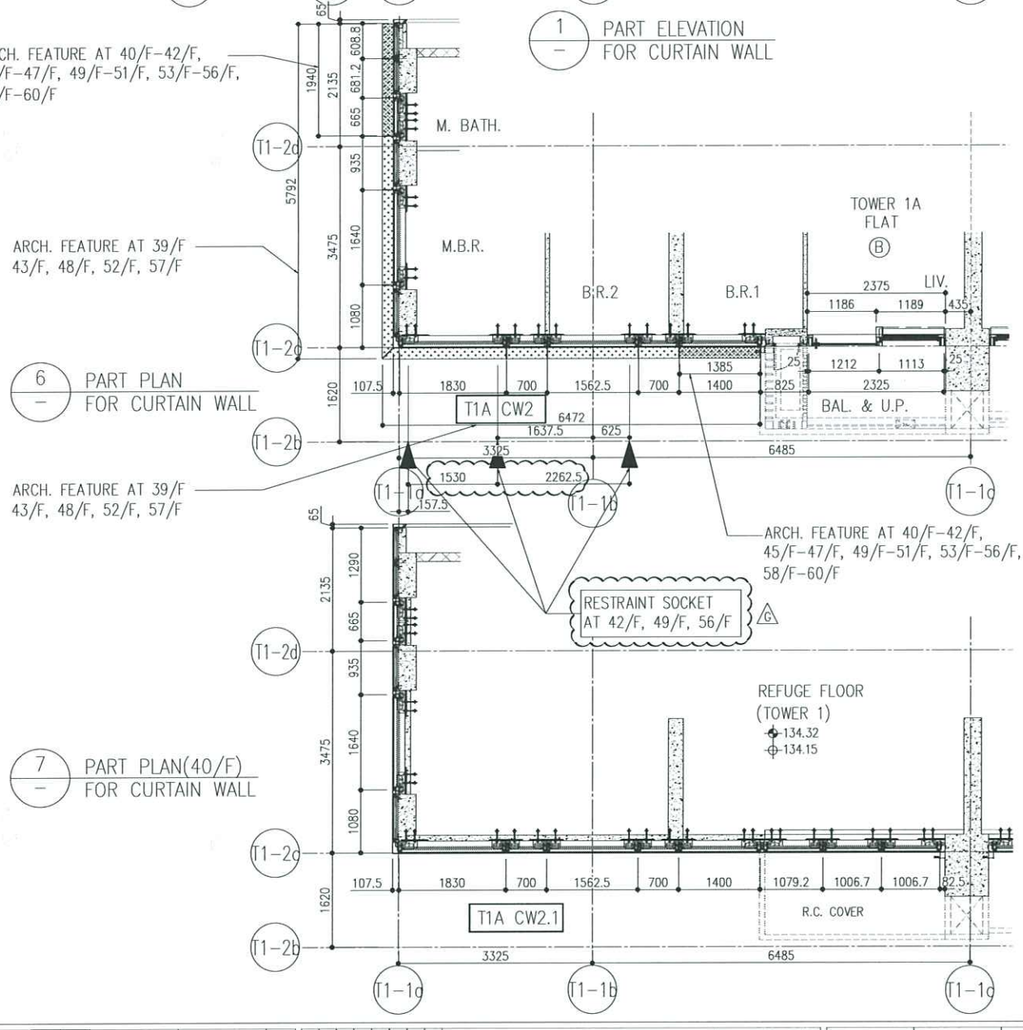

6 / – PART PLAN FOR CURTAIN WALL

7 / – PART PLAN(40/F) FOR CURTAIN WALL

26/F	+91.25	39/F	+130.85	52/F	+170.40		
25/F	+87.95	38/F	+127.55	51/F	+167.10		
23/F	+84.65	37/F	+124.25	50/F	+163.80	R/F	+203.80
22/F	+81.35	36/F	+120.95	49/F	+160.50	62/F	+200.30
21/F	+78.05	35/F	+117.65	48/F	+157.20	61/F	+196.80
20/F	+74.75	33/F	+114.35	47/F	+153.90	60/F	+193.50
19/F	+71.45	32/F	+111.05	46/F	+150.60	59/F	+190.20
18/F	+68.15	31/F	107.75	45/F	+147.30	58/F	+186.90
17/F	+64.85	30/F	+104.45	43/F	+144.00	57/F	+183.60
16/F	+61.55	29/F	+101.15	42/F	+140.70	56/F	+180.30
15/F	+58.25	28/F	+97.85	41/F	+137.40	55/F	+177.00
12/F	+54.95	27/F	+94.55	40/F	+134.15	53/F	+173.70

LEGEND:

- G1 – 10mm THK. HEAT STRENGTHENED GLASS (OUTSIDE) +12mm AIR SPACE + 12mm THK. TEMPERED GLASS
- G2 – 10mm THK. HEAT STRENGTHENED GLASS (OUTSIDE) +12mm AIR SPACE + 10mm THK. TEMPERED GLASS
- G3 – 12mm THK. HEAT STRENGTHENED GLASS
- G4 – 12mm THK. CLEAR TEMPERED GLASS (INTERNAL PROTECTIVE BARRIER)
- G5 – 10mm THK. HEAT STRENGTHENED GLASS (OUTSIDE) +12mm AIR SPACE + 12mm THK. TEMPERED GLASS WITH REFLECTIVE COATING
- S3 – 10mm THK. CLEAR TEMPERED GLASS
- S5 – 8mm THK. CLEAR HEAT-STRENGTHENED GLASS +1.52mm PVB + 8mm THK. CLEAR HEAT-STRENGTHENED GLASS
- 3 mm THK. ALUM. CLADDING
- 3 mm THK. ALUM. BACKPAN
- S.J. – STACK JOINT
- G – RESTRAINT SOCKET

DELETED DELETED

NOTE :
1. ALL DIMENSIONS ARE IN mm.
2. ALL ELEVATIONS ARE VIEWED FROM OUTSIDE.
3. ALL DIMENSIONS TO BE VERIFIED ON SITE BEFORE FABRICATION.

LEGEND :
- X1 / X00 – DETAIL MARK NO. / REFER SHEET NO.
1. F.F.L. --- FINISHED FLOOR LEVEL
2. S.F.L. --- STRUCTURAL FLOOR LEVEL
3. (R) --- REVERSED DETAIL

NO.	DATE	REVISED / REVISED AS PER COMMENTS	BY
G	17/08/22	REVISED AS PER COMMENTS	LS
F	26/07/22	REVISED AS PER COMMENTS	LS
E	23/05/22	REVISED AS PER COMMENTS	LS
D	06/04/22	REVISED AS PER COMMENTS	LS
C	24/01/22	REVISED AS PER COMMENTS	LS
B	20/12/21	REVISED AS PER COMMENTS	LS
A	03/12/21	REVISED AS PER COMMENTS	LS

JOB NO. : J-858

PROJECT : PROPOSED RESIDENTIAL DEVELOPMENT AT TKOTL 70RP, PHASE 11, LOHAS PARK TSEUNG KWAN O, N.T.

TITLE : TYPICAL FLOOR PARTIAL ELEVATION & SECTION, PLAN FOR CURTAIN WALL (TOWER 1)

DATE : 22-OCT-21 | SCALE : 1:50(A1)

DRAWN BY : | CHECKED BY :

DWG NO. : J858-CW-PE104 | REV. : G

美特鋁廠有限公司 MIDI ALUMINIUM FABRICATOR LTD.
Units 6-8, Sunray Industrial Centre, 1/F
Tel:23489211-4 Fax:(852)27727666

B.D. REF :

CLIENT : 恒和置業有限公司 Sino Land Company Limited


ARCHITECT : Ronald lu & partners (HK) Ltd. 呂元祥建築師事務所(香港)有限公司

MAIN CONTRACTOR : Gammon

STRUCTURAL ENGINEER : AECOM

FACADE CONSULTANT : AECOM

4.

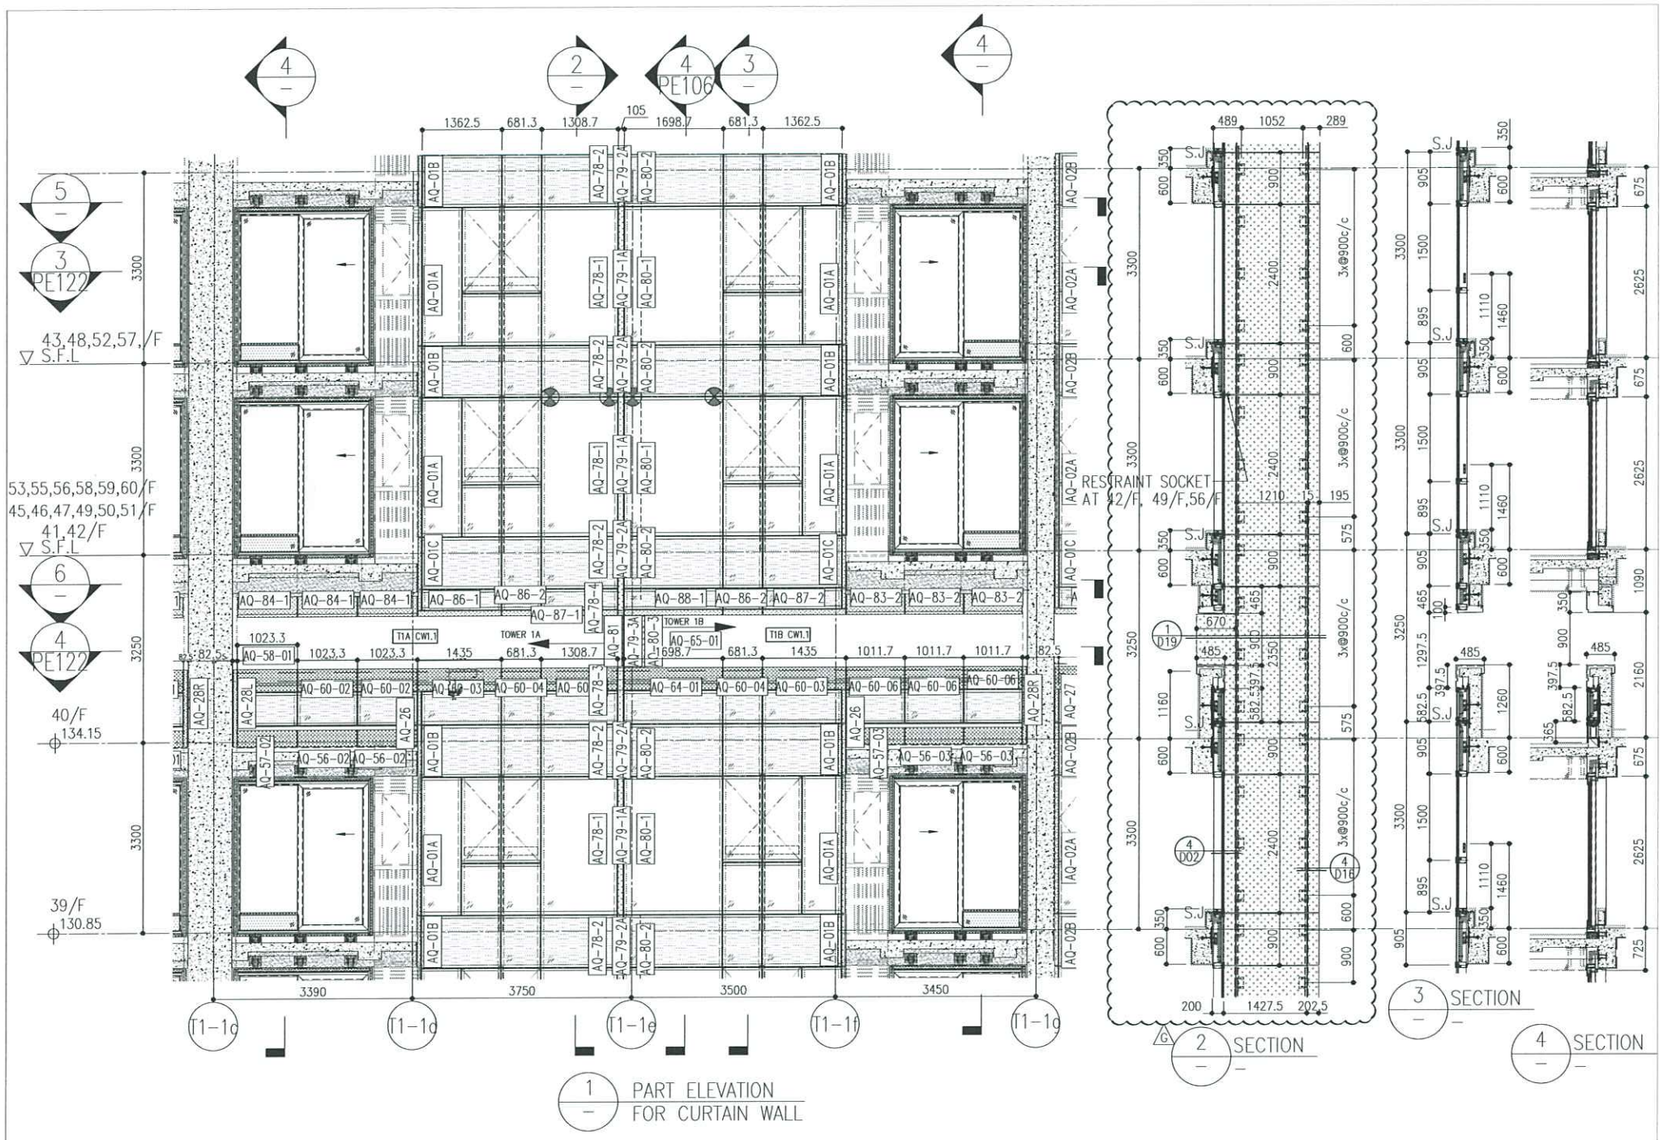


1 PART ELEVATION FOR CURTAIN WALL

2 SECTION

3 SECTION

4 SECTION

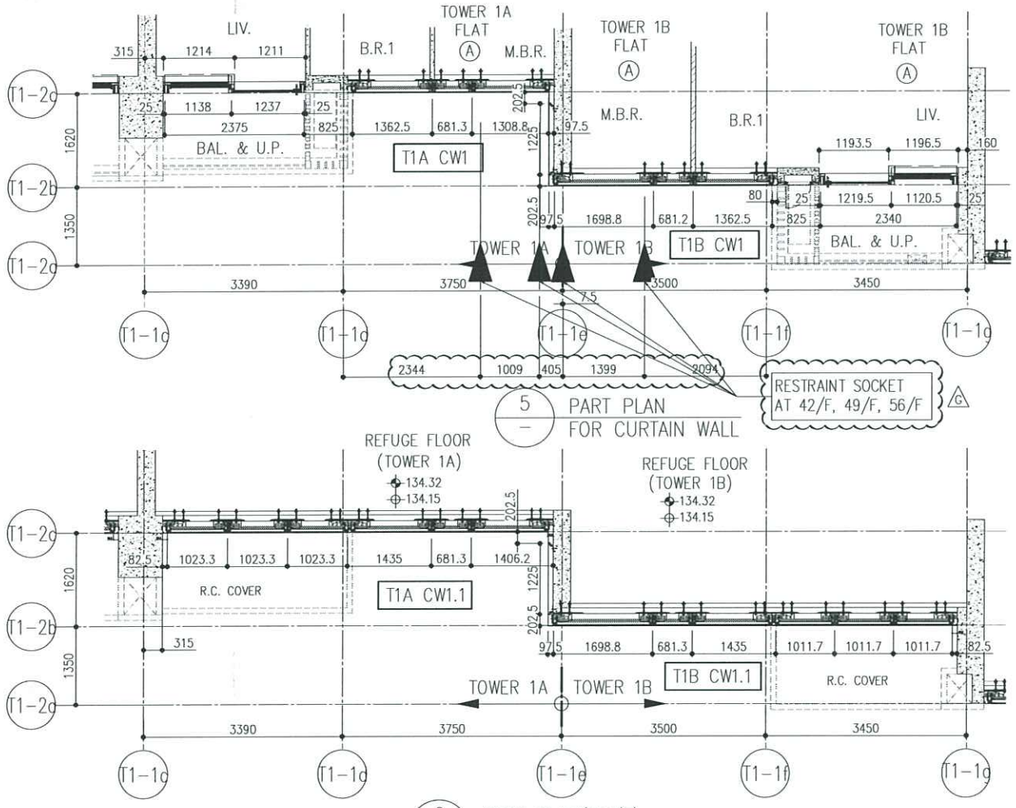

5 PART PLAN FOR CURTAIN WALL

6 PART PLAN(40/F) FOR CURTAIN WALL

26/F	+91.25	39/F	+130.85	52/F	+170.40		
25/F	+87.95	38/F	+127.55	51/F	+167.10		
23/F	+84.65	37/F	+124.25	50/F	+163.80	R/F	+203.80
22/F	+81.35	36/F	+120.95	49/F	+160.50	62/F	+200.30
21/F	+78.05	35/F	+117.65	48/F	+157.20	61/F	+196.80
20/F	+74.75	33/F	+114.35	47/F	+153.90	60/F	+193.50
19/F	+71.45	32/F	+111.05	46/F	+150.60	59/F	+190.20
18/F	+68.15	31/F	107.75	45/F	+147.30	58/F	+186.90
17/F	+64.85	30/F	+104.45	43/F	+144.00	57/F	+183.60
16/F	+61.55	29/F	+101.15	42/F	+140.70	56/F	+180.30
15/F	+58.25	28/F	+97.85	41/F	+137.40	55/F	+177.00
12/F	+54.95	27/F	+94.55	40/F	+134.15	53/F	+173.70

LEGEND:

- G1 – 10mm THK. HEAT STRENGTHENED GLASS (OUTSIDE) +12mm AIR SPACE + 12mm THK. TEMPERED GLASS
- G2 – 10mm THK. HEAT STRENGTHENED GLASS (OUTSIDE) +12mm AIR SPACE + 10mm THK. TEMPERED GLASS
- G3 – 12mm THK. HEAT STRENGTHENED GLASS
- G4 – 12mm THK. CLEAR TEMPERED GLASS (INTERNAL PROTECTIVE BARRIER)
- G5 – 10mm THK. HEAT STRENGTHENED GLASS (OUTSIDE) +12mm AIR SPACE + 12mm THK. TEMPERED GLASS WITH REFLECTIVE COATING
- S1 – 10mm THK. CLEAR TEMPERED GLASS
- S2 – 8mm THK. CLEAR HEAT-STRENGTHENED GLASS +1.52mm PVB + 8mm THK. CLEAR HEAT-STRENGTHENED GLASS
- 3 mm THK. ALUM. CLADDING
- 3 mm THK. ALUM. BACKPAN
- S.J. – STACK JOINT
- G – RESTRAINT SOCKET

DELETED

NOTE:
1. ALL DIMENSIONS ARE IN mm.
2. ALL ELEVATIONS ARE VIEWED FROM OUTSIDE.
3. ALL DIMENSIONS TO BE VERIFIED ON SITE BEFORE FABRICATION.

LEGEND:
- X1 / X(dd) — DETAIL MARK NO. / REFER SHEET NO.
- 1. F.F.L. --FINISHED FLOOR LEVEL
- 2. S.F.L. --STRUCTURAL FLOOR LEVEL
- 3. /R --REVERSED DETAIL

NO.	DATE	REVISED	BY
G	17/08/22	REVISED AS PER COMMENTS	LS
F	26/07/22	REVISED AS PER COMMENTS	LS
E	23/05/22	REVISED AS PER COMMENTS	LS
D	06/04/22	REVISED AS PER COMMENTS	LS
C	24/01/22	REVISED AS PER COMMENTS	LS
B	20/12/21	REVISED AS PER COMMENTS	LS
A	03/12/21	REVISED AS PER COMMENTS	LS

JOB NO. : J-858

PROJECT :
PROPOSED RESIDENTIAL DEVELOPMENT AT TKOTL 70RP, PHASE 11, LOHAS PARK TSEUNG KWAN O, N.T.


TITLE :
TYPICAL FLOOR PARTIAL ELEVATION & SECTION, PLAN FOR CURTAIN WALL (TOWER 1)

DATE : 22-OCT-21 | SCALE : 1:50(A1)
DRAWN BY : | CHECKED BY :
DWG NO. : J858-CW-PE105 | REV. : G

美特鋁質有限公司 MIDI ALUMINIUM FABRICATOR LTD.
Units 6-8, Sunray Industrial Centre, 1/F
610 Cha Kwo Ling Road, Kowloon
Tel:23489211-4 Fax:(852)27727866

CONSULTANTS:
FACADE CONSULTANT: AECOM
STRUCTURAL ENGINEER: AECOM
Gammon
MAIN CONTRACTOR : 呂元祥建築師事務所(香港)有限公司 Ronald Lu & Partners (HK) Ltd.
ARCHITECT : ronald lu & partners
CLIENT : 信和置業有限公司 Sino Land Company Limited

B.D. REF :

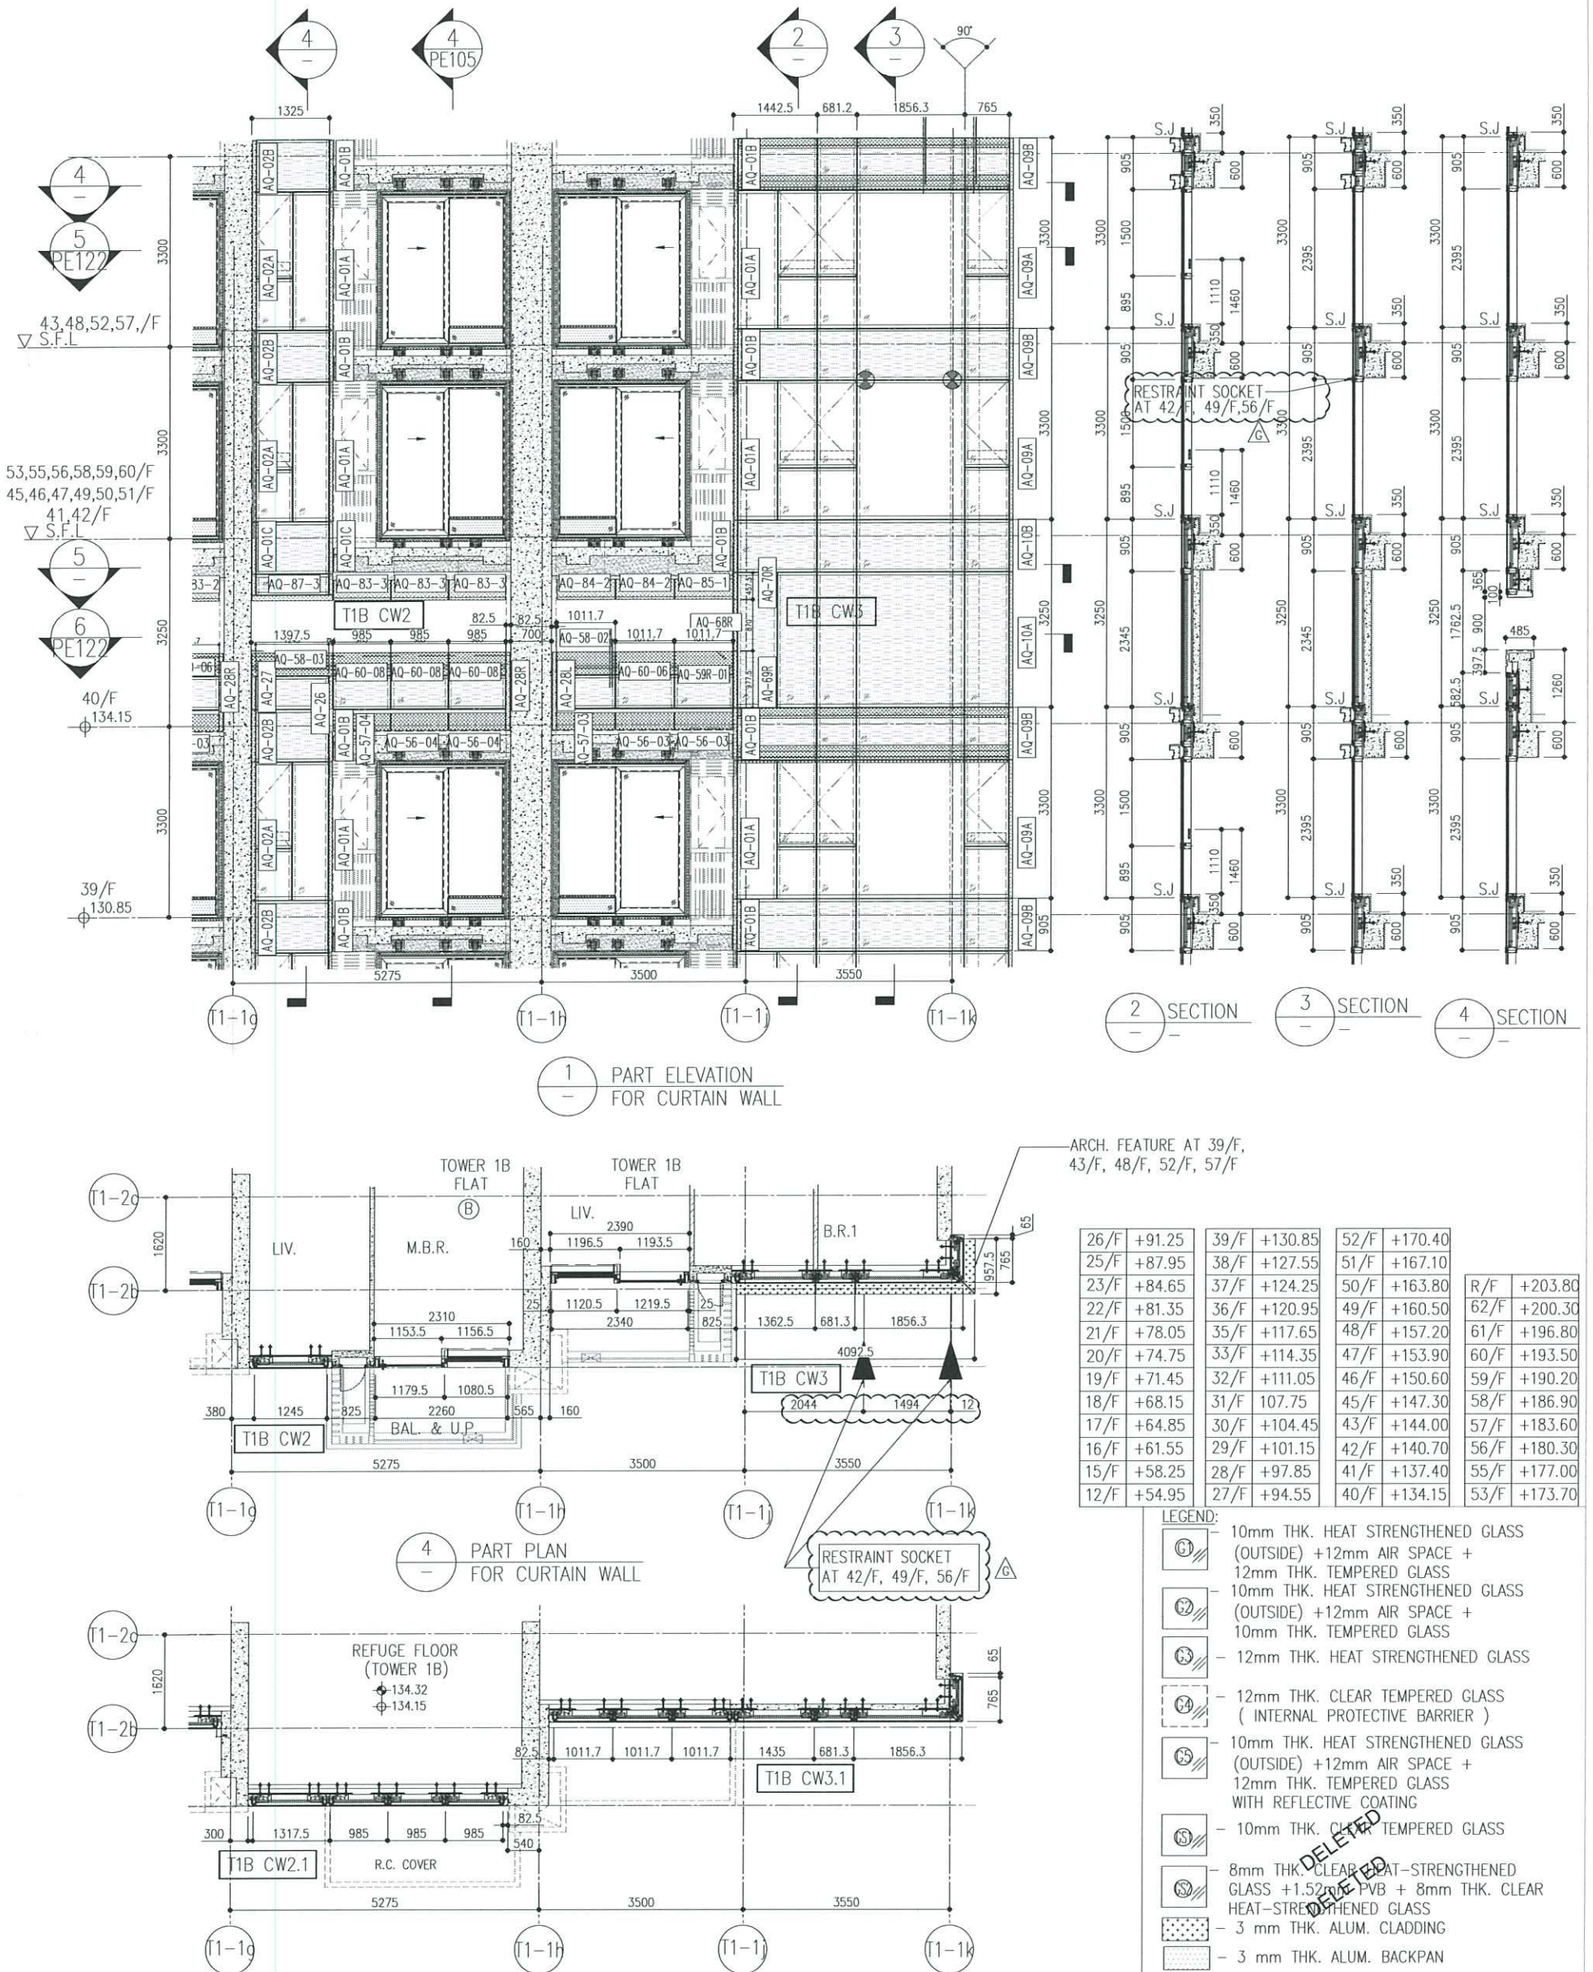

1 PART ELEVATION FOR CURTAIN WALL

2 SECTION

3 SECTION

4 SECTION

4 PART PLAN FOR CURTAIN WALL

5 PART PLAN(40/F) FOR CURTAIN WALL

26/F	+91.25	39/F	+130.85	52/F	+170.40		
25/F	+87.95	38/F	+127.55	51/F	+167.10		
23/F	+84.65	37/F	+124.25	50/F	+163.80	R/F	+203.80
22/F	+81.35	36/F	+120.95	49/F	+160.50	62/F	+200.30
21/F	+78.05	35/F	+117.65	48/F	+157.20	61/F	+196.80
20/F	+74.75	33/F	+114.35	47/F	+153.90	60/F	+193.50
19/F	+71.45	32/F	+111.05	46/F	+150.60	59/F	+190.20
18/F	+68.15	31/F	107.75	45/F	+147.30	58/F	+186.90
17/F	+64.85	30/F	+104.45	43/F	+144.00	57/F	+183.60
16/F	+61.55	29/F	+101.15	42/F	+140.70	56/F	+180.30
15/F	+58.25	28/F	+97.85	41/F	+137.40	55/F	+177.00
12/F	+54.95	27/F	+94.55	40/F	+134.15	53/F	+173.70

LEGEND:

- G1 – 10mm THK. HEAT STRENGTHENED GLASS (OUTSIDE) +12mm AIR SPACE + 12mm THK. TEMPERED GLASS
- G2 – 10mm THK. HEAT STRENGTHENED GLASS (OUTSIDE) +12mm AIR SPACE + 10mm THK. TEMPERED GLASS
- G3 – 12mm THK. HEAT STRENGTHENED GLASS
- G4 – 12mm THK. CLEAR TEMPERED GLASS (INTERNAL PROTECTIVE BARRIER)
- G5 – 10mm THK. HEAT STRENGTHENED GLASS (OUTSIDE) +12mm AIR SPACE + 12mm THK. TEMPERED GLASS WITH REFLECTIVE COATING
- G6 – 10mm THK. CLEAR TEMPERED GLASS
- G7 – 8mm THK CLEAR HEAT-STRENGTHENED GLASS +1.52mm PVB + 8mm THK. CLEAR HEAT-STRENGTHENED GLASS
- 3 mm THK. ALUM. CLADDING
- 3 mm THK. ALUM. BACKPAN
- S.J. – STACK JOINT
- G – RESTRAINT SOCKET

DELETED
DELETED

NOTE :
1. ALL DIMENSIONS ARE IN mm.
2. ALL ELEVATIONS ARE VIEWED FROM OUTSIDE.
3. ALL DIMENSIONS TO BE VERIFIED ON SITE BEFORE FABRICATION.

LEGEND :
- X1 / X001 – DETAIL MARK NO. / REFER SHEET NO.
- 1. F.F.L. --FINISHED FLOOR LEVEL
- 2. S.F.L. --STRUCTURAL FLOOR LEVEL
- 3. (R) --REVERSED DETAIL

NO.	DATE	REVISED	BY
G	17/08/22	REVISED AS PER COMMENTS	LS
F	26/07/22	REVISED AS PER COMMENTS	LS
E	23/05/22	REVISED AS PER COMMENTS	LS
D	06/04/22	REVISED AS PER COMMENTS	LS
C	24/01/22	REVISED AS PER COMMENTS	LS
B	20/12/21	REVISED AS PER COMMENTS	LS
A	03/12/21	REVISED AS PER COMMENTS	LS

JOB NO. : J-858

PROJECT : PROPOSED RESIDENTIAL DEVELOPMENT AT TKOTL 70RP, PHASE 11, LOHAS PARK TSEUNG KWAN O, N.T.

TITLE : TYPICAL FLOOR PARTIAL ELEVATION & SECTION, PLAN FOR CURTAIN WALL (TOWER 1)

DATE : 22-OCT-21 | SCALE : 1:50(A1)

DRAWN BY : | CHECKED BY :

DWG NO. : J858-CW-PE106 | REV. : G

美特鋁製有限公司 MIDI ALUMINIUM FABRICATOR LTD.
Units 6-8, Sunray Industrial Centre, 1/F
610 Cha Kwo Ling Road, Kowloon
Tel:23489211-4 Fax:(852)27727666

B.D. REF :

CLIENT : 信和置業有限公司 Sino Land Company Limited


ARCHITECT : ronald lu & partners 呂元祥建築師事務所(香港)有限公司 Ronald Lu & Partners (HK) Ltd.

MAIN CONTRACTOR : Gammon

STRUCTURAL ENGINEER : AECOM

FACADE CONSULTANT : AECOM

6

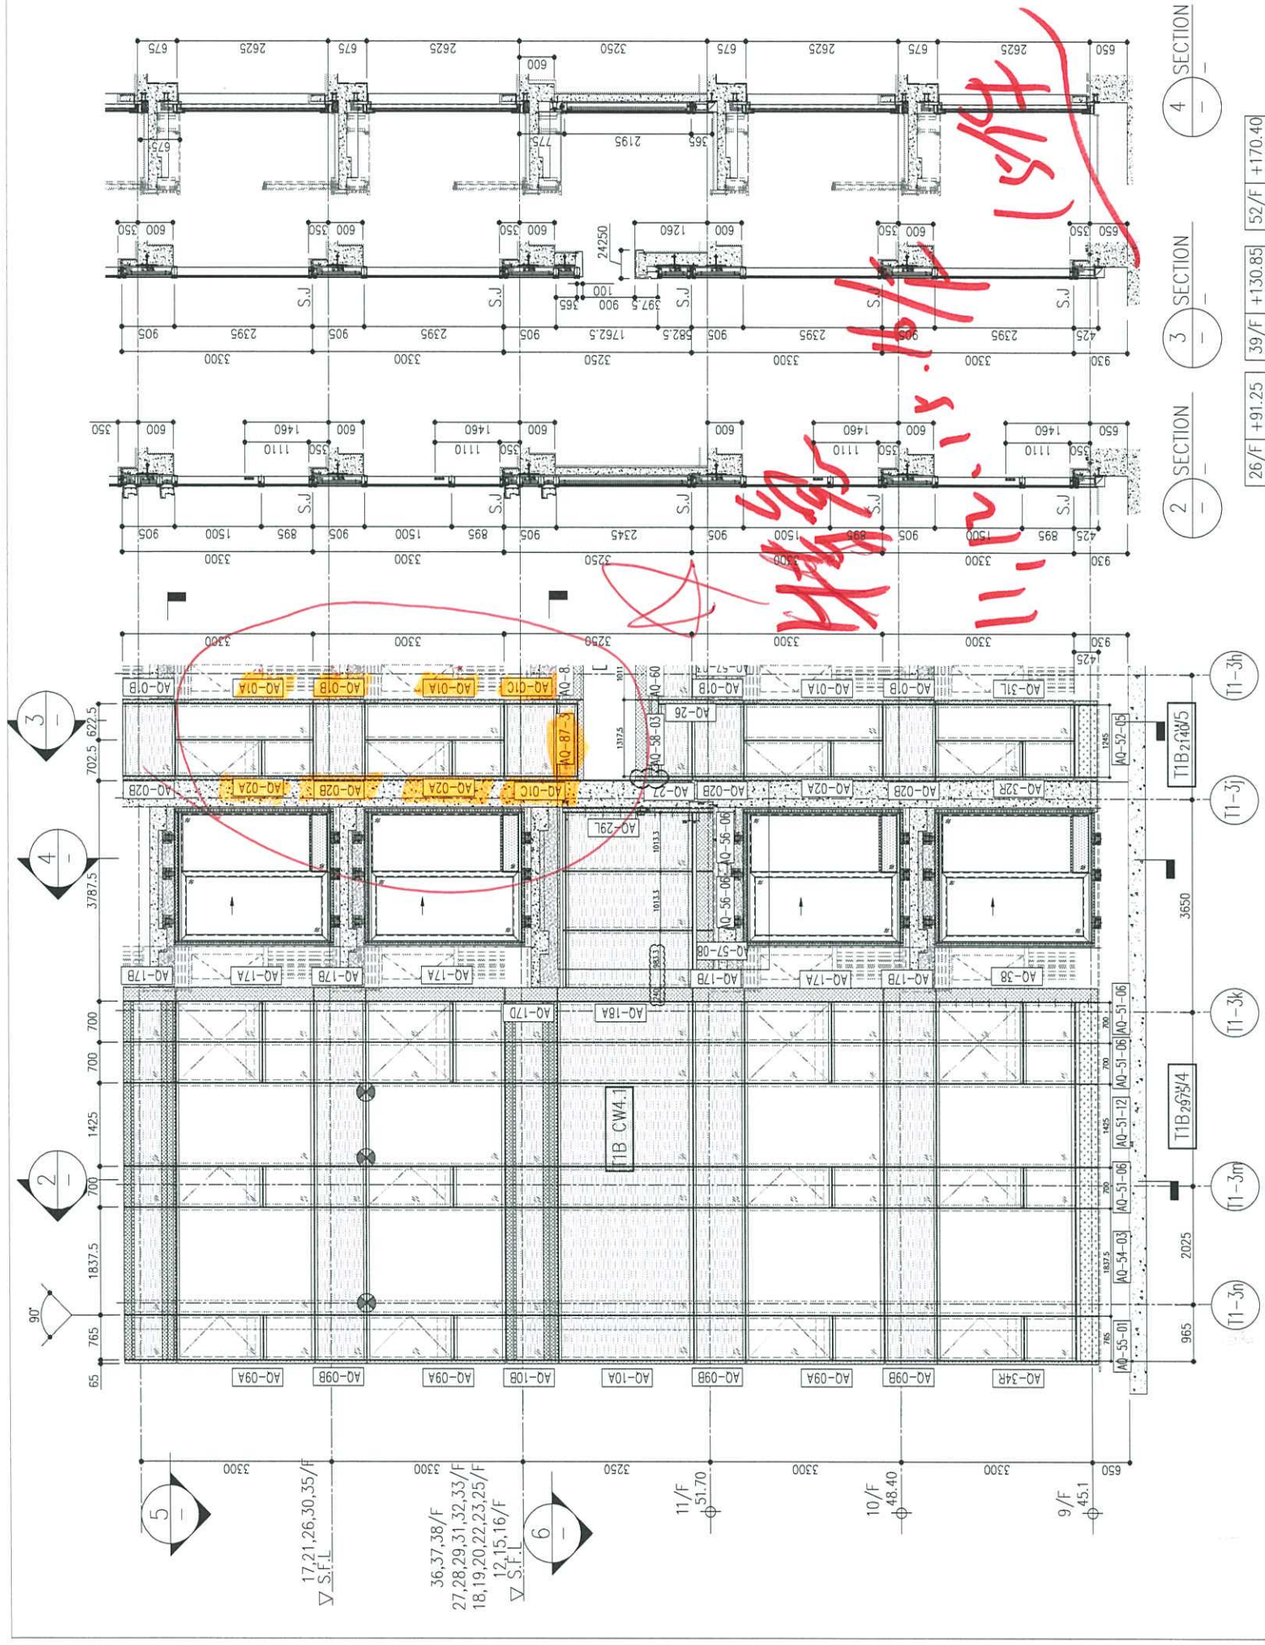

26/F	+91.25	39/F	+130.85
25/F	+87.95	38/F	+127.55
23/F	+84.65	37/F	+124.25
22/F	+81.35	36/F	+120.95
21/F	+78.05	35/F	+117.65
20/F	+74.75	33/F	+114.35
19/F	+71.45	32/F	+111.05
18/F	+68.15	31/F	107.75
17/F	+64.85	30/F	+104.45
16/F	+61.55	29/F	+101.15
15/F	+58.25	28/F	+97.85
12/F	+54.95	27/F	+94.55


52/F	+170.40	R/F	+203.80
51/F	+167.10	62/F	+200.30
50/F	+163.80	61/F	+196.80
49/F	+160.50	60/F	+193.50
48/F	+157.20	59/F	+190.20
47/F	+153.90	58/F	+186.90
46/F	+150.60	57/F	+183.60
45/F	+147.30	56/F	+180.30
43/F	+144.00	55/F	+177.00
42/F	+140.70	53/F	+173.70
41/F	+137.40		
40/F	+134.15		

LEGEND:


- G1 – 10mm THK. HEAT STRENGTHENED GLASS (OUTSIDE) +12mm AIR SPACE + 12mm THK. TEMPERED GLASS
- G2 – 10mm THK. HEAT STRENGTHENED GLASS (OUTSIDE) +12mm AIR SPACE + 10mm THK. TEMPERED GLASS
- G3 – 12mm THK. HEAT STRENGTHENED GLASS
- G4 – 12mm THK. CLEAR TEMPERED GLASS (INTERNAL PROTECTIVE BARRIER)
- G5 – 10mm THK. HEAT STRENGTHENED GLASS (OUTSIDE) +12mm AIR SPACE + 12mm THK. TEMPERED GLASS WITH REFLECTIVE COATING
- G6 – 10mm THK. CLEAR TEMPERED GLASS
- G7 – 8mm THK. CLEAR HEAT-STRENGTHENED GLASS +1.52mm PVB + 8mm THK. CLEAR HEAT-STRENGTHENED GLASS
- – 3 mm THK. ALUM. CLADDING
- – 3 mm THK. ALUM. BACKPAN
- S.J – STACK JOINT
- – RESTRAINT SOCKET

1 PART ELEVATION FOR CURTAIN WALL

ARCH. FEATURE AT 11/F, 17/F, 21/F, 26/F, 30/F, 35/F

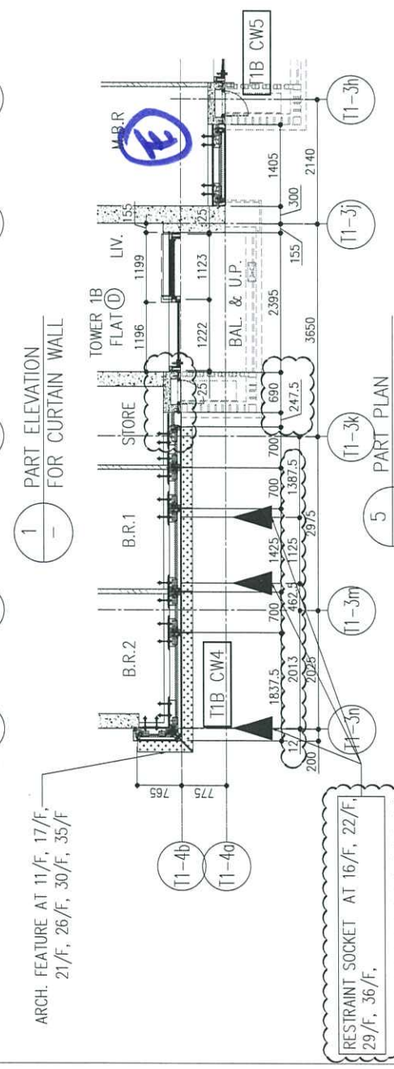

5 PART PLAN FOR CURTAIN WALL

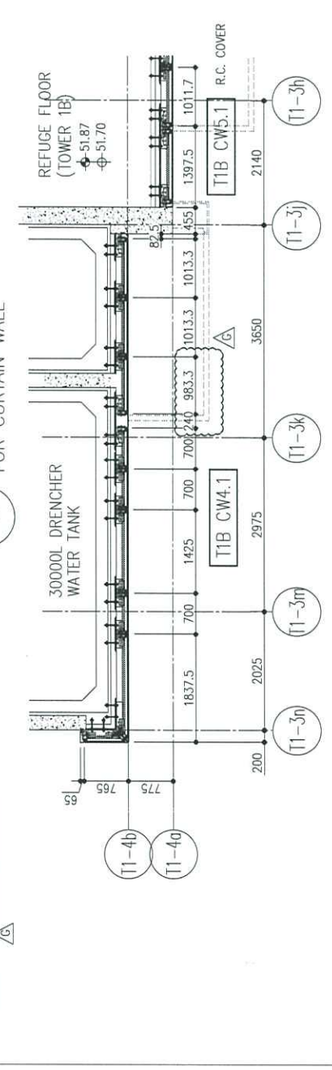

6 PART PLAN(11/F) FOR CURTAIN WALL

B.D. REF :

CLIENT :
信和置業有限公司
Sino Land Company Limited

ARCHITECT :
ronald lu & partners
Architects Planners Interior Designers
Ronald Lu & Partners (HK) Ltd.
呂元祥建築師事務所(香港)有限公司

MAIN CONTRACTOR :
Gammon

STRUCTURAL ENGINEER :
AECOM

FACADE CONSULTANT:
AECOM

NOTE :
1. ALL DIMENSIONS ARE IN mm.
2. ALL ELEVATIONS ARE VIEWED FROM OUTSIDE.
3. ALL DIMENSIONS TO BE VERIFIED ON SITE BEFORE FABRICATION.

LEGEND :
X1 — DETAIL MARK NO.
X001 — REFER SHEET NO.

1. F.F.L. --FINISHED FLOOR LEVEL
2. S.F.L. --STRUCTURAL FLOOR LEVEL
3. /R --REVERSED DETAIL

NO.	DATE	REVISED	BY
G	17/08/22	REVISED AS PER COMMENTS	LS
F	26/07/22	REVISED AS PER COMMENTS	LS
E	23/05/22	REVISED AS PER COMMENTS	LS
D	06/04/22	REVISED AS PER COMMENTS	LS
C	24/01/22	REVISED AS PER COMMENTS	LS
B	20/12/21	REVISED AS PER COMMENTS	LS
A	03/12/21	REVISED AS PER COMMENTS	LS

JOB NO. : J-858

PROJECT :
PROPOSED RESIDENTIAL DEVELOPMENT
AT TKOTL 70RP, PHASE 11, LOHAS PARK
TSEUNG KWAN O, N.T.

TITLE :
TYPICAL FLOOR PARTIAL ELEVATION & SECTION, PLAN FOR CURTAIN WALL (TOWER 1)

DATE : 22-OCT-21 | SCALE : 1:50(A1)

DRAWN BY : | CHECKED BY :

美特鋁質有限公司
MIDI ALUMINUM FABRICATOR LTD.
Units 6-8, Sunray Industrial Centre, 1/F
610 Cha Kwo Ling Road, Kowloon
Tel:23489211-4 Fax:(852)27727666

DWG NO. : J858-CW-PE107 | REV. : G

7

B.D. REF :

118

CLIENT :
信和置業有限公司
Sino Land Company Limited

ARCHITECT :
ronald lu & partners
Architects . Planners . Interior Designers
Ronald Lu & Partners (HK) Ltd.
呂元祥建築師事務所(香港)有限公司

MAIN CONTRACTOR :
Gammon

STRUCTURAL ENGINEER :
AECOM

FACADE CONSULTANT:
AECOM

NOTE :
1. ALL DIMENSIONS ARE IN mm.
2. ALL ELEVATIONS ARE VIEWED FROM OUTSIDE.
3. ALL DIMENSIONS TO BE VERIFIED ON SITE BEFORE FABRICATION.

LEGEND :
- X1 — DETAIL MARK NO.
- X001 — REFER SHEET NO.

1. F.F.L. --FINISHED FLOOR LEVEL
2. S.F.L. --STRUCTURAL FLOOR LEVEL
3. /R --REVERSED DETAIL

NO.	DATE	REVISED	BY
G	17/08/22	REVISED AS PER COMMENTS	LS
F	26/07/22	REVISED AS PER COMMENTS	LS
E	23/05/22	REVISED AS PER COMMENTS	LS
D	06/04/22	REVISED AS PER COMMENTS	LS
C	16/02/22	REVISED AS PER COMMENTS	LS
B	20/12/21	REVISED AS PER COMMENTS	LS
A	03/12/21	REVISED AS PER COMMENTS	LS

JOB NO. : J-858

PROJECT :
PROPOSED RESIDENTIAL DEVELOPMENT
AT TKOTL 70RP, PHASE 11, LOHAS PARK
TSEUNG KWAN O, N.T.

TITLE :
TYPICAL FLOOR PARTIAL
ELEVATION & SECTION, PLAN
FOR CURTAIN WALL (TOWER 1)


DATE : 22-OCT-21 | SCALE : 1:50(A1)

DRAWN BY : | CHECKED BY :

美特鋁質有限公司
MIDI ALUMINUM FABRICATOR LTD.
Units 6-8, Sunray Industrial Centre, 1/F
610 Cha Kwo Ling Road, Kowloon
Tel:23489211-4 Fax:(852)27727666

DWG NO. : J858-CW-PE108 | REV. : G

| LEGEND: | | |

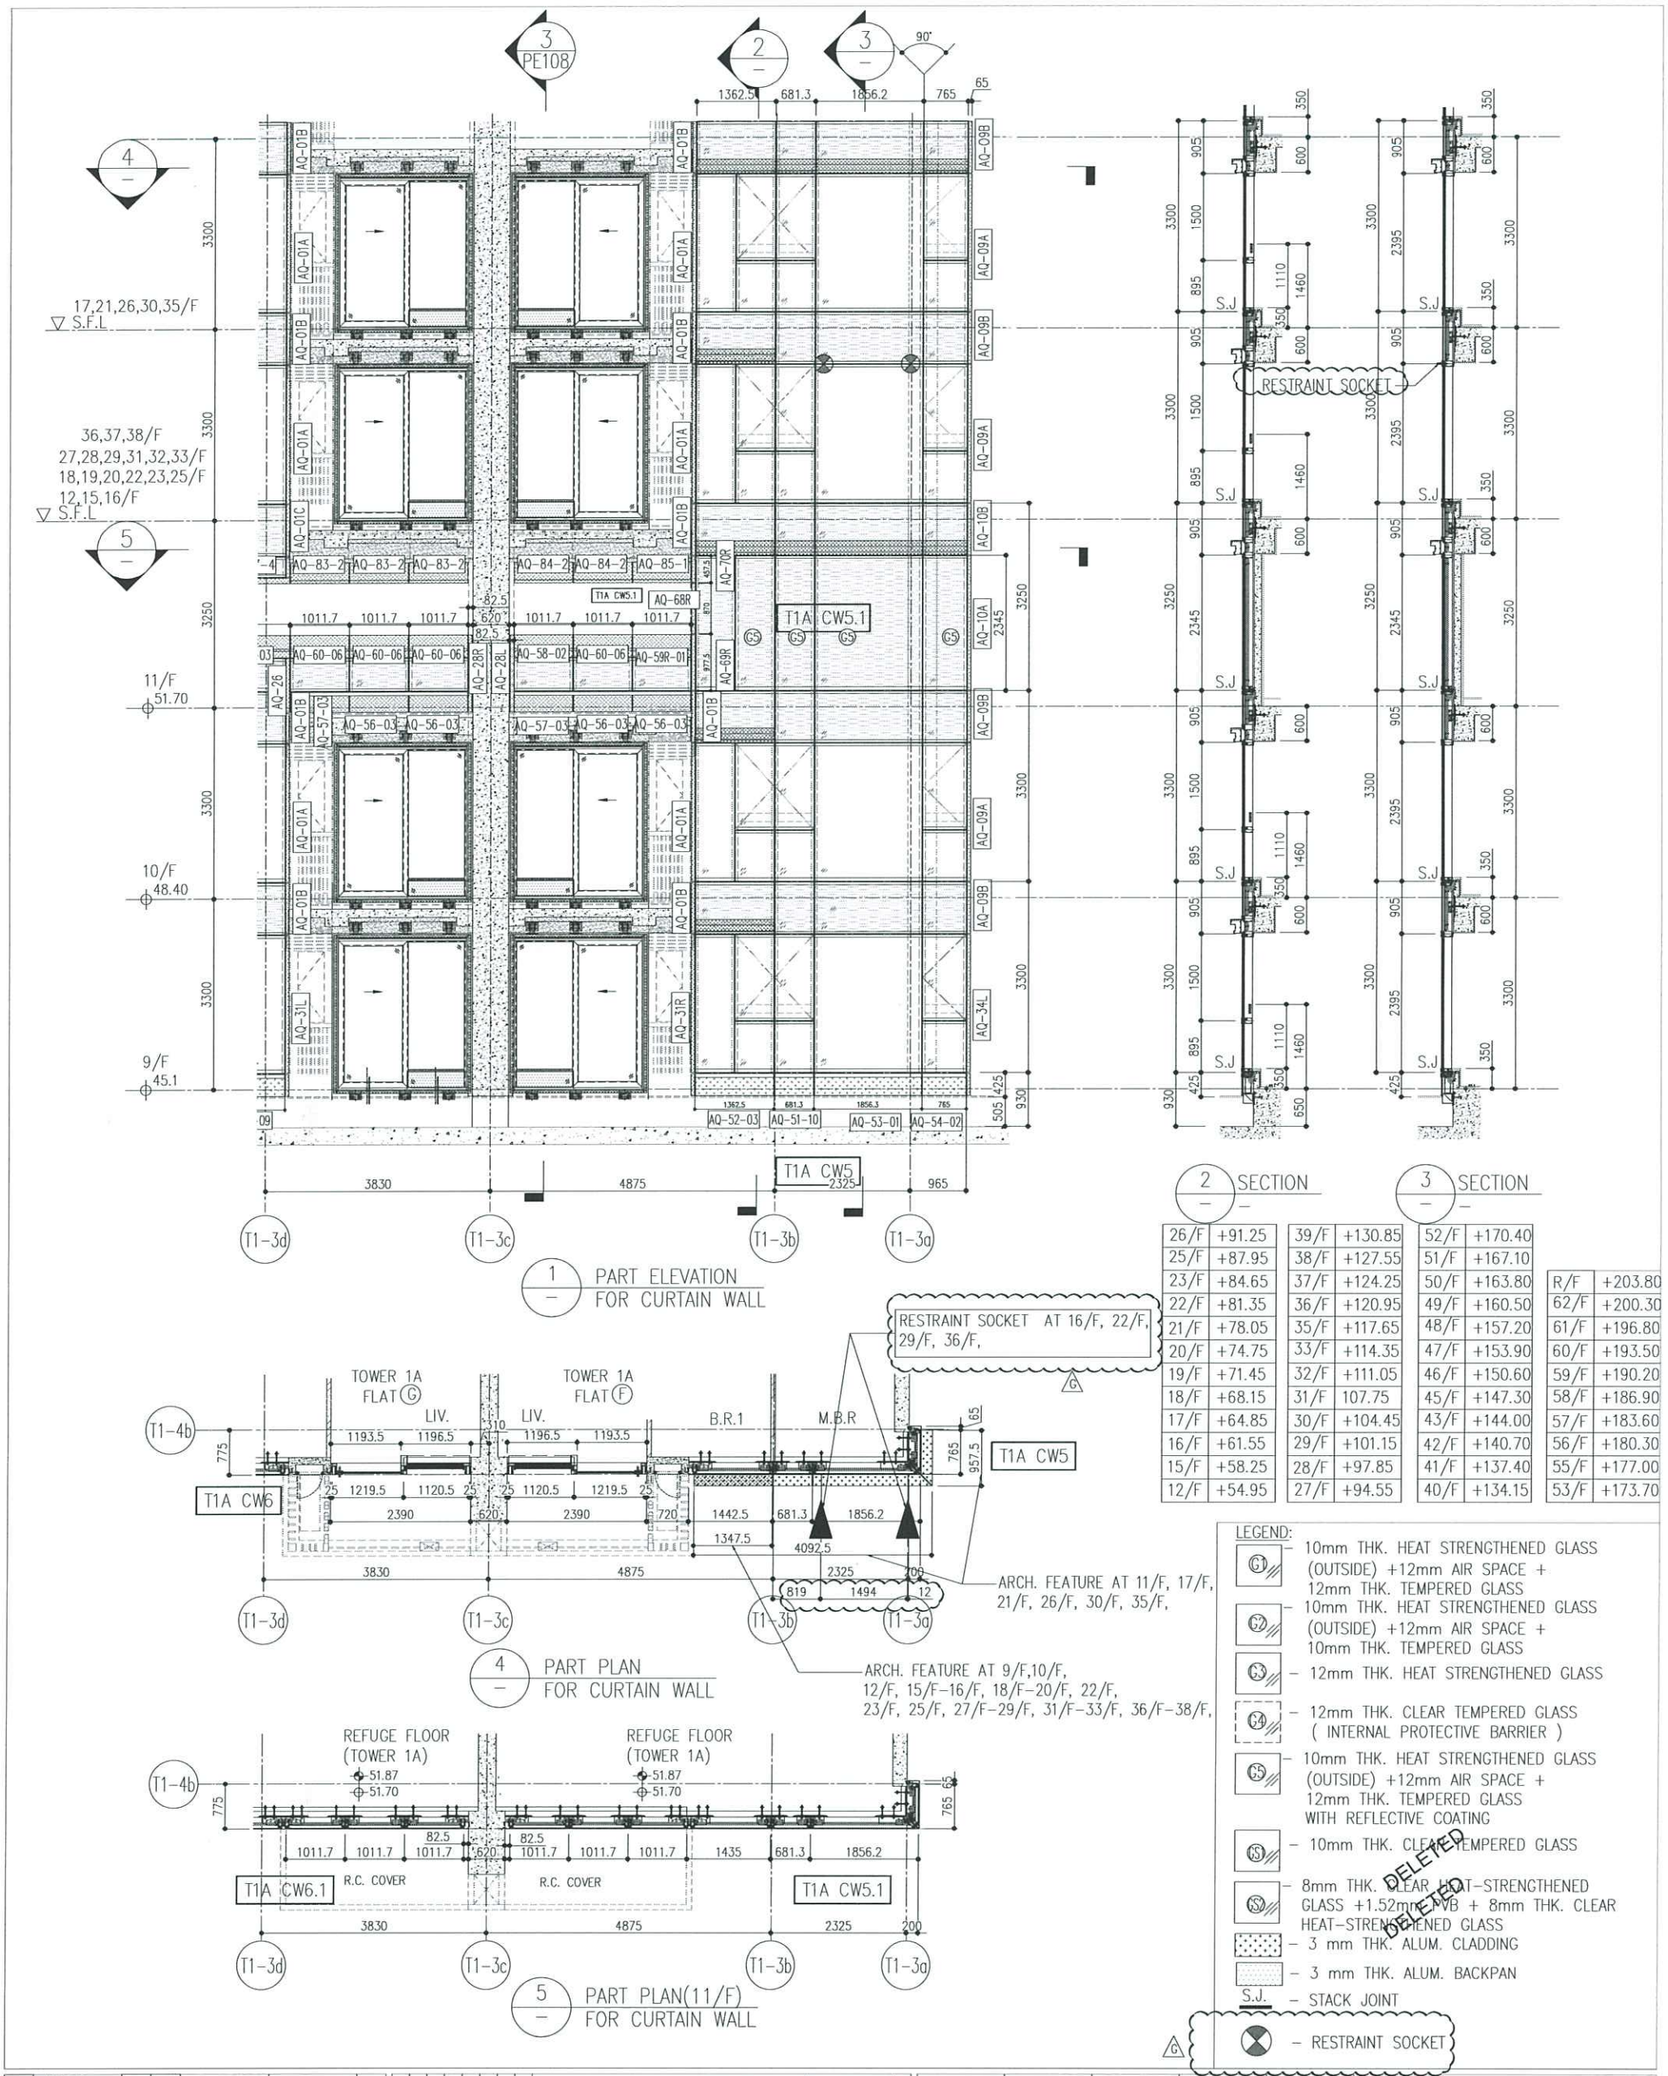

1 PART ELEVATION FOR CURTAIN WALL

4 PART PLAN FOR CURTAIN WALL

5 PART PLAN(11/F) FOR CURTAIN WALL

2 SECTION

26/F	+91.25
25/F	+87.95
23/F	+84.65
22/F	+81.35
21/F	+78.05
20/F	+74.75
19/F	+71.45
18/F	+68.15
17/F	+64.85
16/F	+61.55
15/F	+58.25
12/F	+54.95

3 SECTION

39/F	+130.85
38/F	+127.55
37/F	+124.25
36/F	+120.95
35/F	+117.65
33/F	+114.35
32/F	+111.05
31/F	107.75
30/F	+104.45
29/F	+101.15
28/F	+97.85
27/F	+94.55
52/F	+170.40
51/F	+167.10
50/F	+163.80
49/F	+160.50
48/F	+157.20
47/F	+153.90
46/F	+150.60
45/F	+147.30
R/F	+203.80
62/F	+200.30
61/F	+196.80
60/F	+193.50
59/F	+190.20
58/F	+186.90
57/F	+183.60
56/F	+180.30
55/F	+177.00
53/F	+173.70

LEGEND:

- G1 – 10mm THK. HEAT STRENGTHENED GLASS (OUTSIDE) +12mm AIR SPACE + 12mm THK. TEMPERED GLASS
- G2 – 10mm THK. HEAT STRENGTHENED GLASS (OUTSIDE) +12mm AIR SPACE + 10mm THK. TEMPERED GLASS
- G3 – 12mm THK. HEAT STRENGTHENED GLASS
- G4 – 12mm THK. CLEAR TEMPERED GLASS (INTERNAL PROTECTIVE BARRIER)
- G5 – 10mm THK. HEAT STRENGTHENED GLASS (OUTSIDE) +12mm AIR SPACE + 12mm THK. TEMPERED GLASS WITH REFLECTIVE COATING
- S3 – 10mm THK. CLEAR TEMPERED GLASS
- S5 – 8mm THK. CLEAR HEAT-STRENGTHENED GLASS +1.52mm PVB + 8mm THK. CLEAR HEAT-STRENGTHENED GLASS
- 3 mm THK. ALUM. CLADDING
- 3 mm THK. ALUM. BACKPAN
- S.J. – STACK JOINT
- G – RESTRAINT SOCKET

DELETED

NOTE :
1. ALL DIMENSIONS ARE IN mm.
2. ALL ELEVATIONS ARE VIEWED FROM OUTSIDE.
3. ALL DIMENSIONS TO BE VERIFIED ON SITE BEFORE FABRICATION.

LEGEND :
- X1 / XG5 — DETAIL MARK NO. / REFER SHEET NO.
- 1. F.F.L. --FINISHED FLOOR LEVEL
- 2. S.F.L. --STRUCTURAL FLOOR LEVEL
- 3. (R) --REVERSED DETAIL

NO.	DATE	REVISED	BY
G	17/08/22	REVISED AS PER COMMENTS	LS
F	26/07/22	REVISED AS PER COMMENTS	LS
E	23/05/22	REVISED AS PER COMMENTS	LS
D	06/04/22	REVISED AS PER COMMENTS	LS
C	16/02/22	REVISED AS PER COMMENTS	LS
B	20/12/21	REVISED AS PER COMMENTS	LS
A	03/12/21	REVISED AS PER COMMENTS	LS

JOB NO. : J-858

PROJECT : PROPOSED RESIDENTIAL DEVELOPMENT AT TKOTL 70RP, PHASE 11, LOHAS PARK TSEUNG KWAN O, N.T.

TITLE : TYPICAL FLOOR PARTIAL ELEVATION & SECTION, PLAN FOR CURTAIN WALL (TOWER 1)

DATE : 22-OCT-21 | SCALE : 1:50(A1)

DRAWN BY : | CHECKED BY :

DWG NO. : J858-CW-PE109 | REV. : G

美特鋁製有限公司 MIDI ALUMINIUM FABRICATOR LTD.
Units 6-8, Sunray Industrial Centre, 1/F
610 Cha Kwo Ling Road, Kowloon
Tel:23489211-4 Fax:(852)27727666

CLIENT : 信和置業有限公司 Sino Land Company Limited

ARCHITECT : ronald lu & partners Architects Interior Designers Planners Ronald Lu & Partners (HK) Ltd. 呂元祥建築師事務所(香港)有限公司

MAIN CONTRACTOR : Gammon


STRUCTURAL ENGINEER : AECOM

FACADE CONSULTANT : AECOM


B.D. REF :

T1A

G F

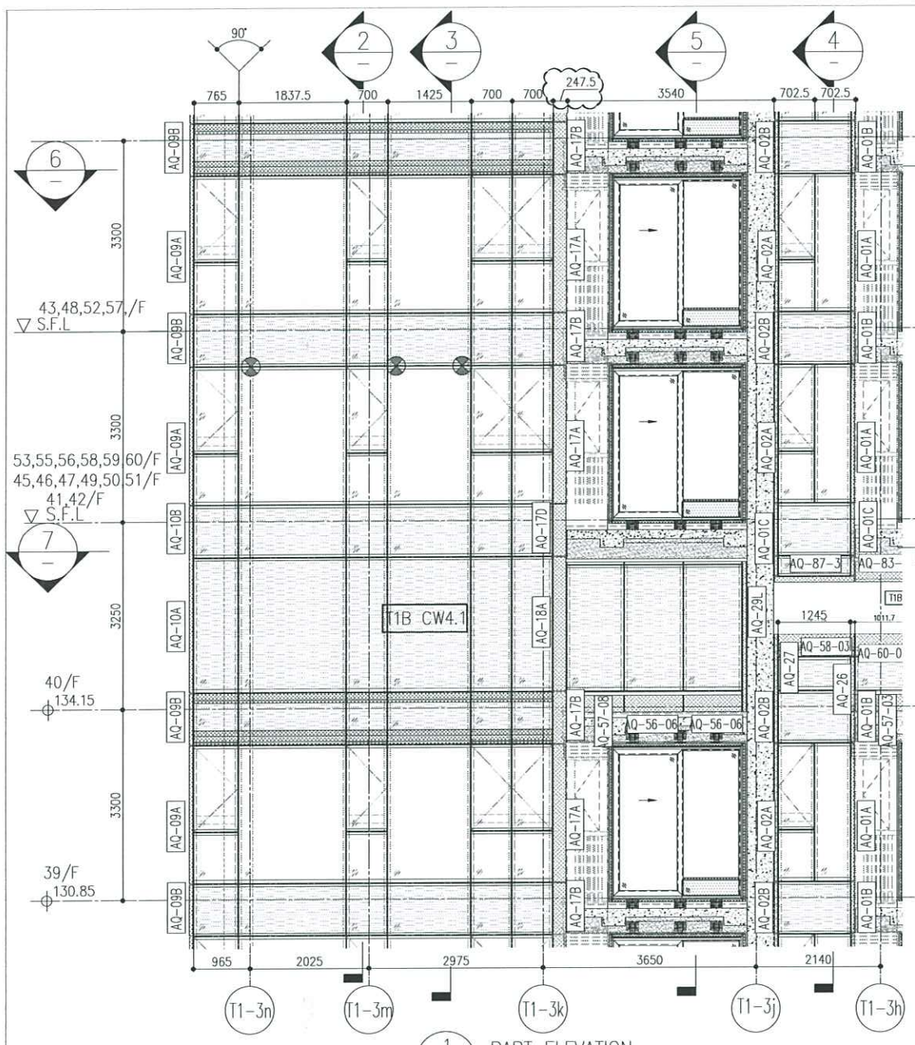

1 / – PART ELEVATION FOR CURTAIN WALL

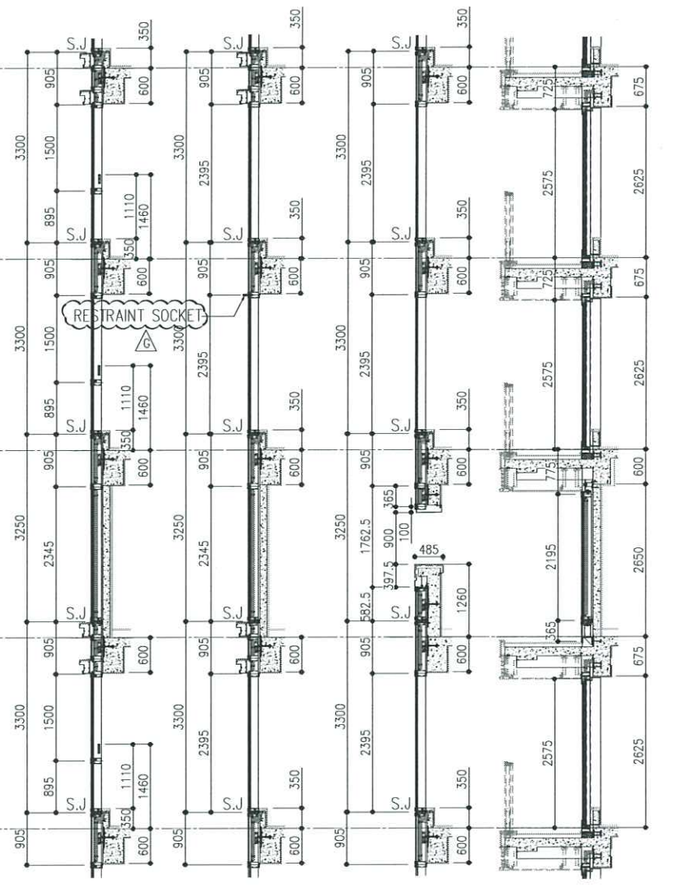


2 / – SECTION

3 / – SECTION


4 / – SECTION

5 / – SECTION

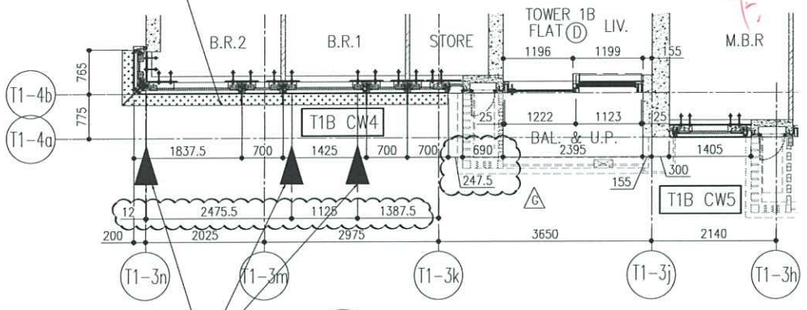

6 / – PART PLAN FOR CURTAIN WALL

RESTRAINT SOCKET AT 42/F, 49/F, 56/F G

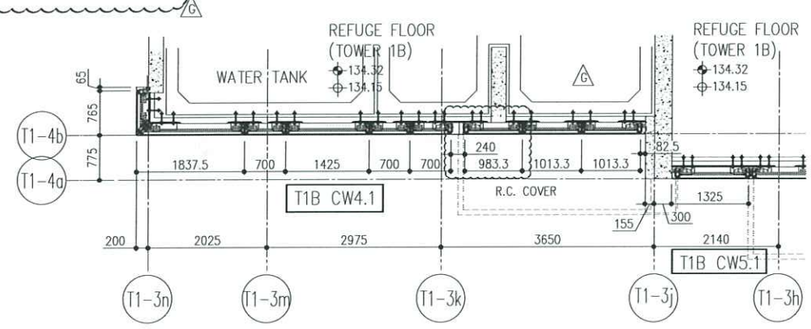

7 / – PART PLAN(40/F) FOR CURTAIN WALL

26/F	+91.25	39/F	+130.85	52/F	+170.40	R/F	+203.80
25/F	+87.95	38/F	+127.55	51/F	+167.10	62/F	+200.30
23/F	+84.65	37/F	+124.25	50/F	+163.80	61/F	+196.80
22/F	+81.35	36/F	+120.95	49/F	+160.50	60/F	+193.50
21/F	+78.05	35/F	+117.65	48/F	+157.20	59/F	+190.20
20/F	+74.75	33/F	+114.35	47/F	+153.90	58/F	+186.90
19/F	+71.45	32/F	+111.05	46/F	+150.60	57/F	+183.60
18/F	+68.15	31/F	107.75	45/F	+147.30	56/F	+180.30
17/F	+64.85	30/F	+104.45	43/F	+144.00	55/F	+177.00
16/F	+61.55	29/F	+101.15	42/F	+140.70	53/F	+173.70
15/F	+58.25	28/F	+97.85	41/F	+137.40		
12/F	+54.95	27/F	+94.55	40/F	+134.15		

LEGEND:

- G1 – 10mm THK. HEAT STRENGTHENED GLASS (OUTSIDE) +12mm AIR SPACE + 12mm THK. TEMPERED GLASS
- G2 – 10mm THK. HEAT STRENGTHENED GLASS (OUTSIDE) +12mm AIR SPACE + 10mm THK. TEMPERED GLASS
- G3 – 12mm THK. HEAT STRENGTHENED GLASS
- G4 – 12mm THK. CLEAR TEMPERED GLASS (INTERNAL PROTECTIVE BARRIER)
- G5 – 10mm THK. HEAT STRENGTHENED GLASS (OUTSIDE) +12mm AIR SPACE + 12mm THK. TEMPERED GLASS WITH REFLECTIVE COATING
- G6 – 10mm THK. CLEAR TEMPERED GLASS
- G7 – 8mm THK. CLEAR HEAT-STRENGTHENED GLASS +1.52mm PVB + 8mm THK. CLEAR HEAT-STRENGTHENED GLASS
- 3 mm THK. ALUM. CLADDING
- 3 mm THK. ALUM. BACKPAN
- S.J. – STACK JOINT
- G – RESTRAINT SOCKET

DELETED DELETED

NOTE:
1. ALL DIMENSIONS ARE IN mm.
2. ALL ELEVATIONS ARE VIEWED FROM OUTSIDE.
3. ALL DIMENSIONS TO BE VERIFIED ON SITE BEFORE FABRICATION.

LEGEND:
- X1 (X68) — DETAIL MARK NO. — REFER SHEET NO.
- 1. F.F.L. --FINISHED FLOOR LEVEL
- 2. S.F.L. --STRUCTURAL FLOOR LEVEL
- 3. (R) --REVERSED DETAIL

NO.	DATE	REVISED	BY
G	17/08/22	REVISED AS PER COMMENTS	LS
F	26/07/22	REVISED AS PER COMMENTS	LS
E	23/05/22	REVISED AS PER COMMENTS	LS
D	06/04/22	REVISED AS PER COMMENTS	LS
C	16/02/22	REVISED AS PER COMMENTS	LS
B	20/12/21	REVISED AS PER COMMENTS	LS
A	03/12/21	REVISED AS PER COMMENTS	LS

JOB NO. : J-858

PROJECT : PROPOSED RESIDENTIAL DEVELOPMENT AT TKOTL 70RP, PHASE 11, LOHAS PARK TSEUNG KWAN O, N.T.

TITLE : TYPICAL FLOOR PARTIAL ELEVATION & SECTION, PLAN FOR CURTAIN WALL (TOWER 1)

DATE : 22-OCT-21 | SCALE : 1:50(A1)

DRAWN BY : | CHECKED BY :

DWG NO. : U856-CW-PE110 | REV. : G

美特鋁製有限公司 MIDI ALUMINIUM FABRICATOR LTD.
Units 6-8, Sunray Industrial Centre, 1/F
610 Cha Kwo Ling Road, Kowloon
Tel:23489211-4 Fax:(852)27727666

B.D. REF :

CLIENT : 信和置業有限公司 Sino Land Company Limited


ARCHITECT : ronald lu & partners (HK) Ltd. 呂元祥建築師事務所(香港)有限公司 Ronald Lu & Partners (HK) Ltd.

MAIN CONTRACTOR : Gammon

STRUCTURAL ENGINEER : AECOM

FACADE CONSULTANT : AECOM

10.

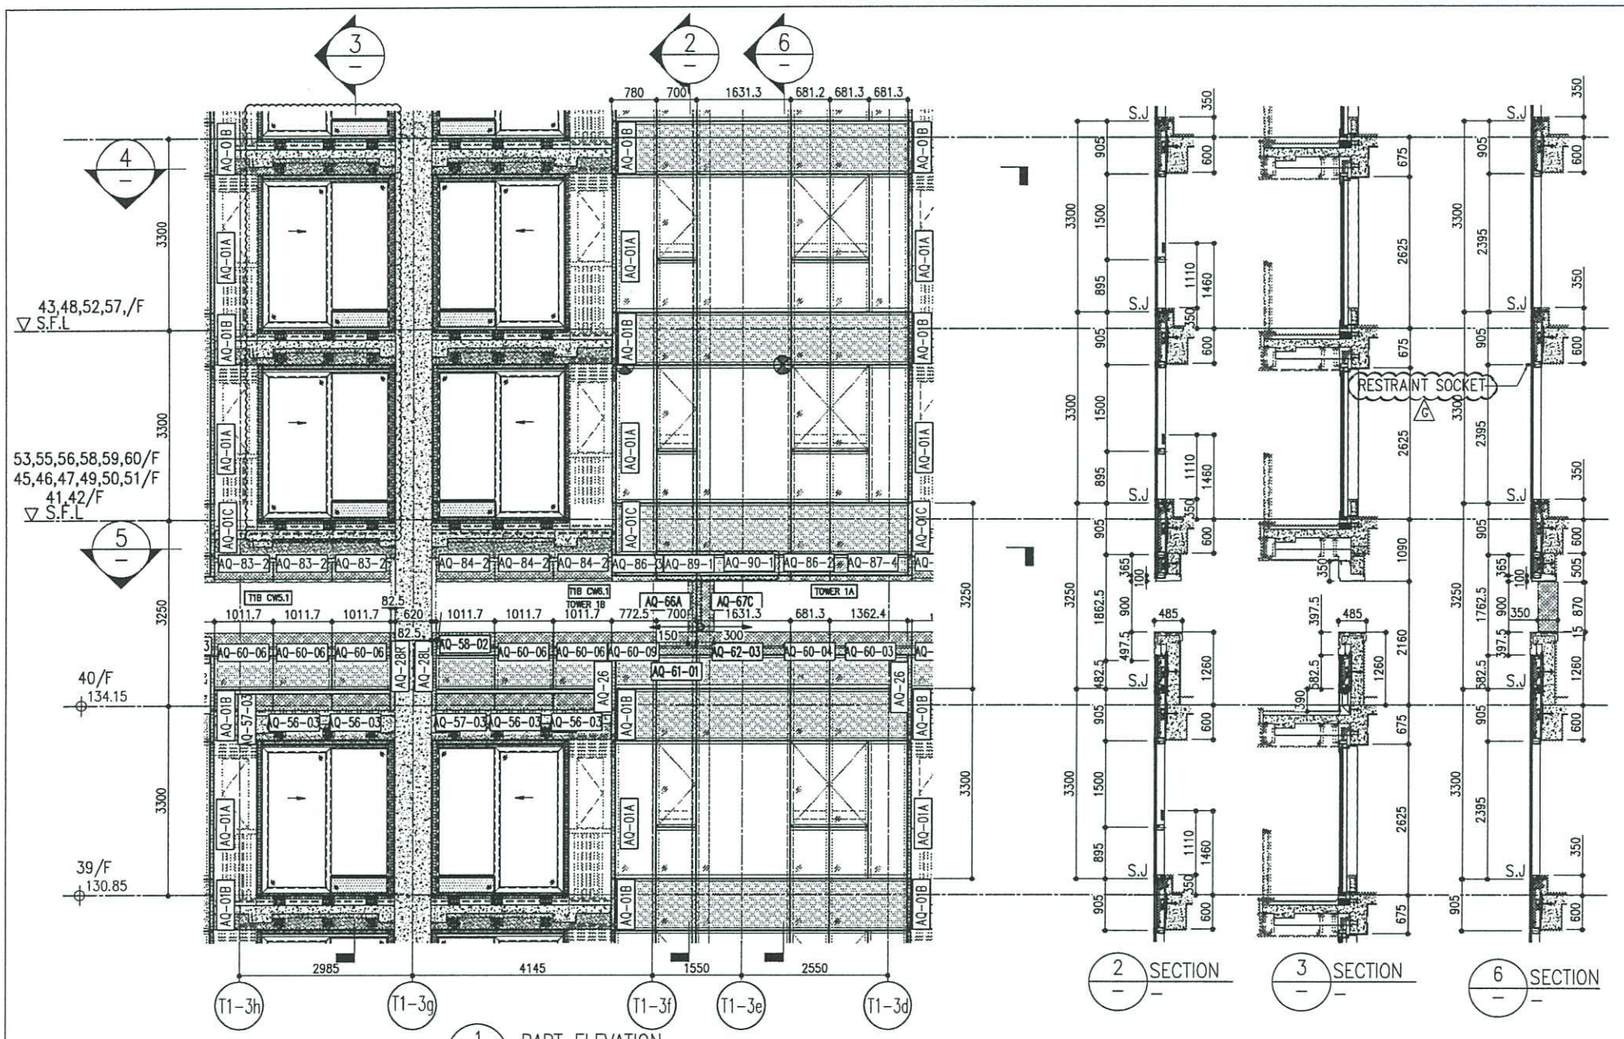


1 PART ELEVATION FOR CURTAIN WALL

2 SECTION


3 SECTION

6 SECTION

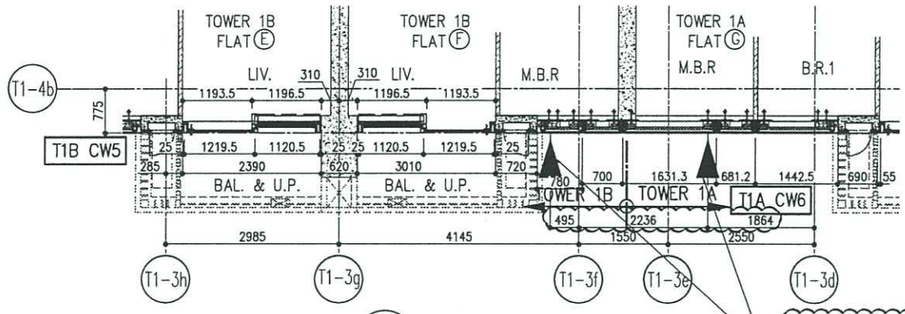

4 PART PLAN FOR CURTAIN WALL

RESTRAINT SOCKET AT 42/F, 49/F, 56/F

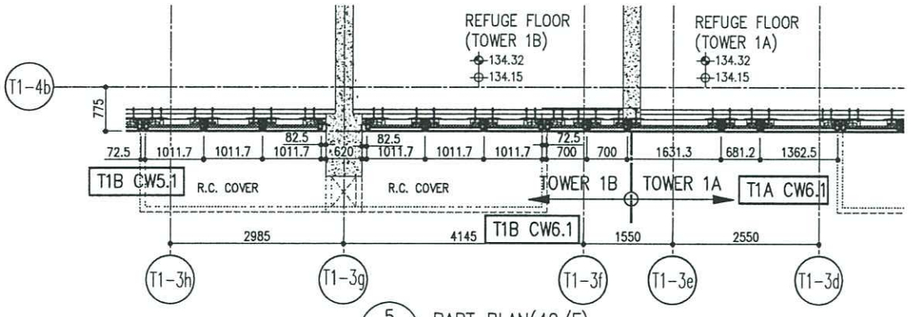

5 PART PLAN(40/F) FOR CURTAIN WALL

26/F	+91.25	39/F	+130.85	52/F	+170.40		
25/F	+87.95	38/F	+127.55	51/F	+167.10		
23/F	+84.65	37/F	+124.25	50/F	+163.80	R/F	+203.80
22/F	+81.35	36/F	+120.95	49/F	+160.50	62/F	+200.30
21/F	+78.05	35/F	+117.65	48/F	+157.20	61/F	+196.80
20/F	+74.75	33/F	+114.35	47/F	+153.90	60/F	+193.50
19/F	+71.45	32/F	+111.05	46/F	+150.60	59/F	+190.20
18/F	+68.15	31/F	107.75	45/F	+147.30	58/F	+186.90
17/F	+64.85	30/F	+104.45	43/F	+144.00	57/F	+183.60
16/F	+61.55	29/F	+101.15	42/F	+140.70	56/F	+180.30
15/F	+58.25	28/F	+97.85	41/F	+137.40	55/F	+177.00
12/F	+54.95	27/F	+94.55	40/F	+134.15	53/F	+173.70

LEGEND:

- G1 – 10mm THK. HEAT STRENGTHENED GLASS (OUTSIDE) +12mm AIR SPACE + 12mm THK. TEMPERED GLASS
- G2 – 10mm THK. HEAT STRENGTHENED GLASS (OUTSIDE) +12mm AIR SPACE + 10mm THK. TEMPERED GLASS
- G3 – 12mm THK. HEAT STRENGTHENED GLASS
- G4 – 12mm THK. CLEAR TEMPERED GLASS (INTERNAL PROTECTIVE BARRIER)
- G5 – 10mm THK. HEAT STRENGTHENED GLASS (OUTSIDE) +12mm AIR SPACE + 12mm THK. TEMPERED GLASS WITH REFLECTIVE COATING
- G6 – 10mm THK. CLEAR TEMPERED GLASS
- G7 – 8mm THK. CLEAR HEAT-STRENGTHENED GLASS +1.52mm PVB + 8mm THK. CLEAR HEAT-STRENGTHENED GLASS
- 3 mm THK. ALUM. CLADDING
- 3 mm THK. ALUM. BACKPAN
- S.J. – STACK JOINT
- G – RESTRAINT SOCKET

DELETED
DELETED

NOTE:
1. ALL DIMENSIONS ARE IN mm.
2. ALL ELEVATIONS ARE VIEWED FROM OUTSIDE.
3. ALL DIMENSIONS TO BE VERIFIED ON SITE BEFORE FABRICATION.

LEGEND:
- X1 (X001) — DETAIL MARK NO. / REFER SHEET NO.
- F.F.L. — FINISHED FLOOR LEVEL
- S.F.L. — STRUCTURAL FLOOR LEVEL
- (R) — REVERSED DETAIL

NO.	DATE	REVISED	BY
G	17/08/22	REVISED AS PER COMMENTS	LS
F	26/07/22	REVISED AS PER COMMENTS	LS
E	23/05/22	REVISED AS PER COMMENTS	LS
D	06/04/22	REVISED AS PER COMMENTS	LS
C	16/02/22	REVISED AS PER COMMENTS	LS
B	20/12/21	REVISED AS PER COMMENTS	LS
A	03/12/21	REVISED AS PER COMMENTS	LS

JOB NO. : J-858

PROJECT : PROPOSED RESIDENTIAL DEVELOPMENT AT TKOTL 70RP, PHASE 11, LOHAS PARK TSEUNG KWAN O, N.T.

TITLE : TYPICAL FLOOR PARTIAL ELEVATION & SECTION, PLAN FOR CURTAIN WALL (TOWER 1)

DATE : 22-OCT-21 | SCALE : 1:50(A1)


DRAWN BY : | CHECKED BY :

美特鋁質有限公司 MIDI ALUMINIUM FABRICATOR LTD.
Units 6–8, Sunray Industrial Centre, 1/F
610 Cha Kwo Ling Road, Kowloon
Tel:23489211–4 Fax:(852)27727666


DWG NO. : J858–CW–PE111 | REV. : G

ARCHITECT : ronald lu & partners 呂元祥建築師事務所 Ronald Lu & Partners (HK) Ltd.
MAIN CONTRACTOR : Gammon
STRUCTURAL ENGINEER : AECOM
FACADE CONSULTANT : AECOM
CLIENT : 信和置業有限公司 Sino Land Company Limited

B.D. REF :

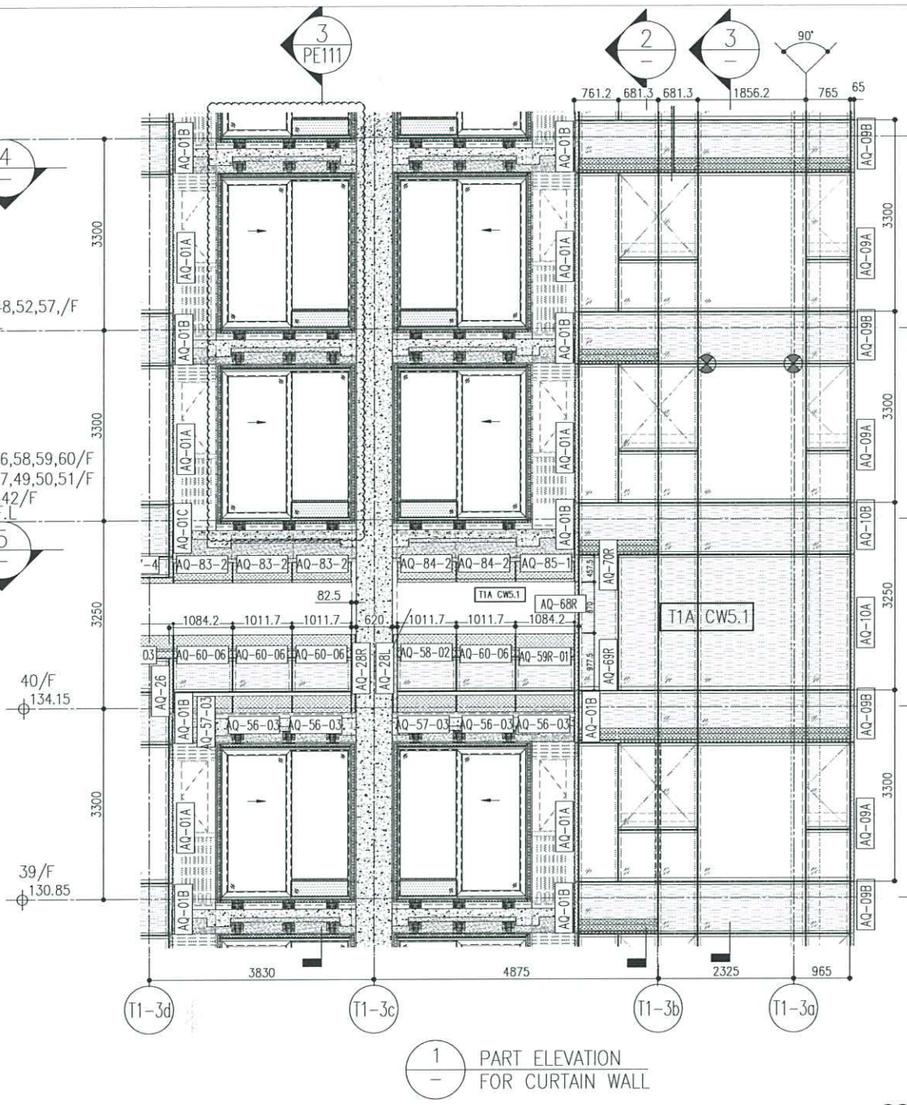


1 PART ELEVATION FOR CURTAIN WALL

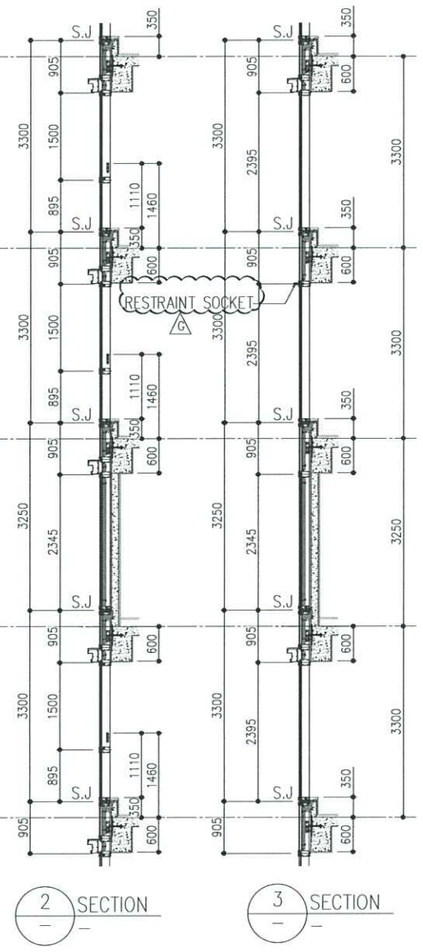


2 SECTION

3 SECTION

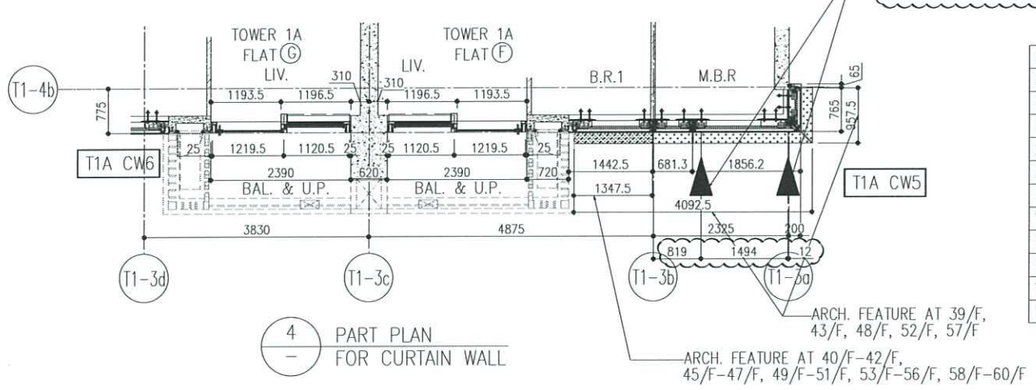

4 PART PLAN FOR CURTAIN WALL

26/F	+91.25	39/F	+130.85	52/F	+170.40		
25/F	+87.95	38/F	+127.55	51/F	+167.10		
23/F	+84.65	37/F	+124.25	50/F	+163.80	R/F	+203.80
22/F	+81.35	36/F	+120.95	49/F	+160.50	62/F	+200.30
21/F	+78.05	35/F	+117.65	48/F	+157.20	61/F	+196.80
20/F	+74.75	33/F	+114.35	47/F	+153.90	60/F	+193.50
19/F	+71.45	32/F	+111.05	46/F	+150.60	59/F	+190.20
18/F	+68.15	31/F	107.75	45/F	+147.30	58/F	+186.90
17/F	+64.85	30/F	+104.45	43/F	+144.00	57/F	+183.60
16/F	+61.55	29/F	+101.15	42/F	+140.70	56/F	+180.30
15/F	+58.25	28/F	+97.85	41/F	+137.40	55/F	+177.00
12/F	+54.95	27/F	+94.55	40/F	+134.15	53/F	+173.70

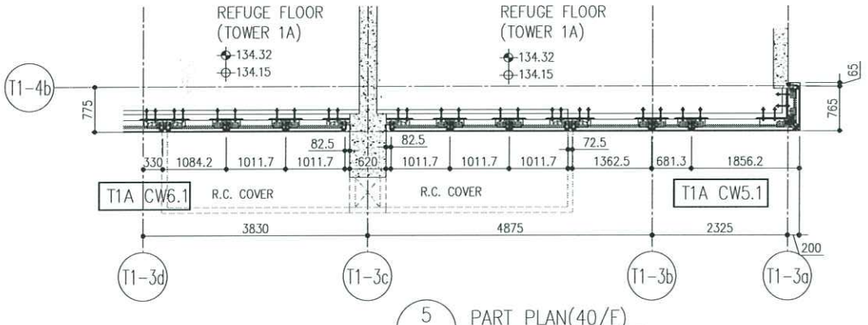

5 PART PLAN(40/F) FOR CURTAIN WALL

LEGEND:

- G1 – 10mm THK. HEAT STRENGTHENED GLASS (OUTSIDE) +12mm AIR SPACE + 12mm THK. TEMPERED GLASS
- G2 – 10mm THK. HEAT STRENGTHENED GLASS (OUTSIDE) +12mm AIR SPACE + 10mm THK. TEMPERED GLASS
- G3 – 12mm THK. HEAT STRENGTHENED GLASS
- G4 – 12mm THK. CLEAR TEMPERED GLASS (INTERNAL PROTECTIVE BARRIER)
- G5 – 10mm THK. HEAT STRENGTHENED GLASS (OUTSIDE) +12mm AIR SPACE + 12mm THK. TEMPERED GLASS WITH REFLECTIVE COATING
- G6 – 10mm THK. CLEAR TEMPERED GLASS
- G7 – 8mm THK. CLEAR HEAT-STRENGTHENED GLASS +1.52mm PVB + 8mm THK. CLEAR HEAT-STRENGTHENED GLASS
- 3 mm THK. ALUM. CLADDING
- 3 mm THK. ALUM. BACKPAN
- S.J. – STACK JOINT
- G – RESTRAINT SOCKET

DELETED
DELETED

NOTE :
1. ALL DIMENSIONS ARE IN mm.
2. ALL ELEVATIONS ARE VIEWED FROM OUTSIDE.
3. ALL DIMENSIONS TO BE VERIFIED ON SITE BEFORE FABRICATION.

LEGEND :
- X1 (X001) — DETAIL MARK NO. / REFER SHEET NO.
1. F.F.L. --FINISHED FLOOR LEVEL
2. S.F.L. --STRUCTURAL FLOOR LEVEL
3. /R --REVERSED DETAIL

NO.	DATE	REVISED	BY
G	17/08/22	REVISED AS PER COMMENTS	LS
F	26/07/22	REVISED AS PER COMMENTS	LS
E	23/05/22	REVISED AS PER COMMENTS	LS
D	06/04/22	REVISED AS PER COMMENTS	LS
C	16/02/22	REVISED AS PER COMMENTS	LS
B	20/12/21	REVISED AS PER COMMENTS	LS
A	03/12/21	REVISED AS PER COMMENTS	LS

JOB NO. : J-858

PROJECT :
PROPOSED RESIDENTIAL DEVELOPMENT AT TKOTL 70RP, PHASE 11, LOHAS PARK TSEUNG KWAN O, N.T.

TITLE :
TYPICAL FLOOR PARTIAL ELEVATION & SECTION, PLAN FOR CURTAIN WALL (TOWER 1)

DATE : 22-OCT-21 | SCALE : 1:50(A1)
DRAWN BY : | CHECKED BY :
DWG NO. : J858-CW-PE112 | REV. : G

美特鋁質有限公司 MIDI ALUMINIUM FABRICATOR LTD.
Units 6-8, Sunroy Industrial Centre, 1/F
610 Cha Kwo Ling Road, Kowloon
Tel:23489211-4 Fax:(852)27727666

ARCHITECT :
ronald lu & partners
Architects Planners Interior Designers
Ronald Lu & Partners (HK) Ltd.
呂元祥建築師事務所(香港)有限公司

MAIN CONTRACTOR :
Gammon


STRUCTURAL ENGINEER :
AECOM

FACADE CONSULTANT :
AECOM

CLIENT :
信和置業有限公司
Sino Land Company Limited

B.D. REF :

12

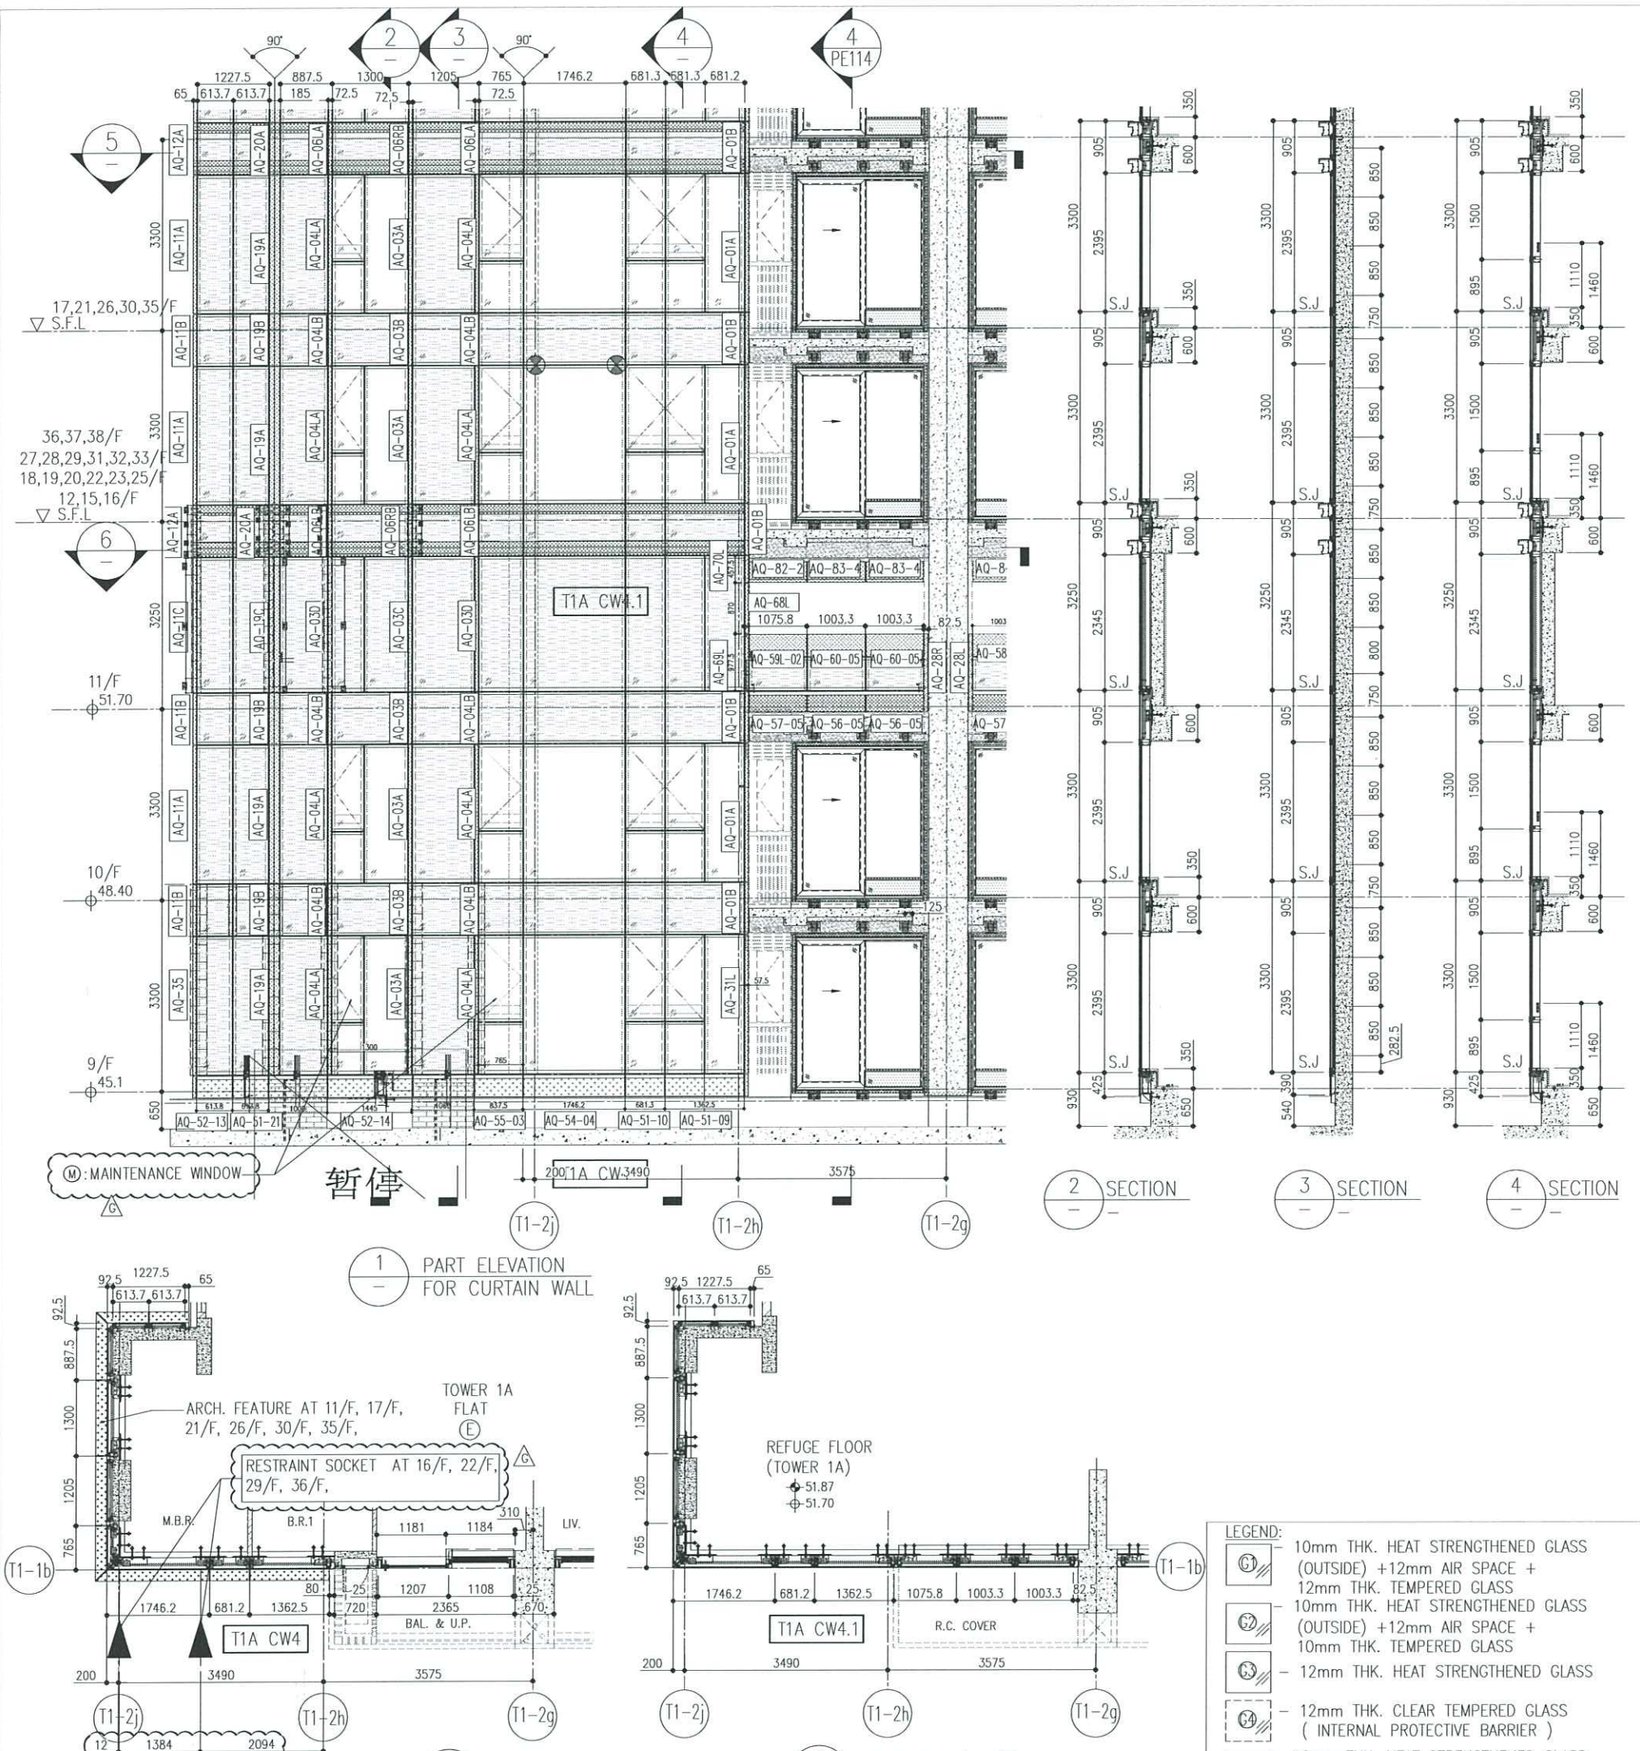

26/F	+91.25	39/F	+130.85	52/F	+170.40	R/F	+203.80
25/F	+87.95	38/F	+127.55	51/F	+167.10	62/F	+200.30
23/F	+84.65	37/F	+124.25	50/F	+163.80	61/F	+196.80
22/F	+81.35	36/F	+120.95	49/F	+160.50	60/F	+193.50
21/F	+78.05	35/F	+117.65	48/F	+157.20	59/F	+190.20
20/F	+74.75	33/F	+114.35	47/F	+153.90	58/F	+186.90
19/F	+71.45	32/F	+111.05	46/F	+150.60	57/F	+183.60
18/F	+68.15	31/F	107.75	45/F	+147.30	56/F	+180.30
17/F	+64.85	30/F	+104.45	43/F	+144.00	55/F	+177.00
16/F	+61.55	29/F	+101.15	42/F	+140.70	53/F	+173.70
15/F	+58.25	28/F	+97.85	41/F	+137.40		
12/F	+54.95	27/F	+94.55	40/F	+134.15		

LEGEND:

- C1 – 10mm THK. HEAT STRENGTHENED GLASS (OUTSIDE) +12mm AIR SPACE + 12mm THK. TEMPERED GLASS
- C2 – 10mm THK. HEAT STRENGTHENED GLASS (OUTSIDE) +12mm AIR SPACE + 10mm THK. TEMPERED GLASS
- C3 – 12mm THK. HEAT STRENGTHENED GLASS
- C4 – 12mm THK. CLEAR TEMPERED GLASS (INTERNAL PROTECTIVE BARRIER)
- C5 – 10mm THK. HEAT STRENGTHENED GLASS (OUTSIDE) +12mm AIR SPACE + 12mm THK. TEMPERED GLASS WITH REFLECTIVE COATING
- CS – 10mm THK. CLEAR TEMPERED GLASS
- CS – 8mm THK. CLEAR HEAT-STRENGTHENED GLASS +1.52mm PVB + 8mm THK. CLEAR HEAT-STRENGTHENED GLASS
- 3 mm THK. ALUM. CLADDING
- 3 mm THK. ALUM. BACKPAN
- S.J. – STACK JOINT
- – RESTRAINT SOCKET

DELETED DELETED

△5

NOTE:
1. ALL DIMENSIONS ARE IN mm.
2. ALL ELEVATIONS ARE VIEWED FROM OUTSIDE.
3. ALL DIMENSIONS TO BE VERIFIED ON SITE BEFORE FABRICATION.

LEGEND:
- X1 / W001 – DETAIL MARK NO. / REFER SHEET NO.
- F.F.L. – FINISHED FLOOR LEVEL
- S.F.L. – STRUCTURAL FLOOR LEVEL
- (R) – REVERSED DETAIL

NO.	DATE	REVISED	BY
G	17/08/22	REVISED AS PER COMMENTS	LS
F	26/07/22	REVISED AS PER COMMENTS	LS
E	23/05/22	REVISED AS PER COMMENTS	LS
D	06/04/22	REVISED AS PER COMMENTS	LS
C	17/02/22	REVISED AS PER COMMENTS	LS
B	20/12/21	REVISED AS PER COMMENTS	LS
A	03/12/21	REVISED AS PER COMMENTS	LS

JOB NO. : J-858

PROJECT : PROPOSED RESIDENTIAL DEVELOPMENT AT TKOTL 70RP, PHASE 11, LOHAS PARK TSEUNG KWAN O, N.T.

TITLE : TYPICAL FLOOR PARTIAL ELEVATION & SECTION, PLAN FOR CURTAIN WALL (TOWER 1)

DATE : 22-OCT-21 | SCALE : 1:50(A1)

DRAWN BY : | CHECKED BY :

DWG NO. : J858-CW-PE113 | REV. : G

美特鋁質有限公司 MIDI ALUMINIUM FABRICATOR LTD.
Units 6-8, Suncoy Industrial Centre, 1/F
610 Cha Kwo Ling Road, Kowloon
Tel:23489211-4 Fax:(852)27727666

CLIENT : 信和置業有限公司 Sino Land Company Limited

ARCHITECT : ronald lu & partners (HK) Ltd. 呂元祥建築師事務所(香港)有限公司

MAIN CONTRACTOR : Gammon

STRUCTURAL ENGINEER : AECOM


FACADE CONSULTANT: AECOM

B.D. REF :

T1A

E

13

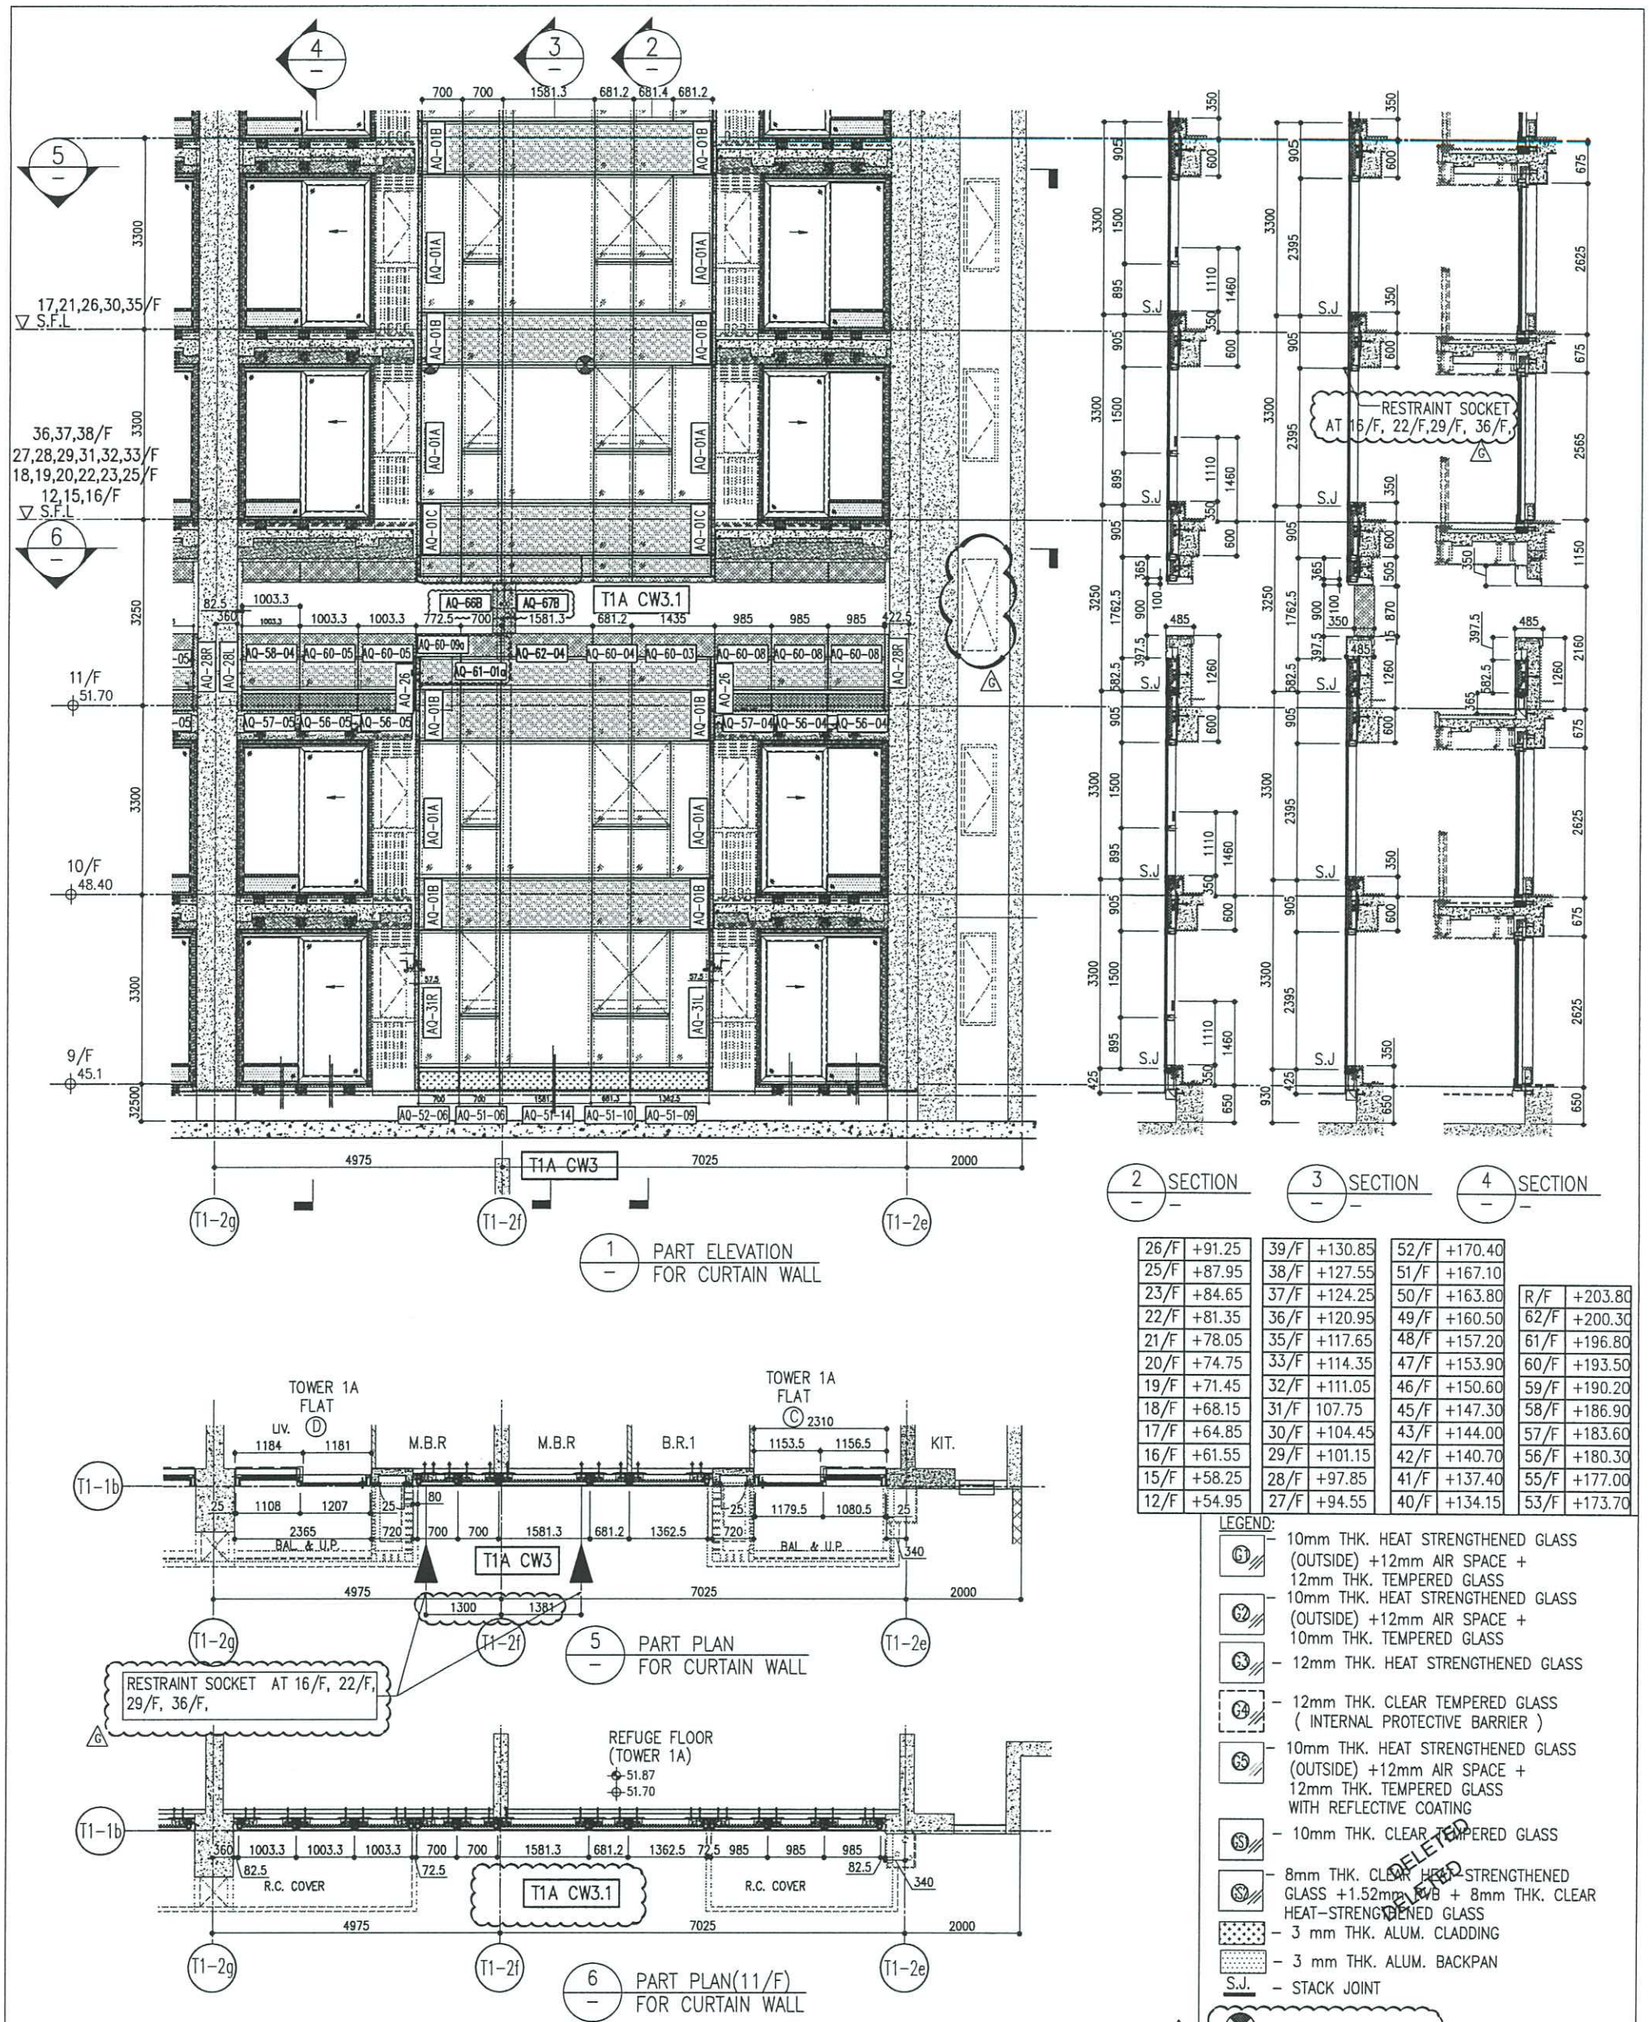

1 PART ELEVATION FOR CURTAIN WALL

2 SECTION

3 SECTION

4 SECTION

5 PART PLAN FOR CURTAIN WALL

6 PART PLAN(11/F) FOR CURTAIN WALL

26/F	+91.25	39/F	+130.85	52/F	+170.40		
25/F	+87.95	38/F	+127.55	51/F	+167.10		
23/F	+84.65	37/F	+124.25	50/F	+163.80	R/F	+203.80
22/F	+81.35	36/F	+120.95	49/F	+160.50	62/F	+200.30
21/F	+78.05	35/F	+117.65	48/F	+157.20	61/F	+196.80
20/F	+74.75	33/F	+114.35	47/F	+153.90	60/F	+193.50
19/F	+71.45	32/F	+111.05	46/F	+150.60	59/F	+190.20
18/F	+68.15	31/F	107.75	45/F	+147.30	58/F	+186.90
17/F	+64.85	30/F	+104.45	43/F	+144.00	57/F	+183.60
16/F	+61.55	29/F	+101.15	42/F	+140.70	56/F	+180.30
15/F	+58.25	28/F	+97.85	41/F	+137.40	55/F	+177.00
12/F	+54.95	27/F	+94.55	40/F	+134.15	53/F	+173.70

LEGEND:

- G1 – 10mm THK. HEAT STRENGTHENED GLASS (OUTSIDE) +12mm AIR SPACE + 12mm THK. TEMPERED GLASS
- G2 – 10mm THK. HEAT STRENGTHENED GLASS (OUTSIDE) +12mm AIR SPACE + 10mm THK. TEMPERED GLASS
- G3 – 12mm THK. HEAT STRENGTHENED GLASS
- G4 – 12mm THK. CLEAR TEMPERED GLASS (INTERNAL PROTECTIVE BARRIER)
- G5 – 10mm THK. HEAT STRENGTHENED GLASS (OUTSIDE) +12mm AIR SPACE + 12mm THK. TEMPERED GLASS WITH REFLECTIVE COATING
- S3 – 10mm THK. CLEAR TEMPERED GLASS
- S2 – 8mm THK. CLEAR HEAT-STRENGTHENED GLASS +1.52mm PVB + 8mm THK. CLEAR HEAT-STRENGTHENED GLASS
- 3 mm THK. ALUM. CLADDING
- 3 mm THK. ALUM. BACKPAN
- S.J. – STACK JOINT
- – RESTRAINT SOCKET

DELETED

NOTE:
1. ALL DIMENSIONS ARE IN mm.
2. ALL ELEVATIONS ARE VIEWED FROM OUTSIDE.
3. ALL DIMENSIONS TO BE VERIFIED ON SITE BEFORE FABRICATION.

LEGEND:
- X1 / X001 — DETAIL MARK NO. / REFER SHEET NO.
1. F.F.L —FINISHED FLOOR LEVEL
2. S.F.L —STRUCTURAL FLOOR LEVEL
3. (R) —REVERSED DETAIL

NO.	DATE	REVISED	BY
G	17/08/22	REVISED AS PER COMMENTS	LS
F	26/07/22	REVISED AS PER COMMENTS	LS
E	23/05/22	REVISED AS PER COMMENTS	LS
D	06/04/22	REVISED AS PER COMMENTS	LS
C	17/02/22	REVISED AS PER COMMENTS	LS
B	20/12/21	REVISED AS PER COMMENTS	LS
A	03/12/21	REVISED AS PER COMMENTS	LS

JOB NO. : J-858

PROJECT :
PROPOSED RESIDENTIAL DEVELOPMENT
AT TKOTL 70RP, PHASE 11, LOHAS PARK
TSEUNG KWAN O, N.T.

TITLE :
TYPICAL FLOOR PARTIAL
ELEVATION & SECTION, PLAN
FOR CURTAIN WALL (TOWER 1)

DATE : 22-OCT-21 | SCALE : 1:50(A1)
DRAWN BY : | CHECKED BY :
DWG NO. : J858-CW-PE114 | REV. : G

美特鋁質有限公司 MIDI ALUMINIUM FABRICATOR LTD.
Units 6-8, Sunray Industrial Centre, 1/F
610 Cha Kwo Ling Road, Kowloon
Tel:23489211-4 Fax:(852)27727866

CLIENT : 傳和置業有限公司 Sino Land Company Limited

ARCHITECT : ronald lu & partners (HONG KONG) Ronald Lu & Partners (HK) Ltd. 呂元祥建築師事務所(香港)有限公司

MAIN CONTRACTOR : Gammon


STRUCTURAL ENGINEER : AECOM

FACADE CONSULTANT : AECOM

B.D. REF :

T1A (D) (C)

14.

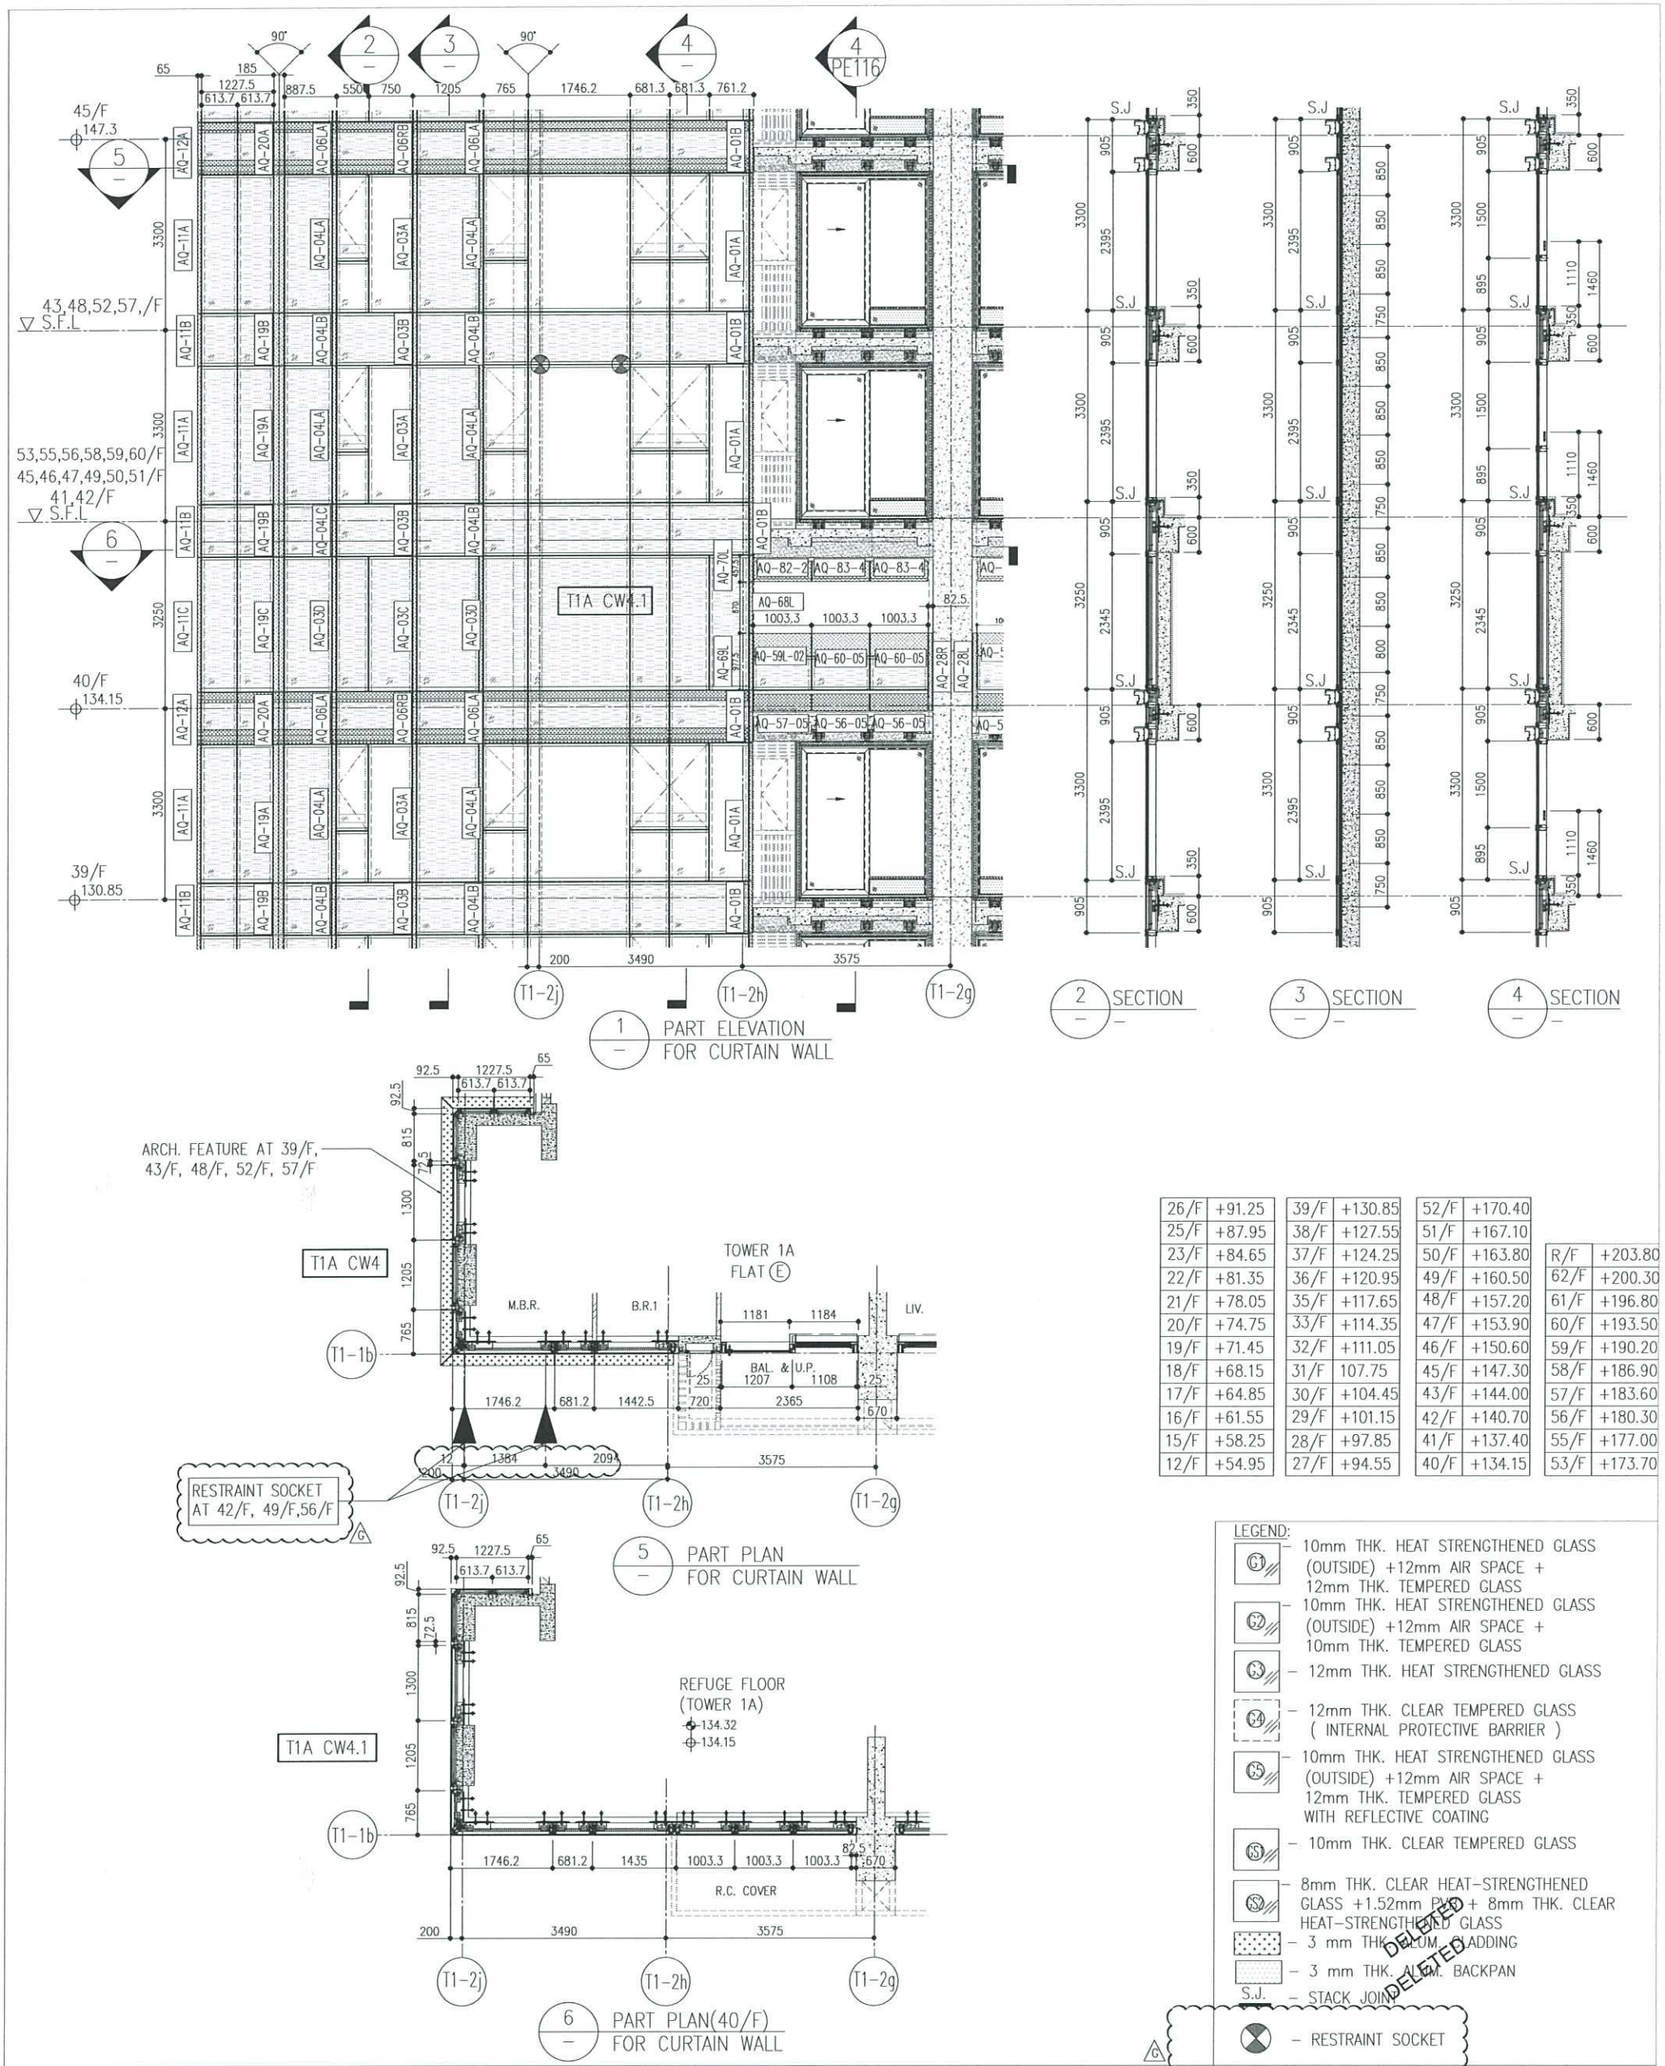

26/F	+91.25	39/F	+130.85	52/F	+170.40	R/F	+203.80
25/F	+87.95	38/F	+127.55	51/F	+167.10	62/F	+200.30
23/F	+84.65	37/F	+124.25	50/F	+163.80	61/F	+196.80
22/F	+81.35	36/F	+120.95	49/F	+160.50	60/F	+193.50
21/F	+78.05	35/F	+117.65	48/F	+157.20	59/F	+190.20
20/F	+74.75	33/F	+114.35	47/F	+153.90	58/F	+186.90
19/F	+71.45	32/F	+111.05	46/F	+150.60	57/F	+183.60
18/F	+68.15	31/F	107.75	45/F	+147.30	56/F	+180.30
17/F	+64.85	30/F	+104.45	43/F	+144.00	55/F	+177.00
16/F	+61.55	29/F	+101.15	42/F	+140.70	53/F	+173.70
15/F	+58.25	28/F	+97.85	41/F	+137.40		
12/F	+54.95	27/F	+94.55	40/F	+134.15		

LEGEND:

- G1 – 10mm THK. HEAT STRENGTHENED GLASS (OUTSIDE) +12mm AIR SPACE + 12mm THK. TEMPERED GLASS
- G2 – 10mm THK. HEAT STRENGTHENED GLASS (OUTSIDE) +12mm AIR SPACE + 10mm THK. TEMPERED GLASS
- G3 – 12mm THK. HEAT STRENGTHENED GLASS
- G4 – 12mm THK. CLEAR TEMPERED GLASS (INTERNAL PROTECTIVE BARRIER)
- G5 – 10mm THK. HEAT STRENGTHENED GLASS (OUTSIDE) +12mm AIR SPACE + 12mm THK. TEMPERED GLASS WITH REFLECTIVE COATING
- S1 – 10mm THK. CLEAR TEMPERED GLASS
- S2 – 8mm THK. CLEAR HEAT-STRENGTHENED GLASS +1.52mm PVB + 8mm THK. CLEAR HEAT-STRENGTHENED GLASS
- – 3 mm THK. ALUM. CLADDING
- – 3 mm THK. ALUM. BACKPAN
- S.J. – STACK JOINT
- – RESTRAINT SOCKET

DELETED DELETED

NOTE :
1. ALL DIMENSIONS ARE IN mm.
2. ALL ELEVATIONS ARE VIEWED FROM OUTSIDE.
3. ALL DIMENSIONS TO BE VERIFIED ON SITE BEFORE FABRICATION.

LEGEND :
- X1 / V001 – DETAIL MARK NO. / REFER SHEET NO.
1. F.F.L. -- FINISHED FLOOR LEVEL
2. S.F.L. -- STRUCTURAL FLOOR LEVEL
3. (R) -- REVERSED DETAIL

NO.	DATE	REMARKED	BY
G	17/08/22	REVISED AS PER COMMENTS	LS
F	26/07/22	REVISED AS PER COMMENTS	LS
E	23/05/22	REVISED AS PER COMMENTS	LS
D	06/04/22	REVISED AS PER COMMENTS	LS
C	17/02/22	REVISED AS PER COMMENTS	LS
B	20/12/21	REVISED AS PER COMMENTS	LS
A	03/12/21	REVISED AS PER COMMENTS	LS

JOB NO. : J-858

PROJECT : PROPOSED RESIDENTIAL DEVELOPMENT AT TKOTL 70RP, PHASE 11, LOHAS PARK TSEUNG KWAN O, N.T.

TITLE : TYPICAL FLOOR PARTIAL ELEVATION & SECTION, PLAN FOR CURTAIN WALL (TOWER 1)

DATE : 22-OCT-21 | SCALE : 1:50(A1)

DRAWN BY : | CHECKED BY :

DWG NO. : J858-CW-PE115 | REV. : G

美特鋁廠有限公司 MIDI ALUMINIUM FABRICATOR LTD.
Units 6-8, Sunray Industrial Centre, 1/F
610 Cha Kwo Ling Road, Kowloon
Tel:23489211-4 Fax:(852)27727666

CLIENT : 信和置業有限公司 Sino Land Company Limited


ARCHITECT : ronald lu & partners Architects Planners Interior Designers 呂元祥建築師事務所(香港)有限公司

MAIN CONTRACTOR : Gammon

STRUCTURAL ENGINEER : AECOM

FACADE CONSULTANT: AECOM

B.D. REF :

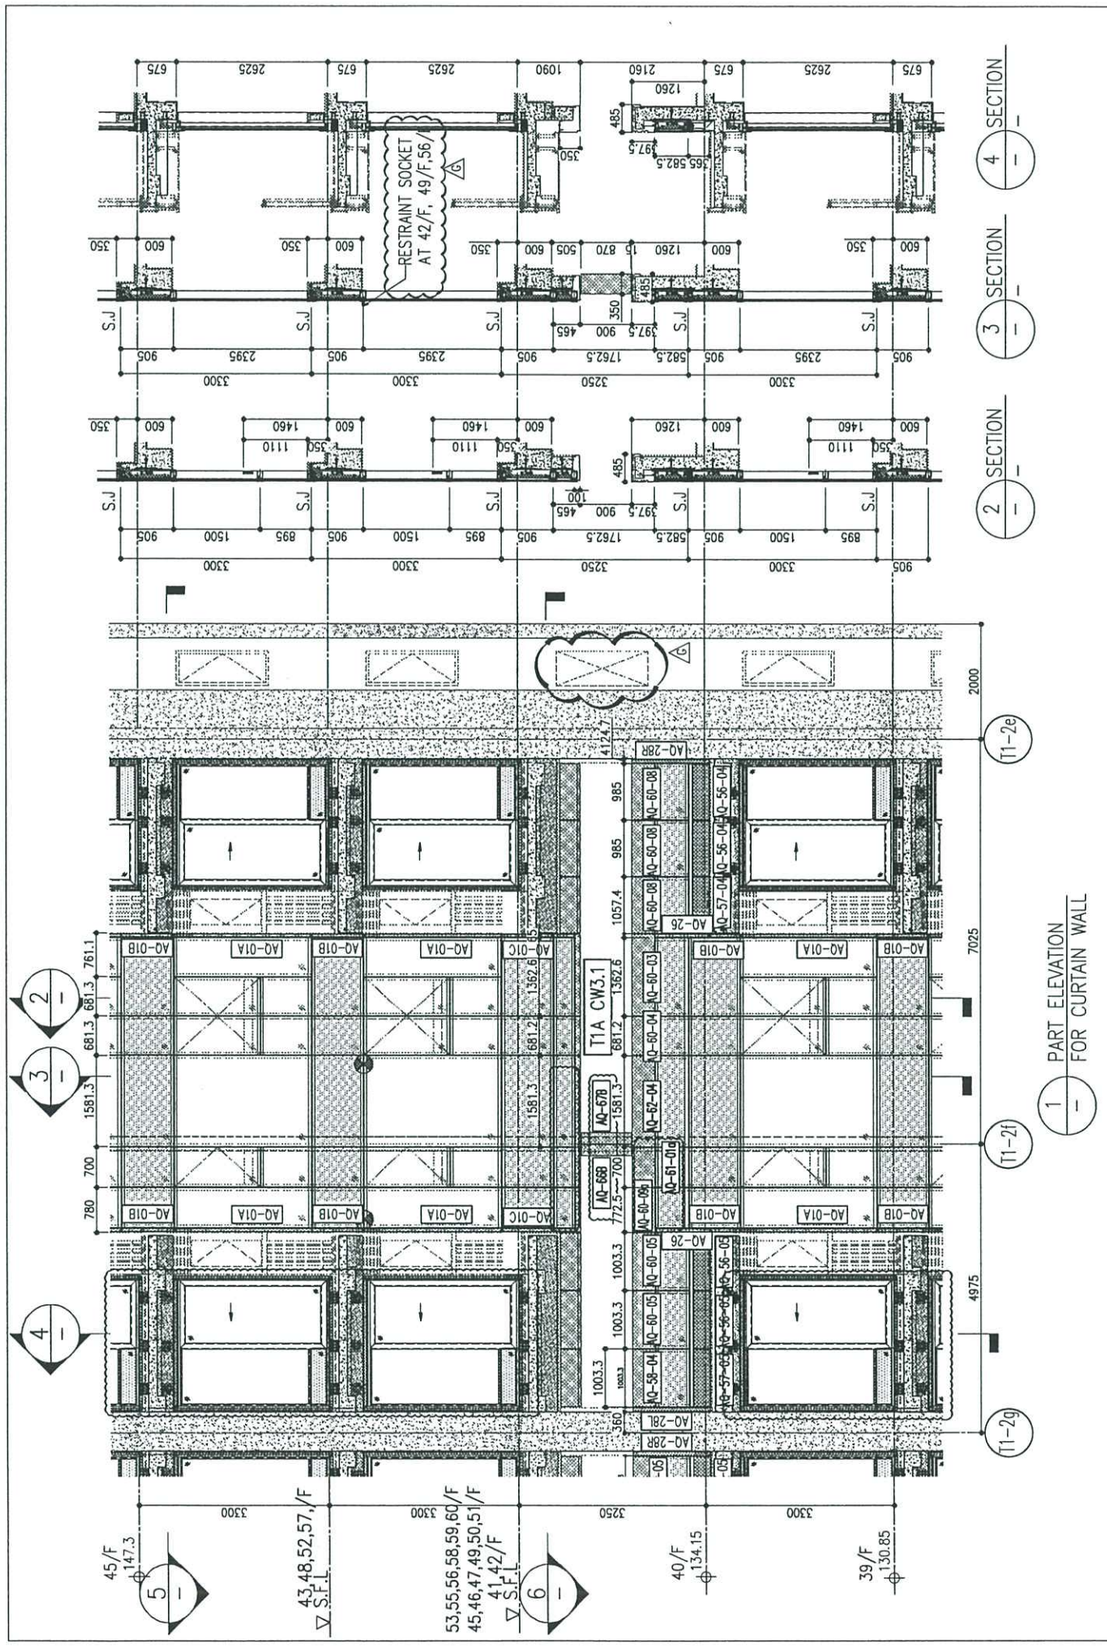

52/F	+170.40
51/F	+167.10
50/F	+163.80
49/F	+160.50
48/F	+157.20
47/F	+153.90
46/F	+150.60
45/F	+147.30
43/F	+144.00
42/F	+140.70
41/F	+137.40
40/F	+134.15

39/F	+130.85
38/F	+127.55
37/F	+124.25
36/F	+120.95
35/F	+117.65
33/F	+114.35
32/F	+111.05
31/F	107.75
30/F	+104.45
29/F	+101.15
28/F	+97.85
27/F	+94.55


26/F	+91.25
25/F	+87.95
23/F	+84.65
22/F	+81.35
21/F	+78.05
20/F	+74.75
19/F	+71.45
18/F	+68.15
17/F	+64.85
16/F	+61.55
15/F	+58.25
12/F	+54.95

R/F	+203.80
62/F	+200.30
61/F	+196.80
60/F	+193.50
59/F	+190.20
58/F	+186.90
57/F	+183.60
56/F	+180.30
55/F	+177.00
53/F	+173.70

LEGEND:

- G1 – 10mm THK. HEAT STRENGTHENED GLASS (OUTSIDE) +12mm AIR SPACE + 12mm THK. TEMPERED GLASS
- G2 – 10mm THK. HEAT STRENGTHENED GLASS (OUTSIDE) +12mm AIR SPACE + 10mm THK. TEMPERED GLASS
- G3 – 12mm THK. HEAT STRENGTHENED GLASS
- G4 – 12mm THK. CLEAR TEMPERED GLASS (INTERNAL PROTECTIVE BARRIER)
- G5 – 10mm THK. HEAT STRENGTHENED GLASS (OUTSIDE) +12mm AIR SPACE + 12mm THK. TEMPERED GLASS WITH REFLECTIVE COATING
- G6 – 10mm THK. CLEAR TEMPERED GLASS
- G7 – 8mm THK. CLEAR HEAT-STRENGTHENED GLASS +1.52mm PVB + 8mm THK. CLEAR HEAT-STRENGTHENED GLASS
- – 3 mm THK. ALUM. CLADDING
- – 3 mm THK. ALUM. BACKPAN
- S.J. – STACK JOINT
- – RESTRAINT SOCKET

REFER TO CLEAR HEAT-STRENGTHENED GLASS

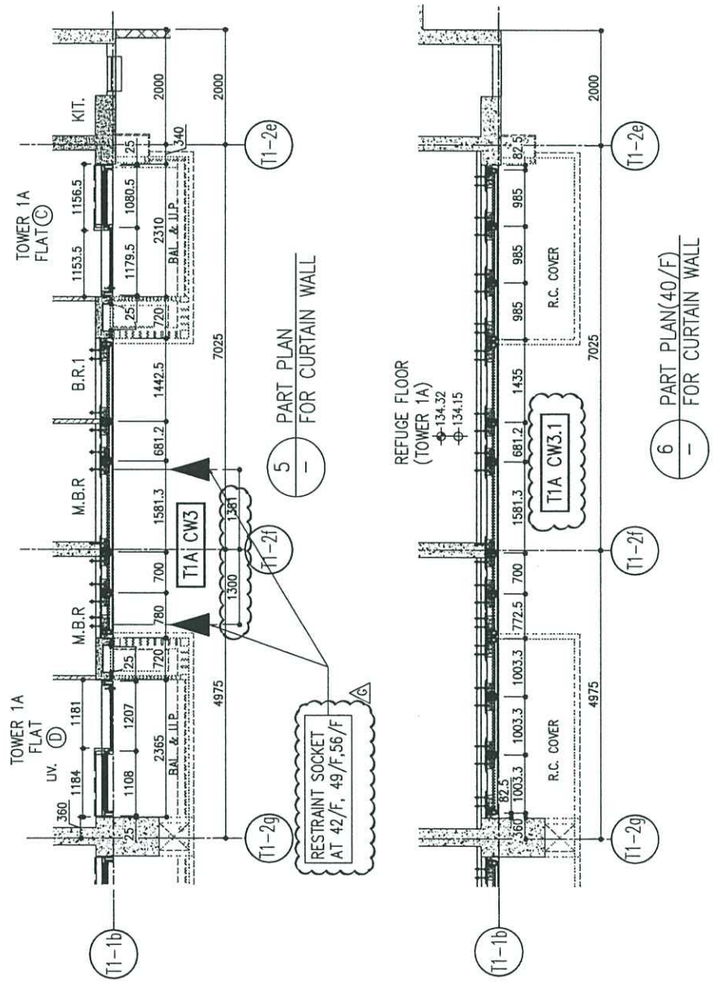

B.D. REF :

CLIENT :
信和置業有限公司
Sino Land Company Limited

ARCHITECT :
ronald lu & partners
Architects . Planners . Interior Designers
Ronald Lu & Partners (HK) Ltd.
呂元祥建築師事務所(香港)有限公司

MAIN CONTRACTOR :
Gammon

STRUCTURAL ENGINEER :
AECOM

FACADE CONSULTANT:
AECOM

NOTE :
1. ALL DIMENSIONS ARE IN mm.
2. ALL ELEVATIONS ARE VIEWED FROM OUTSIDE.
3. ALL DIMENSIONS TO BE VERIFIED ON SITE BEFORE FABRICATION.

LEGEND :
- X1 / XD01 – DETAIL MARK NO. / REFER SHEET NO.
1. F.F.L. --FINISHED FLOOR LEVEL
2. S.F.L. --STRUCTURAL FLOOR LEVEL
3. /R --REVERSED DETAIL

NO.	DATE	REVISED	BY
G	17/08/22	REVISED AS PER COMMENTS	LS
F	26/07/22	REVISED AS PER COMMENTS	LS
E	23/05/22	REVISED AS PER COMMENTS	LS
D	06/04/22	REVISED AS PER COMMENTS	LS
C	17/01/22	REVISED AS PER COMMENTS	LS
B	20/12/21	REVISED AS PER COMMENTS	LS
A	03/12/21	REVISED AS PER COMMENTS	LS

JOB NO. : J-858

PROJECT :
PROPOSED RESIDENTIAL DEVELOPMENT
AT TKOTL 70RP, PHASE 11, LOHAS PARK
TSEUNG KWAN O, N.T.

TITLE :
TYPICAL FLOOR PARTIAL
ELEVATION & SECTION, PLAN
FOR CURTAIN WALL (TOWER 1)


DATE : 22-OCT-21 | SCALE : 1:50(A1)

DRAWN BY : | CHECKED BY :

美特鋁質有限公司
MIDI ALUMINUM FABRICATOR LTD.
Units 6-8, Sunray Industrial Centre, 1/F
610 Cha Kwo Ling Road, Kowloon
Tel:23489211-4 Fax:(852)27727666

DWG NO. : J858-CW-PE116 | REV. : G

16.

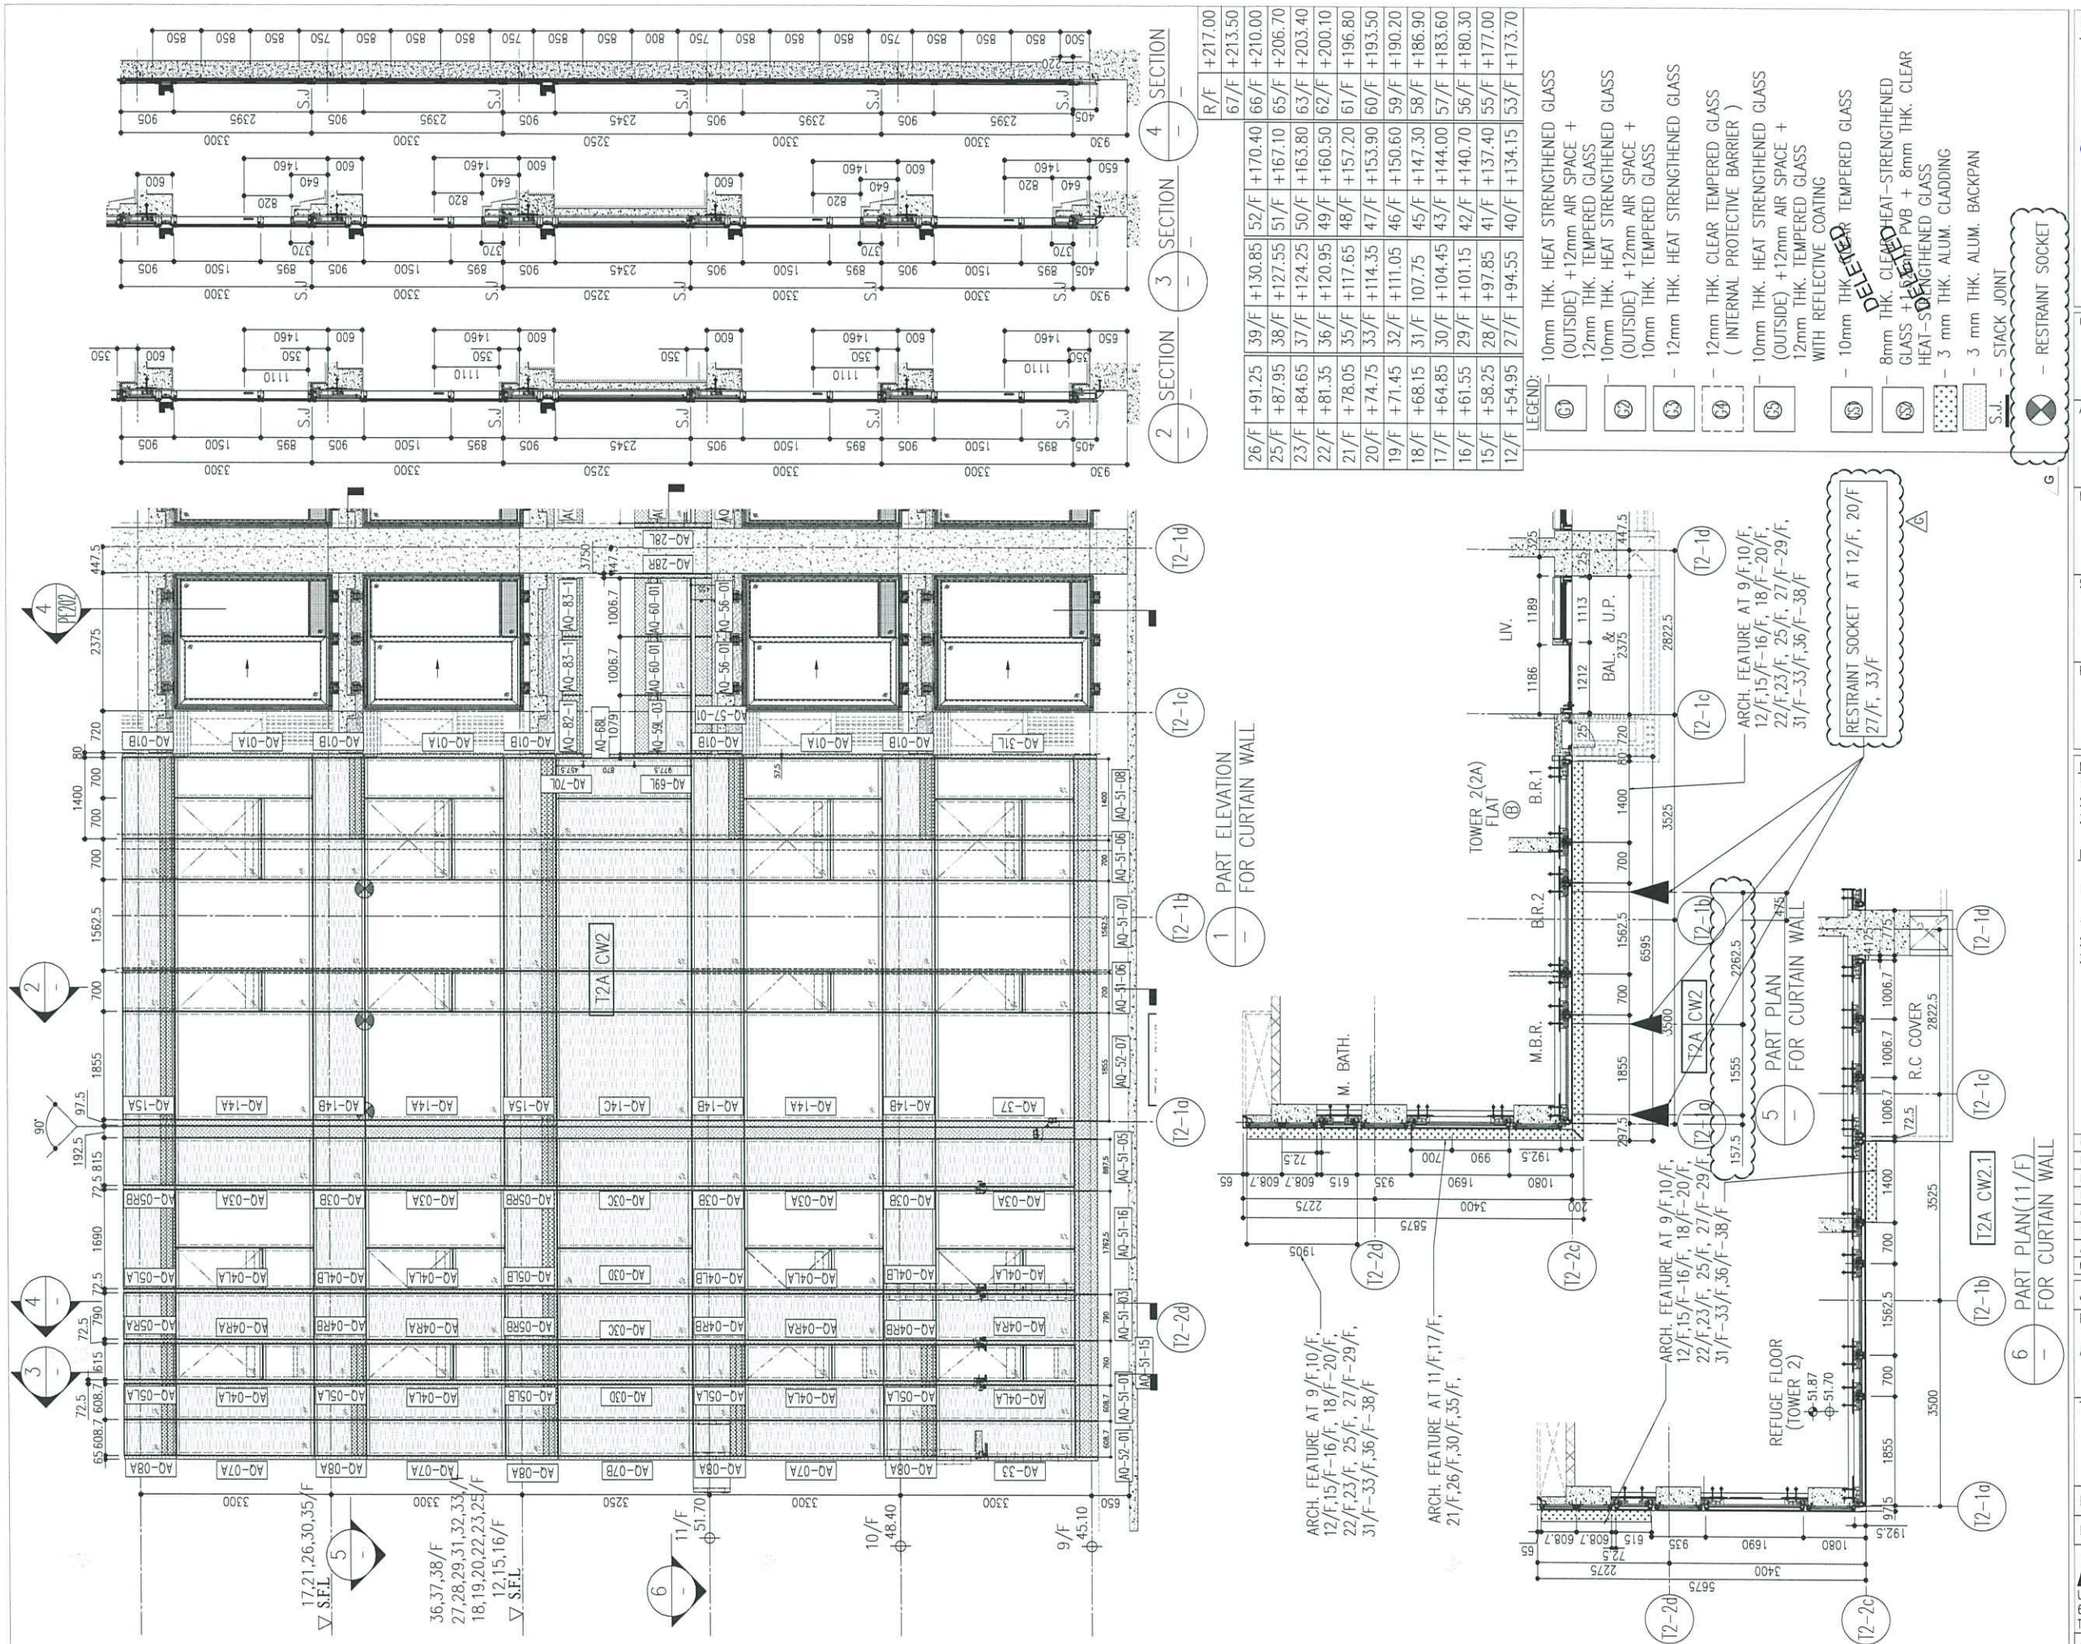

B.D. REF :

T2A

B

CLIENT :
信和置業有限公司
Sino Land Company Limited

ARCHITECT :
ronald lu & partners
Architects Planners Interior Designers
Ronald Lu & Partners (HK) Ltd.
呂元祥建築師事務所(香港)有限公司

MAIN CONTRACTOR :
Gammon

STRUCTURAL ENGINEER :
AECOM

FACADE CONSULTANT:
AECOM

NOTE :
1. ALL DIMENSIONS ARE IN mm.
2. ALL ELEVATIONS ARE VIEWED FROM OUTSIDE.
3. ALL DIMENSIONS TO BE VERIFIED ON SITE BEFORE FABRICATION.

LEGEND :
X1 — DETAIL MARK NO.
X001 — REFER SHEET NO.

1. F.F.L. --FINISHED FLOOR LEVEL
2. S.F.L. --STRUCTURAL FLOOR LEVEL
3. /R --REVERSED DETAIL

NO.	DATE	REVISED	BY
G	18/08/22	REVISED AS PER COMMENTS	LS
F	26/07/22	REVISED AS PER COMMENTS	LS
E	26/05/22	REVISED AS PER COMMENTS	LS
D	06/04/22	REVISED AS PER COMMENTS	LS
C	22/01/22	REVISED AS PER COMMENTS	LS
B	20/12/21	REVISED AS PER COMMENTS	LS
A	03/12/21	REVISED AS PER COMMENTS	LS

JOB NO. : J-858

PROJECT :
PROPOSED RESIDENTIAL DEVELOPMENT AT TKOTL 70RP, PHASE 11, LOHAS PARK TSEUNG KWAN O, N.T.

TITLE :
TYPICAL FLOOR PARTIAL ELEVATION & SECTION, PLAN FOR CURTAIN WALL (TOWER 2)


DATE : 20-OCT-21 | SCALE : 1:50(A1)


DRAWN BY : | CHECKED BY :

美特鋁製有限公司
MIDI ALUMINIUM FABRICATOR LTD.
Units 6-8, Sunray Industrial Centre, 1/F
610 Cha Kwo Ling Road, Kowloon
Tel:23489211-4 Fax:(852)27727666

DWG NO. : J858-CW-PE201 | REV. : G

17.

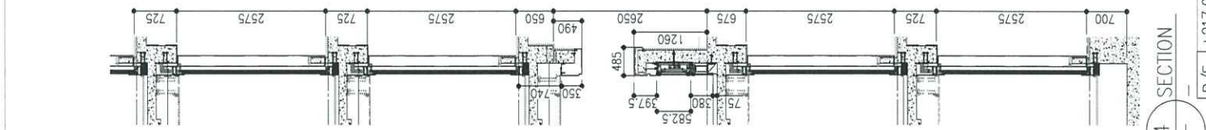

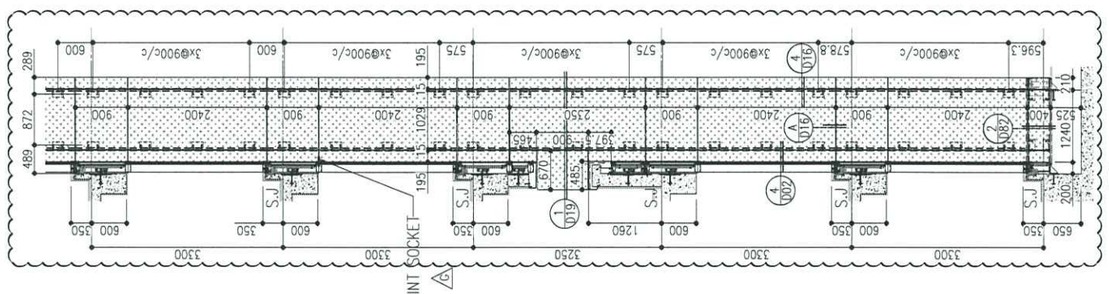



R/F	+217.00		
67/F	+213.50		
66/F	+210.00		
65/F	+206.70		
64/F	+203.40		
63/F	+200.10		
62/F	+196.80		
61/F	+193.50		
60/F	+190.20		
59/F	+186.90		
58/F	+183.60		
57/F	+180.30		
56/F	+177.00		
55/F	+173.70		


LEGEND:

- (G) – 10mm THK. HEAT STRENGTHENED GLASS (OUTSIDE) +12mm AIR SPACE + 12mm THK. TEMPERED GLASS
- (G2) – 10mm THK. HEAT STRENGTHENED GLASS (OUTSIDE) +12mm AIR SPACE + 10mm THK. TEMPERED GLASS
- (G3) – 12mm THK. HEAT STRENGTHENED GLASS
- (G4) – 12mm THK. CLEAR TEMPERED GLASS (INTERNAL PROTECTIVE BARRIER)
- (G5) – 10mm THK. HEAT STRENGTHENED GLASS (OUTSIDE) +12mm AIR SPACE + 12mm THK. TEMPERED GLASS WITH REFLECTIVE COATING
- (G6) – 10mm THK. CLEAR TEMPERED GLASS
- (G7) – 8mm THK. CLEAR HEAT-STRENGTHENED GLASS + 1.52mm PVB + 8mm THK. CLEAR HEAT-STRENGTHENED GLASS
- – 3 mm THK. ALUM. CLADDING
- – 3 mm THK. ALUM. BACKPAN
- S.J. – STACK JOINT
- G – RESTRAINT SOCKET

DELETED

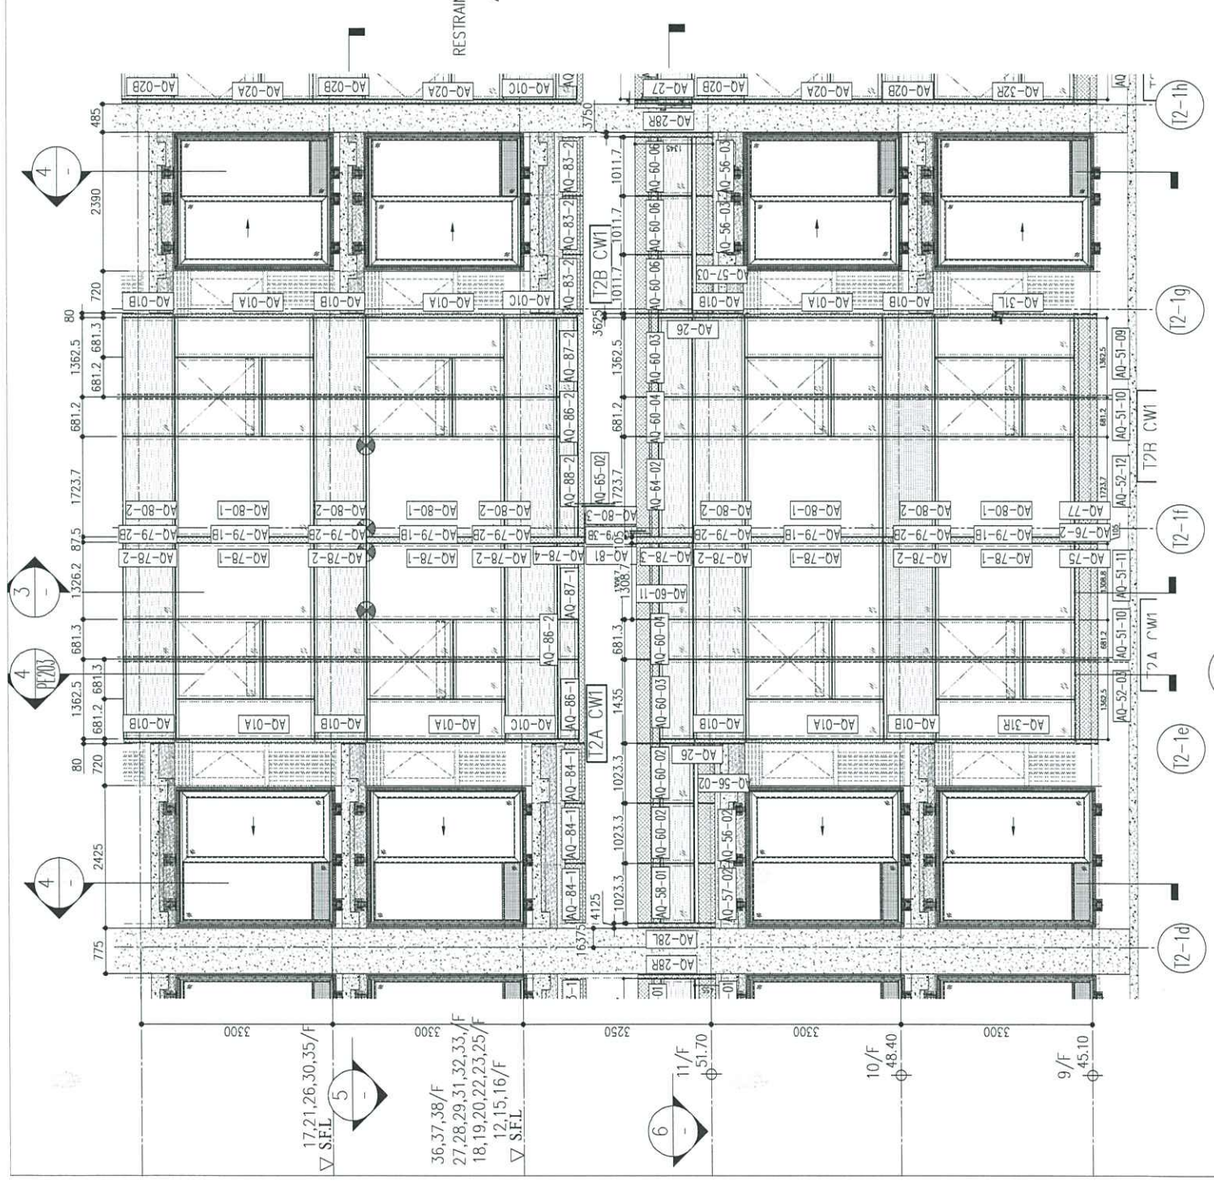

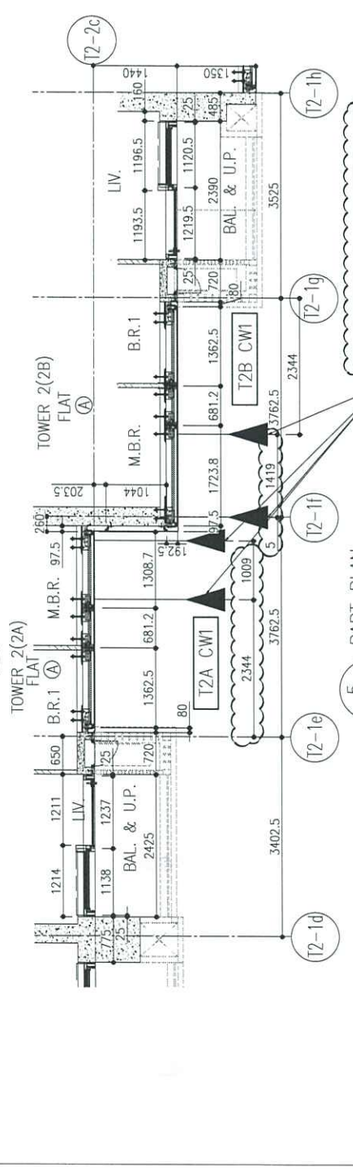

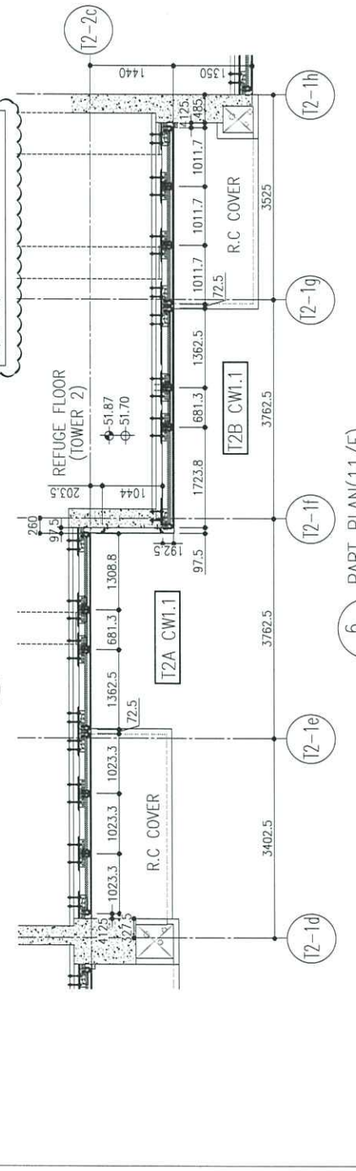

REF :

CLIENT :
信和置業有限公司
Sino Land Company Limited

ARCHITECT :
ronald lu & partners
Architects Planners Interior Designers
Ronald Lu & Partners (HK) Ltd.
呂元祥建築師事務所(香港)有限公司

MAIN CONTRACTOR :
Gammon

STRUCTURAL ENGINEER :
AECOM

FACADE CONSULTANT:
AECOM

NOTE :
1. ALL DIMENSIONS ARE IN mm.
2. ALL ELEVATIONS ARE VIEWED FROM OUTSIDE.
3. ALL DIMENSIONS TO BE VERIFIED ON SITE BEFORE FABRICATION.

LEGEND :
- X1 — DETAIL MARK NO.
- X001 — REFER SHEET NO.

1. F.F.L. --FINISHED FLOOR LEVEL
2. S.F.L. --STRUCTURAL FLOOR LEVEL
3. /R --REVERSED DETAIL

NO.	DATE	REVISED	BY
G	18/08/22	REVISED AS PER COMMENTS	LS
F	26/07/22	REVISED AS PER COMMENTS	LS
E	26/05/22	REVISED AS PER COMMENTS	LS
D	06/04/22	REVISED AS PER COMMENTS	LS
C	22/01/22	REVISED AS PER COMMENTS	LS
B	20/12/21	REVISED AS PER COMMENTS	LS
A	03/12/21	REVISED AS PER COMMENTS	LS

JOB NO. : J-858

PROJECT :
PROPOSED RESIDENTIAL DEVELOPMENT AT TKOTL 70RP, PHASE 11, LOHAS PARK TSEUNG KWAN O, N.T.


TITLE :
TYPICAL FLOOR PARTIAL ELEVATION & SECTION, PLAN FOR CURTAIN WALL (TOWER 2)

DATE : 20-OCT-21 | SCALE : 1:50(A1)

DRAWN BY : | CHECKED BY :

美特鋁質有限公司
MIDI ALUMINIUM FABRICATOR LTD.
Units 6-8, Sunray Industrial Centre, 1/F
610 Cha Kwo Ling Road, Kowloon
Tel:23489211-4 Fax:(852)27727666

DWG NO. : J858-CW-PE202 | REV. : G

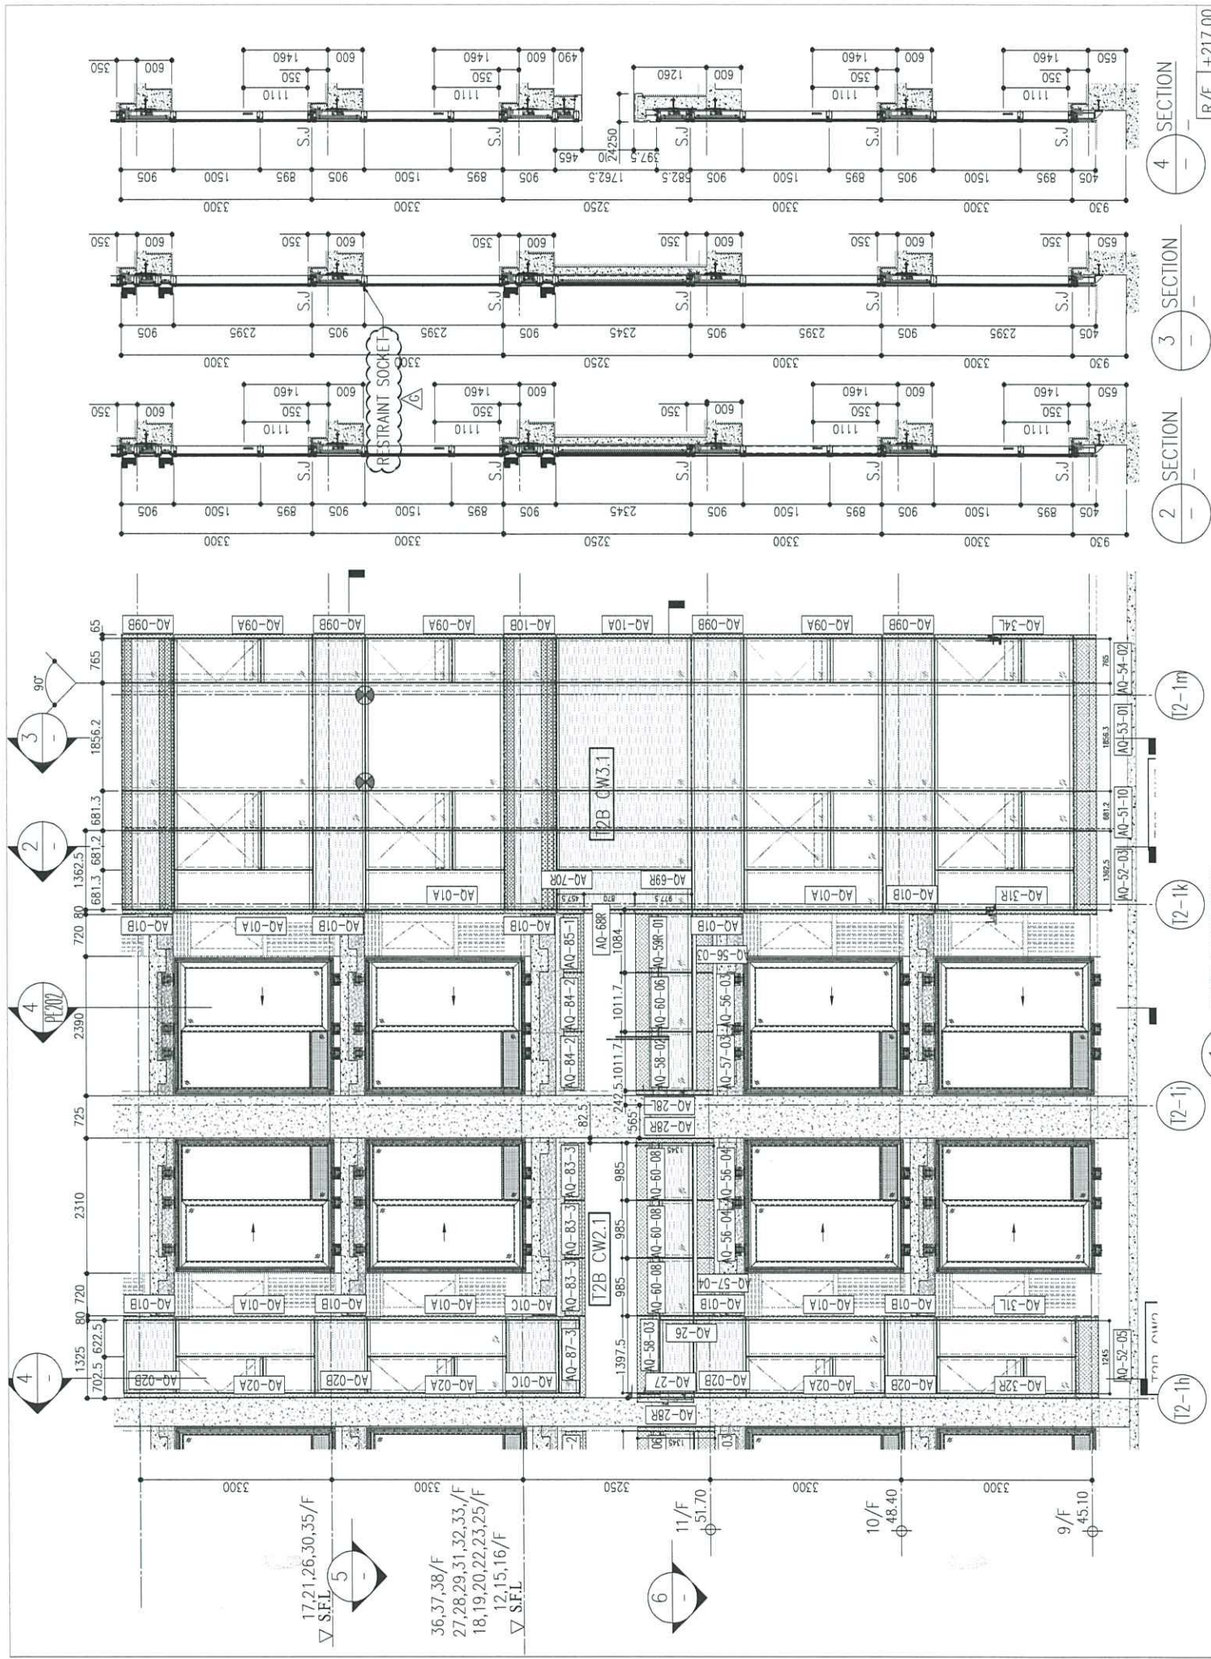

R/F	+217.00
67/F	+213.50
66/F	+210.00
65/F	+206.70
64/F	+203.40
63/F	+200.10
62/F	+196.80
61/F	+193.50
60/F	+190.20
59/F	+186.90
58/F	+183.60
57/F	+180.30
56/F	+177.00
55/F	+173.70
53/F	+170.40
52/F	+167.10
51/F	+163.80
50/F	+160.50
49/F	+157.20
48/F	+153.90
47/F	+150.60
46/F	+147.30
45/F	+144.00
43/F	+140.70
42/F	+137.40
41/F	+134.15
40/F	+130.85
39/F	+127.55
38/F	+124.25
37/F	+120.95
36/F	+117.65
35/F	+114.35
33/F	+111.05
32/F	107.75
31/F	+104.45
30/F	+101.15
29/F	+97.85
28/F	+94.55
27/F	+91.25
26/F	+87.95
25/F	+84.65
23/F	+81.35
22/F	+78.05
21/F	+74.75
20/F	+71.45
19/F	+68.15
18/F	+64.85
17/F	+61.55
16/F	+58.25
15/F	+54.95
12/F	+91.25

LEGEND:

- Ⓖ – 10mm THK. HEAT STRENGTHENED GLASS (OUTSIDE) +12mm AIR SPACE + 12mm THK. TEMPERED GLASS
- Ⓚ – 10mm THK. HEAT STRENGTHENED GLASS (OUTSIDE) +12mm AIR SPACE + 10mm THK. TEMPERED GLASS
- Ⓚ – 12mm THK. HEAT STRENGTHENED GLASS
- Ⓚ – 12mm THK. CLEAR TEMPERED GLASS (INTERNAL PROTECTIVE BARRIER)
- Ⓚ – 10mm THK. HEAT STRENGTHENED GLASS (OUTSIDE) +12mm AIR SPACE + 12mm THK. TEMPERED GLASS WITH REFLECTIVE COATING
- Ⓚ – 10mm THK. CLEAR TEMPERED GLASS
- Ⓚ – 8mm THK. CLEAR HEAT-STRENGTHENED GLASS +1.52mm PVB + 8mm THK. CLEAR HEAT-STRENGTHENED GLASS
- – 3 mm THK. ALUM. CLADDING
- – 3 mm THK. ALUM. BACKPAN
- S.J. – STACK JOINT
- G – RESTRAINT SOCKET

DELETED

B.D. REF :

T2B T2B

(B) (C)

CLIENT :

信和置業有限公司
Sino Land Company Limited

ARCHITECT :

ronald lu & partners
Architects . Planners . Interior Designers
Ronald Lu & Partners (HK) Ltd.
呂元祥建築師事務所(香港)有限公司

MAIN CONTRACTOR :

Gammon

STRUCTURAL ENGINEER :

AECOM

FACADE CONSULTANT:

AECOM

NOTE :

1. ALL DIMENSIONS ARE IN mm.
2. ALL ELEVATIONS ARE VIEWED FROM OUTSIDE.
3. ALL DIMENSIONS TO BE VERIFIED ON SITE BEFORE FABRICATION.

LEGEND :

X1 — DETAIL MARK NO.
X001 — REFER SHEET NO.

1. F.F.L. -- FINISHED FLOOR LEVEL
2. S.F.L. -- STRUCTURAL FLOOR LEVEL
3. /R -- REVERSED DETAIL

NO.	DATE	REVISED	BY
G	18/08/22	REVISED AS PER COMMENTS	LS
F	26/07/22	REVISED AS PER COMMENTS	LS
E	26/05/22	REVISED AS PER COMMENTS	LS
D	06/04/22	REVISED AS PER COMMENTS	LS
C	22/01/22	REVISED AS PER COMMENTS	LS
B	20/12/21	REVISED AS PER COMMENTS	LS
A	03/12/21	REVISED AS PER COMMENTS	LS

JOB NO. : J-858

PROJECT :
PROPOSED RESIDENTIAL DEVELOPMENT AT TKOTL 70RP, PHASE 11, LOHAS PARK TSEUNG KWAN O, N.T.


TITLE :
TYPICAL FLOOR PARTIAL ELEVATION & SECTION, PLAN FOR CURTAIN WALL (TOWER 2)

DATE : 20-OCT-21 | SCALE : 1:50(A1)

DRAWN BY : | CHECKED BY :

美特鋁製有限公司
MIDI ALUMINIUM FABRICATOR LTD.
Units 6-8, Sunray Industrial Centre, 1/F
610 Cha Kwo Ling Road, Kowloon
Tel:23489211-4 Fax:(852)27727666

DWG NO. : J858-CW-PE203 | REV. : G

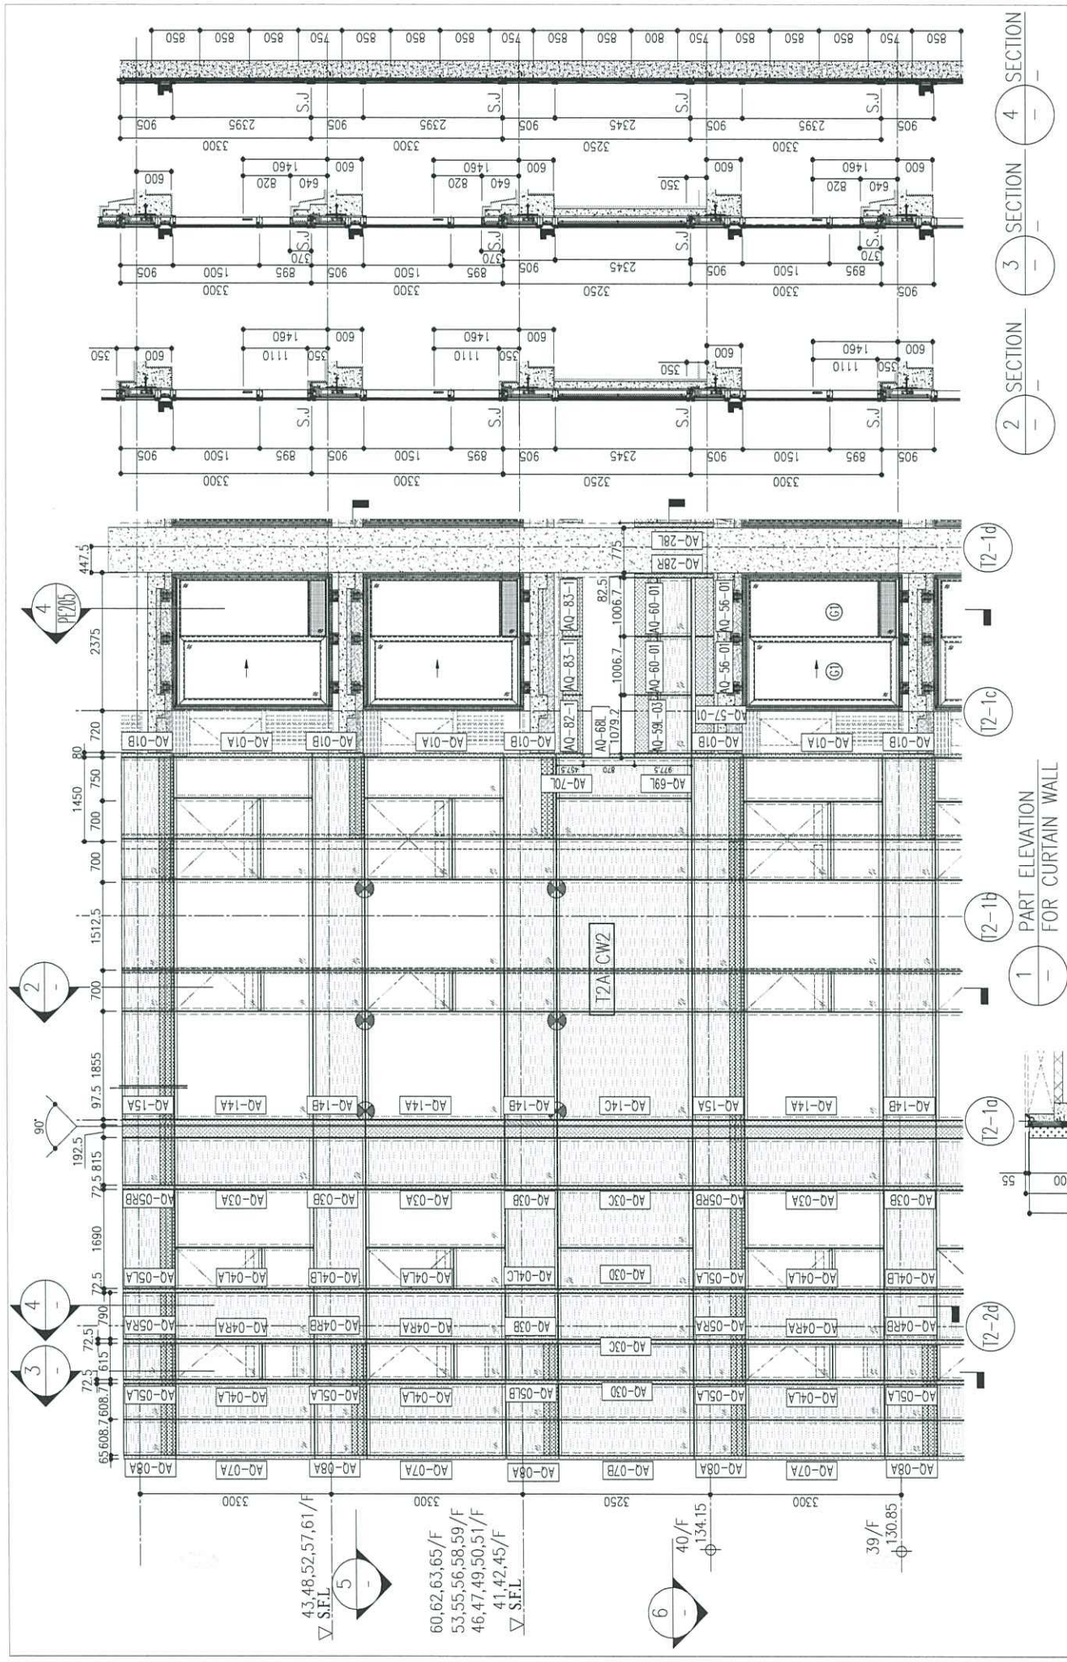

R/F	+217.00
67/F	+213.50
66/F	+210.00
65/F	+206.70
63/F	+203.40
62/F	+200.10
61/F	+196.80
60/F	+193.50
59/F	+190.20
58/F	+186.90
57/F	+183.60
56/F	+180.30
55/F	+177.00
53/F	+173.70

52/F	+170.40
51/F	+167.10
50/F	+163.80
49/F	+160.50
48/F	+157.20
47/F	+153.90
46/F	+150.60
45/F	+147.30
43/F	+144.00
42/F	+140.70
41/F	+137.40
40/F	+134.15


39/F	+130.85
38/F	+127.55
37/F	+124.25
36/F	+120.95
35/F	+117.65
33/F	+114.35
32/F	+111.05
31/F	107.75
30/F	+104.45
29/F	+101.15
28/F	+97.85
27/F	+94.55


26/F	+91.25
25/F	+87.95
23/F	+84.65
22/F	+81.35
21/F	+78.05
20/F	+74.75
19/F	+71.45
18/F	+68.15
17/F	+64.85
16/F	+61.55
15/F	+58.25
12/F	+54.95

LEGEND:

- G1 – 10mm THK. HEAT STRENGTHENED GLASS (OUTSIDE) +12mm AIR SPACE + 12mm THK. TEMPERED GLASS
- G2 – 10mm THK. HEAT STRENGTHENED GLASS (OUTSIDE) +12mm AIR SPACE + 10mm THK. TEMPERED GLASS
- G3 – 12mm THK. HEAT STRENGTHENED GLASS
- G4 – 12mm THK. CLEAR TEMPERED GLASS (INTERNAL PROTECTIVE BARRIER)
- G5 – 10mm THK. HEAT STRENGTHENED GLASS (OUTSIDE) +12mm AIR SPACE + 12mm THK. TEMPERED GLASS WITH REFLECTIVE COATING
- G6 – 10mm THK. CLEAR TEMPERED GLASS
- G7 – 8mm THK. CLEAR HEAT-STRENGTHENED GLASS + 1.52mm PVB + 8mm THK. CLEAR HEAT-STRENGTHENED GLASS
- – 3 mm THK. ALUM. CLADDING
- S.J. – 3 mm THK. ALUM. BACKPAN – STACK JOINT
- – RESTRAINT SOCKET

DELETED

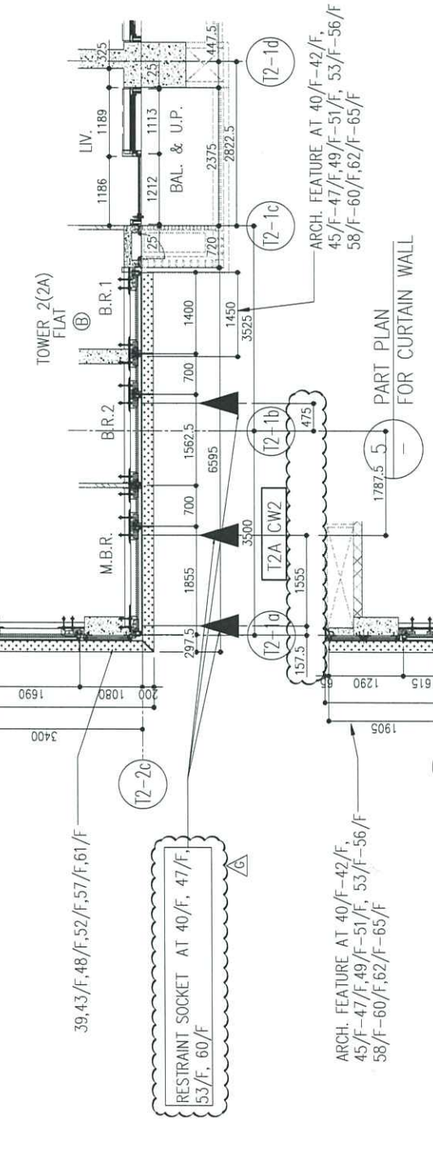

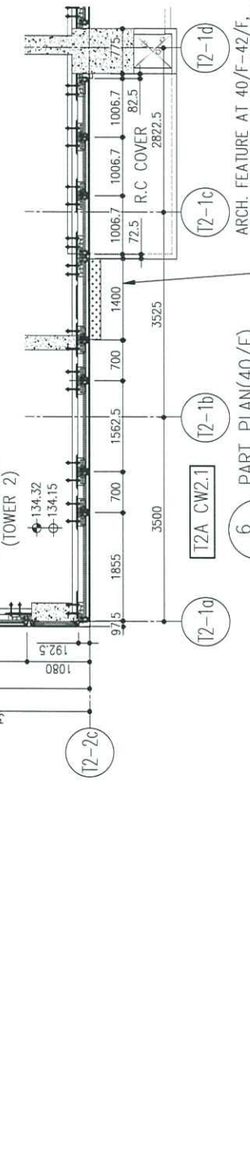

B.D. REF :

17

CLIENT :
信和置業有限公司
Sino Land Company Limited

ARCHITECT :
ronald lu & partners
Architects . Planners . Interior Designers
Ronald Lu & Partners (HK) Ltd.
呂元祥建築師事務所(香港)有限公司

MAIN CONTRACTOR :
Gammon

STRUCTURAL ENGINEER :
AECOM

FACADE CONSULTANT:
AECOM

NOTE :
1. ALL DIMENSIONS ARE IN mm.
2. ALL ELEVATIONS ARE VIEWED FROM OUTSIDE.
3. ALL DIMENSIONS TO BE VERIFIED ON SITE BEFORE FABRICATION.

LEGEND :
- X1 / X001 – DETAIL MARK NO. / REFER SHEET NO.

1. F.F.L. – FINISHED FLOOR LEVEL
2. S.F.L. – STRUCTURAL FLOOR LEVEL
3. /R – REVERSED DETAIL

NO.	DATE	REVISED	BY
G	18/08/22	REVISED AS PER COMMENTS	LS
F	26/07/22	REVISED AS PER COMMENTS	LS
E	26/05/22	REVISED AS PER COMMENTS	LS
D	06/04/22	REVISED AS PER COMMENTS	LS
C	22/01/22	REVISED AS PER COMMENTS	LS
B	20/12/21	REVISED AS PER COMMENTS	LS
A	03/12/21	REVISED AS PER COMMENTS	LS

JOB NO. : J-858

PROJECT :
PROPOSED RESIDENTIAL DEVELOPMENT AT TKOTL 70RP, PHASE 11, LOHAS PARK TSEUNG KWAN O, N.T.

TITLE :
TYPICAL FLOOR PARTIAL ELEVATION & SECTION, PLAN FOR CURTAIN WALL (TOWER 2)


DATE : 20-OCT-21 | SCALE : 1:50(A1)

DRAWN BY : | CHECKED BY :

美特鋁質有限公司
MIDI ALUMINIUM FABRICATOR LTD.
Units 6-8, Sunray Industrial Centre, 1/F
610 Cha Kwo Ling Road, Kowloon
Tel:23489211-4 Fax:(852)27727666

DWG NO. : J858-CW-PE204 | REV. : G


20.

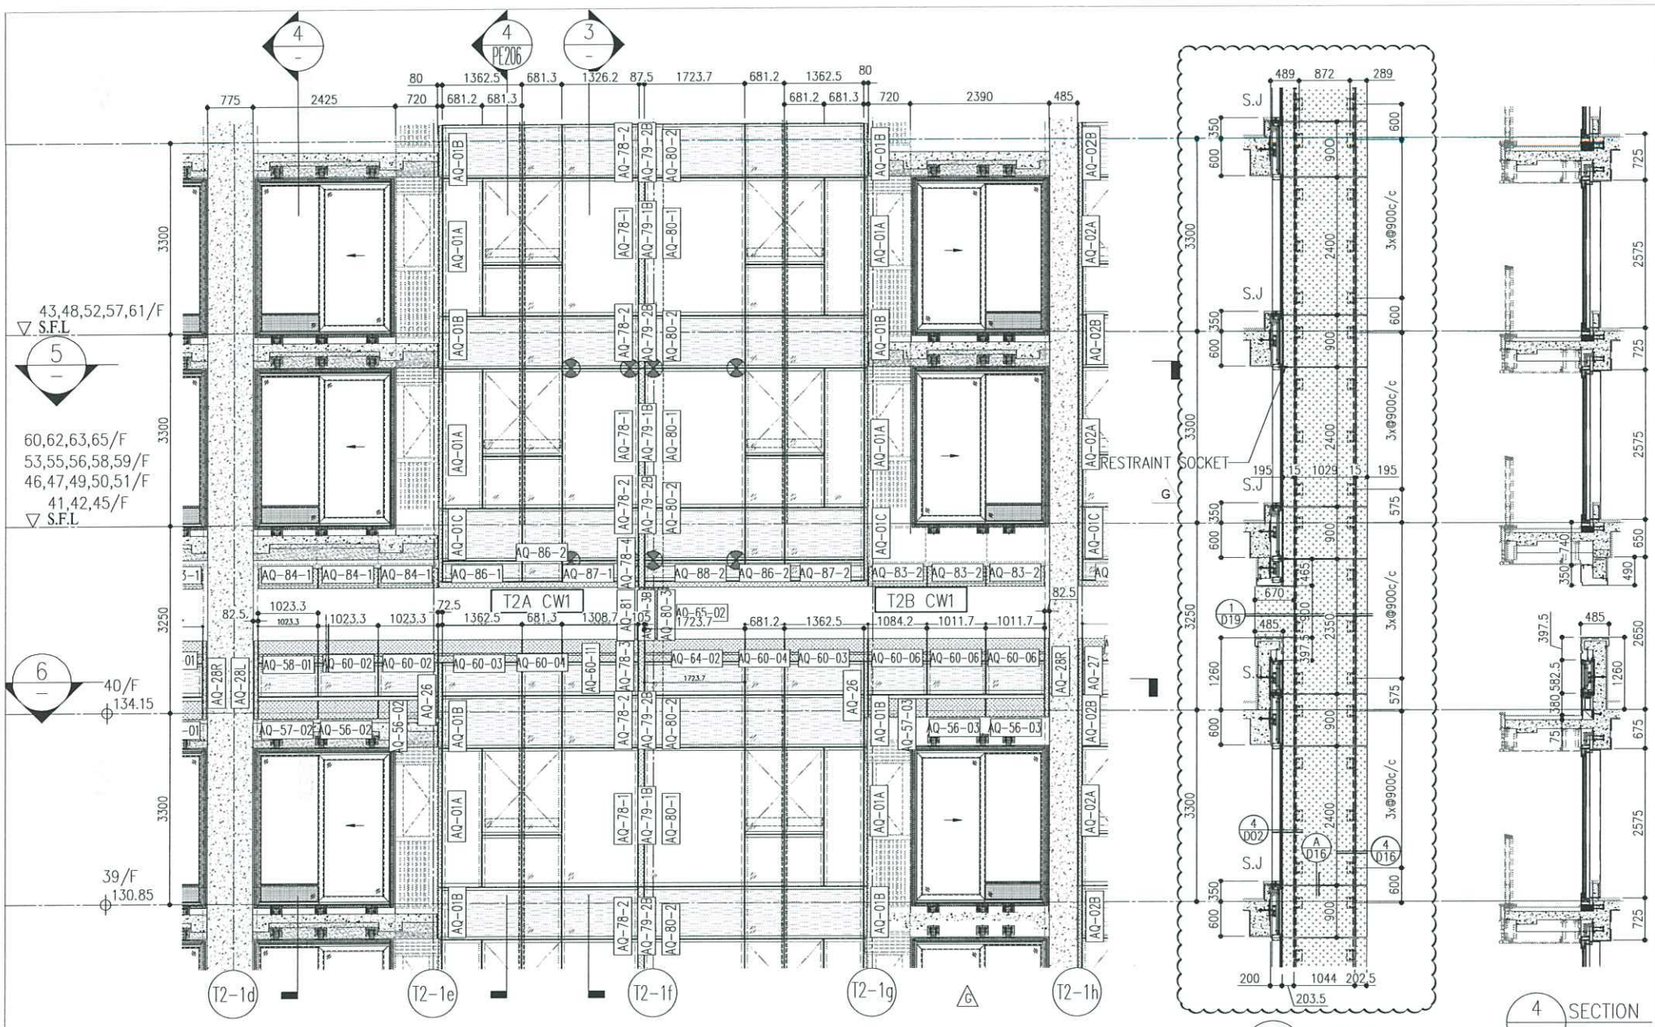

1 PART ELEVATION FOR CURTAIN WALL

3 SECTION

4 SECTION

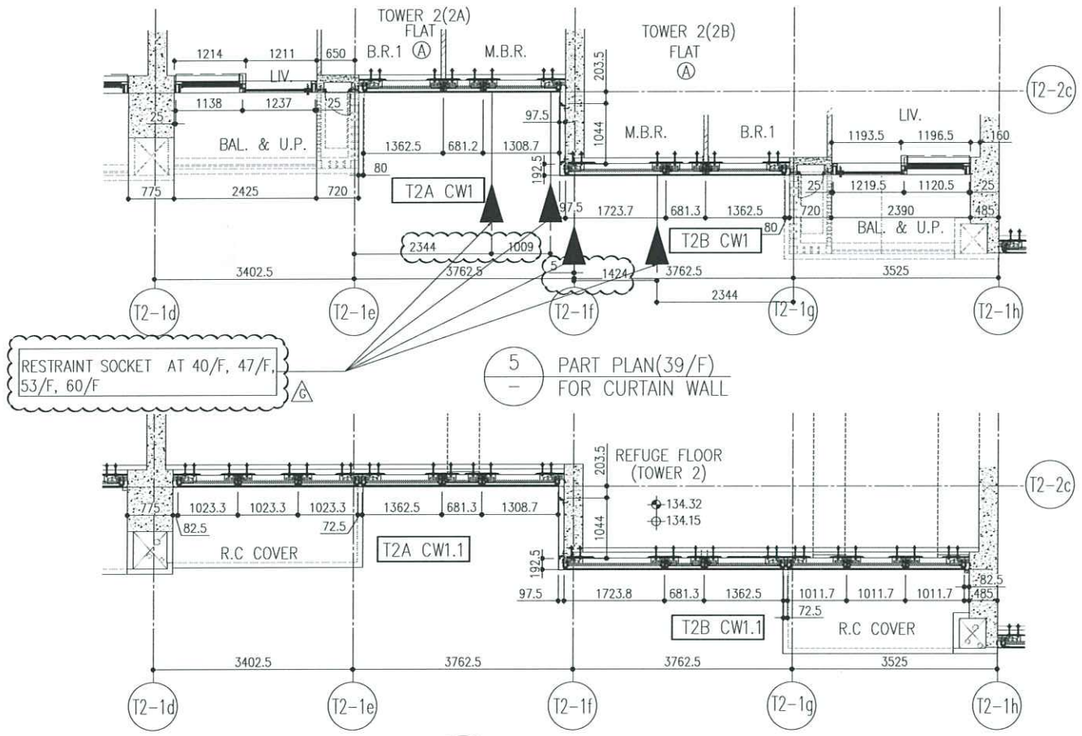

5 PART PLAN(39/F) FOR CURTAIN WALL

6 PART PLAN(40/F) FOR CURTAIN WALL

						R/F	+217.00
						67/F	+213.50
26/F	+91.25	39/F	+130.85	52/F	+170.40	66/F	+210.00
25/F	+87.95	38/F	+127.55	51/F	+167.10	65/F	+206.70
23/F	+84.65	37/F	+124.25	50/F	+163.80	63/F	+203.40
22/F	+81.35	36/F	+120.95	49/F	+160.50	62/F	+200.10
21/F	+78.05	35/F	+117.65	48/F	+157.20	61/F	+196.80
20/F	+74.75	33/F	+114.35	47/F	+153.90	60/F	+193.50
19/F	+71.45	32/F	+111.05	46/F	+150.60	59/F	+190.20
18/F	+68.15	31/F	107.75	45/F	+147.30	58/F	+186.90
17/F	+64.85	30/F	+104.45	43/F	+144.00	57/F	+183.60
16/F	+61.55	29/F	+101.15	42/F	+140.70	56/F	+180.30
15/F	+58.25	28/F	+97.85	41/F	+137.40	55/F	+177.00
12/F	+54.95	27/F	+94.55	40/F	+134.15	53/F	+173.70

LEGEND:

- G1 – 10mm THK. HEAT STRENGTHENED GLASS (OUTSIDE) +12mm AIR SPACE + 12mm THK. TEMPERED GLASS
- G2 – 10mm THK. HEAT STRENGTHENED GLASS (OUTSIDE) +12mm AIR SPACE + 10mm THK. TEMPERED GLASS
- G3 – 12mm THK. HEAT STRENGTHENED GLASS
- G4 – 12mm THK. CLEAR TEMPERED GLASS (INTERNAL PROTECTIVE BARRIER)
- G5 – 10mm THK. HEAT STRENGTHENED GLASS (OUTSIDE) +12mm AIR SPACE + 12mm THK. TEMPERED GLASS WITH REFLECTIVE COATING
- G6 – 10mm THK. CLEAR TEMPERED GLASS
- G8 – 8mm THK. CLEAR HEAT-STRENGTHENED GLASS + 1.52mm PVB + 8mm THK. CLEAR HEAT-STRENGTHENED GLASS
- 3 mm THK. ALUM. CLADDING
- 3 mm THK. ALUM. BACKPAN
- S.J. – STACK JOINT
- G – RESTRAINT SOCKET

DELETED

DELETED

NOTE :
1. ALL DIMENSIONS ARE IN mm.
2. ALL ELEVATIONS ARE VIEWED FROM OUTSIDE.
3. ALL DIMENSIONS TO BE VERIFIED ON SITE BEFORE FABRICATION.

LEGEND :
- (X1) / (X00) — DETAIL MARK NO. / REFER SHEET NO.
- 1. F.F.L. --FINISHED FLOOR LEVEL
- 2. S.F.L. --STRUCTURAL FLOOR LEVEL
- 3. (R) --REVERSED DETAIL

NO.	DATE	REVISED	BY
G	18/08/22	REVISED AS PER COMMENTS	LS
F	26/07/22	REVISED AS PER COMMENTS	LS
E	26/05/22	REVISED AS PER COMMENTS	LS
D	06/04/22	REVISED AS PER COMMENTS	LS
C	22/01/22	REVISED AS PER COMMENTS	LS
B	20/12/21	REVISED AS PER COMMENTS	LS
A	03/12/21	REVISED AS PER COMMENTS	LS

JOB NO. : J-858

PROJECT :
PROPOSED RESIDENTIAL DEVELOPMENT AT TKOTL 70RP, PHASE 11, LOHAS PARK TSEUNG KWAN O, N.T.

TITLE :
TYPICAL FLOOR PARTIAL ELEVATION & SECTION, PLAN FOR CURTAIN WALL (TOWER 2)


DATE : 20-OCT-21 | SCALE : 1:50(A1)
DRAWN BY : | CHECKED BY :
DWG NO. : J858-CW-PE205 | REV. : G

美特鋁廠有限公司 MIDI ALUMINIUM FABRICATOR LTD.
Units 6-8, Sunray Industrial Centre, 1/F
610 Cha Kwo Ling Road, Kowloon
Tel:23489211-4 Fax:(852)27727666

FACADE CONSULTANT: AECOM
STRUCTURAL ENGINEER : AECOM
MAIN CONTRACTOR : Gammon
ARCHITECT : ronald lu & partners (HK) Ltd. 呂元祥建築師事務所(香港)有限公司
CLIENT : 信和置業有限公司 Sino Land Company Limited

B.D. REF :

24

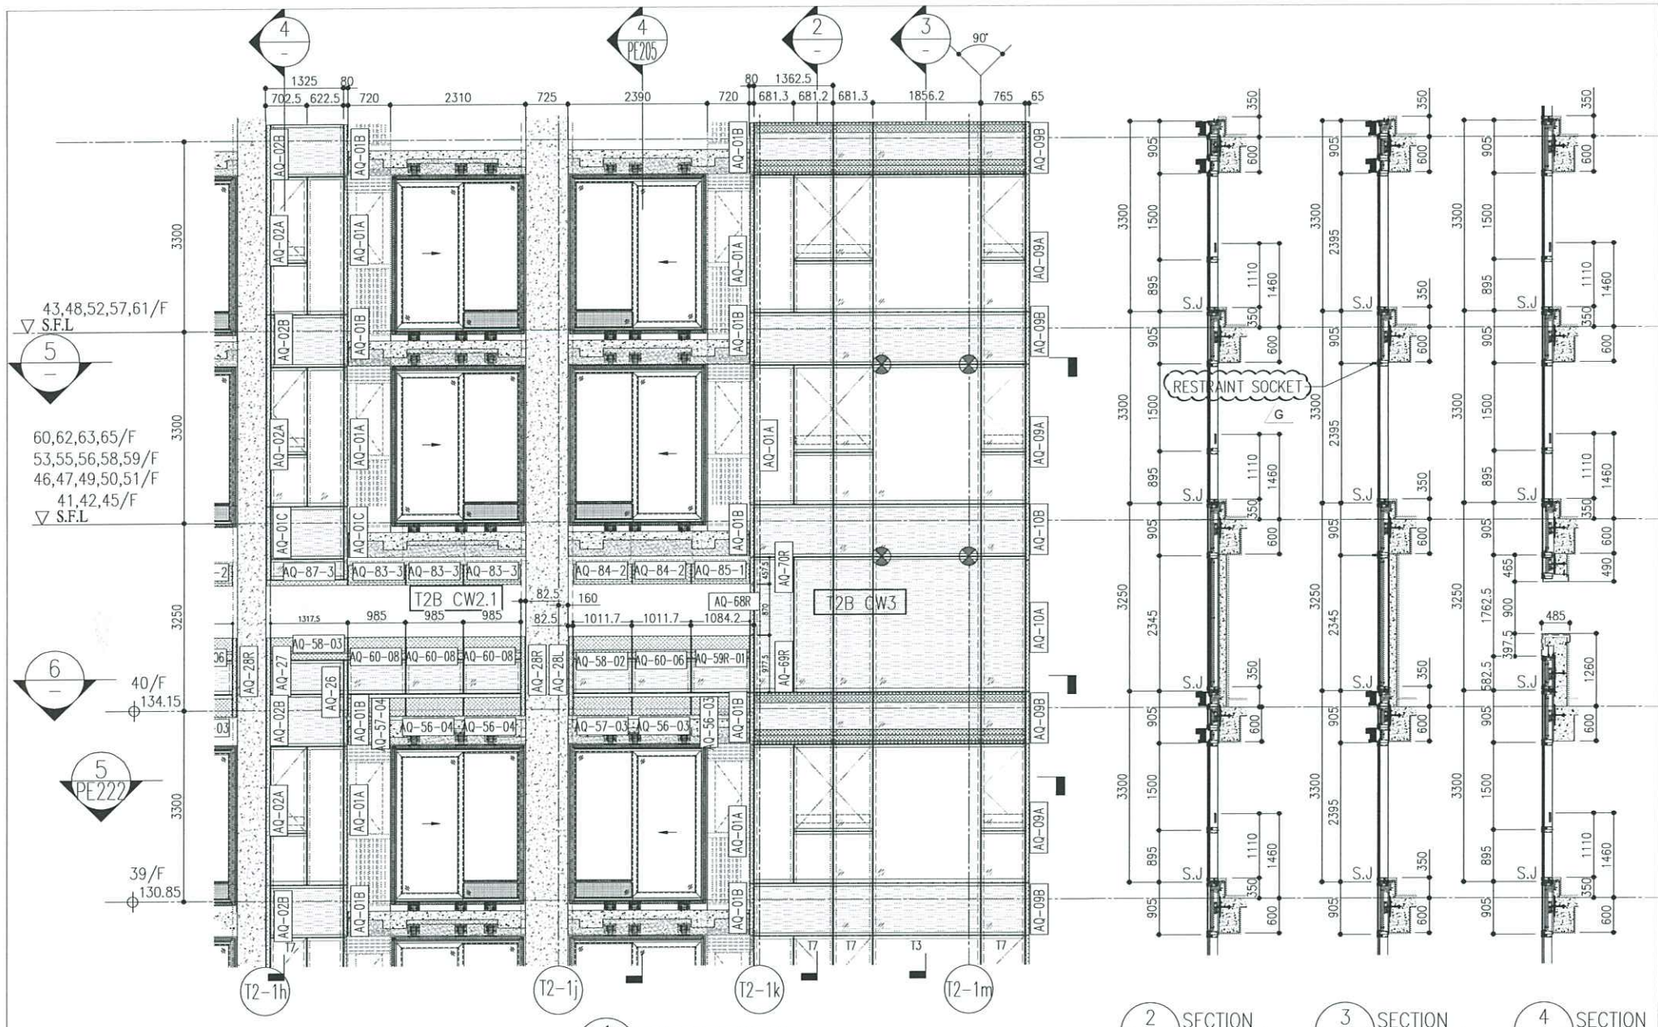


1 PART ELEVATION FOR CURTAIN WALL

2 SECTION

3 SECTION

4 SECTION

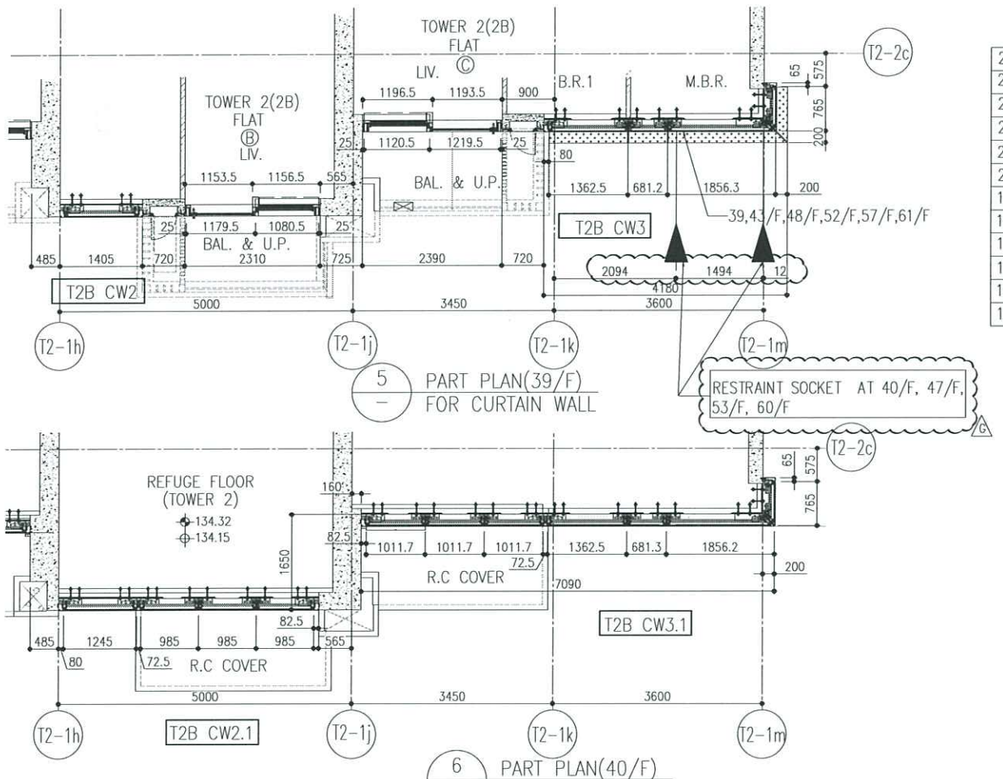

5 PART PLAN(39/F) FOR CURTAIN WALL

6 PART PLAN(40/F) FOR CURTAIN WALL

						R/F	+217.00
						67/F	+213.50
26/F	+91.25	39/F	+130.85	52/F	+170.40	66/F	+210.00
25/F	+87.95	38/F	+127.55	51/F	+167.10	65/F	+206.70
23/F	+84.65	37/F	+124.25	50/F	+163.80	63/F	+203.40
22/F	+81.35	36/F	+120.95	49/F	+160.50	62/F	+200.10
21/F	+78.05	35/F	+117.65	48/F	+157.20	61/F	+196.80
20/F	+74.75	33/F	+114.35	47/F	+153.90	60/F	+193.50
19/F	+71.45	32/F	+111.05	46/F	+150.60	59/F	+190.20
18/F	+68.15	31/F	107.75	45/F	+147.30	58/F	+186.90
17/F	+64.85	30/F	+104.45	43/F	+144.00	57/F	+183.60
16/F	+61.55	29/F	+101.15	42/F	+140.70	56/F	+180.30
15/F	+58.25	28/F	+97.85	41/F	+137.40	55/F	+177.00
12/F	+54.95	27/F	+94.55	40/F	+134.15	53/F	+173.70

LEGEND:

- G1 – 10mm THK. HEAT STRENGTHENED GLASS (OUTSIDE) +12mm AIR SPACE + 12mm THK. TEMPERED GLASS
- G2 – 10mm THK. HEAT STRENGTHENED GLASS (OUTSIDE) +12mm AIR SPACE + 10mm THK. TEMPERED GLASS
- G3 – 12mm THK. HEAT STRENGTHENED GLASS
- G4 – 12mm THK. CLEAR TEMPERED GLASS (INTERNAL PROTECTIVE BARRIER)
- G5 – 10mm THK. HEAT STRENGTHENED GLASS (OUTSIDE) +12mm AIR SPACE + 12mm THK. TEMPERED GLASS WITH REFLECTIVE COATING
- S1 – 10mm THK. CLEAR TEMPERED GLASS
- S2 – 8mm THK. CLEAR HEAT-STRENGTHENED GLASS +1.52mm PVB + 8mm THK. CLEAR HEAT-STRENGTHENED GLASS
- 3 mm THK. ALUM. CLADDING
- 3 mm THK. ALUM. BACKPAN
- S.J. – STACK JOINT
- G – RESTRAINT SOCKET

DELETED

DELETED

NOTE :
1. ALL DIMENSIONS ARE IN mm.
2. ALL ELEVATIONS ARE VIEWED FROM OUTSIDE.
3. ALL DIMENSIONS TO BE VERIFIED ON SITE BEFORE FABRICATION.

LEGEND :
- X1 / X00 – DETAIL MARK NO. / REFER SHEET NO.
- 1. F.F.L. – FINISHED FLOOR LEVEL
- 2. S.F.L. – STRUCTURAL FLOOR LEVEL
- 3. /R – REVERSED DETAIL

NO.	DATE	REVISED	BY
G	18/08/22	REVISED AS PER COMMENTS	LS
F	26/07/22	REVISED AS PER COMMENTS	LS
E	26/05/22	REVISED AS PER COMMENTS	LS
D	06/04/22	REVISED AS PER COMMENTS	LS
C	22/01/22	REVISED AS PER COMMENTS	LS
B	20/12/21	REVISED AS PER COMMENTS	LS
A	03/12/21	REVISED AS PER COMMENTS	LS

JOB NO. : J-85B

PROJECT :
PROPOSED RESIDENTIAL DEVELOPMENT AT TKOTL 70RP, PHASE 11, LOHAS PARK TSEUNG KWAN O, N.T.

TITLE :
TYPICAL FLOOR PARTIAL ELEVATION & SECTION, PLAN FOR CURTAIN WALL (TOWER 2)

DATE : 20-OCT-21 | SCALE : 1:50(A1)
DRAWN BY : | CHECKED BY :
DWG NO. : J85B-CW-PE206 | REV. : G

美特鋁業有限公司 MIDI ALUMINUM FABRICATOR LTD.
Units 6-8, Sunroy Industrial Centre, 1/F
610 Cha Kwo Ling Road, Kowloon
Tel:2348211-4 Fax:(852)27727666

CLIENT : 信和置業有限公司 Sino Land Company Limited


ARCHITECT : ronald lu & partners Architects Planners Interior Designers 呂元祥建築師事務所(香港)有限公司 Ronald Lu & Partners (HK) Ltd.

MAIN CONTRACTOR : Gammon

STRUCTURAL ENGINEER : AECOM

FACADE CONSULTANT : AECOM

B.D. REF :

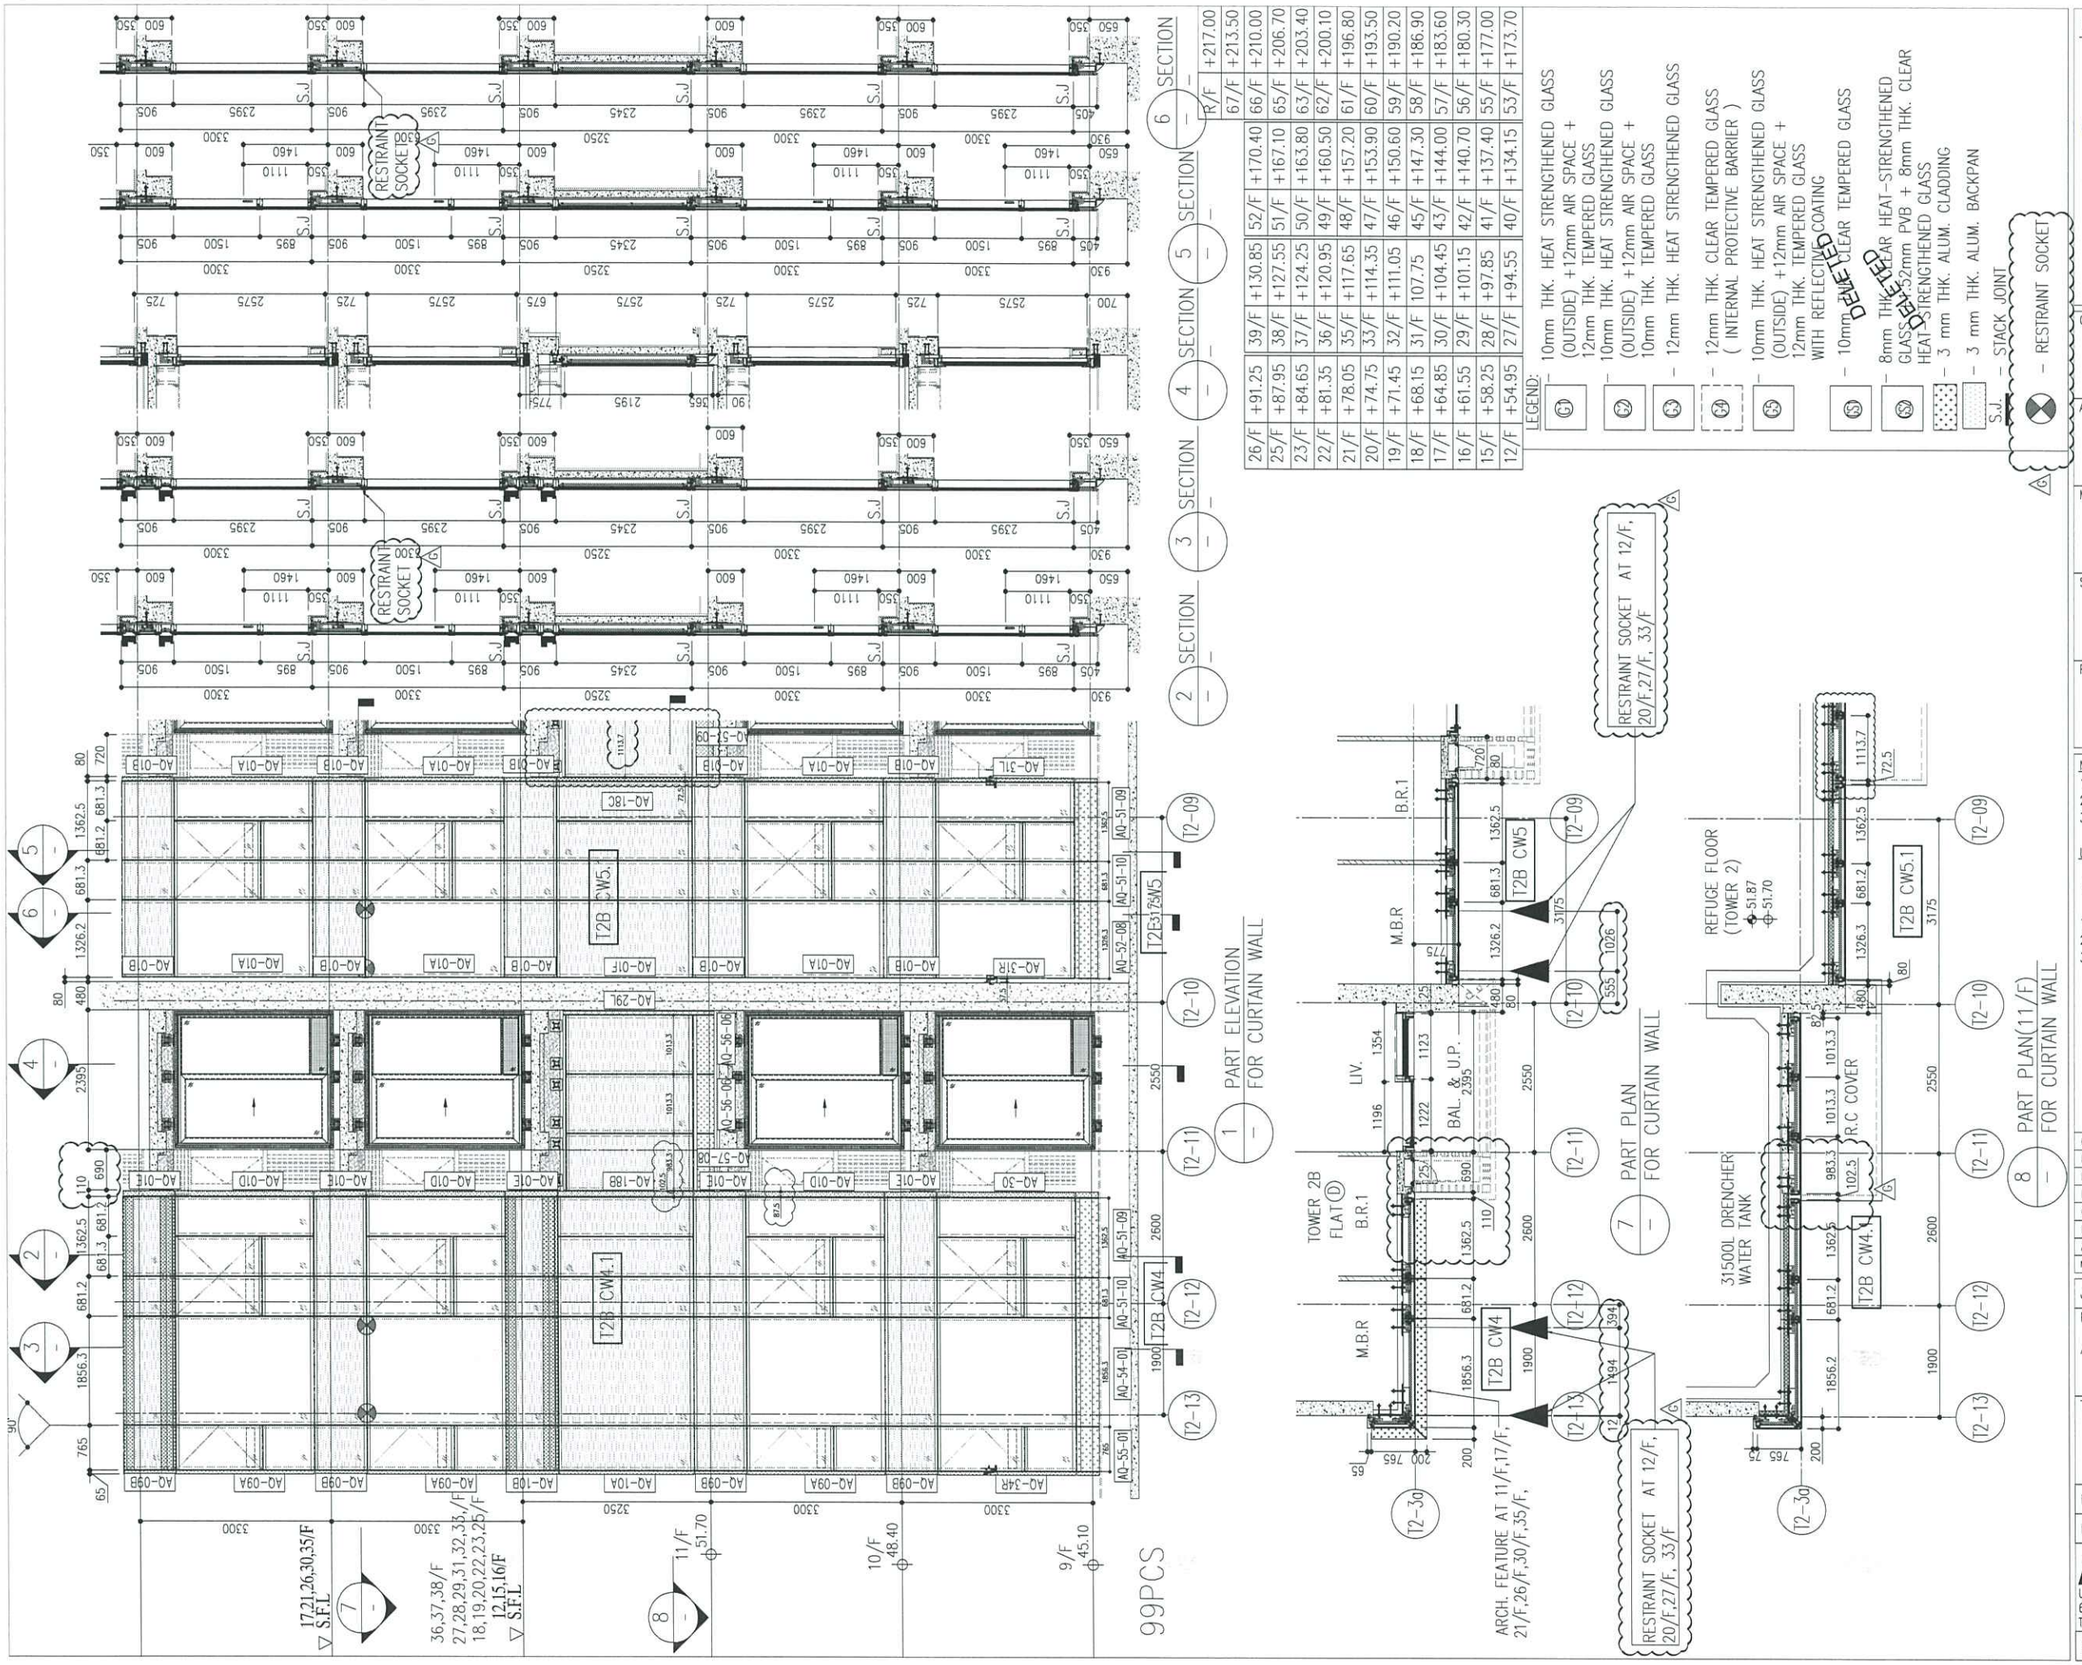

B.D. REF :

T2B

CLIENT :
信和置業有限公司
Sino Land Company Limited

ARCHITECT :
ronald lu & partners
Architects Planners Interior Designers
Ronald Lu & Partners (HK) Ltd.
呂元祥建築師事務所(香港)有限公司

MAIN CONTRACTOR :
Gammon

STRUCTURAL ENGINEER :
AECOM

FACADE CONSULTANT:
AECOM

NOTE :
1. ALL DIMENSIONS ARE IN mm.
2. ALL ELEVATIONS ARE VIEWED FROM OUTSIDE.
3. ALL DIMENSIONS TO BE VERIFIED ON SITE BEFORE FABRICATION.

LEGEND :
X1 — DETAIL MARK NO.
X001 — REFER SHEET NO.

1. F.F.L. --FINISHED FLOOR LEVEL
2. S.F.L. --STRUCTURAL FLOOR LEVEL
3. /R --REVERSED DETAIL

NO.	DATE	REVISED	BY
G	18/08/22	REVISED AS PER COMMENTS	LS
F	26/07/22	REVISED AS PER COMMENTS	LS
E	26/05/22	REVISED AS PER COMMENTS	LS
D	06/04/22	REVISED AS PER COMMENTS	LS
C	22/01/22	REVISED AS PER COMMENTS	LS
B	20/12/21	REVISED AS PER COMMENTS	LS
A	03/12/21	REVISED AS PER COMMENTS	LS

JOB NO. : J-858

PROJECT :
PROPOSED RESIDENTIAL DEVELOPMENT AT TKOTL 70RP, PHASE 11, LOHAS PARK TSEUNG KWAN O, N.T.

TITLE :
TYPICAL FLOOR PARTIAL ELEVATION & SECTION, PLAN FOR CURTAIN WALL (TOWER 2)

DATE : 20-OCT-21 | SCALE : 1:50(A1)

DRAWN BY : | CHECKED BY :

美特鋁製有限公司
MIDI ALUMINIUM FABRICATOR LTD.
Units 6-8, Sunray Industrial Centre, 1/F
610 Cha Kwo Ling Road, Kowloon
Tel:23489211-4 Fax:(852)27727666

DWG NO. : J858-CW-PE207 | REV. : G

B.D. REF :

CLIENT : 信和置業有限公司 Sino Land Company Limited

ARCHITECT : Ronald Lu & Partners (HK) Ltd. 呂元祥建築師事務所(香港)有限公司

MAIN CONTRACTOR : Gammon

STRUCTURAL ENGINEER : AECOM

FACADE CONSULTANT : AECOM

NOTE :
1. ALL DIMENSIONS ARE IN mm.
2. ALL ELEVATIONS ARE VIEWED FROM OUTSIDE.
3. ALL DIMENSIONS TO BE VERIFIED ON SITE BEFORE FABRICATION.

LEGEND :
- X1 (X001) — DETAIL MARK NO. / REFER SHEET NO.
1. F.F.L. —FINISHED FLOOR LEVEL
2. S.F.L. —STRUCTURAL FLOOR LEVEL
3. (R) —REVERSED DETAIL

NO.	DATE	REVISED	BY
G	18/08/22	REVISED AS PER COMMENTS	LS
F	26/07/22	REVISED AS PER COMMENTS	LS
E	28/05/22	REVISED AS PER COMMENTS	LS
D	06/04/22	REVISED AS PER COMMENTS	LS
C	22/01/22	REVISED AS PER COMMENTS	LS
B	20/12/21	REVISED AS PER COMMENTS	LS
A	03/12/21	REVISED AS PER COMMENTS	LS

JOB NO. : J-858

PROJECT : PROPOSED RESIDENTIAL DEVELOPMENT AT TKOTL 70RP, PHASE 11, LOHAS PARK TSEUNG KWAN O, N.T.

TITLE : TYPICAL FLOOR PARTIAL ELEVATION & SECTION, PLAN FOR CURTAIN WALL (TOWER 2)

DATE : 20-OCT-21 | SCALE : 1:50(A1)

DRAWN BY : | CHECKED BY :

美特鋁質有限公司 MIDI ALUMINIUM FABRICATOR LTD.
Units 6-8, Sunray Industrial Centre, 1/F
610 Cha Kwo Ling Road, Kowloon
Tel:23489211-4 Fax:(852)27727666

DWG NO. : J858-CW-PE208 | REV. : G

24

7B/7A

E6/E5

1 PART ELEVATION FOR CURTAIN WALL

6 PART PLAN(11/F) FOR CURTAIN WALL

5 PART PLAN FOR CURTAIN WALL

REFUGE FLOOR (TOWER 2) +51.87 +51.70

RESTRAINT SOCKET AT 12/F, 20/F,27/F, 33/F

T2B CW6

T2B CW6.1

R.C COVER

TOWER 2A FLAT G | TOWER 2B FLAT F | TOWER 2B FLAT E

M.B.R | B.R.1 | LIV. | BAL. & U.P.

12-04 | 12-05 | 12-06 | 12-07 | 12-08 | 12-09 | 12-3a

9/F +45.10
10/F +48.40
11/F +51.70

17,21,26,30,35/F ▽ S.F.L.
36,37,38/F 27,28,29,31,32,33,/F 18,19,20,22,23,25/F 12,15,16/F ▽ S.F.L

4 PE201


SECTION 2 | SECTION 3 | SECTION 4

RESTRAINT SOCKET


S.J.

R/F	+217.00					
67/F	+213.50					
26/F	+91.25	39/F	+130.85	52/F	+170.40	66/F +210.00
25/F	+87.95	38/F	+127.55	51/F	+167.10	65/F +206.70
23/F	+84.65	37/F	+124.25	50/F	+163.80	63/F +203.40
22/F	+81.35	36/F	+120.95	49/F	+160.50	62/F +200.10
21/F	+78.05	35/F	+117.65	48/F	+157.20	61/F +196.80
20/F	+74.75	33/F	+114.35	47/F	+153.90	60/F +193.50
19/F	+71.45	32/F	+111.05	46/F	+150.60	59/F +190.20
18/F	+68.15	31/F	107.75	45/F	+147.30	58/F +186.90
17/F	+64.85	30/F	+104.45	43/F	+144.00	57/F +183.60
16/F	+61.55	29/F	+101.15	42/F	+140.70	56/F +180.30
15/F	+58.25	28/F	+97.85	41/F	+137.40	55/F +177.00
12/F	+54.95	27/F	+94.55	40/F	+134.15	53/F +173.70

LEGEND:
- 10mm THK. HEAT STRENGTHENED GLASS (OUTSIDE) +12mm AIR SPACE + 12mm THK. TEMPERED GLASS
- 10mm THK. HEAT STRENGTHENED GLASS (OUTSIDE) +12mm AIR SPACE + 10mm THK. TEMPERED GLASS
- 12mm THK. HEAT STRENGTHENED GLASS
- 12mm THK. CLEAR TEMPERED GLASS (INTERNAL PROTECTIVE BARRIER)
- 10mm THK. HEAT STRENGTHENED GLASS (OUTSIDE) +12mm AIR SPACE + 12mm THK. TEMPERED GLASS WITH REFLECTIVE COATING
- 10mm THK. CLEAR TEMPERED GLASS
- 8mm THK. CLEAR HEAT-STRENGTHENED GLASS, 52mm PVB + 8mm THK. CLEAR HEAT-STRENGTHENED GLASS
- 3 mm THK. ALUM. CLADDING
- 3 mm THK. ALUM. BACKPAN
- STACK JOINT
- RESTRAINT SOCKET

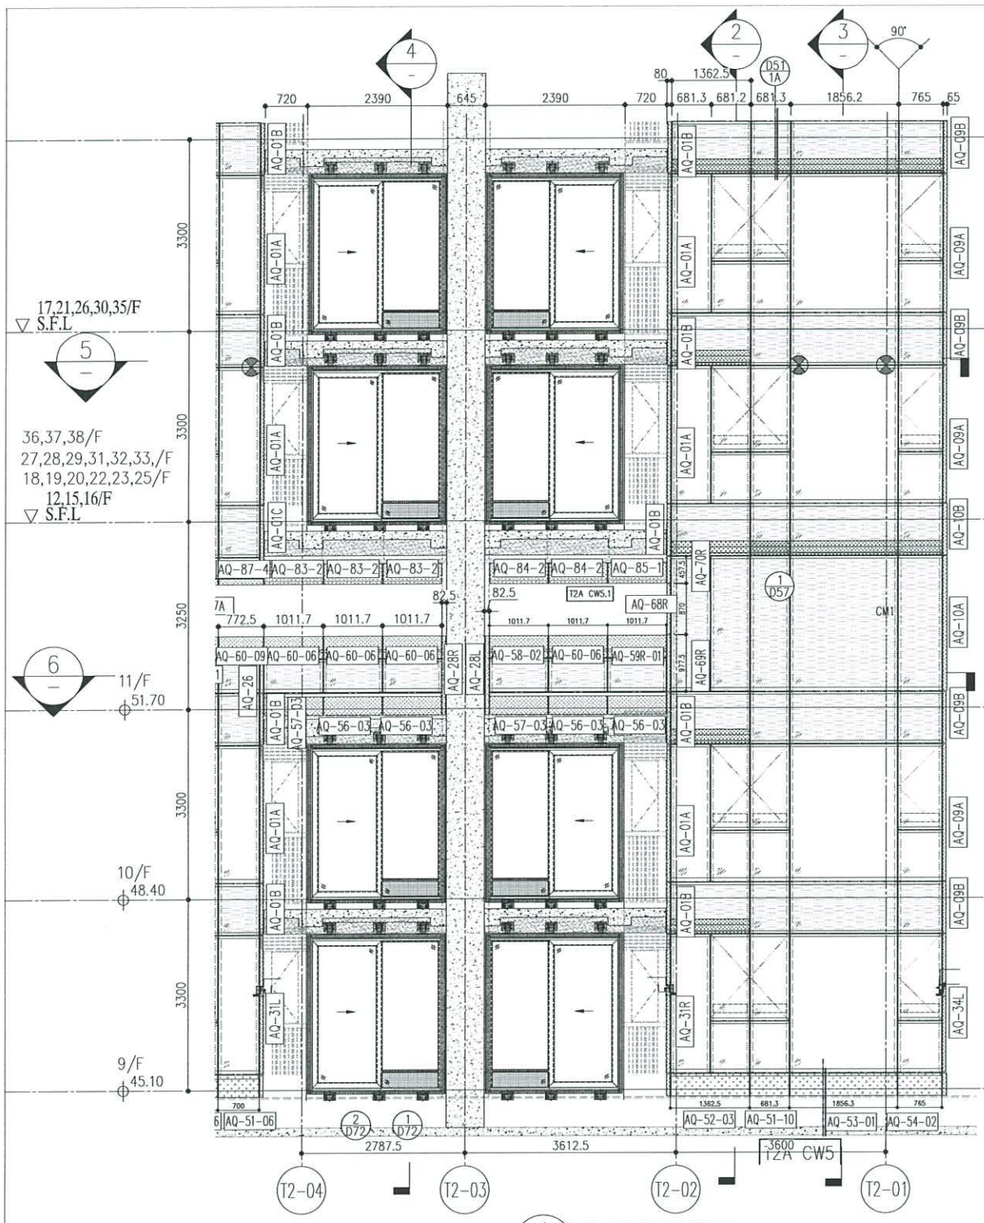

1 PART ELEVATION FOR CURTAIN WALL

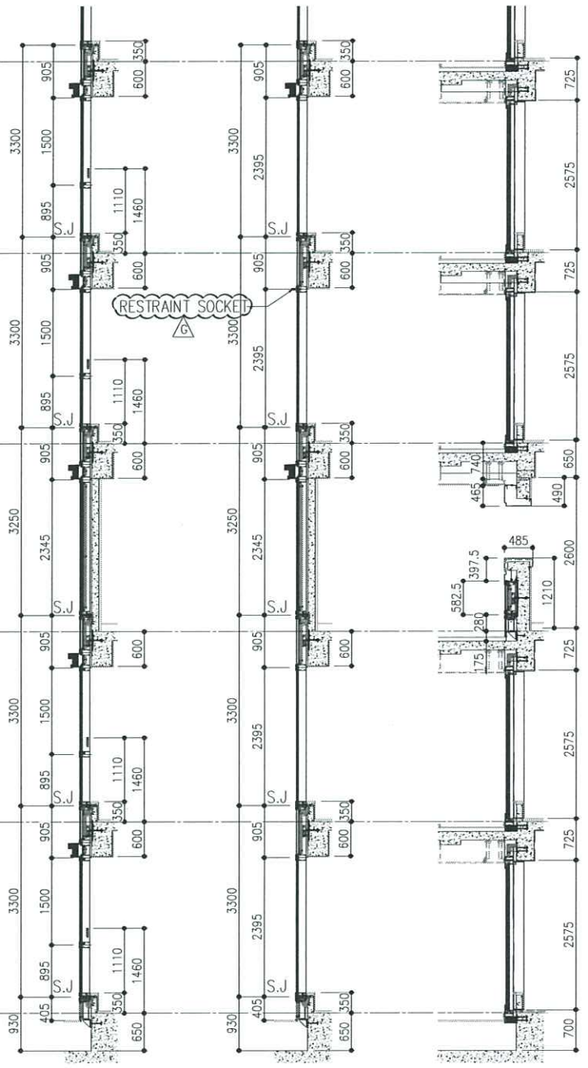


2 SECTION


3 SECTION

4 SECTION

						R/F	+217.00
						67/F	+213.50
26/F	+91.25	39/F	+130.85	52/F	+170.40	66/F	+210.00
25/F	+87.95	38/F	+127.55	51/F	+167.10	65/F	+206.70
23/F	+84.65	37/F	+124.25	50/F	+163.80	63/F	+203.40
22/F	+81.35	36/F	+120.95	49/F	+160.50	62/F	+200.10
21/F	+78.05	35/F	+117.65	48/F	+157.20	61/F	+196.80
20/F	+74.75	33/F	+114.35	47/F	+153.90	60/F	+193.50
19/F	+71.45	32/F	+111.05	46/F	+150.60	59/F	+190.20
18/F	+68.15	31/F	107.75	45/F	+147.30	58/F	+186.90
17/F	+64.85	30/F	+104.45	43/F	+144.00	57/F	+183.60
16/F	+61.55	29/F	+101.15	42/F	+140.70	56/F	+180.30
15/F	+58.25	28/F	+97.85	41/F	+137.40	55/F	+177.00
12/F	+54.95	27/F	+94.55	40/F	+134.15	53/F	+173.70

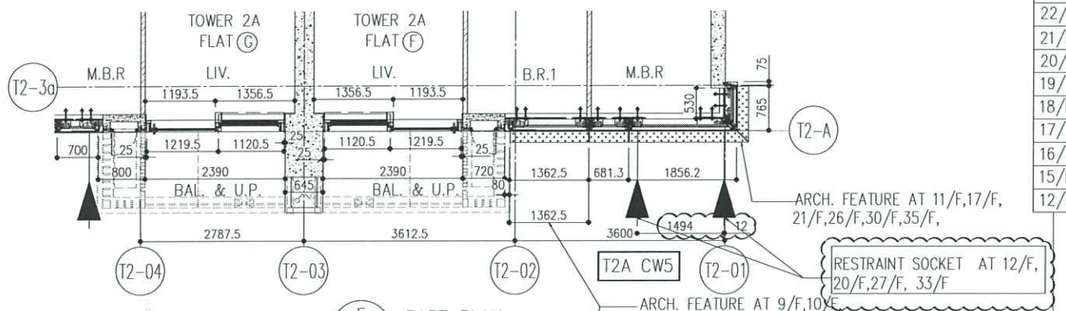

5 PART PLAN FOR CURTAIN WALL

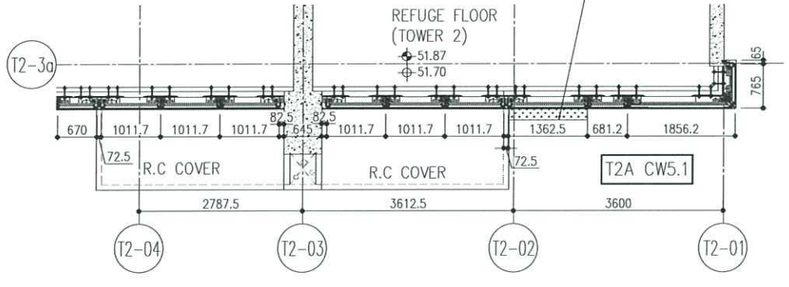

6 PART PLAN(11/F) FOR CURTAIN WALL

LEGEND:

- G1 – 10mm THK. HEAT STRENGTHENED GLASS (OUTSIDE) +12mm AIR SPACE + 12mm THK. TEMPERED GLASS
- G2 – 10mm THK. HEAT STRENGTHENED GLASS (OUTSIDE) +12mm AIR SPACE + 10mm THK. TEMPERED GLASS
- G3 – 12mm THK. HEAT STRENGTHENED GLASS
- G4 – 12mm THK. CLEAR TEMPERED GLASS (INTERNAL PROTECTIVE BARRIER)
- G5 – 10mm THK. HEAT STRENGTHENED GLASS (OUTSIDE) +12mm AIR SPACE + 12mm THK. TEMPERED GLASS WITH REFLECTIVE COATING
- G6 – 10mm THK. CLEAR TEMPERED GLASS DELETED
- G7 – 8mm THK. CLEAR HEAT-STRENGTHENED GLASS +1.52mm PVB + 8mm THK. CLEAR HEAT-STRENGTHENED GLASS DELETED
- 3 mm THK. ALUM. CLADDING
- 3 mm THK. ALUM. BACKPAN
- S.J. – STACK JOINT
- G – RESTRAINT SOCKET

NOTE:
1. ALL DIMENSIONS ARE IN mm.
2. ALL ELEVATIONS ARE VIEWED FROM OUTSIDE.
3. ALL DIMENSIONS TO BE VERIFIED ON SITE BEFORE FABRICATION.

LEGEND:
- X1 (X001) — DETAIL MARK NO. / REFER SHEET NO.
- 1. F.F.L. --FINISHED FLOOR LEVEL
- 2. S.F.L. --STRUCTURAL FLOOR LEVEL
- 3. (R) --REVERSED DETAIL

NO.	DATE	REVISED	BY
G	18/08/22	REVISED AS PER COMMENTS	LS
F	26/07/22	REVISED AS PER COMMENTS	LS
E	26/05/22	REVISED AS PER COMMENTS	LS
D	06/04/22	REVISED AS PER COMMENTS	LS
C	22/01/22	REVISED AS PER COMMENTS	LS
B	20/12/21	REVISED AS PER COMMENTS	LS
A	03/12/21	REVISED AS PER COMMENTS	LS

JOB NO. : J-858

PROJECT : PROPOSED RESIDENTIAL DEVELOPMENT AT TKOTL 70RP, PHASE 11, LOHAS PARK TSEUNG KWAN O, N.T.

TITLE : TYPICAL FLOOR PARTIAL ELEVATION & SECTION, PLAN FOR CURTAIN WALL (TOWER 2)

DATE : 20-OCT-21 | SCALE : 1:50(A1)

DRAWN BY : | CHECKED BY :

DWG NO. : J858-CW-PE209 | REV. : G

美特鋁製有限公司 MIDI ALUMINUM FABRICATOR LTD.
Units 6-8, Sunray Industrial Centre, 1/F
610 Cha Kwo Ling Road, Kowloon
Tel:23489211-4 Fax:(852)27727666

FACADE CONSULTANT: AECOM

STRUCTURAL ENGINEER: Gammon / AECOM


MAIN CONTRACTOR:

ARCHITECT: ronald lu & partners / Ronald Lu & Partners (HK) Ltd. 呂元祥建築師事務所(香港)有限公司

CLIENT: 信和置業有限公司 Sino Land Company Limited


B.D. REF :

T2A G E

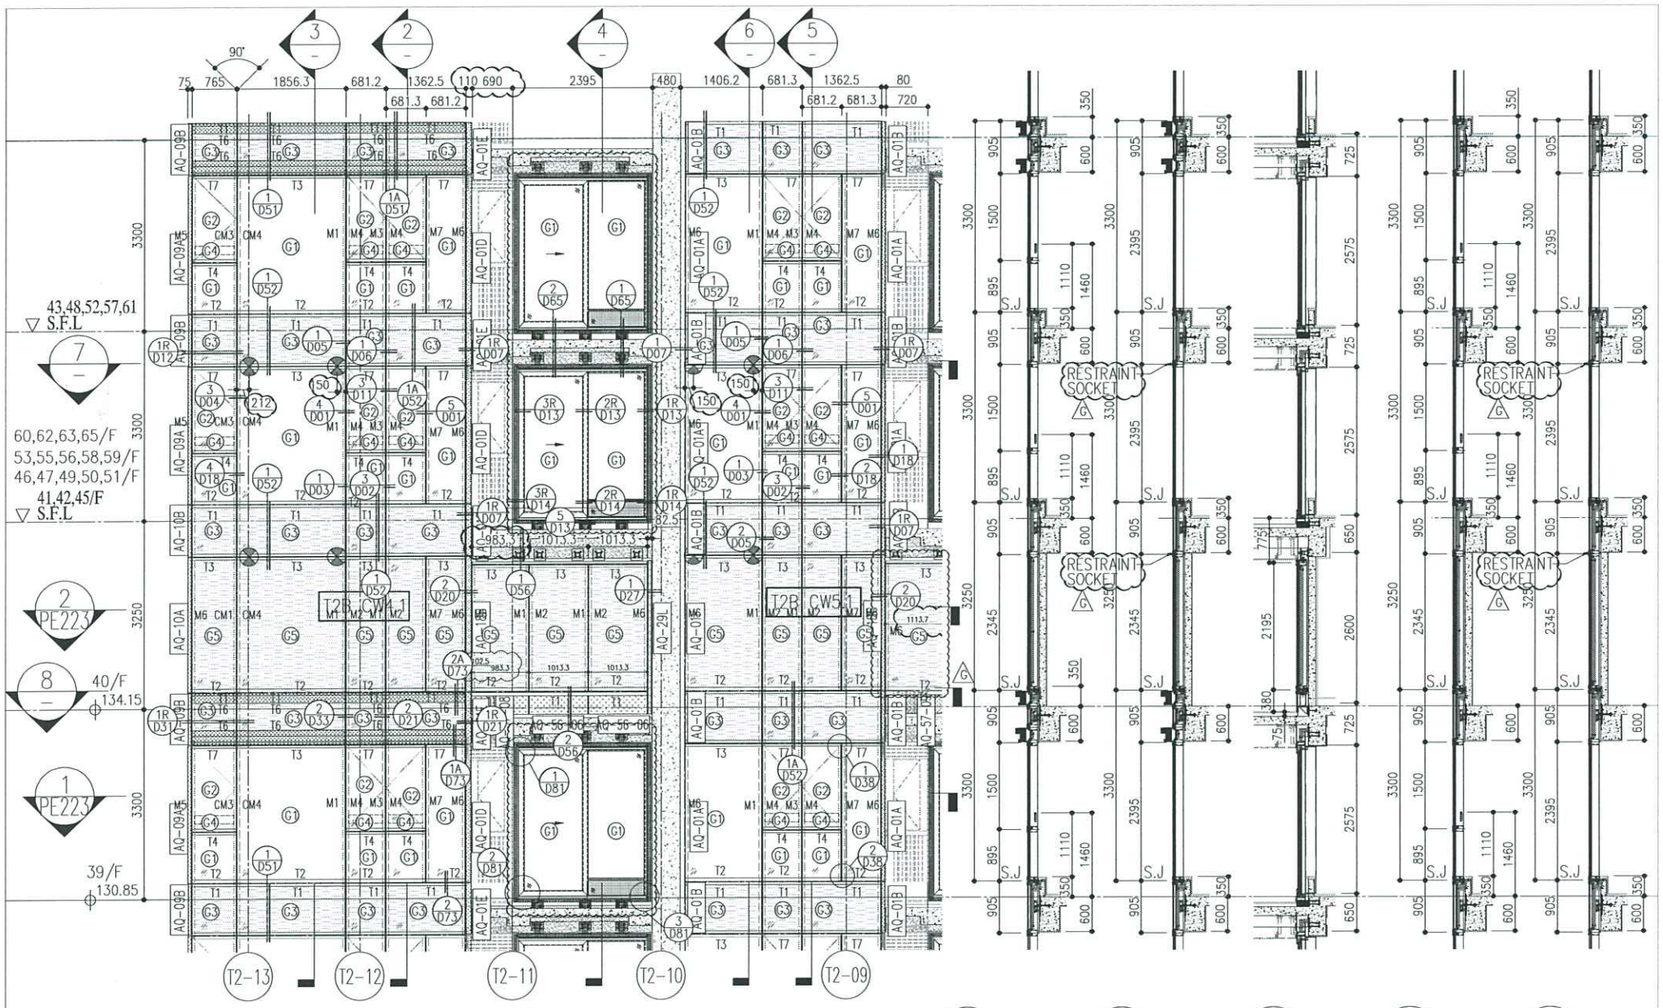

1 PART ELEVATION FOR CURTAIN WALL

2 SECTION — 3 SECTION — 4 SECTION — 5 SECTION — 6 SECTION

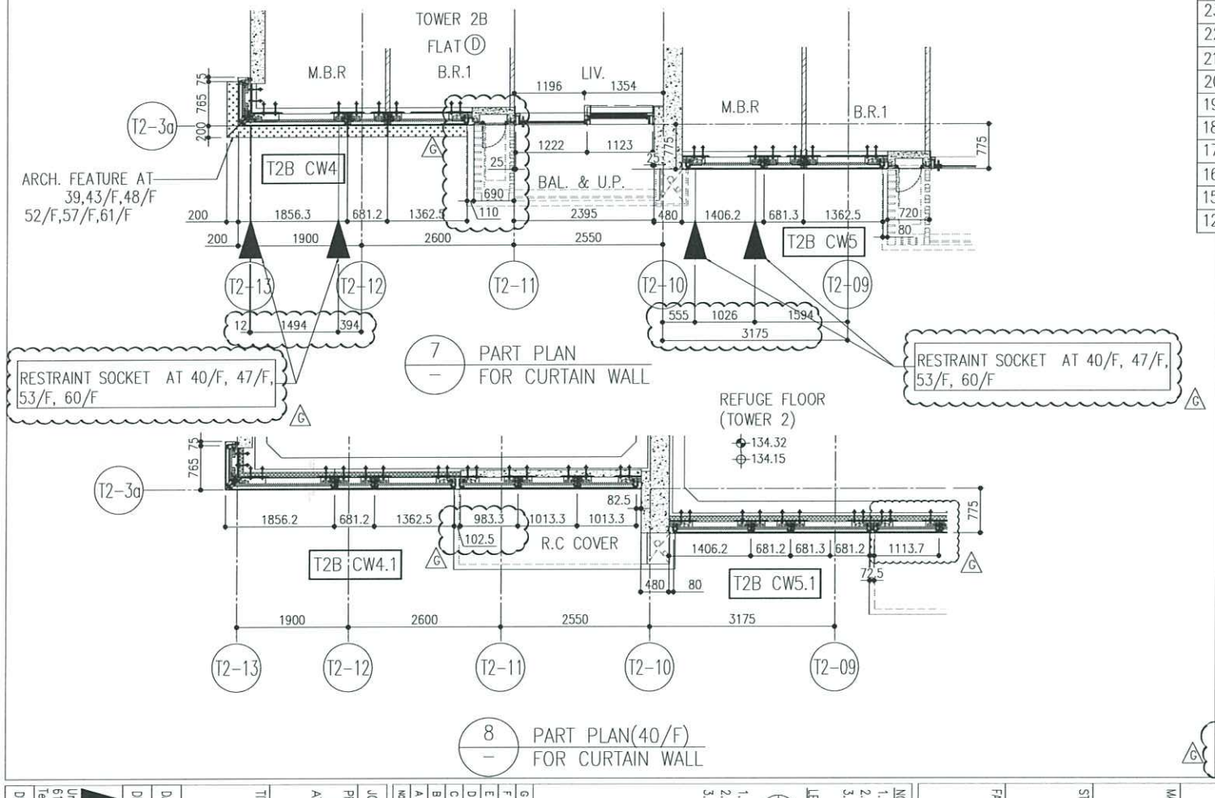

7 PART PLAN FOR CURTAIN WALL

8 PART PLAN(40/F) FOR CURTAIN WALL

						R/F	+217.00
						67/F	+213.50
26/F	+91.25	39/F	+130.85	52/F	+170.40	66/F	+210.00
25/F	+87.95	38/F	+127.55	51/F	+167.10	65/F	+206.70
23/F	+84.65	37/F	+124.25	50/F	+163.80	63/F	+203.40
22/F	+81.35	36/F	+120.95	49/F	+160.50	62/F	+200.10
21/F	+78.05	35/F	+117.65	48/F	+157.20	61/F	+196.80
20/F	+74.75	33/F	+114.35	47/F	+153.90	60/F	+193.50
19/F	+71.45	32/F	+111.05	46/F	+150.60	59/F	+190.20
18/F	+68.15	31/F	107.75	45/F	+147.30	58/F	+186.90
17/F	+64.85	30/F	+104.45	43/F	+144.00	57/F	+183.60
16/F	+61.55	29/F	+101.15	42/F	+140.70	56/F	+180.30
15/F	+58.25	28/F	+97.85	41/F	+137.40	55/F	+177.00
12/F	+54.95	27/F	+94.55	40/F	+134.15	53/F	+173.70

LEGEND:

- G1 – 10mm THK. HEAT STRENGTHENED GLASS (OUTSIDE) +12mm AIR SPACE + 12mm THK. TEMPERED GLASS
- G2 – 10mm THK. HEAT STRENGTHENED GLASS (OUTSIDE) +12mm AIR SPACE + 10mm THK. TEMPERED GLASS
- G3 – 12mm THK. HEAT STRENGTHENED GLASS
- G4 – 12mm THK. CLEAR TEMPERED GLASS (INTERNAL PROTECTIVE BARRIER)
- G5 – 10mm THK. HEAT STRENGTHENED GLASS (OUTSIDE) +12mm AIR SPACE + 12mm THK. TEMPERED GLASS WITH REFLECTIVE COATING
- S1 – 10mm THK. CLEAR TEMPERED GLASS
- S3 – 8mm THK. CLEAR HEAT-STRENGTHENED GLASS + 1.52mm PVB + 8mm THK. CLEAR HEAT-STRENGTHENED GLASS
- 3 mm THK. ALUM. CLADDING
- 3 mm THK. ALUM. BACKPAN
- S.J. – STACK JOINT
- G – RESTRAINT SOCKET

DELETED
DELETED

NOTE:
1. ALL DIMENSIONS ARE IN mm.
2. ALL ELEVATIONS ARE VIEWED FROM OUTSIDE.
3. ALL DIMENSIONS TO BE VERIFIED ON SITE BEFORE FABRICATION.

LEGEND:
- X1 (X00) — DETAIL MARK NO. / REFER SHEET NO.
1. F.F.L. --FINISHED FLOOR LEVEL
2. S.F.L. --STRUCTURAL FLOOR LEVEL
3. (R) --REVERSED DETAIL

NO.	DATE	REVISED	BY
G	18/08/22	REVISED AS PER COMMENTS	LS
F	26/07/22	REVISED AS PER COMMENTS	LS
E	26/05/22	REVISED AS PER COMMENTS	LS
D	06/04/22	REVISED AS PER COMMENTS	LS
C	22/01/22	REVISED AS PER COMMENTS	LS
B	20/12/21	REVISED AS PER COMMENTS	LS
A	03/12/21	REVISED AS PER COMMENTS	LS

JOB NO. : J-858

PROJECT : PROPOSED RESIDENTIAL DEVELOPMENT AT TKOTL 70RP, PHASE 11, LOHAS PARK TSEUNG KWAN O, N.T.

TITLE : TYPICAL FLOOR PARTIAL ELEVATION & SECTION, PLAN FOR CURTAIN WALL (TOWER 2)

DATE : 20-OCT-21 | SCALE : 1:50(A1)

DRAWN BY : | CHECKED BY :

美特鋁製有限公司 MIDI ALUMINIUM FABRICATOR LTD.
Units 6-8, Sunray Industrial Centre, 1/F
610 Cha Kwo Ling Road, Kowloon
Tel:23489211-4 Fax:(852)27726666

DWG NO. : J858-CW-PE210 | REV. : G

FACADE CONSULTANT: AECOM


STRUCTURAL ENGINEER : AECOM

MAIN CONTRACTOR : Gammon

ARCHITECT : ronald lu & partners (Architects Planners Interior Designers) Ronald Lu & Partners (HK) Ltd. 呂元祥建築師事務所(香港)有限公司

CLIENT : 信和置業有限公司 Sino Land Company Limited

B.D. REF :

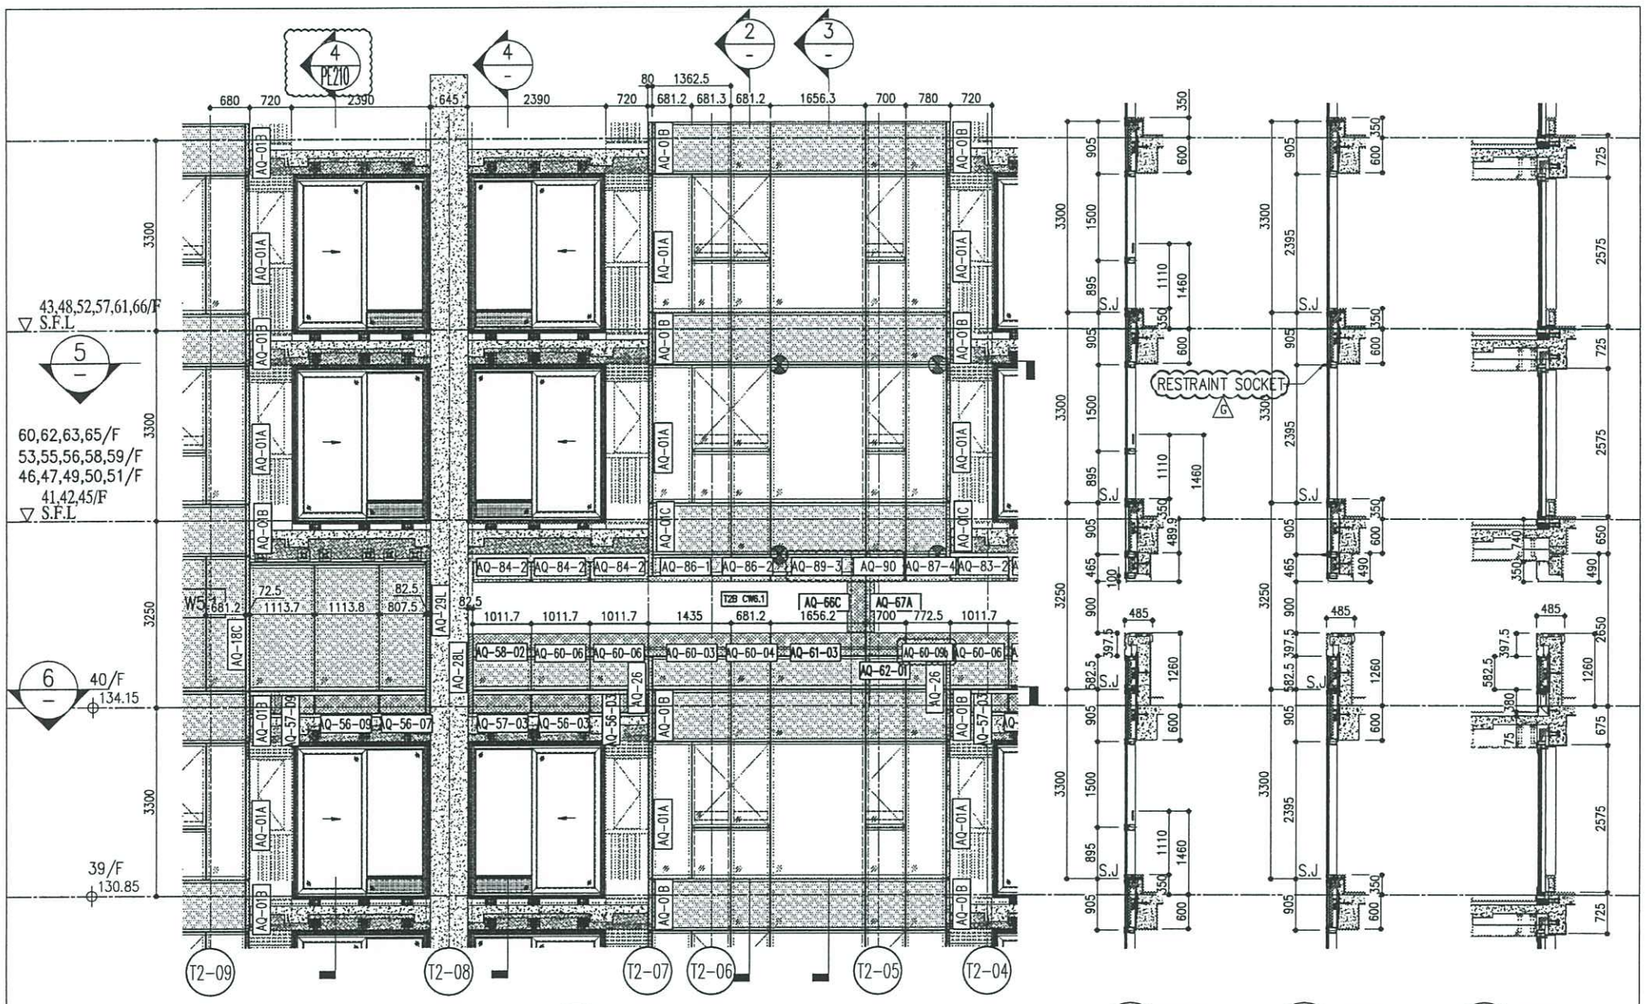


1 PART ELEVATION FOR CURTAIN WALL


2 SECTION

3 SECTION

4 SECTION

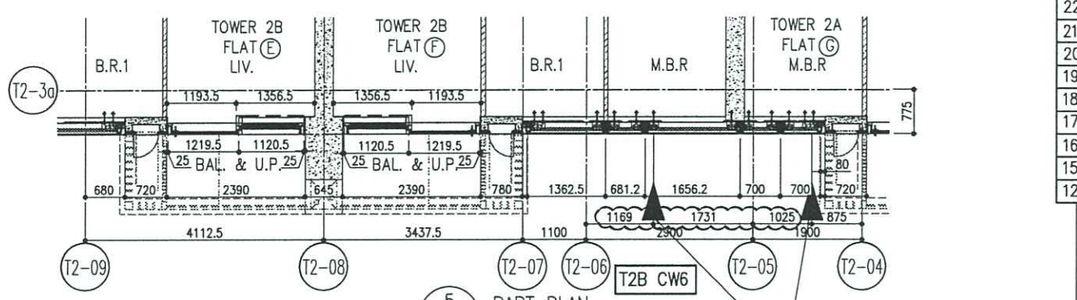

5 PART PLAN FOR CURTAIN WALL

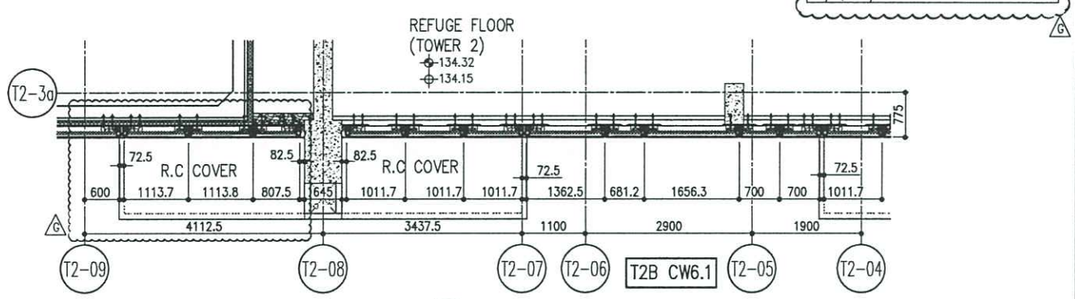

6 PART PLAN(40/F) FOR CURTAIN WALL

						R/F	+217.00
						67/F	+213.50
26/F	+91.25	39/F	+130.85	52/F	+170.40	66/F	+210.00
25/F	+87.95	38/F	+127.55	51/F	+167.10	65/F	+206.70
23/F	+84.65	37/F	+124.25	50/F	+163.80	63/F	+203.40
22/F	+81.35	36/F	+120.95	49/F	+160.50	62/F	+200.10
21/F	+78.05	35/F	+117.65	48/F	+157.20	61/F	+196.80
20/F	+74.75	33/F	+114.35	47/F	+153.90	60/F	+193.50
19/F	+71.45	32/F	+111.05	46/F	+150.60	59/F	+190.20
18/F	+68.15	31/F	107.75	45/F	+147.30	58/F	+186.90
17/F	+64.85	30/F	+104.45	43/F	+144.00	57/F	+183.60
16/F	+61.55	29/F	+101.15	42/F	+140.70	56/F	+180.30
15/F	+58.25	28/F	+97.85	41/F	+137.40	55/F	+177.00
12/F	+54.95	27/F	+94.55	40/F	+134.15	53/F	+173.70

LEGEND:

- (G1) – 10mm THK. HEAT STRENGTHENED GLASS (OUTSIDE) +12mm AIR SPACE + 12mm THK. TEMPERED GLASS
- (G2) – 10mm THK. HEAT STRENGTHENED GLASS (OUTSIDE) +12mm AIR SPACE + 10mm THK. TEMPERED GLASS
- (G3) – 12mm THK. HEAT STRENGTHENED GLASS
- (G4) – 12mm THK. CLEAR TEMPERED GLASS (INTERNAL PROTECTIVE BARRIER)
- (G5) – 10mm THK. HEAT STRENGTHENED GLASS (OUTSIDE) +12mm AIR SPACE + 12mm THK. TEMPERED GLASS WITH REFLECTIVE COATING
- (G6) – 10mm THK. CLEAR TEMPERED GLASS DELETED
- (G7) – 8mm THK. CLEAR HEAT-STRENGTHENED GLASS+1.52mm PVB + 8mm THK. CLEAR HEAT-STRENGTHENED GLASS DELETED
- 3 mm THK. ALUM. CLADDING
- 3 mm THK. ALUM. BACKPAN
- S.J. – STACK JOINT
- (G) – RESTRAINT SOCKET

NOTE :
1. ALL DIMENSIONS ARE IN mm.
2. ALL ELEVATIONS ARE VIEWED FROM OUTSIDE.
3. ALL DIMENSIONS TO BE VERIFIED ON SITE BEFORE FABRICATION.

LEGEND :
- (A1 / 3080) — DETAIL MARK NO. / REFER SHEET NO.
- F.F.L. — FINISHED FLOOR LEVEL
- S.F.L. — STRUCTURAL FLOOR LEVEL
- (/R) — REVERSED DETAIL

NO.	DATE	REMKED	BY
G	18/08/22	REMKED AS PER COMMENTS	LS
F	26/07/22	REMKED AS PER COMMENTS	LS
E	26/05/22	REMKED AS PER COMMENTS	LS
D	06/04/22	REMKED AS PER COMMENTS	LS
C	22/01/22	REMKED AS PER COMMENTS	LS
B	20/12/21	REMKED AS PER COMMENTS	LS
A	03/12/21	REMKED AS PER COMMENTS	LS

JOB NO. : J-858

PROJECT : PROPOSED RESIDENTIAL DEVELOPMENT AT TKOTL 70RP, PHASE 11, LOHAS PARK TSEUNG KWAN O, N.T.

TITLE : TYPICAL FLOOR PARTIAL ELEVATION & SECTION, PLAN FOR CURTAIN WALL (TOWER 2)

DATE : 20-OCT-21 | SCALE : 1:50(A1)

DRAWN BY : | CHECKED BY :

DWG NO. : J858-CW-PE211 | REV. : G

美特鋁質有限公司 MIDI ALUMINIUM FABRICATOR LTD.
Units 6-8, Sunray Industrial Centre, 1/F
610 Cha Kwo Ling Road, Kowloon
Tel:23489211-4 Fax:(852)27727666

CLIENT : 信和置業有限公司 Sino Land Company Limited


ARCHITECT : ronald lu & partners 呂元祥建築師事務所(香港)有限公司 Ronald Lu & Partners (HK) Ltd.

MAIN CONTRACTOR : Gammon


STRUCTURAL ENGINEER : AECOM

FACADE CONSULTANT : AECOM

B.D. REF :

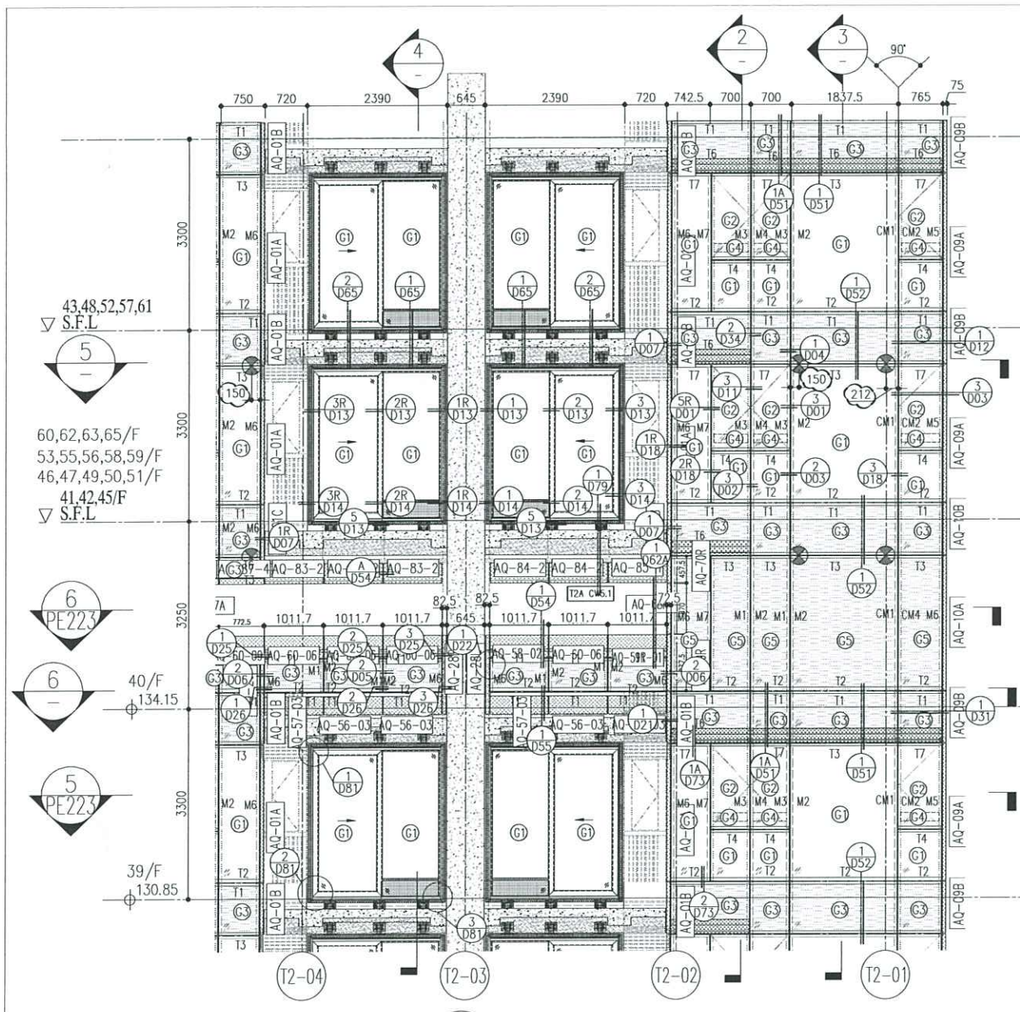


1 PART ELEVATION FOR CURTAIN WALL

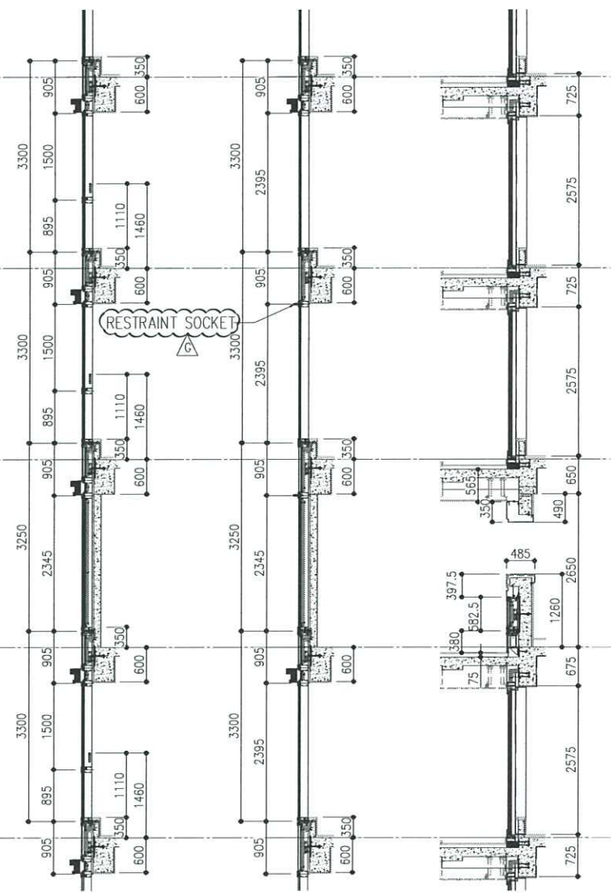

2 SECTION

3 SECTION

4 SECTION

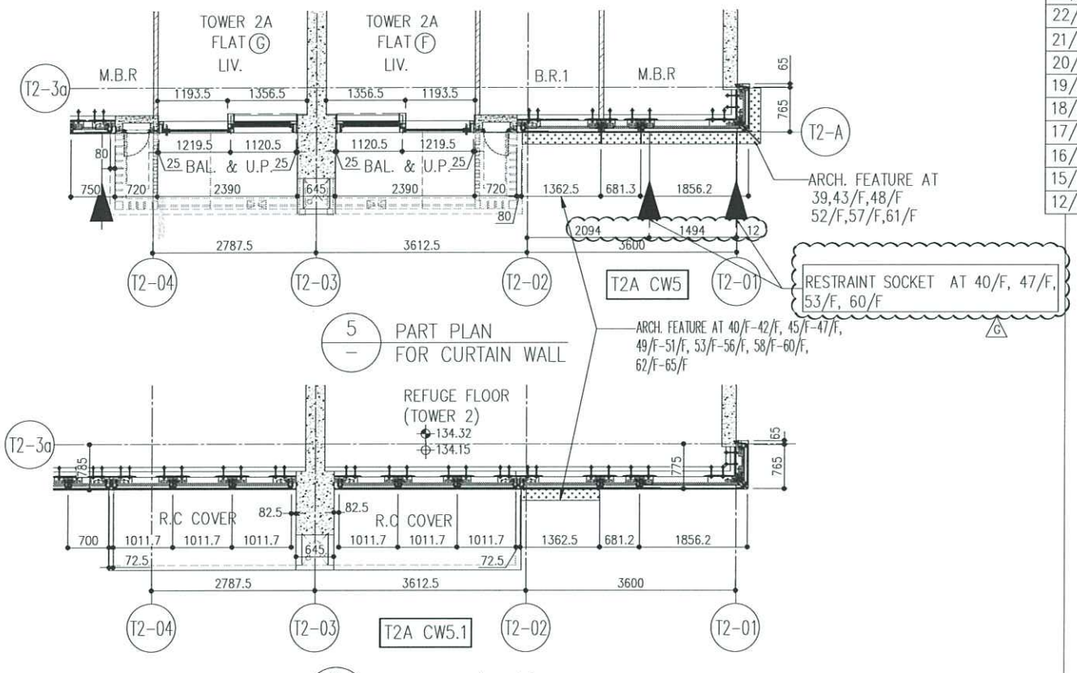

5 PART PLAN FOR CURTAIN WALL

6 PART PLAN(40/F) FOR CURTAIN WALL

						R/F	+217.00
						67/F	+213.50
26/F	+91.25	39/F	+130.85	52/F	+170.40	66/F	+210.00
25/F	+87.95	38/F	+127.55	51/F	+167.10	65/F	+206.70
23/F	+84.65	37/F	+124.25	50/F	+163.80	63/F	+203.40
22/F	+81.35	36/F	+120.95	49/F	+160.50	62/F	+200.10
21/F	+78.05	35/F	+117.65	48/F	+157.20	61/F	+196.80
20/F	+74.75	33/F	+114.35	47/F	+153.90	60/F	+193.50
19/F	+71.45	32/F	+111.05	46/F	+150.60	59/F	+190.20
18/F	+68.15	31/F	107.75	45/F	+147.30	58/F	+186.90
17/F	+64.85	30/F	+104.45	43/F	+144.00	57/F	+183.60
16/F	+61.55	29/F	+101.15	42/F	+140.70	56/F	+180.30
15/F	+58.25	28/F	+97.85	41/F	+137.40	55/F	+177.00
12/F	+54.95	27/F	+94.55	40/F	+134.15	53/F	+173.70

LEGEND:

- G1 – 10mm THK. HEAT STRENGTHENED GLASS (OUTSIDE) +12mm AIR SPACE + 12mm THK. TEMPERED GLASS
- G2 – 10mm THK. HEAT STRENGTHENED GLASS (OUTSIDE) +12mm AIR SPACE + 10mm THK. TEMPERED GLASS
- G3 – 12mm THK. HEAT STRENGTHENED GLASS
- G4 – 12mm THK. CLEAR TEMPERED GLASS (INTERNAL PROTECTIVE BARRIER)
- G5 – 10mm THK. HEAT STRENGTHENED GLASS (OUTSIDE) +12mm AIR SPACE + 12mm THK. TEMPERED GLASS WITH REFLECTIVE COATING
- G6 – 10mm THK. CLEAR TEMPERED GLASS
- G7 – 8mm THK. CLEAR HEAT-STRENGTHENED GLASS + 1.52mm PVB + 8mm THK. CLEAR HEAT-STRENGTHENED GLASS
- 3 mm THK. ALUM. CLADDING
- 3 mm THK. ALUM. BACKPAN
- S.J. – STACK JOINT
- G – RESTRAINT SOCKET

DELETED
DELETED

NOTE:
1. ALL DIMENSIONS ARE IN mm.
2. ALL ELEVATIONS ARE VIEWED FROM OUTSIDE.
3. ALL DIMENSIONS TO BE VERIFIED ON SITE BEFORE FABRICATION.

LEGEND:
- X1 / X001 – DETAIL MARK NO. / REFER SHEET NO.
1. F.F.L. --FINISHED FLOOR LEVEL
2. S.F.L. --STRUCTURAL FLOOR LEVEL
3. (R) --REVERSED DETAIL

NO.	DATE	REVISED	BY
G	18/08/22	REVISED AS PER COMMENTS	LS
F	28/07/22	REVISED AS PER COMMENTS	LS
E	26/05/22	REVISED AS PER COMMENTS	LS
D	06/04/22	REVISED AS PER COMMENTS	LS
C	22/01/22	REVISED AS PER COMMENTS	LS
B	20/12/21	REVISED AS PER COMMENTS	LS
A	03/12/21	REVISED AS PER COMMENTS	LS

JOB NO. : J-85B

PROJECT :
PROPOSED RESIDENTIAL DEVELOPMENT AT TKOTL 70RP, PHASE 11, LOHAS PARK TSEUNG KWAN O, N.T.

TITLE :
TYPICAL FLOOR PARTIAL ELEVATION & SECTION, PLAN FOR CURTAIN WALL (TOWER 2)

DATE : 20-OCT-21 | SCALE : 1:50(A1)

DRAWN BY : | CHECKED BY :

美特鋁廠有限公司 MIDI ALUMINIUM FABRICATOR LTD.
Units 6-8, Sunray Industrial Centre, 1/F,
610 Cha Kwo Ling Road, Kowloon
Tel:23489211-4 Fax:(852)27727666

DWG NO. : J858-CW-PE212 | REV. : G

B.D. REF :


CLIENT : 信和置業有限公司 Sino Land Company Limited


ARCHITECT : ronald lu & partners (HK) Ltd. 呂元祥建築師事務所(香港)有限公司


MAIN CONTRACTOR : Gammon


STRUCTURAL ENGINEER : AECOM

FACADE CONSULTANT : AECOM

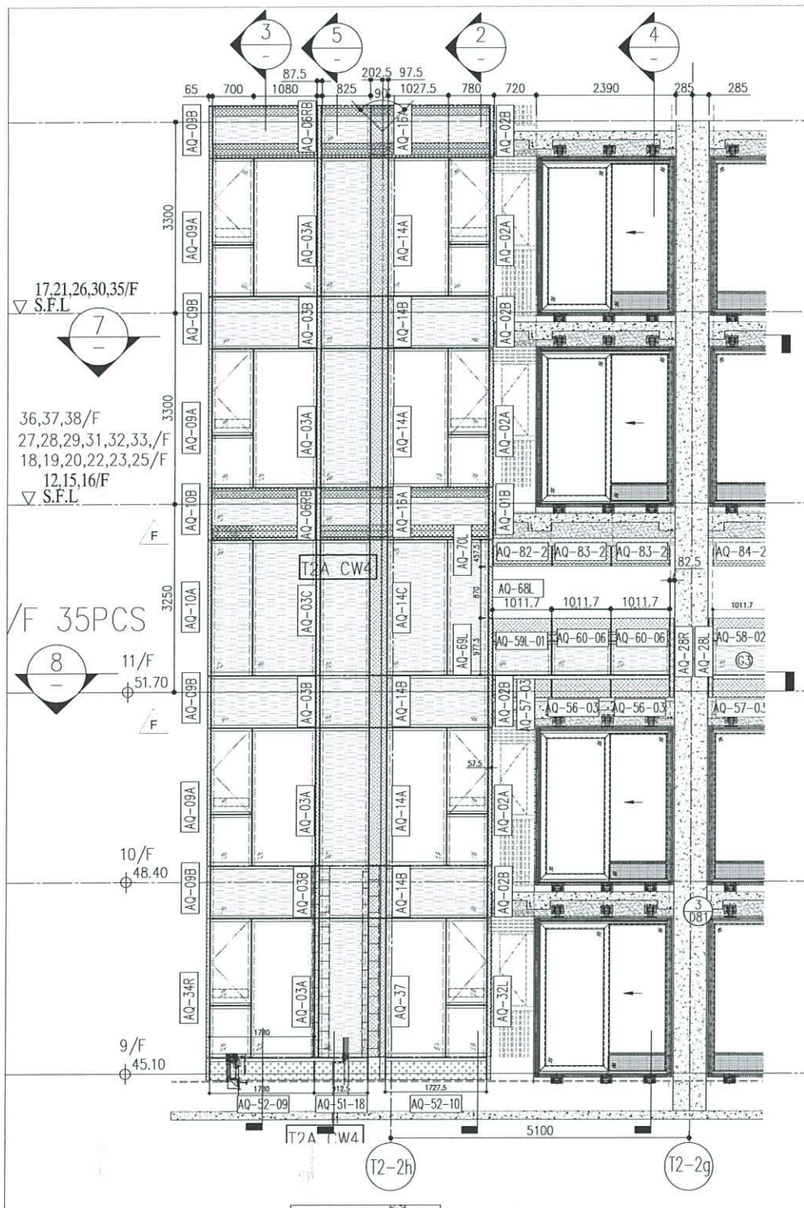

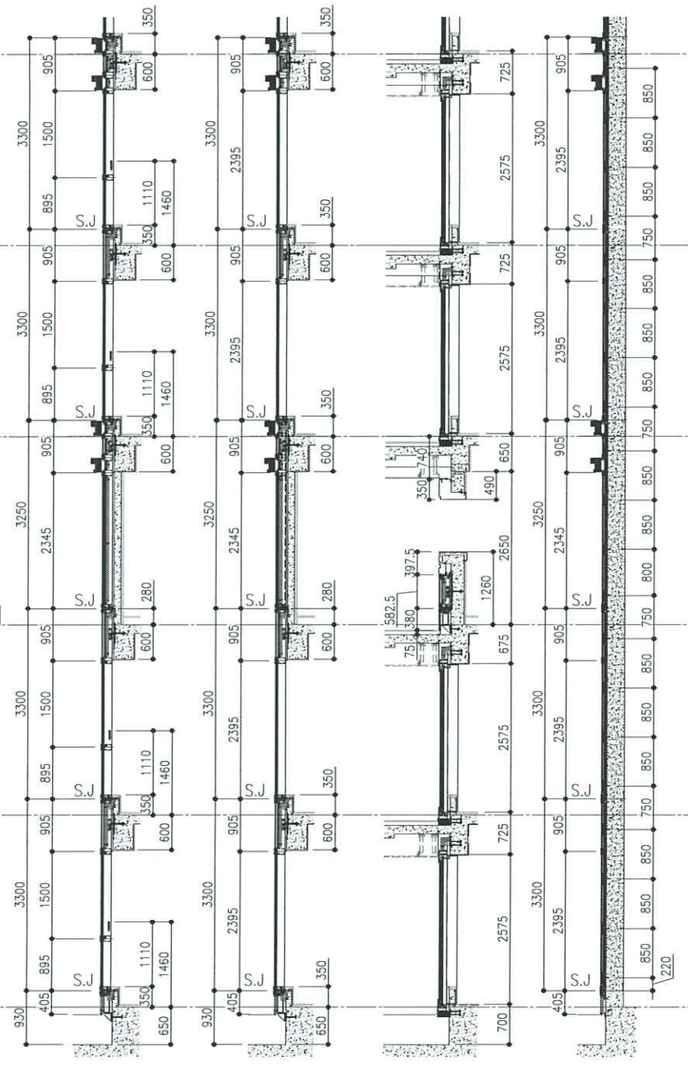

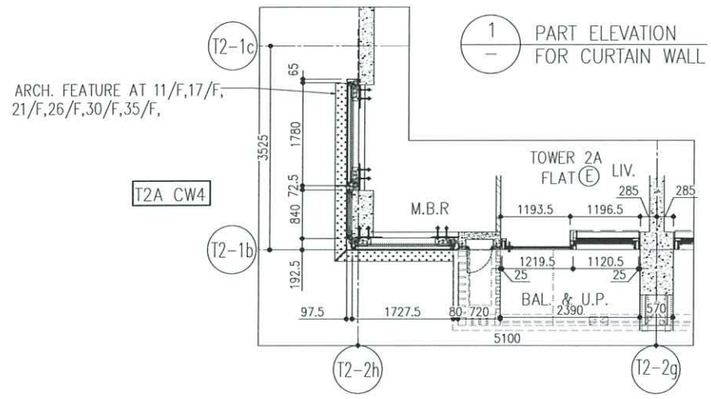

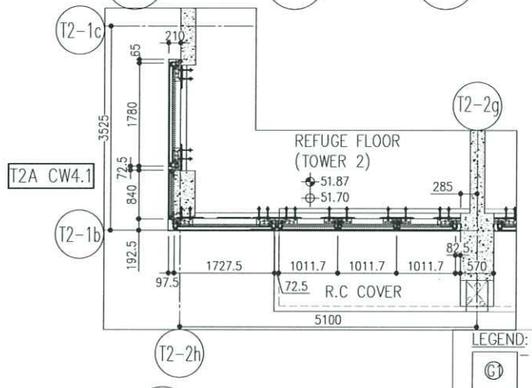

8 PART PLAN(11/F) FOR CURTAIN WALL

7 PART PLAN FOR CURTAIN WALL

						R/F	+217.00
						67/F	+213.50
26/F	+91.25	39/F	+130.85	52/F	+170.40	66/F	+210.00
25/F	+87.95	38/F	+127.55	51/F	+167.10	65/F	+206.70
23/F	+84.65	37/F	+124.25	50/F	+163.80	63/F	+203.40
22/F	+81.35	36/F	+120.95	49/F	+160.50	62/F	+200.10
21/F	+78.05	35/F	+117.65	48/F	+157.20	61/F	+196.80
20/F	+74.75	33/F	+114.35	47/F	+153.90	60/F	+193.50
19/F	+71.45	32/F	+111.05	46/F	+150.60	59/F	+190.20
18/F	+68.15	31/F	107.75	45/F	+147.30	58/F	+186.90
17/F	+64.85	30/F	+104.45	43/F	+144.00	57/F	+183.60
16/F	+61.55	29/F	+101.15	42/F	+140.70	56/F	+180.30
15/F	+58.25	28/F	+97.85	41/F	+137.40	55/F	+177.00
12/F	+54.95	27/F	+94.55	40/F	+134.15	53/F	+173.70

LEGEND:

- G1 – 10mm THK. HEAT STRENGTHENED GLASS (OUTSIDE) +12mm AIR SPACE + 12mm THK. TEMPERED GLASS
- G2 – 10mm THK. HEAT STRENGTHENED GLASS (OUTSIDE) +12mm AIR SPACE + 10mm THK. TEMPERED GLASS
- G3 – 12mm THK. HEAT STRENGTHENED GLASS
- G4 – 12mm THK. CLEAR TEMPERED GLASS (INTERNAL PROTECTIVE BARRIER)
- G5 – 10mm THK. HEAT STRENGTHENED GLASS (OUTSIDE) +12mm AIR SPACE + 12mm THK. TEMPERED GLASS WITH REFLECTIVE COATING
- S1 – 10mm THK. CLEAR TEMPERED GLASS
- S2 – 8mm THK. CLEAR HEAT-STRENGTHENED GLASS +1.52mm PVB + 8mm THK. CLEAR HEAT-STRENGTHENED GLASS
- 3 mm THK. ALUM. CLADDING
- 3 mm THK. ALUM. BACKPAN
- S.J. – STACK JOINT
- RESTRAINT SOCKET

NOTE:
1. ALL DIMENSIONS ARE IN mm.
2. ALL ELEVATIONS ARE VIEWED FROM OUTSIDE.
3. ALL DIMENSIONS TO BE VERIFIED ON SITE BEFORE FABRICATION.

LEGEND:
- (X1) / (X001) — DETAIL MARK NO. / REFER SHEET NO.
- 1. F.F.L. --FINISHED FLOOR LEVEL
- 2. S.F.L. --STRUCTURAL FLOOR LEVEL
- 3. (R) --REVERSED DETAIL

NO.	DATE	REVISED	BY
F	26/07/22	REVISED AS PER COMMENTS	LS
E	25/05/22	REVISED AS PER COMMENTS	LS
D	06/04/22	REVISED AS PER COMMENTS	LS
C	22/01/22	REVISED AS PER COMMENTS	LS
B	20/12/21	REVISED AS PER COMMENTS	LS
A	03/12/21	REVISED AS PER COMMENTS	LS

PROJECT : PROPOSED RESIDENTIAL DEVELOPMENT AT TKOTL 70RP, PHASE 11, LOHAS PARK TSEUNG KWAN O, N.T.

TITLE : TYPICAL FLOOR PARTIAL ELEVATION & SECTION, PLAN FOR CURTAIN WALL (TOWER 2)

JOB NO. : J-858

DATE : 20-OCT-21 | SCALE : 1:50(A1)

DRAWN BY : | CHECKED BY :

DWG NO. : J858-CW-PE213 | REV. : F

美特鋁廠有限公司 MIDI ALUMINIUM FABRICATOR LTD.
Units 6-8, Sunray Industrial Centre, 1/F
610 Cha Kwo Ling Road, Kowloon
Tel:23468211-4 Fax:(852)27727666

ARCHITECT : ronald lu & partners (HK) Ltd. 呂元祥建築師事務所(香港)有限公司

MAIN CONTRACTOR : Gammon

STRUCTURAL ENGINEER : AECOM


FACADE CONSULTANT : AECOM

CLIENT : 信和置業有限公司 Sino Land Company Limited

B.D. REF :

T2A (E)


29.

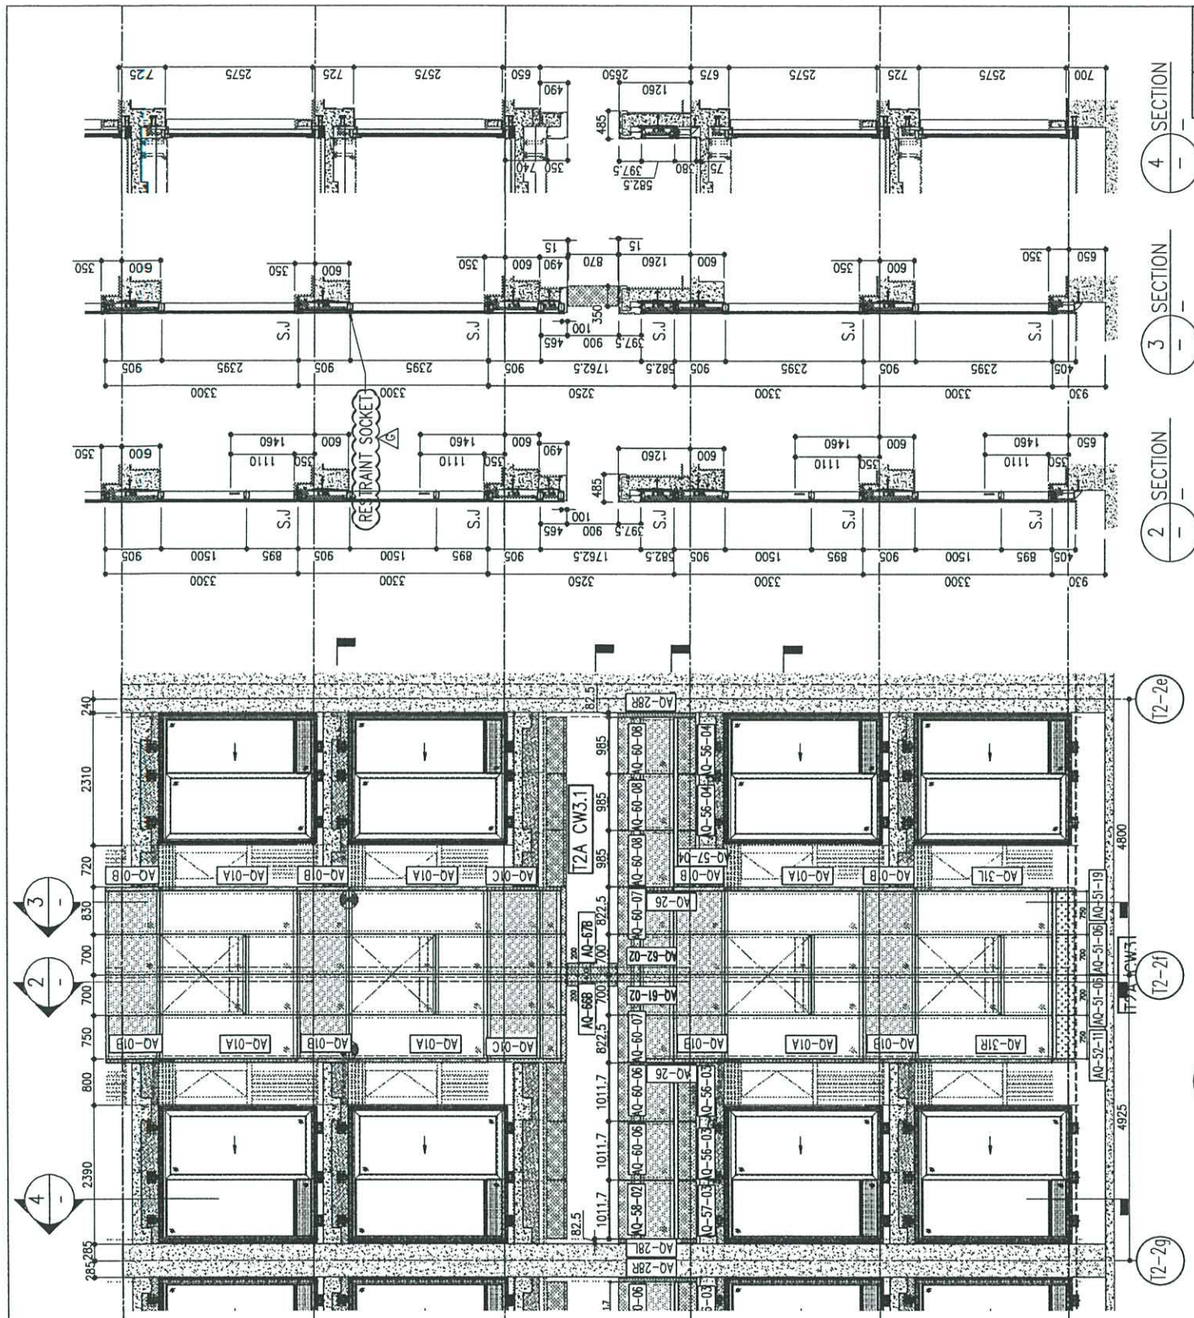


1 PART ELEVATION FOR CURTAIN WALL

4 SECTION	R/F	+217.00
	67/F	+213.50
	66/F	+210.00
	65/F	+206.70
	64/F	+203.40
	63/F	+200.10
	62/F	+196.80
	61/F	+193.50
	60/F	+190.20
	59/F	+186.90
	58/F	+183.60
	57/F	+183.60
	56/F	+180.30
	55/F	+177.00
	53/F	+173.70
3 SECTION	52/F	+170.40
	51/F	+167.10
	50/F	+163.80
	49/F	+160.50
	48/F	+157.20
	47/F	+153.90
	46/F	+150.60
	45/F	+147.30
	43/F	+144.00
	42/F	+140.70
	41/F	+137.40
	40/F	+134.15
2 SECTION	39/F	+130.85
	38/F	+127.55
	37/F	+124.25
	36/F	+120.95
	35/F	+117.65
	33/F	+114.35
	32/F	+111.05
	31/F	107.75
	30/F	+104.45
	29/F	+101.15
	28/F	+97.85
	27/F	+94.55
	26/F	+91.25
	25/F	+87.95
	23/F	+84.65
	22/F	+81.35
	21/F	+78.05
	20/F	+74.75
	19/F	+71.45
	18/F	+68.15
	17/F	+64.85
	16/F	+61.55
	15/F	+58.25
	12/F	+54.95

LEGEND:
- (G1) – 10mm THK. HEAT STRENGTHENED GLASS (OUTSIDE) +12mm AIR SPACE + 12mm THK. TEMPERED GLASS
- (G2) – 10mm THK. HEAT STRENGTHENED GLASS (OUTSIDE) +12mm AIR SPACE + 10mm THK. TEMPERED GLASS
- (G3) – 12mm THK. HEAT STRENGTHENED GLASS
- (G4) – 12mm THK. CLEAR TEMPERED GLASS (INTERNAL PROTECTIVE BARRIER)
- (G5) – 10mm THK. HEAT STRENGTHENED GLASS (OUTSIDE) +12mm AIR SPACE + 12mm THK. TEMPERED GLASS WITH REFLECTIVE COATING
- (G6) – 10mm THK. CLEAR TEMPERED GLASS
- (G7) – 8mm THK. CLEAR HEAT-STRENGTHENED GLASS +1.52mm PVB + 8mm THK. CLEAR HEAT-STRENGTHENED GLASS
- 3 mm THK. ALUM. CLADDING
- 3 mm THK. ALUM. BACKPAN
- S.J. = STACK JOINT
- RESTRAINT SOCKET

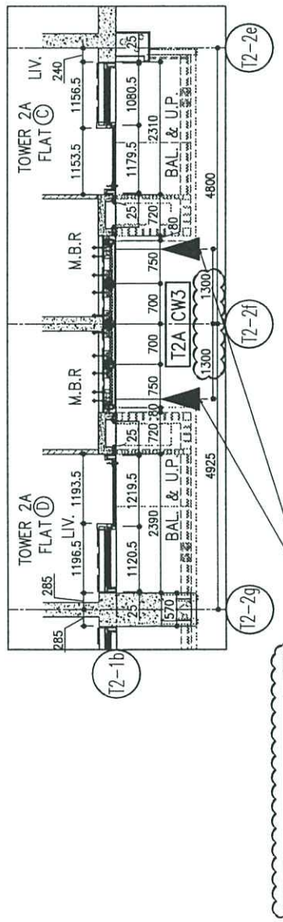

5 PART PLAN FOR CURTAIN WALL

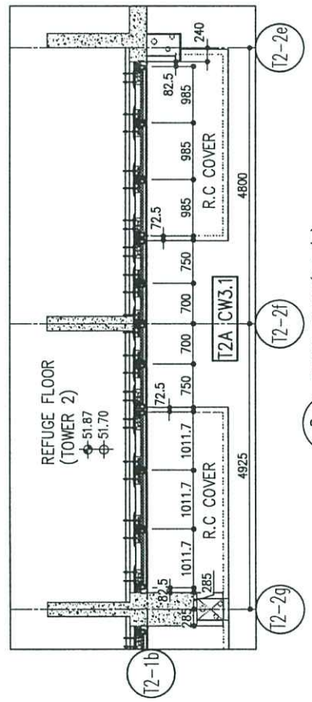

6 PART PLAN(11/F) FOR CURTAIN WALL

B.D. REF :

7 of 9

CLIENT :
信和置業有限公司
Sino Land Company Limited

ARCHITECT :
ronald lu & partners
Architects . Planners . Interior Designers
Ronald Lu & Partners (HK) Ltd.
呂元祥建築師事務所(香港)有限公司

MAIN CONTRACTOR :
Gammon

STRUCTURAL ENGINEER :
AECOM

FACADE CONSULTANT:
AECOM

NOTE :
1. ALL DIMENSIONS ARE IN mm.
2. ALL ELEVATIONS ARE VIEWED FROM OUTSIDE.
3. ALL DIMENSIONS TO BE VERIFIED ON SITE BEFORE FABRICATION.

LEGEND :
- X1 / XOO1 – DETAIL MARK NO. / REFER SHEET NO.
1. F.F.L. --- FINISHED FLOOR LEVEL
2. S.F.L. --- STRUCTURAL FLOOR LEVEL
3. (R) --- REVERSED DETAIL

NO.	DATE	REVISED	BY
G	18/08/22	REVISED AS PER COMMENTS	LS
F	26/07/22	REVISED AS PER COMMENTS	LS
E	25/05/22	REVISED AS PER COMMENTS	LS
D	06/04/22	REVISED AS PER COMMENTS	LS
C	22/01/22	REVISED AS PER COMMENTS	LS
B	20/12/21	REVISED AS PER COMMENTS	LS
A	03/12/21	REVISED AS PER COMMENTS	LS

JOB NO. : J-858

PROJECT :
PROPOSED RESIDENTIAL DEVELOPMENT AT TKOTL 70RP, PHASE 11, LOHAS PARK TSEUNG KWAN O, N.T.

TITLE :
TYPICAL FLOOR PARTIAL ELEVATION & SECTION, PLAN FOR CURTAIN WALL (TOWER 2)


DATE : 20-OCT-21 | SCALE : 1:50(A1)


DRAWN BY : | CHECKED BY :


美特鋁質有限公司
MIDI ALUMINIUM FABRICATOR LTD.
Units 6-8, Sunray Industrial Centre, 1/F
610 Cha Kwo Ling Road, Kowloon
Tel:23489211-4 Fax:(852)27727666

DWG NO. : J858-CW-PE214 | REV. : G

30.

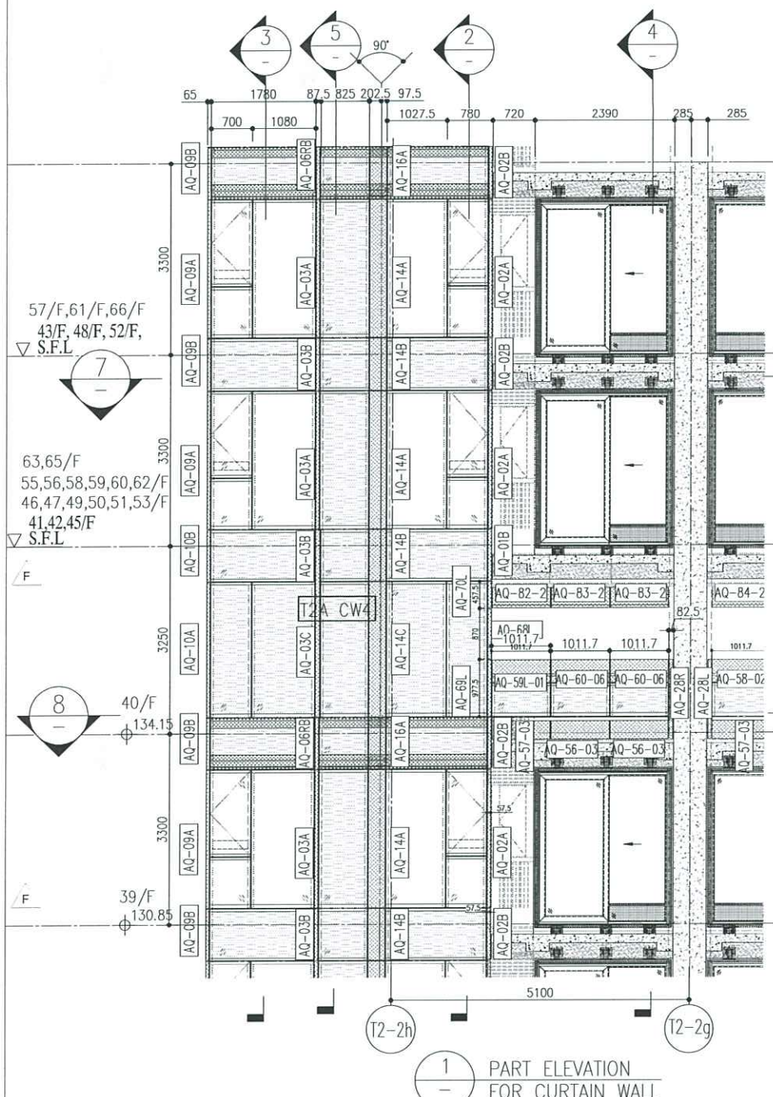

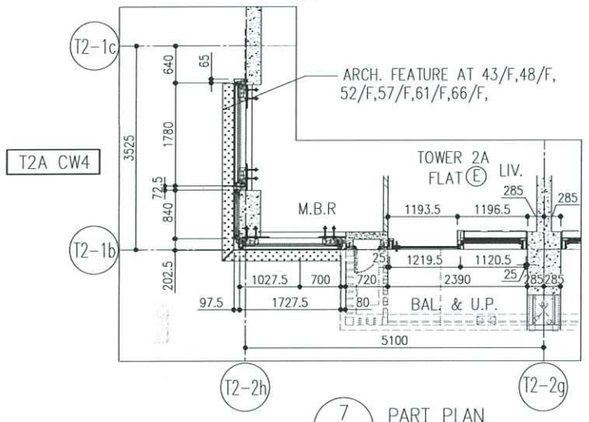

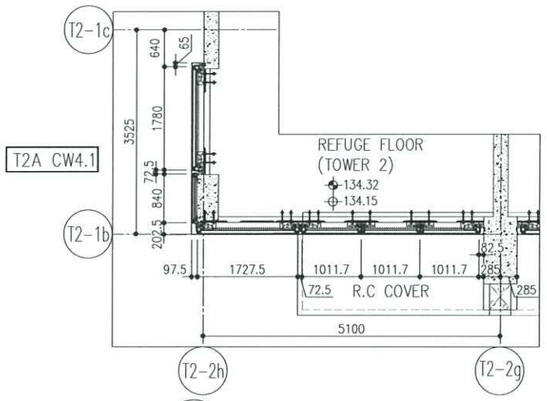

						R/F	+217.00
						67/F	+213.50
26/F	+91.25	39/F	+130.85	52/F	+170.40	66/F	+210.00
25/F	+87.95	38/F	+127.55	51/F	+167.10	65/F	+206.70
23/F	+84.65	37/F	+124.25	50/F	+163.80	63/F	+203.40
22/F	+81.35	36/F	+120.95	49/F	+160.50	62/F	+200.10
21/F	+78.05	35/F	+117.65	48/F	+157.20	61/F	+196.80
20/F	+74.75	33/F	+114.35	47/F	+153.90	60/F	+193.50
19/F	+71.45	32/F	+111.05	46/F	+150.60	59/F	+190.20
18/F	+68.15	31/F	107.75	45/F	+147.30	58/F	+186.90
17/F	+64.85	30/F	+104.45	43/F	+144.00	57/F	+183.60
16/F	+61.55	29/F	+101.15	42/F	+140.70	56/F	+180.30
15/F	+58.25	28/F	+97.85	41/F	+137.40	55/F	+177.00
12/F	+54.95	27/F	+94.55	40/F	+134.15	53/F	+173.70

LEGEND:

- G1 – 10mm THK. HEAT STRENGTHENED GLASS (OUTSIDE) +12mm AIR SPACE + 12mm THK. TEMPERED GLASS
- G2 – 10mm THK. HEAT STRENGTHENED GLASS (OUTSIDE) +12mm AIR SPACE + 10mm THK. TEMPERED GLASS
- G3 – 12mm THK. HEAT STRENGTHENED GLASS
- G4 – 12mm THK. CLEAR TEMPERED GLASS (INTERNAL PROTECTIVE BARRIER)
- G5 – 10mm THK. HEAT STRENGTHENED GLASS (OUTSIDE) +12mm AIR SPACE + 12mm THK. TEMPERED GLASS WITH REFLECTIVE COATING
- S3 – 10mm THK. CLEAR TEMPERED GLASS
- S8 – 8mm THK. CLEAR HEAT-STRENGTHENED GLASS +1.52mm PVB + 8mm THK. CLEAR HEAT-STRENGTHENED GLASS
- 3 mm THK. ALUM. CLADDING
- 3 mm THK. ALUM. BACKPAN
- S.J. – STACK JOINT
- RESTRAINT SOCKET

NOTE:
1. ALL DIMENSIONS ARE IN mm.
2. ALL ELEVATIONS ARE VIEWED FROM OUTSIDE.
3. ALL DIMENSIONS TO BE VERIFIED ON SITE BEFORE FABRICATION.

LEGEND:
- X1 / X001 – DETAIL MARK NO. / REFER SHEET NO.
- 1. F.F.L. – FINISHED FLOOR LEVEL
- 2. S.F.L. – STRUCTURAL FLOOR LEVEL
- 3. (R) – REVERSED DETAIL

NO.	DATE	REVISED	BY
F	26/07/22	REVISED AS PER COMMENTS	LS
E	25/05/22	REVISED AS PER COMMENTS	LS
D	06/04/22	REVISED AS PER COMMENTS	LS
C	22/01/22	REVISED AS PER COMMENTS	LS
B	20/12/21	REVISED AS PER COMMENTS	LS
A	03/12/21	REVISED AS PER COMMENTS	LS

JOB NO. : J-858

PROJECT :
PROPOSED RESIDENTIAL DEVELOPMENT
AT TKOTL 70RP, PHASE 11, LOHAS PARK
TSEUNG KWAN O, N.T.

TITLE :
TYPICAL FLOOR PARTIAL
ELEVATION & SECTION, PLAN
FOR CURTAIN WALL (TOWER 2)

DATE : 20-OCT-21 | SCALE : 1:50(A1)
DRAWN BY : | CHECKED BY :

美特鋁廠有限公司
MIDI ALUMINIUM FABRICATOR LTD.
Units 6-8, Sunroy Industrial Centre, 1/F
610 Cha Kwo Ling Road, Kowloon
Tel:23489211-4 Fax:(852)27727666

DWG NO. : J858-CW-PE215 | REV. : F

CLIENT : 信和置業有限公司 Sino Land Company Limited


ARCHITECT : ronald lu & partners Architects Planners Interior Designers
Ronald Lu & Partners (HK) Ltd. 呂元祥建築師事務所(香港)有限公司

MAIN CONTRACTOR : Gammon

STRUCTURAL ENGINEER : AECOM

FACADE CONSULTANT: AECOM

B.D. REF :

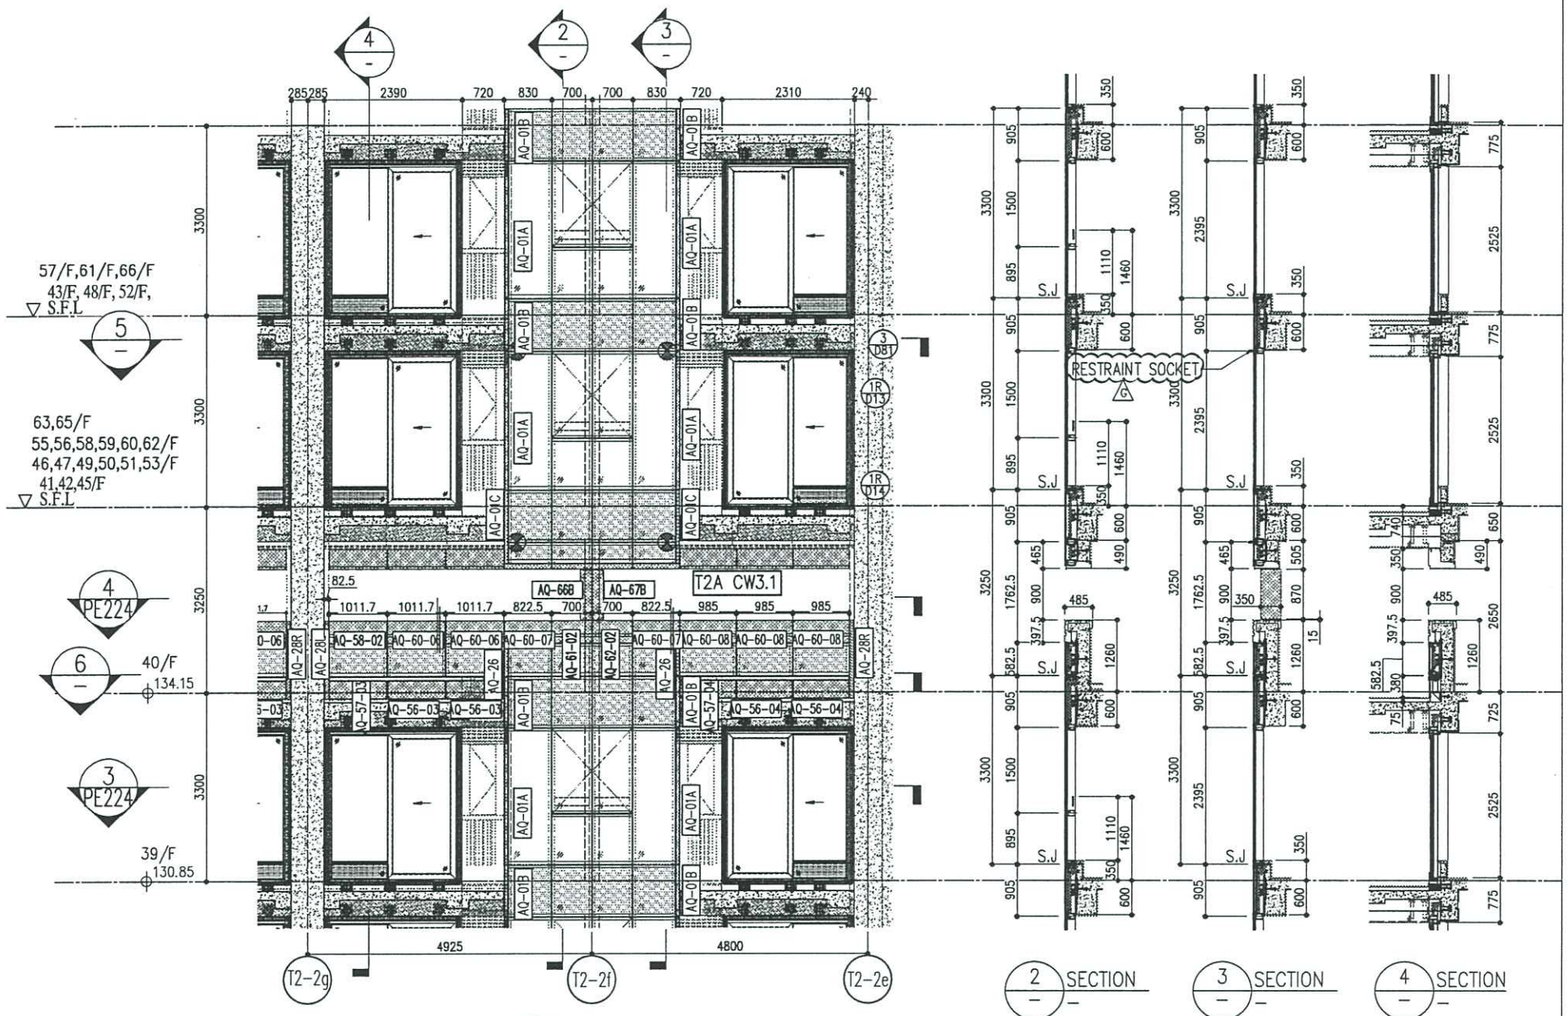


1 PART ELEVATION FOR CURTAIN WALL


2 SECTION

3 SECTION

4 SECTION

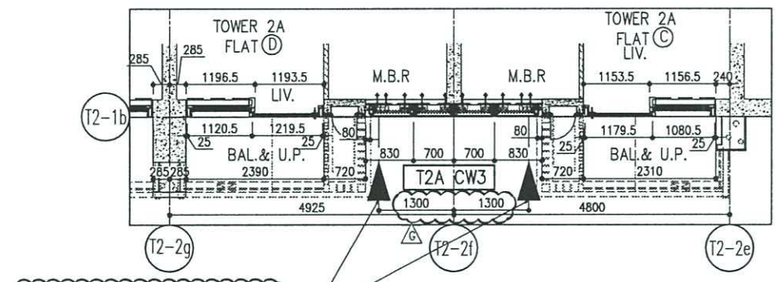

5 PART PLAN FOR CURTAIN WALL

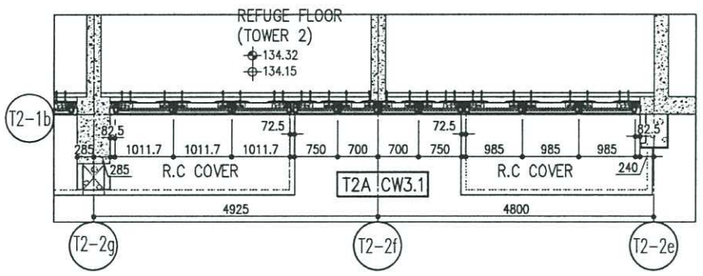

6 PART PLAN(40/F) FOR CURTAIN WALL

						R/F	+217.00
						67/F	+213.50
26/F	+91.25	39/F	+130.85	52/F	+170.40	66/F	+210.00
25/F	+87.95	38/F	+127.55	51/F	+167.10	65/F	+206.70
23/F	+84.65	37/F	+124.25	50/F	+163.80	63/F	+203.40
22/F	+81.35	36/F	+120.95	49/F	+160.50	62/F	+200.10
21/F	+78.05	35/F	+117.65	48/F	+157.20	61/F	+196.80
20/F	+74.75	33/F	+114.35	47/F	+153.90	60/F	+193.50
19/F	+71.45	32/F	+111.05	46/F	+150.60	59/F	+190.20
18/F	+68.15	31/F	107.75	45/F	+147.30	58/F	+186.90
17/F	+64.85	30/F	+104.45	43/F	+144.00	57/F	+183.60
16/F	+61.55	29/F	+101.15	42/F	+140.70	56/F	+180.30
15/F	+58.25	28/F	+97.85	41/F	+137.40	55/F	+177.00
12/F	+54.95	27/F	+94.55	40/F	+134.15	53/F	+173.70

LEGEND:

- G1 – 10mm THK. HEAT STRENGTHENED GLASS (OUTSIDE) +12mm AIR SPACE + 12mm THK. TEMPERED GLASS
- G2 – 10mm THK. HEAT STRENGTHENED GLASS (OUTSIDE) +12mm AIR SPACE + 10mm THK. TEMPERED GLASS
- G3 – 12mm THK. HEAT STRENGTHENED GLASS
- G4 – 12mm THK. CLEAR TEMPERED GLASS (INTERNAL PROTECTIVE BARRIER)
- G5 – 10mm THK. HEAT STRENGTHENED GLASS (OUTSIDE) +12mm AIR SPACE + 12mm THK. TEMPERED GLASS WITH REFLECTIVE COATING
- G6 – 10mm THK. CLEAR TEMPERED GLASS
- G7 – 8mm THK. CLEAR HEAT-STRENGTHENED GLASS +1.52mm PVB + 8mm THK. CLEAR HEAT-STRENGTHENED GLASS
- 3 mm THK. ALUM. CLADDING
- 3 mm THK. ALUM. BACKPAN
- S.J. – STACK JOINT
- G – RESTRAINT SOCKET

NOTE:
1. ALL DIMENSIONS ARE IN mm.
2. ALL ELEVATIONS ARE VIEWED FROM OUTSIDE.
3. ALL DIMENSIONS TO BE VERIFIED ON SITE BEFORE FABRICATION.

LEGEND:
- X1 (X001) — DETAIL MARK NO. / REFER SHEET NO.
1. F.F.L. --- FINISHED FLOOR LEVEL
2. S.F.L. --- STRUCTURAL FLOOR LEVEL
3. (R) --- REVERSED DETAIL

NO.	DATE	REMARKS	BY
G	18/08/22	REVISED AS PER COMMENTS	LS
F	26/07/22	REVISED AS PER COMMENTS	LS
E	25/05/22	REVISED AS PER COMMENTS	LS
D	06/04/22	REVISED AS PER COMMENTS	LS
C	22/01/22	REVISED AS PER COMMENTS	LS
B	20/12/21	REVISED AS PER COMMENTS	LS
A	03/12/21	REVISED AS PER COMMENTS	LS

JOB NO. : J-858

PROJECT :
PROPOSED RESIDENTIAL DEVELOPMENT
AT TKOTL 70RP, PHASE 11, LOHAS PARK
TSEUNG KWAN O, N.T.

TITLE :
TYPICAL FLOOR PARTIAL
ELEVATION & SECTION, PLAN
FOR CURTAIN WALL (TOWER 2)

DATE : 20-OCT-21 | SCALE : 1:50(A1)

DRAWN BY : | CHECKED BY :

美特鋁質有限公司
MIDI ALUMINIUM FABRICATOR LTD.
Units 6-8, Sunray Industrial Centre, 1/F
610 Cha Kwo Ling Road, Kowloon
Tel:23469211-4 Fax:(852)27727656

DWG NO. : J858-CW-PE216 | REV. : G

CLIENT :
信和置業有限公司
Sino Land Company Limited

B.D. REF :


ARCHITECT :
ronald lu & partners
Ronald Lu & Partners (HK) Ltd.
呂元祥建築師事務所(香港)有限公司


MAIN CONTRACTOR :
Gammon

STRUCTURAL ENGINEER :
AECOM

FACADE CONSULTANT:
AECOM

32.

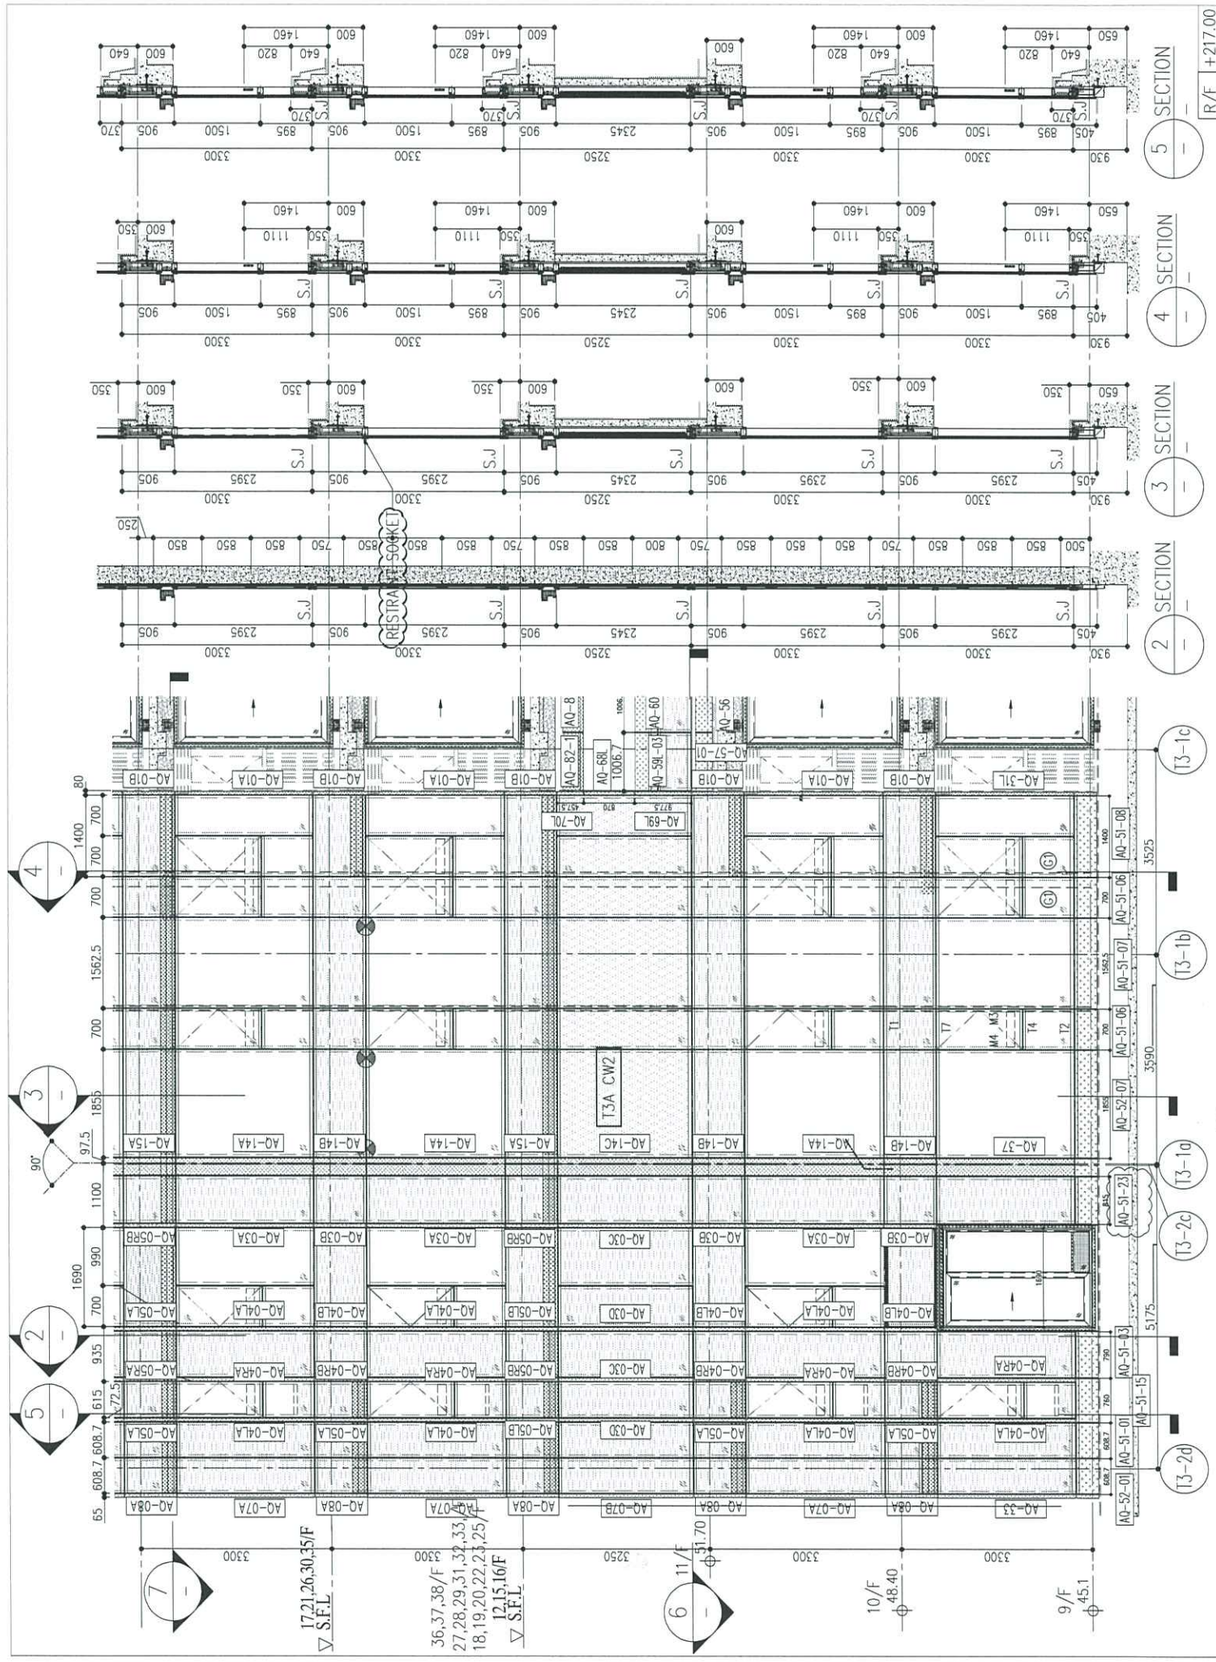
SECTION 5
SECTION 4
SECTION 3
SECTION 2
RESTRAINT SOCKET
T3-1c
T3-1b
T3-1a
T3-2c
T3-2d
T3A CW2
AO-04LA
AO-04LB
AO-04RA
AO-04RB
AO-05LA
AO-05LB
AO-05RA
AO-05RB

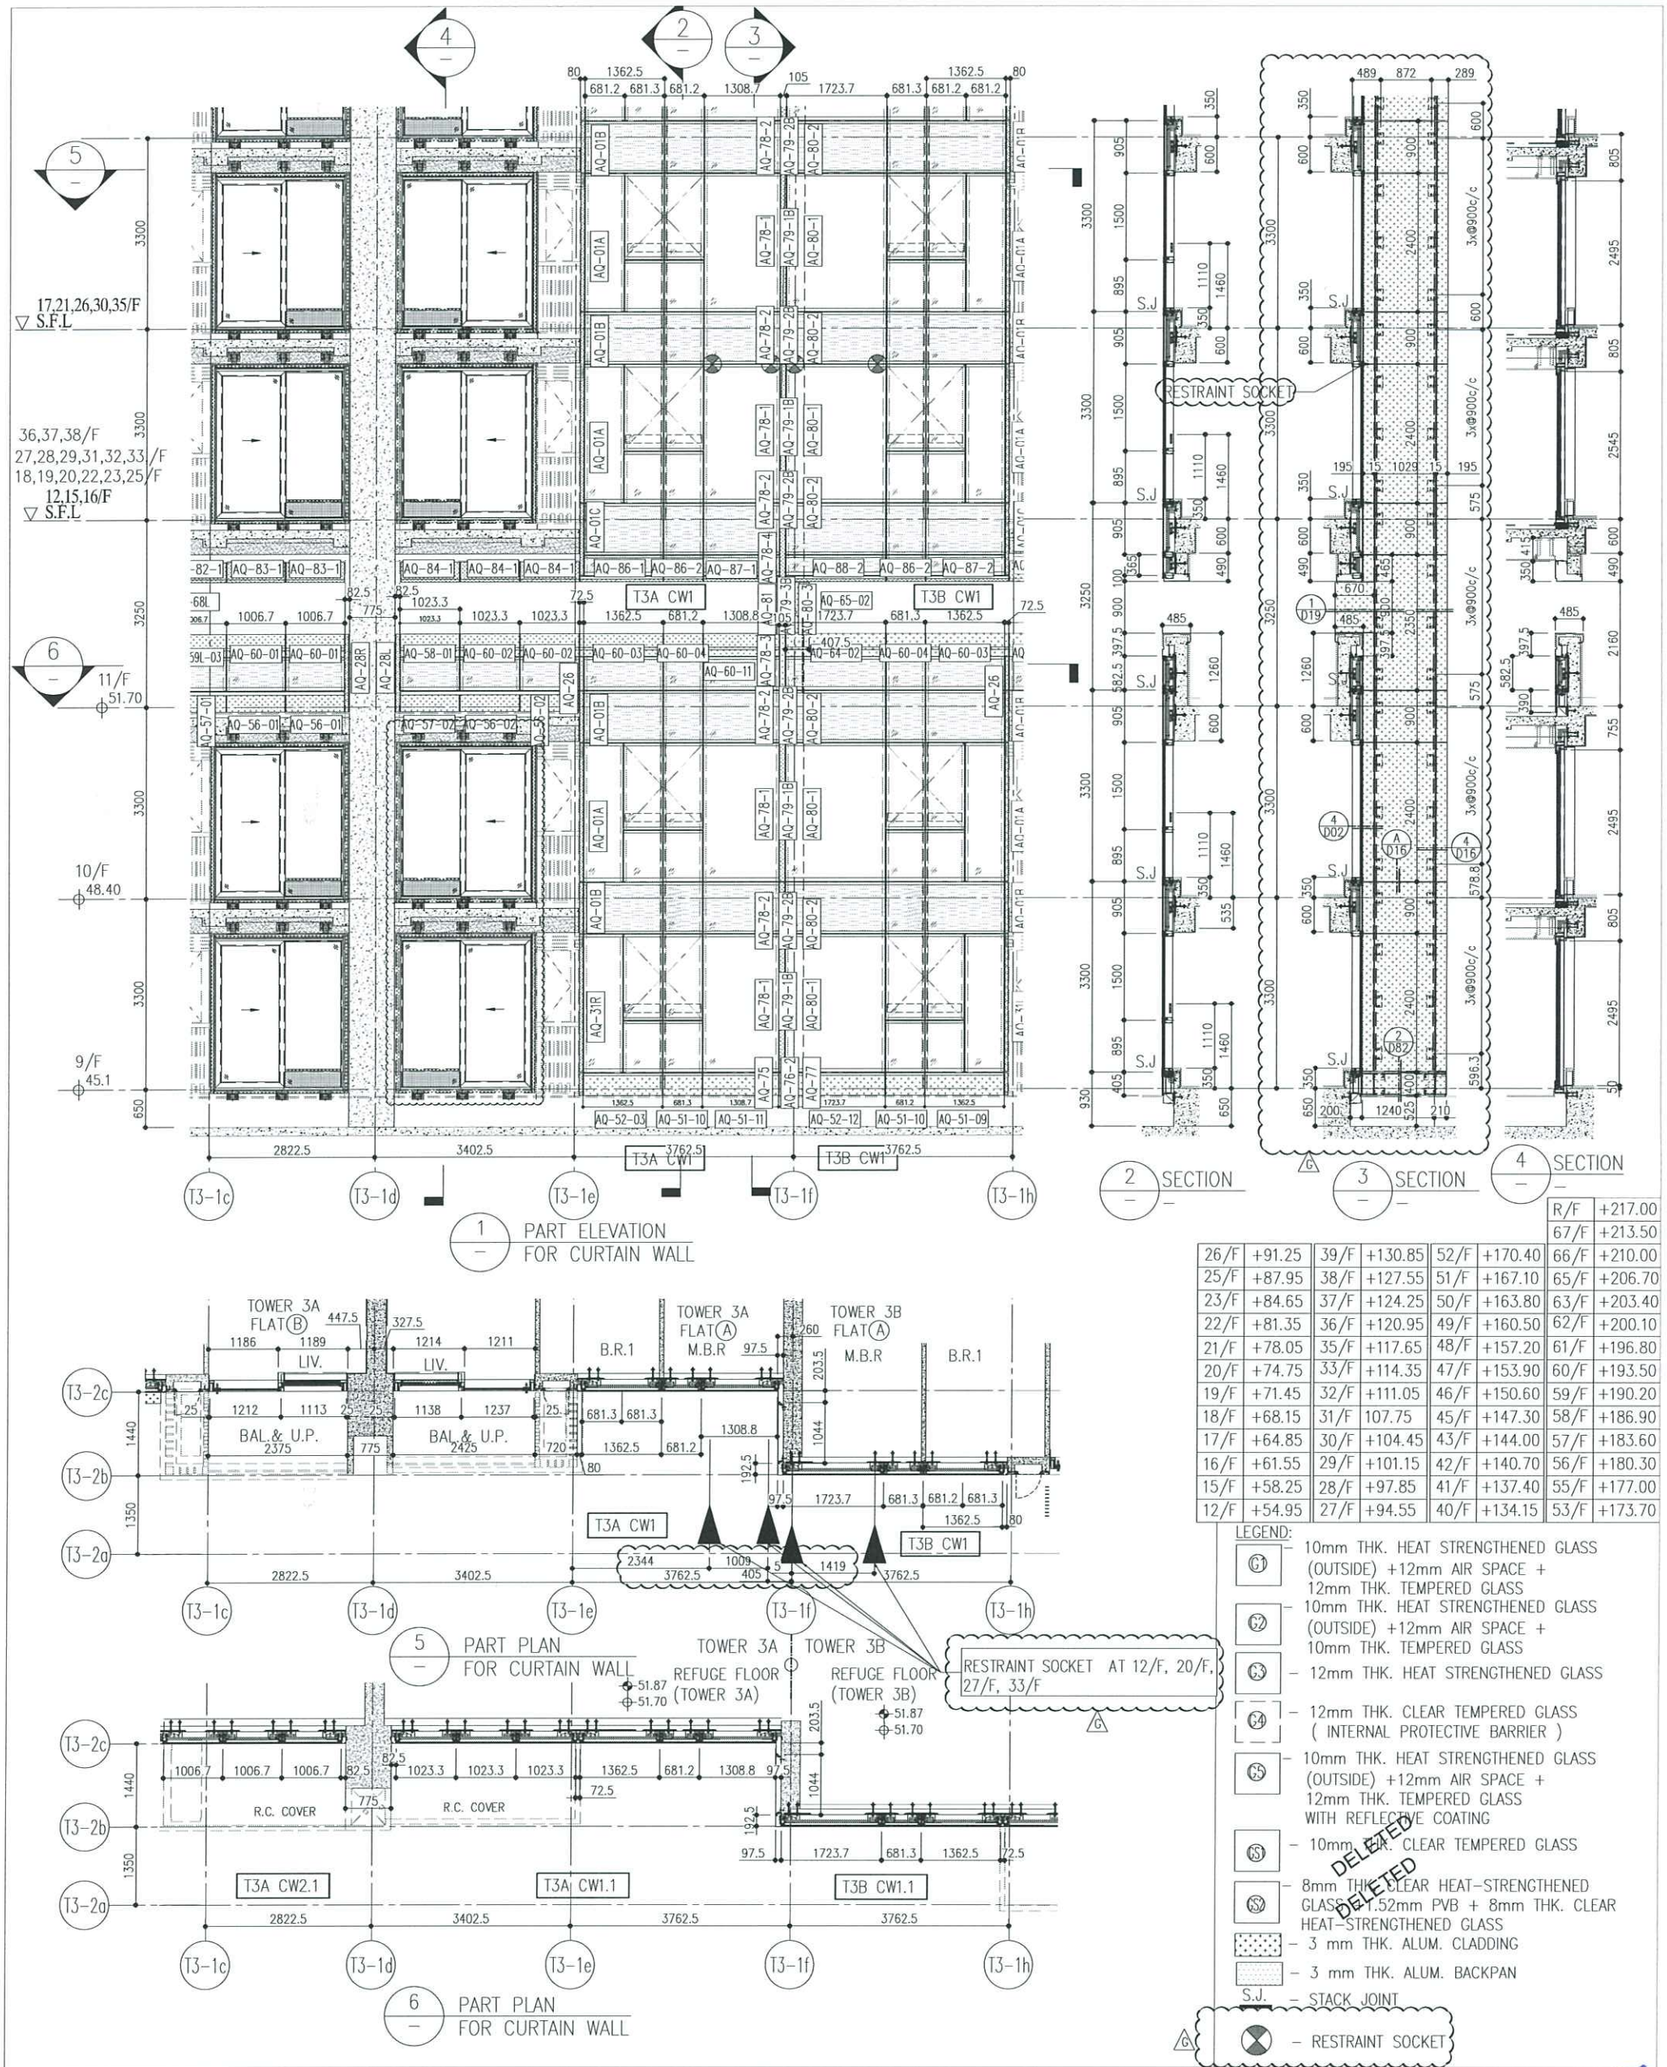

						R/F	+217.00
						67/F	+213.50
26/F	+91.25	39/F	+130.85	52/F	+170.40	66/F	+210.00
25/F	+87.95	38/F	+127.55	51/F	+167.10	65/F	+206.70
23/F	+84.65	37/F	+124.25	50/F	+163.80	63/F	+203.40
22/F	+81.35	36/F	+120.95	49/F	+160.50	62/F	+200.10
21/F	+78.05	35/F	+117.65	48/F	+157.20	61/F	+196.80
20/F	+74.75	33/F	+114.35	47/F	+153.90	60/F	+193.50
19/F	+71.45	32/F	+111.05	46/F	+150.60	59/F	+190.20
18/F	+68.15	31/F	107.75	45/F	+147.30	58/F	+186.90
17/F	+64.85	30/F	+104.45	43/F	+144.00	57/F	+183.60
16/F	+61.55	29/F	+101.15	42/F	+140.70	56/F	+180.30
15/F	+58.25	28/F	+97.85	41/F	+137.40	55/F	+177.00
12/F	+54.95	27/F	+94.55	40/F	+134.15	53/F	+173.70

LEGEND:

- G1 – 10mm THK. HEAT STRENGTHENED GLASS (OUTSIDE) +12mm AIR SPACE + 12mm THK. TEMPERED GLASS
- G2 – 10mm THK. HEAT STRENGTHENED GLASS (OUTSIDE) +12mm AIR SPACE + 10mm THK. TEMPERED GLASS
- G3 – 12mm THK. HEAT STRENGTHENED GLASS
- G4 – 12mm THK. CLEAR TEMPERED GLASS (INTERNAL PROTECTIVE BARRIER)
- G5 – 10mm THK. HEAT STRENGTHENED GLASS (OUTSIDE) +12mm AIR SPACE + 12mm THK. TEMPERED GLASS WITH REFLECTIVE COATING
- S3 – 10mm THK. CLEAR TEMPERED GLASS
- S8 – 8mm THK. CLEAR HEAT-STRENGTHENED GLASS+1.52mm PVB + 8mm THK. CLEAR HEAT-STRENGTHENED GLASS
- 3 mm THK. ALUM. CLADDING
- 3 mm THK. ALUM. BACKPAN
- S.J. – STACK JOINT
- G – RESTRAINT SOCKET

DELETED DELETED

NOTE:
1. ALL DIMENSIONS ARE IN mm.
2. ALL ELEVATIONS ARE VIEWED FROM OUTSIDE.
3. ALL DIMENSIONS TO BE VERIFIED ON SITE BEFORE FABRICATION.

LEGEND:
- X1 / X05 – DETAIL MARK NO. / REFER SHEET NO.
1. F.F.L. --- FINISHED FLOOR LEVEL
2. S.F.L. --- STRUCTURAL FLOOR LEVEL
3. (X) --- REVERSED DETAIL

NO.	DATE	REVISED	BY
G	18/08/22	REVISED AS PER COMMENTS	LS
F	26/07/22	REVISED AS PER COMMENTS	LS
E	25/05/22	REVISED AS PER COMMENTS	LS
D	22/04/06	REVISED AS PER COMMENTS	LS
C	22/01/22	REVISED AS PER COMMENTS	LS
B	20/12/21	REVISED AS PER COMMENTS	LS
A	03/12/21	REVISED AS PER COMMENTS	LS

JOB NO. : J-85B

PROJECT : PROPOSED RESIDENTIAL DEVELOPMENT AT TKOTL 70RP, PHASE 11, LOHAS PARK TSEUNG KWAN O, N.T.

TITLE : TYPICAL FLOOR PARTIAL ELEVATION & SECTION, PLAN FOR CURTAIN WALL (TOWER 3)

DATE : 22-OCT-21 | SCALE : 1:50(A1)

DRAWN BY : | CHECKED BY :

DWG NO. : J85B-CW-PE302 | REV. : G

美特鋁質有限公司 MIDI ALUMINIUM FABRICATOR LTD.
Units 6-8, Sunray Industrial Centre, 1/F
610 Cha Kwo Ling Road, Kowloon
Tel:23489211-4 Fax:(852)27727666

CLIENT : 信和置業有限公司 Sino Land Company Limited

ARCHITECT : ronald lu & partners Architects Planners Interior Designers Ronald Lu & Partners (HK) Ltd. 呂元祥建築師事務所(香港)有限公司


MAIN CONTRACTOR : Gammon

STRUCTURAL ENGINEER : AECOM

FACADE CONSULTANT : AECOM

T3A T3B
B / A

34

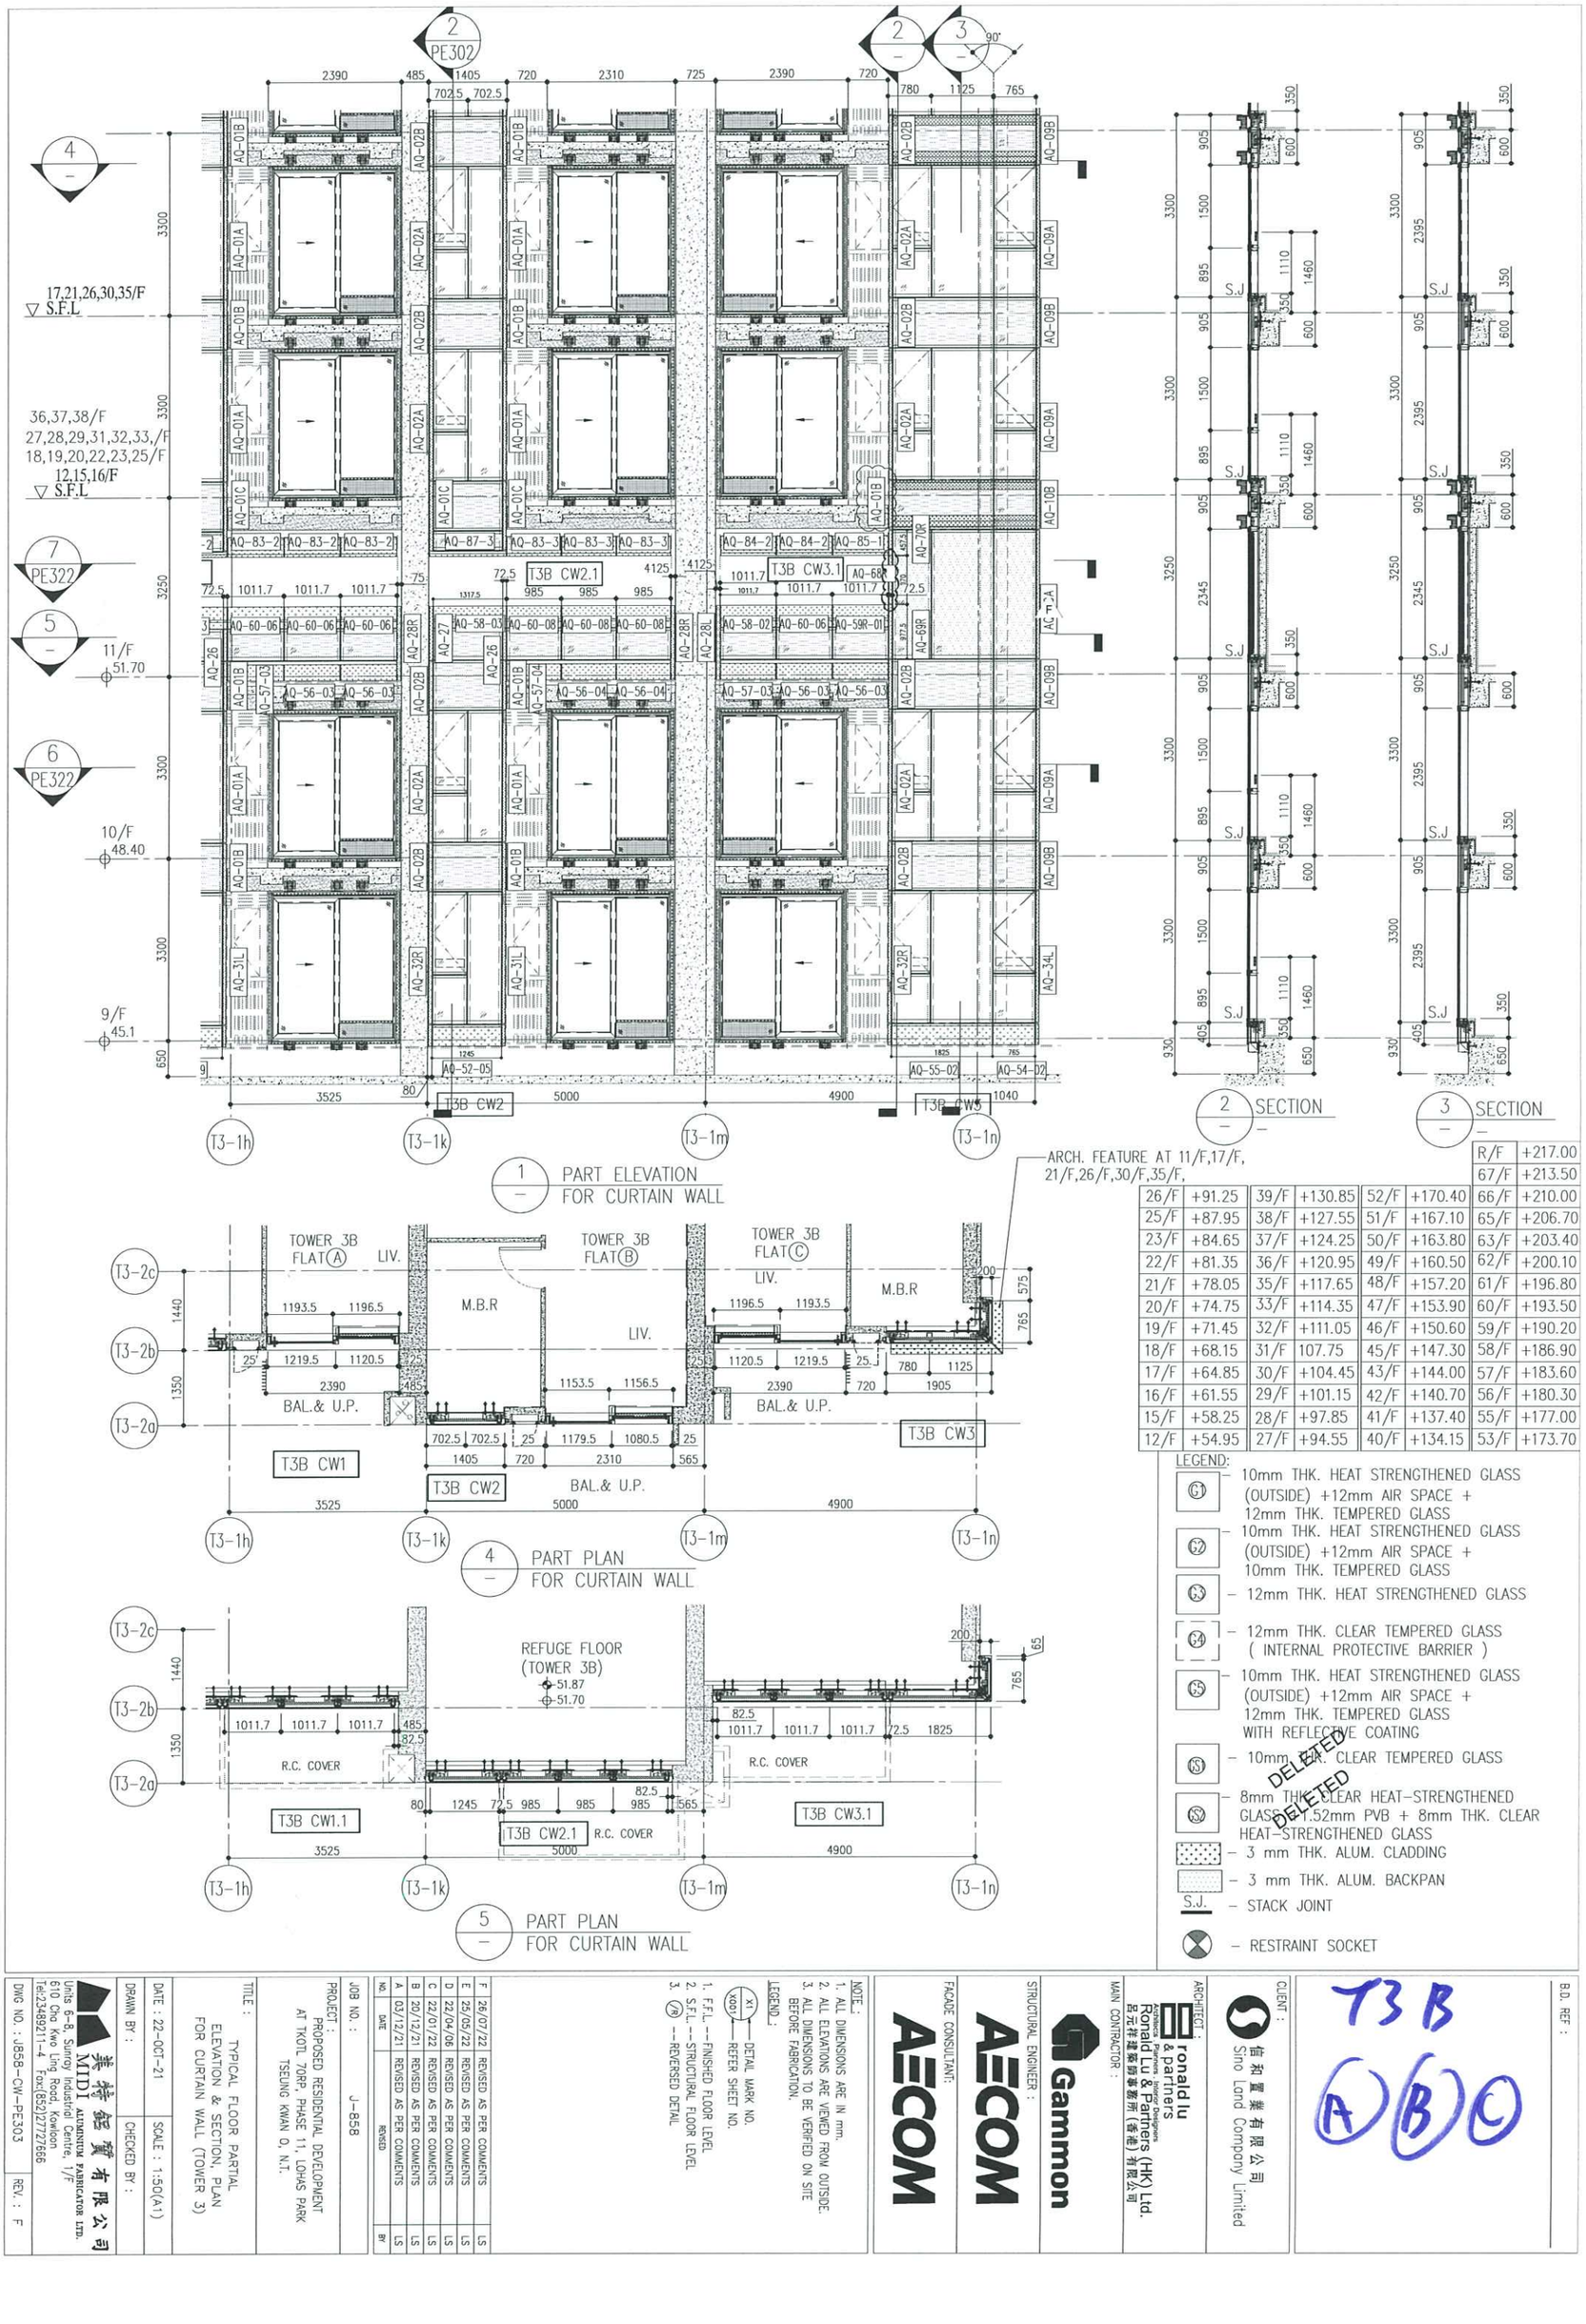

1 / – PART ELEVATION FOR CURTAIN WALL

2 / – SECTION

3 / – SECTION

4 / – PART PLAN FOR CURTAIN WALL

5 / – PART PLAN FOR CURTAIN WALL

ARCH. FEATURE AT 11/F,17/F, 21/F,26/F,30/F,35/F,

						R/F	+217.00
						67/F	+213.50
26/F	+91.25	39/F	+130.85	52/F	+170.40	66/F	+210.00
25/F	+87.95	38/F	+127.55	51/F	+167.10	65/F	+206.70
23/F	+84.65	37/F	+124.25	50/F	+163.80	63/F	+203.40
22/F	+81.35	36/F	+120.95	49/F	+160.50	62/F	+200.10
21/F	+78.05	35/F	+117.65	48/F	+157.20	61/F	+196.80
20/F	+74.75	33/F	+114.35	47/F	+153.90	60/F	+193.50
19/F	+71.45	32/F	+111.05	46/F	+150.60	59/F	+190.20
18/F	+68.15	31/F	107.75	45/F	+147.30	58/F	+186.90
17/F	+64.85	30/F	+104.45	43/F	+144.00	57/F	+183.60
16/F	+61.55	29/F	+101.15	42/F	+140.70	56/F	+180.30
15/F	+58.25	28/F	+97.85	41/F	+137.40	55/F	+177.00
12/F	+54.95	27/F	+94.55	40/F	+134.15	53/F	+173.70

LEGEND:

- G1 – 10mm THK. HEAT STRENGTHENED GLASS (OUTSIDE) +12mm AIR SPACE + 12mm THK. TEMPERED GLASS
- G2 – 10mm THK. HEAT STRENGTHENED GLASS (OUTSIDE) +12mm AIR SPACE + 10mm THK. TEMPERED GLASS
- G3 – 12mm THK. HEAT STRENGTHENED GLASS
- G4 – 12mm THK. CLEAR TEMPERED GLASS (INTERNAL PROTECTIVE BARRIER)
- G5 – 10mm THK. HEAT STRENGTHENED GLASS (OUTSIDE) +12mm AIR SPACE + 12mm THK. TEMPERED GLASS WITH REFLECTIVE COATING
- G6 – 10mm THK. CLEAR TEMPERED GLASS
- G7 – 8mm THK. CLEAR HEAT-STRENGTHENED GLASS + 1.52mm PVB + 8mm THK. CLEAR HEAT-STRENGTHENED GLASS
- 3 mm THK. ALUM. CLADDING
- 3 mm THK. ALUM. BACKPAN
- S.J. – STACK JOINT
- – RESTRAINT SOCKET

DELETED
DELETED

NOTE:
1. ALL DIMENSIONS ARE IN mm.
2. ALL ELEVATIONS ARE VIEWED FROM OUTSIDE.
3. ALL DIMENSIONS TO BE VERIFIED ON SITE BEFORE FABRICATION.

LEGEND:
- X1 / X05 – DETAIL MARK NO. / REFER SHEET NO.
- 1. F.F.L. – FINISHED FLOOR LEVEL
- 2. S.F.L. – STRUCTURAL FLOOR LEVEL
- 3. /R – REVERSED DETAIL

NO.	DATE	REVISED	BY
F	26/07/22	REVISED AS PER COMMENTS	LS
E	25/05/22	REVISED AS PER COMMENTS	LS
D	22/04/06	REVISED AS PER COMMENTS	LS
C	22/01/22	REVISED AS PER COMMENTS	LS
B	20/12/21	REVISED AS PER COMMENTS	LS
A	03/12/21	REVISED AS PER COMMENTS	LS

JOB NO. : J-B5B

PROJECT : PROPOSED RESIDENTIAL DEVELOPMENT AT TKOTL 70RP, PHASE 11, LOHAS PARK TSEUNG KWAN O, N.T.

TITLE : TYPICAL FLOOR PARTIAL ELEVATION & SECTION, PLAN FOR CURTAIN WALL (TOWER 3)

DATE : 22-OCT-21 | SCALE : 1:50(A1)

DRAWN BY : | CHECKED BY :

DWG NO. : J-B5B-CW-PE303 | REV. : F

美特鋁業有限公司 MIDI ALUMINIUM FABRICATOR LTD.
Units 6-8, Sunray Industrial Centre, 1/F
610 Cha Kwo Ling Road, Kowloon
Tel:2348921-4 Fax:(852)27727666

ARCHITECT : ronald lu & partners Architects Planners Interior Designers Ronald Lu & Partners (HK) Ltd. 呂元祥建築師事務所(香港)有限公司

MAIN CONTRACTOR : Gammon

STRUCTURAL ENGINEER : AECOM


FACADE CONSULTANT: AECOM


CLIENT : 信和置業有限公司 Sino Land Company Limited


B.D. REF :

T3B (A)(B)(C)

35.

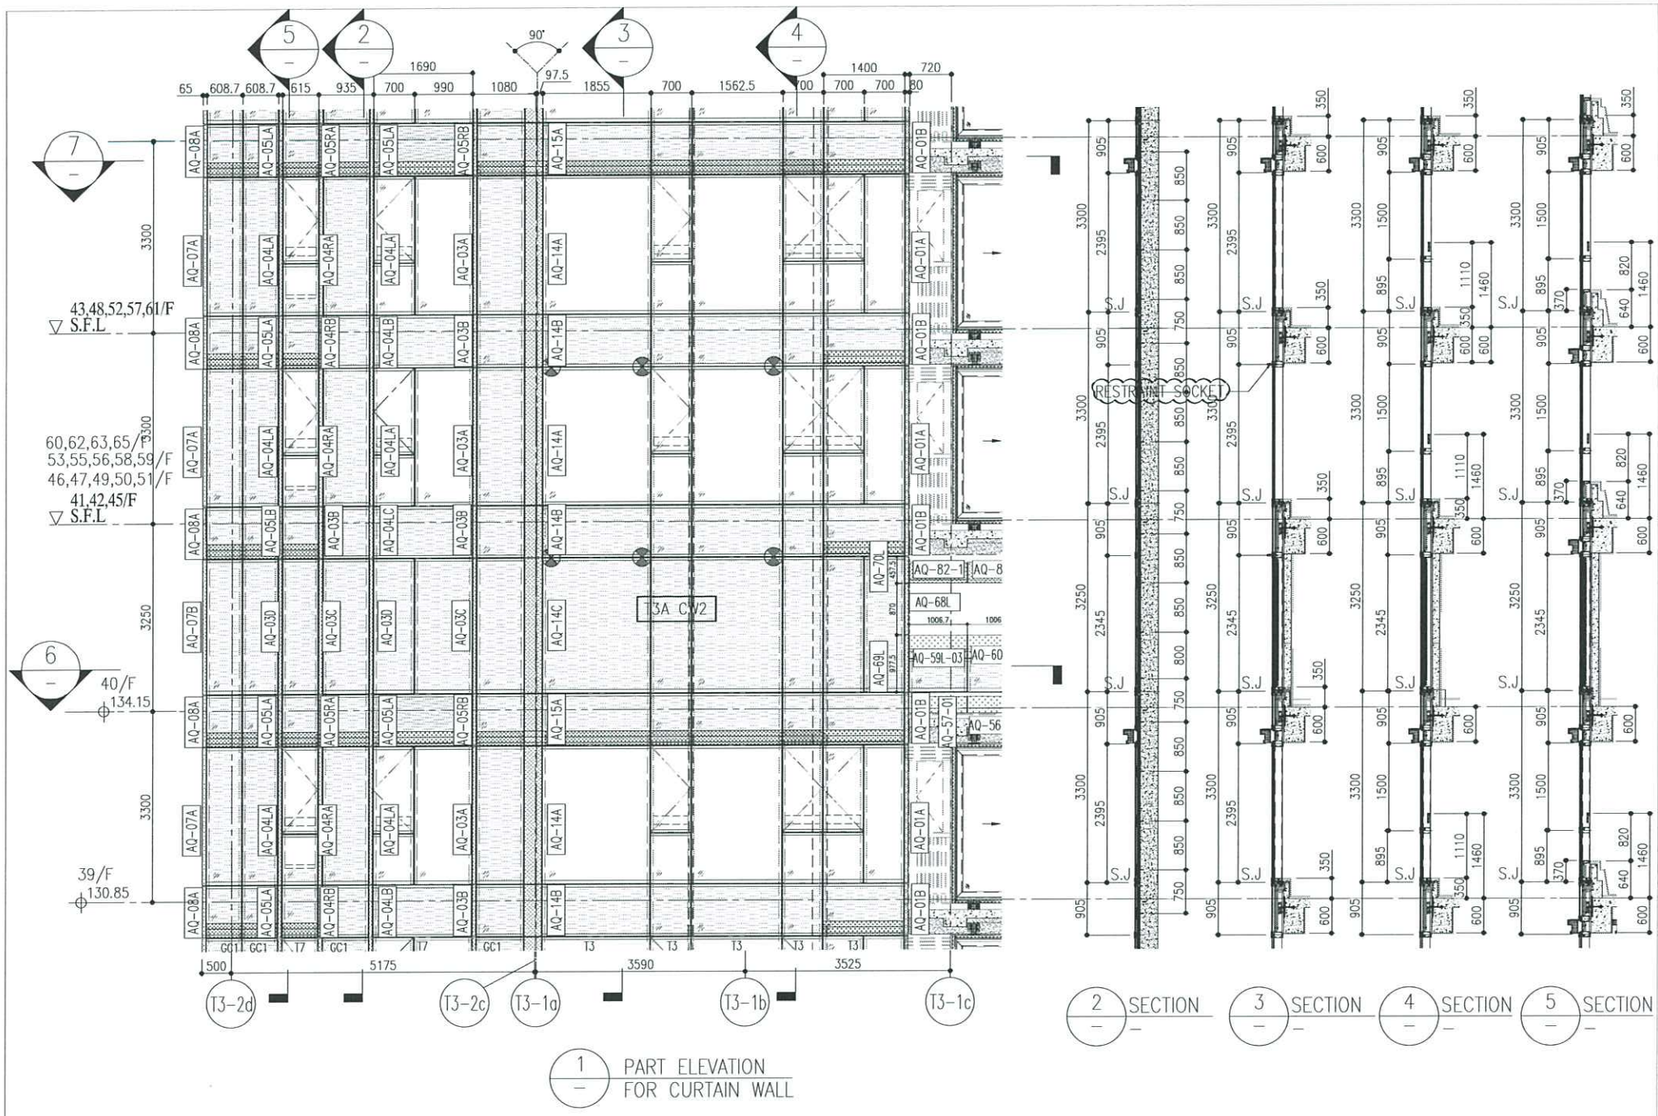

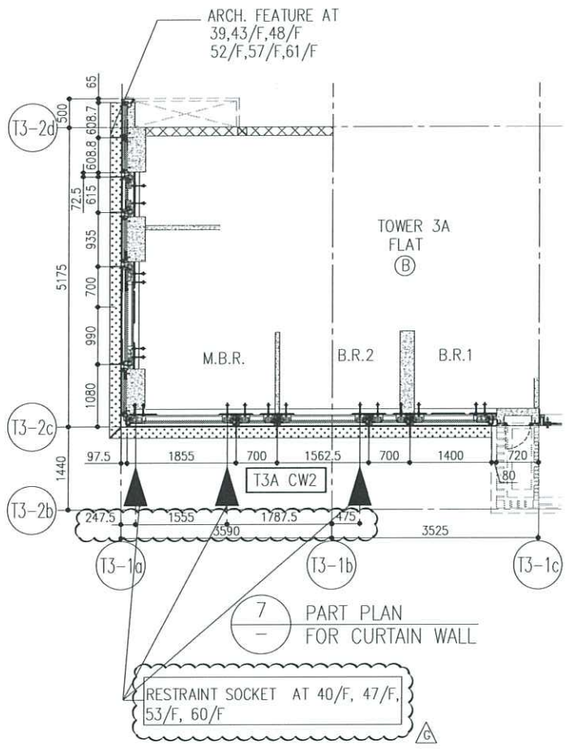

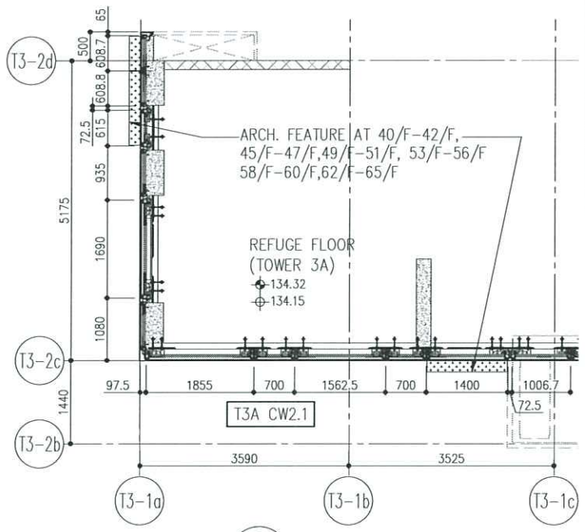

						R/F	+217.00
						67/F	+213.50
26/F	+91.25	39/F	+130.85	52/F	+170.40	66/F	+210.00
25/F	+87.95	38/F	+127.55	51/F	+167.10	65/F	+206.70
23/F	+84.65	37/F	+124.25	50/F	+163.80	63/F	+203.40
22/F	+81.35	36/F	+120.95	49/F	+160.50	62/F	+200.10
21/F	+78.05	35/F	+117.65	48/F	+157.20	61/F	+196.80
20/F	+74.75	33/F	+114.35	47/F	+153.90	60/F	+193.50
19/F	+71.45	32/F	+111.05	46/F	+150.60	59/F	+190.20
18/F	+68.15	31/F	107.75	45/F	+147.30	58/F	+186.90
17/F	+64.85	30/F	+104.45	43/F	+144.00	57/F	+183.60
16/F	+61.55	29/F	+101.15	42/F	+140.70	56/F	+180.30
15/F	+58.25	28/F	+97.85	41/F	+137.40	55/F	+177.00
12/F	+54.95	27/F	+94.55	40/F	+134.15	53/F	+173.70

LEGEND:

- G1 – 10mm THK. HEAT STRENGTHENED GLASS (OUTSIDE) +12mm AIR SPACE + 12mm THK. TEMPERED GLASS
- G2 – 10mm THK. HEAT STRENGTHENED GLASS (OUTSIDE) +12mm AIR SPACE + 10mm THK. TEMPERED GLASS
- G3 – 12mm THK. HEAT STRENGTHENED GLASS
- G4 – 12mm THK. CLEAR TEMPERED GLASS (INTERNAL PROTECTIVE BARRIER)
- G5 – 10mm THK. HEAT STRENGTHENED GLASS (OUTSIDE) +12mm AIR SPACE + 12mm THK. TEMPERED GLASS WITH REFLECTIVE COATING
- S1 – 10mm THK. CLEAR TEMPERED GLASS
- S2 – 8mm THK. CLEAR HEAT-STRENGTHENED GLASS + 1.52mm PVB + 8mm THK. CLEAR HEAT-STRENGTHENED GLASS
- 3 mm THK. ALUM. CLADDING
- 3 mm THK. ALUM. BACKPAN
- S.J. – STACK JOINT
- A/G – RESTRAINT SOCKET

DELETED
DELETED

B.D. REF :

CLIENT :
信和置業有限公司
Sino Land Company Limited

ARCHITECT :
ronald lu & partners
Architects Planners Interior Designers
Ronald Lu & Partners (HK) Ltd.
呂元祥建築師事務所(香港)有限公司

MAIN CONTRACTOR :
Gammon

STRUCTURAL ENGINEER :
AECOM

FACADE CONSULTANT:
AECOM

NOTE :
1. ALL DIMENSIONS ARE IN mm.
2. ALL ELEVATIONS ARE VIEWED FROM OUTSIDE.
3. ALL DIMENSIONS TO BE VERIFIED ON SITE BEFORE FABRICATION.

LEGEND :
- X1 (X80) — DETAIL MARK NO. / REFER SHEET NO.
- 1. F.F.L. --FINISHED FLOOR LEVEL
- 2. S.F.L. --STRUCTURAL FLOOR LEVEL
- 3. (/R) --REVERSED DETAIL

NO.	DATE	REVISED	BY
G	18/08/22	REVISED AS PER COMMENTS	LS
F	26/07/22	REVISED AS PER COMMENTS	LS
E	25/05/22	REVISED AS PER COMMENTS	LS
D	22/04/06	REVISED AS PER COMMENTS	LS
C	22/01/22	REVISED AS PER COMMENTS	LS
B	20/12/21	REVISED AS PER COMMENTS	LS
A	03/12/21	REVISED AS PER COMMENTS	LS

JOB NO. : J-858

PROJECT :
PROPOSED RESIDENTIAL DEVELOPMENT
AT TKOTL 70RP, PHASE 11, LOHAS PARK
TSEUNG KWAN O, N.T.


TITLE :
TYPICAL FLOOR PARTIAL
ELEVATION & SECTION, PLAN
FOR CURTAIN WALL (TOWER 3)

DATE : 22-OCT-21 | SCALE : 1:50(A1)


DRAWN BY : | CHECKED BY :

美特鋁廠有限公司
MIDI ALUMINIUM FABRICATOR LTD.
Units 6-8, Sunray Industrial Centre, 1/F
610 Cha Kwo Ling Road, Kowloon
Tel:23489211-4 Fax:(852)27726666

DWG NO. : J858-CW-PE304 | REV. : G

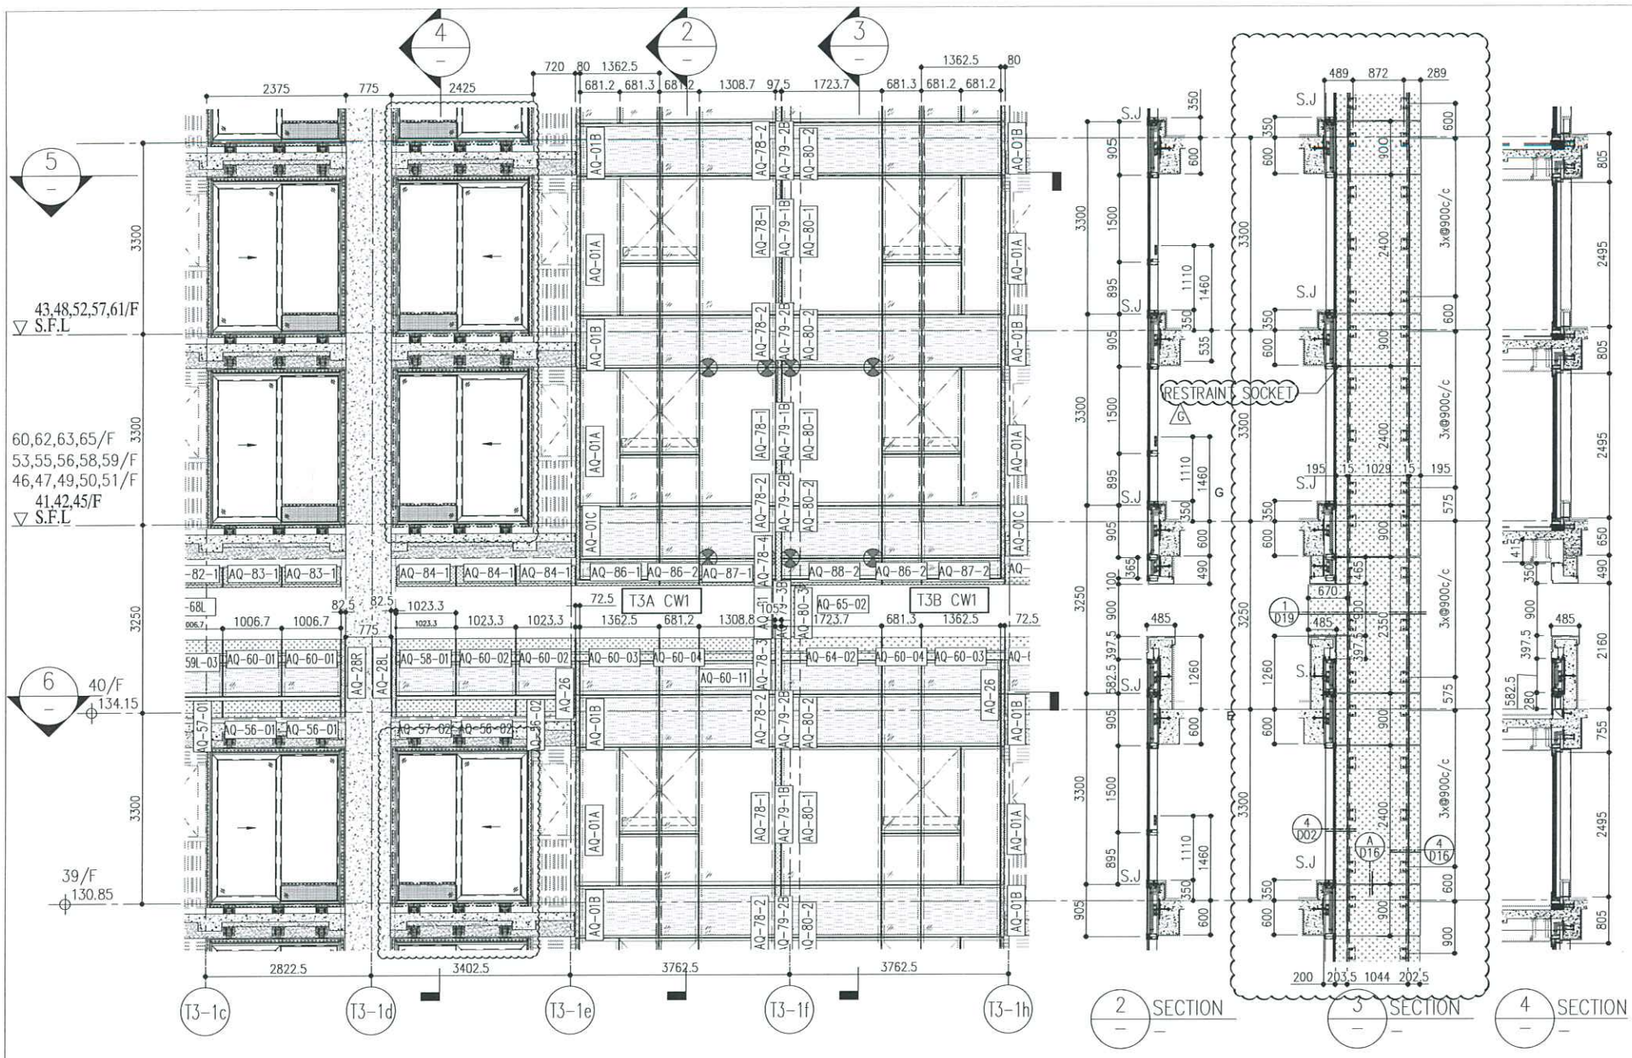

1 PART ELEVATION FOR CURTAIN WALL

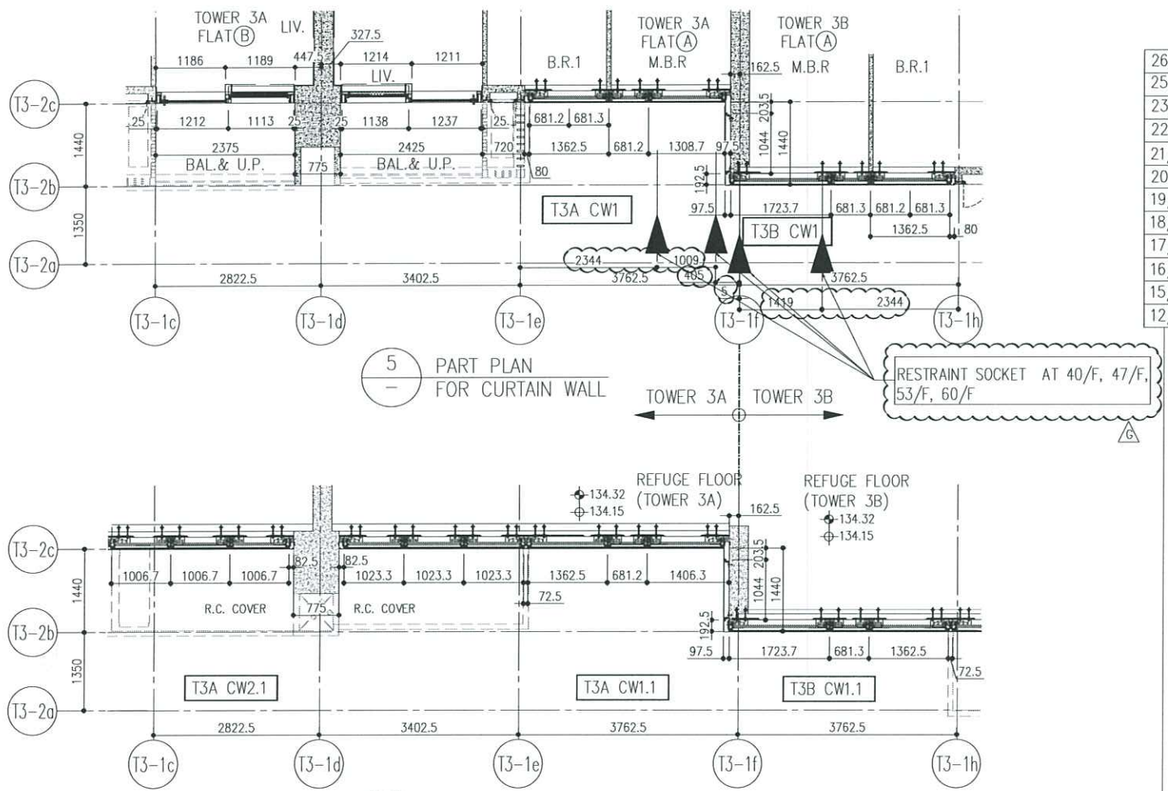

5 PART PLAN FOR CURTAIN WALL

6 PART PLAN FOR CURTAIN WALL

						R/F	+217.00
						67/F	+213.50
26/F	+91.25	39/F	+130.85	52/F	+170.40	66/F	+210.00
25/F	+87.95	38/F	+127.55	51/F	+167.10	65/F	+206.70
23/F	+84.65	37/F	+124.25	50/F	+163.80	63/F	+203.40
22/F	+81.35	36/F	+120.95	49/F	+160.50	62/F	+200.10
21/F	+78.05	35/F	+117.65	48/F	+157.20	61/F	+196.80
20/F	+74.75	33/F	+114.35	47/F	+153.90	60/F	+193.50
19/F	+71.45	32/F	+111.05	46/F	+150.60	59/F	+190.20
18/F	+68.15	31/F	107.75	45/F	+147.30	58/F	+186.90
17/F	+64.85	30/F	+104.45	43/F	+144.00	57/F	+183.60
16/F	+61.55	29/F	+101.15	42/F	+140.70	56/F	+180.30
15/F	+58.25	28/F	+97.85	41/F	+137.40	55/F	+177.00
12/F	+54.95	27/F	+94.55	40/F	+134.15	53/F	+173.70

LEGEND:

- G1 – 10mm THK. HEAT STRENGTHENED GLASS (OUTSIDE) +12mm AIR SPACE + 12mm THK. TEMPERED GLASS
- G2 – 10mm THK. HEAT STRENGTHENED GLASS (OUTSIDE) +12mm AIR SPACE + 10mm THK. TEMPERED GLASS
- G3 – 12mm THK. HEAT STRENGTHENED GLASS
- G4 – 12mm THK. CLEAR TEMPERED GLASS (INTERNAL PROTECTIVE BARRIER)
- G5 – 10mm THK. HEAT STRENGTHENED GLASS (OUTSIDE) +12mm AIR SPACE + 12mm THK. TEMPERED GLASS WITH REFLECTIVE COATING
- S1 – 10mm THK. CLEAR TEMPERED GLASS
- S2 – 8mm THK. CLEAR HEAT-STRENGTHENED GLASS + 1.52mm PVB + 8mm THK. CLEAR HEAT-STRENGTHENED GLASS
- 3 mm THK. ALUM. CLADDING
- 3 mm THK. ALUM. BACKPAN
- S.J. – STACK JOINT
- G – RESTRAINT SOCKET

DELETED
DELETED

NOTE:
1. ALL DIMENSIONS ARE IN mm.
2. ALL ELEVATIONS ARE VIEWED FROM OUTSIDE.
3. ALL DIMENSIONS TO BE VERIFIED ON SITE BEFORE FABRICATION.

LEGEND:
- X1 / X1001 — DETAIL MARK NO. / REFER SHEET NO.
1. F.F.L. --- FINISHED FLOOR LEVEL
2. S.F.L. --- STRUCTURAL FLOOR LEVEL
3. (XB) --- REVERSED DETAIL

NO.	DATE	REVISED	BY
G	18/08/22	REVISED AS PER COMMENTS	LS
F	26/07/22	REVISED AS PER COMMENTS	LS
E	25/05/22	REVISED AS PER COMMENTS	LS
D	22/04/06	REVISED AS PER COMMENTS	LS
C	22/01/22	REVISED AS PER COMMENTS	LS
B	20/12/21	REVISED AS PER COMMENTS	LS
A	03/12/21	REVISED AS PER COMMENTS	LS

JOB NO. : J-858

PROJECT : PROPOSED RESIDENTIAL DEVELOPMENT AT TKOTL 70RP, PHASE 11, LOHAS PARK TSEUNG KWAN O, N.T.

TITLE : TYPICAL FLOOR PARTIAL ELEVATION & SECTION, PLAN FOR CURTAIN WALL (TOWER 3)

DATE : 22-OCT-21 | SCALE : 1:50(A1)

DRAWN BY : | CHECKED BY :

美特鋁廠有限公司 MIDI ALUMINIUM FABRICATOR LTD.
Units 6-8, Sunray Industrial Centre, 1/F
610 Cho Kwo Ling Road, Kowloon
Tel:23489211-4 Fax:(852)27727666

DWG NO. : J858-CW-PE305 | REV. : G

CLIENT : 信和置業有限公司 Sino Land Company Limited

ARCHITECT : ronald lu & partners 呂元祥建築師事務所 Ronald Lu & Partners (HK) Ltd.


MAIN CONTRACTOR : Gammon


STRUCTURAL ENGINEER : AECOM

FACADE CONSULTANT : AECOM

B.D. REF :


37.

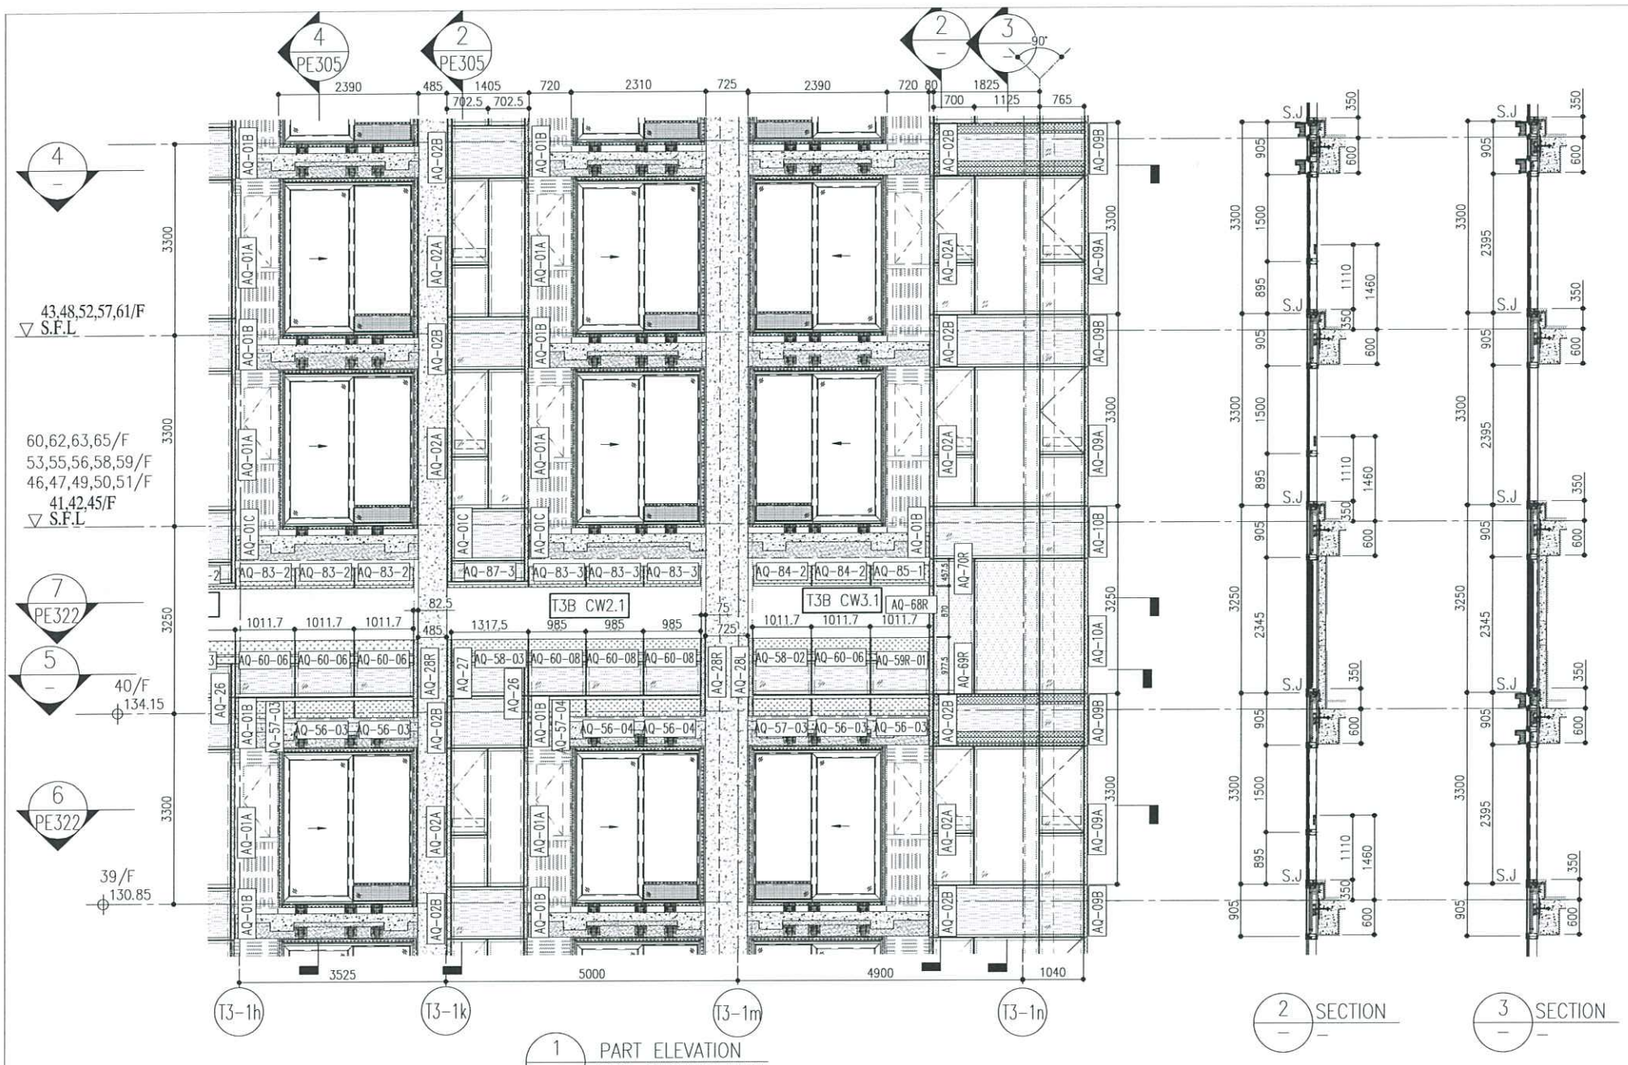

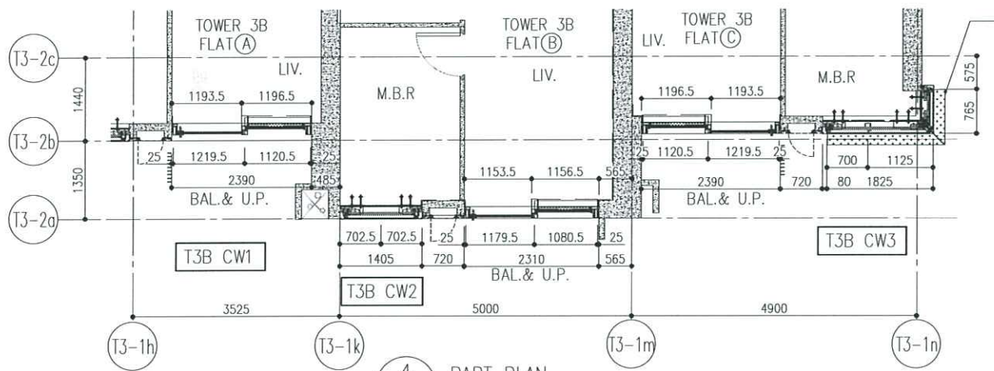

ARCH. FEATURE AT
39,43/F,48/F
52/F,57/F,61/F

						R/F	+217.00
						67/F	+213.50
26/F	+91.25	39/F	+130.85	52/F	+170.40	66/F	+210.00
25/F	+87.95	38/F	+127.55	51/F	+167.10	65/F	+206.70
23/F	+84.65	37/F	+124.25	50/F	+163.80	63/F	+203.40
22/F	+81.35	36/F	+120.95	49/F	+160.50	62/F	+200.10
21/F	+78.05	35/F	+117.65	48/F	+157.20	61/F	+196.80
20/F	+74.75	33/F	+114.35	47/F	+153.90	60/F	+193.50
19/F	+71.45	32/F	+111.05	46/F	+150.60	59/F	+190.20
18/F	+68.15	31/F	107.75	45/F	+147.30	58/F	+186.90
17/F	+64.85	30/F	+104.45	43/F	+144.00	57/F	+183.60
16/F	+61.55	29/F	+101.15	42/F	+140.70	56/F	+180.30
15/F	+58.25	28/F	+97.85	41/F	+137.40	55/F	+177.00
12/F	+54.95	27/F	+94.55	40/F	+134.15	53/F	+173.70

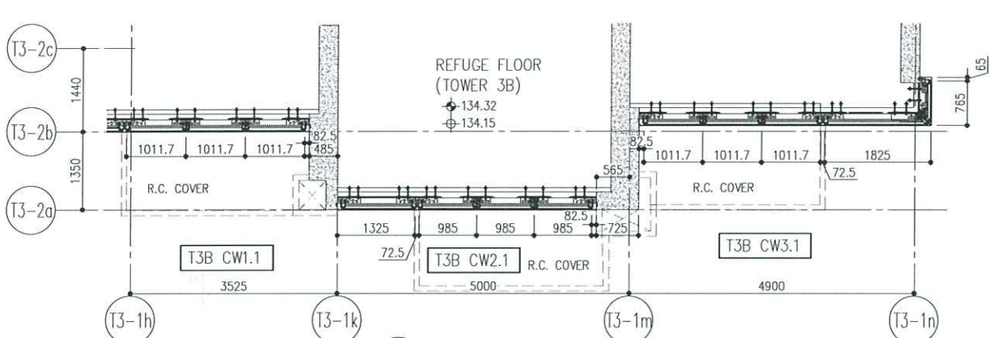

LEGEND:

- G1 – 10mm THK. HEAT STRENGTHENED GLASS (OUTSIDE) +12mm AIR SPACE + 12mm THK. TEMPERED GLASS
- G2 – 10mm THK. HEAT STRENGTHENED GLASS (OUTSIDE) +12mm AIR SPACE + 10mm THK. TEMPERED GLASS
- G3 – 12mm THK. HEAT STRENGTHENED GLASS
- G4 – 12mm THK. CLEAR TEMPERED GLASS (INTERNAL PROTECTIVE BARRIER)
- G5 – 10mm THK. HEAT STRENGTHENED GLASS (OUTSIDE) +12mm AIR SPACE + 12mm THK. TEMPERED GLASS WITH REFLECTIVE COATING
- S1 – 10mm THK. CLEAR TEMPERED GLASS
- S2 – 8mm THK. CLEAR HEAT-STRENGTHENED GLASS + 1.52mm PVB + 8mm THK. CLEAR HEAT-STRENGTHENED GLASS
- 3 mm THK. ALUM. CLADDING
- 3 mm THK. ALUM. BACKPAN
- S.J. – STACK JOINT
- – RESTRAINT SOCKET

DELETED
DELETED

NOTE:
1. ALL DIMENSIONS ARE IN mm.
2. ALL ELEVATIONS ARE VIEWED FROM OUTSIDE.
3. ALL DIMENSIONS TO BE VERIFIED ON SITE BEFORE FABRICATION.

LEGEND:
- (X1) / (X001) – DETAIL MARK NO. / REFER SHEET NO.
- 1. F.F.L. – FINISHED FLOOR LEVEL
- 2. S.F.L. – STRUCTURAL FLOOR LEVEL
- 3. (R) – REVERSED DETAIL

NO.	DATE	REVISED	BY
F	26/07/22	REVISED AS PER COMMENTS	LS
E	25/05/22	REVISED AS PER COMMENTS	LS
D	22/04/06	REVISED AS PER COMMENTS	LS
C	22/01/22	REVISED AS PER COMMENTS	LS
B	20/12/21	REVISED AS PER COMMENTS	LS
A	03/12/21	REVISED AS PER COMMENTS	LS

JOB NO. : J-858

PROJECT : PROPOSED RESIDENTIAL DEVELOPMENT AT TKOTL 70RP, PHASE 11, LOHAS PARK TSEUNG KWAN O, N.T.

TITLE : TYPICAL FLOOR PARTIAL ELEVATION & SECTION, PLAN FOR CURTAIN WALL (TOWER 3)

DATE : 22-OCT-21 | SCALE : 1:50(A1)
DRAWN BY : | CHECKED BY :

美特鋁質有限公司 MIDI ALUMINIUM FABRICATOR LTD.
Units 6-8, Sunray Industrial Centre, 1/F
610 Cha Kwo Ling Road, Kowloon
Tel:23489211-4 Fax:(852)27727666

DWG NO. : J858-CW-PE306 | REV. : F

CLIENT : 信和置業有限公司 Sino Land Company Limited

ARCHITECT : ronald lu & partners 羅永祥建築師事務所 Ronald Lu & Partners (HK) Ltd. 呂元祥建築師事務所(香港)有限公司

MAIN CONTRACTOR : Gammon

STRUCTURAL ENGINEER : AECOM

FACADE CONSULTANT: AECOM

B.D. REF :

38.

B.D. REF :

CLIENT :
信和置業有限公司
Sino Land Company Limited

ARCHITECT :
ronald lu & partners
Architects Planners Interior Designers
Ronald Lu & Partners (HK) Ltd.
呂元祥建築師事務所(香港)有限公司

MAIN CONTRACTOR :
Gammon

STRUCTURAL ENGINEER :
AECOM

FACADE CONSULTANT :
AECOM

NOTE :
1. ALL DIMENSIONS ARE IN mm.
2. ALL ELEVATIONS ARE VIEWED FROM OUTSIDE.
3. ALL DIMENSIONS TO BE VERIFIED ON SITE BEFORE FABRICATION.

LEGEND :
- X1 / X001 — DETAIL MARK NO. / REFER SHEET NO.
1. F.F.L. —FINISHED FLOOR LEVEL
2. S.F.L. —STRUCTURAL FLOOR LEVEL
3. (R) —REVERSED DETAIL

NO.	DATE	REVISED	BY
G	18/08/22	REVISED AS PER COMMENTS	LS
F	26/07/22	REVISED AS PER COMMENTS	LS
E	25/05/22	REVISED AS PER COMMENTS	LS
D	22/04/06	REVISED AS PER COMMENTS	LS
C	22/01/22	REVISED AS PER COMMENTS	LS
B	20/12/21	REVISED AS PER COMMENTS	LS
A	03/12/21	REVISED AS PER COMMENTS	LS

JOB NO. : J-858

PROJECT :
PROPOSED RESIDENTIAL DEVELOPMENT
AT TKOTL 70RP, PHASE 11, LOHAS PARK
TSEUNG KWAN O, N.T.

TITLE :
TYPICAL FLOOR PARTIAL
ELEVATION & SECTION, PLAN
FOR CURTAIN WALL (TOWER 3)

DATE : 22-OCT-21 | SCALE : 1:50(A1)

DRAWN BY : | CHECKED BY :


美特鋁製有限公司
MIDI ALUMINIUM FABRICATOR LTD.
Units 6-8, Sunray Industrial Centre, 1/F
610 Cho Kwo Ling Road, Kowloon
Tel:23489211-4 Fax:(852)27727666


DWG NO. : J858-CW-PE307 | REV. : G

LEGEND:

G1	10mm THK. HEAT STRENGTHENED GLASS (OUTSIDE) +12mm AIR SPACE + 12mm THK. TEMPERED GLASS
G2	10mm THK. HEAT STRENGTHENED GLASS (OUTSIDE) +12mm AIR SPACE + 10mm THK. TEMPERED GLASS
G3	12mm THK. HEAT STRENGTHENED GLASS
G4	12mm THK. CLEAR TEMPERED GLASS (INTERNAL PROTECTIVE BARRIER)
G5	10mm THK. HEAT STRENGTHENED GLASS (OUTSIDE) +12mm AIR SPACE + 12mm THK. TEMPERED GLASS WITH REFLECTIVE COATING
G6	10mm THK. CLEAR TEMPERED GLASS DELETED
G8	8mm THK. CLEAR HEAT-STRENGTHENED GLASS +2mm PVB + 8mm THK. CLEAR HEAT-STRENGTHENED GLASS DELETED
	3 mm THK. ALUM. CLADDING
	3 mm THK. ALUM. BACKPAN
S.J.	STACK JOINT
	RESTRAINT SOCKET

26/F	+91.25	39/F	+130.85	52/F	+170.40	66/F	+210.00
25/F	+87.95	38/F	+127.55	51/F	+167.10	65/F	+206.70
23/F	+84.65	37/F	+124.25	50/F	+163.80	63/F	+203.40
22/F	+81.35	36/F	+120.95	49/F	+160.50	62/F	+200.10
21/F	+78.05	35/F	+117.65	48/F	+157.20	61/F	+196.80
20/F	+74.75	33/F	+114.35	47/F	+153.90	60/F	+193.50
19/F	+71.45	32/F	+111.05	46/F	+150.60	59/F	+190.20
18/F	+68.15	31/F	107.75	45/F	+147.30	58/F	+186.90
17/F	+64.85	30/F	+104.45	43/F	+144.00	57/F	+183.60
16/F	+61.55	29/F	+101.15	42/F	+140.70	56/F	+180.30
15/F	+58.25	28/F	+97.85	41/F	+137.40	55/F	+177.00
12/F	+54.95	27/F	+94.55	40/F	+134.15	53/F	+173.70
R/F	+217.00						
67/F	+213.50						

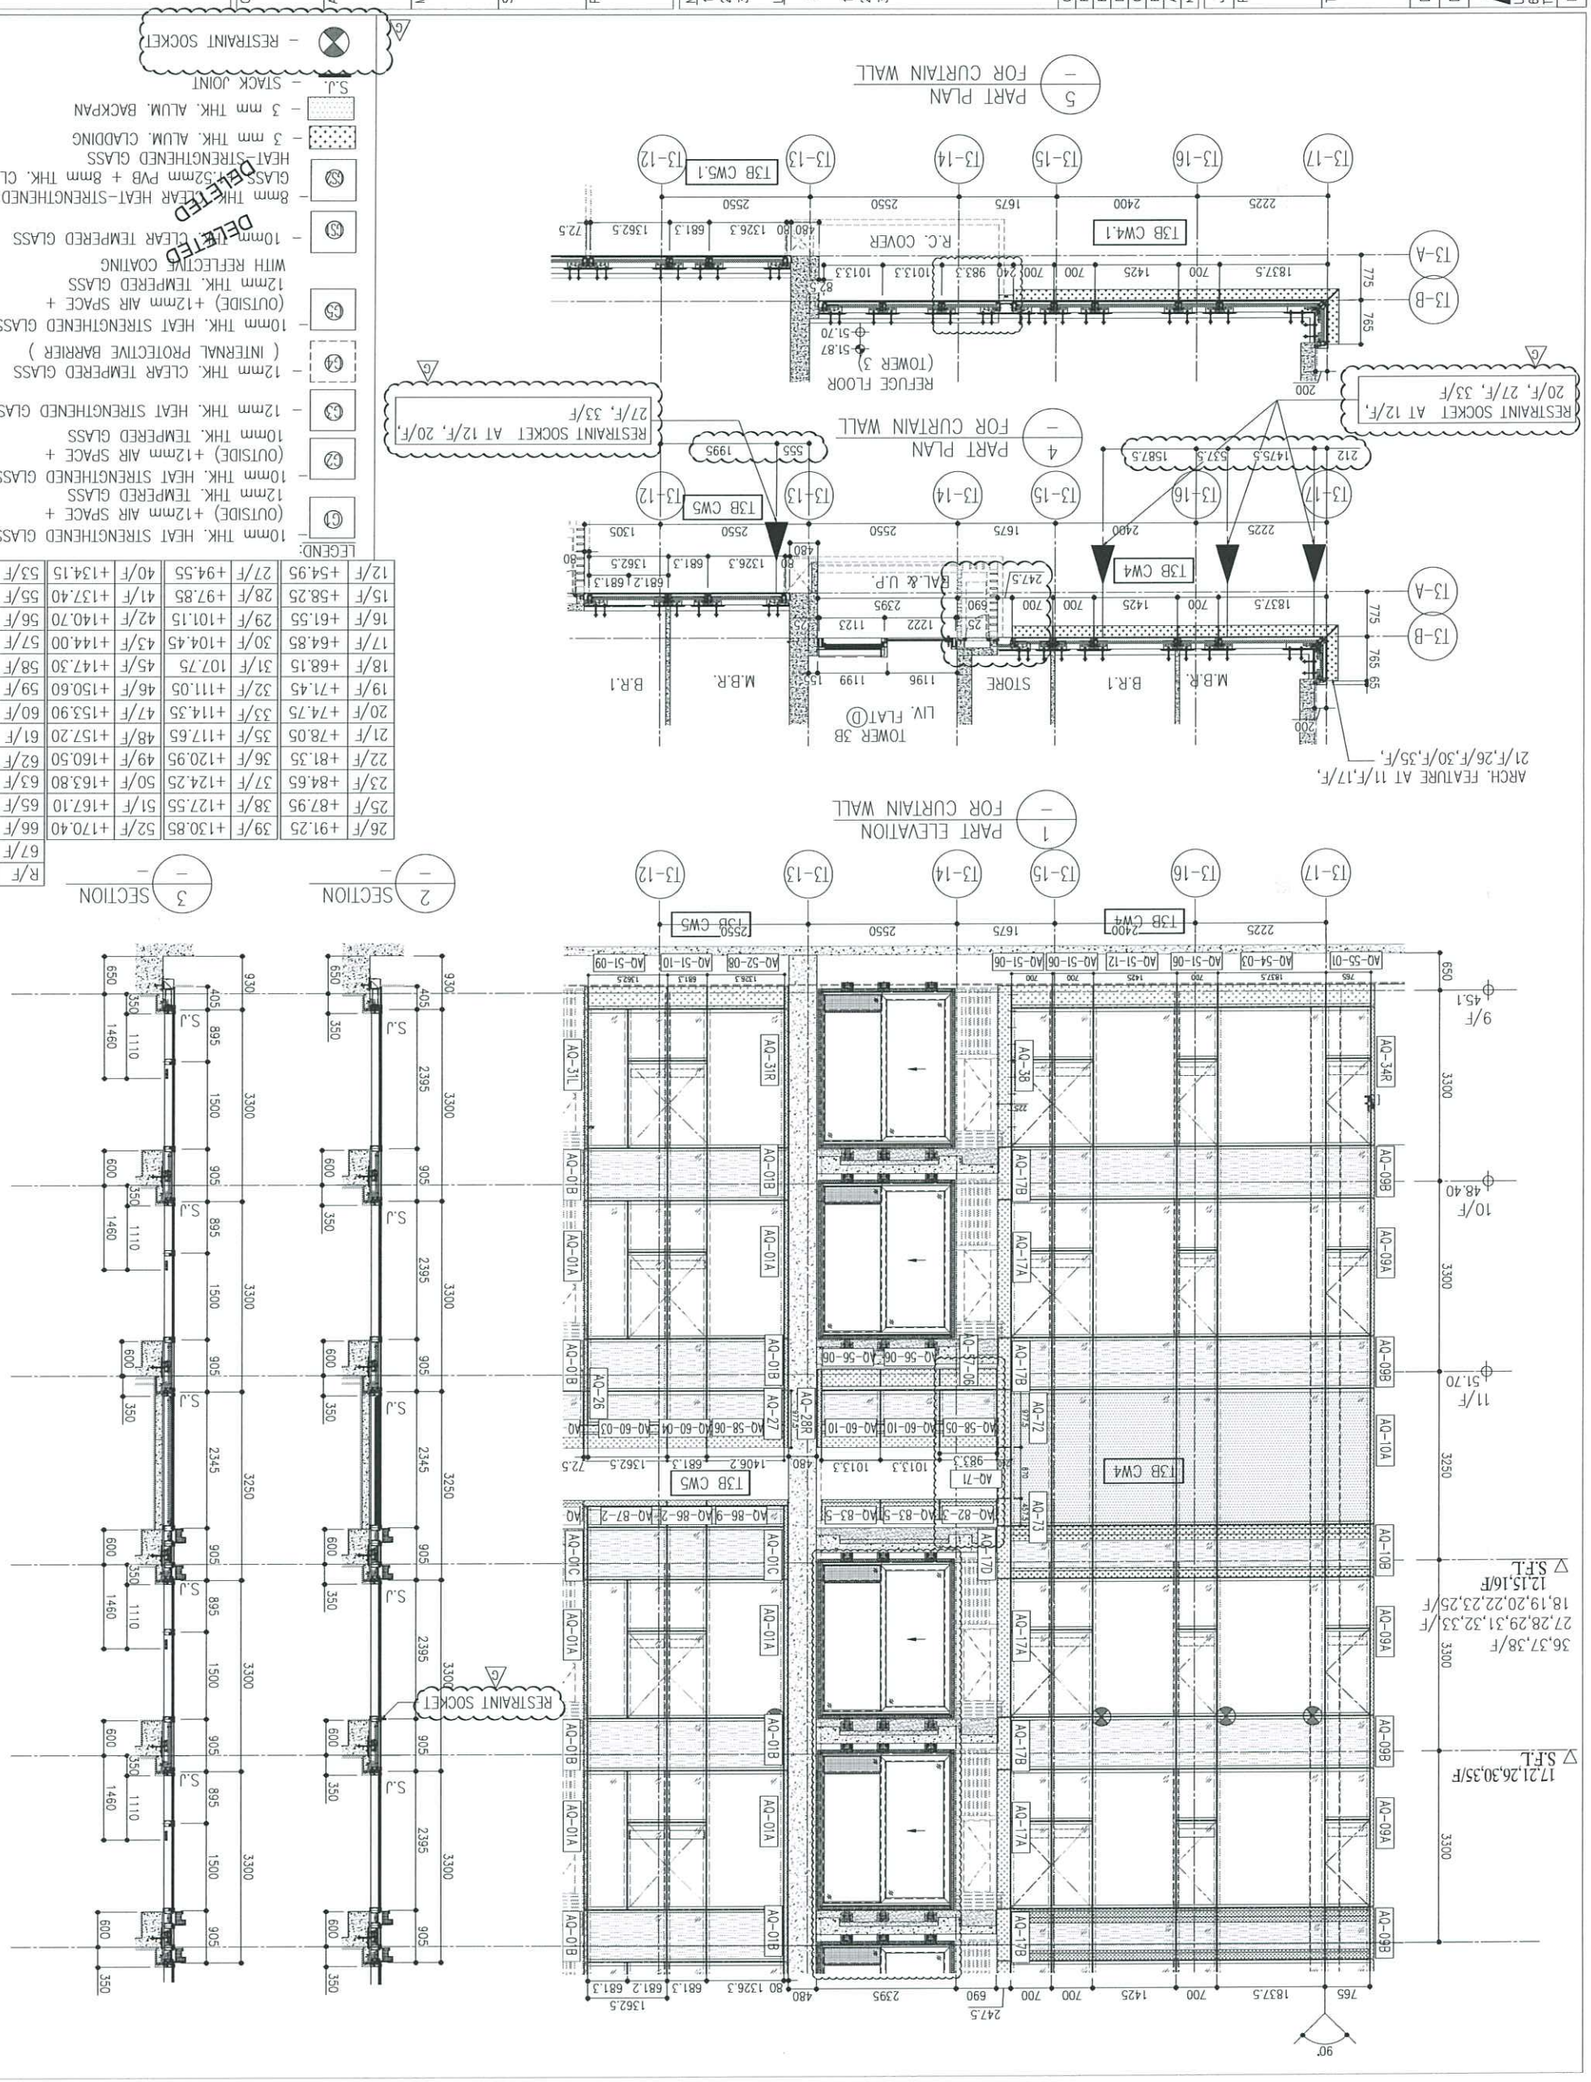

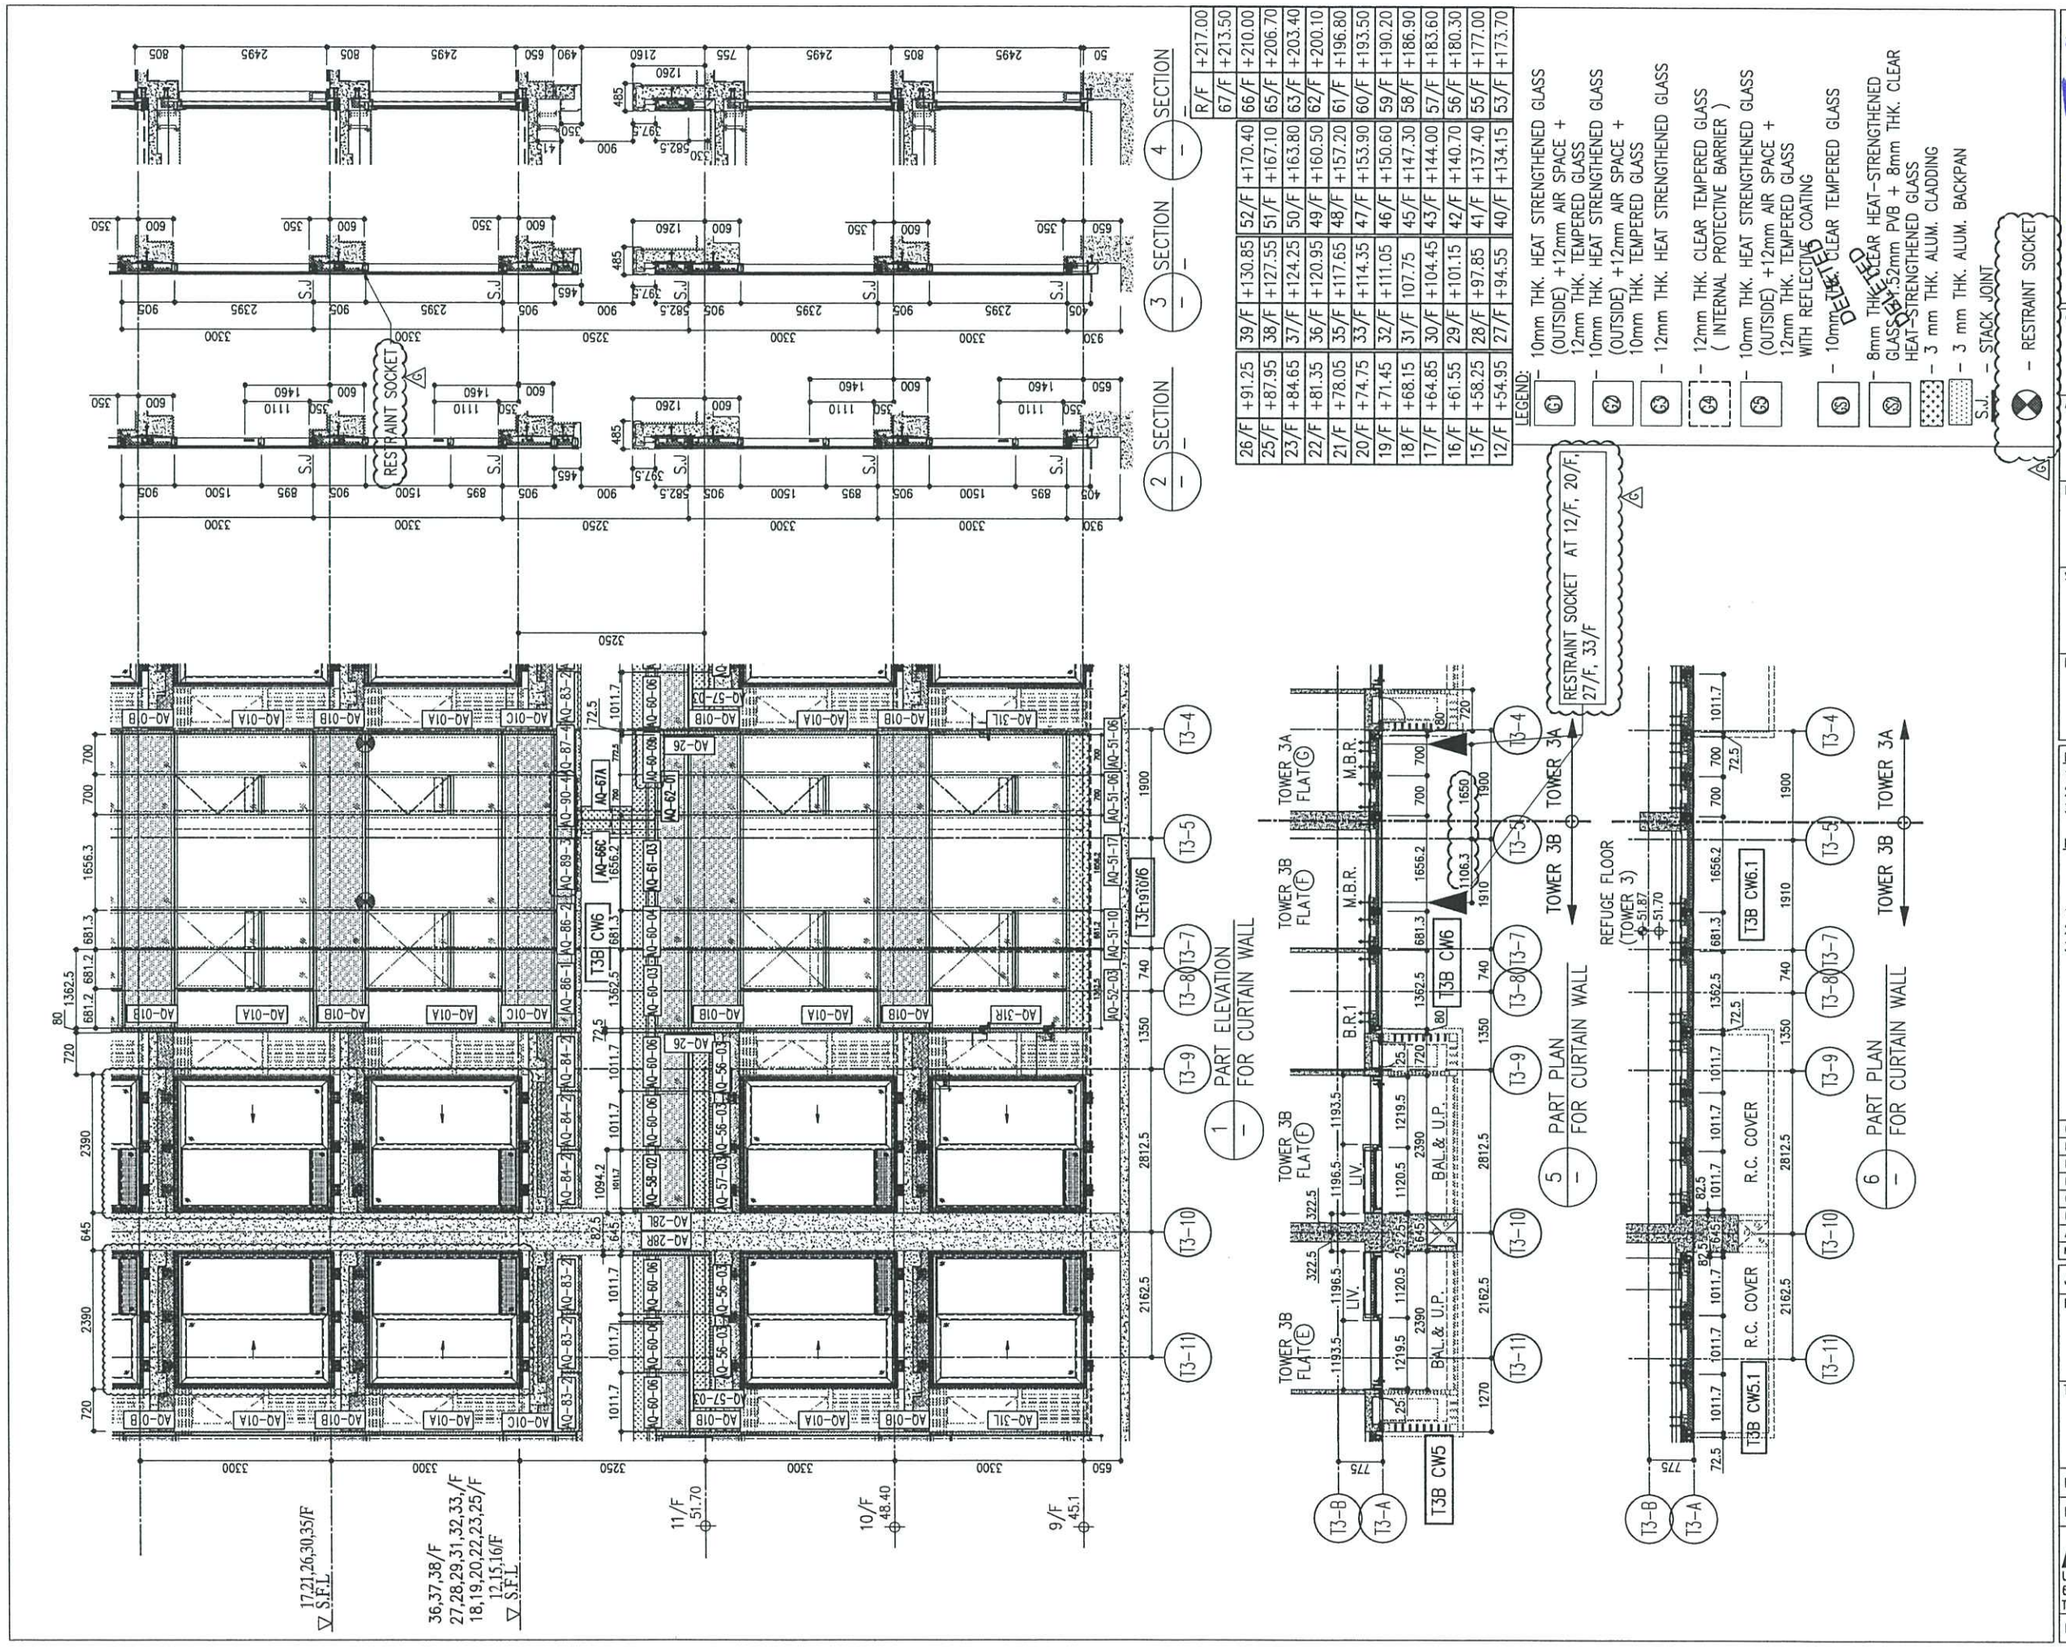

R/F	+217.00
67/F	+213.50
66/F	+210.00
65/F	+206.70
63/F	+203.40
62/F	+200.10
61/F	+196.80
60/F	+193.50
59/F	+190.20
58/F	+186.90
57/F	+183.60
56/F	+180.30
55/F	+177.00
53/F	+173.70
52/F	+170.40
51/F	+167.10
50/F	+163.80
49/F	+160.50
48/F	+157.20
47/F	+153.90
46/F	+150.60
45/F	+147.30
43/F	+144.00
42/F	+140.70
41/F	+137.40
40/F	+134.15
39/F	+130.85
38/F	+127.55
37/F	+124.25
36/F	+120.95
35/F	+117.65
33/F	+114.35
32/F	+111.05
31/F	107.75
30/F	+104.45
29/F	+101.15
28/F	+97.85
27/F	+94.55
26/F	+91.25
25/F	+87.95
23/F	+84.65
22/F	+81.35
21/F	+78.05
20/F	+74.75
19/F	+71.45
18/F	+68.15
17/F	+64.85
16/F	+61.55
15/F	+58.25
12/F	+54.95

LEGEND:

- (C1) – 10mm THK. HEAT STRENGTHENED GLASS (OUTSIDE) +12mm AIR SPACE + 12mm THK. TEMPERED GLASS
- (G2) – 10mm THK. HEAT STRENGTHENED GLASS (OUTSIDE) +12mm AIR SPACE + 10mm THK. TEMPERED GLASS
- (G3) – 12mm THK. HEAT STRENGTHENED GLASS
- (G4) – 12mm THK. CLEAR TEMPERED GLASS (INTERNAL PROTECTIVE BARRIER)
- (G5) – 10mm THK. HEAT STRENGTHENED GLASS (OUTSIDE) +12mm AIR SPACE + 12mm THK. TEMPERED GLASS WITH REFLECTIVE COATING
- (G6) – 10mm THK. CLEAR TEMPERED GLASS
- (G7) – 8mm THK. CLEAR HEAT-STRENGTHENED GLASS + 52mm PVB + 8mm THK. CLEAR HEAT-STRENGTHENED GLASS
- S.J. – 3 mm THK. CLADDING
- S.J. – 3 mm THK. ALUM. BACKPAN
- S.J. – STACK JOINT
- G – RESTRAINT SOCKET

[RESTRAINT SOCKET AT 12/F, 20/F, 27/F, 33/F]

DELETED

B.D. REF :

T3B T3A

CLIENT :
信和置業有限公司
Sino Land Company Limited

ARCHITECT :
ronald lu & partners
Architects, Planners, Interior Designers
Ronald Lu & Partners (HK) Ltd.
呂元祥建築師事務所(香港)有限公司

MAIN CONTRACTOR :
Gammon

STRUCTURAL ENGINEER :
AECOM

FACADE CONSULTANT:
AECOM

NOTE :
1. ALL DIMENSIONS ARE IN mm.
2. ALL ELEVATIONS ARE VIEWED FROM OUTSIDE.
3. ALL DIMENSIONS TO BE VERIFIED ON SITE BEFORE FABRICATION.

LEGEND :
- (X1 / X001) — X1: DETAIL MARK NO.; X001: REFER SHEET NO.
1. F.F.L. --- FINISHED FLOOR LEVEL
2. S.F.L. --- STRUCTURAL FLOOR LEVEL
3. (/R) --- REVERSED DETAIL

NO.	DATE	REVISED	BY
G	18/08/22	REVISED AS PER COMMENTS	LS
F	25/07/22	REVISED AS PER COMMENTS	LS
E	25/05/22	REVISED AS PER COMMENTS	LS
D	22/04/06	REVISED AS PER COMMENTS	LS
C	22/01/22	REVISED AS PER COMMENTS	LS
B	20/12/21	REVISED AS PER COMMENTS	LS
A	03/12/21	REVISED AS PER COMMENTS	LS

JOB NO. : J-858

PROJECT :
PROPOSED RESIDENTIAL DEVELOPMENT
AT TKOTL 70RP, PHASE 11, LOHAS PARK
TSEUNG KWAN O, N.T.

TITLE :
TYPICAL FLOOR PARTIAL ELEVATION & SECTION, PLAN FOR CURTAIN WALL (TOWER 3)

DATE : 22-OCT-21 | SCALE : 1:50(A1)

DRAWN BY : | CHECKED BY :

美特鋁質有限公司
MIDI ALUMINIUM FABRICATOR LTD.
Units 6-8, Sunray Industrial Centre, 1/F
610 Cha Kwo Ling Road, Kowloon
Tel:23489211-4 Fax:(852)27727665

DWG NO. : J858-CW-PE308 | REV. : G

B.D. REF :

CLIENT : 信和置業有限公司 Sino Land Company Limited

ARCHITECT : ronald lu & partners (HK) Ltd. 呂元祥建築師事務所(香港)有限公司

MAIN CONTRACTOR : Gammon

STRUCTURAL ENGINEER : AECOM

FACADE CONSULTANT : AECOM

NOTE :
1. ALL DIMENSIONS ARE IN mm.
2. ALL ELEVATIONS ARE VIEWED FROM OUTSIDE.
3. ALL DIMENSIONS TO BE VERIFIED ON SITE BEFORE FABRICATION.

LEGEND :
- (X1) (X001) — DETAIL MARK NO. / REFER SHEET NO.
1. F.F.L. —FINISHED FLOOR LEVEL
2. S.F.L. —STRUCTURAL FLOOR LEVEL
3. (R) —REVERSED DETAIL

NO.	DATE	REVISED	BY
G	18/08/22	REVISED AS PER COMMENTS	LS
F	26/07/22	REVISED AS PER COMMENTS	LS
E	25/05/22	REVISED AS PER COMMENTS	LS
D	22/04/06	REVISED AS PER COMMENTS	LS
C	22/01/22	REVISED AS PER COMMENTS	LS
B	20/12/21	REVISED AS PER COMMENTS	LS
A	03/12/21	REVISED AS PER COMMENTS	LS

JOB NO. : J-858

PROJECT : PROPOSED RESIDENTIAL DEVELOPMENT AT TKOTL 70RP, PHASE 11, LOHAS PARK TSEUNG KWAN O, N.T.

TITLE : TYPICAL FLOOR PARTIAL ELEVATION & SECTION, PLAN FOR CURTAIN WALL (TOWER 3)

DATE : 22-OCT-21 | SCALE : 1:50(A1)

DRAWN BY : | CHECKED BY :

美特鋁廠有限公司 MIDI ALUMINUM FABRICATOR LTD.
Units 6-8, Sunray Industrial Centre, 1/F
610 Cha Kwo Ling Road, Kowloon
Tel:23489211-4 Fax:(852)27727666

DWG NO. : J858-CW-PE309 | REV. : G

4

73A

6 PART PLAN — FOR CURTAIN WALL

5 PART PLAN — FOR CURTAIN WALL

1 PART ELEVATION — FOR CURTAIN WALL

2 SECTION — 3 SECTION — 4 SECTION

RESTRAINT SOCKET

S.J. — STACK JOINT

3 mm THK. ALUM. BACKPAN

3 mm THK. ALUM. CLADDING

8mm THK. CLEAR HEAT-STRENGTHENED GLASS +52mm PVB + 8mm THK. CLEAR HEAT-STRENGTHENED GLASS (DELETED)

10mm THK. CLEAR TEMPERED GLASS (DELETED)

10mm THK. HEAT STRENGTHENED GLASS (OUTSIDE) +12mm AIR SPACE + 12mm THK. TEMPERED GLASS WITH REFLECTIVE COATING

12mm THK. CLEAR TEMPERED GLASS (INTERNAL PROTECTIVE BARRIER)

10mm THK. HEAT STRENGTHENED GLASS (OUTSIDE) +12mm AIR SPACE + 12mm THK. TEMPERED GLASS

12mm THK. HEAT STRENGTHENED GLASS

10mm THK. HEAT STRENGTHENED GLASS (OUTSIDE) +12mm AIR SPACE + 12mm THK. TEMPERED GLASS

LEGEND:

26/F	+91.25	39/F	+130.85	52/F	+170.40	66/F	+210.00	R/F	+217.00
25/F	+87.95	38/F	+127.55	51/F	+167.10	65/F	+206.70	67/F	+213.50
24/F	+84.65	37/F	+124.25	50/F	+163.80	63/F	+203.40		
23/F	+81.35	36/F	+120.95	49/F	+160.50	62/F	+200.10		
22/F	+78.05	35/F	+117.65	48/F	+157.20	61/F	+196.80		
21/F	+74.75	34/F	+114.35	47/F	+153.90	60/F	+193.50		
20/F	+71.45	33/F	+111.05	46/F	+150.60	59/F	+190.20		
19/F	+68.15	32/F	+107.75	45/F	+147.30	58/F	+186.90		
18/F	+64.85	31/F	+104.45	43/F	+144.00	57/F	+183.60		
17/F	+61.55	30/F	+101.15	42/F	+140.70	56/F	+180.30		
16/F	+58.25	29/F	+97.85	41/F	+137.40	55/F	+177.00		
15/F	+54.95	28/F	+94.55	40/F	+134.15	53/F	+173.70		
12/F		27/F							

RESTRAINT SOCKET AT 12/F, 20/F, 27/F, 33/F

ARCH. FEATURE AT 9/F,10/F, 12/F,15/F-16/F, 18/F-20/F, 22/F,23/F, 25/F, 27/F-29/F, 31/F-33/F,36/F-38/F

ARCH. FEATURE AT 11/F,17/F, 21/F,26/F,30/F,35/F,

RESTRAINT SOCKET AT 12/F, 20/F, 33/F

T3A CW5.1 | T3A CW6.1 | T3A CW5 | T3A CW6

T3-1 T3-2 T3-3 T3-4 T3-2b

R.C. COVER | R.C. COVER

REFUGE FLOOR (TOWER 3)

30000L DRENCHER WATER TANK

TOWER 3A FLAT(G) | TOWER 3A FLAT(F) | LIV. | B.R.1 | M.B.R.


BAL.& U.P. | BAL.& U.P.

AQ-34L | AQ-31R | AQ-03B | AQ-01B | AQ-09A | AQ-01A | AQ-09B | AQ-01B | AQ-10A | AQ-10C | AQ-10B | AQ-01B | AQ-09A | AQ-01A | AQ-09B | AQ-01B | AQ-09A | AQ-01A | AQ-09B | AQ-01B


AQ-35L | AQ-01B | AQ-01A | AQ-01B | AQ-57-03 | AQ-56-03 | AQ-26 | AQ-28R | AQ-01C | AQ-01A | AQ-01B | AQ-01A | AQ-01B

AQ-51-06 | AQ-52-03 | AQ-51-10 | AQ-53-01 | AQ-54-02

9/F 45.1
10/F 48.40
11/F 51.70
S.F.L. 12,15,16/F 18,19,20,22,23,25/F 27,28,29,31,32,33,/F 36,37,38/F
S.F.L. 17,21,26,30,35/F

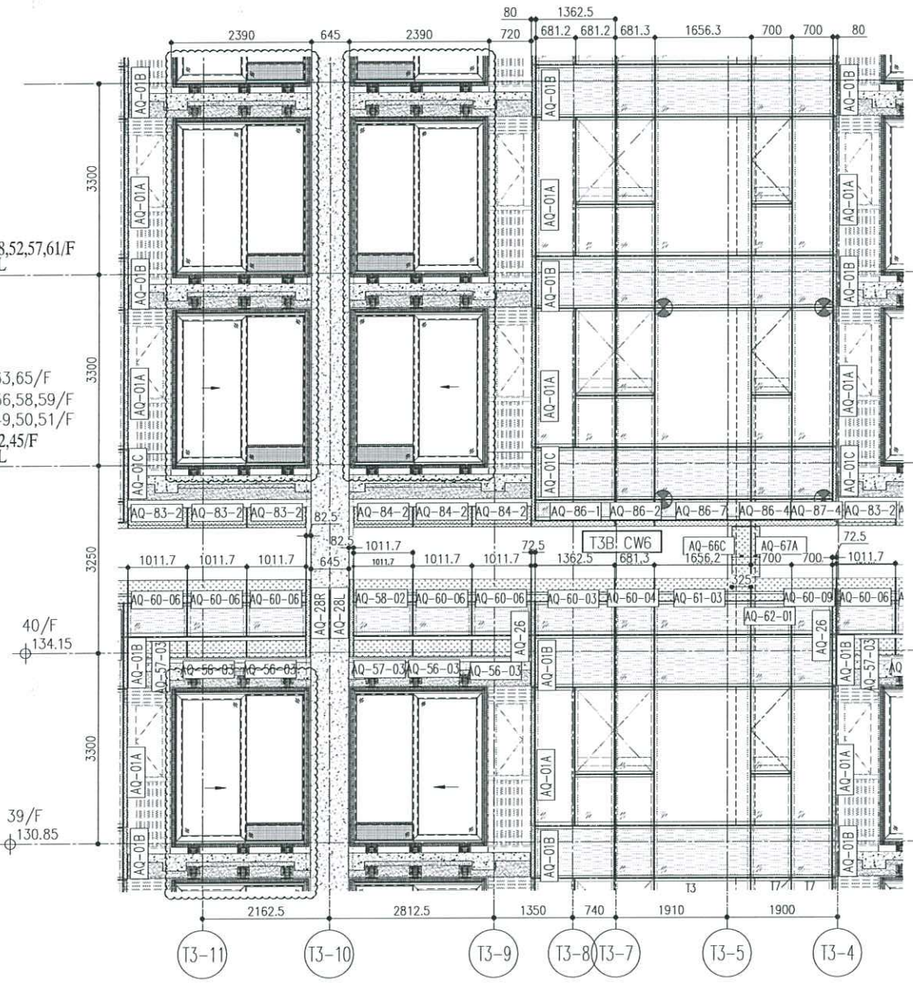


1 PART ELEVATION FOR CURTAIN WALL

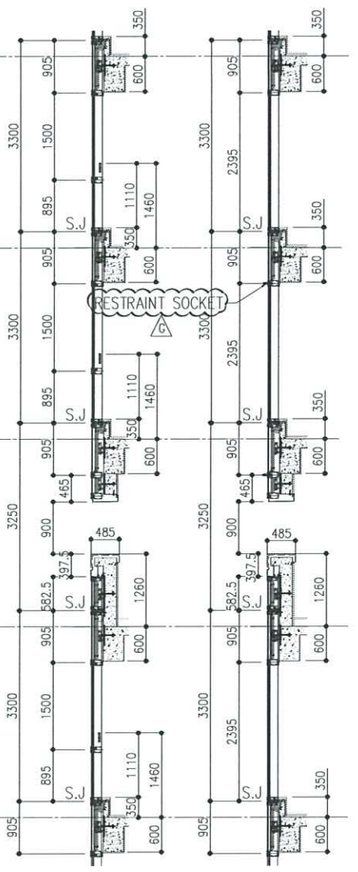


2 SECTION

3 SECTION

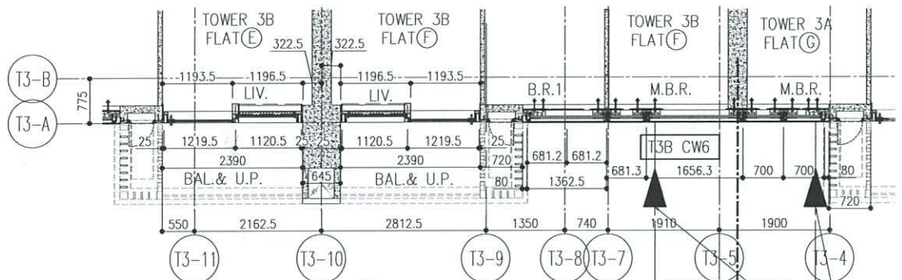

4 PART PLAN FOR CURTAIN WALL

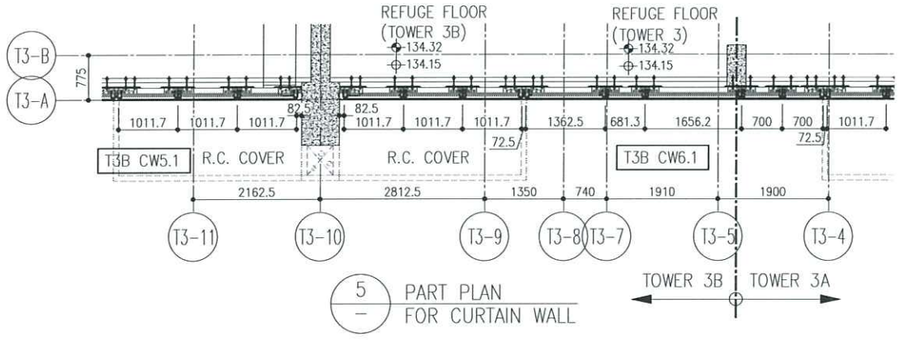

5 PART PLAN FOR CURTAIN WALL

RESTRAINT SOCKET AT 40/F, 47/F, 53/F, 60/F

						R/F	+217.00
						67/F	+213.50
26/F	+91.25	39/F	+130.85	52/F	+170.40	66/F	+210.00
25/F	+87.95	38/F	+127.55	51/F	+167.10	65/F	+206.70
23/F	+84.65	37/F	+124.25	50/F	+163.80	63/F	+203.40
22/F	+81.35	36/F	+120.95	49/F	+160.50	62/F	+200.10
21/F	+78.05	35/F	+117.65	48/F	+157.20	61/F	+196.80
20/F	+74.75	33/F	+114.35	47/F	+153.90	60/F	+193.50
19/F	+71.45	32/F	+111.05	46/F	+150.60	59/F	+190.20
18/F	+68.15	31/F	107.75	45/F	+147.30	58/F	+186.90
17/F	+64.85	30/F	+104.45	43/F	+144.00	57/F	+183.60
16/F	+61.55	29/F	+101.15	42/F	+140.70	56/F	+180.30
15/F	+58.25	28/F	+97.85	41/F	+137.40	55/F	+177.00
12/F	+54.95	27/F	+94.55	40/F	+134.15	53/F	+173.70

LEGEND:

- G1 – 10mm THK. HEAT STRENGTHENED GLASS (OUTSIDE) +12mm AIR SPACE + 12mm THK. TEMPERED GLASS
- G2 – 10mm THK. HEAT STRENGTHENED GLASS (OUTSIDE) +12mm AIR SPACE + 10mm THK. TEMPERED GLASS
- G3 – 12mm THK. HEAT STRENGTHENED GLASS
- G4 – 12mm THK. CLEAR TEMPERED GLASS (INTERNAL PROTECTIVE BARRIER)
- G5 – 10mm THK. HEAT STRENGTHENED GLASS (OUTSIDE) +12mm AIR SPACE + 12mm THK. TEMPERED GLASS WITH REFLECTIVE COATING
- S1 – 10mm THK. CLEAR TEMPERED GLASS DELETED
- S2 – 8mm THK. CLEAR HEAT-STRENGTHENED GLASS + 1.52mm PVB + 8mm THK. CLEAR HEAT-STRENGTHENED GLASS DELETED
- 3 mm THK. ALUM. CLADDING
- 3 mm THK. ALUM. BACKPAN
- S.J. – STACK JOINT
- G – RESTRAINT SOCKET

NOTE:
1. ALL DIMENSIONS ARE IN mm.
2. ALL ELEVATIONS ARE VIEWED FROM OUTSIDE.
3. ALL DIMENSIONS TO BE VERIFIED ON SITE BEFORE FABRICATION.

LEGEND:
- (X1) / (XG01) — DETAIL MARK NO. / REFER SHEET NO.
- F.F.L. --FINISHED FLOOR LEVEL
- S.F.L. --STRUCTURAL FLOOR LEVEL
- (R) --REVERSED DETAIL

NO.	DATE	REVISED	BY
G	18/08/22	REVISED AS PER COMMENTS	LS
F	26/07/22	REVISED AS PER COMMENTS	LS
E	25/05/22	REVISED AS PER COMMENTS	LS
D	22/04/06	REVISED AS PER COMMENTS	LS
C	22/01/22	REVISED AS PER COMMENTS	LS
B	20/12/21	REVISED AS PER COMMENTS	LS
A	03/12/21	REVISED AS PER COMMENTS	LS

JOB NO. : J-858

PROJECT :
PROPOSED RESIDENTIAL DEVELOPMENT
AT TKOTL 70RP, PHASE 11, LOHAS PARK
TSEUNG KWAN O, N.T.

TITLE :
TYPICAL FLOOR PARTIAL
ELEVATION & SECTION, PLAN
FOR CURTAIN WALL (TOWER 3)

DATE : 22-OCT-21 | SCALE : 1:50(A1)
DRAWN BY : | CHECKED BY :
DWG NO. : J858-CW-PE311 | REV. : G

美特鋁質有限公司 MIDI ALUMINIUM FABRICATOR LTD.
Units 6-8, Sunray Industrial Centre, 1/F
610 Cha Kwo Ling Road, Kowloon
Tel:23489211-4 Fax:(852)27727666

B.D. REF :

CLIENT : 信和置業有限公司 Sino Land Company Limited


ARCHITECT : ronald lu & partners 呂元祥建築師事務所(香港) Ronald Lu & Partners (HK) Ltd.

MAIN CONTRACTOR : Gammon

STRUCTURAL ENGINEER : AECOM

FACADE CONSULTANT: AECOM


42

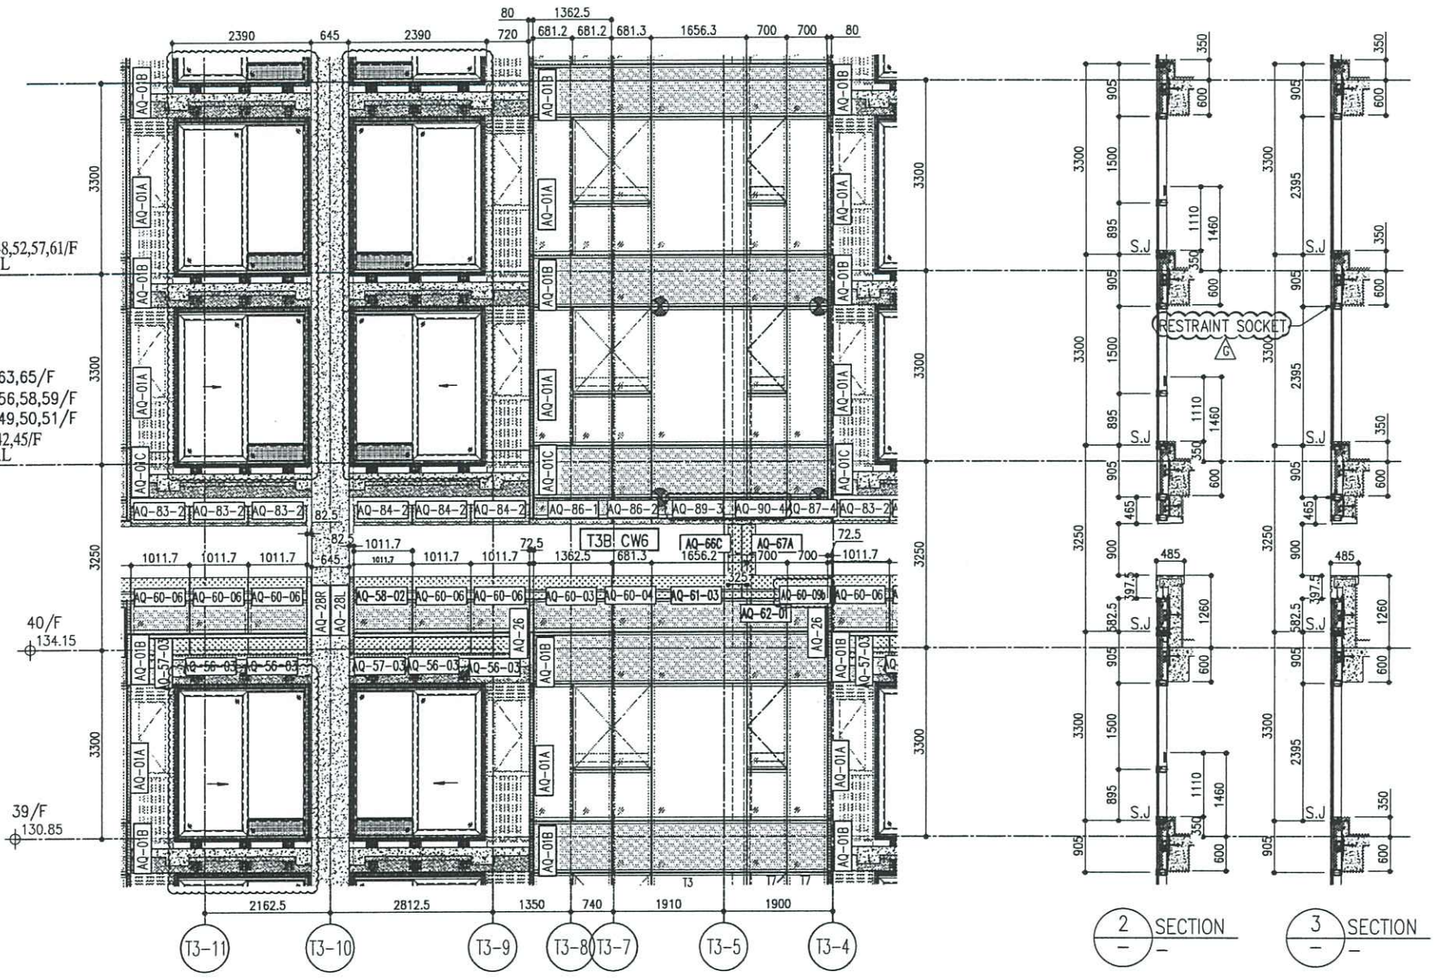

1 / – PART ELEVATION FOR CURTAIN WALL


2 / – SECTION

3 / – SECTION

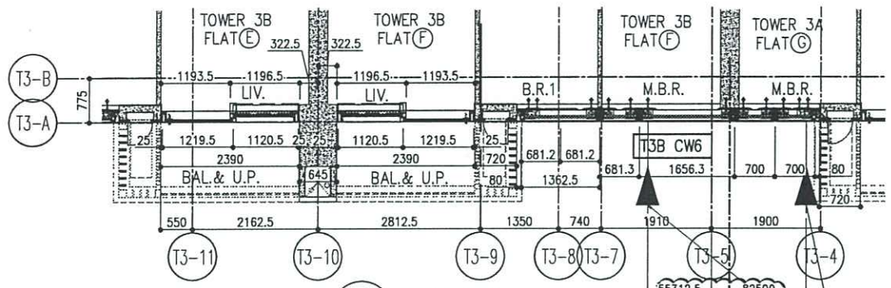

4 / – PART PLAN FOR CURTAIN WALL

RESTRAINT SOCKET AT 40/F, 47/F, 53/F, 60/F

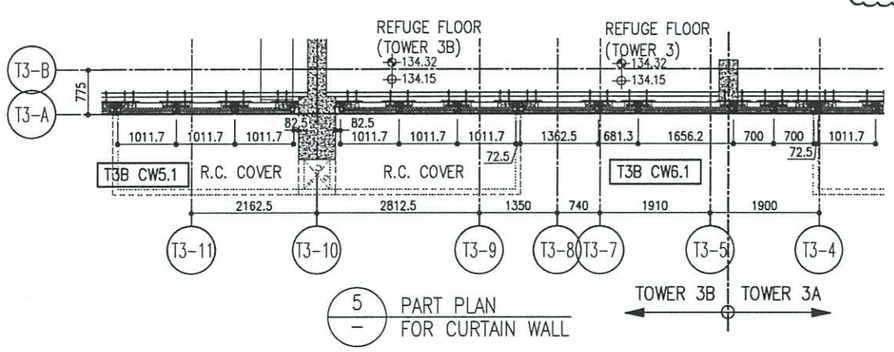

5 / – PART PLAN FOR CURTAIN WALL

						R/F	+217.00
						67/F	+213.50
26/F	+91.25	39/F	+130.85	52/F	+170.40	66/F	+210.00
25/F	+87.95	38/F	+127.55	51/F	+167.10	65/F	+206.70
23/F	+84.65	37/F	+124.25	50/F	+163.80	63/F	+203.40
22/F	+81.35	36/F	+120.95	49/F	+160.50	62/F	+200.10
21/F	+78.05	35/F	+117.65	48/F	+157.20	61/F	+196.80
20/F	+74.75	33/F	+114.35	47/F	+153.90	60/F	+193.50
19/F	+71.45	32/F	+111.05	46/F	+150.60	59/F	+190.20
18/F	+68.15	31/F	107.75	45/F	+147.30	58/F	+186.90
17/F	+64.85	30/F	+104.45	43/F	+144.00	57/F	+183.60
16/F	+61.55	29/F	+101.15	42/F	+140.70	56/F	+180.30
15/F	+58.25	28/F	+97.85	41/F	+137.40	55/F	+177.00
12/F	+54.95	27/F	+94.55	40/F	+134.15	53/F	+173.70

LEGEND:

- G1 – 10mm THK. HEAT STRENGTHENED GLASS (OUTSIDE) +12mm AIR SPACE + 12mm THK. TEMPERED GLASS
- G2 – 10mm THK. HEAT STRENGTHENED GLASS (OUTSIDE) +12mm AIR SPACE + 10mm THK. TEMPERED GLASS
- G3 – 12mm THK. HEAT STRENGTHENED GLASS
- G4 – 12mm THK. CLEAR TEMPERED GLASS (INTERNAL PROTECTIVE BARRIER)
- G5 – 10mm THK. HEAT STRENGTHENED GLASS (OUTSIDE) +12mm AIR SPACE + 12mm THK. TEMPERED GLASS WITH REFLECTIVE COATING
- G6 – 10mm THK. CLEAR TEMPERED GLASS
- G7 – 8mm THK. CLEAR HEAT-STRENGTHENED GLASS + 1.52mm PVB + 8mm THK. CLEAR HEAT-STRENGTHENED GLASS
- 3 mm THK. ALUM. CLADDING
- 3 mm THK. ALUM. BACKPAN
- S.J. – STACK JOINT
- G – RESTRAINT SOCKET

DELETED

NOTE:
1. ALL DIMENSIONS ARE IN mm.
2. ALL ELEVATIONS ARE VIEWED FROM OUTSIDE.
3. ALL DIMENSIONS TO BE VERIFIED ON SITE BEFORE FABRICATION.

LEGEND:
- X1 (X001) — DETAIL MARK NO. / REFER SHEET NO.
- F.F.L. — FINISHED FLOOR LEVEL
- S.F.L. — STRUCTURAL FLOOR LEVEL
- (R) — REVERSED DETAIL

NO.	DATE	REVISED	BY
G	18/08/22	REVISED AS PER COMMENTS	LS
F	26/07/22	REVISED AS PER COMMENTS	LS
E	25/05/22	REVISED AS PER COMMENTS	LS
D	22/04/06	REVISED AS PER COMMENTS	LS
C	22/01/22	REVISED AS PER COMMENTS	LS
B	20/12/21	REVISED AS PER COMMENTS	LS
A	03/12/21	REVISED AS PER COMMENTS	LS

JOB NO. : J-858

PROJECT :
PROPOSED RESIDENTIAL DEVELOPMENT AT TKOTL 70RP, PHASE 11, LOHAS PARK TSEUNG KWAN O, N.T.

TITLE :
TYPICAL FLOOR PARTIAL ELEVATION & SECTION, PLAN FOR CURTAIN WALL (TOWER 3)

DATE : 22-OCT-21 | SCALE : 1:50(A1)


DRAWN BY : | CHECKED BY :

DWG NO. : J858-CW-PE311 | REV. : G

美特鋁質有限公司 MIDI ALUMINIUM FABRICATOR LTD.
Units 6-8, Sunray Industrial Centre, 1/F
610 Cho Kwo Ling Road, Kowloon
Tel:2348211-4 Fax:(852)27727666

CONSULTANTS:
FACADE CONSULTANT: AECOM
STRUCTURAL ENGINEER: AECOM
MAIN CONTRACTOR: Gammon
ARCHITECT: ronald lu & partners (HK) Ltd. 呂元祥建築師事務所(香港)有限公司
CLIENT: 信和置業有限公司 Sino Land Company Limited

B.D. REF :

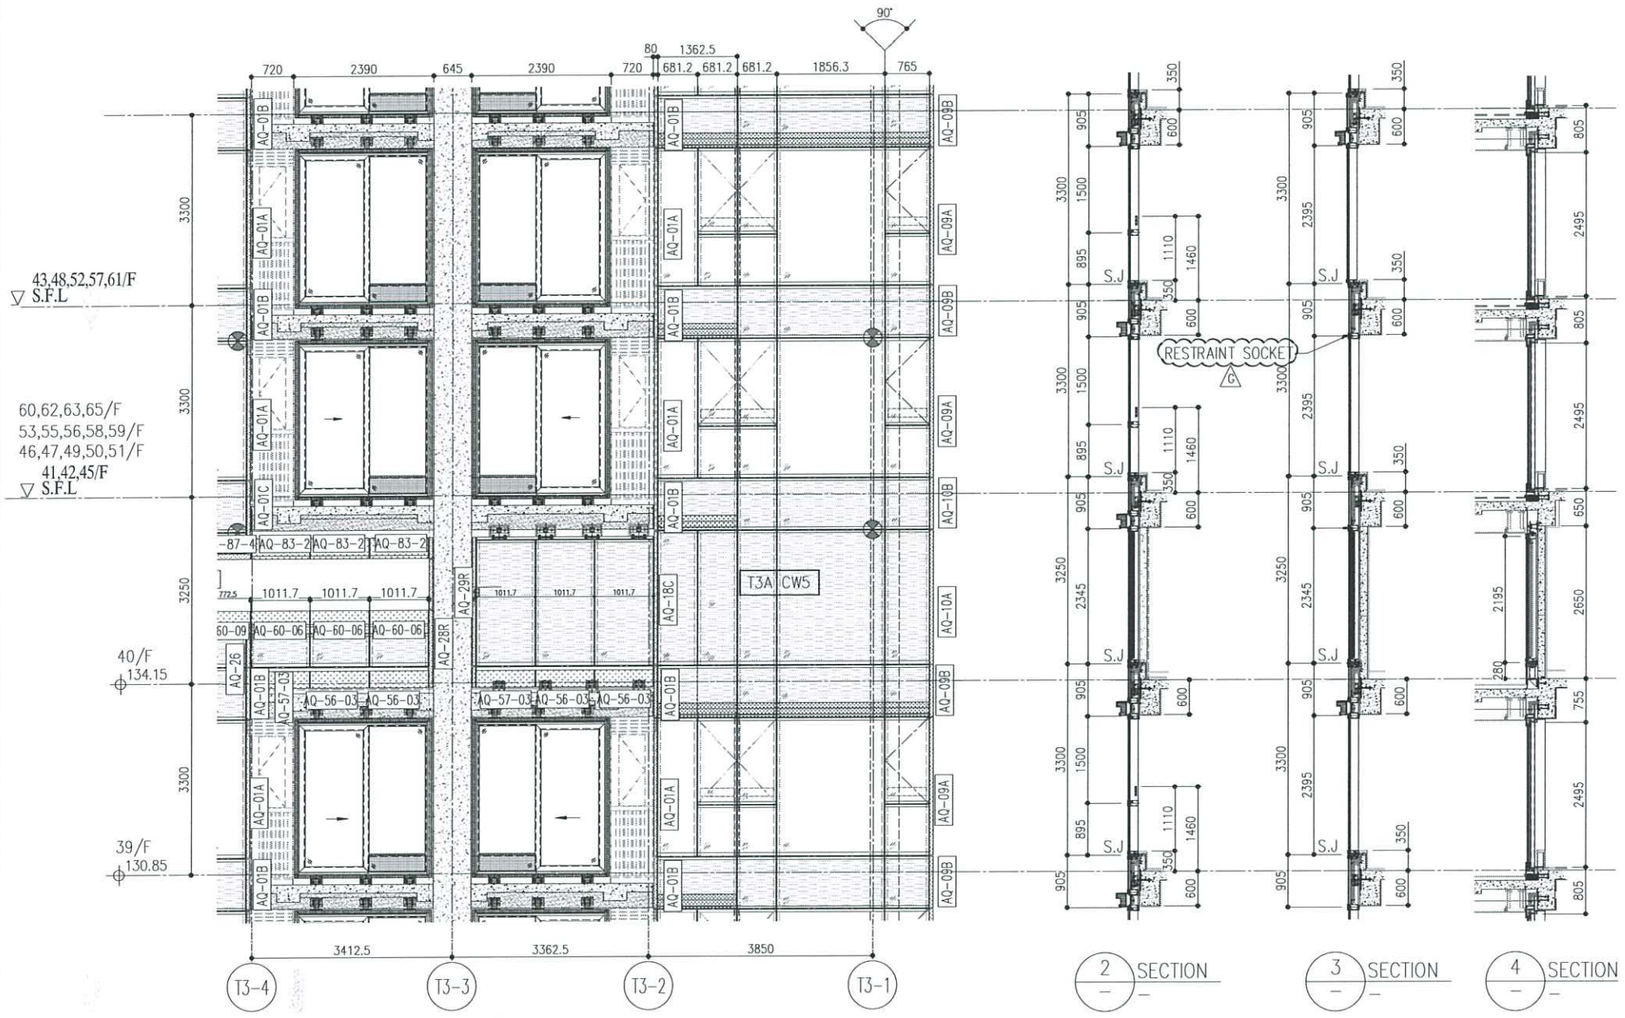


1 PART ELEVATION FOR CURTAIN WALL

2 SECTION

3 SECTION

4 SECTION

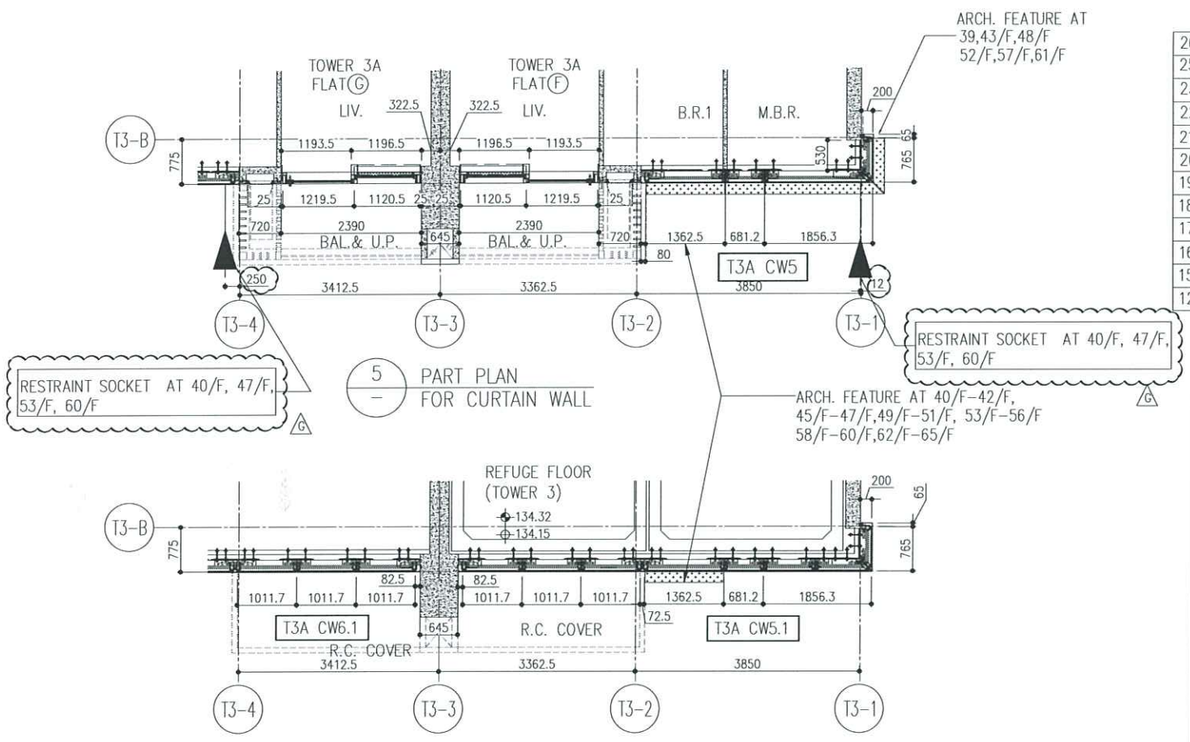

5 PART PLAN FOR CURTAIN WALL

6 PART PLAN FOR CURTAIN WALL

						R/F	+217.00
						67/F	+213.50
26/F	+91.25	39/F	+130.85	52/F	+170.40	66/F	+210.00
25/F	+87.95	38/F	+127.55	51/F	+167.10	65/F	+206.70
23/F	+84.65	37/F	+124.25	50/F	+163.80	63/F	+203.40
22/F	+81.35	36/F	+120.95	49/F	+160.50	62/F	+200.10
21/F	+78.05	35/F	+117.65	48/F	+157.20	61/F	+196.80
20/F	+74.75	33/F	+114.35	47/F	+153.90	60/F	+193.50
19/F	+71.45	32/F	+111.05	46/F	+150.60	59/F	+190.20
18/F	+68.15	31/F	107.75	45/F	+147.30	58/F	+186.90
17/F	+64.85	30/F	+104.45	43/F	+144.00	57/F	+183.60
16/F	+61.55	29/F	+101.15	42/F	+140.70	56/F	+180.30
15/F	+58.25	28/F	+97.85	41/F	+137.40	55/F	+177.00
12/F	+54.95	27/F	+94.55	40/F	+134.15	53/F	+173.70

LEGEND:

- G1 – 10mm THK. HEAT STRENGTHENED GLASS (OUTSIDE) +12mm AIR SPACE + 12mm THK. TEMPERED GLASS
- G2 – 10mm THK. HEAT STRENGTHENED GLASS (OUTSIDE) +12mm AIR SPACE + 10mm THK. TEMPERED GLASS
- G3 – 12mm THK. HEAT STRENGTHENED GLASS
- G4 – 12mm THK. CLEAR TEMPERED GLASS (INTERNAL PROTECTIVE BARRIER)
- G5 – 10mm THK. HEAT STRENGTHENED GLASS (OUTSIDE) +12mm AIR SPACE + 12mm THK. TEMPERED GLASS WITH REFLECTIVE COATING
- G6 – 10mm THK. CLEAR TEMPERED GLASS DELETED
- G7 – 8mm THK. CLEAR HEAT-STRENGTHENED GLASS +1.52mm PVB + 8mm THK. CLEAR HEAT-STRENGTHENED GLASS DELETED
- 3 mm THK. ALUM. CLADDING
- 3 mm THK. ALUM. BACKPAN
- S.J. – STACK JOINT
- G – RESTRAINT SOCKET

NOTE :
1. ALL DIMENSIONS ARE IN mm.
2. ALL ELEVATIONS ARE VIEWED FROM OUTSIDE.
3. ALL DIMENSIONS TO BE VERIFIED ON SITE BEFORE FABRICATION.

LEGEND :
- X1 / V00 – DETAIL MARK NO. / REFER SHEET NO.
- F.F.L. – FINISHED FLOOR LEVEL
- S.F.L. – STRUCTURAL FLOOR LEVEL
- /R – REVERSED DETAIL

NO.	DATE	REVISED	BY
G	18/08/22	REVISED AS PER COMMENTS	LS
F	26/07/22	REVISED AS PER COMMENTS	LS
E	25/05/22	REVISED AS PER COMMENTS	LS
D	22/04/06	REVISED AS PER COMMENTS	LS
C	22/01/22	REVISED AS PER COMMENTS	LS
B	20/12/21	REVISED AS PER COMMENTS	LS
A	03/12/21	REVISED AS PER COMMENTS	LS

JOB NO. : J-858

PROJECT :
PROPOSED RESIDENTIAL DEVELOPMENT AT TKOTL 70RP, PHASE 11, LOHAS PARK TSEUNG KWAN O, N.T.

TITLE :
TYPICAL FLOOR PARTIAL ELEVATION & SECTION, PLAN FOR CURTAIN WALL (TOWER 3)

DATE : 22-OCT-21 | SCALE : 1:50(A1)

DRAWN BY : | CHECKED BY :

DWG NO. : J858-CW-PE312 | REV. : G

兆特鋁質有限公司
MIDI ALUMINIUM FABRICATOR LTD.
Units 6-8, Sunray Industrial Centre, 1/F
610 Cho Kwu Lung Road, Kowloon
Tel:23489211-4 Fax:(852)27727666

B.D. REF :

CLIENT : 信和置業有限公司 Sino Land Company Limited

ARCHITECT : ronald lu & partners (HK) Ltd.

MAIN CONTRACTOR : Gammon

STRUCTURAL ENGINEER : AECOM

FACADE CONSULTANT : AECOM

B.D. REF :

T3A

EOC

CLIENT :

信和置業有限公司
Sino Land Company Limited

ARCHITECT :

ronald lu & partners
Architects, Planners, Interior Designers
Ronald Lu & Partners (HK) Ltd.
呂元祥建築師事務所（香港）有限公司

MAIN CONTRACTOR :

Gammon

STRUCTURAL ENGINEER :

AECOM

FACADE CONSULTANT:

AECOM

NOTE :

1. ALL DIMENSIONS ARE IN mm.
2. ALL ELEVATIONS ARE VIEWED FROM OUTSIDE.
3. ALL DIMENSIONS TO BE VERIFIED ON SITE BEFORE FABRICATION.

LEGEND :

X1 — DETAIL MARK NO.
X001 — REFER SHEET NO.

1. F.F.L. --- FINISHED FLOOR LEVEL
2. S.F.L. --- STRUCTURAL FLOOR LEVEL
3. (R) --- REVERSED DETAIL

NO.	DATE	REVISED	BY
G	18/08/22	REVISED AS PER COMMENTS	LS
F	26/07/22	REVISED AS PER COMMENTS	LS
E	25/05/22	REVISED AS PER COMMENTS	LS
D	22/04/06	REVISED AS PER COMMENTS	LS
C	22/01/22	REVISED AS PER COMMENTS	LS
B	20/12/21	REVISED AS PER COMMENTS	LS
A	03/12/21	REVISED AS PER COMMENTS	LS

JOB NO. : J-858

PROJECT :
PROPOSED RESIDENTIAL DEVELOPMENT
AT TKOTL 70RP, PHASE 11, LOHAS PARK
TSEUNG KWAN O, N.T.

TITLE :
TYPICAL FLOOR PARTIAL
ELEVATION & SECTION, PLAN
FOR CURTAIN WALL (TOWER 3)


DATE : 22-OCT-21 | SCALE : 1:50(A1)

DRAWN BY : | CHECKED BY :

美特鋁質有限公司
MIDI ALUMINIUM FABRICATOR LTD.
Units 6-8, Sunray Industrial Centre, 1/F
610 Cha Kwo Ling Road, Kowloon
Tel:23489211-4 Fax:(852)27727666

DWG NO. : J858-CW-PE313 | REV. : G

45.

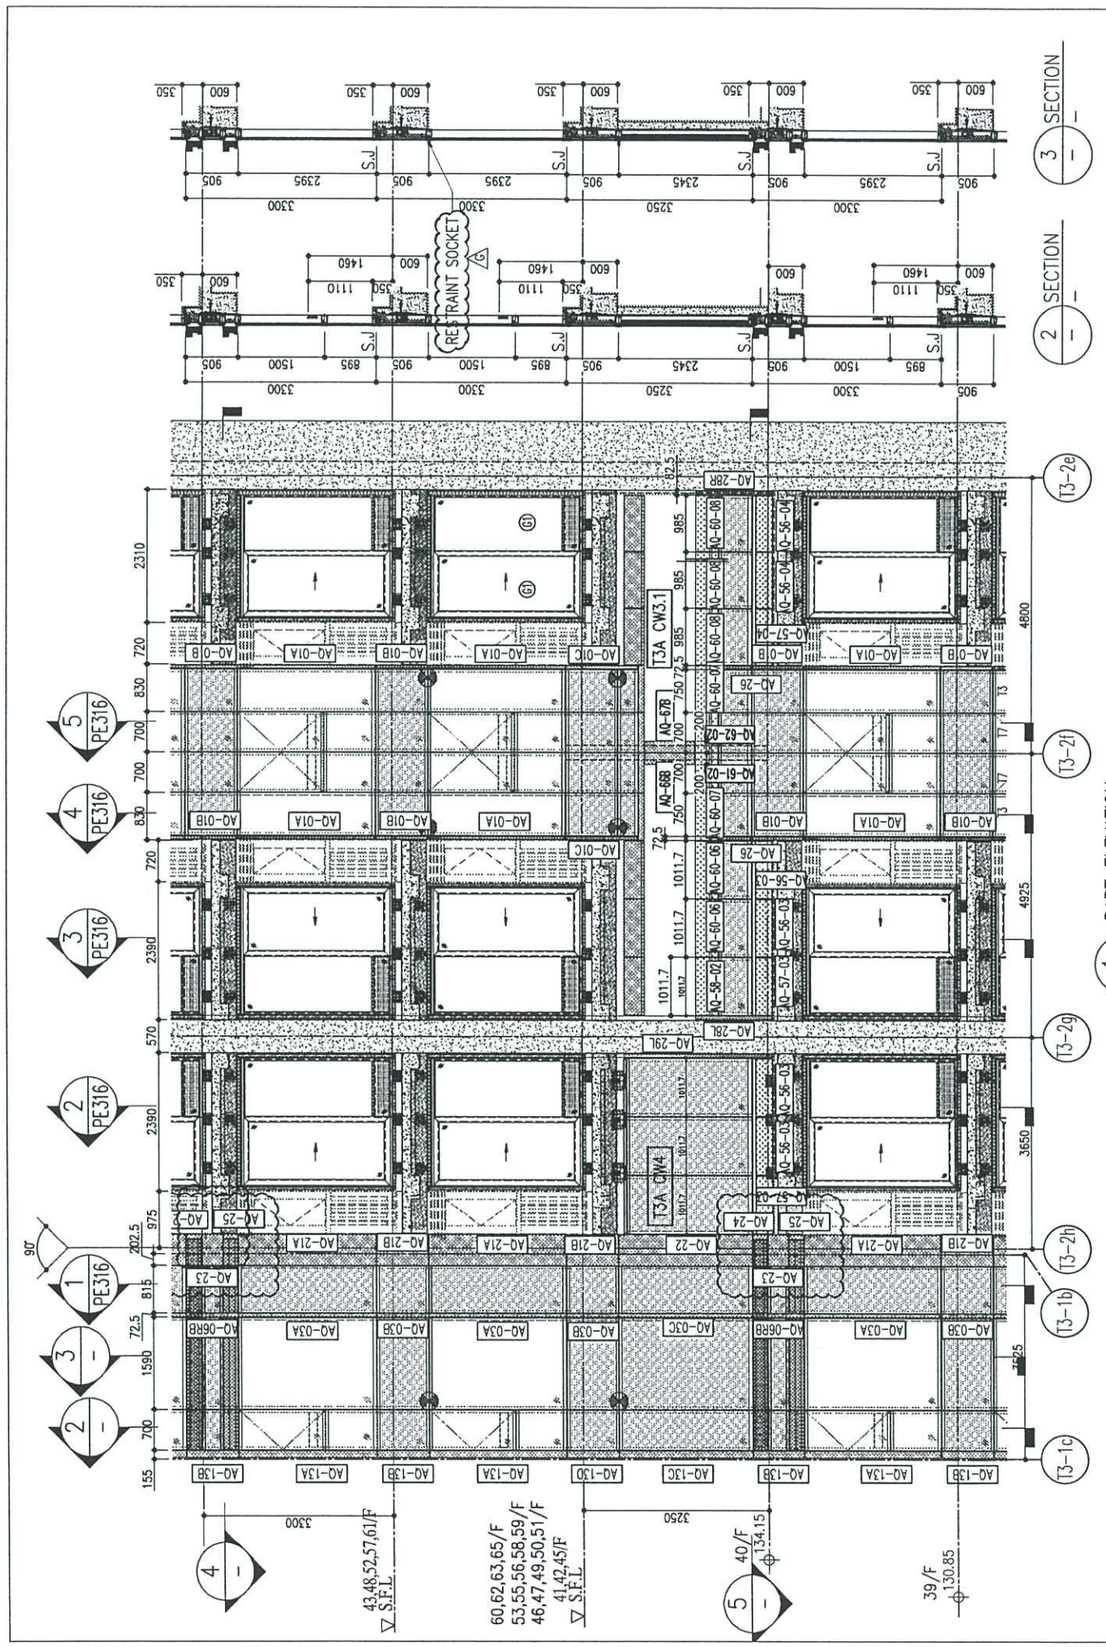

R/F	+217.00
67/F	+213.50
66/F	+210.00
65/F	+206.70
63/F	+203.40
62/F	+200.10
61/F	+196.80
60/F	+193.50
59/F	+190.20
58/F	+186.90
57/F	+183.60
56/F	+180.30
55/F	+177.00
53/F	+173.70
52/F	+170.40
51/F	+167.10
50/F	+163.80
49/F	+160.50
48/F	+157.20
47/F	+153.90
46/F	+150.60
45/F	+147.30
43/F	+144.00
42/F	+140.70
41/F	+137.40
40/F	+134.15
39/F	+130.85
38/F	+127.55
37/F	+124.25
36/F	+120.95
35/F	+117.65
33/F	+114.35
32/F	+111.05
31/F	107.75
30/F	+104.45
29/F	+101.15
28/F	+97.85
27/F	+94.55
26/F	+91.25
25/F	+87.95
23/F	+84.65
22/F	+81.35
21/F	+78.05
20/F	+74.75
19/F	+71.45
18/F	+68.15
17/F	+64.85
16/F	+61.55
15/F	+58.25
12/F	+54.95

LEGEND:

- (G1) – 10mm THK. HEAT STRENGTHENED GLASS (OUTSIDE) +12mm AIR SPACE + 12mm THK. TEMPERED GLASS
- (G2) – 10mm THK. HEAT STRENGTHENED GLASS (OUTSIDE) +12mm AIR SPACE + 10mm THK. TEMPERED GLASS
- (G3) – 12mm THK. HEAT STRENGTHENED GLASS
- (G4) – 12mm THK. CLEAR TEMPERED GLASS (INTERNAL PROTECTIVE BARRIER)
- (G5) – 10mm THK. HEAT STRENGTHENED GLASS (OUTSIDE) +12mm AIR SPACE + 12mm THK. TEMPERED GLASS WITH REFLECTIVE COATING
- (G6) – 10mm THK. CLEAR TEMPERED GLASS
- (G7) – 8mm THK. CLEAR HEAT-STRENGTHENED GLASS +1.52mm PVB + 8mm THK. CLEAR HEAT-STRENGTHENED GLASS
- – 3 mm THK. ALUM. CLADDING
- S.J. – STACK JOINT
- (G) – RESTRAINT SOCKET

DELETED

1 / – PART ELEVATION FOR CURTAIN WALL

4 / – PART PLAN FOR CURTAIN WALL

5 / – PART PLAN(40/F) FOR CURTAIN WALL

B.D. REF :

CLIENT :
信和置業有限公司
Sino Land Company Limited

ARCHITECT :
ronald lu & partners
Architects . Planners . Interior Designers
Ronald Lu & Partners (HK) Ltd.
呂元祥建築師事務所(香港)有限公司

MAIN CONTRACTOR :
Gammon

STRUCTURAL ENGINEER :
AECOM

FACADE CONSULTANT:
AECOM

NOTE :
1. ALL DIMENSIONS ARE IN mm.
2. ALL ELEVATIONS ARE VIEWED FROM OUTSIDE.
3. ALL DIMENSIONS TO BE VERIFIED ON SITE BEFORE FABRICATION.

LEGEND :
- (X1 / X001) – DETAIL MARK NO. / REFER SHEET NO.
1. F.F.L. --FINISHED FLOOR LEVEL
2. S.F.L. --STRUCTURAL FLOOR LEVEL
3. (/R) --REVERSED DETAIL

NO.	DATE	REVISED	BY
G	18/08/22	REVISED AS PER COMMENTS	LS
F	26/07/22	REVISED AS PER COMMENTS	LS
E	25/05/22	REVISED AS PER COMMENTS	LS
D	22/04/06	REVISED AS PER COMMENTS	LS
C	22/01/22	REVISED AS PER COMMENTS	LS
B	20/12/21	REVISED AS PER COMMENTS	LS
A	03/12/21	REVISED AS PER COMMENTS	LS

JOB NO. : J-858

PROJECT :
PROPOSED RESIDENTIAL DEVELOPMENT
AT TKOTL 70RP, PHASE 11, LOHAS PARK
TSEUNG KWAN O, N.T.

TITLE :
TYPICAL FLOOR PARTIAL
ELEVATION & SECTION, PLAN
FOR CURTAIN WALL (TOWER 3)

DATE : 22-OCT-21 | SCALE : 1:50(A1)

DRAWN BY : | CHECKED BY :

美特鋁質有限公司
MIDI ALUMINIUM FABRICATOR LTD.
Units 6-8, Sunray Industrial Centre, 1/F
610 Cha Kwo Ling Road, Kowloon
Tel:23489211-4 Fax:(852)27727666

DWG NO. : J858-CW-PE315 | REV. : G