

工程指示 / 要求簡箋(E.I.)

工程指示編號：EI / 6389 / 23

修改版次：D

工程編號：J - 858

工程名稱：將軍澳日出康城 11

工程項目：幕牆 室內收口鋁料 地盤用 放行大貨

收件人：生統

發件人：Paul Wong

日期：10/11/2023

要求提供 / 確認 事項：

內容：

D 版：

1. 放行大貨，生產收口鋁料 X86457(陣底), X86458(30 呎), X86459(15 呎), X86463(47.5 呎)。

2. 大判保留 15mm 收口，不再要求加大。現放行。附 2023.11.06 電郵

3. 請留意 B 版的 T1B-D, T3B-D 的 X86457-01-14，已減短長度(674 mm)。程

生產：開料留意 / 地盆：安裝留意

4. 分座分層包扎，送地盆

5. 附開料單以 9 層為一批。

6. 分層數量表在 C 版本

7. 附預算出貨期。最急 T1 Low Zone 17/11

8. 附最後版本圖紙

9. 廁所位的收口鋁料用 15mm 呎 X86459 (C 版) 提

C 版：因廁所位的收口鋁料位置圖有誤，A 座 B 單位的廁所位是用 X86459-01A

請生產 T2, T3 12/F, 15/F, 16/F X86459-01A 的用量 (12 支, 2370mm 長) 供地盤使用。

B 版：T1B-D, T3B-D 的 X86457-01-14，減短長度。

因應陣底收口碰白色鋁板改為比橫碰企

(已出貨的不用重做)

請在 2023.08.30 前完成上列要求。

分發東莞各部門：

() 生產技術總監 連附件 (✓) 技術部 連附件 () 生產部 連附件 () 機械設計部 連附件
() 採購部 連附件 (✓) 生產統籌部 連附件 (✓) 小羅&清 連附件
() 質檢部 連附件 () 會計部 連附件 () 報關組 連附件 () 其他 連附件

分發香港各部門：

() 行政部 連附件 () 會計部 連附件 () 統籌部 連附件 (✓) 工程部地盤科文 連附件 積哥, 二寶
() 採購部 連附件 () QS 部 連附件 () 維修部 連附件 () 其他 連附件



傳遞編號：

發件人簽署：R

HK 260) / 23

項目經理簽署：J-PK

 美特鋁質有限公司 MIDI Aluminium Fabricator Ltd.		工程號 J858 地盘 康城11期	類別 制圖 J.L.	物料號 - 2023-16-17	圖號 X86457-01
修改 日期	採用工廠 材料顏色 ECD3X1009 9S-XF1	地盘 <input checked="" type="checkbox"/>	圖紙名稱 幕牆陣底收口 材料 X86457	復核 - 批准 -	數量 - 單件重量 - (KG)

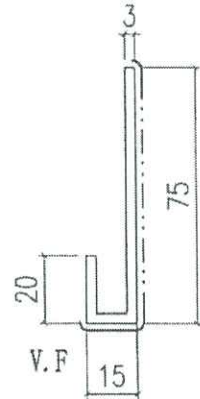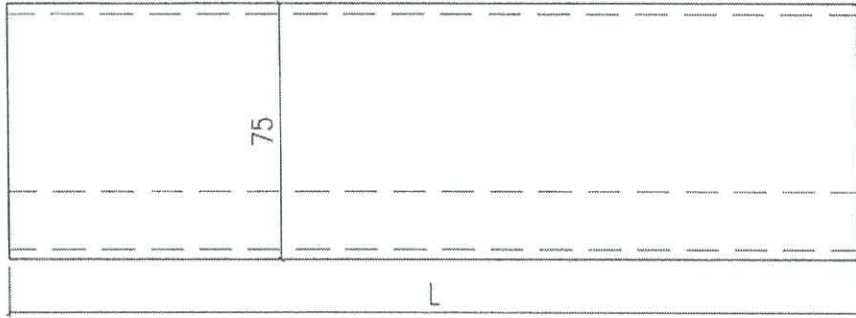

X86457-01-33	511.5	96
X86457-01-32	841.5	96
X86457-01-31	549	44
X86457-01-30	804	44
X86457-01-29	829	44
X86457-01-28	1644	48
X86457-01-27	1555.5	96
X86457-01-26	804	192
X86457-01-25	1405	48
X86457-01-24	1784	48
X86457-01-22	1701.5	48
X86457-01-21	1686.5	48
X86457-01-20	1800	96
X86457-01-19	725	96
X86457-01-18	549	192
X86457-01-17	1410	44
X86457-01-16	524	44
X86457-01-15	754	48
X86457-01-14	841.5	92
X86457-01-13	1373	92
X86457-01-12	1355	184
X86457-01-11	1530	44
X86457-01-10	1380	420
X86457-01-09	629	884
X86457-01-08	1366.5	884
X86457-01-07	1355	140
X86457-01-06	499	140
X86457-01-05	1510.5	140
X86457-01-04	648	324
X86457-01-03	1661.5	44
X86457-01-02	1750	44
X86457-01-01	745	44
編號	L	合計數量

圖紙收
~ B 版

幕牆陣底



T1-B-D 單位
T3-B-D 單位

L = 674 mm
修改表

陣底

P.3

 美特鋁質有限公司 MIDI Aluminium Fabricator Ltd.		工程號 J858 地盘 康城11期	類別 制圖 J.L. 復核 - 批准 -	物料號 - 2023-16-17 - -	圖號 X86457-02 數量 - 單件重量 - (KG)
修改 日期	採用工廠 材料顏色 ECD3X1009 9S-XF1	地盤 <input checked="" type="checkbox"/> 圖紙名稱 幕牆陣底收口 材料 X86457			

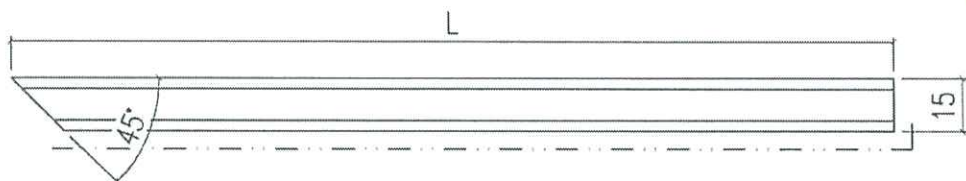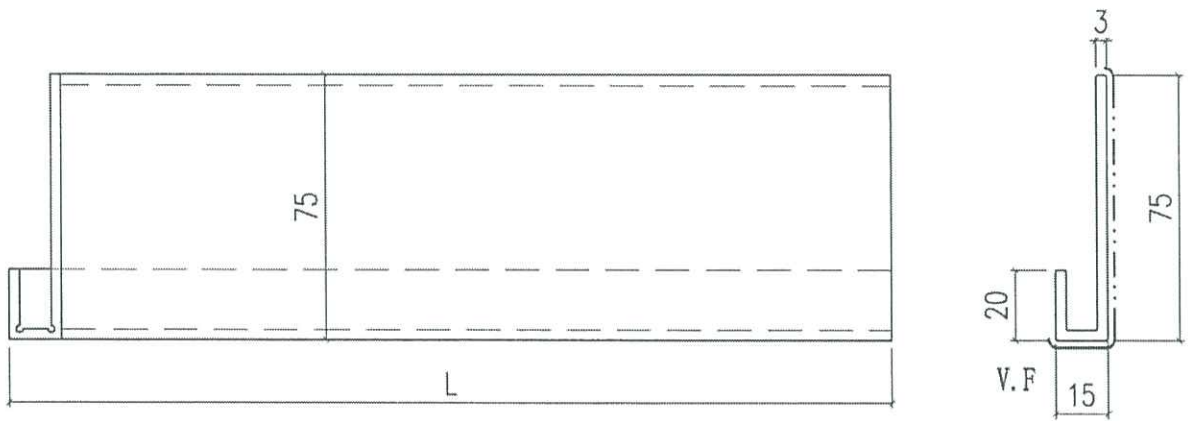



圖紙指
厚板

轉角位
幕牆陣底


X86457-02-04	1703.5	48
X86457-02-03	643.5	44
X86457-02-02	537.5	140
X86457-02-01	1679	232
編號	L	合計數量

陣底 p.4

 美特鋁質有限公司 MIDI Aluminium Fabricator Ltd.				工程號	J858	類別		物料號	-
修改		採用工廠	地盤	✓	圖紙名稱	幕墻陣底收口	復核	-	-
日期		材料顏色	ECD3X1009 9S-XF1		材料	X86457	批准	-	-
								圖號	X86457-03
								數量	-
								單件重量	- (KG)

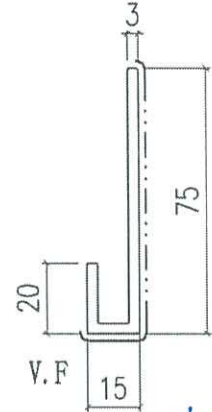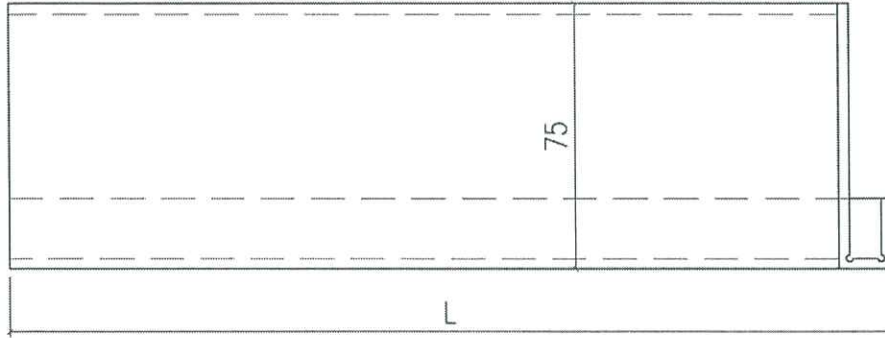


圖紙指
標

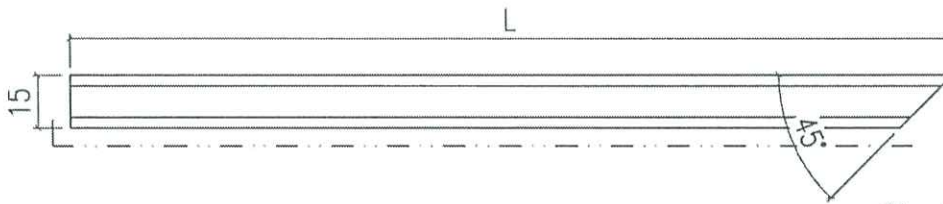

幕墻轉台

X86457-03-04	1568.5	44
X86457-03-03	1660	92
X86457-03-02	537.5	280
X86457-03-01	1679	48
編號	L	合計數量

陣底 8.5



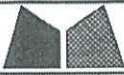


美特鋁質有限公司
MIDI Aluminium Fabricator Ltd.

工程號	J858	類別		物料號	-		
地盘	康城11期	制圖	J.L.	2023-16-17	圖號	X86458-01	
修改	A	採用工廠			數量	-	
日期	16/08	材料颜色	ECD3X1009 9S-XF1	材料	X86458	單件重量	- (KG)
		地盤	✓	圖紙名稱	幕牆邊企收口	復核	-
						批准	-

圖紙按
C 修改

编号	L	合計數量
X86458-01A	2370	2514

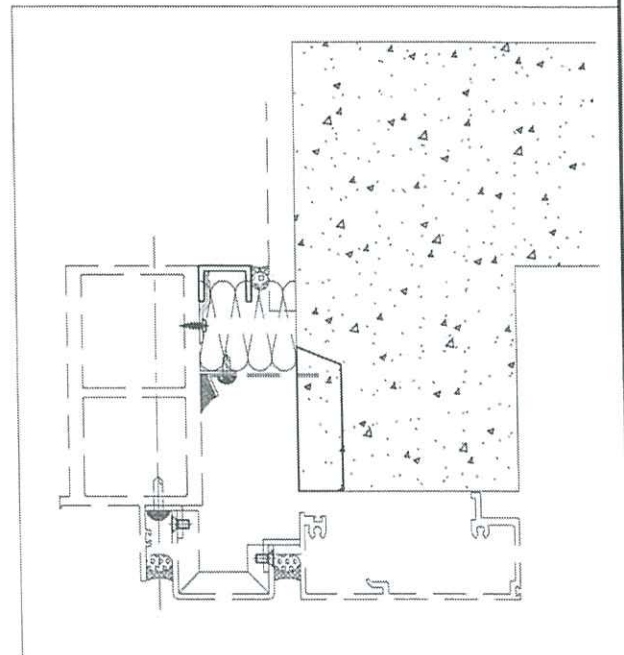
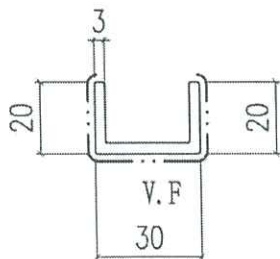
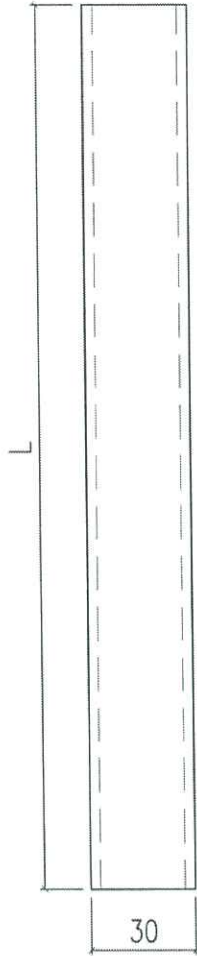


 美特鋁質有限公司 MIDI Aluminium Fabricator Ltd.		工程號 J858 地盘 康城11期	類別 制圖 J.L. 物料號 -	圖號 X86459-01
修改 A 日期 16/08	採用工廠 材料顏色 ECD3X1009 9S-XF1	图纸名称 幕墙砖墙收口 材料 X86459	復核 - 批准 -	數量 - 單件重量 - (KG)

圖紙指
C 版

编号	L	合计数量
X86459-01A	2370	3164



直欄料
 → 磚牆間牆
 → 浴室位 (A座B單位)

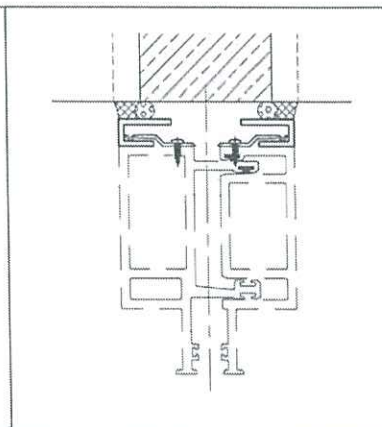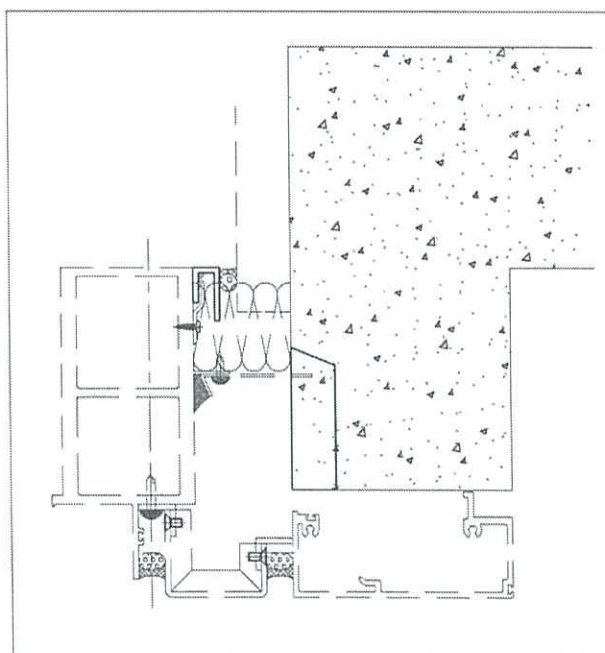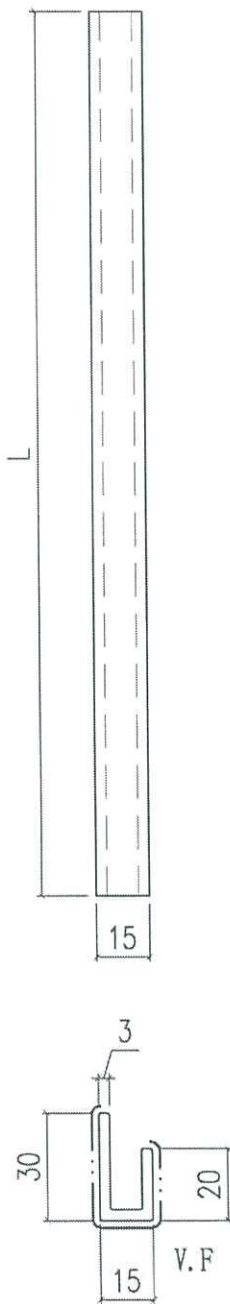



 美特鋁質有限公司 MIDI Aluminium Fabricator Ltd.		工程號 J858 地盘 康城11期	類別 制圖 J.L.	物料號 - 2023-16-17	圖號 X86463-01
修改 日期	採用工廠 材料颜色 ECD3X1009 9S-XF1	地盤 ✓ 图纸名称 幕墙中间收口 材料 X86463	復核 - 批准 -	-	數量 - 單件重量 - (KG)

圖紙 原稿

编号	L	合计数量
X86463-01A	2370	140

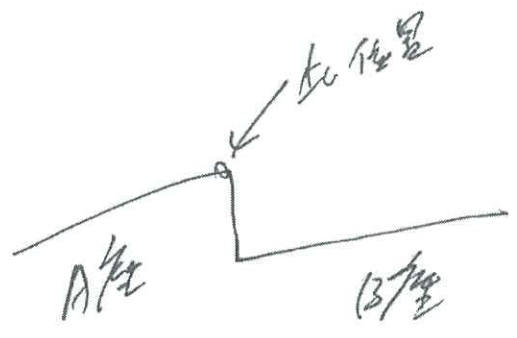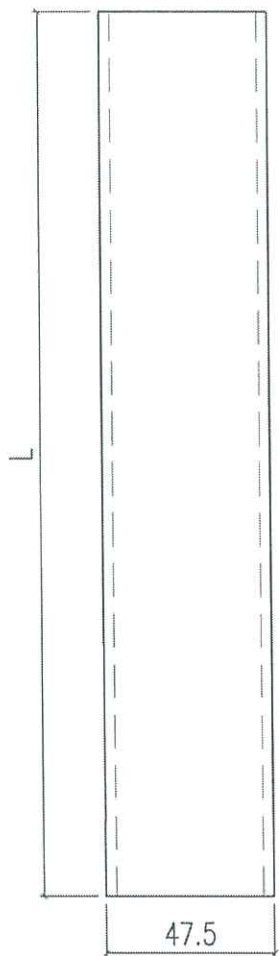

A 層 碰 B 層
中間

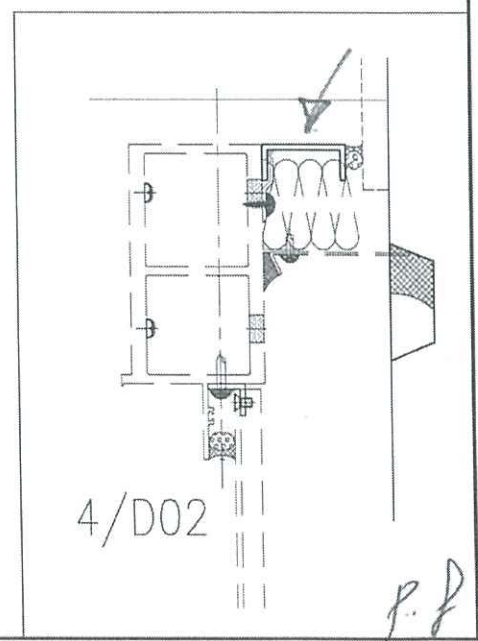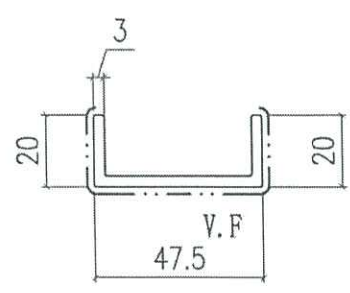

P.F

2023.11.11

LP11 幕牆室內收口、出貨期

		T1		T2		T3		
		已出貨	預算出貨	已出貨	預算出貨	已出貨	預算出貨	
1	67/F			67/F	7(未出開料單)	67/F	7(未出開料單)	
1	66/F			66/F		66/F		
1	65/F			65/F		65/F		
1	63/F			63/F		63/F		
1	62/F		5(未出開料單)	62/F	7	62/F	7	
1	61/F			61/F		61/F		
1	60/F		5	60/F	7	60/F	7	
1	59/F			59/F		59/F		
1	58/F			58/F		58/F		
1	57/F			57/F		57/F		
1	56/F			56/F		56/F		
1	55/F		4	55/F	6	55/F	6	
1	53/F			53/F		53/F		
1	52/F			52/F		52/F		
1	51/F			51/F		51/F		
1	50/F			50/F		50/F		
1	49/F			49/F		49/F		
1	48/F			48/F		48/F		
1	47/F			47/F		47/F		
1	46/F		3	46/F	5	46/F	5	
1	45/F			45/F		45/F		
1	43/F			43/F		43/F		
1	42/F			42/F		42/F		
1	41/F			41/F		41/F		
1	39/F			39/F		39/F		
1	38/F			38/F		38/F		
1	37/F			37/F		37/F		
1	36/F			36/F		36/F		
1	35/F			35/F		35/F		
1	33/F		② 急	33/F	4	33/F	4	
1	32/F			32/F		32/F		
1	31/F			31/F		31/F		
1	30/F			30/F		30/F		
1	29/F			29/F		29/F		
1	28/F			28/F		28/F		
1	27/F			27/F		27/F		
1	26/F		① 日取急 物(7/1/29)	26/F	3	26/F	3	
1	25/F			25/F		25/F		
1	23/F			23/F		23/F		
1	22/F			22/F		22/F		
1	21/F			21/F		21/F		
1	20/F			20/F		20/F		
1	19/F		已出貨	19/F	已出貨	19/F	已出貨	
1	18/F	ok		18/F		18/F		
1	17/F	ok		17/F		17/F		
1	16/F	ok		16/F		16/F		
1	15/F	ok	已出貨	15/F	已出貨	15/F	已出貨	
1	12/F	ok		12/F		12/F		
1	10/F		①	10/F	3	10/F	3	
1	09/F			09/F		09/F		
			T1			T2		
							T3	

鋁材開料總表

工程號碼: J858 工程名稱: 康城11期(CW-收口鋁料-T1-9F, 10F, 17F~23F)

序號	鋁料編號	名稱	表面處理		開料長度	實用長料總數量		浪費率(%)
			顏色	層厚		支數	長度	
1	X86457	幕牆陣底收口	ECD3X10 09 9S-		5600	80	448000	4.18
2	X86458	幕牆邊企收口	ECD3X10 09 9S-		4900	86	421400	2.56
3	X86459	幕牆磚牆收口	ECD3X10 09 9S-		4900	113	553700	2.43
4	X86463	幕牆中間收口	ECD3X10 09 9S-		4900	5	24500	11.70

送至: _____

由: _____

日期: _____

簡短說明: _____

共5頁 第1頁

打印日期: 2023/11/10 打印時間: 10:03

鋁材開料清單 X86463

開料長度: 4900, 總長料支數: 5, 總開料支數: 9

窗號	編號(用料狀況)	實用長度(長料開數)	需要支數	開料支數	長料支數	餘料支數	編號(剩餘長度)
X86463-01A	1-5	2370.0	9	9	5	0	1-4@(98)x4 5@(2474)x1

鋁材開料清單 X86459

開料長度: 4900, 總長料支數: 113, 總開料支數: 225

窗號	編號(用料狀況)	實用長度(長料開數)	需要支數	開料支數	長料支數	餘料支數	編號(剩餘長度)
X86459-01A	1-113	2370.0	225	225	113	0	1-112@(98)x112 113@(2474)x1

鋁材開料清單 X86458

開料長度: 4900, 總長料支數: 86, 總開料支數: 171

窗號	編號(用料狀況)	實用長度(長料開數)	需要支數	開料支數	長料支數	餘料支數	編號(剩餘長度)
X86458-01A	1-86	2370.0	171	171	86	0	1-85@(98)x85 86@(2474)x1

鋁材開料清單 X86457

開料長度: 5600, 總長料支數: 80, 總開料支數: 396

窗號	編號(用料狀況)	實用長度(長料開數)	需要支數	開料支數	長料支數	餘料支數	編號(剩餘長度)
X86457-01-02	1-3	1750.0	9	9	3	0	1-3@(282)x3
X86457-02-01	4-9	1679.0	18	18	6	0	4-9@(495)x6
X86457-01-03	10-12	1661.5	9	9	3	0	10-12@(547.5)x3
X86457-03-03	13-15	1660.0	9	9	3	0	13-15@(552)x3
X86457-03-04	16-18	1568.5	9	9	3	0	16-18@(826.5)x3
X86457-01-11	19-21	1530.0	9	9	3	0	19-21@(942)x3
X86457-01-05	22-24	1510.5	9	9	3	0	22-24@(1000.5)x3
X86457-01-17	25-27	1410.0	9	9	3	0	25-27@(1302)x3
X86457-01-10	28-34	1380.0	27	27	7	0	28-33@(6)x6 34@(1392)x1
X86457-01-13	(餘料)34	1373.0	9	1	0	1	34@(13)x1
X86457-01-13	35-36	1373.0		8	2	0	35-36@(34)x2
X86457-01-08	37-52	1366.5	63	63	16	0	37-51@(60)x15 52@(1432.5)x1
X86457-01-07	(餘料)52	1355.0	27	1	0	1	52@(71.5)x1
X86457-01-07, X86457-	53-59	1355.0		26	7	0	53-58@(106)x6
X86457-01-14	(餘料)19-27	841.5	9	9	0	9	19-21@(94.5)x3 22-24@(153)x3 25-27@(454.5)x3
X86457-01-29	(餘料)59	829.0	9	3	0	1	59@(323)x1
X86457-01-29	60	829.0		6	1	0	60@(540)x1
X86457-01-30	(餘料)16-18	804.0	9	3	0	3	16-18@(16.5)x3
X86457-01-30	61	804.0		6	1	0	61@(690)x1
X86457-01-01	62-63	745.0	9	9	2	0	62@(293)x1 63@(4048)x1
X86457-01-04	(餘料)61, 63	648.0	27	7	0	2	61@(36)x1 63@(124)x1
X86457-01-04	64-66	648.0		20	3	0	64-65@(318)x2
X86457-02-03	(餘料)66	643.5	9	4	0	1	66@(336)x1
X86457-02-03	67	643.5		5	1	0	67@(2302.5)x1
X86457-01-09	(餘料)67	629.0	63	3	0	1	67@(397.5)x1
X86457-01-09	68-75	629.0		60	8	0	68-74@(470)x7
X86457-01-31	(餘料)75	549.0	9	5	0	1	75@(235)x1
X86457-01-31	76	549.0		4	1	0	76@(3330)x1
X86457-02-02, X86457-03-02	(餘料)10-15, 76, 76	537.5	27	12	0	8	10-12@(4)x3 13-15@(8.5)x3 76@(1699.5)x1 76@(69)x1
X86457-03-02	77-78	537.5		15	2	0	77@(115)x1 78@(2832.5)x1
X86457-01-16	(餘料)60, 78	524.0	9	6	0	2	60@(10)x1 78@(182.5)x1
X86457-01-16	79	524.0		3	1	0	79@(3960)x1
X86457-01-06	(餘料)79	499.0	9	7	0	1	79@(425)x1
X86457-01-06	80	499.0		2	1	0	80@(4540)x1

鋁材開料總表

工程號碼: J858 工程名稱: 康城11期(CW-收口鋁料-T1-25F~33F)

序號	鋁料編號	名稱	表面處理		開料長度	實用長料總數量		浪費率(%)
			顏色	層厚		支數	長度	
1	X86457	幕牆陣底收口	ECD3X10 09 9S-		5600	80	448000	4.18
2	X86458	幕牆邊企收口	ECD3X10 09 9S-		4900	86	421400	2.56
3	X86459	幕牆磚牆收口	ECD3X10 09 9S-		4900	113	553700	2.43
4	X86463	幕牆中間收口	ECD3X10 09 9S-		4900	5	24500	11.70

送至: _____

由: _____

日期: _____

簡短說明: _____

共5頁 第1頁

打印日期: 2023/11/10 打印時間: 10:09

工程號碼: J858, 工程名稱: 康城11期 (CW-收口鋁料- T1-25F~33F)

開料長度: 4900, 總長料支數: 5, 總開料支數: 9

鋸片厚度 (mm): 6, 料頭尾總切除 (mm): 50, 浪費率 (%): 11.7

鋁材開料清單 X86463

窗號	編號(用料狀況)	實用長度(長料開數)	需要 支數	開料 支數	長料 支數	餘料 支數	編號(剩餘長度)
X86463-01A	1-5	2370.0	9	9	5	0	1-4@(98)x4 5@(2474)x1

工程號碼: J858, 工程名稱: 康城11期 (CW-收口鋁料-T1-25F~33F)

開料長度: 4900, 總長料支數: 113, 總開料支數: 225

鋸片厚度 (mm): 6, 料頭尾總切除 (mm): 50, 浪費率 (%): 2.43

鋁材開料清單 X86459

窗號	編號(用料狀況)	實用長度(長料開數)	需要 支數	開料 支數	長料 支數	餘料 支數	編號(剩餘長度)
X86459-01A	1-113	2370.0	225	225	113	0	1-112@(98)x112 113@(2474)x1

工程號碼: J858, 工程名稱: 康城11期 (CW-收口鋁料- T1-25F~33F)

開料長度: 4900, 總長料支數: 86, 總開料支數: 171

鋸片厚度 (mm): 6, 料頭尾總切除 (mm): 50, 浪費率 (%): 2.56

鋁材開料清單 X86458

窗號	編號(用料狀況)	實用長度(長料開數)	需要 支數	開料 支數	長料 支數	餘料 支數	編號(剩餘長度)
X86458-01A	1-86	2370.0	171	171	86	0	1-85@(98)x85 86@(2474)x1

鋁材開料清單 X86457

窗號	編號(用料狀況)	實用長度(長料開數)	需要支數	開料支數	長料支數	餘料支數	編號(剩餘長度)
X86457-01-02	1-3	1750.0	9	9	3	0	1-3@(282)x3
X86457-02-01	4-9	1679.0	18	18	6	0	4-9@(495)x6
X86457-01-03	10-12	1661.5	9	9	3	0	10-12@(547.5)x3
X86457-03-03	13-15	1660.0	9	9	3	0	13-15@(552)x3
X86457-03-04	16-18	1568.5	9	9	3	0	16-18@(826.5)x3
X86457-01-11	19-21	1530.0	9	9	3	0	19-21@(942)x3
X86457-01-05	22-24	1510.5	9	9	3	0	22-24@(1000.5)x3
X86457-01-17	25-27	1410.0	9	9	3	0	25-27@(1302)x3
X86457-01-10	28-34	1380.0	27	27	7	0	28-33@(6)x6 34@(1392)x1
X86457-01-13	(餘料)34	1373.0	9	1	0	1	34@(13)x1
X86457-01-13	35-36	1373.0		8	2	0	35-36@(34)x2
X86457-01-08	37-52	1366.5	63	63	16	0	37-51@(60)x15 52@(1432.5)x1
X86457-01-07	(餘料)52	1355.0	27	1	0	1	52@(71.5)x1
X86457-01-07, X86457-	53-59	1355.0		26	7	0	53-58@(106)x6
X86457-01-14	(餘料)19-27	841.5	9	9	0	9	19-21@(94.5)x3 22-24@(153)x3 25-27@(454.5)x3
X86457-01-29	(餘料)59	829.0	9	3	0	1	59@(323)x1
X86457-01-29	60	829.0		6	1	0	60@(540)x1
X86457-01-30	(餘料)16-18	804.0	9	3	0	3	16-18@(16.5)x3
X86457-01-30	61	804.0		6	1	0	61@(690)x1
X86457-01-01	62-63	745.0	9	9	2	0	62@(293)x1 63@(4048)x1
X86457-01-04	(餘料)61, 63	648.0	27	7	0	2	61@(36)x1 63@(124)x1
X86457-01-04	64-66	648.0		20	3	0	64-65@(318)x2
X86457-02-03	(餘料)66	643.5	9	4	0	1	66@(336)x1
X86457-02-03	67	643.5		5	1	0	67@(2302.5)x1
X86457-01-09	(餘料)67	629.0	63	3	0	1	67@(397.5)x1
X86457-01-09	68-75	629.0		60	8	0	68-74@(470)x7
X86457-01-31	(餘料)75	549.0	9	5	0	1	75@(235)x1
X86457-01-31	76	549.0		4	1	0	76@(3330)x1
X86457-02-02, X86457-03-02	(餘料)10-15, 76, 76	537.5	27	12	0	8	10-12@(4)x3 13-15@(8.5)x3 76@(1699.5)x1 76@(69)x1
X86457-03-02	77-78	537.5		15	2	0	77@(115)x1 78@(2832.5)x1
X86457-01-16	(餘料)60, 78	524.0	9	6	0	2	60@(10)x1 78@(182.5)x1
X86457-01-16	79	524.0		3	1	0	79@(3960)x1
X86457-01-06	(餘料)79	499.0	9	7	0	1	79@(425)x1
X86457-01-06	80	499.0		2	1	0	80@(4540)x1

鋁材開料總表

工程號碼: J858 工程名稱: 康城11期(CW-收口鋁料-T1-35F~45F)

序號	鋁料編號	名稱	表面處理		開料長度	實用長料總數量		浪費率(%)
			顏色	層厚		支數	長度	
1	X86457	幕牆陣底收口	ECD3X10 09 9S-		5600	80	448000	4.18
2	X86458	幕牆邊企收口	ECD3X10 09 9S-		4900	86	421400	2.56
3	X86459	幕牆磚牆收口	ECD3X10 09 9S-		4900	113	553700	2.43
4	X86463	幕牆中間收口	ECD3X10 09 9S-		4900	5	24500	11.70

送至: _____

由: _____

日期: _____

簡短說明: _____

共5頁 第1頁

打印日期: 2023/11/10 打印時間: 10:11

工程號碼: J858, 工程名稱: 康城11期 (CW-收口鋁料-T1-35F~45F)

開料長度: 4900, 總長料支數: 5, 總開料支數: 9

鋸片厚度 (mm): 6, 料頭尾總切除 (mm): 50, 浪費率 (%): 11.7

鋁材開料清單 X86463

窗號	編號(用料狀況)	實用長度(長料開數)	需要 支數	開料 支數	長料 支數	餘料 支數	編號(剩餘長度)
X86463-01A	1-5	2370.0	9	9	5	0	1-4@(98)x4 5@(2474)x1

工程號碼: J858, 工程名稱: 康城11期 (CW-收口鋁料-T1-35F~45F)

開料長度: 4900, 總長料支數: 113, 總開料支數: 225

鋸片厚度 (mm): 6, 料頭尾總切除 (mm): 50, 浪費率 (%): 2.43

鋁材開料清單 X86459

窗號	編號(用料狀況)	實用長度(長料開數)	需要 支數	開料 支數	長料 支數	餘料 支數	編號(剩餘長度)
X86459-01A	1-113	2370.0	225	225	113	0	1-112@(98)x112 113@(2474)x1

工程號碼: J858, 工程名稱: 康城11期 (CW-收口鋁料-T1-35F~45F)

開料長度: 4900, 總長料支數: 86, 總開料支數: 171

鋸片厚度 (mm): 6, 料頭尾總切除 (mm): 50, 浪費率 (%): 2.56

鋁材開料清單 X86458

窗號	編號(用料狀況)	實用長度(長料開數)	需要 支數	開料 支數	長料 支數	餘料 支數	編號(剩餘長度)
X86458-01A	1-86	2370.0	171	171	86	0	1-85@(98)x85 86@(2474)x1

鋁材開料清單 X86457

窗號	編號(用料狀況)	實用長度(長料開數)	需要支數	開料支數	長料支數	餘料支數	編號(剩餘長度)
X86457-01-02	1-3	1750.0	9	9	3	0	1-3@(282)x3
X86457-02-01	4-9	1679.0	18	18	6	0	4-9@(495)x6
X86457-01-03	10-12	1661.5	9	9	3	0	10-12@(547.5)x3
X86457-03-03	13-15	1660.0	9	9	3	0	13-15@(552)x3
X86457-03-04	16-18	1568.5	9	9	3	0	16-18@(826.5)x3
X86457-01-11	19-21	1530.0	9	9	3	0	19-21@(942)x3
X86457-01-05	22-24	1510.5	9	9	3	0	22-24@(1000.5)x3
X86457-01-17	25-27	1410.0	9	9	3	0	25-27@(1302)x3
X86457-01-10	28-34	1380.0	27	27	7	0	28-33@(6)x6 34@(1392)x1
X86457-01-13	(餘料)34	1373.0	9	1	0	1	34@(13)x1
X86457-01-13	35-36	1373.0		8	2	0	35-36@(34)x2
X86457-01-08	37-52	1366.5	63	63	16	0	37-51@(60)x15 52@(1432.5)x1
X86457-01-07	(餘料)52	1355.0	27	1	0	1	52@(71.5)x1
X86457-01-07, X86457-	53-59	1355.0		26	7	0	53-58@(106)x6
X86457-01-14	(餘料)19-27	841.5	9	9	0	9	19-21@(94.5)x3 22-24@(153)x3 25-27@(454.5)x3
X86457-01-29	(餘料)59	829.0	9	3	0	1	59@(323)x1
X86457-01-29	60	829.0		6	1	0	60@(540)x1
X86457-01-30	(餘料)16-18	804.0	9	3	0	3	16-18@(16.5)x3
X86457-01-30	61	804.0		6	1	0	61@(690)x1
X86457-01-01	62-63	745.0	9	9	2	0	62@(293)x1 63@(4048)x1
X86457-01-04	(餘料)61, 63	648.0	27	7	0	2	61@(36)x1 63@(124)x1
X86457-01-04	64-66	648.0		20	3	0	64-65@(318)x2
X86457-02-03	(餘料)66	643.5	9	4	0	1	66@(336)x1
X86457-02-03	67	643.5		5	1	0	67@(2302.5)x1
X86457-01-09	(餘料)67	629.0	63	3	0	1	67@(397.5)x1
X86457-01-09	68-75	629.0		60	8	0	68-74@(470)x7
X86457-01-31	(餘料)75	549.0	9	5	0	1	75@(235)x1
X86457-01-31	76	549.0		4	1	0	76@(3330)x1
X86457-02-02, X86457-03-02	(餘料)10-15, 76, 76	537.5	27	12	0	8	10-12@(4)x3 13-15@(8.5)x3 76@(1699.5)x1 76@(69)x1
X86457-03-02	77-78	537.5		15	2	0	77@(115)x1 78@(2832.5)x1
X86457-01-16	(餘料)60, 78	524.0	9	6	0	2	60@(10)x1 78@(182.5)x1
X86457-01-16	79	524.0		3	1	0	79@(3960)x1
X86457-01-06	(餘料)79	499.0	9	7	0	1	79@(425)x1
X86457-01-06	80	499.0		2	1	0	80@(4540)x1

鋁材開料總表

工程號碼: J858 工程名稱: 康城11期(CW-收口鋁料-T1-46F~55F)

序號	鋁料編號	名稱	表面處理		開料長度	實用長料總數量		浪費率(%)
			顏色	層厚		支數	長度	
1	X86457	幕牆陣底收口	ECD3X10 09 9S-		5600	80	448000	4.18
2	X86458	幕牆邊企收口	ECD3X10 09 9S-		4900	86	421400	2.56
3	X86459	幕牆磚牆收口	ECD3X10 09 9S-		4900	113	553700	2.43
4	X86463	幕牆中間收口	ECD3X10 09 9S-		4900	5	24500	11.70

送至: _____

由: _____

日期: _____

簡短說明: _____

共5頁 第1頁

打印日期: 2023/11/10 打印時間: 10:14

鋁材開料清單 X86463

窗號	編號(用料狀況)	實用長度(長料開數)	需要 支數	開料 支數	長料 支數	餘料 支數	編號(剩餘長度)
X86463-01A	1-5	2370.0	9	9	5	0	1-4@(98)x4 5@(2474)x1

工程號碼: J858, 工程名稱: 康城11期 (CW-收口鋁料-T1-46F~55F)

開料長度: 4900, 總長料支數: 113, 總開料支數: 225

鋸片厚度 (mm): 6, 料頭尾總切除 (mm): 50, 浪費率 (%): 2.43

鋁材開料清單 X86459

窗號	編號(用料狀況)	實用長度(長料開數)	需要 支數	開料 支數	長料 支數	餘料 支數	編號(剩餘長度)
X86459-01A	1-113	2370.0	225	225	113	0	1-112@(98)x112 113@(2474)x1

工程號碼: J858, 工程名稱: 康城11期 (CW-收口鋁料- T1-46F~55F)

開料長度: 4900, 總長料支數: 86, 總開料支數: 171

鋸片厚度 (mm): 6, 料頭尾總切除 (mm): 50, 浪費率 (%): 2.56

鋁材開料清單 X86458

窗號	編號(用料狀況)	實用長度(長料開數)	需要 支數	開料 支數	長料 支數	餘料 支數	編號(剩餘長度)
X86458-01A	1-86	2370.0	171	171	86	0	1-85@(98)x85 86@(2474)x1

鋁材開料清單 X86457

窗號	編號(用料狀況)	實用長度(長料開數)	需要支數	開料支數	長料支數	餘料支數	編號(剩餘長度)
X86457-01-02	1-3	1750.0	9	9	3	0	1-3@(282)x3
X86457-02-01	4-9	1679.0	18	18	6	0	4-9@(495)x6
X86457-01-03	10-12	1661.5	9	9	3	0	10-12@(547.5)x3
X86457-03-03	13-15	1660.0	9	9	3	0	13-15@(552)x3
X86457-03-04	16-18	1568.5	9	9	3	0	16-18@(826.5)x3
X86457-01-11	19-21	1530.0	9	9	3	0	19-21@(942)x3
X86457-01-05	22-24	1510.5	9	9	3	0	22-24@(1000.5)x3
X86457-01-17	25-27	1410.0	9	9	3	0	25-27@(1302)x3
X86457-01-10	28-34	1380.0	27	27	7	0	28-33@(6)x6 34@(1392)x1
X86457-01-13	(餘料)34	1373.0	9	1	0	1	34@(13)x1
X86457-01-13	35-36	1373.0		8	2	0	35-36@(34)x2
X86457-01-08	37-52	1366.5	63	63	16	0	37-51@(60)x15 52@(1432.5)x1
X86457-01-07	(餘料)52	1355.0	27	1	0	1	52@(71.5)x1
X86457-01-07, X86457-	53-59	1355.0		26	7	0	53-58@(106)x6
X86457-01-14	(餘料)19-27	841.5	9	9	0	9	19-21@(94.5)x3 22-24@(153)x3 25-27@(454.5)x3
X86457-01-29	(餘料)59	829.0	9	3	0	1	59@(323)x1
X86457-01-29	60	829.0		6	1	0	60@(540)x1
X86457-01-30	(餘料)16-18	804.0	9	3	0	3	16-18@(16.5)x3
X86457-01-30	61	804.0		6	1	0	61@(690)x1
X86457-01-01	62-63	745.0	9	9	2	0	62@(293)x1 63@(4048)x1
X86457-01-04	(餘料)61, 63	648.0	27	7	0	2	61@(36)x1 63@(124)x1
X86457-01-04	64-66	648.0		20	3	0	64-65@(318)x2
X86457-02-03	(餘料)66	643.5	9	4	0	1	66@(336)x1
X86457-02-03	67	643.5		5	1	0	67@(2302.5)x1
X86457-01-09	(餘料)67	629.0	63	3	0	1	67@(397.5)x1
X86457-01-09	68-75	629.0		60	8	0	68-74@(470)x7
X86457-01-31	(餘料)75	549.0	9	5	0	1	75@(235)x1
X86457-01-31	76	549.0		4	1	0	76@(3330)x1
X86457-02-02, X86457-03-02	(餘料)10-15, 76, 76	537.5	27	12	0	8	10-12@(4)x3 13-15@(8.5)x3 76@(1699.5)x1 76@(69)x1
X86457-03-02	77-78	537.5		15	2	0	77@(115)x1 78@(2832.5)x1
X86457-01-16	(餘料)60, 78	524.0	9	6	0	2	60@(10)x1 78@(182.5)x1
X86457-01-16	79	524.0		3	1	0	79@(3960)x1
X86457-01-06	(餘料)79	499.0	9	7	0	1	79@(425)x1
X86457-01-06	80	499.0		2	1	0	80@(4540)x1

鋁材開料總表

工程號碼: J858 工程名稱: 康城11期(CW-收口鋁料-T1-56F~60F)

序號	鋁料編號	名稱	表面處理		開料長度	實用長料總數量		浪費率(%)
			顏色	層厚		支數	長度	
1	X86457	幕牆陣底收口	ECD3X10 09 9S-		5600	45	252000	5.36
2	X86458	幕牆邊企收口	ECD3X10 09 9S-		4900	48	235200	3.01
3	X86459	幕牆磚牆收口	ECD3X10 09 9S-		4900	63	308700	2.77
4	X86463	幕牆中間收口	ECD3X10 09 9S-		4900	3	14700	18.16

送至: _____

由: _____

日期: _____

簡短說明: _____

共6頁 第1頁

打印日期: 2023/11/10 打印時間: 10:21

工程號碼: J858, 工程名稱: 康城11期 (CW-收口鋁料- T1-56F~60F)

開料長度: 4900, 總長料支數: 3, 總開料支數: 5

鋸片厚度 (mm): 6, 料頭尾總切除 (mm): 50, 浪費率 (%): 18.16

鋁材開料清單 X86463

窗號	編號(用料狀況)	實用長度(長料開數)	需要 支數	開料 支數	長料 支數	餘料 支數	編號(剩餘長度)
X86463-01A	1-3	2370.0	5	5	3	0	1-2@(98)x2 3@(2474)x1

工程號碼: J858, 工程名稱: 康城11期 (CW-收口鋁料-T1-56F~60F)

開料長度: 4900, 總長料支數: 63, 總開料支數: 125

鋸片厚度 (mm): 6, 料頭尾總切除 (mm): 50, 浪費率 (%): 2.77

鋁材開料清單 X86459

窗號	編號(用料狀況)	實用長度(長料開數)	需要 支數	開料 支數	長料 支數	餘料 支數	編號(剩餘長度)
X86459-01A	1-63	2370.0	125	125	63	0	1-62@(98)x62 63@(2474)x1

工程號碼: J858, 工程名稱: 康城11期 (CW-收口鋁料- T1-56F~60F)

開料長度: 4900, 總長料支數: 48, 總開料支數: 95

鋸片厚度 (mm): 6, 料頭尾總切除 (mm): 50, 浪費率 (%): 3.01

鋁材開料清單 X86458

窗號	編號(用料狀況)	實用長度(長料開數)	需要 支數	開料 支數	長料 支數	餘料 支數	編號(剩餘長度)
X86458-01A	1-48	2370.0	95	95	48	0	1-47@(98)x47 48@(2474)x1

鋁材開料清單 X86457

窗號	編號(用料狀況)	實用長度(長料開數)	需要支數	開料支數	長料支數	餘料支數	編號(剩餘長度)
X86457-01-02	1-2	1750.0	5	5	2	0	1@(282)x1 2@(2038)x1
X86457-02-01	(餘料)2	1679.0	10	1	0	1	2@(353)x1
X86457-02-01	3-5	1679.0		9	3	0	3-5@(495)x3
X86457-01-03	6-7	1661.5	5	5	2	0	6@(547.5)x1 7@(2215)x1
X86457-03-03	(餘料)7	1660.0	5	1	0	1	7@(549)x1
X86457-03-03	8-9	1660.0		4	2	0	8@(552)x1
X86457-03-04	(餘料)9	1568.5	5	2	0	1	9@(735)x1
X86457-03-04	10	1568.5		3	1	0	10@(826.5)x1
X86457-01-11	11-12	1530.0	5	5	2	0	11@(942)x1 12@(2478)x1
X86457-01-05	(餘料)12	1510.5	5	1	0	1	12@(961.5)x1
X86457-01-05	13-14	1510.5		4	2	0	13@(1000.5)x1 14@(4033.5)x1
X86457-01-17	(餘料)14	1410.0	5	2	0	1	14@(1201.5)x1
X86457-01-17	15	1410.0		3	1	0	15@(1302)x1
X86457-01-10	16-19	1380.0	15	15	4	0	16-18@(6)x3 19@(1392)x1
X86457-01-13	(餘料)19	1373.0	5	1	0	1	19@(13)x1
X86457-01-13	20	1373.0		4	1	0	20@(34)x1
X86457-01-08	21-29	1366.5	35	35	9	0	21-28@(60)x8 29@(1432.5)x1
X86457-01-07	(餘料)29	1355.0	15	1	0	1	29@(71.5)x1
X86457-01-07, X86457-	30-33	1355.0		14	4	0	30-32@(106)x3
X86457-01-14	(餘料)11-15	841.5	5	5	0	5	11@(94.5)x1 12@(114)x1 13@(153)x1 14@(354)x1 15@(454.5)x1
X86457-01-29	(餘料)33	829.0	5	3	0	1	33@(323)x1
X86457-01-29	34	829.0		2	1	0	34@(3880)x1
X86457-01-30	(餘料)10, 34	804.0	5	5	0	2	10@(16.5)x1 34@(640)x1
X86457-01-01	35	745.0	5	5	1	0	35@(1795)x1
X86457-01-04	(餘料)9, 35	648.0	15	3	0	2	9@(81)x1 35@(487)x1
X86457-01-04	36-37	648.0		12	2	0	36@(318)x1 37@(2934)x1
X86457-02-03	(餘料)37	643.5	5	4	0	1	37@(336)x1
X86457-02-03	38	643.5		1	1	0	38@(4900.5)x1
X86457-01-09	(餘料)34, 38	629.0	35	8	0	2	34@(5)x1 38@(455.5)x1
X86457-01-09	39-42	629.0		27	4	0	39-41@(470)x3
X86457-01-31	(餘料)42	549.0	5	5	0	1	42@(870)x1
X86457-02-02, X86457-03-02	(餘料)6-8, 42-43	537.5	15	13	0	5	6@(4)x1 7@(5.5)x1 8@(8.5)x1 42@(326.5)x1 43@(115)x1

鋁材開料清單 X86457

窗號	編號(用料狀況)	實用長度(長料開數)	需要 支數	開料 支數	長料 支數	餘料 支數	編號(剩餘長度)
X86457-02-02, X86457-	43-44	537.5		2	2	0	43-44@(5006.5)x2
X86457-01-16	(餘料)44	524.0	5	5	0	1	44@(2356.5)x1
X86457-01-06	(餘料)44	499.0	5	4	0	1	44@(336.5)x1
X86457-01-06	45	499.0		1	1	0	45@(5045)x1

鋁材開料總表

工程號碼: J858 工程名稱: 康城11期(CW-收口鋁料-T2-9F, 10F, 17F~23F)

序號	鋁料編號	名稱	表面處理		開料長度	實用長料總數量		浪費率(%)
			顏色	層厚		支數	長度	
1	X86457	幕牆陣底收口	ECD3X10 09 9S-		5600	74	414400	4.89
2	X86458	幕牆邊企收口	ECD3X10 09 9S-		4900	81	396900	2.00
3	X86459	幕牆磚牆收口	ECD3X10 09 9S-		4900	99	485100	2.00
4	X86463	幕牆中間收口	ECD3X10 09 9S-		4900	5	24500	11.70

送至: _____

由: _____

日期: _____

簡短說明: _____

共5頁 第1頁

打印日期: 2023/11/10 打印時間: 10:33

鋁材開料清單 X86463

開料長度: 4900, 總長料支數: 5, 總開料支數: 9

窗號	編號(用料狀況)	實用長度(長料開數)	需要支數	開料支數	長料支數	餘料支數	編號(剩餘長度)
X86463-01A	1-5	2370.0	9	9	5	0	1-4@(98)x4 5@(2474)x1

鋁材開料清單 X86459

開料長度: 4900, 總長料支數: 99, 總開料支數: 198

窗號	編號(用料狀況)	實用長度(長料開數)	需要支數	開料支數	長料支數	餘料支數	編號(剩餘長度)
X86459-01A	1-99	2370.0	198	198	99	0	1-99@(98)x99

鋁材開料清單 X86458

開料長度: 4900, 總長料支數: 81, 總開料支數: 162

窗號	編號(用料狀況)	實用長度(長料開數)	需要支數	開料支數	長料支數	餘料支數	編號(剩餘長度)
X86458-01A	1-81	2370.0	162	162	81	0	1-81@(98)x81

鋁材開料清單 X86457

開料長度: 5600, 總長料支數: 74, 總開料支數: 360

窗號	編號(用料狀況)	實用長度(長料開數)	需要支數	開料支數	長料支數	餘料支數	編號(剩餘長度)
X86457-01-20	1-3	1800.0	9	9	3	0	1-3@(132)x3
X86457-01-24	4-6	1784.0	9	9	3	0	4-6@(180)x3
X86457-01-21	7-9	1686.5	9	9	3	0	7-9@(472.5)x3
X86457-02-01, X86457-03-01	10-18	1679.0	27	27	9	0	10-18@(495)x9
X86457-01-27	19-21	1555.5	9	9	3	0	19-21@(865.5)x3
X86457-01-05	22-24	1510.5	9	9	3	0	22-24@(1000.5)x3
X86457-01-25	25-27	1405.0	9	9	3	0	25-27@(1317)x3
X86457-01-10	28-34	1380.0	27	27	7	0	28-33@(6)x6 34@(1392)x1
X86457-01-08	(餘料)34	1366.5	63	1	0	1	34@(19.5)x1
X86457-01-08	35-50	1366.5		62	16	0	35-49@(60)x15
X86457-01-07, X86457-01-12	(餘料)50, 52	1355.0	18	3	0	2	50@(83)x1 52@(106)x1
X86457-01-07, X86457-01-12	51-54	1355.0		15	4	0	51@(106)x1 52@(1467)x1
X86457-01-32	(餘料)19-27	841.5	9	9	0	9	19-21@(18)x3 22-24@(153)x3 25-27@(469.5)x3
X86457-01-26	55-57	804.0	18	18	3	0	55-57@(690)x3
X86457-01-19	58-59	725.0	9	9	2	0	58@(433)x1 59@(4088)x1
X86457-01-04	(餘料)55-57, 59	648.0	9	9	0	4	55-57@(36)x3 59@(164)x1
X86457-01-09	60-67	629.0	63	63	8	0	60-66@(470)x7 67@(1105)x1
X86457-01-18	(餘料)67	549.0	18	1	0	1	67@(550)x1
X86457-01-18	68-69	549.0		17	2	0	68@(0)x1
X86457-02-02, X86457-03-02	(餘料)67, 69-70	537.5	27	9	0	3	67@(6.5)x1 69@(34.5)x1 70@(115)x1
X86457-02-02, X86457-03-02	70-72	537.5		18	3	0	70@(2832.5)x1 71@(115)x1
X86457-01-33	(餘料)72	511.5	9	7	0	1	72@(297)x1
X86457-01-33	73	511.5		2	1	0	73@(4515)x1
X86457-01-06	(餘料)73	499.0	9	8	0	1	73@(475)x1
X86457-01-06	74	499.0		1	1	0	74@(5045)x1

鋁材開料總表

工程號碼: J858 工程名稱: 康城11期(CW-收口鋁料-T2-25F~33F)

序號	鋁料編號	名稱	表面處理		開料長度	實用長料總數量		浪費率(%)
			顏色	層厚		支數	長度	
1	X86457	幕牆陣底收口	ECD3X10 09 9S-		5600	74	414400	4.89
2	X86458	幕牆邊企收口	ECD3X10 09 9S-		4900	81	396900	2.00
3	X86459	幕牆磚牆收口	ECD3X10 09 9S-		4900	99	485100	2.00
4	X86463	幕牆中間收口	ECD3X10 09 9S-		4900	5	24500	11.70

送至: _____

由: _____

日期: _____

簡短說明: _____

共5頁 第1頁

打印日期: 2023/11/10 打印時間: 10:39

鋁材開料清單 X86463

窗號	編號(用料狀況)	實用長度(長料開數)	需要 支數	開料 支數	長料 支數	餘料 支數	編號(剩餘長度)
X86463-01A	1-5	2370.0	9	9	5	0	1-4@(98)x4 5@(2474)x1

工程號碼: J858, 工程名稱: 康城11期 (CW-收口鋁料- T2-25F~33F)

開料長度: 4900, 總長料支數: 99, 總開料支數: 198

鋸片厚度 (mm): 6, 料頭尾總切除 (mm): 50, 浪費率 (%): 2

鋁材開料清單 X86459

窗號	編號(用料狀況)	實用長度(長料開數)	需要 支數	開料 支數	長料 支數	餘料 支數	編號(剩餘長度)
X86459-01A	1-99	2370.0	198	198	99	0	1-99@(98)x99

工程號碼: J858, 工程名稱: 康城11期 (CW-收口鋁料- T2-25F~33F)

開料長度: 4900, 總長料支數: 81, 總開料支數: 162

鋸片厚度 (mm): 6, 料頭尾總切除 (mm): 50, 浪費率 (%): 2

鋁材開料清單 X86458

窗號	編號(用料狀況)	實用長度(長料開數)	需要 支數	開料 支數	長料 支數	餘料 支數	編號(剩餘長度)
X86458-01A	1-81	2370.0	162	162	81	0	1-81@(98)x81

鋁材開料清單 X86457

窗號	編號(用料狀況)	實用長度(長料開數)	需要支數	開料支數	長料支數	餘料支數	編號(剩餘長度)
X86457-01-20	1-3	1800.0	9	9	3	0	1-3@(132)x3
X86457-01-24	4-6	1784.0	9	9	3	0	4-6@(180)x3
X86457-01-21	7-9	1686.5	9	9	3	0	7-9@(472.5)x3
X86457-02-01, X86457-03-01	10-18	1679.0	27	27	9	0	10-18@(495)x9
X86457-01-27	19-21	1555.5	9	9	3	0	19-21@(865.5)x3
X86457-01-05	22-24	1510.5	9	9	3	0	22-24@(1000.5)x3
X86457-01-25	25-27	1405.0	9	9	3	0	25-27@(1317)x3
X86457-01-10	28-34	1380.0	27	27	7	0	28-33@(6)x6 34@(1392)x1
X86457-01-08	(餘料)34	1366.5	63	1	0	1	34@(19.5)x1
X86457-01-08	35-50	1366.5		62	16	0	35-49@(60)x15
X86457-01-07, X86457-01-12	(餘料)50, 52	1355.0	18	3	0	2	50@(83)x1 52@(106)x1
X86457-01-07, X86457-01-12	51-54	1355.0		15	4	0	51@(106)x1 52@(1467)x1
X86457-01-32	(餘料)19-27	841.5	9	9	0	9	19-21@(18)x3 22-24@(153)x3 25-27@(469.5)x3
X86457-01-26	55-57	804.0	18	18	3	0	55-57@(690)x3
X86457-01-19	58-59	725.0	9	9	2	0	58@(433)x1 59@(4088)x1
X86457-01-04	(餘料)55-57, 59	648.0	9	9	0	4	55-57@(36)x3 59@(164)x1
X86457-01-09	60-67	629.0	63	63	8	0	60-66@(470)x7 67@(1105)x1
X86457-01-18	(餘料)67	549.0	18	1	0	1	67@(550)x1
X86457-01-18	68-69	549.0		17	2	0	68@(0)x1
X86457-02-02, X86457-03-02	(餘料)67, 69-70	537.5	27	9	0	3	67@(6.5)x1 69@(34.5)x1 70@(115)x1
X86457-02-02, X86457-03-02	70-72	537.5		18	3	0	70@(2832.5)x1 71@(115)x1
X86457-01-33	(餘料)72	511.5	9	7	0	1	72@(297)x1
X86457-01-33	73	511.5		2	1	0	73@(4515)x1
X86457-01-06	(餘料)73	499.0	9	8	0	1	73@(475)x1
X86457-01-06	74	499.0		1	1	0	74@(5045)x1

鋁材開料總表

工程號碼: J858 工程名稱: 康城11期(CW-收口鋁料-T2-35F~45F)

序號	鋁料編號	名稱	表面處理		開料長度	實用長料總數量		浪費率(%)
			顏色	層厚		支數	長度	
1	X86457	幕牆陣底收口	ECD3X10 09 9S-		5600	74	414400	4.89
2	X86458	幕牆邊企收口	ECD3X10 09 9S-		4900	81	396900	2.00
3	X86459	幕牆磚牆收口	ECD3X10 09 9S-		4900	99	485100	2.00
4	X86463	幕牆中間收口	ECD3X10 09 9S-		4900	5	24500	11.70

送至: _____

由: _____

日期: _____

簡短說明: _____

共5頁 第1頁

打印日期: 2023/11/10 打印時間: 10:41

工程號碼: J858, 工程名稱: 康城11期 (CW-收口鋁料- T2-35F~45F)

開料長度: 4900, 總長料支數: 5, 總開料支數: 9

鋸片厚度 (mm): 6, 料頭尾總切除 (mm): 50, 浪費率 (%): 11.7

鋁材開料清單 X86463

窗號	編號(用料狀況)	實用長度(長料開數)	需要 支數	開料 支數	長料 支數	餘料 支數	編號(剩餘長度)
X86463-01A	1-5	2370.0	9	9	5	0	1-4@(98)x4 5@(2474)x1

工程號碼: J858, 工程名稱: 康城11期 (CW-收口鋁料- T2-35F~45F)

開料長度: 4900, 總長料支數: 99, 總開料支數: 198

鋸片厚度 (mm): 6, 料頭尾總切除 (mm): 50, 浪費率 (%): 2

鋁材開料清單 X86459

窗號	編號(用料狀況)	實用長度(長料開數)	需要 支數	開料 支數	長料 支數	餘料 支數	編號(剩餘長度)
X86459-01A	1-99	2370.0	198	198	99	0	1-99@(98)x99

工程號碼: J858, 工程名稱: 康城11期 (CW-收口鋁料- T2-35F~45F)

開料長度: 4900, 總長料支數: 81, 總開料支數: 162

鋸片厚度 (mm): 6, 料頭尾總切除 (mm): 50, 浪費率 (%): 2

鋁材開料清單 X86458

窗號	編號(用料狀況)	實用長度(長料開數)	需要 支數	開料 支數	長料 支數	餘料 支數	編號(剩餘長度)
X86458-01A	1-81	2370.0	162	162	81	0	1-81@(98)x81

鋁材開料清單 X86457

窗號	編號(用料狀況)	實用長度(長料開數)	需要支數	開料支數	長料支數	餘料支數	編號(剩餘長度)
X86457-01-20	1-3	1800.0	9	9	3	0	1-3@(132)x3
X86457-01-24	4-6	1784.0	9	9	3	0	4-6@(180)x3
X86457-01-21	7-9	1686.5	9	9	3	0	7-9@(472.5)x3
X86457-02-01, X86457-03-01	10-18	1679.0	27	27	9	0	10-18@(495)x9
X86457-01-27	19-21	1555.5	9	9	3	0	19-21@(865.5)x3
X86457-01-05	22-24	1510.5	9	9	3	0	22-24@(1000.5)x3
X86457-01-25	25-27	1405.0	9	9	3	0	25-27@(1317)x3
X86457-01-10	28-34	1380.0	27	27	7	0	28-33@(6)x6 34@(1392)x1
X86457-01-08	(餘料)34	1366.5	63	1	0	1	34@(19.5)x1
X86457-01-08	35-50	1366.5		62	16	0	35-49@(60)x15
X86457-01-07, X86457-01-12	(餘料)50, 52	1355.0	18	3	0	2	50@(83)x1 52@(106)x1
X86457-01-07, X86457-01-12	51-54	1355.0		15	4	0	51@(106)x1 52@(1467)x1
X86457-01-32	(餘料)19-27	841.5	9	9	0	9	19-21@(18)x3 22-24@(153)x3 25-27@(469.5)x3
X86457-01-26	55-57	804.0	18	18	3	0	55-57@(690)x3
X86457-01-19	58-59	725.0	9	9	2	0	58@(433)x1 59@(4088)x1
X86457-01-04	(餘料)55-57, 59	648.0	9	9	0	4	55-57@(36)x3 59@(164)x1
X86457-01-09	60-67	629.0	63	63	8	0	60-66@(470)x7 67@(1105)x1
X86457-01-18	(餘料)67	549.0	18	1	0	1	67@(550)x1
X86457-01-18	68-69	549.0		17	2	0	68@(0)x1
X86457-02-02, X86457-03-02	(餘料)67, 69-70	537.5	27	9	0	3	67@(6.5)x1 69@(34.5)x1 70@(115)x1
X86457-02-02, X86457-03-02	70-72	537.5		18	3	0	70@(2832.5)x1 71@(115)x1
X86457-01-33	(餘料)72	511.5	9	7	0	1	72@(297)x1
X86457-01-33	73	511.5		2	1	0	73@(4515)x1
X86457-01-06	(餘料)73	499.0	9	8	0	1	73@(475)x1
X86457-01-06	74	499.0		1	1	0	74@(5045)x1

鋁材開料總表

工程號碼: J858 工程名稱: 康城11期(CW-收口鋁料-T2-46F~55F)

序號	鋁料編號	名稱	表面處理		開料長度	實用長料總數量		浪費率(%)
			顏色	層厚		支數	長度	
1	X86457	幕牆陣底收口	ECD3X10 09 9S-		5600	74	414400	4.89
2	X86458	幕牆邊企收口	ECD3X10 09 9S-		4900	81	396900	2.00
3	X86459	幕牆磚牆收口	ECD3X10 09 9S-		4900	99	485100	2.00
4	X86463	幕牆中間收口	ECD3X10 09 9S-		4900	5	24500	11.70

送至: _____

由: _____

日期: _____

簡短說明: _____

共5頁 第1頁

打印日期: 2023/11/10 打印時間: 10:44

鋁材開料清單 X86463

窗號	編號(用料狀況)	實用長度(長料開數)	需要 支數	開料 支數	長料 支數	餘料 支數	編號(剩餘長度)
X86463-01A	1-5	2370.0	9	9	5	0	1-4@(98)x4 5@(2474)x1

工程號碼: J858, 工程名稱: 康城11期 (CW-收口鋁料- T2-46F~55F)

開料長度: 4900, 總長料支數: 99, 總開料支數: 198

鋸片厚度 (mm): 6, 料頭尾總切除 (mm): 50, 浪費率 (%): 2

鋁材開料清單 X86459

窗號	編號(用料狀況)	實用長度(長料開數)	需要 支數	開料 支數	長料 支數	餘料 支數	編號(剩餘長度)
X86459-01A	1-99	2370.0	198	198	99	0	1-99@(98)x99

工程號碼: J858, 工程名稱: 康城11期 (CW-收口鋁料- T2-46F~55F)

開料長度: 4900, 總長料支數: 81, 總開料支數: 162

鋸片厚度 (mm): 6, 料頭尾總切除 (mm): 50, 浪費率 (%): 2

鋁材開料清單 X86458

窗號	編號(用料狀況)	實用長度(長料開數)	需要 支數	開料 支數	長料 支數	餘料 支數	編號(剩餘長度)
X86458-01A	1-81	2370.0	162	162	81	0	1-81@(98)x81

鋁材開料清單 X86457

窗號	編號(用料狀況)	實用長度(長料開數)	需要支數	開料支數	長料支數	餘料支數	編號(剩餘長度)
X86457-01-20	1-3	1800.0	9	9	3	0	1-3@(132)x3
X86457-01-24	4-6	1784.0	9	9	3	0	4-6@(180)x3
X86457-01-21	7-9	1686.5	9	9	3	0	7-9@(472.5)x3
X86457-02-01, X86457-03-01	10-18	1679.0	27	27	9	0	10-18@(495)x9
X86457-01-27	19-21	1555.5	9	9	3	0	19-21@(865.5)x3
X86457-01-05	22-24	1510.5	9	9	3	0	22-24@(1000.5)x3
X86457-01-25	25-27	1405.0	9	9	3	0	25-27@(1317)x3
X86457-01-10	28-34	1380.0	27	27	7	0	28-33@(6)x6 34@(1392)x1
X86457-01-08	(餘料)34	1366.5	63	1	0	1	34@(19.5)x1
X86457-01-08	35-50	1366.5		62	16	0	35-49@(60)x15
X86457-01-07, X86457-01-12	(餘料)50, 52	1355.0	18	3	0	2	50@(83)x1 52@(106)x1
X86457-01-07, X86457-01-12	51-54	1355.0		15	4	0	51@(106)x1 52@(1467)x1
X86457-01-32	(餘料)19-27	841.5	9	9	0	9	19-21@(18)x3 22-24@(153)x3 25-27@(469.5)x3
X86457-01-26	55-57	804.0	18	18	3	0	55-57@(690)x3
X86457-01-19	58-59	725.0	9	9	2	0	58@(433)x1 59@(4088)x1
X86457-01-04	(餘料)55-57, 59	648.0	9	9	0	4	55-57@(36)x3 59@(164)x1
X86457-01-09	60-67	629.0	63	63	8	0	60-66@(470)x7 67@(1105)x1
X86457-01-18	(餘料)67	549.0	18	1	0	1	67@(550)x1
X86457-01-18	68-69	549.0		17	2	0	68@(0)x1
X86457-02-02, X86457-03-02	(餘料)67, 69-70	537.5	27	9	0	3	67@(6.5)x1 69@(34.5)x1 70@(115)x1
X86457-02-02, X86457-03-02	70-72	537.5		18	3	0	70@(2832.5)x1 71@(115)x1
X86457-01-33	(餘料)72	511.5	9	7	0	1	72@(297)x1
X86457-01-33	73	511.5		2	1	0	73@(4515)x1
X86457-01-06	(餘料)73	499.0	9	8	0	1	73@(475)x1
X86457-01-06	74	499.0		1	1	0	74@(5045)x1

鋁材開料總表

工程號碼: J858 工程名稱: 康城11期(CW-收口鋁料-T2-56F~65F)

序號	鋁料編號	名稱	表面處理		開料長度	實用長料總數量		浪費率(%)
			顏色	層厚		支數	長度	
1	X86457	幕牆陣底收口	ECD3X10 09 9S-		5600	74	414400	4.89
2	X86458	幕牆邊企收口	ECD3X10 09 9S-		4900	81	396900	2.00
3	X86459	幕牆磚牆收口	ECD3X10 09 9S-		4900	99	485100	2.00
4	X86463	幕牆中間收口	ECD3X10 09 9S-		4900	5	24500	11.70

送至: _____

由: _____

日期: _____

簡短說明: _____

共5頁 第1頁

打印日期: 2023/11/10 打印時間: 10:46

鋁材開料清單 X86463

窗號	編號(用料狀況)	實用長度(長料開數)	需要 支數	開料 支數	長料 支數	餘料 支數	編號(剩餘長度)
X86463-01A	1-5	2370.0	9	9	5	0	1-4@(98)x4 5@(2474)x1

工程號碼: J858, 工程名稱: 康城11期 (CW-收口鋁料- T2-56F~65F)

開料長度: 4900, 總長料支數: 99, 總開料支數: 198

鋸片厚度 (mm): 6, 料頭尾總切除 (mm): 50, 浪費率 (%): 2

鋁材開料清單 X86459

窗號	編號(用料狀況)	實用長度(長料開數)	需要 支數	開料 支數	長料 支數	餘料 支數	編號(剩餘長度)
X86459-01A	1-99	2370.0	198	198	99	0	1-99@(98)x99

工程號碼: J858, 工程名稱: 康城11期 (CW-收口鋁料- T2-56F~65F)

開料長度: 4900, 總長料支數: 81, 總開料支數: 162

鋸片厚度 (mm): 6, 料頭尾總切除 (mm): 50, 浪費率 (%): 2

鋁材開料清單 X86458

窗號	編號(用料狀況)	實用長度(長料開數)	需要 支數	開料 支數	長料 支數	餘料 支數	編號(剩餘長度)
X86458-01A	1-81	2370.0	162	162	81	0	1-81@(98)x81

鋁材開料清單 X86457

窗號	編號(用料狀況)	實用長度(長料開數)	需要支數	開料支數	長料支數	餘料支數	編號(剩餘長度)
X86457-01-20	1-3	1800.0	9	9	3	0	1-3@(132)x3
X86457-01-24	4-6	1784.0	9	9	3	0	4-6@(180)x3
X86457-01-21	7-9	1686.5	9	9	3	0	7-9@(472.5)x3
X86457-02-01, X86457-03-01	10-18	1679.0	27	27	9	0	10-18@(495)x9
X86457-01-27	19-21	1555.5	9	9	3	0	19-21@(865.5)x3
X86457-01-05	22-24	1510.5	9	9	3	0	22-24@(1000.5)x3
X86457-01-25	25-27	1405.0	9	9	3	0	25-27@(1317)x3
X86457-01-10	28-34	1380.0	27	27	7	0	28-33@(6)x6 34@(1392)x1
X86457-01-08	(餘料)34	1366.5	63	1	0	1	34@(19.5)x1
X86457-01-08	35-50	1366.5		62	16	0	35-49@(60)x15
X86457-01-07, X86457-01-12	(餘料)50, 52	1355.0	18	3	0	2	50@(83)x1 52@(106)x1
X86457-01-07, X86457-01-12	51-54	1355.0		15	4	0	51@(106)x1 52@(1467)x1
X86457-01-32	(餘料)19-27	841.5	9	9	0	9	19-21@(18)x3 22-24@(153)x3 25-27@(469.5)x3
X86457-01-26	55-57	804.0	18	18	3	0	55-57@(690)x3
X86457-01-19	58-59	725.0	9	9	2	0	58@(433)x1 59@(4088)x1
X86457-01-04	(餘料)55-57, 59	648.0	9	9	0	4	55-57@(36)x3 59@(164)x1
X86457-01-09	60-67	629.0	63	63	8	0	60-66@(470)x7 67@(1105)x1
X86457-01-18	(餘料)67	549.0	18	1	0	1	67@(550)x1
X86457-01-18	68-69	549.0		17	2	0	68@(0)x1
X86457-02-02, X86457-03-02	(餘料)67, 69-70	537.5	27	9	0	3	67@(6.5)x1 69@(34.5)x1 70@(115)x1
X86457-02-02, X86457-03-02	70-72	537.5		18	3	0	70@(2832.5)x1 71@(115)x1
X86457-01-33	(餘料)72	511.5	9	7	0	1	72@(297)x1
X86457-01-33	73	511.5		2	1	0	73@(4515)x1
X86457-01-06	(餘料)73	499.0	9	8	0	1	73@(475)x1
X86457-01-06	74	499.0		1	1	0	74@(5045)x1

鋁材開料總表

工程號碼: J858 工程名稱: 康城11期(CW-收口鋁料-T3-9F, 10F, 17F~23F)

序號	鋁料編號	名稱	表面處理		開料長度	實用長料總數量		浪費率(%)
			顏色	層厚		支數	長度	
1	X86457	幕牆陣底收口	ECD3X10 09 9S-		5600	71	397600	3.74
2	X86458	幕牆邊企收口	ECD3X10 09 9S-		4900	76	372400	2.64
3	X86459	幕牆磚牆收口	ECD3X10 09 9S-		4900	95	465500	2.51
4	X86463	幕牆中間收口	ECD3X10 09 9S-		4900	5	24500	11.70

送至: _____

由: _____

日期: _____

簡短說明: _____

共5頁 第1頁

打印日期: 2023/11/10 打印時間: 11:00

鋁材開料清單 X86463

開料長度: 4900, 總長料支數: 5, 總開料支數: 9

窗號	編號(用料狀況)	實用長度(長料開數)	需要支數	開料支數	長料支數	餘料支數	編號(剩餘長度)
X86463-01A	1-5	2370.0	9	9	5	0	1-4@(98)x4 5@(2474)x1

鋁材開料清單 X86459

開料長度: 4900, 總長料支數: 95, 總開料支數: 189

窗號	編號(用料狀況)	實用長度(長料開數)	需要支數	開料支數	長料支數	餘料支數	編號(剩餘長度)
X86459-01A	1-95	2370.0	189	189	95	0	1-94@(98)x94 95@(2474)x1

鋁材開料清單 X86458

開料長度: 4900, 總長料支數: 76, 總開料支數: 151

窗號	編號(用料狀況)	實用長度(長料開數)	需要支數	開料支數	長料支數	餘料支數	編號(剩餘長度)
X86458-01A	1-76	2370.0	151	151	76	0	1-75@(98)x75 76@(2474)x1

鋁材開料清單 X86457

開料長度: 5600, 總長料支數: 71, 總開料支數: 360

窗號	編號(用料狀況)	實用長度(長料開數)	需要支數	開料支數	長料支數	餘料支數	編號(剩餘長度)
X86457-01-20	1-3	1800.0	9	9	3	0	1-3@(132)x3
X86457-02-04	4-6	1703.5	9	9	3	0	4-6@(421.5)x3
X86457-01-22	7-9	1701.5	9	9	3	0	7-9@(427.5)x3
X86457-02-01	10-12	1679.0	9	9	3	0	10-12@(495)x3
X86457-03-03	13-15	1660.0	9	9	3	0	13-15@(552)x3
X86457-01-28	16-18	1644.0	9	9	3	0	16-18@(600)x3
X86457-01-27	19-21	1555.5	9	9	3	0	19-21@(865.5)x3
X86457-01-05	22-24	1510.5	9	9	3	0	22-24@(1000.5)x3
X86457-01-10	25-31	1380.0	27	27	7	0	25-30@(6)x6 31@(1392)x1
X86457-01-13	(餘料)31	1373.0	9	1	0	1	31@(13)x1
X86457-01-13	32-33	1373.0		8	2	0	32-33@(34)x2
X86457-01-08	34-45	1366.5	45	45	12	0	34-44@(60)x11 45@(4177.5)x1
X86457-01-07, X86457-01-12	(餘料)45, 47	1355.0	18	5	0	2	45@(94.5)x1 47@(106)x1
X86457-01-07, X86457-01-12	46-49	1355.0		13	4	0	46@(106)x1
X86457-01-14, X86457-01-32	(餘料)19-24, 49-50	841.5	18	11	0	8	19-21@(18)x3 22-24@(153)x3 49@(619.5)x1 50@(465)x1
X86457-01-14, X86457-01-32	50-51	841.5		7	2	0	50@(3855)x1
X86457-01-26	(餘料)51	804.0	18	1	0	1	51@(502.5)x1
X86457-01-26	52-54	804.0		17	3	0	52-53@(690)x2
X86457-01-15	(餘料)54	754.0	9	1	0	1	54@(740)x1
X86457-01-15	55-56	754.0		8	2	0	55@(230)x1
X86457-01-19	(餘料)54, 56	725.0	9	7	0	2	54@(9)x1 56@(404)x1
X86457-01-19	57	725.0		2	1	0	57@(4088)x1
X86457-01-04	(餘料)52-53, 57	648.0	27	8	0	3	52-53@(36)x2 57@(164)x1
X86457-01-04	58-60	648.0		19	3	0	58-59@(318)x2 60@(3588)x1
X86457-01-09	(餘料)60	629.0	45	5	0	1	60@(413)x1
X86457-01-09	61-65	629.0		40	5	0	61-65@(470)x5
X86457-01-18	(餘料)16-18, 49	549.0	18	4	0	4	16-18@(45)x3 49@(64.5)x1
X86457-01-18	66-67	549.0		14	2	0	66@(0)x1
X86457-02-02	(餘料)13-15, 67	537.5	27	9	0	4	13-15@(8.5)x3 67@(69)x1
X86457-03-02	68-69	537.5		18	2	0	68@(115)x1
X86457-01-33	(餘料)69	511.5	9	2	0	1	69@(167)x1
X86457-01-33	70	511.5		7	1	0	70@(1927.5)x1
X86457-01-06	(餘料)70	499.0	9	3	0	1	70@(412.5)x1
X86457-01-06	71	499.0		6	1	0	71@(2520)x1

鋁材開料總表

工程號碼: J858 工程名稱: 康城11期(CW-收口鋁料-T3-25F~33F)

序號	鋁料編號	名稱	表面處理		開料長度	實用長料總數量		浪費率(%)
			顏色	層厚		支數	長度	
1	X86457	幕牆陣底收口	ECD3X10 09 9S-		5600	71	397600	3.74
2	X86458	幕牆邊企收口	ECD3X10 09 9S-		4900	77	377300	2.63
3	X86459	幕牆磚牆收口	ECD3X10 09 9S-		4900	95	465500	2.51
4	X86463	幕牆中間收口	ECD3X10 09 9S-		4900	5	24500	11.70

送至: _____

由: _____

日期: _____

簡短說明: _____

共5頁 第1頁

打印日期: 2023/11/10 打印時間: 10:52

鋁材開料清單 X86463

窗號	編號(用料狀況)	實用長度(長料開數)	需要 支數	開料 支數	長料 支數	餘料 支數	編號(剩餘長度)
X86463-01A	1-5	2370.0	9	9	5	0	1-4@(98)x4 5@(2474)x1

工程號碼: J858, 工程名稱: 康城11期 (CW-收口鋁料- T3-25F~33F)

開料長度: 4900, 總長料支數: 95, 總開料支數: 189

鋸片厚度 (mm): 6, 料頭尾總切除 (mm): 50, 浪費率 (%): 2.51

鋁材開料清單 X86459

窗號	編號(用料狀況)	實用長度(長料開數)	需要 支數	開料 支數	長料 支數	餘料 支數	編號(剩餘長度)
X86459-01A	1-95	2370.0	189	189	95	0	1-94@(98)x94 95@(2474)x1

工程號碼: J858, 工程名稱: 康城11期 (CW-收口鋁料- T3-25F~33F)

開料長度: 4900, 總長料支數: 77, 總開料支數: 153

鋸片厚度 (mm): 6, 料頭尾總切除 (mm): 50, 浪費率 (%): 2.63

鋁材開料清單 X86458

窗號	編號(用料狀況)	實用長度(長料開數)	需要 支數	開料 支數	長料 支數	餘料 支數	編號(剩餘長度)
X86458-01A	1-77	2370.0	153	153	77	0	1-76@(98)x76 77@(2474)x1

鋁材開料清單 X86457

窗號	編號(用料狀況)	實用長度(長料開數)	需要支數	開料支數	長料支數	餘料支數	編號(剩餘長度)
X86457-01-20	1-3	1800.0	9	9	3	0	1-3@(132)x3
X86457-02-04	4-6	1703.5	9	9	3	0	4-6@(421.5)x3
X86457-01-22	7-9	1701.5	9	9	3	0	7-9@(427.5)x3
X86457-02-01	10-12	1679.0	9	9	3	0	10-12@(495)x3
X86457-03-03	13-15	1660.0	9	9	3	0	13-15@(552)x3
X86457-01-28	16-18	1644.0	9	9	3	0	16-18@(600)x3
X86457-01-27	19-21	1555.5	9	9	3	0	19-21@(865.5)x3
X86457-01-05	22-24	1510.5	9	9	3	0	22-24@(1000.5)x3
X86457-01-10	25-31	1380.0	27	27	7	0	25-30@(6)x6 31@(1392)x1
X86457-01-13	(餘料)31	1373.0	9	1	0	1	31@(13)x1
X86457-01-13	32-33	1373.0		8	2	0	32-33@(34)x2
X86457-01-08	34-45	1366.5	45	45	12	0	34-44@(60)x11 45@(4177.5)x1
X86457-01-07, X86457-01-12	(餘料)45, 47	1355.0	18	5	0	2	45@(94.5)x1 47@(106)x1
X86457-01-07, X86457-01-12	46-49	1355.0		13	4	0	46@(106)x1
X86457-01-14, X86457-01-32	(餘料)19-24, 49-50	841.5	18	11	0	8	19-21@(18)x3 22-24@(153)x3 49@(619.5)x1 50@(465)x1
X86457-01-14, X86457-01-32	50-51	841.5		7	2	0	50@(3855)x1
X86457-01-26	(餘料)51	804.0	18	1	0	1	51@(502.5)x1
X86457-01-26	52-54	804.0		17	3	0	52-53@(690)x2
X86457-01-15	(餘料)54	754.0	9	1	0	1	54@(740)x1
X86457-01-15	55-56	754.0		8	2	0	55@(230)x1
X86457-01-19	(餘料)54, 56	725.0	9	7	0	2	54@(9)x1 56@(404)x1
X86457-01-19	57	725.0		2	1	0	57@(4088)x1
X86457-01-04	(餘料)52-53, 57	648.0	27	8	0	3	52-53@(36)x2 57@(164)x1
X86457-01-04	58-60	648.0		19	3	0	58-59@(318)x2 60@(3588)x1
X86457-01-09	(餘料)60	629.0	45	5	0	1	60@(413)x1
X86457-01-09	61-65	629.0		40	5	0	61-65@(470)x5
X86457-01-18	(餘料)16-18, 49	549.0	18	4	0	4	16-18@(45)x3 49@(64.5)x1
X86457-01-18	66-67	549.0		14	2	0	66@(0)x1
X86457-02-02	(餘料)13-15, 67	537.5	27	9	0	4	13-15@(8.5)x3 67@(69)x1
X86457-03-02	68-69	537.5		18	2	0	68@(115)x1
X86457-01-33	(餘料)69	511.5	9	2	0	1	69@(167)x1
X86457-01-33	70	511.5		7	1	0	70@(1927.5)x1
X86457-01-06	(餘料)70	499.0	9	3	0	1	70@(412.5)x1
X86457-01-06	71	499.0		6	1	0	71@(2520)x1

鋁材開料總表

工程號碼: J858 工程名稱: 康城11期(CW-收口鋁料-T3-35F~45F)

序號	鋁料編號	名稱	表面處理		開料長度	實用長料總數量		浪費率(%)
			顏色	層厚		支數	長度	
1	X86457	幕牆陣底收口	ECD3X10 09 9S-		5600	71	397600	3.74
2	X86458	幕牆邊企收口	ECD3X10 09 9S-		4900	77	377300	2.63
3	X86459	幕牆磚牆收口	ECD3X10 09 9S-		4900	95	465500	2.51
4	X86463	幕牆中間收口	ECD3X10 09 9S-		4900	5	24500	11.70

送至: _____

由: _____

日期: _____

簡短說明: _____

共5頁 第1頁

打印日期: 2023/11/10 打印時間: 10:55

鋁材開料清單 X86463

窗號	編號(用料狀況)	實用長度(長料開數)	需要 支數	開料 支數	長料 支數	餘料 支數	編號(剩餘長度)
X86463-01A	1-5	2370.0	9	9	5	0	1-4@(98)x4 5@(2474)x1

工程號碼: J858, 工程名稱: 康城11期 (CW-收口鋁料-T3-35F~45F)

開料長度: 4900, 總長料支數: 95, 總開料支數: 189

鋸片厚度 (mm): 6, 料頭尾總切除 (mm): 50, 浪費率 (%): 2.51

鋁材開料清單 X86459

窗號	編號(用料狀況)	實用長度(長料開數)	需要 支數	開料 支數	長料 支數	餘料 支數	編號(剩餘長度)
X86459-01A	1-95	2370.0	189	189	95	0	1-94@(98)x94 95@(2474)x1

工程號碼: J858, 工程名稱: 康城11期 (CW-收口鋁料-T3-35F~45F)

開料長度: 4900, 總長料支數: 77, 總開料支數: 153

鋸片厚度 (mm): 6, 料頭尾總切除 (mm): 50, 浪費率 (%): 2.63

鋁材開料清單 X86458

窗號	編號(用料狀況)	實用長度(長料開數)	需要 支數	開料 支數	長料 支數	餘料 支數	編號(剩餘長度)
X86458-01A	1-77	2370.0	153	153	77	0	1-76@(98)x76 77@(2474)x1

鋁材開料清單 X86457

窗號	編號(用料狀況)	實用長度(長料開數)	需要支數	開料支數	長料支數	餘料支數	編號(剩餘長度)
X86457-01-20	1-3	1800.0	9	9	3	0	1-3@(132)x3
X86457-02-04	4-6	1703.5	9	9	3	0	4-6@(421.5)x3
X86457-01-22	7-9	1701.5	9	9	3	0	7-9@(427.5)x3
X86457-02-01	10-12	1679.0	9	9	3	0	10-12@(495)x3
X86457-03-03	13-15	1660.0	9	9	3	0	13-15@(552)x3
X86457-01-28	16-18	1644.0	9	9	3	0	16-18@(600)x3
X86457-01-27	19-21	1555.5	9	9	3	0	19-21@(865.5)x3
X86457-01-05	22-24	1510.5	9	9	3	0	22-24@(1000.5)x3
X86457-01-10	25-31	1380.0	27	27	7	0	25-30@(6)x6 31@(1392)x1
X86457-01-13	(餘料)31	1373.0	9	1	0	1	31@(13)x1
X86457-01-13	32-33	1373.0		8	2	0	32-33@(34)x2
X86457-01-08	34-45	1366.5	45	45	12	0	34-44@(60)x11 45@(4177.5)x1
X86457-01-07, X86457-01-12	(餘料)45, 47	1355.0	18	5	0	2	45@(94.5)x1 47@(106)x1
X86457-01-07, X86457-01-12	46-49	1355.0		13	4	0	46@(106)x1
X86457-01-14, X86457-01-32	(餘料)19-24, 49-50	841.5	18	11	0	8	19-21@(18)x3 22-24@(153)x3 49@(619.5)x1 50@(465)x1
X86457-01-14, X86457-01-32	50-51	841.5		7	2	0	50@(3855)x1
X86457-01-26	(餘料)51	804.0	18	1	0	1	51@(502.5)x1
X86457-01-26	52-54	804.0		17	3	0	52-53@(690)x2
X86457-01-15	(餘料)54	754.0	9	1	0	1	54@(740)x1
X86457-01-15	55-56	754.0		8	2	0	55@(230)x1
X86457-01-19	(餘料)54, 56	725.0	9	7	0	2	54@(9)x1 56@(404)x1
X86457-01-19	57	725.0		2	1	0	57@(4088)x1
X86457-01-04	(餘料)52-53, 57	648.0	27	8	0	3	52-53@(36)x2 57@(164)x1
X86457-01-04	58-60	648.0		19	3	0	58-59@(318)x2 60@(3588)x1
X86457-01-09	(餘料)60	629.0	45	5	0	1	60@(413)x1
X86457-01-09	61-65	629.0		40	5	0	61-65@(470)x5
X86457-01-18	(餘料)16-18, 49	549.0	18	4	0	4	16-18@(45)x3 49@(64.5)x1
X86457-01-18	66-67	549.0		14	2	0	66@(0)x1
X86457-02-02	(餘料)13-15, 67	537.5	27	9	0	4	13-15@(8.5)x3 67@(69)x1
X86457-03-02	68-69	537.5		18	2	0	68@(115)x1
X86457-01-33	(餘料)69	511.5	9	2	0	1	69@(167)x1
X86457-01-33	70	511.5		7	1	0	70@(1927.5)x1
X86457-01-06	(餘料)70	499.0	9	3	0	1	70@(412.5)x1
X86457-01-06	71	499.0		6	1	0	71@(2520)x1

鋁材開料總表

工程號碼: J858 工程名稱: 康城11期(CW-收口鋁料-T3-46F~55F)

序號	鋁料編號	名稱	表面處理		開料長度	實用長料總數量		浪費率(%)
			顏色	層厚		支數	長度	
1	X86457	幕牆陣底收口	ECD3X10 09 9S-		5600	71	397600	3.74
2	X86458	幕牆邊企收口	ECD3X10 09 9S-		4900	77	377300	2.63
3	X86459	幕牆磚牆收口	ECD3X10 09 9S-		4900	95	465500	2.51
4	X86463	幕牆中間收口	ECD3X10 09 9S-		4900	5	24500	11.70

送至: _____

由: _____

日期: _____

簡短說明: _____

共5頁 第1頁

打印日期: 2023/11/10 打印時間: 10:56

工程號碼: J858, 工程名稱: 康城11期 (CW-收口鋁料- T3-46F~55F)

開料長度: 4900, 總長料支數: 5, 總開料支數: 9

鋸片厚度 (mm): 6, 料頭尾總切除 (mm): 50, 浪費率 (%): 11.7

鋁材開料清單 X86463

窗號	編號(用料狀況)	實用長度(長料開數)	需要 支數	開料 支數	長料 支數	餘料 支數	編號(剩餘長度)
X86463-01A	1-5	2370.0	9	9	5	0	1-4@(98)x4 5@(2474)x1

工程號碼: J858, 工程名稱: 康城11期 (CW-收口鋁料-T3-46F~55F)

開料長度: 4900, 總長料支數: 95, 總開料支數: 189

鋸片厚度 (mm): 6, 料頭尾總切除 (mm): 50, 浪費率 (%): 2.51

鋁材開料清單 X86459

窗號	編號(用料狀況)	實用長度(長料開數)	需要 支數	開料 支數	長料 支數	餘料 支數	編號(剩餘長度)
X86459-01A	1-95	2370.0	189	189	95	0	1-94@(98)x94 95@(2474)x1

工程號碼: J858, 工程名稱: 康城11期 (CW-收口鋁料-T3-46F~55F)

開料長度: 4900, 總長料支數: 77, 總開料支數: 153

鋸片厚度 (mm): 6, 料頭尾總切除 (mm): 50, 浪費率 (%): 2.63

鋁材開料清單 X86458

窗號	編號(用料狀況)	實用長度(長料開數)	需要 支數	開料 支數	長料 支數	餘料 支數	編號(剩餘長度)
X86458-01A	1-77	2370.0	153	153	77	0	1-76@(98)x76 77@(2474)x1

鋁材開料清單 X86457

窗號	編號(用料狀況)	實用長度(長料開數)	需要支數	開料支數	長料支數	餘料支數	編號(剩餘長度)
X86457-01-20	1-3	1800.0	9	9	3	0	1-3@(132)x3
X86457-02-04	4-6	1703.5	9	9	3	0	4-6@(421.5)x3
X86457-01-22	7-9	1701.5	9	9	3	0	7-9@(427.5)x3
X86457-02-01	10-12	1679.0	9	9	3	0	10-12@(495)x3
X86457-03-03	13-15	1660.0	9	9	3	0	13-15@(552)x3
X86457-01-28	16-18	1644.0	9	9	3	0	16-18@(600)x3
X86457-01-27	19-21	1555.5	9	9	3	0	19-21@(865.5)x3
X86457-01-05	22-24	1510.5	9	9	3	0	22-24@(1000.5)x3
X86457-01-10	25-31	1380.0	27	27	7	0	25-30@(6)x6 31@(1392)x1
X86457-01-13	(餘料)31	1373.0	9	1	0	1	31@(13)x1
X86457-01-13	32-33	1373.0		8	2	0	32-33@(34)x2
X86457-01-08	34-45	1366.5	45	45	12	0	34-44@(60)x11 45@(4177.5)x1
X86457-01-07, X86457-01-12	(餘料)45, 47	1355.0	18	5	0	2	45@(94.5)x1 47@(106)x1
X86457-01-07, X86457-01-12	46-49	1355.0		13	4	0	46@(106)x1
X86457-01-14, X86457-01-32	(餘料)19-24, 49-50	841.5	18	11	0	8	19-21@(18)x3 22-24@(153)x3 49@(619.5)x1 50@(465)x1
X86457-01-14, X86457-01-32	50-51	841.5		7	2	0	50@(3855)x1
X86457-01-26	(餘料)51	804.0	18	1	0	1	51@(502.5)x1
X86457-01-26	52-54	804.0		17	3	0	52-53@(690)x2
X86457-01-15	(餘料)54	754.0	9	1	0	1	54@(740)x1
X86457-01-15	55-56	754.0		8	2	0	55@(230)x1
X86457-01-19	(餘料)54, 56	725.0	9	7	0	2	54@(9)x1 56@(404)x1
X86457-01-19	57	725.0		2	1	0	57@(4088)x1
X86457-01-04	(餘料)52-53, 57	648.0	27	8	0	3	52-53@(36)x2 57@(164)x1
X86457-01-04	58-60	648.0		19	3	0	58-59@(318)x2 60@(3588)x1
X86457-01-09	(餘料)60	629.0	45	5	0	1	60@(413)x1
X86457-01-09	61-65	629.0		40	5	0	61-65@(470)x5
X86457-01-18	(餘料)16-18, 49	549.0	18	4	0	4	16-18@(45)x3 49@(64.5)x1
X86457-01-18	66-67	549.0		14	2	0	66@(0)x1
X86457-02-02	(餘料)13-15, 67	537.5	27	9	0	4	13-15@(8.5)x3 67@(69)x1
X86457-03-02	68-69	537.5		18	2	0	68@(115)x1
X86457-01-33	(餘料)69	511.5	9	2	0	1	69@(167)x1
X86457-01-33	70	511.5		7	1	0	70@(1927.5)x1
X86457-01-06	(餘料)70	499.0	9	3	0	1	70@(412.5)x1
X86457-01-06	71	499.0		6	1	0	71@(2520)x1

鋁材開料總表

工程號碼: J858 工程名稱: 康城11期(CW-收口鋁料-T3-56F~65F)

序號	鋁料編號	名稱	表面處理		開料長度	實用長料總數量		浪費率(%)
			顏色	層厚		支數	長度	
1	X86457	幕牆陣底收口	ECD3X10 09 9S-		5600	71	397600	3.74
2	X86458	幕牆邊企收口	ECD3X10 09 9S-		4900	77	377300	2.63
3	X86459	幕牆磚牆收口	ECD3X10 09 9S-		4900	95	465500	2.51
4	X86463	幕牆中間收口	ECD3X10 09 9S-		4900	5	24500	11.70

送至: _____

由: _____

日期: _____

簡短說明: _____

共5頁 第1頁

打印日期: 2023/11/10 打印時間: 10:57

鋁材開料清單 X86463

窗號	編號(用料狀況)	實用長度(長料開數)	需要 支數	開料 支數	長料 支數	餘料 支數	編號(剩餘長度)
X86463-01A	1-5	2370.0	9	9	5	0	1-4@(98)x4 5@(2474)x1

工程號碼: J858, 工程名稱: 康城11期 (CW-收口鋁料-T3-56F~65F)

開料長度: 4900, 總長料支數: 95, 總開料支數: 189

鋸片厚度 (mm): 6, 料頭尾總切除 (mm): 50, 浪費率 (%): 2.51

鋁材開料清單 X86459

窗號	編號(用料狀況)	實用長度(長料開數)	需要 支數	開料 支數	長料 支數	餘料 支數	編號(剩餘長度)
X86459-01A	1-95	2370.0	189	189	95	0	1-94@(98)x94 95@(2474)x1

工程號碼: J858, 工程名稱: 康城11期 (CW-收口鋁料-T3-56F~65F)

開料長度: 4900, 總長料支數: 77, 總開料支數: 153

鋸片厚度 (mm): 6, 料頭尾總切除 (mm): 50, 浪費率 (%): 2.63

鋁材開料清單 X86458

窗號	編號(用料狀況)	實用長度(長料開數)	需要 支數	開料 支數	長料 支數	餘料 支數	編號(剩餘長度)
X86458-01A	1-77	2370.0	153	153	77	0	1-76@(98)x76 77@(2474)x1

鋁材開料清單 X86457

窗號	編號(用料狀況)	實用長度(長料開數)	需要支數	開料支數	長料支數	餘料支數	編號(剩餘長度)
X86457-01-20	1-3	1800.0	9	9	3	0	1-3@(132)x3
X86457-02-04	4-6	1703.5	9	9	3	0	4-6@(421.5)x3
X86457-01-22	7-9	1701.5	9	9	3	0	7-9@(427.5)x3
X86457-02-01	10-12	1679.0	9	9	3	0	10-12@(495)x3
X86457-03-03	13-15	1660.0	9	9	3	0	13-15@(552)x3
X86457-01-28	16-18	1644.0	9	9	3	0	16-18@(600)x3
X86457-01-27	19-21	1555.5	9	9	3	0	19-21@(865.5)x3
X86457-01-05	22-24	1510.5	9	9	3	0	22-24@(1000.5)x3
X86457-01-10	25-31	1380.0	27	27	7	0	25-30@(6)x6 31@(1392)x1
X86457-01-13	(餘料)31	1373.0	9	1	0	1	31@(13)x1
X86457-01-13	32-33	1373.0		8	2	0	32-33@(34)x2
X86457-01-08	34-45	1366.5	45	45	12	0	34-44@(60)x11 45@(4177.5)x1
X86457-01-07, X86457-01-12	(餘料)45, 47	1355.0	18	5	0	2	45@(94.5)x1 47@(106)x1
X86457-01-07, X86457-01-12	46-49	1355.0		13	4	0	46@(106)x1
X86457-01-14, X86457-01-32	(餘料)19-24, 49-50	841.5	18	11	0	8	19-21@(18)x3 22-24@(153)x3 49@(619.5)x1 50@(465)x1
X86457-01-14, X86457-01-32	50-51	841.5		7	2	0	50@(3855)x1
X86457-01-26	(餘料)51	804.0	18	1	0	1	51@(502.5)x1
X86457-01-26	52-54	804.0		17	3	0	52-53@(690)x2
X86457-01-15	(餘料)54	754.0	9	1	0	1	54@(740)x1
X86457-01-15	55-56	754.0		8	2	0	55@(230)x1
X86457-01-19	(餘料)54, 56	725.0	9	7	0	2	54@(9)x1 56@(404)x1
X86457-01-19	57	725.0		2	1	0	57@(4088)x1
X86457-01-04	(餘料)52-53, 57	648.0	27	8	0	3	52-53@(36)x2 57@(164)x1
X86457-01-04	58-60	648.0		19	3	0	58-59@(318)x2 60@(3588)x1
X86457-01-09	(餘料)60	629.0	45	5	0	1	60@(413)x1
X86457-01-09	61-65	629.0		40	5	0	61-65@(470)x5
X86457-01-18	(餘料)16-18, 49	549.0	18	4	0	4	16-18@(45)x3 49@(64.5)x1
X86457-01-18	66-67	549.0		14	2	0	66@(0)x1
X86457-02-02	(餘料)13-15, 67	537.5	27	9	0	4	13-15@(8.5)x3 67@(69)x1
X86457-03-02	68-69	537.5		18	2	0	68@(115)x1
X86457-01-33	(餘料)69	511.5	9	2	0	1	69@(167)x1
X86457-01-33	70	511.5		7	1	0	70@(1927.5)x1
X86457-01-06	(餘料)70	499.0	9	3	0	1	70@(412.5)x1
X86457-01-06	71	499.0		6	1	0	71@(2520)x1

2622
22

From: Ken Hoi Ming Wong <Ken.HM.Wong@gammonconstruction.com>
To: "j858@midiltd.com.hk" <j858@midiltd.com.hk>
Copies to: "midiqs@midiltd.com.hk" <midiqs@midiltd.com.hk>,
"deltasung@midiltd.com.hk" <deltasung@midiltd.com.hk>,
"georgeleung@midiltd.com.hk" <georgeleung@midiltd.com.hk>,
"marcus.ssw.midi@gmail.com" <marcus.ssw.midi@gmail.com>,
Billy Kin Pui Kan
<Billy.Kan@gammonconstruction.com>,
Chase Ka Lok Yau
<Chase.Yau@gammonconstruction.com>,
Rick Kwok Ho Chung
<Rick.Chung@gammonconstruction.com>,
Ben Kwok Pan Chan
<Ben.Chan@gammonconstruction.com>
Subject: RE: [E] LP11 - QTN/11049/858/43 : Quotation
- 額外提供間牆企身和陣底室內
收口 (25mm)
Date sent: Mon, 6 Nov 2023 10:15:31 +0000

6/11 敬行

不加註，保留15mm
厚度

Dear Midi,

As per the discussion between our site team and your Mr. Jason Leung, the additional 25mm alum. capping is no longer required, hence this VO shall be waived.

In addition, please note that as the setting out of block wall followed the setting out of curtain wall post provided by Midi, any incorrect interface dimension caused are solely your responsibility (refer to the attached NTP-1318).

Thanks and regards,
Ken Wong
Gammon Engineering & Construction Company Limited
Tel: (852) 3487 9365

From: j858@midiltd.com.hk <j858@midiltd.com.hk>
Sent: Tuesday, October 31, 2023 12:06 PM
To: Billy Kin Pui Kan <Billy.Kan@gammonconstruction.com>; Chase Ka Lok Yau <Chase.Yau@gammonconstruction.com>; Ken Hoi Ming Wong <Ken.HM.Wong@gammonconstruction.com>; Shane Pak Wai Law <Shane.Law@gammonconstruction.com>
Cc: midiqs@midiltd.com.hk; deltasung@midiltd.com.hk; georgeleung@midiltd.com.hk; marcus.ssw.midi@gmail.com
Subject: [E] LP11 - QTN/11049/858/43 : Quotation – 額外提供間牆企身和陣底室內收口 (25mm)

▶ This email is from EXTERNAL – be cautious with any link and attachment ◀

Dear Sir/ Madam,
Please find the attachment for your information.
Ref QTN/11049/858/43
Thank you for your kind attention.
MIDI ALUMINIUM FABRICATOR LTD.
MIDI Aluminium Fabricator Ltd., Tel:(852) 2348 9211, Fax:(852) 2772 7666