

工程指示 / 要求簡箋(E.I.)

工程指示編號：EI / 7069 / 23

修改版次：-

工程編號：J - 858

工程名稱：將軍澳日出康城 11

工程項目：R/F + 9/F AC Grille 廠用鋁料 BM

收件人：生統

發件人：Ant Yeung

日期：30/11/2023

要求提供 / 確認 事項：

請按 BM 訂購，AC Grille 柵格 兩款鋁料送廠， 謝謝

1. J857 興發鋁模

2. J857 餘料 X86361 有 Mill 料 (300 支)，如可用。可不訂。

把 Mill 料送噴 ECD3X1009 9S-XF1 香檳金

3. 附 AI -263, AI-277

請在 2023.12.31 前完成上列要求。

附： 頁

以上項目為：

 原合約工程包 原合約工程加 / 減賬 新工程報價

原因：-

分發東莞各部門：

() 生產技術總監 連附件 () 技術部 連附件 () 生產部 連附件 () 機械設計部 連附件() 採購部 連附件 (✓) 生產統籌部 連附件 (✓) 小羅&清 連附件() 質檢部 連附件 () 會計部 連附件 () 報關組 連附件 () 其他 _____ 連附件

分發香港各部門：


() 行政部 連附件 () 會計部 連附件 () 統籌部 連附件 () 工程部地盤科文 連附件 積哥，二寶() 採購部 連附件 () QS 部 連附件 () 維修部 連附件 () 其他 _____ 連附件

傳遞編號：


HK 2797 / 23

發件人簽署：

項目經理簽署：

 美特鋁制有限公司 MIDI Aluminium Fabricator Ltd. 廠用鋁型材BOM表		工程號: J-858 地盤名稱: 康城11期 項目類別: 頂樓格柵(T1,T2,T3)	Kevin 日期: 2023-11-17 送呈: 副本:	日期: 2023-11-17 送呈: 副本:								
BM編號: A/C Code:		數量(支) 0 無顏色鋁料(Kg): 2773 V.F總面積(米²): 0	重量(Kgs) Kg/M 總重量 2.540 2682.24 0.086 90.82	V.F.(米²) 米²/米 Total_V.F. 0.228 0.24 0.038 0.04	備注 silver champagne silver champagne							
序號	修改標示	物料編號	鋁料名稱	顏色	長度(mm)	實用	後備	總數	Kg/M	總重量	V.F. (米²)	備注
1	先用餘料	X86361	格柵	ECD3X1009 9S-XF1	4800	210	10	220	2.540	2682.24	0.228	0.24 silver champagne
2		X86362	格柵扣蓋	ECD3X1009 9S-XF1	4800	210	10	220	0.086	90.82	0.038	0.04 silver champagne
3												
4												
壁厚尺寸公差(单位:mm)	
ø100<ø≤ø250	
壁厚	实心 空心
0<T≤2	±0.15 ±0.23
2<T≤3	±0.15 ±0.25
3<T≤6	±0.18 ±0.30
6<T≤10	±0.20 ±0.60
10<T≤15	±0.20 —
15<T≤20	±0.23 —
20<T≤30	±0.25 —
30<T≤40	±0.30 —
未注非壁厚尺寸公差H(单位:mm)	
0<H≤3	±0.15
3<H≤10	±0.18
10<H≤15	±0.20
15<H≤30	±0.23
30<H≤45	±0.30
45<H≤60	±0.36
60<H≤90	±0.60
90<H≤120	±0.60
120<H≤150	±0.86
150<H≤200	±1.10
200<H≤250	±1.35

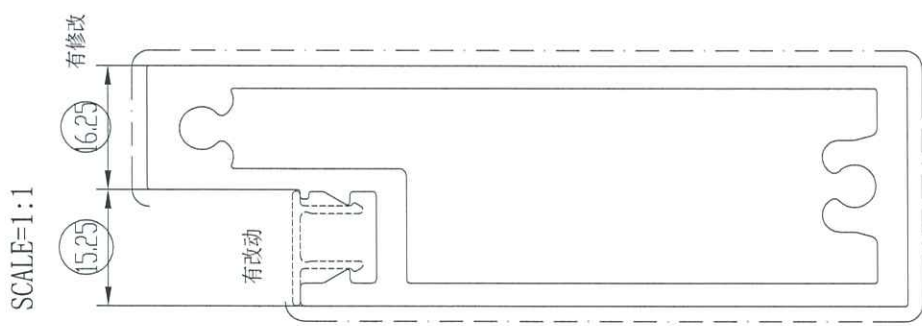

技术要求

1. 装饰面为: _____
 2. 基材验收标准按EN755-9执行
 3. 表面处理是: 粉末喷涂
 4. 带“★”尺寸以实配为准 5. ○=R0.5
- 此型材如停止订货一年以上, 我司有权对模具进行报废或销毁
如私自改动而确认, 导致生产出来有异, 我司一律不承担责任!
- 特此声明
1. 此图与客户“来样/来图”相符, 若涉及专利或商标事宜, 概由需方负责。
 2. 如与其它型材或配件配合, 需注明或提供配套件, 否则产生的装配问题, 由客户自行承担。
 3. 客户确认图纸, 包括确认并认可图纸上所示的图形、公差、验收标准, 模具费, 单重和装饰面积等图面上的信息。

A		1		型号			
版次		1		型号			
未注实心部位壁厚	机 型	未注圆角	R 0.3	外 D	104.68 mm	材 料	6063-T6
未注空心部位壁厚	备 注	周 长	287.2 mm	比 例	1:1	材 料	6063-T6
装饰面积	0.2278 m ² /m	材 料	6063-T6	型 号	X86361	材 料	6063-T6
设计	黄海华	客户编号	X86361	型 号		材 料	6063-T6
校 核	周文泽	型 号		材 料		材 料	6063-T6
批 准	陆承强	材 料		材 料		材 料	6063-T6
广东兴发铝业有限公司		材 料		材 料		材 料	6063-T6
兴发铝业(成都)有限公司		材 料		材 料		材 料	6063-T6
广东兴发铝业(江西)有限公司		材 料		材 料		材 料	6063-T6
广东兴发铝业(河南)有限公司		材 料		材 料		材 料	6063-T6
总部技术部E-mail: tech@xingfa.com 联系电话: 0757-66695205		材 料		材 料		材 料	6063-T6



122069633

ARCHITECT'S INSTRUCTION NO.

MC-A-263

Our Ref. : 19084NT-MC-A-263 BY FAX & TO BE COLLECTED
Date : 19 October 2023
Project : Proposed Residential Development at TKOTL 70 RP, Phase 11,
Lohas Park, Tseung Kwan O, New Territories
Contract : Superstructure Main Contract Works
Contractor : Gammon Engineering and Construction Company Ltd
Attn. : Mr. Percy Chan/Mr. Lawrence Pun

DRAFT

Under the terms of the Contract, we hereby issue to the Contractor named above the following instructions (where applicable, the Contract Sum will be adjusted in accordance with the terms of the relevant condition):

Design, Supply and Installation of Air-conditioning Metal Grille for Tower 1 to Tower 3

This serves to confirm the Named Sub-contractor for the design, supply and installation of Air-conditioning Metal Grille at Tower Roof Floors for Tower 1 to Tower 3 to be Midi Aluminium Fabricator Limited.

You are reminded that no loss and/ or expenses claim, and no extension of time shall be granted as a result of this instruction.

You are required to make timely submission for relevant drawings / documents as required under the Contract for our consideration / approval.

Variation of works and/ or Prime Cost Rates adjustment, if required, shall be submitted for assessment in strict accordance with the Contract provisions.

Distribution:

		c.c.	w/e
	MTR Corporation Ltd.	- Mr. K.S. Lee/ Mr. Jacky Cheung	<input checked="" type="checkbox"/> <input checked="" type="checkbox"/>
	Sino Land Co. Ltd.	- Mr. Herbert Thung/ Mr. Francis Lai	<input checked="" type="checkbox"/> <input checked="" type="checkbox"/>
	AECOM	- Mr. Henry Lo/ Mr. Steven Lau	<input checked="" type="checkbox"/> <input checked="" type="checkbox"/>
	AECOM(RE)	- Mr. Ken Siu/ Mr. Simon Tso	<input checked="" type="checkbox"/> <input checked="" type="checkbox"/>
	WSP	- Mr. Tommy Leung/ Mr. Simon Kaan	<input checked="" type="checkbox"/> <input checked="" type="checkbox"/>
Wong Chi Kin Kenneth Director	Beria Consultants Ltd.	- Ms. May Chung/ Mr. Matthew Hung	<input checked="" type="checkbox"/> <input checked="" type="checkbox"/>
For and on behalf of	ADI	- Mr. Wilter So/ Mr. Kenif Ng	<input checked="" type="checkbox"/> <input checked="" type="checkbox"/>
Ronald Lu & Partners (Hong Kong) Ltd.	AECOM(Façade)	- Mr. Kim Wong / Ms. Crystal Wong	<input checked="" type="checkbox"/> <input checked="" type="checkbox"/>
	Moty's Deign	- Mr. Moses Lau/ Ms. Chan Hei Man	<input checked="" type="checkbox"/> <input checked="" type="checkbox"/>
FCH/GCH/AUL/kmy	IsBim	- Mr. Keith Chiu	<input checked="" type="checkbox"/> <input checked="" type="checkbox"/>
	Ramboll	- Ms. Brain Tam	<input checked="" type="checkbox"/> <input checked="" type="checkbox"/>

ARCHITECT'S INSTRUCTION NO.

MC-A-277

Our Ref. : 19084NT-MC-A-277 BY FAX & TO BE COLLECTED
Date : 22 November 2023
Project : Proposed Residential Development at TKOTL 70 RP, Phase 11,
Lohas Park, Tseung Kwan O, New Territories
Contract : Superstructure Main Contract Works
Contractor : Gammon Engineering and Construction Company Ltd
Attn. : Mr. Percy Chan/Mr. Lawrence Pun

DRAFT

Under the terms of the Contract, we hereby issue to the Contractor named above the following instructions (where applicable, the Contract Sum will be adjusted in accordance with the terms of the relevant condition):

Additional A/C Grille and Sink Cabinet at flat roofs at 9/F of Tower 1, Tower 2 and Tower 3

We confirm herewith the instruction to you regarding the additional A/C Grille and Sink Cabinet at flat roofs of 9/F of Tower 1, Tower 2 and Tower 3 by Midi Aluminium Fabricator Limited as per attached drawing list, with remarks and corresponding supplementary information enclosed under respective appendices for your execution/ construction.

You are required to make timely submission for relevant drawings / documents as required under the Contract for our consideration / approval.

Variation of works and/ or Cost Implication, if any, shall be submitted by your office for assessment in strict accordance with the Contract provisions.

Distribution:

		c.c.	w/e		
	MTR Corporation Ltd.	-	Mr. K.S. Lee/ Mr. Jacky Cheung	<input checked="" type="checkbox"/>	<input checked="" type="checkbox"/>
	Sino Land Co. Ltd.	-	Mr. Herbert Thung/ Mr. Francis Lai	<input checked="" type="checkbox"/>	<input checked="" type="checkbox"/>
	AECOM	-	Mr. Henry Lo/Mr. Louis Lai	<input checked="" type="checkbox"/>	<input checked="" type="checkbox"/>
	AECOM(RE)	-	Mr. Simon Tso	<input checked="" type="checkbox"/>	<input checked="" type="checkbox"/>
	WSP	-	Mr. Tommy Leung/ Mr. Simon Kaan	<input checked="" type="checkbox"/>	<input checked="" type="checkbox"/>
	Beria Consultants Ltd.	-	Ms. May Chung/ Mr. Matthew Hung	<input checked="" type="checkbox"/>	<input checked="" type="checkbox"/>
Wong Chi Kin Kenneth	ADI	-	Mr. Wilter So/ Mr. Kenif Ng	<input checked="" type="checkbox"/>	<input checked="" type="checkbox"/>
Director	AECOM(Façade)	-	Mr. Kim Wong / Ms. Crystal Wong	<input checked="" type="checkbox"/>	<input checked="" type="checkbox"/>
For and on behalf of	Moty's Deign	-	Mr. Moses Lau/ Ms. Chan Hei Man	<input checked="" type="checkbox"/>	<input checked="" type="checkbox"/>
Ronald Lu & Partners (Hong Kong) Ltd.	IsBim	-	Mr. Keith Chiu	<input checked="" type="checkbox"/>	<input checked="" type="checkbox"/>
FCH/GCH/AUL/kmy	Ramboll	-	Mr. Brain Tam	<input checked="" type="checkbox"/>	<input checked="" type="checkbox"/>

請查查此兩款鋁料有無存貨??

j857 的。

謝謝



20/11/2023 下午3:47



X86361 6 m

ECK3X10063S-XF1 20
支

X86362 6 m

ECK3X10063S-XF1 80
支

X86361 6 m MILL 300
支

20/11/2023 下午4:19



13x 1200 AC grille



30x30



3

1200 x 90

1200 x 90 x 30

1200 x 90 x 30 = 27000

13x

12

1200

13x 1200

1200