

工程指示 / 要求簡箋(E.I.)

工程指示編號：EI / 89<sup>52</sup> / 25      修改版次：  
 工程編號      : J - 858      工程名稱      : 將軍澳日出康城  
 工程項目      : 幕牆 第 2 次 補玻璃 25 件 (小業主單)  
 收件人      : Maggie      發件人      : Jason      日期 : 23/05/2025

要求提供 / 確認 事項：

- |                                    |                                     |                               |
|------------------------------------|-------------------------------------|-------------------------------|
| <input type="checkbox"/> 初步鋁料 B.M. | <input type="checkbox"/> 加工拆圖，然後生產  | <input type="checkbox"/> 尺寸表  |
| <input type="checkbox"/> 正式鋁料 B.M. | <input type="checkbox"/> 技術上資料 / 指示 | <input type="checkbox"/> 報價   |
| <input type="checkbox"/> 配件 B.M.   | <input type="checkbox"/> 樣辦或貨品說明書   | <input type="checkbox"/> 分判合約 |

內容：

由於地盤需要更換玻璃，請按玻璃 BM 生產玻璃，共 25 件 送地盤。  
請安排熱浸

1. 不要印上熱浸標籤。只給”可移除”的標籤。
2. 依原 EI 4867, EI 4943, EI 4942 尺寸補，
3. \*\*\*\*\*分座包箱，玻璃標籤請註明樓層、單位。\*\*\*\*\* 請留意。
4. 第一次補 25 件 EI8938; 第 2 次補 25 件本次;
5. 地盆：更換幕牆玻璃，需用吊船。
6. 按芳姐 二寶 資料

謝謝

請在 2025.06.30 前完成上列要求。

分發東莞各部門：

- |                                 |                              |                                |                              |                               |                              |                                |                              |
|---------------------------------|------------------------------|--------------------------------|------------------------------|-------------------------------|------------------------------|--------------------------------|------------------------------|
| <input type="checkbox"/> 生產技術總監 | <input type="checkbox"/> 連附件 | <input type="checkbox"/> 技術部   | <input type="checkbox"/> 連附件 | <input type="checkbox"/> 生產部  | <input type="checkbox"/> 連附件 | <input type="checkbox"/> 機械設計部 | <input type="checkbox"/> 連附件 |
| <input type="checkbox"/> 採購部    | <input type="checkbox"/> 連附件 | <input type="checkbox"/> 生產統籌部 | <input type="checkbox"/> 連附件 | <input type="checkbox"/> 小羅&清 | <input type="checkbox"/> 連附件 |                                |                              |
| <input type="checkbox"/> 質檢部    | <input type="checkbox"/> 連附件 | <input type="checkbox"/> 會計部   | <input type="checkbox"/> 連附件 | <input type="checkbox"/> 報關組  | <input type="checkbox"/> 連附件 | <input type="checkbox"/> 其他    | <input type="checkbox"/> 連附件 |

分發香港各部門：

- |   |   |                               |                              |                              |                              |  |   |
|---|---|-------------------------------|------------------------------|------------------------------|------------------------------|--|---|
| <input type="checkbox"/> 行政部            | <input type="checkbox"/> 連附件            | <input type="checkbox"/> 會計部  | <input type="checkbox"/> 連附件 | <input type="checkbox"/> 統籌部 | <input type="checkbox"/> 連附件 | <input checked="" type="checkbox"/> 工程部地盤科文 二寶 | <input checked="" type="checkbox"/> 連附件 |
| <input checked="" type="checkbox"/> 採購部 | <input checked="" type="checkbox"/> 連附件 | <input type="checkbox"/> QS 部 | <input type="checkbox"/> 連附件 | <input type="checkbox"/> 維修部 | <input type="checkbox"/> 連附件 | <input type="checkbox"/> 其他                    | <input type="checkbox"/> 連附件            |


傳遞編號：

HK / 25


發件人簽署：

項目經理簽署：

序號	ET	項目	座	樓層	單位	作數	玻璃編號	W (mm)	H (mm)	厚度 (mm)	Letter
90	本次E1	20/5二單	T3	37/F	AF	1	GL01-14	644	2332	10mm THK. HEAT STRENGTHEN GLASS (OUTSIDER) W/ LOW-E COATING ON SURFACE AIR SPACE + 12mm THK. CLEAR TEMPERED GLASS(INSIDE) IGU (R2022014001)	
91	本次E1	21/5小業主單	T1	41/F	AE	1	GL01-54	713	X	10mm THK. HEAT STRENGTHEN GLASS (OUTSIDER) W/ LOW-E COATING ON SURFACE AIR SPACE + 12mm THK. CLEAR TEMPERED GLASS(INSIDE) IGU (R2022014001)	
92	本次E1	21/5小業主單	T1	35/F	AB	1	GL01-06	903	2332	10mm THK. HEAT STRENGTHEN GLASS (OUTSIDER) W/ LOW-E COATING ON SURFACE AIR SPACE + 12mm THK. CLEAR TEMPERED GLASS(INSIDE) IGU (R2022014001)	
93	本次E1	21/5小業主單	T1	16/F	AB	1	GL02-03	663	1443	10mm THK. HEAT STRENGTHEN GLASS (OUTSIDER) W/ LOW-E COATING ON SURFACE AIR SPACE + 12mm THK. CLEAR TEMPERED GLASS(INSIDE) IGU (R2022014001)	
94	本次E1	21/5小業主單	T1	41/F	BD	1	GL01-23	1388	2332	10mm THK. HEAT STRENGTHEN GLASS (OUTSIDER) W/ LOW-E COATING ON SURFACE AIR SPACE + 12mm THK. CLEAR TEMPERED GLASS(INSIDE) IGU (R2022014001)	
95	本次E1	21/5小業主單	T1	27/F	BB	1	GL02-07	585	1443	10mm THK. HEAT STRENGTHEN GLASS (OUTSIDER) W/ LOW-E COATING ON SURFACE AIR SPACE + 12mm THK. CLEAR TEMPERED GLASS(INSIDE) IGU (R2022014001)	
96	本次E1	21/5小業主單	T1	36/F	BB	1	GL02-07	585	1443	10mm THK. HEAT STRENGTHEN GLASS (OUTSIDER) W/ LOW-E COATING ON SURFACE AIR SPACE + 12mm THK. CLEAR TEMPERED GLASS(INSIDE) IGU (R2022014001)	
97	本次E1	21/5小業主單	T1	43/F	BD	1	GL01-24	1751	X	10mm THK. HEAT STRENGTHEN GLASS (OUTSIDER) W/ LOW-E COATING ON SURFACE AIR SPACE + 12mm THK. CLEAR TEMPERED GLASS(INSIDE) IGU (R2022014001)	
98	本次E1	21/5小業主單	T1	43/F	BD	1	GL02-08	655.5	1443	10mm THK. HEAT STRENGTHEN GLASS (OUTSIDER) W/ LOW-E COATING ON SURFACE AIR SPACE + 12mm THK. CLEAR TEMPERED GLASS(INSIDE) IGU (R2022014001)	
99	本次E1	21/5小業主單	T1	35/F	AD	1	GL01-02	663	832	10mm THK. HEAT STRENGTHEN GLASS (OUTSIDER) W/ LOW-E COATING ON SURFACE AIR SPACE + 12mm THK. CLEAR TEMPERED GLASS(INSIDE) IGU (R2022014001)	
100	本次E1	21/5小業主單	T1	33/F	AD	1	GL02-03	663	1443	10mm THK. HEAT STRENGTHEN GLASS (OUTSIDER) W/ LOW-E COATING ON SURFACE AIR SPACE + 12mm THK. CLEAR TEMPERED GLASS(INSIDE) IGU (R2022014001)	
101	本次E1	21/5小業主單	T1	32/F	BD	1	GL01-02	663	832	10mm THK. HEAT STRENGTHEN GLASS (OUTSIDER) W/ LOW-E COATING ON SURFACE AIR SPACE + 12mm THK. CLEAR TEMPERED GLASS(INSIDE) IGU (R2022014001)	
102	本次E1	21/5小業主單	T1	22/F	BC	1	GL01-03	644	832	10mm THK. HEAT STRENGTHEN GLASS (OUTSIDER) W/ LOW-E COATING ON SURFACE AIR SPACE + 12mm THK. CLEAR TEMPERED GLASS(INSIDE) IGU (R2022014001)	
103	本次E1	21/5小業主單	T1	20/F	AE	1	GL02-05	636	1443	10mm THK. HEAT STRENGTHEN GLASS (OUTSIDER) W/ LOW-E COATING ON SURFACE AIR SPACE + 12mm THK. CLEAR TEMPERED GLASS(INSIDE) IGU (R2022014001)	
104	本次E1	21/5小業主單	T1	39/F	AG	1	GL02-05	636	1443	10mm THK. HEAT STRENGTHEN GLASS (OUTSIDER) W/ LOW-E COATING ON SURFACE AIR SPACE + 12mm THK. CLEAR TEMPERED GLASS(INSIDE) IGU (R2022014001)	
105	本次E1	21/5小業主單	T1	17/F	AF	1	GL02-05	636	1443	10mm THK. HEAT STRENGTHEN GLASS (OUTSIDER) W/ LOW-E COATING ON SURFACE AIR SPACE + 12mm THK. CLEAR TEMPERED GLASS(INSIDE) IGU (R2022014001)	
106	本次E1	21/5小業主單	T1	20/F	AC	1	GL01-14	644	2332	10mm THK. HEAT STRENGTHEN GLASS (OUTSIDER) W/ LOW-E COATING ON SURFACE AIR SPACE + 12mm THK. CLEAR TEMPERED GLASS(INSIDE) IGU (R2022014001)	
107	本次E1	21/5小業主單	T1	20/F	AC	2	GL02-05	636	1443	10mm THK. HEAT STRENGTHEN GLASS (OUTSIDER) W/ LOW-E COATING ON SURFACE AIR SPACE + 12mm THK. CLEAR TEMPERED GLASS(INSIDE) IGU (R2022014001)	
108	本次E1	21/5小業主單	T1	18/F	AG	1	GL01-03	644	832	10mm THK. HEAT STRENGTHEN GLASS (OUTSIDER) W/ LOW-E COATING ON SURFACE AIR SPACE + 12mm THK. CLEAR TEMPERED GLASS(INSIDE) IGU (R2022014001)	
109	本次E1	21/5小業主單	T1	16/F	AE	1	GL01-03	644	832	10mm THK. HEAT STRENGTHEN GLASS (OUTSIDER) W/ LOW-E COATING ON SURFACE AIR SPACE + 12mm THK. CLEAR TEMPERED GLASS(INSIDE) IGU (R2022014001)	
110	本次E1	21/5小業主單	T1	12/F	BA	1	GL02-05	636	1443	10mm THK. HEAT STRENGTHEN GLASS (OUTSIDER) W/ LOW-E COATING ON SURFACE AIR SPACE + 12mm THK. CLEAR TEMPERED GLASS(INSIDE) IGU (R2022014001)	
111	本次E1	21/5小業主單	T1	30/F	BE	1	GL02-07	585	1443	10mm THK. HEAT STRENGTHEN GLASS (OUTSIDER) W/ LOW-E COATING ON SURFACE AIR SPACE + 12mm THK. CLEAR TEMPERED GLASS(INSIDE) IGU (R2022014001)	
112	本次E1	21/5小業主單	T1	29/F	BE	1	GL02-07	585	1443	10mm THK. HEAT STRENGTHEN GLASS (OUTSIDER) W/ LOW-E COATING ON SURFACE AIR SPACE + 12mm THK. CLEAR TEMPERED GLASS(INSIDE) IGU (R2022014001)	
113	本次E1	21/5小業主單	T1	29/F	BE	1	GL01-04	585	832	10mm THK. HEAT STRENGTHEN GLASS (OUTSIDER) W/ LOW-E COATING ON SURFACE AIR SPACE + 12mm THK. CLEAR TEMPERED GLASS(INSIDE) IGU (R2022014001)	
					補玻璃總數		25				
	GL01	=		10mm THK. HEAT STRENGTHEN GLASS (OUTSIDE) W/ LOW-E COATING ON SURFACE 5ET / 2 + 12mm AIR SPACE + 12mm THK. CLEAR TEMPERED GLASS(INSIDE) IGU (R2022014001)							
	GL02	=		10mm THK. HEAT STRENGTHEN GLASS (OUTSIDE) W/ LOW-E COATING ON SURFACE 5ET / 2 + 12mm AIR SPACE + 10mm THK. CLEAR TEMPERED GLASS(INSIDE) IGU (R2022014003)							
	GL03	=		12mm THK. HEAT STRENGTHEN GLASS. Reflective Glass SSC1-60T (R20220324054)							

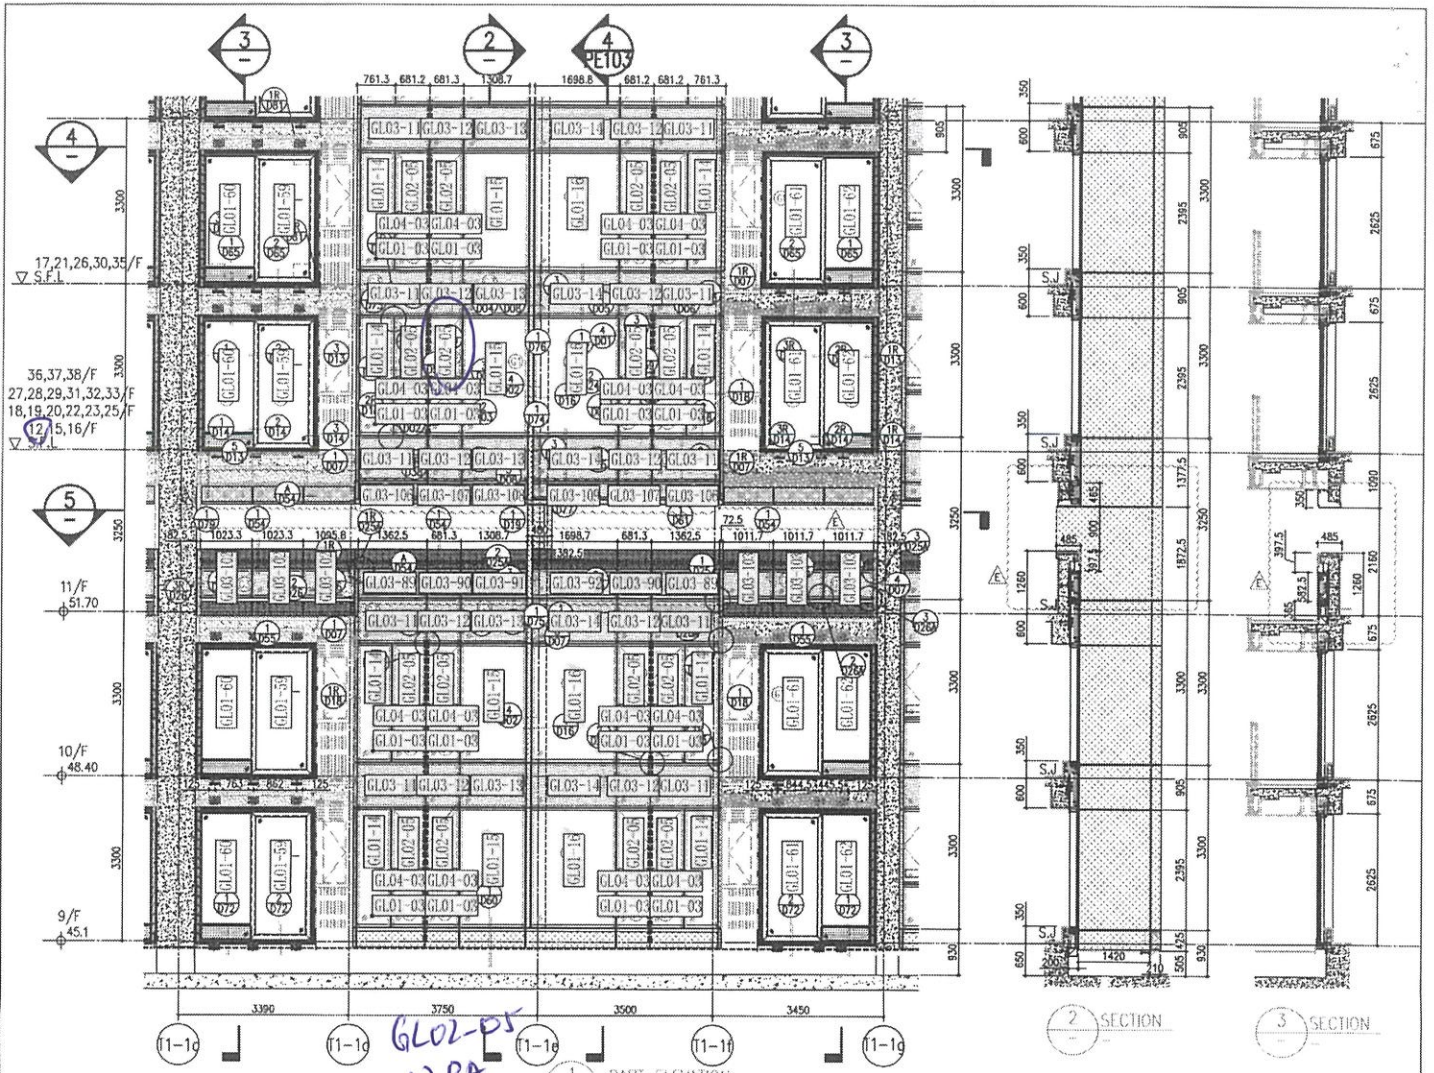

26/F +91.25	39/F +130.85	52/F +170.40	
25/F +87.95	38/F +127.55	51/F +167.10	R/F +203.80
23/F +84.65	37/F +124.25	50/F +163.80	62/F +200.30
22/F +81.35	36/F +120.95	49/F +160.50	61/F +196.80
21/F +78.05	35/F +117.65	48/F +157.20	60/F +193.50
20/F +74.75	33/F +114.35	47/F +153.90	59/F +190.20
19/F +71.45	32/F +111.05	46/F +150.60	58/F +186.90
18/F +68.15	31/F 107.75	45/F +147.30	57/F +183.60
17/F +64.85	30/F +104.45	43/F +144.00	56/F +180.30
16/F +61.55	29/F +101.15	42/F +140.70	55/F +177.00
15/F +58.25	28/F +97.85	41/F +137.40	
12/F +54.95	27/F +94.55	40/F +134.15	

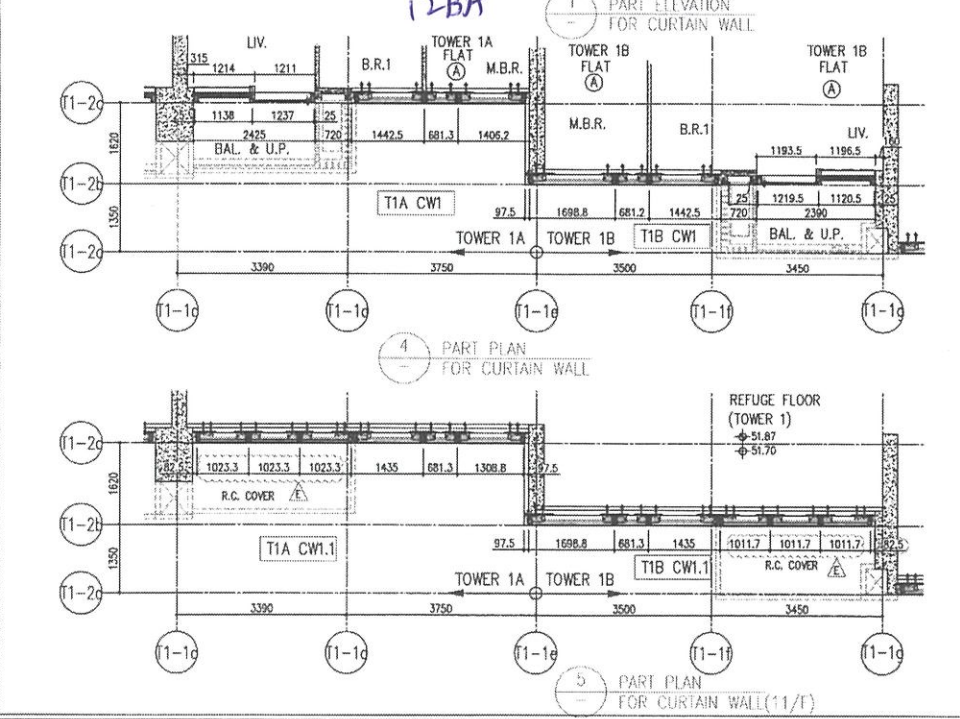

**LEGEND:**

- 10mm THK. HEAT STRENGTHENED GLASS (OUTSIDE) + 12mm AIR SPACE + 12mm THK. TEMPERED GLASS
- 10mm THK. HEAT STRENGTHENED GLASS (OUTSIDE) + 12mm AIR SPACE + 10mm THK. TEMPERED GLASS
- 12mm THK. HEAT STRENGTHENED GLASS
- 12mm THK. CLEAR TEMPERED GLASS (INTERNAL PROTECTIVE BARRIER)
- 12mm CLEAR STRENGTHENED GLASS
- 10mm THK. CLEAR TEMPERED GLASS
- 8mm THK. CLEAR HEAT STRENGTHENED GLASS + 1.52mm AIR SPACE + 8mm THK. CLEAR HEAT-STRENGTHENED GLASS
- 3 mm THK. ALUM. CLADDING
- 3 mm THK. ALUM. BACKPAN
- S.J. - STACK JOINT

<p><b>REVISIONS:</b></p> <table border="1"> <tr><th>NO.</th><th>DATE</th><th>REVISION</th></tr> <tr><td>1</td><td>23/09/22</td><td>ISSUED AS PER COMMENTS</td></tr> <tr><td>2</td><td>09/09/22</td><td>ISSUED AS PER COMMENTS</td></tr> <tr><td>3</td><td>27/07/22</td><td>ISSUED AS PER COMMENTS</td></tr> <tr><td>4</td><td>22/07/22</td><td>ISSUED AS PER COMMENTS</td></tr> <tr><td>5</td><td>03/07/22</td><td>ISSUED AS PER COMMENTS</td></tr>COMMENTS	<p><b>PROJECT:</b></p> <p>PROPOSED RESIDENTIAL DEVELOPMENT AT TOWER 7&amp;8, PHASE 11, LUNGS PARK, TSEUNG KWAN O, N.T.</p> <p><b>JOB NO.:</b> J-658</p> <p><b>DATE:</b> 22-OCT-21</p> <p><b>SCALE:</b> 1:150(A1)</p> <p><b>TITLE:</b> TYPICAL FLOOR PARTIAL ELEVATION &amp; SECTION, PLAN FOR CURTAIN WALL (TOWER 1)</p> <p><b>DESIGNER:</b> [Signature]</p> <p><b>CHECKED BY:</b> [Signature]</p> <p><b>APPROVED BY:</b> [Signature]</p>	<p><b>CLIENT:</b> 信榮置業有限公司 Sino Land Company Limited</p> <p><b>ARCHITECT:</b> ronaid lu &amp; partners Ronald Lu &amp; Partners (HK) Ltd 香港信榮建築師(信榮)有限公司</p> <p><b>MAIN CONTRACTOR:</b></p>	<p><b>STRUCTURAL ENGINEER:</b> <b>Gammron</b></p> <p><b>MECHANICAL ENGINEER:</b> <b>AECOM</b></p> <p><b>ELECTRICAL ENGINEER:</b> <b>AECOM</b></p> <p><b>PLUMBING ENGINEER:</b> <b>AECOM</b></p> <p><b>MECHANICAL ENGINEER:</b> <b>AECOM</b></p> <p><b>ELECTRICAL ENGINEER:</b> <b>AECOM</b></p> <p><b>PLUMBING ENGINEER:</b> <b>AECOM</b></p>	<p><b>DATE:</b></p> <p><b>NO.:</b></p> <p><b>SCALE:</b></p> <p><b>PROJECT:</b></p> <p><b>TITLE:</b></p> <p><b>DESIGNER:</b></p> <p><b>CHECKED BY:</b></p> <p><b>APPROVED BY:</b></p>
NO.	DATE	REVISION	
1	23/09/22	ISSUED AS PER COMMENTS	
2	09/09/22	ISSUED AS PER COMMENTS	
3	27/07/22	ISSUED AS PER COMMENTS	
4	22/07/22	ISSUED AS PER COMMENTS	
5	03/07/22	ISSUED AS PER COMMENTS	
6	03/07/22	ISSUED AS PER COMMENTS	
玻璃記錄

減11期

座數	單位	工作範圍	內/外	分類
已到 89 38A	T1	房安全		575
已到	22 AF	主細樑	外崩	
89 38A	20 AC	房1安全		
已到	"	房1細樑	外崩	
已到	19BA	主安全 + 房安全		555 x 2
已到	19BD	房2安全		
89 38B	19BE	房大樑	外崩	
已到	17BA	主安全		555
89 38A	17AF	主大樑	外崩	
89 38A	17 AF	主生窗	外崩	
89 43	17BF	厅門玉	外崩	
已到	16AG	房1安全		
89 38B	16AD	房生窗	外崩	
89 38B	17AD	房大樑	外崩	
89 43	17AD	厅門玉	內外花	
已到	12AF	安全主		
89 38B	"	房1生窗	外崩	
89 38B		房1細樑	外崩	
89 43		厅門樑	內人為破壞	
已到	12BA	房安全		555
8896 14-5-2025 已訂貨 ↑	10BC	主大樑	外	
已到	<del>39AG</del>	<del>房1生窗</del>	<del>外</del>	
已到	<del>39AG</del>	<del>主房大樑</del>	<del>外</del>	
8952	<del>37AF</del>	<del>房1細樑</del>	<del>外</del>	
	35AB	主別大樑	外崩	
	33AF	主安全		
	30AF	房1細樑	外崩	
19-5-2025 更換	29AF	主安全		675
		主生窗	外崩	
		房安全		560

地盤代表簽名: \_\_\_\_\_

日期: \_\_\_\_\_

玻璃記錄


地盤名稱：日出康城11期

日期	座數	單位	工作範圍	內/外	分類
	T1	<del>22AF</del>	<del>主房細樑</del>	<del>外崩</del>	
已 8938		20AB	主房大樑	外崩	斷
8952		16AB	主房生窗	外崩	
已到	19-5-2025	50AC	主房安全		
已到		47BD	主房安全 正面		575
8952 太邊 磨不到		41BD	房1大樑		
8952		36BB	房生窗	外崩	
8952		35AD	房細樑	內外花	
8952		33AD	房生窗		
8952		43BD	主房大樑	外崩	
8952		43BD	主房轉角生窗	外崩	
已到		41BB	房安全	內外花	
8952		32BD	主房正面細樑	外崩	
8952		22BC	主房正面細樑	泡	
8952 太邊 磨不到		20AE	主房正面生窗近房	內外	
已到		20AE	主房正面安全近房		
8952		20AC	房1大樑	外花	
8952			房1生窗	內	
			房1安全		
			房1細樑	外崩	
8952			主房生窗	外崩	


地盤代表簽名： \_\_\_\_\_

日期： \_\_\_\_\_




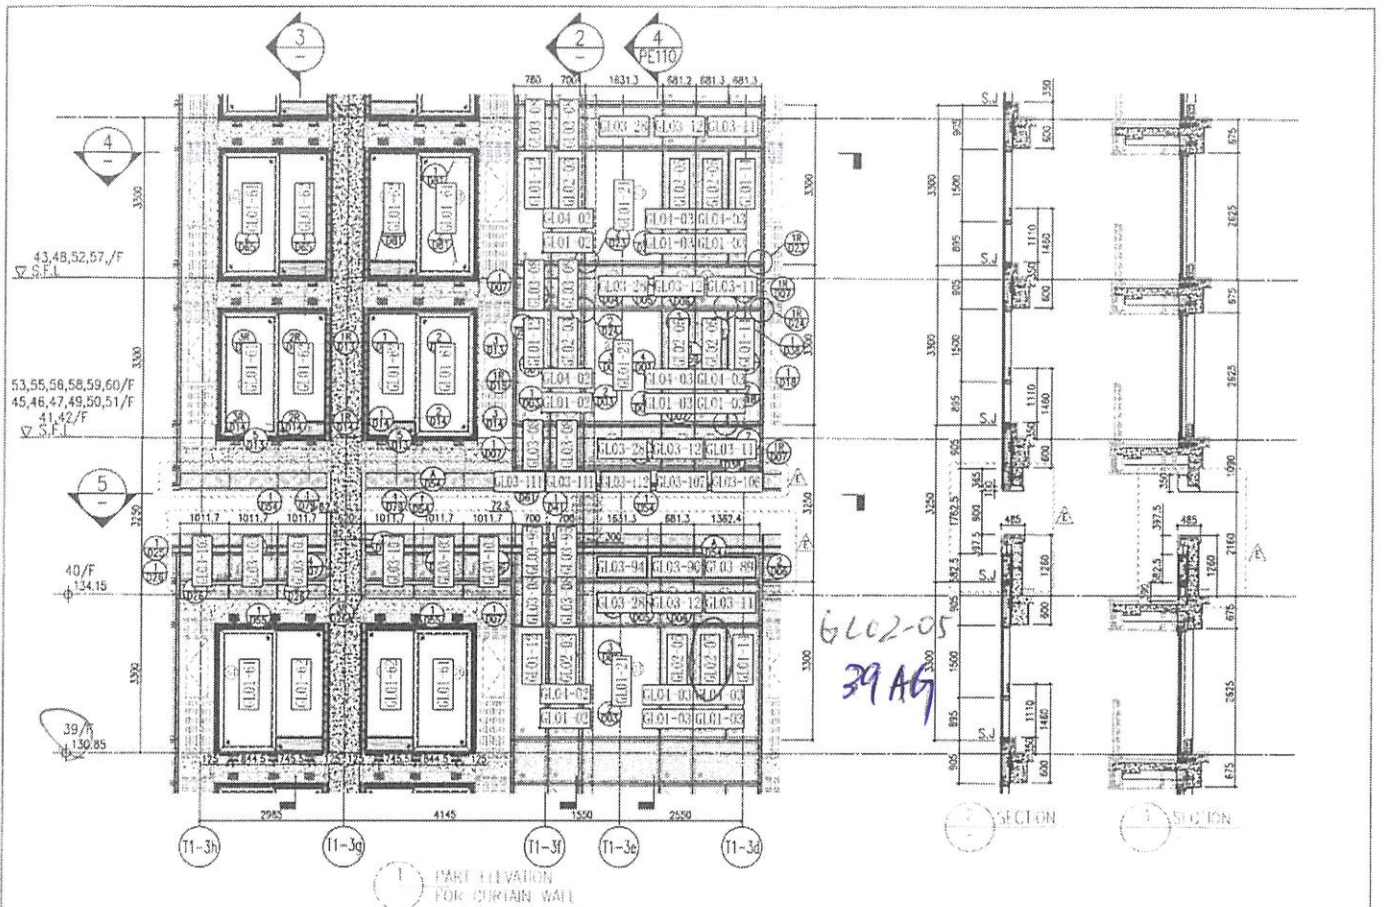

1 PART ELEVATION FOR CURTAIN WALL

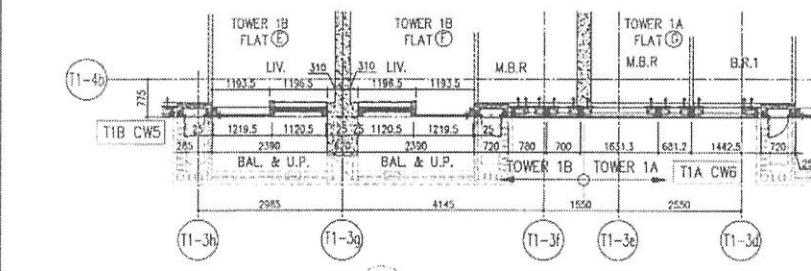

4 PART PLAN FOR CURTAIN WALL

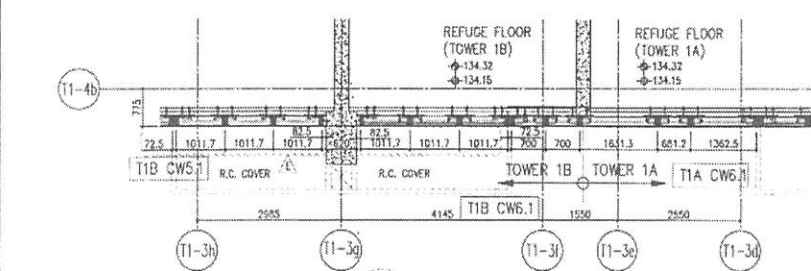

5 PART PLAN (40/F) FOR CURTAIN WALL

26/F	+91.25	39/F	+130.89	52/F	+170.40
25/F	+87.95	38/F	+127.55	51/F	+167.10
23/F	+84.65	37/F	+124.25	50/F	+163.80
22/F	+81.35	36/F	+120.95	49/F	+160.50
21/F	+78.05	35/F	+117.65	48/F	+157.20
20/F	+74.75	33/F	+114.35	47/F	+153.90
19/F	+71.45	32/F	+111.05	46/F	+150.60
18/F	+68.15	31/F	+107.75	45/F	+147.30
17/F	+64.85	30/F	+104.45	43/F	+144.00
16/F	+61.55	29/F	+101.15	42/F	+140.70
15/F	+58.25	28/F	+97.85	41/F	+137.40
12/F	+54.95	27/F	+94.55	40/F	+134.15
				58/F	+186.90
				57/F	+183.60
				56/F	+180.30
				55/F	+177.00
				53/F	+173.70
				R/F	+203.80
				62/F	+200.30
				61/F	+196.80
				60/F	+193.50
				59/F	+190.20

- LEGEND:**





2025.05.21 - T1 業主單幕牆玻

璃訂料更換表.xlsx

21 kB • XLSX

10:26 ✓✓



2025.05.21 - T1 業主單幕磨玻

璃牆玻表.xlsx

31 kB • XLSX

10:26 ✓✓






18AG一定要訂，客房生下梗

10:36





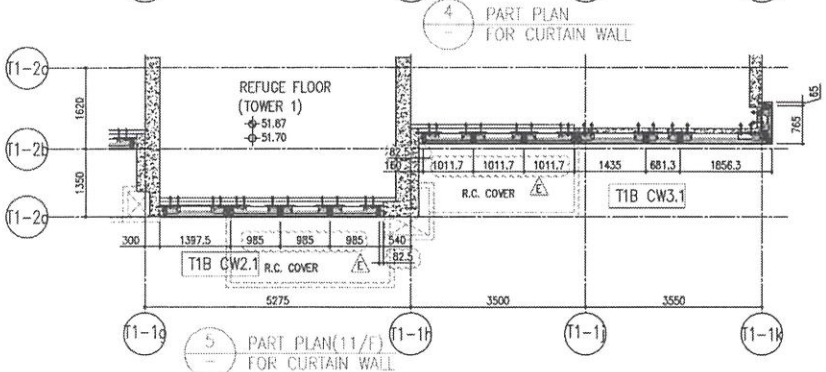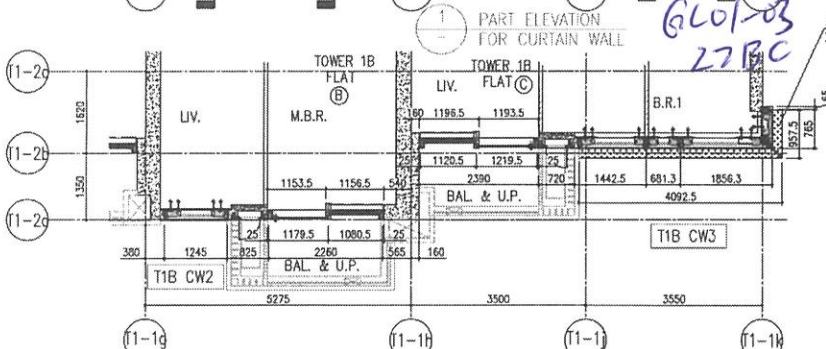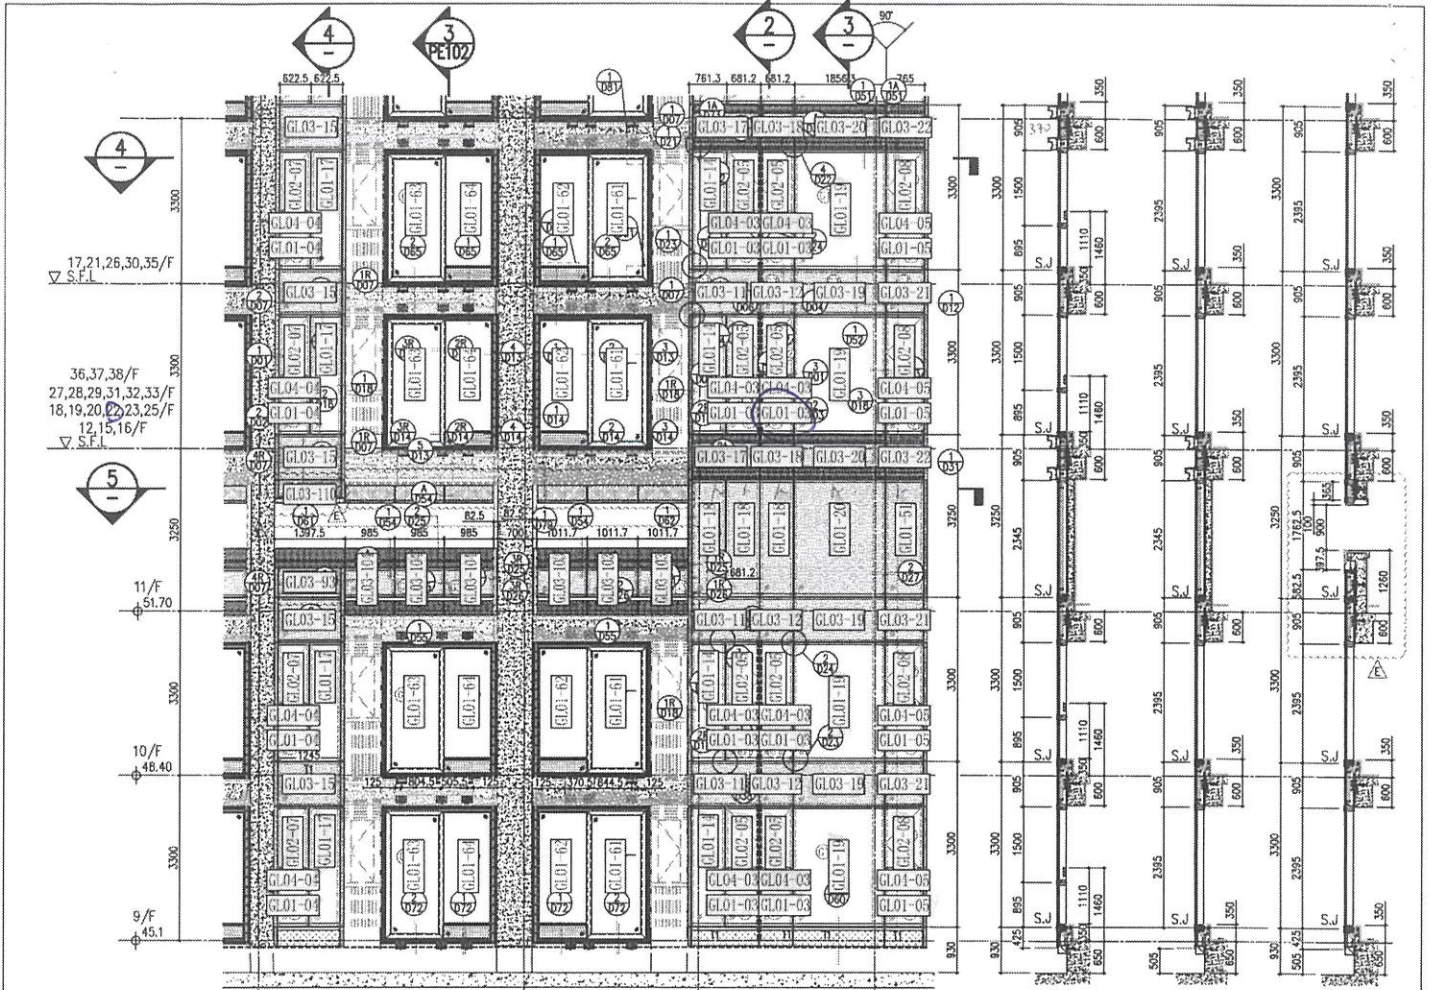

2 SECTION 3 SECTION 4 SECTION

ARCH. FEATURE AT 11/F, 17/F, 21/F, 26/F, 30/F, 35/F

26/F	+91.25	39/F	+130.85	52/F	+170.40		
25/F	+87.95	38/F	+127.55	51/F	+167.10	R/F	+203.80
23/F	+84.65	37/F	+124.25	50/F	+163.80	62/F	+200.30
22/F	+81.35	36/F	+120.95	49/F	+160.50	61/F	+196.80
21/F	+78.05	35/F	+117.65	48/F	+157.20	60/F	+193.50
20/F	+74.75	33/F	+114.35	47/F	+153.90	59/F	+190.20
19/F	+71.45	32/F	+111.05	46/F	+150.60	58/F	+186.90
18/F	+68.15	31/F	107.75	45/F	+147.30	57/F	+183.60
17/F	+64.85	30/F	+104.45	44/F	+144.00	56/F	+180.30
16/F	+61.55	29/F	+101.15	42/F	+140.70	55/F	+177.00
15/F	+58.25	28/F	+97.85	41/F	+137.40	53/F	+173.70
12/F	+54.95	27/F	+94.55				

- LEGEND:**
- 10mm THK. HEAT STRENGTHENED GLASS (OUTSIDE) +12mm AIR SPACE + 12mm THK. TEMPERED GLASS
  - 10mm THK. HEAT STRENGTHENED GLASS (OUTSIDE) +12mm AIR SPACE + 10mm THK. TEMPERED GLASS
  - 12mm THK. HEAT STRENGTHENED GLASS
  - 12mm THK. CLEAR TEMPERED GLASS (INTERNAL PROTECTIVE BARRIER)
  - 12mm CLEAR STRENGTHENED GLASS
  - 10mm THK. CLEAR TEMPERED GLASS
  - 8mm THK. CLEAR HEAT STRENGTHENED GLASS +1.52mm AIR SPACE + 8mm THK. CLEAR HEAT-STRENGTHENED GLASS
  - 3mm THK. ALUM. CLADDING
  - 3mm THK. ALUM. BACKPAN
  - STACK JOINT

**TITLE:**  
TYPICAL FLOOR PARTIAL ELEVATION & SECTION, PLAN FOR CURTAIN WALL (TOWER 1)

**DATE:** 22-07-21 **SCALE:** 1:50(A1)


Sino Land Company Limited

**ARCHITECT:** Ronald Liu & Partners  
Ronald Liu & Partners (HK) Ltd.  
宏利建築師事務所(香港)有限公司

**STRUCTURAL ENGINEER:** Gammon

**PROJECT CONSULTANT:** AECOM








**REVISIONS:**

NO.	DATE	REVISION
1	22/07/21	ISSUED AS PER COMMENTS
2	22/07/21	ISSUED AS PER COMMENTS
3	22/07/21	ISSUED AS PER COMMENTS
4	22/07/21	ISSUED AS PER COMMENTS
5	22/07/21	ISSUED AS PER COMMENTS

**NOTES:**

- ALL DIMENSIONS ARE IN MM.
- ALL DIMENSIONS FROM OUTSIDE UNLESS OTHERWISE STATED.
- ALL DIMENSIONS TO BE REVERSED ON SITE BEFORE FABRICATION.

**LEGEND:**

- (X) DETAIL MARK NO.
- (S) REFER SHEET NO.
- 1. F.F.L. -- FINISHED FLOOR LEVEL.
- 2. S.F.L. -- STRUCTURAL FLOOR LEVEL.
- 3. (R) -- REVERSED DETAIL.

**REV.:** E















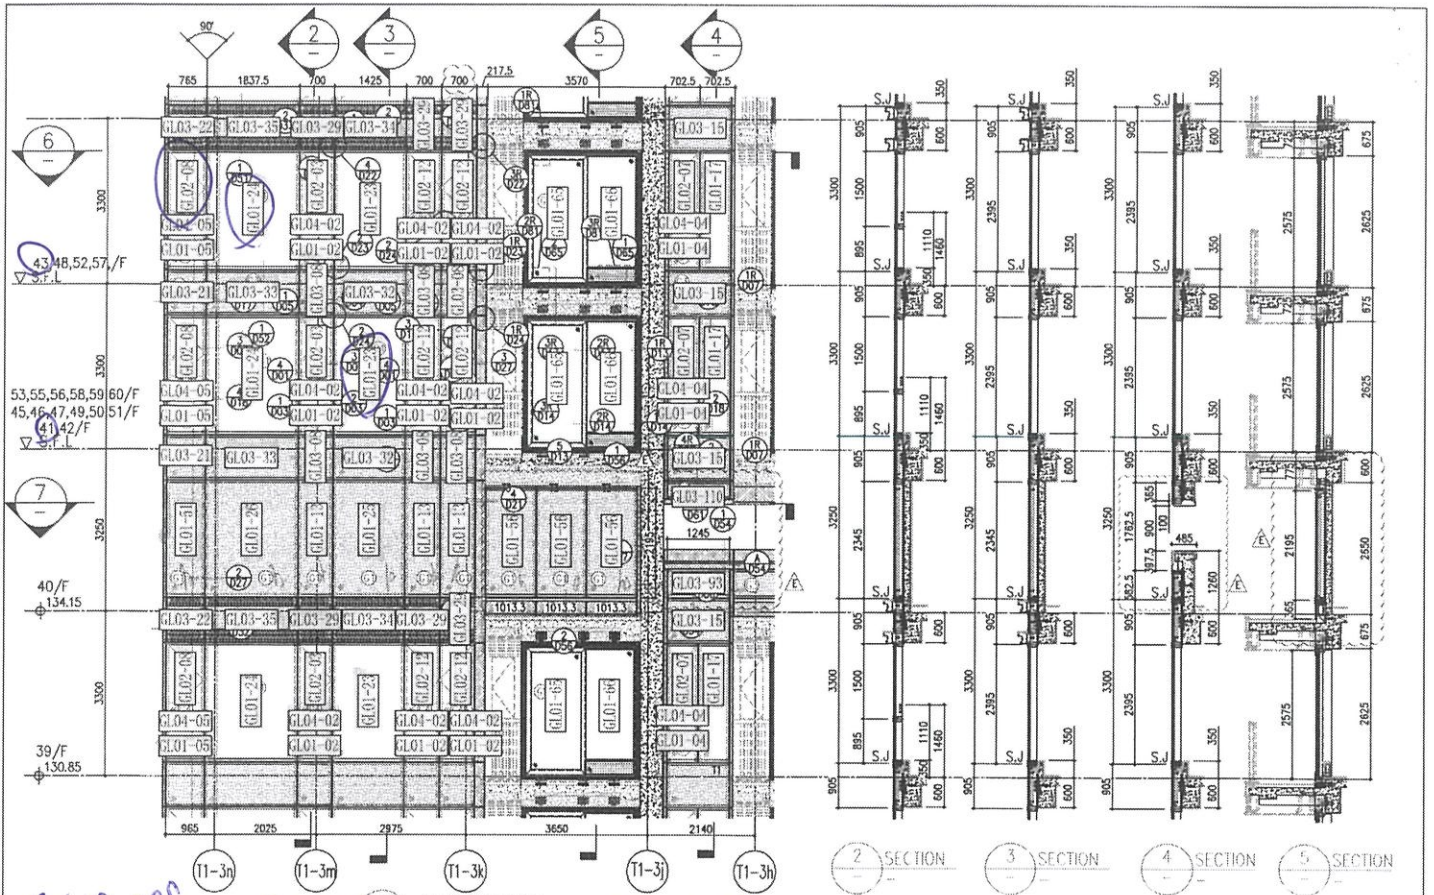

2 SECTION SECTION 3 SECTION 4 SECTION 5 SECTION

GL02-08  
 ARCH. FEATURE AT 39/F  
 43/F, 48/F, 52/F, 57/F


GL01-24  
 43/F BD

GL01-23  
 41BD.


26/F	+91.25	39/F	+130.85	52/F	+170.40
25/F	+87.95	38/F	+127.55	51/F	+167.10
23/F	+84.65	37/F	+124.25	50/F	+163.80
22/F	+81.35	36/F	+120.95	49/F	+160.50
21/F	+78.05	35/F	+117.65	48/F	+157.20
20/F	+74.75	33/F	+114.35	47/F	+153.90
19/F	+71.45	32/F	+111.05	46/F	+150.60
18/F	+68.15	31/F	+107.75	45/F	+147.30
17/F	+64.85	30/F	+104.45	43/F	+144.00
16/F	+61.55	29/F	+101.15	42/F	+140.70
15/F	+58.25	28/F	+97.85	41/F	+137.40
12/F	+54.95	27/F	+94.55	40/F	+134.15
				R/F	+203.80
				62/F	+200.30
				61/F	+196.80
				60/F	+193.50
				59/F	+190.20
				58/F	+186.90
				57/F	+183.60
				56/F	+180.30
				55/F	+177.00
				53/F	+173.70

**LEGEND:**

- 10mm THK. HEAT STRENGTHENED GLASS (OUTSIDE) + 12mm AIR SPACE + 12mm THK. TEMPERED GLASS
- 10mm THK. HEAT STRENGTHENED GLASS (OUTSIDE) + 12mm AIR SPACE + 10mm THK. TEMPERED GLASS
- 12mm THK. HEAT STRENGTHENED GLASS
- 12mm THK. CLEAR TEMPERED GLASS (INTERNAL PROTECTIVE BARRIER)
- 12mm CLEAR HEAT STRENGTHENED GLASS
- 10mm THK. CLEAR TEMPERED GLASS
- 8mm THK. CLEAR HEAT STRENGTHENED GLASS + 1.52mm ALUM. GLASS + 8mm THK. CLEAR HEAT STRENGTHENED GLASS
- 5mm THK. ALUM. GLASSING
- 3mm THK. ALUM. BACKPAN
- STACK JOINT

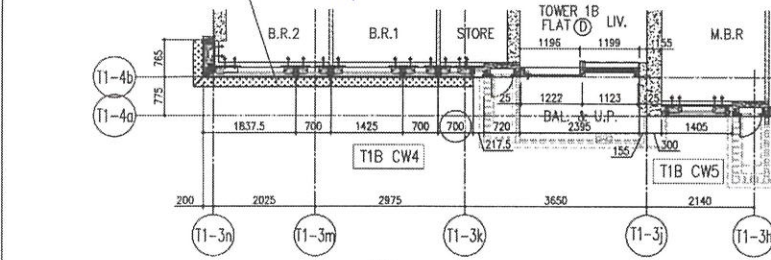

6 PART PLAN FOR CURTAIN WALL

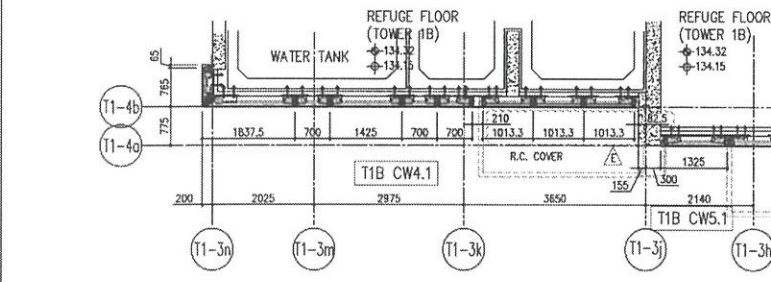


7 PART PLAN (40/F) FOR CURTAIN WALL

<p><b>CLIENT:</b>          信和置業有限公司          Sino Land Company Limited</p>	<p><b>ARCHITECT:</b>          Ronald Yu &amp; Partners          Ronald Yu &amp; Partners (HK) Ltd.          吳定邦建築師事務所(香港)有限公司</p>	<p><b>STRUCTURAL ENGINEER:</b>          Gammon          AECOM</p>	<p><b>FACE CONSULTANT:</b>          AECOM</p>	<p><b>DATE:</b> 22-07-21  <b>SCALE:</b> 1:50(A4)</p>	<p><b>TITLE:</b>          TYPICAL FLOOR PARTIAL ELEVATION &amp; SECTION, PLAN FOR CURTAIN WALL (TOWER 1)</p>	<p><b>PROJECT:</b>          PROPOSED RESEARCH DEVELOPMENT AT TOWER 708P, PHASE 11, LUNGS PARK, TSEUNG KWAN O, N.T.</p>	<p><b>JOB NO.:</b> J-858</p>	<p><b>REVISIONS:</b></p> <table border="1"> <tr><th>NO.</th><th>DATE</th><th>REVISION</th></tr> <tr><td>1</td><td>12/09/21</td><td>REVISED AS PER COMMENTS</td></tr> <tr><td>2</td><td>09/09/21</td><td>REVISED AS PER COMMENTS</td></tr> <tr><td>3</td><td>18/09/21</td><td>REVISED AS PER COMMENTS</td></tr> <tr><td>4</td><td>30/09/21</td><td>REVISED AS PER COMMENTS</td></tr> <tr><td>5</td><td>02/10/21</td><td>REVISED AS PER COMMENTS</td></tr>DIMENSIONS ARE IN mm.</li> <li>2. ALL DIMENSIONS ARE TAKEN FROM OUTSIDE.</li> <li>3. ALL DIMENSIONS ARE TO BE VERIFIED ON SITE BEFORE FABRICATION.</li> </ol> <p><b>LEGEND:</b></p> <ul style="list-style-type: none"> <li>① DETAIL MARK NO.




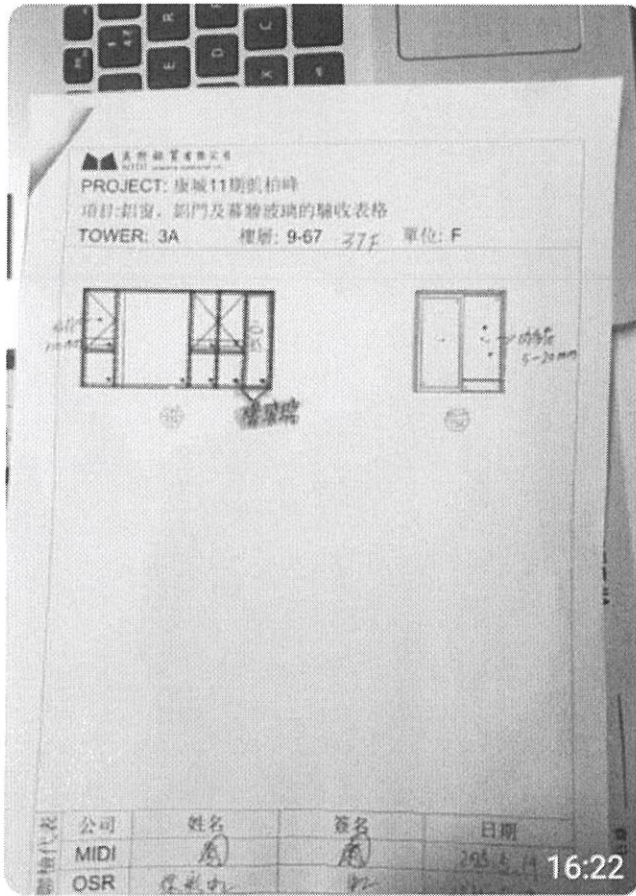

20/5

- 21-5-2025, T3开工人数
- T3BD305.借宝发
- T3BE露台304借宝发
- T3BE304A借宝发
- T3AE319.已完成幕墙清洁
- T3AB315.收螺丝叭胶
- T3AB314, 已经完成清洁
- T3AB313, 借宝发
- T3AA312.已完成清洁
- T3AA铝板墙311.已完成清洁
- T3BB.309 借宝发
- T3AGBF.303.已完成清洁
- T3AE315.302 借宝发



訊息



PROJECT: 康城11期凱柏峰

項目: 鋁窗, 鋁門及幕牆玻璃的驗收表格

TOWER: 3A 樓層: 9-67 37F 單位: F

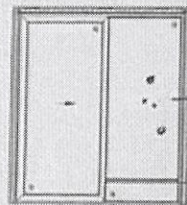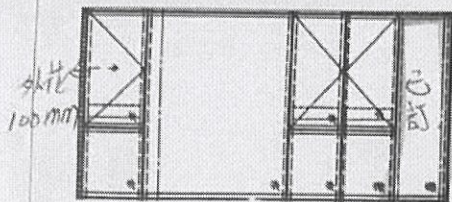

爆玻璃



GL01-14  
644x2332

聯檢代表	公司	姓名	簽名	日期
	MIDI			2025.5.19
	OSR	保彩虹		2025.5.19

