美特鋁質有限公司
MIDI ALUMINIUM FABRICATOR LTD.

工程指示 / 要求簡箋 ENGINEER INSTRUCTIONS(E.I.)

工程指示編號:	**EI-** 5455	**修改版本:**	-
	HK- 2218		
工程編號:	J 859	**工程名稱:**	NKIL6551
收件人:	林仁安 / 生統	**發件人:**	BearLam
工程項目:	T1-T9A 佛沙窗大貨拆加工圖	**日期:**	12/12/2022

☐ 原合約工程包	☐ 原合約工程加 / 減賬 QT-	☐ 新工程報價 QT-

信件批核號碼/圖紙參考編號:	**批核模具圖紙編號:**
客戶指示附件:	**管理內部批簽署:**

☐ 初步鋁料 B.M.	☐ 加工拆圖，然後生產	☐ 尺寸表
☐ 正式鋁料 B.M.	☐ 技術上資料／指示	☐ 報價
☐ 配件 B.M.	☐ 樣辦或貨品說明書	☐ 分判合約
☐ 其他:		

內容: 請根據最新的10th Precast Facade Window Shop Drawing 進行拆圖，請先完成EI4151F 的試模窗拆圖，由於時間趕急，請盡快完成有關拆圖。

完成上列要求日期: ASAP

國內

☐ 生產技術總監	☐ 連附件	☐ 技術部	☐ 連附件	☐ 生產部	☐ 連附件
☐ 採購部	☐ 連附件	☑ 生產統籌部	☑ 連附件	☐ 報關組	☐ 連附件
☐ 質檢部	☐ 連附件	☐ 會計部	☐ 連附件	☐ 機械設計部	☐ 連附件
☑ 香港辦	☑ 連附件	☑ 其他: 林仁安			

香港

☐ 行政部	☐ 連附件	☐ 會計部	☐ 連附件	☐ 統籌部	☐ 連附件	☐ 工程部	☐ 連附件
☐ 採購部	☐ 連附件	☐ QS部	☐ 連附件	☐ 地盤管理	☐ 連附件	☐ 維修部	☐ 連附件

*發件人簽署： Bear Lam	*組別成員批核簽署：
傳遞編號：	項目經理簽署：

10

PROJECT :

PROPOSED RESIDENTIAL / COMMERCIAL DEVELOPMENT AT NKIL NO.6551 KAI TAK AREA 4C, SITE 3 KAI TAK, KOWLOON

SHOPDRAWING SUBMISSION FOR
PRE-CAST ALUM. WINDOW & LOUVRE
(TOWER 1, TOWER 2, TOWER 3
(TOWER 5, TOWER 6, TOWER 7
(TOWER 8, TOWER 9, TOWER 9A)

DATE : 04 - Nov - 2022

美特鋁質有限公司
MIDI ALUMINIUM FABRICATOR LTD.
Units 6-8, Sunray Industrial Centre, 1/F
610 Cha Kwo Ling Road, Kowloon
Tel:23489211-4 Fax:(852)27727666

DWG NO. : J859-SD-PW-0000 | REV. : 0

DRAWING SUBMISSION REGISTER

PROJECT:
PROPOSED RESIDENTIAL / COMMERCIAL DEVELOPMENT
AT NKIL NO. 6551 KAI TAK AREA 4C, SITE 3
KAI TAK, KOWLOON

TITLE:
SHOPDRAWING SUBMISSION FOR
PRE-CAST ALUM. WINDOW & LOUVRE

NO.	DRAWING TITLE	DWG. NO.	DATE OF ISSUE										SUBMISSION STATE (FOR B.D / A.S.D)			SUBMISSION STATE (FOR CLIENT / CONSULTANT)			SUBMISSION STATE (FOR ARCHITECT)			FABRICATION / CONSTRUCTION STATE					
			ISSUE	1	2	3	4	5	6	7	8	9	10	AP - APPROVED AC - APPROVED SUB. TO CONDITION NA - NOT APPROVED			AP - APPROVED AC - APPROVED SUB. TO CONDITION NA - NOT APPROVED			AP - APPROVED AC - APPROVED SUB. TO CONDITION NA - NOT APPROVED			ISSUE TO CHINA OFFICE		ISSUE TO SITE		ISSUE TO SUB-CONTRACTOR	
			DAY	04	28	13	27	16	4	8	10	13	04													
			MONTH	03	03	04	04	05	7	8	9	10	11													
			YEAR	22	22	22	22	22	22	22	22	22	22													
			REVISIONS											COMMENT DATE	REV.	STATE	COMMENT DATE	REV.	STATE	COMMENT DATE	REV.	STATE	REV.	DATE	REV.	DATE	REV.	DATE
01	COVER PAGE	J859-SD-PW-0000		1	2	3	4	5	6	7	8	9	10													
02	DRAWING REGISTER	J859-SD-PW-0001		–	A	B	C	D	E	F	G	H	I													
03	DRAWING REGISTER	J859-SD-PW-0002		–	A	B	C	D	E	F	G	H	I													
04	DRAWING REGISTER	J859-SD-PW-0003								–	A	B	C													
05	GENERNAL NOTES FOR ALUM. WINDOW	J859-SD-GN-0005		–	A	B	C	D	D	D	E	F	G													
06	GENERNAL NOTES FOR ALUM. WINDOW	J859-SD-GN-0006								–	A	B														
07	DIE LIST FOR ALUM. WINDOW (TOWER 1 – TOWER 9)	J859-SD-PW-0011		–	–	–	–	–	–	–	–	–	–													
08	DIE LIST FOR ALUM. WINDOW (TOWER 1 – TOWER 9)	J859-SD-PW-0012		–	–	–	–	–	–	–	–	–	A													
09	DIE LIST FOR ALUM. WINDOW (TOWER 1 – TOWER 9)	J859-SD-PW-0013		–	–	–	–	A	A	A	A	A	B													
10	2–6/F WINDOW LOCATION PLAN FOR PRECAST FACADE AT TOWER 1	J859-SD-PL-101		–	–	A	A	A	A	A	A	B	B													
11	7–21/F, 23–25/F WINDOW LOCATION PLAN FOR PRECAST FACADE AT TOWER 1	J859-SD-PL-102		–	–	A	A	A	A	B	B	C	C													
12	22/F WINDOW LOCATION PLAN FOR PRECAST FACADE AT TOWER 1	J859-SD-PL-102a										–	–													
13	26/F WINDOW LOCATION PLAN FOR PRECAST FACADE AT TOWER 1	J859-SD-PL-103		–	–	A	B	B	B	B	B	C	C													
14	27/F WINDOW LOCATION PLAN FOR PRECAST FACADE AT TOWER 1	J859-SD-PL-104		–	–	A	A	A	A	A	A	B	B													
15	2–19/F WINDOW LOCATION PLAN FOR PRECAST FACADE AT TOWER 2	J859-SD-PL-201		–	–	A	A	A	A	A	A	B	B													
16	20/F WINDOW LOCATION PLAN FOR PRECAST FACADE AT TOWER 2	J859-SD-PL-202		–	–	A	B	B	B	B	B	C	C													
17	21/F WINDOW LOCATION PLAN FOR PRECAST FACADE AT TOWER 2	J859-SD-PL-203		–	–	A	B	B	B	B	B	C	C													
18	22/F WINDOW LOCATION PLAN FOR PRECAST FACADE AT TOWER 2	J859-SD-PL-204		–	–	A	A	A	A	A	A	A	A													
19	23–25/F WINDOW LOCATION PLAN FOR PRECAST FACADE AT TOWER 2	J859-SD-PL-205		–	–	A	A	A	A	A	A	B	B													
20	26/F WINDOW LOCATION PLAN FOR PRECAST FACADE AT TOWER 2	J859-SD-PL-206		–	–	A	A	A	A	A	A	B	B													
21	2–26/F WINDOW LOCATION PLAN FOR PRECAST FACADE AT TOWER 3	J859-SD-PL-301		–	–	A	B	C	C	C	D	E	E													
22	27/F WINDOW LOCATION PLAN FOR PRECAST FACADE AT TOWER 3	J859-SD-PL-302		–	–	A	B	C	C	C	D	E	E													
23	28/F WINDOW LOCATION PLAN FOR PRECAST FACADE AT TOWER 3	J859-SD-PL-303		–	–	A	B	C	C	C	D	E	E													
24	2–26/F WINDOW LOCATION PLAN FOR PRECAST FACADE AT TOWER 5	J859-SD-PL-501		–	–	A	A	A	A	A	A	B	B													
25	27/F WINDOW LOCATION PLAN FOR PRECAST FACADE AT TOWER 5	J859-SD-PL-502		–	–	A	A	A	A	A	A	B	B													
26	2–26/F WINDOW LOCATION PLAN FOR PRECAST FACADE AT TOWER 6	J859-SD-PL-601		–	–	A	A	A	A	A	A	B	B													
27	27/F WINDOW LOCATION PLAN FOR PRECAST FACADE AT TOWER 6	J859-SD-PL-602		–	–	A	A	A	A	A	A	B	B													
28	2–26/F WINDOW LOCATION PLAN FOR PRECAST FACADE AT TOWER 7	J859-SD-PL-701		–	–	A	B	C	C	C	D	E	E													
29	27/F WINDOW LOCATION PLAN FOR PRECAST FACADE AT TOWER 7	J859-SD-PL-702		–	–	A	B	C	C	C	D	E	E													
30	28/F WINDOW LOCATION PLAN FOR PRECAST FACADE AT TOWER 7	J859-SD-PL-703		–	–	A	B	C	C	C	D	E	E													
31	2~8/F WINDOW LOCATION PLAN FOR PRECAST FACADE AT TOWER 8	J859-SD-PL-801		–	–	A	B	C	D	D	E	F	F													
32	9~26/F WINDOW LOCATION PLAN FOR PRECAST FACADE AT TOWER 8	J859-SD-PL-802		–	–	A	B	C	C	C	D	E	E													
33	27/F WINDOW LOCATION PLAN FOR PRECAST FACADE AT TOWER 8	J859-SD-PL-803		–	–	A	B	C	C	C	D	E	E													
34	28/F WINDOW LOCATION PLAN FOR PRECAST FACADE AT TOWER 8	J859-SD-PL-804		–	–	A	B	C	C	C	D	E	E													
35	2~8/F WINDOW LOCATION PLAN FOR PRECAST FACADE AT TOWER 9 / 9A	J859-SD-PL-901		–	–	A	B	B	C	C	D	E	E													
36	9~25/F WINDOW LOCATION PLAN FOR PRECAST FACADE AT TOWER 9 / 9A	J859-SD-PL-902		–	–	A	B	B	C	C	D	E	E													
37	26/F WINDOW LOCATION PLAN FOR PRECAST FACADE AT TOWER 9 / 9A	J859-SD-PL-903		–	–	A	B	B	C	C	D	E	F													
38	27/F WINDOW LOCATION PLAN FOR PRECAST FACADE AT TOWER 9 / 9A	J859-SD-PL-904		–	–	A	A	A	B	B	C	D	E													
39	WINDOW SCHEDULE FOR PRECAST FACADE AT TOWER 1	J859-SD-PW-1101		–	A	B	C	D	E	F	F	G	H													
40	WINDOW SCHEDULE FOR PRECAST FACADE AT TOWER 1	J859-SD-PW-1102		–	A	B	C	D	E	E	F	G	H													
41	WINDOW SCHEDULE FOR PRECAST FACADE AT TOWER 2	J859-SD-PW-2101		–	A	B	C	D	E	E	E	E	E													
42	WINDOW SCHEDULE FOR PRECAST FACADE AT TOWER 2	J859-SD-PW-2102		–	A	A	B	C	C	C	D	E	E													
43	WINDOW SCHEDULE FOR PRECAST FACADE AT TOWER 3	J859-SD-PW-3101		–	A	B	C	D	E	E	F	F	F													
44	WINDOW SCHEDULE FOR PRECAST FACADE AT TOWER 5	J859-SD-PW-5101		–	A	B	C	D	E	E	F	F	F													
45	WINDOW SCHEDULE FOR PRECAST FACADE AT TOWER 5	J859-SD-PW-5102		–	A	B	C	D	E	E	E	F	F													
46	WINDOW SCHEDULE FOR PRECAST FACADE AT TOWER 6	J859-SD-PW-6101		–	A	B	C	D	D	D	D	D	D													
47	WINDOW SCHEDULE FOR PRECAST FACADE AT TOWER 6	J859-SD-PW-6102		–	A	B	C	D	E	E	E	F	F													
48	WINDOW SCHEDULE FOR PRECAST FACADE AT TOWER 7	J859-SD-PW-7101		–	A	B	C	D	E	E	F	F	F													

B.D. REF :

ARCHITECT :
WONG TUNG & PARTNERS LIMITED
ARCHITECTS & PLANNERS

STRUCTURAL ENGINEER :
SUN HUNG KAI
ARCHITECTS AND ENGINEERS LTD.
SUN HUNG KAI CENTRE, WANCHAI, HONGKONG
TEL. 28276111 FAX. 28272894

FACADE CONSULTANT:
ALPHA CONSULTING LIMITED
Steel Structure & Facade Specialist

MAIN CONTRACTOR :
Sanfield Engineering
Construction Ltd.

CLIENT :
SUN HUNG KAI
REAL ESTATE AGENCY LTD.
42/F SUN HUNG KAI CENTRE, WANCHAI, HONGKONG

NOTE :
1. ALL DIMENSIONS ARE IN mm.
2. ALL ELEVATIONS ARE VIEWED FROM OUTSIDE.
3. ALL DIMENSIONS TO BE VERIFIED ON SITE BEFORE FABRICATION.

LEGEND :
DETAIL MARK NO.
REFER SHEET NO.
1. F.F.L. --- FINISHED FLOOR LEVEL
2. S.F.L. --- STRUCTURAL FLOOR LEVEL
3. R --- REVERSED DETAIL

NO.	DATE	REMARK	BY
I	04-11-2022	REVISION SUBJECT TO ARCH. COMMENT	YL
H	13-10-2022	REVISION SUBJECT TO ARCH. COMMENT	YL
G	09-09-2022	REVISION SUBJECT TO ARCH. COMMENT	MMS
F	02-09-2022	REVISION SUBJECT TO ARCH. COMMENT	MMS
E	29-08-2022	REVISION SUBJECT TO ARCH. COMMENT	MMS
D	15-08-2022	REVISION SUBJECT TO ARCH. COMMENT	MMS
C	27-04-2022	REVISION SUBJECT TO ARCH. COMMENT	MMS
B	13-04-2022	REVISION SUBJECT TO ARCH. COMMENT	MMS
A	28-03-2022	REVISION SUBJECT TO ARCH. COMMENT	MMS

JOB NO. : J-859

PROJECT :
PROPOSED RESIDENTIAL / COMMERCIAL DEVELOPMENT AT NKIL NO.6551 KAI TAK AREA 4C, SITE 3
KAI TAK, KOWLOON

TITLE :
DRAWING LIST OF
PRE-CAST ALUM. WINDOW
(TOWER 7, TOWER 8, TOWER 9 / 9A)

DATE : 15-Nov-21 | SCALE : 1:2 (A3)

DRAWN BY : IVAN | CHECKED BY :

美特鋁質有限公司
MIDI ALUMINIUM FABRICATOR LTD.
Units 6-8, Sunray Industrial Centre, 1/F
610 Cha Kwo Ling Road, Kowloon
Tel:23489211-4 Fax:(852)27727666

DWG NO. : J859-SD-PW-0001 | REV. : I

DRAWING SUBMISSION REGISTER

PROJECT:
PROPOSED RESIDENTIAL / COMMERCIAL DEVELOPMENT
AT NKIL NO. 6551 KAI TAK AREA 4C, SITE 3
KAI TAK, KOWLOON

TITLE:
SHOPDRAWING SUBMISSION FOR
PRE-CAST ALUM. WINDOW & LOUVRE

NO.	DRAWING TITLE	DWG. NO.	DATE OF ISSUE / REVISIONS										SUBMISSION STATE (FOR B.D / A.S.D)			SUBMISSION STATE (FOR CLIENT / CONSULTANT)			SUBMISSION STATE (FOR ARCHITECT)			FABRICATION / CONSTRUCTION STATE					
			ISSUE	1	2	3	4	5	6	7	8	9	10	AP - APPROVED AC - APPROVED SUB. TO CONDITION NA - NOT APPROVED			AP - APPROVED AC - APPROVED SUB. TO CONDITION NA - NOT APPROVED			AP - APPROVED AC - APPROVED SUB. TO CONDITION NA - NOT APPROVED			ISSUE TO CHINA OFFICE		ISSUE TO SITE		ISSUE TO SUB-CONTRACTOR	
			DAY	04	28	13	27	16	4	8	10	13	04													
			MONTH	03	03	04	04	05	7	8	9	10	11													
			YEAR	22	22	22	22	22	22	22	22	22	22													
														COMMENT DATE	REV.	STATE	COMMENT DATE	REV.	STATE	COMMENT DATE	REV.	STATE	REV.	DATE	REV.	DATE	REV.	DATE
01	WINDOW SCHEDULE FOR PRECAST FACADE AT TOWER 8	J859-SD-PW-8101		–	A	B	C	D	E	F	G	G	G													
02	WINDOW SCHEDULE FOR PRECAST FACADE AT TOWER 9	J859-SD-PW-9101		–	A	A	B	C	D	D	D	D	D													
03	WINDOW SCHEDULE FOR PRECAST FACADE AT TOWER 9	J859-SD-PW-9102		–	A	A	B	C	D	D	E	E	E													
04	WINDOW SCHEDULE FOR PRECAST FACADE AT TOWER 9	J859-SD-PW-9103		–	A	A	B	C	D	E	E	F	G													
05	WINDOW SCHEDULE FOR PRECAST FACADE AT TOWER 9	J859-SD-PW-9104		–	A	B	C	D	D	D	D	D	D													
06	WINDOW SCHEDULE FOR PRECAST FACADE AT TOWER 9	J859-SD-PW-9105		–	A	A	B	C	D	D	E	F	G													
07	TYPICAL DETAILS FOR ALUM. WINDOW	J859-SD-PW-DT61		–	A	A	A	B	C	C	D	E	E													
08	TYPICAL DETAILS FOR ALUM. WINDOW	J859-SD-PW-DT62		–	A	A	A	A	A	A	B	B	B													
09	TYPICAL DETAILS FOR ALUM. WINDOW	J859-SD-PW-DT63		–	A	A	A	A	A	A	A	A	A													
10	TYPICAL DETAILS FOR ALUM. WINDOW	J859-SD-PW-DT63a		–	A	A	A	B	B	C	C	C	C													
11	TYPICAL DETAILS FOR ALUM. WINDOW	J859-SD-PW-DT63b		–	A	A	A	A	A	A	A	B	B													
12	TYPICAL DETAILS FOR ALUM. WINDOW	J859-SD-PW-DT64		–	A	A	A	B	C	C	C	C	C													
13	TYPICAL DETAILS FOR ALUM. WINDOW	J859-SD-PW-DT65		–	A	A	A	B	C	C	C	C	C													
14	TYPICAL DETAILS FOR ALUM. WINDOW	J859-SD-PW-DT66		–	A	A	A	B	B	B	C	C	C													
15	TYPICAL DETAILS FOR ALUM. WINDOW	J859-SD-PW-DT67		–	A	A	A	A	B	B	B	B	B													
16	TYPICAL DETAILS FOR ALUM. WINDOW	J859-SD-PW-DT68		–	A	A	A	A	A	A	A	A	A													
17	TYPICAL DETAILS FOR ALUM. WINDOW	J859-SD-PW-DT68a		–	A	A	A	B	B	B	C	C	C													
18	TYPICAL DETAILS FOR ALUM. WINDOW	J859-SD-PW-DT68b		–	A	A	A	A	A	A	B	B	B													
19	TYPICAL DETAILS FOR ALUM. WINDOW	J859-SD-PW-DT69		–	A	A	A	A	A	A	A	A	A													
20	TYPICAL DETAILS FOR ALUM. WINDOW	J859-SD-PW-DT69a		–	A	A	A	A	A	A	A	A	A													
21	TYPICAL DETAILS FOR ALUM. WINDOW	J859-SD-PW-DT69b		–	A	A	A	B	B	B	C	C	C													
22	TYPICAL DETAILS FOR ALUM. WINDOW	J859-SD-PW-DT70		–	A	A	A	A	A	B	B	B	B													
23	TYPICAL DETAILS FOR ALUM. WINDOW	J859-SD-PW-DT70a		–	A	A	A	A	A	B	C	D	D													
24	TYPICAL DETAILS FOR ALUM. WINDOW	J859-SD-PW-DT70b		–	A	A	A	B	C	C	D	D	D													
25	TYPICAL DETAILS FOR ALUM. WINDOW	J859-SD-PW-DT70c		–	A	A	A	B	C	C	C	C	C													
26	TYPICAL DETAILS FOR ALUM. WINDOW	J859-SD-PW-DT70d		–	A	A	A	B	C	C	D	D	D													
27	TYPICAL DETAILS FOR ALUM. WINDOW	J859-SD-PW-DT70e			–	–	A	A	A	A	B	B	B													
28	TYPICAL DETAILS FOR ALUM. WINDOW	J859-SD-PW-DT70f								–	A	B	B													
29	TYPICAL DETAILS FOR ALUM. WINDOW	J859-SD-PW-DT71		–	A	A	A	B	C	C	C	D	D													
30	TYPICAL DETAILS FOR ALUM. WINDOW	J859-SD-PW-DT72		–	A	A	A	A	A	A	A	A	A													
31	TYPICAL DETAILS FOR ALUM. WINDOW	J859-SD-PW-DT72a		–	A	A	A	A	A	A	A	A	A													
32	TYPICAL DETAILS FOR ALUM. WINDOW	J859-SD-PW-DT72b			–	–	A	A	A	A	A	A	A													
33	TYPICAL DETAILS FOR ALUM. WINDOW	J859-SD-PW-DT73		–	A	A	A	B	C	C	C	C	C													
34	TYPICAL DETAILS FOR ALUM. WINDOW	J859-SD-PW-DT74		–	A	A	A	B	C	C	C	C	C													
35	TYPICAL DETAILS FOR ALUM. WINDOW	J859-SD-PW-DT75		–	A	A	A	B	C	C	C	C	C													
36	TYPICAL DETAILS FOR ALUM. WINDOW	J859-SD-PW-DT76		–	A	A	B	C	D	D	D	D	D													
37	TYPICAL DETAILS FOR ALUM. WINDOW	J859-SD-PW-DT77		–	–	–	–	–	–	–	A	A	A													
38	TYPICAL DETAILS FOR ALUM. WINDOW	J859-SD-PW-DT78		–	A	A	A	B	B	B	B	B	B													
39	TYPICAL DETAILS FOR ALUM. WINDOW	J859-SD-PW-DT79		–	A	A	A	A	A	A	A	A	A													
40	TYPICAL DETAILS FOR ALUM. WINDOW	J859-SD-PW-DT80		–	A	A	A	A	B	B	B	B	B													
41	TYPICAL DETAILS FOR ALUM. WINDOW	J859-SD-PW-DT80a		–	–	–	A	B	B	B	B	B	B													
42	TYPICAL DETAILS FOR ALUM. WINDOW	J859-SD-PW-DT80b								–	–	–	A													
43	TYPICAL DETAILS FOR ALUM. WINDOW	J859-SD-PW-DT80c								–	–	–	–													
44	TYPICAL DETAILS FOR ALUM. WINDOW	J859-SD-PW-DT80d								–	–	–	A													
45	TYPICAL DETAILS FOR ALUM. WINDOW	J859-SD-PW-DT80e								–	–	–	A													
46	TYPICAL DETAILS FOR ALUM. WINDOW	J859-SD-PW-DT81		–	A	A	B	C	D	D	D	D	D													
47	TYPICAL DETAILS FOR ALUM. WINDOW	J859-SD-PW-DT82		–	A	A	B	C	D	D	D	D	D													
48	TYPICAL EARTHING BONDING DETAILS OF PRECAST	J859-SD-PW-DT83		–	–	–	–	–	–	A	A	A	B													

B.D. REF :

ARCHITECT :
WONG TUNG & PARTNERS LIMITED
ARCHITECTS & PLANNERS

STRUCTURAL ENGINEER :
SUN HUNG KAI
ARCHITECTS AND ENGINEERS LTD.
SUN HUNG KAI CENTRE, WANCHAI, HONGKONG
TEL. 28278111 FAX. 28272584

FACADE CONSULTANT:
ALPHA CONSULTING LIMITED
Steel Structure & Facade Specialist

MAIN CONTRACTOR :
Sanfield Engineering
Construction Ltd.

CLIENT :
SUN HUNG KAI
REAL ESTATE AGENCY LTD.
42/F SUN HUNG KAI CENTRE, WANCHAI, HONGKONG

NOTE :
1. ALL DIMENSIONS ARE IN mm.
2. ALL ELEVATIONS ARE VIEWED FROM OUTSIDE.
3. ALL DIMENSIONS TO BE VERIFIED ON SITE BEFORE FABRICATION.

LEGEND :
DETAIL MARK NO.
REFER SHEET NO.
1. F.F.L. — FINISHED FLOOR LEVEL
2. S.F.L. — STRUCTURAL FLOOR LEVEL
3. (A) — REVERSED DETAIL

NO.	DATE	REMARK	BY
I	04-11-2022	REVISION SUBJECT TO AMCH. COMMENT	YI
H	13-10-2022	REVISION SUBJECT TO AMCH. COMMENT	YI
G	08-09-2022	REVISION SUBJECT TO AMCH. COMMENT	IVAN
F	08-09-2022	REVISION SUBJECT TO AMCH. COMMENT	IVAN
E	30-08-2022	REVISION SUBJECT TO AMCH. COMMENT	IVAN
D	16-05-2022	REVISION SUBJECT TO AMCH. COMMENT	IVAN
C	27-04-2022	REVISION SUBJECT TO AMCH. COMMENT	IVAN
B	13-04-2022	REVISION SUBJECT TO AMCH. COMMENT	IVAN
A	28-03-2022	REVISION SUBJECT TO AMCH. COMMENT	IVAN

JOB NO. : J-859

PROJECT :
PROPOSED RESIDENTIAL / COMMERCIAL DEVELOPMENT AT NKIL NO.6551 KAI TAK AREA 4C, SITE 3 KAI TAK, KOWLOON

TITLE :
DRAWING LIST OF
PRE-CAST ALUM. WINDOW
(TOWER 7, TOWER 8, TOWER 9 / 9A)

DATE : 15-Nov-21 | SCALE : 1:2 (A3)

DRAWN BY : IVAN | CHECKED BY :

美特鋁質有限公司
MIDI ALUMINIUM FABRICATOR LTD.
Units 6-8, Sunray Industrial Centre, 1/F
610 Cha Kwo Ling Road, Kowloon
Tel:23489211-4 Fax:(852)27727666

DWG NO. : J859-SD-PW-0002 | REV. : I

DRAWING SUBMISSION REGISTER

PROJECT:
PROPOSED RESIDENTIAL / COMMERCIAL DEVELOPMENT
AT NKIL NO. 6551 KAI TAK AREA 4C, SITE 3
KAI TAK, KOWLOON

TITLE:
SHOPDRAWING SUBMISSION FOR
PRE-CAST ALUM. WINDOW & LOUVRE

NO.	DRAWING TITLE	DWG. NO.	DATE OF ISSUE										SUBMISSION STATE (FOR B.D / A.S.D)			SUBMISSION STATE (FOR CLIENT / CONSULTANT)			SUBMISSION STATE (FOR ARCHITECT)			FABRICATION / CONSTRUCTION STATE					
			ISSUE	1	2	3	4	5	6	7	8	9	10	AP - APPROVED AC - APPROVED SUB. TO CONDITION NA - NOT APPROVED			AP - APPROVED AC - APPROVED SUB. TO CONDITION NA - NOT APPROVED			AP - APPROVED AC - APPROVED SUB. TO CONDITION NA - NOT APPROVED			ISSUE TO CHINA OFFICE		ISSUE TO SITE		ISSUE TO SUB-CONTRACTOR	
			DAY	04	28	13	27	16	4	8	10	13	04														
			MONTH	03	03	04	04	05	7	8	9	10	11														
			YEAR	22	22	22	22	22	22	22	22	22	22														
			REVISIONS											COMMENT DATE	REV.	STATE	COMMENT DATE	REV.	STATE	COMMENT DATE	REV.	STATE	REV.	DATE	REV.	DATE	REV.	DATE
01	TYPICAL DETAILS FOR ALUM. WINDOW	J859-SD-PW-DT83a	–	A	A	A	A	A	A	A	A	A															
02	TYPICAL DETAILS FOR ALUM. WINDOW	J859-SD-PW-DT84	–	A	A	A	B	C	C	C	C	C															
03	G.M.S FIXING LUG TYPICAL DETAIL FOR ALUM. WINDOW	J859-SD-PW-DT84a	–	–	A	A	A	A	A	A	A	B															
04	TYPICAL DETAILS FOR ALUM. WINDOW	J859-SD-PW-DT85	–	A	A	A	A	A	A	A	A	A															
05	TYPICAL ASSEMBLY DETAILS FOR ALUM. WINDOW	J859-SD-PW-DT85a	–	A	B	B	B	C	C	D	D	D															
06	TYPICAL ASSEMBLY DETAILS FOR ALUM. WINDOW	J859-SD-PW-DT86	–	–	A	B	B	C	C	D	D	D															
07	TYPICAL DETAILS FOR ALUM. WINDOW	J859-SD-PW-DT87	–	A	A	A	B	C	C	C	C	C															
08	TYPICAL DETAILS FOR ALUM. WINDOW	J859-SD-PW-DT88		–	A	B	B	B	B	B	B	B															
09																											
10																											
B.D. REF :

ARCHITECT :
WONG TUNG & PARTNERS LIMITED
ARCHITECTS & PLANNERS

STRUCTURAL ENGINEER :
SUN HUNG KAI
ARCHITECTS AND ENGINEERS LTD.
SUN HUNG KAI CENTRE, WANCHAI, HONGKONG
TEL. 28278111 FAX. 28272884

FACADE CONSULTANT:
ALPHA CONSULTING LIMITED
Steel Structure & Facade Specialist

MAIN CONTRACTOR :
Sanfield Engineering
Construction Ltd.

CLIENT :
SUN HUNG KAI
REAL ESTATE AGENCY LTD.
42/F SUN HUNG KAI CENTRE, WANCHAI, HONGKONG

NOTE :
1. ALL DIMENSIONS ARE IN mm.
2. ALL ELEVATIONS ARE VIEWED FROM OUTSIDE.
3. ALL DIMENSIONS TO BE VERIFIED ON SITE BEFORE FABRICATION.

LEGEND :
DETAIL MARK NO.
REFER SHEET NO.
1. F.F.L. --FINISHED FLOOR LEVEL
2. S.F.L. --STRUCTURAL FLOOR LEVEL
3. R --REVERSED DETAIL

NO.	DATE	REMARK	BY
C	04-11-2022	REVISION SUBJECT TO ARCH. COMMENT	YS
B	13-10-2022	REVISION SUBJECT TO ARCH. COMMENT	YS
A	09-09-2022	REVISION SUBJECT TO ARCH. COMMENT	WAH

JOB NO. : J-859

PROJECT :
PROPOSED RESIDENTIAL / COMMERCIAL DEVELOPMENT AT NKIL NO.6551 KAI TAK AREA 4C, SITE 3 KAI TAK, KOWLOON

TITLE :
DRAWING LIST OF
PRE-CAST ALUM. WINDOW
(TOWER 7, TOWER 8, TOWER 9 / 9A)

DATE : 15-Nov-21 | SCALE : 1:2 (A3)

DRAWN BY : IVAN | CHECKED BY :

美特鋁質有限公司
MIDI ALUMINIUM FABRICATOR LTD.
Units 6-8, Sunray Industrial Centre, 1/F
610 Cha Kwo Ling Road, Kowloon
Tel:23489211-4 Fax:(852)27727866

DWG NO. : J859-SD-PW-0003 | REV. : C

GENERAL NOTES FOR PRECAST ALUM. WINDOW page 1

CODES AND STANDARDS

1. CODE OF PRACTICE ON WIND EFFECTS IN HONG KONG 2004.
2. CODE OF PRACTICE FOR DEAD AND IMPOSED LOADS 2011.
3. CODE OF PRACTICE FOR STRUCTURAL USE OF CONCRETE 2013.
4. CODE OF PRACTICE FOR THE STRUCTURAL USE OF STEEL 2011.
5. CODE OF PRACTICE FOR STRUCTURAL USE OF GLASS 2018.
6. STRUCTURAL USE OF ALUMINIUM, BS 8118-1:1991. (WIND LOAD FACTOR OF 1.4 FOR ALUMINIUM DESIGN TO PNAP APP53)
7. BUILDING (CONSTRUCTION) REGULATIONS CAP 123.
8. APP37 CURTAIN WALL, WINDOW AND WINDOW WALL SYSTEM.
9. APP110 PROTECTIVE BARRIERS.
10. APP118 ALUMINIUM WINDOW.

DESIGN WIND LOAD

CODE OF PRACTICE ON WIND EFFECTS IN HONG KONG 2004.

	VERTICAL SURFACE
HEIGHT ABOVE GROUND LEVEL	<100m
BASIC WIND PRESSURE	2.86kPa
TOPOGRAPHY FACTOR (Sa)	1.00
PRESSURE COEFFICIENT (Cp)	+1.0/−1.4
DESIGN WIND PRESSURE	+2.86/−4.00kPa

IMPOSED LOAD ON PROTECTIVE BARRIERS (FOR DOMESTIC USE)

LINE LOADS TO BE	UNIFORMLY APPLIED AT A HEIGHT OF 1.1m ABOVE THE FLOOR LEVEL (kN/m)	CONCENTRATED LOAD DISTRIBUTED LOAD TO BE APPLIED ON THE INFILL BETWEEN FLOOR AND TOP RAIL (kPa)	TO BE APPLIED ON ANY PART OF THE INFILL BETWEEN FLOOR AND TOP RAIL (kN)
AREAS WHERE CONGREGATION OF PEOPLE IS NOT EXPECTED	0.75	1.0	0.5

STEEL

ALL STRUCTURAL STEEL SECTIONS SHALL BE OF GRADE S275 J0 CLASS 1 WELDABLE STRUCTURAL STEEL AND COMPLYING WITH BS EN 10210-1 FOR HOLLOW SECTIONS AND BS EN 10025 FOR OTHER SECTIONS.

ALL STRUCTURAL STEEL TO BE HOT-DIP GALVANIZED TO BS EN ISO 1461 WITH MIN 85 μm COATING THICKNESS.

ALL CUT/WELDED AREAS IN GALVANIZED STEEL TO BE MAKE GOOD BY AT LEAST TWO COATS OF ZINC RICH PRIMER TO BS 4652.

DENSITY	77kN/m³
YOUNG'S MODULUS	205,000MPa
YIELD STRENGTH	275MPa
MINIMUM TENSILE STRENGTH	430MPa
DESIGN STRENGTH (t≤16mm)	275MPa
DESIGN STRENGTH (t≤40mm)	265MPa

ALUMINIUM EXTRUSION

UNLESS OTHERWISE STATED, ALL ALUMINIUM EXTRUSIONS SHALL BE GRADE 6063-T6/6061-T6 AND COMPLY WITH BS EN 755-2 AND BS EN 573-3.

DENSITY	27.2kN/m³
YOUNG'S MODULUS	70,000MPa

	6063-T6	6061-T6	6063-T5
0.2% PROOF STRESS	170MPa	240MPa	110MPa
MINIMUM TENSILE STRENGTH	215MPa	260MPa	150MPa
LIMITING BENDING STRENGTH	180MPa	240MPa	110MPa
LIMITING TENSILE STRENGTH	175MPa	260MPa	130MPa
LIMITING SHEAR STRENGTH	95MPa	145MPa	65MPa

FASTENERS/SCREWS

ALL STAINLESS STEEL SCREW AND BOLT SHALL BE GRADE 316 AND COMPLY WITH BS EN ISO 3506.

0.2% PROOF STRESS	450MPa
MINIMUM TENSILE STRENGTH	700MPa
DESIGN TENSILE STRENGTH	450MPa
DESIGN SHEAR STRENGTH	311MPa
DESIGN BEARING STRENGTH	828MPa

PROTECTION OF BI-MATALIC CORROSION (BITAMEN PAINT ECT.)

ALL EXPOSED SURFACE OF ALUM. EXTRUSION SHALL BE FINISHED WITH PVF2 COATING : 40 MICRONS

ALL SCREWS SHOULD BE M5 S.S SCREW SPACING @300c/c MAX. UNLESS OTHERWISE STATED.

STAINLESS STEEL

ALL STAINLESS STEEL SECTION BE OF GRADE 304 AND COMPLYING WITH BS EN 10088 PART 1-3 : 2005

DENSITY	8000kg/m³
MODULES OF ELASTICITY	200,000 N/mm²
0.2% PROOF STRENGTH	200 N/mm²
TENSILE STRENGTH	530 N/mm²
DESIGN BENDING STRENGTH	200 N/mm²

GLASS

ALL GLASS PANELS SHALL BE COMPLIED WITH BS 952 AND DESIGN TO CODE OF PRACTICE FOR STRUCTURAL USE OF GLASS 2018.

IMPACT TEST TO BE COMPLIED WITH BS EN 12600(CLASS 1)

DENSITY	26kN/m³
YOUNG'S MODULUS	70,000MPa

ULTIMATE DESIGN STRENGTH OF GLASS

	BENDING STRENGTH (SHORT TERM DURATION)
HEAT STRENGTHENED GLASS(HS)	40MPa
TEMPERED GLASS(TP)	80MPa


ALL TEMPERED GLASS SHALL COMPLY WITH HEAT SOAK TEST REQUIREMENT IN ACCORDANCE WITH PNAP APP 37-2022.
HEAT SOAK PROCESS CONFORMING TO BS EN 14179-1: 2016 AND COMPLYING WITH CODE OF PRACTICE FOR STRUCTURAL USE OF GLASS 2018 SHOULD BE CARRIED OUT.

G1-8mmHS+12mm AIR GAP+10mmTP THK. I.G.U.

G2-8mmHS+12mm AIR GAP+8mmTP THK. I.G.U.

G2a-8mmHS+12mm AIR GAP+8mmTP+1.52PVB +6mmTP(PLANNING) FEATURED GLASS (I.G.U.)


G8-6mm GREY HS+1.52PVB+6mm CLEAR HS

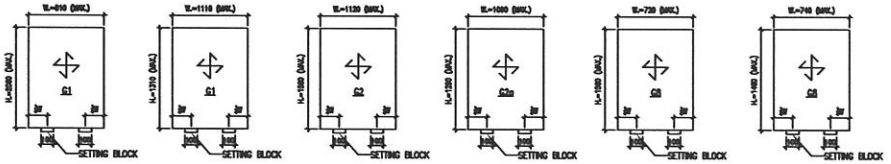

TYPICAL GLASS DETAIL

FOR DOUBLE GLAZING GLASS UNIT (I.G.U)

QUALITY ASSURANCE DOCUMENT SUCH AS TEST REPORT / CERTIFICATES INDICATING COMPLIES WITH ASTM E2190 OR EQUIVALENT WITH RESPECT TO THE SEAL PERFORMANCE.
FOR INSTALLING GLASS UNIT SHALL BE SUBMITTED BEFORE COMMENCEMENT OF WORK.

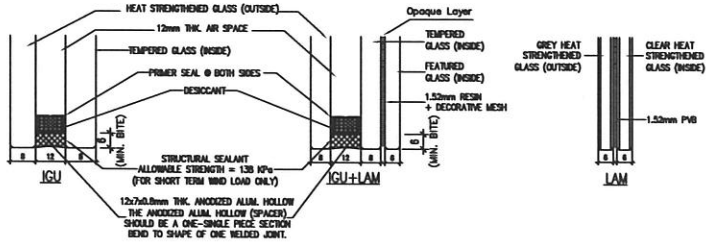

SEALANT, GASKET AND SETTING BLOCK

ALL STRUCTURAL SEALANT SHALL BE 'DOWSIL 983' (BD-SS001), ALLOWABLE STRESS = 138kPa.

ALL WEATHER SEALANT SHALL BE 'DOWSIL 791'.

ALL SETTING BLOCK SHALL BE SILICONE RUBBER WITH HARDNESS OF 85±5 SHORE A, MINIMUM 100mm IN LENGTH AT 1/4 SPAN UNLESS OTHERWISE STATED

ALL GASKET SHALL BE NEOPRENE OR SILICONE RUBBER WHEN IN CONTACT WITH SEALANT, WITH HARDNESS OF 60±5 SHORE A.


ISOLATOR

PVC TAPE TO BE APPLIED BETWEEN DISSIMILAR METAL TO PREVENT BIMETALLIC CORROSION TO PD6484.

CONCRETE


ALL CONCRETE STRUCTURES SHOWN IN THIS SUBMISSION ARE FOR INFORMATION ONLY.

CONCRETE STRINGTH SHALL BE 45MPa. (MIN.)

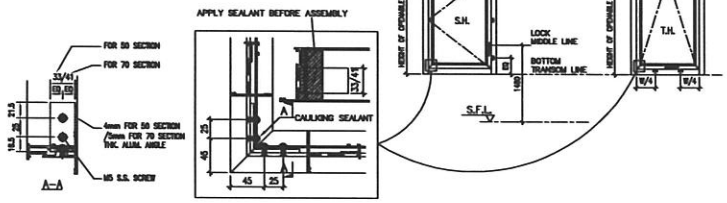

FIXING LUG

THE SIZE OF S.S. FIXING LUG TO BE 2mm THK. AND SPACING @300mm C/C MAX. UNLESS OTHERS STATED.

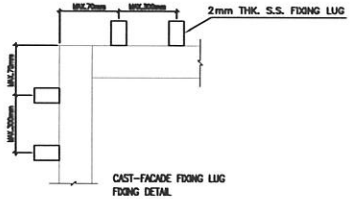

WINDOW SASH LOAD TABLE OF TOP HUNG WINDOW & SIDE HUNG WINDOW

Item	WINDOW MARK	GLAZING TYPE	TOP HUNG (TH) / SIDE HUNG (SH)	SASH Width (mm)	SASH Height (mm)	4 Bar Hinge Type	WEIGHT (kg)	MAX LOADING (kg)	85% LOADING (kg)
1	W1/P-T1	G8	SH	602	1226.5	HYLS16	29.48	83	70.55
2	W2/P-T1	G2	TH	786.5	1256.5	HYLP14	48.55	92	78.20
3	W4/P-T1	G2a	SH	687	1256.5	HYLS16	56.12	82	69.70
4	W5/P-T1	G2	SH	687	1256.5	HYLS16	42.39	82	69.70
5	W6/P-T1	G8	SH	632	1255	HYLS16	31.36	83	70.55
6	W9/P-T1	G8	SH	582	1226.5	HHMS-N14	28.58	69.5	59.08
7	W12-T1	G8	SH	612	1255	HYLS16	30.50	83	70.55
8	W8a/P-T1	G2	TH	774.5	1277	HYLP14	48.61	92	78.20
9	W8a/P-T1	G2	TH	774.5	1277	HYLP14	48.61	92	78.20
10	W1/P-T2	G2	TH	666.5	1256.5	HYLP14	41.76	92	78.20
11	W3/P-T2	G8	SH	602	1226.5	HYLS16	29.43	83	70.55
12	W4/P-T2	G2	SH	656.5	1226.5	HYLS16	40.26	83	70.55
13	W5/P-T2	G8	TH	612	1256.5	HYLP14	30.53	92	78.20
14	W12/P-T2	G8	TH	642.5	1482	HYLP14	37.19	92	78.20
15	W1/P-T3	G2	TH	742	1256.5	HYLP14	46.03	92	78.20
16	W1/P-T5	G8	TH	642	1256.5	HYLP14	31.83	92	78.20
17	W2/P-T5	G8	TH	642	1256.5	HYLP14	31.83	92	78.20
18	W3/P-T5	G2a	TH	716.5	1256.5	HYLP14	58.90	92	78.20
19	W4/P-T5	G2a	TH	1012.5	1256.5	HYLP16	80.93	120	102.00
20	W5/P-T5	G2	SH	542	1271	HHMS-N14	35.10	69.5	59.08
21	W7a/P-T5	G8	TH	642	1256.5	HYLP14	31.83	92	78.20
22	W8a/P-T5	G2	TH	794	1256.5	HYLP14	48.97	92	78.20
23	W8a/P-T5	G2	TH	794	1256.5	HYLP14	48.97	92	78.20
24	W1/P-T6	G8	TH	642	1256.5	HYLP14	31.83	92	78.20
25	W2/P-T6	G8	TH	642	1256.5	HYLP14	31.83	92	78.20
26	W3/P-T6	G2a	TH	717	1256.5	HYLP14	58.94	92	78.20
27	W4/P-T6	G2a	TH	697	1256.5	HYLP14	57.41	92	78.20
28	W5/P-T6	G2	SH	542	1271	HHMS-N14	35.10	69.5	59.08
29	W10/P-T6	G8	SH	531.5	1256.5	HHMS-N14	27.05	69.5	59.08
30	W10/P-T6	G8	SH	531.5	1256.5	HHMS-N14	27.05	69.5	59.08
31	W11/P-T6	G8	SH	656.5	1226.5	HYLS16	31.73	83	70.55
32	W1/P-T7	G2	TH	667	1226.5	HYLP14	40.84	92	78.20
33	W1/P-T7	G2	SH	442	1226.5	HHMS-N14	28.41	69.5	59.08
34	W2/P-T7	G2	TH	762	1256.5	HYLP14	47.16	92	78.20
35	W1/P-T8	G2	SH	501.5	1226.5	HHMS-N14	32.43	69.5	59.08
36	W6/P-T8	G8	SH	592	1277	HYLS16	30.12	83	70.55
37	W1/P-T9	G2a	TH	602	1226.5	HYLP14	48.96	92	78.20
38	W3/P-T9	G2	TH	1042.5	1232	HYLP14	61.85	92	78.20
39	W4/P-T9	G2	SH	646.5	1256.5	HYLS16	40.63	83	70.55
40	W5/P-T9	G8	TH	642	1256.5	HYLP14	31.83	92	78.20
41	W9/P-T9	G2	TH	742	1232	HYLP14	45.18	92	78.20
42	W10/P-T9	G2	TH	922	1256.5	HYLP14	56.20	92	78.20
43	W10/P-T9	G2	TH	603.5	1256.5	HYLP14	38.09	92	78.20
44	W12/P-T9	G2	SH	646.5	1256.5	HYLS16	40.63	83	70.55
45	W13/P-T9	G2	TH	816.5	1256.5	HYLP14	50.24	92	78.20
46	W13/P-T9	G2	TH	816.5	1256.5	HYLP14	50.24	92	78.20
47	W13a/P-T9	G2	TH	806.5	1256.5	HYLP14	49.68	92	78.20
48	W14/P-T9	G8	TH	482	1256.5	HYLP14	24.91	92	78.20
49	W15/P-T9	G2	SH	666.5	1256.5	HYLS16	41.76	83	70.55
50	W15/P-T9	G2	SH	666.5	1256.5	HYLS16	41.76	83	70.55
51	W2/P-T9A	G8	TH	602	1226.5	HYLP14	29.43	92	78.20
52	W2a/P-T9A	G2a	TH	442.5	1232	HYLP14	37.23	92	78.20
53	W3/P-T9A	G2	TH	712	1256.5	HYLP14	44.33	92	78.20
54	W4/P-T9A	G2	TH	802	1256.5	HYLP14	49.42	92	78.20
55	W16a/P-T9	G2	SH	557	1226.5	HHMS-N14	34.27	69.5	59.08

B.D. REF :

ARCHITECT :
WONG TUNG & PARTNERS LIMITED
ARCHITECTS & PLANNERS

STRUCTURAL ENGINEER :
SUN HUNG KAI
ARCHITECTS AND ENGINEERS LTD.
SUN HUNG KAI CENTRE, WANCHAI, HONGKONG
TEL. 28278111 FAX. 28272804

FACADE CONSULTANT:
ALPHA CONSULTING LIMITED
Steel Structure & Facade Specialist

MAIN CONTRACTOR :
Sanfield Engineering Construction Ltd.

CLIENT :
SUN HUNG KAI
REAL ESTATE AGENCY LTD.
42/F SUN HUNG KAI CENTRE, WANCHAI, HONGKONG

NOTE :
1. ALL DIMENSIONS ARE IN mm.
2. ALL ELEVATIONS ARE VIEWED FROM OUTSIDE.
3. ALL DIMENSIONS TO BE VERIFIED ON SITE BEFORE FABRICATION.

LEGEND :
X1 — DETAIL MARK NO.
X001 — REFER SHEET NO.

1. F.F.L. -- FINISHED FLOOR LEVEL
2. S.F.L. -- STRUCTURAL FLOOR LEVEL
3. /R -- REVERSED DETAIL

NO.	DATE	REVISED	BY
G	04/11/2022	REVISION SUBJECT TO ALPHA COMMENT	YI
F	13/10/2022	REVISION SUBJECT TO ALPHA COMMENT	YI
E	8/09/2022	REVISION SUBJECT TO ALPHA COMMENT	MM
D	16/05/2022	REVISION SUBJECT TO ALPHA COMMENT	MM
C	25/04/2022	REVISION SUBJECT TO ARCH.COMMENT	MM
B	13/04/2022	REVISION SUBJECT TO ARCH.COMMENT	MM
A	07/03/2022	REVISION SUBJECT TO ARCH.COMMENT	MM

JOB NO. : J-859

PROJECT :
PROPOSED RESIDENTIAL / COMMERCIAL DEVELOPMENT AT NKIL NO.6551 KAI TAK AREA 4C, SITE 3 KAI TAK, KOWLOON

TITLE :
GENERNAL NOTES FOR ALUM. WINDOW


DATE : 13-Nov-21 | SCALE : 1:50 (A3)


DRAWN BY : IVAN | CHECKED BY :

美特鋁質有限公司
MIDI ALUMINIUM FABRICATOR LTD.
Units 6-8, Sunray Industrial Centre, 1/F
610 Cha Kwo Ling Road, Kowloon
Tel:23489211-4 Fax:(852)27727666


DWG NO. : J859-SD-GN-0005 | REV. : G

GENERAL NOTES FOR PRECAST ALUM. WINDOW page 2

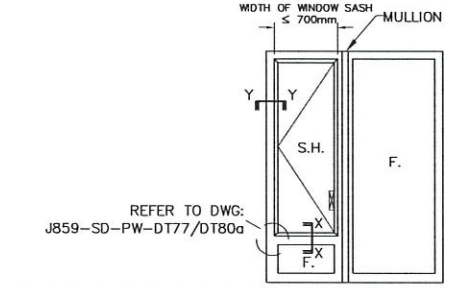


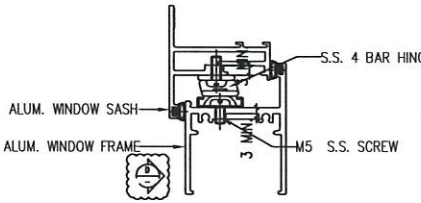


SECTION X-X FOR 50SECTION
WINDOW WITH S.S. PLATE/BAR

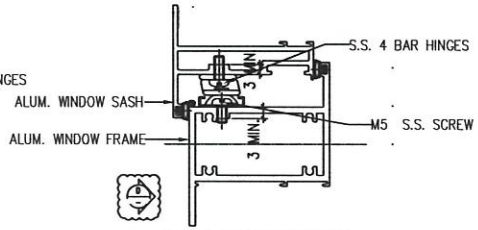

SECTION X-X FOR 70SECTION
WINDOW WITH S.S. PLATE/BAR

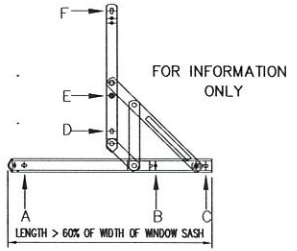

S.S. 4 BAR HINGE (LIP HING)
A,B,C,E,F-LOCATION FOR SCREW TO WINDOW FRAME/SASH
(LOCAL THICKENING BY S.S. PLATE/BAR(MIN.3mm))
D=LOCATION FOR SCREW TO WINDOW SASH
(LOCAL THICKENING BY ANGLE)

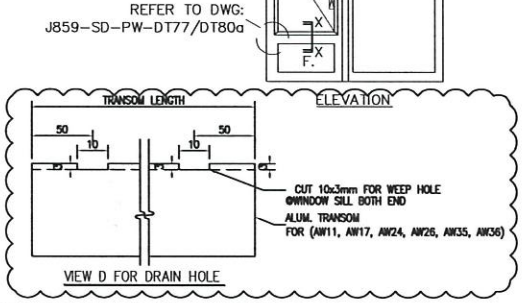


CONFIGURATION FOR WINDOW DEVICES

1. STAINLESS STEEL 4 BAR HINGE
   - -LIP HING(MODEL: H4MS-H/4YLS FOR SIDE HUNG)
   - -LIP HING(MODEL: HYLP FOR TOP HUNG)


ITEM	MODEL NO.	SH / TH	MAX. SASH WIDTH (mm)/ MAX. SASH HEIGHT (mm)	MAX. LOADING (KG)	SDS LOADING (KG)
1	H4MS-H14	SH	W≤985 / H≤1700	<47	<39.95
2	HYLS16	SH	W≤882 / H≤1700	<53	<70.55
3	HYLS18	SH	W≤985 / H≤1700	<82	<88.7
4	HYLP14	TH	W≤1300 / H≤1000	<82	<78.2
5	HYLP16	TH	W≤1300 / H≤1300	<120	<102

2. LOCKING POINT
   - -LIP HING(MODEL: H4MP/4SRP)
3. PULLING BLOCK
   - -LIP HING(MODEL: H8SF&H8SS)
4. ALUMINUM HANDLE
   - -LIP HING(MODEL: MLDF08-16)
5. GUIDER
6. LIMIT HINGE
   - -LIP HING(MODEL: TRST 10)

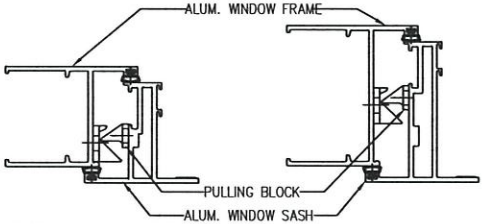



SECTION Y-Y FOR 50SECTION
WINDOW WITH PULLING BLOCK


SECTION Y-Y FOR 70SECTION
WINDOW WITH PULLING BLOCK

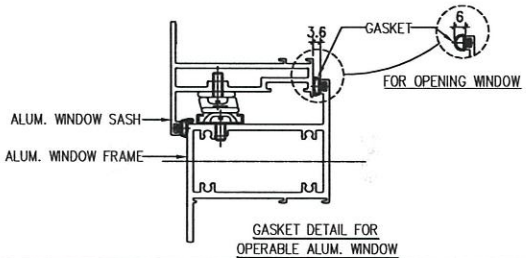



GASKET DETAIL FOR
OPERABLE ALUM. WINDOW

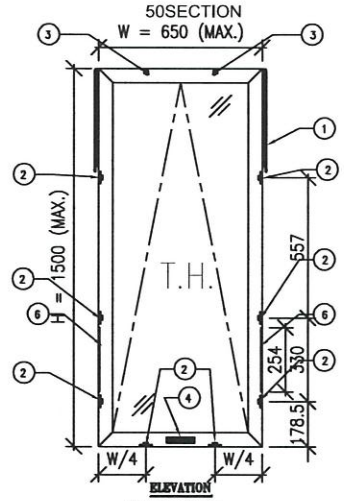


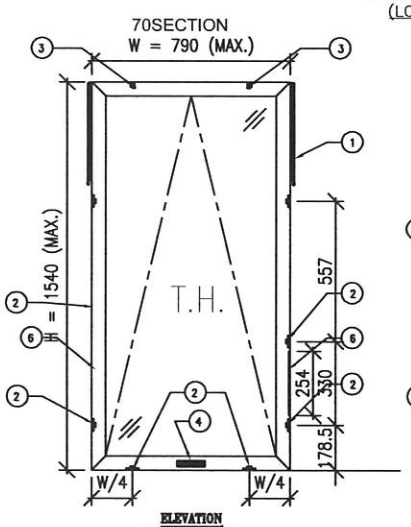

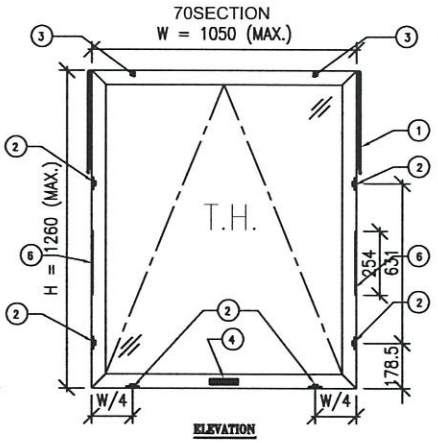

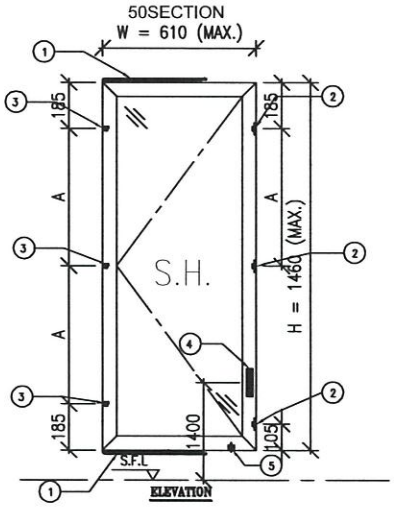

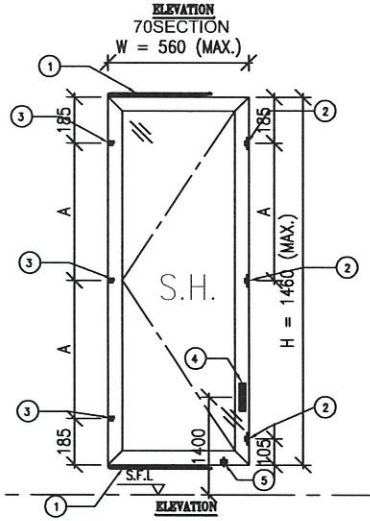

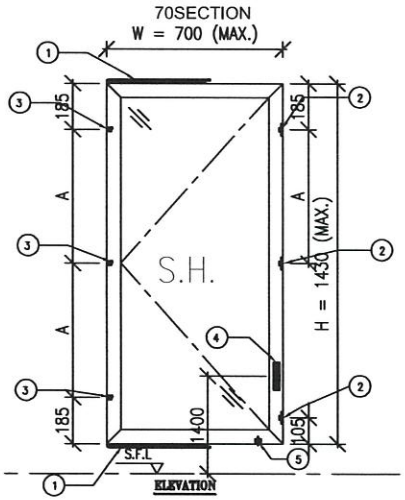

B.D. REF :

ARCHITECT :
WONG TUNG & PARTNERS LIMITED
ARCHITECTS & PLANNERS

STRUCTURAL ENGINEER :
SUN HUNG KAI
ARCHITECTS AND ENGINEERS LTD.
SUN HUNG KAI CENTRE, WANCHAI, HONGKONG
TEL. 28276111 FAX. 28272804

FACADE CONSULTANT:
ALPHA CONSULTING LIMITED
Steel Structure & Facade Specialist

MAIN CONTRACTOR :
Sanfield Engineering Construction Ltd.

CLIENT :
SUN HUNG KAI
REAL ESTATE AGENCY LTD.
42/F SUN HUNG KAI CENTRE, WANCHAI, HONGKONG

NOTE :
1. ALL DIMENSIONS ARE IN mm.
2. ALL ELEVATIONS ARE VIEWED FROM OUTSIDE.
3. ALL DIMENSIONS TO BE VERIFIED ON SITE BEFORE FABRICATION.

LEGEND :
- X1 / X001 — DETAIL MARK NO. / REFER SHEET NO.
1. F.F.L. --FINISHED FLOOR LEVEL
2. S.F.L. --STRUCTURAL FLOOR LEVEL
3. /R --REVERSED DETAIL

NO.	DATE	REVISED	BY
B	04/11/2022	GENERAL REVISED	W
A	13/10/2022	REVISION SUBJECT TO ALPHA COMMENT	W

JOB NO. : J-859

PROJECT :
PROPOSED RESIDENTIAL / COMMERCIAL DEVELOPMENT AT NKIL NO.6551 KAI TAK AREA 4C, SITE 3 KAI TAK, KOWLOON

TITLE :
GENERNAL NOTES FOR ALUM. WINDOW

DATE : 13-Nov-21 | SCALE : 1:50 (A3)


DRAWN BY : IVAN | CHECKED BY :

美特鋁質有限公司
MIDI ALUMINIUM FABRICATOR LTD.
Units 6-8, Sunray Industrial Centre, 1/F
610 Cha Kwo Ling Road, Kowloon
Tel:23489211-4 Fax:(852)27727666

DWG NO. : J859-SD-GN-0006 | REV. : B


PROPERTIES

MEMBER : AW-01
GRADE : 6063-T6
FINISH : PVF2 3-COATING

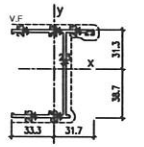

PROPERTIES


MEMBER : AW-02
GRADE : 6063-T6
FINISH : PVF2 3-COATING

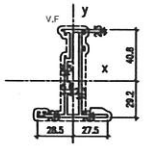

PROPERTIES

MEMBER : AW-03
GRADE : 6063-T6
FINISH : PVF2 3-COATING


DELETE

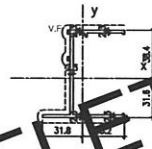

PROPERTIES


MEMBER : AW-04
GRADE : 6063-T6
FINISH : PVF2 3-COATING

DELETE

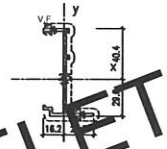

PROPERTIES


MEMBER : AW-05
GRADE : 6063-T6
FINISH : PVF2 3-COATING

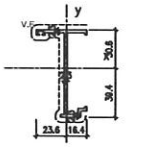

PROPERTIES


MEMBER : AW-06
GRADE : 6063-T6
FINISH : PVF2 3-COATING

DELETE

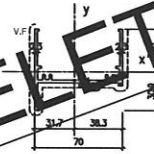


PROPERTIES

MEMBER : AW-07
GRADE : 6063-T6
FINISH : PVF2 3-COATING

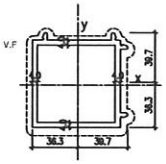


PROPERTIES

MEMBER : AW-08
GRADE : 6063-T6
FINISH : PVF2 3-COATING

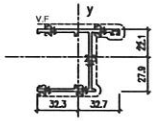


PROPERTIES

MEMBER : AW-09
GRADE : 6063-T6
FINISH : PVF2 3-COATING

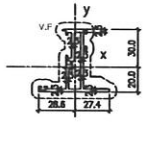


PROPERTIES

MEMBER : AW-10
GRADE : 6063-T6
FINISH : PVF2 3-COATING

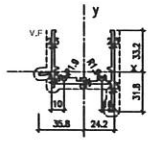


PROPERTIES

MEMBER : AW-11
GRADE : 6063-T6
FINISH : PVF2 3-COATING

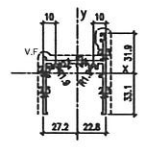


PROPERTIES

MEMBER : AW-12
GRADE : 6063-T6
FINISH : PVF2 3-COATING

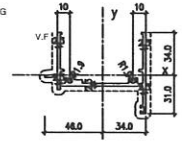

PROPERTIES


MEMBER : AW-13
GRADE : 6063-T6
FINISH : PVF2 3-COATING

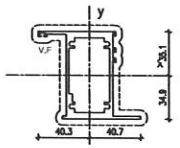

PROPERTIES


MEMBER : AW-14
GRADE : 6063-T6
FINISH : PVF2 3-COATING

DELETE

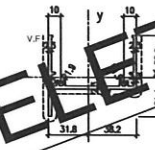


PROPERTIES

MEMBER : AW-15
GRADE : 6063-T5
FINISH : PVF2 3-COATING

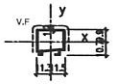

PROPERTIES

MEMBER : AW-16
GRADE : 6063-T5
FINISH : PVF2 3-COATING

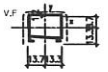

B.D. REF :

ARCHITECT :
WONG TUNG & PARTNERS LIMITED
ARCHITECTS & PLANNERS

STRUCTURAL ENGINEER :
SUN HUNG KAI
ARCHITECTS AND ENGINEERS LTD.
SUN HUNG KAI CENTRE, WANCHAI, HONGKONG
TEL. 28278111 FAX. 28272884

FACADE CONSULTANT:
ALPHA CONSULTING LIMITED
Steel Structure & Facade Specialist

MAIN CONTRACTOR :
Sanfield Engineering Construction Ltd.

CLIENT :
SUN HUNG KAI
REAL ESTATE AGENCY LTD.
42/F SUN HUNG KAI CENTRE, WANCHAI, HONGKONG

NOTE :
1. ALL DIMENSIONS ARE IN mm.
2. ALL ELEVATIONS ARE VIEWED FROM OUTSIDE.
3. ALL DIMENSIONS TO BE VERIFIED ON SITE BEFORE FABRICATION.

LEGEND :
X1 — DETAIL MARK NO.
X001 — REFER SHEET NO.
1. F.F.L. --FINISHED FLOOR LEVEL
2. S.F.L. --STRUCTURAL FLOOR LEVEL
3. /R --REVERSED DETAIL

NO.	DATE	REVISED	BY

JOB NO. : J-859

PROJECT :
PROPOSED RESIDENTIAL / COMMERCIAL DEVELOPMENT AT NKIL NO.6551 KAI TAK AREA 4C, SITE 3 KAI TAK, KOWLOON

TITLE :
DIE LIST FOR ALUM. WINDOW (TOWER 1 – TOWER 9)

DATE : 10-Nov-21 | SCALE : 1:4 (A3)


DRAWN BY : IVAN | CHECKED BY :

美特鋁質有限公司
MIDI ALUMINIUM FABRICATOR LTD.
Units 6-8, Sunray Industrial Centre, 1/F
810 Cha Kwo Ling Road, Kowloon
Tel:23489211-4 Fax:(852)27727666

DWG NO. : J859-SD-PW-0011 | REV. : –

PROPERTIES


MEMBER : AW-17
GRADE : 6063-T6
FINISH : PVF2 3-COATING

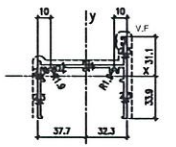



PROPERTIES


MEMBER : AW-18
GRADE : 6063-T6
FINISH : PVF2 3-COATING

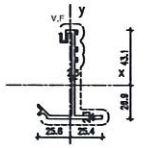



PROPERTIES


MEMBER : AW-19
GRADE : 6061-T6
FINISH : Chromate or Andolze

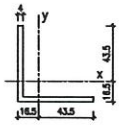



PROPERTIES


MEMBER : AW-20
GRADE : 6061-T6
FINISH : Chromate or Andolze

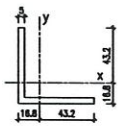



PROPERTIES

MEMBER : AW-21
GRADE : 6063-T5
FINISH : PVF2 3-COATING

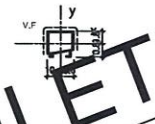


DELETE



PROPERTIES


MEMBER : AW-22
GRADE : 6063-T5
FINISH : PVF2 3-COATING

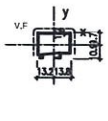



PROPERTIES


MEMBER : AW-23
GRADE : 6063-T6
FINISH : PVF2 3-COATING

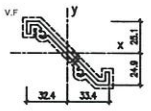



PROPERTIES


MEMBER : AW-24
GRADE : 6063-T6
FINISH : PVF2 3-COATING

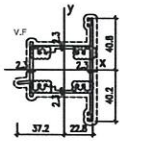



PROPERTIES


MEMBER : AW-25
GRADE : 6063-T6
FINISH : PVF2 3-COATING

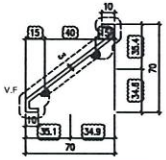



PROPERTIES


MEMBER : AW-26
GRADE : 6063-T6
FINISH : PVF2 3-COATING

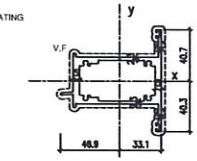



PROPERTIES


MEMBER : AW-27
GRADE : 6063-T6
FINISH : PVF2 3-COATING

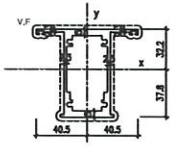



PROPERTIES


MEMBER : AW-28
GRADE : 6063-T6
FINISH : PVF2 3-COATING

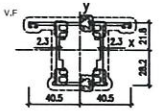



PROPERTIES


MEMBER : AW-29
GRADE : 6063-T6
FINISH : PVF2 3-COATING

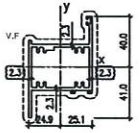



PROPERTIES

MEMBER : AW-30
GRADE : 6063-T6
FINISH : PVF2 3-COATING

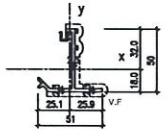



PROPERTIES

MEMBER : AW-31
GRADE : 6063-T6
FINISH : PVF2 3-COATING




DELETE



PROPERTIES

MEMBER : AW-32
GRADE : 6063-T6
FINISH : PVF2 3-COATING

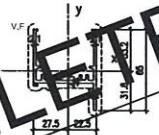

DELETE



B.D. REF :

ARCHITECT :
WONG TUNG & PARTNERS LIMITED
ARCHITECTS & PLANNERS

STRUCTURAL ENGINEER :
SUN HUNG KAI
ARCHITECTS AND ENGINEERS LTD.
SUN HUNG KAI CENTRE, WANCHAI, HONGKONG
TEL. 28276111 FAX. 28272804

FACADE CONSULTANT:
ALPHA CONSULTING LIMITED
Steel Structure & Facade Specialist

MAIN CONTRACTOR :
Sanfield Engineering Construction Ltd.

CLIENT :
SUN HUNG KAI
REAL ESTATE AGENCY LTD.
40/F SUN HUNG KAI CENTRE, WANCHAI, HONGKONG

NOTE :
1. ALL DIMENSIONS ARE IN mm.
2. ALL ELEVATIONS ARE VIEWED FROM OUTSIDE.
3. ALL DIMENSIONS TO BE VERIFIED ON SITE BEFORE FABRICATION.

LEGEND :
X1 / X001 — DETAIL MARK NO. / REFER SHEET NO.
1. F.F.L. — FINISHED FLOOR LEVEL
2. S.F.L. — STRUCTURAL FLOOR LEVEL
3. (R) — REVERSED DETAIL

NO.	DATE	REVISED	BY
A	04/11/2022	GENERAL REVISED	YI

JOB NO. : J-859

PROJECT :
PROPOSED RESIDENTIAL / COMMERCIAL DEVELOPMENT AT NKIL NO.6551 KAI TAK AREA 4C, SITE 3 KAI TAK, KOWLOON

TITLE :
DIE LIST FOR ALUM. WINDOW (TOWER 1 – TOWER 9)

DATE : 10-Nov-21 | SCALE : 1:4 (A3)


DRAWN BY : IVAN | CHECKED BY :

美特鋁質有限公司
MIDI ALUMINIUM FABRICATOR LTD.
Units 6-8, Sunray Industrial Centre, 1/F
810 Cha Kwo Ling Road, Kowloon
Tel:23489211-4 Fax:(852)27727666

DWG NO. : J859-SD-PW-0012 | REV. : A


PROPERTIES

MEMBER : AW-33
GRADE : 6063-T6
FINISH : PVF2 3-COATING

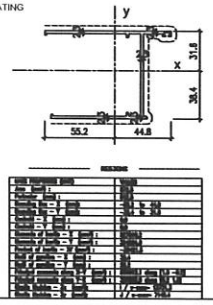


PROPERTIES

MEMBER : AW-34
GRADE : 6063-T6
FINISH : PVF2 3-COATING

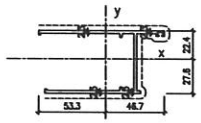


PROPERTIES

MEMBER : AW-35
GRADE : 6063-T6
FINISH : PVF2
3-COATING

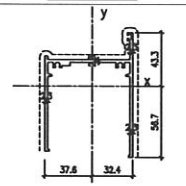


PROPERTIES

MEMBER : AW-36
GRADE : 6063-T6
FINISH : PVF2
3-COATING

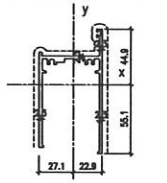

PROPERTIES


MEMBER : AW-37
GRADE : 6063-T5
FINISH : PVF2 3-COATING

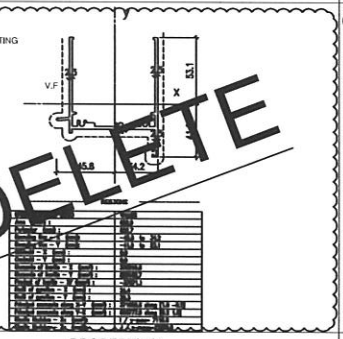

DELETE

PROPERTIES


MEMBER : AW-38
GRADE : 6063-T6
FINISH : PVF2 3-COATING

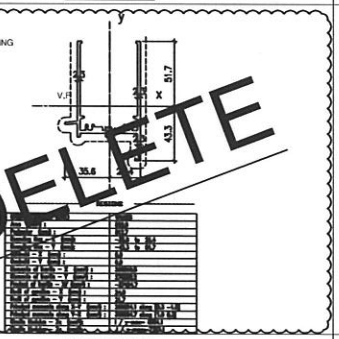

DELETE

PROPERTIES

MEMBER : AW-39
GRADE : 6063-T6
FINISH : PVF2 3-COATING

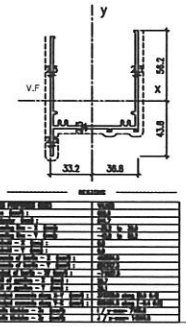

PROPERTIES


MEMBER : AW-40
GRADE : 6063-T6
FINISH : PVF2 3-COATING



DELETE


PROPERTIES

MEMBER : AW-41
GRADE : 6063-T5
FINISH : PVF2 3-COATING

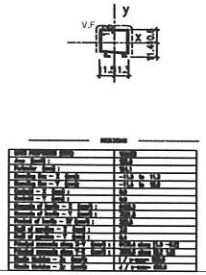

PROPERTIES

MEMBER : AW-42
GRADE : 6063-T6
FINISH : PVF2 3-COATING

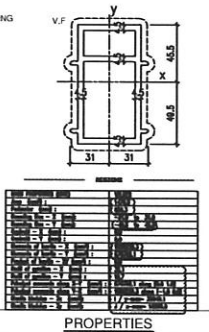


PROPERTIES

MEMBER : 25×15×3mm THK. ALUM. ANGLE (CUT FROM 25×30×3mm THK. ALUM. CHANNEL)
GRADE : 6061-T6
FINISH : Chromate or
Anodize



PROPERTIES

MEMBER : 25×30×3mm THK. ALUM. CHANNEL
GRADE : 6061-T6
FINISH : Chromate or
Anodize

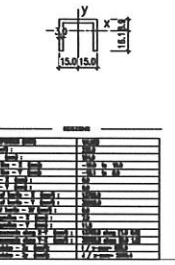

PROPERTIES

MEMBER :
GRADE :
FINISH :

PROPERTIES

MEMBER :
GRADE :
FINISH :

PROPERTIES

MEMBER :
GRADE :
FINISH :

PROPERTIES

MEMBER :
GRADE :
FINISH :

B.D. REF :

ARCHITECT :
WONG TUNG & PARTNERS LIMITED
ARCHITECTS & PLANNERS

STRUCTURAL ENGINEER :
SUN HUNG KAI
ARCHITECTS AND ENGINEERS LTD.
SUN HUNG KAI CENTRE, WANCHAI, HONGKONG
TEL. 28273111 FAX. 28272884

FACADE CONSULTANT:
ALPHA CONSULTING LIMITED
Steel Structure & Facade Specialist

MAIN CONTRACTOR :
Sanfield Engineering
Construction Ltd.

CLIENT :
SUN HUNG KAI
REAL ESTATE AGENCY LTD.
42/F SUN HUNG KAI CENTRE, WANCHAI, HONGKONG

NOTE :
1. ALL DIMENSIONS ARE IN mm.
2. ALL ELEVATIONS ARE VIEWED FROM OUTSIDE.
3. ALL DIMENSIONS TO BE VERIFIED ON SITE BEFORE FABRICATION.

LEGEND :
- (21 / X001) — DETAIL MARK NO. / REFER SHEET NO.
1. F.F.L. --FINISHED FLOOR LEVEL
2. S.F.L. --STRUCTURAL FLOOR LEVEL
3. (/B) --REVERSED DETAIL

NO.	DATE	REVISED	BY
B	04/11/2022	GENERAL REVISED	YB
A	13/05/2022	REVISION SUBJECT TO AMENDMENT	CHAN

JOB NO. : J-859

PROJECT :
PROPOSED RESIDENTIAL / COMMERCIAL DEVELOPMENT AT NKIL NO.6551 KAI TAK AREA 4C, SITE 3
KAI TAK, KOWLOON


TITLE :
DIE LIST FOR
ALUM. WINDOW
(TOWER 1 – TOWER 9)

DATE : 10-Nov-21 | SCALE : 1:4 (A3)


DRAWN BY : IVAN | CHECKED BY :

美特鋁質有限公司
MIDI ALUMINIUM FABRICATOR LTD.
Units 6-8, Sunray Industrial Centre, 1/F
610 Cha Kwo Ling Road, Kowloon
Tel:23489211-4 Fax:(852)27727666

DWG NO. : J859-SD-PW-0013 | REV. : B

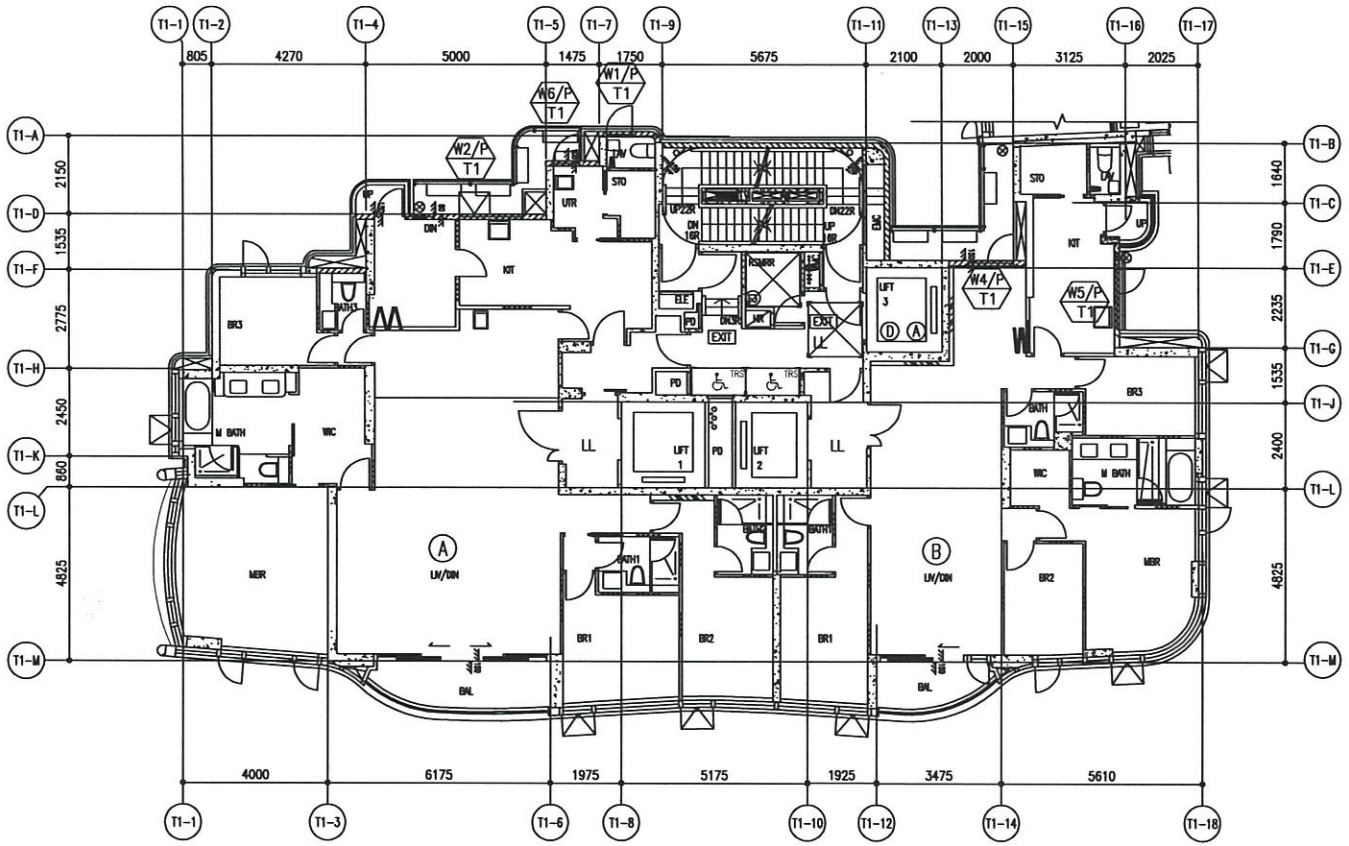

2/F TO 6/F WINDOW LOCATION PLAN FOR PRECAST FACADE AT TOWER 1 (4 STOREYS, 4/F OMITTED)

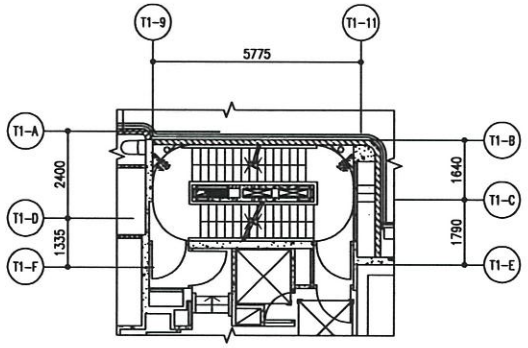

2/F PART PLAN OF TOWER 1

B.D. REF :

ARCHITECT :
WONG TUNG & PARTNERS LIMITED
ARCHITECTS & PLANNERS

STRUCTURAL ENGINEER :
SUN HUNG KAI
ARCHITECTS AND ENGINEERS LTD.
SUN HUNG KAI CENTRE, WANCHAI, HONGKONG
TEL. 28278111 FAX. 28272884

FACADE CONSULTANT:
ALPHA CONSULTING LIMITED
Steel Structure & Facade Specialist

MAIN CONTRACTOR :
Sanfield Engineering Construction Ltd.

CLIENT :
SUN HUNG KAI
REAL ESTATE AGENCY LTD.
42/F SUN HUNG KAI CENTRE, WANCHAI, HONGKONG

NOTE :
1. ALL DIMENSIONS ARE IN mm.
2. ALL ELEVATIONS ARE VIEWED FROM OUTSIDE.
3. ALL DIMENSIONS TO BE VERIFIED ON SITE BEFORE FABRICATION.

LEGEND :
X1 / X001 — DETAIL MARK NO. / REFER SHEET NO.
1. F.F.L. -- FINISHED FLOOR LEVEL
2. S.F.L. -- STRUCTURAL FLOOR LEVEL
3. (R) -- REVERSED DETAIL

NO.	DATE	REVISED	BY
B	13/10/2022	REVIEW LOCATION PLAN REFER TO A1604	YH
A	11/04/2022	REVIEW LOCATION PLAN REFER TO A0827	YHH

JOB NO. : J-859

PROJECT :
PROPOSED RESIDENTIAL / COMMERCIAL DEVELOPMENT AT NKIL NO.6551 KAI TAK AREA 4C, SITE 3 KAI TAK, KOWLOON


TITLE :
2~6/F WINDOW LOCATION PLAN FOR PRECAST FACADE AT TOWER 1

DATE : 21-Nov-21 | SCALE : 1:70 (A3)

DRAWN BY : IVAN | CHECKED BY :

美特鋁製有限公司
MIDI ALUMINIUM FABRICATOR LTD.
Units 6-8, Sunray Industrial Centre, 1/F
610 Cha Kwo Ling Road, Kowloon
Tel:23489211-4 Fax:(852)27727666

DWG NO. : J859-SD-PL-101 | REV. : B

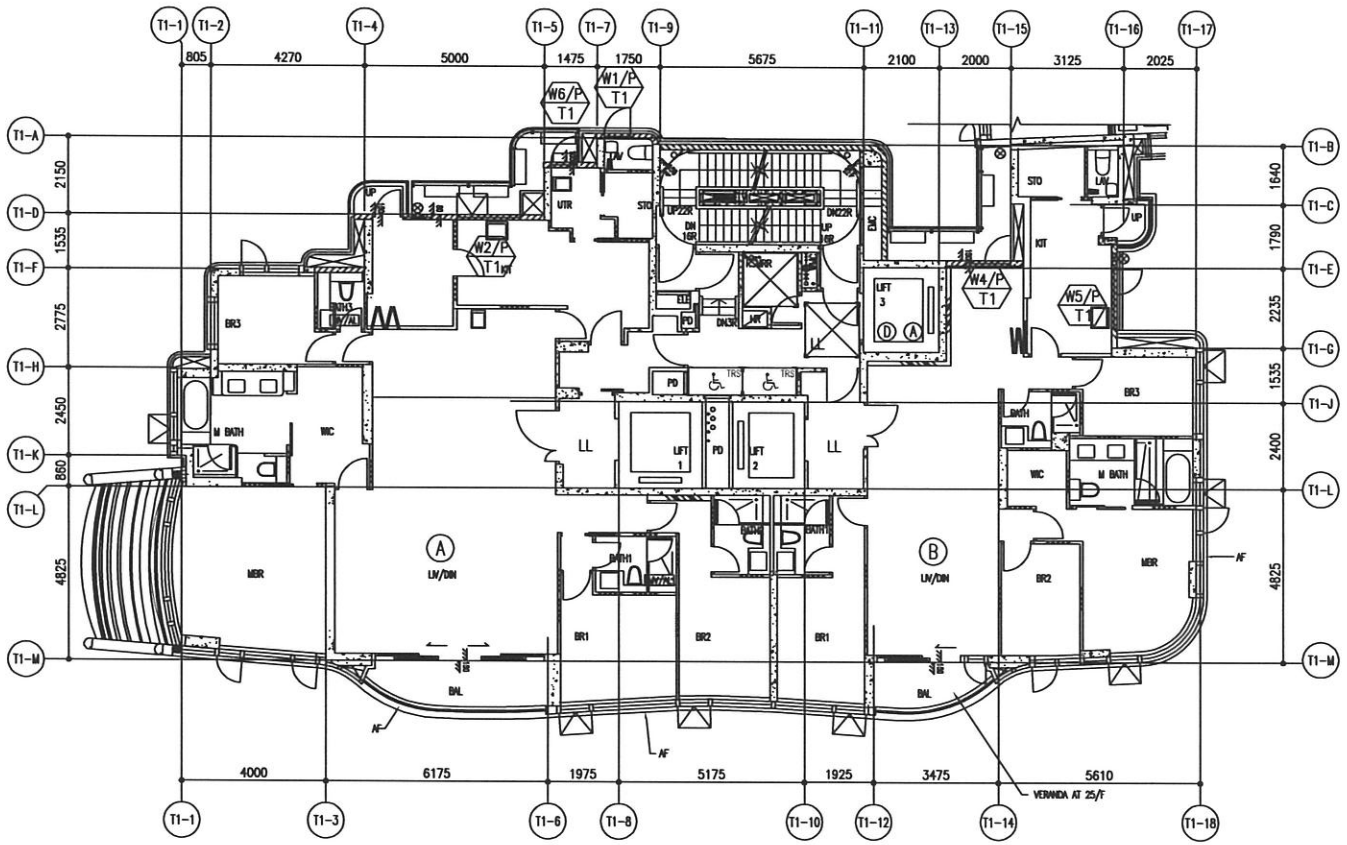

7/F TO 21/F, 23/F & 25/F WINDOW LOCATION PLAN FOR PRECAST FACADE
AT TOWER 1 (15 STOREYS, 13/F,14/F,24/F OMITTED)

B.D. REF :

ARCHITECT :
WONG TUNG & PARTNERS LIMITED
ARCHITECTS & PLANNERS

STRUCTURAL ENGINEER :
SUN HUNG KAI
ARCHITECTS AND ENGINEERS LTD.
SUN HUNG KAI CENTRE, WANCHAI, HONGKONG
TEL. 28278111 FAX. 28272884

FACADE CONSULTANT:
ALPHA CONSULTING LIMITED
Steel Structure & Facade Specialist

MAIN CONTRACTOR :
Sanfield Engineering Construction Ltd.

CLIENT :
SUN HUNG KAI
REAL ESTATE AGENCY LTD.
42/F SUN HUNG KAI CENTRE, WANCHAI, HONGKONG

NOTE :
1. ALL DIMENSIONS ARE IN mm.
2. ALL ELEVATIONS ARE VIEWED FROM OUTSIDE.
3. ALL DIMENSIONS TO BE VERIFIED ON SITE BEFORE FABRICATION.

LEGEND :
X1 — DETAIL MARK NO.
X001 — REFER SHEET NO.
1. F.F.L. -- FINISHED FLOOR LEVEL
2. S.F.L. -- STRUCTURAL FLOOR LEVEL
3. (/R) -- REVERSED DETAIL

NO.	DATE	REVISED	BY
C	13/10/2022	REVIEW LOCATION PLAN REFER TO A1041	
B	08/08/2022	REVIEW LOCATION PLAN REFER TO A1067	
A	11/04/2022	REVIEW LOCATION PLAN REFER TO A1067	

JOB NO. : J-859

PROJECT :
PROPOSED RESIDENTIAL / COMMERCIAL DEVELOPMENT AT NKIL NO.6551 KAI TAK AREA 4C, SITE 3 KAI TAK, KOWLOON


TITLE :
7~21/F, 23~25/F WINDOW LOCATION PLAN FOR PRECAST FACADE AT TOWER 1

DATE : 21-Nov-21 | SCALE : 1:60 (A3)

DRAWN BY : IVAN | CHECKED BY :

美特鋁質有限公司
MIDI ALUMINIUM FABRICATOR LTD.
Units 6-8, Sunray Industrial Centre, 1/F
610 Cha Kwo Ling Road, Kowloon
Tel:23489211-4 Fax:(852)27727666

DWG NO. : J859-SD-PL-102 | REV. : C

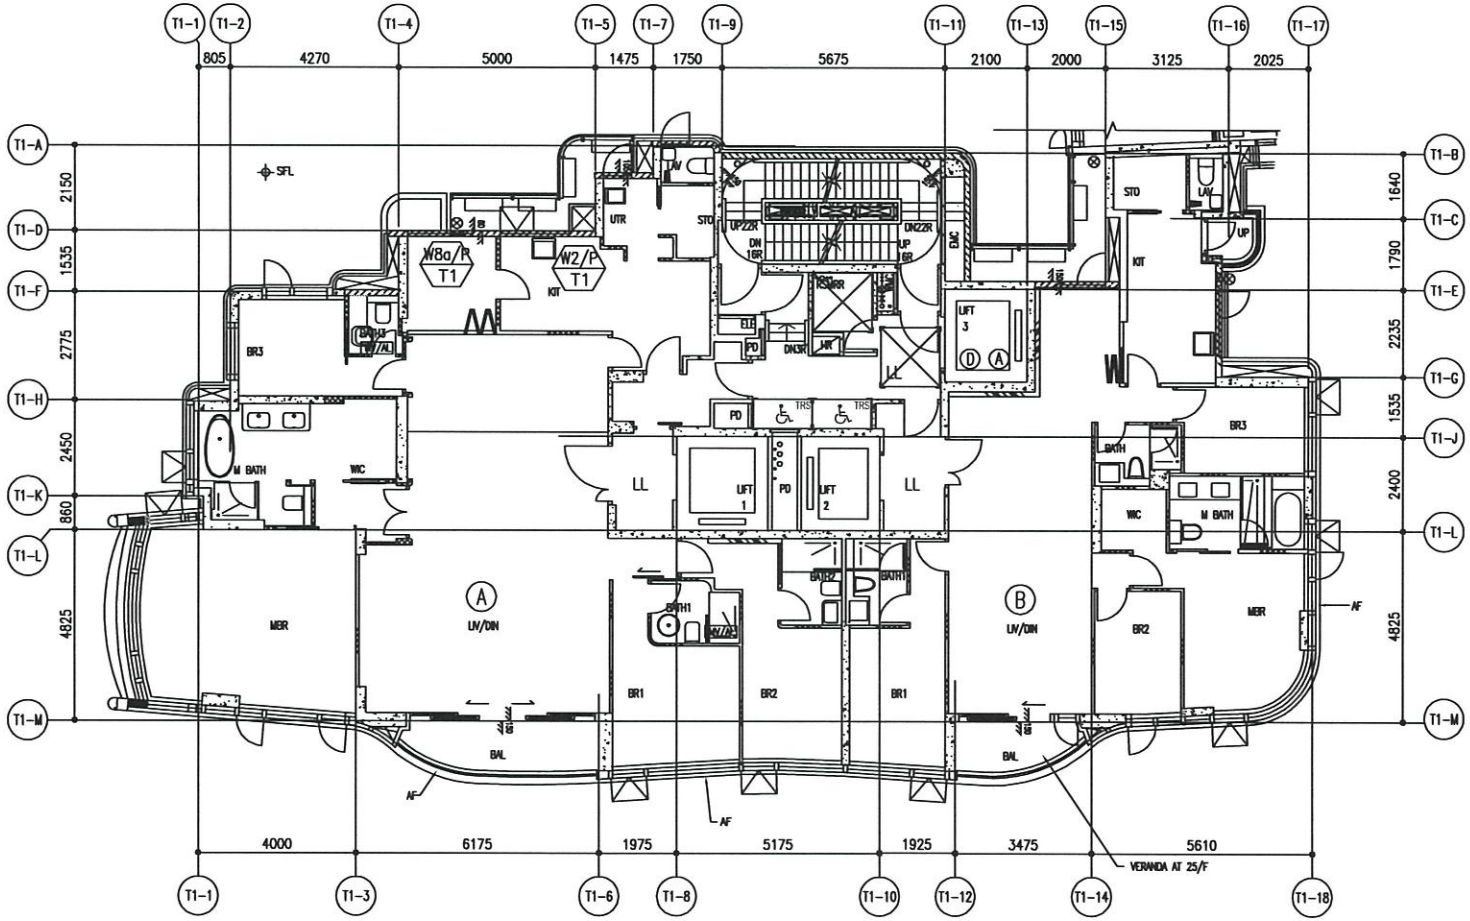

22/F WINDOW LOCATION PLAN FOR PRECAST FACADE AT TOWER 1

B.D. REF :

ARCHITECT :
WONG TUNG & PARTNERS LIMITED
ARCHITECTS & PLANNERS

STRUCTURAL ENGINEER :
SUN HUNG KAI
ARCHITECTS AND ENGINEERS LTD.
SUN HUNG KAI CENTRE, WANCHAI, HONGKONG
TEL. 28278111 FAX. 28272884

FACADE CONSULTANT:
ALPHA CONSULTING LIMITED
Steel Structure & Facade Specialist

MAIN CONTRACTOR :
Sanfield Engineering Construction Ltd.

CLIENT :
SUN HUNG KAI
REAL ESTATE AGENCY LTD.
42/F SUN HUNG KAI CENTRE, WANCHAI, HONGKONG

NOTE :
1. ALL DIMENSIONS ARE IN mm.
2. ALL ELEVATIONS ARE VIEWED FROM OUTSIDE.
3. ALL DIMENSIONS TO BE VERIFIED ON SITE BEFORE FABRICATION.

LEGEND :
X1 / X001 — DETAIL MARK NO. / REFER SHEET NO.
1. F.F.L. --FINISHED FLOOR LEVEL
2. S.F.L. --STRUCTURAL FLOOR LEVEL
3. (R) --REVERSED DETAIL

NO.	DATE	REVISED	BY
–	13/10/2022	NEW LOCATION PLAN REFER TO A104	YI

JOB NO. : J-859

PROJECT :
PROPOSED RESIDENTIAL / COMMERCIAL DEVELOPMENT AT NKIL NO.6551 KAI TAK AREA 4C, SITE 3 KAI TAK, KOWLOON


TITLE :
22/F WINDOW LOCATION PLAN FOR PRECAST FACADE AT TOWER 1

DATE : 21-Nov-21 | SCALE : 1:60 (A3)

DRAWN BY : IVAN | CHECKED BY :

美特鋁質有限公司
MIDI ALUMINIUM FABRICATOR LTD.
Units 6-8, Sunray Industrial Centre, 1/F
610 Cha Kwo Ling Road, Kowloon
Tel:23409211-4 Fax:(852)27727666

DWG NO. : J859-SD-PL-102a | REV. : –

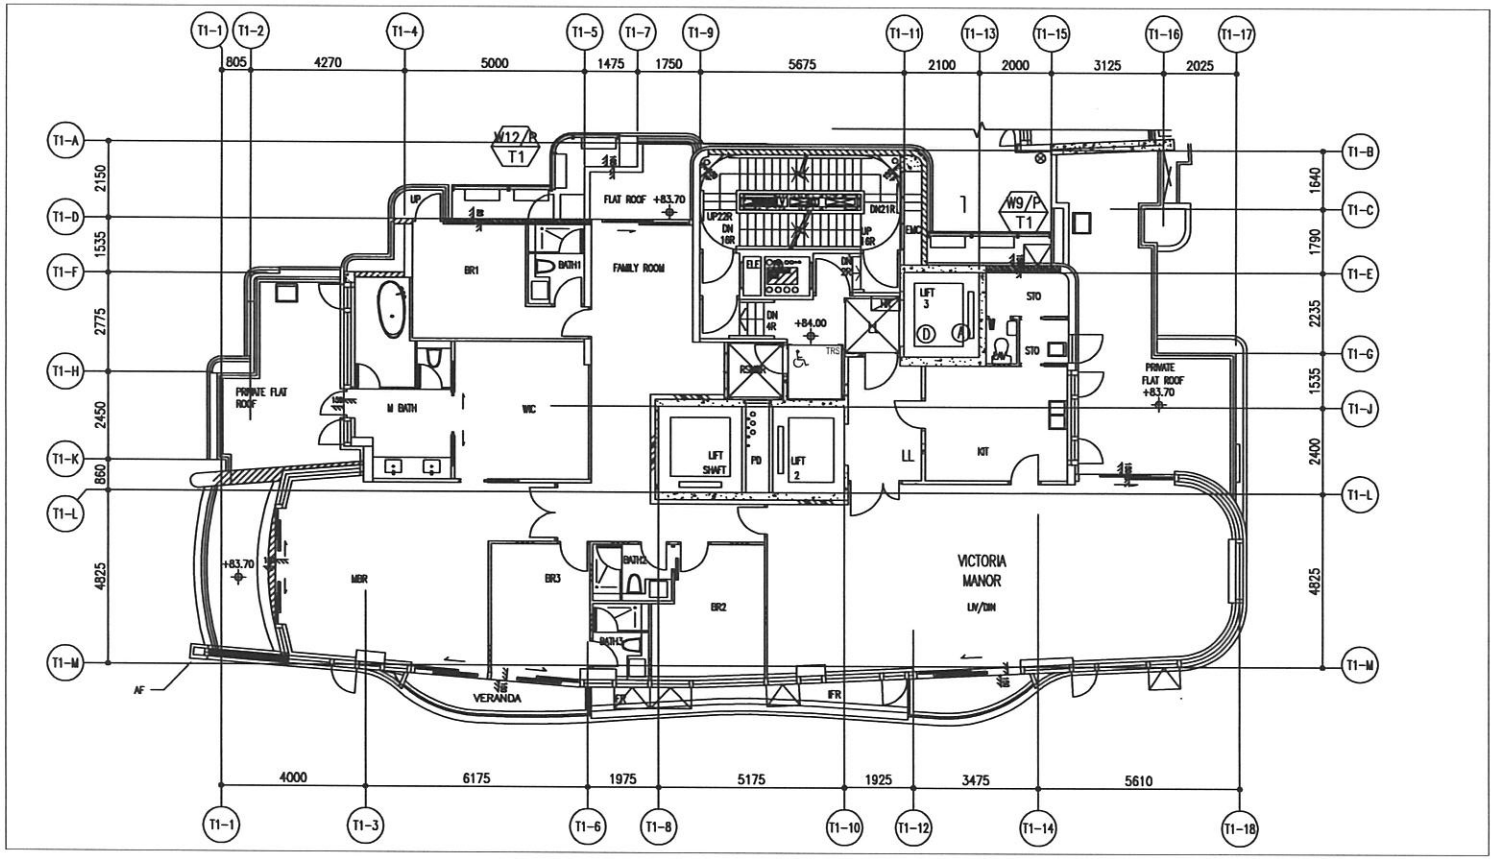

26/F WINDOW LOCATION PLAN
FOR PRECAST FACADE AT TOWER 1

B.D. REF :
-

ARCHITECT :
WONG TUNG & PARTNERS LIMITED
ARCHITECTS & PLANNERS

STRUCTURAL ENGINEER :
SUN HUNG KAI
ARCHITECTS AND ENGINEERS LTD.
SUN HUNG KAI CENTRE, WANCHAI, HONGKONG
TEL. 28276111 FAX. 28272884

FACADE CONSULTANT:
ALPHA CONSULTING LIMITED
Steel Structure & Facade Specialist

MAIN CONTRACTOR :
Sanfield Engineering Construction Ltd.

CLIENT :
SUN HUNG KAI
REAL ESTATE AGENCY LTD.
42/F SUN HUNG KAI CENTRE, WANCHAI, HONGKONG

NOTE :
1. ALL DIMENSIONS ARE IN mm.
2. ALL ELEVATIONS ARE VIEWED FROM OUTSIDE.
3. ALL DIMENSIONS TO BE VERIFIED ON SITE BEFORE FABRICATION.

LEGEND :
X1 — DETAIL MARK NO.
X001 — REFER SHEET NO.
1. F.F.L. --- FINISHED FLOOR LEVEL
2. S.F.L. --- STRUCTURAL FLOOR LEVEL
3. /R --- REVERSED DETAIL

NO.	DATE	REVISED	BY
C	13/10/2022	RENEW LOCATION PLAN REFER TO A1041	YH
B	27/04/2022	REVISION SUBJECT TO ARCH.COMMENT	YHM
A	11/04/2022	RENEW LOCATION PLAN REFER TO A1067	YHM

JOB NO. : J-859

PROJECT :
PROPOSED RESIDENTIAL / COMMERCIAL DEVELOPMENT AT NKIL NO.6551 KAI TAK AREA 4C, SITE 3 KAI TAK, KOWLOON


TITLE :
26/F WINDOW LOCATION PLAN FOR PRECAST FACADE AT TOWER 1

DATE : 21-Nov-21 | SCALE : 1:60 (A3)

DRAWN BY : IVAN | CHECKED BY :

美特鋁質有限公司
MIDI ALUMINIUM FABRICATOR LTD.
Units 6-8, Sunray Industrial Centre, 1/F
610 Cha Kwo Ling Road, Kowloon
Tel:23489211-4 Fax:(852)27727666

DWG NO. : J859-SD-PL-103 | REV. : C

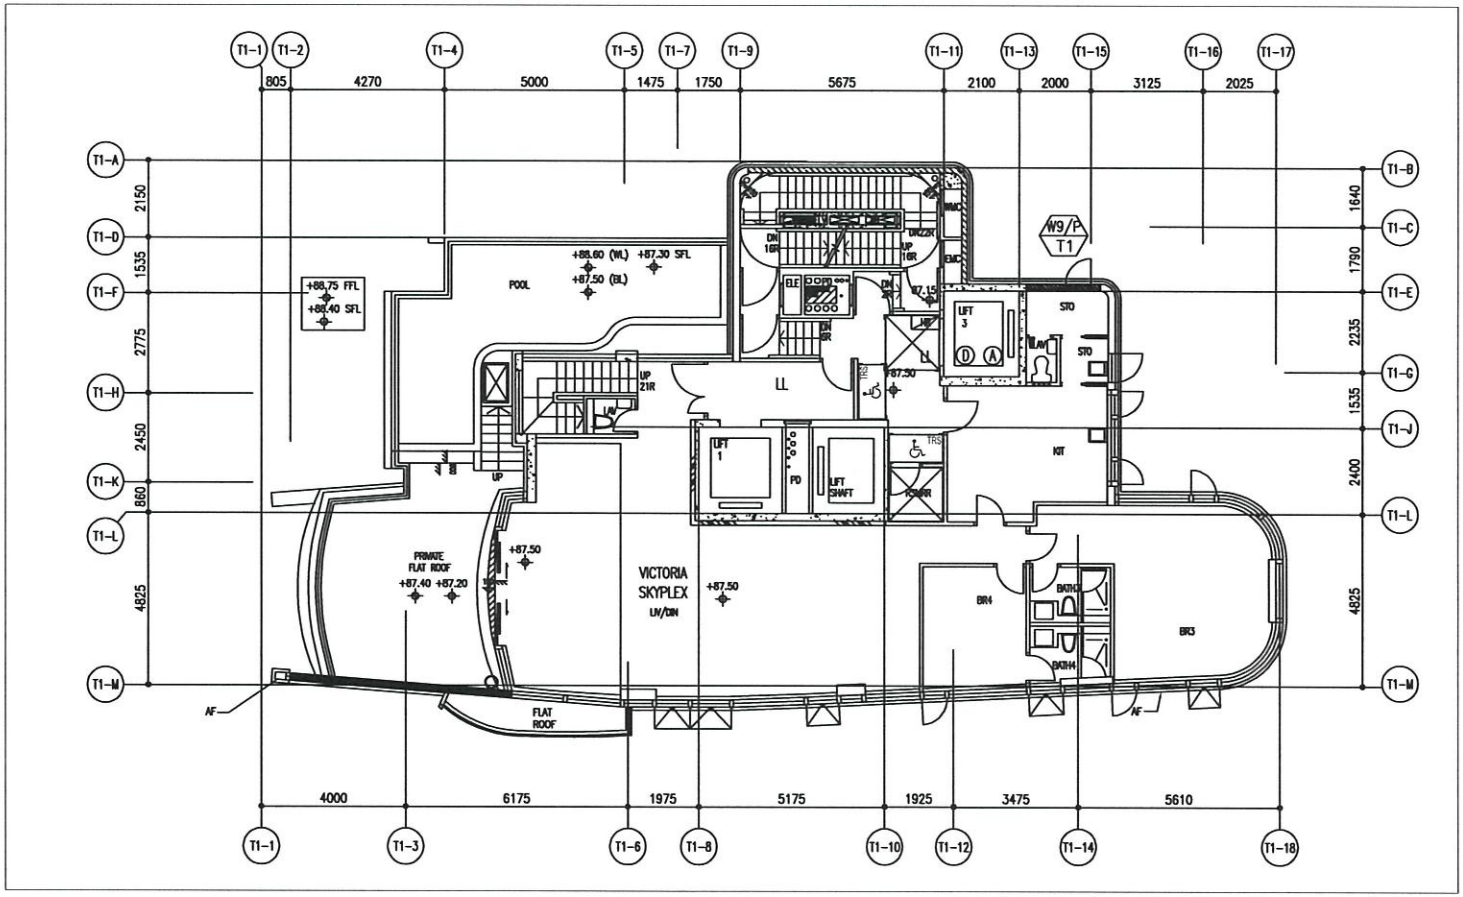

27/F WINDOW LOCATION PLAN
FOR PRECAST FACADE AT TOWER 1

B.D. REF :

ARCHITECT :
WONG TUNG & PARTNERS LIMITED
ARCHITECTS & PLANNERS

STRUCTURAL ENGINEER :
SUN HUNG KAI
ARCHITECTS AND ENGINEERS LTD.
SUN HUNG KAI CENTRE, WANCHAI, HONGKONG
TEL. 28276111 FAX. 28272804

FACADE CONSULTANT:
ALPHA CONSULTING LIMITED
Steel Structure & Façade Specialist

MAIN CONTRACTOR :
Sanfield Engineering Construction Ltd.

CLIENT :
SUN HUNG KAI
REAL ESTATE AGENCY LTD.
42/F SUN HUNG KAI CENTRE, WANCHAI, HONGKONG

NOTE :
1. ALL DIMENSIONS ARE IN mm.
2. ALL ELEVATIONS ARE VIEWED FROM OUTSIDE.
3. ALL DIMENSIONS TO BE VERIFIED ON SITE BEFORE FABRICATION.

LEGEND :
X1 — DETAIL MARK NO.
X001 — REFER SHEET NO.
1. F.F.L. --FINISHED FLOOR LEVEL
2. S.F.L. --STRUCTURAL FLOOR LEVEL
3. /R --REVERSED DETAIL

NO.	DATE	REVISED	BY
B	13/10/2022	RENEW LOCATION PLAN REFER TO AR04	YH
A	11/04/2022	RENEW LOCATION PLAN REFER TO AR67	YH

JOB NO. : J-859

PROJECT :
PROPOSED RESIDENTIAL / COMMERCIAL DEVELOPMENT AT NKIL NO.6551 KAI TAK AREA 4C, SITE 3 KAI TAK, KOWLOON


TITLE :
27/F WINDOW LOCATION PLAN FOR PRECAST FACADE AT TOWER 1


DATE : 21-Nov-21 | SCALE : 1:60 (A3)

DRAWN BY : IVAN | CHECKED BY :

美特鋁質有限公司
MIDI ALUMINIUM FABRICATOR LTD.
Units 6-8, Sunray Industrial Centre, 1/F
610 Cha Kwo Ling Road, Kowloon
Tel:23489211-4 Fax:(852)27727666

DWG NO. : J859-SD-PL-104 | REV. : B

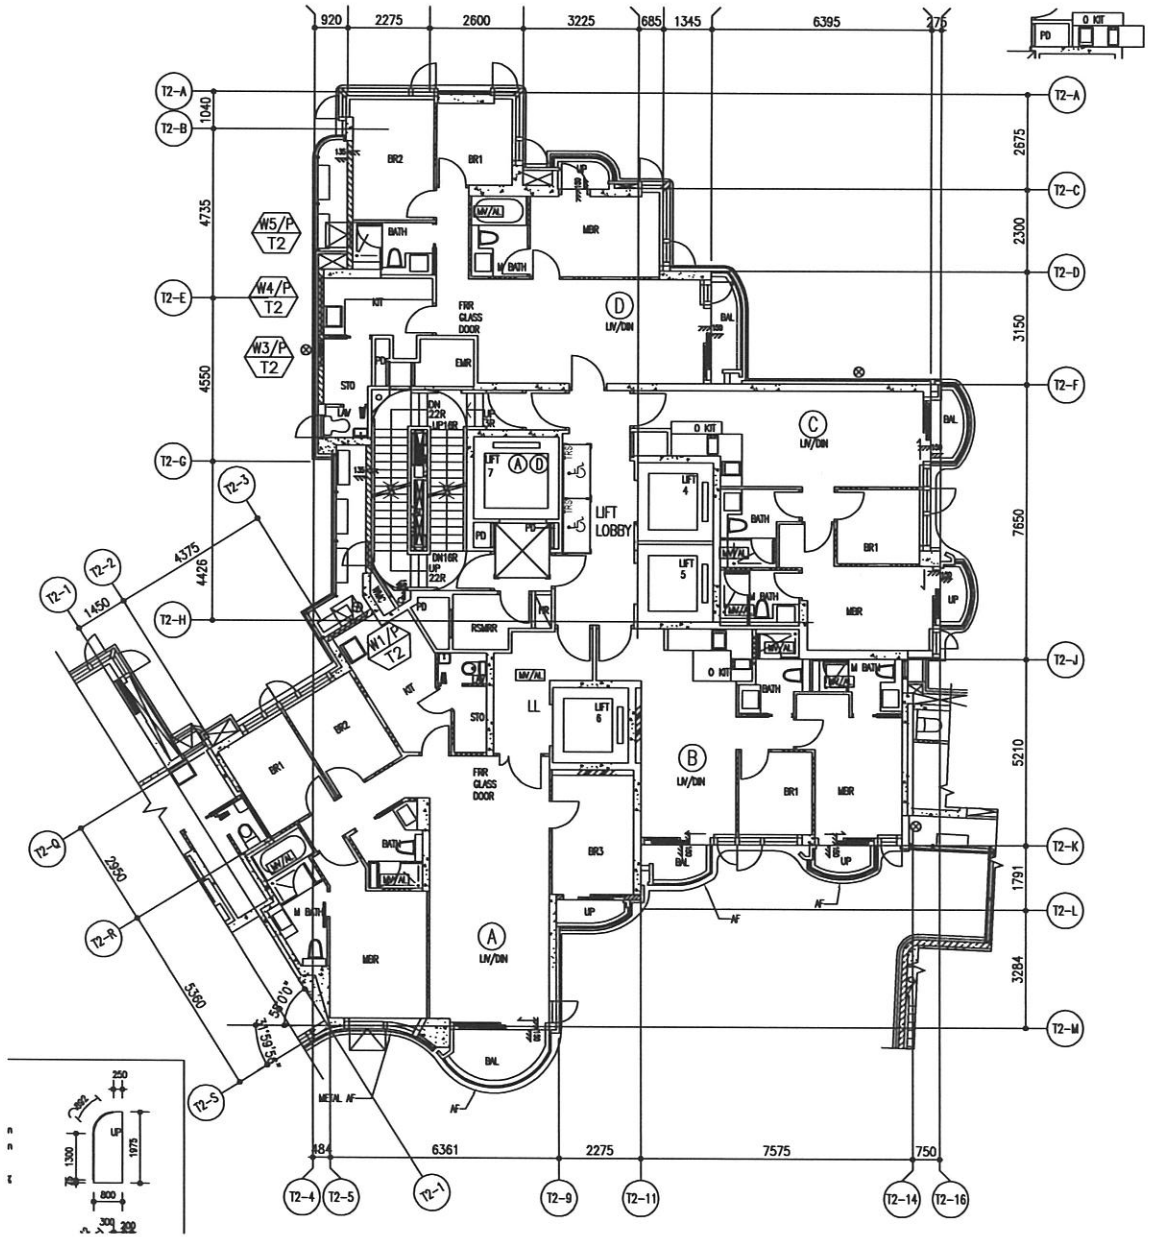
920
2275
2600
3225
685
1345
6395
275
T2-A
T2-B
T2-C
T2-D
T2-E
T2-F
T2-G
T2-H
T2-J
T2-K
T2-L
T2-M
T2-1
T2-2
T2-3
T2-4
T2-5
T2-9
T2-11
T2-14
T2-16
1040
4735
4550
2675
2300
3150
7650
5210
1791
3284
4375
4426
1450
2900
5350
59°00'
31°59'58"
484
6361
2275
7575
750
W5/P T2
W4/P T2
W3/P T2
W1/A T2
LIFT LOBBY
MEDIAL AF
AF
BAL
UP
MBR
BR1
BR2
BR3
BATH
M BATH
KIT
O KIT
STO
PD
LIFT 4
LIFT 5
LIFT

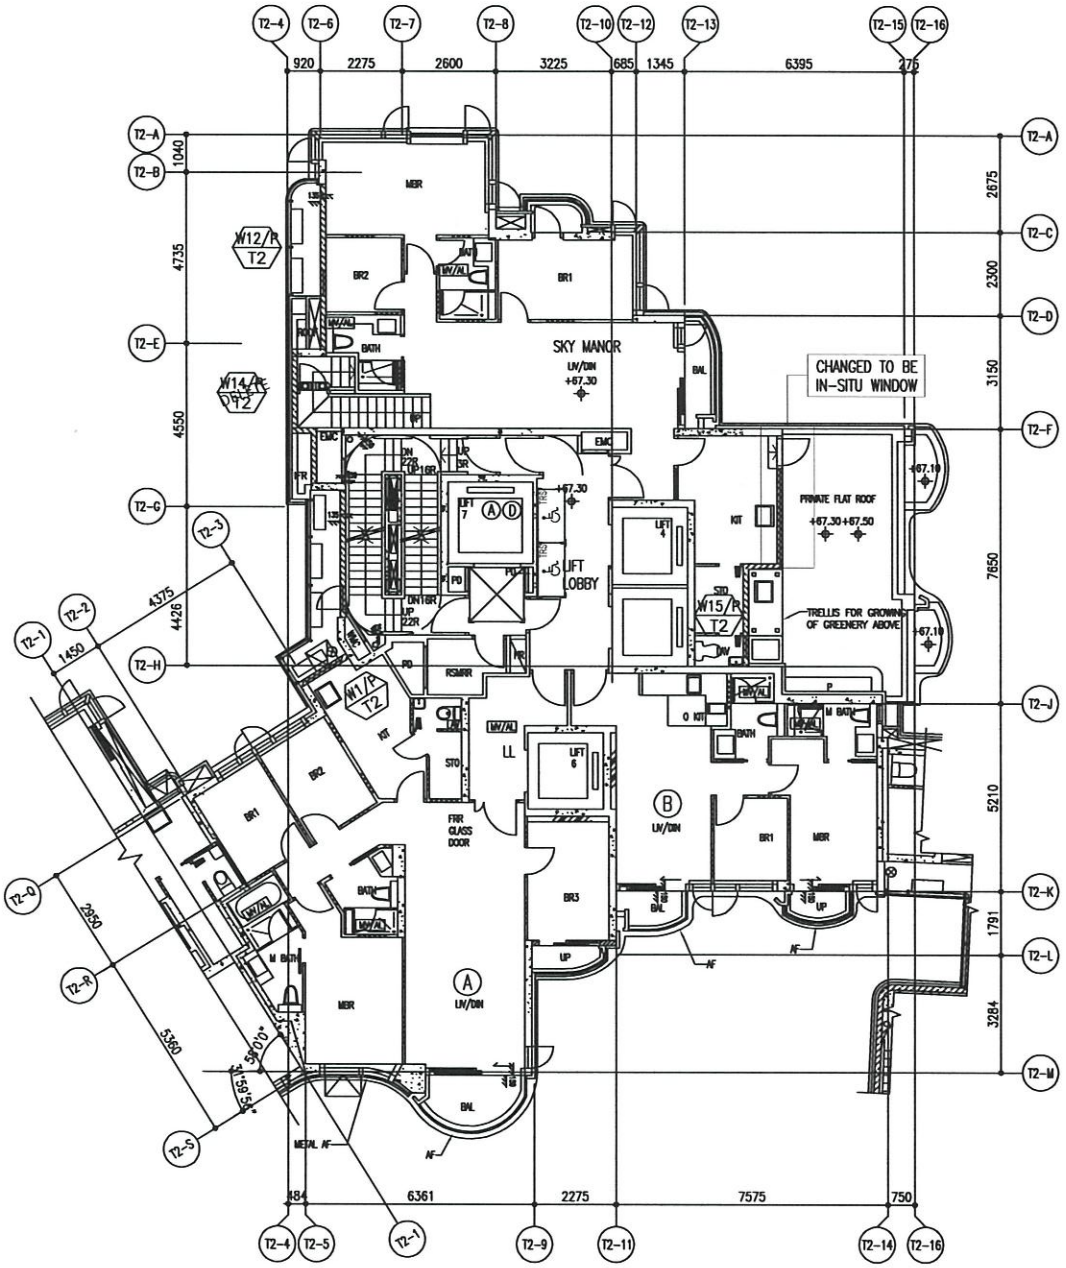

20/F WINDOW LOCATION PLAN
FOR PRECAST FACADE AT TOWER 2

PI
A

B.D. REF :

ARCHITECT :
WONG TUNG & PARTNERS LIMITED
ARCHITECTS & PLANNERS

STRUCTURAL ENGINEER :
SUN HUNG KAI
ARCHITECTS AND ENGINEERS LTD.
SUN HUNG KAI CENTRE, WANCHAI, HONGKONG
TEL. 28278111 FAX. 28272884

FACADE CONSULTANT:
ALPHA CONSULTING LIMITED
Steel Structure & Facade Specialist

MAIN CONTRACTOR :
Sanfield Engineering
Construction Ltd.

CLIENT :
SUN HUNG KAI
REAL ESTATE AGENCY LTD.
42/F SUN HUNG KAI CENTRE, WANCHAI, HONGKONG

NOTE :
1. ALL DIMENSIONS ARE IN mm.
2. ALL ELEVATIONS ARE VIEWED FROM OUTSIDE.
3. ALL DIMENSIONS TO BE VERIFIED ON SITE BEFORE FABRICATION.

LEGEND :
X1 — DETAIL MARK NO.
X001 — REFER SHEET NO.
1. F.F.L. --- FINISHED FLOOR LEVEL
2. S.F.L. --- STRUCTURAL FLOOR LEVEL
3. /R --- REVERSED DETAIL

NO.	DATE	REVISED	BY
C	27/04/2022	REVISION SUBJECT TO ARCHCOMMENT &/R RENEW LOCATION PLAN REFER TO A904	
B	27/04/2022	REVISION SUBJECT TO ARCHCOMMENT	
A	11/04/2022	RENEW LOCATION PLAN REFER TO A887	

JOB NO. : J-859

PROJECT :
PROPOSED RESIDENTIAL / COMMERCIAL DEVELOPMENT AT NKIL NO.6551 KAI TAK AREA 4C, SITE 3 KAI TAK, KOWLOON


TITLE :
20/F WINDOW LOCATION PLAN FOR PRECAST FACADE AT TOWER 2

DATE : 21-Nov-21 | SCALE : 1:70 (A3)

DRAWN BY : IVAN | CHECKED BY :

美特鋁質有限公司
MIDI ALUMINIUM FABRICATION LTD.
Units 6-8, Sunray Industrial Centre, 1/F
610 Cha Kwo Ling Road, Kowloon
Tel:23489211-4 Fax:(852)27727666

DWG NO. : J859-SD-PL-202 | REV. : C

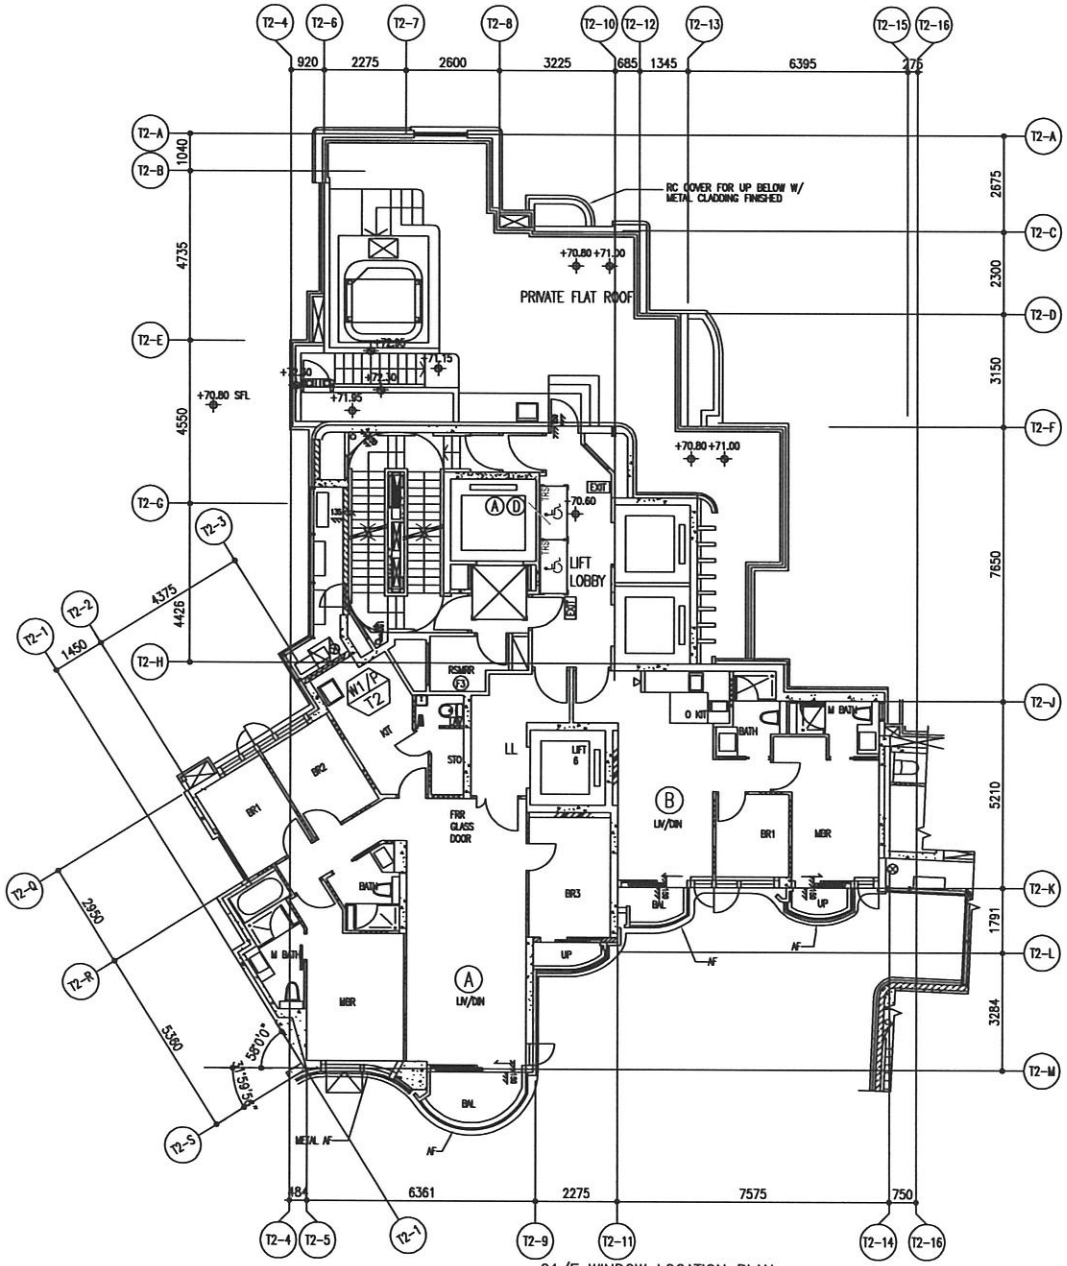

21/F WINDOW LOCATION PLAN
FOR PRECAST FACADE AT TOWER 2

B.D. REF :

ARCHITECT :
WONG TUNG & PARTNERS LIMITED
ARCHITECTS & PLANNERS

STRUCTURAL ENGINEER :
SUN HUNG KAI
ARCHITECTS AND ENGINEERS LTD.
SUN HUNG KAI CENTRE, WANCHAI, HONGKONG
TEL 28276111 FAX 28272884

FACADE CONSULTANT:
ALPHA CONSULTING LIMITED
Steel Structure & Facade Specialist

MAIN CONTRACTOR :
Sanfield Engineering Construction Ltd.

CLIENT :
SUN HUNG KAI
REAL ESTATE AGENCY LTD.
42/F SUN HUNG KAI CENTRE, WANCHAI, HONGKONG

NOTE :
1. ALL DIMENSIONS ARE IN mm.
2. ALL ELEVATIONS ARE VIEWED FROM OUTSIDE.
3. ALL DIMENSIONS TO BE VERIFIED ON SITE BEFORE FABRICATION.

LEGEND :
X1 — DETAIL MARK NO.
X001 — REFER SHEET NO.
1. F.F.L. — FINISHED FLOOR LEVEL
2. S.F.L. — STRUCTURAL FLOOR LEVEL
3. (/R) — REVERSED DETAIL

NO.	DATE	REVISED	BY
C	13/10/2022	RENEW LOCATION PLAN REFER TO A104	YS
B	27/04/2022	REVISION SUBJECT TO ARCH COMMENT	YSCH
A	11/04/2022	RENEW LOCATION PLAN REFER TO A087	YSCH

JOB NO. : J-859

PROJECT :
PROPOSED RESIDENTIAL / COMMERCIAL DEVELOPMENT AT NKIL NO.6551 KAI TAK AREA 4C, SITE 3 KAI TAK, KOWLOON


TITLE :
21/F WINDOW LOCATION PLAN FOR PRECAST FACADE AT TOWER 2

DATE : 21-Nov-21 | SCALE : 1:70 (A3)

DRAWN BY : IVAN | CHECKED BY :

美特鋁實有限公司
MIDI ALUMINIUM FABRICATOR LTD.
Units 6-8, Sunray Industrial Centre, 1/F
610 Cha Kwo Ling Road, Kowloon
Tel:23489211-4 Fax:(852)27727666

DWG NO. : J859-SD-PL-203 | REV. : C

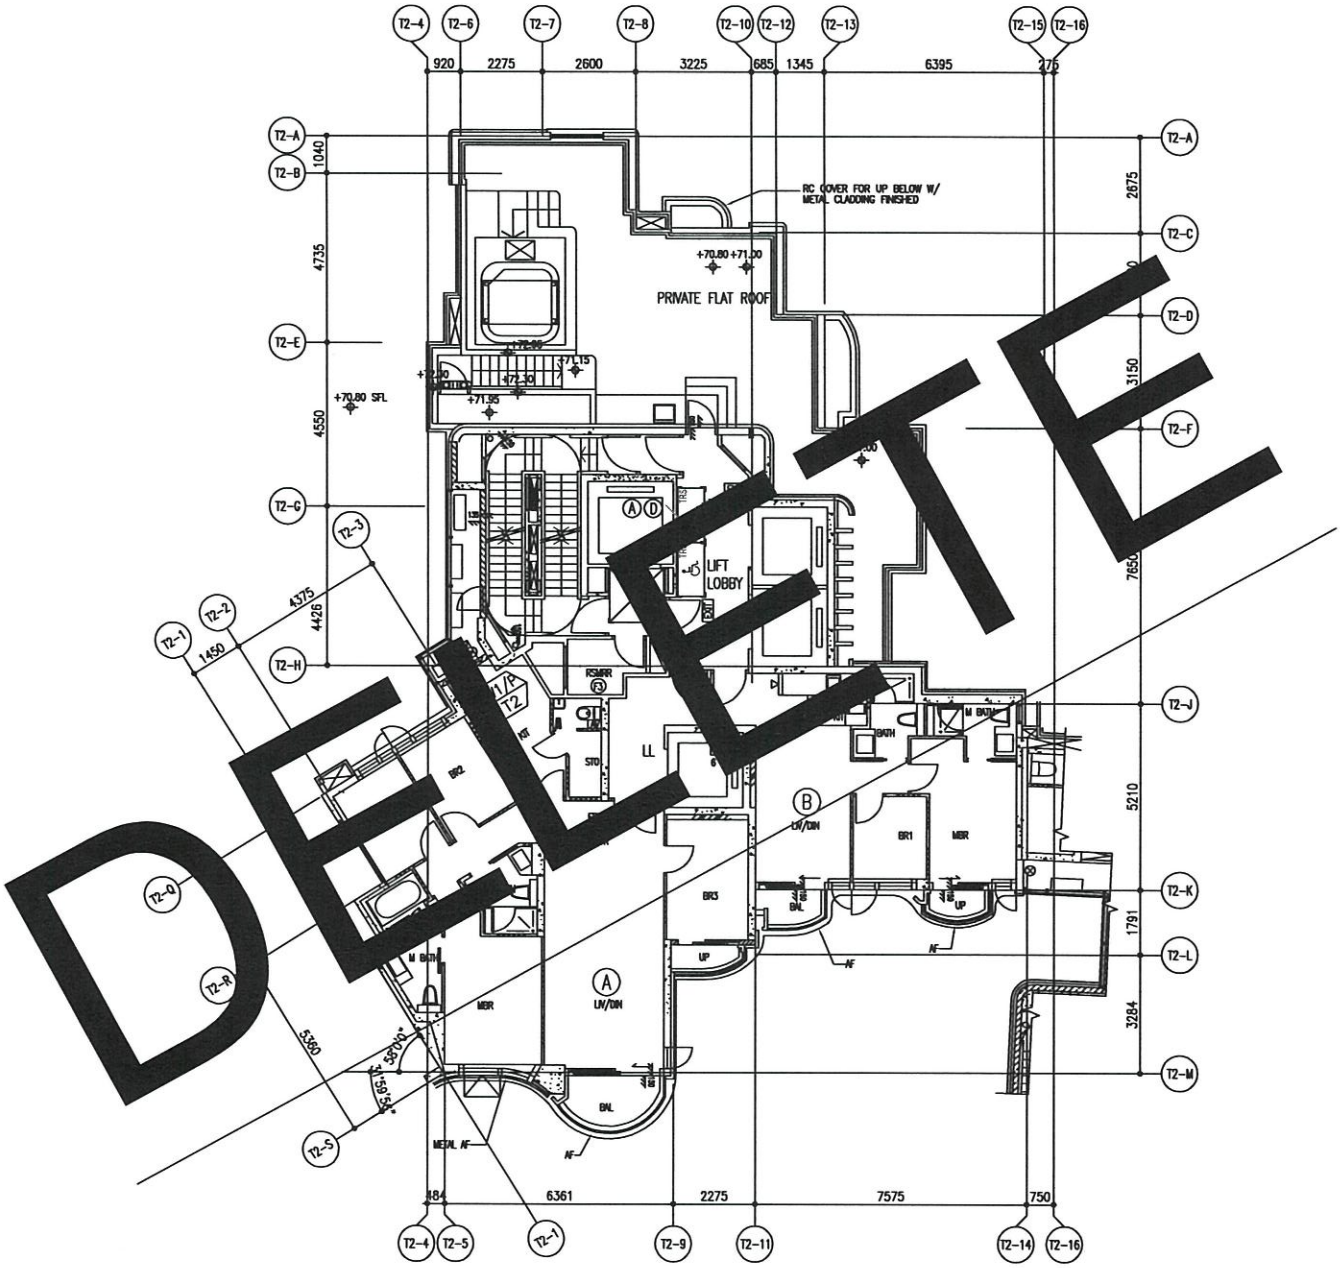

DELETE

22/F WINDOW LOCATION PLAN
FOR PRECAST FACADE AT TOWER 2

B.D. REF :

ARCHITECT :
WONG TUNG & PARTNERS LIMITED
ARCHITECTS & PLANNERS

STRUCTURAL ENGINEER :
SUN HUNG KAI
ARCHITECTS AND ENGINEERS LTD.
SUN HUNG KAI CENTRE, WANCHAI, HONGKONG
TEL. 28276111 FAX. 28272894

FACADE CONSULTANT:
ALPHA CONSULTING LIMITED
Steel Structure & Facade Specialist

MAIN CONTRACTOR :
Sanfield Engineering Construction Ltd.

CLIENT :
SUN HUNG KAI
REAL ESTATE AGENCY LTD.
42/F SUN HUNG KAI CENTRE, WANCHAI, HONGKONG

NOTE :
1. ALL DIMENSIONS ARE IN mm.
2. ALL ELEVATIONS ARE VIEWED FROM OUTSIDE.
3. ALL DIMENSIONS TO BE VERIFIED ON SITE BEFORE FABRICATION.

LEGEND :
X1 — DETAIL MARK NO.
X001 — REFER SHEET NO.
1. F.F.L. — FINISHED FLOOR LEVEL
2. S.F.L. — STRUCTURAL FLOOR LEVEL
3. /R — REVERSED DETAIL

NO.	DATE	REVISED	BY
A	11/04/2022	REVIEW LOCATION PLAN REFER TO A067	

JOB NO. : J-859

PROJECT :
PROPOSED RESIDENTIAL / COMMERCIAL DEVELOPMENT AT NKIL NO.6551 KAI TAK AREA 4C, SITE 3 KAI TAK, KOWLOON


TITLE :
22/F WINDOW LOCATION PLAN FOR PRECAST FACADE AT TOWER 2

DATE : 21-Nov-21 | SCALE : 1:70 (A3)

DRAWN BY : IVAN | CHECKED BY :

美特鋁製有限公司
MIDI ALUMINIUM FABRICATOR LTD.
Units 6-8, Sunray Industrial Centre, 1/F
610 Cha Kwo Ling Road, Kowloon
Tel:23489211-4 Fax:(852)27727666

DWG NO. : J859-SD-PL-204 | REV. : A

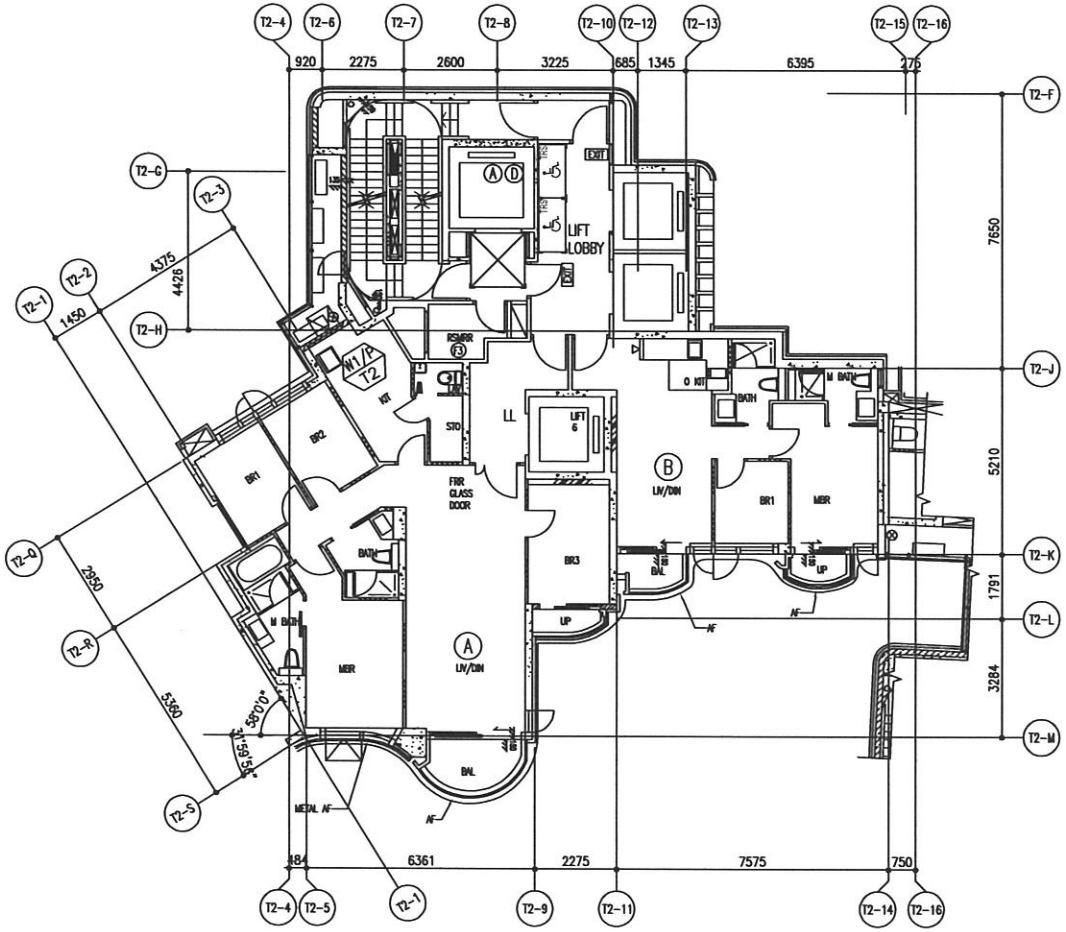

22/F TO 25/F WINDOW LOCATION PLAN FOR PRECAST FACADE
AT TOWER 2 (2 STOREYS, 24/F OMITTED)

B.D. REF :

ARCHITECT :
WONG TUNG & PARTNERS LIMITED
ARCHITECTS & PLANNERS

STRUCTURAL ENGINEER :
SUN HUNG KAI
ARCHITECTS AND ENGINEERS LTD.
SUN HUNG KAI CENTRE, WANCHAI, HONGKONG
TEL. 28278111 FAX. 28272884

FACADE CONSULTANT:
ALPHA CONSULTING LIMITED
Steel Structure & Facade Specialist

MAIN CONTRACTOR :
Sanfield Engineering Construction Ltd.

CLIENT :
SUN HUNG KAI
REAL ESTATE AGENCY LTD.
42/F SUN HUNG KAI CENTRE, WANCHAI, HONGKONG

NOTE :
1. ALL DIMENSIONS ARE IN mm.
2. ALL ELEVATIONS ARE VIEWED FROM OUTSIDE.
3. ALL DIMENSIONS TO BE VERIFIED ON SITE BEFORE FABRICATION.

LEGEND :
X1 — DETAIL MARK NO.
X001 — REFER SHEET NO.
1. F.F.L. — FINISHED FLOOR LEVEL
2. S.F.L. — STRUCTURAL FLOOR LEVEL
3. /R — REVERSED DETAIL

NO.	DATE	REVISED	BY
B	13/10/2022	RENEW LOCATION PLAN REFER TO A104	YK
A	11/04/2022	RENEW LOCATION PLAN REFER TO A067	YKWONG

JOB NO. : J-859

PROJECT :
PROPOSED RESIDENTIAL / COMMERCIAL DEVELOPMENT AT NKIL NO.6551 KAI TAK AREA 4C, SITE 3
KAI TAK, KOWLOON


TITLE :
23~25/F WINDOW LOCATION PLAN FOR PRECAST FACADE AT TOWER 2

DATE : 21-Nov-21 | SCALE : 1:60 (A3)

DRAWN BY : IVAN | CHECKED BY :

美特鋁製有限公司
MIDI ALUMINIUM FABRICATOR LTD.
Units 6-8, Sunray Industrial Centre, 1/F
610 Cha Kwo Ling Road, Kowloon
Tel:23489211-4 Fax:(852)27727666

DWG NO. : J859-SD-PL-205 | REV. : B

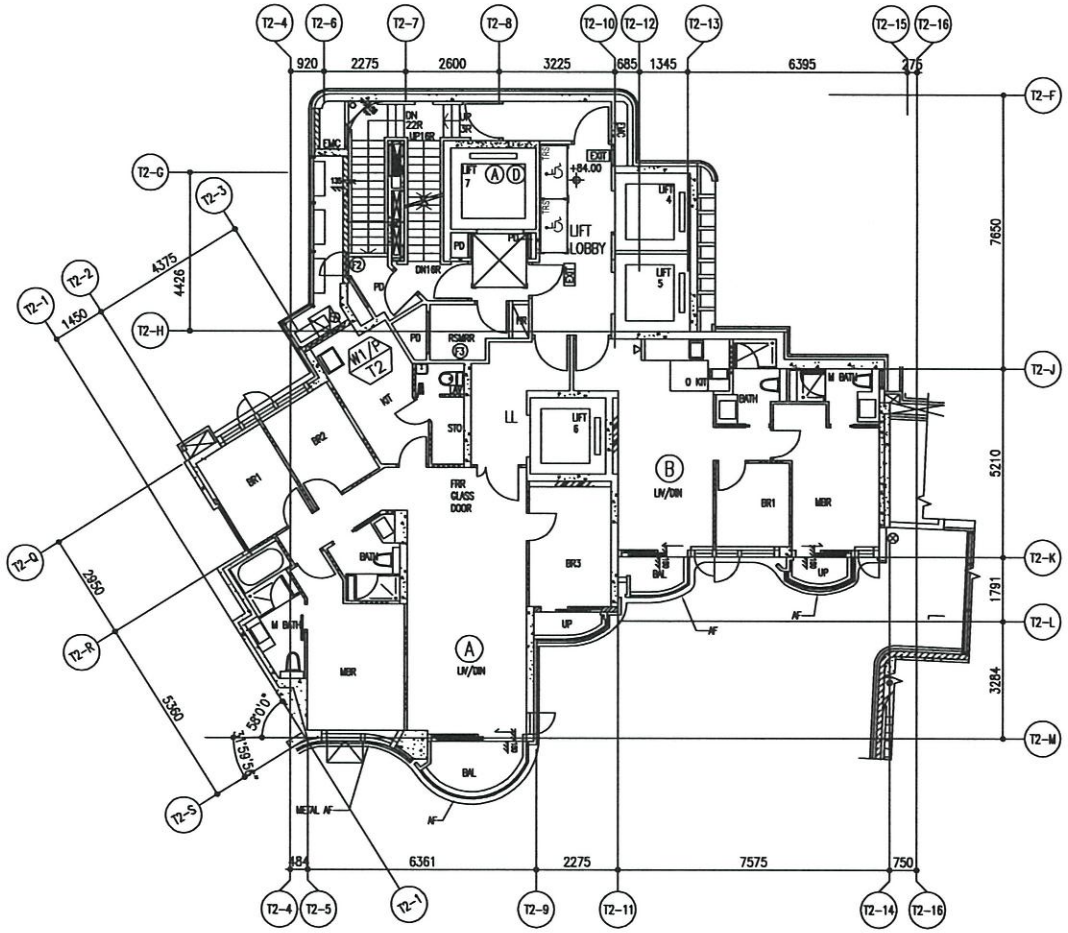

26/F WINDOW LOCATION PLAN
FOR PRECAST FACADE AT TOWER 2

B.D. REF :

ARCHITECT :
WONG TUNG & PARTNERS LIMITED
ARCHITECTS & PLANNERS

STRUCTURAL ENGINEER :
SUN HUNG KAI
ARCHITECTS AND ENGINEERS LTD.
SUN HUNG KAI CENTRE, WANCHAI, HONGKONG
TEL. 28278111 FAX. 28272804

FACADE CONSULTANT:
ALPHA CONSULTING LIMITED
Steel Structure & Facade Specialist

MAIN CONTRACTOR :
Sanfield Engineering Construction Ltd.

CLIENT :
SUN HUNG KAI
REAL ESTATE AGENCY LTD.
42/F SUN HUNG KAI CENTRE, WANCHAI, HONGKONG

NOTE :
1. ALL DIMENSIONS ARE IN mm.
2. ALL ELEVATIONS ARE VIEWED FROM OUTSIDE.
3. ALL DIMENSIONS TO BE VERIFIED ON SITE BEFORE FABRICATION.

LEGEND :
X1 / X001 — DETAIL MARK NO. / REFER SHEET NO.
1. F.F.L. — FINISHED FLOOR LEVEL
2. S.F.L. — STRUCTURAL FLOOR LEVEL
3. /R — REVERSED DETAIL

NO.	DATE	REVISED	BY
B	13/10/2022	RENEW LOCATION PLAN REFER TO A104	YH
A	11/04/2022	RENEW LOCATION PLAN REFER TO A067	YHM

JOB NO. : J-859

PROJECT :
PROPOSED RESIDENTIAL / COMMERCIAL DEVELOPMENT AT NKIL NO.6551 KAI TAK AREA 4C, SITE 3 KAI TAK, KOWLOON


TITLE :
26/F WINDOW LOCATION PLAN FOR PRECAST FACADE AT TOWER 2

DATE : 21-Nov-21 | SCALE : 1:60 (A3)


DRAWN BY : IVAN | CHECKED BY :

美特鋁製有限公司
MIDI ALUMINIUM FABRICATOR LTD.
Units 6-8, Sunray Industrial Centre, 1/F
610 Cha Kwo Ling Road, Kowloon
Tel:23489211-4 Fax:(852)27727666

DWG NO. : J859-SD-PL-206 | REV. : B

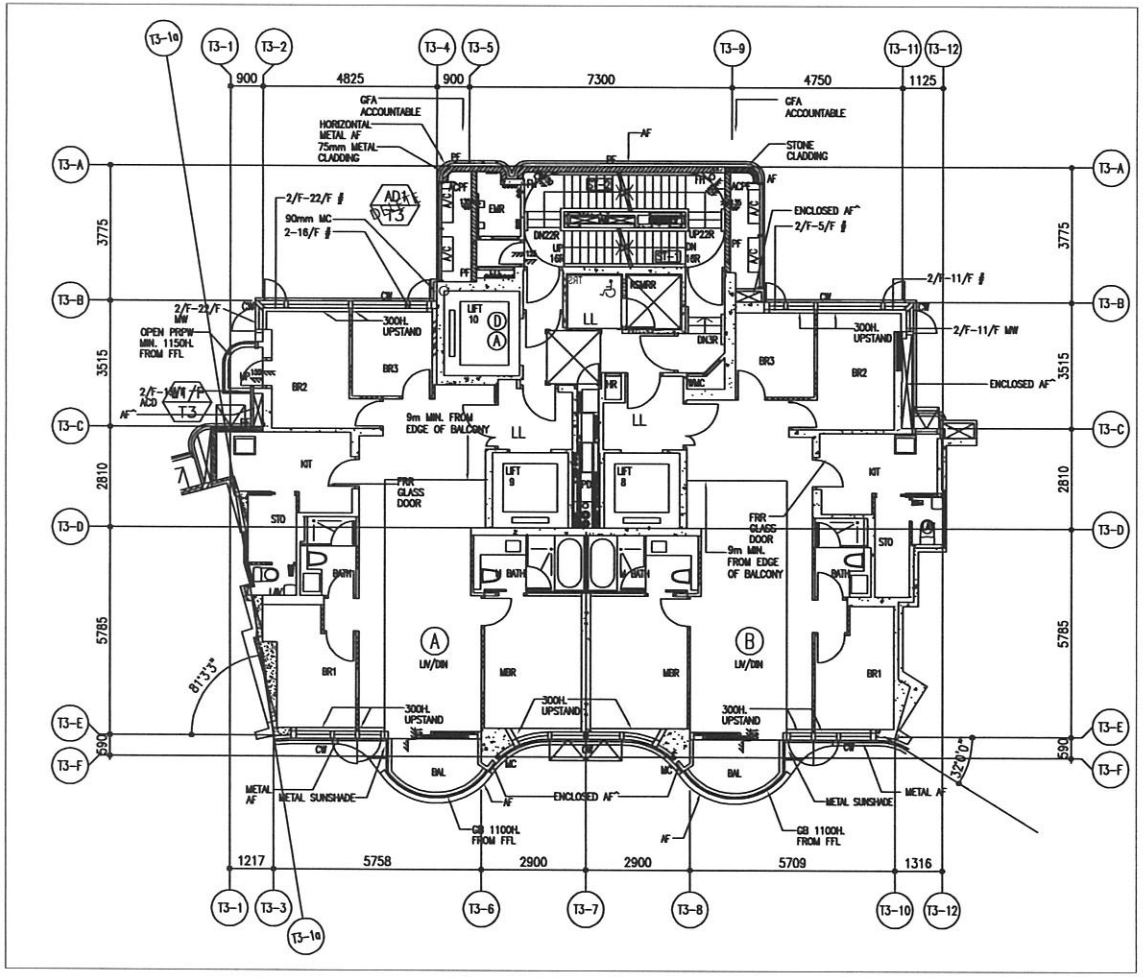

2/F TO 26/F WINDOW LOCATION PLAN FOR PRECAST FACADE AT TOWER 3 (21 STOREYS, 4/F,13/F,14/F,24/F OMITTED)

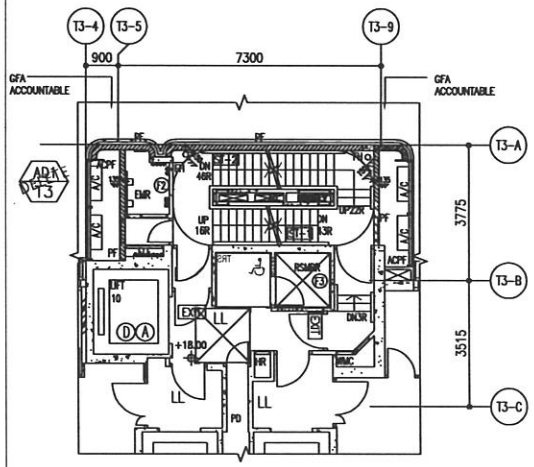

2/F PART PLAN OF TOWER 3

B.D. REF :

ARCHITECT :
WONG TUNG & PARTNERS LIMITED
ARCHITECTS & PLANNERS

STRUCTURAL ENGINEER :
SUN HUNG KAI
ARCHITECTS AND ENGINEERS LTD.
SUN HUNG KAI CENTRE, WANCHAI, HONGKONG
TEL. 2827 8111 FAX. 2827 2884

FACADE CONSULTANT:
ALPHA CONSULTING LIMITED
Steel Structure & Facade Specialist

MAIN CONTRACTOR :
Sanfield Engineering Construction Ltd.

CLIENT :
SUN HUNG KAI
REAL ESTATE AGENCY LTD.
42/F SUN HUNG KAI CENTRE, WANCHAI, HONGKONG

NOTE :
1. ALL DIMENSIONS ARE IN mm.
2. ALL ELEVATIONS ARE VIEWED FROM OUTSIDE.
3. ALL DIMENSIONS TO BE VERIFIED ON SITE BEFORE FABRICATION.

LEGEND :
X1 — DETAIL MARK NO.
X001 — REFER SHEET NO.
1. F.F.L. --- FINISHED FLOOR LEVEL
2. S.F.L. --- STRUCTURAL FLOOR LEVEL
3. (R) --- REVERSED DETAIL

NO.	DATE	REVISED	BY
E	13/10/2022	RENEW LOCATION PLAN REFER TO A904	YW
D	8/09/2022	REVISION SUBJECT TO ARCH.COMMENT	YWH
C	13/05/2022	REVISION SUBJECT TO ARCH.COMMENT	YWH
B	25/04/2022	REVISION SUBJECT TO ARCH.COMMENT	YWH
A	11/04/2022	RENEW LOCATION PLAN REFER TO A857	YWH

JOB NO. : J-859

PROJECT :
PROPOSED RESIDENTIAL / COMMERCIAL DEVELOPMENT AT NKIL NO.6551 KAI TAK AREA 4C, SITE 3 KAI TAK, KOWLOON


TITLE :
2~26/F WINDOW LOCATION PLAN FOR PRECAST FACADE AT TOWER 3

DATE : 17-Nov-21 | SCALE : 1:60 (A3)

DRAWN BY : IVAN | CHECKED BY :

美特鋁質有限公司
MIDI ALUMINIUM FABRICATOR LTD.
Units 6-8, Sunray Industrial Centre, 1/F
610 Cha Kwo Ling Road, Kowloon
Tel:23489211-4 Fax:(852)27727666

DWG NO. : J859-SD-PL-301 | REV. : E

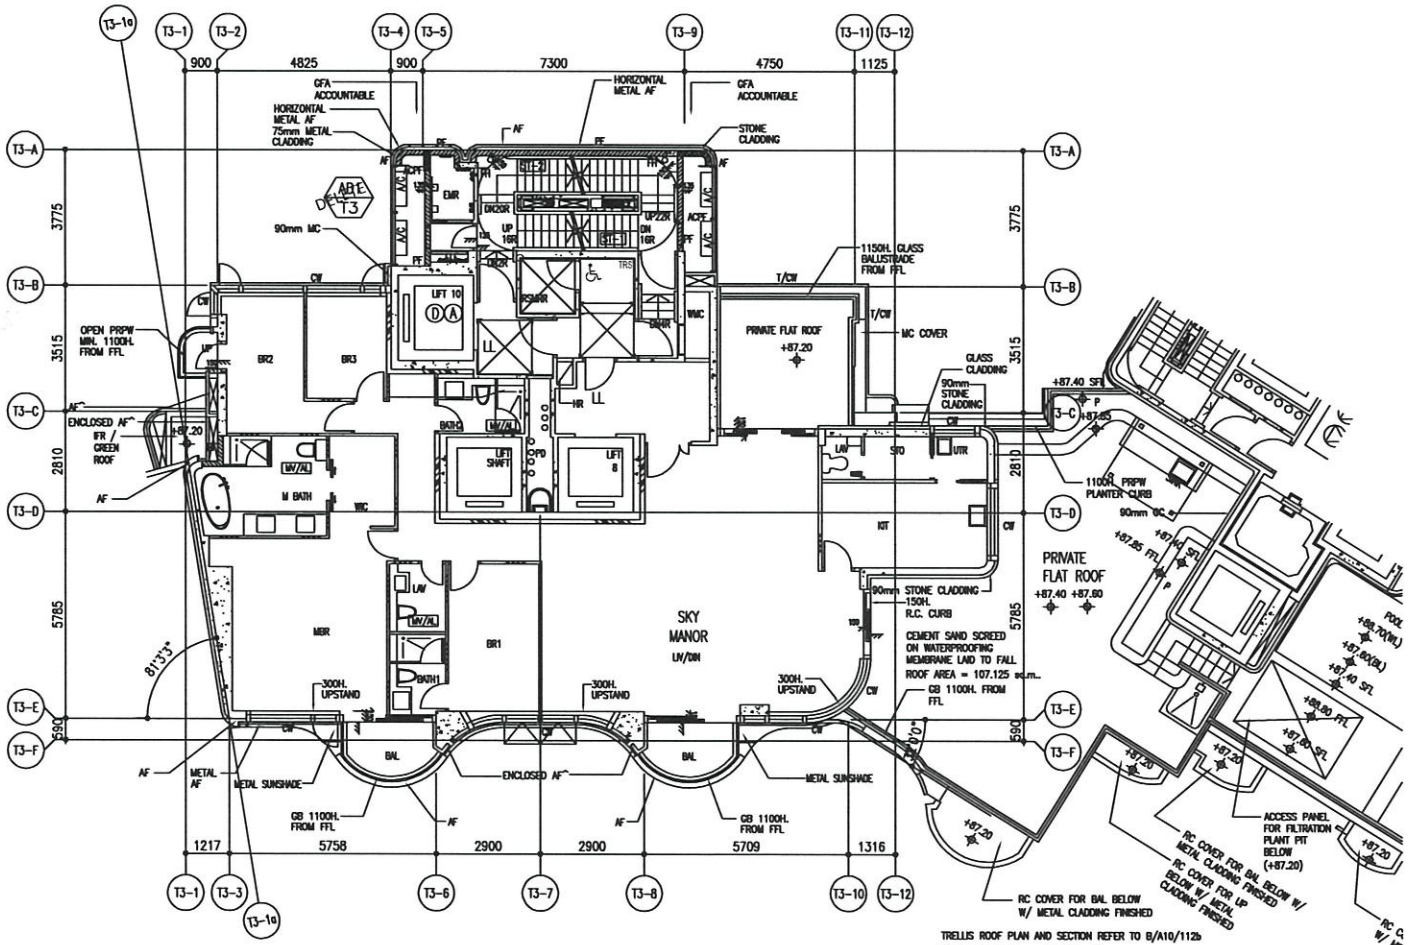

27/F WINDOW LOCATION PLAN
FOR PRECAST FACADE AT TOWER 3

B.D. REF :

ARCHITECT :
WONG TUNG & PARTNERS LIMITED
ARCHITECTS & PLANNERS

STRUCTURAL ENGINEER :
SUN HUNG KAI
ARCHITECTS AND ENGINEERS LTD.
SUN HUNG KAI CENTRE, WANCHAI, HONGKONG
TEL. 28278111 FAX. 28272884

FACADE CONSULTANT:
ALPHA CONSULTING LIMITED
Steel Structure & Facade Specialist

MAIN CONTRACTOR :
Sanfield Engineering Construction Ltd.

CLIENT :
SUN HUNG KAI
REAL ESTATE AGENCY LTD.
42/F SUN HUNG KAI CENTRE, WANCHAI, HONGKONG

NOTE :
1. ALL DIMENSIONS ARE IN mm.
2. ALL ELEVATIONS ARE VIEWED FROM OUTSIDE.
3. ALL DIMENSIONS TO BE VERIFIED ON SITE BEFORE FABRICATION.

LEGEND :
X1 — DETAIL MARK NO.
X001 — REFER SHEET NO.

1. F.F.L. --FINISHED FLOOR LEVEL
2. S.F.L. --STRUCTURAL FLOOR LEVEL
3. (R) --REVERSED DETAIL

NO.	DATE	REVISED	BY
E	13/10/2022	RENEW LOCATION PLAN REFER TO A/A04	YB
D	08/08/2022	REVISION SUBJECT TO ARCH.COMMENT	YWM
C	13/05/2022	REVISION SUBJECT TO ARCH.COMMENT	YWM
B	28/04/2022	REVISION SUBJECT TO ARCH.COMMENT	YWM
A	11/04/2022	RENEW LOCATION PLAN REFER TO A/A07	YWM

JOB NO. : J-859

PROJECT :
PROPOSED RESIDENTIAL / COMMERCIAL DEVELOPMENT AT NKIL NO.6551 KAI TAK AREA 4C, SITE 3 KAI TAK, KOWLOON


TITLE :
27/F WINDOW LOCATION PLAN FOR PRECAST FACADE AT TOWER 3

DATE : 17-Nov-21 | SCALE : 1:60 (A3)

DRAWN BY : IVAN | CHECKED BY :

美特鋁製有限公司
MIDI ALUMINIUM FABRICATOR LTD.
Units 6-8, Sunray Industrial Centre, 1/F
610 Cha Kwo Ling Road, Kowloon
Tel:23489211-4 Fax:(852)27727666

DWG NO. : J859-SD-PL-302 | REV. : E

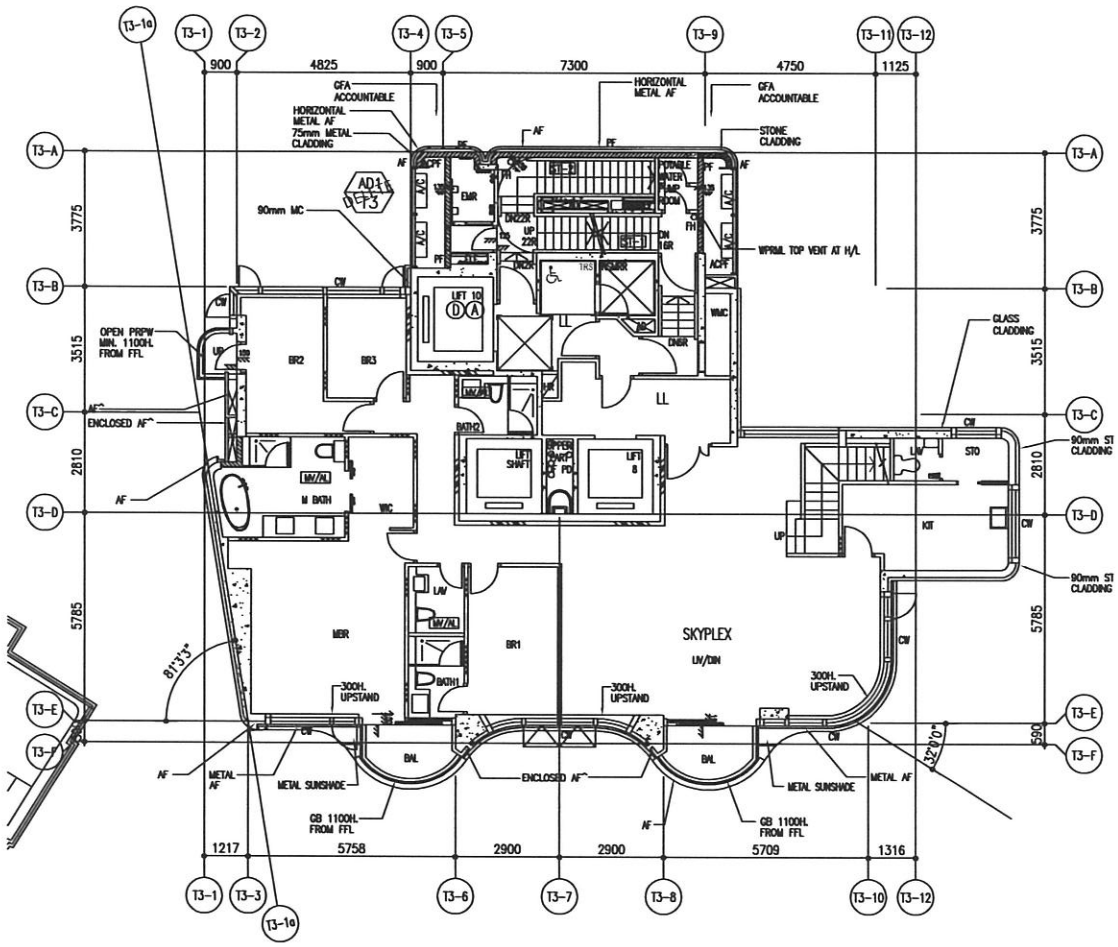

28/F WINDOW LOCATION PLAN
FOR PRECAST FACADE AT TOWER 3

B.D. REF :

ARCHITECT :
WONG TUNG & PARTNERS LIMITED
ARCHITECTS & PLANNERS

STRUCTURAL ENGINEER :
SUN HUNG KAI
ARCHITECTS AND ENGINEERS LTD.
SUN HUNG KAI CENTRE, WANCHAI, HONGKONG
TEL. 28278111 FAX. 28272884

FACADE CONSULTANT:
ALPHA CONSULTING LIMITED
Steel Structure & Facade Specialist

MAIN CONTRACTOR :
Sanfield Engineering Construction Ltd.

CLIENT :
SUN HUNG KAI
REAL ESTATE AGENCY LTD.
42/F SUN HUNG KAI CENTRE, WANCHAI, HONGKONG

NOTE :
1. ALL DIMENSIONS ARE IN mm.
2. ALL ELEVATIONS ARE VIEWED FROM OUTSIDE.
3. ALL DIMENSIONS TO BE VERIFIED ON SITE BEFORE FABRICATION.

LEGEND :
X1 — DETAIL MARK NO.
X001 — REFER SHEET NO.
1. F.F.L. -- FINISHED FLOOR LEVEL
2. S.F.L. -- STRUCTURAL FLOOR LEVEL
3. /R -- REVERSED DETAIL

NO.	DATE	REVISED	BY
E	13/10/2022	RENEW LOCATION PLAN REFER TO A104	YB
D	8/09/2022	REVISION SUBJECT TO ARCH.COMMENT	IVAN
C	13/05/2022	REVISION SUBJECT TO ARCH.COMMENT	IVAN
B	25/04/2022	REVISION SUBJECT TO ARCH.COMMENT	IVAN
A	11/04/2022	RENEW LOCATION PLAN REFER TO A067	IVAN

JOB NO. : J-859

PROJECT :
PROPOSED RESIDENTIAL / COMMERCIAL DEVELOPMENT AT NKIL NO.6551 KAI TAK AREA 4C, SITE 3 KAI TAK, KOWLOON


TITLE :
28/F WINDOW LOCATION PLAN FOR PRECAST FACADE AT TOWER 3

DATE : 17-Nov-21 | SCALE : 1:60 (A3)


DRAWN BY : IVAN | CHECKED BY :

美特鋁質有限公司
MIDI ALUMINIUM FABRICATOR LTD.
Units 6-8, Sunray Industrial Centre, 1/F
610 Cha Kwo Ling Road, Kowloon
Tel:23489211-4 Fax:(852)27727866

DWG NO. : J859-SD-PL-303 | REV. : E

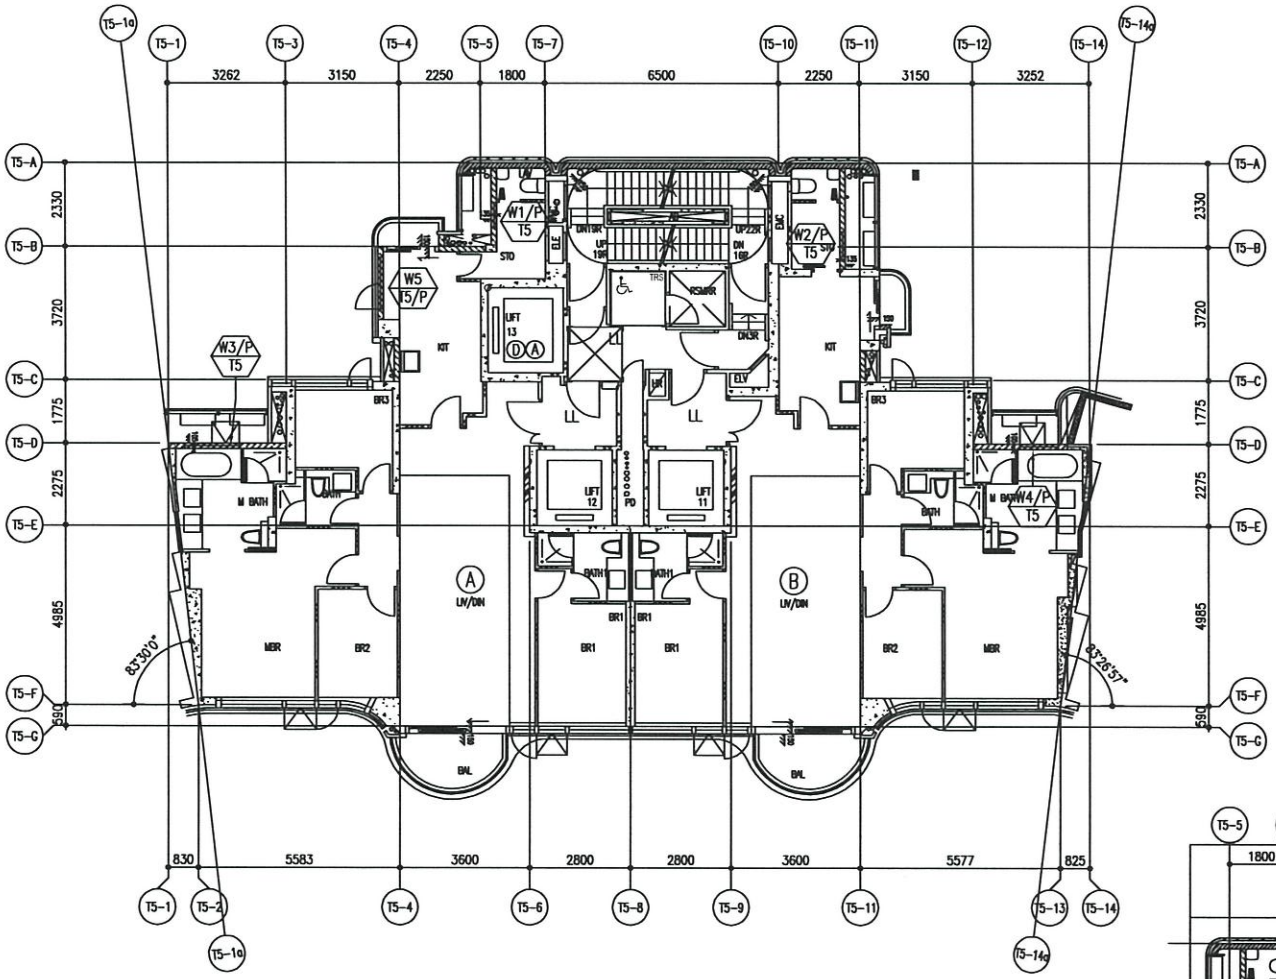

2/F TO 26/F WINDOW LOCATION PLAN FOR PRECAST FACADE
AT TOWER 5 (21 STOREYS, 4/F,13/F,14/F,24/F OMITTED)

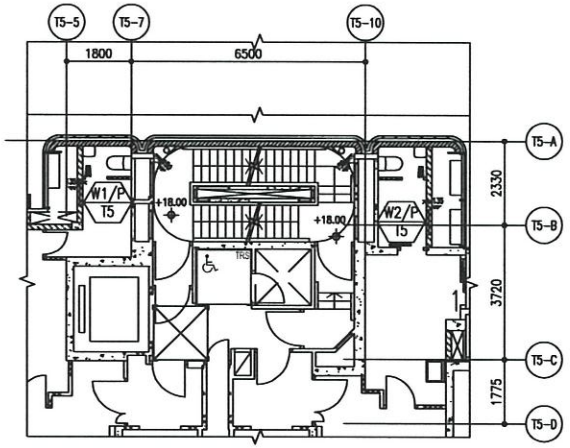

2/F PART PLAN OF TOWER 5

B.D. REF :

ARCHITECT :
WONG TUNG & PARTNERS LIMITED
ARCHITECTS & PLANNERS

STRUCTURAL ENGINEER :
SUN HUNG KAI
ARCHITECTS AND ENGINEERS LTD.
SUN HUNG KAI CENTRE, WANCHAI, HONGKONG
TEL. 28276111 FAX. 28272884

FACADE CONSULTANT:
ALPHA CONSULTING LIMITED
Steel Structure & Facade Specialist

MAIN CONTRACTOR :
Sanfield Engineering Construction Ltd.

CLIENT :
SUN HUNG KAI
REAL ESTATE AGENCY LTD.
42/F SUN HUNG KAI CENTRE, WANCHAI, HONGKONG

NOTE :
1. ALL DIMENSIONS ARE IN mm.
2. ALL ELEVATIONS ARE VIEWED FROM OUTSIDE.
3. ALL DIMENSIONS TO BE VERIFIED ON SITE BEFORE FABRICATION.

LEGEND :
X1 / X001 — DETAIL MARK NO. / REFER SHEET NO.
1. F.F.L. --- FINISHED FLOOR LEVEL
2. S.F.L. --- STRUCTURAL FLOOR LEVEL
3. (R) --- REVERSED DETAIL

NO.	DATE	REVISED	BY
B	13/10/2022	RENEW LOCATION PLAN REFER TO A1041	
A	11/04/2022	RENEW LOCATION PLAN REFER TO A1057	

JOB NO. : J-859

PROJECT :
PROPOSED RESIDENTIAL / COMMERCIAL DEVELOPMENT AT NKIL NO.6551 KAI TAK AREA 4C, SITE 3 KAI TAK, KOWLOON


TITLE :
2~26/F WINDOW LOCATION PLAN FOR PRECAST FACADE AT TOWER 5

DATE : 17-Nov-21 | SCALE : 1:70 (A3)

DRAWN BY : IVAN | CHECKED BY :

美特鋁製有限公司
MIDI ALUMINIUM FABRICATION LTD.
Units 6-8, Sunray Industrial Centre, 1/F
610 Cha Kwo Ling Road, Kowloon
Tel:23489211-4 Fax:(852)27727666

DWG NO. : J859-SD-PL-501 | REV. : B

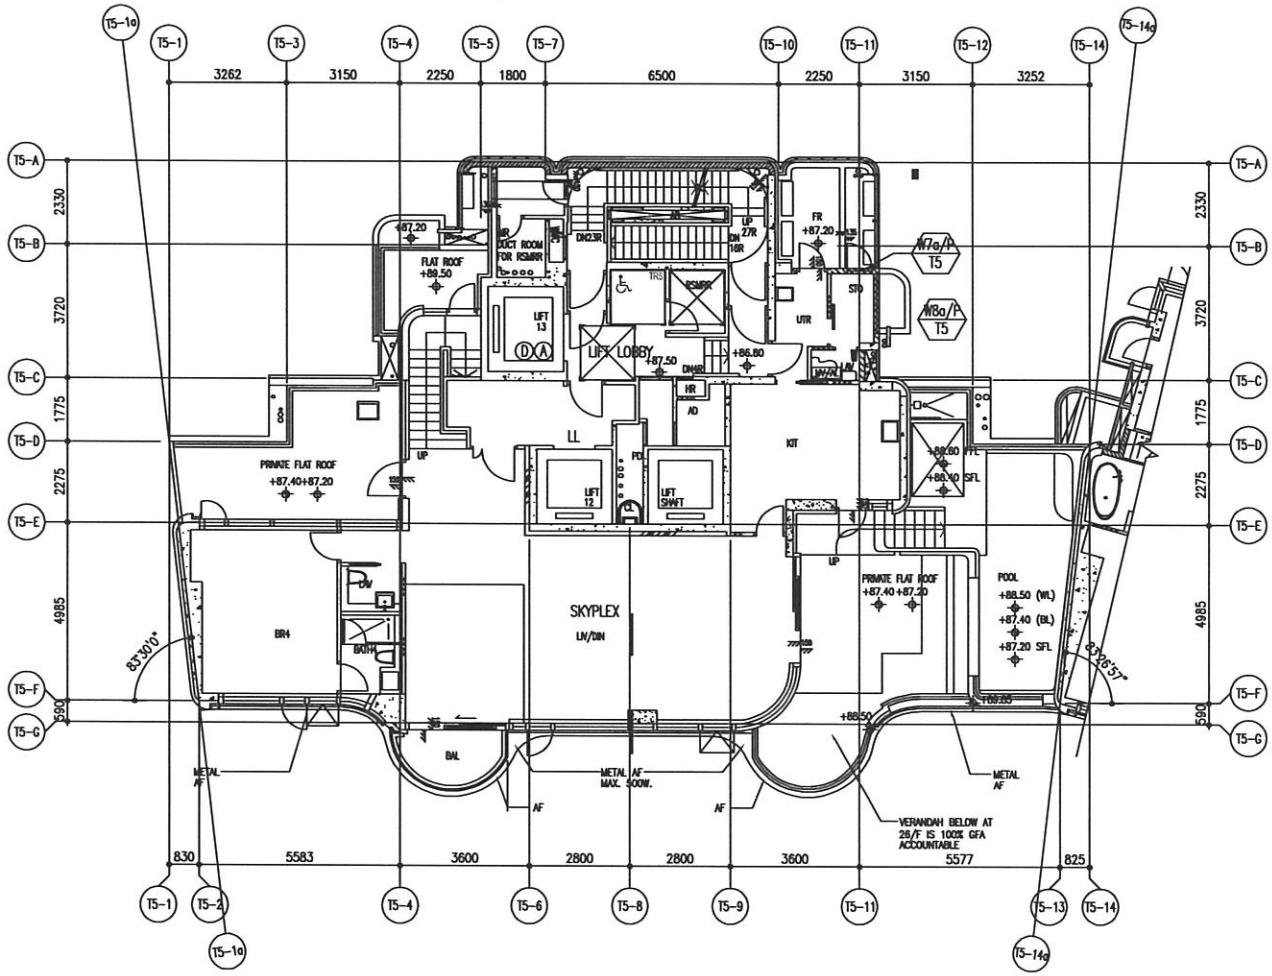

27/F WINDOW LOCATION PLAN
FOR PRECAST FACADE AT TOWER 5

B.D. REF :

ARCHITECT :
WONG TUNG & PARTNERS LIMITED
ARCHITECTS & PLANNERS

STRUCTURAL ENGINEER :
SUN HUNG KAI
ARCHITECTS AND ENGINEERS LTD.
SUN HUNG KAI CENTRE, WANCHAI, HONGKONG
TEL: 28278111 FAX: 28272884

FACADE CONSULTANT:
ALPHA CONSULTING LIMITED
Steel Structure & Facade Specialist

MAIN CONTRACTOR :
Sanfield Engineering Construction Ltd.

CLIENT :
SUN HUNG KAI
REAL ESTATE AGENCY LTD.
42/F SUN HUNG KAI CENTRE, WANCHAI, HONGKONG

NOTE :
1. ALL DIMENSIONS ARE IN mm.
2. ALL ELEVATIONS ARE VIEWED FROM OUTSIDE.
3. ALL DIMENSIONS TO BE VERIFIED ON SITE BEFORE FABRICATION.

LEGEND :
X1 / X001 — DETAIL MARK NO. / REFER SHEET NO.
1. F.F.L. -- FINISHED FLOOR LEVEL
2. S.F.L. -- STRUCTURAL FLOOR LEVEL
3. /R -- REVERSED DETAIL

NO.	DATE	REVISED	BY
B	13/10/2022	RENEW LOCATION PLAN REFER TO A1041B	
A	11/04/2022	RENEW LOCATION PLAN REFER TO A1067A	

JOB NO. : J-859

PROJECT :
PROPOSED RESIDENTIAL / COMMERCIAL DEVELOPMENT AT NKIL NO.6551 KAI TAK AREA 4C, SITE 3 KAI TAK, KOWLOON


TITLE :
27/F WINDOW LOCATION PLAN FOR PRECAST FACADE AT TOWER 5


DATE : 17-Nov-21 | SCALE : 1:60 (A3)

DRAWN BY : IVAN | CHECKED BY :

美特鋁實有限公司
MIDI ALUMINIUM FABRICATOR LTD.
Units 6-8, Sunray Industrial Centre, 1/F
610 Cha Kwo Ling Road, Kowloon
Tel:23489211-4 Fax:(852)27727666

DWG NO. : J859-SD-PL-502 | REV. : B

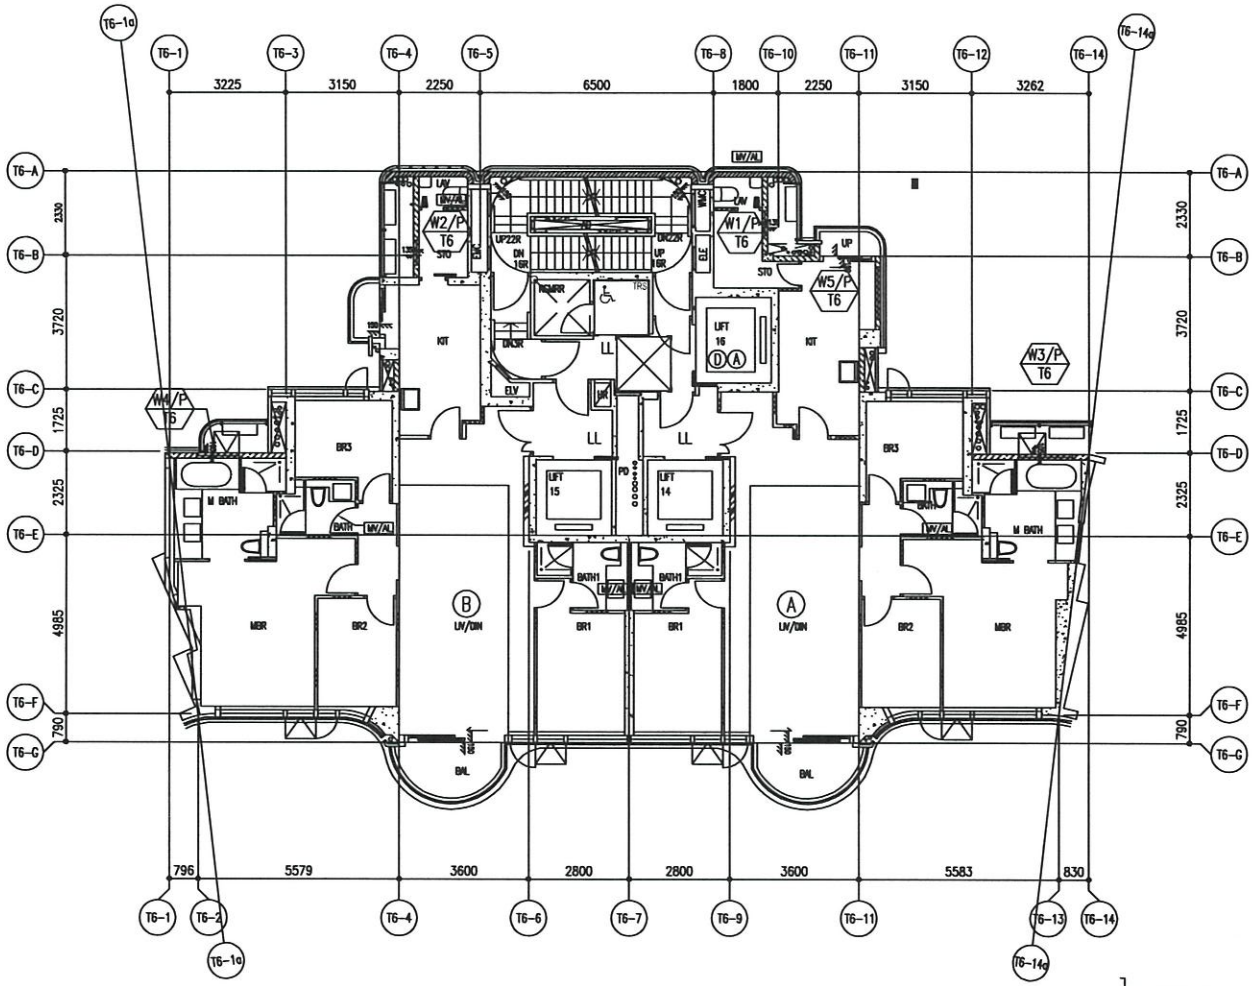
T6-1a
T6-1
T6-3
T6-4
T6-5
T6-8
T6-10
T6-11
T6-12
T6-14
T6-14a
3225
3150
2250
6500
1800
2250
3150
3262
T6-A
T6-B
T6-C
T6-D
T6-E
T6-F
T6-G
2330
3720
1725
2325
4985
790
W2/P T6
W1/P T6
W5/P T6
W3/P T6
W4/P T6
W4/P T6
W4

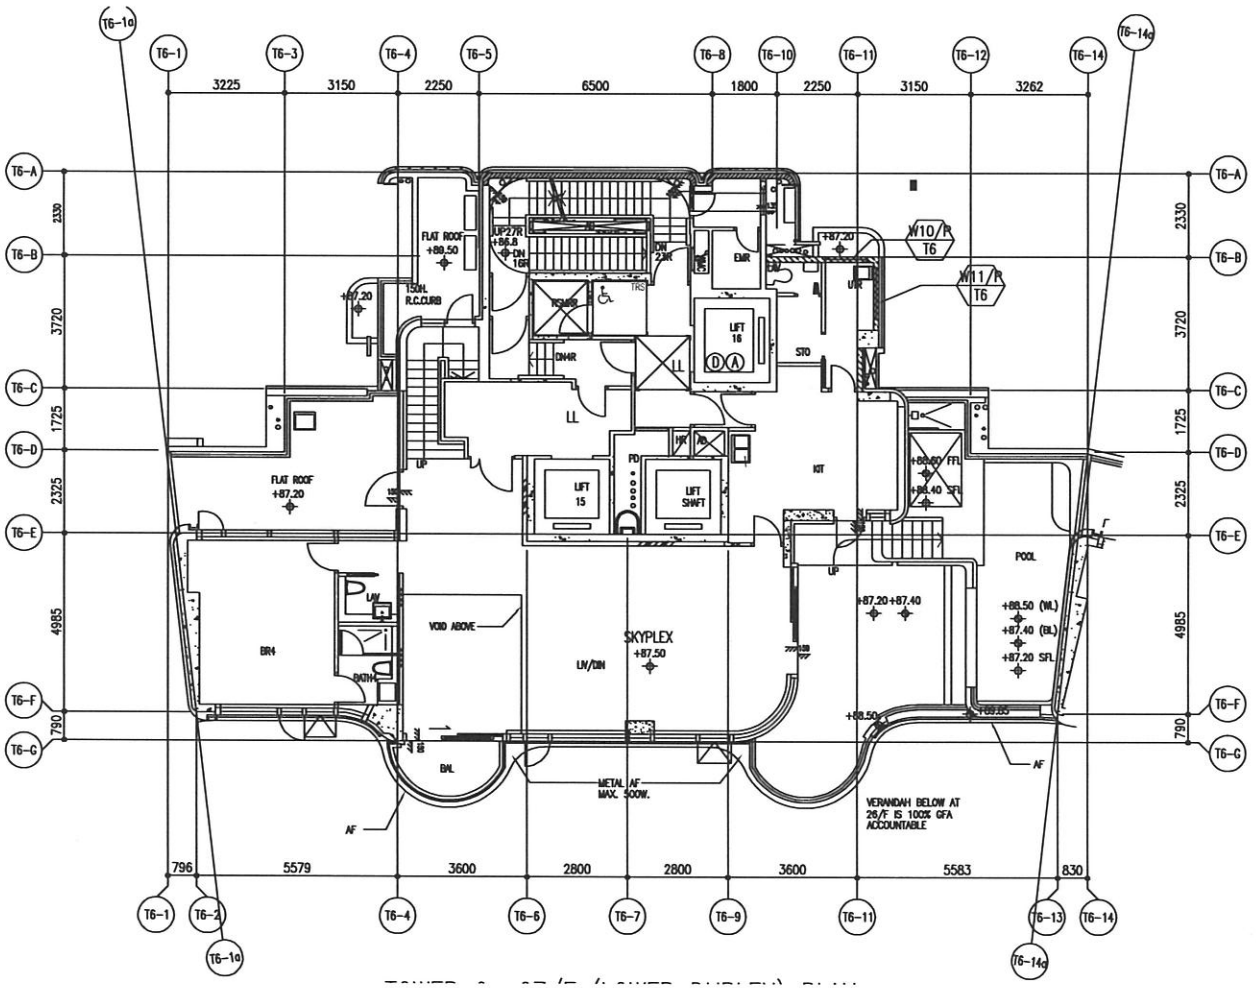

27/F WINDOW LOCATION PLAN
FOR PRECAST FACADE AT TOWER 6

B.D. REF :
-

ARCHITECT :
WONG TUNG & PARTNERS LIMITED
ARCHITECTS & PLANNERS

STRUCTURAL ENGINEER :
SUN HUNG KAI
ARCHITECTS AND ENGINEERS LTD.
SUN HUNG KAI CENTRE, WANCHAI, HONGKONG
TEL: 28278111 FAX: 28272884

FACADE CONSULTANT:
ALPHA CONSULTING LIMITED
Steel Structure & Facade Specialist

MAIN CONTRACTOR :
Sanfield Engineering Construction Ltd.

CLIENT :
SUN HUNG KAI
REAL ESTATE AGENCY LTD.
42/F SUN HUNG KAI CENTRE, WANCHAI, HONGKONG

NOTE :
1. ALL DIMENSIONS ARE IN mm.
2. ALL ELEVATIONS ARE VIEWED FROM OUTSIDE.
3. ALL DIMENSIONS TO BE VERIFIED ON SITE BEFORE FABRICATION.

LEGEND :
X1 / X001 — DETAIL MARK NO. / REFER SHEET NO.
1. F.F.L. -- FINISHED FLOOR LEVEL
2. S.F.L. -- STRUCTURAL FLOOR LEVEL
3. /R -- REVERSED DETAIL

NO.	DATE	REVISED	BY
B	13/10/2022	RENEW LOCATION PLAN REFER TO A804	YK
A	11/04/2022	RENEW LOCATION PLAN REFER TO A857	YMK

JOB NO. : J-859

PROJECT :
PROPOSED RESIDENTIAL / COMMERCIAL DEVELOPMENT AT NKIL NO.6551 KAI TAK AREA 4C, SITE 3 KAI TAK, KOWLOON


TITLE :
27/F WINDOW LOCATION PLAN FOR PRECAST FACADE AT TOWER 6

DATE : 17-Nov-21 | SCALE : 1:60 (A3)


DRAWN BY : IVAN | CHECKED BY :

美特鋁質有限公司
MIDI ALUMINIUM FABRICATOR LTD.
Units 6-8, Sunray Industrial Centre, 1/F
610 Cha Kwo Ling Road, Kowloon
Tel:23489211-4 Fax:(852)27727666

DWG NO. : J859-SD-PL-602 | REV. : B

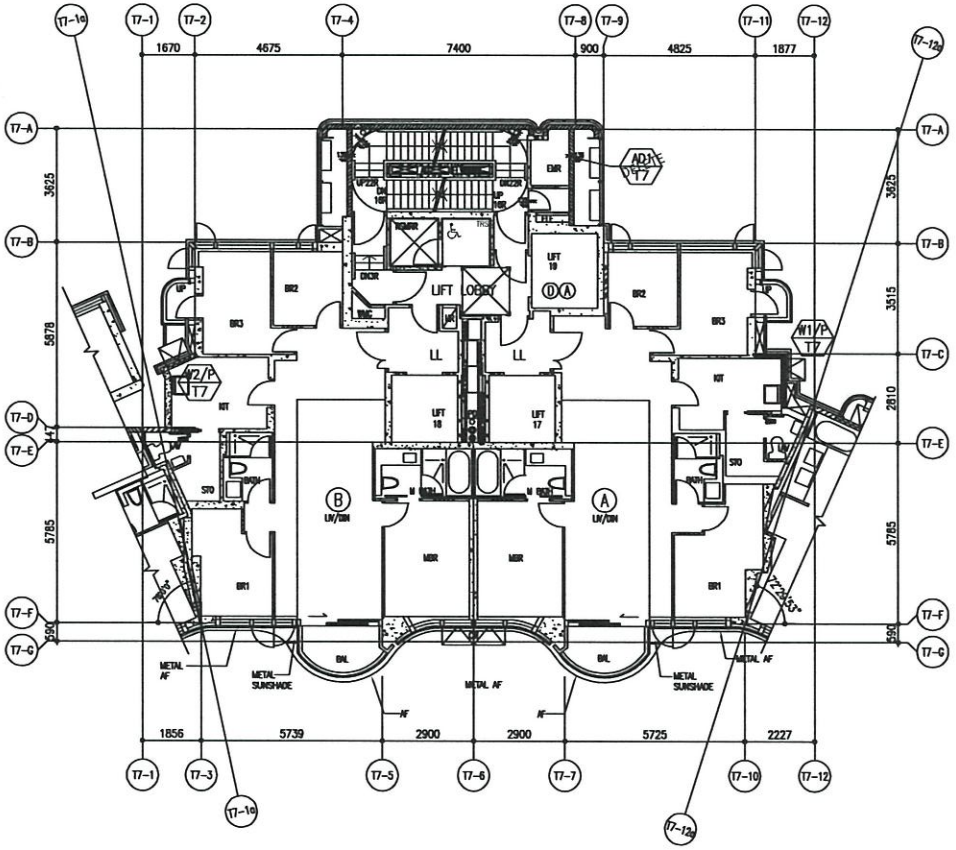

2/F TO 26/F WINDOW LOCATION PLAN FOR PRECAST FACADE AT TOWER 7 (21 STOREYS, 4/F,13/F,14/F,24/F OMITTED)

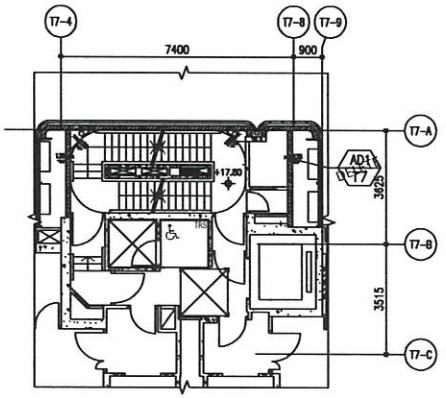

2/F PART PLAN OF TOWER 7

B.D. REF :

ARCHITECT :
WONG TUNG & PARTNERS LIMITED
ARCHITECTS & PLANNERS

STRUCTURAL ENGINEER :
SUN HUNG KAI
ARCHITECTS AND ENGINEERS LTD.
SUN HUNG KAI CENTRE, WANCHAI, HONGKONG
TEL. 28278111 FAX. 28272004

FACADE CONSULTANT:
ALPHA CONSULTING LIMITED
Steel Structure & Facade Specialist

MAIN CONTRACTOR :
Sanfield Engineering Construction Ltd.

CLIENT :
SUN HUNG KAI
REAL ESTATE AGENCY LTD.
42/F SUN HUNG KAI CENTRE, WANCHAI, HONGKONG

NOTE :
1. ALL DIMENSIONS ARE IN mm.
2. ALL ELEVATIONS ARE VIEWED FROM OUTSIDE.
3. ALL DIMENSIONS TO BE VERIFIED ON SITE BEFORE FABRICATION.

LEGEND :
X1 / X001 — DETAIL MARK NO. / REFER SHEET NO.
1. F.F.L. -- FINISHED FLOOR LEVEL
2. S.F.L. -- STRUCTURAL FLOOR LEVEL
3. /R -- REVERSED DETAIL

NO.	DATE	REVISED	BY
E	13/10/2022	RENEW LOCATION PLAN REFER TO AR11	YS
D	8/09/2022	REVISION SUBJECT TO ARCH.COMMENT	YWH
C	13/05/2022	REVISION SUBJECT TO ARCH.COMMENT	YWH
B	25/04/2022	REVISION SUBJECT TO ARCH.COMMENT	YWH
A	11/04/2022	RENEW LOCATION PLAN REFER TO AR67	YWH

JOB NO. : J-859

PROJECT :
PROPOSED RESIDENTIAL / COMMERCIAL DEVELOPMENT AT NKIL NO.6551 KAI TAK AREA 4C, SITE 3 KAI TAK, KOWLOON


TITLE :
2~26/F WINDOW LOCATION PLAN FOR PRECAST FACADE AT TOWER 7

DATE : 14-Nov-21 | SCALE : 1:80 (A3)

DRAWN BY : IVAN | CHECKED BY :

美特鋁製有限公司
MIDI ALUMINIUM FABRICATOR LTD.
Units 6-8, Sunray Industrial Centre, 1/F
610 Cha Kwo Ling Road, Kowloon
Tel:23409211-4 Fax:(852)27727866

DWG NO. : J859-SD-PL-701 | REV. : E

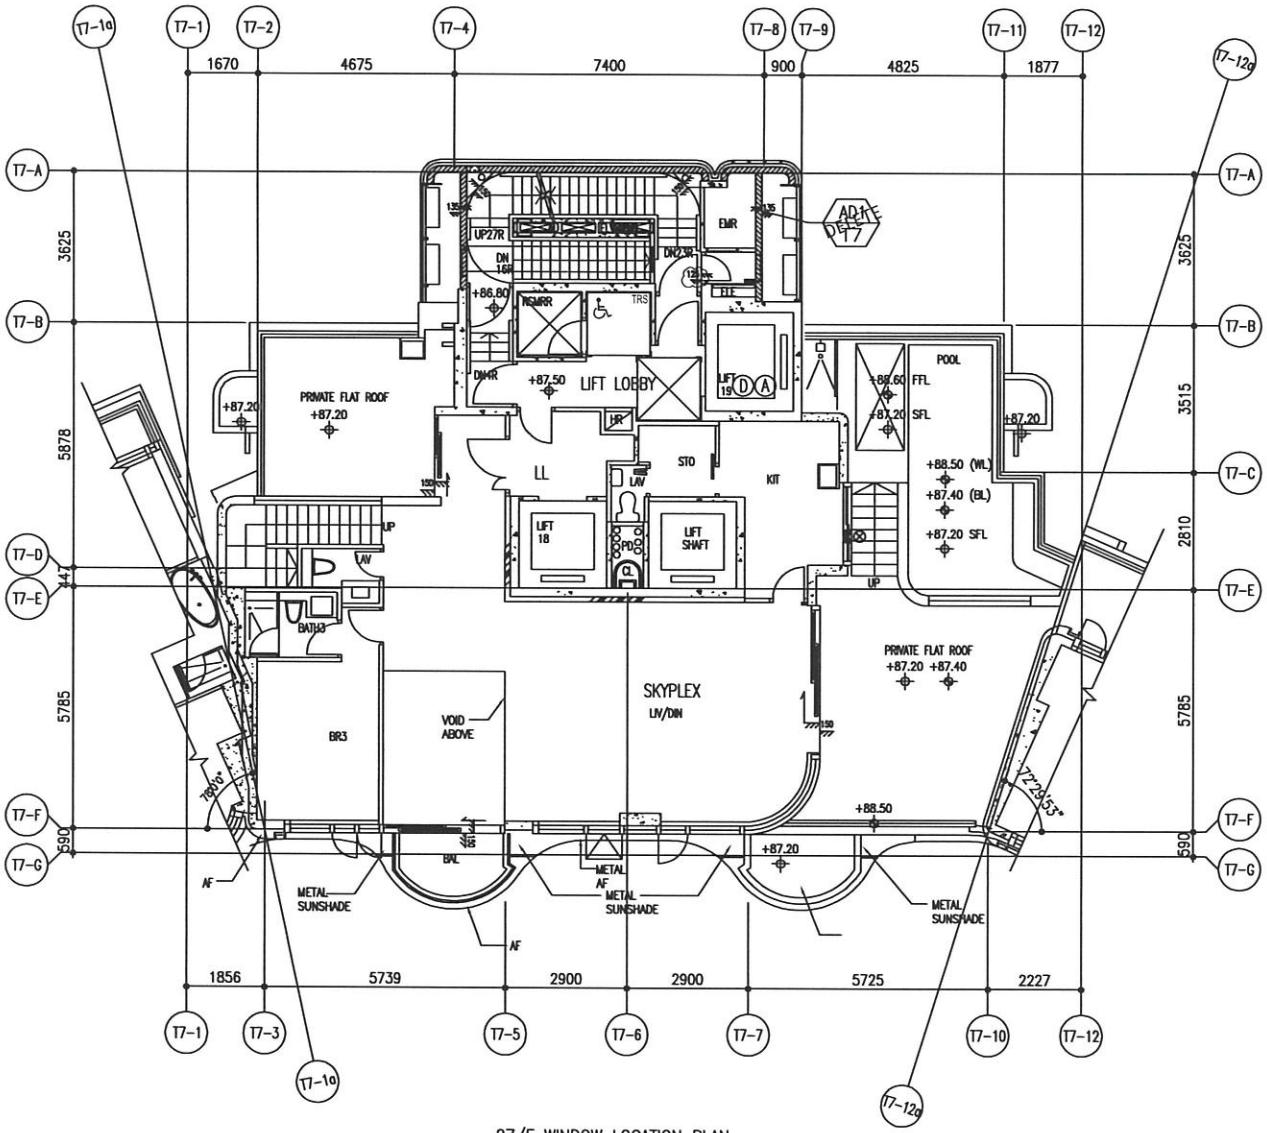

27/F WINDOW LOCATION PLAN
FOR PRECAST FACADE AT TOWER 7

B.D. REF :

ARCHITECT :
WONG TUNG & PARTNERS LIMITED
ARCHITECTS & PLANNERS

STRUCTURAL ENGINEER :
SUN HUNG KAI
ARCHITECTS AND ENGINEERS LTD.
SUN HUNG KAI CENTRE, WANCHAI, HONGKONG
TEL. 28278111 FAX. 28272884

FACADE CONSULTANT:
ALPHA CONSULTING LIMITED
Steel Structure & Facade Specialist

MAIN CONTRACTOR :
Sanfield Engineering Construction Ltd.

CLIENT :
SUN HUNG KAI
REAL ESTATE AGENCY LTD.
42/F SUN HUNG KAI CENTRE, WANCHAI, HONGKONG

NOTE :
1. ALL DIMENSIONS ARE IN mm.
2. ALL ELEVATIONS ARE VIEWED FROM OUTSIDE.
3. ALL DIMENSIONS TO BE VERIFIED ON SITE BEFORE FABRICATION.

LEGEND :
X1 — DETAIL MARK NO.
X001 — REFER SHEET NO.
1. F.F.L. --FINISHED FLOOR LEVEL
2. S.F.L. --STRUCTURAL FLOOR LEVEL
3. /R --REVERSED DETAIL

NO.	DATE	REVISED	BY
E	13/10/2022	RENEW LOCATION PLAN REFER TO A911	YK
D	8/09/2022	REVISION SUBJECT TO ARCH.COMMENT	YKMK
C	13/05/2022	REVISION SUBJECT TO ARCH.COMMENT	YKMK
B	25/04/2022	REVISION SUBJECT TO ARCH.COMMENT	YKMK
A	11/04/2022	RENEW LOCATION PLAN REFER TO A867	YKMK

JOB NO. : J-859

PROJECT :
PROPOSED RESIDENTIAL / COMMERCIAL DEVELOPMENT AT NKIL NO.6551 KAI TAK AREA 4C, SITE 3 KAI TAK, KOWLOON


TITLE :
27/F WINDOW LOCATION PLAN FOR PRECAST FACADE AT TOWER 7

DATE : 14-Nov-21 | SCALE : 1:60 (A3)


DRAWN BY : IVAN | CHECKED BY :

美特鋁質有限公司
MIDI ALUMINIUM FABRICATOR LTD.
Units 6-8, Sunray Industrial Centre, 1/F
610 Cha Kwo Ling Road, Kowloon
Tel:23489211-4 Fax:(852)27727666

DWG NO. : J859-SD-PL-702 | REV. : E

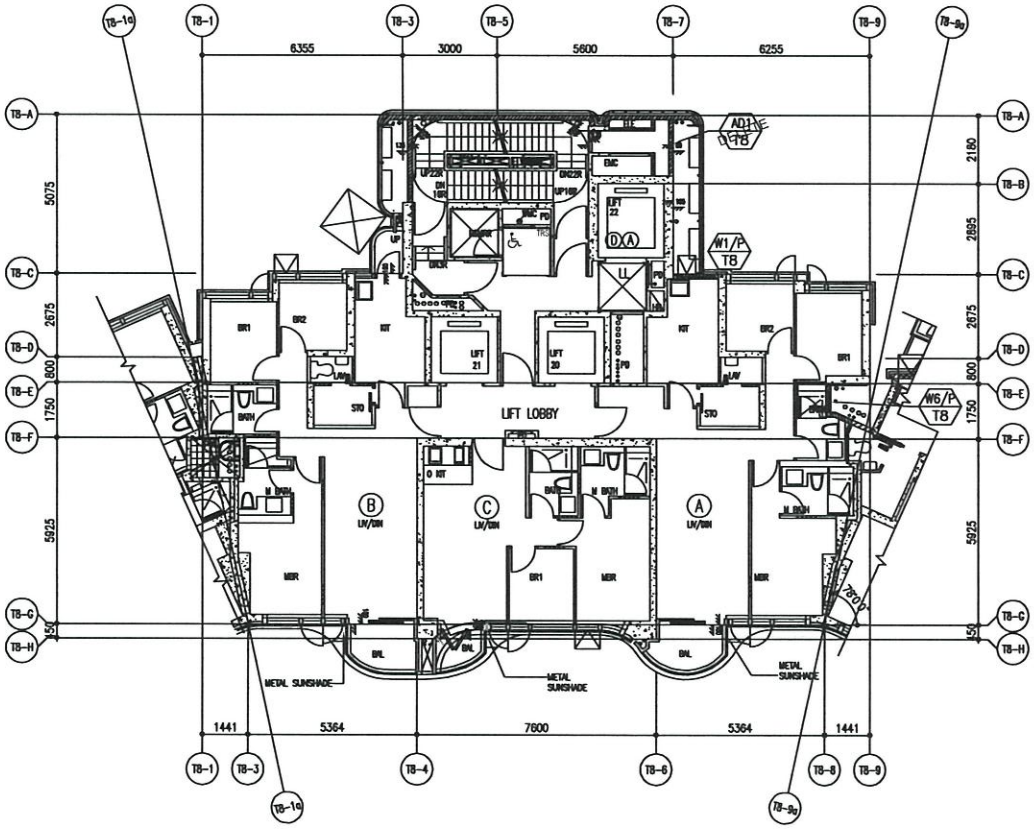

2/F TO 8/F WINDOW LOCATION PLAN FOR PRECAST FACADE
AT TOWER 8 (6 STOREYS, 4/F OMITTED)

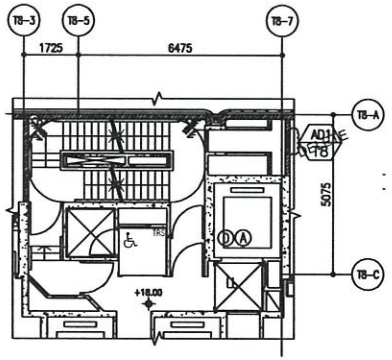

2/F PART PLAN OF TOWER 8

B.D. REF :

ARCHITECT :
WONG TUNG & PARTNERS LIMITED
ARCHITECTS & PLANNERS

STRUCTURAL ENGINEER :
SUN HUNG KAI
ARCHITECTS AND ENGINEERS LTD.
SUN HUNG KAI CENTRE, WANCHAI, HONGKONG
TEL. 28278111 FAX. 28272684

FACADE CONSULTANT:
ALPHA CONSULTING LIMITED
Steel Structure & Facade Specialist

MAIN CONTRACTOR :
Sanfield Engineering
Construction Ltd.

CLIENT :
SUN HUNG KAI
REAL ESTATE AGENCY LTD.
42/F SUN HUNG KAI CENTRE, WANCHAI, HONGKONG

NOTE :
1. ALL DIMENSIONS ARE IN mm.
2. ALL ELEVATIONS ARE VIEWED FROM OUTSIDE.
3. ALL DIMENSIONS TO BE VERIFIED ON SITE BEFORE FABRICATION.

LEGEND :
X1 — DETAIL MARK NO.
X001 — REFER SHEET NO.
1. F.F.L. — FINISHED FLOOR LEVEL
2. S.F.L. — STRUCTURAL FLOOR LEVEL
3. (/R) — REVERSED DETAIL

NO.	DATE	REVISED	BY
F	13/10/2022	REVIEW LOCATION PLAN REFER TO A011	YH
E	8/09/2022	REVISION SUBJECT TO ARCH.COMMENT	YMH
D	30/08/2022	REVISION SUBJECT TO ARCH.COMMENT	YMH
C	13/05/2022	REVISION SUBJECT TO ARCH.COMMENT	YMH
B	25/04/2022	REVISION SUBJECT TO ARCH.COMMENT	YMH
A	11/04/2022	REVIEW LOCATION PLAN REFER TO A057	YMH

JOB NO. : J-859

PROJECT :
PROPOSED RESIDENTIAL / COMMERCIAL
DEVELOPMENT AT NKIL NO.6551 KAI
TAK AREA 4C, SITE 3
KAI TAK, KOWLOON


TITLE :
2-8/F WINDOW LOCATION PLAN
FOR PRECAST FACADE
AT TOWER 8

DATE : 14-Nov-21 | SCALE : 1:80 (A3)

DRAWN BY : IVAN | CHECKED BY :

美特鋁質有限公司
MIDI ALUMINIUM FABRICATOR LTD.
Units 6-8, Sunray Industrial Centre, 1/F
810 Cha Kwo Ling Road, Kowloon
Tel:23489211-4 Fax:(852)27727666

DWG NO. : J859-SD-PL-801 | REV. : F

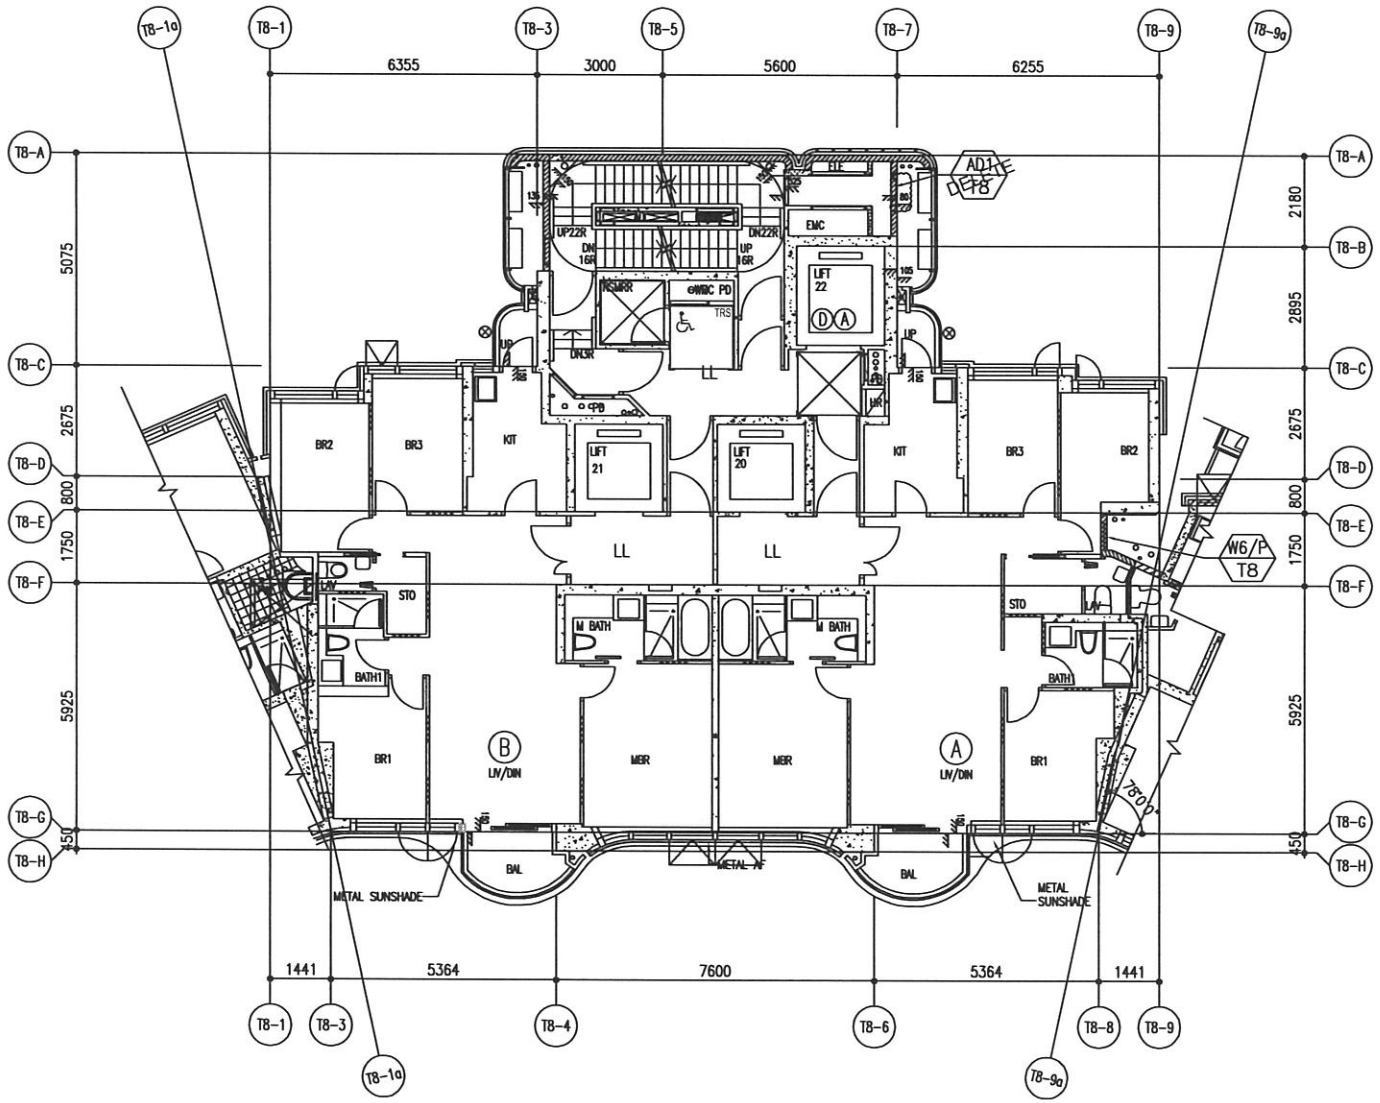

9/F TO 26/F WINDOW LOCATION PLAN FOR PRECAST FACADE
AT TOWER 8 (15 STOREYS, 13/F,14/F,24/F OMITTED)

B.D. REF :

ARCHITECT :
WONG TUNG & PARTNERS LIMITED
ARCHITECTS & PLANNERS

STRUCTURAL ENGINEER :
SUN HUNG KAI
ARCHITECTS AND ENGINEERS LTD.
SUN HUNG KAI CENTRE, WANCHAI, HONGKONG
TEL. 28278111 FAX. 28272884

FACADE CONSULTANT:
ALPHA CONSULTING LIMITED
Steel Structure & Facade Specialist

MAIN CONTRACTOR :
Sanfield Engineering Construction Ltd.

CLIENT :
SUN HUNG KAI
REAL ESTATE AGENCY LTD.
42/F SUN HUNG KAI CENTRE, WANCHAI, HONGKONG

NOTE :
1. ALL DIMENSIONS ARE IN mm.
2. ALL ELEVATIONS ARE VIEWED FROM OUTSIDE.
3. ALL DIMENSIONS TO BE VERIFIED ON SITE BEFORE FABRICATION.

LEGEND :
X1 — DETAIL MARK NO.
X001 — REFER SHEET NO.
1. F.F.L. -- FINISHED FLOOR LEVEL
2. S.F.L. -- STRUCTURAL FLOOR LEVEL
3. /F8 -- REVERSED DETAIL

NO.	DATE	REVISED	BY
E	13/10/2022	RENEW LOCATION PLAN REFER TO A011	YB
D	08/08/2022	REVISION SUBJECT TO ARCH.COMMENT	YMW
C	13/05/2022	REVISION SUBJECT TO ARCH.COMMENT	YMW
B	25/04/2022	REVISION SUBJECT TO ARCH.COMMENT	YMW
A	11/04/2022	RENEW LOCATION PLAN REFER TO A067	YMW

JOB NO. : J-859

PROJECT :
PROPOSED RESIDENTIAL / COMMERCIAL DEVELOPMENT AT NKIL NO.6551 KAI TAK AREA 4C, SITE 3 KAI TAK, KOWLOON


TITLE :
9~26/F WINDOW LOCATION PLAN FOR PRECAST FACADE AT TOWER 8

DATE : 14-Nov-21 | SCALE : 1:60 (A3)

DRAWN BY : IVAN | CHECKED BY :

美特鋁質有限公司
MIDI ALUMINIUM FABRICATOR LTD.
Units 6-8, Sunray Industrial Centre, 1/F
610 Cha Kwo Ling Road, Kowloon
Tel:23489211-4 Fax:(852)27727866

DWG NO. : J859-SD-PL-802 | REV. : E

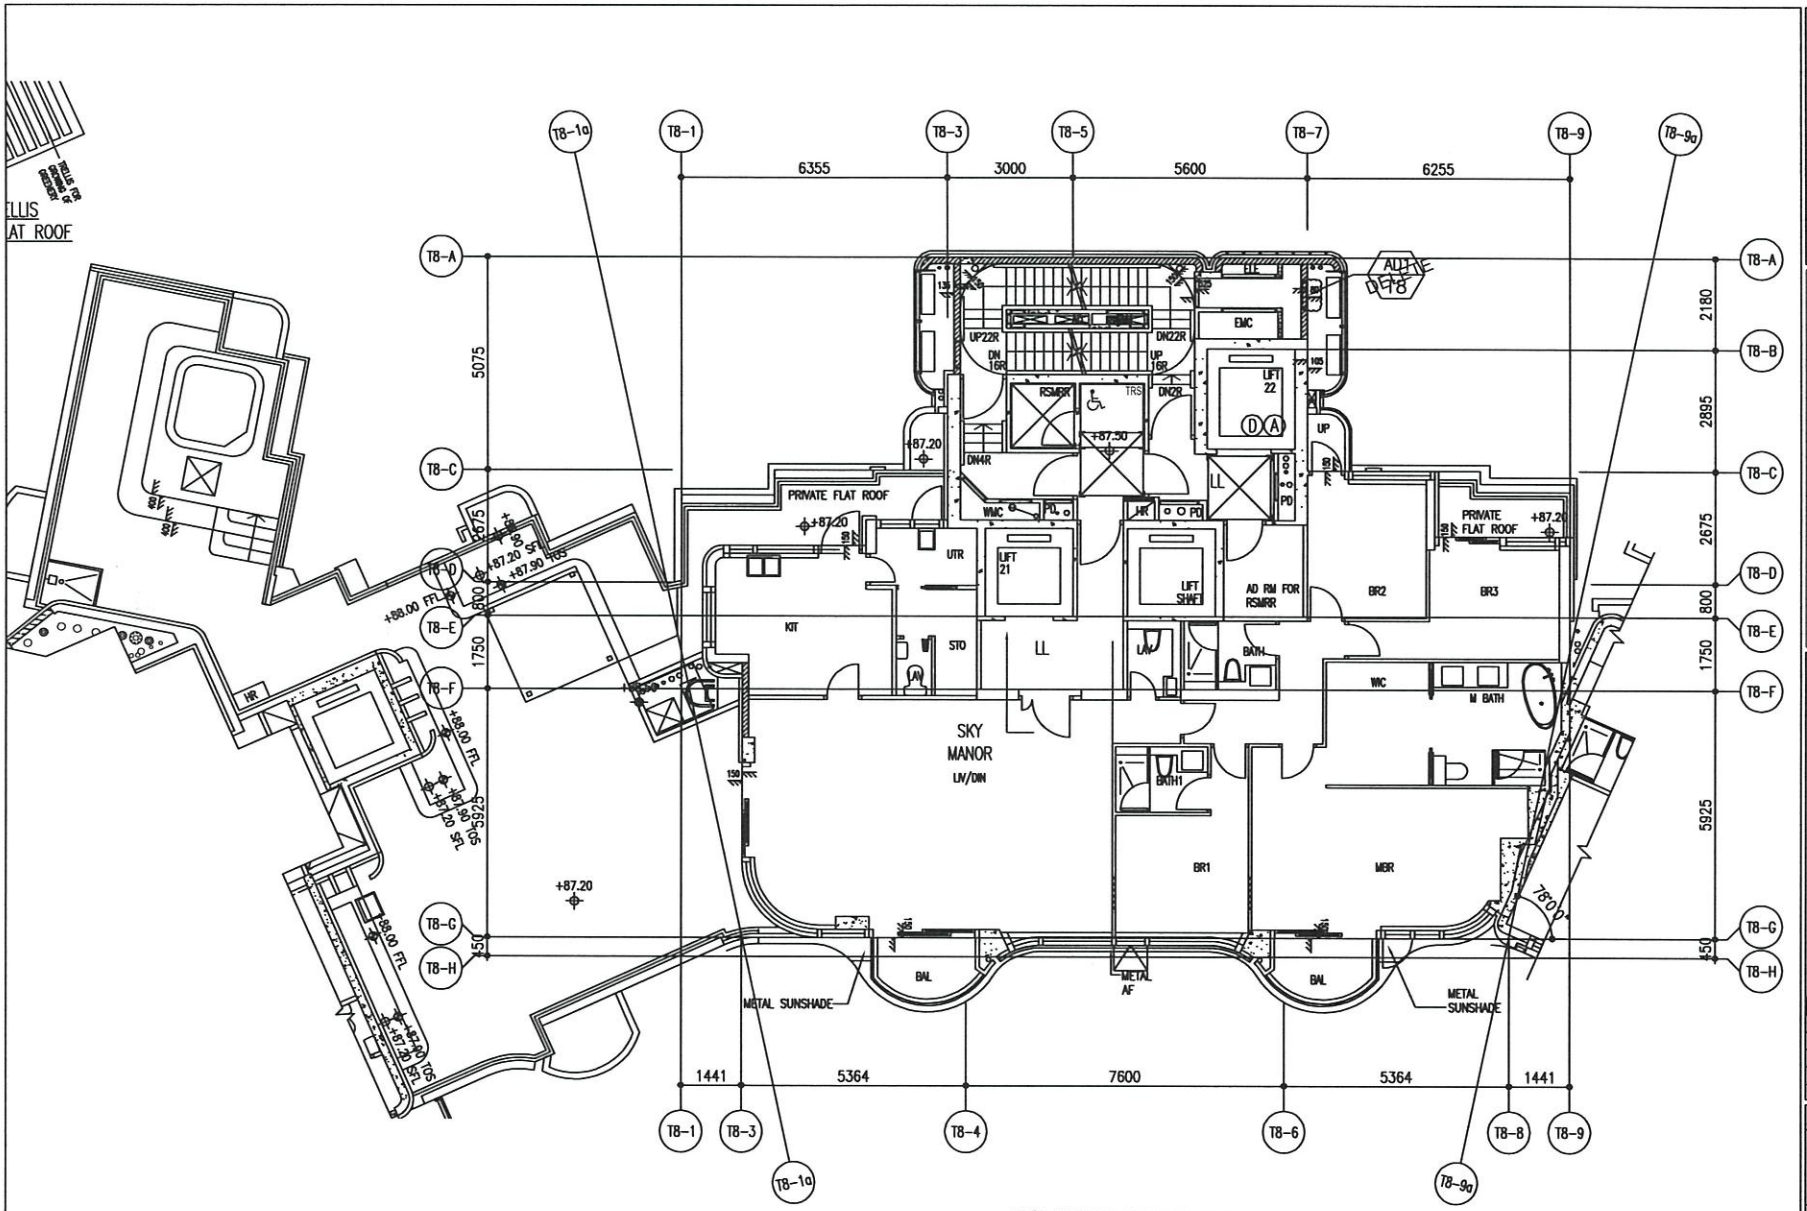

27/F WINDOW LOCATION PLAN
FOR PRECAST FACADE AT TOWER 8

B.D. REF :

ARCHITECT :
WONG TUNG & PARTNERS LIMITED
ARCHITECTS & PLANNERS

STRUCTURAL ENGINEER :
SUN HUNG KAI
ARCHITECTS AND ENGINEERS LTD.
SUN HUNG KAI CENTRE, WANCHAI, HONGKONG
TEL. 28278111 FAX. 28272804

FACADE CONSULTANT:
ALPHA CONSULTING LIMITED
Steel Structure & Facade Specialist

MAIN CONTRACTOR :
Sanfield Engineering Construction Ltd.

CLIENT :
SUN HUNG KAI
REAL ESTATE AGENCY LTD.
42/F SUN HUNG KAI CENTRE, WANCHAI, HONGKONG

NOTE :
1. ALL DIMENSIONS ARE IN mm.
2. ALL ELEVATIONS ARE VIEWED FROM OUTSIDE.
3. ALL DIMENSIONS TO BE VERIFIED ON SITE BEFORE FABRICATION.

LEGEND :
X1 — DETAIL MARK NO.
X001 — REFER SHEET NO.
1. F.F.L. --FINISHED FLOOR LEVEL
2. S.F.L. --STRUCTURAL FLOOR LEVEL
3. /R --REVERSED DETAIL

NO.	DATE	REVISED	BY
E	13/10/2022	RENEW LOCATION PLAN REFER TO A1011	Ivan
D	6/09/2022	REVISION SUBJECT TO ARCH.COMMENT	Ivan
C	13/05/2022	REVISION SUBJECT TO ARCH.COMMENT	Ivan
B	25/04/2022	REVISION SUBJECT TO ARCH.COMMENT	Ivan
A	11/04/2022	RENEW LOCATION PLAN REFER TO A1067	Ivan

JOB NO. : J-859

PROJECT :
PROPOSED RESIDENTIAL / COMMERCIAL DEVELOPMENT AT NIKIL NO.6551 KAI TAK AREA 4C, SITE 3 KAI TAK, KOWLOON


TITLE :
27/F WINDOW LOCATION PLAN FOR PRECAST FACADE AT TOWER 8

DATE : 14-Nov-21 | SCALE : 1:60 (A3)

DRAWN BY : IVAN | CHECKED BY :

美特鋁製有限公司
MIDI ALUMINIUM FABRICATOR LTD.
Units 6-8, Sunray Industrial Centre, 1/F
810 Cha Kwo Ling Road, Kowloon
Tel:23489211-4 Fax:(852)27727666

DWG NO. : J859-SD-PL-803 | REV. : E

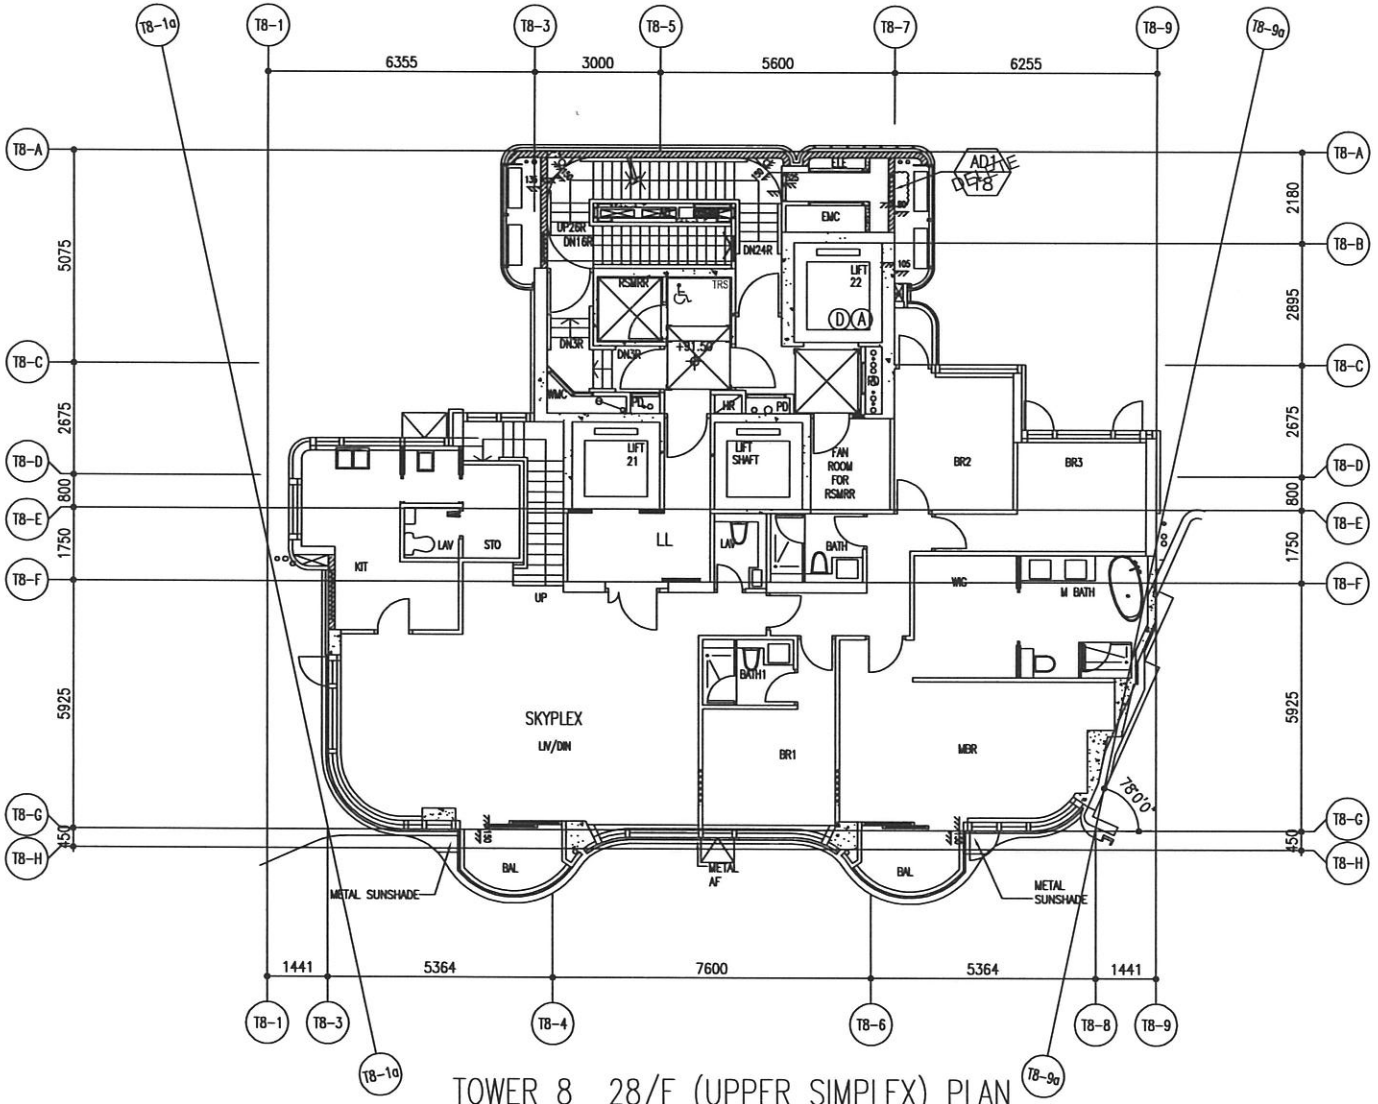

TOWER 8 28/F (UPPER SIMPLEX) PLAN

28/F WINDOW LOCATION PLAN FOR PRECAST FACADE AT TOWER 8

B.D. REF :

ARCHITECT :
WONG TUNG & PARTNERS LIMITED
ARCHITECTS & PLANNERS

STRUCTURAL ENGINEER :
SUN HUNG KAI
ARCHITECTS AND ENGINEERS LTD.
SUN HUNG KAI CENTRE, WANCHAI, HONGKONG
TEL. 28278111 FAX. 28272884

FACADE CONSULTANT:
ALPHA CONSULTING LIMITED
Steel Structure & Facade Specialist

MAIN CONTRACTOR :
Sanfield Engineering Construction Ltd.

CLIENT :
SUN HUNG KAI
REAL ESTATE AGENCY LTD.
42/F SUN HUNG KAI CENTRE, WANCHAI, HONGKONG

NOTE :
1. ALL DIMENSIONS ARE IN mm.
2. ALL ELEVATIONS ARE VIEWED FROM OUTSIDE.
3. ALL DIMENSIONS TO BE VERIFIED ON SITE BEFORE FABRICATION.

LEGEND :
X1 — DETAIL MARK NO.
X001 — REFER SHEET NO.
1. F.F.L. --FINISHED FLOOR LEVEL
2. S.F.L. --STRUCTURAL FLOOR LEVEL
3. /R --REVERSED DETAIL

NO.	DATE	REVISED	BY
E	13/10/2022	REVIEW LOCATION PLAN REFER TO A911	YB
D	08/09/2022	REVISION SUBJECT TO ARCH.COMMENT	YMW
C	13/05/2022	REVISION SUBJECT TO ARCH.COMMENT	YMW
B	25/04/2022	REVISION SUBJECT TO ARCH.COMMENT	YMW
A	11/04/2022	REVIEW LOCATION PLAN REFER TO A867	YMW

JOB NO. : J-859

PROJECT :
PROPOSED RESIDENTIAL / COMMERCIAL DEVELOPMENT AT NKIL NO.6551 KAI TAK AREA 4C, SITE 3 KAI TAK, KOWLOON


TITLE :
28/F WINDOW LOCATION PLAN FOR PRECAST FACADE AT TOWER 8

DATE : 14-Nov-21 | SCALE : 1:60 (A3)

DRAWN BY : IVAN | CHECKED BY :

美特鋁質有限公司
MIDI ALUMINIUM FABRICATOR LTD.
Units 6-8, Sunray Industrial Centre, 1/F
610 Cha Kwo Ling Road, Kowloon
Tel:23489211-4 Fax:(852)27727666

DWG NO. : J859-SD-PL-804 | REV. : E

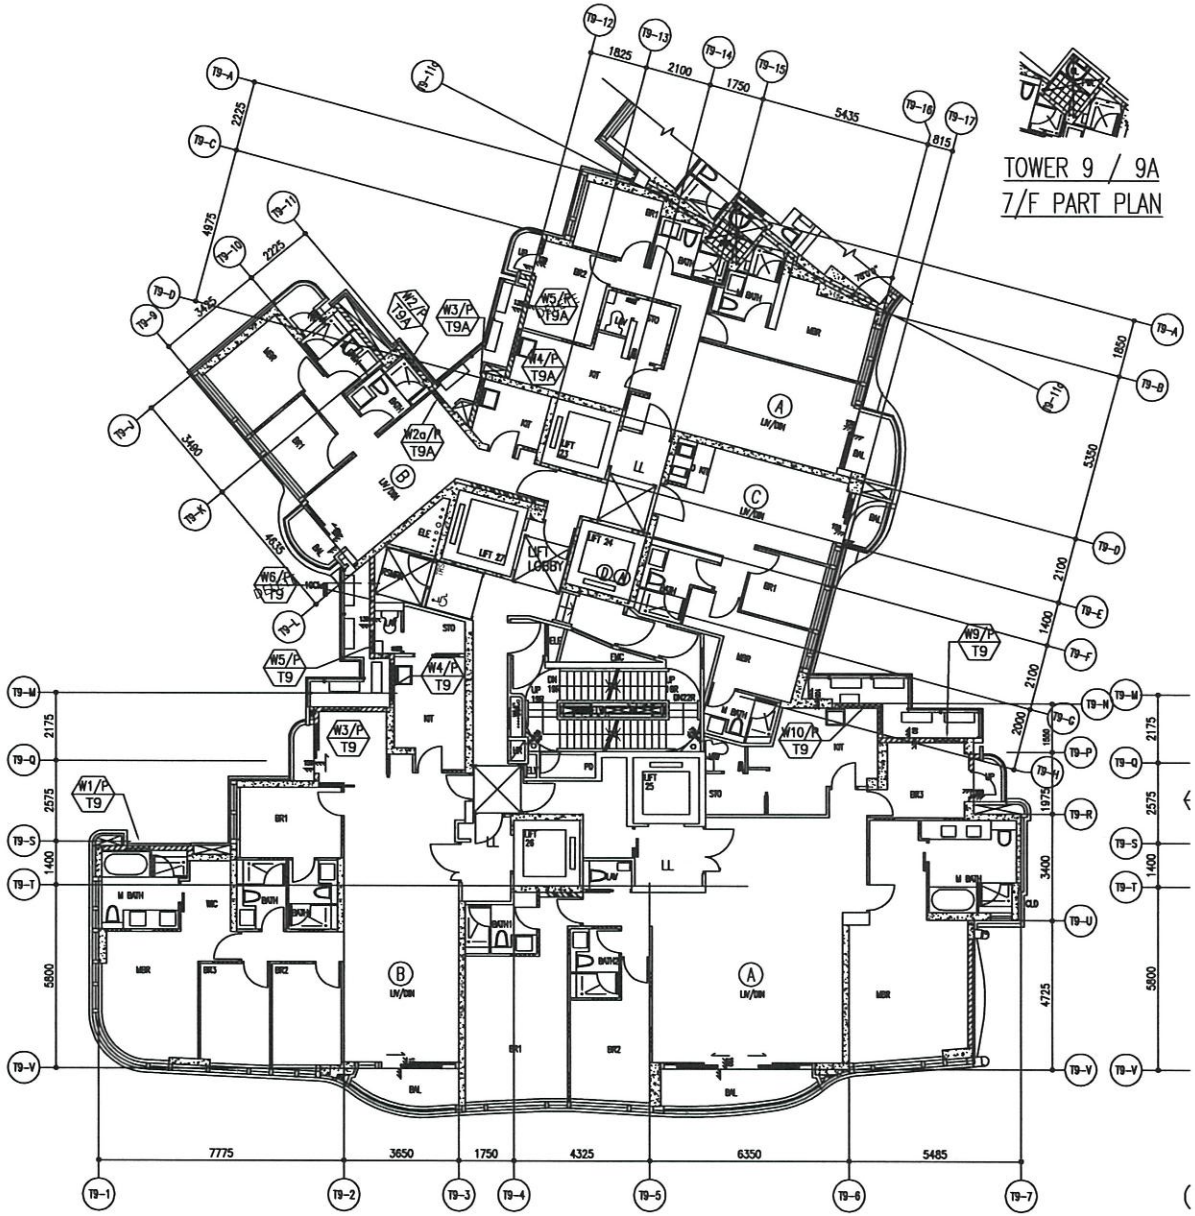

2/F TO 8/F WINDOW LOCATION PLAN FOR PRECAST FACADE
AT TOWER 9 / 9A (6 STOREYS, 4/F OMITTED)

B.D. REF :

ARCHITECT :
WONG TUNG & PARTNERS LIMITED
ARCHITECTS & PLANNERS

STRUCTURAL ENGINEER :
SUN HUNG KAI
ARCHITECTS AND ENGINEERS LTD.
SUN HUNG KAI CENTRE, WANCHAI, HONGKONG
TEL. 28276111 FAX. 28272684

FACADE CONSULTANT:
ALPHA CONSULTING LIMITED
Steel Structure & Facade Specialist

MAIN CONTRACTOR :
Sanfield Engineering Construction Ltd.

CLIENT :
SUN HUNG KAI
REAL ESTATE AGENCY LTD.
42/F SUN HUNG KAI CENTRE, WANCHAI, HONGKONG

NOTE :
1. ALL DIMENSIONS ARE IN mm.
2. ALL ELEVATIONS ARE VIEWED FROM OUTSIDE.
3. ALL DIMENSIONS TO BE VERIFIED ON SITE BEFORE FABRICATION.

LEGEND :
X1 / X001 — DETAIL MARK NO. / REFER SHEET NO.
1. F.F.L. — FINISHED FLOOR LEVEL
2. S.F.L. — STRUCTURAL FLOOR LEVEL
3. (R) — REVERSED DETAIL

NO.	DATE	REVISED	BY
E	13/10/2022	RENEW LOCATION PLAN REFER TO A011	YS
D	08/09/2022	REVISION SUBJECT TO ARCH COMMENT	YWH
C	30/08/2022	REVISION SUBJECT TO ARCH COMMENT	YWH
B	28/04/2022	RENEW LOCATION PLAN REFER TO A057	YWH
A	11/04/2022	RENEW LOCATION PLAN REFER TO A057	YWH

JOB NO. : J-859

PROJECT :
PROPOSED RESIDENTIAL / COMMERCIAL DEVELOPMENT AT NKIL NO.6551 KAI TAK AREA 4C, SITE 3 KAI TAK, KOWLOON

TITLE :
2~8/F WINDOW LOCATION PLAN FOR PRECAST FACADE AT TOWER 9 / 9A

DATE : 14-Nov-21 | SCALE : 1:80 (A3)


DRAWN BY : IVAN | CHECKED BY :

美特鋁製有限公司
MIDI ALUMINIUM FABRICATOR LTD.
Units 6-8, Sunray Industrial Centre, 1/F
610 Cha Kwo Ling Road, Kowloon
Tel:23489211-4 Fax:(852)27727866

DWG NO. : J859-SD-PL-901 | REV. : E

/ 9A
PLAN

TOWER 9 / 9A
11/F, 17/F &
21/F PART PLAN

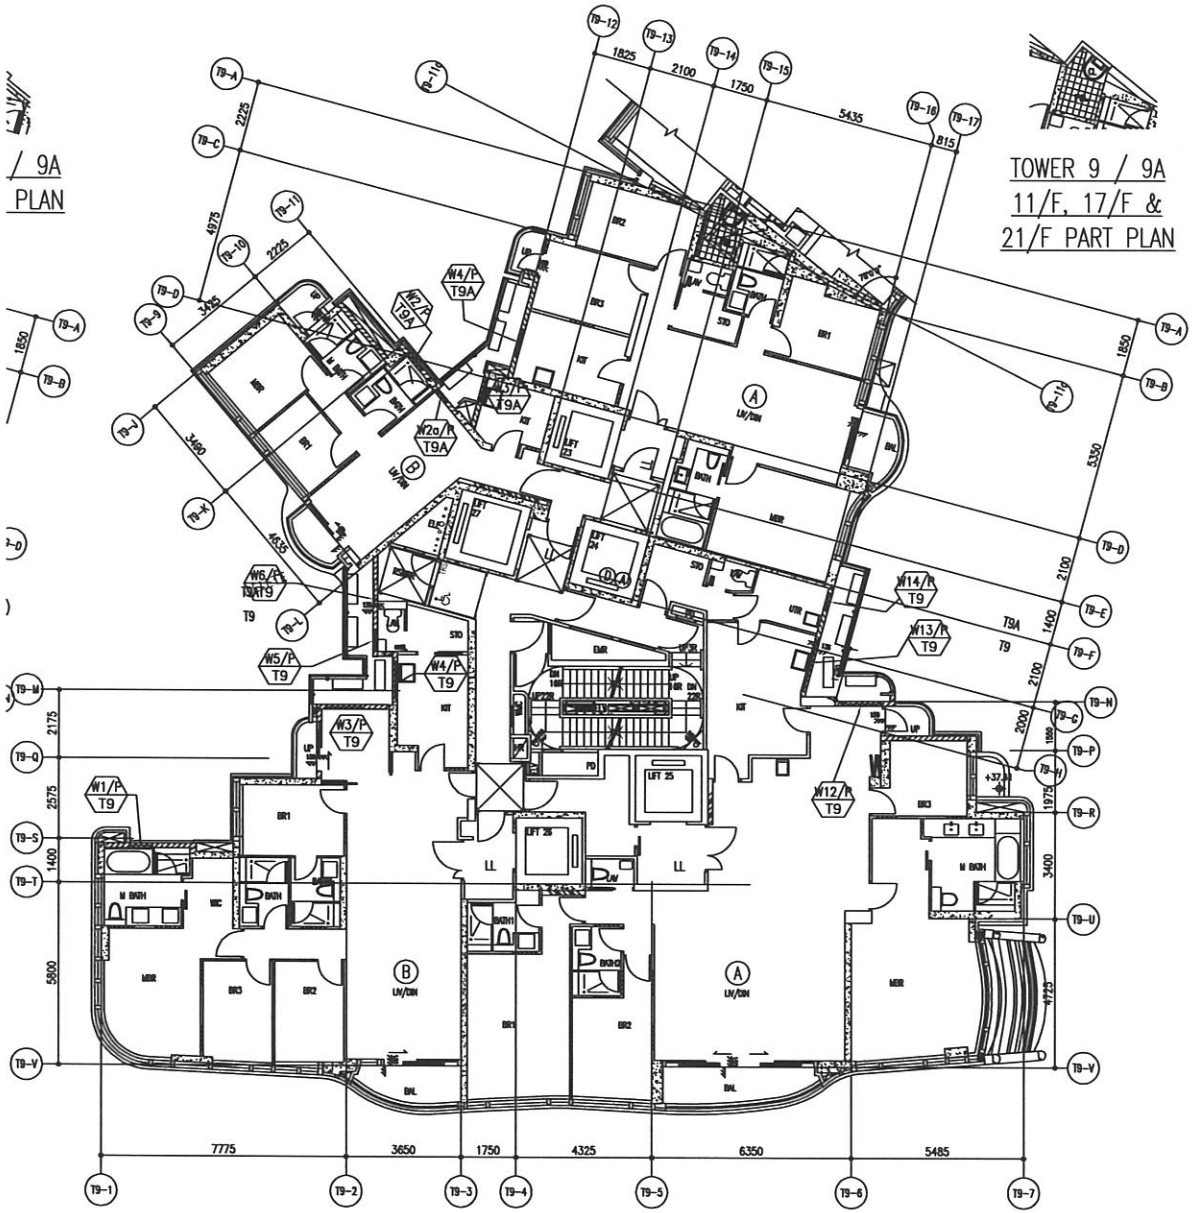

9/F TO 25/F WINDOW LOCATION PLAN FOR PRECAST FACADE
AT TOWER 9 /9A (14 STOREYS, 13/F,14/F,24/F OMITTED)

B.D. REF :

ARCHITECT :
WONG TUNG & PARTNERS LIMITED
ARCHITECTS & PLANNERS

STRUCTURAL ENGINEER :
SUN HUNG KAI
ARCHITECTS AND ENGINEERS LTD.
SUN HUNG KAI CENTRE, WANCHAI, HONGKONG
TEL 28278111 FAX. 28272884

FACADE CONSULTANT:
ALPHA CONSULTING LIMITED
Steel Structure & Facade Specialist

MAIN CONTRACTOR :
Sanfield Engineering
Construction Ltd.

CLIENT :
SUN HUNG KAI
REAL ESTATE AGENCY LTD.
42/F SUN HUNG KAI CENTRE, WANCHAI, HONGKONG

NOTE :
1. ALL DIMENSIONS ARE IN mm.
2. ALL ELEVATIONS ARE VIEWED FROM OUTSIDE.
3. ALL DIMENSIONS TO BE VERIFIED ON SITE BEFORE FABRICATION.

LEGEND :
X1 / X001 — DETAIL MARK NO. / REFER SHEET NO.
1. F.F.L. -- FINISHED FLOOR LEVEL
2. S.F.L. -- STRUCTURAL FLOOR LEVEL
3. /R -- REVERSED DETAIL

NO.	DATE	REVISED	BY
E	13/10/2022	RENEW LOCATION PLAN REFER TO A911	YI
D	08/09/2022	REVISION SUBJECT TO ARCH.COMMENT	IVAN
C	30/06/2022	REVISION SUBJECT TO ARCH.COMMENT	IVAN
B	28/04/2022	REVISION SUBJECT TO ARCH.COMMENT	IVAN
A	11/04/2022	RENEW LOCATION PLAN REFER TO A867	IVAN

JOB NO. : J-859

PROJECT :
PROPOSED RESIDENTIAL / COMMERCIAL DEVELOPMENT AT NKIL NO.6551 KAI TAK AREA 4C, SITE 3 KAI TAK, KOWLOON


TITLE :
9~25/F WINDOW LOCATION PLAN FOR PRECAST FACADE AT TOWER 9 / 9A


DATE : 14-Nov-21 | SCALE : 1:80 (A3)

DRAWN BY : IVAN | CHECKED BY :

美特鋁製有限公司
MIDI ALUMINIUM FABRICATOR LTD.
Units 6-8, Sunray Industrial Centre, 1/F
610 Cha Kwo Ling Road, Kowloon
Tel:23489211-4 Fax:(852)27727666

DWG NO. : J859-SD-PL-902 | REV. : E

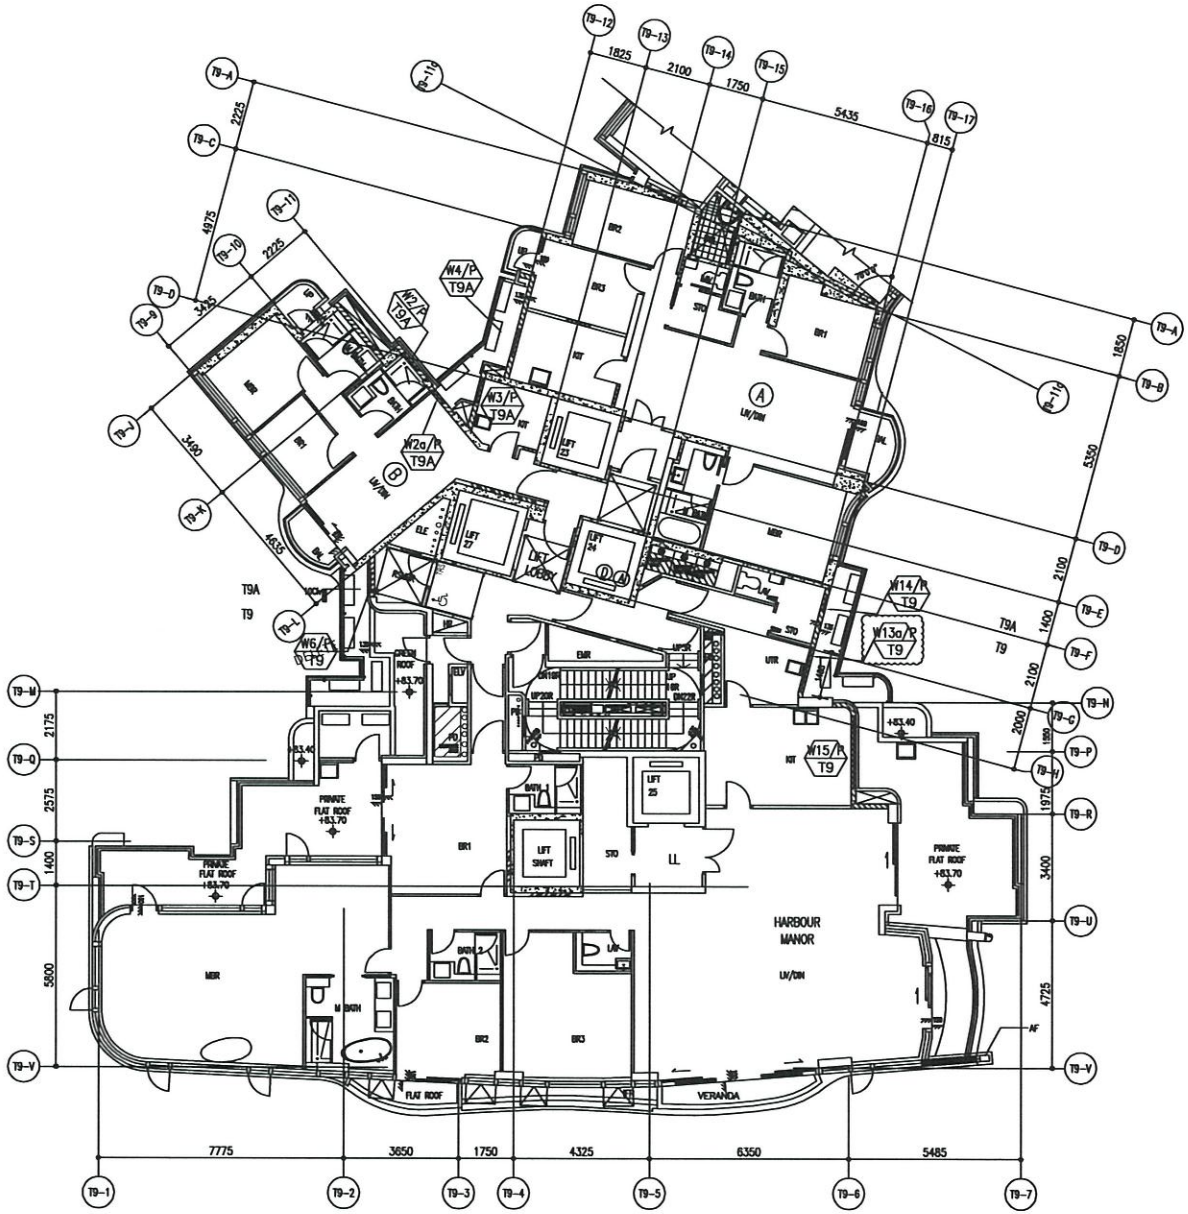
T9-A
T9-B
T9-C
T9-D
T9-E
T9-F
T9-G
T9-H
T9-J
T9-K
T9-L
T9-M
T9-N
T9-P
T9-Q
T9-R
T9-S
T9-T
T9-U
T9-V
T9-1
T9-2
T9-3
T9-4
T9-5
T9-6
T9-7
T9-9
T9-10
T9-11
T9-12
T9-13
T9-14
T9-15
T9-16
T9-17
T9-18
T9-19
1825
2100
1750
5435
815
2225
4975
2225
3485
3400
4635
1850
5550
2100
1400
2100
2000
1180
1975
3400
4725
2175
2575
1400
5800
7775
3650
1750
4325
6350
5485
W4/R T9A
W2/R T9A
W3/R T9A
W2a/R T9A
W14/R T9
W13a/R T9
W6/R T9
W15/R T9
T9A
T9
BR1
BR2
BR3
MBR
M BATH
BATH 2
LIFT LOBBY
LIFT SHAFT
LIFT 25
LIFT 26
LIFT

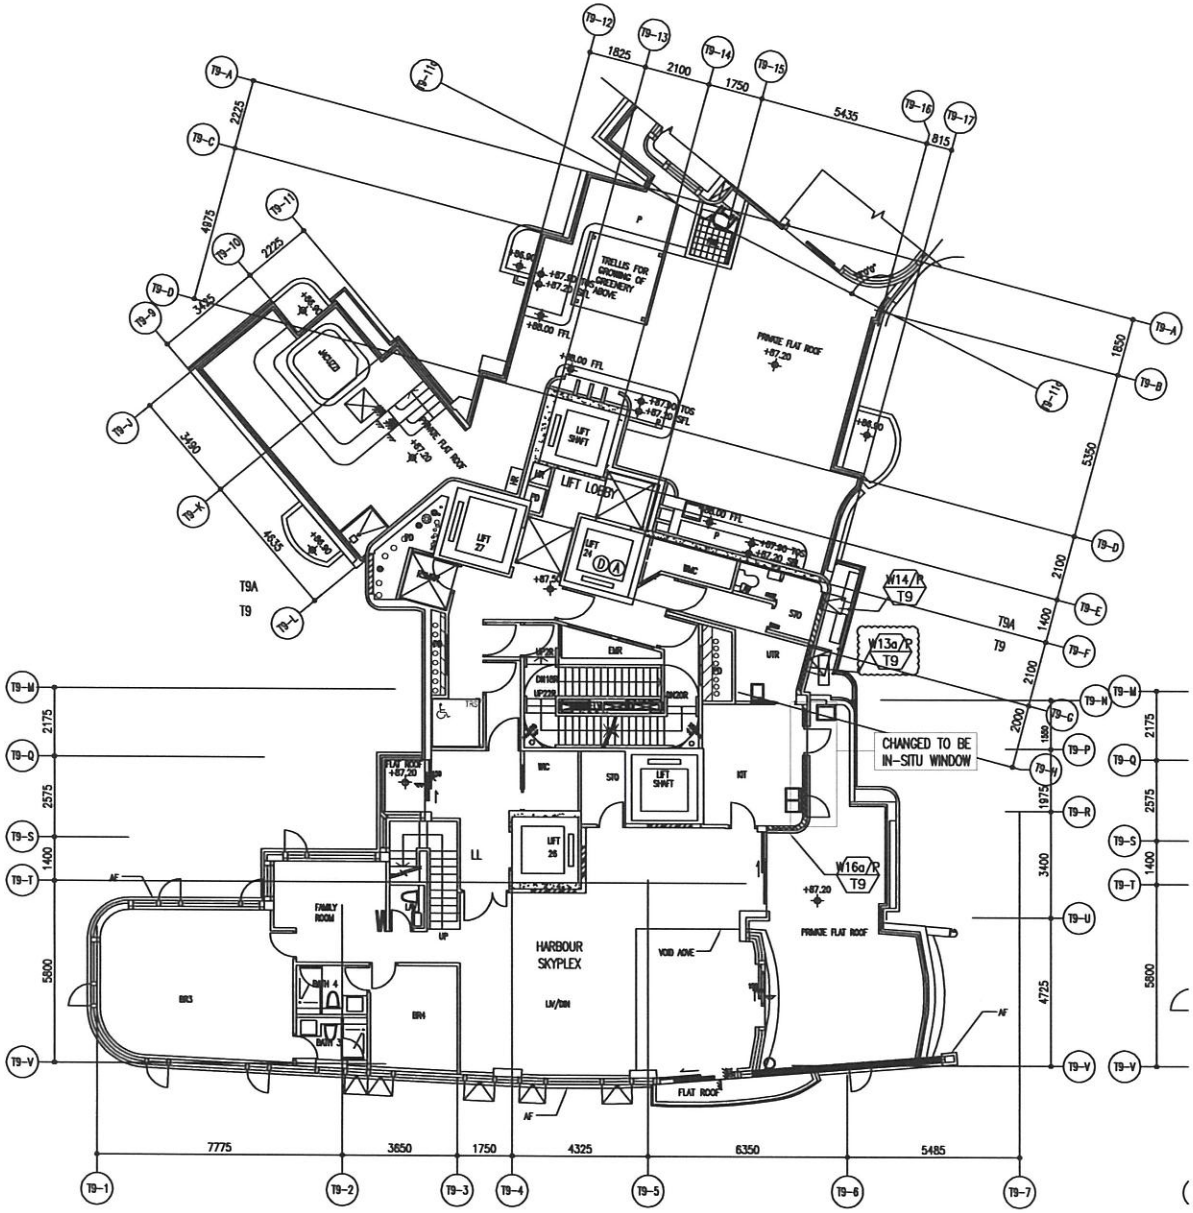

27/F WINDOW LOCATION PLAN FOR PRECAST FACADE AT TOWER 9 / 9A

B.D. REF :

ARCHITECT :
WONG TUNG & PARTNERS LIMITED
ARCHITECTS & PLANNERS

STRUCTURAL ENGINEER :
SUN HUNG KAI
ARCHITECTS AND ENGINEERS LTD.
SUN HUNG KAI CENTRE, WANCHAI, HONGKONG
TEL. 28278111 FAX. 28272884

FACADE CONSULTANT:
ALPHA CONSULTING LIMITED
Steel Structure & Facade Specialist

MAIN CONTRACTOR :
Sanfield Engineering Construction Ltd.

CLIENT :
SUN HUNG KAI
REAL ESTATE AGENCY LTD.
42/F SUN HUNG KAI CENTRE, WANCHAI, HONGKONG

NOTE :
1. ALL DIMENSIONS ARE IN mm.
2. ALL ELEVATIONS ARE VIEWED FROM OUTSIDE.
3. ALL DIMENSIONS TO BE VERIFIED ON SITE BEFORE FABRICATION.

LEGEND :
X1 — DETAIL MARK NO.
X001 — REFER SHEET NO.

1. F.F.L. --FINISHED FLOOR LEVEL
2. S.F.L. --STRUCTURAL FLOOR LEVEL
3. (/R) --REVERSED DETAIL

NO.	DATE	REVISED	BY
E	04/11/2022	GENERAL REVISED	YK
D	13/10/2022	REVISION SUBJECT TO ARCHCOMMENT A/R RIDEW LOCATION PLAN REFER TO A911	
C	08/08/2022	REVISION SUBJECT TO ARCHCOMMENT	YKM
B	30/06/2022	REVISION SUBJECT TO ARCHCOMMENT	YKM
A	11/04/2022	RIDEW LOCATION PLAN REFER TO A967	YKM

JOB NO. : J-859

PROJECT :
PROPOSED RESIDENTIAL / COMMERCIAL DEVELOPMENT AT NKIL NO.6551 KAI TAK AREA 4C, SITE 3 KAI TAK, KOWLOON

TITLE :
27/F WINDOW LOCATION PLAN FOR PRECAST FACADE AT TOWER 9 / 9A


DATE : 14-Nov-21 | SCALE : 1:80 (A3)

DRAWN BY : IVAN | CHECKED BY :

美特鋁質有限公司
MIDI ALUMINIUM FABRICATOR LTD.
Units 6-8, Sunray Industrial Centre, 1/F
610 Cha Kwo Ling Road, Kowloon
Tel:23489211-4 Fax:(852)27727666


DWG NO. : J859-SD-PL-904 | REV. : E

FREE AREA(%)	S.O.	PROVIDED		REQUIRE	
		OPENABLE AREA	GLAZING AREA	OPENABLE AREA	GLAZING AREA
53.7%	1590	0.646	0.546	0.114	0.114

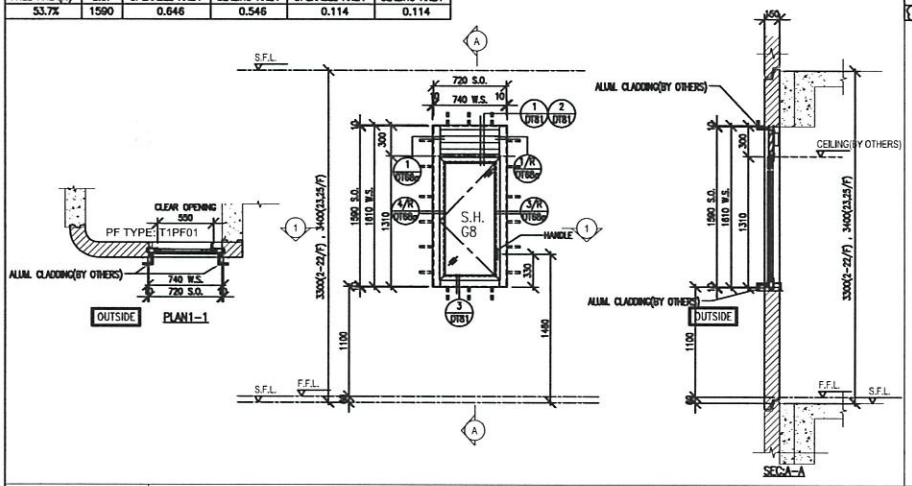


WINDOW MARK	W1/P T1 — 2/F–22/F 18 nos. — 23/F,25/F 2 nos.
LOCATION	FLAT A LAV AT 2/F TO 25/F FLOOR (T1) (4,13,14,24/F OMITTED)
GLAZING	G8
WINDOW FRAME	50mm ALUM. WINDOW SECTION , 4 BAR HINGE–LIP HING (HYLS16)

S.O.	PROVIDED		REQUIRE	
	OPENABLE AREA	GLAZING AREA	OPENABLE AREA	GLAZING AREA
(1335)	(0.900)	(1.685)	0.844	1.351

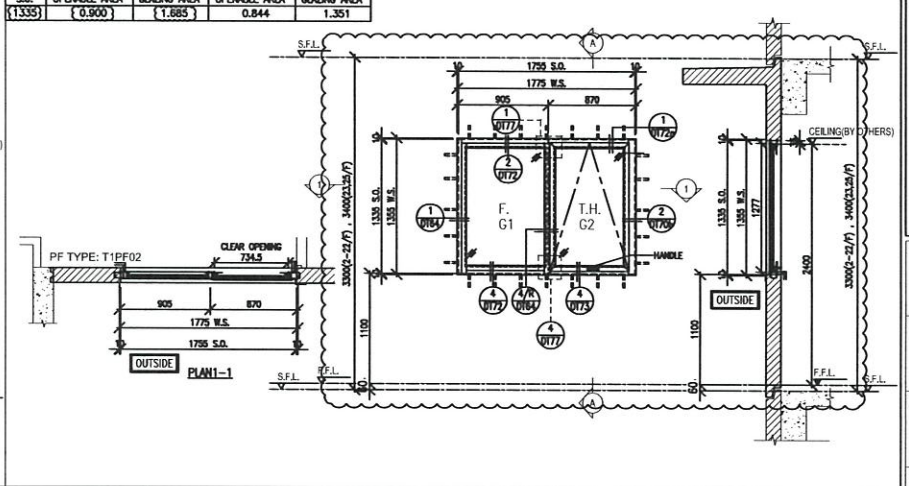


WINDOW MARK	W2/P T1 — 2/F–22/F 18 nos. — 23/F,25/F 2 nos.
LOCATION	FLAT A KIT AT 2/F TO 25/F FLOOR (T1) (4,13,14,24/F OMITTED)
GLAZING	G1,G2
WINDOW FRAME	70mm ALUM. WINDOW SECTION , 4 BAR HINGE–LIP HING (HYLP14)

FREE AREA(%)	S.O.	PROVIDED		REQUIRE	
		OPENABLE AREA	GLAZING AREA	OPENABLE AREA	GLAZING AREA
54.4%	1540	0.764	0.848	1.067	5.639

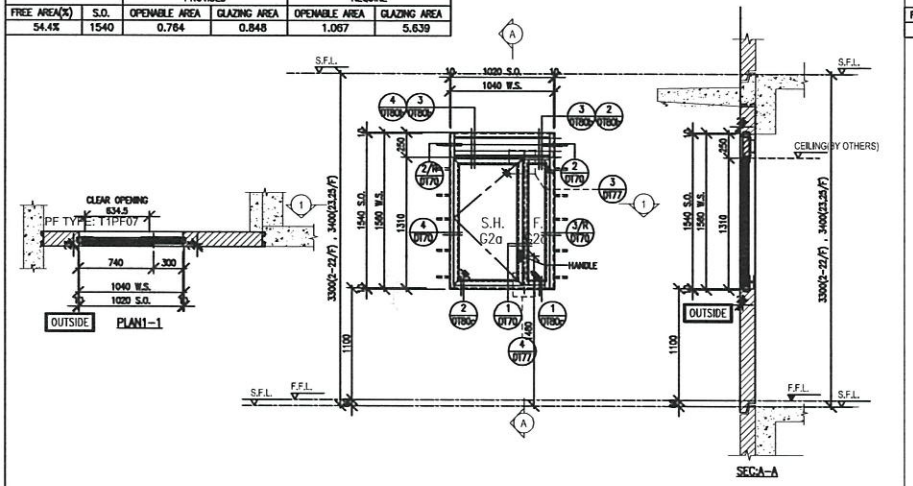

WINDOW MARK	W4/P T1 — 2/F–22/F 18 nos. — 23/F,25/F 2 nos.
LOCATION	FLAT B DIN AT 2/F TO 25/F FLOOR (T1) (4,13,14,24/F OMITTED)
GLAZING	G2a
WINDOW FRAME	70mm ALUM. WINDOW SECTION , 4 BAR HINGE–LIP HING (HYLS18)

FREE AREA(%)	S.O.	PROVIDED		REQUIRE	
		OPENABLE AREA	GLAZING AREA	OPENABLE AREA	GLAZING AREA
62%	1590	0.761	1.588	0.585	0.936

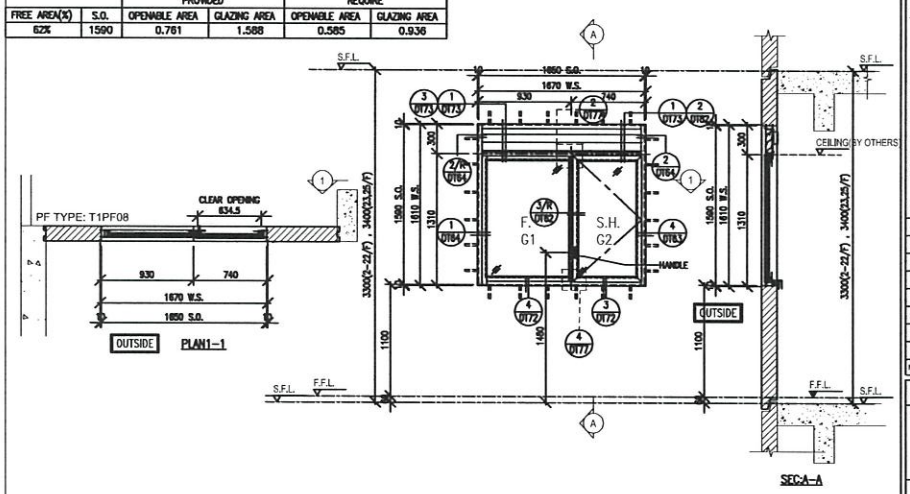

WINDOW MARK	W5/P T1 — 2/F–22/F 18 nos. — 23/F,25/F 2 nos.
LOCATION	FLAT B KIT AT 2/F TO 25/F FLOOR (T1) (4,13,14,24/F OMITTED)
GLAZING	G1, G2
WINDOW FRAME	70mm ALUM. WINDOW SECTION , 4 BAR HINGE–LIP HING (HYLS18)

B.D. REF :

ARCHITECT :
WONG TUNG & PARTNERS LIMITED
ARCHITECTS & PLANNERS

STRUCTURAL ENGINEER :
SUN HUNG KAI
ARCHITECTS AND ENGINEERS LTD.
SUN HUNG KAI CENTRE, WANCHAI, HONGKONG
TEL. 28278111 FAX. 28272894

FACADE CONSULTANT:
ALPHA CONSULTING LIMITED
Steel Structure & Facade Specialist

MAIN CONTRACTOR :
Sanfield Engineering Construction Ltd.

CLIENT :
SUN HUNG KAI
REAL ESTATE AGENCY LTD.
42/F SUN HUNG KAI CENTRE, WANCHAI, HONGKONG

NOTE :
1. ALL DIMENSIONS ARE IN mm.
2. ALL ELEVATIONS ARE VIEWED FROM OUTSIDE.
3. ALL DIMENSIONS TO BE VERIFIED ON SITE BEFORE FABRICATION.

LEGEND :
X1 / X001 — DETAIL MARK NO. / REFER SHEET NO.
1. F.F.L. — FINISHED FLOOR LEVEL
2. S.F.L. — STRUCTURAL FLOOR LEVEL
3. /R — REVERSED DETAIL
4. GLASS LEGEND
G1–8mmHS+12mm AIR GAP+10mmTP I.G.U.
G2–8mmHS+12mm AIR GAP+8mmTP I.G.U.
G2a–8mmHS+12mm AIR GAP+8mmTP+1.52PVB +6mm(PLANNING) FEATURED GLASS (I.G.U.)
G8–6mm GREY HS+1.52PVB+6mm CLEAR HS

NO	DATE	REVISED	BY
H	04/11/2022	REVISION SUBJECT TO ARCHITECT'S COMMENT	YW
G	13/10/2022	REVISION SUBJECT TO ARCHITECT'S COMMENT	YW
F	02/08/2022	REVISION SUBJECT TO ARCHITECT'S COMMENT	YWM
E	28/06/2022	REVISION SUBJECT TO ARCHITECT'S COMMENT	YWM
D	11/05/2022	REVISION SUBJECT TO ARCHITECT'S COMMENT	YWM
C	25/04/2022	REVISION SUBJECT TO ARCHITECT'S COMMENT	YWM
B	13/04/2022	REVISION SUBJECT TO ARCHITECT'S COMMENT	YWM
A	28/03/2022	REVISION SUBJECT TO ARCHITECT'S COMMENT	YWM

JOB NO. : J–859

PROJECT :
PROPOSED RESIDENTIAL / COMMERCIAL DEVELOPMENT AT NKIL NO.6551 KAI TAK AREA 4C, SITE 3 KAI TAK, KOWLOON

TITLE :
WINDOW SCHEDULE FOR PRECAST FACADE AT TOWER 1


DATE : 23–Nov–21 | SCALE : 1:50 (A3)

DRAWN BY : IVAN | CHECKED BY :

美特鋁製有限公司
MIDI ALUMINIUM FABRICATOR LTD.
Units 6–8, Sunray Industrial Centre, 1/F
610 Cha Kwo Ling Road, Kowloon
Tel:23409211–4 Fax:(852)27727666

DWG NO. : J859–SD–PW–1101 | REV. : H


FREE AREA(%)	S.O.	PROVIDED		REQUIRE	
		OPENABLE AREA	GLAZING AREA	OPENABLE AREA	GLAZING AREA
62%	1590	0.699	0.595		

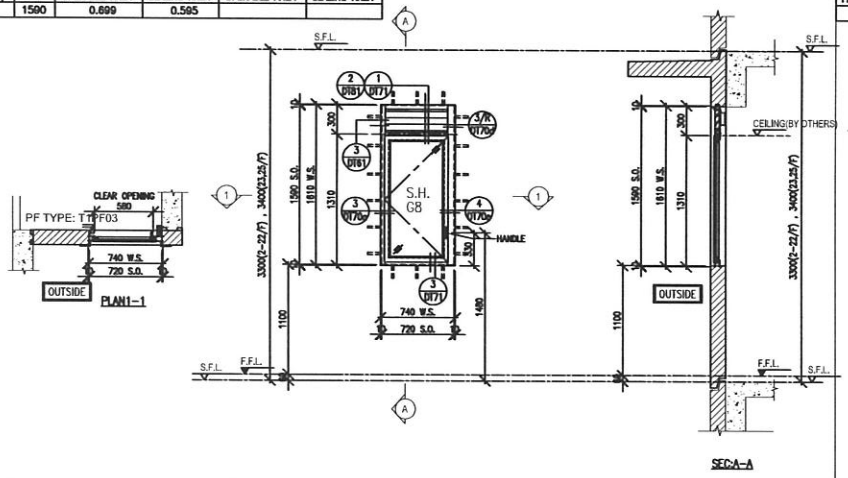

SEC:A-A

WINDOW MARK	W6/P T1 — 2/F–22/F: 18 nos. 23/F,25/F: 2 nos.
LOCATION	FLAT A UTR. AT 2/F TO 25/F FLOOR (T1) (4,13,14,24/F OMITTED)
GLAZING	G8
WINDOW FRAME	50mm ALUM. WINDOW SECTION , 4 BAR HINGE–LIP HING (HYLS16)


FREE AREA(%)	S.O.	PROVIDED		REQUIRE	
		OPENABLE AREA	GLAZING AREA	OPENABLE AREA	GLAZING AREA
46.4%	1540	0.622	0.524		

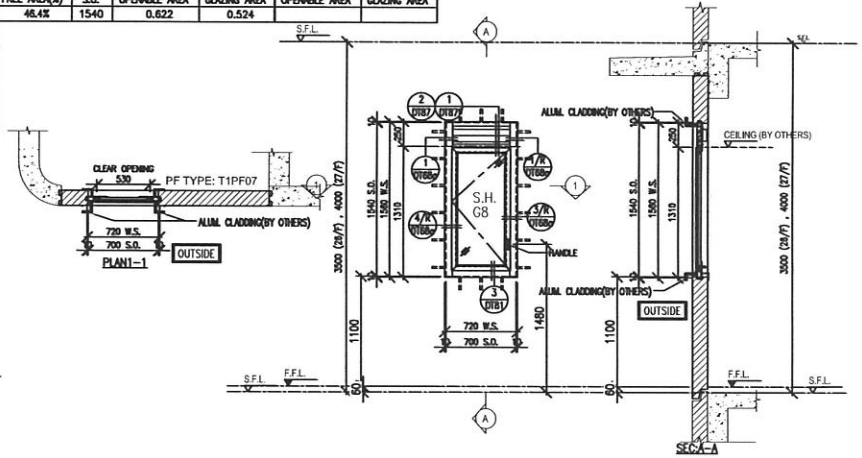

SEC:A-A

WINDOW MARK	W9/P T1 — 2 nos.
LOCATION	FLAT B STO AT 26/F TO 27/F FLOOR (T1)
GLAZING	G8
WINDOW FRAME	50mm ALUM. WINDOW SECTION , 4 BAR HINGE–LIP HING (HHMS–N14)


FREE AREA(%)	S.O.	PROVIDED		REQUIRE	
		OPENABLE AREA	GLAZING AREA	OPENABLE AREA	GLAZING AREA
54.4%	1540	0.675	0.573		

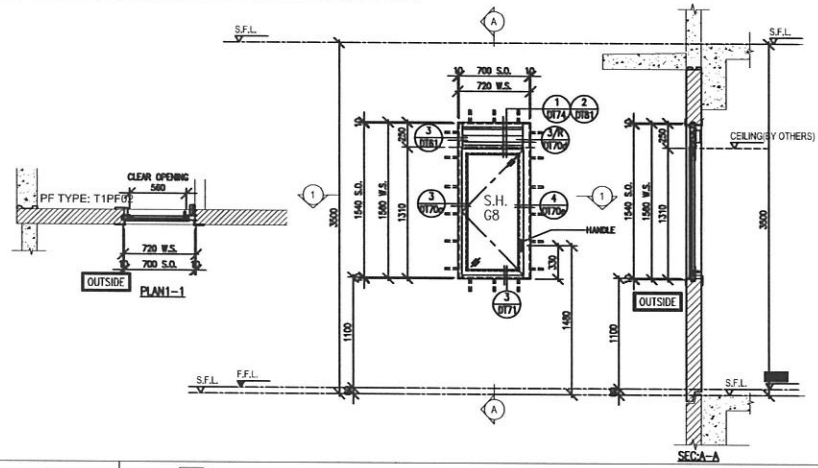

SEC:A-A

WINDOW MARK	W12/P T1 — 1no.
LOCATION	Victoria Manor Bath 1 AT 26/F FLOOR (T1)
GLAZING	G8
WINDOW FRAME	50mm ALUM. WINDOW SECTION , 4 BAR HINGE–LIP HING (HYLS16)

S.O.	PROVIDED		REQUIRE	
	OPENABLE AREA	GLAZING AREA	OPENABLE AREA	GLAZING AREA
(1335)	(1.769)	(1.542)		

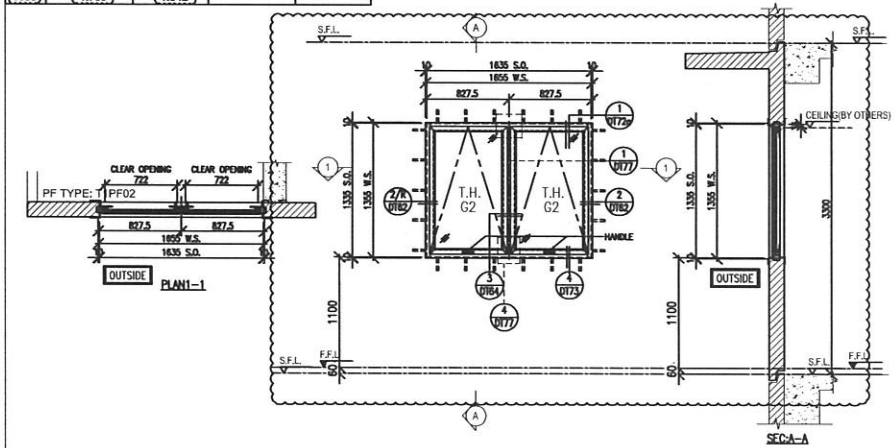

SEC:A-A

WINDOW MARK	W8a T1 — 1no.
LOCATION	22/F FLOOR (T1)
GLAZING	G2
WINDOW FRAME	70mm ALUM. WINDOW SECTION , 4 BAR HINGE–LIP HING (HYLP14)

B.D. REF :

ARCHITECT :
WONG TUNG & PARTNERS LIMITED
ARCHITECTS & PLANNERS

STRUCTURAL ENGINEER :
SUN HUNG KAI
ARCHITECTS AND ENGINEERS LTD.
SUN HUNG KAI CENTRE, WANCHAI, HONGKONG
TEL: 28278111 FAX: 28272884

FACADE CONSULTANT:
ALPHA CONSULTING LIMITED
Steel Structure & Facade Specialist

MAIN CONTRACTOR :
Sanfield Engineering Construction Ltd.

CLIENT :
SUN HUNG KAI
REAL ESTATE AGENCY LTD.
42/F SUN HUNG KAI CENTRE, WANCHAI, HONGKONG

NOTE :
1. ALL DIMENSIONS ARE IN mm.
2. ALL ELEVATIONS ARE VIEWED FROM OUTSIDE.
3. ALL DIMENSIONS TO BE VERIFIED ON SITE BEFORE FABRICATION.

LEGEND :
X1 — DETAIL MARK NO.
X001 — REFER SHEET NO.
1. F.F.L. --FINISHED FLOOR LEVEL
2. S.F.L. --STRUCTURAL FLOOR LEVEL
3. /R --REVERSED DETAIL
4. GLASS LEGEND
G1–8mmHS+12mm AIR GAP+10mmTP I.G.U.
G2–8mmHS+12mm AIR GAP+8mmTP I.G.U.
G2a–8mmHS+12mm AIR GAP+8mmTP+1.52PVB +6mm(PLANNING) FEATURED GLASS (I.G.U.)
G8–6mm GREY HS+1.52PVB+6mm CLEAR HS

NO.	DATE	REVISED	BY
H	04/11/2022	REVISION SUBJECT TO ARCH.COMMENT	YL
G	13/10/2022	REVISION SUBJECT TO ARCH.COMMENT	YL
F	20/08/2022	REVISION SUBJECT TO ALPHA COMMENT	PWM
E	28/06/2022	REVISION SUBJECT TO ALPHA COMMENT	PWM
D	11/05/2022	REVISION SUBJECT TO ARCH.COMMENT	PWM
C	27/04/2022	REVISION SUBJECT TO ARCH.COMMENT	PWM
B	11/04/2022	REVISION SUBJECT TO ARCH.COMMENT	PWM
A	28/03/2022	REVISION SUBJECT TO ARCH.COMMENT	PWM

JOB NO. : J-859

PROJECT :
PROPOSED RESIDENTIAL / COMMERCIAL DEVELOPMENT AT NKIL NO.8551 KAI TAK AREA 4C, SITE 3 KAI TAK, KOWLOON

TITLE :
WINDOW SCHEDULE FOR PRECAST FACADE AT TOWER 1


DATE : 23-Nov-21 | SCALE : 1:50 (A3)

DRAWN BY : IVAN | CHECKED BY :

美特鋁質有限公司
MIDI ALUMINIUM FABRICATOR LTD.
Units 6-8, Sunray Industrial Centre, 1/F
610 Cha Kwo Ling Road, Kowloon
Tel:23489211-4 Fax:(852)27727666


DWG NO. : J859-SD-PW-1102 | REV. : H

	PROVIDED		REQUIRE	
FREE AREA(%)	S.O.	OPENABLE AREA	GLAZING AREA	OPENABLE AREA	GLAZING AREA
62%	1590	0.74	0.905	0.481	0.769

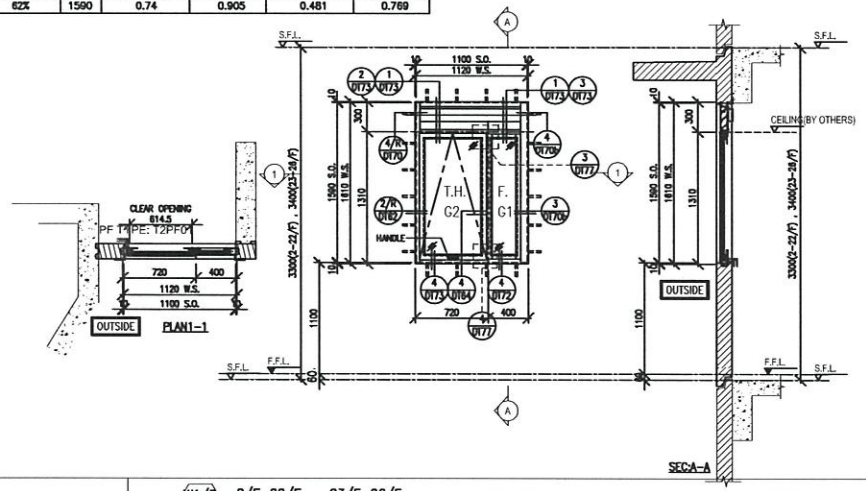


WINDOW MARK	W1/P T2 — 2/F–22/F: 18 nos.; 23/F–26/F: 3 nos.
LOCATION	FLAT A KIT AT 2/F TO 26/F FLOOR (T2) (4,13,14,24/F OMITTED)
GLAZING	G1, G2
WINDOW FRAME	70mm ALUM. WINDOW SECTION , 4 BAR HINGE–LIP HING (HYLP14)

	PROVIDED		REQUIRE	
FREE AREA(%)	S.O.	OPENABLE AREA	GLAZING AREA	OPENABLE AREA	GLAZING AREA
50.0%	1540	0.646	0.546	0.103	0.103

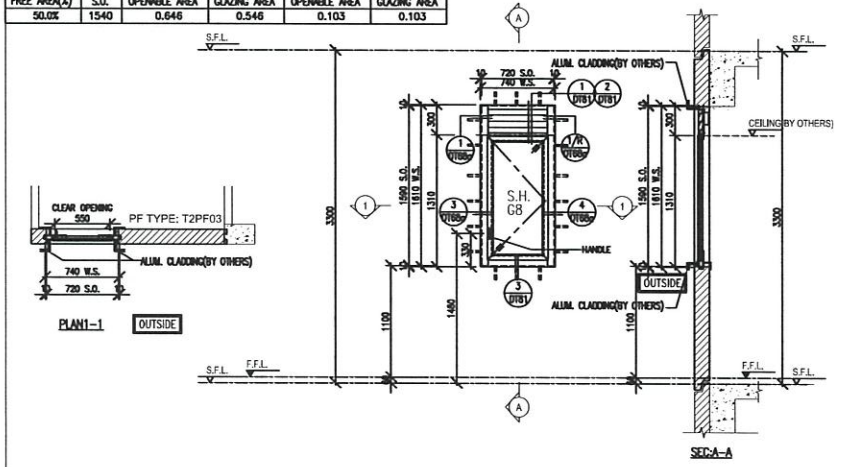


WINDOW MARK	W3/P T2 — 15 nos.
LOCATION	FLAT D STO AT 2/F TO 19/F FLOOR (T2) (4,13,14/F OMITTED)
GLAZING	G8
WINDOW FRAME	50mm ALUM. WINDOW SECTION , 4 BAR HINGE–LIP HING (HYLS16)

	PROVIDED		REQUIRE	
FREE AREA(%)	S.O.	OPENABLE AREA	GLAZING AREA	OPENABLE AREA	GLAZING AREA
62%	1590	0.71	1.406	0.329	0.526

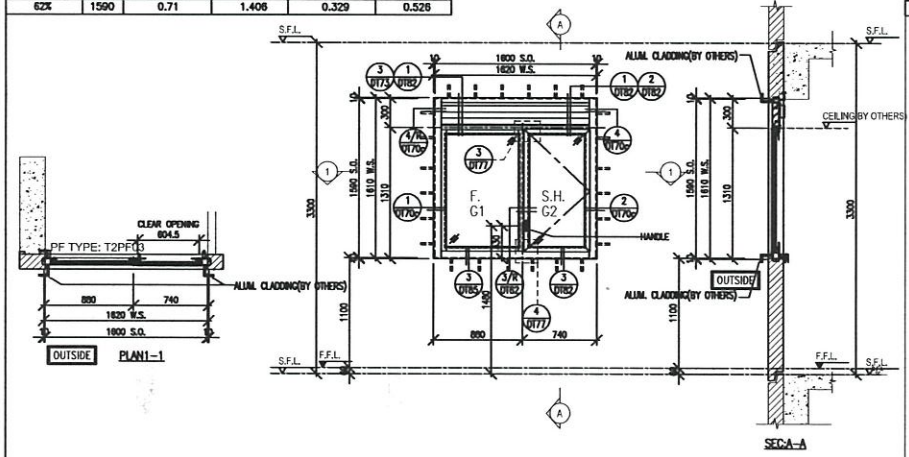

WINDOW MARK	W4/P T2 — 15 nos.
LOCATION	FLAT D KIT AT 2/F TO 19/F FLOOR (T2) (4,13,14/F OMITTED)
GLAZING	G1, G2
WINDOW FRAME	70mm ALUM. WINDOW SECTION , 4 BAR HINGE–LIP HING (HYLS16)

	PROVIDED		REQUIRE	
FREE AREA(%)	S.O.	OPENABLE AREA	GLAZING AREA	OPENABLE AREA	GLAZING AREA
53.7%	1590	0.675	0.572	0.316	0.316

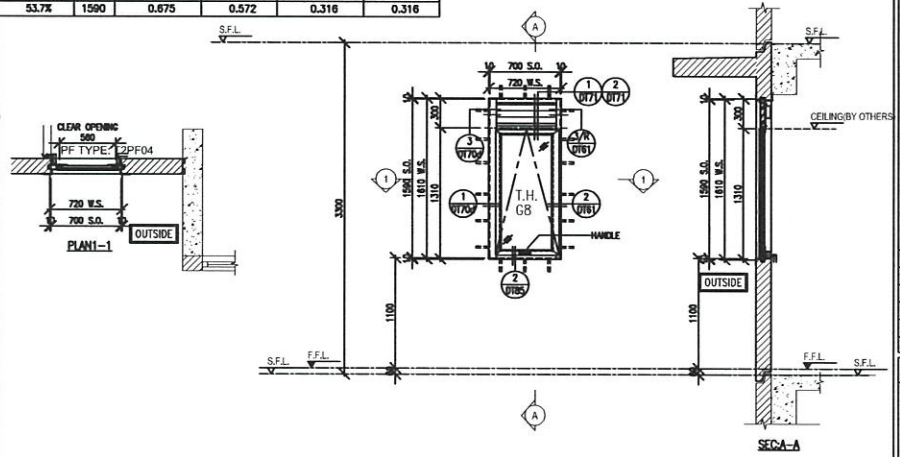

WINDOW MARK	W5/P T2 — 15 nos.
LOCATION	FLAT D BATH AT 2/F TO 19/F FLOOR (T2) (4,13,14/F OMITTED)
GLAZING	G8
WINDOW FRAME	50mm ALUM. WINDOW SECTION , 4 BAR HINGE–LIP HING (HYLP14)

B.D. REF :

ARCHITECT :
WONG TUNG & PARTNERS LIMITED
ARCHITECTS & PLANNERS

STRUCTURAL ENGINEER :
SUN HUNG KAI
ARCHITECTS AND ENGINEERS LTD.
SUN HUNG KAI CENTRE, WANCHAI, HONGKONG
TEL. 28276111 FAX. 28272684

FACADE CONSULTANT:
ALPHA CONSULTING LIMITED
Steel Structure & Facade Specialist

MAIN CONTRACTOR :
Sanfield Engineering Construction Ltd.

CLIENT :
SUN HUNG KAI
REAL ESTATE AGENCY LTD.
48/F SUN HUNG KAI CENTRE, WANCHAI, HONGKONG

NOTE :
1. ALL DIMENSIONS ARE IN mm.
2. ALL ELEVATIONS ARE VIEWED FROM OUTSIDE.
3. ALL DIMENSIONS TO BE VERIFIED ON SITE BEFORE FABRICATION.

LEGEND :
X1 / X001 — DETAIL MARK NO. / REFER SHEET NO.
1. F.F.L. --FINISHED FLOOR LEVEL
2. S.F.L. --STRUCTURAL FLOOR LEVEL
3. /R --REVERSED DETAIL
4. GLASS LEGEND
G1–8mmHS+12mm AIR GAP+10mmTP I.G.U.
G2–8mmHS+12mm AIR GAP+8mmTP I.G.U.
G2a–8mmHS+12mm AIR GAP+8mmTP+1.52PVB +6mm(PLANNING) FEATURED GLASS (I.G.U.)
G8–6mm GREY HS+1.52PVB+6mm CLEAR HS

NO.	DATE	REVISED	BY
E	28/03/2022	REVISION SUBJECT TO ARCHITECT	WM
D	11/03/2022	REVISION SUBJECT TO ARCHITECT	WM
C	25/04/2022	REVISION SUBJECT TO ARCHITECT	WM
B	13/04/2022	REVISION SUBJECT TO ARCHITECT	WM
A	28/03/2022	REVISION SUBJECT TO ARCHITECT	WM

JOB NO. : J-859

PROJECT :
PROPOSED RESIDENTIAL / COMMERCIAL DEVELOPMENT AT NKIL NO.6551 KAI TAK AREA 4C, SITE 3 KAI TAK, KOWLOON

TITLE :
WINDOW SCHEDULE FOR PRECAST FACADE AT TOWER 2


DATE : 23–Nov–21 | SCALE : 1:50 (A3)

DRAWN BY : IVAN | CHECKED BY :

美特鋁製有限公司
MIDI ALUMINIUM FABRICATOR LTD.
Units 6–8, Sunray Industrial Centre, 1/F
810 Cha Kwo Ling Road, Kowloon
Tel:23489211–4 Fax:(852)27727666

DWG NO. : J859–SD–PW–2101 | REV. : E


	PROVIDED		REQUIRE	
S.O.	OPENABLE AREA	GLAZING AREA	OPENABLE AREA	GLAZING AREA
1290	1.497	2.397		

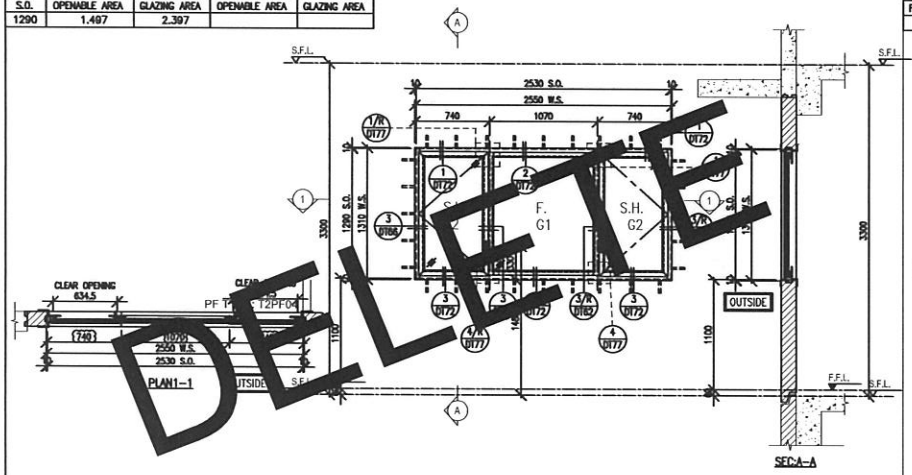

DELETE


WINDOW MARK	W13/P T2 1 nos.
LOCATION	SKY MANOR BR2 AT 21/F (T2)
GLAZING	G1, G2
WINDOW FRAME	70mm ALUM. WINDOW SECTION , 4 BAR HINGE-LIP HING (HYLS16)

	PROVIDED		REQUIRE	
FREE AREA(%)	S.O.	OPENABLE AREA	GLAZING AREA	OPENABLE AREA	GLAZING AREA
62%	1540	0.844	0.726		

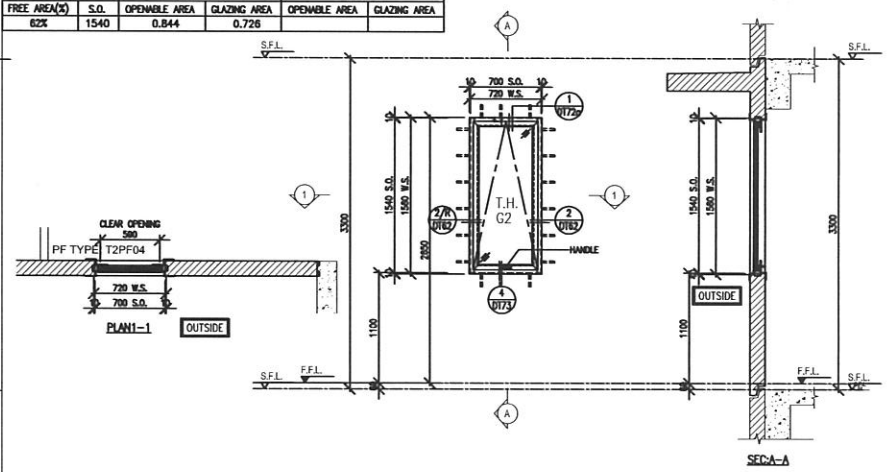

WINDOW MARK	W12/P T2 1 nos.
LOCATION	SKY MANOR BR2 AT 20/F (T2)
GLAZING	G2
WINDOW FRAME	70mm ALUM. WINDOW SECTION , 4 BAR HINGE-LIP HING (HYLP14)


	PROVIDED		REQUIRE	
S.O.	OPENABLE AREA	GLAZING AREA	OPENABLE AREA	GLAZING AREA
1540		2.52		

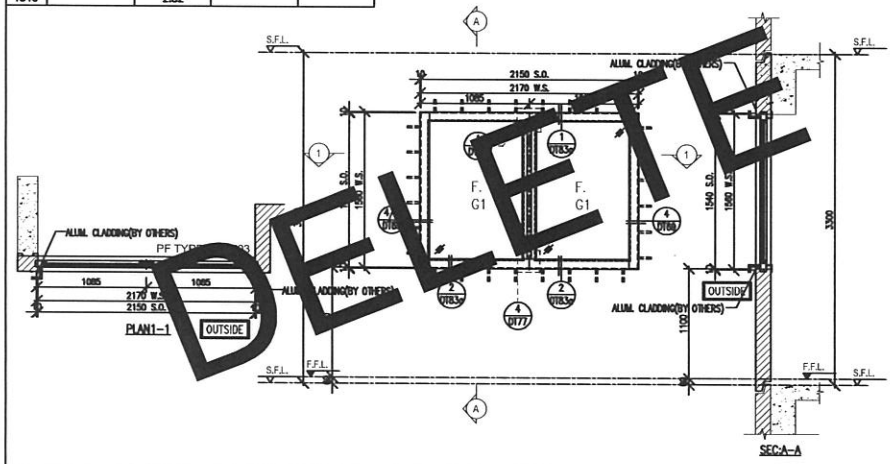

DELETE

WINDOW MARK	W14/P T2 2 nos.
LOCATION	SKY MANOR STAIRCASE FROM 20/F TO 21/F FLOOR (T2)
GLAZING	G1
WINDOW FRAME	70mm ALUM. WINDOW SECTION

	PROVIDED		REQUIRE	
FREE AREA(%)	S.O.	OPENABLE AREA	GLAZING AREA	OPENABLE AREA	GLAZING AREA
53.7%	1590	–	0.495	–	–

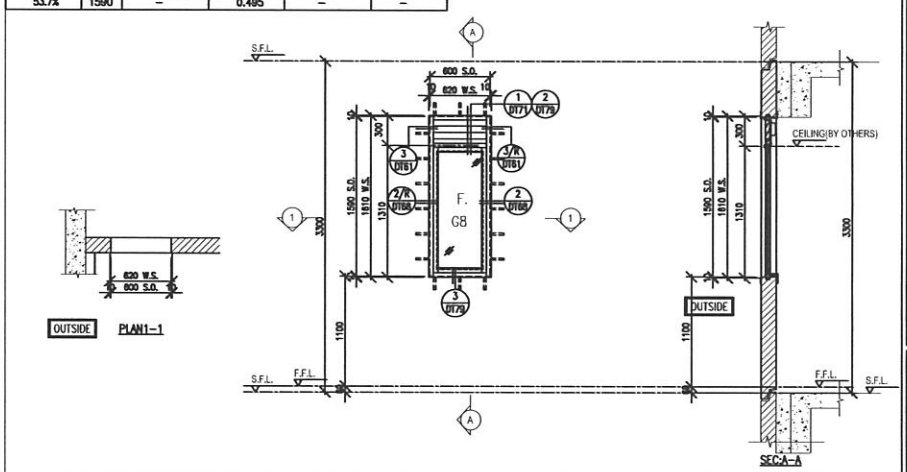

WINDOW MARK	W15/P T2 20/F 1 no.
LOCATION	SKY MANOR LAV. AT 20/F (T2)
GLAZING	G8
WINDOW FRAME	50mm ALUM. WINDOW SECTION

B.D. REF :

ARCHITECT :
WONG TUNG & PARTNERS LIMITED
ARCHITECTS & PLANNERS

STRUCTURAL ENGINEER :
SUN HUNG KAI
ARCHITECTS AND ENGINEERS LTD.
SUN HUNG KAI CENTRE, WANCHAI, HONGKONG
TEL: 28276111 FAX: 28272884

FACADE CONSULTANT:
ALPHA CONSULTING LIMITED
Steel Structure & Facade Specialist

MAIN CONTRACTOR :
Sanfield Engineering Construction Ltd.

CLIENT :
SUN HUNG KAI
REAL ESTATE AGENCY LTD.
42/F SUN HUNG KAI CENTRE, WANCHAI, HONGKONG

NOTE :
1. ALL DIMENSIONS ARE IN mm.
2. ALL ELEVATIONS ARE VIEWED FROM OUTSIDE.
3. ALL DIMENSIONS TO BE VERIFIED ON SITE BEFORE FABRICATION.

LEGEND :
- X1 / X001 — DETAIL MARK NO. / REFER SHEET NO.
1. F.F.L. -- FINISHED FLOOR LEVEL
2. S.F.L. -- STRUCTURAL FLOOR LEVEL
3. /R -- REVERSED DETAIL
4. GLASS LEGEND

G1-8mmHS+12mm AIR GAP+10mmTP I.G.U.

G2-8mmHS+12mm AIR GAP+8mmTP I.G.U.

G2a-8mmHS+12mm AIR GAP+8mmTP+1.52PVB +6mm(PLANNING) FEATURED GLASS (I.G.U.)

G8-6mm GREY HS+1.52PVB+6mm CLEAR HS

NO.	DATE	REVISED	BY
E	13/10/2022	REVISION SUBJECT TO ARCHITECT	YU
D	08/08/2022	REVISION SUBJECT TO ARCHITECT	IVAN
C	07/05/2022	REVISION SUBJECT TO ARCHITECT	IVAN
B	25/04/2022	REVISION SUBJECT TO ARCHITECT	IVAN
A	28/03/2022	REVISION SUBJECT TO ARCHITECT	IVAN

JOB NO. : J-859

PROJECT :
PROPOSED RESIDENTIAL / COMMERCIAL DEVELOPMENT AT NKIL NO.6551 KAI TAK AREA 4C, SITE 3 KAI TAK, KOWLOON

TITLE :
WINDOW SCHEDULE FOR PRECAST FACADE AT TOWER 2


DATE : 23-Nov-21 | SCALE : 1:50 (A3)

DRAWN BY : IVAN | CHECKED BY :


美特鋁質有限公司
MIDI ALUMINIUM FABRICATOR LTD.
Units 6-8, Sunray Industrial Centre, 1/F
610 Cha Kwo Ling Road, Kowloon
Tel:23489211-4 Fax:(852)27727666

DWG NO. : J859-SD-PW-2102 | REV. : E

	PROVIDED		REQUIRE	
FREE AREA(%) / S.O.	OPENABLE AREA	GLAZING AREA	OPENABLE AREA	GLAZING AREA
62% / 1590	0.831	0.721	0.430	0.689

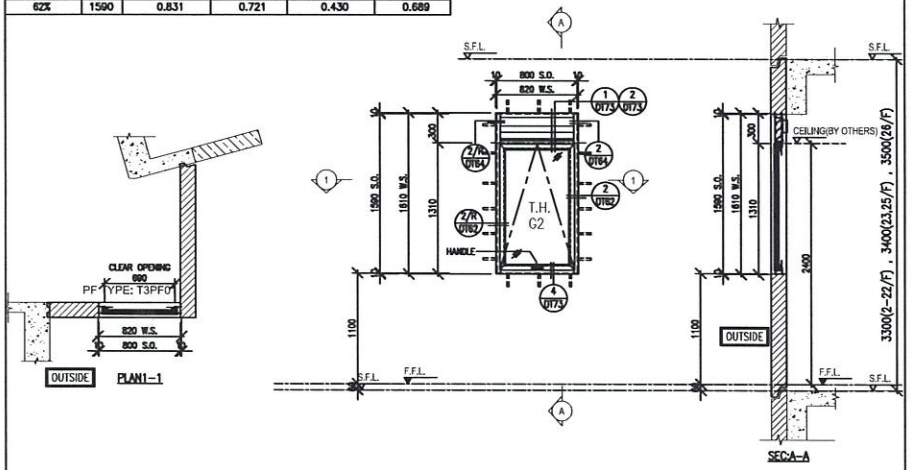

WINDOW MARK	W1/P, T3 — 2/F–22/F: 18 nos. / 23/F,25/F: 2 nos. / 26/F: 1 no.
LOCATION	FLAT A KIT AT 2/F TO 26/F FLOOR (T3) (4,13,14,24/F OMITTED)
GLAZING	G2
WINDOW FRAME	70mm ALUM. WINDOW SECTION , 4 BAR HINGE–LIP HING (HYLP14)

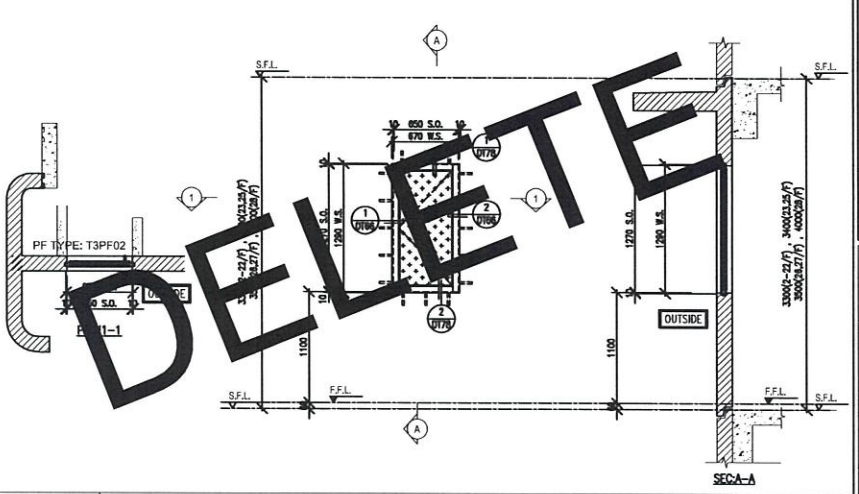

WINDOW MARK	AD1, T3 — 2/F–22/F: 18 nos. / 23/F,25/F: 2 nos. / 26/F–28/F: 3 nos.
LOCATION	EMR AT 2/F TO 28/F FLOOR (T3) (4,13,14,24/F OMITTED)
GLAZING	–
WINDOW FRAME	50mm ALUM. WINDOW SECTION & 3mm THK. ALUM. CLADDING , DOOR HINGE LIP HING (HHB)

WINDOW MARK	
LOCATION	
GLAZING	
WINDOW FRAME	

WINDOW MARK	
LOCATION	
GLAZING	
WINDOW FRAME	

B.D. REF :

ARCHITECT :
WONG TUNG & PARTNERS LIMITED
ARCHITECTS & PLANNERS

STRUCTURAL ENGINEER :
SUN HUNG KAI
ARCHITECTS AND ENGINEERS LTD.
SUN HUNG KAI CENTRE, WANCHAI, HONGKONG
TEL. 28278111 FAX. 28272884

FACADE CONSULTANT:
ALPHA CONSULTING LIMITED
Steel Structure & Facade Specialist

MAIN CONTRACTOR :
Sanfield Engineering Construction Ltd.

CLIENT :
SUN HUNG KAI
REAL ESTATE AGENCY LTD.
42/F SUN HUNG KAI CENTRE, WANCHAI, HONGKONG

NOTE :
1. ALL DIMENSIONS ARE IN mm.
2. ALL ELEVATIONS ARE VIEWED FROM OUTSIDE.
3. ALL DIMENSIONS TO BE VERIFIED ON SITE BEFORE FABRICATION.

LEGEND :
X1 / X001 — DETAIL MARK NO. / REFER SHEET NO.
1. F.F.L. --- FINISHED FLOOR LEVEL
2. S.F.L. --- STRUCTURAL FLOOR LEVEL
3. /R --- REVERSED DETAIL
4. GLASS LEGEND
G1–8mmHS+12mm AIR GAP+10mmTP LG.U.
G2–8mmHS+12mm AIR GAP+8mmTP LG.U.
G2a–8mmHS+12mm AIR GAP+8mmTP+1.52PVB +6mm (PLANNING) FEATURED GLASS (LG.U.)
G8–6mm GREY HS+1.52PVB+6mm CLEAR HS

NO.	DATE	REVISED	BY
F	8/08/2022	REVISION SUBJECT TO ALPHA COMMENT	WAN
E	28/06/2022	REVISION SUBJECT TO ALPHA COMMENT	WAN
D	11/05/2022	REVISION SUBJECT TO ARCH.COMMENT	WAN
C	25/04/2022	REVISION SUBJECT TO ARCH.COMMENT	WAN
B	13/04/2022	REVISION SUBJECT TO ARCH.COMMENT	WAN
A	28/03/2022	REVISION SUBJECT TO ARCH.COMMENT	WAN

JOB NO. : J–859

PROJECT :
PROPOSED RESIDENTIAL / COMMERCIAL DEVELOPMENT AT NKIL NO.6551 KAI TAK AREA 4C, SITE 3 KAI TAK, KOWLOON


TITLE :
WINDOW SCHEDULE FOR PRECAST FACADE AT TOWER 3

DATE : 17–Nov–21 | SCALE : 1:50 (A3)
DRAWN BY : IVAN | CHECKED BY :

美特鋁質有限公司
MIDI ALUMINIUM FABRICATION LTD.
Units 6–8, Sunray Industrial Centre, 1/F
610 Cha Kwo Ling Road, Kowloon
Tel:23489211–4 Fax:(852)27727666


DWG NO. : J859–SD–PW–3101 | REV. : F

FREE AREA(%)	S.O.	PROVIDED		REQUIRE	
		OPENABLE AREA	GLAZING AREA	OPENABLE AREA	GLAZING AREA
46.4%	1540	0.711	0.607	0.345	

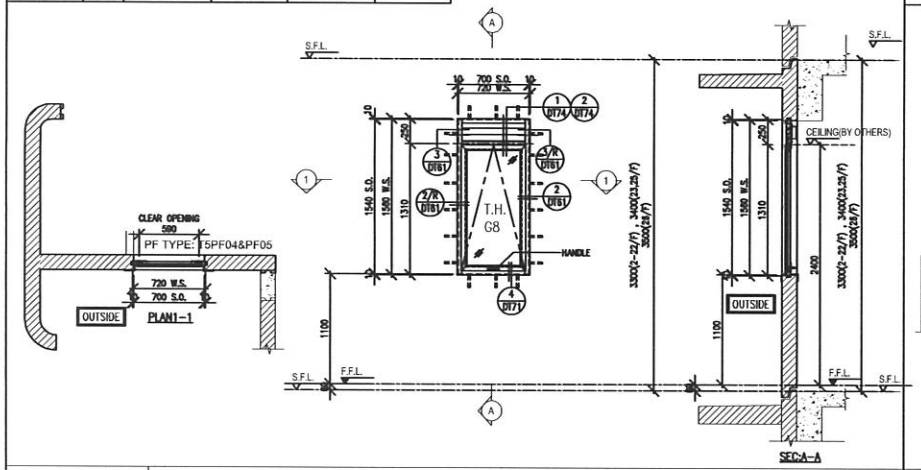


WINDOW MARK	W1/P T5 — 2/F–22/F: 18 nos. / 23/F,25/F: 2 nos. / 26/F: 1 no.
LOCATION	FLAT A STO AT 2/F TO 26/F FLOOR (T5) (4,13,14,24/F OMITTED)
GLAZING	G8
WINDOW FRAME	50mm ALUM. WINDOW SECTION , 4 BAR HINGE–LIP HING (HYLP14)

FREE AREA(%)	S.O.	PROVIDED		REQUIRE	
		OPENABLE AREA	GLAZING AREA	OPENABLE AREA	GLAZING AREA
46.4%	1540	0.711	0.607	0.273	

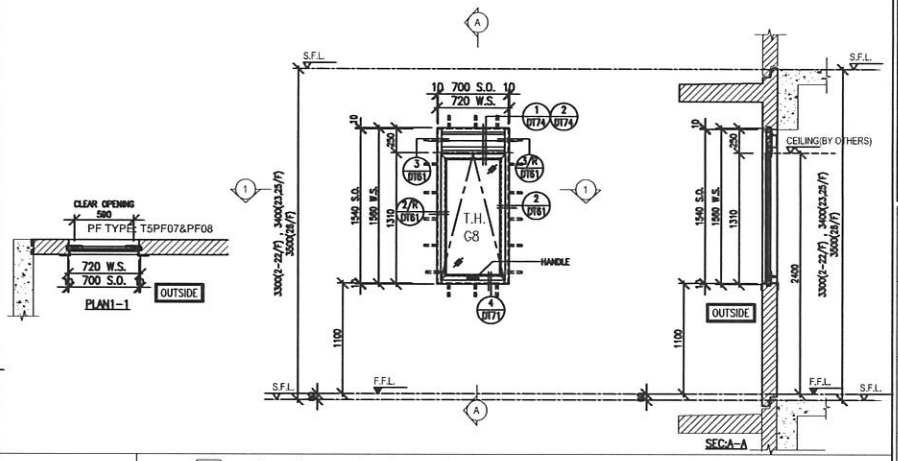


WINDOW MARK	W2/P T5 — 2/F–22/F: 18 nos. / 23/F,25/F: 2 nos. / 26/F: 1 no.
LOCATION	FLAT B STO AT 2/F TO 26/F FLOOR (T5) (4,13,14,24/F OMITTED)
GLAZING	G8
WINDOW FRAME	50mm ALUM. WINDOW SECTION , 4 BAR HINGE–LIP HING (HYLP14)

FREE AREA(%)	S.O.	PROVIDED		REQUIRE	
		OPENABLE AREA	GLAZING AREA	OPENABLE AREA	GLAZING AREA
54.4%	1540	0.8	1.398	0.757	0.757

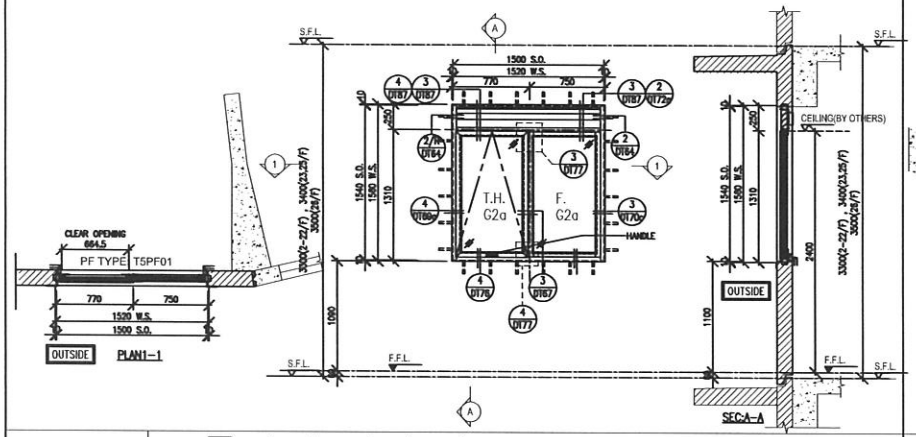

WINDOW MARK	W3/P T5 — 2/F–22/F: 18 nos. / 23/F,25/F: 2 nos. / 26/F: 1 no.
LOCATION	FLAT A M.BATH AT 2/F TO 26/F FLOOR (T5) (4,13,14,24/F OMITTED)
GLAZING	G2a
WINDOW FRAME	70mm ALUM. WINDOW SECTION , 4 BAR HINGE–LIP HING (HYLP14)

FREE AREA(%)	S.O.	PROVIDED		REQUIRE	
		OPENABLE AREA	GLAZING AREA	OPENABLE AREA	GLAZING AREA
54.4%	1540	1.156	1.03	0.763	0.763

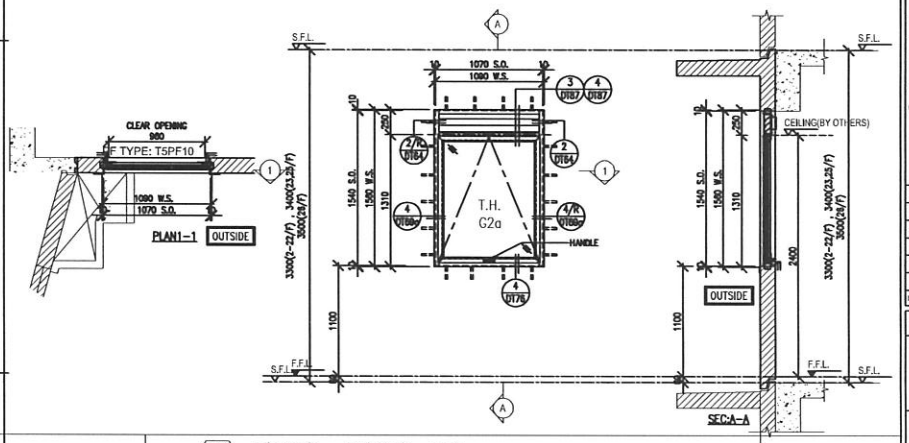

WINDOW MARK	W4/P T5 — 2/F–22/F: 18 nos. / 23/F,25/F: 2 nos. / 26/F: 1 no.
LOCATION	FLAT B M.BATH AT 2/F TO 26/F FLOOR (T5) (4,13,14,24/F OMITTED)
GLAZING	G2a
WINDOW FRAME	70mm ALUM. WINDOW SECTION , 4 BAR HINGE–LIP HING (HYLP16)

B.D. REF :

ARCHITECT :
WONG TUNG & PARTNERS LIMITED
ARCHITECTS & PLANNERS

STRUCTURAL ENGINEER :
SUN HUNG KAI
ARCHITECTS AND ENGINEERS LTD.
SUN HUNG KAI CENTRE, WANCHAI, HONGKONG
TEL: 28278111 FAX: 28272884

FACADE CONSULTANT:
ALPHA CONSULTING LIMITED
Steel Structure & Façade Specialist

MAIN CONTRACTOR :
Sanfield Engineering Construction Ltd.

CLIENT :
SUN HUNG KAI
REAL ESTATE AGENCY LTD.
42/F SUN HUNG KAI CENTRE, WANCHAI, HONGKONG

NOTE :
1. ALL DIMENSIONS ARE IN mm.
2. ALL ELEVATIONS ARE VIEWED FROM OUTSIDE.
3. ALL DIMENSIONS TO BE VERIFIED ON SITE BEFORE FABRICATION.

LEGEND :
X1 — DETAIL MARK NO.
X001 — REFER SHEET NO.

1. F.F.L. --FINISHED FLOOR LEVEL
2. S.F.L. --STRUCTURAL FLOOR LEVEL
3. /R --REVERSED DETAIL
4. GLASS LEGEND

G1–8mmHS+12mm AIR GAP+10mmTP I.G.U.

G2–8mmHS+12mm AIR GAP+8mmTP I.G.U.

G2a–8mmHS+12mm AIR GAP+8mmTP+1.52PVB +6mm (PLANNING) FEATURED GLASS (I.G.U.)

G8–6mm GREY HS+1.52PVB+6mm CLEAR HS

NO.	DATE	REVISED	BY
F	2/09/2022	REVISION SUBJECT TO ALPHA COMMENT	PWM
E	28/06/2022	REVISION SUBJECT TO ALPHA COMMENT	PWM
D	11/05/2022	REVISION SUBJECT TO ARCH.COMMENT	PWM
C	25/04/2022	REVISION SUBJECT TO ARCH.COMMENT	PWM
B	13/04/2022	REVISION SUBJECT TO ARCH.COMMENT	PWM
A	28/03/2022	REVISION SUBJECT TO ARCH.COMMENT	PWM

JOB NO. : J–859

PROJECT :
PROPOSED RESIDENTIAL / COMMERCIAL DEVELOPMENT AT NKIL NO.6551 KAI TAK AREA 4C, SITE 3 KAI TAK, KOWLOON

TITLE :
WINDOW SCHEDULE FOR PRECAST FACADE AT TOWER 5


DATE : 18–Nov–21 | SCALE : 1:50 (A3)

DRAWN BY : IVAN | CHECKED BY :

美特鋁質有限公司
MIDI ALUMINIUM FABRICATOR LTD.
Units 6–8, Sunray Industrial Centre, 1/F
610 Cha Kwo Ling Road, Kowloon
Tel:23489211–4 Fax:(852)27727666


DWG NO. : J859–SD–PW–5101 | REV. : F

PROVIDED				REQUIRE	
FREE AREA(%)	S.O.	OPENABLE AREA	GLAZING AREA	OPENABLE AREA	GLAZING AREA
62%	2390	0.597	1.312		

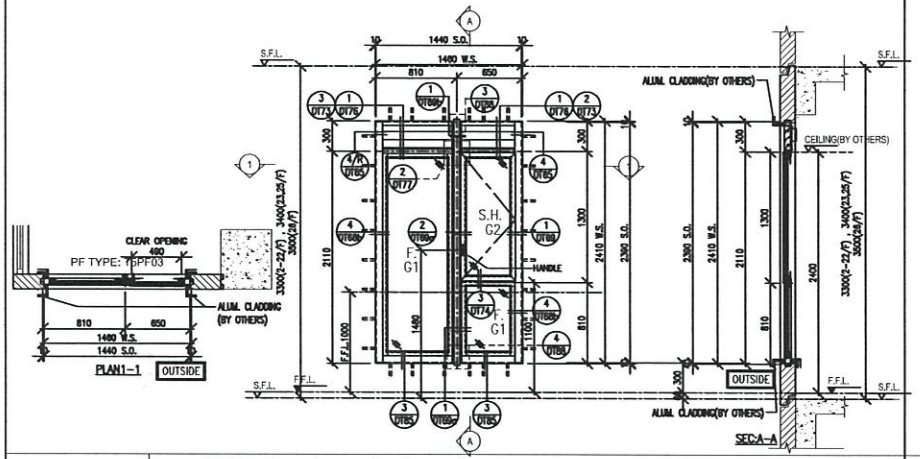


WINDOW MARK	W5/P T5 — 2/F–22/F: 18 nos.; 23/F,25/F: 2 nos.; 26/F: 1 no.
LOCATION	FLAT A KIT AT 2/F TO 26/F FLOOR (T5) (4,13,14,24/F OMITTED)
GLAZING	G1, G2
WINDOW FRAME	70mm ALUM. WINDOW SECTION , 4 BAR HINGE–LIP HING (HHMS–N14)

PROVIDED				REQUIRE	
FREE AREA(%)	S.O.	OPENABLE AREA	GLAZING AREA	OPENABLE AREA	GLAZING AREA
46.4%	1540	0.711	0.807		

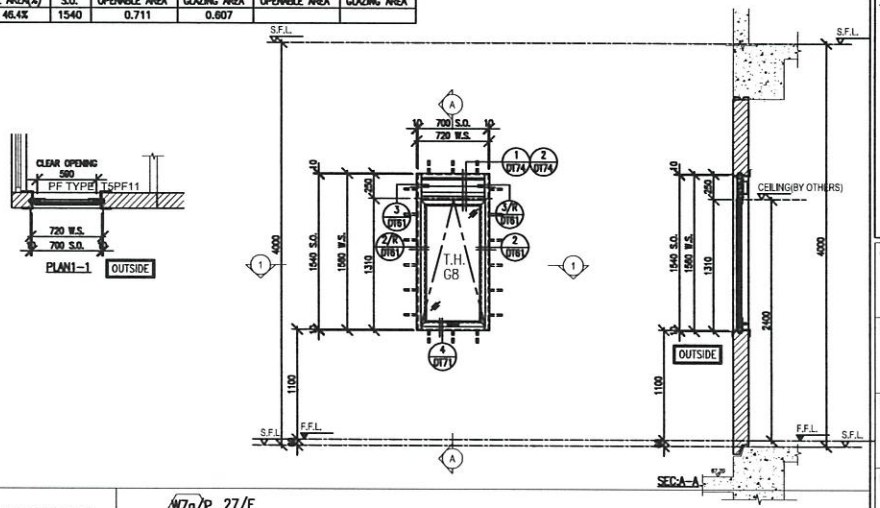

WINDOW MARK	W7a/P T5 — 27/F: 1 no.
LOCATION	STO AT 27/F FLOOR
GLAZING	G8
WINDOW FRAME	50mm ALUM. WINDOW SECTION , 4 BAR HINGE–LIP HING (HYLP14)

PROVIDED				REQUIRE	
FREE AREA(%)	S.O.	OPENABLE AREA	GLAZING AREA	OPENABLE AREA	GLAZING AREA
54.4%	1540	1.787	1.562		

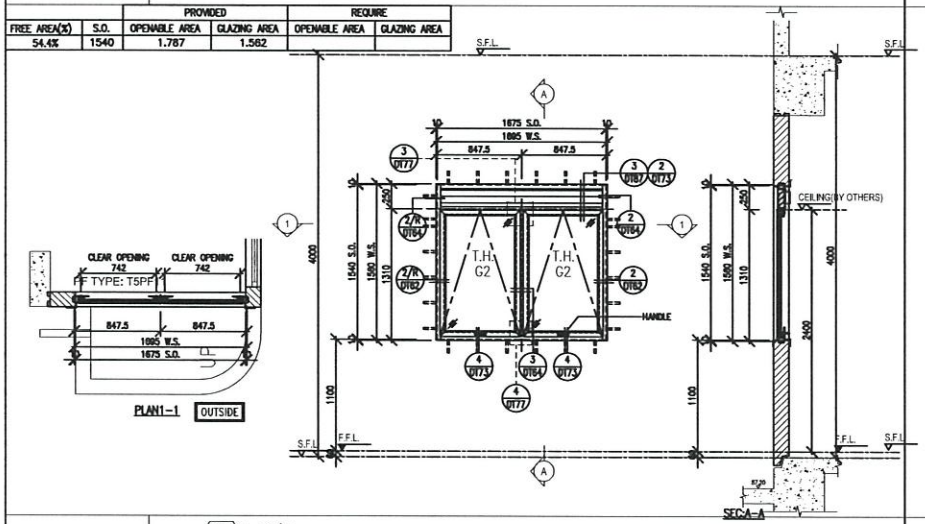

WINDOW MARK	W8a/P T5 — 27/F: 1 no.
LOCATION	STO AT 27/F (T5)
GLAZING	G2
WINDOW FRAME	70mm ALUM. WINDOW SECTION , 4 BAR HINGE–LIP HING (HYLP14)

WINDOW MARK	
LOCATION	
GLAZING	
WINDOW FRAME	

B.D. REF :

ARCHITECT :
WONG TUNG & PARTNERS LIMITED
ARCHITECTS & PLANNERS

STRUCTURAL ENGINEER :
SUN HUNG KAI
ARCHITECTS AND ENGINEERS LTD.
SUN HUNG KAI CENTRE, WANCHAI, HONGKONG
TEL. 28276111 FAX. 28272884

FACADE CONSULTANT:
ALPHA CONSULTING LIMITED
Steel Structure & Facade Specialist

MAIN CONTRACTOR :
Sanfield Engineering Construction Ltd.

CLIENT :
SUN HUNG KAI
REAL ESTATE AGENCY LTD.
48/F SUN HUNG KAI CENTRE, WANCHAI, HONGKONG

NOTE :
1. ALL DIMENSIONS ARE IN mm.
2. ALL ELEVATIONS ARE VIEWED FROM OUTSIDE.
3. ALL DIMENSIONS TO BE VERIFIED ON SITE BEFORE FABRICATION.

LEGEND :
X1 / X001 — DETAIL MARK NO. / REFER SHEET NO.
1. F.F.L. — FINISHED FLOOR LEVEL
2. S.F.L. — STRUCTURAL FLOOR LEVEL
3. (R) — REVERSED DETAIL
4. GLASS LEGEND
G1–8mmHS+12mm AIR GAP+10mmTP I.G.U.
G2–8mmHS+12mm AIR GAP+8mmTP I.G.U.
G2a–8mmHS+12mm AIR GAP+8mmTP+1.52PVB +6mm (PLANNING) FEATURED GLASS (I.G.U.)
G8–6mm GREY HS+1.52PVB+6mm CLEAR HS

NO.	DATE	REVISED	BY
F	13/10/2022	REVISION SUBJECT TO ARCH. COMMENT	W
E	28/09/2022	REVISION SUBJECT TO Alpha COMMENT	WAI
D	11/05/2022	REVISION SUBJECT TO ARCH.COMMENT	WAI
C	25/04/2022	REVISION SUBJECT TO ARCH.COMMENT	WAI
B	13/04/2022	REVISION SUBJECT TO ARCH.COMMENT	WAI
A	28/03/2022	REVISION SUBJECT TO ARCH.COMMENT	WAI

JOB NO. : J–859

PROJECT :
PROPOSED RESIDENTIAL / COMMERCIAL DEVELOPMENT AT NKIL NO.6551 KAI TAK AREA 4C, SITE 3 KAI TAK, KOWLOON

TITLE :
WINDOW SCHEDULE FOR PRECAST FACADE AT TOWER 5


DATE : 18–Nov–21 | SCALE : 1:50 (A3)

DRAWN BY : IVAN | CHECKED BY :

美特鋁製有限公司
MIDI ALUMINIUM FABRICATOR LTD.
Units 6–8, Sunray Industrial Centre, 1/F
810 Cha Kwo Ling Road, Kowloon
Tel:23489211–4 Fax:(852)27727666


DWG NO. : J859–SD–PW–5102 | REV. : F

FREE AREA(%)	S.O.	PROVIDED		REQUIRE	
		OPENABLE AREA	GLAZING AREA	OPENABLE AREA	GLAZING AREA
46.4%	1540	0.711	0.607	0.273	

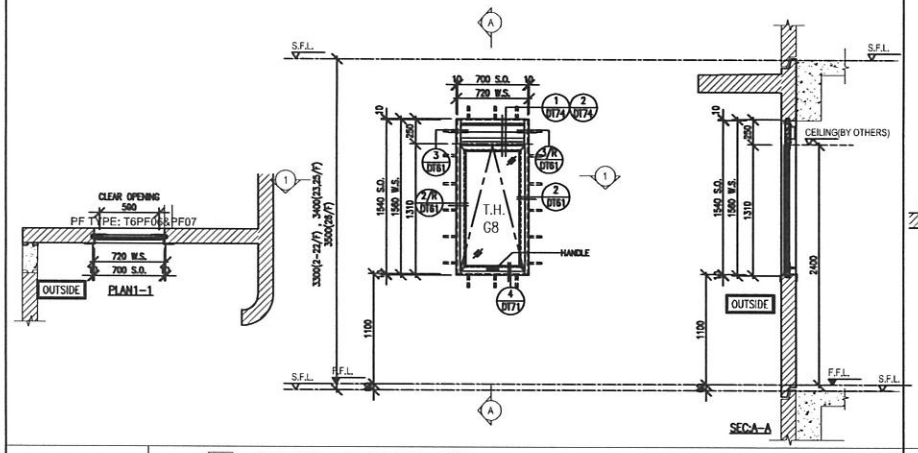


WINDOW MARK	W1/P T6 — 2/F–22/F: 18 nos. / 23/F,25/F: 2 nos. / 26/F: 1 no.
LOCATION	FLAT A STO AT 2/F TO 26/F FLOOR (T6) (4,13,14,24/F OMITTED)
GLAZING	G8
WINDOW FRAME	50mm ALUM. WINDOW SECTION , 4 BAR HINGE–LIP HING (HYLP14)

FREE AREA(%)	S.O.	PROVIDED		REQUIRE	
		OPENABLE AREA	GLAZING AREA	OPENABLE AREA	GLAZING AREA
46.4%	1540	0.711	0.607	0.345	

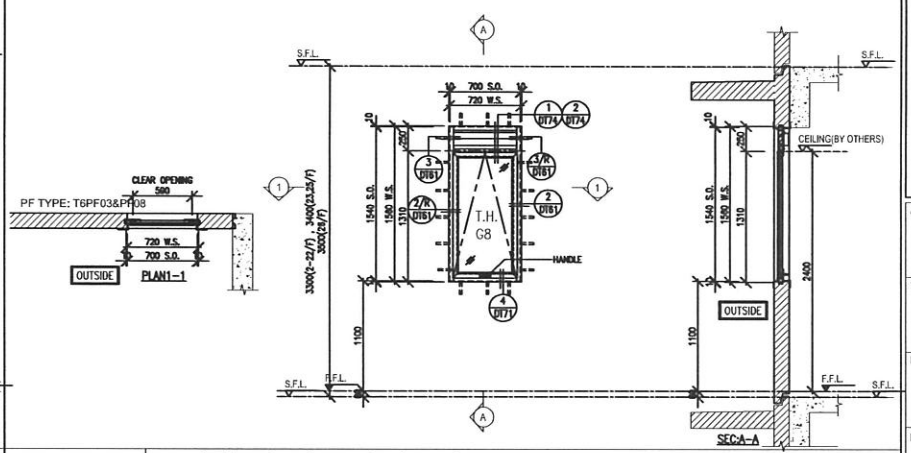


WINDOW MARK	W2/P T6 — 2/F–22/F: 18 nos. / 23/F,25/F: 2 nos. / 26/F: 1 no.
LOCATION	FLAT B STO AT 2/F TO 26/F FLOOR (T6) (4,13,14,24/F OMITTED)
GLAZING	G8
WINDOW FRAME	50mm ALUM. WINDOW SECTION , 4 BAR HINGE–LIP HING (HYLP14)

FREE AREA(%)	S.O.	PROVIDED		REQUIRE	
		OPENABLE AREA	GLAZING AREA	OPENABLE AREA	GLAZING AREA
54.4%	1540	0.8	1.398	0.753	0.753

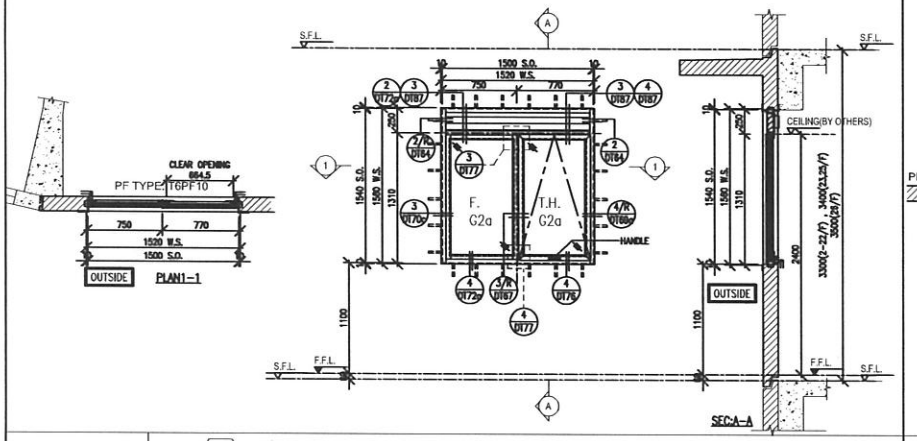

WINDOW MARK	W3/P T6 — 2/F–22/F: 18 nos. / 23/F,25/F: 2 nos. / 26/F: 1 no.
LOCATION	FLAT A M.BATH AT 2/F TO 26/F FLOOR (T6) (4,13,14,24/F OMITTED)
GLAZING	G2a
WINDOW FRAME	70mm ALUM. WINDOW SECTION , 4 BAR HINGE–LIP HING (HYLP14)

FREE AREA(%)	S.O.	PROVIDED		REQUIRE	
		OPENABLE AREA	GLAZING AREA	OPENABLE AREA	GLAZING AREA
54.4%	1540	0.776	1.031	0.746	0.746

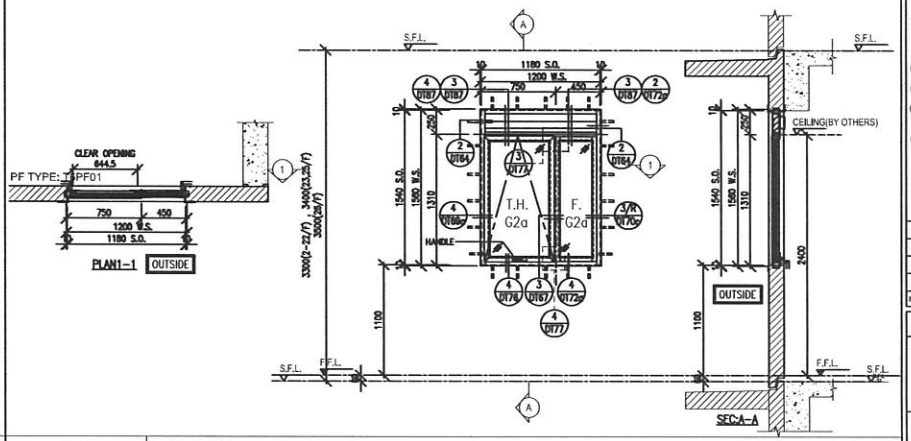

WINDOW MARK	W4/P T6 — 2/F–22/F: 18 nos. / 23/F,25/F: 2 nos. / 26/F: 1 no.
LOCATION	FLAT B M.BATH AT 2/F TO 26/F FLOOR (T6) (4,13,14,24/F OMITTED)
GLAZING	G2a
WINDOW FRAME	70mm ALUM. WINDOW SECTION , 4 BAR HINGE–LIP HING (HYLP14)

B.D. REF :

ARCHITECT :
WONG TUNG & PARTNERS LIMITED
ARCHITECTS & PLANNERS

STRUCTURAL ENGINEER :
SUN HUNG KAI
ARCHITECTS AND ENGINEERS LTD.
SUN HUNG KAI CENTRE, WANCHAI, HONGKONG
TEL: 28278111 FAX: 28272884

FACADE CONSULTANT:
ALPHA CONSULTING LIMITED
Steel Structure & Facade Specialist

MAIN CONTRACTOR :
Sanfield Engineering Construction Ltd.

CLIENT :
SUN HUNG KAI
REAL ESTATE AGENCY LTD.
42/F SUN HUNG KAI CENTRE, WANCHAI, HONGKONG

NOTE :
1. ALL DIMENSIONS ARE IN mm.
2. ALL ELEVATIONS ARE VIEWED FROM OUTSIDE.
3. ALL DIMENSIONS TO BE VERIFIED ON SITE BEFORE FABRICATION.

LEGEND :
X1 — DETAIL MARK NO.
X001 — REFER SHEET NO.

1. F.F.L. --FINISHED FLOOR LEVEL
2. S.F.L. --STRUCTURAL FLOOR LEVEL
3. /R --REVERSED DETAIL
4. GLASS LEGEND

G1–8mmHS+12mm AIR GAP+10mmTP I.G.U.

G2–8mmHS+12mm AIR GAP+8mmTP I.G.U.

G2a–8mmHS+12mm AIR GAP+8mmTP+1.52PVBI +6mm (PLANNING) FEATURED GLASS (I.G.U.)

G8–6mm GREY HS+1.52PVBI+6mm CLEAR HS

NO.	DATE	REVISED	BY
D	11/05/2022	REVISION SUBJECT TO ARCHITECTURAL	IVAN
C	25/04/2022	REVISION SUBJECT TO ARCHITECTURAL	IVAN
B	13/04/2022	REVISION SUBJECT TO ARCHITECTURAL	IVAN
A	28/03/2022	REVISION SUBJECT TO ARCHITECTURAL	IVAN

JOB NO. : J–859

PROJECT :
PROPOSED RESIDENTIAL / COMMERCIAL DEVELOPMENT AT NKIL NO.6551 KAI TAK AREA 4C, SITE 3 KAI TAK, KOWLOON

TITLE :
WINDOW SCHEDULE FOR PRECAST FACADE AT TOWER 6


DATE : 18–Nov–21 | SCALE : 1:50 (A3)

DRAWN BY : IVAN | CHECKED BY :

美特鋁質有限公司
MIDI ALUMINIUM FABRICATOR LTD.
Units 6–8, Sunray Industrial Centre, 1/F
610 Cha Kwo Ling Road, Kowloon
Tel:23489211–4 Fax:(852)27727666


DWG NO. : J859–SD–PW–6101 | REV. : D

		PROVIDED		REQUIRE	
FREE AREA(%)	S.O.	OPENABLE AREA	GLAZING AREA	OPENABLE AREA	GLAZING AREA
62%	2390	0.597	1.312		

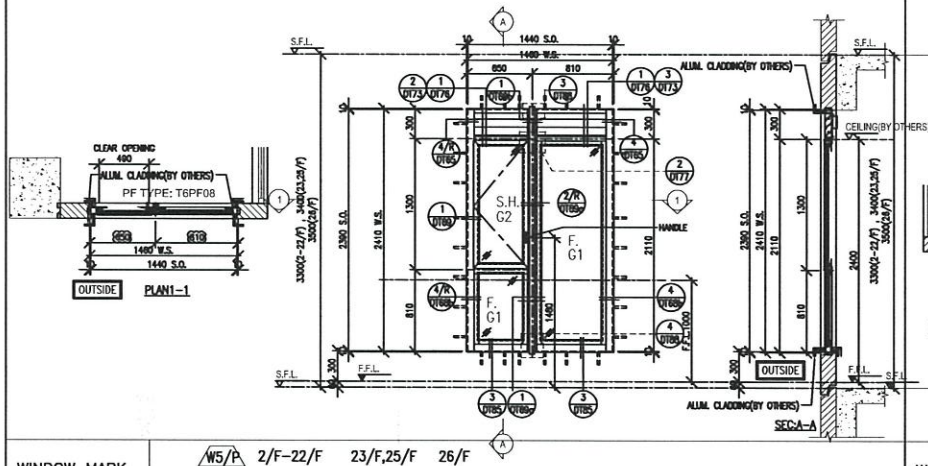


WINDOW MARK	W5/P T6 — 2/F–22/F: 18 nos.; 23/F,25/F: 2 nos.; 26/F: 1 no.
LOCATION	FLAT A KIT AT 2/F TO 26/F FLOOR (T6) (4,13,14,24/F OMITTED)
GLAZING	G1, G2
WINDOW FRAME	70mm ALUM. WINDOW SECTION , 4 BAR HINGE–LIP HING (HHMS–N14)

		PROVIDED		REQUIRE	
FREE AREA(%)	S.O.	OPENABLE AREA	GLAZING AREA	OPENABLE AREA	GLAZING AREA
46.4%	1540	1.155	0.960		

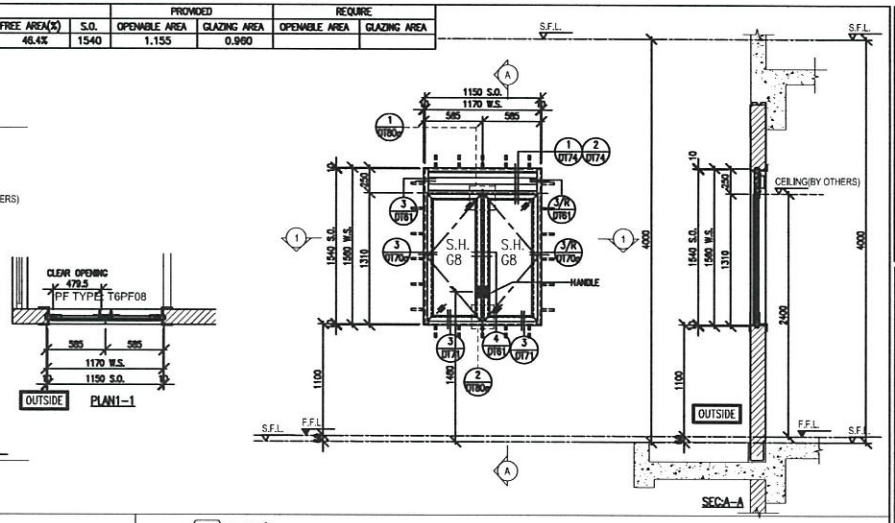

WINDOW MARK	W10/P T6 — 27/F: 1 no.
LOCATION	UTR AT 27/F FLOOR
GLAZING	G8
WINDOW FRAME	50mm ALUM. WINDOW SECTION , 4 BAR HINGE–LIP HING (HHMS–N14)

		PROVIDED		REQUIRE	
FREE AREA(%)	S.O.	OPENABLE AREA	GLAZING AREA	OPENABLE AREA	GLAZING AREA
54.4%	1540	0.710	1.227		

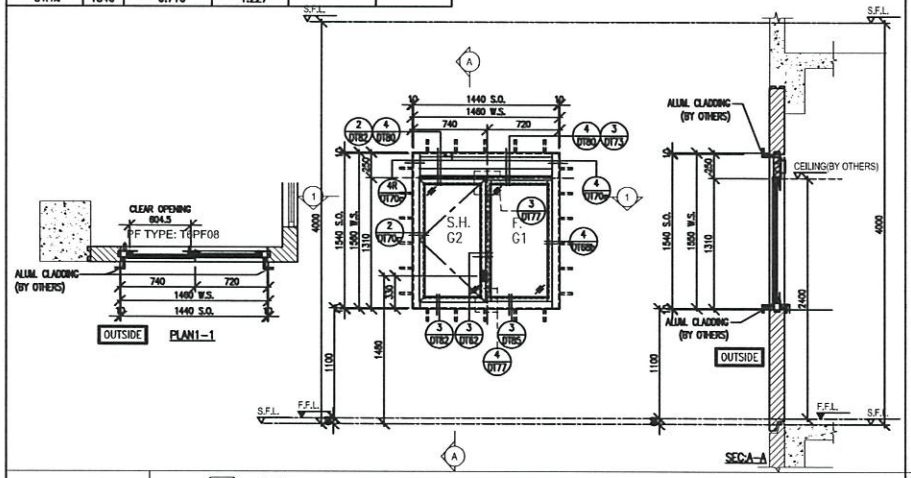

WINDOW MARK	W11/P T6 — 27/F: 1 no.
LOCATION	UTR AT 27/F FLOOR
GLAZING	G1, G2
WINDOW FRAME	70mm ALUM. WINDOW SECTION , 4 BAR HINGE–LIP HING (HYLS16)

WINDOW MARK	
LOCATION	
GLAZING	
WINDOW FRAME	

B.D. REF :

ARCHITECT :
WONG TUNG & PARTNERS LIMITED
ARCHITECTS & PLANNERS

STRUCTURAL ENGINEER :
SUN HUNG KAI
ARCHITECTS AND ENGINEERS LTD.
SUN HUNG KAI CENTRE, WANCHAI, HONGKONG
TEL: 28276111 FAX: 28272804

FACADE CONSULTANT:
ALPHA CONSULTING LIMITED
Steel Structure & Facade Specialist

MAIN CONTRACTOR :
Sanfield Engineering Construction Ltd.

CLIENT :
SUN HUNG KAI
REAL ESTATE AGENCY LTD.
42/F SUN HUNG KAI CENTRE, WANCHAI, HONGKONG

NOTE :
1. ALL DIMENSIONS ARE IN mm.
2. ALL ELEVATIONS ARE VIEWED FROM OUTSIDE.
3. ALL DIMENSIONS TO BE VERIFIED ON SITE BEFORE FABRICATION.

LEGEND :
X1 / X001 — DETAIL MARK NO. / REFER SHEET NO.
1. F.F.L. --FINISHED FLOOR LEVEL
2. S.F.L. --STRUCTURAL FLOOR LEVEL
3. /R --REVERSED DETAIL
4. GLASS LEGEND
G1–8mmHS+12mm AIR GAP+10mmTP I.G.U.
G2–8mmHS+12mm AIR GAP+8mmTP I.G.U.
G2a–8mmHS+12mm AIR GAP+8mmTP+1.52PVB +6mm (PLANNING) FEATURED GLASS (I.G.U.)
G8–6mm GREY HS+1.52PVB+6mm CLEAR HS

NO.	DATE	REVISED	BY
F	13/10/2022	REVISION SUBJECT TO ARCH. COMMENT	YI
E	28/09/2022	REVISION SUBJECT TO Alpha COMMENT	YWK
D	11/09/2022	REVISION SUBJECT TO ARCH.COMMENT	YWK
C	25/04/2022	REVISION SUBJECT TO ARCH.COMMENT	YWK
B	13/04/2022	REVISION SUBJECT TO ARCH.COMMENT	YWK
A	28/03/2022	REVISION SUBJECT TO ARCH.COMMENT	YWK

JOB NO. : J–859

PROJECT :
PROPOSED RESIDENTIAL / COMMERCIAL DEVELOPMENT AT NKIL NO.6551 KAI TAK AREA 4C, SITE 3 KAI TAK, KOWLOON

TITLE :
WINDOW SCHEDULE FOR PRECAST FACADE AT TOWER 6


DATE : 18–Nov–21 | SCALE : 1:50 (A3)

DRAWN BY : IVAN | CHECKED BY :

美特鋁質有限公司
MIDI ALUMINIUM FABRICATOR LTD.
Units 6–8, Sunray Industrial Centre, 1/F
610 Cha Kwo Ling Road, Kowloon
Tel:23489211–4 Fax:(852)27727666


DWG NO. : J859–SD–PW–6102 | REV. : F

		PROVIDED		REQUIRE	
FREE AREA(%)	S.O.	OPENABLE AREA	GLAZING AREA	OPENABLE AREA	GLAZING AREA
62%	1590	1.18	0.986	0.393	0.628

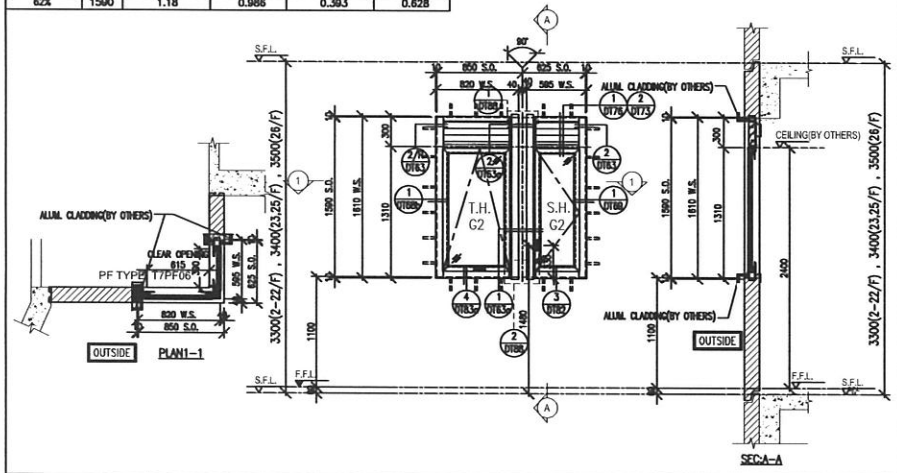


WINDOW MARK	W1/P T7 — 2/F–22/F: 18 nos. / 23/F,25/F: 2 nos. / 26/F: 1 no.
LOCATION	FLAT A KIT AT 2/F TO 26/F FLOOR (T7) (4,13,14,24/F OMITTED)
GLAZING	G2
WINDOW FRAME	70mm ALUM. WINDOW SECTION , 4 BAR HINGE–LIP HING (HHMS–N14) FOR SIDE HUNG/(HYLP14) FOR TOP HUNG

		PROVIDED		REQUIRE	
FREE AREA(%)	S.O.	OPENABLE AREA	GLAZING AREA	OPENABLE AREA	GLAZING AREA
62%	1590	0.855	0.744	0.424	0.678

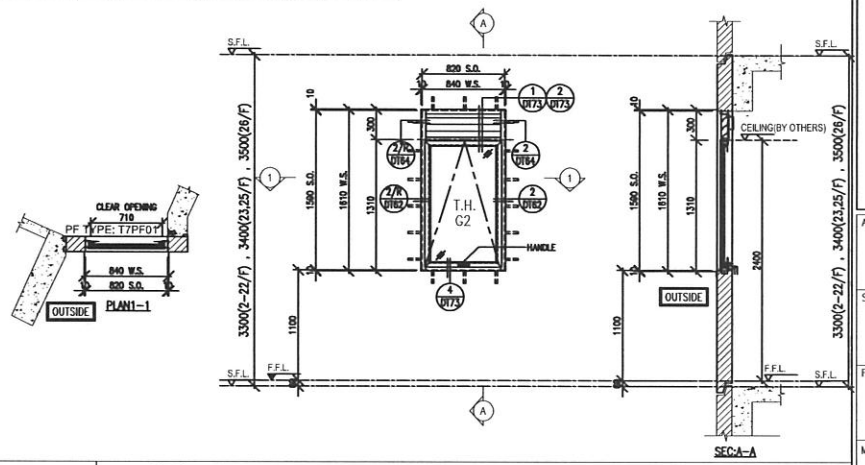

WINDOW MARK	W2/P T7 — 2/F–22/F: 18 nos. / 23/F,25/F: 2 nos. / 26/F: 1 no.
LOCATION	FLAT B KIT AT 2/F TO 26/F FLOOR (T7) (4,13,14,24/F OMITTED)
GLAZING	G2
WINDOW FRAME	70mm ALUM. WINDOW SECTION , 4 BAR HINGE–LIP HING (HYLP14)

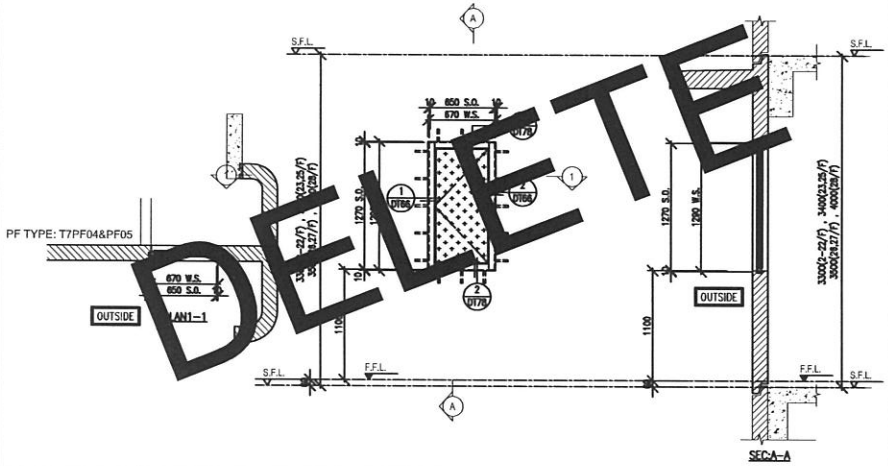

DELETE

WINDOW MARK	AD1 T7 — 2/F–22/F: 18 nos. / 23/F,25/F: 2 nos. / 26/F–28/F: 3 nos.
LOCATION	WMC AT 2/F TO 28/F FLOOR (T7) (4,13,14,24/F OMITTED)
GLAZING	–
WINDOW FRAME	50mm ALUM. WINDOW SECTION & 3mm THK. ALUM. CLADDING , DOOR HINGE LIP HING (HHB)

B.D. REF :

ARCHITECT :
WONG TUNG & PARTNERS LIMITED
ARCHITECTS & PLANNERS

STRUCTURAL ENGINEER :
SUN HUNG KAI
ARCHITECTS AND ENGINEERS LTD.
SUN HUNG KAI CENTRE, WANCHAI, HONGKONG
TEL: 28279111 FAX: 28272884

FACADE CONSULTANT:
ALPHA CONSULTING LIMITED
Steel Structure & Facade Specialist

MAIN CONTRACTOR :
Sanfield Engineering Construction Ltd.

CLIENT :
SUN HUNG KAI
REAL ESTATE AGENCY LTD.
42/F SUN HUNG KAI CENTRE, WANCHAI, HONGKONG

NOTE :
1. ALL DIMENSIONS ARE IN mm.
2. ALL ELEVATIONS ARE VIEWED FROM OUTSIDE.
3. ALL DIMENSIONS TO BE VERIFIED ON SITE BEFORE FABRICATION.

LEGEND :
X1 / X001 — DETAIL MARK NO. / REFER SHEET NO.
1. F.F.L. – FINISHED FLOOR LEVEL
2. S.F.L. – STRUCTURAL FLOOR LEVEL
3. /R – REVERSED DETAIL
4. GLASS LEGEND
G1–8mmHS+12mm AIR GAP+10mmTP I.G.U.
G2–8mmHS+12mm AIR GAP+8mmTP I.G.U.
G2a–8mmHS+12mm AIR GAP+8mmTP+1.52PVBI +6mm(PLANNING) FEATURED GLASS (I.G.U.)
G8–6mm GREY HS+1.52PVBI+6mm CLEAR HS

NO.	DATE	REVISED	BY
F	8/09/2022	REVISION SUBJECT TO ALPHA COMMENT	PANG
E	30/08/2022	REVISION SUBJECT TO ALPHA COMMENT	PANG
D	12/08/2022	REVISION SUBJECT TO ARCHCOMMENT	PANG
C	25/04/2022	REVISION SUBJECT TO ARCHCOMMENT	PANG
B	13/04/2022	REVISION SUBJECT TO ARCHCOMMENT	PANG
A	28/03/2022	REVISION SUBJECT TO ARCHCOMMENT	PANG

JOB NO. : J–859

PROJECT :
PROPOSED RESIDENTIAL / COMMERCIAL DEVELOPMENT AT NKIL NO.6551 KAI TAK AREA 4C, SITE 3 KAI TAK, KOWLOON


TITLE :
WINDOW SCHEDULE FOR PRECAST FACADE AT TOWER 7

DATE : 13–Nov–21 | SCALE : 1:50 (A3)
DRAWN BY : IVAN | CHECKED BY :

美特鋁質有限公司
MIDI ALUMINIUM FABRICATOR LTD.
Units 6–8, Sunray Industrial Centre, 1/F
610 Cha Kwo Ling Road, Kowloon
Tel:23489211–4 Fax:(852)27727666


DWG NO. : J859–SD–PW–7101 | REV. : F

PROVIDED				REQUIRE	
FREE AREA(%)	S.O.	OPENABLE AREA	GLAZING AREA	OPENABLE AREA	GLAZING AREA
62%	1590	0.541	0.974	0.460	0.736

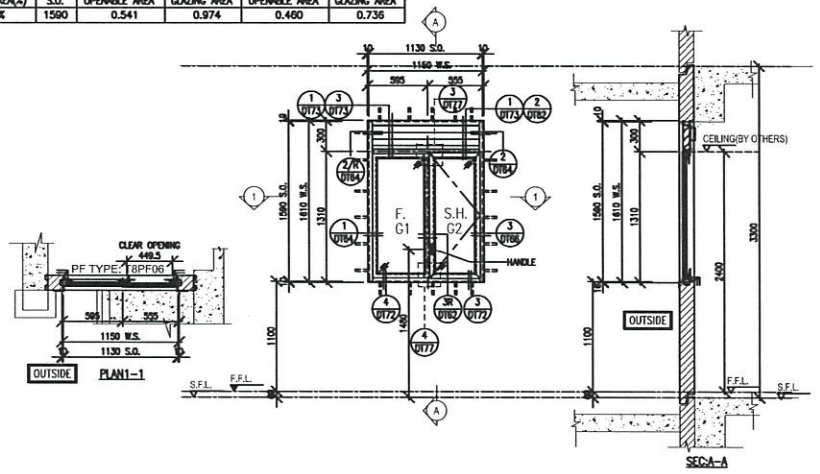


WINDOW MARK	W1/P T8 — 2/F–8/F: 6 nos.
LOCATION	FLAT A KIT AT 2/F TO 8/F FLOOR (T8) (4/F OMITTED)
GLAZING	G1,G2
WINDOW FRAME	70mm ALUM. WINDOW SECTION , 4 BAR HINGE–LIP HING (HHMS–N14)

PROVIDED				REQUIRE	
FREE AREA(%)	S.O.	OPENABLE AREA	GLAZING AREA	OPENABLE AREA	GLAZING AREA
53.7%	1475	0.63	0.53		
	1575	0.69	0.58		
	1675	0.74	0.63		

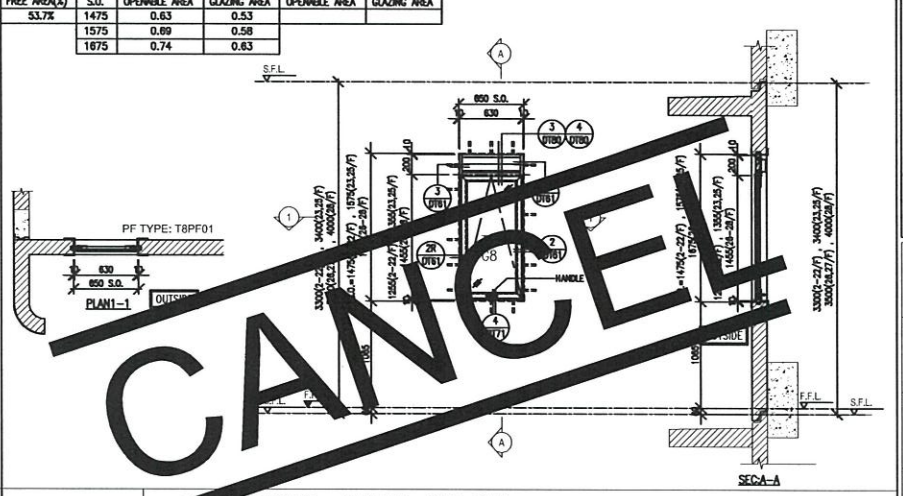


CANCEL

WINDOW MARK	W6/P T8 — 2/F–22/F: 18 nos.; 23/F,25/F: 2 nos.; 26/F–28/F: 3 nos.
LOCATION	ST–2 AT 2/F TO 28/F FLOOR (T8) (4,13,14,24/F OMITTED)
GLAZING	G8
WINDOW FRAME	50mm ALUM. WINDOW SECTION

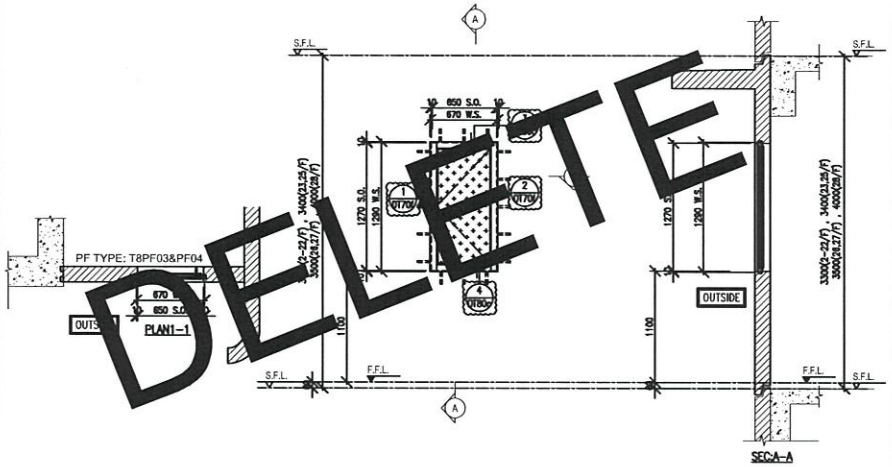

DELETE

PROVIDED			REQUIRE	
S.O.	OPENABLE AREA	GLAZING AREA	OPENABLE AREA	GLAZING AREA
(1335)	(0.662)	(0.559)		

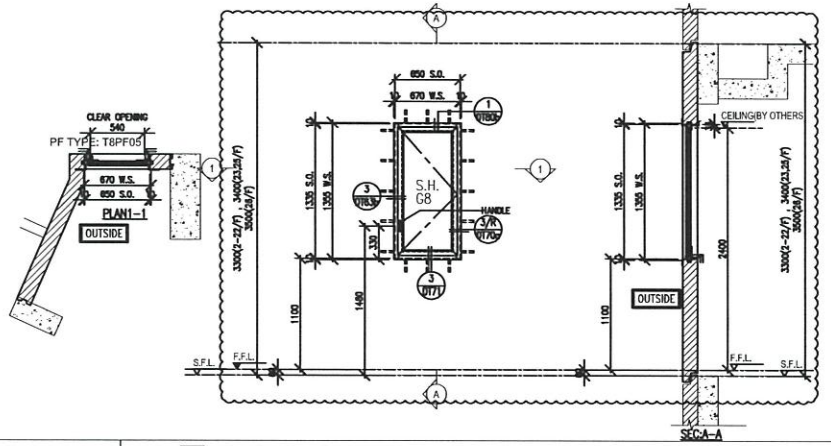

WINDOW MARK	AD1 T8 — 2/F–22/F: 18 nos.; 23/F,25/F: 2 nos.; 26/F–28/F: 3 nos.
LOCATION	EMR AT 2/F TO 28/F FLOOR (T8) (4,13,14,24/F OMITTED)
GLAZING	–
WINDOW FRAME	50mm ALUM. WINDOW SECTION & 3mm THK. ALUM. CLADDING , DOOR HINGE LIP HING (HHB)

WINDOW MARK	W6/P T8 — 2/F–22/F: 18 nos.; 23/F,25/F: 2 nos.; 26/F: 1 nos.
LOCATION	FLAT A (BATH AT 2/F TO 8/F) (BR2 AT 9/F TO 26/F) , (T8) (4,13,14,24/F OMITTED)
GLAZING	G8
WINDOW FRAME	50mm ALUM. WINDOW SECTION , 4 BAR HINGE–LIP HING (HYLS16)

B.D. REF :

ARCHITECT :
WONG TUNG & PARTNERS LIMITED
ARCHITECTS & PLANNERS

STRUCTURAL ENGINEER :
SUN HUNG KAI
ARCHITECTS AND ENGINEERS LTD.
SUN HUNG KAI CENTRE, WANCHAI, HONGKONG
TEL. 28278111 FAX. 28272804

FACADE CONSULTANT:
ALPHA CONSULTING LIMITED
Steel Structure & Facade Specialist

MAIN CONTRACTOR :
Sanfield Engineering Construction Ltd.

CLIENT :
SUN HUNG KAI
REAL ESTATE AGENCY LTD.
42/F SUN HUNG KAI CENTRE, WANCHAI, HONGKONG

NOTE :
1. ALL DIMENSIONS ARE IN mm.
2. ALL ELEVATIONS ARE VIEWED FROM OUTSIDE.
3. ALL DIMENSIONS TO BE VERIFIED ON SITE BEFORE FABRICATION.

LEGEND :
X1 / X001 — DETAIL MARK NO. / REFER SHEET NO.

1. F.F.L. – FINISHED FLOOR LEVEL
2. S.F.L. – STRUCTURAL FLOOR LEVEL
3. /R – REVERSED DETAIL
4. GLASS LEGEND

G1–8mmHS+12mm AIR GAP+10mmTP I.G.U.

G2–8mmHS+12mm AIR GAP+8mmTP I.G.U.

G2a–8mmHS+12mm AIR GAP+8mmTP+1.52PVB +6mm(PLANNING) FEATURED GLASS (I.G.U.)

G8–6mm GREY HS+1.52PVB+6mm CLEAR HS

NO.	DATE	REVISED	BY
H	04/11/2022	REVISION SUBJECT TO ARCHITECT COMMENT	YH
G	08/08/2022	REVISION SUBJECT TO ARCHITECT COMMENT	IVAN
F	02/08/2022	REVISION SUBJECT TO ARCHITECT COMMENT	IVAN
E	26/05/2022	REVISION SUBJECT TO ALPHA COMMENT	IVAN
D	12/05/2022	REVISION SUBJECT TO ARCHITECT COMMENT	IVAN
C	25/04/2022	REVISION SUBJECT TO ARCHITECT COMMENT	IVAN
B	13/04/2022	REVISION SUBJECT TO ARCHITECT COMMENT	IVAN
A	28/03/2022	REVISION SUBJECT TO ARCHITECT COMMENT	IVAN

JOB NO. : J–859

PROJECT :
PROPOSED RESIDENTIAL / COMMERCIAL DEVELOPMENT AT NKIL NO.6551 KAI TAK AREA 4C, SITE 3 KAI TAK, KOWLOON

TITLE :
WINDOW SCHEDULE FOR PRECAST FACADE AT TOWER 8


DATE : 13–Nov–21 | SCALE : 1:50 (A3)

DRAWN BY : IVAN | CHECKED BY :

美特鋁製有限公司
MIDI ALUMINIUM FABRICATOR LTD.
Units 6–8, Sunray Industrial Centre, 1/F
610 Cha Kwo Ling Road, Kowloon
Tel:23489211–4 Fax:(852)27727666


DWG NO. : J859–SD–PW–8101 | REV. : H

FREE AREA(%)	S.O.	PROVIDED		REQUIRE	
		OPENABLE AREA	GLAZING AREA	OPENABLE AREA	GLAZING AREA
54.4%	1540	0.646	0.548	0.632	0.632

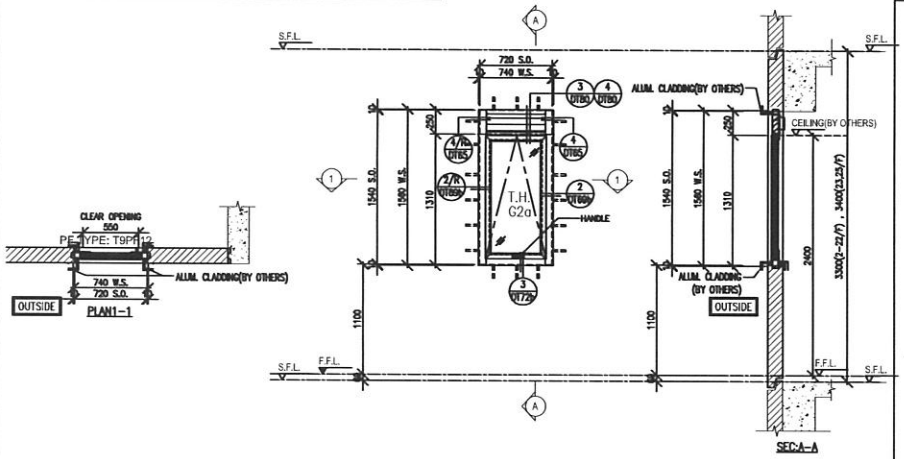


WINDOW MARK	W1/P T9 — 2/F–22/F: 18 nos.; 23/F,25/F: 2 nos.
LOCATION	FLAT B M.BATH AT 2/F TO 25/F FLOOR (T9) (4,13,14,24/F OMITTED)
GLAZING	G2a
WINDOW FRAME	70mm ALUM. WINDOW SECTION , 4 BAR HINGE–LIP HING (HYLP14)

S.O.	PROVIDED		REQUIRE	
	OPENABLE AREA	GLAZING AREA	OPENABLE AREA	GLAZING AREA
1290	1.168	1.042		

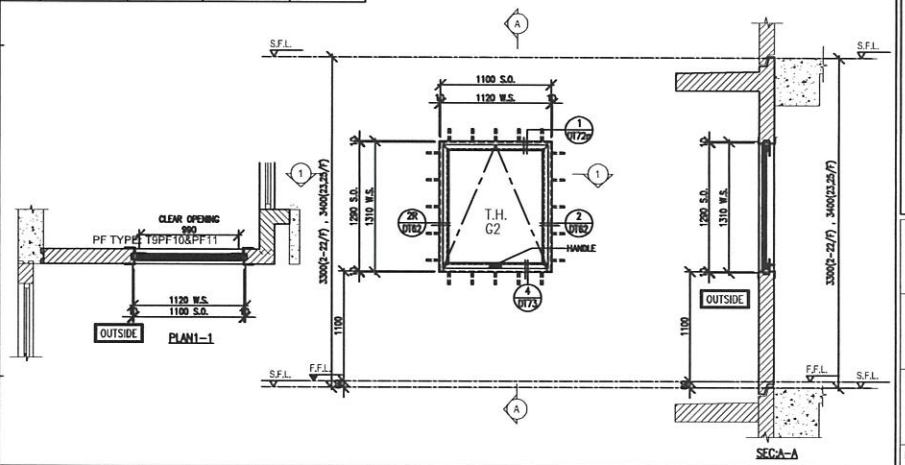


WINDOW MARK	W3/P T9 — 2/F–22/F: 18 nos.; 23/F,25/F: 2 nos.
LOCATION	FLAT B DIN AT 2/F TO 25/F FLOOR (T9) (4,13,14,24/F OMITTED)
GLAZING	G2
WINDOW FRAME	70mm ALUM. WINDOW SECTION , 4 BAR HINGE–LIP HING (HYLP14)

FREE AREA(%)	S.O.	PROVIDED		REQUIRE	
		OPENABLE AREA	GLAZING AREA	OPENABLE AREA	GLAZING AREA
62%	1590	0.716	1.054	0.477	0.763

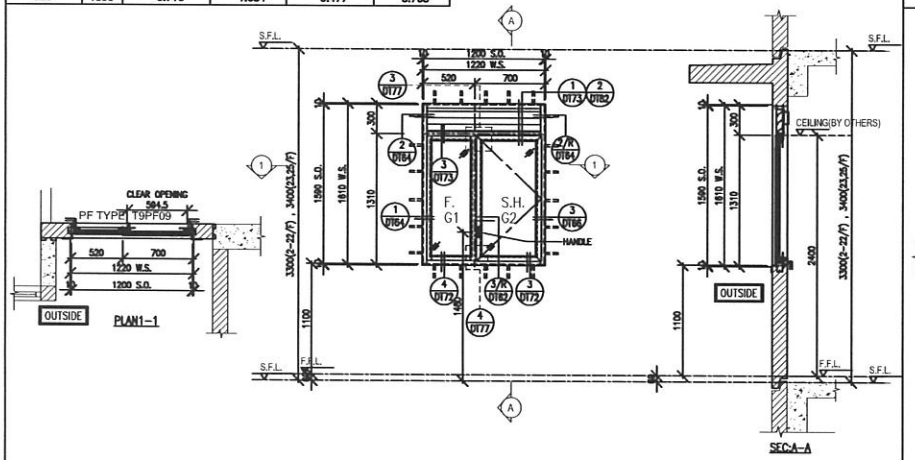

WINDOW MARK	W4/P T9 — 2/F–22/F: 18 nos.; 23/F,25/F: 2 nos.
LOCATION	FLAT B KIT AT 2/F TO 25/F FLOOR (T9) (4,13,14,24/F OMITTED)
GLAZING	G1 & G2
WINDOW FRAME	70mm ALUM. WINDOW SECTION , 4 BAR HINGE–LIP HING (HYLS16)

FREE AREA(%)	S.O.	PROVIDED		REQUIRE	
		OPENABLE AREA	GLAZING AREA	OPENABLE AREA	GLAZING AREA
53.7%	1590	0.711	0.607	0.115	

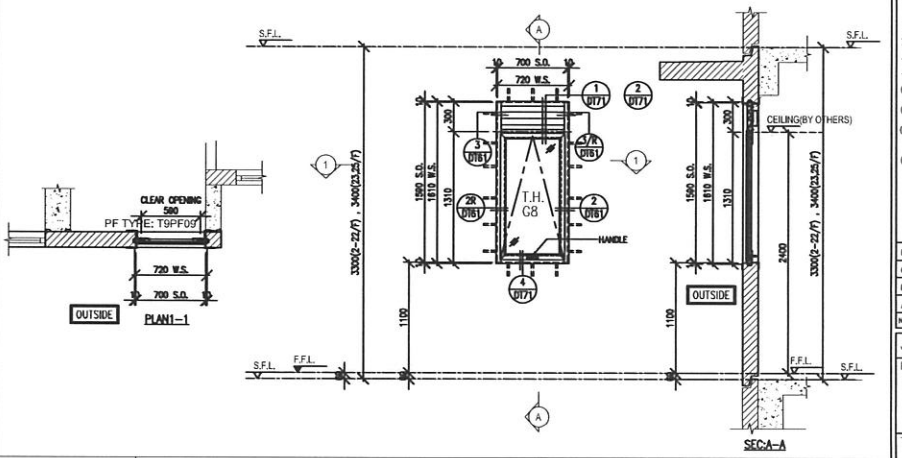

WINDOW MARK	W5/P T9 — 2/F–22/F: 18 nos.; 23/F,25/F: 2 nos.
LOCATION	MAID ROOM AT 2/F TO 25/F FLOOR (T9) (4,13,14,24/F OMITTED)
GLAZING	G8
WINDOW FRAME	50mm ALUM. WINDOW SECTION , 4 BAR HINGE–LIP HING (HYLP14)

B.D. REF :

ARCHITECT :
WONG TUNG & PARTNERS LIMITED
ARCHITECTS & PLANNERS

STRUCTURAL ENGINEER :
SUN HUNG KAI
ARCHITECTS AND ENGINEERS LTD.
SUN HUNG KAI CENTRE, WANCHAI, HONGKONG
TEL: 28278111 FAX: 28272884

FACADE CONSULTANT:
ALPHA CONSULTING LIMITED
Steel Structure & Facade Specialist

MAIN CONTRACTOR :
Sanfield Engineering Construction Ltd.

CLIENT :
SUN HUNG KAI
REAL ESTATE AGENCY LTD.
42/F SUN HUNG KAI CENTRE, WANCHAI, HONGKONG

NOTE :
1. ALL DIMENSIONS ARE IN mm.
2. ALL ELEVATIONS ARE VIEWED FROM OUTSIDE.
3. ALL DIMENSIONS TO BE VERIFIED ON SITE BEFORE FABRICATION.

LEGEND :
- X1 / X001 — DETAIL MARK NO. / REFER SHEET NO.
1. F.F.L. --FINISHED FLOOR LEVEL
2. S.F.L. --STRUCTURAL FLOOR LEVEL
3. /R --REVERSED DETAIL
4. GLASS LEGEND

G1-8mmHS+12mm AIR GAP+10mmTP I.G.U.

G2-8mmHS+12mm AIR GAP+8mmTP I.G.U.

G2a-8mmHS+12mm AIR GAP+8mmTP+1.52PVB +6mm(PLANNING) FEATURED GLASS (I.G.U.)

G8-6mm GREY HS+1.52PVB+6mm CLEAR HS

NO.	DATE	REVISED	BY
D	28/06/2022	REVISION SUBJECT TO ALPHA COMMENT	IVAN
C	12/05/2022	REVISION SUBJECT TO ARCHCOMMENT	IVAN
B	25/04/2022	REVISION SUBJECT TO ARCHCOMMENT	IVAN
A	28/03/2022	REVISION SUBJECT TO ARCHCOMMENT	IVAN

JOB NO. : J-859

PROJECT :
PROPOSED RESIDENTIAL / COMMERCIAL DEVELOPMENT AT NKIL NO.6551 KAI TAK AREA 4C, SITE 3 KAI TAK, KOWLOON

TITLE :
WINDOW SCHEDULE FOR PRECAST FACADE AT TOWER 9


DATE : 13-Nov-21 | SCALE : 1:50 (A3)

DRAWN BY : IVAN | CHECKED BY :

美特鋁質有限公司
MIDI ALUMINIUM FABRICATOR LTD.
Units 6-8, Sunray Industrial Centre, 1/F
610 Cha Kwo Ling Road, Kowloon
Tel:23489211-4 Fax:(852)27727666


DWG NO. : J859-SD-PW-9101 | REV. : D

DELETE

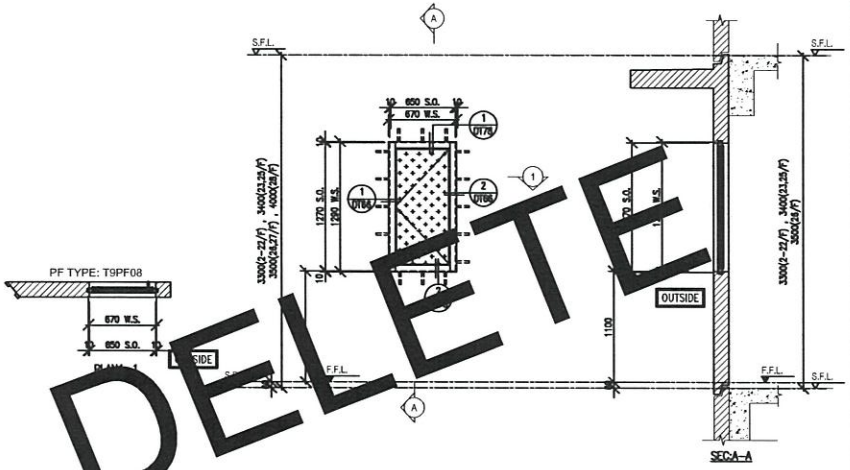


WINDOW MARK	W6/P T9 — 2/F–22/F 18 nos. / 23/F,25/F 2 nos. / 26/F 1 nos.
LOCATION	RSMRR AT 2/F TO 26/F FLOOR (T9) (4,13,14,24/F OMITTED)
GLAZING	–
WINDOW FRAME	50mm ALUM. WINDOW SECTION & 3mm THK. ALUM. CLADDING , DOOR HINGE LIP HING (HHB)

S.O.	PROVIDED OPENABLE AREA	PROVIDED GLAZING AREA	REQUIRE OPENABLE AREA	REQUIRE GLAZING AREA
1290	0.81	0.71	0.414	1.325

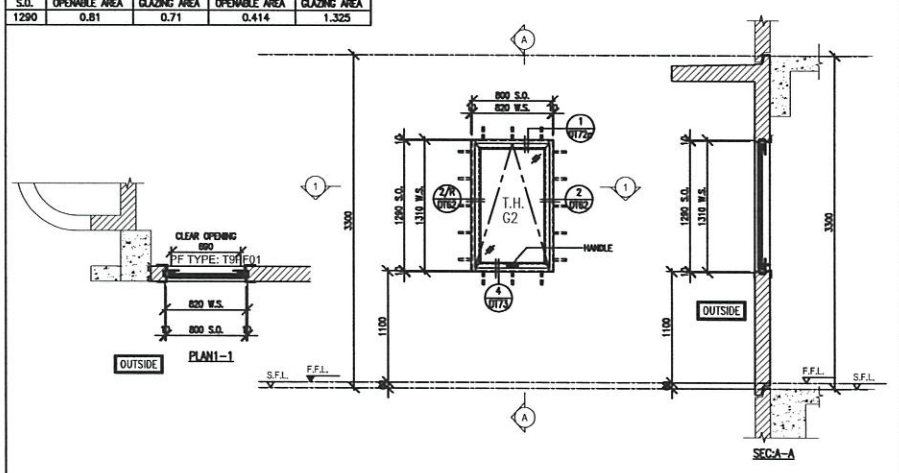


WINDOW MARK	W9/P T9 — 2/F–8/F 6 nos.
LOCATION	FLAT A BR3 AT 2/F TO 8/F FLOOR (T9) (4/F OMITTED)
GLAZING	G2
WINDOW FRAME	70mm ALUM. WINDOW SECTION , 4 BAR HINGE–LIP HING (HYLP14)

FREE AREA(%)	S.O.	PROVIDED OPENABLE AREA	PROVIDED GLAZING AREA	REQUIRE OPENABLE AREA	REQUIRE GLAZING AREA
62%	1590	1.71	2.13	0.649	2.077

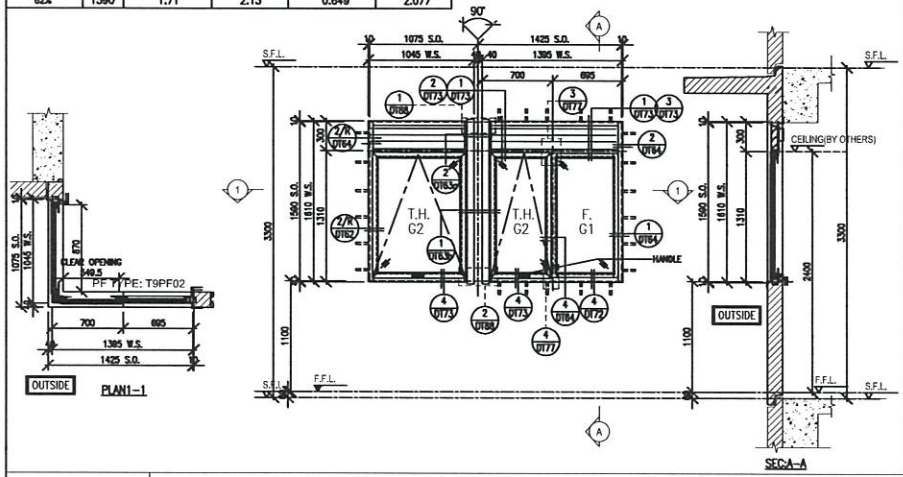

WINDOW MARK	W10/P T9 — 2/F–8/F 6 nos.
LOCATION	KIT AT 2/F TO 8/F FLOOR (T9) (4/F OMITTED)
GLAZING	G1, G2
WINDOW FRAME	70mm ALUM. WINDOW SECTION , 4 BAR HINGE–LIP HING (HYLP14)

FREE AREA(%)	S.O.	PROVIDED OPENABLE AREA	PROVIDED GLAZING AREA	REQUIRE OPENABLE AREA	REQUIRE GLAZING AREA
62%	1590	0.716	1.111		

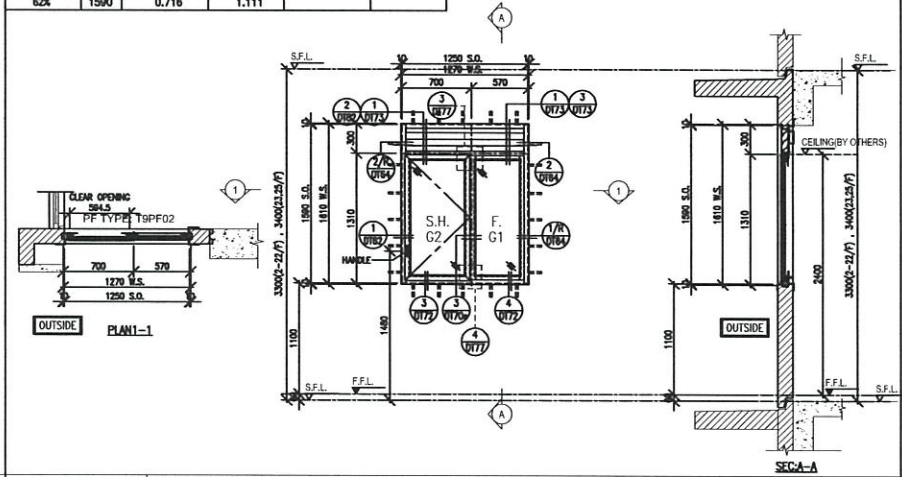

WINDOW MARK	W12/P T9 — 9/F–22/F 12 nos. / 23/F,25/F 2 nos.
LOCATION	FLAT A DIN AT 9/F TO 25/F FLOOR (T9) (13,14,24/F OMITTED)
GLAZING	G1 & G2
WINDOW FRAME	70mm ALUM. WINDOW SECTION , 4 BAR HINGE–LIP HING (HYLS16)

B.D. REF :

ARCHITECT :
WONG TUNG & PARTNERS LIMITED
ARCHITECTS & PLANNERS

STRUCTURAL ENGINEER :
SUN HUNG KAI
ARCHITECTS AND ENGINEERS LTD.
SUN HUNG KAI CENTRE, WANCHAI, HONGKONG
TEL. 28278111 FAX. 28272804

FACADE CONSULTANT:
ALPHA CONSULTING LIMITED
Steel Structure & Facade Specialist

MAIN CONTRACTOR :
Sanfield Engineering Construction Ltd.

CLIENT :
SUN HUNG KAI
REAL ESTATE AGENCY LTD.
48/F SUN HUNG KAI CENTRE, WANCHAI, HONGKONG

NOTE :
1. ALL DIMENSIONS ARE IN mm.
2. ALL ELEVATIONS ARE VIEWED FROM OUTSIDE.
3. ALL DIMENSIONS TO BE VERIFIED ON SITE BEFORE FABRICATION.

LEGEND :
X1 / X001 — DETAIL MARK NO. / REFER SHEET NO.
1. F.F.L. — FINISHED FLOOR LEVEL
2. S.F.L. — STRUCTURAL FLOOR LEVEL
3. /R — REVERSED DETAIL
4. GLASS LEGEND
G1–8mmHS+12mm AIR GAP+10mmTP I.G.U.
G2–8mmHS+12mm AIR GAP+8mmTP I.G.U.
G2a–8mmHS+12mm AIR GAP+8mmTP+1.52PVB +6mm(PLANNING) FEATURED GLASS (I.G.U.)
G8–6mm GREY HS+1.52PVB+6mm CLEAR HS

NO.	DATE	REVISED	BY
E	08/09/2022	REVISION SUBJECT TO ARCHITECT	IVAN
D	29/08/2022	REVISION SUBJECT TO ARCHITECT	IVAN
C	12/05/2022	REVISION SUBJECT TO ARCHITECT	IVAN
B	25/04/2022	REVISION SUBJECT TO ARCHITECT	IVAN
A	28/03/2022	REVISION SUBJECT TO ARCHITECT	IVAN

JOB NO. : J–859

PROJECT :
PROPOSED RESIDENTIAL / COMMERCIAL DEVELOPMENT AT NKIL NO.6551 KAI TAK AREA 4C, SITE 3 KAI TAK, KOWLOON


TITLE :
WINDOW SCHEDULE FOR PRECAST FACADE AT TOWER 9

DATE : 13–Nov–21 | SCALE : 1:50 (A3)
DRAWN BY : IVAN | CHECKED BY :

美特鋁製有限公司
MIDI ALUMINIUM FABRICATOR LTD.
Units 6–8, Sunray Industrial Centre, 1/F
610 Cha Kwo Ling Road, Kowloon
Tel:23489211–4 Fax:(852)27727666


DWG NO. : J859–SD–PW–9102 | REV. : E

FREE AREA(%)	S.O.	PROVIDED		REQUIRE	
		OPENABLE AREA	GLAZING AREA	OPENABLE AREA	GLAZING AREA
62%	1590	1.811	1.584	0.897	1.435

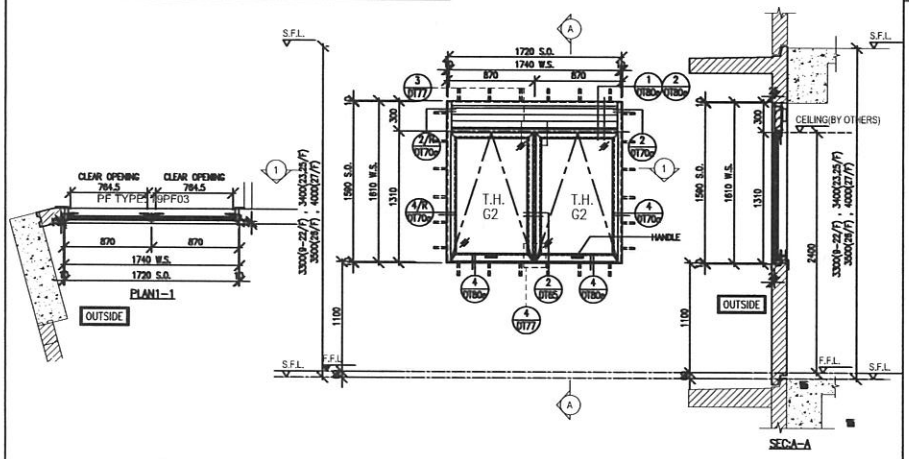


WINDOW MARK	W13/P T9 — 9/F–22/F 12 nos. ; 23/F,25/F 2 nos.
LOCATION	FLAT A KIT AT 9/F TO 25/F FLOOR (T9) (13,14,24/F OMITTED)
GLAZING	G2
WINDOW FRAME	70mm ALUM. WINDOW SECTION , 4 BAR HINGE–LIP HING (HYLP14)

FREE AREA(%)	S.O.	PROVIDED		REQUIRE	
		OPENABLE AREA	GLAZING AREA	OPENABLE AREA	GLAZING AREA
62%	1590	0.518	0.423		

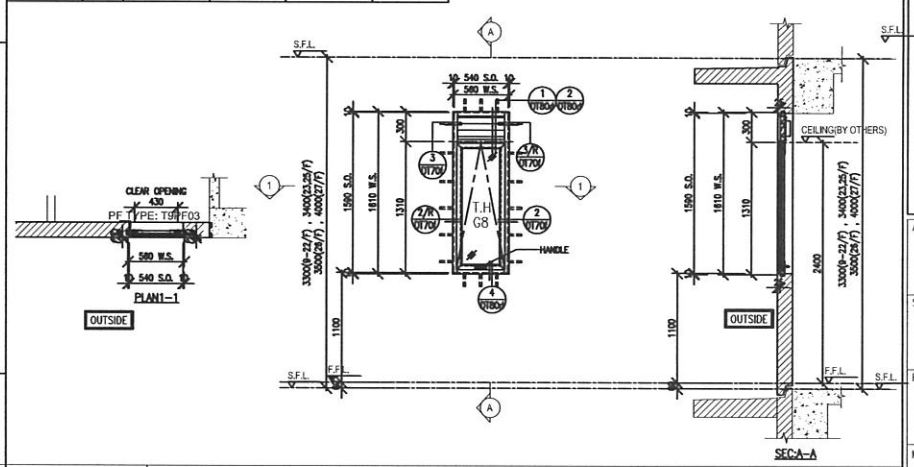


WINDOW MARK	W14/P T9 — 9/F–22/F 12 nos. ; 23/F,25/F 2 nos. ; 26/F,27/F 2 nos.
LOCATION	FLAT A UTR AT 9/F TO 27/F FLOOR (T9) (13,14,24/F OMITTED)
GLAZING	G8
WINDOW FRAME	50mm ALUM. WINDOW SECTION , 4 BAR HINGE–LIP HING (HYLP14)

FREE AREA(%)	S.O.	PROVIDED		REQUIRE	
		OPENABLE AREA	GLAZING AREA	OPENABLE AREA	GLAZING AREA
62%	1590	1.48	2.119		

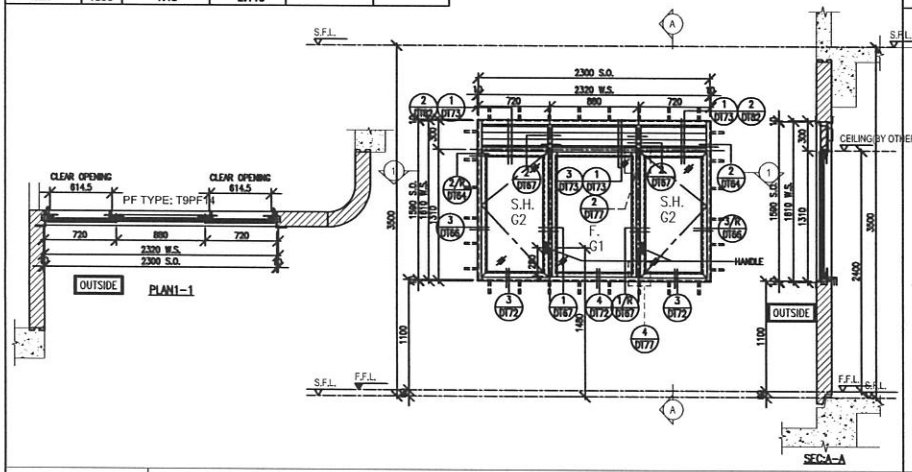

WINDOW MARK	W15/P T9 — 26/F 1 no.
LOCATION	FLAT A KIT. AT 26/F FLOOR (T9)
GLAZING	G1, G2
WINDOW FRAME	70mm ALUM. WINDOW SECTION , 4 BAR HINGE–LIP HING (HYLS16)

FREE AREA(%)	S.O.	PROVIDED		REQUIRE	
		OPENABLE AREA	GLAZING AREA	OPENABLE AREA	GLAZING AREA
46.4%	1540	0.635	0.536	0.333	0.333

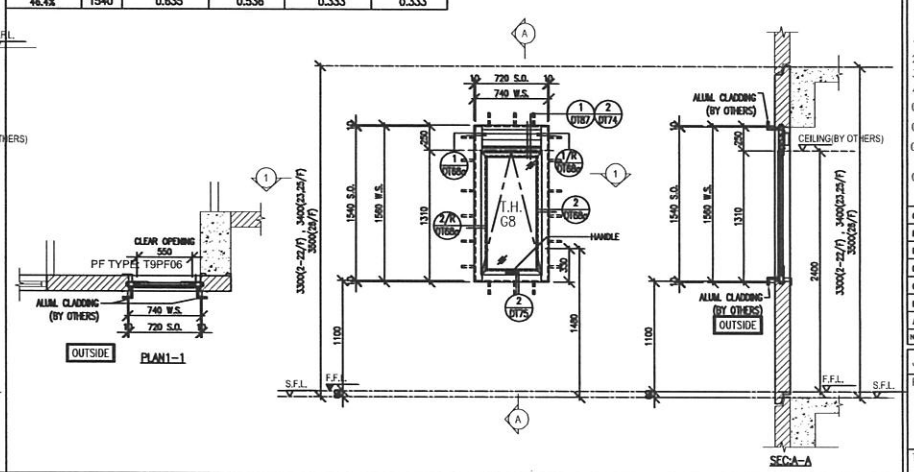

WINDOW MARK	W2/P T9A — 2/F–22/F 18 nos. ; 23/F,25/F 2 nos. ; 26/F 1 no.
LOCATION	UNIT B BATH AT 2/F TO 26/F FLOOR (T9A) (4,13,14,24/F OMITTED)
GLAZING	G8
WINDOW FRAME	50mm ALUM. WINDOW SECTION , 4 BAR HINGE–LIP HING (HYLP14)

B.D. REF :

ARCHITECT :
WONG TUNG & PARTNERS LIMITED
ARCHITECTS & PLANNERS

STRUCTURAL ENGINEER :
SUN HUNG KAI
ARCHITECTS AND ENGINEERS LTD.
SUN HUNG KAI CENTRE, WANCHAI, HONGKONG
TEL: 28279111 FAX: 28272884

FACADE CONSULTANT:
ALPHA CONSULTING LIMITED
Steel Structure & Facade Specialist

MAIN CONTRACTOR :
Sanfield Engineering Construction Ltd.

CLIENT :
SUN HUNG KAI
REAL ESTATE AGENCY LTD.
42/F SUN HUNG KAI CENTRE, WANCHAI, HONGKONG

NOTE :
1. ALL DIMENSIONS ARE IN mm.
2. ALL ELEVATIONS ARE VIEWED FROM OUTSIDE.
3. ALL DIMENSIONS TO BE VERIFIED ON SITE BEFORE FABRICATION.

LEGEND :
X1 / X001 — DETAIL MARK NO. / REFER SHEET NO.
1. F.F.L. --FINISHED FLOOR LEVEL
2. S.F.L. --STRUCTURAL FLOOR LEVEL
3. /R --REVERSED DETAIL
4. GLASS LEGEND
G1–8mmHS+12mm AIR GAP+10mmTP I.G.U.
G2–8mmHS+12mm AIR GAP+8mmTP I.G.U.
G2a–8mmHS+12mm AIR GAP+8mmTP+1.52PVBI +6mm(PLANNING) FEATURED GLASS (I.G.U.)
G8–6mm GREY HS+1.52PVBI+6mm CLEAR HS

NO.	DATE	REVISED	BY
G	04/11/2022	GENERAL REVISED	YL
F	13/10/2022	REVISION SUBJECT TO ALPHA COMMENT	YL
E	5/9/2022	REVISION SUBJECT TO ALPHA COMMENT	PANG
D	29/06/2022	REVISION SUBJECT TO ALPHA COMMENT	PANG
C	12/05/2022	REVISION SUBJECT TO ARCHLOGMENT	PANG
B	25/04/2022	REVISION SUBJECT TO ARCHLOGMENT	PANG
A	28/03/2022	REVISION SUBJECT TO ARCHLOGMENT	PANG

JOB NO. : J–859

PROJECT :
PROPOSED RESIDENTIAL / COMMERCIAL DEVELOPMENT AT NKIL NO.8551 KAI TAK AREA 4C, SITE 3 KAI TAK, KOWLOON

TITLE :
WINDOW SCHEDULE FOR PRECAST FACADE AT TOWER 9A


DATE : 13–Nov–21 | SCALE : 1:50 (A3)

DRAWN BY : IVAN | CHECKED BY :

美特鋁質有限公司
MIDI ALUMINIUM FABRICATOR LTD.
Units 6–8, Sunray Industrial Centre, 1/F
610 Cha Kwo Ling Road, Kowloon
Tel:23489211–4 Fax:(852)27727666


DWG NO. : J859–SD–PW–9103 | REV. : G

	PROVIDED		REQUIRE	
S.O.	OPENABLE AREA	GLAZING AREA	OPENABLE AREA	GLAZING AREA
1290	0.46	0.37		

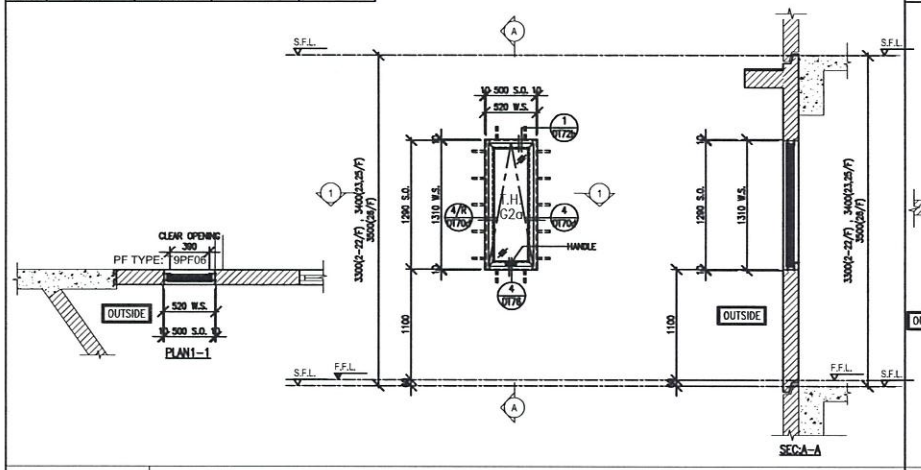


WINDOW MARK	W2a/P T9A — 2/F–22/F: 18 nos. / 23/F,25/F: 2 nos. / 26/F: 1 no.
LOCATION	UNIT B LIV.DIN AT 2/F TO 26/F FLOOR (T9A) (4,13,14,24/F OMITTED)
GLAZING	G2a
WINDOW FRAME	70mm ALUM. WINDOW SECTION , 4 BAR HINGE–LIP HING (HYLP14)

	PROVIDED		REQUIRE	
FREE AREA(%)	S.O.	OPENABLE AREA	GLAZING AREA	OPENABLE AREA	GLAZING AREA
62%	1590	0.795	0.687	0.267	0.426

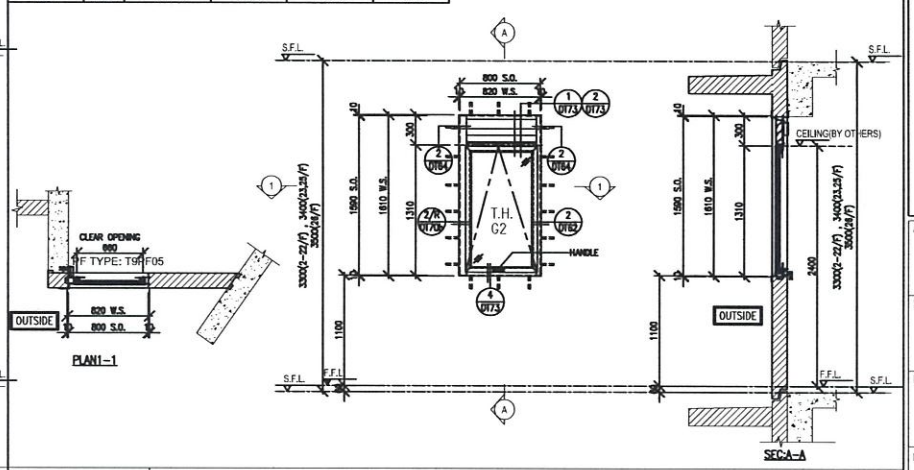


WINDOW MARK	W3/P T9A — 2/F–22/F: 18 nos. / 23/F,25/F: 2 nos. / 26/F: 1 no.
LOCATION	UNIT B KIT AT 2/F TO 26/F FLOOR (T9A) (4,13,14,24/F OMITTED)
GLAZING	G2
WINDOW FRAME	70mm ALUM. WINDOW SECTION , 4 BAR HINGE–LIP HING (HYLP14)

	PROVIDED		REQUIRE	
FREE AREA(%)	S.O.	OPENABLE AREA	GLAZING AREA	OPENABLE AREA	GLAZING AREA
62%	1590	0.903	0.79	0.467	0.747

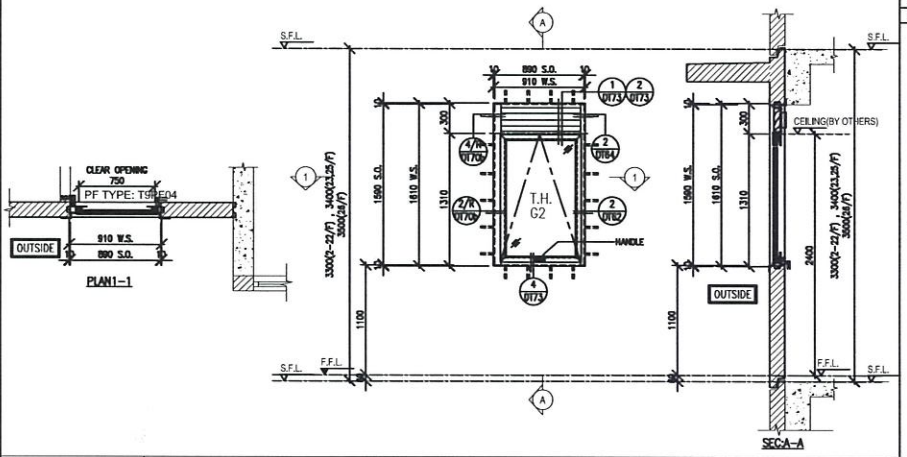

WINDOW MARK	W4/P T9A — 2/F–22/F: 18 nos. / 23/F,25/F: 2 nos. / 26/F: 1 no.
LOCATION	UNIT A KIT AT 2/F TO 26/F FLOOR (T9A) (4,13,14,24/F OMITTED)
GLAZING	G2
WINDOW FRAME	70mm ALUM. WINDOW SECTION , 4 BAR HINGE–LIP HING (HYLP14)

	PROVIDED		REQUIRE	
S.O.	OPENABLE AREA	GLAZING AREA	OPENABLE AREA	GLAZING AREA
1290	0.58	0.48		
1390	0.63	0.53		
1490	0.68	0.57		

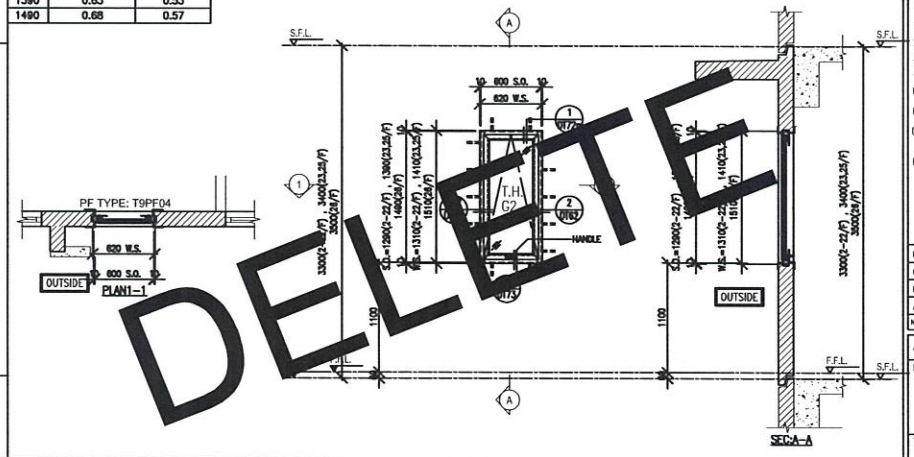

DELETE

WINDOW MARK	W5/P T9A — 2/F–8/F: 6 nos.
LOCATION	UNIT A BR2 2/F TO 8/F FLOOR (T9A) (4/F OMITTED)
GLAZING	G2
WINDOW FRAME	70mm ALUM. WINDOW SECTION

B.D. REF :

ARCHITECT :
WONG TUNG & PARTNERS LIMITED
ARCHITECTS & PLANNERS

STRUCTURAL ENGINEER :
SUN HUNG KAI
ARCHITECTS AND ENGINEERS LTD.
SUN HUNG KAI CENTRE, WANCHAI, HONGKONG
TEL. 28276111 FAX. 28272884

FACADE CONSULTANT:
ALPHA CONSULTING LIMITED
Steel Structure & Facade Specialist

MAIN CONTRACTOR :
Sanfield Engineering Construction Ltd.

CLIENT :
SUN HUNG KAI
REAL ESTATE AGENCY LTD.
42/F SUN HUNG KAI CENTRE, WANCHAI, HONGKONG

NOTE :
1. ALL DIMENSIONS ARE IN mm.
2. ALL ELEVATIONS ARE VIEWED FROM OUTSIDE.
3. ALL DIMENSIONS TO BE VERIFIED ON SITE BEFORE FABRICATION.

LEGEND :
X1 / X001 — DETAIL MARK NO. / REFER SHEET NO.
1. F.F.L. — FINISHED FLOOR LEVEL
2. S.F.L. — STRUCTURAL FLOOR LEVEL
3. (/R) — REVERSED DETAIL
4. GLASS LEGEND
G1–8mmHS+12mm AIR GAP+10mmTP I.G.U.
G2–8mmHS+12mm AIR GAP+8mmTP I.G.U.
G2a–8mmHS+12mm AIR GAP+8mmTP+1.52PVB +6mm(PLANNING) FEATURED GLASS (I.G.U.)
G8–6mm GREY HS+1.52PVB+6mm CLEAR HS

NO.	DATE	REVISED	BY
D	12/05/2022	REVISION SUBJECT TO ARCH.COMMENT	IVAN
C	25/04/2022	REVISION SUBJECT TO ARCH.COMMENT	IVAN
B	13/04/2022	REVISION SUBJECT TO ARCH.COMMENT	IVAN
A	28/03/2022	REVISION SUBJECT TO ARCH.COMMENT	IVAN

JOB NO. : J-859

PROJECT :
PROPOSED RESIDENTIAL / COMMERCIAL DEVELOPMENT AT NKIL NO.6551 KAI TAK AREA 4C, SITE 3 KAI TAK, KOWLOON


TITLE :
WINDOW SCHEDULE FOR PRECAST FACADE AT TOWER 9A

DATE : 13–Nov–21 | SCALE : 1:50 (A3)
DRAWN BY : IVAN | CHECKED BY :

美特鋁質有限公司
MIDI ALUMINIUM FABRICATOR LTD.
Units 6–8, Sunray Industrial Centre, 1/F
610 Cha Kwo Ling Road, Kowloon
Tel:23489211–4 Fax:(852)27727666

DWG NO. : J859–SD–PW–9104 | REV. : D


PROVIDED				REQUIRE	
FREE AREA(%)	S.O.	OPENABLE AREA	GLAZING AREA	OPENABLE AREA	GLAZING AREA
62%	1590	0.593	0.496		

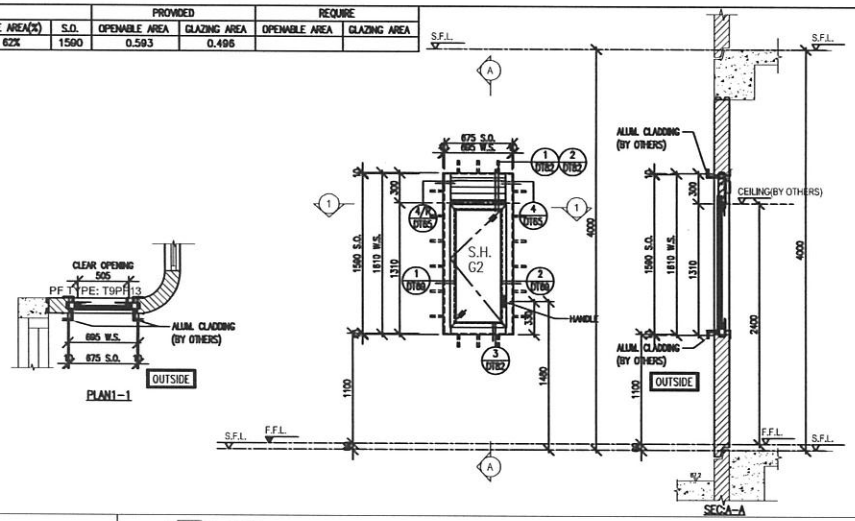

WINDOW MARK	W16a/P T9 27/F 1 no.
LOCATION	FLAT A KIT. AT 27/F FLOOR (T9)
GLAZING	G2
WINDOW FRAME	70mm ALUM. WINDOW SECTION , 4 BAR HINGE-LIP HING (HHMS-N14)

WINDOW MARK	
LOCATION	
GLAZING	
WINDOW FRAME	

PROVIDED				REQUIRE	
FREE AREA(%)	S.O.	OPENABLE AREA	GLAZING AREA	OPENABLE AREA	GLAZING AREA
62%	1590	0.909	1.380	–	–

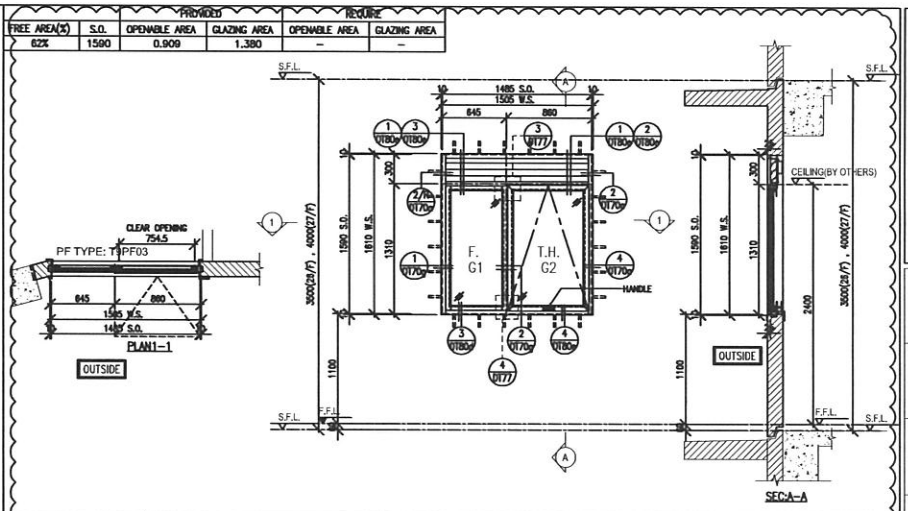

WINDOW MARK	W13a/P T9 26/F,27/F 2 nos.
LOCATION	UTR AT 26/F TO 27/F FLOOR (T9)
GLAZING	G1, G2
WINDOW FRAME	70mm ALUM. WINDOW SECTION , 4 BAR HINGE-LIP HING (HYLP14)

WINDOW MARK	
LOCATION	
GLAZING	
WINDOW FRAME	

B.D. REF :

ARCHITECT :
WONG TUNG & PARTNERS LIMITED
ARCHITECTS & PLANNERS

STRUCTURAL ENGINEER :
SUN HUNG KAI
ARCHITECTS AND ENGINEERS LTD.
SUN HUNG KAI CENTRE, WANCHAI, HONGKONG
TEL: 28278111 FAX: 28272884

FACADE CONSULTANT:
ALPHA CONSULTING LIMITED
Steel Structure & Facade Specialist

MAIN CONTRACTOR :
Sanfield Engineering Construction Ltd.

CLIENT :
SUN HUNG KAI
REAL ESTATE AGENCY LTD.
42/F SUN HUNG KAI CENTRE, WANCHAI, HONGKONG

NOTE :
1. ALL DIMENSIONS ARE IN mm.
2. ALL ELEVATIONS ARE VIEWED FROM OUTSIDE.
3. ALL DIMENSIONS TO BE VERIFIED ON SITE BEFORE FABRICATION.

LEGEND :
X1 — DETAIL MARK NO.
X001 — REFER SHEET NO.

1. F.F.L. --FINISHED FLOOR LEVEL
2. S.F.L. --STRUCTURAL FLOOR LEVEL
3. (R) --REVERSED DETAIL
4. GLASS LEGEND

G1-8mmHS+12mm AIR GAP+10mmTP I.G.U.

G2-8mmHS+12mm AIR GAP+8mmTP I.G.U.

G2a-8mmHS+12mm AIR GAP+8mmTP+1.52PVB +6mm(PLANNING) FEATURED GLASS (I.G.U.)

G8-6mm GREY HS+1.52PVB+6mm CLEAR HS

NO.	DATE	REVISED	BY
G	04/11/2022	GENERAL REVISED	YL
F	13/10/2022	REVISION SUBJECT TO ARCHITECT COMMENT	YL
E	08/09/2022	REVISION SUBJECT TO ARCHITECT COMMENT	NWW
D	30/08/2022	REVISION SUBJECT TO ARCHITECT COMMENT	NWW
C	12/05/2022	REVISION SUBJECT TO ARCHITECT COMMENT	NWW
B	25/04/2022	REVISION SUBJECT TO ARCHITECT COMMENT	NWW
A	28/03/2022	REVISION SUBJECT TO ARCHITECT COMMENT	NWW

JOB NO. : J-859

PROJECT :
PROPOSED RESIDENTIAL / COMMERCIAL DEVELOPMENT AT NKIL NO.6551 KAI TAK AREA 4C, SITE 3 KAI TAK, KOWLOON


TITLE :
WINDOW SCHEDULE FOR PRECAST FACADE AT TOWER 9A

DATE : 13-Nov-21 | SCALE : 1:50 (A3)


DRAWN BY : IVAN | CHECKED BY :

美特鋁質有限公司
MIDI ALUMINIUM FABRICATOR LTD.
Units 6-8, Sunray Industrial Centre, 1/F
610 Cha Kwo Ling Road, Kowloon
Tel:23489211-4 Fax:(852)27727666


DWG NO. : J859-SD-PW-9105 | REV. : G

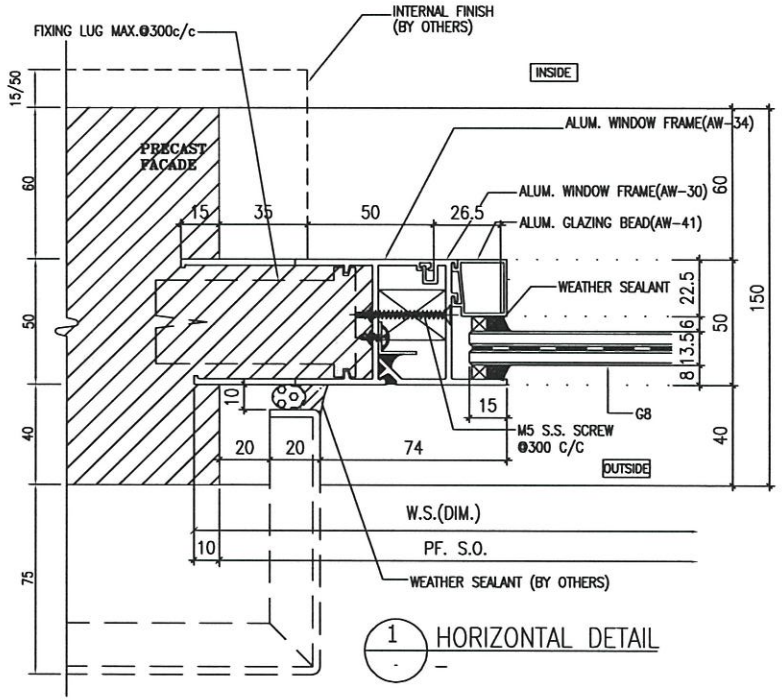


1 HORIZONTAL DETAIL

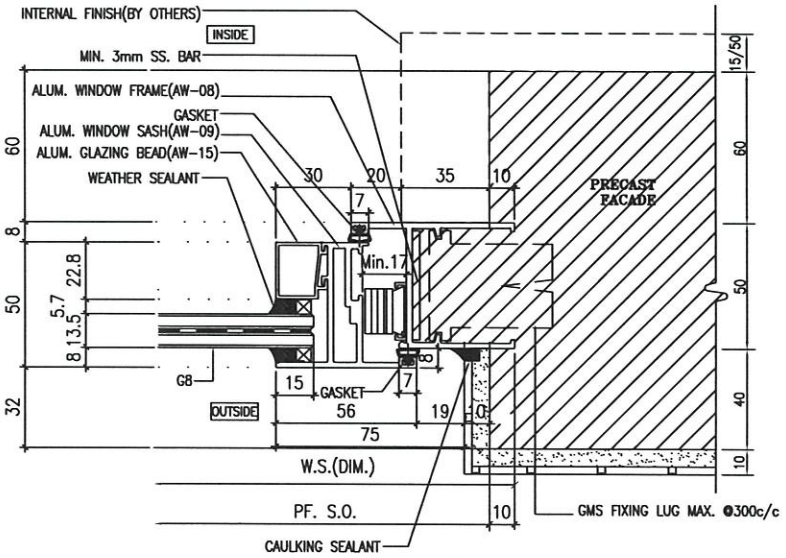

2 HORIZONTAL DETAIL

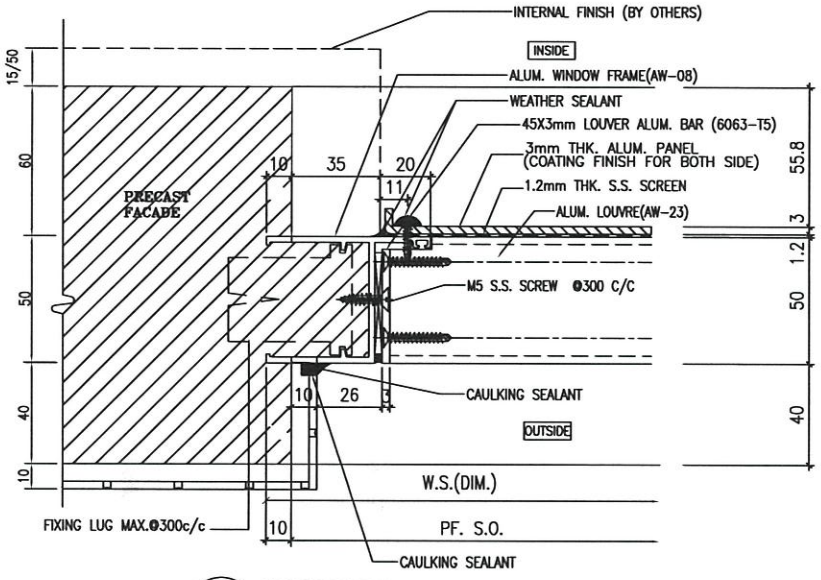

3 HORIZONTAL DETAIL

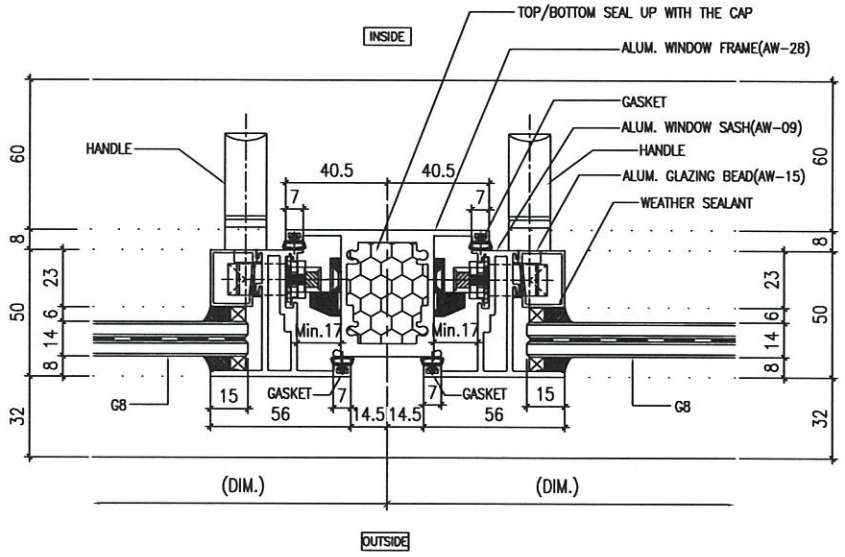

4 HORIZONTAL DETAIL

B.D. REF :

ARCHITECT :
WONG TUNG & PARTNERS LIMITED
ARCHITECTS & PLANNERS

STRUCTURAL ENGINEER :
SUN HUNG KAI
ARCHITECTS AND ENGINEERS LTD.
SUN HUNG KAI CENTRE, WANCHAI, HONGKONG
TEL. 28278111 FAX. 28272284

FACADE CONSULTANT:
ALPHA CONSULTING LIMITED
Steel Structure & Facade Specialist

MAIN CONTRACTOR :
Sanfield Engineering Construction Ltd.

CLIENT :
SUN HUNG KAI
REAL ESTATE AGENCY LTD.
42/F SUN HUNG KAI CENTRE, WANCHAI, HONGKONG

NOTE :
1. ALL DIMENSIONS ARE IN mm.
2. ALL ELEVATIONS ARE VIEWED FROM OUTSIDE.
3. ALL DIMENSIONS TO BE VERIFIED ON SITE BEFORE FABRICATION.

LEGEND :
X1 — DETAIL MARK NO.
X001 — REFER SHEET NO.

1. F.F.L. --FINISHED FLOOR LEVEL
2. S.F.L. --STRUCTURAL FLOOR LEVEL
3. (R) --REVERSED DETAIL
4. GLASS LEGEND

G1-8mmHS+12mm AIR GAP+10mmTP I.G.U.

G2-8mmHS+12mm AIR GAP+8mmTP I.G.U.

G2a-8mmHS+12mm AIR GAP+8mmTP+1.52PVB +6mmTP(PLANNING) FEATURED GLASS (I.G.U.)

G8-6mm GREY HS+1.52PVB+6mm CLEAR HS

NO.	DATE	REVISED	BY
E	13/10/2022	REVISION SUBJECT TO ALPHA COMMENT	W
D	8/9/2022	REVISION SUBJECT TO ALPHA COMMENT	WWW
C	28/8/2022	REVISION SUBJECT TO ALPHA COMMENT	WWW
B	7/8/2022	REVISION SUBJECT TO ALPHA COMMENT	WWW
A	28/3/2022	REVISION SUBJECT TO ARCHCOMMENT	WWW

JOB NO. : J-859

PROJECT :
PROPOSED RESIDENTIAL / COMMERCIAL DEVELOPMENT AT NKIL NO.6551 KAI TAK AREA 4C, SITE 3 KAI TAK, KOWLOON


TITLE :
TYPICAL DETAILS FOR ALUM. WINDOW

DATE : 10-Nov-21 | SCALE : 1:2 (A3)


DRAWN BY : IVAN | CHECKED BY :

美特鋁製有限公司
MIDI ALUMINIUM FABRICATOR LTD.
Units 6-8, Sunray Industrial Centre, 1/F
610 Cha Kwo Ling Road, Kowloon
Tel:23489211-4 Fax:(852)27727666


DWG NO. : J859-SD-PW-DT61 | REV. : E

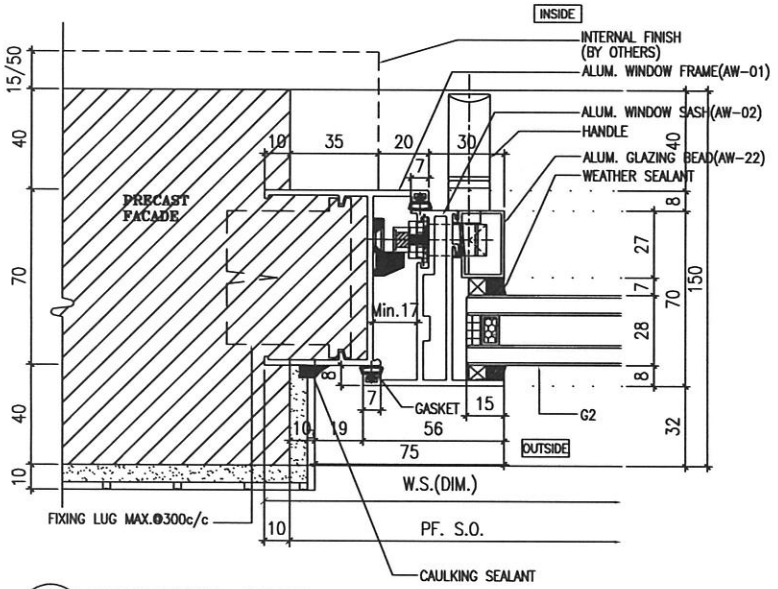


1 HORIZONTAL DETAIL

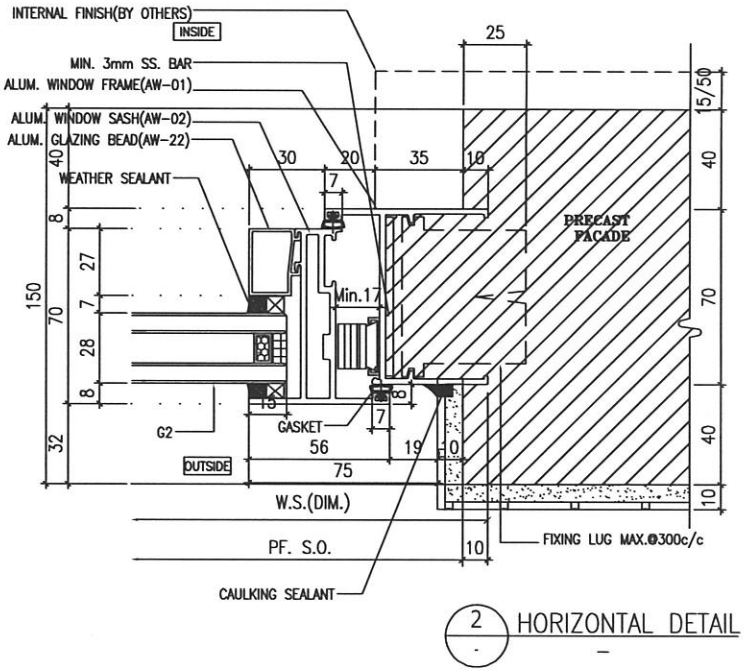

2 HORIZONTAL DETAIL

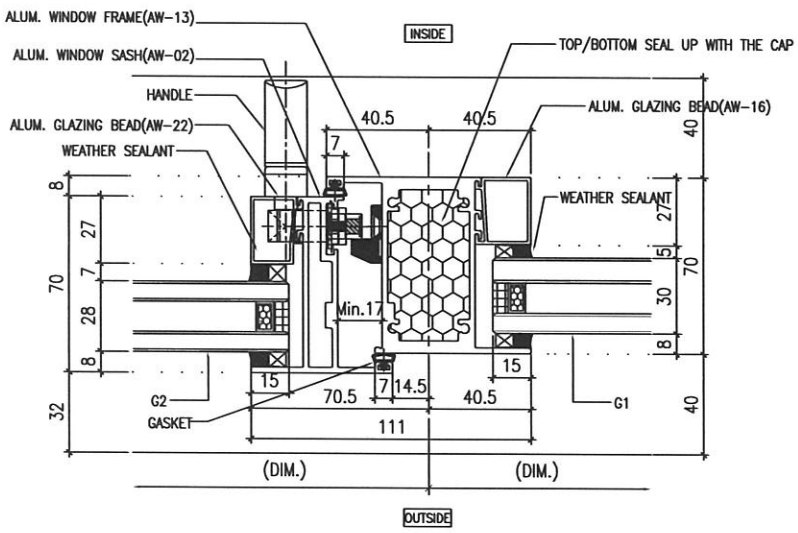

3 HORIZONTAL DETAIL

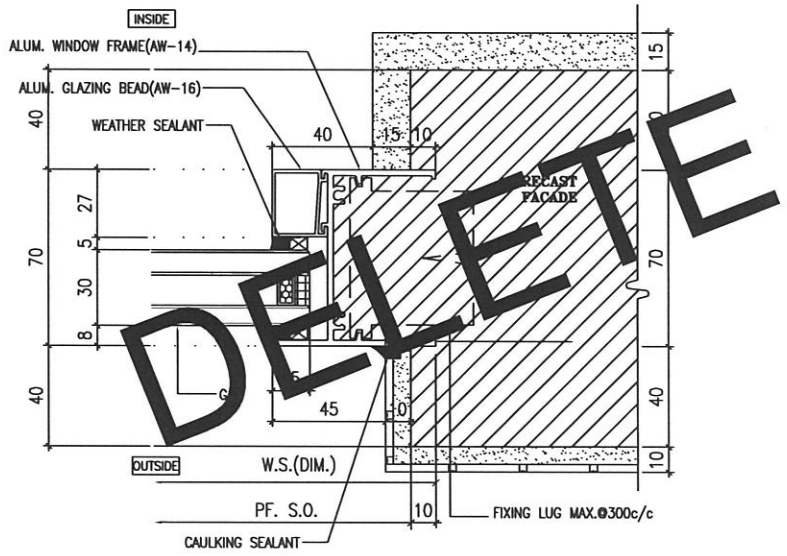

4 HORIZONTAL DETAIL

DELETE

B.D. REF :

ARCHITECT :
WONG TUNG & PARTNERS LIMITED
ARCHITECTS & PLANNERS

STRUCTURAL ENGINEER :
SUN HUNG KAI
ARCHITECTS AND ENGINEERS LTD.
SUN HUNG KAI CENTRE, WANCHAI, HONGKONG
TEL. 28278111 FAX. 28272884

FACADE CONSULTANT:
ALPHA CONSULTING LIMITED
Steel Structure & Facade Specialist

MAIN CONTRACTOR :
Sanfield Engineering Construction Ltd.

CLIENT :
SUN HUNG KAI
REAL ESTATE AGENCY LTD.
42/F SUN HUNG KAI CENTRE, WANCHAI, HONGKONG

NOTE :
1. ALL DIMENSIONS ARE IN mm.
2. ALL ELEVATIONS ARE VIEWED FROM OUTSIDE.
3. ALL DIMENSIONS TO BE VERIFIED ON SITE BEFORE FABRICATION.

LEGEND :
X1 — DETAIL MARK NO.
X001 — REFER SHEET NO.
1. F.F.L. -- FINISHED FLOOR LEVEL
2. S.F.L. -- STRUCTURAL FLOOR LEVEL
3. /R — REVERSED DETAIL
4. GLASS LEGEND
G1-8mmHS+12mm AIR GAP+10mmTP I.G.U.
G2-8mmHS+12mm AIR GAP+8mmTP I.G.U.
G2a-8mmHS+12mm AIR GAP+8mmTP+1.52PVBI +6mmTP(PLANNING) FEATURED GLASS (I.G.U.)
G8-6mm GREY HS+1.52PVBI+6mm CLEAR HS

NO.	DATE	REVISED	BY
B	8/9/2022	REVISION SUBJECT TO ARCHITECT	
A	28/3/2022	REVISION SUBJECT TO ARCHITECT	

JOB NO. : J-859

PROJECT :
PROPOSED RESIDENTIAL / COMMERCIAL DEVELOPMENT AT NKIL NO.6551 KAI TAK AREA 4C, SITE 3 KAI TAK, KOWLOON


TITLE :
TYPICAL DETAILS FOR ALUM. WINDOW

DATE : 10-Nov-21 | SCALE : 1:2 (A3)


DRAWN BY : IVAN | CHECKED BY :

美特鋁質有限公司
MIDI ALUMINIUM FABRICATOR LTD.
Units 6-8, Sunray Industrial Centre, 1/F
610 Cha Kwo Ling Road, Kowloon
Tel:23489211-4 Fax:(852)27727666


DWG NO. : J859-SD-PW-DT62 | REV. : B

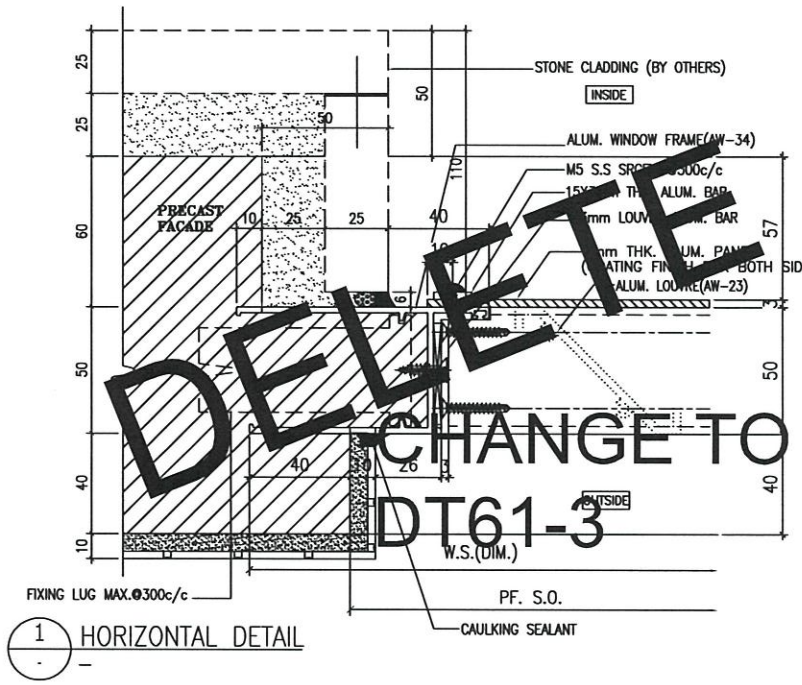


1 HORIZONTAL DETAIL

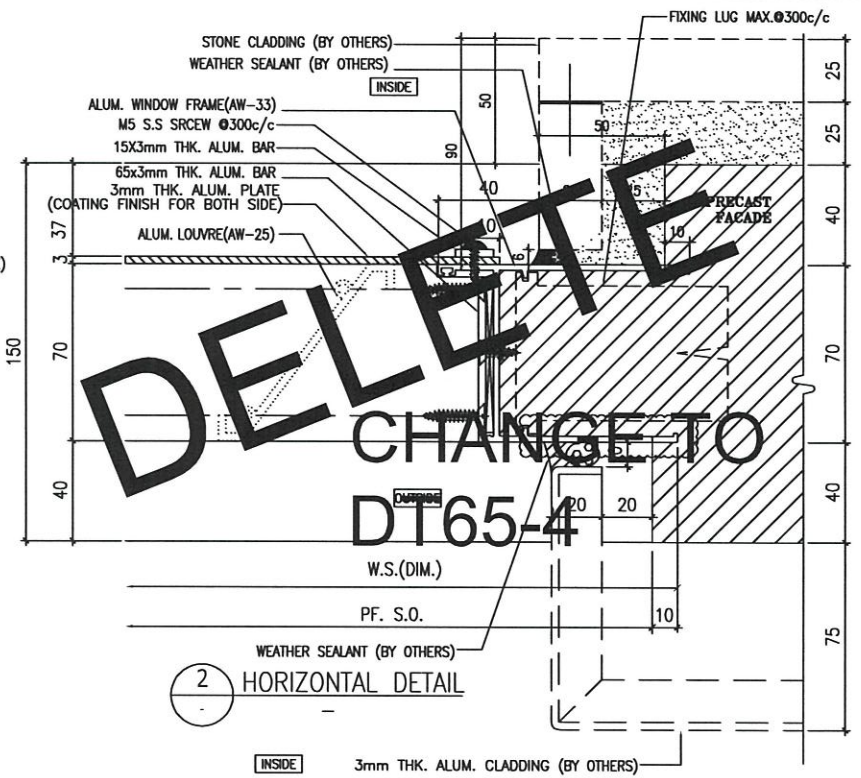

2 HORIZONTAL DETAIL

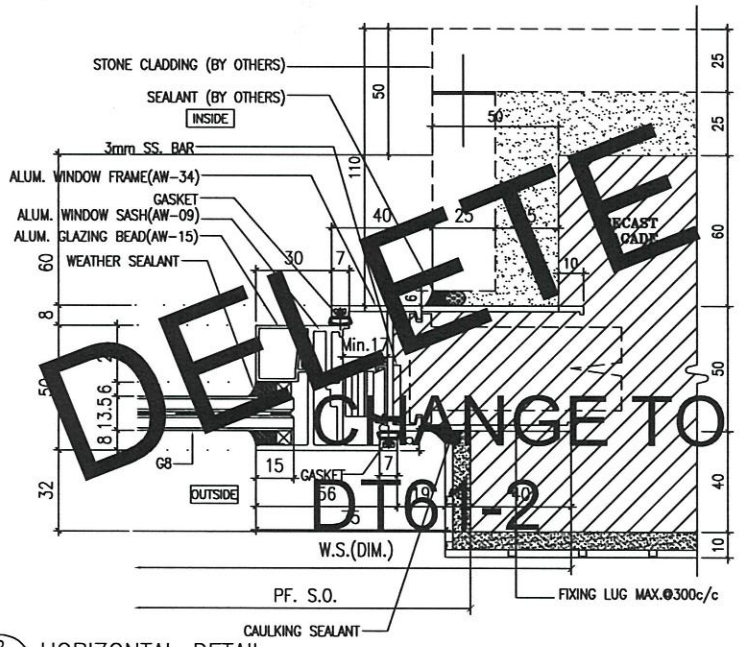

3 HORIZONTAL DETAIL

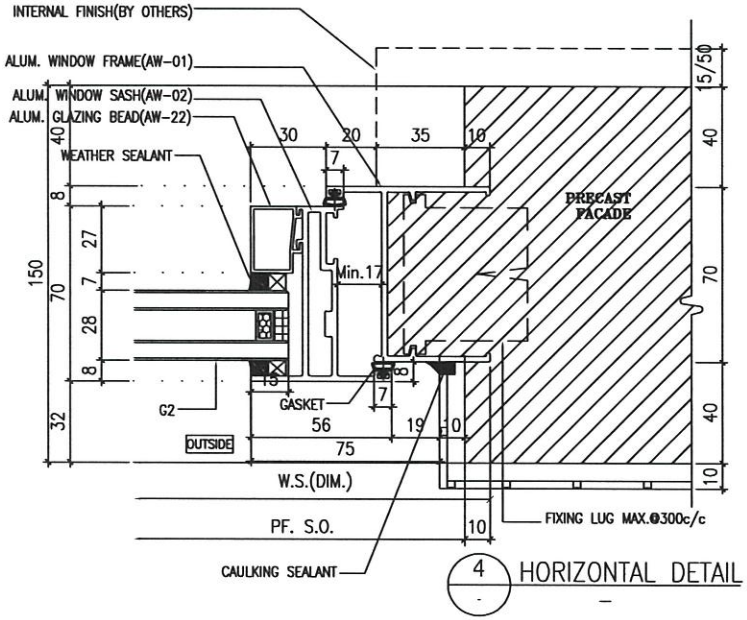

4 HORIZONTAL DETAIL

B.D. REF :

ARCHITECT :
WONG TUNG & PARTNERS LIMITED
ARCHITECTS & PLANNERS

STRUCTURAL ENGINEER :
SUN HUNG KAI
ARCHITECTS AND ENGINEERS LTD.
SUN HUNG KAI CENTRE, WANCHAI, HONGKONG
TEL. 28276111 FAX. 28272884

FACADE CONSULTANT:
ALPHA CONSULTING LIMITED
Steel Structure & Facade Specialist

MAIN CONTRACTOR :
Sanfield Engineering Construction Ltd.

CLIENT :
SUN HUNG KAI
REAL ESTATE AGENCY LTD.
42/F SUN HUNG KAI CENTRE, WANCHAI, HONGKONG

NOTE :
1. ALL DIMENSIONS ARE IN mm.
2. ALL ELEVATIONS ARE VIEWED FROM OUTSIDE.
3. ALL DIMENSIONS TO BE VERIFIED ON SITE BEFORE FABRICATION.

LEGEND :
X1 / X001 — DETAIL MARK NO. / REFER SHEET NO.
1. F.F.L. — FINISHED FLOOR LEVEL
2. S.F.L. — STRUCTURAL FLOOR LEVEL
3. (R) — REVERSED DETAIL
4. GLASS LEGEND
G1–8mmHS+12mm AIR GAP+10mmTP I.G.U.
G2–8mmHS+12mm AIR GAP+8mmTP I.G.U.
G2a–8mmHS+12mm AIR GAP+8mmTP+1.52PVB +6mmTP(PLANNING) FEATURED GLASS (I.G.U.)
G8–6mm GREY HS+1.52PVB+6mm CLEAR HS

NO.	DATE	REVISED	BY
A	28/3/2022	REVISION SUBJECT TO ARCHITECT	

JOB NO. : J-859

PROJECT :
PROPOSED RESIDENTIAL / COMMERCIAL DEVELOPMENT AT NKIL NO.6551 KAI TAK AREA 4C, SITE 3 KAI TAK, KOWLOON


TITLE :
TYPICAL DETAILS FOR ALUM. WINDOW

DATE : 10-Nov-21 | SCALE : 1:2 (A3)


DRAWN BY : IVAN | CHECKED BY :

美特鋁質有限公司
MIDI ALUMINIUM FABRICATION LTD.
Units 6-8, Sunray Industrial Centre, 1/F
810 Cha Kwo Ling Road, Kowloon
Tel:23489211-4 Fax:(852)27727666

DWG NO. : J859-SD-PW-DT63 | REV. : A

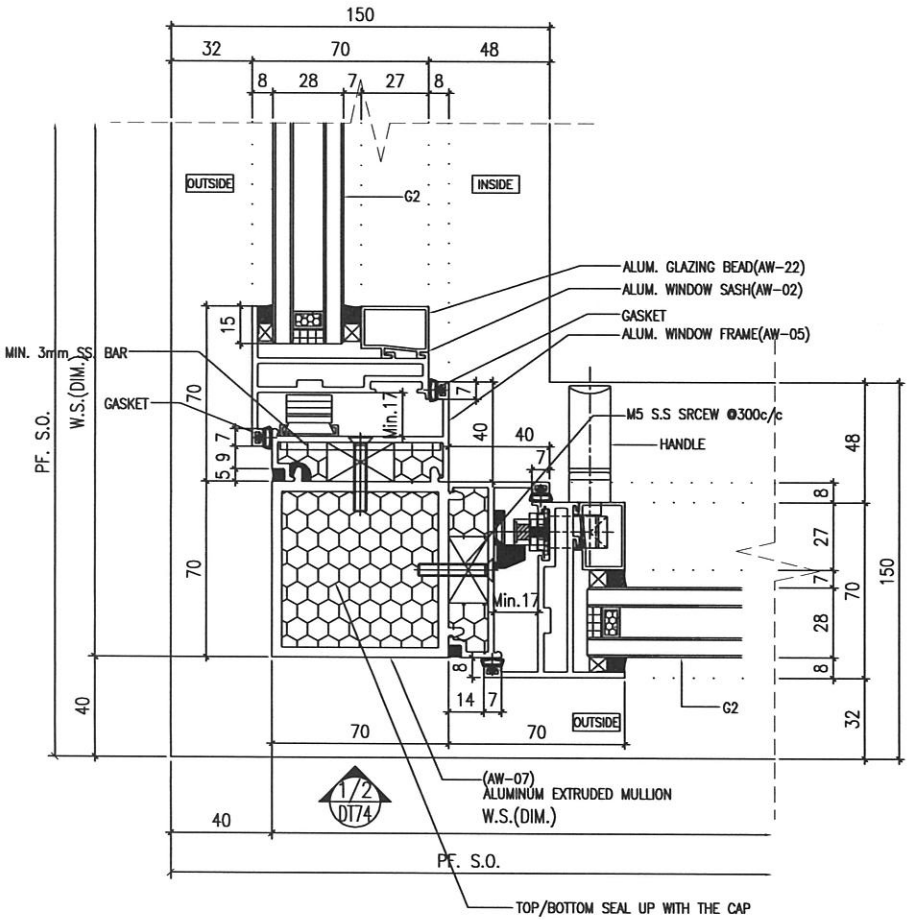

1 HORIZONTAL DETAIL

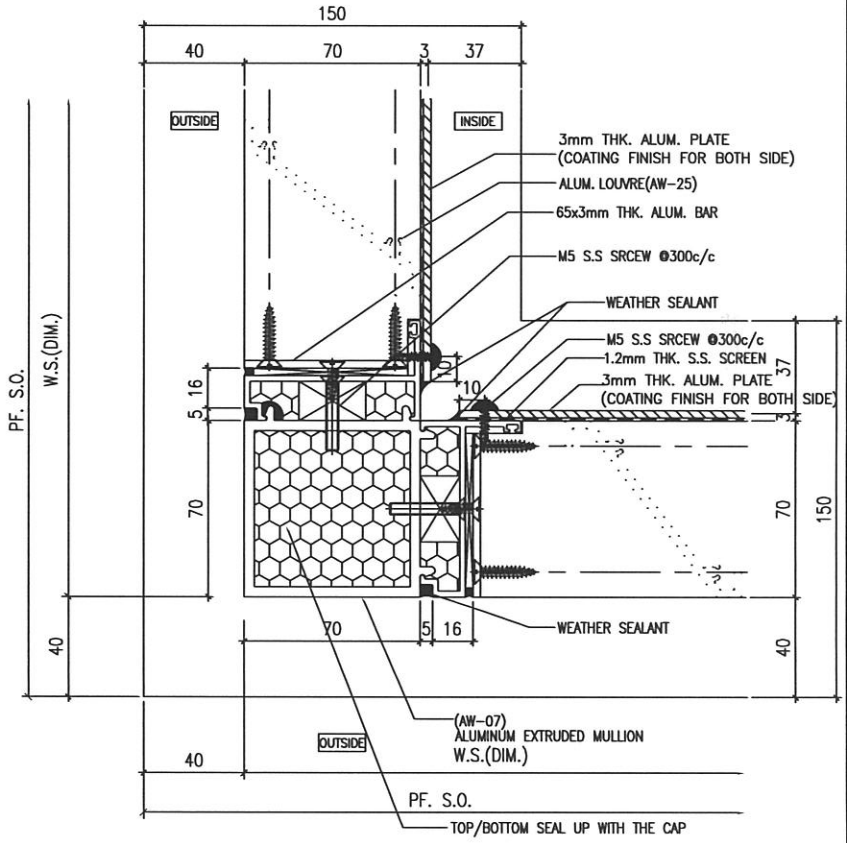

2 HORIZONTAL DETAIL

B.D. REF :

ARCHITECT :
WONG TUNG & PARTNERS LIMITED
ARCHITECTS & PLANNERS

STRUCTURAL ENGINEER :
SUN HUNG KAI
ARCHITECTS AND ENGINEERS LTD.
SUN HUNG KAI CENTRE, WANCHAI, HONGKONG
TEL: 28279111 FAX: 28272884

FACADE CONSULTANT:
ALPHA CONSULTING LIMITED
Steel Structure & Facade Specialist

MAIN CONTRACTOR :
Sanfield Engineering Construction Ltd.

CLIENT :
SUN HUNG KAI
REAL ESTATE AGENCY LTD.
42/F SUN HUNG KAI CENTRE, WANCHAI, HONGKONG

NOTE :
1. ALL DIMENSIONS ARE IN mm.
2. ALL ELEVATIONS ARE VIEWED FROM OUTSIDE.
3. ALL DIMENSIONS TO BE VERIFIED ON SITE BEFORE FABRICATION.

LEGEND :
X1 / X001 — DETAIL MARK NO. / REFER SHEET NO.
1. F.F.L. --FINISHED FLOOR LEVEL
2. S.F.L. --STRUCTURAL FLOOR LEVEL
3. /R --REVERSED DETAIL
4. GLASS LEGEND
G1-8mmHS+12mm AIR GAP+10mmTP I.G.U.
G2-8mmHS+12mm AIR GAP+8mmTP I.G.U.
G2a-8mmHS+12mm AIR GAP+8mmTP+1.52PVB +6mmTP(PLANNING) FEATURED GLASS (I.G.U.)
G8-6mm GREY HS+1.52PVB+6mm CLEAR HS

NO.	DATE	REVISED	BY
C	28/9/2022	REVISION SUBJECT TO ALPHA COMMENT	
B	07/9/2022	REVISION SUBJECT TO ALPHA COMMENT	
A	26/3/2022	REVISION SUBJECT TO ARCHITECT	

JOB NO. : J-859

PROJECT :
PROPOSED RESIDENTIAL / COMMERCIAL DEVELOPMENT AT NKIL NO.8551 KAI TAK AREA 4C, SITE 3 KAI TAK, KOWLOON


TITLE :
TYPICAL DETAILS FOR ALUM. WINDOW

DATE : 10-Nov-21 | SCALE : 1:2 (A3)


DRAWN BY : IVAN | CHECKED BY :

美特鋁質有限公司
MIDI ALUMINIUM FABRICATOR LTD.
Units 6-8, Sunray Industrial Centre, 1/F
610 Cha Kwo Ling Road, Kowloon
Tel:23489211-4 Fax:(852)27727666


DWG NO. : J859-SD-PW-DT63a | REV. : C

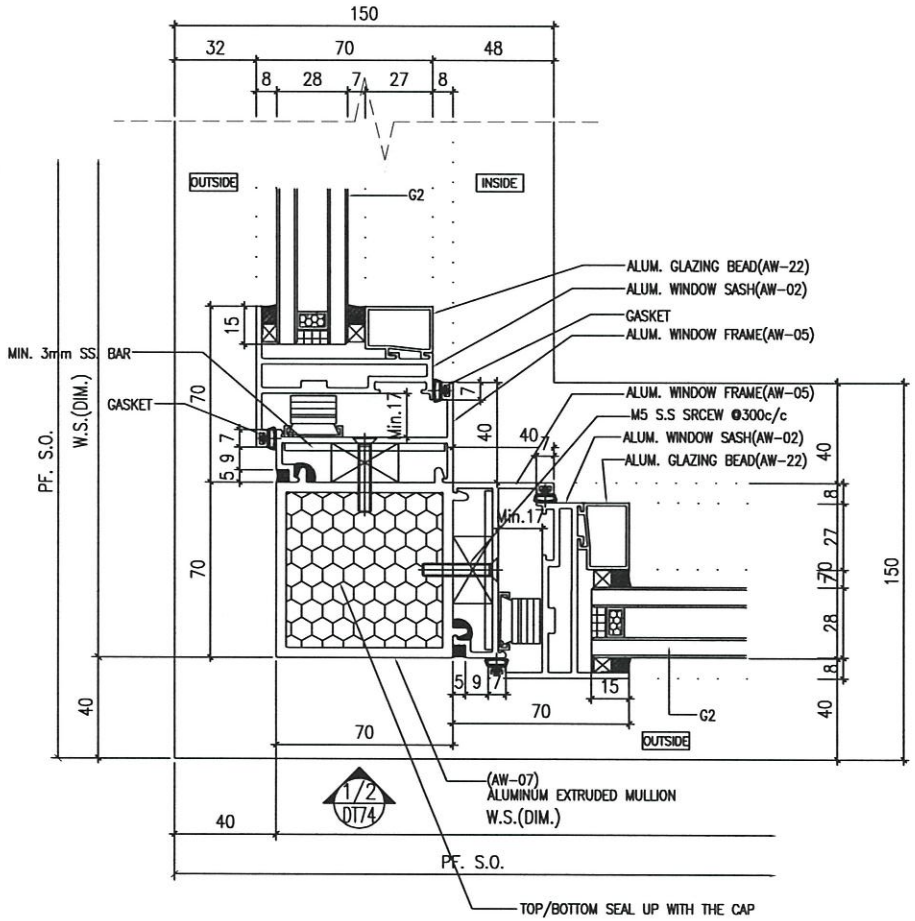

1 HORIZONTAL DETAIL

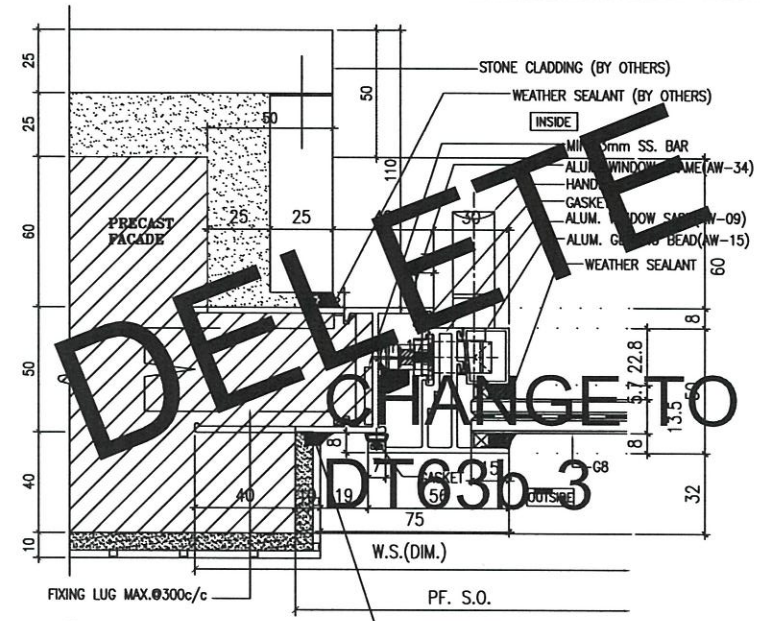

2 HORIZONTAL DETAIL

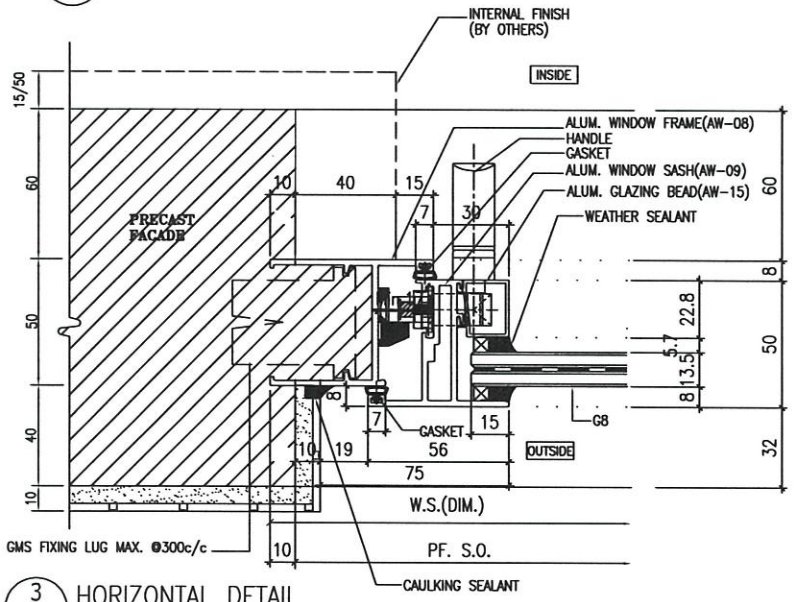

3 HORIZONTAL DETAIL

B.D. REF :

ARCHITECT :
WONG TUNG & PARTNERS LIMITED
ARCHITECTS & PLANNERS

STRUCTURAL ENGINEER :
SUN HUNG KAI
ARCHITECTS AND ENGINEERS LTD.
SUN HUNG KAI CENTRE, WANCHAI, HONGKONG
TEL. 28278111 FAX. 28272804

FACADE CONSULTANT:
ALPHA CONSULTING LIMITED
Steel Structure & Facade Specialist

MAIN CONTRACTOR :
Sanfield Engineering Construction Ltd.

CLIENT :
SUN HUNG KAI
REAL ESTATE AGENCY LTD.
42/F SUN HUNG KAI CENTRE, WANCHAI, HONGKONG

NOTE :
1. ALL DIMENSIONS ARE IN mm.
2. ALL ELEVATIONS ARE VIEWED FROM OUTSIDE.
3. ALL DIMENSIONS TO BE VERIFIED ON SITE BEFORE FABRICATION.

LEGEND :
X1 — DETAIL MARK NO.
X001 — REFER SHEET NO.

1. F.F.L. --FINISHED FLOOR LEVEL
2. S.F.L. --STRUCTURAL FLOOR LEVEL
3. /R --REVERSED DETAIL
4. GLASS LEGEND

G1-8mmHS+12mm AIR GAP+10mmTP I.G.U.

G2-8mmHS+12mm AIR GAP+8mmTP I.G.U.

G2a-8mmHS+12mm AIR GAP+8mmTP+1.52PVB +6mmTP(PLANNING) FEATURED GLASS (I.G.U.)

G8-6mm GREY HS+1.52PVB+6mm CLEAR HS

NO.	DATE	REVISED	BY
B	13/10/2022	REVISION SUBJECT TO ALPHA COMMENT	YL
A	28/3/2022	REVISION SUBJECT TO ARCH.COMMENT	HWM

JOB NO. : J-859

PROJECT :
PROPOSED RESIDENTIAL / COMMERCIAL DEVELOPMENT AT NKIL NO.6551 KAI TAK AREA 4C, SITE 3 KAI TAK, KOWLOON


TITLE :
TYPICAL DETAILS FOR ALUM. WINDOW

DATE : 10-Nov-21 | SCALE : 1:2 (A3)


DRAWN BY : IVAN | CHECKED BY :

美特鋁製有限公司
MIDI ALUMINIUM FABRICATOR LTD.
Units 6-8, Sunray Industrial Centre, 1/F
610 Cha Kwo Ling Road, Kowloon
Tel:23489211-4 Fax:(852)27727666


DWG NO. : J859-SD-PW-DT63b | REV. : B

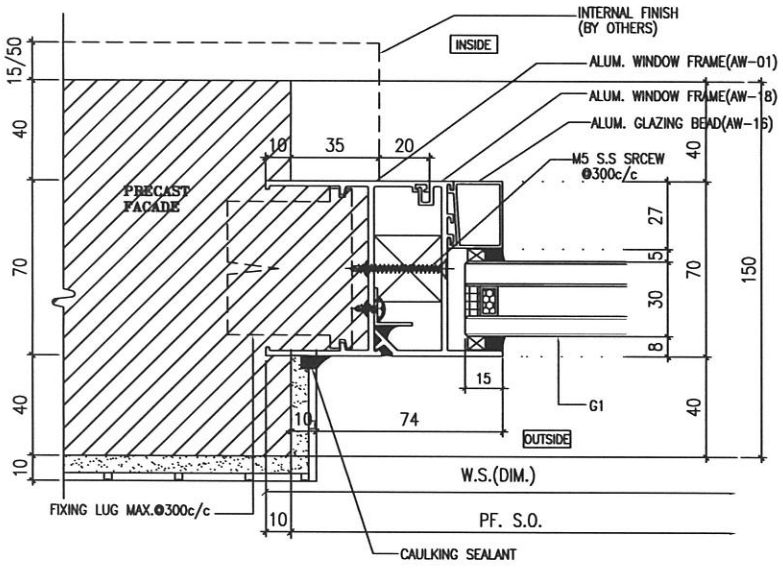


1 HORIZONTAL DETAIL
-

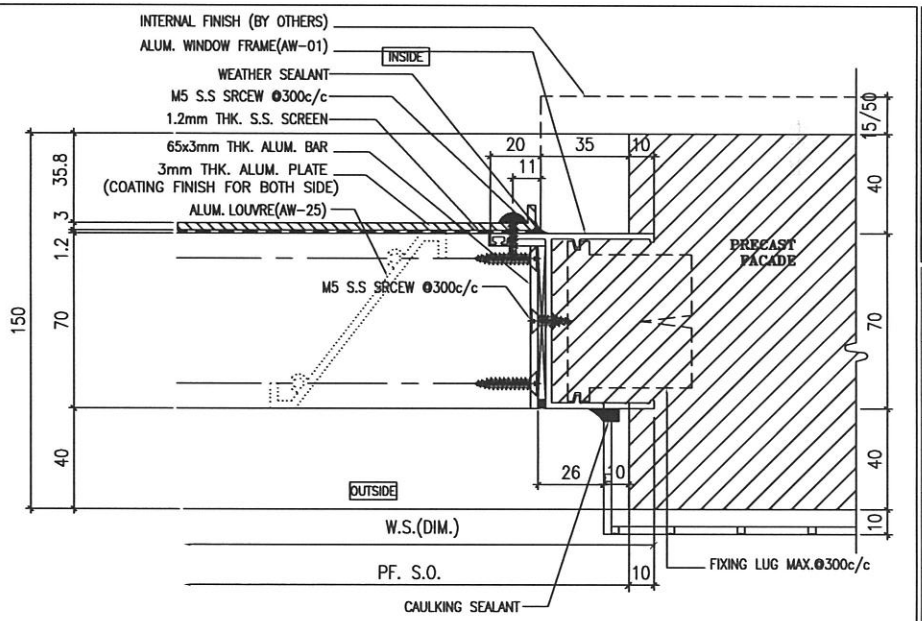

2 HORIZONTAL DETAIL
-

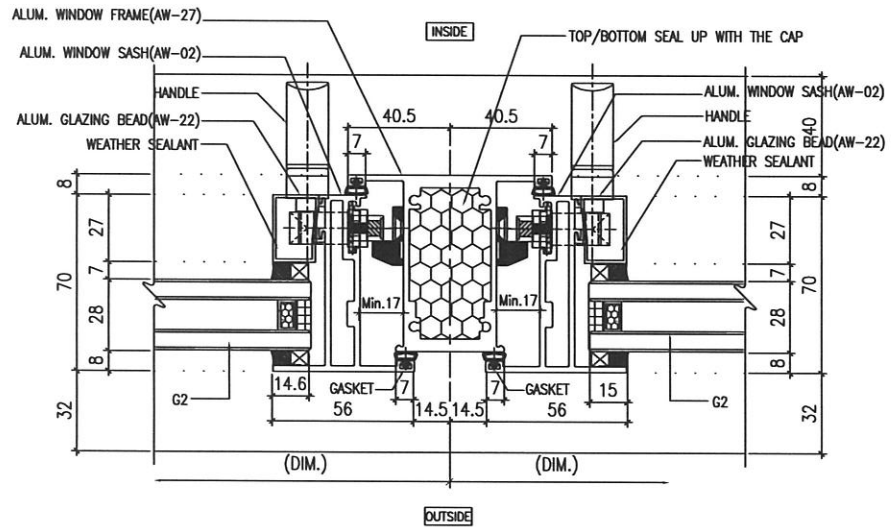

3 HORIZONTAL DETAIL
-

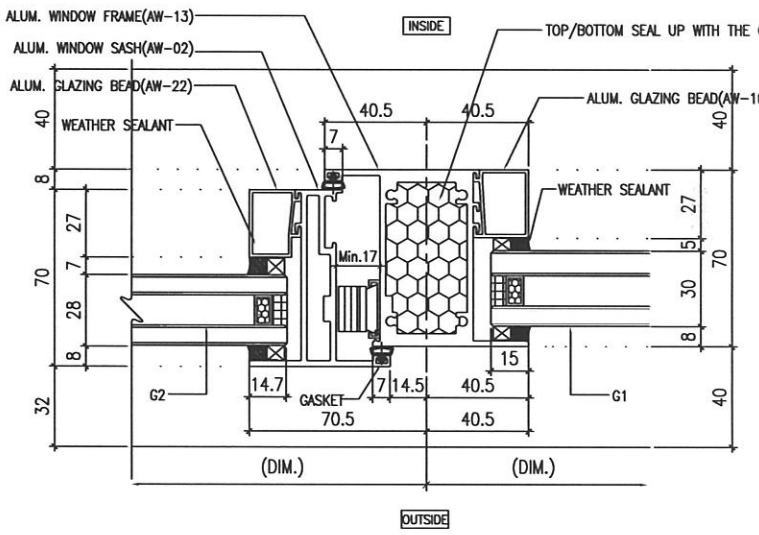

4 HORIZONTAL DETAIL
-

B.D. REF :

ARCHITECT :
WONG TUNG & PARTNERS LIMITED
ARCHITECTS & PLANNERS

STRUCTURAL ENGINEER :
SUN HUNG KAI
ARCHITECTS AND ENGINEERS LTD.
SUN HUNG KAI CENTRE, WANCHAI, HONGKONG
TEL: 28278111 FAX: 28272884

FACADE CONSULTANT:
ALPHA CONSULTING LIMITED
Steel Structure & Facade Specialist

MAIN CONTRACTOR :
Sanfield Engineering Construction Ltd.

CLIENT :
SUN HUNG KAI
REAL ESTATE AGENCY LTD.
42/F SUN HUNG KAI CENTRE, WANCHAI, HONGKONG

NOTE :
1. ALL DIMENSIONS ARE IN mm.
2. ALL ELEVATIONS ARE VIEWED FROM OUTSIDE.
3. ALL DIMENSIONS TO BE VERIFIED ON SITE BEFORE FABRICATION.

LEGEND :
X1 — DETAIL MARK NO.
X001 — REFER SHEET NO.

1. F.F.L. --FINISHED FLOOR LEVEL
2. S.F.L. --STRUCTURAL FLOOR LEVEL
3. /R --REVERSED DETAIL
4. GLASS LEGEND

G1-8mmHS+12mm AIR GAP+10mmTP I.G.U.
G2-8mmHS+12mm AIR GAP+8mmTP I.G.U.
G2a-8mmHS+12mm AIR GAP+8mmTP+1.52PVBI +6mmTP(PLANNING) FEATURED GLASS (I.G.U.)
G8-6mm GREY HS+1.52PVBI+6mm CLEAR HS

NO.	DATE	REVISED	BY
C	28/6/2022	REVISION SUBJECT TO ARCHITECT	
B	07/5/2022	REVISION SUBJECT TO ARCHITECT	
A	28/3/2022	REVISION SUBJECT TO ARCHITECT	

JOB NO. : J-859

PROJECT :
PROPOSED RESIDENTIAL / COMMERCIAL DEVELOPMENT AT NKIL NO.8551 KAI TAK AREA 4C, SITE 3 KAI TAK, KOWLOON


TITLE :
TYPICAL DETAILS FOR ALUM. WINDOW

DATE : 10-Nov-21 | SCALE : 1:2 (A3)


DRAWN BY : IVAN | CHECKED BY :

美特鋁質有限公司
MIDI ALUMINIUM FABRICATOR LTD.
Units 6-8, Sunray Industrial Centre, 1/F
810 Cha Kwo Ling Road, Kowloon
Tel:23489211-4 Fax:(852)27727666


DWG NO. : J859-SD-PW-DT64 | REV. : C

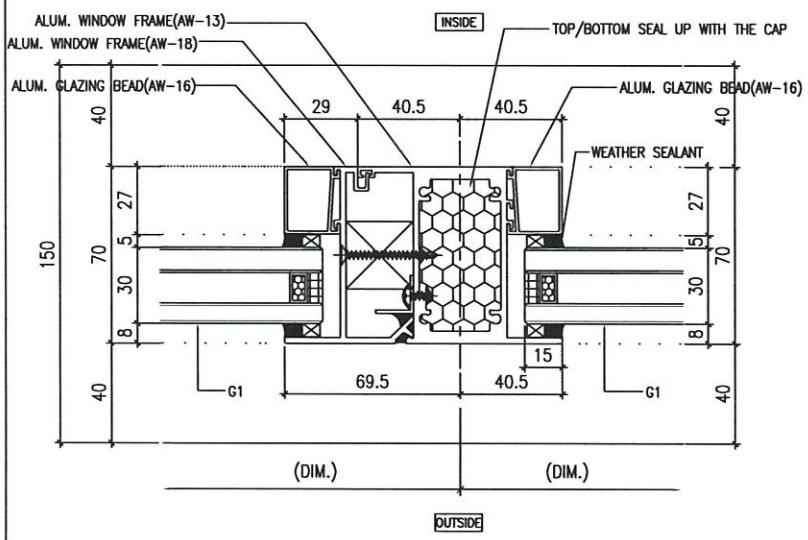


1 HORIZONTAL DETAIL

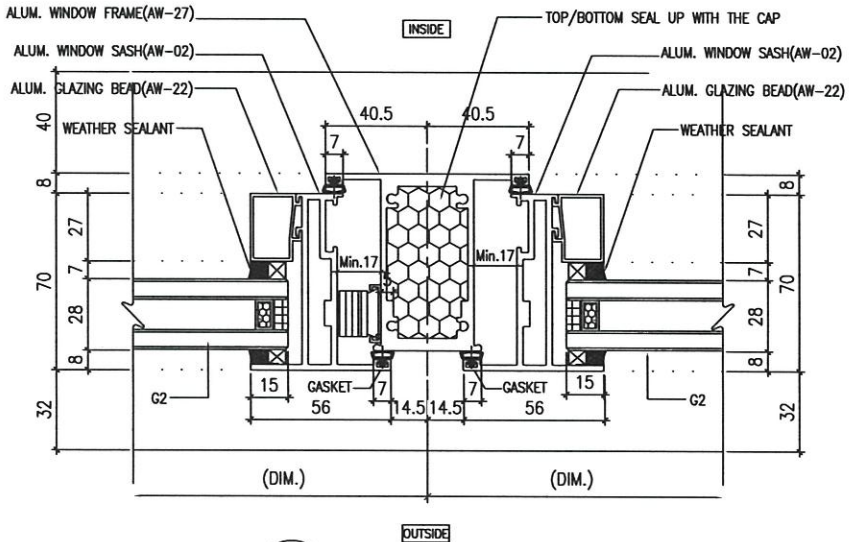

2 HORIZONTAL DETAIL

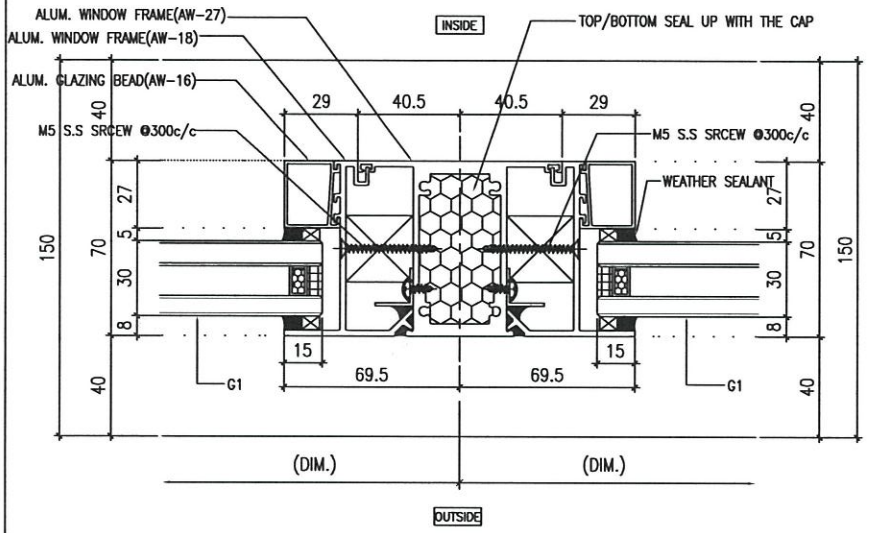

3 HORIZONTAL DETAIL

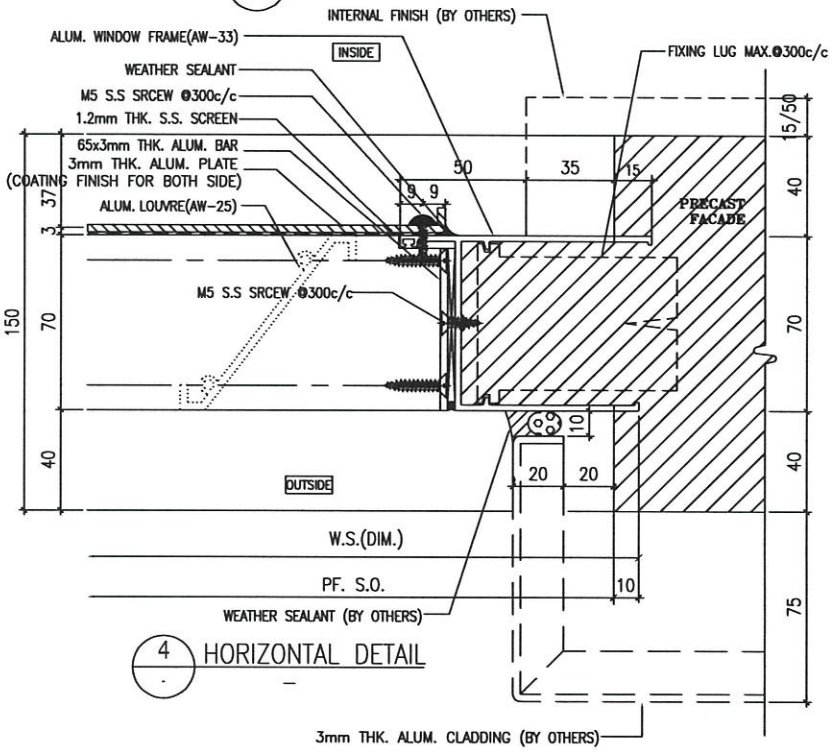

4 HORIZONTAL DETAIL

B.D. REF :

ARCHITECT :
WONG TUNG & PARTNERS LIMITED
ARCHITECTS & PLANNERS

STRUCTURAL ENGINEER :
SUN HUNG KAI
ARCHITECTS AND ENGINEERS LTD.
SUN HUNG KAI CENTRE, WANCHAI, HONGKONG
TEL. 2827 8811 FAX. 2827 2004

FACADE CONSULTANT:
ALPHA CONSULTING LIMITED
Steel Structure & Facade Specialist

MAIN CONTRACTOR :
Sanfield Engineering Construction Ltd.

CLIENT :
SUN HUNG KAI
REAL ESTATE AGENCY LTD.
42/F SUN HUNG KAI CENTRE, WANCHAI, HONGKONG

NOTE :
1. ALL DIMENSIONS ARE IN mm.
2. ALL ELEVATIONS ARE VIEWED FROM OUTSIDE.
3. ALL DIMENSIONS TO BE VERIFIED ON SITE BEFORE FABRICATION.

LEGEND :
X1 / X001 — DETAIL MARK NO. / REFER SHEET NO.
1. F.F.L. — FINISHED FLOOR LEVEL
2. S.F.L. — STRUCTURAL FLOOR LEVEL
3. /R — REVERSED DETAIL
4. GLASS LEGEND
G1–8mmHS+12mm AIR GAP+10mmTP I.G.U.
G2–8mmHS+12mm AIR GAP+8mmTP I.G.U.
G2a–8mmHS+12mm AIR GAP+8mmTP+1.52PVB +6mmTP(PLANNING) FEATURED GLASS (I.G.U.)
G8–6mm GREY HS+1.52PVB+6mm CLEAR HS

NO.	DATE	REVISED	BY
C	28/6/2022	REVISION SUBJECT TO ALPHA COMMENT	
B	07/6/2022	REVISION SUBJECT TO ALPHA COMMENT	
A	25/3/2022	REVISION SUBJECT TO ARCHITECTMENT	

JOB NO. : J-859

PROJECT :
PROPOSED RESIDENTIAL / COMMERCIAL DEVELOPMENT AT NKIL NO.6551 KAI TAK AREA 4C, SITE 3 KAI TAK, KOWLOON


TITLE :
TYPICAL DETAILS FOR ALUM. WINDOW

DATE : 10–Nov–21 | SCALE : 1:2 (A3)


DRAWN BY : IVAN | CHECKED BY :

美特鋁質有限公司
MIDI ALUMINIUM FABRICATOR LTD.
Units 6–8, Sunray Industrial Centre, 1/F
610 Cha Kwo Ling Road, Kowloon
Tel:23489211–4 Fax:(852)27727666


DWG NO. : J859–SD–PW–DT65 | REV. : C

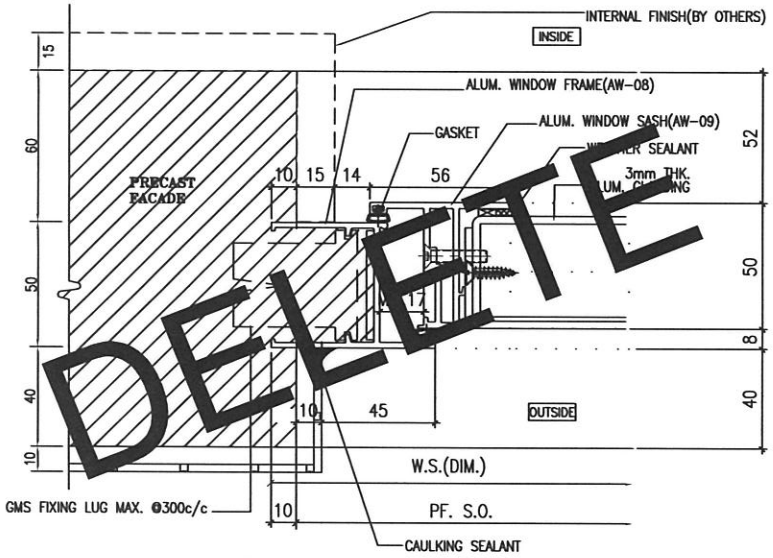


1 HORIZONTAL DETAIL

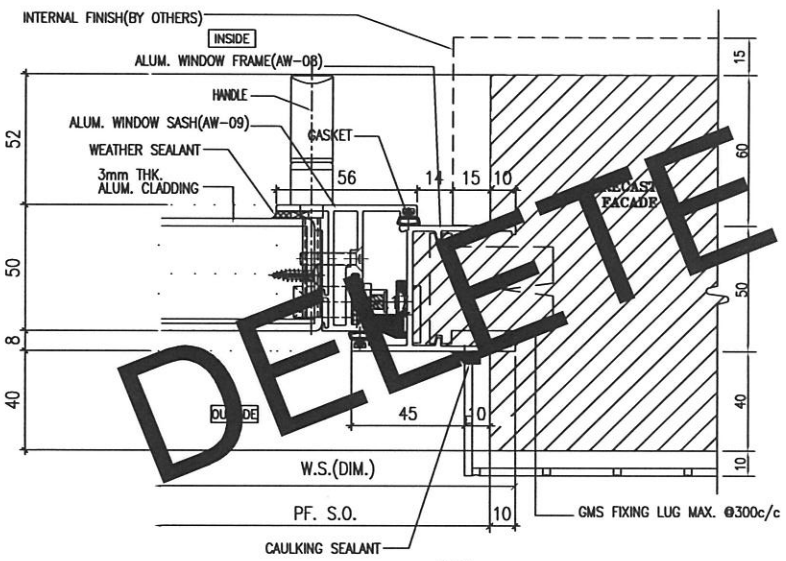

2 HORIZONTAL DETAIL

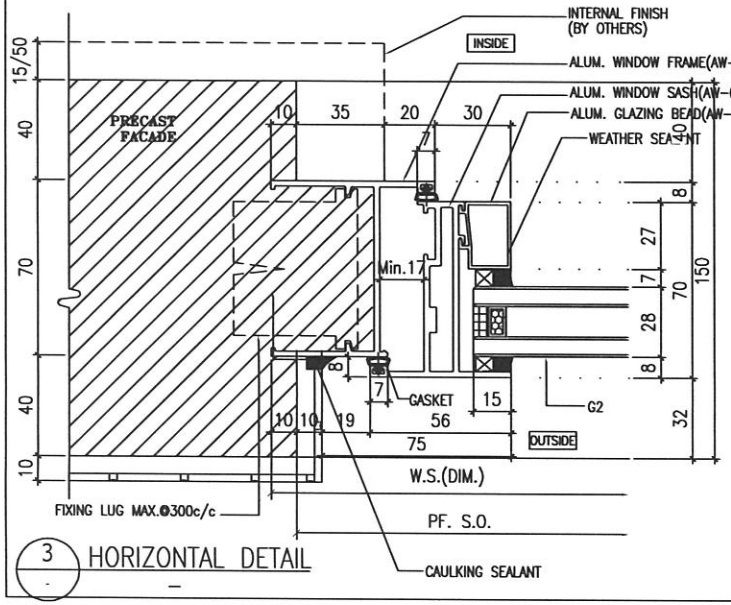

3 HORIZONTAL DETAIL

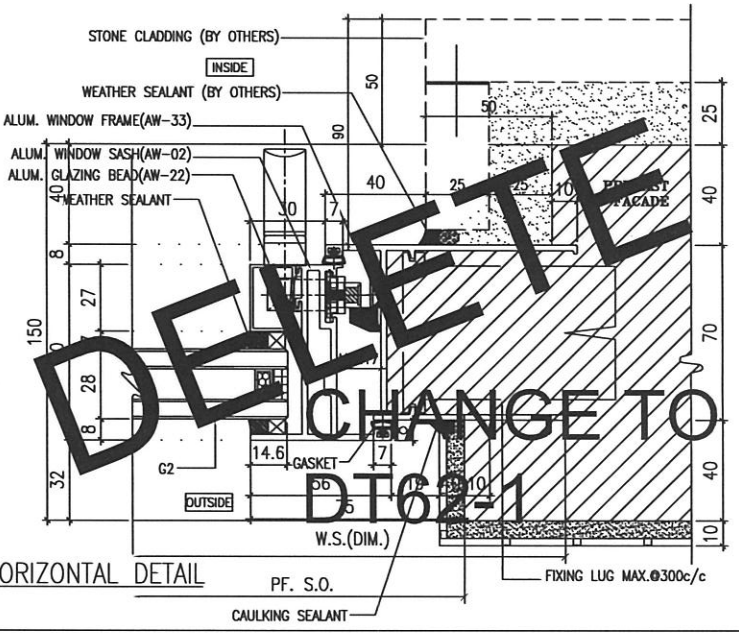

4 HORIZONTAL DETAIL

B.D. REF :

ARCHITECT :
WONG TUNG & PARTNERS LIMITED
ARCHITECTS & PLANNERS

STRUCTURAL ENGINEER :
SUN HUNG KAI
ARCHITECTS AND ENGINEERS LTD.
SUN HUNG KAI CENTRE, WANCHAI, HONGKONG
TEL. 28278111 FAX. 28272884

FACADE CONSULTANT:
ALPHA CONSULTING LIMITED
Steel Structure & Facade Specialist

MAIN CONTRACTOR :
Sanfield Engineering Construction Ltd.

CLIENT :
SUN HUNG KAI
REAL ESTATE AGENCY LTD.
42/F SUN HUNG KAI CENTRE, WANCHAI, HONGKONG

NOTE :
1. ALL DIMENSIONS ARE IN mm.
2. ALL ELEVATIONS ARE VIEWED FROM OUTSIDE.
3. ALL DIMENSIONS TO BE VERIFIED ON SITE BEFORE FABRICATION.

LEGEND :
- X1 / X001 — DETAIL MARK NO. / REFER SHEET NO.
1. F.F.L. --FINISHED FLOOR LEVEL
2. S.F.L. --STRUCTURAL FLOOR LEVEL
3. (R) --REVERSED DETAIL
4. GLASS LEGEND
G1-8mmHS+12mm AIR GAP+10mmTP I.G.U.
G2-8mmHS+12mm AIR GAP+8mmTP I.G.U.
G2a-8mmHS+12mm AIR GAP+8mmTP+1.52PVB +6mmTP(PLANNING) FEATURED GLASS (I.G.U.)
G8-6mm GREY HS+1.52PVB+6mm CLEAR HS

NO.	DATE	REVISED	BY
C	8/9/2022	REVISION SUBJECT TO ARCHITECT	
B	13/8/2022	REVISION SUBJECT TO ARCHITECT	
A	28/3/2022	REVISION SUBJECT TO ARCHITECT	

JOB NO. : J-859

PROJECT :
PROPOSED RESIDENTIAL / COMMERCIAL DEVELOPMENT AT NKIL NO.6551 KAI TAK AREA 4C, SITE 3 KAI TAK, KOWLOON


TITLE :
TYPICAL DETAILS FOR ALUM. WINDOW

DATE : 10-Nov-21 | SCALE : 1:2 (A3)


DRAWN BY : IVAN | CHECKED BY :

美特鋁製有限公司
MIDI ALUMINIUM FABRICATOR LTD.
Units 6-8, Sunray Industrial Centre, 1/F
610 Cha Kwo Ling Road, Kowloon
Tel:23489211-4 Fax:(852)27727666


DWG NO. : J859-SD-PW-DT66 | REV. : C

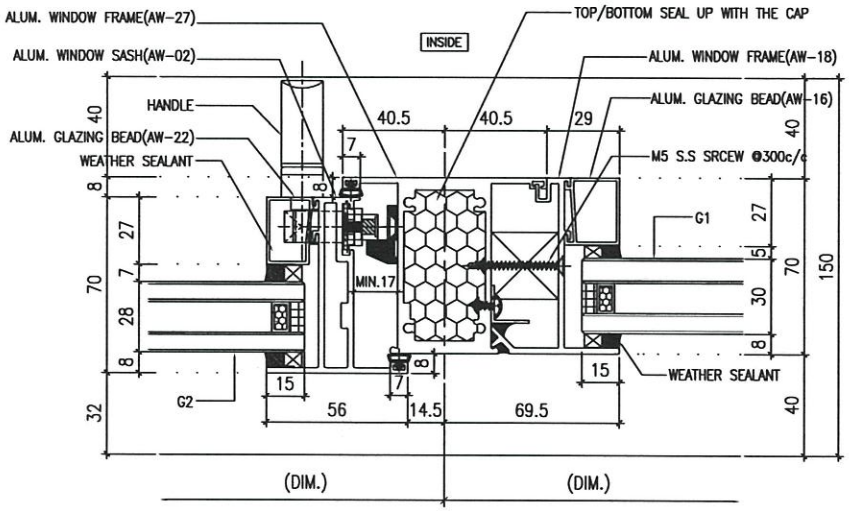


1 HORIZONTAL DETAIL

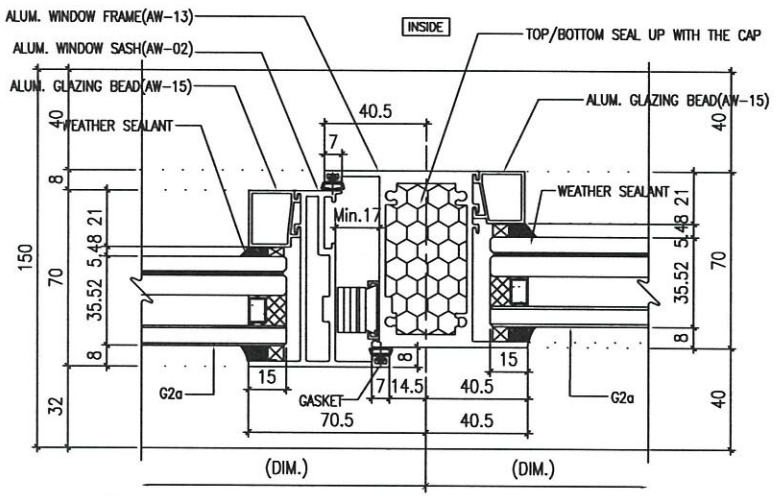

3 HORIZONTAL DETAIL

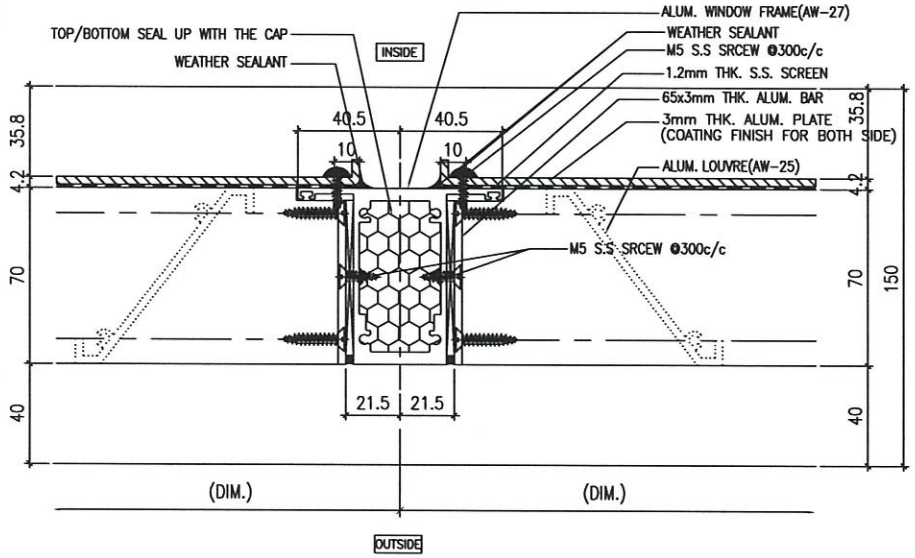

2 HORIZONTAL DETAIL

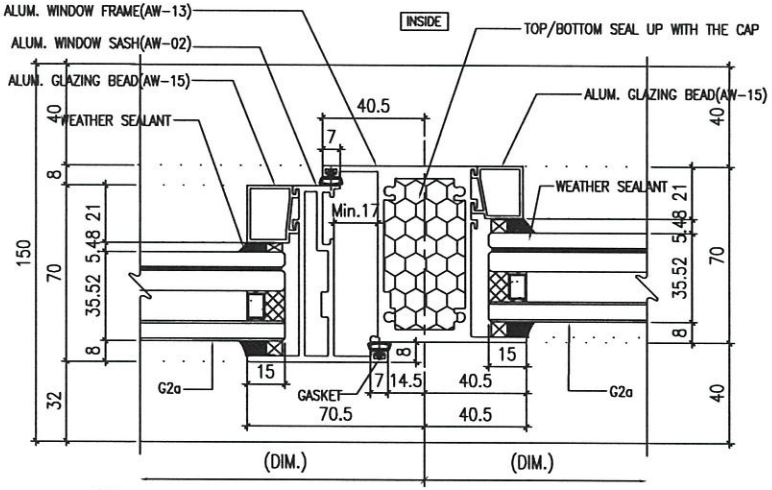

4 HORIZONTAL DETAIL

B.D. REF :

ARCHITECT :
WONG TUNG & PARTNERS LIMITED
ARCHITECTS & PLANNERS

STRUCTURAL ENGINEER :
SUN HUNG KAI
ARCHITECTS AND ENGINEERS LTD.
SUN HUNG KAI CENTRE, WANCHAI, HONGKONG
TEL. 28278111 FAX. 28272884

FACADE CONSULTANT:
ALPHA CONSULTING LIMITED
Steel Structure & Facade Specialist

MAIN CONTRACTOR :
Sanfield Engineering Construction Ltd.

CLIENT :
SUN HUNG KAI
REAL ESTATE AGENCY LTD.
42/F SUN HUNG KAI CENTRE, WANCHAI, HONGKONG

NOTE :
1. ALL DIMENSIONS ARE IN mm.
2. ALL ELEVATIONS ARE VIEWED FROM OUTSIDE.
3. ALL DIMENSIONS TO BE VERIFIED ON SITE BEFORE FABRICATION.

LEGEND :
X1 / X001 — DETAIL MARK NO. / REFER SHEET NO.
1. F.F.L. --FINISHED FLOOR LEVEL
2. S.F.L. --STRUCTURAL FLOOR LEVEL
3. (7/8) --REVERSED DETAIL
4. GLASS LEGEND
G1-8mmHS+12mm AIR GAP+10mmTP I.G.U.
G2-8mmHS+12mm AIR GAP+8mmTP I.G.U.
G2a-8mmHS+12mm AIR GAP+8mmTP+1.52PVB +6mmTP(PLANNING) FEATURED GLASS (I.G.U.)
G8-6mm GREY HS+1.52PVB+6mm CLEAR HS

NO.	DATE	REVISED	BY
B	28/6/2022	REVISION SUBJECT TO AMENDMENT	
A	28/3/2022	REVISION SUBJECT TO AMENDMENT	

JOB NO. : J-859

PROJECT :
PROPOSED RESIDENTIAL / COMMERCIAL DEVELOPMENT AT NKIL NO.6551 KAI TAK AREA 4C, SITE 3 KAI TAK, KOWLOON


TITLE :
TYPICAL DETAILS FOR ALUM. WINDOW

DATE : 10-Nov-21 | SCALE : 1:2 (A3)


DRAWN BY : IVAN | CHECKED BY :

美特鋁製有限公司
MIDI ALUMINIUM FABRICATOR LTD.
Units 6-8, Sunray Industrial Centre, 1/F
610 Cha Kwo Ling Road, Kowloon
Tel:23489211-4 Fax:(852)27727666


DWG NO. : J859-SD-PW-DT67 | REV. : B

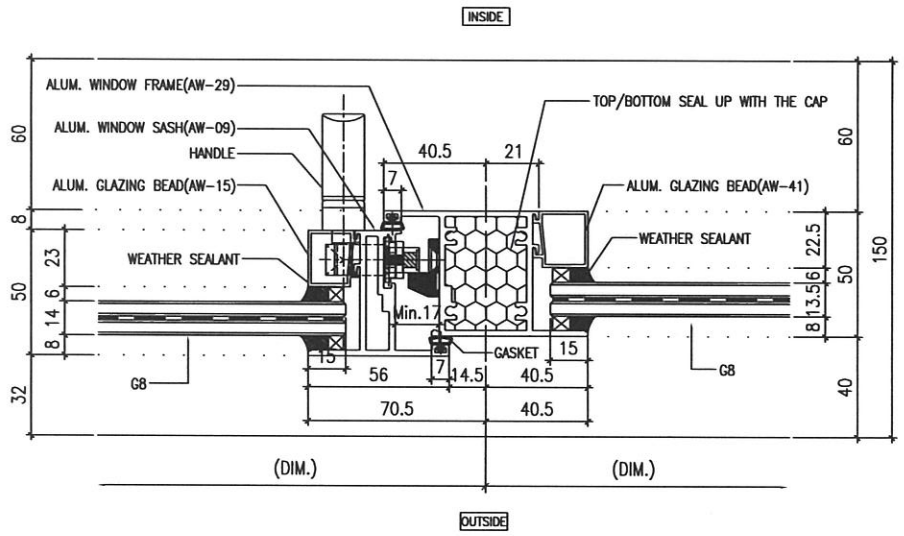


1 HORIZONTAL DETAIL

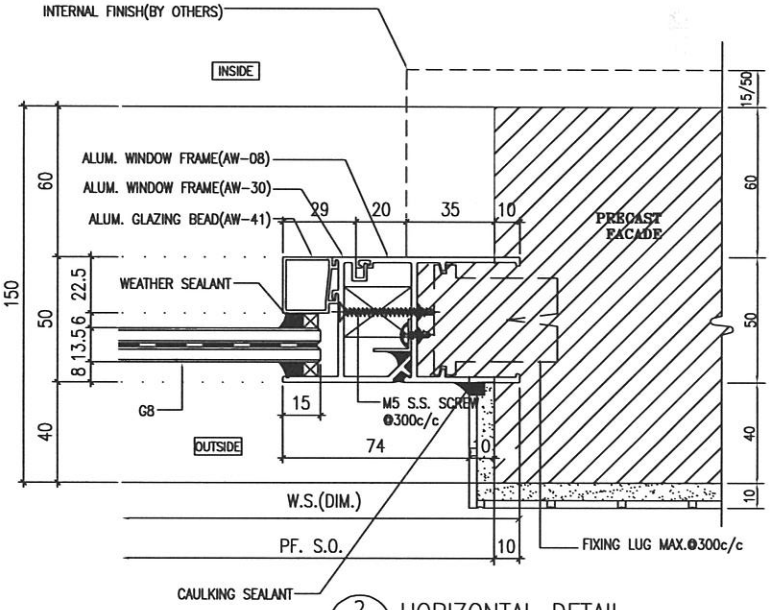

2 HORIZONTAL DETAIL

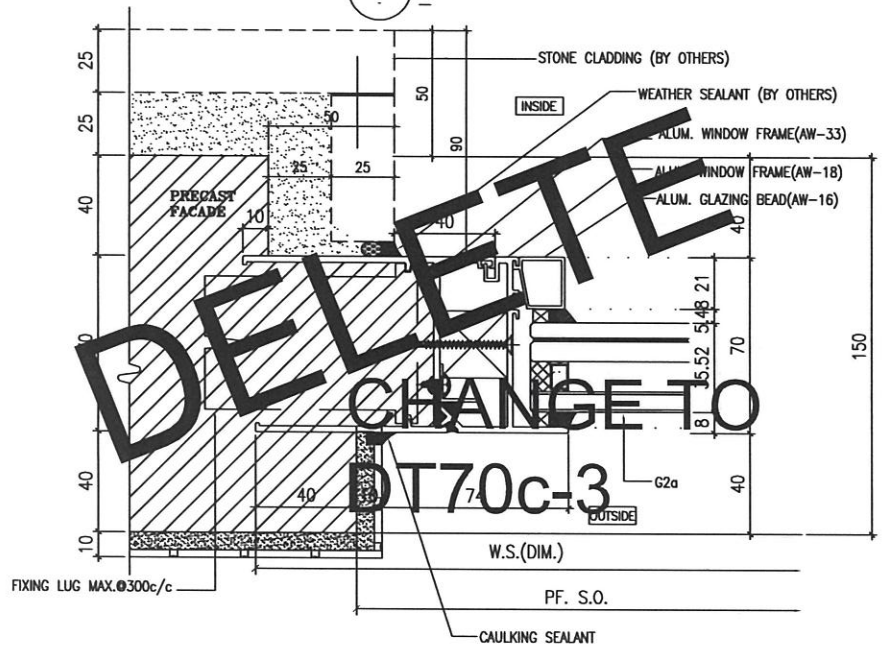

3 HORIZONTAL DETAIL

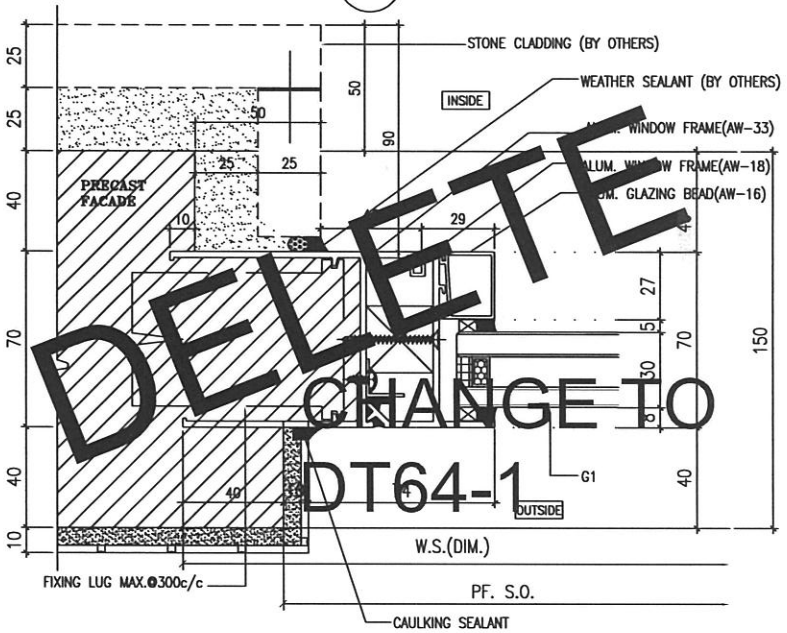

4 HORIZONTAL DETAIL

DELETE
CHANGE TO
DT70c-3

DELETE
CHANGE TO
DT64-1

B.D. REF :

ARCHITECT :
WONG TUNG & PARTNERS LIMITED
ARCHITECTS & PLANNERS

STRUCTURAL ENGINEER :
SUN HUNG KAI
ARCHITECTS AND ENGINEERS LTD.
SUN HUNG KAI CENTRE, WANCHAI, HONGKONG
TEL. 28278111 FAX. 28272884

FACADE CONSULTANT:
ALPHA CONSULTING LIMITED
Steel Structure & Facade Specialist

MAIN CONTRACTOR :
Sanfield Engineering Construction Ltd.

CLIENT :
SUN HUNG KAI
REAL ESTATE AGENCY LTD.
42/F SUN HUNG KAI CENTRE, WANCHAI, HONGKONG

NOTE :
1. ALL DIMENSIONS ARE IN mm.
2. ALL ELEVATIONS ARE VIEWED FROM OUTSIDE.
3. ALL DIMENSIONS TO BE VERIFIED ON SITE BEFORE FABRICATION.

LEGEND :
X1 — DETAIL MARK NO.
X001 — REFER SHEET NO.
1. F.F.L. --- FINISHED FLOOR LEVEL
2. S.F.L. --- STRUCTURAL FLOOR LEVEL
3. /R — REVERSED DETAIL
4. GLASS LEGEND
G1-8mmHS+12mm AIR GAP+10mmTP I.G.U.
G2-8mmHS+12mm AIR GAP+8mmTP I.G.U.
G2a-8mmHS+12mm AIR GAP+8mmTP+1.52PVB +6mmTP(PLANNING) FEATURED GLASS (I.G.U.)
G8-6mm GREY HS+1.52PVB+6mm CLEAR HS

NO.	DATE	REVISED	BY
A	26/1/2022	REVISION SUBJECT TO ACKLOWMENT	

JOB NO. : J-859


PROJECT :
PROPOSED RESIDENTIAL / COMMERCIAL DEVELOPMENT AT NKIL NO.6551 KAI TAK AREA 4C, SITE 3 KAI TAK, KOWLOON

TITLE :
TYPICAL DETAILS FOR ALUM. WINDOW


DATE : 10-Nov-21 | SCALE : 1:2 (A3)
DRAWN BY : IVAN | CHECKED BY :

美特鋁質有限公司
MIDI ALUMINIUM FABRICATOR LTD.
Units 6-8, Sunray Industrial Centre, 1/F
810 Cha Kwo Ling Road, Kowloon
Tel:23489211-4 Fax:(852)27727666


DWG NO. : J859-SD-PW-DT68 | REV. : A

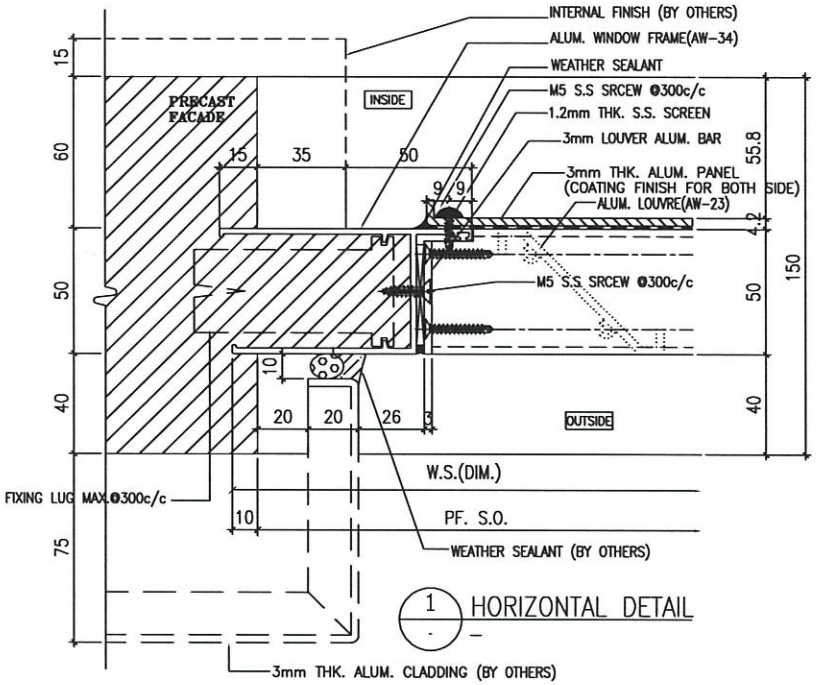


1 HORIZONTAL DETAIL

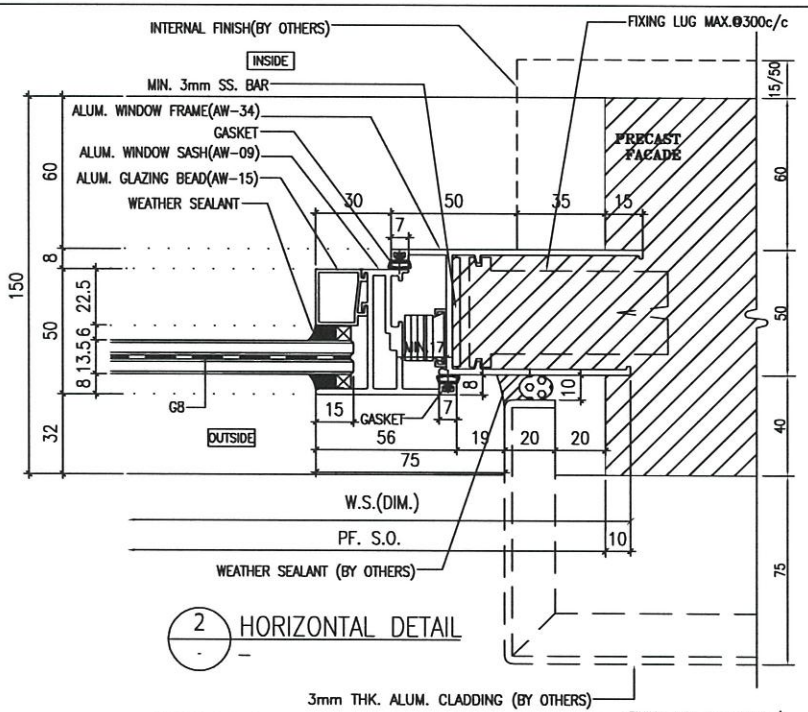

2 HORIZONTAL DETAIL

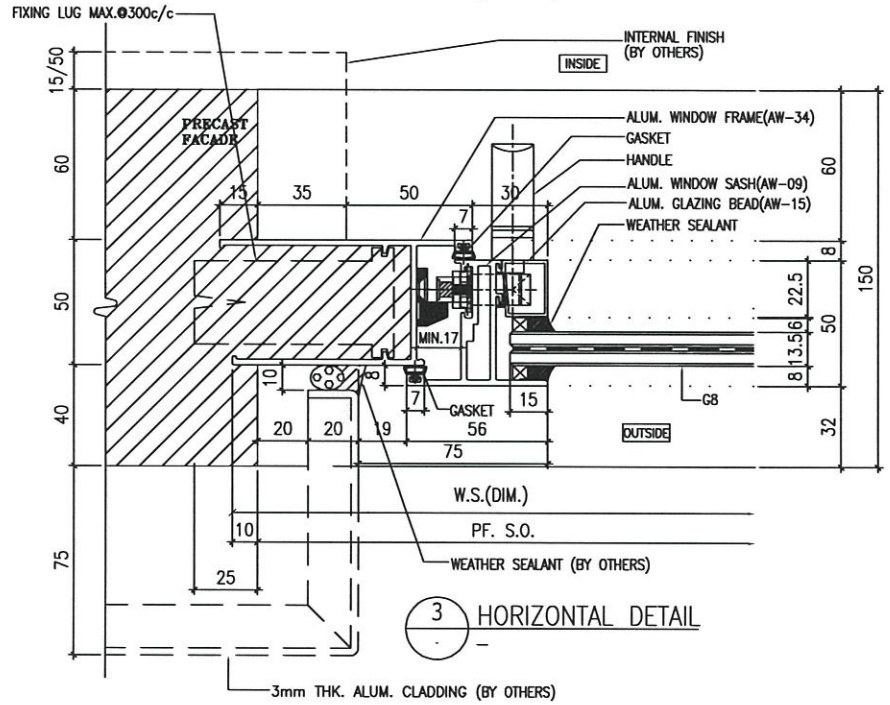

3 HORIZONTAL DETAIL

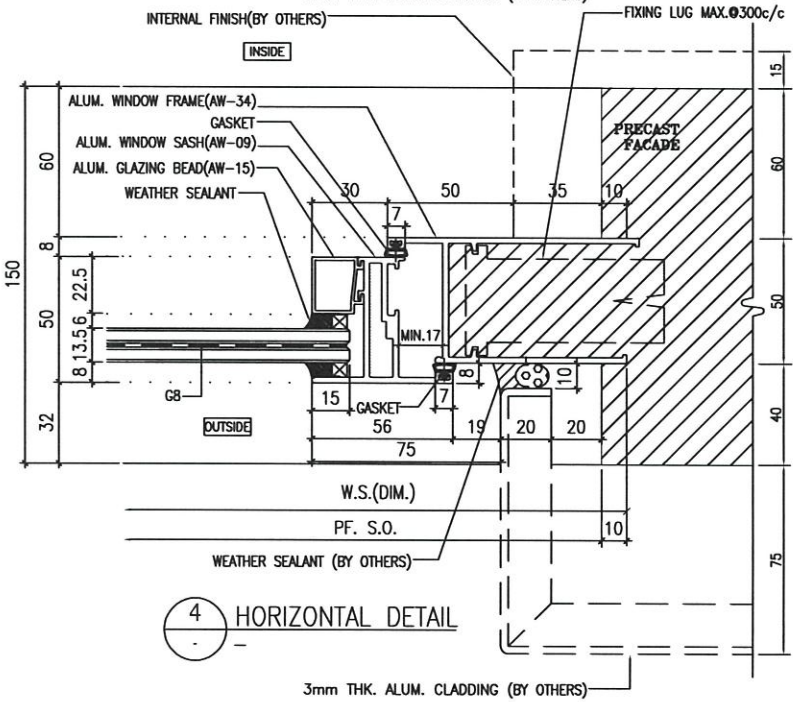

4 HORIZONTAL DETAIL

B.D. REF :

ARCHITECT :
WONG TUNG & PARTNERS LIMITED
ARCHITECTS & PLANNERS

STRUCTURAL ENGINEER :
SUN HUNG KAI
ARCHITECTS AND ENGINEERS LTD.
SUN HUNG KAI CENTRE, WANCHAI, HONGKONG
TEL. 28278111 FAX. 28272884

FACADE CONSULTANT:
ALPHA CONSULTING LIMITED
Steel Structure & Facade Specialist

MAIN CONTRACTOR :
Sanfield Engineering Construction Ltd.

CLIENT :
SUN HUNG KAI
REAL ESTATE AGENCY LTD.
42/F SUN HUNG KAI CENTRE, WANCHAI, HONGKONG

NOTE :
1. ALL DIMENSIONS ARE IN mm.
2. ALL ELEVATIONS ARE VIEWED FROM OUTSIDE.
3. ALL DIMENSIONS TO BE VERIFIED ON SITE BEFORE FABRICATION.

LEGEND :
X1 — DETAIL MARK NO.
X001 — REFER SHEET NO.

1. F.F.L. --- FINISHED FLOOR LEVEL
2. S.F.L. --- STRUCTURAL FLOOR LEVEL
3. /R --- REVERSED DETAIL
4. GLASS LEGEND

G1–8mmHS+12mm AIR GAP+10mmTP I.G.U.

G2–8mmHS+12mm AIR GAP+8mmTP I.G.U.

G2a–8mmHS+12mm AIR GAP+8mmTP+1.52PVB +6mmTP(PLANNING) FEATURED GLASS (I.G.U.)

G8–6mm GREY HS+1.52PVB+6mm CLEAR HS

NO.	DATE	REVISED	BY
C	8/9/2022	REVISION SUBJECT TO ALPHA COMMENT	MIDI
B	7/9/2022	REVISION SUBJECT TO ALPHA COMMENT	MIDI
A	29/3/2022	REVISION SUBJECT TO ARCH.COMMENT	MIDI

JOB NO. : J-859

PROJECT :
PROPOSED RESIDENTIAL / COMMERCIAL DEVELOPMENT AT NKIL NO.6551 KAI TAK AREA 4C, SITE 3 KAI TAK, KOWLOON


TITLE :
TYPICAL DETAILS FOR ALUM. WINDOW

DATE : 10–Nov–21 | SCALE : 1:2 (A3)


DRAWN BY : IVAN | CHECKED BY :

美特鋁質有限公司
MIDI ALUMINIUM FABRICATOR LTD.
Units 6–8, Sunray Industrial Centre, 1/F
610 Cha Kwo Ling Road, Kowloon
Tel:23489211–4 Fax:(852)27727666

DWG NO. : J859–SD–PW–DT68a | REV. : C

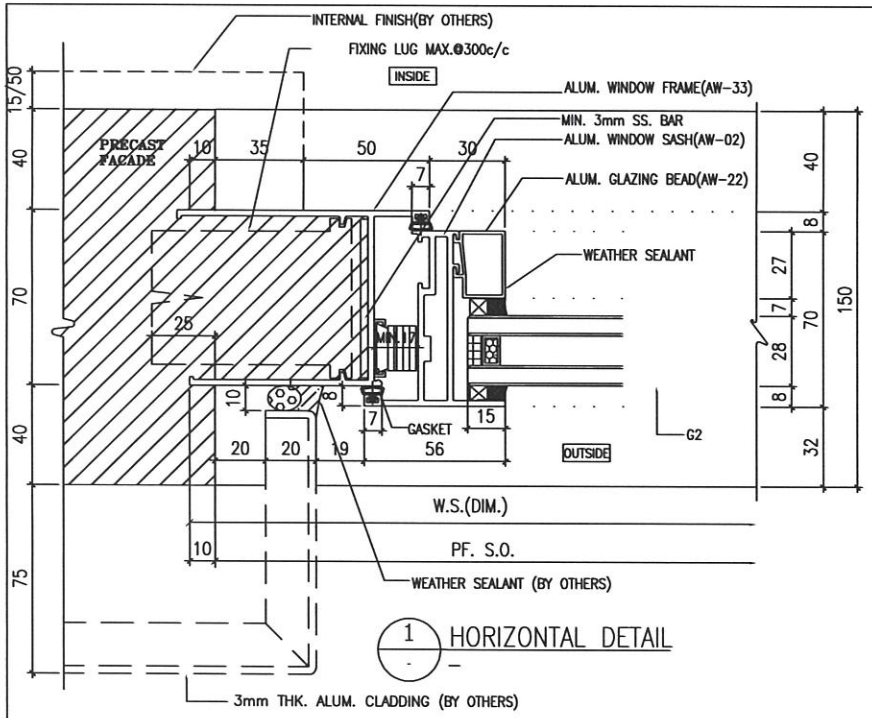


1 HORIZONTAL DETAIL

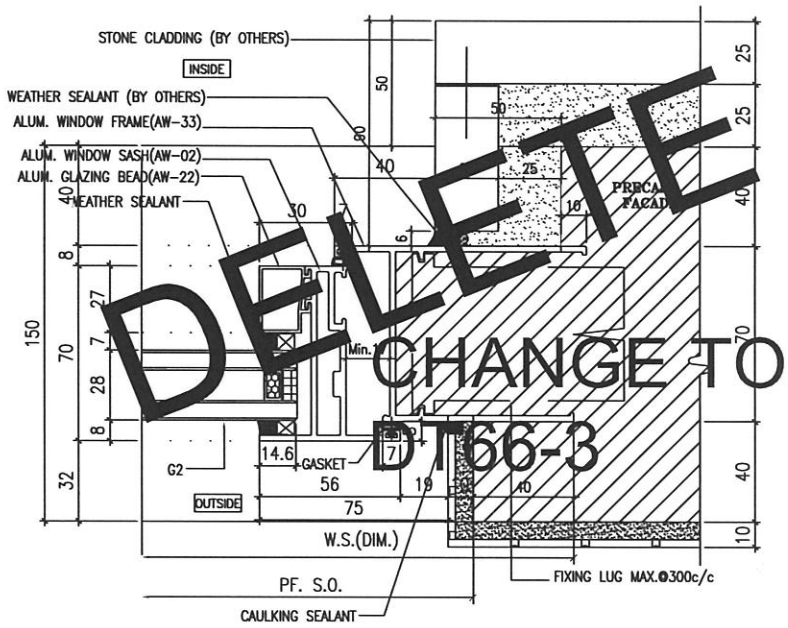

2 HORIZONTAL DETAIL

DELETE


CHANGE TO DT66-3

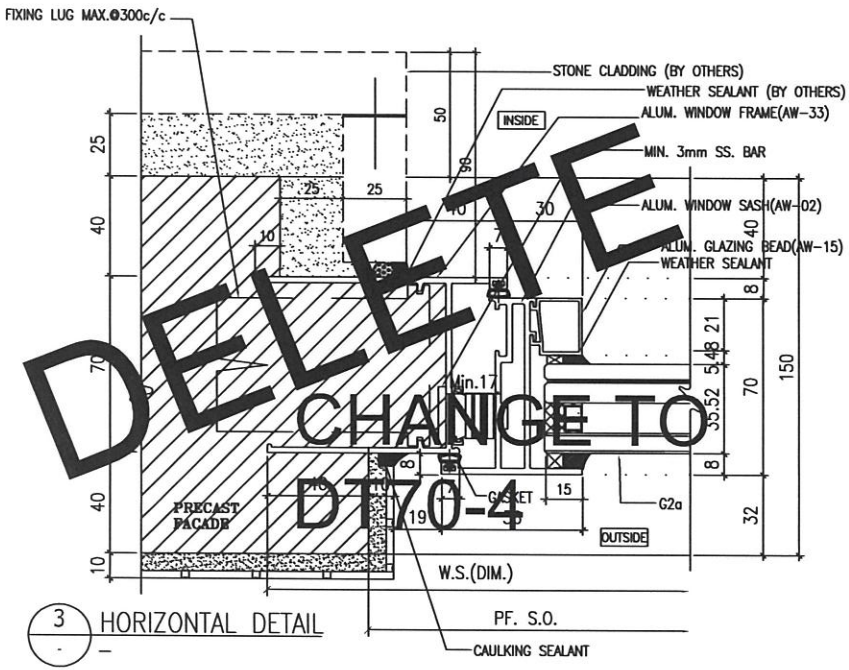

3 HORIZONTAL DETAIL

DELETE

CHANGE TO DT70-4

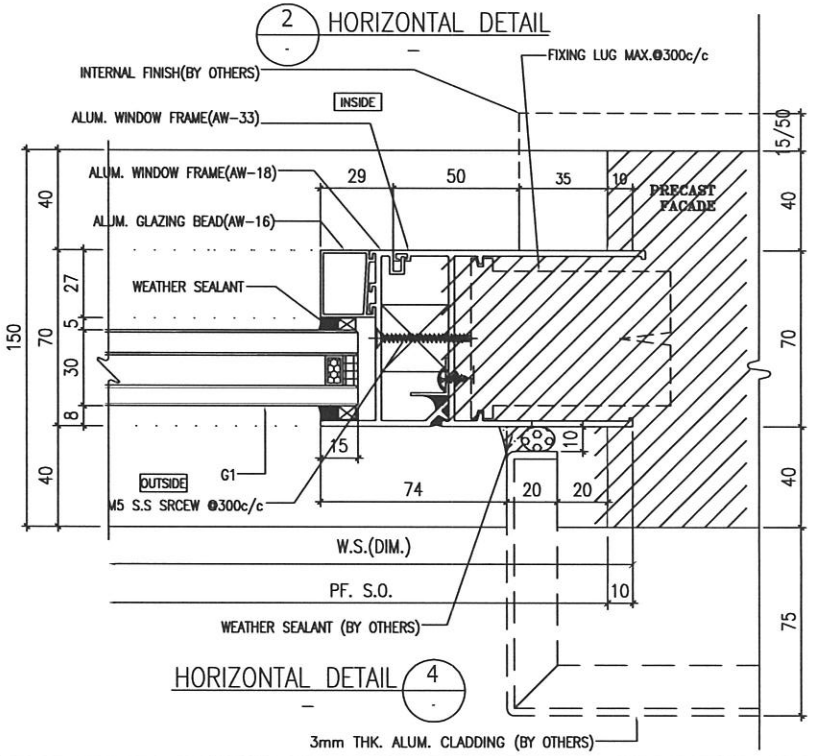

4 HORIZONTAL DETAIL

B.D. REF :

ARCHITECT :
WONG TUNG & PARTNERS LIMITED
ARCHITECTS & PLANNERS

STRUCTURAL ENGINEER :
SUN HUNG KAI
ARCHITECTS AND ENGINEERS LTD.
SUN HUNG KAI CENTRE, WANCHAI, HONGKONG
TEL: 28279111 FAX: 28272884

FACADE CONSULTANT:
ALPHA CONSULTING LIMITED
Steel Structure & Facade Specialist

MAIN CONTRACTOR :
Sanfield Engineering Construction Ltd.

CLIENT :
SUN HUNG KAI
REAL ESTATE AGENCY LTD.
42/F SUN HUNG KAI CENTRE, WANCHAI, HONGKONG

NOTE :
1. ALL DIMENSIONS ARE IN mm.
2. ALL ELEVATIONS ARE VIEWED FROM OUTSIDE.
3. ALL DIMENSIONS TO BE VERIFIED ON SITE BEFORE FABRICATION.

LEGEND :
X1 — DETAIL MARK NO.
X001 — REFER SHEET NO.
1. F.F.L. -- FINISHED FLOOR LEVEL
2. S.F.L. -- STRUCTURAL FLOOR LEVEL
3. (R) -- REVERSED DETAIL
4. GLASS LEGEND
G1-8mmHS+12mm AIR GAP+10mmTP I.G.U.
G2-8mmHS+12mm AIR GAP+8mmTP I.G.U.
G2a-8mmHS+12mm AIR GAP+8mmTP+1.52PVB +6mmTP(PLANNING) FEATURED GLASS (I.G.U.)
G8-6mm GREY HS+1.52PVB+6mm CLEAR HS

NO.	DATE	REVISED	BY
B	8/9/2022	REVISION SUBJECT TO ARCHITECT	
A	28/3/2022	REVISION SUBJECT TO ARCHITECT	

JOB NO. : J-859

PROJECT :
PROPOSED RESIDENTIAL / COMMERCIAL DEVELOPMENT AT NKIL NO.6551 KAI TAK AREA 4C, SITE 3 KAI TAK, KOWLOON


TITLE :
TYPICAL DETAILS FOR ALUM. WINDOW

DATE : 10-Nov-21 | SCALE : 1:2 (A3)


DRAWN BY : IVAN | CHECKED BY :

美特鋁質有限公司
MIDI ALUMINIUM FABRICATOR LTD.
Units 6-8, Sunray Industrial Centre, 1/F
610 Cha Kwo Ling Road, Kowloon
Tel:23489211-4 Fax:(852)27727666


DWG NO. : J859-SD-PW-DT68b | REV. : B

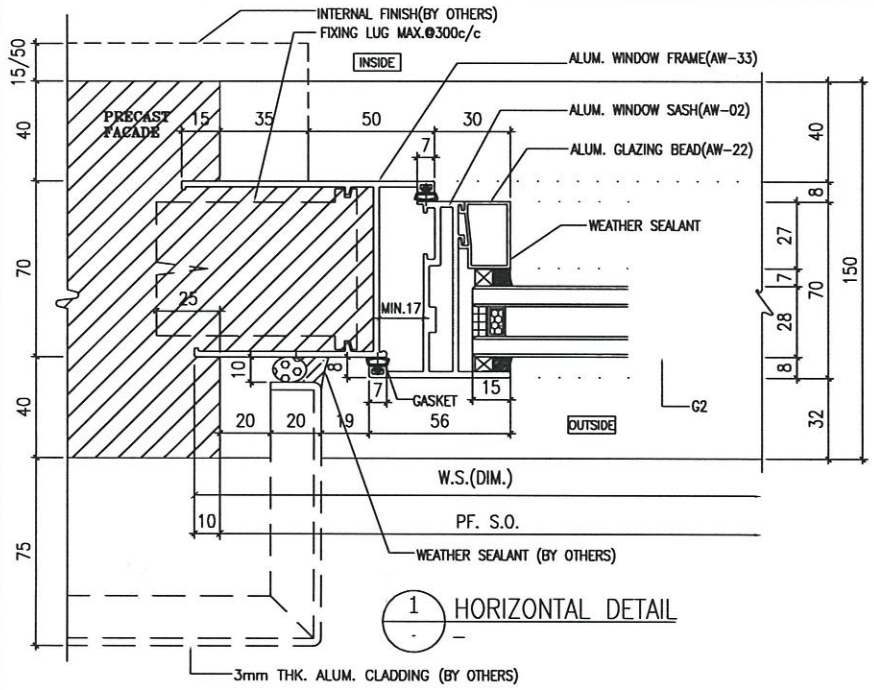


1 HORIZONTAL DETAIL

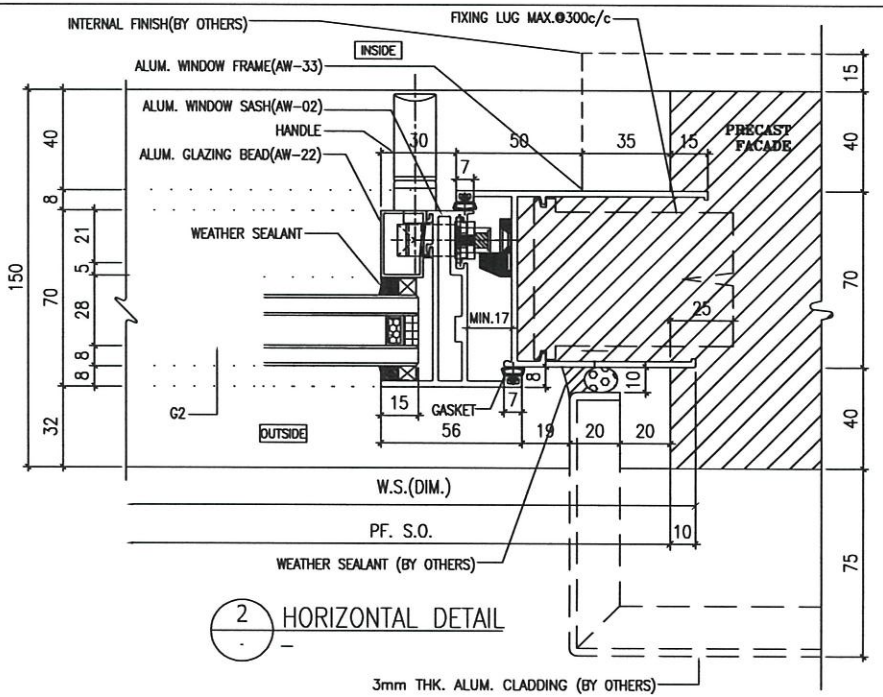

2 HORIZONTAL DETAIL

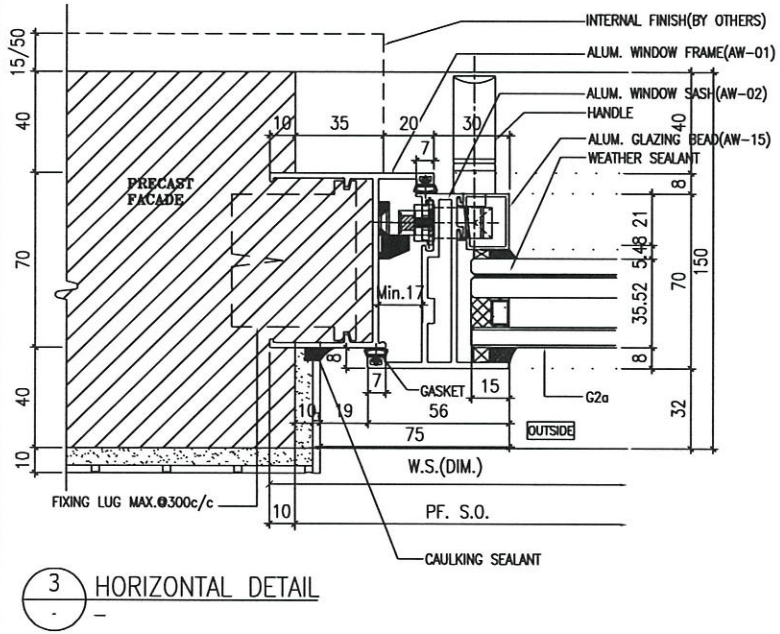

3 HORIZONTAL DETAIL

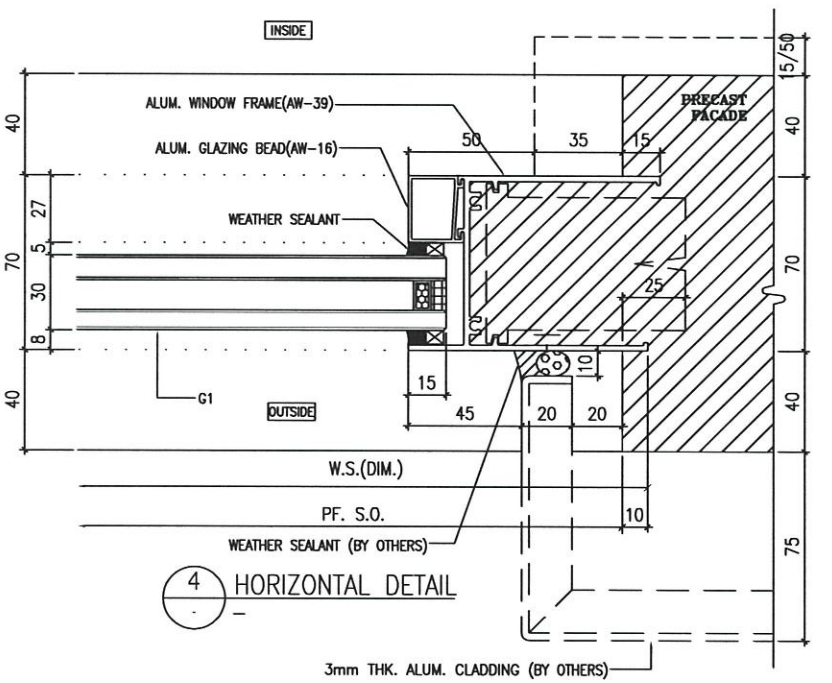

4 HORIZONTAL DETAIL

B.D. REF :

ARCHITECT :
WONG TUNG & PARTNERS LIMITED
ARCHITECTS & PLANNERS

STRUCTURAL ENGINEER :
SUN HUNG KAI
ARCHITECTS AND ENGINEERS LTD.
SUN HUNG KAI CENTRE, WANCHAI, HONGKONG
TEL. 28278111 FAX. 28272884

FACADE CONSULTANT:
ALPHA CONSULTING LIMITED
Steel Structure & Facade Specialist

MAIN CONTRACTOR :
Sanfield Engineering Construction Ltd.

CLIENT :
SUN HUNG KAI
REAL ESTATE AGENCY LTD.
42/F SUN HUNG KAI CENTRE, WANCHAI, HONGKONG

NOTE :
1. ALL DIMENSIONS ARE IN mm.
2. ALL ELEVATIONS ARE VIEWED FROM OUTSIDE.
3. ALL DIMENSIONS TO BE VERIFIED ON SITE BEFORE FABRICATION.

LEGEND :
X1 / X001 — DETAIL MARK NO. / REFER SHEET NO.
1. F.F.L. — FINISHED FLOOR LEVEL
2. S.F.L. — STRUCTURAL FLOOR LEVEL
3. /R — REVERSED DETAIL
4. GLASS LEGEND
G1–8mmHS+12mm AIR GAP+10mmTP I.G.U.
G2–8mmHS+12mm AIR GAP+8mmTP I.G.U.
G2a–8mmHS+12mm AIR GAP+8mmTP+1.52PVB +6mmTP(PLANNING) FEATURED GLASS (I.G.U.)
G8–6mm GREY HS+1.52PVB+6mm CLEAR HS

NO.	DATE	REVISED	BY
A	25/3/2022	REVISION SUBJECT TO ARCHITECT	

JOB NO. : J-859

PROJECT :
PROPOSED RESIDENTIAL / COMMERCIAL DEVELOPMENT AT NKIL NO.6551 KAI TAK AREA 4C, SITE 3 KAI TAK, KOWLOON


TITLE :
TYPICAL DETAILS FOR ALUM. WINDOW

DATE : 10-Nov-21 | SCALE : 1:2 (A3)


DRAWN BY : IVAN | CHECKED BY :

美特鋁質有限公司
MIDI ALUMINIUM FABRICATOR LTD.
Units 6-8, Sunray Industrial Centre, 1/F
610 Cha Kwo Ling Road, Kowloon
Tel:23489211-4 Fax:(852)27727666


DWG NO. : J859-SD-PW-DT69 | REV. : A

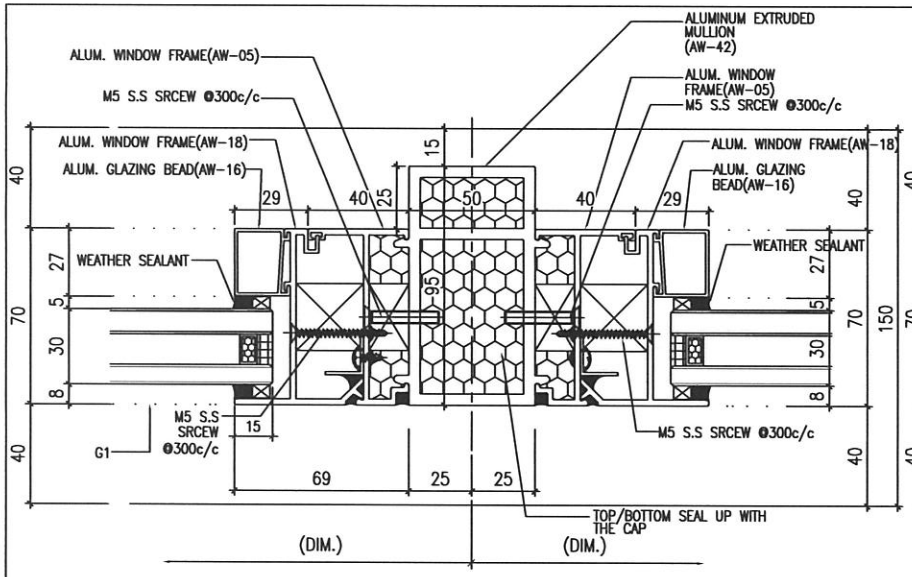


1 HORIZONTAL DETAIL

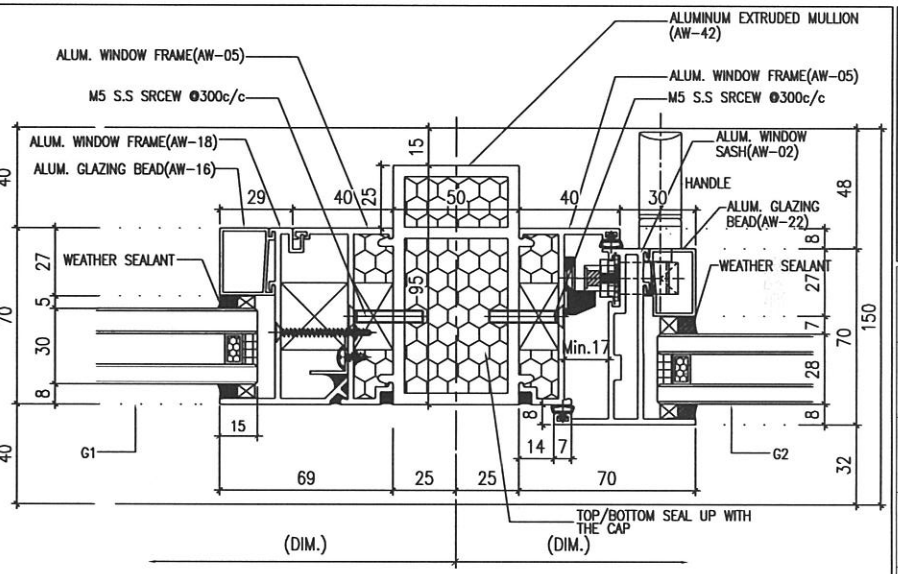

2 HORIZONTAL DETAIL

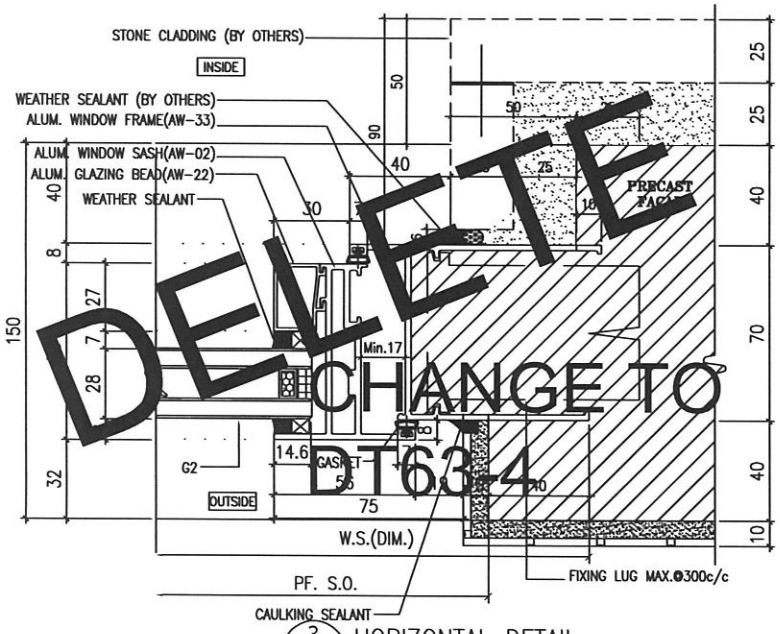

3 HORIZONTAL DETAIL

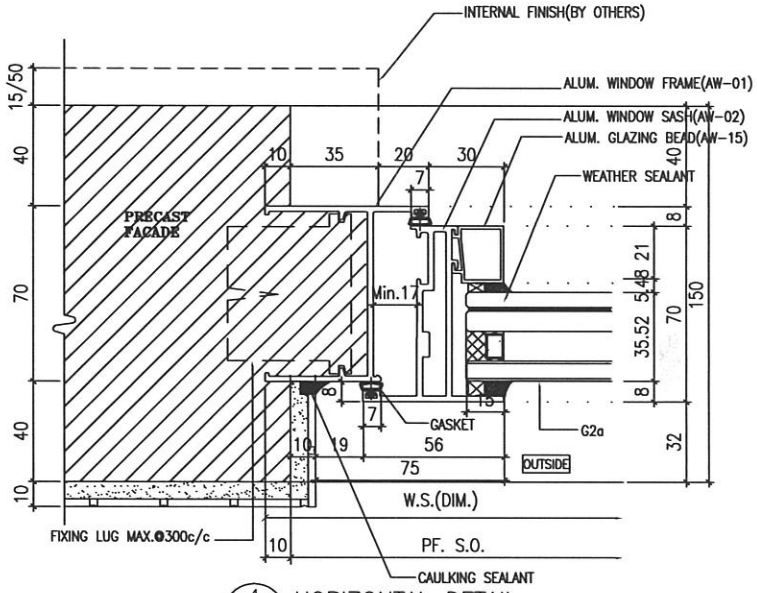

4 HORIZONTAL DETAIL

DELETE

CHANGE TO DT63-4

B.D. REF :

ARCHITECT :
WONG TUNG & PARTNERS LIMITED
ARCHITECTS & PLANNERS

STRUCTURAL ENGINEER :
SUN HUNG KAI
ARCHITECTS AND ENGINEERS LTD.
SUN HUNG KAI CENTRE, WANCHAI, HONGKONG
TEL. 28278111 FAX. 28272884

FACADE CONSULTANT:
ALPHA CONSULTING LIMITED
Steel Structure & Facade Specialist

MAIN CONTRACTOR :
Sanfield Engineering Construction Ltd.

CLIENT :
SUN HUNG KAI
REAL ESTATE AGENCY LTD.
42/F SUN HUNG KAI CENTRE, WANCHAI, HONGKONG

NOTE :
1. ALL DIMENSIONS ARE IN mm.
2. ALL ELEVATIONS ARE VIEWED FROM OUTSIDE.
3. ALL DIMENSIONS TO BE VERIFIED ON SITE BEFORE FABRICATION.

LEGEND :
X1 — DETAIL MARK NO.
X001 — REFER SHEET NO.
1. F.F.L. -- FINISHED FLOOR LEVEL
2. S.F.L. -- STRUCTURAL FLOOR LEVEL
3. (R) -- REVERSED DETAIL
4. GLASS LEGEND
G1-8mmHS+12mm AIR GAP+10mmTP I.G.U.
G2-8mmHS+12mm AIR GAP+8mmTP I.G.U.
G2a-8mmHS+12mm AIR GAP+8mmTP+1.52PVB +6mmTP(PLANNING) FEATURED GLASS (I.G.U.)
G8-6mm GREY HS+1.52PVB+6mm CLEAR HS

NO.	DATE	REVISED	BY
A	28/3/2022	REVISION SUBJECT TO ARCHITECT	

JOB NO. : J-859

PROJECT :
PROPOSED RESIDENTIAL / COMMERCIAL DEVELOPMENT AT NKIL NO.8551 KAI TAK AREA 4C, SITE 3 KAI TAK, KOWLOON


TITLE :
TYPICAL DETAILS FOR ALUM. WINDOW

DATE : 10-Nov-21 | SCALE : 1:2 (A3)


DRAWN BY : IVAN | CHECKED BY :

美特鋁質有限公司
MIDI ALUMINIUM FABRICATOR LTD.
Units 6-8, Sunray Industrial Centre, 1/F
610 Cha Kwo Ling Road, Kowloon
Tel:23489211-4 Fax:(852)27727666


DWG NO. : J859-SD-PW-DT69a | REV. : A

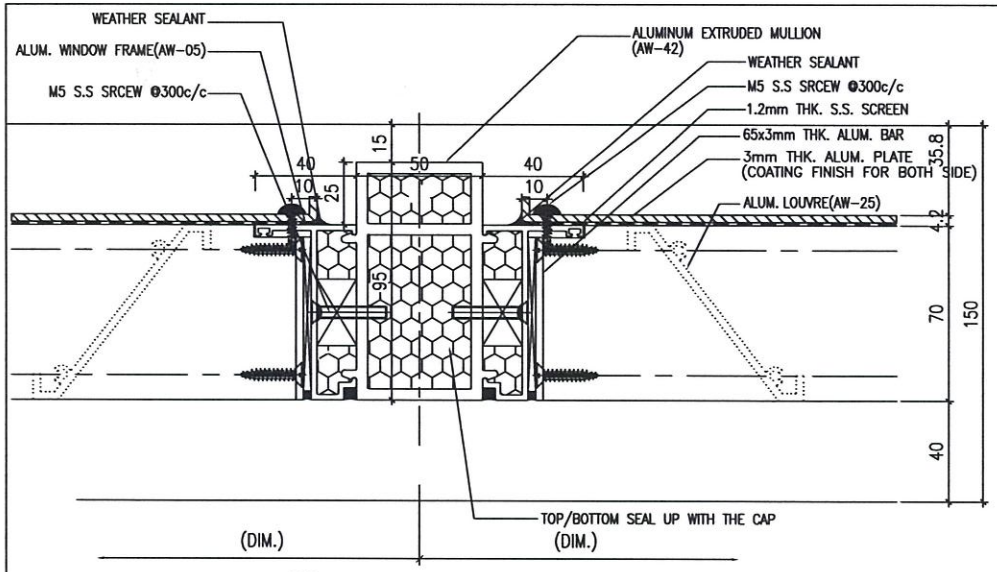


1 HORIZONTAL DETAIL

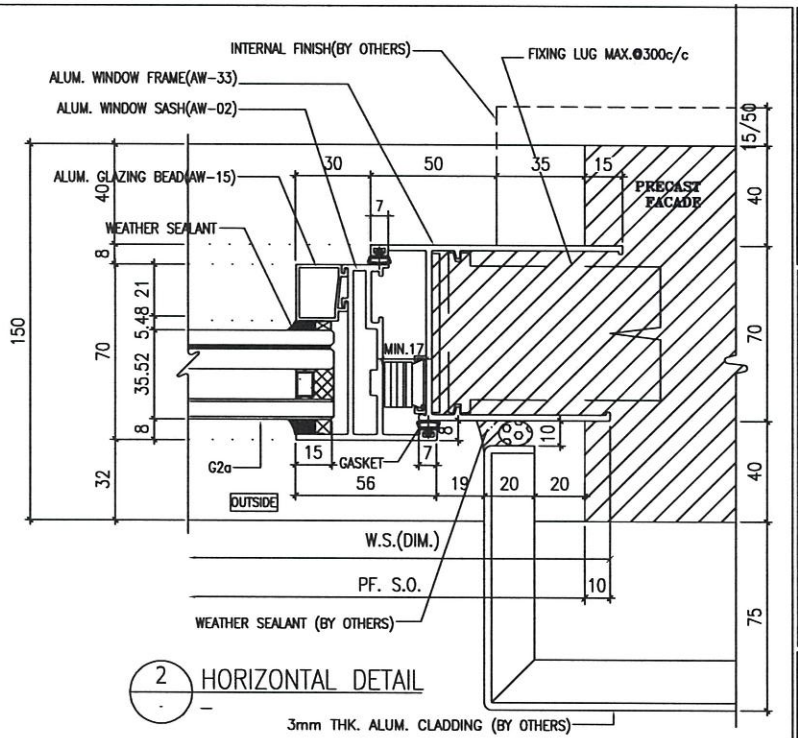

2 HORIZONTAL DETAIL

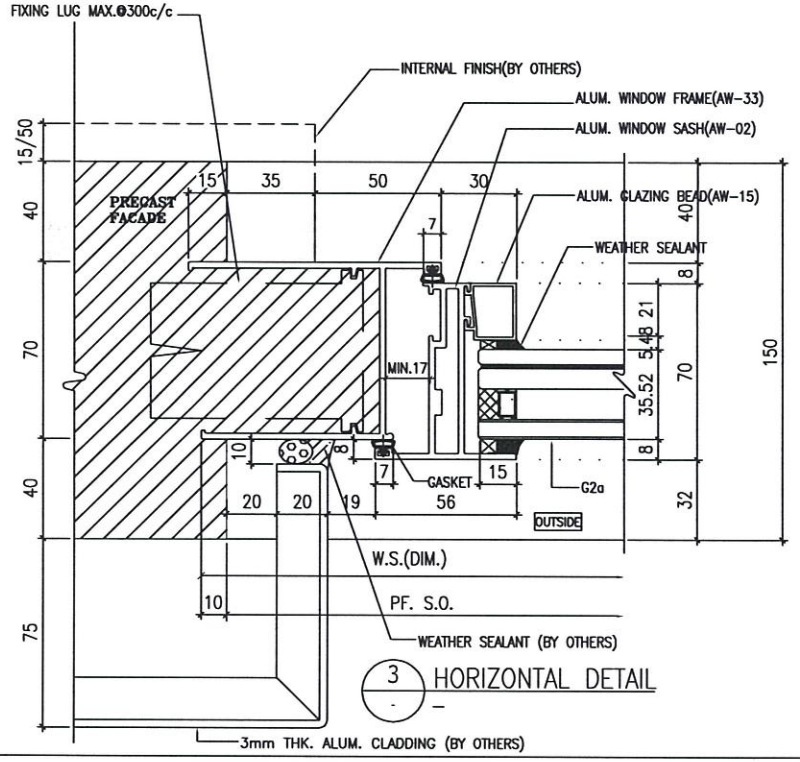

3 HORIZONTAL DETAIL

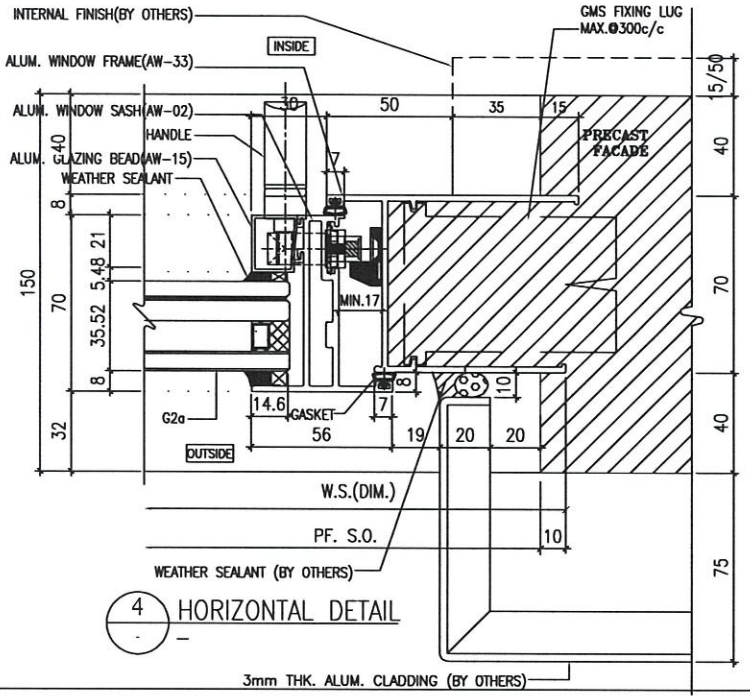

4 HORIZONTAL DETAIL

B.D. REF :

ARCHITECT :
WONG TUNG & PARTNERS LIMITED
ARCHITECTS & PLANNERS

STRUCTURAL ENGINEER :
SUN HUNG KAI
ARCHITECTS AND ENGINEERS LTD.
SUN HUNG KAI CENTRE, WANCHAI, HONGKONG
TEL. 28276111 FAX. 28272884

FACADE CONSULTANT:
ALPHA CONSULTING LIMITED
Steel Structure & Facade Specialist

MAIN CONTRACTOR :
Sanfield Engineering Construction Ltd.

CLIENT :
SUN HUNG KAI
REAL ESTATE AGENCY LTD.
40/F SUN HUNG KAI CENTRE, WANCHAI, HONGKONG

NOTE :
1. ALL DIMENSIONS ARE IN mm.
2. ALL ELEVATIONS ARE VIEWED FROM OUTSIDE.
3. ALL DIMENSIONS TO BE VERIFIED ON SITE BEFORE FABRICATION.

LEGEND :
X1 — DETAIL MARK NO.
X001 — REFER SHEET NO.
1. F.F.L. — FINISHED FLOOR LEVEL
2. S.F.L. — STRUCTURAL FLOOR LEVEL
3. (/R) — REVERSED DETAIL
4. GLASS LEGEND
G1–8mmHS+12mm AIR GAP+10mmTP I.G.U.
G2–8mmHS+12mm AIR GAP+8mmTP I.G.U.
G2a–8mmHS+12mm AIR GAP+8mmTP+1.52PVB +6mmTP(PLANNING) FEATURED GLASS (I.G.U.)
G8–6mm GREY HS+1.52PVB+6mm CLEAR HS

NO.	DATE	REVISED	BY
C	09/9/2022	REVISION SUBJECT TO ALPHA COMMENT	
B	07/9/2022	REVISION SUBJECT TO ALPHA COMMENT	
A	29/3/2022	REVISION SUBJECT TO ARCH.COMMENT	

JOB NO. : J-859

PROJECT :
PROPOSED RESIDENTIAL / COMMERCIAL DEVELOPMENT AT NIKIL NO.6551 KAI TAK AREA 4C, SITE 3 KAI TAK, KOWLOON


TITLE :
TYPICAL DETAILS FOR ALUM. WINDOW

DATE : 10-Nov-21 | SCALE : 1:2 (A3)


DRAWN BY : IVAN | CHECKED BY :

美特鋁質有限公司
MIDI ALUMINIUM FABRICATOR LTD.
Units 6-8, Sunray Industrial Centre, 1/F
810 Cha Kwo Ling Road, Kowloon
Tel:23489211-4 Fax:(852)27727666


DWG NO. : J859-SD-PW-DT69b | REV. : C

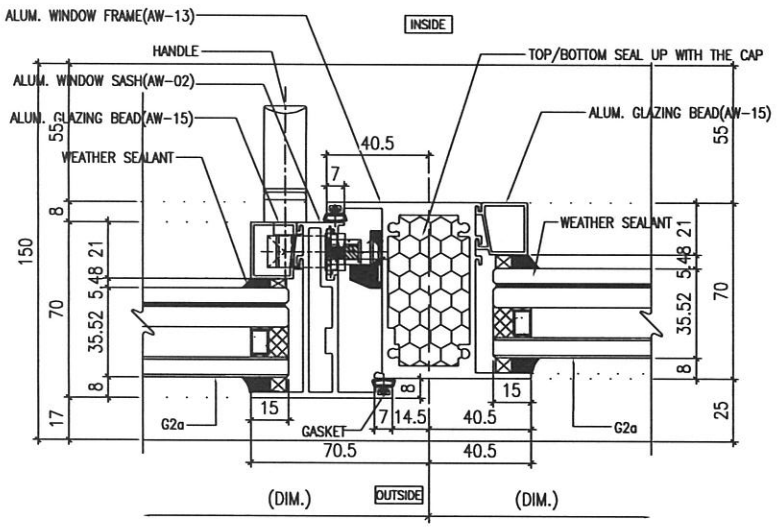


1 HORIZONTAL DETAIL

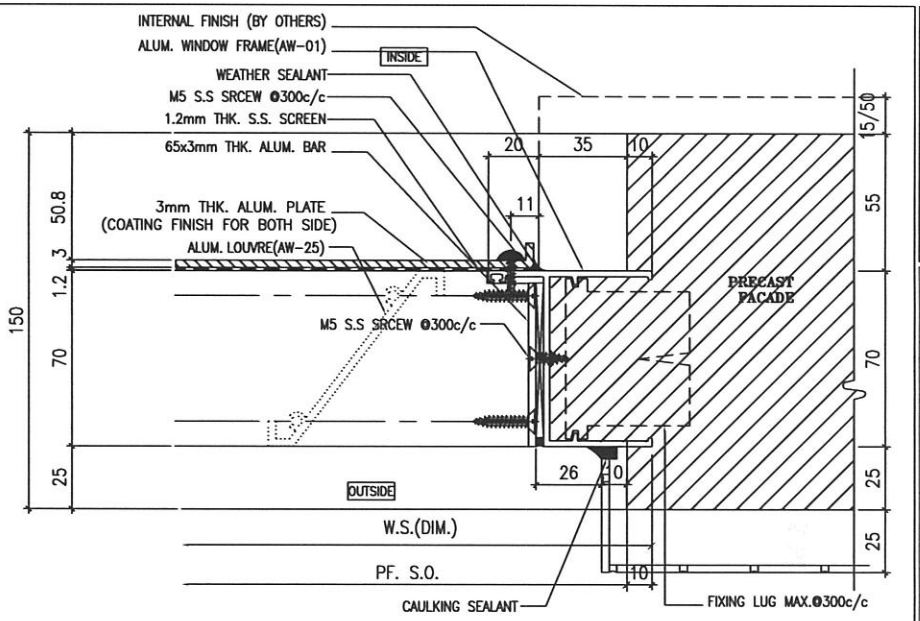

2 HORIZONTAL DETAIL

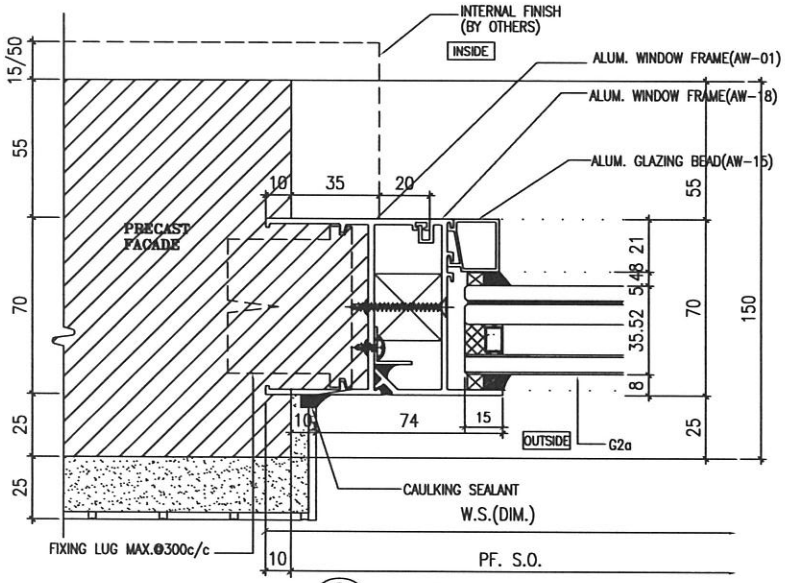

3 HORIZONTAL DETAIL

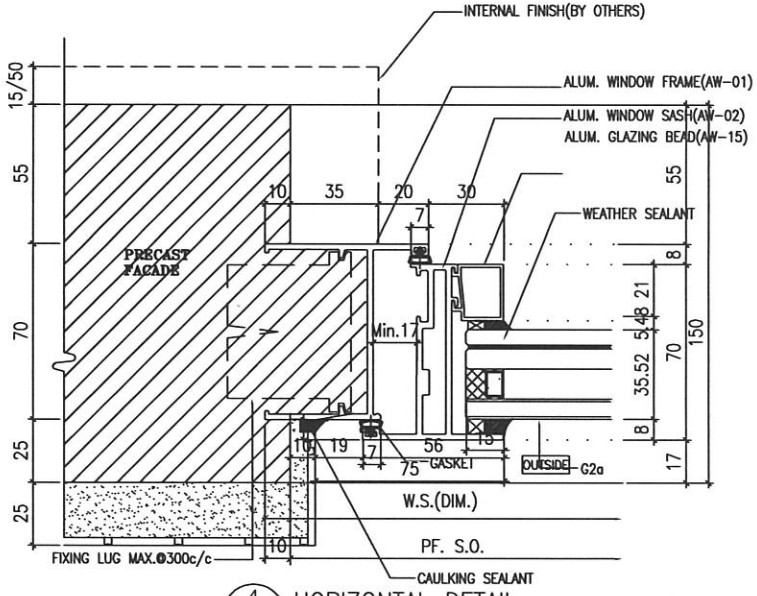

4 HORIZONTAL DETAIL

B.D. REF :

ARCHITECT :
WONG TUNG & PARTNERS LIMITED
ARCHITECTS & PLANNERS

STRUCTURAL ENGINEER :
SUN HUNG KAI
ARCHITECTS AND ENGINEERS LTD.
SUN HUNG KAI CENTRE, WANCHAI, HONGKONG
TEL. 28278111 FAX. 28272884

FACADE CONSULTANT:
ALPHA CONSULTING LIMITED
Steel Structure & Facade Specialist

MAIN CONTRACTOR :
Sanfield Engineering Construction Ltd.

CLIENT :
SUN HUNG KAI
REAL ESTATE AGENCY LTD.
42/F SUN HUNG KAI CENTRE, WANCHAI, HONGKONG

NOTE :
1. ALL DIMENSIONS ARE IN mm.
2. ALL ELEVATIONS ARE VIEWED FROM OUTSIDE.
3. ALL DIMENSIONS TO BE VERIFIED ON SITE BEFORE FABRICATION.

LEGEND :
X1 — DETAIL MARK NO.
X001 — REFER SHEET NO.
1. F.F.L. -- FINISHED FLOOR LEVEL
2. S.F.L. -- STRUCTURAL FLOOR LEVEL
3. /R -- REVERSED DETAIL
4. GLASS LEGEND
G1-8mmHS+12mm AIR GAP+10mmTP I.G.U.
G2-8mmHS+12mm AIR GAP+8mmTP I.G.U.
G2a-8mmHS+12mm AIR GAP+8mmTP+1.52PVB +6mmTP(PLANNING) FEATURED GLASS (I.G.U.)
G8-6mm GREY HS+1.52PVB+6mm CLEAR HS

NO.	DATE	REVISED	BY
B	2/8/2022	REVISION SUBJECT TO ARCHITECT	
A	28/3/2022	REVISION SUBJECT TO ARCHITECT	

JOB NO. : J-859

PROJECT :
PROPOSED RESIDENTIAL / COMMERCIAL DEVELOPMENT AT NKIL NO.6551 KAI TAK AREA 4C, SITE 3 KAI TAK, KOWLOON


TITLE :
TYPICAL DETAILS FOR ALUM. WINDOW

DATE : 10-Nov-21 | SCALE : 1:2 (A3)


DRAWN BY : IVAN | CHECKED BY :

美特鋁質有限公司
MIDI ALUMINIUM FABRICATOR LTD.
Units 6-8, Sunray Industrial Centre, 1/F
610 Cha Kwo Ling Road, Kowloon
Tel:23489211-4 Fax:(852)27727666


DWG NO. : J859-SD-PW-DT70 | REV. : B

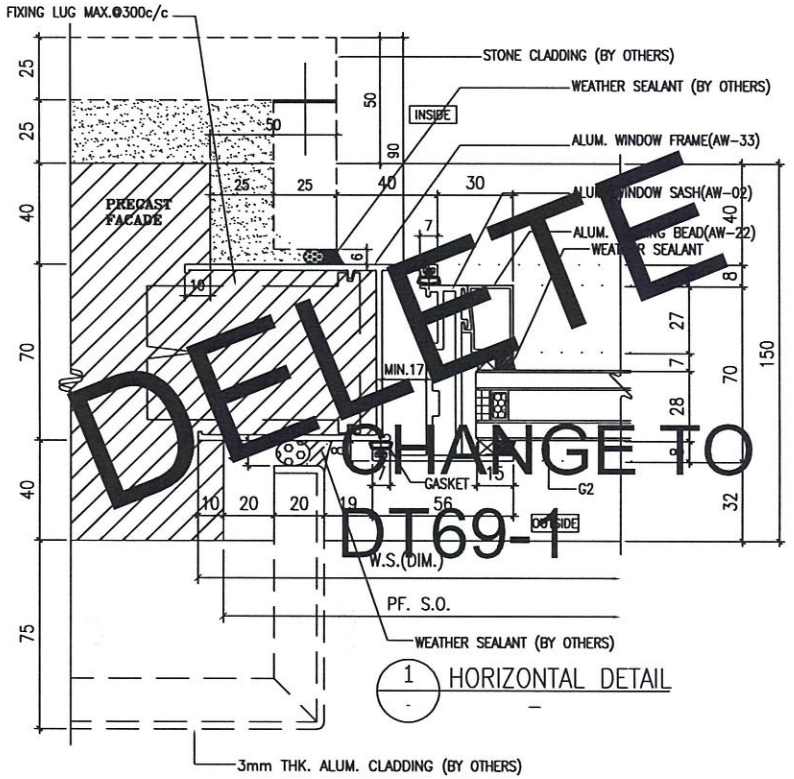


1 HORIZONTAL DETAIL

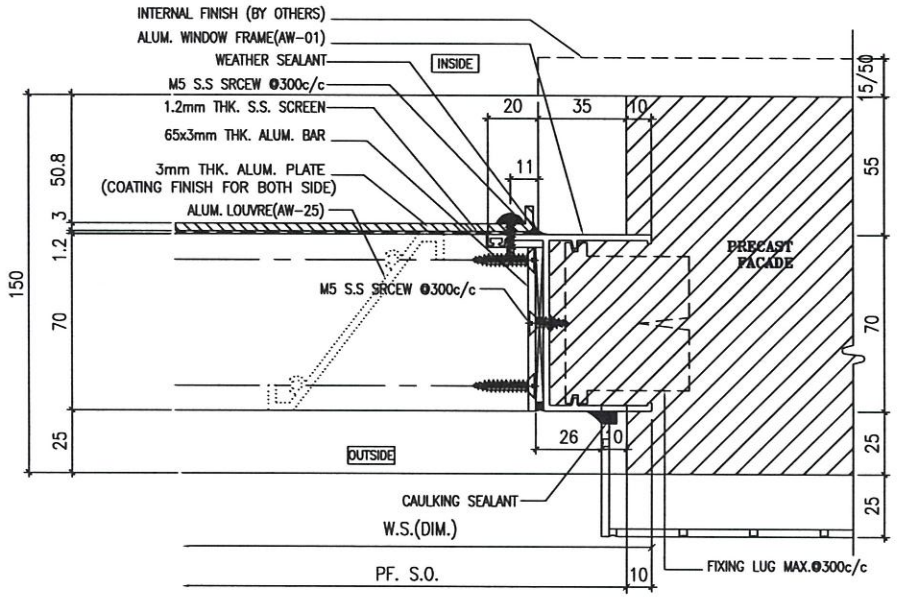

2 HORIZONTAL DETAIL

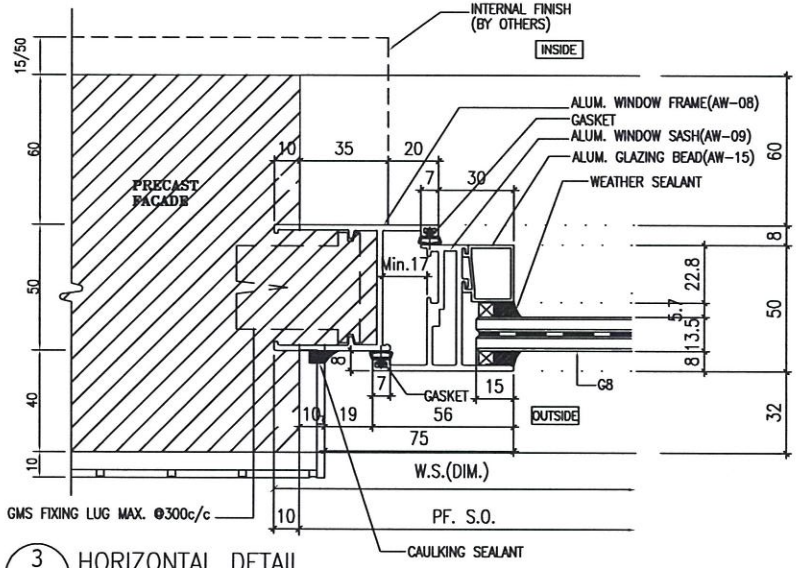

3 HORIZONTAL DETAIL

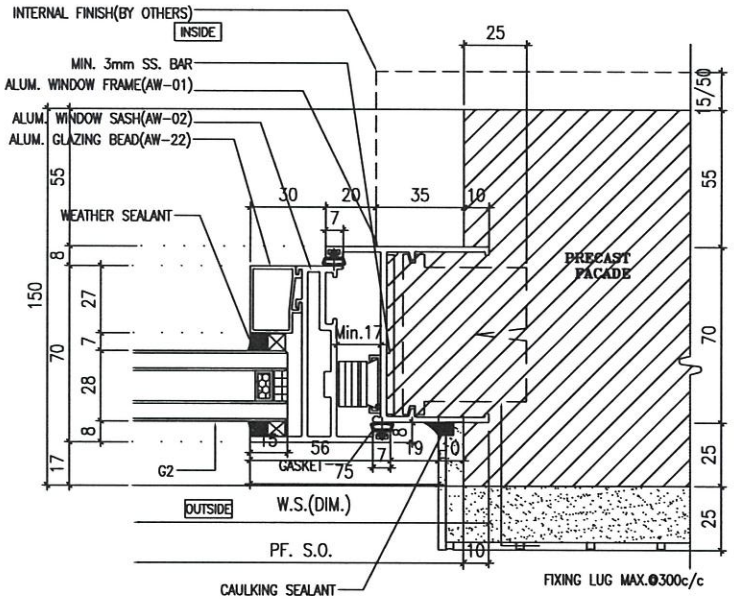

4 HORIZONTAL DETAIL

B.D. REF :

ARCHITECT :
WONG TUNG & PARTNERS LIMITED
ARCHITECTS & PLANNERS

STRUCTURAL ENGINEER :
SUN HUNG KAI
ARCHITECTS AND ENGINEERS LTD.
SUN HUNG KAI CENTRE, WANCHAI, HONGKONG
TEL. 28276111 FAX. 28272804

FACADE CONSULTANT:
ALPHA CONSULTING LIMITED
Steel Structure & Facade Specialist

MAIN CONTRACTOR :
Sanfield Engineering Construction Ltd.

CLIENT :
SUN HUNG KAI
REAL ESTATE AGENCY LTD.
42/F SUN HUNG KAI CENTRE, WANCHAI, HONGKONG

NOTE :
1. ALL DIMENSIONS ARE IN mm.
2. ALL ELEVATIONS ARE VIEWED FROM OUTSIDE.
3. ALL DIMENSIONS TO BE VERIFIED ON SITE BEFORE FABRICATION.

LEGEND :
X1 — DETAIL MARK NO.
X001 — REFER SHEET NO.
1. F.F.L. — FINISHED FLOOR LEVEL
2. S.F.L. — STRUCTURAL FLOOR LEVEL
3. (R) — REVERSED DETAIL
4. GLASS LEGEND
G1-8mmHS+12mm AIR GAP+10mmTP I.G.U.
G2-8mmHS+12mm AIR GAP+8mmTP I.G.U.
G2a-8mmHS+12mm AIR GAP+8mmTP+1.52PVB +6mmTP(PLANNING) FEATURED GLASS (I.G.U.)
G8-6mm GREY HS+1.52PVB+6mm CLEAR HS

NO.	DATE	REVISED	BY
D	13/10/2022	REVISION SUBJECT TO ALPHA COMMENT	W
C	6/9/2022	REVISION SUBJECT TO ARCH.COMMENT	WWW
B	6/8/2022	REVISION SUBJECT TO ARCH.COMMENT	WWW
A	28/3/2022	REVISION SUBJECT TO ARCH.COMMENT	WWW

JOB NO. : J-859

PROJECT :
PROPOSED RESIDENTIAL / COMMERCIAL DEVELOPMENT AT NKIL NO.6551 KAI TAK AREA 4C, SITE 3 KAI TAK, KOWLOON


TITLE :
TYPICAL DETAILS FOR ALUM. WINDOW

DATE : 10-Nov-21 | SCALE : 1:2 (A3)


DRAWN BY : IVAN | CHECKED BY :

美特鋁實有限公司
MIDI ALUMINIUM FABRICATOR LTD.
Units 6-8, Sunray Industrial Centre, 1/F
610 Cha Kwo Ling Road, Kowloon
Tel:23489211-4 Fax:(852)27727666


DWG NO. : J859-SD-PW-DT70a | REV. : D

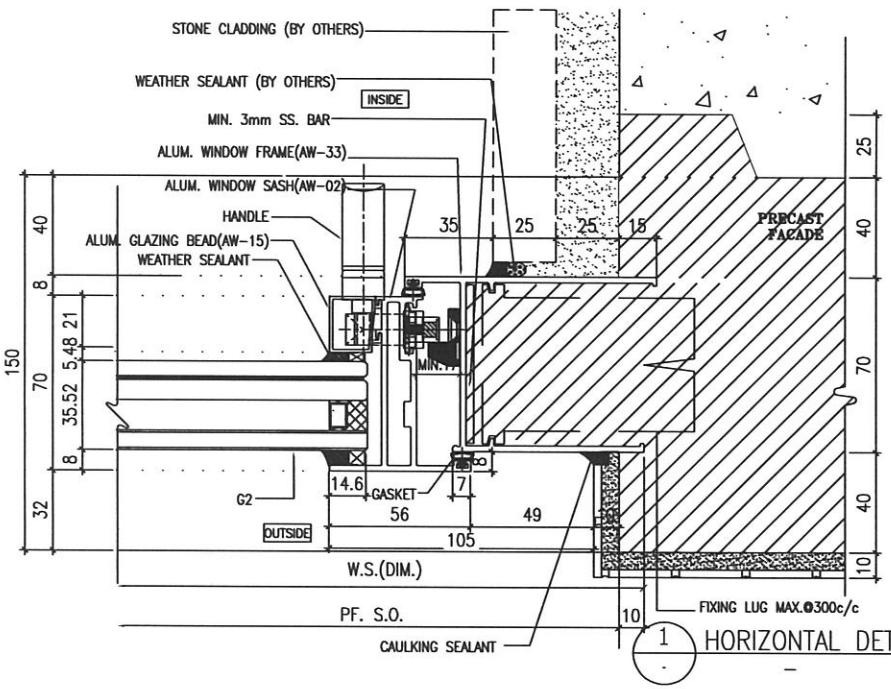


1 HORIZONTAL DETAIL

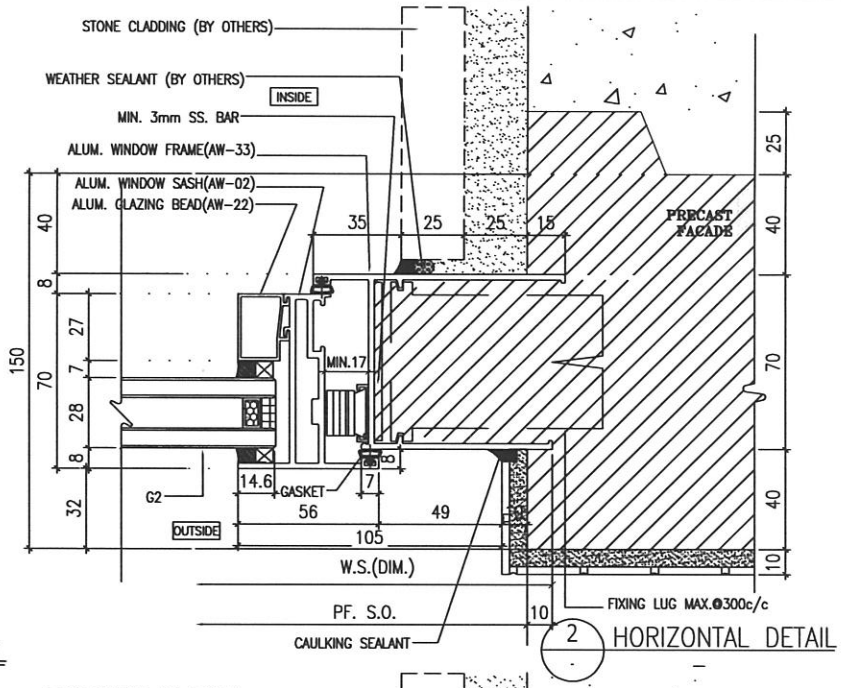

2 HORIZONTAL DETAIL

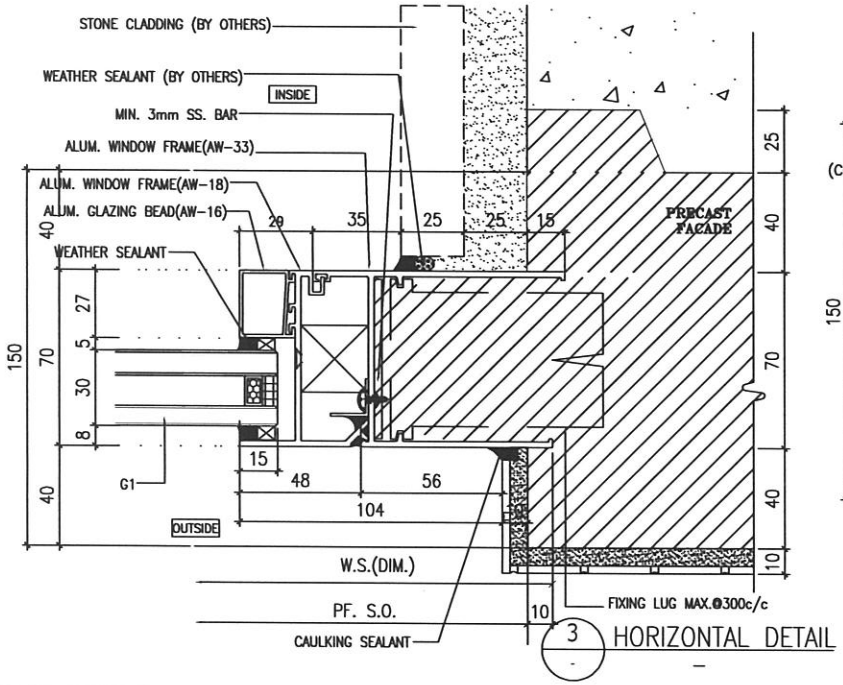

3 HORIZONTAL DETAIL

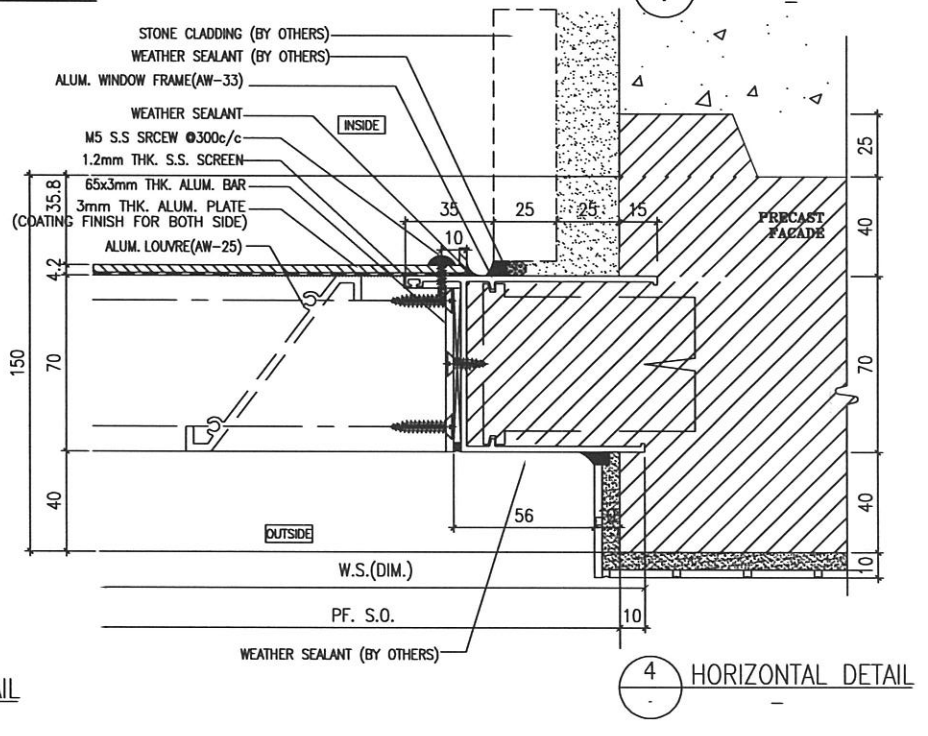

4 HORIZONTAL DETAIL

B.D. REF :

ARCHITECT :
WONG TUNG & PARTNERS LIMITED
ARCHITECTS & PLANNERS

STRUCTURAL ENGINEER :
SUN HUNG KAI
ARCHITECTS AND ENGINEERS LTD.
SUN HUNG KAI CENTRE, WANCHAI, HONGKONG
TEL. 28278111 FAX. 28272884

FACADE CONSULTANT:
ALPHA CONSULTING LIMITED
Steel Structure & Facade Specialist

MAIN CONTRACTOR :
Sanfield Engineering Construction Ltd.

CLIENT :
SUN HUNG KAI
REAL ESTATE AGENCY LTD.
42/F SUN HUNG KAI CENTRE, WANCHAI, HONGKONG

NOTE :
1. ALL DIMENSIONS ARE IN mm.
2. ALL ELEVATIONS ARE VIEWED FROM OUTSIDE.
3. ALL DIMENSIONS TO BE VERIFIED ON SITE BEFORE FABRICATION.

LEGEND :
X1 — DETAIL MARK NO.
X001 — REFER SHEET NO.
1. F.F.L. --FINISHED FLOOR LEVEL
2. S.F.L. --STRUCTURAL FLOOR LEVEL
3. (FR) --REVERSED DETAIL
4. GLASS LEGEND
G1-8mmHS+12mm AIR GAP+10mmTP I.G.U.
G2-8mmHS+12mm AIR GAP+8mmTP I.G.U.
G2a-8mmHS+12mm AIR GAP+8mmTP+1.52PVB +6mmTP(PLANNING) FEATURED GLASS (I.G.U.)
G8-6mm GREY HS+1.52PVB+6mm CLEAR HS

NO.	DATE	REVISED	BY
D	8/9/2022	REVISION SUBJECT TO ALPHA COMMENT	
C	28/8/2022	REVISION SUBJECT TO ALPHA COMMENT	
B	07/5/2022	REVISION SUBJECT TO ARCHITECT	
A	28/3/2022	REVISION SUBJECT TO ARCHITECT	

JOB NO. : J-859

PROJECT :
PROPOSED RESIDENTIAL / COMMERCIAL DEVELOPMENT AT NKIL NO.6551 KAI TAK AREA 4C, SITE 3 KAI TAK, KOWLOON


TITLE :
TYPICAL DETAILS FOR ALUM. WINDOW

DATE : 10-Nov-21 | SCALE : 1:2 (A3)


DRAWN BY : IVAN | CHECKED BY :

美特鋁質有限公司
MIDI ALUMINIUM FABRICATOR LTD.
Units 6-8, Sunray Industrial Centre, 1/F
610 Cha Kwo Ling Road, Kowloon
Tel:23489211-4 Fax:(852)27727666


DWG NO. : J859-SD-PW-DT70b | REV. : D

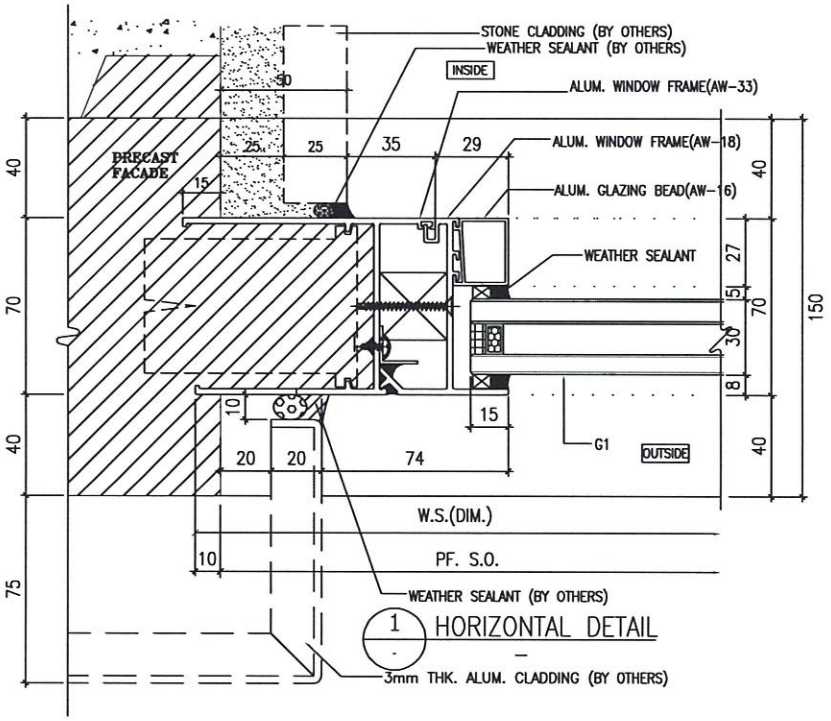


1 HORIZONTAL DETAIL

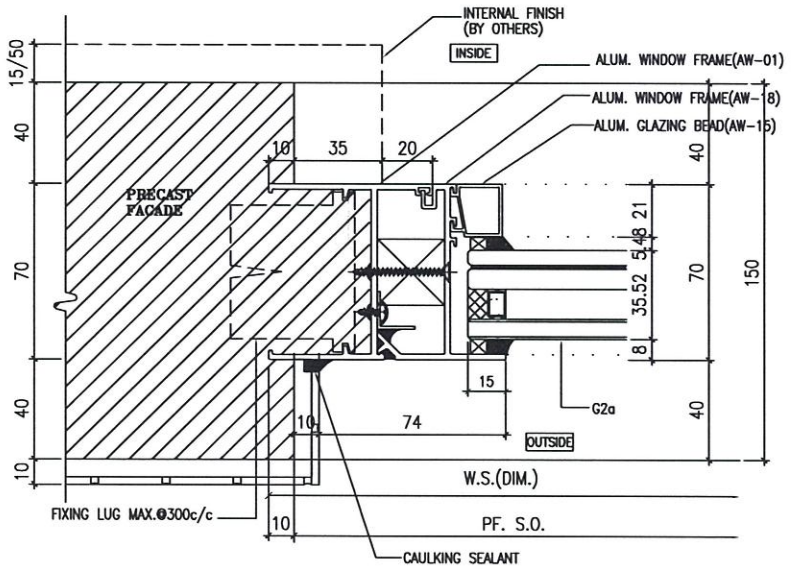

3 HORIZONTAL DETAIL

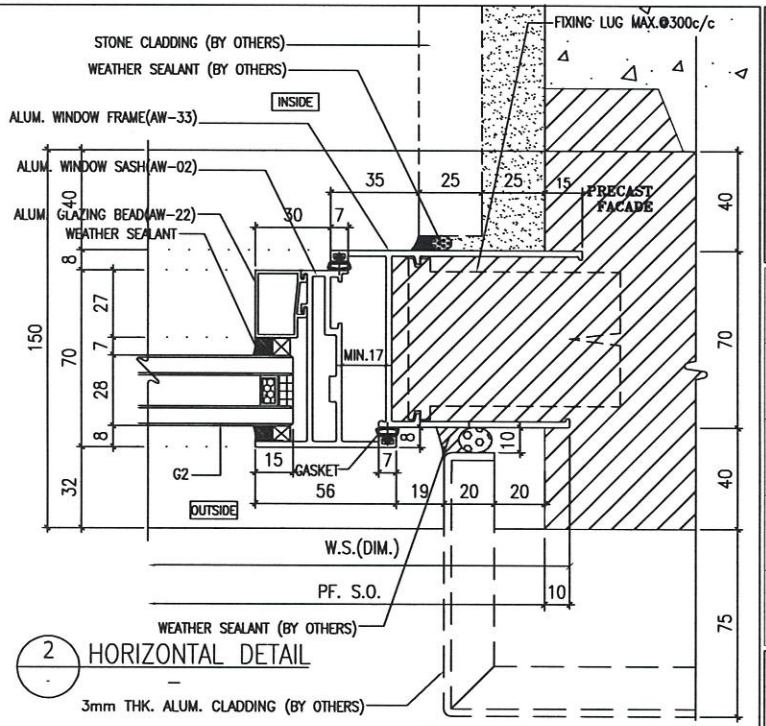

2 HORIZONTAL DETAIL

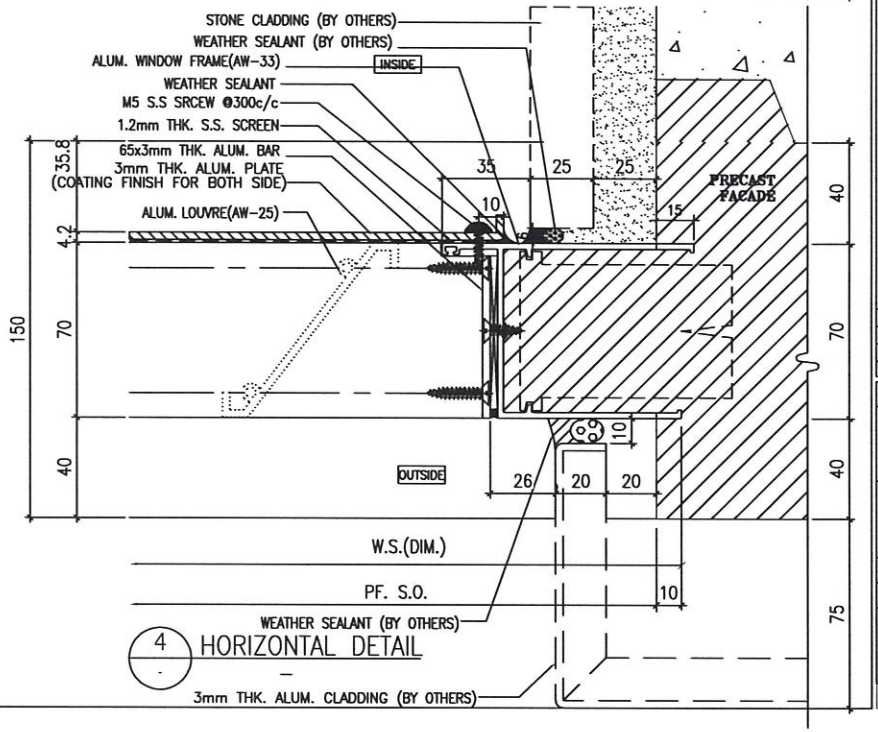

4 HORIZONTAL DETAIL

B.D. REF :

ARCHITECT :
WONG TUNG & PARTNERS LIMITED
ARCHITECTS & PLANNERS

STRUCTURAL ENGINEER :
SUN HUNG KAI
ARCHITECTS AND ENGINEERS LTD.
SUN HUNG KAI CENTRE, WANCHAI, HONGKONG
TEL. 2827 8811 FAX. 2827 2804

FACADE CONSULTANT:
ALPHA CONSULTING LIMITED
Steel Structure & Facade Specialist

MAIN CONTRACTOR :
Sanfield Engineering Construction Ltd.

CLIENT :
SUN HUNG KAI
REAL ESTATE AGENCY LTD.
42/F SUN HUNG KAI CENTRE, WANCHAI, HONGKONG

NOTE :
1. ALL DIMENSIONS ARE IN mm.
2. ALL ELEVATIONS ARE VIEWED FROM OUTSIDE.
3. ALL DIMENSIONS TO BE VERIFIED ON SITE BEFORE FABRICATION.

LEGEND :
X1 / X001 — DETAIL MARK NO. / REFER SHEET NO.
1. F.F.L. -- FINISHED FLOOR LEVEL
2. S.F.L. -- STRUCTURAL FLOOR LEVEL
3. /R -- REVERSED DETAIL
4. GLASS LEGEND
G1-8mmHS+12mm AIR GAP+10mmTP I.G.U.
G2-8mmHS+12mm AIR GAP+8mmTP I.G.U.
G2a-8mmHS+12mm AIR GAP+8mmTP+1.52PVB +6mmTP(PLANNING) FEATURED GLASS (I.G.U.)
G8-6mm GREY HS+1.52PVB+6mm CLEAR HS

NO.	DATE	REVISED	BY
C	28/10/2022	REVISION SUBJECT TO ALPHA COMMENT	
B	07/10/2022	REVISION SUBJECT TO ALPHA COMMENT	
A	28/09/2022	REVISION SUBJECT TO ARCHITECT	

JOB NO. : J-859

PROJECT :
PROPOSED RESIDENTIAL / COMMERCIAL DEVELOPMENT AT NKIL NO.6551 KAI TAK AREA 4C, SITE 3 KAI TAK, KOWLOON


TITLE :
TYPICAL DETAILS FOR ALUM. WINDOW

DATE : 10-Nov-21 | SCALE : 1:2 (A3)


DRAWN BY : IVAN | CHECKED BY :

美特鋁製有限公司
MIDI ALUMINIUM FABRICATOR LTD.
Units 6-8, Sunray Industrial Centre, 1/F
610 Cha Kwo Ling Road, Kowloon
Tel:23489211-4 Fax:(852)27727666

DWG NO. : J859-SD-PW-DT70c | REV. : C

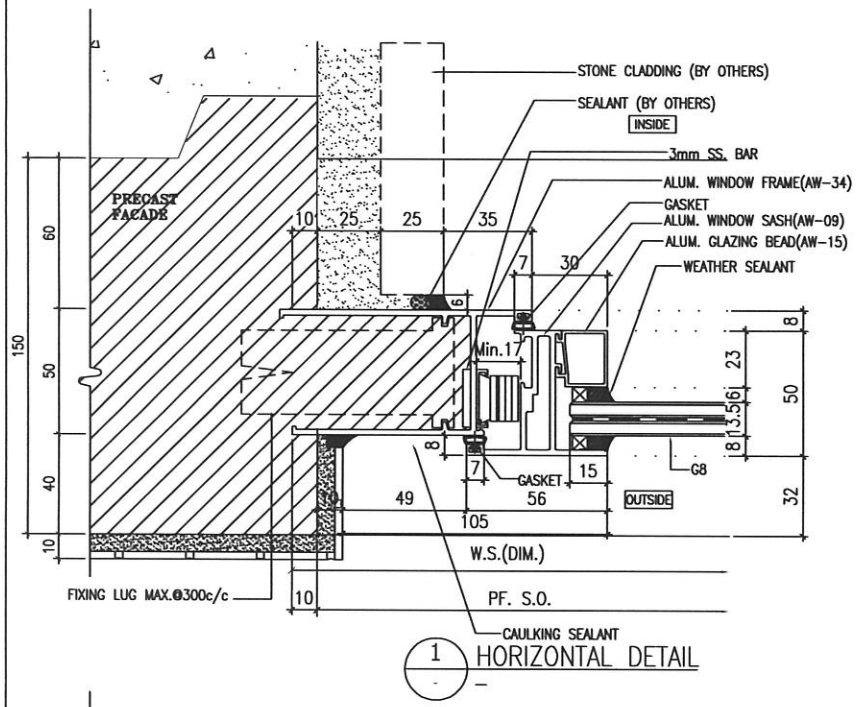


1 HORIZONTAL DETAIL

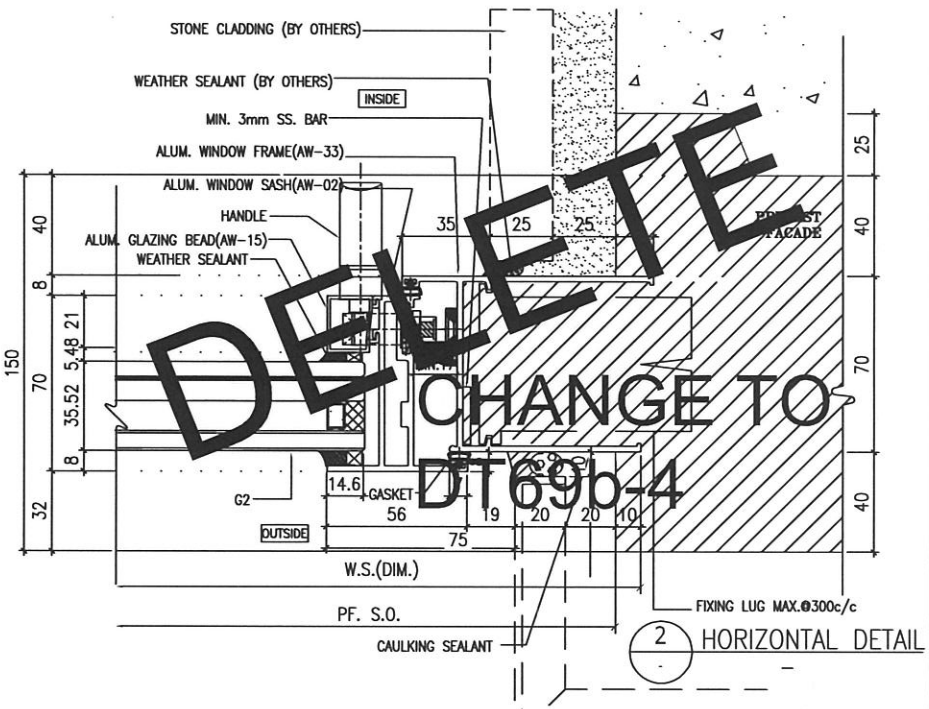


2 HORIZONTAL DETAIL

DELETE

CHANGE TO DT69b-4

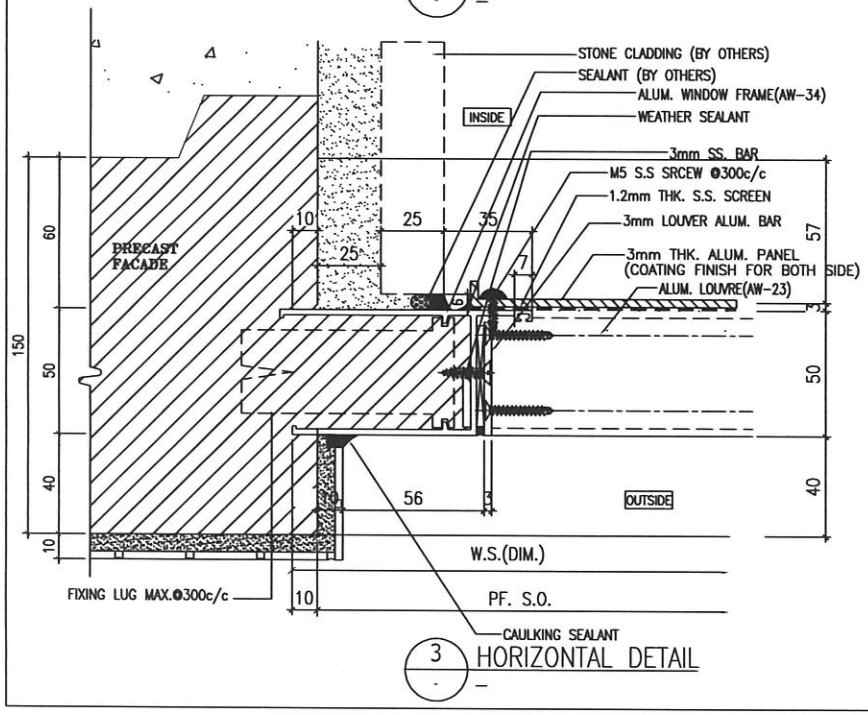

3 HORIZONTAL DETAIL

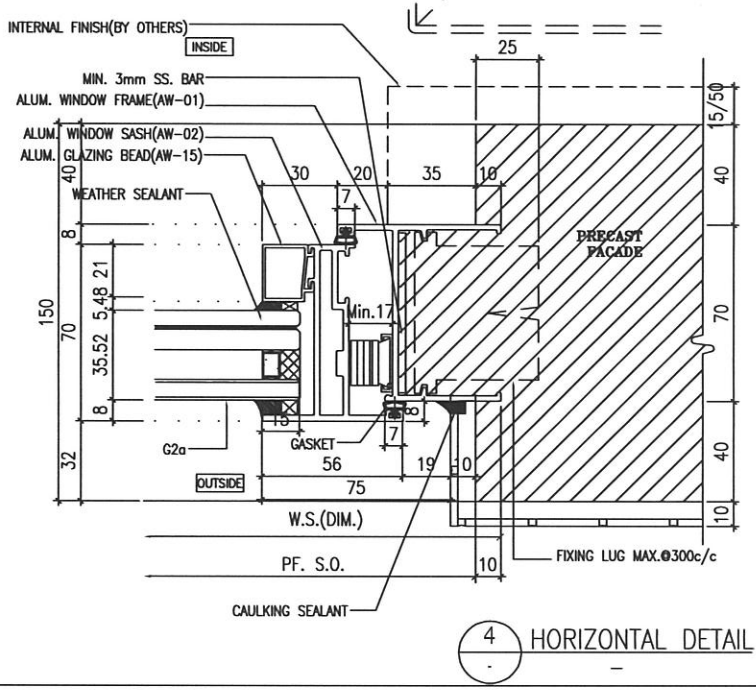

4 HORIZONTAL DETAIL

B.D. REF :

ARCHITECT :
WONG TUNG & PARTNERS LIMITED
ARCHITECTS & PLANNERS

STRUCTURAL ENGINEER :
SUN HUNG KAI
ARCHITECTS AND ENGINEERS LTD.
SUN HUNG KAI CENTRE, WANCHAI, HONGKONG
TEL. 28277011 FAX. 28272884

FACADE CONSULTANT:
ALPHA CONSULTING LIMITED
Steel Structure & Facade Specialist

MAIN CONTRACTOR :
Sanfield Engineering Construction Ltd.

CLIENT :
SUN HUNG KAI
REAL ESTATE AGENCY LTD.
42/F SUN HUNG KAI CENTRE, WANCHAI, HONGKONG

NOTE :
1. ALL DIMENSIONS ARE IN mm.
2. ALL ELEVATIONS ARE VIEWED FROM OUTSIDE.
3. ALL DIMENSIONS TO BE VERIFIED ON SITE BEFORE FABRICATION.

LEGEND :
- DETAIL MARK NO.
- REFER SHEET NO.

1. F.F.L. --FINISHED FLOOR LEVEL
2. S.F.L. --STRUCTURAL FLOOR LEVEL
3. /R --REVERSED DETAIL
4. GLASS LEGEND

G1-8mmHS+12mm AIR GAP+10mmTP I.G.U.
G2-8mmHS+12mm AIR GAP+8mmTP I.G.U.
G2a-8mmHS+12mm AIR GAP+8mmTP+1.52PVB +6mmTP(PLANNING) FEATURED GLASS (I.G.U.)
G8-6mm GREY HS+1.52PVB+6mm CLEAR HS

NO.	DATE	REVISED	BY
D	08/09/2022	REVISION SUBJECT TO ALPHA COMMENT	
C	29/08/2022	REVISION SUBJECT TO ALPHA COMMENT	
B	07/05/2022	REVISION SUBJECT TO ARCHCOMMENT	
A	28/03/2022	REVISION SUBJECT TO ARCHCOMMENT	

JOB NO. : J-859

PROJECT :
PROPOSED RESIDENTIAL / COMMERCIAL DEVELOPMENT AT NKIL NO.6551 KAI TAK AREA 4C, SITE 3 KAI TAK, KOWLOON


TITLE :
TYPICAL DETAILS FOR ALUM. WINDOW

DATE : 10-Nov-21 | SCALE : 1:2 (A3)


DRAWN BY : IVAN | CHECKED BY :

美特鋁質有限公司
MIDI ALUMINIUM FABRICATOR LTD.
Units 6-8, Sunray Industrial Centre, 1/F
610 Cha Kwo Ling Road, Kowloon
Tel:23489211-4 Fax:(852)27727666


DWG NO. : J859-SD-PW-DT70d | REV. : D

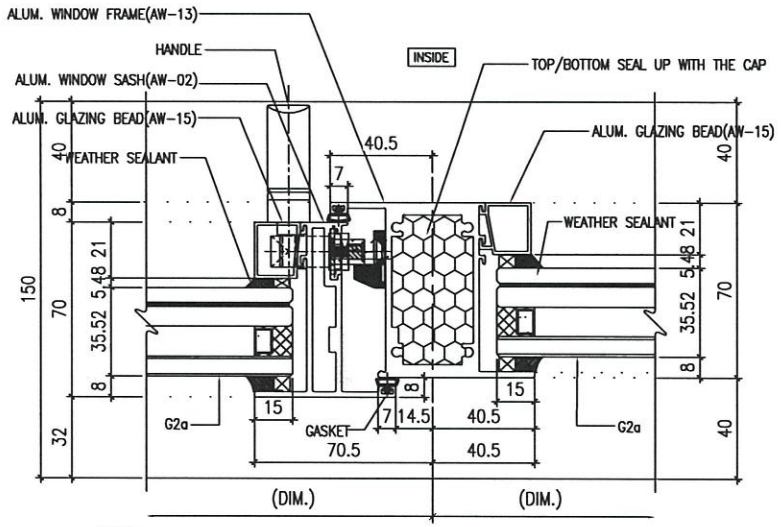


1 HORIZONTAL DETAIL

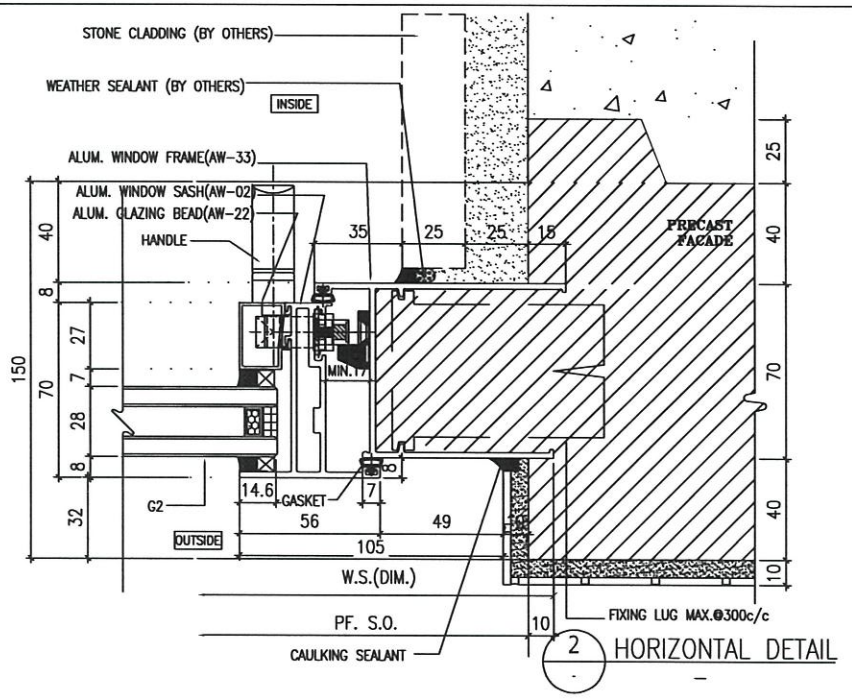

2 HORIZONTAL DETAIL

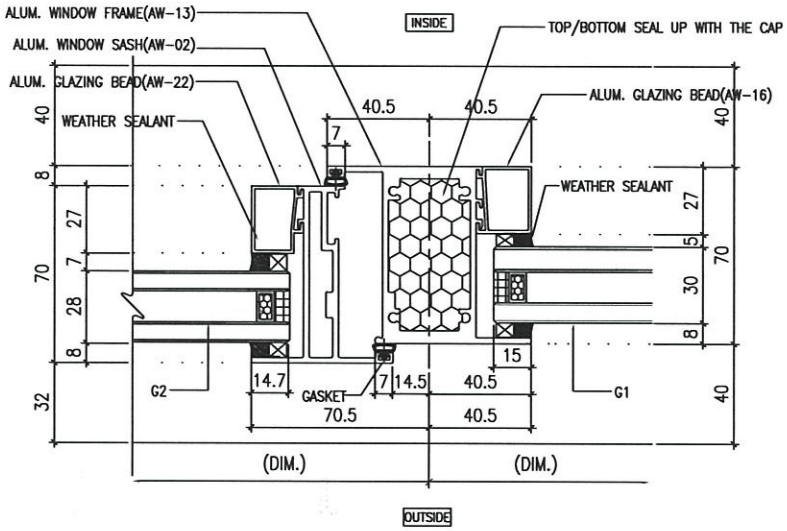

3 HORIZONTAL DETAIL

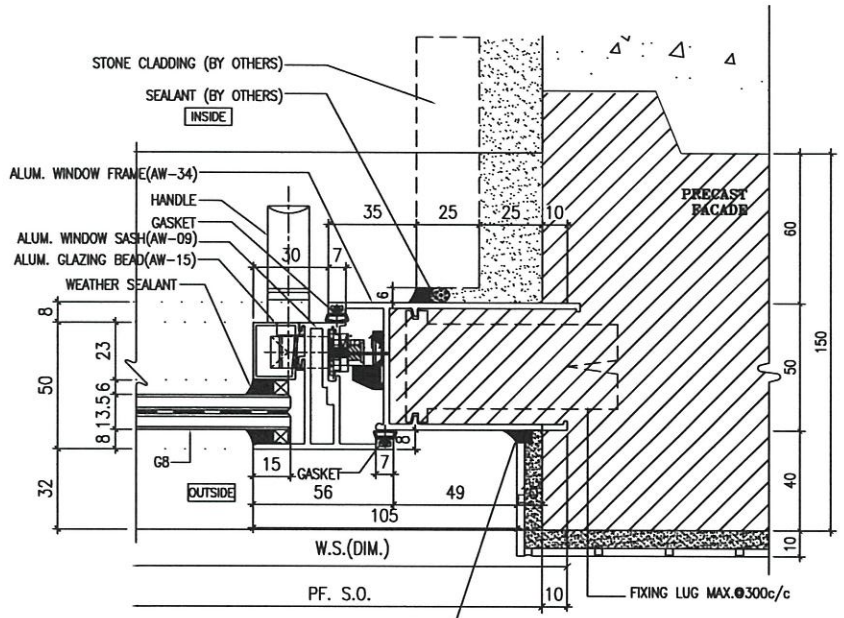

4 HORIZONTAL DETAIL

B.D. REF :

ARCHITECT :
WONG TUNG & PARTNERS LIMITED
ARCHITECTS & PLANNERS

STRUCTURAL ENGINEER :
SUN HUNG KAI
ARCHITECTS AND ENGINEERS LTD.
SUN HUNG KAI CENTRE, WANCHAI, HONGKONG
TEL. 28278111 FAX. 28272894

FACADE CONSULTANT:
ALPHA CONSULTING LIMITED
Steel Structure & Facade Specialist

MAIN CONTRACTOR :
Sanfield Engineering Construction Ltd.

CLIENT :
SUN HUNG KAI
REAL ESTATE AGENCY LTD.
42/F SUN HUNG KAI CENTRE, WANCHAI, HONGKONG

NOTE :
1. ALL DIMENSIONS ARE IN mm.
2. ALL ELEVATIONS ARE VIEWED FROM OUTSIDE.
3. ALL DIMENSIONS TO BE VERIFIED ON SITE BEFORE FABRICATION.

LEGEND :
X1 — DETAIL MARK NO.
X001 — REFER SHEET NO.

1. F.F.L. — FINISHED FLOOR LEVEL
2. S.F.L. — STRUCTURAL FLOOR LEVEL
3. (R) — REVERSED DETAIL
4. GLASS LEGEND
G1-8mmHS+12mm AIR GAP+10mmTP I.G.U.
G2-8mmHS+12mm AIR GAP+8mmTP I.G.U.
G2a-8mmHS+12mm AIR GAP+8mmTP+1.52PVB +6mmTP(PLANNING) FEATURED GLASS (I.G.U.)
G8-6mm GREY HS+1.52PVB+6mm CLEAR HS

NO.	DATE	REVISED	BY
B	08/08/2022	REVISION SUBJECT TO AMENDMENT	
A	25/04/2022	REVISION SUBJECT TO AMENDMENT	

JOB NO. : J-859

PROJECT :
PROPOSED RESIDENTIAL / COMMERCIAL DEVELOPMENT AT NKIL NO.6551 KAI TAK AREA 4C, SITE 3 KAI TAK, KOWLOON


TITLE :
TYPICAL DETAILS FOR ALUM. WINDOW

DATE : 28-Mar-22 | SCALE : 1:2 (A3)


DRAWN BY : IVAN | CHECKED BY :

美特鋁質有限公司
MIDI ALUMINIUM FABRICATOR LTD.
Units 6-8, Sunray Industrial Centre, 1/F
610 Cha Kwo Ling Road, Kowloon
Tel:23489211-4 Fax:(852)27727666


DWG NO. : J859-SD-PW-DT70e | REV. : B

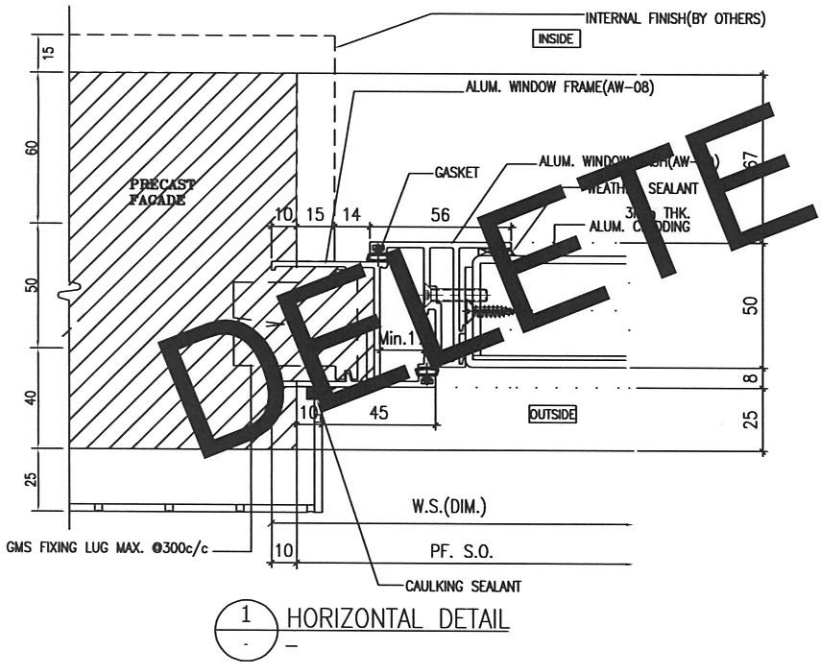


1 HORIZONTAL DETAIL

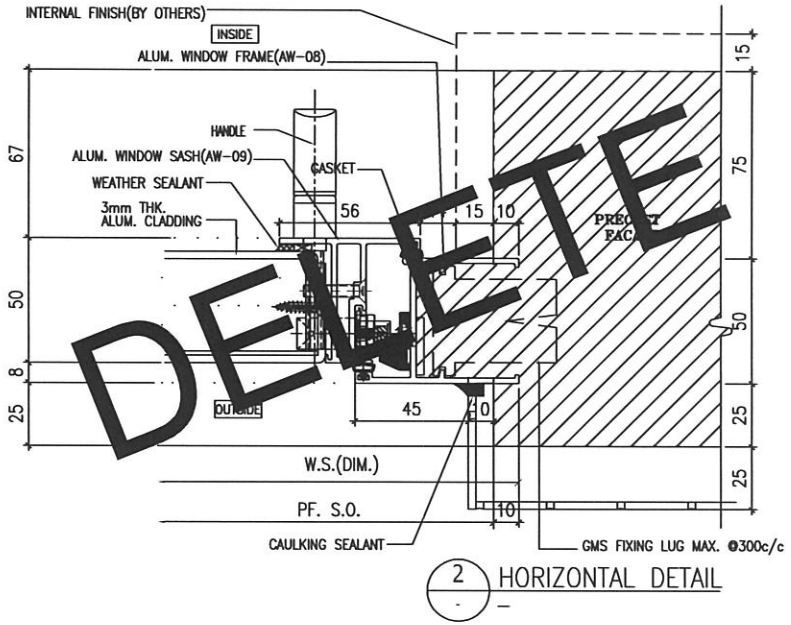

2 HORIZONTAL DETAIL

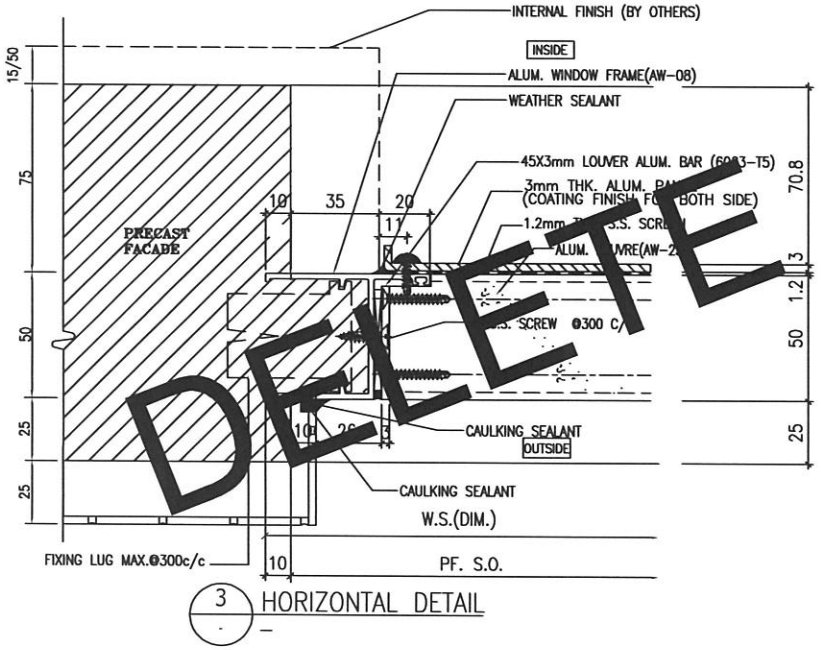

3 HORIZONTAL DETAIL

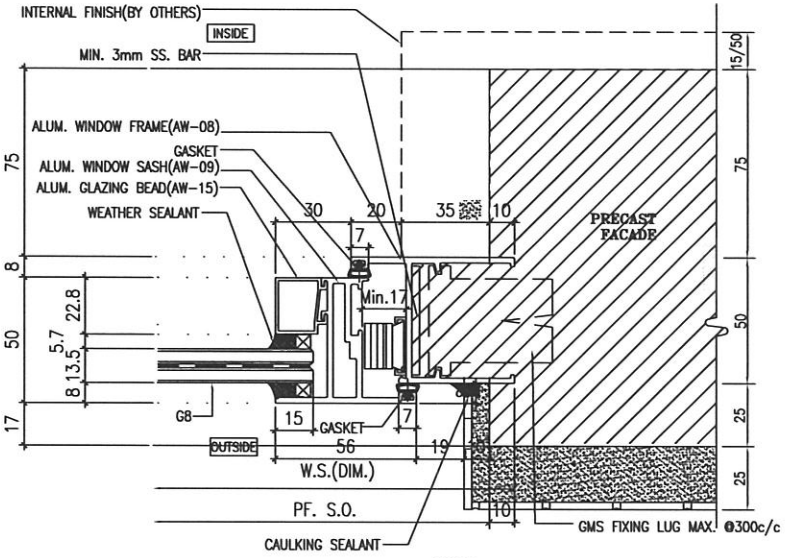

4 HORIZONTAL DETAIL

B.D. REF :

ARCHITECT :
WONG TUNG & PARTNERS LIMITED
ARCHITECTS & PLANNERS

STRUCTURAL ENGINEER :
SUN HUNG KAI
ARCHITECTS AND ENGINEERS LTD.
SUN HUNG KAI CENTRE, WANCHAI, HONGKONG
TEL. 28278111 FAX. 28272884

FACADE CONSULTANT:
ALPHA CONSULTING LIMITED
Steel Structure & Facade Specialist

MAIN CONTRACTOR :
Sanfield Engineering Construction Ltd.

CLIENT :
SUN HUNG KAI
REAL ESTATE AGENCY LTD.
42/F SUN HUNG KAI CENTRE, WANCHAI, HONGKONG

NOTE :
1. ALL DIMENSIONS ARE IN mm.
2. ALL ELEVATIONS ARE VIEWED FROM OUTSIDE.
3. ALL DIMENSIONS TO BE VERIFIED ON SITE BEFORE FABRICATION.

LEGEND :
X1 — DETAIL MARK NO.
X001 — REFER SHEET NO.
1. F.F.L. --FINISHED FLOOR LEVEL
2. S.F.L. --STRUCTURAL FLOOR LEVEL
3. /R --REVERSED DETAIL
4. GLASS LEGEND
G1-8mmHS+12mm AIR GAP+10mmTP I.G.U.
G2-8mmHS+12mm AIR GAP+8mmTP I.G.U.
G2a-8mmHS+12mm AIR GAP+8mmTP+1.52PVB +6mmTP(PLANNING) FEATURED GLASS (I.G.U.)
G8-6mm GREY HS+1.52PVB+6mm CLEAR HS

NO.	DATE	REVISED	BY
B	13/10/2022	REVISION SUBJECT TO ALPHA COMMENT	YH
A	08/08/2022	REVISION SUBJECT TO ARCHITECT	YHN

JOB NO. : J-859

PROJECT :
PROPOSED RESIDENTIAL / COMMERCIAL DEVELOPMENT AT NKIL NO.6551 KAI TAK AREA 4C, SITE 3 KAI TAK, KOWLOON


TITLE :
TYPICAL DETAILS FOR ALUM. WINDOW

DATE : 28-Mar-22 | SCALE : 1:2 (A3)


DRAWN BY : IVAN | CHECKED BY :

美特鋁質有限公司
MIDI ALUMINIUM FABRICATOR LTD.
Units 6-8, Sunray Industrial Centre, 1/F
610 Cha Kwo Ling Road, Kowloon
Tel:23489211-4 Fax:(852)27727666

DWG NO. : J859-SD-PW-DT70f | REV. : B

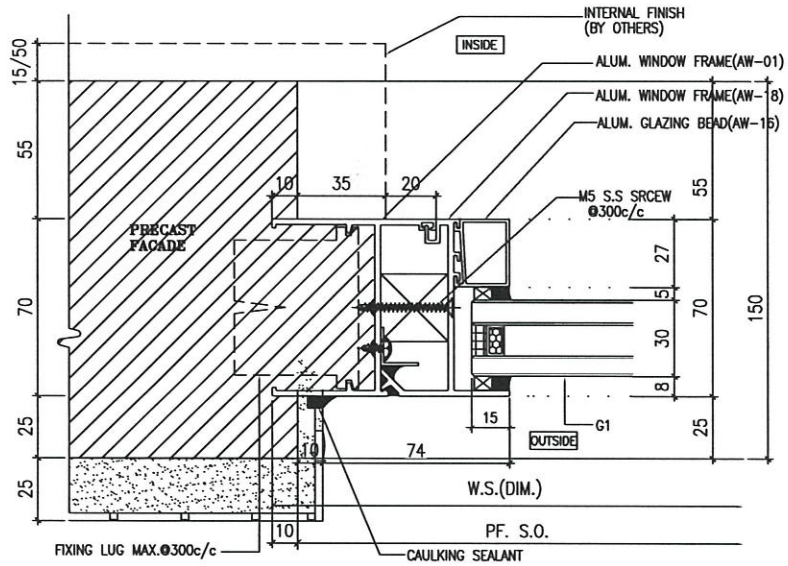

1 HORIZONTAL DETAIL
–

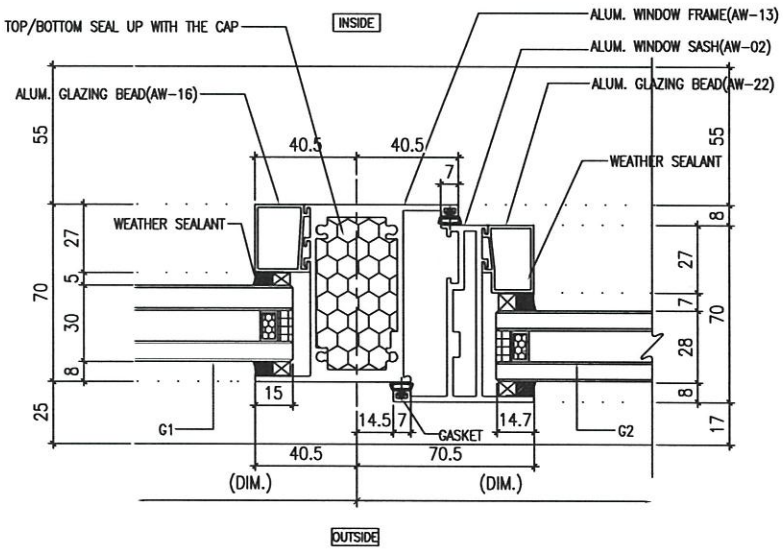

2 HORIZONTAL DETAIL
–

B.D. REF :

ARCHITECT :
WONG TUNG & PARTNERS LIMITED
ARCHITECTS & PLANNERS

STRUCTURAL ENGINEER :
SUN HUNG KAI
ARCHITECTS AND ENGINEERS LTD.
SUN HUNG KAI CENTRE, WANCHAI, HONGKONG
TEL. 28278111 FAX. 28272884

FACADE CONSULTANT:
ALPHA CONSULTING LIMITED
Steel Structure & Facade Specialist

MAIN CONTRACTOR :
Sanfield Engineering
Construction Ltd.

CLIENT :
SUN HUNG KAI
REAL ESTATE AGENCY LTD.
42/F SUN HUNG KAI CENTRE, WANCHAI, HONGKONG

NOTE :
1. ALL DIMENSIONS ARE IN mm.
2. ALL ELEVATIONS ARE VIEWED FROM OUTSIDE.
3. ALL DIMENSIONS TO BE VERIFIED ON SITE BEFORE FABRICATION.

LEGEND :
X1 — DETAIL MARK NO.
X001 — REFER SHEET NO.

1. F.F.L. --FINISHED FLOOR LEVEL
2. S.F.L. --STRUCTURAL FLOOR LEVEL
3. (R) --REVERSED DETAIL
4. GLASS LEGEND

G1-8mmHS+12mm AIR GAP+10mmTP I.G.U.

G2-8mmHS+12mm AIR GAP+8mmTP I.G.U.

G2a-8mmHS+12mm AIR GAP+8mmTP+1.52PVB +6mmTP(PLANNING) FEATURED GLASS (I.G.U.)

G8-6mm GREY HS+1.52PVB+6mm CLEAR HS

NO.	DATE	REVISED	BY
–	04/11/2022	REF DRAWING	W

JOB NO. : J-859

PROJECT :
PROPOSED RESIDENTIAL / COMMERCIAL DEVELOPMENT AT NKIL NO.6551 KAI TAK AREA 4C, SITE 3 KAI TAK, KOWLOON


TITLE :
TYPICAL DETAILS FOR ALUM. WINDOW

DATE : 28-Mar-22 | SCALE : 1:2 (A3)

DRAWN BY : IVAN | CHECKED BY :

美特鋁實有限公司
MIDI ALUMINIUM FABRICATOR LTD.
Units 6-8, Sunray Industrial Centre, 1/F
610 Cha Kwo Ling Road, Kowloon
Tel:23489211-4 Fax:(852)27727666

DWG NO. : J859-SD-PW-DT70g | REV. : –

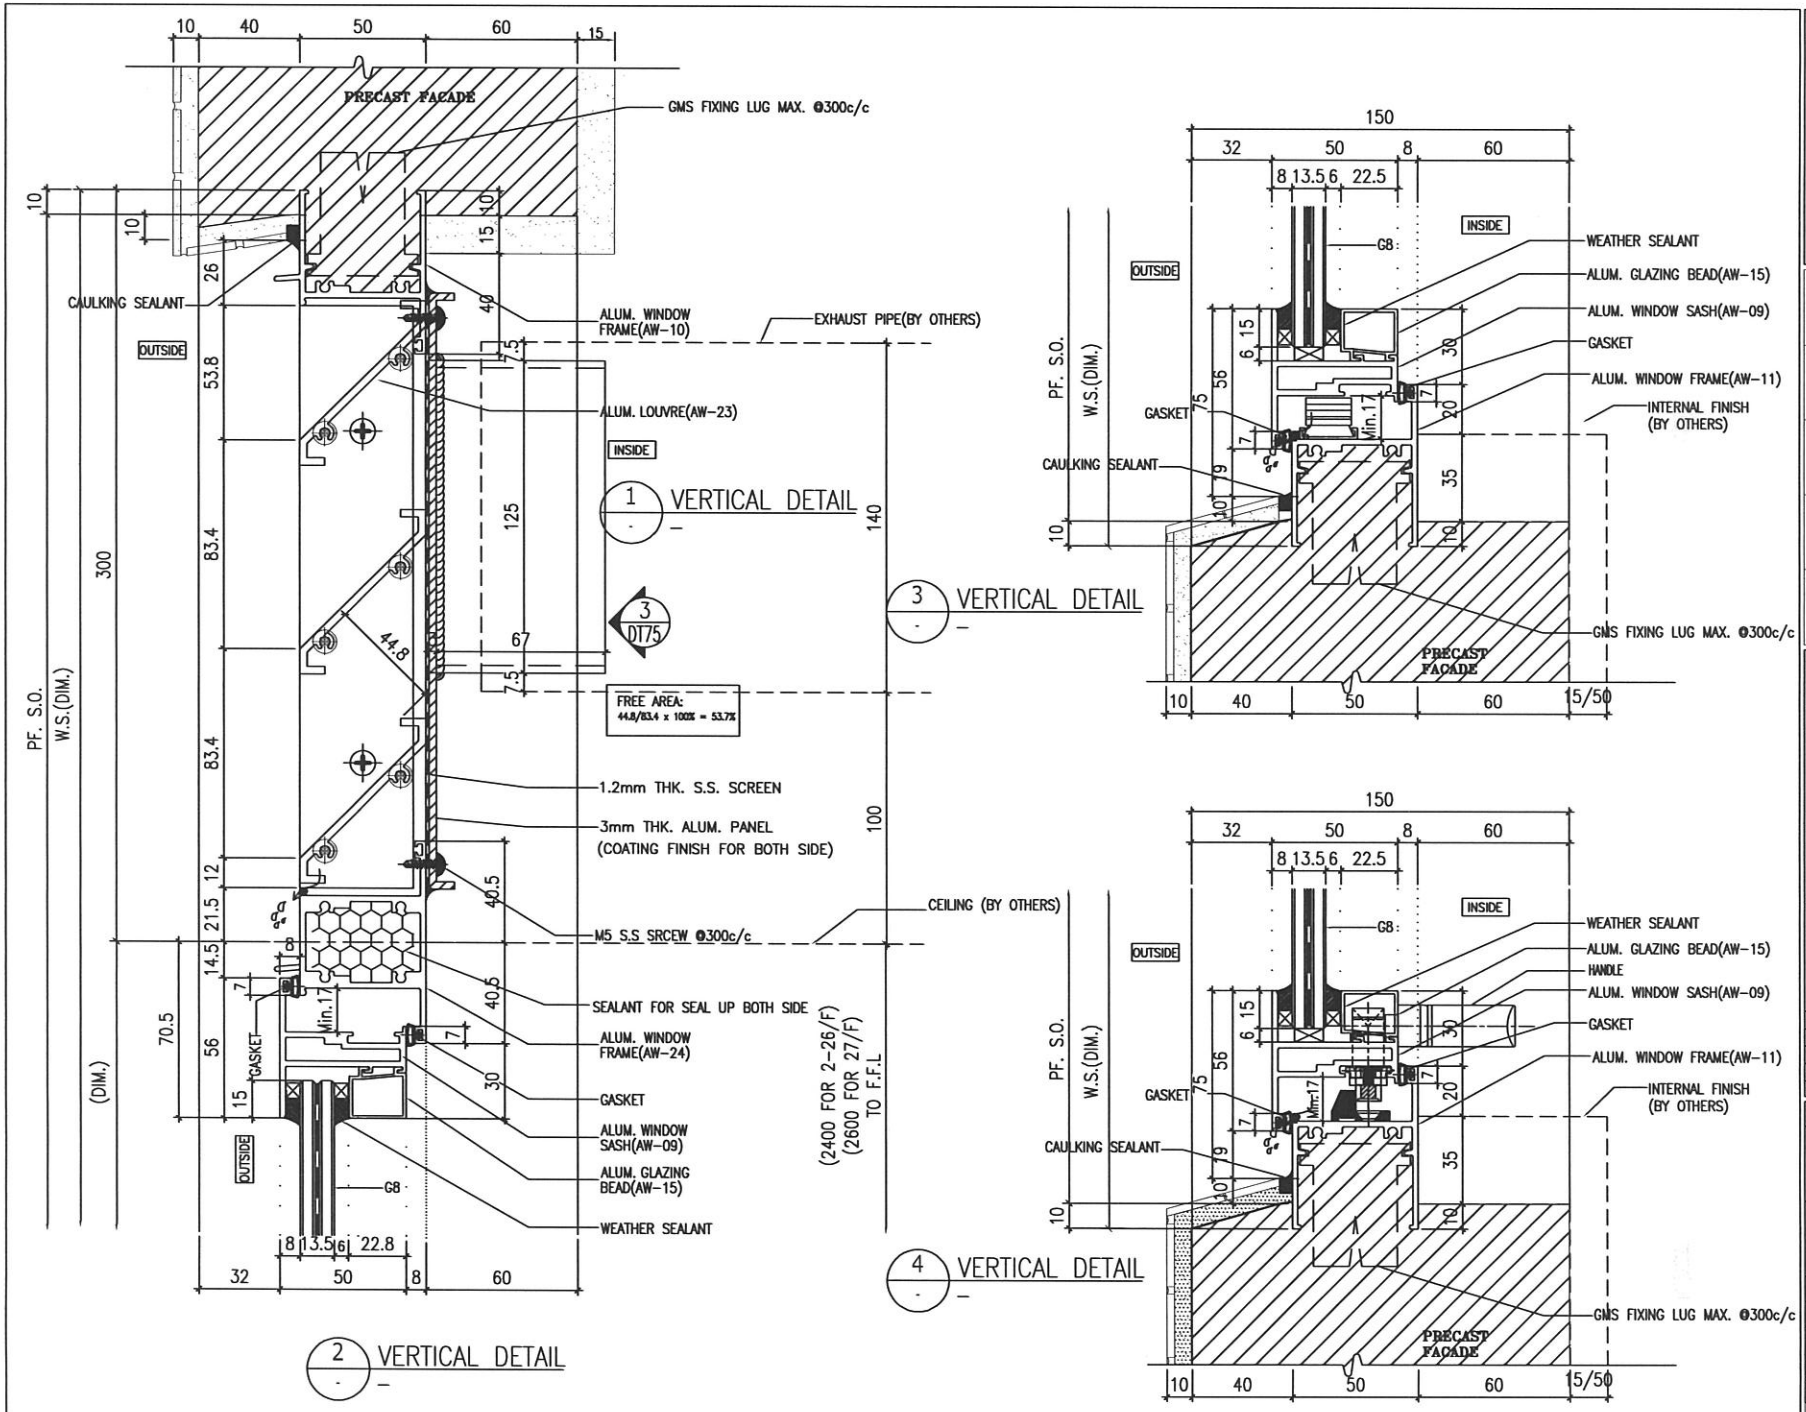

B.D. REF :

ARCHITECT :
WONG TUNG & PARTNERS LIMITED
ARCHITECTS & PLANNERS

STRUCTURAL ENGINEER :
SUN HUNG KAI
ARCHITECTS AND ENGINEERS LTD.
SUN HUNG KAI CENTRE, WANCHAI, HONGKONG
TEL. 28278111 FAX. 28272884

FACADE CONSULTANT:
ALPHA CONSULTING LIMITED
Steel Structure & Facade Specialist

MAIN CONTRACTOR :
Sanfield Engineering Construction Ltd.

CLIENT :
SUN HUNG KAI
REAL ESTATE AGENCY LTD.
42/F SUN HUNG KAI CENTRE, WANCHAI, HONGKONG

NOTE :
1. ALL DIMENSIONS ARE IN mm.
2. ALL ELEVATIONS ARE VIEWED FROM OUTSIDE.
3. ALL DIMENSIONS TO BE VERIFIED ON SITE BEFORE FABRICATION.

LEGEND :
X1 — DETAIL MARK NO.
X001 — REFER SHEET NO.
1. F.F.L. -- FINISHED FLOOR LEVEL
2. S.F.L. -- STRUCTURAL FLOOR LEVEL
3. /R -- REVERSED DETAIL
4. GLASS LEGEND
G1-8mmHS+12mm AIR GAP+10mmTP I.G.U.
G2-8mmHS+12mm AIR GAP+8mmTP I.G.U.
G2a-8mmHS+12mm AIR GAP+8mmTP+1.52PVB +6mmTP(PLANNING) FEATURED GLASS (I.G.U.)
G8-6mm GREY HS+1.52PVB+6mm CLEAR HS

NO.	DATE	REVISED	BY
D	13/10/2022	REVISION SUBJECT TO ALPHA COMMENT	W
C	28/9/2022	REVISION SUBJECT TO ARCHITECT	IVAN
B	11/8/2022	REVISION SUBJECT TO ARCHITECT	IVAN
A	28/3/2022	REVISION SUBJECT TO ARCHITECT	IVAN

JOB NO. : J-859

PROJECT :
PROPOSED RESIDENTIAL / COMMERCIAL DEVELOPMENT AT NKIL NO.6551 KAI TAK AREA 4C, SITE 3 KAI TAK, KOWLOON


TITLE :
TYPICAL DETAILS FOR ALUM. WINDOW

DATE : 10-Nov-21 | SCALE : 1:2 (A3)


DRAWN BY : IVAN | CHECKED BY :

美特鋁質有限公司
MIDI ALUMINIUM FABRICATOR LTD.
Units 6-8, Sunray Industrial Centre, 1/F
610 Cha Kwo Ling Road, Kowloon
Tel:23489211-4 Fax:(852)27727666


DWG NO. : J859-SD-PW-DT71 | REV. : D

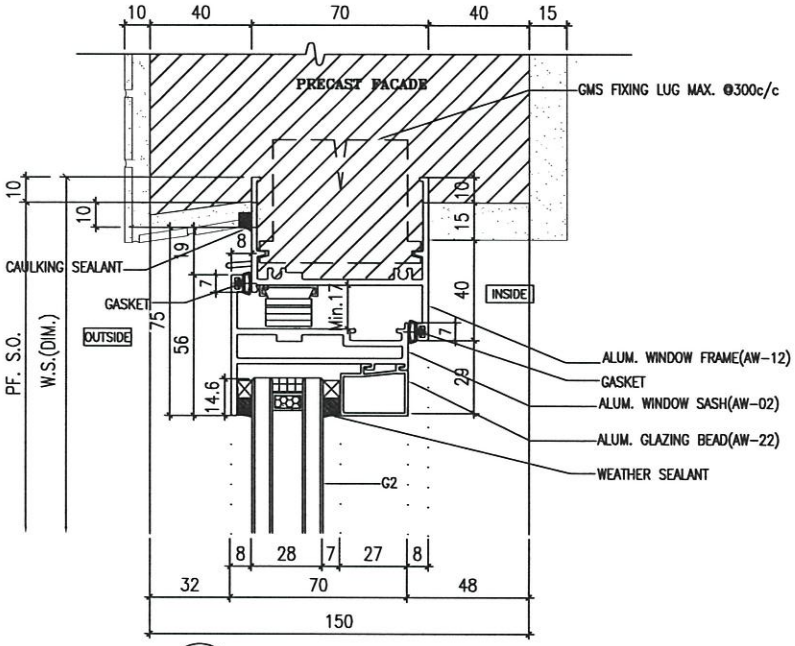


1 VERTICAL DETAIL

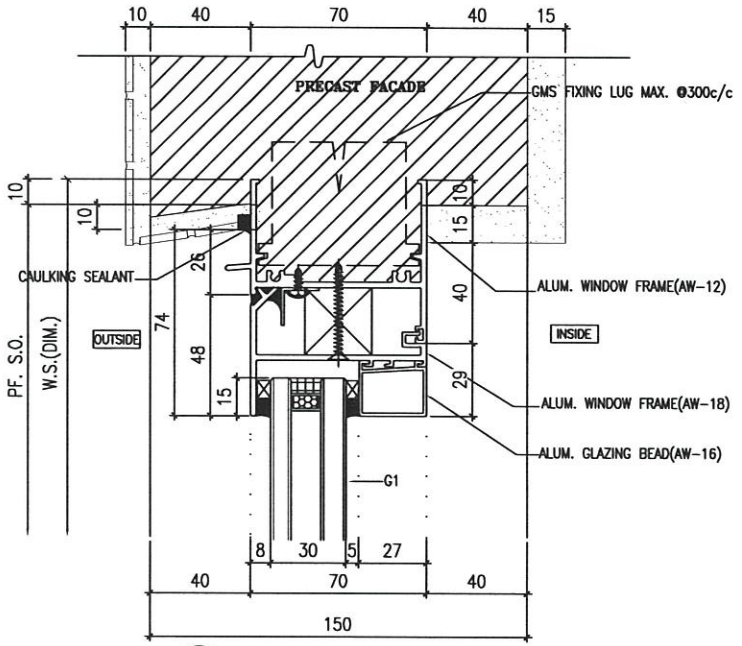

2 VERTICAL DETAIL

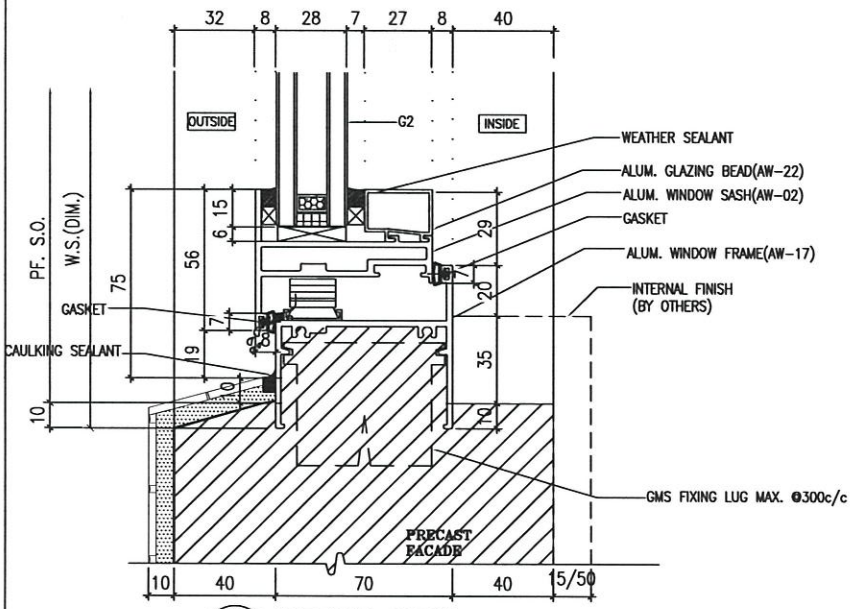

3 VERTICAL DETAIL

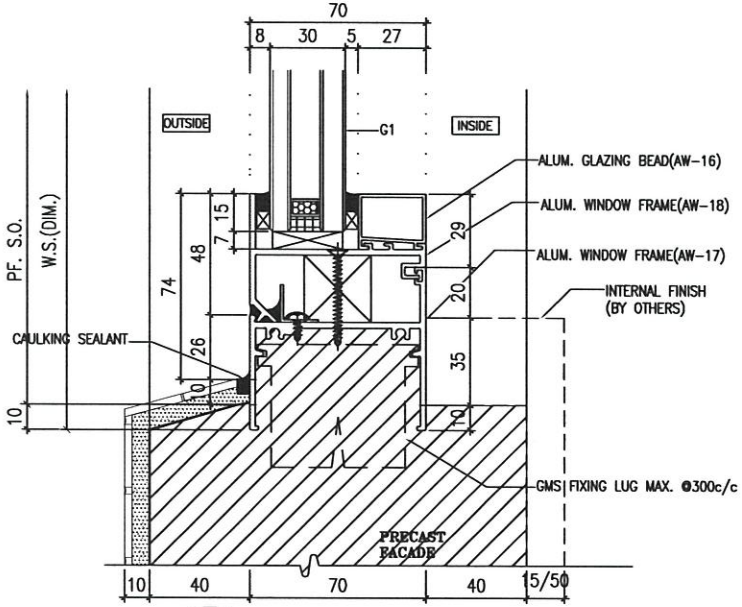

4 VERTICAL DETAIL

B.D. REF :

ARCHITECT :
WONG TUNG & PARTNERS LIMITED
ARCHITECTS & PLANNERS

STRUCTURAL ENGINEER :
SUN HUNG KAI
ARCHITECTS AND ENGINEERS LTD.
SUN HUNG KAI CENTRE, WANCHAI, HONGKONG
TEL. 28276111 FAX. 28272684

FACADE CONSULTANT:
ALPHA CONSULTING LIMITED
Steel Structure & Facade Specialist

MAIN CONTRACTOR :
Sanfield Engineering
Construction Ltd.

CLIENT :
SUN HUNG KAI
REAL ESTATE AGENCY LTD.
42/F SUN HUNG KAI CENTRE, WANCHAI, HONGKONG

NOTE :
1. ALL DIMENSIONS ARE IN mm.
2. ALL ELEVATIONS ARE VIEWED FROM OUTSIDE.
3. ALL DIMENSIONS TO BE VERIFIED ON SITE BEFORE FABRICATION.

LEGEND :
X1 — DETAIL MARK NO.
X001 — REFER SHEET NO.

1. F.F.L. — FINISHED FLOOR LEVEL
2. S.F.L. — STRUCTURAL FLOOR LEVEL
3. (R) — REVERSED DETAIL
4. GLASS LEGEND

G1-8mmHS+12mm AIR GAP+10mmTP I.G.U.

G2-8mmHS+12mm AIR GAP+8mmTP I.G.U.

G2a-8mmHS+12mm AIR GAP+8mmTP+1.52PVB +6mmTP(PLANNING) FEATURED GLASS (I.G.U.)

G8-6mm GREY HS+1.52PVB+6mm CLEAR HS

NO.	DATE	REVISED	BY
A	26/3/2022	REVISION SUBJECT TO ARCHCOMMENT	

JOB NO. : J-859

PROJECT :
PROPOSED RESIDENTIAL / COMMERCIAL DEVELOPMENT AT NKIL NO.6551 KAI TAK AREA 4C, SITE 3 KAI TAK, KOWLOON


TITLE :
TYPICAL DETAILS FOR ALUM. WINDOW

DATE : 10-Nov-21 | SCALE : 1:2 (A3)


DRAWN BY : IVAN | CHECKED BY :

美特鋁質有限公司
MIDI ALUMINIUM FABRICATOR LTD.
Units 6-8, Sunray Industrial Centre, 1/F
610 Cha Kwo Ling Road, Kowloon
Tel:23489211-4 Fax:(852)27727666


DWG NO. : J859-SD-PW-DT72 | REV. : A

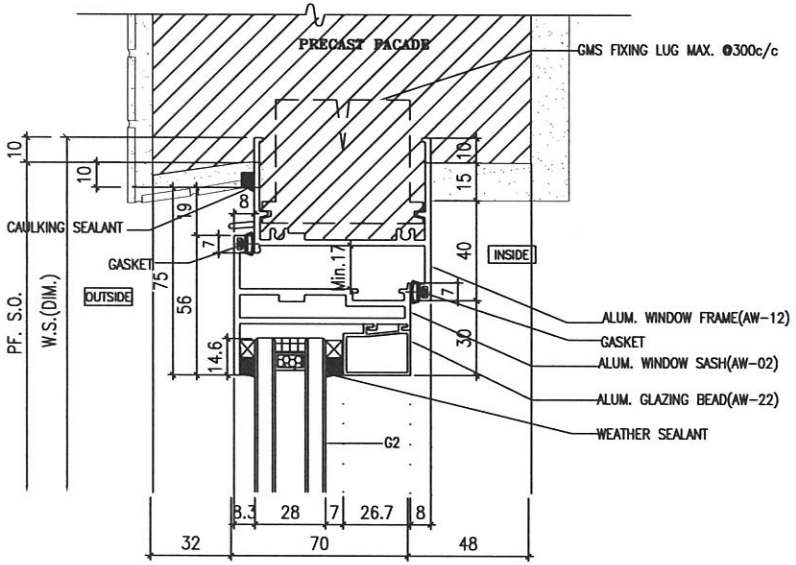

1 VERTICAL DETAIL

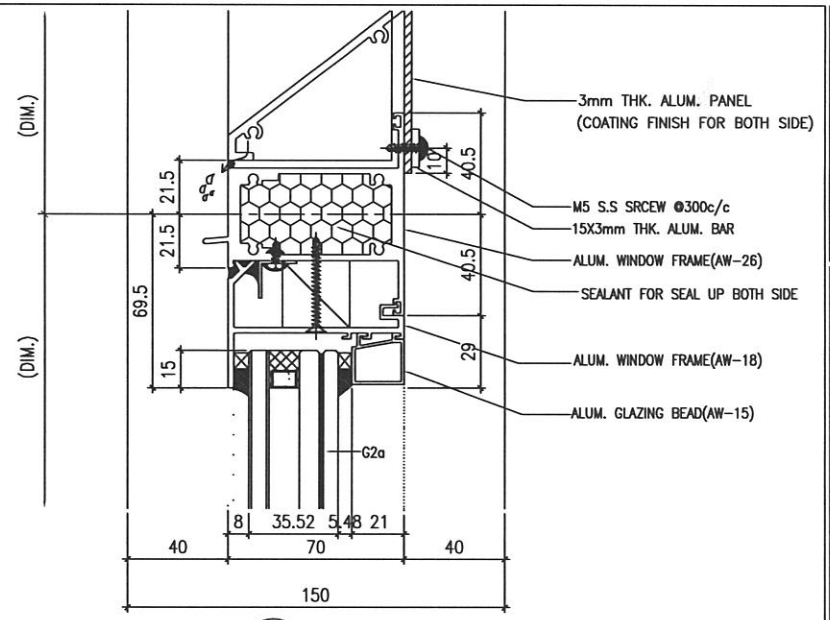


2 VERTICAL DETAIL

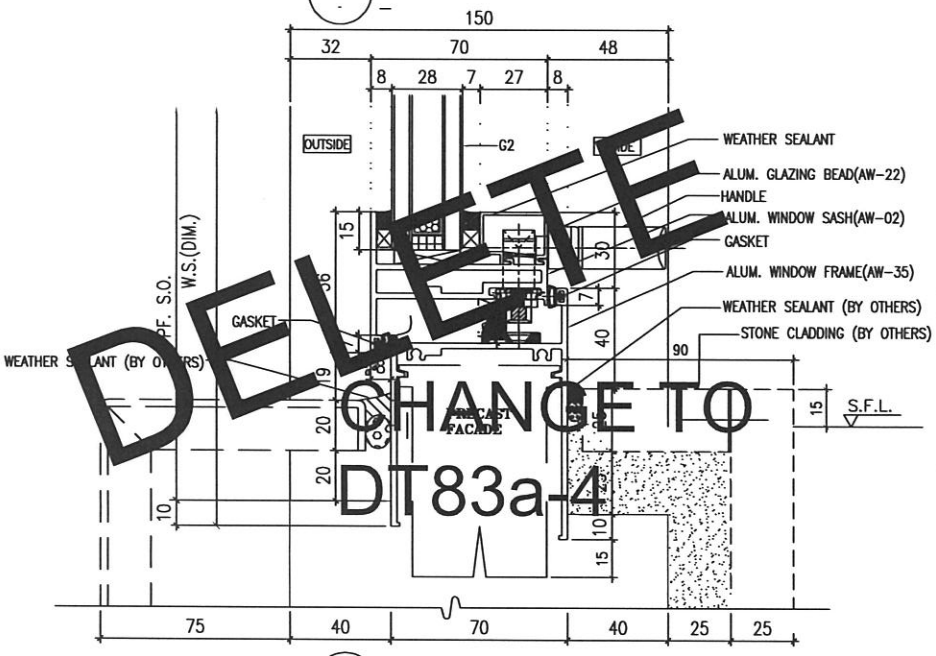

3 VERTICAL DETAIL

DELETE

CHANGE TO DT83a-4

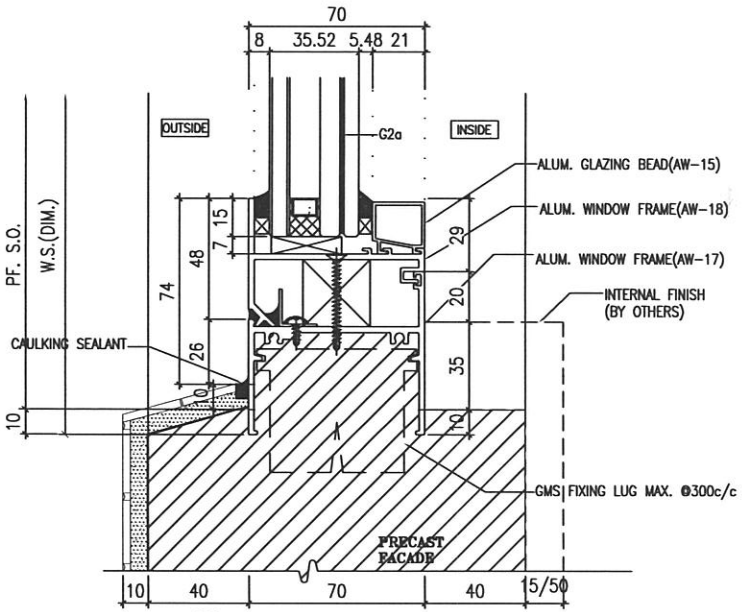

4 VERTICAL DETAIL

B.D. REF :

ARCHITECT :
WONG TUNG & PARTNERS LIMITED
ARCHITECTS & PLANNERS

STRUCTURAL ENGINEER :
SUN HUNG KAI
ARCHITECTS AND ENGINEERS LTD.
SUN HUNG KAI CENTRE, WANCHAI, HONGKONG
TEL. 28278111 FAX. 28272884

FACADE CONSULTANT:
ALPHA CONSULTING LIMITED
Steel Structure & Facade Specialist

MAIN CONTRACTOR :
Sanfield Engineering Construction Ltd.

CLIENT :
SUN HUNG KAI
REAL ESTATE AGENCY LTD.
42/F SUN HUNG KAI CENTRE, WANCHAI, HONGKONG

NOTE :
1. ALL DIMENSIONS ARE IN mm.
2. ALL ELEVATIONS ARE VIEWED FROM OUTSIDE.
3. ALL DIMENSIONS TO BE VERIFIED ON SITE BEFORE FABRICATION.

LEGEND :
X1 — DETAIL MARK NO.
X001 — REFER SHEET NO.

1. F.F.L. -- FINISHED FLOOR LEVEL
2. S.F.L. -- STRUCTURAL FLOOR LEVEL
3. /R -- REVERSED DETAIL
4. GLASS LEGEND

G1-8mmHS+12mm AIR GAP+10mmTP I.G.U.

G2-8mmHS+12mm AIR GAP+8mmTP I.G.U.

G2a-8mmHS+12mm AIR GAP+8mmTP+1.52PVB +6mmTP(PLANNING) FEATURED GLASS (I.G.U.)

G8-6mm GREY HS+1.52PVB+6mm CLEAR HS

NO.	DATE	REVISED	BY
A	28/03/2022	REVISION SUBJECT TO ARCHITECT	

JOB NO. : J-859

PROJECT :
PROPOSED RESIDENTIAL / COMMERCIAL DEVELOPMENT AT NKIL NO.6551 KAI TAK AREA 4C, SITE 3 KAI TAK, KOWLOON


TITLE :
TYPICAL DETAILS FOR ALUM. WINDOW

DATE : 10-Nov-21 | SCALE : 1:2 (A3)


DRAWN BY : IVAN | CHECKED BY :

美特鋁質有限公司
MIDI ALUMINIUM FABRICATOR LTD.
Units 6-8, Sunray Industrial Centre, 1/F
610 Cha Kwo Ling Road, Kowloon
Tel:23489211-4 Fax:(852)27727666


DWG NO. : J859-SD-PW-DT72a | REV. : A

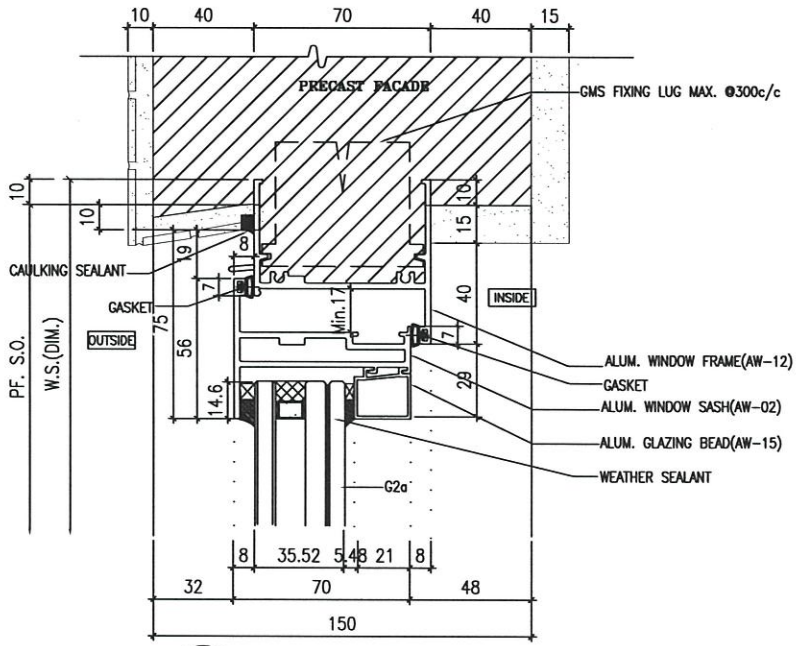

1 VERTICAL DETAIL

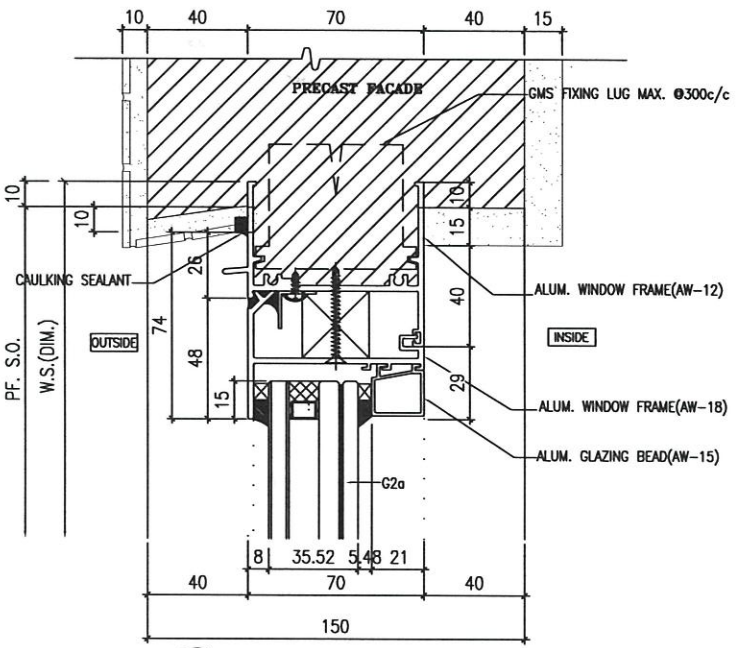

2 VERTICAL DETAIL

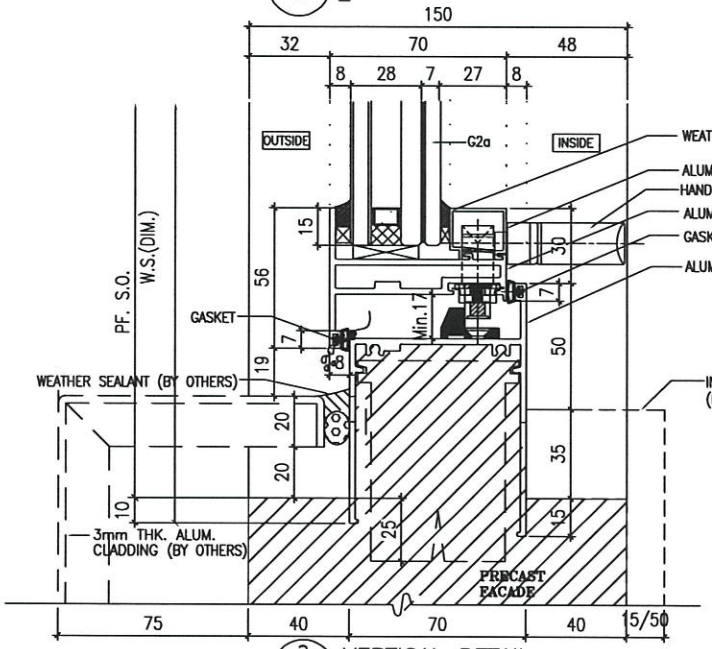

3 VERTICAL DETAIL

B.D. REF :

ARCHITECT :
WONG TUNG & PARTNERS LIMITED
ARCHITECTS & PLANNERS

STRUCTURAL ENGINEER :
SUN HUNG KAI
ARCHITECTS AND ENGINEERS LTD.
SUN HUNG KAI CENTRE, WANCHAI, HONGKONG
TEL. 28278111 FAX. 28272004

FACADE CONSULTANT:
ALPHA CONSULTING LIMITED
Steel Structure & Facade Specialist

MAIN CONTRACTOR :
Sanfield Engineering
Construction Ltd.

CLIENT :
SUN HUNG KAI
REAL ESTATE AGENCY LTD.
42/F SUN HUNG KAI CENTRE, WANCHAI, HONGKONG

NOTE :
1. ALL DIMENSIONS ARE IN mm.
2. ALL ELEVATIONS ARE VIEWED FROM OUTSIDE.
3. ALL DIMENSIONS TO BE VERIFIED ON SITE BEFORE FABRICATION.

LEGEND :
X1 — DETAIL MARK NO.
X001 — REFER SHEET NO.

1. F.F.L. -- FINISHED FLOOR LEVEL
2. S.F.L. -- STRUCTURAL FLOOR LEVEL
3. (R) -- REVERSED DETAIL
4. GLASS LEGEND

G1-8mmHS+12mm AIR GAP+10mmTP I.G.U.

G2-8mmHS+12mm AIR GAP+8mmTP I.G.U.

G2a-8mmHS+12mm AIR GAP+8mmTP+1.52PVB +6mmTP(PLANNING) FEATURED GLASS (I.G.U.)

G8-6mm GREY HS+1.52PVB+6mm CLEAR HS

NO.	DATE	REVISED	BY
A	25/4/2022	REVISION SUBJECT TO ACKLOWLEDGEMENT	

JOB NO. : J-859

PROJECT :
PROPOSED RESIDENTIAL / COMMERCIAL DEVELOPMENT AT NKIL NO.6551 KAI TAK AREA 4C, SITE 3 KAI TAK, KOWLOON


TITLE :
TYPICAL DETAILS FOR ALUM. WINDOW

DATE : 10-Nov-21 | SCALE : 1:2 (A3)

DRAWN BY : IVAN | CHECKED BY :

美特鋁質有限公司
MIDI ALUMINIUM FABRICATOR LTD.
Units 6-8, Sunray Industrial Centre, 1/F
610 Cha Kwo Ling Road, Kowloon
Tel:23489211-4 Fax:(852)27727686

DWG NO. : J859-SD-PW-DT72b | REV. : A

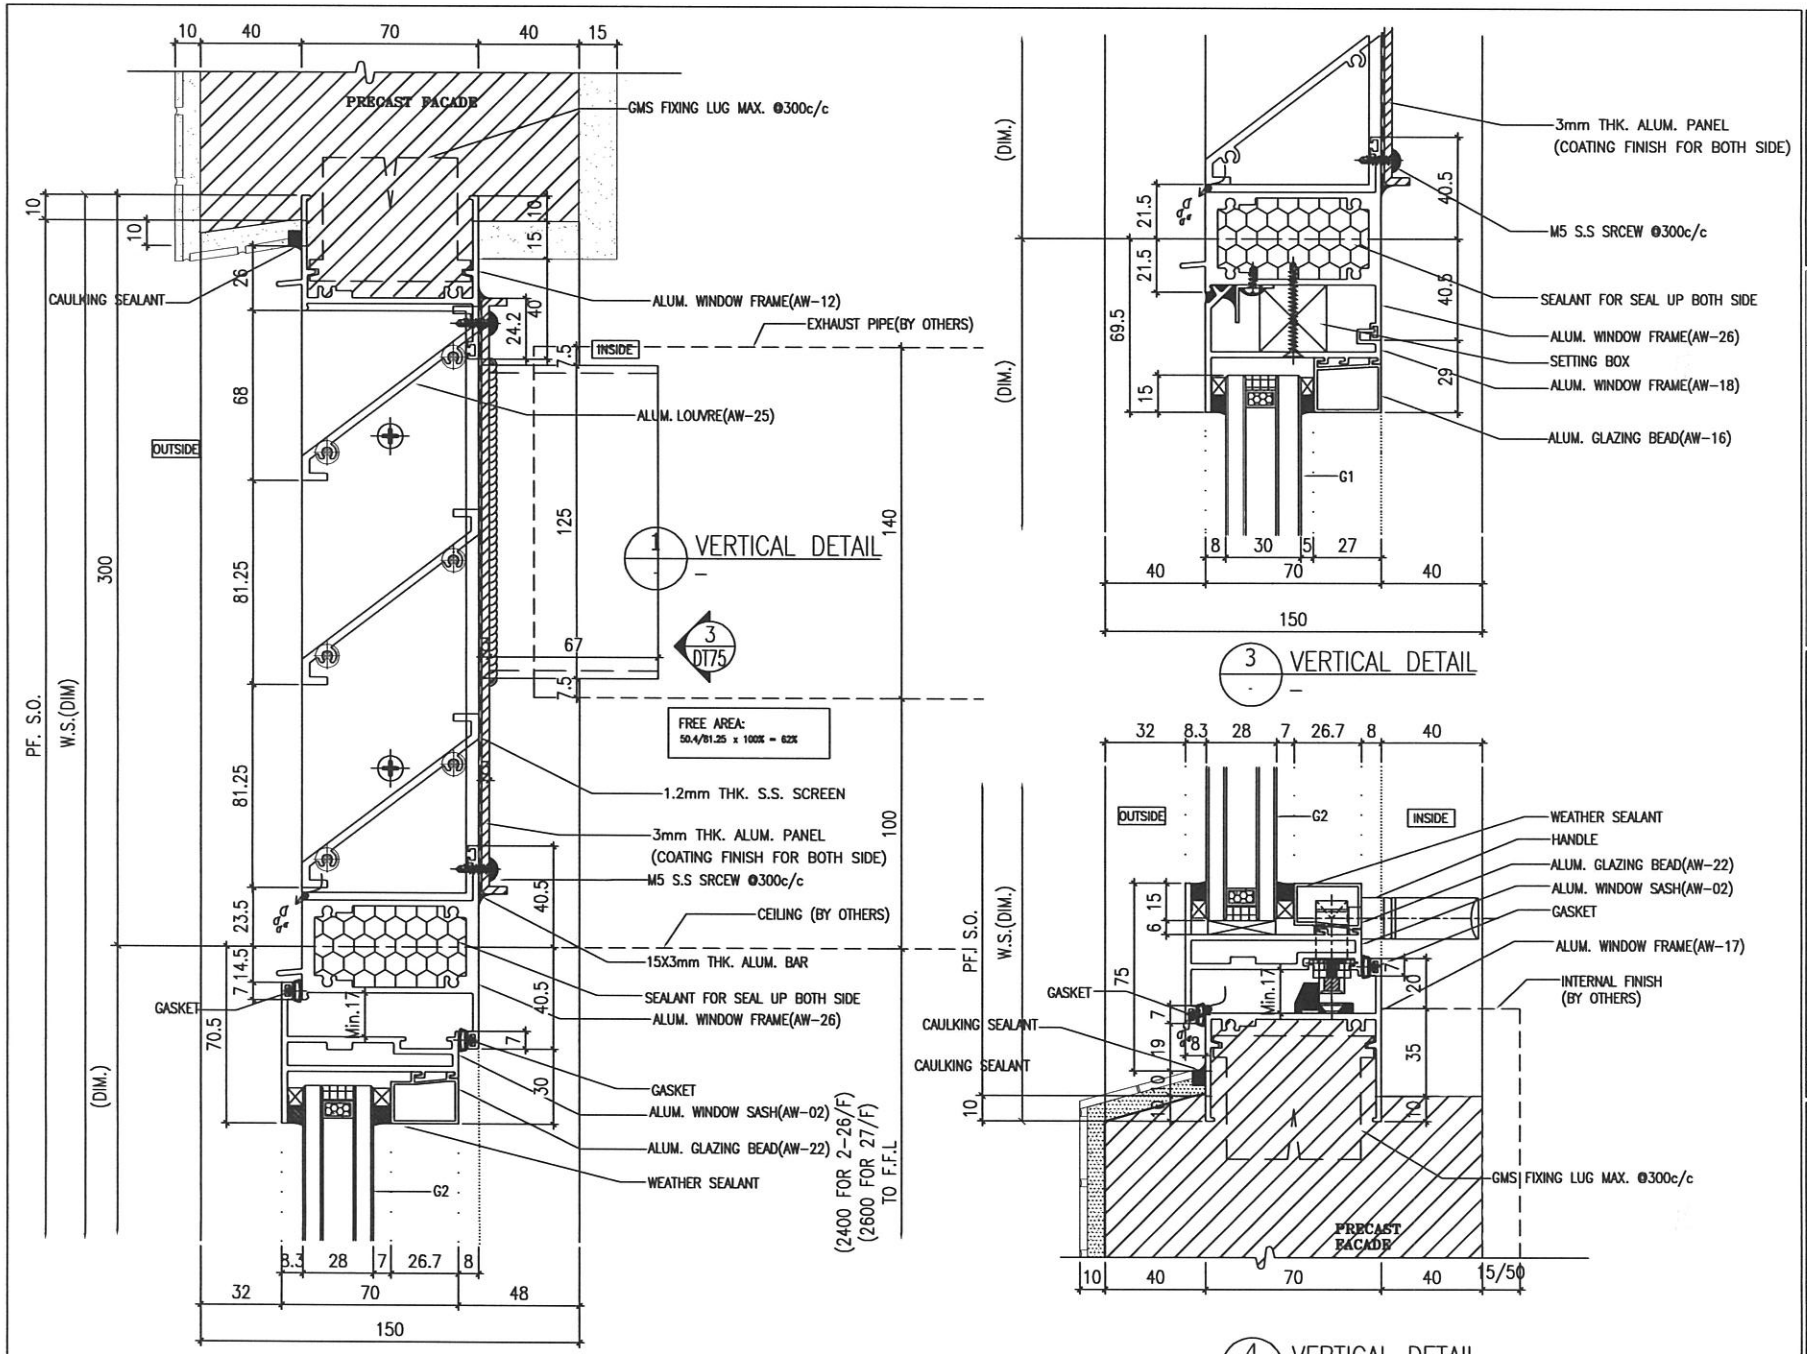

B.D. REF :

ARCHITECT :
WONG TUNG & PARTNERS LIMITED
ARCHITECTS & PLANNERS

STRUCTURAL ENGINEER :
SUN HUNG KAI
ARCHITECTS AND ENGINEERS LTD.
SUN HUNG KAI CENTRE, WANCHAI, HONGKONG
TEL. 2827 8111 FAX. 28272884

FACADE CONSULTANT:
ALPHA CONSULTING LIMITED
Steel Structure & Facade Specialist

MAIN CONTRACTOR :
Sanfield Engineering
Construction Ltd.

CLIENT :
SUN HUNG KAI
REAL ESTATE AGENCY LTD.
42/F SUN HUNG KAI CENTRE, WANCHAI, HONGKONG

NOTE :
1. ALL DIMENSIONS ARE IN mm.
2. ALL ELEVATIONS ARE VIEWED FROM OUTSIDE.
3. ALL DIMENSIONS TO BE VERIFIED ON SITE BEFORE FABRICATION.

LEGEND :
X1 — DETAIL MARK NO.
X001 — REFER SHEET NO.
1. F.F.L. --- FINISHED FLOOR LEVEL
2. S.F.L. --- STRUCTURAL FLOOR LEVEL
3. /R --- REVERSED DETAIL
4. GLASS LEGEND
G1-8mmHS+12mm AIR GAP+10mmTP I.G.U.
G2-8mmHS+12mm AIR GAP+8mmTP I.G.U.
G2a-8mmHS+12mm AIR GAP+8mmTP+1.52PVB +6mmTP(PLANNING) FEATURED GLASS (I.G.U.)
G8-6mm GREY HS+1.52PVB+6mm CLEAR HS

NO.	DATE	REVISED	BY
C	28/9/2022	REVISION SUBJECT TO ALPHA COMMENT	
B	07/9/2022	REVISION SUBJECT TO ARCH.COMMENT	
A	26/3/2022	REVISION SUBJECT TO ARCH.COMMENT	

JOB NO. : J-859


PROJECT :
PROPOSED RESIDENTIAL / COMMERCIAL DEVELOPMENT AT NKIL NO.6551 KAI TAK AREA 4C, SITE 3
KAI TAK, KOWLOON


TITLE :
TYPICAL DETAILS FOR
ALUM. WINDOW


DATE : 10-Nov-21 | SCALE : 1:2 (A3)
DRAWN BY : IVAN | CHECKED BY :

美特鋁質有限公司
MIDI ALUMINIUM FABRICATOR LTD.
Units 6-8, Sunray Industrial Centre, 1/F
610 Cha Kwo Ling Road, Kowloon
Tel:23489211-4 Fax:(852)27727666

DWG NO. : J859-SD-PW-DT73 | REV. : C

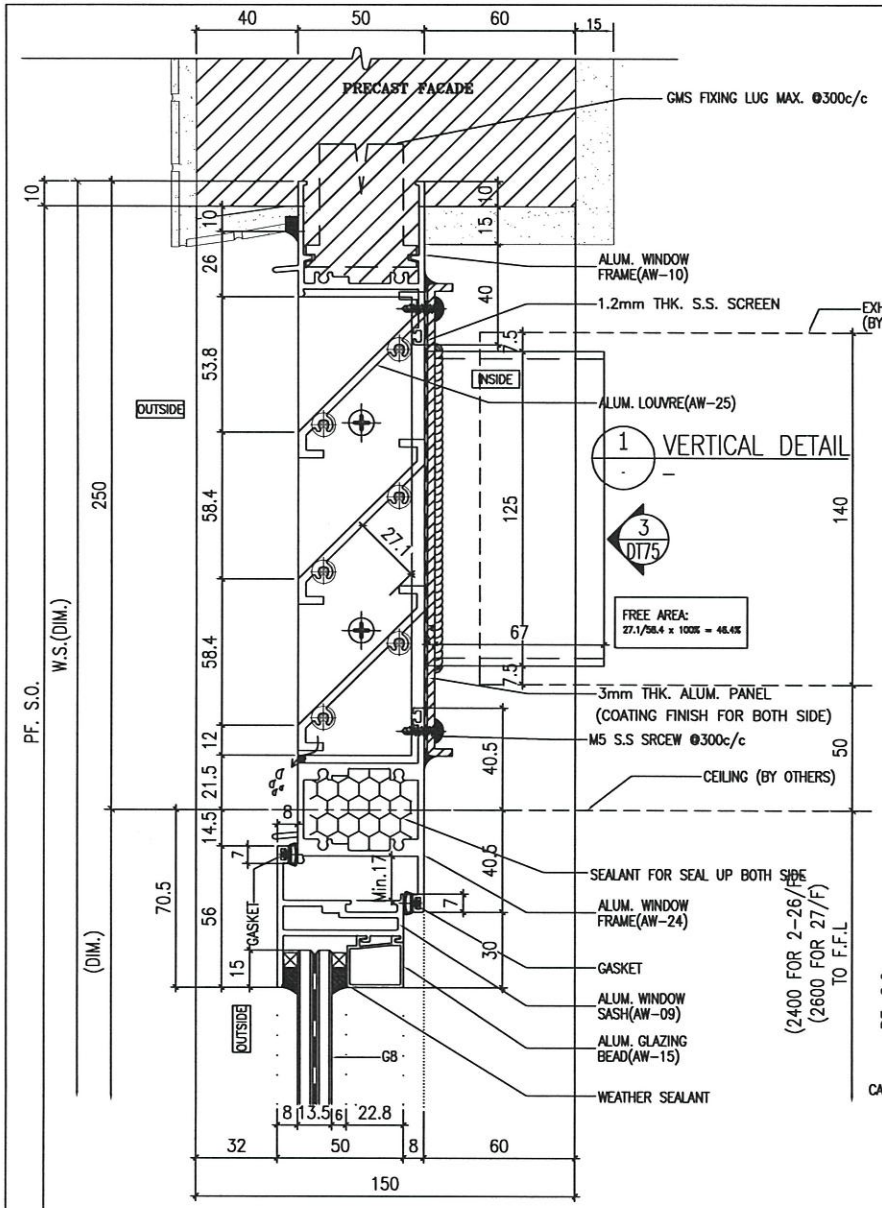

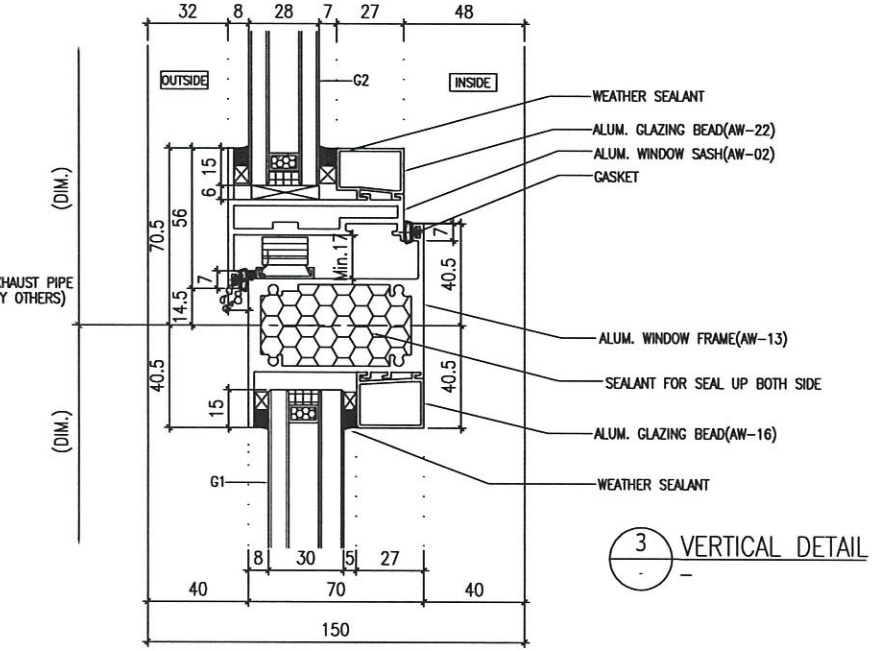

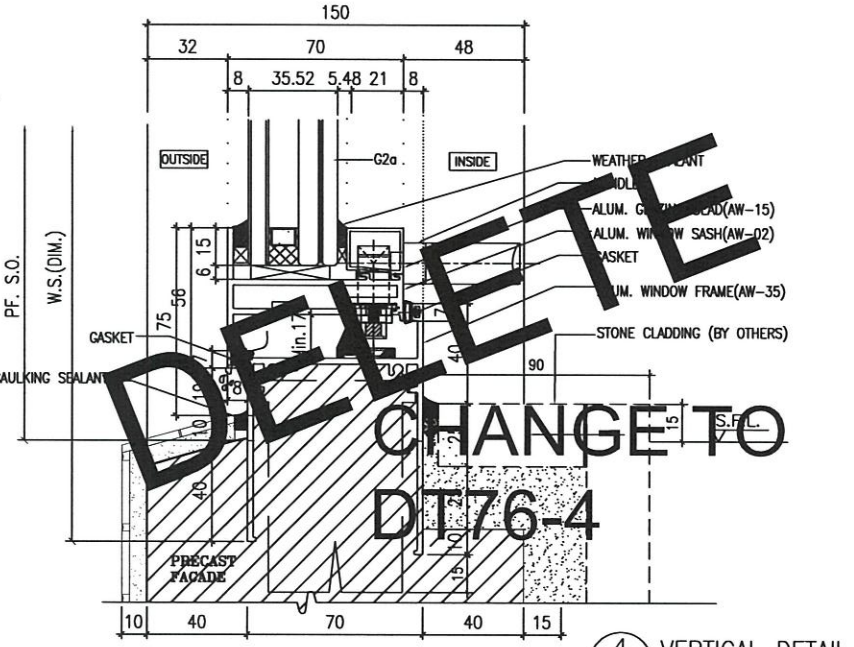

DELETE

CHANGE TO DT76-4

B.D. REF :

ARCHITECT :
WONG TUNG & PARTNERS LIMITED
ARCHITECTS & PLANNERS

STRUCTURAL ENGINEER :
SUN HUNG KAI
ARCHITECTS AND ENGINEERS LTD.
SUN HUNG KAI CENTRE, WANCHAI, HONGKONG
TEL. 28276111 FAX. 28272804

FACADE CONSULTANT:
ALPHA CONSULTING LIMITED
Steel Structure & Facade Specialist

MAIN CONTRACTOR :
Sanfield Engineering Construction Ltd.

CLIENT :
SUN HUNG KAI
REAL ESTATE AGENCY LTD.
42/F SUN HUNG KAI CENTRE, WANCHAI, HONGKONG

NOTE :
1. ALL DIMENSIONS ARE IN mm.
2. ALL ELEVATIONS ARE VIEWED FROM OUTSIDE.
3. ALL DIMENSIONS TO BE VERIFIED ON SITE BEFORE FABRICATION.

LEGEND :
X1 — DETAIL MARK NO.
X001 — REFER SHEET NO.
1. F.F.L. — FINISHED FLOOR LEVEL
2. S.F.L. — STRUCTURAL FLOOR LEVEL
3. /R — REVERSED DETAIL
4. GLASS LEGEND
G1-8mmHS+12mm AIR GAP+10mmTP I.G.U.
G2-8mmHS+12mm AIR GAP+8mmTP I.G.U.
G2a-8mmHS+12mm AIR GAP+8mmTP+1.52PVB +6mmTP(PLANNING) FEATURED GLASS (I.G.U.)
G8-6mm GREY HS+1.52PVB+6mm CLEAR HS

NO.	DATE	REVISED	BY
C	28/8/2022	REVISION SUBJECT TO ALPHA COMMENT	
B	23/3/2022	REVISION SUBJECT TO ARCH.COMMENT	
A	28/2/2022	REVISION SUBJECT TO ARCH.COMMENT	

JOB NO. : J-859

PROJECT :
PROPOSED RESIDENTIAL / COMMERCIAL DEVELOPMENT AT NKIL NO.6551 KAI TAK AREA 4C, SITE 3 KAI TAK, KOWLOON


TITLE :
TYPICAL DETAILS FOR ALUM. WINDOW

DATE : 10-Nov-21 | SCALE : 1:2 (A3)


DRAWN BY : IVAN | CHECKED BY :


美特鋁質有限公司
MIDI ALUMINIUM FABRICATOR LTD.
Units 6-8, Sunray Industrial Centre, 1/F
610 Cha Kwo Ling Road, Kowloon
Tel:23489211-4 Fax:(852)27727666

DWG NO. : J859-SD-PW-DT74 | REV. : C

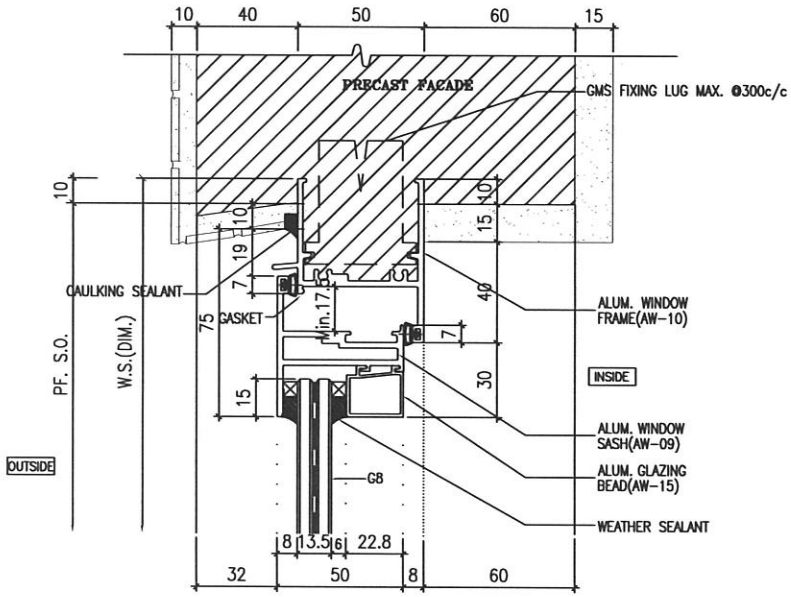


1 VERTICAL DETAIL

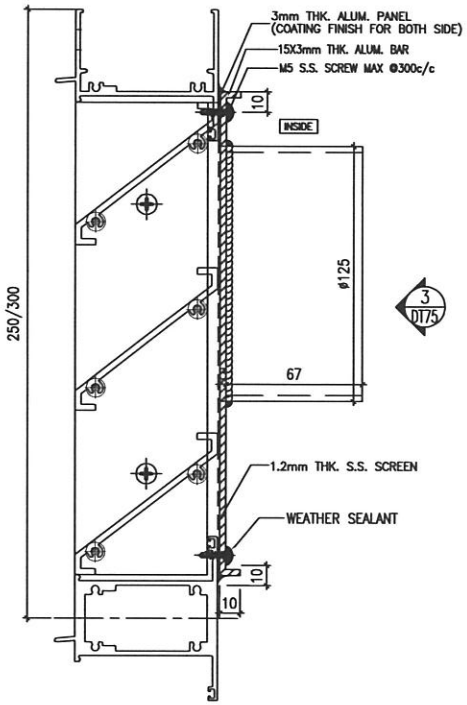

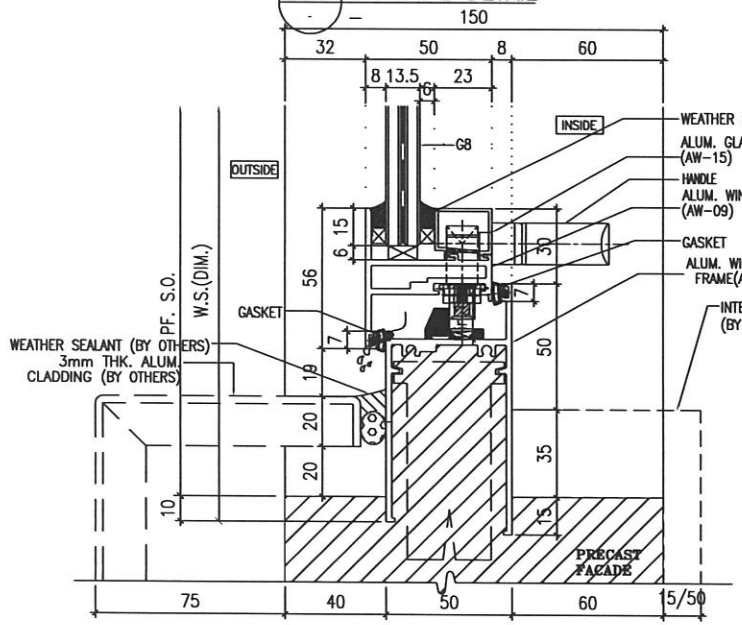

2 VERTICAL DETAIL

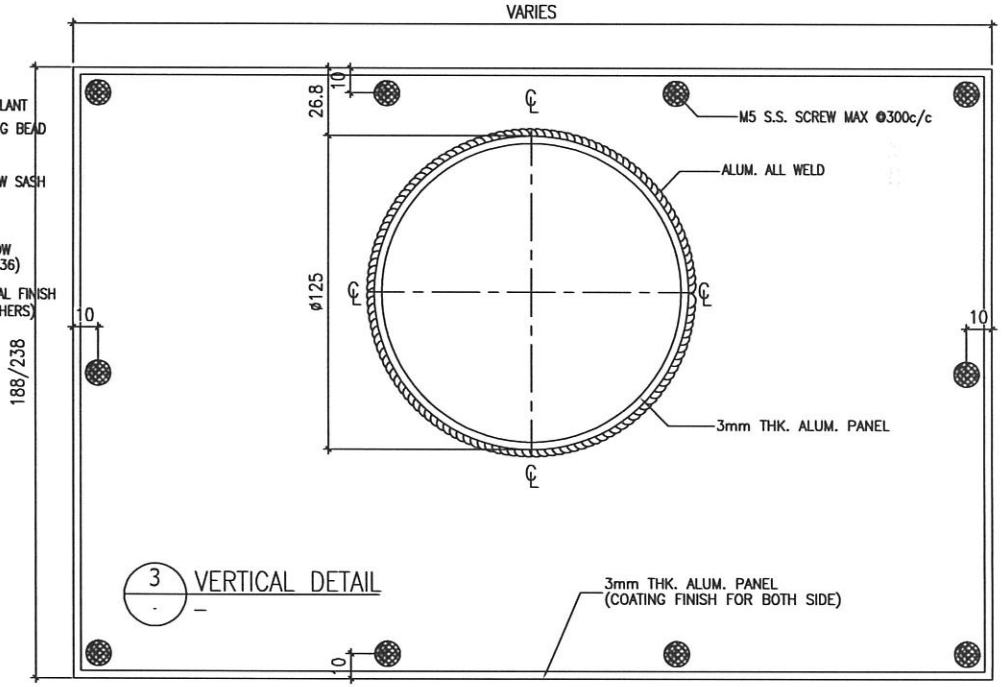

3 VERTICAL DETAIL

3mm THK. ALUM. PANEL (COATING FINISH FOR BOTH SIDE)

B.D. REF :

ARCHITECT :
WONG TUNG & PARTNERS LIMITED
ARCHITECTS & PLANNERS

STRUCTURAL ENGINEER :
SUN HUNG KAI
ARCHITECTS AND ENGINEERS LTD.
SUN HUNG KAI CENTRE, WANCHAI, HONGKONG
TEL. 28278111 FAX. 28272884

FACADE CONSULTANT:
ALPHA CONSULTING LIMITED
Steel Structure & Facade Specialist

MAIN CONTRACTOR :
Sanfield Engineering Construction Ltd.

CLIENT :
SUN HUNG KAI
REAL ESTATE AGENCY LTD.
42/F SUN HUNG KAI CENTRE, WANCHAI, HONGKONG

NOTE :
1. ALL DIMENSIONS ARE IN mm.
2. ALL ELEVATIONS ARE VIEWED FROM OUTSIDE.
3. ALL DIMENSIONS TO BE VERIFIED ON SITE BEFORE FABRICATION.

LEGEND :
X1 — DETAIL MARK NO.
X001 — REFER SHEET NO.
1. F.F.L. --FINISHED FLOOR LEVEL
2. S.F.L. --STRUCTURAL FLOOR LEVEL
3. /R --REVERSED DETAIL
4. GLASS LEGEND
G1-8mmHS+12mm AIR GAP+10mmTP I.G.U.
G2-8mmHS+12mm AIR GAP+8mmTP I.G.U.
G2a-8mmHS+12mm AIR GAP+8mmTP+1.52PVB +6mmTP(PLANNING) FEATURED GLASS (I.G.U.)
G8-6mm GREY HS+1.52PVB+6mm CLEAR HS

NO.	DATE	REVISED	BY
C	28/9/2022	REVISION SUBJECT TO ALPHA COMMENT	
B	12/9/2022	REVISION SUBJECT TO ARCHCOMMENT	
A	28/3/2022	REVISION SUBJECT TO ARCHCOMMENT	

JOB NO. : J-859


PROJECT :
PROPOSED RESIDENTIAL / COMMERCIAL DEVELOPMENT AT NKIL NO.6551 KAI TAK AREA 4C, SITE 3
KAI TAK, KOWLOON

TITLE :
TYPICAL DETAILS FOR ALUM. WINDOW

DATE : 10-Nov-21 | SCALE : 1:2 (A3)
DRAWN BY : IVAN | CHECKED BY :

美特鋁質有限公司
MIDI ALUMINIUM FABRICATOR LTD.
Units 6-8, Sunray Industrial Centre, 1/F
610 Cha Kwo Ling Road, Kowloon
Tel:23489211-4 Fax:(852)27727666

DWG NO. : J859-SD-PW-DT75 | REV. : C

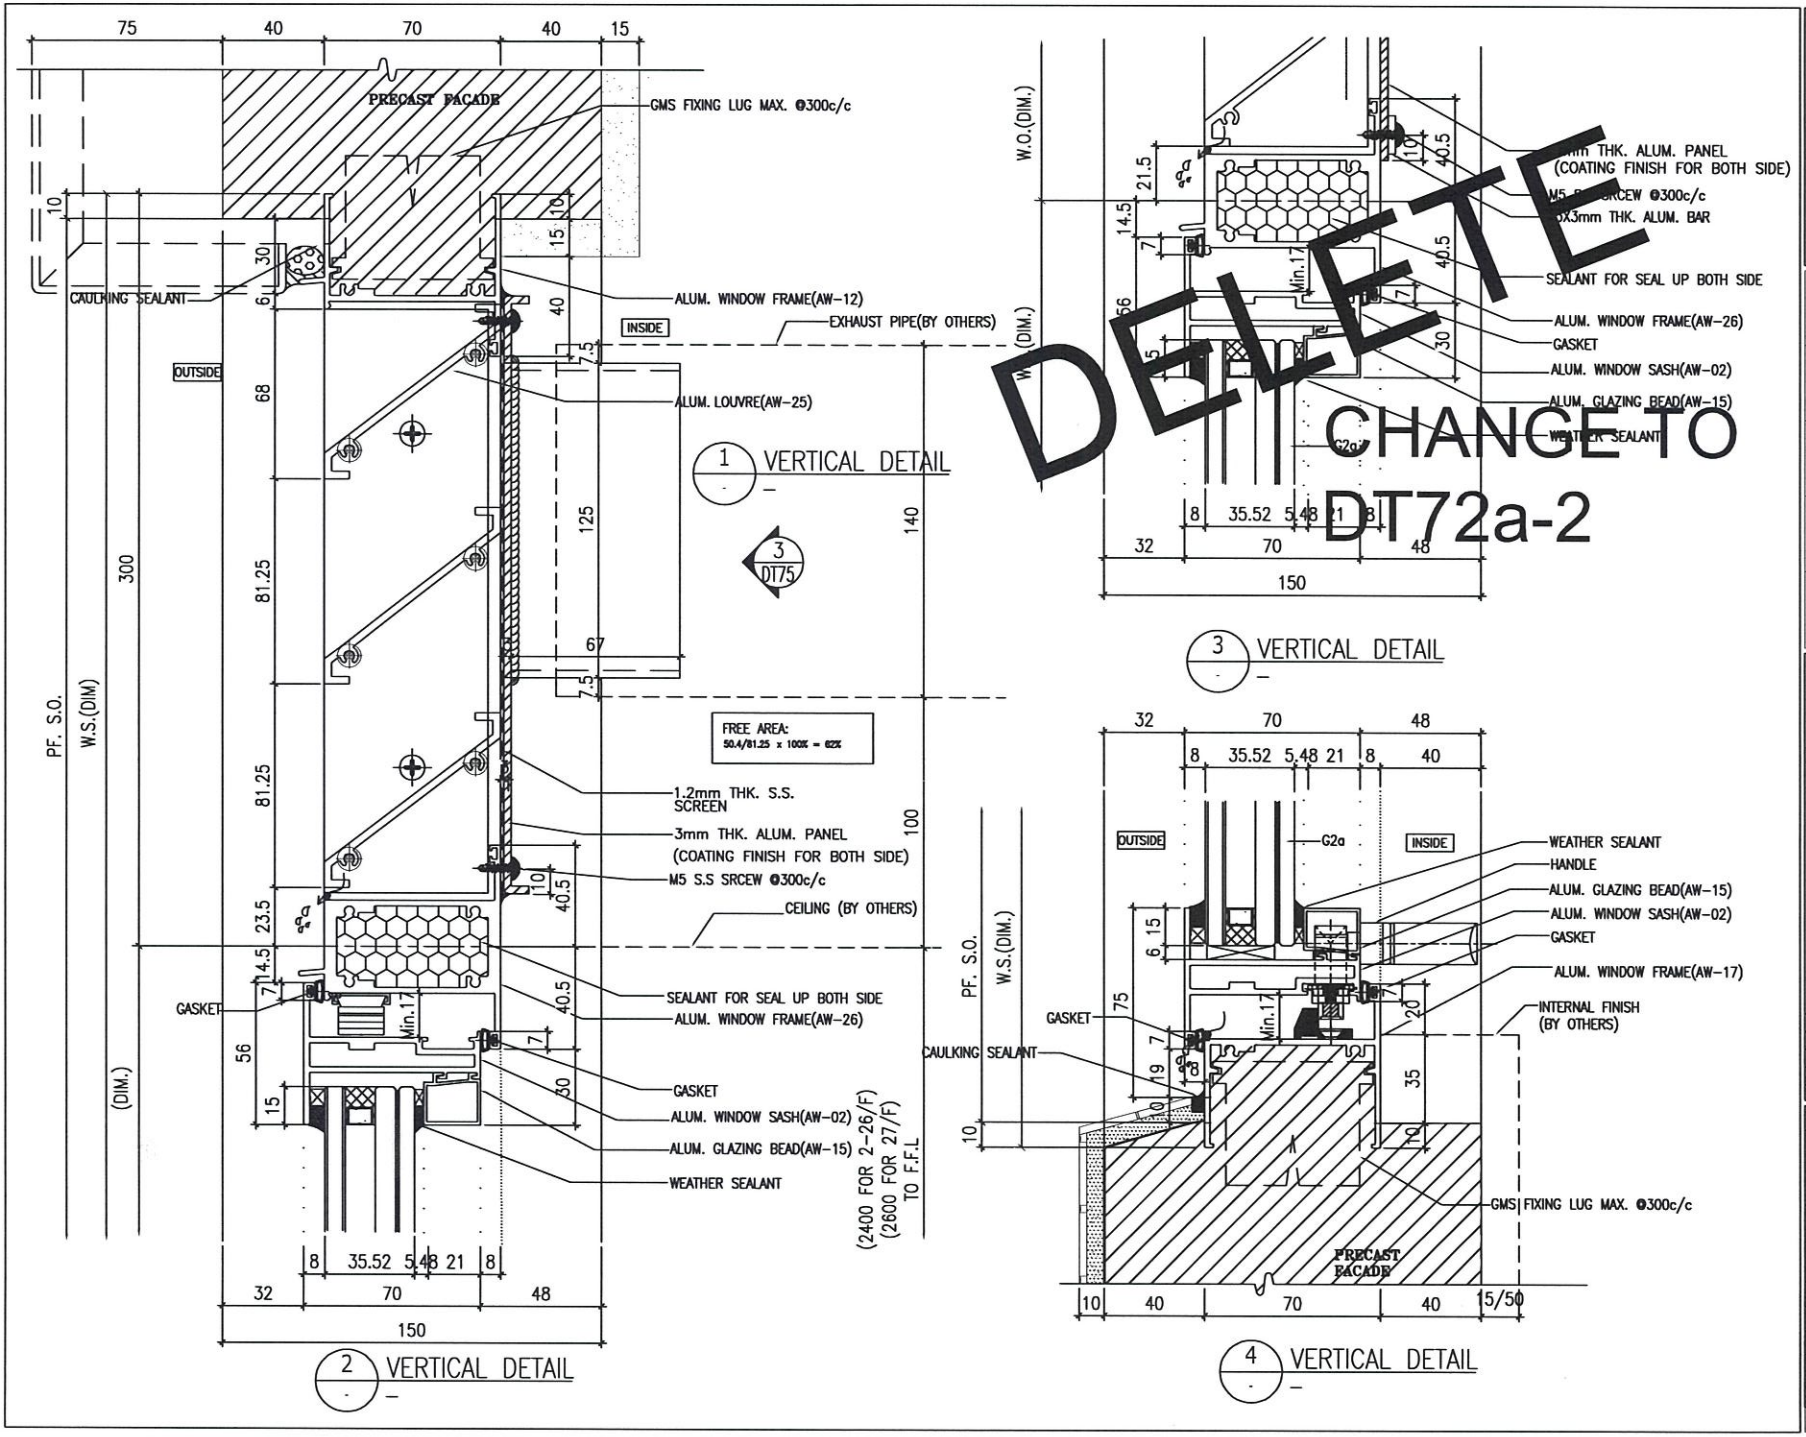

B.D. REF :

ARCHITECT :
WONG TUNG & PARTNERS LIMITED
ARCHITECTS & PLANNERS

STRUCTURAL ENGINEER :
SUN HUNG KAI
ARCHITECTS AND ENGINEERS LTD.
SUN HUNG KAI CENTRE, WANCHAI, HONGKONG
TEL. 28278111 FAX. 28272804

FACADE CONSULTANT:
ALPHA CONSULTING LIMITED
Steel Structure & Facade Specialist

MAIN CONTRACTOR :
Sanfield Engineering Construction Ltd.

CLIENT :
SUN HUNG KAI
REAL ESTATE AGENCY LTD.
42/F SUN HUNG KAI CENTRE, WANCHAI, HONGKONG

NOTE :
1. ALL DIMENSIONS ARE IN mm.
2. ALL ELEVATIONS ARE VIEWED FROM OUTSIDE.
3. ALL DIMENSIONS TO BE VERIFIED ON SITE BEFORE FABRICATION.

LEGEND :
X1 / X001 — DETAIL MARK NO. / REFER SHEET NO.
1. F.F.L. --FINISHED FLOOR LEVEL
2. S.F.L. --STRUCTURAL FLOOR LEVEL
3. (R) --REVERSED DETAIL
4. GLASS LEGEND
G1-8mmHS+12mm AIR GAP+10mmTP I.G.U.
G2-8mmHS+12mm AIR GAP+8mmTP I.G.U.
G2a-8mmHS+12mm AIR GAP+8mmTP+1.52PVB +6mmTP(PLANNING) FEATURED GLASS (I.G.U.)
G8-6mm GREY HS+1.52PVB+6mm CLEAR HS

NO.	DATE	REVISED	BY
D	28/09/2022	REVISION SUBJECT TO ARCHCOMMENT	
C	07/09/2022	REVISION SUBJECT TO ARCHCOMMENT	
B	25/04/2022	REVISION SUBJECT TO ARCHCOMMENT	
A	28/03/2022	REVISION SUBJECT TO ARCHCOMMENT	

JOB NO. : J-859

PROJECT :
PROPOSED RESIDENTIAL / COMMERCIAL DEVELOPMENT AT NKIL NO.6551 KAI TAK AREA 4C, SITE 3 KAI TAK, KOWLOON


TITLE :
TYPICAL DETAILS FOR ALUM. WINDOW

DATE : 10-Nov-21 | SCALE : 1:2 (A3)


DRAWN BY : IVAN | CHECKED BY :


美特鋁製有限公司
MIDI ALUMINIUM FABRICATOR LTD.
Units 6-8, Sunray Industrial Centre, 1/F
610 Cha Kwo Ling Road, Kowloon
Tel:23489211-4 Fax:(852)27727666

DWG NO. : J859-SD-PW-DT76 | REV. : D

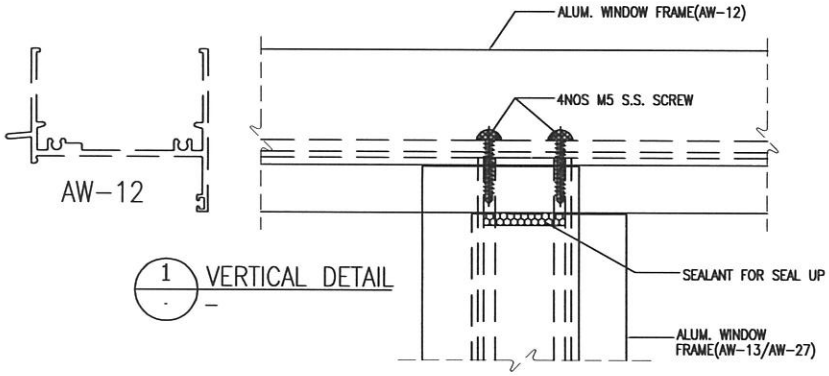



1 VERTICAL DETAIL

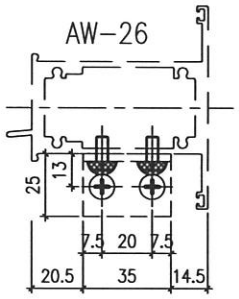


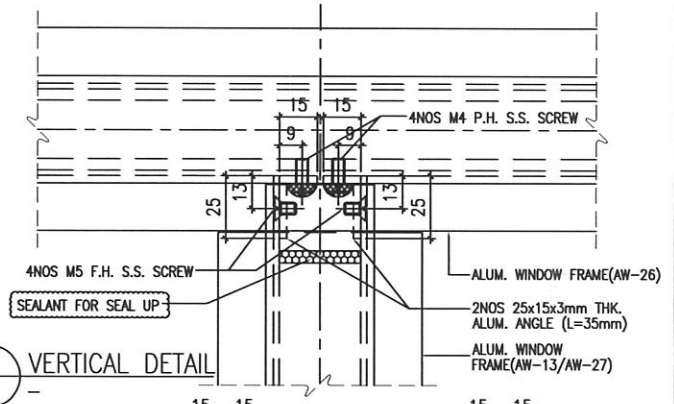



3 VERTICAL DETAIL

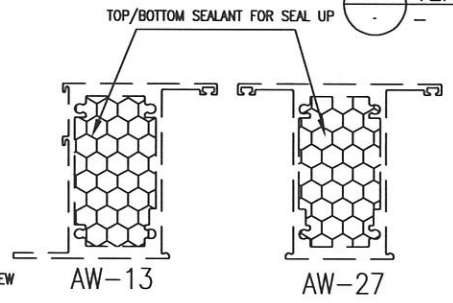


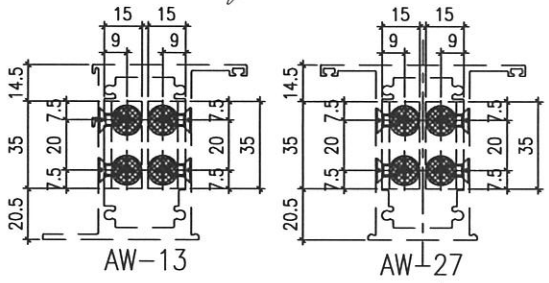

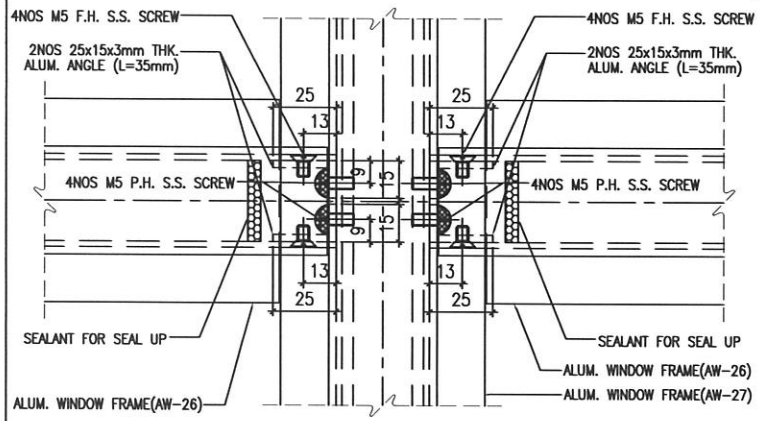


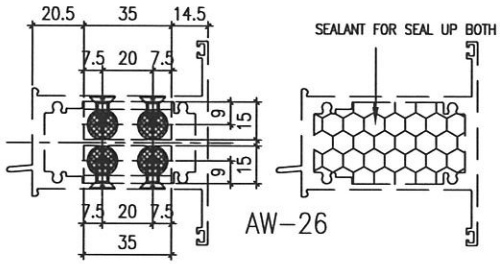


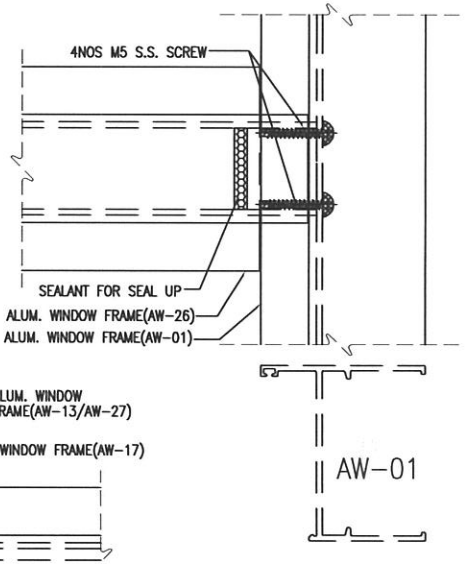

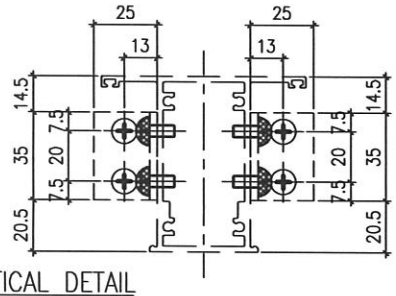

2 VERTICAL DETAIL

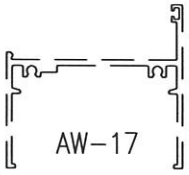

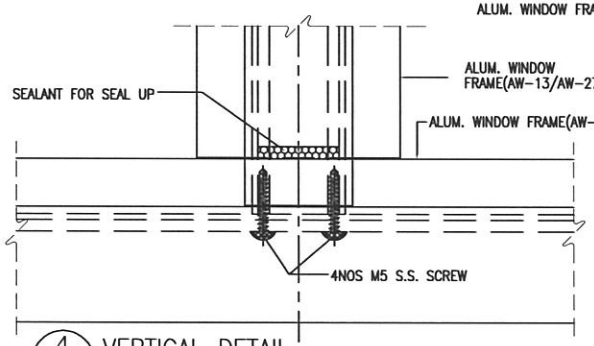

4 VERTICAL DETAIL

5 VERTICAL DETAIL

B.D. REF :

ARCHITECT :
WONG TUNG & PARTNERS LIMITED
ARCHITECTS & PLANNERS

STRUCTURAL ENGINEER :
SUN HUNG KAI
ARCHITECTS AND ENGINEERS LTD.
SUN HUNG KAI CENTRE, WANCHAI, HONGKONG
TEL. 28278111 FAX. 28272884

FACADE CONSULTANT:
ALPHA CONSULTING LIMITED
Steel Structure & Facade Specialist

MAIN CONTRACTOR :
Sanfield Engineering Construction Ltd.

CLIENT :
SUN HUNG KAI
REAL ESTATE AGENCY LTD.
42/F SUN HUNG KAI CENTRE, WANCHAI, HONGKONG

NOTE :
1. ALL DIMENSIONS ARE IN mm.
2. ALL ELEVATIONS ARE VIEWED FROM OUTSIDE.
3. ALL DIMENSIONS TO BE VERIFIED ON SITE BEFORE FABRICATION.

LEGEND :
X1 — DETAIL MARK NO.
X001 — REFER SHEET NO.

1. F.F.L. --- FINISHED FLOOR LEVEL
2. S.F.L. --- STRUCTURAL FLOOR LEVEL
3. (R) --- REVERSED DETAIL
4. GLASS LEGEND

G1-8mmHS+12mm AIR GAP+10mmTP I.G.U.

G2-8mmHS+12mm AIR GAP+8mmTP I.G.U.

G2a-8mmHS+12mm AIR GAP+8mmTP+1.52PVB +6mmTP(PLANNING) FEATURED GLASS (I.G.U.)

G8-6mm GREY HS+1.52PVB+6mm CLEAR HS

NO.	DATE	REVISED	BY
A	30/08/2022	REVISION SUBJECT TO ARCHITECT COMMENT	MMH

JOB NO. : J-859

PROJECT :
PROPOSED RESIDENTIAL / COMMERCIAL DEVELOPMENT AT NKIL NO.6551 KAI TAK AREA 4C, SITE 3 KAI TAK, KOWLOON


TITLE :
TYPICAL DETAILS FOR ALUM. WINDOW

DATE : 10-Nov-21 | SCALE : 1:2 (A3)


DRAWN BY : IVAN | CHECKED BY :

美特鋁質有限公司
MIDI ALUMINIUM FABRICATOR LTD.
Units 6-8, Sunray Industrial Centre, 1/F
610 Cha Kwo Ling Road, Kowloon
Tel:23489211-4 Fax:(852)27727666


DWG NO. : J859-SD-PW-DT77 | REV. : A

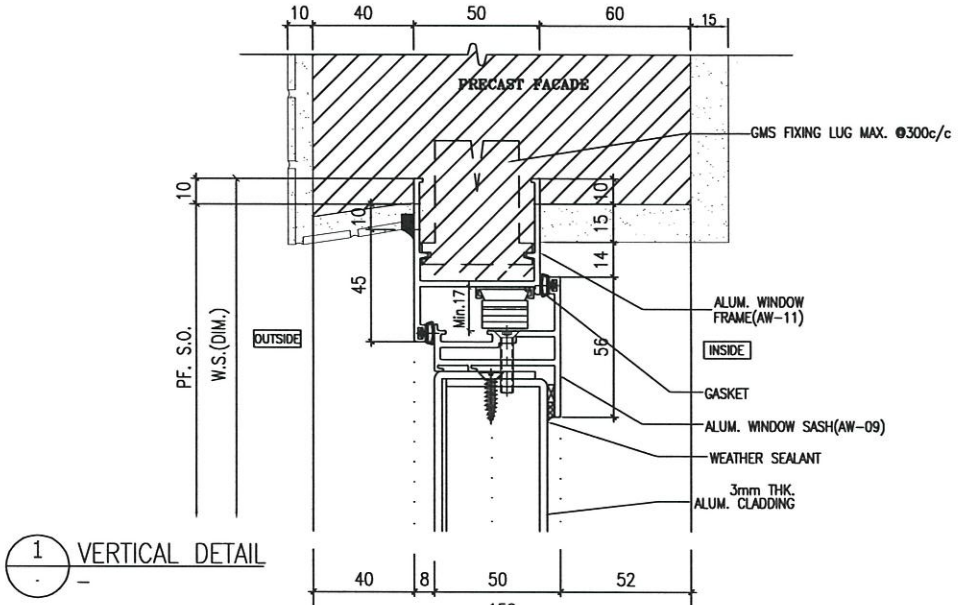

1 VERTICAL DETAIL

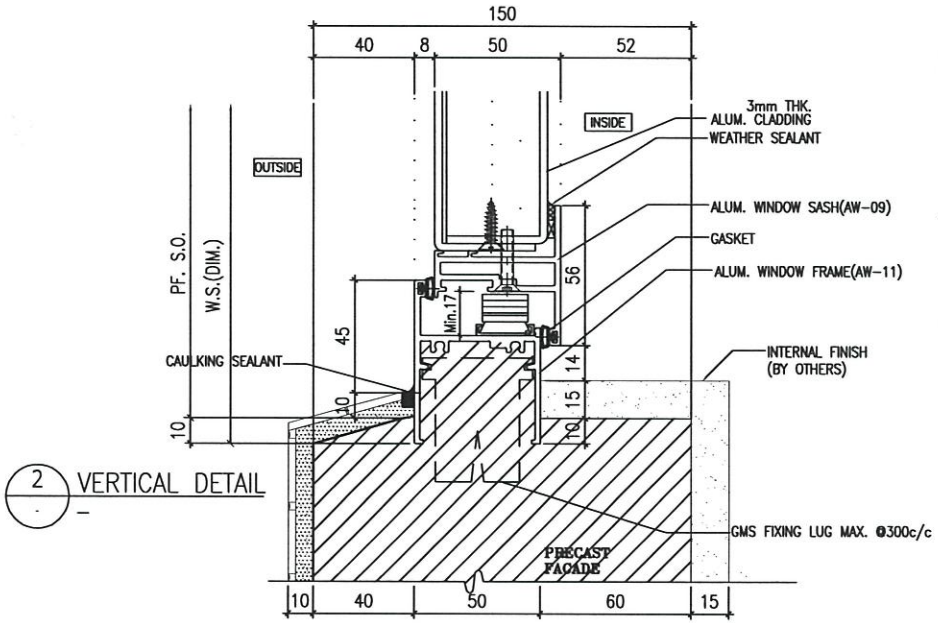

2 VERTICAL DETAIL

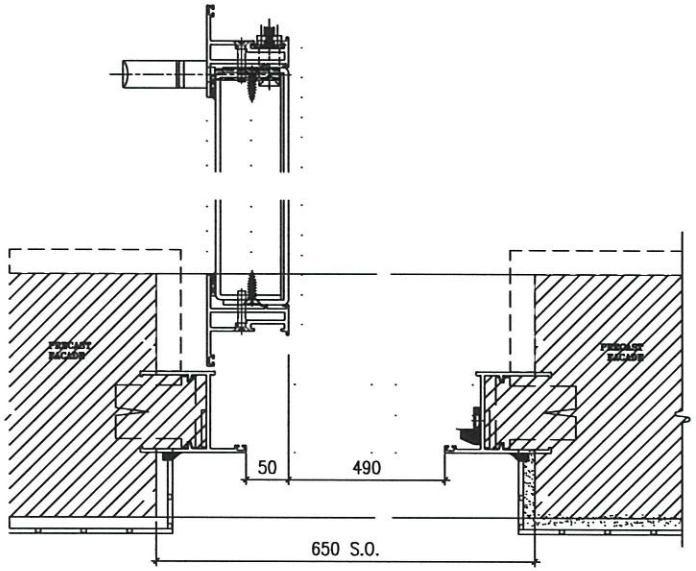

3 ALUM. DOOR OPENING

B.D. REF :

ARCHITECT :
WONG TUNG & PARTNERS LIMITED
ARCHITECTS & PLANNERS

STRUCTURAL ENGINEER :
SUN HUNG KAI
ARCHITECTS AND ENGINEERS LTD.
SUN HUNG KAI CENTRE, WANCHAI, HONGKONG
TEL. 28278111 FAX. 28272884

FACADE CONSULTANT:
ALPHA CONSULTING LIMITED
Steel Structure & Facade Specialist

MAIN CONTRACTOR :
Sanfield Engineering Construction Ltd.

CLIENT :
SUN HUNG KAI
REAL ESTATE AGENCY LTD.
42/F SUN HUNG KAI CENTRE, WANCHAI, HONGKONG

NOTE :
1. ALL DIMENSIONS ARE IN mm.
2. ALL ELEVATIONS ARE VIEWED FROM OUTSIDE.
3. ALL DIMENSIONS TO BE VERIFIED ON SITE BEFORE FABRICATION.

LEGEND :
X1 / X001 — DETAIL MARK NO. / REFER SHEET NO.
1. F.F.L. --FINISHED FLOOR LEVEL
2. S.F.L. --STRUCTURAL FLOOR LEVEL
3. (R) --REVERSED DETAIL
4. GLASS LEGEND
G1-8mmHS+12mm AIR GAP+10mmTP LG.U.
G2-8mmHS+12mm AIR GAP+8mmTP LG.U.
G2a-8mmHS+12mm AIR GAP+8mmTP+1.52PVB +6mmTP(PLANNING) FEATURED GLASS (LG.U.)
G8-6mm GREY HS+1.52PVB+6mm CLEAR HS

NO.	DATE	REVISED	BY
B	13/05/2022	REVISION SUBJECT TO ARCHITECT	
A	28/01/2022	REVISION SUBJECT TO ARCHITECT	

JOB NO. : J-859

PROJECT :
PROPOSED RESIDENTIAL / COMMERCIAL DEVELOPMENT AT NKIL NO.6551 KAI TAK AREA 4C, SITE 3 KAI TAK, KOWLOON


TITLE :
TYPICAL DETAILS FOR ALUM. WINDOW

DATE : 10-Nov-21 | SCALE : 1:2 (A3)


DRAWN BY : IVAN | CHECKED BY :

美特鋁製有限公司
MIDI ALUMINIUM FABRICATOR LTD.
Units 6-8, Sunray Industrial Centre, 1/F
610 Cha Kwo Ling Road, Kowloon
Tel:23489211-4 Fax:(852)27727666


DWG NO. : J859-SD-PW-DT78 | REV. : B

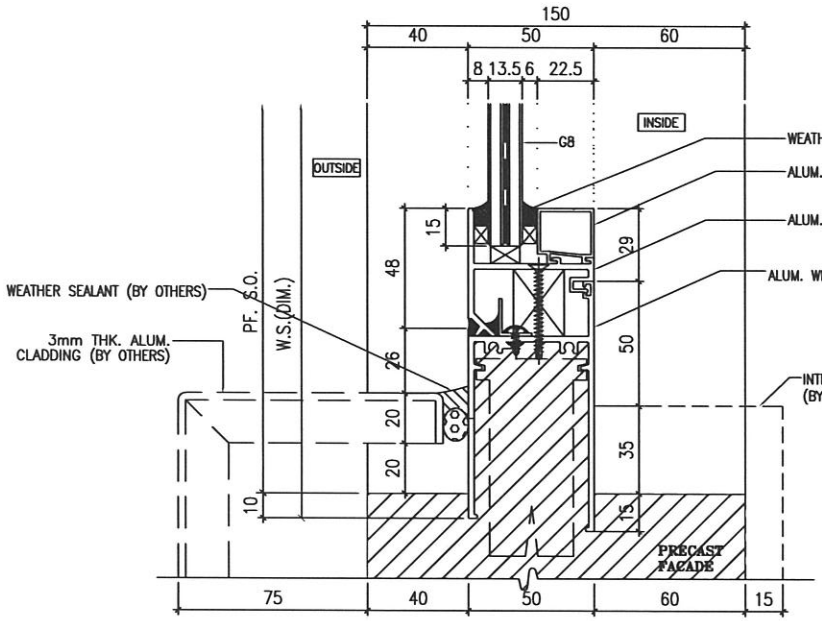


1 VERTICAL DETAIL

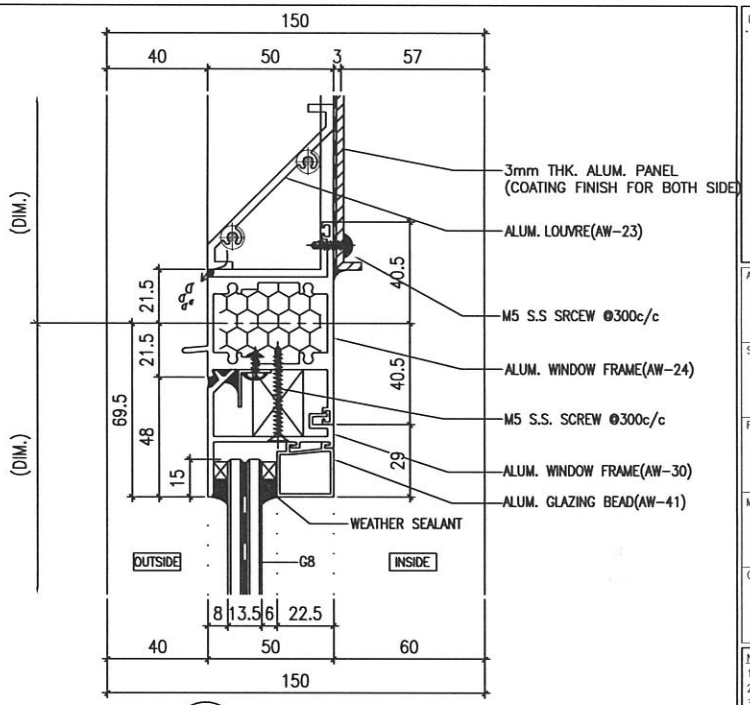

2 VERTICAL DETAIL

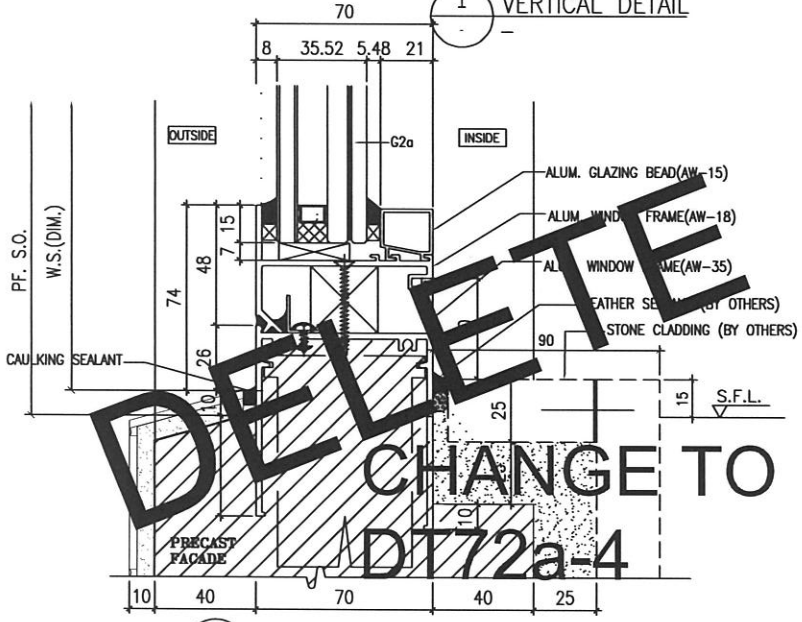

4 VERTICAL DETAIL

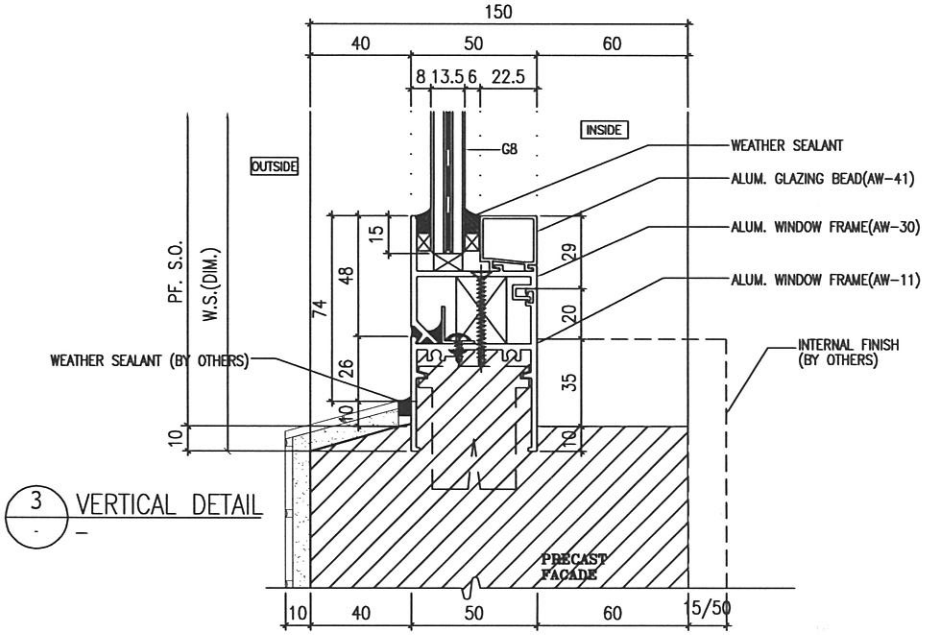

3 VERTICAL DETAIL

DELETE

CHANGE TO

DT72a-4

B.D. REF :

ARCHITECT :
WONG TUNG & PARTNERS LIMITED
ARCHITECTS & PLANNERS

STRUCTURAL ENGINEER :
SUN HUNG KAI
ARCHITECTS AND ENGINEERS LTD.
SUN HUNG KAI CENTRE, WANCHAI, HONGKONG
TEL: 28278111 FAX: 28272884

FACADE CONSULTANT:
ALPHA CONSULTING LIMITED
Steel Structure & Facade Specialist

MAIN CONTRACTOR :
Sanfield Engineering Construction Ltd.

CLIENT :
SUN HUNG KAI
REAL ESTATE AGENCY LTD.
42/F SUN HUNG KAI CENTRE, WANCHAI, HONGKONG

NOTE :
1. ALL DIMENSIONS ARE IN mm.
2. ALL ELEVATIONS ARE VIEWED FROM OUTSIDE.
3. ALL DIMENSIONS TO BE VERIFIED ON SITE BEFORE FABRICATION.

LEGEND :
X1 — DETAIL MARK NO.
X001 — REFER SHEET NO.

1. F.F.L. -- FINISHED FLOOR LEVEL
2. S.F.L. -- STRUCTURAL FLOOR LEVEL
3. /R -- REVERSED DETAIL
4. GLASS LEGEND

G1-8mmHS+12mm AIR GAP+10mmTP I.G.U.

G2-8mmHS+12mm AIR GAP+8mmTP I.G.U.

G2a-8mmHS+12mm AIR GAP+8mmTP+1.52PVB +6mmTP(PLANNING) FEATURED GLASS (I.G.U.)

G8-6mm GREY HS+1.52PVB+6mm CLEAR HS

NO.	DATE	REVISED	BY
A	28/03/2022	REVISION SUBJECT TO ARCHITECT	MM

JOB NO. : J-859

PROJECT :
PROPOSED RESIDENTIAL / COMMERCIAL DEVELOPMENT AT NKIL NO.6551 KAI TAK AREA 4C, SITE 3 KAI TAK, KOWLOON


TITLE :
TYPICAL DETAILS FOR ALUM. WINDOW

DATE : 10-Nov-21 | SCALE : 1:2 (A3)


DRAWN BY : IVAN | CHECKED BY :

美特鋁質有限公司
MIDI ALUMINIUM FABRICATOR LTD.
Units 6-8, Sunray Industrial Centre, 1/F
610 Cha Kwo Ling Road, Kowloon
Tel:23489211-4 Fax:(852)27727666


DWG NO. : J859-SD-PW-DT79 | REV. : A

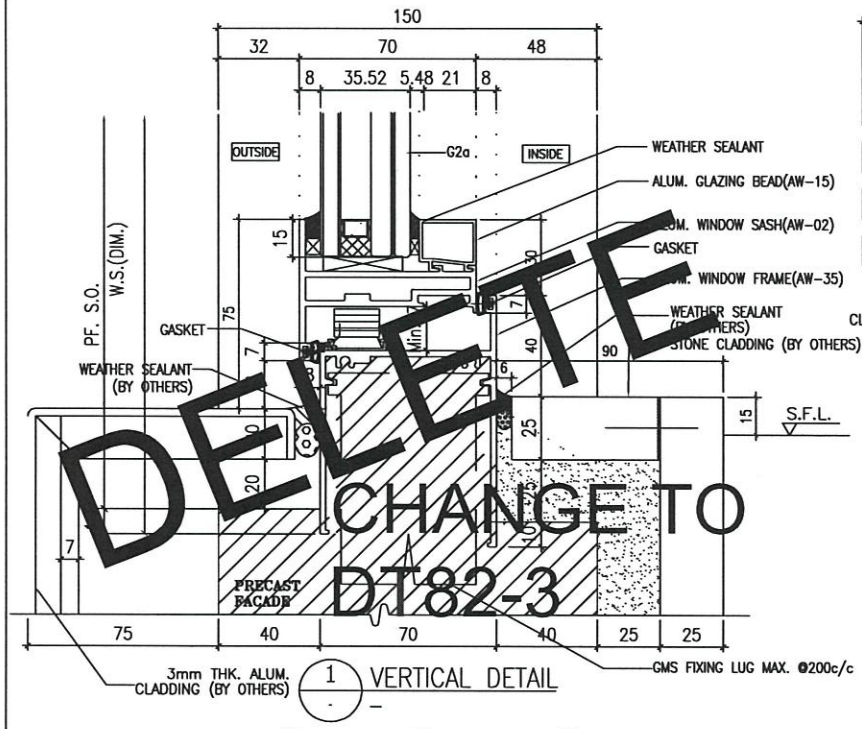

1 VERTICAL DETAIL

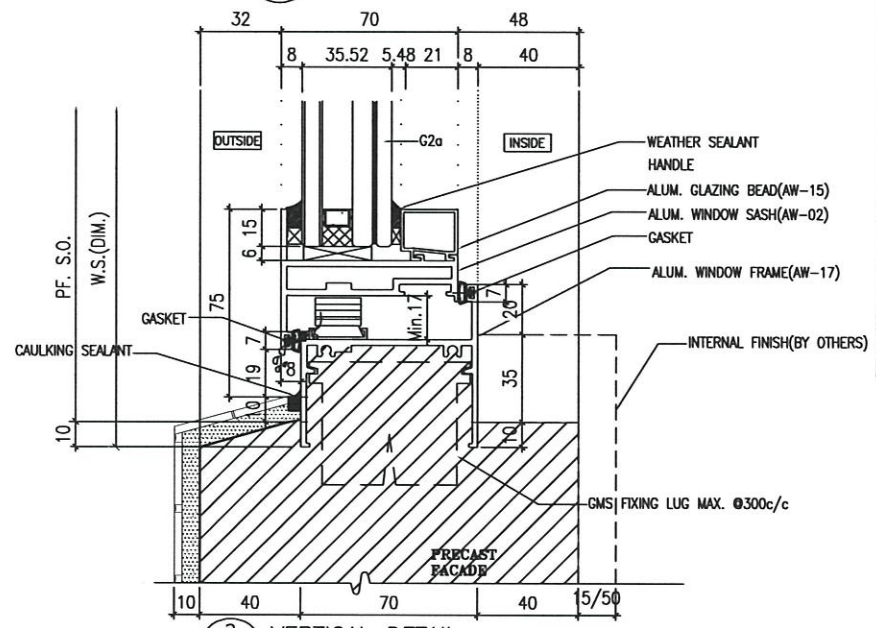

2 VERTICAL DETAIL

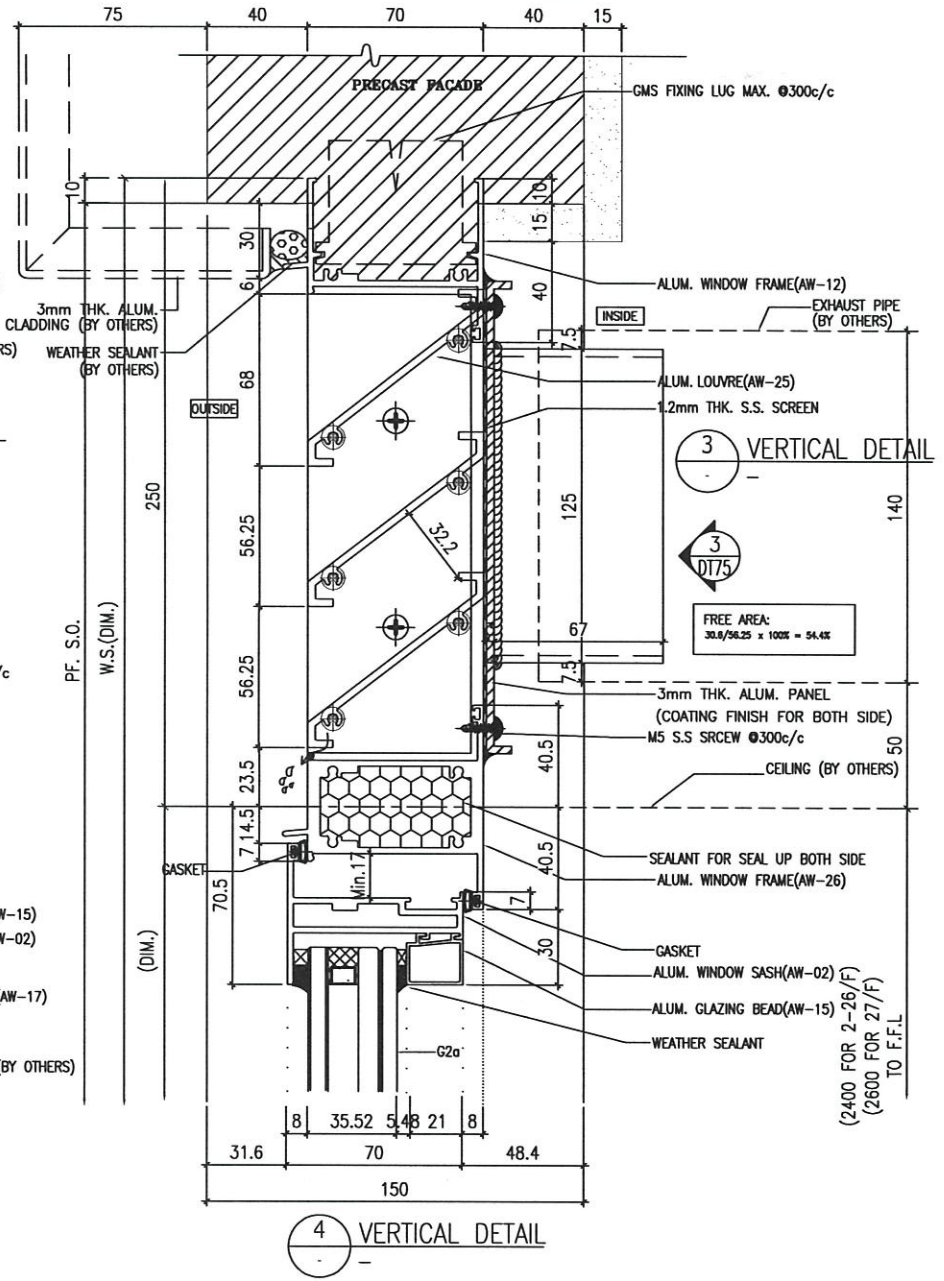

3 VERTICAL DETAIL

3 / DT75

4 VERTICAL DETAIL

B.D. REF :

ARCHITECT :
WONG TUNG & PARTNERS LIMITED
ARCHITECTS & PLANNERS

STRUCTURAL ENGINEER :
SUN HUNG KAI
ARCHITECTS AND ENGINEERS LTD.
SUN HUNG KAI CENTRE, WANCHAI, HONGKONG
TEL. 28278111 FAX. 28272884

FACADE CONSULTANT:
ALPHA CONSULTING LIMITED
Steel Structure & Facade Specialist

MAIN CONTRACTOR :
Sanfield Engineering Construction Ltd.

CLIENT :
SUN HUNG KAI
REAL ESTATE AGENCY LTD.
42/F SUN HUNG KAI CENTRE, WANCHAI, HONGKONG

NOTE :
1. ALL DIMENSIONS ARE IN mm.
2. ALL ELEVATIONS ARE VIEWED FROM OUTSIDE.
3. ALL DIMENSIONS TO BE VERIFIED ON SITE BEFORE FABRICATION.

LEGEND :
X1 / X001 — DETAIL MARK NO. / REFER SHEET NO.
1. F.F.L. --- FINISHED FLOOR LEVEL
2. S.F.L. --- STRUCTURAL FLOOR LEVEL
3. (R) --- REVERSED DETAIL
4. GLASS LEGEND
G1-8mmHS+12mm AIR GAP+10mmTP LG.U.
G2-8mmHS+12mm AIR GAP+8mmTP LG.U.
G2a-8mmHS+12mm AIR GAP+8mmTP+1.52PVB +6mmTP(PLANNING) FEATURED GLASS (LG.U.)
G8-6mm GREY HS+1.52PVB+6mm CLEAR HS

NO.	DATE	REVISED	BY
B	28/01/2022	REVISION SUBJECT TO ALPHA COMMENT	MMH
A	28/03/2022	REVISION SUBJECT TO ARCHCOMMENT	MMH

JOB NO. : J-859

PROJECT :
PROPOSED RESIDENTIAL / COMMERCIAL DEVELOPMENT AT NKIL NO.6551 KAI TAK AREA 4C, SITE 3 KAI TAK, KOWLOON


TITLE :
TYPICAL DETAILS FOR ALUM. WINDOW

DATE : 10-Nov-21 | SCALE : 1:2 (A3)


DRAWN BY : IVAN | CHECKED BY :


美特鋁質有限公司
MIDI ALUMINIUM FABRICATOR LTD.
Units 6-8, Sunray Industrial Centre, 1/F
610 Cha Kwo Ling Road, Kowloon
Tel:23489211-4 Fax:(852)27727686

DWG NO. : J859-SD-PW-DT80 | REV. : B

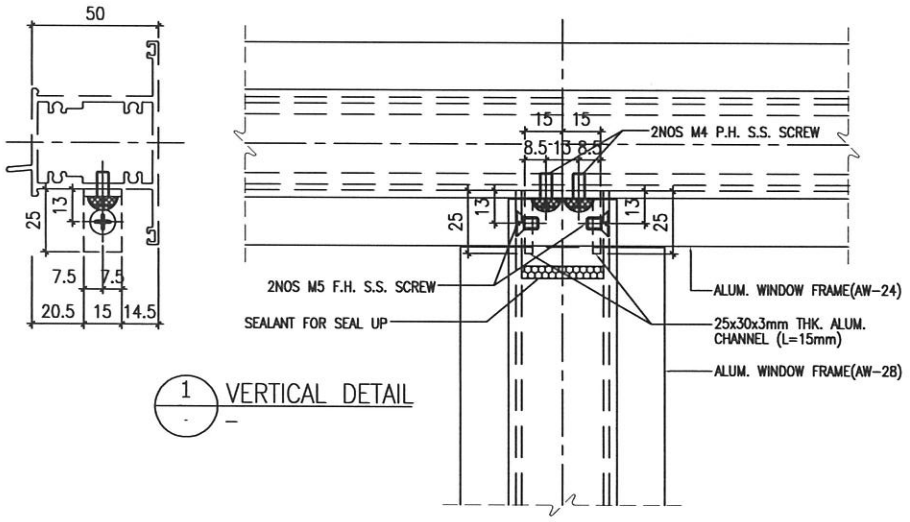

1 VERTICAL DETAIL

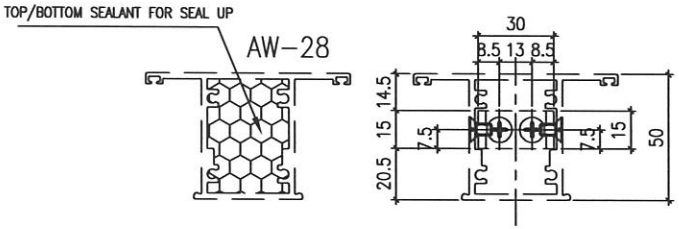

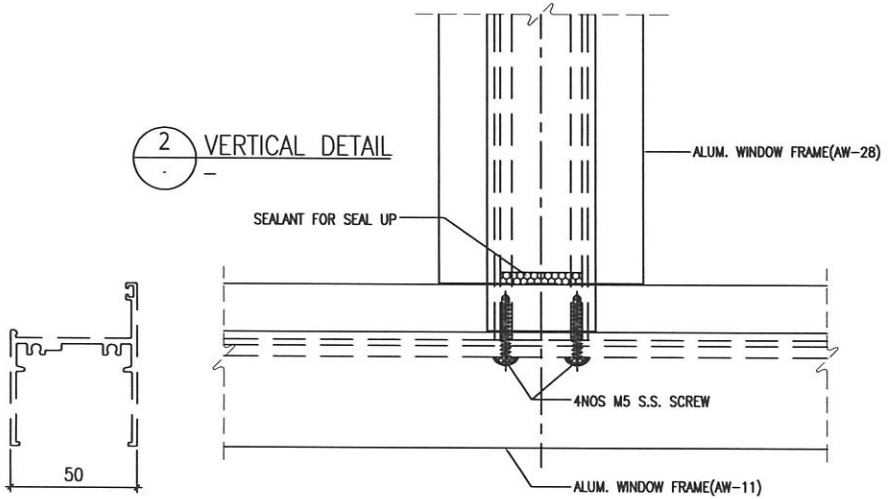

2 VERTICAL DETAIL

B.D. REF :

ARCHITECT :
WONG TUNG & PARTNERS LIMITED
ARCHITECTS & PLANNERS

STRUCTURAL ENGINEER :
SUN HUNG KAI
ARCHITECTS AND ENGINEERS LTD.
SUN HUNG KAI CENTRE, WANCHAI, HONGKONG
TEL: 28278111 FAX: 28272884

FACADE CONSULTANT:
ALPHA CONSULTING LIMITED
Steel Structure & Facade Specialist

MAIN CONTRACTOR :
Sanfield Engineering Construction Ltd.

CLIENT :
SUN HUNG KAI
REAL ESTATE AGENCY LTD.
42/F SUN HUNG KAI CENTRE, WANCHAI, HONGKONG

NOTE :
1. ALL DIMENSIONS ARE IN mm.
2. ALL ELEVATIONS ARE VIEWED FROM OUTSIDE.
3. ALL DIMENSIONS TO BE VERIFIED ON SITE BEFORE FABRICATION.

LEGEND :
X1 — DETAIL MARK NO.
X001 — REFER SHEET NO.

1. F.F.L. -- FINISHED FLOOR LEVEL
2. S.F.L. -- STRUCTURAL FLOOR LEVEL
3. /R -- REVERSED DETAIL
4. GLASS LEGEND

G1-8mmHS+12mm AIR GAP+10mmTP I.G.U.

G2-8mmHS+12mm AIR GAP+8mmTP I.G.U.

G2a-8mmHS+12mm AIR GAP+8mmTP+1.52PVB +6mmTP(PLANNING) FEATURED GLASS (I.G.U.)

G8-6mm GREY HS+1.52PVB+6mm CLEAR HS

NO.	DATE	REVISED	BY
C	30/08/2022	REVISION SUBJECT TO ALPHA COMMENT	
B	13/08/2022	REVISION SUBJECT TO ALPHA COMMENT	
A	25/04/2022	REVISION SUBJECT TO ARCH.COMMENT	

JOB NO. : J-859

PROJECT :
PROPOSED RESIDENTIAL / COMMERCIAL DEVELOPMENT AT NKIL NO.6551 KAI TAK AREA 4C, SITE 3 KAI TAK, KOWLOON


TITLE :
TYPICAL DETAILS FOR ALUM. WINDOW

DATE : 10-Nov-21 | SCALE : 1:2 (A3)


DRAWN BY : IVAN | CHECKED BY :

美特鋁質有限公司
MIDI ALUMINIUM FABRICATOR LTD.
Units 6-8, Sunray Industrial Centre, 1/F
610 Cha Kwo Ling Road, Kowloon
Tel:23489211-4 Fax:(852)27727866


DWG NO. : J859-SD-PW-DT80a | REV. : B

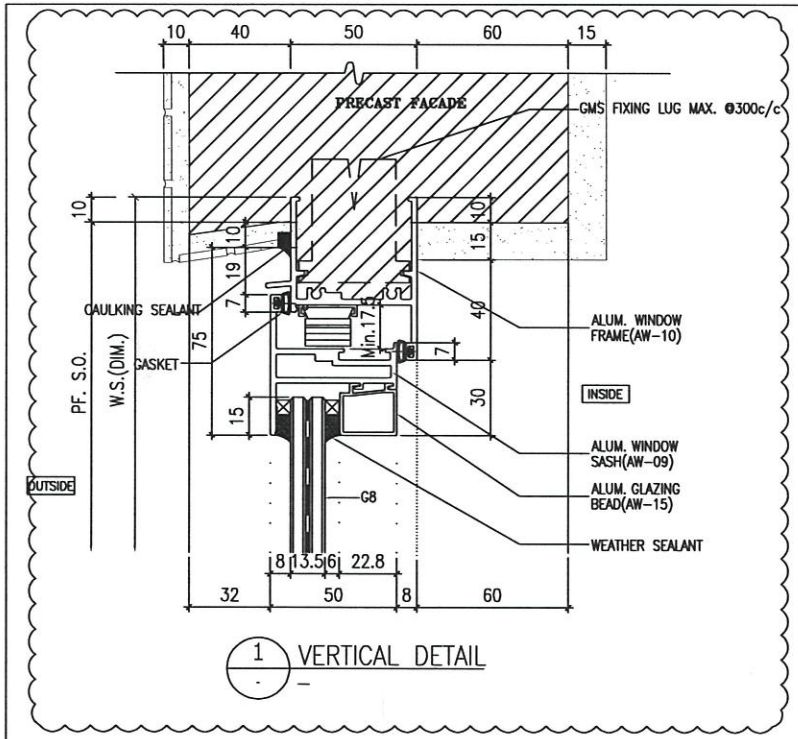

1 VERTICAL DETAIL

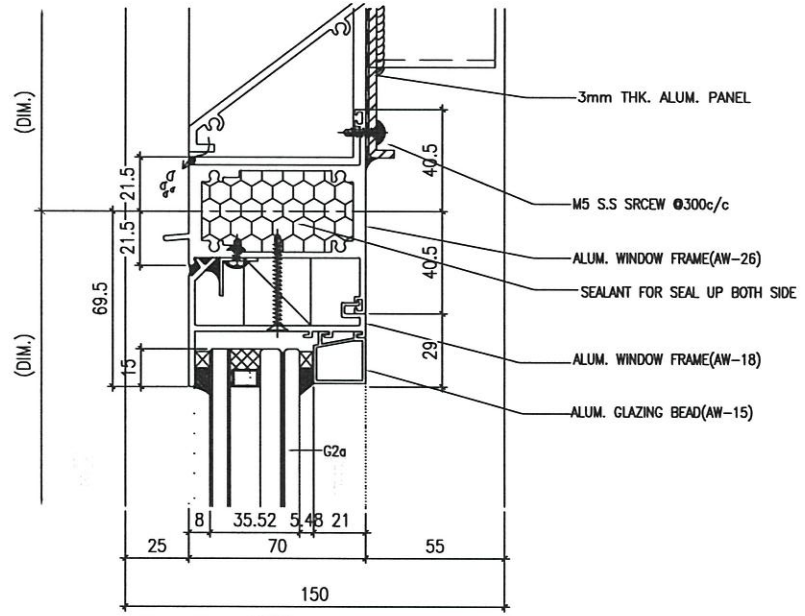

2 VERTICAL DETAIL

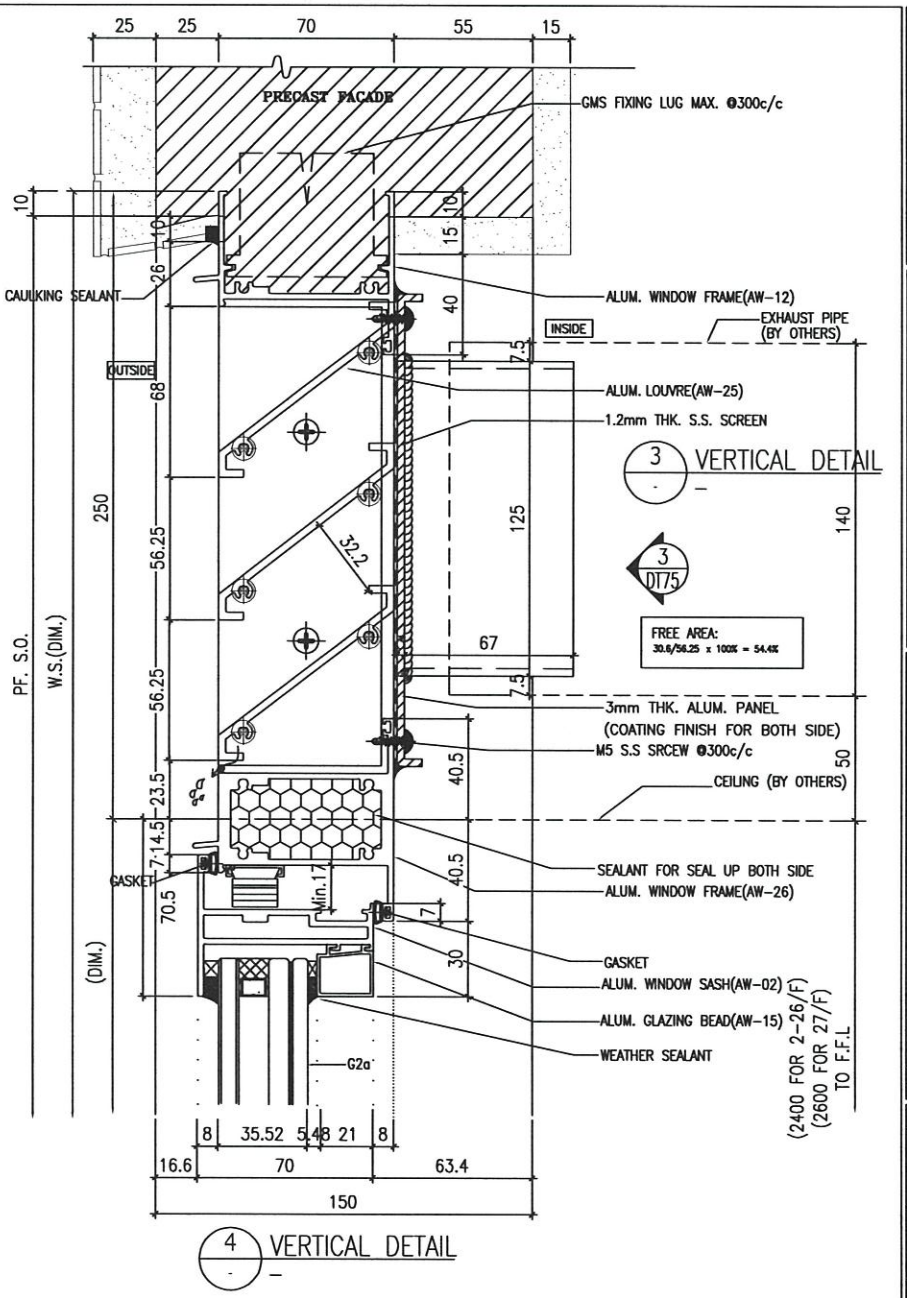

4 VERTICAL DETAIL

B.D. REF :

ARCHITECT :
WONG TUNG & PARTNERS LIMITED
ARCHITECTS & PLANNERS

STRUCTURAL ENGINEER :
SUN HUNG KAI
ARCHITECTS AND ENGINEERS LTD.
SUN HUNG KAI CENTRE, WANCHAI, HONGKONG
TEL. 2827 8811 FAX. 2827 2804

FACADE CONSULTANT:
ALPHA CONSULTING LIMITED
Steel Structure & Facade Specialist

MAIN CONTRACTOR :
Sanfield Engineering Construction Ltd.

CLIENT :
SUN HUNG KAI
REAL ESTATE AGENCY LTD.
42/F SUN HUNG KAI CENTRE, WANCHAI, HONGKONG

NOTE :
1. ALL DIMENSIONS ARE IN mm.
2. ALL ELEVATIONS ARE VIEWED FROM OUTSIDE.
3. ALL DIMENSIONS TO BE VERIFIED ON SITE BEFORE FABRICATION.

LEGEND :
X1 — DETAIL MARK NO.
X001 — REFER SHEET NO.
1. F.F.L. — FINISHED FLOOR LEVEL
2. S.F.L. — STRUCTURAL FLOOR LEVEL
3. (R) — REVERSED DETAIL
4. GLASS LEGEND
G1-8mmHS+12mm AIR GAP+10mmTP I.G.U.
G2-8mmHS+12mm AIR GAP+8mmTP I.G.U.
G2a-8mmHS+12mm AIR GAP+8mmTP+1.52PVB +6mmTP(PLANNING) FEATURED GLASS (I.G.U.)
G8-6mm GREY HS+1.52PVB+6mm CLEAR HS

NO.	DATE	REVISED	BY
A	04/11/2022	REVISION SUBJECT TO ARCHITECT	W

JOB NO. : J-859

PROJECT :
PROPOSED RESIDENTIAL / COMMERCIAL DEVELOPMENT AT NKIL NO.6551 KAI TAK AREA 4C, SITE 3 KAI TAK, KOWLOON


TITLE :
TYPICAL DETAILS FOR ALUM. WINDOW

DATE : 10-Nov-21 | SCALE : 1:2 (A3)


DRAWN BY : IVAN | CHECKED BY :

美特鋁質有限公司
MIDI ALUMINIUM FABRICATOR LTD.
Units 6-8, Sunray Industrial Centre, 1/F
610 Cha Kwo Ling Road, Kowloon
Tel:23489211-4 Fax:(852)27727666


DWG NO. : J859-SD-PW-DT80b | REV. : A

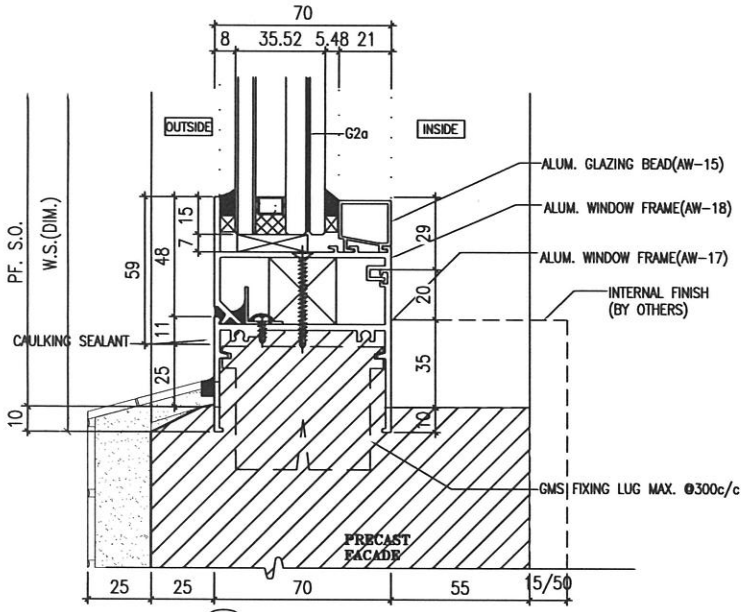


1 VERTICAL DETAIL
–

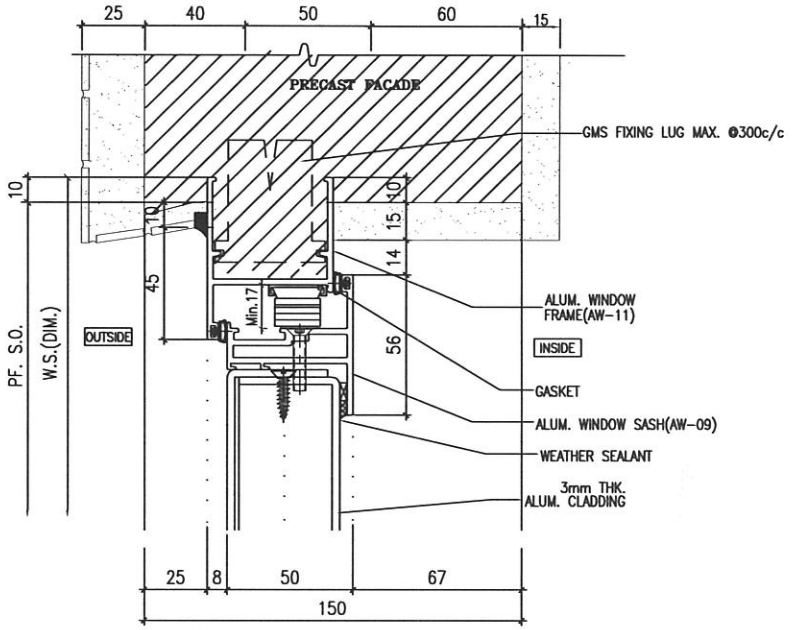

3 VERTICAL DETAIL
–

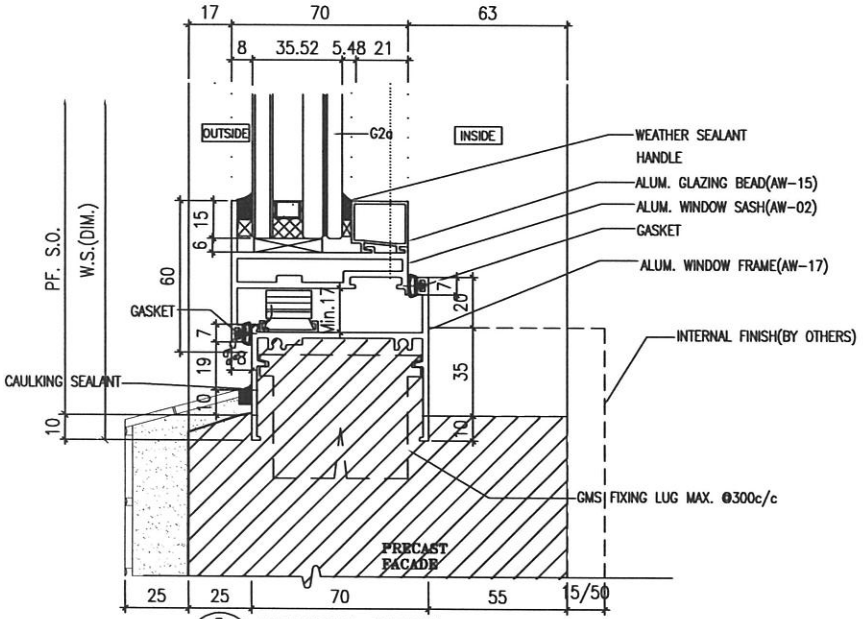

2 VERTICAL DETAIL
–

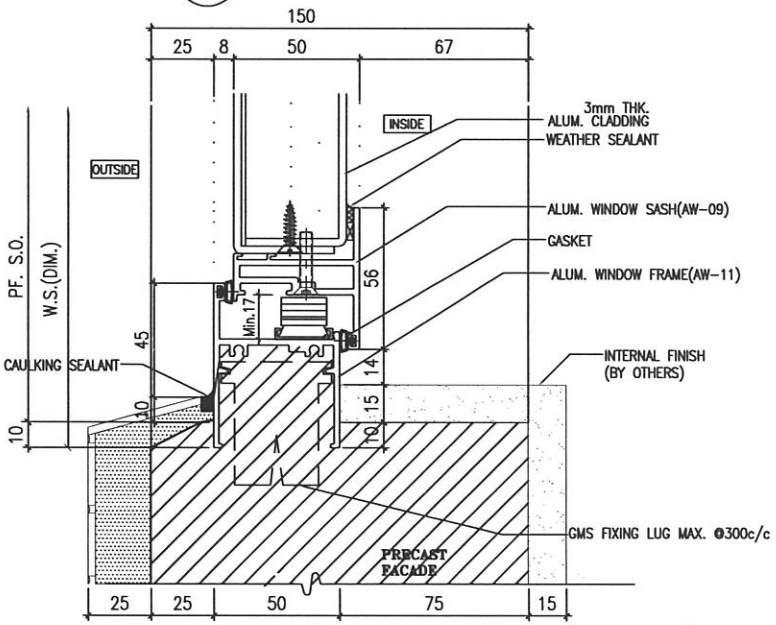

4 VERTICAL DETAIL
–

B.D. REF :

ARCHITECT :
WONG TUNG & PARTNERS LIMITED
ARCHITECTS & PLANNERS

STRUCTURAL ENGINEER :
SUN HUNG KAI
ARCHITECTS AND ENGINEERS LTD.
SUN HUNG KAI CENTRE, WANCHAI, HONGKONG
TEL. 28278111 FAX. 28272884

FACADE CONSULTANT:
ALPHA CONSULTING LIMITED
Steel Structure & Facade Specialist

MAIN CONTRACTOR :
Sanfield Engineering Construction Ltd.

CLIENT :
SUN HUNG KAI
REAL ESTATE AGENCY LTD.
42/F SUN HUNG KAI CENTRE, WANCHAI, HONGKONG

NOTE :
1. ALL DIMENSIONS ARE IN mm.
2. ALL ELEVATIONS ARE VIEWED FROM OUTSIDE.
3. ALL DIMENSIONS TO BE VERIFIED ON SITE BEFORE FABRICATION.

LEGEND :
X1 — DETAIL MARK NO.
X001 — REFER SHEET NO.
1. F.F.L. --- FINISHED FLOOR LEVEL
2. S.F.L. --- STRUCTURAL FLOOR LEVEL
3. (/R) --- REVERSED DETAIL
4. GLASS LEGEND
G1–8mmHS+12mm AIR GAP+10mmTP I.G.U.
G2–8mmHS+12mm AIR GAP+8mmTP I.G.U.
G2a–8mmHS+12mm AIR GAP+8mmTP+1.52PVB +6mmTP(PLANNING) FEATURED GLASS (I.G.U.)
G8–6mm GREY HS+1.52PVB+6mm CLEAR HS

NO.	DATE	REVISED	BY

JOB NO. : J-859

PROJECT :
PROPOSED RESIDENTIAL / COMMERCIAL DEVELOPMENT AT NKIL NO.6551 KAI TAK AREA 4C, SITE 3 KAI TAK, KOWLOON


TITLE :
TYPICAL DETAILS FOR ALUM. WINDOW

DATE : 10–Nov–21 | SCALE : 1:2 (A3)


DRAWN BY : IVAN | CHECKED BY :

美特鋁製有限公司
MIDI ALUMINIUM FABRICATOR LTD.
Units 6–8, Sunray Industrial Centre, 1/F
610 Cha Kwo Ling Road, Kowloon
Tel:23489211–4 Fax:(852)27727666


DWG NO. : J859–SD–PW–DT80c | REV. : –

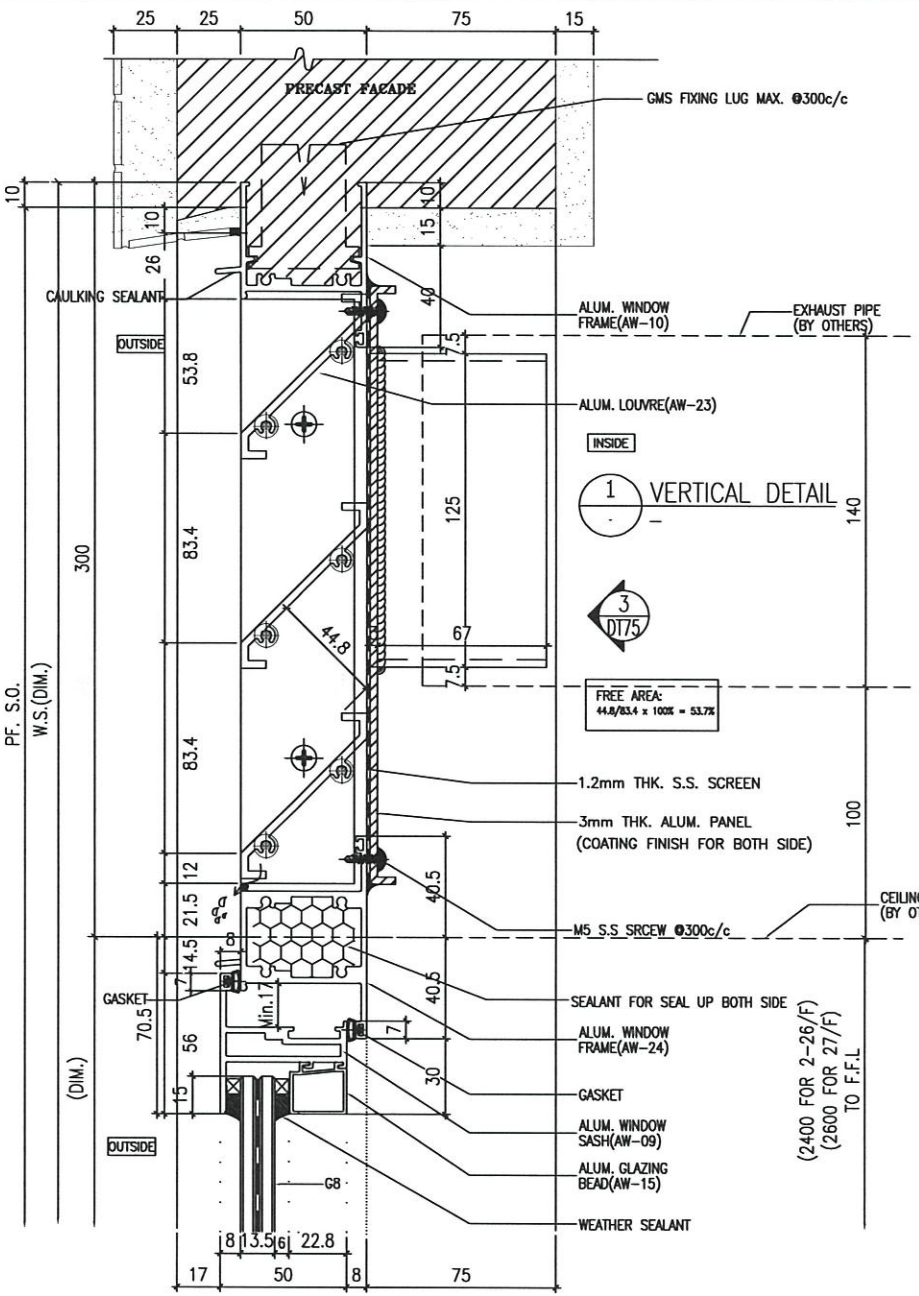

2 VERTICAL DETAIL

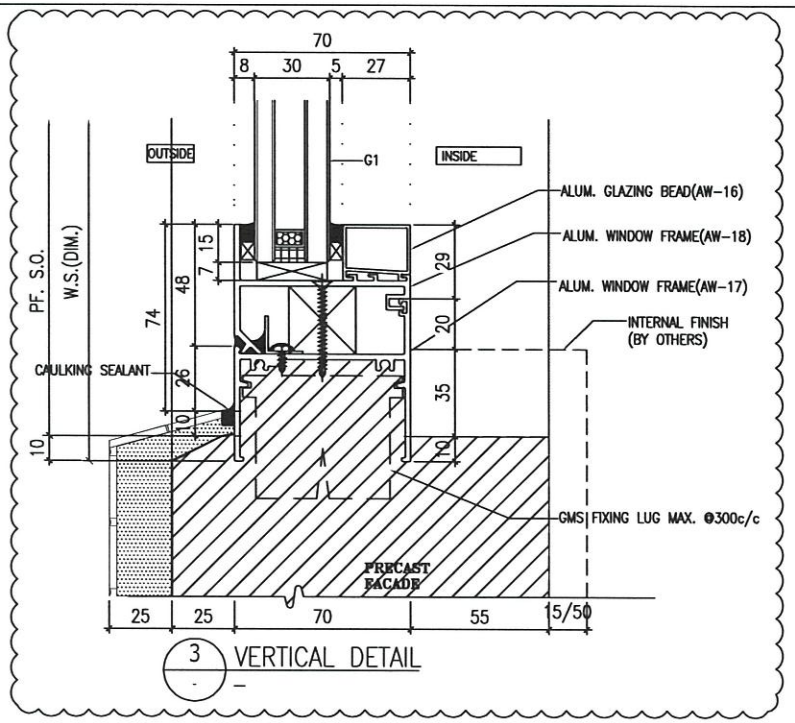

3 VERTICAL DETAIL

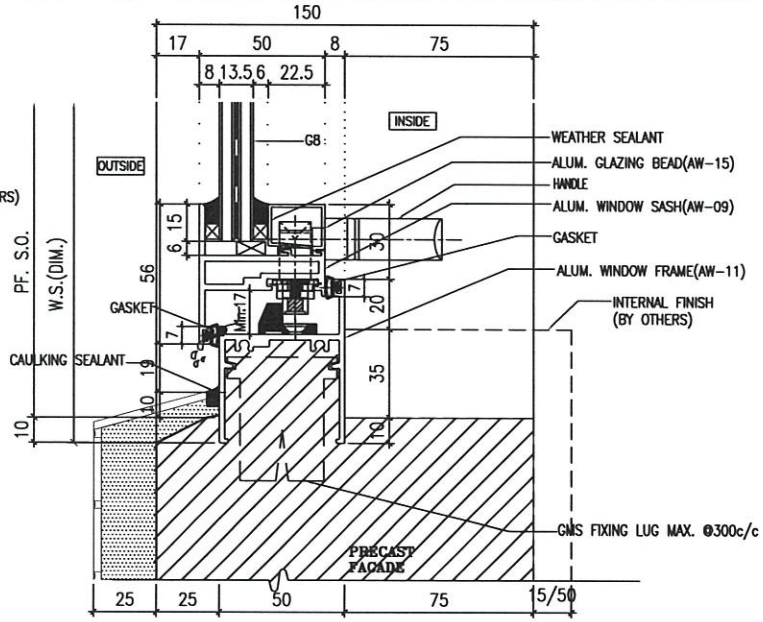

4 VERTICAL DETAIL

B.D. REF :

ARCHITECT :
WONG TUNG & PARTNERS LIMITED
ARCHITECTS & PLANNERS

STRUCTURAL ENGINEER :
SUN HUNG KAI ARCHITECTS AND ENGINEERS LTD.
SUN HUNG KAI CENTRE, WANCHAI, HONGKONG
TEL. 28276111 FAX. 28272804

FACADE CONSULTANT:
ALPHA CONSULTING LIMITED
Steel Structure & Facade Specialist

MAIN CONTRACTOR :
Sanfield Engineering Construction Ltd.

CLIENT :
SUN HUNG KAI REAL ESTATE AGENCY LTD.
42/F SUN HUNG KAI CENTRE, WANCHAI, HONGKONG

NOTE :
1. ALL DIMENSIONS ARE IN mm.
2. ALL ELEVATIONS ARE VIEWED FROM OUTSIDE.
3. ALL DIMENSIONS TO BE VERIFIED ON SITE BEFORE FABRICATION.

LEGEND :
X1 / X001 — DETAIL MARK NO. / REFER SHEET NO.
1. F.F.L. --- FINISHED FLOOR LEVEL
2. S.F.L. --- STRUCTURAL FLOOR LEVEL
3. /R --- REVERSED DETAIL
4. GLASS LEGEND
G1-8mmHS+12mm AIR GAP+10mmTP I.G.U.
G2-8mmHS+12mm AIR GAP+8mmTP I.G.U.
G2a-8mmHS+12mm AIR GAP+8mmTP+1.52PVB +6mmTP(PLANNING) FEATURED GLASS (I.G.U.)
G8-6mm GREY HS+1.52PVB+6mm CLEAR HS

NO.	DATE	REVISED	BY
A	04/11/2022	GENERAL REVISED	W

JOB NO. : J-859

PROJECT :
PROPOSED RESIDENTIAL / COMMERCIAL DEVELOPMENT AT NKIL NO.6551 KAI TAK AREA 4C, SITE 3 KAI TAK, KOWLOON


TITLE :
TYPICAL DETAILS FOR ALUM. WINDOW


DATE : 10-Nov-21 | SCALE : 1:2 (A3)


DRAWN BY : IVAN | CHECKED BY :

美特鋁製有限公司
MIDI ALUMINIUM FABRICATION LTD.
Units G-8, Sunray Industrial Centre, 1/F
810 Cha Kwo Ling Road, Kowloon
Tel:23489211-4 Fax:(852)27727666

DWG NO. : J859-SD-PW-DT80d | REV. : A

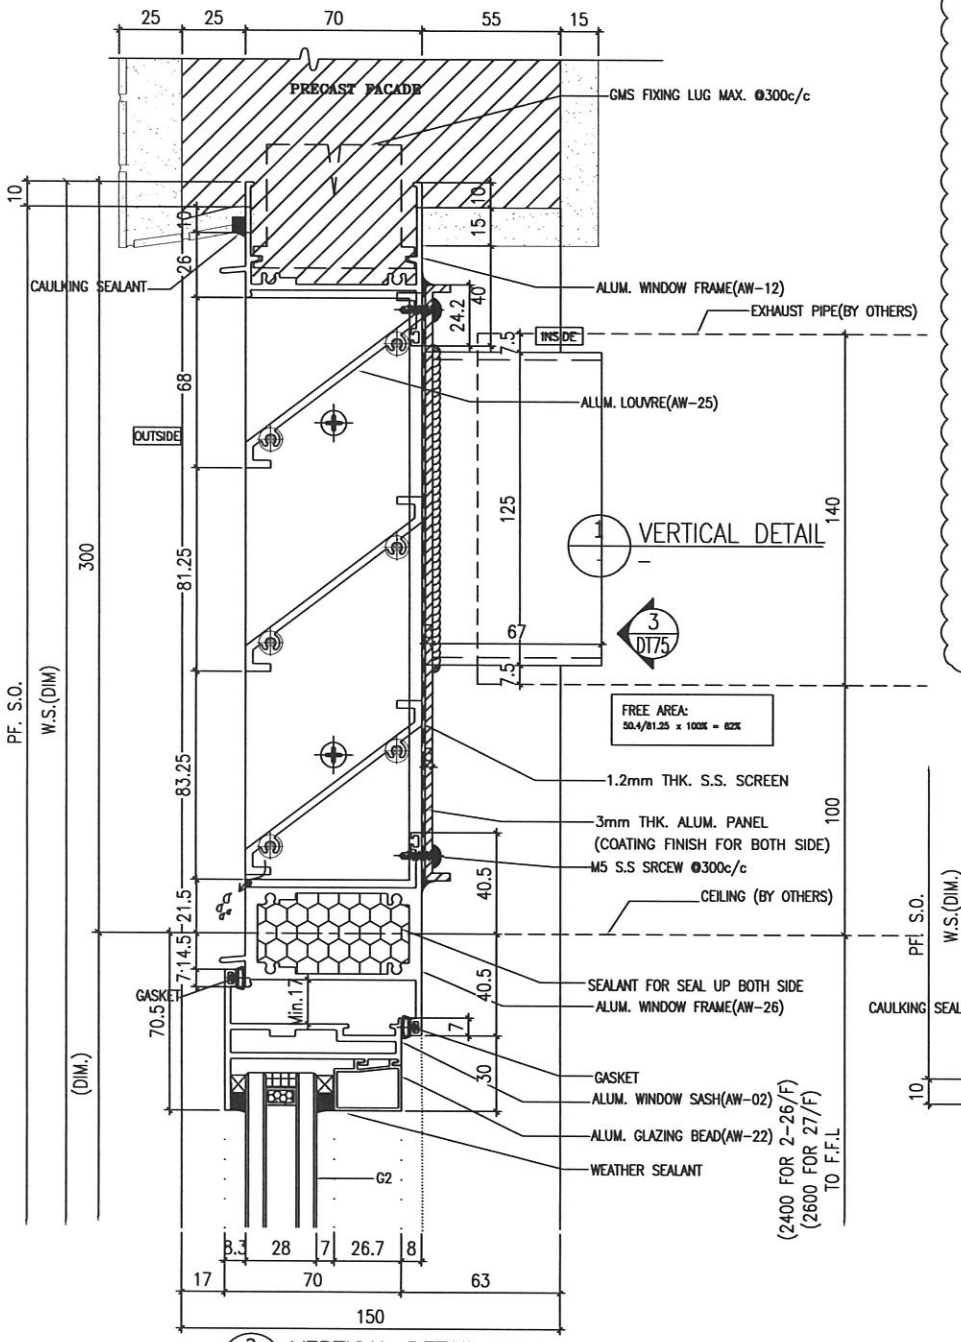

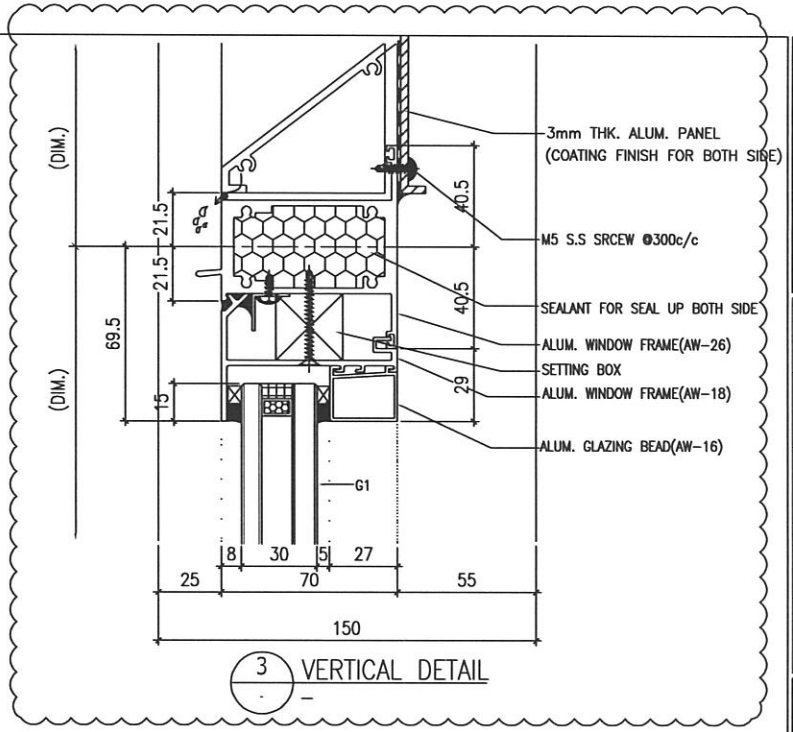

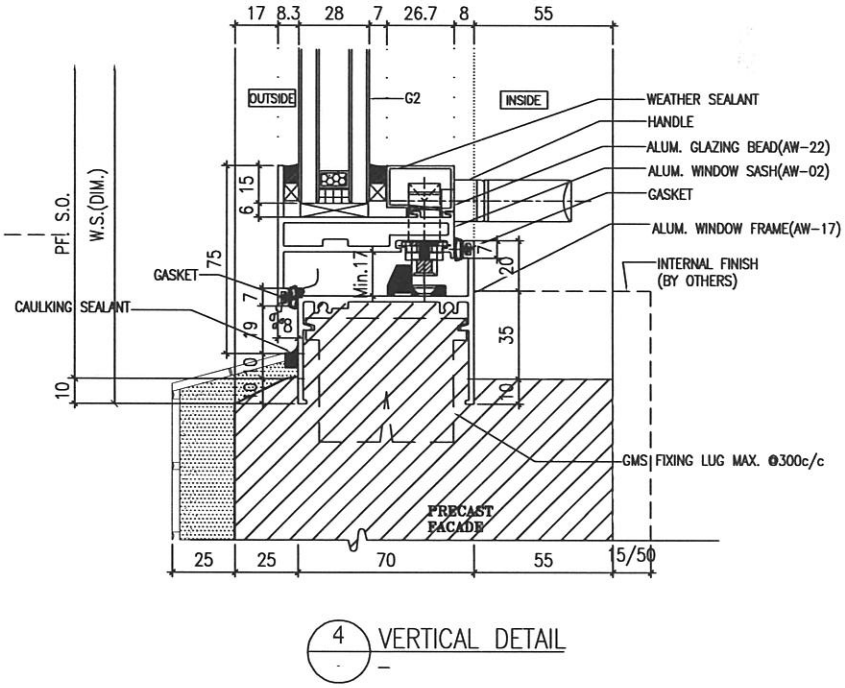

B.D. REF :

ARCHITECT :
WONG TUNG & PARTNERS LIMITED
ARCHITECTS & PLANNERS

STRUCTURAL ENGINEER :
SUN HUNG KAI
ARCHITECTS AND ENGINEERS LTD.
SUN HUNG KAI CENTRE, WANCHAI, HONGKONG
TEL. 28278111 FAX. 28272884

FACADE CONSULTANT:
ALPHA CONSULTING LIMITED
Steel Structure & Facade Specialist

MAIN CONTRACTOR :
Sanfield Engineering Construction Ltd.

CLIENT :
SUN HUNG KAI
REAL ESTATE AGENCY LTD.
42/F SUN HUNG KAI CENTRE, WANCHAI, HONGKONG

NOTE :
1. ALL DIMENSIONS ARE IN mm.
2. ALL ELEVATIONS ARE VIEWED FROM OUTSIDE.
3. ALL DIMENSIONS TO BE VERIFIED ON SITE BEFORE FABRICATION.

LEGEND :
X1 — DETAIL MARK NO.
X001 — REFER SHEET NO.
1. F.F.L. --- FINISHED FLOOR LEVEL
2. S.F.L. --- STRUCTURAL FLOOR LEVEL
3. (R) --- REVERSED DETAIL
4. GLASS LEGEND
G1-8mmHS+12mm AIR GAP+10mmTP I.G.U.
G2-8mmHS+12mm AIR GAP+8mmTP I.G.U.
G2a-8mmHS+12mm AIR GAP+8mmTP+1.52PVB +6mmTP(PLANNING) FEATURED GLASS (I.G.U.)
G8-6mm GREY HS+1.52PVB+6mm CLEAR HS

NO.	DATE	REVISED	BY
A	04/11/2022	GENERAL REVISED	W

JOB NO. : J-859


PROJECT :
PROPOSED RESIDENTIAL / COMMERCIAL DEVELOPMENT AT NKIL NO.6551 KAI TAK AREA 4C, SITE 3 KAI TAK, KOWLOON

TITLE :
TYPICAL DETAILS FOR ALUM. WINDOW


DATE : 10-Nov-21 | SCALE : 1:2 (A3)
DRAWN BY : IVAN | CHECKED BY :

美特鋁質有限公司
MIDI ALUMINIUM FABRICATOR LTD.
Units 6-8, Sunray Industrial Centre, 1/F
610 Cha Kwo Ling Road, Kowloon
Tel:23489211-4 Fax:(852)27727686


DWG NO. : J859-SD-PW-DT80e | REV. : A

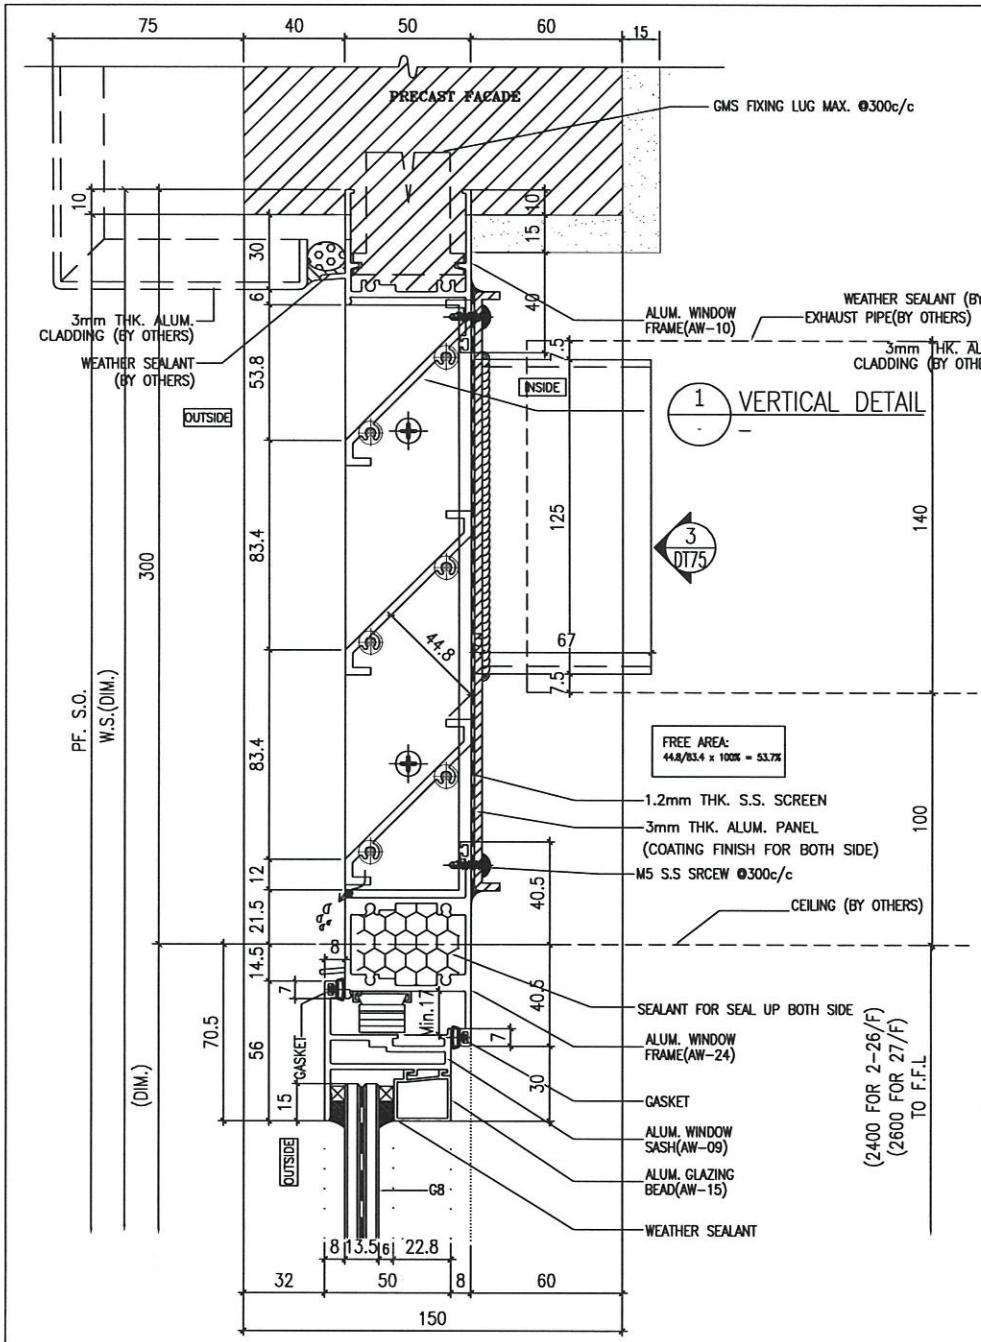

2 VERTICAL DETAIL

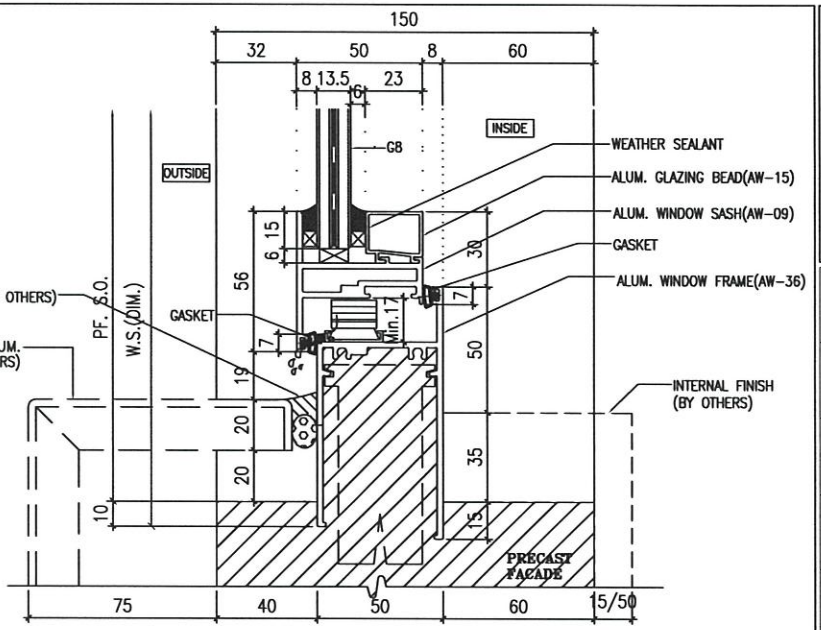

3 VERTICAL DETAIL

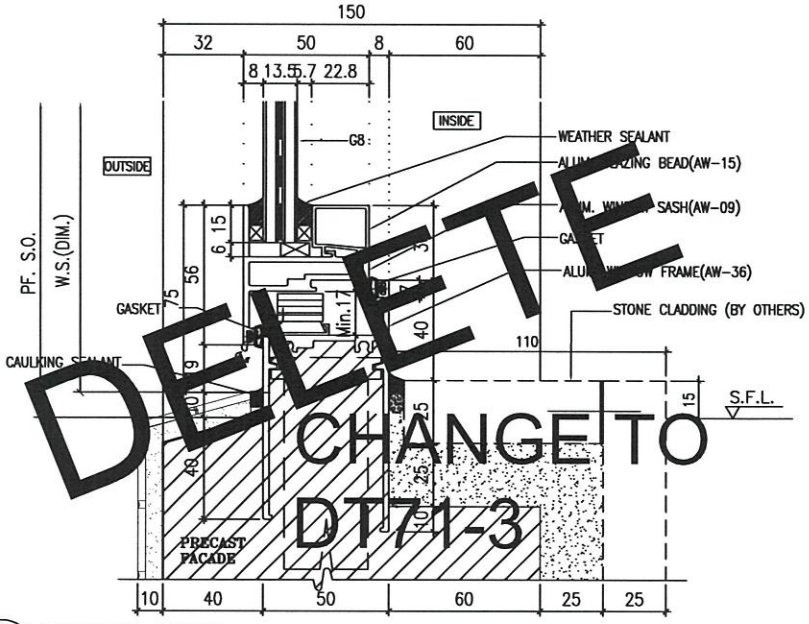

4 VERTICAL DETAIL

DELETE

CHANGE TO

DT71-3

1 VERTICAL DETAIL

B.D. REF :

ARCHITECT :
WONG TUNG & PARTNERS LIMITED
ARCHITECTS & PLANNERS

STRUCTURAL ENGINEER :
SUN HUNG KAI
ARCHITECTS AND ENGINEERS LTD.
SUN HUNG KAI CENTRE, WANCHAI, HONGKONG
TEL. 28278111 FAX. 28272884

FACADE CONSULTANT:
ALPHA CONSULTING LIMITED
Steel Structure & Facade Specialist

MAIN CONTRACTOR :
Sanfield Engineering Construction Ltd.

CLIENT :
SUN HUNG KAI
REAL ESTATE AGENCY LTD.
42/F SUN HUNG KAI CENTRE, WANCHAI, HONGKONG

NOTE :
1. ALL DIMENSIONS ARE IN mm.
2. ALL ELEVATIONS ARE VIEWED FROM OUTSIDE.
3. ALL DIMENSIONS TO BE VERIFIED ON SITE BEFORE FABRICATION.

LEGEND :
X1 / X001 — DETAIL MARK NO. / REFER SHEET NO.
1. F.F.L. — FINISHED FLOOR LEVEL
2. S.F.L. — STRUCTURAL FLOOR LEVEL
3. (R) — REVERSED DETAIL
4. GLASS LEGEND
G1–8mmHS+12mm AIR GAP+10mmTP LG.U.
G2–8mmHS+12mm AIR GAP+8mmTP LG.U.
G2a–8mmHS+12mm AIR GAP+8mmTP+1.52PVB +6mmTP(PLANNING) FEATURED GLASS (LG.U.)
G8–6mm GREY HS+1.52PVB+6mm CLEAR HS

NO.	DATE	REVISED	BY
D	28/9/2022	REVISION SUBJECT TO ARCHITECT	
C	07/9/2022	REVISION SUBJECT TO ARCHITECT	
B	25/4/2022	REVISION SUBJECT TO ARCHITECT	
A	28/3/2022	REVISION SUBJECT TO ARCHITECT	

JOB NO. : J-859

PROJECT :
PROPOSED RESIDENTIAL / COMMERCIAL DEVELOPMENT AT NKIL NO.6551 KAI TAK AREA 4C, SITE 3 KAI TAK, KOWLOON


TITLE :
TYPICAL DETAILS FOR ALUM. WINDOW

DATE : 10-Nov-21 | SCALE : 1:2 (A3)

DRAWN BY : IVAN | CHECKED BY :

美特鋁質有限公司
MIDI ALUMINIUM FABRICATOR LTD.
Units 6-8, Sunray Industrial Centre, 1/F
610 Cha Kwo Ling Road, Kowloon
Tel:23489211-4 Fax:(852)27727666

DWG NO. : J859-SD-PW-DT81 | REV. : D

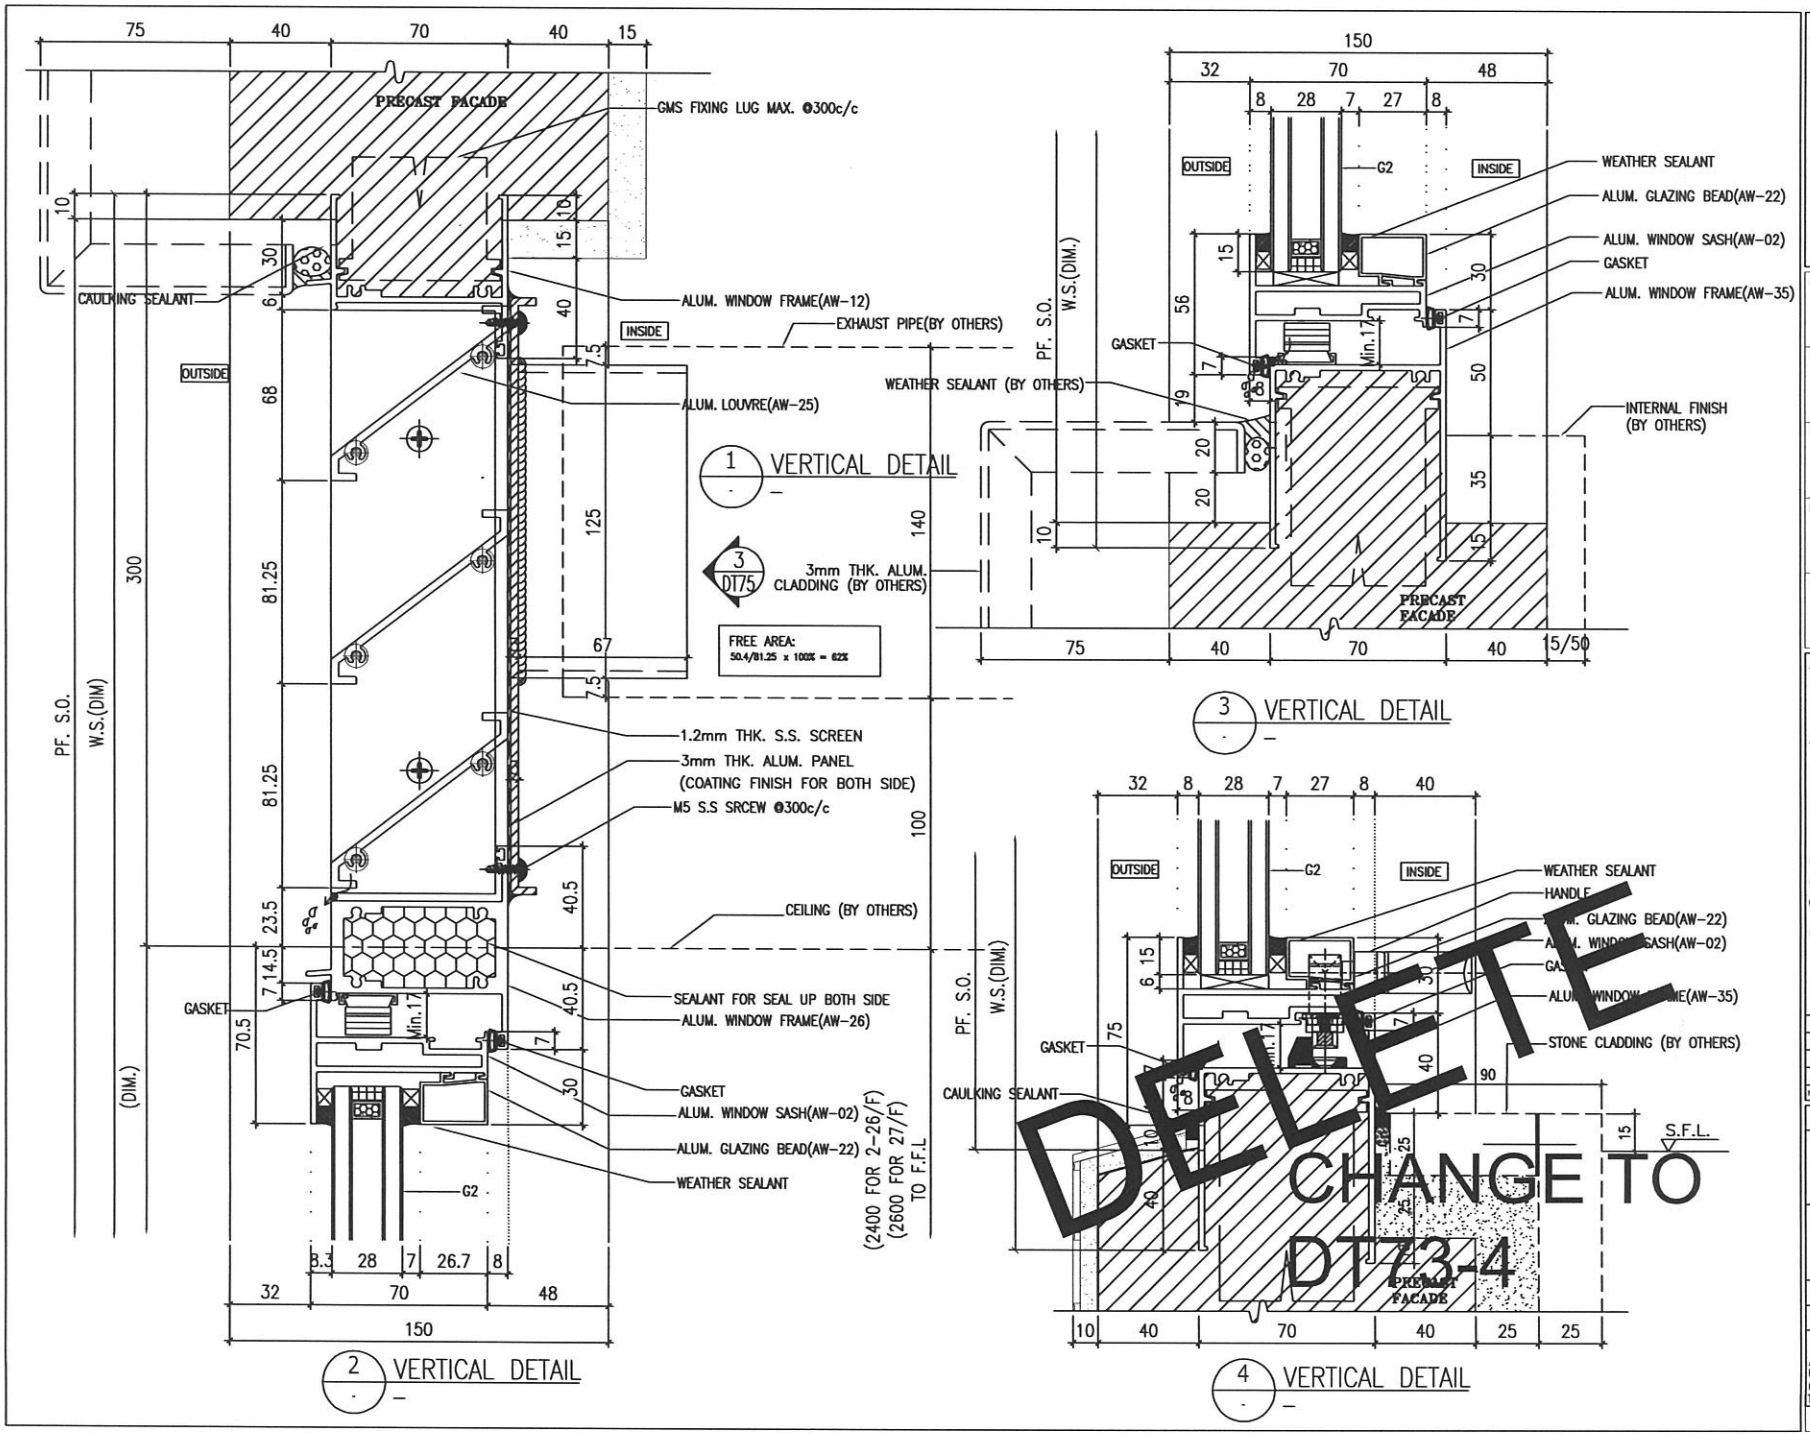

B.D. REF :

ARCHITECT :
WONG TUNG & PARTNERS LIMITED
ARCHITECTS & PLANNERS

STRUCTURAL ENGINEER :
SUN HUNG KAI
ARCHITECTS AND ENGINEERS LTD.
SUN HUNG KAI CENTRE, WANCHAI, HONGKONG
TEL. 28278111 FAX. 28272884

FACADE CONSULTANT:
ALPHA CONSULTING LIMITED
Steel Structure & Facade Specialist

MAIN CONTRACTOR :
Sanfield Engineering Construction Ltd.

CLIENT :
SUN HUNG KAI
REAL ESTATE AGENCY LTD.
42/F SUN HUNG KAI CENTRE, WANCHAI, HONGKONG

NOTE :
1. ALL DIMENSIONS ARE IN mm.
2. ALL ELEVATIONS ARE VIEWED FROM OUTSIDE.
3. ALL DIMENSIONS TO BE VERIFIED ON SITE BEFORE FABRICATION.

LEGEND :
X1 — DETAIL MARK NO.
X001 — REFER SHEET NO.
1. F.F.L. — FINISHED FLOOR LEVEL
2. S.F.L. — STRUCTURAL FLOOR LEVEL
3. (FR) — REVERSED DETAIL
4. GLASS LEGEND
G1–8mmHS+12mm AIR GAP+10mmTP I.G.U.
G2–8mmHS+12mm AIR GAP+8mmTP I.G.U.
G2a–8mmHS+12mm AIR GAP+8mmTP+1.52PVB +6mmTP(PLANNING) FEATURED GLASS (I.G.U.)
G8–6mm GREY HS+1.52PVB+6mm CLEAR HS

NO.	DATE	REVISED	BY
D	28/8/2022	REVISION SUBJECT TO ARCHITECT	
C	07/8/2022	REVISION SUBJECT TO ARCHITECT	
B	25/4/2022	REVISION SUBJECT TO ARCHITECT	
A	28/3/2022	REVISION SUBJECT TO ARCHITECT	

JOB NO. : J-859


PROJECT :
PROPOSED RESIDENTIAL / COMMERCIAL DEVELOPMENT AT NKIL NO.6551 KAI TAK AREA 4C, SITE 3 KAI TAK, KOWLOON

TITLE :
TYPICAL DETAILS FOR ALUM. WINDOW


DATE : 10-Nov-21 | SCALE : 1:2 (A3)
DRAWN BY : IVAN | CHECKED BY :

美特鋁質有限公司
MIDI ALUMINIUM FABRICATOR LTD.
Units 6-8, Sunray Industrial Centre, 1/F
610 Cha Kwo Ling Road, Kowloon
Tel:23489211-4 Fax:(852)27727666

DWG NO. : J859-SD-PW-DT82 | REV. : D

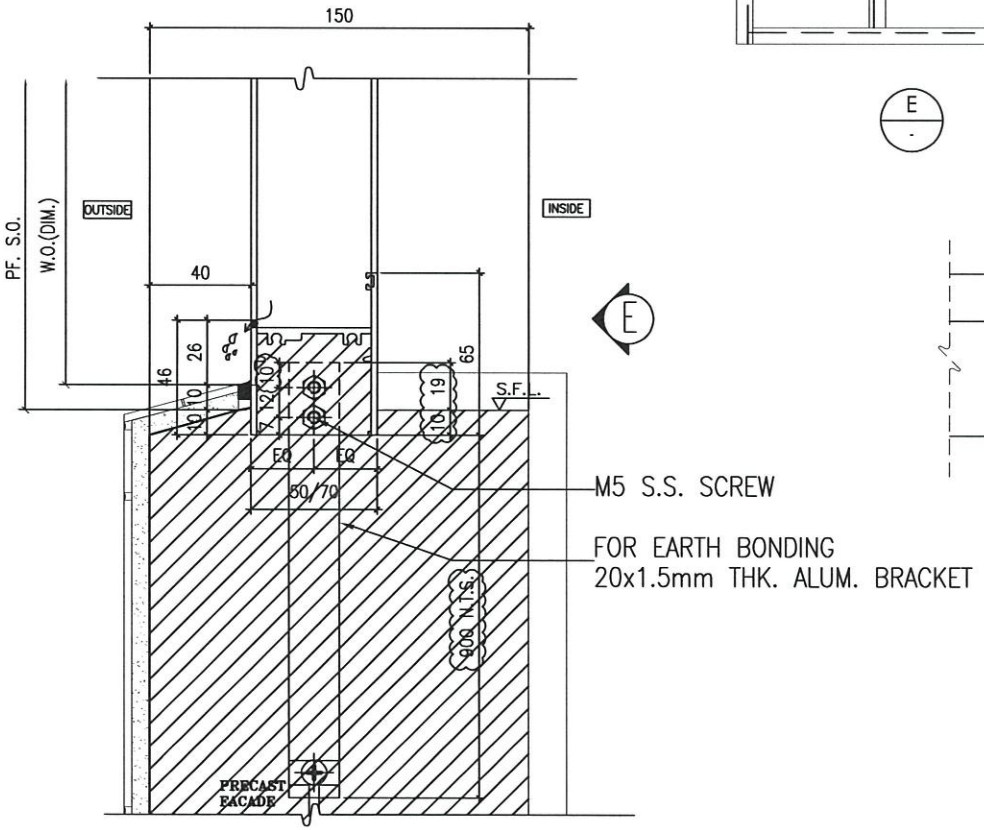


1 VERTICAL DETAIL

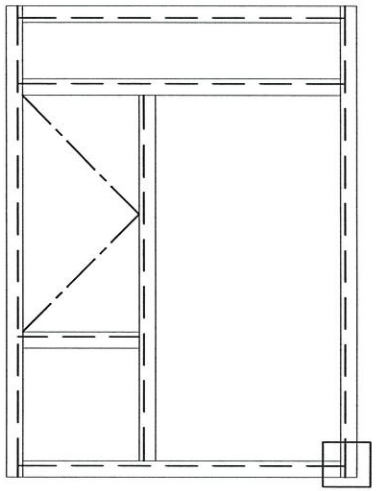

E

VIEW: C

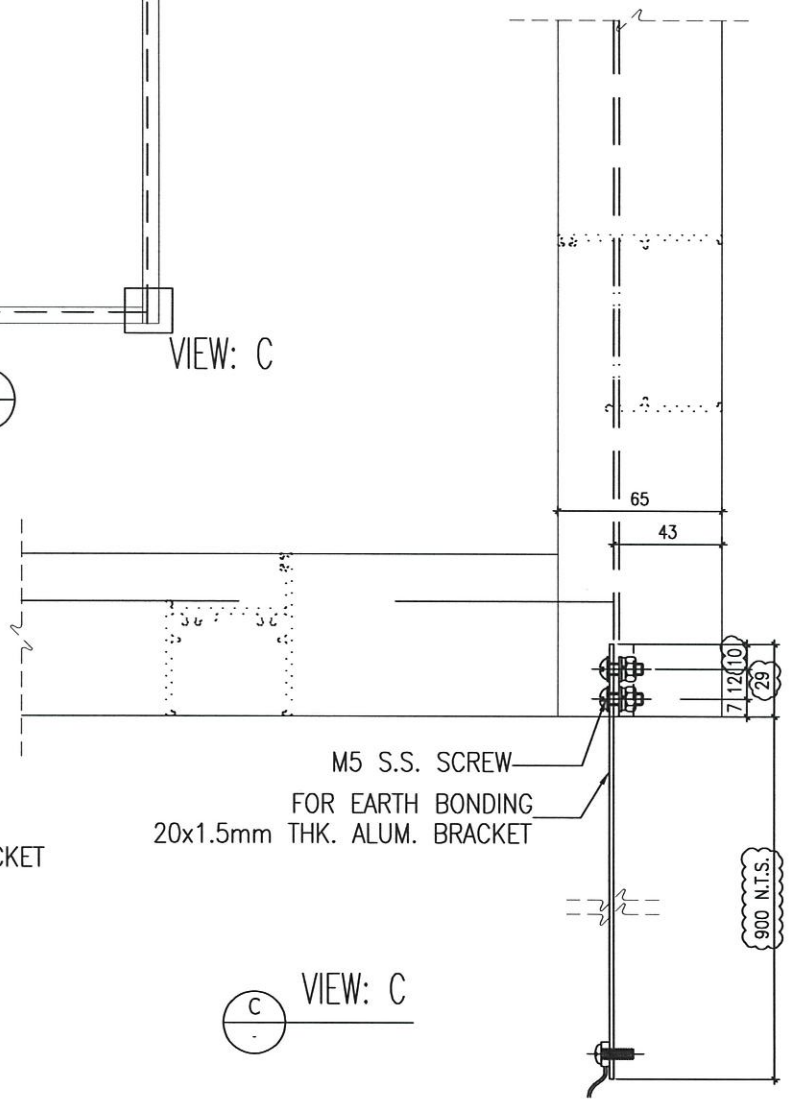

C VIEW: C

B.D. REF :

ARCHITECT :
WONG TUNG & PARTNERS LIMITED
ARCHITECTS & PLANNERS

STRUCTURAL ENGINEER :
SUN HUNG KAI
ARCHITECTS AND ENGINEERS LTD.
SUN HUNG KAI CENTRE, WANCHAI, HONGKONG
TEL. 28276111 FAX. 28272804

FACADE CONSULTANT:
ALPHA CONSULTING LIMITED
Steel Structure & Facade Specialist

MAIN CONTRACTOR :
Sanfield Engineering
Construction Ltd.

CLIENT :
SUN HUNG KAI
REAL ESTATE AGENCY LTD.
42/F SUN HUNG KAI CENTRE, WANCHAI, HONGKONG

NOTE :
1. ALL DIMENSIONS ARE IN mm.
2. ALL ELEVATIONS ARE VIEWED FROM OUTSIDE.
3. ALL DIMENSIONS TO BE VERIFIED ON SITE BEFORE FABRICATION.

LEGEND :
X1 / X001 — DETAIL MARK NO. / REFER SHEET NO.
1. F.F.L. -- FINISHED FLOOR LEVEL
2. S.F.L. -- STRUCTURAL FLOOR LEVEL
3. /R -- REVERSED DETAIL
4. GLASS LEGEND
G1-8mmHS+12mm AIR GAP+10mmTP I.G.U.
G2-8mmHS+12mm AIR GAP+8mmTP I.G.U.
G2a-8mmHS+12mm AIR GAP+8mmTP+1.52PVB +6mmTP(PLANNING) FEATURED GLASS (I.G.U.)
G8-6mm GREY HS+1.52PVB+6mm CLEAR HS

NO.	DATE	REVISED	BY
B	04/11/2022	GENERAL REVISED	YL
A	6/9/2022	REVISION SUBJECT TO ARCHITECT COMMENT	WMH

JOB NO. : J-859

PROJECT :
PROPOSED RESIDENTIAL / COMMERCIAL DEVELOPMENT AT NKIL NO.6551 KAI TAK AREA 4C, SITE 3 KAI TAK, KOWLOON


TITLE :
TYPICAL EARTHING BONDING DETAILS OF PRECAST

DATE : 10-Nov-21 | SCALE : 1:2 (A3)


DRAWN BY : IVAN | CHECKED BY :

美特鋁質有限公司
MIDI ALUMINIUM FABRICATOR LTD.
Units 6-8, Sunray Industrial Centre, 1/F
610 Cha Kwo Ling Road, Kowloon
Tel:23489211-4 Fax:(852)27727666


DWG NO. : J859-SD-PW-DT83 | REV. : B

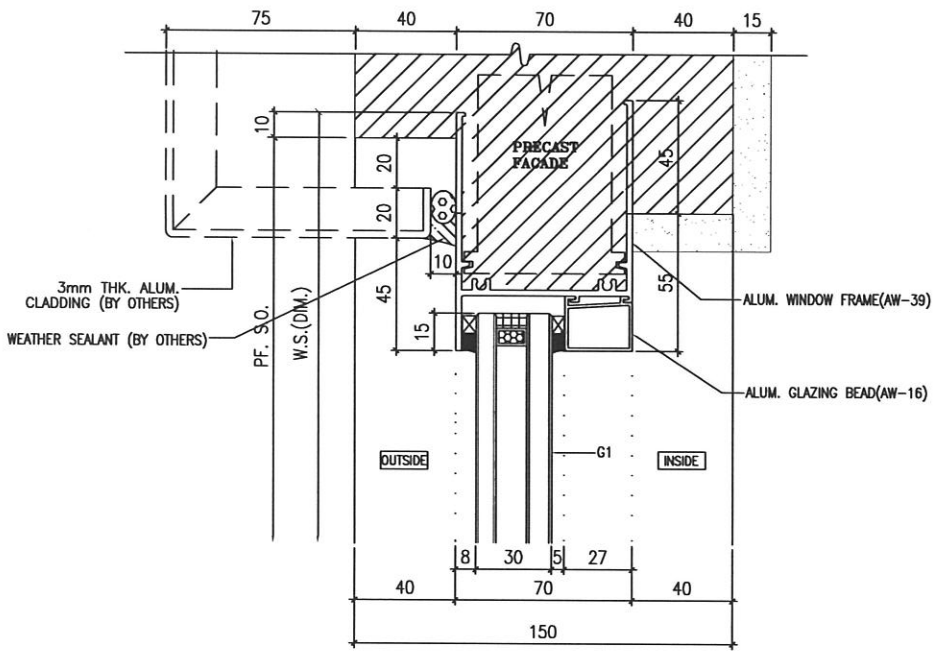

1 VERTICAL DETAIL

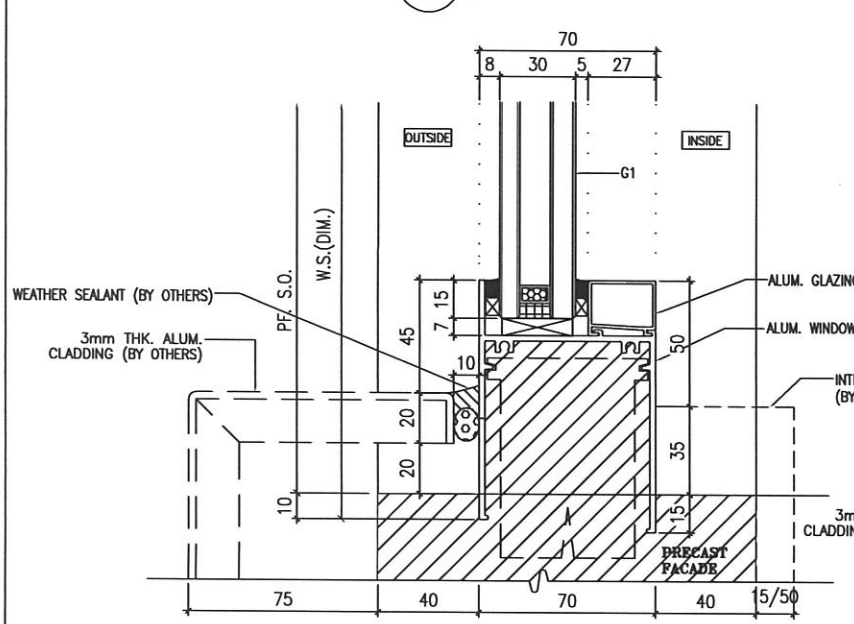

2 VERTICAL DETAIL

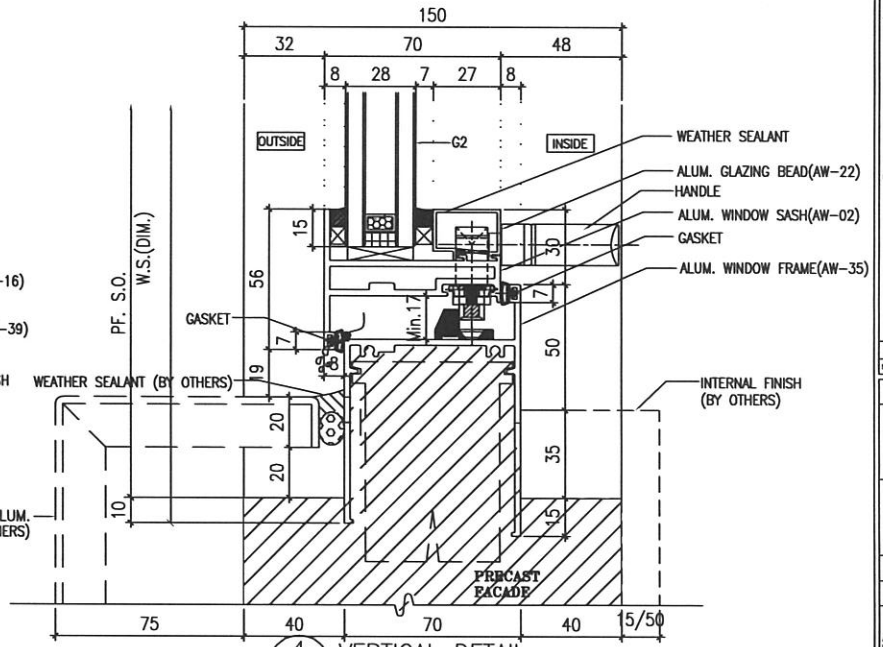

4 VERTICAL DETAIL

B.D. REF :

ARCHITECT :
WONG TUNG & PARTNERS LIMITED
ARCHITECTS & PLANNERS

STRUCTURAL ENGINEER :
SUN HUNG KAI
ARCHITECTS AND ENGINEERS LTD.
SUN HUNG KAI CENTRE, WANCHAI, HONGKONG
TEL. 28278111 FAX. 28272884

FACADE CONSULTANT:
ALPHA CONSULTING LIMITED
Steel Structure & Facade Specialist

MAIN CONTRACTOR :
Sanfield Engineering Construction Ltd.

CLIENT :
SUN HUNG KAI
REAL ESTATE AGENCY LTD.
42/F SUN HUNG KAI CENTRE, WANCHAI, HONGKONG

NOTE :
1. ALL DIMENSIONS ARE IN mm.
2. ALL ELEVATIONS ARE VIEWED FROM OUTSIDE.
3. ALL DIMENSIONS TO BE VERIFIED ON SITE BEFORE FABRICATION.

LEGEND :
X1 — DETAIL MARK NO.
X001 — REFER SHEET NO.

1. F.F.L. — FINISHED FLOOR LEVEL
2. S.F.L. — STRUCTURAL FLOOR LEVEL
3. (/R) — REVERSED DETAIL
4. GLASS LEGEND

G1–8mmHS+12mm AIR GAP+10mmTP I.G.U.

G2–8mmHS+12mm AIR GAP+8mmTP I.G.U.

G2a–8mmHS+12mm AIR GAP+8mmTP+1.52PVB +6mmTP(PLANNING) FEATURED GLASS (I.G.U.)

G8–6mm GREY HS+1.52PVB+6mm CLEAR HS

NO.	DATE	REVISED	BY
A	28/3/2022	REVISION SUBJECT TO ARCH.COMMENT	MMH

JOB NO. : J-859

PROJECT :
PROPOSED RESIDENTIAL / COMMERCIAL DEVELOPMENT AT NKIL NO.6551 KAI TAK AREA 4C, SITE 3 KAI TAK, KOWLOON


TITLE :
TYPICAL DETAILS FOR ALUM. WINDOW

DATE : 10-Nov-21 | SCALE : 1:2 (A3)


DRAWN BY : IVAN | CHECKED BY :

美特鋁質有限公司
MIDI ALUMINIUM FABRICATOR LTD.
Units 6-8, Sunray Industrial Centre, 1/F
610 Cha Kwo Ling Road, Kowloon
Tel:23489211-4 Fax:(852)27727666


DWG NO. : J859-SD-PW-DTB3a | REV. : A

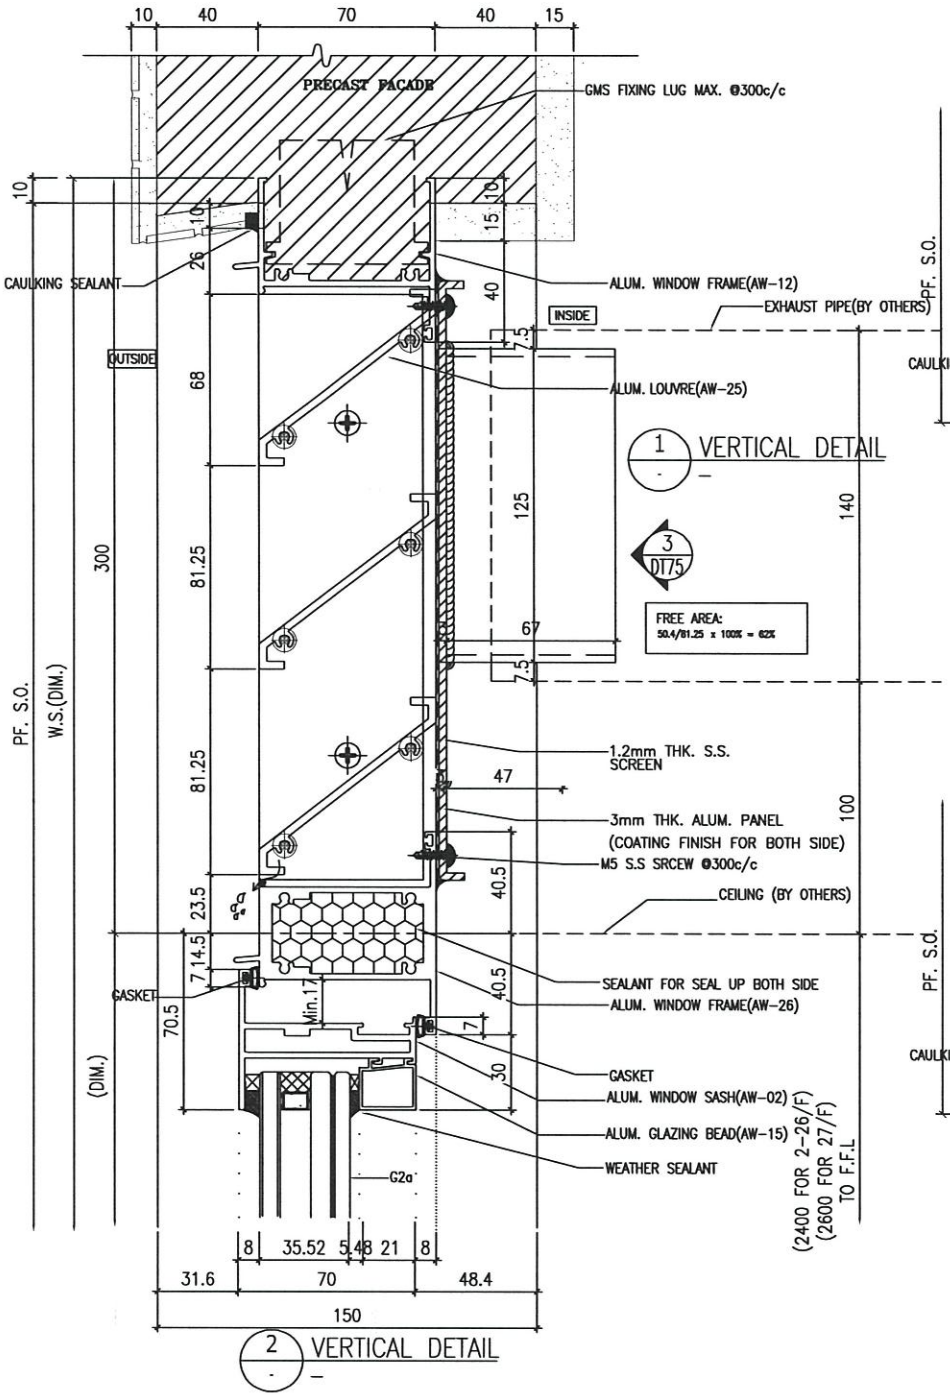

2 VERTICAL DETAIL

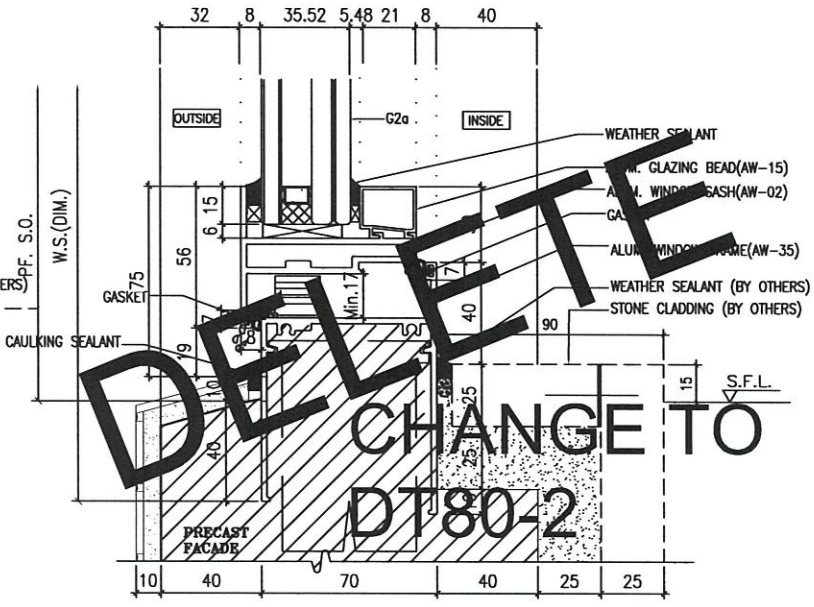

3 VERTICAL DETAIL

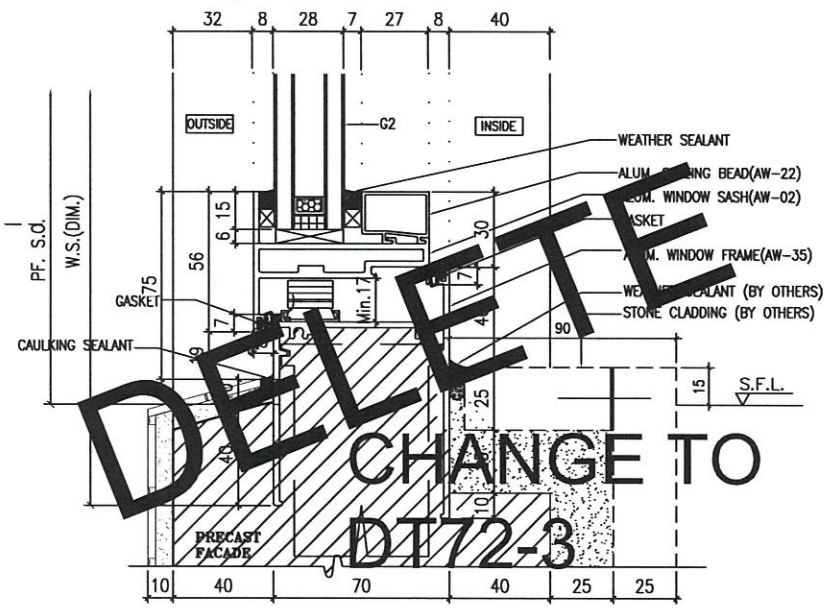

4 VERTICAL DETAIL

B.D. REF :

ARCHITECT :
WONG TUNG & PARTNERS LIMITED
ARCHITECTS & PLANNERS

STRUCTURAL ENGINEER :
SUN HUNG KAI
ARCHITECTS AND ENGINEERS LTD.
SUN HUNG KAI CENTRE, WANCHAI, HONGKONG
TEL. 28276111 FAX. 28272884

FACADE CONSULTANT:
ALPHA CONSULTING LIMITED
Steel Structure & Facade Specialist

MAIN CONTRACTOR :
Sanfield Engineering Construction Ltd.

CLIENT :
SUN HUNG KAI
REAL ESTATE AGENCY LTD.
42/F SUN HUNG KAI CENTRE, WANCHAI, HONGKONG

NOTE :
1. ALL DIMENSIONS ARE IN mm.
2. ALL ELEVATIONS ARE VIEWED FROM OUTSIDE.
3. ALL DIMENSIONS TO BE VERIFIED ON SITE BEFORE FABRICATION.

LEGEND :
X1 — DETAIL MARK NO.
X001 — REFER SHEET NO.

1. F.F.L. --FINISHED FLOOR LEVEL
2. S.F.L. --STRUCTURAL FLOOR LEVEL
3. (R) --REVERSED DETAIL
4. GLASS LEGEND

G1-8mmHS+12mm AIR GAP+10mmTP LG.U.
G2-8mmHS+12mm AIR GAP+8mmTP LG.U.
G2a-8mmHS+12mm AIR GAP+8mmTP+1.52PVB +6mmTP(PLANNING) FEATURED GLASS (LG.U.)
G8-6mm GREY HS+1.52PVB+6mm CLEAR HS

NO.	DATE	REVISED	BY
C	28/9/2022	REVISION SUBJECT TO ARCHITECT	
B	07/9/2022	REVISION SUBJECT TO ARCHITECT	
A	26/3/2022	REVISION SUBJECT TO ARCHITECT	

JOB NO. : J-859

PROJECT :
PROPOSED RESIDENTIAL / COMMERCIAL DEVELOPMENT AT NKIL NO.6551 KAI TAK AREA 4C, SITE 3 KAI TAK, KOWLOON


TITLE :
TYPICAL DETAILS FOR ALUM. WINDOW

DATE : 10-Nov-21 | SCALE : 1:2 (A3)

DRAWN BY : IVAN | CHECKED BY :

美特鋁製有限公司
MIDI ALUMINIUM FABRICATOR LTD.
Units 6-8, Sunray Industrial Centre, 1/F
610 Cha Kwo Ling Road, Kowloon
Tel:23489211-4 Fax:(852)27727866

DWG NO. : J859-SD-PW-DT84 | REV. : C

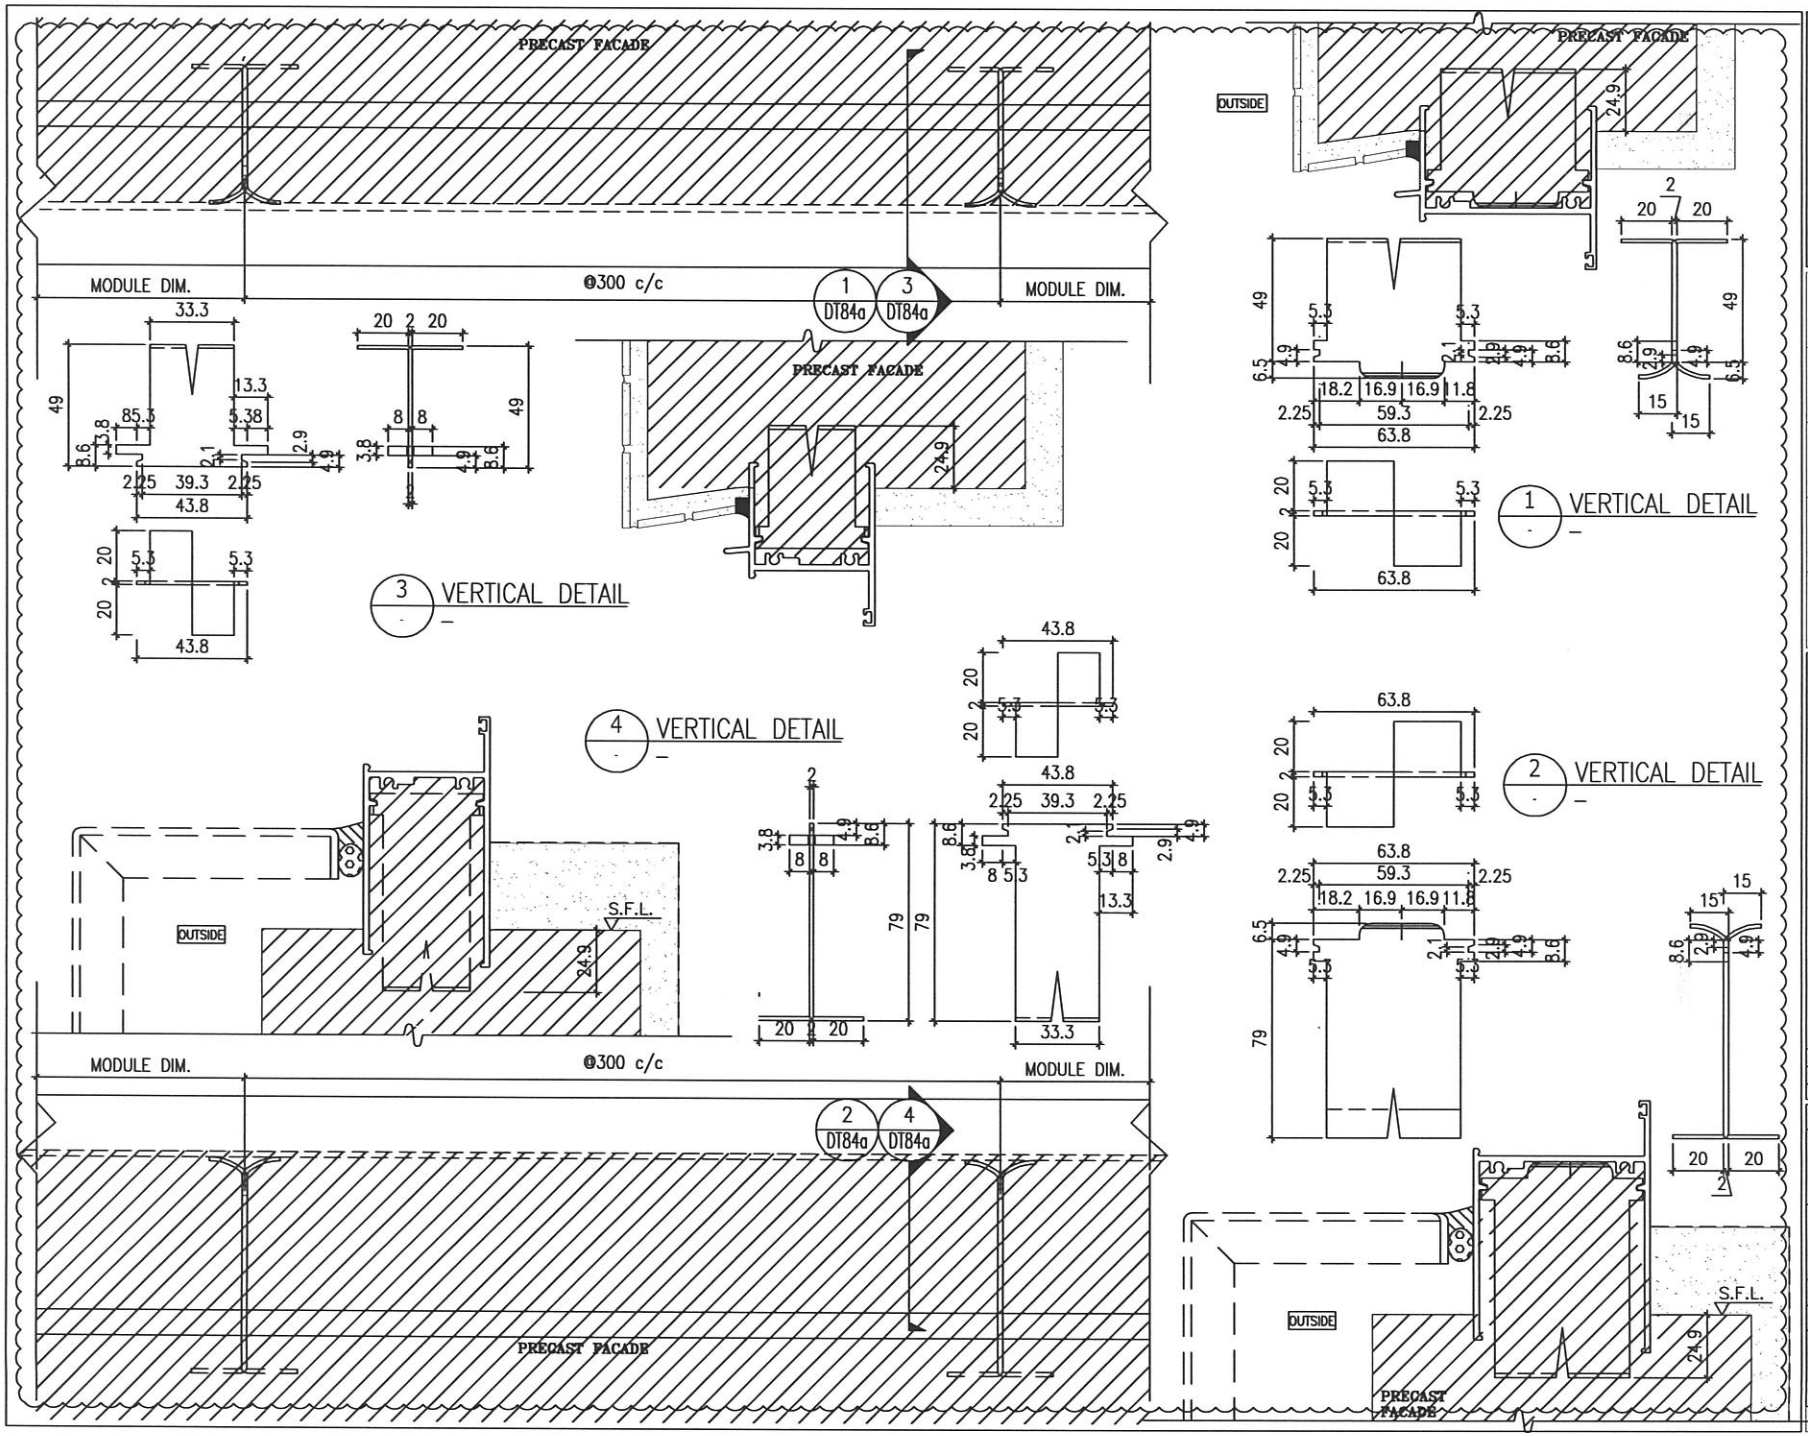

B.D. REF :

ARCHITECT :
WONG TUNG & PARTNERS LIMITED
ARCHITECTS & PLANNERS

STRUCTURAL ENGINEER :
SUN HUNG KAI
ARCHITECTS AND ENGINEERS LTD.
SUN HUNG KAI CENTRE, WANCHAI, HONGKONG
TEL. 28272811 FAX. 28272884

FACADE CONSULTANT:
ALPHA CONSULTING LIMITED
Steel Structure & Facade Specialist

MAIN CONTRACTOR :
Sanfield Engineering Construction Ltd.

CLIENT :
SUN HUNG KAI
REAL ESTATE AGENCY LTD.
42/F SUN HUNG KAI CENTRE, WANCHAI, HONGKONG

NOTE :
1. ALL DIMENSIONS ARE IN mm.
2. ALL ELEVATIONS ARE VIEWED FROM OUTSIDE.
3. ALL DIMENSIONS TO BE VERIFIED ON SITE BEFORE FABRICATION.

LEGEND :
X1 — DETAIL MARK NO.
X001 — REFER SHEET NO.

1. F.F.L. --FINISHED FLOOR LEVEL
2. S.F.L. --STRUCTURAL FLOOR LEVEL
3. (FR) --REVERSED DETAIL
4. GLASS LEGEND

G1–8mmHS+12mm AIR GAP+10mmTP I.G.U.
G2–8mmHS+12mm AIR GAP+8mmTP I.G.U.
G2a–8mmHS+12mm AIR GAP+8mmTP+1.52PVB +6mmTP(PLANNING) FEATURED GLASS (I.G.U.)
G8–6mm GREY HS+1.52PVB+6mm CLEAR HS

NO.	DATE	REVISED	BY
B	04/11/2022	GENERAL REVISED	YW
A	11/4/2022	REVISION SUBJECT TO AMENDMENT	YWW

JOB NO. : J–859

PROJECT :
PROPOSED RESIDENTIAL / COMMERCIAL DEVELOPMENT AT NKIL NO.6551 KAI TAK AREA 4C, SITE 3 KAI TAK, KOWLOON


TITLE :
G.M.S FIXING LUG TYPICAL DETAIL FOR ALUM. WINDOW

DATE : 10–Nov–21 | SCALE : 1:2 (A3)


DRAWN BY : IVAN | CHECKED BY :

美特鋁實有限公司
MIDI ALUMINIUM FABRICATOR LTD.
Units 6–8, Sunray Industrial Centre, 1/F
610 Cha Kwo Ling Road, Kowloon
Tel:23489211–4 Fax:(852)27727666


DWG NO. : J859–SD–PW–DT84a | REV. : B

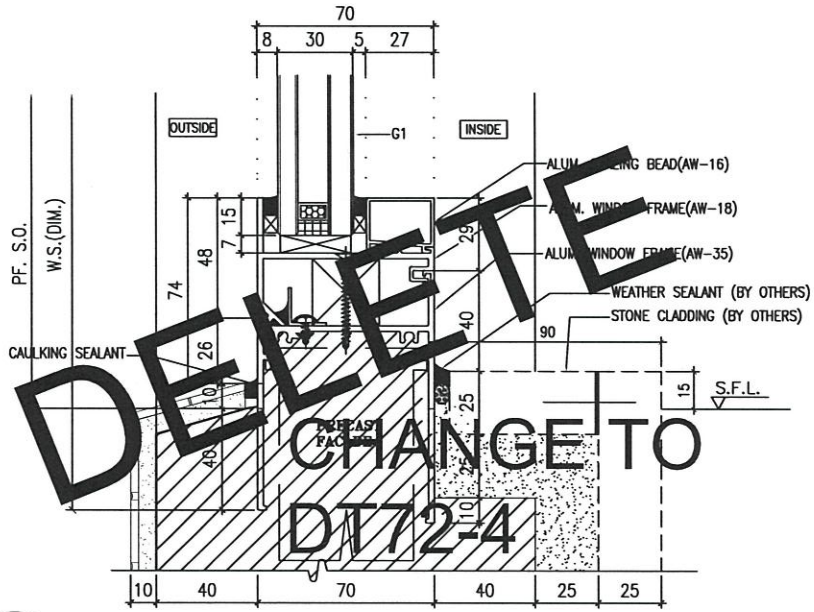


1 / - VERTICAL DETAIL

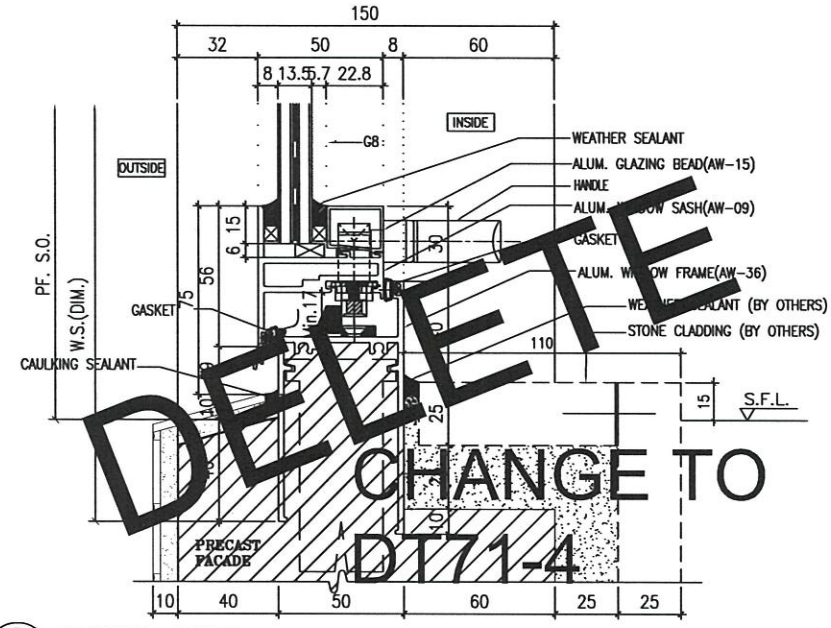

2 / - VERTICAL DETAIL

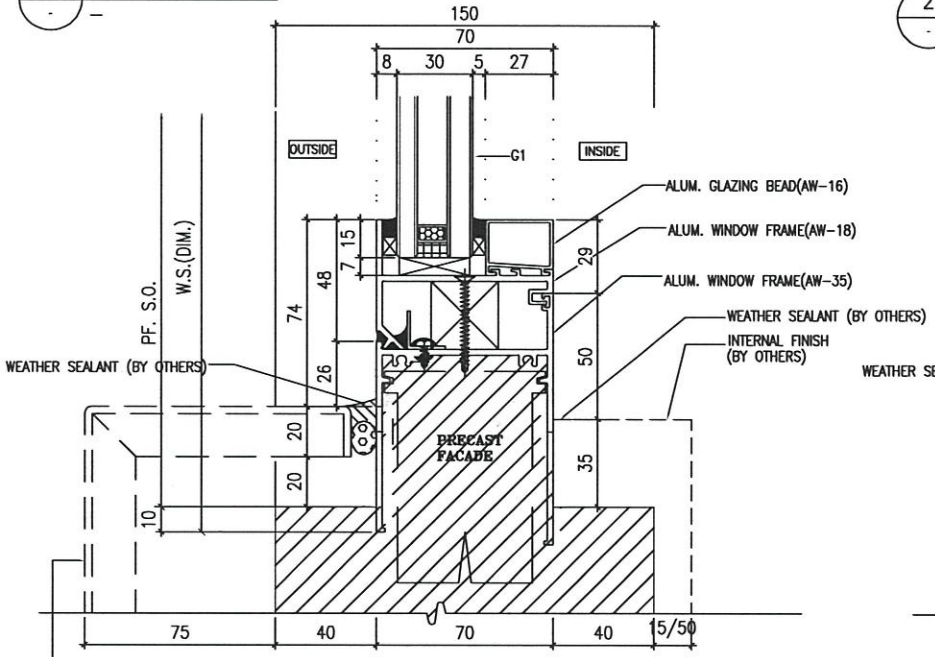

3 / - VERTICAL DETAIL

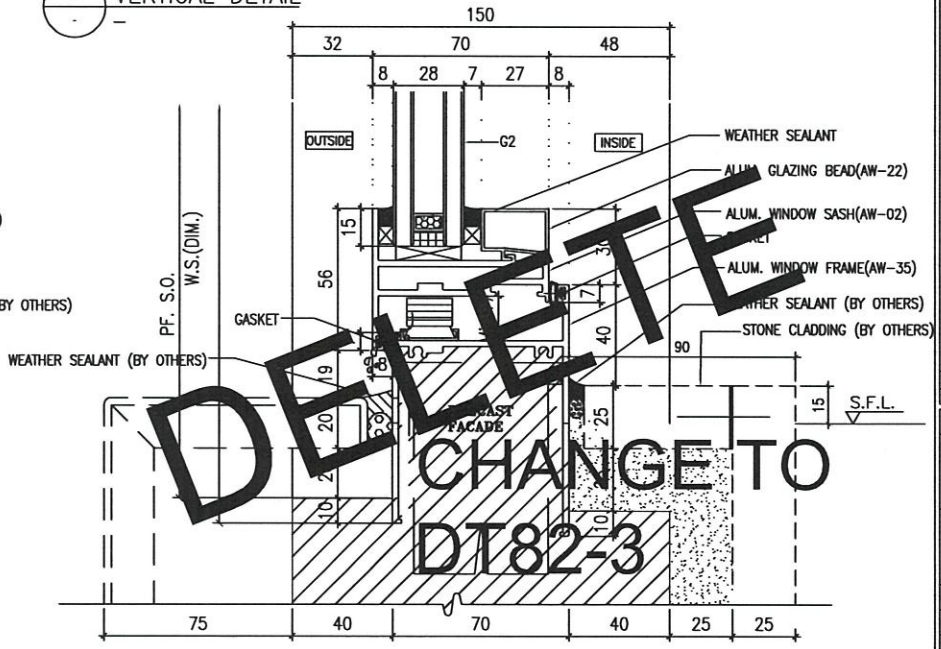

4 / - VERTICAL DETAIL

B.D. REF :

ARCHITECT :
WONG TUNG & PARTNERS LIMITED
ARCHITECTS & PLANNERS

STRUCTURAL ENGINEER :
SUN HUNG KAI
ARCHITECTS AND ENGINEERS LTD.
SUN HUNG KAI CENTRE, WANCHAI, HONGKONG
TEL. 28278111 FAX. 28272004

FACADE CONSULTANT:
ALPHA CONSULTING LIMITED
Steel Structure & Facade Specialist

MAIN CONTRACTOR :
Sanfield Engineering Construction Ltd.

CLIENT :
SUN HUNG KAI
REAL ESTATE AGENCY LTD.
42/F SUN HUNG KAI CENTRE, WANCHAI, HONGKONG

NOTE :
1. ALL DIMENSIONS ARE IN mm.
2. ALL ELEVATIONS ARE VIEWED FROM OUTSIDE.
3. ALL DIMENSIONS TO BE VERIFIED ON SITE BEFORE FABRICATION.

LEGEND :
X1 / X001 — DETAIL MARK NO. / REFER SHEET NO.
1. F.F.L. — FINISHED FLOOR LEVEL
2. S.F.L. — STRUCTURAL FLOOR LEVEL
3. (R) — REVERSED DETAIL
4. GLASS LEGEND
G1–8mmHS+12mm AIR GAP+10mmTP LG.U.
G2–8mmHS+12mm AIR GAP+8mmTP LG.U.
G2a–8mmHS+12mm AIR GAP+8mmTP+1.52PVB +6mmTP(PLANNING) FEATURED GLASS (LG.U.)
G8–6mm GREY HS+1.52PVB+6mm CLEAR HS

NO.	DATE	REVISED	BY
A	28/3/2022	REVISION SUBJECT TO AMENDMENT	

JOB NO. : J-859

PROJECT :
PROPOSED RESIDENTIAL / COMMERCIAL DEVELOPMENT AT NKIL NO.6551 KAI TAK AREA 4C, SITE 3 KAI TAK, KOWLOON


TITLE :
TYPICAL DETAILS FOR ALUM. WINDOW


DATE : 10-Nov-21 | SCALE : 1:2 (A3)


DRAWN BY : IVAN | CHECKED BY :

美特鋁製有限公司
MIDI ALUMINIUM FABRICATOR LTD.
Units 6-8, Sunray Industrial Centre, 1/F
610 Cha Kwo Ling Road, Kowloon
Tel:23489211-4 Fax:(852)27727666

DWG NO. : J859-SD-PW-DT85 | REV. : A

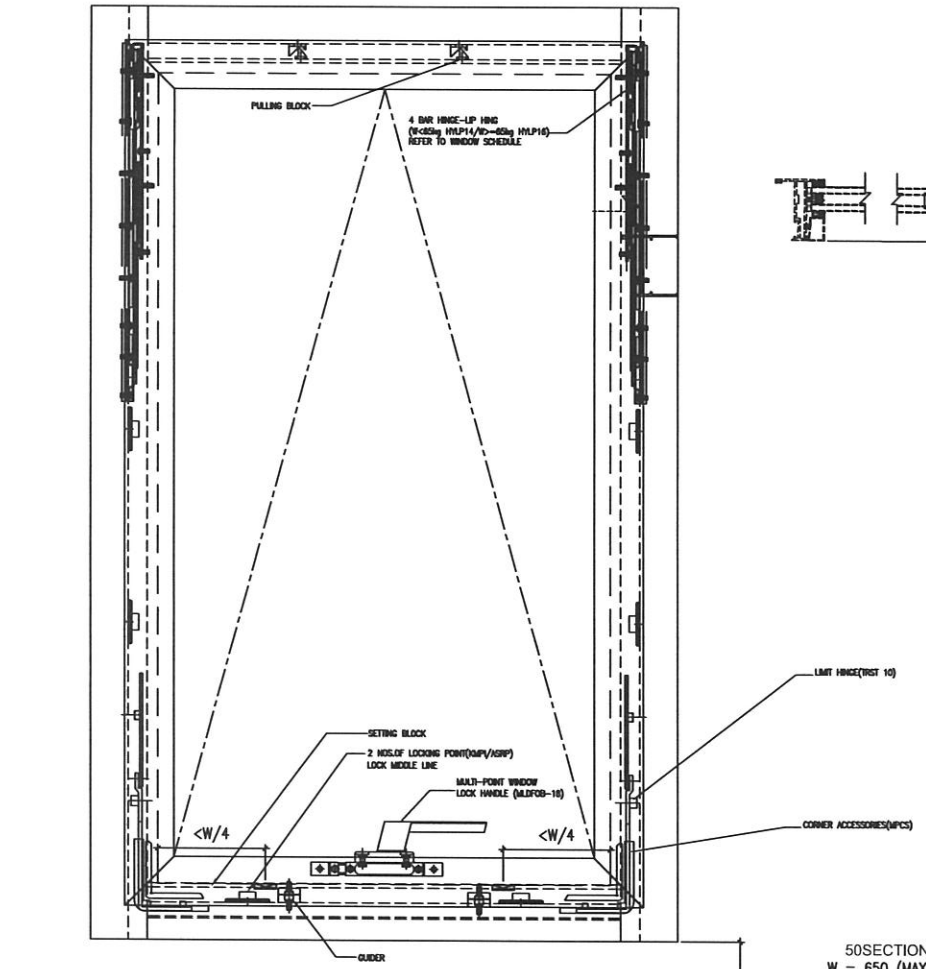

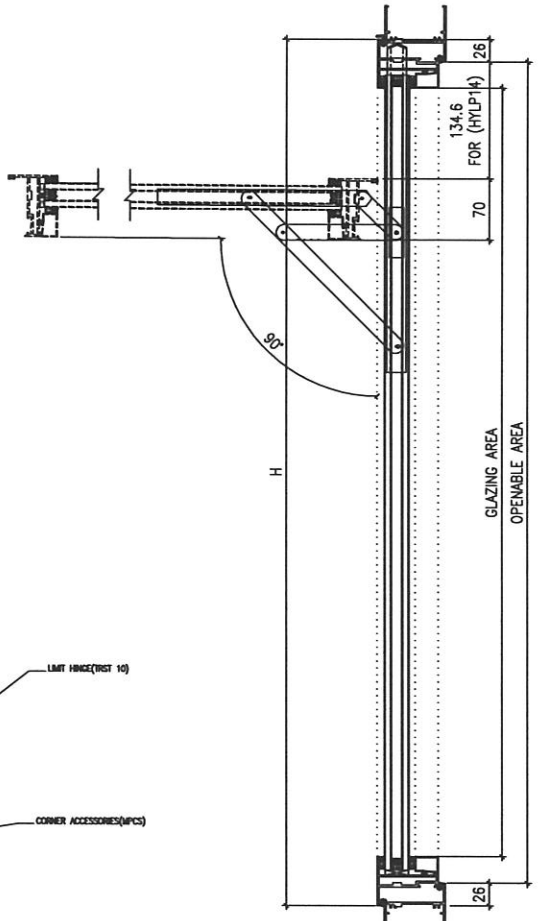

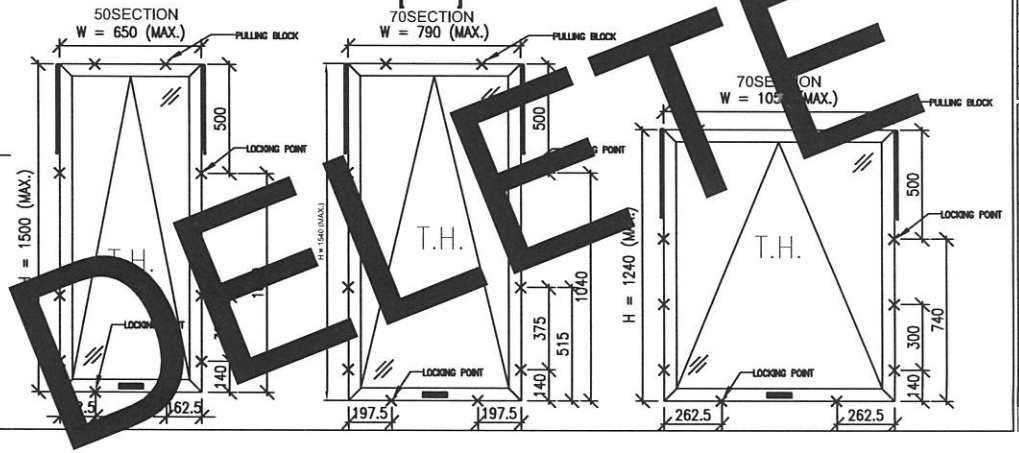

DELETE

B.D. REF :

ARCHITECT :
WONG TUNG & PARTNERS LIMITED
ARCHITECTS & PLANNERS

STRUCTURAL ENGINEER :
SUN HUNG KAI
ARCHITECTS AND ENGINEERS LTD.
SUN HUNG KAI CENTRE, WANCHAI, HONGKONG
TEL: 28278111 FAX: 28272884

FACADE CONSULTANT:
ALPHA CONSULTING LIMITED
Steel Structure & Facade Specialist

MAIN CONTRACTOR :
Sanfield Engineering Construction Ltd.

CLIENT :
SUN HUNG KAI
REAL ESTATE AGENCY LTD.
42/F SUN HUNG KAI CENTRE, WANCHAI, HONGKONG

NOTE :
1. ALL DIMENSIONS ARE IN mm.
2. ALL ELEVATIONS ARE VIEWED FROM OUTSIDE.
3. ALL DIMENSIONS TO BE VERIFIED ON SITE BEFORE FABRICATION.

LEGEND :
X1 — DETAIL MARK NO.
X001 — REFER SHEET NO.
1. F.F.L. --FINISHED FLOOR LEVEL
2. S.F.L. --STRUCTURAL FLOOR LEVEL
3. /R --REVERSED DETAIL
4. GLASS LEGEND
G1-8mmHS+12mm AIR GAP+10mmTP I.G.U.
G2-8mmHS+12mm AIR GAP+8mmTP I.G.U.
G2a-8mmHS+12mm AIR GAP+8mmTP+1.52PVB +6mmTP(PLANNING) FEATURED GLASS (I.G.U.)
G8-6mm GREY HS+1.52PVB+6mm CLEAR HS

NO.	DATE	REVISED	BY
D	8/8/2022	REVISION SUBJECT TO ARCHITECT	
C	29/6/2022	REVISION SUBJECT TO ARCHITECT	
B	25/4/2022	REVISION SUBJECT TO ARCHITECT	
A	28/3/2022	REVISION SUBJECT TO ARCHITECT	

JOB NO. : J-859

PROJECT :
PROPOSED RESIDENTIAL / COMMERCIAL DEVELOPMENT AT NKIL NO.6551 KAI TAK AREA 4C, SITE 3 KAI TAK, KOWLOON


TITLE :
TYPICAL ASSEMBLY DETAILS OF ALUM. WINDOW


DATE : 10-Nov-21 | SCALE : 1:4 (A3)


DRAWN BY : IVAN | CHECKED BY :

美特鋁質有限公司
MIDI ALUMINIUM FABRICATOR LTD.
Units 6-8, Sunray Industrial Centre, 1/F
610 Cha Kwo Ling Road, Kowloon
Tel:23489211-4 Fax:(852)27727666

DWG NO. : J859-SD-PW-DT85a | REV. : D

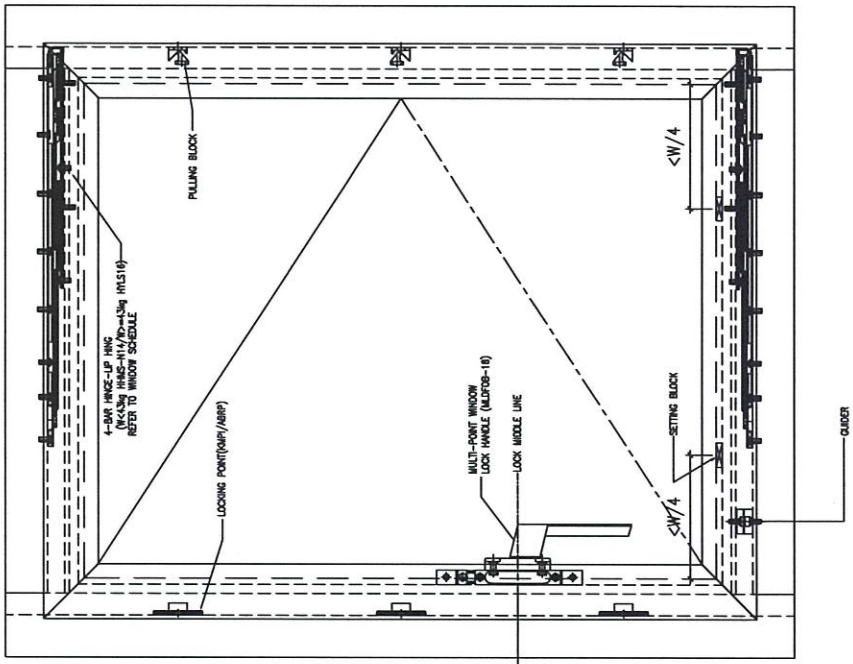

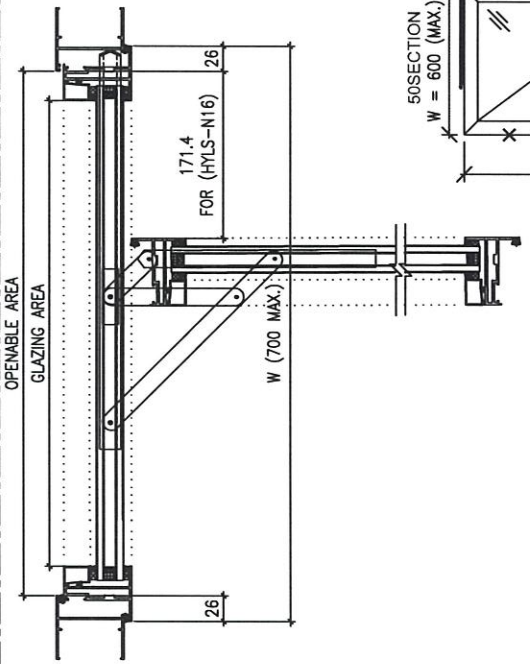

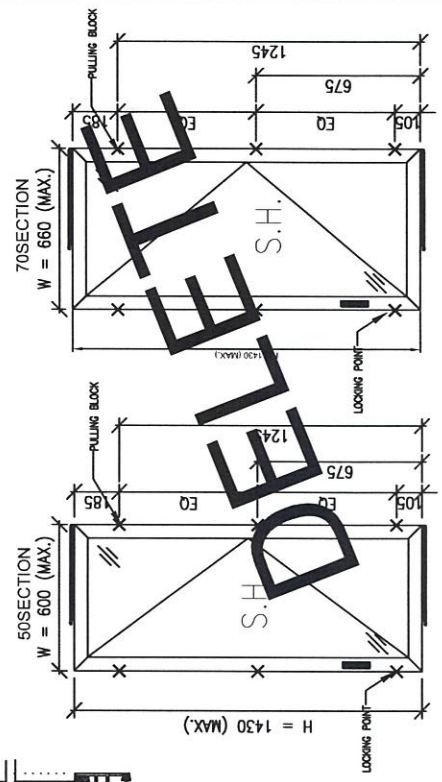

B.D. REF :

ARCHITECT :
WONG TUNG & PARTNERS LIMITED
ARCHITECTS & PLANNERS

STRUCTURAL ENGINEER :
SUN HUNG KAI
ARCHITECTS AND ENGINEERS LTD.
SUN HUNG KAI CENTRE, WANCHAI, HONGKONG
TEL. 28278111 FAX. 28272804

FACADE CONSULTANT:
ALPHA CONSULTING LIMITED
Steel Structure & Facade Specialist

MAIN CONTRACTOR :
Sanfield Engineering
Construction Ltd.

CLIENT :
SUN HUNG KAI
REAL ESTATE AGENCY LTD.
42/F SUN HUNG KAI CENTRE, WANCHAI, HONGKONG

NOTE :
1. ALL DIMENSIONS ARE IN mm.
2. ALL ELEVATIONS ARE VIEWED FROM OUTSIDE.
3. ALL DIMENSIONS TO BE VERIFIED ON SITE BEFORE FABRICATION.

LEGEND :
X1 / X001 — DETAIL MARK NO. / REFER SHEET NO.
1. F.F.L. --- FINISHED FLOOR LEVEL
2. S.F.L. --- STRUCTURAL FLOOR LEVEL
3. (R) --- REVERSED DETAIL
4. GLASS LEGEND
G1-8mmHS+12mm AIR GAP+10mmTP I.G.U.
G2-8mmHS+12mm AIR GAP+8mmTP I.G.U.
G2a-8mmHS+12mm AIR GAP+8mmTP+1.52PVB +6mmTP(PLANNING) FEATURED GLASS (I.G.U.)
G8-6mm GREY HS+1.52PVB+6mm CLEAR HS

NO.	DATE	REVISED	BY
D	8/9/2022	REVISION SUBJECT TO ARCH.COMMENT	
C	28/8/2022	REVISION SUBJECT TO ARCH.COMMENT	
B	25/4/2022	REVISION SUBJECT TO ARCH.COMMENT	
A	28/3/2022	REVISION SUBJECT TO ARCH.COMMENT	

JOB NO. : J-859

PROJECT :
PROPOSED RESIDENTIAL / COMMERCIAL DEVELOPMENT AT NKIL NO.6551 KAI TAK AREA 4C, SITE 3 KAI TAK, KOWLOON


TITLE :
TYPICAL ASSEMBLY DETAILS OF ALUM. WINDOW

DATE : 10-Nov-21 | SCALE : 1:4 (A3)

DRAWN BY : IVAN | CHECKED BY :

美特鋁質有限公司
MIDI ALUMINIUM FABRICATOR LTD.
Units 6-8, Sunray Industrial Centre, 1/F
610 Cha Kwo Ling Road, Kowloon
Tel:23489211-4 Fax:(852)27727666

DWG NO. : J859-SD-PW-DT86 | REV. : D

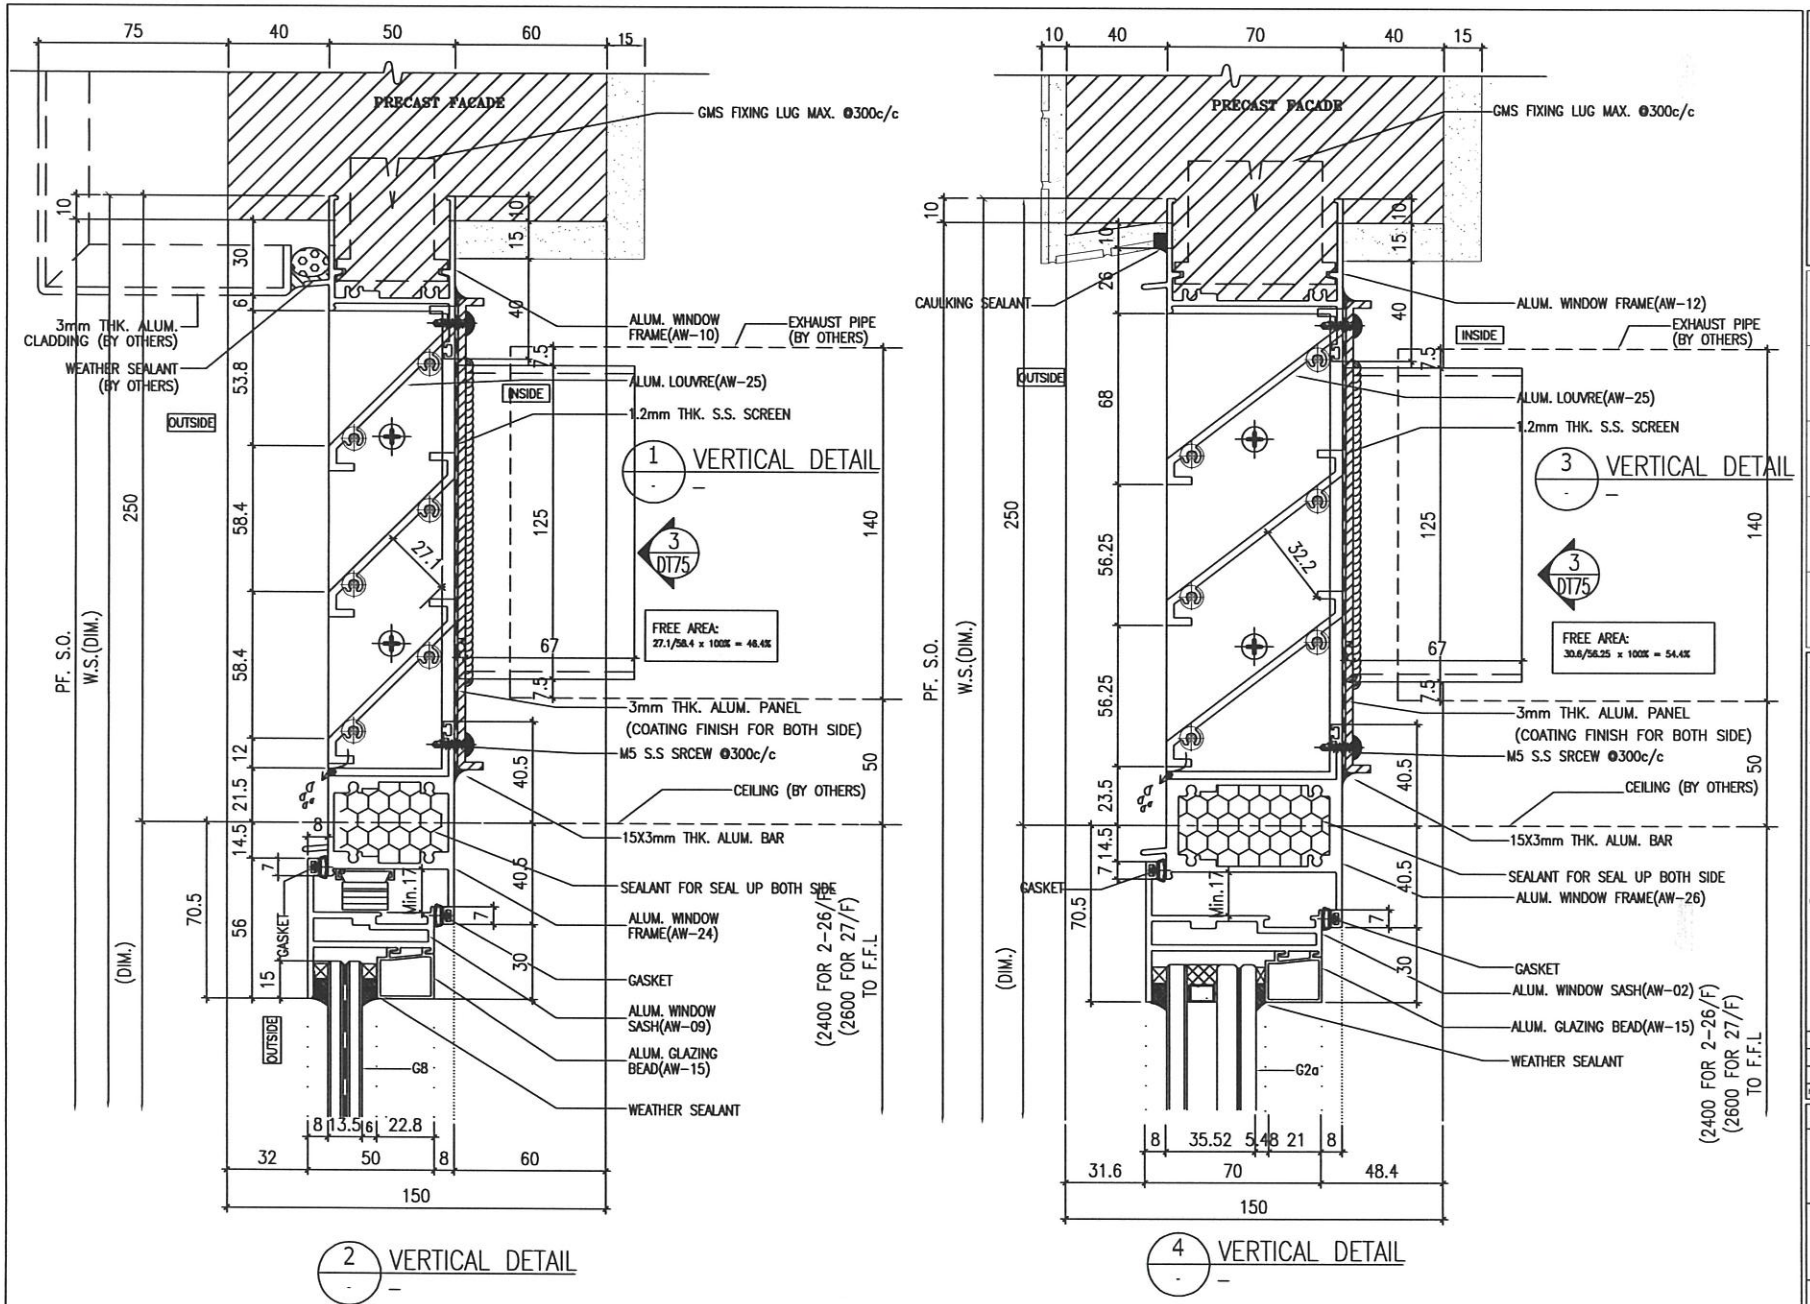

B.D. REF :

ARCHITECT :
WONG TUNG & PARTNERS LIMITED
ARCHITECTS & PLANNERS

STRUCTURAL ENGINEER :
SUN HUNG KAI ARCHITECTS AND ENGINEERS LTD.
SUN HUNG KAI CENTRE, WANCHAI, HONGKONG
TEL. 28276111 FAX. 28272884

FACADE CONSULTANT:
ALPHA CONSULTING LIMITED
Steel Structure & Facade Specialist

MAIN CONTRACTOR :
Sanfield Engineering Construction Ltd.

CLIENT :
SUN HUNG KAI REAL ESTATE AGENCY LTD.
42/F SUN HUNG KAI CENTRE, WANCHAI, HONGKONG

NOTE :
1. ALL DIMENSIONS ARE IN mm.
2. ALL ELEVATIONS ARE VIEWED FROM OUTSIDE.
3. ALL DIMENSIONS TO BE VERIFIED ON SITE BEFORE FABRICATION.

LEGEND :
X1 — DETAIL MARK NO.
X001 — REFER SHEET NO.

1. F.F.L. — FINISHED FLOOR LEVEL
2. S.F.L. — STRUCTURAL FLOOR LEVEL
3. (R) — REVERSED DETAIL
4. GLASS LEGEND

G1–8mmHS+12mm AIR GAP+10mmTP I.G.U.

G2–8mmHS+12mm AIR GAP+8mmTP I.G.U.

G2a–8mmHS+12mm AIR GAP+8mmTP+1.52PVB +6mmTP(PLANNING) FEATURED GLASS (I.G.U.)

G8–6mm GREY HS+1.52PVB+6mm CLEAR HS

NO.	DATE	REVISED	BY
C	28/6/2022	REVISION SUBJECT TO ARCH.COMMENT	
B	23/5/2022	REVISION SUBJECT TO ARCH.COMMENT	
A	28/3/2022	REVISION SUBJECT TO ARCH.COMMENT	

JOB NO. : J-859

PROJECT :
PROPOSED RESIDENTIAL / COMMERCIAL DEVELOPMENT AT NKIL NO.6551 KAI TAK AREA 4C, SITE 3 KAI TAK, KOWLOON


TITLE :
TYPICAL DETAILS FOR ALUM. WINDOW

DATE : 10-Nov-21 | SCALE : 1:2 (A3)


DRAWN BY : IVAN | CHECKED BY :

美特鋁質有限公司
MIDI ALUMINIUM FABRICATOR LTD.
Units 6-8, Sunray Industrial Centre, 1/F
610 Cha Kwo Ling Road, Kowloon
Tel:23489211-4 Fax:(852)27727666


DWG NO. : J859-SD-PW-DT87 | REV. : C

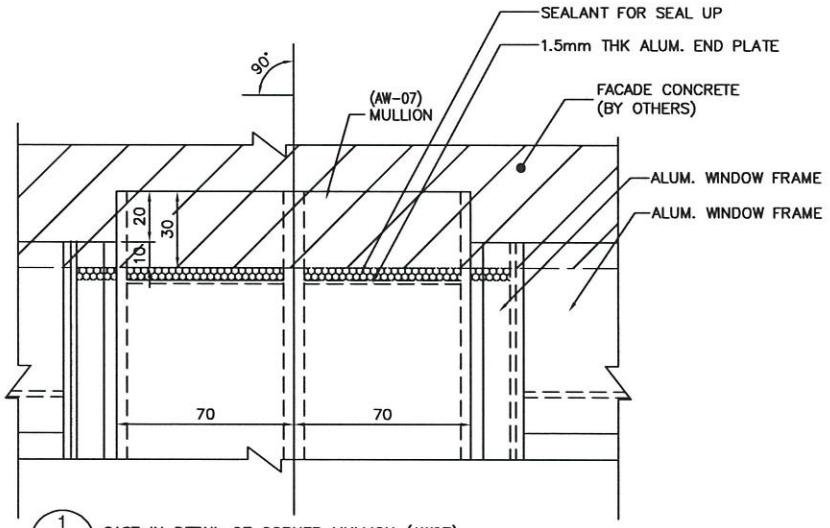


1 CAST IN DETAIL OF CORNER MULLION (AW07)

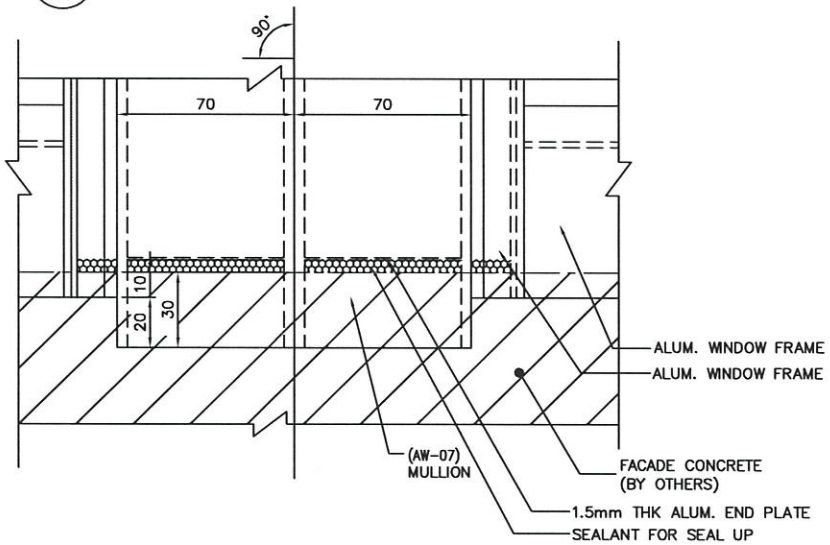

2 CAST IN DETAIL OF CORNER MULLION (AW07)

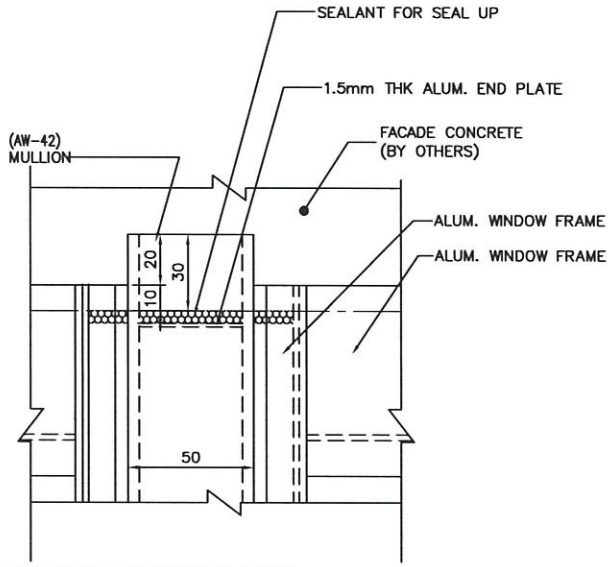

3 CAST IN DETAIL OF MULLION (AW42)

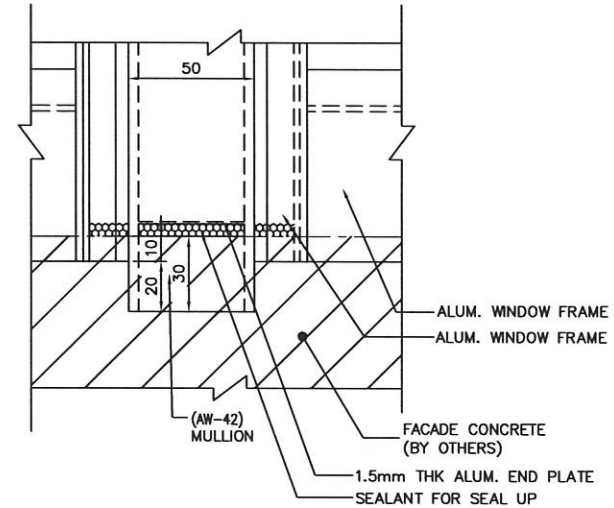

4 CAST IN DETAIL OF MULLION (AW42)

B.D. REF :

ARCHITECT :
WONG TUNG & PARTNERS LIMITED
ARCHITECTS & PLANNERS

STRUCTURAL ENGINEER :
SUN HUNG KAI
ARCHITECTS AND ENGINEERS LTD.
SUN HUNG KAI CENTRE, WANCHAI, HONGKONG
TEL. 28276111 FAX. 28272804

FACADE CONSULTANT:
ALPHA CONSULTING LIMITED
Steel Structure & Facade Specialist

MAIN CONTRACTOR :
Sanfield Engineering
Construction Ltd.

CLIENT :
SUN HUNG KAI
REAL ESTATE AGENCY LTD.
42/F SUN HUNG KAI CENTRE, WANCHAI, HONGKONG

NOTE :
1. ALL DIMENSIONS ARE IN mm.
2. ALL ELEVATIONS ARE VIEWED FROM OUTSIDE.
3. ALL DIMENSIONS TO BE VERIFIED ON SITE BEFORE FABRICATION.

LEGEND :
X1 — DETAIL MARK NO.
X001 — REFER SHEET NO.

1. F.F.L. -- FINISHED FLOOR LEVEL
2. S.F.L. -- STRUCTURAL FLOOR LEVEL
3. (R) -- REVERSED DETAIL
4. GLASS LEGEND

G1-8mmHS+12mm AIR GAP+10mmTP I.G.U.

G2-8mmHS+12mm AIR GAP+8mmTP I.G.U.

G2a-8mmHS+12mm AIR GAP+8mmTP+1.52PVB +6mmTP(PLANNING) FEATURED GLASS (I.G.U.)

G8-6mm GREY HS+1.52PVB+6mm CLEAR HS

NO.	DATE	REVISED	BY
B	25/4/2022	REVISION SUBJECT TO ARCH.COMMENT	
A	28/3/2022	REVISION SUBJECT TO ARCH.COMMENT	

JOB NO. : J-859

PROJECT :
PROPOSED RESIDENTIAL / COMMERCIAL DEVELOPMENT AT NKIL NO.6551 KAI TAK AREA 4C, SITE 3 KAI TAK, KOWLOON

TITLE :
TYPICAL DETAILS FOR ALUM. WINDOW

DATE : 10-Nov-21 | SCALE : 1:2 (A3)

DRAWN BY : IVAN | CHECKED BY :

美特鋁質有限公司
MIDI ALUMINIUM FABRICATOR LTD.
Units 6-8, Sunray Industrial Centre, 1/F
810 Cha Kwo Ling Road, Kowloon
Tel:23489211-4 Fax:(852)27727666

DWG NO. : J859-SD-PW-DT88 | REV. : B