



工程指示 / 要求簡箋 ENGINEER INSTRUCTIONS(E.I.)

工程指示編號:	EI- 8640	修改版本:	-
	HK- 2186		
工程編號:	J 861	工程名稱:	己連拿利
收件人:	Maggie/廠生統	發件人:	細佬
工程項目:	幕牆膠條 - 確認四頁膠條模圖 修改一頁膠條模圖尺寸	日期:	10/12/2024

<input type="checkbox"/> 原合約工程包	<input type="checkbox"/> 原合約工程加 / 減賬 QT-	<input type="checkbox"/> 新工程報價 QT-
---------------------------------	--	------------------------------------

信件批核號碼/圖紙參考編號:	批核模具圖紙編號:
客戶指示附件:	管理內部批簽署:

<input type="checkbox"/> 初步鋁料 B.M.	<input type="checkbox"/> 加工拆圖, 然後生產	<input type="checkbox"/> 尺寸表
<input type="checkbox"/> 正式鋁料 B.M.	<input type="checkbox"/> 技術上資料/指示	<input type="checkbox"/> 報價
<input type="checkbox"/> 配件 B.M.	<input type="checkbox"/> 樣辦或貨品說明書	<input type="checkbox"/> 分判合約
<input type="checkbox"/> 其他:		


內容: 附頁確認四頁膠條模圖 (USER NO:2091-J861-JT01、 2091-J861-JT02、 2091-J861-JT03、 2091-J861-JT04、) 修改一頁膠條模圖尺寸 (USER NO:2091-J861-JT05)
完成上列要求日期: 08/01/2025

國內


<input type="checkbox"/> 生產技術總監	<input type="checkbox"/> 連附件	<input checked="" type="checkbox"/> 技術部	<input checked="" type="checkbox"/> 連附件	<input type="checkbox"/> 生產部	<input type="checkbox"/> 連附件
<input type="checkbox"/> 採購部	<input type="checkbox"/> 連附件	<input checked="" type="checkbox"/> 生產統籌部	<input checked="" type="checkbox"/> 連附件	<input type="checkbox"/> 報關組	<input type="checkbox"/> 連附件
<input checked="" type="checkbox"/> 質檢部	<input checked="" type="checkbox"/> 連附件	<input type="checkbox"/> 會計部	<input type="checkbox"/> 連附件	<input type="checkbox"/> 機械設計部	<input type="checkbox"/> 連附件
<input type="checkbox"/> 香港辦	<input type="checkbox"/> 連附件	<input type="checkbox"/> 其他:			

香港

<input type="checkbox"/> 行政部	<input type="checkbox"/> 連附件	<input type="checkbox"/> 會計部	<input type="checkbox"/> 連附件	<input type="checkbox"/> 統籌部	<input type="checkbox"/> 連附件	<input type="checkbox"/> 工程部	<input type="checkbox"/> 連附件
<input type="checkbox"/> 採購部	<input type="checkbox"/> 連附件	<input type="checkbox"/> QS部	<input type="checkbox"/> 連附件	<input type="checkbox"/> 地盤管理	<input type="checkbox"/> 連附件	<input type="checkbox"/> 維修部	<input type="checkbox"/> 連附件

*發件人簽署:	*組別成員批核簽署:
傳遞編號: HK-2186	項目經理簽署: 

LINEAR DENSITY 0.070 ±5%Kg/m	AREA 55.40 mm <sup>2</sup>	WEIGHT ±5%Kg/pcs	VOLUME cm <sup>3</sup>	VERSION A
---------------------------------	-------------------------------	---------------------	---------------------------	--------------

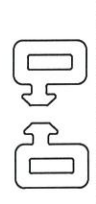

皮带面


SCALE 1:1

<p>包装方式：普通包装</p>

安装方式：穿入式

技术说明：

- 1、未标注公差按IT14级执行；
- 2、表面不得有扭曲、锯齿边、杂质颗粒及气泡等缺陷；
- 3、带“\*”尺寸为关键尺寸。
- 4、带“-----”面为见光面，表面光洁度Ra=0.1，其余表面光洁度Ra=0.4。
- 5、如无特殊要求，则按我司《密封胶条激光打标技术规范》执行。

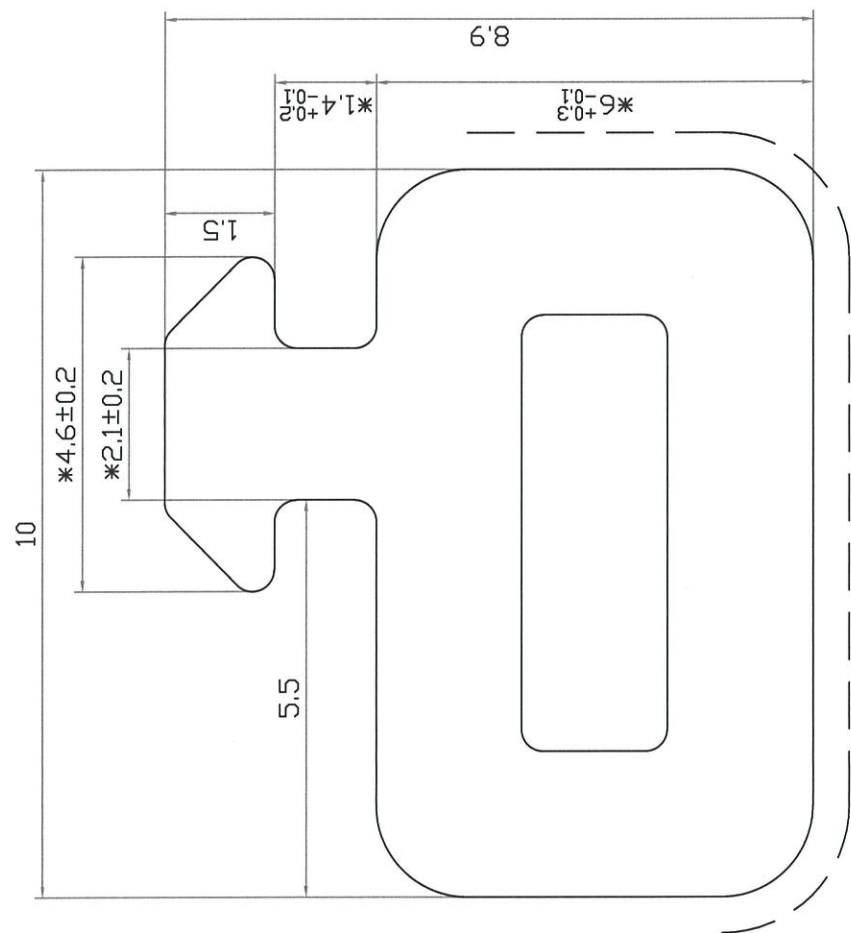

SCALE 10:1

CUSTOMERS APPROVAL DRAWING  
(客户批准图)

EXCLUSIVE SHAPES IN THESE INSTANCES WHERE THE SHAPE IS DEVELOPED AS AN "EXCLUSIVE" THE CUSTOMER WHOSE NAME APPEARS ON THIS DRAWING SHALL ACCEPT FULL RESPONSIBILITY FOR ALL CLAIMS MADE AGAINST THE CUSTOMER OR PERSONS CLAIMING UNDER THE CUSTOMER, OR WING KAY.


THAT THE EXTENDED SHAPES SURF AND PRODUCTS MADE FROM IT, INFRINGES ANY PATENT, REGISTERED DESIGN OR COPYRIGHT IS THE SUBJECT OF CONFIDENTIAL INFORMATION, THE CUSTOMER SHALL INDEMNIFY WING KAY AGAINST ALL DAMAGES, LOSSES AND EXPENSES ARISING OUT OF ANY CLAIM.


SHAPE DIMENSIONS THIS DRAWING HAS BEEN CHECKED FOR CORRECT DIMENSIONS, TOLERANCES AND ANY OTHER SPECIAL REQUIREMENTS BY THE CUSTOMER. ALTERATIONS MADE AFTER TOOL AGE MANUFACTURE DOK ACCOUNT.


美特铝质有限公司

承認圖

日期 10/17/2024

CUSTOMER: [Signature]

SIGNATURE: [Signature]

PROJECT XX-XXX

PRC TEL +86 757 25330008 FAX +86 757 25330009  
HK TEL +852 29046818 FAX +852 25625688  
Http://www.wingkay.com wingkay@wingkay.com


THE TABLE OF CHANGE RECORD		USER NO.	APPROVED & DATE
MARK	OLD-VER.	2091-J861-JT01	PROOFREADING & DATE
1	CONTENT	KIND NO.	CHECKED & DATE
2		MOULD&RACK NO.	DESIGN&DRAWN & DATE
3		MATERIAL	HARDNESS
		HARDNESS	Tracking & DATE



LINEAR DENSITY 0.083 ±5%Kg/m    AREA 65.89 mm<sup>2</sup>    WEIGHT ±5%Kg/pcs    VOLUME cm<sup>3</sup>    VERSION A


**CUSTOMERS APPROVAL DRAWING**  
 (客户批准)  
 EXCLUSIVE SHAPES IN THESE INSTANCES WHERE THE SHAPE IS DEVELOPED AS AN "EXCLUSIVE" THE CUSTOMER WHOSE NAME APPEARS ON THIS DRAWING SHALL ACCEPT FULL RESPONSIBILITY FOR ALL CLAIMS MADE AGAINST THE CUSTOMER OR PERSONS CLAIMING UNDER THE CUSTOMER, OR WING KAY.  
 THE EXTENDED SHAPES SHOWN AND PRODUCT'S MADE FROM IT, PATENTED DESIGN OR COPYRIGHT IS THE SUBJECT OF THIS DRAWING. INFORMATION, THE CUSTOMER SHALL BE RESPONSIBLE FOR ALL DAMAGES SUSTAINED AND ALL EXPENSES ARISING OUT OF ANY CLAIM.  
 SHAPE DIMENSIONS THIS DRAWING HAS BEEN CHECKED FOR CORRECT DIMENSIONS, TOLERANCES AND ANY OTHER SPECIAL REQUIREMENTS BY THE CUSTOMER. ALTERATIONS MADE AFTER TOOL AGE MANUFACTURE IS COMMENCED WILL BE AT OUR ACCOUNT.  

美特铝业有限公司  
 承認圖面  
 日期 12-2024

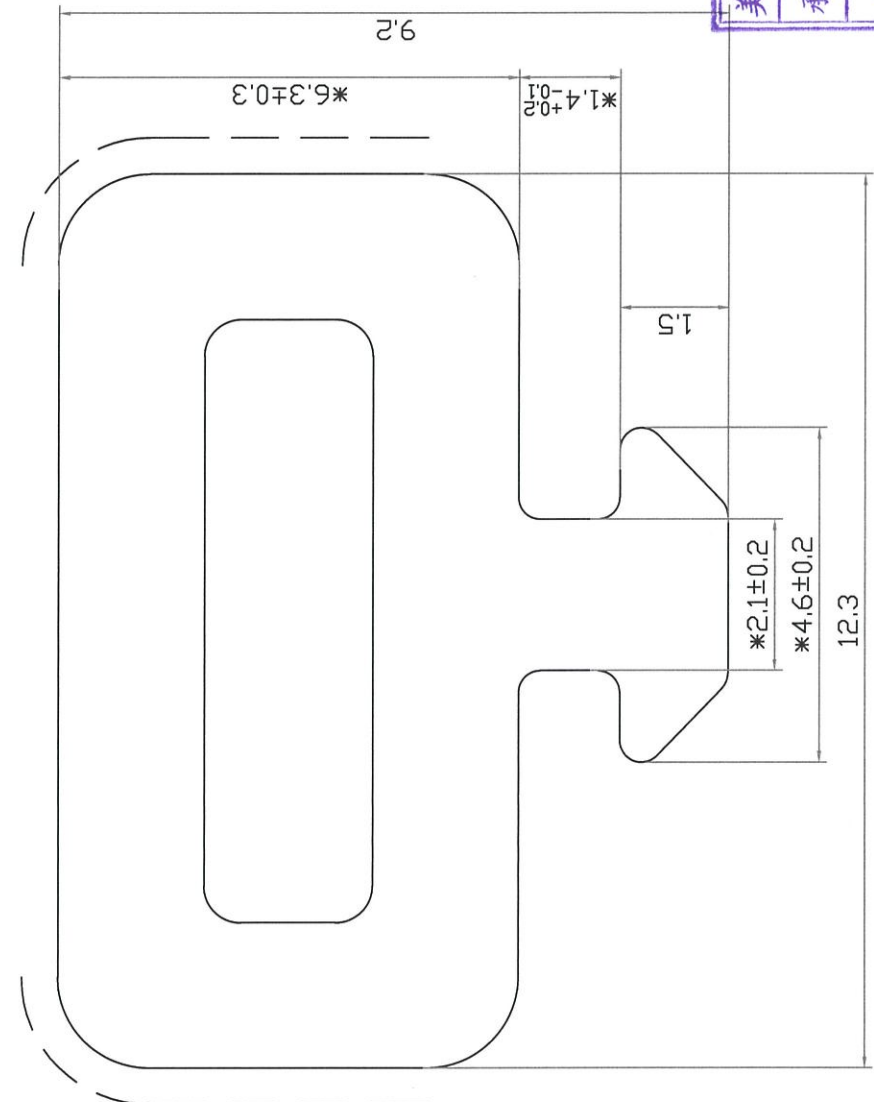

SCALE 10:1

PROJECT XX-XXX  
  
 PRC TEL +86 757 25330008 FAX +86 757 25330009  
 HK TEL +852 29046818 FAX +852 25625688  
 Http://www.wingkay.com wingkay@wingkay.com

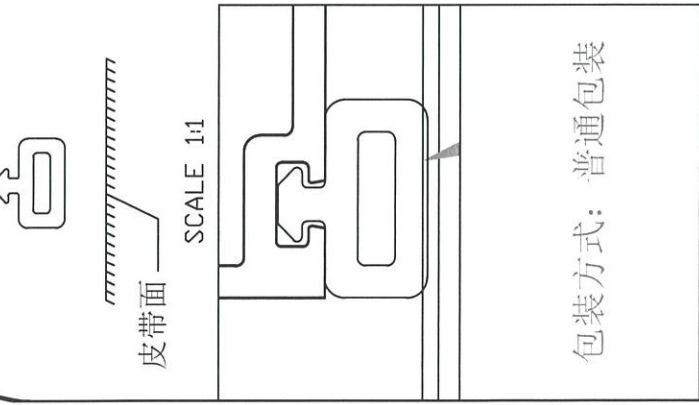

包装方式：普通包装

安装方式：穿入式

技术说明：

- 1、未标注公差按 IT14 级执行；
- 2、表面不得有扭曲、锯齿边、杂质颗粒及气泡等缺陷；
- 3、带“\*”尺寸为关键尺寸。
- 4、带“-----”面为见光面，表面光洁度 Ra=0.1，其余表面光洁度 Ra=0.4。
- 5、如无特殊要求，则按我司《密封胶条激光打标技术规范》执行。


THE TABLE OF CHANGE RECORD		SIZE TOLERANCE		USER NO.		APPROVED & DATE	
MARK	OLD-VER.	CONTENT	DESIGN	DATE	RANGE	TOLERANCE	PROOFREADING & DATE
①					2091-J861-JT03	0-1.5 ±0.15	
②					KIND NO.	1.5-2.5 ±0.20	
③					MOULD&RACK NO.	2.5-4.0 ±0.25	
					MATERIAL	4.0-6.3 ±0.35	卢静仪 2024/11/28
					HARDNESS	6.3-10 ±0.40	DESIGN&DRAWN & DATE
						10-16 ±0.50	000
						16-25 ±0.70	Tracking & DATE
						25-40 ±0.80	苏志君 2024/11/28
						40-63 ±1.00	
						63-100 ±1.30	
						ABOVE 100 ±1.50	



修改尺寸

**CUSTOMERS APPROVAL DRAWING**  
 (客户批准的)  
 EXCLUSIVE SHAPES IN THESE INSTANCES WHERE THE SHAPE IS DEVELOPED AS AN "EXCLUSIVE" THE CUSTOMER WHOSE NAME APPEARS ON THIS DRAWING SHALL ACCEPT FULL RESPONSIBILITY FOR ALL CLAIMS MADE AGAINST THE CUSTOMER OR PERSONS CLAIMING UNDER THE CUSTOMER, OR WING KAY.  
 THAT THE EXTRUDED SHAPES SHOWN AND PRODUCTS MADE FROM IT, INFRINGES ANY PATENT, REGISTERED DESIGN OR COPYRIGHT IS THE SUBJECT OF CONFIDENTIAL INFORMATION, THE CUSTOMER SHALL INDEMNIFY WING KAY AGAINST ALL DAMAGES, LOSSES AND EXPENSES ARISING OUT OF ANY CLAIM.  
 SHAPE DIMENSIONS THIS DRAWING HAS BEEN CHECKED FOR CORRECT DIMENSIONS, TOLERANCES AND ANY OTHER SPECIAL REQUIREMENTS BY THE CUSTOMER. ALTERATIONS MADE AFTER TOOL AGE MANUFACTURE IS COMMENCED WILL BE AT OUR ACCOUNT.  

VERSION A  
 VOLUME cm<sup>3</sup>  
 WEIGHT ±5%Kg/pcs  
 AREA 28.20 mm<sup>2</sup>  
 LINEAR DENSITY ±5%Kg/m 0.037  
 包装方式: 普通包装  
 安装方式: 穿入式

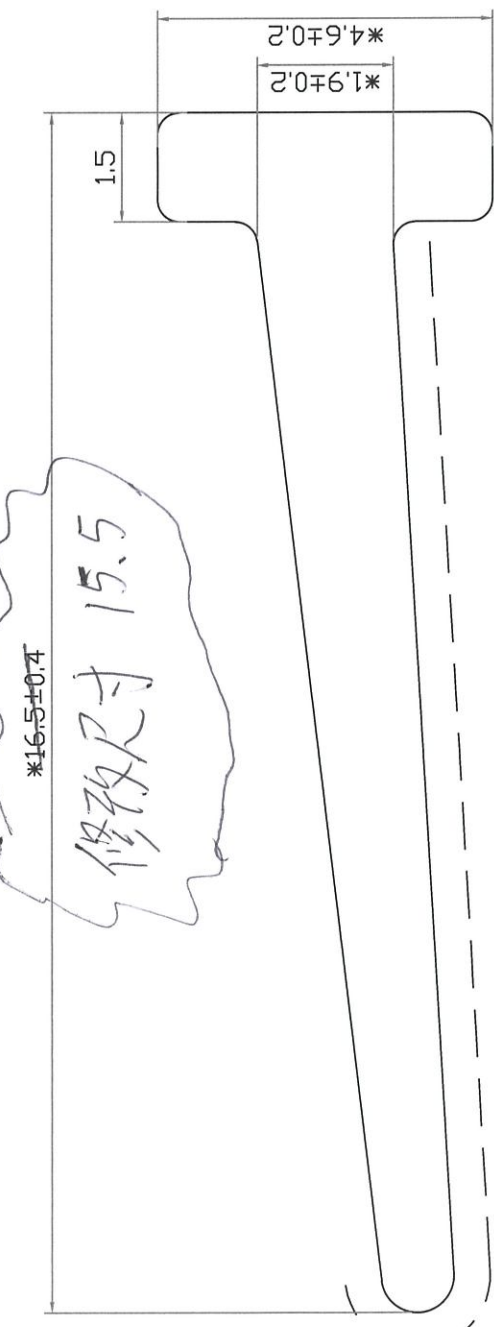

**技术说明:**

- 1、未标注公差按IT1.4级执行;
- 2、表面不得有扭曲、锯齿边、杂质颗粒及气泡等缺陷;
- 3、带“\*”尺寸为关键尺寸。
- 4、带“-----”面为见光面, 表面光洁度Ra=0.1, 其余表面光洁度Ra=0.4。
- 5、如无特殊要求, 则按我司《密封胶条激光扫码技术规范》执行。

SCALE 10:1

美特铝质有限公司  
 承認圖面  
 日期 10/12/2024

PROJECT XX-XXX

PRC TEL +86 757 25330008 FAX +86 757 25330009  
 HK TEL +852 29046818 FAX +852 25625688  
 Http://www.wingkay.com wingkay@wingkay.com

THE TABLE OF CHANGE RECORD		USER NO.		APPROVED & DATE	
MARK	OLD-VER.	CONTENT	DESIGN	DATE	PROOFREADING & DATE
1			2091-J861-JT05		
2			KIND NO.		CHECKED & DATE 卢静仪 2024/12/04
3			MOULD&RACK NO.		DESIGN&DRAWN & DATE 000
			MATERIAL	EPDM	Tracking & DATE 苏志君 2024/12/04
			HARDNESS	80±5	
			SIZE TOLERANCE RANGE	TOLERANCE	
			0-<1.5	±0.15	
			1.5-<2.5	±0.20	
			2.5-<4.0	±0.25	
			4.0-<6.3	±0.35	
			6.3-<10	±0.40	
			10-<16	±0.50	
			16-<25	±0.70	
			25-<40	±0.80	
			40-<63	±1.00	
			63-<100	±1.30	
			ABOVE 100	±1.50	