



工程指示 / 要求簡箋 ENGINEER INSTRUCTIONS(E.I.)

工程指示編號:	EI- 9168	修改版本:	E
	HK- 0878		
工程編號:	J 861	工程名稱:	己連拿利
收件人:	生統/技術部	發件人:	細佬
工程項目:	幕牆施工圖更新	日期:	07/11/2025

<input type="checkbox"/> 原合約工程包	<input type="checkbox"/> 原合約工程加 / 減賬 QT-	<input type="checkbox"/> 新工程報價 QT-
---------------------------------	--	------------------------------------

信件批核號碼/圖紙參考編號:	批核模具圖紙編號:
客戶指示附件:	管理內部批簽署:

<input type="checkbox"/> 初步鋁料 B.M.	<input type="checkbox"/> 加工拆圖, 然後生產	<input type="checkbox"/> 尺寸表
<input type="checkbox"/> 正式鋁料 B.M.	<input type="checkbox"/> 技術上資料/指示	<input type="checkbox"/> 報價
<input type="checkbox"/> 配件 B.M.	<input type="checkbox"/> 樣辦或貨品說明書	<input type="checkbox"/> 分判合約
<input type="checkbox"/> 其他:		

內容:	<p>給技術部: 幕牆施工圖更新, 請製作相關的加工圖。</p> <p>1.可按CAD檔案繼續做31F和32F加工圖</p> <p>2.附頁在微信回覆廠的紀錄</p> <p>3.FD門底加收口槽</p> <p>CAD文件在以下位置</p> <p>J:\midi_sharepoint\Public\to_china\謝永林\J861\EI9168E_HK0878_CAD</p>
完成上列要求日期:	26/11/2025

國內


<input type="checkbox"/> 生產技術總監	<input type="checkbox"/> 連附件	<input checked="" type="checkbox"/> 技術部	<input checked="" type="checkbox"/> 連附件	<input type="checkbox"/> 生產部	<input type="checkbox"/> 連附件
<input type="checkbox"/> 採購部	<input type="checkbox"/> 連附件	<input type="checkbox"/> 生產統籌部	<input type="checkbox"/> 連附件	<input type="checkbox"/> 報關組	<input type="checkbox"/> 連附件
<input type="checkbox"/> 質檢部	<input type="checkbox"/> 連附件	<input type="checkbox"/> 會計部	<input type="checkbox"/> 連附件	<input type="checkbox"/> 機械設計部	<input type="checkbox"/> 連附件
<input type="checkbox"/> 香港辦	<input type="checkbox"/> 連附件	<input type="checkbox"/> 其他:			

香港

<input type="checkbox"/> 行政部	<input type="checkbox"/> 連附件	<input type="checkbox"/> 會計部	<input type="checkbox"/> 連附件	<input type="checkbox"/> 統籌部	<input type="checkbox"/> 連附件	<input type="checkbox"/> 工程部	<input type="checkbox"/> 連附件
<input type="checkbox"/> 採購部	<input type="checkbox"/> 連附件	<input type="checkbox"/> QS部	<input type="checkbox"/> 連附件	<input type="checkbox"/> 地盤管理	<input type="checkbox"/> 連附件	<input type="checkbox"/> 維修部	<input type="checkbox"/> 連附件

*發件人簽署:	*組別成員批核簽署:
傳遞編號:	項目經理簽署: 

# 可按CAD檔案繼續做31F和32F加工圖

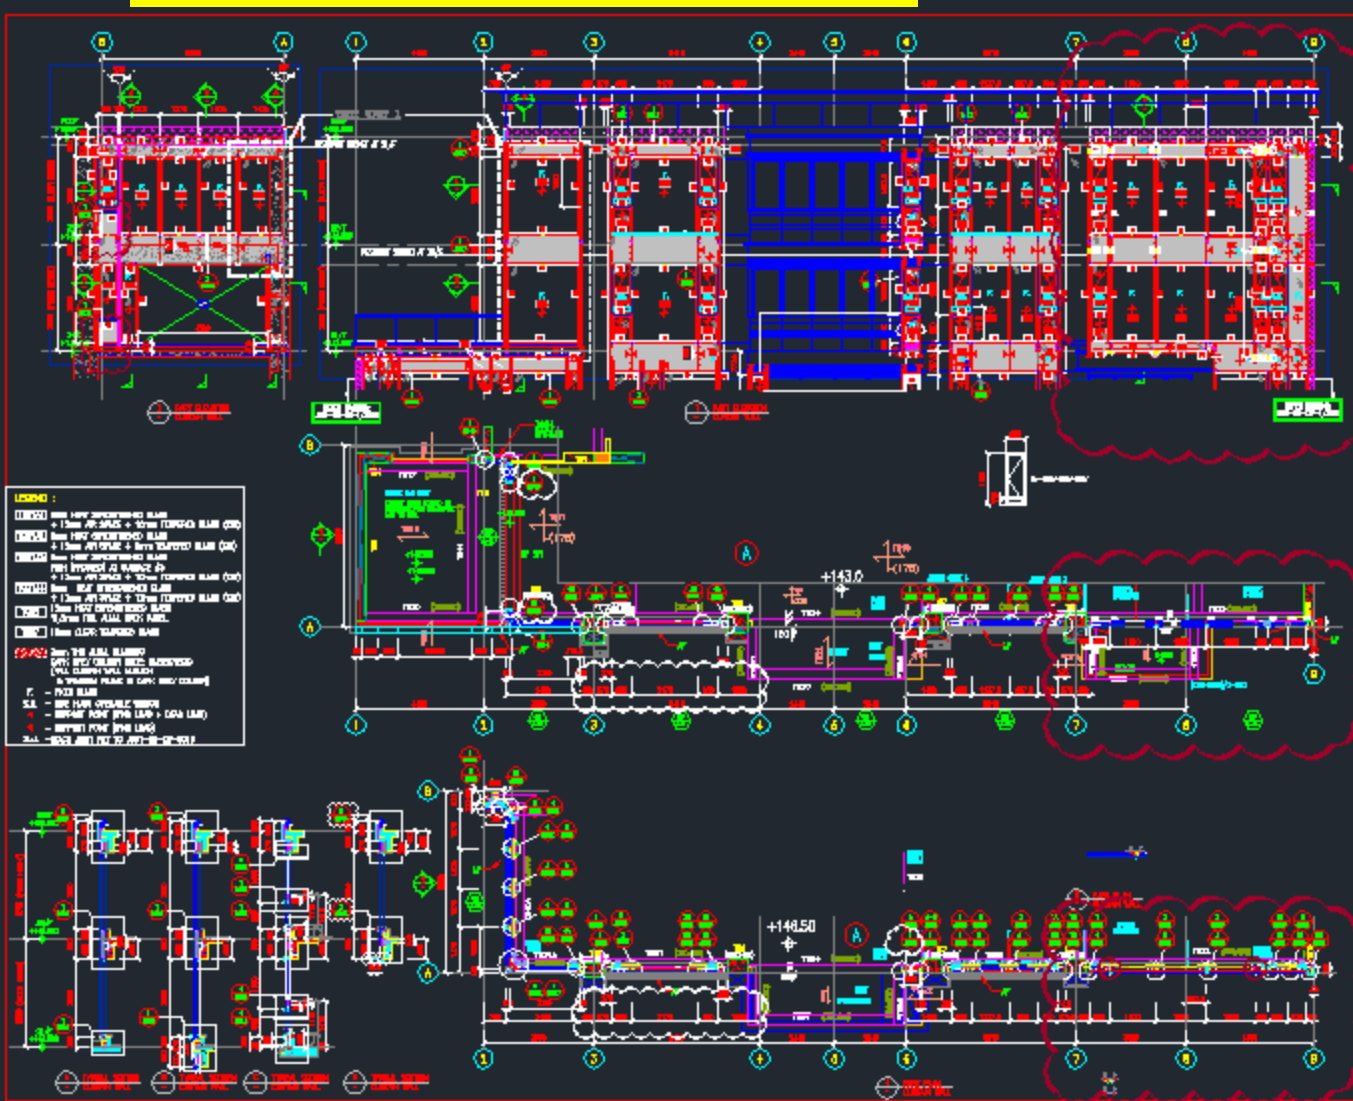















20251106回復廠

這條企料用哪個節點?

1/5022

2/5022

3/5022




4/5022

這個節點是否錯誤了





用2/5001, 拉手在另一邊

綠色框靠牆壁百葉位用哪個節點?

1 - PART ELEVATION CURTAIN WALL

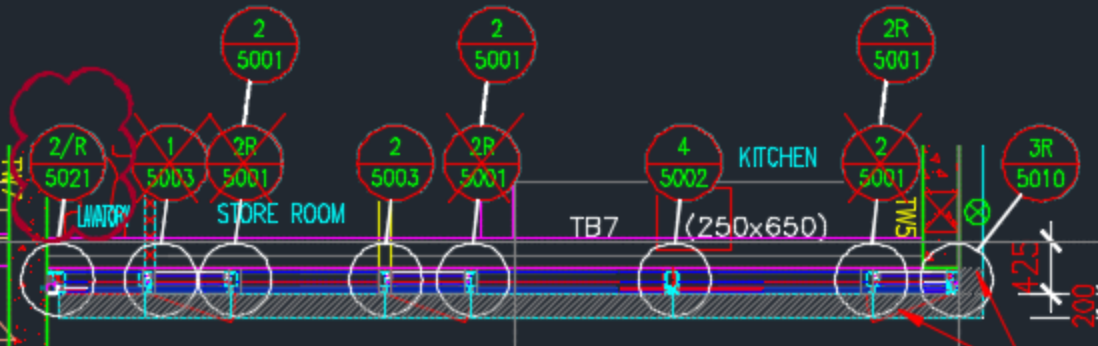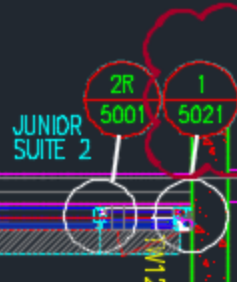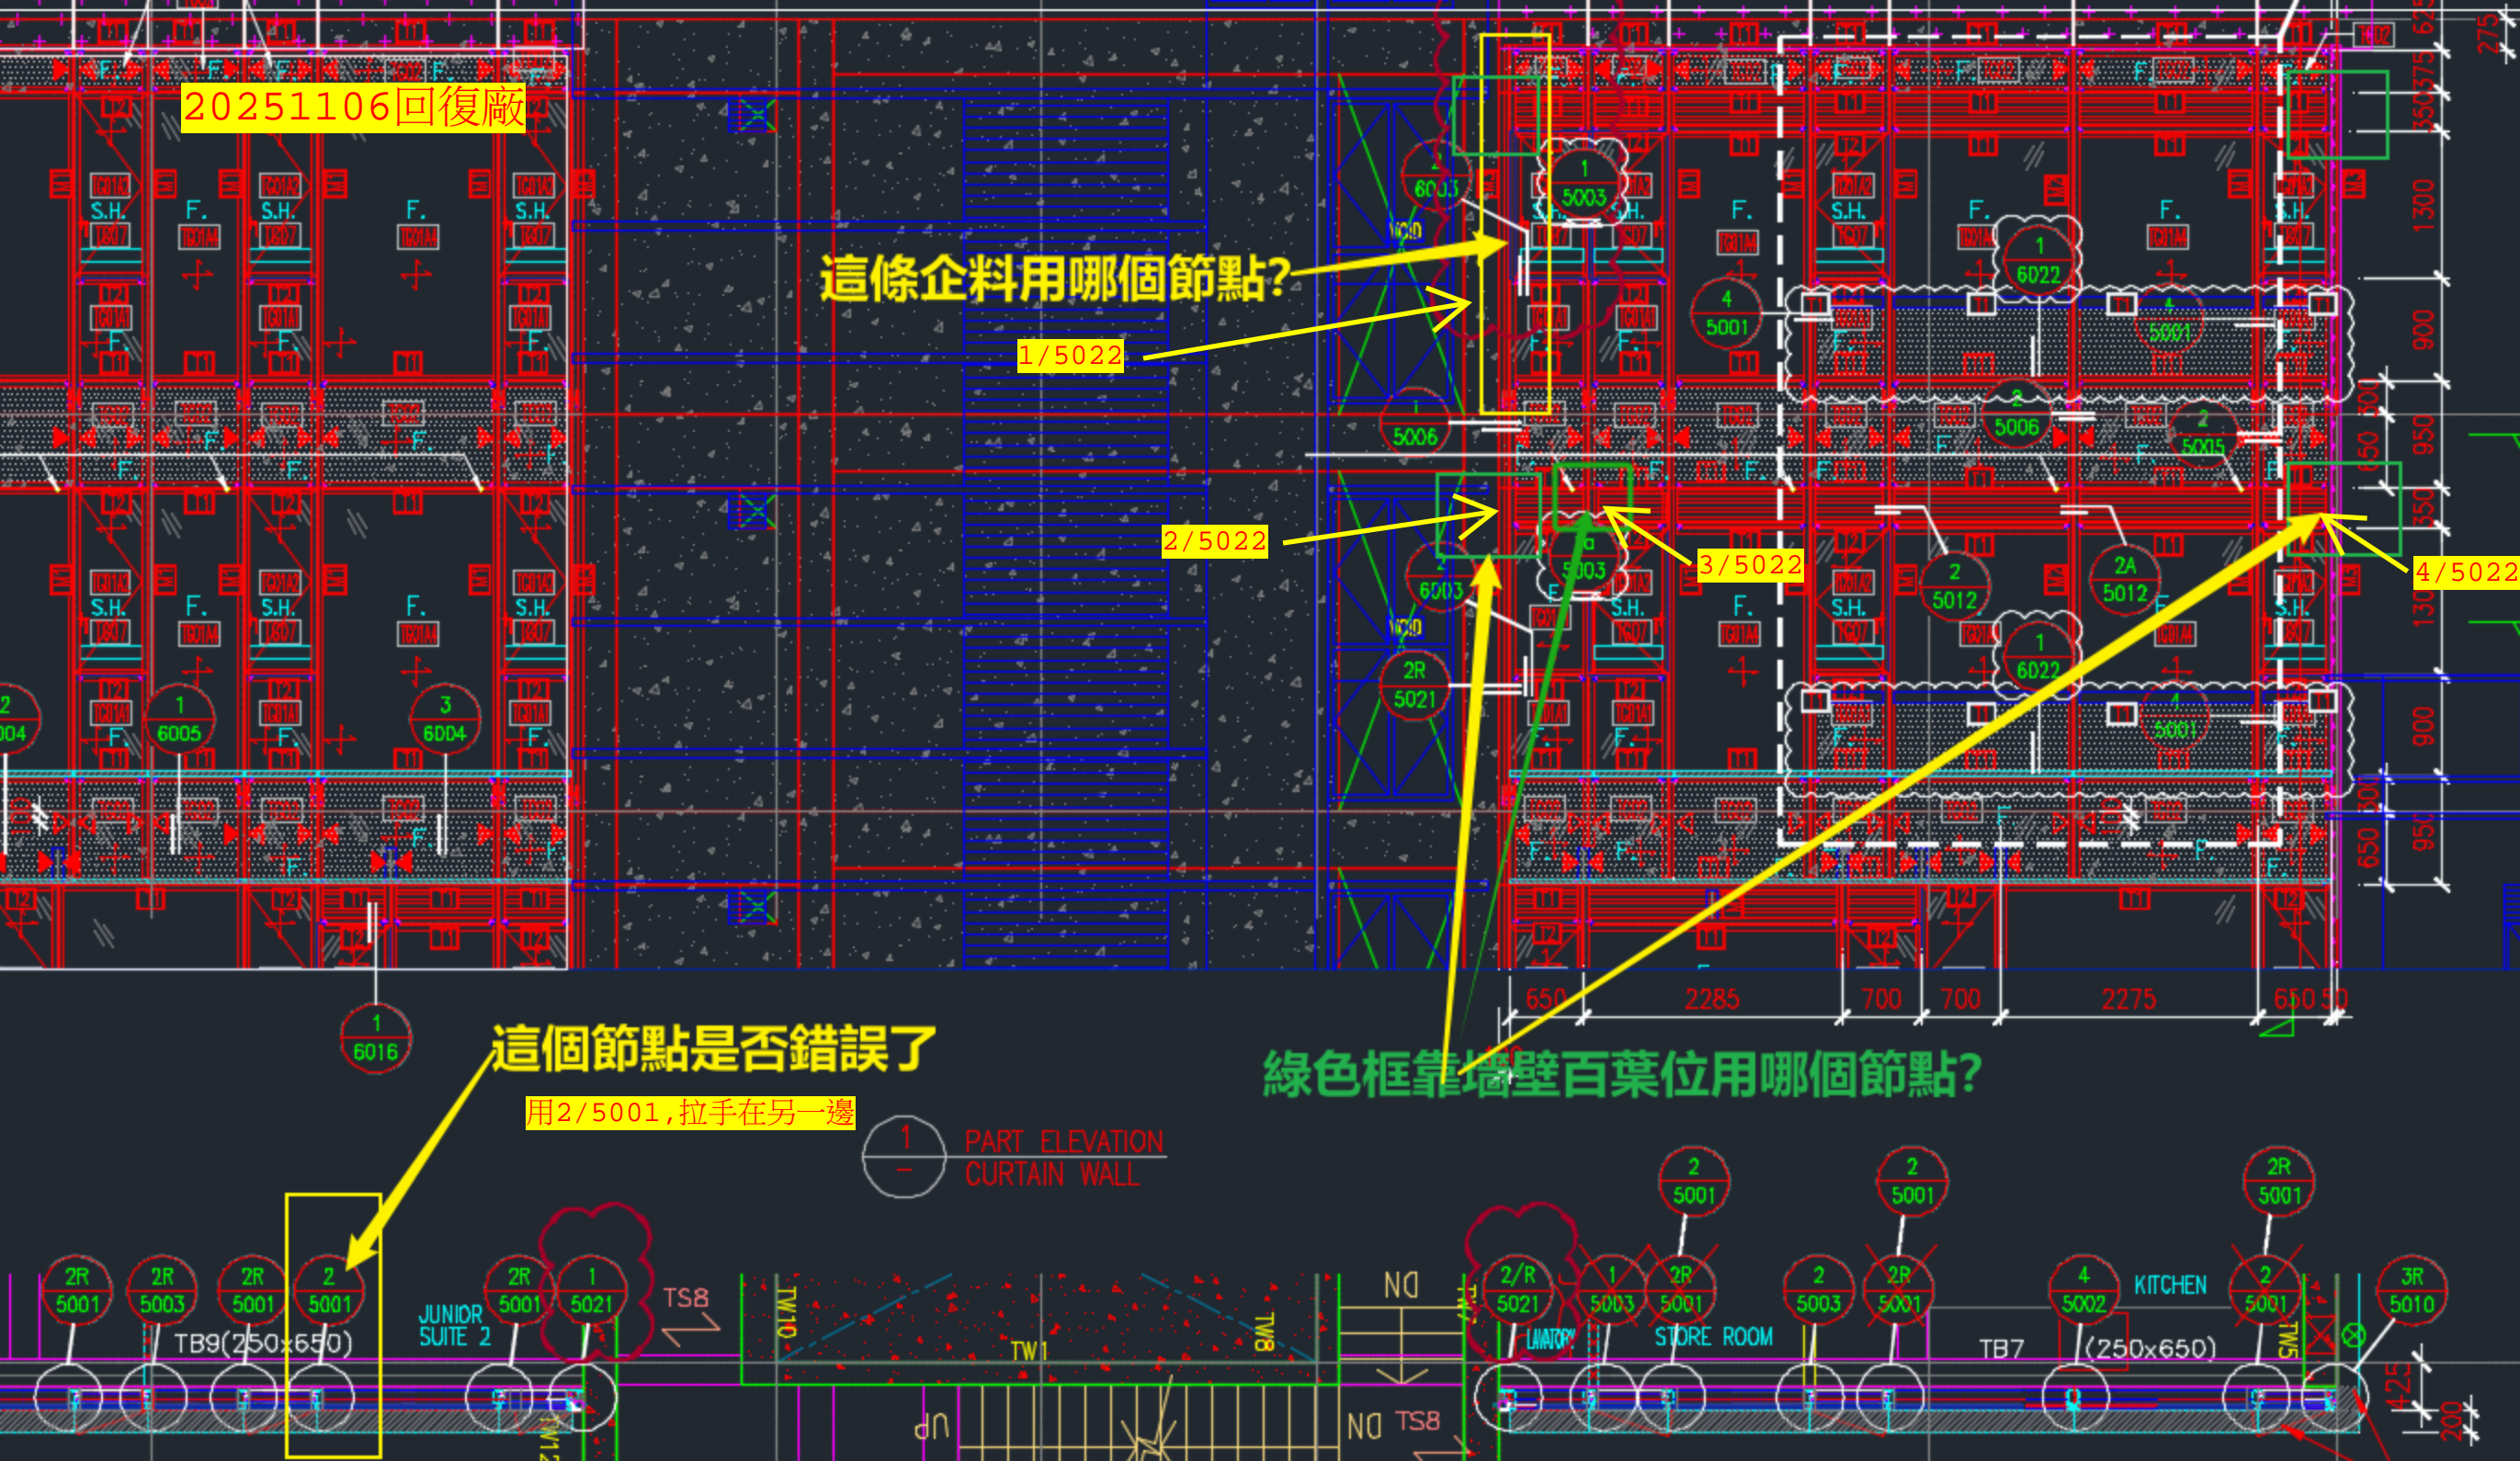

# 20251106回復廠

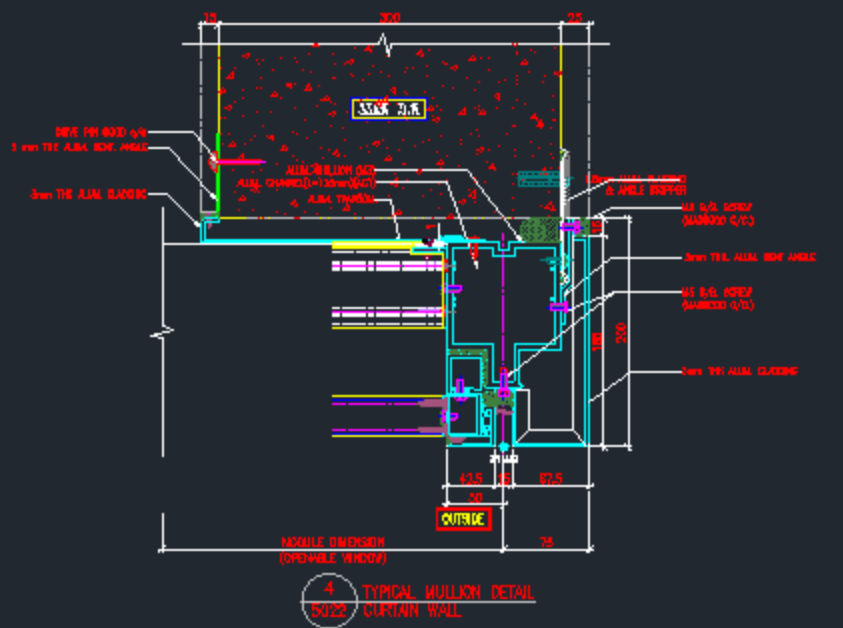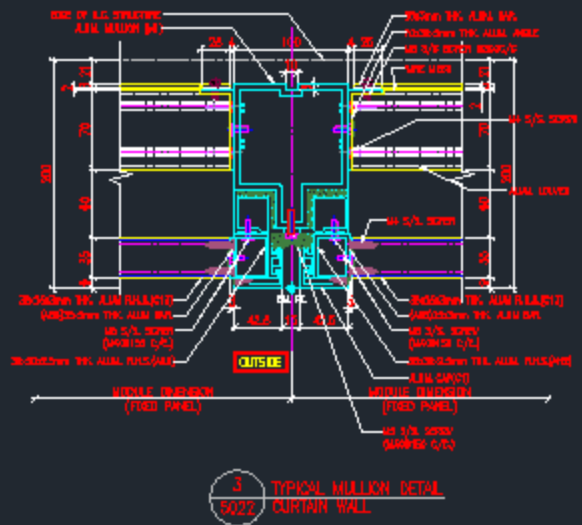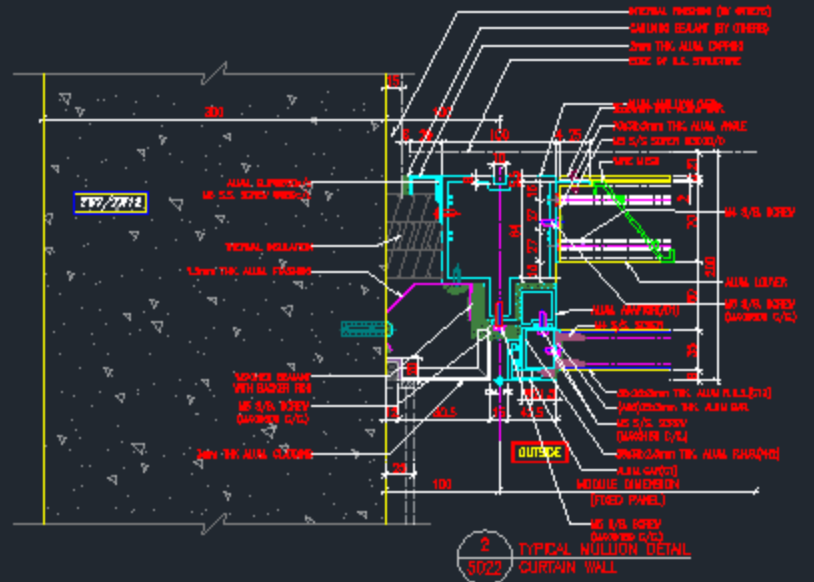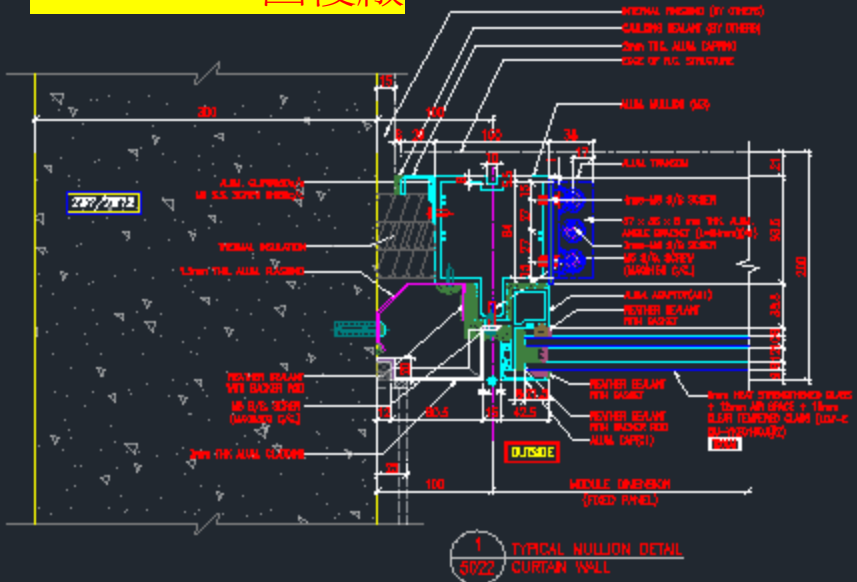




20251107回復廠

這兩個死牆位標註的節點是用生梗企的


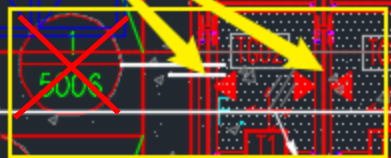


但是這兩個位置標註的節點又是雙生企

650


2285

700

700

100

# 20251107回復廠

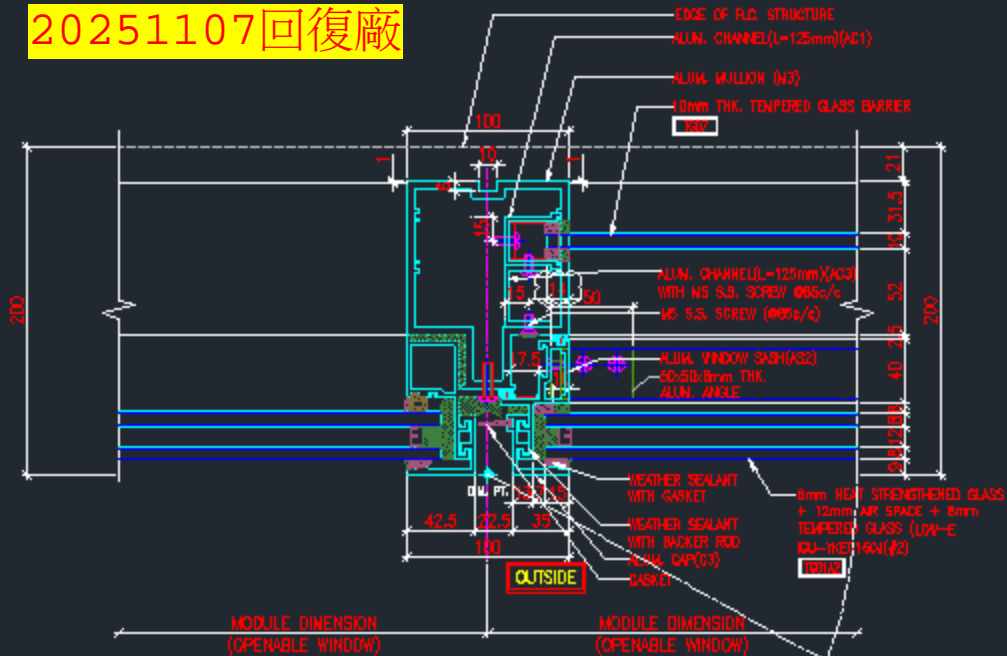

5  
5022 TYPICAL MULLION DETAIL  
CURTAIN WALL

FD門底加收口槽

15/F  
+92.300

12/F  
+89.000

11/F(+85.700)  
10/F(+82.400)  
9/F(+79.100)  
8/F(+75.800)  
7/F(+72.500)  
6/F(+69.200)  
5/F(+65.900)

3/F  
+62.600

3300 (FLOOR HEIGHT)

3300 (FLOOR HEIGHT)

3300 (FLOOR HEIGHT)

300

200 800 1575 550 690 550 1205 1030 1030 1205 550 690 550 1575 800

RESTRAINT SOCKET AT 9/F

1 - PART ELEVATION  
- CURTAIN WALL

3  
6008

MASTER


LIVING & DINING

NO


ROOM  
LIVING & DINING

ENSUITE  
WATER

3R  
6008

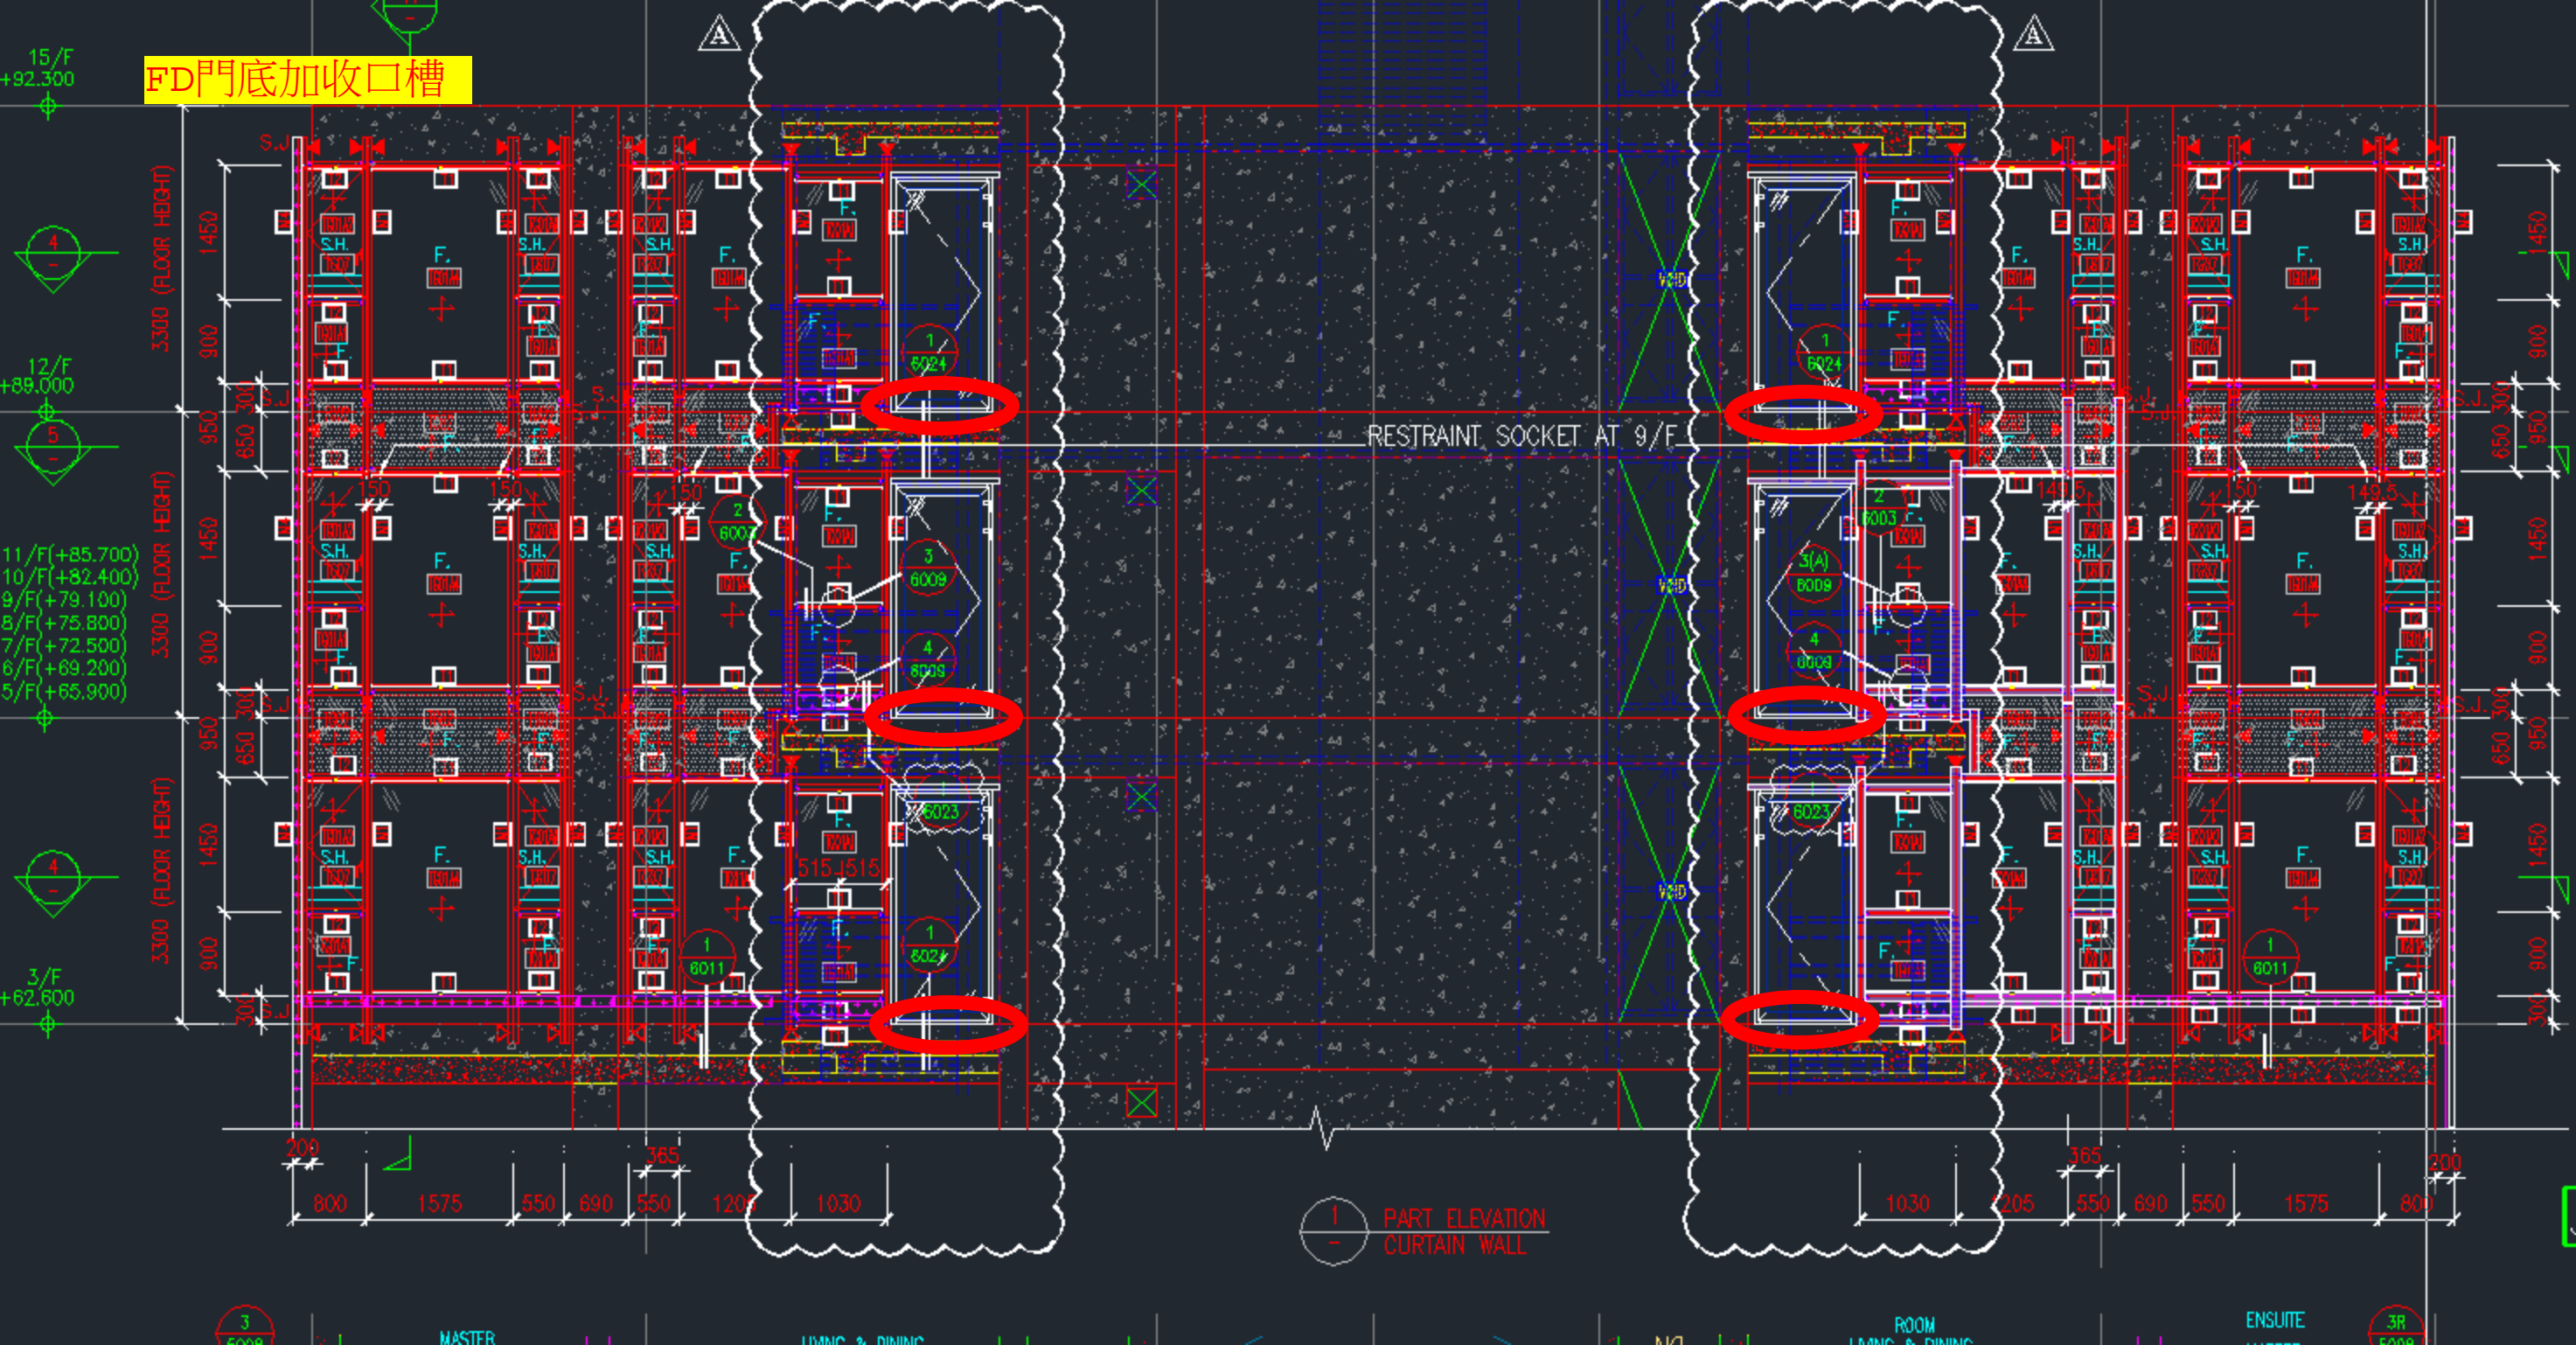

FD門底加收口槽

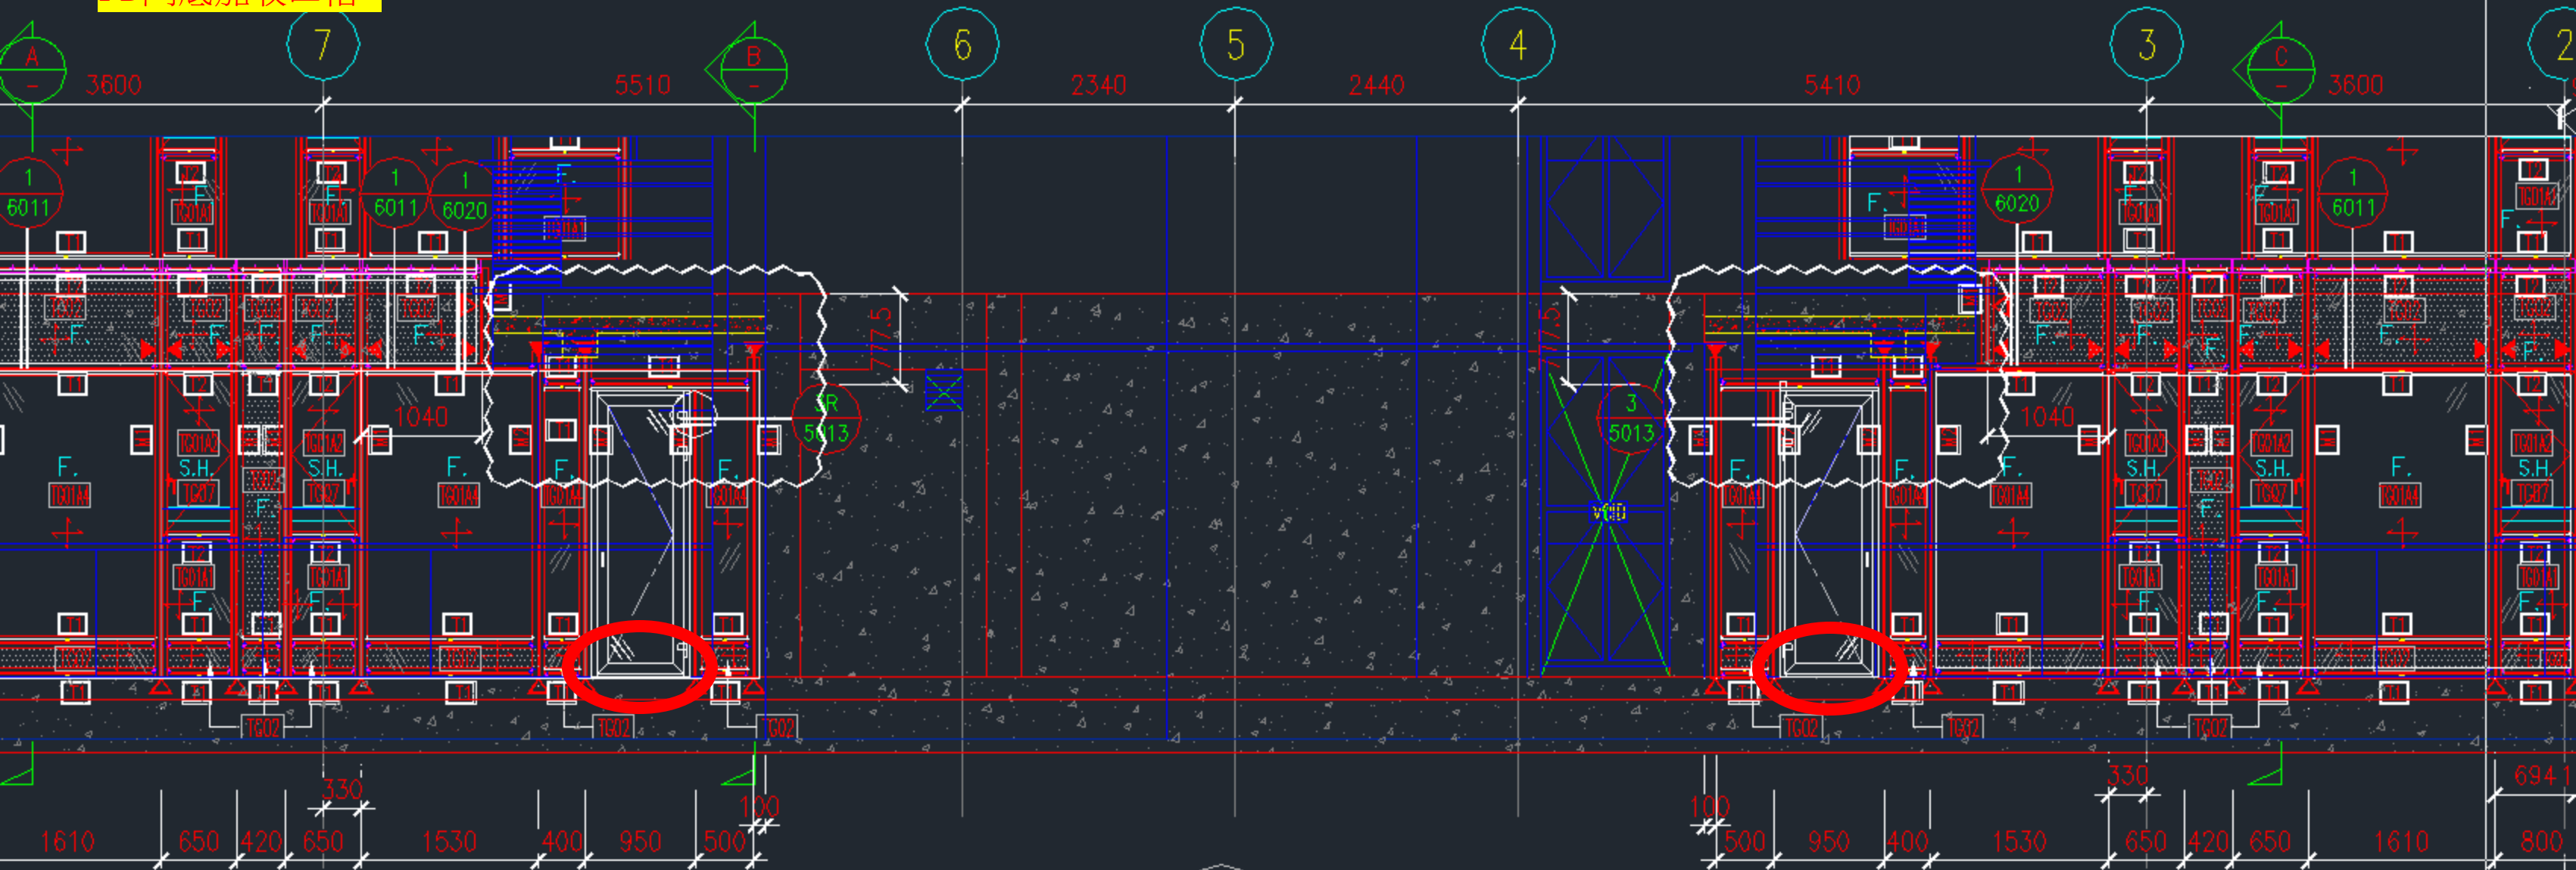

1  
-  
PART ELEVATION  
CURTAIN WALL

ME

92

47

/C


VG

FD門底加收口槽  
紅圈的位置

69

S)

25

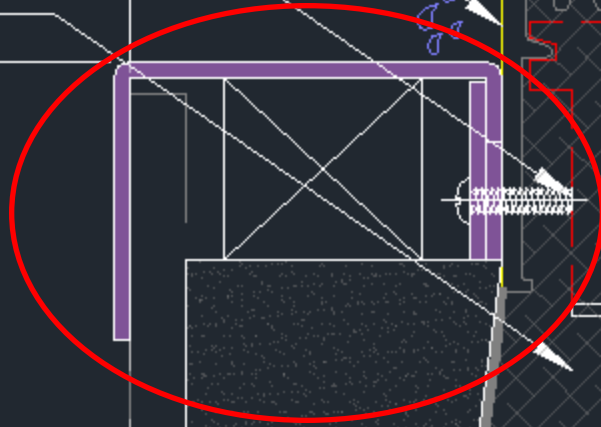

50